



RICK SNYDER  
GOVERNOR

STATE OF MICHIGAN  
DEPARTMENT OF ENVIRONMENTAL QUALITY  
LANSING



DAN WYANT  
DIRECTOR

June 18, 2012

VIA E-MAIL and U.S. MAIL

Ms. Shari Kennett  
Responsible Care Leader  
Michigan Operations  
The Dow Chemical Company  
1790 Building, Washington Street  
Midland, Michigan 48674

Dear Ms. Kennett:

**SUBJECT:** Minor Hazardous Waste Management Facility Operating License (License) Modification; Amendment 13 - Approval of 1163 Building Conveyor and External Ancillary Equipment Removal; The Dow Chemical Company (Dow), Michigan Operations, Midland, Michigan; MID 000 724 724

Staff of the Department of Environmental Quality (DEQ), Resource Management Division (RMD), has reviewed your, March 16, 2012, request for a minor modification to Dow's License issued, June 12, 2003, as amended. The modification request is for the removal of the pressed wastewater treatment plant solids conveyor and other external ancillary equipment around the exterior of the 1163 Building that are no longer in use. These revisions are shown in the enclosed Drawing B2-300-927122, 1163 Building Containment & Leak Detection Renovation Floor Plan, and Drawing B2-303-927122, 1163 Building Plot Plan & Unit Boundary, from Attachment 10, Tank System Drawings, of the License.

The RMD approves Dow's minor License modification request. Dow shall submit as-built Drawings B2-300-927122 and B2-303-927122 reflecting the revision dates once the alterations have been completed. The RMD is not updating the text of the affected condition in Part IV of the License or Attachment 10 at this time, but will make these updates the next time the text of the License is amended. This approval does not relieve Dow of its responsibility to obtain any other necessary environmental permits or approvals.

In accordance with R 299.9519(6)(b) of the administrative rules promulgated pursuant to Part 111, Hazardous Waste Management, of the Natural Resources and Environmental Protection Act, 1994 PA 451, as amended, Dow is required to send notice of this minor modification to all persons on the facility mailing list and to the appropriate units of state and local government. Such notice must be provided within 90 calendar days of this approval. The updated facility mailing list is being e-mailed

separately to Mr. Brent Gaudreau. Please notify the RMD of any addresses on the facility mailing list that are returned to sender.

Should you have any questions regarding this approval, please contact Ms. Cheryl Howe, Hazardous Waste Section, RMD, at 517-373-9881; howec@michigan.gov; or DEQ, P.O. Box 30241, Lansing, Michigan 48909-7741; or you may contact me.

Sincerely,




Liane J. Shekter Smith, P.E., Chief  
Resource Management Division  
517-373-9523

Enclosures

cclenc: Ms. Kip Cosan, Dow  
Mr. Brent Gaudreau, Dow  
Ms. DeLores Montgomery, DEQ  
Mr. Jon Bloemker/Ms. Trisha Confer, DEQ  
Mr. David Slayton/Ms. Cheryl Howe, DEQ  
Mr. Al Taylor, DEQ  
Operating License File



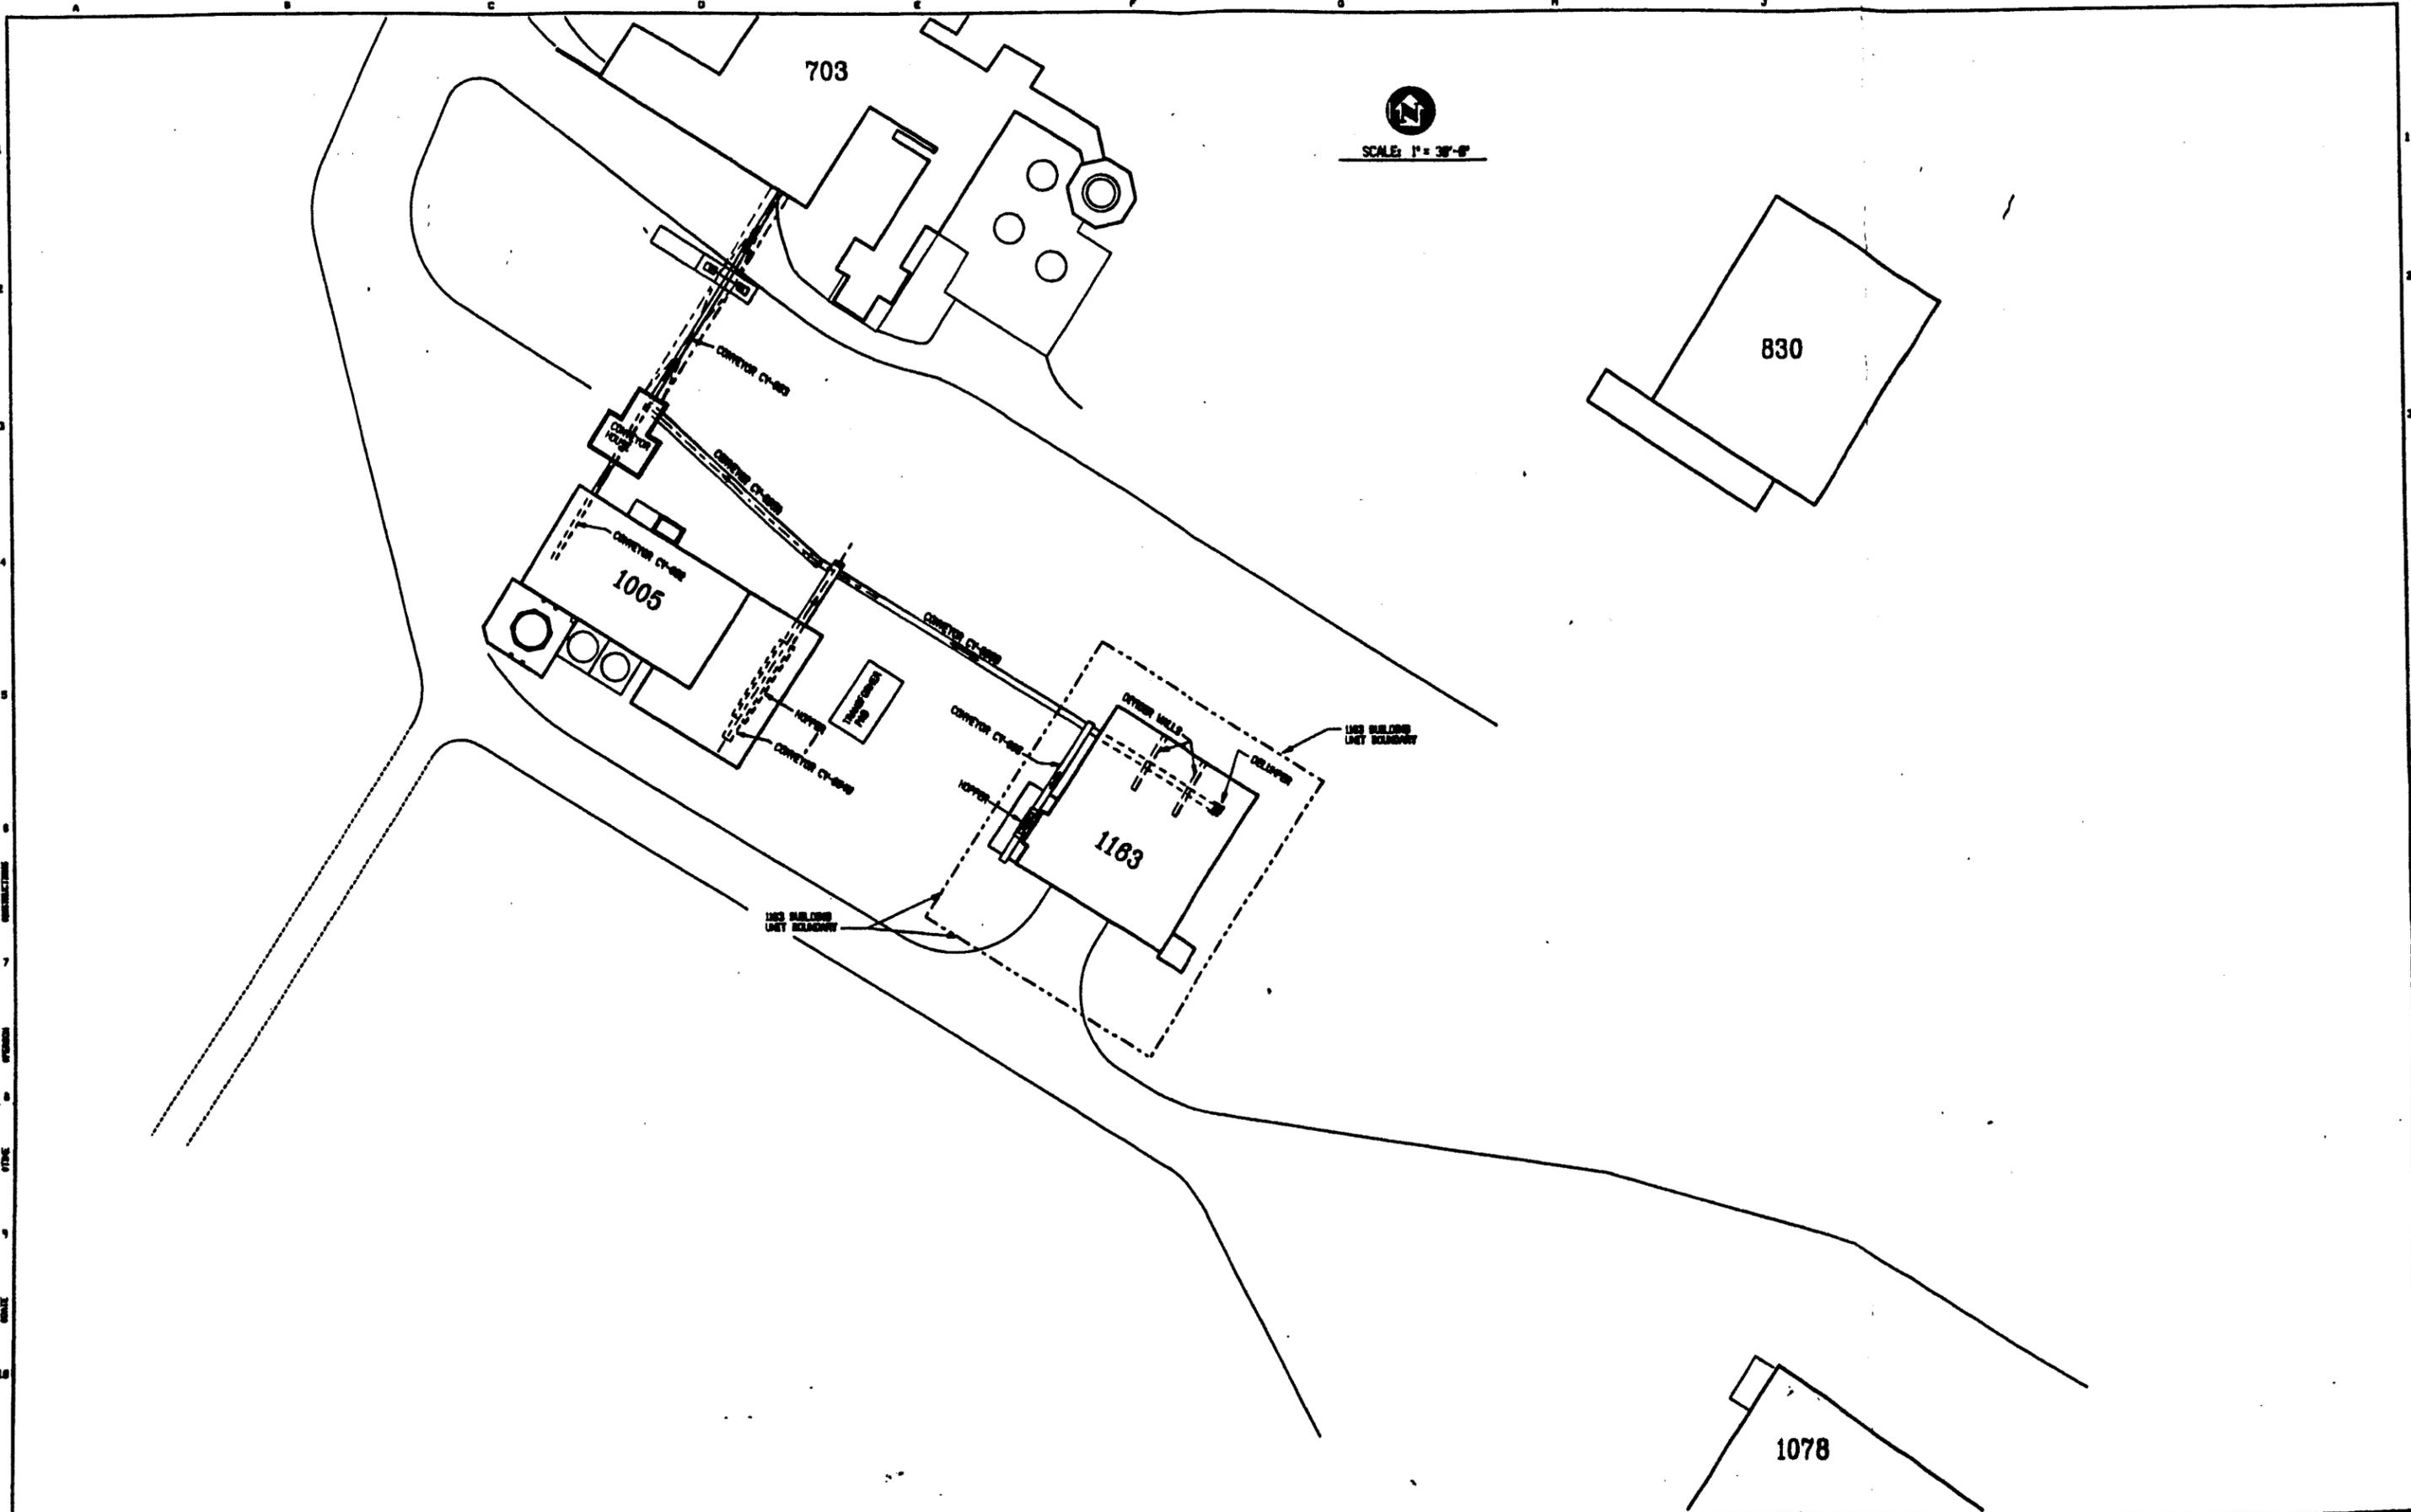

REVISION					REVISION					CHANGES ISSUE RECORD					APPROVED		DATE		DRAWN		CHECKED				
NO.	BY	CHK	APP	DATE	NO.	BY	CHK	APP	DATE	NO.	BY	CHK	APP	DATE	NO.	BY	CHK	APP	DATE	NO.	BY	CHK	APP	DATE	
A																									
B																									

<b>THE DOW CHEMICAL COMPANY</b> MICHIGAN DIVISION 1163 BLDG		HOLLAND, MICHIGAN 1163 BLDG	
<b>1163 BUILDING</b> <b>PLOT PLAN &amp; UNIT BOUNDARY</b>			
PROJECT NO.	DATE	PHONE NO.	PLANT NO.
42722	1-30-82	82-383-92722	2