

STATE OF MICHIGAN
DEPARTMENT OF STATE HIGHWAYS AND TRANSPORTATION


PLANS OF PROPOSED
MICHIGAN PROJECT I-75-2(176)62
CONTROL SECTION Is 63174
JOB NUMBER 08517A

I-75
OAKLAND COUNTY
CITIES OF MADISON HEIGHTS AND ROYAL OAK

ROUTE	JOB NUMBER	FEDERAL NUMBER	SHEET NO.	TOTAL SHEETS
I-75	08517A	I-75-2(176)62	1	

THE IMPROVEMENTS COVERED BY THESE PLANS SHALL BE DONE IN ACCORDANCE WITH THE MICHIGAN DEPARTMENT OF STATE HIGHWAYS 1973 STANDARD SPECIFICATIONS AND SUPPLEMENTAL SPECIFICATIONS.

INDEX	SH. NO.
TITLE SHEET.....	1
TYPICAL CROSS SECTION.....	2
NOTE SHEET.....	3
PLAN SHEETS - ROAD.....	4 - 7
PROFILE SHEETS - ROAD.....	8
SPECIAL DETAILS.....	9 - 14
NOTES & LEGEND ELECTRICAL.....	15
SOIL BORINGS.....	16
LIGHT TOWER FOUNDATION DETAILS.....	17
ELECTRICAL PLANS.....	18 - 23
ELECTRICAL DETAILS.....	24 - 31
TRUSS EXTENSION DETAILS.....	32 - 33
QUANTITY SHEETS.....	34 - 36

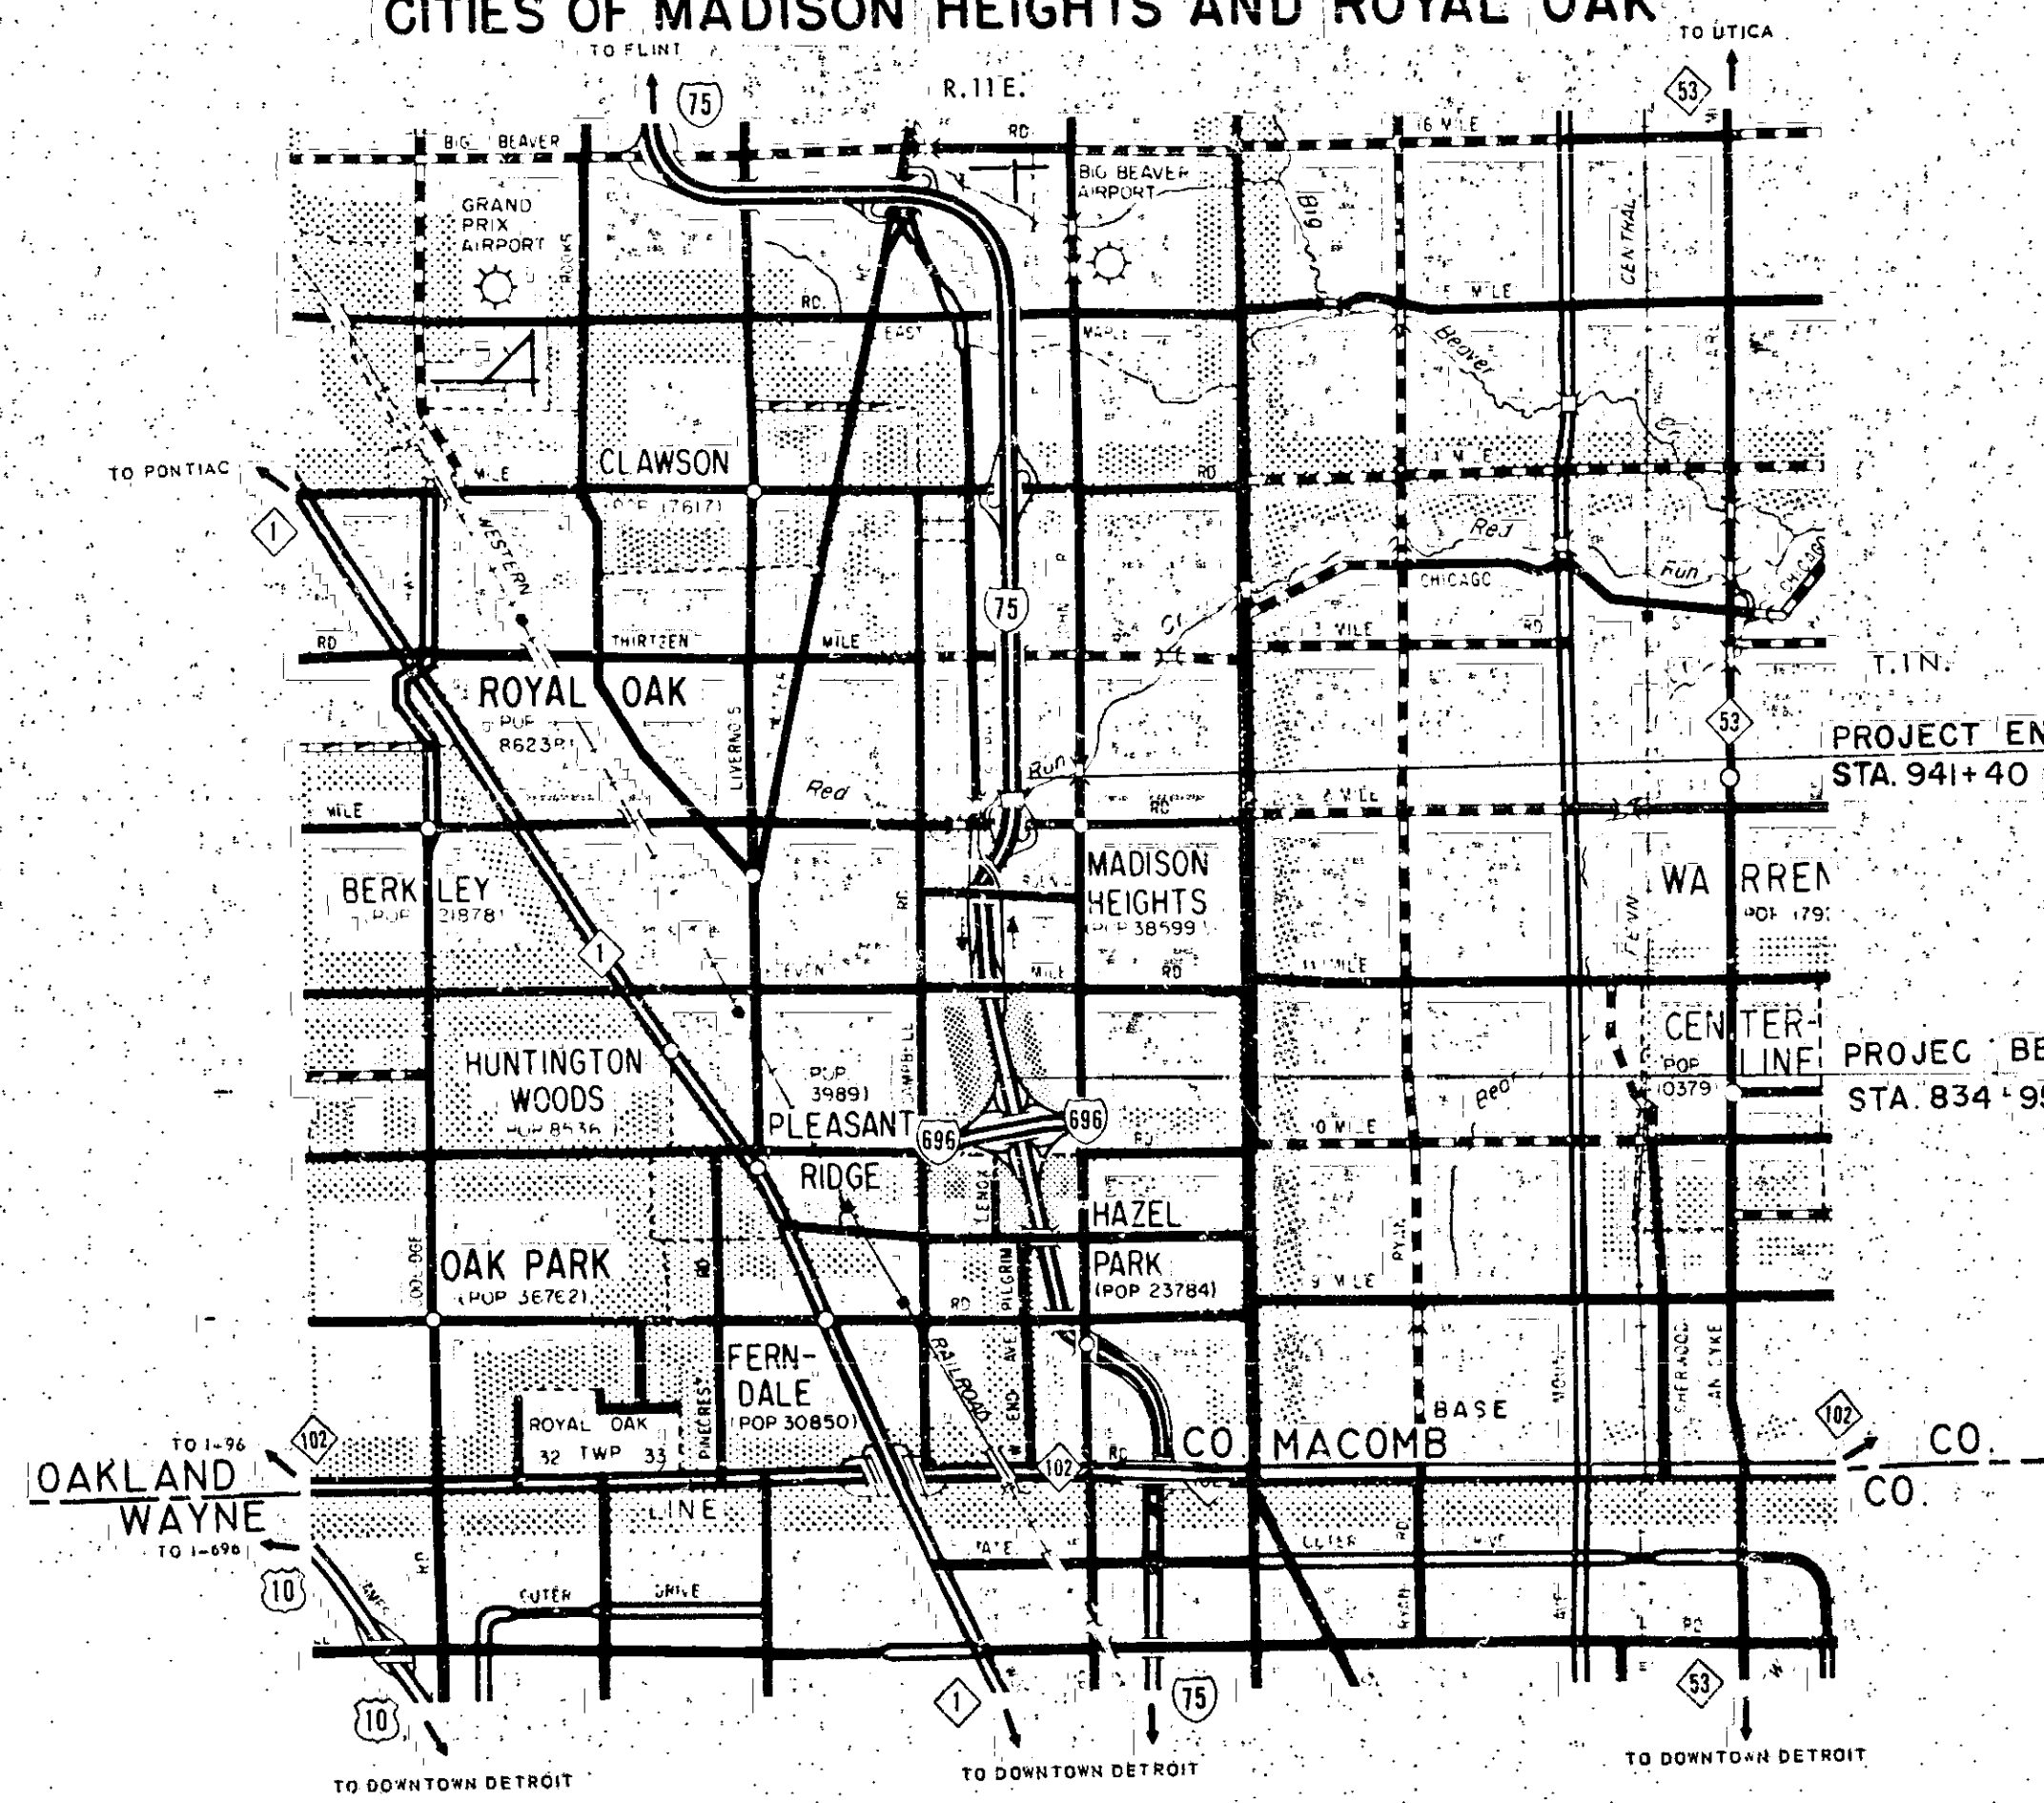

CS Is 63174, JOB NO. 08517A
MICH. PROJECT I-75-2(176)62

AS CONSULTED

ITEM NO. N1762

CONTRACT FOR FREEWAY LIGHTING AND MEDIAN RECONSTRUCTION

APPROVALS		
CHECKED	<i>C. J. Zanic</i>	1-7-75 DATE
RECOMMENDED FOR APPROVAL	<i>A. W. Lambert</i>	1-9-75 DATE
RECOMMENDED FOR APPROVAL	<i>Louise J. Doyle</i>	1-11-75 DATE
RECOMMENDED FOR APPROVAL	<i>W. E. Cal</i>	1/14/75 DATE

DEPARTMENT OF STATE HIGHWAYS AND TRANSPORTATION
JOHN P. WOODFORD - DIRECTOR

APPROVED BY: *John P. Woodford* 1-9-75
DEPUTY DIRECTOR - HIGHWAYS DATE

PLANS PREPARED BY: JILDEH ROUSH
DEPARTMENT OF STATE HIGHWAYS AND TRANSPORTATION








U.S. DEPARTMENT OF TRANSPORTATION
FEDERAL HIGHWAY ADMINISTRATION

APPROVED: [Signature]

CONTROL SECTION	JOB NUMBER	FEDERAL PROJECT	SHEET NO.
Is63174	08517A	I-75-2(176)62	1

CONTROL SECTION - 08517A

F.W.A. REG. NO.	STATE	FEDERAL PROJECT	P.O. NO.	SHEET NO.	TOTAL SHEETS
5	MICH.	I-75-2(170)22		2	
ROUTE		COUNTY	CONTROL SECTION	JOB NO.	
I-75		OAKLAND	14 63 174	08517A	

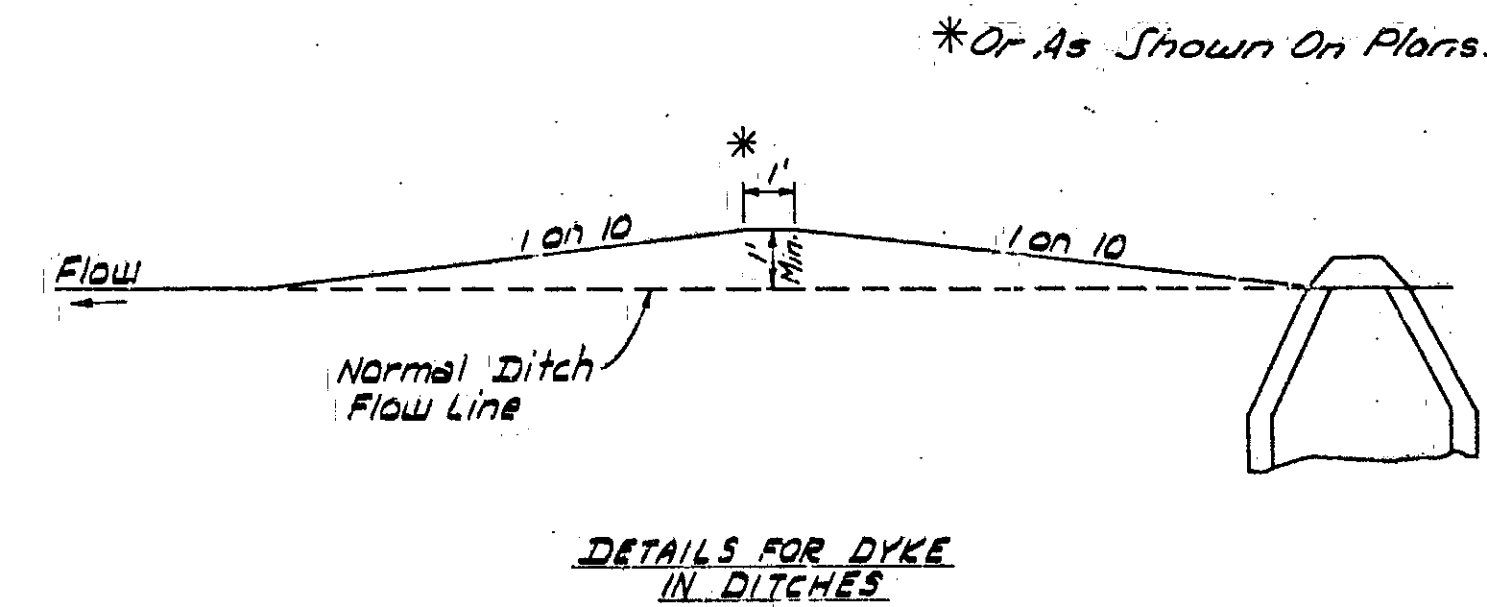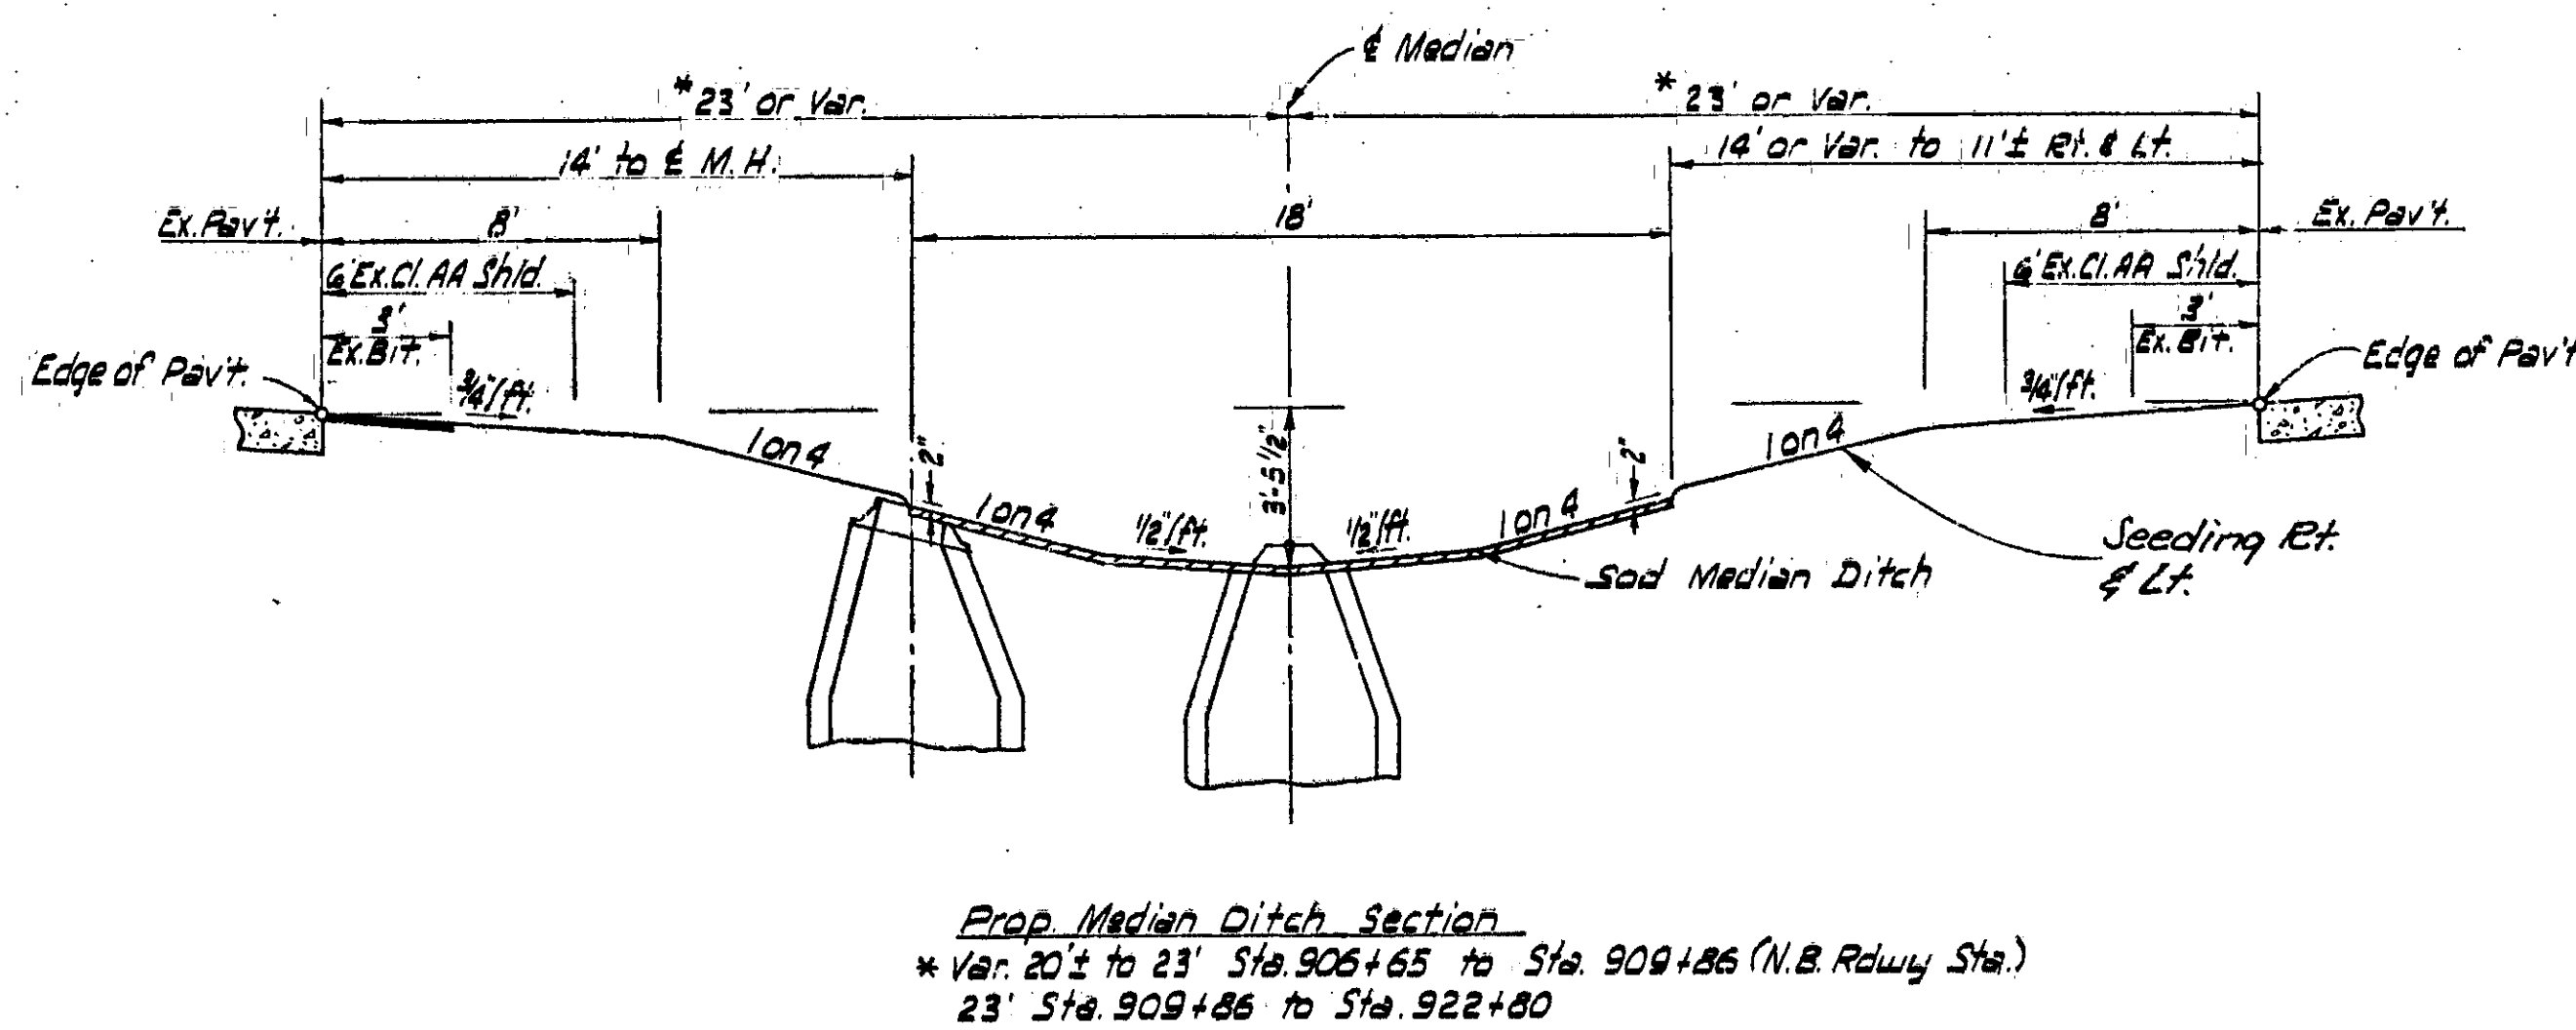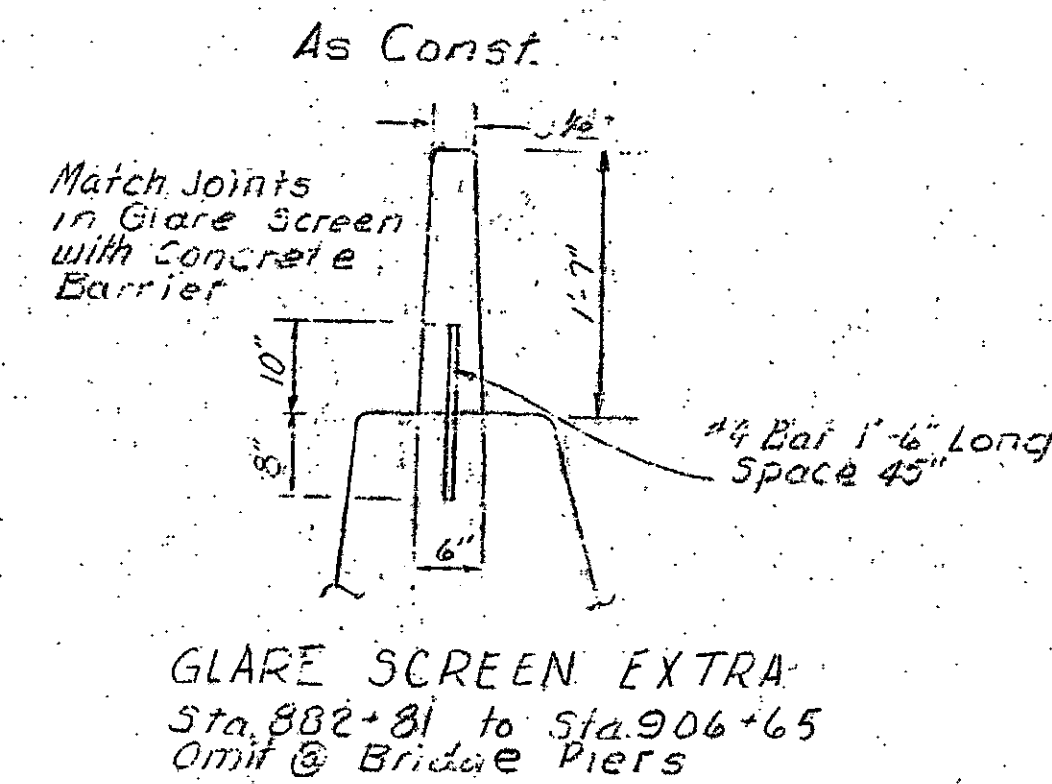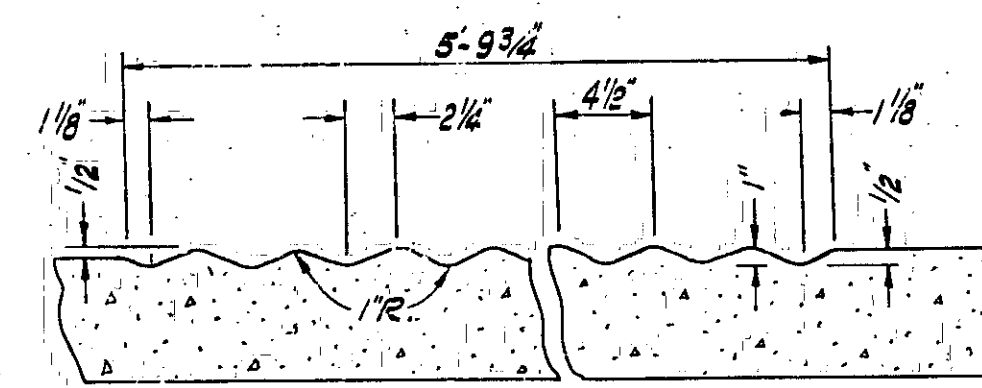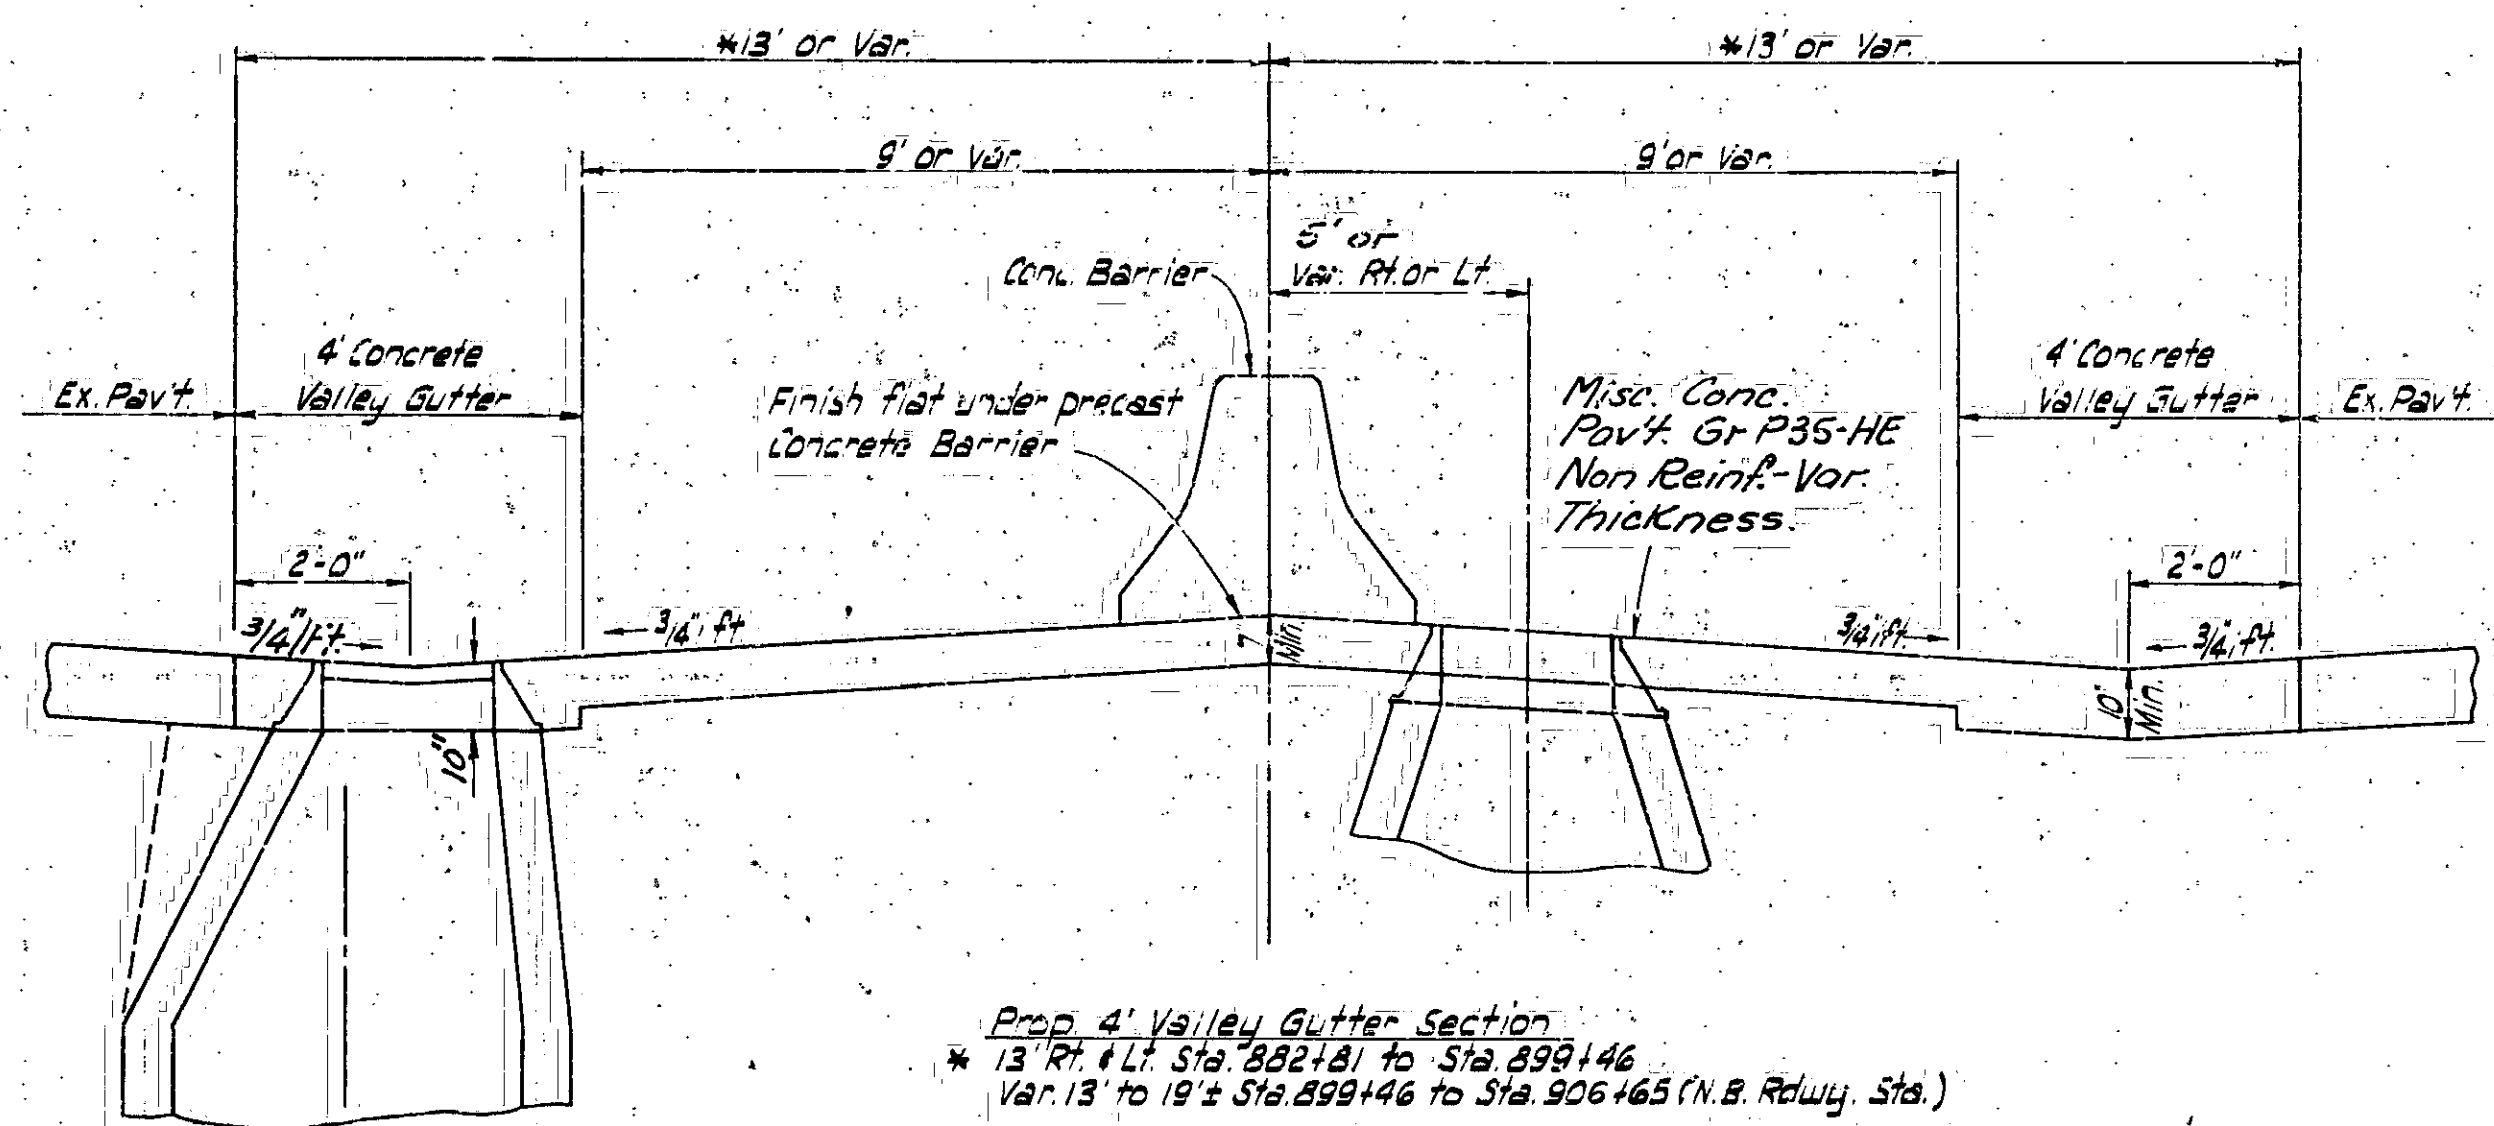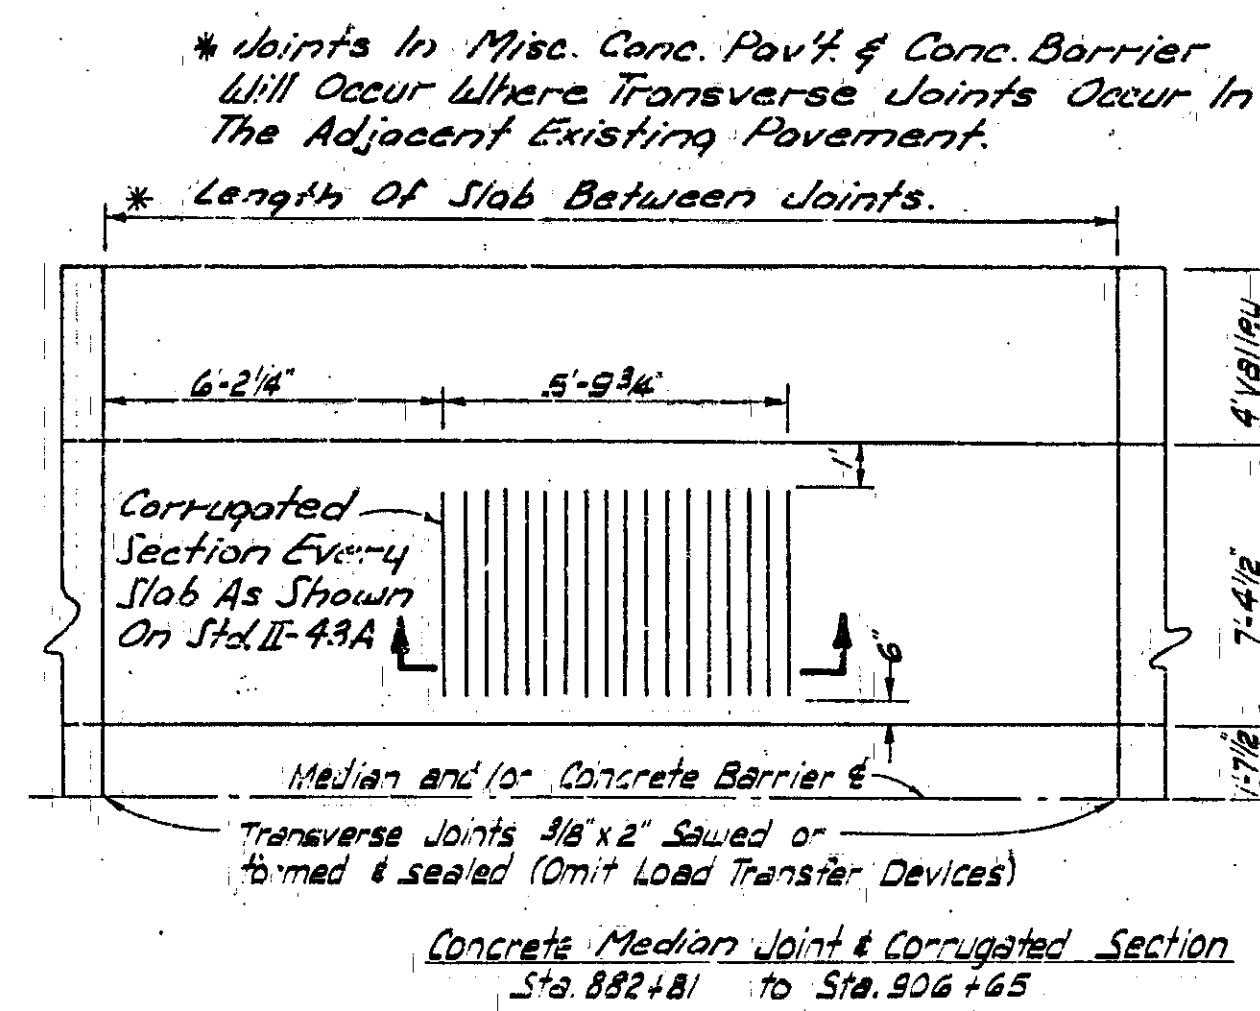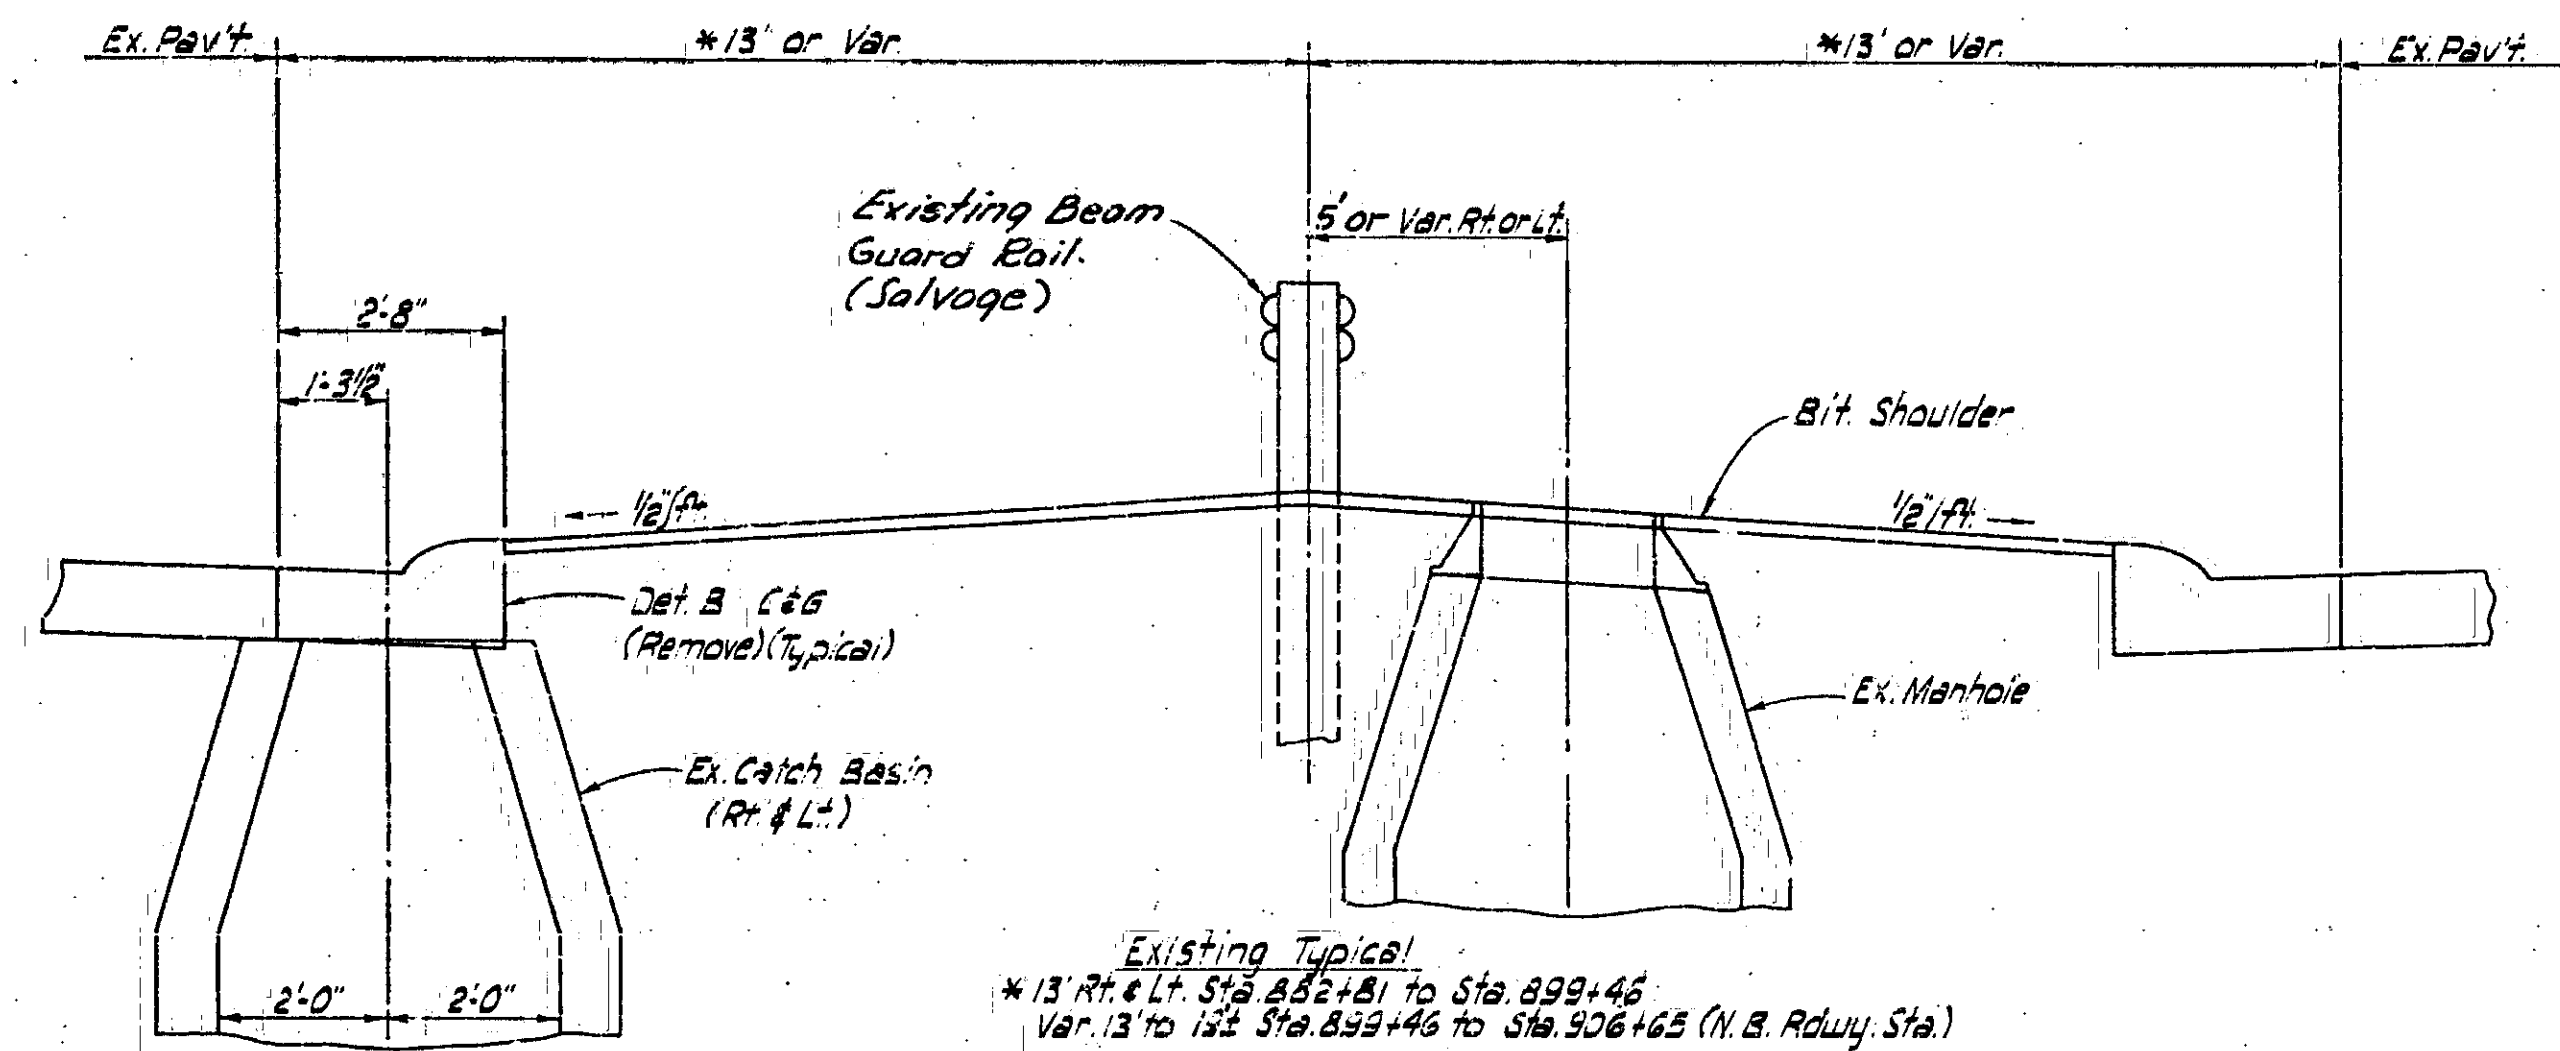

NOTES

No Lane Ties will be required on this job.

The edge of the existing pavement shall be thoroughly cleaned before concrete shoulder is placed.

Place 1" transverse expansion joints in concrete shoulders in line with all joints in the adjacent pavement, omitting the load transfer device.

NOTE SHEET

FED. PROJ. NO.	STATE	FEDERAL PROJECT NO.	SHEET NO.	TOTAL SHEETS
5	MICH.	I-75-2(176)62	3	3
ROUTE	COUNTY	CONTROL SECTION	JOB NO.	
I-75	OAKLAND	1s 63174	08517A	

GENERAL PLAN NOTES

CLASS B SODDING

Where Class B Sodding is called for on the plans, the beds shall be trimmed within the tolerances specified for Class A slopes.

DELINEATORS

Delineators may be removed, salvaged & replaced as per Engineer. This will not be paid for separately but will be incidental to Removing Beam Guard Rail.

MISCELLANEOUS ESTIMATES

The following items of work shall be done as they apply throughout the project. These items are not detailed or included on the plan and profile sheets.

Federal Participation	Royal Oak	Madison Hts.	
Maintaining Traffic	42 %	48 %	L.S.
Subgrade Undercutting Type I (To be backfilled with Granular Material Class II).	100		C. Yd.
Edge Drains-6" (For undercutting areas)	100		L. Ft.
Edge Drains-6" (For reconnecting existing edge drain)	25		L. Ft.
6" Sewer Taps	5		Ea.
Lighted Arrow Type A - Furnished	47 %	53 %	Ea.
Lighted Arrow Type A - Operated	47 %	53 %	Ea.
Hazard Light - Furnished	47 %	53 %	Ea.
Hazard Light - Operated	47 %	53 %	Ea.
Non Federal Participation			
Maintaining Traffic	4%	6 %	L.S.

PUBLIC UTILITIES

The existing utilities listed below have been shown on the plans as they appeared on various "as constructed" highway plans. This information does not relieve the contractor of the responsibility to satisfy himself as to their accuracy or his responsibility in case utilities have been constructed, relocated or removed, and do not conform to these plans.

NAME AND ADDRESS OF OWNER	KIND OF UTILITY
Dept. of Public Services City of Southfield	Water, Sewer
S. E. Oakland Co. Water Auth. Berkley	Water
Detroit Metro Water Services	Water, Sewer
Consumers Power Company 212 Michigan Avenue Jackson, Michigan 49201	Gas
Mich. Consolidated Gas Company One Woodward Ave. Detroit, Michigan 48226	Gas
Detroit Edison Co. 2000 Second Ave. Detroit, Michigan	Electric
Mich. Bell Telephone Company 23500 Northwestern Southfield, Michigan	Telephone

The Contractor may call the "Miss Dig" telephone number 24 hours in advance of any operation to obtain underground utility information.


NOTES APPLYING TO STANDARD PLANS

Where the following items are called for on plans, they are to be constructed according to the standard plan given below opposite each item unless otherwise indicated.

Manholes 42" Pipe and Under	I-1B
Catch Basins and Inlets	I-5B
Cover D	I-9B
Concrete Curb and Concrete Curb & Gutter	II-30A
Corrugated Concrete Divider	II-38A
Location of Transverse Expan & Contr. Joints in Conc. Pav't	II-43A
Concrete Barrier	II-49 (Special Detail)
Light Std. Foundation (Concrete Barrier)	II-50 (Special Detail)
Concrete Valley Gutter	II-53A
Guard Rail Ending with Cable Anchorage	III-58A
Beam Guard Rail (Terminal End Shoes)	III-60B
Beam Guard Rail - Type C	III-63B
Structure Guard Rail Anchorage (Type C)	III-69A
Beam Guard Rail - Type CD	III-64B
Granular Blanket, Underdrains, & 6" Culvert End Section	IV-80A
Utility Trenches	IV-83B (Special Detail)
Drum Guide Rail, Drum Guide Rail Double, Drums, Timber Curb & Snow Fence, Timber Curb & Splash	IV-124B
Types II & III Barricades and Lighted Arrows	VI-125C
Sodding	E-4-A-10E
Concrete Barrier at Existing Sign Trusses	(Special Detail)
Guard Rail Flairing Details	(Special Detail)
Beam Guard Rail - Type B	III-61B
Structure Guard Rail Anch. (Median)	(Special Detail)
Post And Delineator	(Special Detail)
Erosion Control	V-96A

SQUAD: ROUSH

STATE	FEDERAL PROJECT	R.O.W. NO.	SHEET NO.	TOTAL SHEETS
5 MICH.	I-75-2(176)C2		4	
ROUTE	COUNTY	CONTROL SECTION		
I-75	OKLAND	IS 63174	08517A	

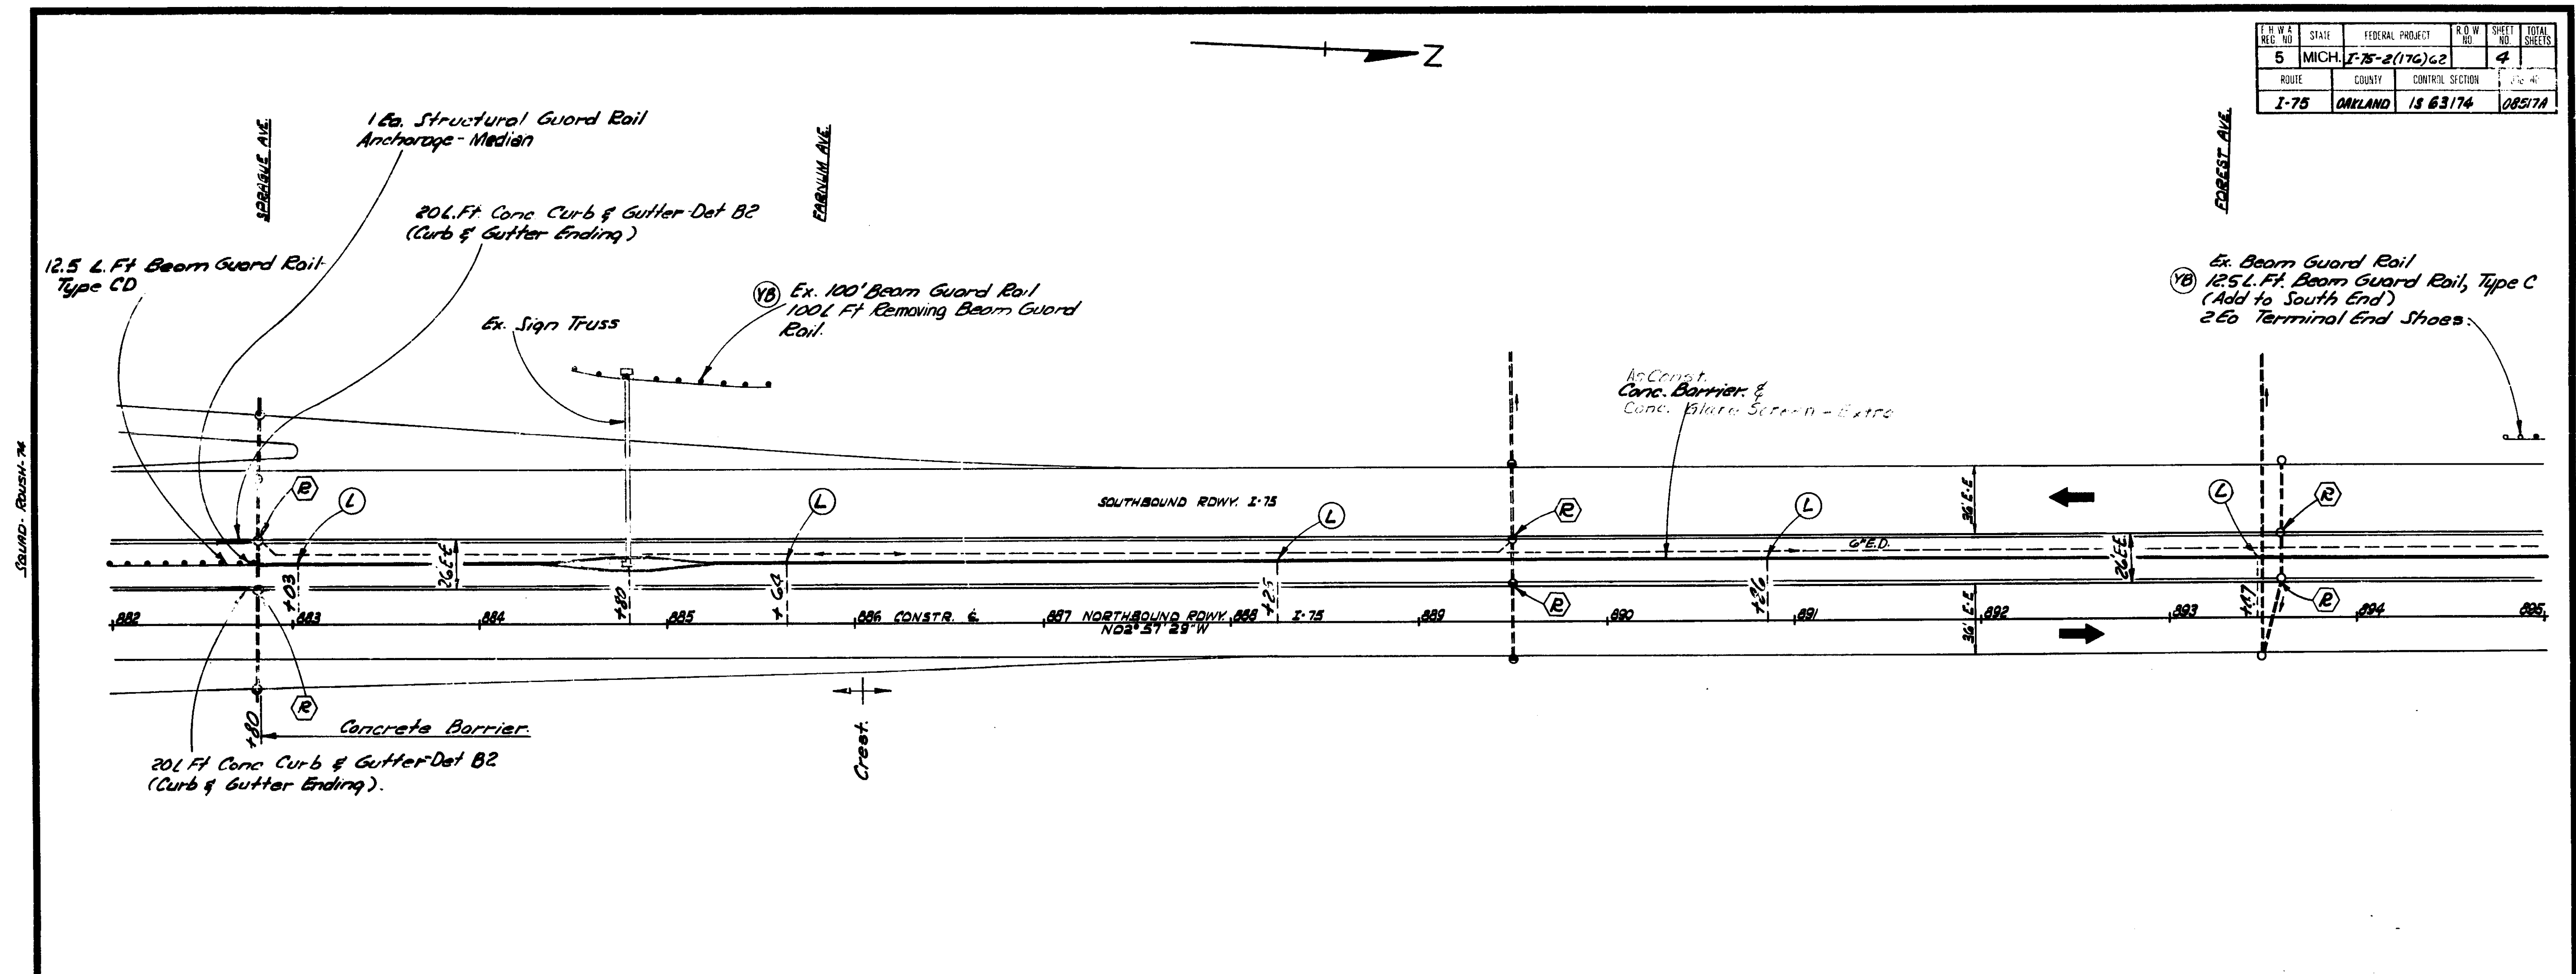

308 STA. 834+50
 I.S. 63174, Job No. 08517A

- LEGEND.**
- (44)--- Erosion Control Work
 - (YB)--- Yellow Book Safety Work
 - (R)--- Reconstruct Drainage Structure
 - (Adj)--- Adjust Drainage Structure Cover
 - (L)--- Light Standard Foundation - Conc Barrier (for Details See Sheet #11)

NOTE:
 If There Is A Conflict Between The Light Standard Foundation (L) And Existing Drainage Structures, The Light Standard Foundation Location May Be Moved As Directed By The Engineer.
 Where called for On Plans Slopes Shall Be Flattened To 1 on 4 Or Flatter

QUANTITIES THIS SHEET.

Item	Quantity	City Of Royal Oak
Beam Guard Rail - Type C	12.5 L.Ft.	
Terminal End Shoes	2 Ea.	
Removing Curb & Gutter	2480 L.Ft.	
Removing Beam Guard Rail	1345 L.Ft.	
Earth Excavation - Special	12.2 Yds	
Misc Conc Pav't Grade 35 P.H.E. - Variable Thickness - Non Reinforced	35.34.4.5 Yds	
Concrete Barrier	1220 L.Ft.	
Conc. Curb & Gutter - Det. B2 (C & G. Ending)	40 L.Ft.	
*Light Standard Foundation - Conc Barrier	5 Ea.	
Reconstruct Drainage Structures	6 Ea.	
Drainage Structure Covers (G Cover D)	2730 Lbs	
Beam Guard Rail - Type CD	12.5 L.Ft.	
Structure Guard Rail Anchorage - Median	1 Each	

* Federal Participation Non-City

I-75 STA 882+00 To STA 895+00

CONTROL SECTION	IS63174	JOB NO.	08517A	FEDERAL PROJECT	I-75-2(176)C2	SHEET	4
-----------------	---------	---------	--------	-----------------	---------------	-------	---

B.M. #76A El. 637.24
R.R. spike in P. Right
133 Ft. of N.B. &
Sta. 894+64

Wit. to P.C. 894+46.29 N.B.
N.47°W. 40.63' S.E. cor.
S. Bridge Pier
S.89°W. 41.83' N.E. cor. of C.B.
Due E. 20.20' N.E. cor. of C.B.



Curve Data N.B. Consté
Δ = 29° 59' 53"
D = 3° 00' 00"
R = 1809.86'
T = 511.71'
L = 992.94'
E = 67.36'
P.C. = 899+46.29
P.T. = 909+46.23
S.E. = 0.0614%

Curve Data S.B. Consté
Δ = 29° 59' 53"
D = 2° 52' 35"
R = 1991.86'
T = 533.68'
L = 1042.87'
E = 70.26'
P.C. = 899+80.93
P.T. = 905+14.64
S.E. = 0.0614%

B.M. #73A El. 638.06
Wit. to P.C. Sta. 899+80.93

Wit. to P.C. 899+80.93 S.B.
N.12°W. 85.30' S.W. cor. of C.B.
N.30°E. 56.76' S.W. cor. N. Pier
S.30°E. 40.32' N.E. cor. of C.B.

F.W.D. DIST. NO.	STATE	FEDERAL PROJECT NO.	S.D.W. NO.	SHEET NO.	TOTAL SHEETS
5	MICH.	I-75-2(176)62		5	
ROUTE	COUNTY	CONTROL SECTION	JOB NO.		
I-75	OAKLAND	I-563174	06405		

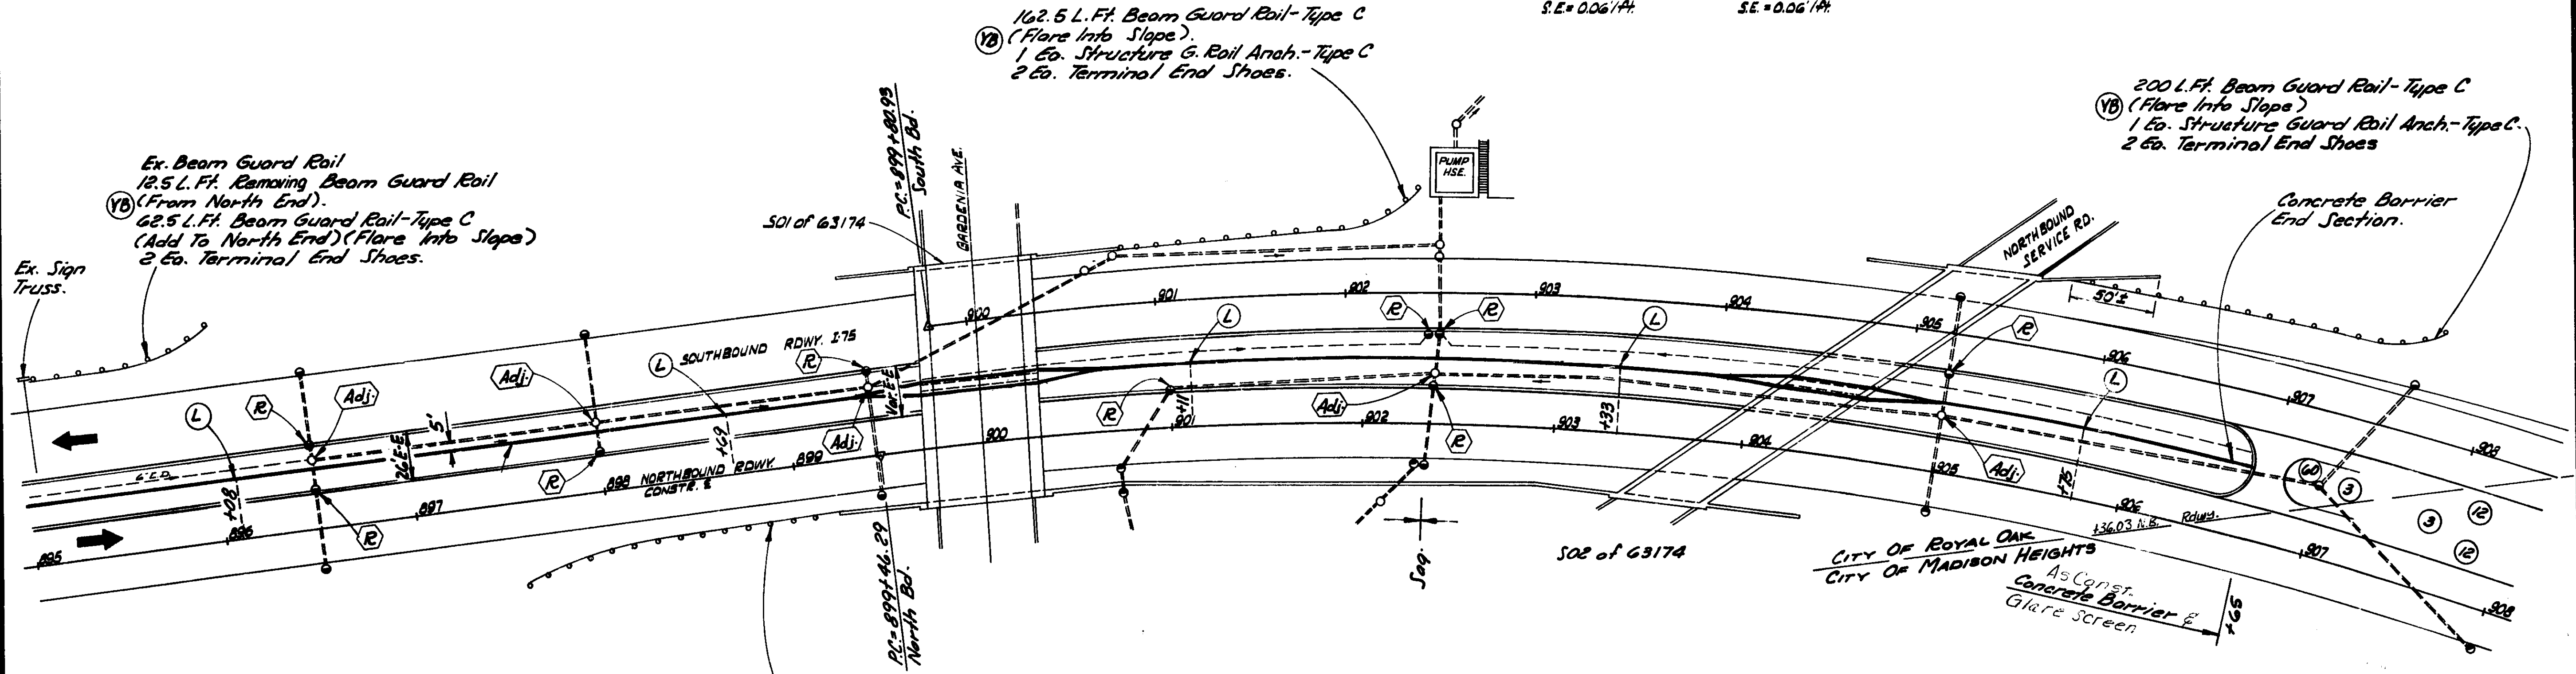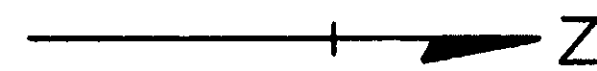

162.5 L.F. Beam Guard Rail - Type C
(Flare Into Slope)
1 Co. Structure Guard Rail Anch. - Type C
2 Co. Terminal End Shoes.

QUANTITIES THIS SHEET
Non-Federal Participation

	Royal Oak	Madison Heights	
Earth Excavation	50	10	C.Yd.
Embankment (C.I.P.)	10	23	C.Yd.
Machine Grading	50	70	Sy.
Roadside Seeding	1	1	Lbs.
Mulch	02	03	Ton
Chemical Fertilizer Nutrient	2	3	Lb.
Sediment Traps	1		Co.

QUANTITIES THIS SHEET
Federal Participation

	Royal Oak	Madison Heights	
Beam Guard Rail - Type C	587.5		L.F.
Structural Guard Rail Anchorage - Type C	3		Co.
Terminal End Shoes	8		Co.
Removing Curb & Gutter	2372		L.F.
Removing Beam Guard Rail	1079.0		L.F.
Earth Excavation - Special	11.8		Sta.
Concrete Barrier	1174		L.F.
Misc. Conc. Pav't. Gr. 35P-HE-Variable Thick-Non Reinf.	3920.6		S.Yd.
* Light Standard Foundation-Conc. Barrier	5		Co.
Reconstruct Drainage Structure	9		Co.
Drainage Structure Covers (9 Cover D)	4095		Lb.
Adjust Drainage Structure Cover	5		Co.


* Federal Participation - Non City

I-75 STA. 895+00 To STA. 908+00 (North Bd. Sta.)

STATE	FEDERAL PROJECT	P.O. NO.	SHEET NO.	TOTAL SHEETS
5 MICH.	I-75-2(176)G2		6	
ROUTE	COUNTY	CONTRACT SECTION	JOB NO.	
I-75	OAKLAND	IS 63174	08517A	

Witness to P.C. North Bound
 915+39.23 Boat Spike
 N44°E 65.11' in Sta. 916+00
 S07°E 52.92' S.W. Bolt Light P.
 S77°E 63.02' " in Sta. 91+00

Curve Data
 Δ = 29°02' 20"
 D = 3°00' 00"
 R = 1909.86'
 T = 434.61'
 L = 367.96'
 E = 63.01'
 P.C. = 915+39.23
 P.T. = 920+33.84
 A.T. = 925+07.19
 Super = 2.037/44'

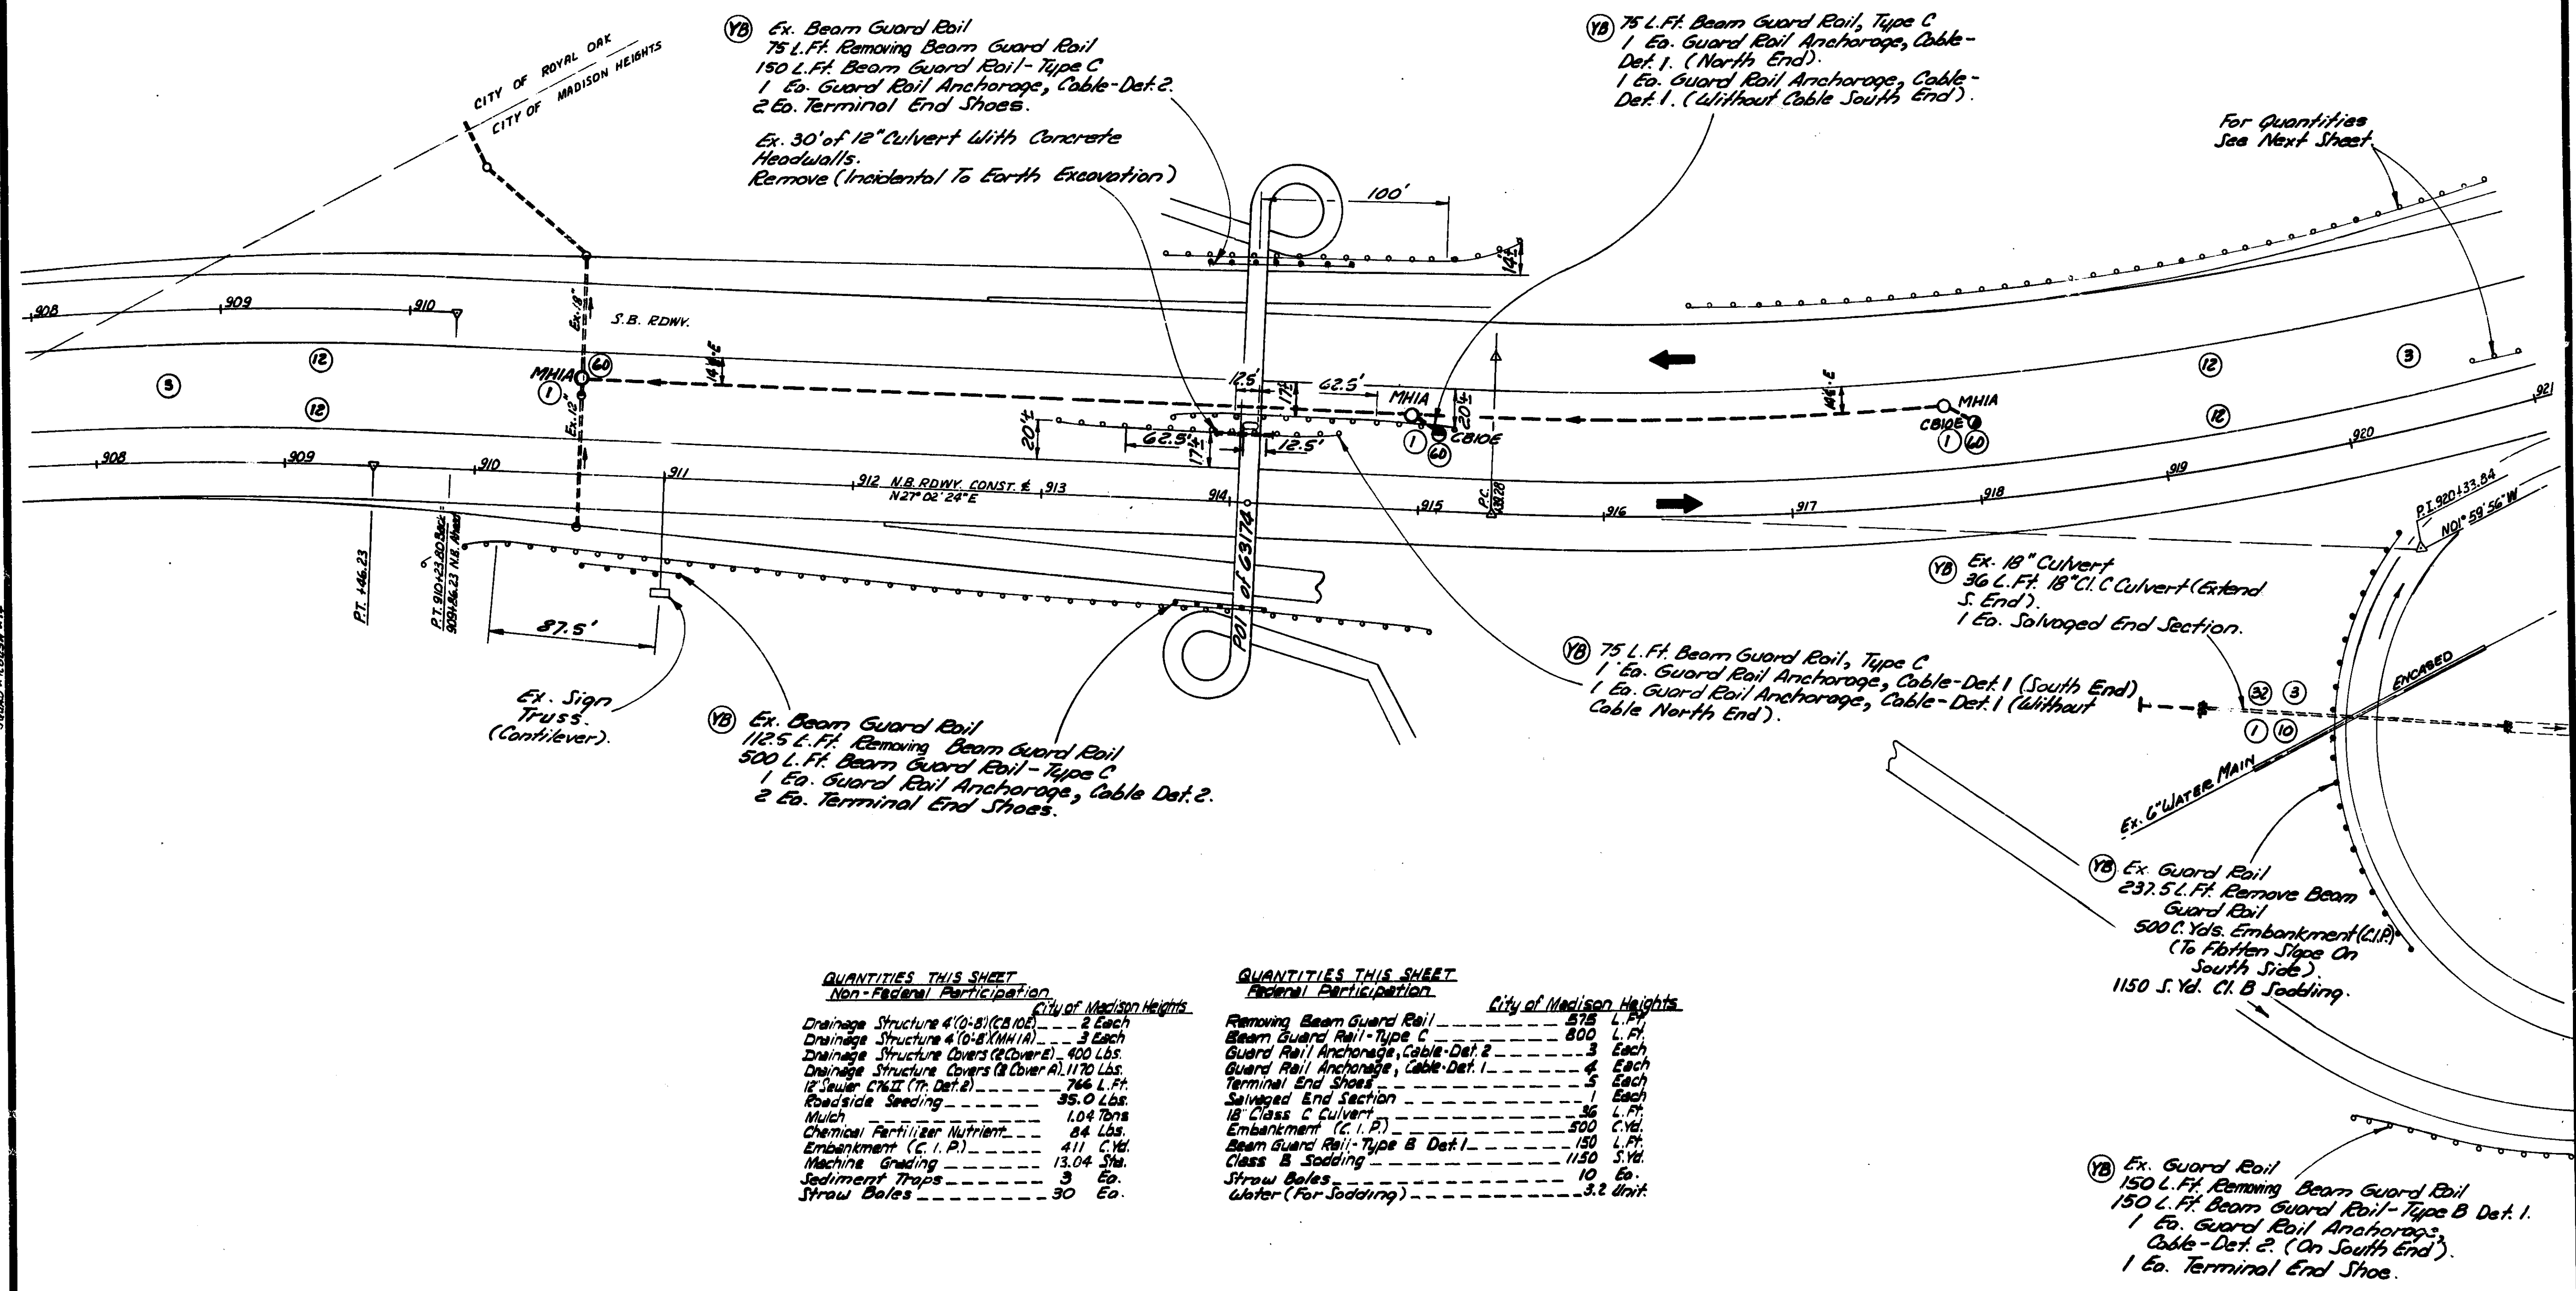

Ⓜ Ex. Beam Guard Rail
 75 L.F. Removing Beam Guard Rail
 150 L.F. Beam Guard Rail - Type C
 1 Ea. Guard Rail Anchorage, Cable-Def. 2.
 2 Ea. Terminal End Shoes.
 Ex. 30' of 12" Culvert With Concrete
 Headwalls.
 Remove (Incidental To Earth Excavation)

Ⓜ 75 L.F. Beam Guard Rail, Type C
 1 Ea. Guard Rail Anchorage, Cable-
 Def. 1. (North End).
 1 Ea. Guard Rail Anchorage, Cable-
 Def. 1. (Without Cable South End).

Ⓜ Ex. 18" Culvert
 36 L.F. 18" Cl. C Culvert (Extend
 S. End).
 1 Ea. Salvaged End Section.

Ⓜ 75 L.F. Beam Guard Rail, Type C
 1 Ea. Guard Rail Anchorage, Cable-Def. 1 (South End)
 1 Ea. Guard Rail Anchorage, Cable-Def. 1 (Without
 Cable North End).

Ⓜ Ex. Beam Guard Rail
 112.5 L.F. Removing Beam Guard Rail
 500 L.F. Beam Guard Rail - Type C
 1 Ea. Guard Rail Anchorage, Cable Def. 2.
 2 Ea. Terminal End Shoes.

Ⓜ Ex. Guard Rail
 237.5 L.F. Remove Beam
 Guard Rail
 500 C. Yds. Embankment (C.I.P.)
 (To Flatten Slope On
 South Side).
 1150 S. Yd. Cl. B Sodding.

Ⓜ Ex. Guard Rail
 150 L.F. Removing Beam Guard Rail
 150 L.F. Beam Guard Rail - Type B Def. 1.
 1 Ea. Guard Rail Anchorage,
 Cable-Def. 2. (On South End).
 1 Ea. Terminal End Shoe.

QUANTITIES THIS SHEET
 Non-Federal Participation
 City of Madison Heights

Drainage Structure 4 (0-8) (CB100)	2	Each
Drainage Structure 4 (0-8) (MH1A)	3	Each
Drainage Structure Covers (2 Cover E)	400	Lbs.
Drainage Structure Covers (2 Cover A)	1170	Lbs.
12" Sewer C762 (T. Def. 2)	766	L.F.
Roadside Seeding	35.0	Lbs.
Mulch	1.04	Tons
Chemical Fertilizer Nutrient	84	Lbs.
Embankment (C.I.P.)	411	C.Yd.
Machine Grading	13.04	Syd.
Sediment Traps	3	Ea.
Straw Bales	30	Ea.


QUANTITIES THIS SHEET
 Federal Participation
 City of Madison Heights

Removing Beam Guard Rail	575	L.F.
Beam Guard Rail - Type C	800	L.F.
Guard Rail Anchorage, Cable-Def. 2	3	Each
Guard Rail Anchorage, Cable-Def. 1	4	Each
Terminal End Shoes	5	Each
Salvaged End Section	1	Each
18" Class C Culvert	36	L.F.
Embankment (C.I.P.)	500	C.Yd.
Beam Guard Rail - Type B Def. 1	150	L.F.
Class B Sodding	1150	S.Yd.
Straw Bales	10	Ea.
Water (For Sodding)	3.2	Unit

I-75 STA. 908+00 To STA. 921+00 (North Bd. Sta.)

CONTRACT SECTION	IS63174	JOB NO.	08517A	DATE	12-1-74	BY	WJ	NO.	6
------------------	---------	---------	--------	------	---------	----	----	-----	---

F.H.W.A. REG. NO.	STATE	FEDERAL PROJECT NO.	R.O.W. NO.	SHEET NO.	TOTAL SHEETS
5	MICH.	I-75-2(176)62		7	
ROUTE	COUNTY	CONTROL SECTION	JOB NO.		
I-75	OAKLAND	Is 63174	08517A		

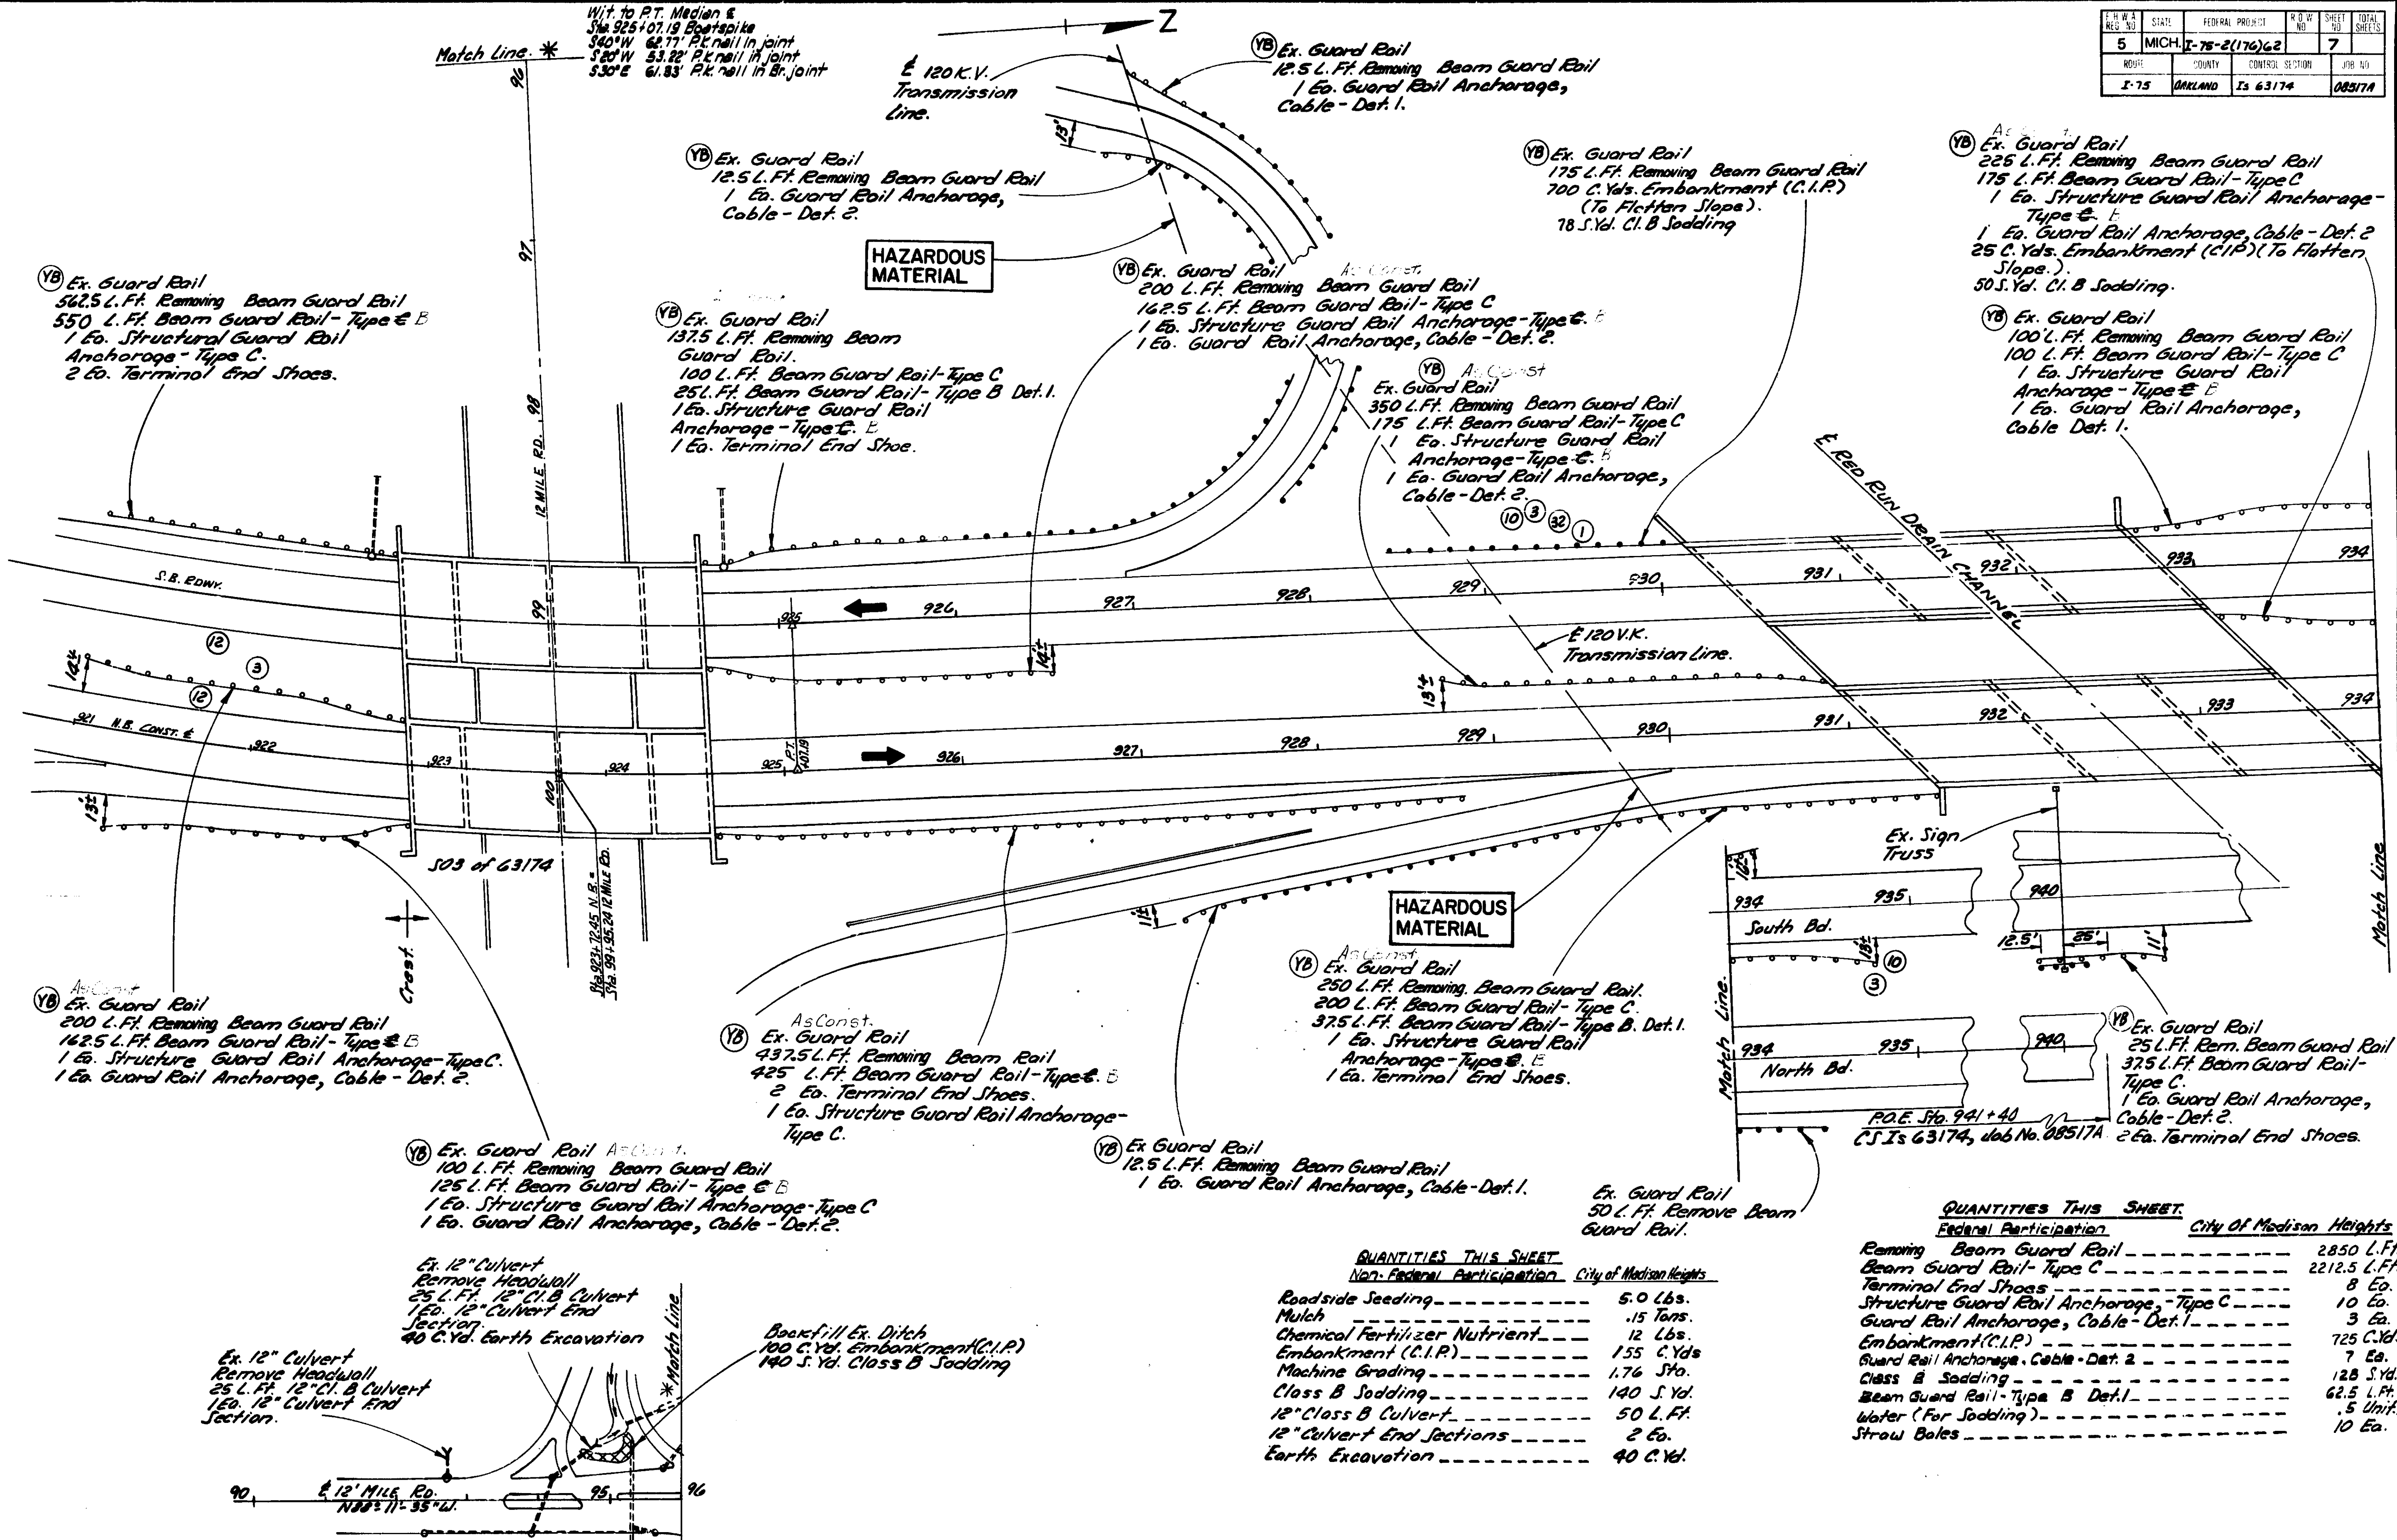

QUANTITIES THIS SHEET

Non-Federal Participation	City of Madison Heights
Roadside Seeding	5.0 Lbs.
Mulch	.15 Tons
Chemical Fertilizer Nutrient	12 Lbs.
Embankment (C.I.P.)	155 C.Yds
Machine Grading	1.76 Sfo.
Class B Sodding	140 S.Yd.
12" Class B Culvert	50 L.Ft.
12" Culvert End Sections	2 Ea.
Earth Excavation	40 C.Yd.


QUANTITIES THIS SHEET

Federal Participation	City of Madison Heights
Removing Beam Guard Rail	2850 L.Ft.
Beam Guard Rail - Type C	2212.5 L.Ft.
Terminal End Shoes	8 Ea.
Structure Guard Rail Anchorage - Type C	10 Ea.
Guard Rail Anchorage, Cable - Det. 1	3 Ea.
Embankment (C.I.P.)	725 C.Yd.
Guard Rail Anchorage, Cable - Det. 2	7 Ea.
Class B Sodding	128 S.Yd.
Beam Guard Rail - Type B Det. 1	62.5 L.Ft.
Water (For Sodding)	.5 Unit.
Straw Bales	10 Ea.

I-75 STA. 921+00 To STA. 941+00 (North Bd. Sta.)

S4420-20154-74

PLAN GRADE
 MEDIAN PROFILE

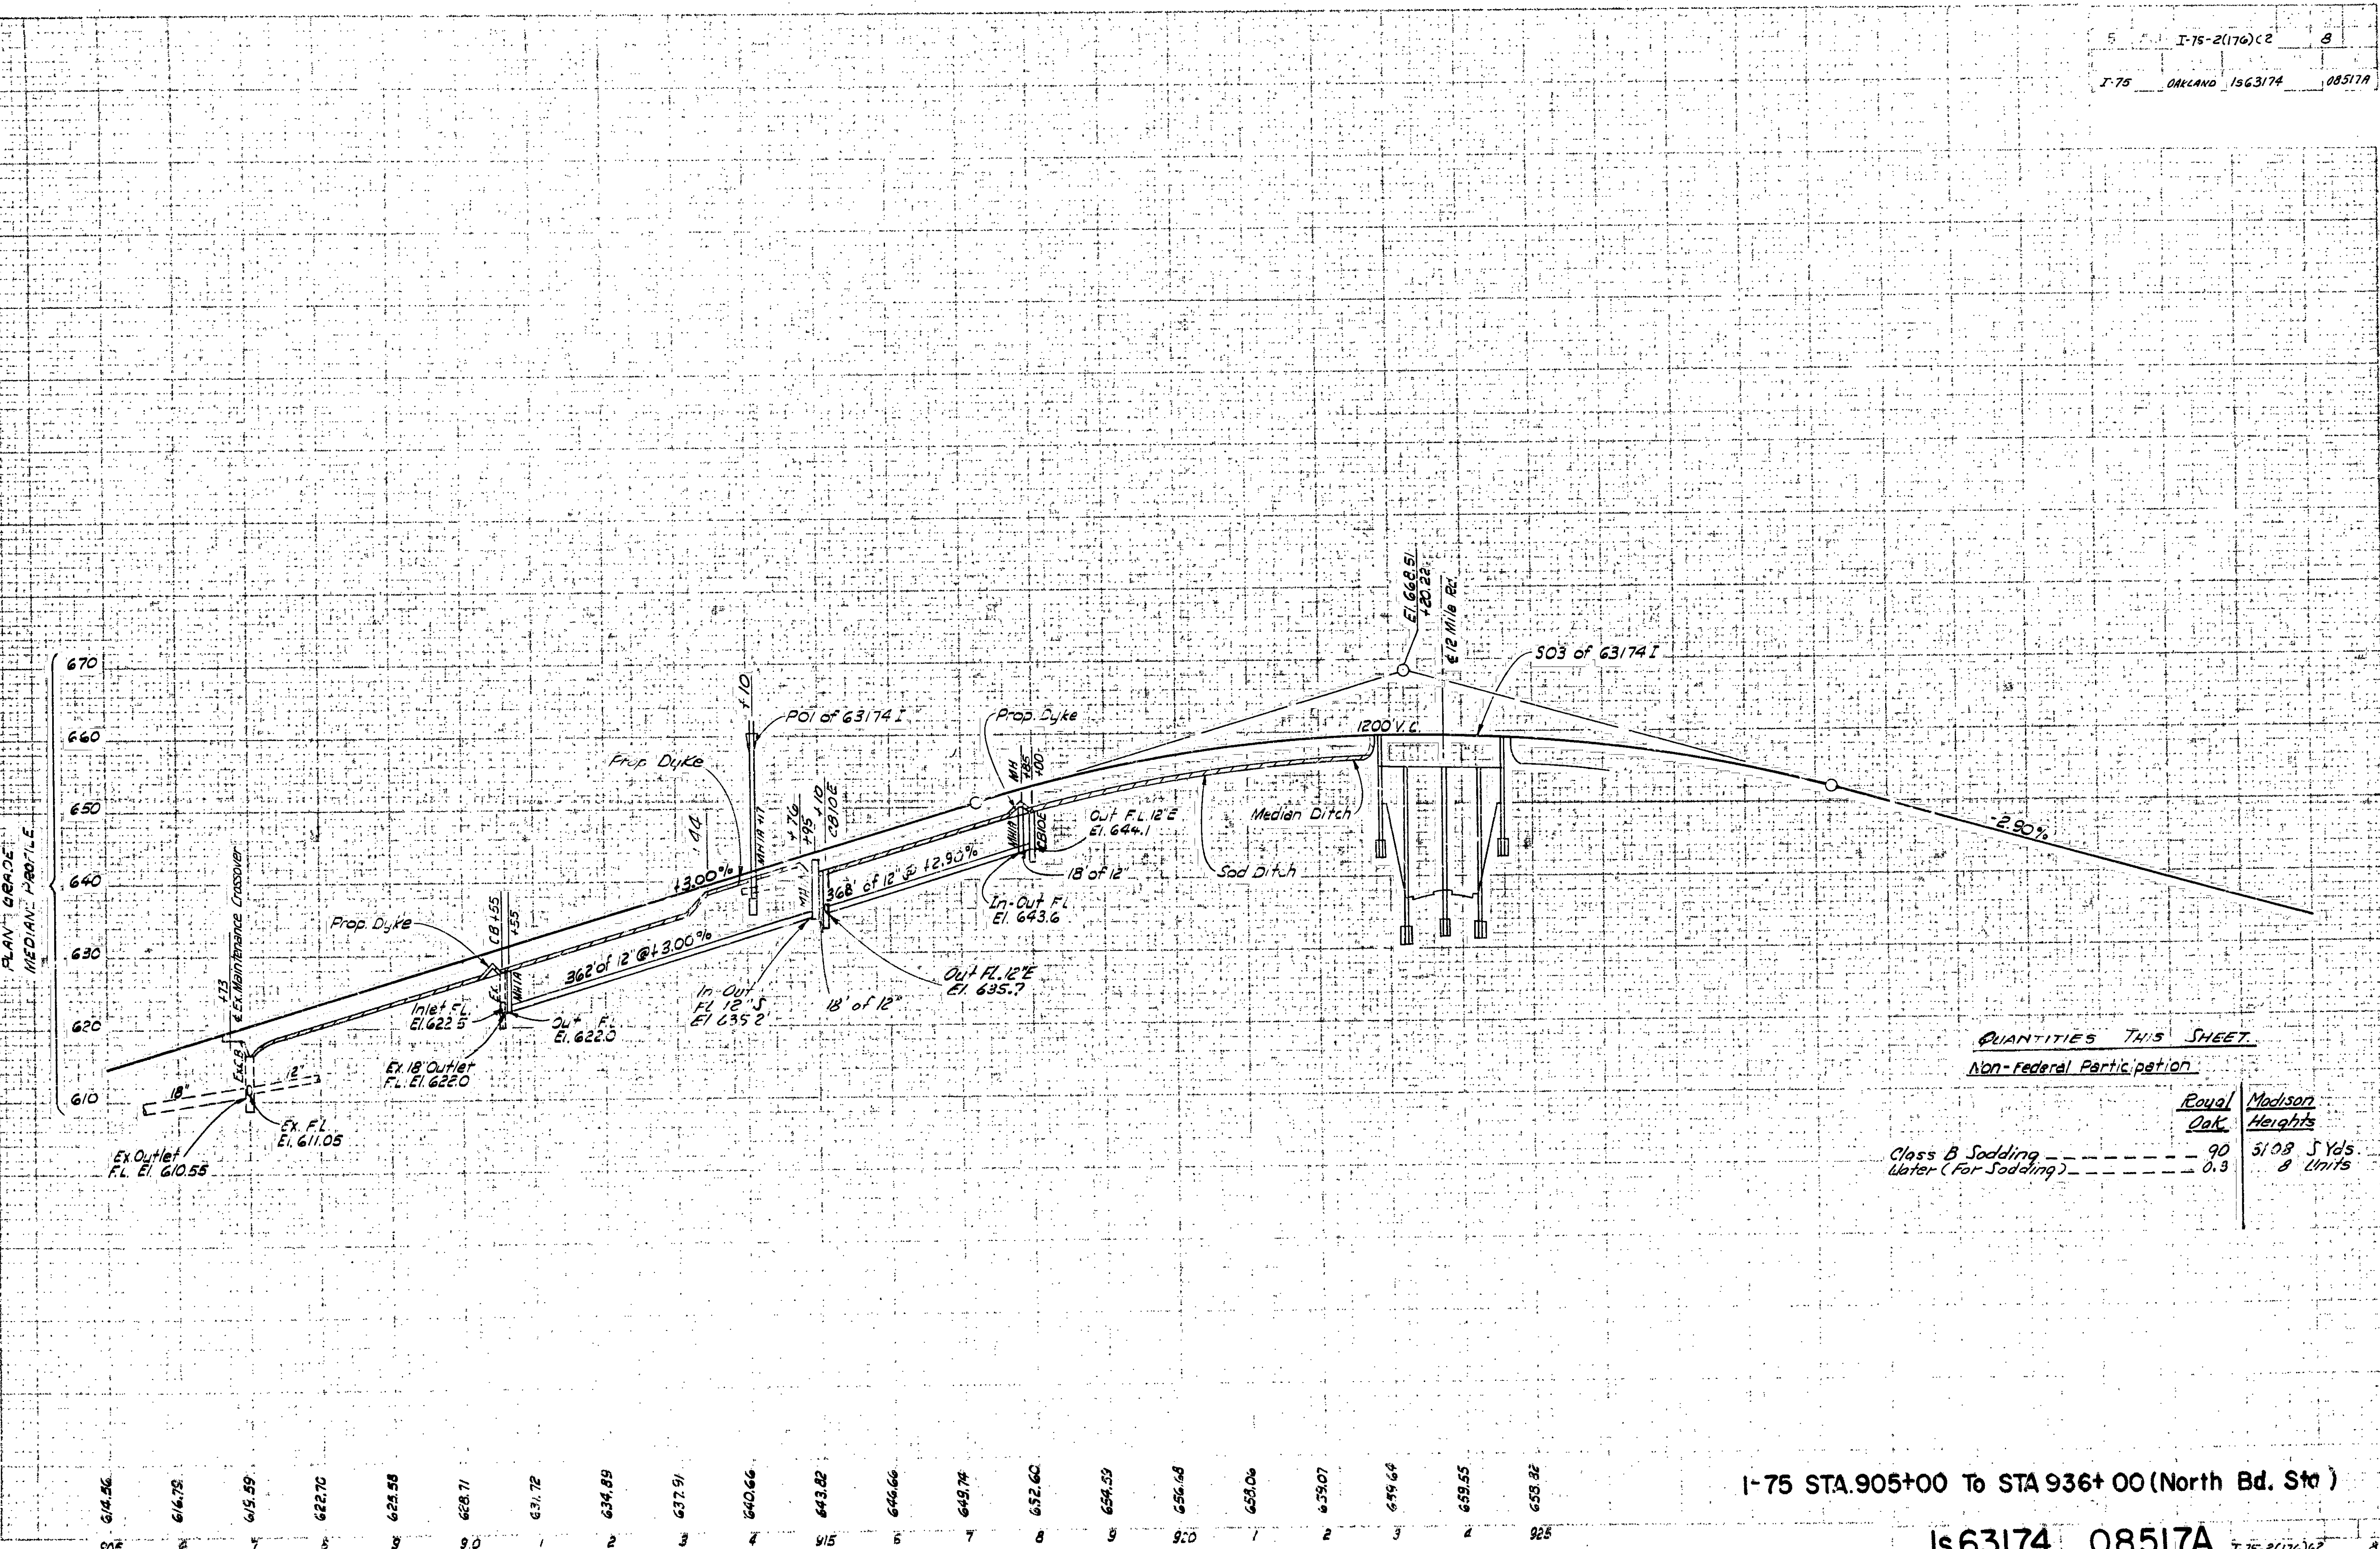


QUANTITIES THIS SHEET
 Non-Federal Participation

	Royal Oak	Madison Heights
Class B Sodding	90	51.08 S Yds
Water (For Sodding)	0.3	8 Units

I-75 STA. 905+00 To STA 936+00 (North Bd. Sta)

1563174 08517A I-75-2(176)C2 8

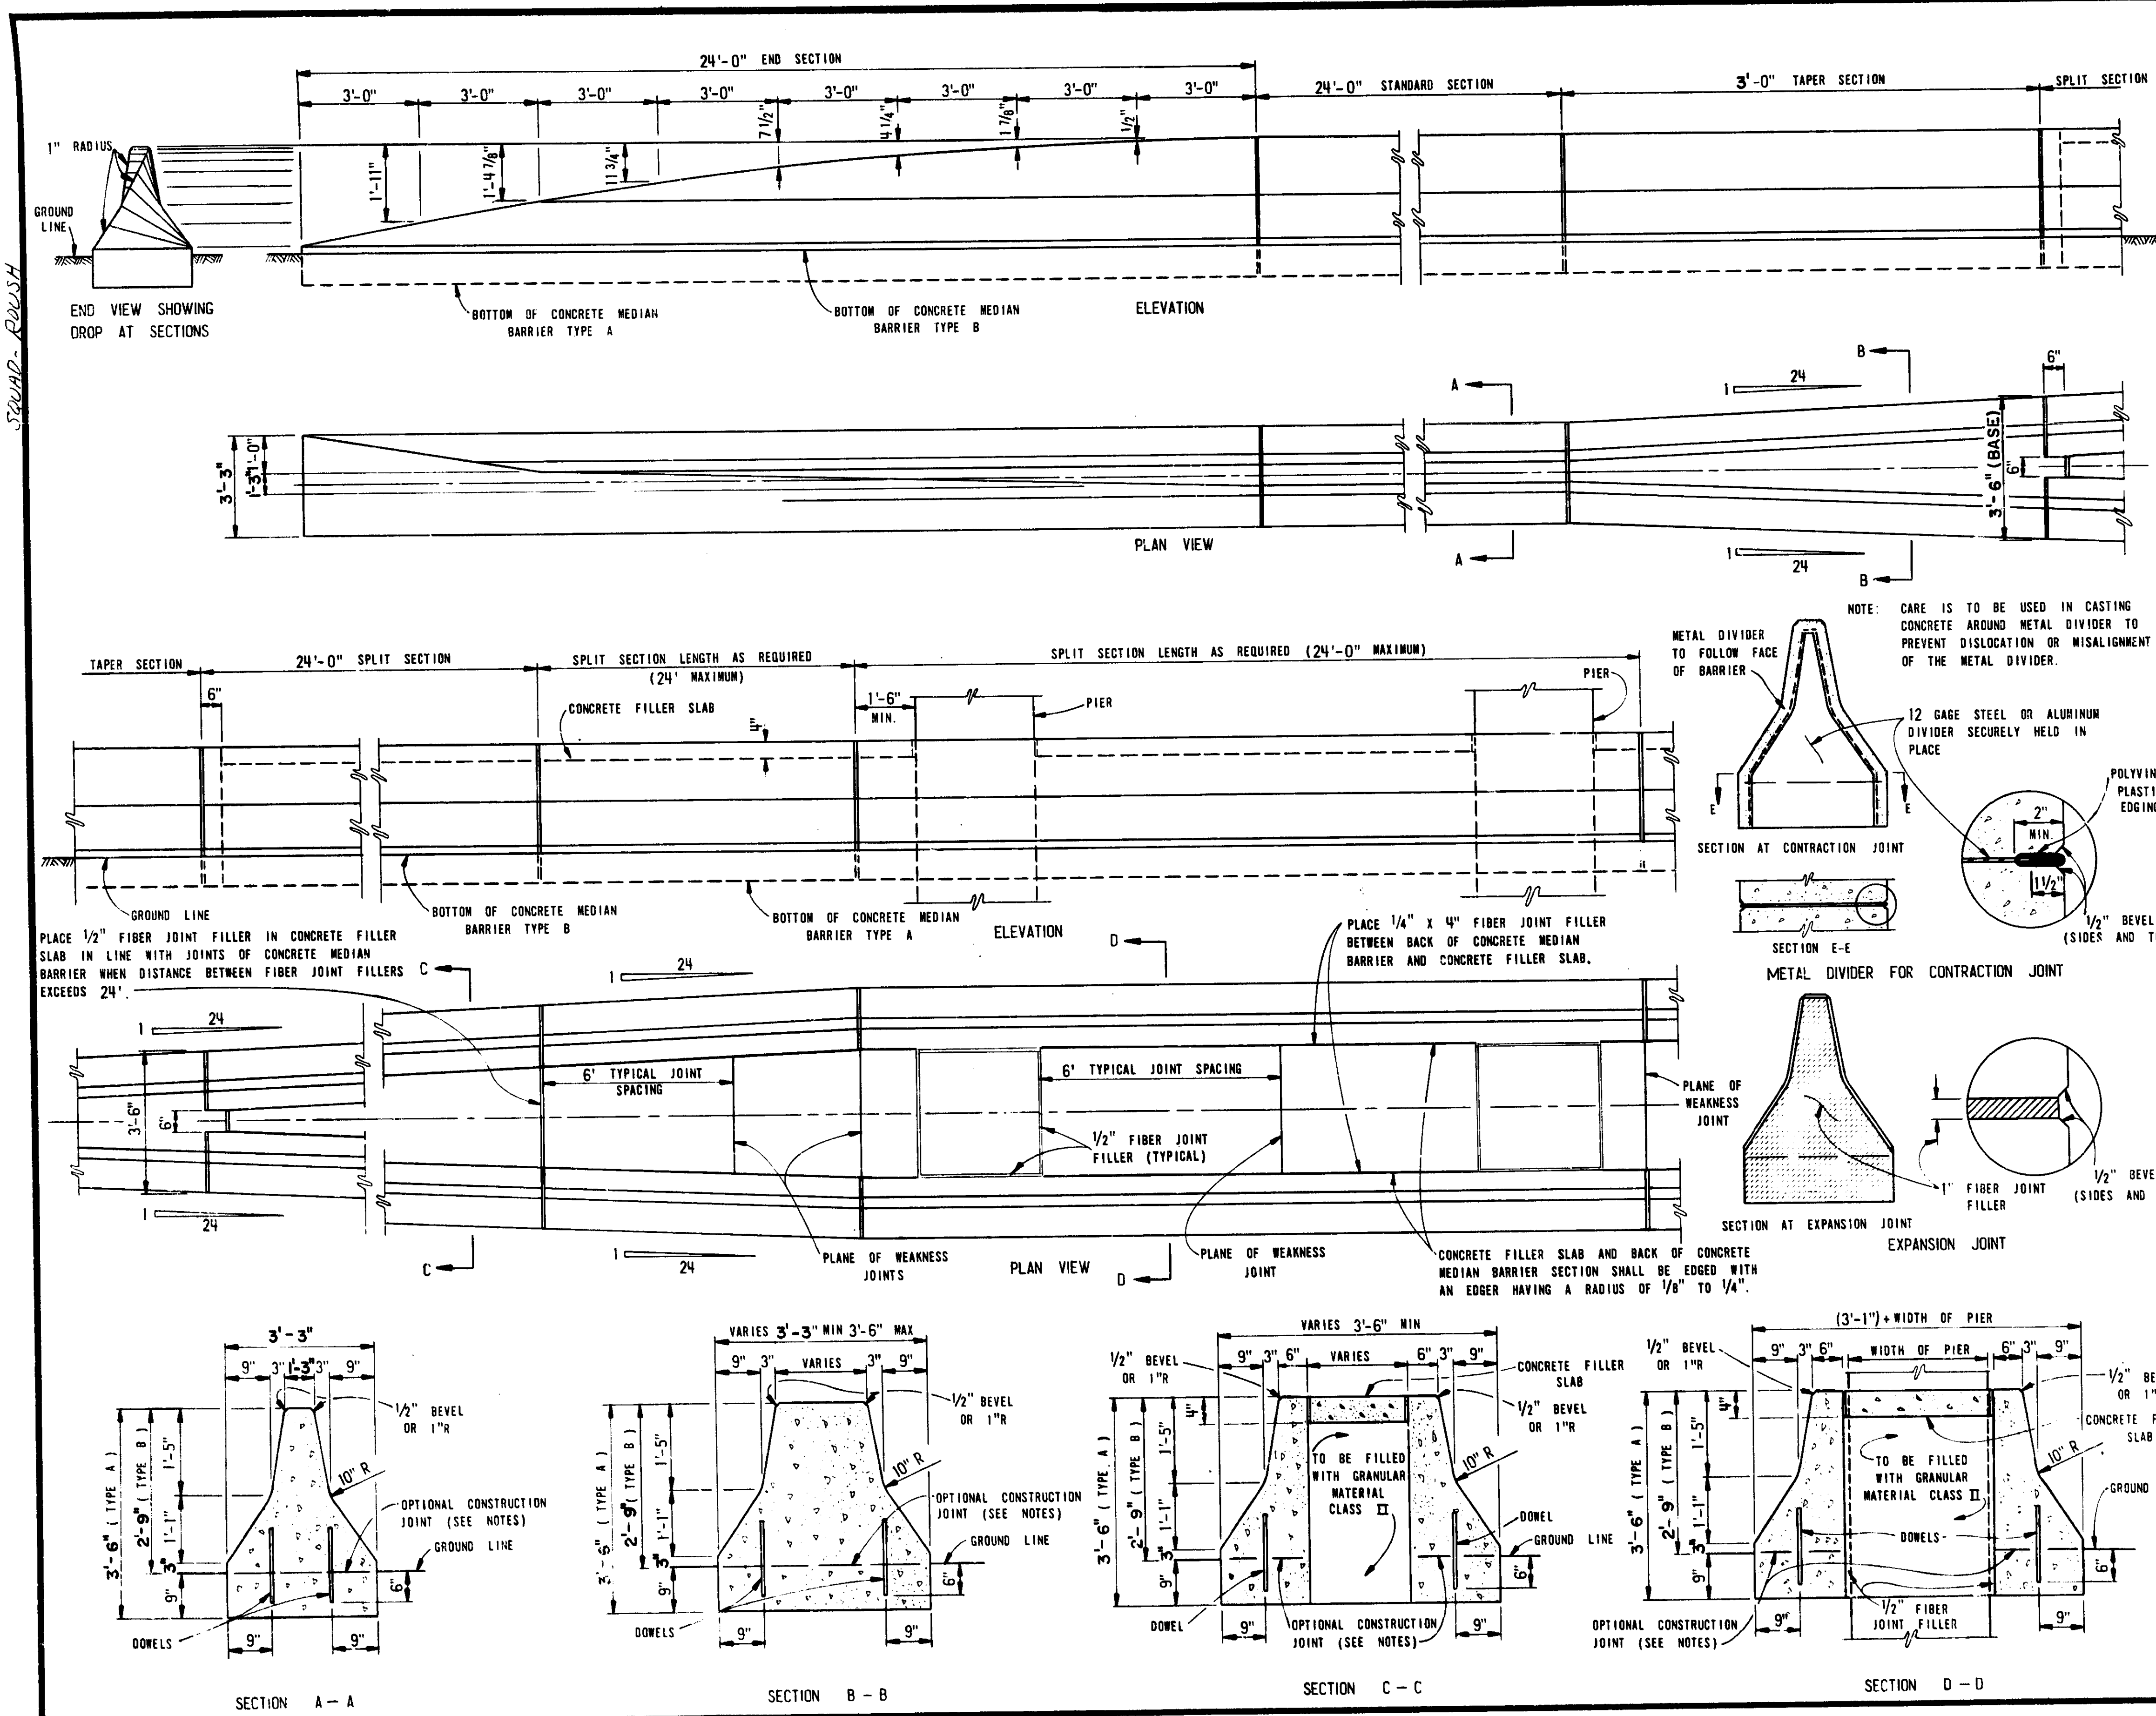

STATE OF MICHIGAN
 DEPARTMENT OF STATE HIGHWAYS
 STANDARD PLAN FOR
CONCRETE BARRIER
SPECIAL DETAIL

APPROVALS

CHECKED	ENGINEER DESIGN SECTION 1	DATE
RECOMMENDED FOR APPROVAL	ENGINEER OF DESIGN	DATE
RECOMMENDED FOR APPROVAL	TRAFFIC AND SAFETY DIVISION	DATE
RECOMMENDED FOR APPROVAL	CONSTRUCTION DIVISION	DATE
RECOMMENDED FOR APPROVAL	CHIEF BUREAU OF ENGINEERING	DATE
DEPARTMENT OF STATE HIGHWAYS		
BY	DEPUTY STATE HIGHWAY DIRECTOR	DATE

DRAWN BY H. A. W. CHECKED BY _____ REVISED BY _____ DATE 11-20-73



Is63174 08517A

Concrete Barrier Transition Details to Vertical Face at Pier Columns (2'-6" to 4'-9" in Width)



5	MICH.	I-75-2(176)62	10
I-75	OAKLAND	Is 63174	085174

TABLE I

Width of Pier Columns (Ft.)	Variable Part of Trans. Length (Ft.)	Total Length of Transition of Conc. Bar. (Ft.)
2'-6"	9'	15'
3'-0"	15'	21'
3'-3"	18'	24'
3'-6"	21'	27'
4'-0"	27'	33'
4'-6"	33'	39'
4'-8"	35'	41'
4'-9"	36'	42'

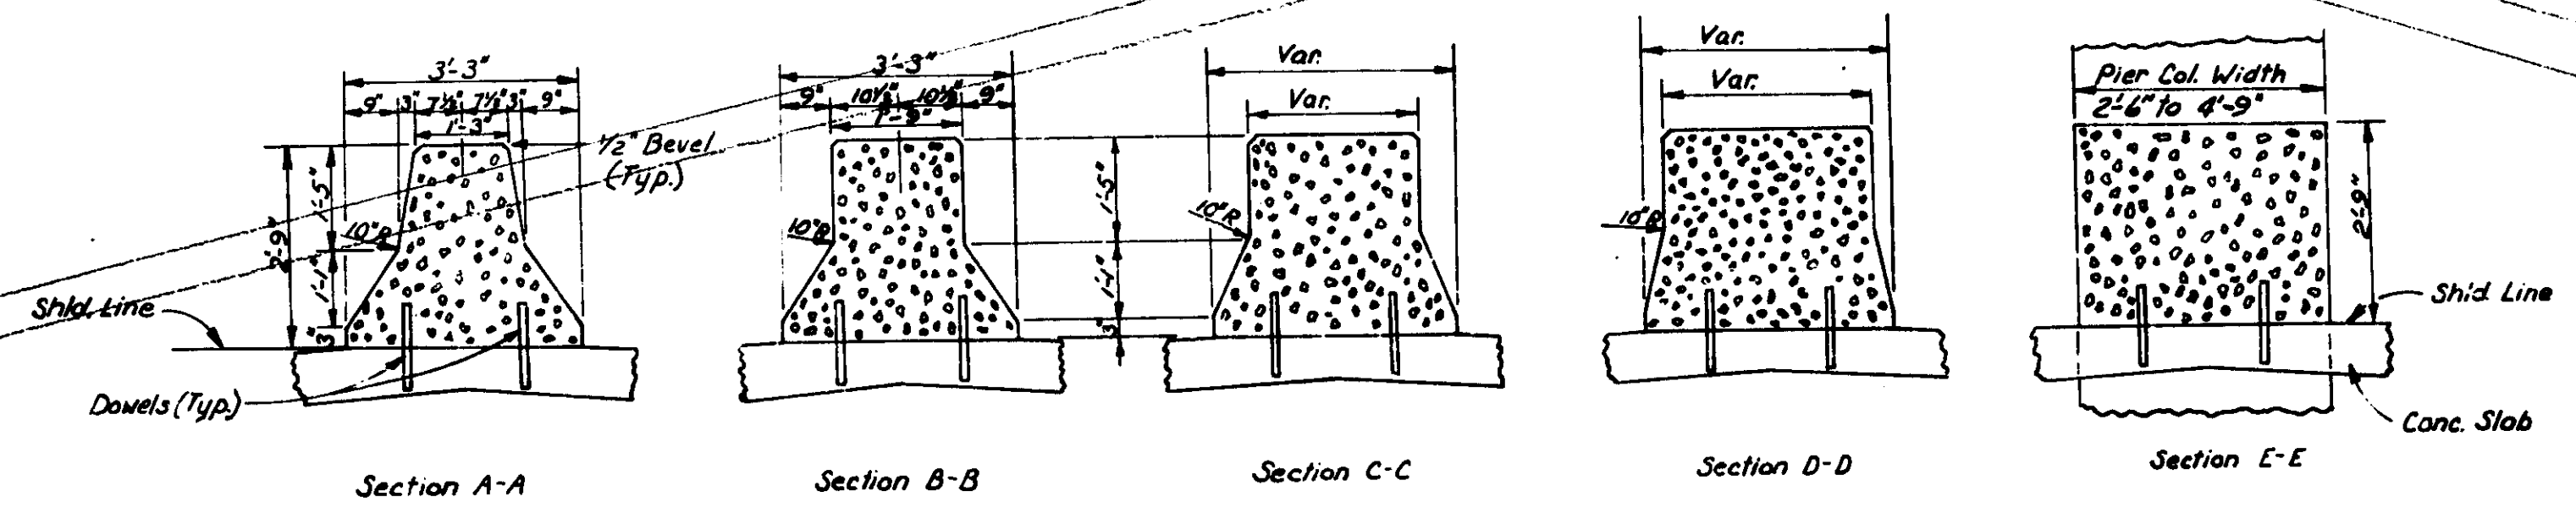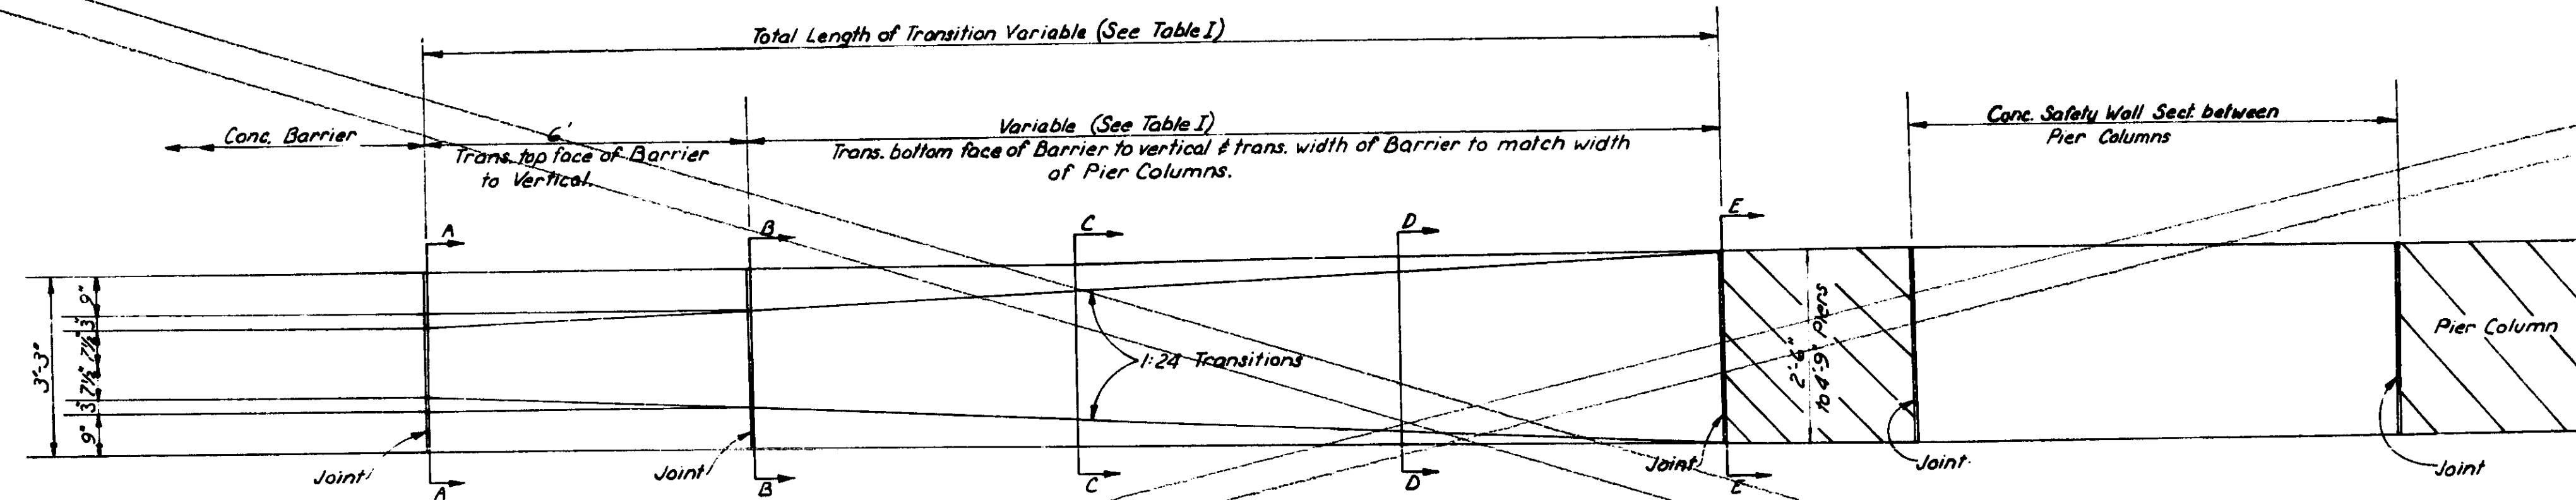

Note: See Special Details of Conc. Barrier Sh. No. Transitions will be Paid for as Concrete Barrier.

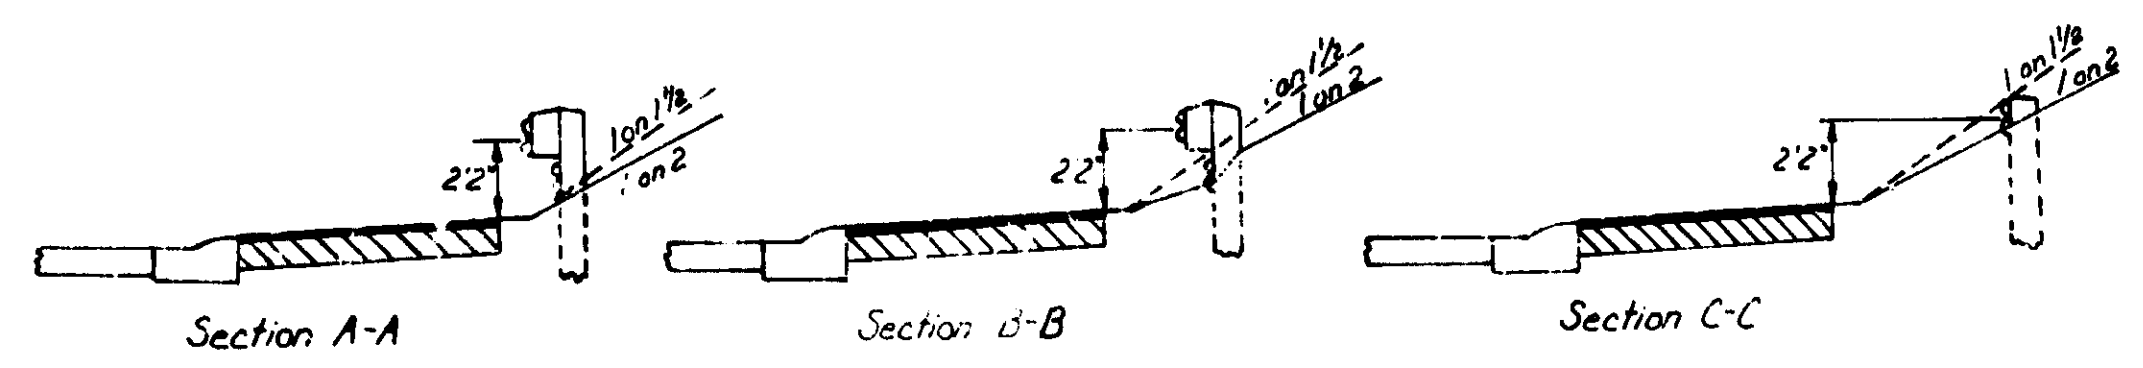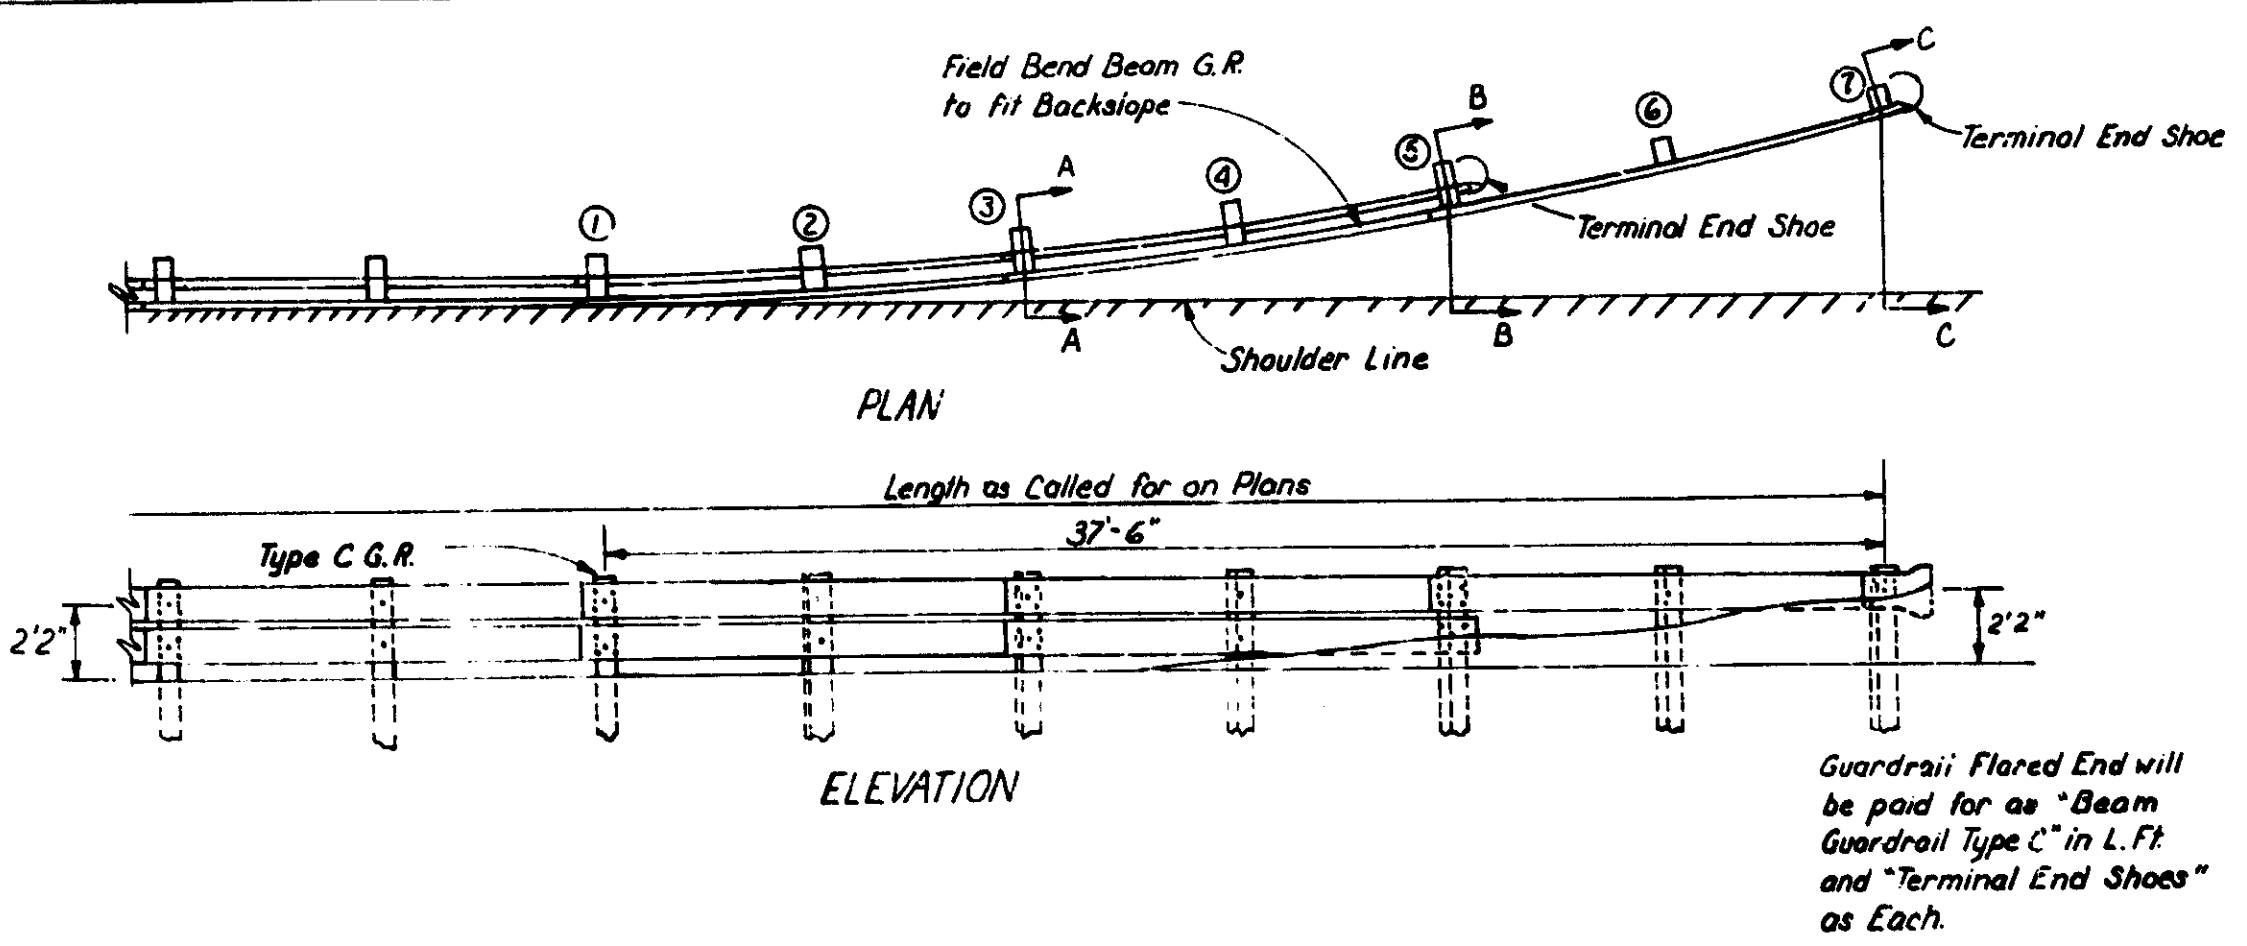


POST NO.	OFFSET DISTANCE FROM FACE OF GUARDRAIL TO SHOULDER LINE	
	LANE 2 A.S.	LANE 1/2 A.S.
1	0"	0"
2	2"	5"
3	2'-3"	10"
4	3'-6"	1'-5"
5	3'-0"	3'-6"

Guardrail offset distances may be modified to fit backslope conditions




GUARDRAIL FLARING DETAIL FOR URBAN DEPRESSED ROADWAYS

SPECIAL DETAILS


Guard Rail Flaring Details

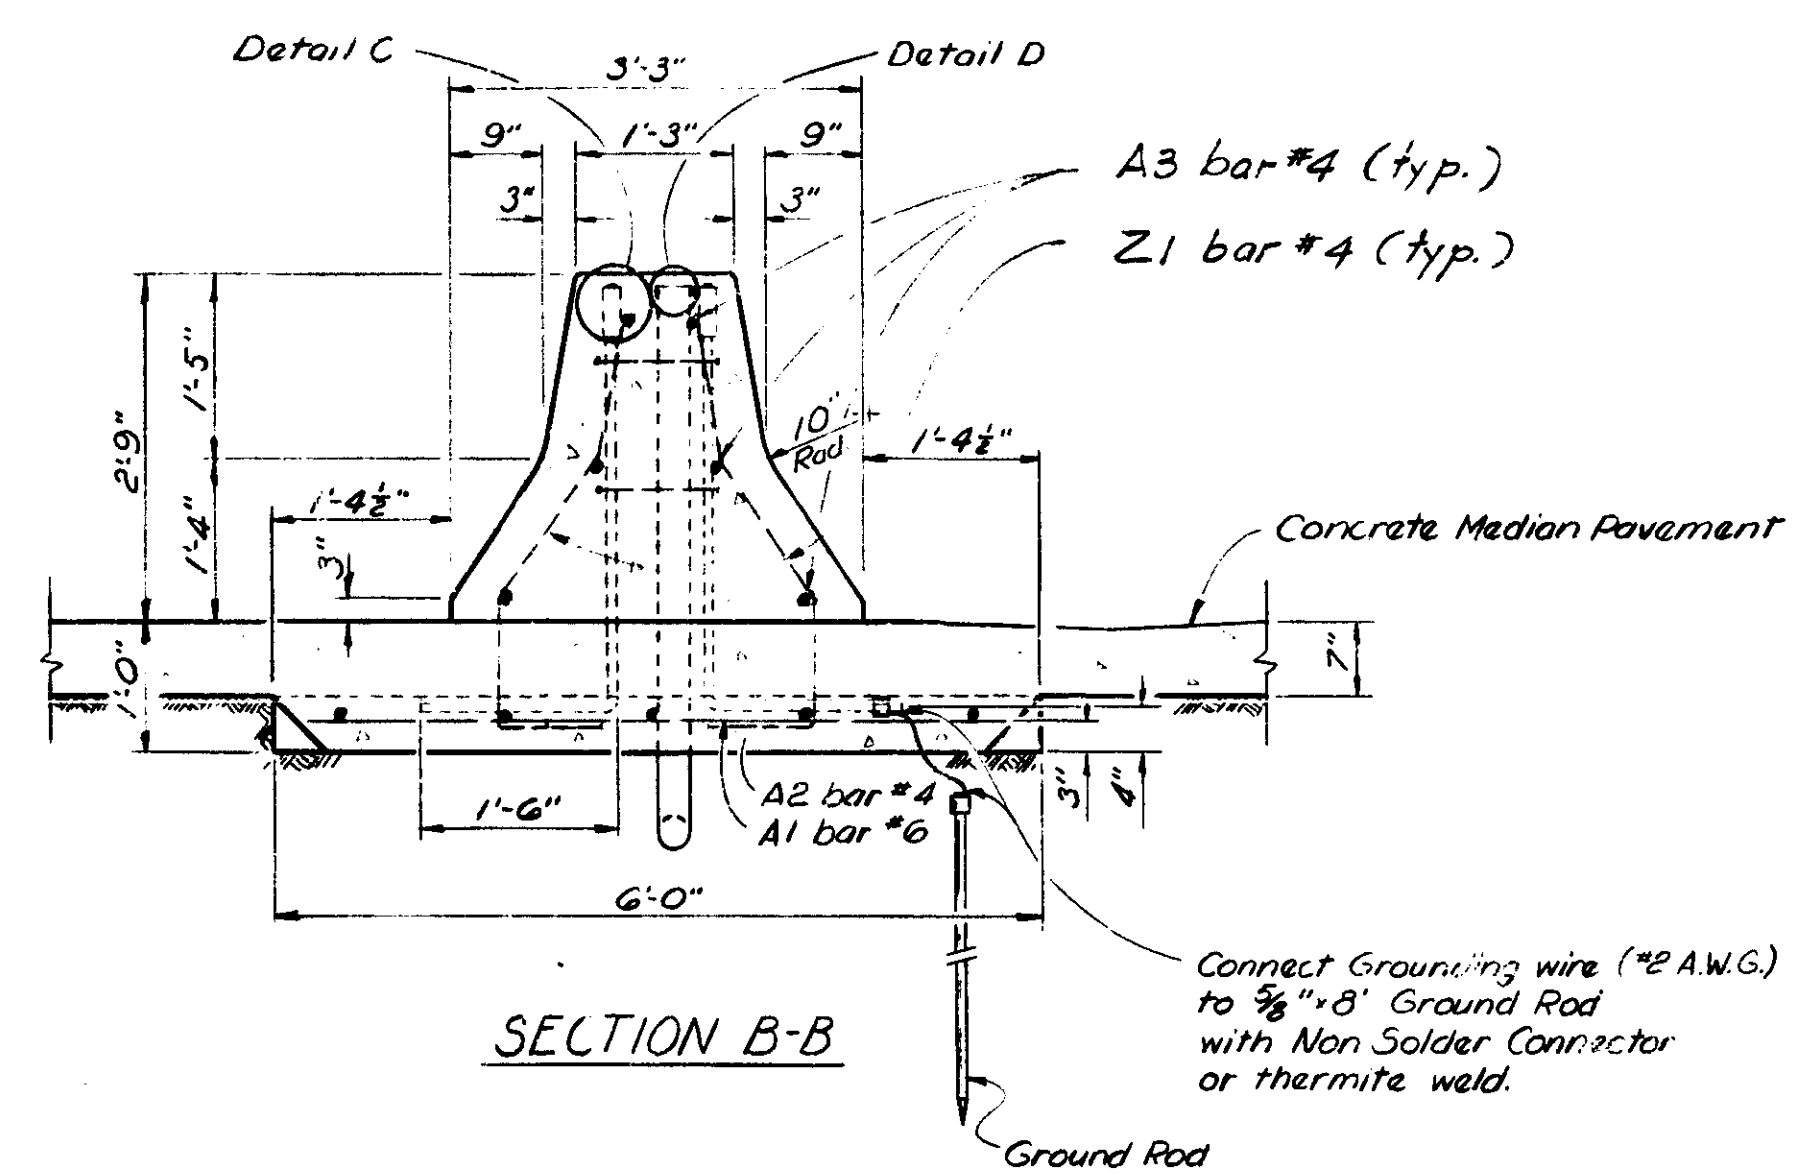

Note: Optional construction joint in Median Barrier and footing, or transverse plane of weakness joint in Median Barrier only (typ.)

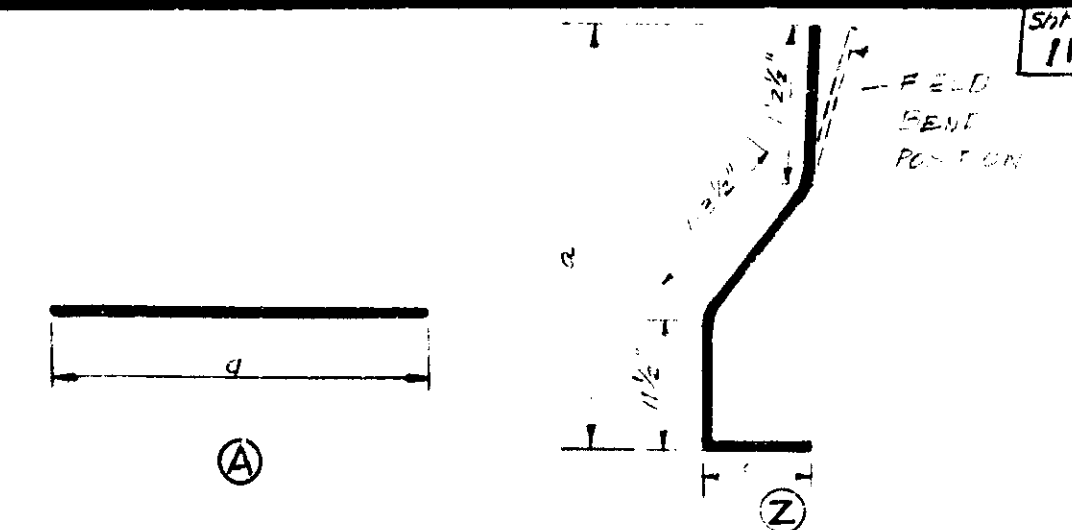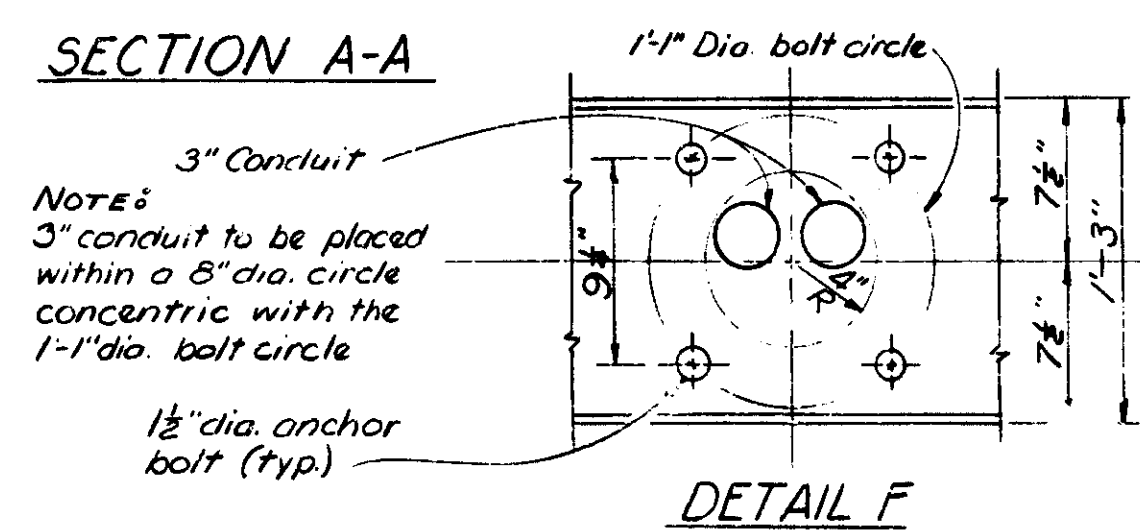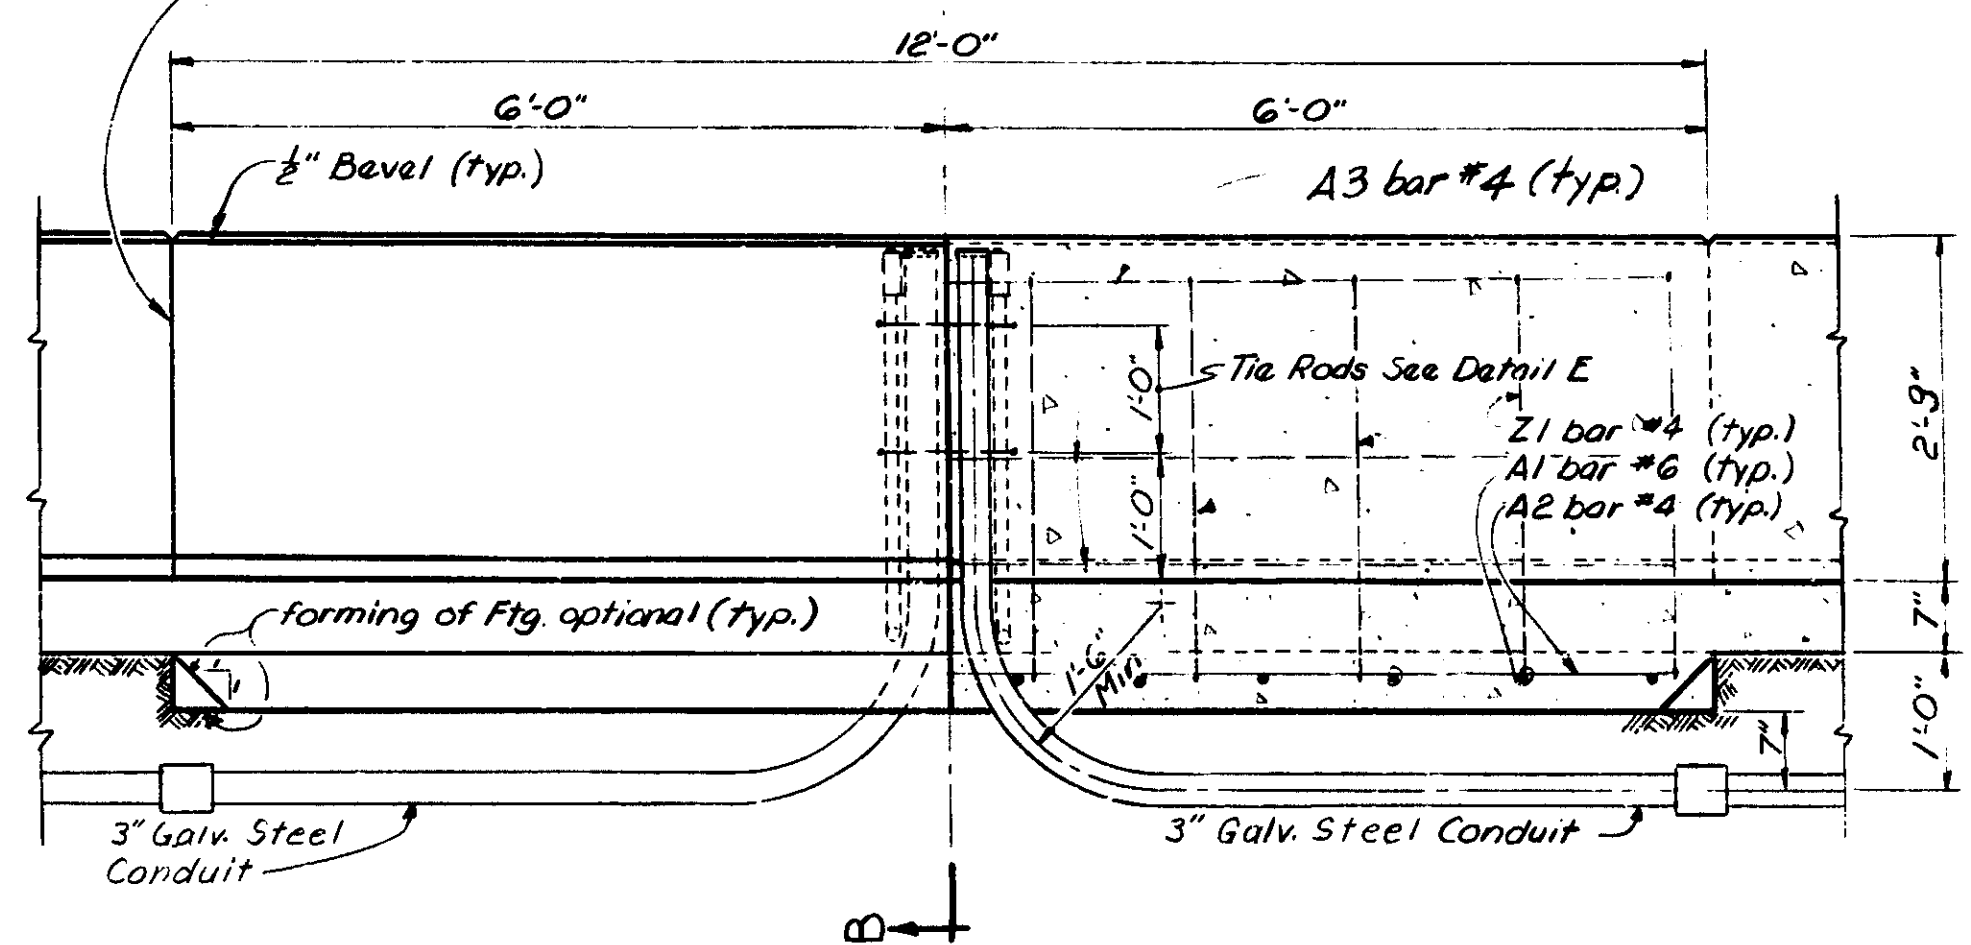


BAR BENDING DIAGRAM

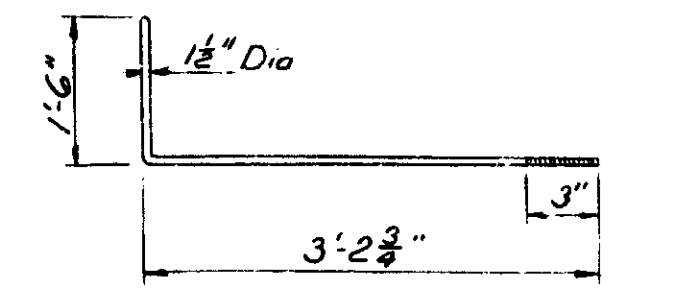


ANCHOR BOLT DETAIL

STEEL REINFORCEMENT SCHEDULE						
Bar	DIMENSIONS		Size	Length	No.	Weight
	a	b				
A1	5'-6"		6	5'-6"	12	99
A2	11'-6"		4	11'-6"	5	39
A3	11'-6"		4	11'-6"	6	47
Z1	3'-3"	10"	4	4'-3"	20	57
*TOTAL WEIGHT OF STEEL (Lbs.)						242


NOTES:
 All materials and workmanship shall be in accordance with the current standard specifications.
 Anchor bolts and associated nuts, studs, and couplings shall conform to the requirements of current Standard specifications for low-carbon externally and internally threaded standard fasteners, ASTM designation A307 or equivalent. Nuts, washers, studs, couplings, and 3" of threaded ends of anchor bolts shall be galvanized in accordance with ASTM designation A153.
 A coupling shall be placed on the ends of all conduit terminations and plugged with a suitable removable plug.
 Ground wire to be #2 A.W.G. Bare Stranded Ground Wire with not less than 2'-0" slack below foundation.

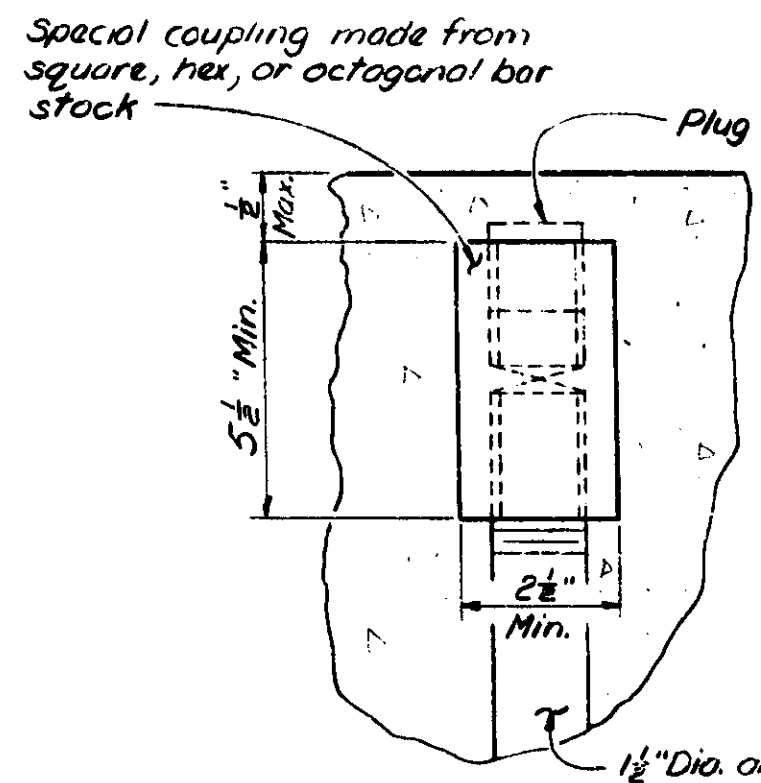


DETAIL C

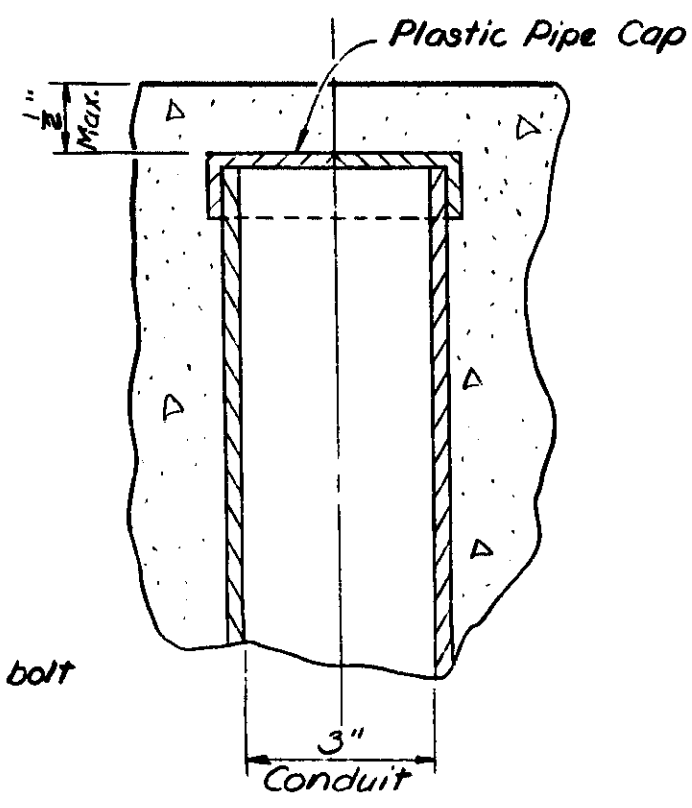


DETAIL D

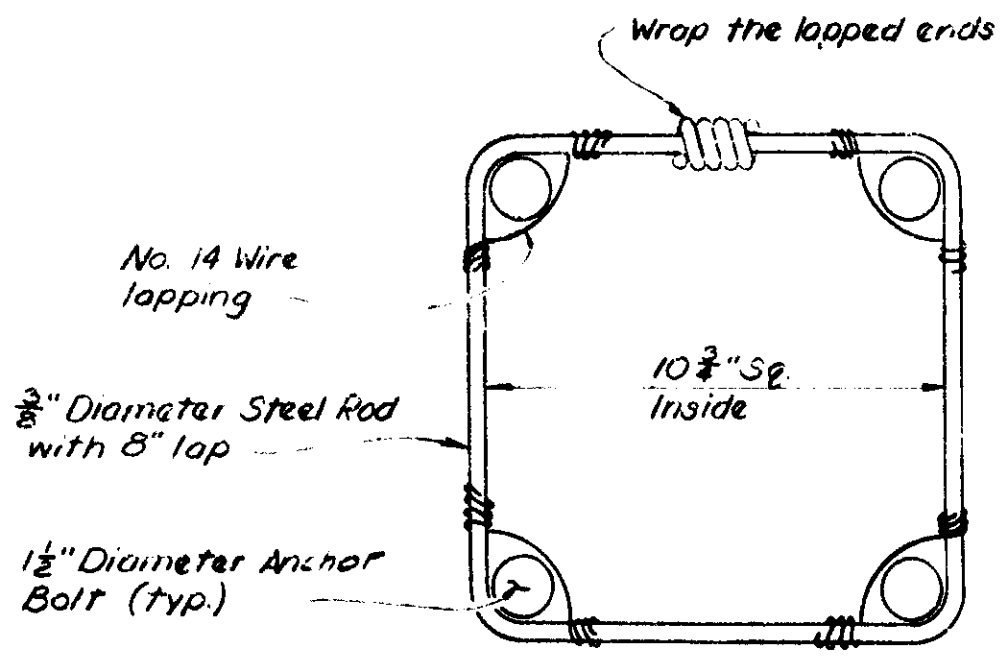

DETAIL E Tie Rods

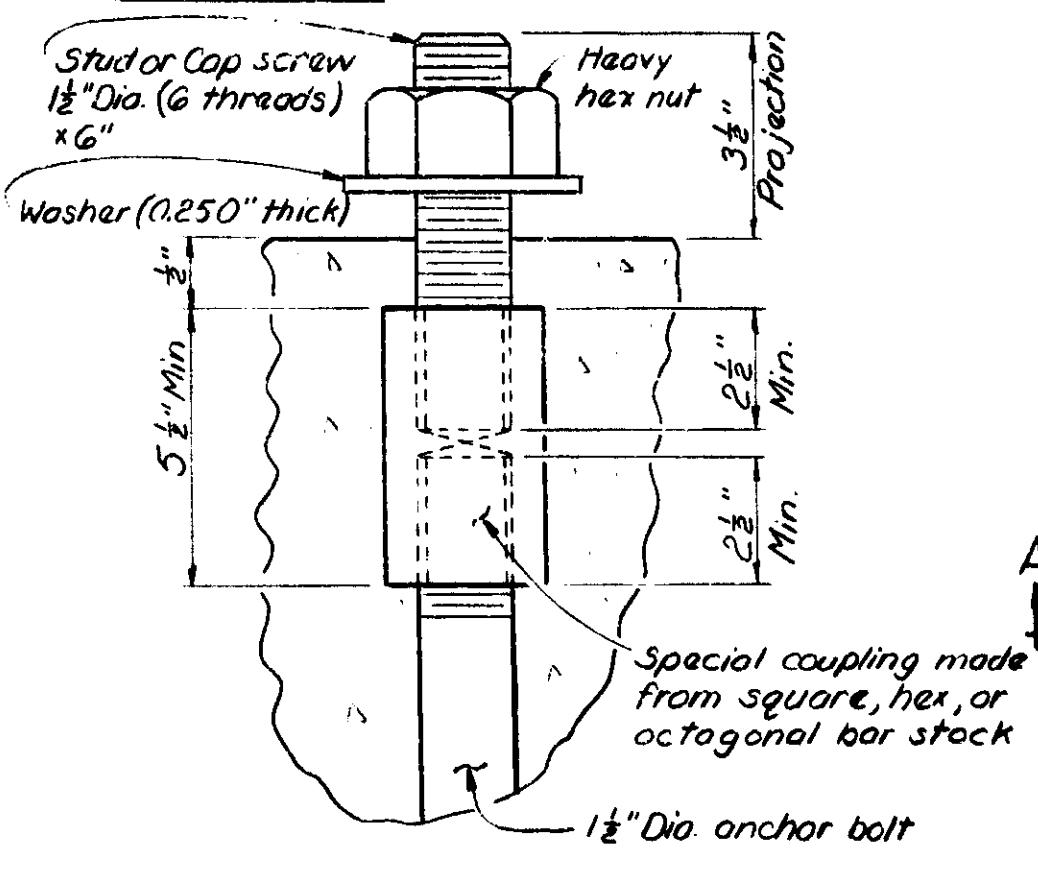

SHEAR STUD DETAIL

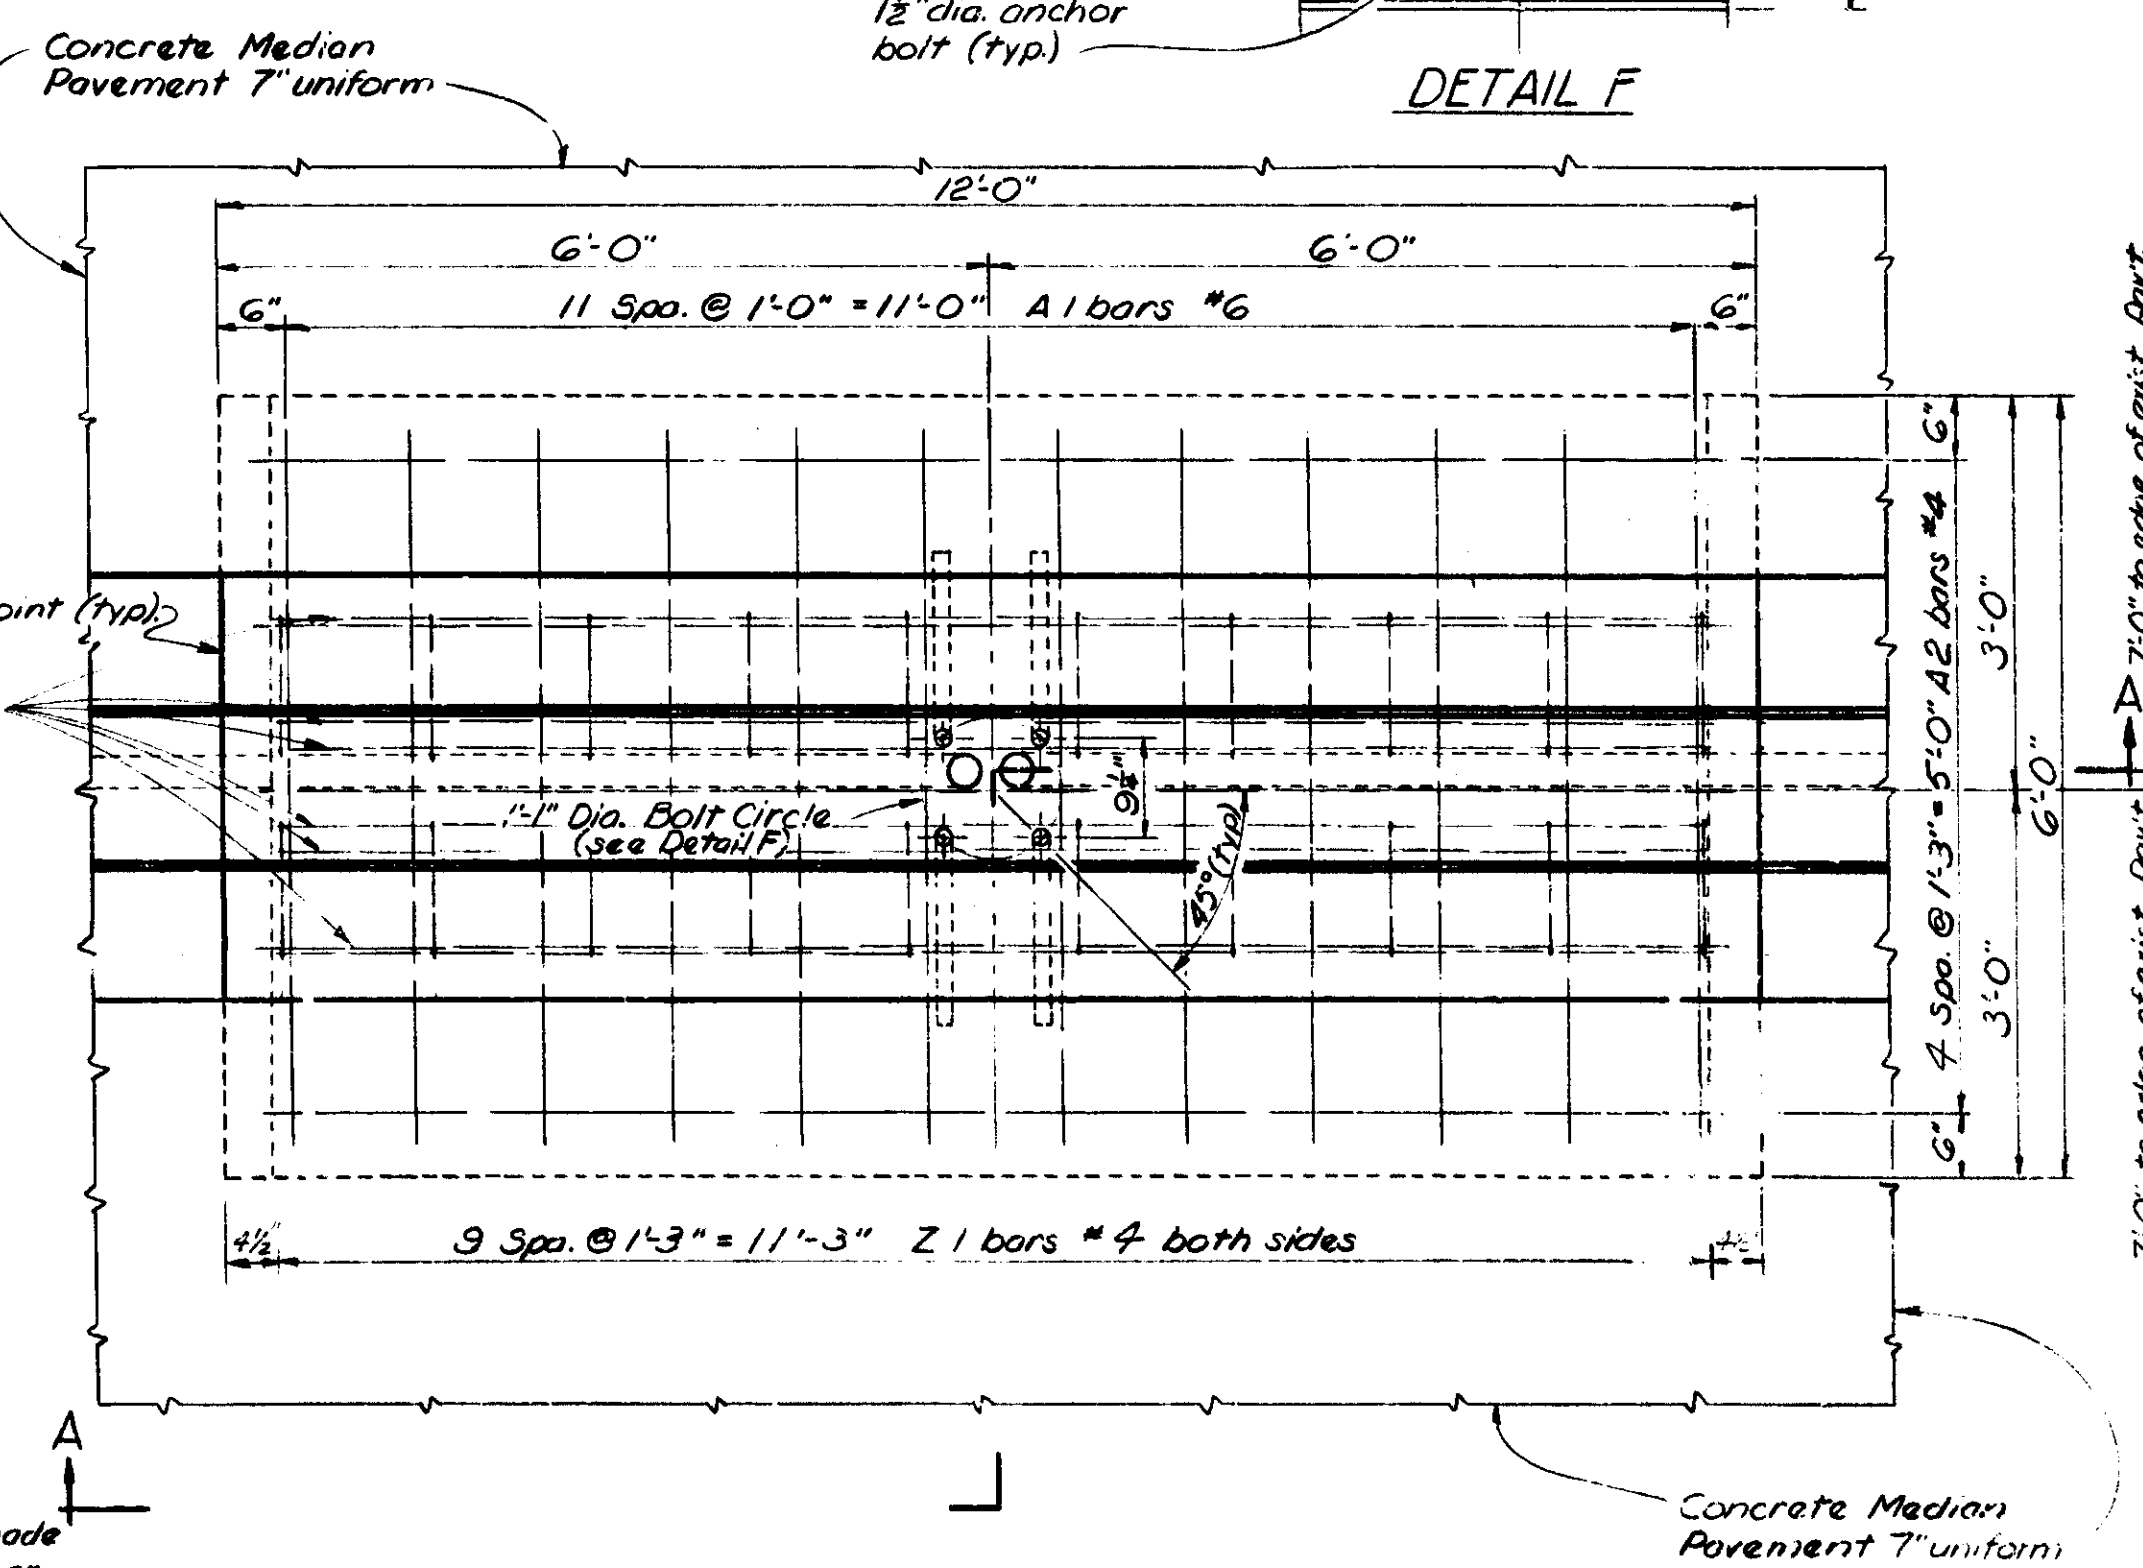

PLAN VIEW

MISCELLANEOUS QUANTITIES	
ITEM	UNIT
Anchor Bolts (1 1/2" dia.)	* 4 ea.
Anchor Bolt Coupling	* 4 ea.
Stud or Cap Screw (1 1/2" dia 6 threads x 6")	* 4 ea.
Washer (0.250" thick)	* 4 ea.
Tie Rods (3/8" dia.)	* 2 ea.
Ground Rod (3/8" x 8')	* 1 ea.
Nut	* 4 ea.
#2 A.W.G. Bare Stranded Ground Wire	* 3 Ft.




* These quantities are not Pay Items & are for each Light Standard Full.

MICHIGAN DEPARTMENT OF STATE HIGHWAYS
 LIGHT STANDARD FOUNDATION -
 CONCRETE MEDIAN BARRIER


REVISIONS			
NO.	DESCRIPTION	DATE	BY

DRAWN BY: Kallez
 CHECKED BY: [Signature]
 SHEET NO. 11


PROJECT NO. IS63174
 FEDERAL PROJECT NO. 08517A
 FEDERAL PROJECT ROW NO. 2(176)2

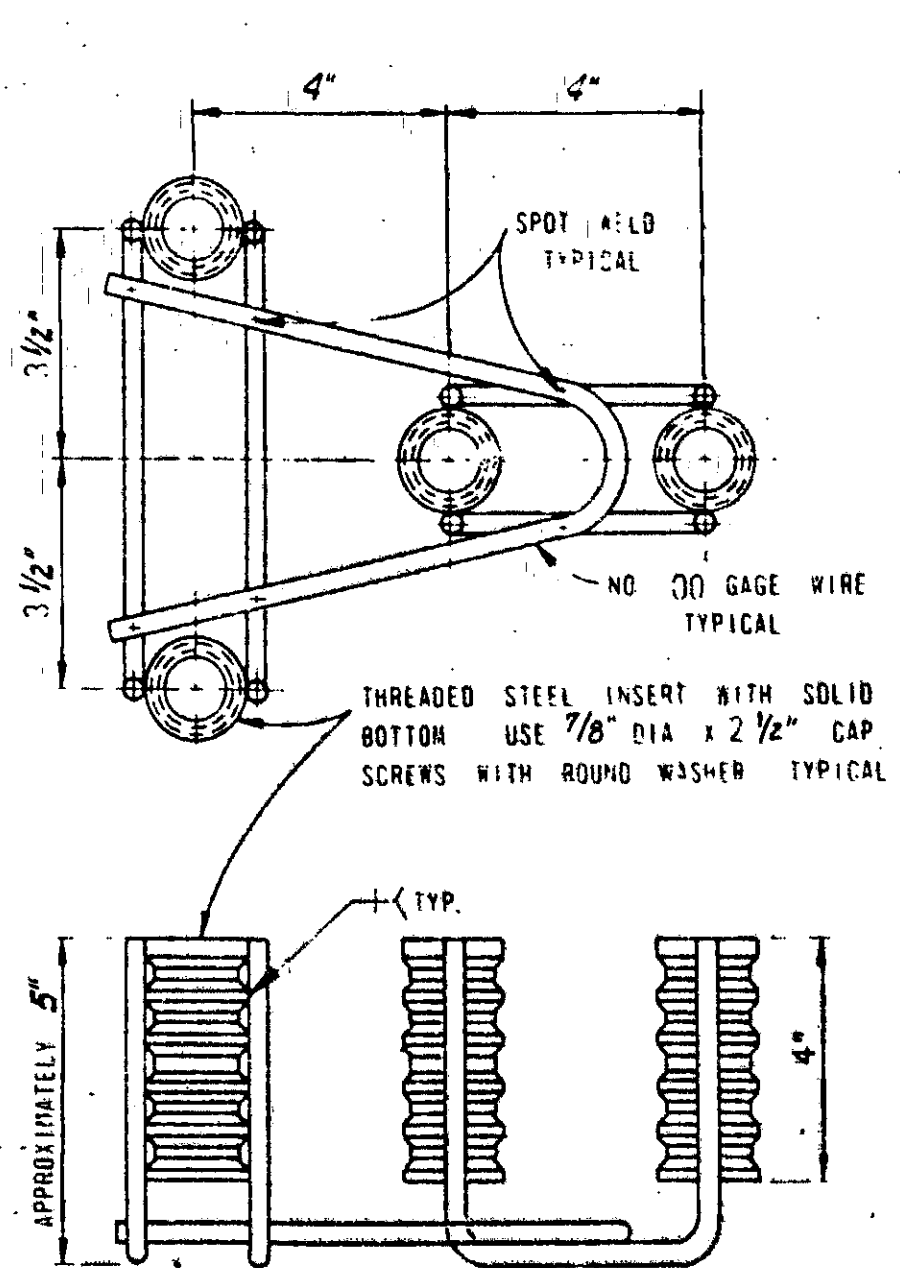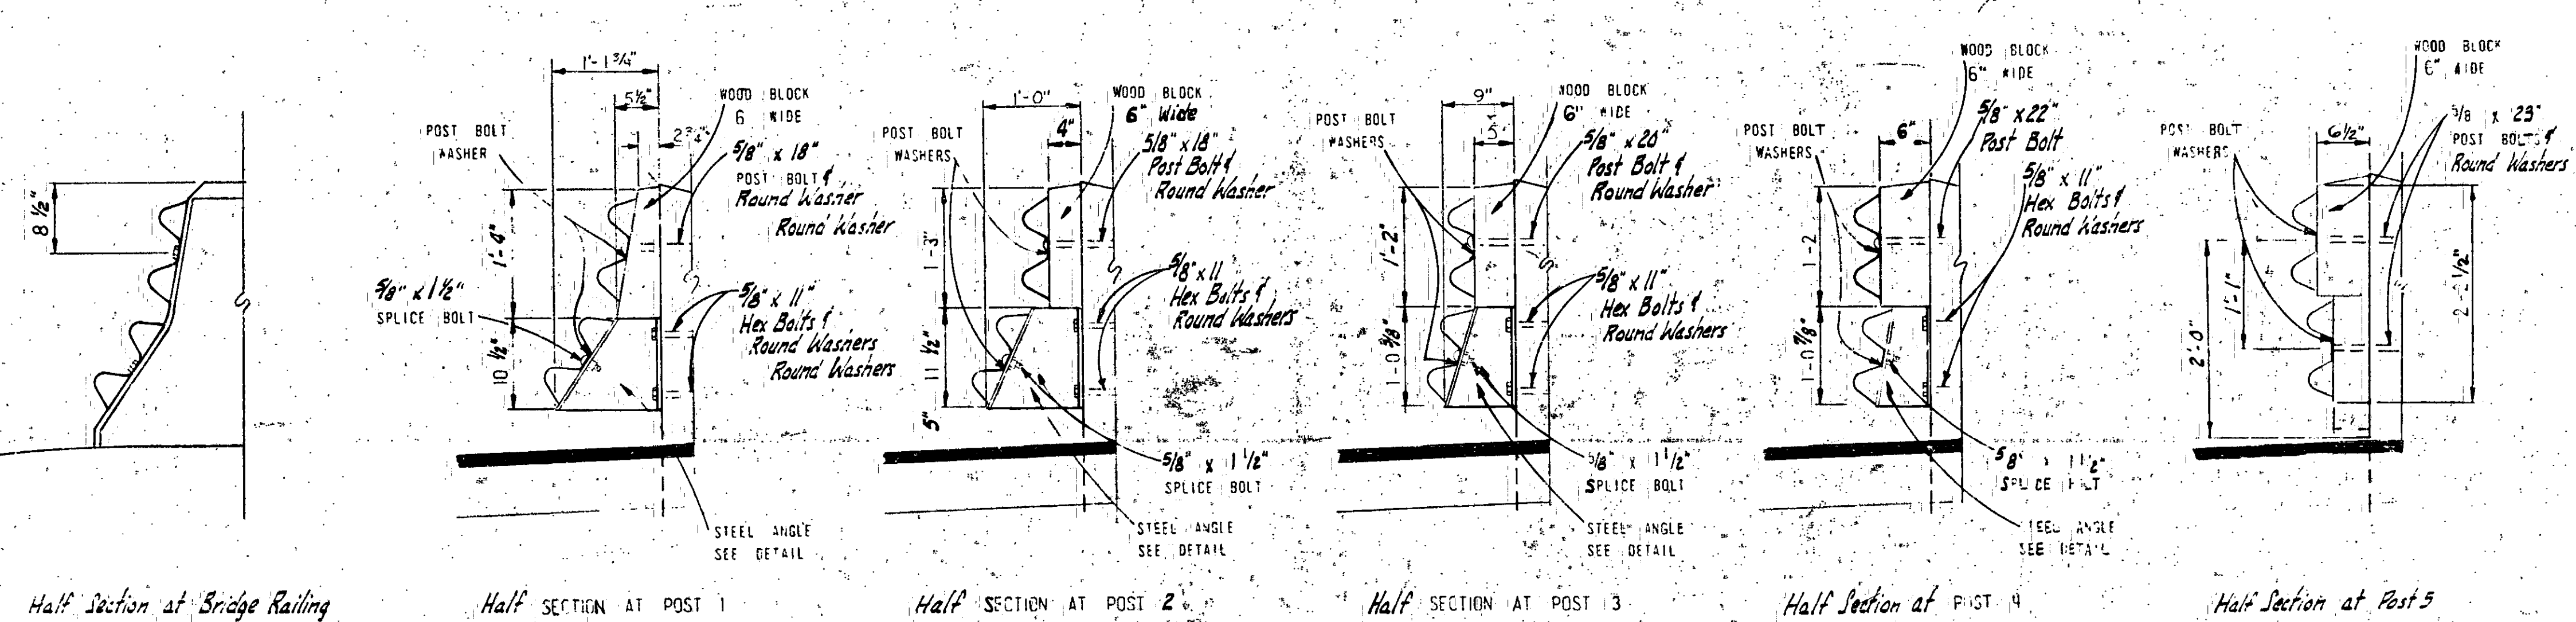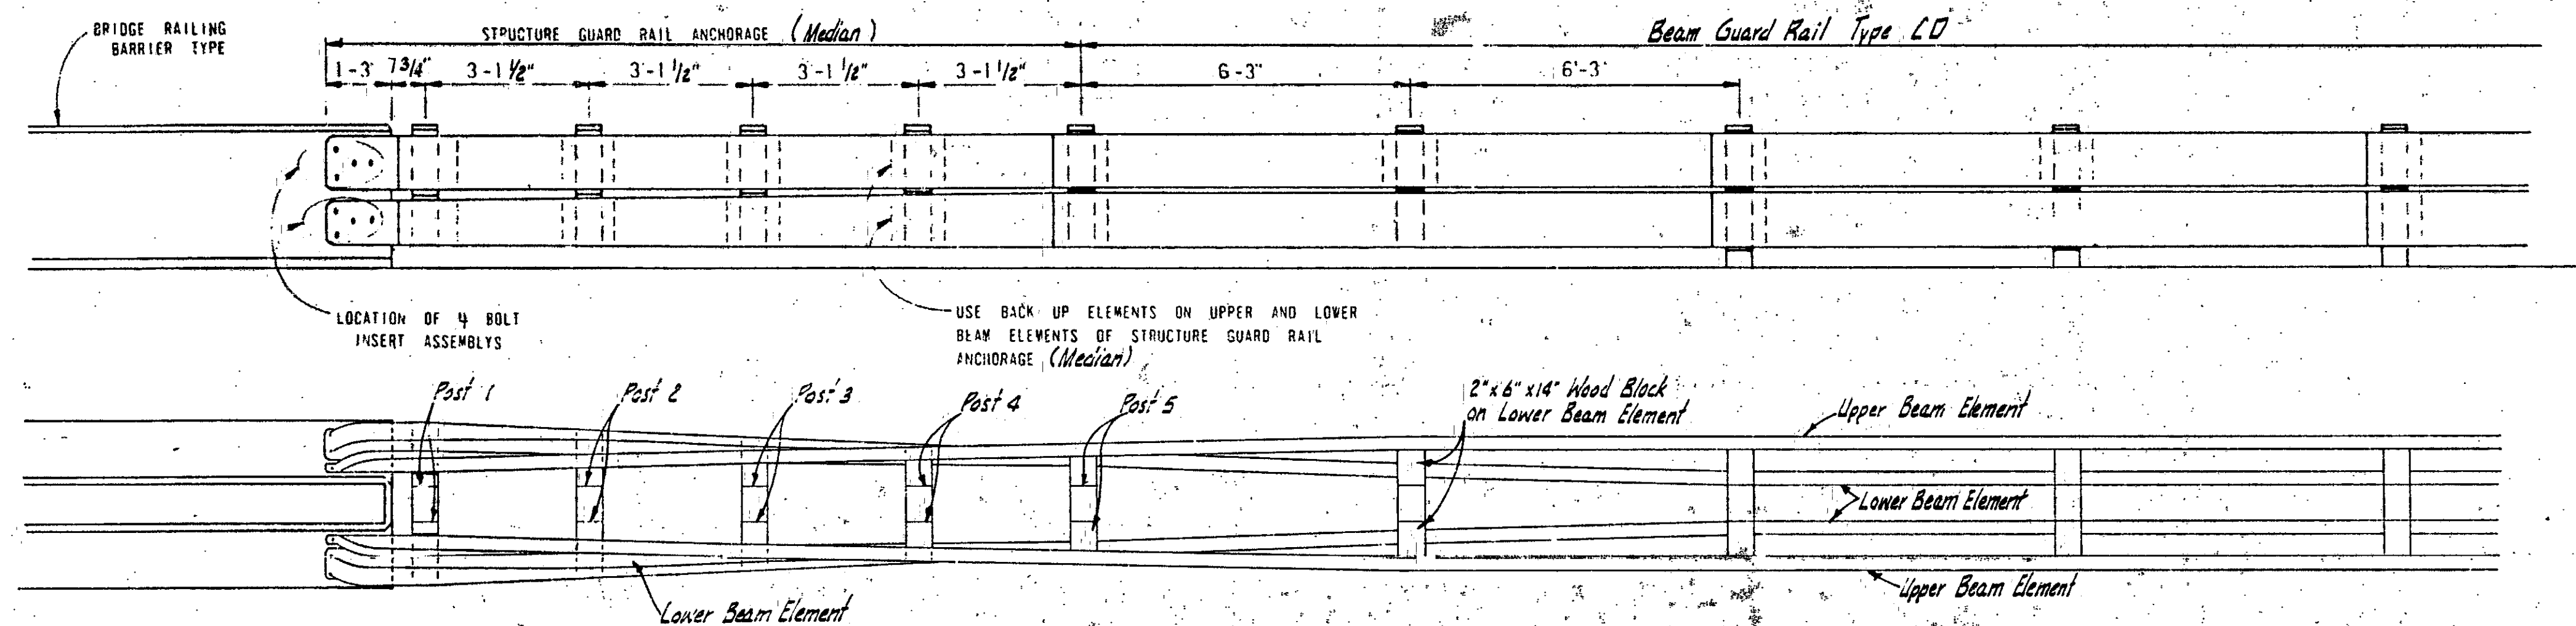


4 BOLT INSERT ASSEMBLY
INCLUDES CAP SCREWS AND WASHERS

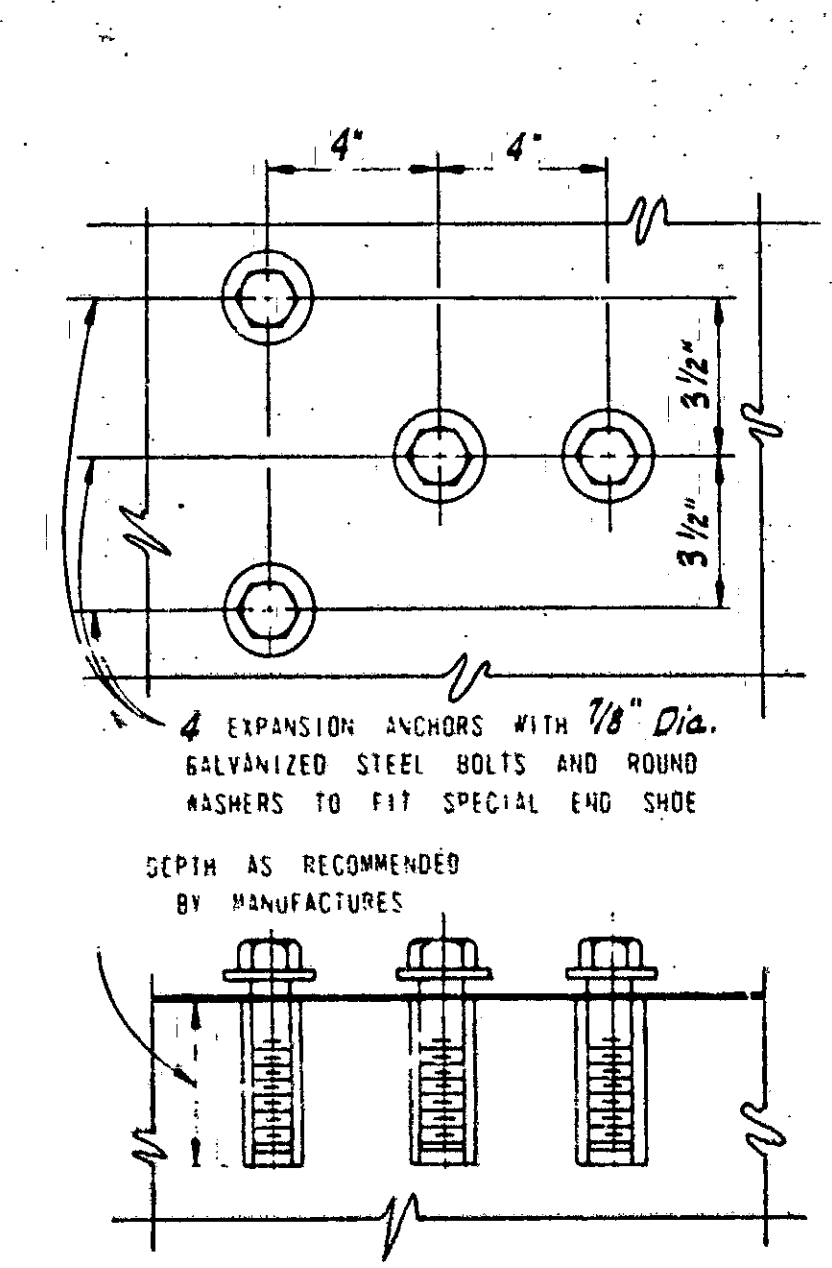

ALTERNATE FOR
4 BOLT INSERT ASSEMBLY

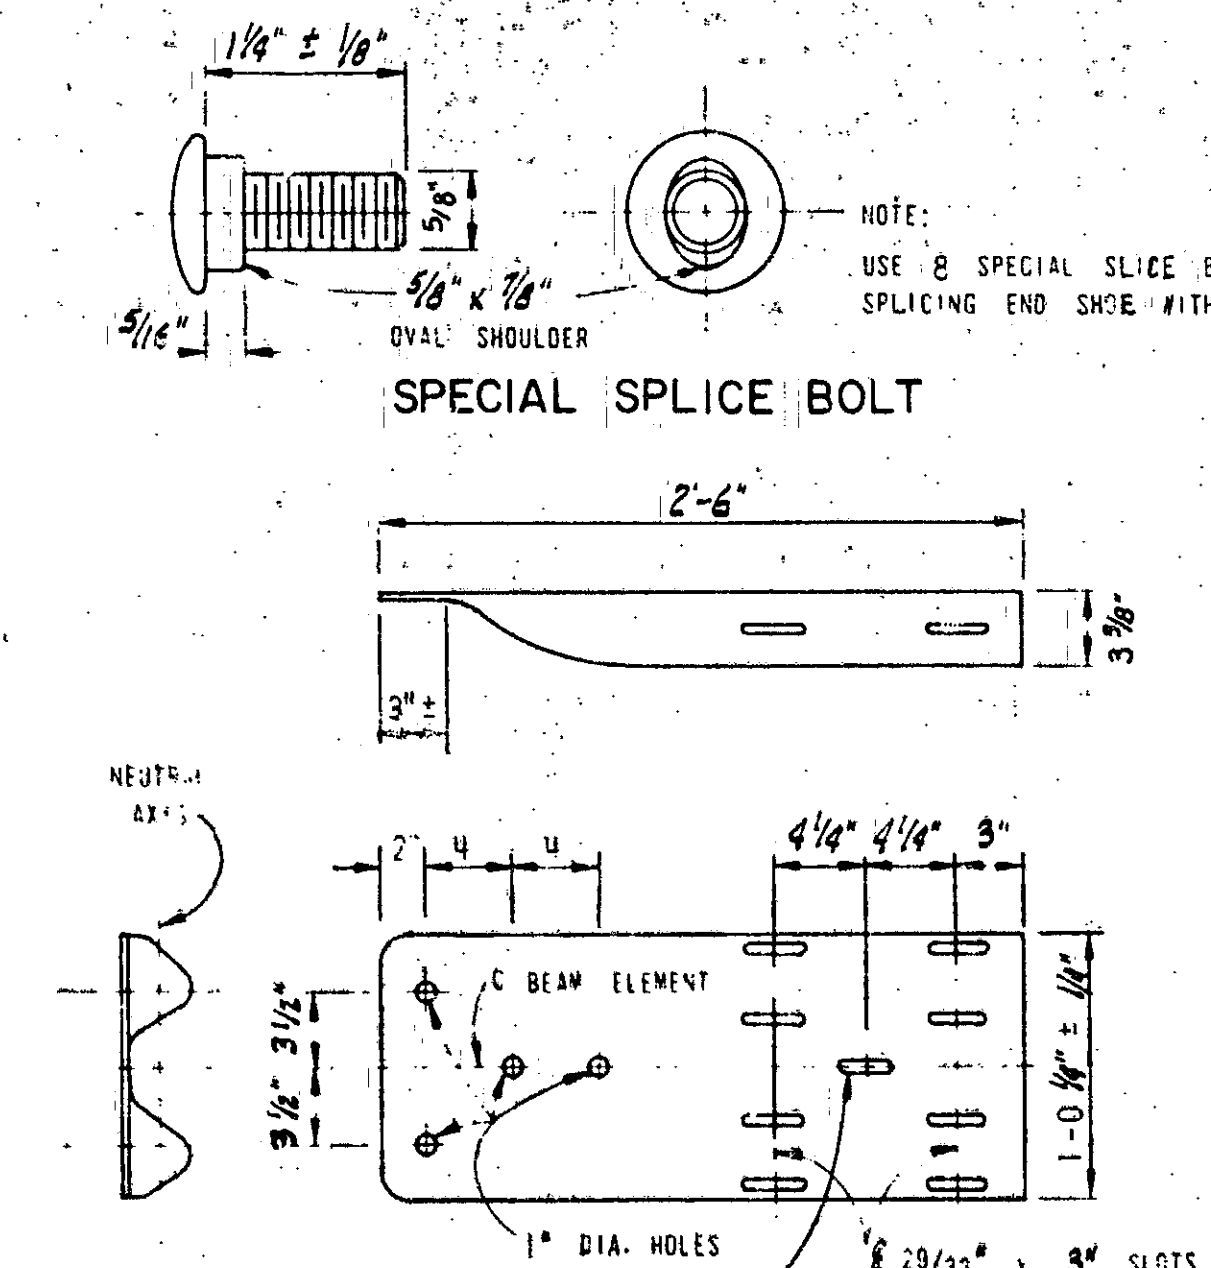

SPECIAL END SHOE

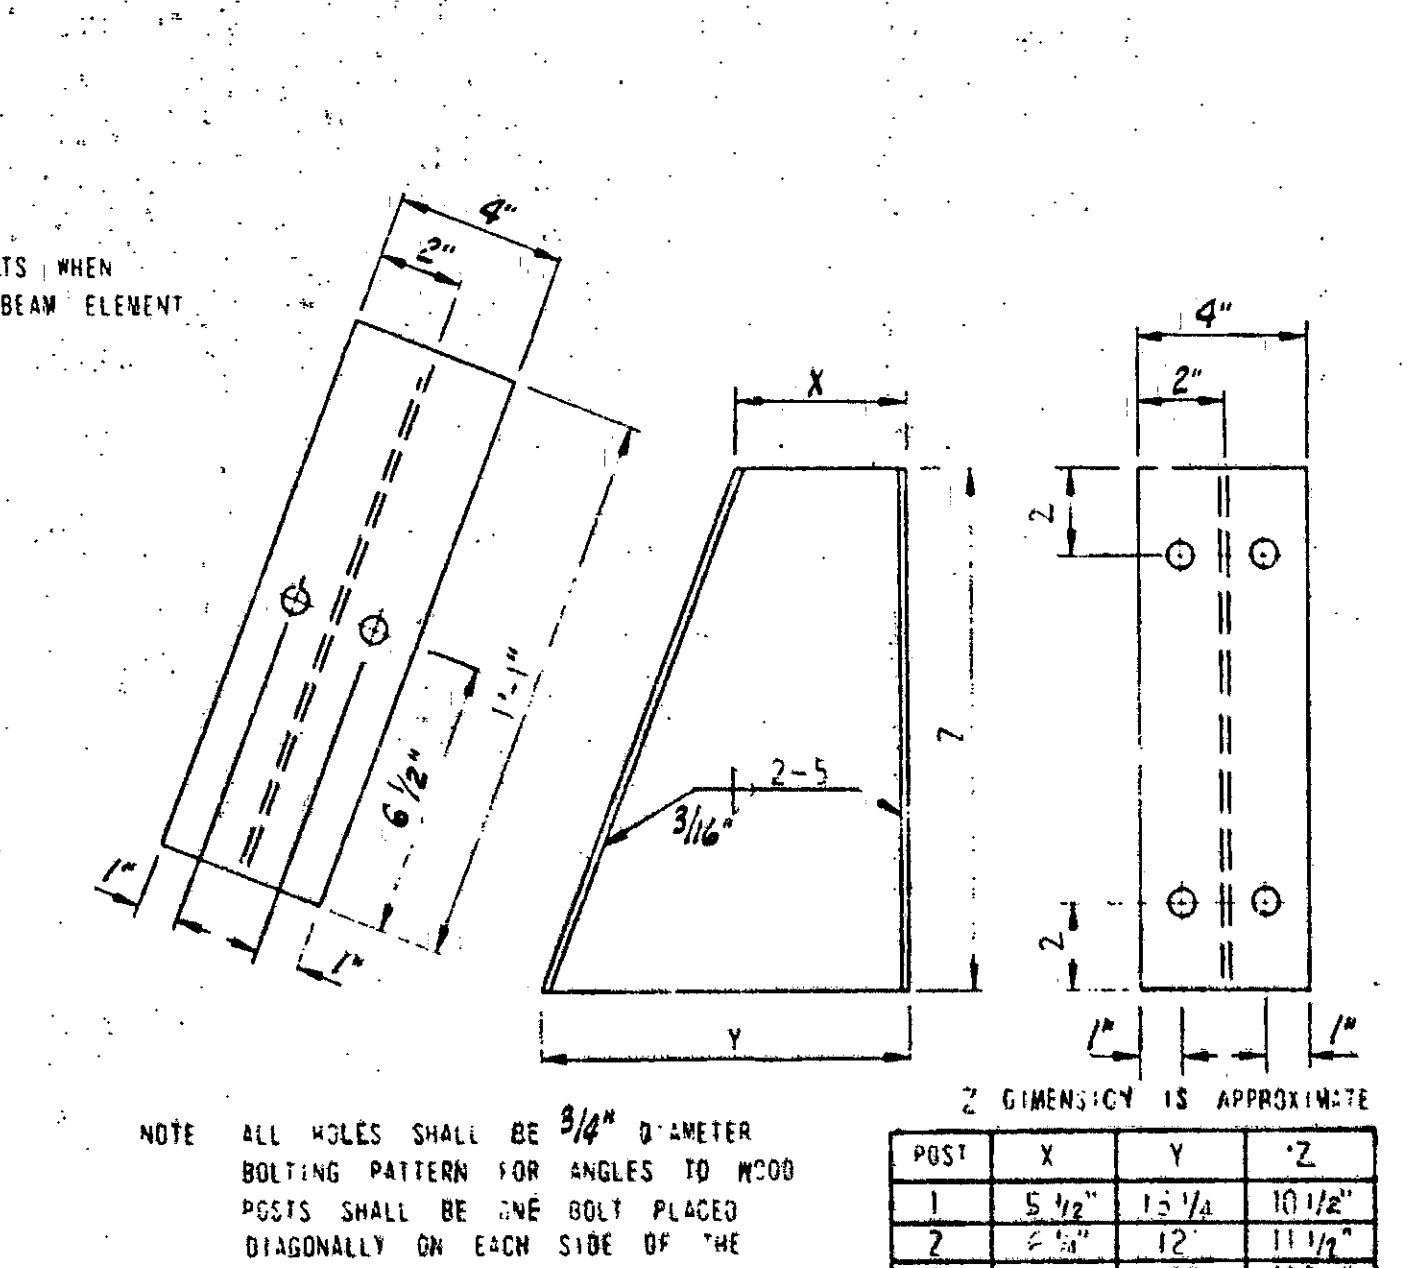

NOTE ALL HOLES SHALL BE 3/4\"/>

POST	X	Y	Z
1	5 1/2	13 1/4	10 1/2
2	5 1/2	12	11 1/4
3	5	9	12 3/8
4	4 1/2	6 3/4	12 7/8

STEEL ANGLES

NOTES:
 ALL MATERIALS AND WORKMANSHIP SHALL BE IN ACCORDANCE WITH THE CURRENT STANDARD SPECIFICATIONS.
 ALL WOOD POSTS AND BLOCKS, BEAM AND BACK UP ELEMENTS, ANGLES, FITTINGS, INCLUDING BOLTS, NUTS, AND WASHERS SHALL CONFORM TO THE DIMENSIONS AND SPECIFICATIONS SHOWN ON THE CURRENT STANDARD PLAN III-63 SERIES, BEAM GUARD RAIL TYPE C WHERE APPLICABLE, EXCEPT AS SHOWN ON THIS STANDARD.
 THE PAY ITEM FOR STRUCTURE ANCHORAGE DETAILS SHOWN ON THIS SHEET SHALL BE STRUCTURE GUARD RAIL ANCHORAGE (MEDIAN)
 STRUCTURE GUARD RAIL ANCHORAGE (MEDIAN) WHICH INCLUDES SPECIAL END SHOES SHALL BE PAID FOR AT THE CONTRACT UNIT PRICE EACH WHICH PRICE INCLUDES PAYMENT IN FULL FOR ALL MATERIALS AND MATERIALS.
 SPECIAL END SHOES SHALL BE GALVANIZED AND OF THE MATERIAL USED FOR BEAM ELEMENTS IN THE CURRENT STANDARD SPECIFICATIONS, EXCEPT THAT THEY SHALL NOT BE LIGHTER THAN 10 GA.
 ALL ANGLES SHOWN ARE MINIMUM ALLOWABLE SIZE AND SHALL CONFORM TO THE CURRENT STANDARD SPECIFICATIONS FOR COLD DRAWN STEEL ARE ASTM DESIGNATION A 82.
 THE SIZE OF WIRE SHOWN SHALL CONFORM TO THE UNITED STATES STEEL WIRE GAGE STANDARD.
 EXPANSION ANCHORS OF THE SIZE INDICATED SHALL BE PHILLIPS HEAD HEAD ANCHOR CHICAGO EXPANSION BOLT CO SPECIAL FLUSH SELF DRILLING ANCHORS APPROVED EQUAL.
 BEAM ELEMENTS SHALL BE LAPPED IN THE DIRECTION OF TRAFFIC.
 SECTIONS OF BEAM ELEMENT REQUIRED TO BE TWISTED FOR USE IN ANCHORAGE SHALL BE FIELD BENT.
 ALL STEEL ANGLES SHALL BE 7 GAGE MINIMUM AND GALVANIZED AFTER FABRICATION ACCORDING TO THE CURRENT STANDARD SPECIFICATIONS FOR STEEL POSTS

STATE OF MICHIGAN
 DEPARTMENT OF STATE HIGHWAYS
 STANDARD PLAN FOR
 STRUCTURE GUARD RAIL
 ANCHORAGE (MEDIAN)

APPROVALS

UNCHECKED	ENGINEER DESIGN SECTION	DATE
RECOMMENDED FOR APPROVAL	ENGINEER OF DESIGN	DATE
RECOMMENDED FOR APPROVAL	TRAFFIC DIVISION	DATE
RECOMMENDED FOR APPROVAL	CONSTRUCTION DIVISION	DATE
RECOMMENDED FOR APPROVAL	CHIEF BUREAU OF ENGINEERING	DATE
	DEPARTMENT OF STATE HIGHWAYS	
	HENRIK E. STAFSETH STATE HIGHWAY DIRECTOR	






BY: _____
 DEPUTY STATE HIGHWAY DIRECTOR

DATE: _____

CHECKED BY: H.A.W. DATE: _____

REVISOR BY: _____ DATE: _____

PROJECT NO. **Is63174** DRAWING NO. **08517A** FEDERAL PROJECT NO. **T-75-2170** G2

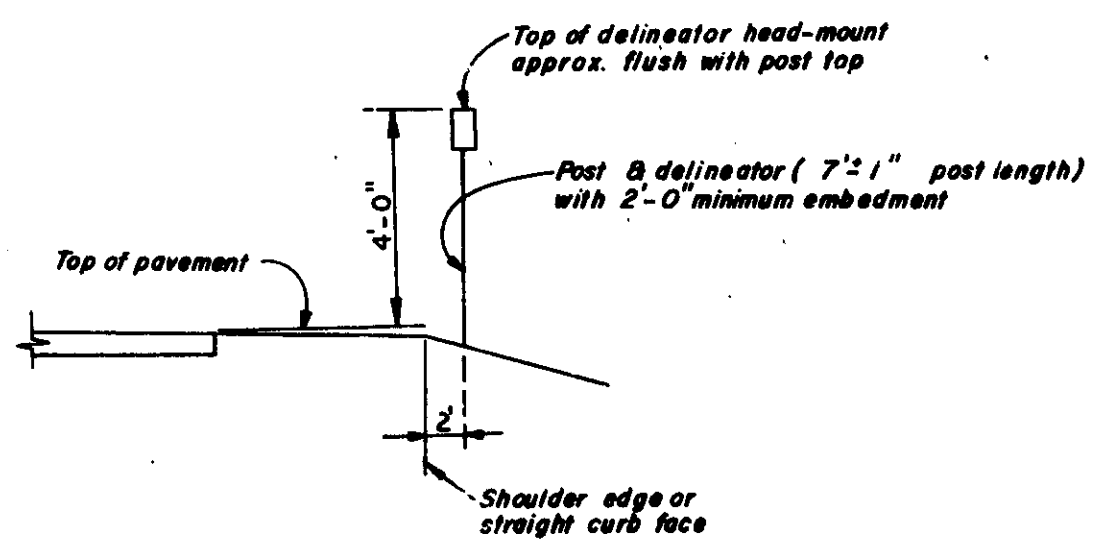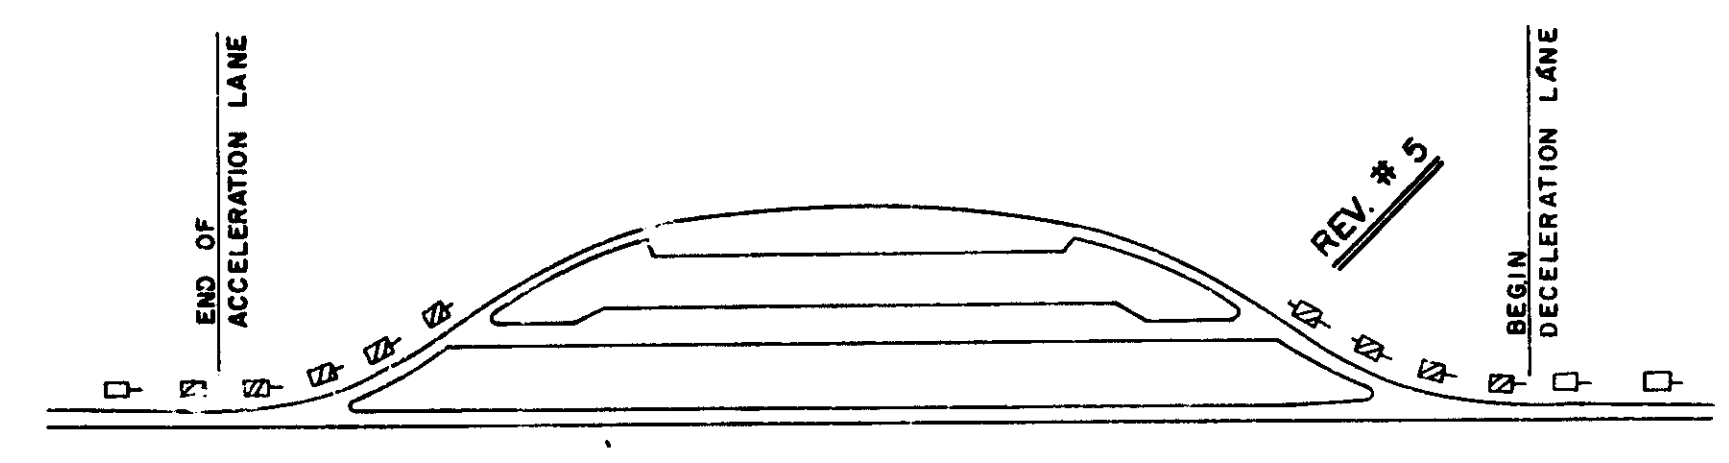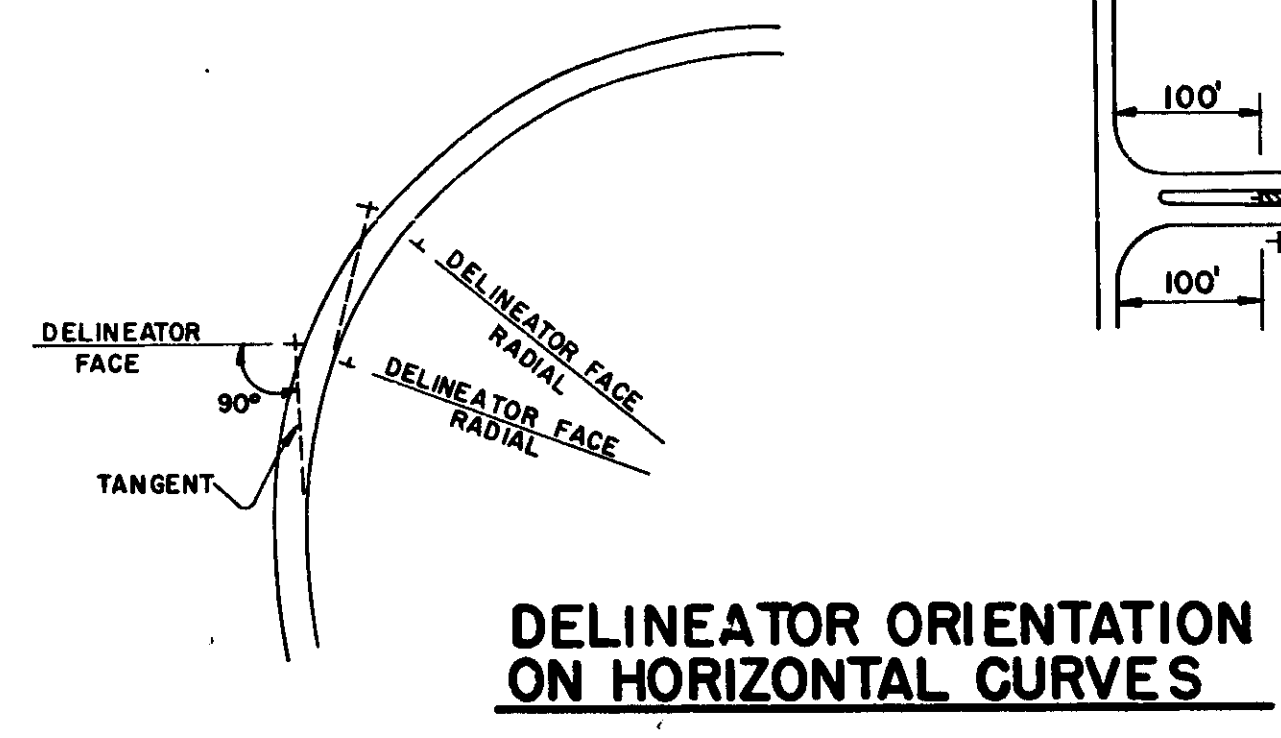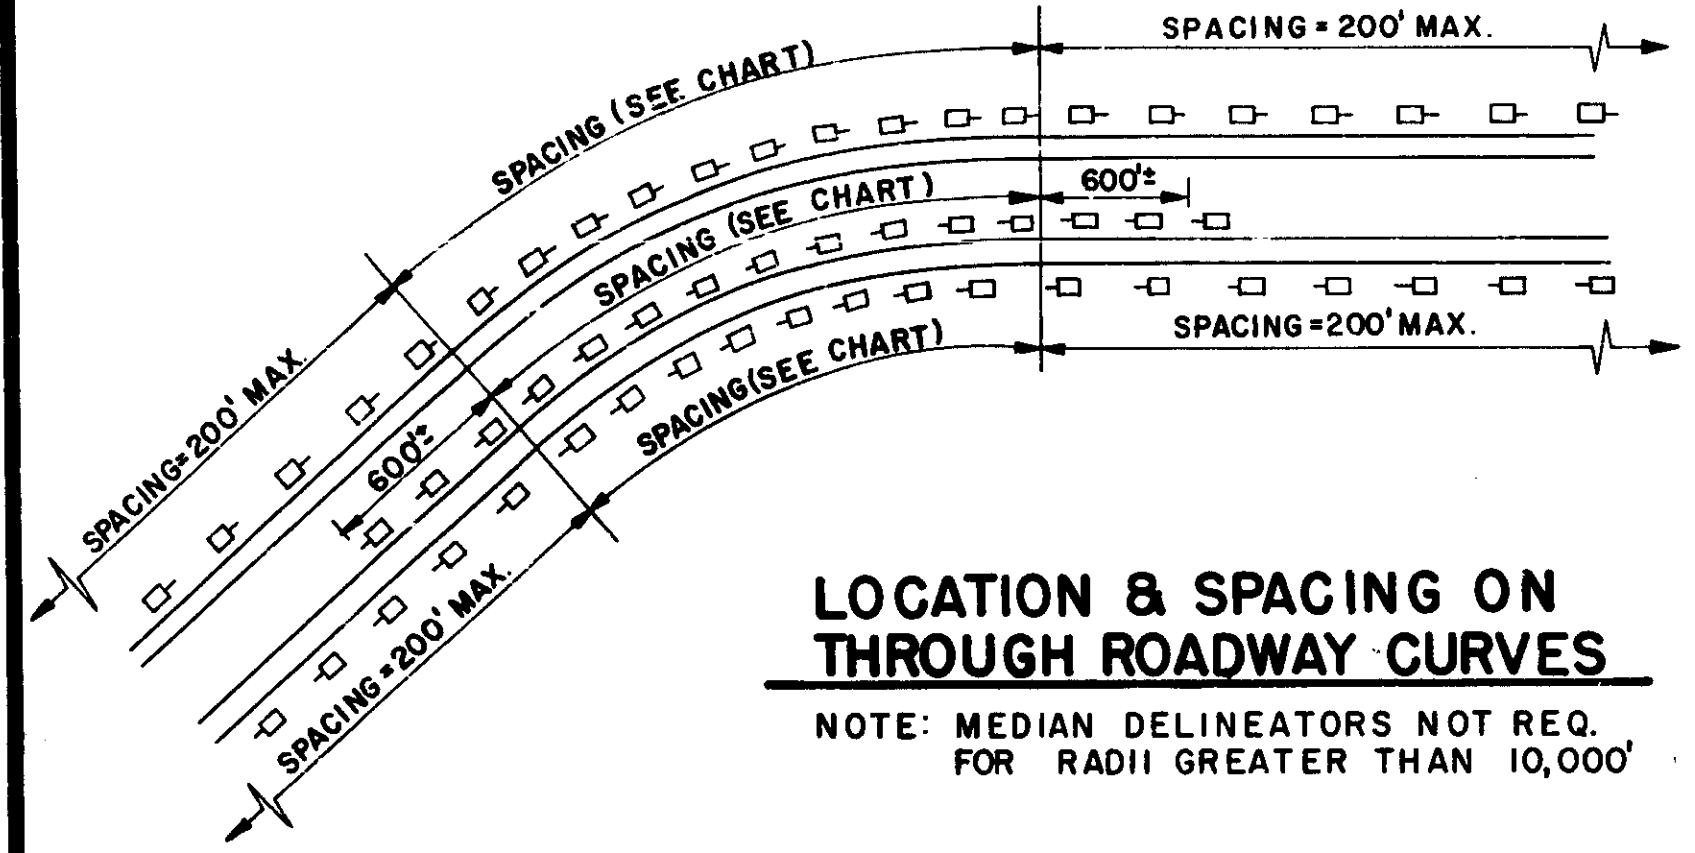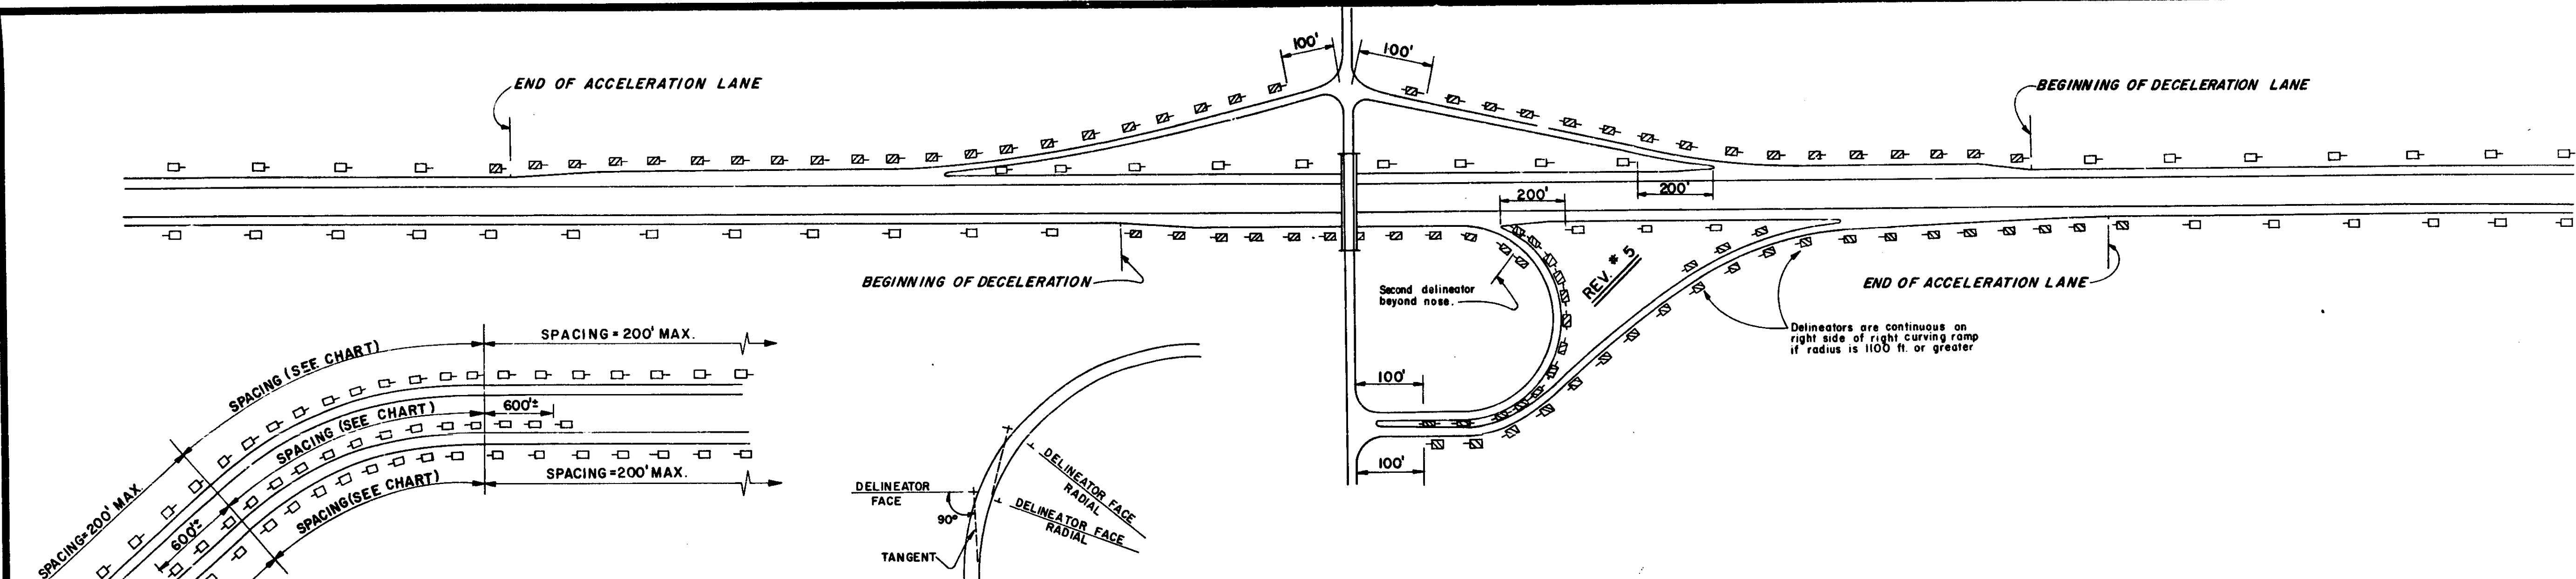


SPACING FOR HIGHWAY DELINEATORS ON HORIZONTAL CURVES

DEGREE OF CURVE	RADIUS IN FEET	SPACING ON CURVE	SPACING IN ADVANCE AND BEYOND CURVE		
			1ST SPACE	2ND SPACE	3RD SPACE
1	10,000	200	200	200	200
	5,000	152	200	200	200
	3,000	141	200	200	200
2	2,500	109	196	200	200
	2,000	99	178	200	200
3	1,800	88	158	200	200
	1,600	86	155	200	200
4	1,400	84	151	200	200
	1,200	78	140	200	200
5	1,400	74	133	200	200
	1,000	68	122	200	200
7	1,000	66	119	198	200
	900	62	112	186	200
9	900	58	104	174	200
	800	55	99	165	200
12	700	51	92	153	200
	600	48	86	144	200
15	500	47	85	141	200
	400	42	76	126	200
18	400	41	74	123	200
	350	37	67	111	200
21	350	36	65	108	200
	300	35	63	105	200
25	300	33	59	99	198
	250	32	58	96	192
30	250	30	54	90	180
	200	28	50	84	168
40	200	24	43	72	144
	150	24	43	72	144
100	150	20	36	60	120
	100	19	34	57	114


- NOTES:**
- Single crystal delineators at 200' max. spacing
 - Double yellow delineators @ 100' max. spacing
 - Single red delineators on back of double yellow
 - Delineators shall be placed two feet beyond the outer edge of the roadway shoulder, two feet beyond the face of a barrier curb, or in the line of the guard rail.
 - Delineators shall be located along the outside of the ramps, i.e., on the left side for right-curving ramps and on the right for others. Delineators shall also be located on the right for right-curving ramps which have radii of 1100 ft. or greater.
 - Where delineation on one side of the roadway or ramp ends and delineation on the other side appears, the delineators should be overlapped for a distance required to place a minimum of two units.
 - On speed change lanes, delineators shall be located on right for right-hand connections and on the left for left-hand connections.
 - Delineators shall be omitted along the through roadway between interchanges where fixed source lighting exists but shall be placed on all roadways at all interchange, whether or not the interchanges are lighted.
 - Single crystal delineators at 100' max. spacing shall be used in lieu of double yellow delineators at interchanges where both roadways are interstate.
 - Red delineators shall be located on the back of double yellow ramp delineators to face possible wrong way traffic movements. Placement shall start at ramp terminal and end at last double yellow delineator before gore between ramp and freeway.

THE SPACING S ON THE CURVE IS FOUND FROM THE FORMULA $S = 2\sqrt{NR - 50}$, WHERE R IS THE RADIUS OF THE CURVE IN FEET. THE SPACING TO THE FIRST DELINEATOR IN ADVANCE OF AND BEYOND THE CURVE IS 1.8 S, TO THE NEXT DELINEATOR 3 S, AND TO THE NEXT 6 S, BUT NOT TO EXCEED 200 FEET.

MINIMUM SPACING = 10 FEET

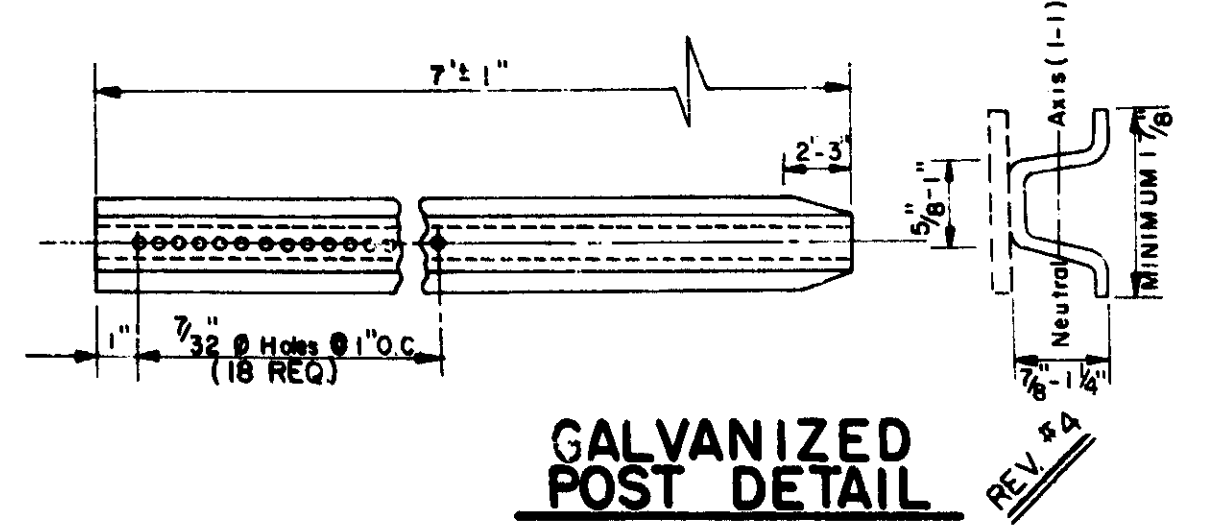

NOTE: Minimum weight - 1.33 lbs. per ft.
Minimum thickness - 3/32 in.
Minimum moment of inertia about I-I axis - 0.040 in. 4
Dimensions shown are minimum and maximum permissible.

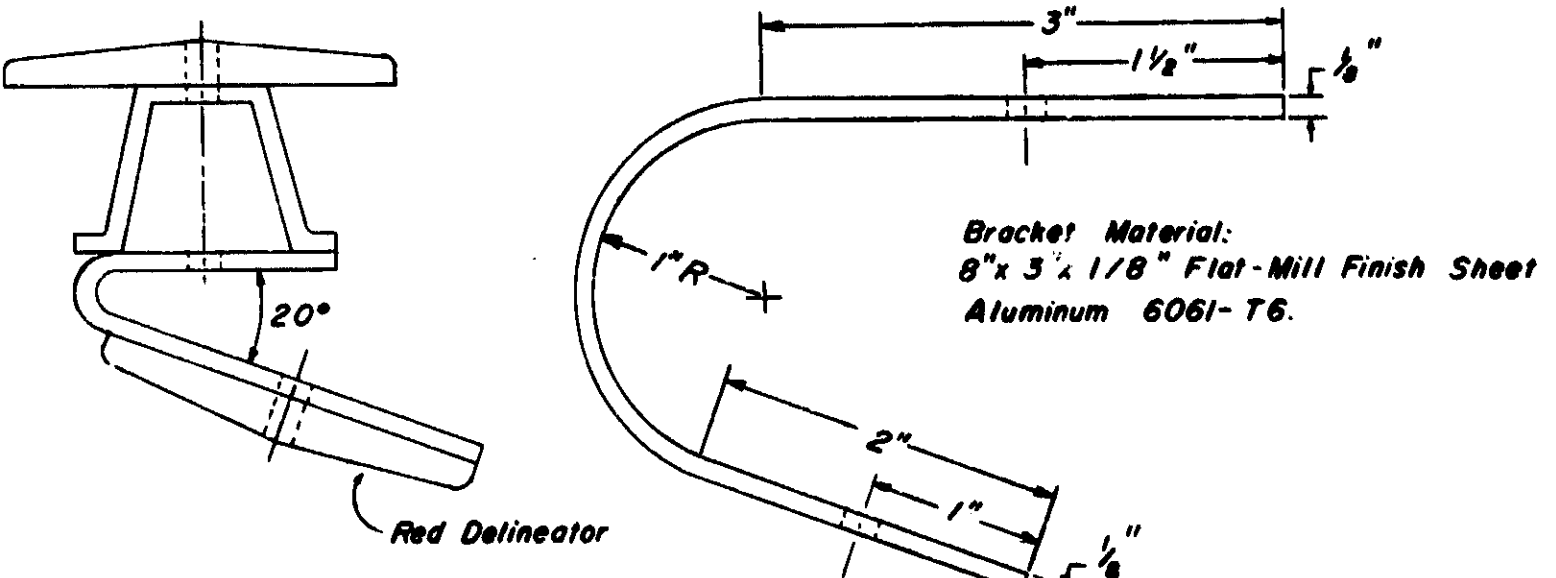

RED DELINEATOR MOUNTING BRACKET

NOTES:

1. Delineator to post attachment shall be as specified in the M.D.S.H. current Standard Specifications For Highway Construction. Crimp Type Collar may be swaged on either the delineator face side or the post side.

**MICHIGAN DEPARTMENT OF STATE HIGHWAYS
POST & DELINEATOR**

REVISIONS

NO. DESCRIPTION DATE BY


NOTE CLARIFICATION & ELIMINATION

CONTROL SECTION: **63174** JOB NO. **08517A**

FEDERAL PROJECT ROW SHEET NO. **7-75-2(176)2** SHEET **13** OF **2**

DATE: 11-12-63

JUNCTION OF MAJOR ROADWAYS

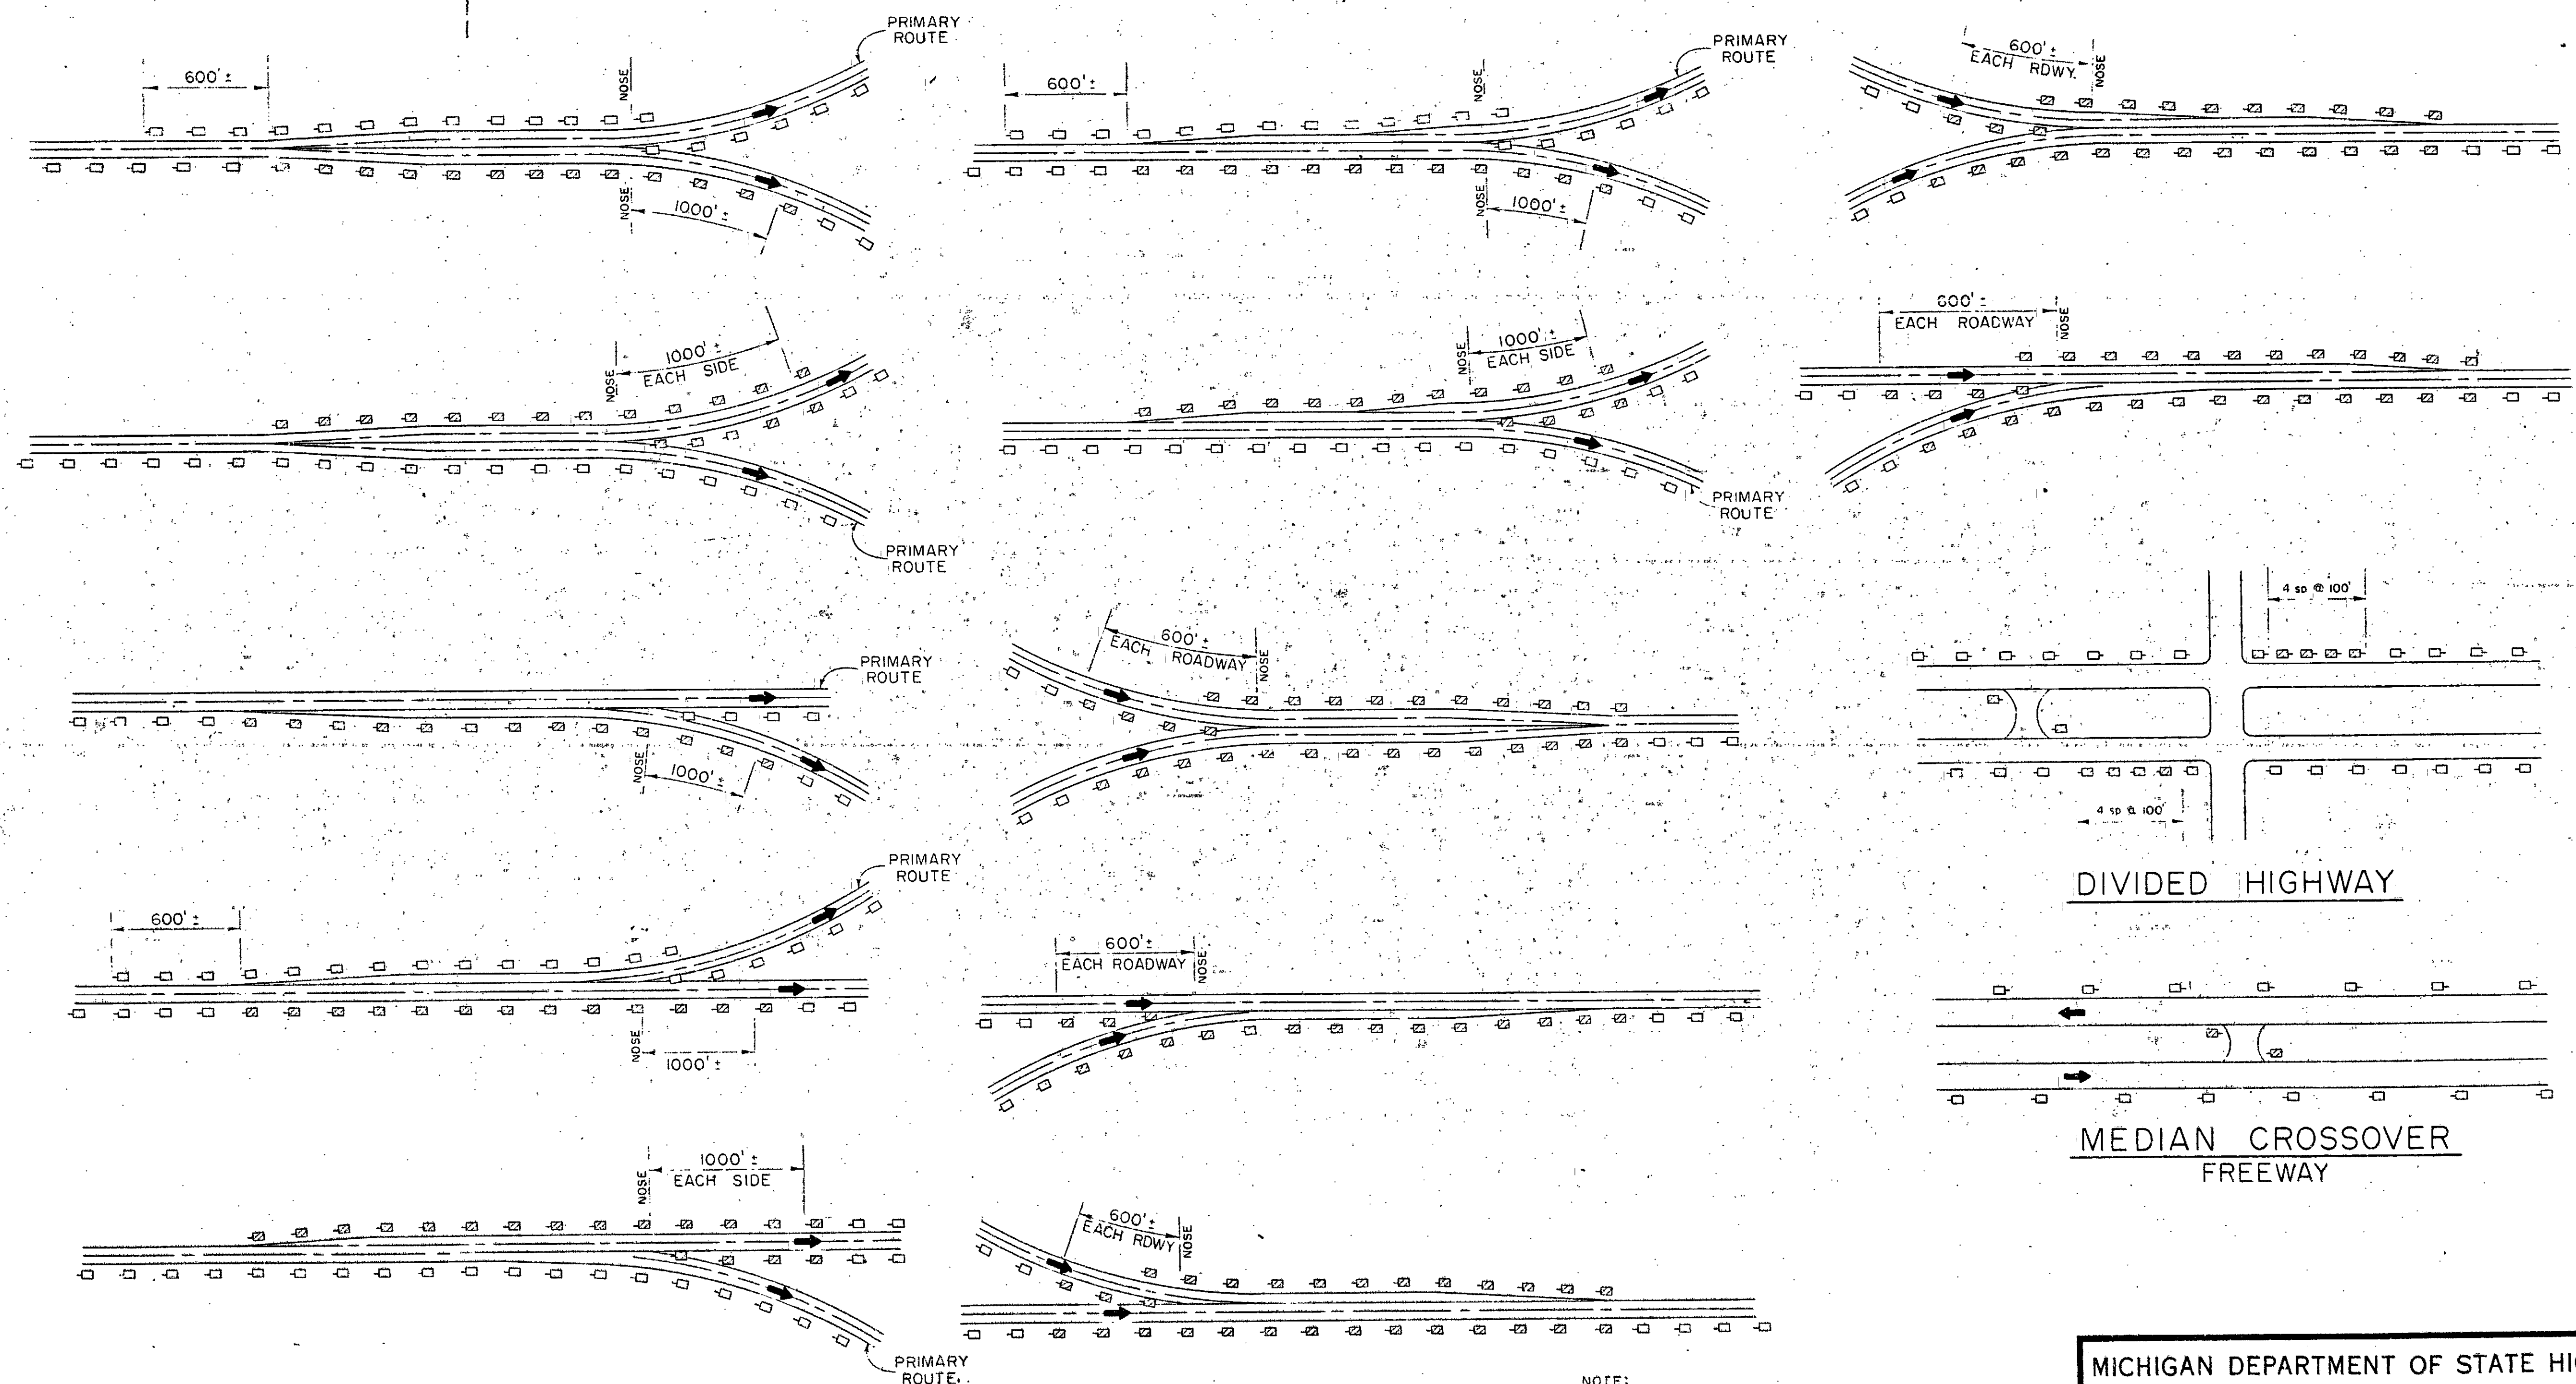

NOTE:
 Single crystal delineators at 100' max. spacing shall be used in lieu of double yellow delineators at interchanges where both roadways are Interstate.

**MICHIGAN DEPARTMENT OF STATE HIGHWAYS
 POST & DELINEATOR**

REVISIONS		DATE	BY
NO.	DESCRIPTION		
1	NOTE ADDED	7-66	

DRAWN BY: _____
 CHECKED BY: _____
 FEDERAL PROJECT R.O.M. No. 7-75-2(176)62
 SHEET 2 OF 2
 SHEET NO. 14

UNDERGROUND


- EXISTING MANHOLE
- MANHOLE (2-WAY)
- △ MANHOLE (3-WAY)
- ◇ MANHOLE (4-WAY)
- △ MANHOLE (CORNER)
- EXISTING HANDHOLE
- HANDHOLE
- ^{+3"}— EXISTING CONDUIT (4-3" SHOWN)
- ^x— ABANDON EXISTING CONDUIT
- ^{1-3"}— ENCASED CONDUIT (1-3" SHOWN)
- ^{1-3"}— GALVANIZED STEEL CONDUIT (1-3" SHOWN)
- ^{1-2"}— GALVANIZED STEEL CONDUIT, JACKING-BORING (1-2" SHOWN)
- ==== CONDUIT RUN - "NOT A PART OF ELECTRICAL CONTRACT"
- — — DIRECT BURIAL CABLE (NO. & SIZE AS INDICATED)
- — — EXISTING DIRECT BURIAL CABLE
- — — ABANDON CABLE
- ^{1-3"}— BUILD 6" SEWER
- ^{1-3"}— DIRECT BURIAL CONDUIT TYPE II (1-3" SHOWN)
- CONCRETE FOUNDATION FOR PAD MOUNT TRANSFORMER
- ▲ CONCRETE FOUNDATION FOR FIRE OR POLICE CALL BOX
- ⊙ EXISTING UG-FED ST. LTG. UNIT
- ⊗ REMOVE UG-FED ST. LTG. UNIT (BY OTHERS)
- ⊙ INSTALL SALVAGED UG-FED ST. LTG. UNIT ON NEW FDN.
- ⊙ UG-FED, 250 W. TYPE II, CLEAR, HIGH PRESSURE SODIUM LTG. UNIT WITH 12 FT. BRACKET ARM ON NEW FOUNDATION WITH 30 FT. MOUNTING HEIGHT. (EXCEPT WHERE OTHERWISE NOTED)
- ⊙ UG-FED, 400 W. TYPE III, CLEAR, HIGH PRESSURE SODIUM LTG. UNIT WITH 15 FT. BRACKET ARM ON NEW FOUNDATION WITH 45 FT. MOUNTING HEIGHT (EXCEPT WHERE OTHERWISE NOTED)
- ⊙ UG-FED, 400 W. TYPE III, CLEAR, HIGH PRESSURE SODIUM LTG. UNIT WITH DBL. BRACKET ARM (30 FT.) ON MEDIUM WALL WITH 45 FT. MOUNTING HEIGHT (EXCEPT WHERE OTHERWISE NOTED)
- ⊙ UG-FED 250 W. TYPE II, CLEAR, HIGH PRESSURE SODIUM LTG. WITH 10 FT. BRACKET ARM ON BRIDGE OR RETAINING WALL WITH 30 FT. MOUNTING HEIGHT. (EXCEPT WHERE OTHERWISE NOTED)
- WALL MOUNTED MERCURY VAPOR U.B. LTG. UNIT.
- FB INDICATES ST. LTG. STANDARD WITH FRANGIBLE TRANSFORMER BASE
- ☀ FUTURE LIGHT STANDARD
- ☀ U.G. FED 400 W. HIGH PRESSURE SODIUM LUMINAIRE-(SPECIAL) ON LIGHT STANDARD WITH NO ARM, 40 FT. MOUNTING HEIGHT, SHAFT LENGTH AS SPECIFIED. SEE DETAIL ON SHEET # 8 OF PLANS.
- ⊗₈ TOWER LIGHTING UNIT WITH 1000 W. METAL HALIDE LUMINAIRE TYPE X, 100 FT. MOUNTING HEIGHT (T₂ TOWER NO. SHOWN & 8 NO. OF LUMINAIRE). (EXCEPT AS OTHERWISE NOTED)
- ⊗₁₁ TOWER LIGHTING UNIT WITH 4-1000 W. METAL HALIDE LUMINAIRE WITH ASYMMETRIC LIGHT DISTRIBUTION, 2 LUMINAIRE ON EACH SIDE OF POLE WITH LONG AXES OF PATTERNS IN DIRECTION OF ARROWS, 80 FT. MOUNTING HEIGHT. (T₁ TOWER NO. SHOWN).

OVERHEAD

- EXISTING WOOD POLE
- WOOD POLE (HEIGHT & CLASS AS INDICATED)
- O.H.-FED, 400 W. TYPE II, CLEAR, MERCURY VAPOR ST. LTG. UNIT WITH 15 FT. BRACKET ARM ON WOOD POLE AND 30 FT. MOUNTING HEIGHT.
- EXISTING O.H.-FED ST. LTG. UNIT WITH WOOD POLE
- ^{3-6"}— EXISTING O.H. LINE (3-6" SHOWN)
- ^{2-6"}— OVERHEAD LINE (2-6" SHOWN)
- — — REMOVE O.H. LINE.
- 400 W. TYPE I CLEAR, MERCURY VAPOR ST. LTG. UNIT ON SPAN WIRE AND MIN. 25 FT. MOUNTING HEIGHT.

GENERAL

- R.O.W. — RIGHT OF WAY LINE
- *— L.A.R.O.W. — LIMITED ACCESS RIGHT OF WAY LINE
- — — PROPOSED PAVEMENT JOINT LINE
- P.L.C. — INDICATES THE PUBLIC LIGHTING COMMISSION
- D.E.CO. — INDICATES THE DETROIT EDISON COMPANY
- C.P.CO. — INDICATES THE CONSUMERS POWER COMPANY

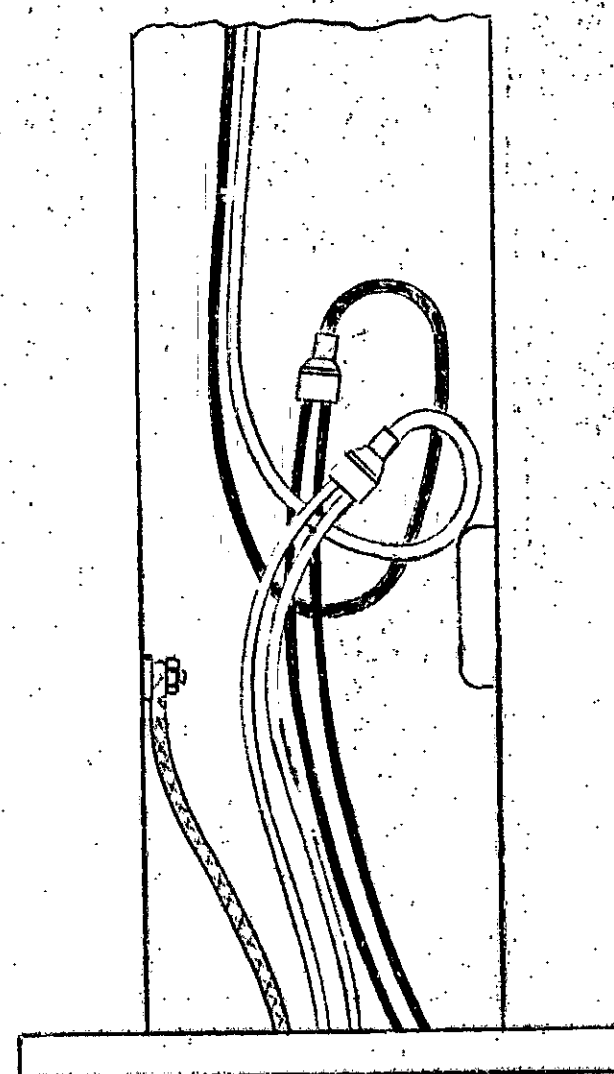


TYPICAL MULTIPLE STREET LIGHTING CONNECTION FOR 2-WIRE, 480 V 1Ø, UNDERGROUND SYSTEM FOR CONVENTIONAL LIGHTING

20. THE ITEM "DOUBLE BEAM GUARD RAIL SPECIAL-TYPE I" SHALL INCLUDE REMOVING THE EXISTING SECTIONS OF 6" CHANNEL BEAM, INSTALLING THE REQUIRED SPACING BLOCKS, AND INSTALLING BEAM GUARD RAIL COMPLETE AS SHOWN ON THE PLAN DETAIL.
21. THE ITEM "DOUBLE BEAM GUARD RAIL SPECIAL-TYPE II" SHALL INCLUDE REMOVING THE LOWER BEAM GUARD RAIL, INSTALLING THE REQUIRED SPACING BLOCKS, AND REINSTALLING THE BEAM GUARD RAIL AS SHOWN ON THE PLAN DETAIL.
22. EXISTING LIGHTS ARE TO REMAIN IN OPERATION UNTIL THE PROPOSED LIGHTS ARE IN OPERATION AND ACCEPTED AS DIRECTED BY THE ENGINEER. ANY DAMAGES TO THE EXISTING SYSTEM CAUSED BY THE CONTRACTOR SHALL BE REPAIRED AT THE CONTRACTOR'S OWN EXPENSE WITHIN A REASONABLE TIME AS DIRECTED BY THE ENGINEER.
23. THE MAINTENANCE DIVISION OF THE M.D.S.H. & TR. WILL REMOVE AND SALVAGE STREET LIGHT STANDARDS THAT ARE TO BE REMOVED INCLUDING ARM AND LUMINAIRE.
24. LIGHT STANDARD FOUNDATIONS ARE TO BE REMOVED ENTIRELY. NECESSARY BACKFILLING AND SHOULDER RESTORATION WILL BE INCIDENTAL TO THE ITEM "REMOVE LIGHT STANDARD FOUNDATION" AND WILL NOT BE PAID FOR SEPARATELY.
25. THE 6" EDGE DRAIN REQUIRED TO REPLACE DAMAGED EDGE DRAIN DUE TO LIGHTING CONSTRUCTION SHALL BE INCIDENTAL TO THE PROJECT AND WILL NOT BE PAID FOR SEPARATELY.
26. TRUSS FOUNDATION IS TO BE REMOVED ENTIRELY. NECESSARY BACKFILLING AND SHOULDER RESTORATION WILL BE INCIDENTAL TO THE ITEM, "REMOVE TRUSS FOUNDATION" AND WILL NOT BE PAID FOR SEPARATELY.

DESIGN CRITERIA

AVERAGE INITIAL INTENSITY 1. FC
AVERAGE UNIFORMITY RATIO 3 TO 1

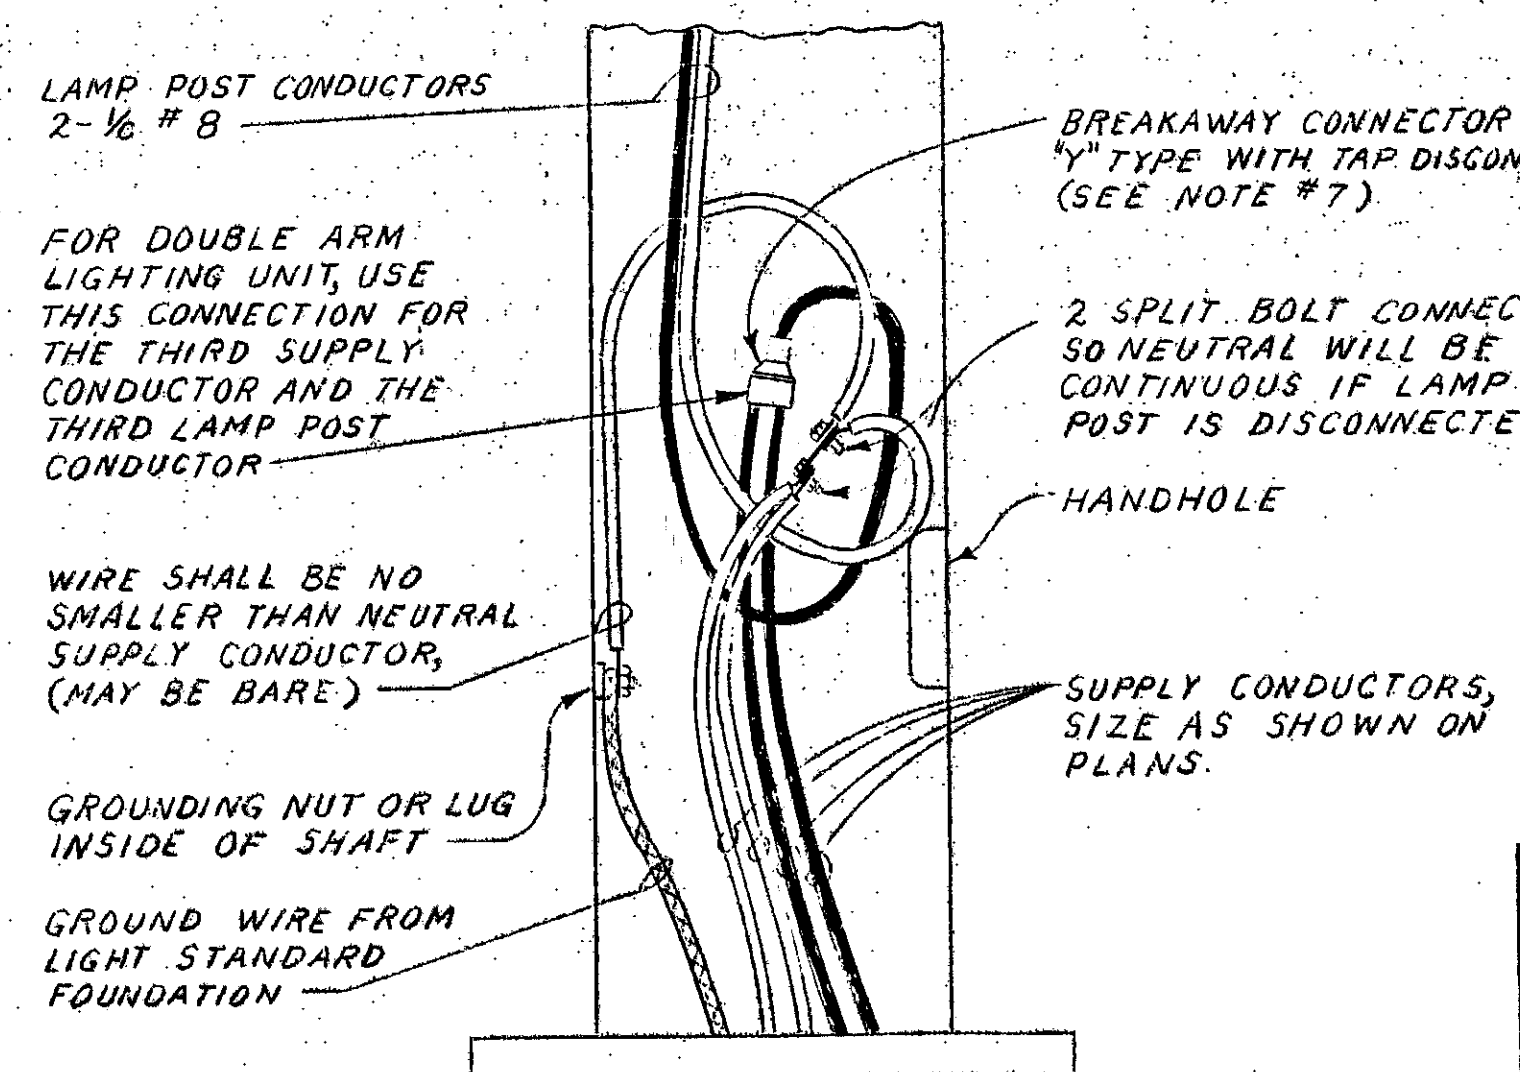

TYPICAL MULTIPLE STREET LIGHTING CONNECTION FOR 3-WIRE, SINGLE PHASE UNDERGROUND SYSTEM FOR CONVENTIONAL LIGHTING

GENERAL NOTES

1. ALL CONDUITS CROSSING PAVEMENTS, SHALL EXTEND 4" BACK OF CURB OR EDGE OF PAVEMENT (EXCEPT AS OTHERWISE NOTED) AND SHALL HAVE A MINIMUM OF 2'-6" COVER.
2. ALL DIRECT BURIAL CABLES SHALL BE INSTALLED IN CONTINUOUS UNCUT LENGTH BETWEEN STREET LIGHTING STANDARDS OR HANDHOLES.
3. STREET LIGHTING LUMINAIRE SHALL BE HIGH PRESSURE SODIUM, TYPE AS INDICATED, MEDIUM DISTRIBUTION, SEMICUTOFF, WITH 240 V. INTEGRAL BALLAST, EXCEPT AS OTHERWISE NOTED.
4. LIGHT STANDARDS SHALL BE ALUMINUM OR GALVANIZED STEEL.
5. DIRECT BURIAL CONDUIT, UNDER PAVED MEDIAN SHALL HAVE A MINIMUM OF 2' COVER.
6. ALL LIGHT STANDARDS WITH FRANG. TRANSFORMER BASES LOCATED ON RAMPS SHALL BE SET BACK 12' FROM THE EDGE OF THE PAVEMENT.
7. BREAKAWAY CONNECTOR SHALL BE ELASTIMOLD STYLE #835; JOY MFG. CO. #XB918, BUSSMAN TYPE HEP WITH INSULATING BOOTS, OR APPROVED EQUAL.
8. THE ITEM "1-3" DIRECT BURIAL CONDUIT (SPECIAL) SHALL INCLUDE SAWING THE BITUMINOUS MEDIAN PAVEMENT, REMOVING BITUMINOUS, TRENCHING, FURNISHING AND LAYING CONDUIT, BACKFILLING & COMPACTING, SURFACING & RESTORING THE BLACK TOP SHOULDERS WITH THE SAME MATERIAL AS THE EXISTING CONSTRUCTION.
9. THE ITEM "1-3" GALV. STEEL CONDUIT, JACKING-BORING" SHALL INCLUDE RESTORING SHOULDER AND BITUMINOUS SHOULDER PAVEMENT & SHOULDERS (INCLUDING SEEDING & SODDING).
10. JACKING PITS SHALL BE LOCATED OUTSIDE OF SHOULDER AREA AS DIRECTED BY THE ENGINEER.
11. ELECTRIC SERVICE FOR TOWER LIGHTING SHALL BE 480 VOLT, SINGLE PHASE, 2 WIRE.
12. THE CONTRACTOR MAY BUILD EITHER CYLINDRICAL OR SPREAD-FOOTING TYPE FDN. EXCEPT THAT AT STA. 917+40 AS DETAILED ON SHEET # 4 WITHOUT ADDITIONAL COST.
13. IN THE EVENT THERE IS DAMAGED GUARD RAIL, THE MDSH WILL REPAIR OR REPLACE THE SECTIONS OF GUARD RAIL PRIOR TO THE SETTING OF LIGHT STANDARDS.
14. LUMINAIRE FOR TOWER LIGHTING SHALL BE PROVIDED WITH 480 V. METAL HALIDE TYPE BALLAST.
15. THE POLES FOR TOWER LIGHTING UNITS MAY BE ONE SECTION, OR NOT MORE THAN 4 SECTIONS FOR THE 100' POLE, OR 3 SECTIONS FOR THE 80' POLE.
16. THE LUMINAIRE MOUNTING FRAMES FOR THE TOWER LIGHTING UNITS WITH 4 ASYMMETRICAL LUMINAIRE SHALL BE EQUIPPED IN SUCH A MANNER THAT MAKES IT ADAPTABLE FOR ADDITIONAL LIGHTING IN THE FUTURE. THE LUMINAIRE MOUNTING FRAME SHALL BE DESIGNED SIMILAR TO THAT FOR THE EIGHT LUMINAIRE WITH UNUSED HOLES PLUGGED.
17. ALL LIGHT STANDARDS FURNISHED ON THIS CONTRACT SHALL BE OF THE SAME STYLE AND MATERIAL, AND FROM THE SAME MANUFACTURER, EXCEPT WHERE OTHERWISE SPECIFIED ON THE PLANS.
18. ALL TOWER LIGHTING UNITS SHALL BE MADE BY THE SAME MANUFACTURER.
19. ELECTRIC SERVICE FOR CONVENTIONAL LIGHTING BETWEEN STA. 835+26 TO 905+75 SHALL BE 480/240 V, 1Ø, 3 WIRE & BETWEEN STA. 907+46 TO 940+40 SHALL BE 480V, 1Ø, 2 WIRE.

MICHIGAN DEPARTMENT OF STATE HIGHWAYS
NOTES & LEGEND
FREEWAY


NO.	DESCRIPTION	DATE	BY

63174 08517A
 11/20
 3-23-70
 SHEET 15 OF 60
 JOB NO.

SQUAD: JILDEH

TOWER NO. 1
T.H. #1


50' Rt. of Sta. 917+40

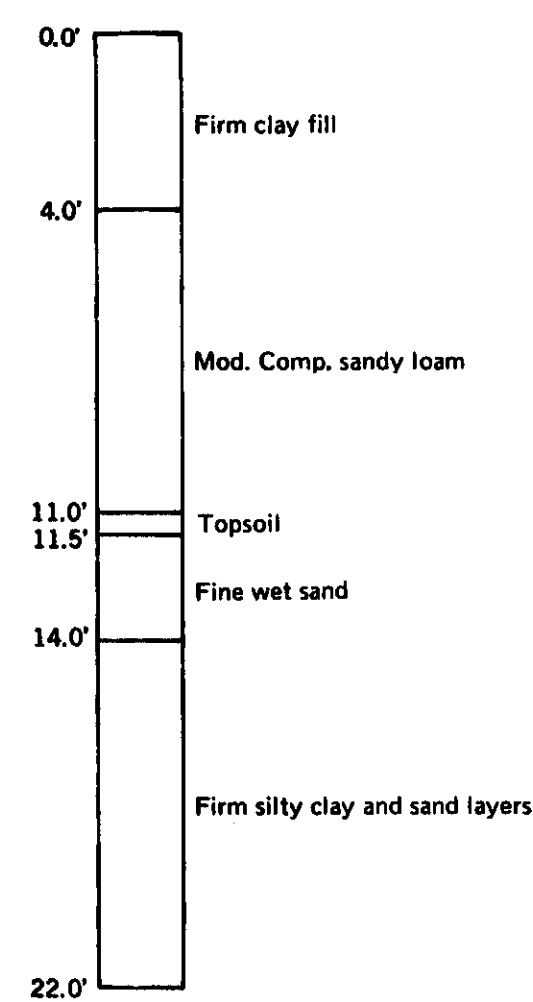

W.T. @ 9.0'
E.O.B. = 22.0'

TOWER NO. 2
T.H. #2


80' Rt. of Sta. 921+40

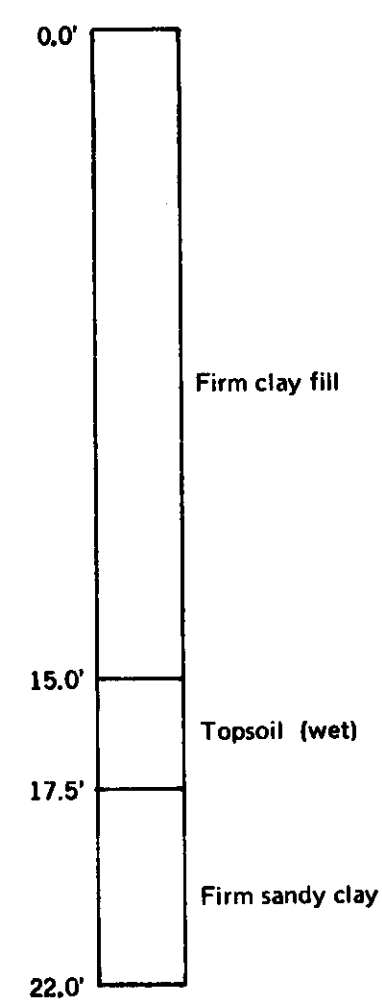

E.O.B. = 22.0'

TOWER NO. 3
T.H. #3


100' Lt. of Sta. 926+38

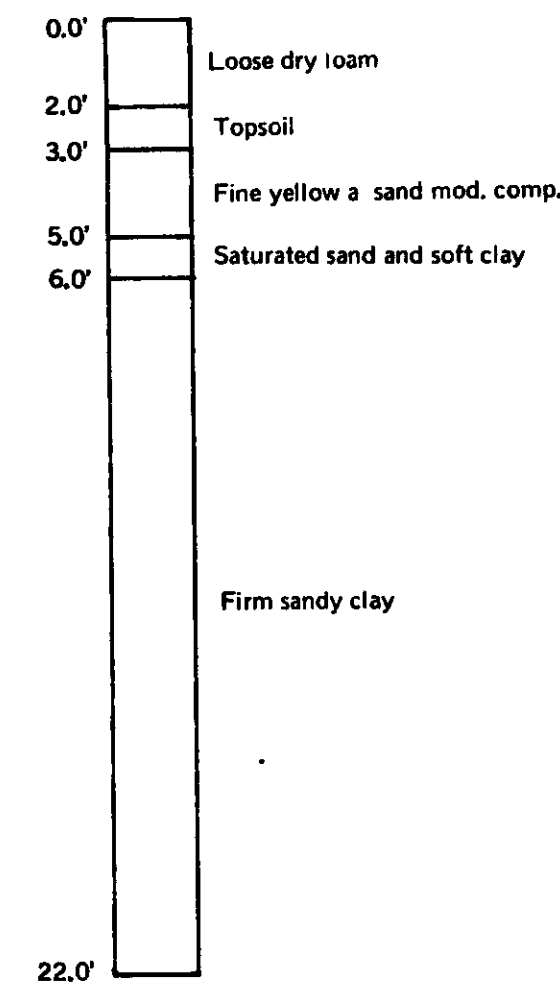

E.O.B. = 22.0'

TOWER NO. 4
T.H. #4

80' Lt. of Sta. 931+90

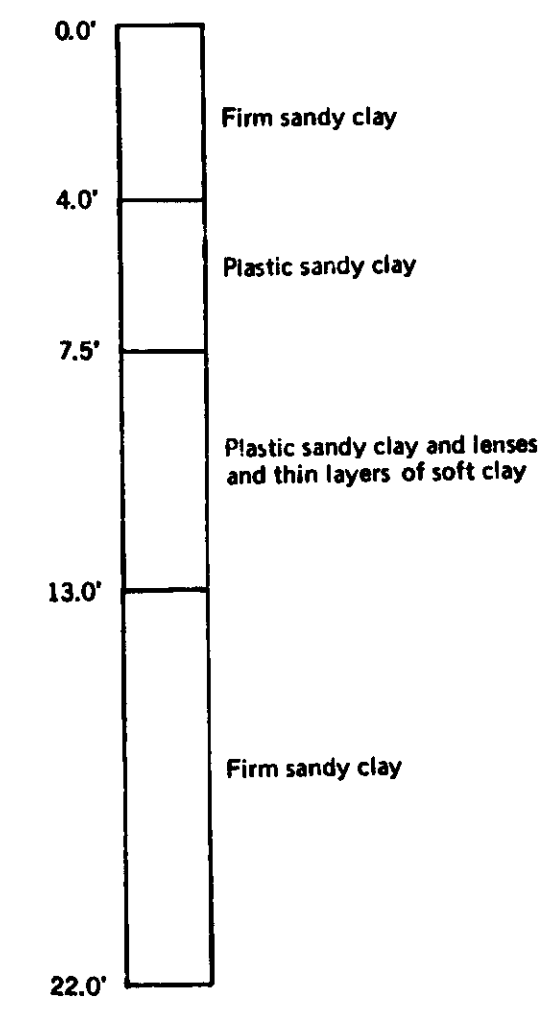


E.O.B. = 22.0'


**I-75 & I2 MILE ROAD
INTERCHANGE**

TOWER LIGHTING


**MICHIGAN DEPARTMENT OF STATE HIGHWAYS
AND TRANSPORTATION
SOIL BORING DATA**

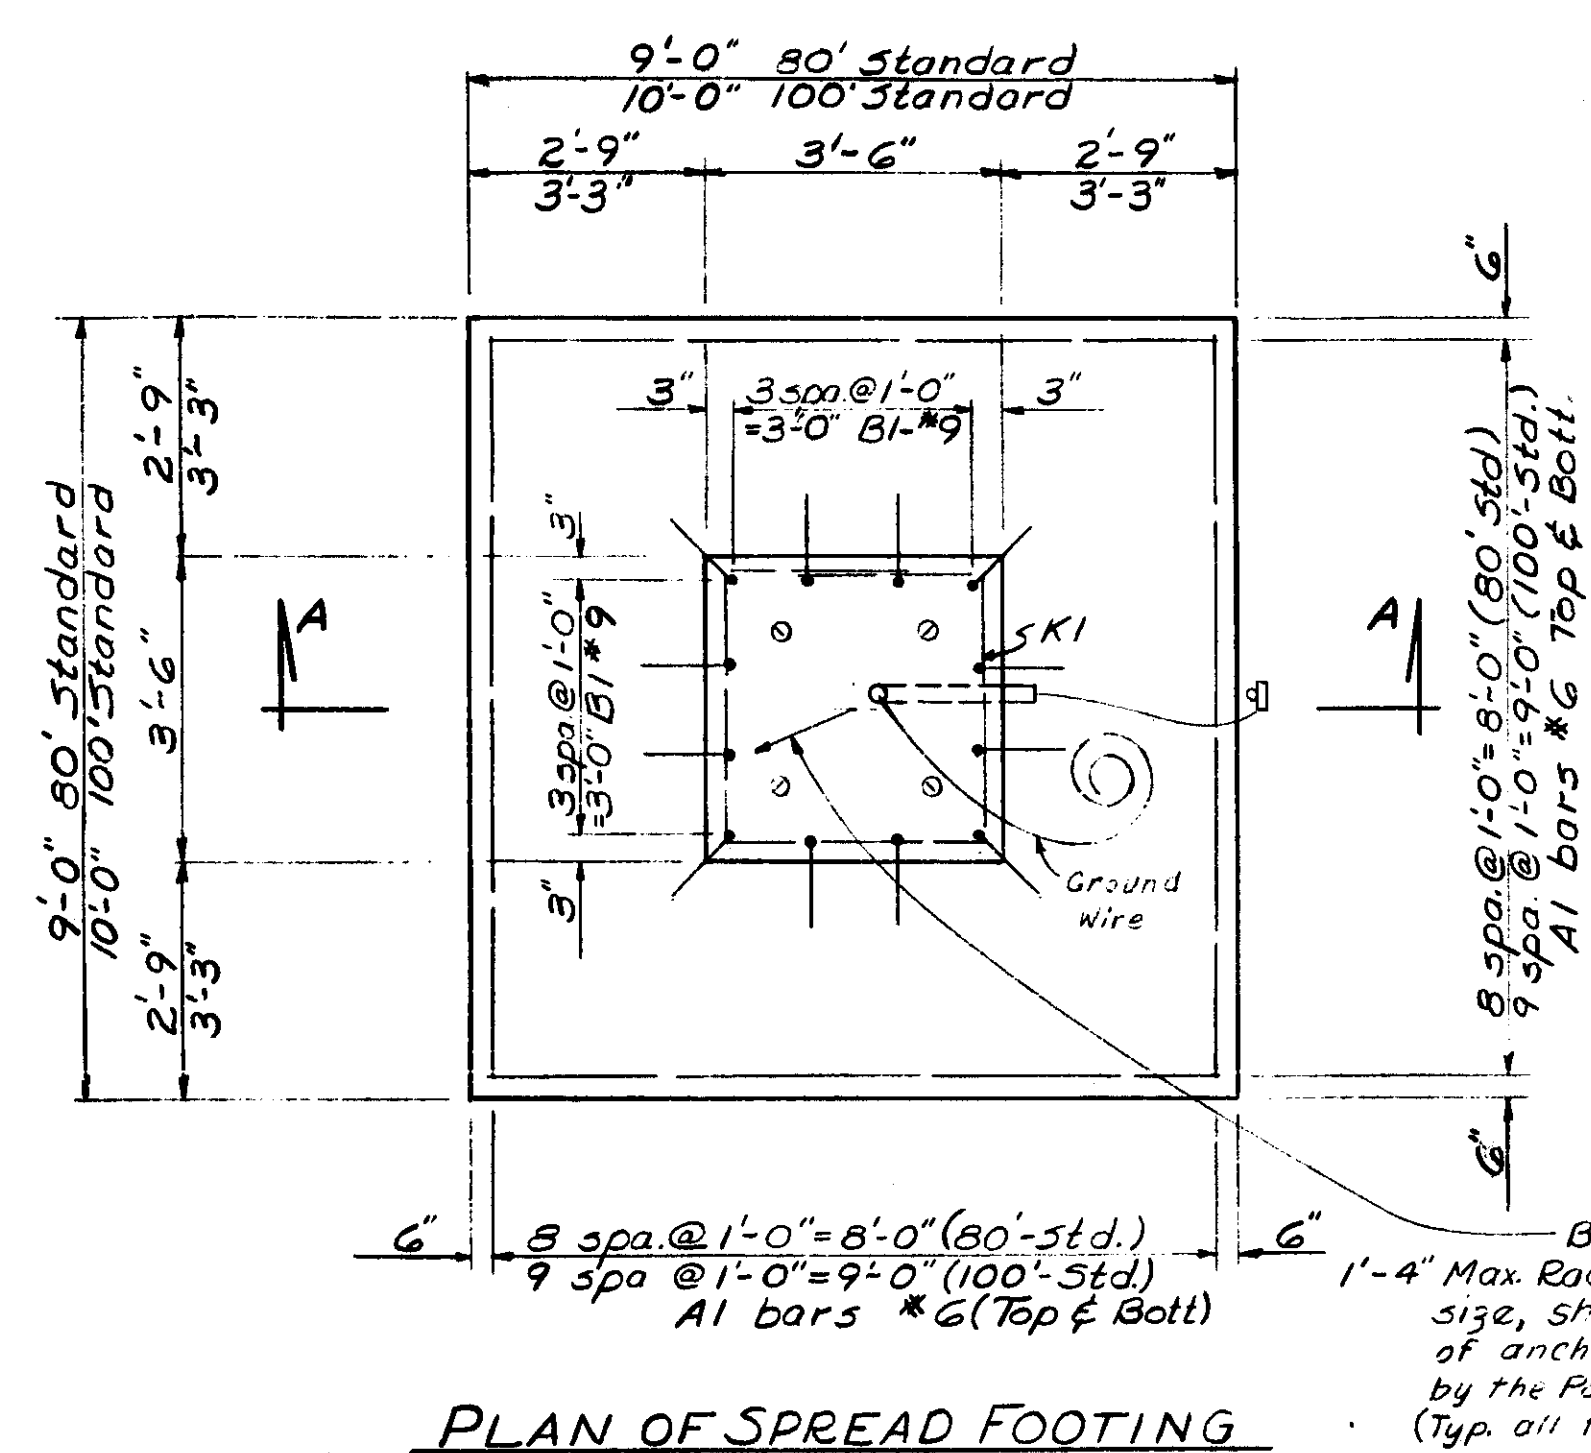


PLAN OF SPREAD FOOTING

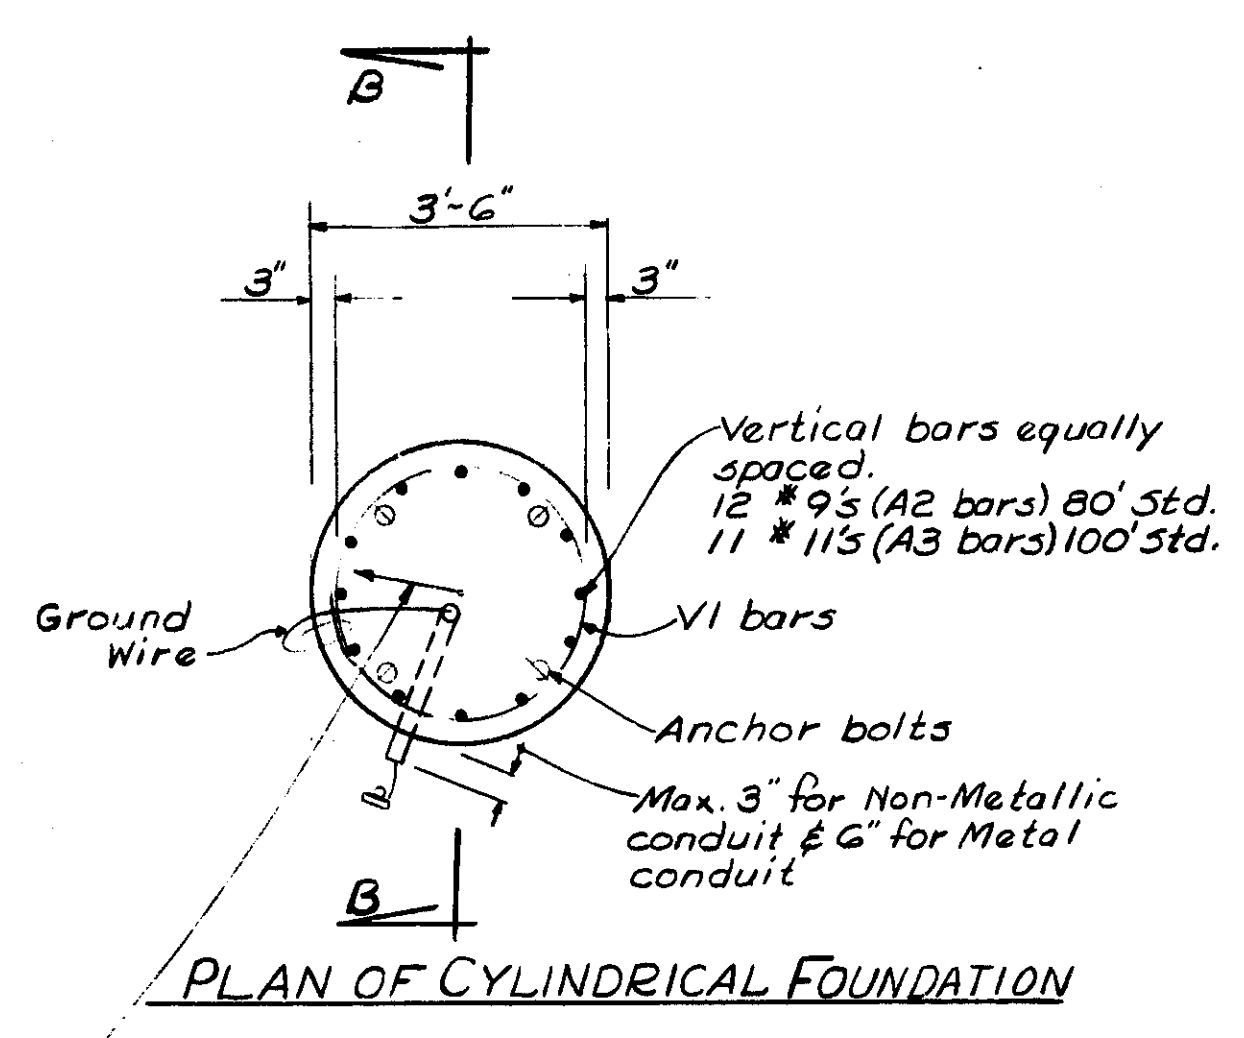


PLAN OF CYLINDRICAL FOUNDATION

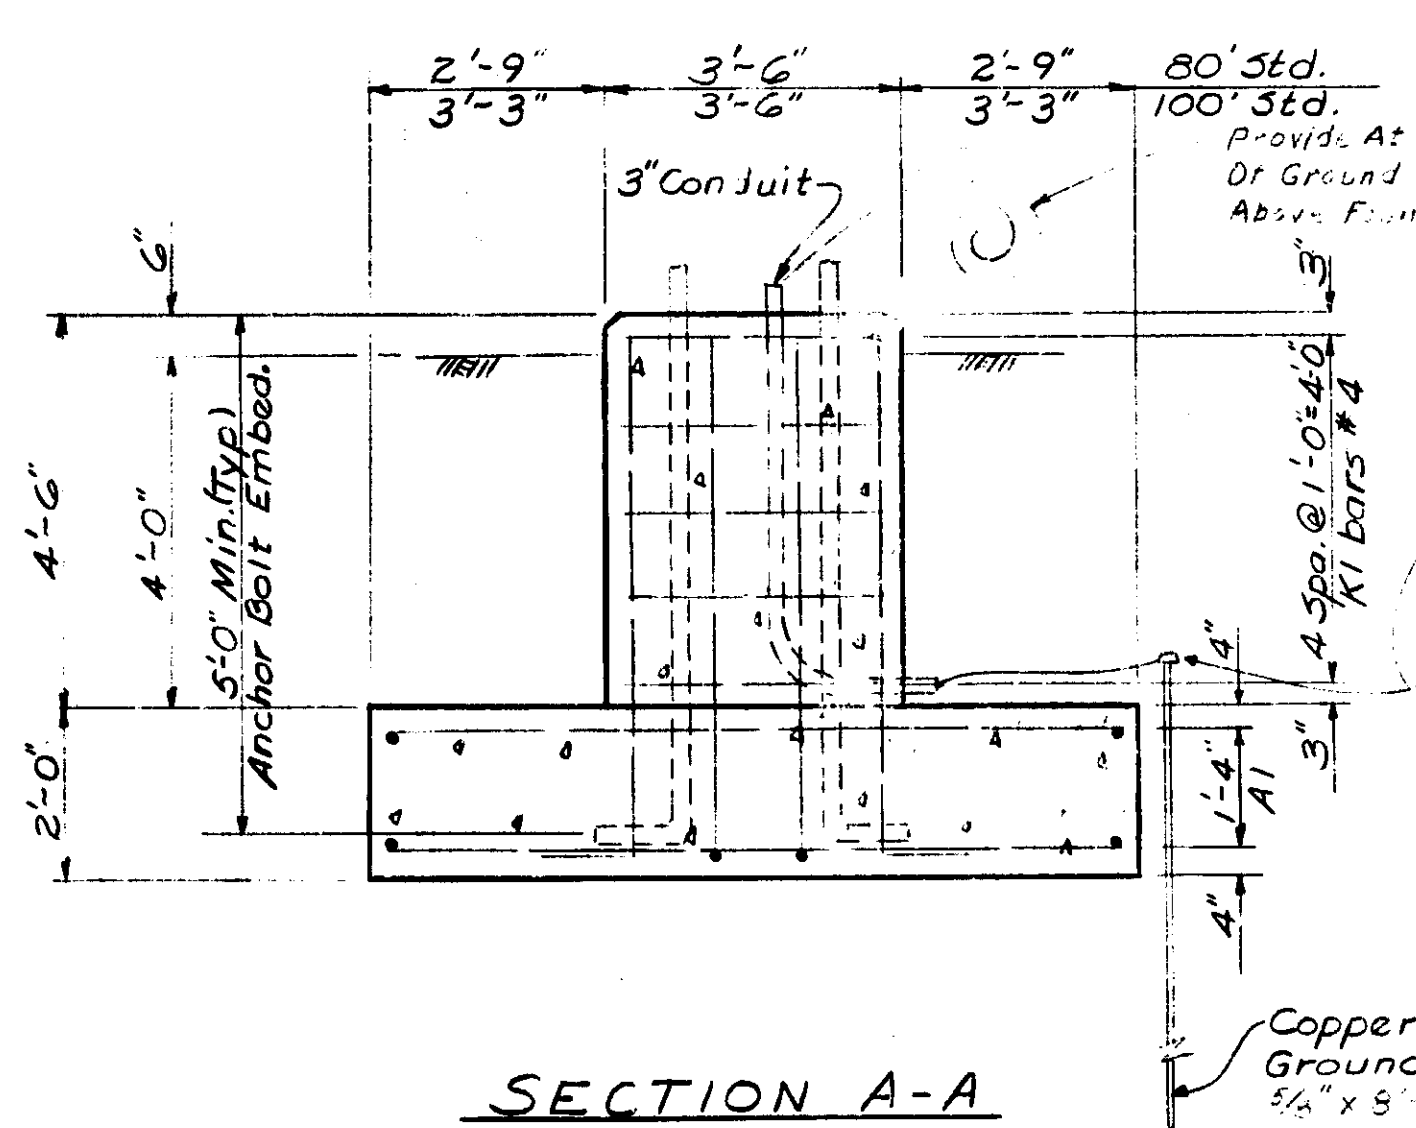

SECTION A-A

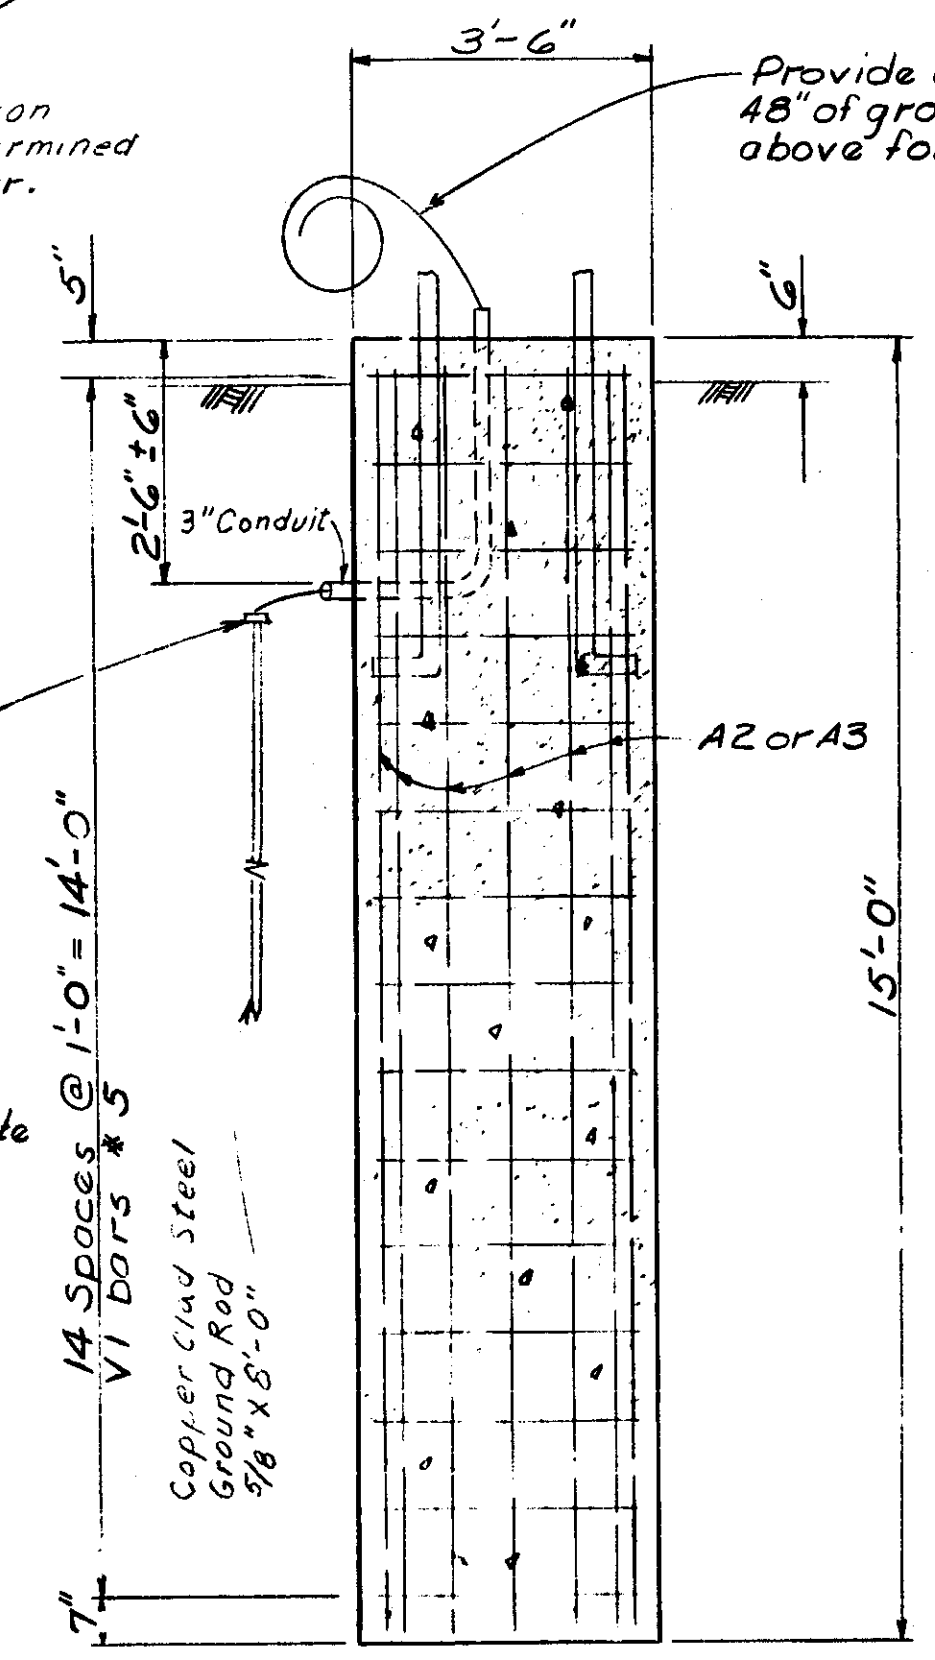

SECTION B-B

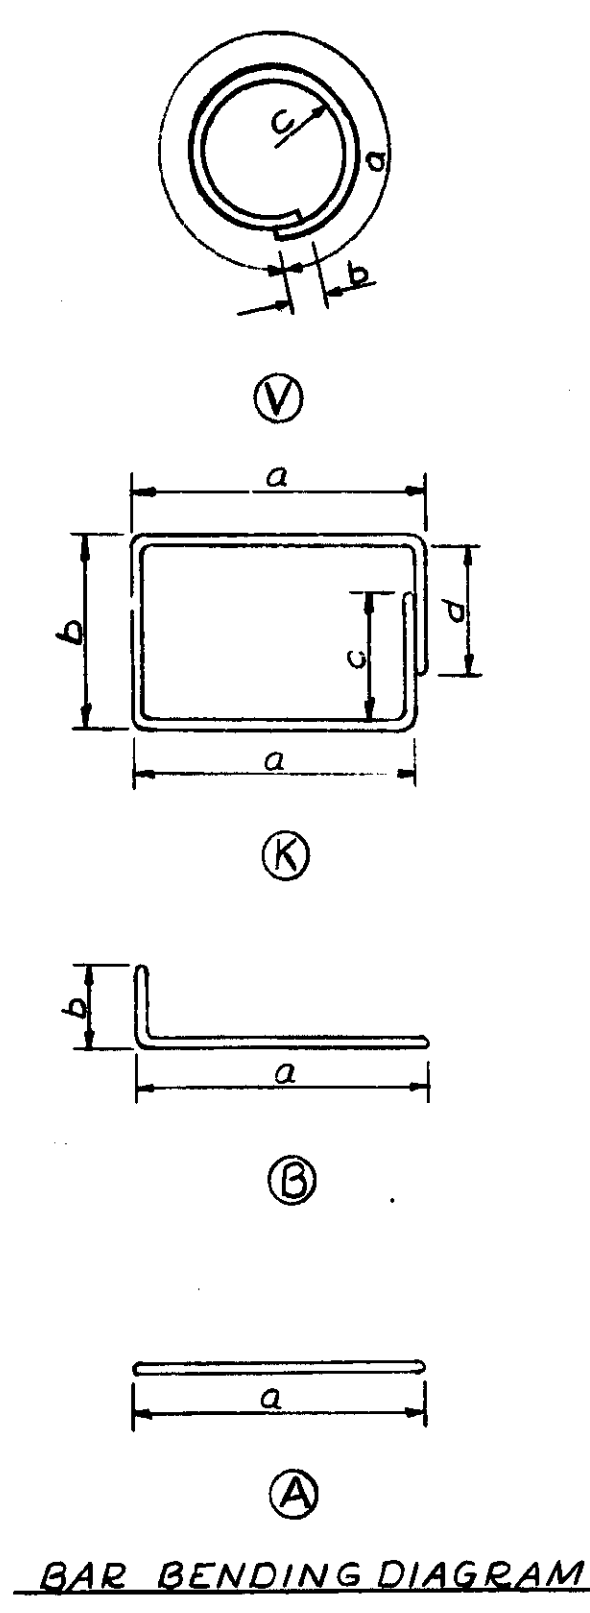

BAR BENDING DIAGRAM

STEEL REINFORCEMENT SCHEDULE										
Bar	Dimensions					Size	Length	No.	Total Weight	
	a	b	c	d	e					
A1	8'-0"					6	8'-0"	36	433	
B1	6'-0"	1'-1"				9	7'-0"	12	286	
K1	3'-2"	3'-2"	1'-6 1/2"	1'-6 1/2"		4	12'-6"	5	42	
									Total	761
SPREAD FOOTING (80' T.L. UNIT)										
A1	9'-0"					6	9'-0"	40	541	
B1	6'-0"	1'-1"				9	7'-0"	12	286	
K1	3'-2"	3'-2"	1'-6 1/2"	1'-6 1/2"		4	12'-6"	5	42	
									Total	869
SPREAD FOOTING (100' T.L. UNIT)										
A2	17'-6"					9	14'-6"	12	592	
V1	9'-2"	1'-10"	1'-4"			5	10'-2"	15	159	
									Total	751
CYLINDRICAL FOUNDATION (80' T.L. UNIT)										
A3	17'-6"					11	14'-6"	11	847	
V1	9'-2"	1'-10"	1'-4"			5	10'-2"	15	159	
									Total	1006
CYLINDRICAL FOUNDATION (100' T.L. UNIT)										


CONCRETE QUANTITIES GRADE 355		
Spread Footing - (80' Tower Ltg. Unit)	Cu. Yds.	8.0
Spread Footing - (100' Tower Ltg. Unit)	Cu. Yds.	9.4
Cylindrical Foundation	Cu. Yds.	5.3

NOTE:
 All concrete to be Grade 355
 The grades and working stresses of the structural materials used in these foundations are as follows:
 Steel Reinforcement $f_s = 20000$ psi
 Concrete Grade 355 $f'_c = 3000$ psi
 These tower lgt. unit foundations are to be poured against undisturbed soil inasmuch as possible
 Maximum average foundation pressure
 D.L. only - (80' T.L. Unit) - 900 psi
 100' T.L. Unit) - 850 psi
 Maximum foundation pressure
 D.L. + LL - (80' T.L. Unit) - 2700 psi
 100' T.L. Unit) - 2750 psi
 Either type foundation is acceptable at each site, except that spread footing type required for tower located 50' R. of Sta. 917+40

MICHIGAN DEPARTMENT OF STATE HIGHWAYS
 FOUNDATION DETAILS FOR TOWER LIGHTING UNIT
 I-75 AND 12 MILE ROAD INTERCHANGE

REVISIONS			
No.	DESCRIPTION	DATE	BY


DESIGN NO. G-1474
 DRAWN BY D.E.
 CHECKED BY
 UNIT 17 OF
63174 08517A

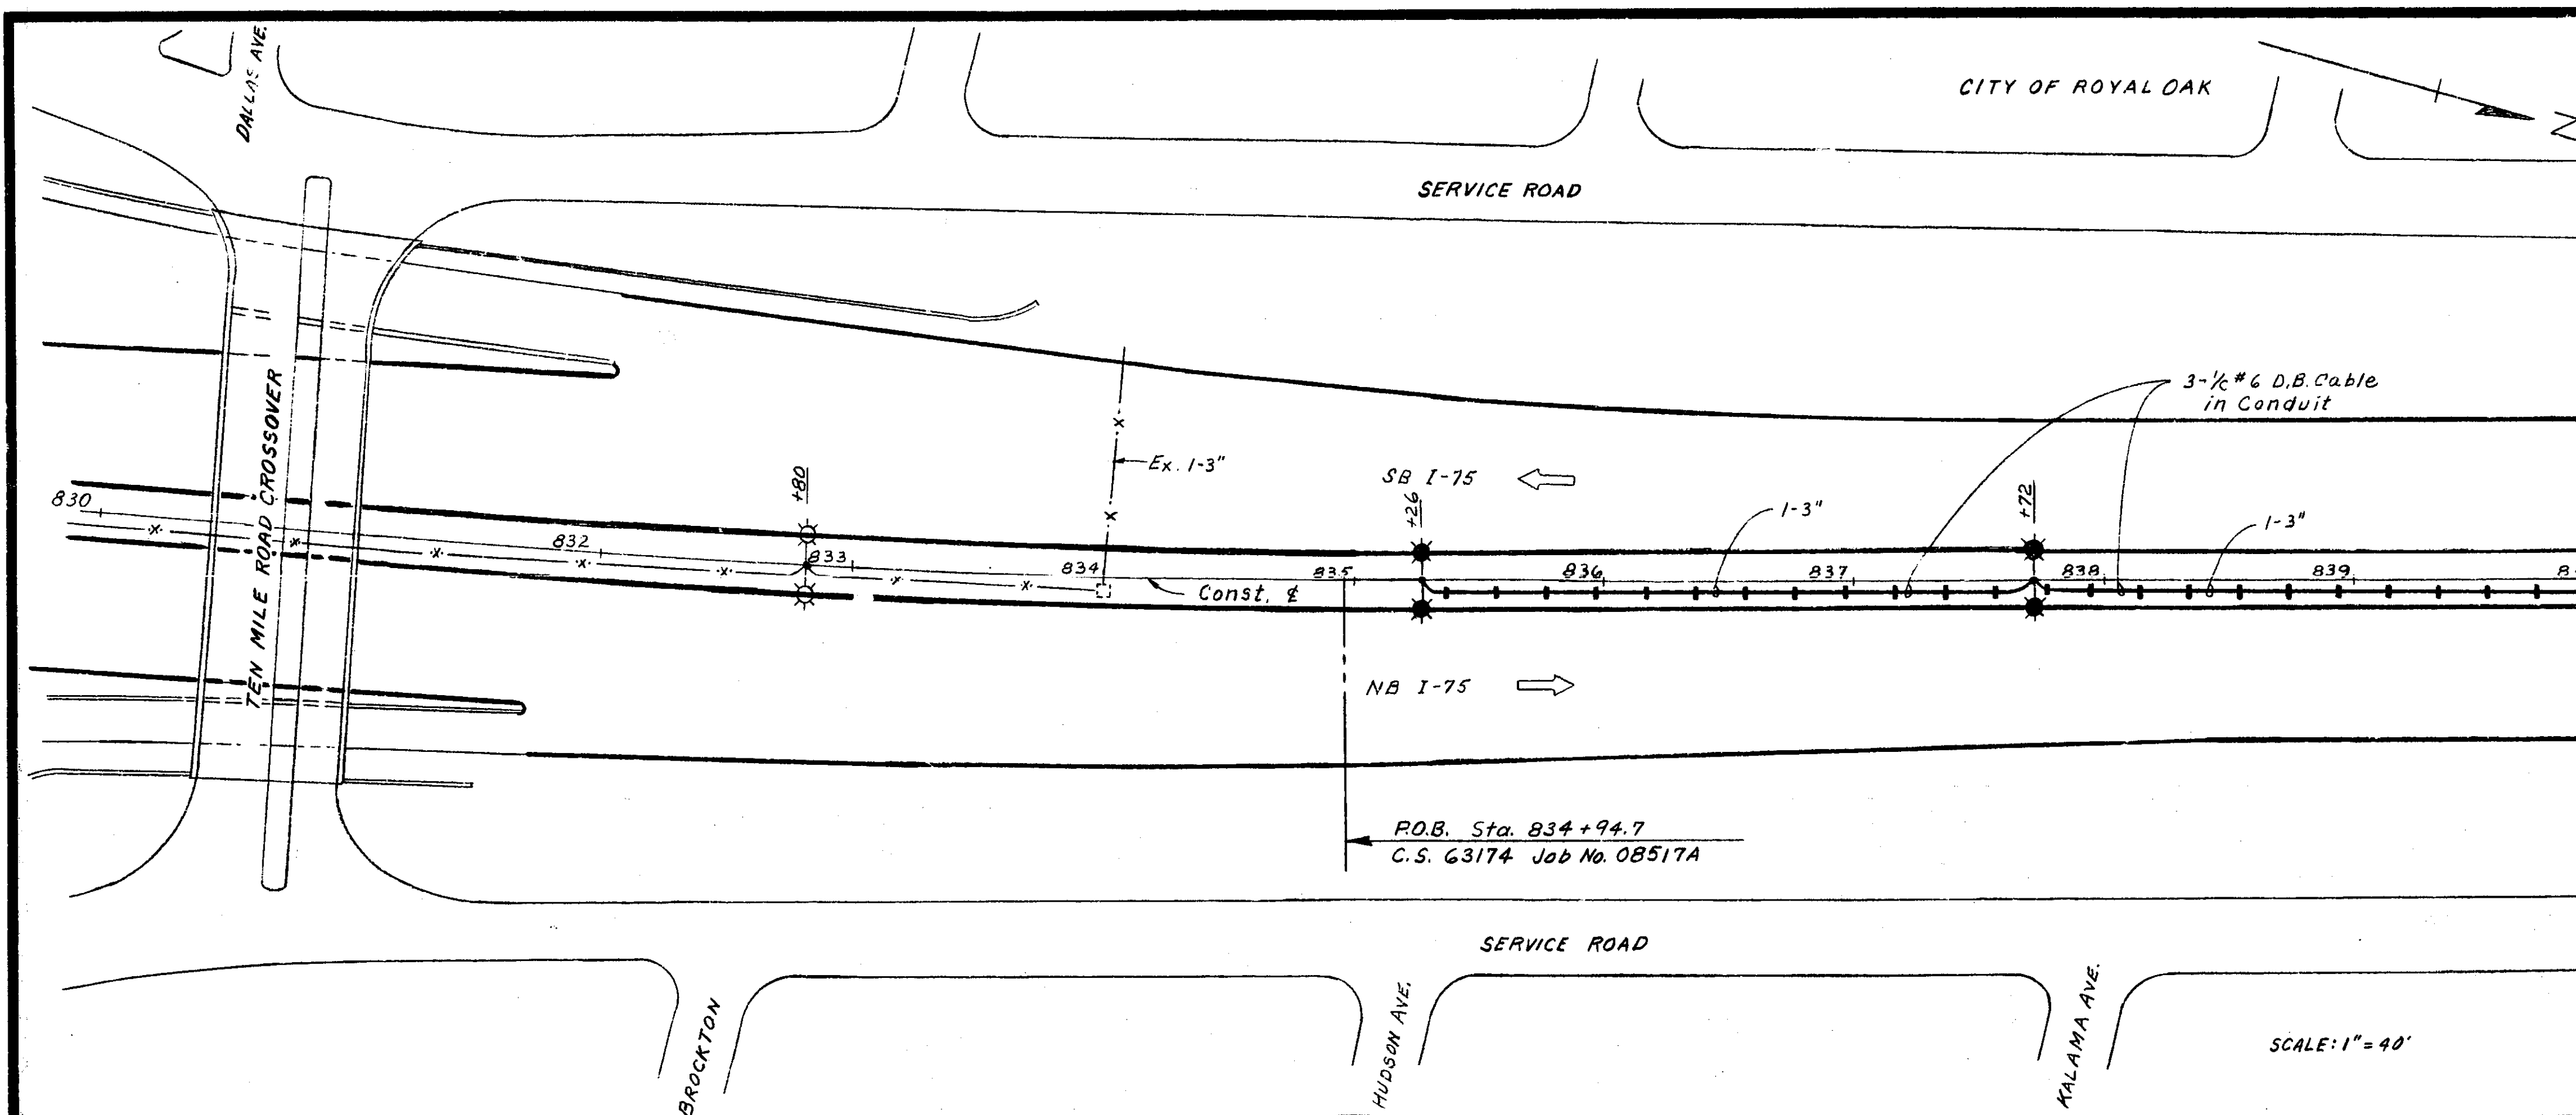

ENTIRE PROJECT
 THE FOLLOWING ITEM OF WORK SHALL BE DONE AS IT APPLIES THROUGHOUT THE ENTIRE PROJECT. THIS ITEM IS NOT INCLUDED ON THE PLANS.

ELECTRIC DRILL 1 EACH

SCALE: 1" = 40'

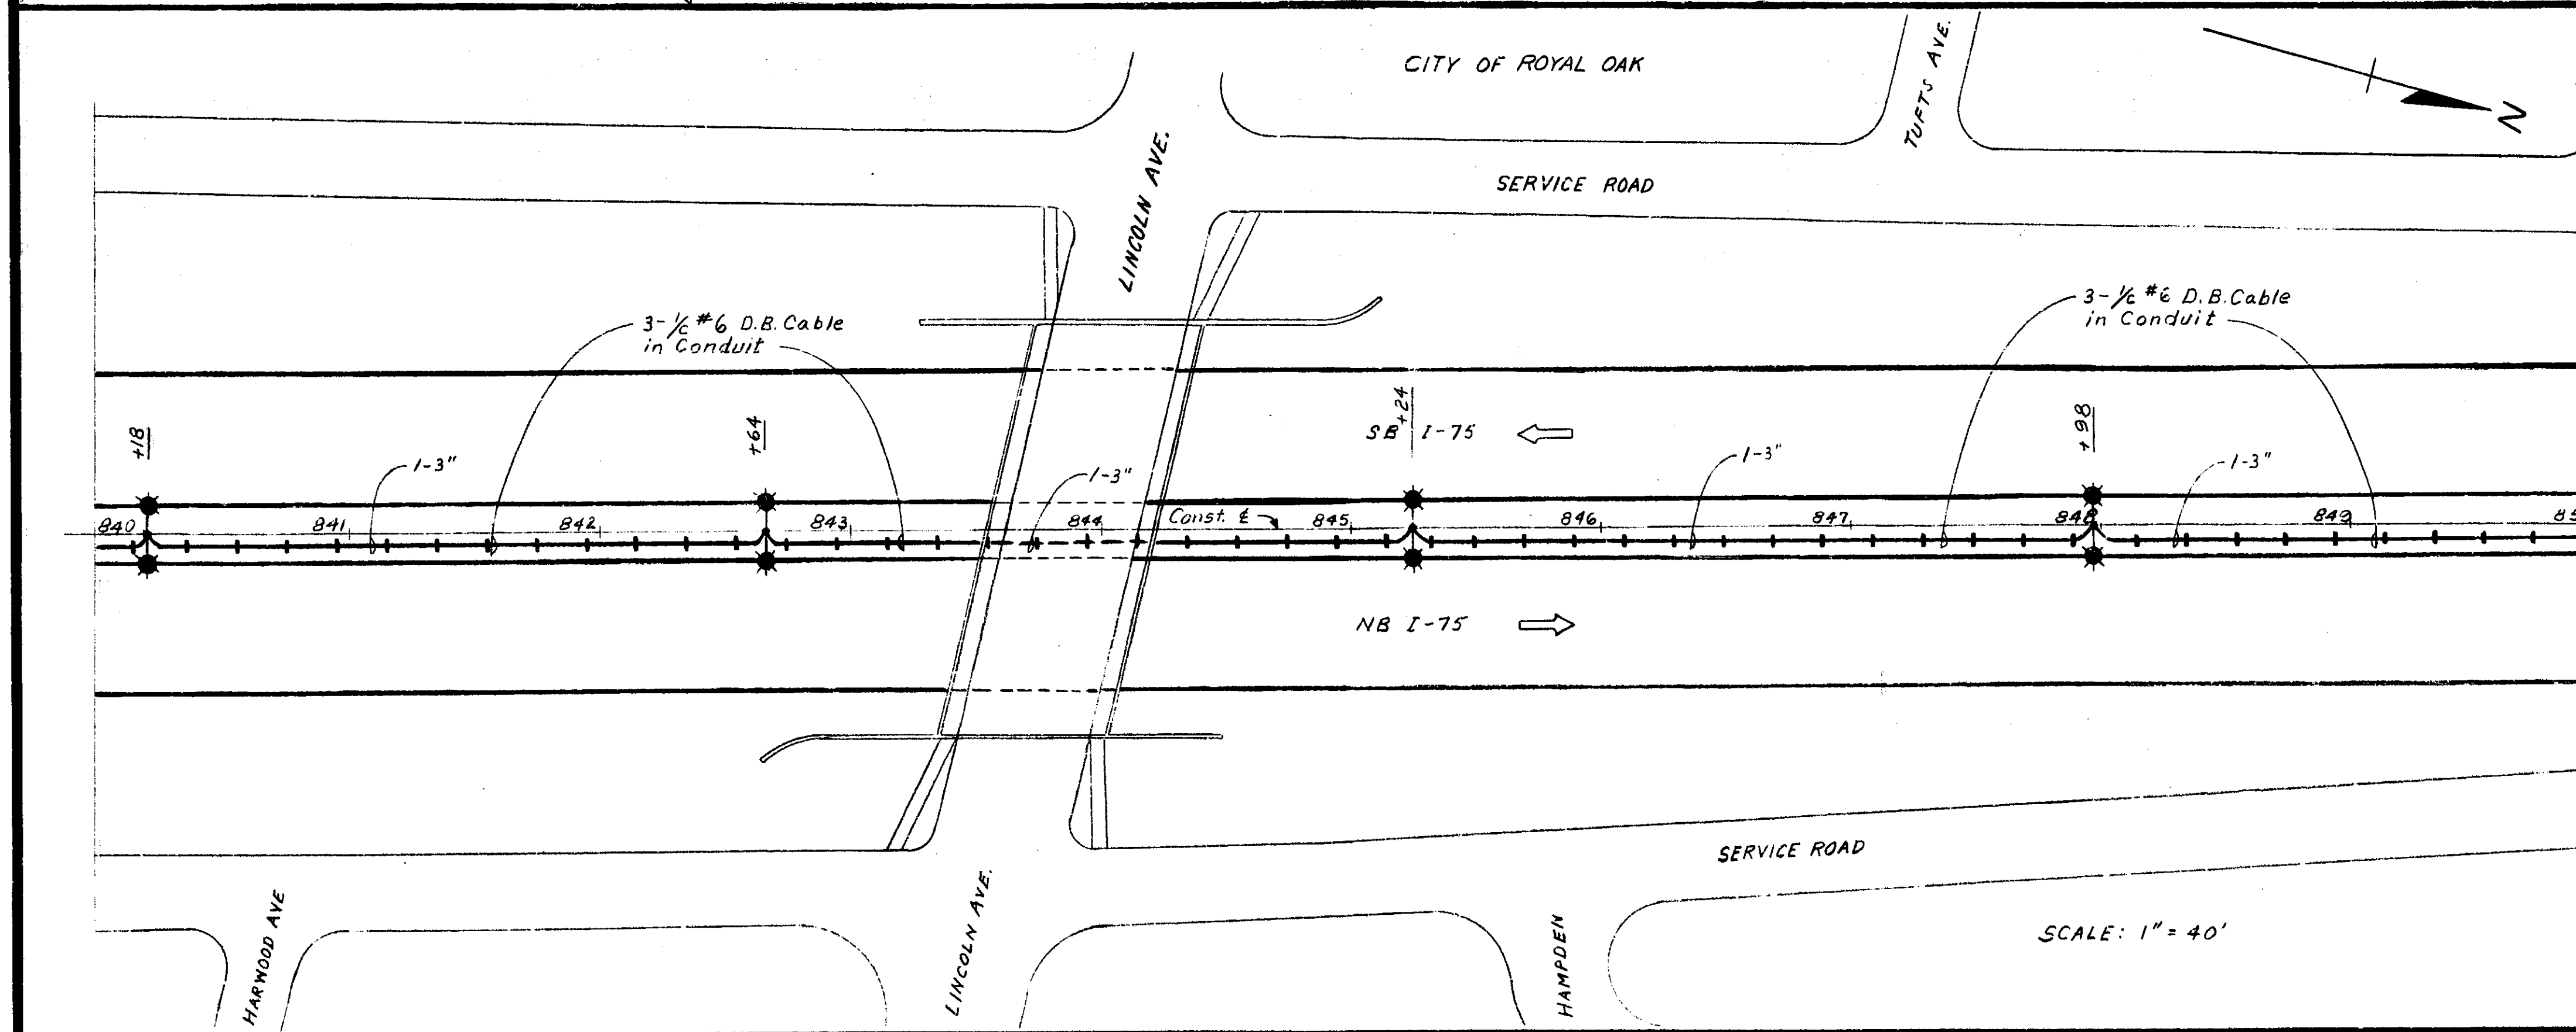

SCALE: 1" = 40'


QUANTITIES ON THIS SHEET		
ITEM	UNIT	QUANTITY
1-3" Direct Burial Conduit (Special)	L.Ft.	1474
600V, 3-1/2 #6 Direct Burial Cable in Conduit	L.Ft.	1474
Lt. Std. #5 Ft. M.H. 12 Ft. Dbl. Arm, New Foundation	Each	6
400w. High Pressure Sodium Luminaire	Each	12
Double Beam Guard Rail Special-Type I	L.Ft.	375

MICHIGAN DEPARTMENT OF STATE HIGHWAYS
FREEWAY LIGHTING
 I-75 FROM I-696 FREEWAY TO 12 MILE RD.
 CITY OF ROYAL OAK


REVISIONS			
NO.	DESCRIPTION	DATE	BY

DESIGNED BY T. J. J. 1973
 DRAWN BY K.B. 10-22-73
 CHECKED BY C. P. 5-30-73
 DIRECTED BY C.B.F.J. 10-22-73

SHEET 12 OF
 JOB NO. 63174 08517A

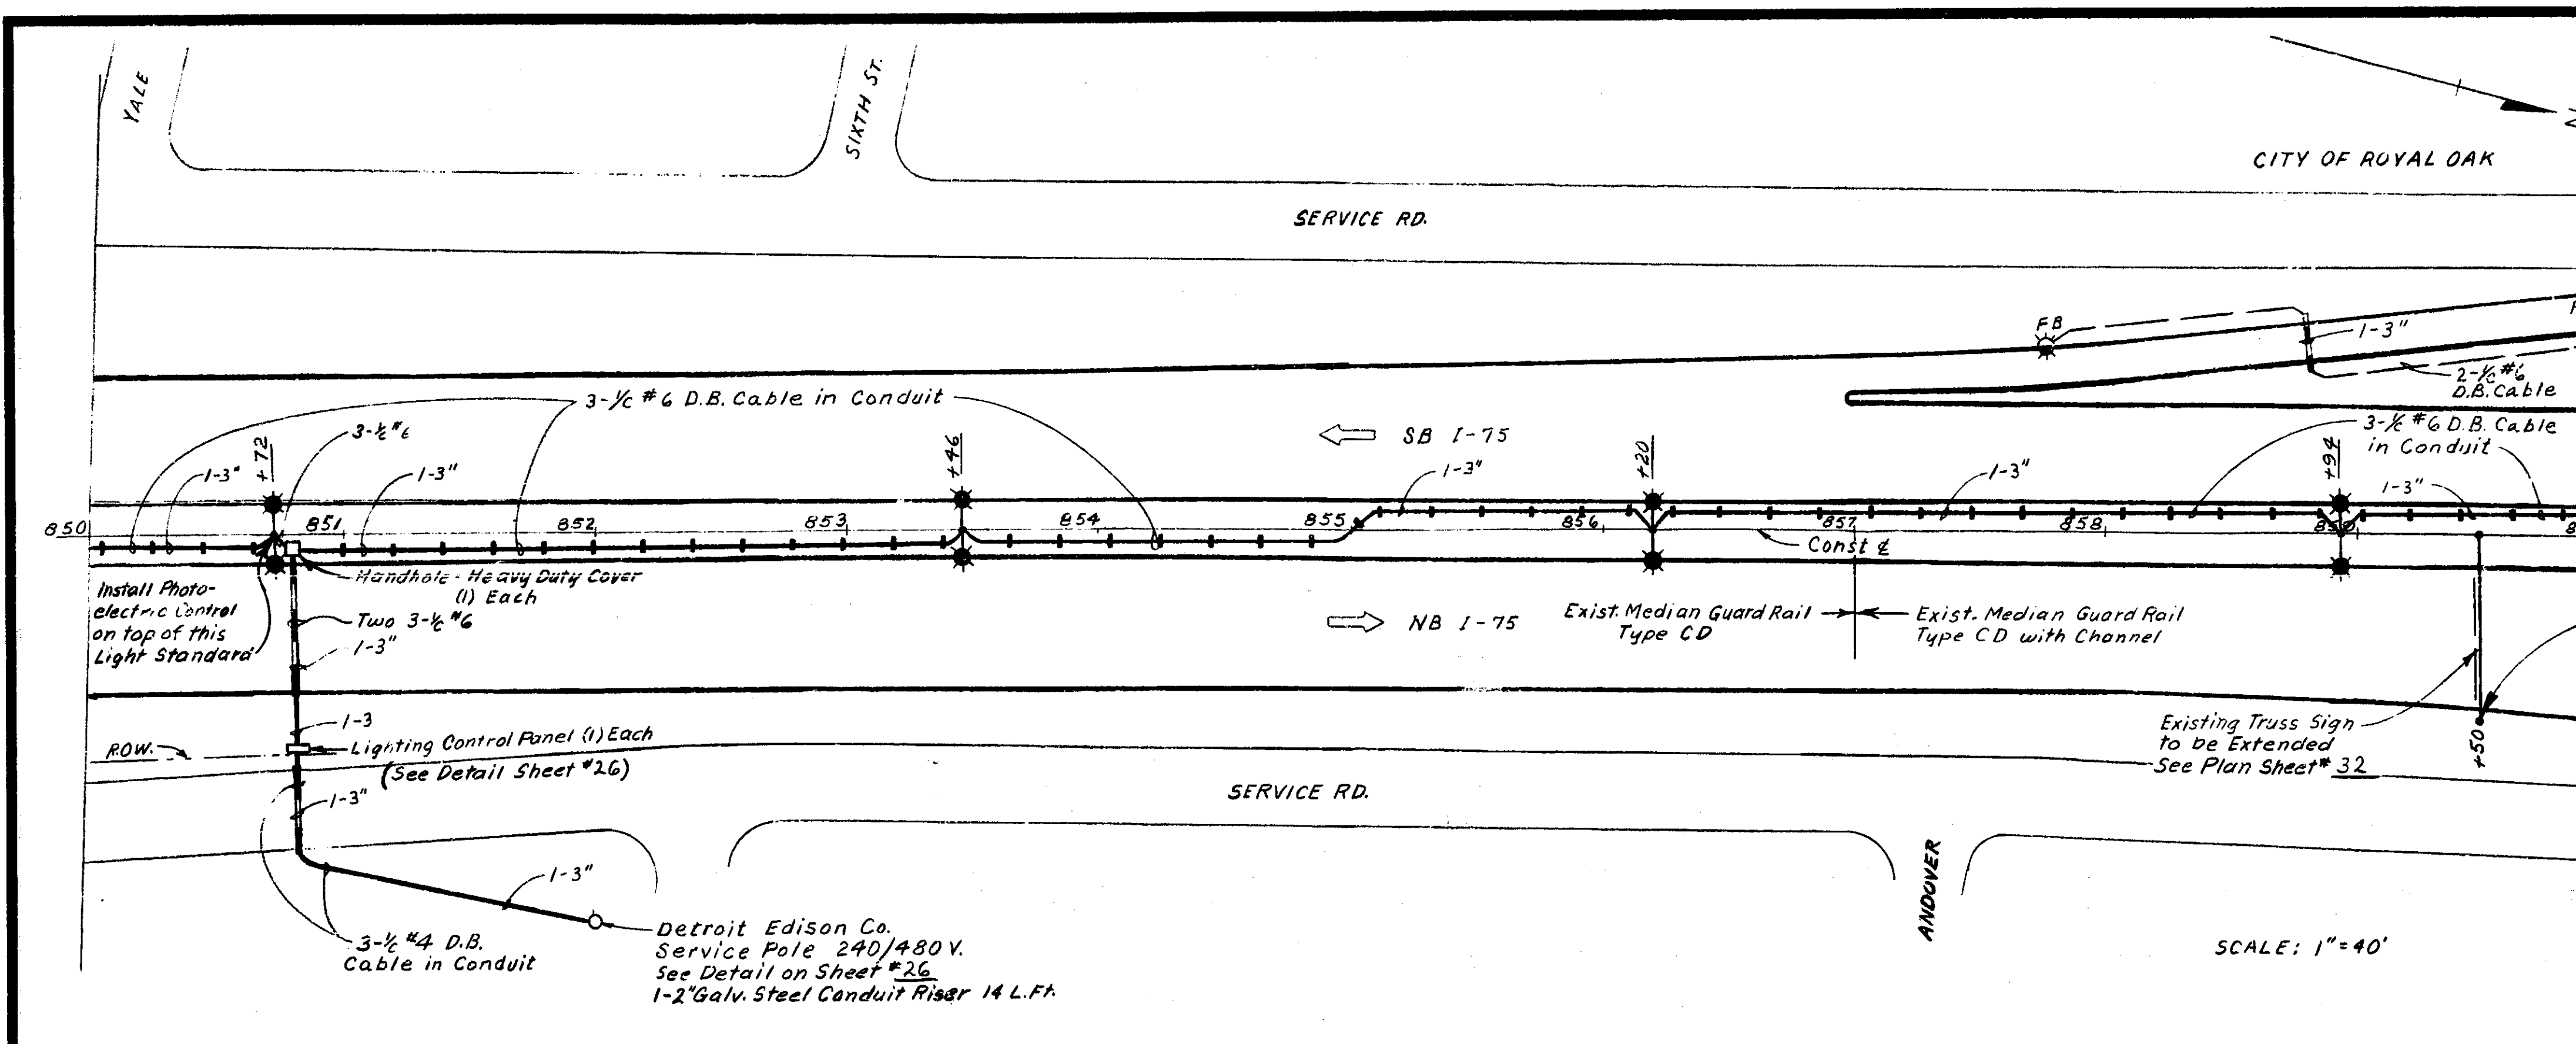

YB QUANTITIES CITY OF ROYAL OAK
 1- Each, Truss (Extended) Type "B"
 1- Each, Truss Foundation Type "B"
 1- Each, Remove Truss Foundation
 41 Lin. Ft. Remove Beam Guard Rail


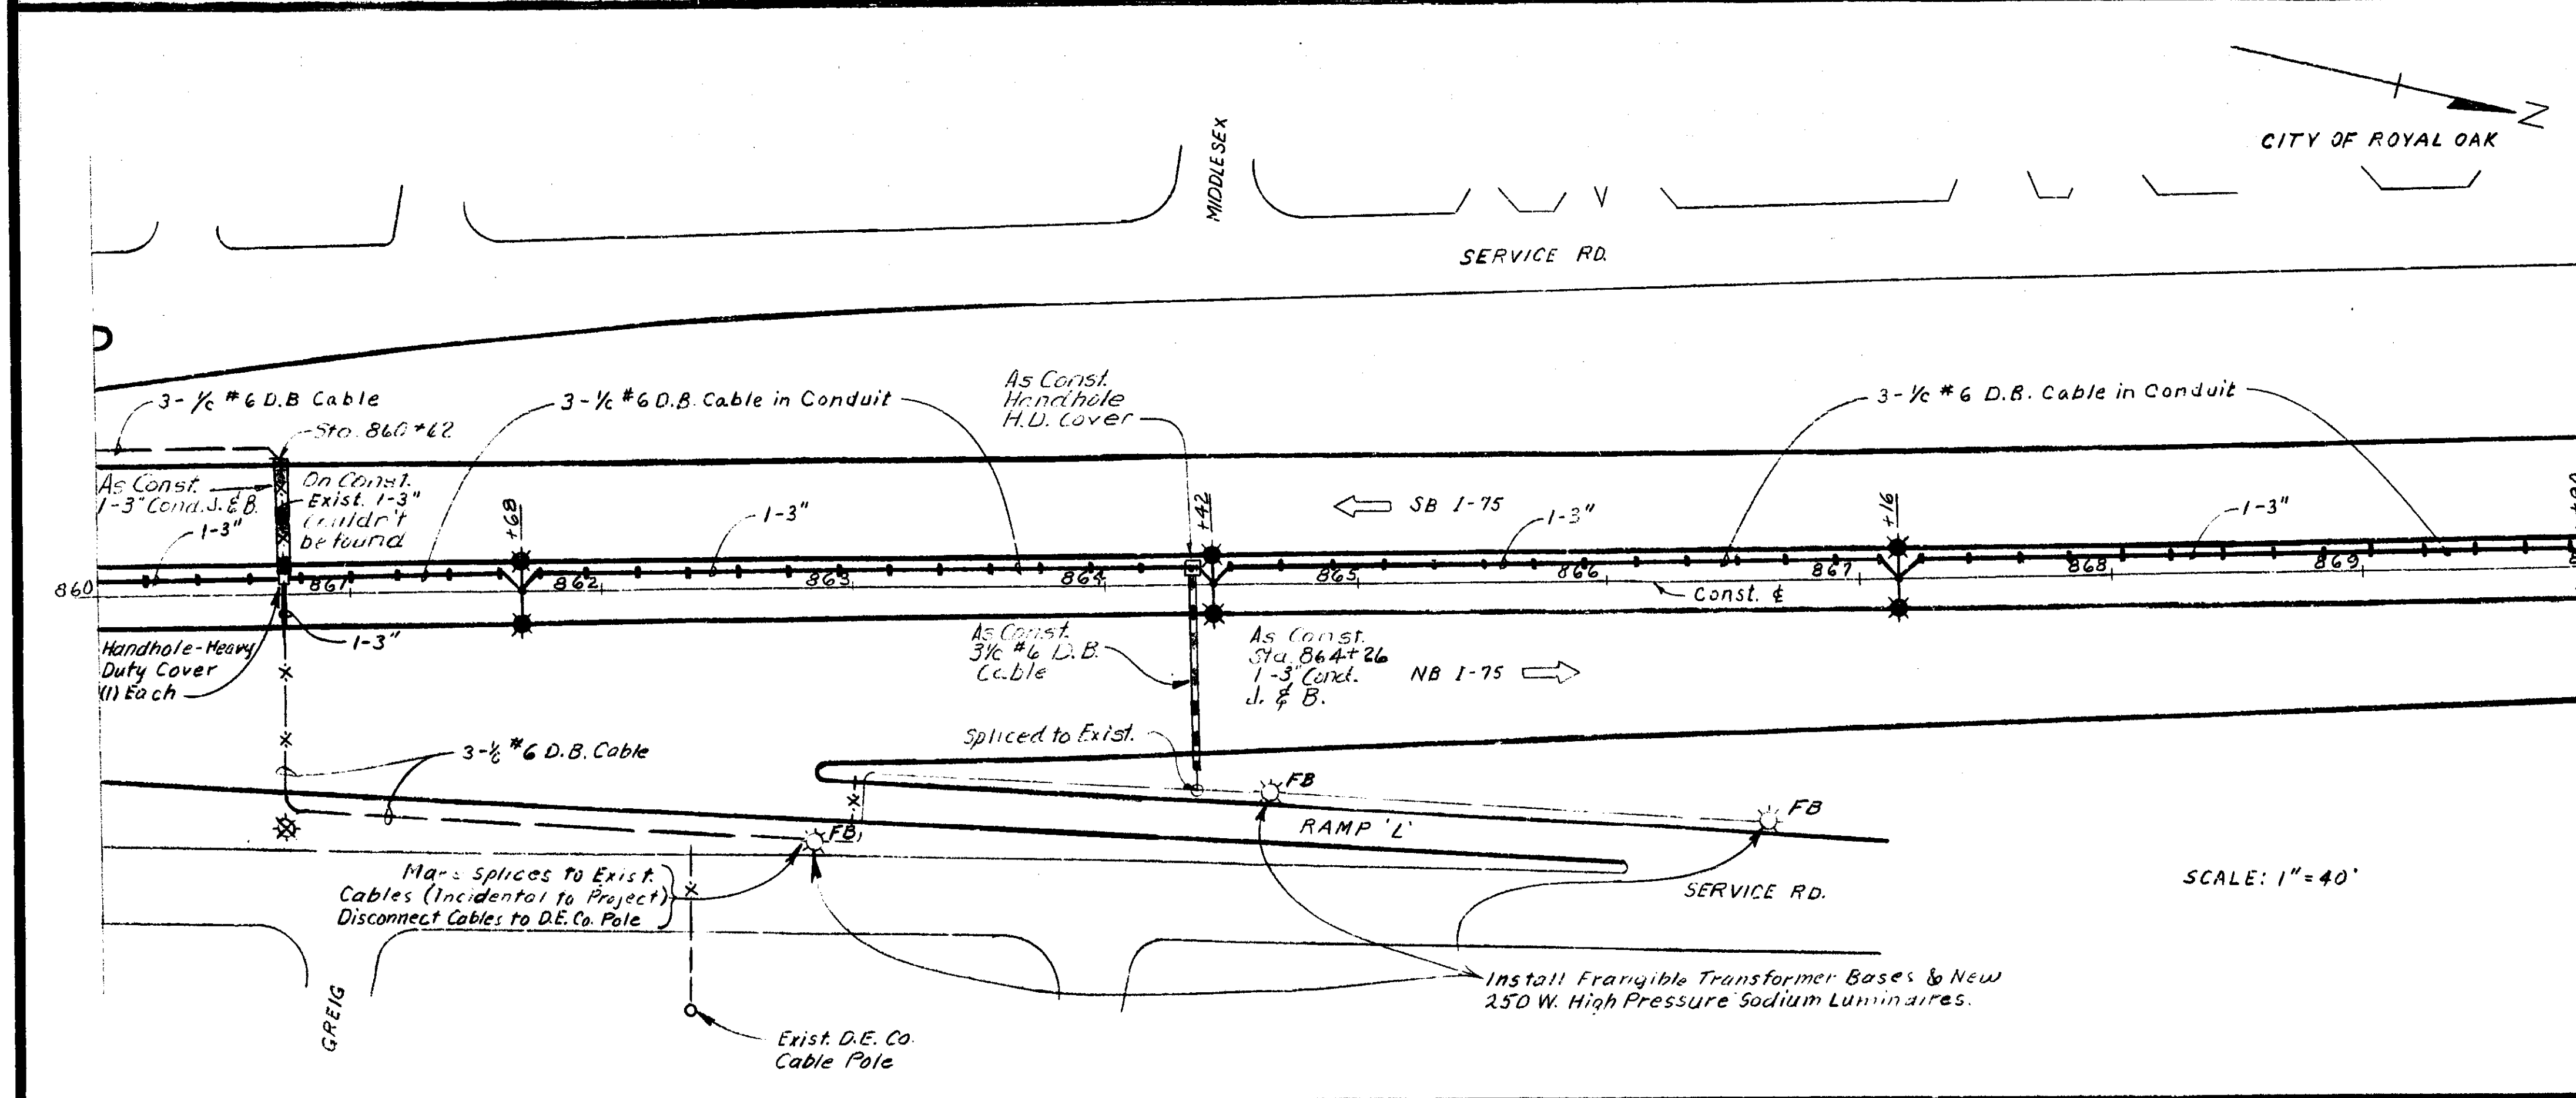


QUANTITIES ON THIS SHEET		
ITEM	UNIT	QUANTITY
Lighting Control Panel	Each	1
600V, 3-1/2 No. 4 Direct Burial Cable in Conduit	L. Ft.	160
1-2" Galv. Steel Conduit Riser	L. Ft.	14
1-3" Galv. Steel Conduit	L. Ft.	175
1-3" Galv. Steel Conduit, Jacking-Boring	L. Ft.	125
1-3" Direct Burial Conduit (Special)	L. Ft.	2000
Handhole - Heavy Duty Cover	Each	2
600V, 3-1/2 No. 6 D.B. Cable in Conduit	L. Ft.	2170
600V, Two 3-1/2 No. 6 D.B. Cable in Conduit	L. Ft.	80
600V, 2-1/2 No. 6 D.B. Cable in Earth	L. Ft.	220
600V, 2-1/2 No. 6 D.B. Cable in Conduit	L. Ft.	20
600V, 3-1/2 No. 6 D.B. Cable in Earth	L. Ft.	315
Lt. Std., 25 Ft. M.H., 12 Ft. Dbl. Arm, New Fdn.	Each	8
Lt. Std., 30 Ft. M.H., 12 Ft. Arm, Frng. Trnsf. Base & Fdn.	Each	2
250 W. High Pressure Sodium Luminaire	Each	5
400 W. High Pressure Sodium Luminaire	Each	16
Double Beam Guard Rail, Special-Type I	L. Ft.	1875
Install Frng. Trnsf. Base in Existing Ltq. Unit	Each	3
Dbl. Beam Guard Rail, Special-Type II	L. Ft.	312.5
Remove Lt. Std. Foundation	Each	1

MICHIGAN DEPARTMENT OF STATE HIGHWAYS
FREWAY LIGHTING
 I-75 FROM I-696 FREEWAY TO 12 MILE RD.
 CITY OF ROYAL OAK

REVISIONS			
NO.	DESCRIPTION	DATE	BY

ROAD DIST. F. J. J. 1973
 DRAWN BY K.G. 10-21-74
 CHECKED BY C. P. 10-21-74
 SHEET 19 OF 24
 JOB NO. 63174 08517A

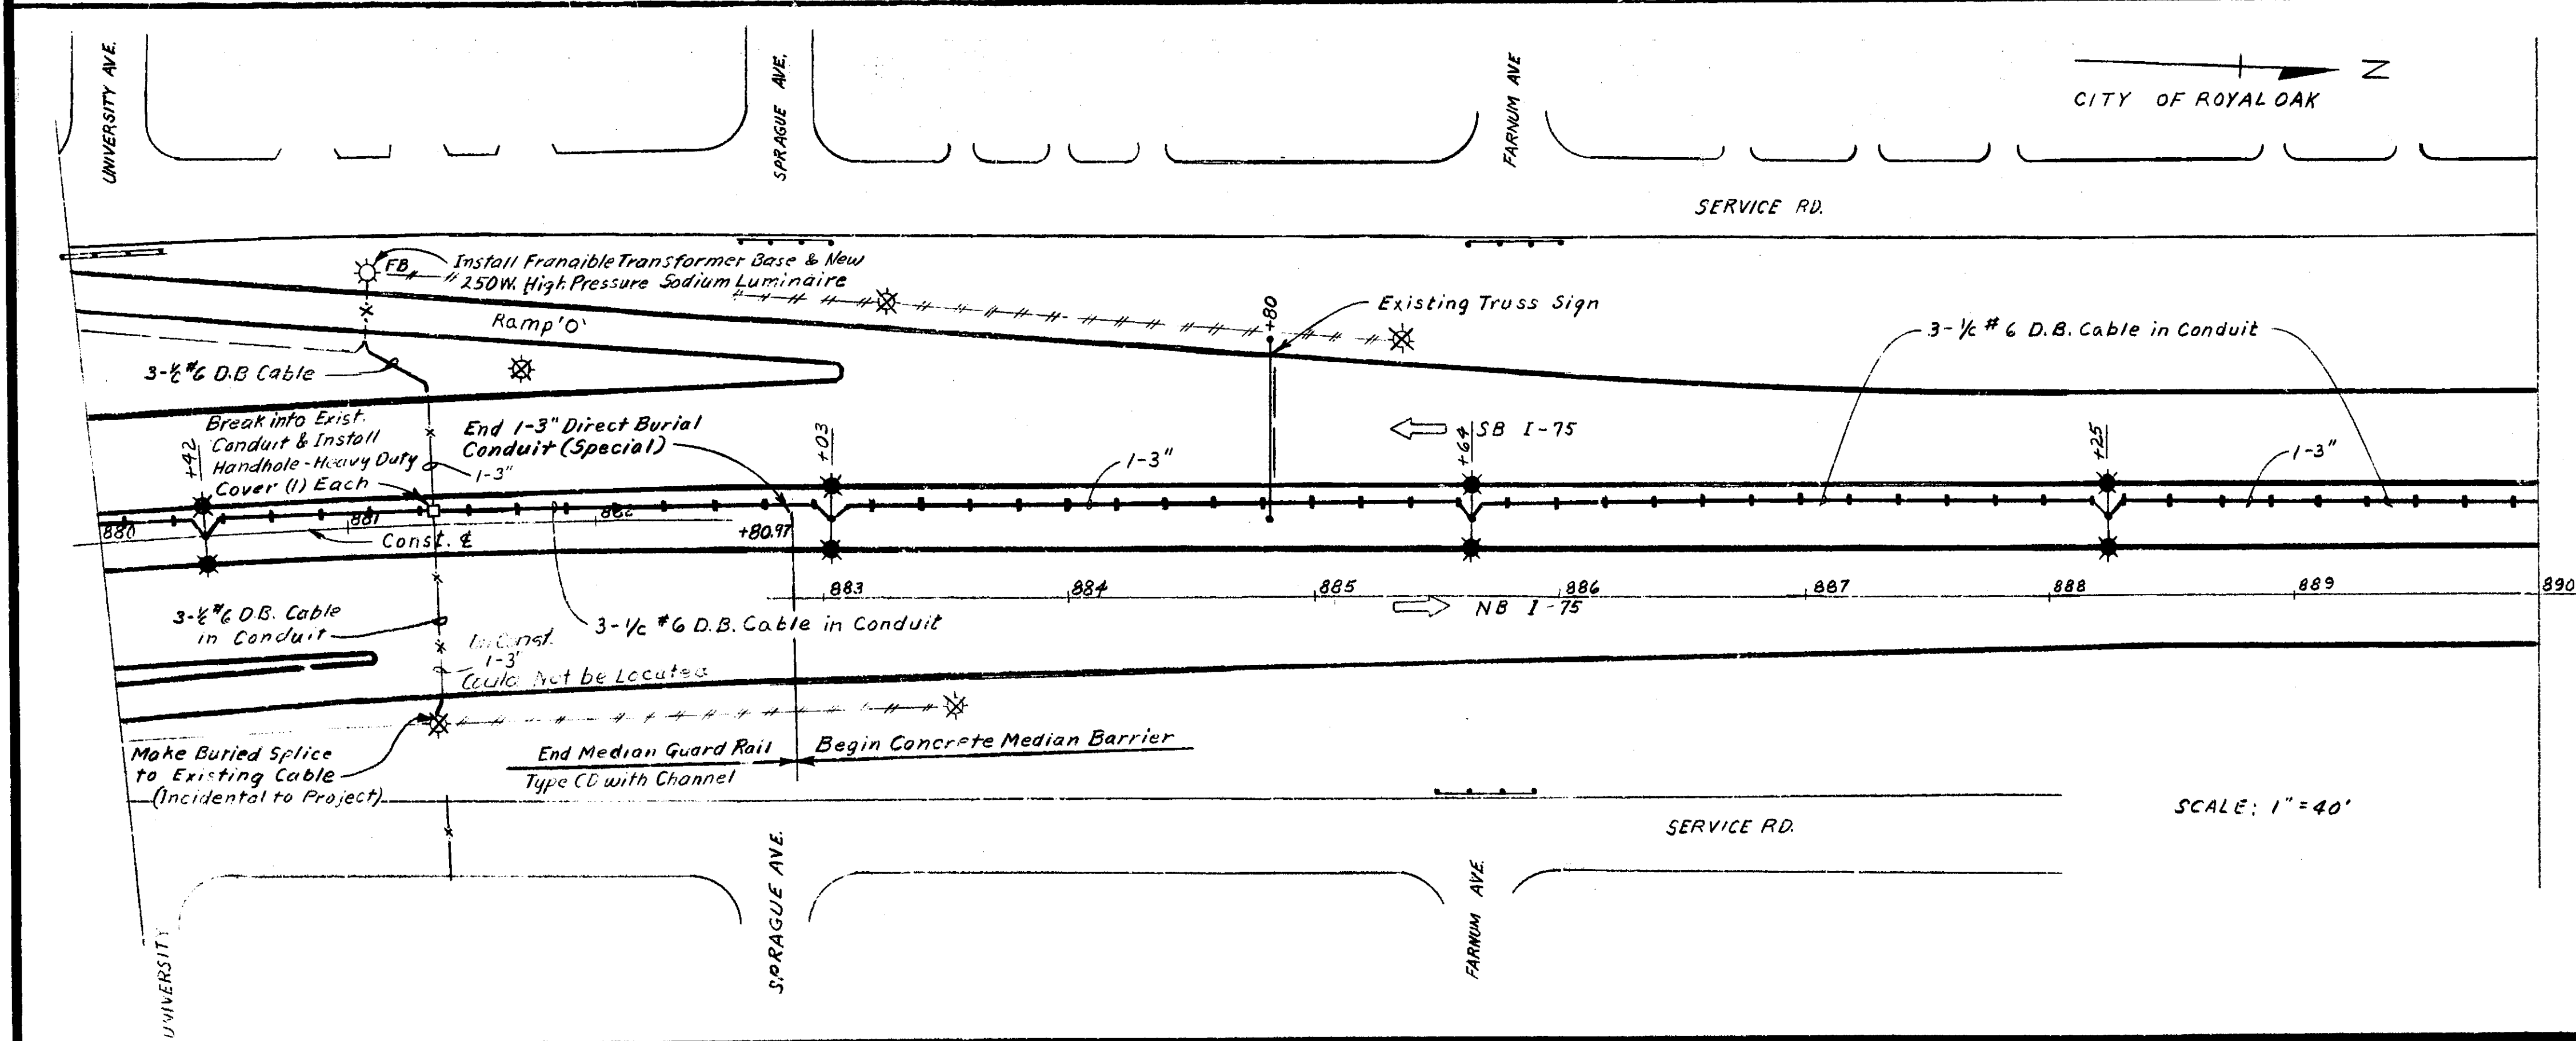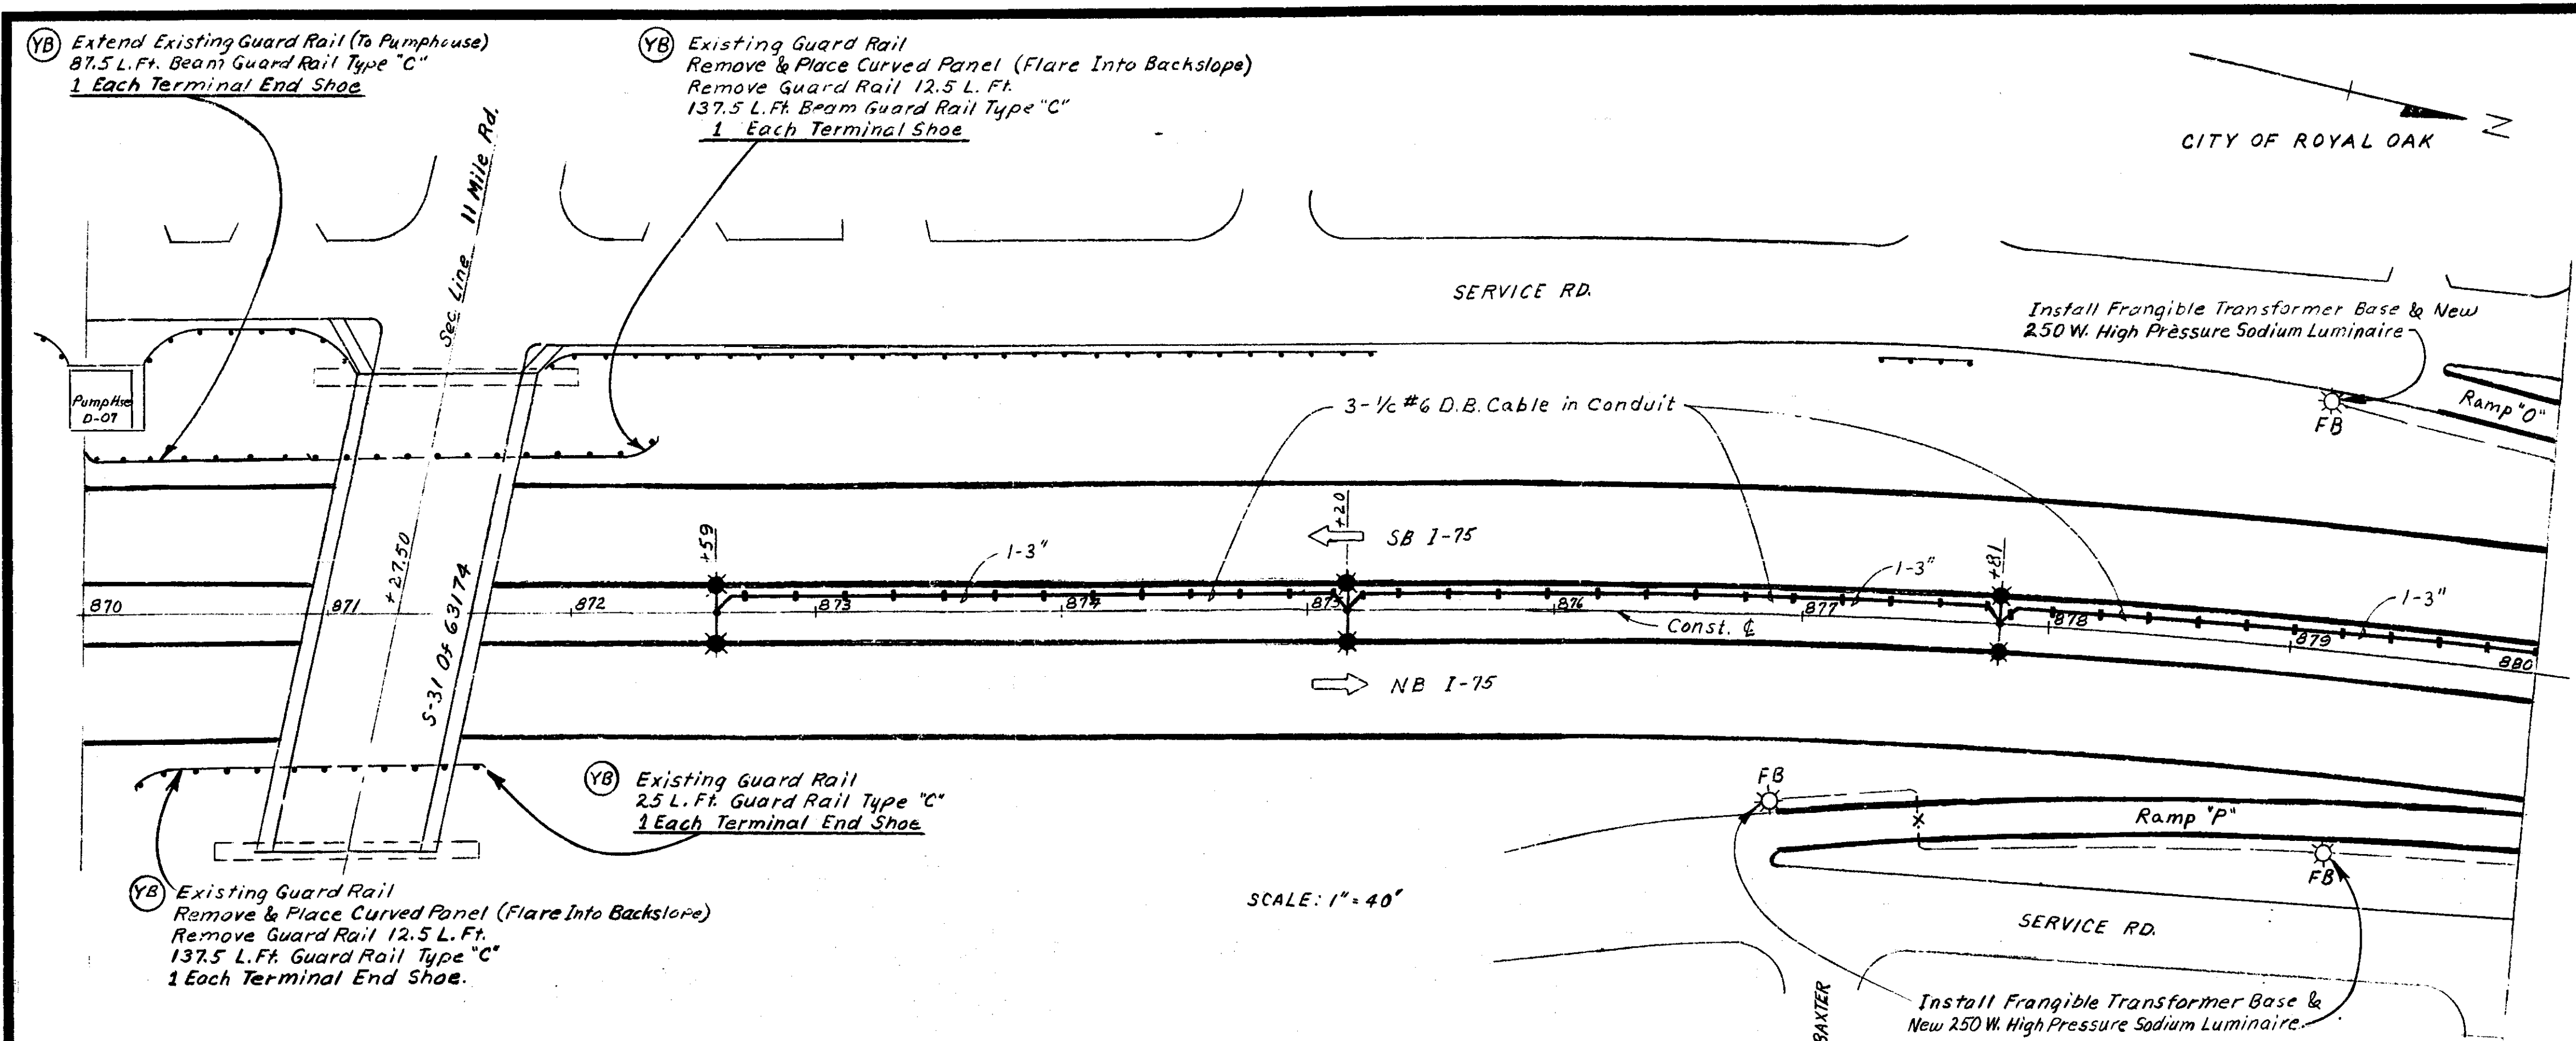




QUANTITIES CITY OF ROYAL OAK
 387.5 Lin. Ft. Beam Guard Rail Type "C"
 25 Lin. Ft. Remove Beam Guard Rail
 4 Each Terminal End Shoe.

QUANTITIES ON THIS SHEET		
ITEM	UNIT	QUANTITY
Remove Lt. Std. Foundation	Each	5
Handhole-Heavy Duty Cover	Each	1
600V, 3-1/2" No. 6 D.B. Cable in Earth	L. Ft.	35
1-3" Direct Burial Conduit (Special)	L. Ft.	1022
600V, 3-1/2" No. 6 D.B. Cable in Conduit	L. Ft.	1896
Lt. Std., 45 Ft. M.H., 12 Ft. Dbl. Arm, New Fdn.	Each	4
Lt. Std., 45 Ft. M.H., 12 Ft. Dbl. Arm - Med. Wall	Each	3
400 W. High Pressure Sodium Luminaire	Each	14
Double Beam Guard Rail Special Type II	L. Ft.	250
250 W. High Pressure Sodium Luminaire	Each	4
Install Frng. Trnsf. Base in Existing Ltg. Unit.	Each	4
1-3" Direct Burial Conduit	L. Ft.	719

MICHIGAN DEPARTMENT OF STATE HIGHWAYS
FREEWAY LIGHTING
 I-75 FROM I-696 FREEWAY TO 12 MILE RD.
 CITY OF ROYAL OAK

REVISIONS			
NO.	DESCRIPTION	DATE	BY

DRAWN BY: F. J. J. / J. J. / 1973
 CHECKED BY: C. P. / C. P. / 6-5-73
 SHEET 20 OF 4
63174 08517A

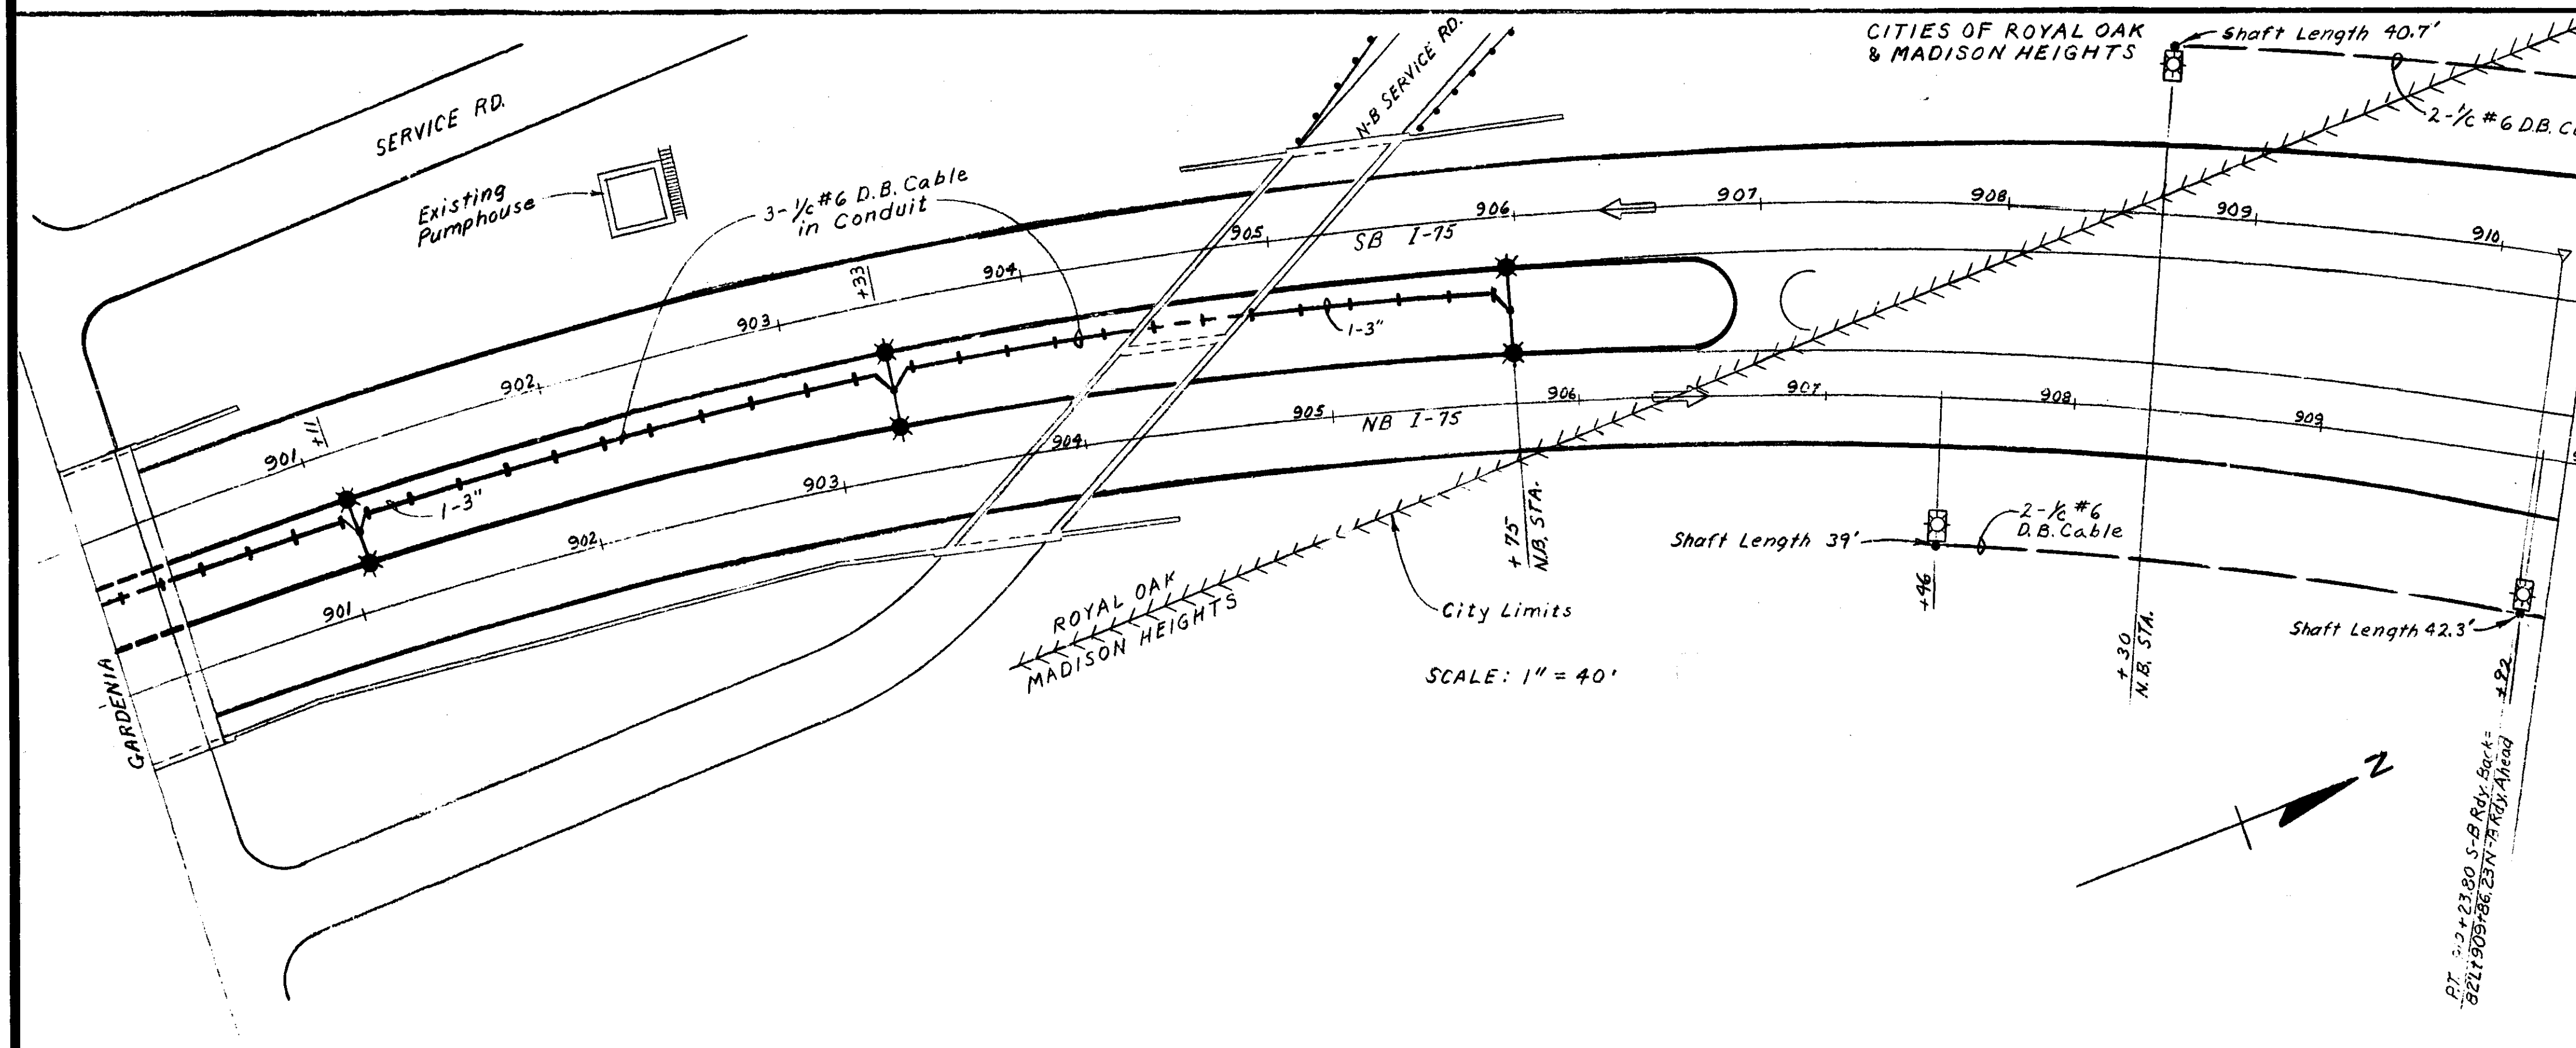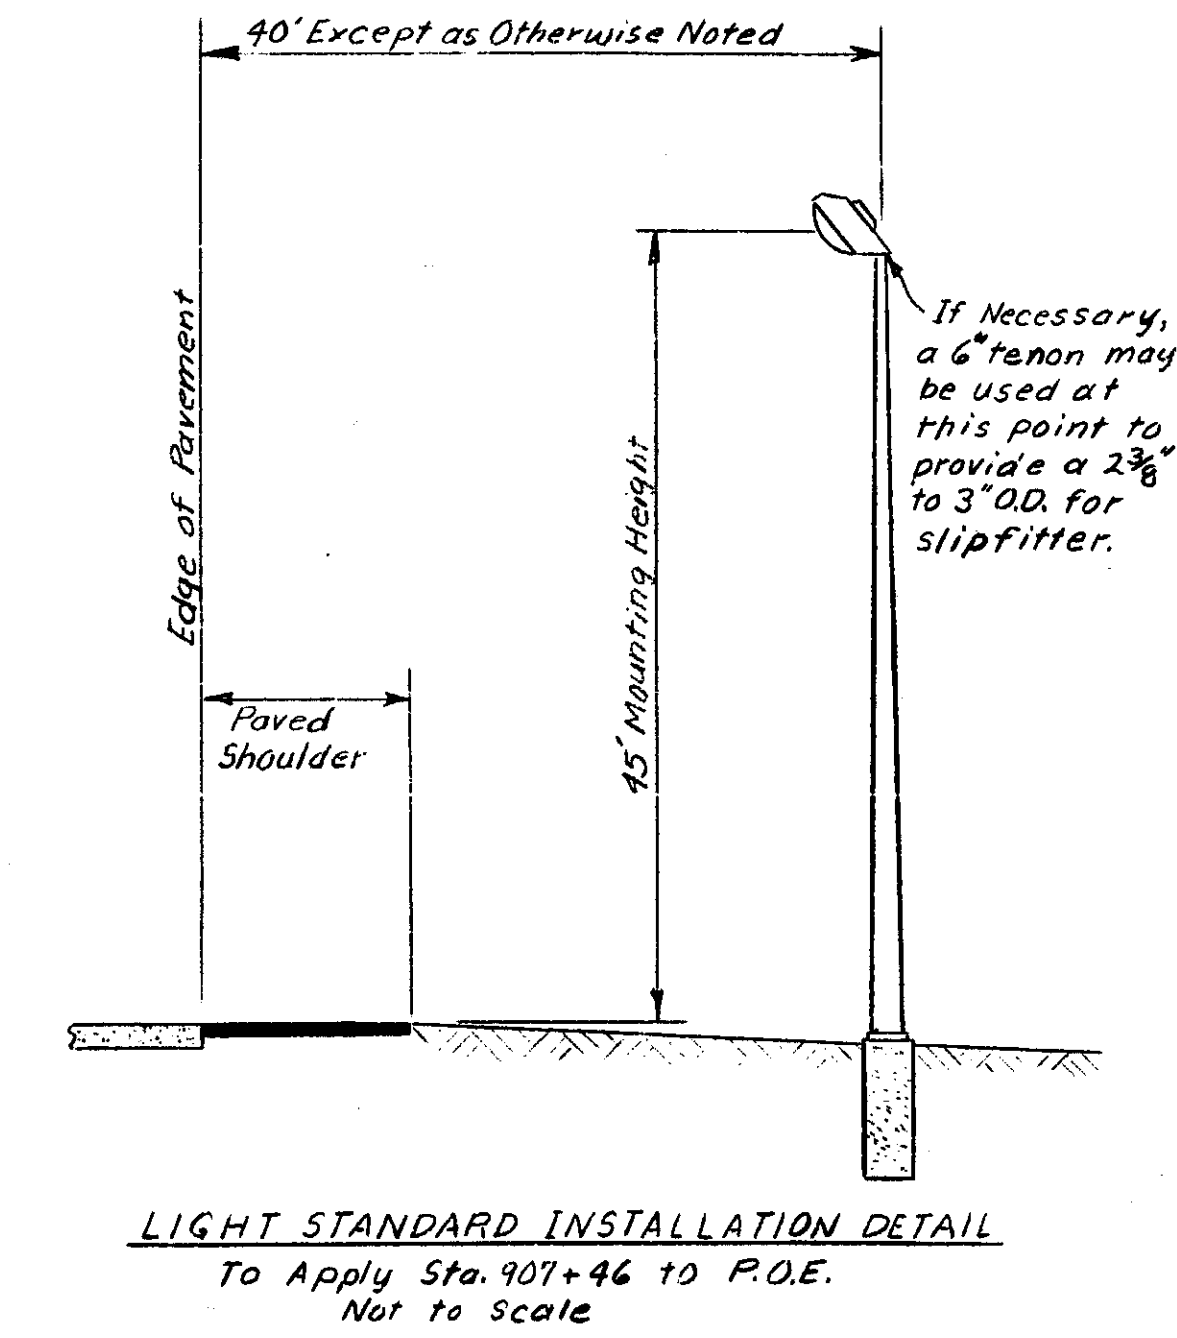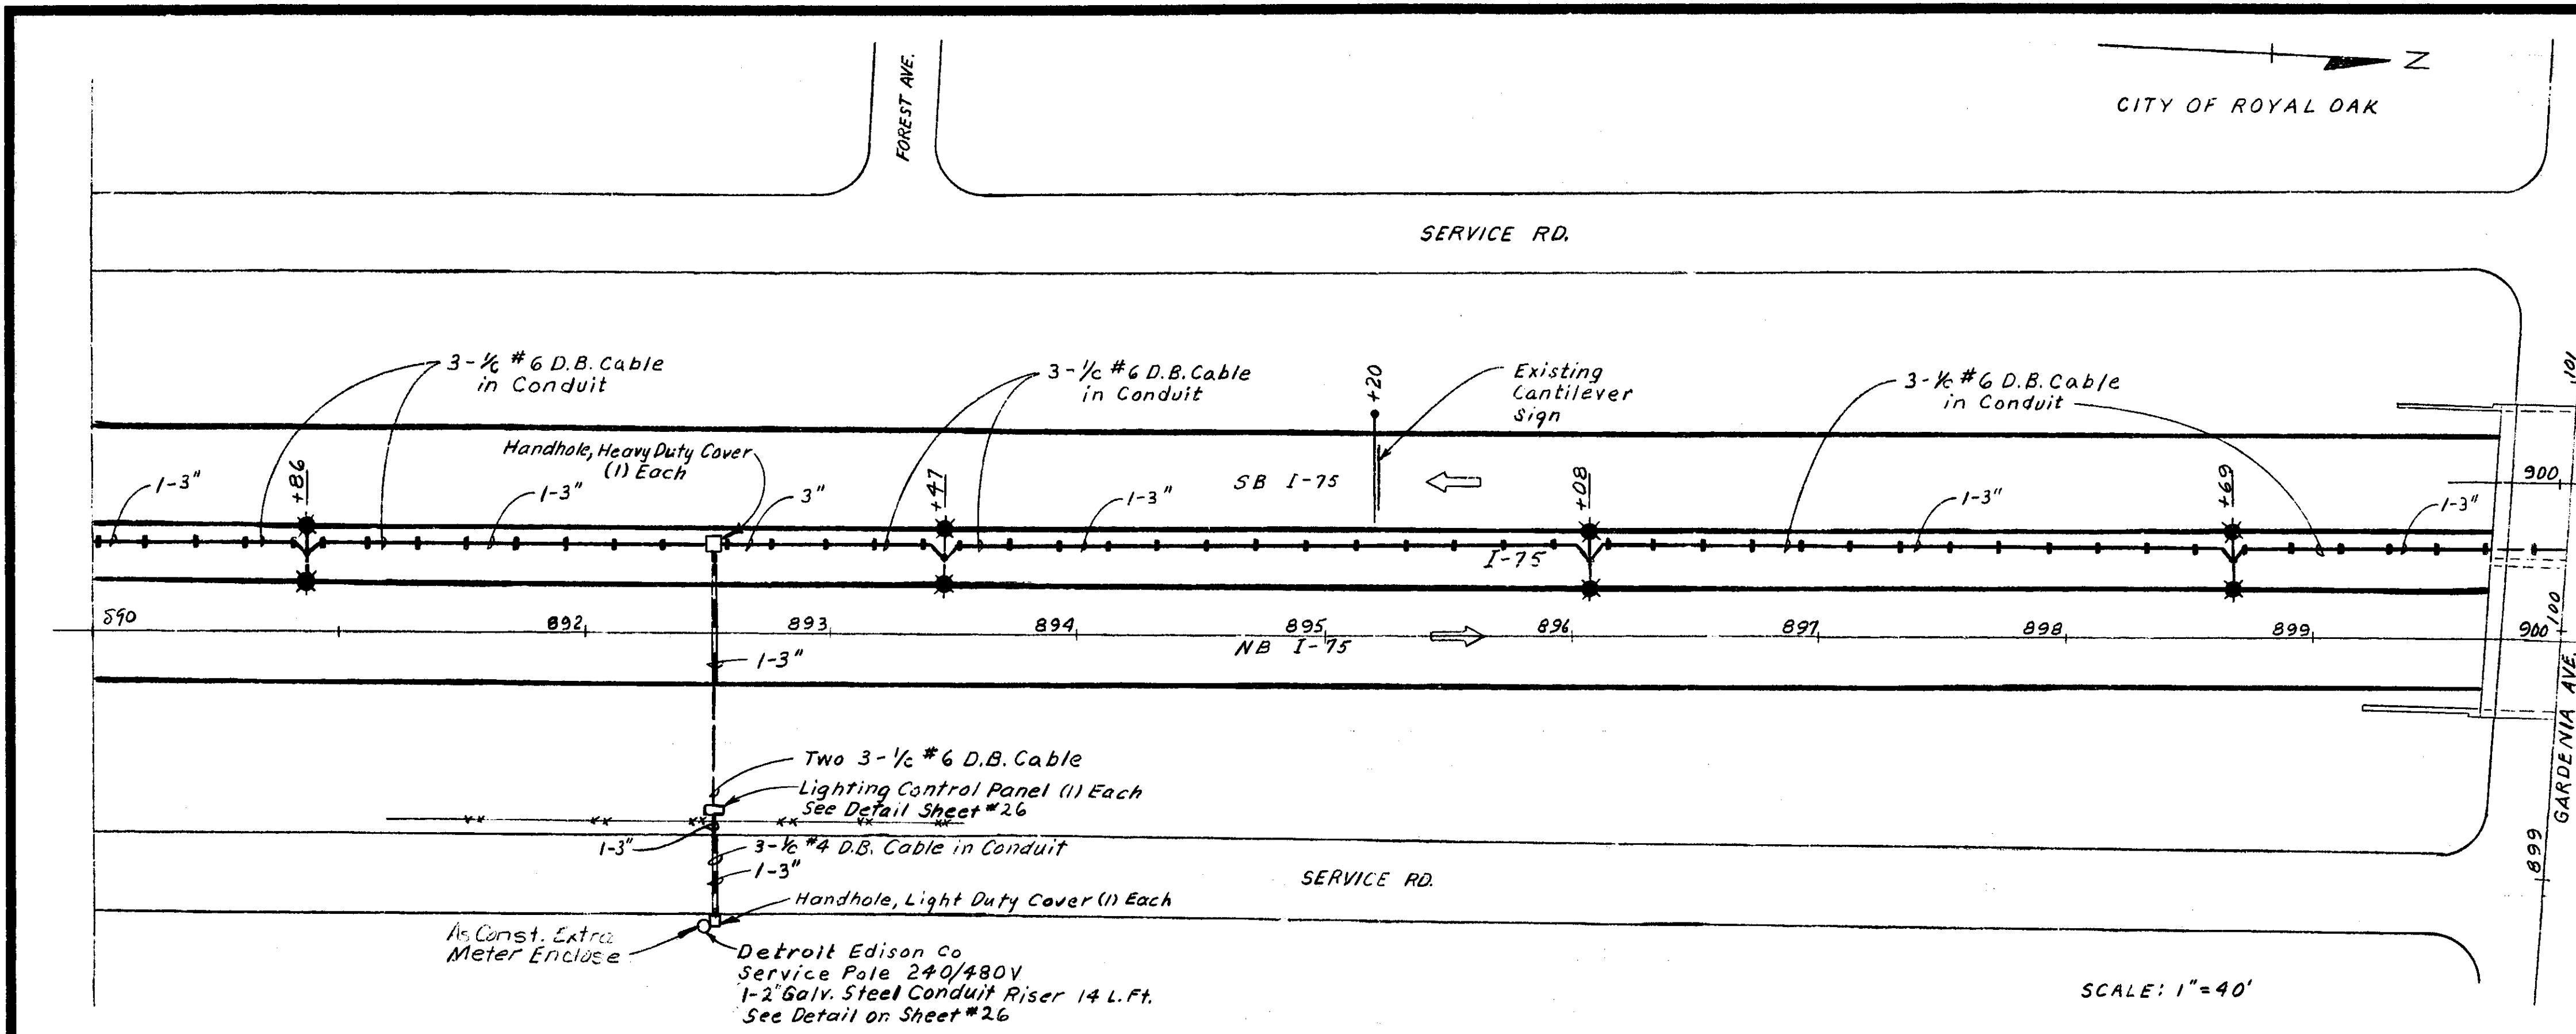

NOTE: The 400W. High Pressure Sodium Luminaire-Special shall be Interstate Type Luminaire. Manufactured by Ames Electric. ITT Catalog No. 185-6646 or Holophane Expressway Luminaire, Catalog No. 1230-480-D. The Unit shall be furnished with Lamp.

QUANTITIES ON THIS SHEET		
ITEM	UNIT	QUANTITY
1-2" Galv. Steel Conduit Riser	L. Ft.	14
1-3" Galv. Steel Conduit, Jacking-Boring	L. Ft.	90
1-3" Direct Burial Conduit	L. Ft.	1575
Handhole - Heavy Duty Cover	Each	1
600V, 3-1/2" No. 6 D.B. Cable in Conduit	L. Ft.	1575
600V, Two 3-1/2" No. 6 D.B. Cable in Conduit	L. Ft.	90
600V, 2-1/2" No. 6 D.B. Cable in Earth	L. Ft.	430
600V, 3-1/2" No. 4 D.B. Cable in Conduit	L. Ft.	50
600V, Two 3-1/2" No. 6 D.B. Cable in Earth	L. Ft.	60
Lt. Std., 45 Ft. M.H. & Foundation	Each	3
Lt. Std., 45 Ft. M.H., 12 Ft. Dbl. Arm - Med. Wall	Each	7
400W. High Pressure Sodium Luminaire	Each	14
400W. High Pressure Sodium Luminaire - Special	Each	3
Lighting Control Panel	Each	1
Handhole, Light Duty Cover	Each	1

MICHIGAN DEPARTMENT OF STATE HIGHWAYS
FREEWAY LIGHTING
 I-75 FROM I-596 FREEWAY TO 12 MILE RD.
 CITIES OF ROYAL OAK & MADISON HEIGHTS


REVISIONS

NO.	DESCRIPTION	DATE	BY

DESIGNED BY: T.J. J. 1/97
 DRAWN BY: K.G. 10-2-97
 CHECKED BY: C. P. 10-2-97
 SHEET 21 OF 21

JOB NO. 63174 08517A

CITY OF MADISON HEIGHTS

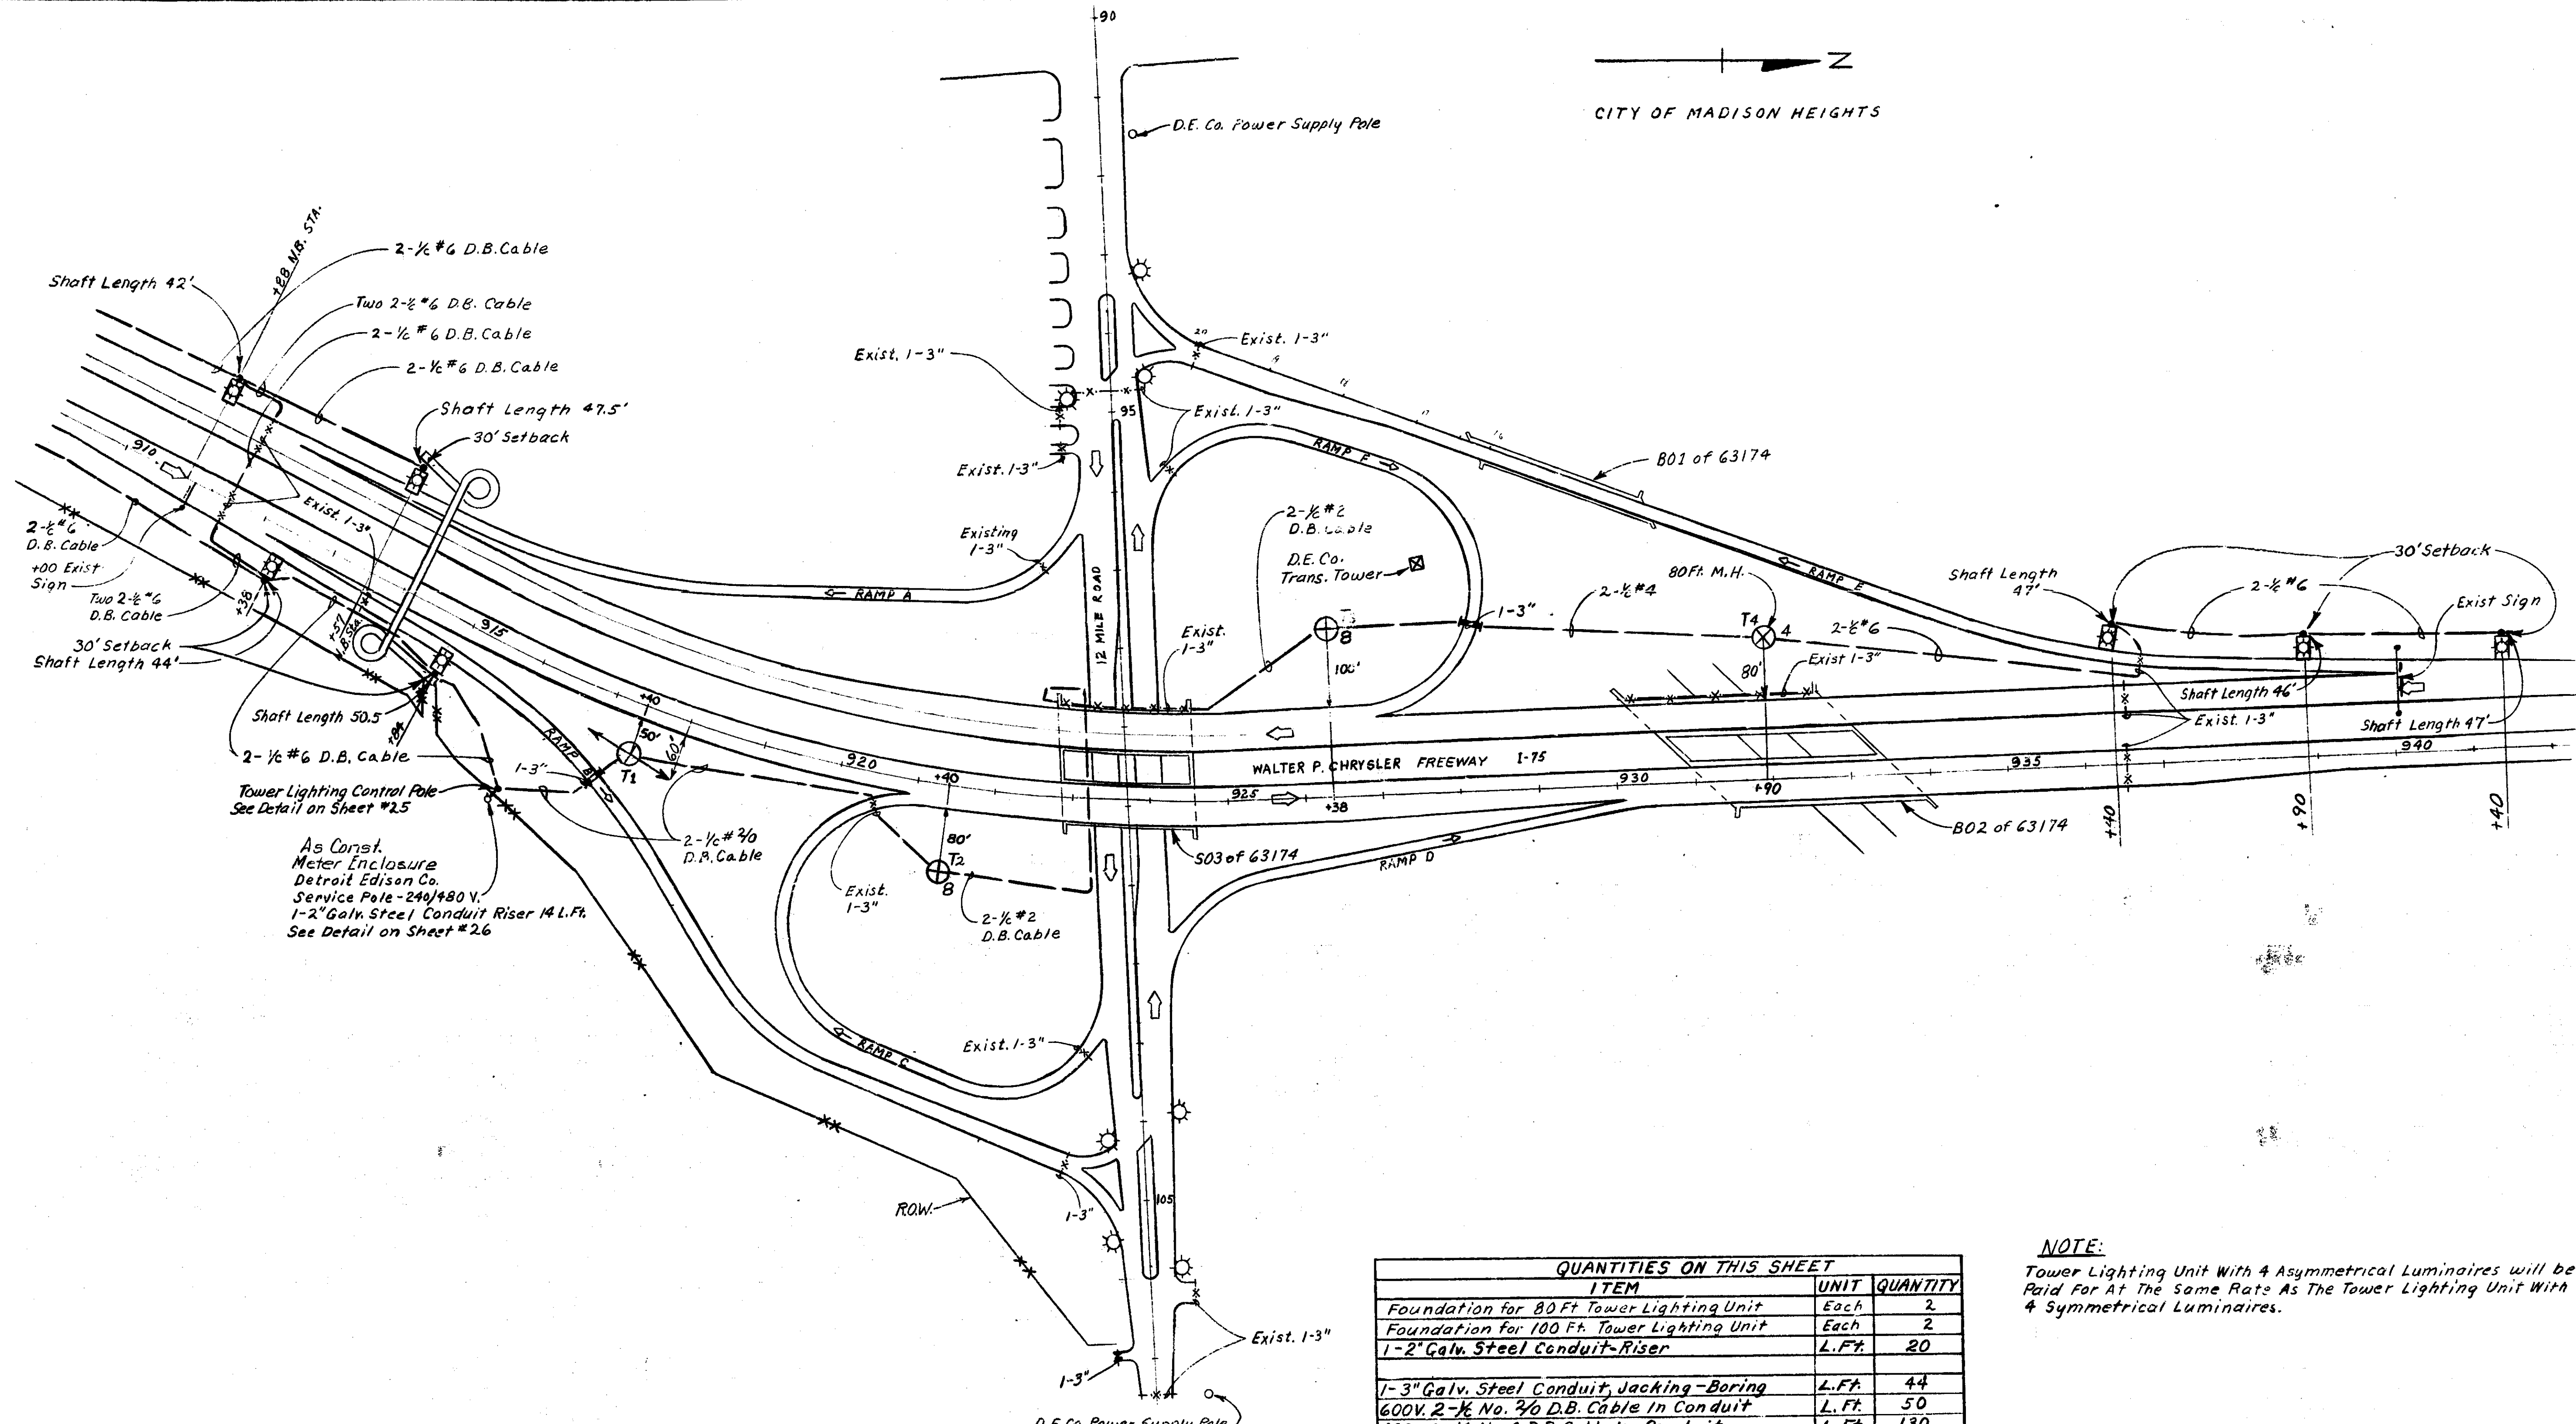

As Const.
Meter Enclosure
Detroit Edison Co.
Service Pole - 240/480V.
1-2" Galv. Steel Conduit Riser 14 L.Ft.
See Detail on Sheet #26


QUANTITIES ON THIS SHEET		
ITEM	UNIT	QUANTITY
Foundation for 80 Ft. Tower Lighting Unit	Each	2
Foundation for 100 Ft. Tower Lighting Unit	Each	2
1-2" Galv. Steel Conduit-Riser	L.Ft.	20
1-3" Galv. Steel Conduit, Jacking-Boring	L.Ft.	44
600V. 2-1/2 No. 2 D.B. Cable In Conduit	L.Ft.	50
600V. 2-1/2 No. 6 D.B. Cable In Conduit	L.Ft.	130
600V. 2-1/2 No. 4 D.B. Cable In Conduit	L.Ft.	24
600V. 2-1/2 No. 2 D.B. Cable In Conduit	L.Ft.	180
600V. Two 2-1/2 No. 6 D.B. Cable In Earth	L.Ft.	160
600V. 2-1/2 No. 6 D.B. Cable in Earth	L.Ft.	2030
600V. 2-1/2 No. 4 D.B. Cable in Earth	L.Ft.	540
600V. 2-1/2 No. 2 D.B. Cable in Earth	L.Ft.	820
600V. 2-1/2 No. 2/3 D.B. Cable in Earth	L.Ft.	600
Lt. Std. 45 Ft. M.H. & Foundation	Each	7
Tower Lighting Unit, 100 Ft., 8 Luminaire	Each	2
Tower Lighting Unit, 80 Ft., 4 Luminaire	Each	2
400w. High Pressure Sodium Luminaire (Special)	Each	7
Tower Lighting Control Pole	Each	1

NOTE:
Tower Lighting Unit With 4 Asymmetrical Luminaires will be Paid For At The Same Rate As The Tower Lighting Unit With 4 Symmetrical Luminaires.


**MICHIGAN DEPARTMENT OF STATE HIGHWAYS
FREEWAY LIGHTING**
I-75 FROM I-696 FREEWAY TO 12 MILE RD.
CITY OF MADISON HEIGHTS

REVISIONS			
NO.	DESCRIPTION	DATE	BY


ROAD DATE: T.J. Ideh 1974
 DRAWN BY: K.S. 10-21-74
 TRACED BY: C. Potter 5-31-74
 CHECKED BY: C.A. 5/21/10-23-74
 SHEET NO. 22 OF
 JOB NO. 63174 08517A

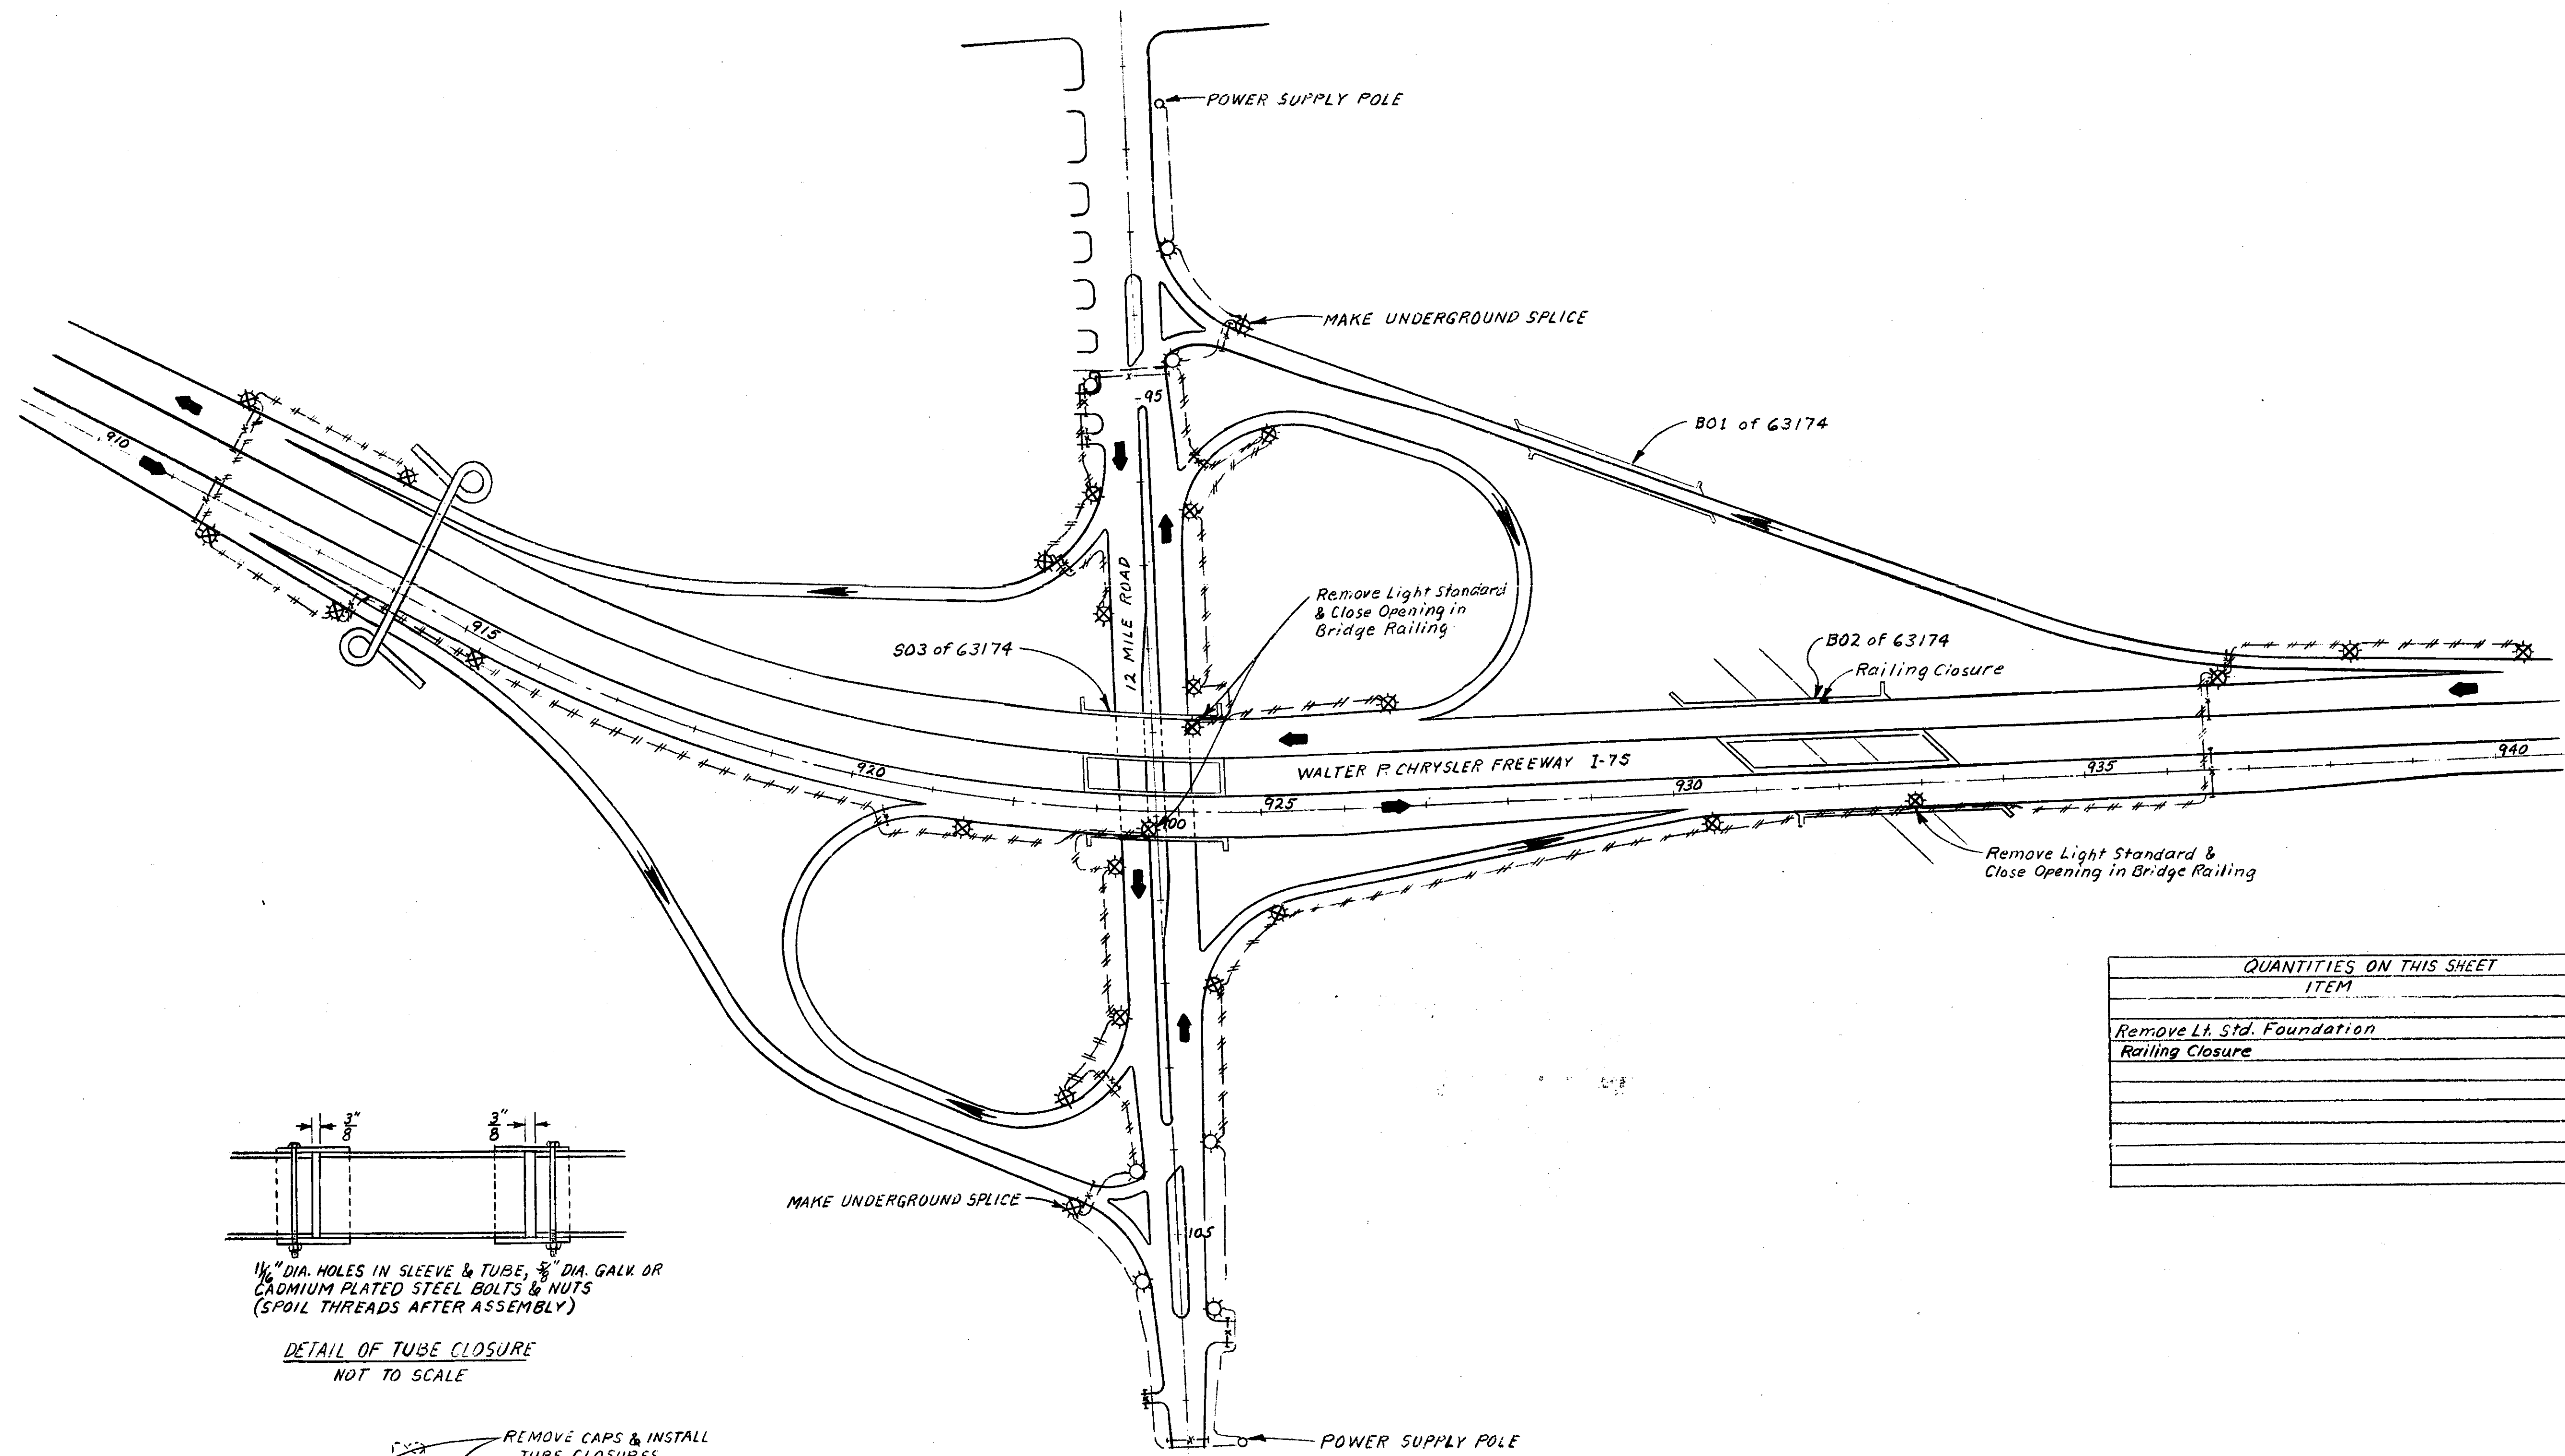

QUANTITIES ON THIS SHEET		
ITEM	UNIT	QUANTITY
Remove Lt. Std. Foundation	Each	24
Railing Closure	Each	4

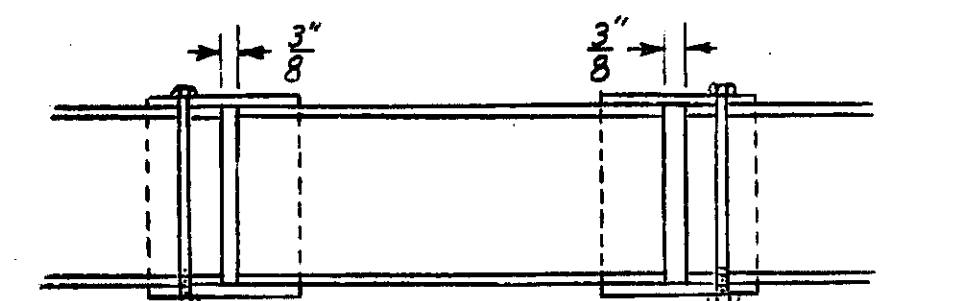

1/8" DIA. HOLES IN SLEEVE & TUBE, 3/8" DIA. GALV. OR CADMIUM PLATED STEEL BOLTS & NUTS (SPOIL THREADS AFTER ASSEMBLY)
DETAIL OF TUBE CLOSURE
 NOT TO SCALE

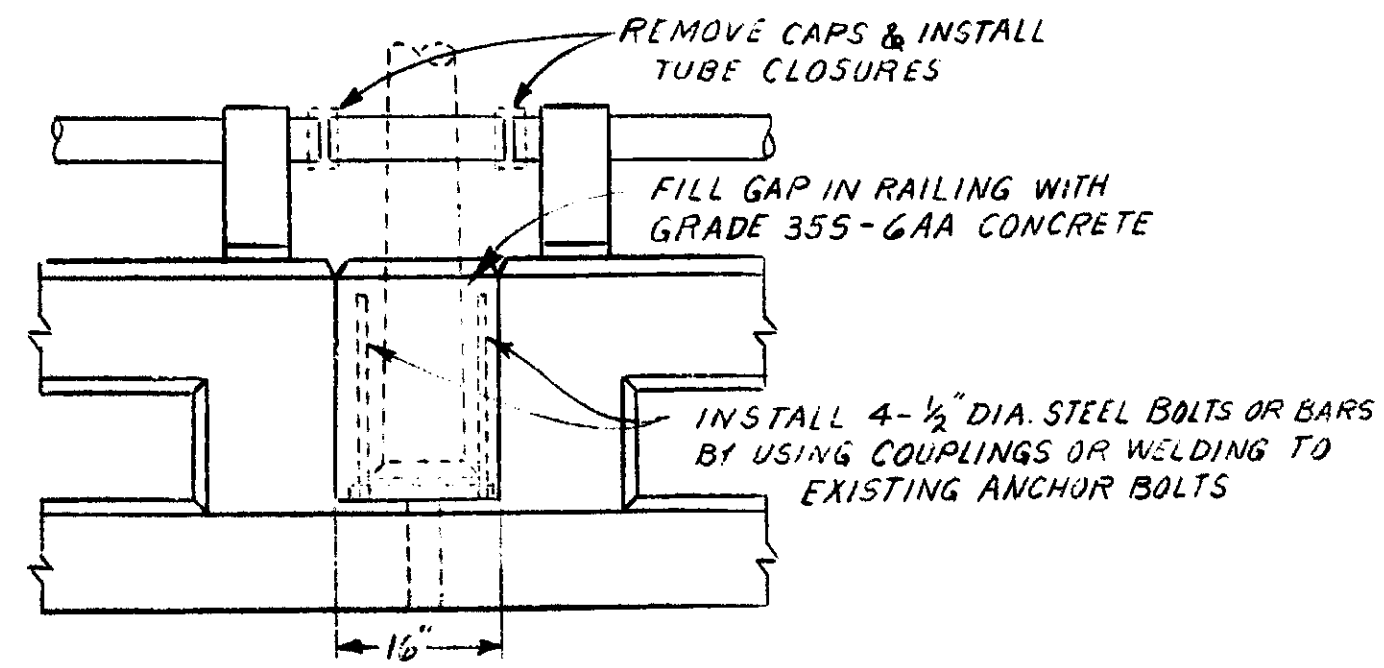

RAILING CLOSURE TYPE I DETAILS
 NOT TO SCALE

SCALE: 1" = 100'


REMOVAL SHEET

MICHIGAN DEPARTMENT OF STATE HIGHWAYS
FREEWAY LIGHTING REMOVAL
 I-75 FROM I-696 FREEWAY TO 12 MILE RD.
 CITY OF MADISON HEIGHTS


REVISIONS			
NO.	DESCRIPTION	DATE	BY

SQUAD BOSS	F. J. Idak	12.7.74
DRAWN BY	K. G.	10-21-74
TRACED BY	D. W.	10-23-74
CHECKED BY	C. B. & T. J.	10-23-74
SHEET	23	OF


63174 08517A

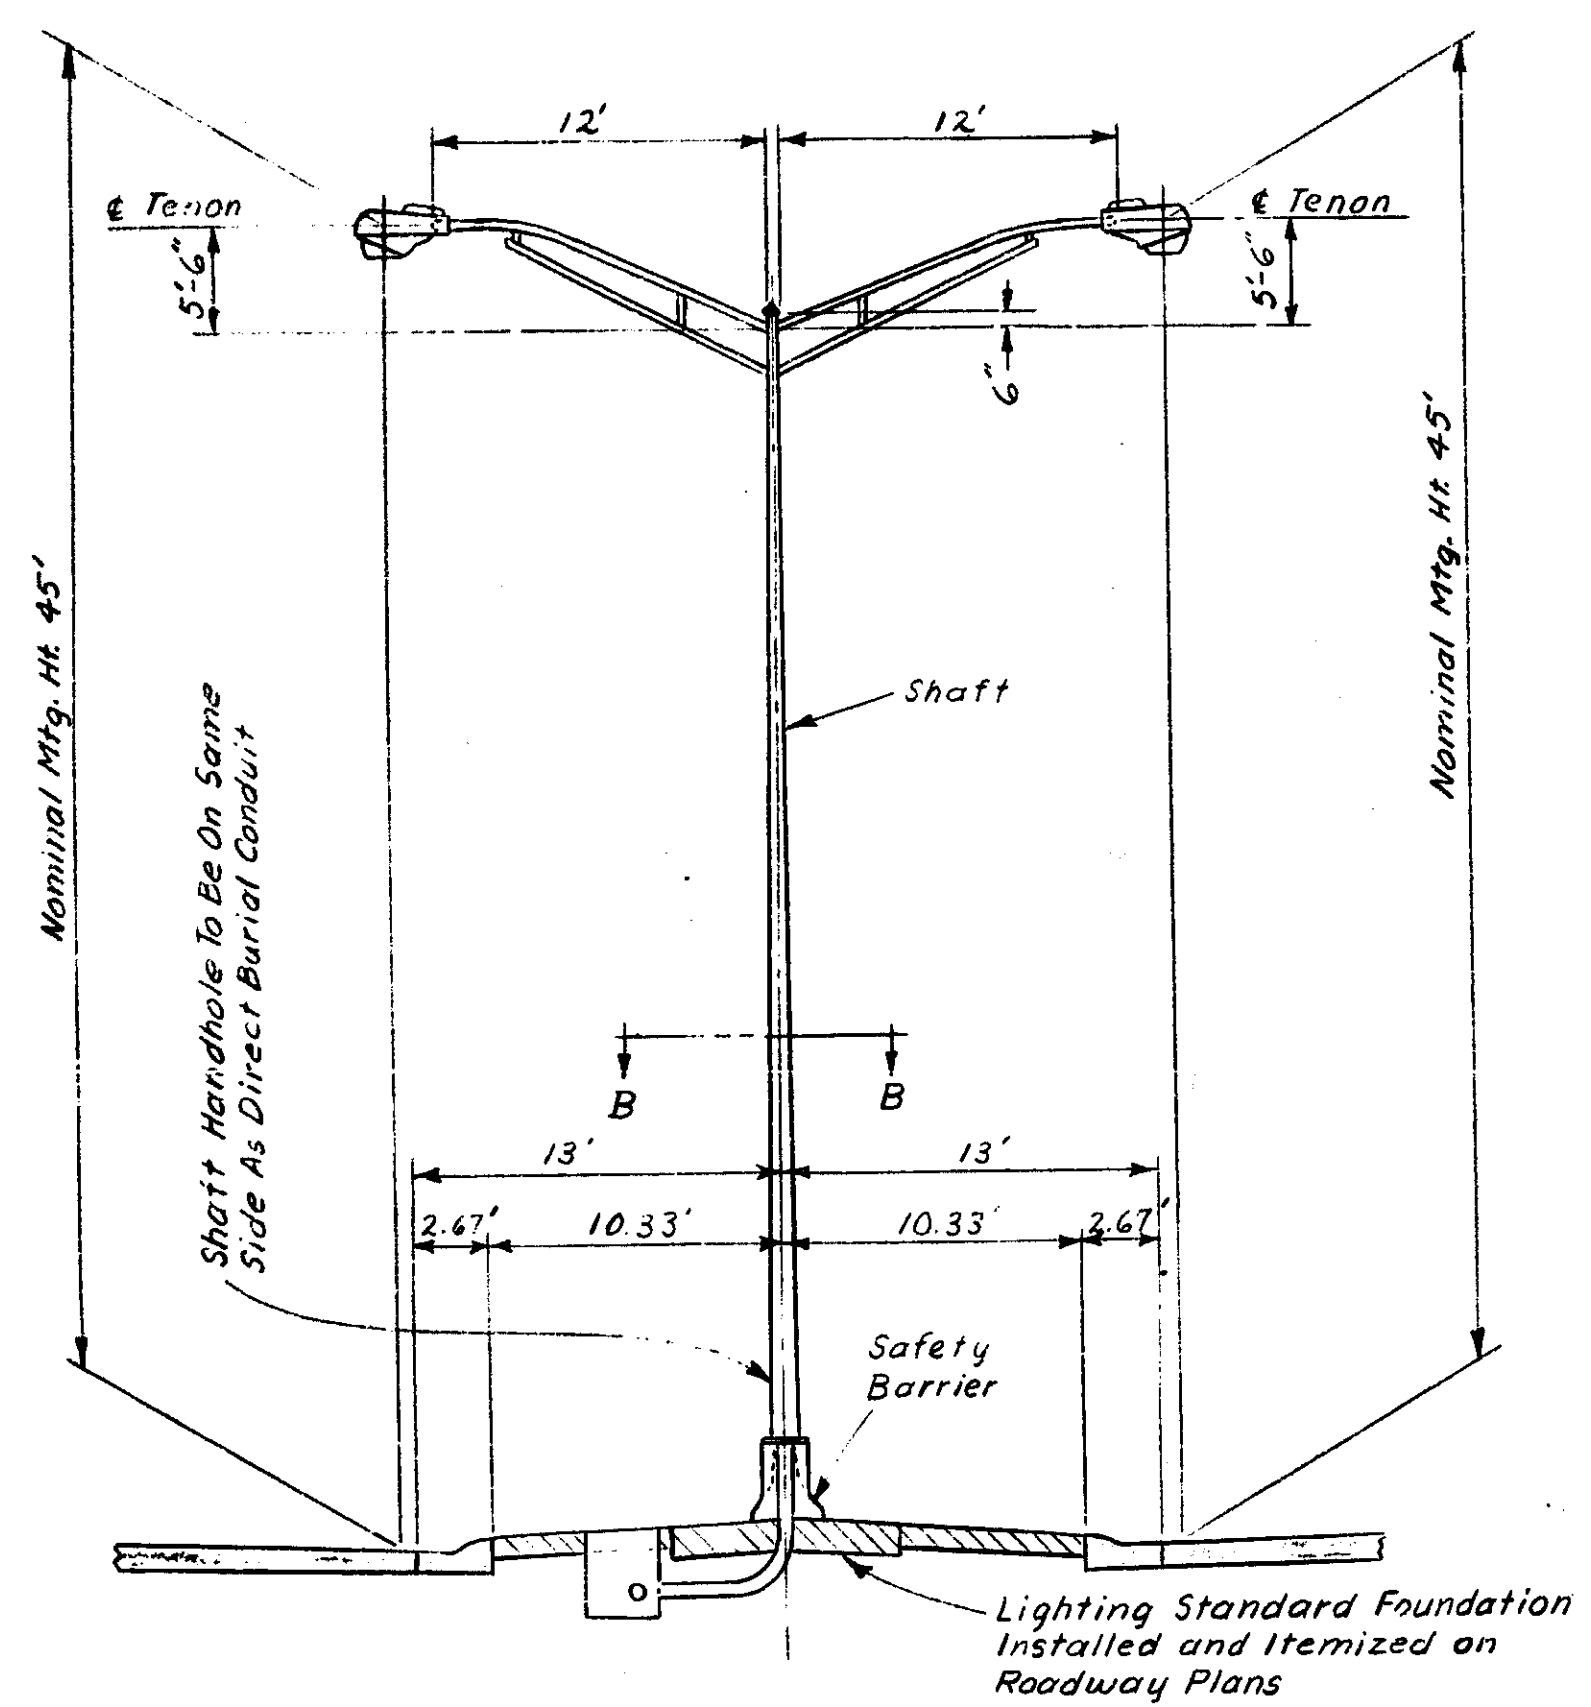


TYPICAL BARRIER SECTION INSTALLATION

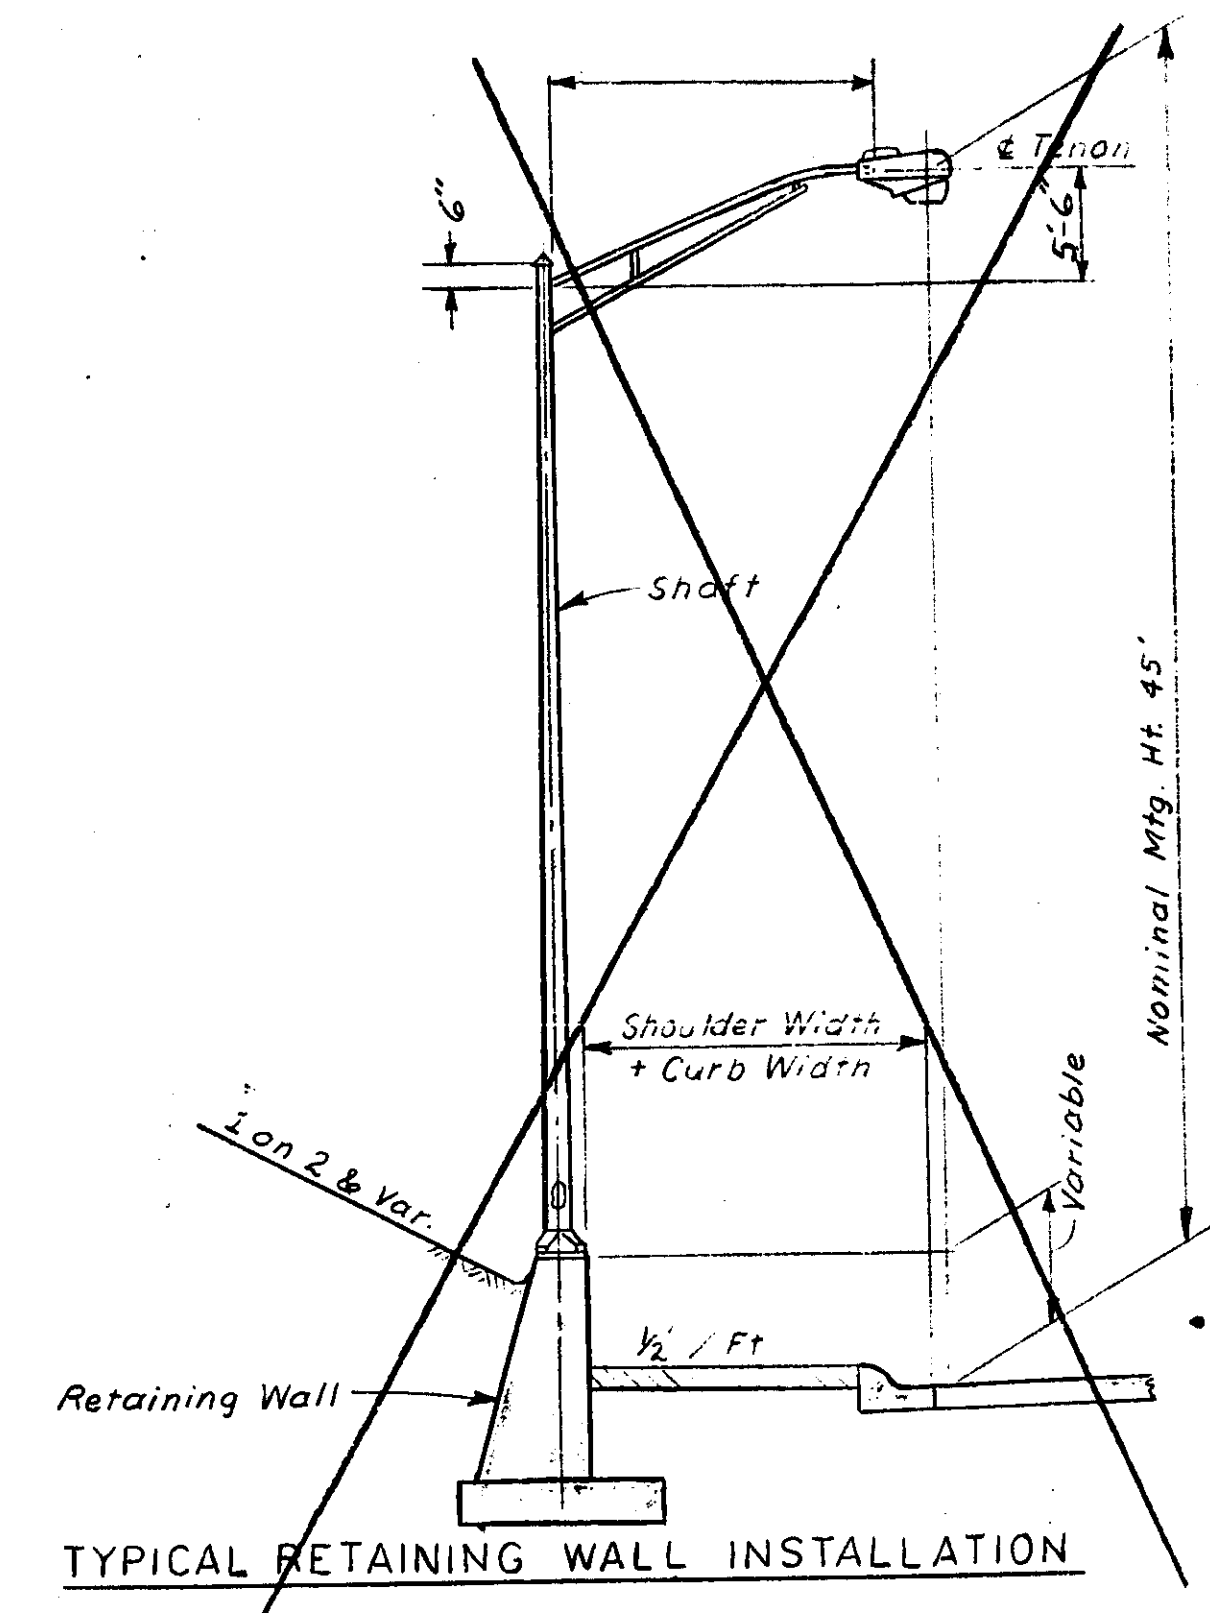


TYPICAL RETAINING WALL INSTALLATION

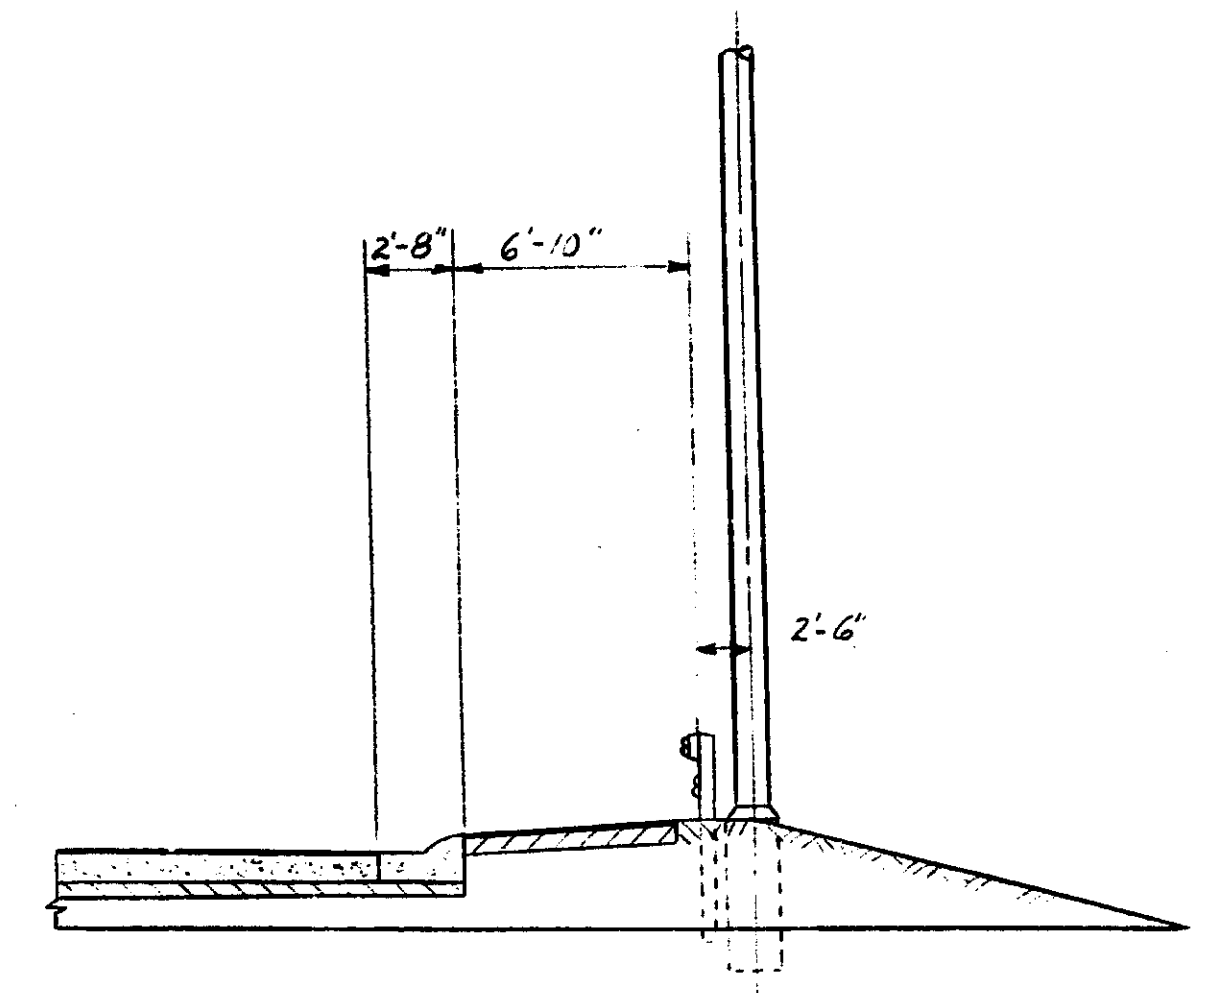


TYPICAL RAMP IN FILL

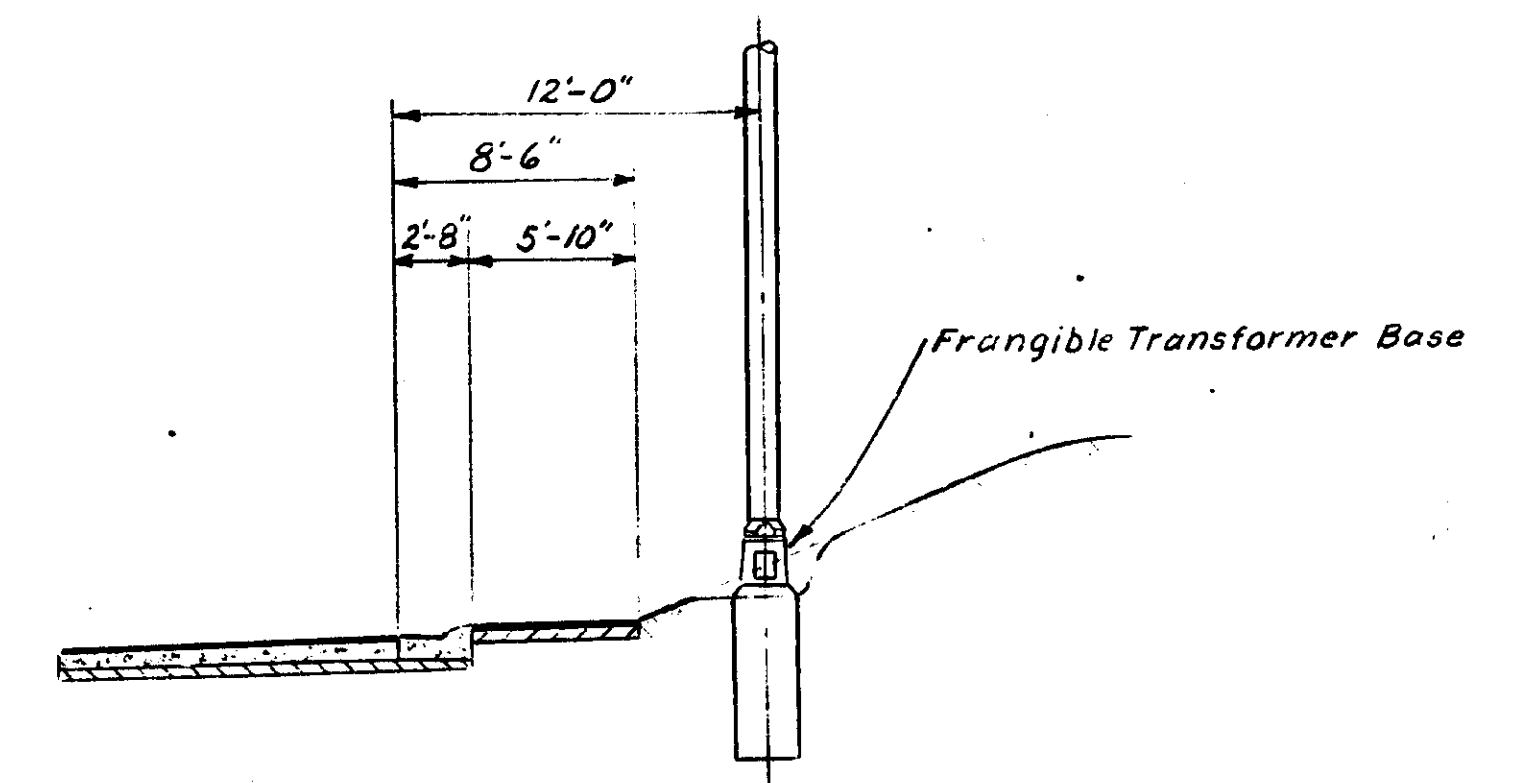

TYPICAL RAMP IN CUT

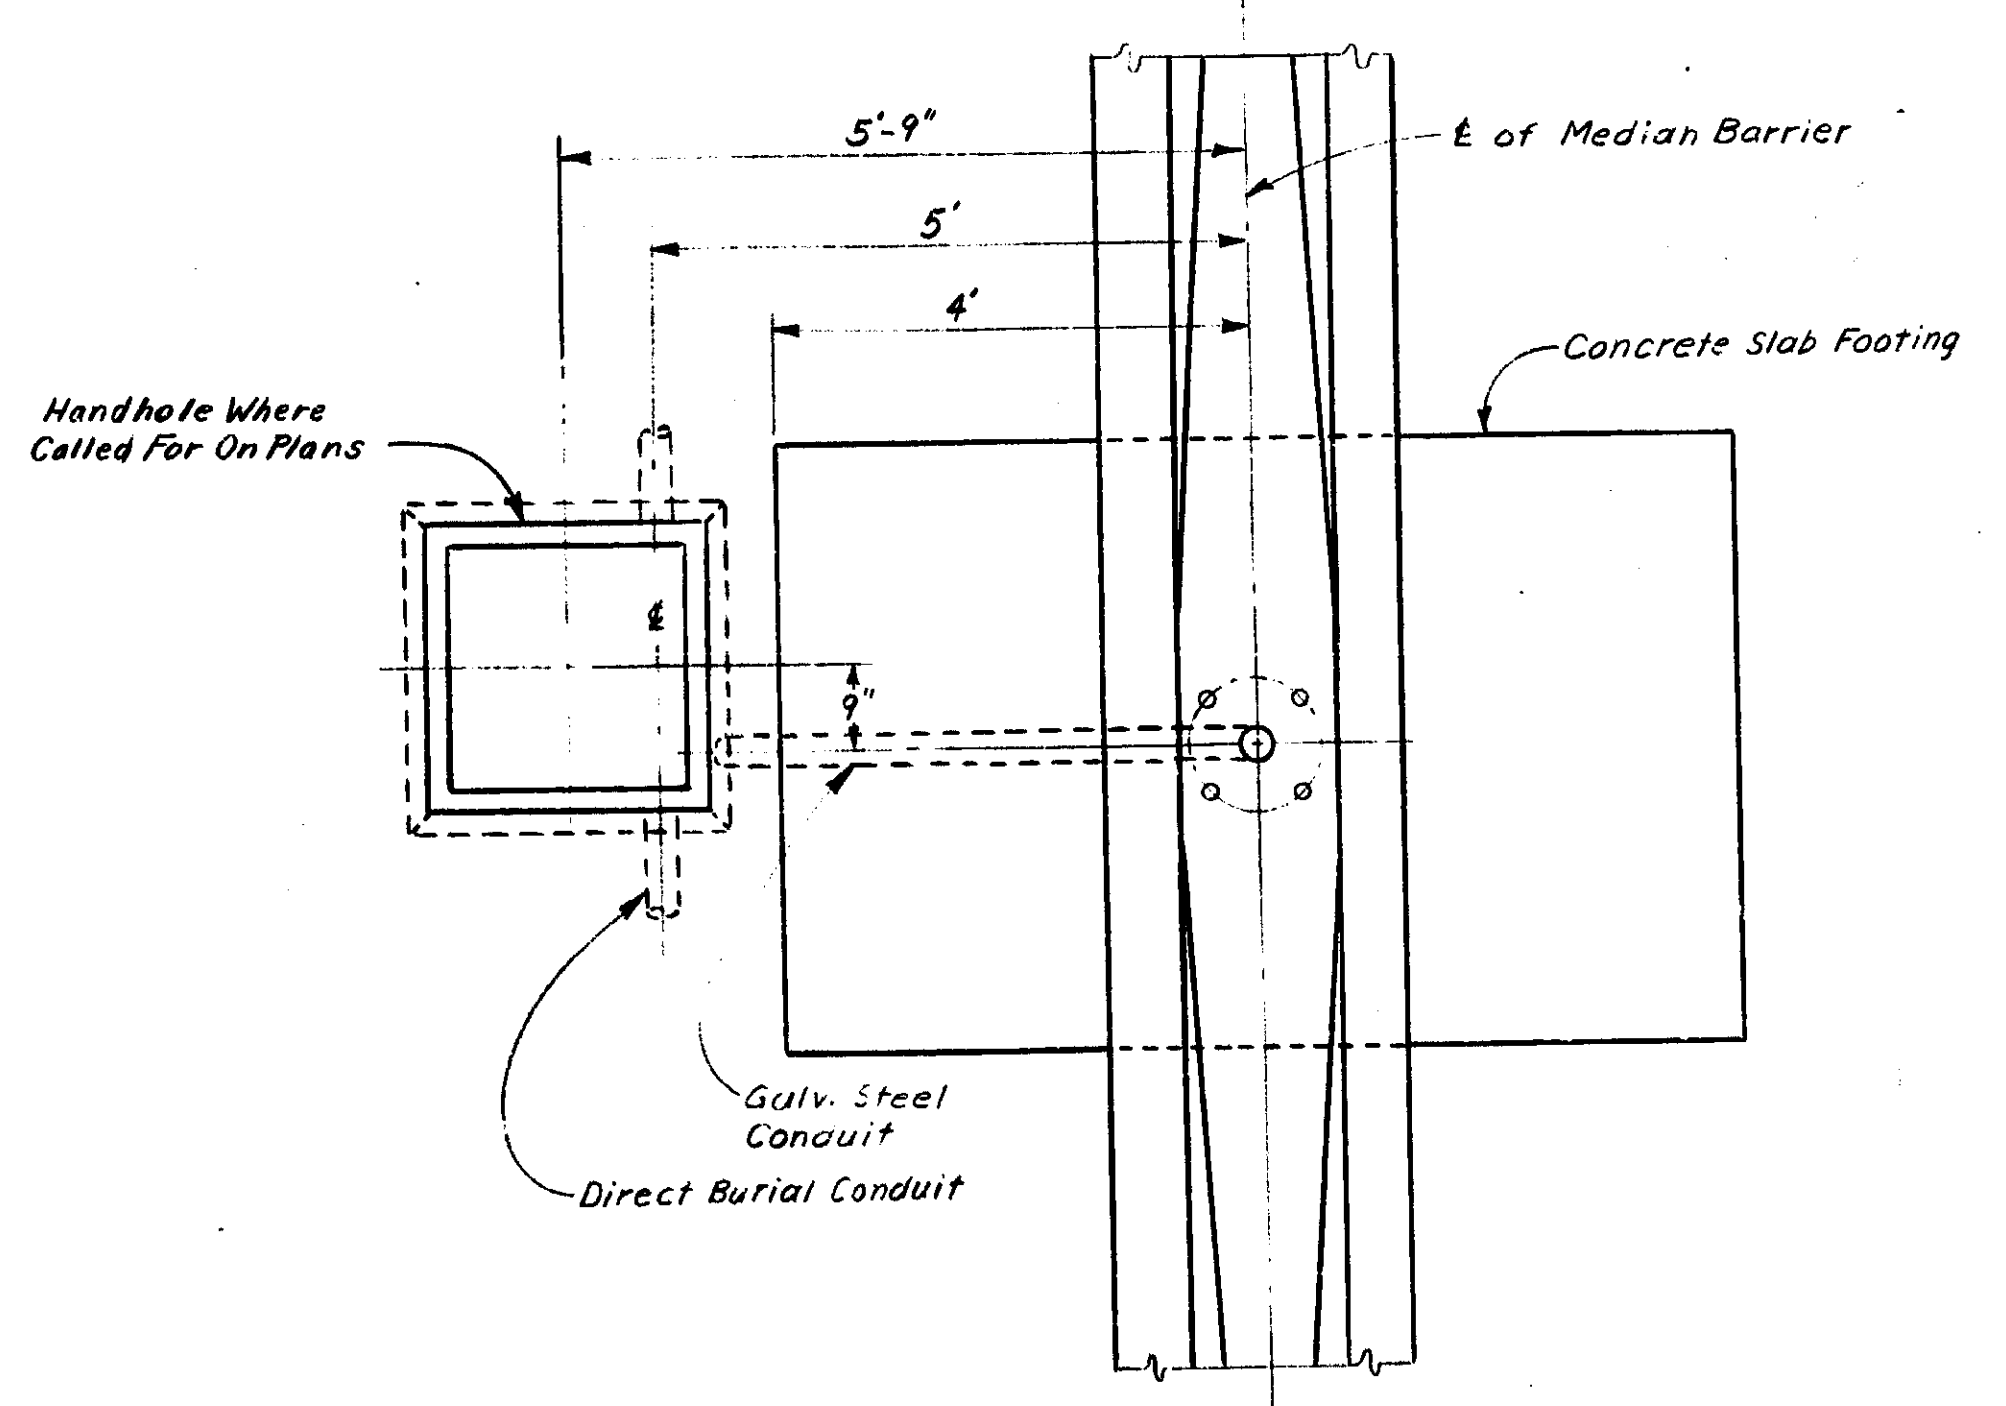

SECTION B-B
To Apply From Sta. 882+80.97 To 903+33

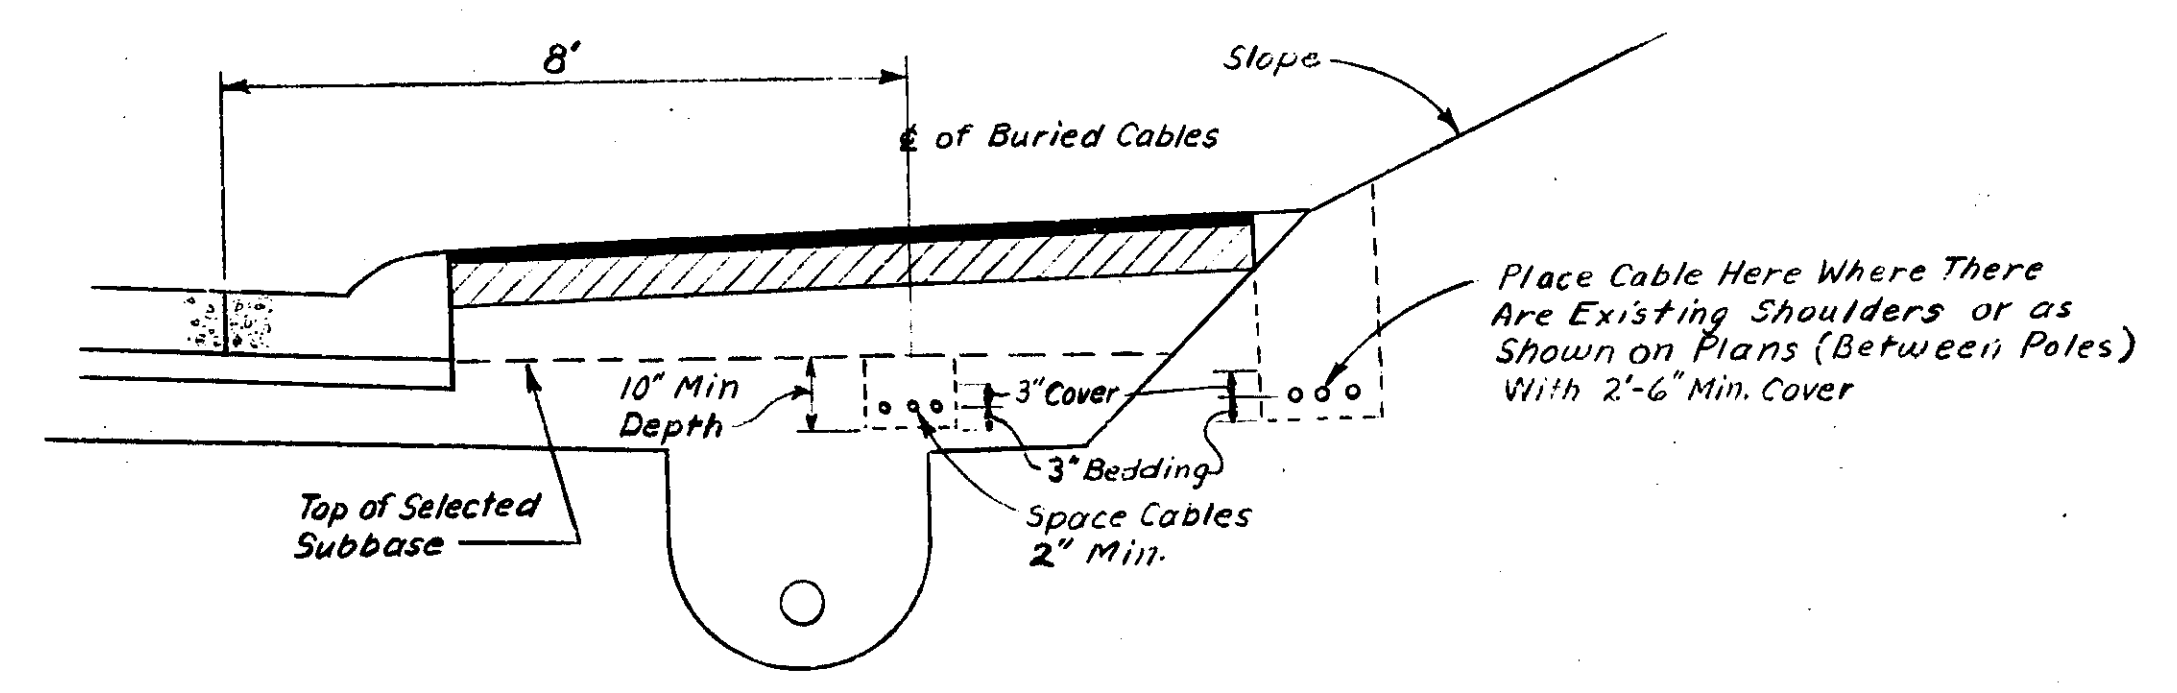

LOCATION OF DIRECT BURIAL CABLES

NOT TO SCALE


MICHIGAN DEPARTMENT OF STATE HIGHWAYS
TYPICAL FREEWAY LIGHTING STANDARD
INSTALLATION

DESIGNED BY	T. J. J. / J. J. J.	1973
DRAWN BY	J. J. J.	11-15-73
CHECKED BY	J. J. J.	11-15-73
DATE	11-15-73	


CONTROL SECTION 63174 JOB NO. 08517A

* Chain Reduction Gear Type Lowering Device Will be Accepted in Lieu of Cable Drum Type Hoist.


NOTE:
The Following Features Shall Be Used & Incorporated In The Design Of The Lowering Device:
1. Swivel Between The Three Cables & The Single Drum Cable And/Or
2. Guide Cable.
Minor Variations Will Be Adjusted, Subject To Approval Of The Design Section.

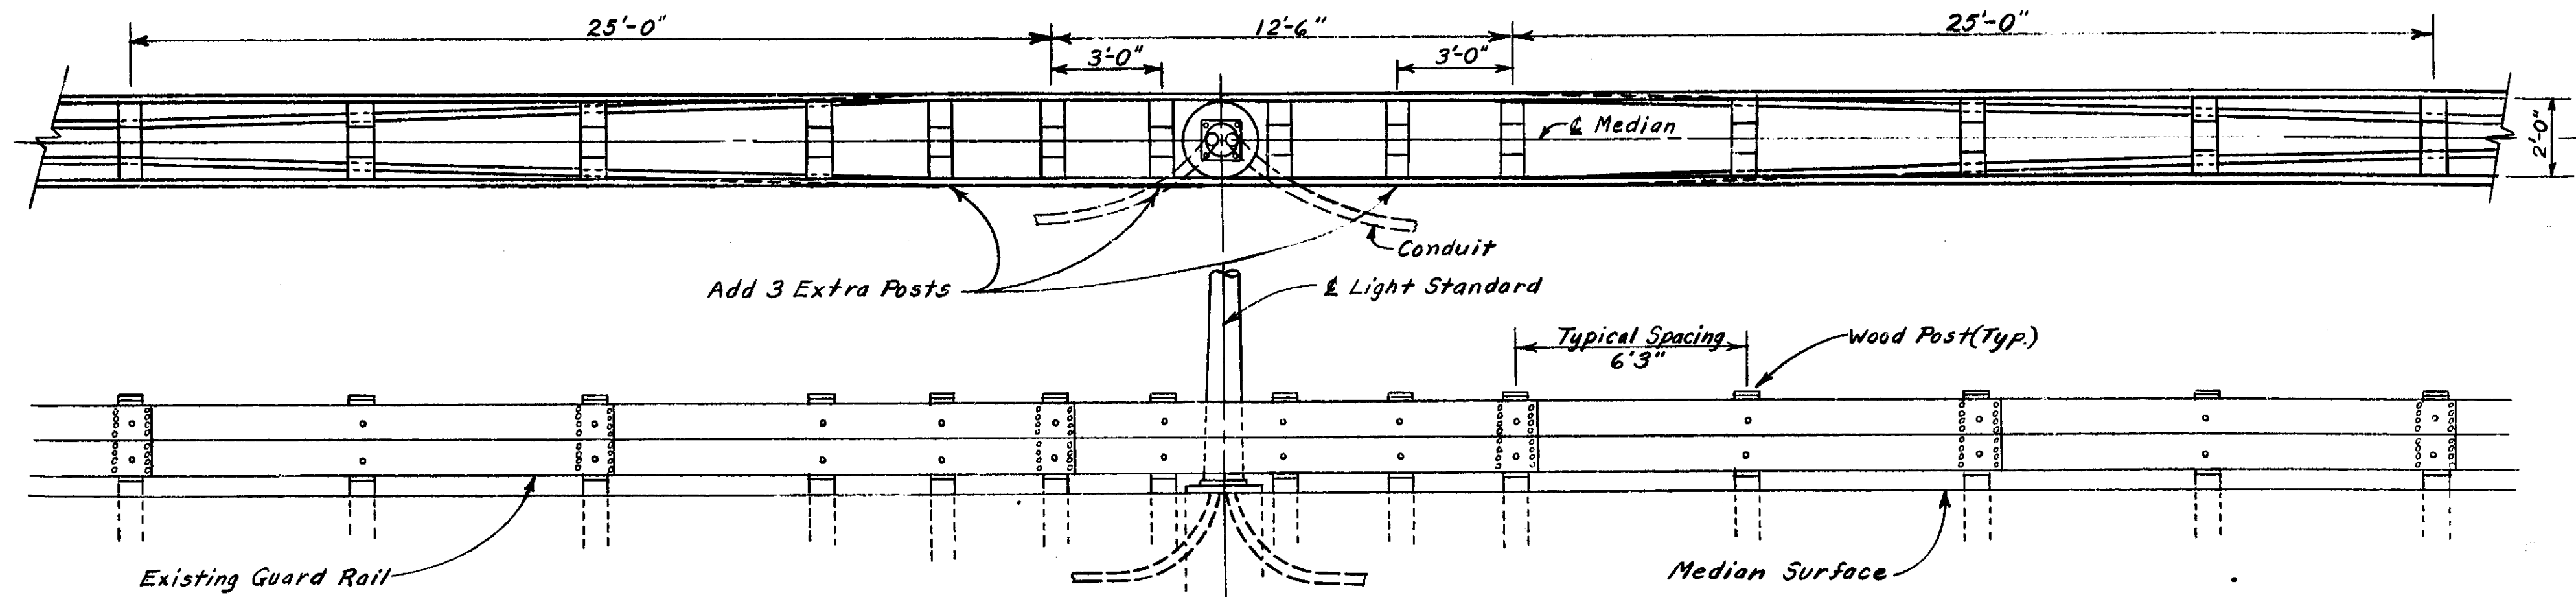

DETAIL OF "DOUBLE BEAM GUARD RAIL TYPE II"
To Apply at Light Standards, Station 834+94.7 to 857+00.
(Beam Guard Rail, Hardware, Wood Blocks, and Related)
Material Shall be in Accordance to Standard Plan III-64B
(Not to Scale)

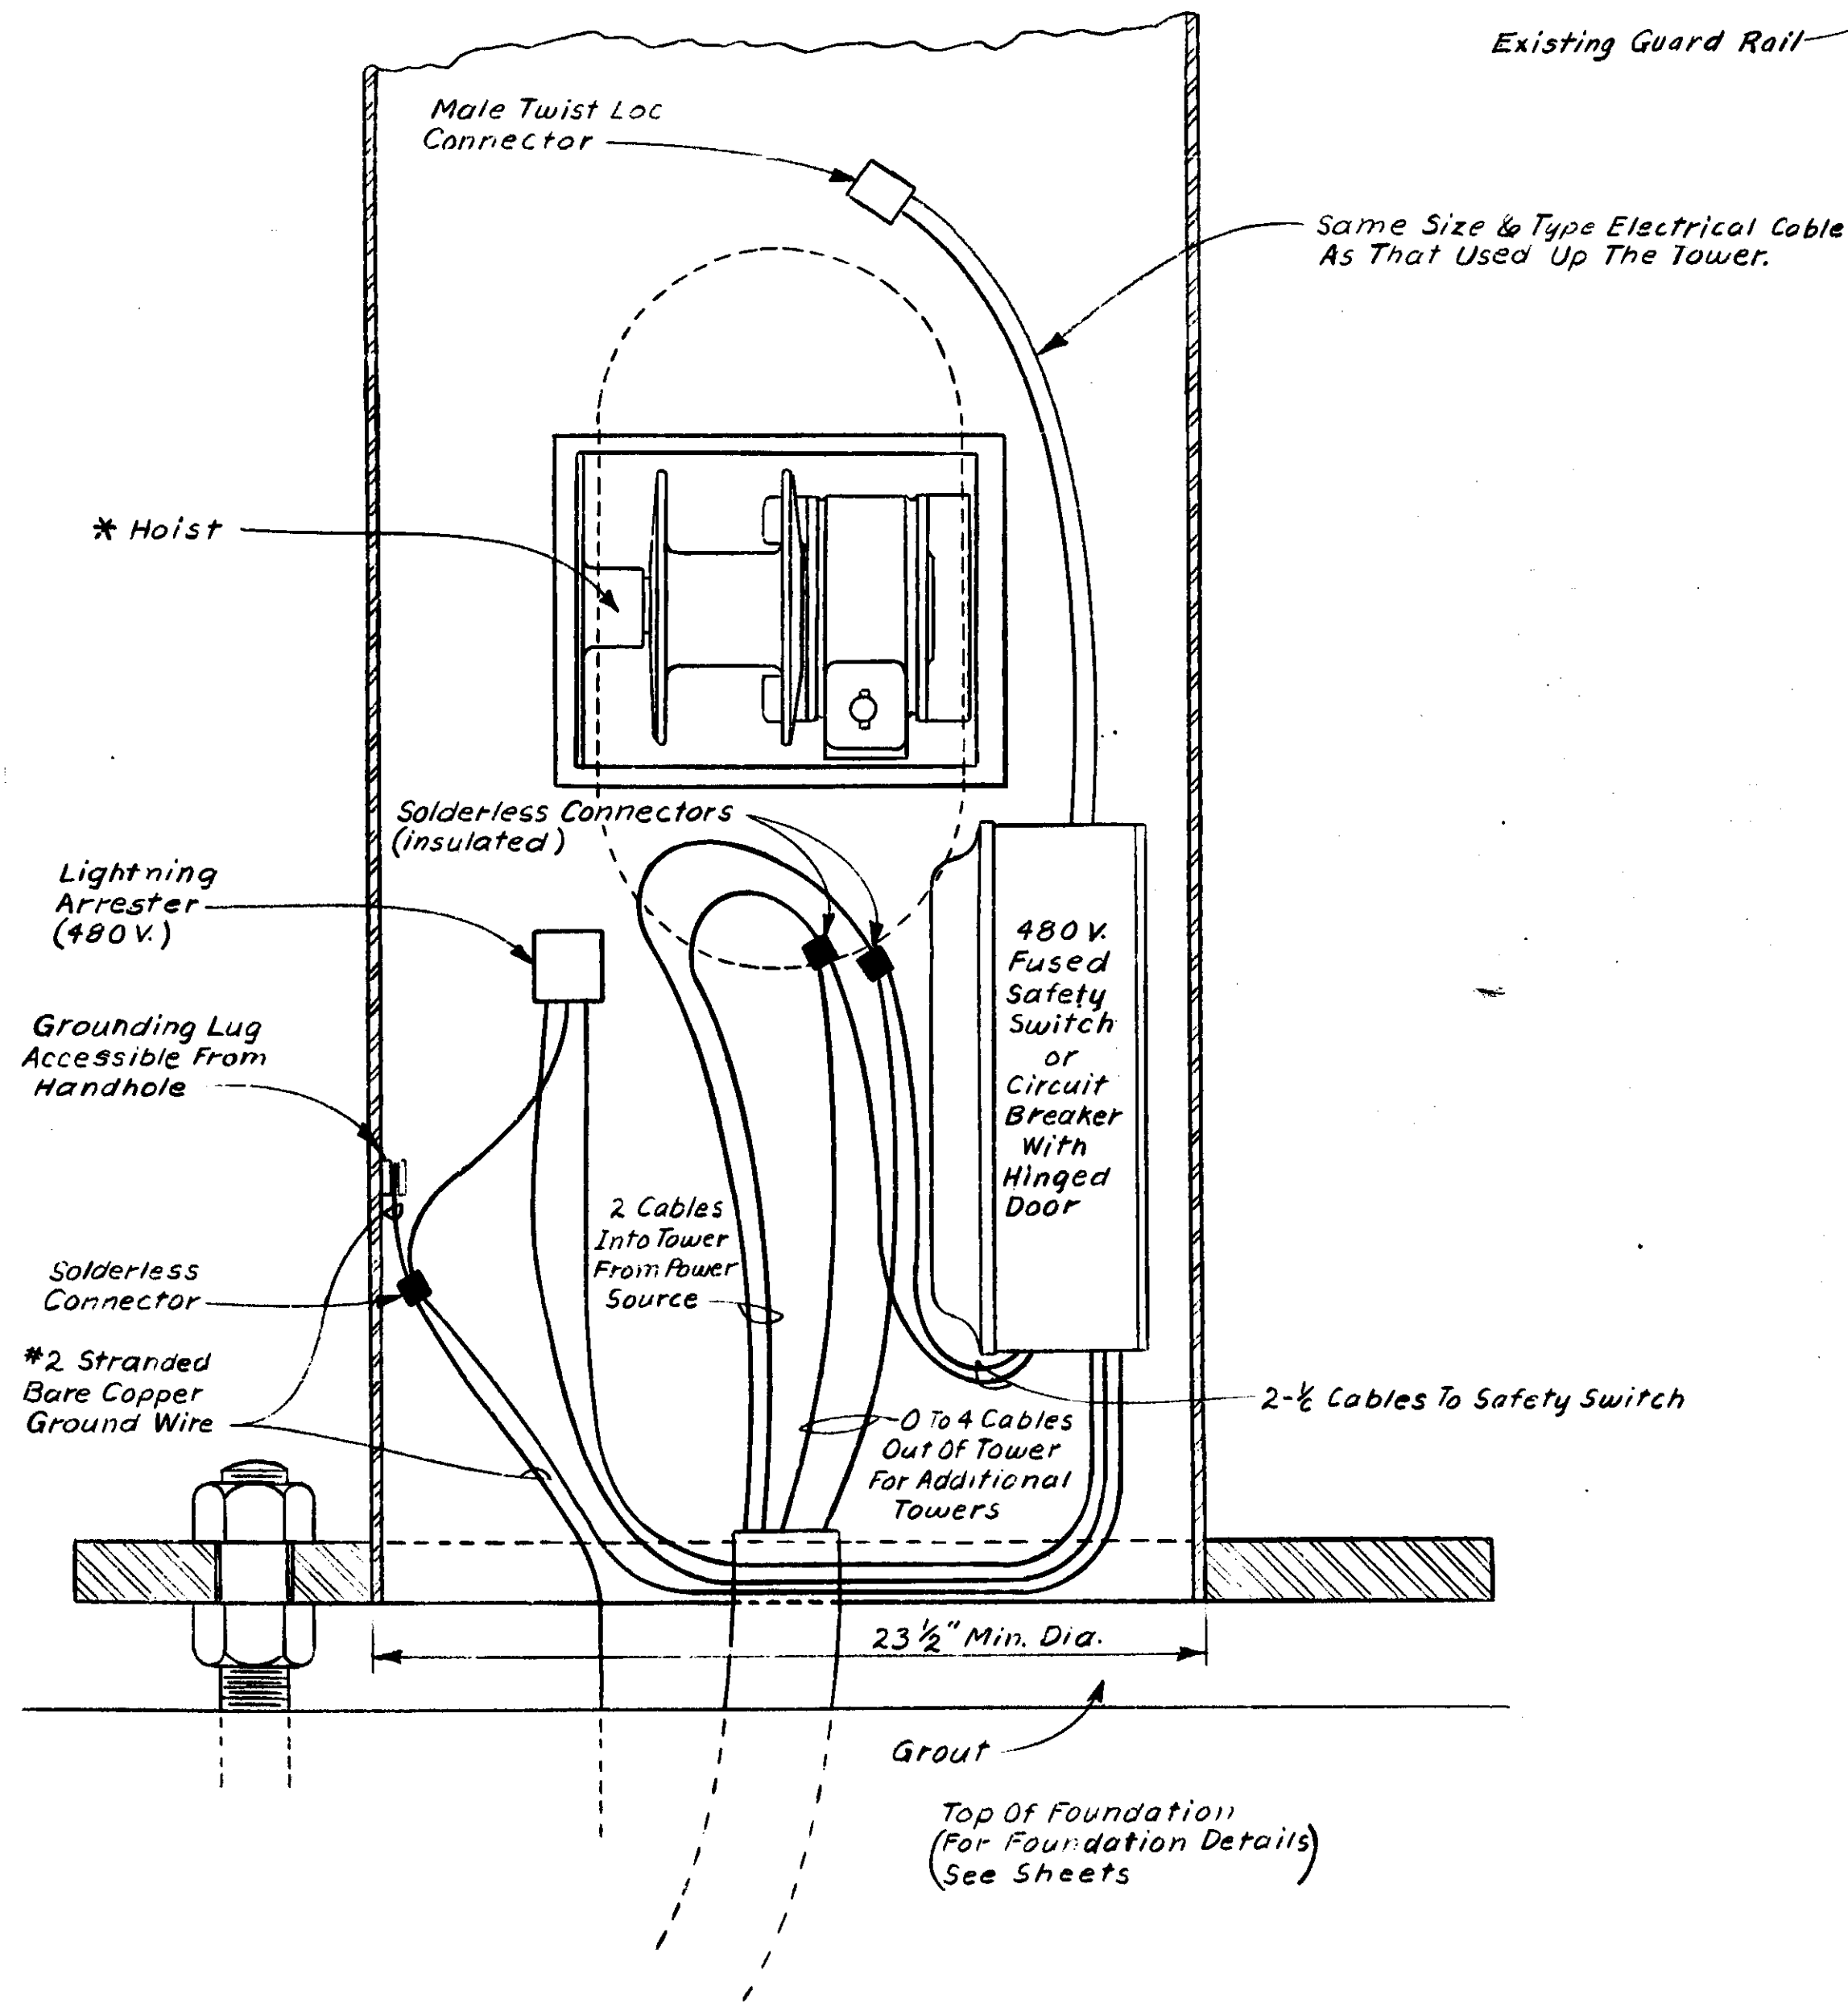

DETAIL OF CONNECTIONS INSIDE TOWER
Not to Scale

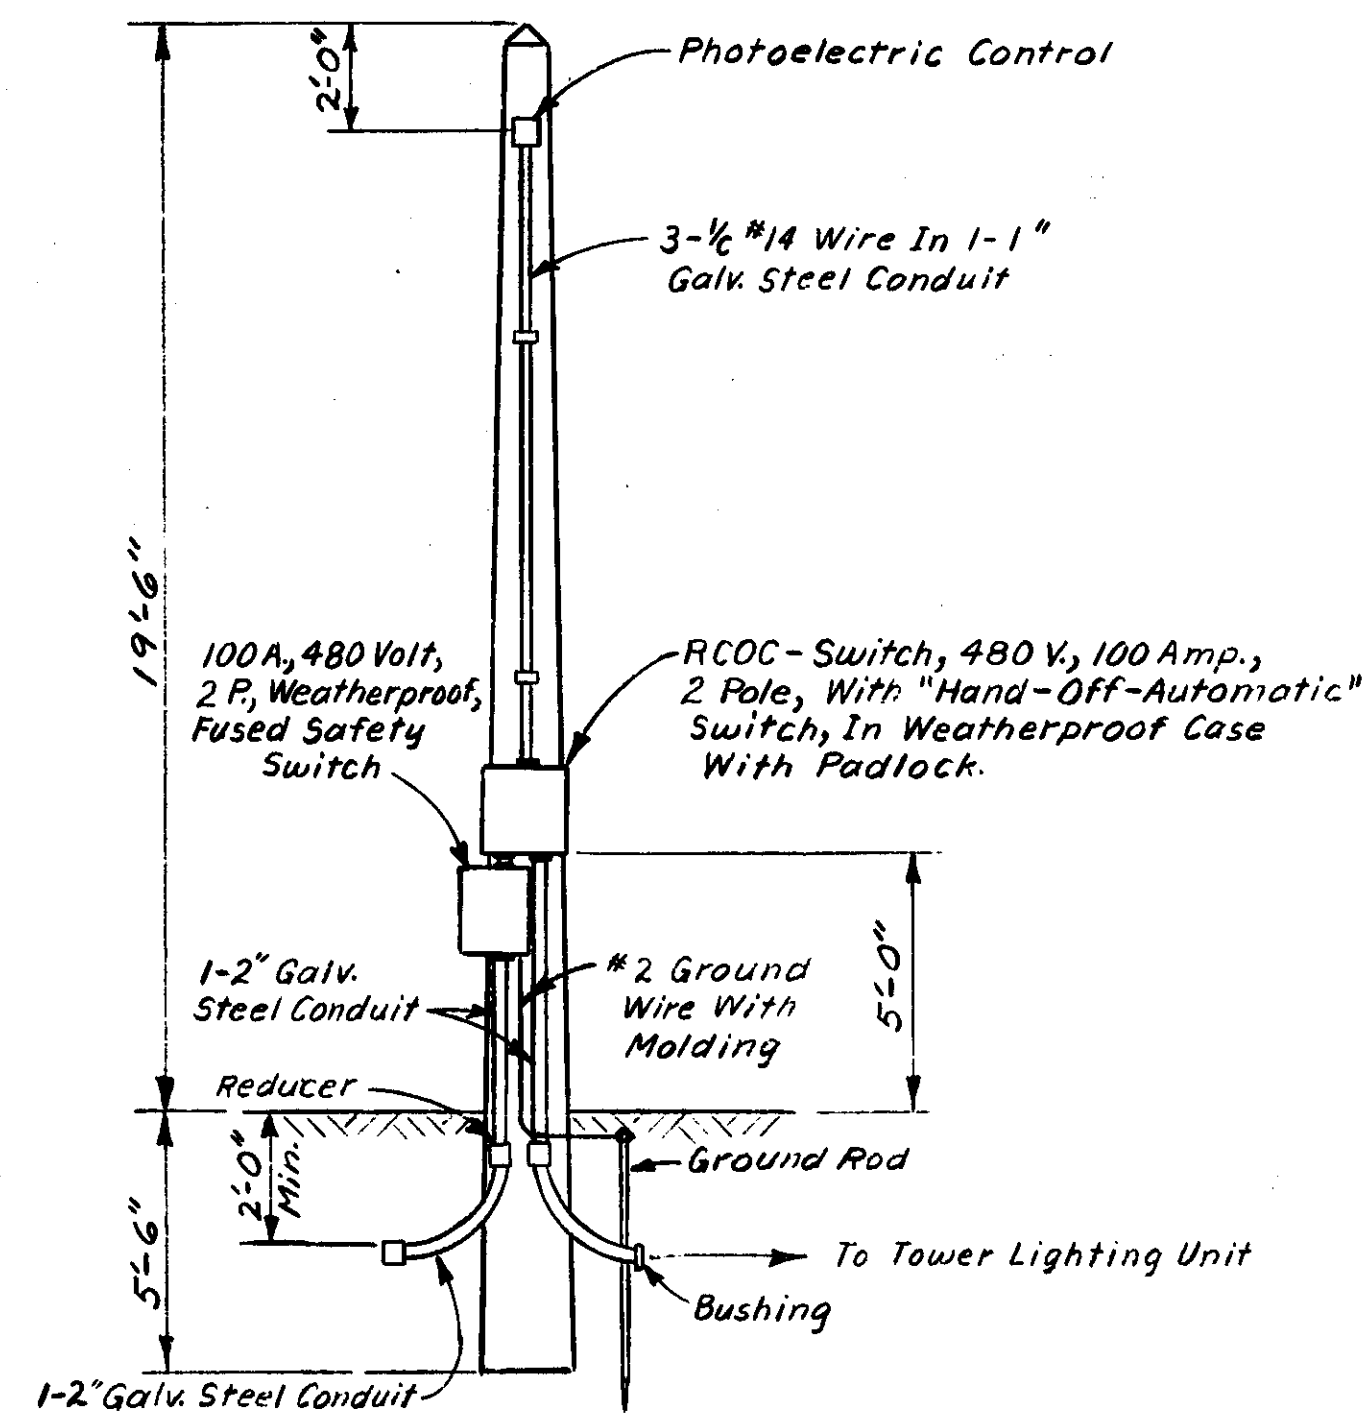


TOWER LIGHTING CONTROL POLE
Not to Scale


MICHIGAN DEPARTMENT OF STATE HIGHWAYS
ELECTRICAL DETAILS

REVISIONS			
NO.	DESCRIPTION	DATE	BY


DESIGNED BY T.J./D.C. 1974
 DRAWN BY D.W. 6-13-74
 CHECKED BY
 SHEET 25 OF
 JOB NO.
63174 08517A

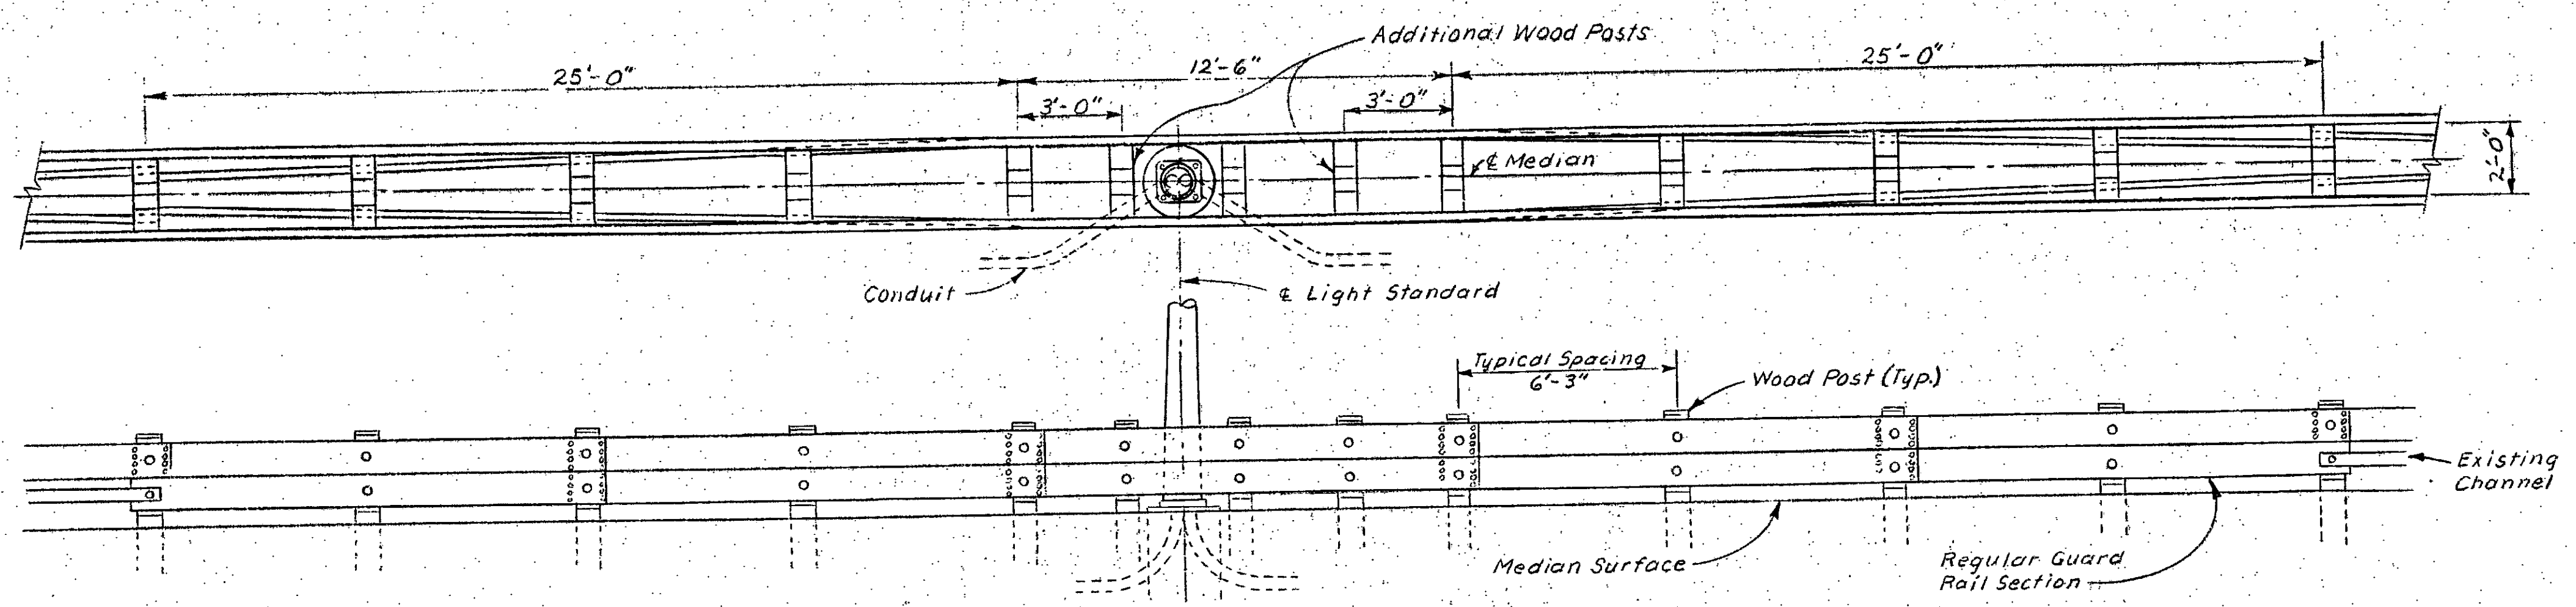


DETAIL OF "DOUBLE BEAM GUARD RAIL SPECIAL TYPE I"
 To Apply at Light Standards, Station 857+00 to Station 882+80.97
 (Beam Guard Rail, Hardware, Wood Blocks, and Related Material Shall be
 in Accordance to Standard Plan III-64B
 (Not to Scale)

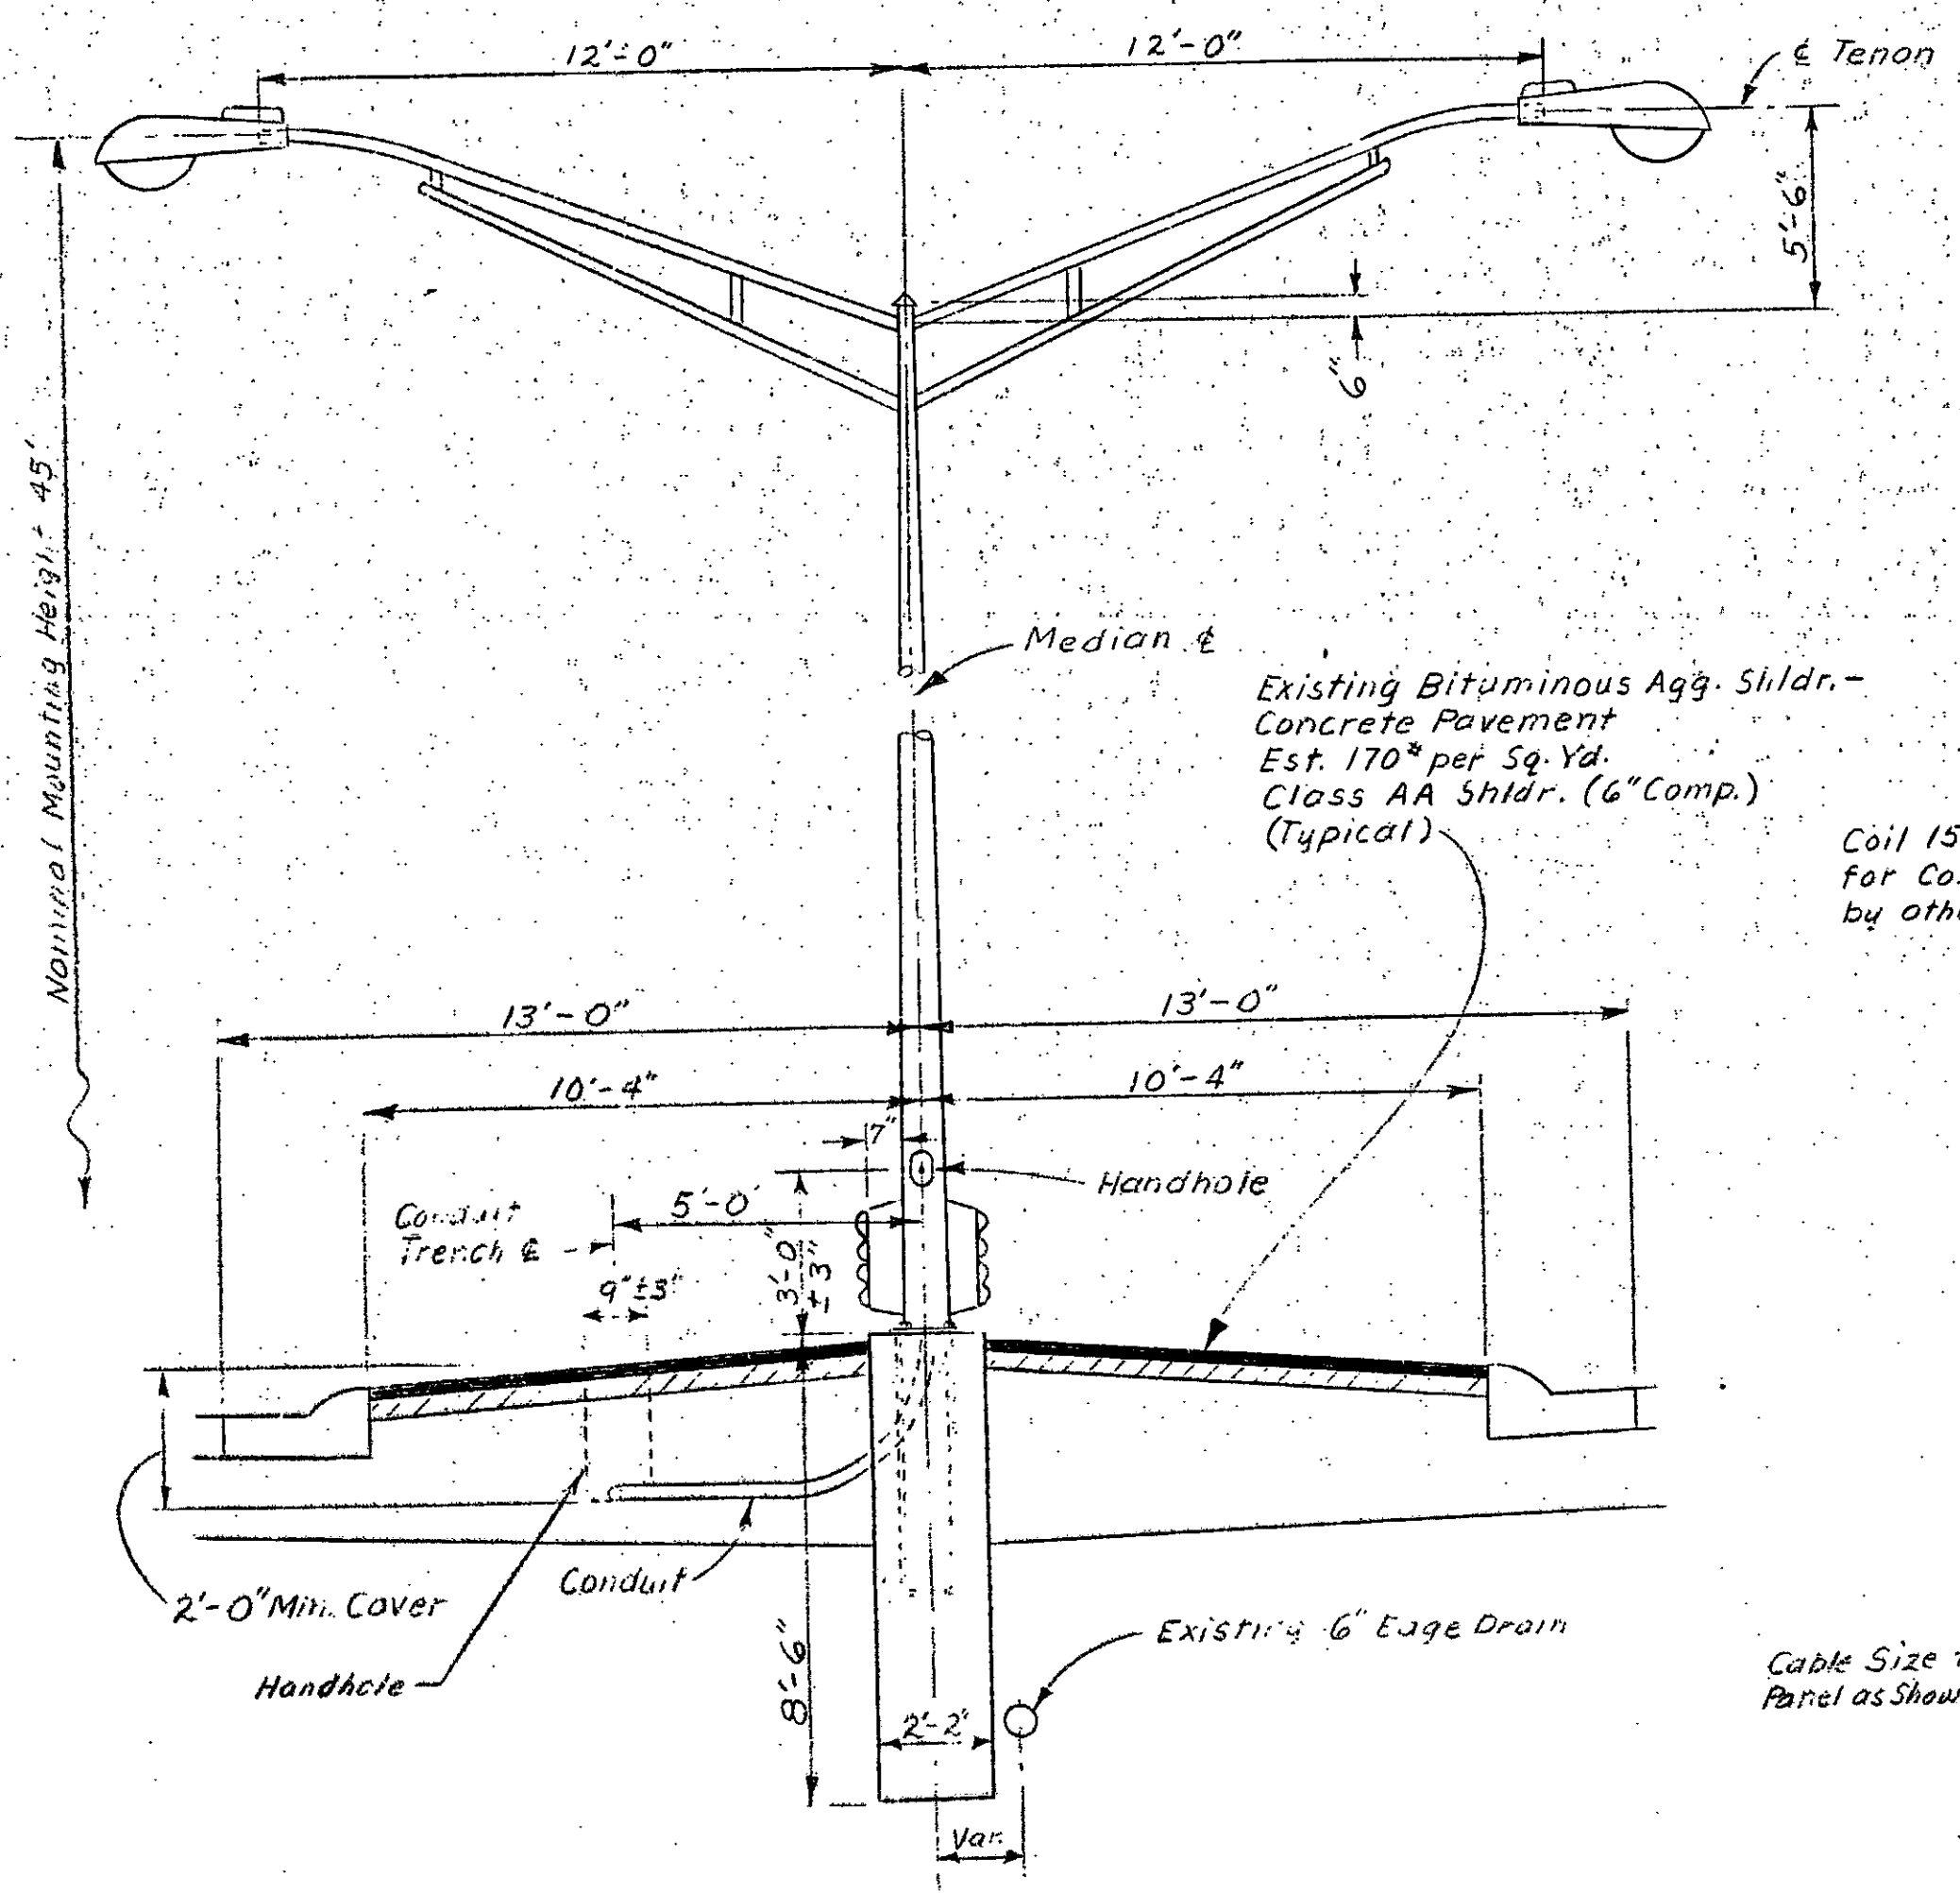

TYPICAL MEDIAN INSTALLATION
 (Not to Scale)
 To Apply: Sta. 834+94.7 To 882+80.97

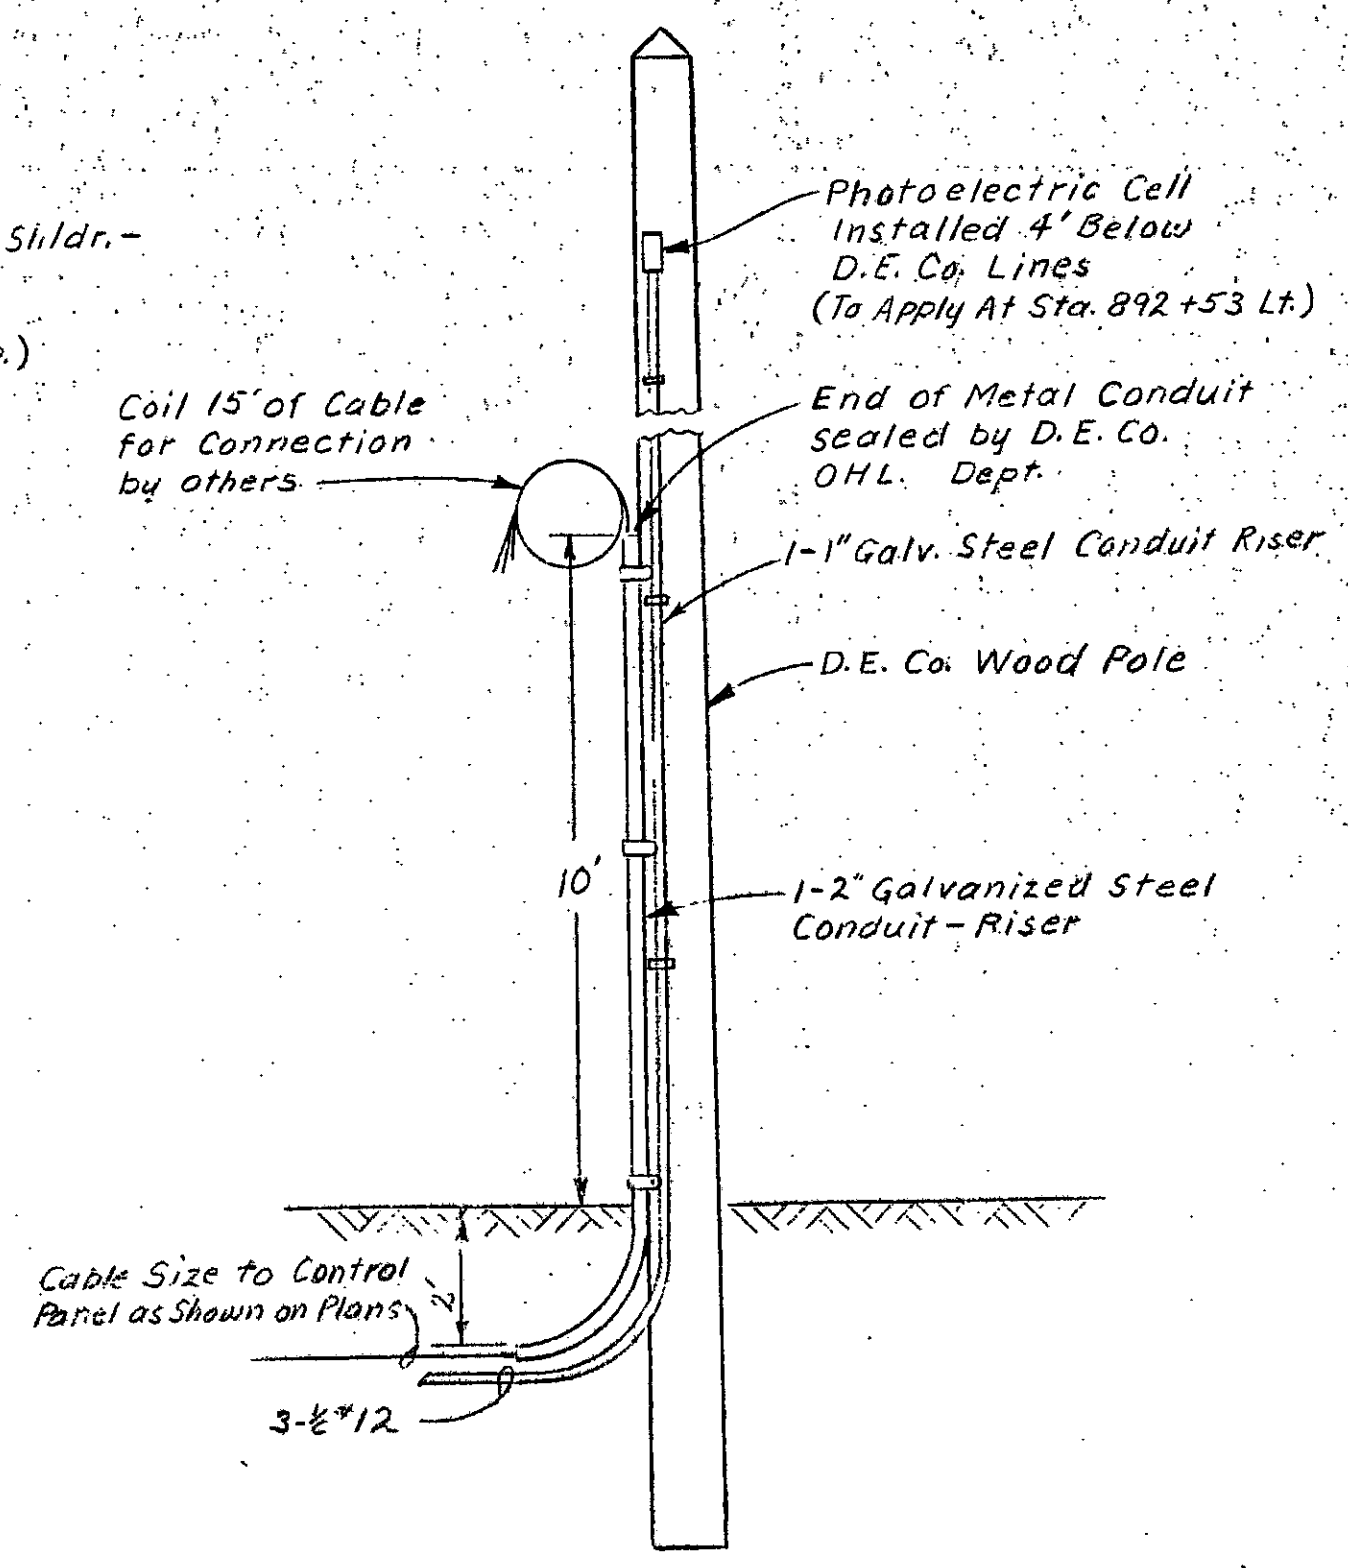

DETAIL OF CONDUIT AND CABLE INSTALLATION ON D.E. CO. SERVICE POLE
 (Not to Scale)

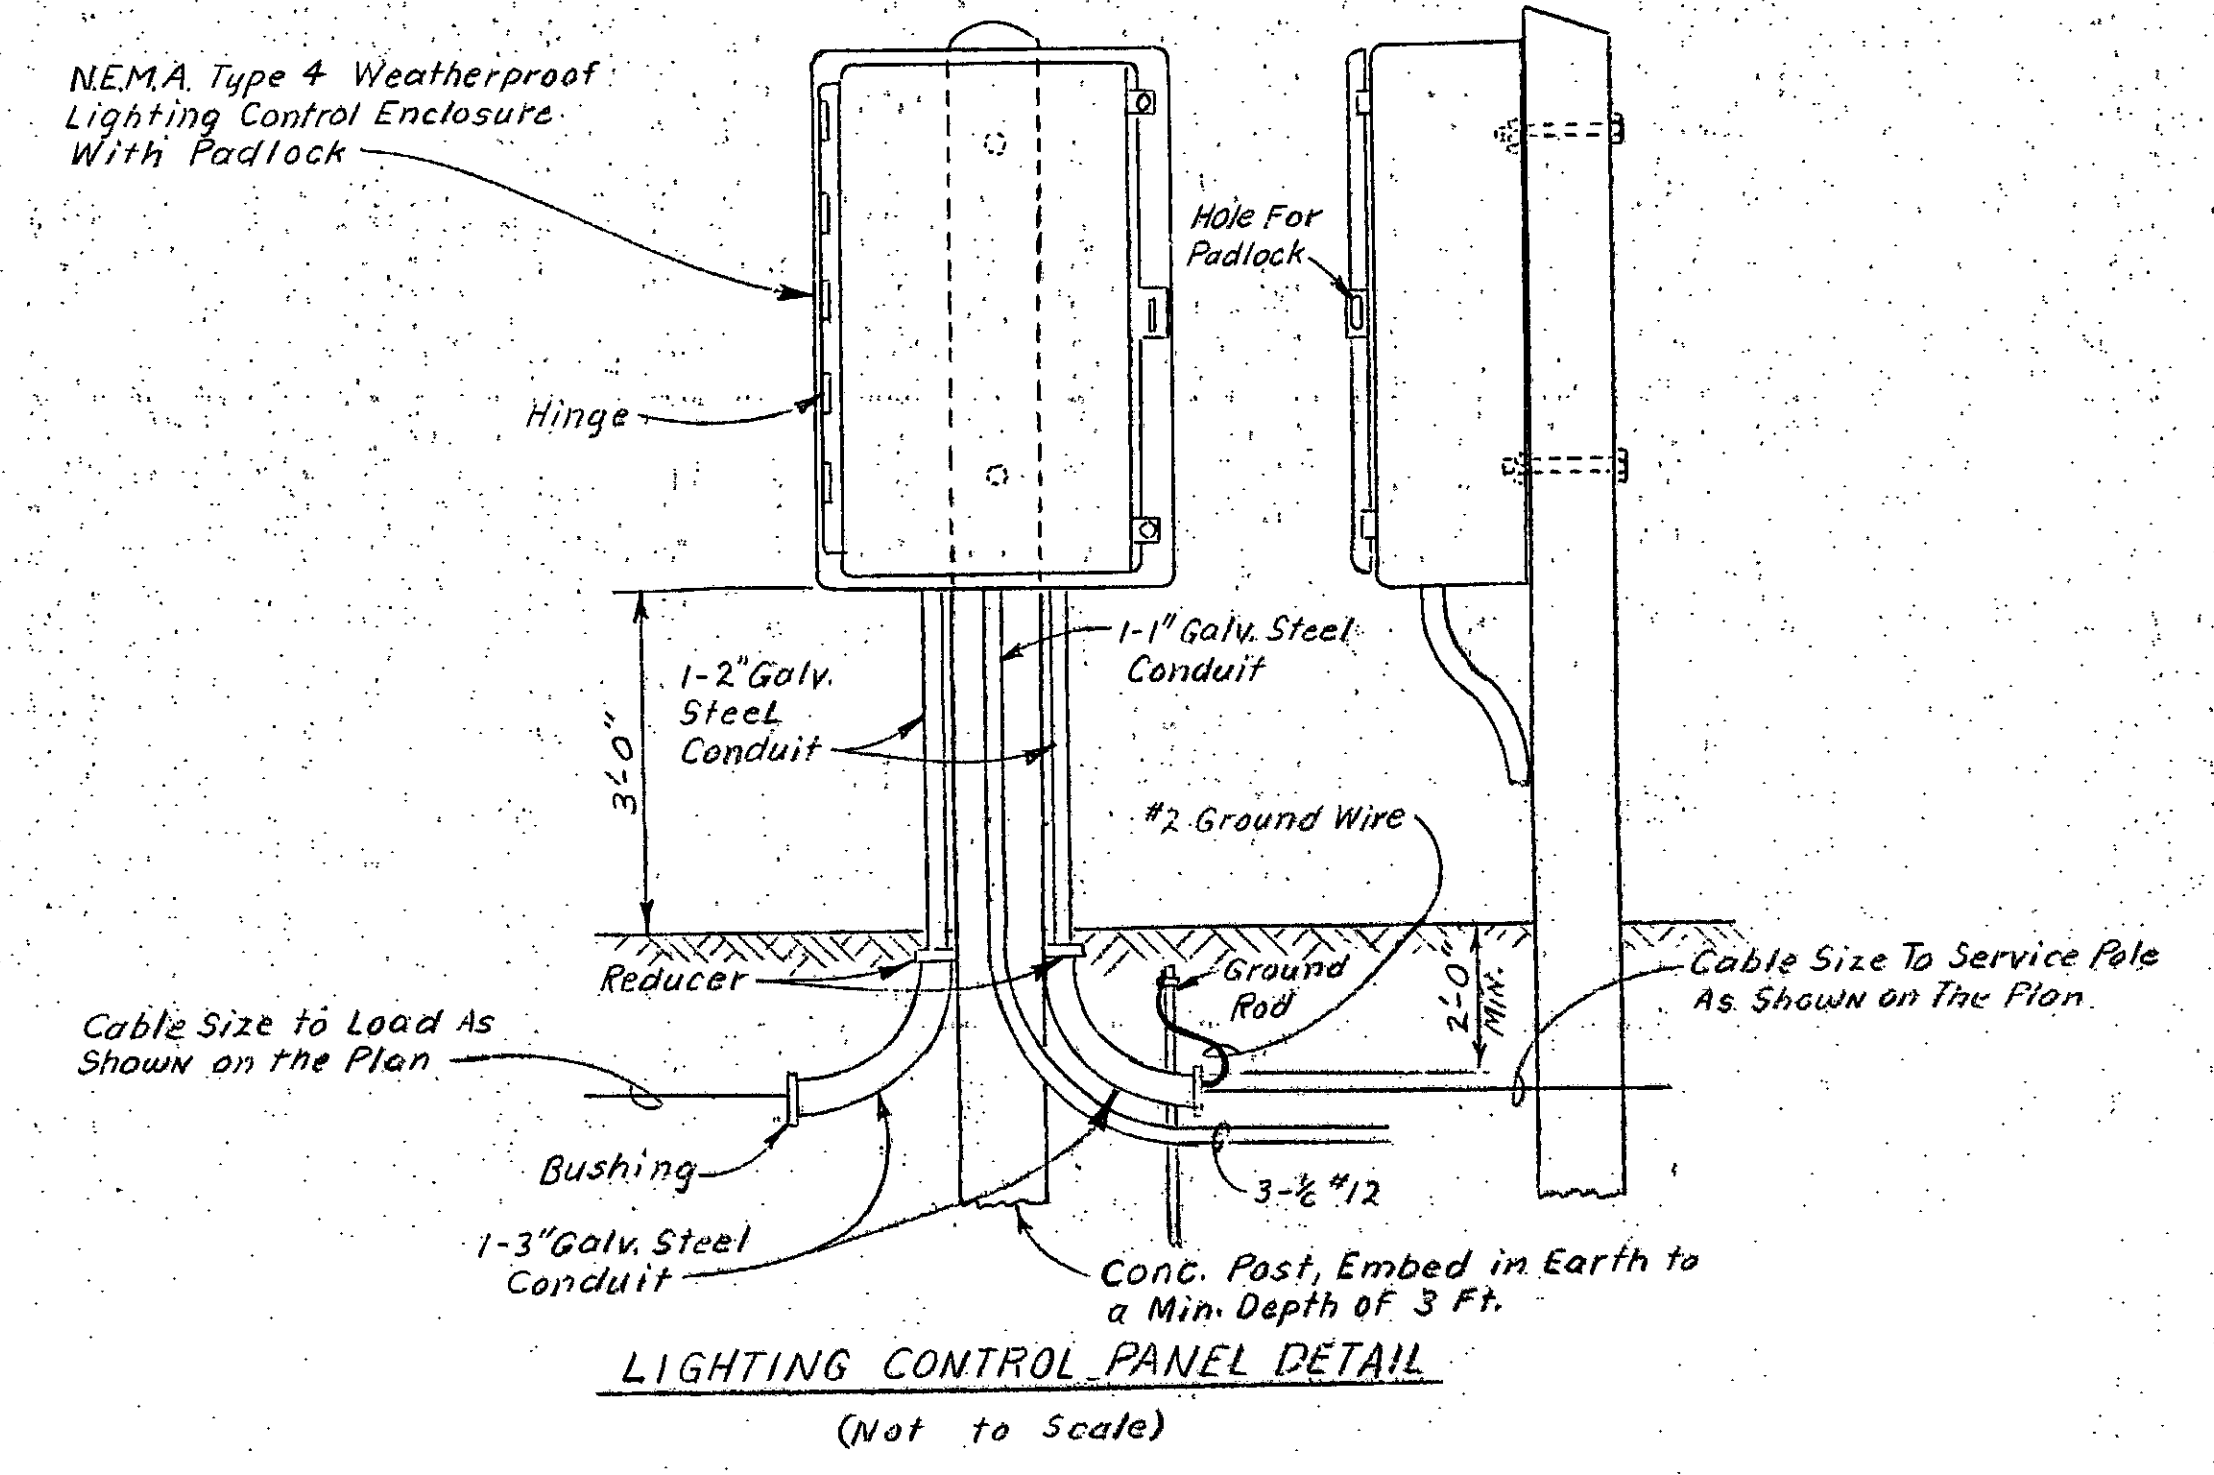

LIGHTING CONTROL PANEL DETAIL
 (Not to Scale)


MICHIGAN DEPARTMENT OF STATE HIGHWAYS ELECTRICAL DETAILS

REVISIONS			
NO.	DESCRIPTION	DATE	BY


DESIGNED BY	E. J. J. J.	11-74
DRAWN BY	K. E.	10-23-74
CHECKED BY	R. W.	6-19-79
APPROVED BY	C. E. J.	10-25-79

SHEET 26 OF 26
 JOB NO. 63174 08517 A


Revised 6-26-68 (Anchor Base Plan changed to Anchor Base Plan)
 Revised 1-8-68 (B.C. for 40' & 45' M.H. & Alum. T.B. for 30' M.H.)
 Revised 1-17-68 (B.C. & Four to Five Detail)
 Deleted Fluorescent Brkt. Arm Detail
 Rev. 4-25-73

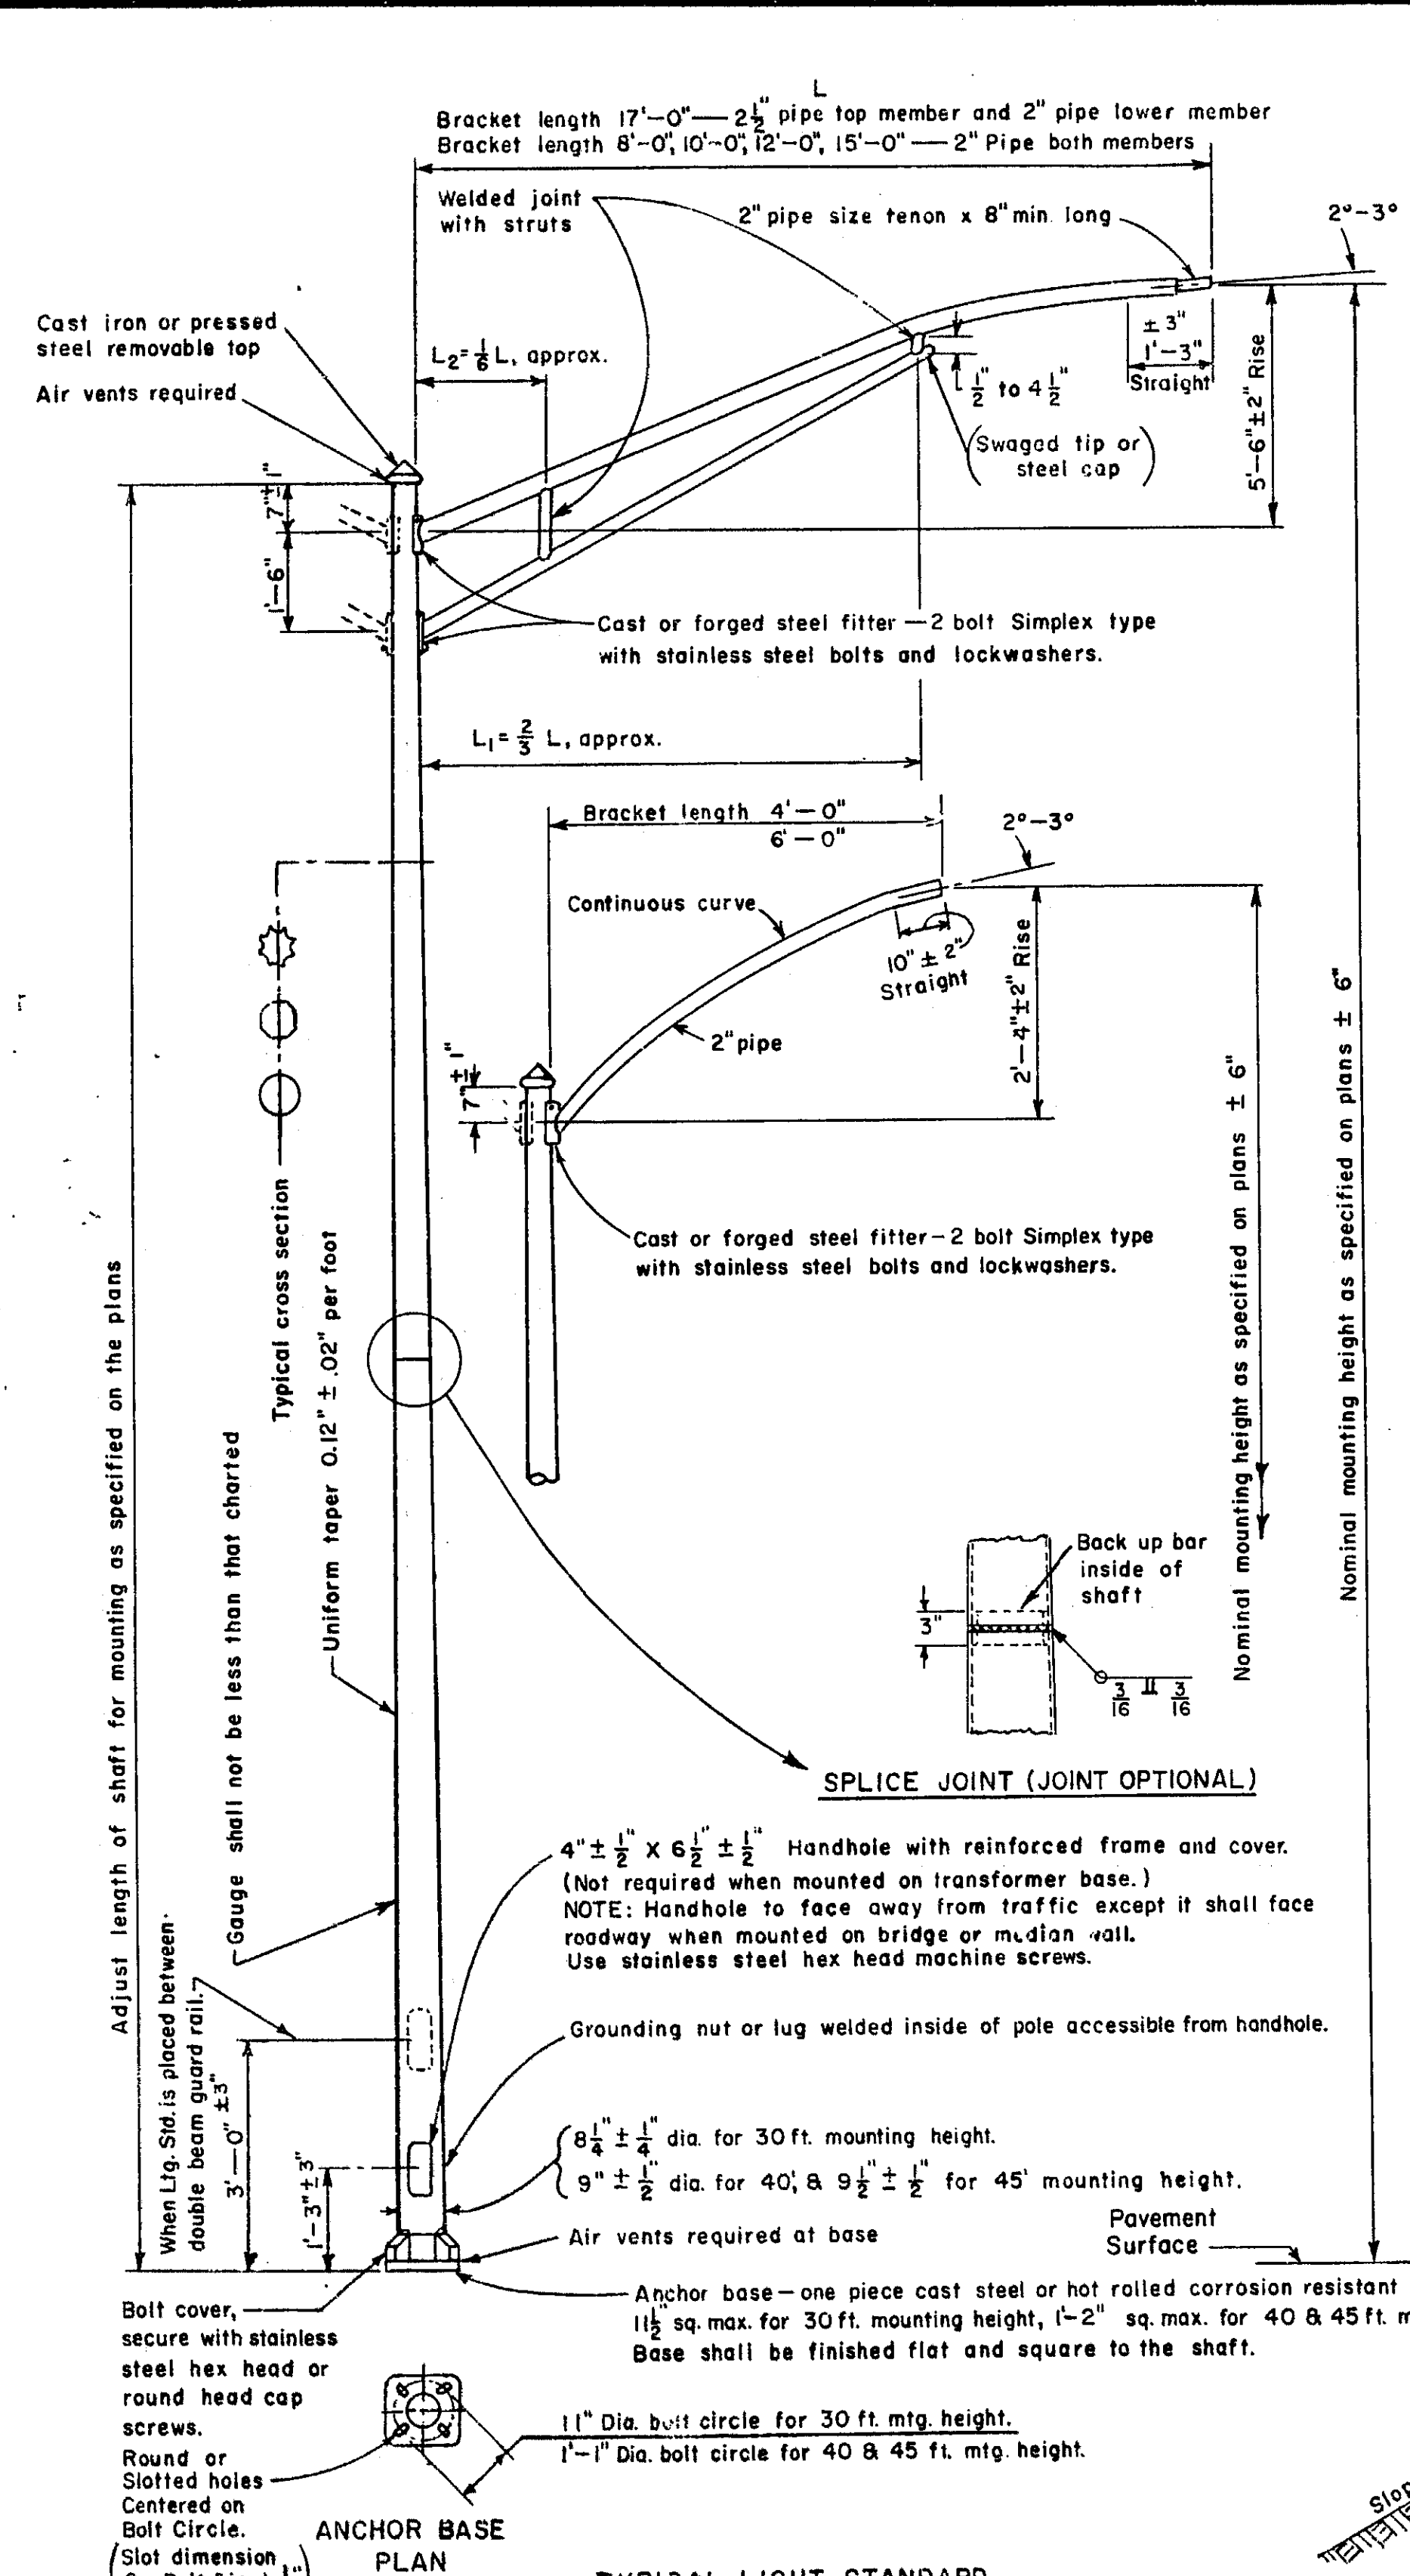


TYPICAL LIGHT STANDARD DESIGN FOR MERCURY AND INCANDESCENT LUMINAIRES

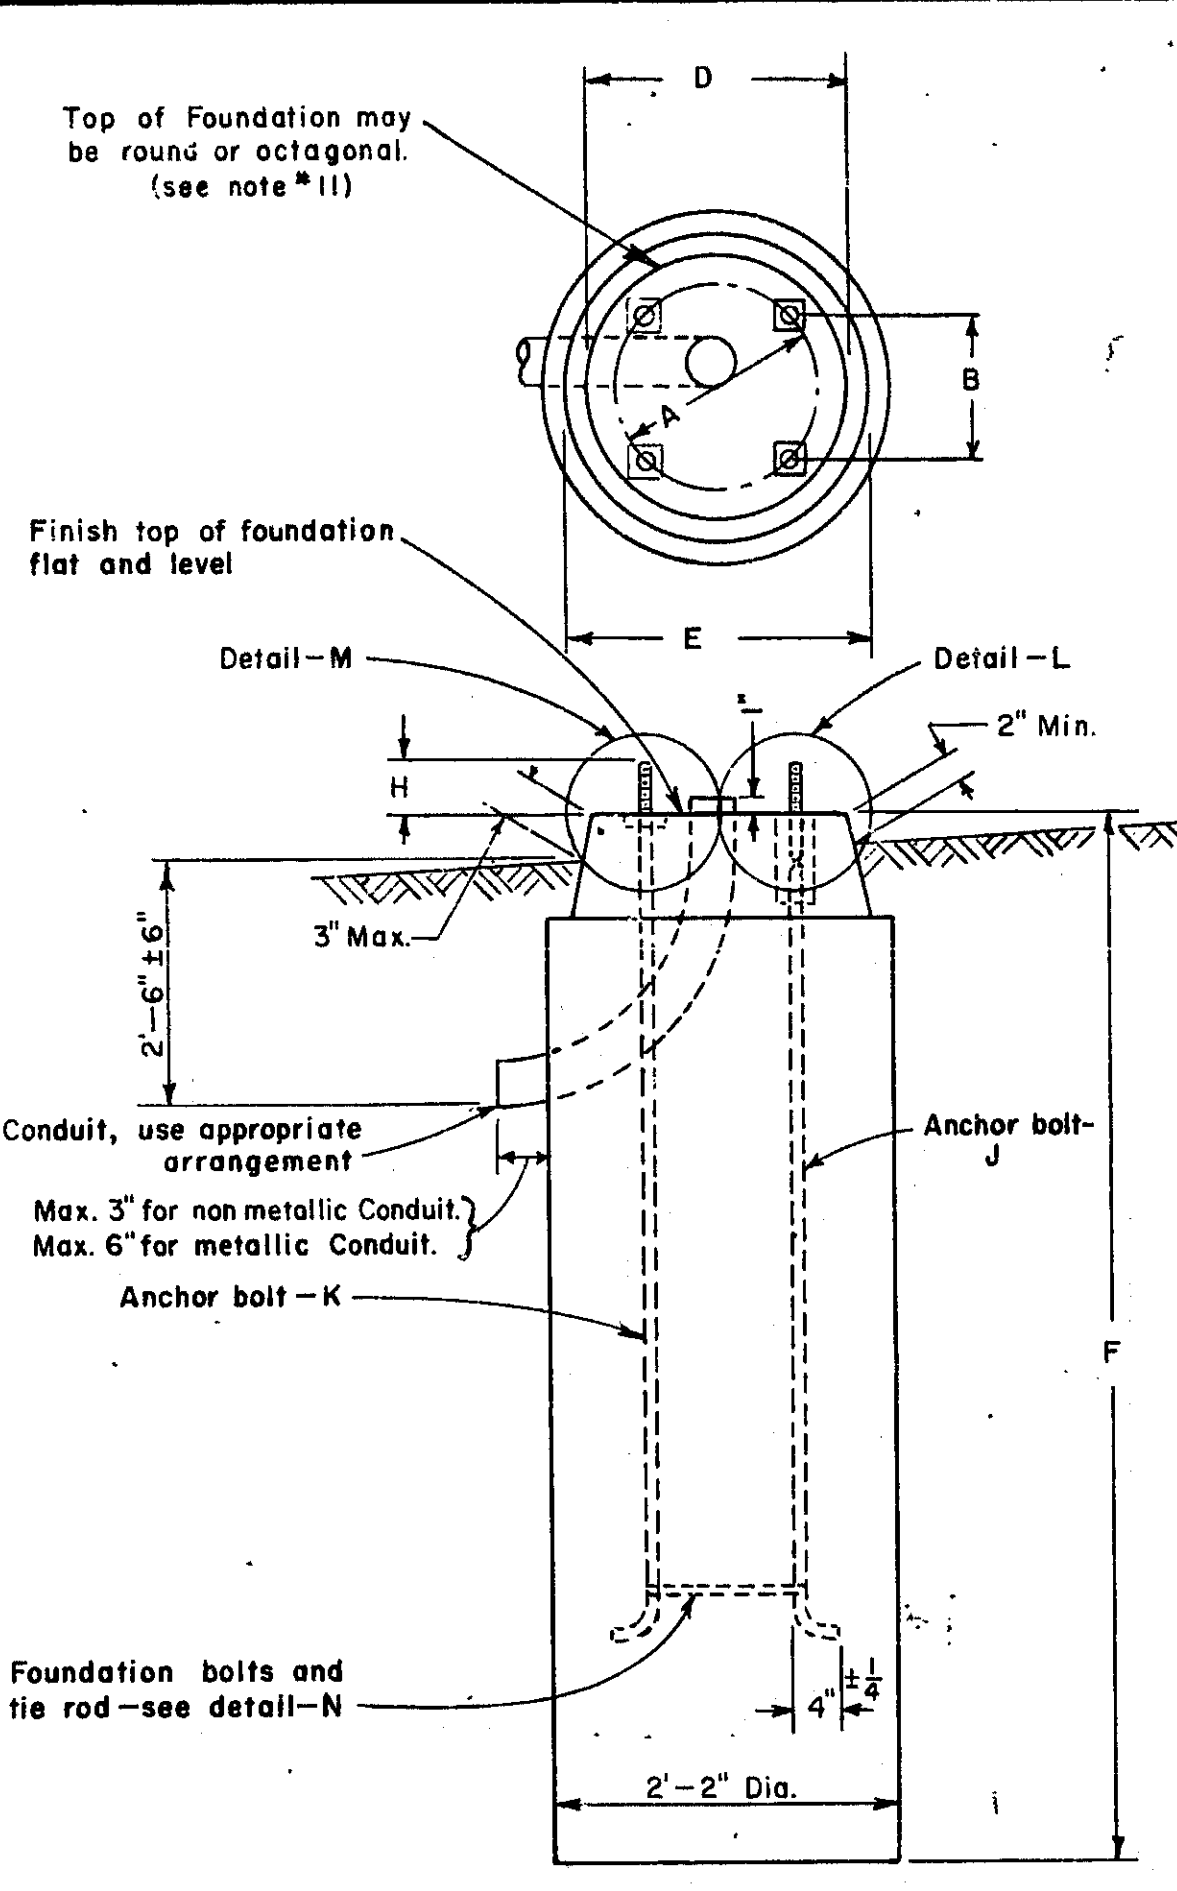

TYPICAL LIGHT STANDARD FOUNDATION WITH OR WITHOUT SHEAR STUDS (FOUNDATION INCIDENTAL TO LIGHT STANDARD)

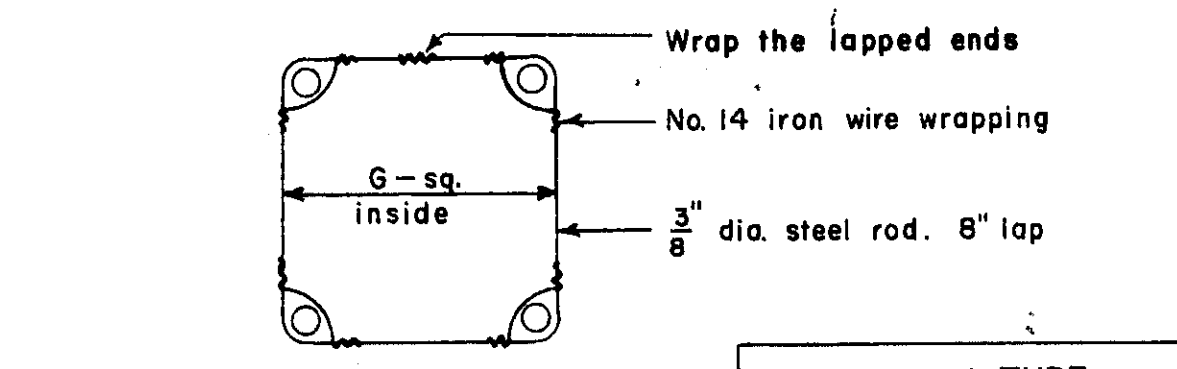


DETAIL - N ANCHOR BOLTS & TIE ROD

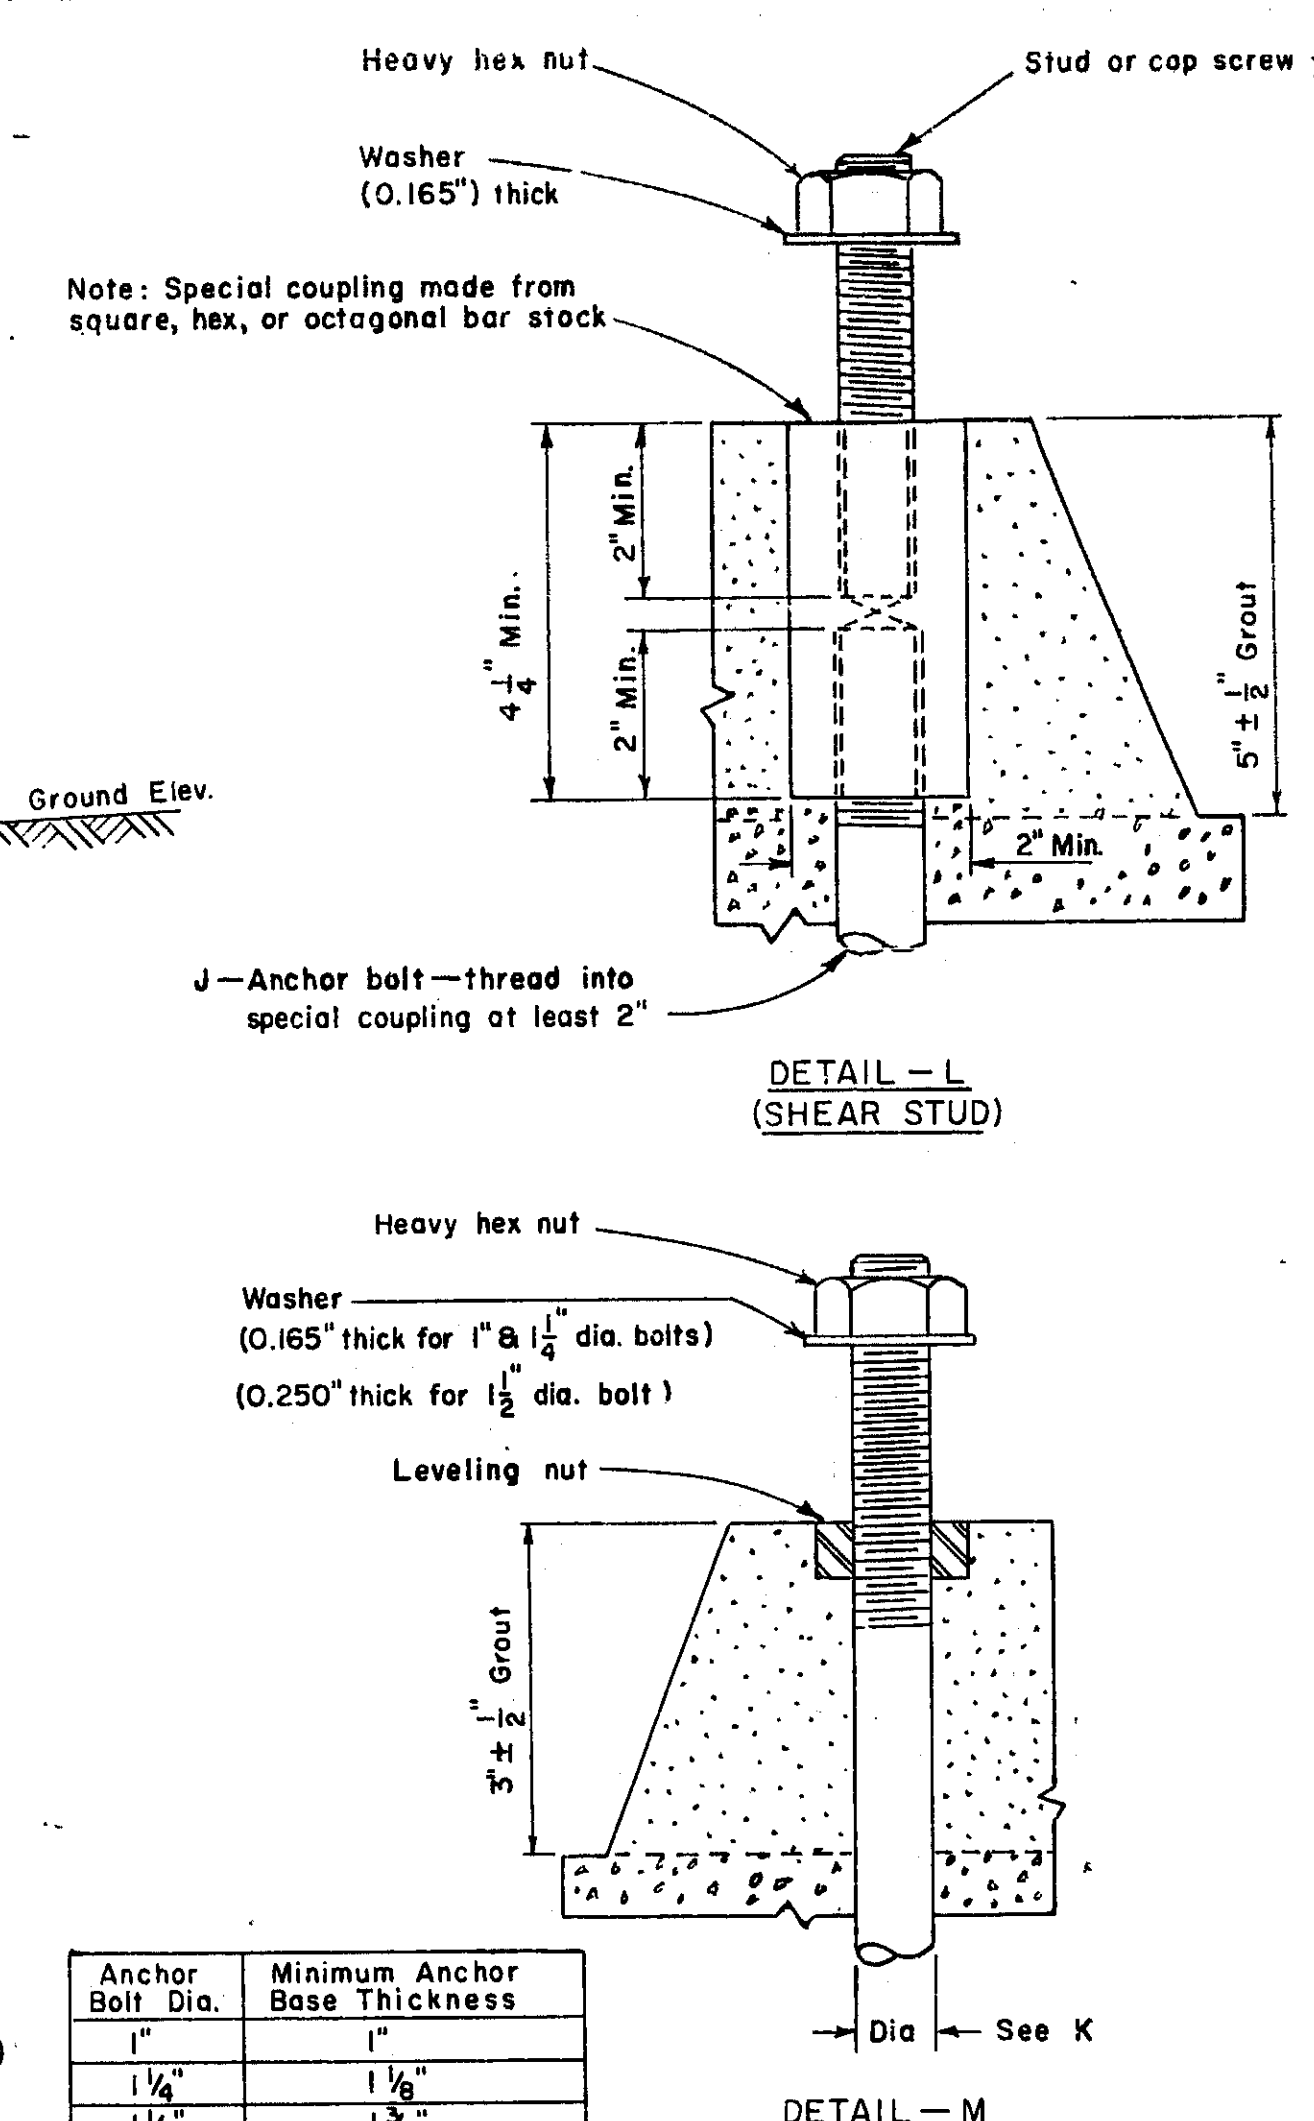

ANCHOR BASE THICKNESS CHART

Anchor Bolt Dia.	Minimum Anchor Base Thickness
1"	1"
1 1/4"	1 1/8"
1 1/2"	1 3/8"

TYPE	A	B	D	E	F	G	H	Ga. (min.)	J	K
Mercury vapor or incandescent transformer base for 30 ft. mounting height.	11"	7 1/2"	1'-7"	1'-9"	6'-0"	8 3/4"	2 5/8"	see note 6		see note 7
Mercury vapor anchor base for 30 ft. mounting height and 4 or 6 ft. single or double bracket arm.	11"	7 1/4"	1'-7"	1'-9"	5'-0"	8 1/4"	2 1/8"	11	1" x 3'-4"	1" x 3'-9"
Mercury vapor anchor base for 30 ft. mounting height and 8, 10, 12 ft. single or double bracket arm.	11"	7 1/4"	1'-7"	1'-9"	6'-0"	8 1/4"	2 1/8"	11	1" x 5'-0"	1" x 5'-0"
Mercury vapor anchor base for 30 ft. mounting height and 17 ft. single or double bracket arm.	11"	7 1/4"	1'-7"	1'-9"	6'-0"	9"	3"	7		1 1/4" x 5'-0"
Mercury vapor anchor base for 30 ft. mounting height and 15 ft. single or double bracket arm.	11"	7 1/4"	1'-7"	1'-9"	6'-0"	8 3/4"	2 5/8"	7	1" x 5'-0"	1" x 5'-0"
Mercury vapor or incandescent transformer base for 40 & 45 ft. mounting height.	1'-5 1/2"	1'-0 3/4"	2'-0"	2'-2"	8'-6"	1'-11 1/8"	3 1/2"	see note 6		see note 7
Mercury vapor anchor base for 40 & 45 ft. and 4, 6, 8, 10, 12, 15, 17 ft. single or double bracket arm.	1'-1"	9 1/4"	2'-0"	2'-2"	8'-6"	10 3/4"	3 1/2"	11 Ga. up to 15' Brkt. Arm 7 Ga. for 17' Brkt. Arm		1 1/2" x 5'-0"

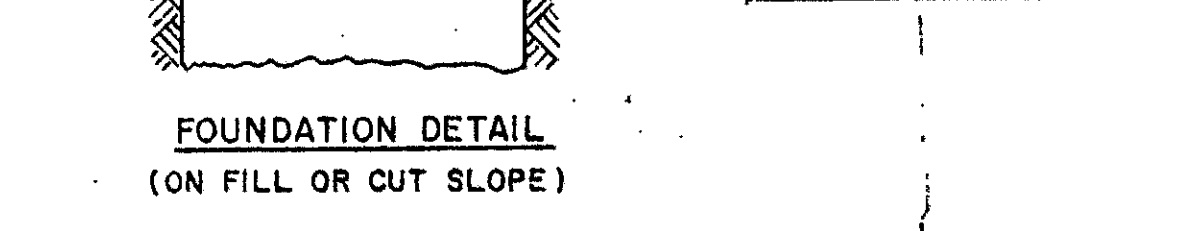



FOUNDATION DETAIL (ON FILL OR CUT SLOPE)

- NOTES:**
- All materials and workmanship shall be in accordance with the current Michigan Department of State Highways Supplemental Specifications For Electrical Construction.
 - Use detail "M" anchor bolts unless shear studs are specified in the plans. Anchor bolt length "J" or "K" is length before bending. Final standard adjustment shall be leveled by use of galvanized sheet steel shims if required.
 - Supply bracket arm fitters for each arm used only.
 - Supply 1/8" elastomeric fabric bound pad for mounting between street light standard base and foundation on bridge mounted units (incidental).
 - Cast steel or hot rolled plate anchor bases shall have a thickness as shown in Chart below.
 - Standards mounted on transformer bases shall have the same dimensions as anchor base types, except shaft length.
 - Use the same anchor bolts for transformer base as for corresponding anchor base types.
 - For grounding Light Standards see Light Standard Grounding Details sheet.
 - Bolt circle dimension "A" for Anchor Bolts must be exact. Anchor Bolts are to be set to a template.
 - Non metallic Conduit for Foundation shall be asbestos cement, plastic, or bituminized fiber. Metallic Conduit shall be rigid galvanized steel. In lieu of Conduit, a raceway formed by a Murray Hose is acceptable. Conduit of whatever material, if used, is incidental to the Light Standard.
 - If octagonal Foundation top is used, top of Foundation must extend 1" min. outside of Light Standard Base.



**MICHIGAN DEPARTMENT OF STATE HIGHWAYS
ELECTRICAL DETAILS
STEEL LIGHT STANDARDS
FOR 30, 40, & 45 FT. MOUNTING HEIGHTS**

NO.	DESCRIPTION	DATE	BY


DRAWN BY: T. J. J. 1967
 CHECKED BY: D. W. 1-1-67
 SHEET 27 OF 27
63174
 JOB NO. **08517A**

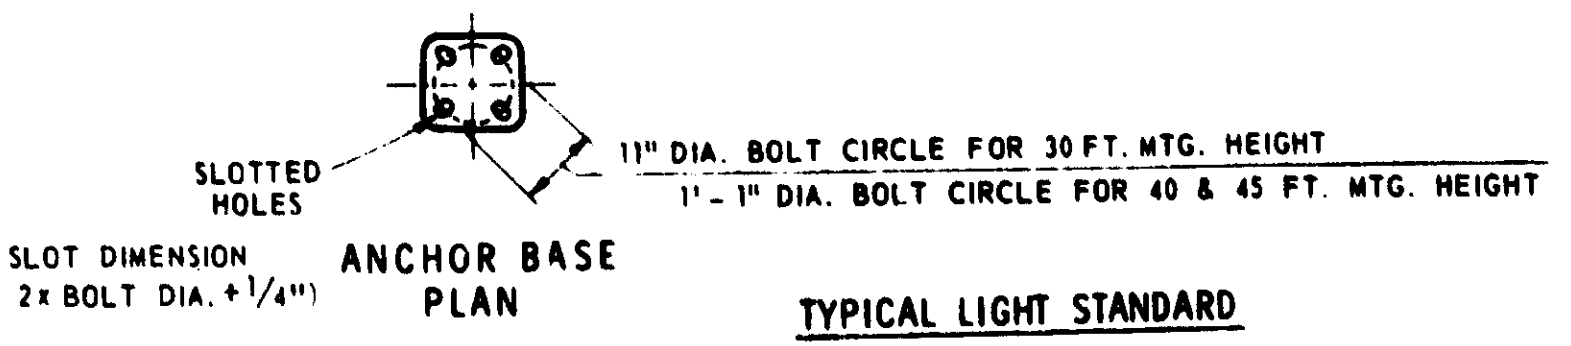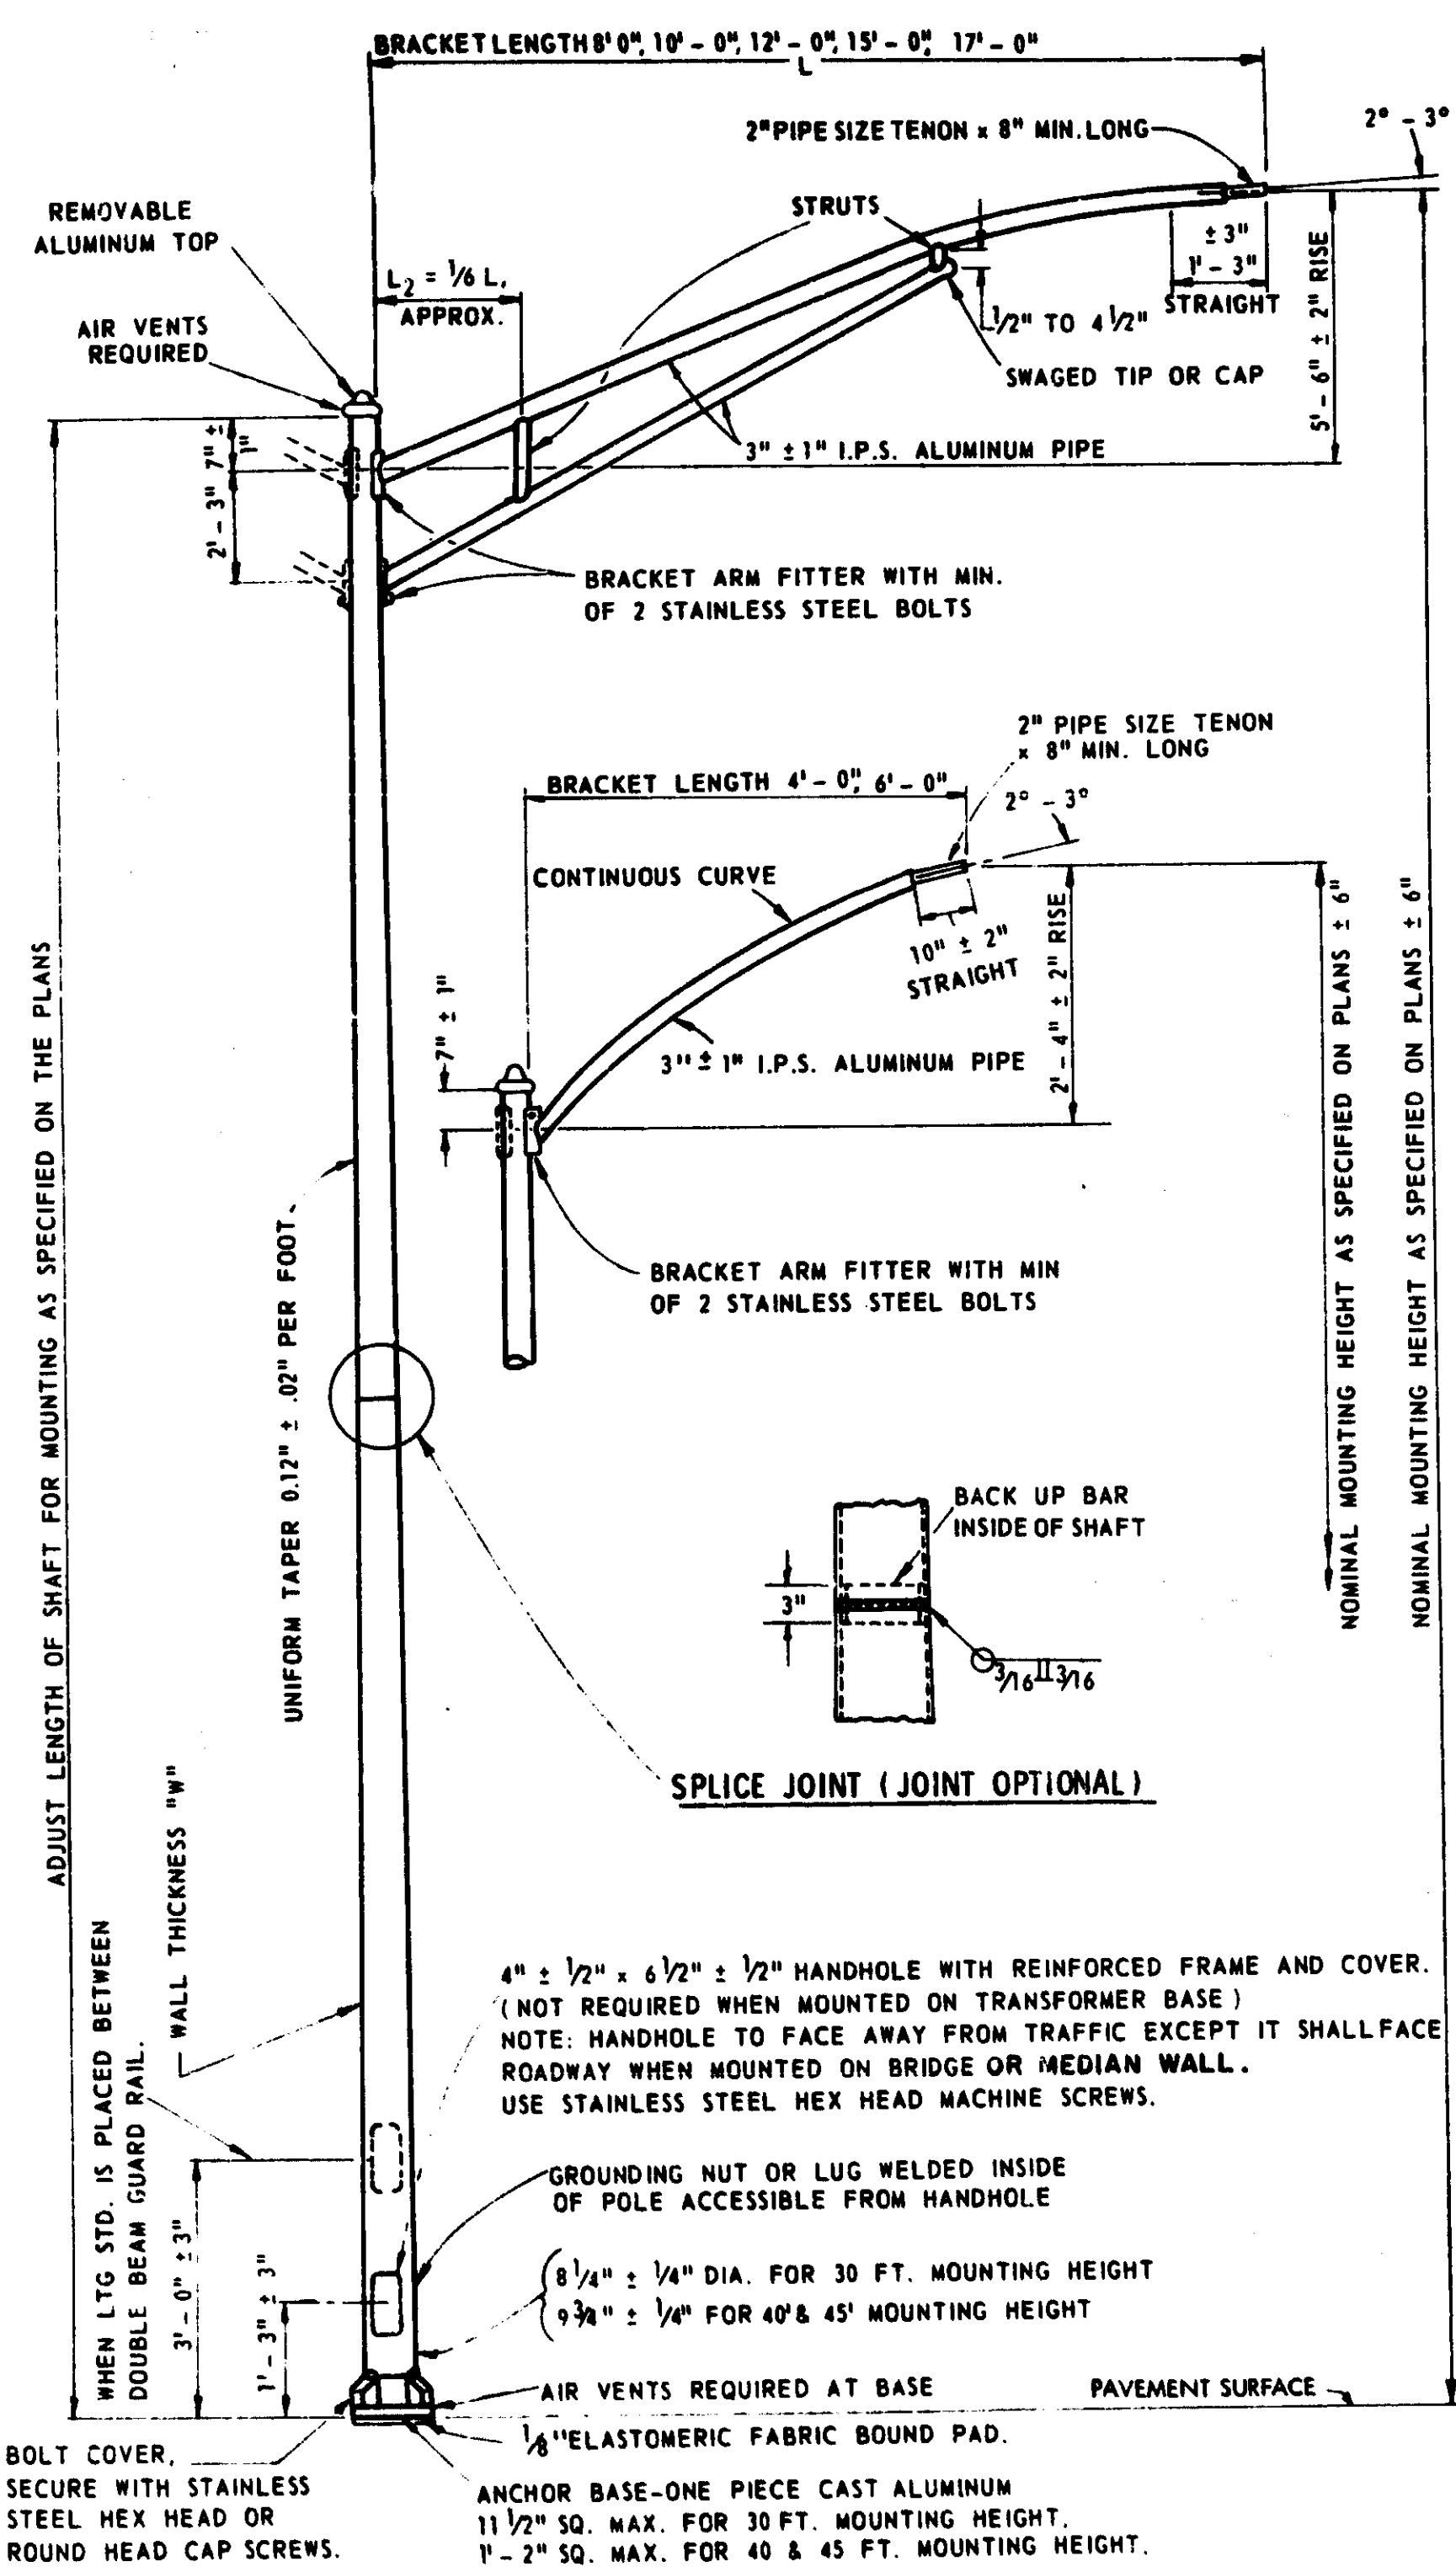

TYPICAL LIGHT STANDARD
DESIGN FOR MERCURY AND
INCANDESCENT LUMINAIRES

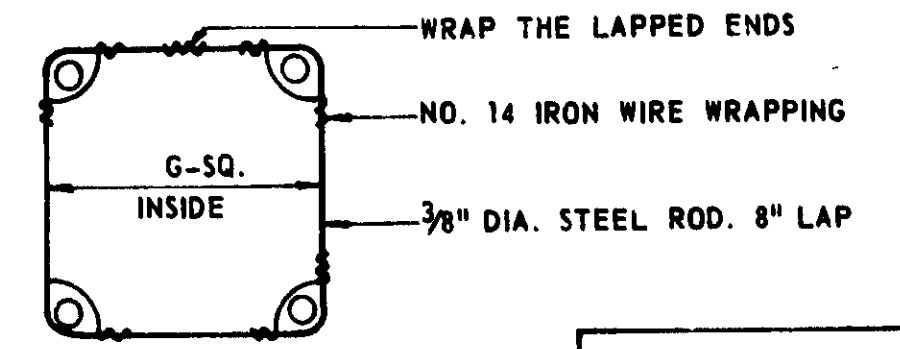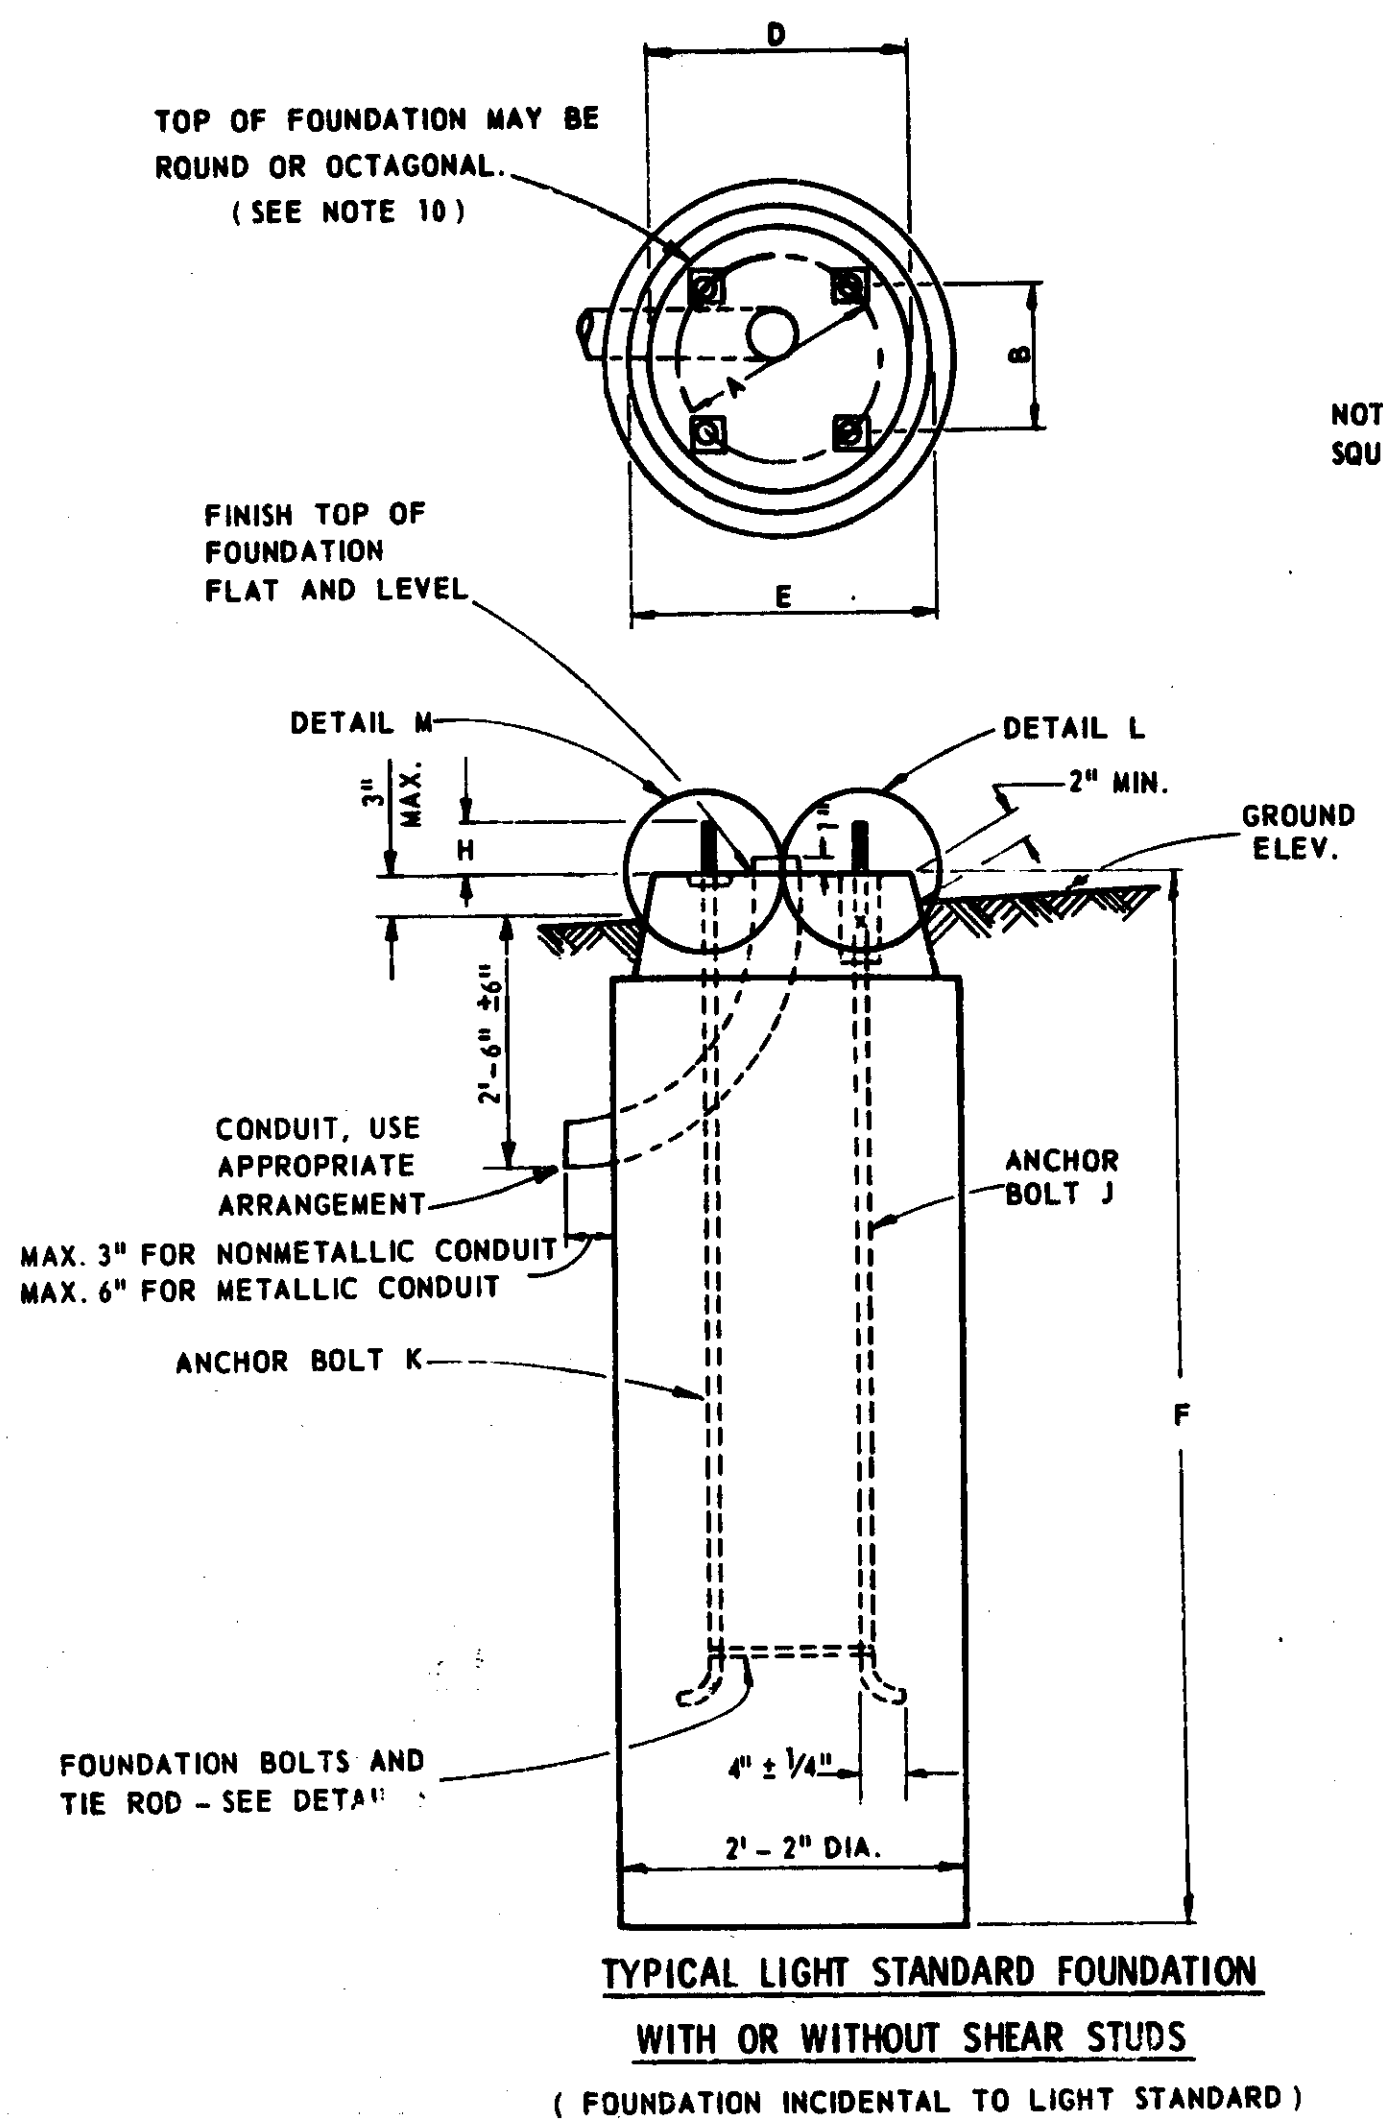

DETAIL - N
ANCHOR BOLTS
& TIE RODS

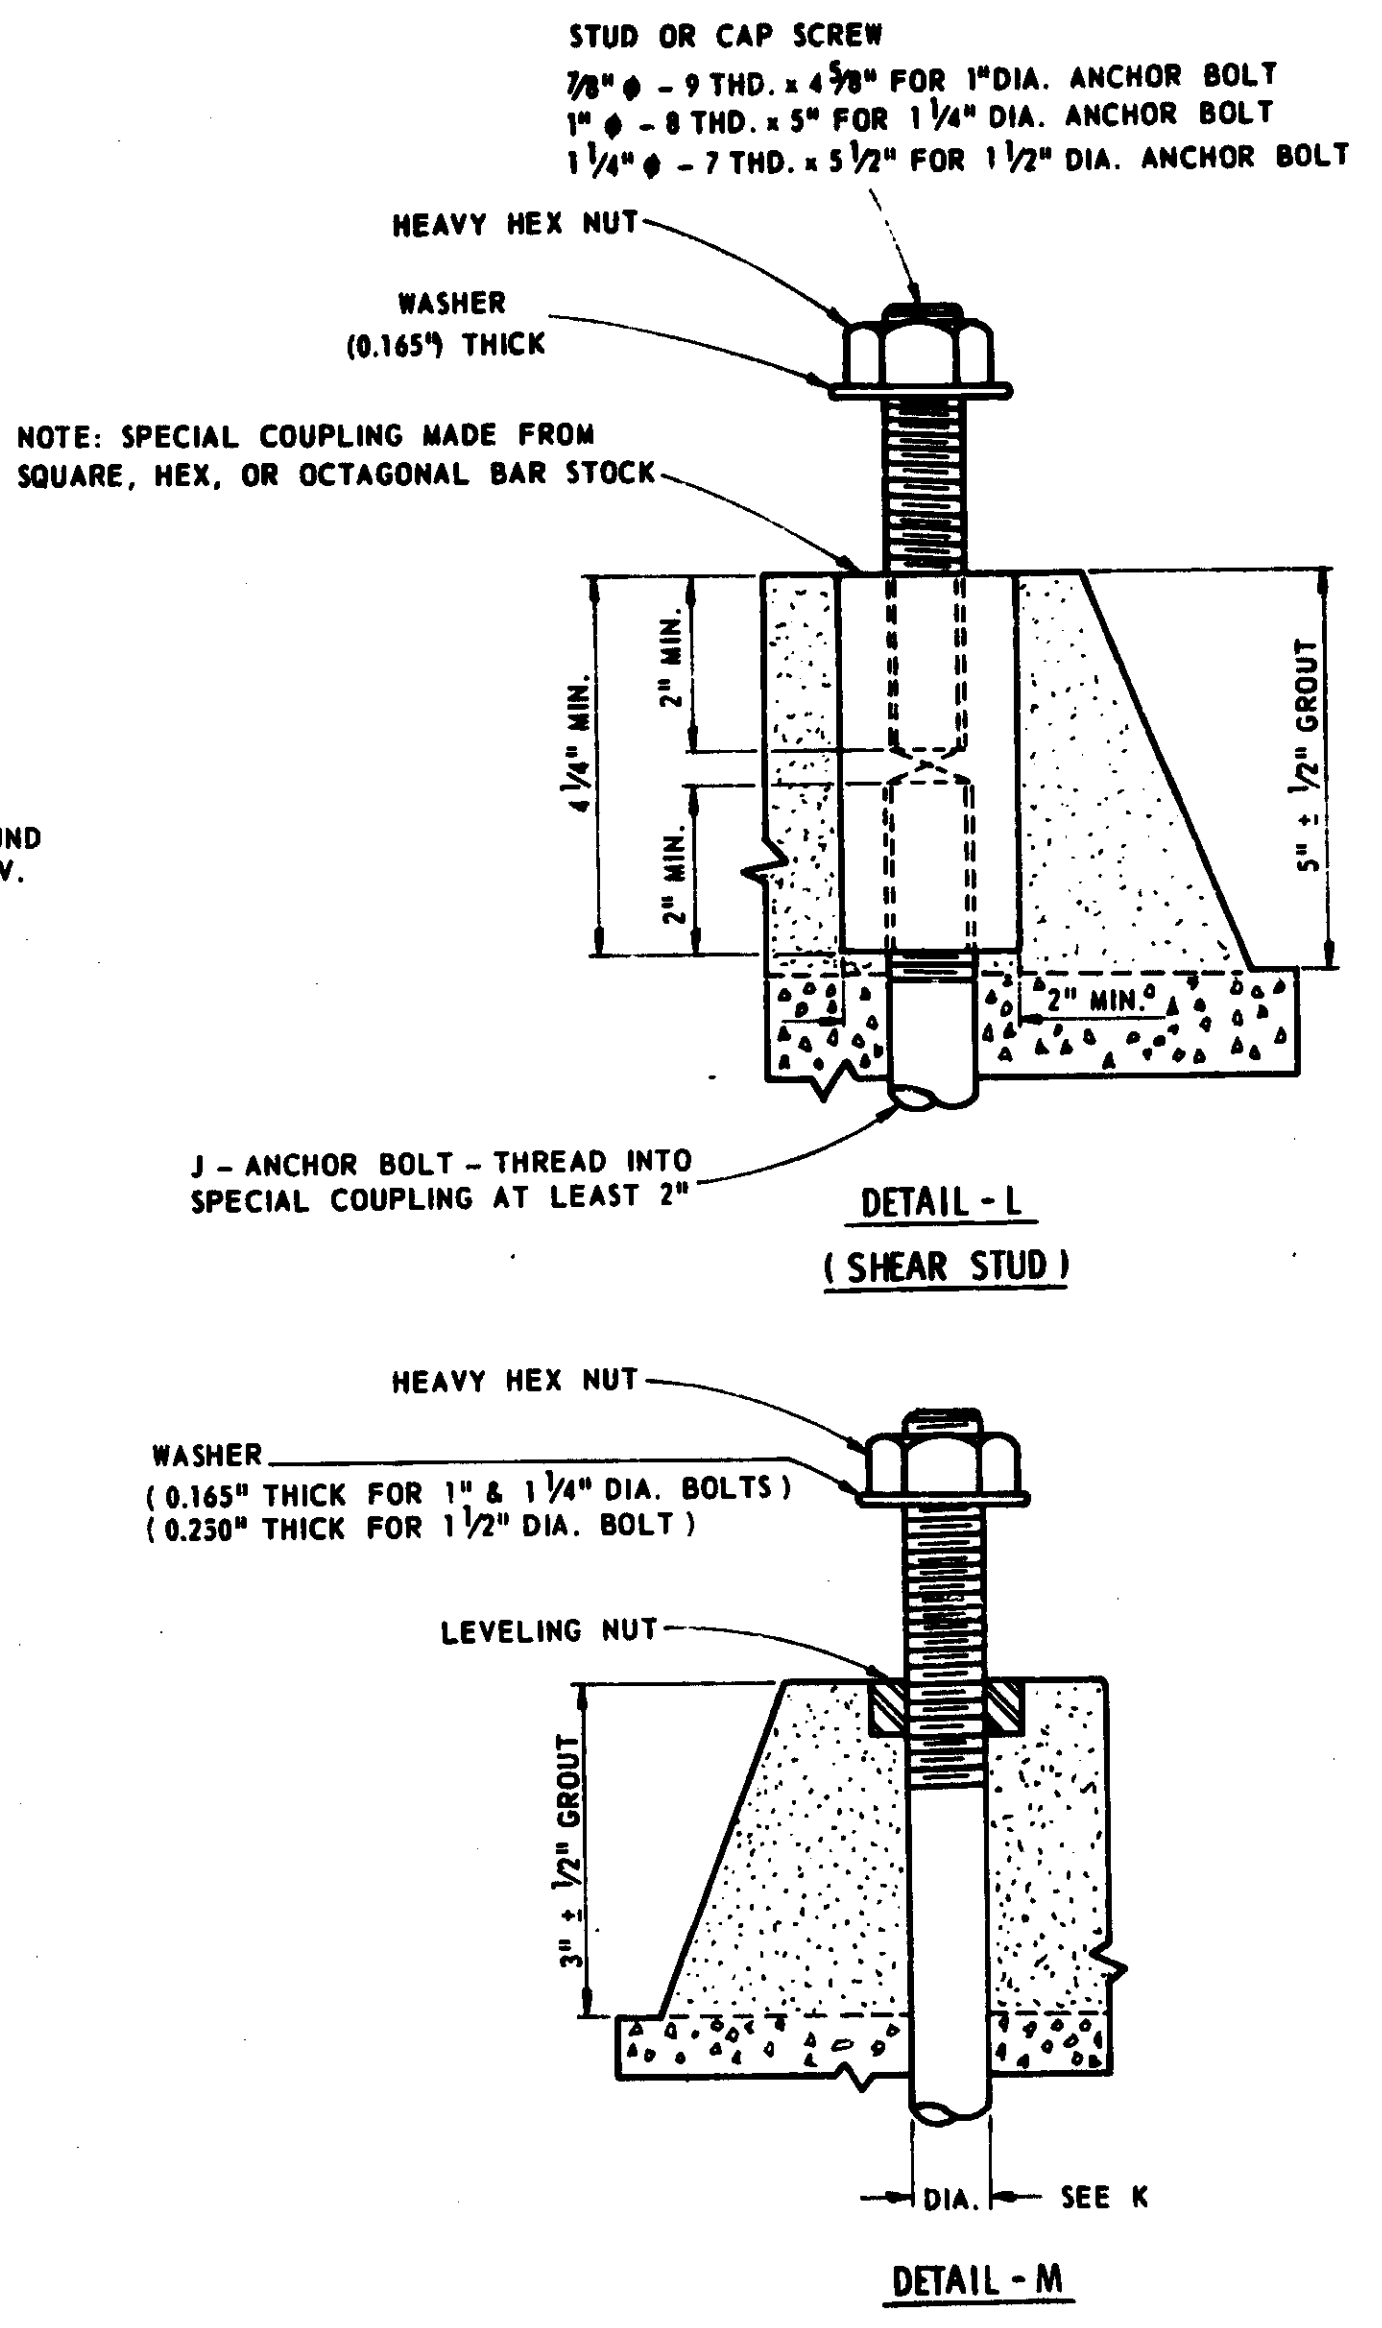

- NOTES:
1. ALL MATERIALS AND WORKMANSHIP SHALL BE IN ACCORDANCE WITH THE CURRENT MICHIGAN DEPARTMENT OF STATE HIGHWAYS SPECIFICATIONS FOR ELECTRICAL CONSTRUCTION.
 2. USE DETAIL "M" ANCHOR BOLTS UNLESS SHEAR STUDS ARE SPECIFIED IN THE PLANS. ANCHOR BOLT LENGTH "J" OR "K" IS LENGTH BEFORE BENDING. FINAL STANDARD ADJUSTMENT SHALL BE LEVELED BY USE OF GALVANIZED SHEET STEEL SHIMS IF REQUIRED.
 3. SUPPLY BRACKET ARM FITTERS FOR EACH ARM USED ONLY.
 4. PLACE 1/8" ELASTOMERIC FABRIC BOUND PAD FOR MOUNTING ONLY BETWEEN STREET LIGHT STANDARD BASE AND FOUNDATION.
 5. STANDARDS MOUNTED ON TRANSFORMER BASES SHALL HAVE THE SAME DIMENSIONS AS ANCHOR BASE TYPES, EXCEPT SHAFT LENGTH.
 6. USE THE SAME ANCHOR BOLTS FOR TRANSFORMER BASE AS FOR CORRESPONDING ANCHOR BASE TYPES.
 7. FOR GROUNDING LIGHT STANDARDS SEE LIGHT STANDARD GROUNDING DETAILS SHEET.
 8. BOLT CIRCLE DIMENSION "A" FOR ANCHOR BOLTS MUST BE EXACT. ANCHOR BOLTS ARE TO BE SET TO A TEMPLATE.
 9. NON METALLIC CONDUIT FOR FOUNDATION SHALL BE ASBESTOS CEMENT, PLASTIC, OR BITUMINIZED FIBER. METALLIC CONDUIT SHALL BE RIGID GALVANIZED STEEL. IN LIEU OF CONDUIT, A RACEWAY FORMED BY A MURRAY HOSE IS ACCEPTABLE. CONDUIT OF WHATEVER MATERIAL, IF USED, IS INCIDENTAL TO THE LIGHT STANDARD.
 10. IF OCTAGONAL FOUNDATION TOP IS USED, TOP OF FOUNDATION MUST EXTEND 1" MIN. OUTSIDE OF LIGHT STANDARD BASE, OR T-BASE

TYPE	A	B	D	E	F	G	H	W. (min.)	J	K
MERCURY VAPOR OR INCANDESCENT TRANSFORMER BASE FOR 30 FT. MOUNTING HEIGHT.	11"	7 3/4"	1' - 7"	1' - 9"	6' - 0"	8 3/4"	2 3/8"	SEE NOTE 5		SEE NOTE 6
MERCURY VAPOR ANCHOR BASE FOR 30 FT. MOUNTING HEIGHT AND 4 OR 6 FT. SINGLE OR DOUBLE BRACKET ARM.	11"	7 3/4"	1' - 7"	1' - 9"	5' - 0"	8 3/4"	2 3/8"	.188"	1" φ x 3' - 0"	1" φ x 3' - 0"
MERCURY VAPOR ANCHOR BASE FOR 30 FT. MOUNTING HEIGHT AND 8, 10, 12, 15 FT. SINGLE OR DOUBLE BRACKET ARM.	11"	7 3/4"	1' - 7"	1' - 9"	6' - 0"	8 3/4"	2 3/8"	.188" SGL. BKT. ARM 219" DBL. BKT. ARM	1" φ x 5' - 0"	1" φ x 5' - 0"
MERCURY VAPOR ANCHOR BASE FOR 30 FT. MOUNTING HEIGHT AND 17 FT. SINGLE OR DOUBLE BRACKET ARM.	11"	7 3/4"	1' - 7"	1' - 9"	6' - 0"	9"	3"	.188" SGL. BKT. ARM 219" DBL. BKT. ARM		1 1/2" φ x 5' - 0"
MERCURY VAPOR OR INCANDESCENT TRANSFORMER BASE FOR 40 & 45 FT. MOUNTING HEIGHT.	1' - 5 1/2"	1' - 0 3/4"	2' - 0"	2' - 2"	8' - 6"	1' - 1 1/4"	3 1/2"	SEE NOTE 5		SEE NOTE 6
MERCURY VAPOR ANCHOR BASE FOR 40 FT. MOUNTING HEIGHT AND 4, 6, 8, 10, 12, 15, 17 FT. SINGLE OR DOUBLE BRACKET ARM.	1' - 1"	9 1/4"	2' - 0"	2' - 2"	8' - 6"	10 3/4"	3 1/2"	.188" SGL. BKT. ARM 219" DBL. BKT. ARM		1 1/2" φ x 5' - 0"
MERCURY VAPOR ANCHOR BASE FOR 45 FT. MOUNTING HEIGHT AND 4, 6, 8, 10, 12, 15, 17 FT. SINGLE OR DOUBLE BRACKET ARM.	1' - 1"	9 1/4"	2' - 0"	2' - 2"	8' - 6"	10 3/4"	3 1/2"	219" LOWER SECTION 188" UPPER SECTION		1 1/2" φ x 5' - 0"

MICHIGAN DEPARTMENT OF STATE HIGHWAYS
ELECTRICAL DETAILS
ALUMINUM LIGHT STANDARDS
FOR 30, 40 & 45 FT. MOUNTING HEIGHTS

E-4

APPR. DATE

DESIGNED BY: DW 1-8-68


CHECKED BY: DW 1-8-68

NO. 28


63174

JOB NO. 08517A



REVISIONS	DATE	BY

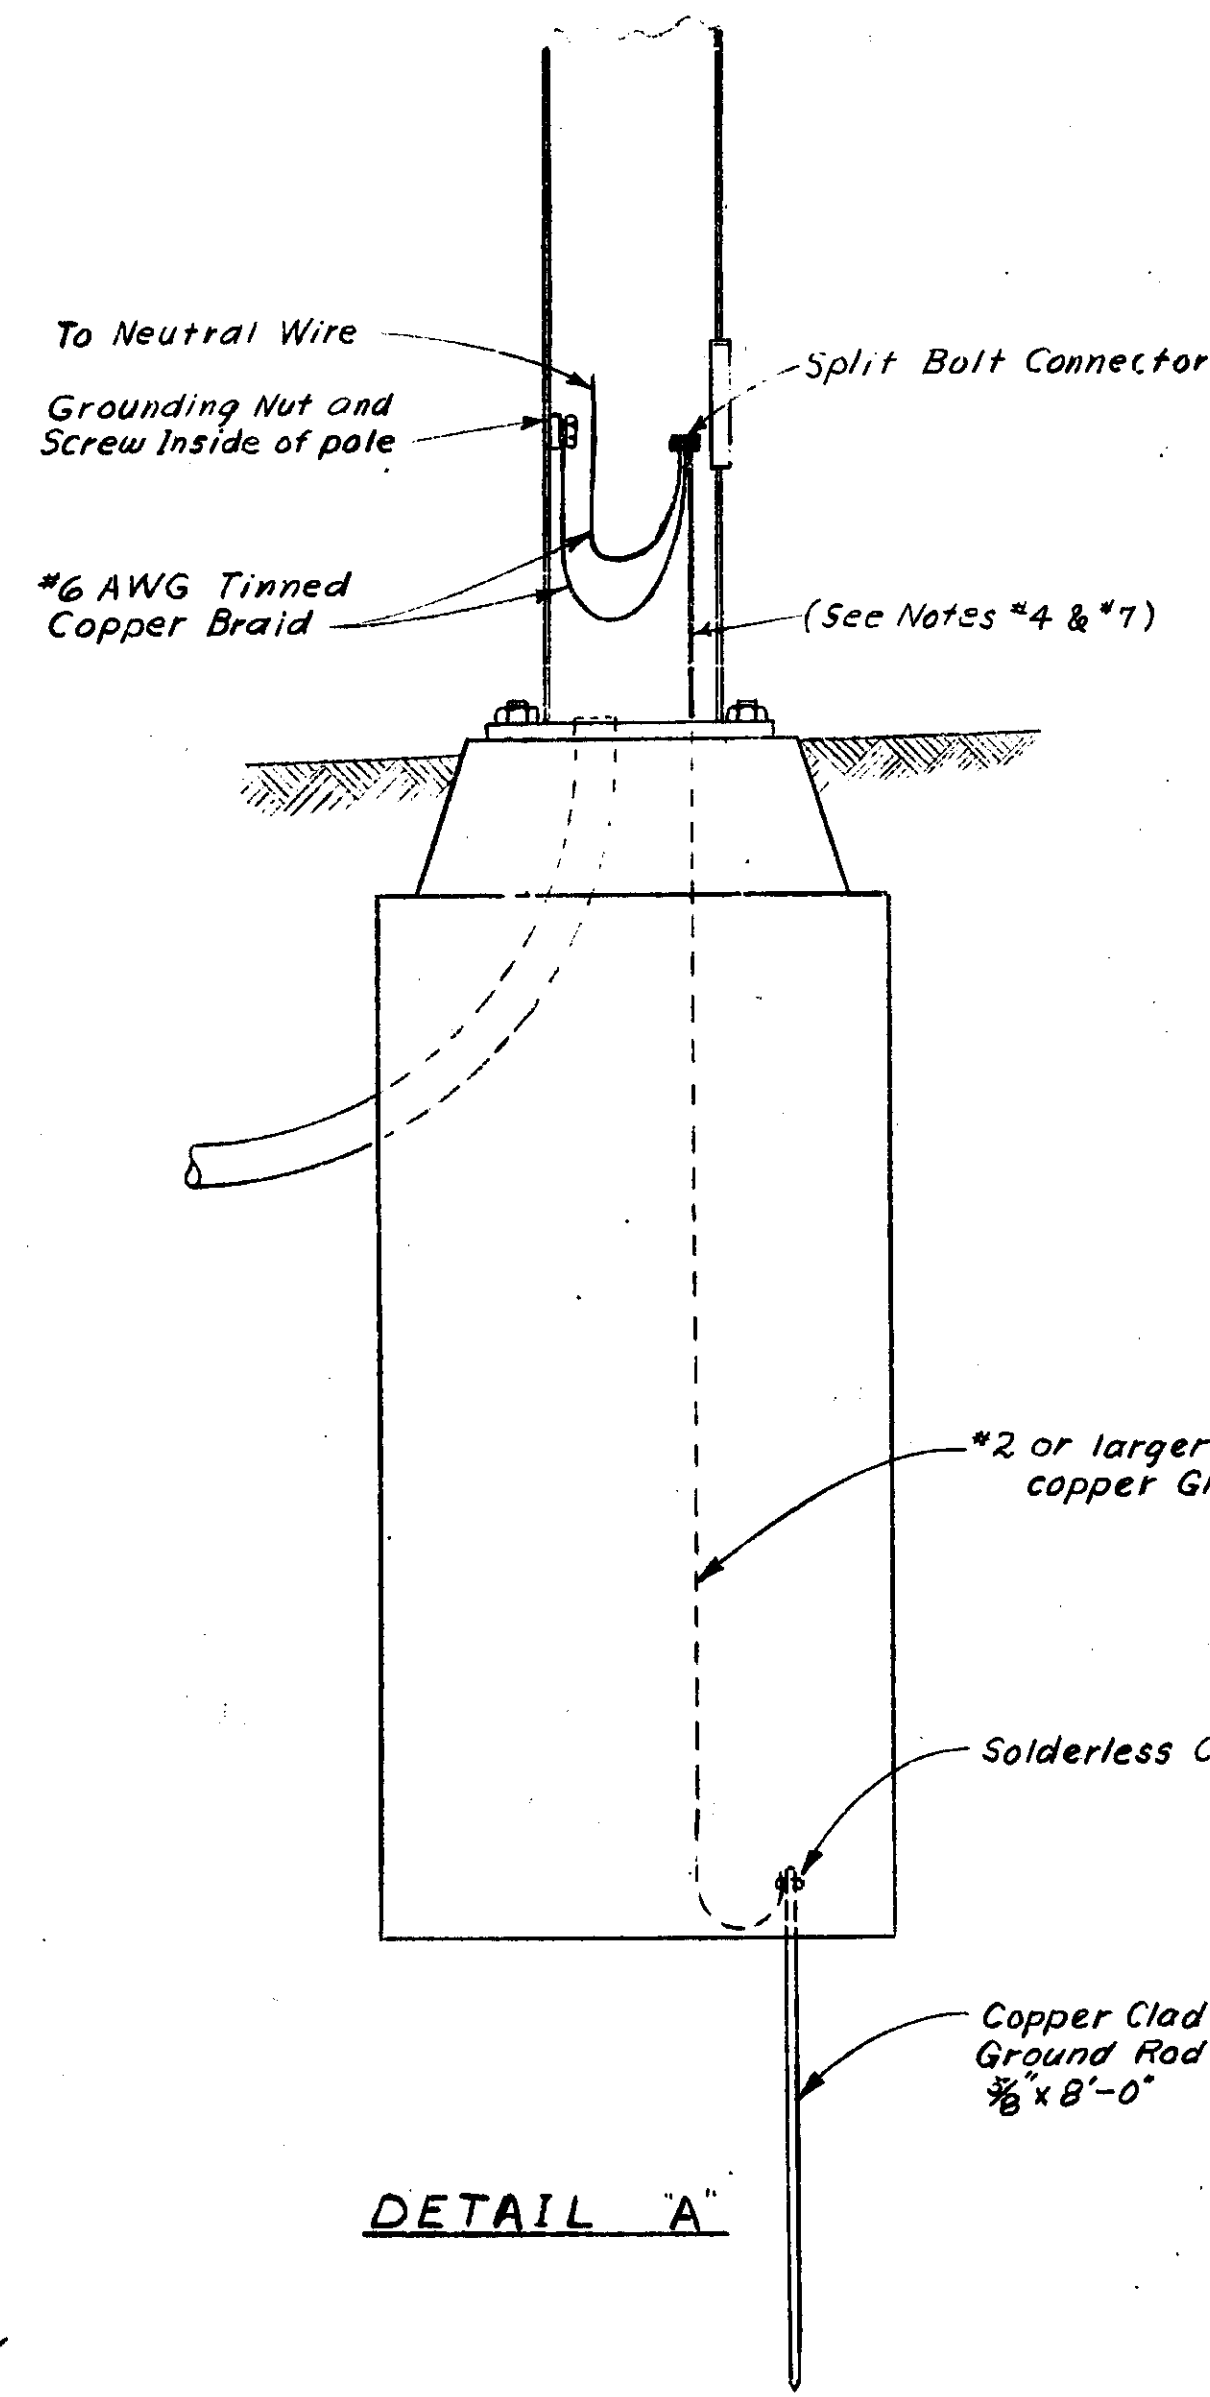

DETAIL A

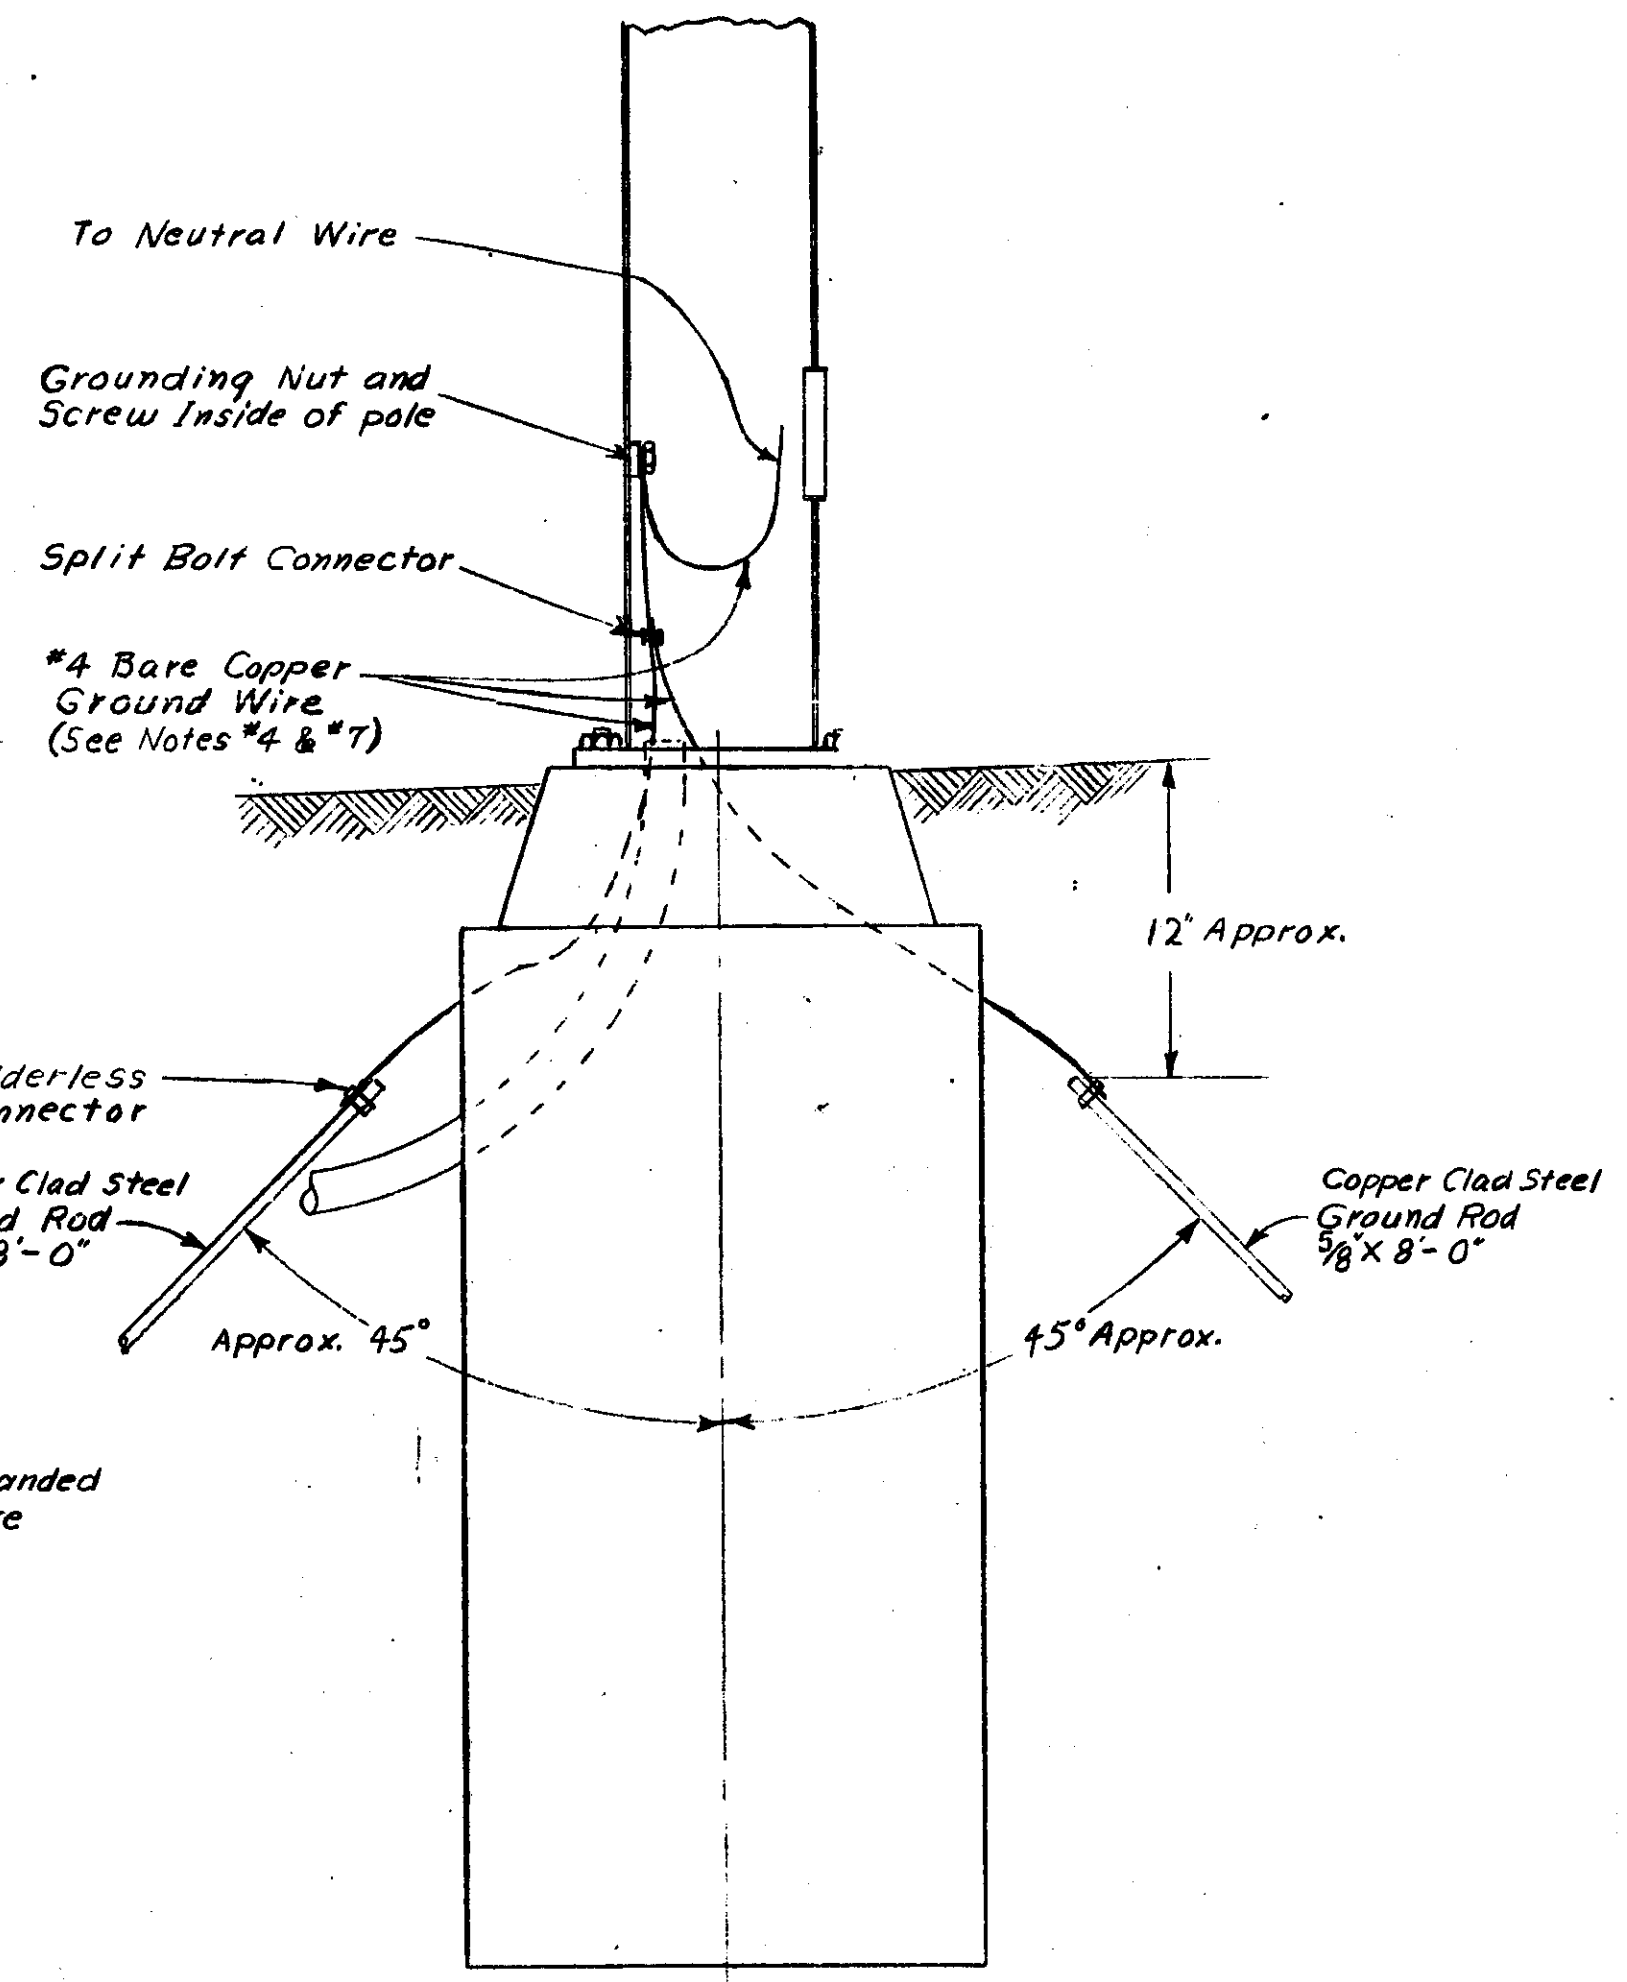

DETAIL B

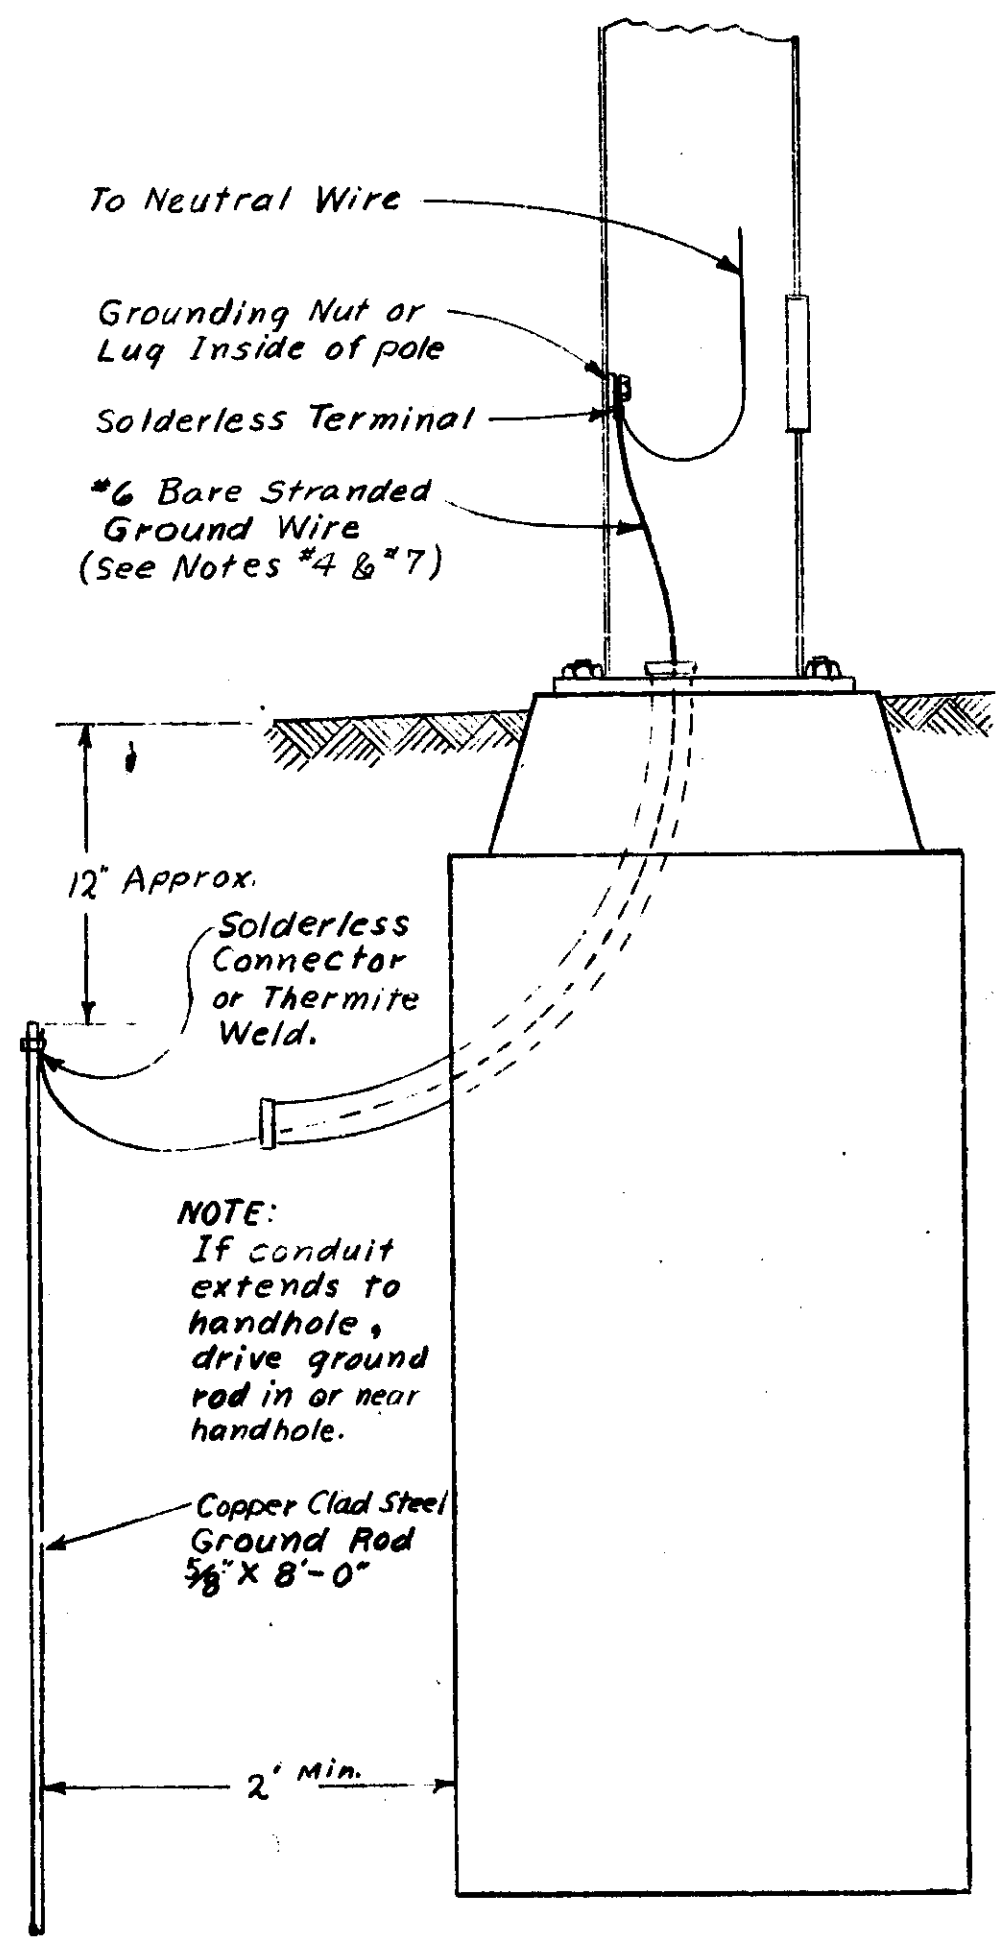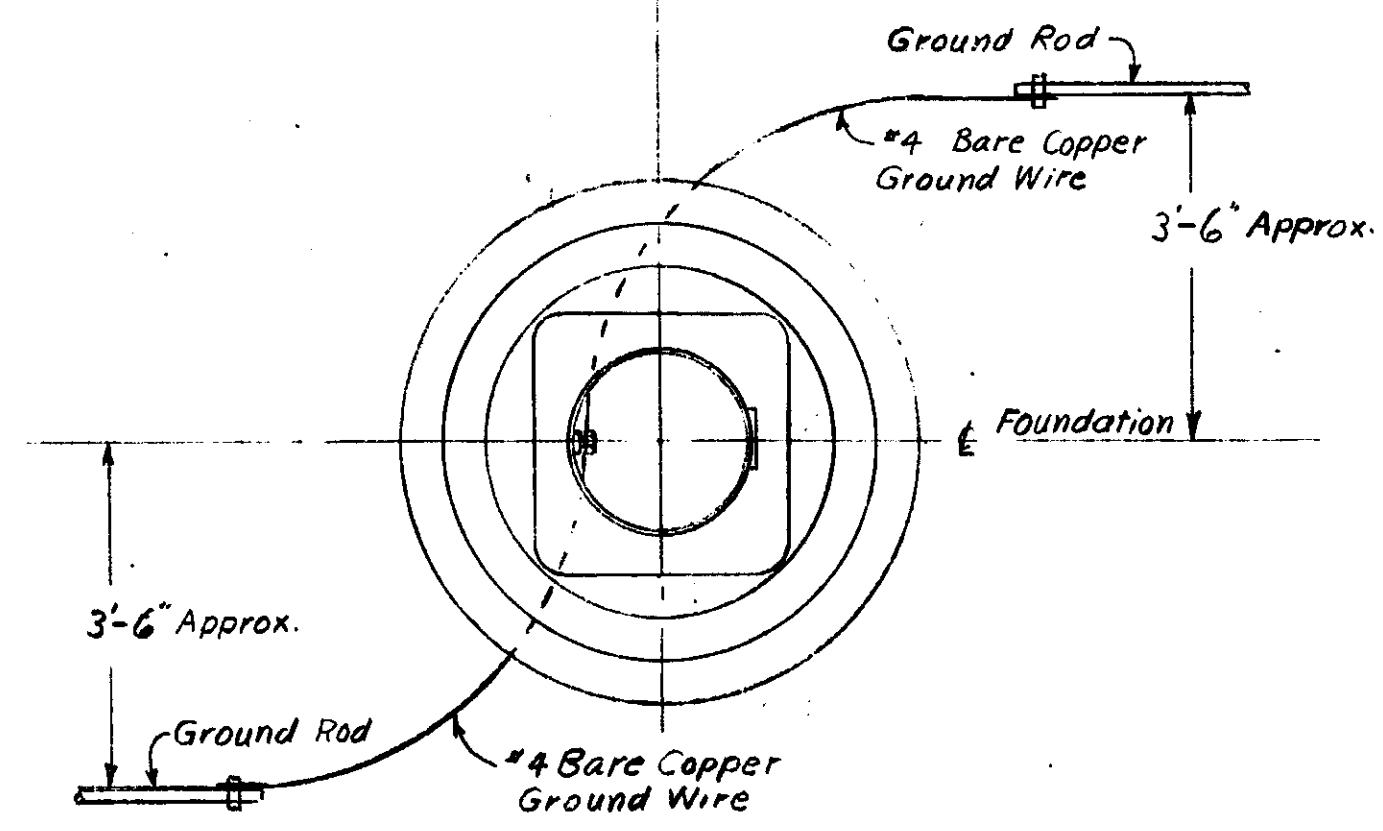


DETAIL C

- NOTES:
1. Detail 'A' is to be used for Lighting Standards maintained by City of Detroit Public Lighting Commission.
 2. ~~Detail 'B' is to be used for Lighting Standards maintained by Detroit Edison Co.~~
 3. Detail 'C' is to be used for Lighting Standards maintained by other than P.L.C.
 4. If Frangible Base is used between foundation and pole base, increase length of ground wire above foundation by height of Frangible Base.
 5. Ground Lighting Standards on bridges, retaining walls, and other structures by #6 copper bare or green insulated wire. Connect to ground rods driven near structure, to nearest ground of lighting system or to structural steelwork (if steelwork is grounded).
 6. Resistance of grounding electrodes shall be in accordance with The National Electrical Code.
 7. Ground wire shall be stranded soft drawn copper wire per A.S.T.M. B8.


MICHIGAN DEPARTMENT OF STATE HIGHWAYS
LIGHTING STANDARD GROUNDING DETAILS

E-7			
APPR. DATE			
DRAWN BY T Jildek 1-9-67			
CHECKED BY D Wincup 12-11-67			
SHEET 29 OF			
63174			
JOB NO. 08517A			


ENTRANCE HOLES AS REQUIRED FOR 3" & 4" CONDUIT CONDUIT ARRANGEMENT MAY BE MODIFIED. ADDITIONAL OPENINGS SHALL BE PROVIDED AS REQUIRED. SEE PLANS. PLUG ALL UNUSED ENTRANCE HOLES AND SEAL AROUND HOLES ENTERED.

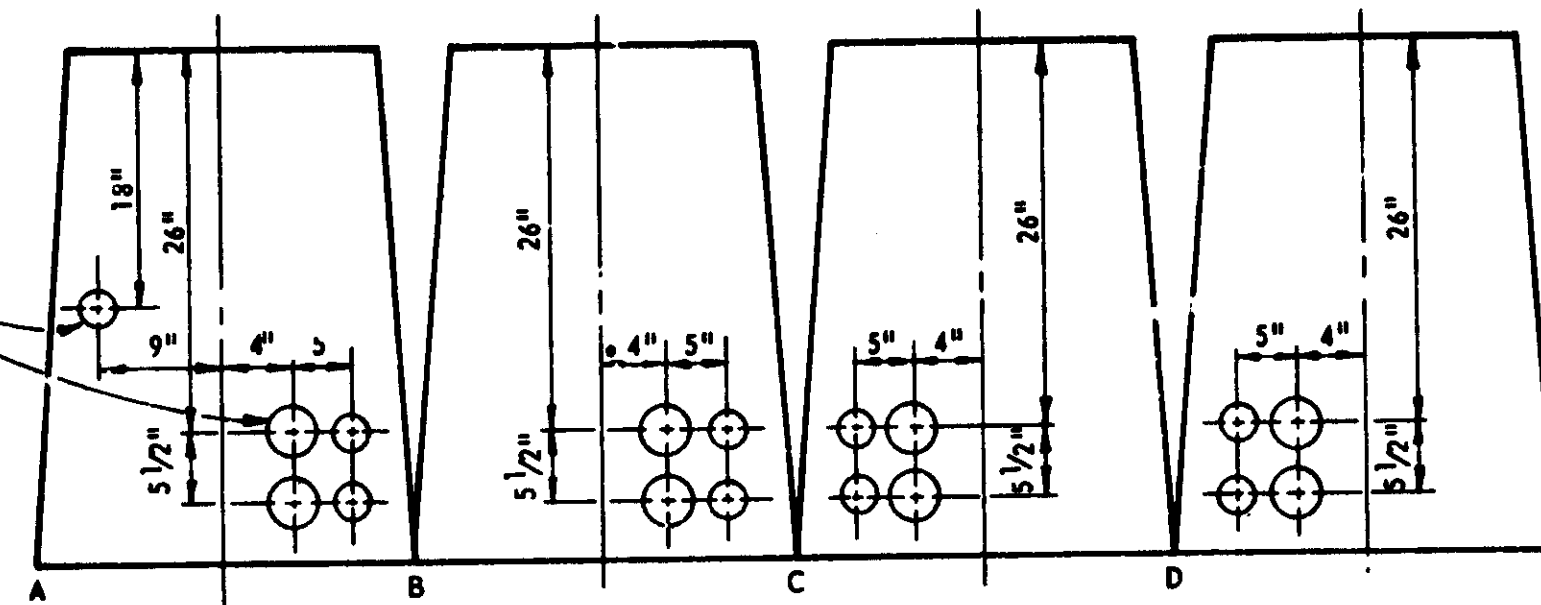

INTERIOR WALL ELEVATIONS-LIGHT AND HEAVY DUTY COVER TYPES

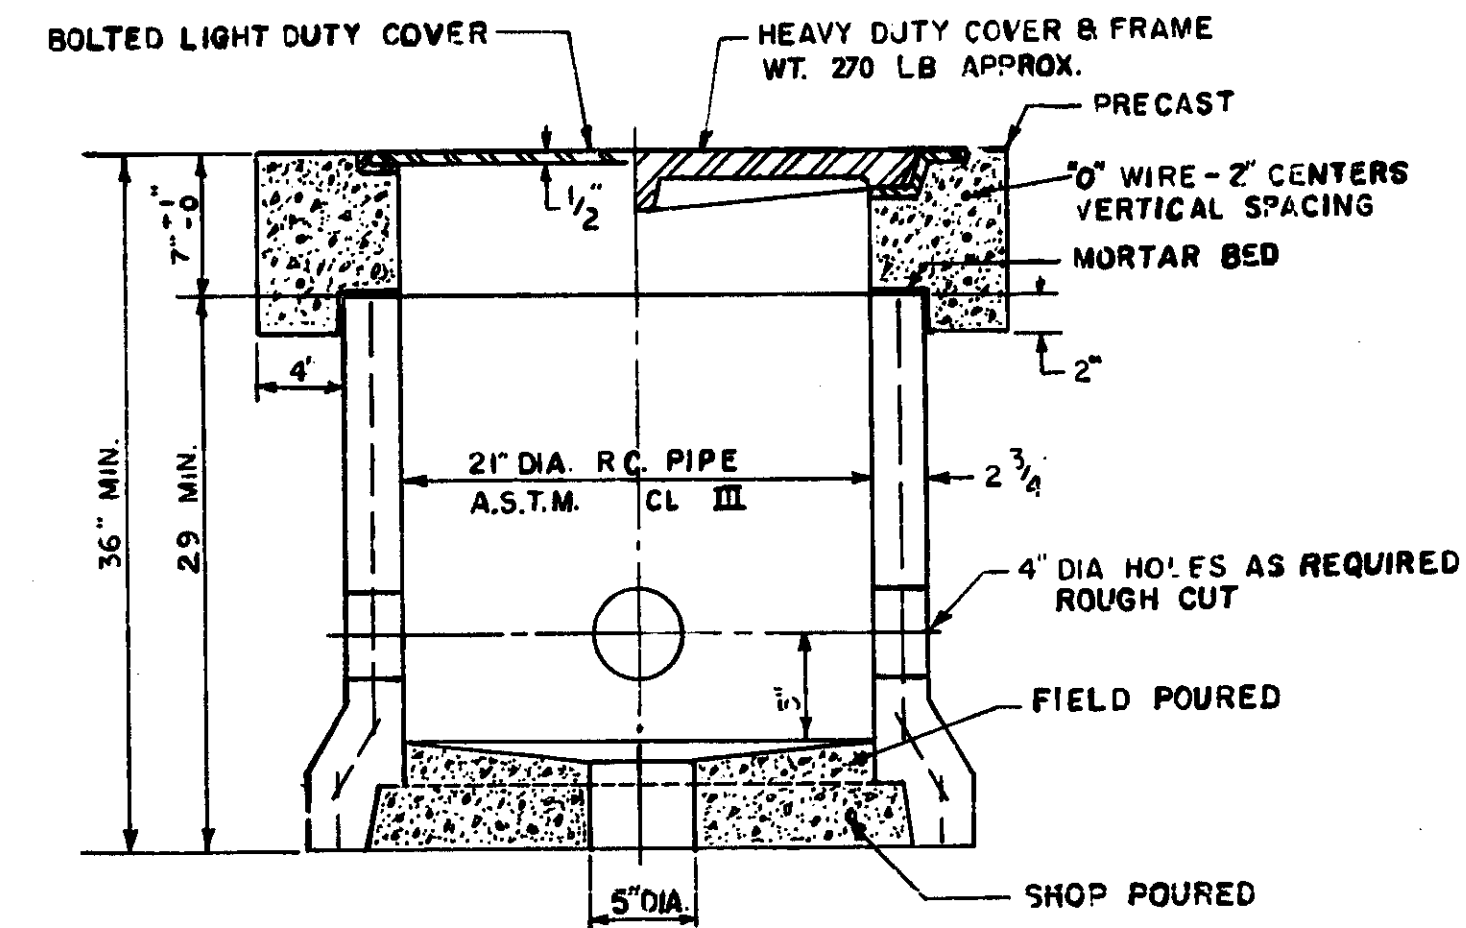


ALTERNATE PRECAST CONCRETE HANDHOLE USING R.C. PIPE

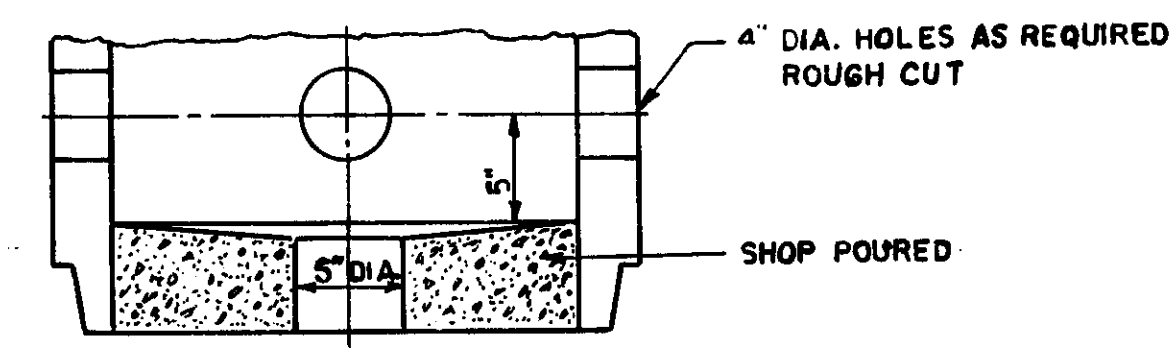


USE OF OPPOSITE END OF PIPE (ALL OTHER DIMENSIONS SAME)


NOTES:
 THE MATERIAL AND WORKMANSHIP SHALL BE IN ACCORDANCE WITH THE CURRENT M.D.S.H. STANDARD SPECIFICATIONS.
 THE CONTRACTOR MAY CONSTRUCT THE HANDHOLE STRUCTURE OF BRICK, CEMENT CONCRETE MASONRY, OR OF PRECAST REINFORCED CONCRETE.
 ALL CONCRETE MASONRY SHALL BE GRADE C.
 THE INNER SURFACE OF THE HANDHOLE SHALL BE SMOOTH.
 HEAVY DUTY COVERS SHALL BE CASTINGS WHICH MEET THE REQUIREMENTS OF THE CURRENT SPECIFICATIONS FOR GRAY IRON CASTINGS ASTM DESIGNATION A48 AND SHALL HAVE A MINIMUM STRENGTH AS PROVIDED FOR CLASS NO. 30 GRAY IRON CASTING.
 ALL CASTINGS SHALL BE CLEANED BY SAND BLASTING.
 THE SEATING FACE OF THE COVER AND THE SEAT FOR SAME ON THE FRAME IF REQUIRED, SHALL BE GROUND OR MACHINED SO THAT THE COVER SHALL HAVE AN EVEN BEARING ON ITS SEAT TO PREVENT ROCKING OR TILTING.
 THE CASTINGS SHALL BE FREE OF POURING FAULTS, BLOW HOLES, CRACKS, AND OTHER IMPERFECTIONS. THEY SHALL BE SOUND, TRUE TO FORM AND THICKNESS, CLEAN AND NEATLY FINISHED, AND SHALL BE COATED WITH COAL TAR PITCH VARNISH.
 LIGHT DUTY COVER SHALL BE BOLTED TO FRAME WITH NOT LESS THAN 2 COUNTERSUNK HEX HEAD BRONZE BOLTS.
 PRECAST HANDHOLE WITH HEAVY DUTY COVER SHALL BE SET ON A CONCRETE SLAB SIMILAR TO DETAIL FOR BRICK HANDHOLE.
 THE HEAVY DUTY COVER & FRAME SHALL BE EAST JORDAN IRON WORKS #8206, NEENAH FOUNDRY #R-6662-HP OR APPROVED EQUAL

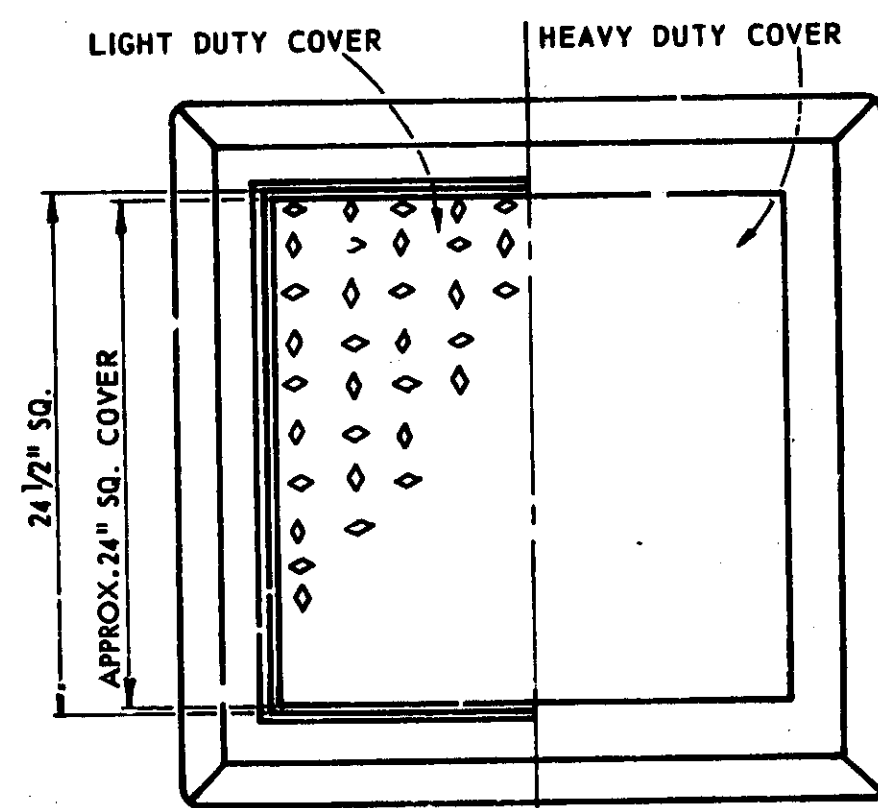


TOP PLAN VIEW OF CONCRETE HANDHOLE

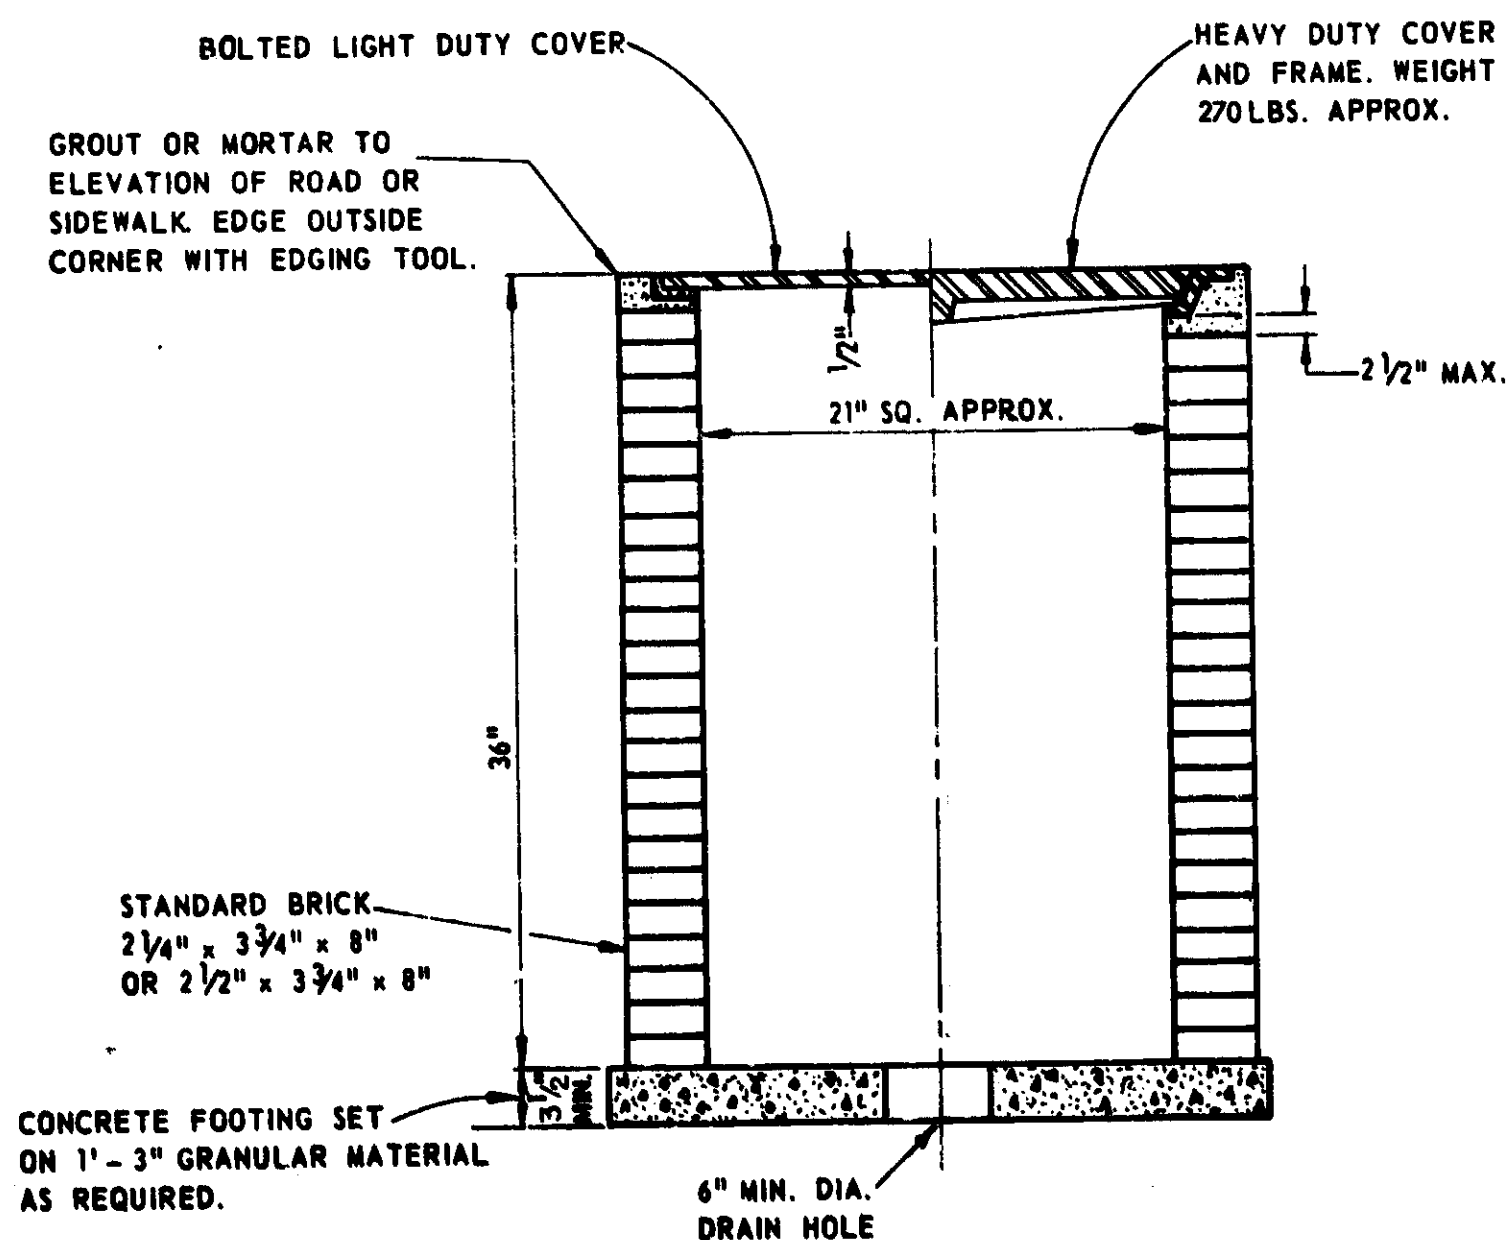


BRICK HANDHOLE

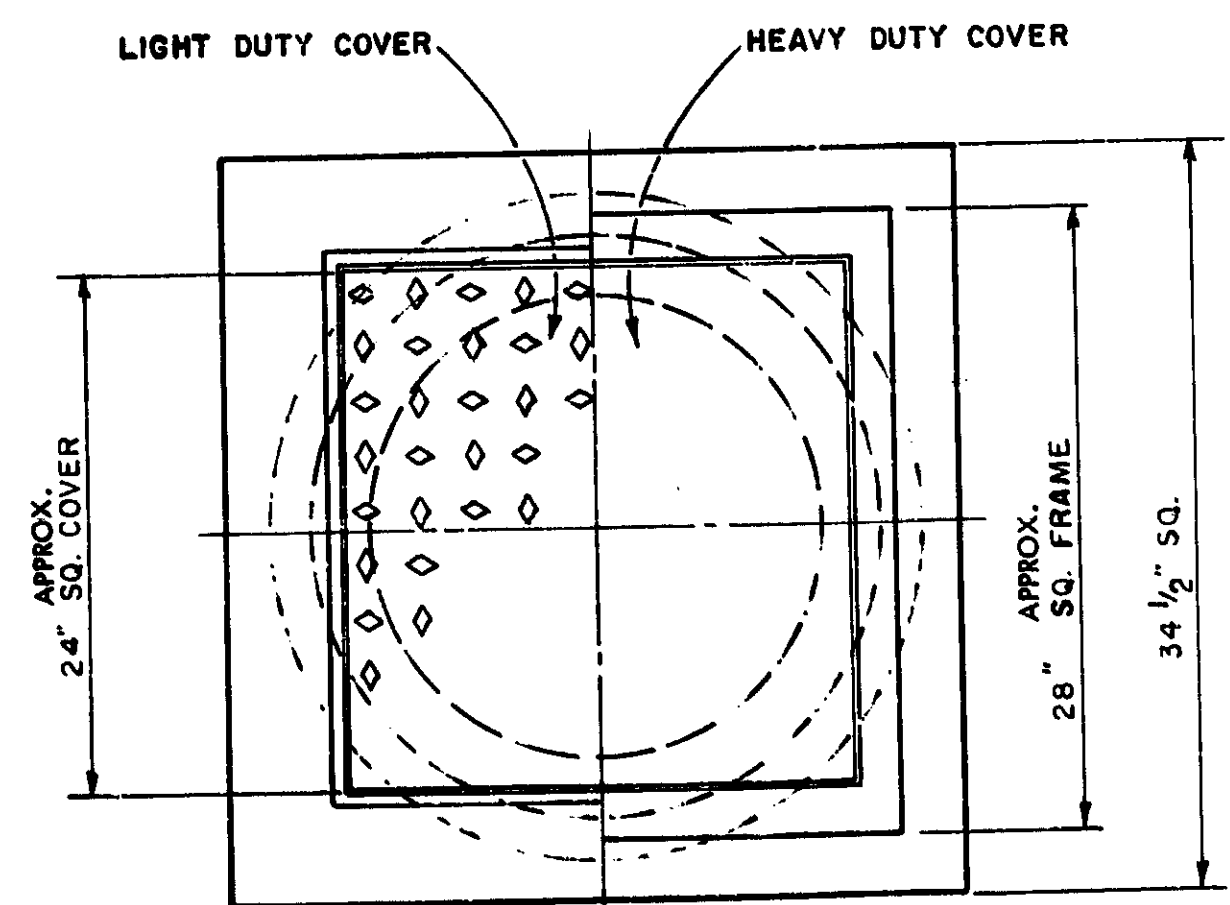

TOP PLAN VIEW OF R.C. PIPE HANDHOLE

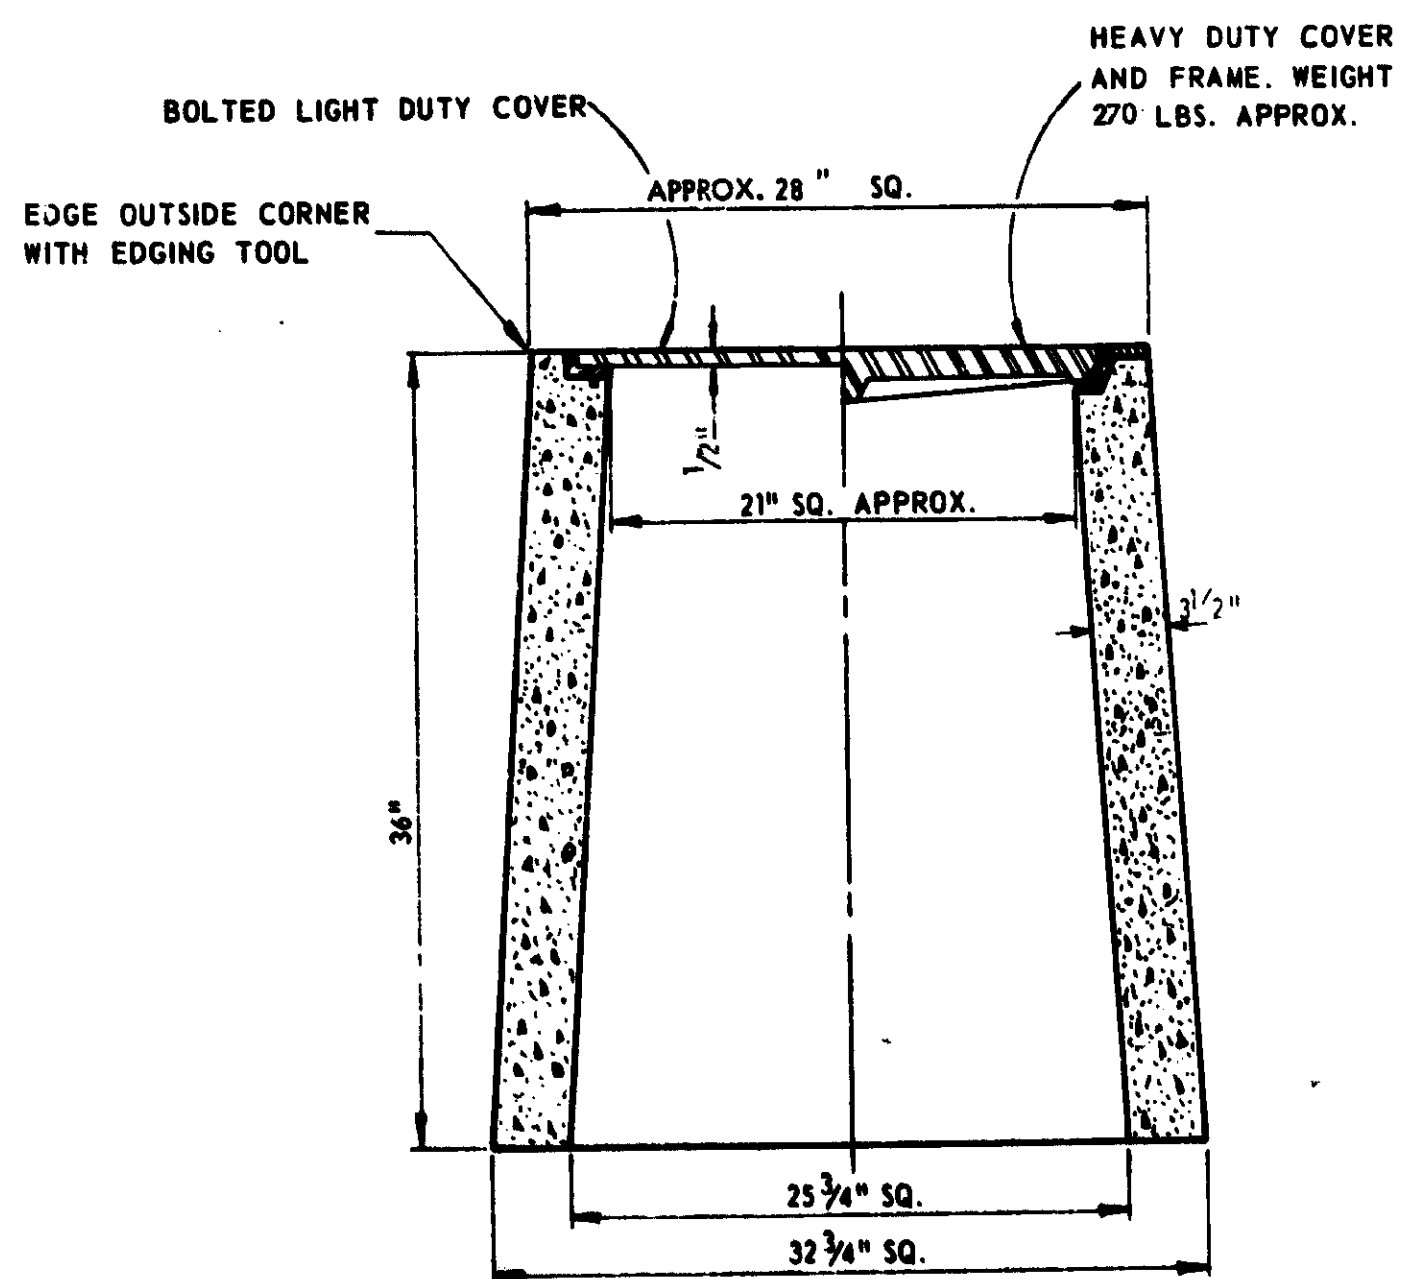

PRECAST CONCRETE HANDHOLE

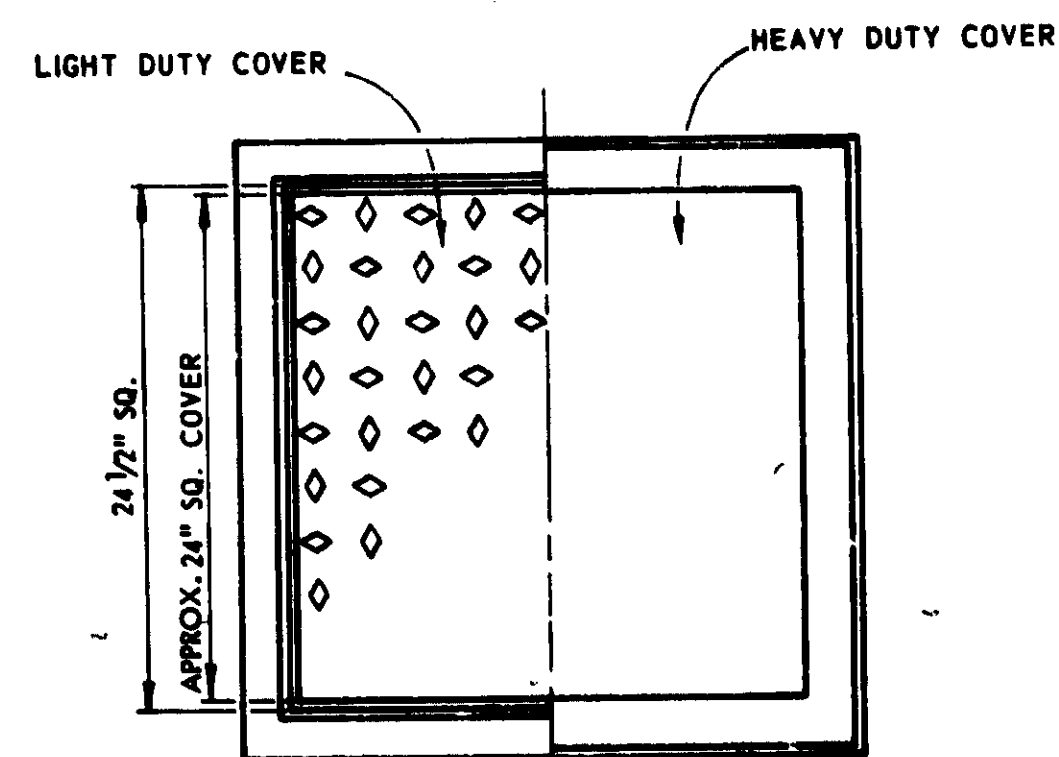

TOP PLAN VIEW OF BRICK HANDHOLE

Rev. 8-31-72 Changed Weight of Cover and Added Note T.J.
 Rev. 8-13-71 Removed (Minimum) from 36" Dim. (T.J.)

MICHIGAN DEPARTMENT OF STATE HIGHWAYS

ELECTRICAL HANDHOLE DETAILS E-8

REVISIONS			
NO.	DESCRIPTION	DATE	BY

APPROVED DATE _____

DRWN BY _____


TRACED BY D. V. NEGAR

CHECKED BY _____

SHEET 30 OF _____

63174

JOB NO. 08517A












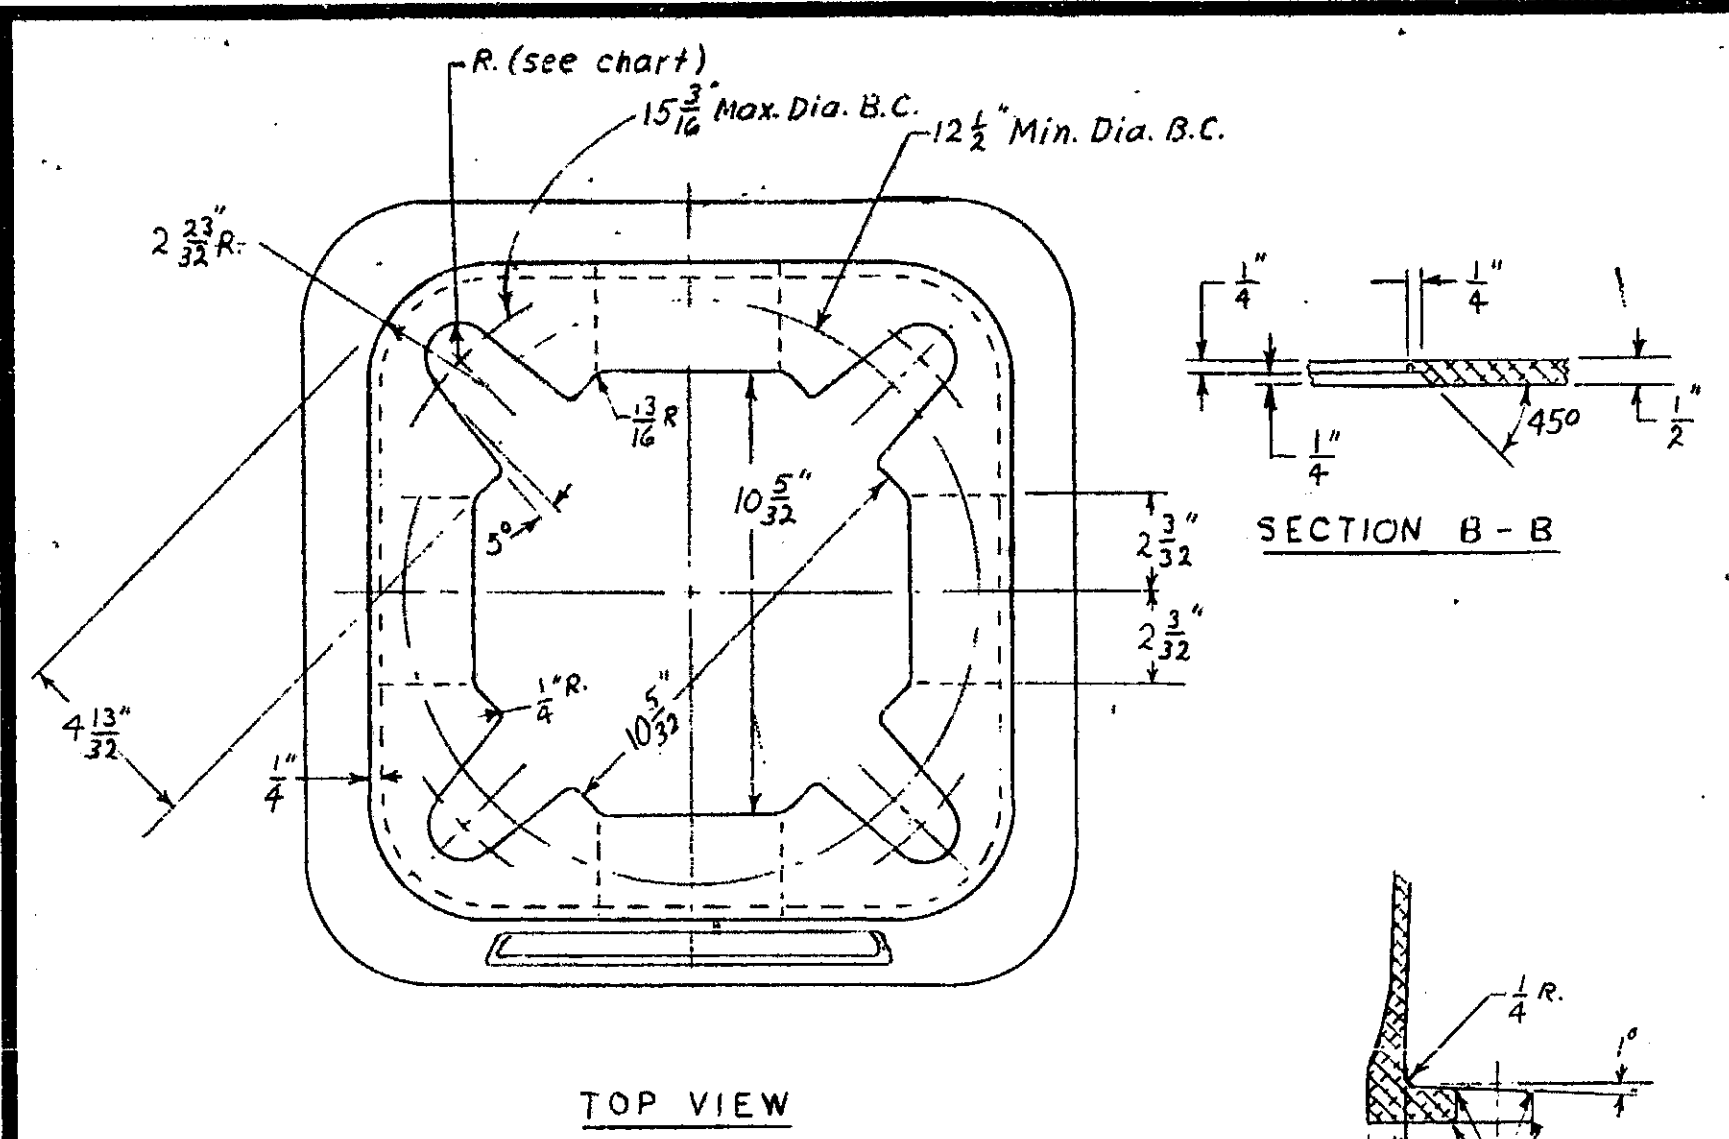


TYPE OF MOUNTING	BOLT SIZE IN INCHES	BOLT LENGTH IN INCHES	SLOT RADIUS (R) IN INCHES
A	1	3 1/2	5/8
B	1 1/4	4	3/4
C	1 1/2	4 1/2	7/8

A-30' nom. mounting height M.V. luminaire with single or double bracket arm up to 15 ft.

B-30' nom. mounting height M.V. luminaire with single or double 17 ft. bracket arm, or fluorescent luminaire with single or double bracket arm up to 6 ft.

C-40' & 45' nom. mounting height M.V. luminaire with single or double bracket arm up to 17 ft.

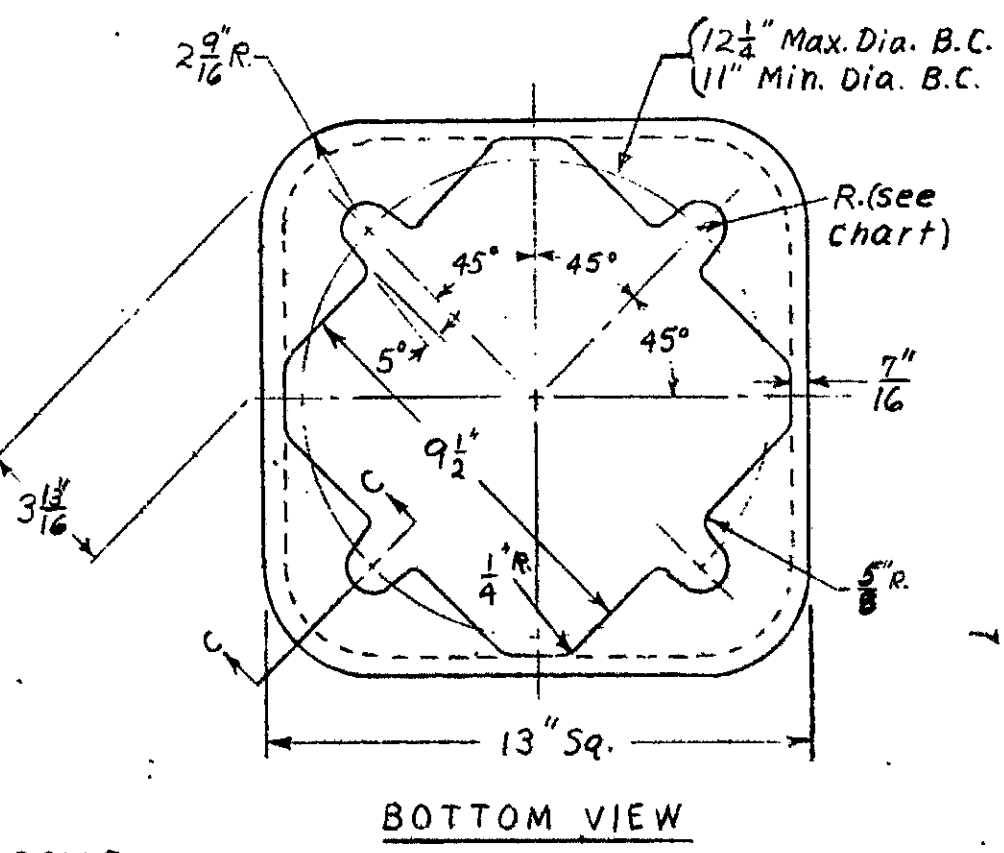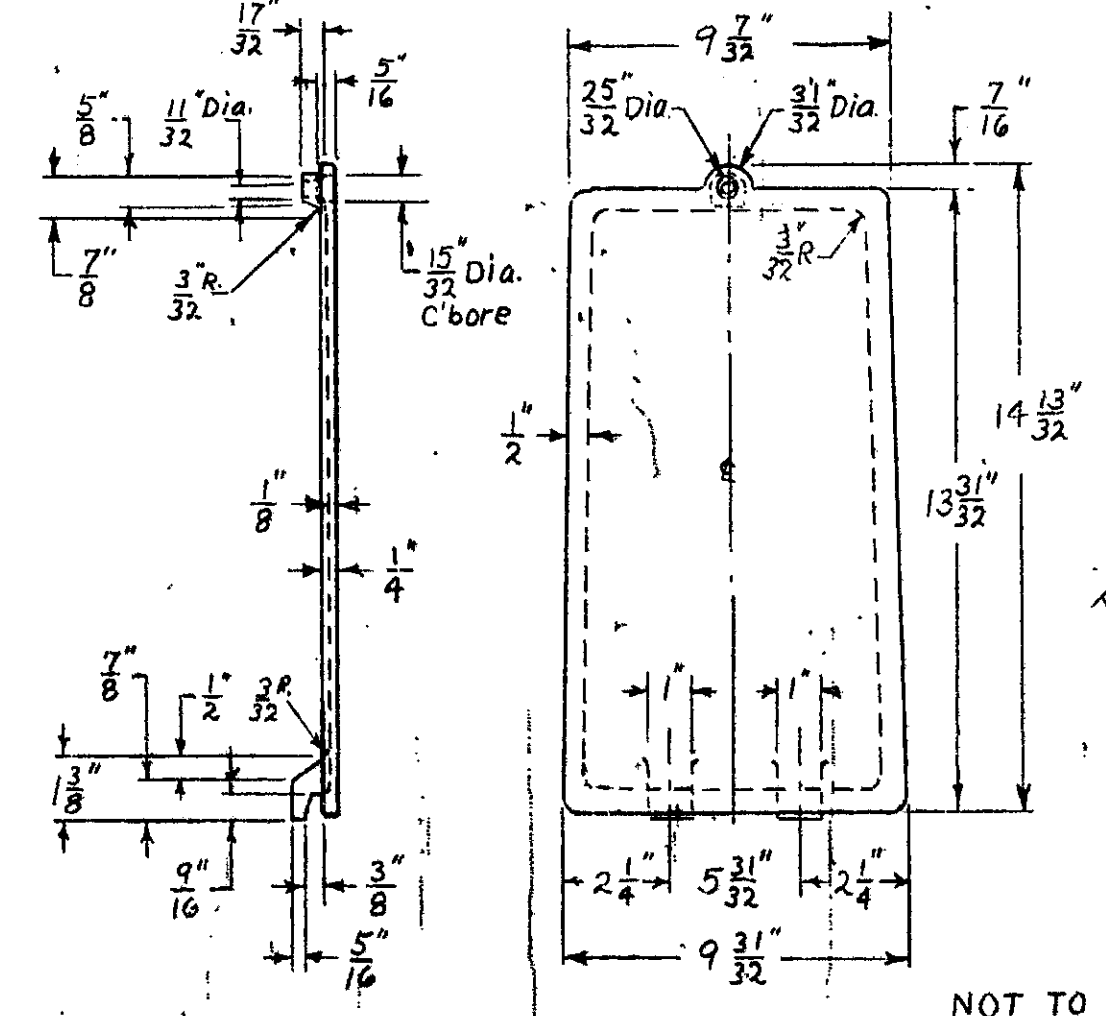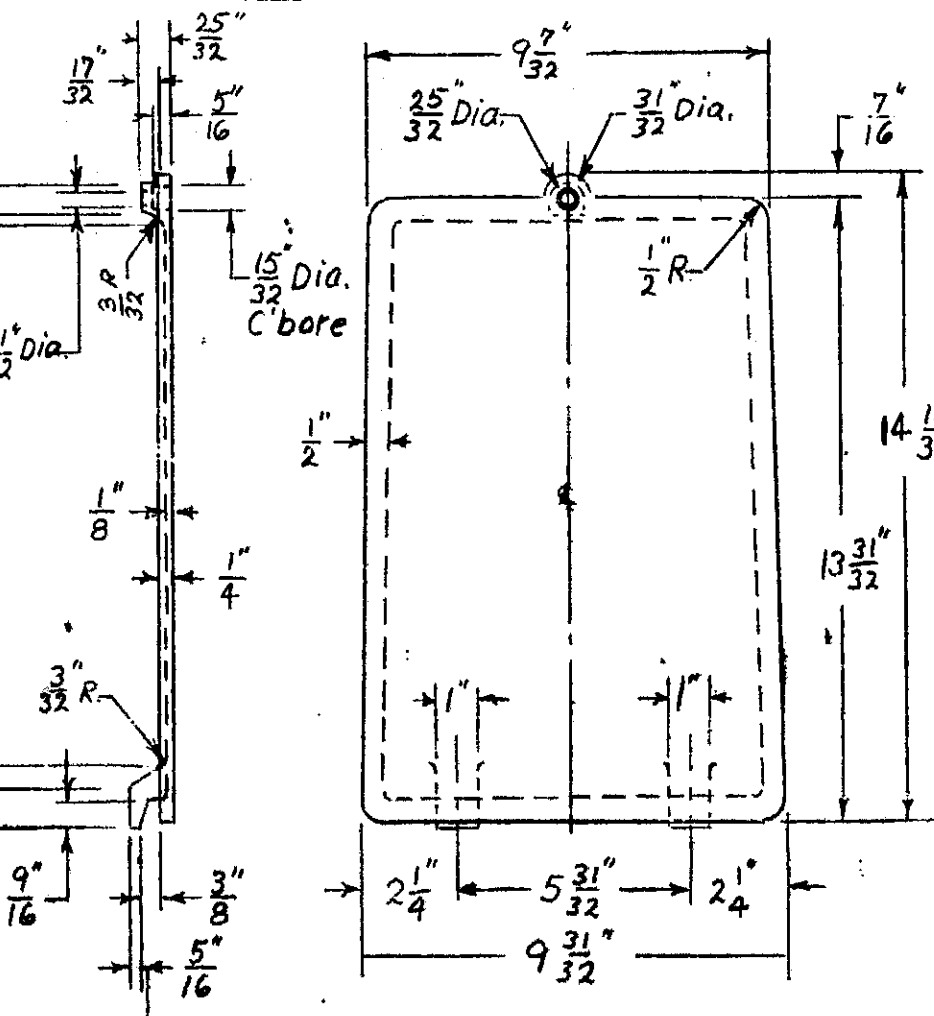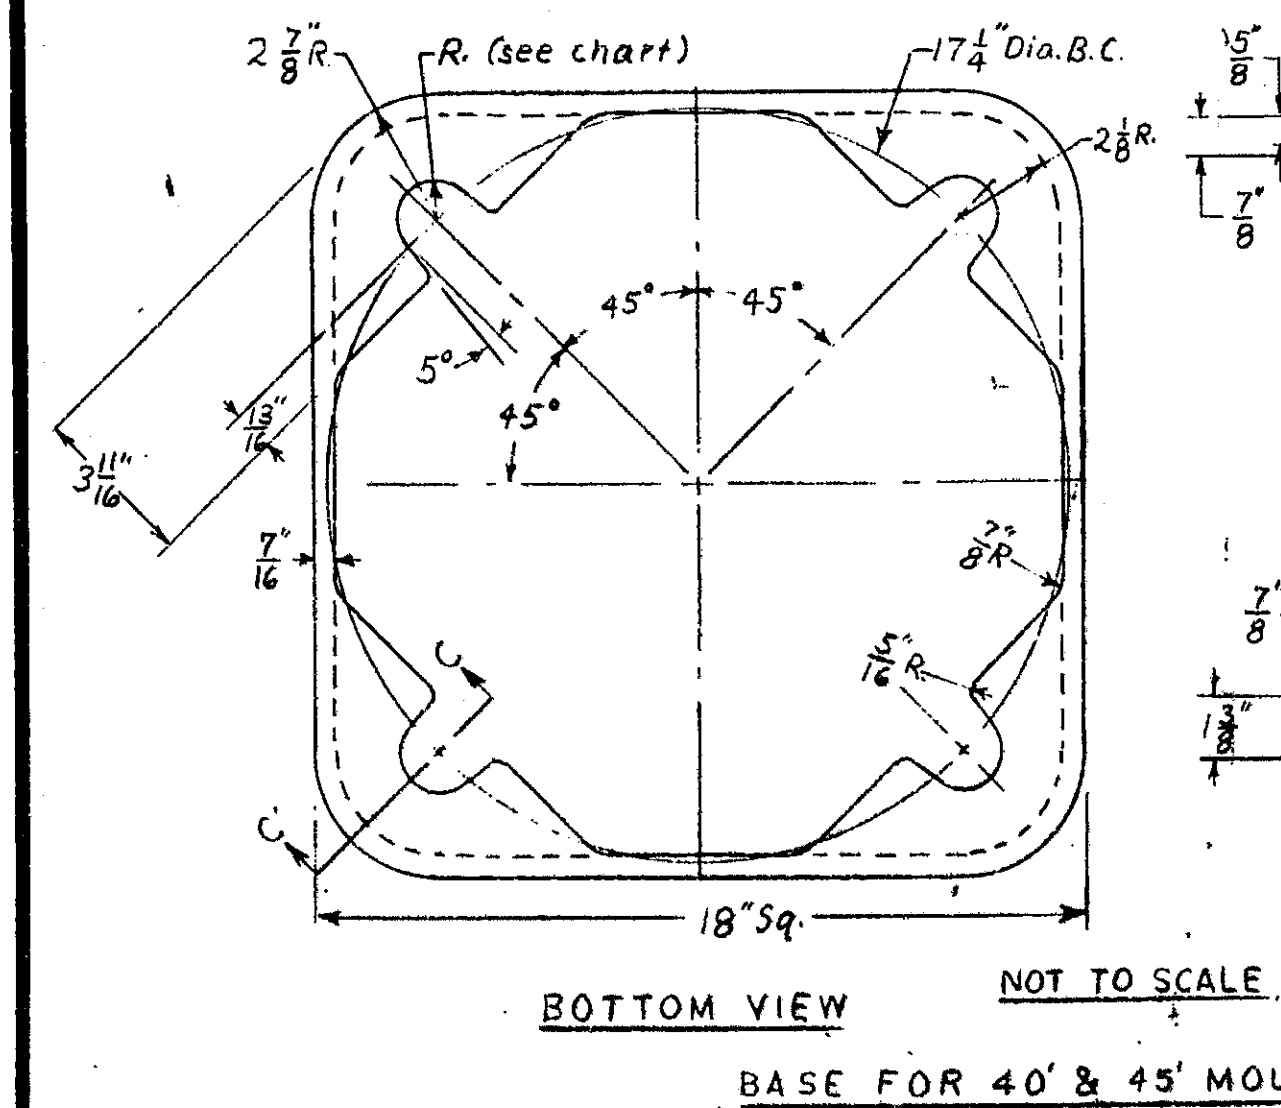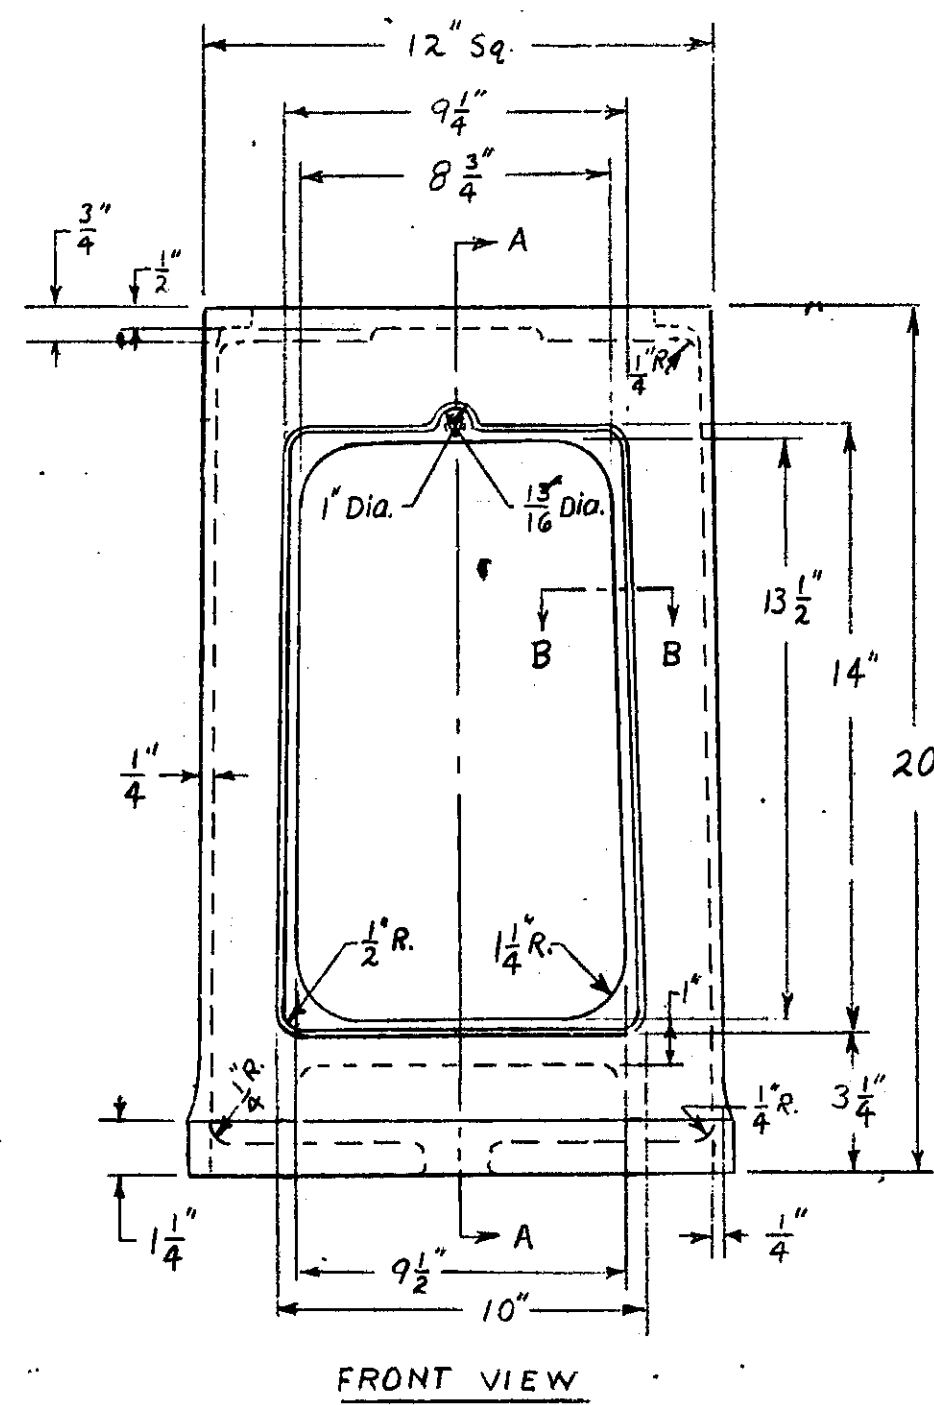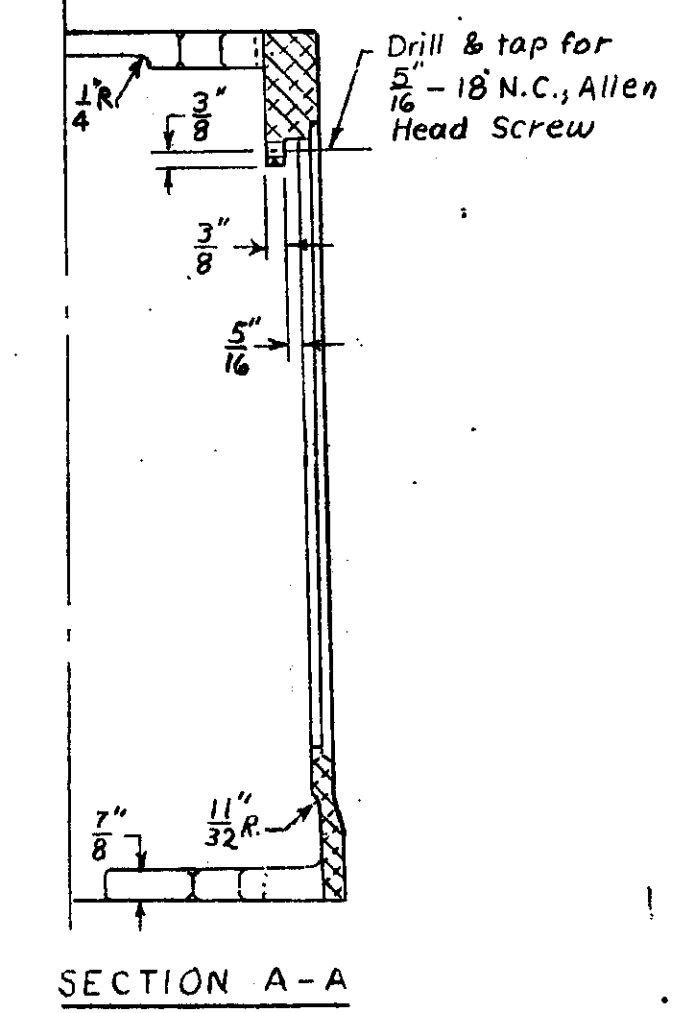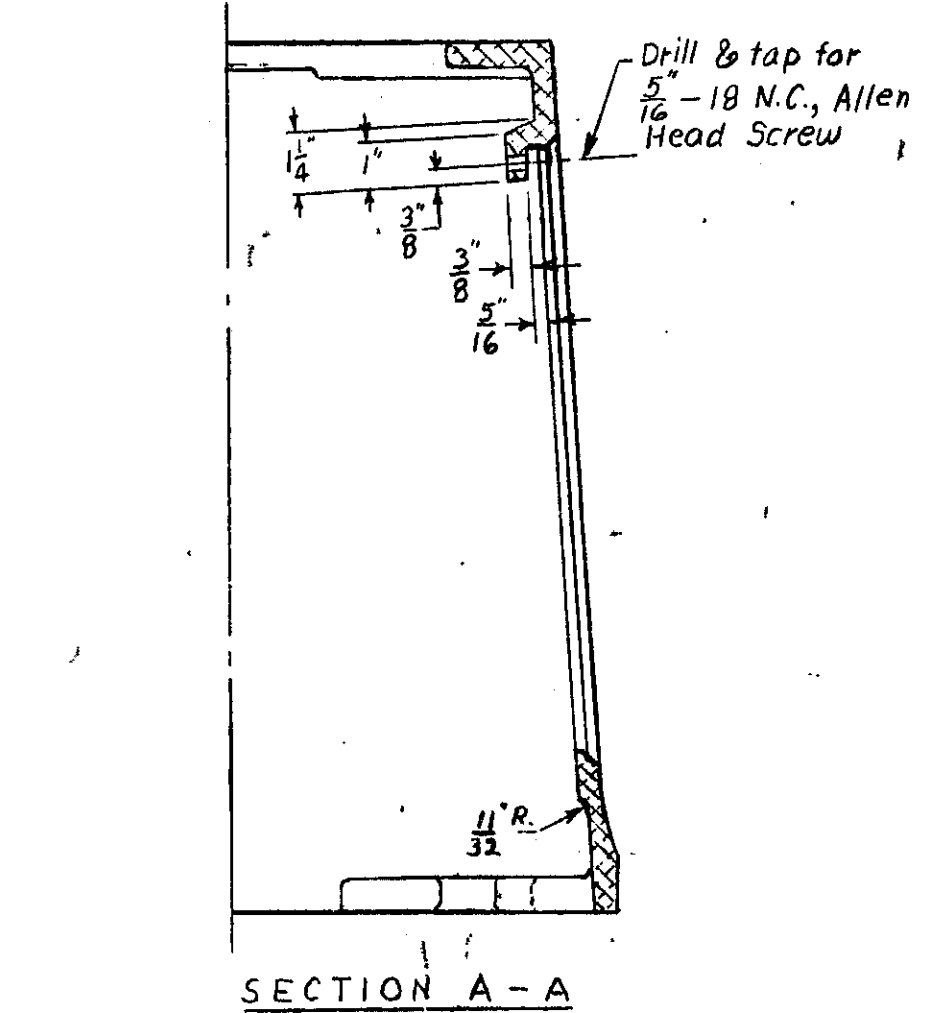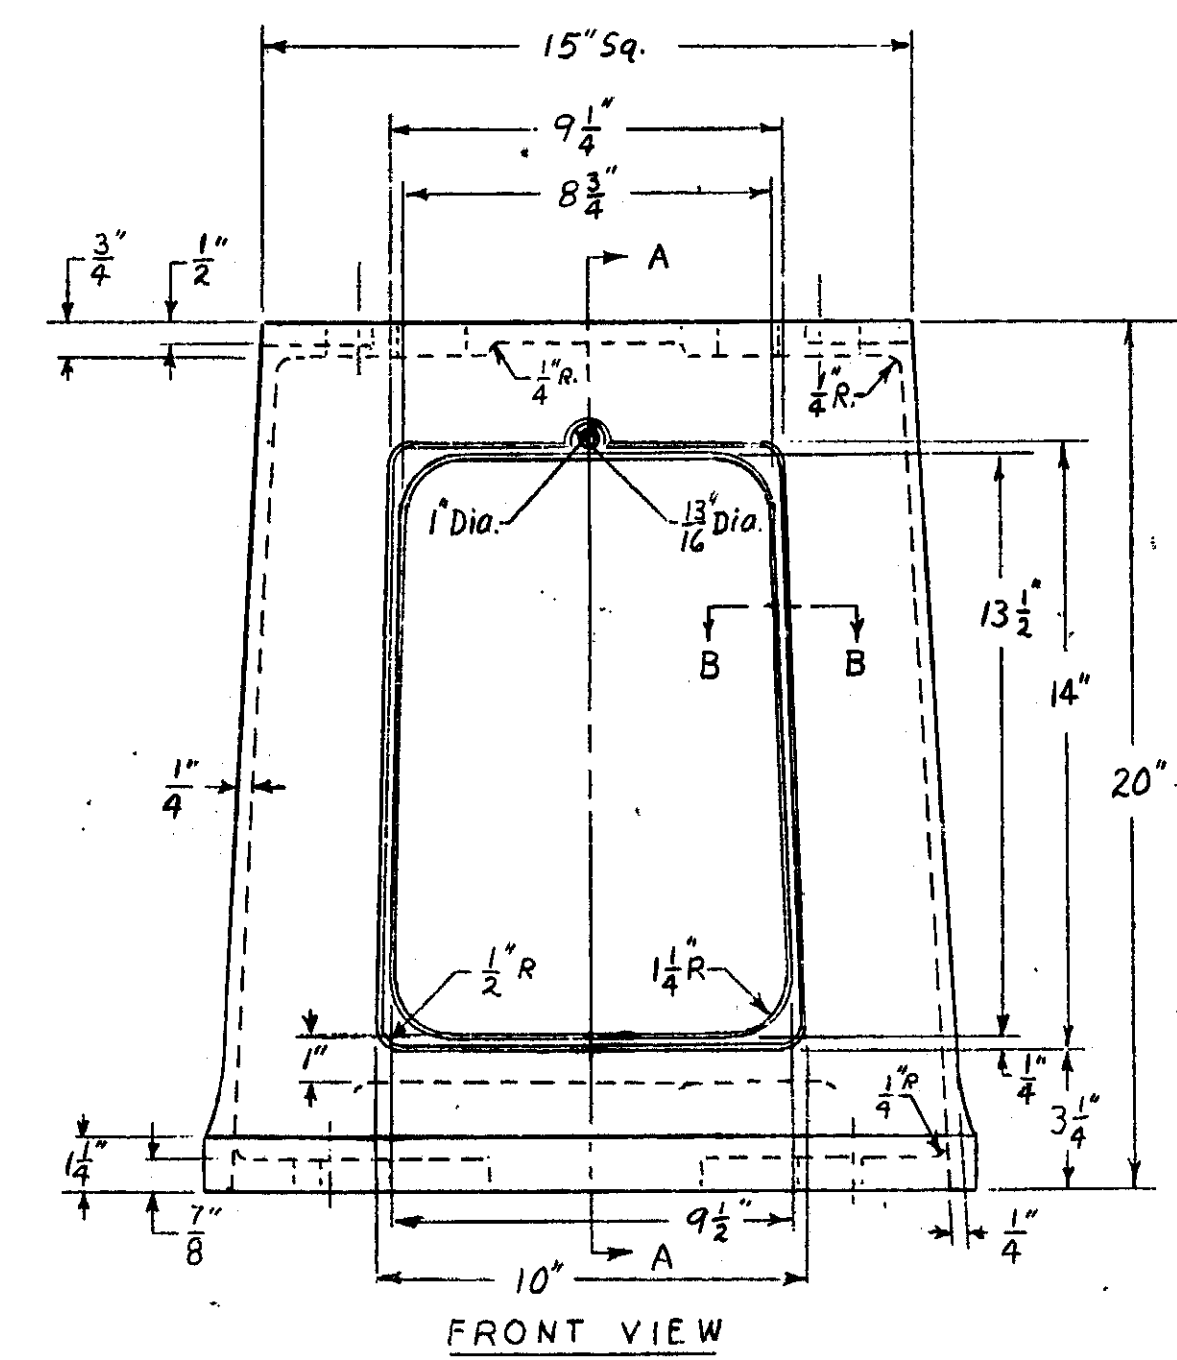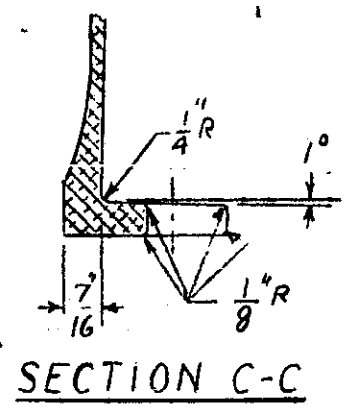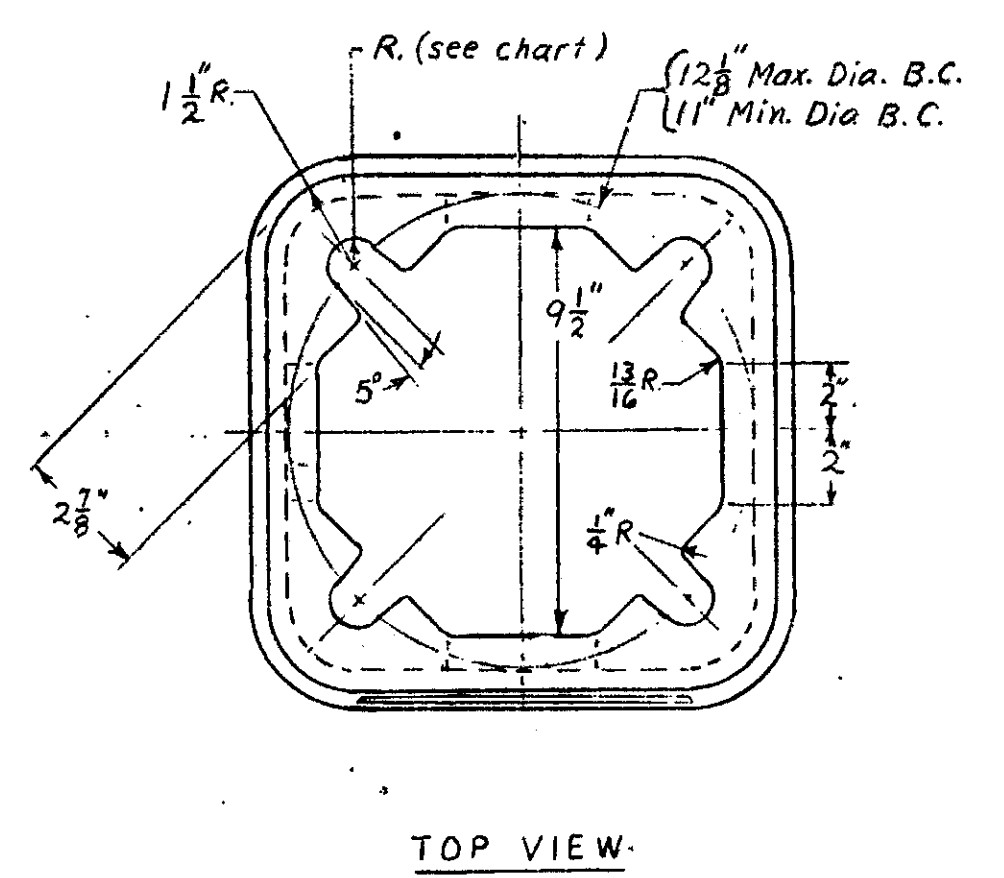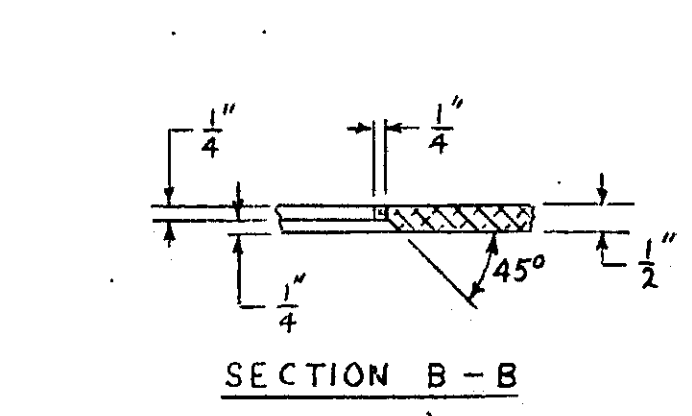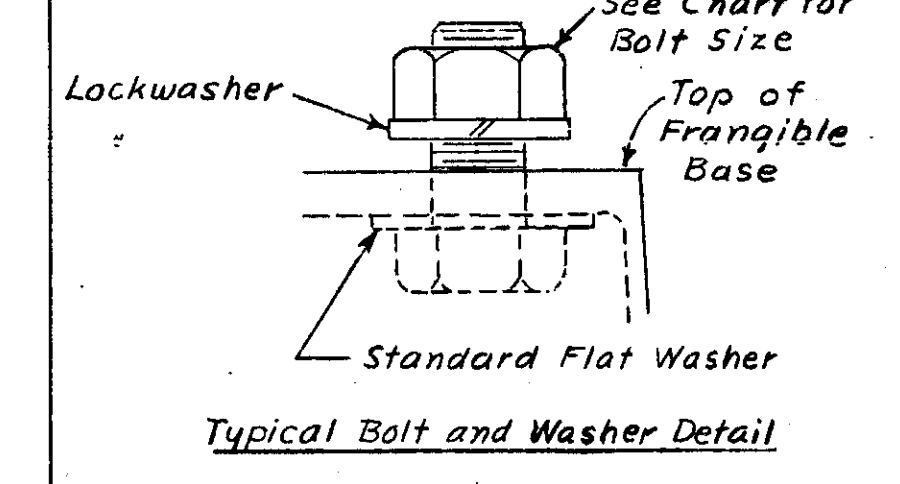

NOTES:
 1. MINOR VARIATIONS IN THE DESIGN OF THE FRANGIBLE T-BASE MAY BE ACCEPTABLE UPON DEMONSTRATION BY THE MANUFACTURER THAT THE UNIT WILL SUSTAIN THE TEST LOADS PRESCRIBED IN THE M.D.S.H. SPECIFICATIONS.

MICHIGAN DEPARTMENT OF STATE HIGHWAYS
 FRANGIBLE TRANSFORMER BASE DETAILS
 FOR 30', 40' & 45' NOMINAL MOUNTING HEIGHTS
 LIGHT STANDARDS

E-6

APPR. DATE
 T. W. G. 12-68

DESIGNED BY
 DW 1-5-68


CHECKED BY
 HEP & LMT 1-5-68

REVISIONS

NO.	DESCRIPTION	DATE	BY

63174

JOB NO. 08517A




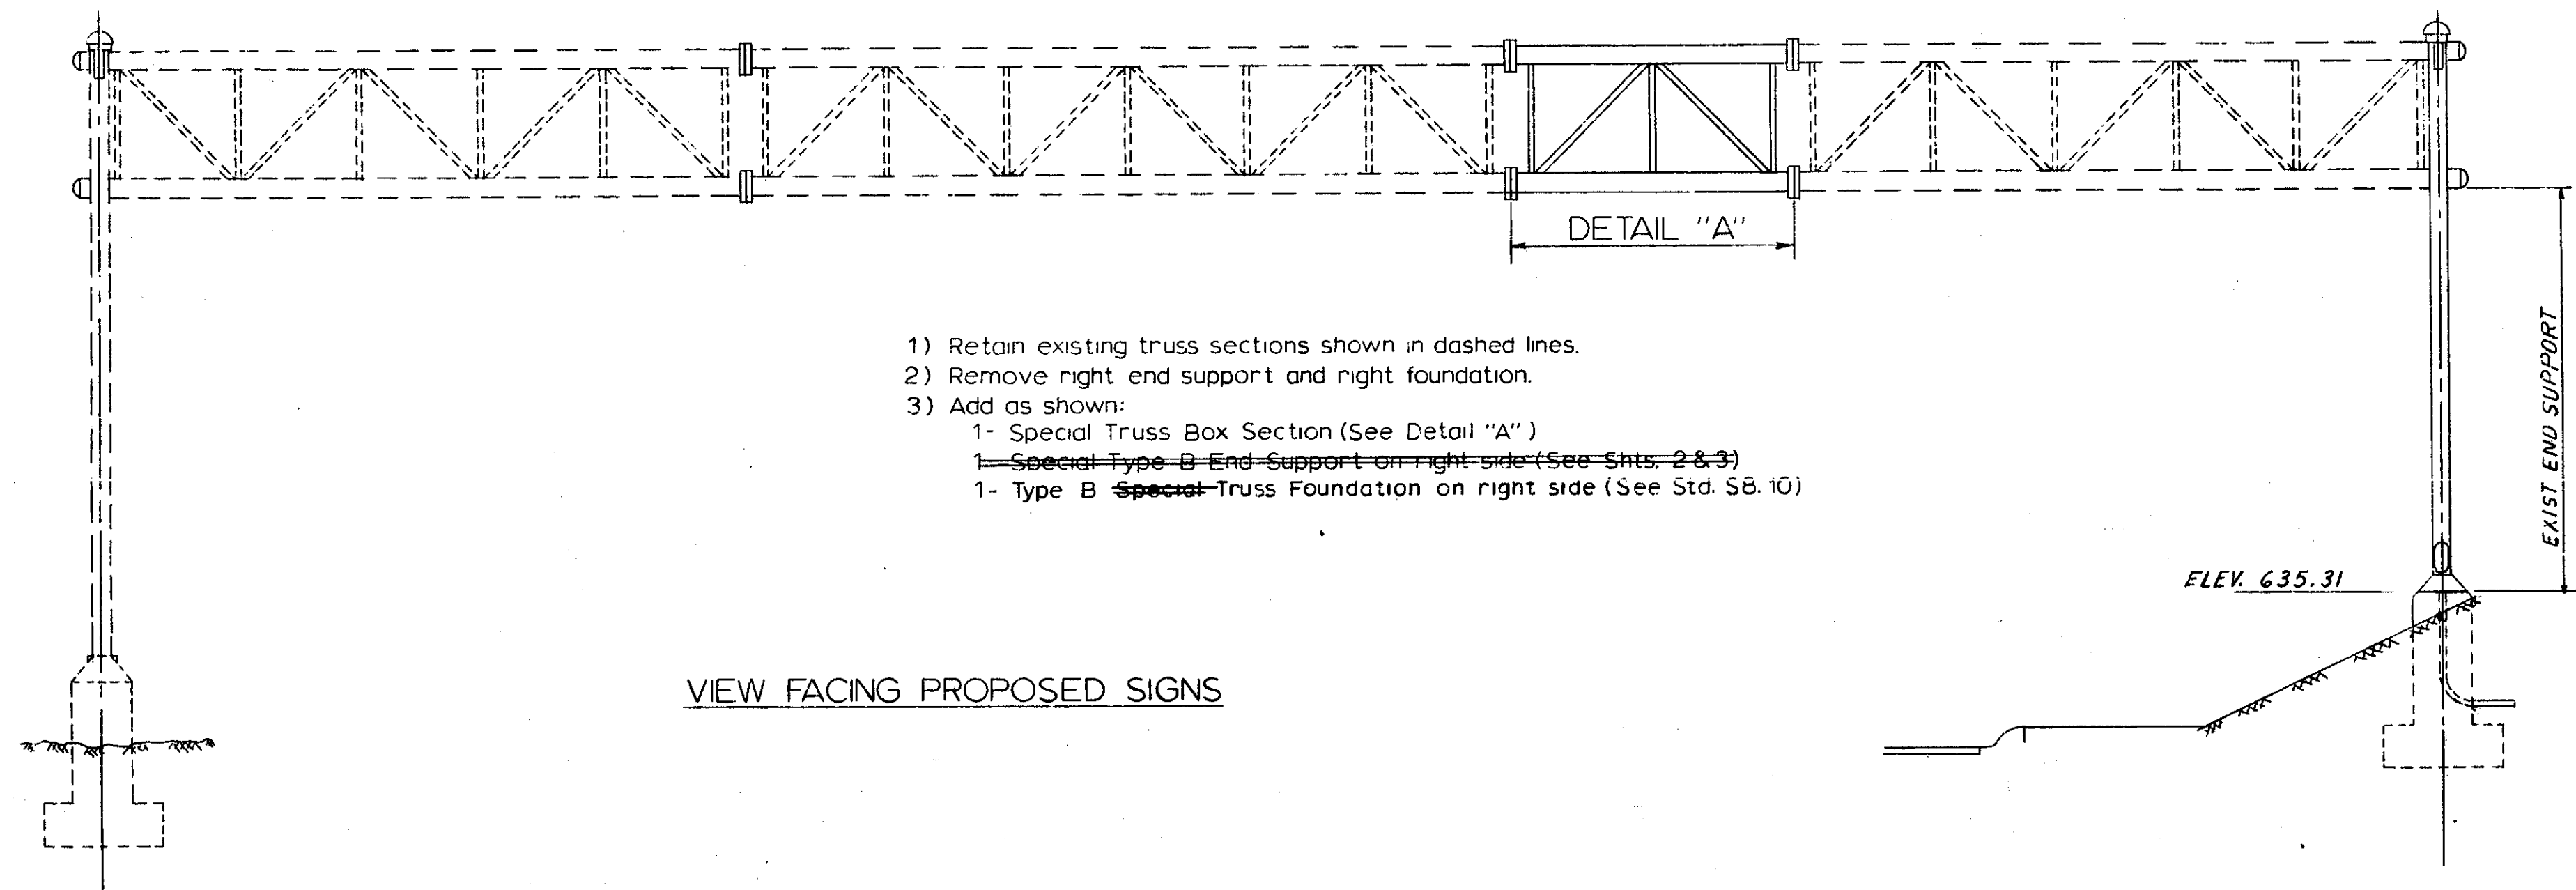


- 1) Retain existing truss sections shown in dashed lines.
- 2) Remove right end support and right foundation.
- 3) Add as shown:
 - 1- Special Truss Box Section (See Detail "A")
 - 1- Special Type B End Support on right side (See Shts. 2 & 3)
 - 1- Type B Special Truss Foundation on right side (See Std. S8.10)

VIEW FACING PROPOSED SIGNS

- NOTES:**
- 1) Materials and fabrication shall conform to the requirements of Michigan Department of State Highways Standard and Supplemental Specifications.
 - 2) All chord members shall be aluminum alloy 6061-T6. All web members shall be aluminum alloy 6063-T6. Castings shall be aluminum alloy 356-T7. Connections shall be welded with filler alloy 5356.
 - 3) METHOD OF MEASUREMENT:
Truss (Extended) Type B will be measured as a unit.
 - 4) BASIS OF PAYMENT:
Truss(Extended) Type B, will be paid for at the contract unit price each, which price shall be payment in full for fabrication and erection of the horizontal section, ~~removal of those portions of the truss being replaced~~, furnishing all necessary fastening devices (including nuts, bolts and washers) for erection of the new portion and removal of the entire truss (if required) in the process of the work.
 - 5) For existing 3 span trusses, the special truss box section (Detail A) shall be inserted between spans 2 and 3. For existing 4 span trusses, the special truss box section shall be inserted between spans 3 and 4.

Part Mark No.	Section Sym.	DESCRIPTION OF MATERIAL	LENGTH		Parts For One Unit
			FEET	INCH	
TRUSS SECTION					
aw	Tube	7" Dia. x .1275	9	6 1/4	4
at	"	3 1/2" Dia. x .1875	5	6 7/8	4
v	"	2" Dia. x .125	5	2 5/8	3
av	"	2" Dia. x .125	5	6 1/2	4
w	"	2" Dia. x .125	3	6 3/4	6
y	"	2" Dia. x .125	3	6 3/8	6

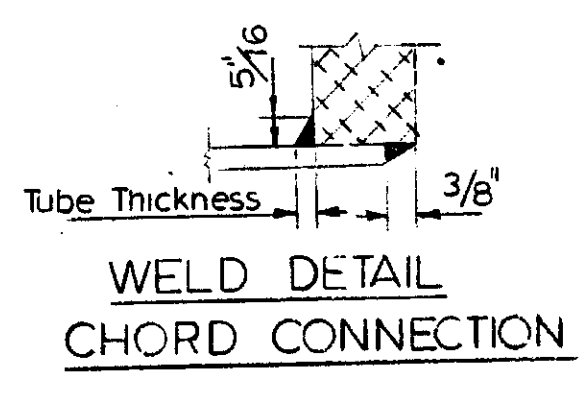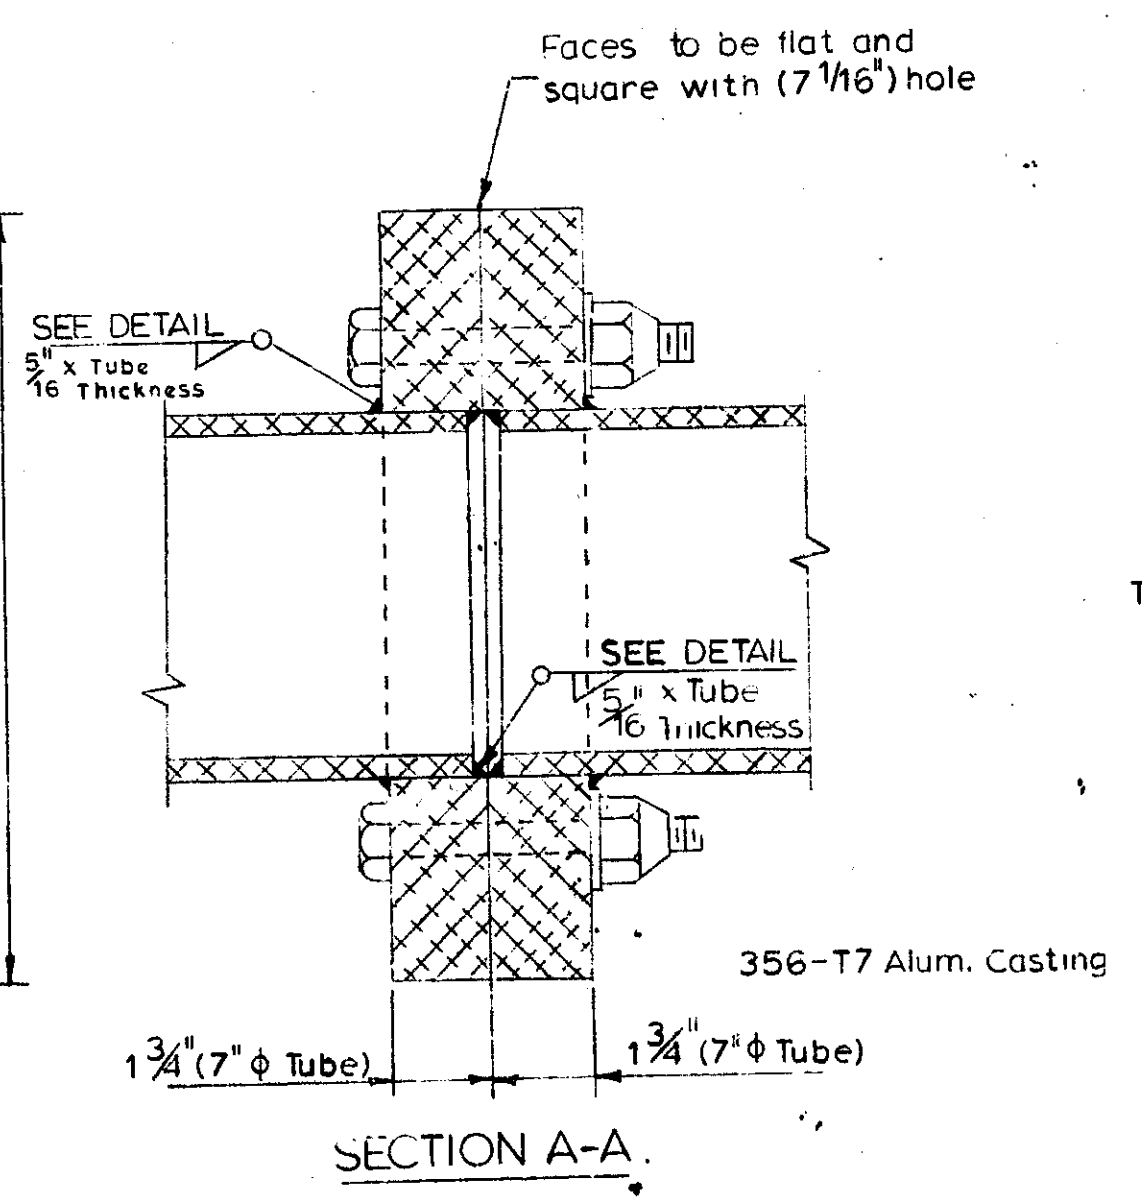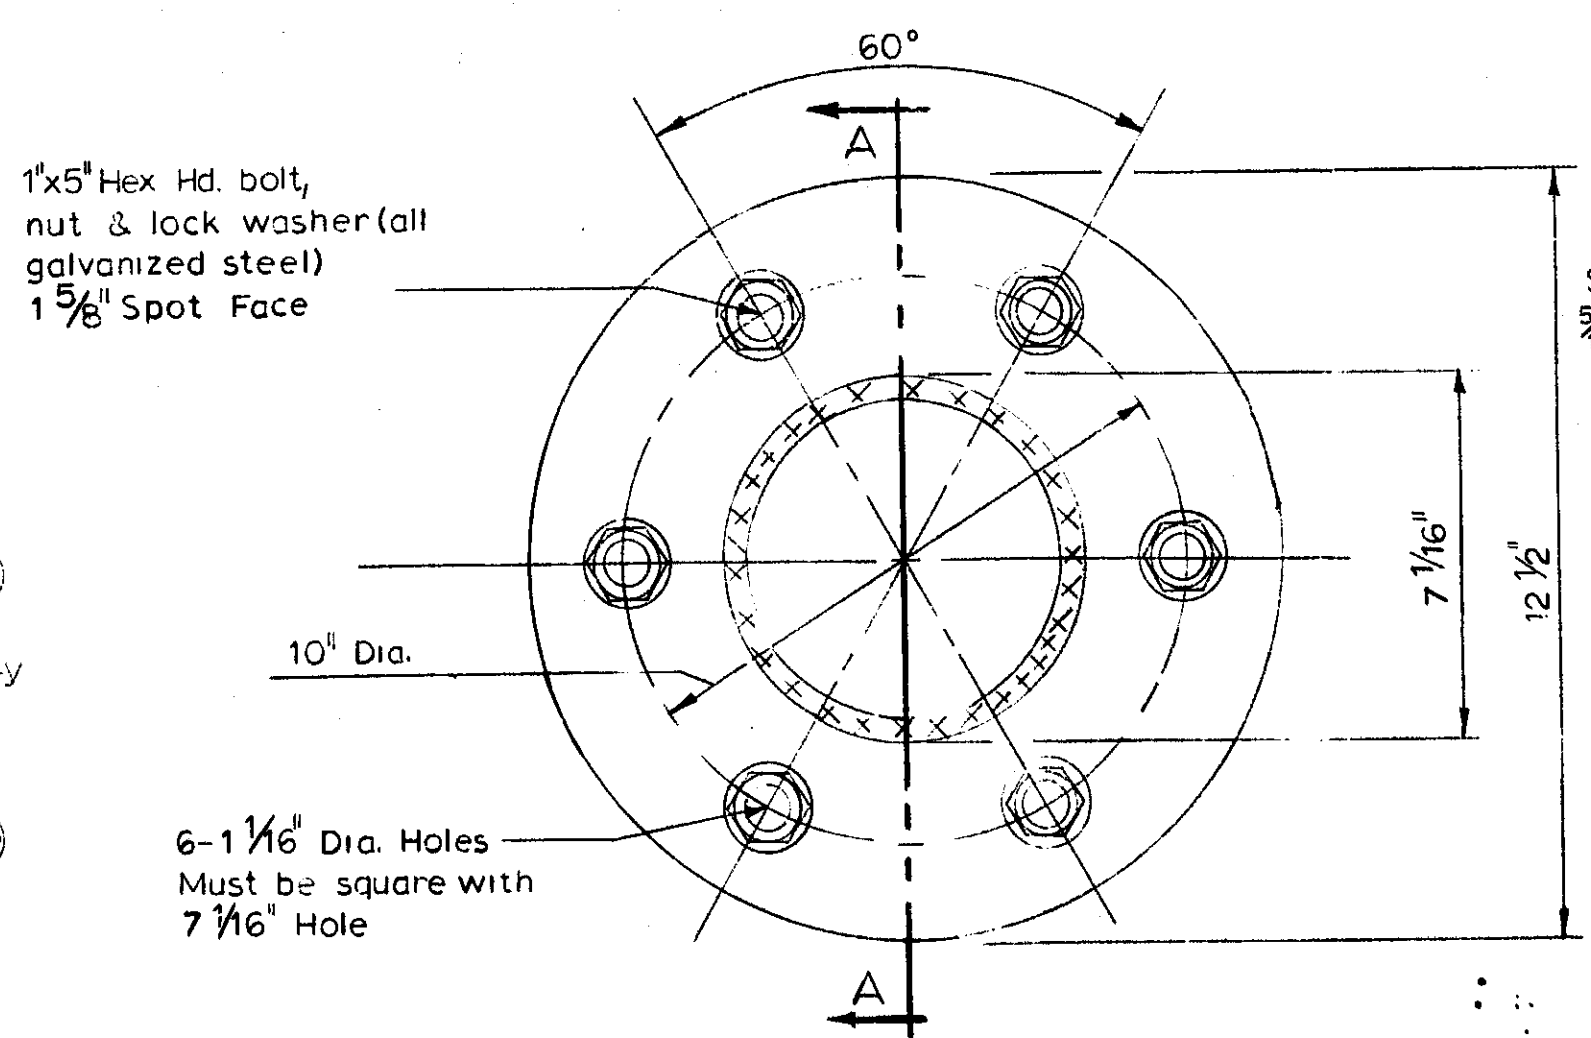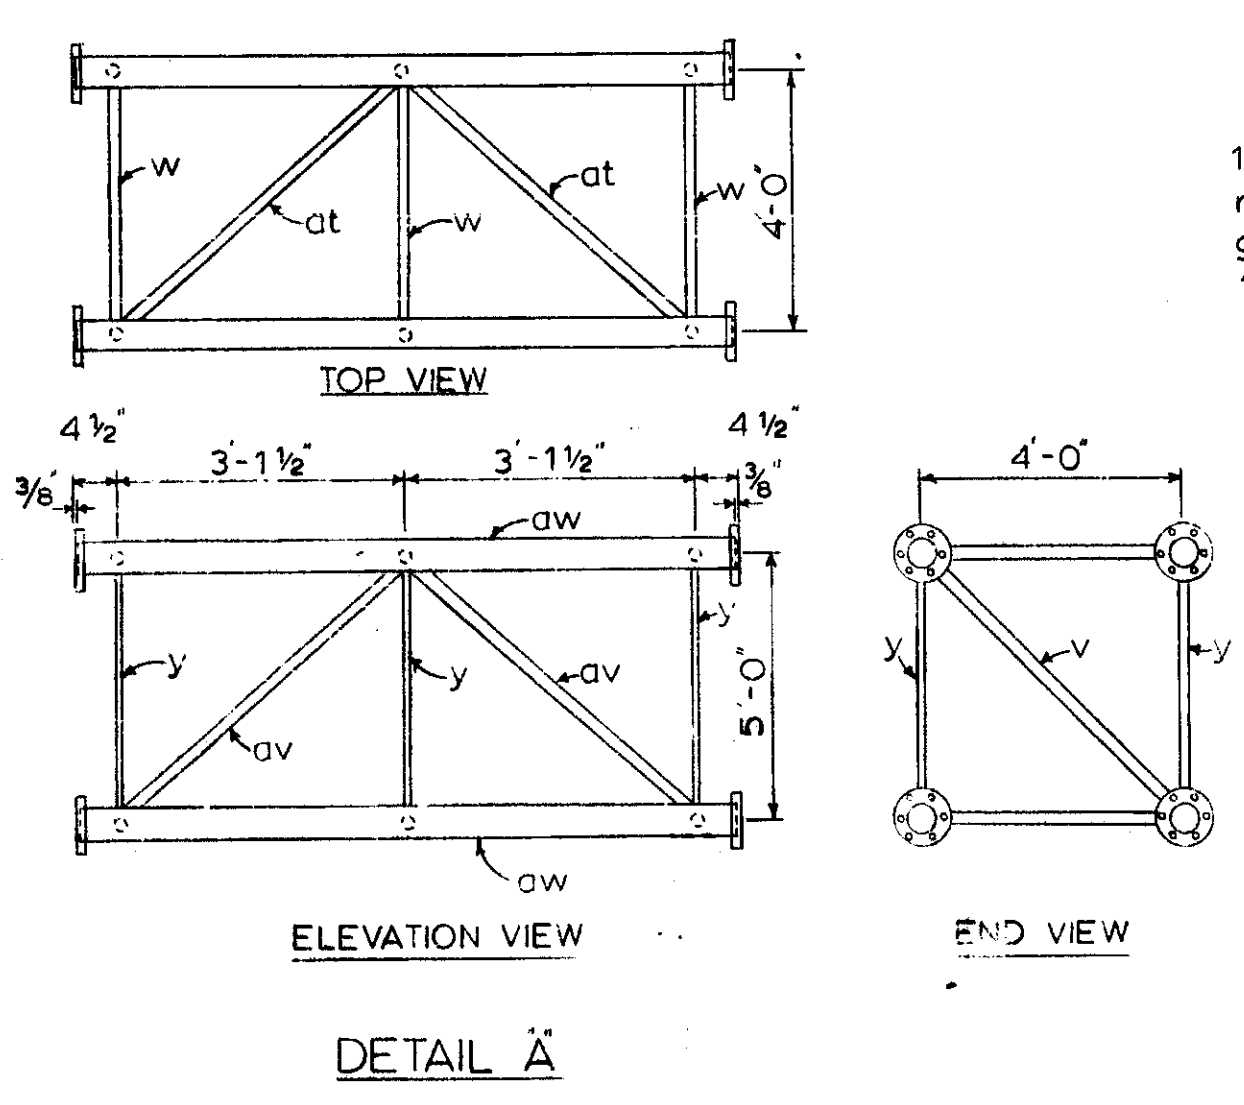


MICHIGAN DEPARTMENT OF STATE HIGHWAYS
 EXTENDED ALUMINUM TRUSS
 TYPE B
 STA 859+50 N.B. I-75


\$6.04

NO.	DESCRIPTION	DATE	BY


DRAWN BY: KJO 8-29-70
 CHECKED BY:
 SHEET 32 OF
63174 08517A

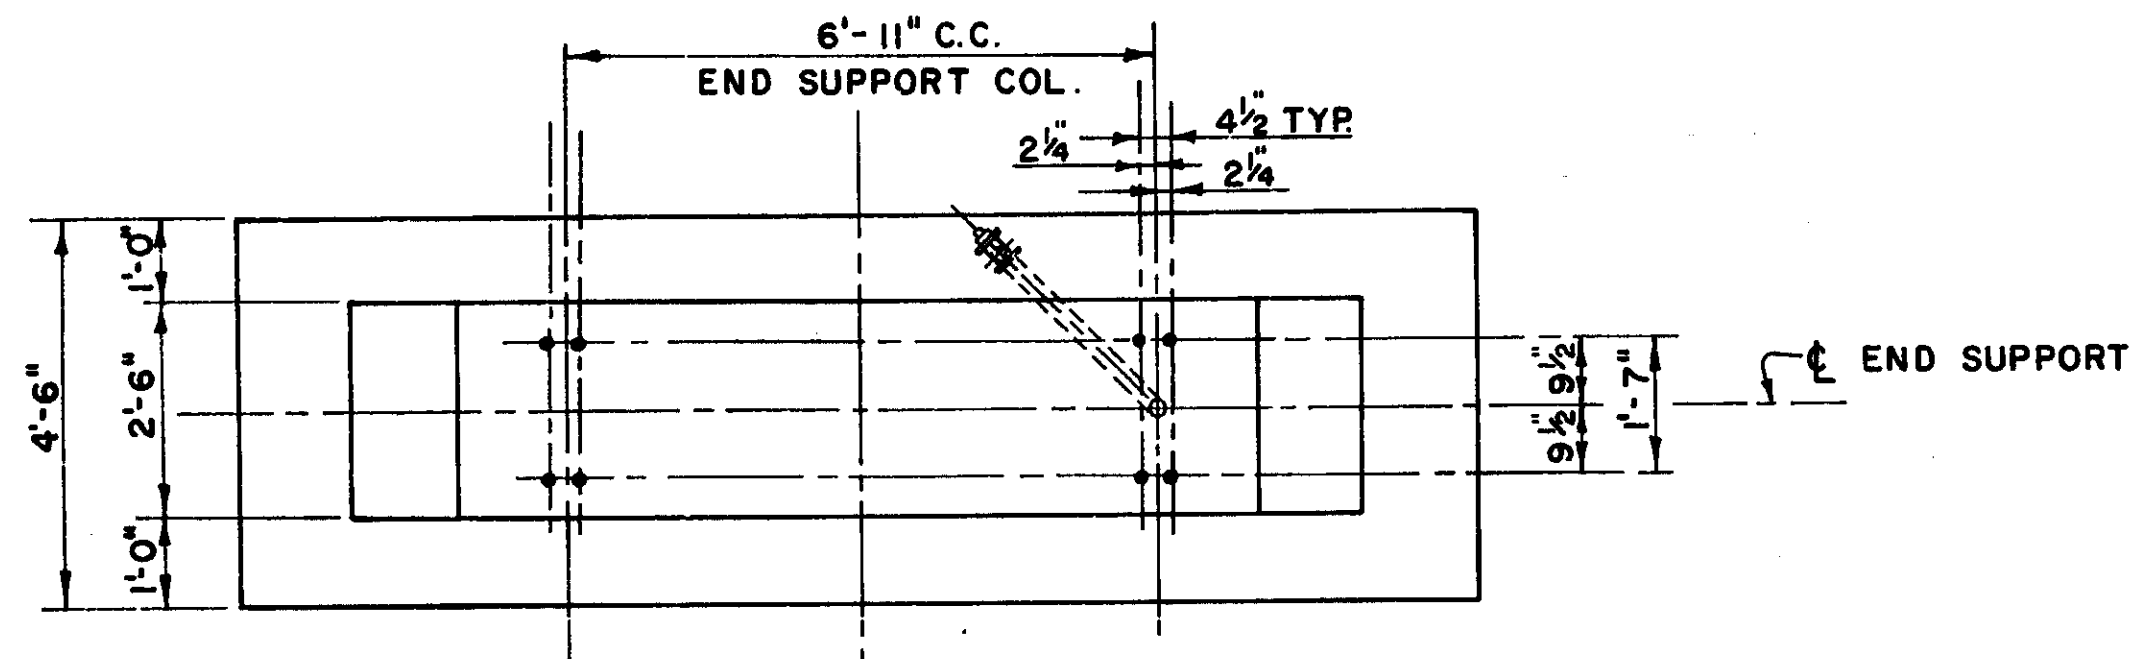

PLAN

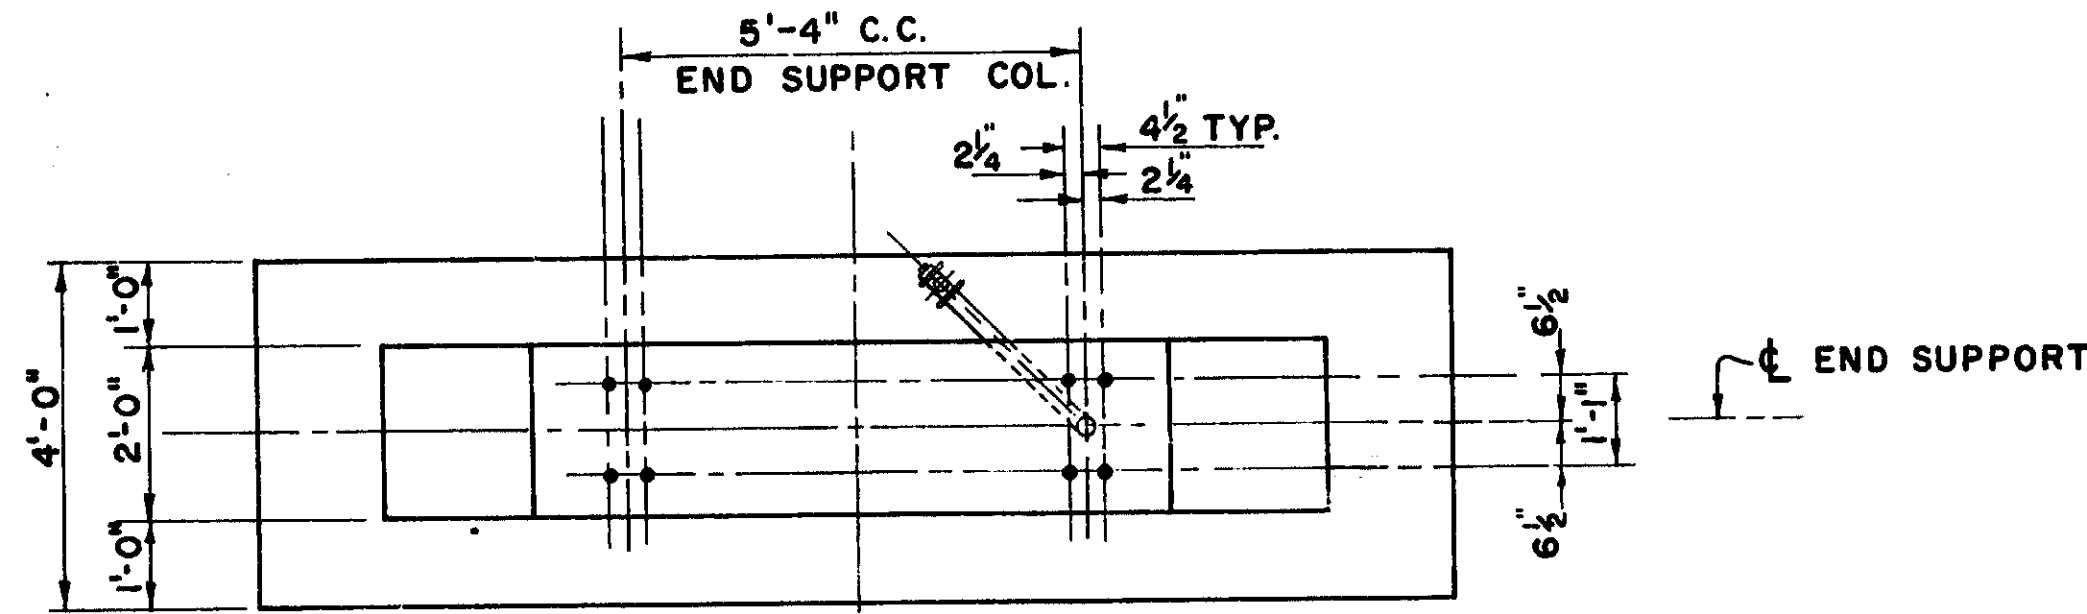


PLAN

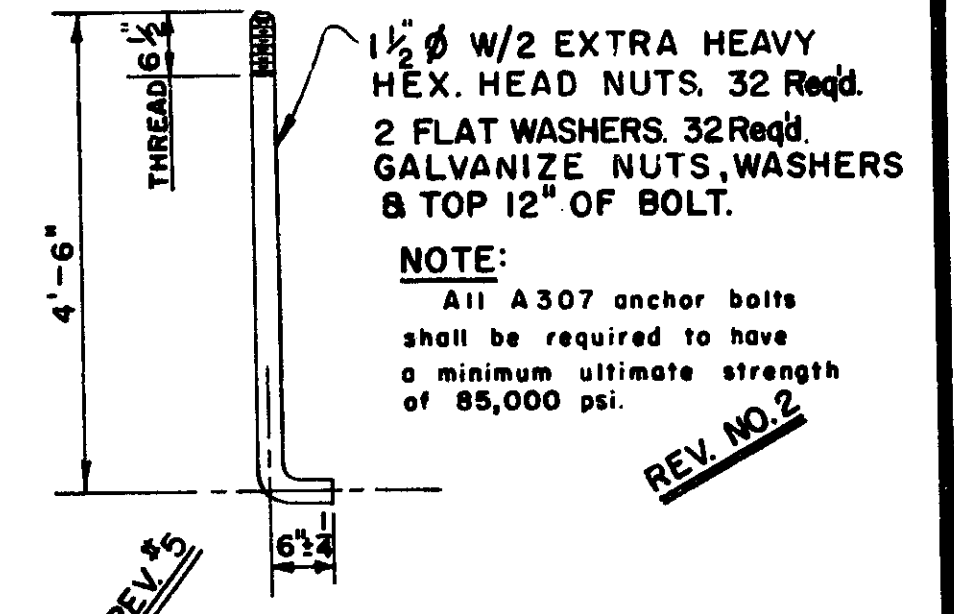


ANCHOR BOLT DETAIL

16 Required


DIRECTION OF TRAFFIC

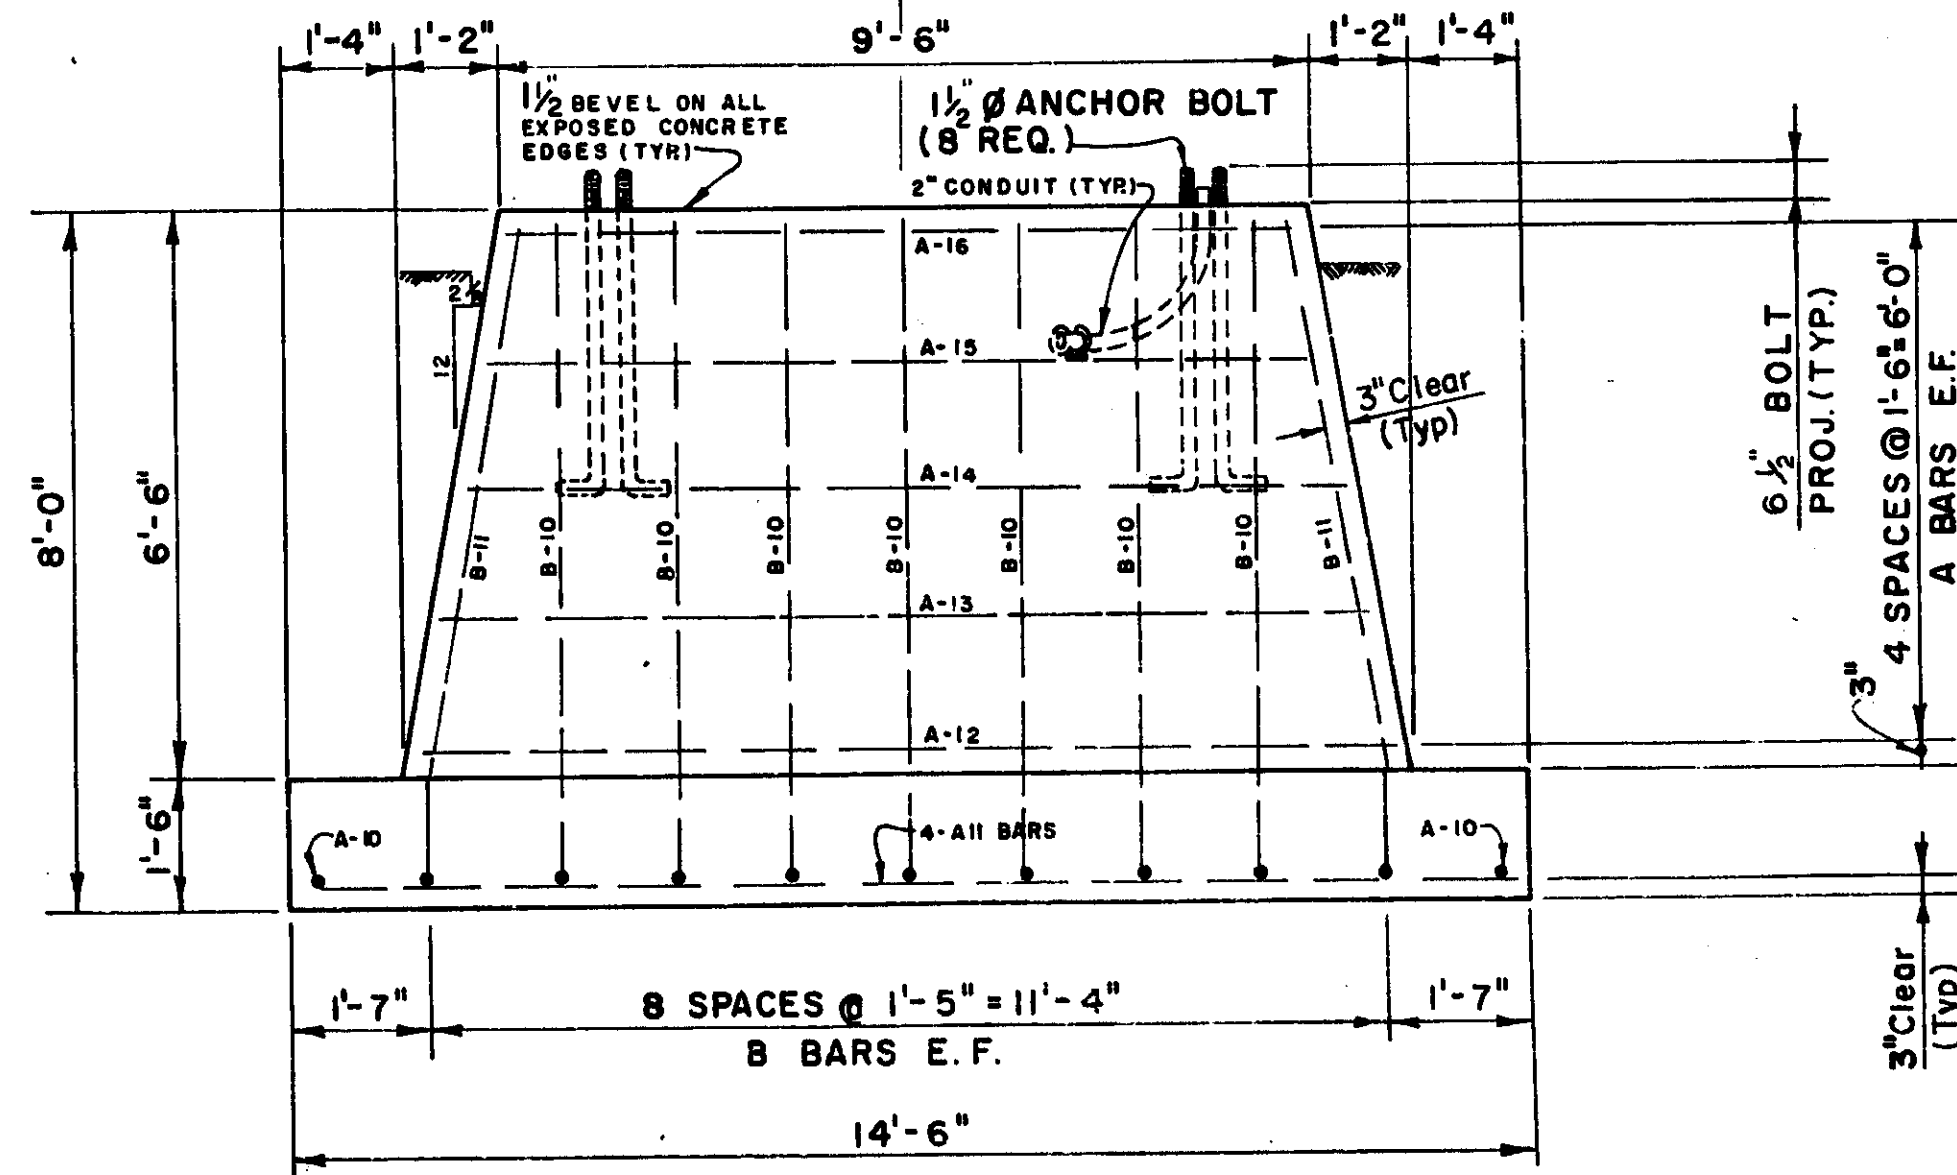

ELEVATION

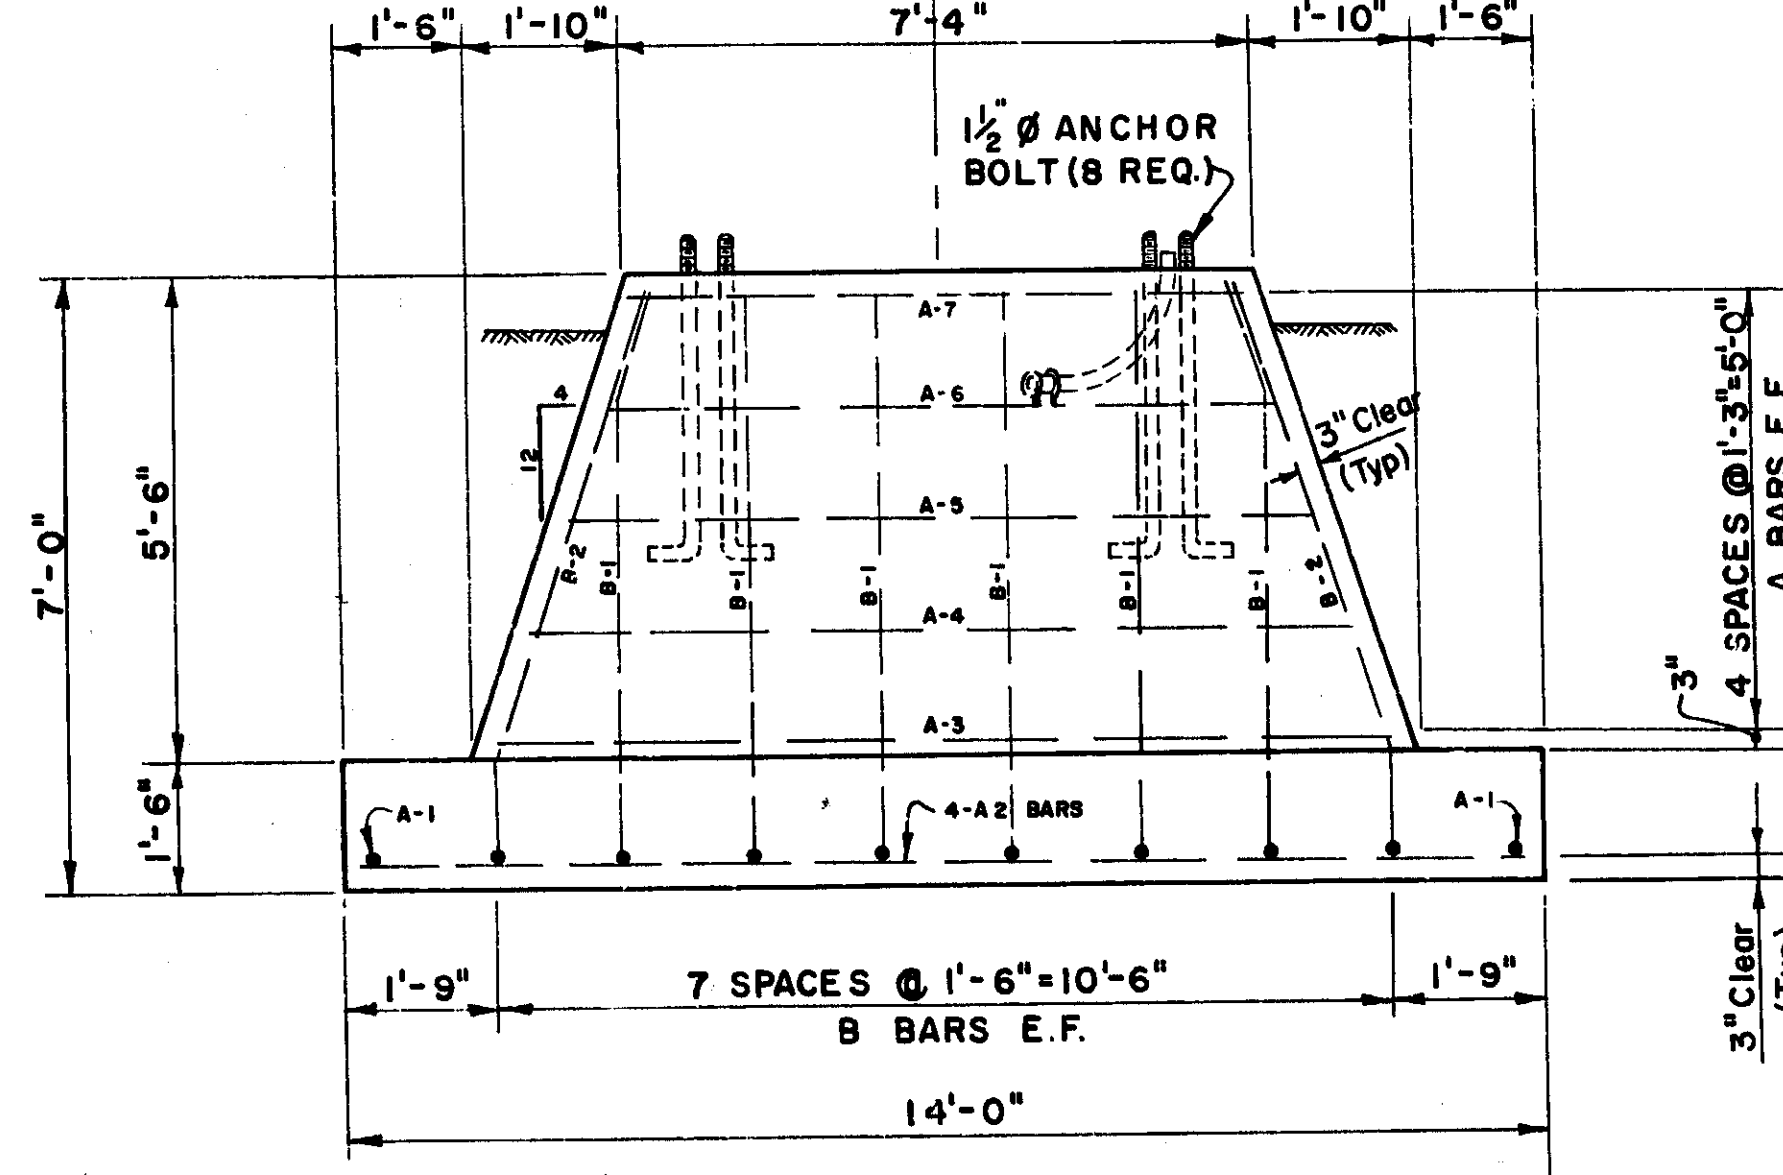

ELEVATION

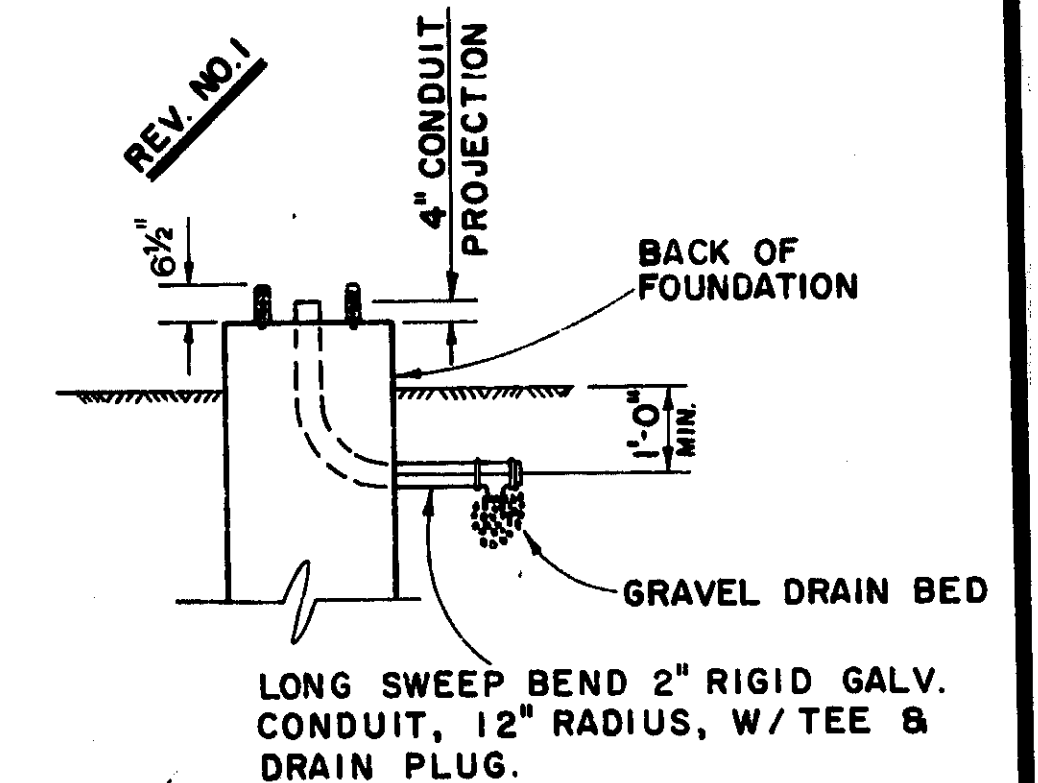

CONDUIT DETAIL

NOTES:

- 1) CONDUIT SHALL BE INSTALLED IN RIGHT FOUNDATION OR AS OTHERWISE SPECIFIED BY THE ENGINEER.
- 2) TOP OF CONC. SHALL BE 3" MIN. ABOVE GROUND (DESIRABLE)
- 3) ANCHOR BOLTS SHALL BE CAREFULLY SET AND HELD VERTICAL AT THE CORRECT LOCATION AND AT THE PROPER ELEVATION UNTIL CONCRETE HAS SET, IF DESIRED, EACH SET OF FOUR BOLTS MAY BE TIED TOGETHER NEAR THE TOP AND BOTTOM BY WELDING INTO A BASKET WITH BAR STOCK OR EQUIVALENT MATERIAL.

BAR SIZE	DIMENSIONS	NO. REQ.
A-10 #4	4'-0"	2
A-11 #4	14'-0"	4
A-12 #4	11'-3"	2
A-13 #4	10'-8"	2
A-14 #4	10'-2"	2
A-15 #4	9'-7"	2
A-16 #4	9'-1"	2
B-10 #4	7'-6" x 3'-0"	14
B-11 #4	7'-7" x 3'-0"	4

10.0 CU. YDS. CONC.
237 # REINF. STEEL

TYPE C
SCALE 1/2" = 1'-0"

BAR SIZE	DIMENSIONS	NO. REQ.
A-1 #4	3'-6"	2
A-2 #4	13'-6"	4
A-3 #4	10'-4"	2
A-4 #4	9'-6"	2
A-5 #4	8'-8"	2
A-6 #4	7'-10"	2
A-7 #4	7'-0"	2
B-1 #4	6'-0" x 2'-6"	12
B-2 #4	6'-0" x 2'-6"	4

6.82 CU. YDS. CONC.
196 # REINF. STEEL

TYPE B
SCALE 1/2" = 1'-0"

MICHIGAN DEPARTMENT OF STATE HIGHWAYS

TRUSS FOUNDATION
TYPE B, C S8.10

STA. 859+50 NB I75

NO.	DESCRIPTION	DATE	BY
1	WIRE ENTRANCE	11/7/66	TMW
2	Anchor bolt strength note	5-3-67	TMW
3	Re-bar dimension change	3/20/67	TMW
4	NOTE ADDED	8-28-69	TMW

63174 08517A

5 ANCHOR BOLT DETAIL REVISED 8/73 TMW
6 QUANTITIES ADDED TO ANCHOR BOLT DETAIL 2/74 JOB

ITEM	UNIT	QUANTITY AS PER PLAN	FEDERAL PARTICIPATION - NON CITY												QUANTITY AS CONSTRUCTED	PLAN EXTRAS				
																DATE	DESCRIPTION	UNIT	QUANTITY ESTIMATE	FINAL
HANDHOLE, LIGHT DUTY COVER	EACH	1														1				
1-3" DIRECT BURIAL CONDUIT	L.FT.	2299														2299				
1-3" GALV. STEEL CONDUIT (SPECIAL)	L.FT.	4496														4651				
1-3" GALV. STEEL CONDUIT	L.FT.	175														149				
1-3" GALV. STEEL CONDUIT - JACKING BORING	L.FT.	259														316				
1-2" GALV. STEEL CONDUIT - RISER	L.FT.	48														46				
HANDHOLE, HEAVY DUTY COVER	EACH	4														5				
600V. 2-1/2 NO. 2 D.B. CABLE IN EARTH	L.FT.	600														630				
600V. 2-1/2 NO. 2 D.B. CABLE IN CONDUIT	L.FT.	50														70				
600V. 2-1/2 NO. 2 D.B. CABLE IN EARTH	L.FT.	820														756				
600V. 2-1/2 NO. 2 D.B. CABLE IN CONDUIT	L.FT.	180														170				
600V. 2-1/2 NO. 4 D.B. CABLE IN EARTH	L.FT.	540														536				
600V. 2-1/2 NO. 4 D.B. CABLE IN CONDUIT	L.FT.	24														40				
600V. 2-1/2 NO. 6 D.B. CABLE IN EARTH	L.FT.	2680														2596				
600V. 2-1/2 NO. 6 D.B. CABLE IN CONDUIT	L.FT.	150														180				
600V. 3-1/2 NO. 6 D.B. CABLE IN EARTH	L.FT.	350														194				
600V. 3-1/2 NO. 6 D.B. CABLE IN CONDUIT	L.FT.	7115														7212				
600V. TWO 3-1/2 NO. 6 D.B. CABLE IN EARTH	L.FT.	60														96				
600V. TWO 3-1/2 NO. 6 D.B. CABLE IN CONDUIT	L.FT.	170														139				
LT. STD. 30 FT. M.H. 12 FT. ARM. FRNG. TRNSF. BASE & EDN.	EACH	2														2				
LT. STD. 35 FT. M.H. 12 FT. DBL. ARM, NEW FDN.	EACH	18														18				
LT. STD. 45 FT. M.H. 12 FT. DBL. ARM - MED. WALL	EACH	10														10				
LT. STD. 45 FT. M.H. AND FOUNDATION	EACH	10														10				
250W. HIGH PRESSURE SODIUM LUMINAIRE	EACH	9														9				
400W. HIGH PRESSURE SODIUM LUMINAIRE	EACH	56														56				
TOWER LIGHTING UNIT, 100 FT., 8 LUMINAIRE	EACH	2														2				
TOWER LIGHTING UNIT, 80 FT., 4 LUMINAIRE	EACH	2														2				
TOWER LIGHTING CONTROL POLE	EACH	1														1				
DOUBLE BEAM GUARD RAIL - SPECIAL TYPE I	L.FT.	562.5														562.5				
DOUBLE BEAM GUARD RAIL - SPECIAL TYPE II	L.FT.	562.5														562.5				
INSTALL FRNG. TRNSF. BASE IN EXISTING LTC. UNIT	EACH	7														7				
REMOVE LT. STD. FOUNDATION	EACH	30														28				
600V. 3-1/2 NO. 4 D.B. CABLE IN CONDUIT	L.FT.	210														243				
600V. TWO 2-1/2 NO. 6 D.B. CABLE IN EARTH	L.FT.	160														165				
RAILING CLOSURE	EACH	4														4				
400W. HIGH PRESSURE SODIUM LUMINAIRE (SPECIAL)	EACH	10														10				
LIGHTING CONTROL PANEL	EACH	2														2				
ON THE JOB TRAINING	EACH	1														1				
ELECTRIC DRILL	EACH	1														1				
FOUNDATION FOR 80 FT. TOWER LIGHTING UNIT	EACH	2														2				
FOUNDATION FOR 100 FT. TOWER LIGHTING UNIT	EACH	2														2				

CHECKED
 CONTRACT SECTION
 DATE 10-18-76
8/2

MICHIGAN STATE HIGHWAY DEPARTMENT

BILL OF MATERIAL

ISSUED BY	J.C. BROWN	10/15/76
MADE BY	J.W.	10/15/76
CHECKED BY	J.W.	10/15/76

63174 08517A

AS PER PLANS

B.P.S. DIV. NO.	STATE	PROJ. NO.	FISCAL YEAR	SHEET NO.	TOTAL SHEETS
A	MICH.				
ROUTE PROJECT	COUNTY	TWP.	SHEET NO.	TOTAL SHEETS	
I-75	OAKLAND		35		

Sheet No.	REMOVALS		GRADING		CONCRETE & STEEL		GUARD RAIL		DRAINAGE ITEMS		MAINTAINING TRAFFIC ITEMS		MISCELLANEOUS	
	REMOVING EXISTING CURBS AND CUTTERS	REMOVING EXISTING L.P.	TYPE CURB/PAVEMENT	EXPLANATION C.Y.	EXPLANATION C.Y.	CONCRETE C.Y.	STEEL LBS.	TYPE GUARD RAIL	EXPLANATION	EXPLANATION	TYPE CURB/PAVEMENT	EXPLANATION	EXPLANATION	EXPLANATION
FEDERAL PARTICIPATION - CITY OF ROYAL OAK														
3			100											
4	1345	2480		12.2	3524	1220	40							
5	1079	2372		11.8	3826	1174		1	12.5	12.5	2	6	2770	25
19	41												9	4095
20	25													5
Subtotal	2490	4852	100	24.0	7445	2394	40	1	12.5	25	2	6	2770	25
FEDERAL PARTICIPATION - CITY OF MADISON HEIGHTS														
3														
6	575			500										
7	2850			725										
Subtotal	3425			1225										
NON-FEDERAL PARTICIPATION - CITY OF ROYAL OAK														
3														
5			50	10										
6														
Subtotal			50	10										
NON-FEDERAL PARTICIPATION - CITY OF MADISON HEIGHTS														
3														
5			10	23										
6			41	13.04										
7			40	155										
8														
Subtotal			91	188										
FEDERAL PARTICIPATION - NON CITY														
4														
5														
19														
Subtotal														
TOTALS	5915	4852	100	100	1024	16	24	7445	2394	40	10	1	12.5	13

All as per plan quantities except Bm Guard Rail & Matching are shown to the nearest whole unit.

CENTRAL SECTION
43/100/16/16
12/74

SQUAD - ROUSH '74

AS CONSTRUCTED

STATE	PROJ. NO.	FISCAL YEAR	SHEET NO.	TOTAL SHEETS
MICH.			36	
ROUTE	COUNTY	TWP.	SHEET NO.	TOTAL SHEETS
			36	

Sheet No.	R. MOVALS			GRADING			CONCRETE & STEEL			GUARD RAIL			DRAINAGE ITEMS			MAINTAINING TRAFFIC ITEMS			MISCELLANEOUS				
	REMOVE EXISTING	NEW	ADJUST	EXCAVATION	EMBANKMENT	GRAVEL	CONC. WALL	CONC. CURB	STEEL	WOOD	CAST IRON	CONCRETE	PIPE	OPENINGS	TRAFFIC LIGHTS	TRAFFIC SIGNALS	TRAFFIC SIGNS	TRAFFIC MARKINGS	ROADSIDE	MULCH	LANDSCAPING	UTILITIES	EA.
	FEDERAL PARTICIPATION - CITY OF ROYAL OAK																						
3																							
4	123.5	247			12.2		3544	1222	39	1222		1	125	125	2		6	2720					
5	10534	2307			11.8		40091	1170		1236.4				3	8		9	4025	5				
19	625																						
20	25																						
Subtotal	2170	4789			24.0		7560	2392	39	2256.4		1	125	125	3	18	15	6225	5				
	FEDERAL PARTICIPATION - CITY OF MADISON HEIGHTS																						
3																							
6	600			58	1096																		
7	300				740						10												
Subtotal	360			58	1836						10												
	NON-FEDERAL PARTICIPATION - CITY OF ROYAL OAK																						
3																							
5																							
8																							
Subtotal																							
	NON-FEDERAL PARTICIPATION - CITY OF MADISON HEIGHTS																						
3																							
5																							
6																							
7																							
8																							
Subtotal																							
	FEDERAL PARTICIPATION - NON CITY																						
4																							
5																							
19																							
Subtotal																							
Totals	4066	4789			166	1896	3	160	240	7560	2392	39	10	125	125	3	18	15	6225	5			

Squid - Pouch '74

63174-09458A

CS: 63174

ID: 09458A

Ms 63174 - 09458A

0.18 mi of geometric im-
provements, including
G&DS, concrete base crse
wdng, concrete curb &
gutter, and bit. concrete
surface on the SE I-75
Service Rd. commencing
275' S of 9-Mile Rd.,
thence N'ly to a point
700' N of 9-Mile Rd.,
City of Hazel Park,
Oakland Co. Item 4
Invitational



STATE OF MICHIGAN DEPARTMENT OF STATE HIGHWAYS AND TRANSPORTATION

PLANS OF PROPOSED MICHIGAN PROJECT CONTROL SECTION Ms 63174

JOB NUMBER 09458A

1 - 75 AT NINE MILE ROAD
OAKLAND COUNTY
CITY OF HAZEL PARK


ROUTE	JOB NUMBER	FEDERAL NUMBER	SHEET NO.	TOTAL SHEETS
I-75	09458A		1	3

THE IMPROVEMENTS COVERED BY THESE PLANS SHALL BE DONE IN ACCORDANCE WITH THE MICHIGAN DEPARTMENT OF STATE HIGHWAYS 1973 STANDARD SPECIFICATIONS AND SUPPLEMENTAL SPECIFICATIONS.

ROAD PLANS	SHEET NO'S.
TITLE	1
TYPICAL CROSS SECTION	2
NOTE SHEET	
PLANS & PROFILES	3
SPECIAL DETAILS	
MASS DIAGRAMS	
QUANTITY SHEETS	3

BRIDGE PLANS
SIGNING PLANS

LEGEND
A.D.T.
D.H.V.
COMM. %
DESIGN SPEED.

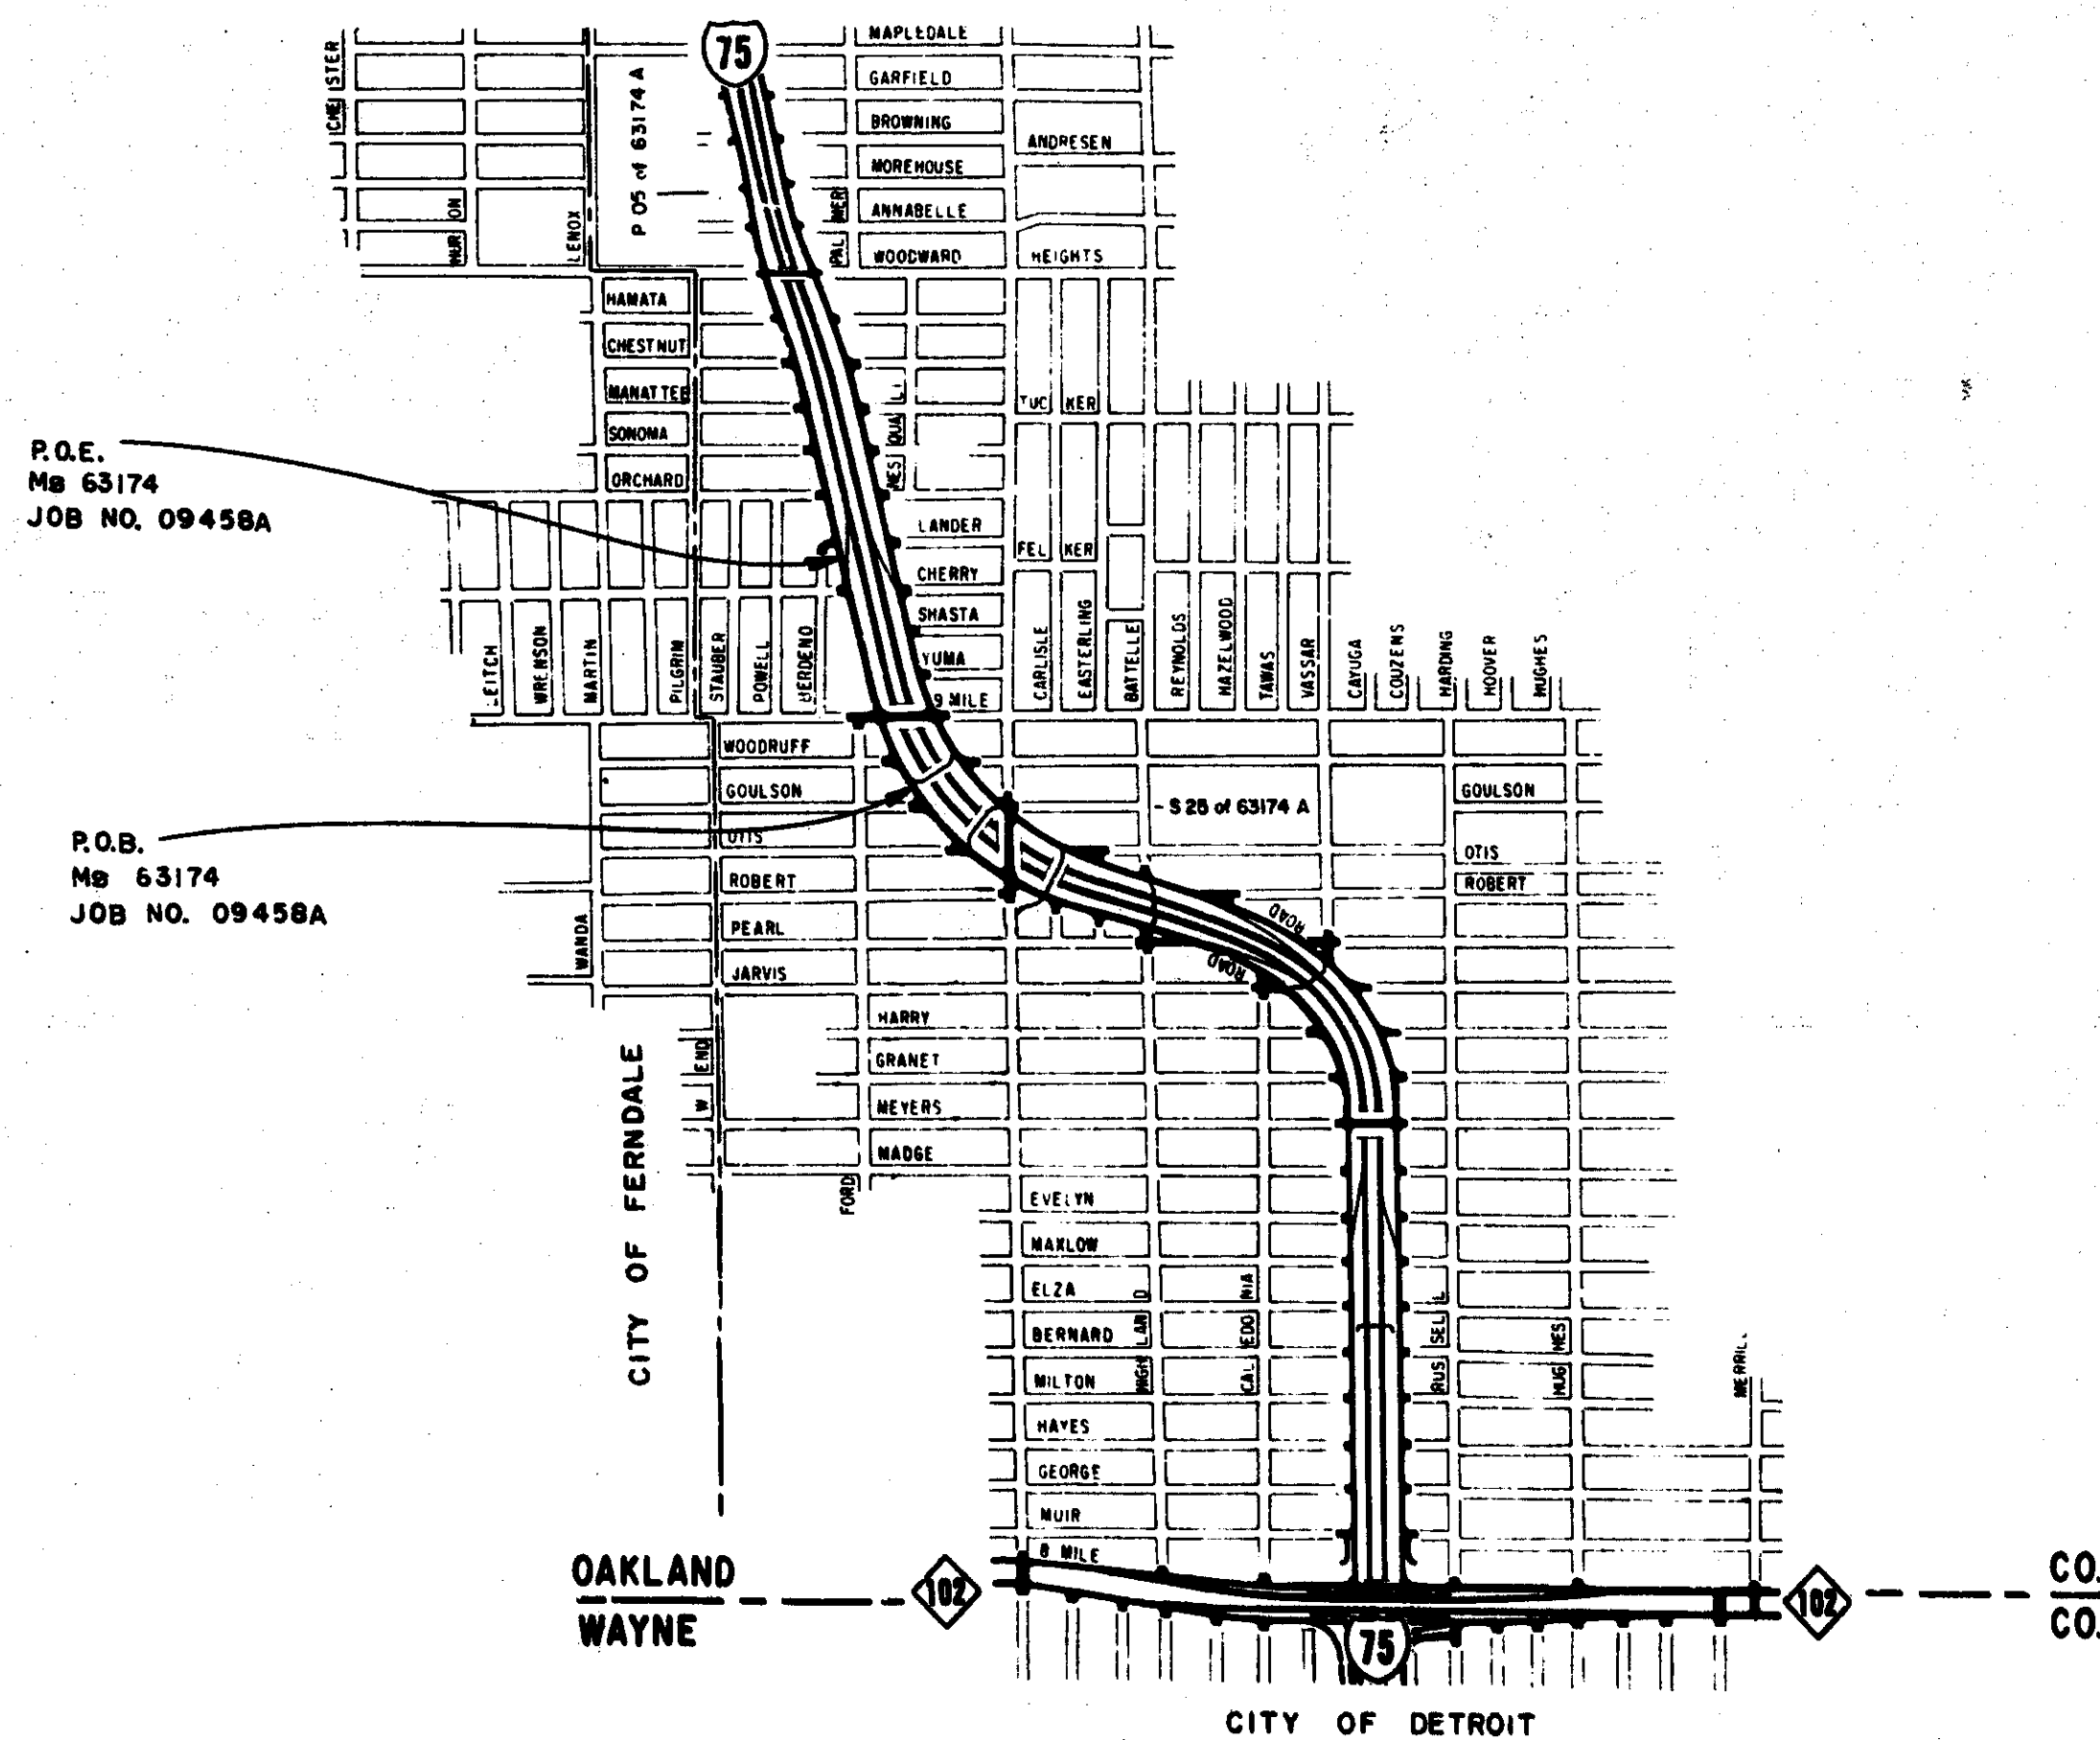

TITLE SHEET LEGEND

	EXISTING CONDITION
PAVED	
BITUMINOUS	
GRAVEL	
UNIMPROVED OR CITY STREET	
SECTION LINE	
TOWNSHIP LINE	
COUNTY LINE	
CITY OR VILLAGE LIMITS	
RAILROADS	

3-79
AS CONSTRUCTED
ACCORDING TO MARKED PLANS
PREPARED BY PROJECT ENGINEER

SAFETY INVENTORY ITEM NO. 12625

CONTRACT FOR INTERSECTION IMPROVEMENT APPROVALS		
CHECKED	<i>C.P. Ryan</i> ENGINEER-ROAD DESIGN	8-28-75 DATE
RECOMMENDED FOR APPROVAL	<i>Tom Dabrowski</i> ENGINEER OF DESIGN	8-29-75 DATE
RECOMMENDED FOR APPROVAL	<i>J.B. Ligon</i> ENGINEER OF TRAFFIC & SAFETY	9/2/75 DATE
RECOMMENDED FOR APPROVAL	<i>Wm. Rot</i> ENGINEER OF CONSTRUCTION	8/29/75 DATE

DEPARTMENT OF STATE HIGHWAYS AND TRANSPORTATION
JOHN P. WOODFORD - DIRECTOR

APPROVED BY: *B. Ryan* 9/2/75
DEPUTY DIRECTOR - HIGHWAYS DATE

U.S. DEPARTMENT OF TRANSPORTATION
FEDERAL HIGHWAY ADMINISTRATION

APPROVED: _____




LUTHER

Ms 63174	JOB NUMBER 09458A	FEDERAL PROJECT	SHEET NO. 1
----------	----------------------	-----------------	----------------

JOB NUMBER
SECTION
Ms 63174 09458A

TYPICAL CROSS-SECTIONS

F. H. W. A. REG. NO.	STATE	FEDERAL PROJECT	R.O.W. NO.	SHEET NO.	TOTAL SHEETS
5	MICH.			2	
ROUTE	COUNTY	CONTROL SECTION	JOB NO.		
I-75	Vander	Ms 63174	09458A		

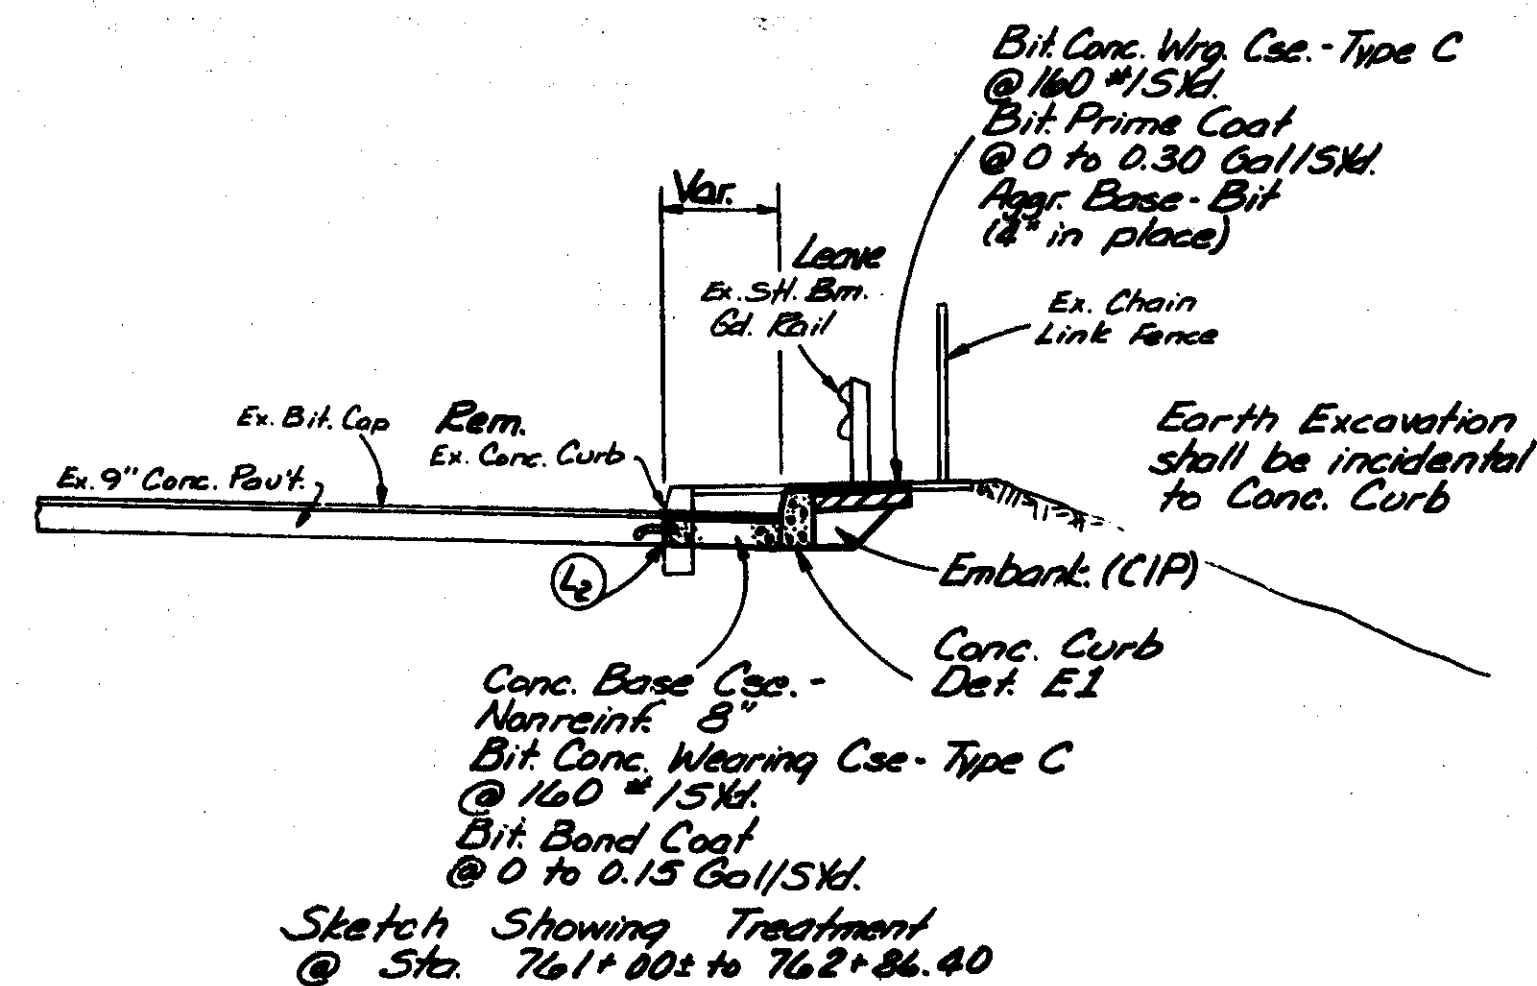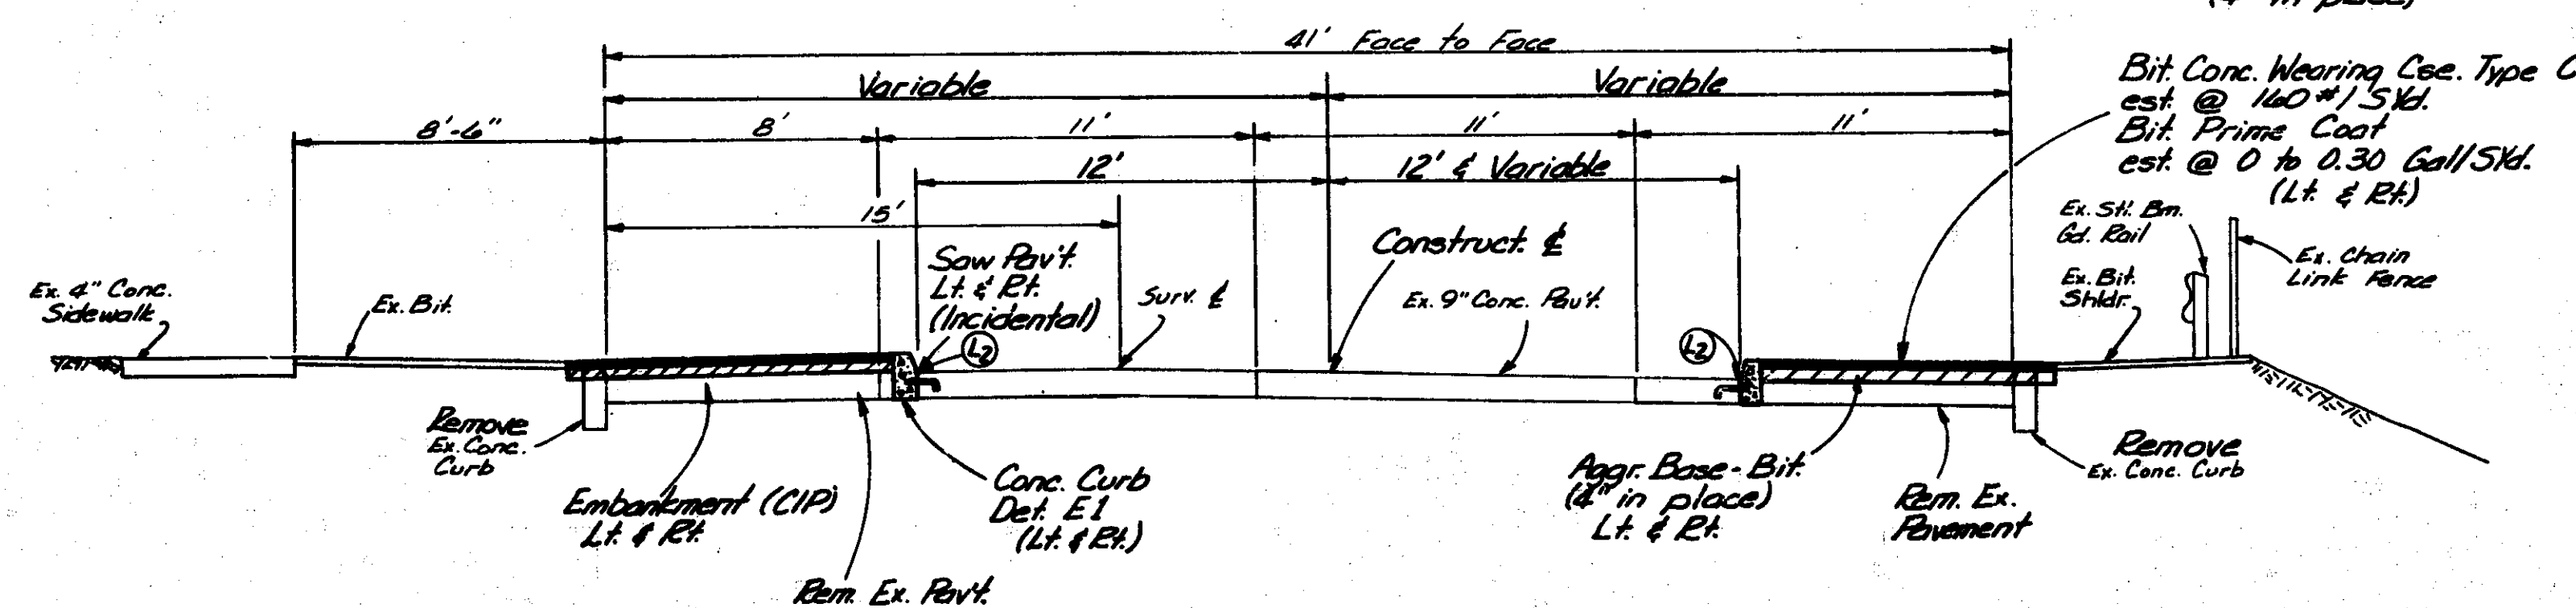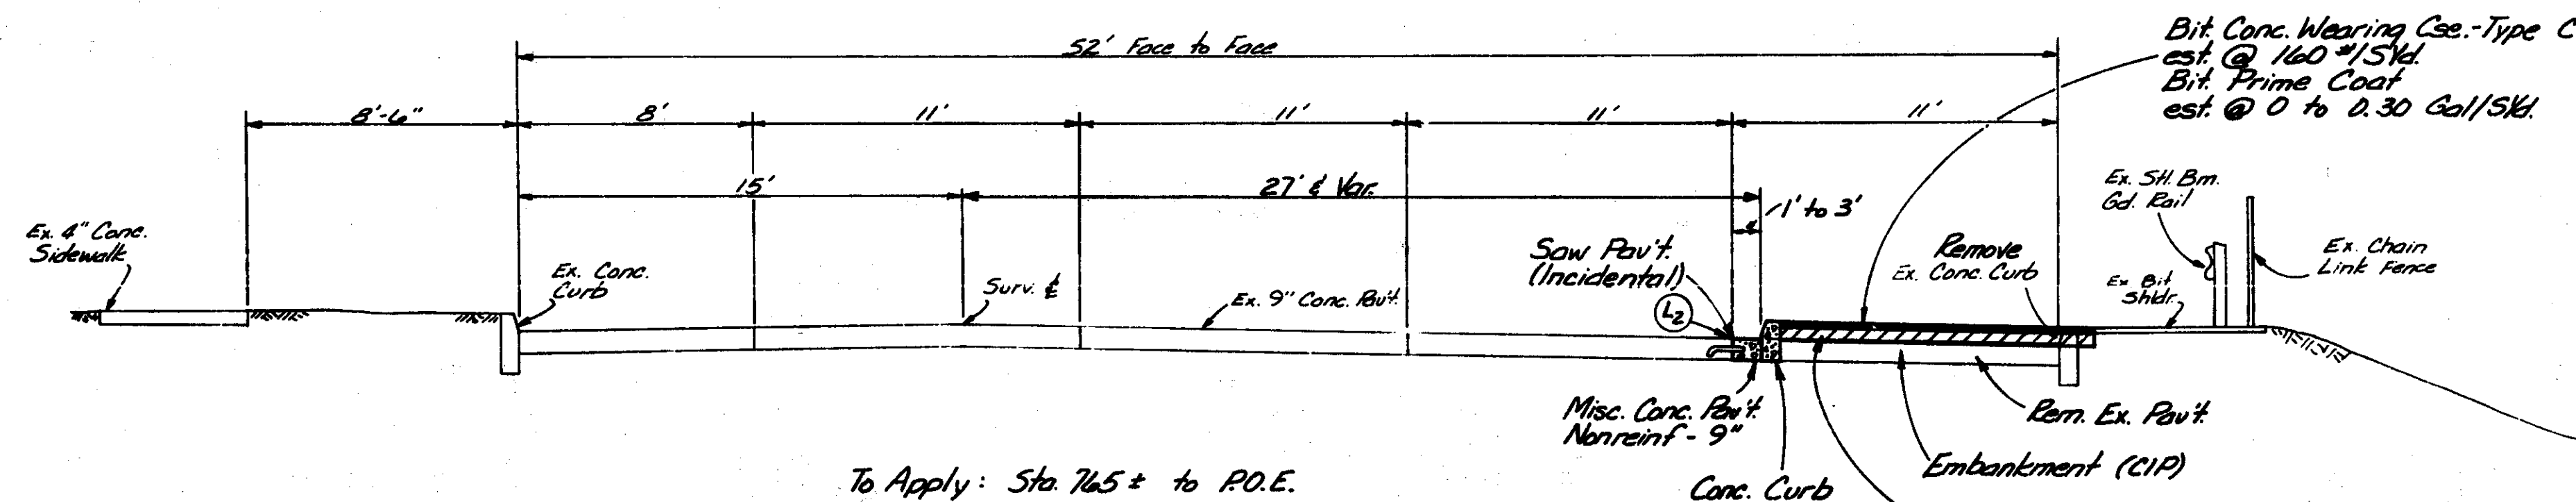

Notes:

The edges of the existing pavement shall be thoroughly cleaned before concrete widening or curb is placed.
 Bit Concrete Wearing Cse.-Type C shall be applied at a rate of 160 #15Kd. (1 1/2" thick) with an asphalt penetration of 85-100

Joint Legend:

L2 - Longitudinal Bulkhead Construction Joint, according to Std. Plan II-39C, Detail 4A. (Widening with Expansion Anchored Lane Ties)

Hand finishing according to Article 4.14.11-b of the Standard Specifications will be permitted on all pavement to be placed on this project.

Notes Applying to Standard Plans

Where the following items are called for on plans, they are to be constructed according to the Standard Plan given below opposite each item unless otherwise indicated.

Catch Basins and Inlets	I-5B
Cover D	I-9B
Cover M	I-17B
Sidewalk Ramp Details	II-28F
Concrete Driveway Openings, Concrete Pavement	
7" Uniform and Concrete Sidewalk	II-29A
Concrete Curb and Concrete Curb and Gutter	II-30B
Concrete Pavement Joints	II-39C
Utility Trenches	IV-83B
Types II & III Barricades and Lighted Arrows	II-125C

PUBLIC UTILITIES

Name of Owner	Kind of Utility
Consumers Power Co.	Gas
Detroit Edison Co.	Electricity
Michigan Bell Telephone	Telephone
City of Hazel Park	Water

The existing utilities listed above and shown on the plans represent the best information available as obtained from original construction plans dated January, 1965. This information does not relieve the contractor of the responsibility to satisfy himself as to their accuracy or of his responsibility in case utilities have been constructed or removed since the above date. For protection of underground utilities the contractor shall dial "Miss Dig" (647-7344) a minimum of 48 hours prior to excavating in the vicinity of utility lines.

Squad: Luther 1975 FINAL P.O.W.

DATE	REVISION	FINAL R.O.W.

Removing Curb, shown
 Removing Sidewalk, shown
 Removing Pavement, shown

Sidewalk Ramp Quantities
 Removing Curb 52 L.F.
 Removing Sidewalk 33 S.F.
 Conc. Curb - Det. E-1 41 L.F.
 Sidewalk Ramps - Type 1 325 S.F.
 Sidewalk Ramps - Type 3 45 S.F.

TIN; R.11E
 Sec. 35

Note:
 Any bituminous repair work needed as a result of Sidewalk Ramp construction shall be incidental to the Sidewalk Ramp.
 Earth Excavation for Sidewalk Ramps shall be incidental to the Sidewalk Ramp.


Curve DATA Construct. &
 Δ = 10°29'00" RT
 Δ = 3°40'
 R = 1562.61'
 T = 143.35'
 L = 285.91'
 E = 6.56'
 PC = 760+00.89
 PT = 761+43.84
 P.I. = 762+22.37
 PT = 762+22.37

TIN; R.11E
 Sec. 26

Curve DATA (Surv. Const.)
 Δ = 2°51'40" LT
 Δ = 1°30'
 R = 3819.72'
 T = 98.73'
 L = 197.41'
 E = 1.28'
 PC = 764+28.32
 PT = 765+27.05
 P.I. = 764+27.73

Curve DATA (Ramp)
 Δ = 5°21'46" LT
 Δ = 5°20'
 R = 1079.30'
 T = 31.53'
 L = 63.06'
 E = 0.46'
 PC = 767+74.11 (26' Rt Constr. &)
 PT = 768+10.67 (26' Rt 768+25.64 Const. &)
 P.I. = 767+42.39

TIN	STATE	FEDERAL PROJECT	R.O.W.	SHEET NO.	TOTAL SHEETS
5	MICH.			3	
ROUTE	COUNTY	CONTROL SECTION	JOB NO.		
I-75	Oakland	Ms 63174	09458A		

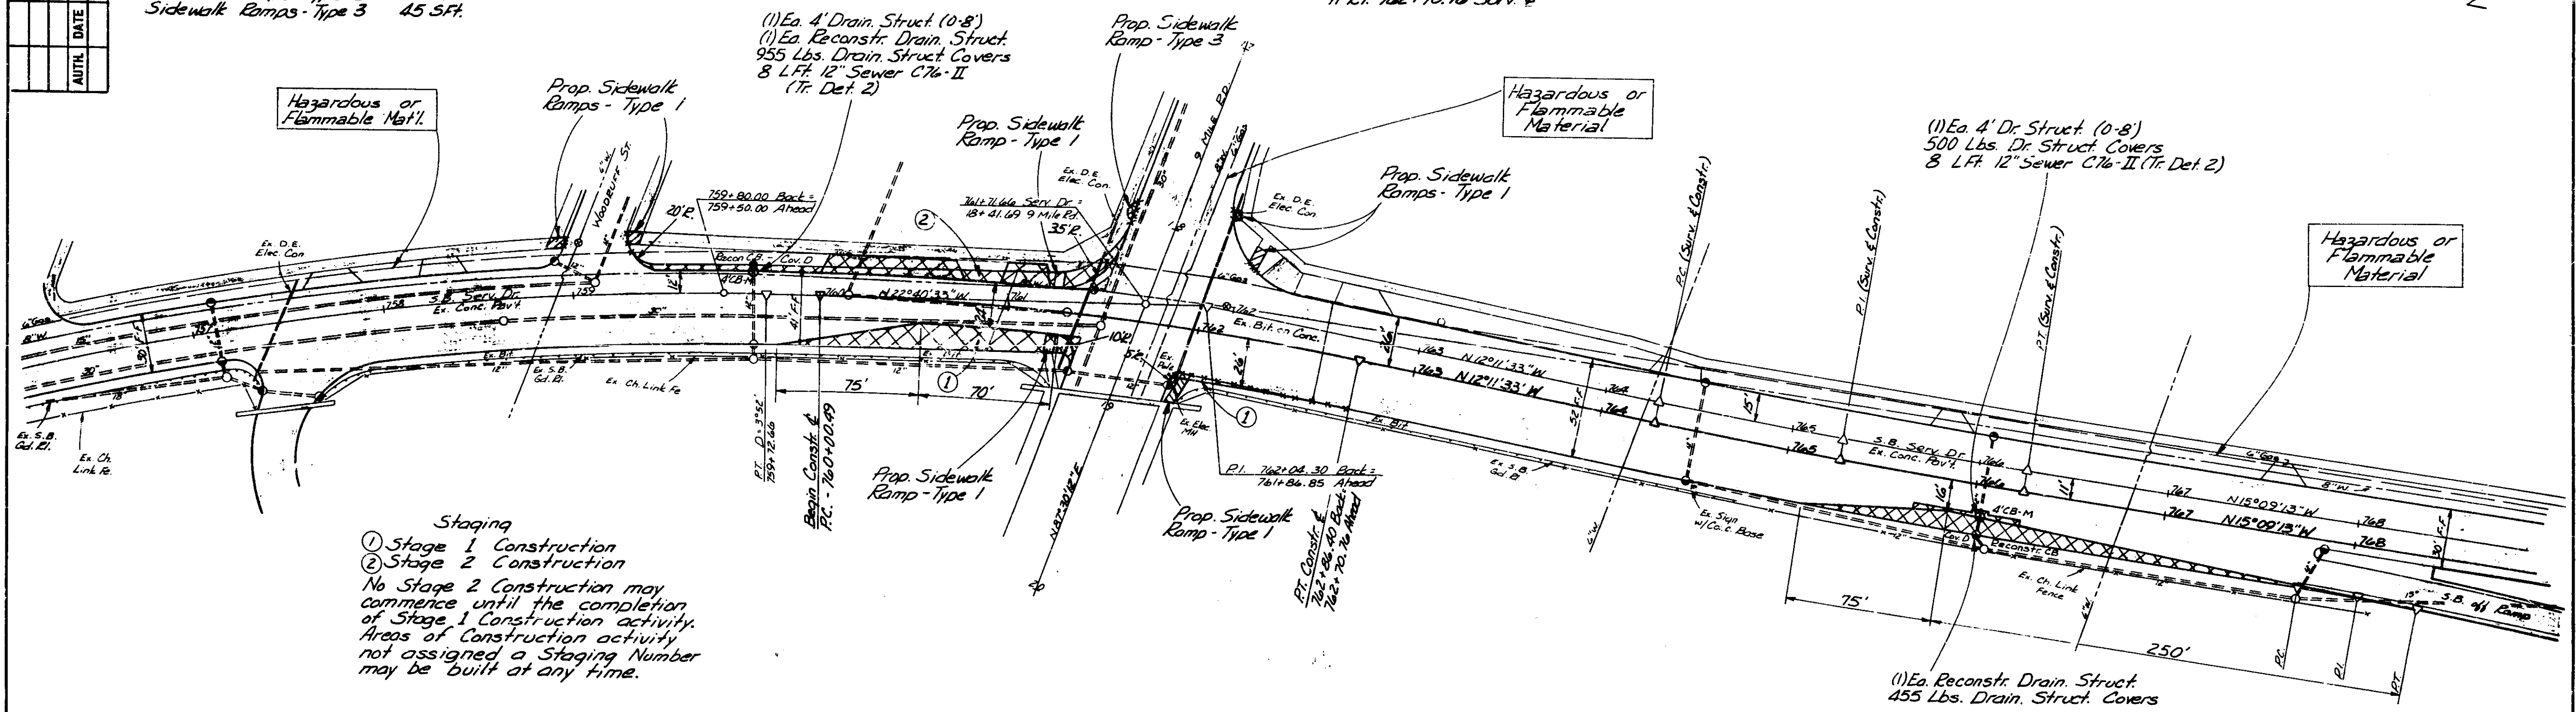

Staging
 ① Stage 1 Construction
 ② Stage 2 Construction
 No Stage 2 Construction may commence until the completion of Stage 1 Construction activity. Areas of Construction activity not assigned a Staging Number may be built at any time.

As Per Plans			As Constructed			EXTRAS		
Item	Unit	Amount	Item	Unit	Amount	Item	Unit	Amount
Removing Pavement	Sq. Yd.	587	Removing Pavement	Sq. Yd.	593	2001 Rem. Drainage Structures	Each	1250.00
Removing Curb	L. Ft.	154	Removing Curb	L. Ft.	154	2001 12" Sewer Tap	Each	75.00
Removing Sidewalk	Sq. Yd.	33	Removing Sidewalk	Sq. Yd.	49	2001 4" Conc. Sidewalk	331 S.F.	1.25
Embankment (C&G)	Cu. Yd.	128	Embankment (C&G)	Cu. Yd.	149	2001 Cement	4 Sacks	2.40
Apply Base - Bit. (4" in place)	Sq. Yd.	510	Apply Base - Bit. (4" in place)	Sq. Yd.	478	2001 Extra Work to Corr. Drain	1 Each	225.00
Conc. Base Course - Max. 4"	Sq. Yd.	42	Conc. Base Course - Max. 4"	Sq. Yd.	37			
Bit. Conc. Wearing Course - Type C	Ton	45	Bit. Conc. Wearing Course - Type C	Ton	45			
Bit. Prime Coat	Gal.	153	Bit. Prime Coat	Gal.	65			
Crack Patch Material 7"	Sq. Yd.	120	Crack Patch Material 7"	Sq. Yd.	122			
Mass Concrete Patch - Max. 9"	Sq. Yd.	15	Mass Concrete Patch - Max. 9"	Sq. Yd.	29			
Expansion Joints for Lane Ties	Sta.	9	Expansion Joints for Lane Ties	Sta.	2			
12" Sewer C. 76-8' (Tr. Det. 2)	L. Ft.	14	12" Sewer C. 76-8' (Tr. Det. 2)	L. Ft.	63			
Drainage Struct. 4' (0-8)	Each	2	Drainage Struct. 4' (0-8)	Each	3			
Drainage Struct. Covers	Lb.	1910	Drainage Struct. Covers	Lb.	1955			
Reconstruct Drain Struct.	Each	2	Reconstruct Drain Struct.	Each	2			
Concrete Curb - Det. E-1	L. Ft.	900	Concrete Curb - Det. E-1	L. Ft.	760			
Sidewalk Ramps - Type 1	Sq. Ft.	325	Sidewalk Ramps - Type 1	Sq. Ft.	211			
Sidewalk Ramps - Type 3	Sq. Ft.	45	Sidewalk Ramps - Type 3	Sq. Ft.	0			
Lighted Arrow Type A (Guaranteed)	Each	2	Lighted Arrow Type A (Guaranteed)	Each	2			
Lighted Arrow Type A (Optional)	Each	2	Lighted Arrow Type A (Optional)	Each	2			
Minor Traffic Devices	Lump Sum	1	Minor Traffic Devices	Lump Sum	1			

CHECKED
 CONTRACT SECTION
 DATE: 8-2-88

CS: 63174

ID: 10453

63174-10453

LOG JOB

X

STATE OF MICHIGAN
DEPARTMENT OF STATE HIGHWAYS AND TRANSPORTATION
CONTROL SECTION U63174
JOB NUMBER 10453 A
1-75
OAKLAND COUNTY
CITY OF MADISON HEIGHTS

Mich. Proj.
UI 75-2(186)

Item 947
DEPARTMENT OF STATE HIGHWAYS AND TRANSPORTATION
JOHN P. WOODFORD, DIRECTOR
DEPUTY DIRECTOR

TITLE	DATE	SIGNATURE	APPROVED	DATE
Design Engr. Road	12/2/75	<i>[Signature]</i>	<i>[Signature]</i>	1/17/76
Engr. of Design	12/2/75	<i>[Signature]</i>		
Construction Division	12/2/75	<i>[Signature]</i>		

LOG OF JOB NO. 10453A


Location of Work
Commencing on I-75 399' North of Red Run Drain at a point 110' east of I-75 Cl. N.B., thence northerly along R.O.W. Fence Line to a point adjacent to S.E. bridge abutment at 13 Mile Rd. Structure.

Description of Work
Remove Woven Wire Fence and replace with 4' Chain Link Fence along I-75 R.O.W.
All connections to existing chain link fence shall be made to existing corner or end posts.

Standard Plan
Chain Link Fence V-98A


Quantities - Entire Project

48 inch Chain Link Fence	4300 Lin. Ft.
Removing Fence	4300 Lin. Ft.
Sign, Type IIB Temporary	128 Sq. Ft.
Minor Traffic Devices	1 Lump Sum

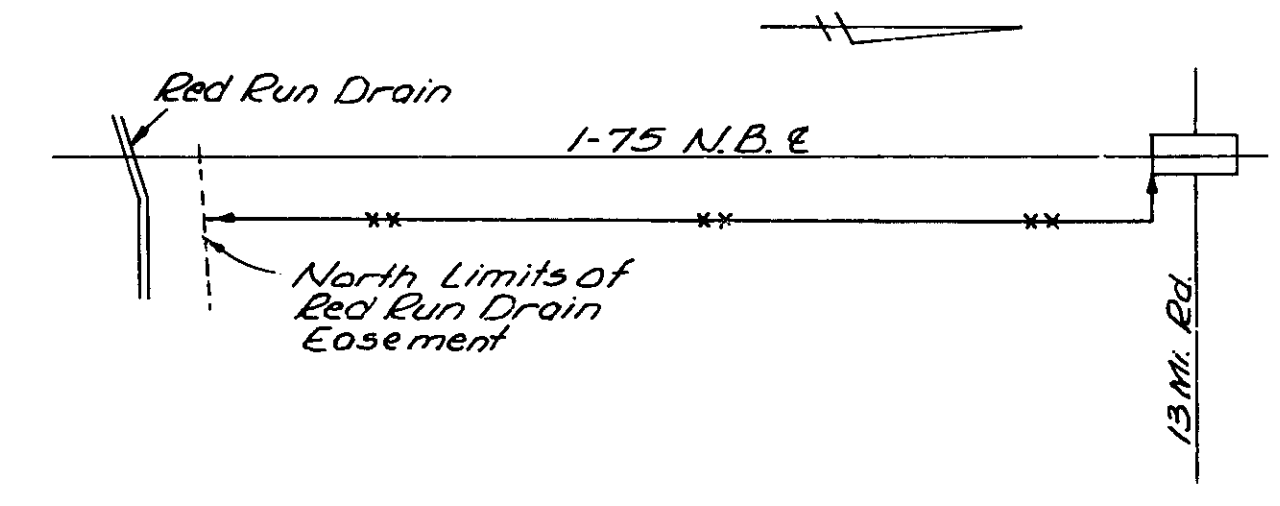

PAY ITEM	UNIT	AS PER PLANS		AS CONSTRUCTED	
		10453A	TOTALS	10453A	TOTALS
48inch Chain Link Fence	Lin Ft	4300	4300		
Removing Fence	Lin Ft	4300	4300		
Sign, Type IIB Temporary	Sq Ft	128	128		
Minor Traffic Devices	Lump Sum	1	1		

CONTRACTORS CODE
1
ITEM NUMBER

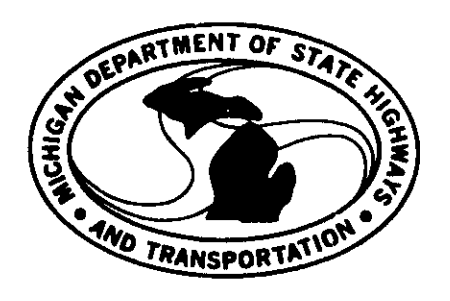

BUREAU OF HIGHWAYS

PROPOSAL FOR PROJECT

INVITATIONAL BID

PROJECT	JOB NO.	FEDERAL NO.
U 63174	10453 A	UI 75-2(186)

CON-SEC ID	JOB NO.	MICHIGAN PROJECT
U 63174	10453A	UI 75-2(186)

LOCATION:
City of Madison Heights in Oakland County.

TYPE OF WORK:
48" Chain Link Fence.

DESCRIPTION:
Along Northbound I-75 between 12 Mile and 13 Mile Roads.

NOTE TO BIDDERS
This bid proposal must be signed by the bidder on Page III.

THE RIGHT IS RESERVED TO REJECT ANY OR ALL PROPOSALS

- SEE INSIDE OF COVER PAGE FOR INSTRUCTIONS TO BIDDERS -


CS: 63174

ID: 10454

63174-10454

LOG JOB

X

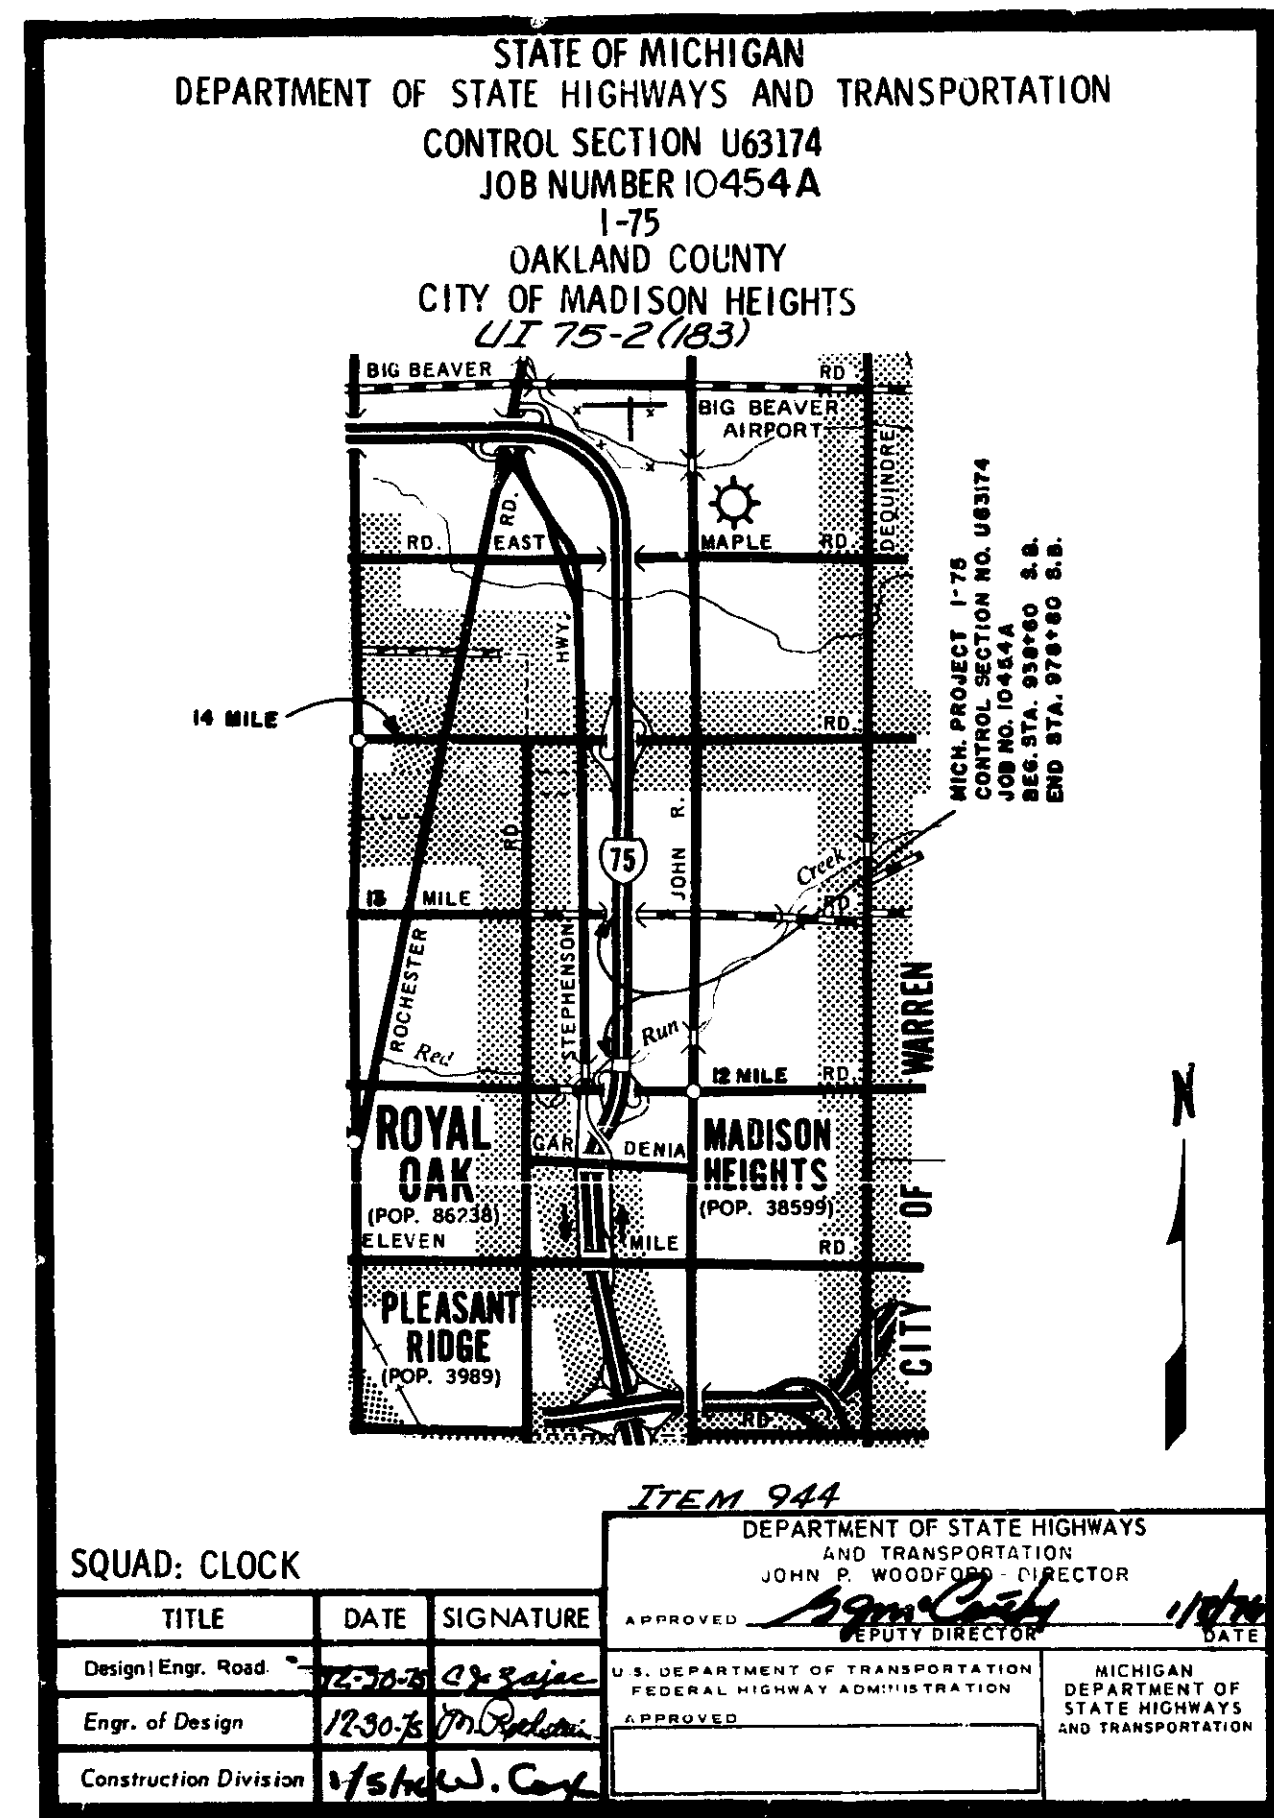

PAY ITEM	UNIT	AS PER PLANS		AS CONSTRUCTED	
		10454A	TOTALS	10454A	TOTALS
Removing Fence	Lin. Ft.	4080	4080		
48 inch Chain Link Fence	Lin. Ft.	3680	3680		
Sign Type II B Temporary	Sq. Ft.	178	178		
Minor Traffic Devices	Lump Sum	1	1		

LOG OF JOB NO 10454A

Location of Work

Commencing on I-75, 615' north of Red Run Drain at a point 100' west of I-75 S.B., thence northerly along R.O.W. fence line to a point adjacent to the S.W. bridge abutment of 13 Mi. Rd. Structure.

Description of Work

Remove Woven Wire Fence and replace with 4' Chain Link Fence along S.B. I-75 R.O.W. extent as noted in the following:

- Omit from Sta. 963+15 to 968+00 I-75 S.B. and connect to existing private fence on east-west fence line.
- At approximately Sta. 978+80 I-75 S.B. connect fence to S.W. bridge abutment.

All connections to private fence shall be made to existing corner or end posts except as noted.


Standard Plan

Chain Link Fence V-98A.


QUANTITIES - ENTIRE PROJECT

Removing Fence	4080 Lin. Ft.
48 inch Chain Link Fence	3680 Lin. Ft.
Sign, Type II B Temporary	178 Sq. Ft.
Minor Traffic Devices	1 Lump Sum

FENCE UPGRADING LIMITS OF JOB NO. 10454A

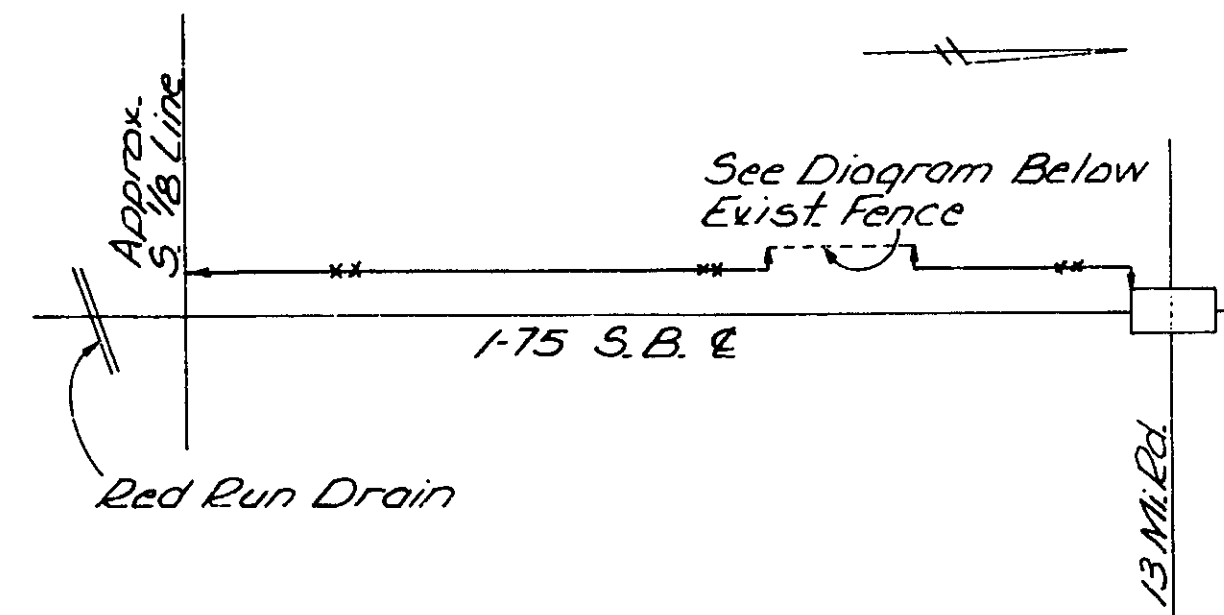

R.O.W. Fence Connection to Private Fence

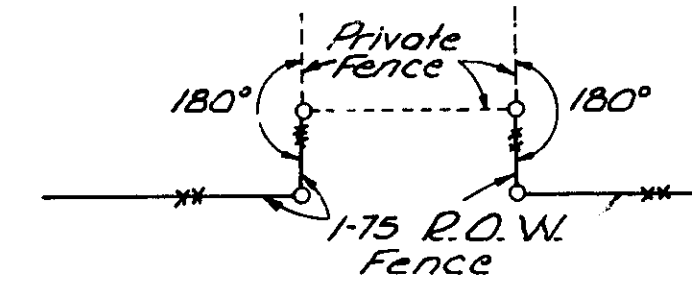


U 63174

- 42 -

U 63174

- 43 -

CONTRACTORS CODE
1
ITEM NUMBER

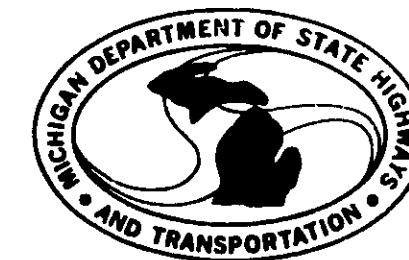

BUREAU OF HIGHWAYS

PROPOSAL FOR INVITATIONAL BID PROJECT

PROJECT: U 63174
JOB NO.: 10454A
FEDERAL NO.: UI 75-2(183)

BIDS WILL BE OPENED AT 3:30 P.M., E.S.T., ON WEDNESDAY, APRIL 21, 1976 IN THE FIRST FLOOR CONFERENCE ROOM, STATE HIGHWAYS BUILDING, LANSING, MICHIGAN

THE RIGHT IS RESERVED TO REJECT ANY OR ALL PROPOSALS

- SEE INSIDE OF COVER PAGE FOR INSTRUCTIONS TO BIDDERS -

CON-SEC ID: U 63174
JOB NO.: 10454A
MICHIGAN PROJECT: UI 75-2(183)

LOCATION: City of Madison Heights in Oakland County.

TYPE OF WORK: 48" Chain Link Fence.

DESCRIPTION: On I-75 southbound between 12 Mile and 13 Mile Roads.

U 63174

- 1 -

CS: 63174

ID: 10455

63174-10455

LOG JOB

X

STATE OF MICHIGAN
DEPARTMENT OF STATE HIGHWAYS AND TRANSPORTATION
CONTROL SECTION U63174
JOB NUMBER IO455A
1-75
OAKLAND COUNTY
CITY OF MADISON HEIGHTS

Mich. Proj. UI 75-2(187)

MICH. PROJECT 1-75
CONTROL SECTION NO. U63174
JOB NO. IO455A
BEG. STA. 880+18 N.B.
END STA. 106+86 14 MILE RD.

Item 948
DEPARTMENT OF STATE HIGHWAYS AND TRANSPORTATION
JOHN P. WOODFORD, DIRECTOR

SQUAD: CLOCK

TITLE	DATE	SIGNATURE	APPROVED	DATE
Design/Engr. Road	12-24-75	<i>C. J. Ziege</i>	<i>John P. Woodford</i>	1/21/76
Engr. of Design	12-24-75	<i>M. J. ...</i>		
Construction Division		<i>W. C. ...</i>		

U 63174 -38-

LOG OF JOB NO. 10455A


Location of Work
Commencing on I-75, 70' north of 13 Mile Rd. CL 110' east of I-75 CL N.B., thence northerly along R.O.W. fence line to a point 100' south of Sta. 106+86 14 Mile Rd.

Description of Work
Remove woven wire fence and replace with 6' chain link fence from Sta. 980+18 N.B. to Sta. 1018+98 N.B. (Approximate north line of adjacent apartment complex.)
Remove woven wire fence and replace with 4' chain link fence from Sta. 1018+98 N.B. to Sta. 106+86 14 Mile Rd.

Standard Plan
Chain Link Fence V-98A.

Quantities - Entire Project

72 Inch Chain Link Fence	3946 Lin. Ft.
48 Inch Chain Link Fence	1489 Lin. Ft.
Removing Fence	5499 Lin. Ft.
Sign, Type IIB Temporary	128 Sq. Ft.
Minor Traffic Devices	1 Lump Sum

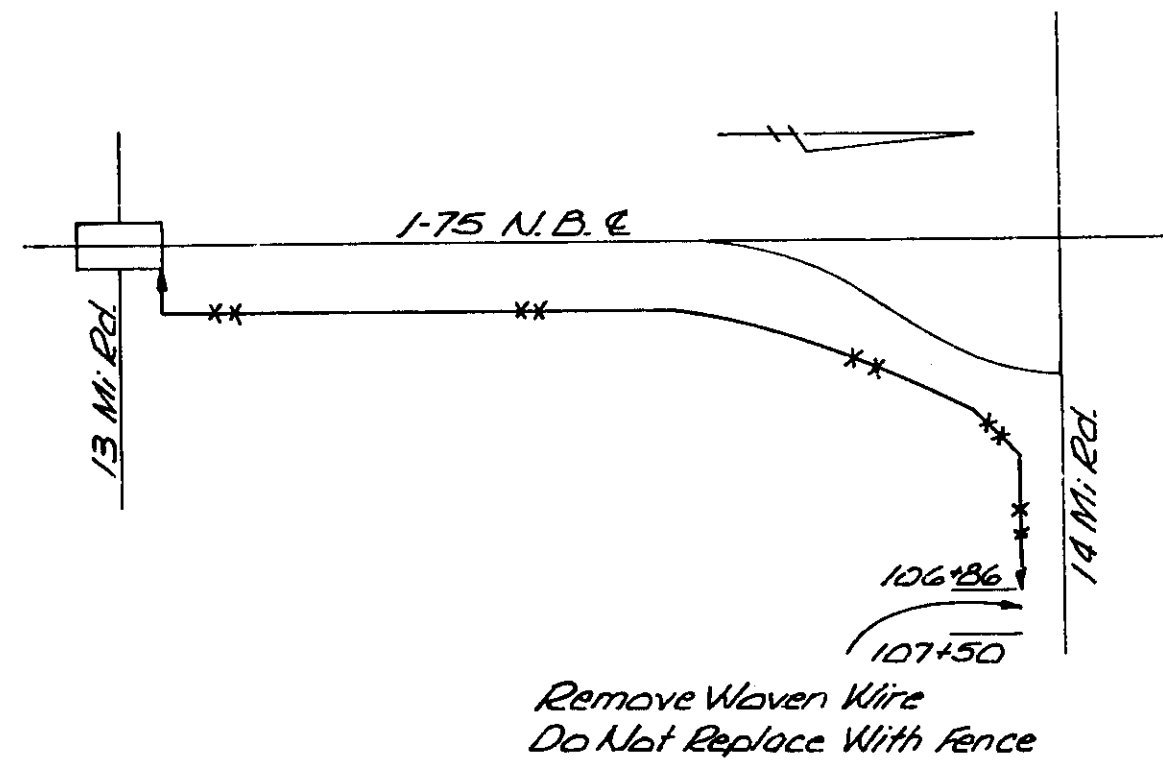


U 63174 -39-

PAY ITEM	UNIT	AS PER PLANS		AS CONSTRUCTED	
		10455A	TOTALS	10455A	TOTALS
72 inch Chain Link Fence	Lin. Ft.	3946	3946		
48 inch Chain Link Fence	Lin. Ft.	1489	1489		
Removing Fence	Lin. Ft.	5499	5499		
Sign, Type IIB Temporary	Sq. Ft.	128	128		
Minor Traffic Devices	Lump Sum	1	1		

U 63174 -40-

CONTRACTORS
CODE
2
ITEM
NUMBER

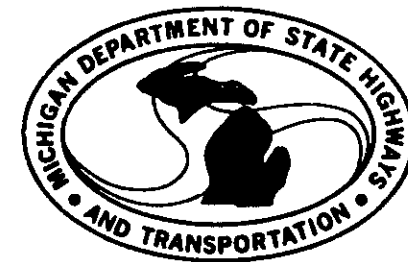

BUREAU OF HIGHWAYS

PROPOSAL
FOR
PROJECT

INVITATIONAL BID

PROJECT	JOB NO.	FEDERAL NO.
U 63174	10455 A	UI 75-2(187)

CON-SEC ID	JOB NO.	MICHIGAN PROJECT
U 63174	10455A	UI 75-2(187)

LOCATION:
City of Madison Heights in Oakland County.

TYPE OF WORK:
48" and 72" Chain Link Fence.

DESCRIPTION:
Along Northbound I-75 between 13 and 14 Mile Roads.

BIDS WILL BE OPENED AT 3:30 P.M., E.S.T., ON WEDNESDAY, FEBRUARY 18, 1976
IN THE FIRST FLOOR CONFERENCE ROOM, HIGHWAYS BUILDING, LANSING, MICHIGAN

NOTE TO BIDDERS
This bid proposal must be signed by the bidder on Page III.

- SEE INSIDE OF COVER PAGE FOR INSTRUCTIONS TO BIDDERS -

CS: 63174

ID: 10456A

63174-10456A
LOG JOB



STATE OF MICHIGAN
DEPARTMENT OF STATE HIGHWAYS AND TRANSPORTATION
CONTROL SECTION U63174
JOB NUMBER 10456A
1-75
OAKLAND COUNTY
CITY OF MADISON HEIGHTS
UI 75-2 (BA)

14 MILE
13 MILE
12 MILE
ROYAL OAK (POP. 8673)
PLEASANT RIDGE (POP. 3909)
MADISON HEIGHTS (POP. 38599)
CITY OF WARREN

ITEM 945

TITLE	DATE	SIGNATURE	APPROVED	DATE
Design/Engr. Road	12-20-75	[Signature]	[Signature]	12/24
Engr. of Design	12-30-75	[Signature]	[Signature]	1/12
Construction Division	1/5/76	[Signature]	[Signature]	

U 63174

LOG OF JOB NO. 10456A


Location of Work
Commencing on I-75, at 13 Mi. Rd. and 100' west of I-75 S.B., thence northerly along R.O.W. fence line to a point 100' south of Sta. 89473 14 Mi. Rd.

Description of Work
Remove existing Woven Wire Fence and replace with 4' Chain Link Fence from Sta. 980418 S.B. to 89473 14 Mi. Rd. except as noted in the following:
a. Extend 4' Chain Link Fence along R.O.W. fence line at Sta. 1011449. Remove existing woven wire fence to culvert headwall. Do not replace it.

Standard Plan
Chain Link Fence V-98A.

QUANTITIES - ENTIRE PROJECT

Removing Fence	5604 Lin.Ft.
48 inch Chain Link Fence	5452 Lin.Ft.
Sign Type IIB Temporary	128 Sq.Ft.
Minor Traffic Devices	1 Lump Sum
Mobilization	1 Lump Sum

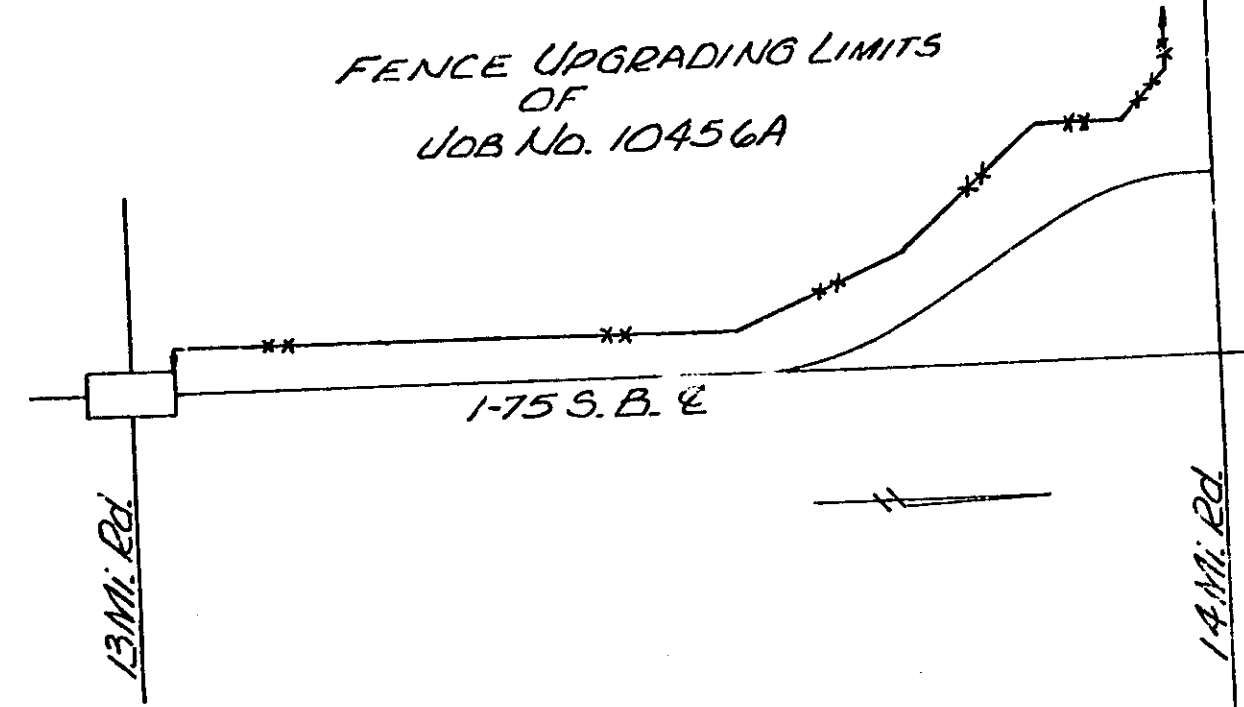

PAY ITEM	UNIT	AS PER PLAN		AS CONSTRUCTED TOTALS
		10456A	TOTALS	
Removing Fence	Lin.Ft.	5604	5604	
48 inch Chain Link Fence	Lin.Ft.	5452	5452	
Sign Type IIB Temporary	Sq.Ft.	128	128	
Minor Traffic Devices	Lump Sum	1	1	
Mobilization	Lump Sum	1	1	

LOG OF JOB NO. 10456A


Location of Work
Commencing on I-75, at 13 Mi. Rd. and 100' west of I-75 S.B., thence northerly along R.O.W. fence line to a point 100' south of Sta. 89473 14 Mi. Rd.

Description of Work
Remove existing Woven Wire Fence and replace with 4' Chain Link Fence from Sta. 980418 S.B. to 89473 14 Mi. Rd. except as noted in the following:
a. Extend 4' Chain Link Fence along R.O.W. fence line at Sta. 1011449. Remove existing woven wire fence to culvert headwall. Do not replace it.

Standard Plan
Chain Link Fence V-98A.

QUANTITIES - ENTIRE PROJECT

Removing Fence	5604 Lin.Ft.
48 inch Chain Link Fence	5452 Lin.Ft.
Sign Type IIB Temporary	128 Sq.Ft.
Minor Traffic Devices	1 Lump Sum
Mobilization	1 Lump Sum

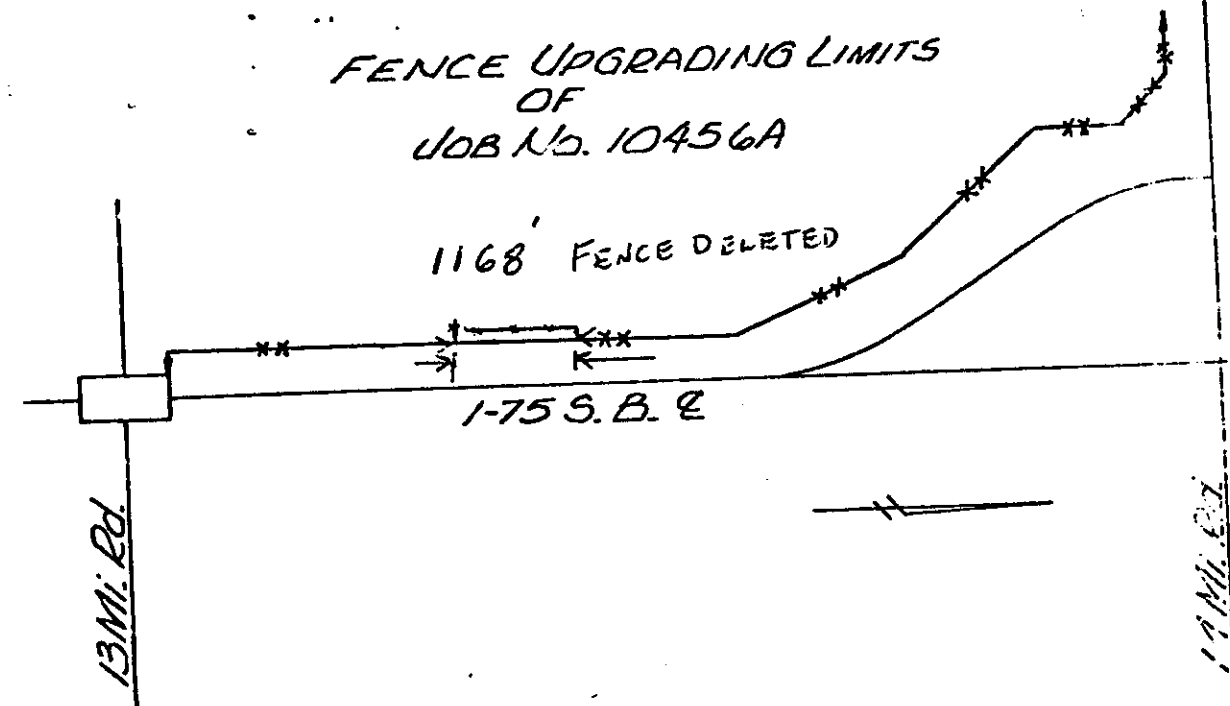

PAY ITEM	UNIT	AS PER PLAN		AS CONSTRUCTED	
		10456A	TOTALS	10456A	TOTALS
Removing Fence	Lin.Ft.	5604	5604	5124	5124
48 inch Chain Link Fence	Lin.Ft.	5452	5452	4284	4284
Sign Type IIB Temporary	Sq.Ft.	128	128	64	64
Minor Traffic Devices	Lump Sum	1	1	1	1
Mobilization	Lump Sum	1	1	1	1
REMOVE CENTER POST				3	3
72" CHAIN LINK FENCE				10	10
LICU 10456A DAMAGE - Adj.				-346	-346
				-210	-210

CONTRACTORS CODE
1

ITEM NUMBER

MICHIGAN DEPARTMENT OF STATE HIGHWAYS AND TRANSPORTATION

BUREAU OF HIGHWAYS

PROPOSAL FOR PROJECT

PROJECT: U 63174
JOB NO.: 10456 A
FEDERAL NO.: UI 75-2(184)

BIDS WILL BE OPENED AT 3:30 P.M., E.D.T., ON WEDNESDAY, MAY 19, 1976 IN THE FIRST FLOOR CONFERENCE ROOM, HIGHWAYS BUILDING, LANSING, MICHIGAN

THE RIGHT IS RESERVED TO REJECT ANY OR ALL PROPOSALS

- SEE INSIDE OF COVER PAGE FOR INSTRUCTIONS TO BIDDERS -

7

<u>CON-SEC ID</u>	<u>JOB NO.</u>	<u>MICHIGAN PROJECT</u>
U 63174	10456A	UI 75-2(184)

LOCATION:
City of Madison Heights in Oakland County.

TYPE OF WORK:
48" Chain Link Fence.

DESCRIPTION:
On I-75 southbound between 13 Mile and 14 Mile Roads.

U 63174

-1-

63174-14165A
14166A
14824A

63174 14165A I 75 2(222)59
63174 14166A FIR 75 2(223)59
63174 14824A I 75 2(199)

CS: 63174

ID: 14165A 14166A 14824A

4.5 MI OF CONC SHLDRS, MEDIAN BARRIER,
FILLER WALLS & BARRIER AT BRIDGE PIERS.
ALSO, JT REPAIR & SIGNING, ALL ON I-75 FR
S OAKLAND CO LINE (8 MILE RD), THENCE N'LY
TO N OF 12 MILE RD IN CITIES OF HAZEL
PARK, ROYAL OAK & MADISON HGTS, OAKLAC CO
ITEM 7910009

.....

STATE OF MICHIGAN
DEPARTMENT OF STATE HIGHWAYS AND TRANSPORTATION

PLANS OF PROPOSED
MICHIGAN PROJECT I-75-2(222)59 & I-75-2(199) FIR-75-2(223)59


CONTROL SECTION Is 63174 & FUR 63174

JOB NUMBER 14165A & 14824A 14166A

I-75

OAKLAND COUNTY

CITIES OF HAZEL PARK, ROYAL OAK, MADISON HEIGHTS

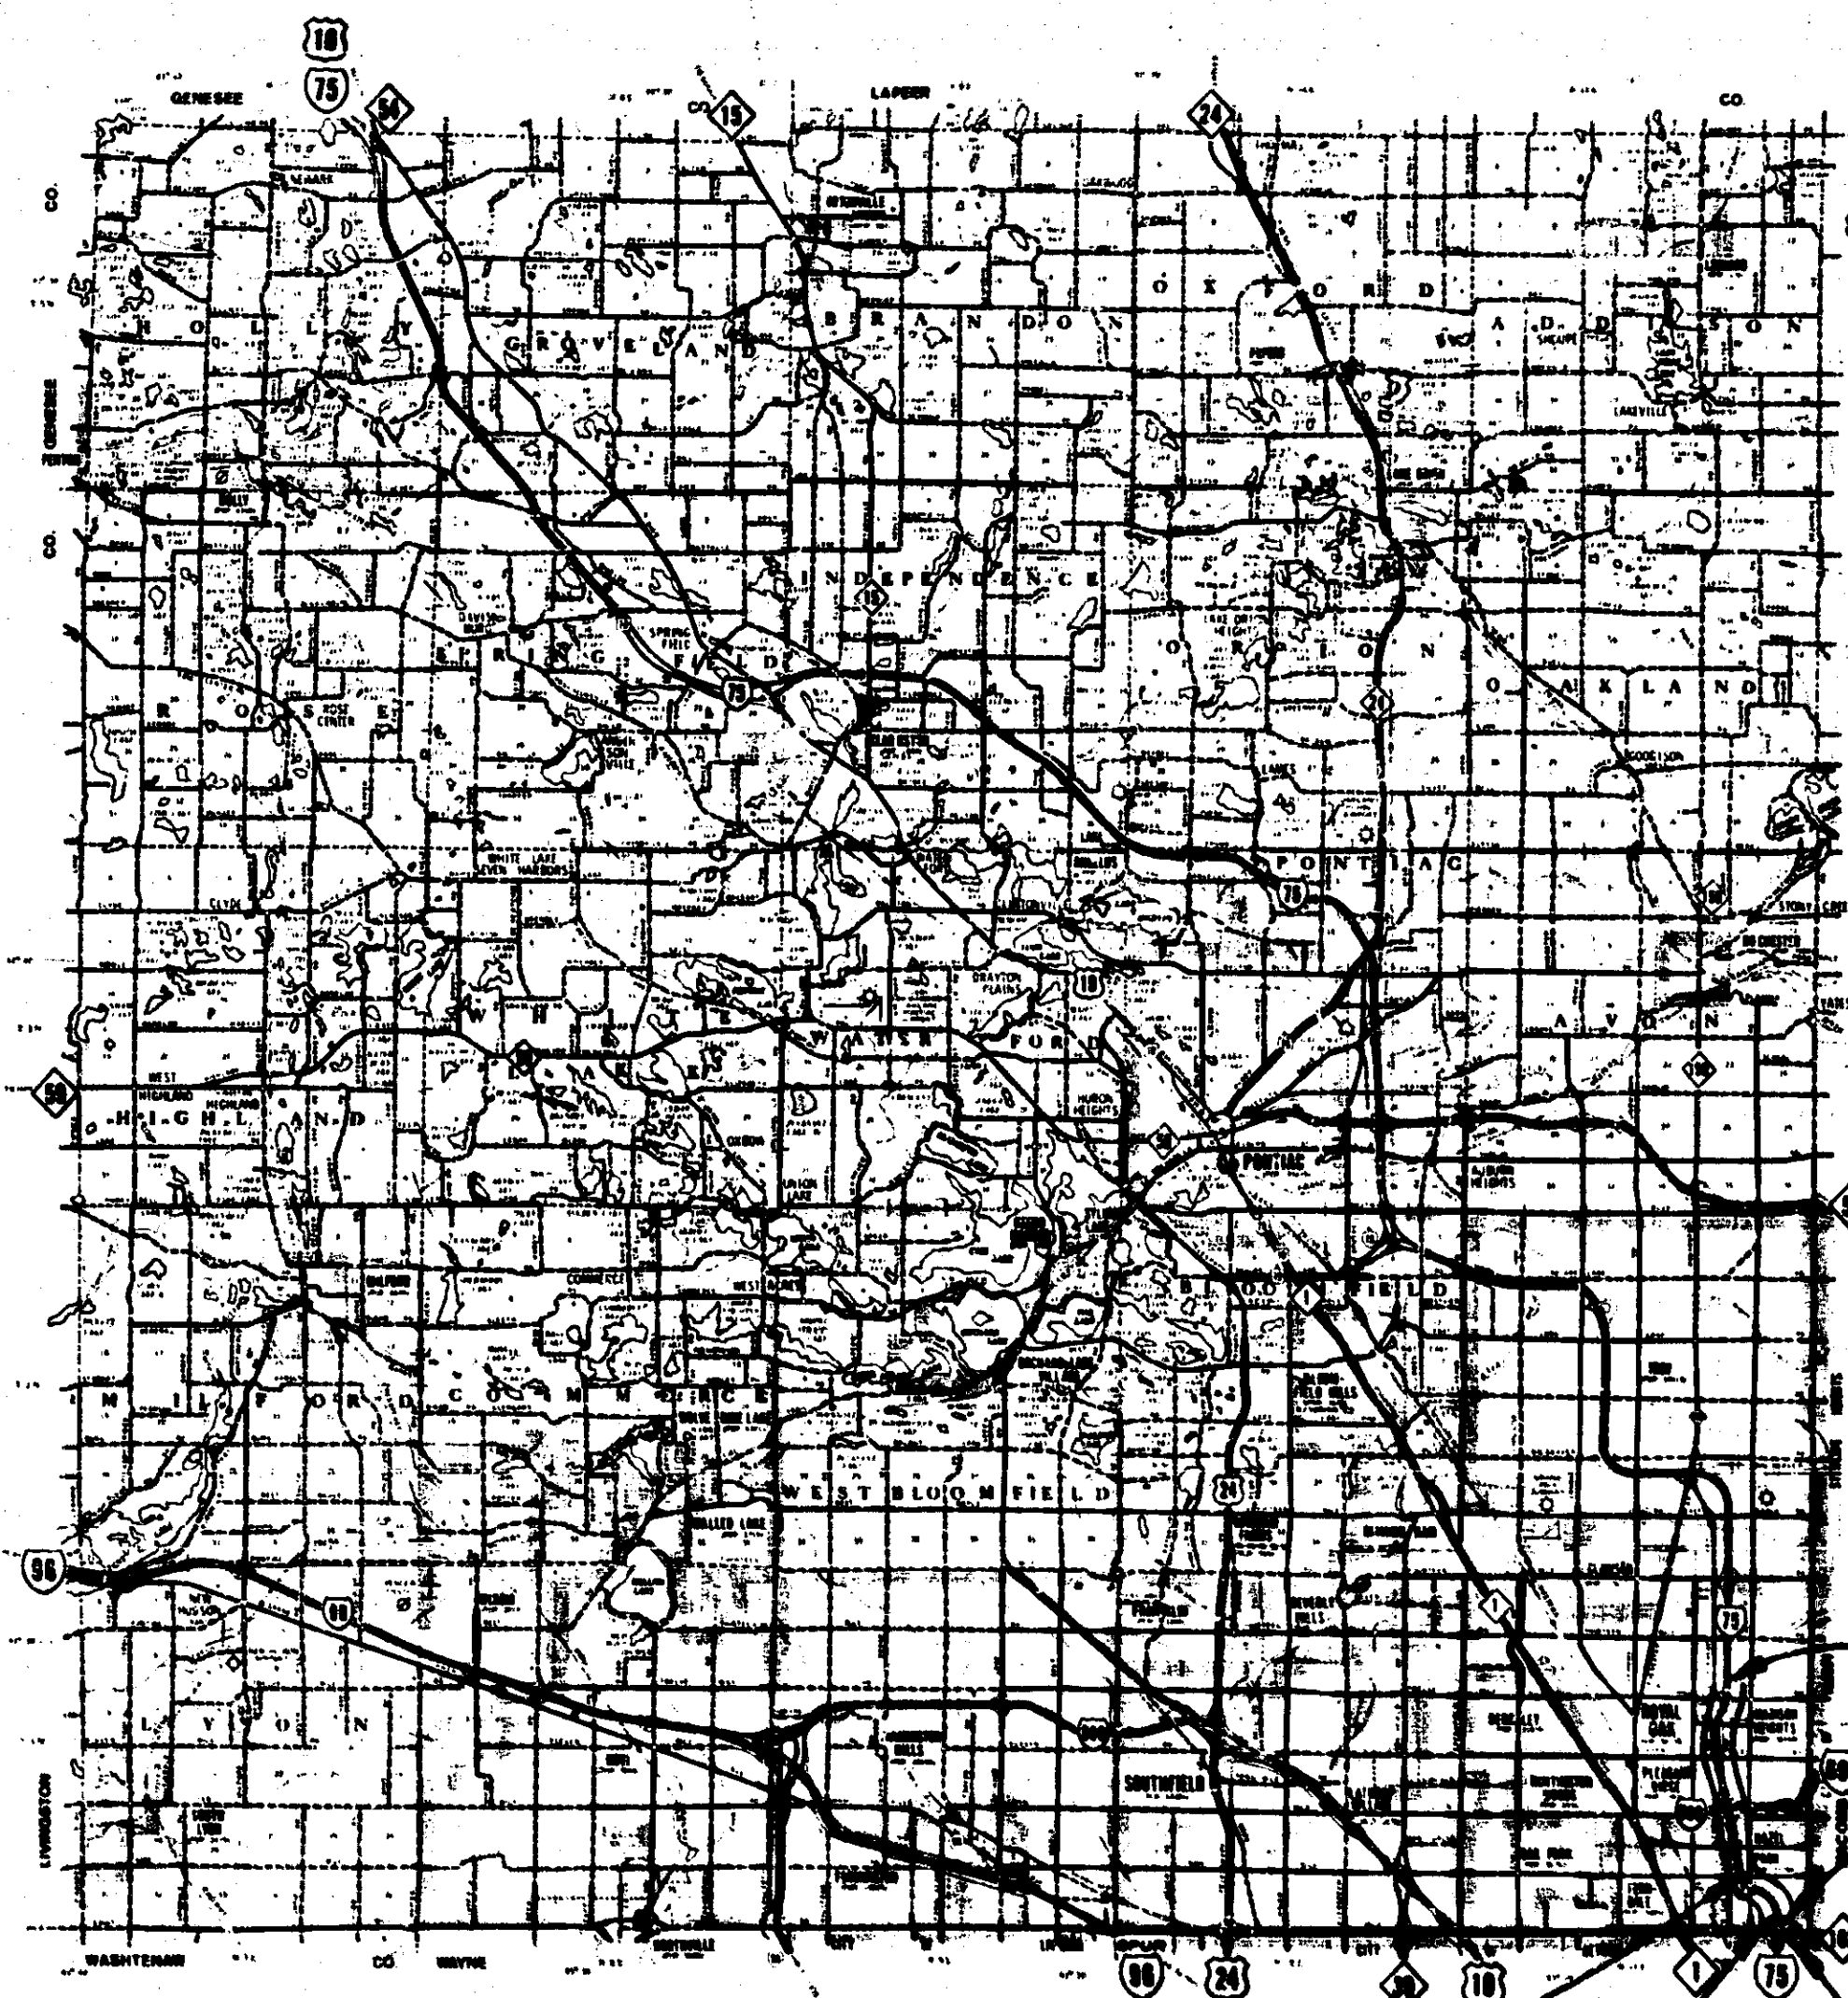

ROAD PLANS	SHEET NO'S.
TITLE	1
TYPICAL CROSS SECTION	2
NOTE SHEET	3
PLANS & PROFILES	4-9 14165A I-75-2(222)59
SPECIAL DETAILS	10-19
Joint Repair Sheets	20-24 14166A FIR-75-2(223)59
Lighting Plans	25-40 & 35A added by Rev. A 1-9-80
Signing Plans	41-93 14824A I-75-2(199)
Quantity Sheets	94-96

TITLE SHEET LEGEND

	EXISTING CONDITION
PROPOSED PROJECT	—————
PAVED	—————
BITUMINOUS	—————
GRAVEL	—————
UNIMPROVED OR CITY STREET	—————
SECTION LINE	—————
TOWNSHIP LINE	—————
COUNTY LINE	—————
CITY OR VILLAGE LIMITS	—————
RAILROADS	—————

Station Equation
Sta. 161+50.59 Back
Sta. 161+57.64 Ahead
Line Shortens 7.05'

Station Equation
Sta. 272+98.36 Back
Sta. 272+98.36 Ahead
Line Shortens 0.50'

Station Relation
Sta. 285+81.50 Back
Sta. 706+83.00 Ahead

Mich. Proj. I-75-2(222)59
Mich. Proj. I-75-2(199)
Cont. Sect. Is 63174
Job Number 14165A & 14824A
Mich. Proj. FIR-75-2(223)59
Cont. Sect. FUR 63174
Job Number 14166A
Begins Sta. 272+98.36
Ends Sta. 940+100

ROUTE	JOB NUMBER	FEDERAL NUMBER	SHEET NO.	TOTAL SHEETS
I-75	14165A 14824A	F-75-2(222)59 F-75-2(199) FIR-75-2(223)59	1	96

THE IMPROVEMENTS COVERED BY THESE PLANS SHALL BE DONE IN ACCORDANCE WITH THE MICHIGAN DEPARTMENT OF STATE HIGHWAYS 1976 STANDARD SPECIFICATIONS AND SUPPLEMENTAL SPECIFICATIONS.

LEGEND 1975

A.D.T.....	12M:	89,200
D.H.V.....	11M:	107,000
COMM. %.....	7%	105,000
DESIGN SPEED.....	9M:	103,700
	8M:	126,800

AS CONSTRUCTED
ACCORDING TO MARKED PLANS
PREPARED BY PROJECT ENGINEER

ITEM NO. (Is) 92329 (Is) 92055 (FUR) 90175

CONTRACT FOR "Yellowbook" Roadside Safety Improvements & Joint Repair

APPROVALS

CHECKED	<i>E. J. Zojan</i>	6/18/79
RECOMMENDED FOR APPROVAL	<i>W. M. Green</i>	6/18/79
RECOMMENDED FOR APPROVAL	<i>A. C. Bucknall</i>	6/18/79
RECOMMENDED FOR APPROVAL	<i>[Signature]</i>	6/18/79

DEPARTMENT OF STATE HIGHWAYS AND TRANSPORTATION
JOHN P. WOODFORD - DIRECTOR

APPROVED BY: *[Signature]* 6/18/79
DEPUTY DIRECTOR - HIGHWAYS

PREPARED BY: CHRISTY
MICHIGAN DEPARTMENT OF STATE HIGHWAYS AND TRANSPORTATION
FEDERAL HIGHWAY ADMINISTRATION


JOB NUMBER	FEDERAL NUMBER	SHEET NO.	TOTAL SHEETS
Is 63174	F-75-2(222)59	1	96
FUR 63174	FIR-75-2(223)59	1	96

IS 63174; 14165A & 14824A-FUR63174; 14166A

TYPICAL CROSS-SECTIONS


STATE	FEDERAL PROJECT	R.O.W. NO.	SHEET NO.	TOTAL SHEETS
5 MICH.	I-75-2(222)59		2	96
ROUTE	COUNTY	CONTROL SECTION	JOB NO.	
I-75	Oakland	63174	14165	

FINAL R.O.W.

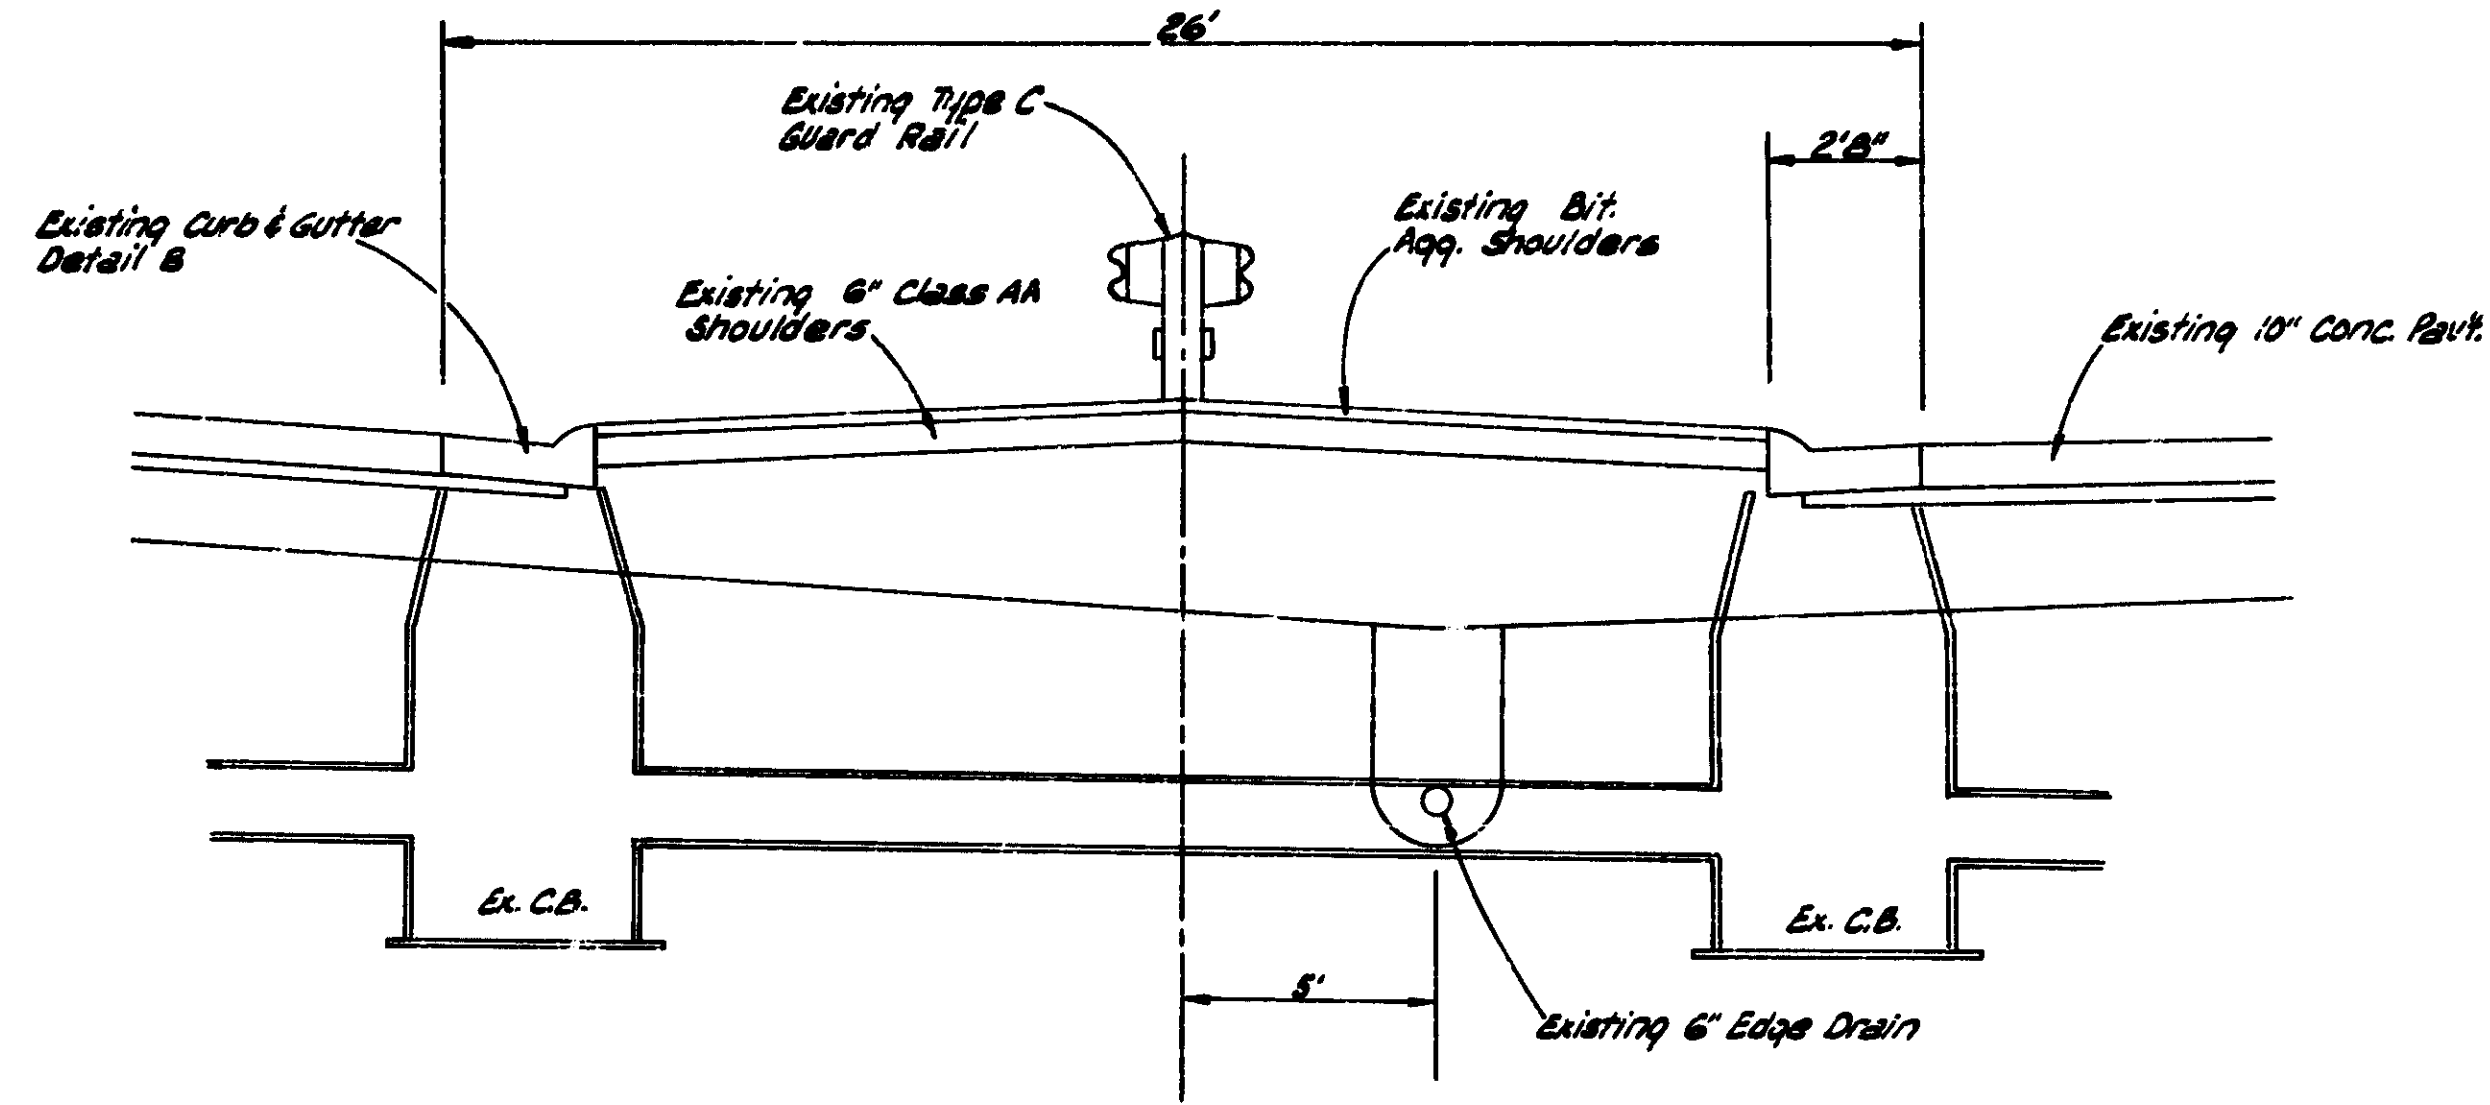

EXISTING SECTION

NOTES:
 The edges of the existing pavement shall be thoroughly cleaned before concrete widening is placed.
 Class A Slopes will be required on this project.
 * Remove the base of the existing lighting foundations to a minimum of 2" below the bottom of the proposed 6" concrete shoulders.

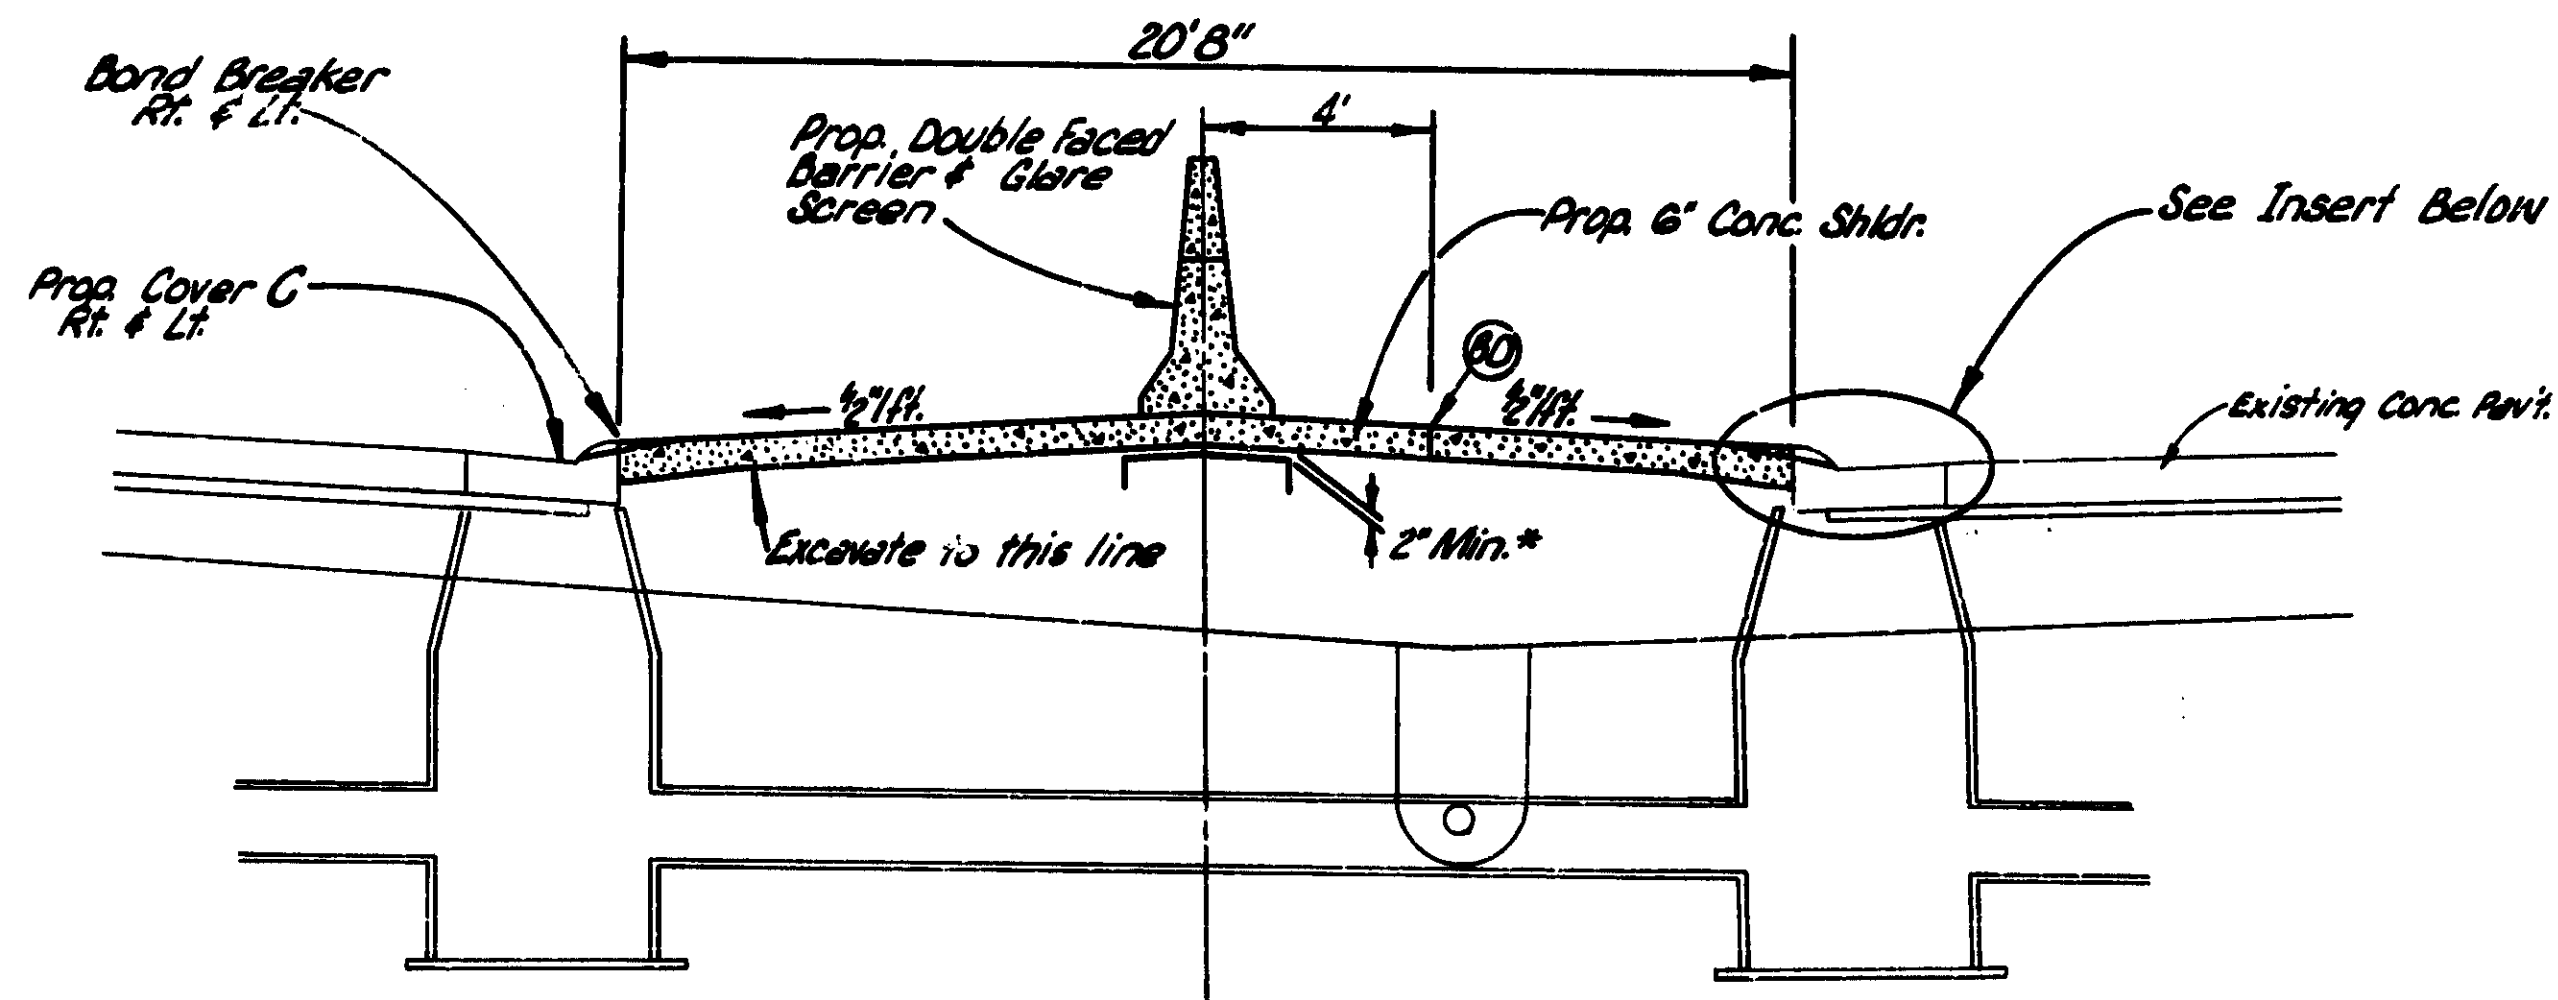


PROPOSED SECTION

The 1/2" per foot slope is a minimum and may vary depending upon the elevation of the respective curbs, which are not always equal.

JOINT LEGEND FOR PAVEMENT JOINTS

- B - Longitudinal Bulkhead Construction Joint, according to Standard Plan II-41C
- D - Longitudinal Lane Tie Joint with Tie Bars, according to Standard Plan II-41C
- BD - Optional B or D

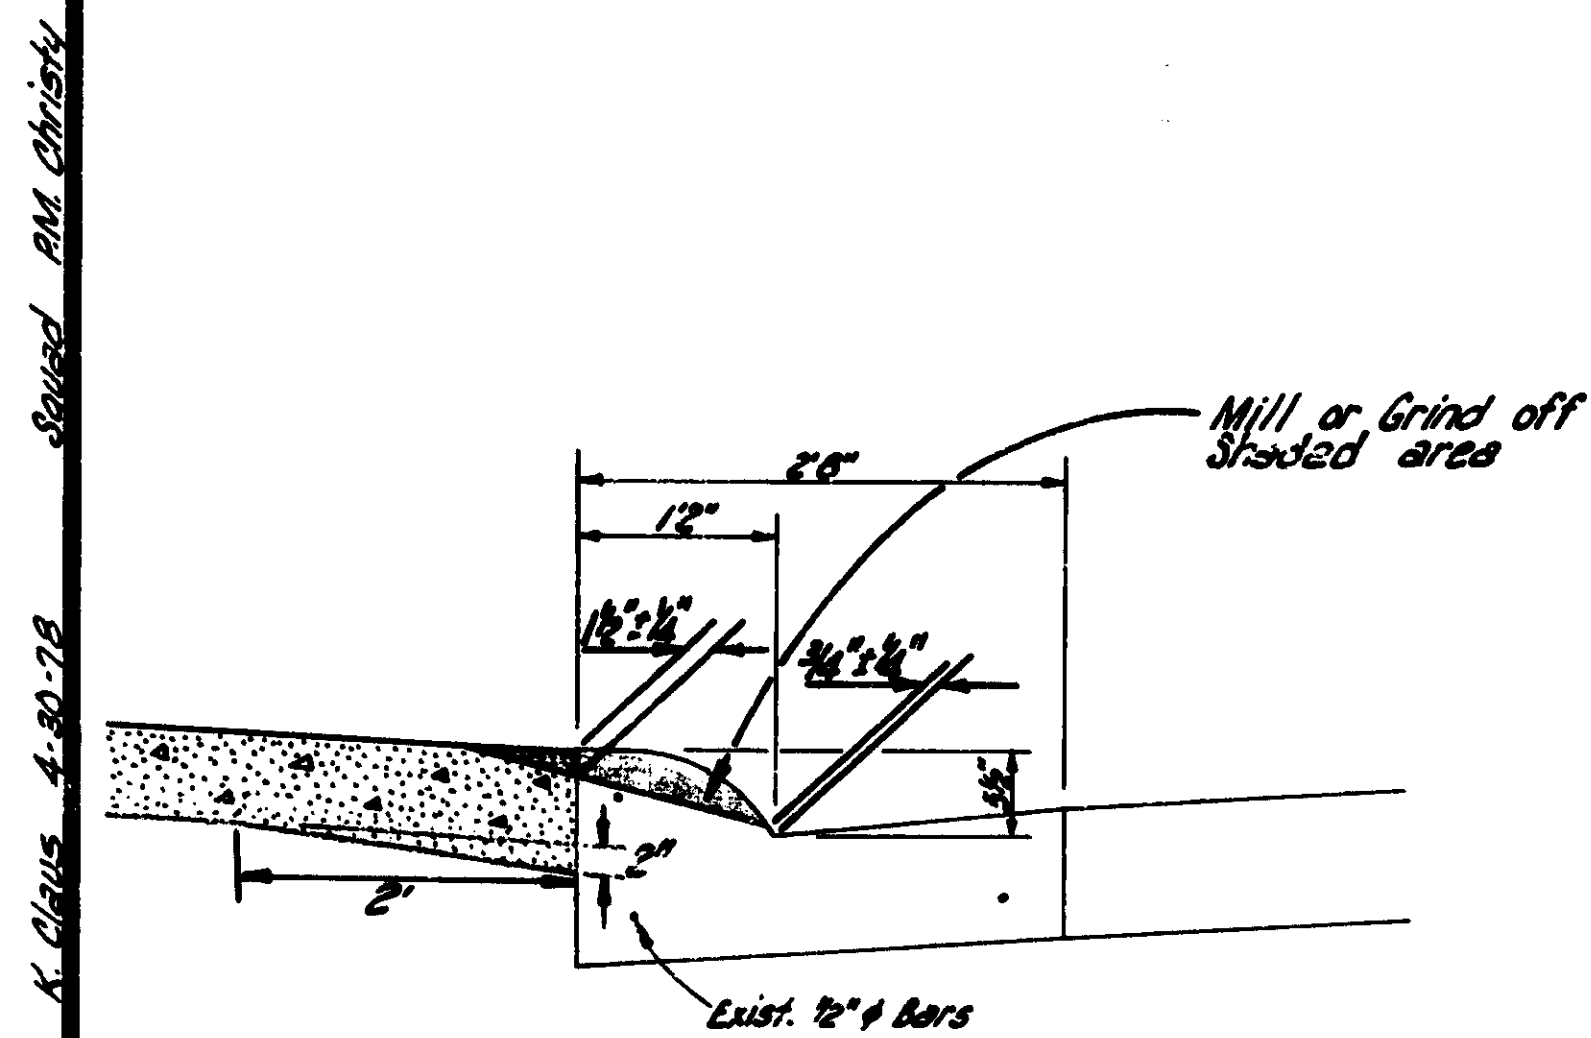

NOTE:
 The existing reinforcement may not occur exactly where it is shown. If a reinforcing bar is encountered at the intended grade and in the opinion of the Engineer it should be removed, the bar shall be removed and the surface lowered to eliminate the indentation left after removal of the bar. The removal of the bar will be paid for in Linear Feet as "Removing Curb Reinforcement".

DETAIL SHOWING
 "REMOVING CURB-PARTIAL"

K. Claus 4-30-78 Seward AM Christy

NOTE SHEET

F. D. N. O. NO.	STATE	FEDERAL PROJECT NO.	SHEET NO.	TOTAL SHEETS
5	MICH.	1-75-202239 1-75-202239	3	96
ROUTE	COUNTY	CONTROL SECTION	JOB NO.	
1-75	OAKLAND	FUR& IS	63174 14165A & 14166A	

GENERAL PLAN NOTES

UNDERGROUND UTILITIES

For protection of underground utilities, the contractor shall dial 1-800-482-7171 a minimum of 48 hours prior to excavating in the vicinity of utility lines. All "Miss Dig" participating members will thus be routinely notified. This does not relieve the contractor of the responsibility of notifying utility owners who may not be a part of the "Miss Dig" alert system.

ADJUSTING MONUMENT BOXES

It is the intent that all government corners on this project be preserved and that, where necessary, monument boxes be placed or adjusted, whether shown or not.

HAND FINISHING

Hand finishing of concrete pours to be struck off and consolidated by hand methods will be permitted on all pavement to be placed on this project.

CLASS B SODDING

Where Class B Sodding is called for in the plans, the beds shall be trimmed within the tolerances specified for Class A Slopes.

BEDDING AND FILLING

Bedding and filling around pipe culverts shall be done as specified on Standard Plan IV-82 Series.

MISCELLANEOUS ESTIMATES

The following items of work shall be done as they apply throughout the project. These items are not detailed or included on the plan or profile sheets:

	M.D.O.T.	City of Royal Oak	City of Madison Hts	
Lighted Arrow Type A-Furnished	1	1	1	Each
Lighted Arrow Type A-Operated	1	1	1	Each
Barricade Type II Lighted-Furnished	540	444	156	Each
Barricade Type II Lighted-Operated	202	167	58	Each
Sign Type IIB Temporary	324	266	94	S. F.
3 lb. Steel Post Temporary	450	370	130	L. F.
Removing Pavement Markings	76	63	22	L. F.
Minor Traffic Devices	.45	.37	.13	L. S.
Mobilization	.45	.37	.13	L. S.
On-the-Job Training	1	1	1	Each
Drainage Marker Post			7	Each
Reflectorized Washers			22	Each
Class B Sodding	4750	3515	1235	S. Y.
Removing Curb Reinforcement	2882	1518		L. F.

PUBLIC UTILITIES

The existing utilities listed below and shown on these plans represent the best information available as obtained on our office inquiry dated 4-12-79. This information does not relieve the contractor of the responsibility to satisfy himself as to their accuracy or of his responsibility in case utilities have been constructed or removed since the above survey date.

NAME AND ADDRESS OF OWNER	KIND OF UTILITY
Michigan Bell Telephone	Telephone
Detroit Edison Co.	Electric
Consumers Power Co.	Gas
Michigan Consolidated Gas	Gas

Owners of public utilities will not be required by the Department to move additional poles and structures that are not within grading or structure limits in order to facilitate the operation of construction equipment, unless it is determined by the engineer that such pole line or structures constitute a hazard to the public or are extraordinarily dangerous to the Contractor's operations.

NOTES APPLYING TO STANDARD PLANS

Where the following items are called for on plans, they are to be constructed according to standard plan given below opposite each item unless otherwise indicated.

Cover A	I-7A
Longitudinal Pavement Joints	II-41C
Concrete Pavement Repair	II-44C
Concrete Barrier - Median	II-49D
Light Standard Foundation (Concrete Barrier - Median)	II-50C
Truss Support Foundation (Concrete Barrier - Median)	II-51C
Concrete Valley Gutter	II-53C
Guard Rail Ending with Cable Anchorage	III-58D
Guard Rail at Structures	III-59C
Beam Guard Rail - Types A, B, and C	III-60D
Concrete Glare Screen	III-76E
Bedding and Filling around Pipe Culverts	IV-82D
Outlet Headwalls, Concrete Rings, Drainage Marker, Mailbox & Wood Guard Posts	IV-85C
Precast Concrete End Section for Pipe Culvert	IV-86A (Except the Concrete Shall Have Air Entrained Content of 6 ± 2 Percent)
Sodding	V-100A
Drum Guide Rail, Drum Guide Rail Double, Drums, Timber Curb & Snow Fence, Timber Curb, and Splash Boards	VI-124C
Types II & III Barricades and Lighted Arrows	VI-125D
Special Details not listed under Standard Plans	<u>SPECIAL DETAIL</u>
Fillerwalls between Existing Bridge Piers	5
Structure Guard Rail Anchorage	7-1
Concrete Barrier - Single Face	II-54A
Freeway Shoulders	V-112D




UNIT: CHRISTY

F.H.W.A. REG. NO.	STATE	FEDERAL PROJECT	R.O.W. NO.	SHEET NO.	TOTAL SHEETS
5	MICH.	I-75-2(222)59		4	96
ROUTE	COUNTY	CONTROL SECTION	JOB NO.		
I-75	Oakland	63174	14165		

CITY OF DETROIT

CITY OF HAZEL PARK

- S10 of 82252 (Outside)
- Remove existing guard rail and place barrier & fillerwall.
- 225 Lin. Ft. Salv. Beam Guard Rail
- 125 Lin. Ft. Concrete Barrier - Single Face
- 1.4 Cu. Yds. Fillerwall Concrete Grade 353
- 89 Lbs. Steel Reinforcement
- 6 Each 3/4" Expansion Anchored Bolt
- 141 Lin. Ft. Rem. Curb - Partial
- 232 Sq. Yds. Concrete Shoulders
- 75 Cu. Yds. Structure Backfill (L.M.)

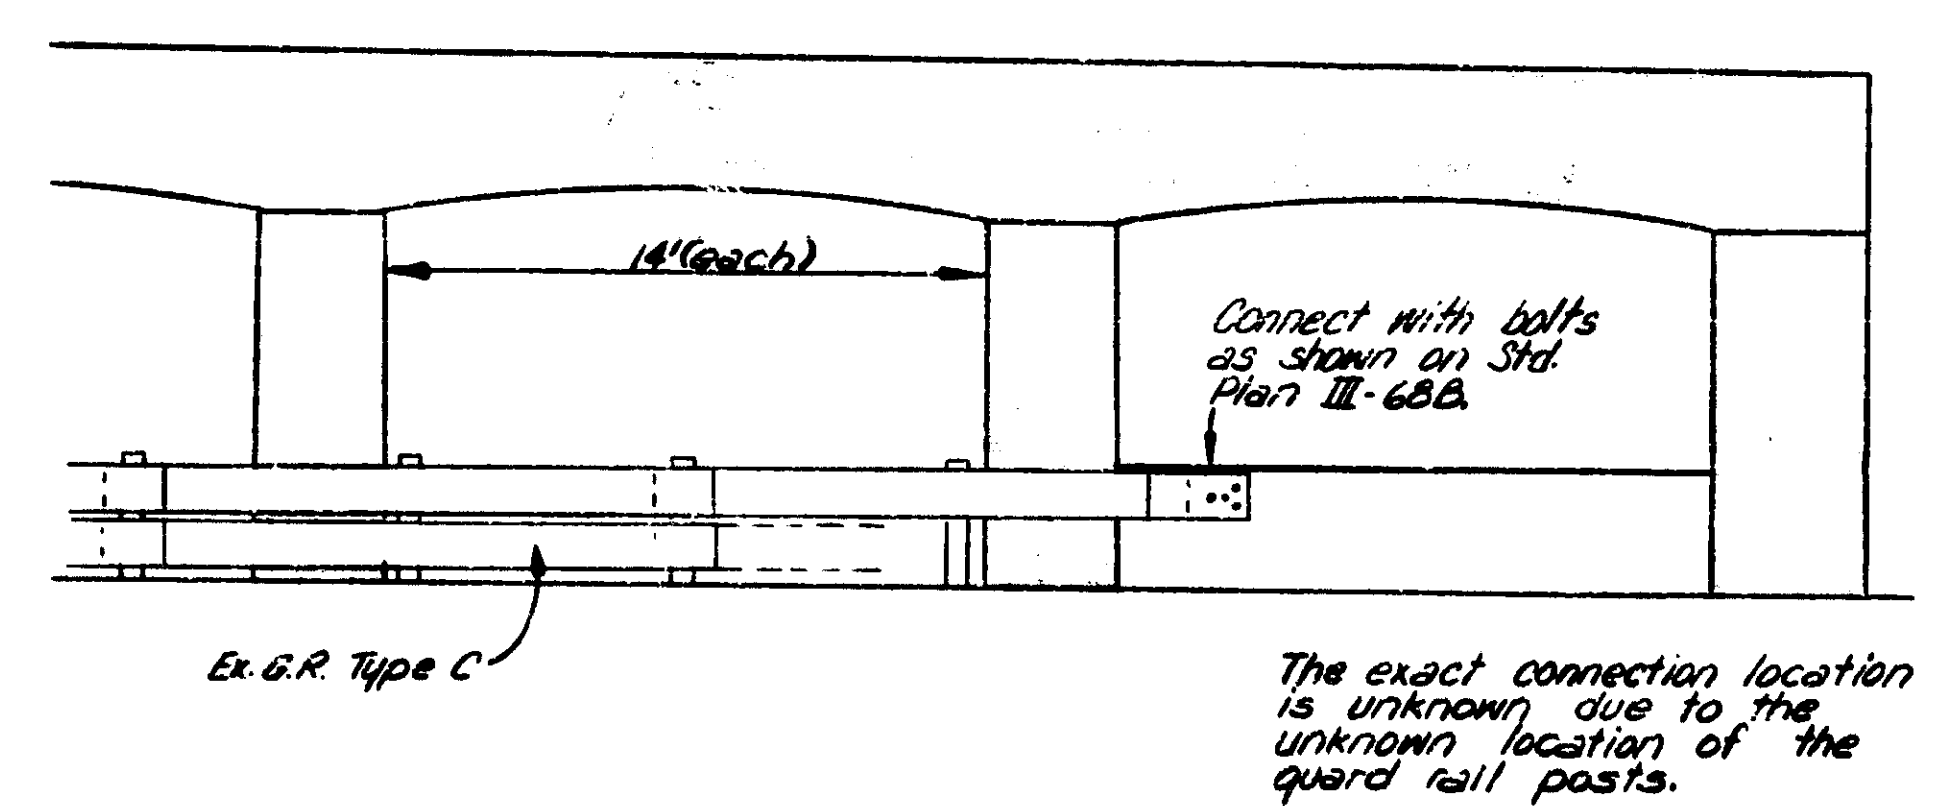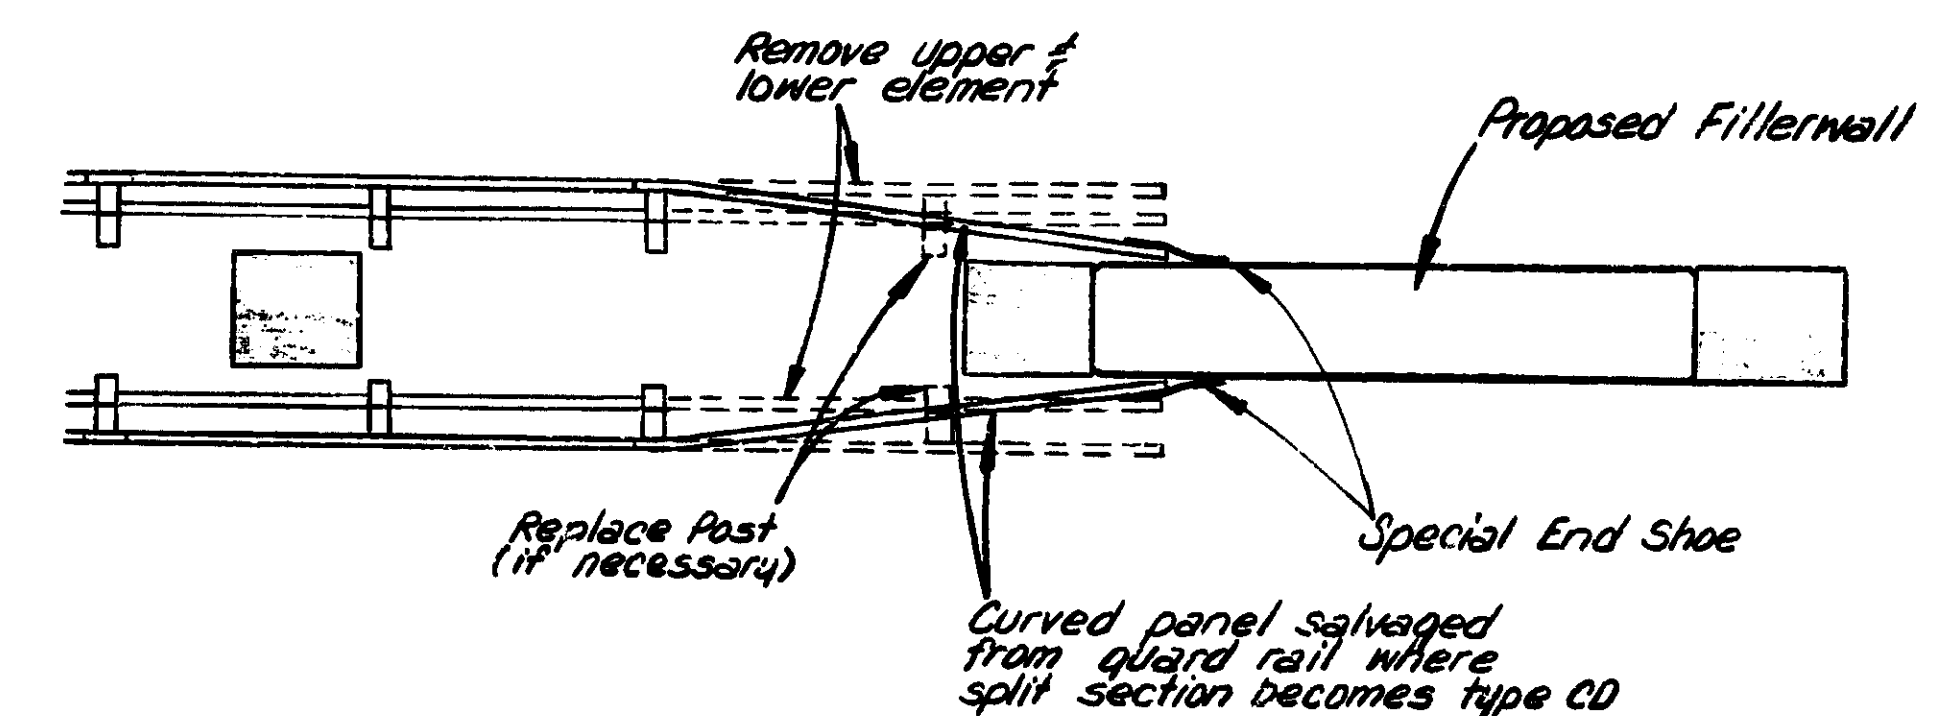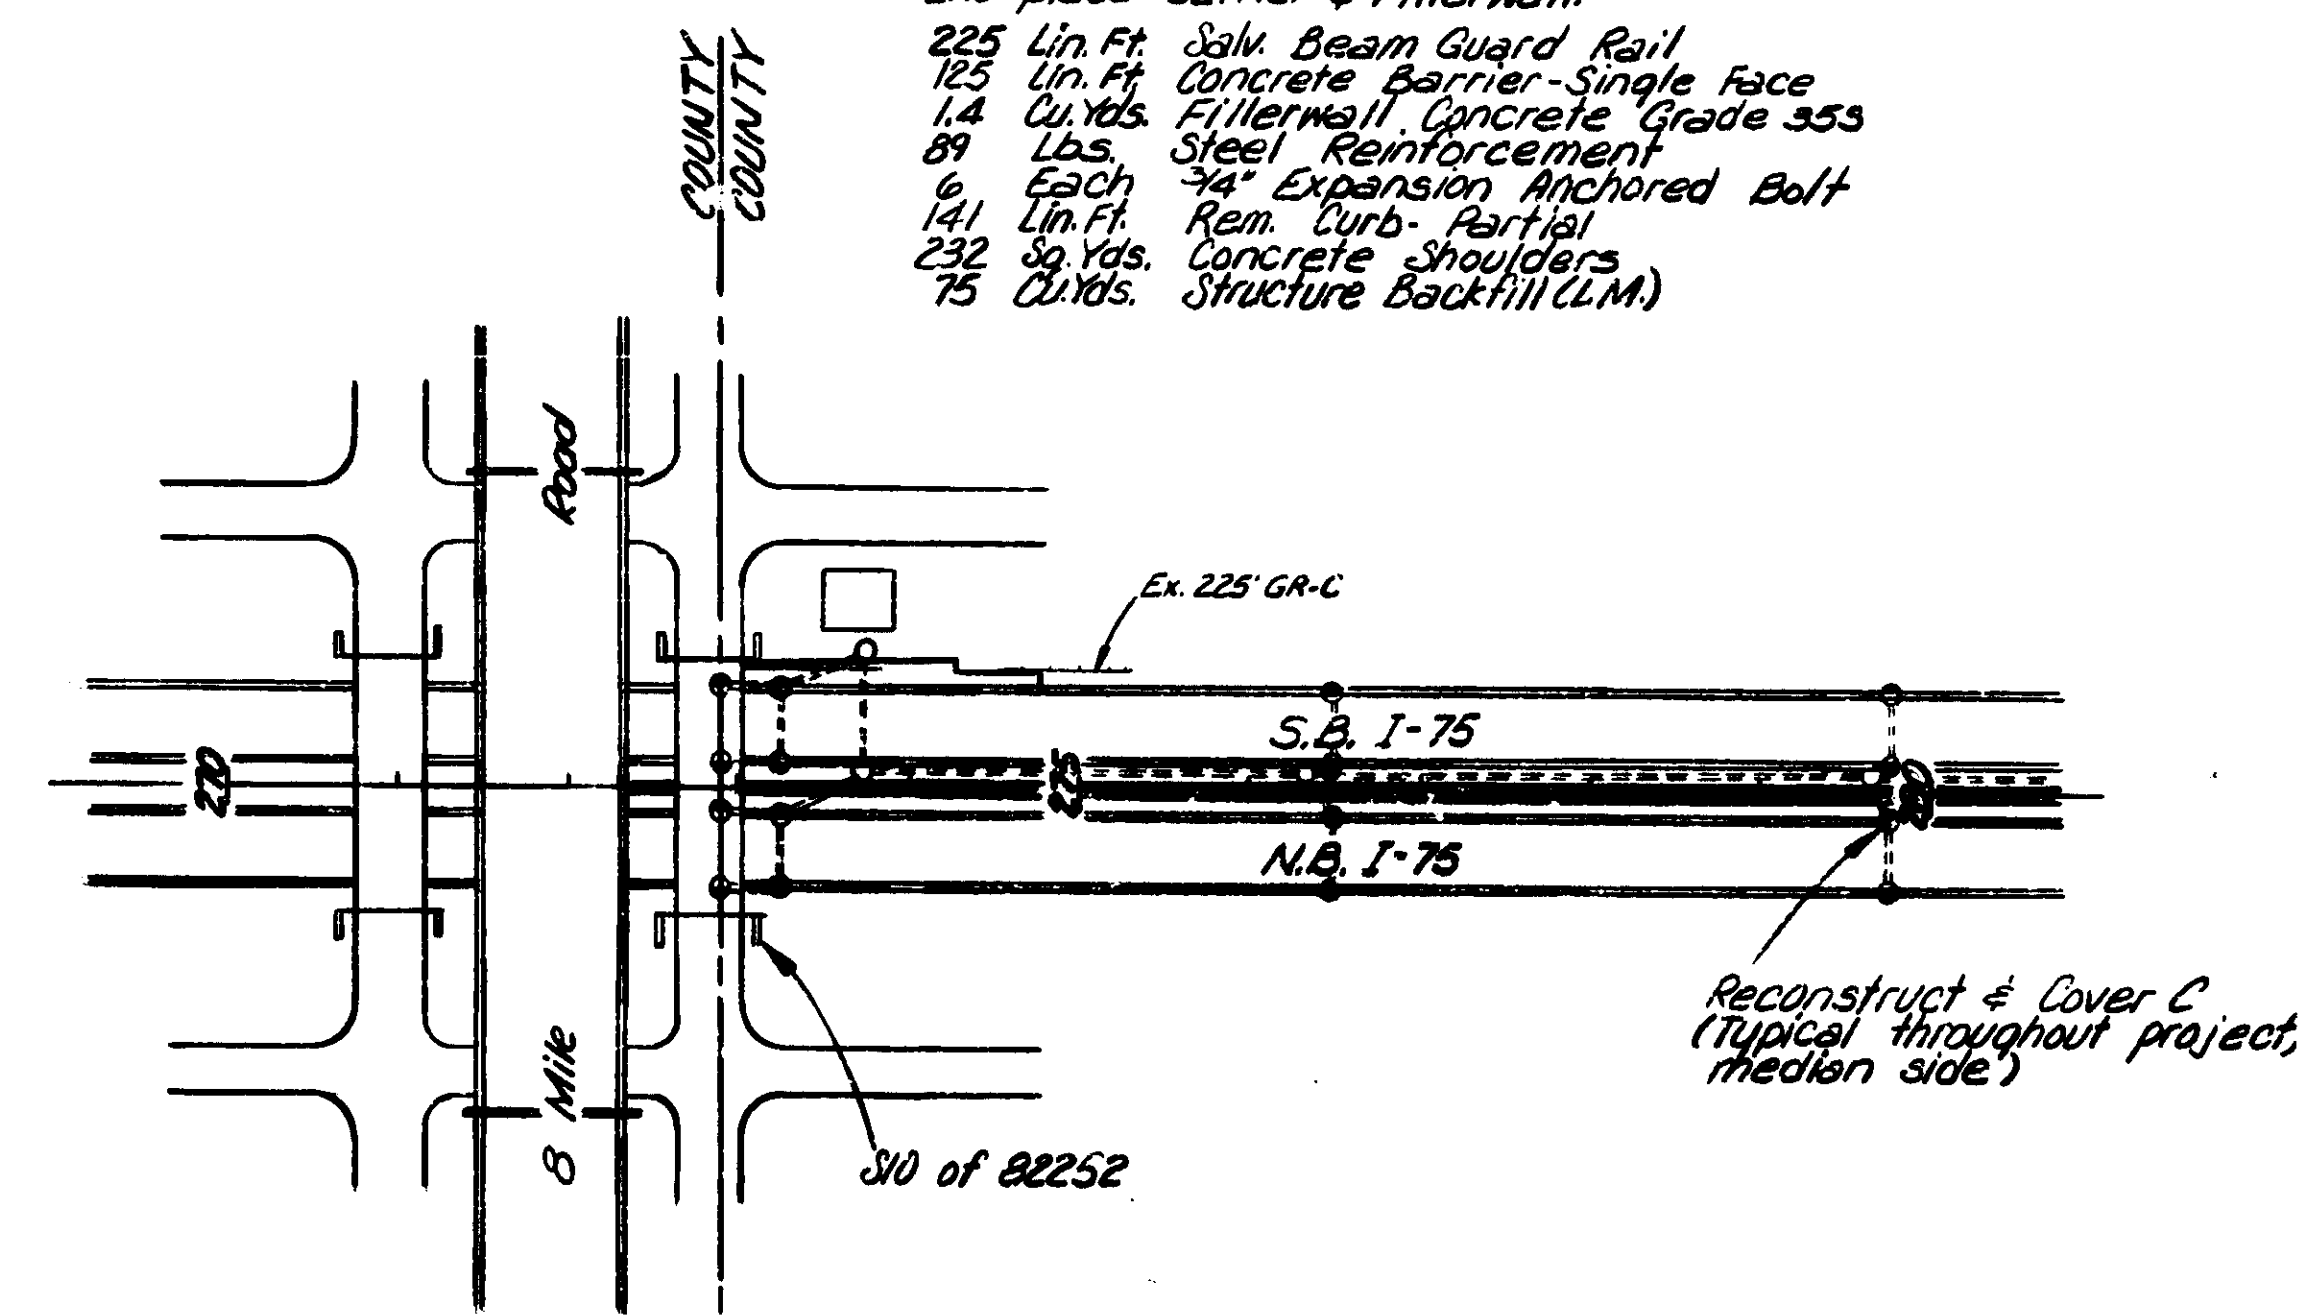


DETAIL OF TEMPORARY GUARD RAIL CONNECTION
 Incidental to "Fillerwall Concrete-Grade 353"

MEDIAN QUANTITIES: This Sheet

- 435 Cu. Yds. Earth Excavation
- 1402 Lin. Ft. Rem. Curb - Partial
- 701 Lin. Ft. Salv. Beam Guard Rail
- 1610 Sq. Yds. Concrete Shoulder
- 701 Lin. Ft. Concrete Barrier - Double Face
- 701 Lin. Ft. Concrete Glare Screen
- 3000 Lbs. Drainage Structure Covers (6 Coy. C's)
- 6 Each Reconstruct Drainage Structure
- 5.5 Cu. Yds. Fillerwall Concrete Grade 353
- 147 Lbs. Steel Reinforcement
- 8 Each 3/4" Expansion Anchored Bolt
- 3 Each Light Standard Foundation, Concrete Barrier

NOTE:
 See Lighting Plans for locations of "Light Standard Foundation, Concrete Barrier".

STATION EQUATION
 Sta 272+98.86 Back =
 Sta 272+99.36 Ahead
 Line Shortens 0.50'

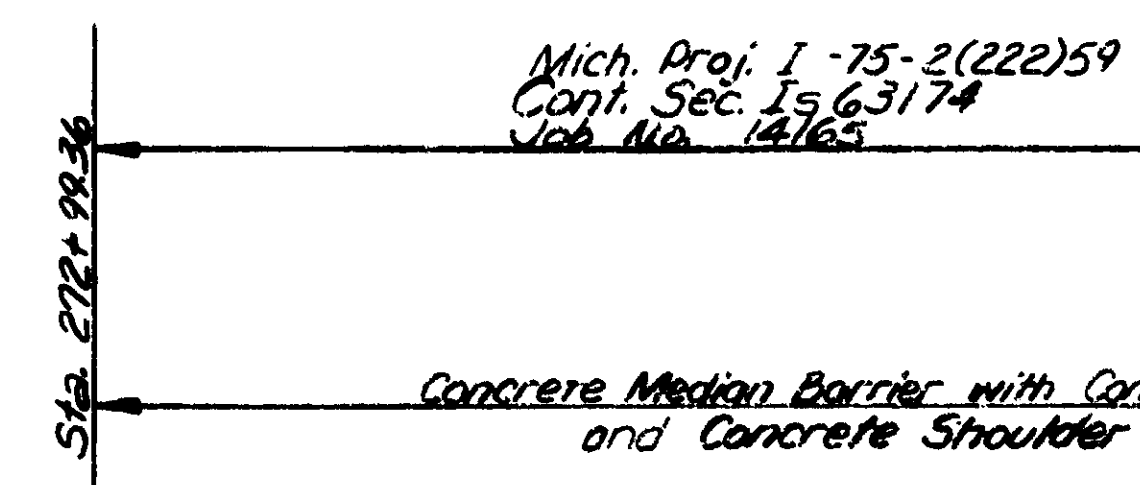


F.W. NO.	STATE	FEDERAL PROJECT	P.W. NO.	SHEET NO.	TOTAL SHEETS
6	MICH.	E-15-2(222)59		5	96
ROUTE	COUNTY	CONTROL SECTION	JOB NO.		
I-75	Oakland	63174	14165		

MEDIAN QUANTITIES
Sta. 280+00 to Sta. 730+00

- 2899 Lin. Ft. Salvaging Beam Guard Rail
- 5798 Lin. Ft. Removing Curb - Partial
- 110 Cu. Yds. Earth Excavation
- 6657 Sq. Yds. Concrete Shoulders
- 2856 Lin. Ft. Concrete Barrier - Double Face
- 2856 Lin. Ft. Concrete Glare Screen
- 8500 Lbs. Drainage Structure Covers (17 Covers C)
- 17 Each Reconstruct Drainage Structure
- 14.3 Cu. Yds. Fillerwall Concrete - Grade 353
- 518 Lbs. Steel Reinforcement
- 24 Each 3/4" Expansion Anchored Bolt
- 12 Each Light Standard Foundation, Concrete Barrier


City of Hazel Park

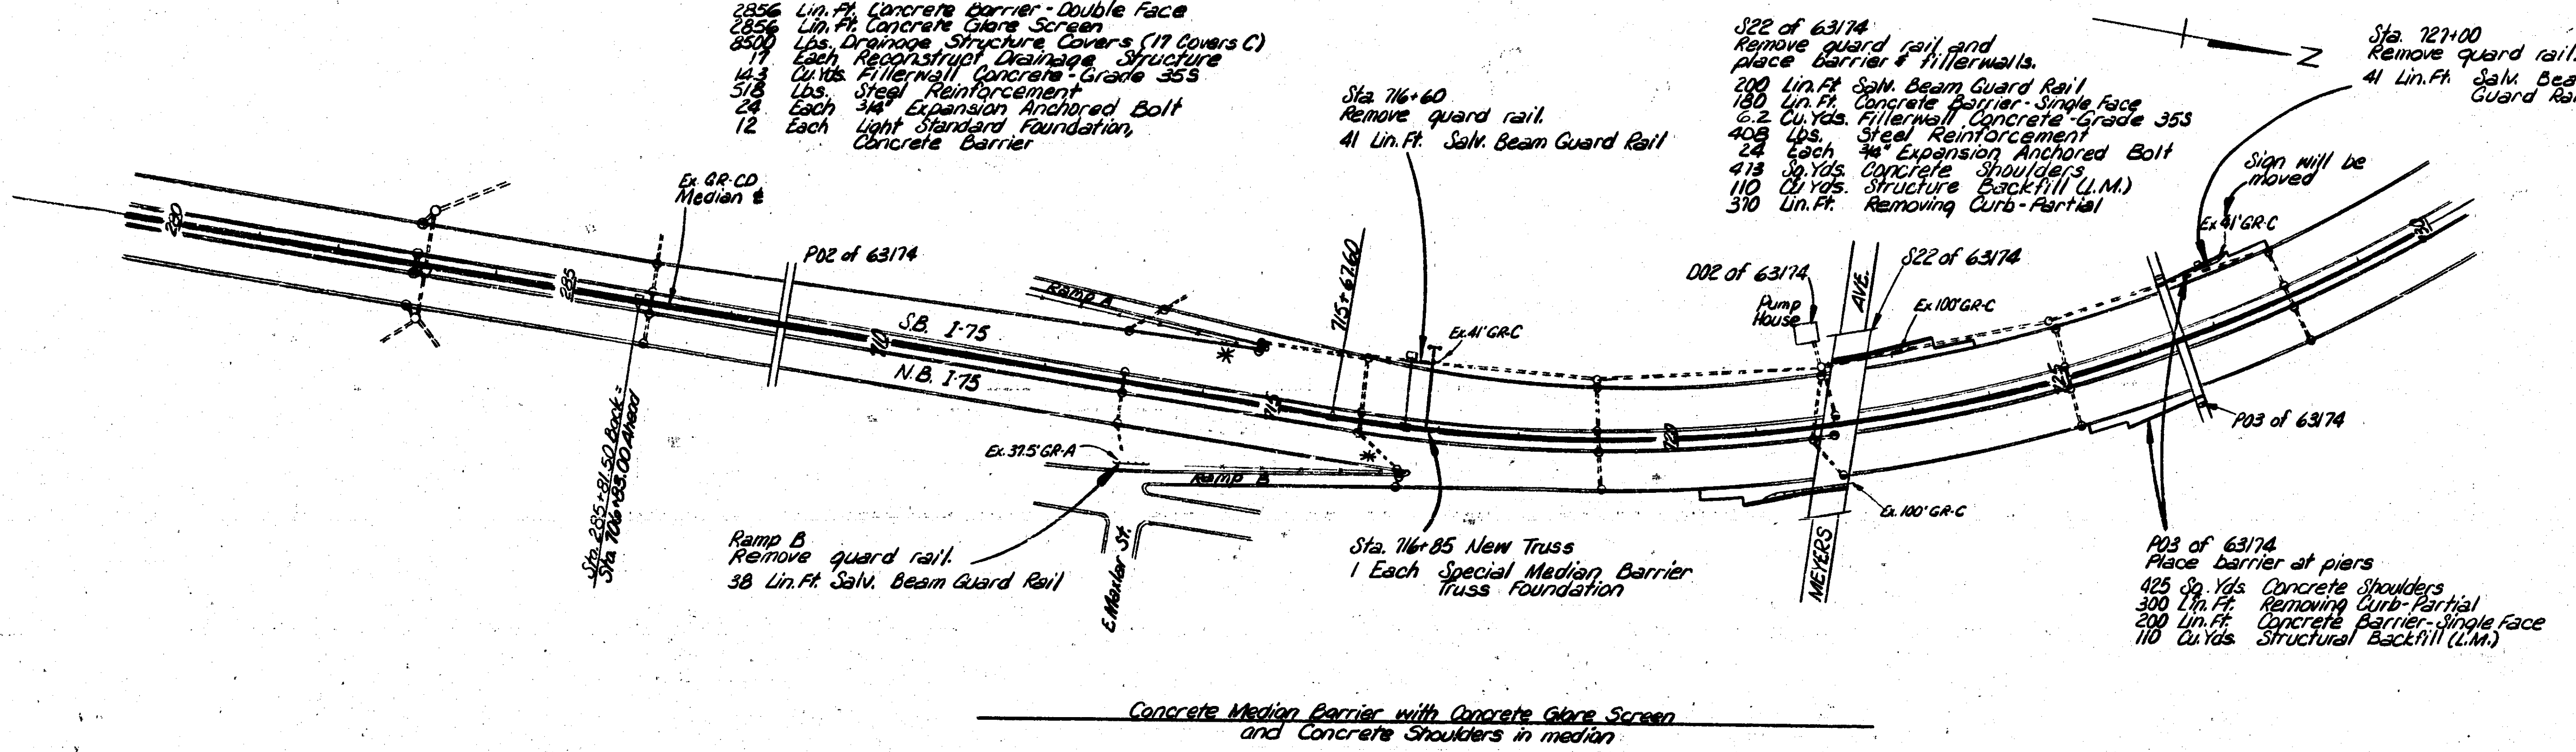

MEDIAN QUANTITIES
Sta. 730+00 to Sta. 760+00

- 2925 Lin. Ft. Salv. Beam Guard Rail
- 6000 Lin. Ft. Rem. Curb - Partial
- 1150 Cu. Yds. Earth Excavation
- 6889 Sq. Yds. Concrete Shoulders
- 2845 Lin. Ft. Concrete Barrier - Double Face
- 2845 Lin. Ft. Concrete Glare Screen
- 18 Each Reconstruct Drainage Structure
- 9000 Lbs. Drainage Structure Covers (18 Covers C)
- 18.8 Cu. Yds. Fillerwall Concrete - Grade 353
- 485 Lbs. Steel Reinforcement
- 24 Each 3/4" Expansion Anchored Bolt
- 13 Each Light Standard Foundation, Concrete Barrier

City of Hazel Park

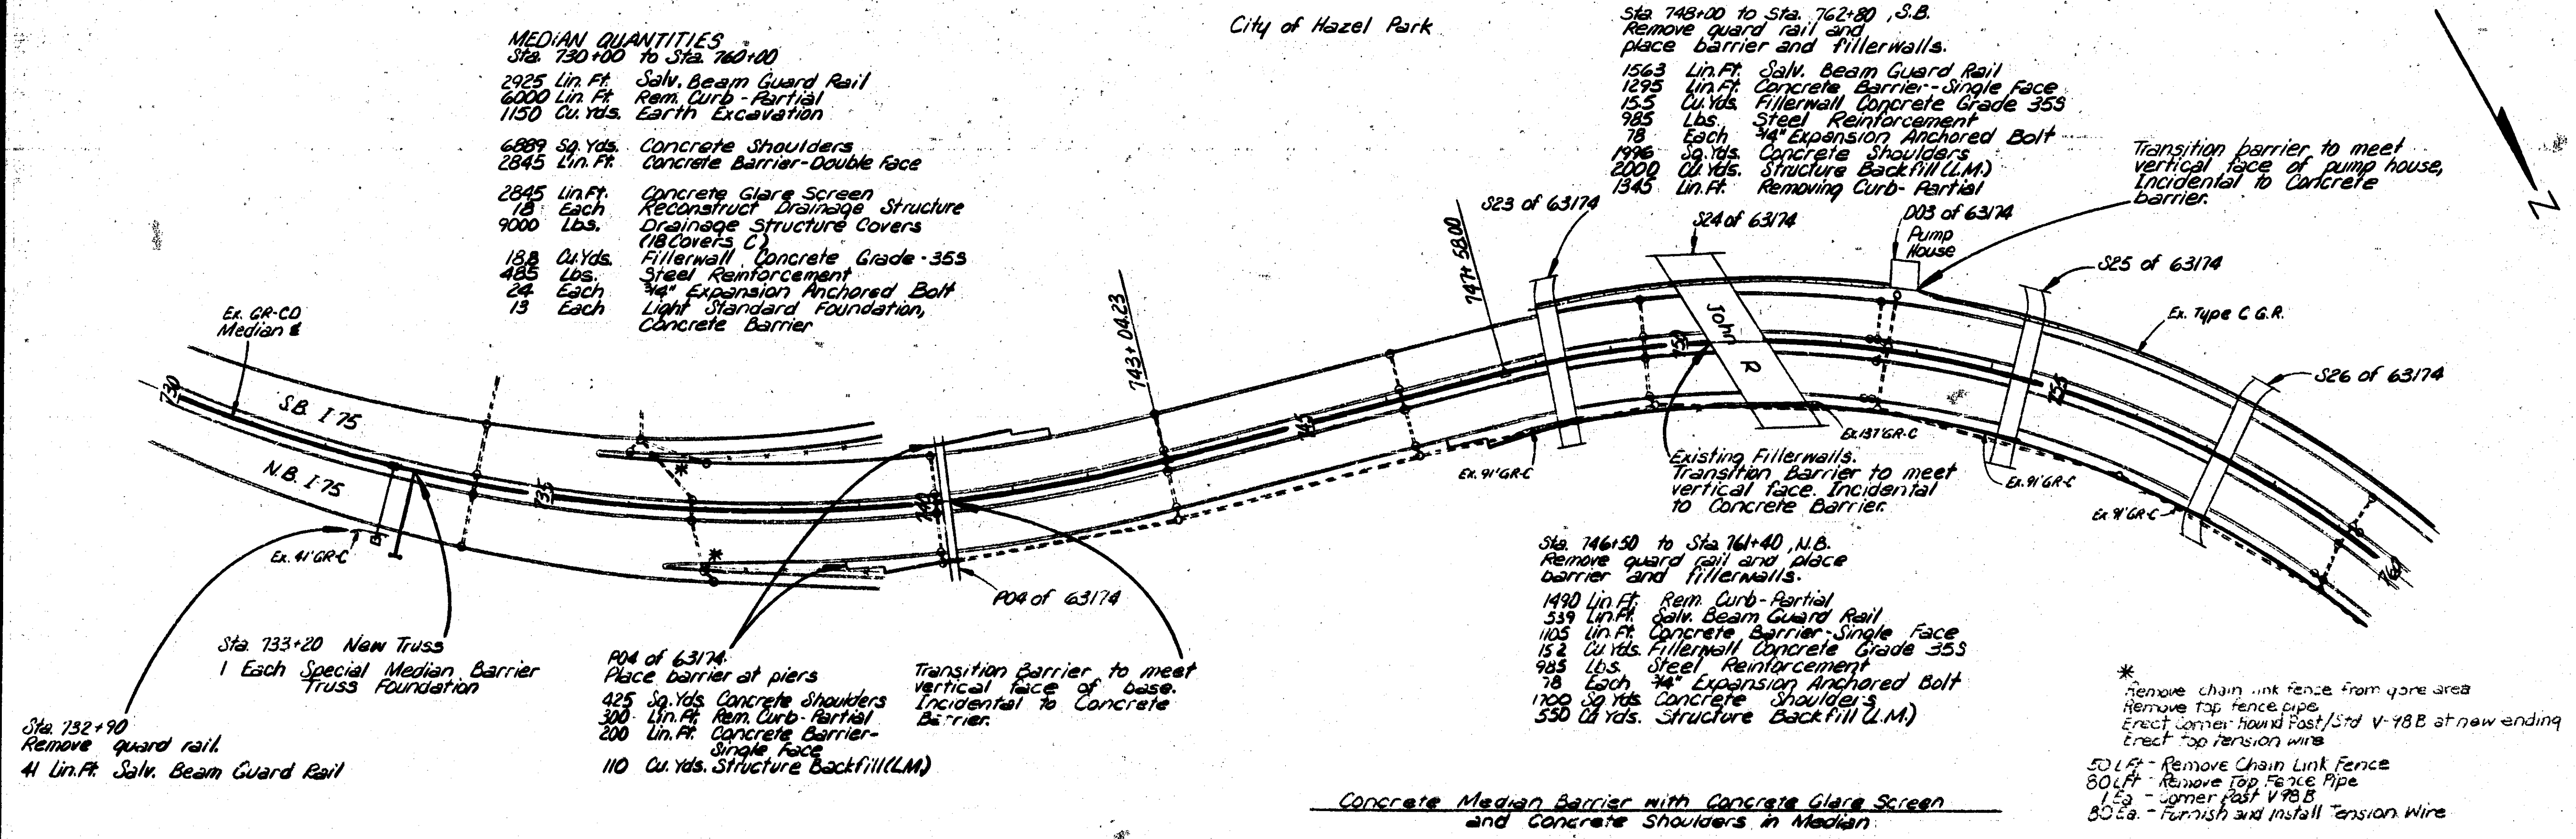


K. CIVUS 5-78
K. CIVUS 5-78
P.M. CIVUS 1978

H.T. MCGUIRE 2-18-79

Station Equation
Sta. 761+50.59 Back-
Sta. 761+57.64 Ahead
Line Shortens 7.05'

MEDIAN QUANTITIES
Sta. 760+00 to Sta. 790+00

3250	Lin. Ft.	Salv. Beam Guard Rail
5986	Lin. Ft.	Rem. Curb - Partial
1148	Cu. Yds.	Earth Excavation
22	Each	Reconstruct Drainage Structure
6889	Sq. Yds.	Concrete Shoulders
2860	Lin. Ft.	Concrete Barrier - Double Face
2860	Lin. Ft.	Concrete Glare Screen
11000	Lbs.	Drainage Structure Covers (22 Covers C)
129	Cu. Yds.	Fillerwall Concrete Grade 35.3
579	Lbs.	Steel Reinforcement
12	Each	3/4" Expansion Anchored Bolt
11	Each	Light Standard Foundation, Concrete Barrier

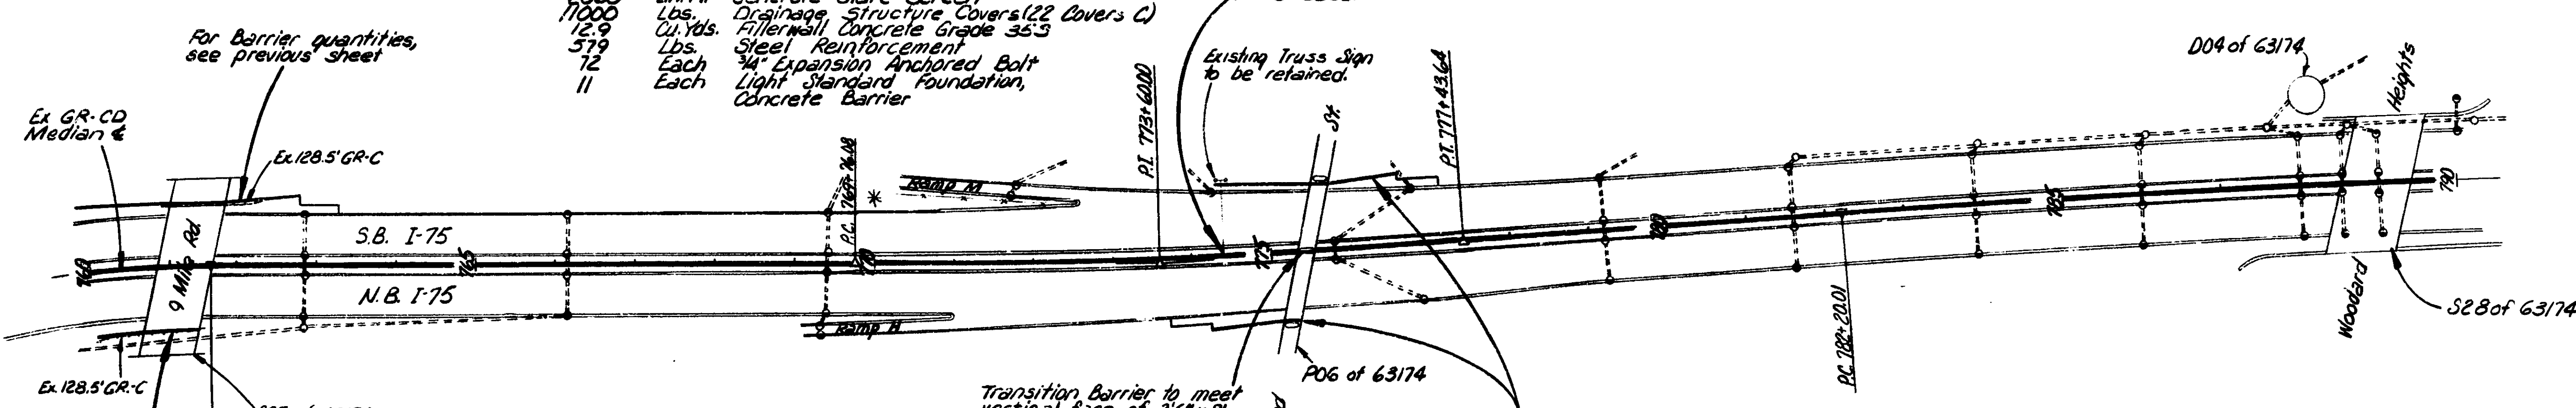

* Remove chain link fence from gore area.
Remove Top Fence Pipe.
Erect Corner Round Post/Std. V-98B at new ending.
Erect Top Tension Wire.
50 L.Ft. - Remove Chain Link Fence
80 L.Ft. - Remove Top Fence Pipe
1 Ea. - Corner Post V98B
80 Ea. - Furnish and Install Tension Wire

Transition Barrier to meet vertical face of 2'6" x 8' base. Incidental to Concrete Barrier.

P06 of 63174
Place barrier.
345 Lin. Ft. Concrete Barrier - Single Face
557 Sq. Yds. Concrete Shoulders
355 Lin. Ft. Rem. Curb - Partial
1487 Cu. Yds. Structure Backfill (L.M.)


Concrete Median Barrier with Concrete Glare Screen and Concrete Shoulders in Median

F.H.W.A. REG. NO.	STATE	FEDERAL PROJECT	R.O.W. NO.	SHEET NO.	TOTAL SHEETS
5	MICH.	I-75 (222) 59		6	96
ROUTE	COUNTY	CONTROL SECTION	JOB NO.		
I-75	Oakland	63174	14165		

H. Claus 5-78
H. Claus 5-78
P.M. Christy 1978

MEDIAN QUANTITIES
Sta. 790+00 to Sta. 820+00

M.A.O.T.	ROYAL OAK	City of Hazel Park
2610	215	Lin. Ft. Salv. Beam Guard Rail
5320	680	Lin. Ft. Rem. Curb - Partial
1018	130	Cu. Yds. Earth Excavation
6108	780	Sq. Yds. Concrete Shoulders
2597	225	Lin. Ft. Concrete Barrier - Double Face
2597	225	Lin. Ft. Concrete Glare Screen
11,000	4000	Lbs. Drainage Structure Covers (30 Covers C)
22	8	Each Reconstruct Drainage Structure
9		Each Light Standard Foundation, Concrete Barrier

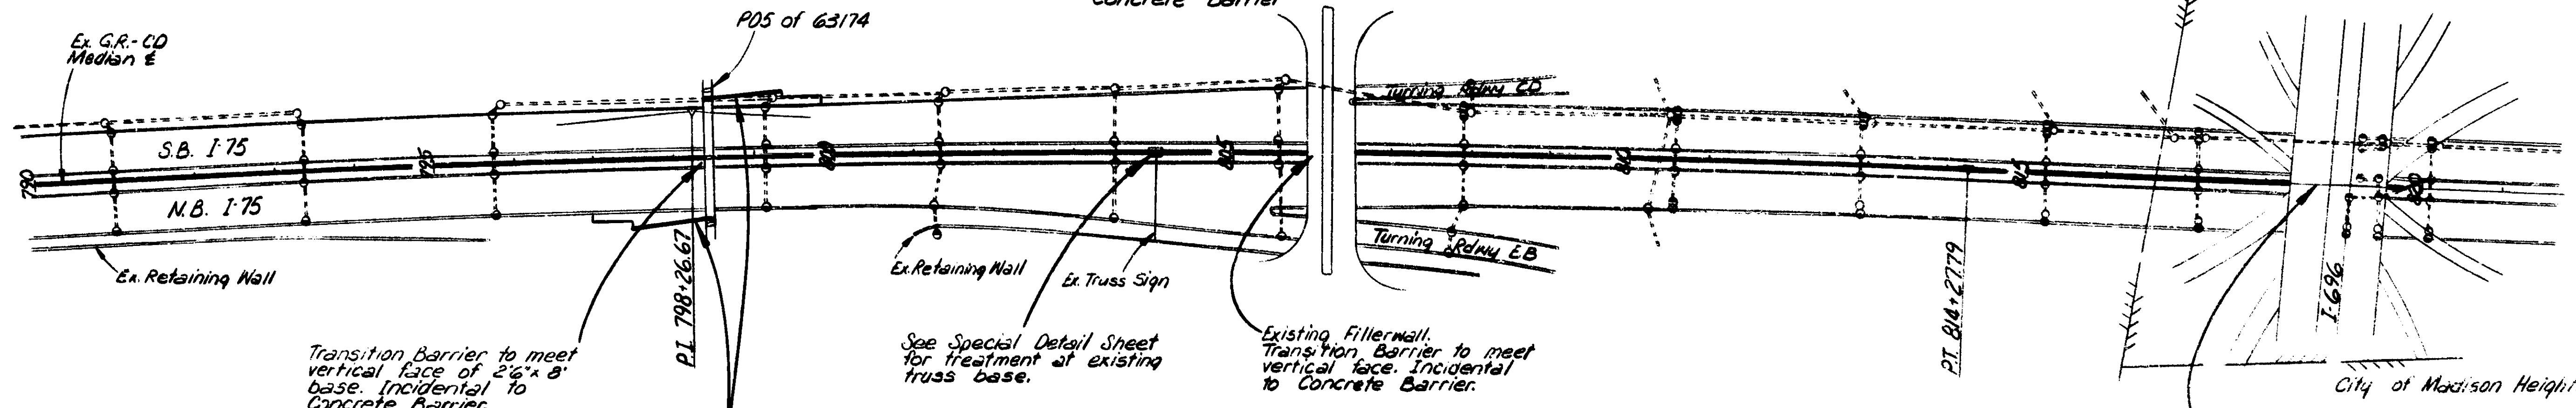

Transition Barrier to meet vertical face of 2'6" x 8' base. Incidental to Concrete Barrier.

See Special Detail Sheet for treatment at existing truss base.

Existing Fillerwall. Transition Barrier to meet vertical face. Incidental to Concrete Barrier.

P05 of 63174
Place barrier at piers
425 Sq. Yds. Concrete Shoulders
300 Lin. Ft. Rem. Curb - Partial
200 Lin. Ft. Concrete Barrier - Single Face
110 Cu. Yds. Structure Backfill (L.M.)
1 Each Reconstruct Drainage Structure
500 Lbs. Drainage Structure Covers (1 Cov.)


Concrete Median Barrier with Concrete Glare Screen and Concrete Shoulders in Median

H.T. August 2-18-79

F.H.W.A. DIST. NO.	STATE	FEDERAL PROJECT	R.O.W. NO.	SHEET NO.	TOTAL SHEETS
6	MICH.	I-75-2(22)59		7	96
ROUTE	COUNTY	CONTROL SECTION	JOB NO.		
I-75	Oakland	63174	14165		

MEDIAN QUANTITIES
Sta. 820+00 to 850+00

2945	Lin. Ft.	Salv. Beam Guard Rail
6000	Lin. Ft.	Rem. Curb-Partial
1148	Cu. Yds.	Earth Excavation
6889	Sq. Yds.	Concrete Shoulders
2932	Lin. Ft.	Concrete Barrier-Double Face
2932	Lin. Ft.	Concrete Glare Screen
14,000	Lbs.	Drainage Structure Cover (20 Covers C)
251	Cu. Yds.	Fillerwall Concrete-Grade 355
355	Lbs.	Steel Reinforcement
32	Each	3/4" Expansion Anchored Bolt
10	Each	Light Standard Foundation, Concrete Barrier

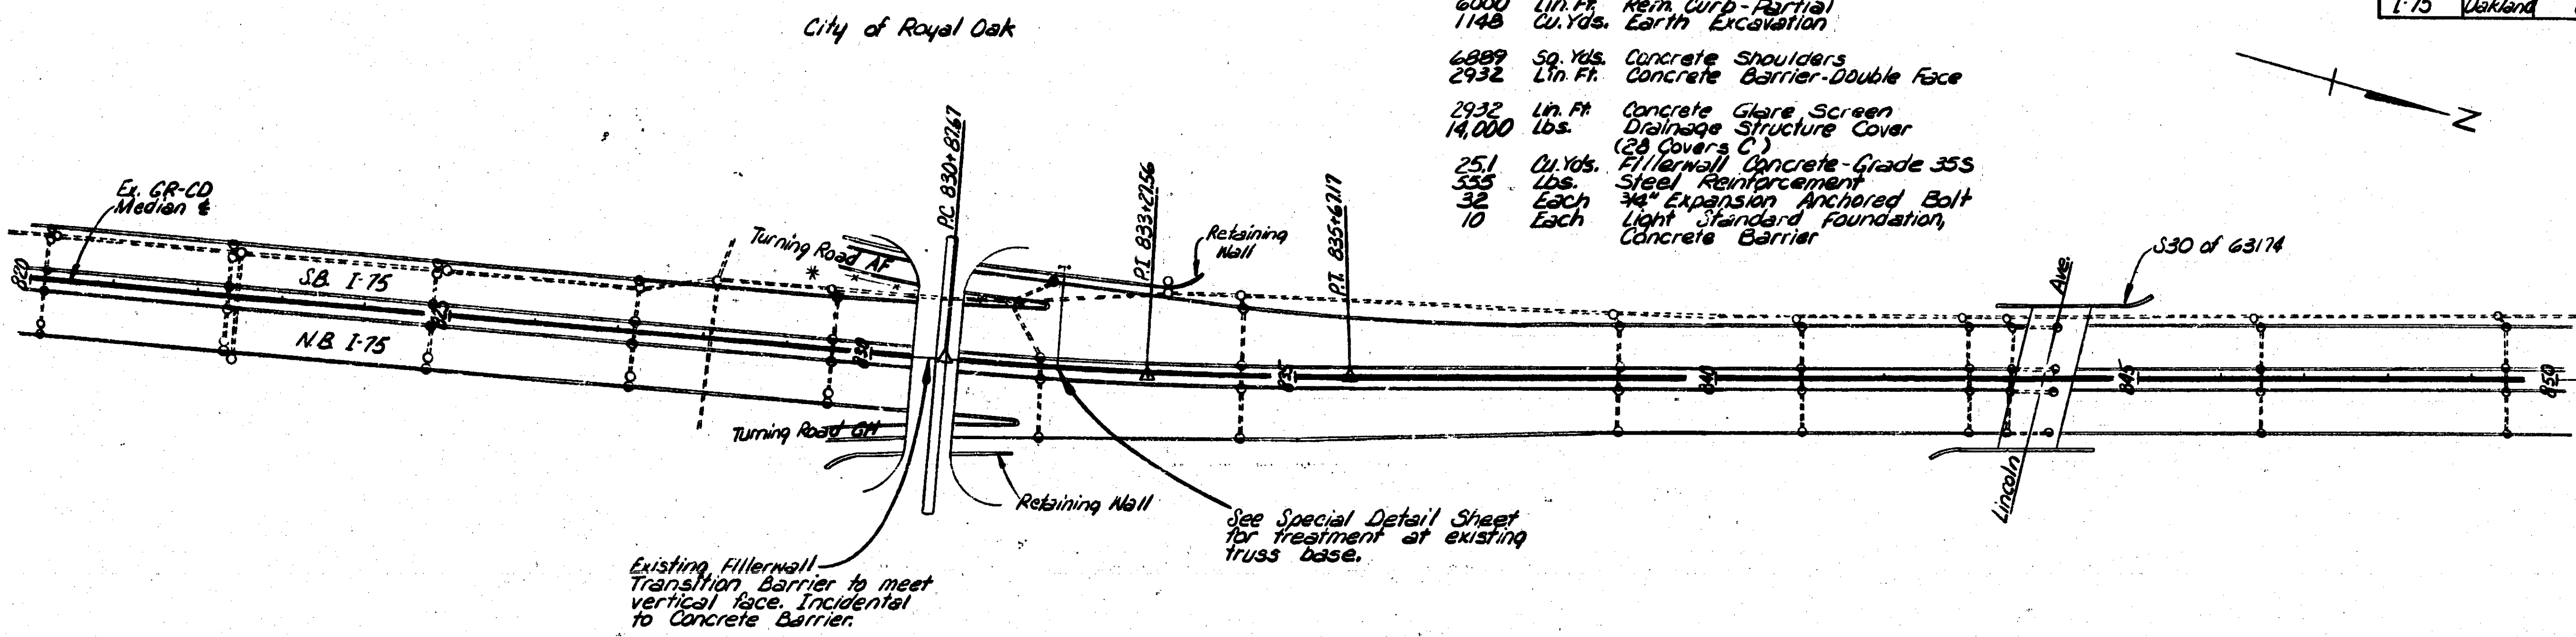

Existing Fillerwall
Transition Barrier to meet vertical face. Incidental to Concrete Barrier.

See Special Detail Sheet for treatment at existing truss base.

Concrete Median Barrier with Concrete Glare Screen and Concrete Shoulders in Median

K. Claus 5-78
A. Claus 6-78
B.M. Cluskey 1-78


City of Royal Oak

MEDIAN QUANTITIES
Sta. 850+00 to Sta. 880+00

3100	Lin. Ft.	Salv. Beam Guard Rail
6000	Lin. Ft.	Rem. Curb-Partial
1148	Cu. Yds.	Earth Excavation
6889	Sq. Yds.	Concrete Shoulders
2927	Lin. Ft.	Concrete Barrier-Double Face
2927	Lin. Ft.	Concrete Glare Screen
19,000	Lbs.	Drainage Structure Cover (20 Covers C)
25.4	Cu. Yds.	Fillerwall Concrete Grade 355
575	Lbs.	Steel Reinforcement
40	Each	3/4" Expansion Anchored Bolt
11	Each	Light Standard Foundation, Concrete Barrier

S31 of 63174
Remove guard rail and place barrier & Fillerwalls.

624	Lin. Ft.	Salv. Beam Guard Rail
180	Lin. Ft.	Concrete Barrier-Single Face
55	Cu. Yds.	Fillerwall Concrete Grade 355
347	Lbs.	Steel Reinforcement
30	Each	3/4" Expansion Anchored Bolt
410	Lin. Ft.	Rem. Curb-Partial
535	Sq. Yds.	Concrete Shoulders
110	Cu. Yds.	Structure Backfill (L.M.)

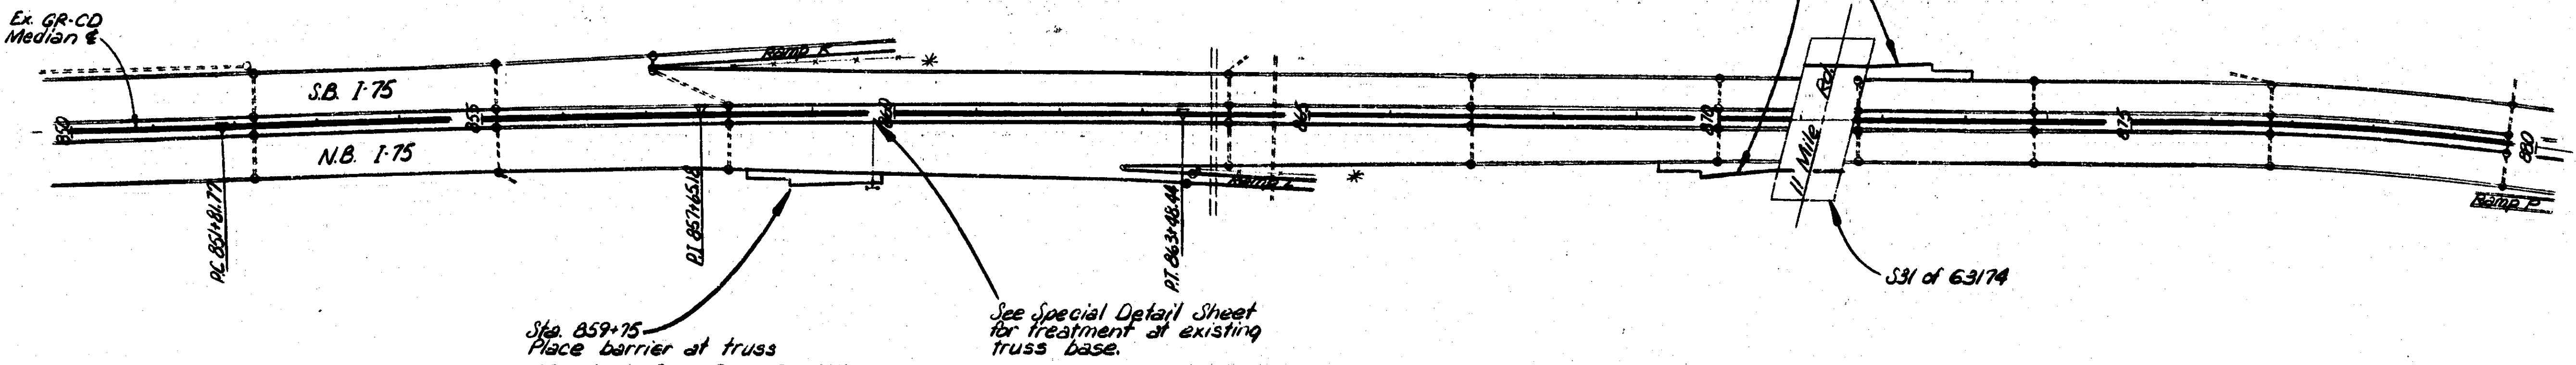

Sta. 859+75
Place barrier at truss
150 Lin. Ft. Rem. Curb-Partial
110 Lin. Ft. Concrete Barrier-Single Face
212 Sq. Yds. Concrete Shoulders
35 Cu. Yds. Structure Backfill (L.M.)

See Special Detail Sheet for treatment at existing truss base.

Concrete Median Barrier with Concrete Glare Screen and Concrete Shoulders in Median

*
Remove chain link fence from gore area
Remove top fence pipe
Erect corner Round Post/Std. V-95B at new ending
Erect top tension wire
50 Lin. Ft. - Remove Chain Link Fence
30 Lin. Ft. - Remove Top Fence Pipe
1 Ea - Corner Post V-95B
80 Ea - Furnish and Install Tension Wire

A.J. August 2-73-79

MEDIAN QUANTITIES
Sta 880+00 to 882+20

- 220 Lin. Ft. Salv. Beam Guard Rail
- 440 Lin. Ft. Rem. Curb-Partial
- 84 Cu. Yds. Earth Excavation
- 505 Sq. Yds. Concrete Shoulders
- 220 Lin. Ft. Concrete Barrier-Double Face
- 220 Lin. Ft. Concrete Glare Screen
- 1 Each Light Standard Foundation, Concrete Barrier

- Sta 885+00
Remove 35' of the existing barrier and shoulders to facilitate the placement of the new truss. Removal shall be incidental to the new items.
- 80 Sq. Yds. Concrete Shoulders
 - 35 Lin. Ft. Concrete Barrier-Double Face
 - 1 Each Special Median Barrier Truss Foundation

ROYAL OAK TWP
Sec. 14
T1N R1E
CITY OF
ROYAL OAK

B.M. No. 73, Elev. 638.77
4.5' H.D. Tag in base of 20"
Oak Tree 248' Lt. of Sta.
903 + 37 Survey

FED. PROJ. NO.	STATE	FEDERAL PROJECT	R.O.W. NO.	SHEET NO.	TOTAL SHEETS
5	MICH.	I-75-2(222)59		8	96
ROUTE	COUNTY	CONTROL SECTION	SECTION	JOB NO.	
I-75	Oakland	Is 63174		14165	



- Sta 900+75 to Sta 908+25
Remove guard rail and place barrier
- 613 Lin. Ft. Salv. Beam Guard Rail
 - 470 Lin. Ft. Concrete Barrier-Single Face
 - 1367 Sq. Yds. Concrete Shoulders
 - 700 Lin. Ft. Rem. Curb-Partial
 - 471 Cu. Yds. Structure Backfill (L.M.)
 - 3 Each Reconstruct Drainage Structure
 - 1500 Lbs. Drainage Structure Covers (3 Covc.)

- Sta 897+40 to Sta 899+20
Remove guard rail and place barrier.
- 163 Lin. Ft. Salv. Beam Guard Rail
 - 90 Lin. Ft. Concrete Barrier-Single Face
 - 140 Lin. Ft. Retn. Curb-Partial
 - 190 Sq. Yds. Concrete Shoulders
 - 55 Cu. Yds. Structure Backfill (L.M.)

- Sta 906+10 to 910+00
Remove existing curb & gutter at end of barrier. Remove 50' of existing barrier to facilitate placing barrier to maintain drainage at existing CB. Removals shall be incidental to Conc. Barrier-Single Face.

Madison Royal Oak

Hts.	Oak	Excavation
100	50	Cu. Yds. Earth Excavation
290	150	Cu. Yds. Subbase
500	180	Lin. Ft. Concrete Valley Gutter
525	275	Sq. Yds. Concrete Shoulders
520	260	Lin. Ft. Concrete Barrier-Single Face
235	155	Lin. Ft. Concrete Glare Screen
1	1	Each 2' Dia. Drainage Structure
455	455	Lbs. Drainage Structure Covers (2 Cov D)

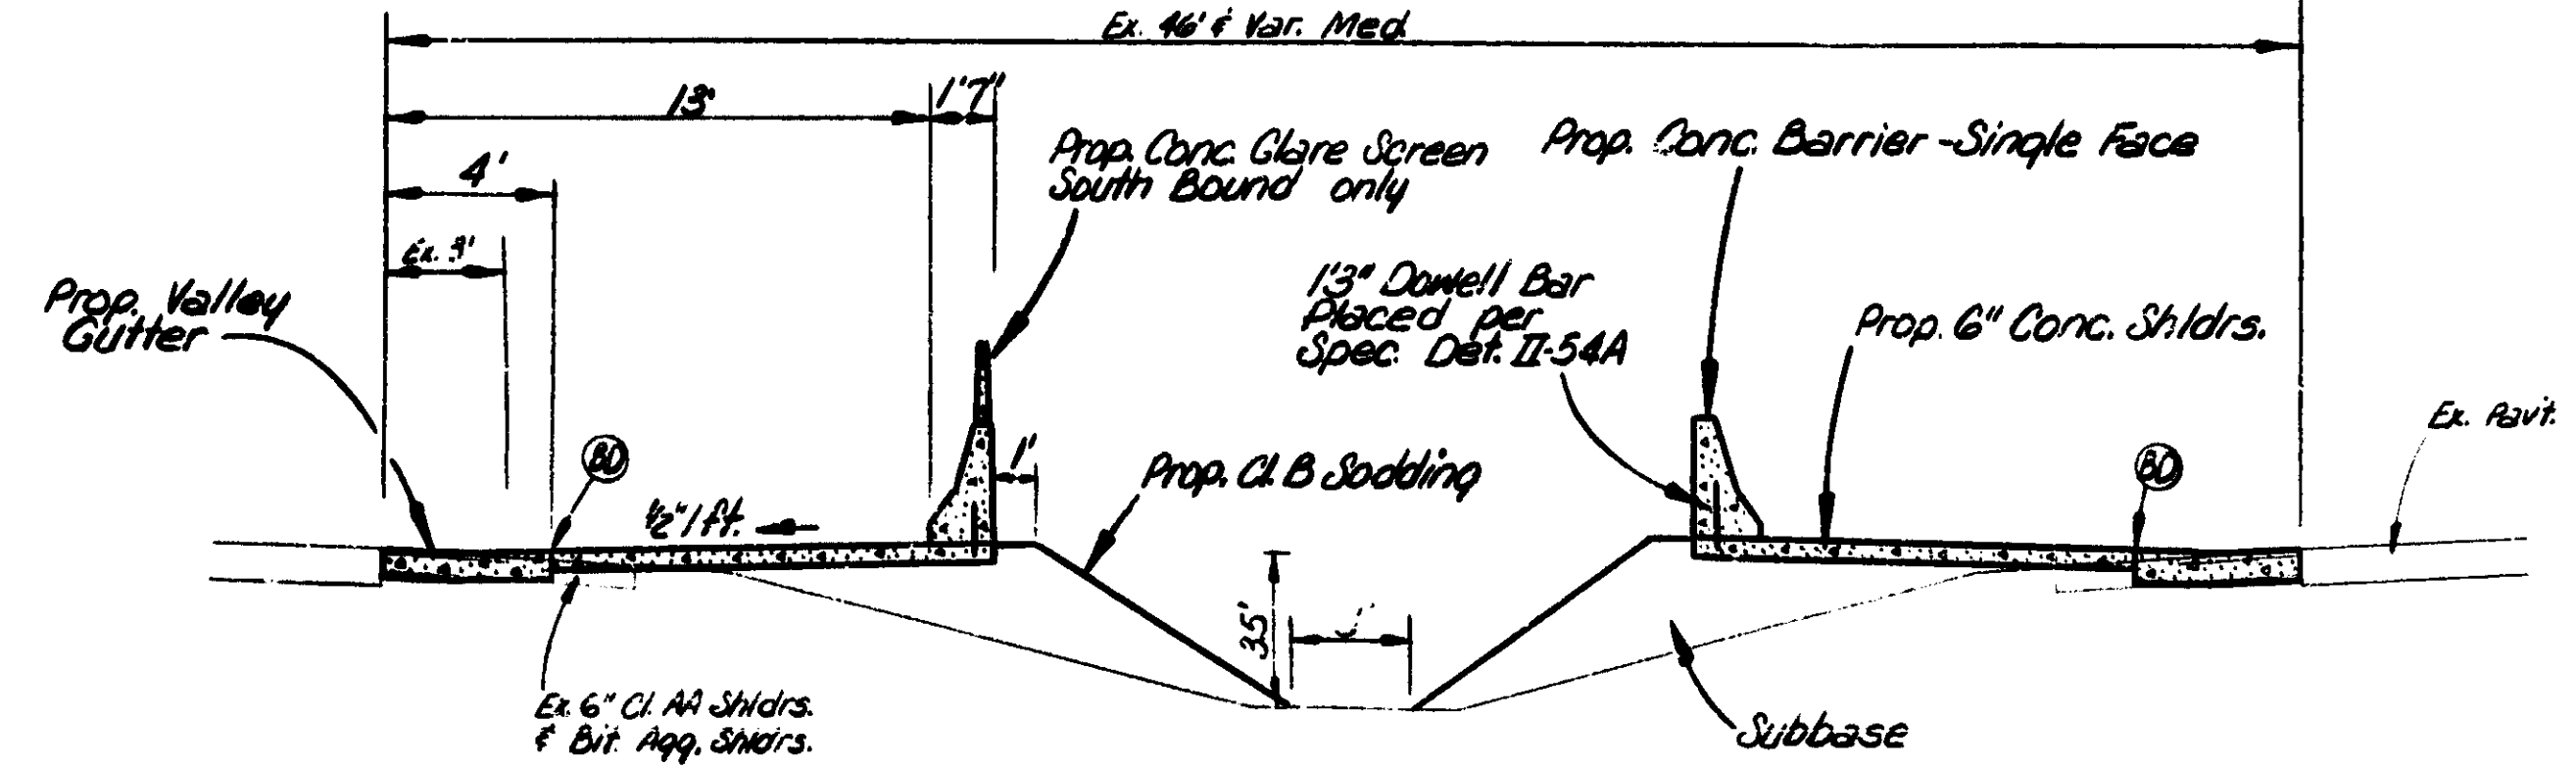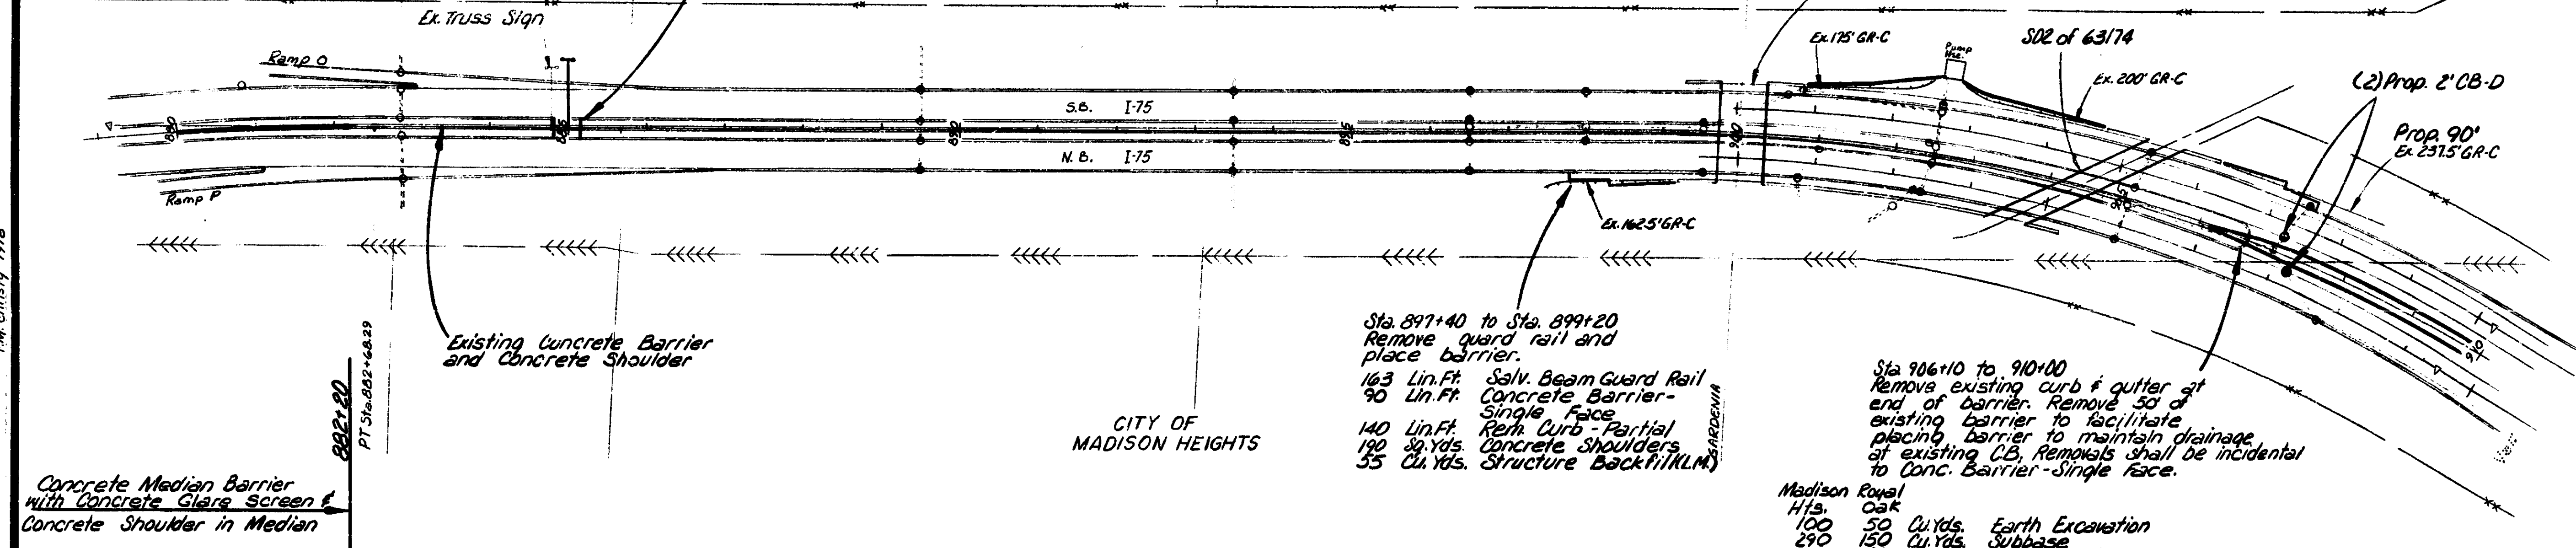

SECTION TO APPLY
Sta. 906+65 to 931+15

- JOINT LEGEND FOR PAVEMENT JOINTS**
- ⓐ Longitudinal Bulkhead Joint, according to Standard Plan II-41C
 - ⓑ Longitudinal Lane Tie Joint with Tie Bars, according to Standard Plan II-41C
 - ⓒ Optional B or D

K. Claus 5-78
 K. Claus 5-78
 P.M. Christy 1978
 H.T. Myquist 2-15-79


Sec. 14
TIN RILE
Royal Oak Twp.

CITY OF ROYAL OAK

B.M. No. 71, Elev. 638.34
M.S.M.O. Tag in Roof of 24" Elm
187 Rt. 912 + 60 N. B. Rdwy.

B.M. No. 68 Elev. 638.31
M.S.M.O. Tag in Roof of 24" Elm
241' Lt. 939 + 43 N. B. Rdwy.

FED. PROJ. NO.	STATE	FEDERAL PROJECT	R.O.W. NO.	SHEET NO.	TOTAL SHEETS
5	MICH.	I-75-2(222)59		9	96
ROUTE	COUNTY	CONTROL SECTION	JOB NO.		
I-75	Oakland	Is 63174	14165		

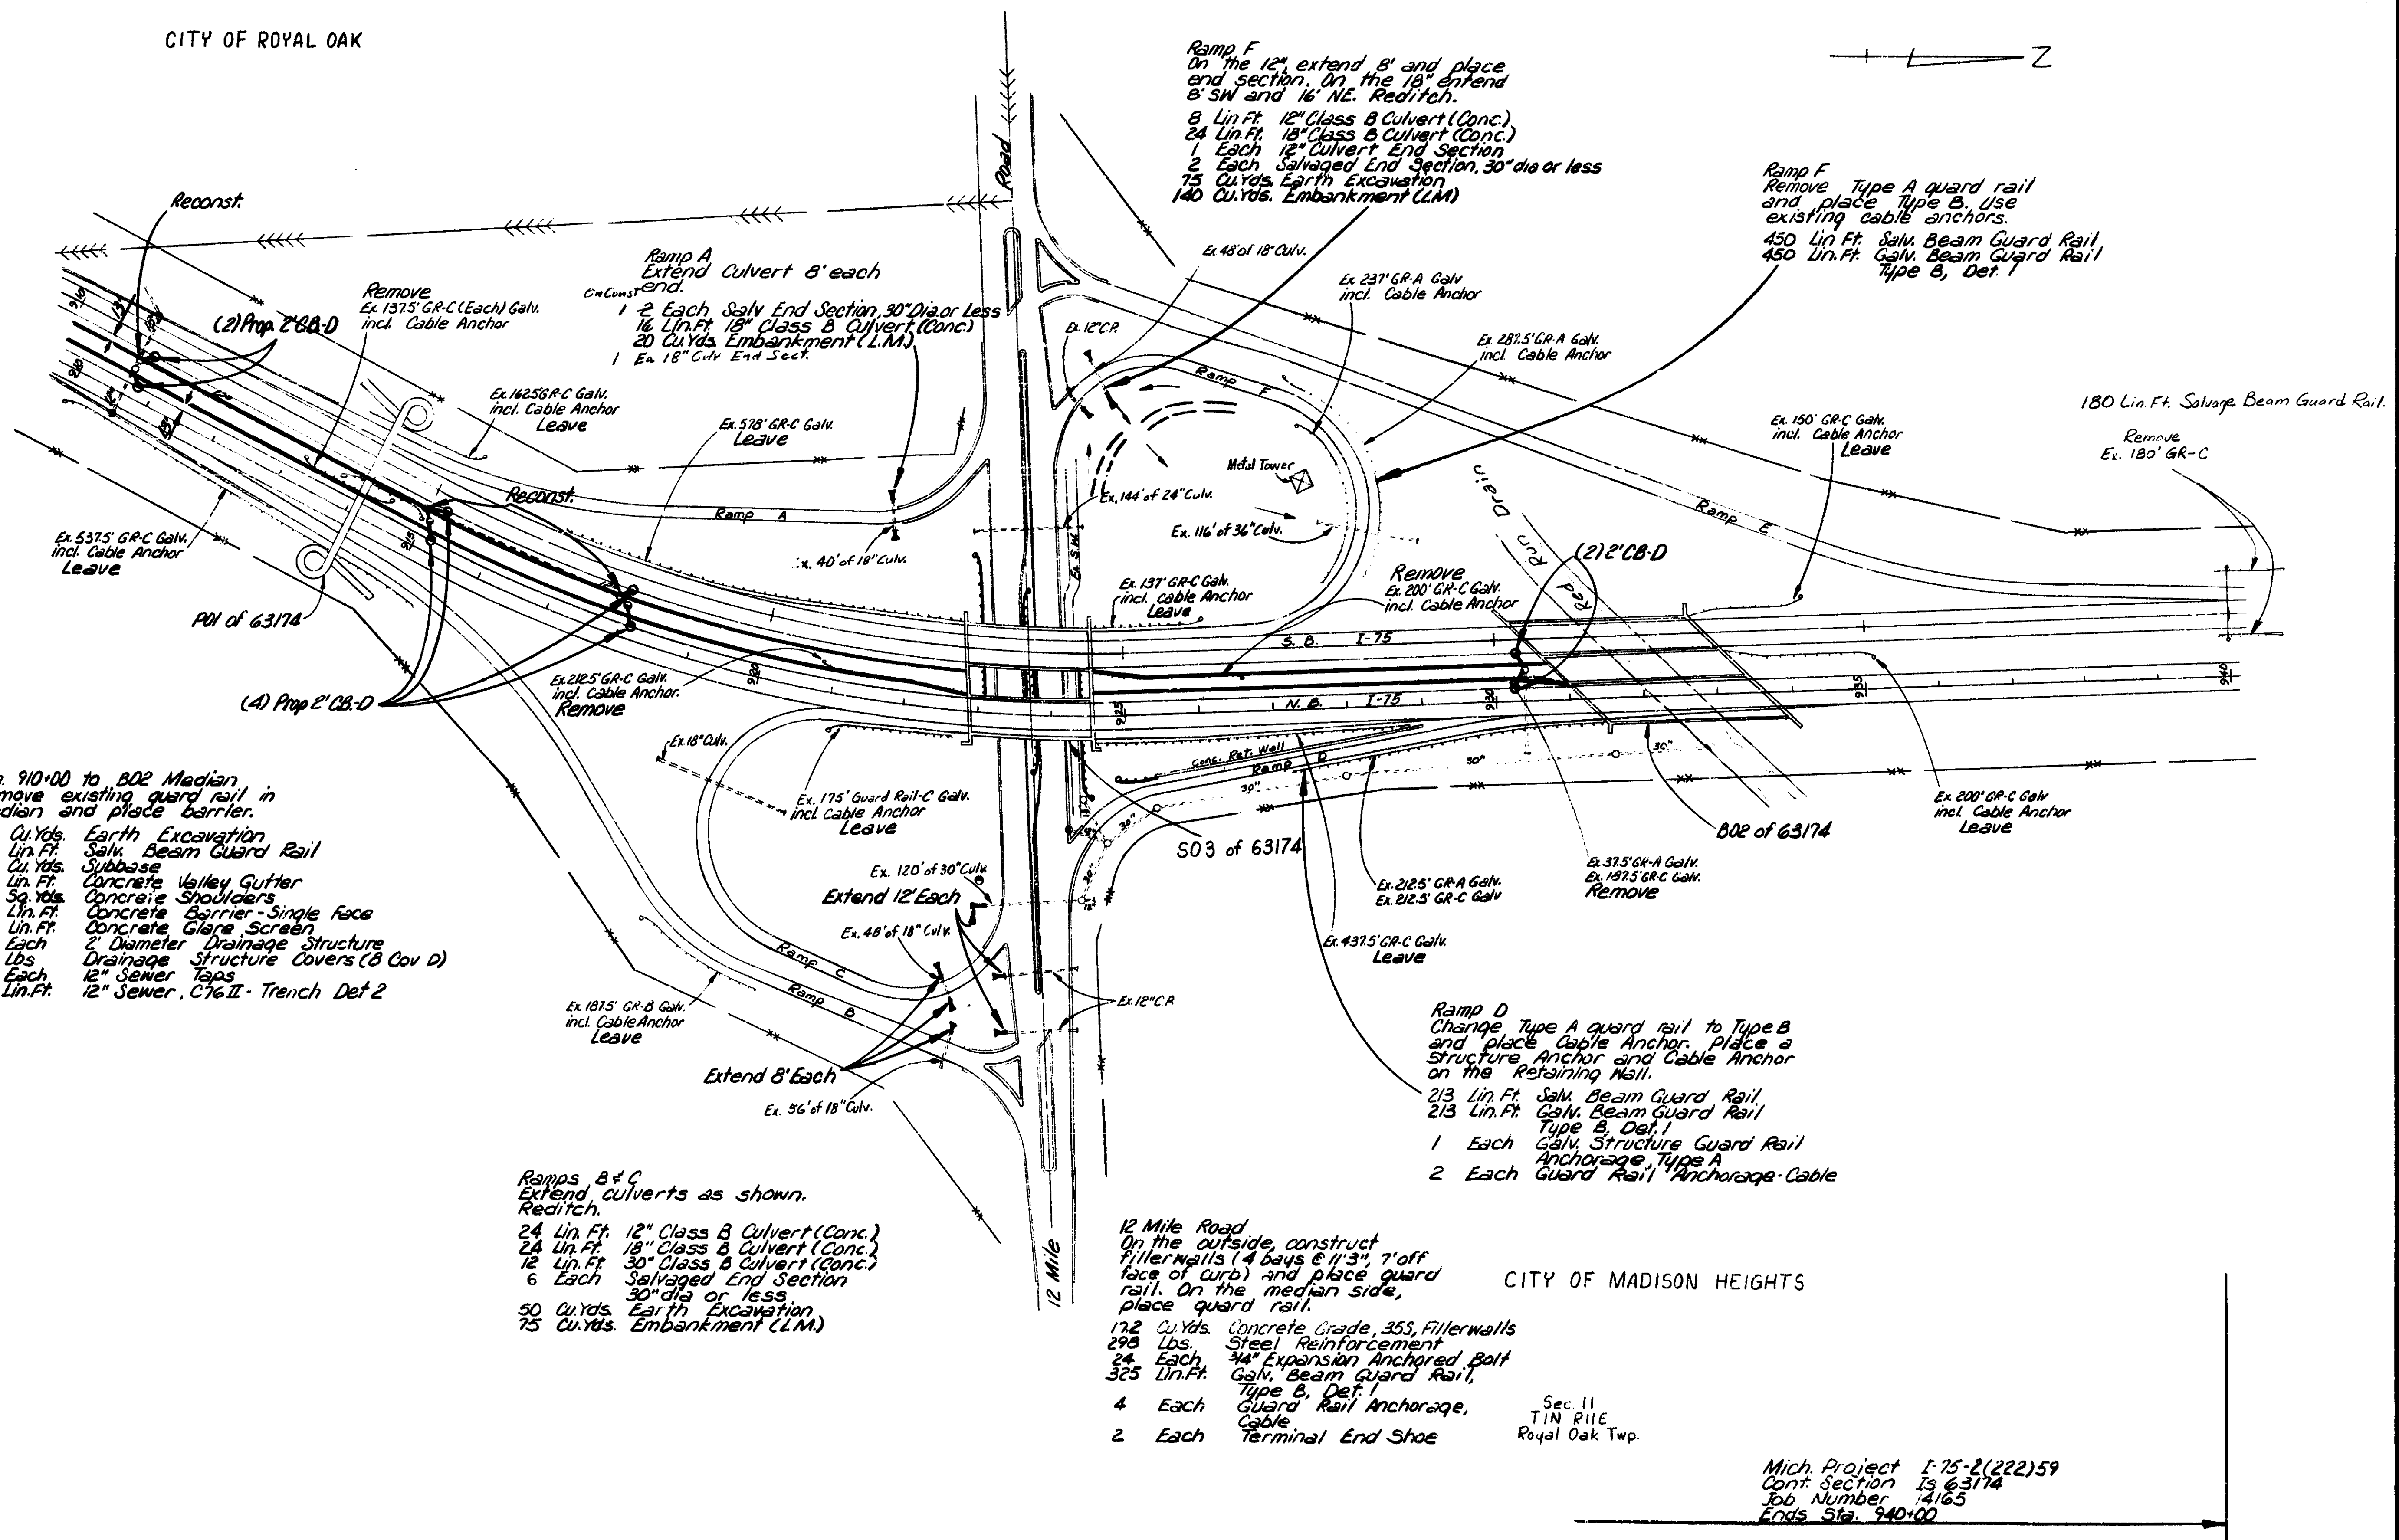

- Sta. 910+00 to 802 Median
Remove existing guard rail in median and place barrier.
- 425 Cu.Yds. Earth Excavation
 - 913 Lin.Ft. Salv. Beam Guard Rail
 - 1975 Cu.Yds. Subbase
 - 3805 Lin.Ft. Concrete Valley Gutter
 - 6165 Sq.Yds. Concrete Shoulders
 - 3805 Lin.Ft. Concrete Barrier-Single face
 - 1885 Lin.Ft. Concrete Glare Screen
 - 8 Each 2" Diameter Drainage Structure
 - 3640 Lbs. Drainage Structure Covers (B Cov D)
 - 8 Each 12" Sewer Taps
 - 128 Lin.Ft. 12" Sewer, C76 II - Trench Det 2

- Ramps B & C
Extend culverts as shown.
Reditch.
- 24 Lin.Ft. 12" Class B Culvert (Conc.)
 - 24 Lin.Ft. 18" Class B Culvert (Conc.)
 - 12 Lin.Ft. 30" Class B Culvert (Conc.)
 - 6 Each Salvaged End Section 30" dia or less
 - 50 Cu.Yds. Earth Excavation
 - 75 Cu.Yds. Embankment (L.M.)


- 12 Mile Road
On the outside, construct filler walls (4 bays @ 11'3", 7' off face of curb) and place guard rail. On the median side, place guard rail.
- 172 Cu.Yds. Concrete Grade, 355, Filler walls
 - 298 Lbs. Steel Reinforcement
 - 24 Each 3/4" Expansion Anchored Bolt
 - 325 Lin.Ft. Galv. Beam Guard Rail, Type B, Det. 1
 - 4 Each Guard Rail Anchorage, Cable
 - 2 Each Terminal End Shoe

- Ramp D
Change Type A guard rail to Type B and place Cable Anchor. Place a Structure Anchor and Cable Anchor on the Retaining Wall.
- 213 Lin.Ft. Salv. Beam Guard Rail
 - 213 Lin.Ft. Galv. Beam Guard Rail Type B, Det. 1
 - 1 Each Galv. Structure Guard Rail Anchorage, Type A
 - 2 Each Guard Rail Anchorage-Cable



K. Claus 6-78
 H. Meeker 6-78
 K. Claus 6-78
 B.M. Christy 1978
 H.T. Myquist 2-13-79

Mich. Project I-75-2(222)59
Cont. Section Is 63174
Job Number 14165
Ends Sta. 940+00



CONTROL SHEET	63174	JOB NO.	14165	FEDERAL PROJECT	I-75-2(222)59	SHEET NO.	9	TOTAL SHEETS	96
---------------	-------	---------	-------	-----------------	---------------	-----------	---	--------------	----

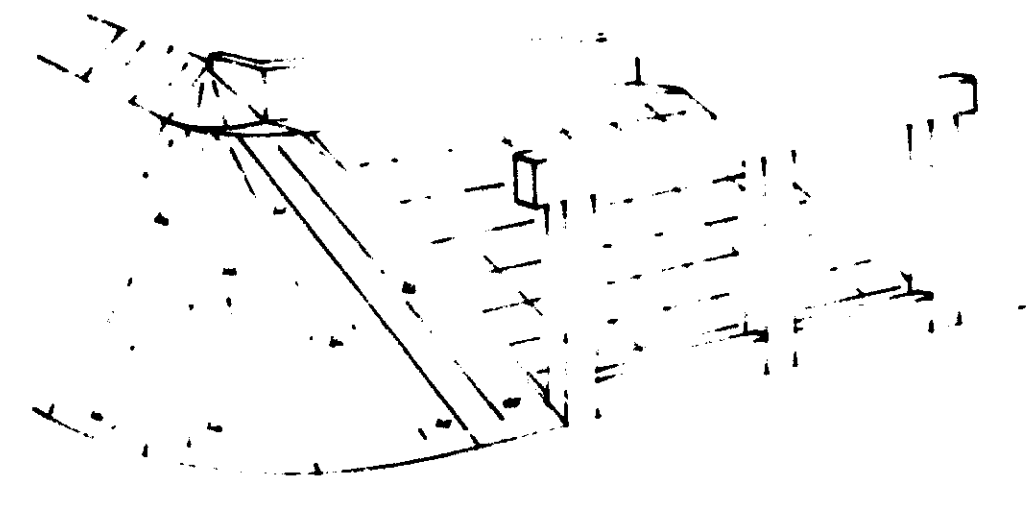

SKETCH OF FILLER WALLS AT SQUARE PIER COLUMNS

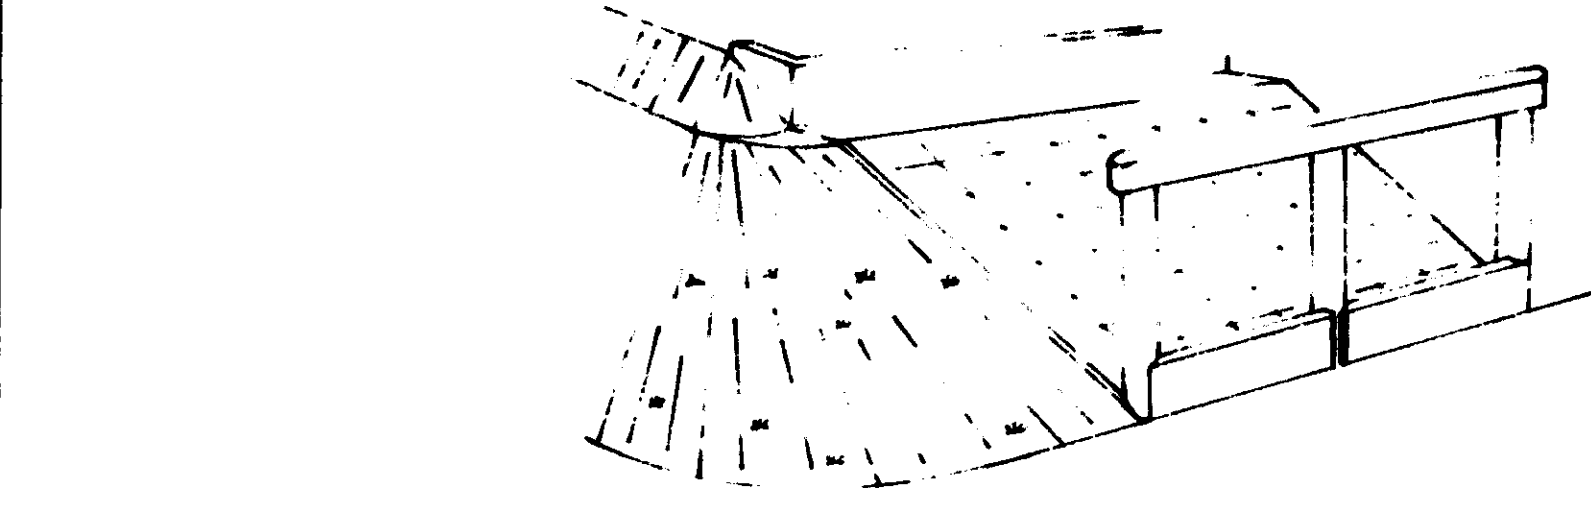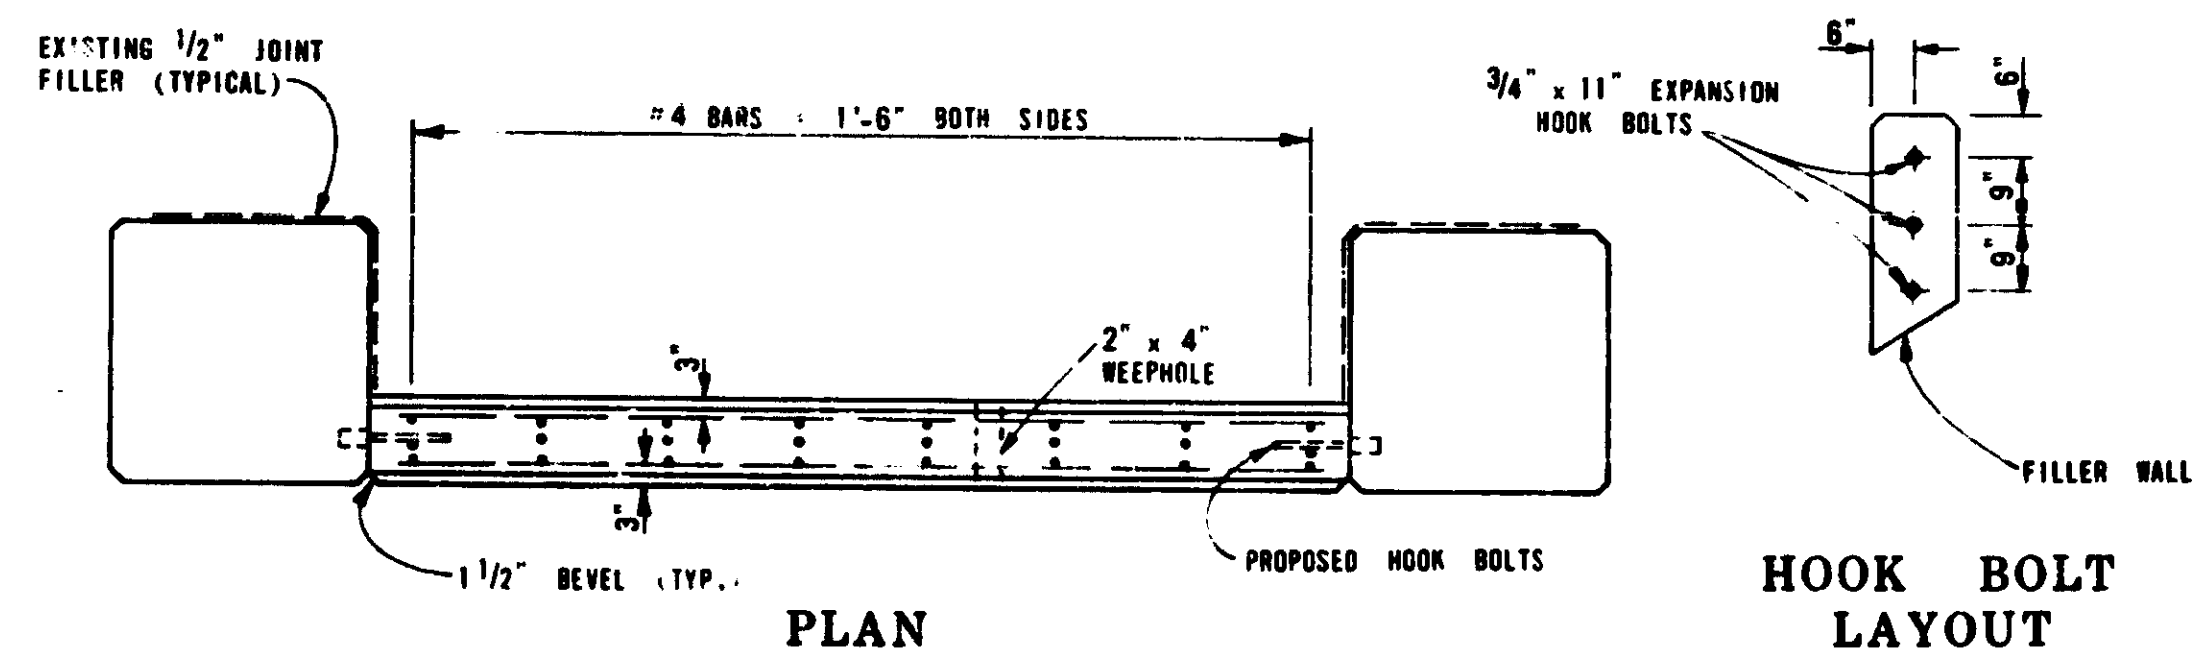


SKETCH OF FILLER WALLS AT ROUND PIER COLUMNS

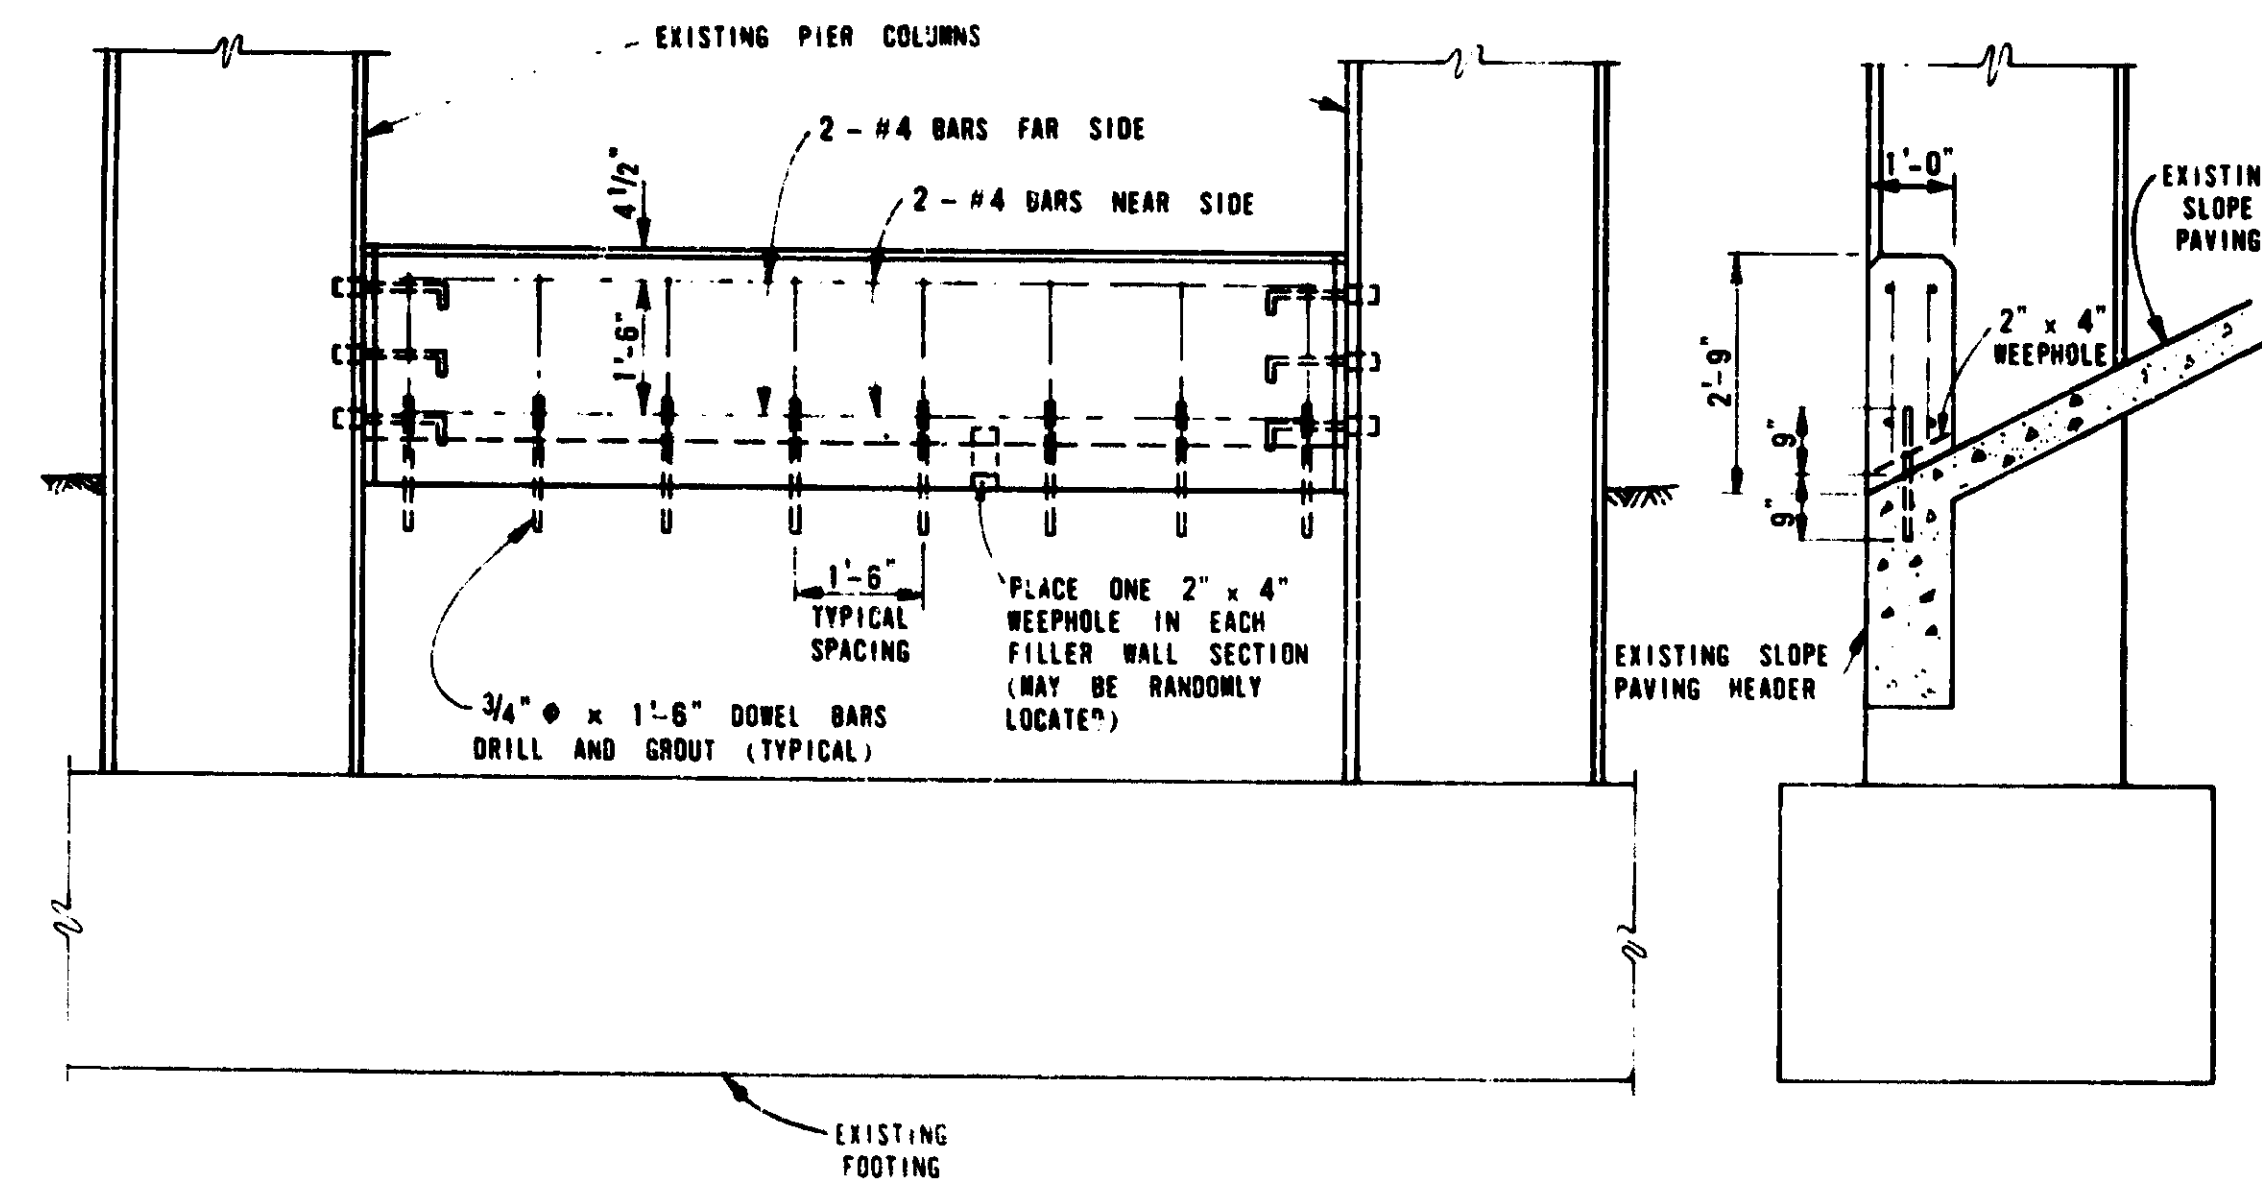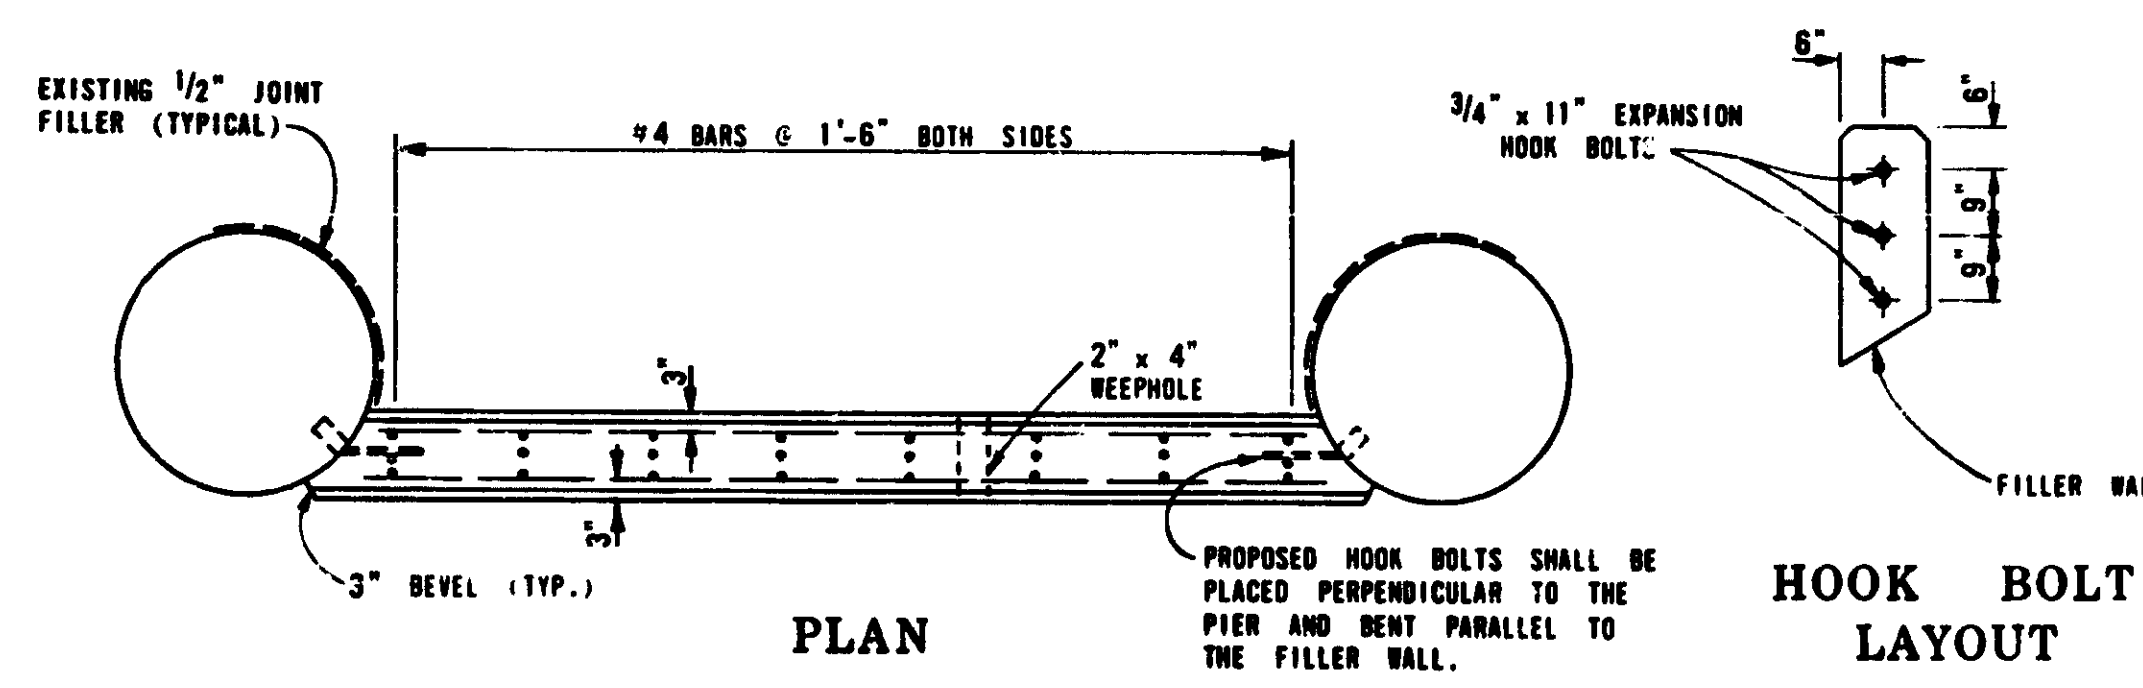

ELEVATION

SECTION

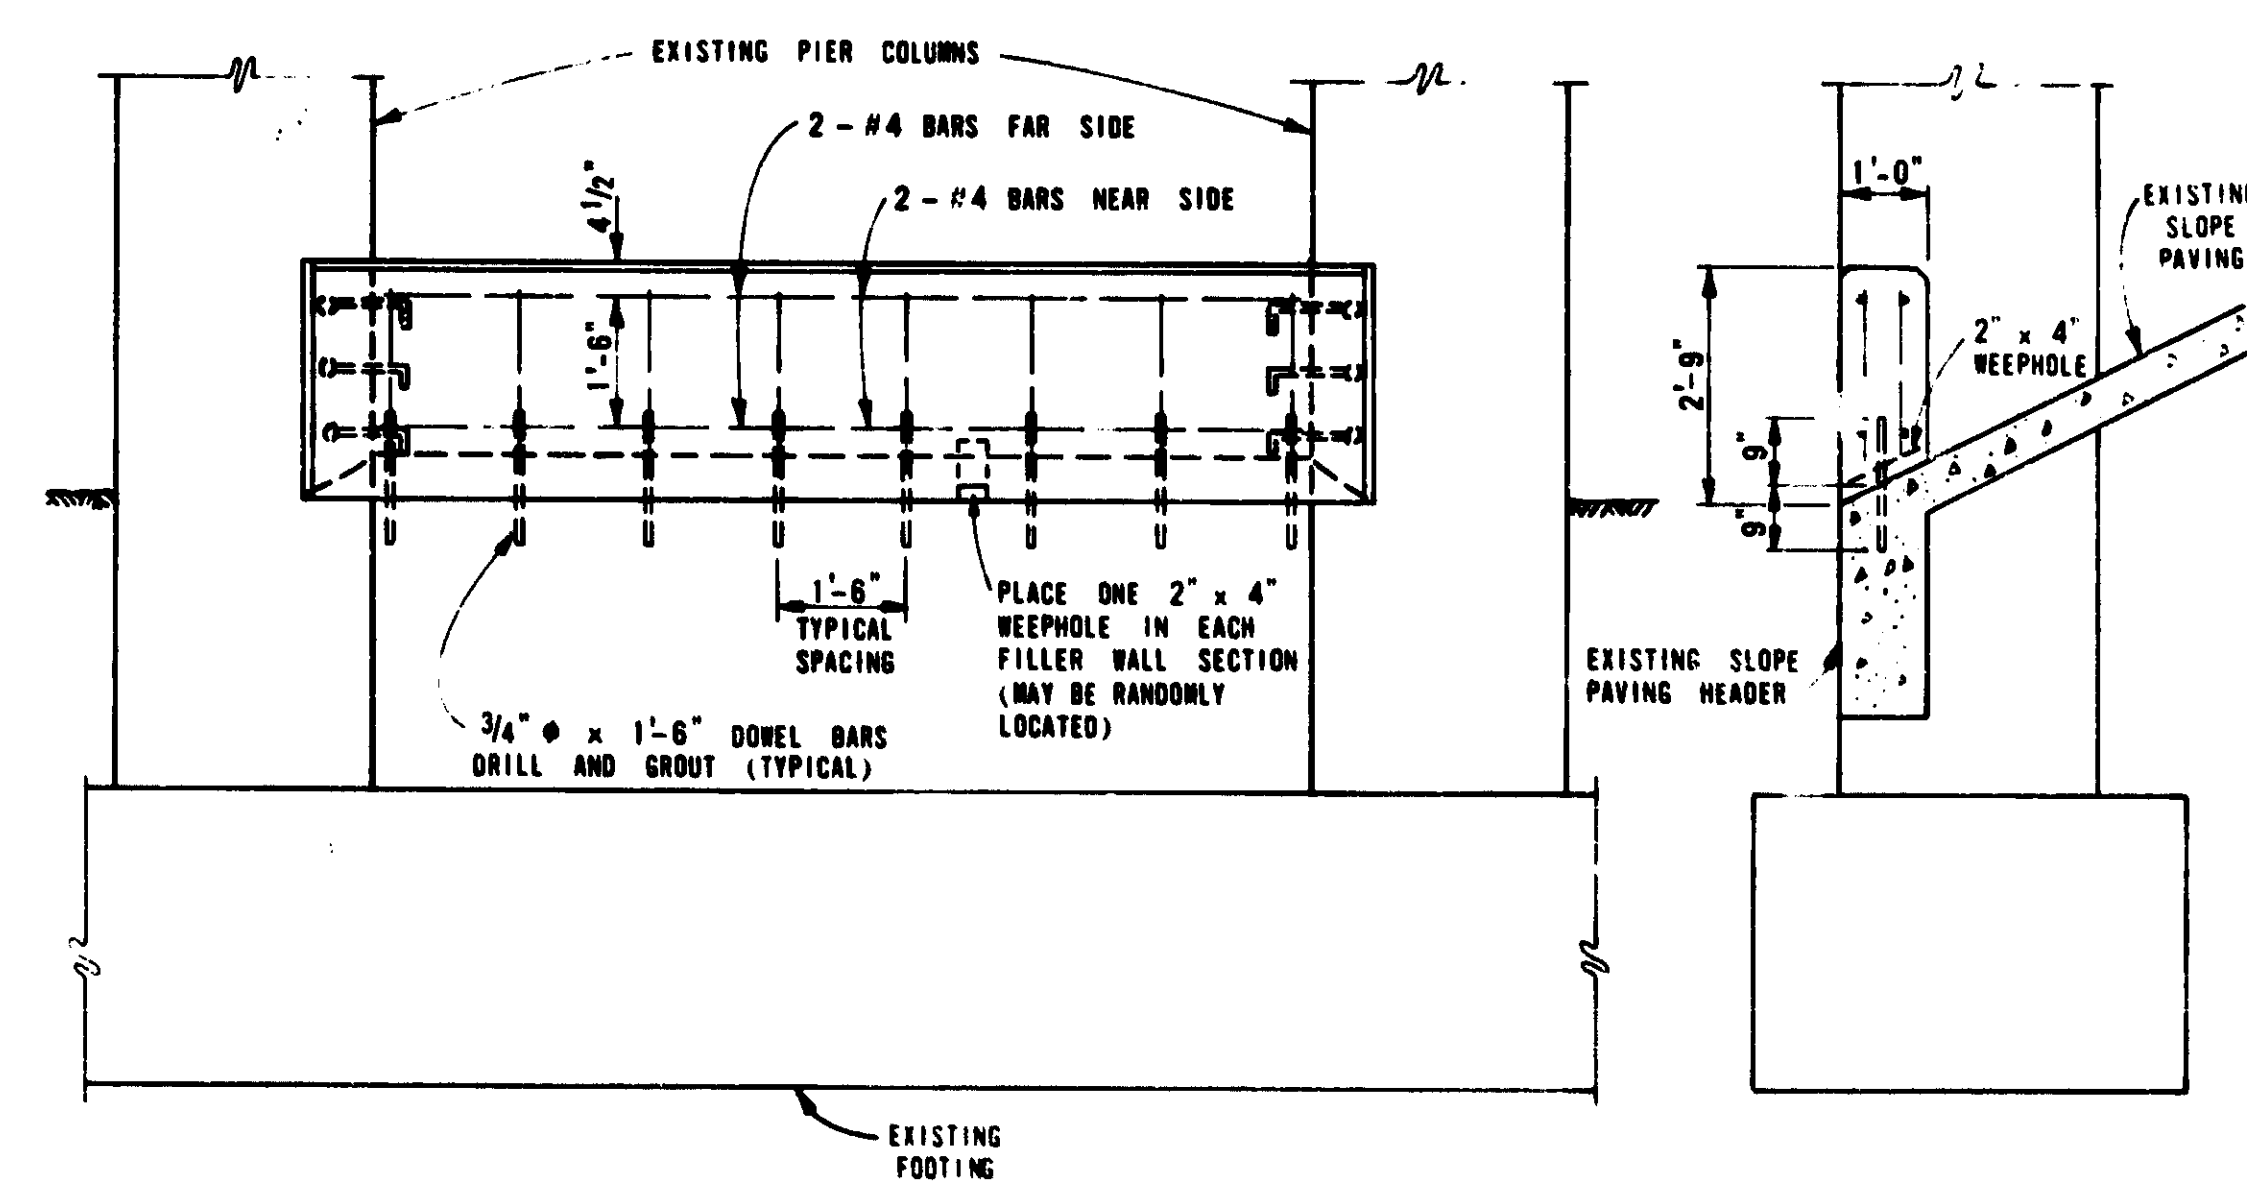

ELEVATION

SECTION

NOTES:
 GUARD RAIL ATTACHMENT TO FILLER WALLS SHALL BE AS SHOWN ON SPECIAL DETAIL 7-1.
 WHEN "NEW JERSEY" SHAPE BARRIER IS PLACED IN FRONT OF BRIDGE PIERS, SEE STANDARD PLAN B-49 SERIES.

STATE OF MICHIGAN
 DEPARTMENT OF STATE HIGHWAYS AND TRANSPORTATION
 SPECIAL DETAIL
**FILLER WALLS BETWEEN
 EXISTING BRIDGE PIERS**

APPROVALS		
CHECKED	<i>C. J. Zajac</i>	1-30-78
	ENGINEER - ROAD DESIGN	DATE
CHECKED	<i>J. P. MacFarland</i>	1/30/78
	ENGINEER - BRIDGE DESIGN	DATE
RECOMMENDED FOR APPROVAL	ENGINEER OF DESIGN	DATE
RECOMMENDED FOR APPROVAL	<i>J. P. MacFarland</i>	2-24-78
	ENGINEER OF TRAFFIC AND SAFETY	DATE
RECOMMENDED FOR APPROVAL	<i>W. S. L. Frame</i>	3-27-78
	ENGINEER OF CONSTRUCTION	DATE


DEPARTMENT OF STATE HIGHWAYS AND TRANSPORTATION
 JOHN P. WOODFORD - DIRECTOR

BY *S. G. C. Carty* 3/27/78
 DEPUTY DIRECTOR - HIGHWAYS DATE


DRAWN	CHECKED	REVISOR	DATE
BY	BY	BY	2-9-78
PREPARED BY	APPROVED	SPECIAL DETAIL 5	
DESIGN DIVISION	F. H. W. A.	DATE	

CONTROL SECTION 15 63174 JOB NO 14165 175-2(222)59 10


F.H.W.A. REG. NO.	STATE	FEDERAL PROJECT	R.O.W. NO.	SHEET NO.	TOTAL SHEETS
5	MICH.	175-2(222)59		11	96
ROUTE	COUNTY	CONTRACT SECTION	JOB NO.		
1-25	Oakland	63174	14165		

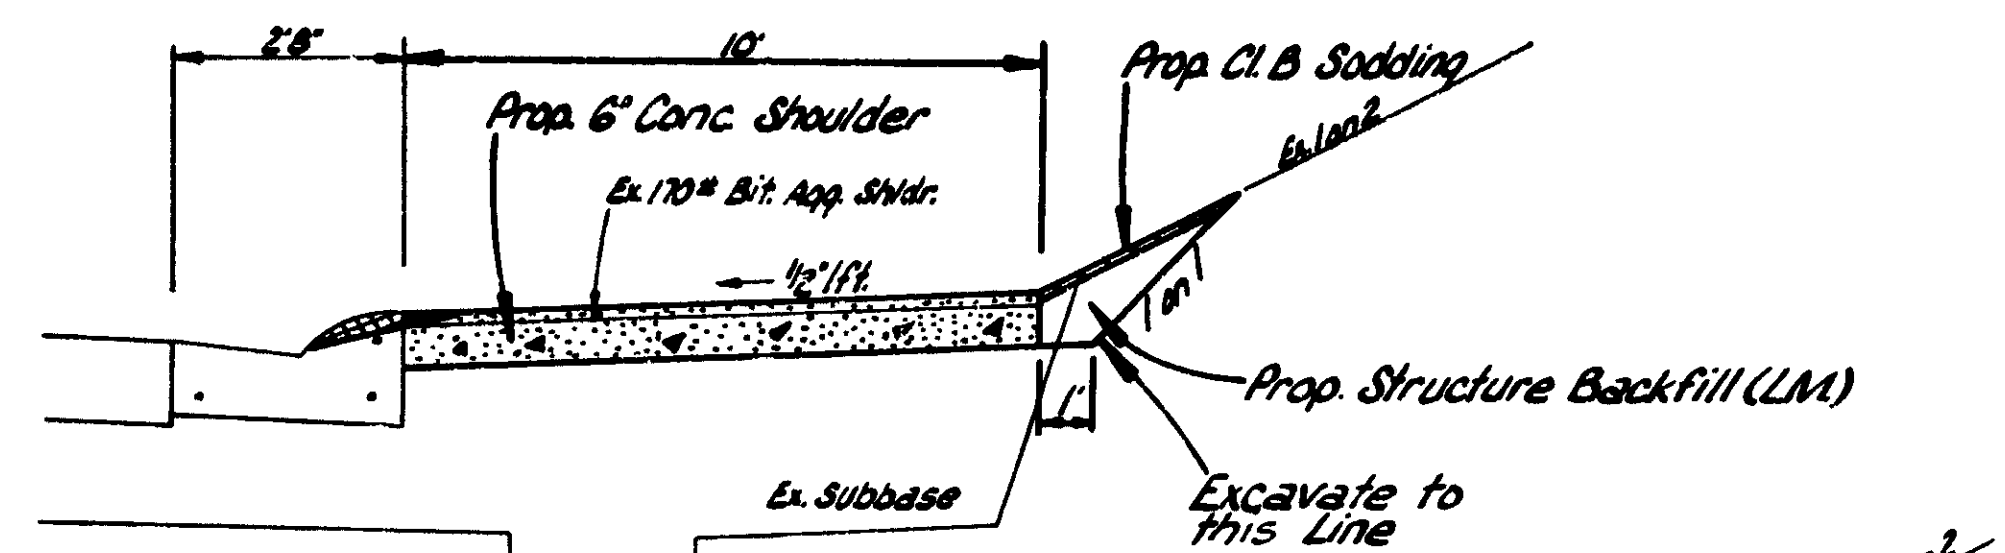


SECTION A-A
(No Scale)

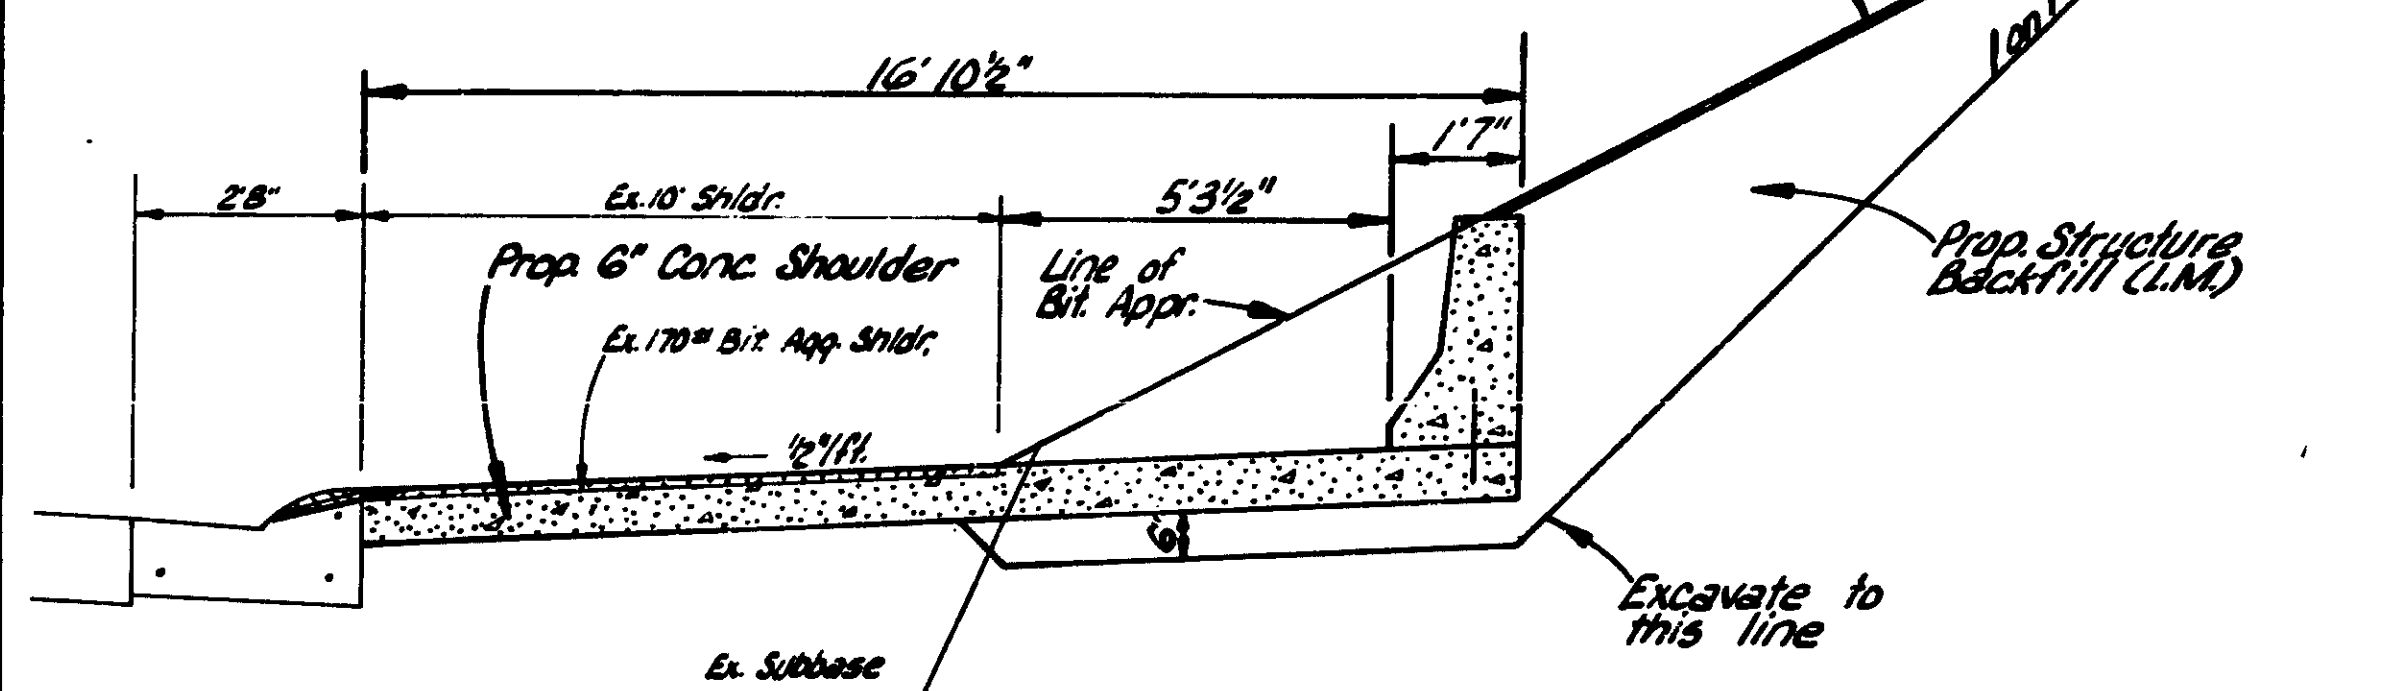


SECTION B-B
(No Scale)

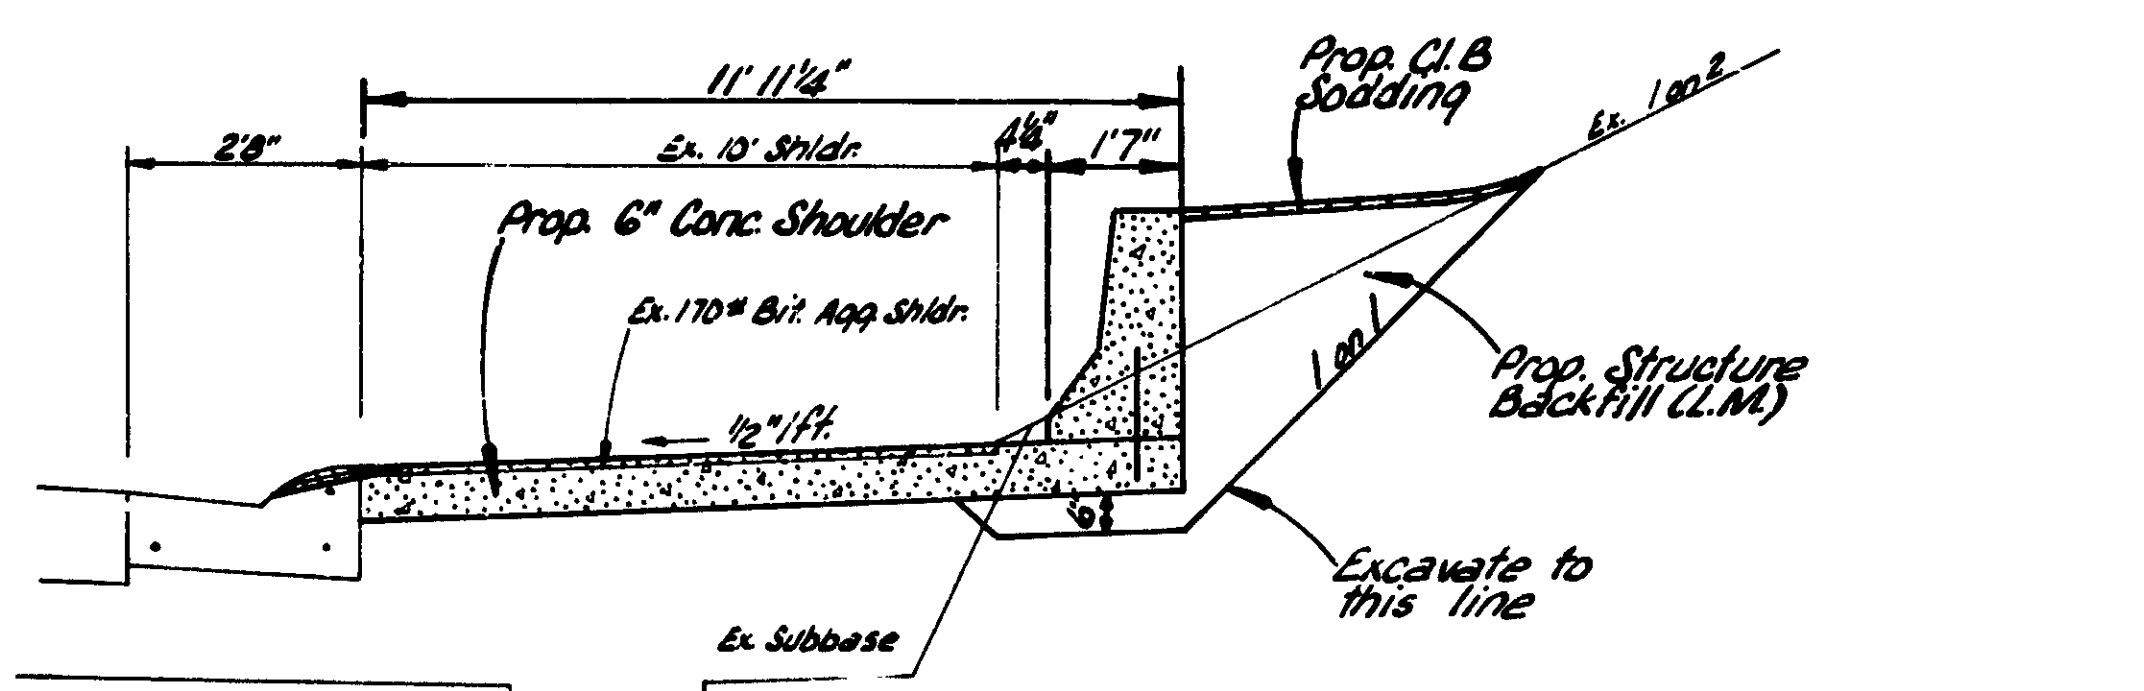

SECTION C-C
(No Scale)

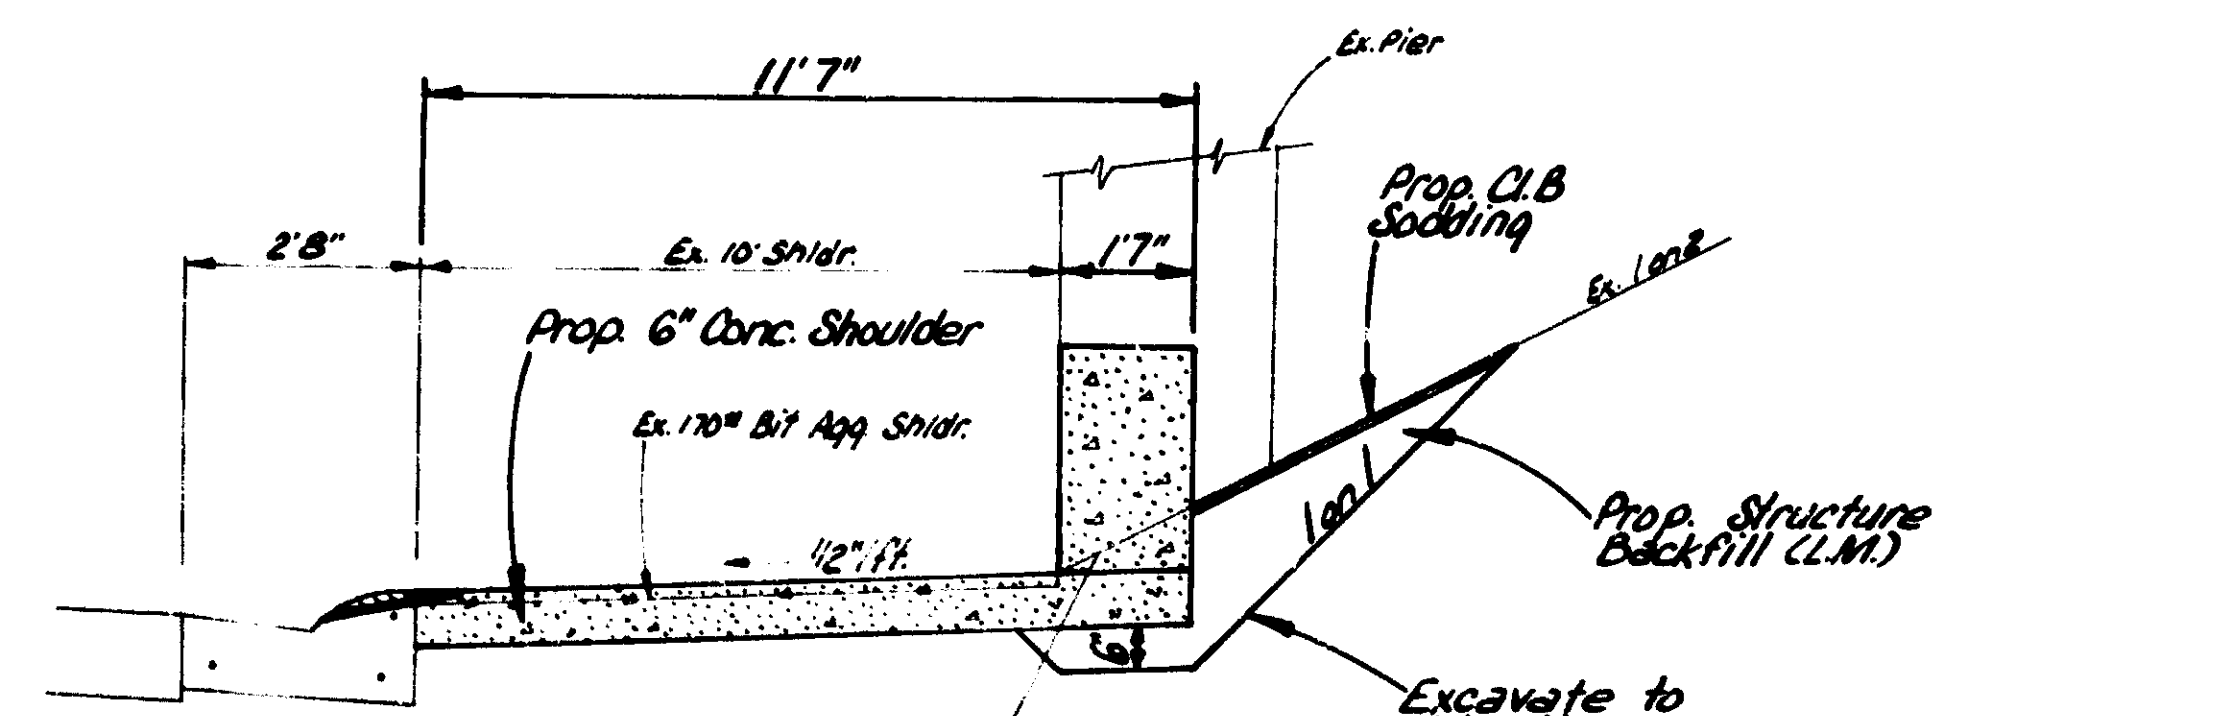

SECTION D-D
(No Scale)

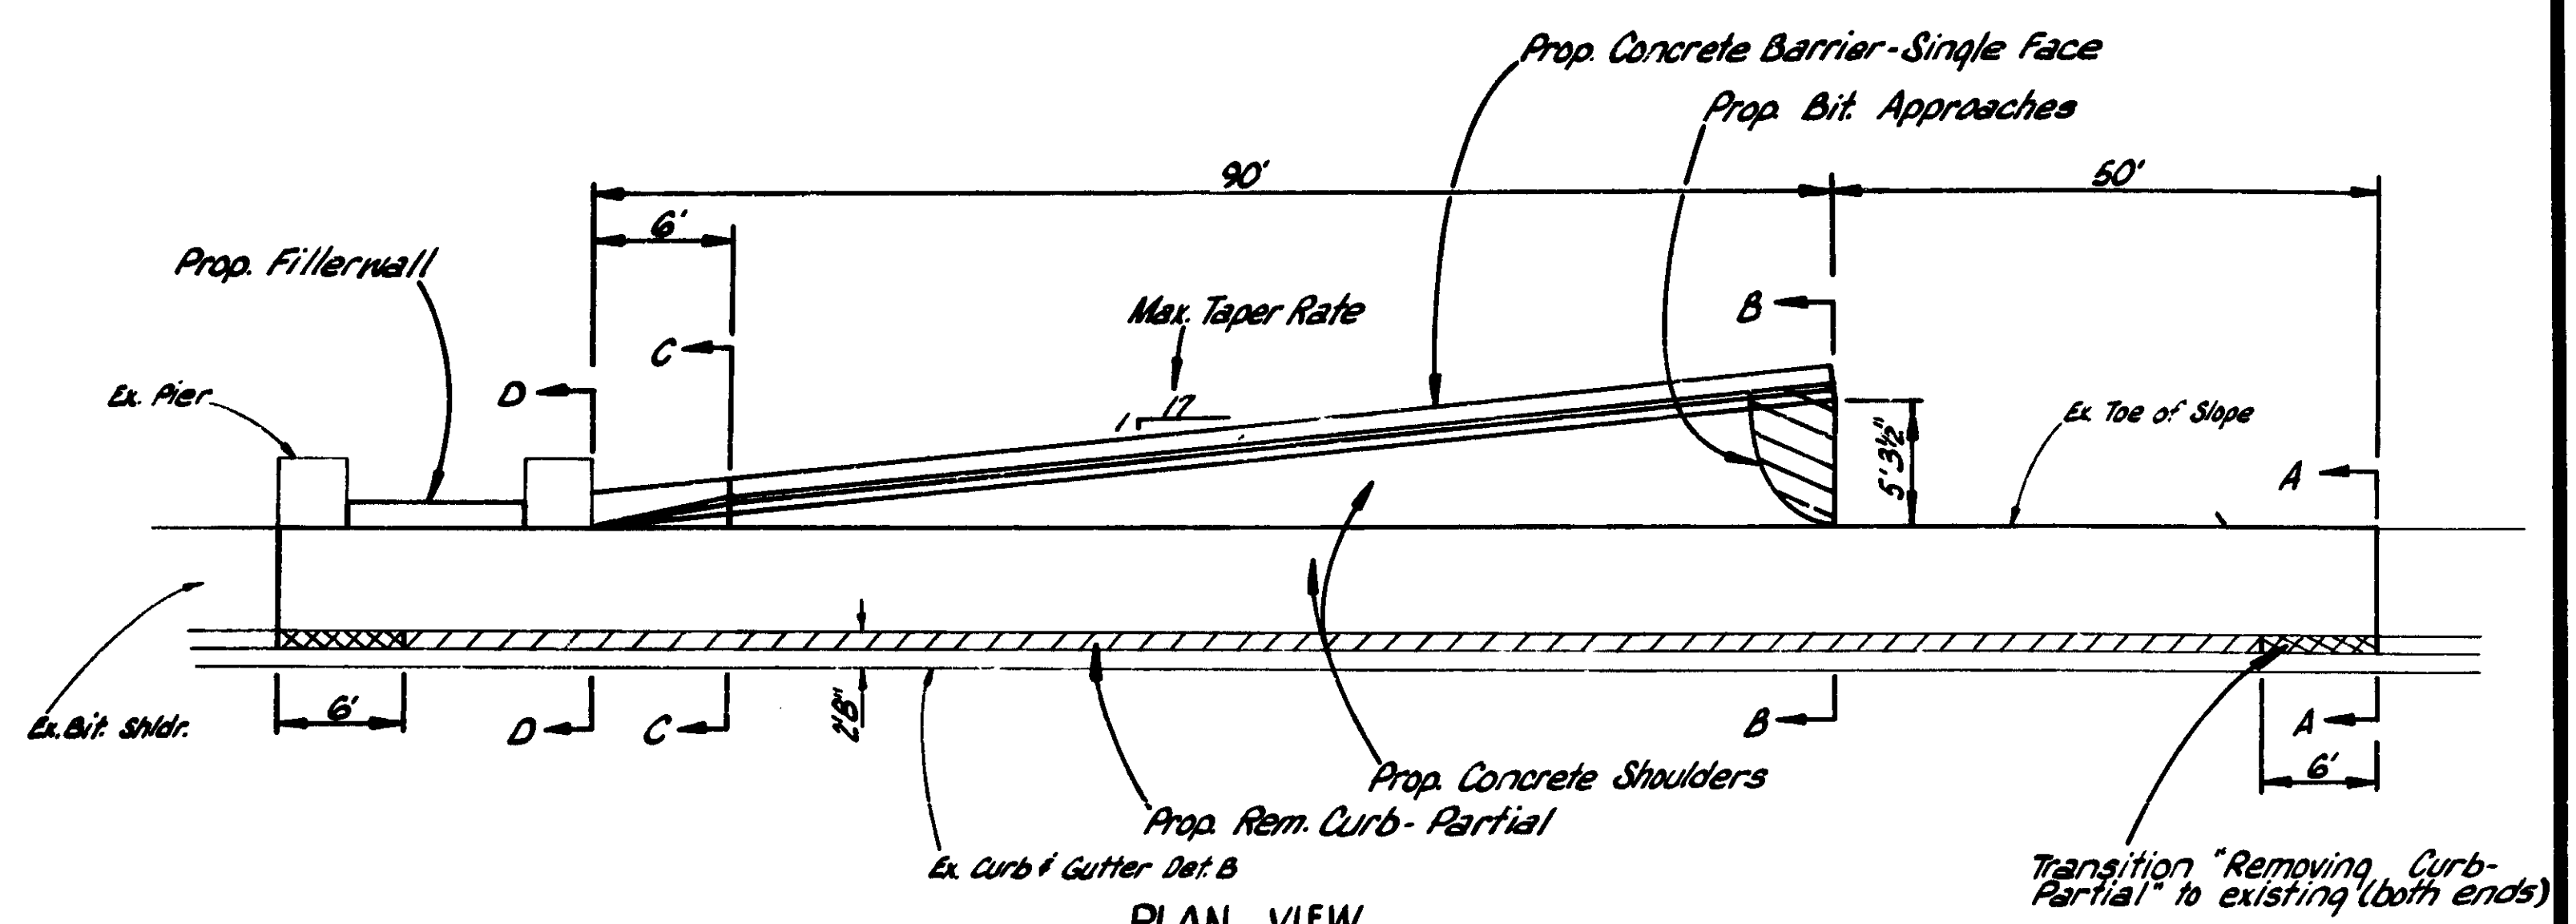



PLAN VIEW
No Scale

NOTES:
 See Special Detail II-54A for cross-section of barrier, location of steel and location of joints.
 See TYPICAL CROSS-SECTION sheet for detail of "Removing Curb-Partial".
 The necessary excavation to install the barrier and shoulders shall be incidental to "Concrete Shoulders".
 "Bituminous Approaches" shall be incidental to "Concrete Barrier-Single Face".


SPECIAL DETAIL
 FOR
 CONCRETE BARRIER-SINGLE FACE

Drawn by K. Claus
 Scaled P.M. Christy


175 63174	14165	175-2(222)59	11	96
-----------	-------	--------------	----	----

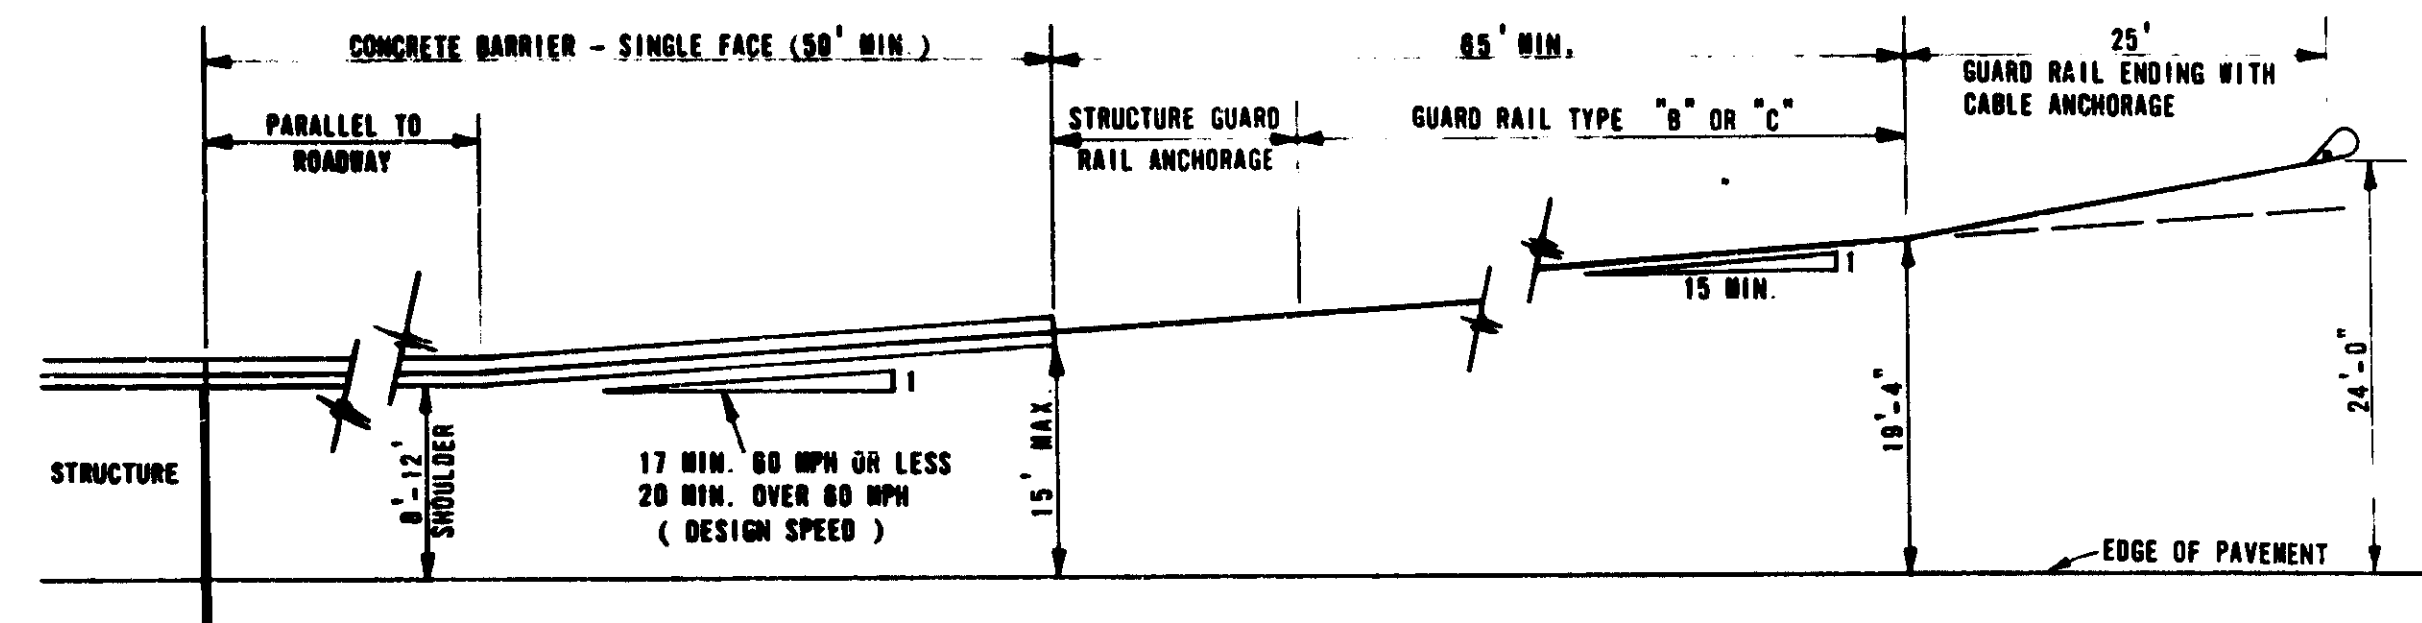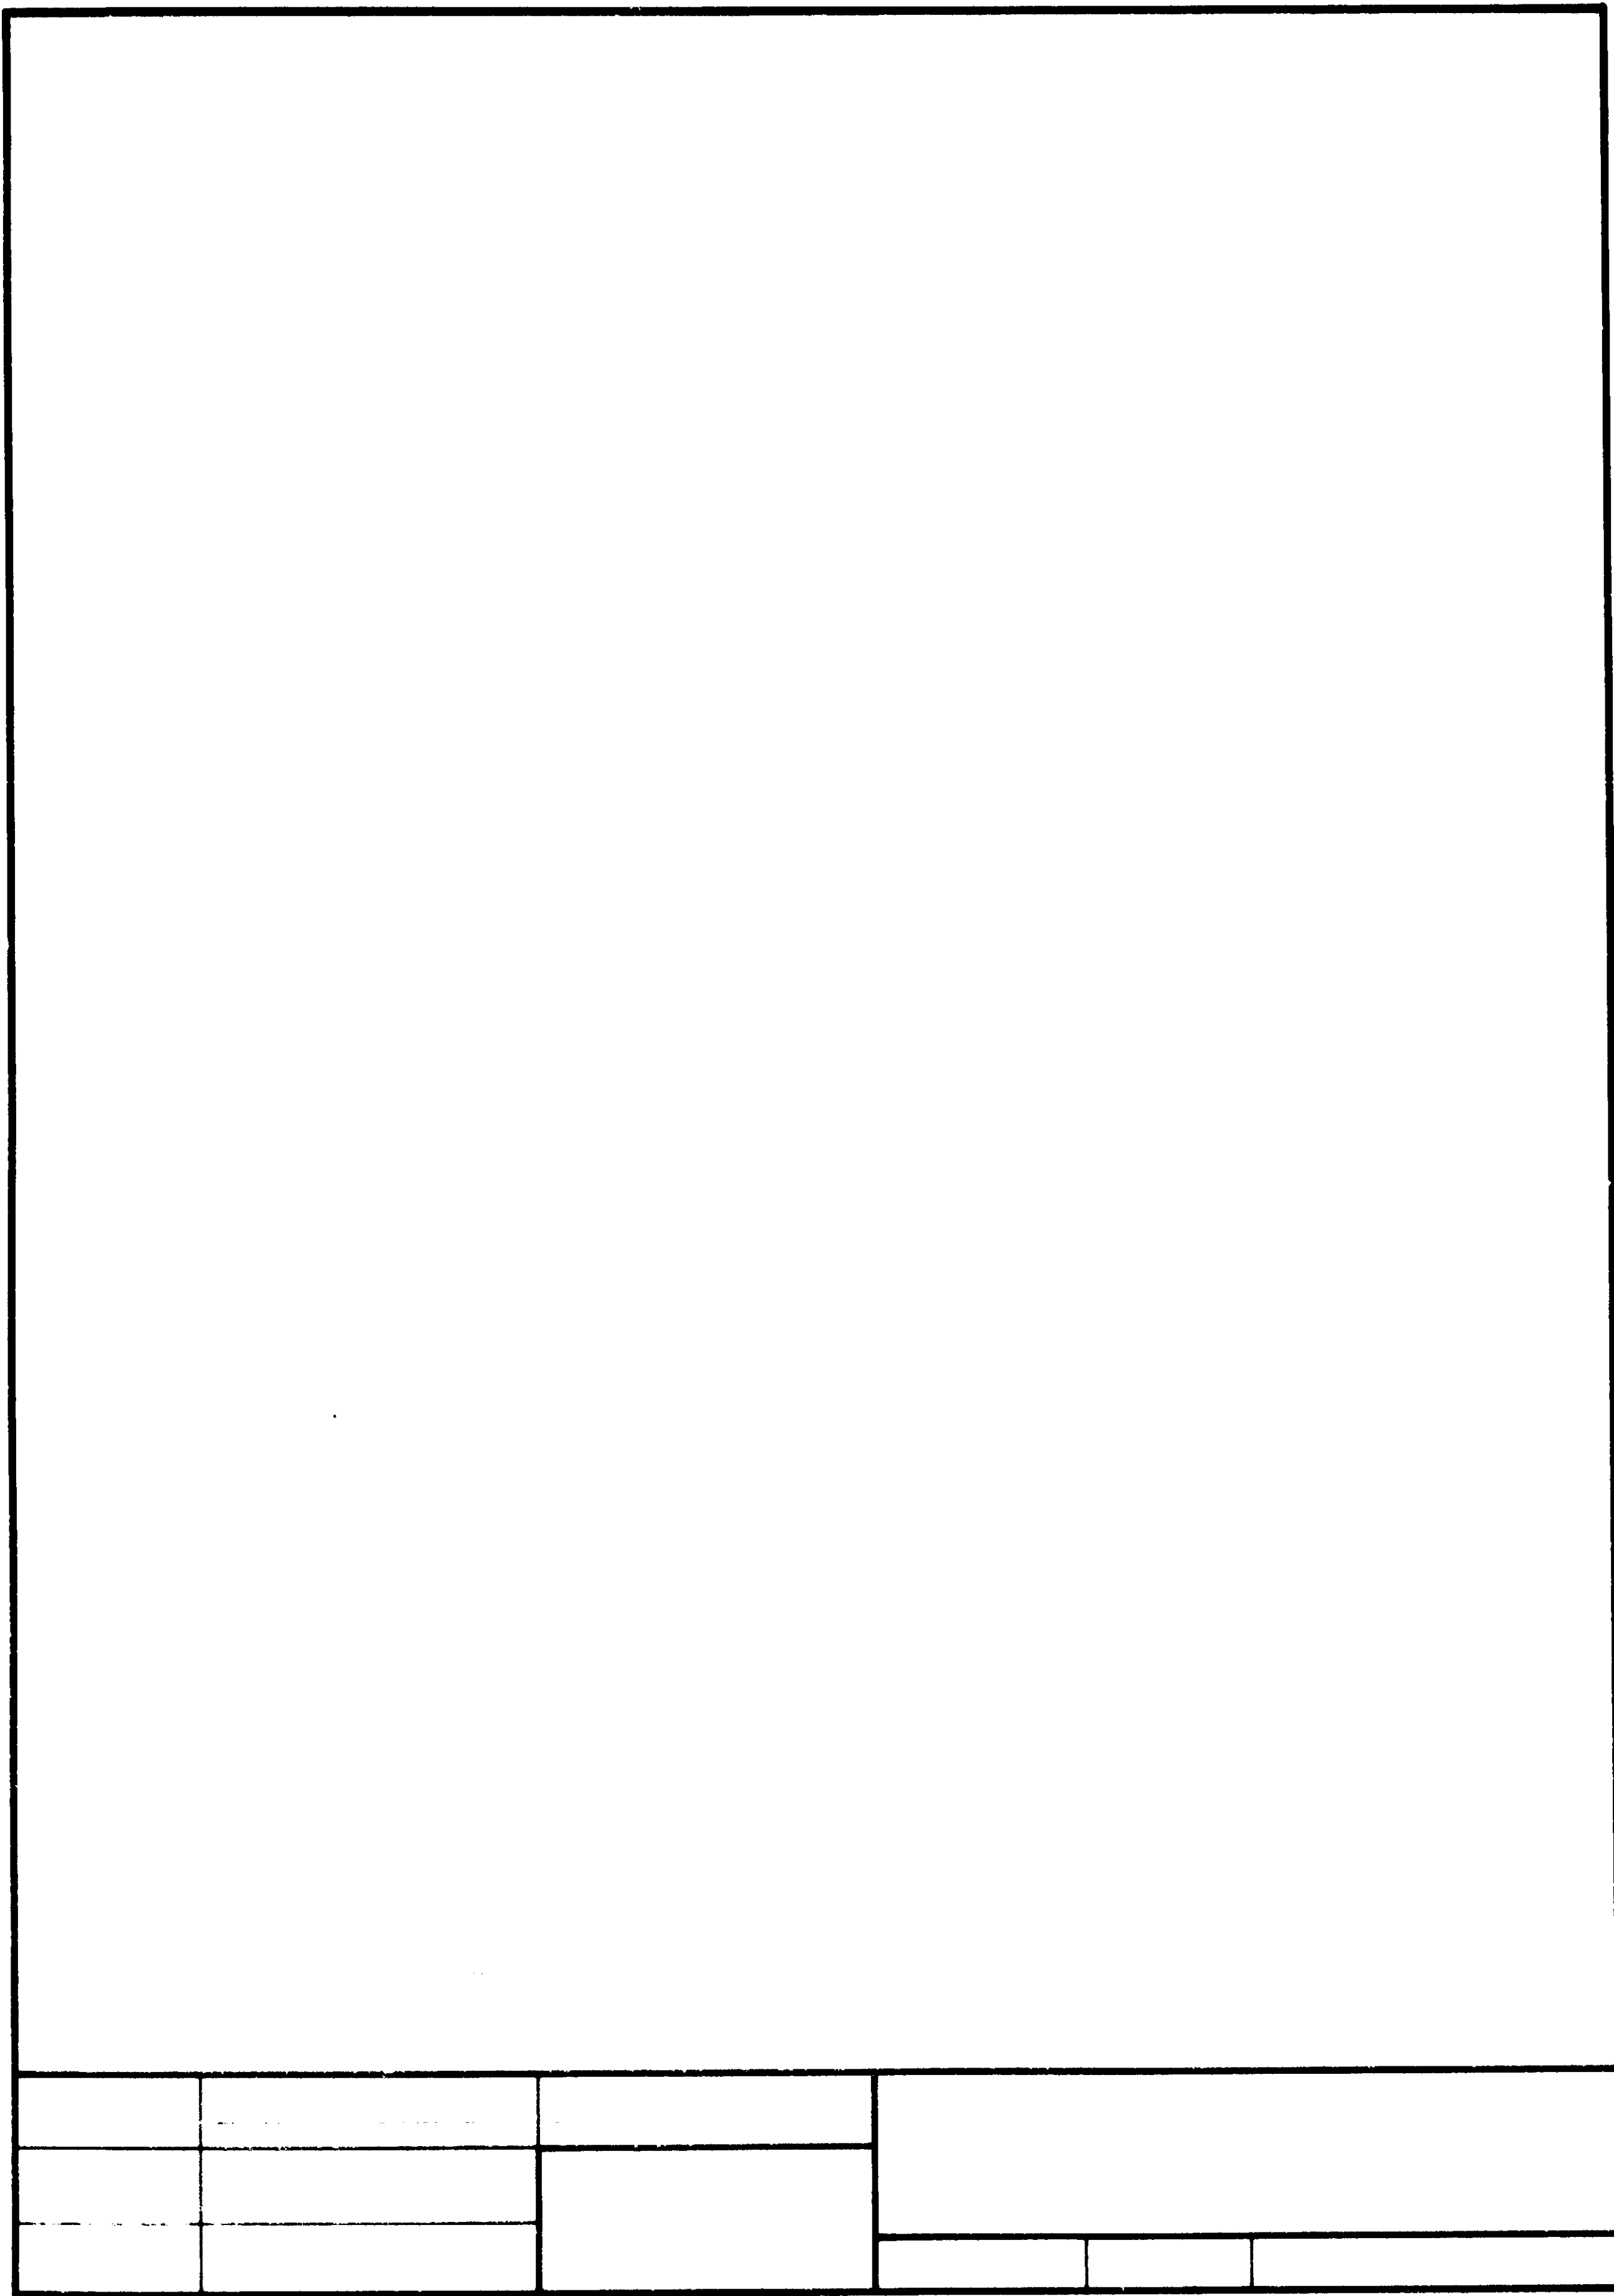

CONCRETE BARRIER - SINGLE FACE WITH GUARD RAIL ENDING

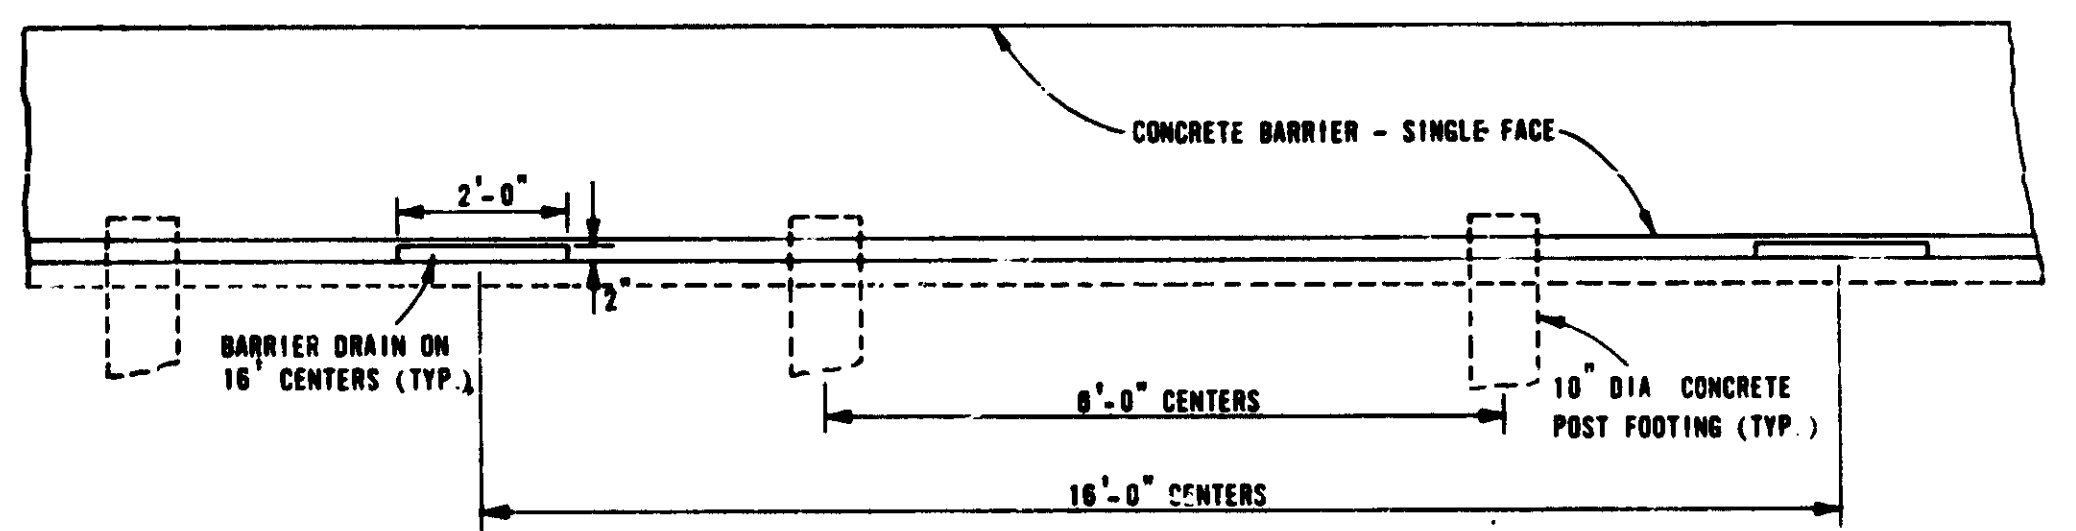

SECTION SHOWING BARRIER DRAIN

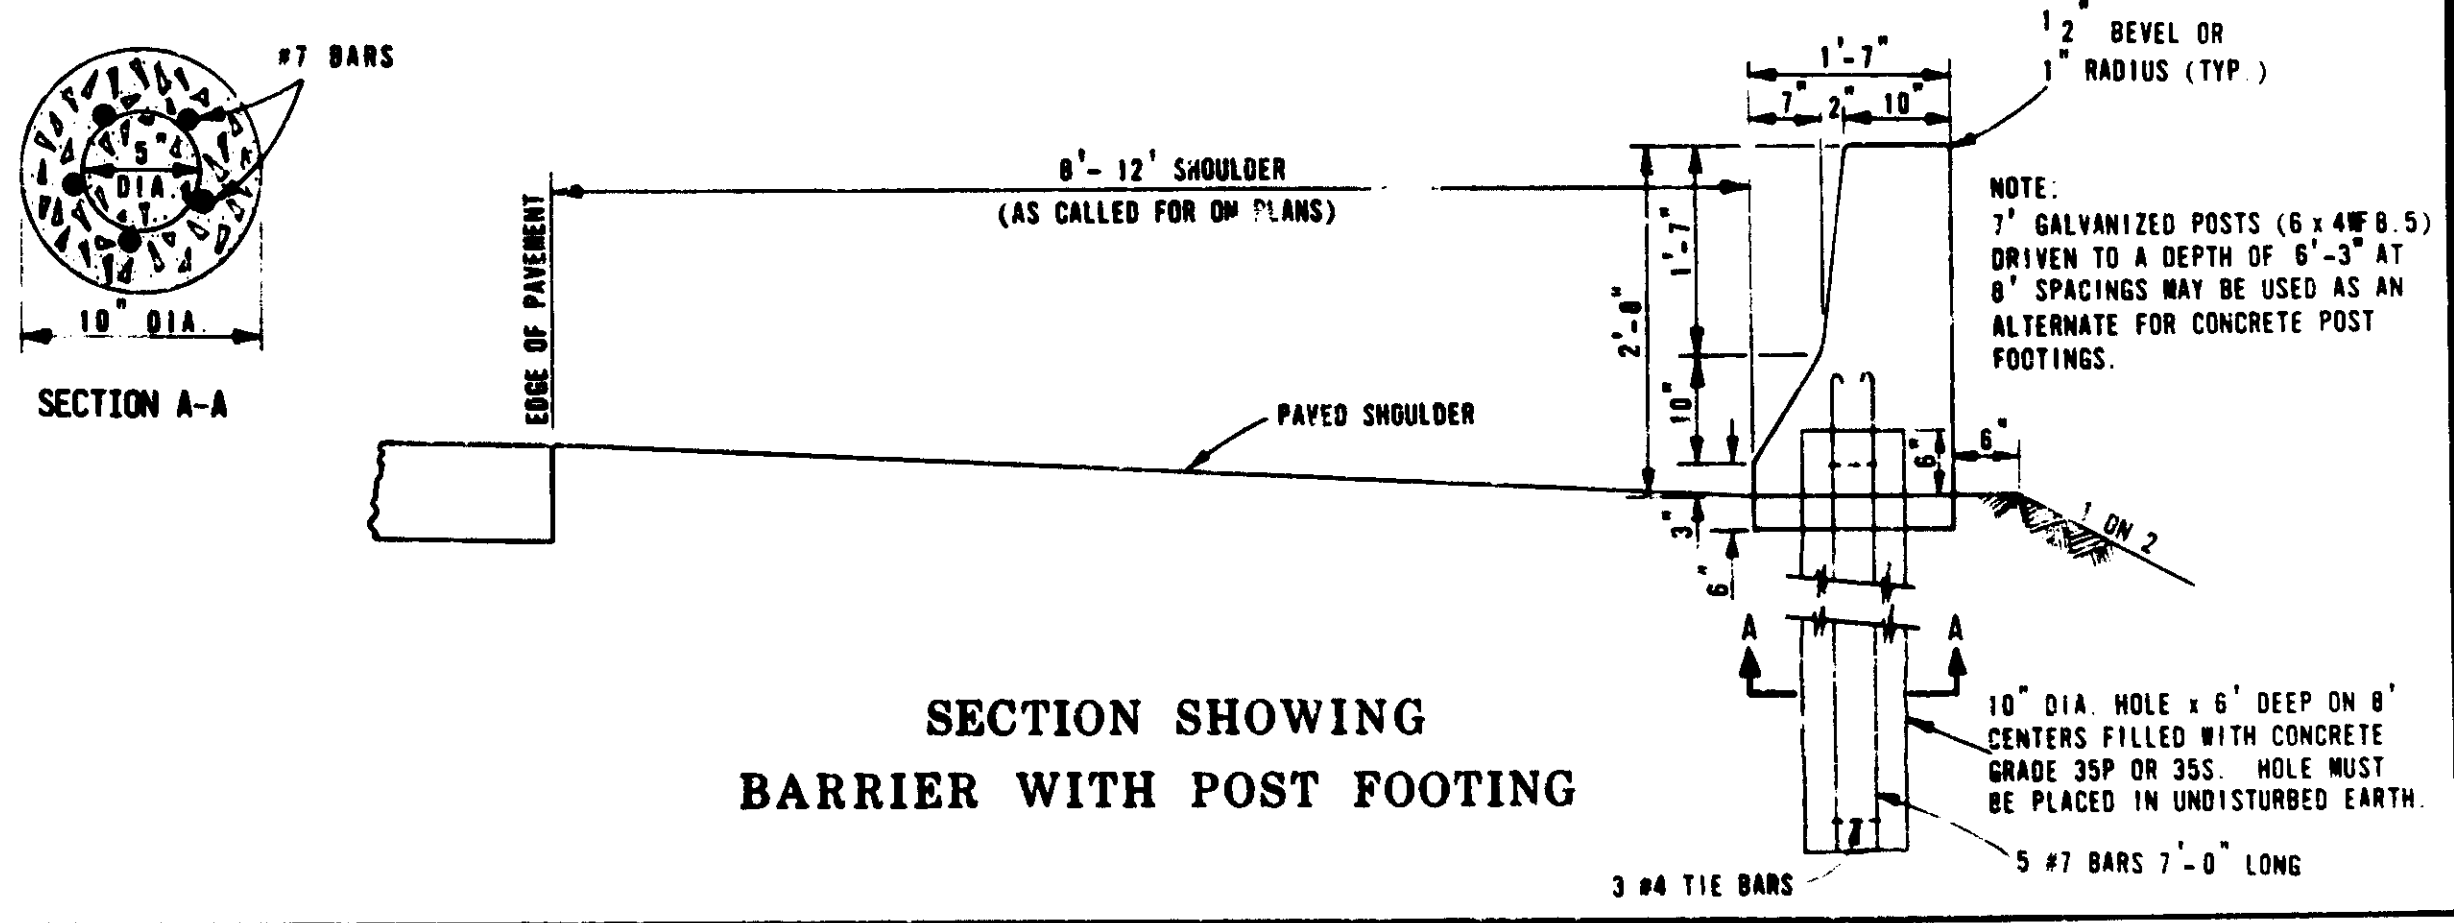

SECTION SHOWING BARRIER WITH POST FOOTING


NOTES:
 PLACE 1" EXPANSION JOINTS IN BARRIER AT 400' INTERVALS. ALSO, PLACE 1" EXPANSION JOINTS AT BEGINNING OF SECTIONS AT STRUCTURES (INCLUDING SIGN SUPPORTS, LIGHT STANDARD FOUNDATIONS, BRIDGE PIERS, OR ANY STRUCTURE WITH A FOUNDATION) AND AT THE P.C. AND P.T. OF CURVED BARRIER WHEN THE CURVE IS SHARPER THAN 2°30'. LOCATION OF EXPANSION JOINTS SHOULD BE ADJUSTED TO MATCH EXPANSION JOINTS IN SHOULDER. PLANE OF WEARNESS JOINT SPACING SHALL BE 20'-0" MAXIMUM AND 12'-0" MINIMUM. IF THE BARRIER IS ON A CONCRETE SHOULDER, PLANE OF WEARNESS JOINT SPACING SHALL COINCIDE WITH THAT IN THE SHOULDER.

PLANE OF WEARNESS JOINTS IN BARRIER SHALL BE TO A DEPTH OF AT LEAST 4" AND SHALL BE EDGED.


BARRIER SHALL BE ENDED BY BURYING IN SIDE SLOPE (DEPRESSED ROADWAY), AND BY GUARD RAIL ENDING WITH CABLE ANCHORAGE (FILL AREAS) IN ACCORDANCE WITH CURRENT STANDARD PLAN III-58 SERIES.

STRUCTURE GUARD RAIL ANCHORAGE SEE STANDARD PLAN III-67 SERIES.



PREPARED BY DESIGN DIVISION	<i>C. J. Zajac</i> ENGINEER - ROAD DESIGN	<i>John P. Woodford</i> ENGINEER OF DESIGN	MICHIGAN DEPARTMENT OF STATE HIGHWAYS AND TRANSPORTATION STANDARD PLAN FOR
DRAWN BY D.F.W.	ENGINEER OF TRAFFIC AND SAFETY	DEPARTMENT DIRECTOR JOHN P. WOODFORD	CONCRETE BARRIER - SINGLE FACE (FILL AREAS)
CHECKED BY V.R.	ENGINEER OF CONSTRUCTION	DEPUTY DIRECTOR - HIGHWAYS	F.H.D.A. APPROVAL DATE: 4-10-78 PLAN DATE: II-54A
			SHEET 1 OF 3 CONTRACT NO. 1563174 JOB NO. 14165 REVISION NO. 5222259 DATE 12

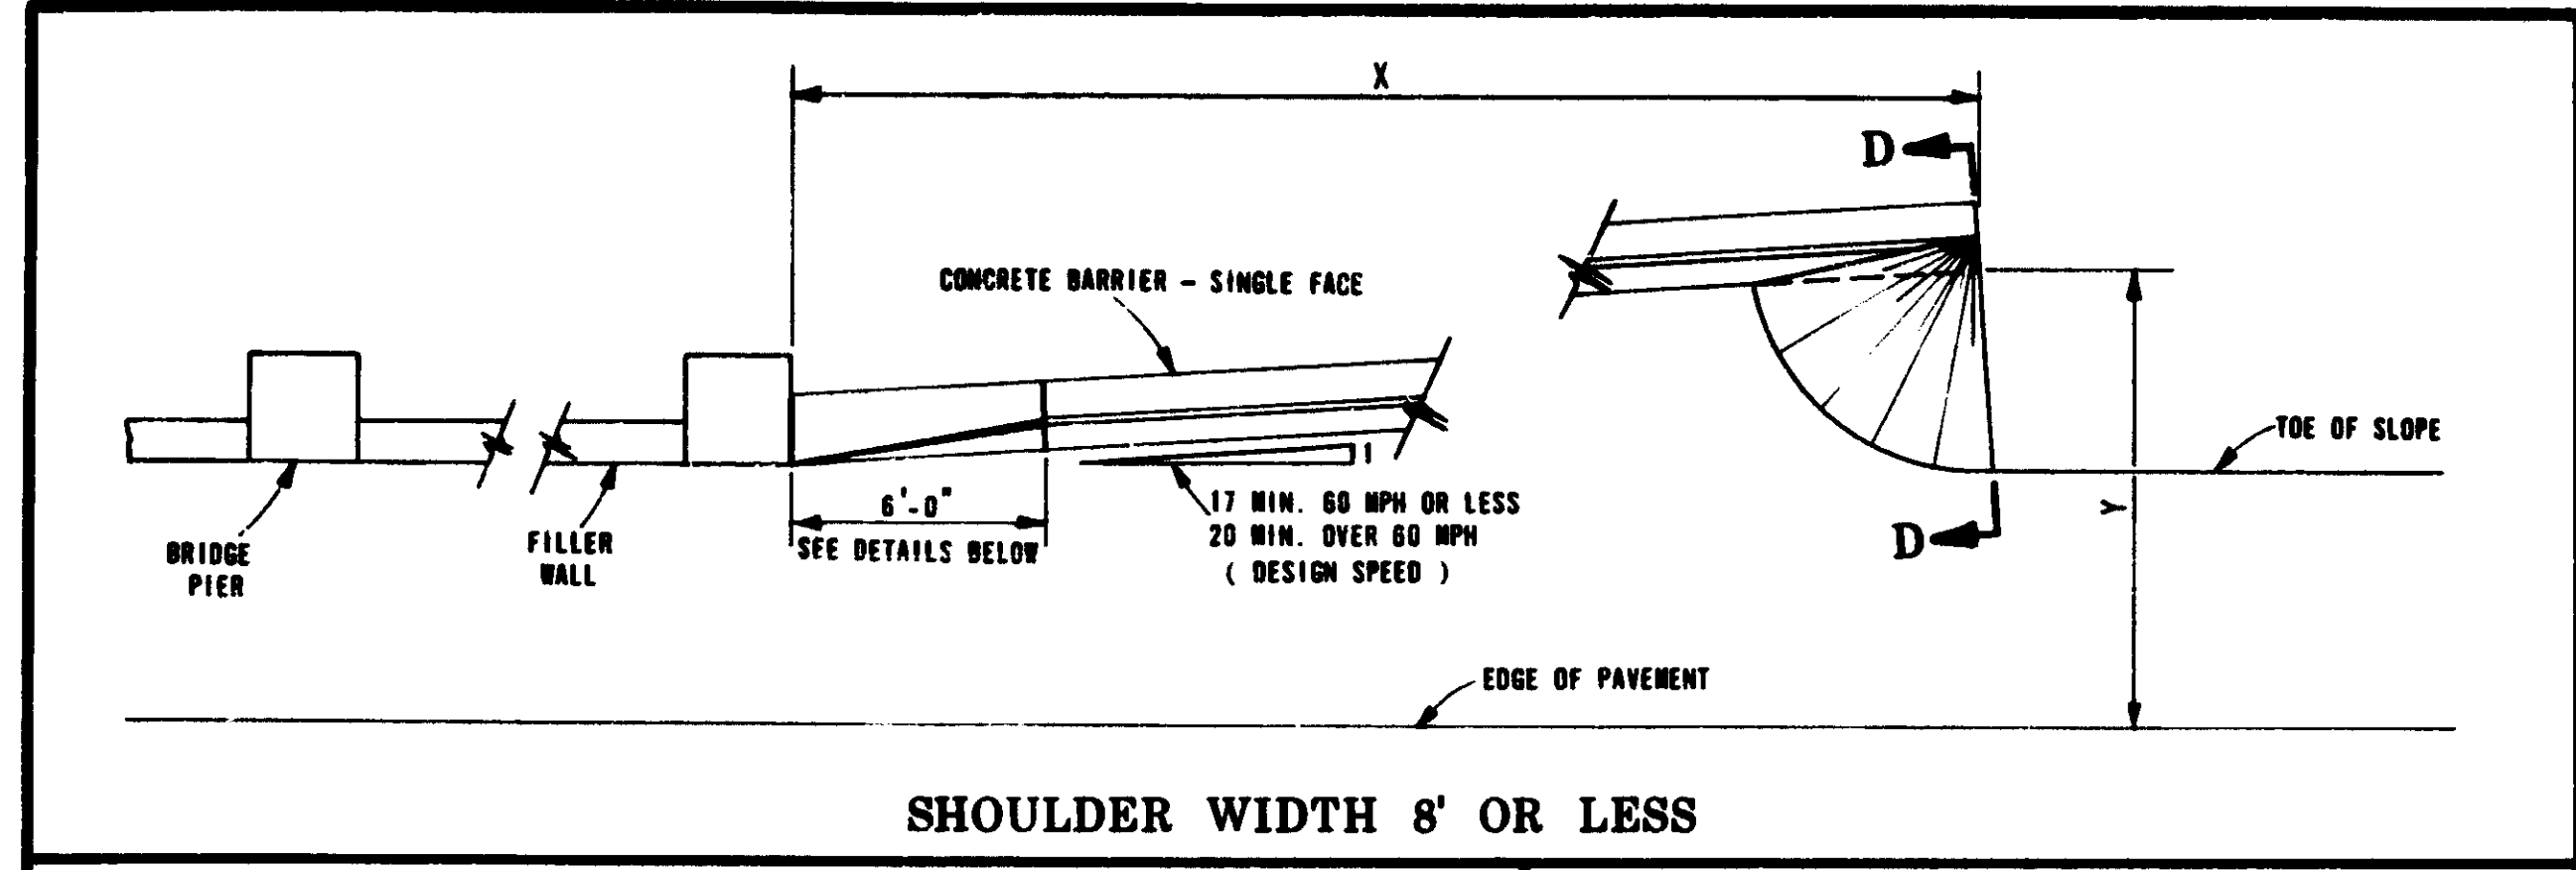

SHOULDER WIDTH 8' OR LESS

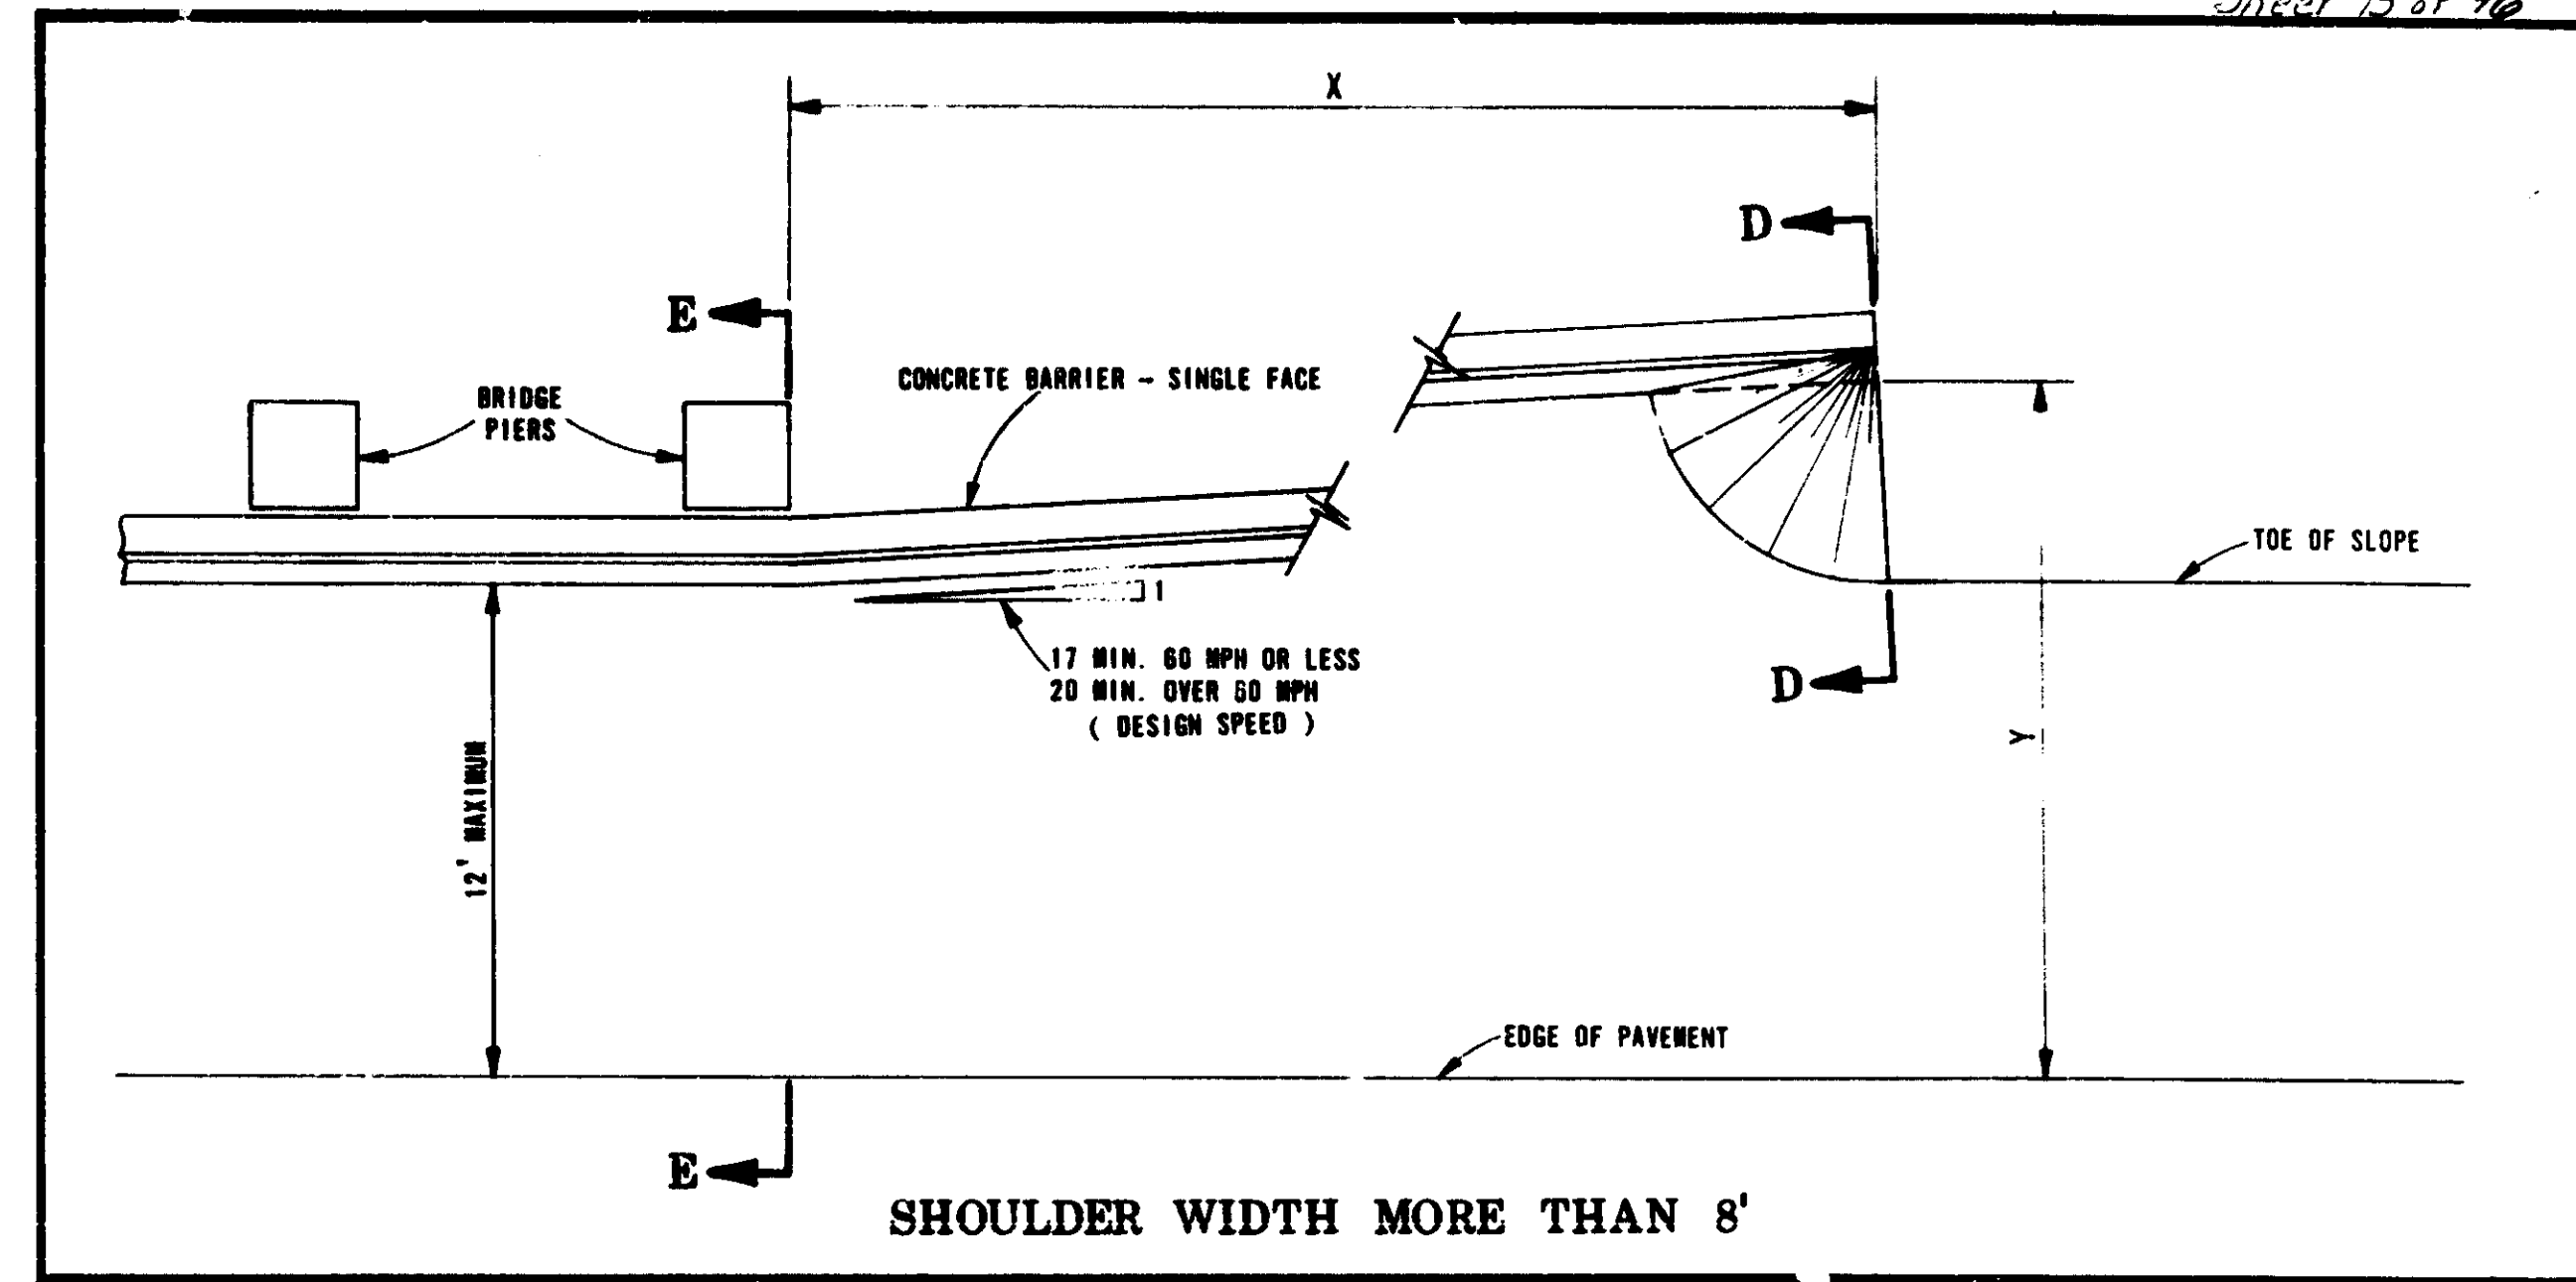


SHOULDER WIDTH MORE THAN 8'

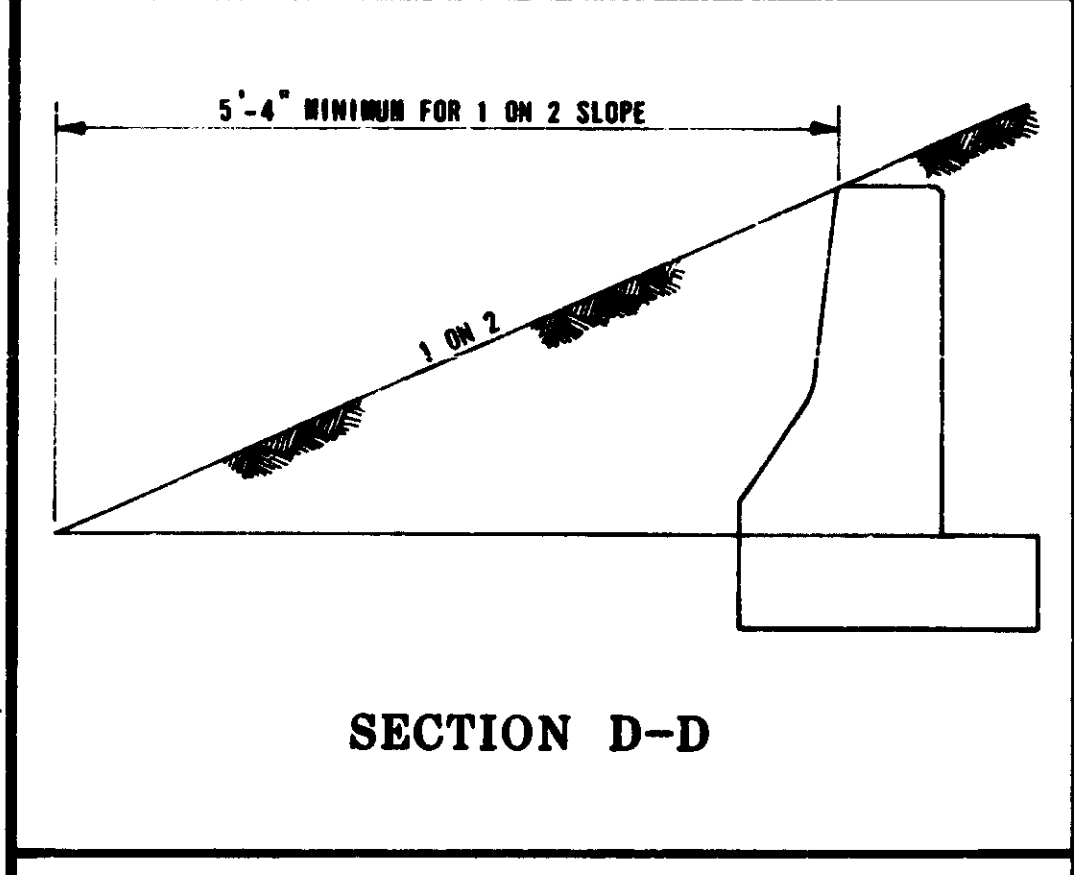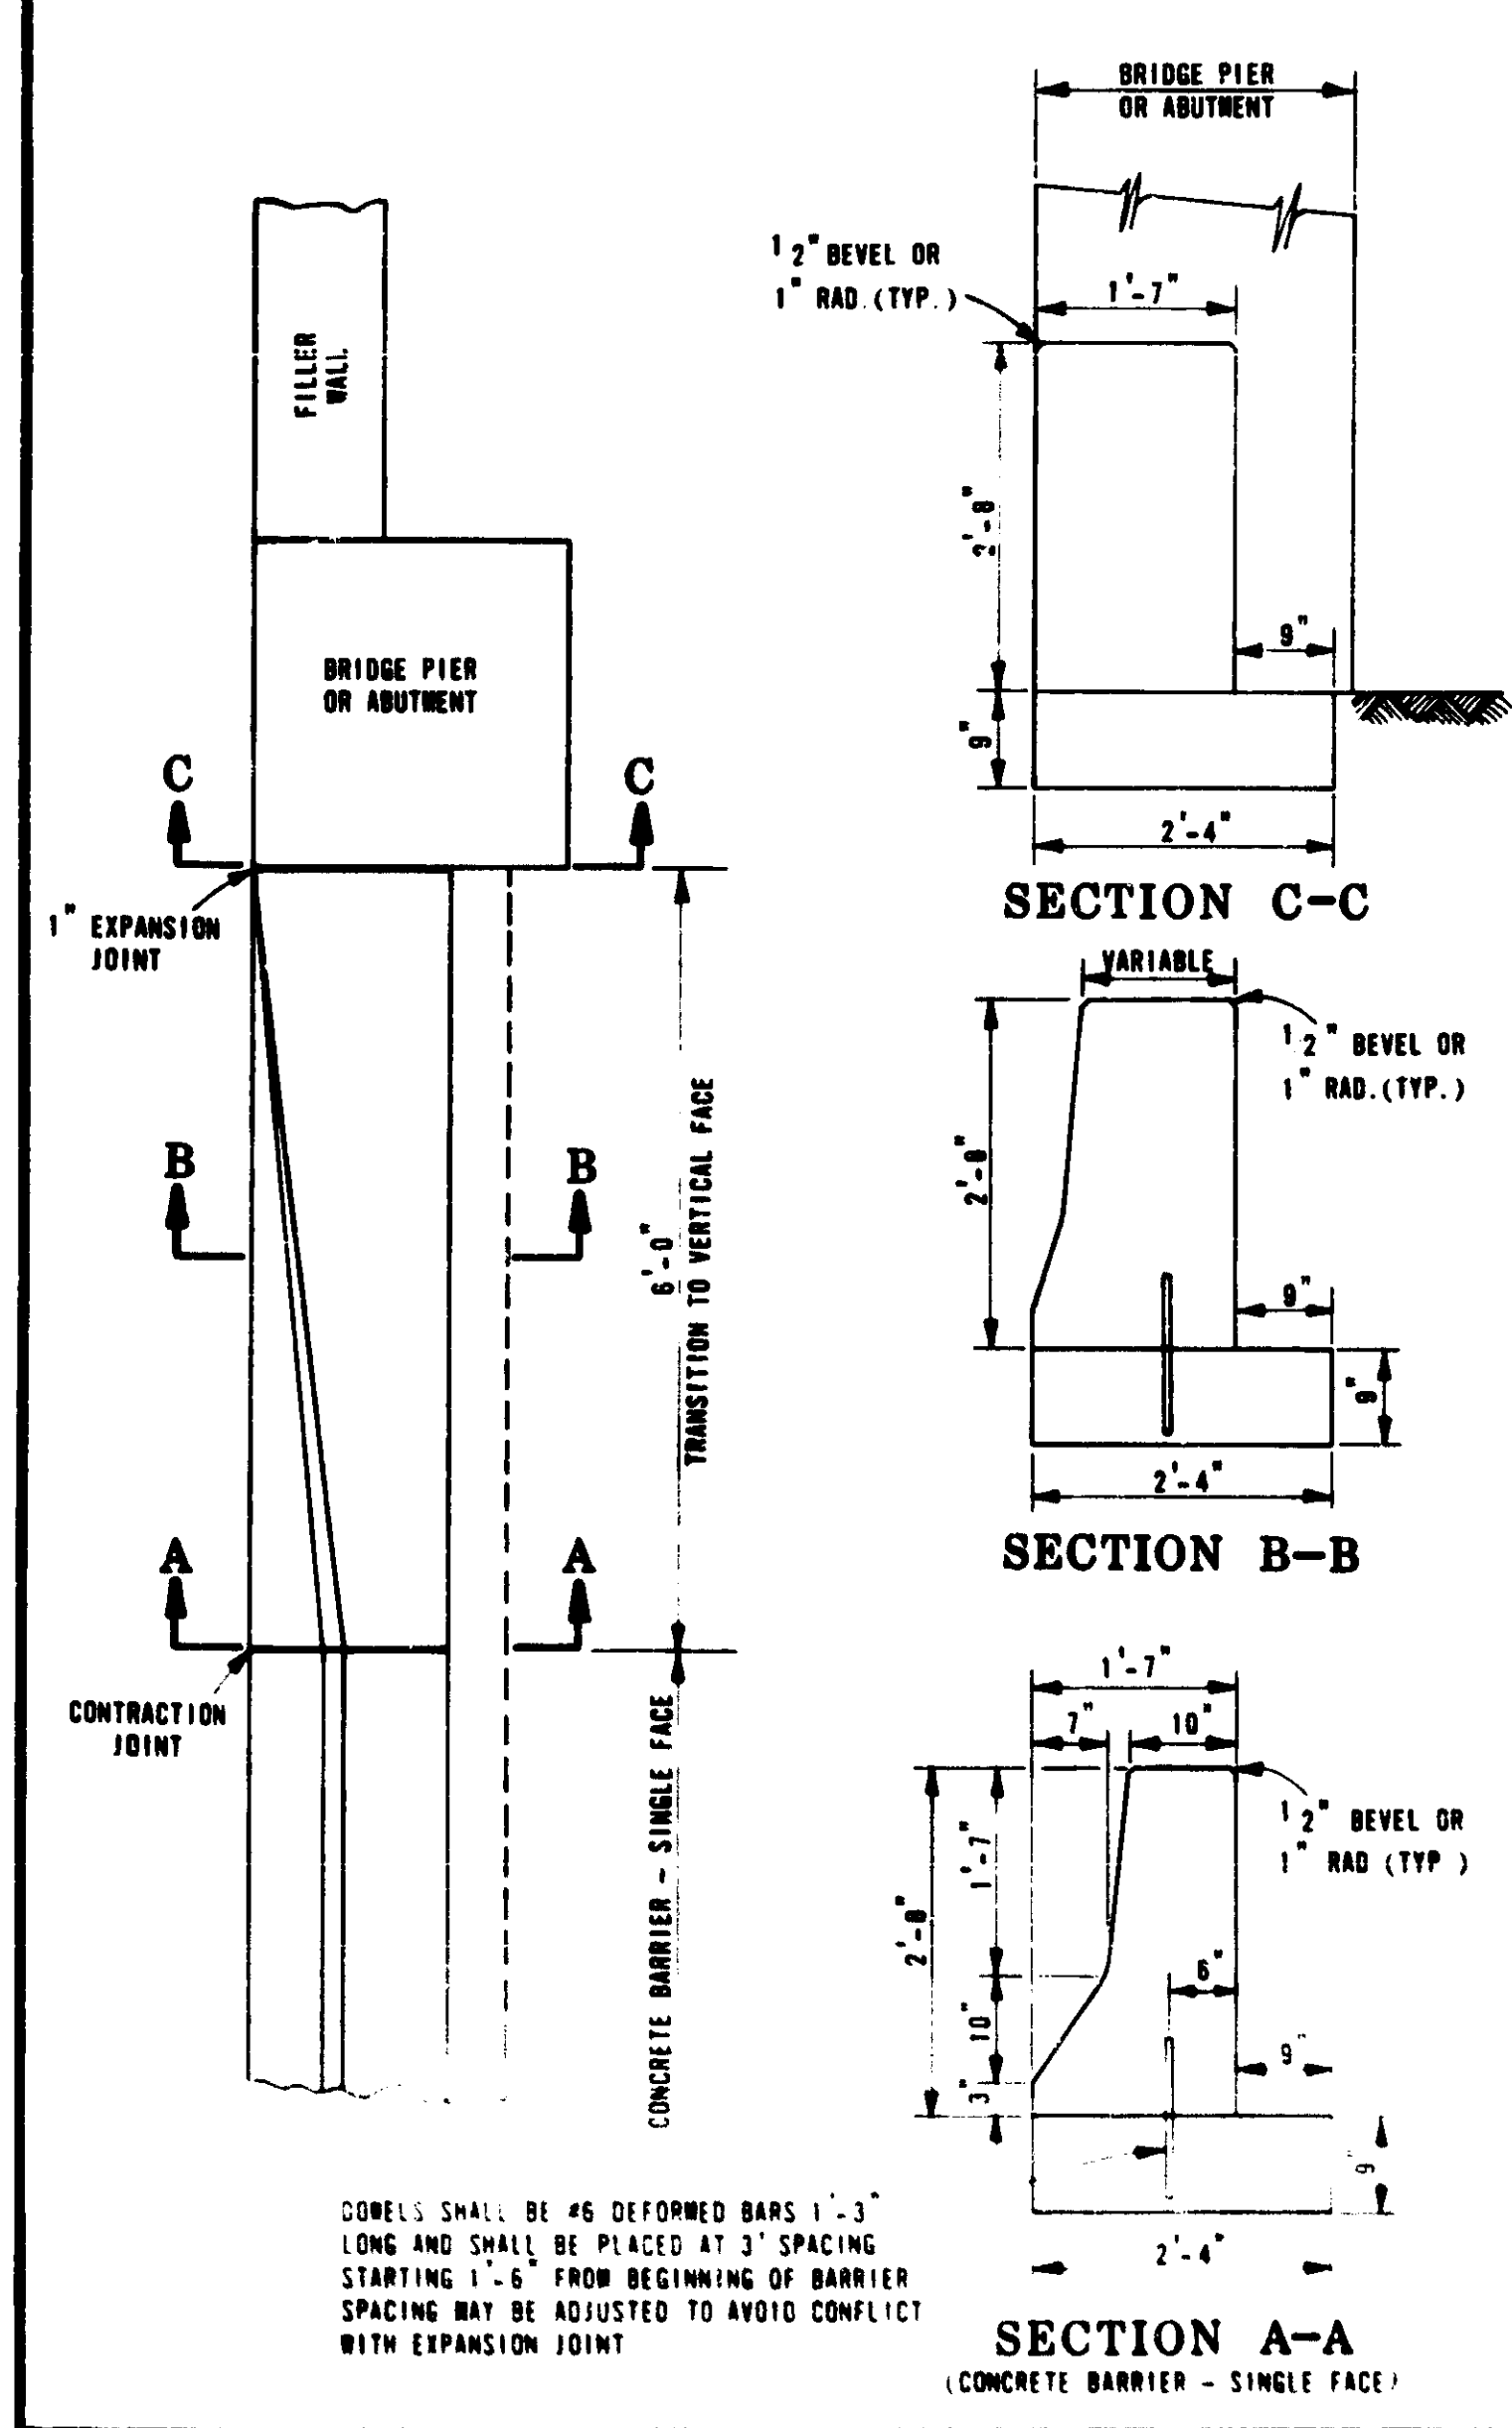

SECTION D-D

SHOULDER WIDTH	MIN LENGTH X	MIN OFFSET Y
6'	170'	11.3'
8'	130'	13.3'
10'	90'	15.3'
12'	90'	17.3'

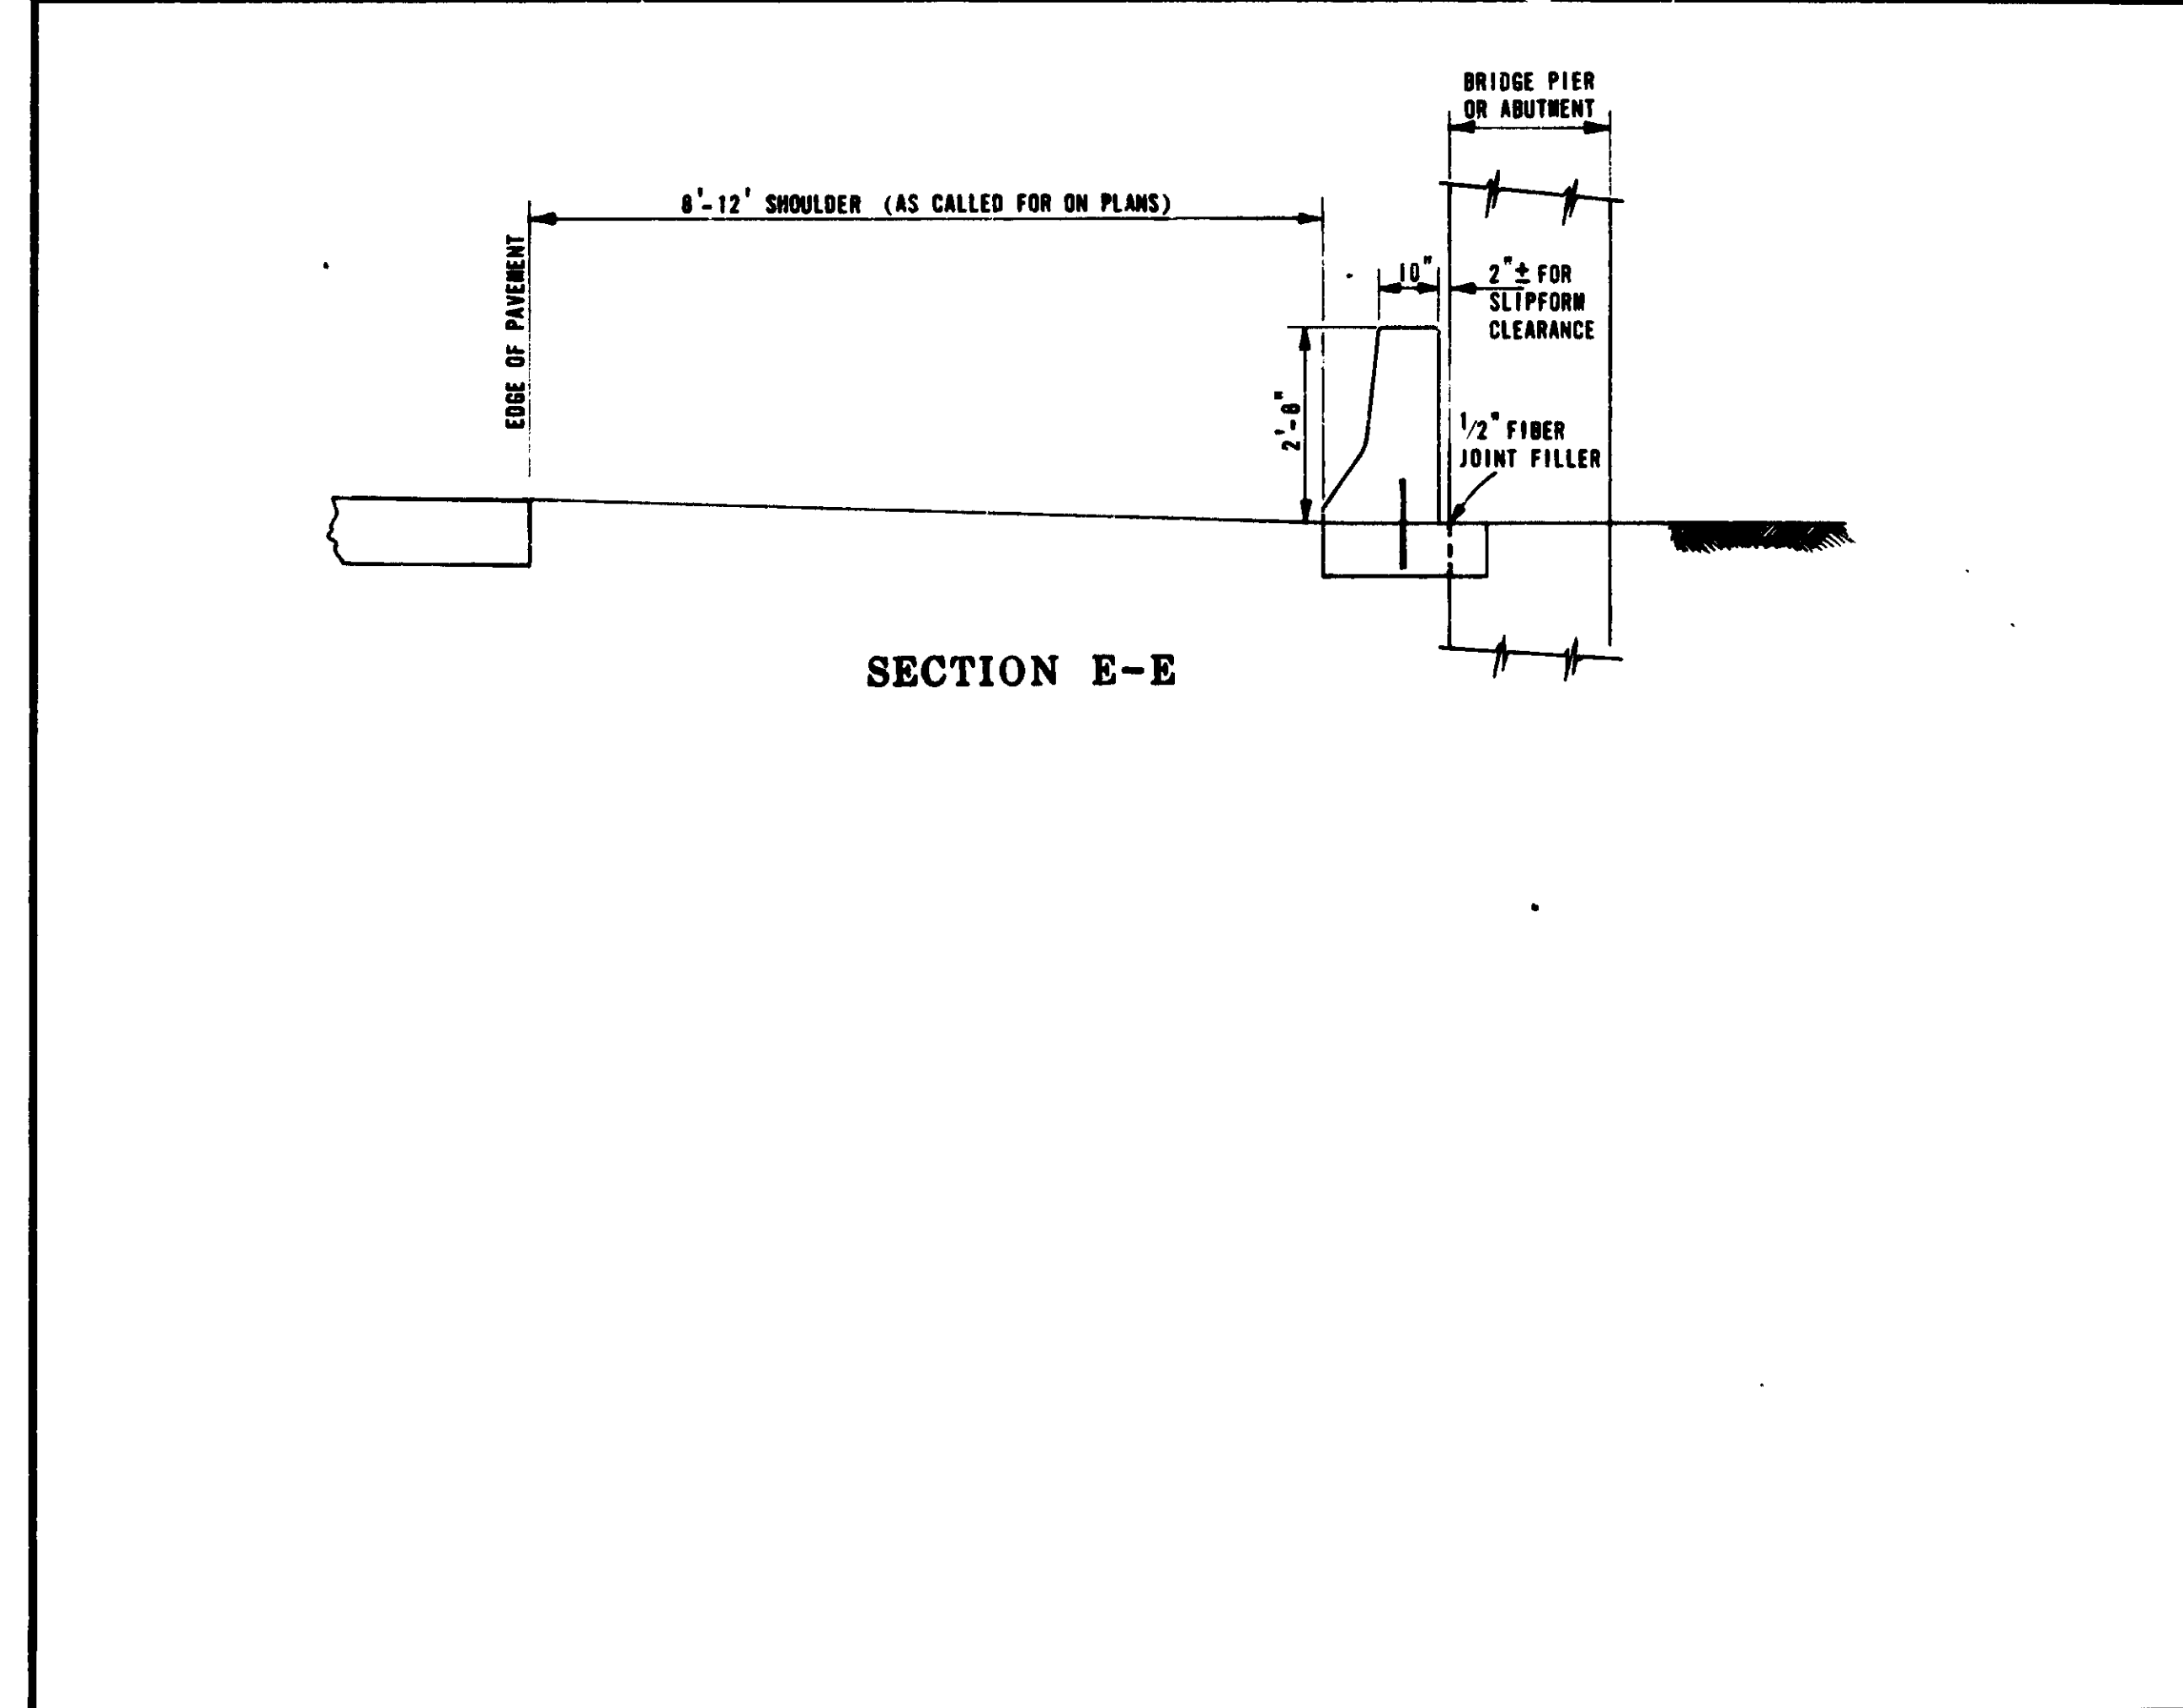

SECTION E-E


PREPARED BY DESIGN DIVISION <i>C.D. Zipes</i> ENGINEER - ROAD DESIGN	<i>John P. Woodford</i> ENGINEER OF DESIGN	MICHIGAN DEPARTMENT OF STATE HIGHWAYS AND TRANSPORTATION STANDARD PLAN FOR CONCRETE BARRIER - SINGLE FACE (DEPRESSED ROADWAY)
DRAWN BY D.F.W. ENGINEER OF TRAFFIC AND SAFETY	DEPARTMENT DIRECTOR JOHN P. WOODFORD	
CHECKED BY V.D. ENGINEER OF CONSTRUCTION	BY: DEPUTY DIRECTOR - HIGHWAYS	F.H.W.A. APPROVAL DATE 4-18-78 PLAN DATE □ - 54A SHEET 2 OF 3

PREPARED BY DESIGN DIVISION <i>C.D. Zipes</i> ENGINEER - ROAD DESIGN	<i>John P. Woodford</i> ENGINEER OF DESIGN	MICHIGAN DEPARTMENT OF STATE HIGHWAYS AND TRANSPORTATION STANDARD PLAN FOR CONCRETE BARRIER - SINGLE FACE (DEPRESSED ROADWAY)
DRAWN BY D.F.W. ENGINEER OF TRAFFIC AND SAFETY	DEPARTMENT DIRECTOR JOHN P. WOODFORD	
CHECKED BY V.R. ENGINEER OF CONSTRUCTION	BY: DEPUTY DIRECTOR - HIGHWAYS	F.H.W.A. APPROVAL DATE 4-18-78 PLAN DATE □ - 54A SHEET 3 OF 3

SECTION 13 63174 TOP 14165
1522229

F.H.W.A. REL. NO.	STATE	FEDERAL PROJECT	P.O.W. NO.	SHEET NO.	TOTAL SHEETS
5	MICH.	I-75-2(222)59		14	14
ROUTE	COUNTY	CONTROL SECTION	JOB NO.		
I-75	Valkland	63174	14165		


Variable Length

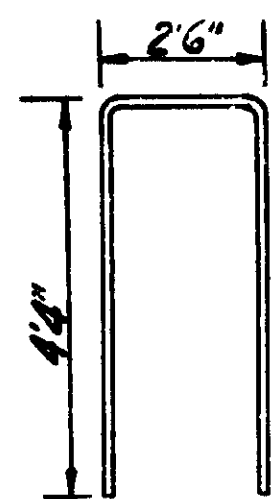


#4 A Bar

#4 D Bar

Structure Number & Location	Number of Bays	Bay Width
S10 of 82252 - 8 Mile	1	14'
S22 of 63174 - Meyers	3	10'1"
S23 of 63174	1	16'
S24 of 63174 - John R.	5	11'9"
S25 of 63174	1	16'
S26 of 63174	1	15'
S27 of 63174 - 9 Mile	5	9'6"
S28 of 63174 - Woodard Hts.	4	13'5"
S30 of 63174 - Lincoln	4	13'4"
S31 of 63174 - 11 Mile	5	10'9"

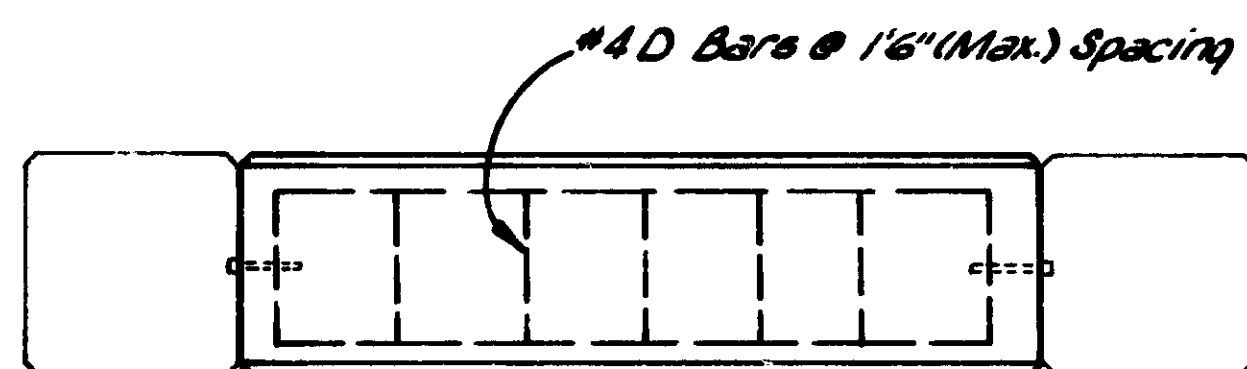


PLAN

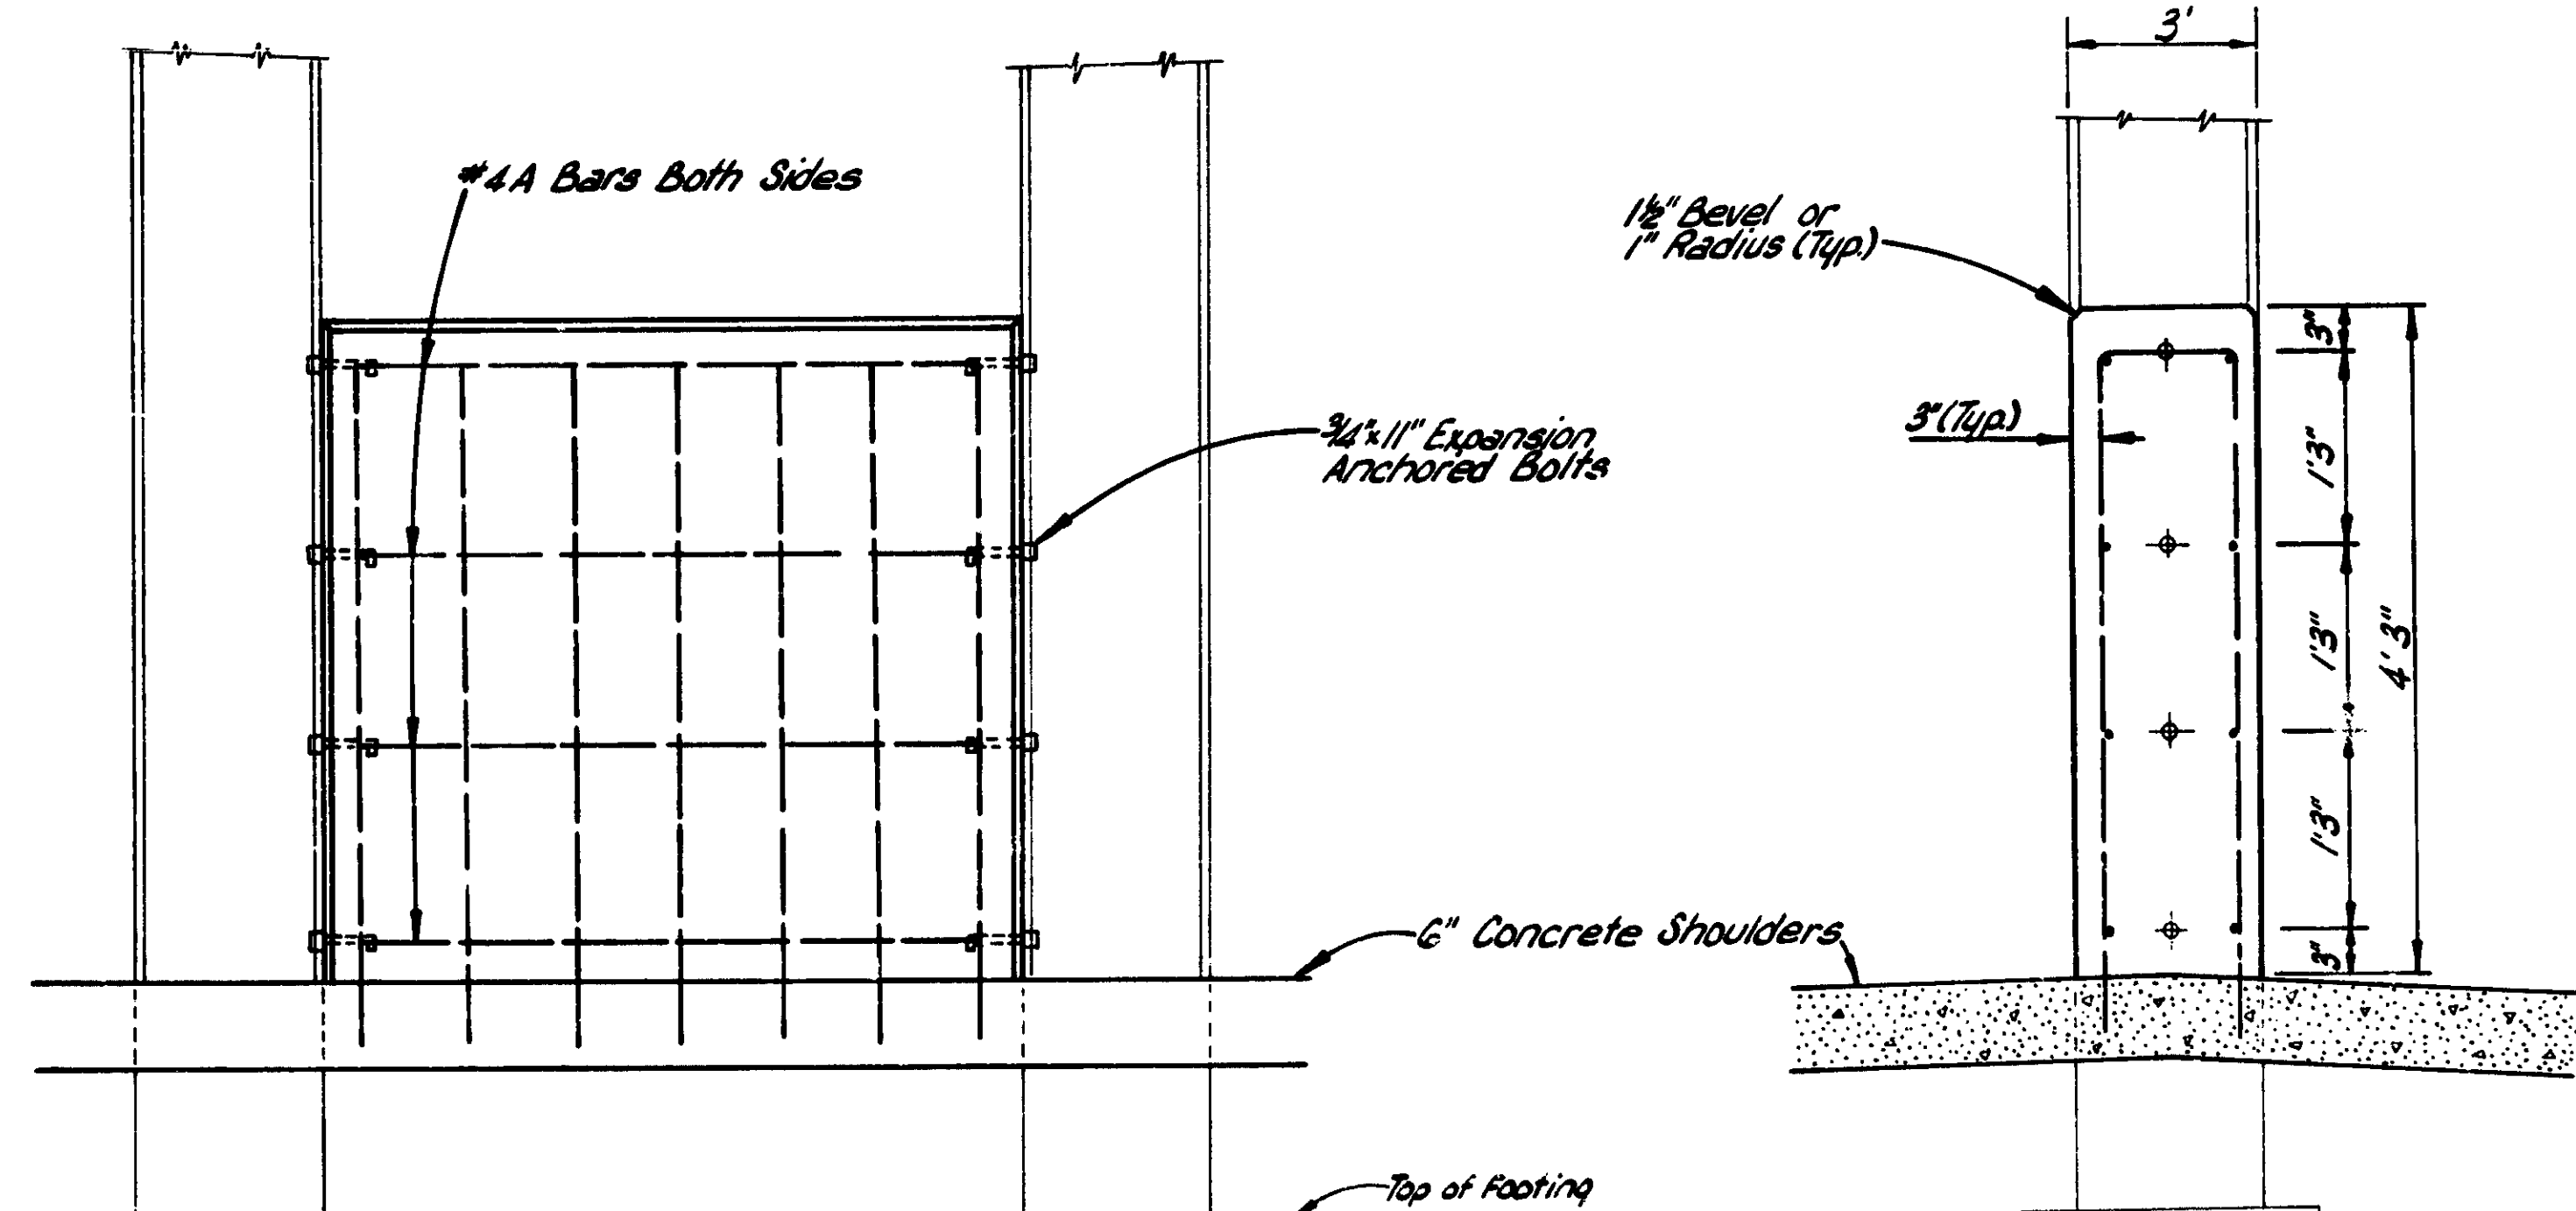

ELEVATION

SECTION






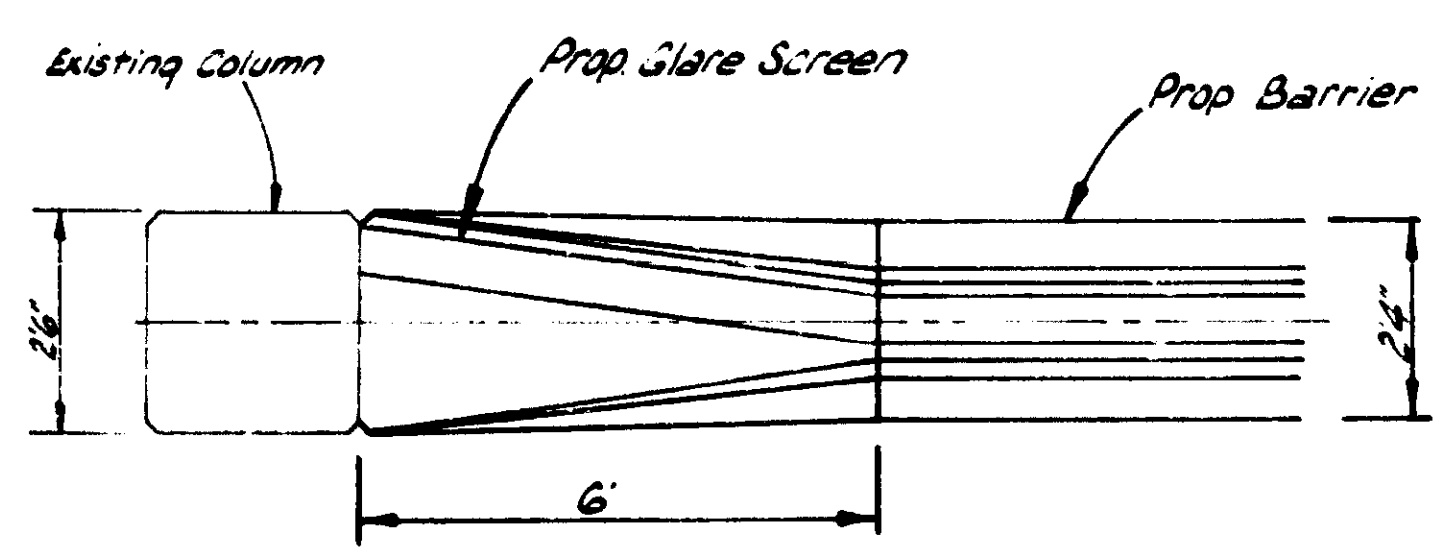


DETAIL SHOWING
BARRIER TRANSITION TO
BRIDGE COLUMN
(At no additional cost to "Concrete
Barrier-Double Face".)

SPECIAL DETAIL
FOR
MEDIAN PIER FILLERWALLS

Squad: P.M. Christy Drawn by: K. Cleus

F.H.W.A. REG. NO.	STATE	FEDERAL PROJECT	R.O.W. NO.	SHEET NO.	TOTAL SHEETS
5	MICH.	I-75-2(222)59		15	96
ROUTE	COUNTY	CONTROL SECTION	JOB NO.		
I-75	Oakland	63174	14165		

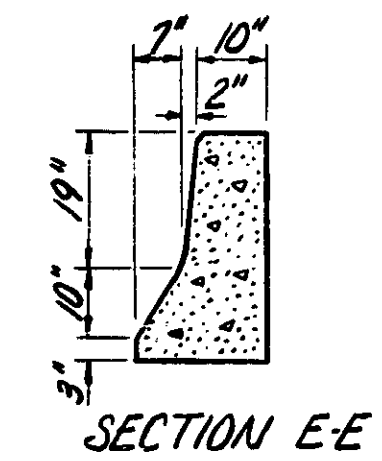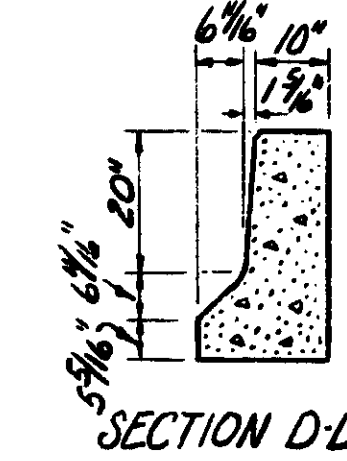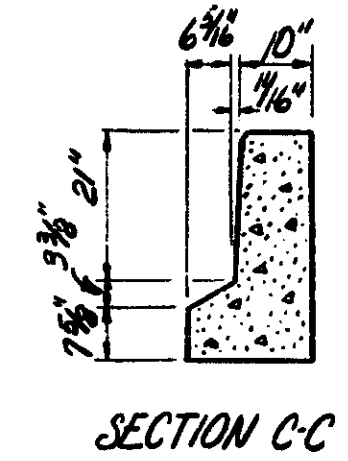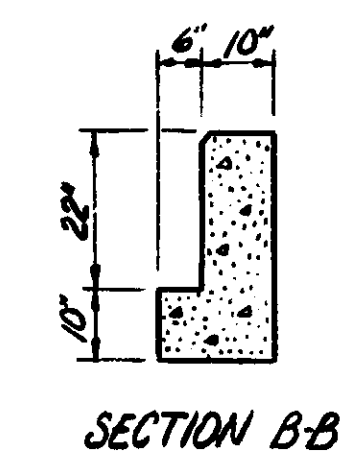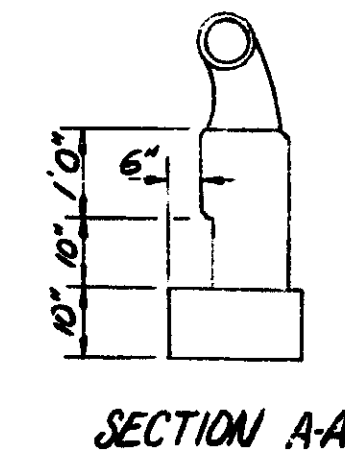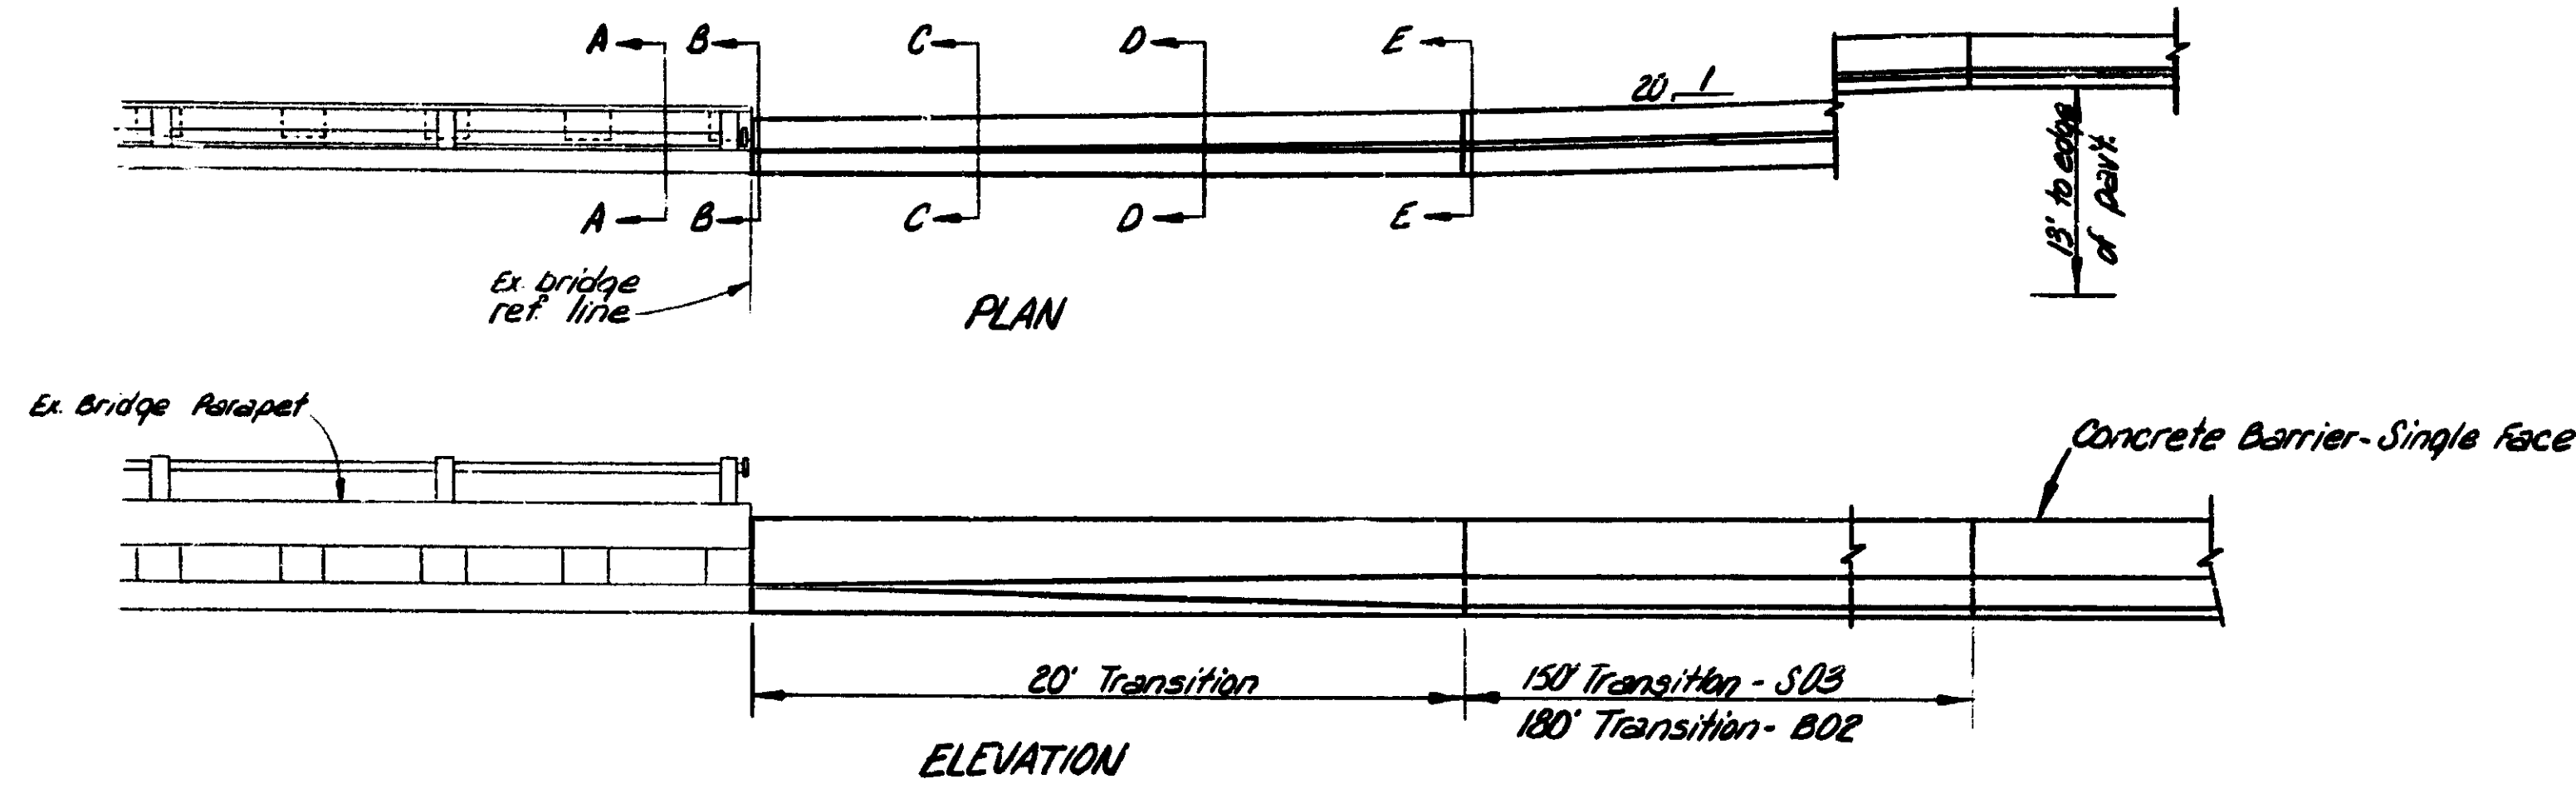

Sections Apply at both approach & departure end

DETAIL OF
CONCRETE BARRIER TRANSITION
TO BRIDGE PARAPET
AT
S03 OF 63174 (Over 12 Mile)


B02 OF 63174 (Over Red Run Drain)

Solved AM Christy Drawn by K. Olesis 3-22-79

SPECIAL DETAIL
SHOWING
CONCRETE BARRIER TRANSITION
TO BRIDGE PARAPET


63174	14165	1-75-2(222)59	15
-------	-------	---------------	----

REG. NO.	STATE	DEPT.	PROJECT	SHEET	TOTAL
1-75-2(222)59	16	96			
DATE	PROJECT	NO.	DATE	NO.	NO.
1-75	Oakland	1563174			14165

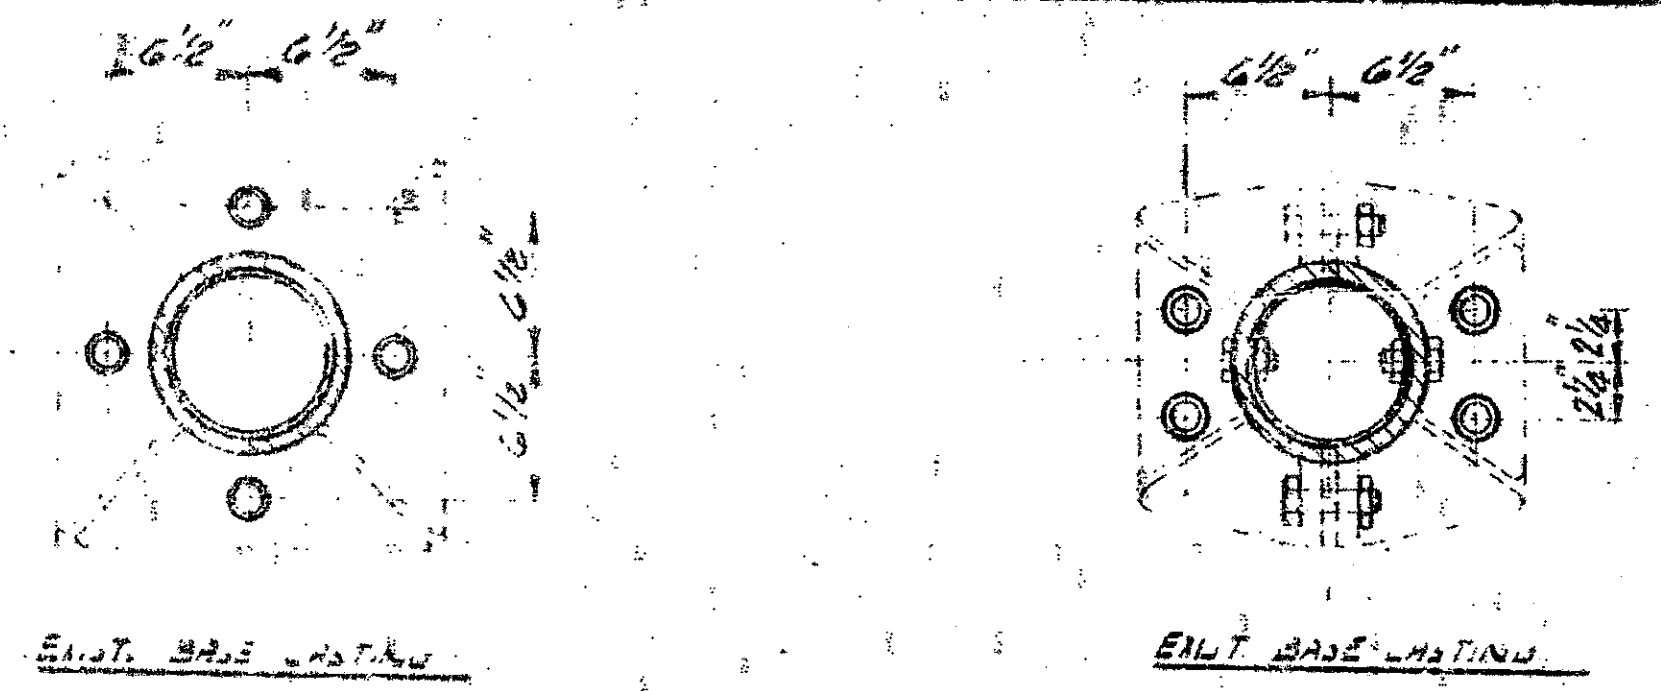

Non-sag sealant, Fed. Specs. T.F.S-230C on 3/4" x 3/4" annular space thoroughly cleaned by sand blasting or with steel wool before application.

Coupling with sealant.

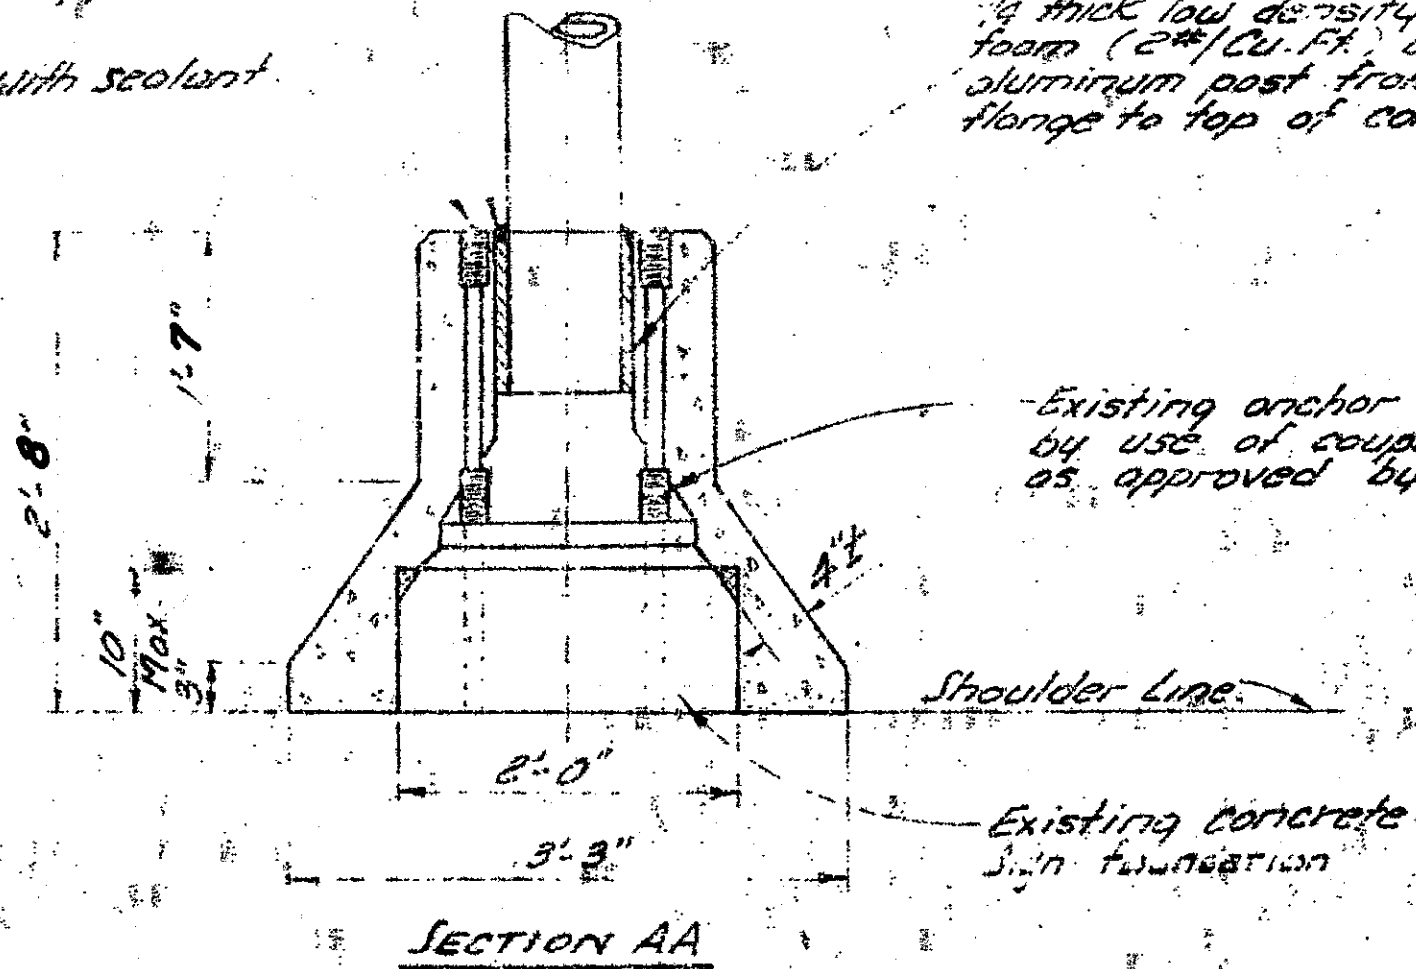

1/4" thick low density polyethylene foam (2# Cu. Ft.) wrapped around aluminum post from top of base flange to top of concrete barrier.

Existing anchor bolt, extended by use of coupling or weld as approved by the Engineer.


Shoulder Line

Existing concrete sign foundation

SECTION AA

Non-sag sealant, Fed. Specs. T.F.S-230C on 3/4" x 3/4" annular space thoroughly cleaned by sand blasting or with steel wool before application.

Coupling with sealant.

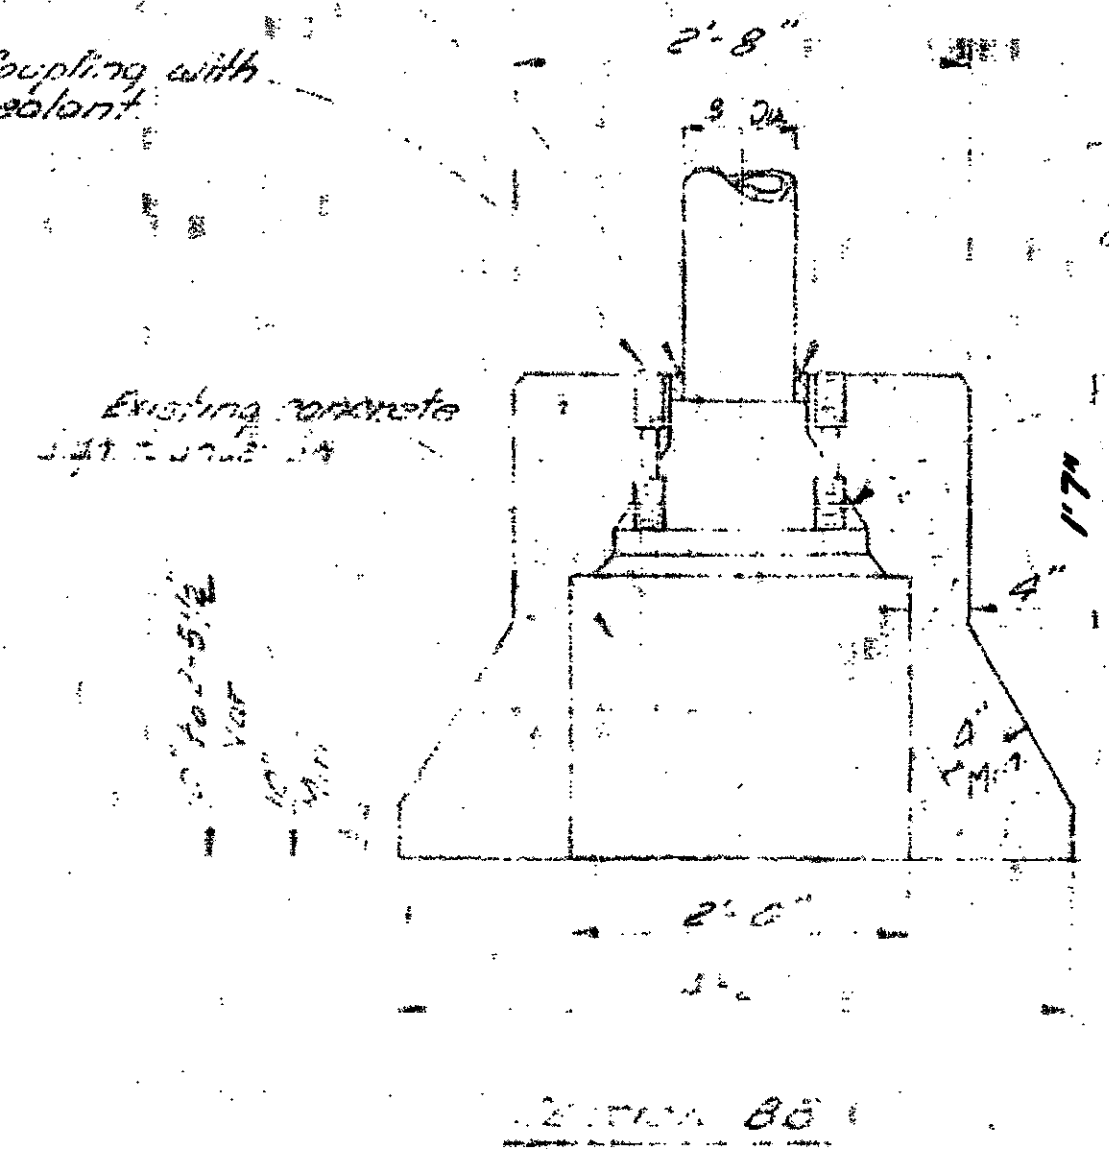


1/4" thick low density polyethylene foam (2# Cu. Ft.) wrapped around aluminum post from top of base flange to top of concrete barrier.

Existing anchor bolt, extended by use of coupling or weld as approved by the Engineer.


Shoulder Line

SECTION BB

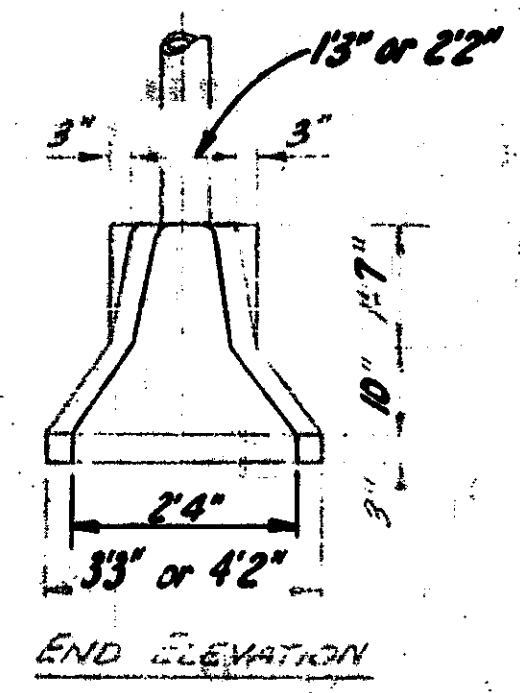

END ELEVATION


Regular Concrete Barrier

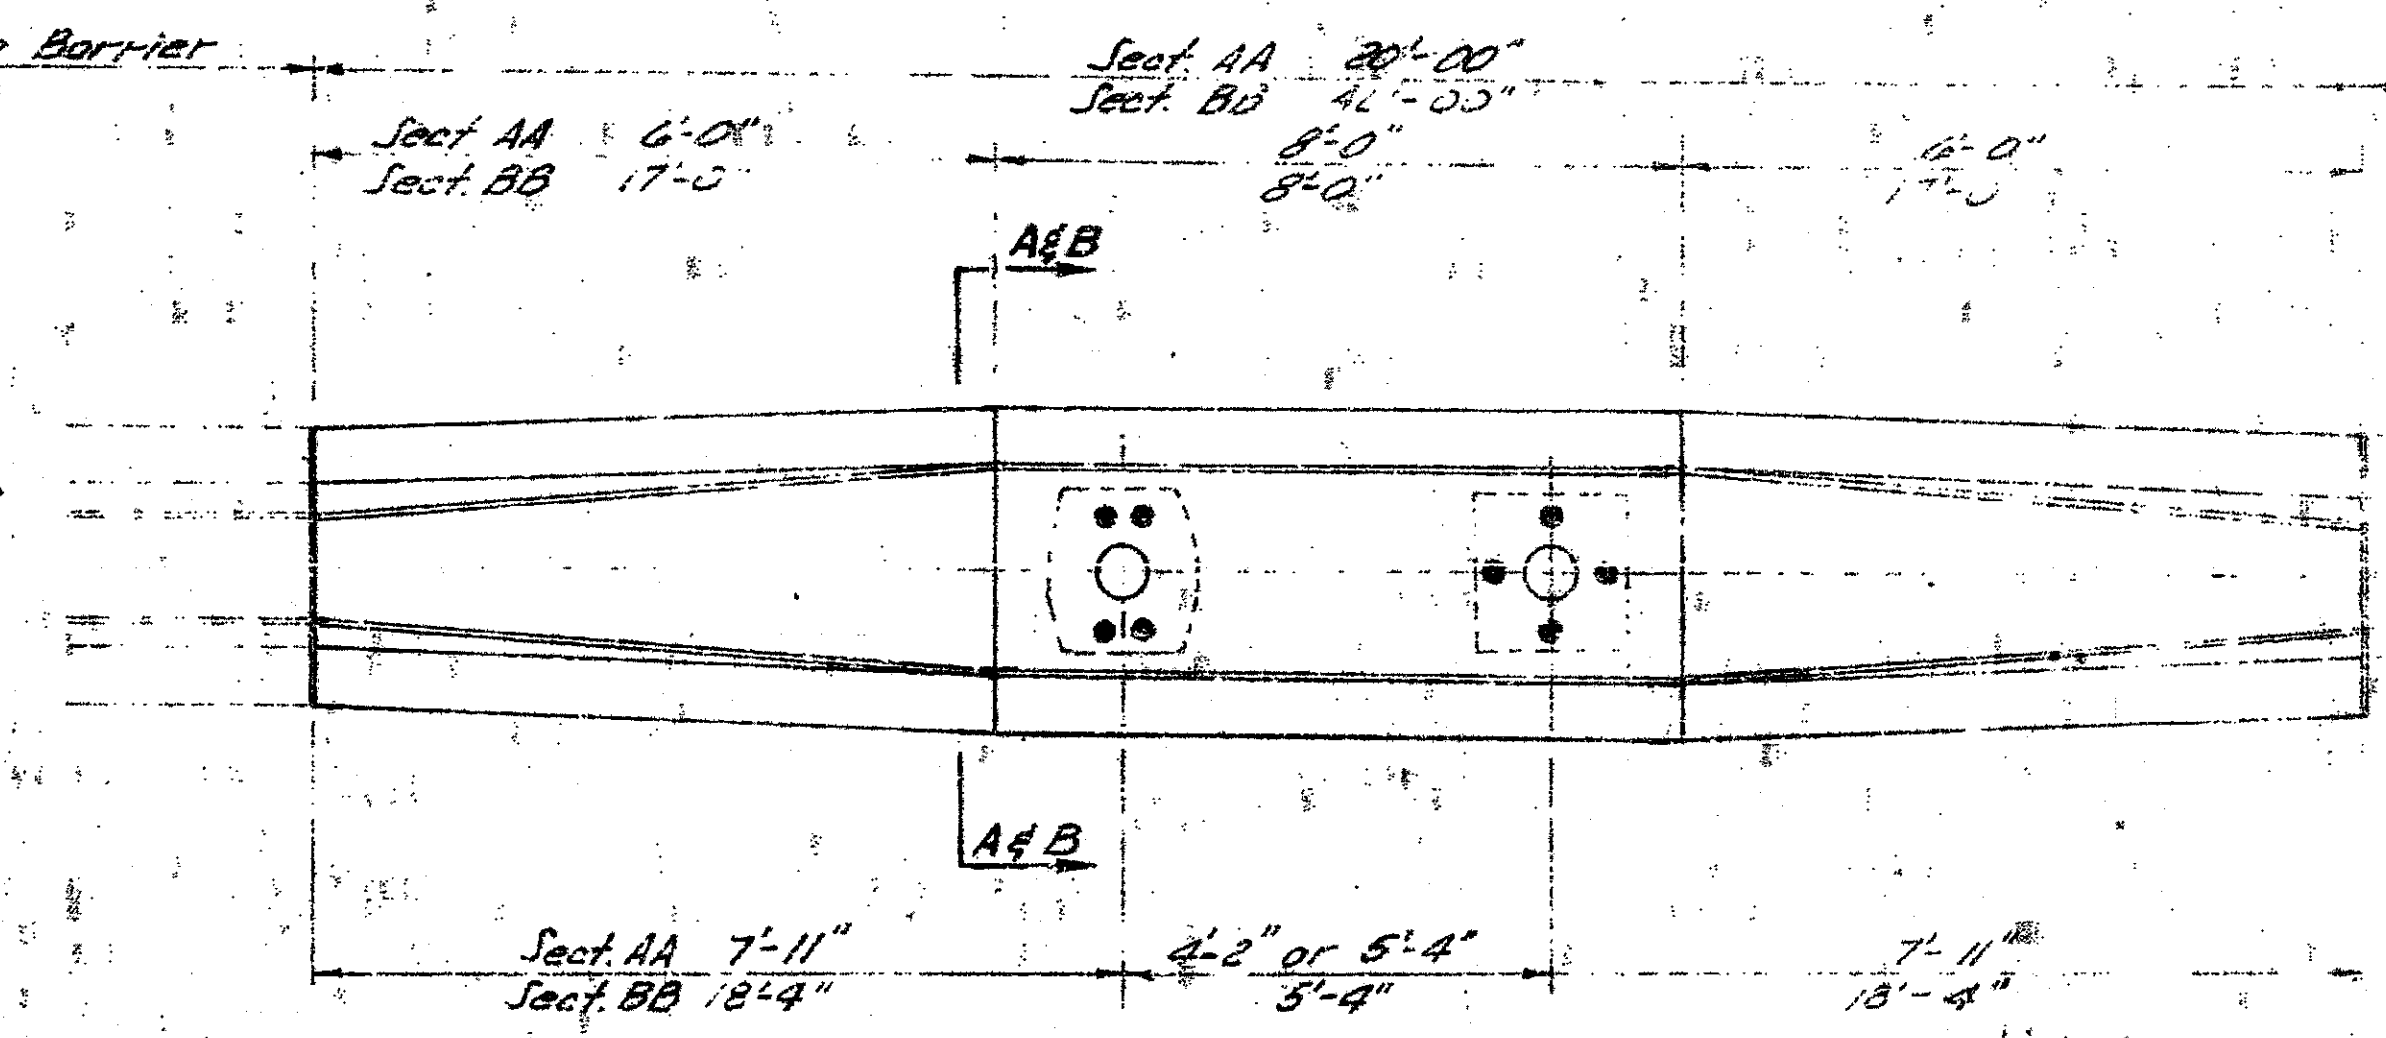

PLAN


Notes

1. The existing concrete sign foundation shall be thoroughly cleaned before the new concrete barrier is poured around it.
2. Two different bolt patterns are shown. Extend the bolt using the pattern existing in the field.
3. The additional work involved in placing the concrete barrier around the existing sign foundation shall be included in the item of Concrete Barrier. No additional payment will be made for this work.
4. All material and workmanship shall be in accordance with the Current Standard Specifications, Special Provisions, and the Special Details for Concrete Barrier.

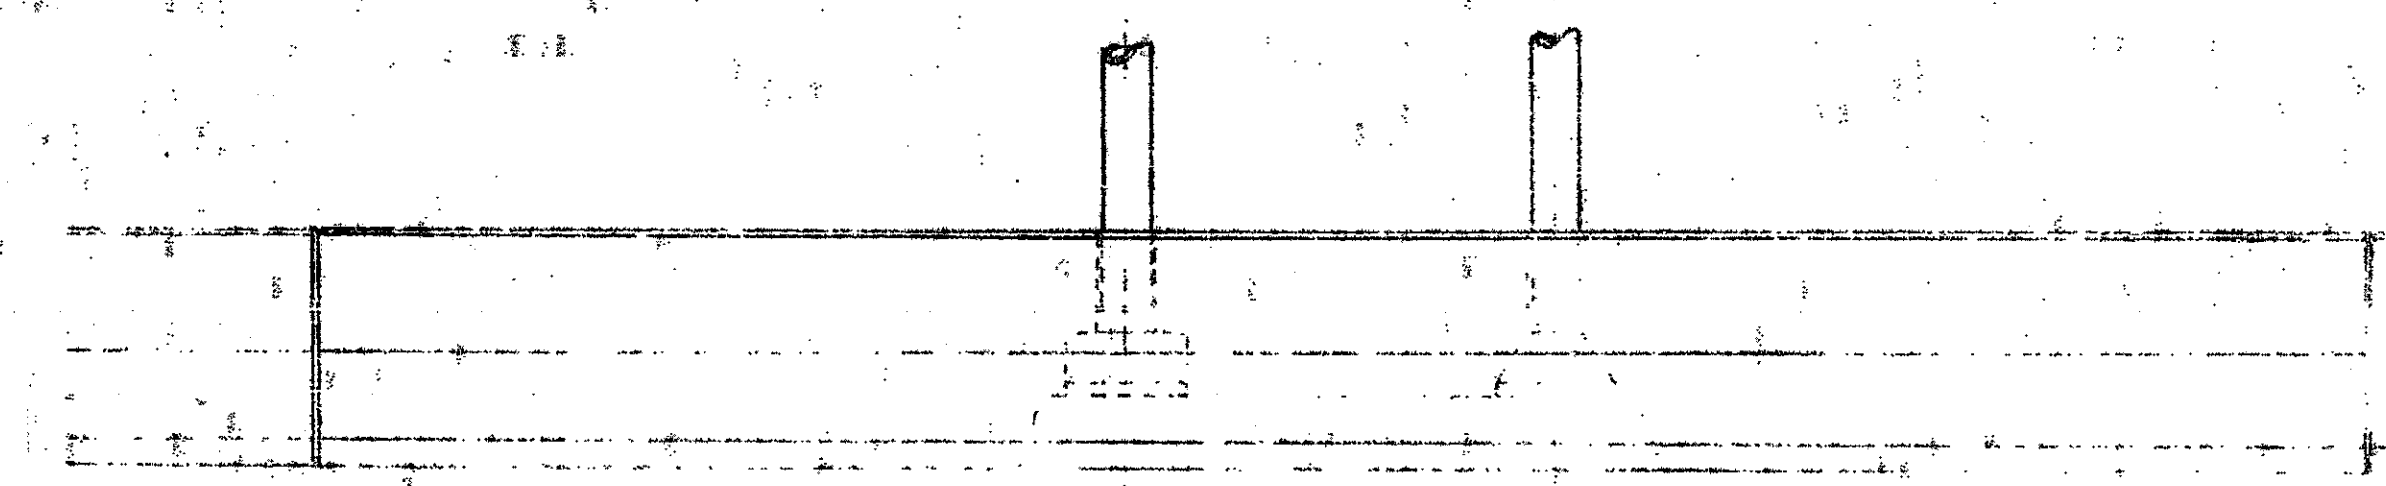


ELEVATION


DETAIL OF CONCRETE BARRIER AT EXISTING SIGN TRUSSES.

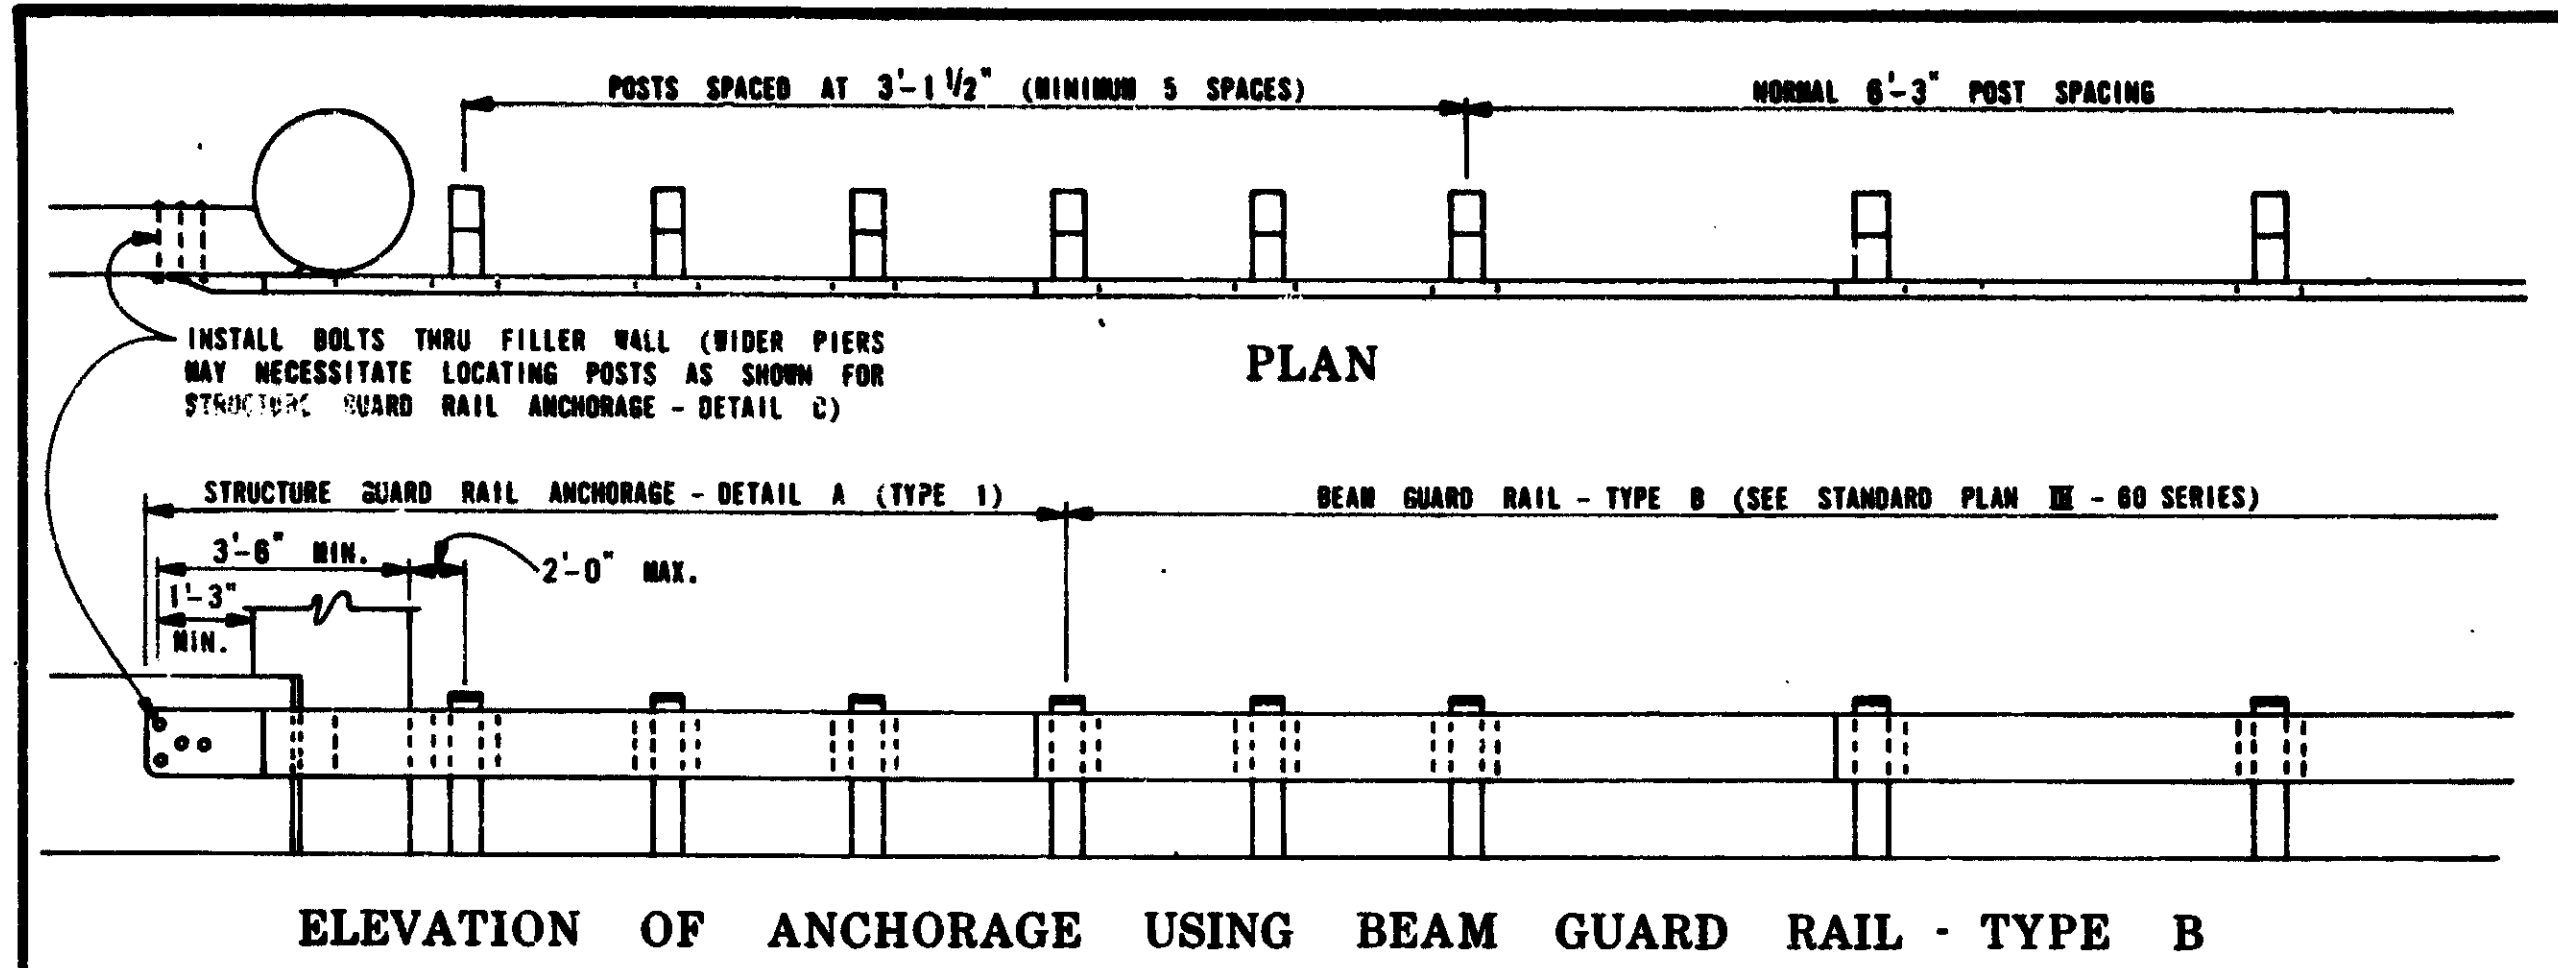


ELEVATION OF ANCHORAGE USING BEAM GUARD RAIL - TYPE B

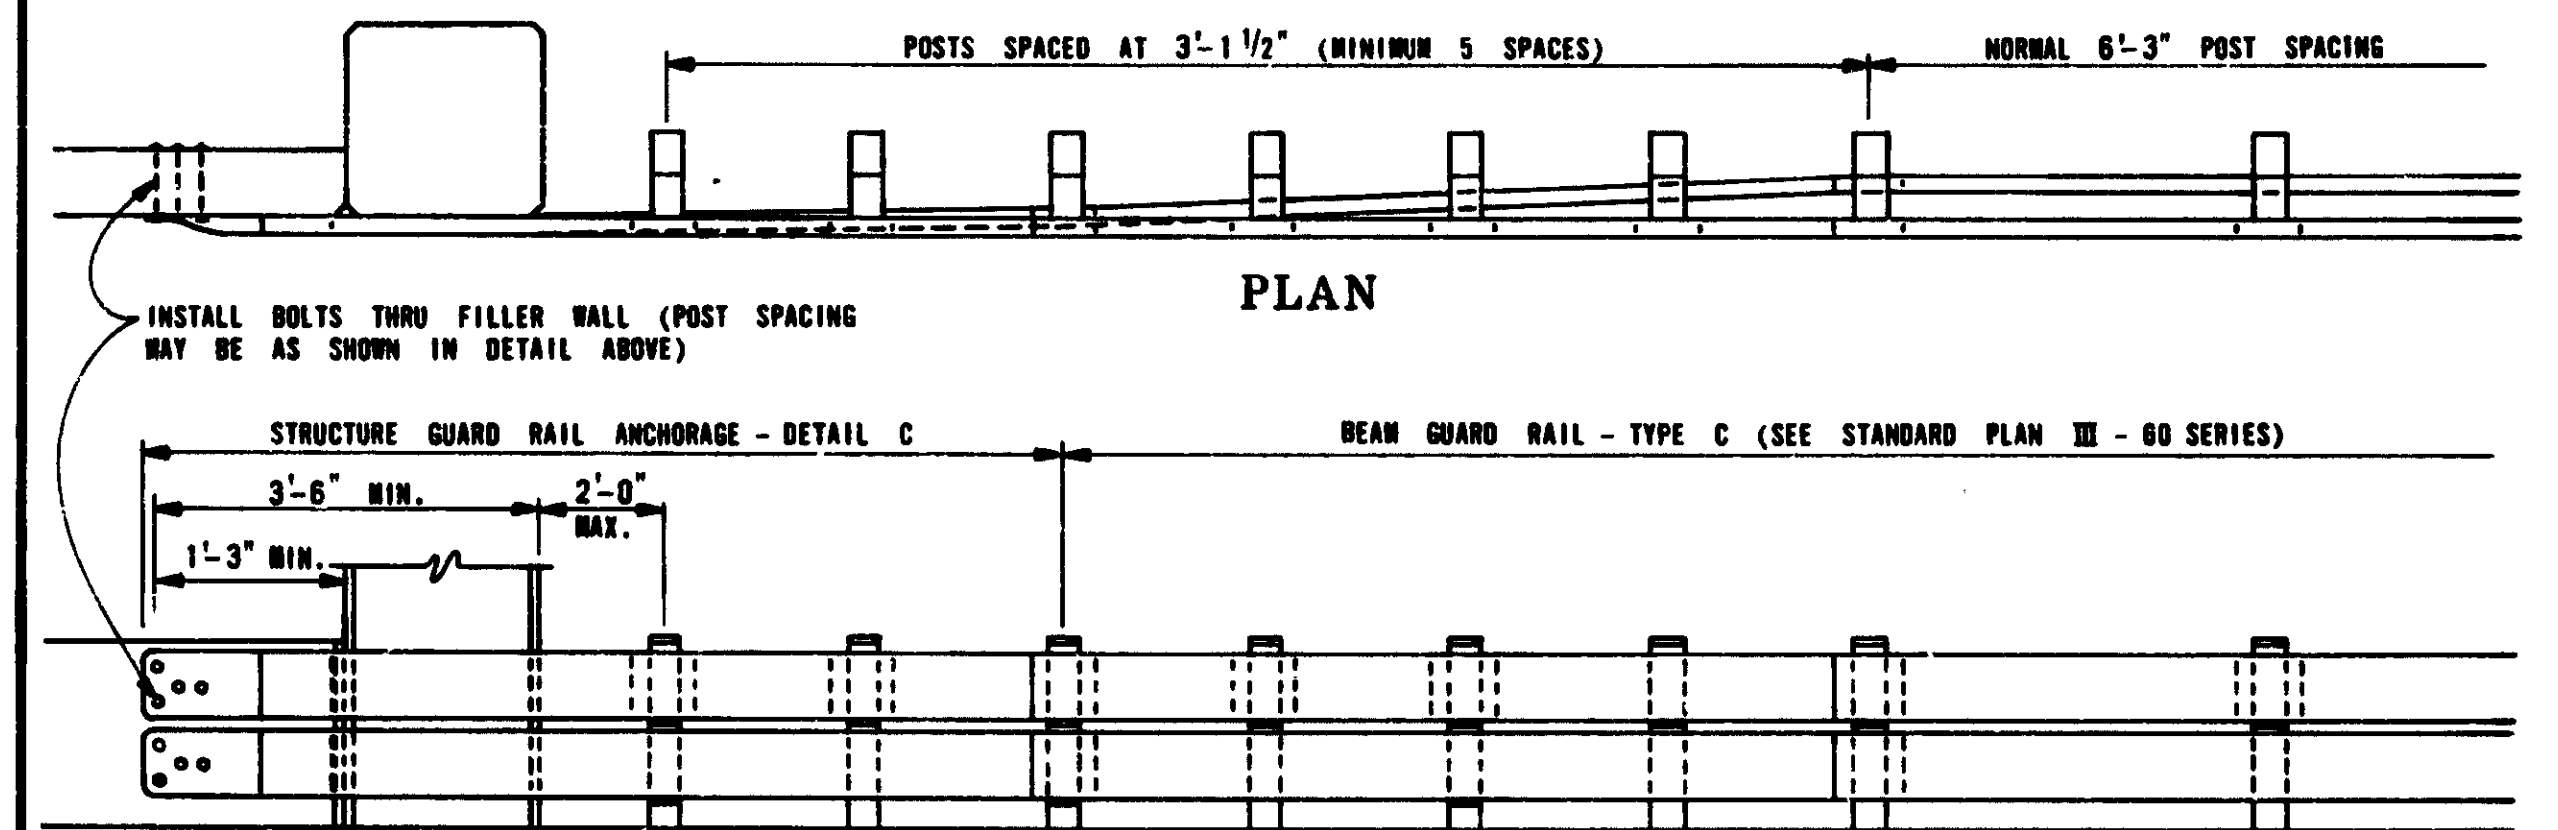


ELEVATION OF ANCHORAGE USING BEAM GUARD RAIL - TYPE C

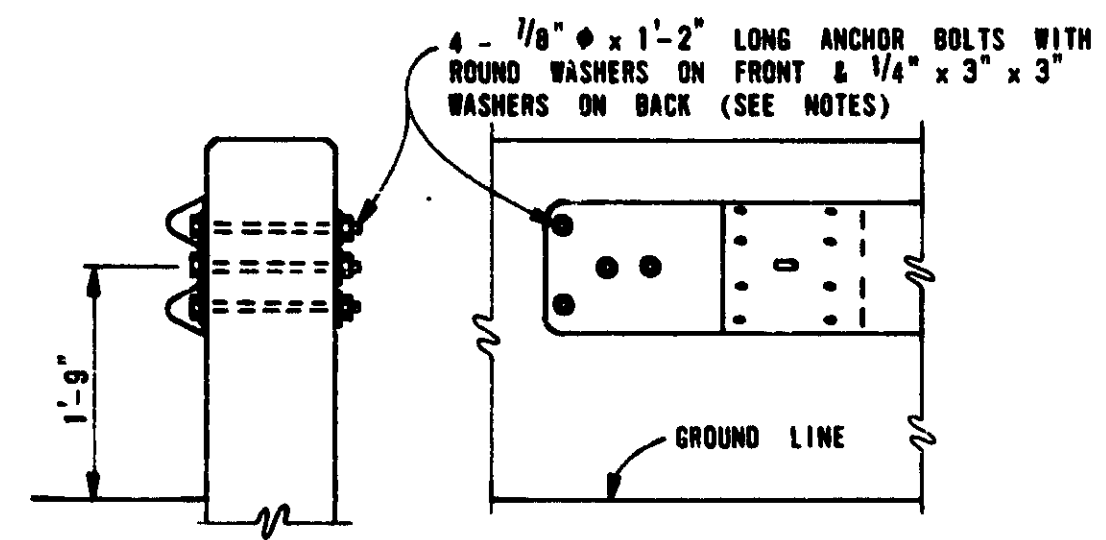

ANCHORAGE ATTACHMENT DETAILS FOR BEAM GUARD RAIL - TYPE B

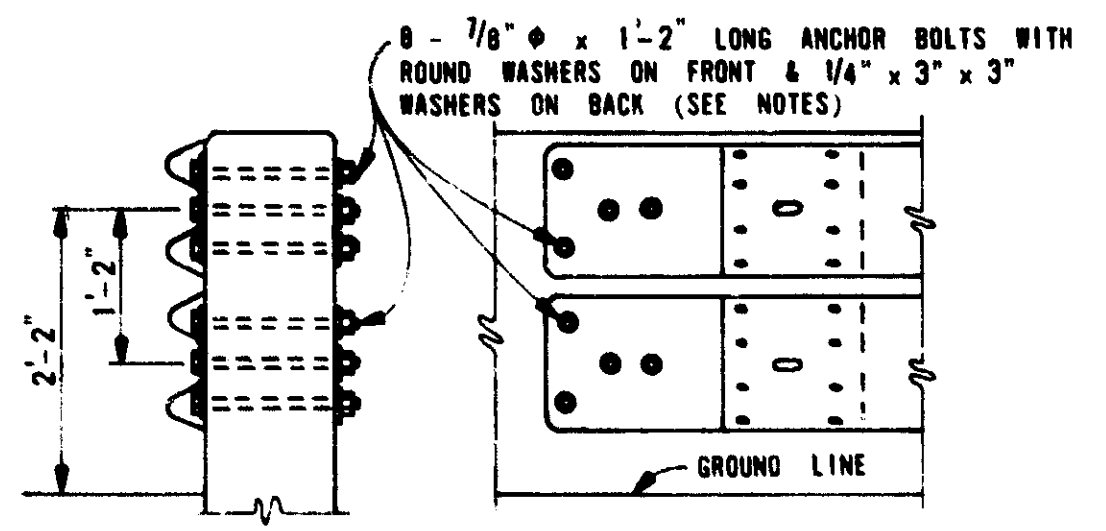


ANCHORAGE ATTACHMENT DETAILS FOR BEAM GUARD RAIL - TYPE C

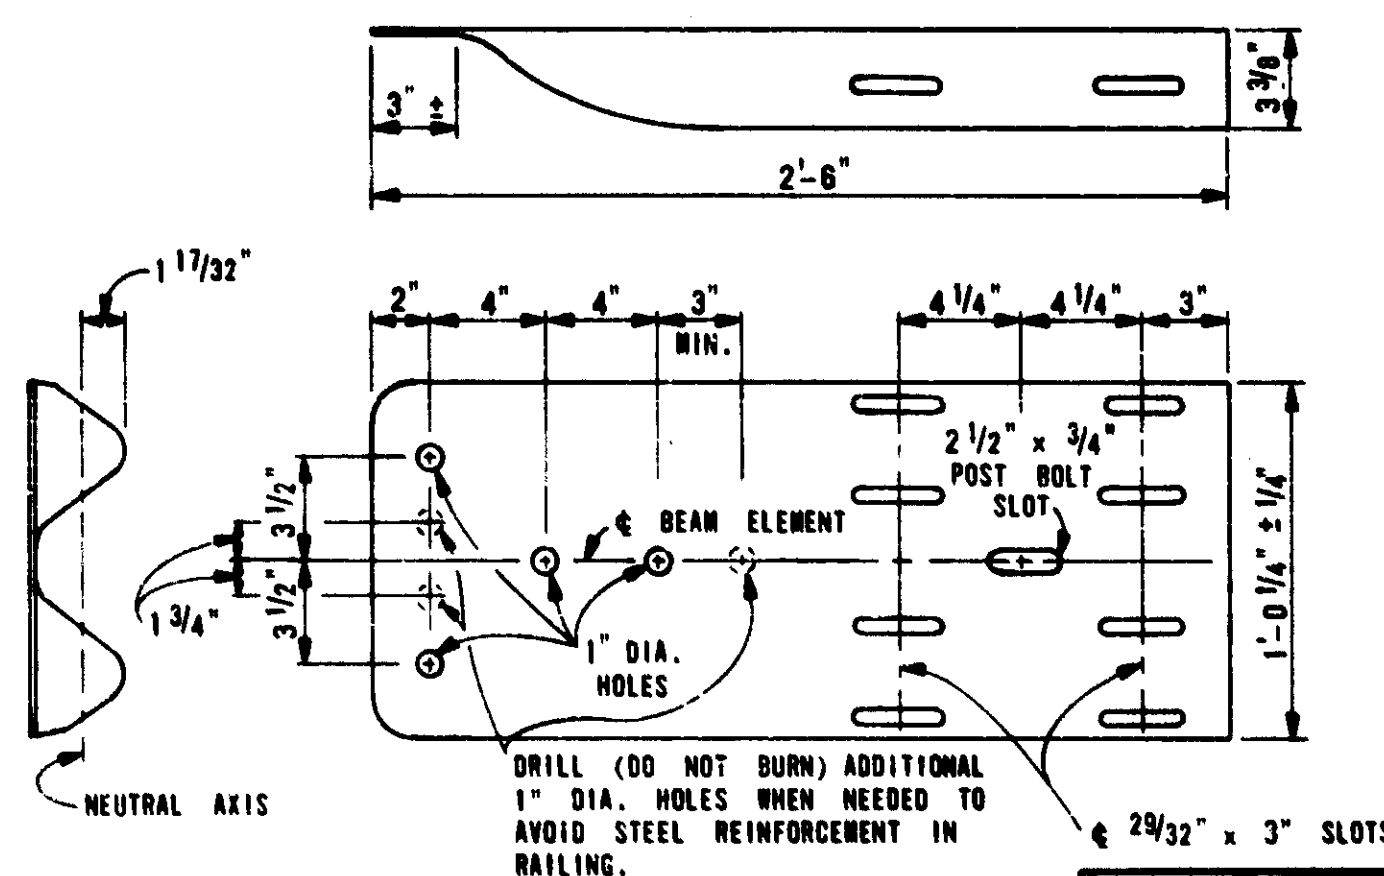

SPECIAL END SHOE


PREPARED BY DESIGN DIVISION

ENGINEER - BRIDGE DESIGN H.A.W.		ENGINEER - ROAD DESIGN C.G. Zojer		ENGINEER OF DESIGN J.P. Woodford		MICHIGAN DEPARTMENT OF STATE HIGHWAYS AND TRANSPORTATION SPECIAL DETAIL FOR STRUCTURE GUARD RAIL ANCHORAGES		F.H.W.A. APPROVAL DATE 12-14-78 PLAN DATE 12-14-78 SPECIAL DETAIL 7-1 SHEET 1 OF 2	
DRAWN BY H.A.W.		ENGINEER OF TRAFFIC AND SAFETY J.C. Bunnell		DEPARTMENT DIRECTOR JOHN P. WOODFORD		STRUCTURE GUARD RAIL ANCHORAGES		SHEET 1 OF 2	
CHECKED BY V.R.		ENGINEER OF CONSTRUCTION J.P. Woodford		DEPUTY DIRECTOR - HIGHWAYS J.P. Woodford		SPECIAL DETAIL 7-1		SHEET 1 OF 2	

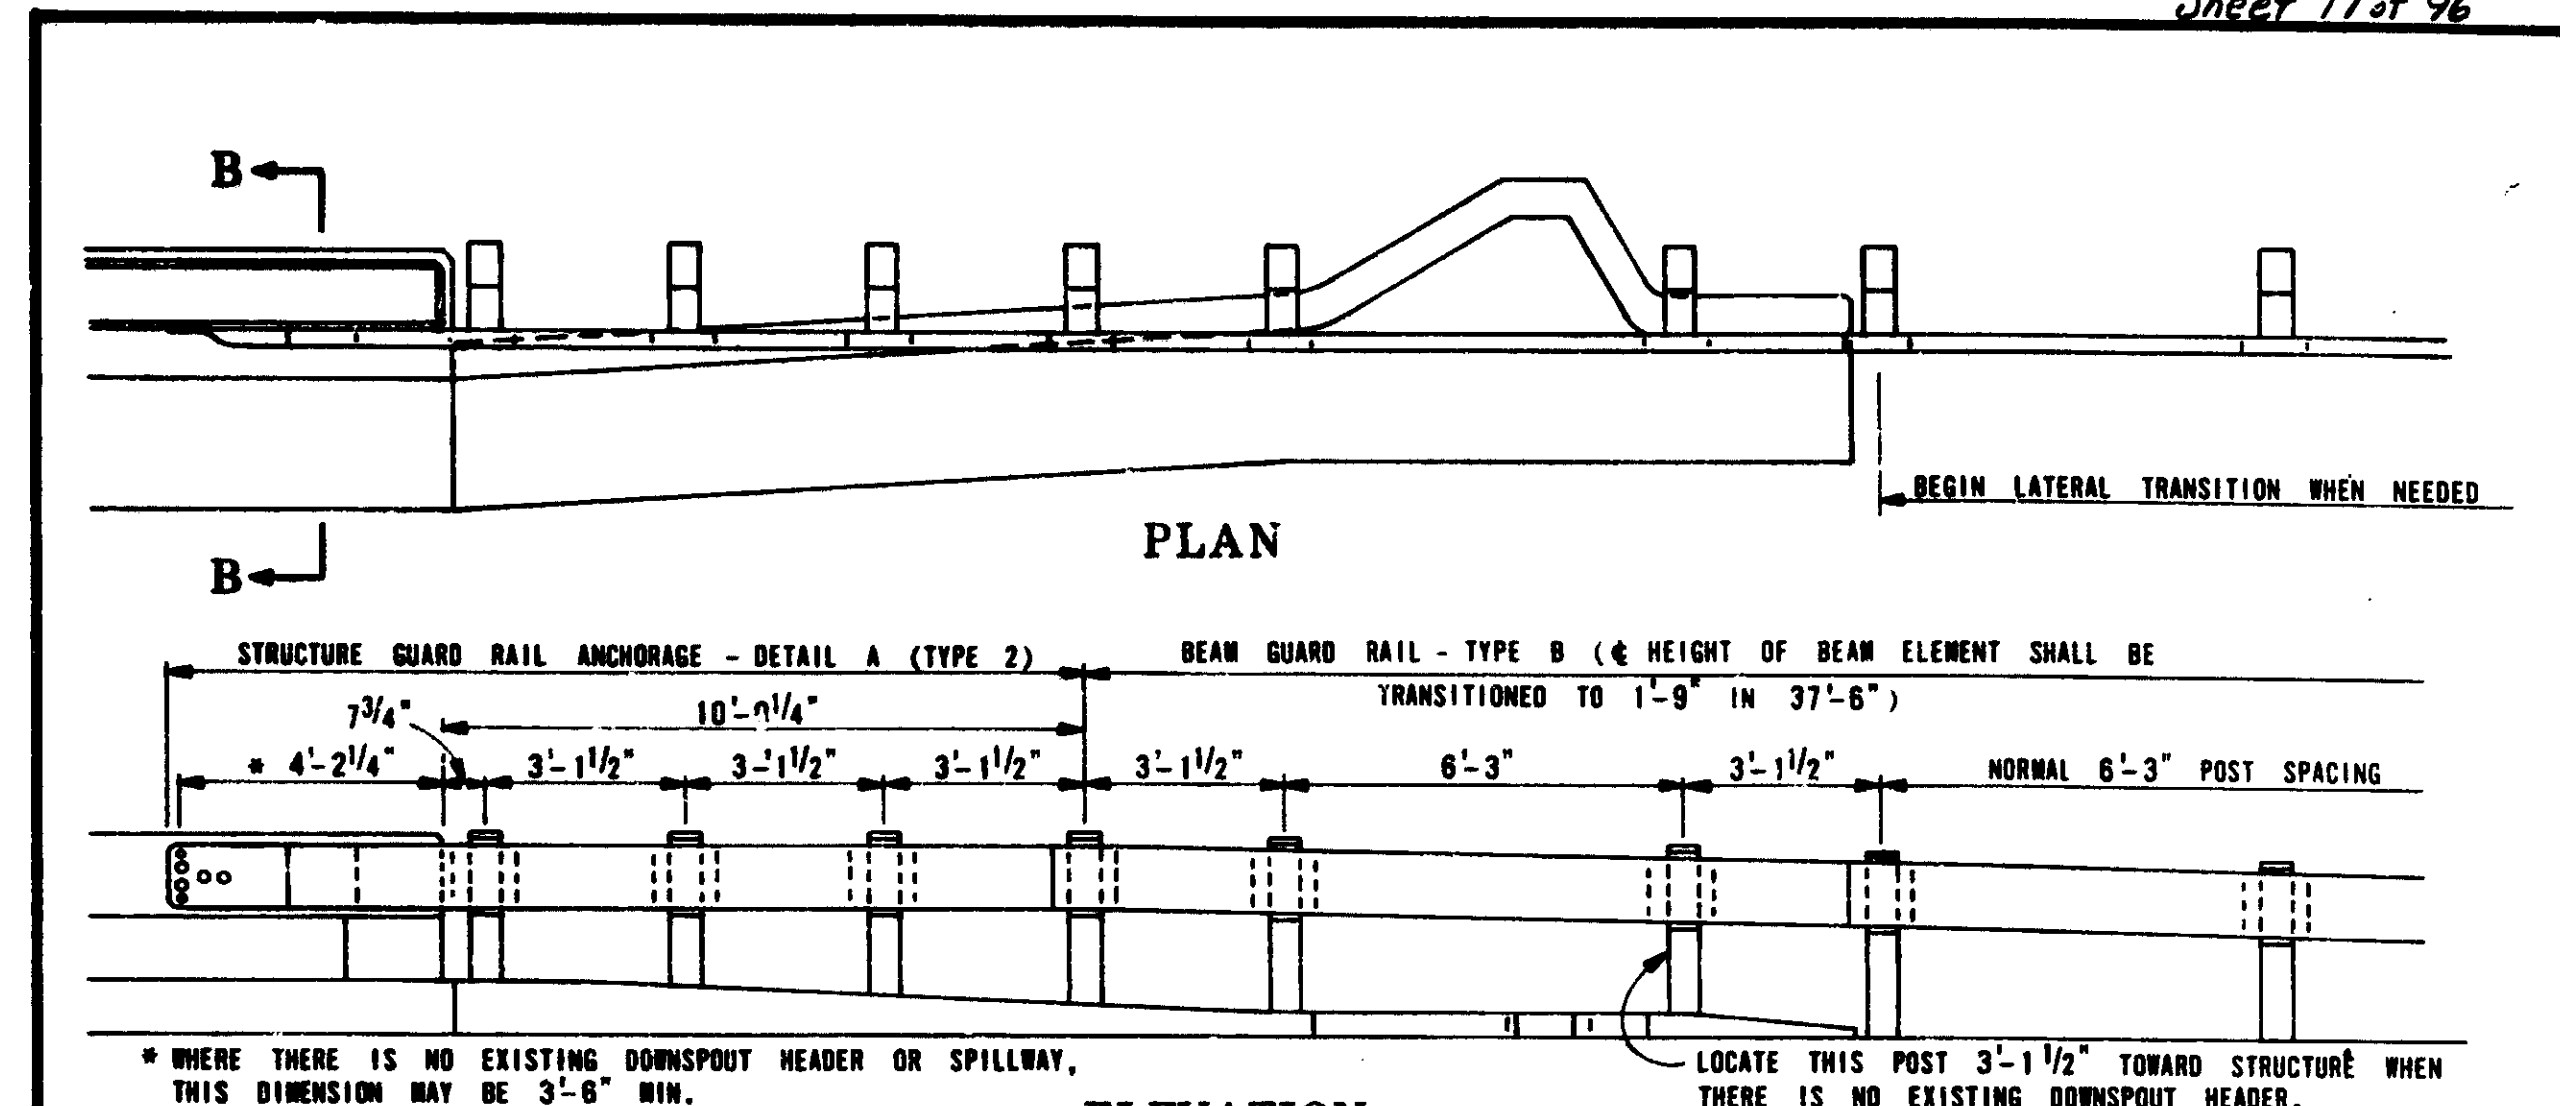


ELEVATION

TO BE USED WHEN ANCHORING GUARD RAIL TO EXISTING BRIDGE PARAPET RAILING WHERE THERE IS AN EXISTING DOWNSPOUT HEADER (SHOWN) OR WHERE THERE IS NO DOWNSPOUT HEADER (NOT SHOWN, BUT NOTED)

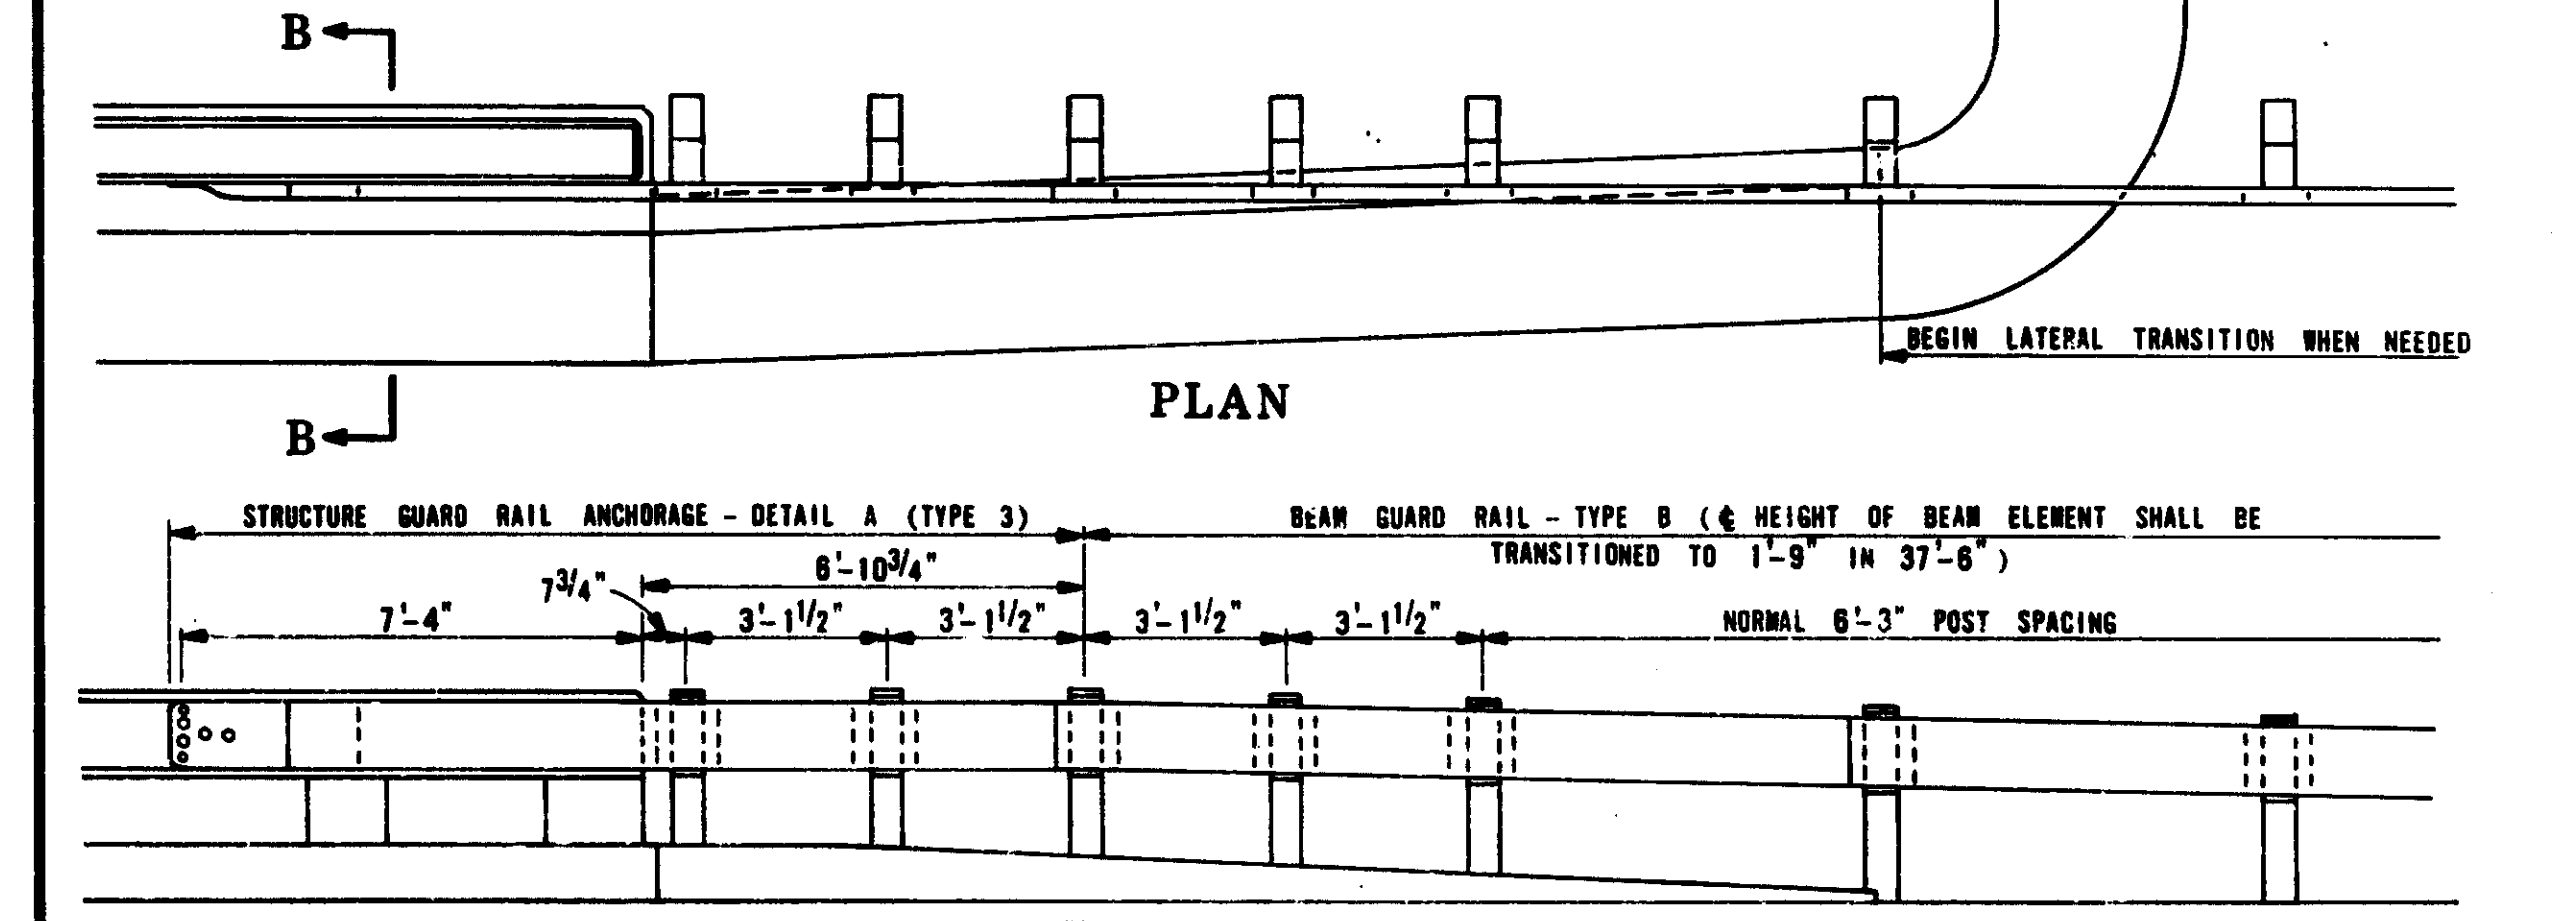

ELEVATION

TO BE USED WHEN ANCHORING GUARD RAIL TO EXISTING BRIDGE PARAPET RAILING WHERE THERE IS AN EXISTING SPILLWAY

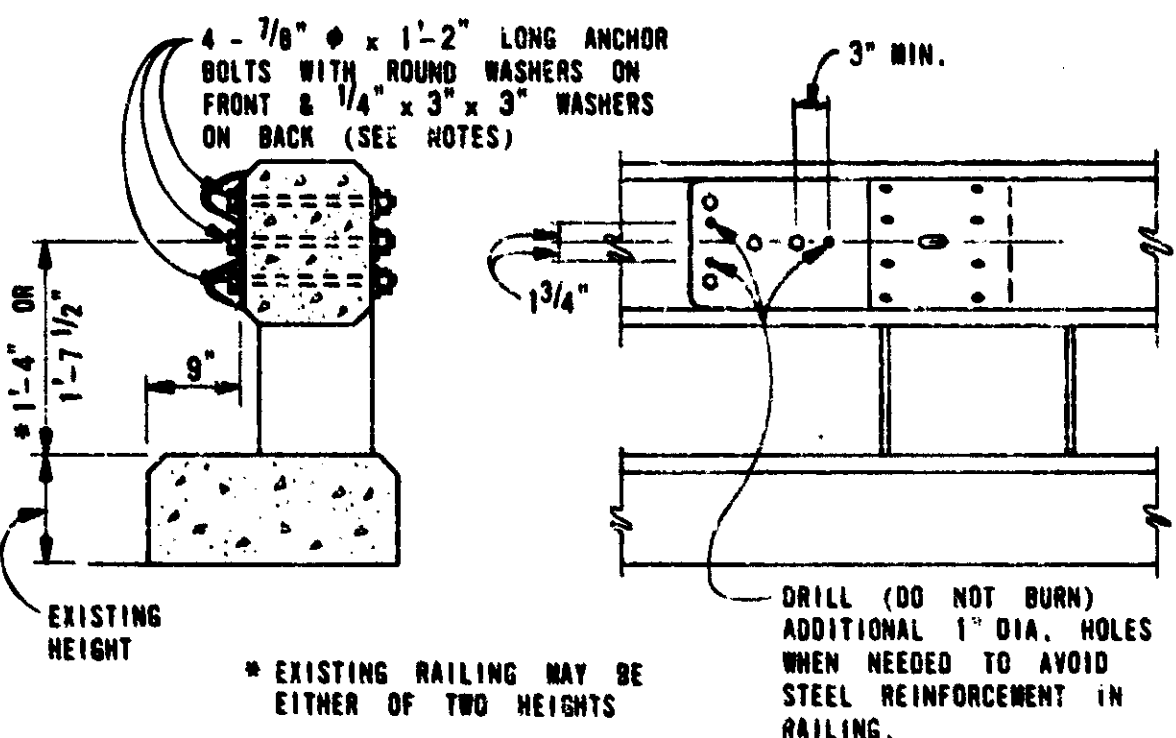


SECTION B-B ELEVATION SHOWING BOLT PLACEMENT

NOTES:
 THIS SPECIAL DETAIL IS INTENDED FOR USE IN SAFETY UP-DATING OF EXISTING GUARD RAIL. FOR NEW CONSTRUCTION, AND FOR DETAILS OF GUARD RAIL HARDWARE, SEE STANDARD PLANS.
 PLANS WILL SHOW APPLICABLE ANCHORAGE DETAIL TO GO WITH INDIVIDUAL GUARD RAIL INSTALLATIONS. THE PAY ITEM FOR STRUCTURE ANCHORAGE DETAILS SHOWN ON THIS PLAN WILL BE "STRUCTURE GUARD RAIL ANCHORAGE - DETAIL", EACH.
 NUTS, BOLTS AND WASHERS SHALL BE GALVANIZED OR CORROSION RESISTANT STEEL IN ACCORDANCE WITH THE CURRENT STANDARD SPECIFICATIONS.
 BEAM ELEMENTS SHALL BE LAPPED IN THE DIRECTION OF TRAFFIC. CONNECT STRUCTURE GUARD RAIL OR ANCHORAGE TO APPROACH GUARD RAIL WITH 1 ON 15 LATERAL SHIFT.
 7/8" ANCHOR BOLTS SHALL BE MADE OF HIGH STRENGTH STEEL.


ENGINEER - BRIDGE DESIGN H.A.W.		ENGINEER - ROAD DESIGN C.G. Zojer		ENGINEER OF DESIGN J.P. Woodford		MICHIGAN DEPARTMENT OF STATE HIGHWAYS AND TRANSPORTATION SPECIAL DETAIL FOR STRUCTURE GUARD RAIL ANCHORAGES		F.H.W.A. APPROVAL DATE 12-14-78 PLAN DATE 12-14-78 SPECIAL DETAIL 7-1 SHEET 2 OF 2	
DRAWN BY H.A.W.		ENGINEER OF TRAFFIC AND SAFETY J.C. Bunnell		DEPARTMENT DIRECTOR JOHN P. WOODFORD		STRUCTURE GUARD RAIL ANCHORAGES		SHEET 2 OF 2	
CHECKED BY V.R.		ENGINEER OF CONSTRUCTION J.P. Woodford		DEPUTY DIRECTOR - HIGHWAYS J.P. Woodford		SPECIAL DETAIL 7-1		SHEET 2 OF 2	

CONTROL SECTION	15 63174	JOB NO.	14165	FEDERAL PROJECT NO.	7-75-2(222)59	ROW NO.	17
-----------------	----------	---------	-------	---------------------	---------------	---------	----


BITUMINOUS PAVED SHOULDERS

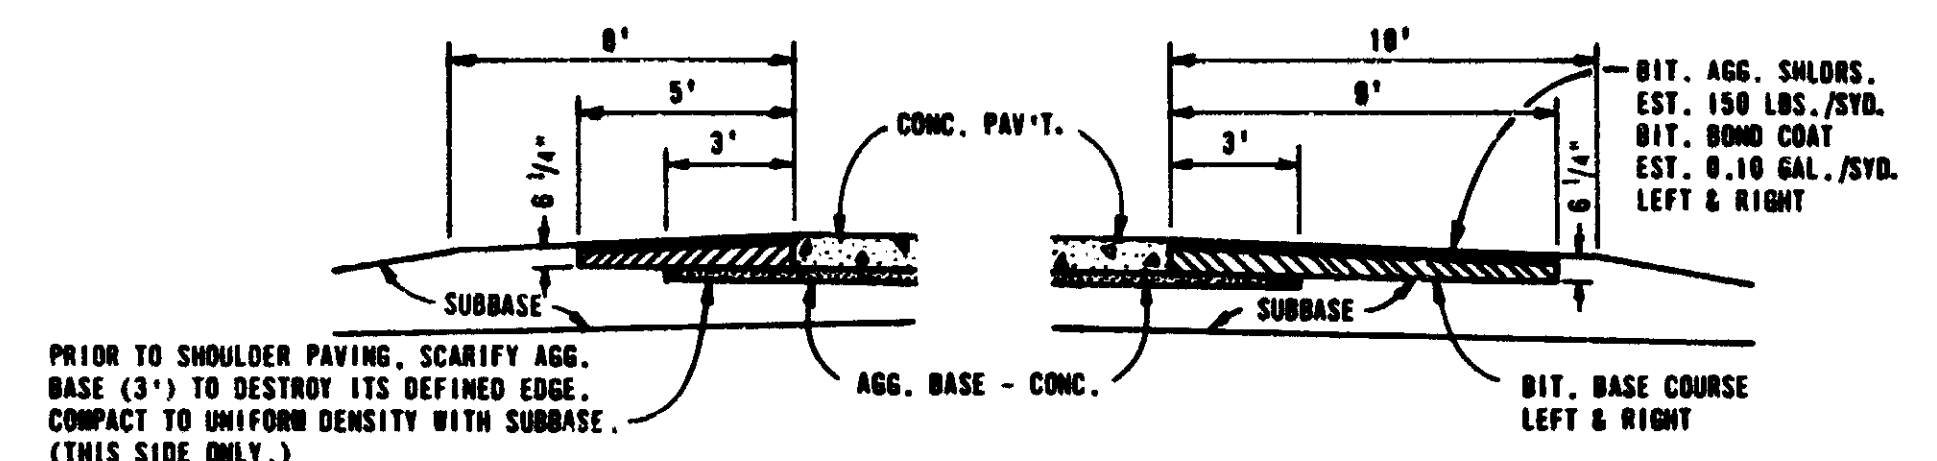


RURAL DUAL CONCRETE ROADWAY

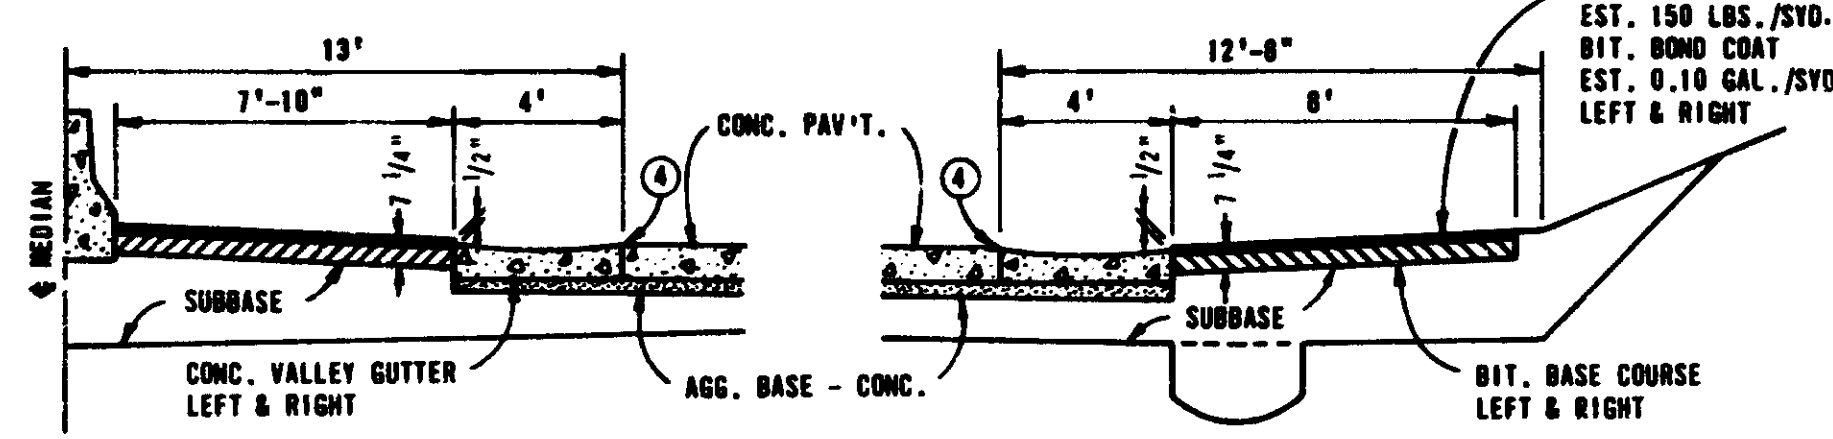


URBAN DUAL CONCRETE ROADWAY

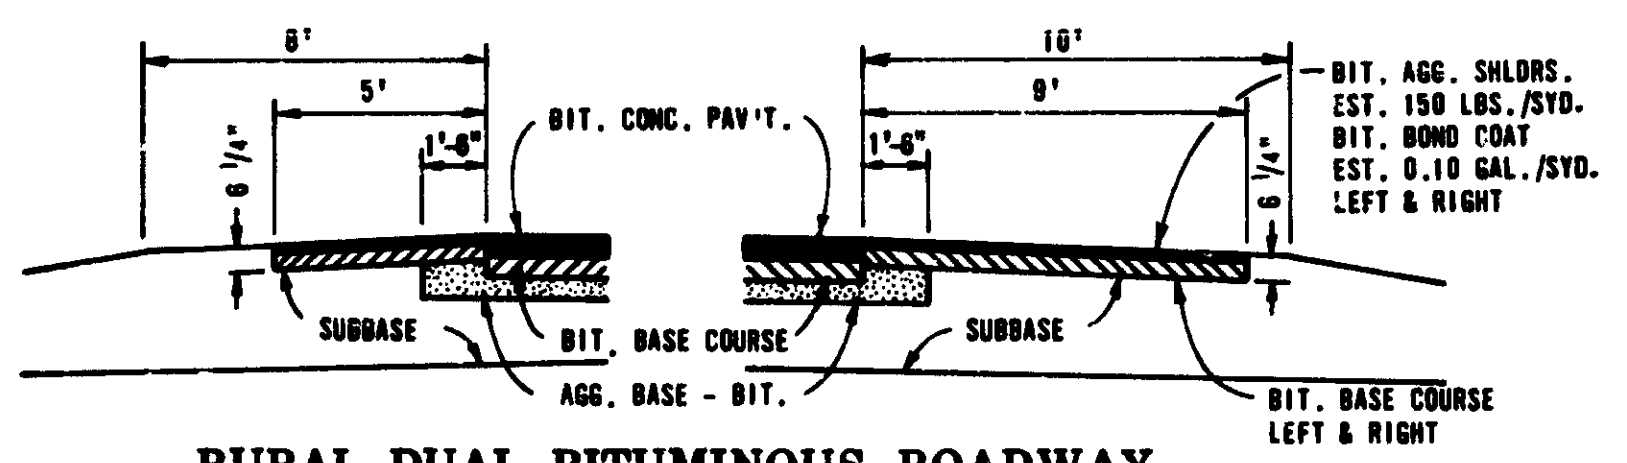


RURAL DUAL BITUMINOUS ROADWAY

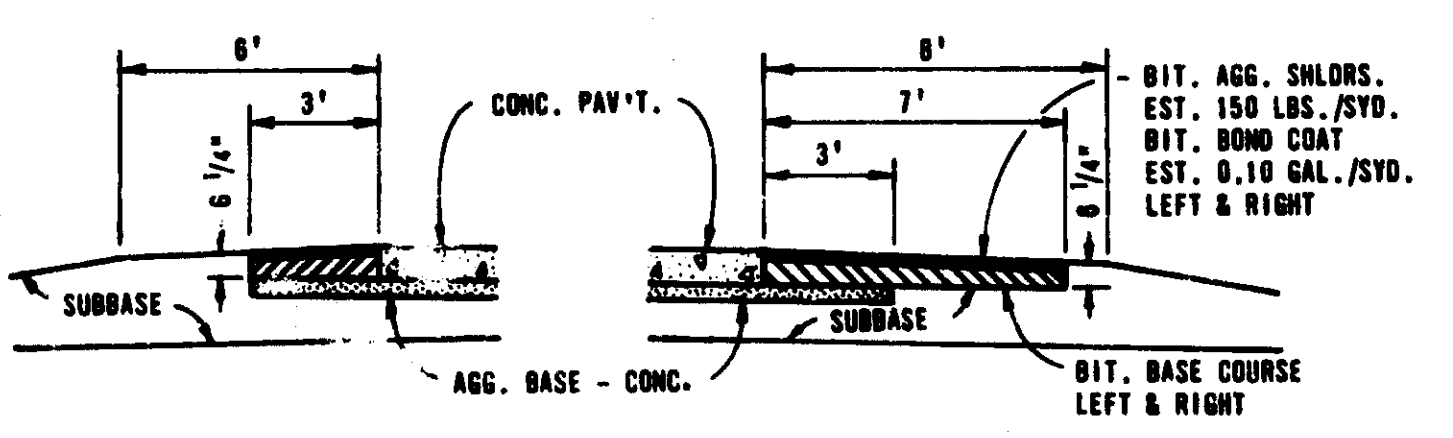


RURAL CONCRETE RAMP

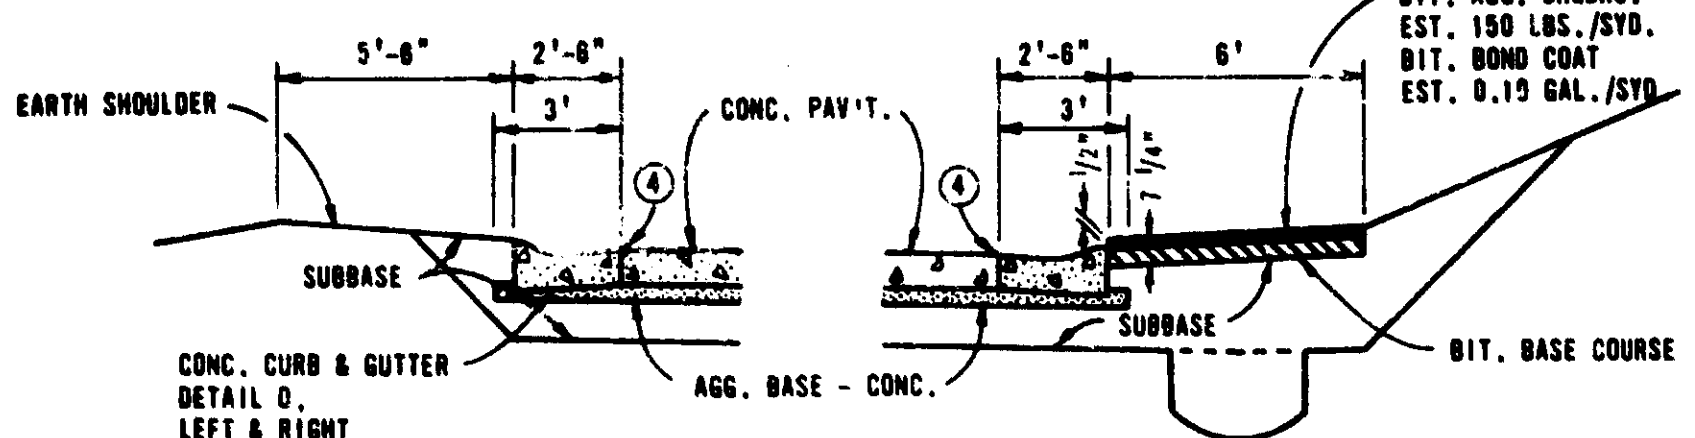

URBAN CONCRETE RAMP

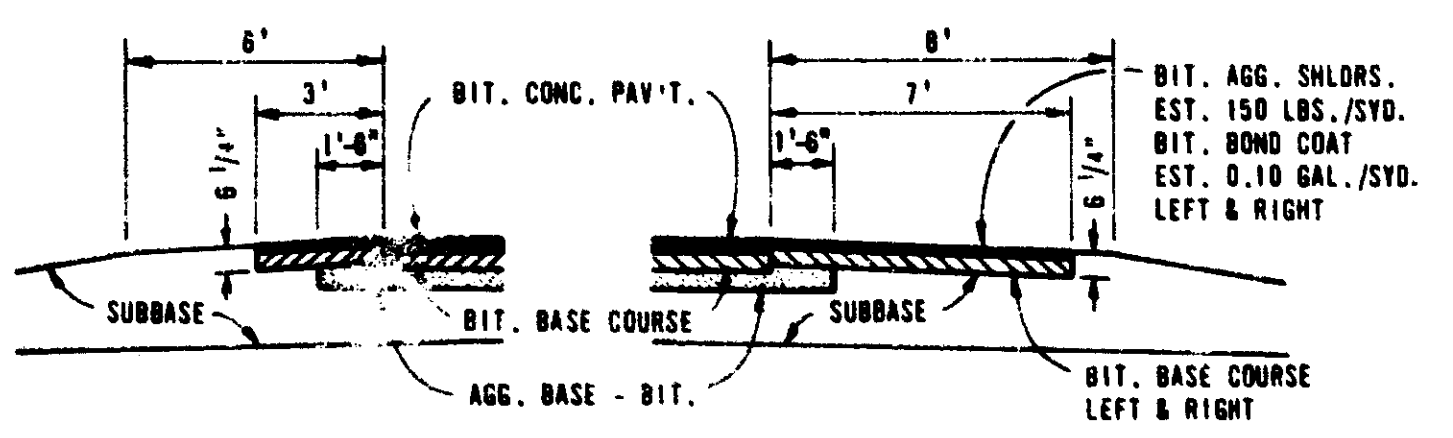

RURAL BITUMINOUS RAMP

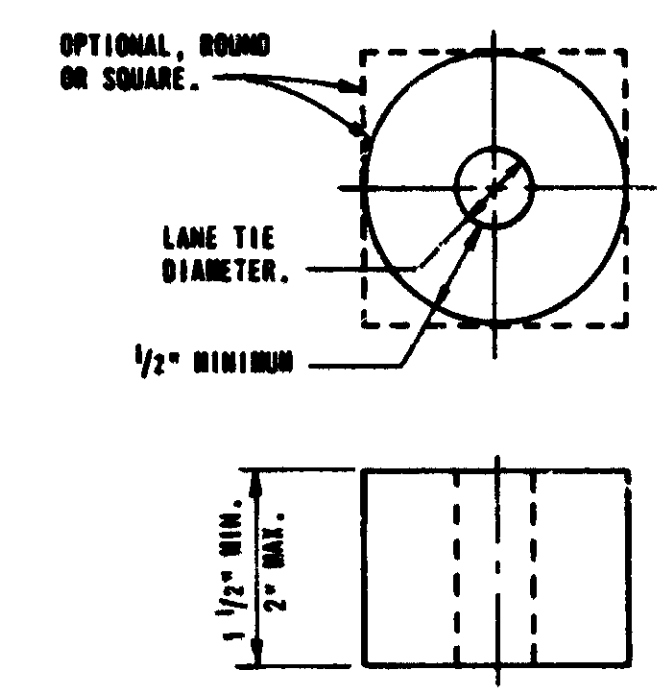

SLEEVE DETAIL
(INCIDENTAL TO LANE TIE)

LONGITUDINAL JOINT TYPE (SEE STANDARD PLAN II-41 SERIES)


- ① OPTIONAL B OR D ON ONE SIDE OF MEDIAN BARRIER ONLY. SEAL JOINT BUT OMIT LANE TIES. OMIT JOINT WHEN MEDIAN WIDTH IS LESS THAN 20' EDGE TO EDGE OF TRAVELED LANES. SAWING AND SEALING WILL NOT BE PAID FOR SEPARATELY.
- ② 1/2" LONGITUDINAL EXPANSION JOINT WHEN MEDIAN IS ENTIRELY PAVED WITH PORTLAND CEMENT CONCRETE. OTHERWISE, B OR D WITHOUT LANE TIES OR SEALS.
- ③ B JOINT, OMIT SEALS AND LANE TIES. APPLY TWO ADDITIONAL COATS OF CURING COMPOUND, AS A BOND BREAKER, AT THE RATE OF 1 GALLON PER 100 SQUARE FEET PER COAT. IF THE SHOULDER IS RESTRAINED ON THE OUTSIDE BY A RETAINING WALL, ABUTMENT, OR SLOPE PAVING TOE HEADER, PLACE 1/2" EXPANSION JOINT FILLER BETWEEN THE SHOULDER AND STRUCTURE.
- ④ OPTIONAL B OR D.

NOTE: IF CONTRACTOR ELECTS TO CAST CONCRETE SHOULDERS THICKER THAN CALLED FOR, "D" JOINTS SHALL BE MINIMUM 1/4 DEPTH OF MAXIMUM THICKNESS.


IF THE CONTRACTOR ELECTS TO CAST CONCRETE SHOULDERS AS PART OF THE "FREEWAY SHOULDER" OPTION, THE EXTERNAL LONGITUDINAL JOINT WILL NOT BE PAID FOR SEPARATELY.

FOR CONCRETE SHOULDERS ADJACENT TO CONTINUOUSLY REINFORCED CONCRETE PAVEMENT SEE SPECIAL DETAILS.


CONCRETE PAVED SHOULDERS

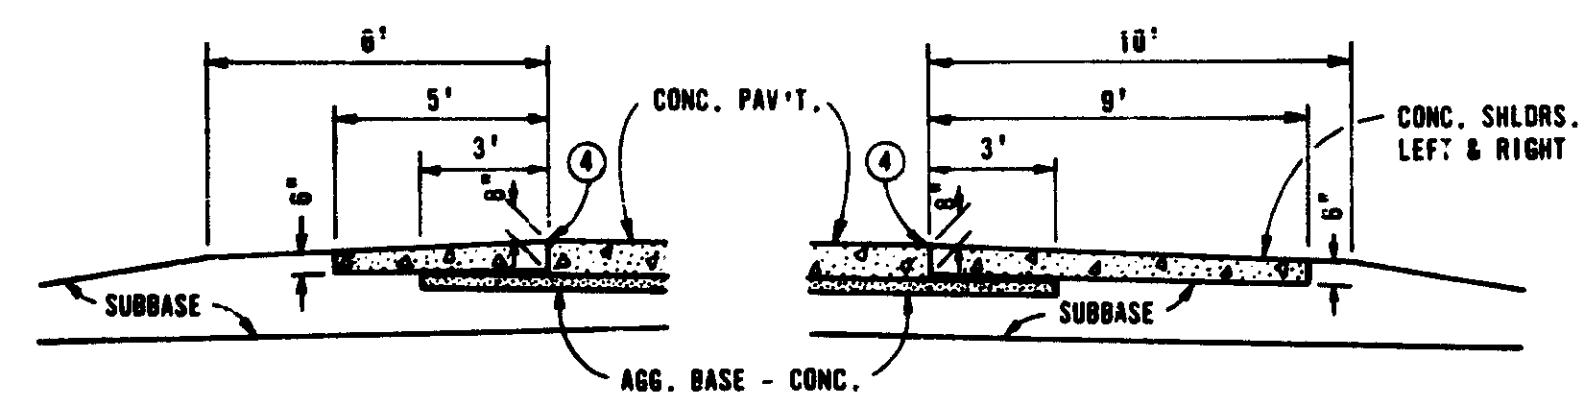


RURAL DUAL CONCRETE ROADWAY

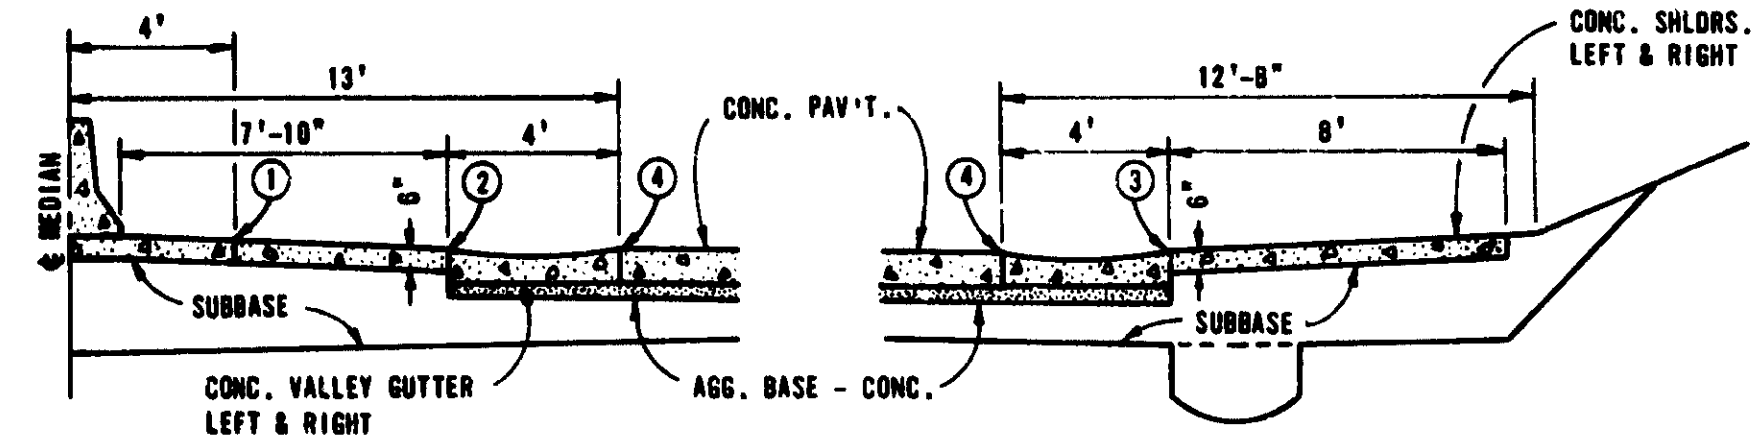

RURAL CONCRETE RAMP

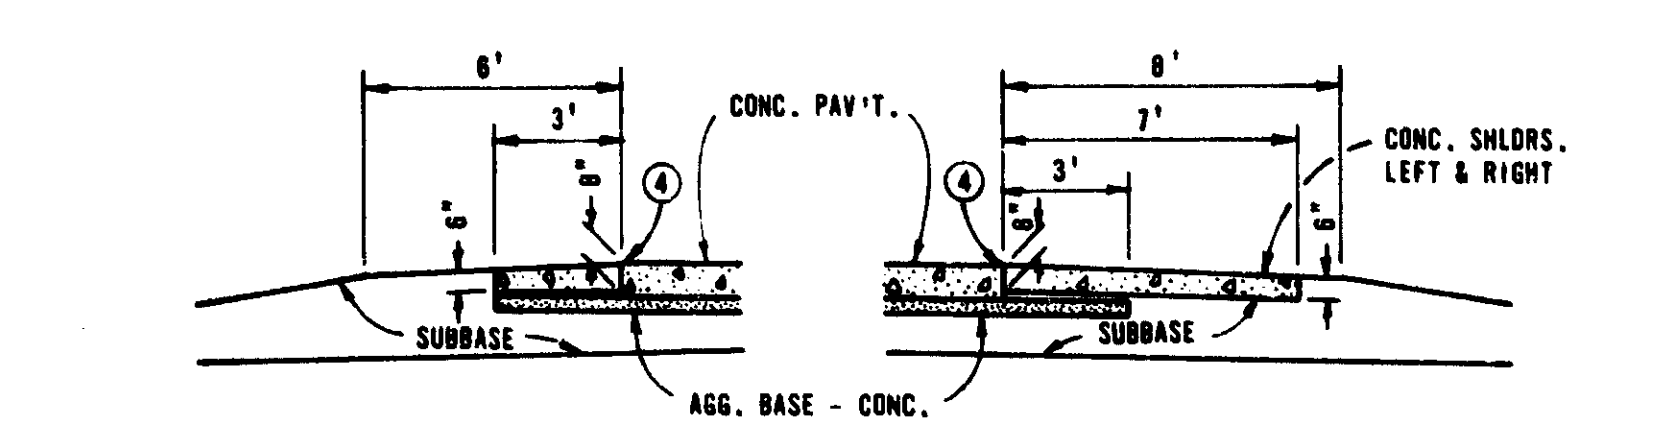

URBAN CONCRETE RAMP

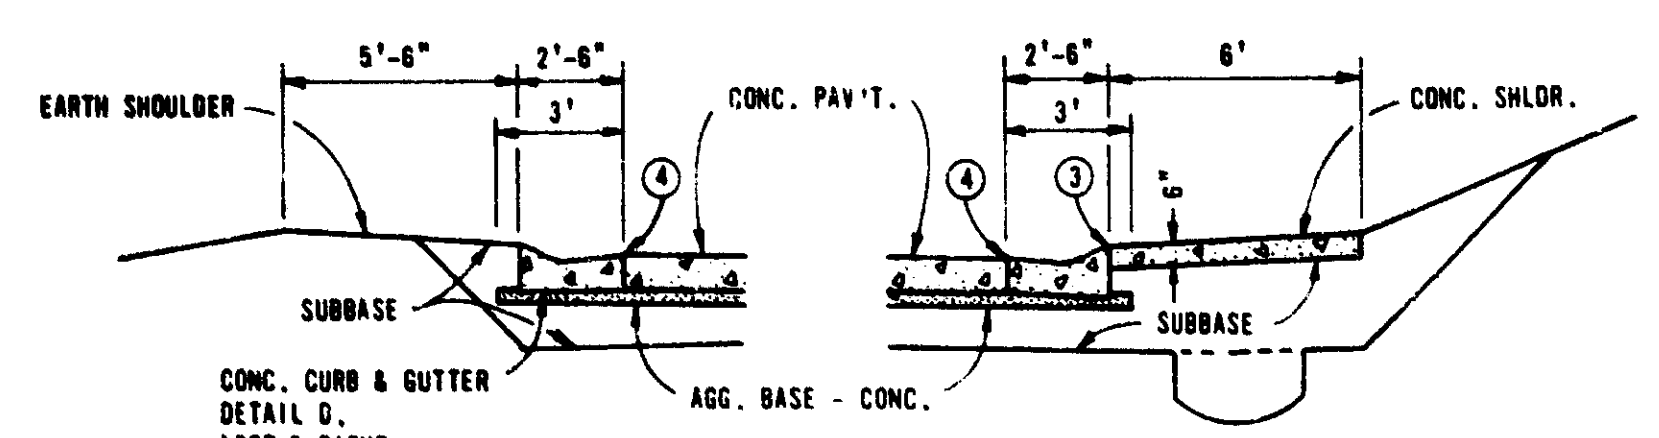


URBAN CONCRETE RAMP (ROLL CURB AND GUTTER ILLUSTRATED)


PREPARED BY DESIGN DIVISION	<i>C. J. Zujewski</i> ENGINEER - ROAD DESIGN	<i>John P. Woodford</i> ENGINEER OF DESIGN	MICHIGAN DEPARTMENT OF TRANSPORTATION BUREAU OF HIGHWAYS STANDARD PLAN FOR	
DRAWN BY	J. L. R. ENGINEER OF TESTING AND RESEARCH	DEPARTMENT DIRECTOR JOHN P. WOODFORD	FREEWAY SHOULDERS	
CHECKED BY	V. R. ENGINEER OF CONSTRUCTION	BY: <i>John P. Woodford</i> DEPUTY DIRECTOR - HIGHWAYS	F. H. W. A. APPROVAL DATE	5-2-79 PLAN DATE
			V-112E	SHEET 1 OF 4

PREPARED BY DESIGN DIVISION	<i>C. J. Zujewski</i> ENGINEER - ROAD DESIGN	<i>John P. Woodford</i> ENGINEER OF DESIGN	MICHIGAN DEPARTMENT OF TRANSPORTATION BUREAU OF HIGHWAYS STANDARD PLAN FOR	
DRAWN BY	J. L. R. ENGINEER OF TESTING AND RESEARCH	DEPARTMENT DIRECTOR JOHN P. WOODFORD	FREEWAY SHOULDERS	
CHECKED BY	V. R. ENGINEER OF CONSTRUCTION	BY: <i>John P. Woodford</i> DEPUTY DIRECTOR - HIGHWAYS	F. H. W. A. APPROVAL DATE	5-2-79 PLAN DATE
			V-112E	SHEET 2 OF 4


CONTROL SECTION 15 63174 JOB NO 14165 FEDERAL PROJECT NO 175-2(22)59

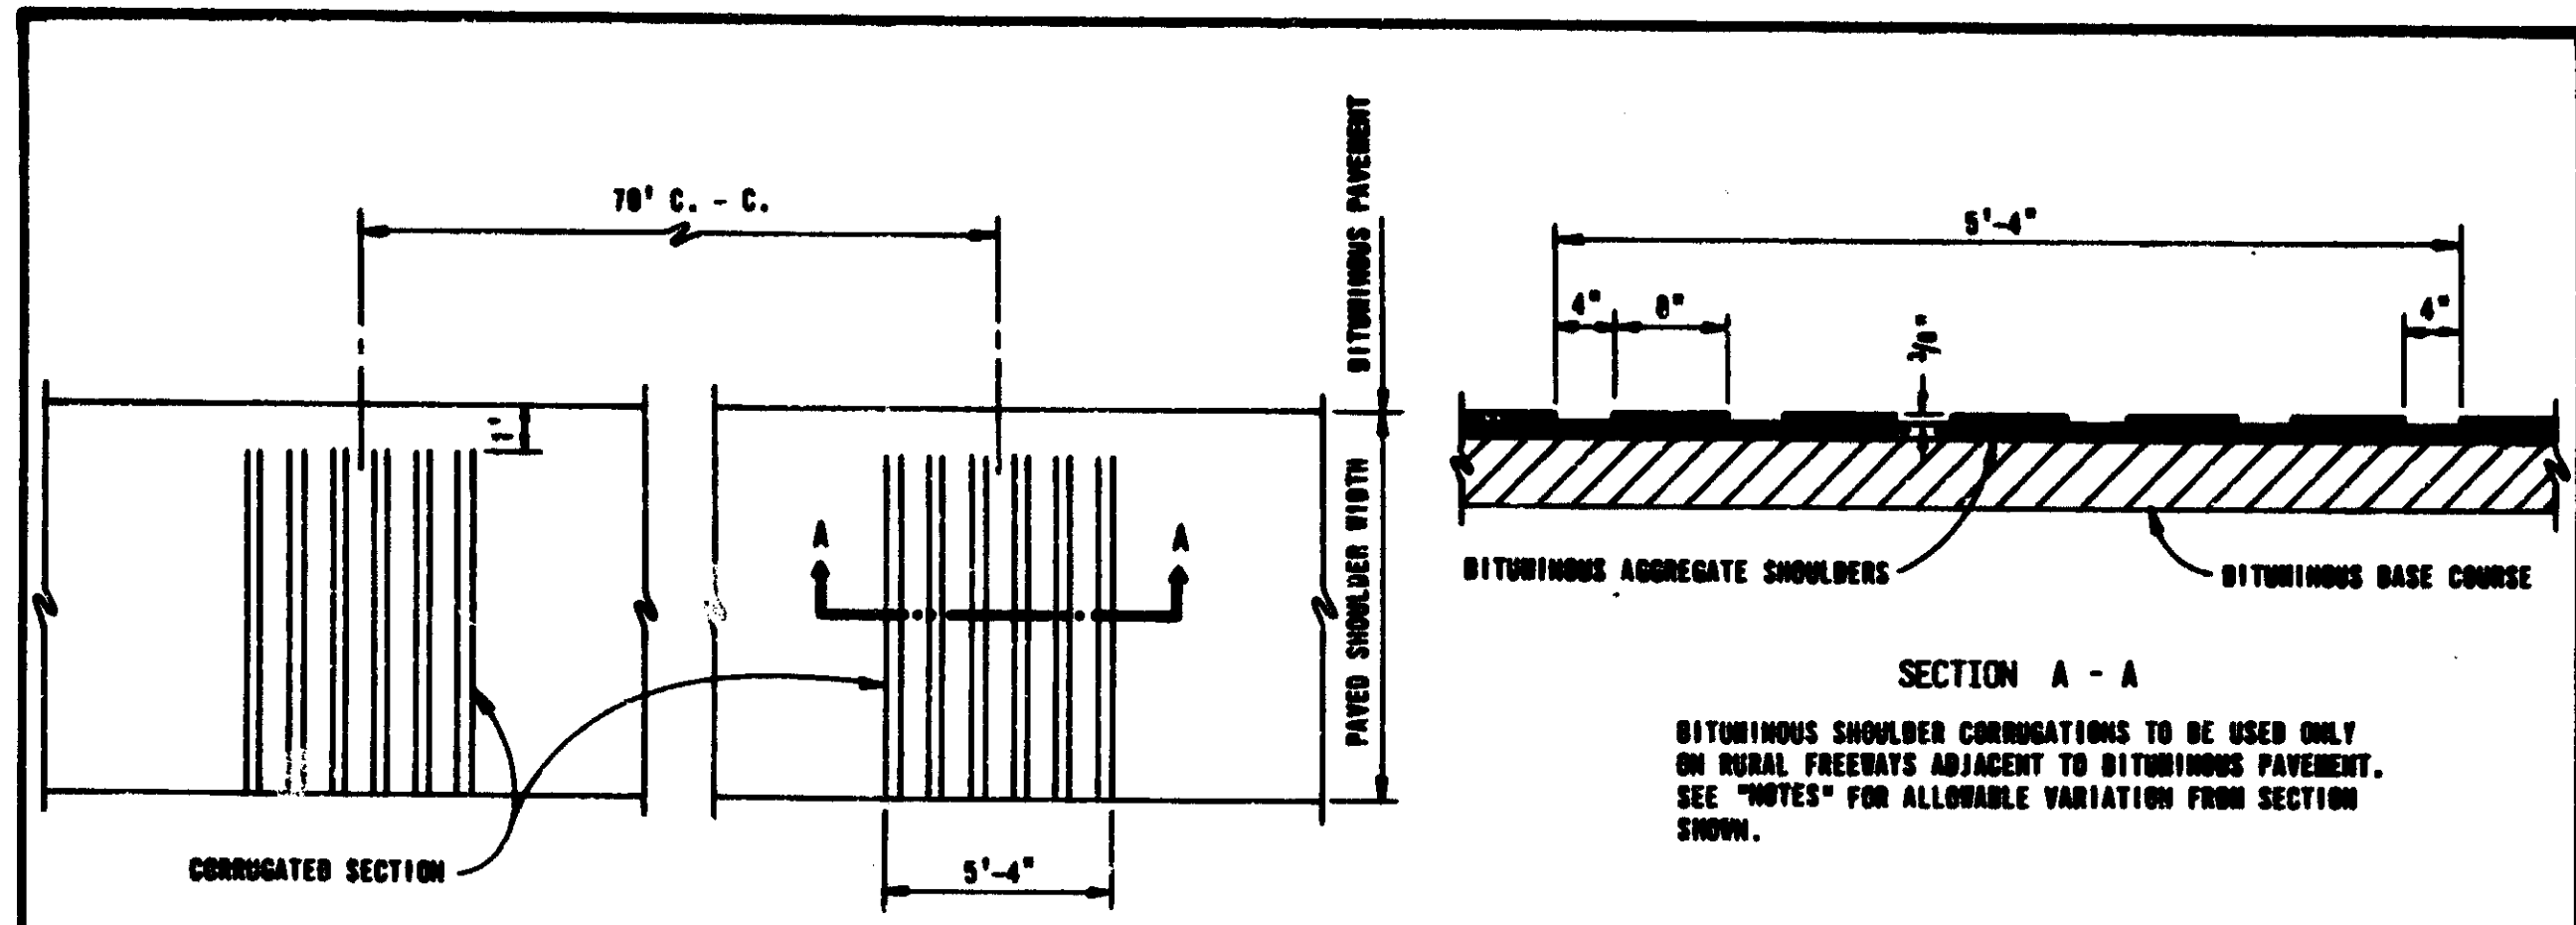

BITUMINOUS SHOULDER AND CORRUGATED SECTION

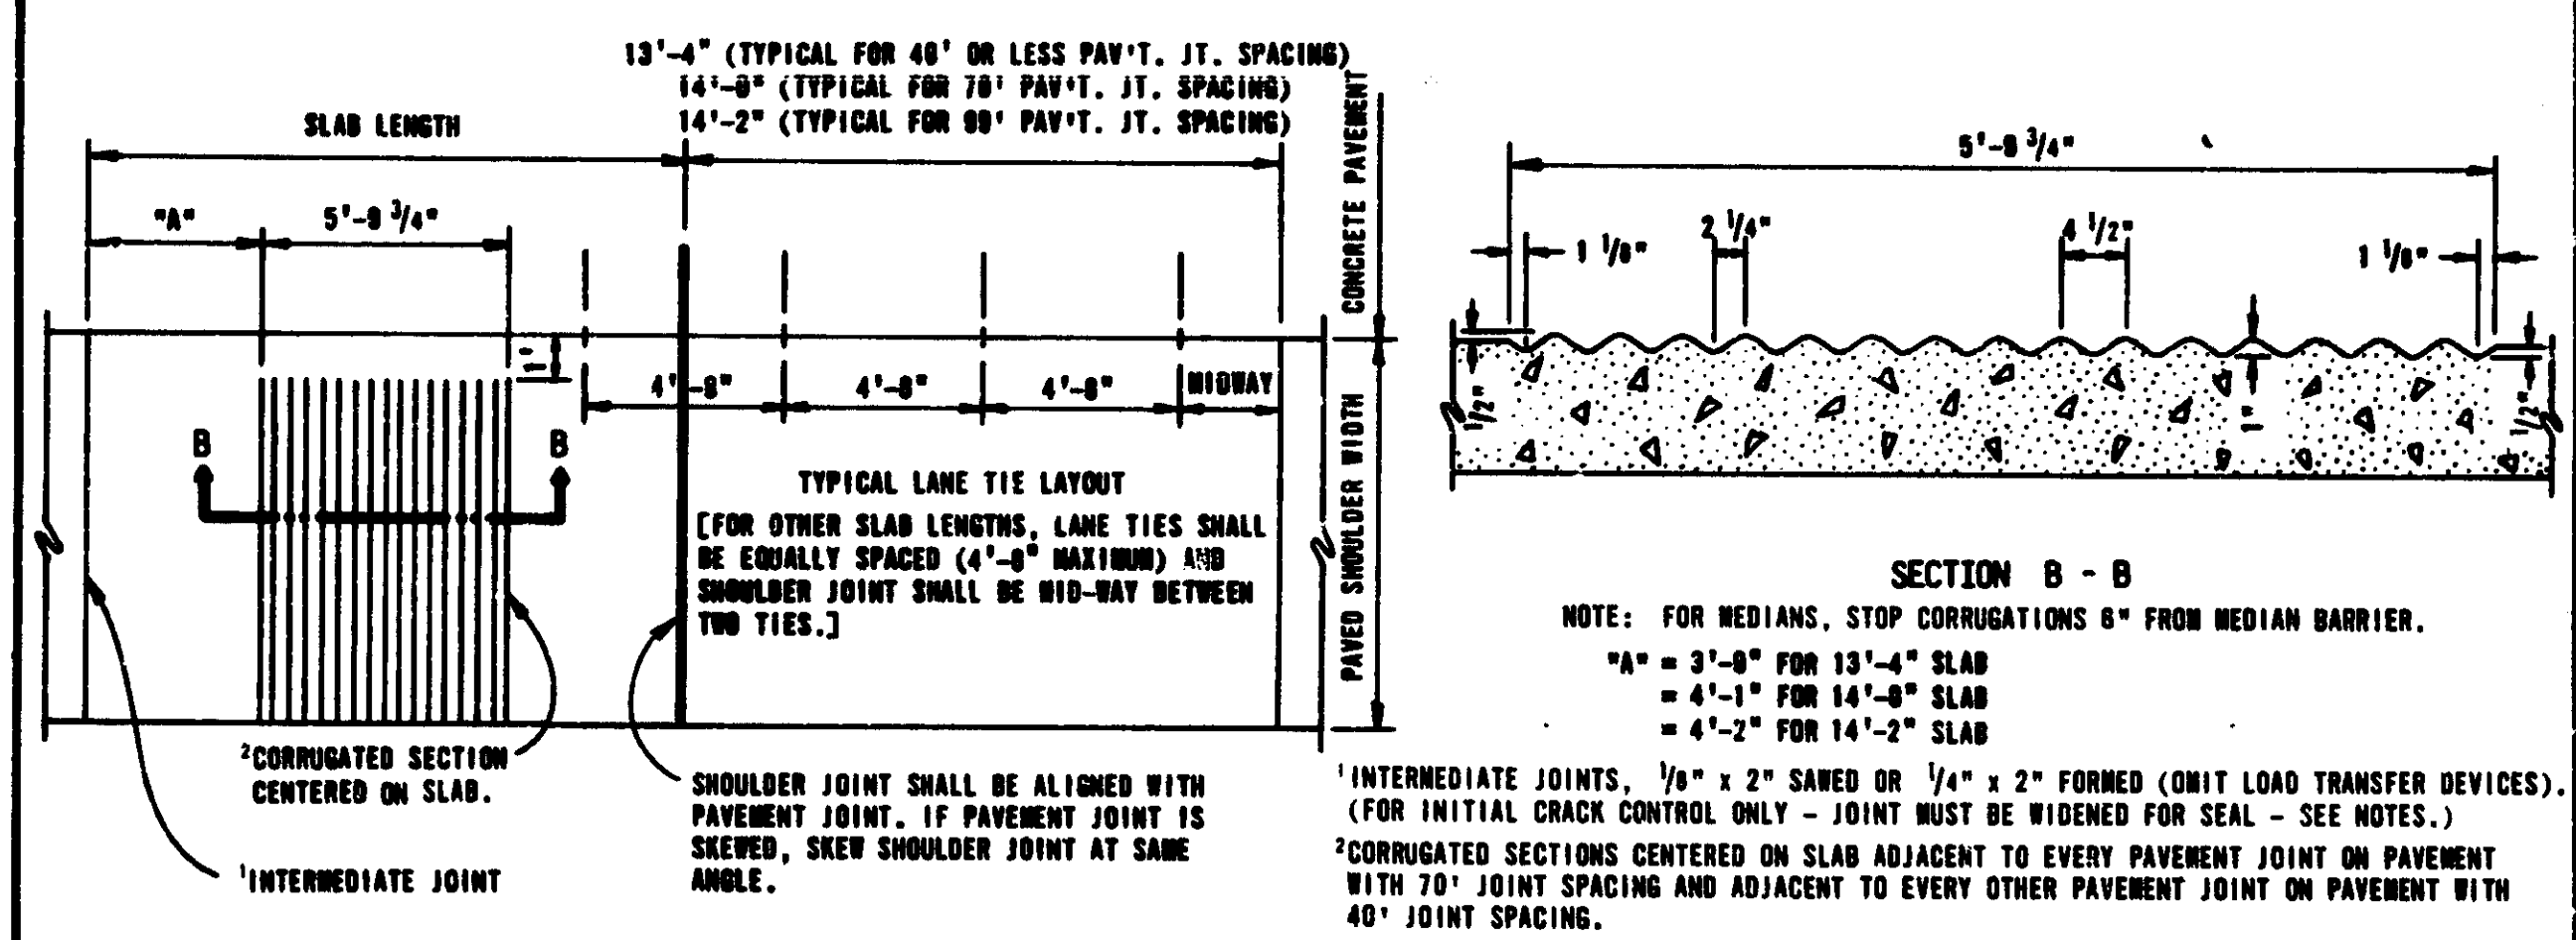

CONCRETE SHOULDER, JOINTS, AND CORRUGATED SECTION
(SHOWN ADJACENT TO JOINTED PAVEMENT)

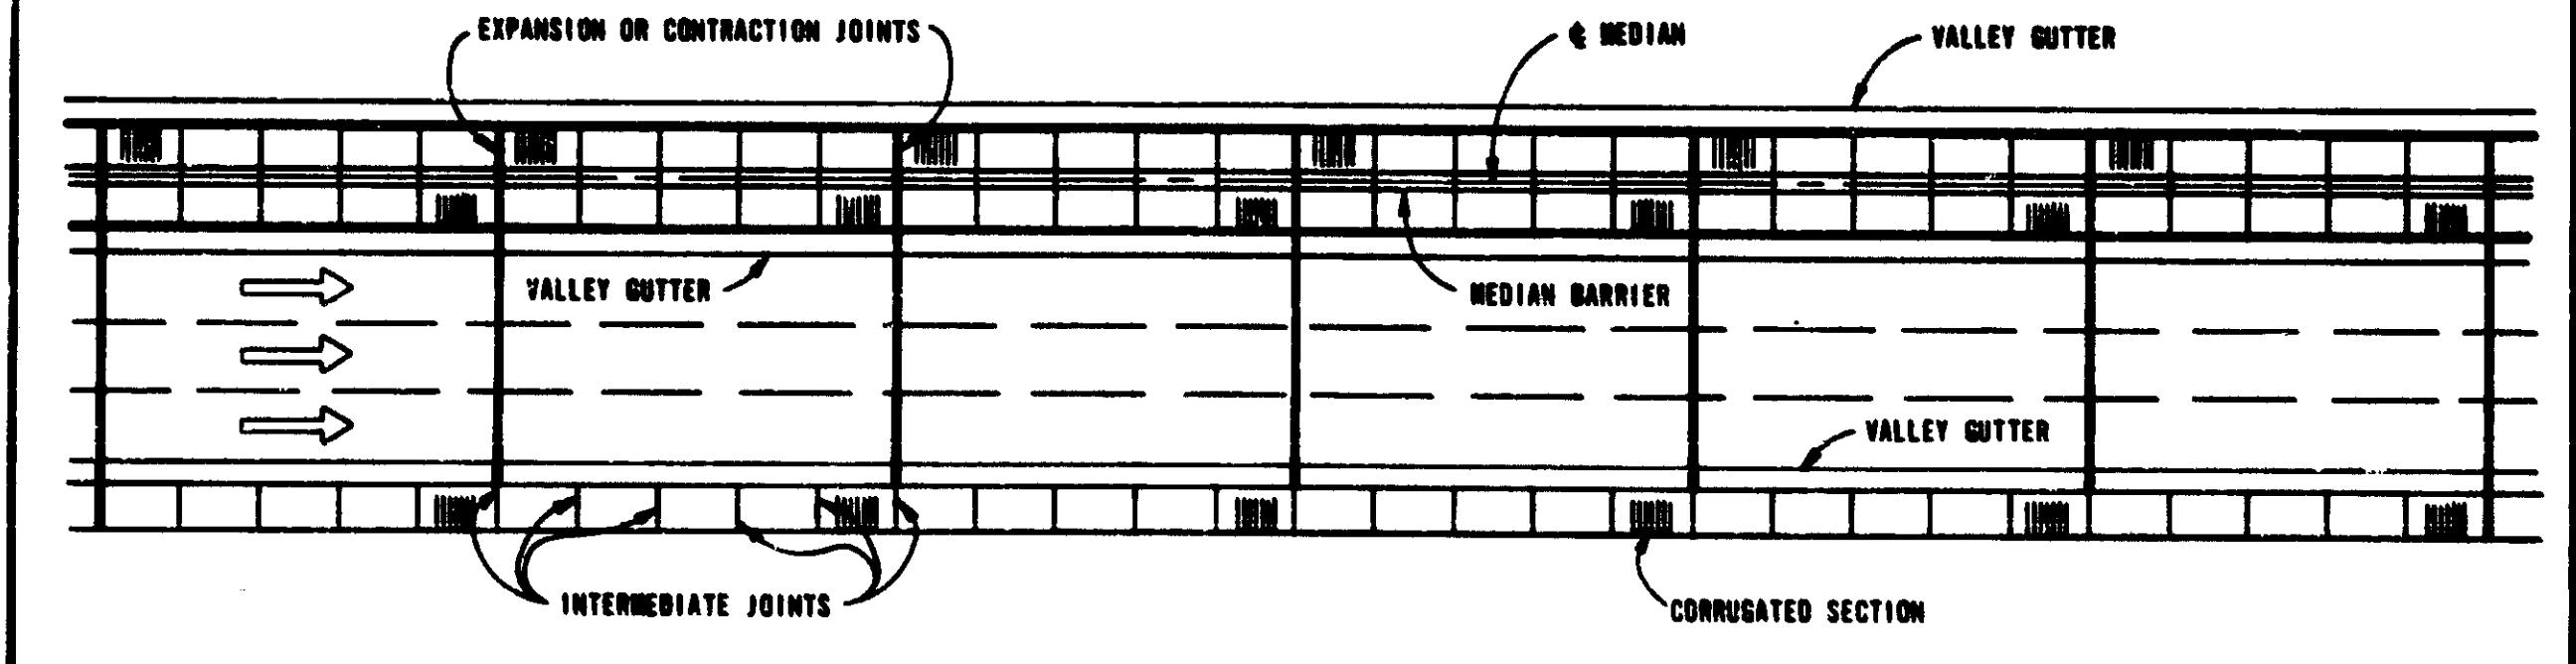

CONCRETE SHOULDER JOINT LAYOUT ON URBAN EXPRESSWAY
(SHOWN FOR CONCRETE PAVEMENT WITH 70' JOINT SPACING)

PREPARED BY DESIGN DIVISION	<i>C. J. Zojke</i> ENGINEER - ROAD DESIGN	<i>W. H. McCreary</i> ENGINEER OF DESIGN	MICHIGAN DEPARTMENT OF TRANSPORTATION BUREAU OF HIGHWAYS STANDARD PLAN FOR
DRAWN BY	<i>J. L. R.</i> ENGINEER OF TESTING AND RESEARCH	<i>John P. Woodford</i> DEPARTMENT DIRECTOR	FREWAY SHOULDERS
CHECKED BY	<i>V. R.</i> ENGINEER OF CONSTRUCTION	<i>John P. Woodford</i> DEPUTY DIRECTOR - HIGHWAYS	F.N.R.A. APPROVAL DATE: 5-2-79 PLAN DATE: V-112E SHEET 3 OF 4

NOTES:

- RURAL FREEWAY SHOULDER WIDTHS ARE FOR TWO-LANE ROADWAYS. FOR THREE OR MORE LANES, INSIDE SHOULDER WIDTH IS INCREASED TO 10' WITH 9' PAVED. WHEN TRUCK VOLUMES EXCEED 250 VEHICLES PER HOUR, OUTSIDE SHOULDER MAY BE WIDENED TO 12' WITH 11' PAVED (WIDTHS SHOWN ON TYPICAL CROSS-SECTION SHEET SHALL GOVERN).
- NORMAL SHOULDER SLOPE IS 1/2" PER FOOT FOR ALL SECTIONS.
- CORRUGATIONS IN CONCRETE AND BITUMINOUS SHOULDERS:
- USE WITH:
 - a. FULL WIDTH SHOULDERS (7' OUTSIDE, 5' INSIDE, OR WIDER).
 - b. VALLEY CUTTER AND SHOULDER.
- DO NOT USE WITH:
 - a. 3' INSIDE SHOULDERS.
 - b. ROLL CURB AND CUTTER.
- SLEEVE TO BE MADE OF SOFT RUBBER, CORK, EXPANDED POLYETHYLENE OR OTHER APPROVED COMPRESSIBLE MATERIAL. SLEEVE MUST BE PLACED ADJACENT TO FIRST POUR.
- CONCRETE SHOULDERS ADJACENT TO CONCRETE PAVEMENT:
- CAST SEPARATELY FROM CONVENTIONAL REINFORCED PAVEMENT:
 - a. PLACE SLEEVES ON ALL LANE TIES.
 - b. TRANSVERSE JOINT CORRESPONDING WITH PAVEMENT JOINT SHALL BE SAME SIZE, TYPE AND SEALANT, OMITTING LOAD TRANSFER DEVICE. THE NEOPRENE SEALS, IF USED, SHALL BE INSTALLED IN ONE CONTINUOUS PIECE ACROSS BOTH PAVEMENT AND SHOULDER(S), AND CONTINUED DOWN THE OUTSIDE EDGE OF THE SHOULDER.
 - c. THE CONTRACTOR SHALL HAVE THE OPTION OF SEALING INTERMEDIATE JOINTS IN THE CONCRETE SHOULDER USING ONE OF THE FOLLOWING METHODS:
 - 1. HOT-POURED TYPE JOINT SEALANT - THE RESERVOIR SHALL BE SAVED OR FORMED 3/4" WIDE AND 1" DEEP, WITH THE TOP OF SEALANT DERESSED 1/4" BELOW THE TOP OF SHOULDER ELEVATION. AN APPROVED BOND BREAKER SHALL BE USED AS SHOWN FOR SYMBOL (C2) ON STANDARD PLAN II-30 SERIES.
 - 2. PREFORMED NEOPRENE JOINT SEALER - THE JOINT SHALL BE IN ACCORDANCE WITH SYMBOL (D) ON STANDARD PLAN II-30 SERIES.
 - d. PLACE A BOND BREAKER BETWEEN SHOULDER AND PAVEMENT. BOND BREAKER SHALL BE TWO ADDITIONAL COATS OF CURING COMPOUND AT THE RATE OF 1 GALLON PER 100 SQUARE FEET PER COAT.
- CAST INTEGRALLY WITH CONVENTIONAL REINFORCED PAVEMENT:
 - e. OMIT COMPRESSIBLE SLEEVES FROM LANE TIES.
 - f. FOR RAMP ONLY, CROSS-SLOPE MAY BE INCREASED TO 3/16" PER FOOT AND NORMAL SHOULDER SLOPE MAY BE REDUCED TO 3/16" PER FOOT. IN SUPERELEVATION THE RAMP AND SHOULDERS MAY BE SLOPED AT THE SAME RATE.
 - g. TRANSVERSE JOINTS AS IN "b" AND "c" ABOVE.
- CAST SEPARATELY FROM NON-REINFORCED PAVEMENT (RAMPS):
 - h. PLACE SLEEVES ON ALL LANE TIES.
 - i. TRANSVERSE JOINTS AS IN "b" ABOVE EXCEPT INTERMEDIATE JOINTS WILL BE SEALED WITH NEOPRENE SEALS.
 - j. USE BOND BREAKER AS IN "a" ABOVE.
- CAST INTEGRALLY WITH NON-REINFORCED PAVEMENT (RAMPS):
 - k. OMIT COMPRESSIBLE SLEEVES FROM LANE TIES.
 - l. SEE "f" ABOVE FOR CROSS-SLOPE.
 - m. TRANSVERSE JOINTS AS IN "b" ABOVE EXCEPT INTERMEDIATE JOINTS WILL BE SEALED WITH NEOPRENE SEALS.

CONCRETE SHOULDERS SEPARATED FROM CONCRETE PAVEMENT BY CURB AND GUTTER OR VALLEY CUTTER:

- a. PLACE 1" EXPANSION JOINTS IN THE OUTSIDE CONCRETE SHOULDERS AT APPROXIMATELY 400' INTERVALS BETWEEN SEPTEMBER 15th AND MAY 15th, SEALED IN ACCORDANCE WITH DETAILS SHOWN FOR SYMBOL (E) OF STANDARD PLAN II-30 SERIES. EXPANSION AND INTERMEDIATE JOINTS IN MEDIAN SHOULDERS AND CONCRETE MEDIAN BARRIER MUST COINCIDE.
- b. FOR INITIAL CUT, PLACE 2" DEEP TRANSVERSE INTERMEDIATE JOINT IN THE OUTSIDE CONCRETE SHOULDER AT 13'-4" INTERVALS FOR 40', OR 14'-0" INTERVALS FOR 70', OR 14'-2" INTERVALS FOR 90' PAVEMENT JOINT SPACING, LINING UP THE JOINTS WITH THE JOINTS IN THE CURB AND GUTTER, OR VALLEY CUTTER. ALL JOINTS IN THE OUTSIDE SHOULDER ARE INTERMEDIATE JOINTS, EXCEPT THE EXPANSION JOINTS AT 400' INTERVALS (IF USED).
- c. SEAL INTERMEDIATE JOINTS IN ACCORDANCE WITH "c" UNDER "CONCRETE SHOULDERS ADJACENT TO CONCRETE PAVEMENT".


BITUMINOUS SHOULDERS ADJACENT TO BITUMINOUS PAVEMENT:

- FOR RAMP ONLY, CROSS-SLOPE MAY BE INCREASED TO 3/16" PER FOOT AND NORMAL SHOULDER SLOPE MAY BE REDUCED TO 3/16" PER FOOT. IN SUPERELEVATION, THE RAMP AND SHOULDERS MAY BE SLOPED AT THE SAME RATE.
- FOR CORRUGATIONS IN BITUMINOUS SHOULDERS, THE CONTRACTOR MAY SUBMIT, FOR THE APPROVAL OF THE ENGINEER OF CONSTRUCTION, ALTERNATE DIMENSIONS OR CONFIGURATIONS WHICH WILL PROVIDE AN EQUIVALENT "RUMBLE" EFFECT. THE CONTRACTOR WILL HAVE THE OPTION OF FORMING OR CUTTING GROOVES IN THE SHOULDER TO FORM THE RUMBLE STRIP. IF THE RUMBLE STRIP IS TO BE SAVED IN, OR ROTO-BILLED IN, THE CONTRACTOR SHOULD WAIT A MINIMUM OF 72 HOURS AFTER THE MAT IS PLACED BEFORE SAWING OR ROTO-BILLING.

SEE STANDARD PLAN II-49 SERIES.

PREPARED BY DESIGN DIVISION	<i>C. J. Zojke</i> ENGINEER - ROAD DESIGN	<i>W. H. McCreary</i> ENGINEER OF DESIGN	MICHIGAN DEPARTMENT OF TRANSPORTATION BUREAU OF HIGHWAYS STANDARD PLAN FOR
DRAWN BY	<i>J. L. R.</i> ENGINEER OF TESTING AND RESEARCH	<i>John P. Woodford</i> DEPARTMENT DIRECTOR	FREWAY SHOULDERS
CHECKED BY	<i>V. R.</i> ENGINEER OF CONSTRUCTION	<i>John P. Woodford</i> DEPUTY DIRECTOR - HIGHWAYS	F.N.R.A. APPROVAL DATE: 5-2-79 PLAN DATE: V-112E SHEET 4 OF 4

CONTROL SECTION	15 63174	JOB NO.	14165	GENERAL PROJECT	1752(222)59
-----------------	----------	---------	-------	-----------------	-------------

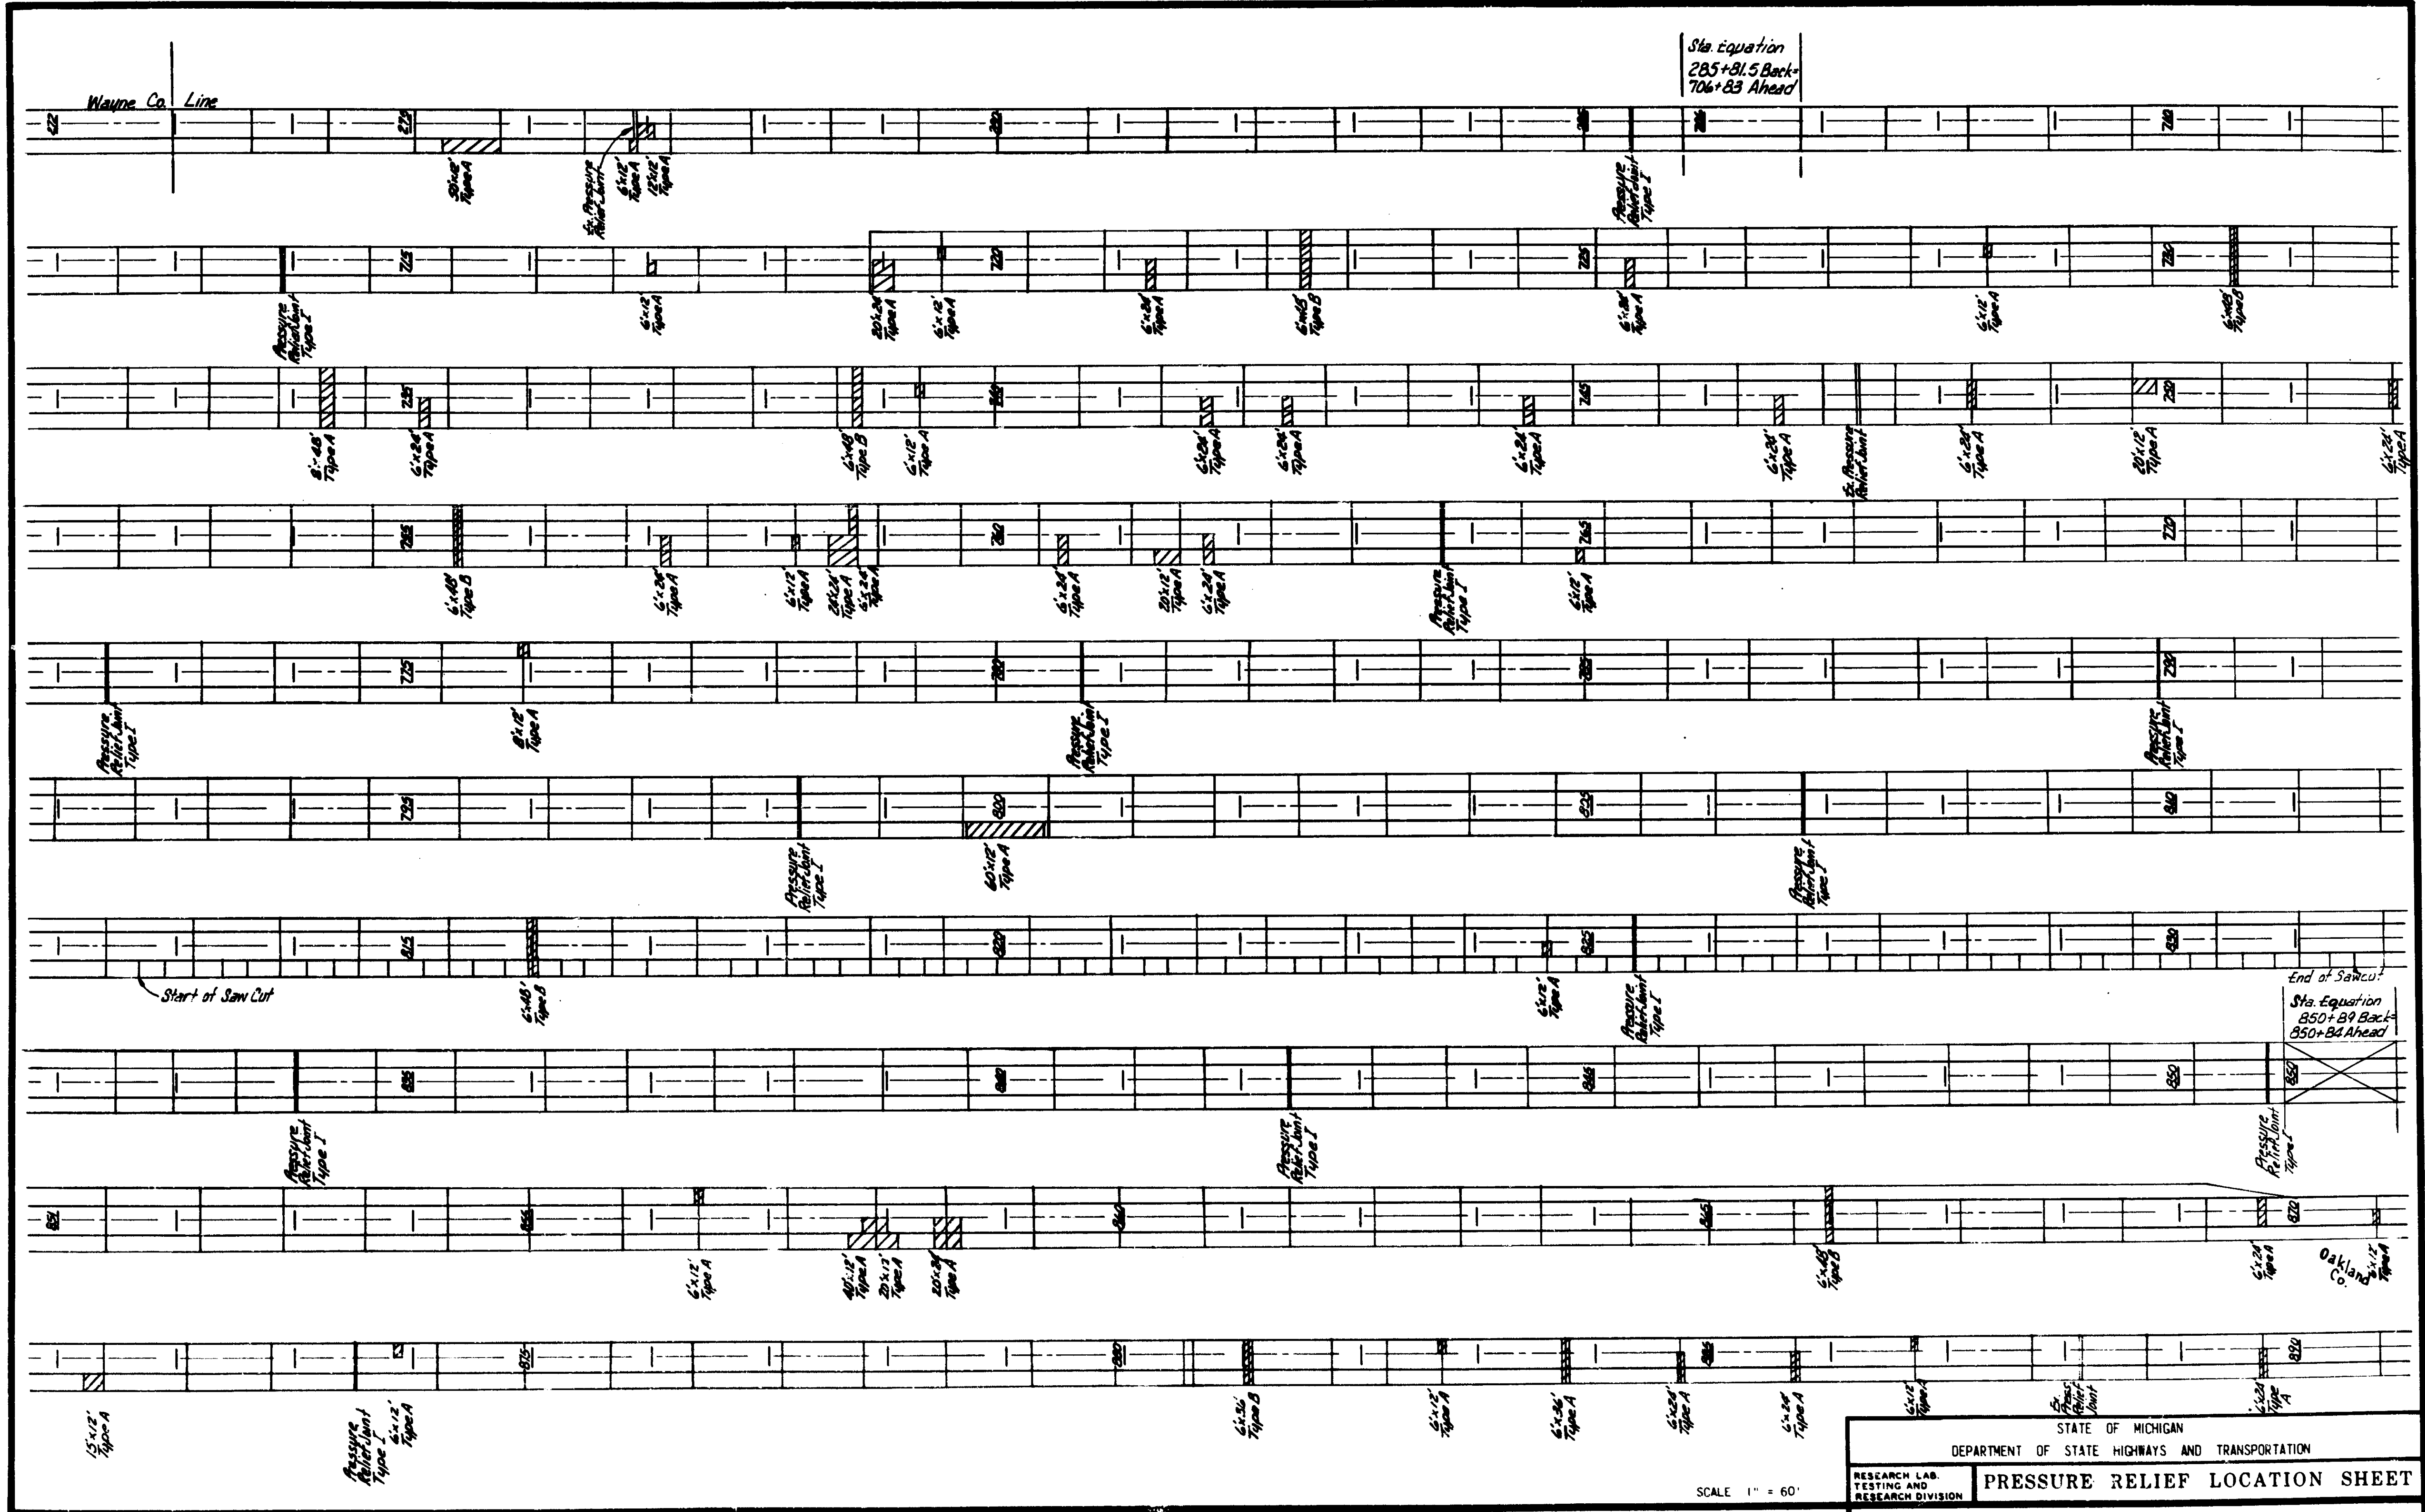

SCALE 1" = 60'


STATE OF MICHIGAN
DEPARTMENT OF STATE HIGHWAYS AND TRANSPORTATION

RESEARCH LAB. TESTING AND RESEARCH DIVISION **PRESSURE RELIEF LOCATION SHEET**

LOCATION Oakland Co. (N.B. Rdwy.) SHEET OF ROUTE 7-75

STATE PROJECT MAINT PROJECT Sheet No. 21

SECTION 408 PLAN 63174 JOB 14166 A

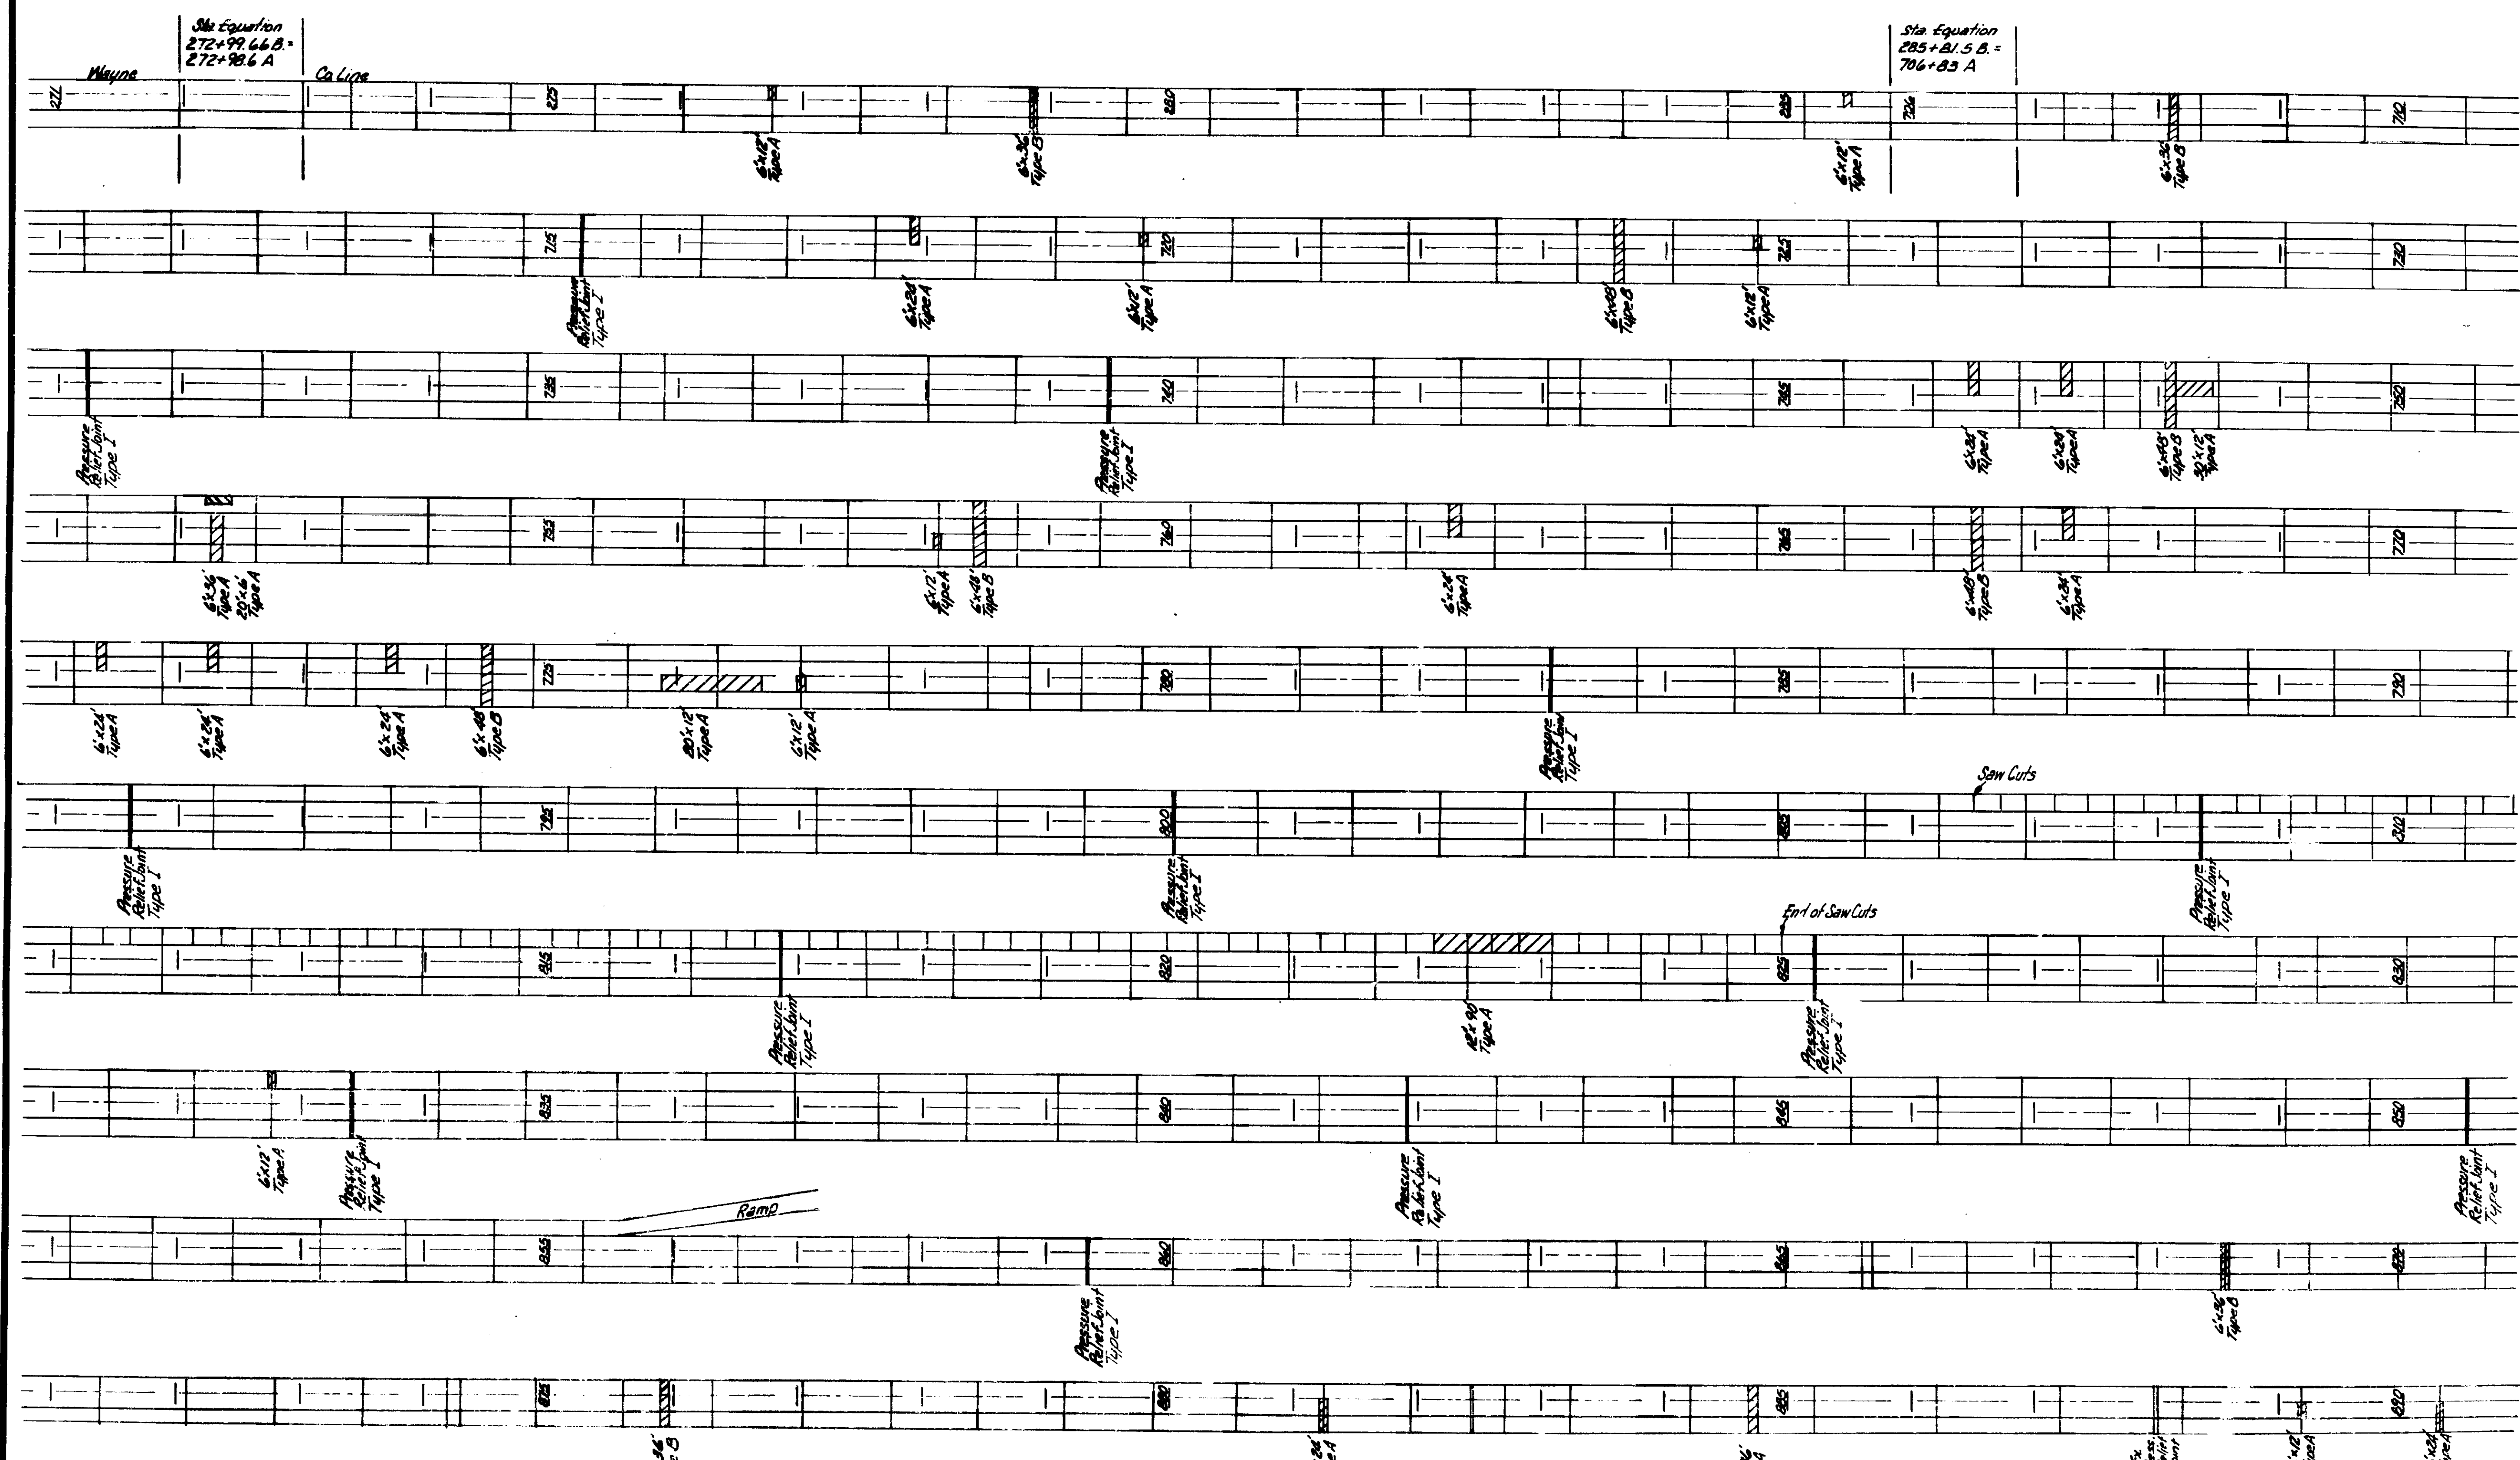

STATE OF MICHIGAN
DEPARTMENT OF STATE HIGHWAYS AND TRANSPORTATION

RESEARCH LAB. TESTING AND RESEARCH DIVISION


PRESSURE RELIEF LOCATION SHEET

LOCATION: Oakland Co. (S.A. Hwy.)

STATE PROJECT _____ SHEET _____ OF _____ ROUTE 7-75

CONTROL SECTION 63174 JOB NO. 14166 A Sheet No. _____

SCALE 1" = 60'

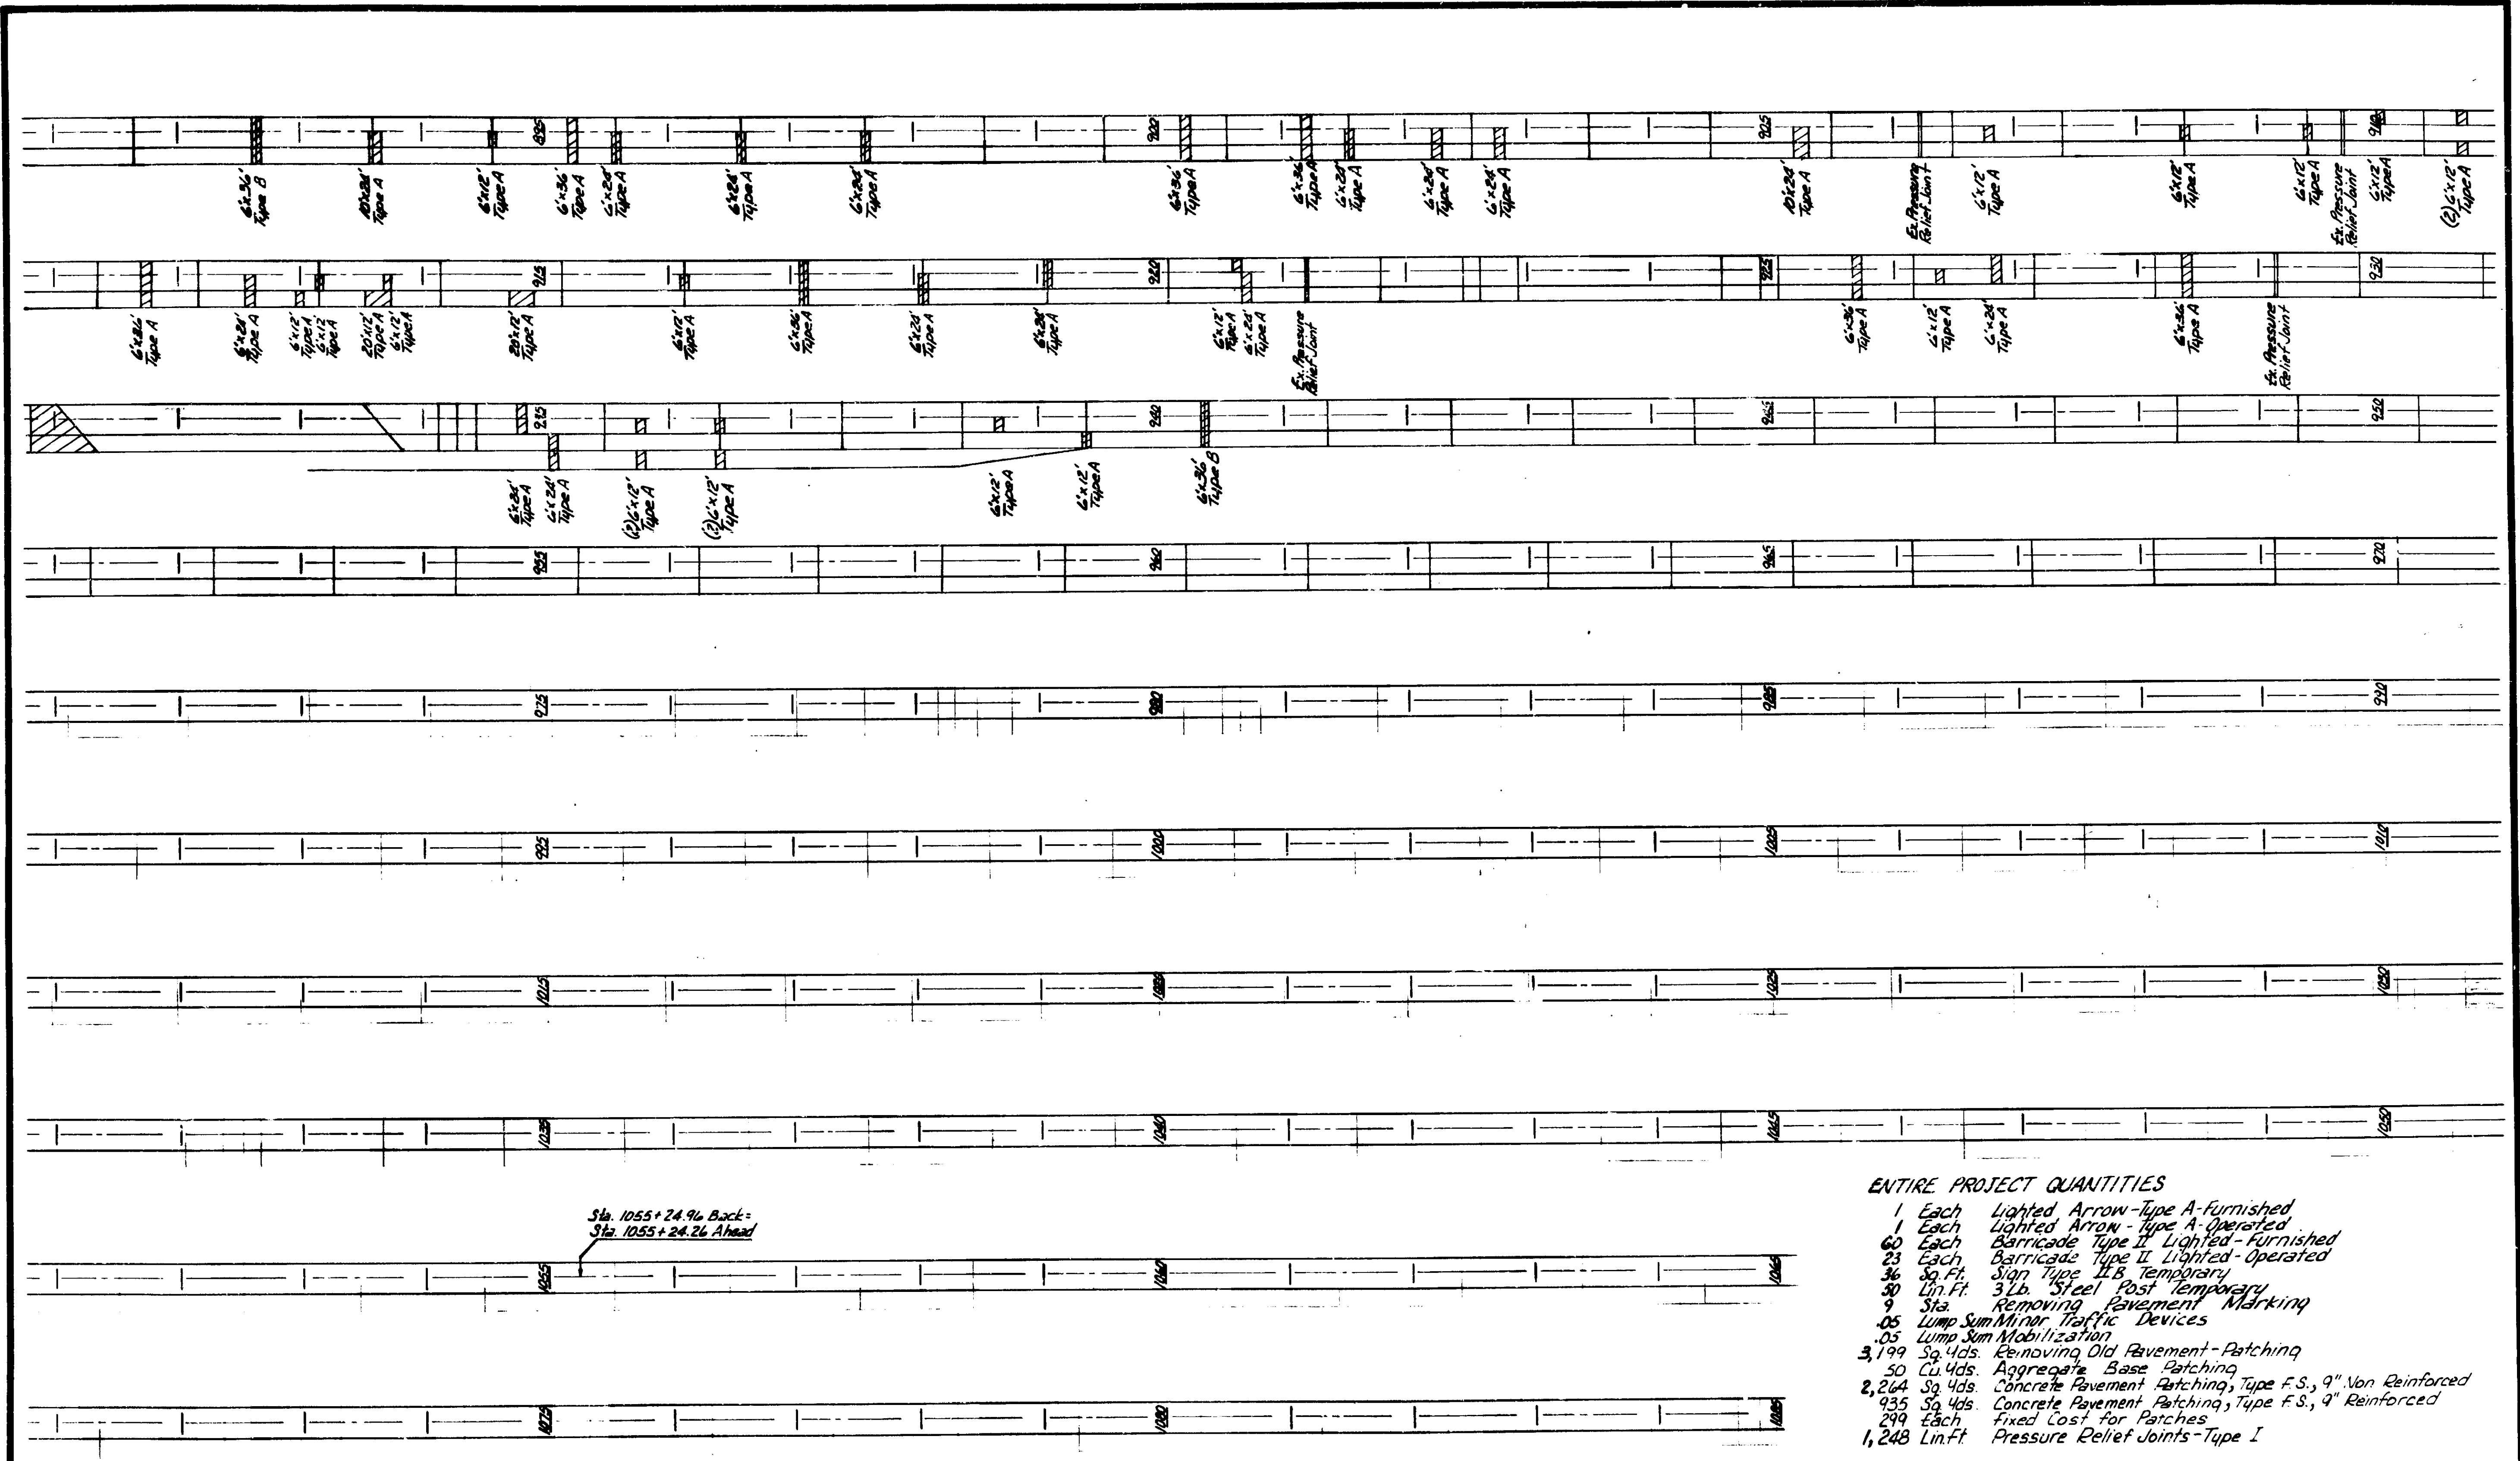

Sta. 1055 + 24.96 Back =
Sta. 1055 + 24.26 Ahead

- ENTIRE PROJECT QUANTITIES**
- 1 Each Lighted Arrow - Type A - Furnished
 - 1 Each Lighted Arrow - Type A - Operated
 - 60 Each Barricade Type II - Lighted - Operated
 - 23 Each Barricade Type II - Lighted - Furnished
 - 36 Sq. Ft. Sign Type II - Temporary
 - 30 Lin. Ft. 3 Lb. Steel Post Temporary
 - 9 Sta. Removing Pavement Marking
 - .05 Lump Sum Minor Traffic Devices
 - .05 Lump Sum Mobilization
 - 3,199 Sq. Yds. Removing Old Pavement - Patching
 - 50 Cu. Yds. Aggregate Base Patching
 - 2,264 Sq. Yds. Concrete Pavement Patching, Type F.S., 9" Non Reinforced
 - 935 Sq. Yds. Concrete Pavement Patching, Type F.S., 9" Reinforced
 - 299 Each Fixed Cost for Patches
 - 1,248 Lin. Ft. Pressure Relief Joints - Type I

SCALE 1" = 60'

STATE OF MICHIGAN	
DEPARTMENT OF STATE HIGHWAYS AND TRANSPORTATION	
RESEARCH LAB. TESTING AND RESEARCH DIVISION	PRESSURE RELIEF LOCATION SHEET
LOCATION <u>Oakland Co. (N.B. Hwy)</u>	SHEET <u>24</u> OF <u>96</u>
STATE PROJECT <u>63174</u>	ROUTE <u>I-75</u>
CONTROL SECTION <u>63174 JOB NO. 14166 A</u>	MAINT PROJECT <u>200359 Sheet No. 24</u>

UNDERGROUND


- ◻ EXISTING MANHOLE
- ◻ MANHOLE (2-WAY)
- △ MANHOLE (3-WAY)
- ◇ MANHOLE (4-WAY)
- ◻ MANHOLE (CORNER)
- ◻ EXISTING HANDHOLE
- ◻ HANDHOLE
- 4-3" — EXISTING CONDUIT (4-3" SHOWN)
- x — ABANDON EXISTING CONDUIT
- 1-3" — ENCASED CONDUIT (1-3" SHOWN)
- 1-3" — GALVANIZED STEEL CONDUIT (1-3" SHOWN)
- 1-2" — GALVANIZED STEEL CONDUIT, JACKING-BORING (1-2" SHOWN)
- — CONDUIT RUN - NOT A PART OF ELECTRICAL CONTRACT
- — DIRECT BURIAL CABLE (NO. & SIZE AS INDICATED)
- — EXISTING DIRECT BURIAL CABLE
- — ABANDON CABLE
- — BUILD 6" SEWER
- 1-3" — DIRECT BURIAL CONDUIT TYPE II (1-3" SHOWN)
- CONCRETE FOUNDATION FOR PAD MOUNT TRANSFORMER
- ◀ CONCRETE FOUNDATION FOR FIRE OR POLICE CALL BOX
- ☼ EXISTING U.G.-FED ST. LTG. UNIT
- ☼_R REMOVE U.G.-FED ST. LTG. UNIT
- ☼_S INSTALL SALVAGED U.G.-FED ST. LTG. UNIT ON NEW FDN.
- ☼_H U.G.-FED, 250 W. TYPE II, HIGH PRESSURE SODIUM ST. LTG. UNIT WITH 30 FT. BRACKET ARM ON NEW FOUNDATION WITH 30 FT. MOUNTING HEIGHT. (EXCEPT WHERE OTHERWISE NOTED)
- ☼_L U.G.-FED, 400 W. TYPE III, HIGH PRESSURE SODIUM ST. LTG. UNIT WITH 45 FT. BRACKET ARM ON NEW FOUNDATION WITH 45 FT. MOUNTING HEIGHT. (EXCEPT WHERE OTHERWISE NOTED)
- ☼_M U.G.-FED, 400 W. TYPE III, HIGH PRESSURE SODIUM ST. LTG. UNIT WITH DBL. BRACKET ARM (12 FT.) ON MEDIAN WALL WITH 45 FT. MOUNTING HEIGHT. (EXCEPT WHERE OTHERWISE NOTED)
- ☼_N U.G.-FED 250 W. TYPE II, HIGH PRESSURE SODIUM ST. LTG. UNIT WITH 30 FT. BRACKET ARM ON BRIDGE OR RETAINING WALL WITH 30 FT. MOUNTING HEIGHT. (EXCEPT WHERE OTHERWISE NOTED)
- WALL MOUNTED U.B. LIGHTING UNIT
- FB INDICATES ST. LTG. STANDARD WITH FRANGIBLE TRANSFORMER BASE
- RF INDICATES FOUNDATION TO BE REMOVED

OVERHEAD

- EXISTING WOOD POLE
- WOOD POLE (HEIGHT & CLASS AS INDICATED)
- OH.-FED, 400 W. TYPE II, CLEAR, MERCURY VAPOR ST. LTG. UNIT WITH 15 FT. BRACKET ARM ON WOOD POLE AND 30 FT. MOUNTING HEIGHT.
- EXISTING OH.-FED ST. LTG. UNIT WITH WOOD POLE
- 3-#6 — EXISTING O.H. LINE (3-#6 SHOWN)
- 2-#6 — OVERHEAD LINE (2-#6 SHOWN)
- REMOVE O.H. LINE
- 400 W. TYPE I CLEAR, MERCURY VAPOR ST. LTG. UNIT ON SPAN WIRE AND MIN. 25 FT. MOUNTING HEIGHT.


GENERAL

- R.O.W. — RIGHT OF WAY LINE
- L.A.R.O.W. — LIMITED ACCESS RIGHT OF WAY LINE
- — PROPOSED PAVEMENT JOINT LINE
- P.L.D. — INDICATES THE PUBLIC LIGHTING DEPARTMENT.
- D.E. CO. — INDICATES THE DETROIT EDISON COMPANY
- C.P. CO. — INDICATES THE CONSUMERS POWER COMPANY

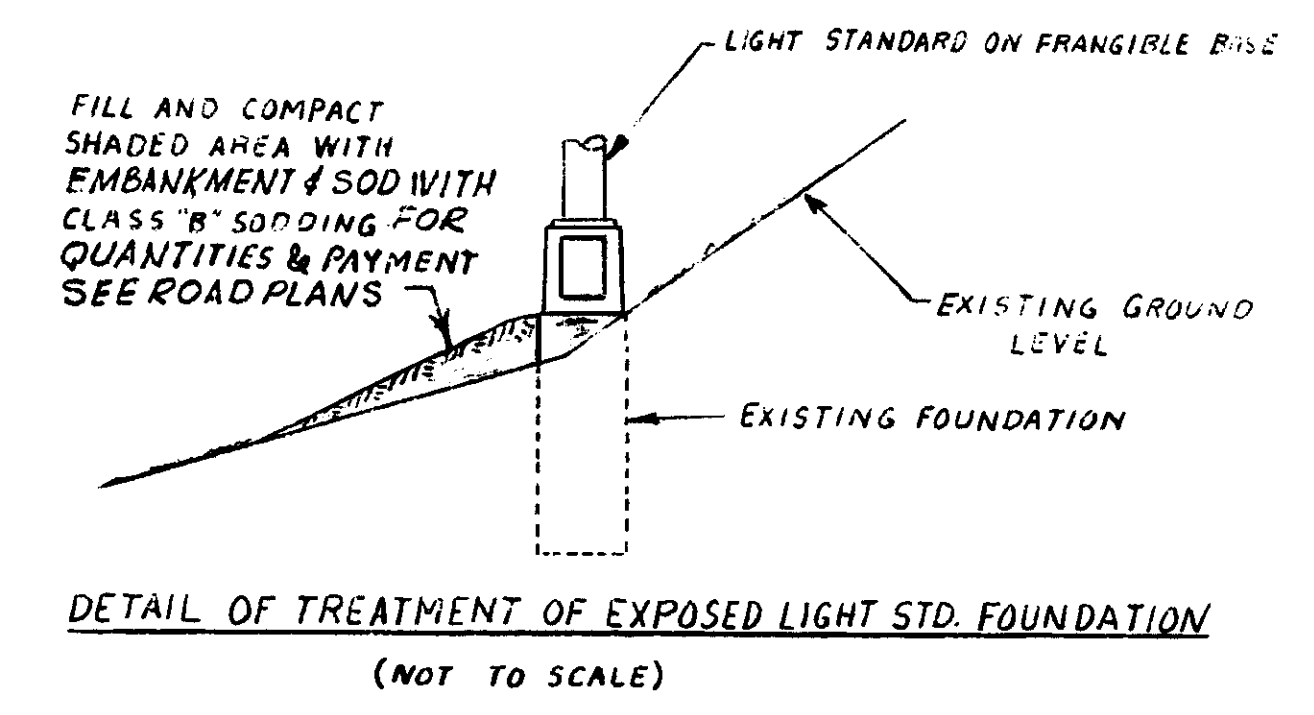

NOTES

1. NOTIFY THE SYSTEM OPERATING ENGINEER D.E. CO. 48 HRS. PRIOR TO WORKING ON LIGHTING CIRCUITS.
2. WHERE ABANDONING U.G. CABLES, THE CONTRACTOR SHALL CUT AND REMOVE CABLES WITHIN HANDHOLES AND MANHOLES, (INCIDENTAL)
3. HIGH PRESSURE SODIUM LUMINAIRE SHALL BE MEDIUM DISTRIBUTION IES TYPE III SEMI-CUTOFF FOR 400W & TYPE II FOR 250W.
4. STREET LIGHTING STANDARD SHALL BE EITHER ALUMINUM OR GALVANIZED STEEL.
5. WHERE THE EXISTING LUMINAIRE IS TO BE REPLACED WITH HIGH PRESSURE SODIUM, THE REMOVAL OF THE EXISTING LUMINAIRE SHALL BE INCIDENTAL TO THE PROJECT AND WILL NOT BE PAID FOR SEPARATELY.
6. LIGHT STANDARD FOUNDATIONS, WHERE INDICATED, SHALL BE REMOVED ENTIRELY. NECESSARY BACKFILLING AND SHOULDER RESTORATION WILL BE INCIDENTAL TO THE ITEM "REMOVE FOUNDATION" AND WILL NOT BE PAID FOR SEPARATELY.
7. LUMINAIRE BALLASTS SHALL BE 240V.
8. EXISTING LIGHTS ARE TO REMAIN IN OPERATION UNTIL THE PROPOSED LIGHTS ARE IN OPERATION AND ACCEPTED, AS DIRECTED BY THE ENGINEER.
9. THE FRANGIBLE TRANSFORMER BASE SHALL BE 20" HIGH, MADE OF ALUMINUM ALLOY 35% HEAT TREATED TO T55 TEMPER, MEETING THE 1976 A.A.S.H.T.O. REQUIREMENTS FHWA NOTICE N 5040 20 (CERTIFICATION WILL BE REQUIRED)
10. THE 6" EDGE DRAIN REQUIRED TO REPLACE DAMAGED EDGE DRAIN DUE TO LIGHTING CONSTRUCTION SHALL BE INCIDENTAL TO THE PROJECT AND WILL NOT BE PAID FOR SEPARATELY.
11. ALL SPLICES, TEMPORARY CIRCUITS, AND CABLE CUTTING, REQUIRED TO MAINTAIN CONTINUITY OF THE CIRCUITS ARE INCIDENTAL TO THE PROJECT AND WILL NOT BE PAID FOR SEPARATELY.
12. ANY DAMAGES TO THE FREEWAY LIGHTING SYSTEM CAUSED BY THE CONTRACTOR SHALL BE REPAIRED AT THE CONTRACTOR'S OWN EXPENSE, WITHIN A REASONABLE TIME, AS DIRECTED BY THE ENGINEER.
13. DIRECT BURIAL CONDUIT UNDER PAVED MEDIAN SHALL BE INSTALLED AS SHOWN ON PLANS.
14. BREAKAWAY CONNECTOR SHALL BE ELASTIMOLD STYLE # 83 S; JOY MFG. CO. #X 8918, BUSSMAN TYPE HEB WITH INSULATING BOOTS, OR APPROVED EQUAL.
15. THE CONTRACTOR SHALL GAP OUT THE CONCRETE BARRIER WALL AT THE EXISTING STREET LIGHTING IN THE MEDIAN. IF, FOR ANY REASON, THE CABLE IS CUT IT WILL BE THE RESPONSIBILITY OF THE CONTRACTOR TO EXTEND & SPLICE THE CABLE ON THE SAME DAY IN ORDER TO KEEP THE LIGHTING SYSTEM OPERATIONAL. AFTER THE NEW PROPOSED LIGHTING IS INSTALLED AND OPERATIONAL, THE CONTRACTOR WILL REMOVE THE EXISTING LIGHTING UNITS (POLES, BRACKET ARMS & LUMINAIRE) AND POUR CONCRETE TO PAVE THE MEDIAN SHOULDER AND FILL IN THE GAP WITH CONCRETE BARRIER WALL. ALL THIS WORK WILL BE PART OF THE ITEM "CONCRETE BARRIER-DOUBLE FACE" AND WILL NOT BE PAID FOR SEPARATELY.
16. EXISTING LIGHTS ON RAMP WHERE FRANGIBLE TRANSFORMER BASES ARE TO BE INSTALLED & LUMINAIRE TO BE REPLACED SHALL REMAIN OPERATIONAL AT ALL TIMES. (ALL WORK TO BE DONE DURING PAYLIGHT HOURS.)
17. THE ITEM "REMOVE U.G. FED STREET LIGHTING UNIT" SHALL INCLUDE THE REMOVAL OF THE LIGHT STANDARD, LUMINAIRE, ARM OR DOUBLE ARMS.
18. ALL LIGHT STANDARDS FURNISHED ON THIS CONTRACT SHALL BE OF THE SAME STYLE AND MATERIAL AND FROM THE SAME MANUFACTURER, EXCEPT WHERE OTHERWISE SPECIFIED ON THE PLANS.
19. THE ITEM "INSTALL NEW FRANGIBLE TRANSFORMER BASE" SHALL INCLUDE REMOVING EXISTING LIGHT STANDARD, INSTALLING A NEW FRANGIBLE TRANSFORMER BASE ON THE EXISTING FOUNDATION AND INSTALLING THE EXISTING LIGHT STANDARD ON THE NEW FRANGIBLE TRANSFORMER BASE.
20. THE 1-2" GALV. STEEL CONDUIT ATTACHED TO THE DETROIT EDISON CO. POLE WILL BE PAID FOR AT THE SAME RATE AS THE 1-2" GALV. STEEL CONDUIT. ALL FASTENERS AND HARDWARE NEEDED TO INSTALL THE CONDUIT WILL BE INCIDENTAL TO THE PAY ITEM, "1-2" GALV. STEEL CONDUIT", AND WILL NOT BE PAID FOR SEPARATELY.
21. EXISTING FOUNDATIONS BETWEEN THE MEDIAN GUARD RAILS ARE TO BE PARTIALLY REMOVED AND ANCHOR BOLTS TO BE CUT OFF TO A LINE BELOW GRADE.

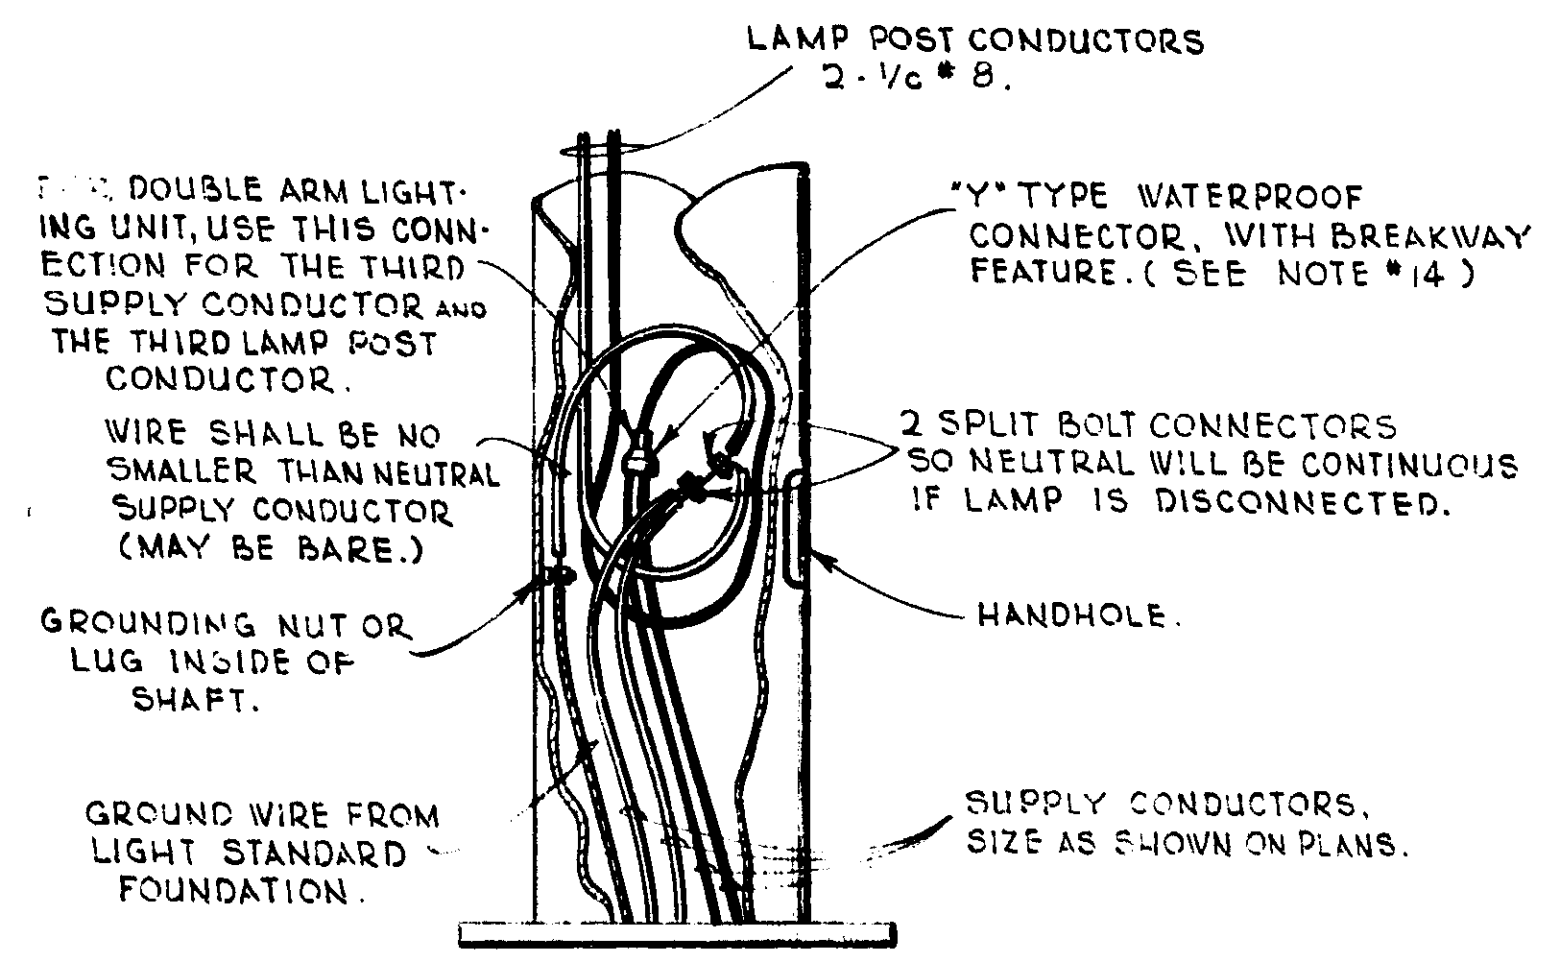


TYPICAL MULTIPLE STREET LIGHTING CONNECTION
NOT TO SCALE


MICHIGAN DEPARTMENT OF STATE HIGHWAYS
NOTES & LEGEND
FREEWAY

NO.	DESCRIPTION	DATE	BY


63174 14165A

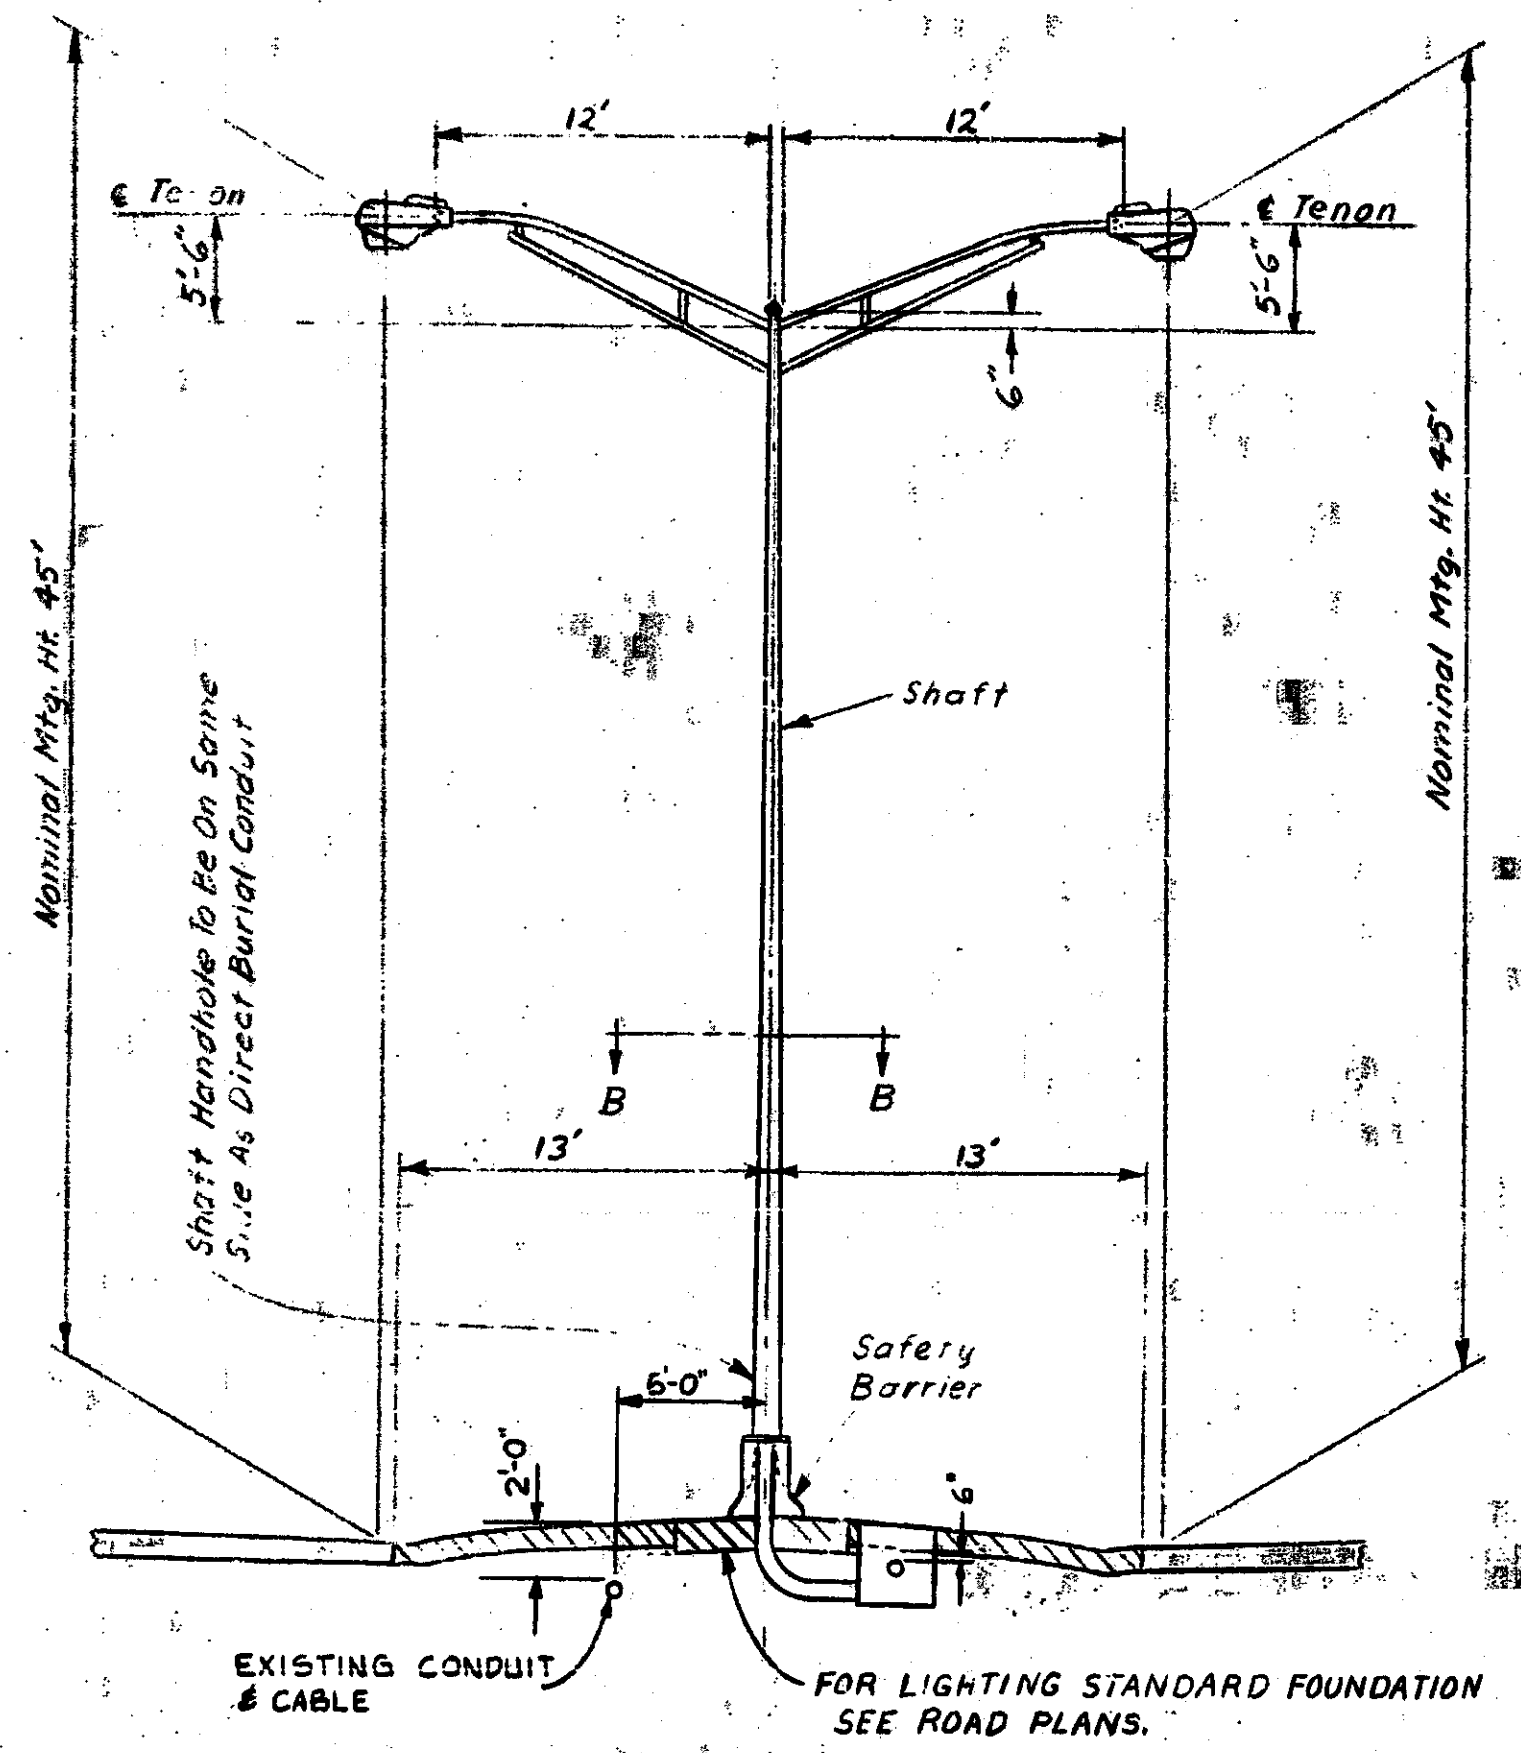


TYPICAL BARRIER SECTION INSTALLATION

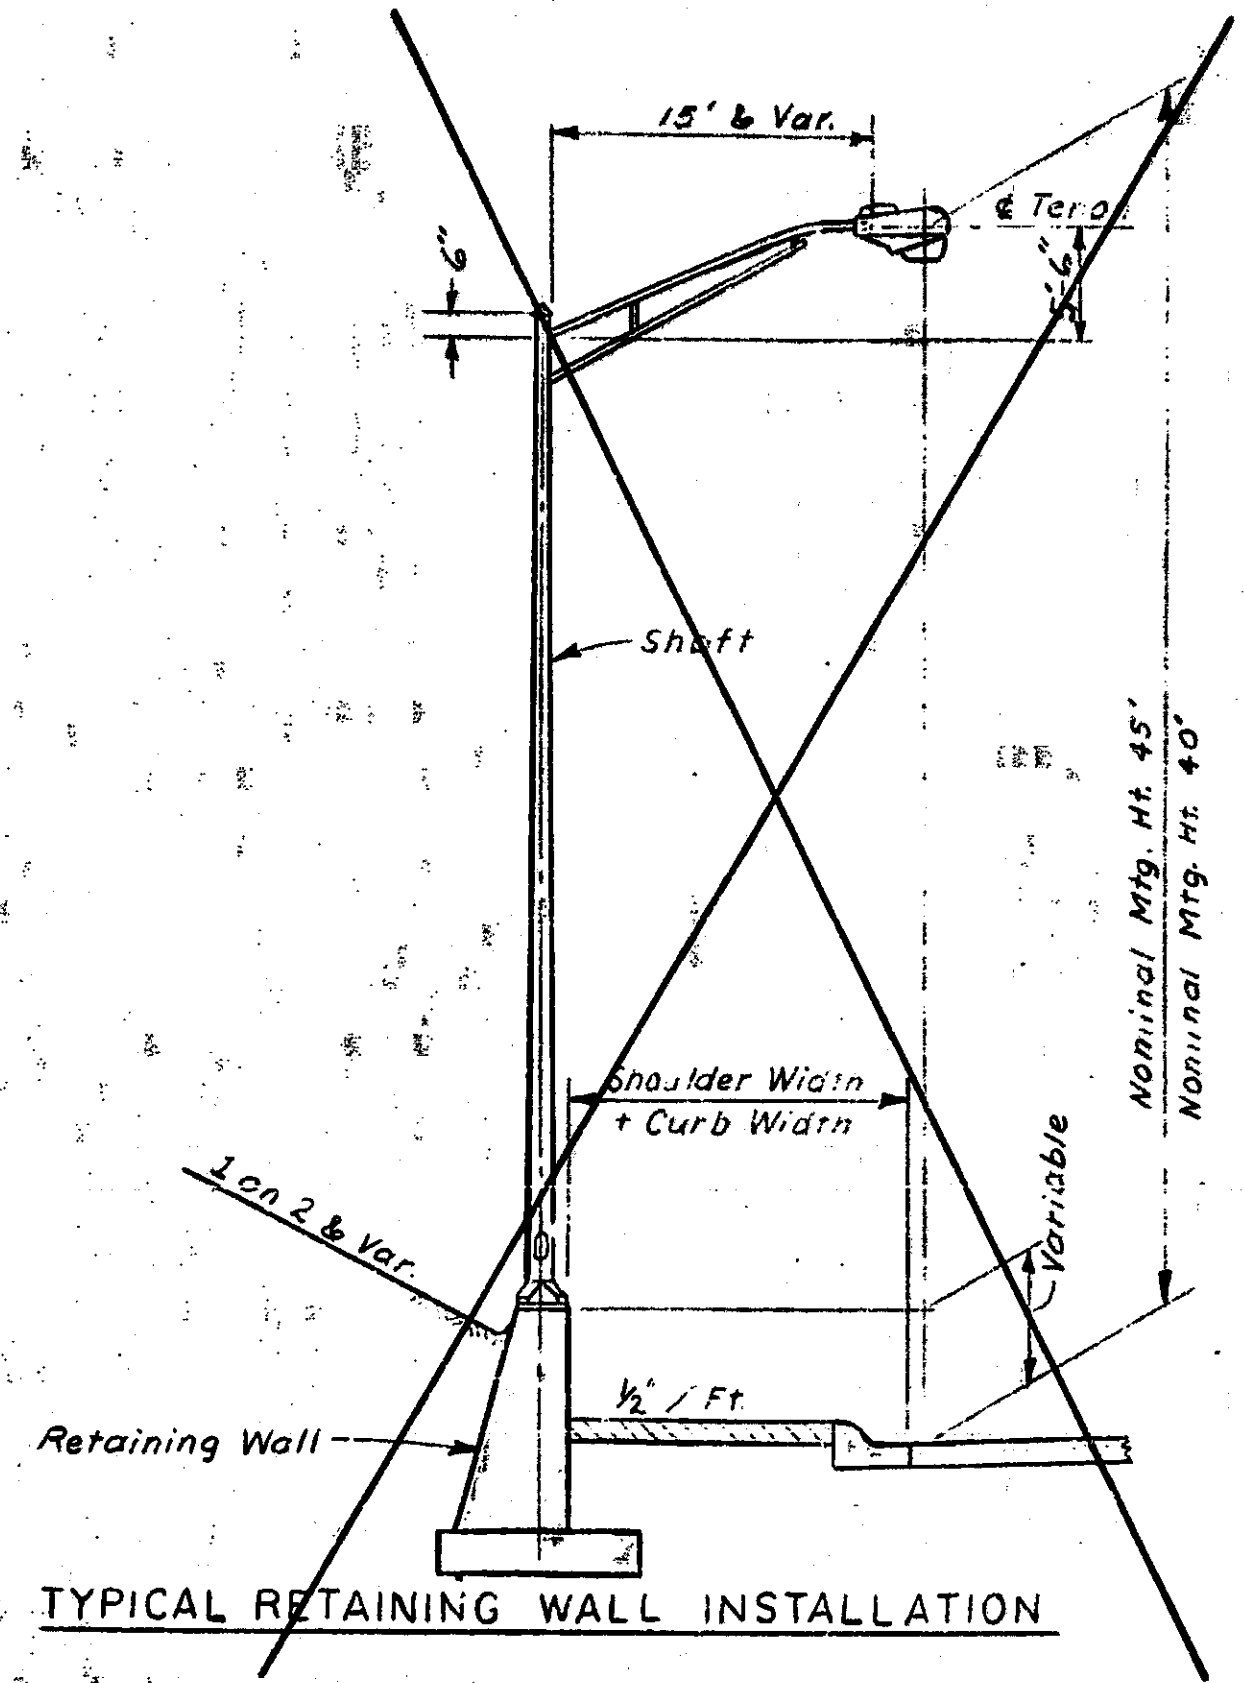


TYPICAL RETAINING WALL INSTALLATION

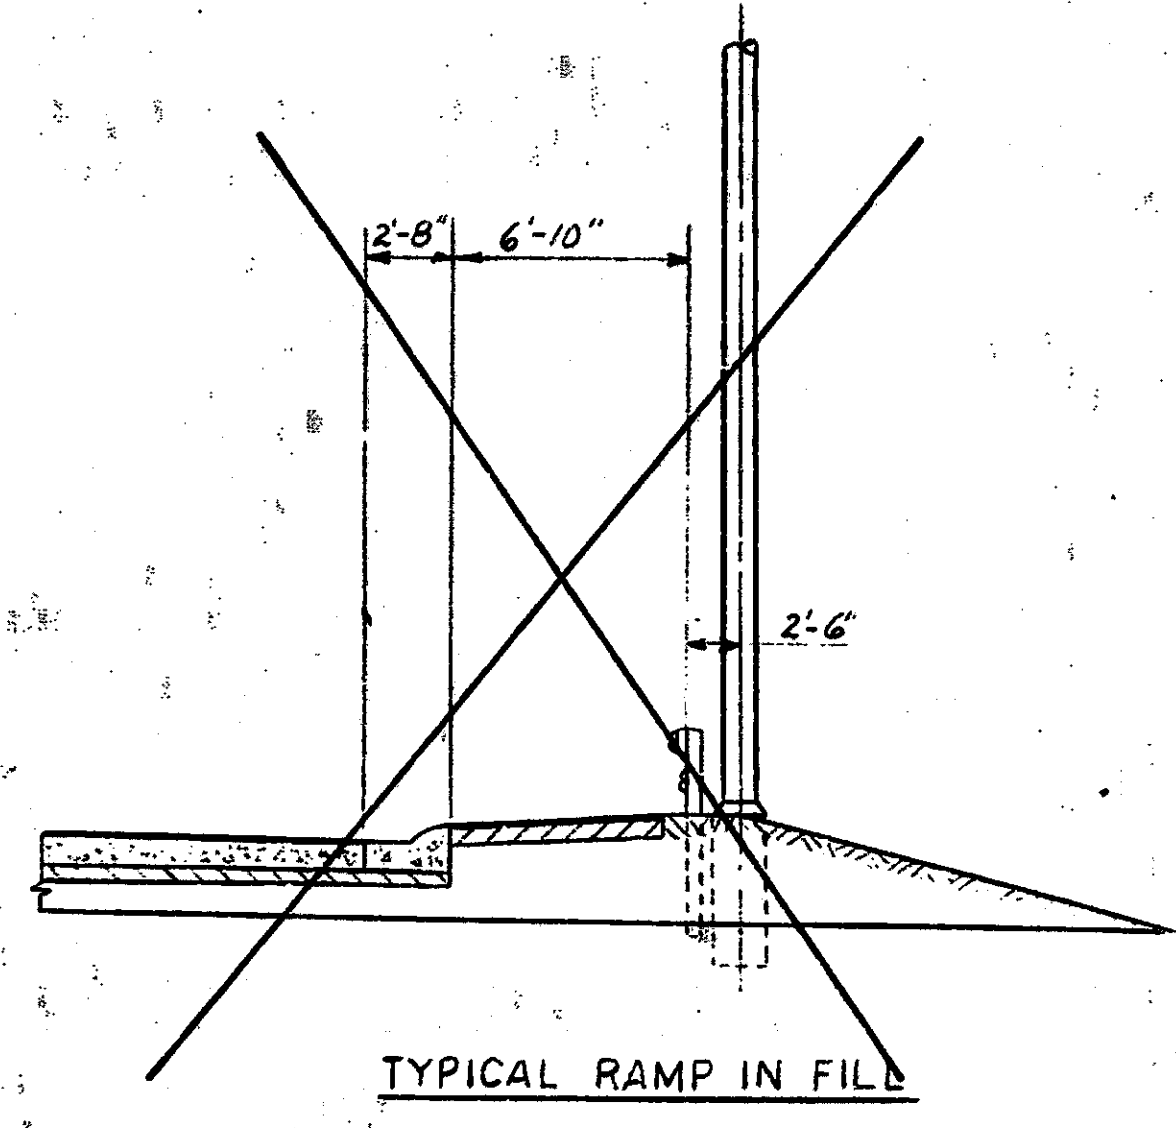


TYPICAL RAMP IN FILL

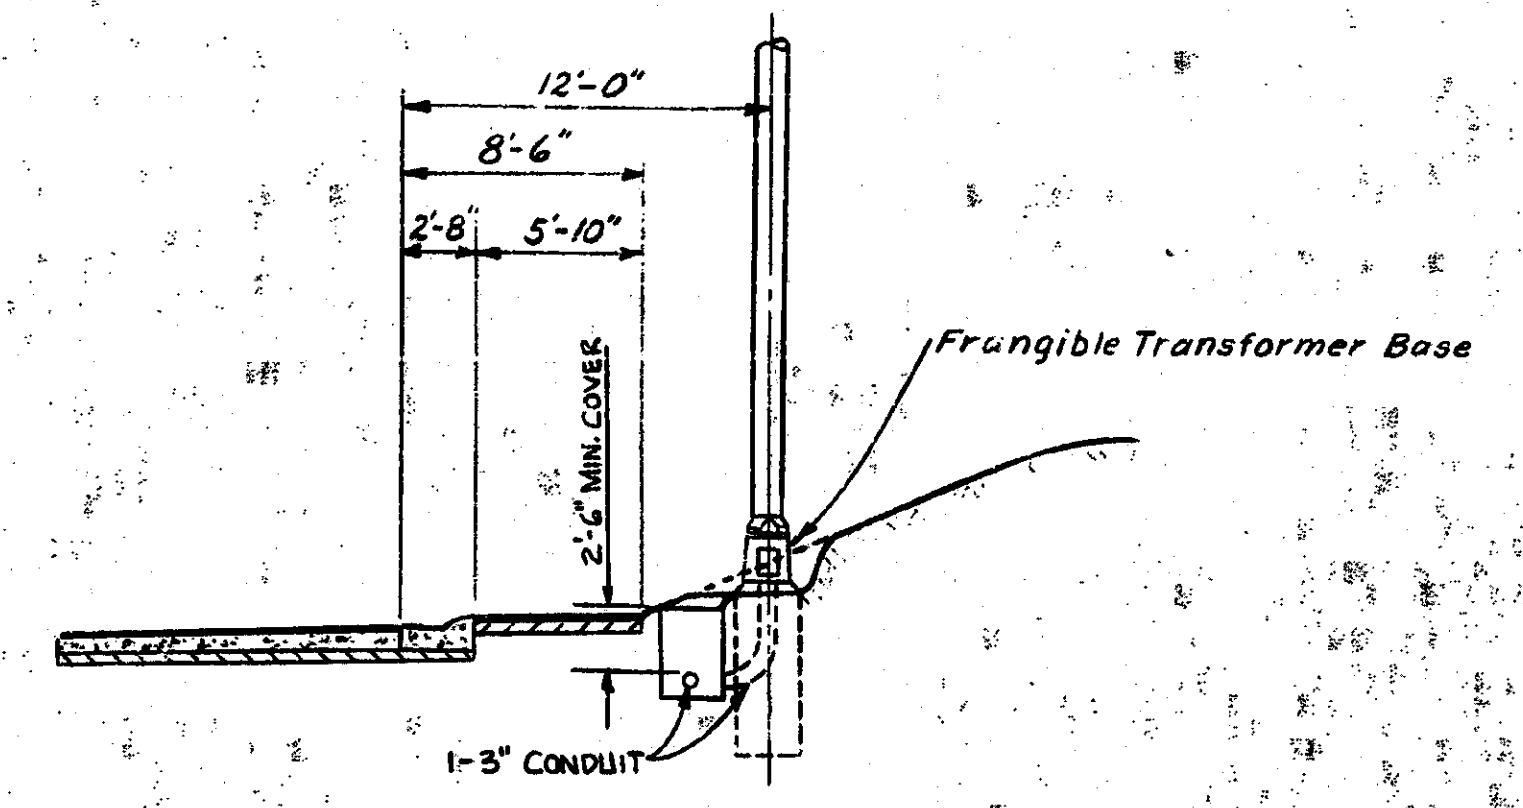


TYPICAL RAMP IN CUT

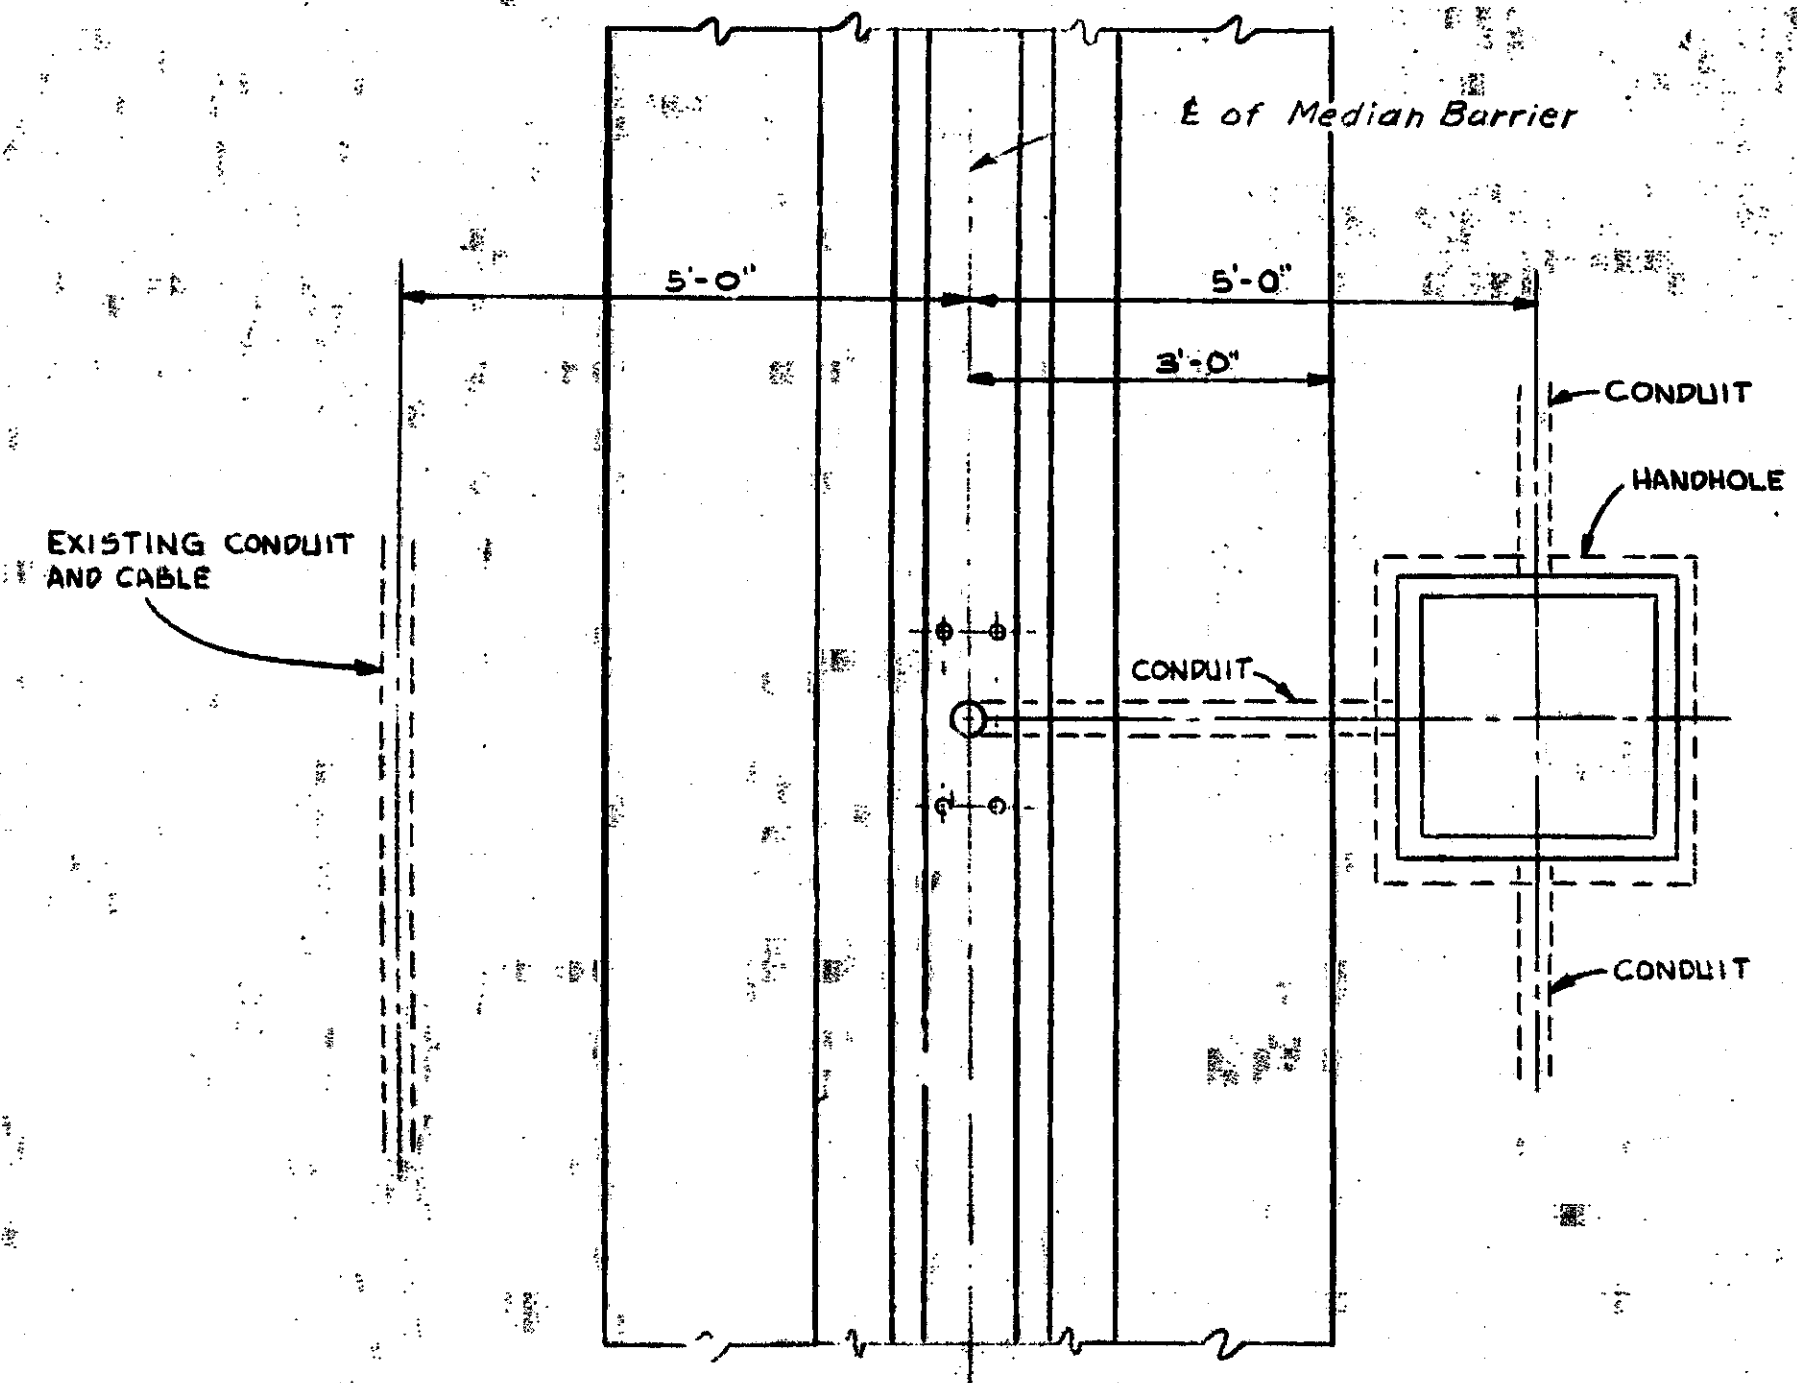

SECTION B-B

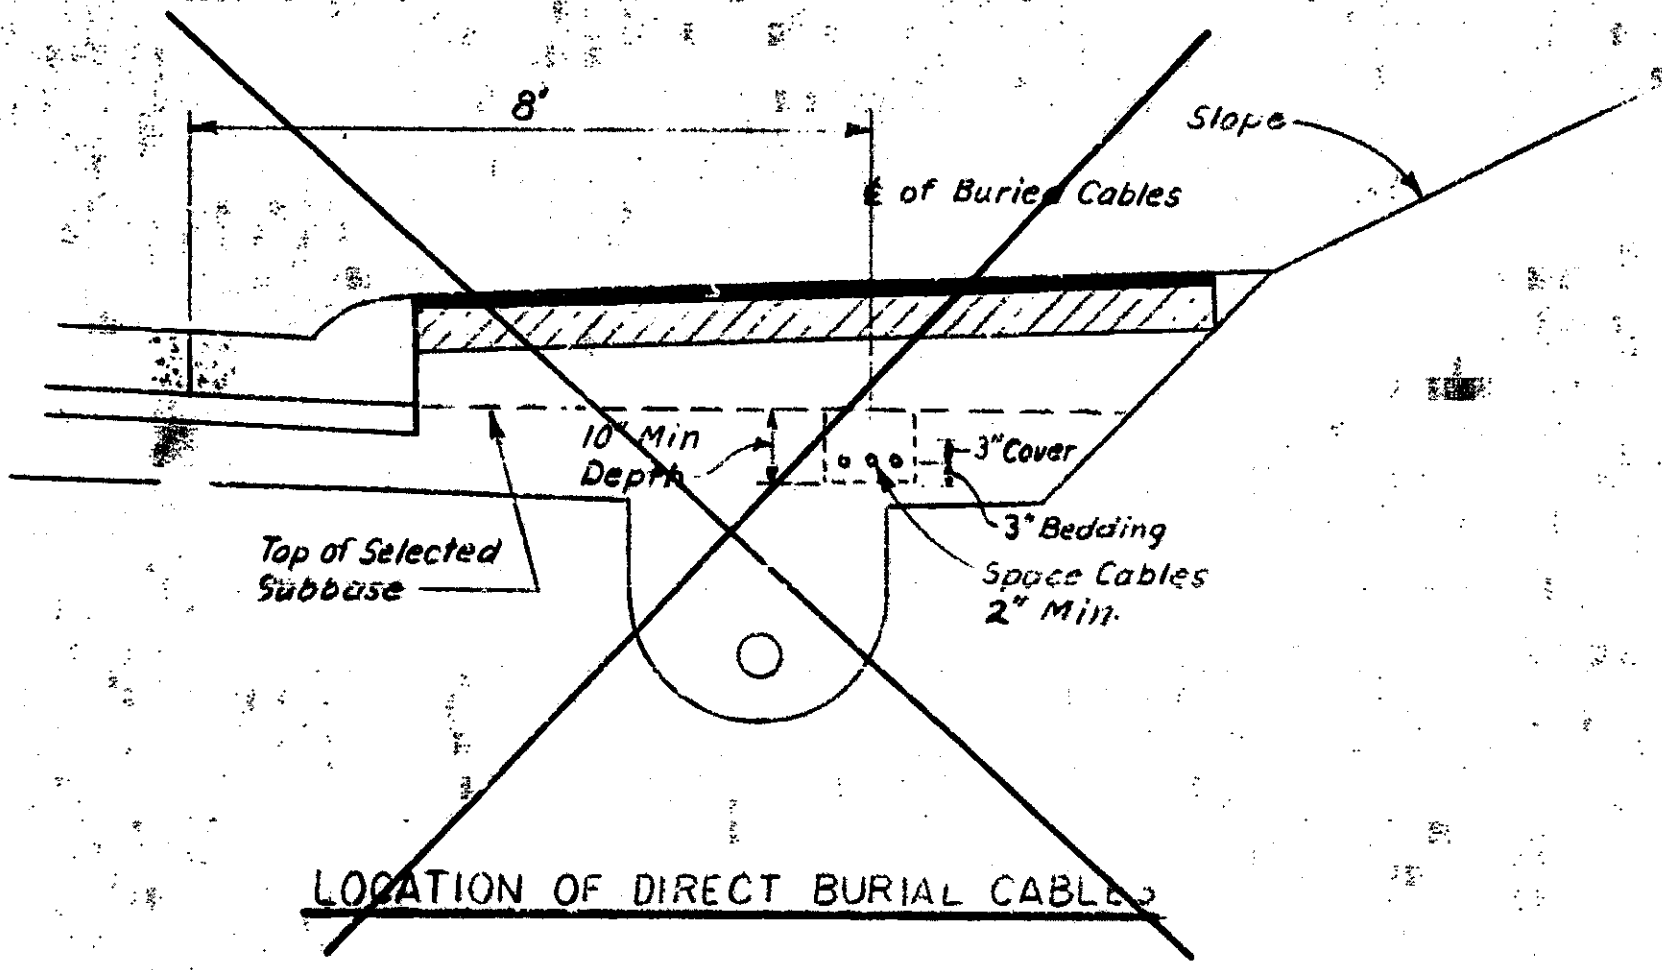

LOCATION OF DIRECT BURIAL CABLES

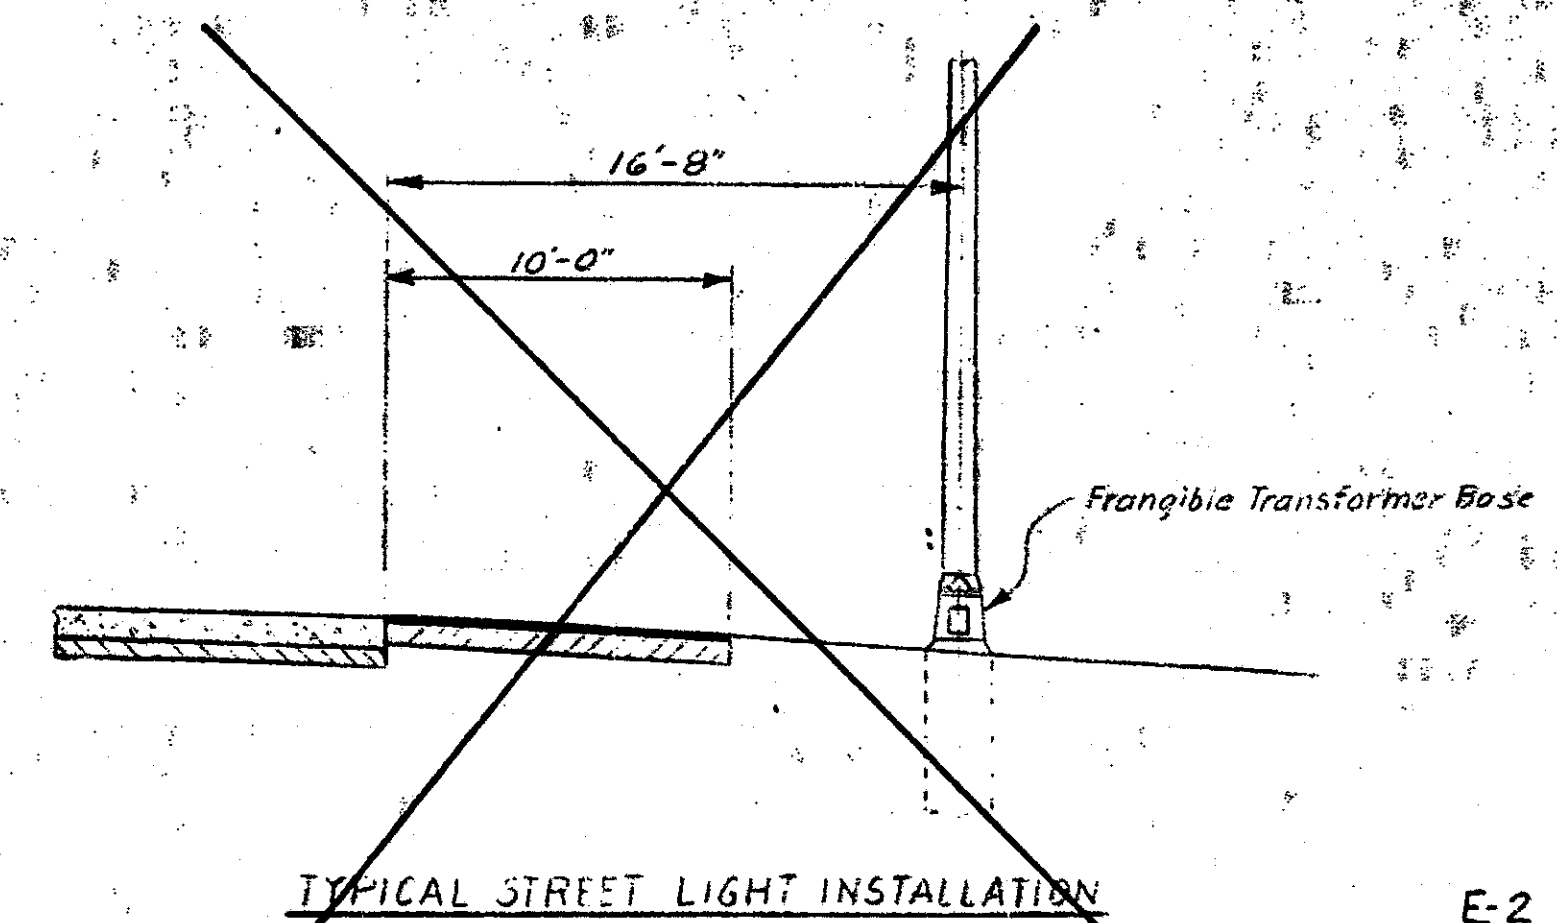

TYPICAL STREET LIGHT INSTALLATION


NOT TO SCALE

MICHIGAN DEPARTMENT OF STATE HIGHWAYS
TYPICAL FREEWAY LIGHTING STANDARD
INSTALLATION


DESIGNED BY	V. J. J. 1973
DRAWN BY	D. W. 11-2-73
CHECKED BY	L. J. 11-2-73
DATE	

CONTROL SECTION 63174

NO. 14165 A

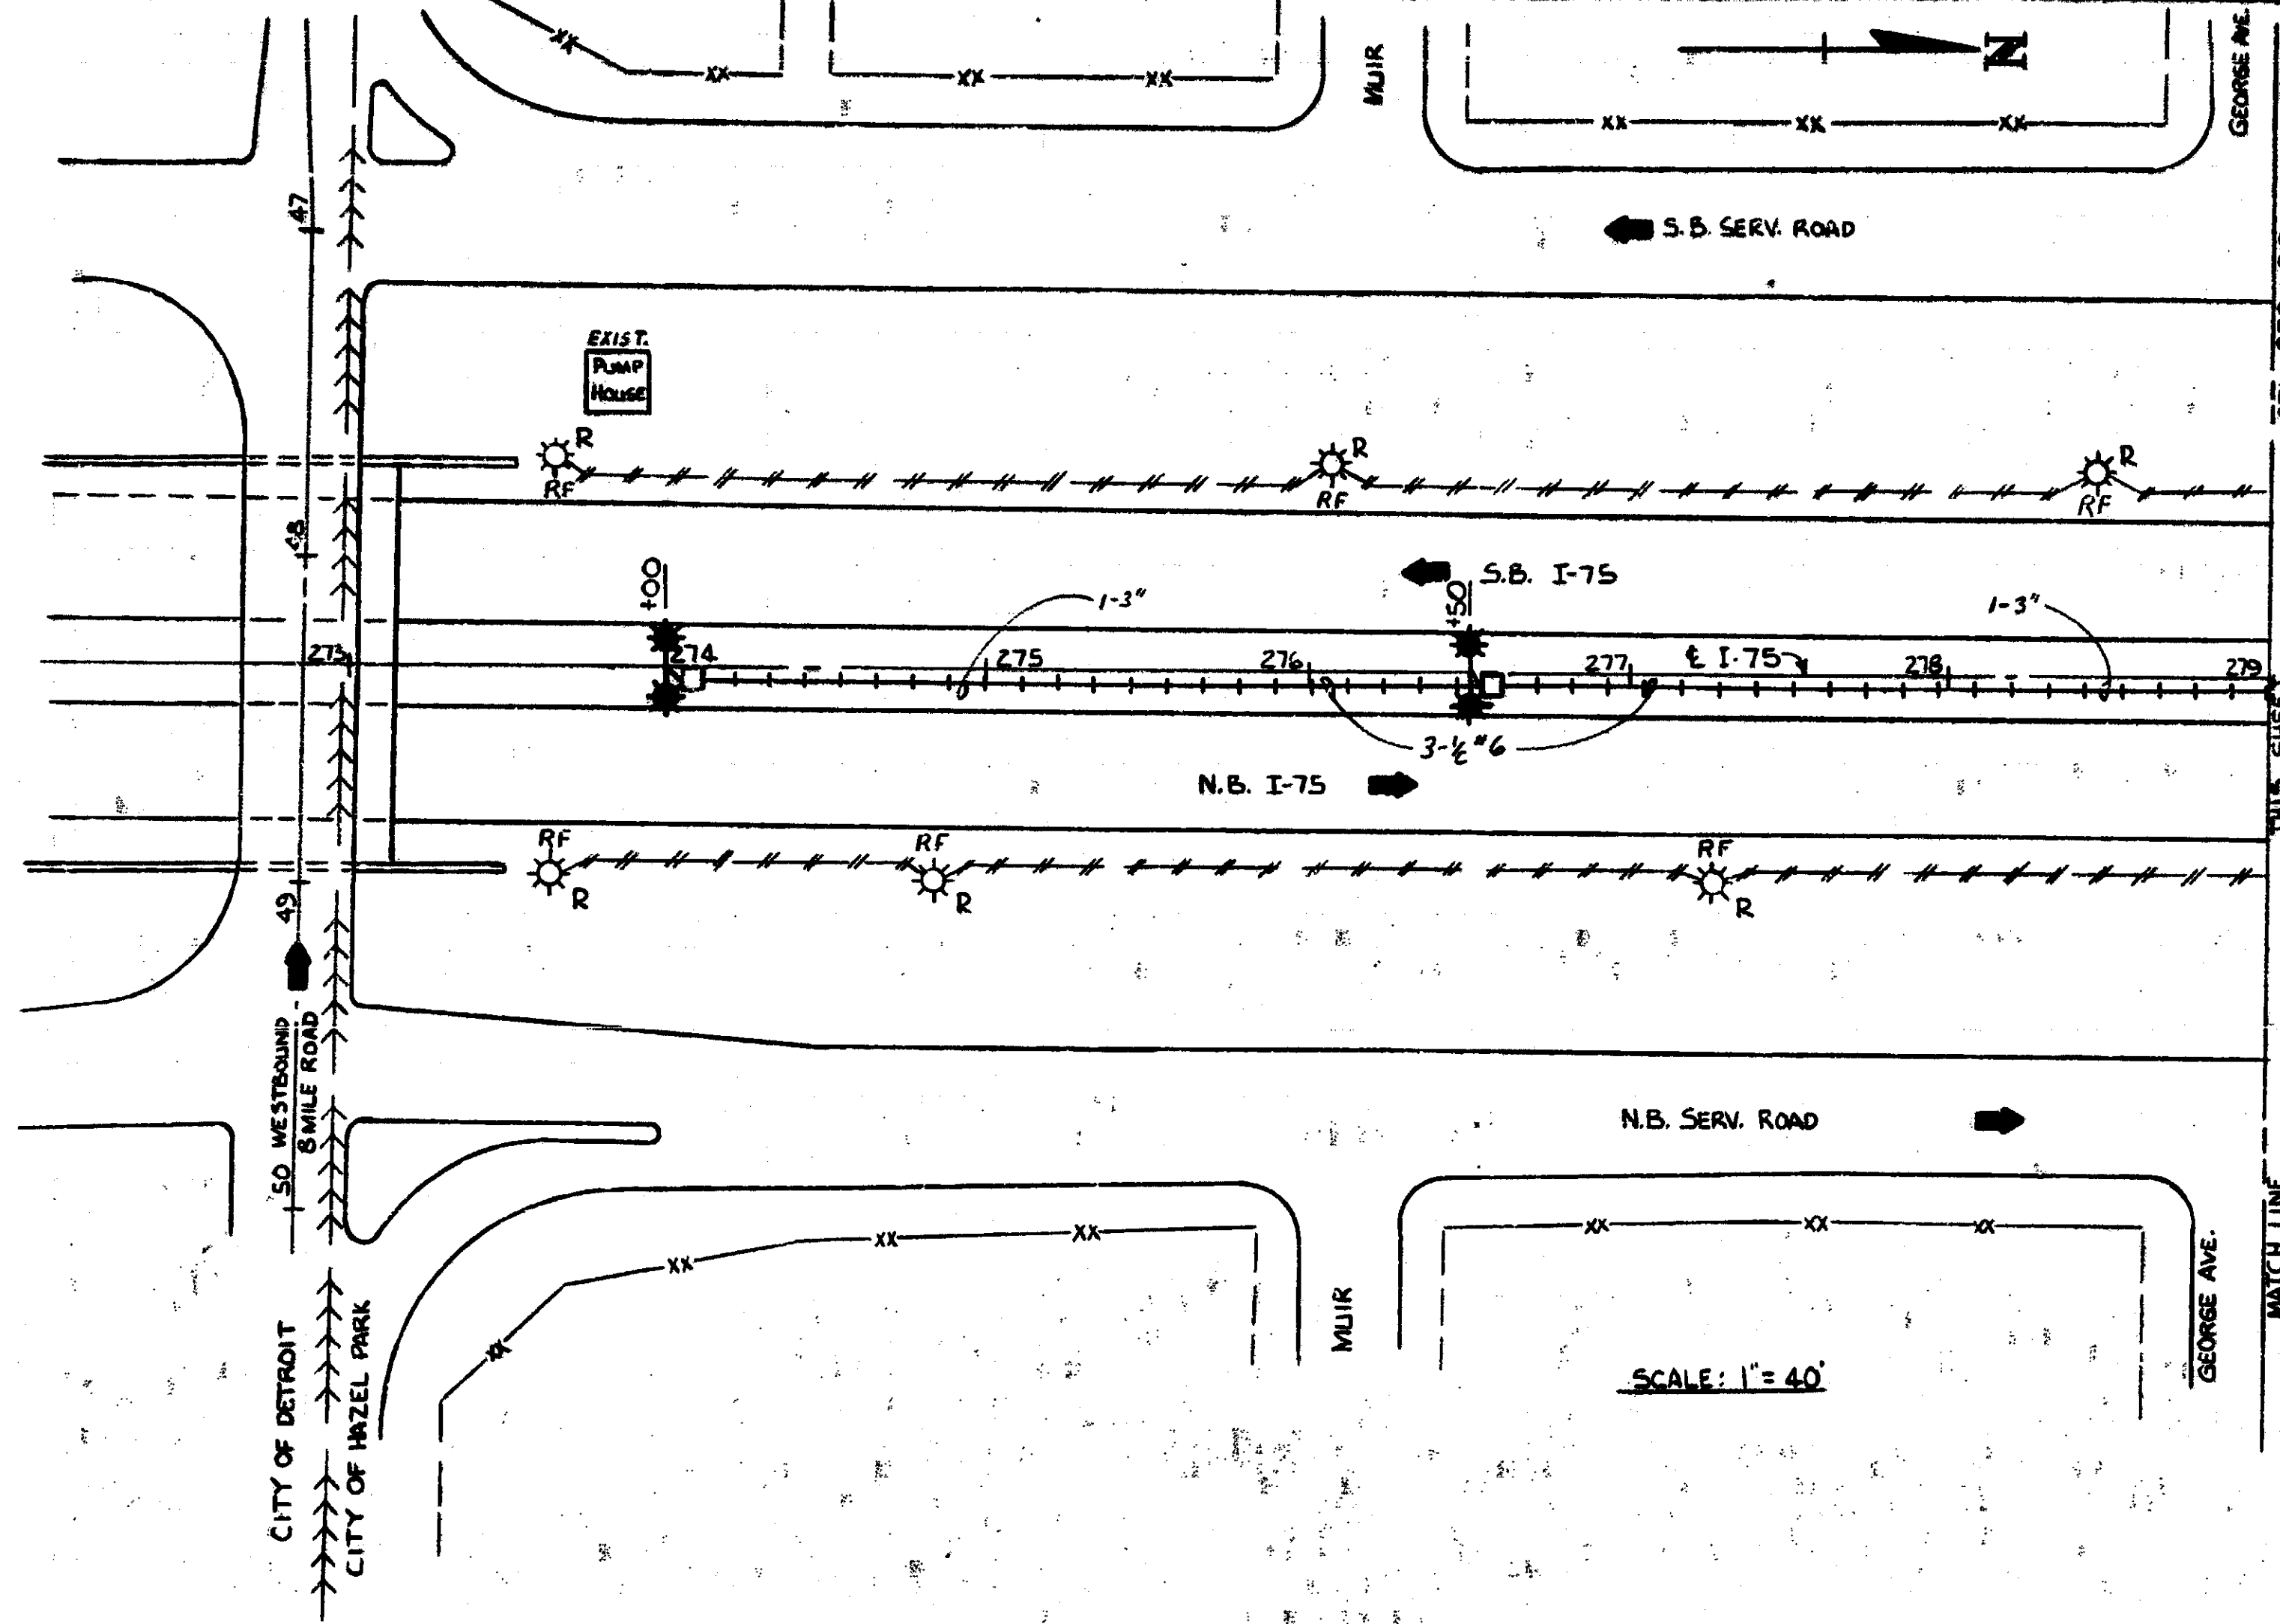

QUANTITIES ON THIS SHEET.		
ITEM	UNIT	QUANTITY
REMOVE U.G. FED. ST. L.T.G. UNIT	EA.	12
1-3" DIRECT BURIAL CONDUIT	L.F.T.	1228
HANDHOLE-HEAVY DUTY COVER	EA	5
600V 3/4" NO. 6 P.B. CABLE IN CONDUIT	L.F.T.	1228
LT. STD. 4.5 FT. M.H. 12 FT. DBL. ARM ON MEDIAN WALL	EACH	5
400 W. HIGH PRESSURE SODIUM LUMINAIRE	EACH	10
REMOVE FOUNDATION	EACH	12

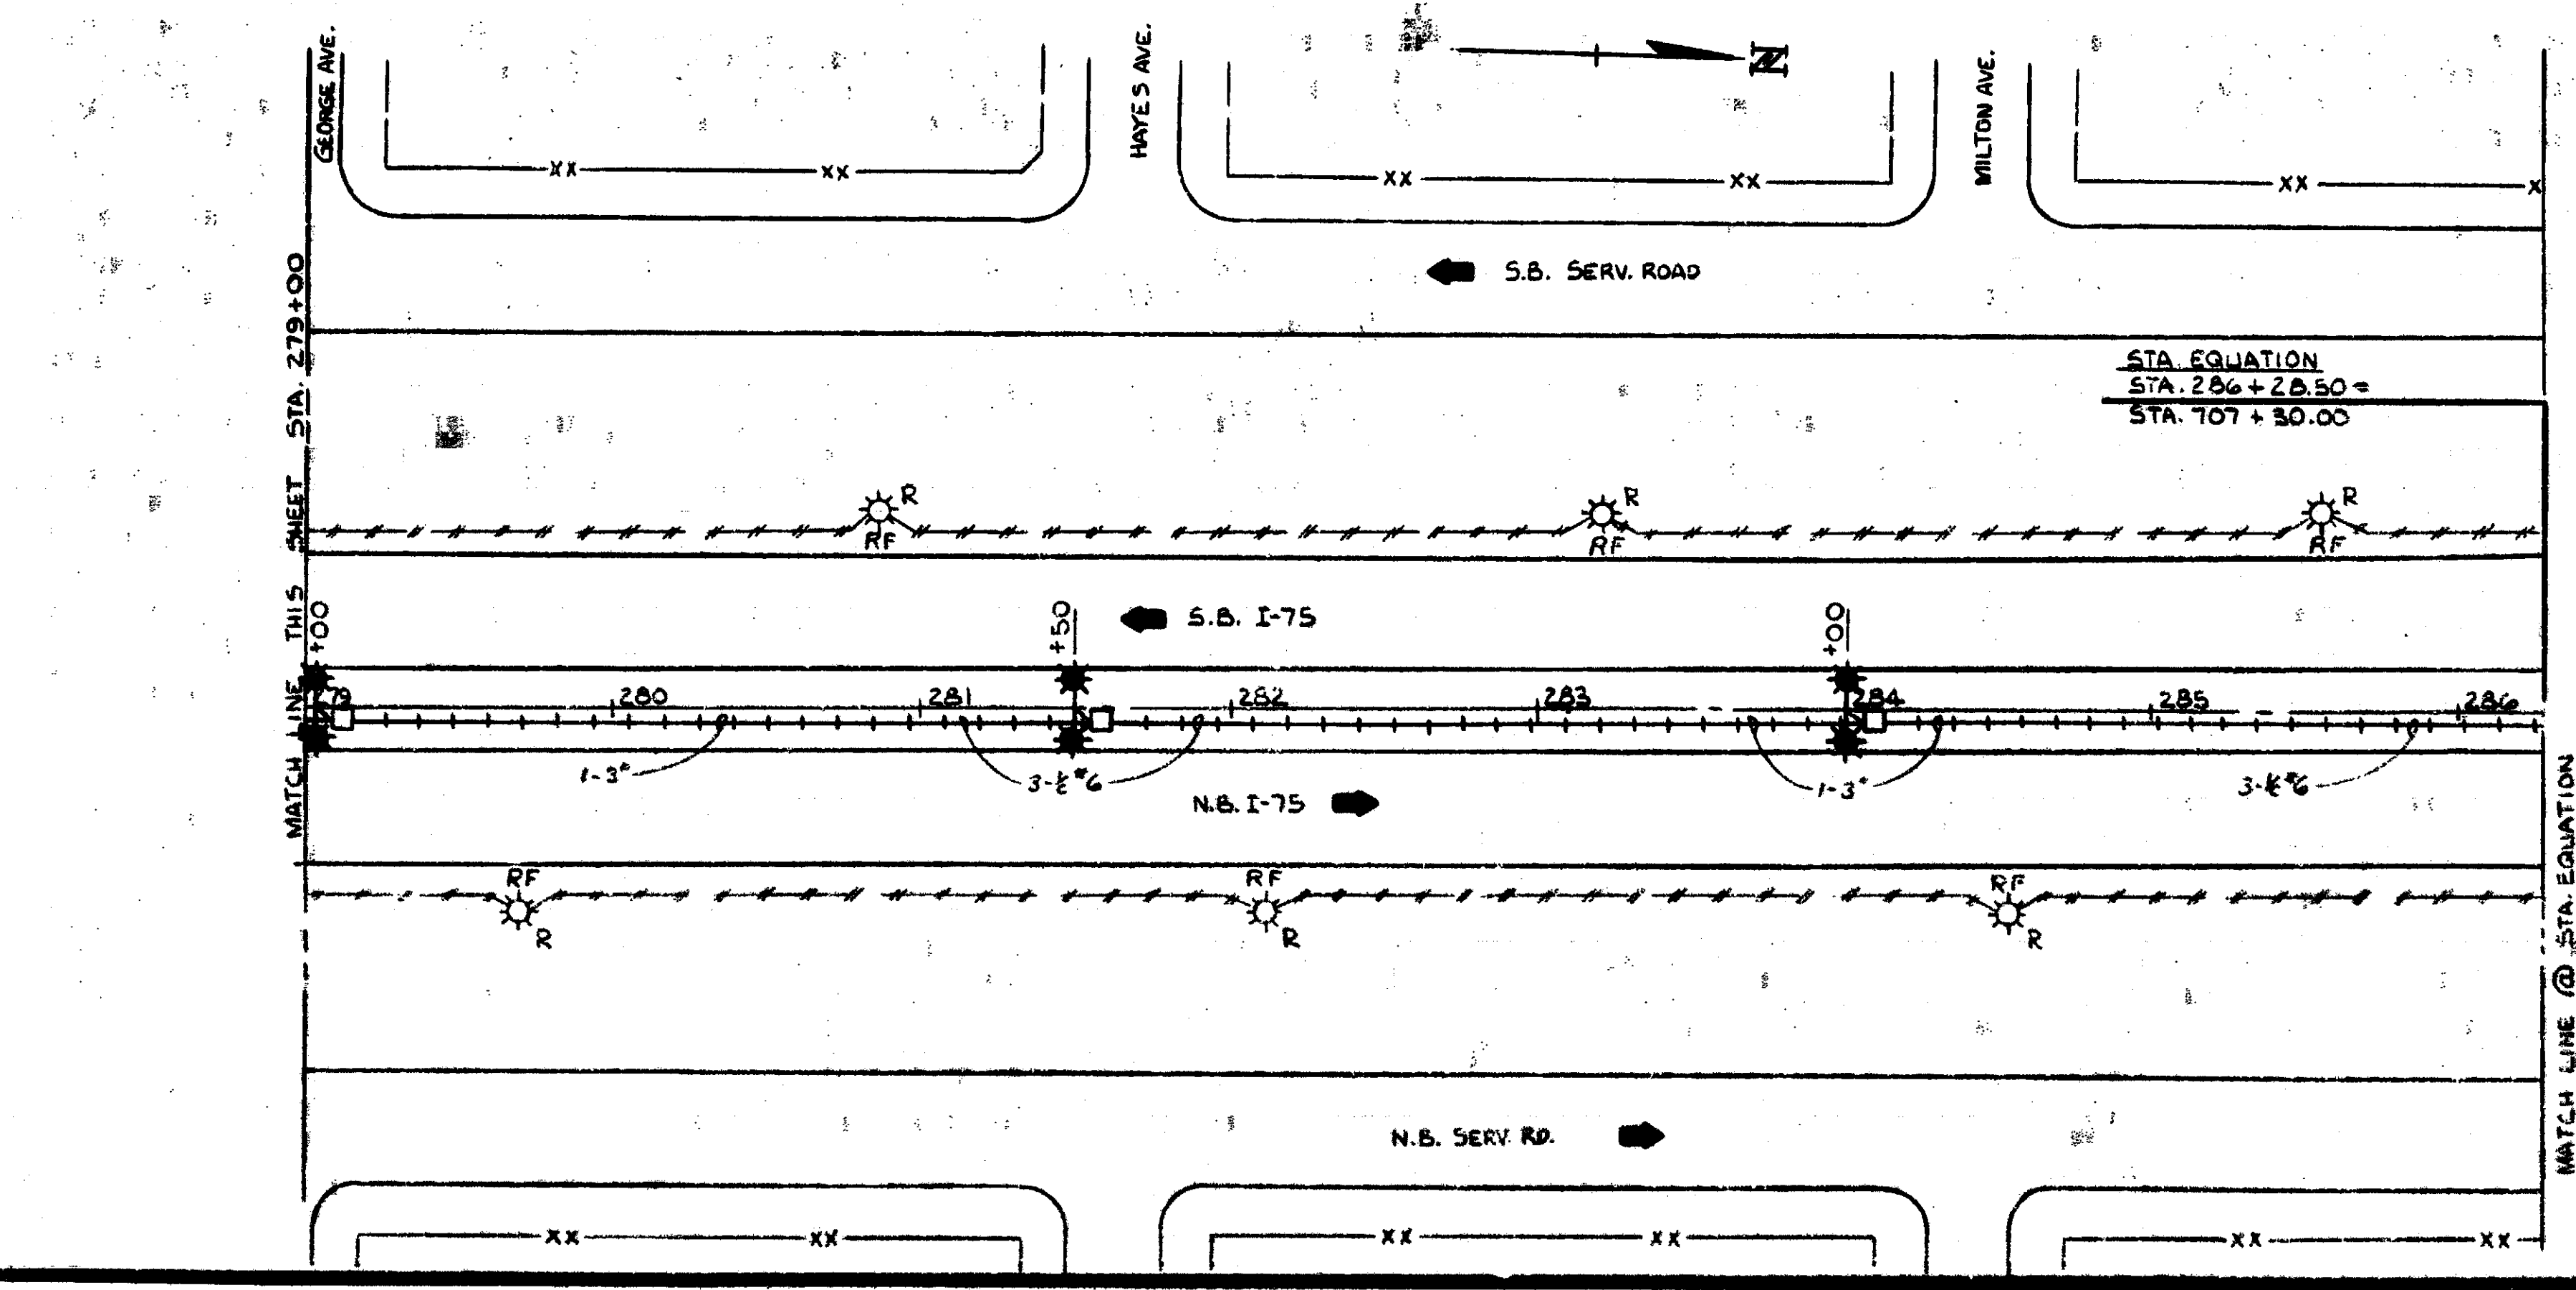

E-3

MICHIGAN DEPARTMENT OF STATE HIGHWAYS
FREEWAY LIGHTING
I-75
8 MILE RD. TO 12 MILE RD.


REVISIONS			
NO.	DESCRIPTION	DATE	BY

DESIGNED BY: T. N. HUGHES	1977
DRAWN BY: J. L. G. R.	3-74
CHECKED BY: E. J. G. R.	5-77


63174 14165A

SCALE: 1"=40'

SCALE: 1"=40'

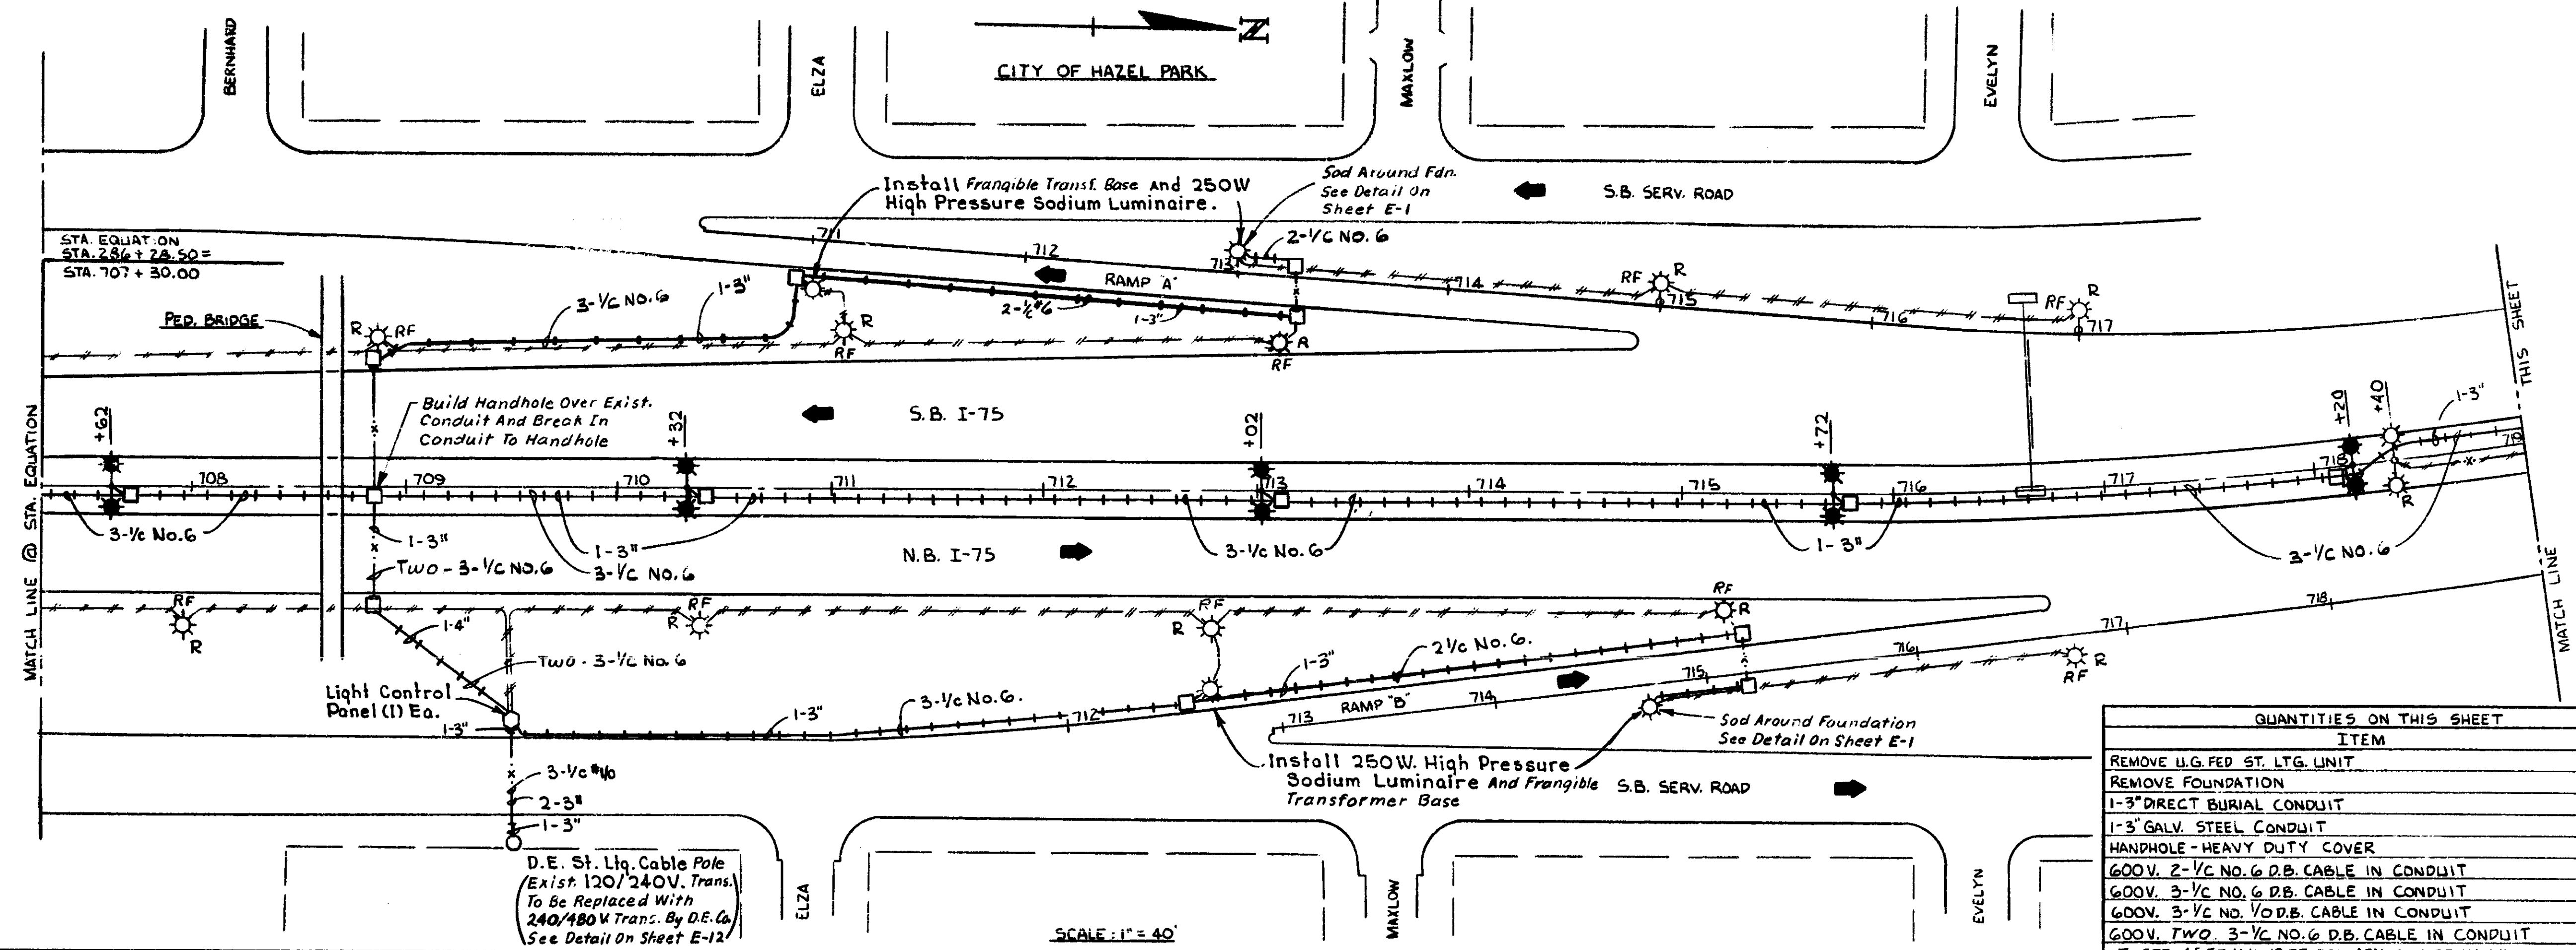

QUANTITIES ON THIS SHEET		
ITEM	UNIT	QUANTITY
REMOVE U.G. FED. ST. LTG. UNIT	EACH	16
REMOVE FOUNDATION	EACH	10
1-3" DIRECT BURIAL CONDUIT	L.F.T.	3480
1-3" GALV. STEEL CONDUIT	L.F.T.	20
HANDHOLE - HEAVY DUTY COVER	EACH	19
600V. 2-1/2" NO. 6 D.B. CABLE IN CONDUIT	L.F.T.	595
600V. 3-1/2" NO. 6 D.B. CABLE IN CONDUIT	L.F.T.	2725
600V. 3-1/2" NO. 10 D.B. CABLE IN CONDUIT	L.F.T.	50
600V. TWO 3-1/2" NO. 6 D.B. CABLE IN CONDUIT	L.F.T.	140
LT. STD. 45FT. M.H. 12FT. DBL. ARM ON MEDIAN WALL	EACH	10
250W. HIGH PRESSURE SODIUM LUMINAIRE	EACH	4
400W. HIGH PRESSURE SODIUM LUMINAIRE	EACH	20
INSTALL NEW FRANGIBLE TRANSFORMER BASE	EACH	4
LIGHTING CONTROL PANEL	EACH	1
1-4" DIRECT BURIAL CONDUIT	L.F.T.	80
REMOVE FOUNDATION - PARTIAL	EACH	6

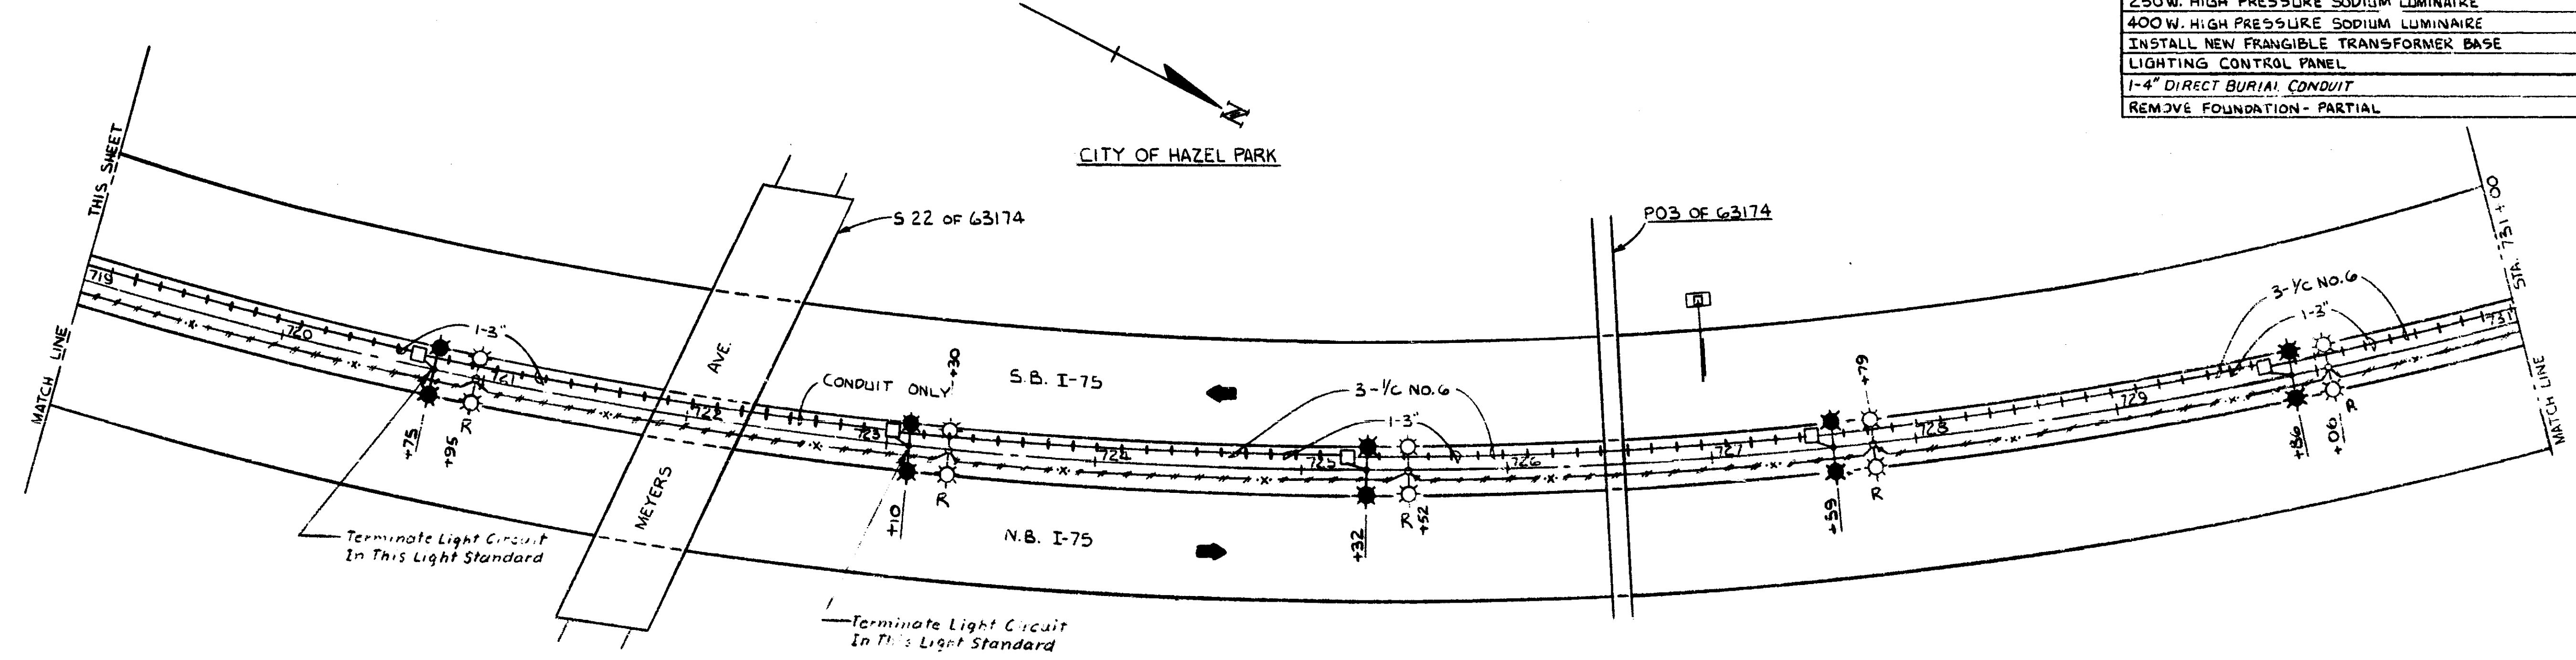



MICHIGAN DEPARTMENT OF STATE HIGHWAYS
FREEWAY LIGHTING
I-75
 8 MILE RD TO 12 MILE RD.

NO.	DESCRIPTION	DATE	BY

DESIGN NO.	T.N. 1125H	977
DRAWN BY	J. S. G. B.	3-79
TRACED BY	R. S. A.	5-77
CHECKED BY	T. H. C. B.	2-79

63174 14165A

E-4

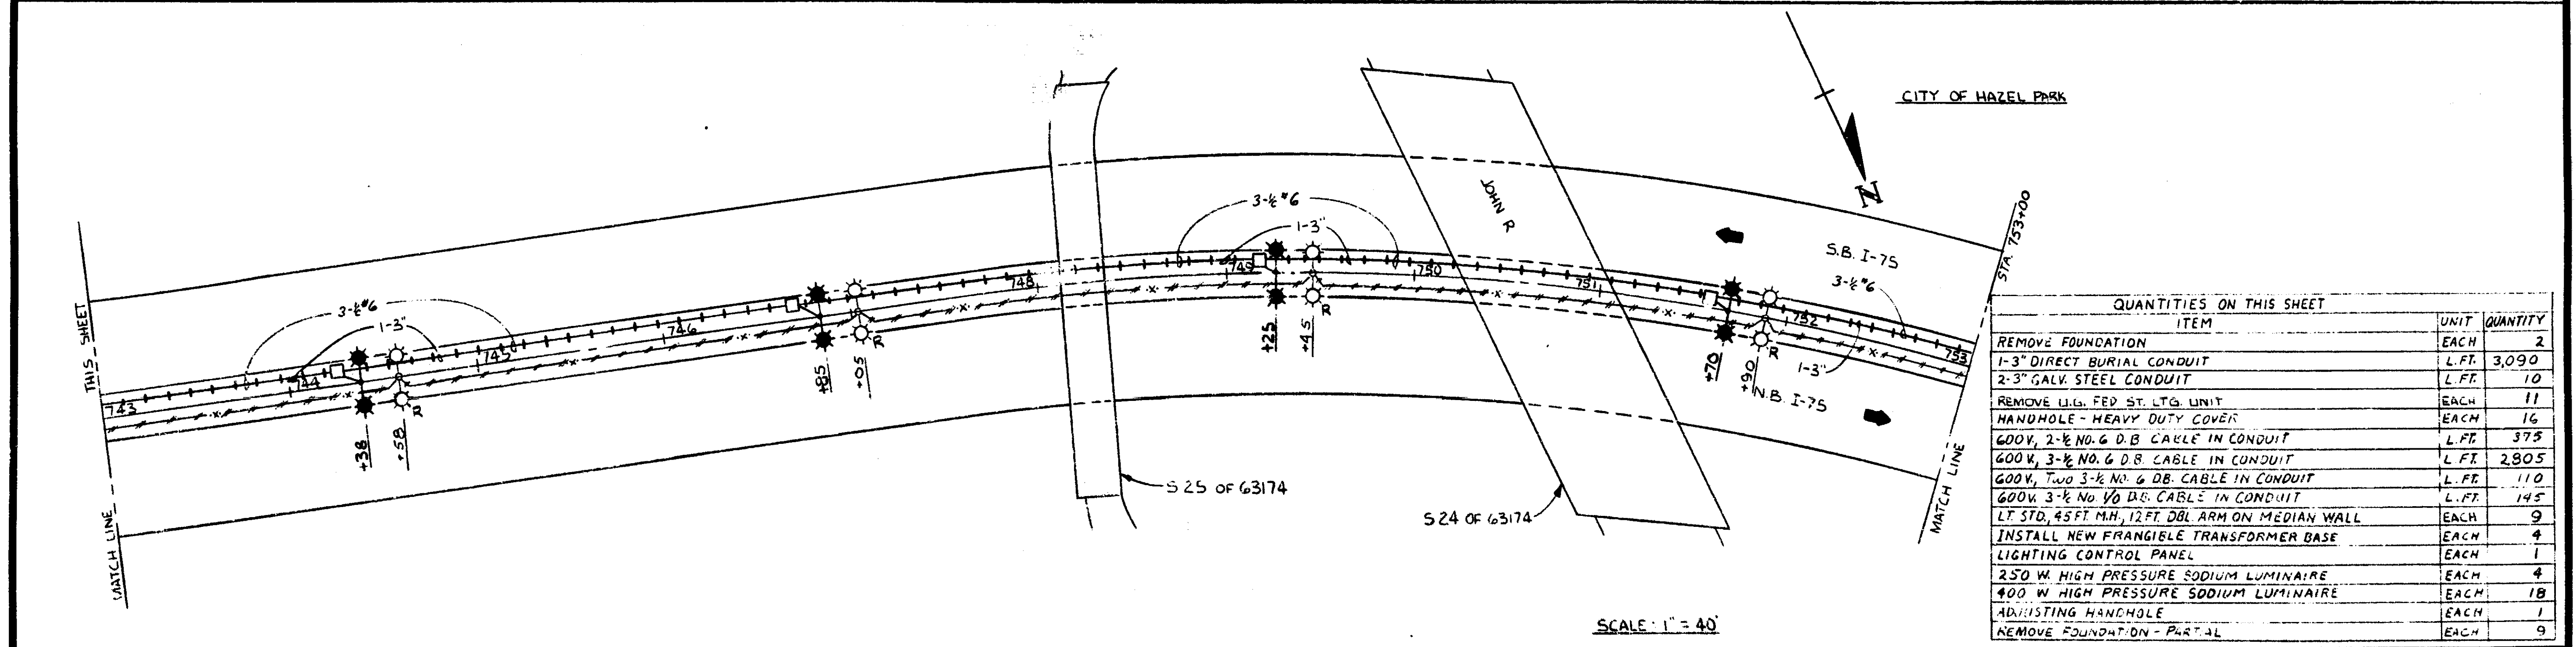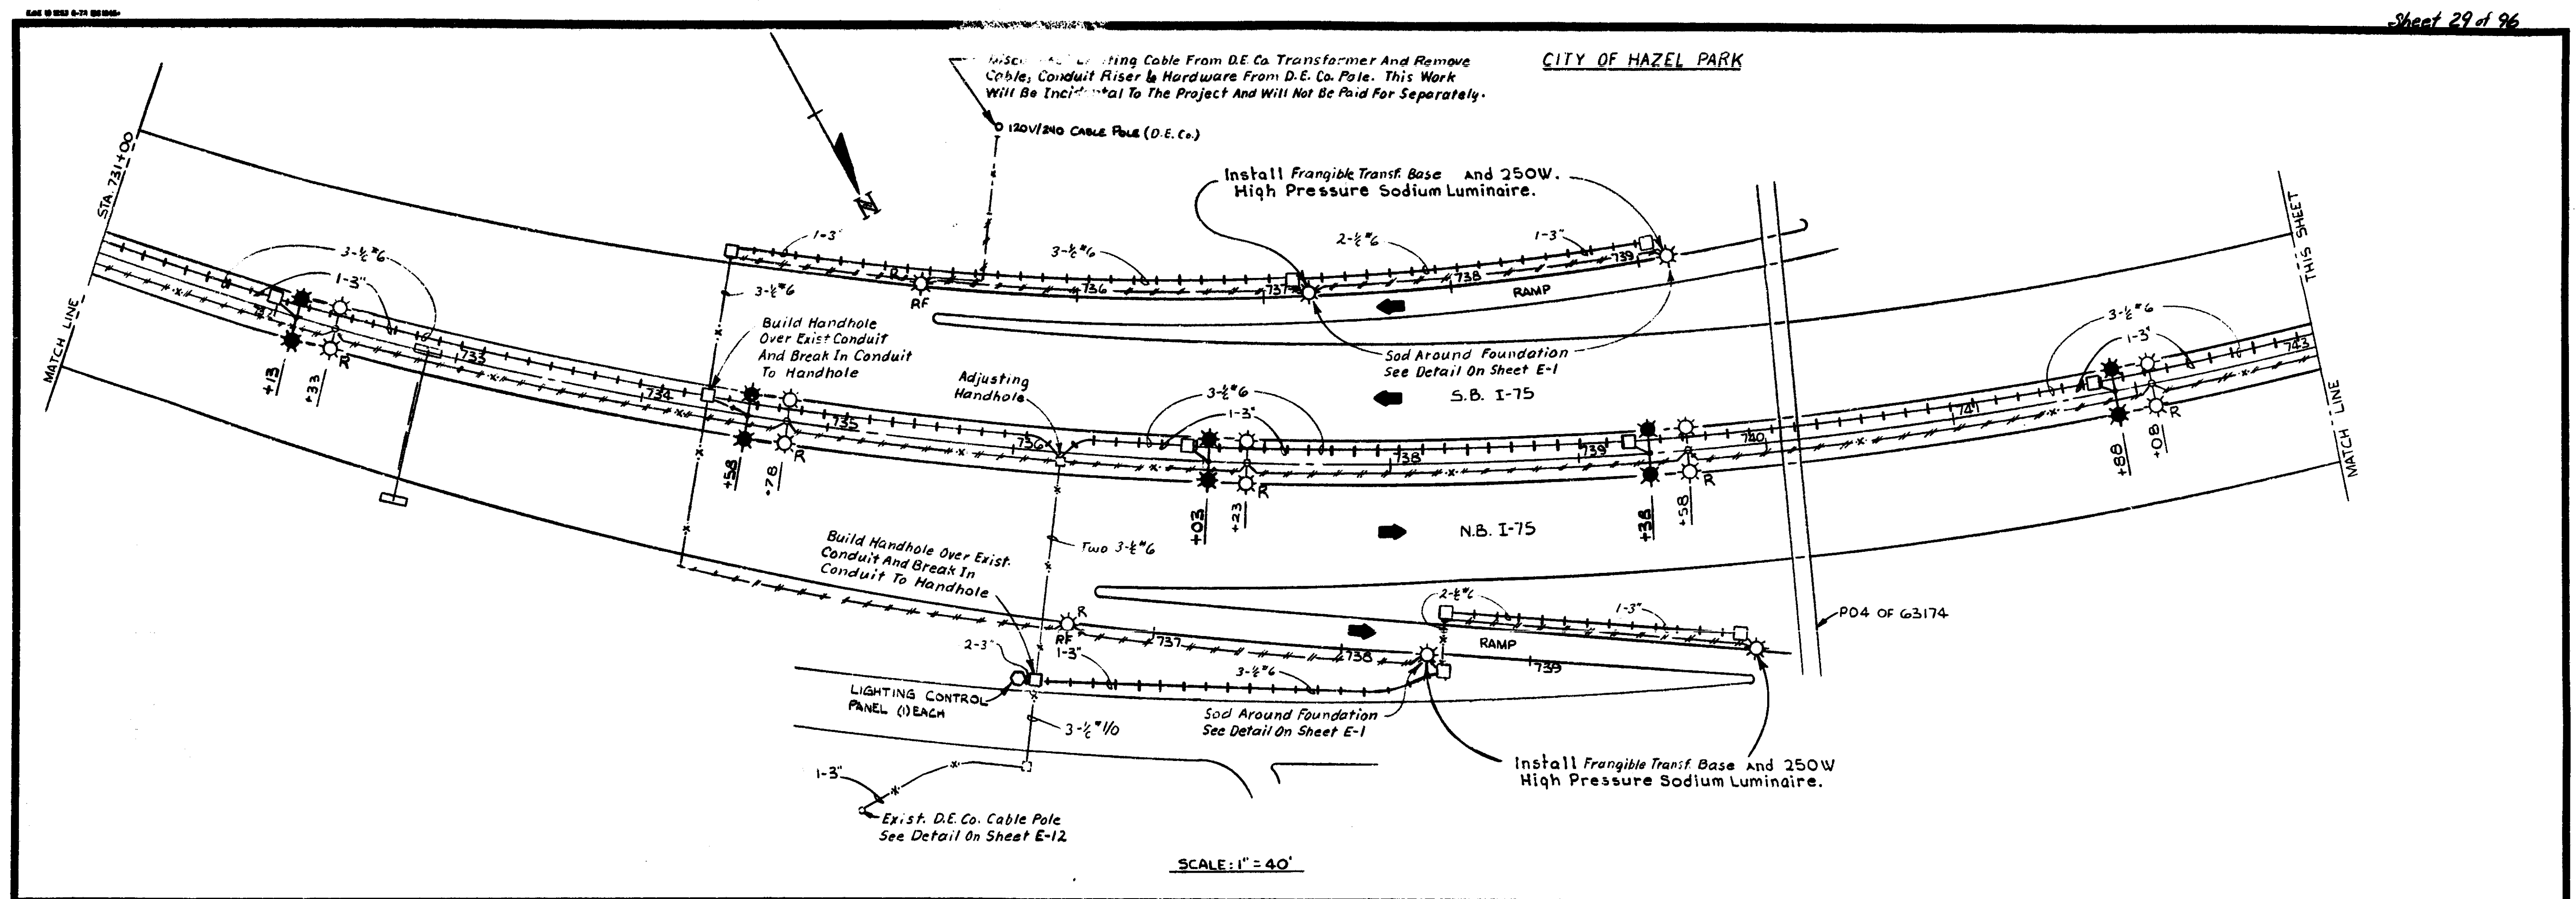

QUANTITIES ON THIS SHEET

ITEM	UNIT	QUANTITY
REMOVE FOUNDATION	EACH	2
1-3" DIRECT BURIAL CONDUIT	L. FT.	3,090
2-3" GALV. STEEL CONDUIT	L. FT.	10
REMOVE 110V. FED. ST. LTG. UNIT	EACH	11
HANDHOLE - HEAVY DUTY COVER	EACH	16
600V, 2-1/2 NO. 6 D.B. CABLE IN CONDUIT	L. FT.	375
600V, 3-1/2 NO. 6 D.B. CABLE IN CONDUIT	L. FT.	2,805
600V, Two 3-1/2 NO. 6 D.B. CABLE IN CONDUIT	L. FT.	110
600V, 3-1/2 NO. 1/0 D.B. CABLE IN CONDUIT	L. FT.	145
LT STD. 45FT. MH., 12FT. DBL. ARM ON MEDIAN WALL	EACH	9
INSTALL NEW FRANGIBLE TRANSFORMER BASE	EACH	4
LIGHTING CONTROL PANEL	EACH	1
250 W. HIGH PRESSURE SODIUM LUMINAIRE	EACH	4
400 W. HIGH PRESSURE SODIUM LUMINAIRE	EACH	18
ADJUSTING HANDHOLE	EACH	1
REMOVE FOUNDATION - PARTIAL	EACH	9

MICHIGAN DEPARTMENT OF STATE HIGHWAYS

FREEWAY LIGHTING

I-75


8 MILE RD. TO 12 MILE RD.

ES

63174 14165A


NO.	DESCRIPTION	DATE	BY

DESIGNED BY: J.V. JONES 1977
 DRAWN BY: W.M. ASB 3-77
 CHECKED BY: R.J.A. 5-77
 APPROVED BY: T.L. & C. 3-77

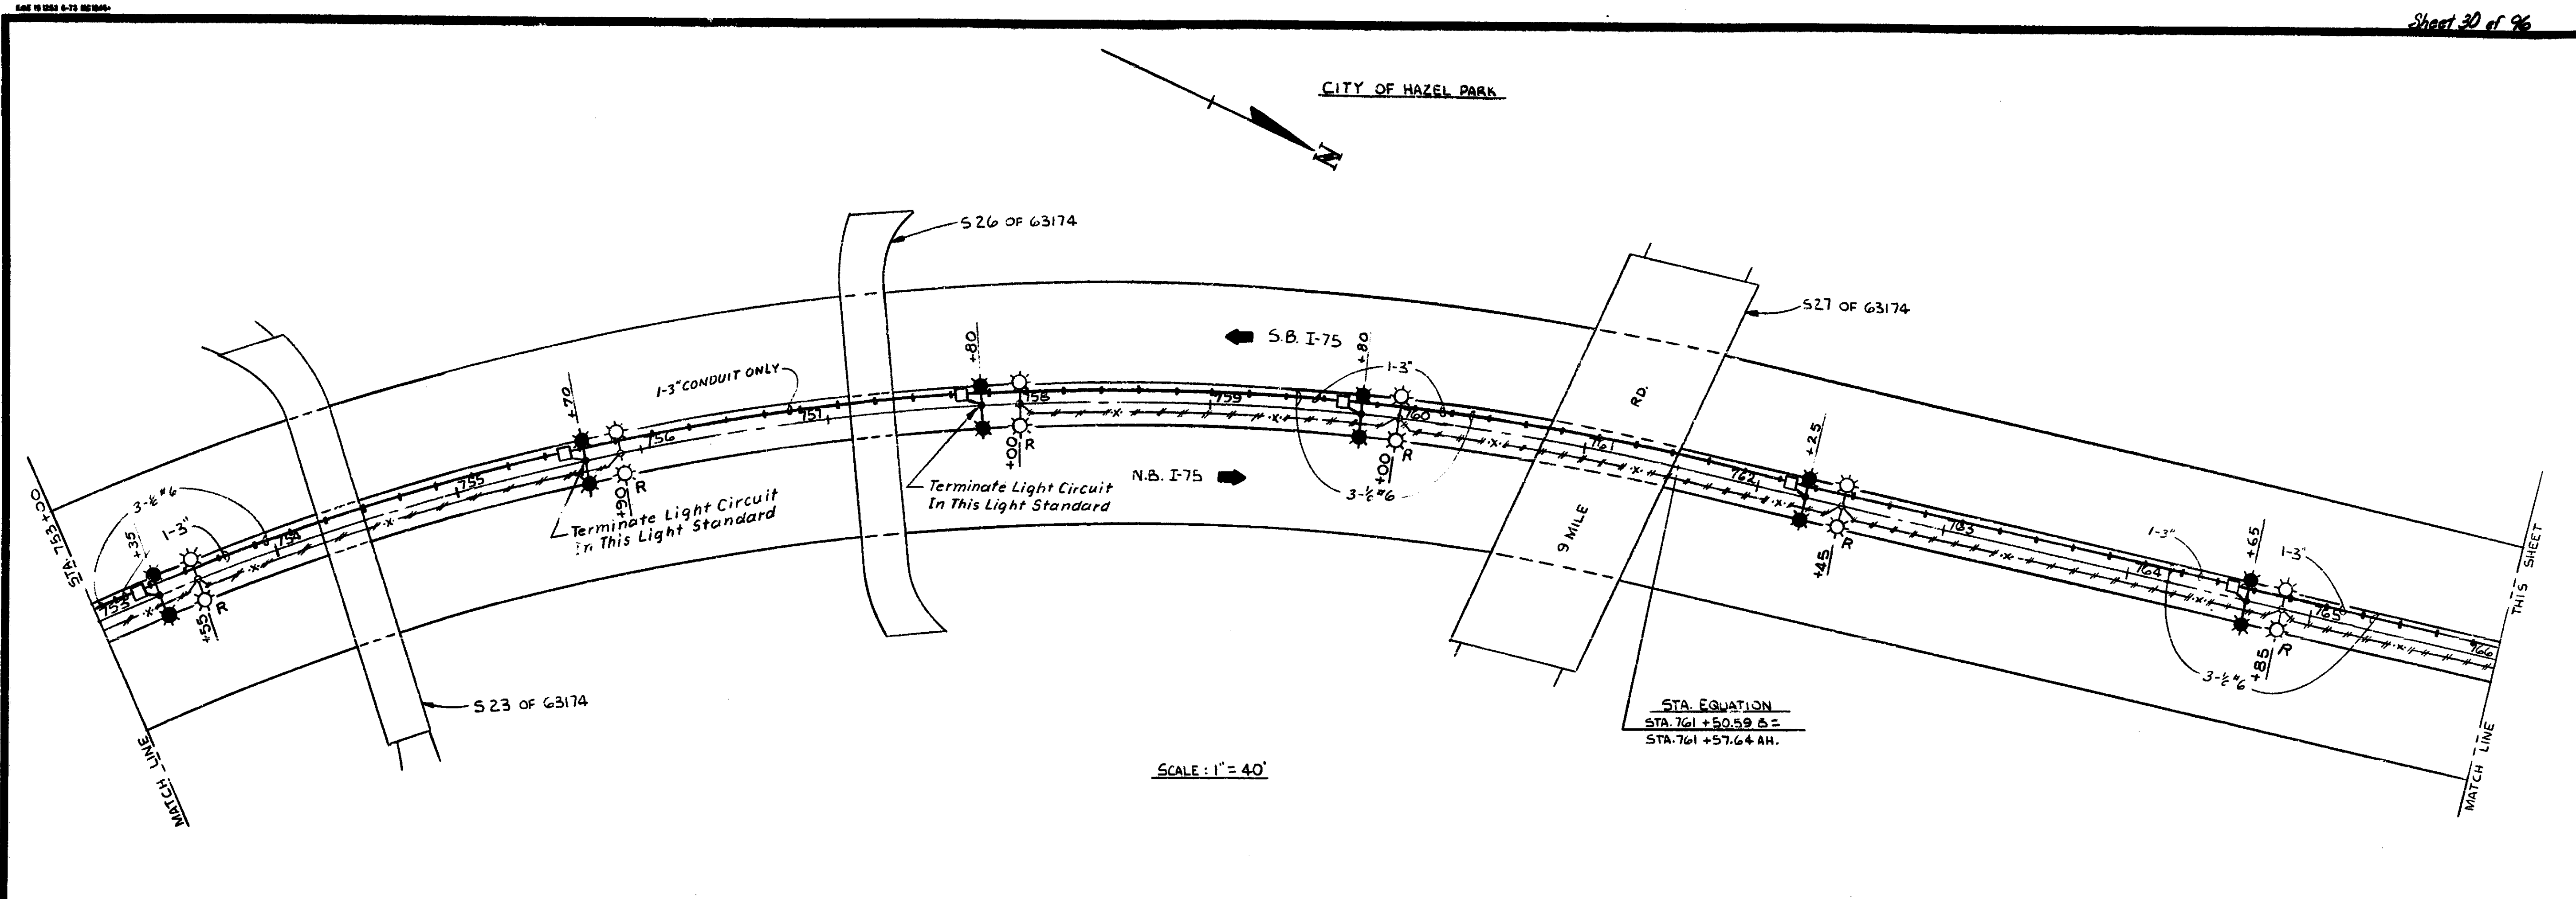

SCALE: 1" = 40'

STA. EQUATION
STA. 761 + 50.59 Δ =
STA. 761 + 57.64 ΔH.

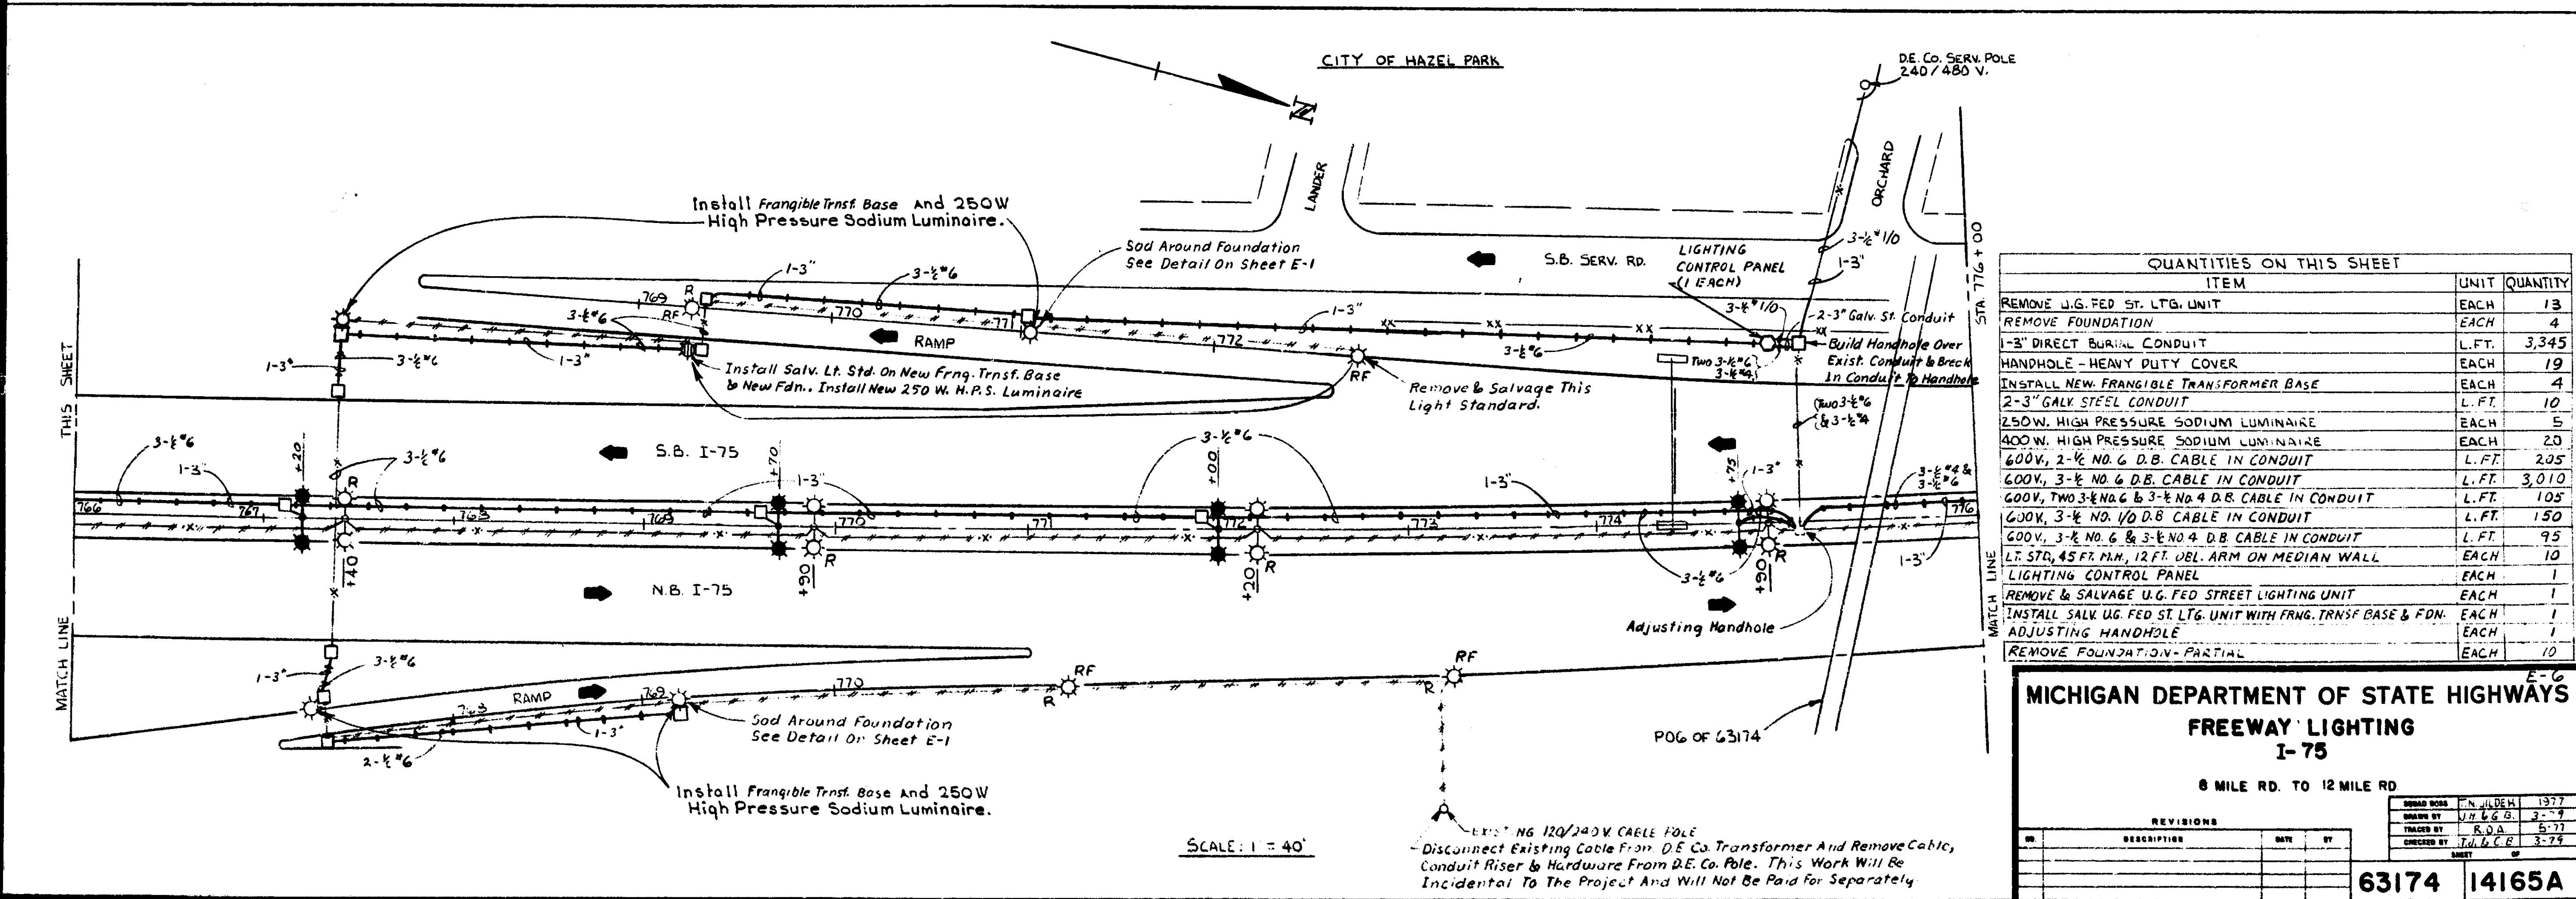

SCALE: 1" = 40'

DISCONNECT EXISTING CABLE FROM D.E. CO. TRANSFORMER AND REMOVE CABLE, CONDUIT RISER & HARDWARE FROM D.E. CO. POLE. THIS WORK WILL BE INCIDENTAL TO THE PROJECT AND WILL NOT BE PAID FOR SEPARATELY.



QUANTITIES ON THIS SHEET		
ITEM	UNIT	QUANTITY
REMOVE U.G. FED ST. LTG. UNIT	EACH	13
REMOVE FOUNDATION	EACH	4
1-3" DIRECT BURIAL CONDUIT	L. FT.	3,345
HANDHOLE - HEAVY DUTY COVER	EACH	19
INSTALL NEW FRANGIBLE TRANSFORMER BASE	EACH	4
2-3" GALV. STEEL CONDUIT	L. FT.	10
250W. HIGH PRESSURE SODIUM LUMINAIRE	EACH	5
400W. HIGH PRESSURE SODIUM LUMINAIRE	EACH	20
600V, 2-1/2 NO. 6 D.B. CABLE IN CONDUIT	L. FT.	205
600V, 3-1/2 NO. 6 D.B. CABLE IN CONDUIT	L. FT.	3,010
600V, TWO 3-1/2 NO. 6 & 3-1/2 NO. 4 D.B. CABLE IN CONDUIT	L. FT.	105
600V, 3-1/2 NO. 10 D.B. CABLE IN CONDUIT	L. FT.	150
600V, 3-1/2 NO. 6 & 3-1/2 NO. 4 D.B. CABLE IN CONDUIT	L. FT.	95
LT. STD., 45 FT. P.M., 12 FT. UBL. ARM ON MEDIAN WALL	EACH	10
LIGHTING CONTROL PANEL	EACH	1
REMOVE & SALVAGE U.G. FED STREET LIGHTING UNIT	EACH	1
INSTALL SALV. U.G. FED ST. LTG. UNIT WITH FRANG. TRNSF. BASE & FDN.	EACH	1
ADJUSTING HANDHOLE	EACH	1
REMOVE FOUNDATION - PARTIAL	EACH	10

MICHIGAN DEPARTMENT OF STATE HIGHWAYS
FREWAY LIGHTING
I-75
 8 MILE RD. TO 12 MILE RD.

REVISIONS

NO.	DESCRIPTION	DATE	BY

63174 14165A

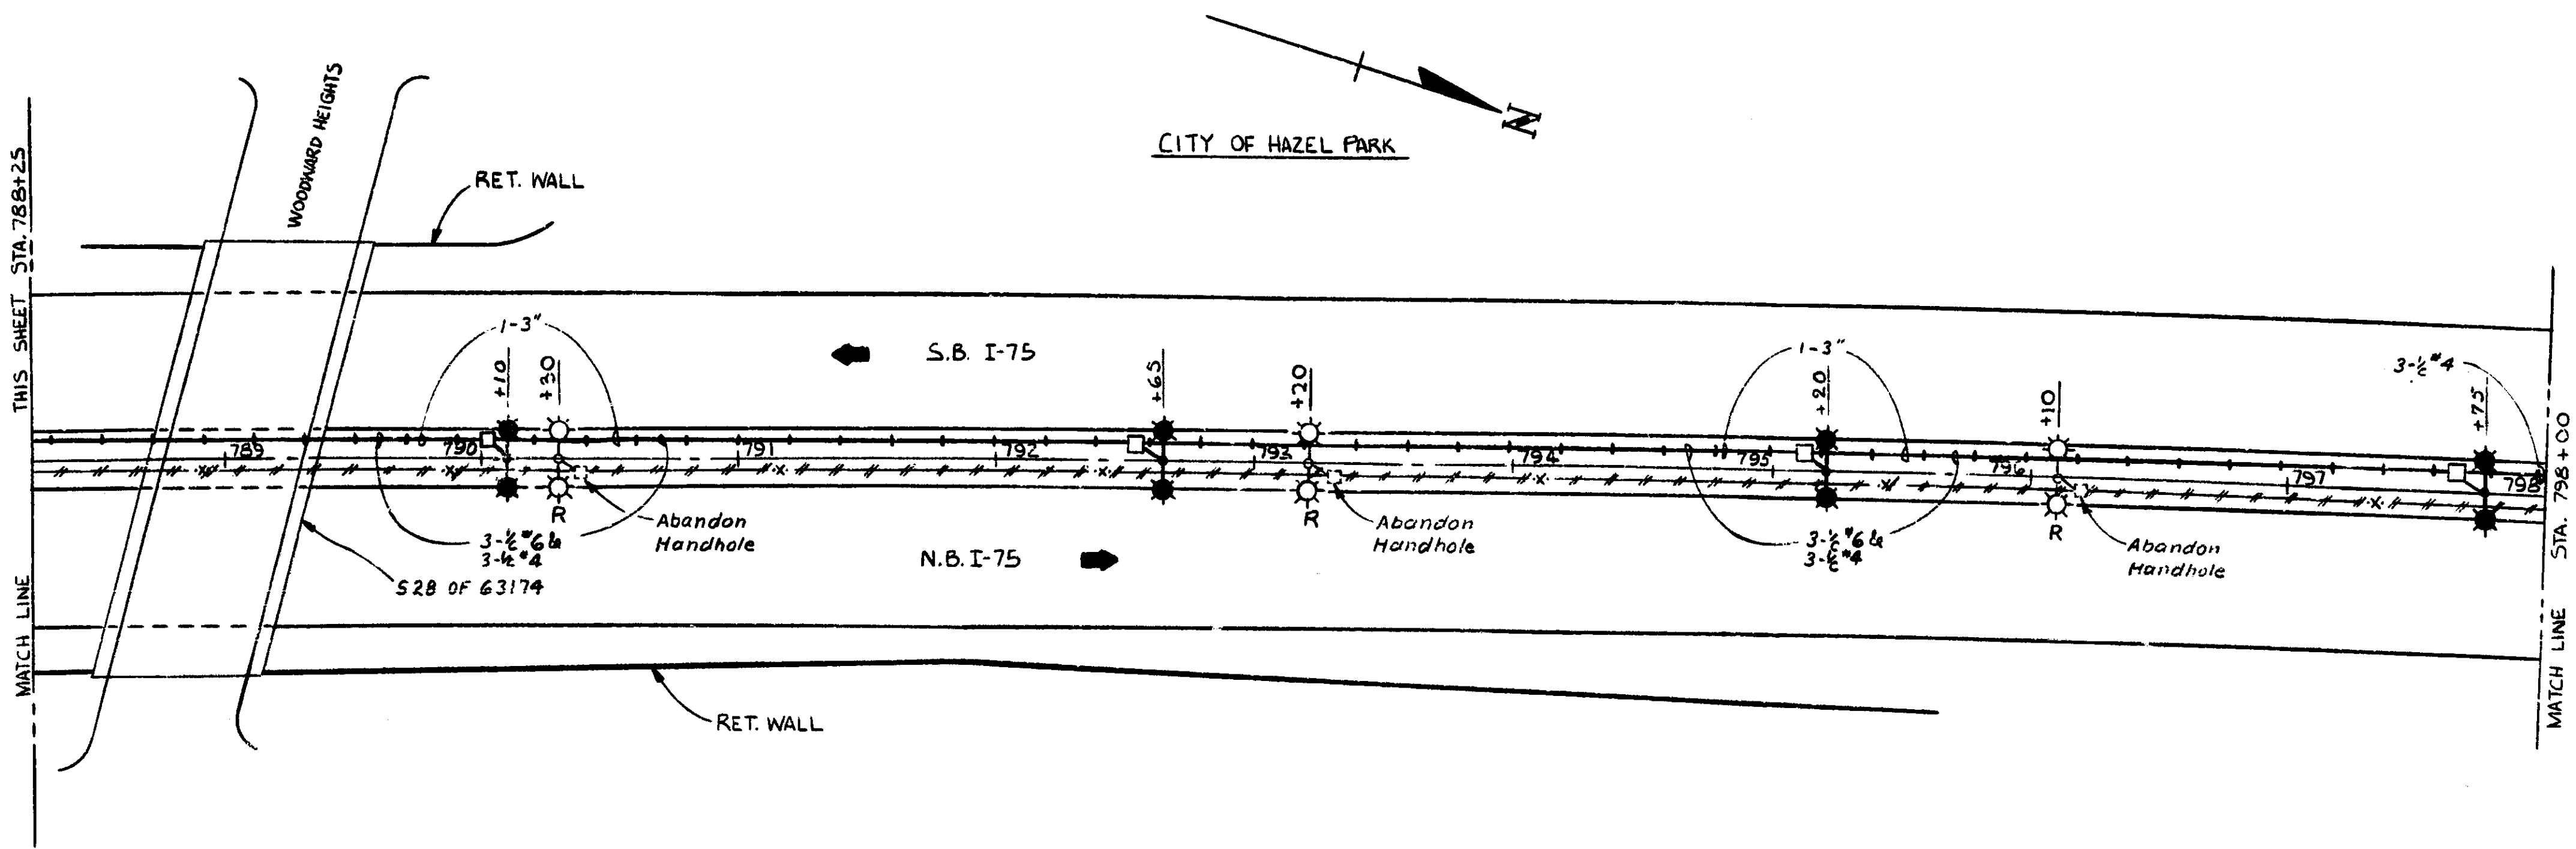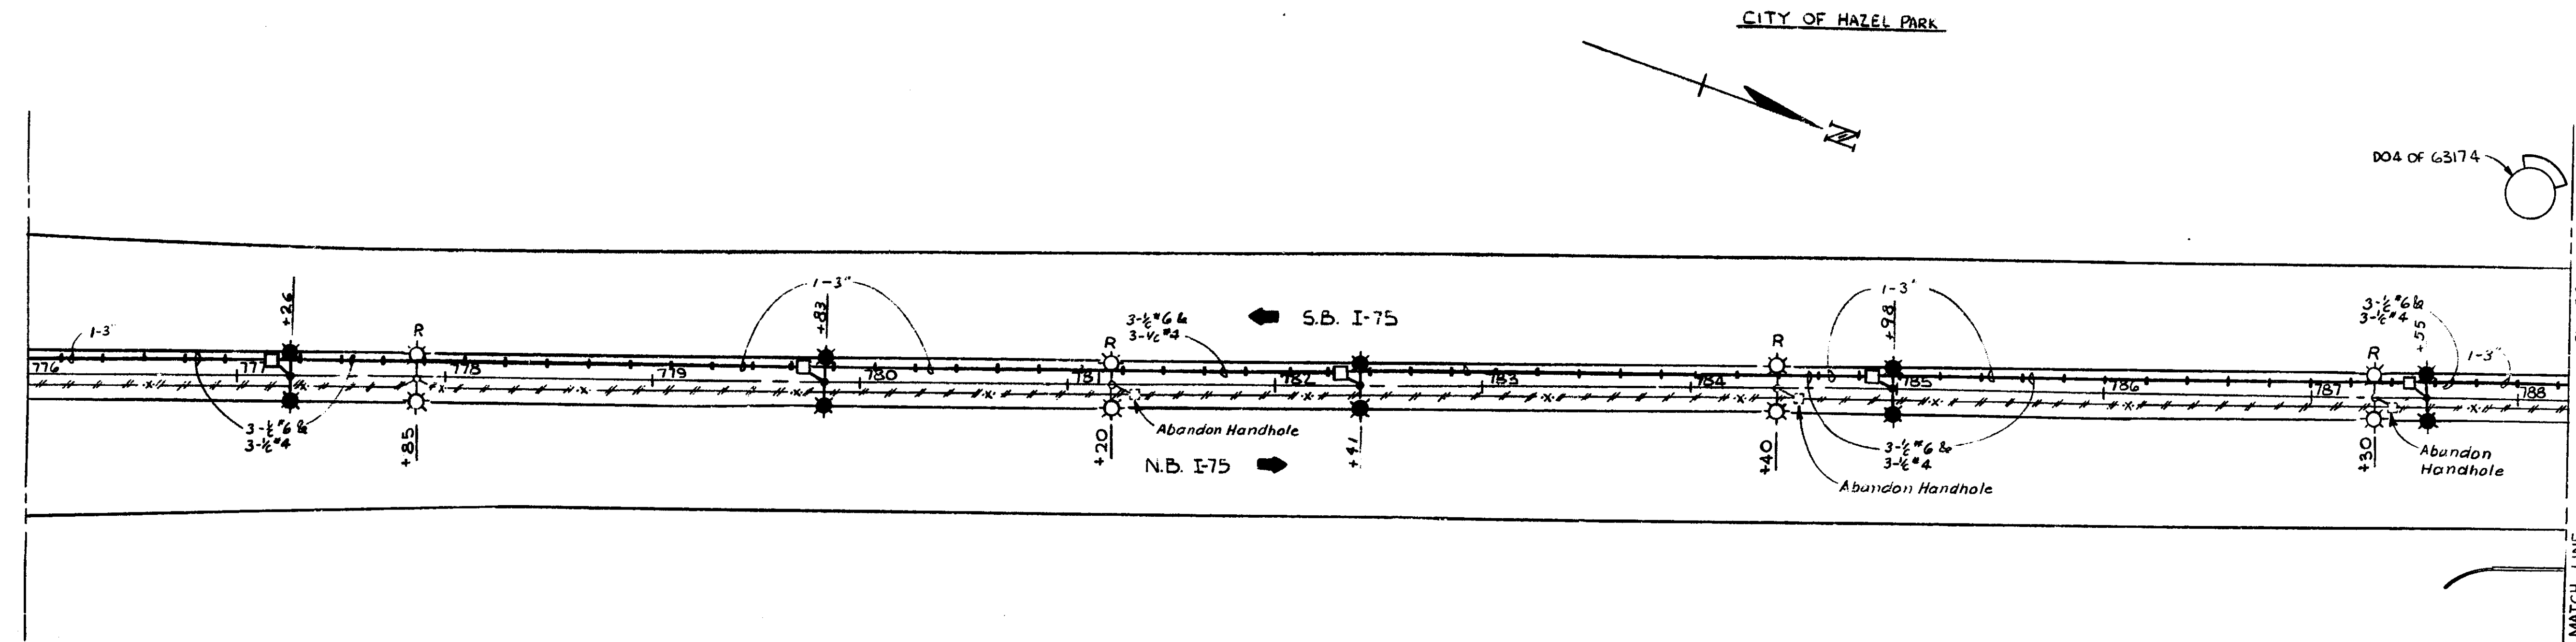

QUANTITIES ON THIS SHEET		
ITEM	UNIT	QUANTITY
REMOVE U.G. FED. ST. LTG. UNIT	EACH	7
HANDHOLE - HEAVY DUTY COVER	EACH	9
LT. STD, 45 FT. M.H., 12 FT. DEL. ARM ON MEDIAN WALL	EACH	9
400 W HIGH PRESSURE SODIUM LUMINAIRE	EACH	18
1-3" DIRECT BURIAL CONDUIT	L.FT.	2,240
600V, 3-1/2" NO. 6 & 3-1/2" NO. 4 D.B. CABLE IN CONDUIT	L.FT.	2,175
600V, 3-1/2" NO. 4 D.B. CABLE IN CONDUIT	L.FT.	25
600V, 3-1/2" NO. 6 D.B. CABLE IN CONDUIT	L.FT.	40
REMOVE FOUNDATION - PARTIAL	EACH	7
ABANDON HANDHOLE - ELECTRICAL	EACH	6

E-7



MICHIGAN DEPARTMENT OF STATE HIGHWAYS
FREEWAY LIGHTING
I-75
 8 MILE RD. TO 12 MILE RD.

REVISIONS			
NO.	DESCRIPTION	DATE	BY

DESIGNED BY	J.N. JILDEH	1977
DRAWN BY	M.C. & G.B.	7-79
CHECKED BY	R.O.A.	5-77
CHECKED BY	F.V. & C.B.	3-79

63174 14165A

FORM 103 (10-76) 62222-

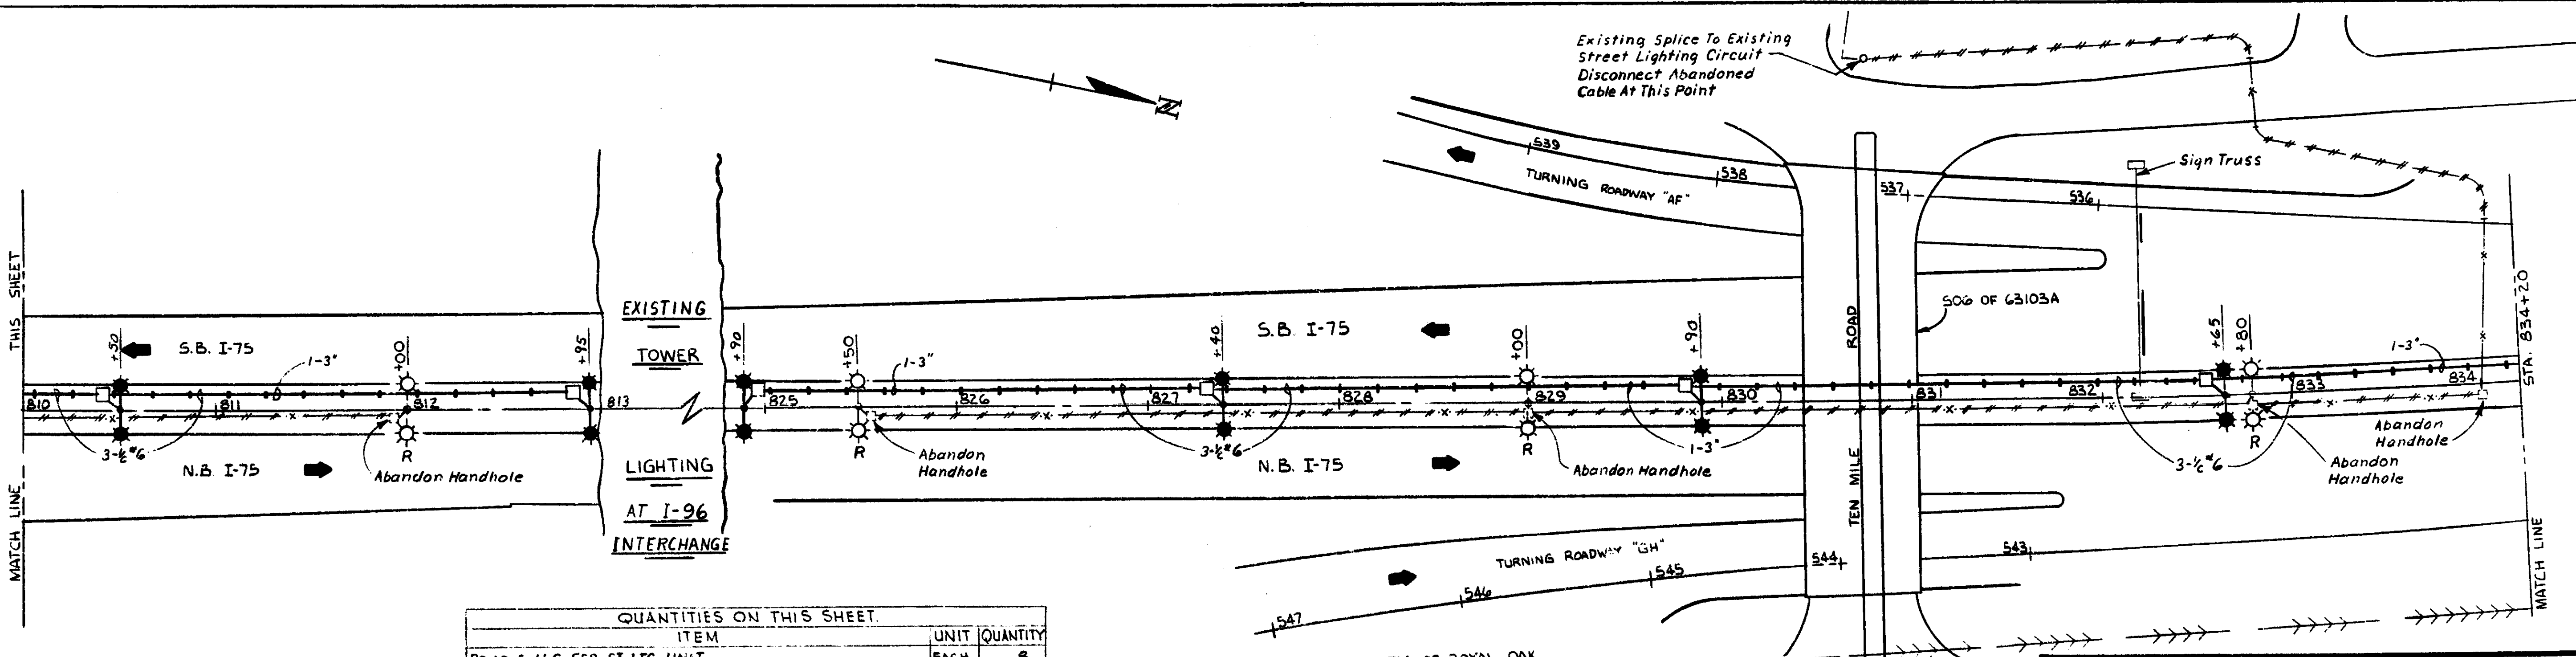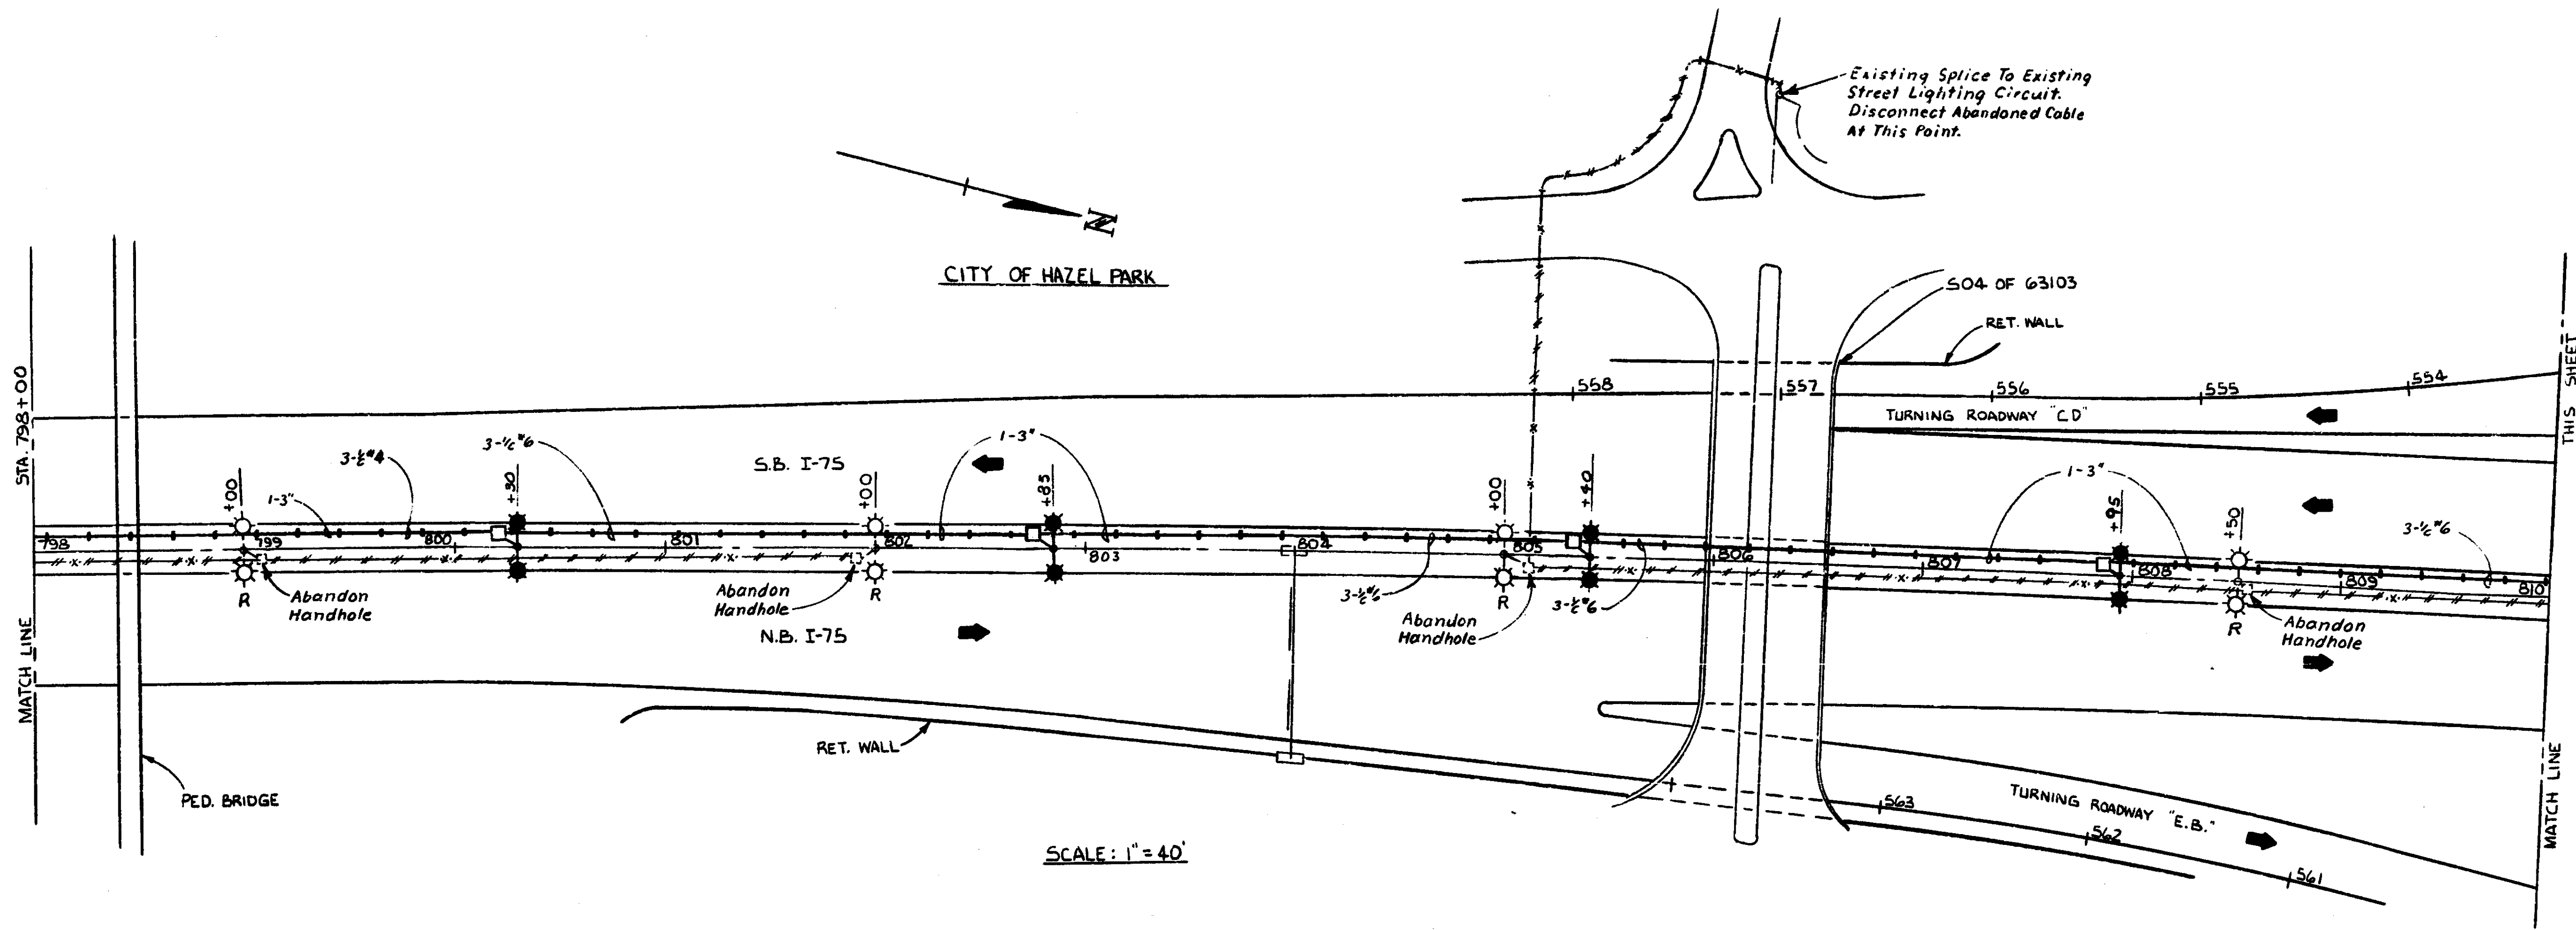

QUANTITIES ON THIS SHEET


ITEM	UNIT	QUANTITY
REMOVE U.G. FED ST. L.T.C. UNIT	EACH	8
1-3" DIRECT BURIAL CONDUIT	L.F.T.	2470
LT. STD. 4.5 FT. M.H., 12 FT. DBL. ARM ON MEDIAN WALL	EACH	10
400 W. HIGH PRESSURE SODIUM LUMINAIRE	EACH	20
600 V., 3-1/2 NO. 6 D.B. CABLE IN CONDUIT	L.F.T.	2240
600 V., 3-1/2 NO. 4 D.B. CABLE IN CONDUIT	L.F.T.	230
HANDHOLE - HEAVY DUTY COVER	EACH	10
REMOVE FOUNDATION - PARTIAL	EACH	8
ABANDON HANDHOLE - ELECTRICAL	EACH	9

MICHIGAN DEPARTMENT OF STATE HIGHWAYS AND TRANSPORTATION
FREEWAY LIGHTING
I-75
 8 MILE RD. TO 12 MILE RD.


NO.	DESCRIPTION	DATE	BY

DRAWN BY: J.H.G.B. 3-79
 CHECKED BY: T.V. & C.B. 3-79
 SHEET OF: 32

63174 14165A

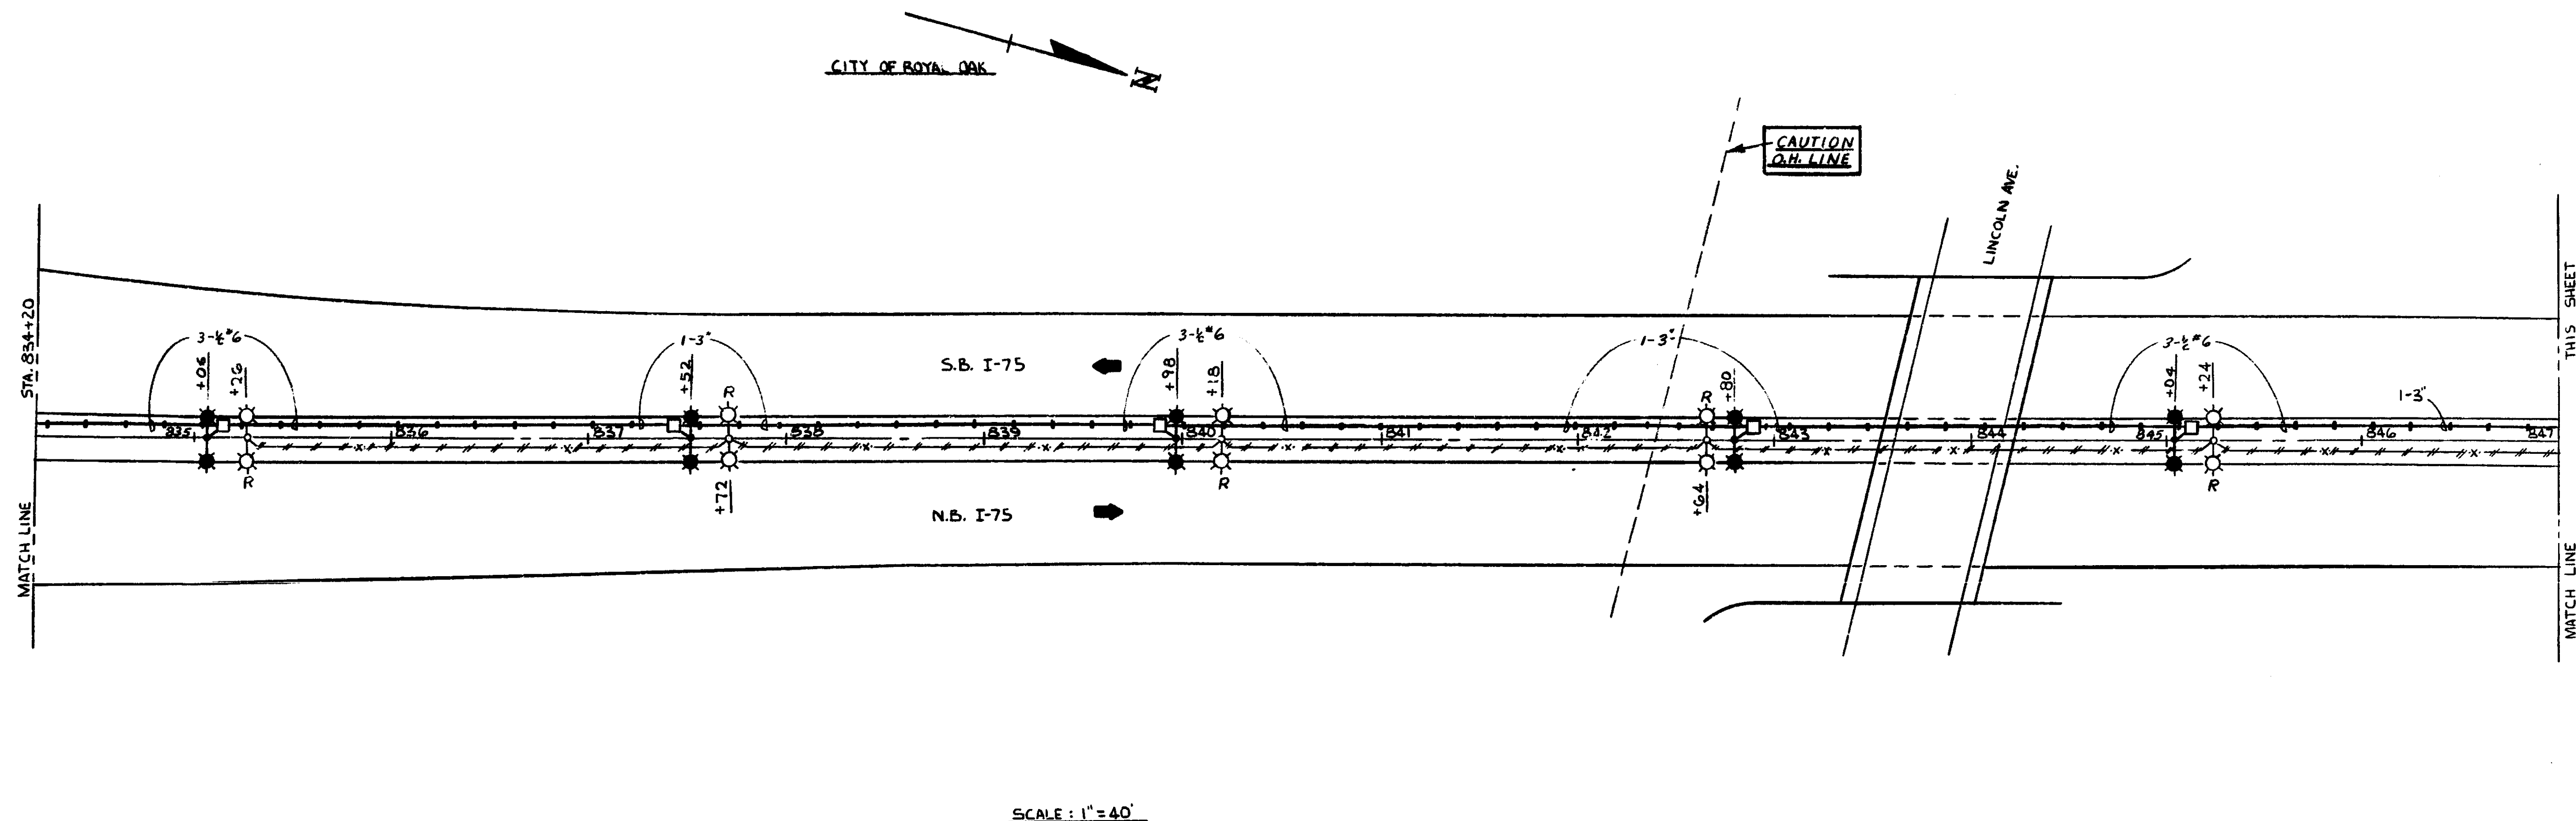

SCALE: 1" = 40'

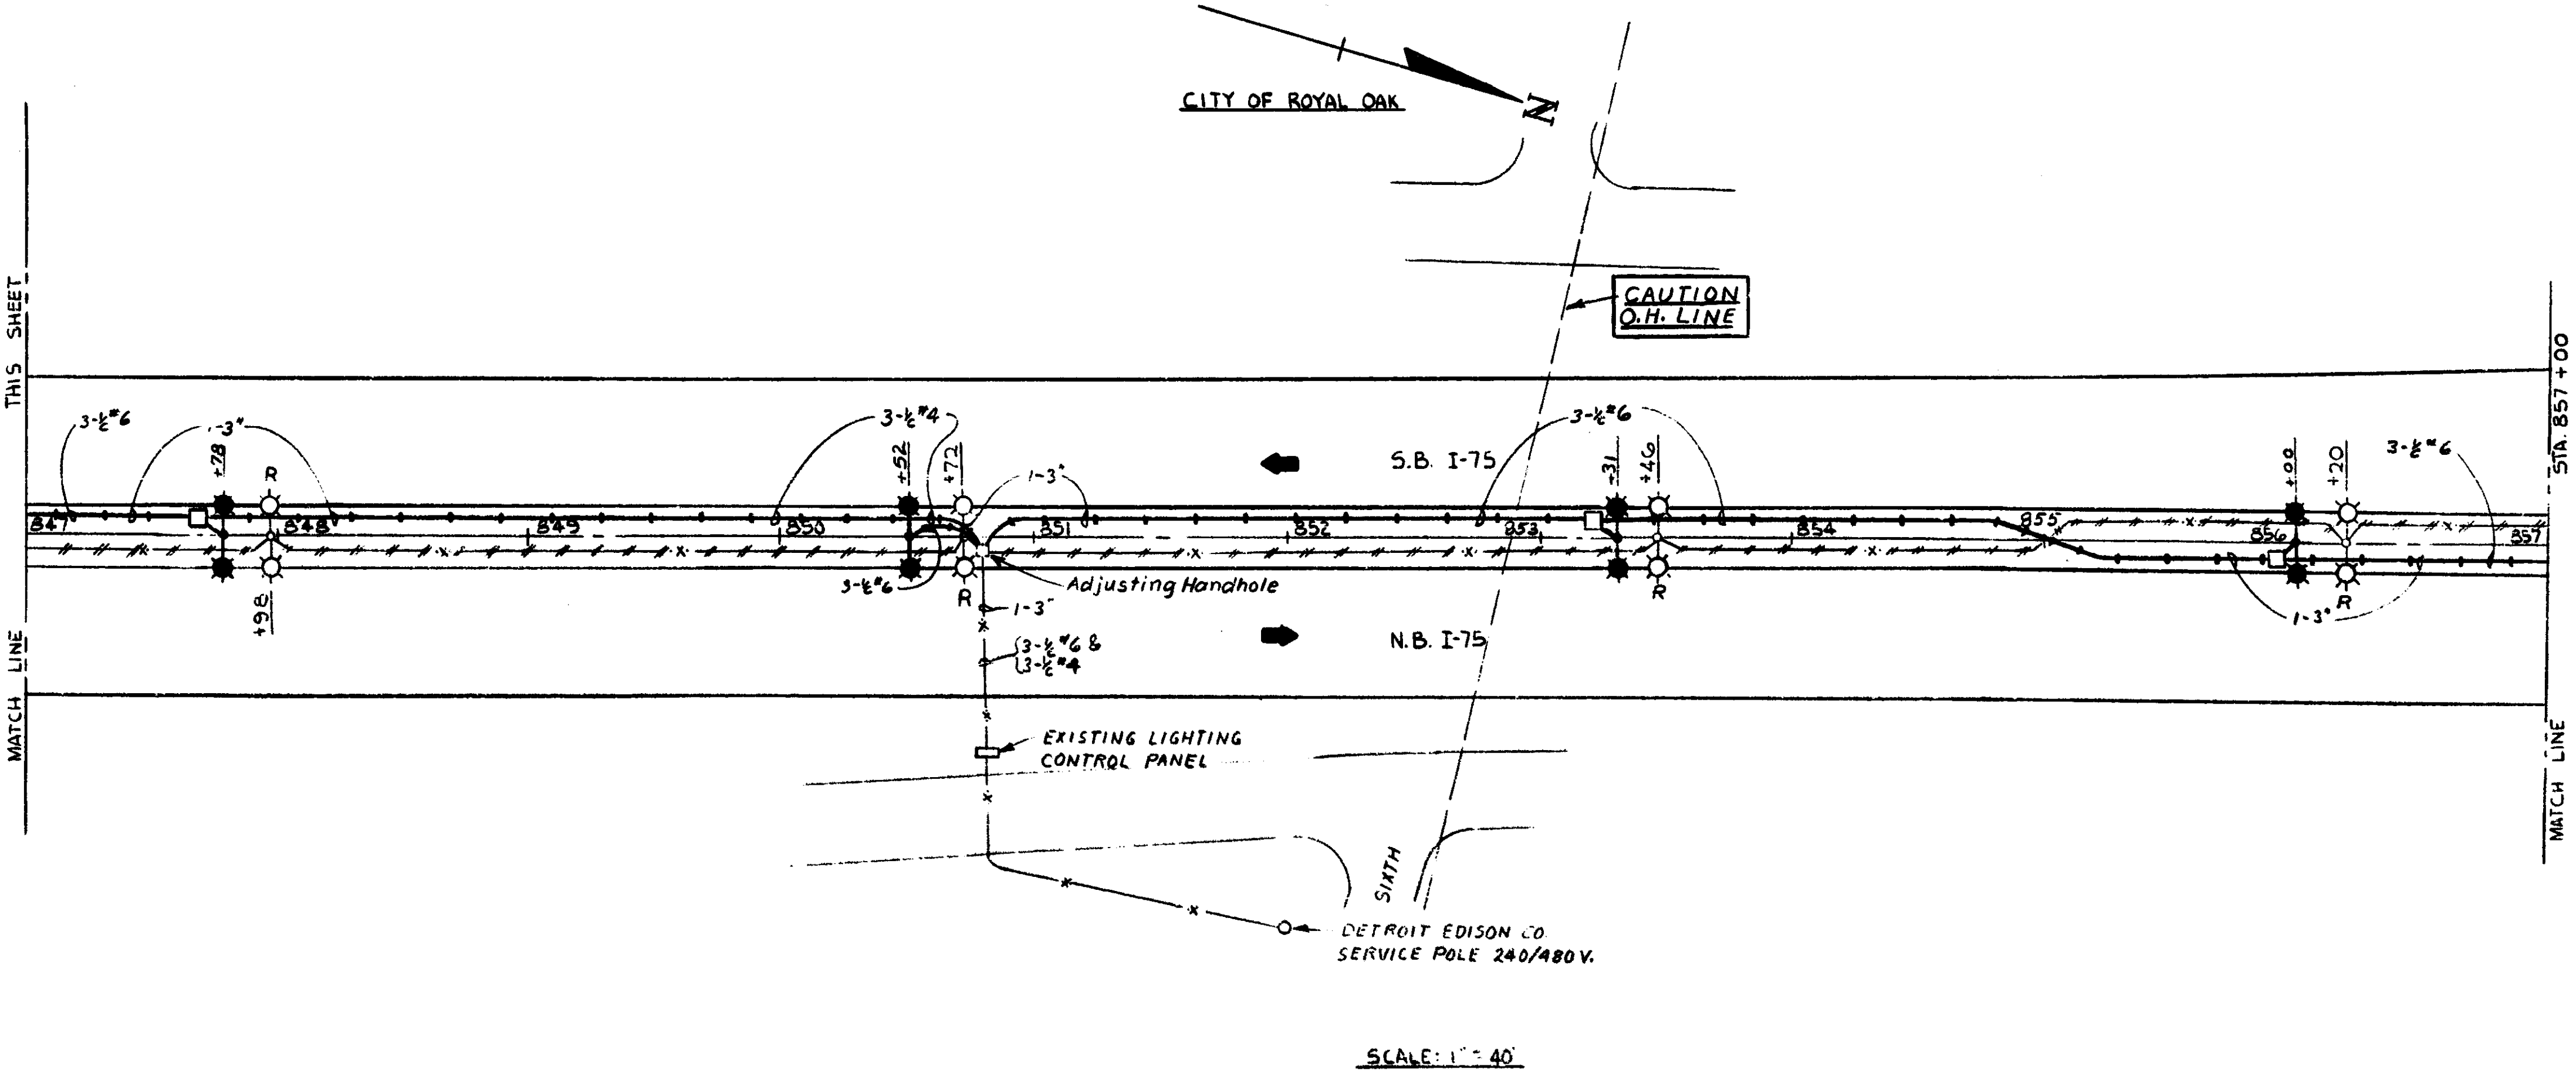

SCALE: 1" = 40'

QUANTITIES ON THIS SHEET		
ITEM	UNIT	QUANTITY
REMOVE U.G. FED ST. LTG. UNIT	EACH	9
1-3" DIRECT BURIAL CONDUIT	EACH	2300
HANDHOLE - HEAVY DUTY COVER	EACH	8
L.T. STD., 45 FT. M.H., 12 FT. DBL. ARM ON MEDIAN WALL	EACH	9
400W. HIGH PRESSURE SODIUM LUMINAIRE	EACH	18
600V, 3-1/2 NO. 6 D.B. CABLE IN CONDUIT	L.FT.	2,000
600V, 3-1/2 NO. 4 D.B. CABLE IN CONDUIT	L.FT.	314
600V, 3-1/2 NO. 6 & 3-1/2 NO. 4 D.B. CABLE IN CONDUIT	L.FT.	90
ADJUSTING HANDHOLE	EACH	1
REMOVE FOUNDATION - PARTIAL	EACH	9


E-9

**MICHIGAN DEPARTMENT OF STATE HIGHWAYS
AND TRANSPORTATION
FREEWAY LIGHTING
I-75
8 MILE RD. TO 12 MILE RD.**


REVISIONS			
NO.	DESCRIPTION	DATE	BY

SQUAD WORK	T.N. JILDEH	1977
DRAWN BY	J.M. R.G.B.	3-79
CHECKED BY	R.O.A.	5-79
DESIGNED BY	F.J. L.C.B.	3-79

63174 14165A

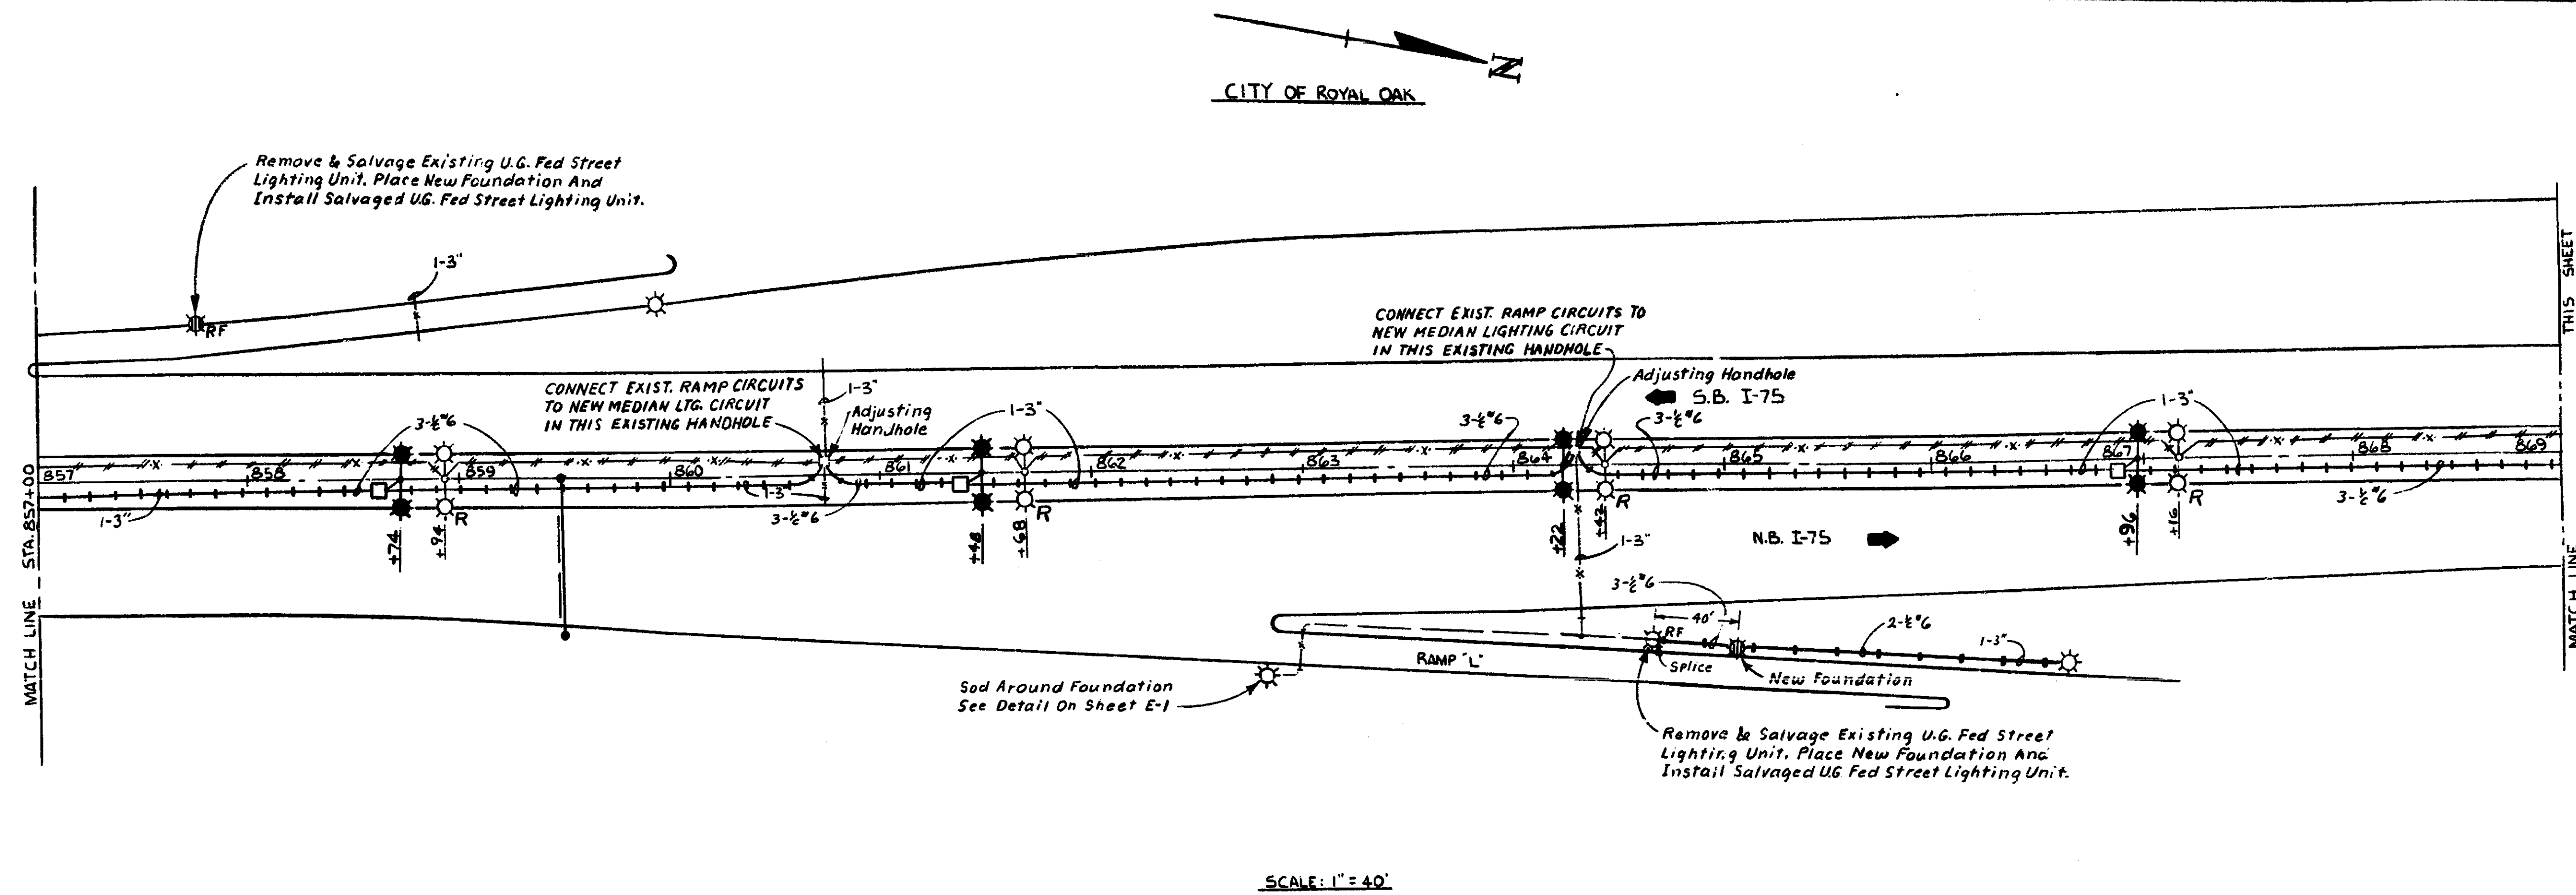

SCALE: 1" = 40'

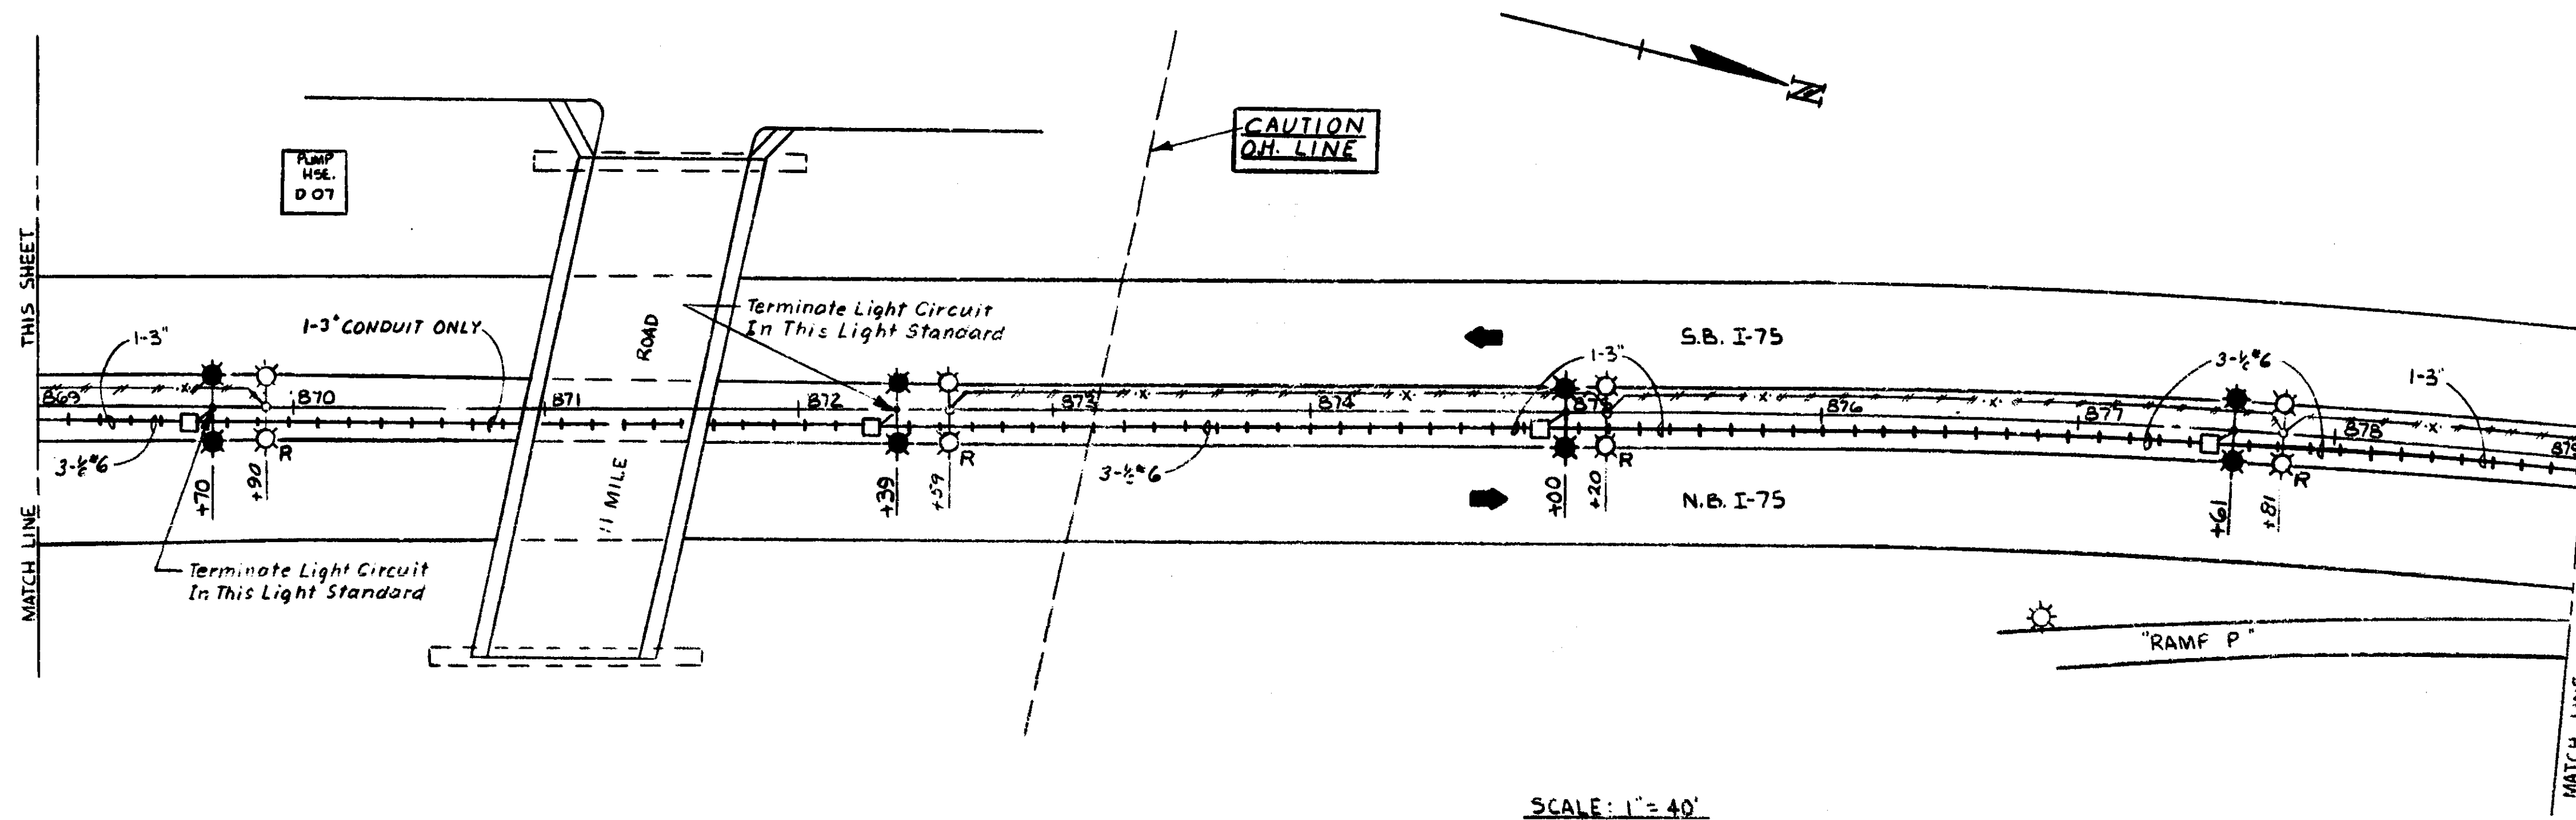

SCALE: 1" = 40'

QUANTITIES ON THIS SHEET		
ITEM	UNIT	QUANTITY
REMOVE U.G. FED ST. LTG. UNIT	EACH	8
LT. STD., 45 FT. MH., 12 FT. DBL. ARM ON MEDIAN WALL	EACH	8
1-3" DIRECT BURIAL CONDUIT	L. FT.	2,410
HANDHOLE - HEAVY DUTY COVER	EACH	7
400 W. HIGH PRESSURE SODIUM LUMINAIRE	EACH	16
600 V., 3-# NO. 6 D.B. CABLE IN CONDUIT	L. FT.	2,000
ADJUSTING HANDHOLE	EACH	2
REMOVE FOUNDATION	EACH	2
REMOVE & SALVAGE U.G. FED STREET LIGHTING UNIT	EACH	2
INSTALL SALV. U.G. FED ST. LTG. UNIT WITH FRNG. TRNSF. BASE & FDN.	EACH	2
600V. 2-# NO. 6 D.B. CABLE IN CONDUIT	L. FT.	160
REMOVE FOUNDATION	EACH	8

E-10


**MICHIGAN DEPARTMENT OF STATE HIGHWAYS
AND TRANSPORTATION
FREEWAY LIGHTING
I-75
8 MILE RD. TO 12 MILE RD.**

REVISIONS			
NO.	DESCRIPTION	DATE	BY


DESIGNED BY	R.N. JILDEH	1977
DRAWN BY	V.N. G.C.	3-74
TRACED BY	R.O.A.	5-77
CHECKED BY	F.V. & C.B.	3-79

63174 14165A

Sheet # 34

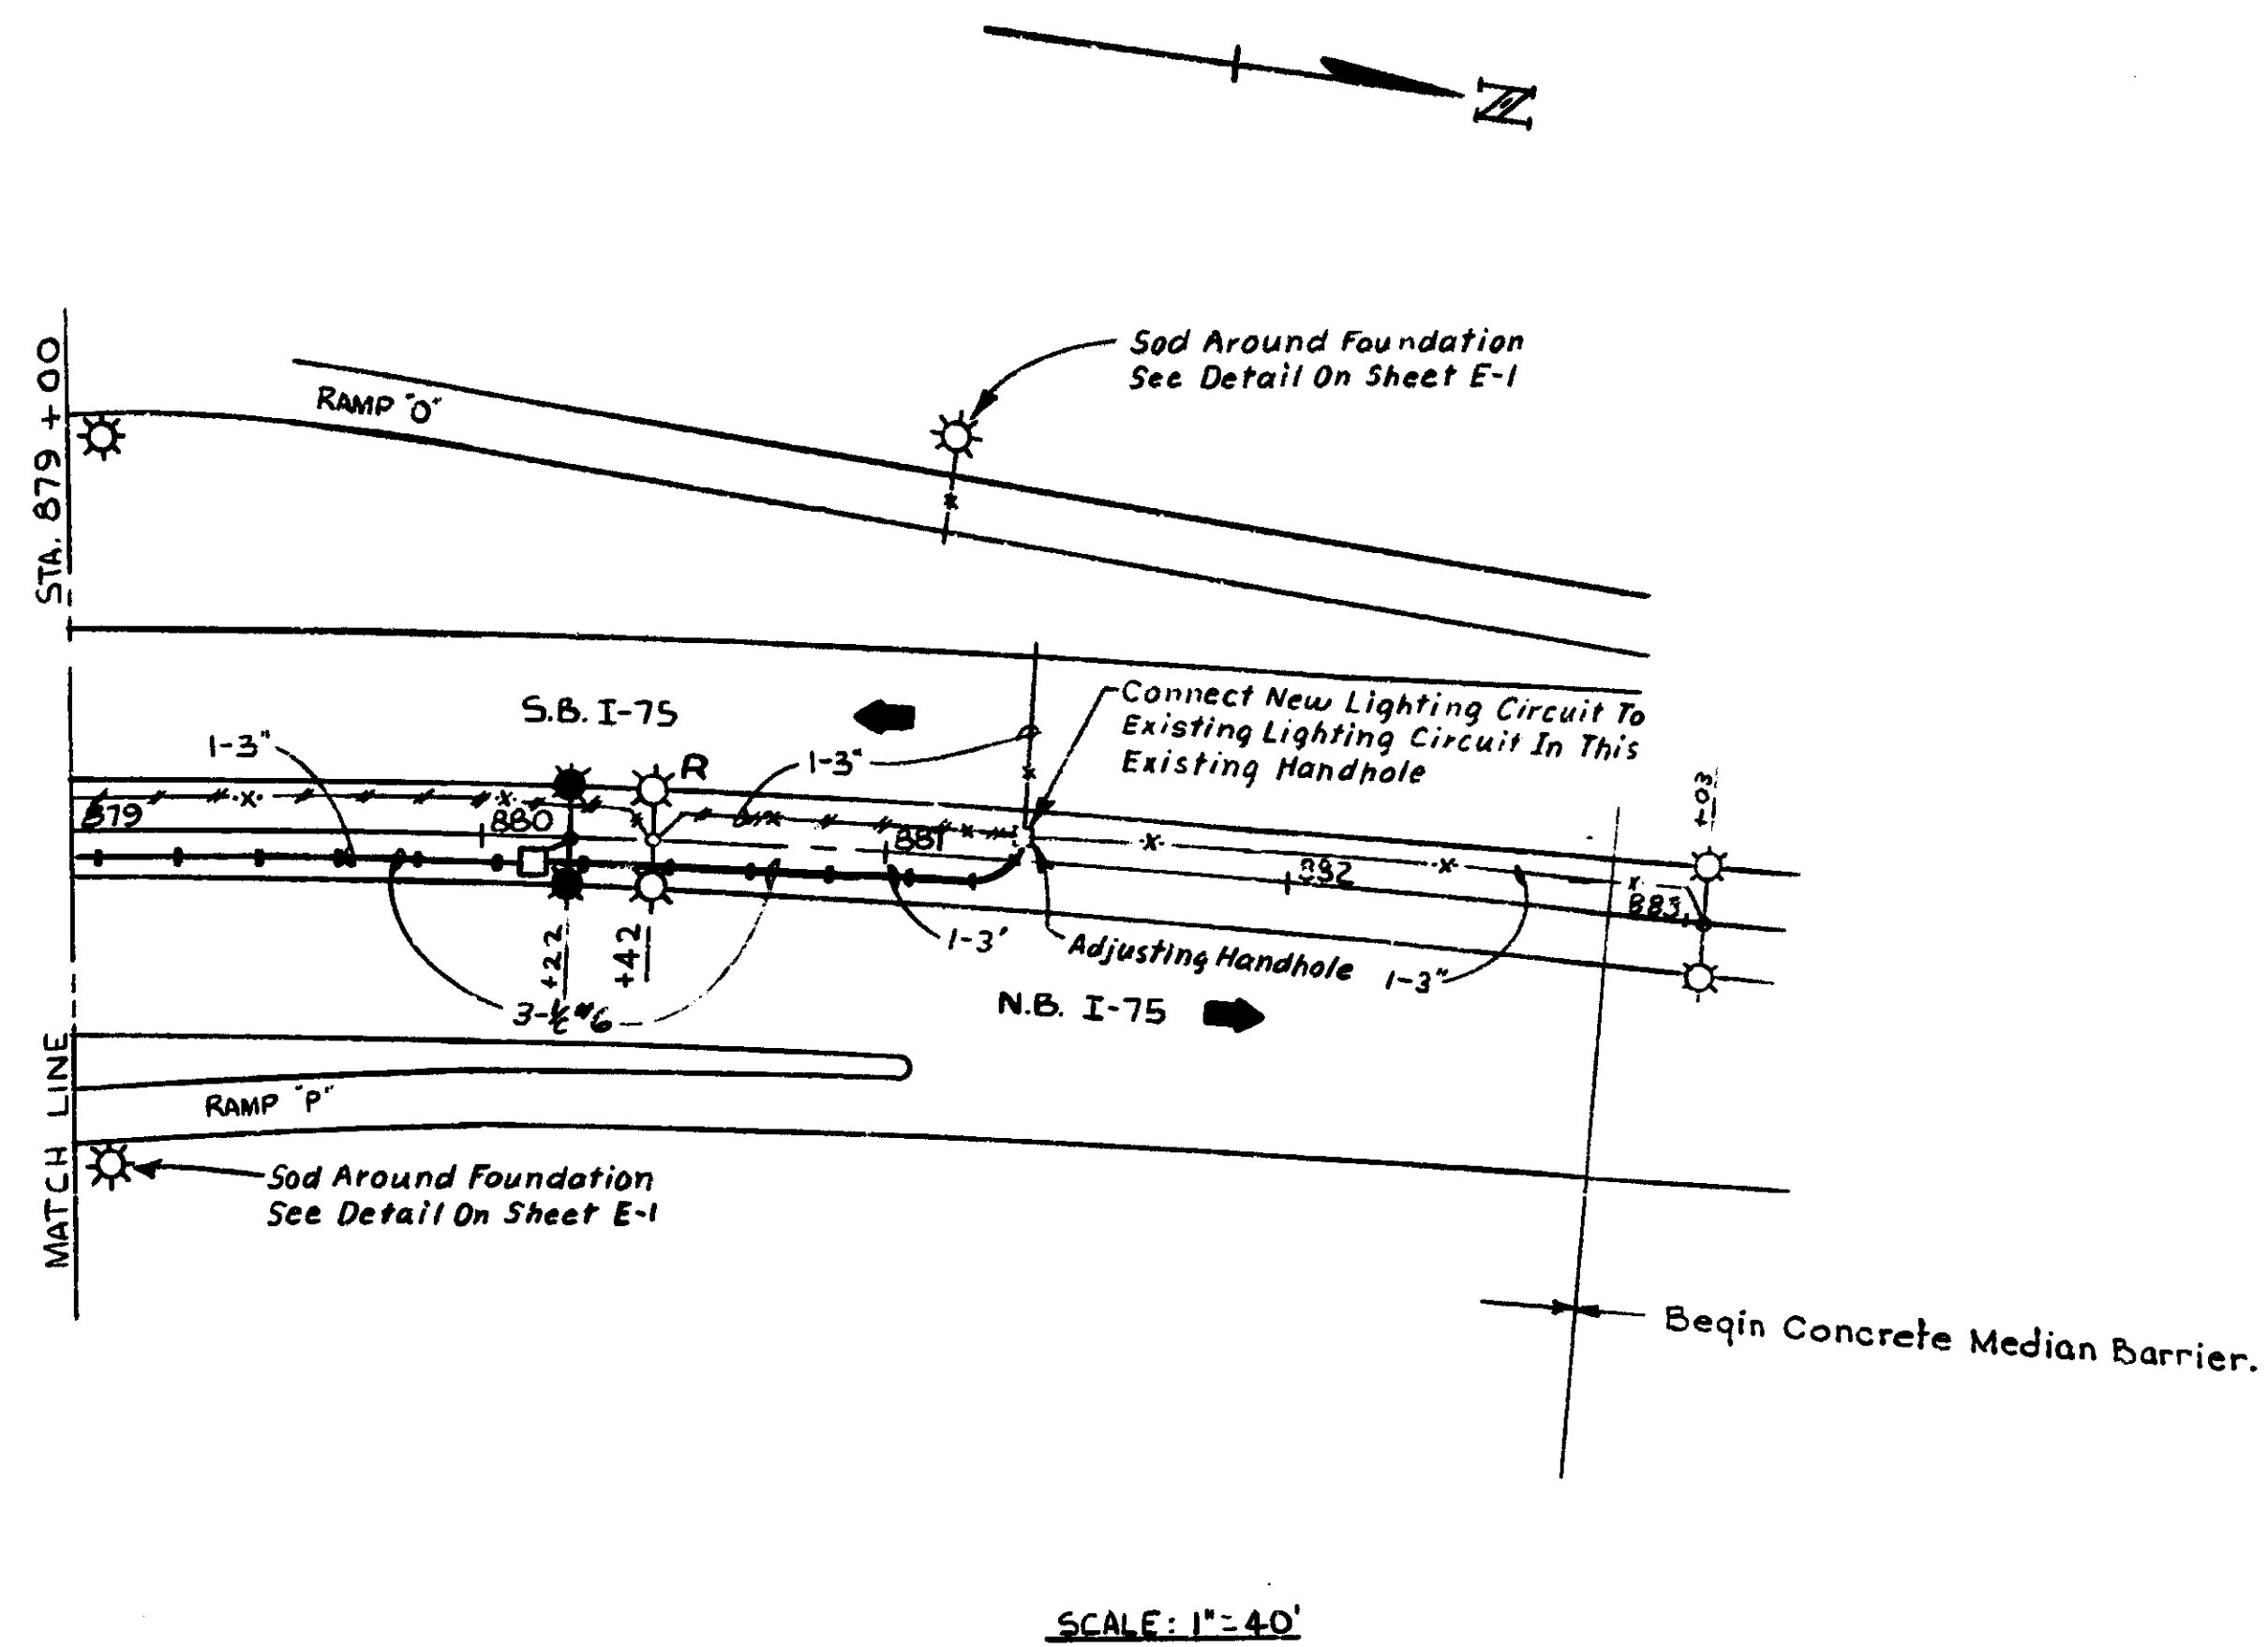

QUANTITIES ON THIS SHEET		
ITEM	UNIT	QUANTITY
REMOVE U.G. FED. ST. LTG. UNIT	EACH	1
HANDHOLE - HEAVY DUTY COVER	EACH	1
LT. STD. 45 FT. M.H., 12 FT. DBL. ARM ON MEDIAN WALL	EACH	1
600 V, 3-1/2" No. 6 D.B. CABLE IN CONDUIT	L. FT.	240
400 W, HIGH PRESSURE SODIUM LUMINAIRE	EACH	2
1-3" DIRECT BURIAL CONDUIT	L. FT.	240
ADJUSTING HANDHOLE	EACH	1
REMOVE FOUNDATION - PARTIAL	EACH	1

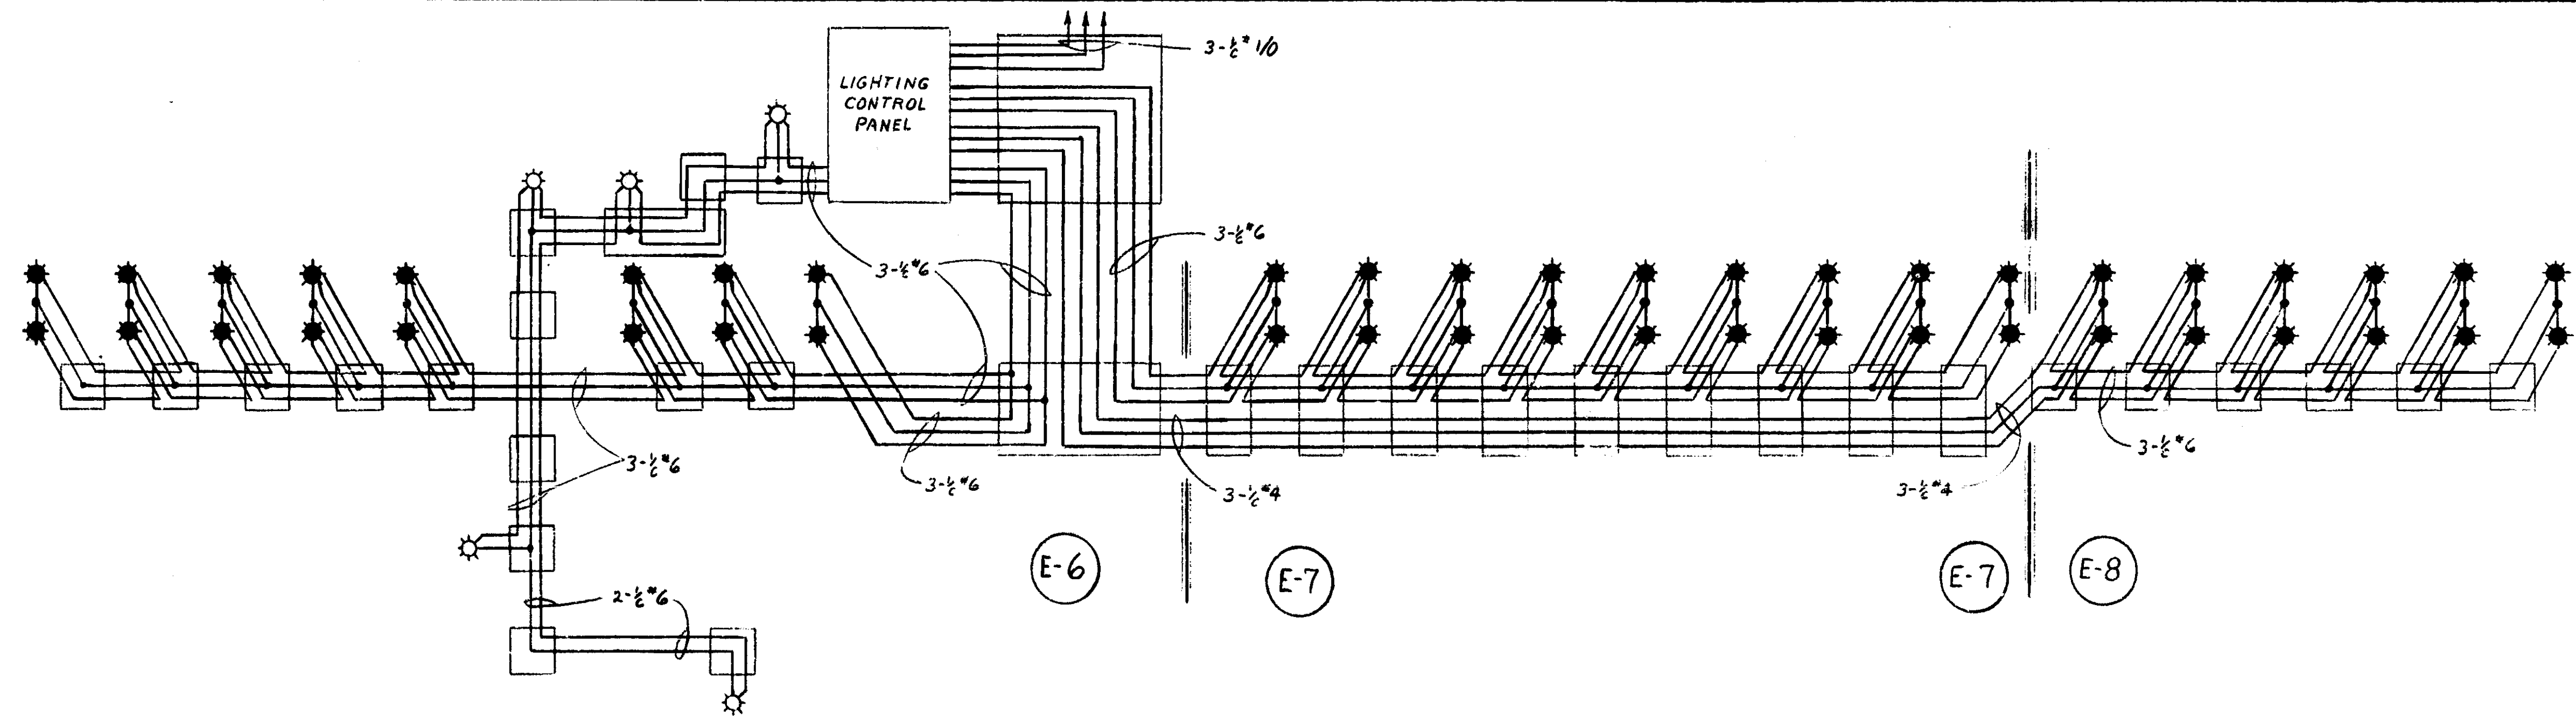



E-11

MICHIGAN DEPARTMENT OF STATE HIGHWAYS AND TRANSPORTATION
FREWAY LIGHTING
I-75
 8 MILE RD. TO 12 MILE RD.

REVISIONS			
NO.	DESCRIPTION	DATE	BY

SO. NO. 6055	IN. J.A. DEN	9-77
DRAWN BY	J.H. R.S.B.	2-79
CHECKED BY	R.O. J.	5-77
CHECKED BY	F.J. K.C.B.	2-79

63174 14165A

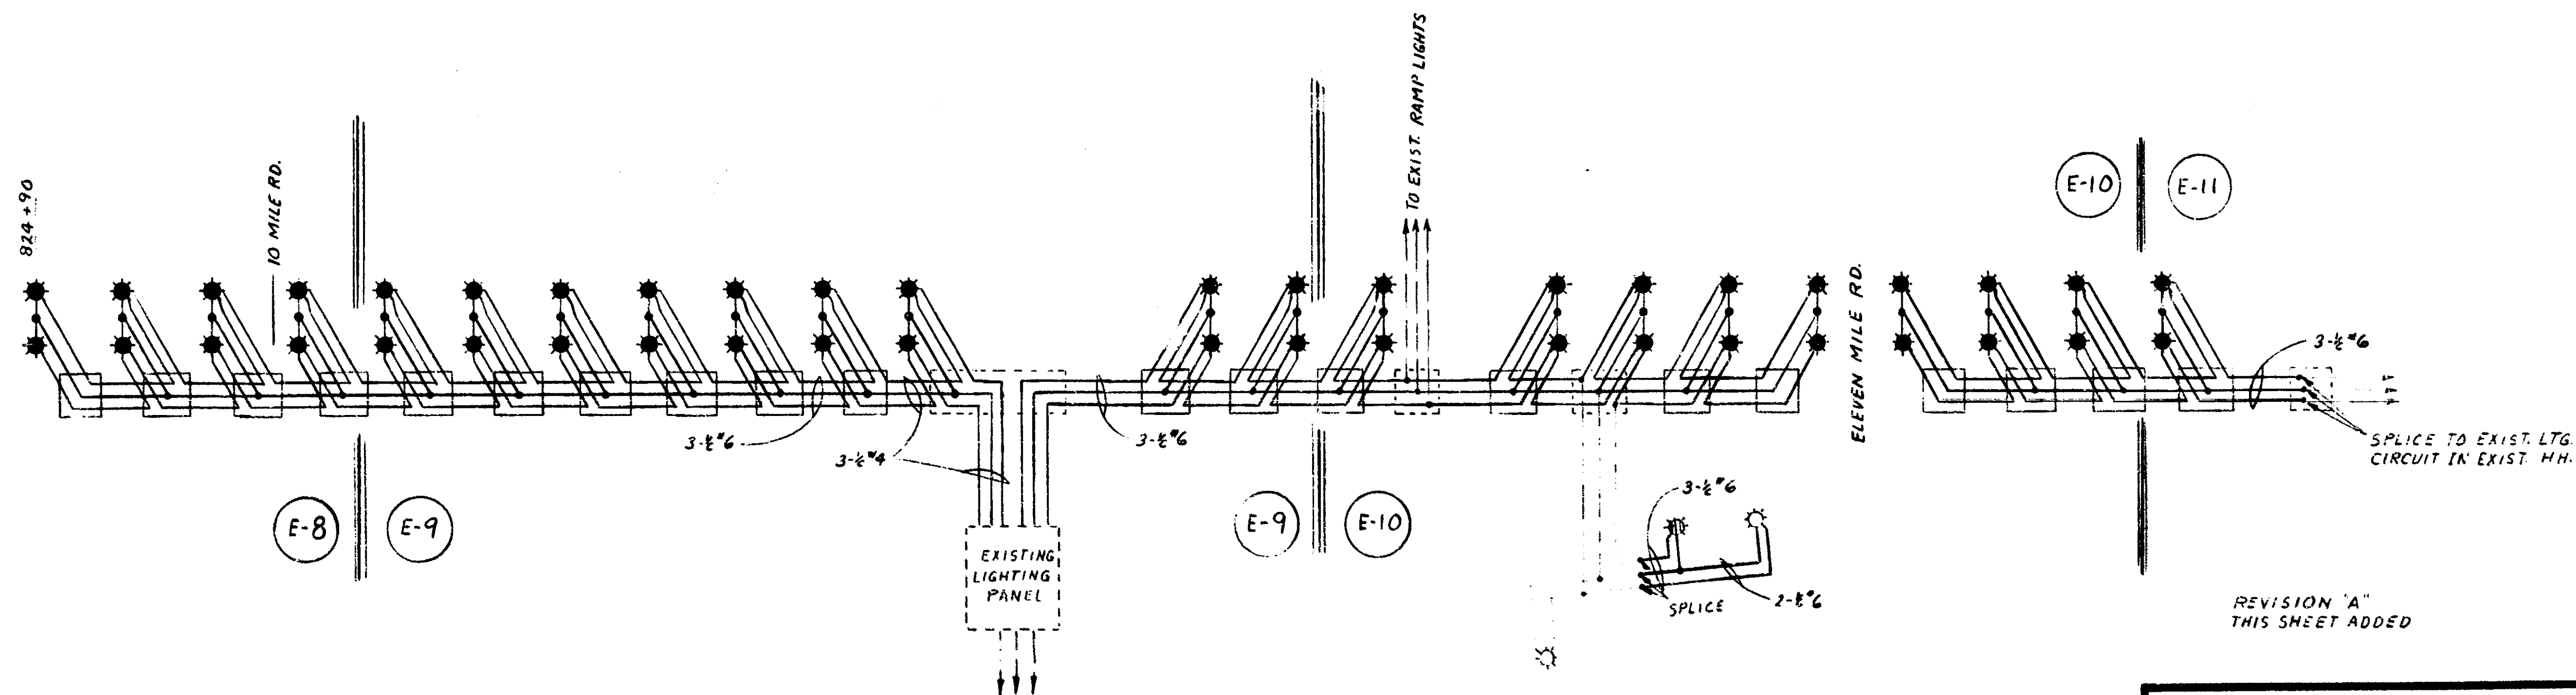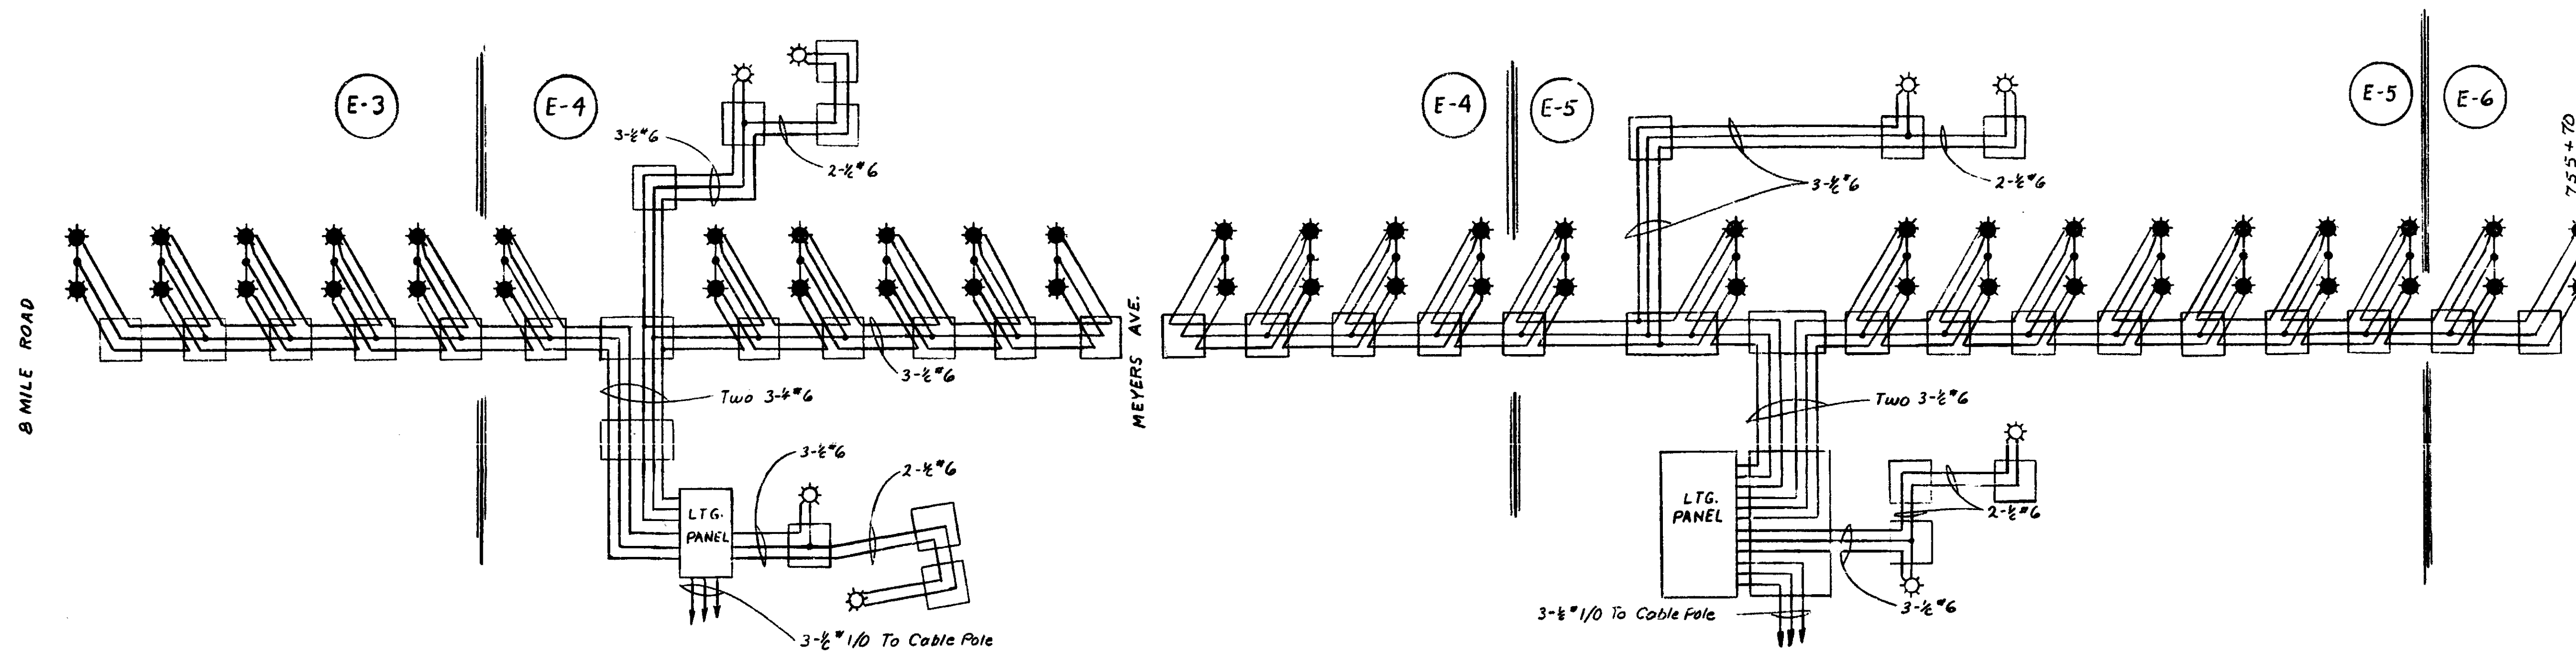

E-11A


MICHIGAN DEPARTMENT OF TRANSPORTATION
FREWAY LIGHTING 1-75
 8 MILE RD. TO 12 MILE RD.

REVISIONS			
NO.	DESCRIPTION	DATE	BY
A	This Sheet Added	1-80	E.S.


DESIGNED BY	J. J. Dech	1-80
DRAWN BY		
CHECKED BY	J. J. Dech	1-80
APPROVED BY		

63174 14165A

Sheet 35A


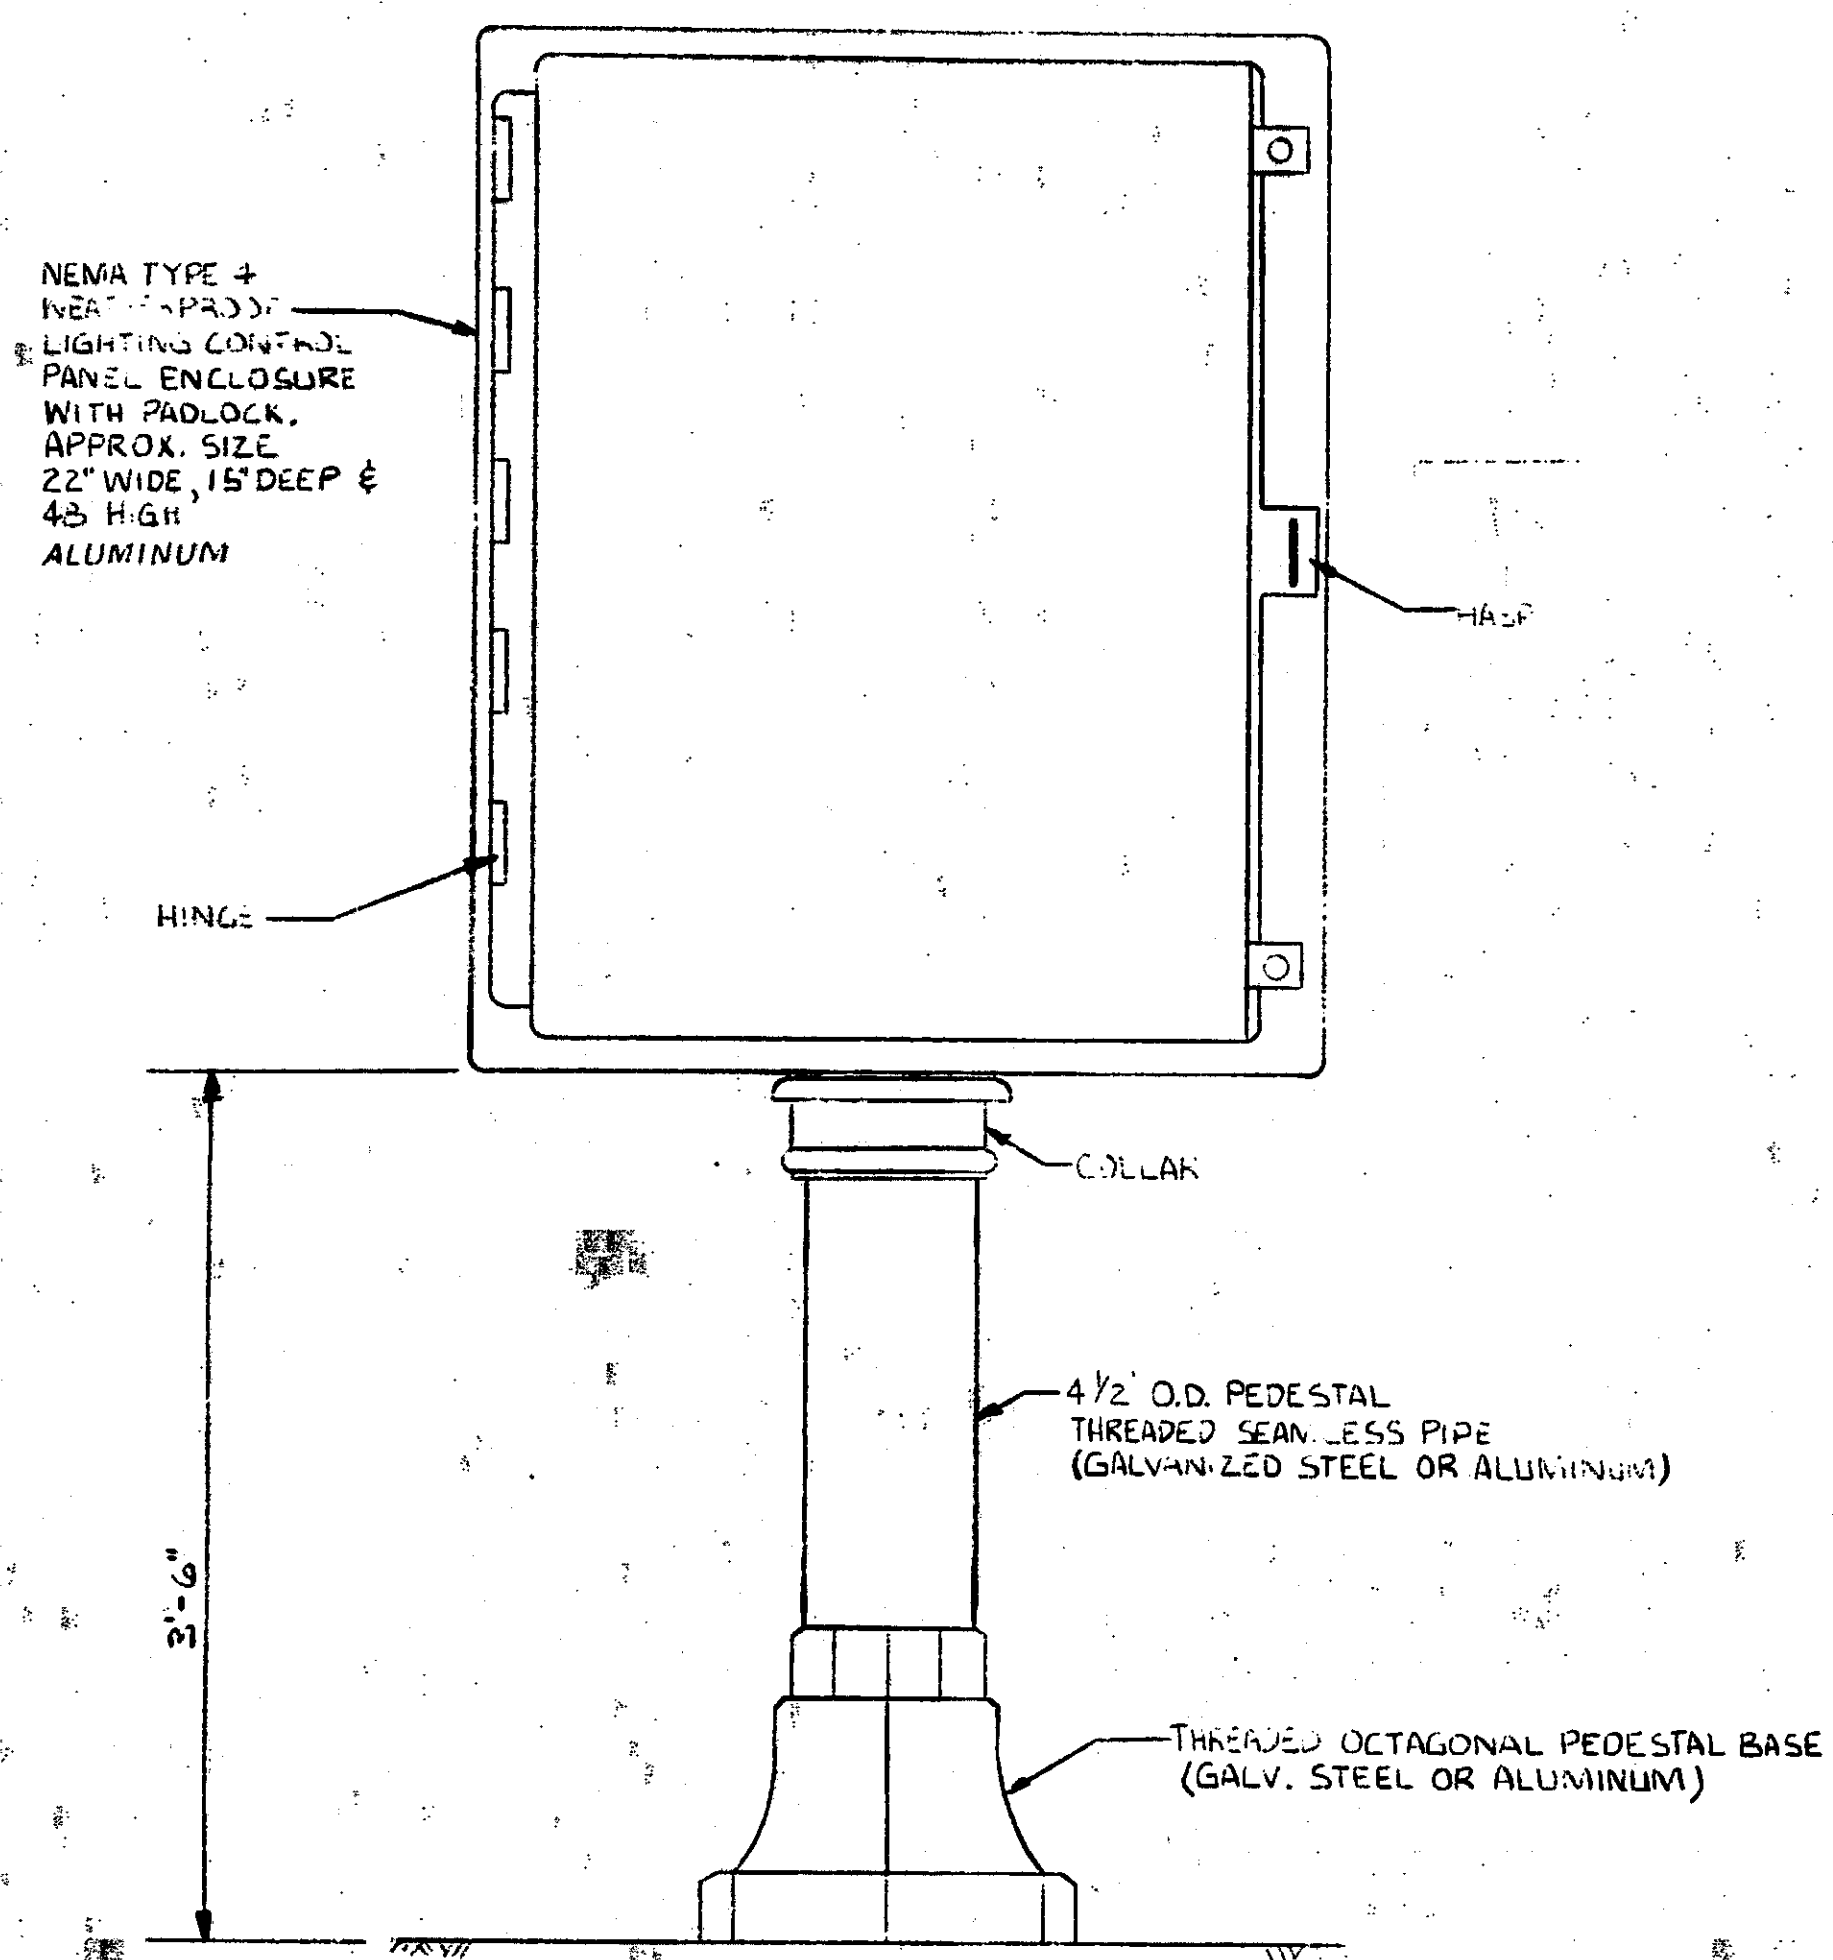


LIGHTING CONTROL PANEL
NOT TO SCALE

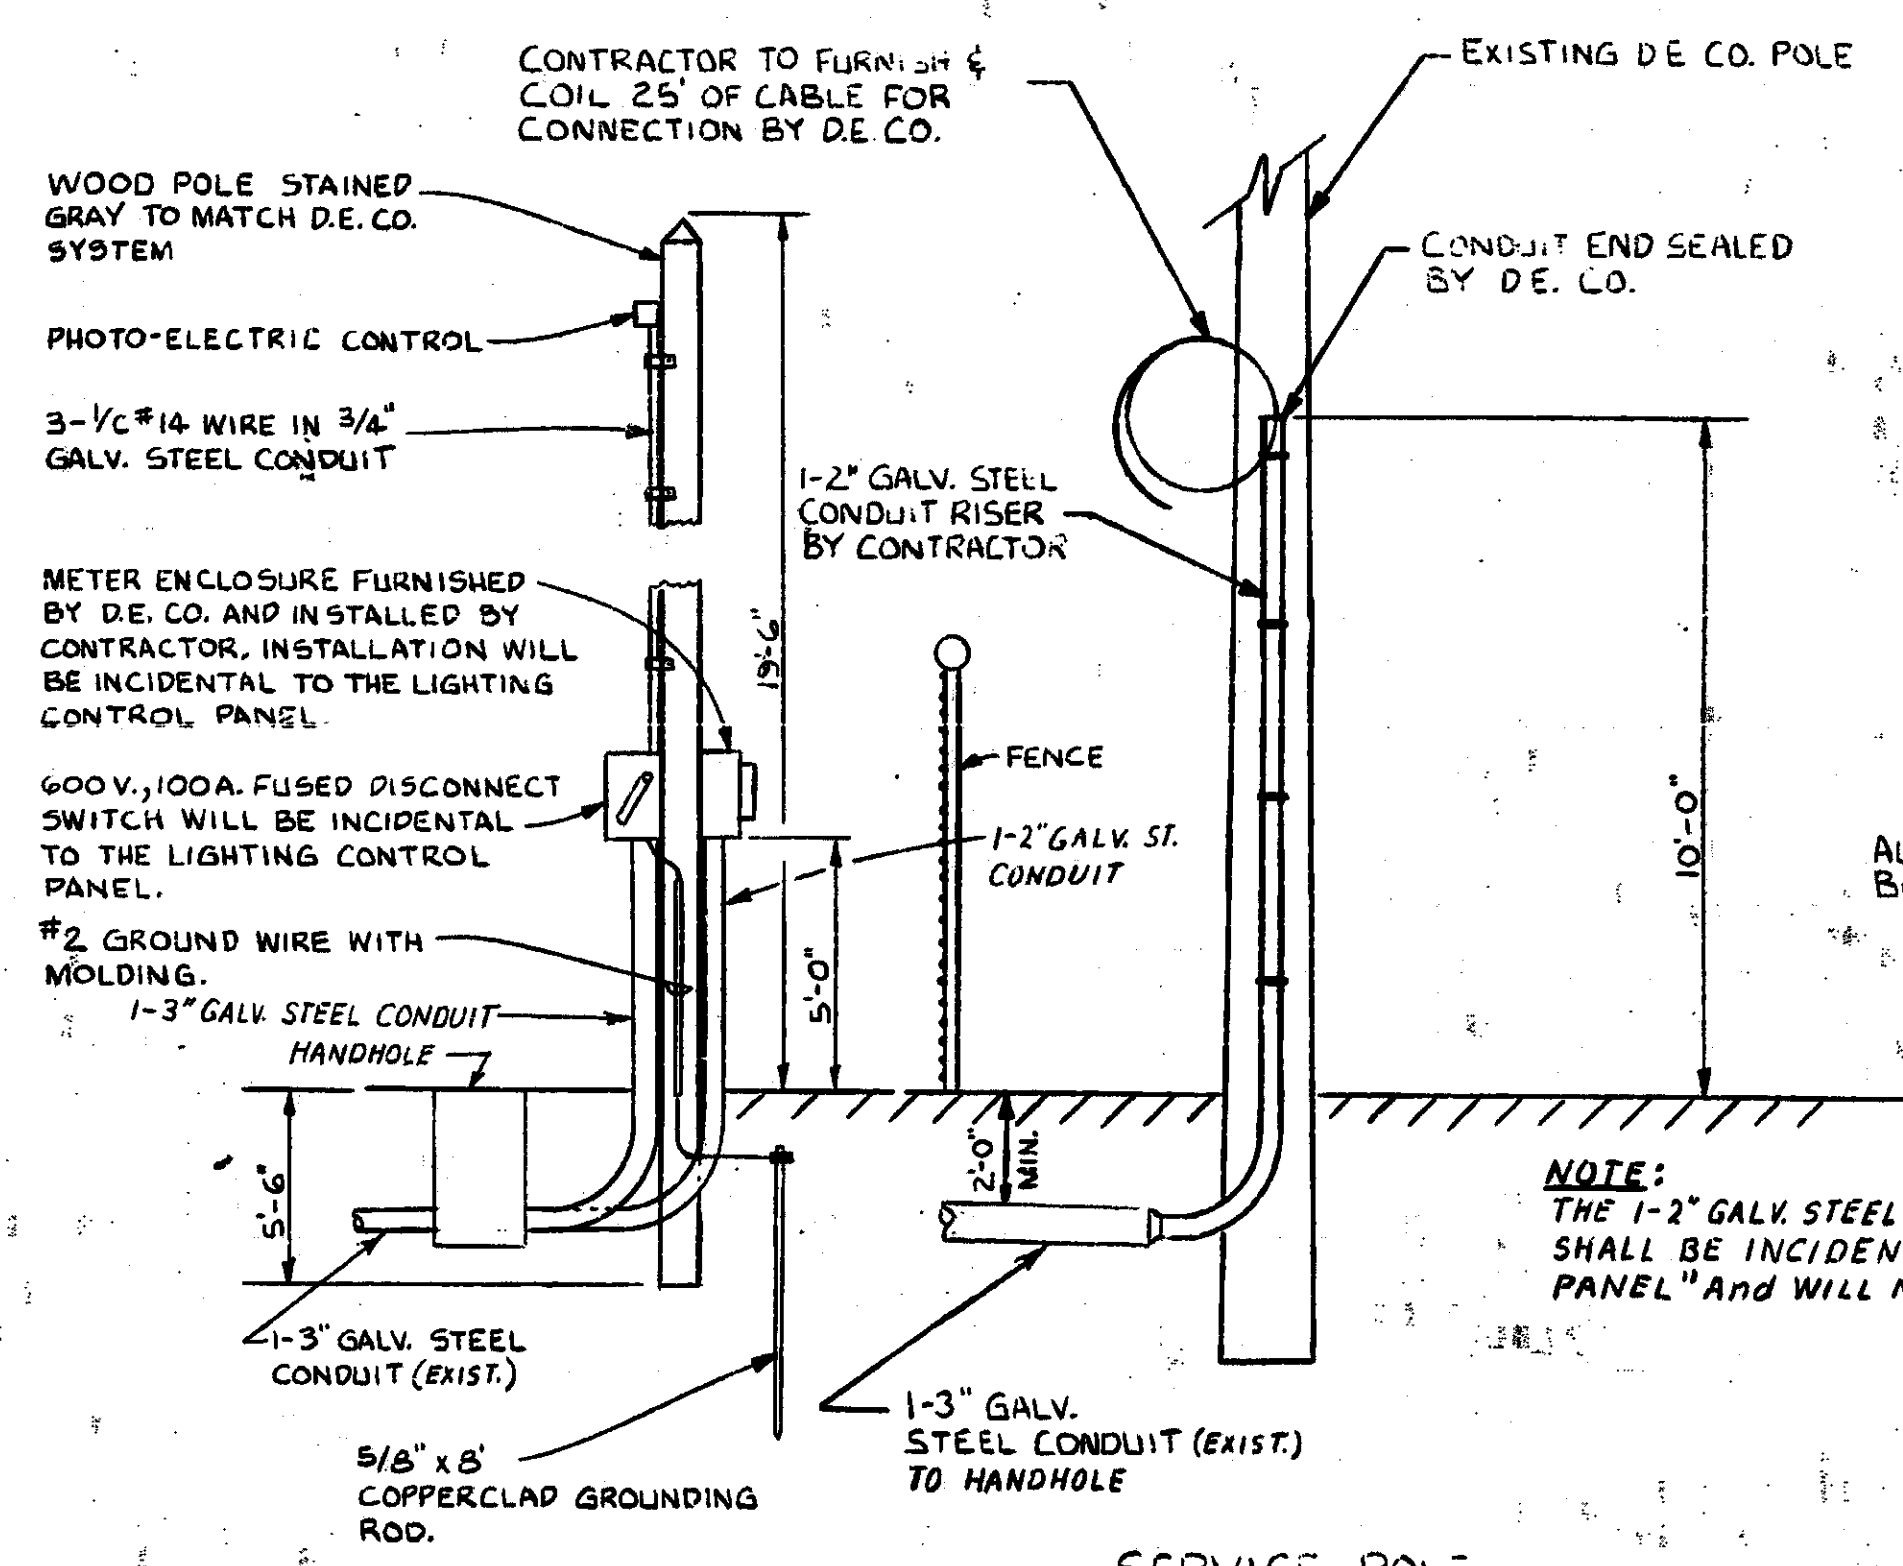

NOTE:
THE 1-2" GALV. STEEL CONDUIT ATTACHED TO METER POLE SHALL BE INCIDENTAL TO THE ITEM "LIGHTING CONTROL PANEL" AND WILL NOT BE PAID FOR SEPARATELY.

SERVICE POLE
NOT TO SCALE

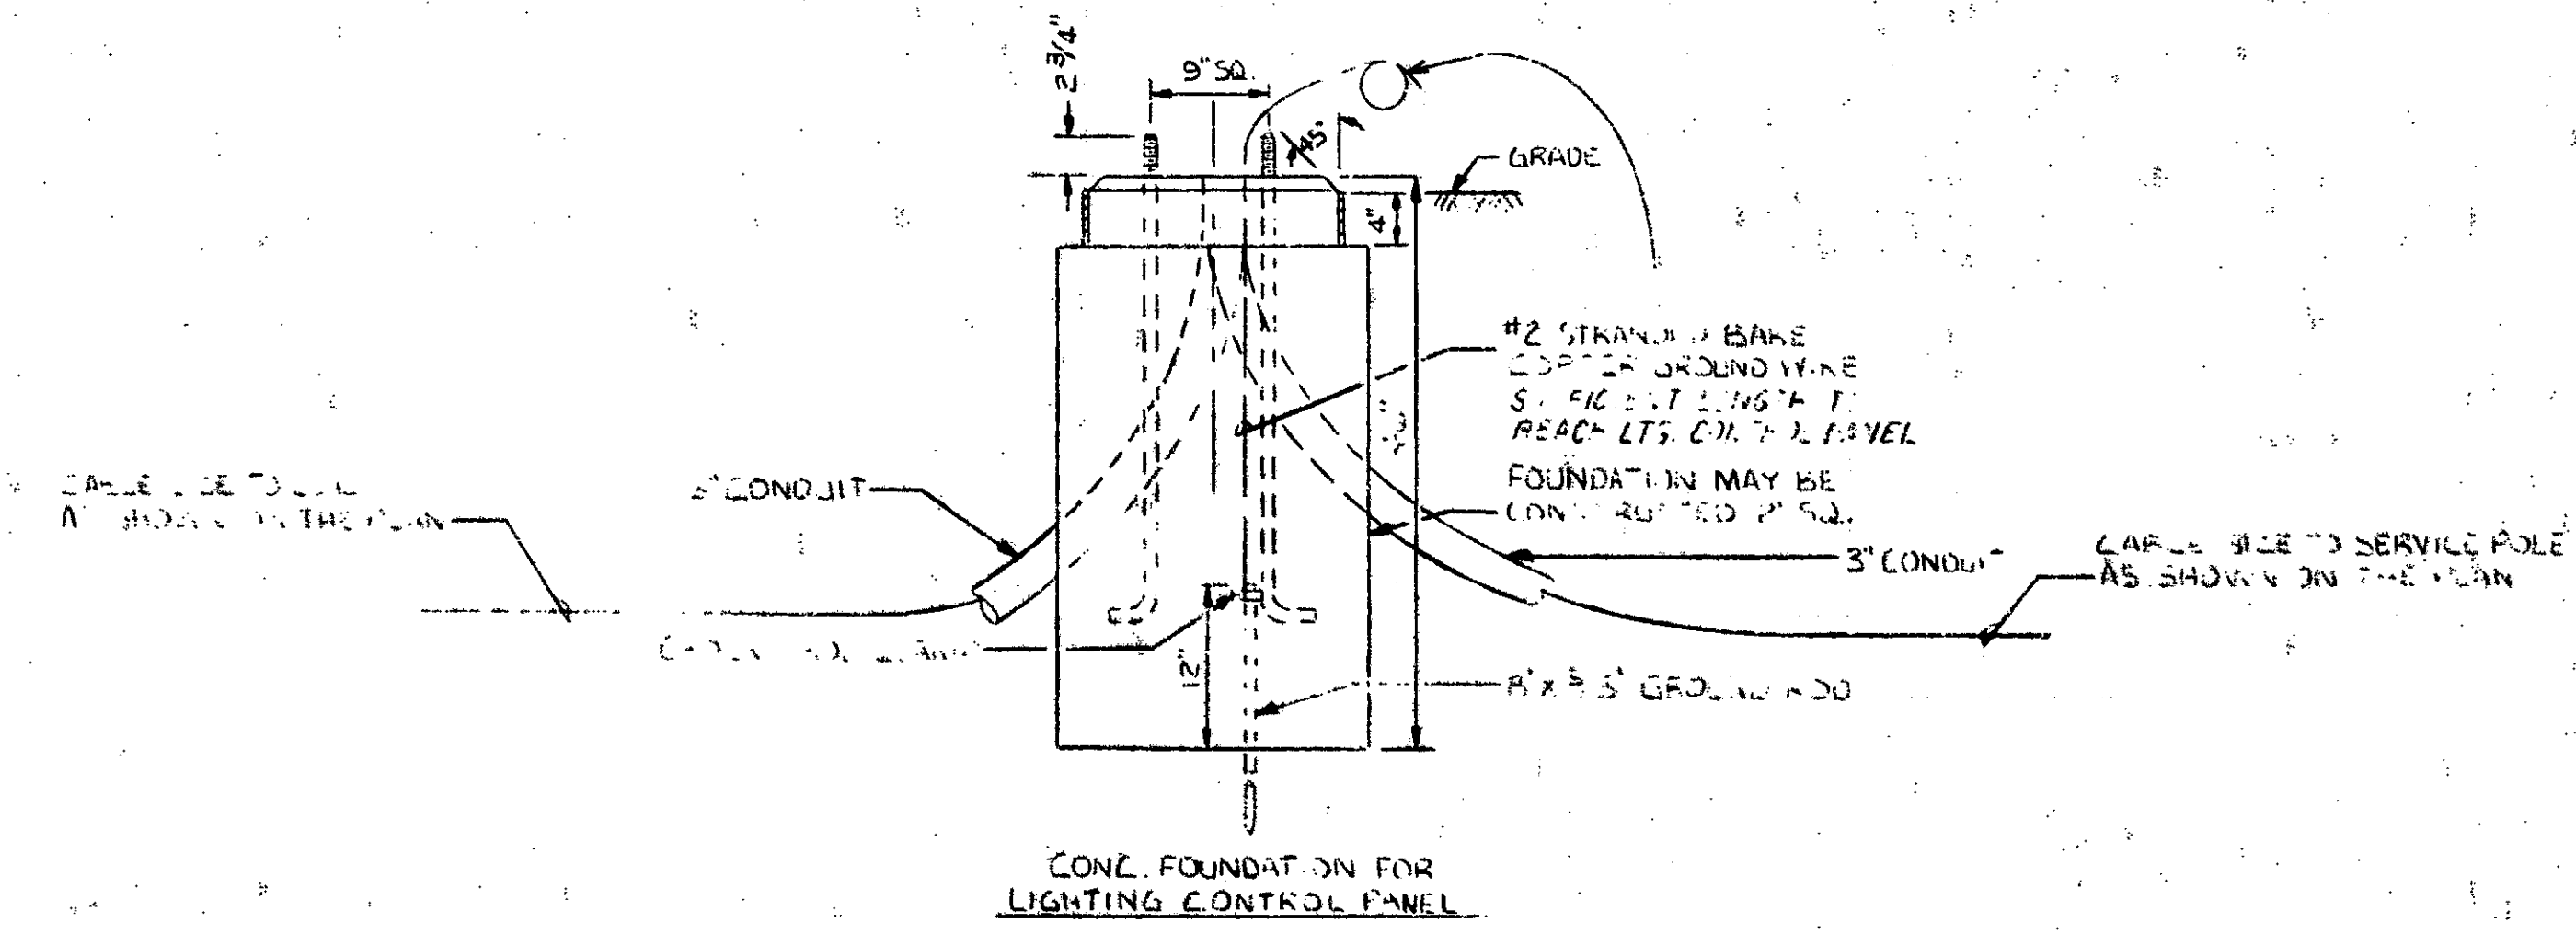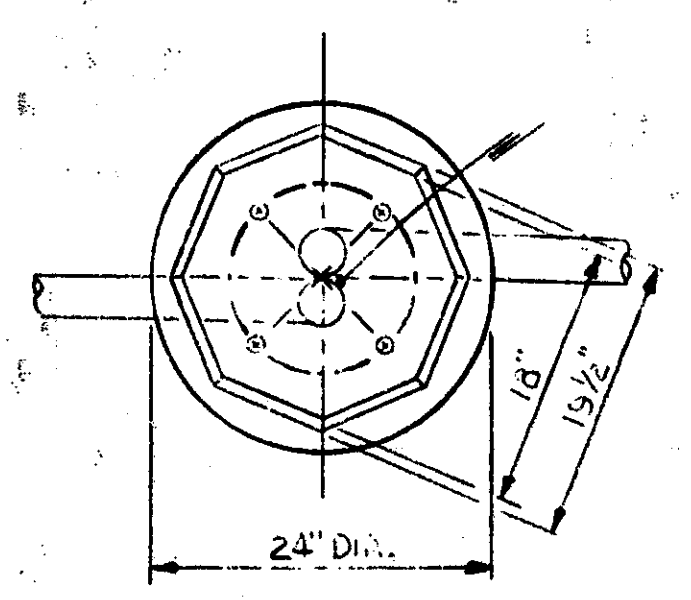


MICHIGAN DEPARTMENT OF STATE HIGHWAYS
FREEWAY LIGHTING
LIGHTING CONTROL PANEL DETAIL

REVISIONS			
NO.	DESCRIPTION	DATE	BY


DESIGNED BY	T. HENDERSON	3-75
DRAWN BY	D. J.	3-75
CHECKED BY		

63174 14165A


Revised 6-16-68 (Anchor Bolt Nish. changed to Anchor Base Plate)
 Revised 1-8-71 (B.L. for 40' & 45' M.H. & Arm. T.B. for 30' M.H.)
 Revised 1-17-69 (T.C. & T.B. for 30' M.H.)
 Revised 1-15-67 (Added Anchor Base Thickness)
 Revised 5-1-64 (Prop. of Mounting Height)
 Rev. 4-25-63 (Detailed Fluorescent B.L. Arm. T.B.)

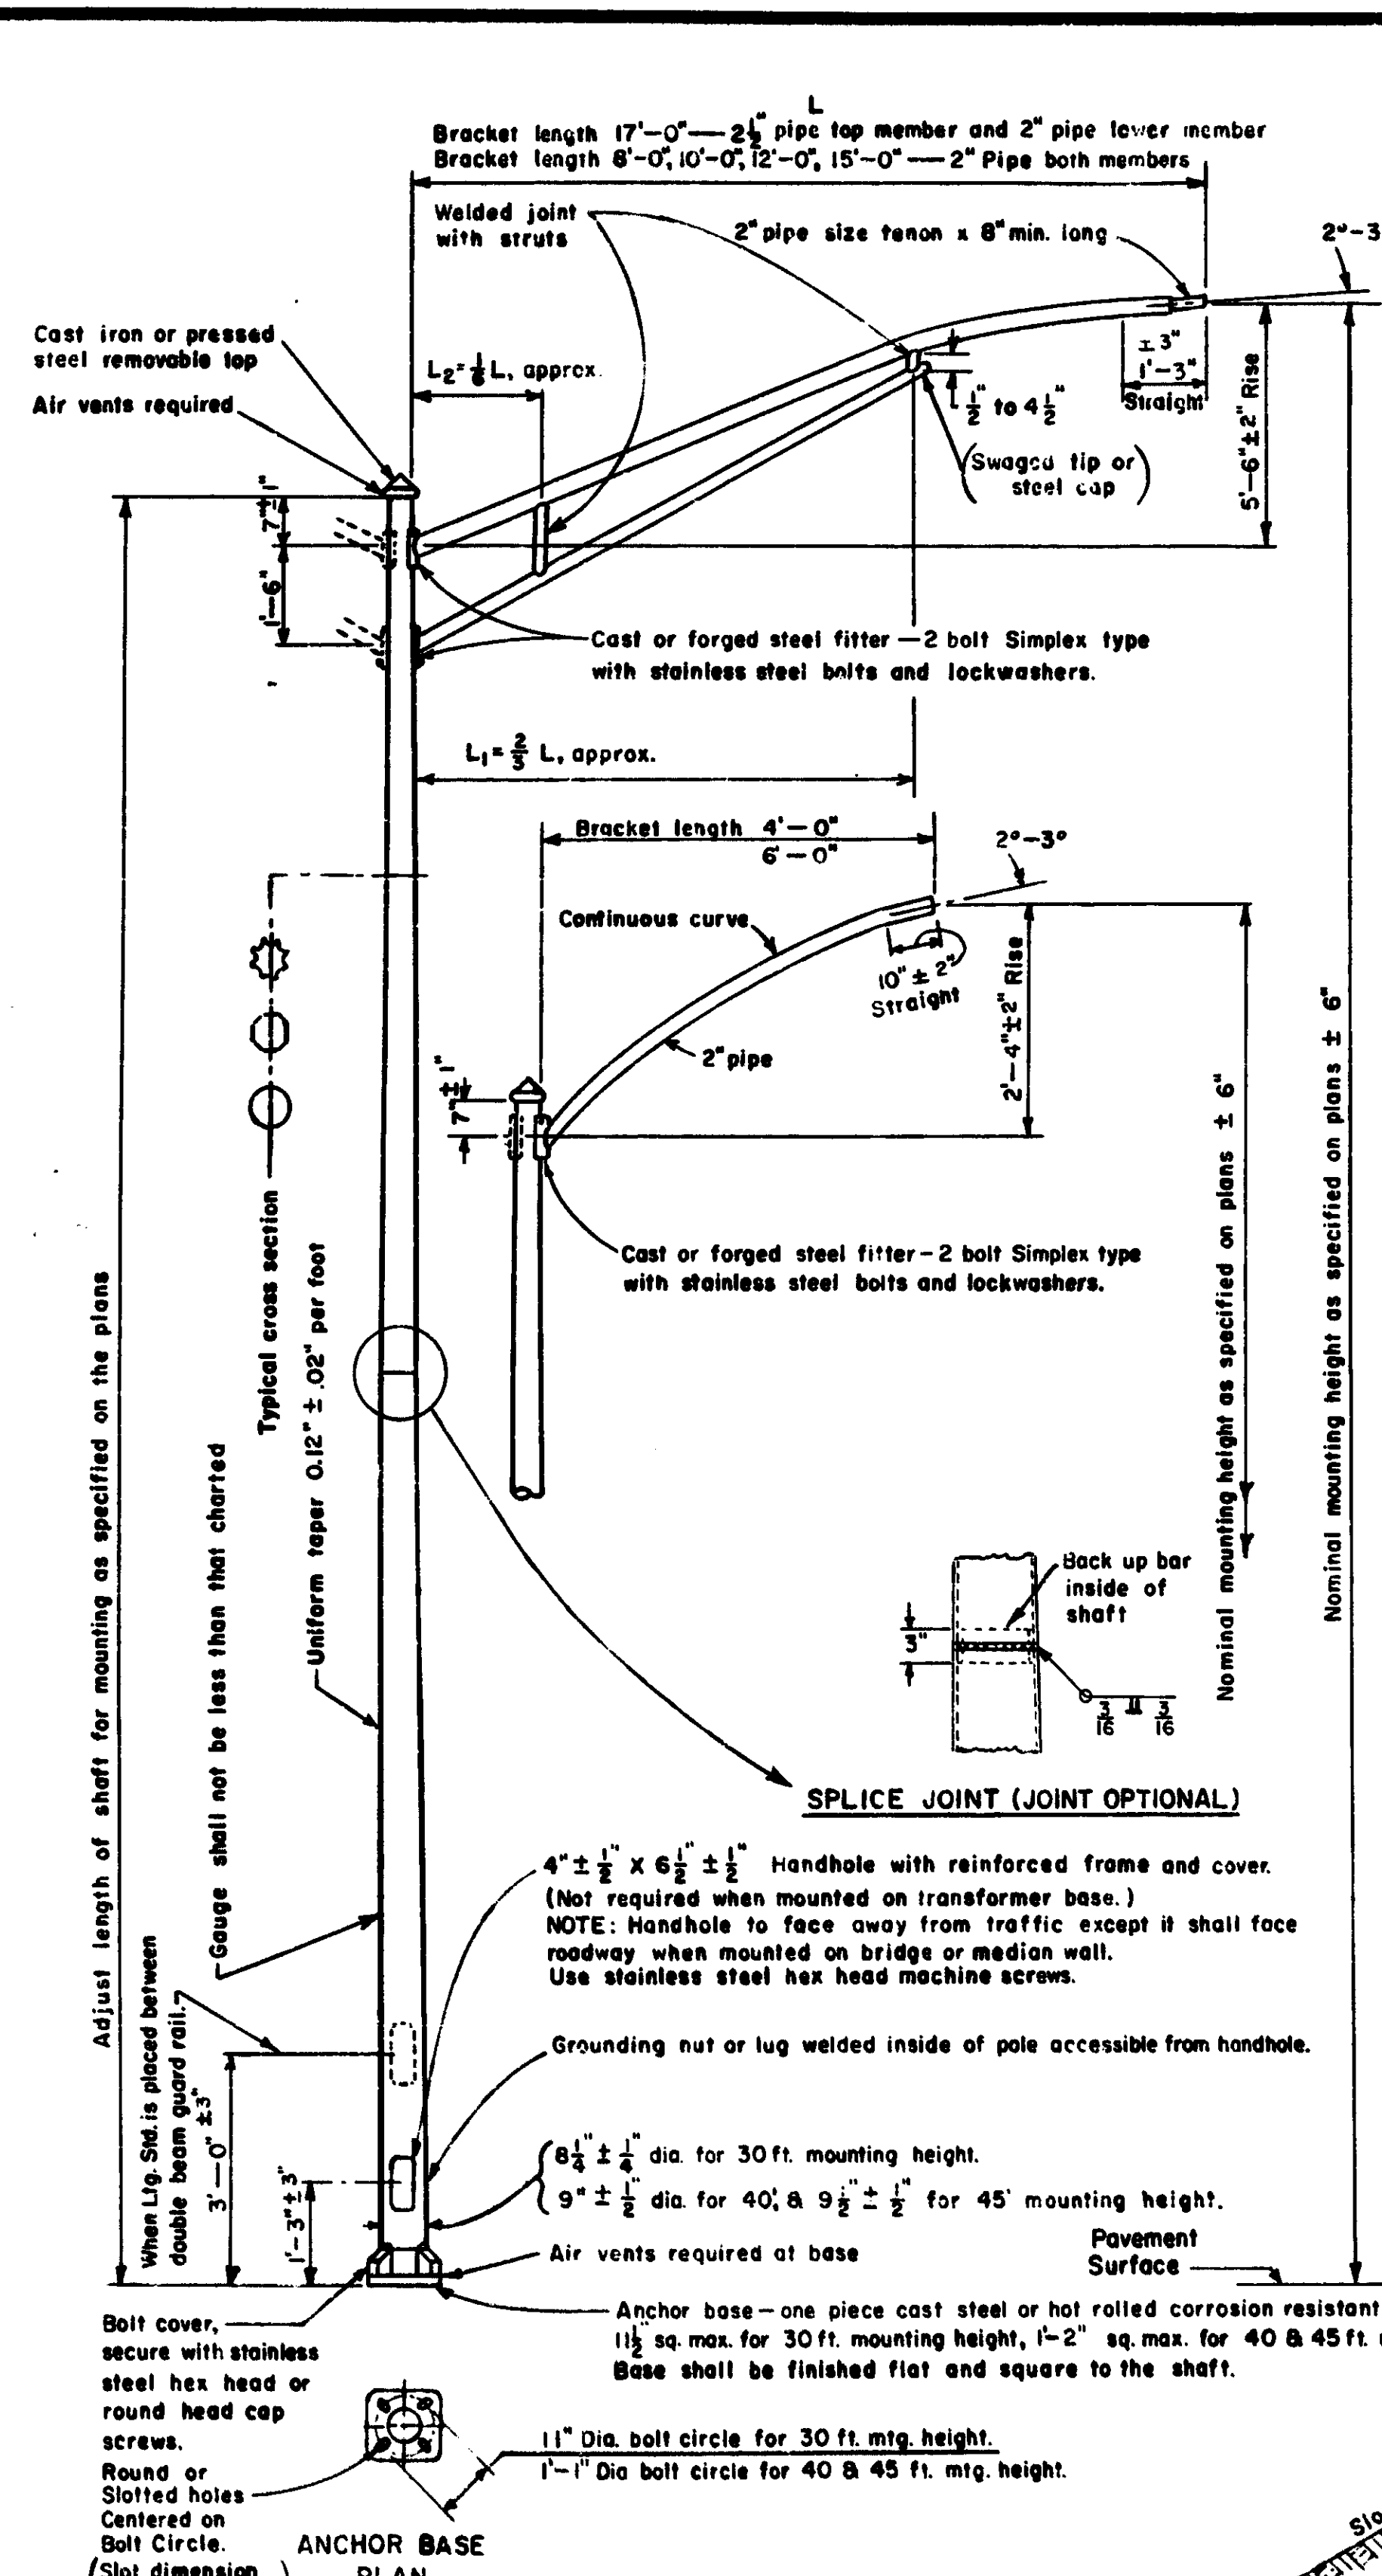


TYPICAL LIGHT STANDARD DESIGN FOR MERCURY AND INCANDESCENT LUMINAIRES

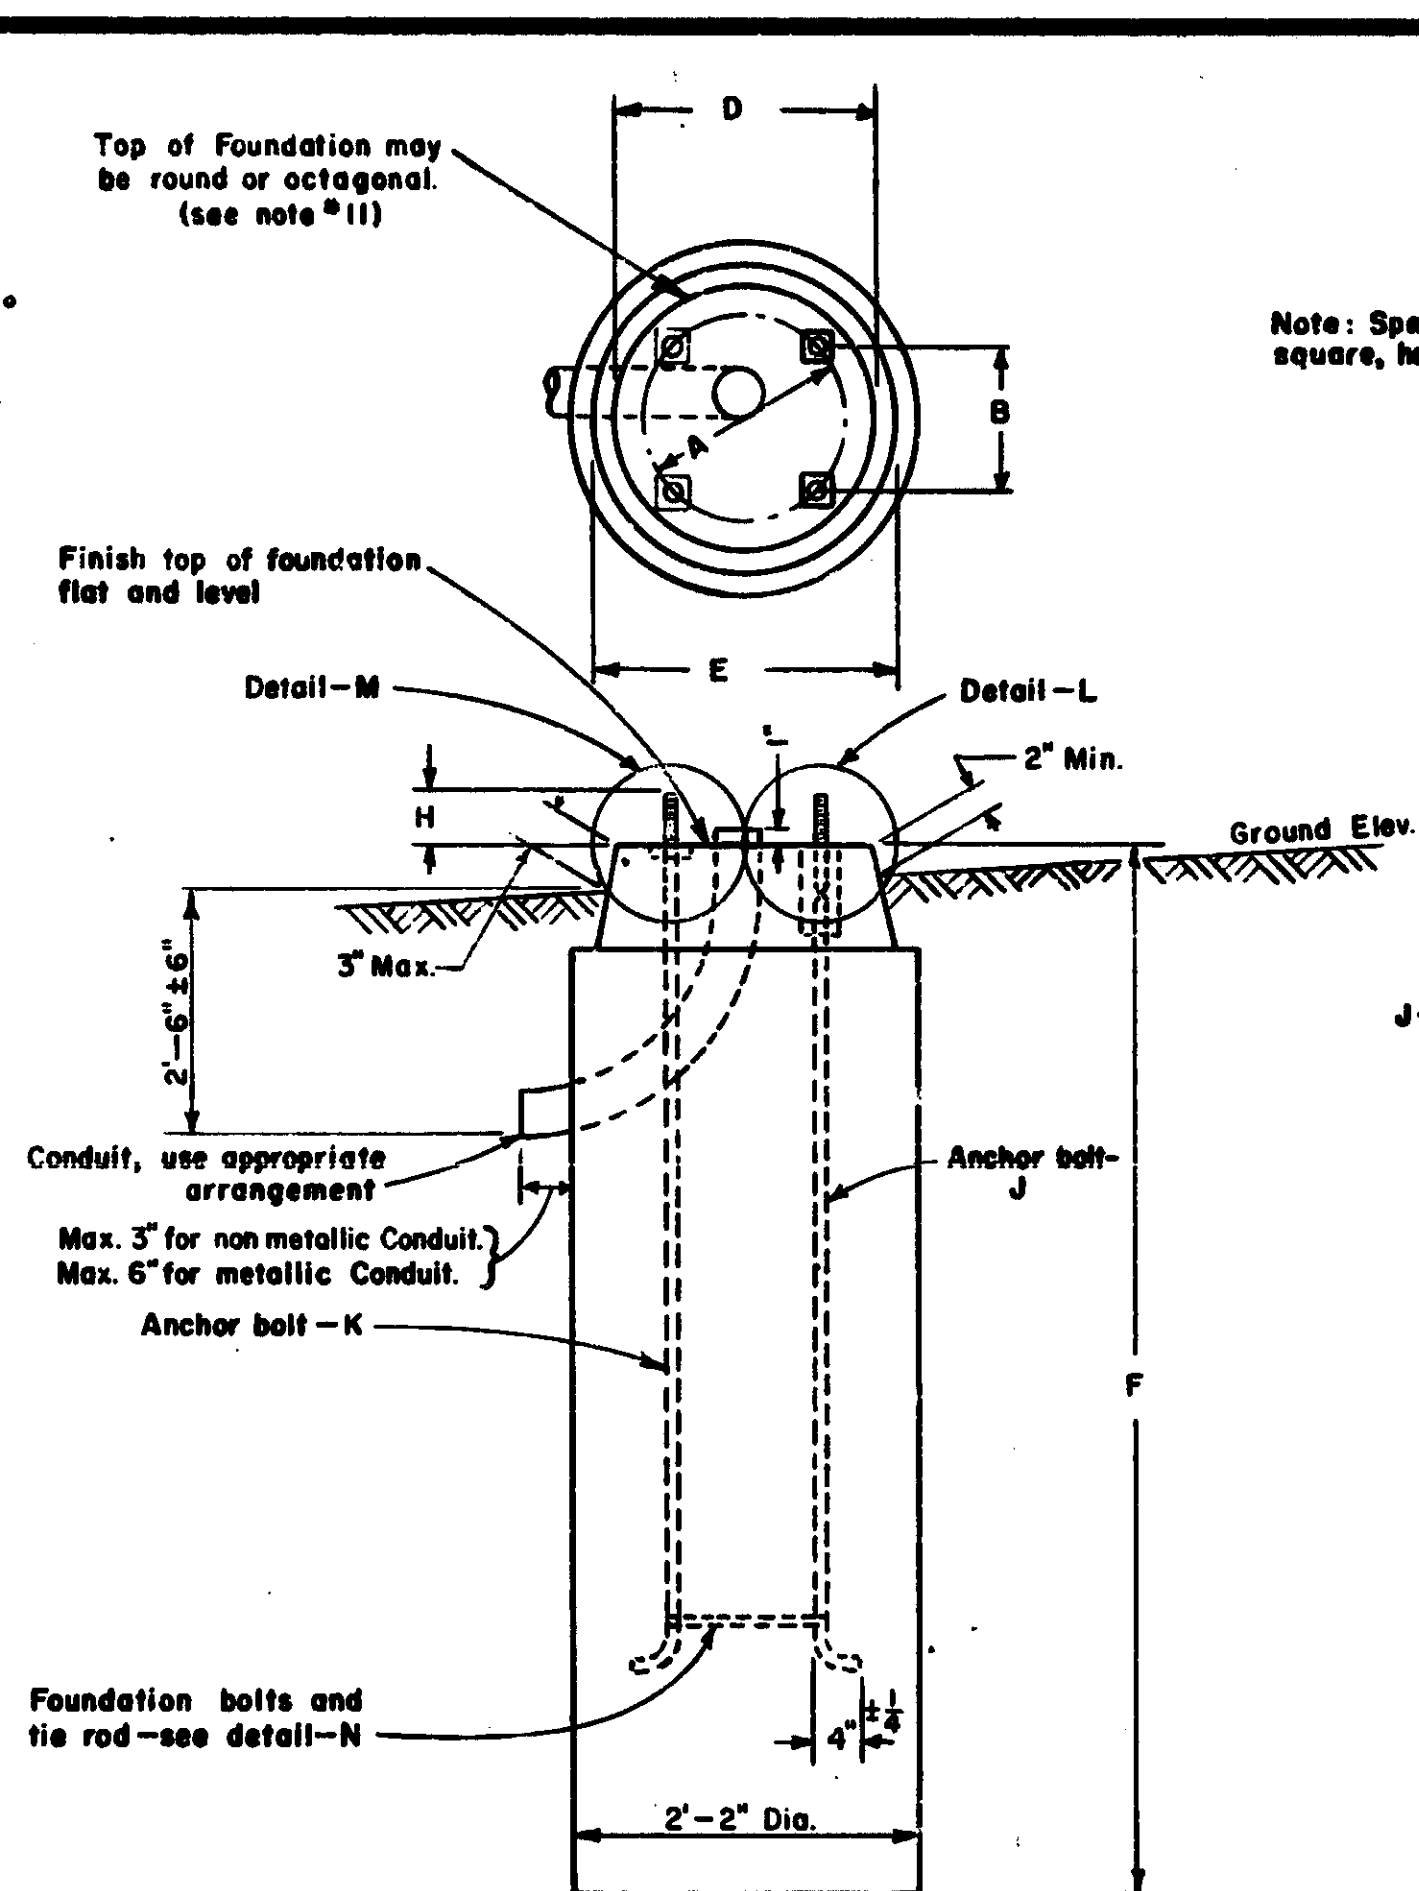



TYPICAL LIGHT STANDARD FOUNDATION WITH OR WITHOUT SHEAR STUDS (FOUNDATION INCIDENTAL TO LIGHT STANDARD)

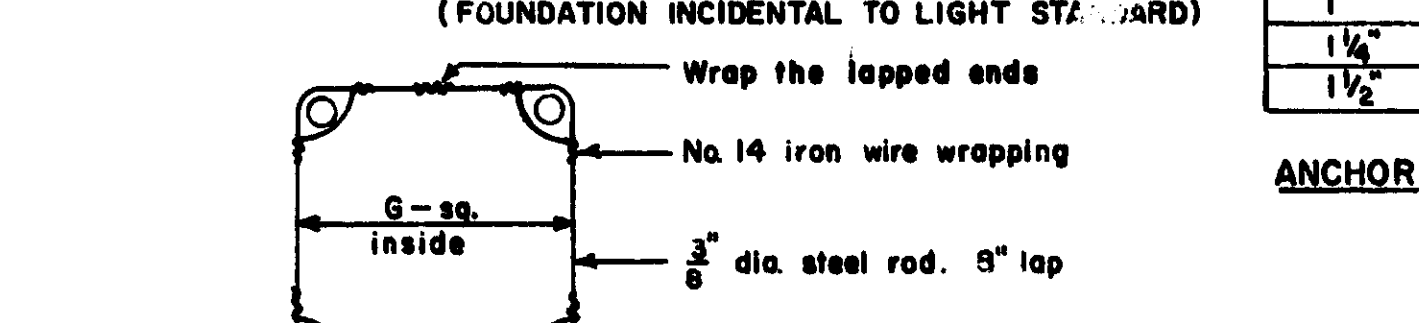

ANCHOR BOLTS & TIE ROD

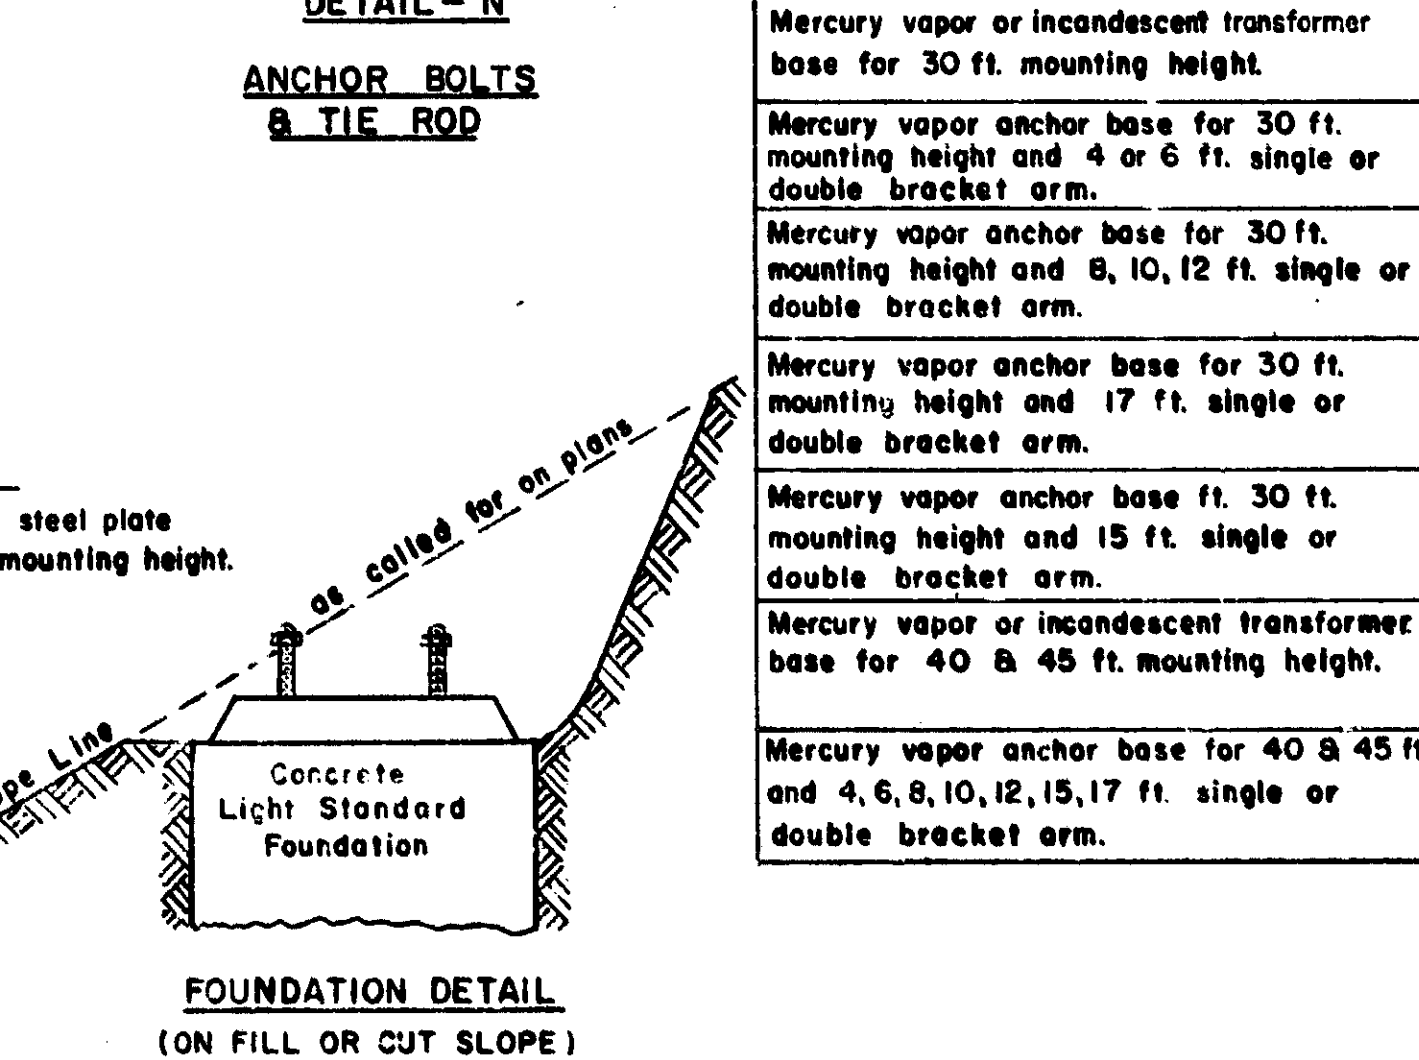


FOUNDATION DETAIL (ON FILL OR CUT SLOPE)

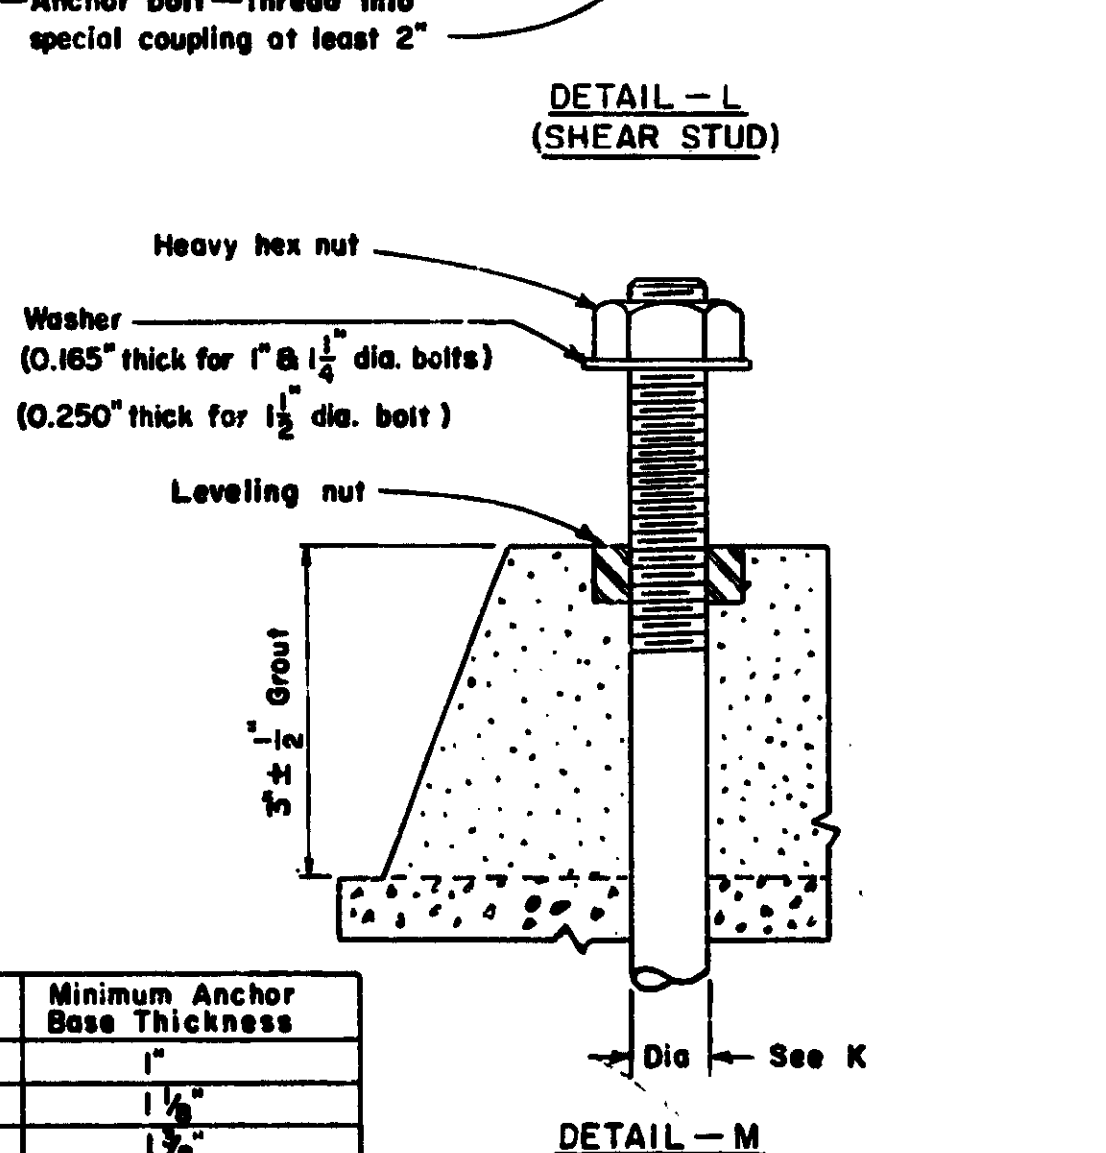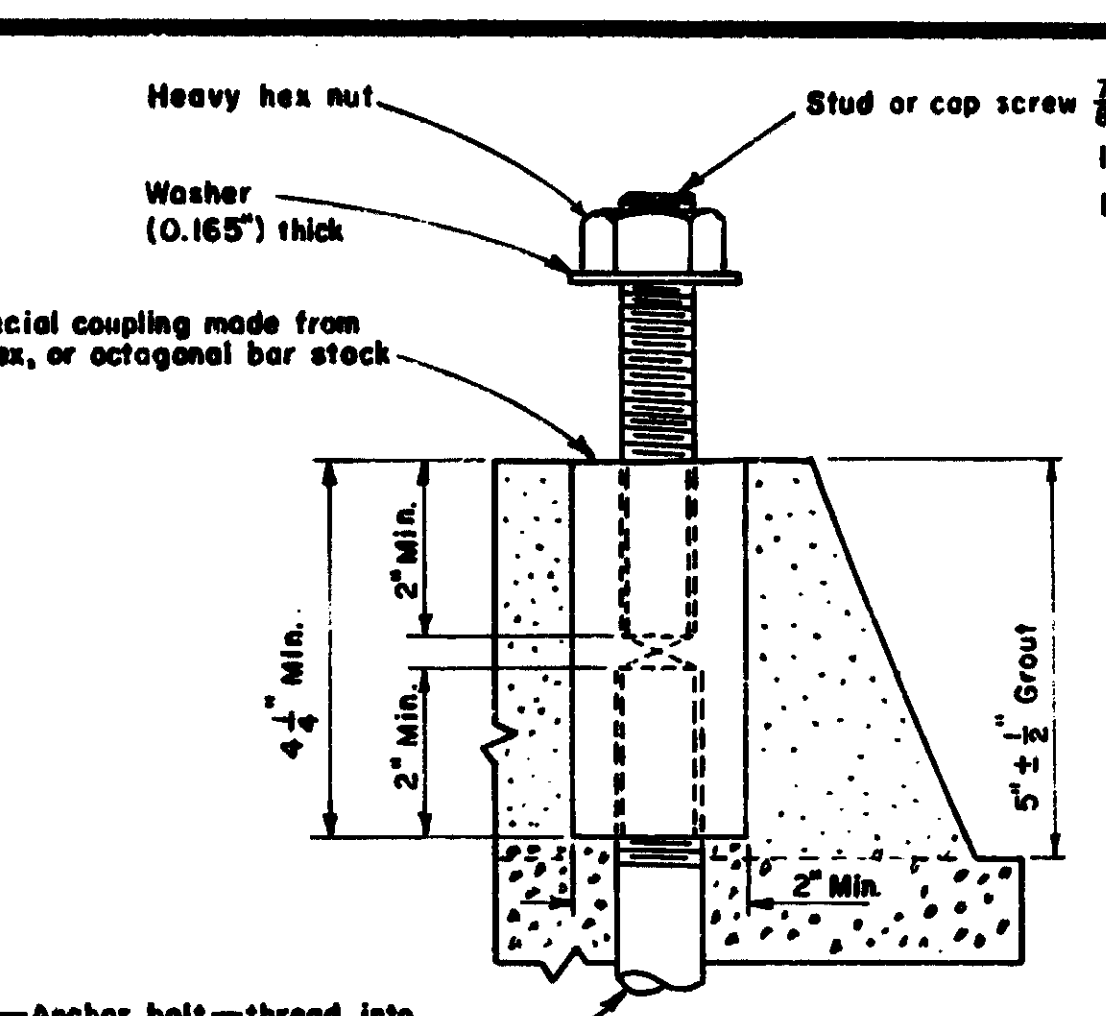

ANCHOR BASE THICKNESS CHART

TYPE	A	B	D	E	F	G	H	Ga (min.)	J	K
Mercury vapor or incandescent transformer base for 30 ft. mounting height.	11"	7 3/4"	1'-7"	1'-9"	6'-0"	8 3/4"	2 3/8"	see note 6		see note 7
Mercury vapor anchor base for 30 ft. mounting height and 4 or 6 ft. single or double bracket arm.	11"	7 3/4"	1'-7"	1'-9"	5'-0"	8 3/4"	2 3/8"	11	1" x 3'-4"	1" x 3'-9"
Mercury vapor anchor base for 30 ft. mounting height and 8, 10, 12 ft. single or double bracket arm.	11"	7 3/4"	1'-7"	1'-9"	6'-0"	8 3/4"	2 3/8"	11	1" x 5'-0"	1" x 5'-0"
Mercury vapor anchor base for 30 ft. mounting height and 17 ft. single or double bracket arm.	11"	7 3/4"	1'-7"	1'-9"	6'-0"	9"	3"	7		1 1/2" x 5'-0"
Mercury vapor anchor base ft. 30 ft. mounting height and 15 ft. single or double bracket arm.	11"	7 3/4"	1'-7"	1'-9"	6'-0"	8 3/4"	2 3/8"	7	1" x 5'-0"	1" x 5'-0"
Mercury vapor or incandescent transformer base for 40 & 45 ft. mounting height.	1'-5 1/4"	1'-0 1/2"	2'-0"	2'-2"	8'-6"	1'-1 1/8"	3 1/2"	see note 6		see note 7
Mercury vapor anchor base for 40 & 45 ft. and 4, 6, 8, 10, 12, 15, 17 ft. single or double bracket arm.	1'-1"	9 1/4"	2'-0"	2'-2"	8'-6"	10 3/4"	3 1/2"	11 Ga. up to 15' Brkt. Arm 7 Ga. for 17' Brkt. Arm		1 1/2" x 5'-0"

- NOTES:**
- All materials and workmanship shall be in accordance with the current Michigan Department of State Highways Supplemental Specifications For Electrical Construction.
 - Use detail "M" anchor bolts unless shear studs are specified in the plans. Anchor bolt length "J" or "K" is length before bending. Final Standard adjustment shall be leveled by use of galvanized sheet steel shims if required.
 - Supply bracket arm fitters for each arm used only.
 - Supply 1/2" elastomeric fabric bound pad for mounting between street light standard base and foundation on bridge mounted units only (incidental).
 - Cast steel or hot rolled plate anchor bases shall have a thickness as shown in Chart below.
 - Standards mounted on transformer bases shall have the same dimensions as anchor base types, except shaft length.
 - Use the same anchor bolts for transformer base as for corresponding anchor base types.
 - For grounding Light Standards see Light Standard Grounding Details sheet.
 - Bolt Circle dimension "A" for Anchor Bolts must be exact. Anchor Bolts are to be set to a template.
 - Non metallic Conduit for Foundation shall be asbestos cement, plastic, or bituminized fiber. Metallic Conduit shall be rigid galvanized steel. In lieu of Conduit, a raceway formed by a Murray Hose is acceptable. Conduit of whatever material, if used, is incidental to the Light Standard.
 - If octagonal Foundation top is used, top of Foundation must extend 1" min. outside of Light Standard Base.

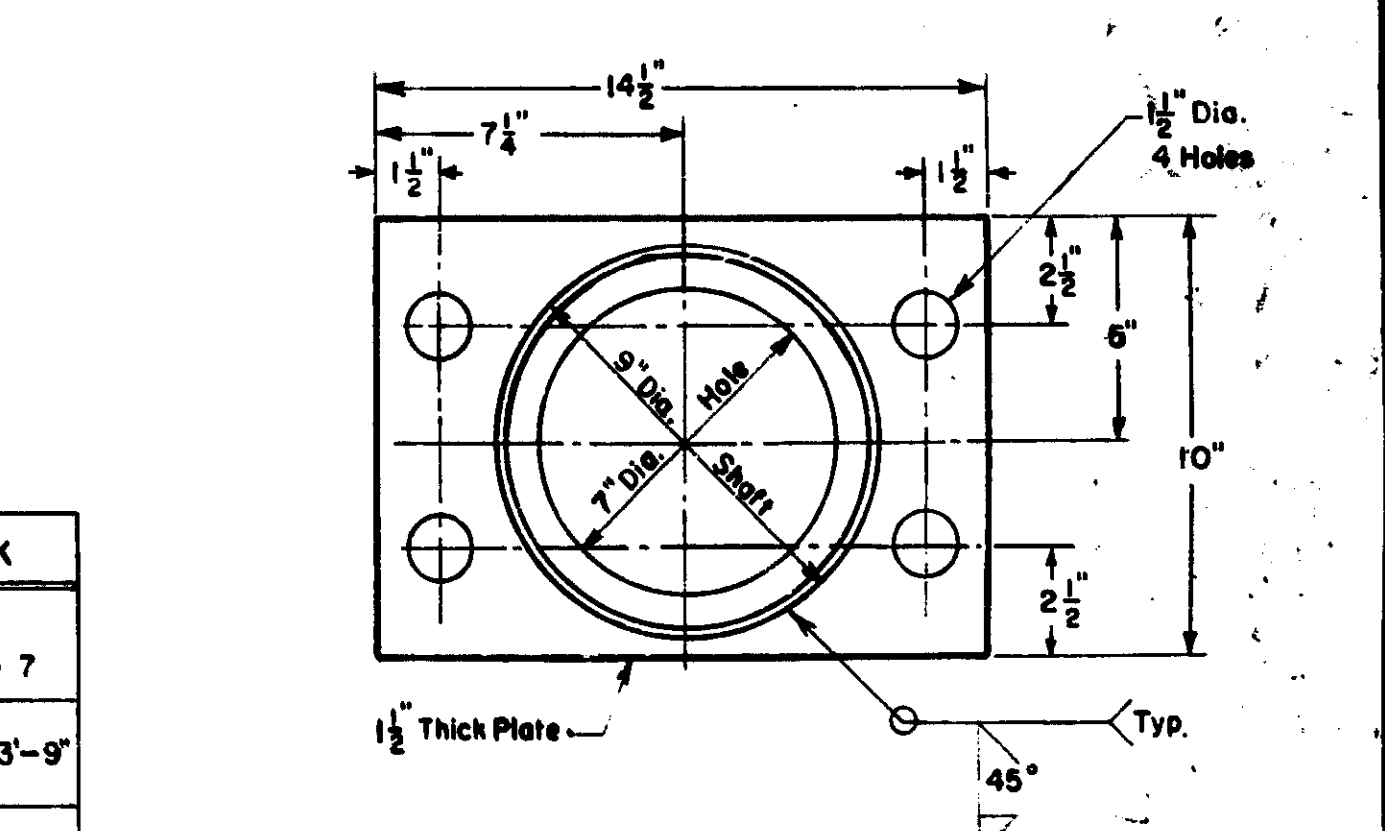

ANCHOR BASE DETAIL FOR LIGHT STANDARDS USED ON 10" TOP CONCRETE BARRIER
See Detail Sheet For Light Standard Foundation (Concrete Barrier)

MICHIGAN DEPARTMENT OF STATE HIGHWAYS
ELECTRICAL DETAILS
STEEL LIGHT STANDARDS
 FOR 30, 40, & 45 FT. MOUNTING HEIGHTS

E-3

APPROVED: [Signature] DATE: 7-1-69

DESIGNED BY: [Signature] DATE: 7-1-69





TRACED BY: [Signature] DATE: 7-1-69

CHECKED BY: [Signature] DATE: 7-1-69

SHEET NO. 63174

OR NO. 14165A

Sheet 37

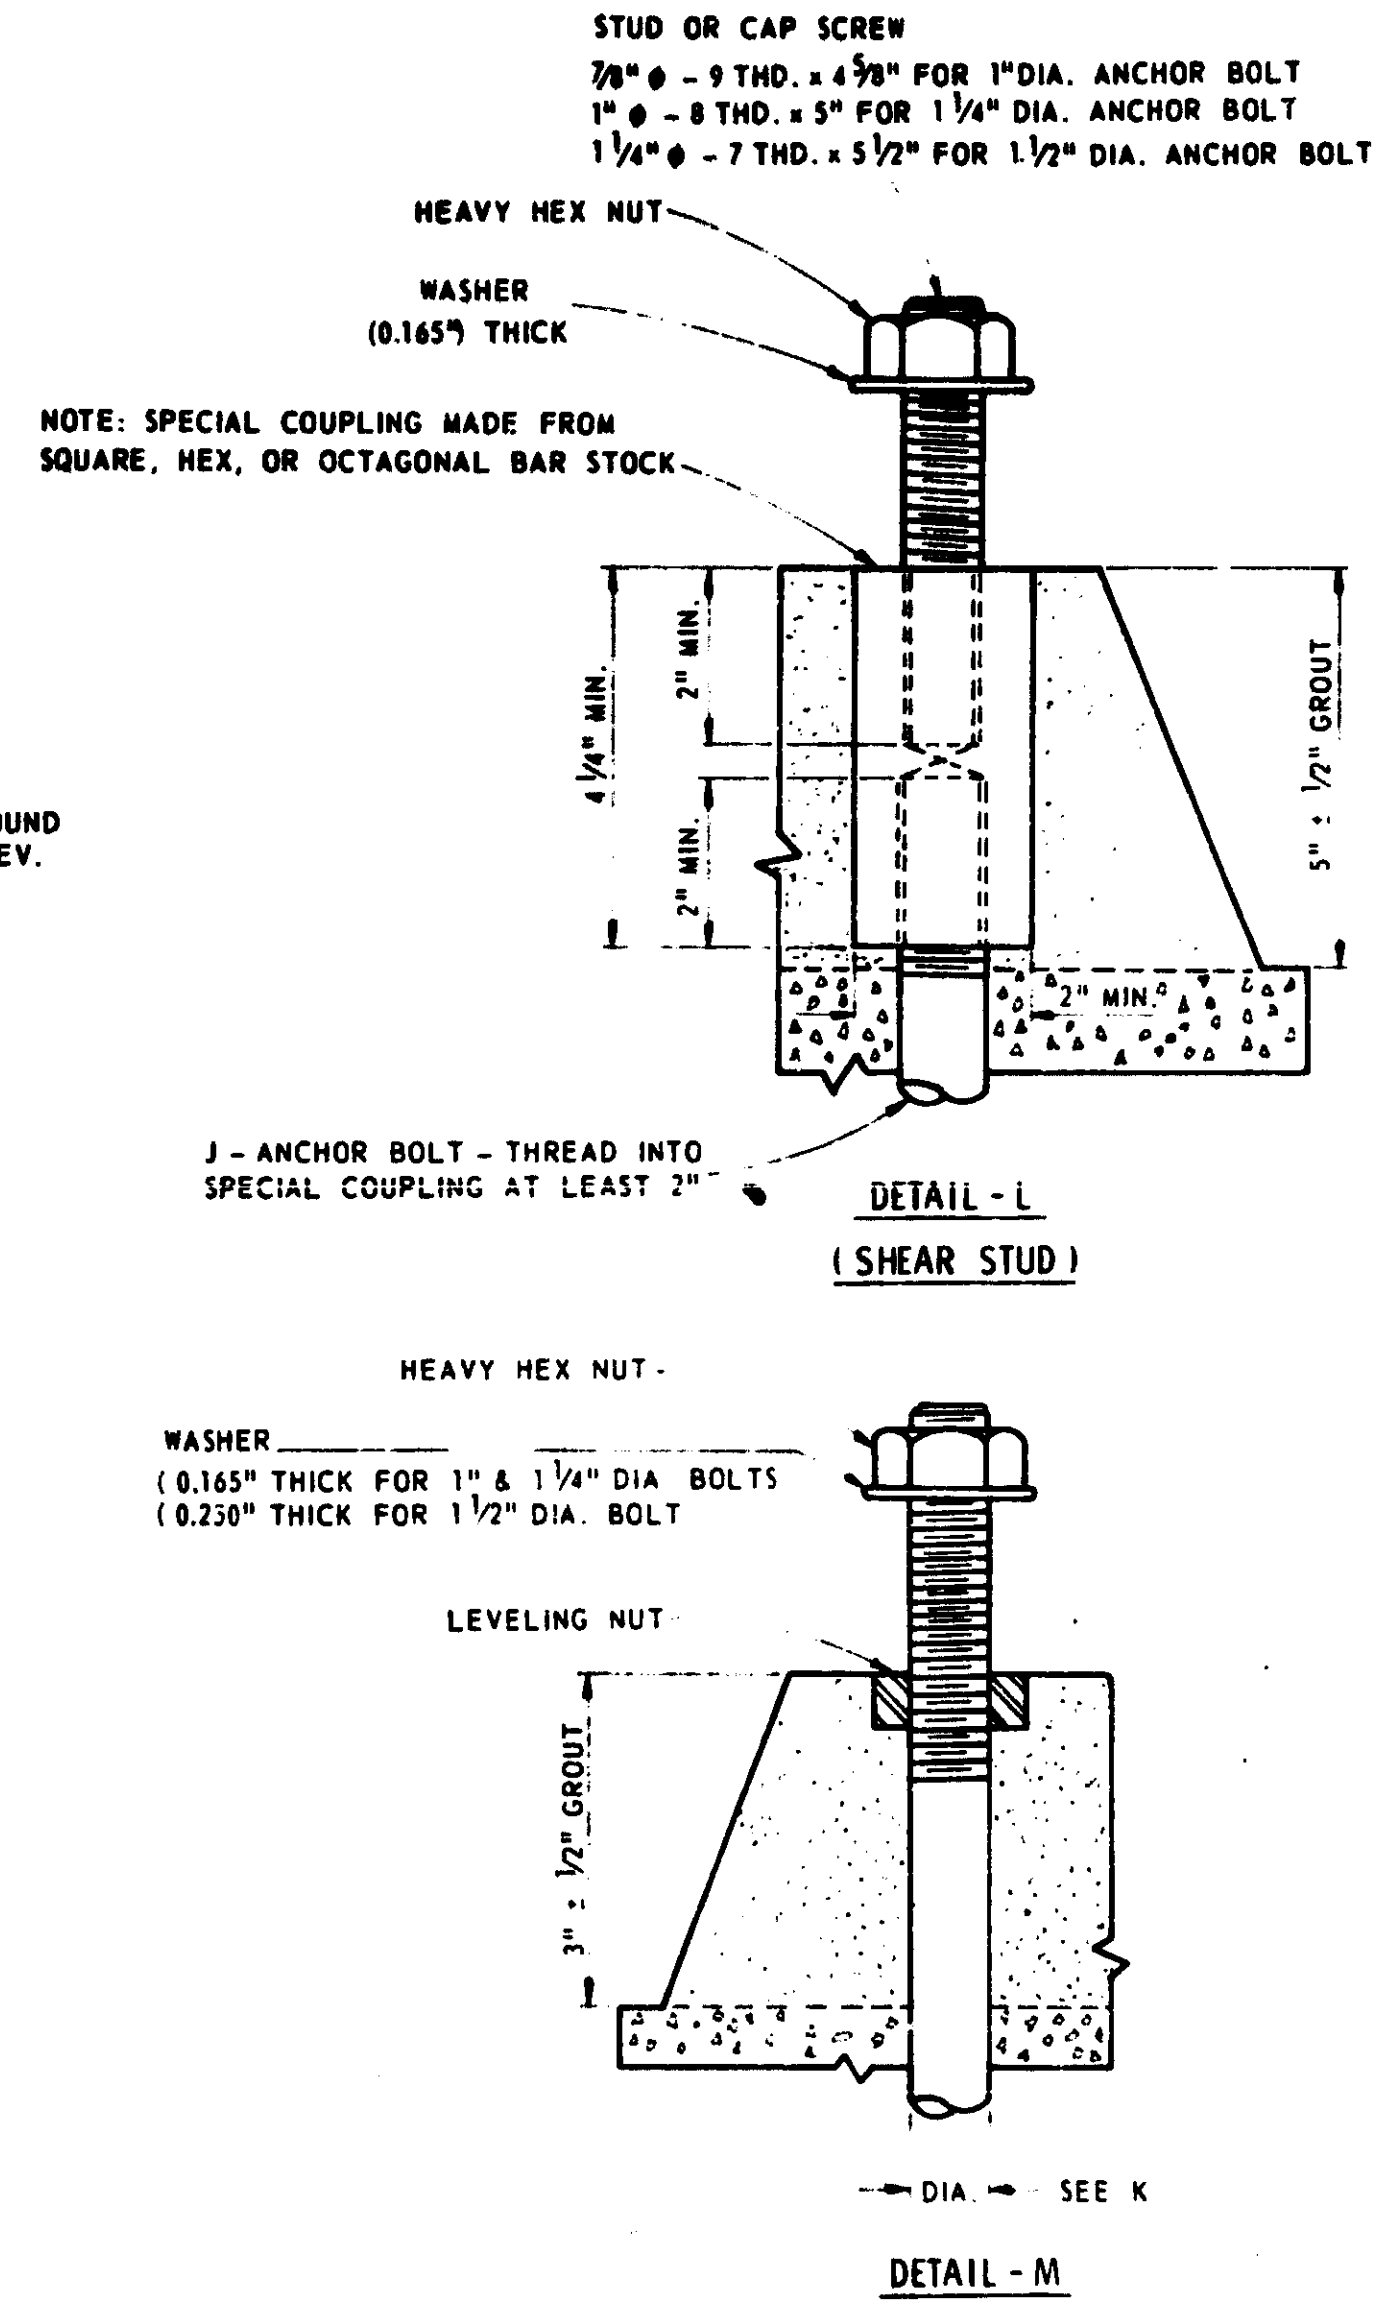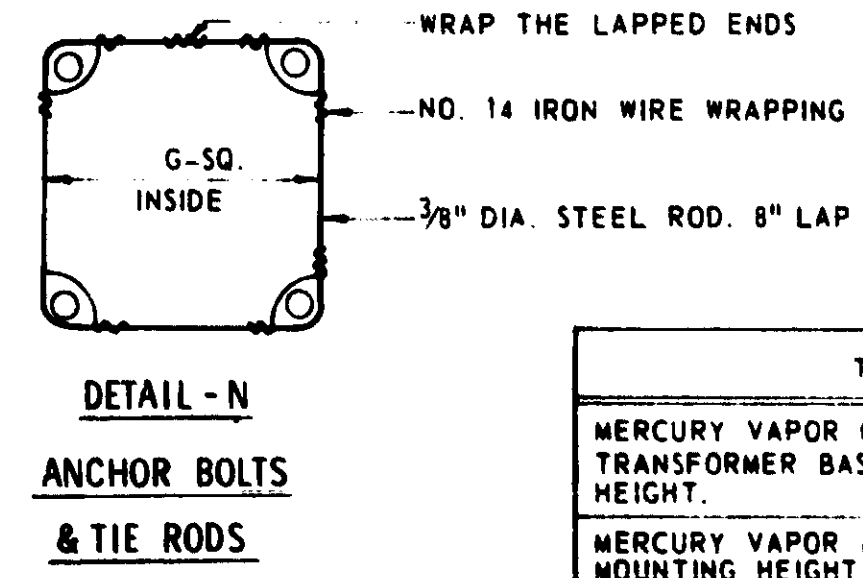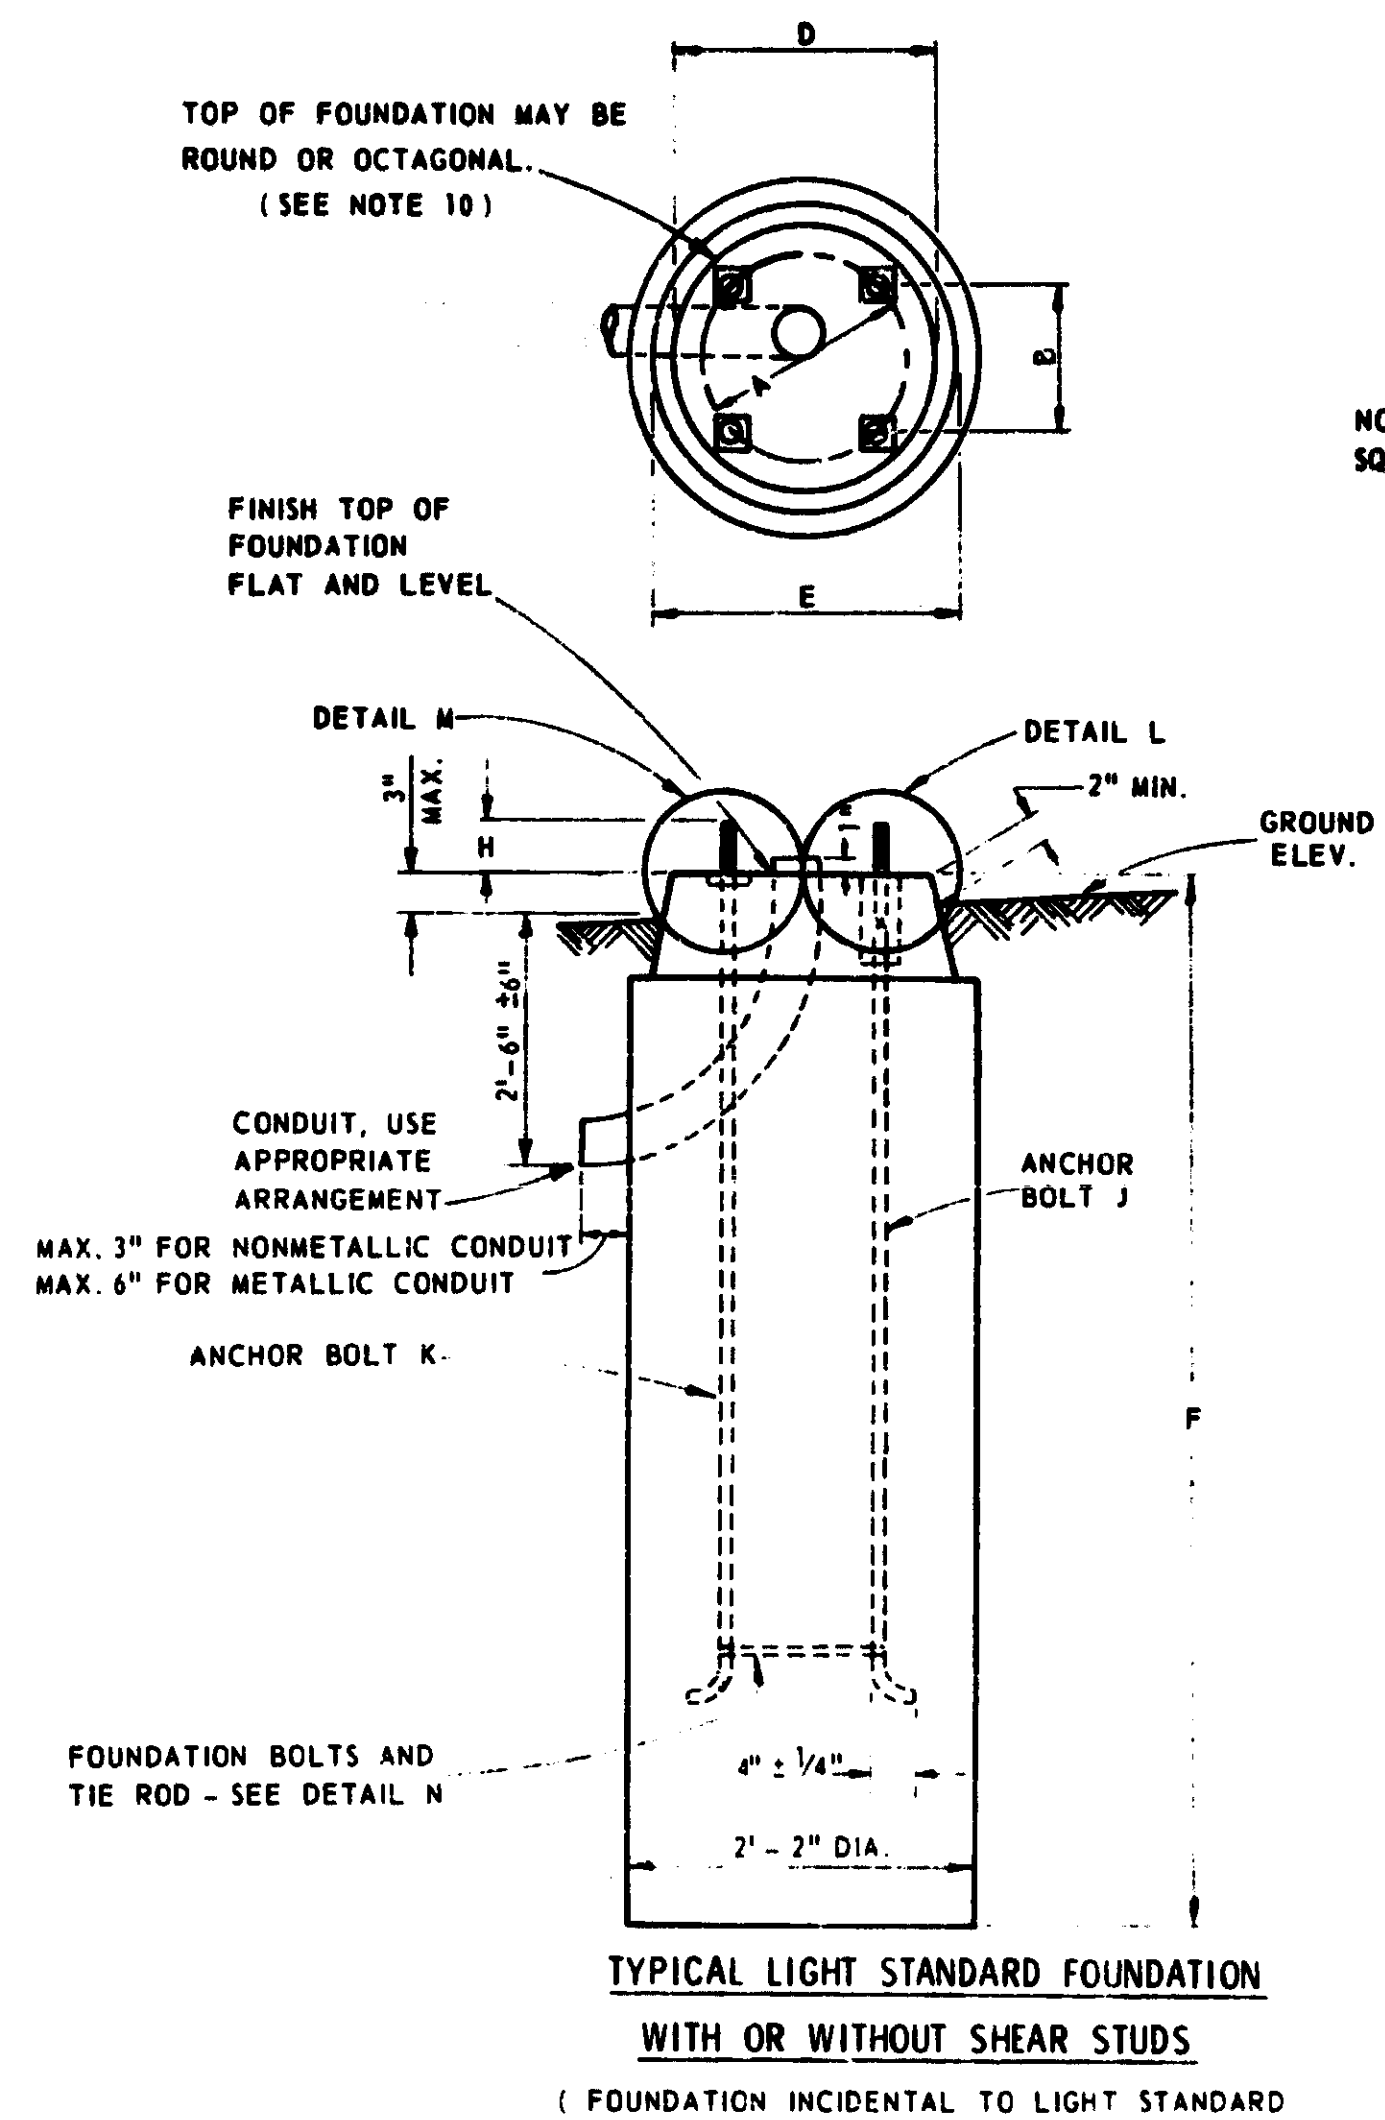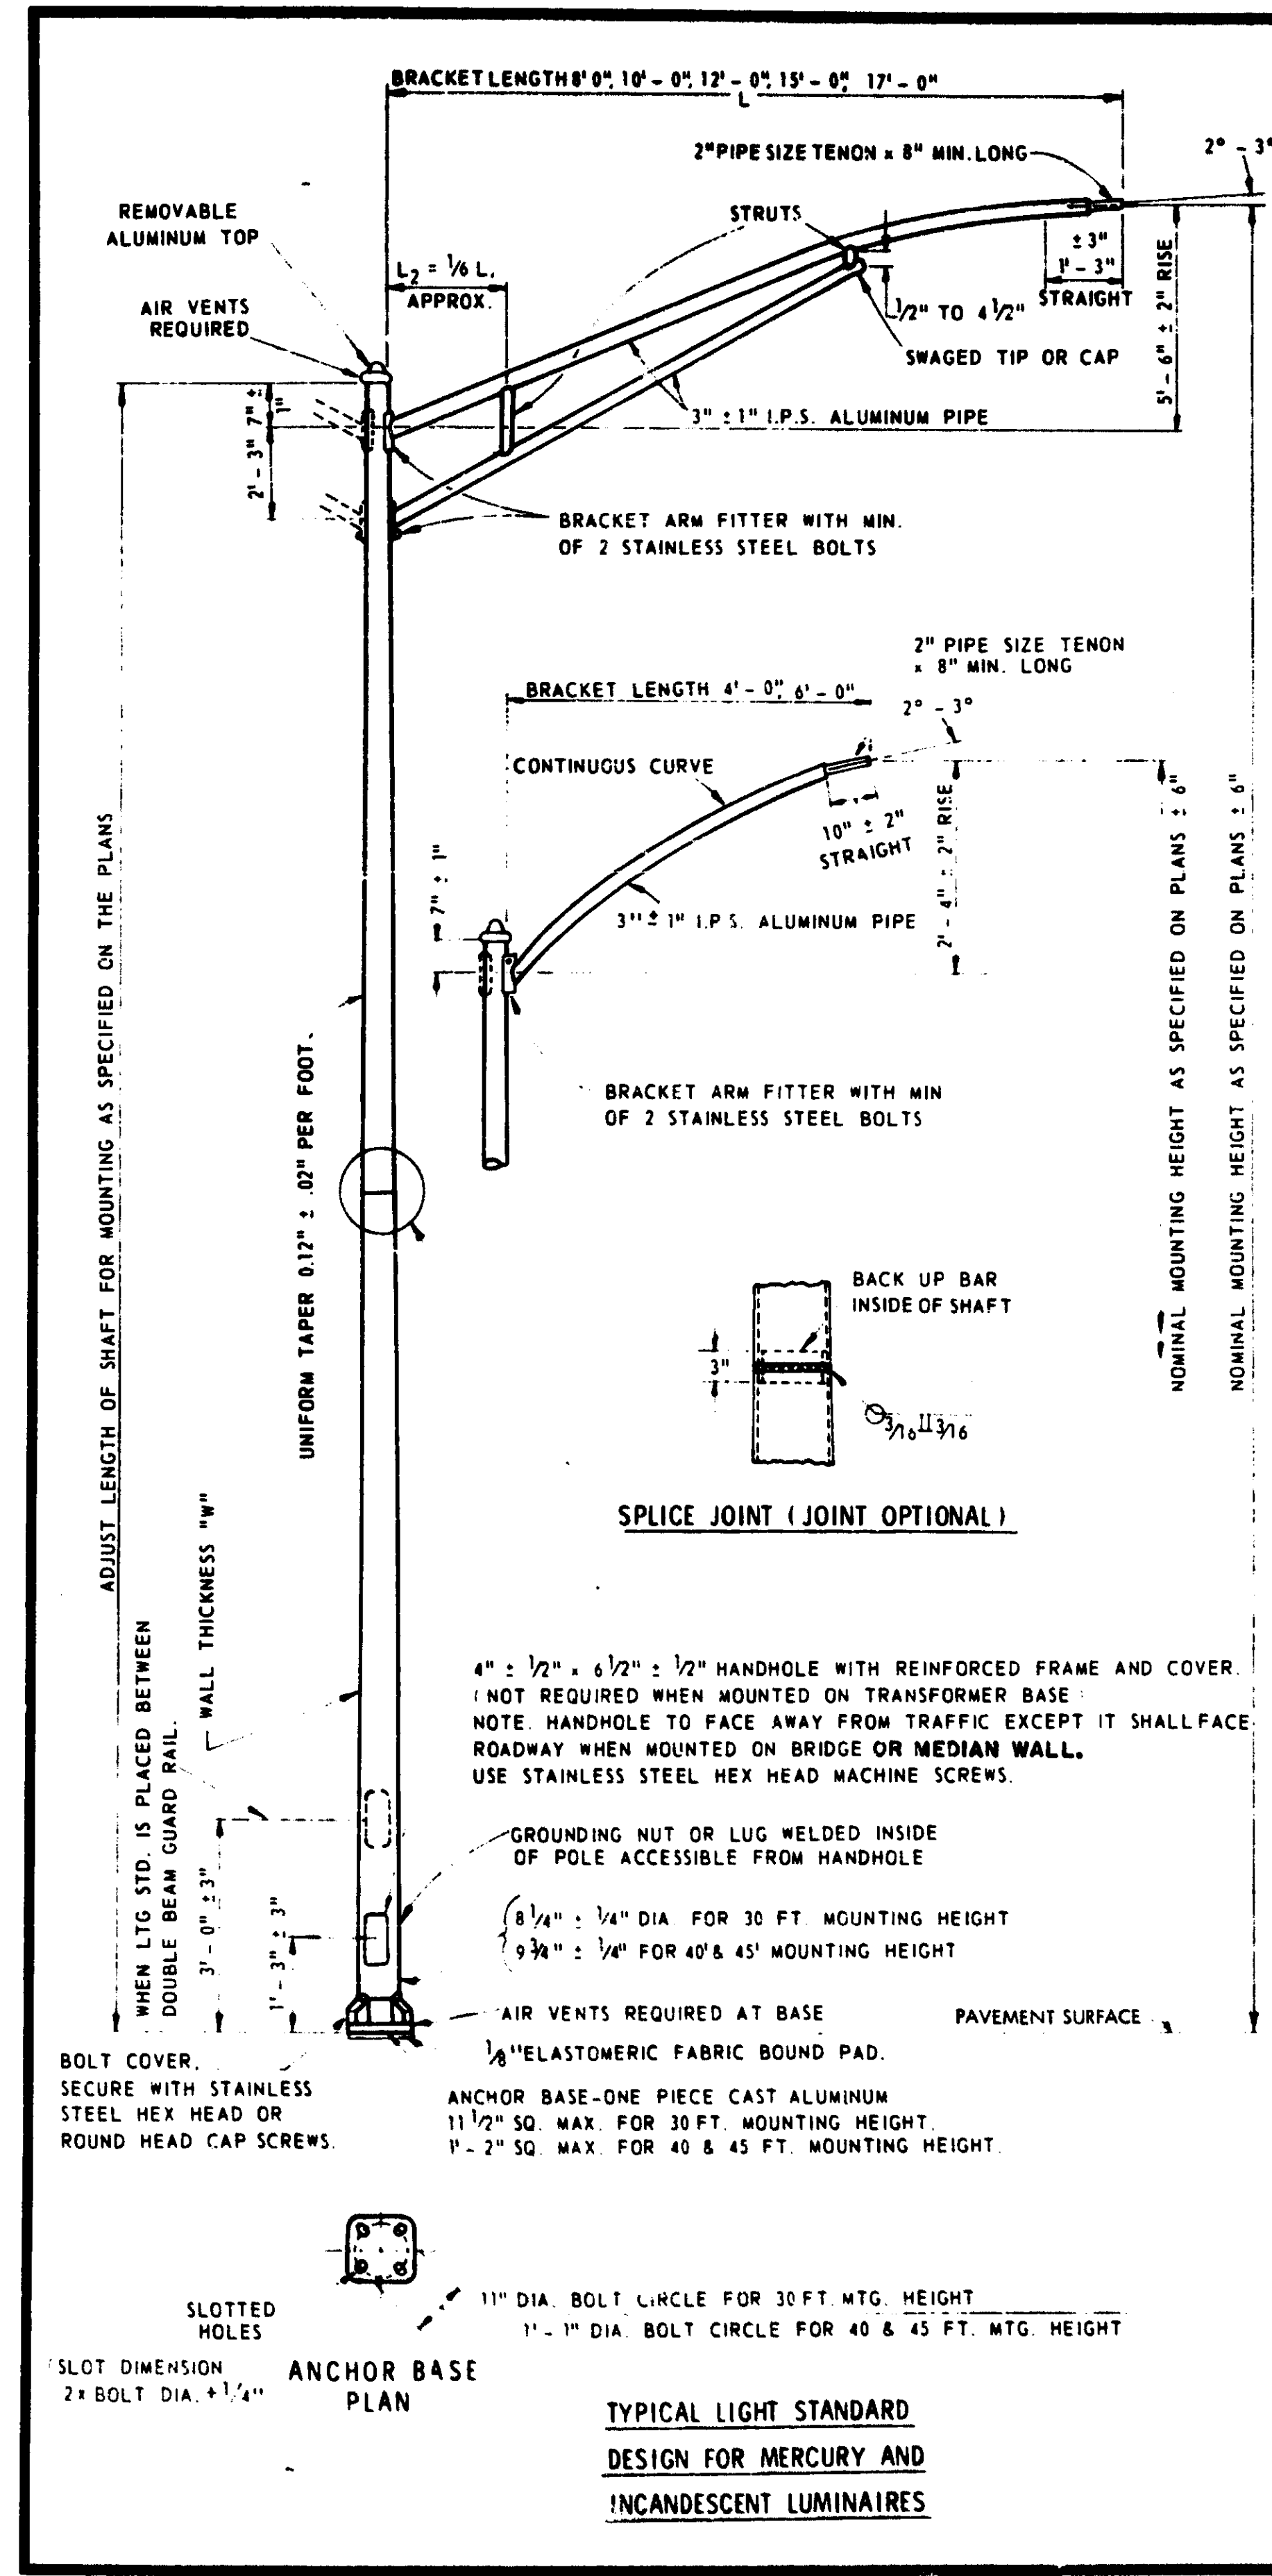

- NOTES:**
1. ALL MATERIALS AND WORKMANSHIP SHALL BE IN ACCORDANCE WITH THE CURRENT MICHIGAN DEPARTMENT OF STATE HIGHWAYS SPECIFICATIONS FOR ELECTRICAL CONSTRUCTION.
 2. USE DETAIL "M" ANCHOR BOLTS UNLESS SHEAR STUDS ARE SPECIFIED IN THE PLANS. ANCHOR BOLT LENGTH "J" OR "K" IS LENGTH BEFORE BENDING. FINAL STANDARD ADJUSTMENT SHALL BE LEVELED BY USE OF GALVANIZED SHEET STEEL SHIMS IF REQUIRED.
 3. SUPPLY BRACKET ARM FITTERS FOR EACH ARM USED ONLY.
 4. PLACE 1/2" ELASTOMERIC FABRIC BOUND PAD FOR MOUNTING ONLY BETWEEN STREET LIGHT STANDARD BASE AND FOUNDATION.
 5. STANDARDS MOUNTED ON TRANSFORMER BASES SHALL HAVE THE SAME DIMENSIONS AS ANCHOR BASE TYPES, EXCEPT SHAFT LENGTH.
 6. USE THE SAME ANCHOR BOLTS FOR TRANSFORMER BASE AS FOR CORRESPONDING ANCHOR BASE TYPES.
 7. FOR GROUNDING LIGHT STANDARDS SEE LIGHT STANDARD GROUNDING DETAILS SHEET.
 8. BOLT CIRCLE DIMENSION "A" FOR ANCHOR BOLTS MUST BE EXACT. ANCHOR BOLTS ARE TO BE SET TO A TEMPLATE.
 9. NON METALLIC CONDUIT FOR FOUNDATION SHALL BE ASBESTOS CEMENT, PLASTIC, OR BITUMINIZED FIBER METALLIC CONDUIT SHALL BE RIGID GALVANIZED STEEL IN LIEU OF CONDUIT, A RACEWAY FORMED BY A MURRAY HOSE IS ACCEPTABLE. CONDUIT OF WHATEVER MATERIAL, IF USED, IS INCIDENTAL TO THE LIGHT STANDARD.
 10. IF OCTAGONAL FOUNDATION TOP IS USED, TOP OF FOUNDATION MUST EXTEND 1" MIN OUTSIDE OF LIGHT STANDARD BASE, OR T-BASE

TYPE	A	B	D	E	F	G	H	W	J	K
MERCURY VAPOR OR INCANDESCENT TRANSFORMER BASE FOR 30 FT. MOUNTING HEIGHT.	11"	7 3/4"	1' - 7"	1' - 9"	6' - 0"	8 3/4"	2 5/8"	SEE NOTE 5		SEE NOTE 6
MERCURY VAPOR ANCHOR BASE FOR 30 FT. MOUNTING HEIGHT AND 4 OR 6 FT. SINGLE OR DOUBLE BRACKET ARM.	11"	7 3/4"	1' - 7"	1' - 9"	5' - 0"	8 3/4"	2 5/8"	188" SGL BKT ARM 219" DBL BKT ARM	1" Ø x 3" ± 4" Ø x 3" ± 2"	
MERCURY VAPOR ANCHOR BASE FOR 30 FT. MOUNTING HEIGHT AND 8, 10, 12, 15 FT. SINGLE OR DOUBLE BRACKET ARM.	11"	7 3/4"	1' - 7"	1' - 9"	6' - 0"	8 3/4"	2 5/8"	188" SGL BKT ARM 219" DBL BKT ARM	1" Ø x 5' - 0"	
MERCURY VAPOR ANCHOR BASE FOR 30 FT. MOUNTING HEIGHT AND 17 FT. SINGLE OR DOUBLE BRACKET ARM.	11"	7 3/4"	1' - 7"	1' - 9"	6' - 0"	9"	3"	188" SGL BKT ARM 219" DBL BKT ARM	1 1/2" Ø x 5' - 0"	
MERCURY VAPOR OR INCANDESCENT TRANSFORMER BASE FOR 40 & 45 FT. MOUNTING HEIGHT.	1' - 5 1/2"	10 - 0 7/8"	2' - 0"	2' - 2"	8' - 6"	10 1/2"	3 1/2"	SEE NOTE 5		SEE NOTE 6
MERCURY VAPOR ANCHOR BASE FOR 40 FT. MOUNTING HEIGHT AND 4, 6, 8, 10, 12, 15, 17 FT. SINGLE OR DOUBLE BRACKET ARM.	1' - 1"	9 1/4"	2' - 0"	2' - 2"	8' - 6"	10 3/4"	3 1/2"	188" SGL BKT ARM 219" DBL BKT ARM	1 1/2" Ø x 5' - 0"	
MERCURY VAPOR ANCHOR BASE FOR 45 FT. MOUNTING HEIGHT AND 4, 6, 8, 10, 12, 15, 17 FT. SINGLE OR DOUBLE BRACKET ARM.	1' - 1"	9 1/4"	2' - 0"	2' - 2"	8' - 6"	10 3/4"	3 1/2"	219" LOWER SECTION 188" UPPER SECTION	1 1/2" Ø x 5' - 0"	

ALUMINUM LIGHT STANDARDS WITH RECTANGULAR BASE (10" x 14 1/2") WITH ELLIPTICAL SHAFT AT BOTTOM FOR USE ON MEDIAN BARRIER WALL WILL BE CONSIDERED UPON APPROVAL BY THE ENGINEER.

MICHIGAN DEPARTMENT OF STATE HIGHWAYS
ELECTRICAL DETAILS
ALUMINUM LIGHT STANDARDS
 FOR 30, 40 & 45 FT. MOUNTING HEIGHTS

E-4

APPR. DATE: 1-8-68

DESIGNED BY: T. J. J. / 1-8-68

TRACED BY: DMK





CHECKED BY: DMK

NO. DESCRIPTION DATE BY

63174

JOB NO. **14165A**

Sheet # 38

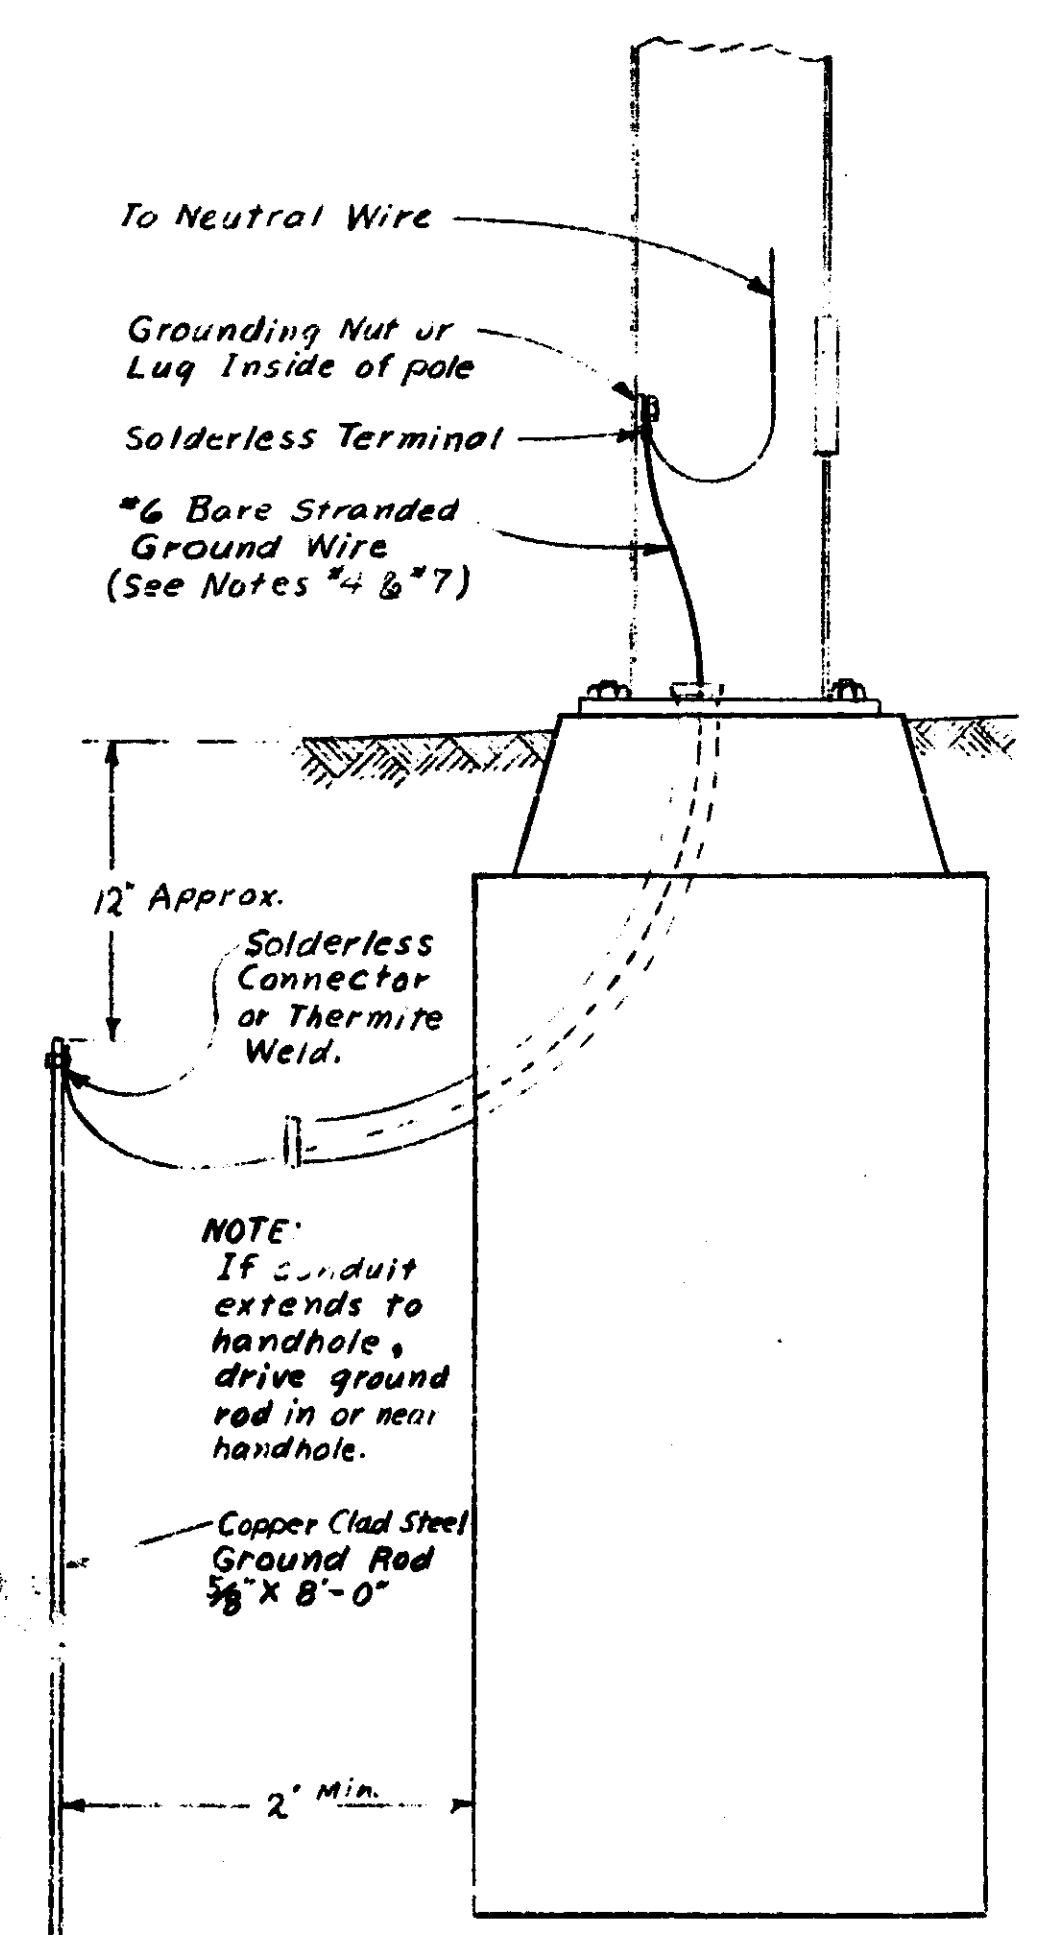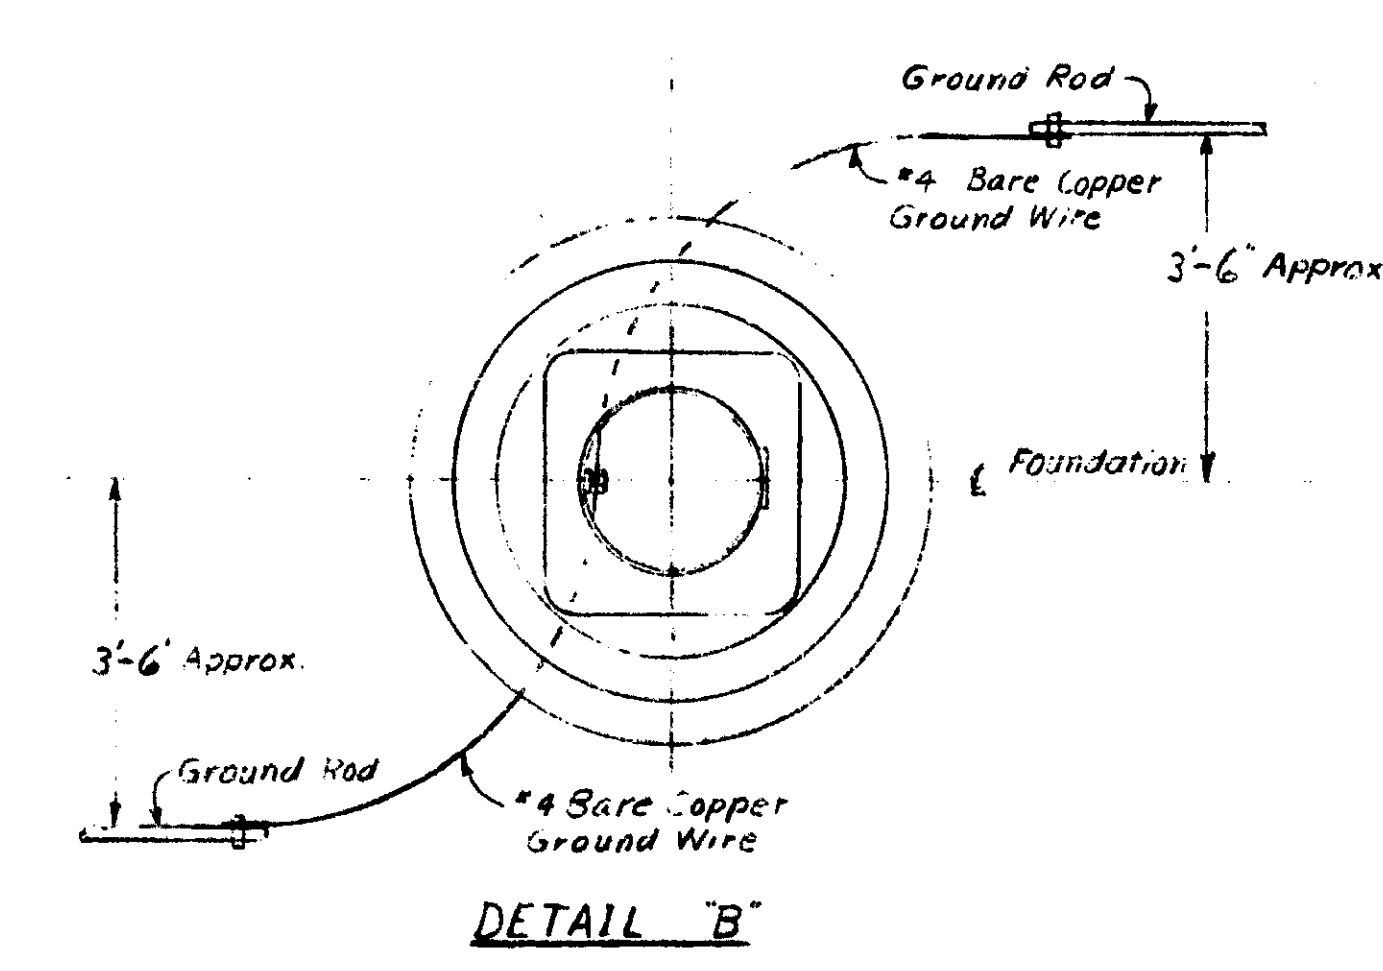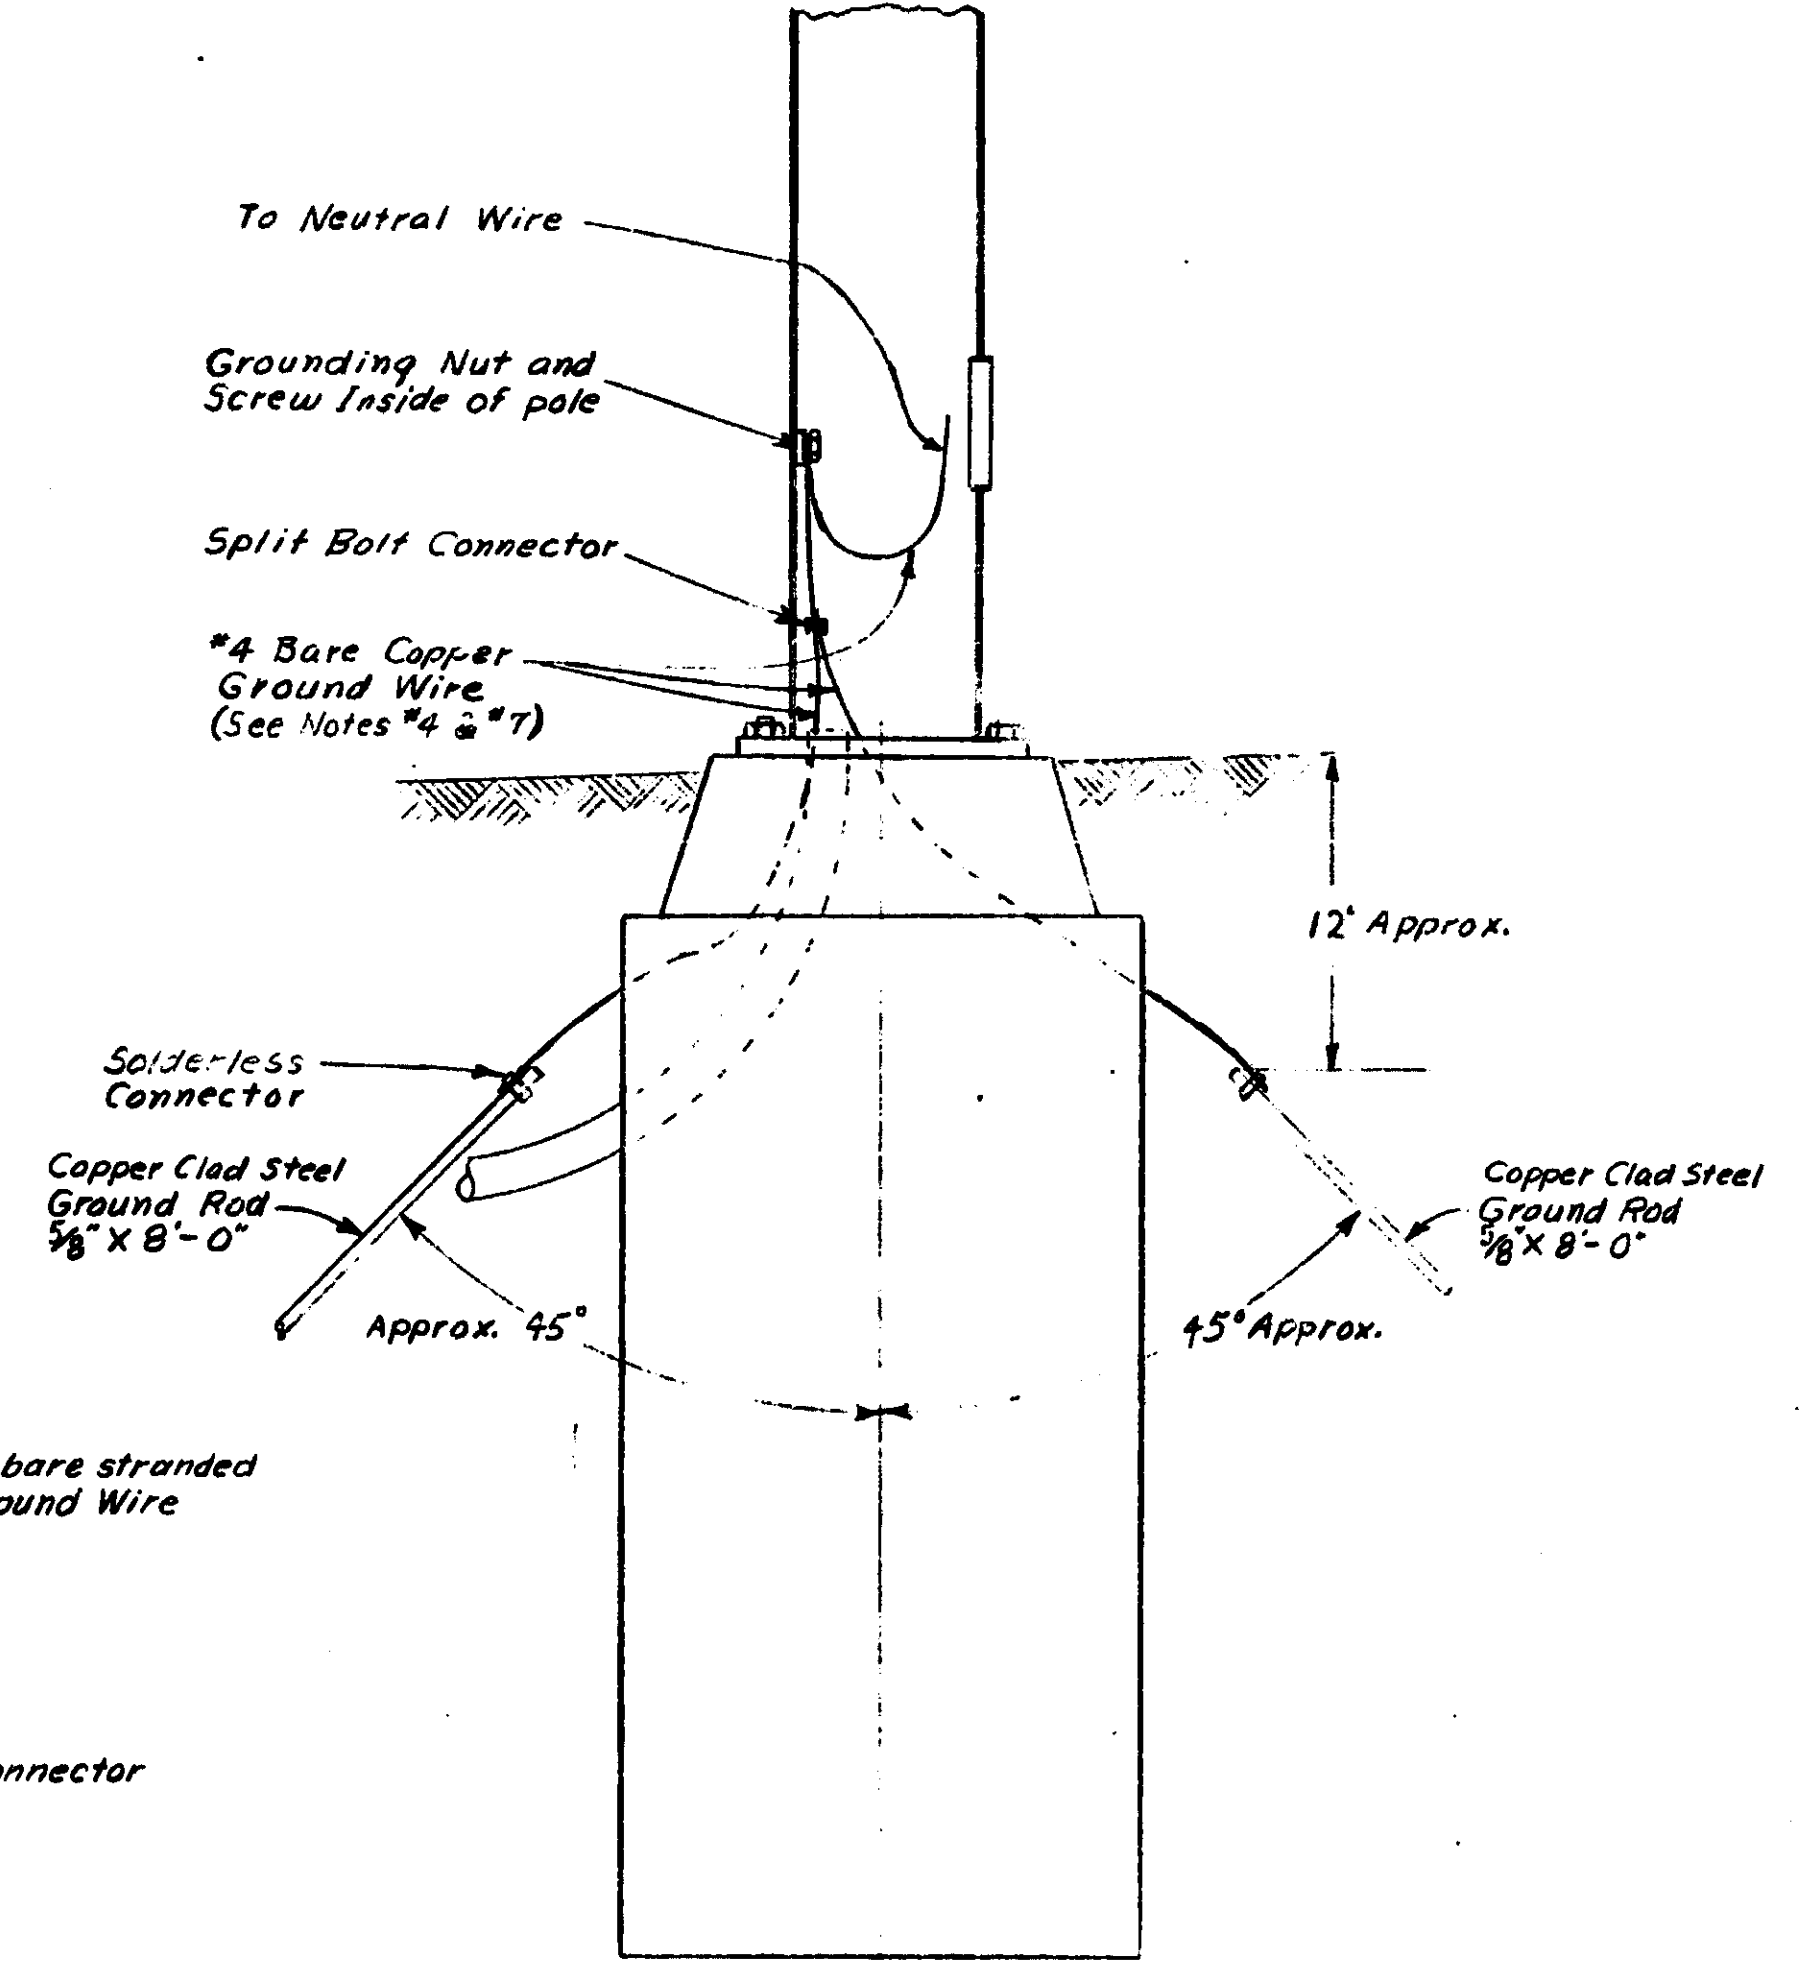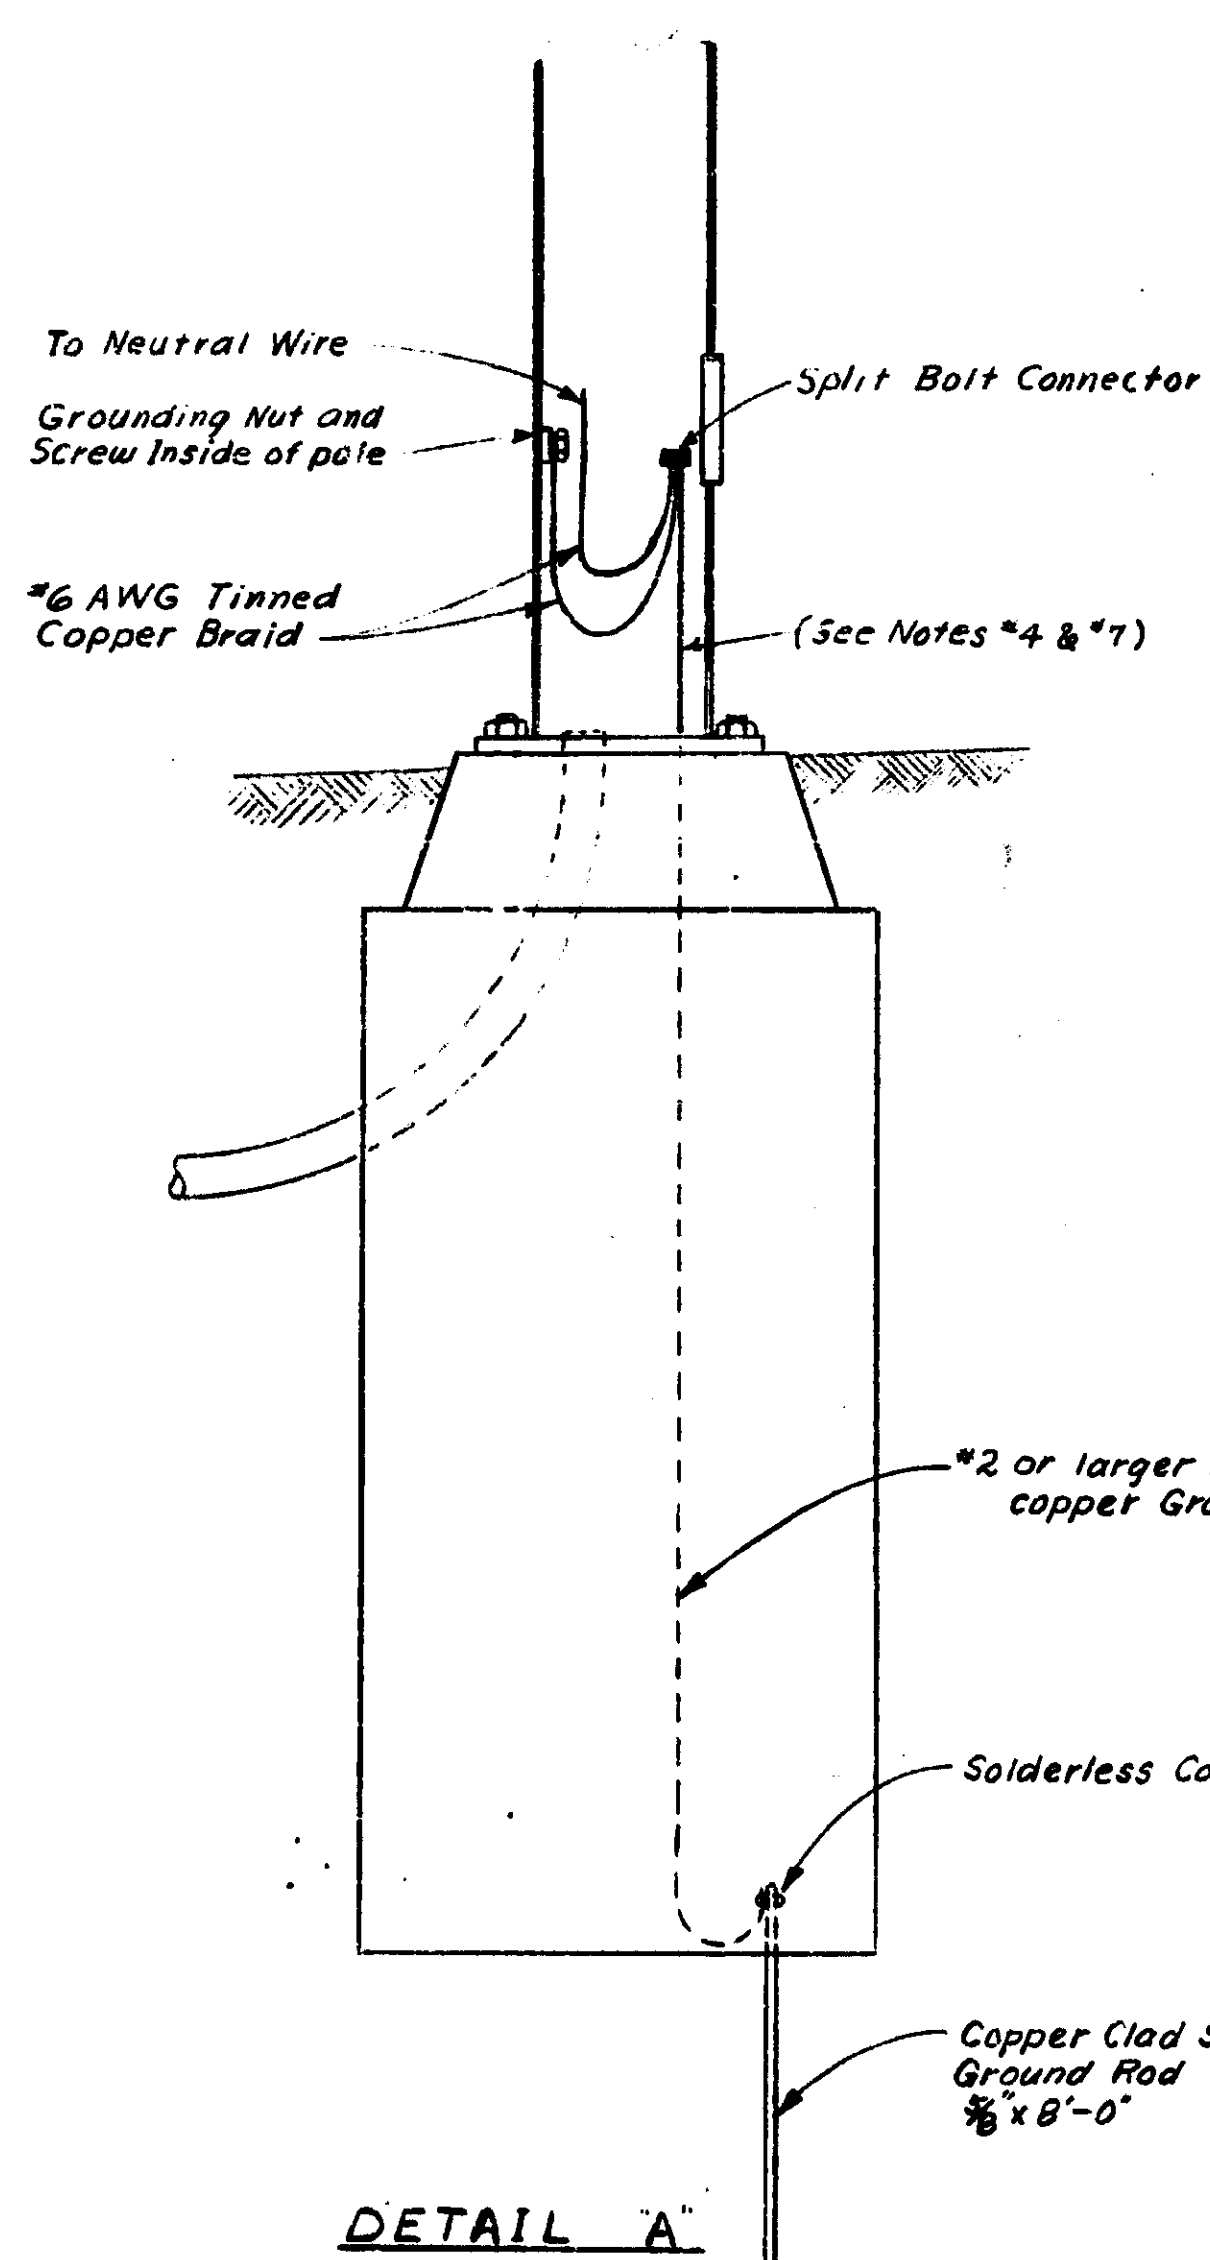

- NOTES:**
1. Detail 'A' is to be used for Lighting Standards maintained by City of Detroit Public Lighting Commission.
 2. Detail 'B' is to be used for Lighting Standards maintained by Detroit Edison Co.
 3. Detail 'C' is to be used for Lighting Standards maintained by others than the above.
 4. If Frangible Base is used between foundation and pole base, increase length of ground wire above foundation by height of Frangible Base.
 5. Ground Lighting Standards on bridges, retaining walls, and other structures by #6 copper bare or green insulated wire. Connect to ground rods driven near structure, to nearest ground of lighting system or to structural steelwork (if steelwork is grounded).
 6. Resistance of grounding electrodes shall be in accordance with The National Electrical Code.
 7. Ground wire shall be stranded soft drawn copper wire per ASTM B8.


E-15

MICHIGAN DEPARTMENT OF STATE HIGHWAYS
LIGHTING STANDARD GROUNDING DETAILS

APPR. DATE		E-7	
DRAWN BY		T. Wilson 1967	
CHECKED BY		D. Wincup 11-67	
NO.	DESCRIPTION	DATE	BY
63174			
JOB NO. 14165A			


Sheet 39

ENTRANCE HOLES AS REQUIRED FOR 3" & 4" CONDUIT
CONDUIT ARRANGEMENT MAY BE MODIFIED. ADDITIONAL
OPENINGS SHALL BE PROVIDED AS REQUIRED. SEE
PLANS. PLUG ALL UNUSED ENTRANCE HOLES AND SEAL
AROUND HOLES ENTERED

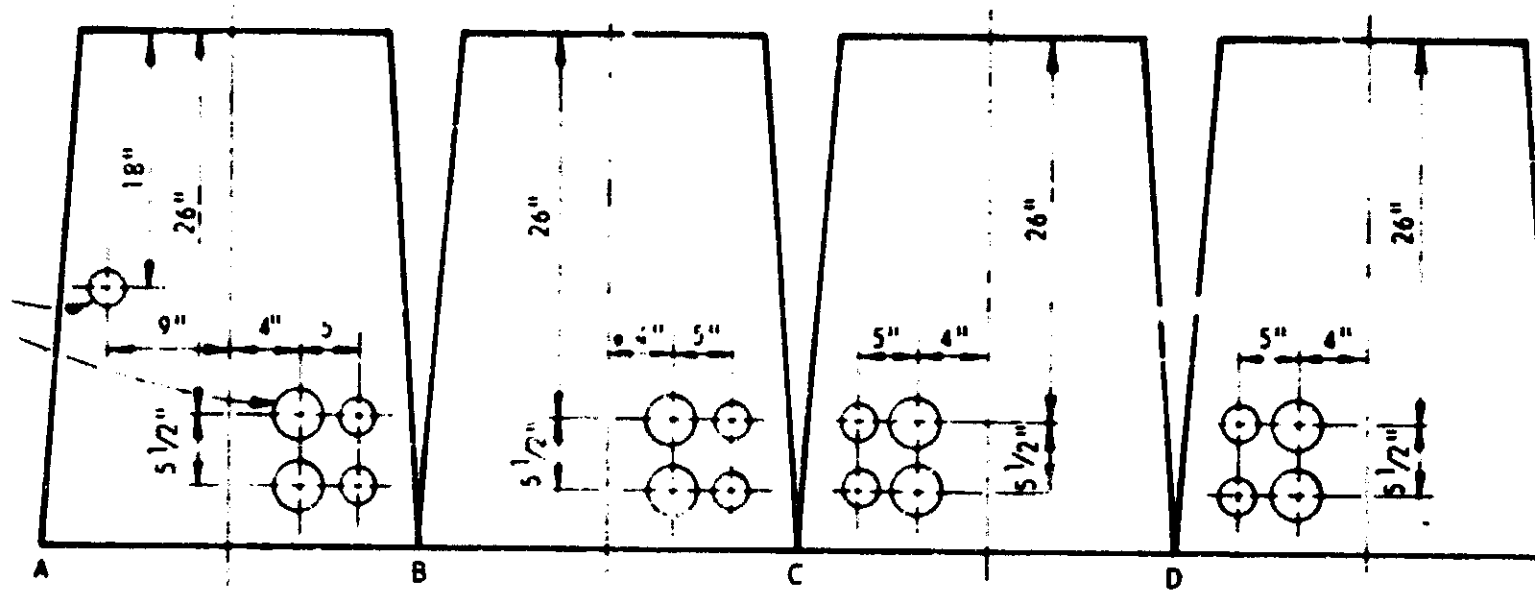


INTERIOR WALL ELEVATIONS - LIGHT AND HEAVY DUTY COVER TYPES

BOLTED LIGHT DUTY COVER
(CHECKERED TYPE DESIGN)

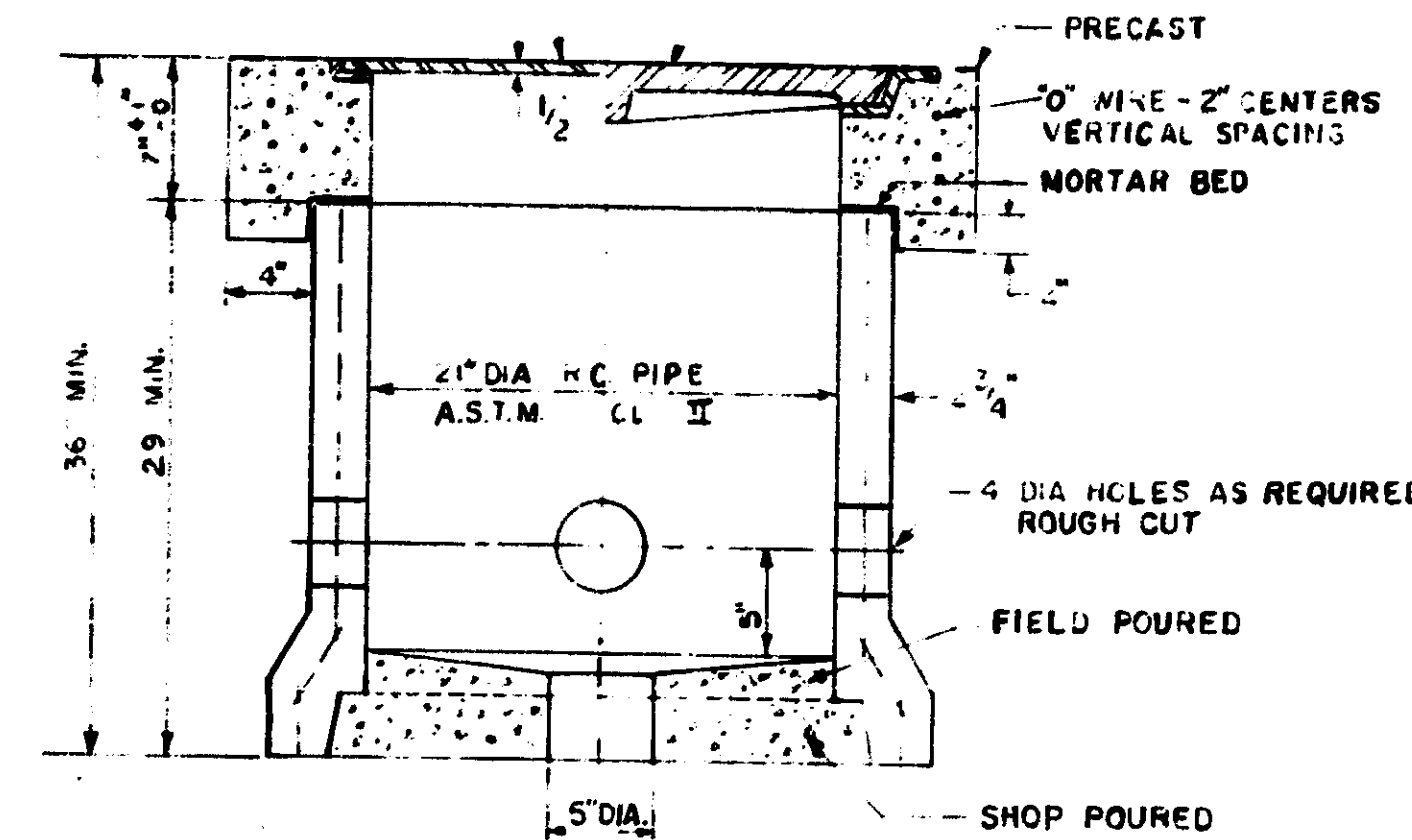

ALTERNATE PRECAST CONCRETE HANDHOLE
USING RC PIPE

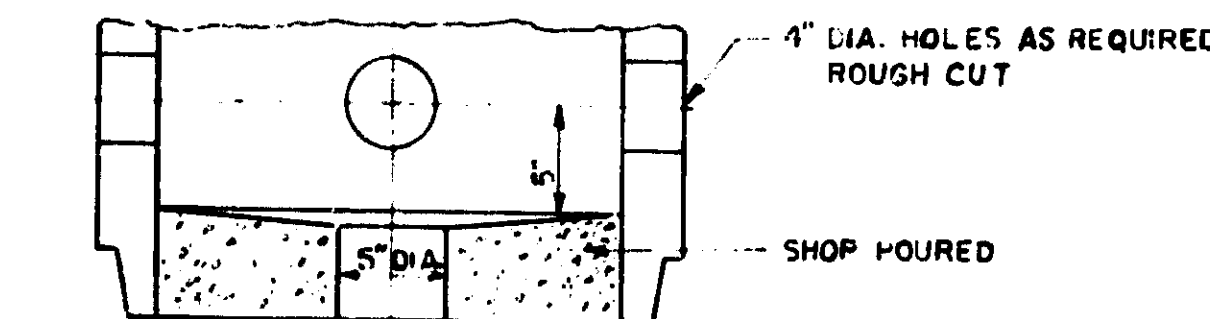

USE OF OPPOSITE END OF PIPE
(ALL OTHER DIMENSIONS SAME)

NOTES

THE MATERIAL AND WORKMANSHIP SHALL BE IN ACCORDANCE WITH THE CURRENT M.D.S.H. STANDARD SPECIFICATIONS.

THE CONTRACTOR MAY CONSTRUCT THE HANDHOLE STRUCTURE OF BRICK, CEMENT CONCRETE MASONRY OR OF PRECAST REINFORCED CONCRETE.

ALL CONCRETE MASONRY SHALL BE GRADE 30M.

THE INNER SURFACE OF THE HANDHOLE SHALL BE SMOOTH.

HEAVY DUTY COVERS SHALL BE CASTINGS WHICH MEET THE REQUIREMENTS OF THE CURRENT SPECIFICATIONS FOR GRAY IRON CASTINGS ASTM DESIGNATION A48 AND SHALL HAVE A MINIMUM STRENGTH AS PROVIDED FOR CLASS NO. 30 GRAY IRON CASTINGS.

ALL CASTINGS SHALL BE CLEANED BY SAND BLASTING.

THE SEATING FACE OF THE COVER AND THE SEAT FOR SAME ON THE FRAME IF REQUIRED SHALL BE GROUND OR MACHINED SO THAT THE COVER SHALL HAVE AN EVEN BEARING ON ITS SEAT TO PREVENT ROCKING OR TILTING.


THE CASTINGS SHALL BE FREE OF POURING FAULTS, BLOW HOLES, CRACKS, AND OTHER IMPERFECTIONS. THEY SHALL BE SOUND, TRUE TO FORM AND THICKNESS, CLEAN AND NEATLY FINISHED AND SHALL BE COATED WITH COAL TAR FITCH VARNISH.

LIGHT DUTY COVER SHALL BE BOLTED TO FRAME WITH NOT LESS THAN 2 COUNTERSUNK HEX HEAD BRONZE BOLTS.


PRECAST HANDHOLE WITH HEAVY DUTY COVER SHALL BE SET ON A CONCRETE SLAB SIMILAR TO DETAIL FOR BRICK HANDHOLE.

THE HEAVY DUTY COVER & FRAME SHALL BE EAST JORDAN IRON WORKS #B208, NEENAH FOUNDRY #R-6662-HP FOR SQUARE COVER OR EAST JORDAN IRON WORKS #2860 TYPE "A", NEENAH FOUNDRY #R-6052 D FOR CIRCULAR COVER OR AN APPROVED EQUAL.

Rev. 8-31-72 Chng'd Weight of Cover and Added Note T.U.
Rev. 8-13-71 Removed (Minimum) from 36" Dim. (T.U.)
Rev. 8-13-75 Added Round Cover. (T.U.)

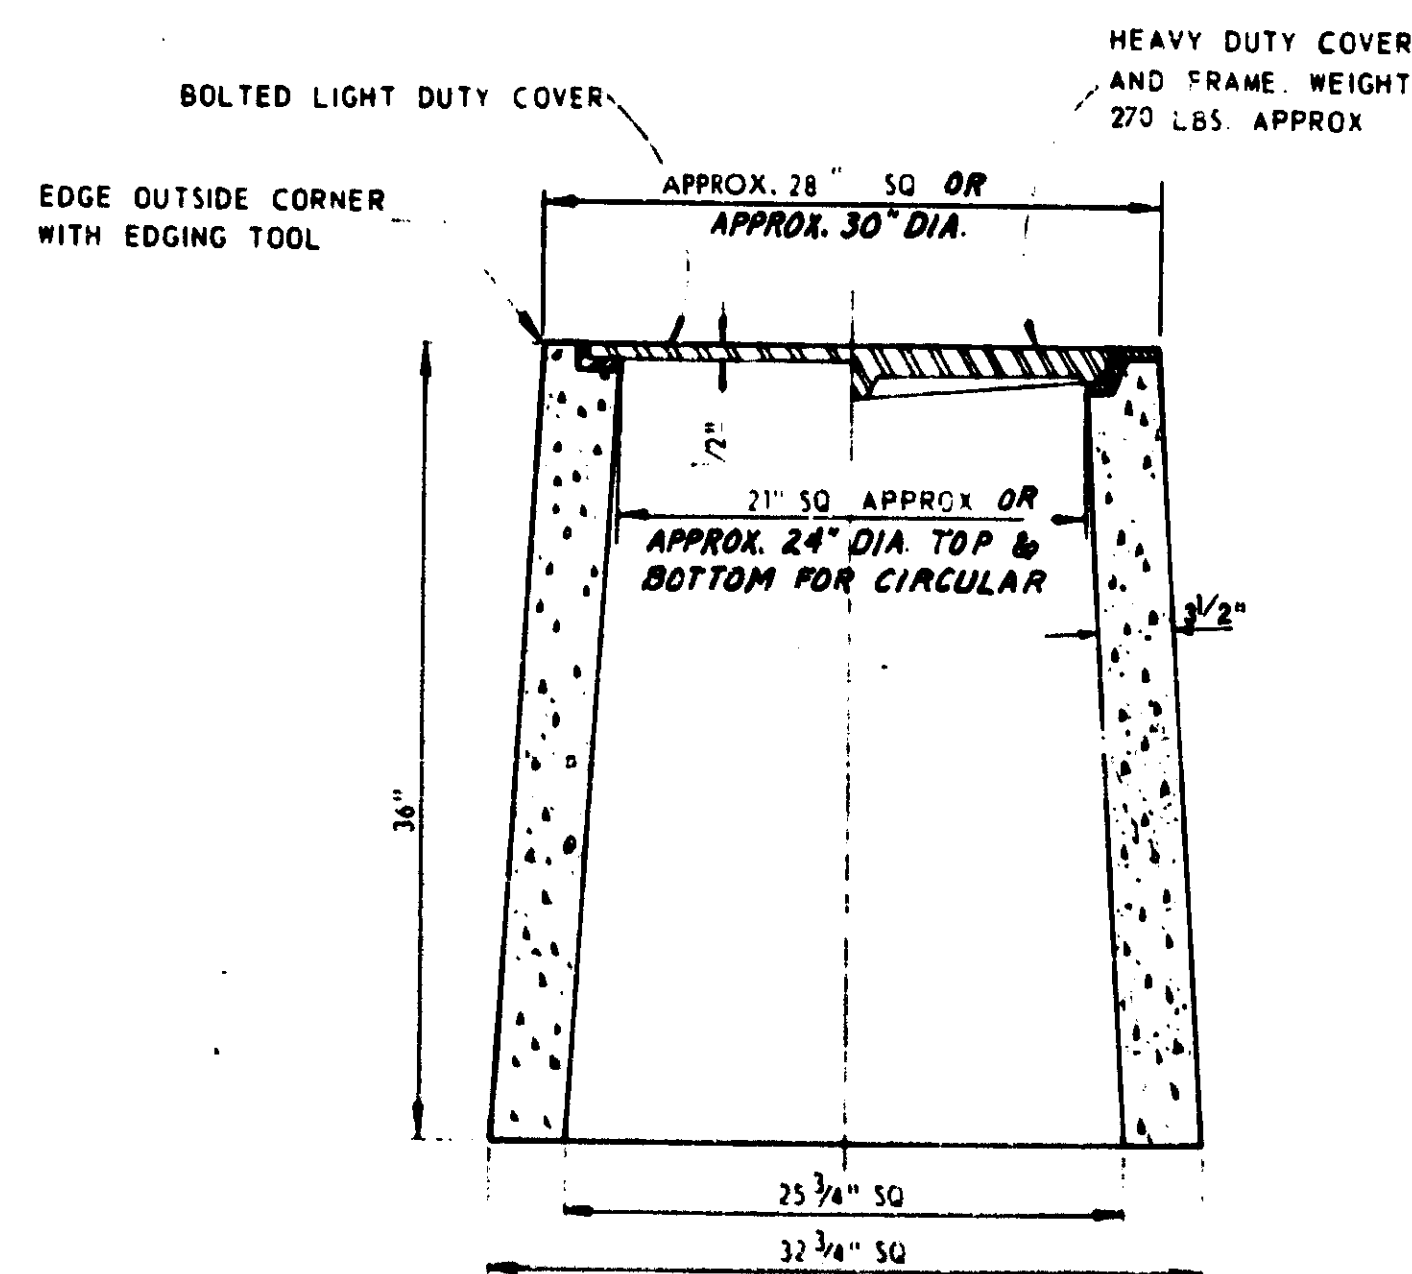

PRECAST CONCRETE HANDHOLE

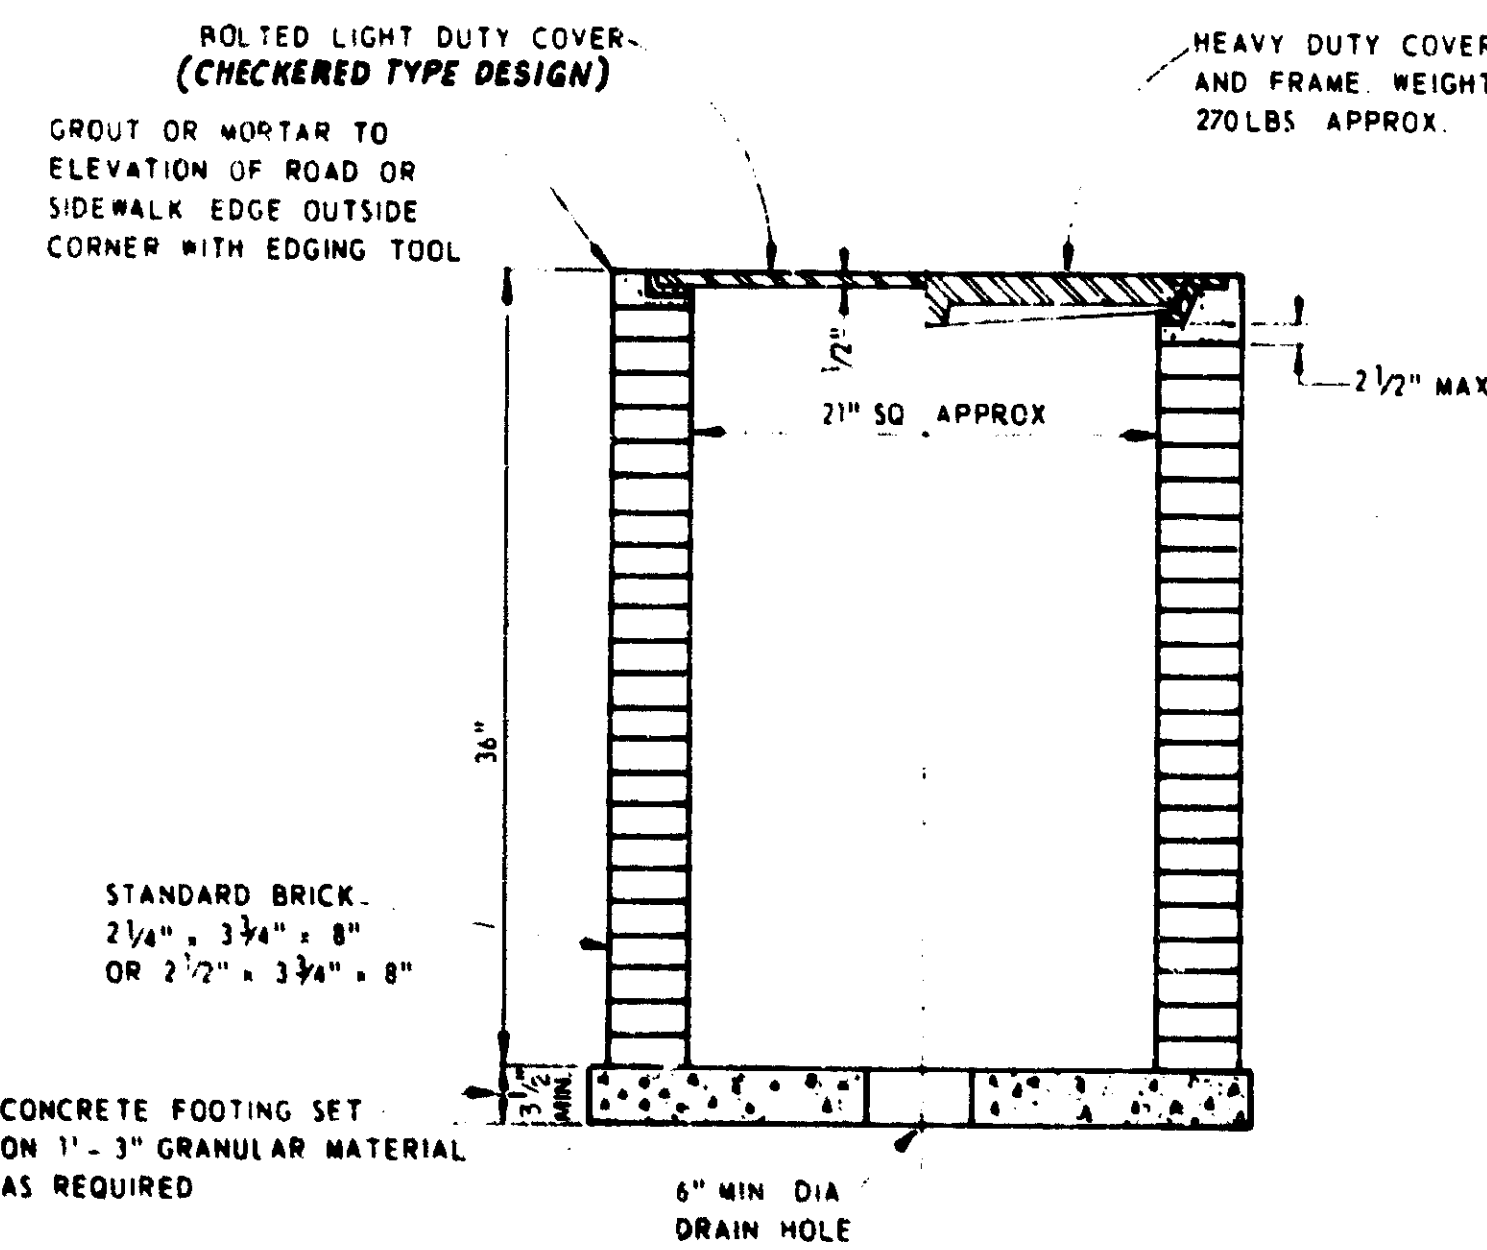

BRICK HANDHOLE

MICHIGAN DEPARTMENT OF STATE HIGHWAYS

ELECTRICAL HANDHOLE DETAILS E-8

DATE	
DESIGNED BY	JILDEM
CHECKED BY	
APPROVED BY	
NO. 63174	
14165A	

INDEX					
STD.PLAN NO.	SIGN NO.	TITLE	STD.PLAN NO.	SIGN NO.	TITLE
S 1.10		STD. SIGN INSTALLATIONS	S 7.10		A-588 STEEL TRUSS TYPE C - 50' TO 70'
S 1.20		STD. ROUTE MARKER INSTALLATIONS	S 7.20		A-588 STEEL TRUSS DETAILS TYPE C
			S 7.30		A-588 STEEL TRUSS DETAILS TYPE C
			S 7.40		A-588 STEEL TRUSS TYPE C - 75' TO 100'
			S 7.50		A-588 STEEL TRUSS DETAILS TYPE C
S 2.10		TYPICAL LOCATIONS SIGNS & SUPPORTS.	S 7.60		A-588 STEEL TRUSS TYPE D - 105' TO 125'
S 2.20		TYPICAL LOCATIONS & SUPPORT FOR CONSTRUCTION SIGNS.	S 7.70		A-588 STEEL TRUSS DETAILS TYPE D
			S 7.80		A-588 STEEL TRUSS DETAILS TYPE D
S 3.10		STEEL POST - 2" x 3" x 4"	S 7.81		A-36 GALVANIZED STEEL TRUSS TYPE D - 105' TO 125'
S 3.20		STEEL POST - 6" x 6"	S 7.82		A-36 GALVANIZED STEEL TRUSS DETAILS - TYPE D
S 3.30		WOOD POST - 4" x 6", 6" x 8"	S 7.83		A-36 GALVANIZED STEEL TRUSS DETAILS - TYPE D
			S 7.84		A-36 GALVANIZED STEEL TRUSS TYPE C - 75' TO 100'
			S 7.85		A-36 GALVANIZED STEEL TRUSS DETAILS - TYPE C
			S 7.86		A-36 GALVANIZED STEEL TRUSS DETAILS - TYPE C
S 4.30		STEEL COLUMN (I)	S 7.87		A-36 GALVANIZED STEEL TRUSS TYPE C - 50' TO 70'
S 4.40		STEEL COLUMN (B, W)	S 7.88		A-36 GALVANIZED STEEL TRUSS DETAILS - TYPE C
S 4.50		COLUMN FOUNDATION	S 7.89		A-36 GALVANIZED STEEL TRUSS DETAILS - TYPE C
			S 8.10		TRUSS FOUNDATION - TYPE B, C
			S 8.20		TRUSS FOUNDATION - TYPE D
S 5.10		STEEL CANTILEVER TYPE A, B, C, D & E.			
S 5.20		STEEL CANTILEVER DETAILS TYPE A, B, C, D & E.	S 9.10		SIGN CONNECTION DETAILS TRUSS-CANTILEVER-EXIT NO.
S 5.30		CANTILEVER FOUNDATION TYPE A, B, C, D & E.	S 9.10A		SIGN CONNECTION DETAILS COLUMN
S 5.40		STEEL CANTILEVER TYPE G, H.	S 9.20		MISCELLANEOUS SIGN CONNECTION DETAILS
S 5.50		STEEL CANTILEVER DETAILS TYPE G, H.	S 9.30		MISCELLANEOUS SIGN CONNECTION DETAILS
S 5.60		CANTILEVER FOUNDATION TYPE G, H.	S 9.12A		CONCRETE GLARE SCREEN SIGN CONNECTION-TYPE II
			S 10.50		BOLTED BRIDGE CONNECTION TYPE A, B
			S 10.60		BOLTED BRIDGE CONNECTION TYPE C, D
			S 10.70		BOLTED BRIDGE CONNECTION TYPE E, F
S 6.10		ALUMINUM TRUSS-TYPE B			
S 6.20		ALUMINUM TRUSS-TYPE C.			
S 6.30		ALUMINUM TRUSS DETAILS TYPE B, C.	S 11.10		GUARD RAIL
S 6.40		ALUMINUM END SUPPORT DETAILS-TYPE B, C.	S 11.20		GUIDELINES FOR LATERAL PLACEMENT OF RIGID SIGN SUPPORTS(F/W)
S 6.50		ALUMINUM TRUSS-TYPE D			
S 6.60		ALUMINUM TRUSS DETAILS TYPE D.			
S 6.70		ALUMINUM TRUSS DETAILS TYPE D.			

GENERAL NOTES			NOTES TO CONTRACTOR		
1.)	MINIMUM VERTICAL CLEARANCE FOR OVERHEAD SIGNS SHALL BE AS INDICATED ON THE PLAN SHEETS.		1.)	ALL OVERHEAD GUIDE SIGNS SHALL BE HIGH-INTENSITY REFLECTIVE SHEETING, LEGENDS AND BORDERS (TYPE 3) OR DEMOUNTABLE CHARACTERS WITH PLASTIC REFLECTORS, ON HIGH INTENSITY REFLECTIVE SHEETING BACKGROUND (TYPE 3). ALL ROADSIDE GUIDE SIGNS SHALL BE ENGINEERING GRADE LEGENDS AND BORDERS (TYPE 3) OR DEMOUNTABLE CHARACTERS WITH PLASTIC REFLECTORS, ON HIGH INTENSITY REFLECTIVE SHEETING BACKGROUND (TYPE 3). INTERSTATE SHIELDS FOR GUIDE SIGN USE AND INDEPENDENT USE INCLUDING AUXILIARY PANELS SHALL BE TYPE 3.	
2.)	ROADSIDE SIGN SUPPORT LENGTH QUANTITIES ARE APPROXIMATE ONLY AND BASED ON TYPICAL SIGN LOCATIONS.		2.)	GUARDRAIL, CALLED FOR REMOVAL IN THE PLANS, SHALL BE REMOVED WITHIN 48 HOURS AFTER ALL SIGNS, SUPPORTS AND FOUNDATIONS BEHIND THE GUARDRAIL HAVE BEEN REMOVED.	
3.)	ALL SIGNS SHALL BE INSTALLED ACCORDING TO THE "MICHIGAN MANUAL OF UNIFORM TRAFFIC CONTROL DEVICES" 1973 EDITION INCLUDING REVISIONS.		3.)	SIGNS OFFSET 30' OR MORE FROM EDGE OF PAVEMENT SHALL HAVE A MINIMUM BOTTOM HEIGHT OF 5'-0". SIGNS ERECTED ON THE BACKSLOPES SHALL HAVE MINIMUM DISTANCE OF 4'-0" FROM GROUND TO BOTTOM EDGE OF SIGN.	
4.)	OVERHEAD SIGNS ATTACHED TO BRIDGE STRUCTURES SHALL BE SHIFTED SLIGHTLY TO THE LEFT OR RIGHT TO AVOID STIFFENERS OR EXPANSION JOINTS WHEN NECESSARY.		4.)	WHEN EXISTING SIGNS ARE BEING REPLACED BY A NEW SIGN OR SIGNS, THE CONTRACTOR SHALL REMOVE ALL THE SIGNS BEING REPLACED AT THE SAME TIME THAT THE NEW SIGNS BECOME VISIBLE TO THE MOTORIST.	
5.)	SIGNS SHALL NOT BE INSTALLED BEHIND ANY OBSTRUCTIONS. (BRIDGE PIERS, LIGHT POLES, ETC.)		5.)	WHEN TRUSSES ARE CALLED FOR REMOVAL IN THE PLANS, THE TRUSS BOX SHALL BE CAREFULLY DISMANTLED BEFORE THE END SUPPORTS ARE REMOVED.	
6.)	RETAIN ALL OTHER SIGNS NOT SHOWN ON THESE PLANS UNLESS OTHERWISE DIRECTED BY THE ENGINEER.		6.)	ALL R1-1 AND R1-2 SIGNS SHALL BE RED TRANSPARENT SCREENED ON HIGH-INTENSITY (TYPE 3) SILVER SHEETING.	
7.)	ALL NUMERAL AND INITIAL LETTERS FOR WORDS UTILIZING UPPER AND LOWER CASE LETTERS SHALL BE SERIES "E" (MODIFIED) F.H.W.A. STANDARD ALPHABET. STROKE WIDTH SHALL BE 1/3 OF THE UPPER CASE LETTER HEIGHT.		7.)	ALL OVERHEAD GUIDE SIGNS MUST REMAIN IN PLACE UNTIL THE NEW SIGNS ARE ERECTED.	
8.)	LOCATE BRIDGE MOUNTED ROAD NAME SIGNS WITH LEFT EDGE OF SIGN OVER RIGHT EDGE OF RIGHT SHOULDER UNLESS OTHERWISE SHOWN IN THE PLANS. THE LOCATION SHALL BE VARIED SLIGHTLY TO AVOID STIFFENERS AND EXPANSION JOINTS WHEN NECESSARY.		8.)	THE SECOND SENTENCE OF ARTICLE 6.26.14 "REMOVAL OF SIGNS" IN THE DEPARTMENT'S 1976 STANDARD SPECIFICATIONS IS HEREBY REVISED AS FOLLOWS: THE TRUSS(ES) AND/OR CANTILEVER(S) DESIGNATED AS "PROPERTY OF MDT" (MICHIGAN DEPARTMENT OF TRANSPORTATION), ALL STEEL COLUMNS & WOOD POSTS, ALONG WITH SIGNS AND SUPPORTS CALLED FOR RELOCATION IN THE PLANS ARE THE PROPERTY OF THE DEPARTMENT. ALL OTHER ITEMS CALLED FOR REMOVAL IN THE PLANS SHALL BECOME THE PROPERTY OF THE CONTRACTOR AND SHALL BE REMOVED FROM THE PROJECT SITE AS DIRECTED BY THE PROJECT ENGINEER. THE "PROPERTY OF MDT" ITEMS NOT CALLED FOR RELOCATION SHALL BE CAREFULLY REMOVED, HAULED AND NEATLY STOCKPILED AT THE FOLLOWING LOCATION(S): (THE CONTRACTOR SHALL NOTIFY MR. JERRY RADEMACHER, TELEPHONE (517) 373-2155 AT THE TIME THE MATERIAL IS STOCKPILED.)	
9.)	LOCATE LOW CLEARANCE SIGNS (W12-3) WITH LEFT EDGE OF SIGN OVER LEFT EDGE OF RIGHT LANE UNLESS OTHERWISE SHOWN IN THE PLANS. THE LOCATION SHALL BE VARIED SLIGHTLY TO AVOID THE STIFFENERS AND EXPANSION JOINTS WHEN NECESSARY.				
10.)	LATERAL "OFFSET" IS DEFINED AS THE DISTANCE FROM THE EDGE OF THE PAVEMENT TO THE EDGE OF THE SIGN.				
11.)	<input type="checkbox"/> DENOTES NON-FEDERAL PARTICIPATION.				
12.)	* DENOTES EXIT NUMBERING FEDERAL PARTICIPATION.				

MDOT MAINTENANCE YARD
173 SOUTH FORMAN STREET.
DETROIT, MICHIGAN.

[CONTRACTOR SHALL CONTACT ROBERT SOMMERS
TELEPHONE 313-843-1223 OR HAROLD SHEFFER
TELEPHONE 313-569-3993 TO ARRANGE ACCESS
TO THE YARD.]


**MICHIGAN DEPARTMENT OF STATE HIGHWAYS
AND TRANSPORTATION**

STANDARD PLAN INDEX


REVISIONS			
NO.	DESCRIPTION	DATE	BY

DESIGNED BY	
DRAWN BY	
CHECKED BY	
DATE	


F.R.A. REG. NO.	STATE	FEDERAL PROJECT	R.O.W. NO.	SHEET NO.	TOTAL SHEETS
5	MICH.	I-75-2(199)		42	96
ROUTE	COUNTY	CONTROL SECTION	JOB NO.		
I-75	Oakland	63174	14824A		

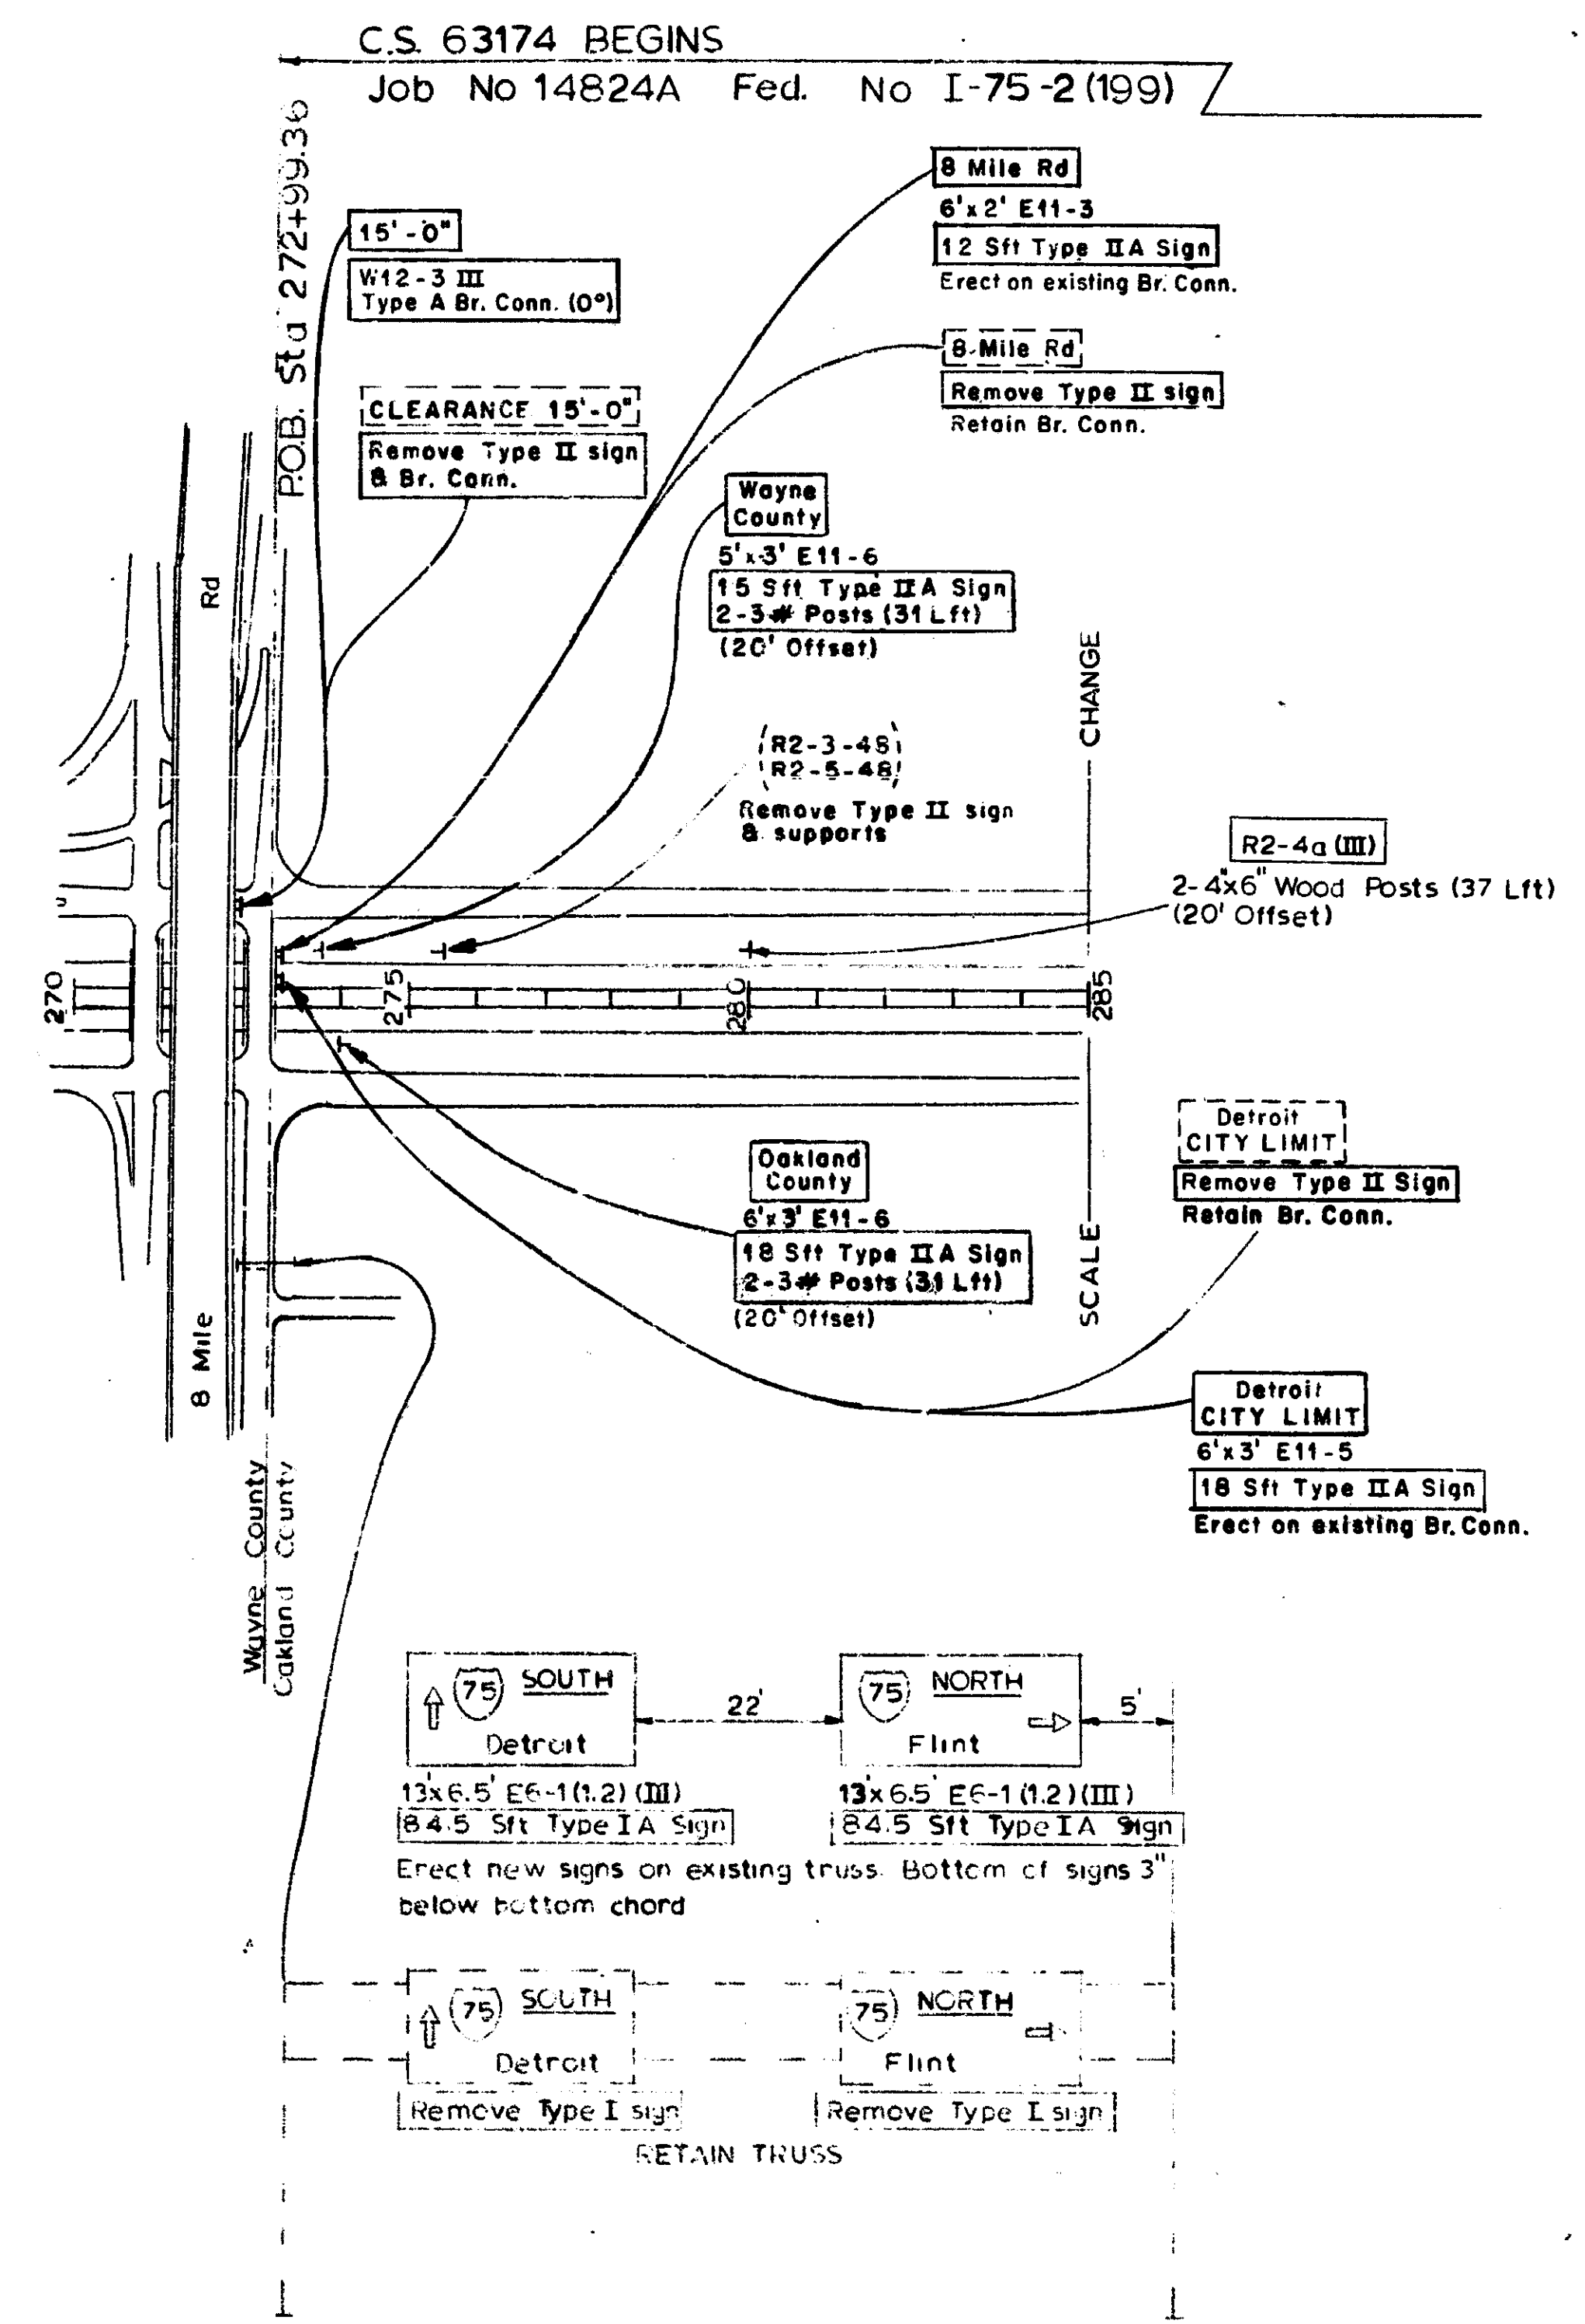


F.H.W.A. REG. NO.	STATE	FEDERAL PROJECT	R.O.W. NO.	SHEET NO.	TOTAL SHEETS
5	MICH.	I-75-2 (159)		43	43
ROUTE	COUNTY	CONTROL SECTION	JOB NO.		
I-75	Oakland	63174	14R24A		

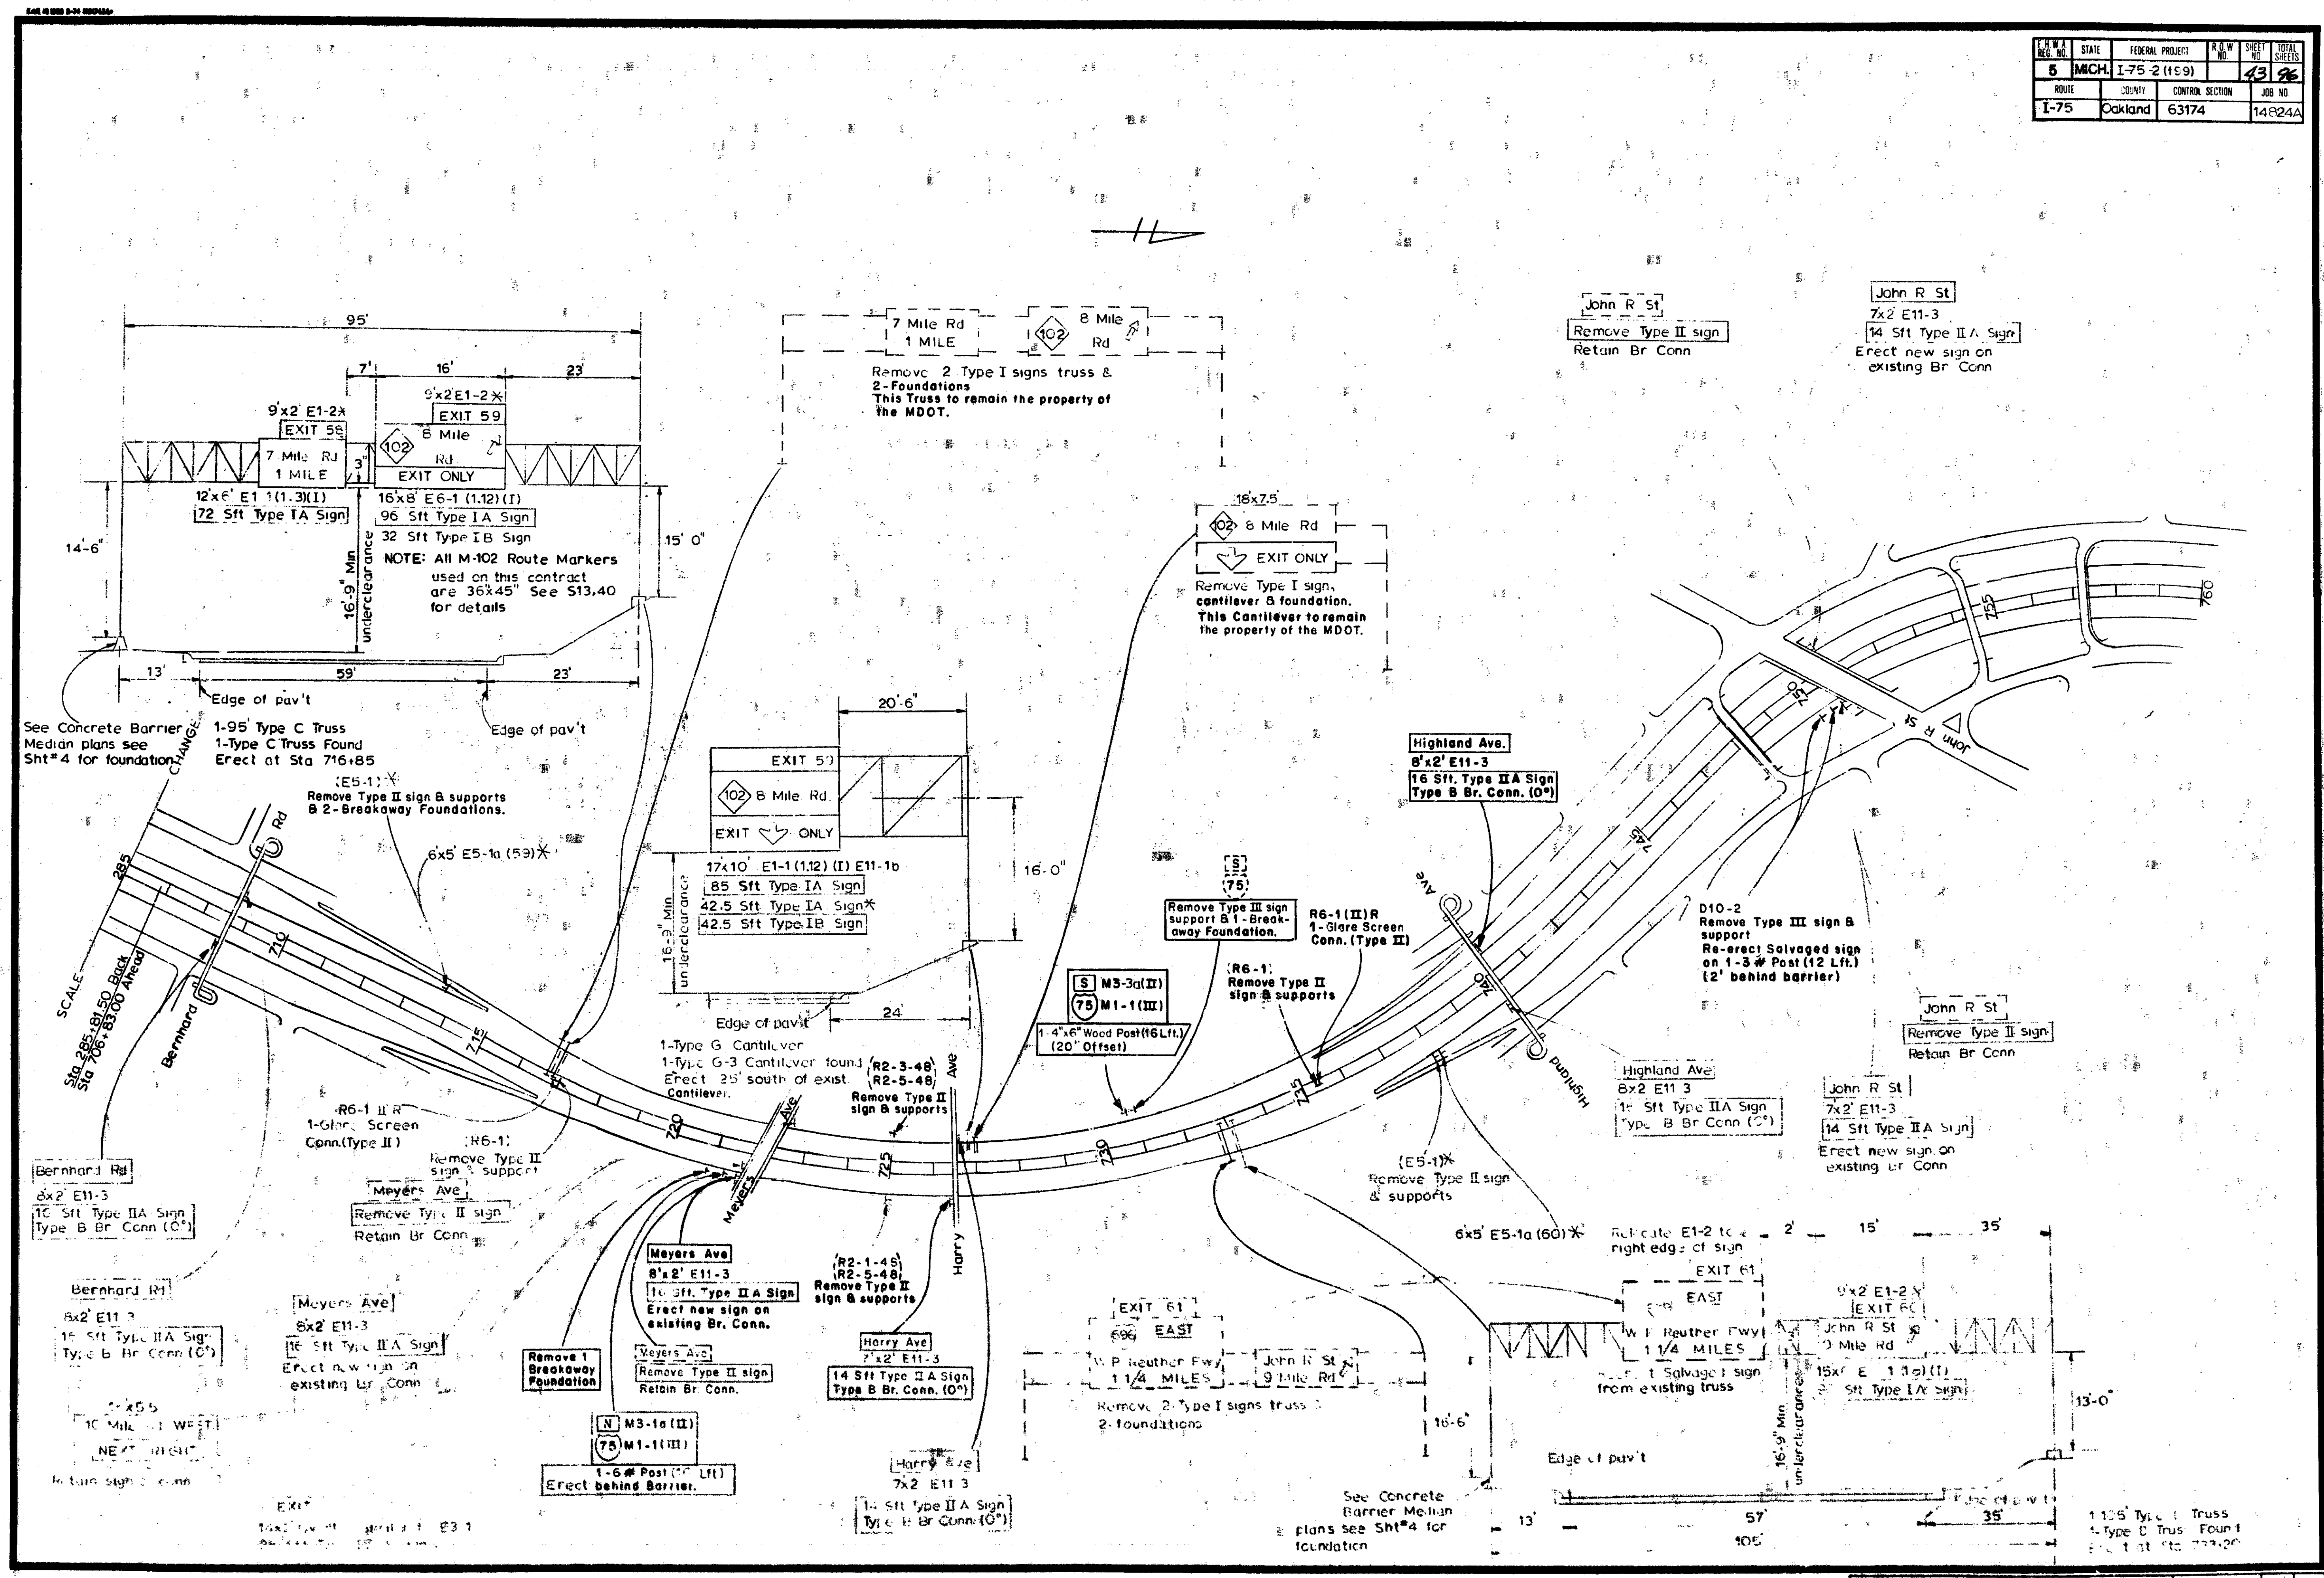

STATE	FEDERAL PROJECT	R.O.W. NO.	SHEET NO.	TOTAL SHEETS
5 MICH.	I-75-2 (199)		44	96
ROUTE	COUNTY	CONTROL SECTION	JOB NO.	
I-75	Oakland	63174	14824A	

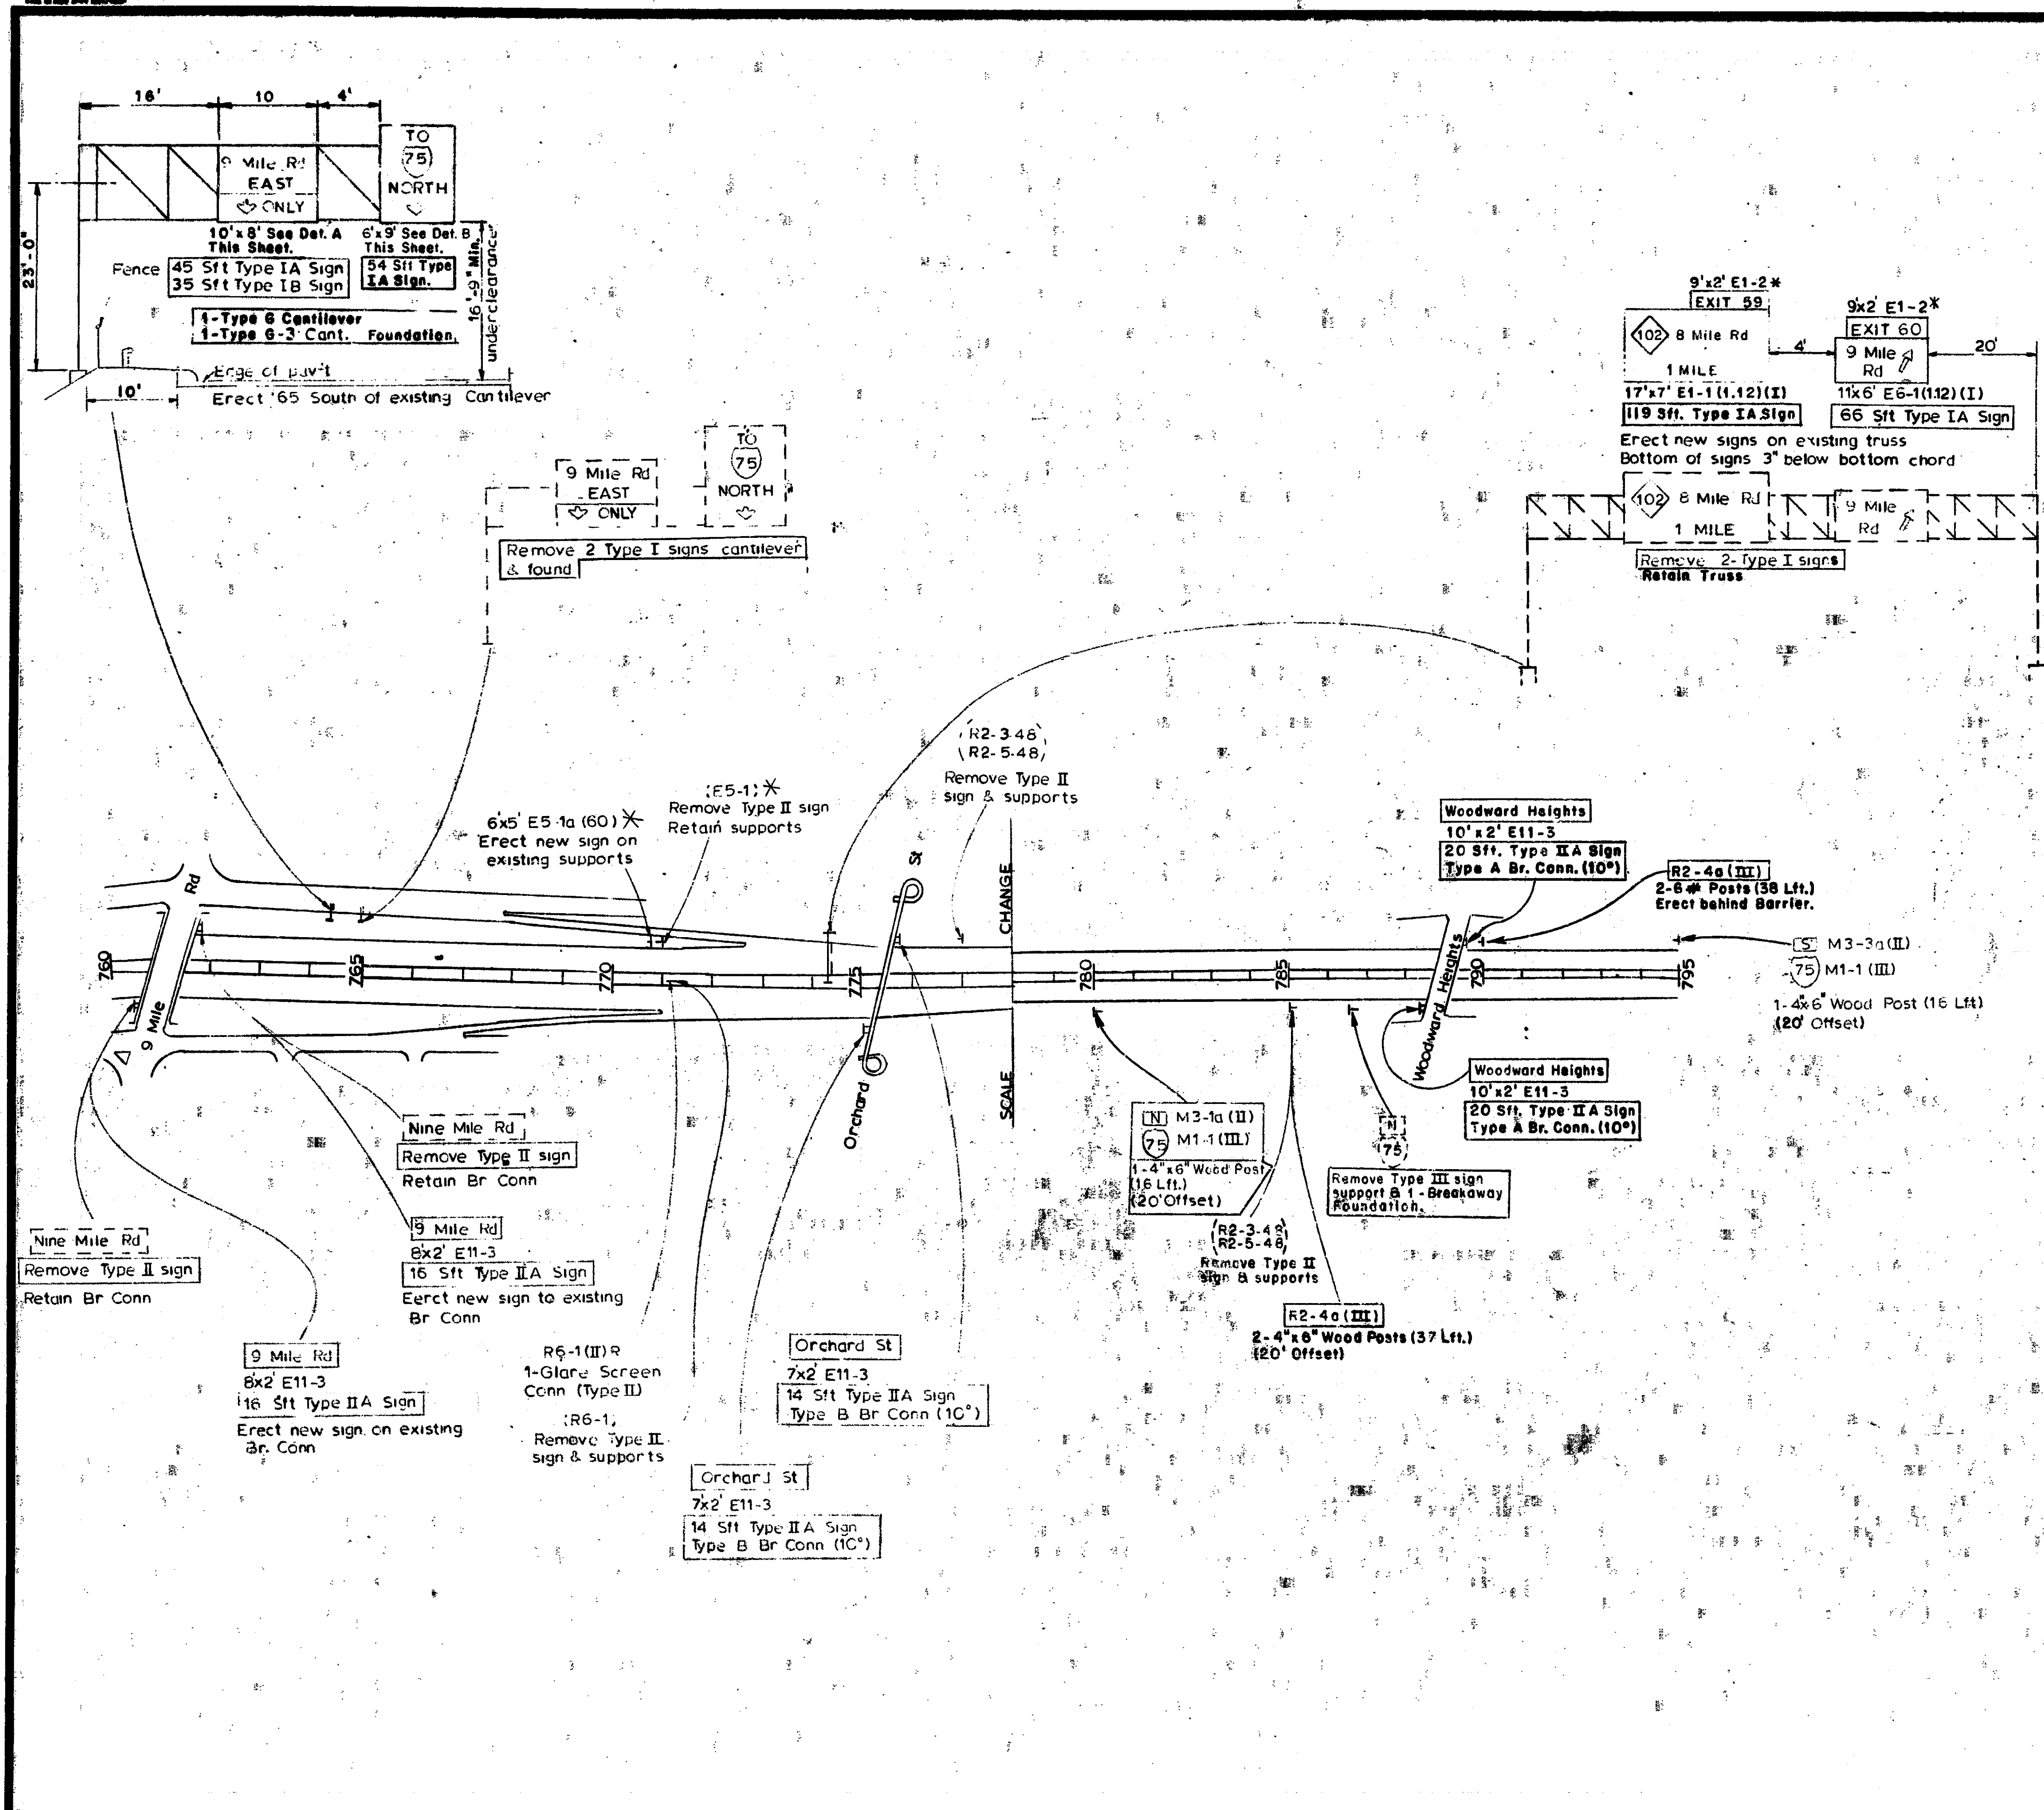


DETAIL A

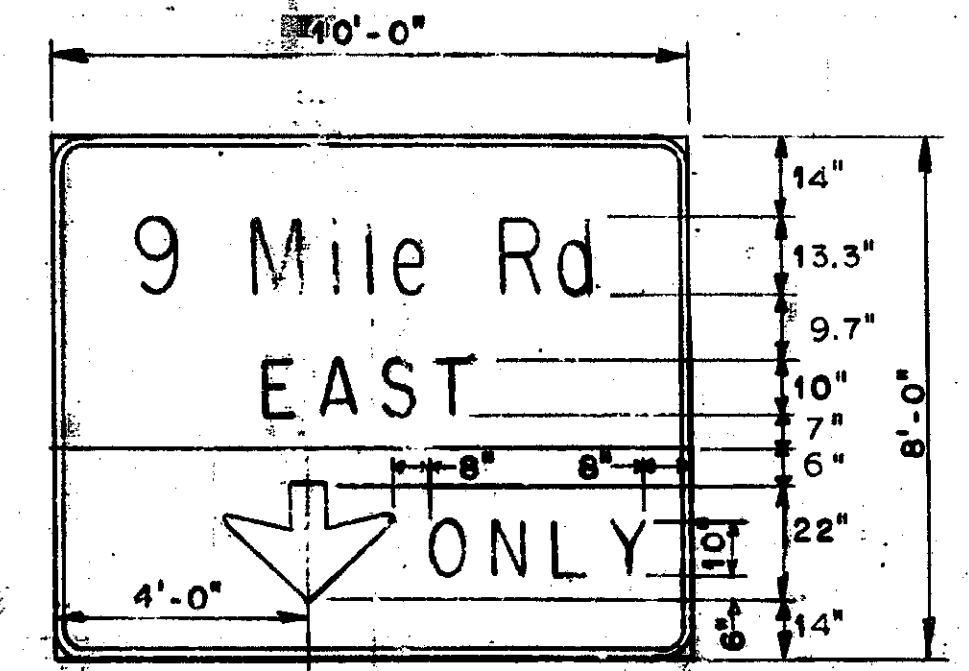


SPECIFICATIONS
Same as E1-1 & E11-1b except where shown.

DETAIL B


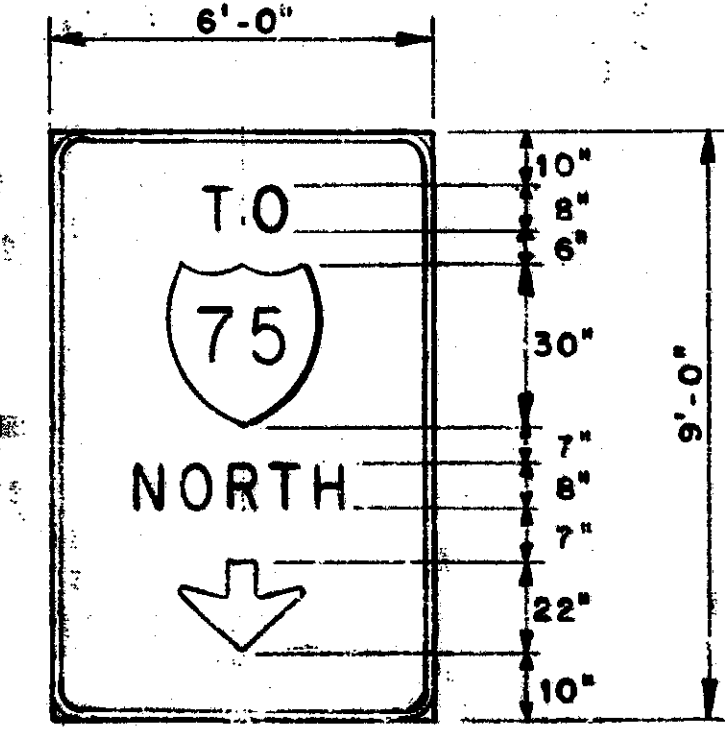


SPECIFICATIONS
Same as E6-2 except where shown.

FED. AID DIST. NO.	STATE	FEDERAL PROJECT	R.O.W. NO.	SHEET NO.	TOTAL SHEETS
6	MICH.	I-75-2 (199)		45	96
ROUTE	COUNTY	CONTROL SECTION	JOB NO.		
I-75	Oakland	63174	14824C		

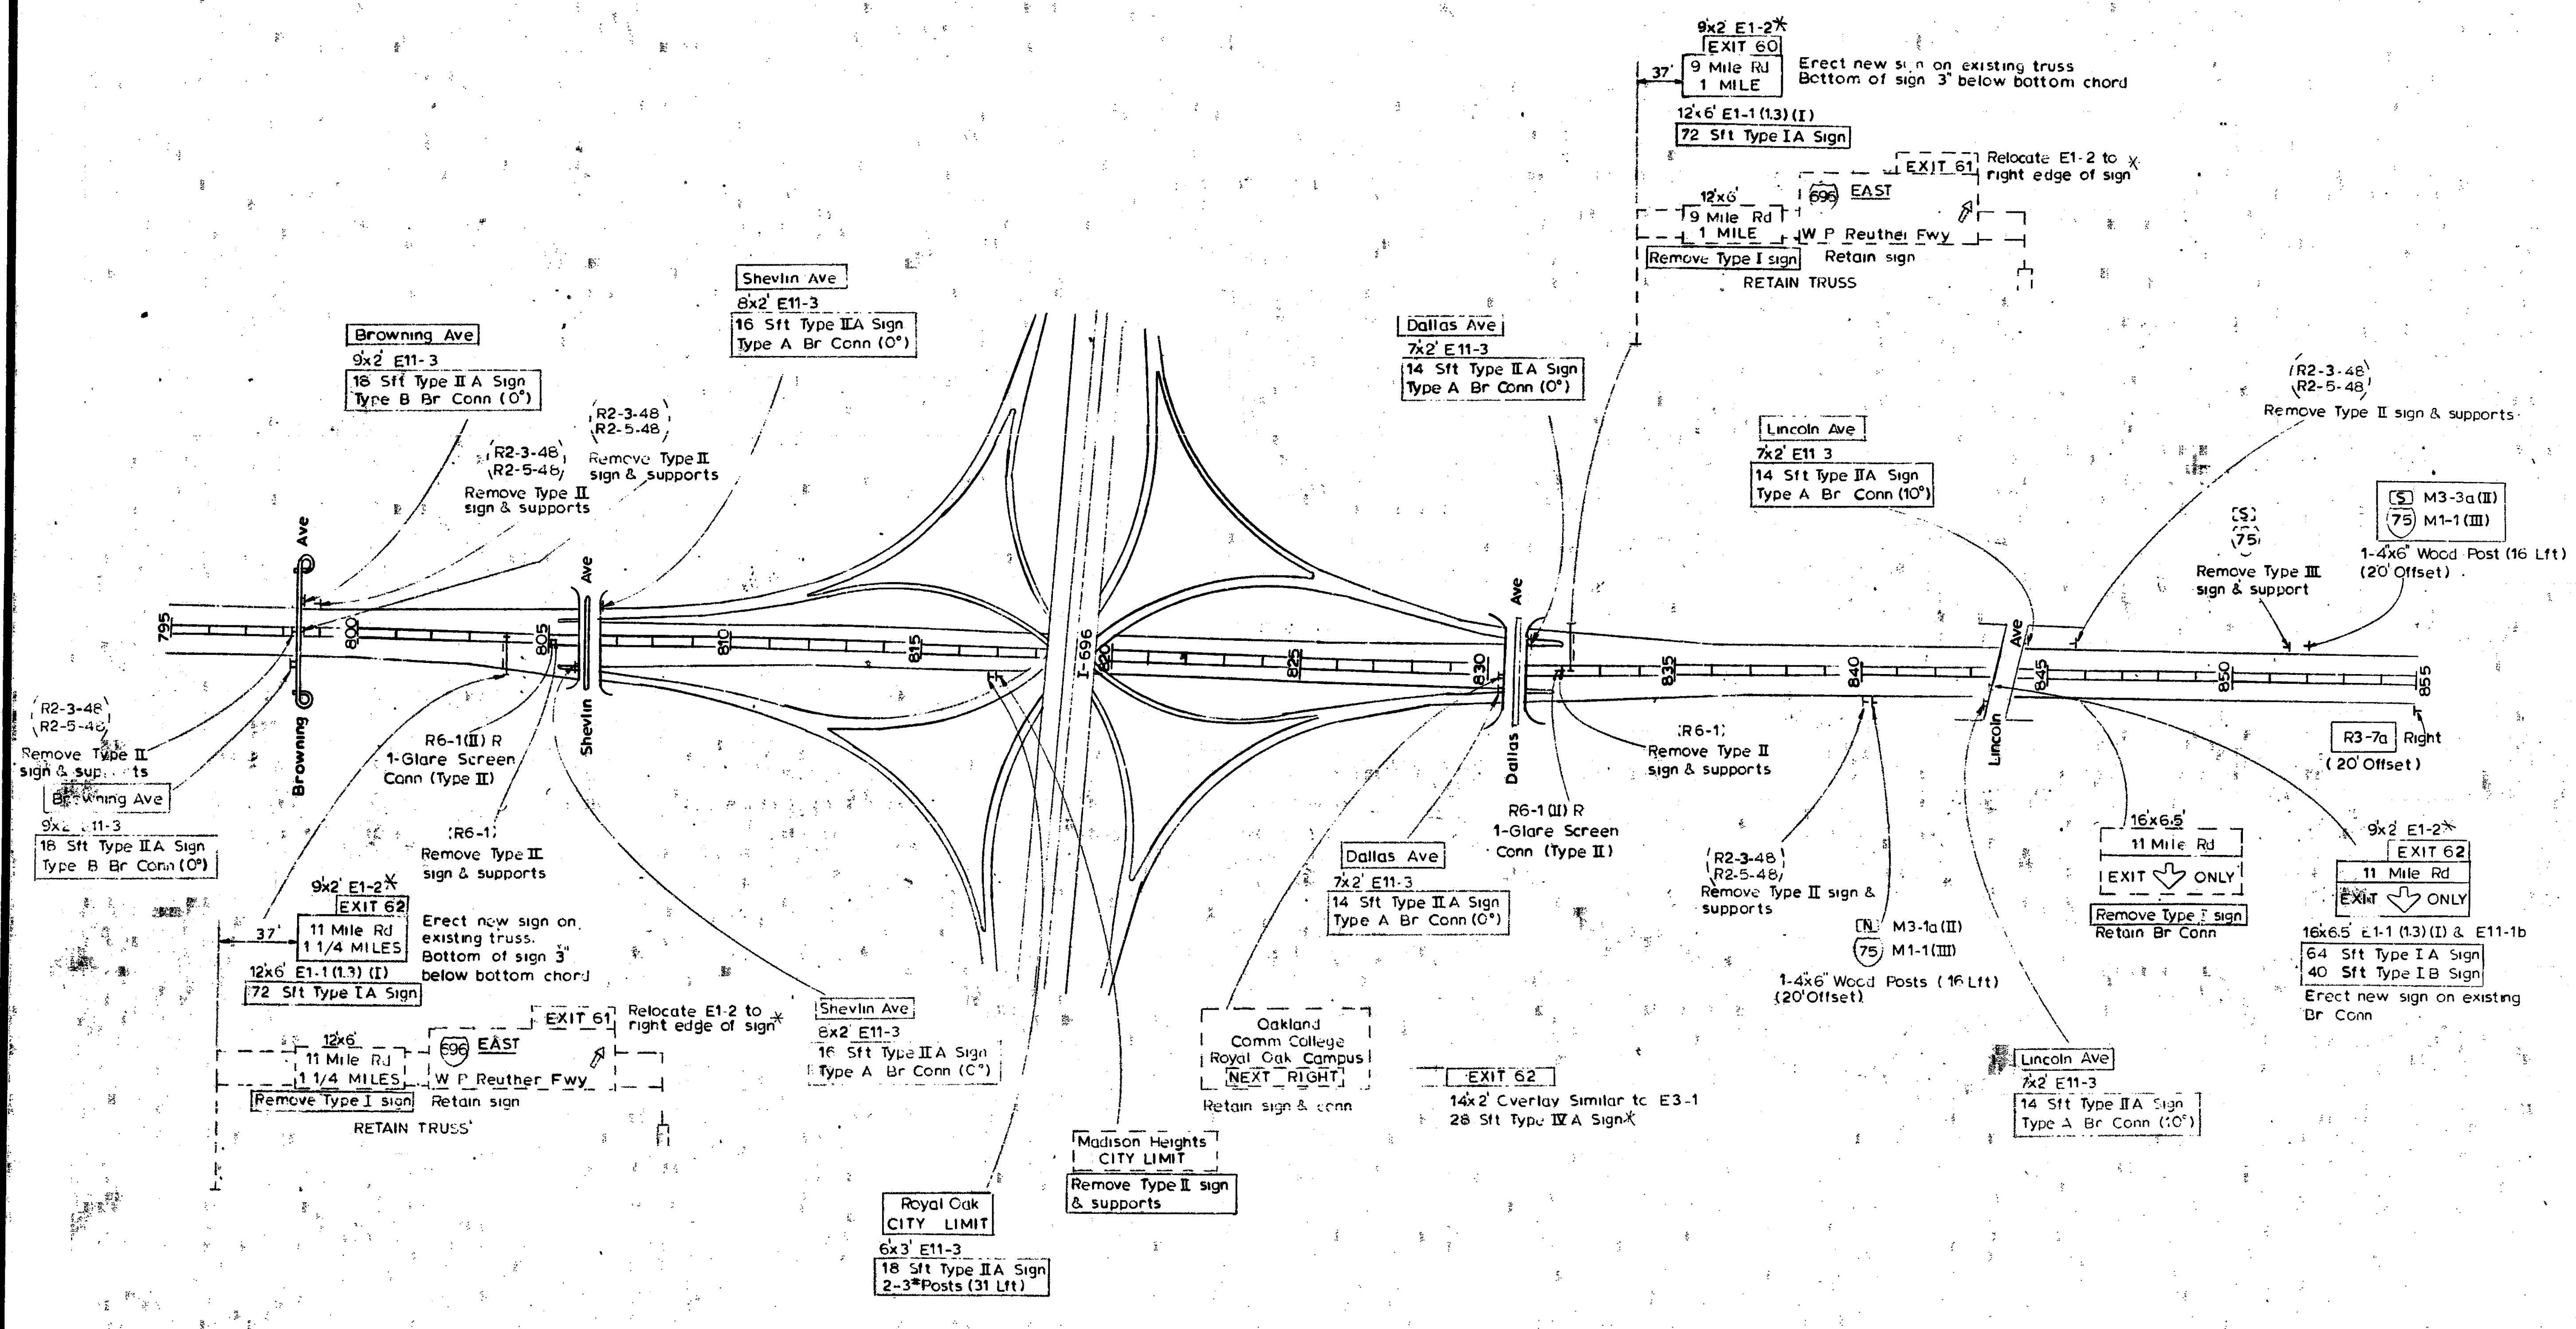


STATE	FEDERAL PROJECT	R.O.W. NO.	SHEET NO.	TOTAL SHEETS
6 MICH	I-75-2 (199)		46	96
ROUTE	COUNTY	CONTROL SECTION	JOB NO.	
I-75	Oakland	63174	14824A	

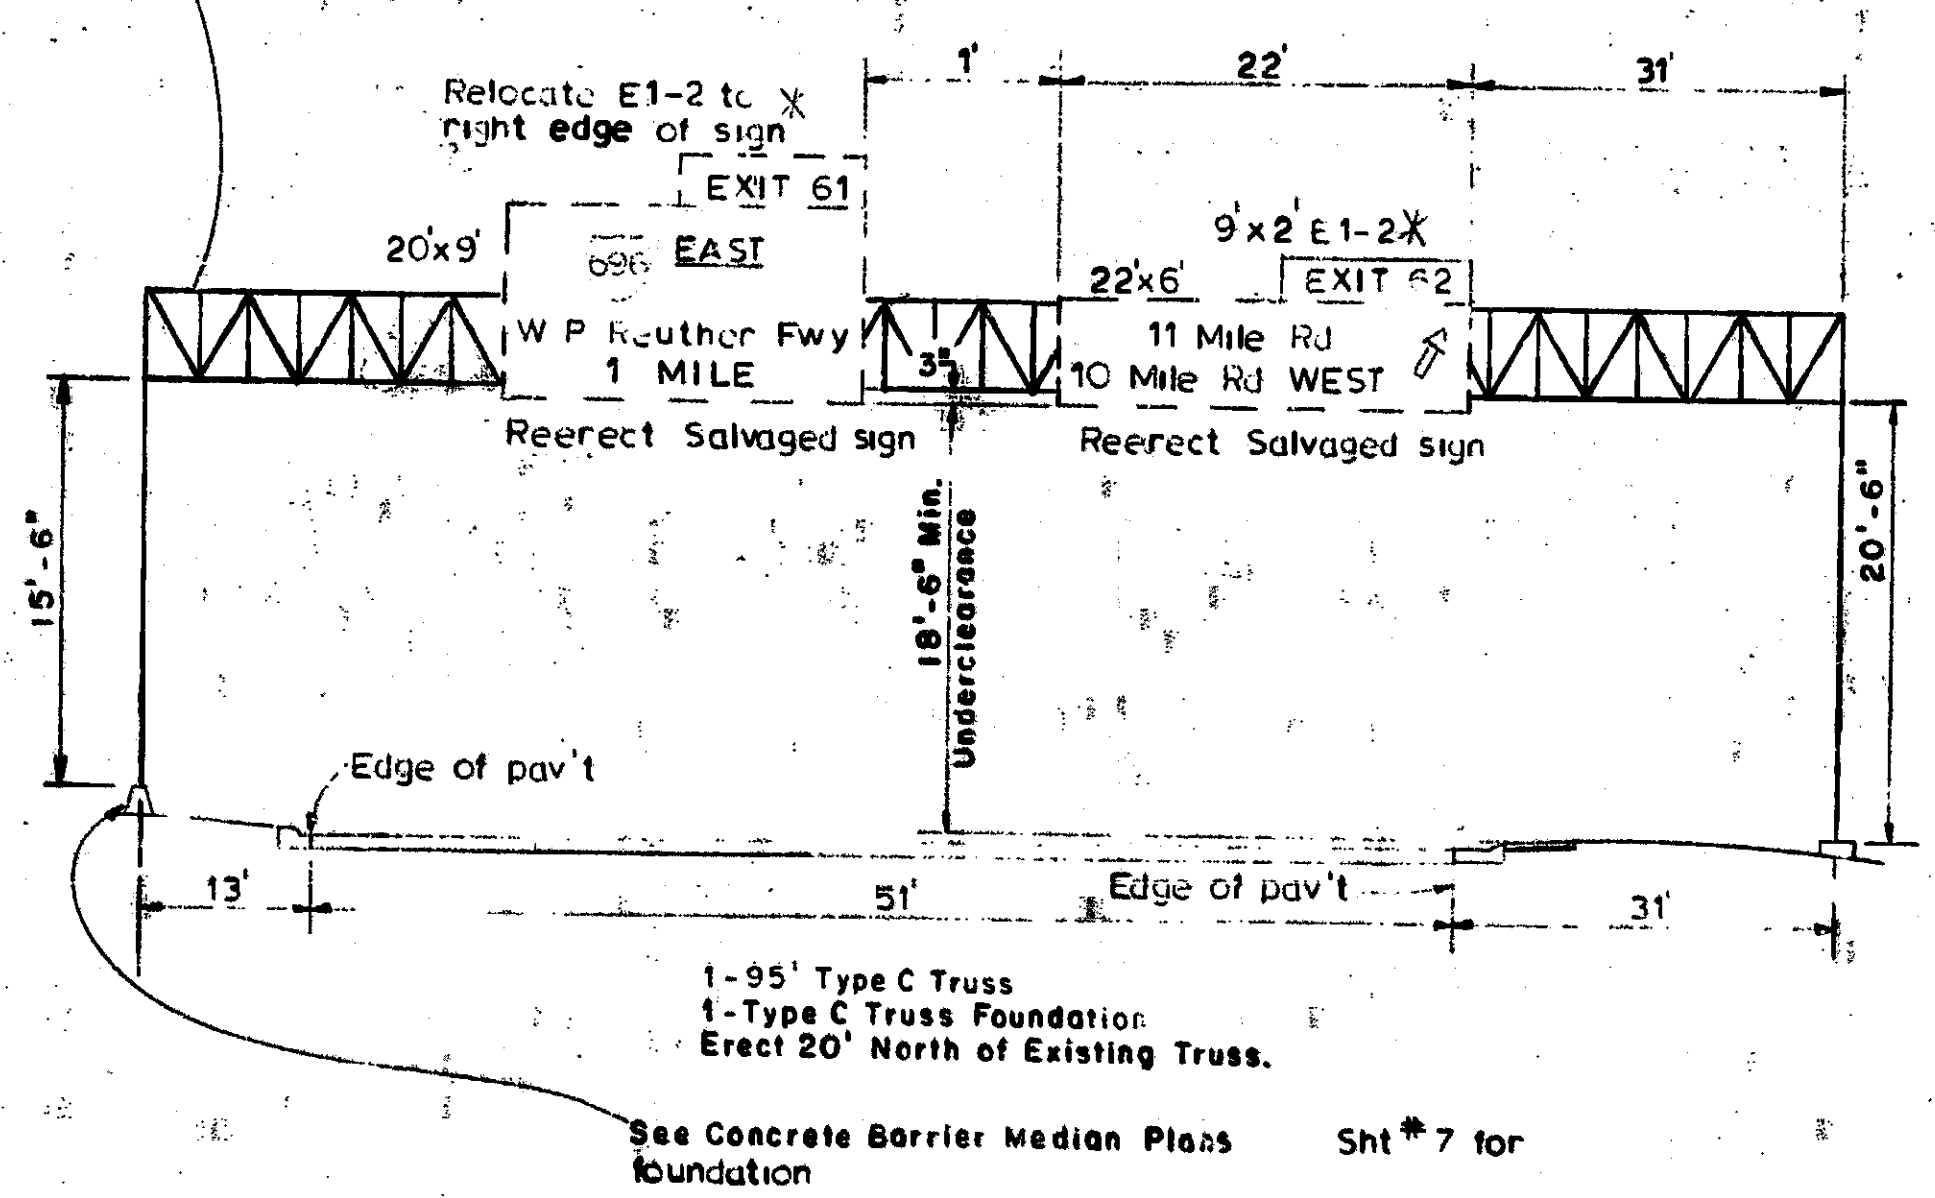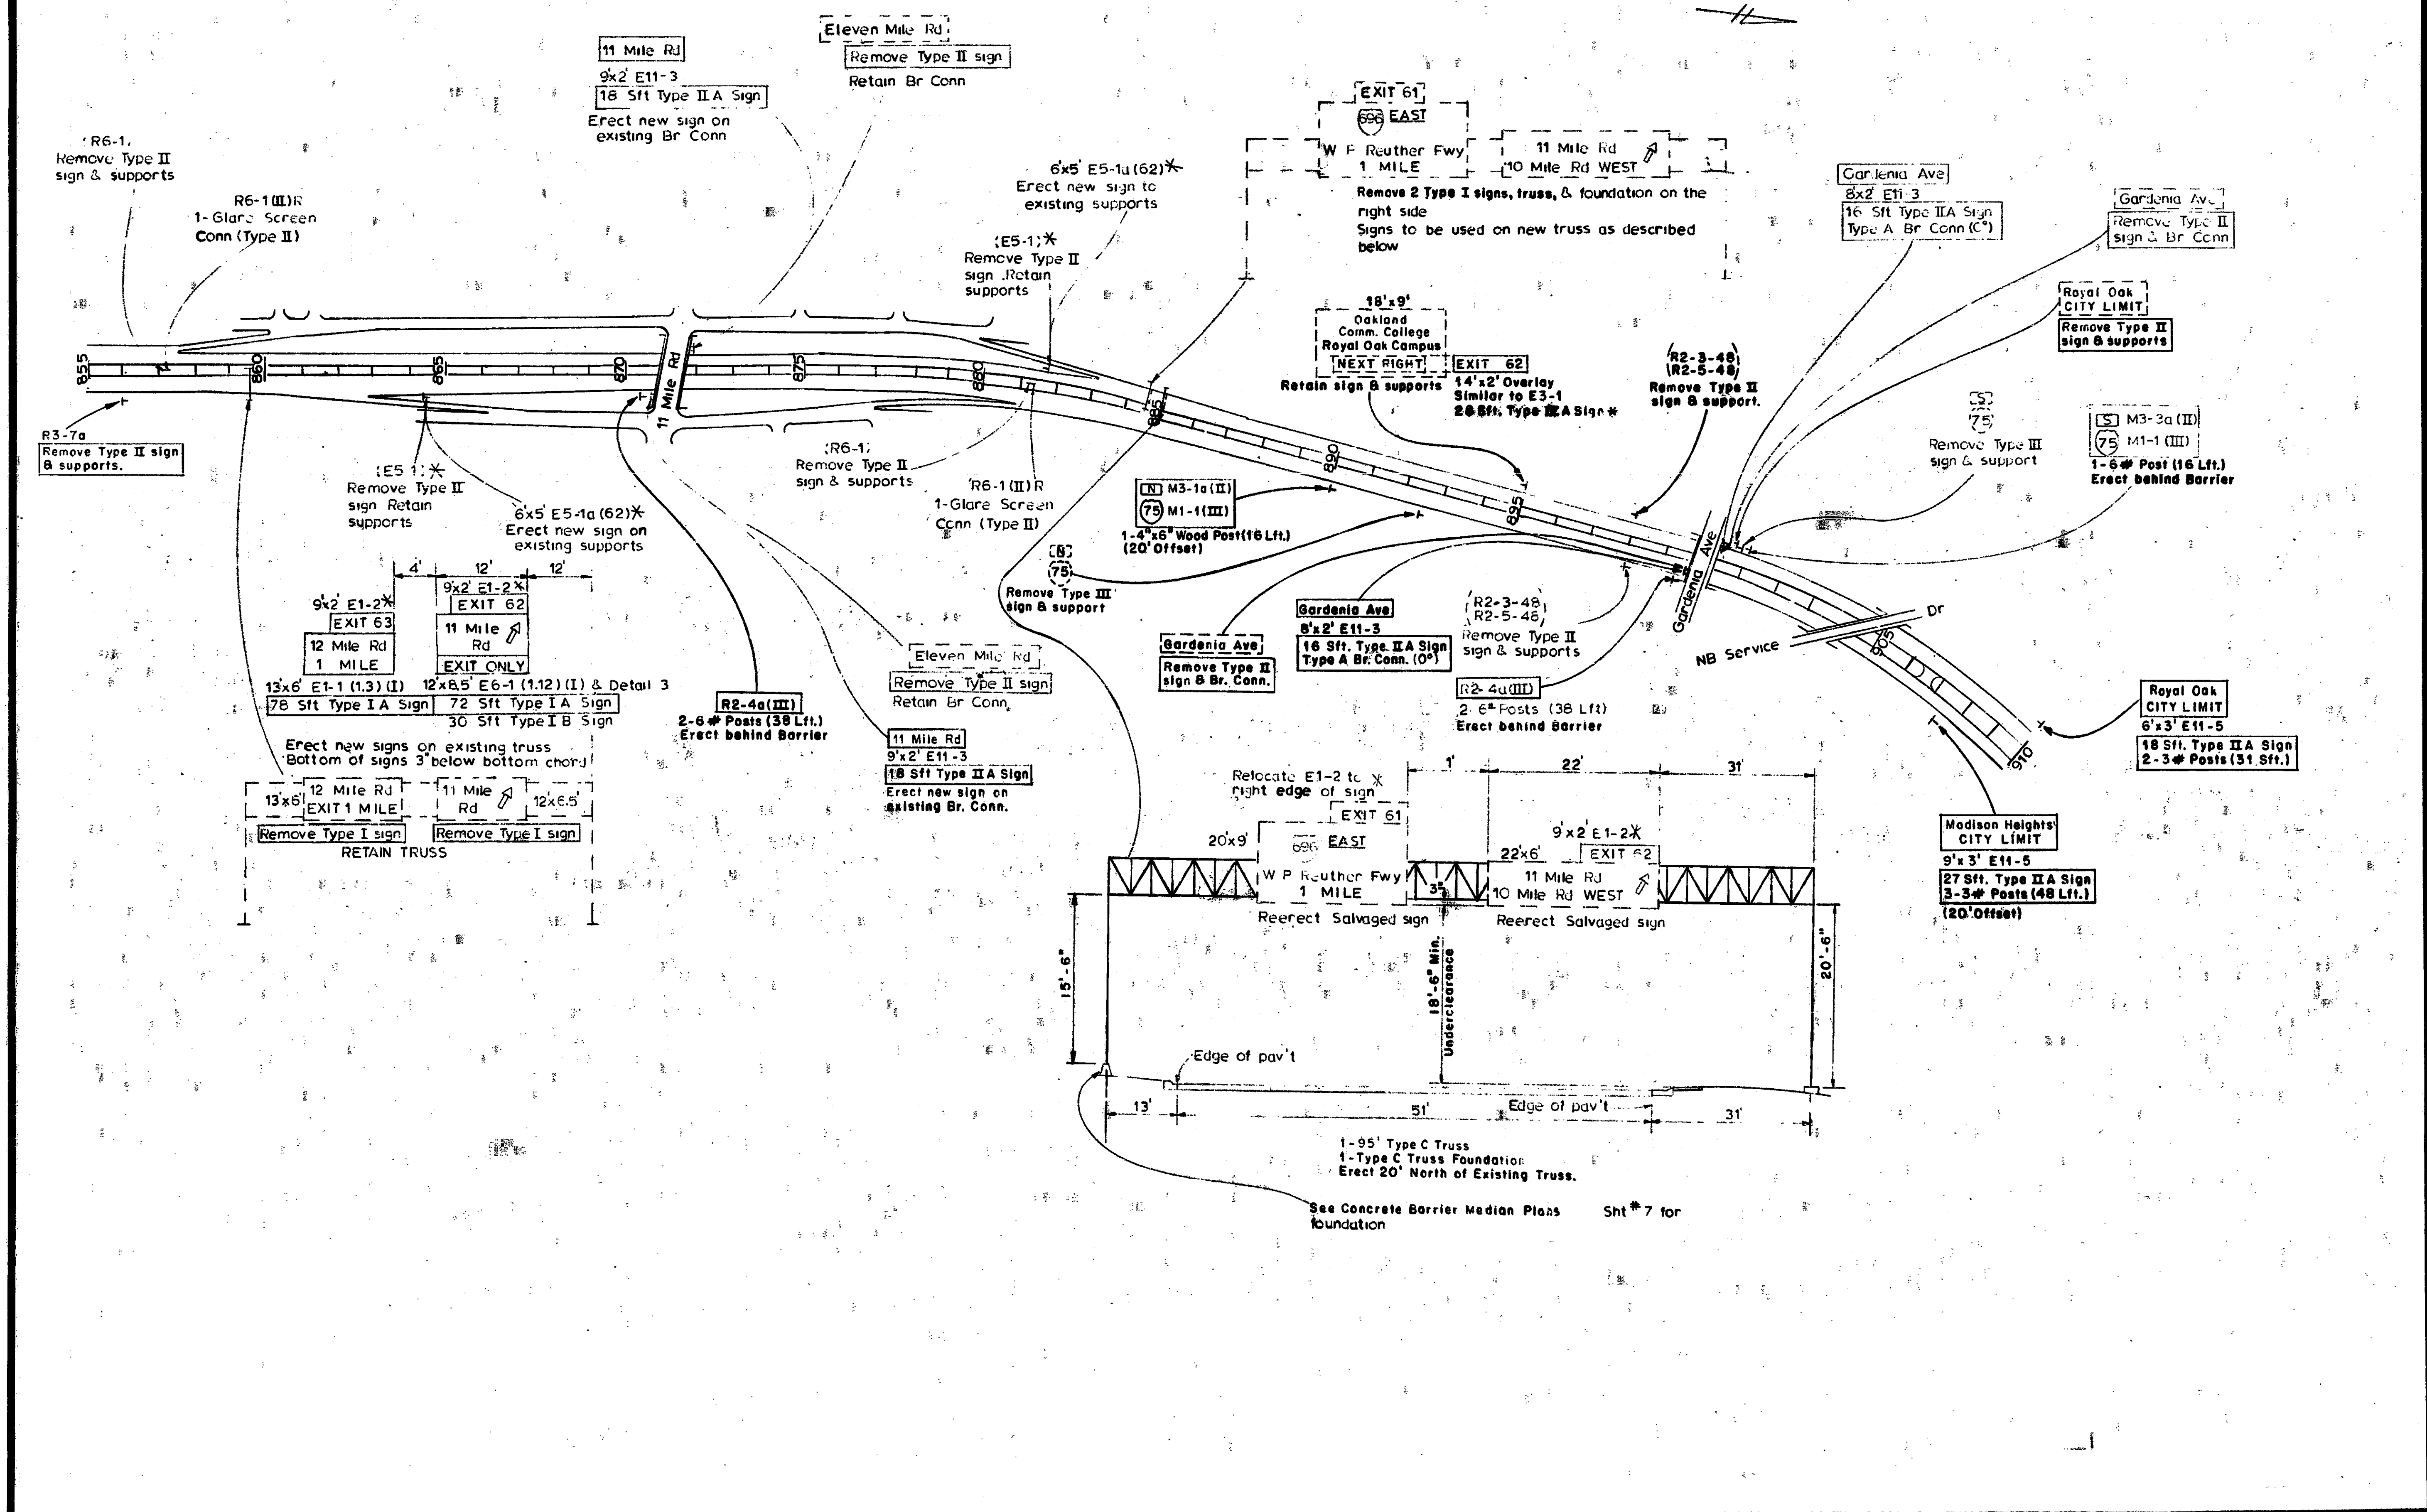

FHW A RD NO	STATE	FEDERAL PROJECT	R O W NO	SHEET NO	TOTAL SHEETS
5	MICH	I-75-2 (199)		47	96
ROUTE	COUNTY	CONTROL SECTION	JOB NO		
I-75	Oakland	63174	14824A		

C.S. 63174 ENDS
Job No 14824A Fed No I-75-2(199)

ROE Sta 940+00

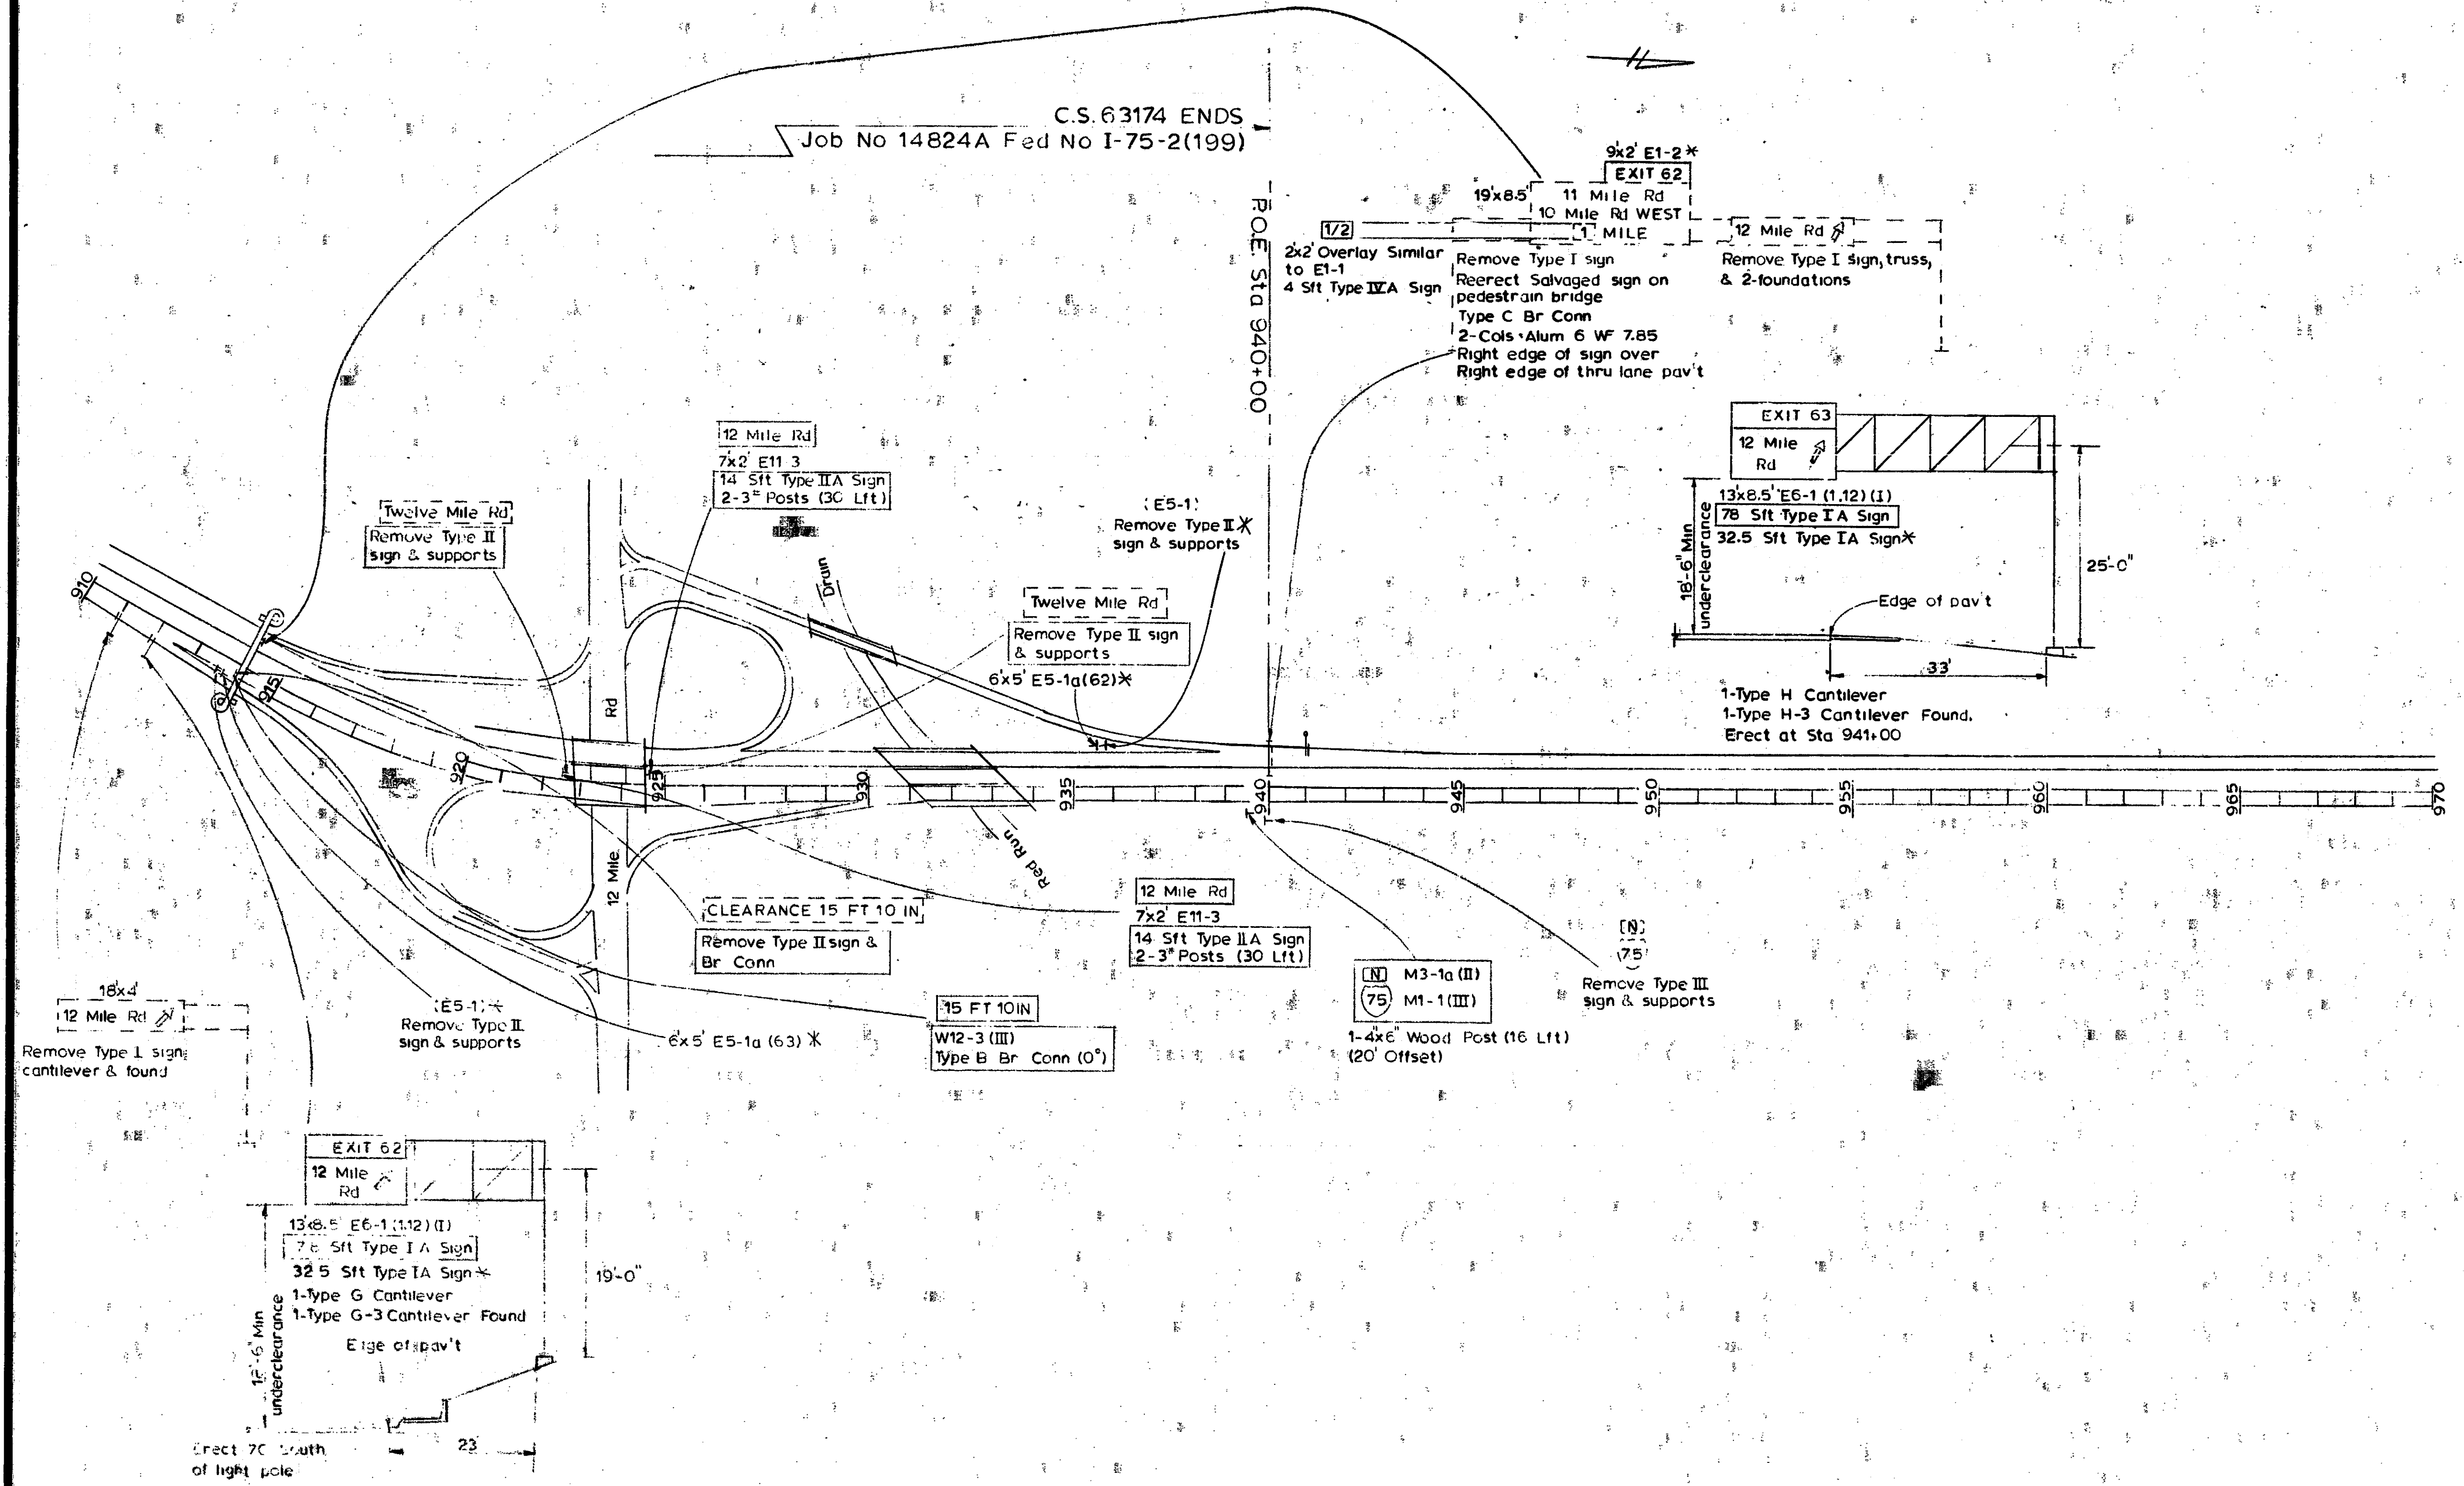

SIZE	SIGN NO.	SIZE FT.	SIGN AREA SQ. FT.	SIGN TYPE	SUPPORT				FOUNDATION	SIZE	SIGN NO.	SIZE FT.	SIGN AREA SQ. FT.	SIGN TYPE	SUPPORT				FOUNDATION	SIZE	SIGN NO.	SIZE FT.	SIGN AREA SQ. FT.	SIGN TYPE	SUPPORT				FOUNDATION	
					NO.	SIZE	TOTAL LIN. FT.	BOT HT.							NO.	SIZE	TOTAL LIN. FT.	BOT HT.							NO.	SIZE	TOTAL LIN. FT.	BOT HT.		NO.
	R1-1(H)	2.5x2.5	6.3	HA	1	3#	13	5			R6-1(H)	6x2	12	HB	2	2#	26	6			W6-2(H)	3x3	9	HB	2	3#	26	5		
	R1-1(HI)	3x3	9	HA	2	3#	28	5			R6-1(HR)	6x2	12	HB	2	2#	26	6			W6-2(V)	4x4	16	HB	2	3#	30	6		
	R1-2(H)	3x3x3	4	HA	1	2#	14	5			W1-1(HI)	3x3	9	HB	2	2#	29	5			FREEWAY ENDS	W6-4	4x4	16	HB	2	3#	32	6	
	R1-2(HI)	4x4x4	7	HA	2	3#	30	5			W1-1(IV)	4x4	16	HB	2	3#	30	5				PLAQUE FOR W6-4	4x2	8	HB	2	3#	32	6	
SPEED LIMIT 55	R2-4(H)	2x2.5	5	HB	1	3#	12	5			W1-2(HI)	3x3	9	HB	2	2#	29	5			1 MILE (COMBINATION)	W9-1(H)	3x3	9	HB	2	2#	29	5	
	R2-4(HI)	3x4	12	HB	2	3#	13	6			W1-2(IV)	4x4	16	HB	2	3#	30	5				W9-1(V)	4x4	16	HB	2	3#	32	6	
SPEED LIMIT 70 45	R2-4a(HI)	4x8	32	HB	2	4"x6" WOOD	37	6			W1-1(HI)	3x3	13	HB	2	3#	28	4			RIGHT LANE ENDS	W9-2(H)	3x3	9	HB	2	2#	29	5	
					2	6#	38	6			W1-1(IV)	4x4	16	HB	2	3#	29	6				W9-2(V)	4x4	16	HB	2	3#	32	6	
	R3-1(HI)	3x3	9	HB	2	3#	28	4			W1-2(HI)	3x3	13	HB	2	3#	28	4			IMPROPER MERGE LEFT	W9-2(H)	3x3	9	HB	2	2#	29	5	
	PLAQUE (H)	3x2	6	HB	2	3#	28	4			W1-2(IV)	4x4	16	HB	2	3#	29	6				W9-2(V)	4x4	16	HB	2	3#	32	6	
LEFT LANE MUST EXIT	R3-7A	4x4	16	HB	2	3#	34	7			W1-6(H)	4x2	8	HB	2	2#	26	5			EXIT 25 MPH	W13-2(HI) OR W13-3(HI)	4x5	20	HB	2	3#	34	6	
	R3-7B	6x3	18	HB	2	3#	27	5			W1-6(HI)	6x3	18	HB	2	3#	27	5				ES-1	6x5	30	HA	3	3#	46	7	
	R4-7(H)	2x2.5	5	HB	1	3#	13	5			W1-7(H)	4x2	8	HB	2	2#	26	5			EXIT 44	ES-1a	6x5	30	HA	3	3#	46	7	
	R4-7(HI)	3x4	12	HB	2	3#	30	5			W1-7(HI)	5x2.5	12.5	HB	2	2#	26	5				ES-1b	7.5x5	37.5	HA	3	4"x6" WOOD	46	7	
	R5-1(H)	2.5x2.5	6.3	HA	1	3#	13	5			W3-1(H)	3x3	9	HB	2	2#	29	5			EXIT 44	DIO-1	1x2	2	HA	1	2#	11	4	
	R5-1(HI)	3x3	9	HA	2	2#	28	5			W3-1(HI)	4x4	16	HB	2	3#	30	5				DIO-2	1x3	3	HA	1	2#	12	4	
WRONG WAY	R5-9(H)	3x2	6	HA	2	2#	26	5			W3-2(H)	3x3	9	HB	2	2#	29	5			MILE 4 4	DIO-3	1x4	4	HA	1	2#	13	4	
	R5-9(HI)	2.5x2.5	10	HA	1	3#	13	4			W3-2(HI)	4x4	16	HB	2	3#	30	5				W3-3(H)	3x3	9	HB	2	3#	26	5	
WRONG WAY	R5-1(H)	2.5x2.5	10	HA	1	3#	13	4			W3-3(HI)	4x4	16	HB	2	3#	30	6				W4-1(H)	2.5x2.5	6.25	HB	1	3#	13	5	
	R5-1(HI)	3x3	15	HA	2	3#	28	4			W4-1(HI)	4x4	16	HB	2	3#	30	6				W4-1(IV)	4x4	16	HB	2	3#	30	6	
MOTOR VEHICLES ONLY	R5-11	2x2.5	5	HB	1	3#	13	4			W4-2(H)	3x3	9	HB	2	2#	29	5				W4-2(HI)	4x4	16	HB	2	3#	32	6	
	R5-12	2x2.5	5	HB	1	3#	13	4			W4-2(HI)	4x4	16	HB	2	3#	32	6				W4-2(HI)	4x4	16	HB	2	3#	32	6	
AUTHORIZED VEHICLES ONLY	R5-15	2x2	4	HB	1	3#	16	6			W6-1(H)	3x3	9	HB	2	3#	26	5				W6-1(HI)	4x4	16	HB	2	3#	30	6	
	R6-1(H)	3x1	3	HB	1	2#	13	7			W6-1(HI)	4x4	16	HB	2	3#	30	6												
	R6-1(HI)	3x1	3	HB	1	2#	13	7																						
	R6-1(HR)	3x1	3	HB	1	2#	13	7																						

GENERAL NOTES

- TOTAL SUPPORT LENGTHS ARE BASED ON TYPICAL SIGN LOCATIONS & SLOPES AND ARE FOR ESTIMATING PURPOSES ONLY.
- ROUTE MARKER CLUSTERS SHALL BE ERECTED ON POST, COLUMN, OR CANTILEVER POLE AS SHOWN ON SIGN LOCATION PLANS SEE STD. PLAN S1.20 & S9.20 FOR ERECTION DETAILS.
- THE SUPPORT(S) LISTED FOR STANDARD SIGNS SHALL BE USED, UNLESS SHOWN OTHERWISE ON SIGN LOCATION PLAN SHEETS.
- ALLOW A VALUE OF h/2" FOR INSTALLATIONS WITH COMBINATIONS OF TWO PANELS.

FOR INFORMATION ONLY


MICHIGAN DEPARTMENT OF STATE HIGHWAYS AND TRANSPORTATION

STANDARD SIGN INSTALLATIONS

NO.	DESCRIPTION	DATE	BY
1	CHANGE EXIT SPEED SIGN SIZE	11/74	LRP

S1.10

SIGN LOCATION

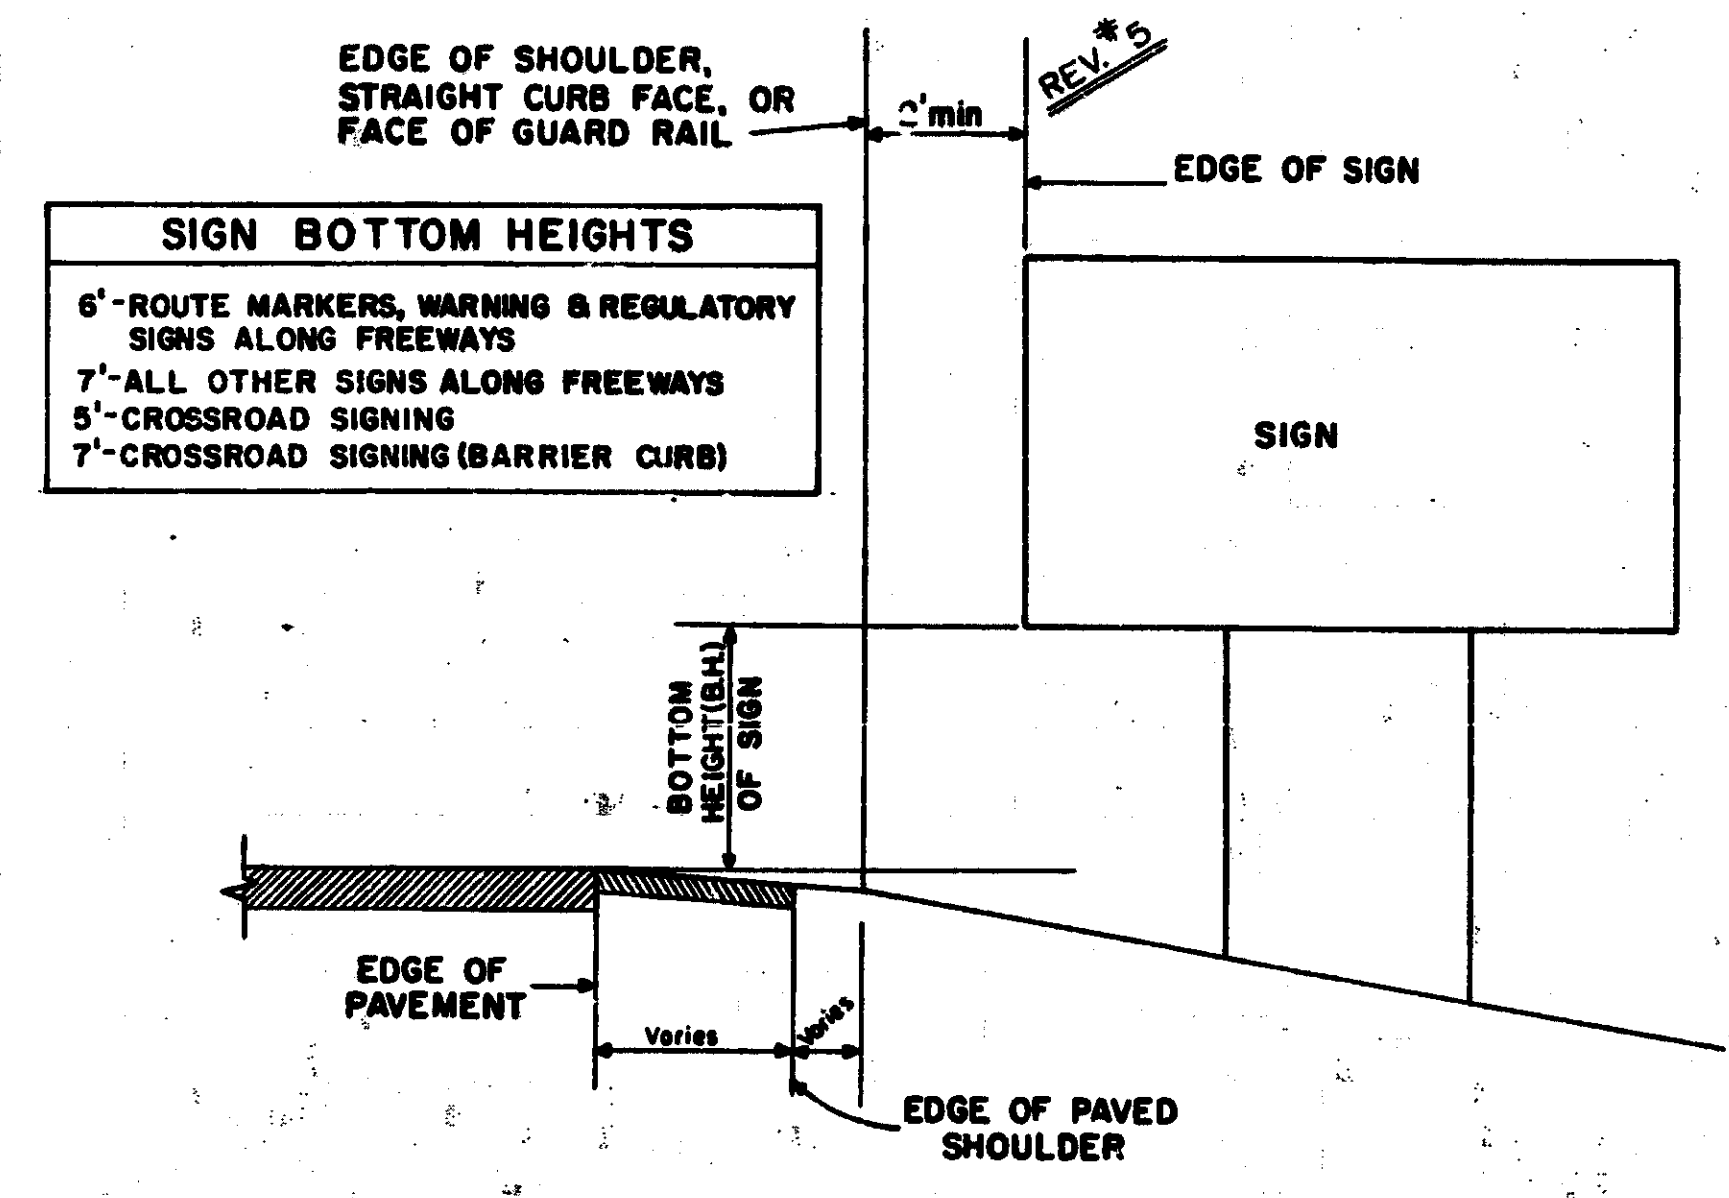


SIGN PLACEMENT - LEFT OR RIGHT SIDE
RAMPS, CROSSROAD OR THROUGH ROADWAY INSTALLATIONS


NOTES

- 1) LATERAL CLEARANCE OF ALL SIGNS SHALL BE AS INDICATED UNLESS OTHERWISE SHOWN ON SIGNING PLANS.
- 2) THE TERM "SIGN" AS USED ON THIS PLAN MEANS ONE OR A GROUP OF PANELS COMBINED TO FORM ONE INSTALLATION.
- 3) OVERHEAD SIGNS SHALL BE INSTALLED AT LOCATIONS AS SHOWN ON THE SIGNING PLANS.
- 4) BOTTOM HEIGHT SHALL BE AS INDICATED UNLESS OTHERWISE SHOWN ON SIGNING PLANS. BOTTOM HEIGHT (B.H.) IS THE HEIGHT FROM THE NEAR EDGE OF THE PAVEMENT TO THE BOTTOM OF THE SIGN.
- 5) SUPPORT LOCATIONS SHALL BE AS SHOWN UNLESS OTHERWISE SPECIFIED ON SIGN DETAIL STANDARDS.

SUPPORT LOCATION

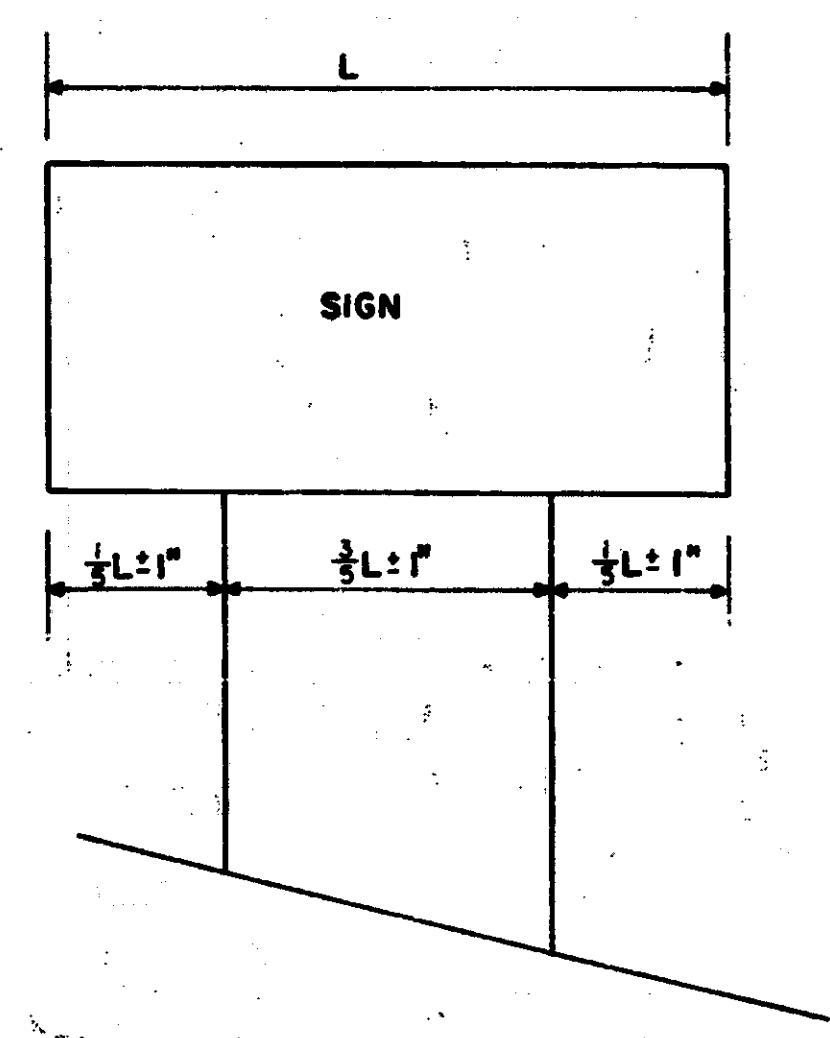


2 SUPPORT ASSEMBLY

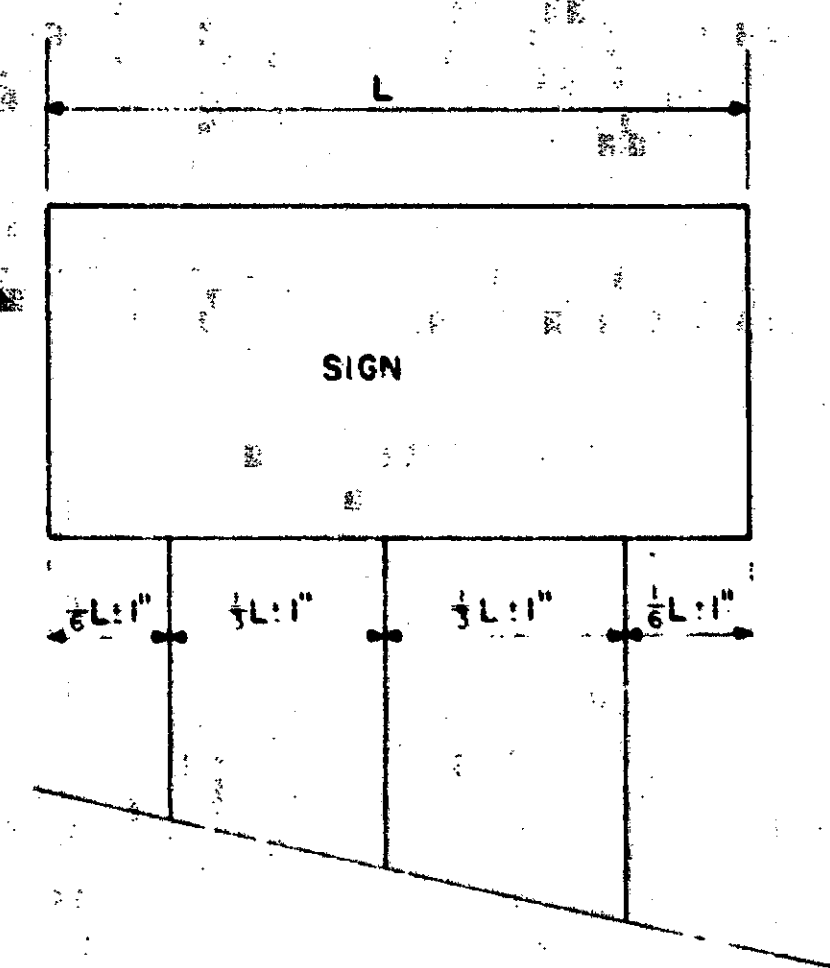


3 SUPPORT ASSEMBLY

LOCATION SKETCH

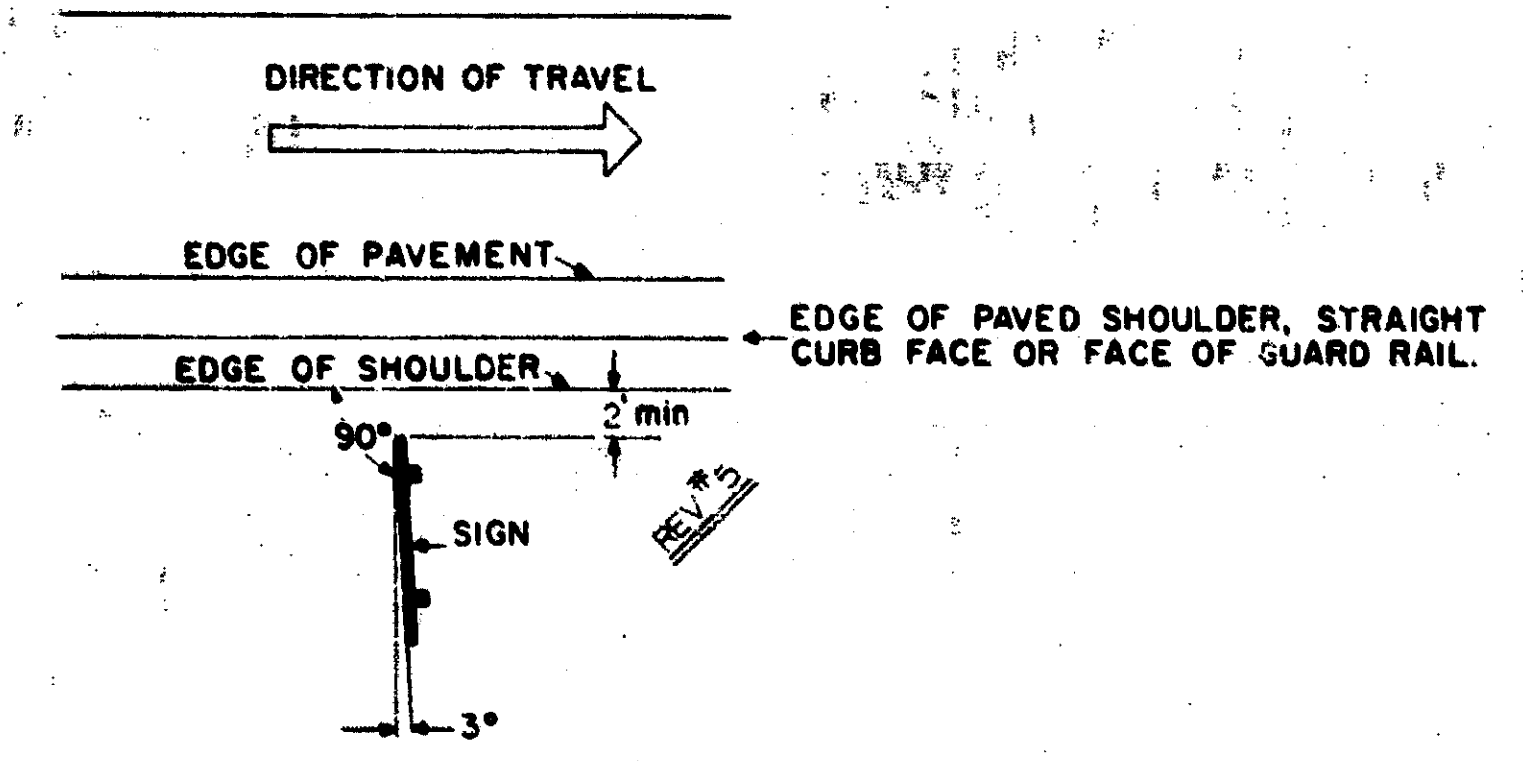

POSITIONING OF SIGNS AT EXIT RAMP TERMINALS

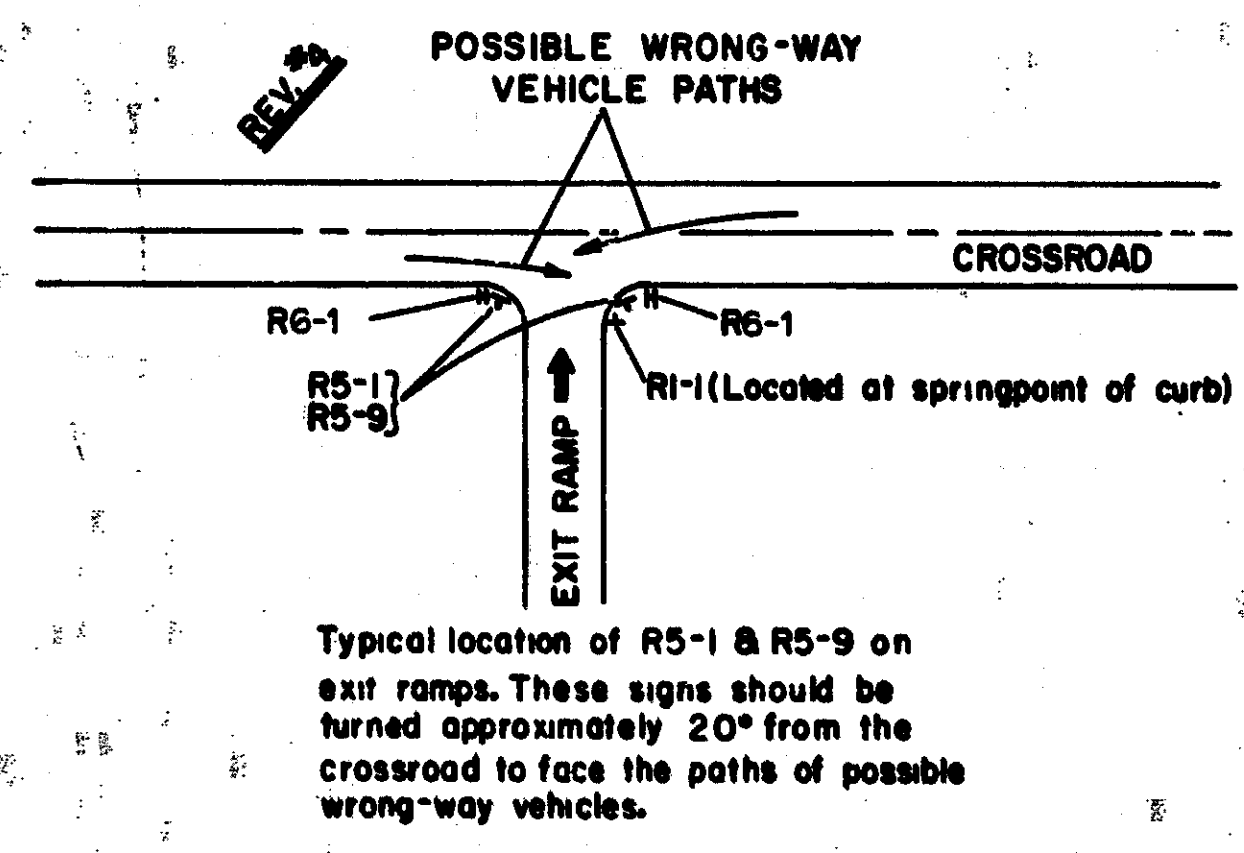


MICHIGAN DEPARTMENT OF STATE HIGHWAYS
TYPICAL LOCATIONS
ROADSIDE SIGNS & SUPPORTS

NO.	REVISIONS	DATE	BY
1	REVISED & REDRAWN	10-68	JCC
2	3-5 9" W ADDED TO SIGN LOCATION	10-71	KJD
3	SIGN BH TABLE, NOTES 1, 4 & 5 ADDED	3-72	TWN
4	POSITION OF SIGNS AT EXIT RAMP		
	TERMINALS ADDED	6-72	YMH


5. SET BACK DISTANCE CHANGED LRP 8-74

DATE DESIGNED: 10-68
DRAWN BY: JCC
CHECKED BY: JCC
SCALE: S2.10


CS 63174 Job No 14824A SHEET NO. 50

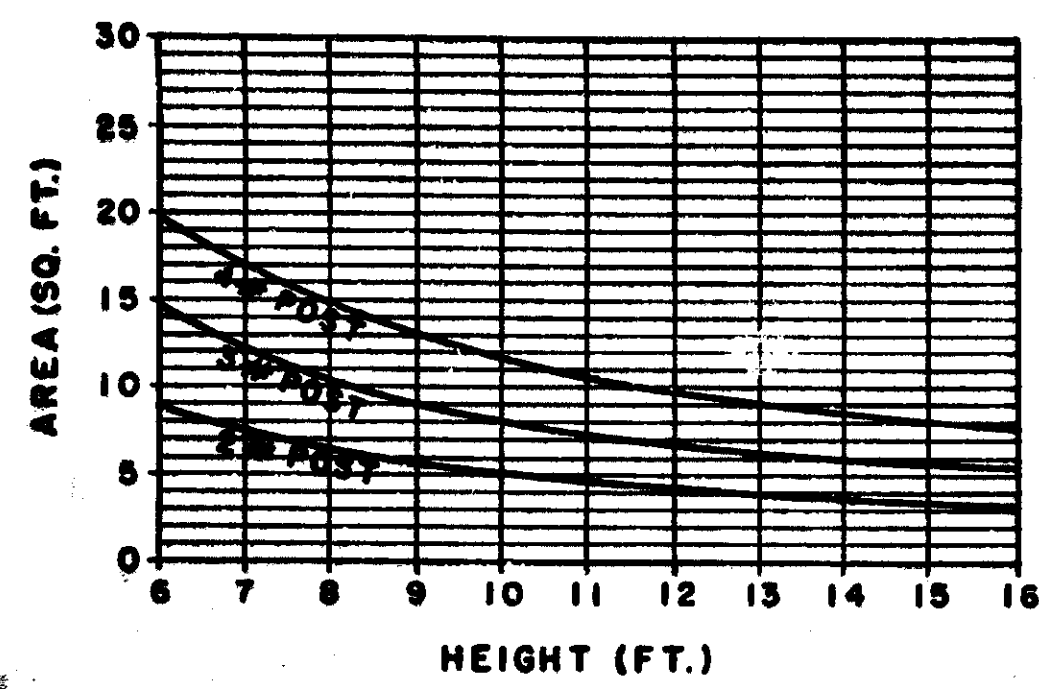

1 - POST ASSEMBLY




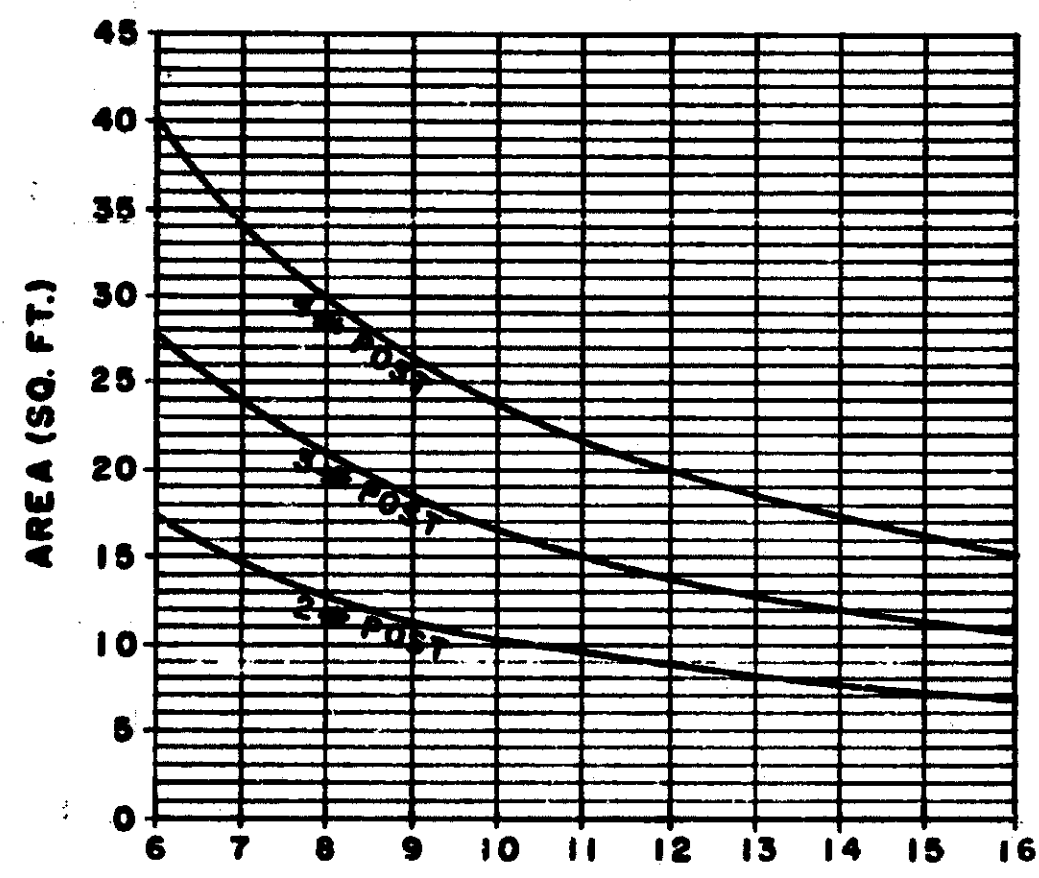


2 - POST ASSEMBLY

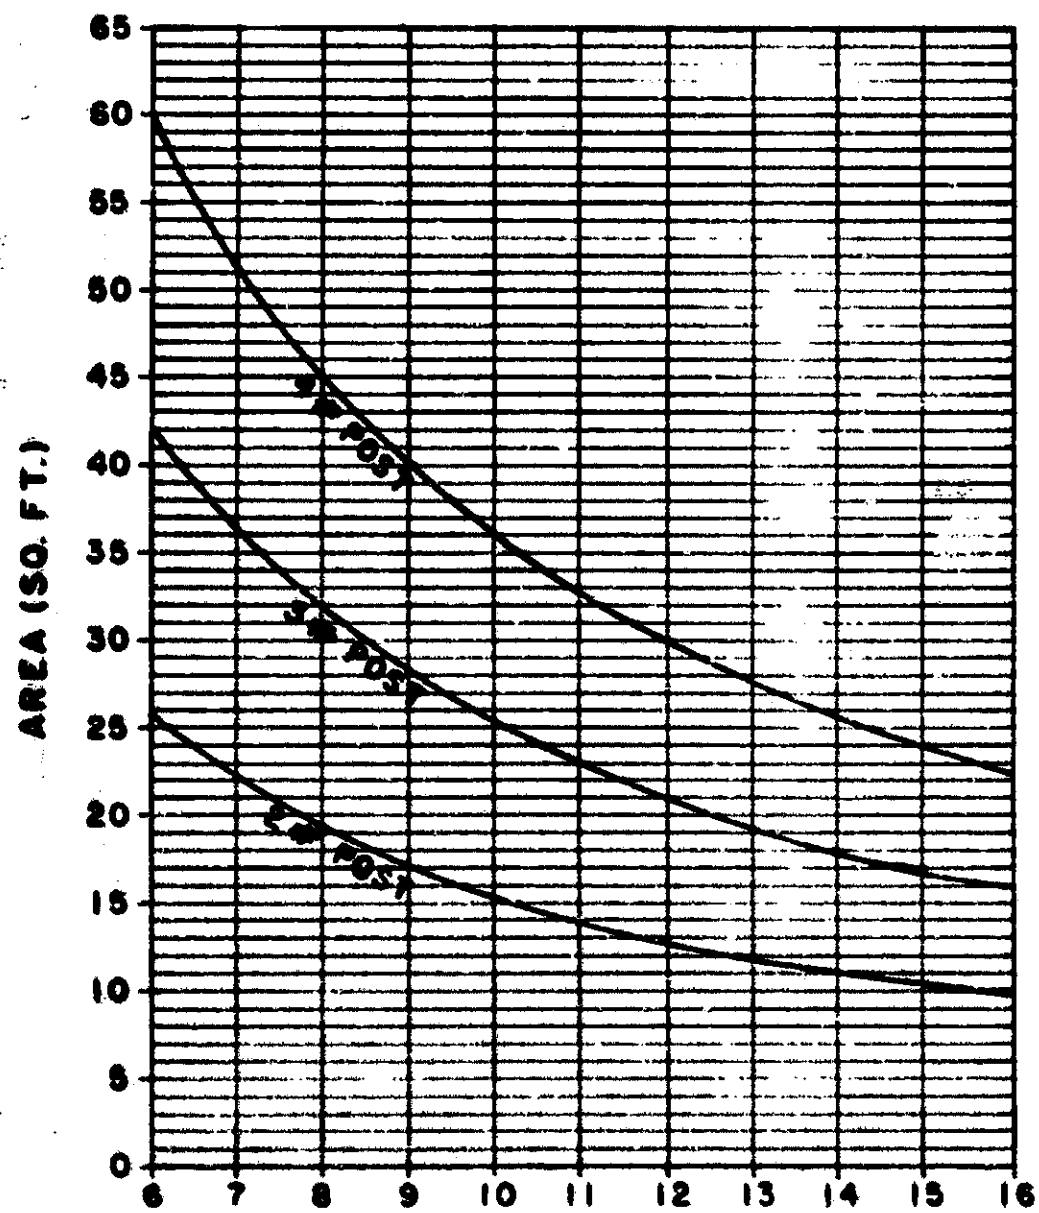


3 - POST ASSEMBLY

HEIGHT = DISTANCE FROM GROUND TO CENTER OF SIGN OR SIGN CLUSTER.

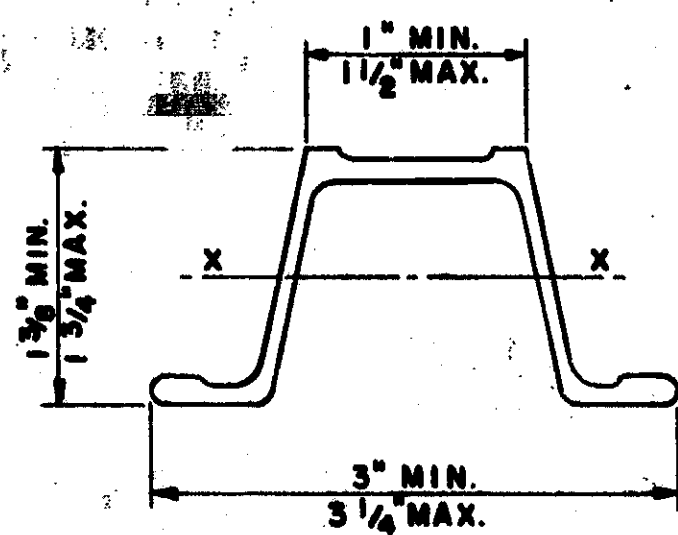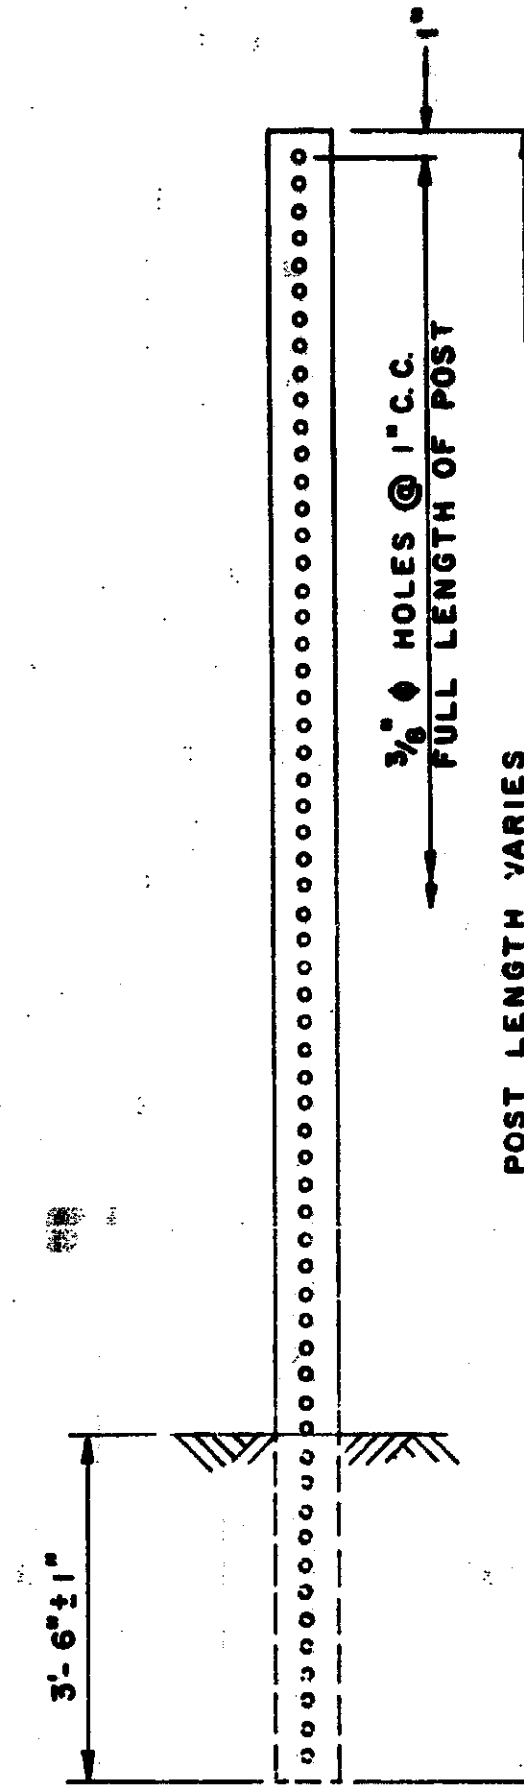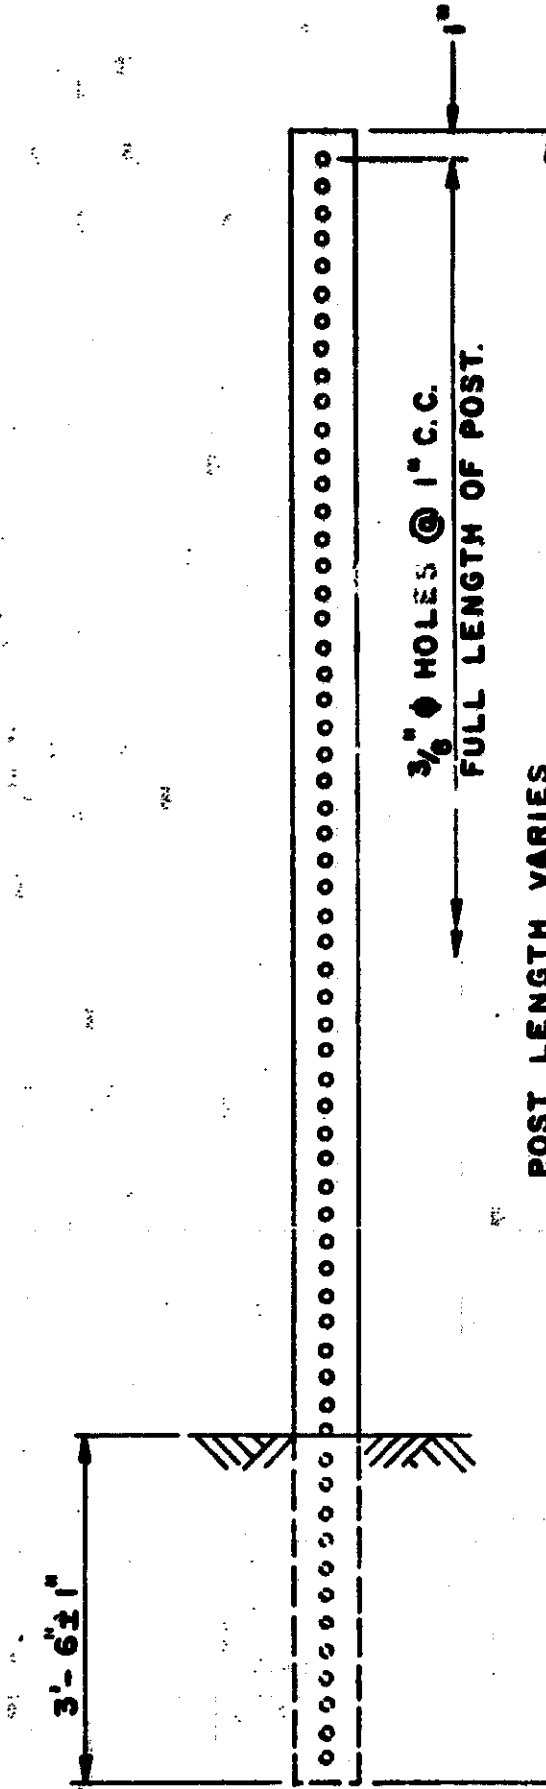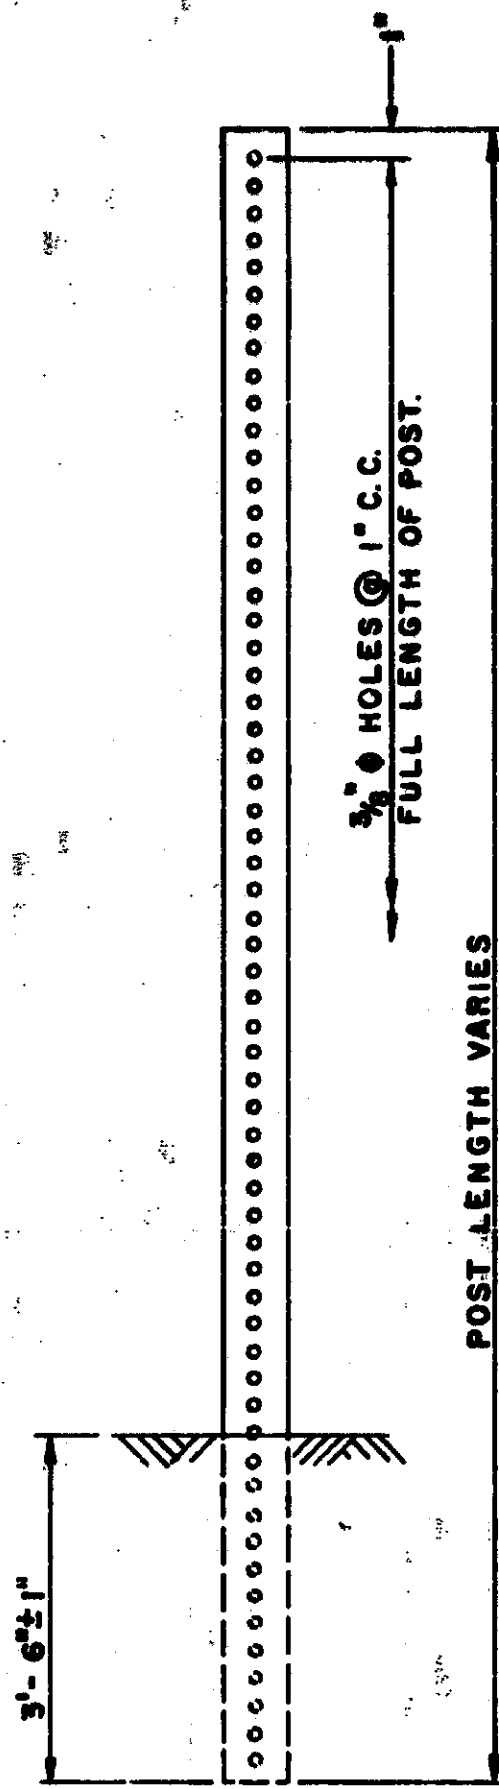


WEIGHT = 2 LB_{FT} MIN.
SECTION MODULUS X - X = 0.19 IN.³ MIN.

2# STEEL POST

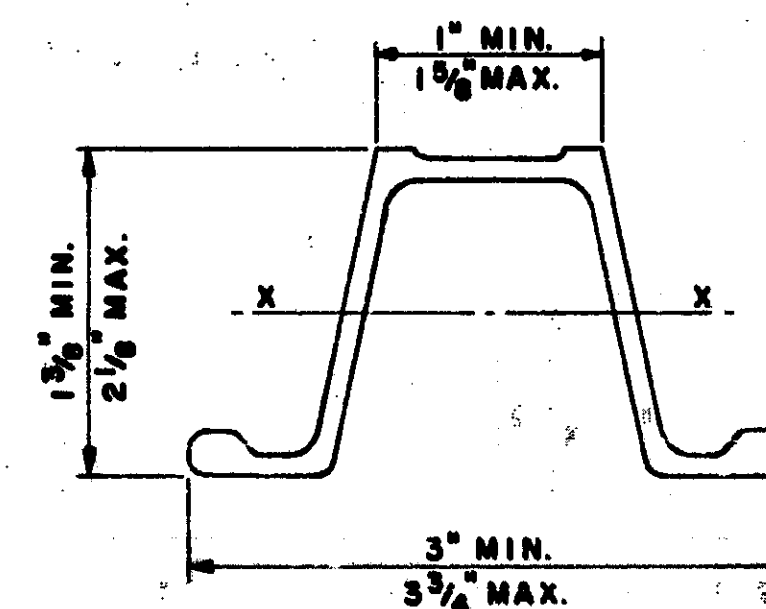

WEIGHT = 3 LB_{FT} MIN.
SECTION MODULUS X - X = 0.31 IN.³ MIN.

3# STEEL POST

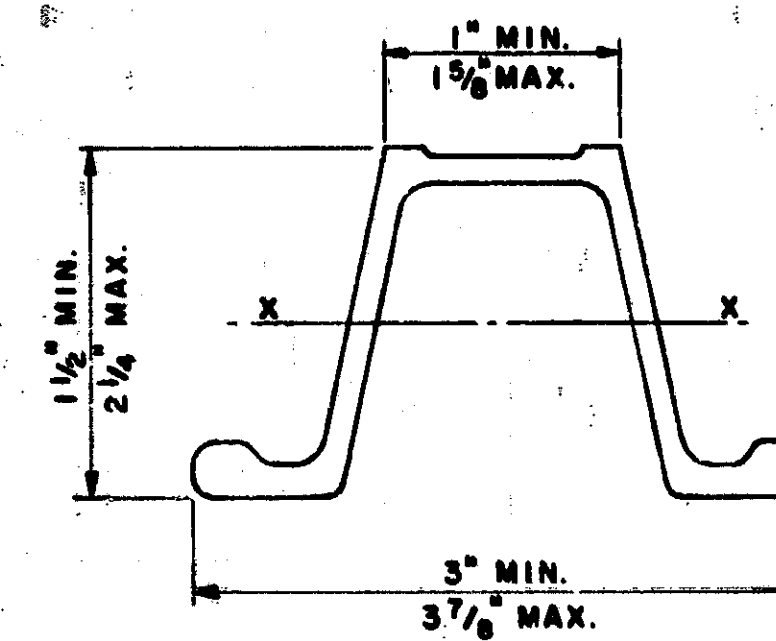

WEIGHT = 4 LB_{FT} MIN.
SECTION MODULUS X - X = 0.44 IN.³ MIN.

4# STEEL POST


NOTES:
(1.) POST SHALL BE GALVANIZED.
(2.) SEE STANDARD PLAN S 9.20 FOR SIGN CONNECTION.

MICHIGAN DEPARTMENT OF STATE HIGHWAYS AND TRANSPORTATION


STEEL POST

REVISIONS			
NO.	DESCRIPTION	DATE	BY


DESIGNED BY	W.C.G.	8-7-75
DRAWN BY		
CHECKED BY	L.W.P.	8-13-75
DATE		
S 3.10		

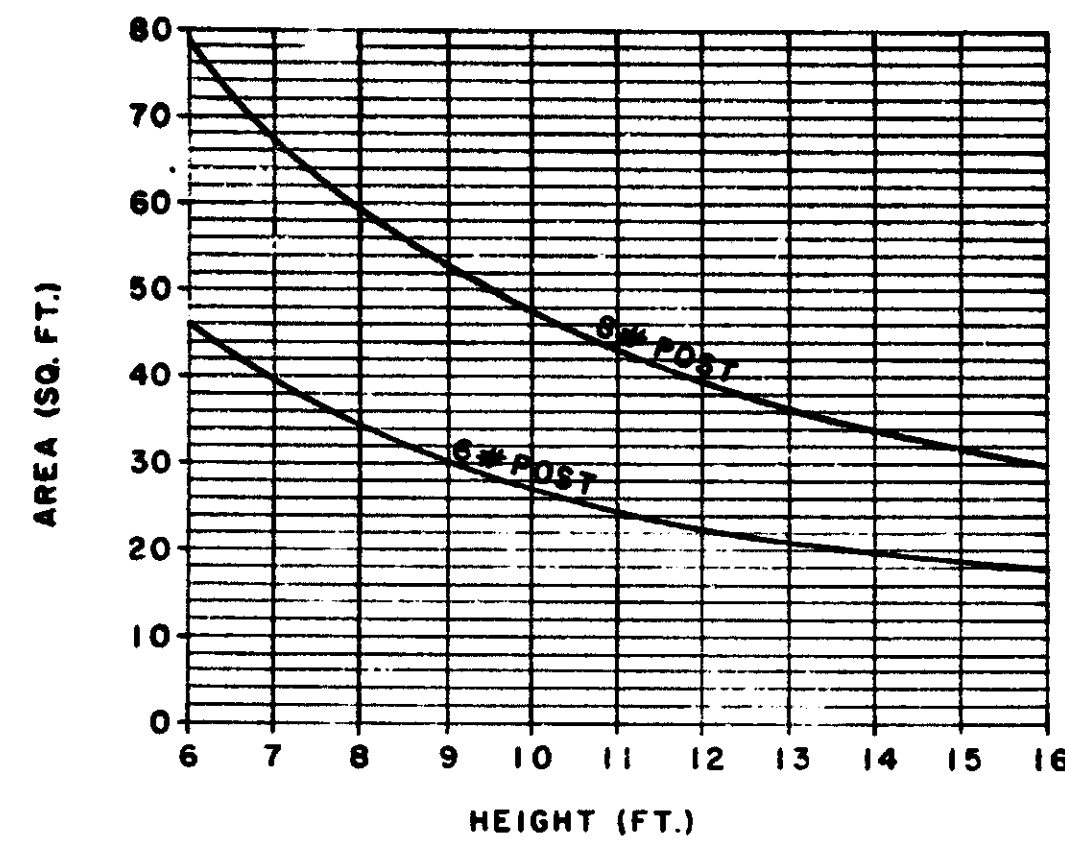

1-POST ASSEMBLY

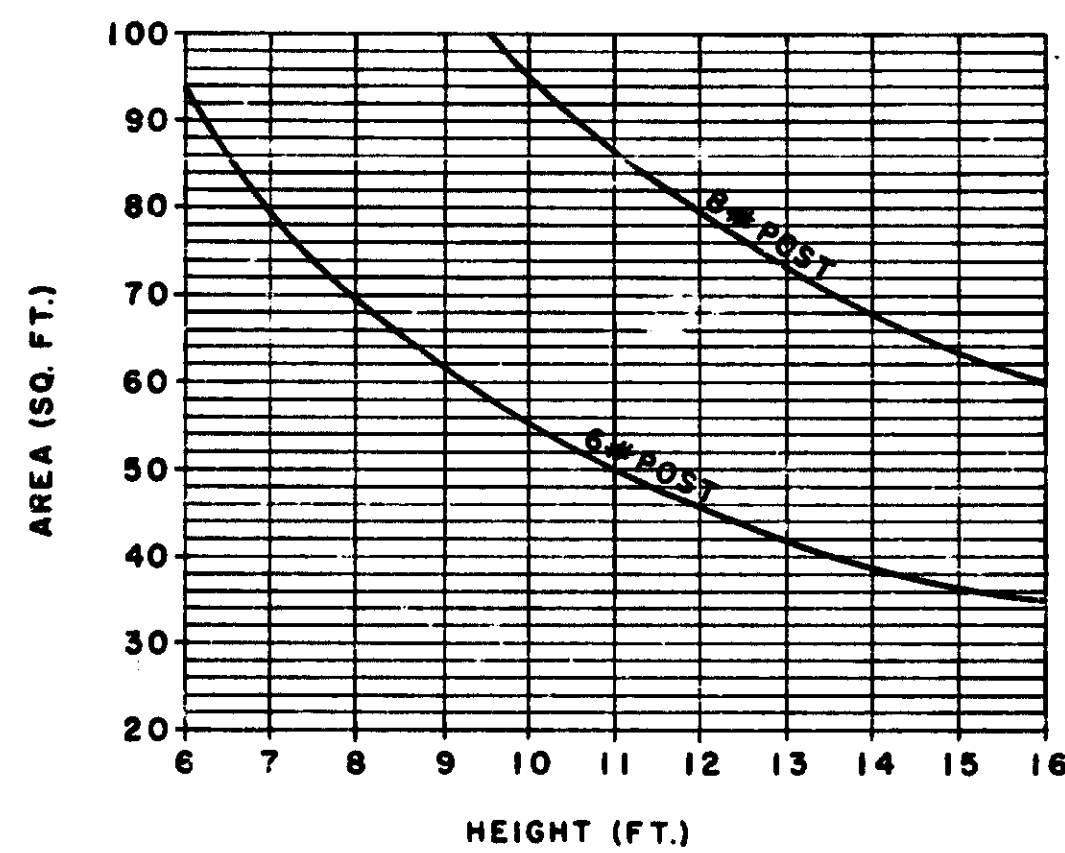


2-POST ASSEMBLY

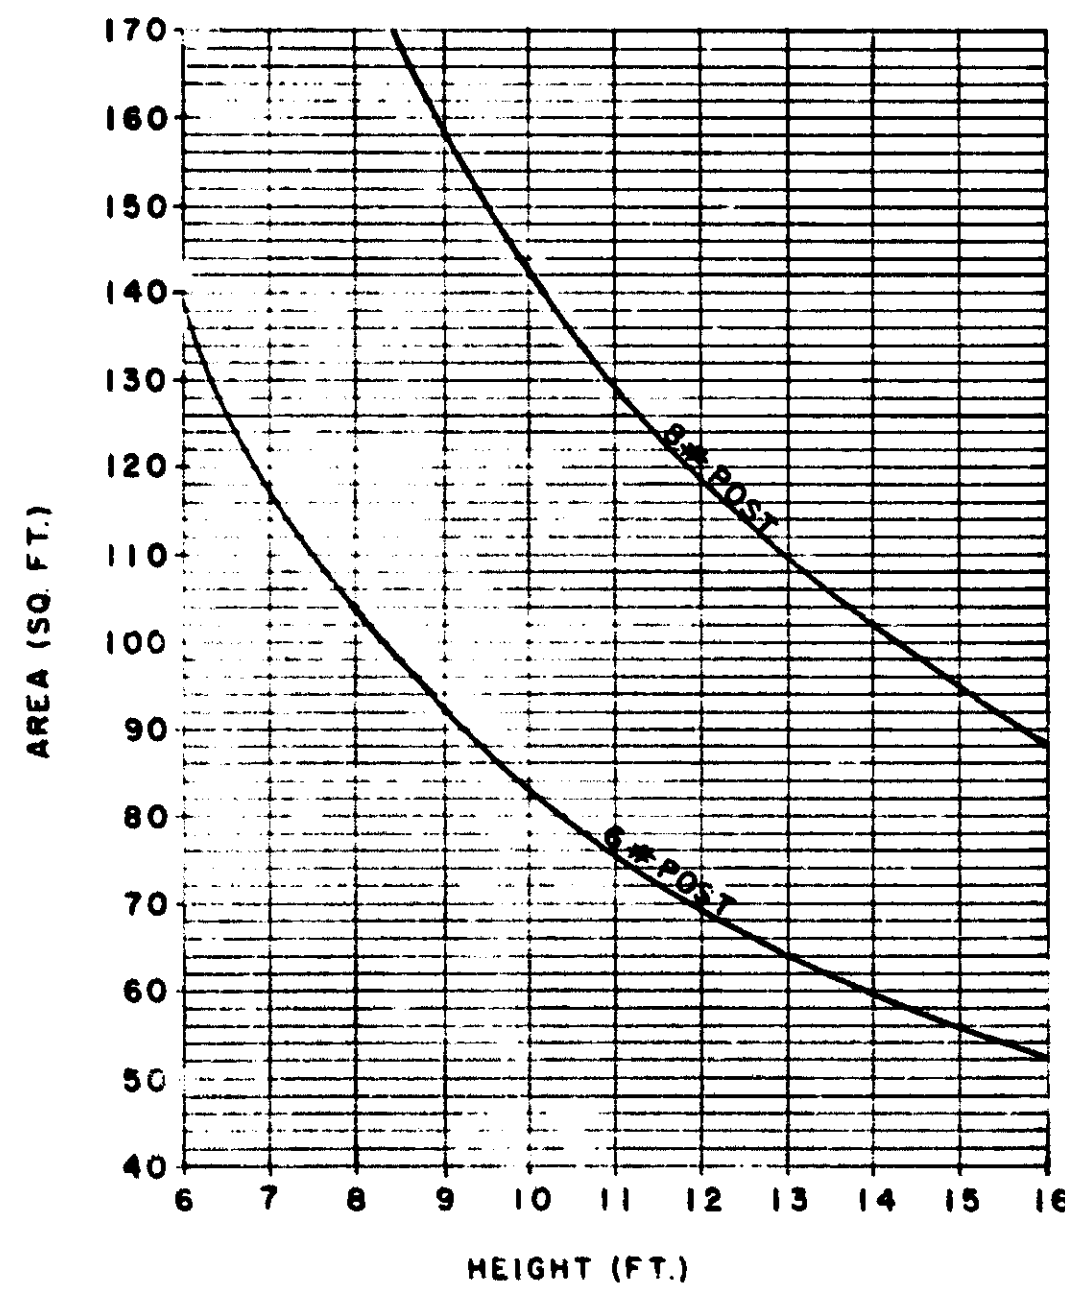


3-POST ASSEMBLY

HEIGHT - DISTANCE FROM GROUND TO CENTER OF SIGN OR SIGN CLUSTER.

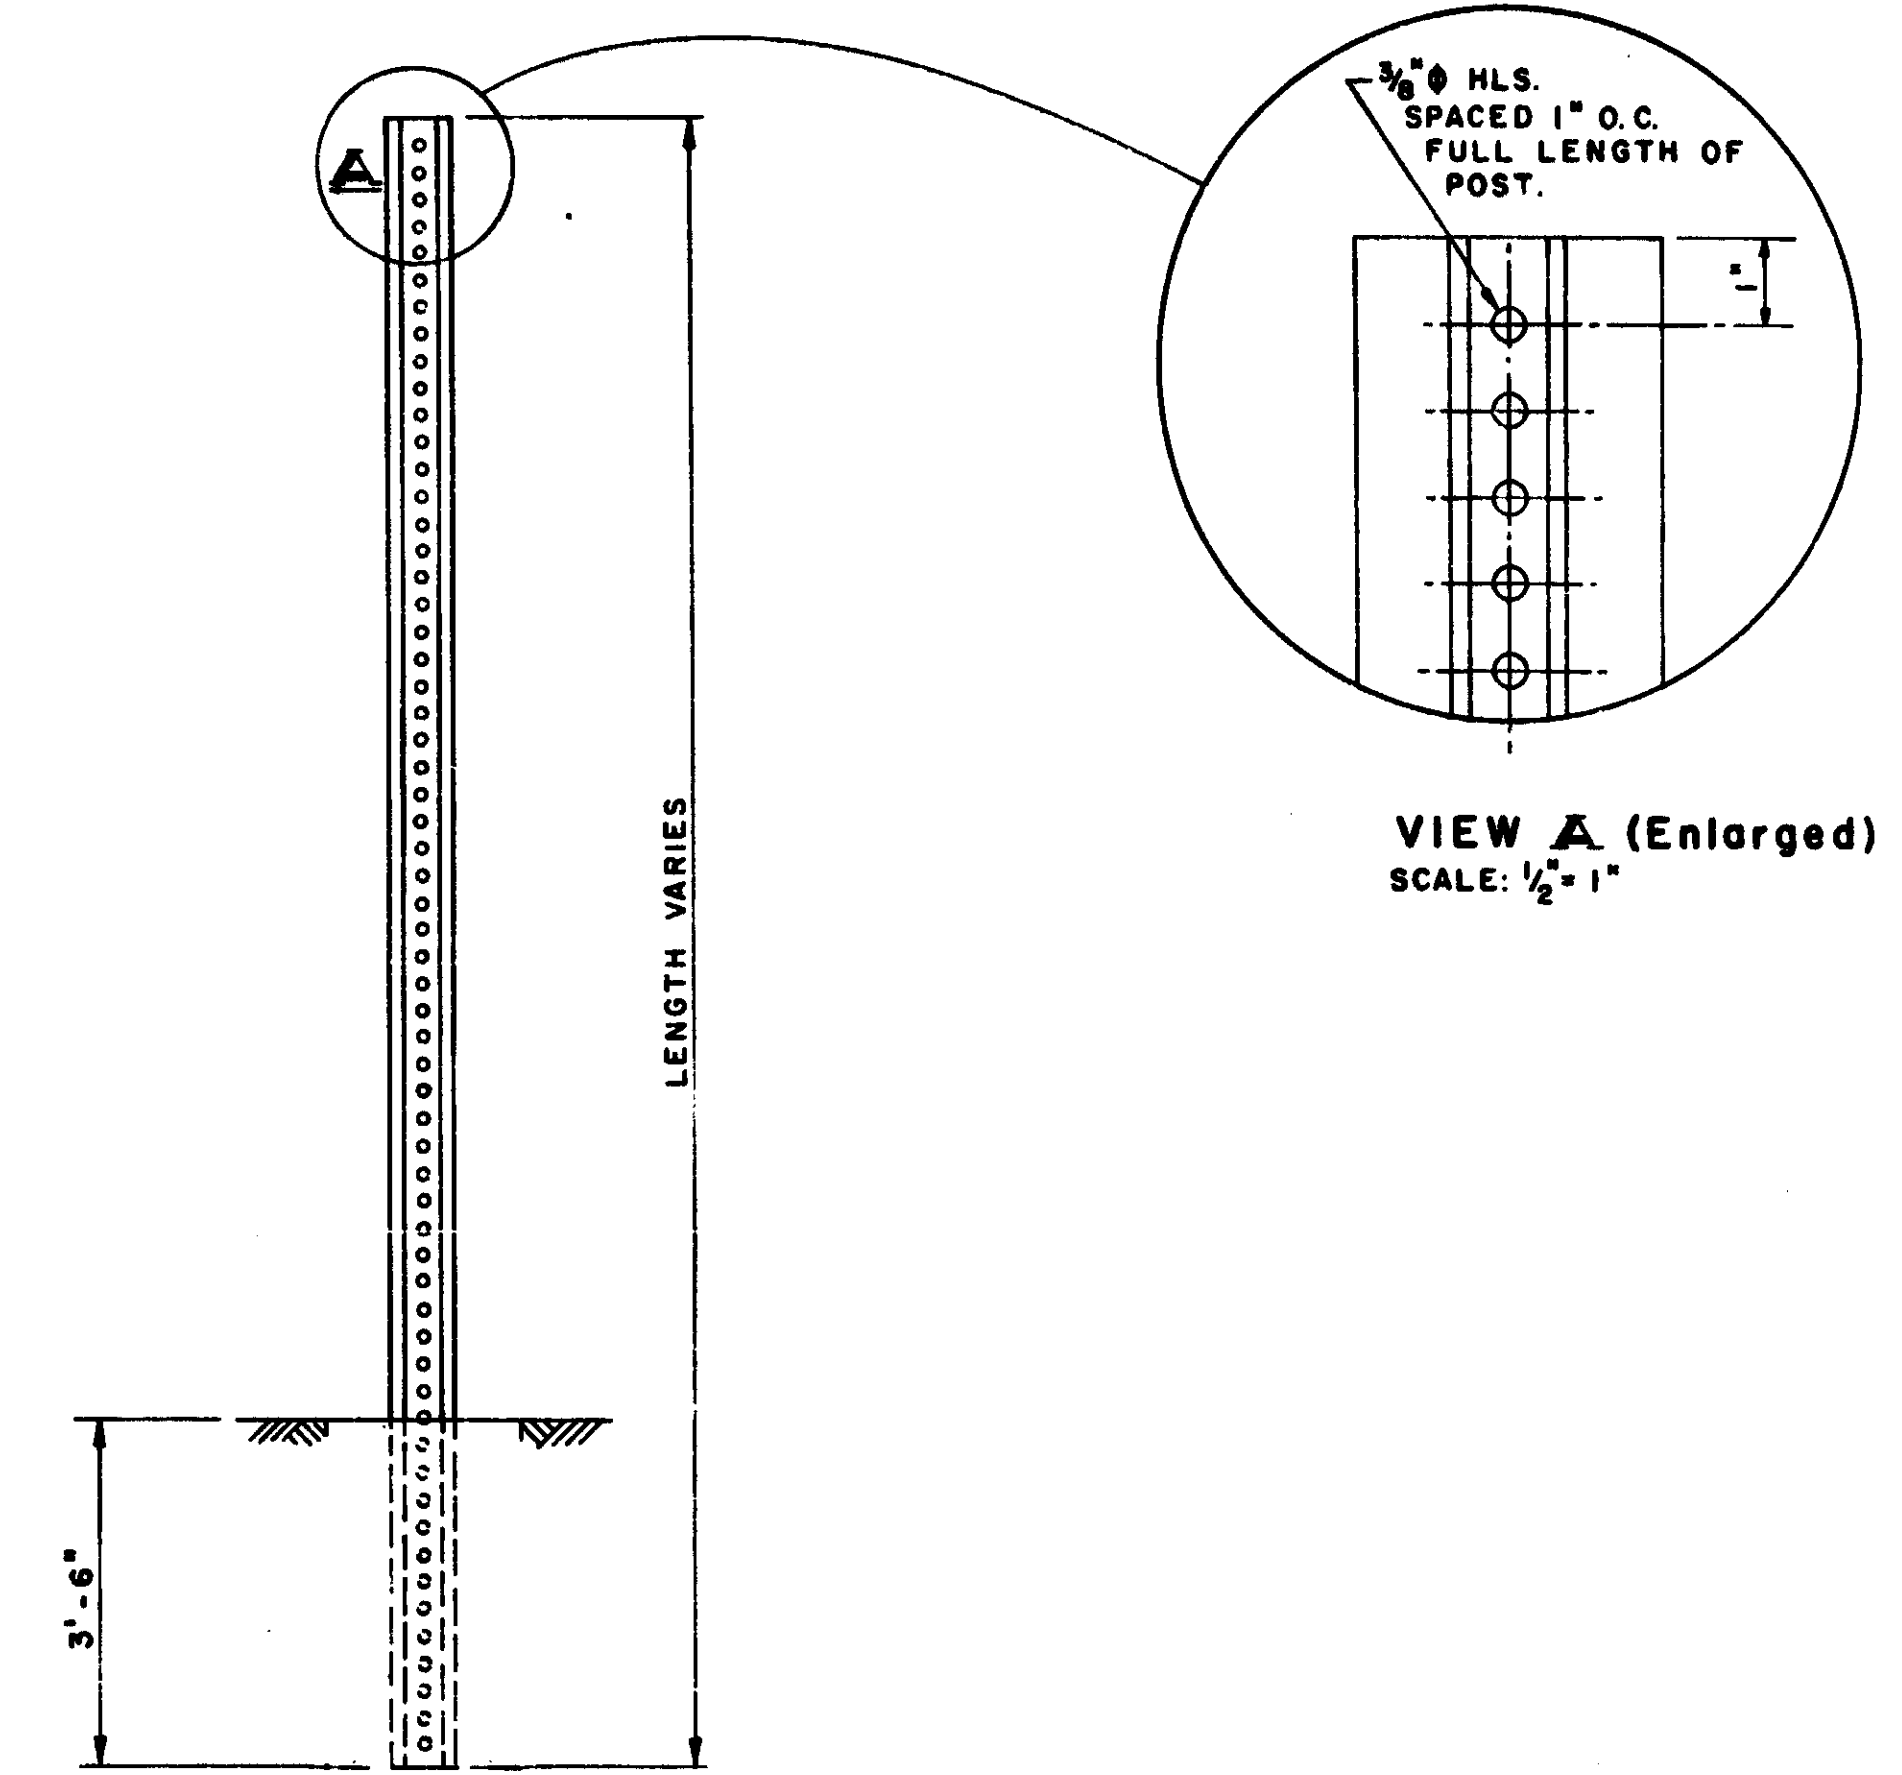

VIEW A (Enlarged)
SCALE: 1/2" = 1"

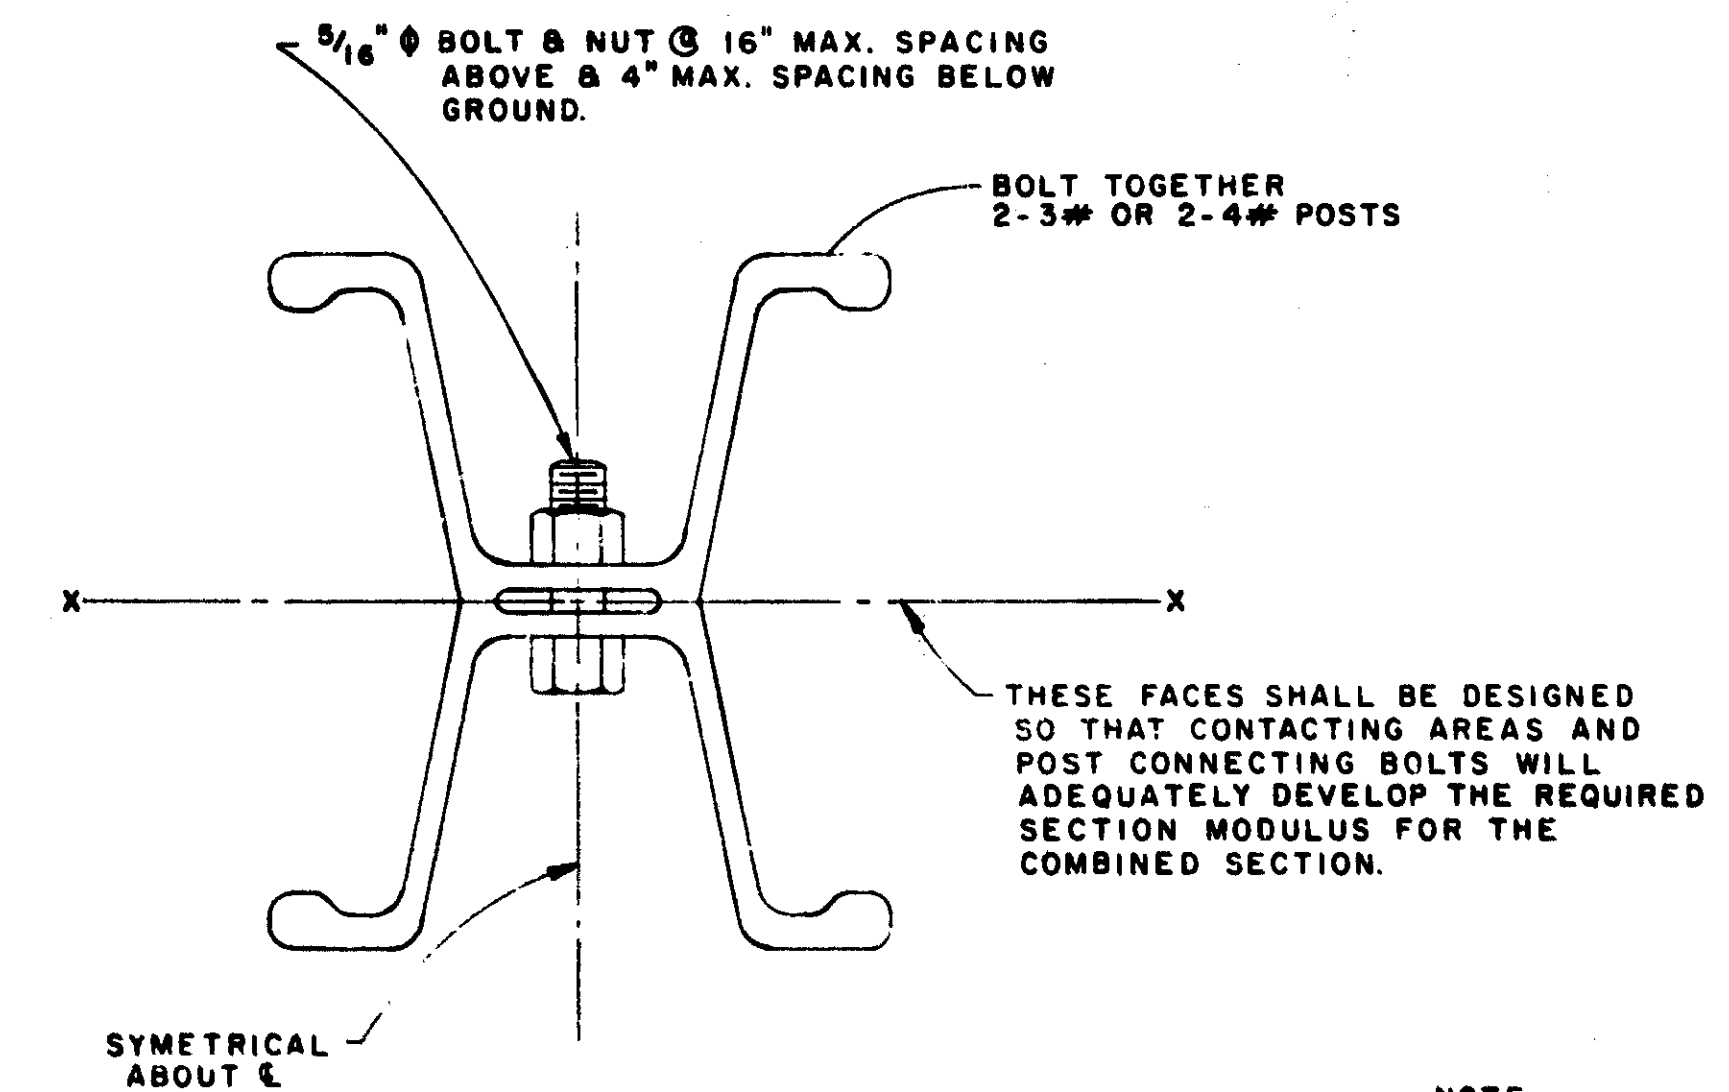

WEIGHT = 6#/FT. MIN. SECT. MOD. X-X = 1.02 in³ MIN.
WEIGHT = 8#/FT. MIN. SECT. MOD. X-X = 1.75 in³ MIN.

NOTE:
1.- POST, BOLTS & NUTS SHALL BE GALVANIZED.
2.- SEE STD. PLAN S 9.20 FOR SIGN CONNECTION.



6# OR 8# STEEL POST

MICHIGAN DEPARTMENT OF STATE HIGHWAYS AND TRANSPORTATION
STEEL POST


REVISIONS			
NO.	DESCRIPTION	DATE	BY

DRAWN BY	W.C.G.	8-11-79
CHECKED BY	L.W.P.	8-13-79
S 3.20		


TYPE I SIGN - ERECTION DETAILS

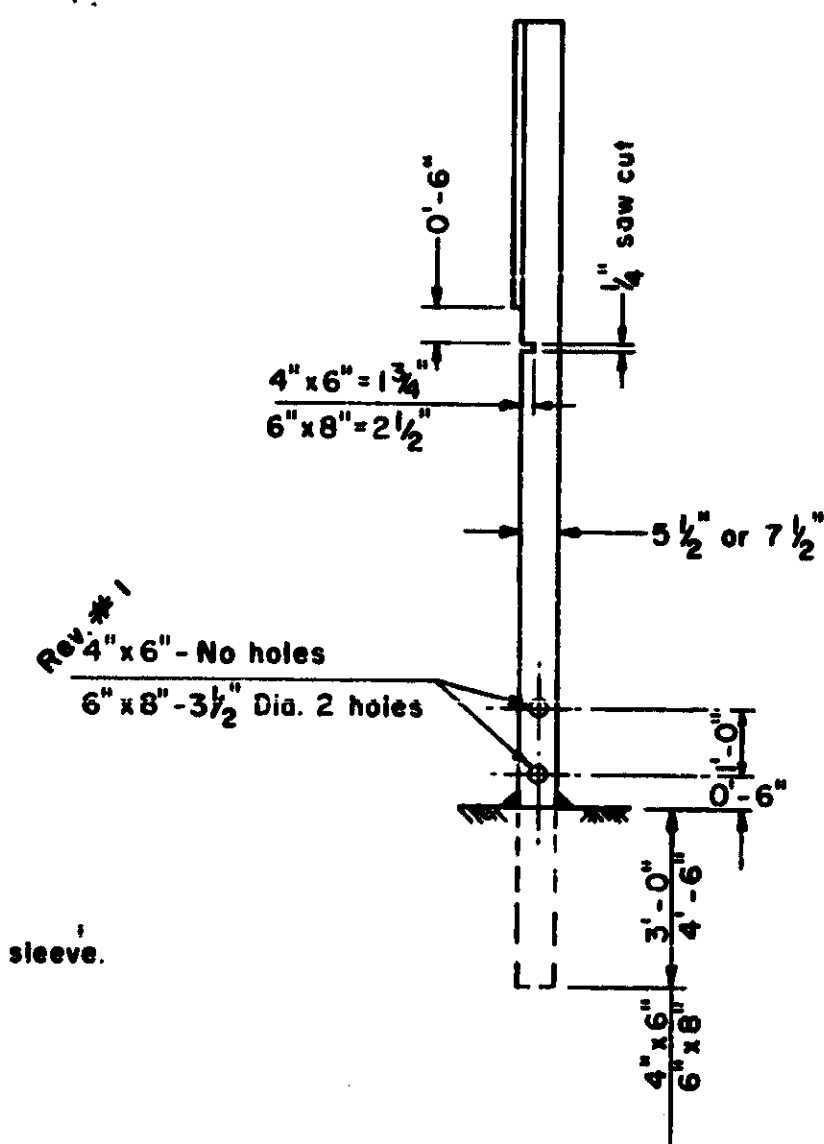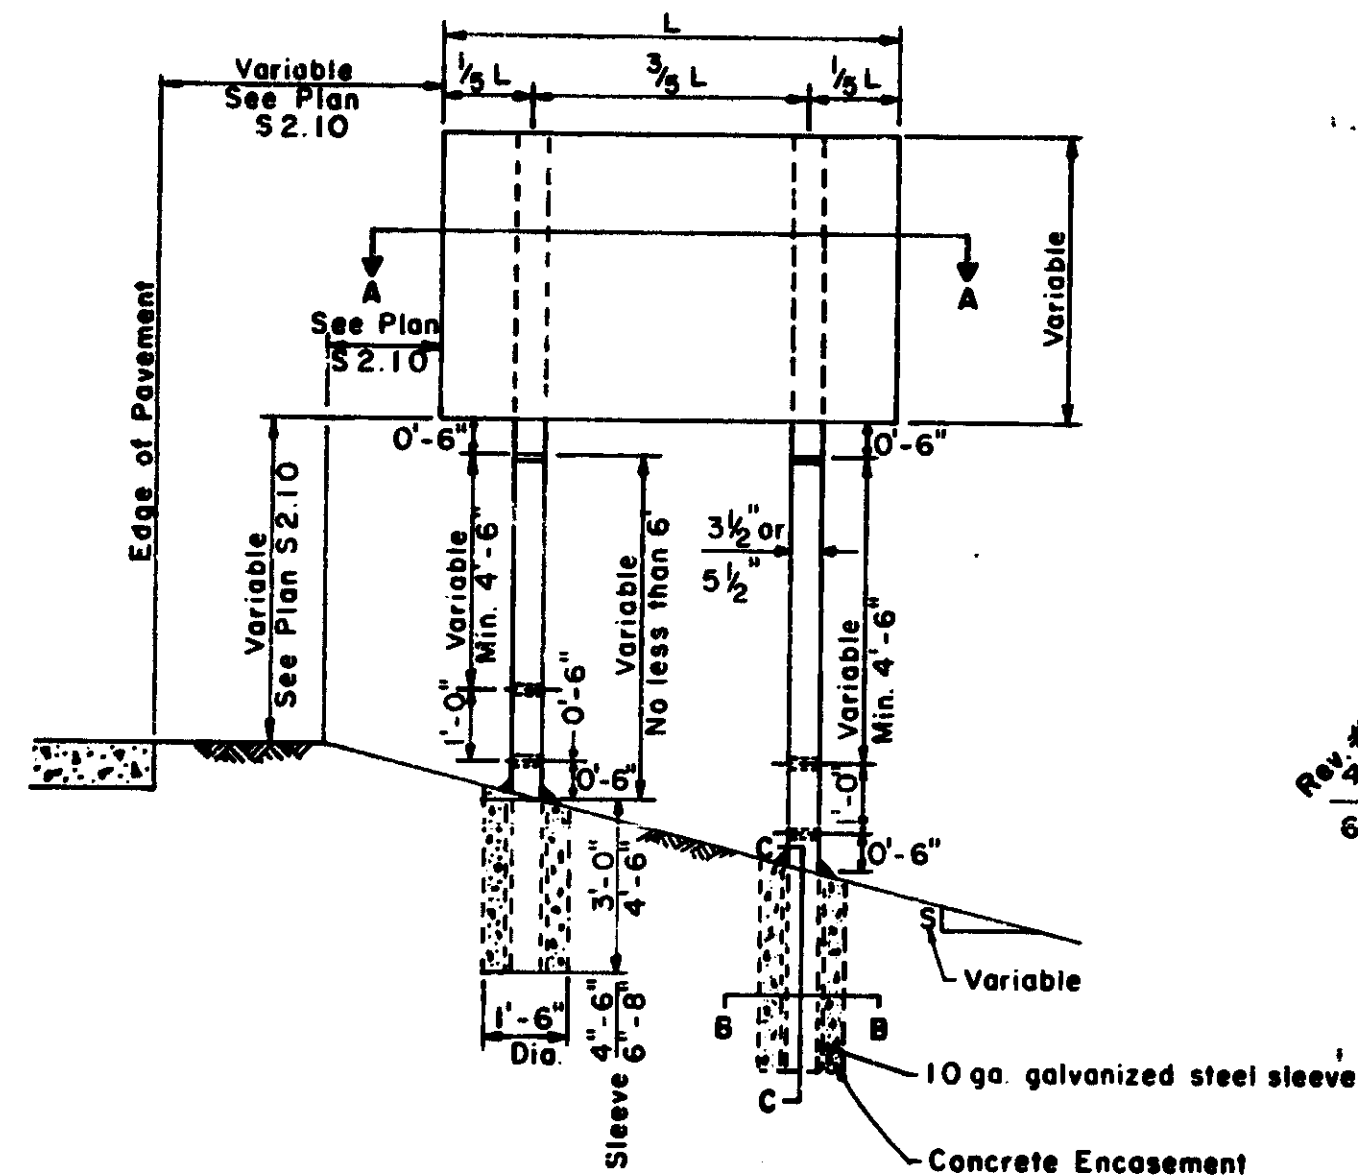


**END VIEW
TYPE II & III SIGN**

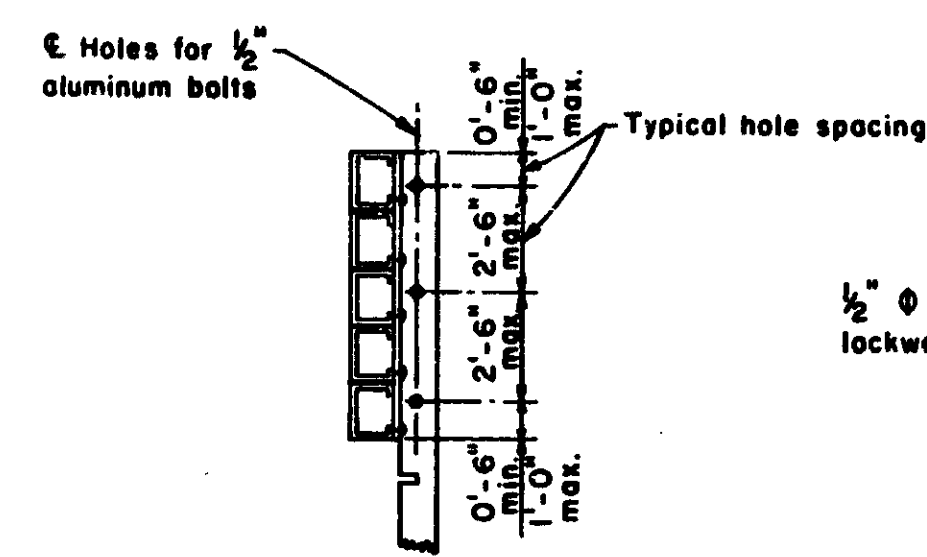


**END VIEW
TYPE I SIGN**

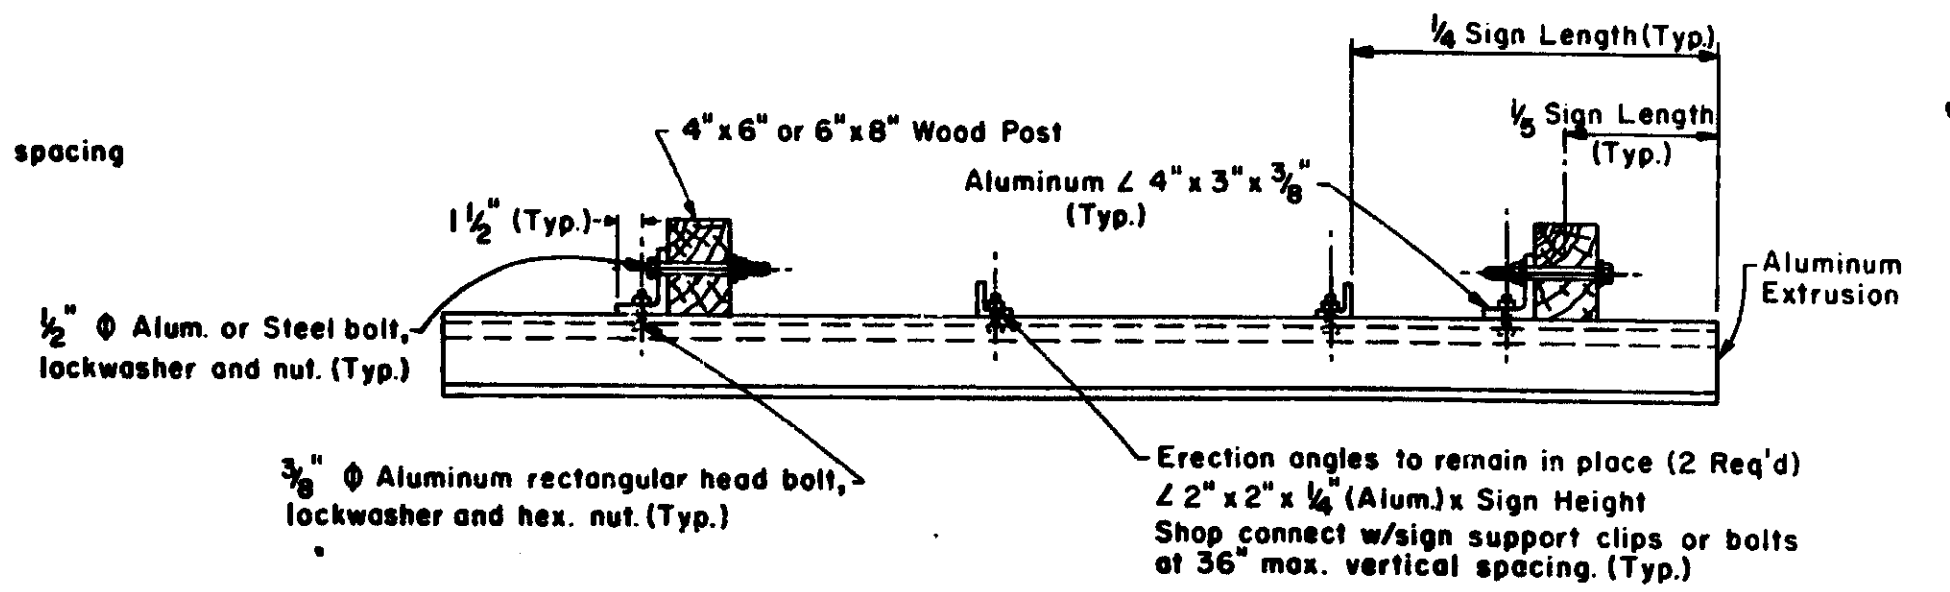

SECTION A-A

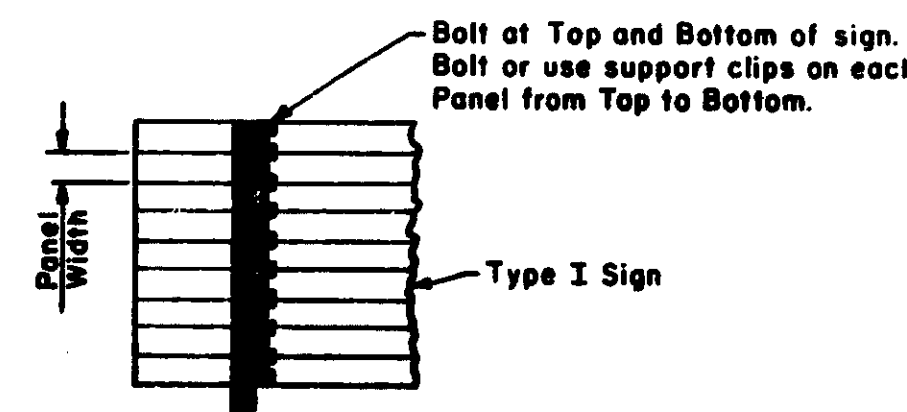

**SIGN SUPPORT BOLT
AND CLIP ARRANGEMENT**


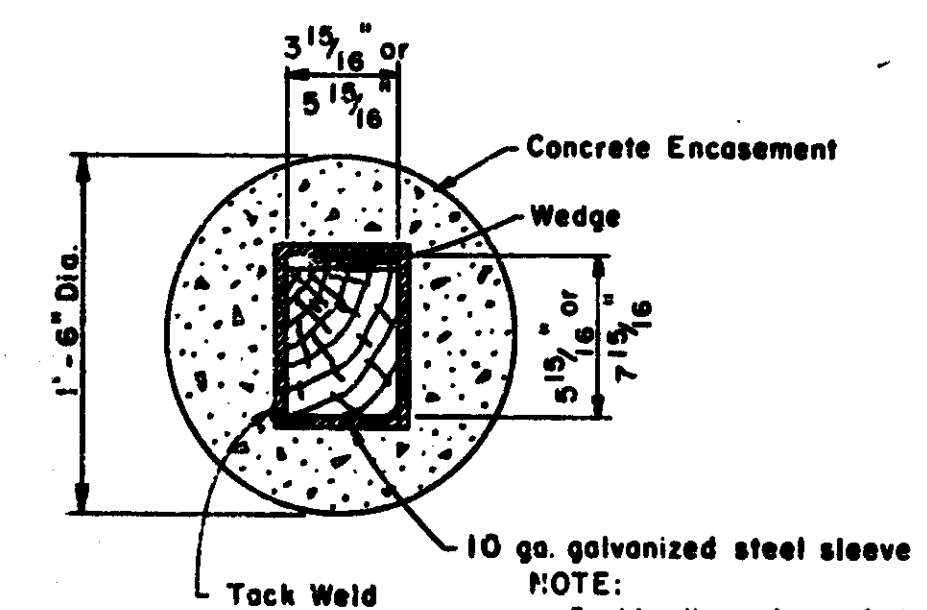


SECTION B-B

NOTE:



1. Above elevation details are for both the 4" x 6" and 6" x 8" wood posts. Whenever two dimensions are shown for the same item, the first one is intended for the 4" x 6" rectangular section and the second one for the 6" x 8" rectangular section.
2. Post sizes can be obtained from the design charts for different elevations of signs above ground.
3. Omit the saw cut in one post assemblies.
4. All 1 1/2" and 3 1/2" drilled holes are to be carefully centered on the posts.
5. All concrete foundations shall be finished as shown in section C-C and any surplus material shall be completely removed.

WOOD POSTS DESIGN CHARTS

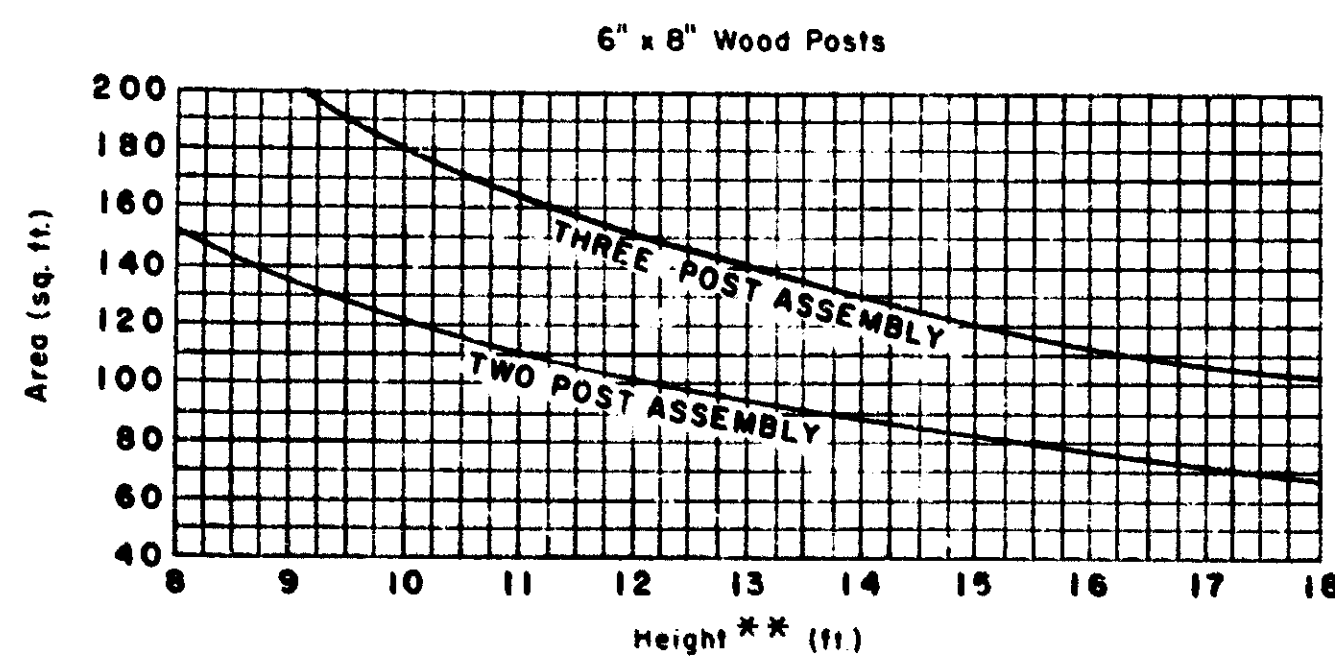
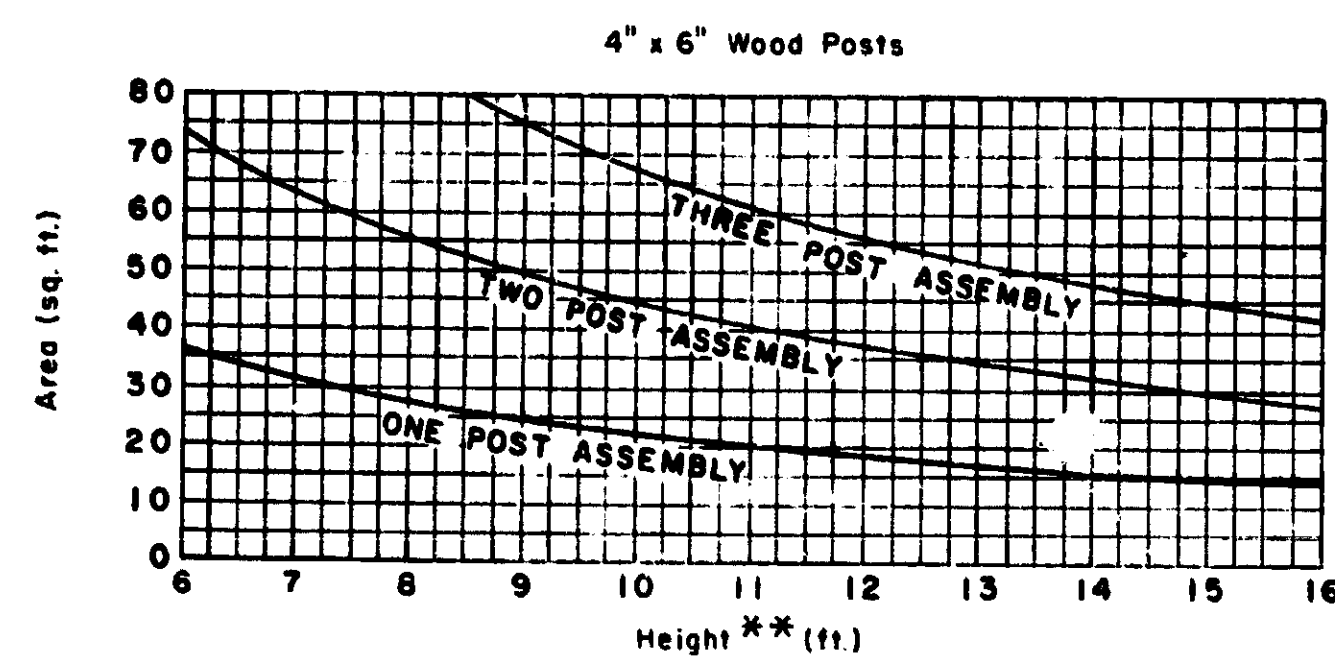


** Height = Distance from ground to center of sign or sign cluster.

TYPES II AND III SIGNS - ERECTION DETAILS

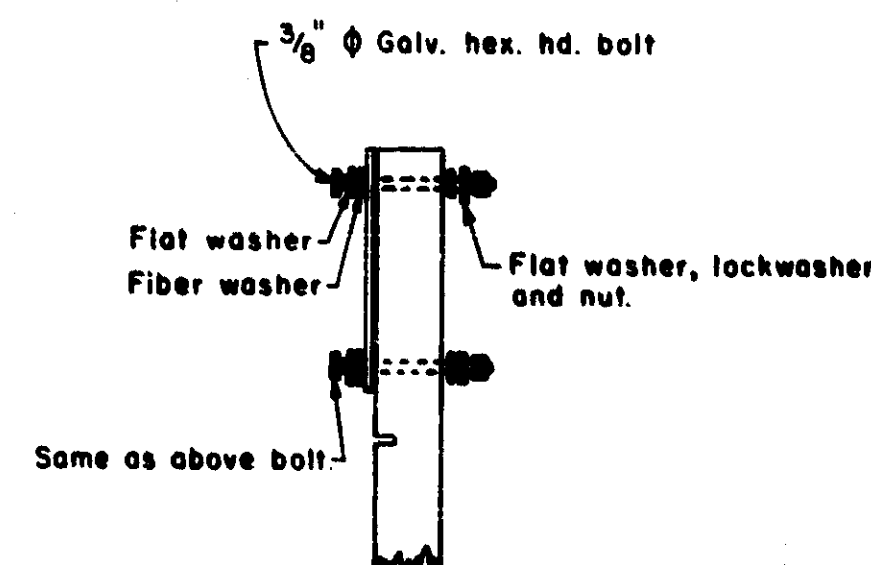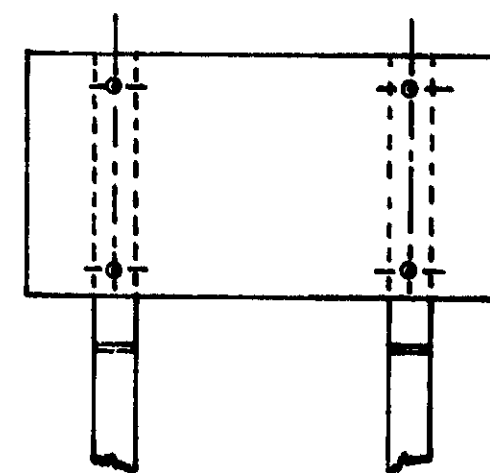

END VIEW

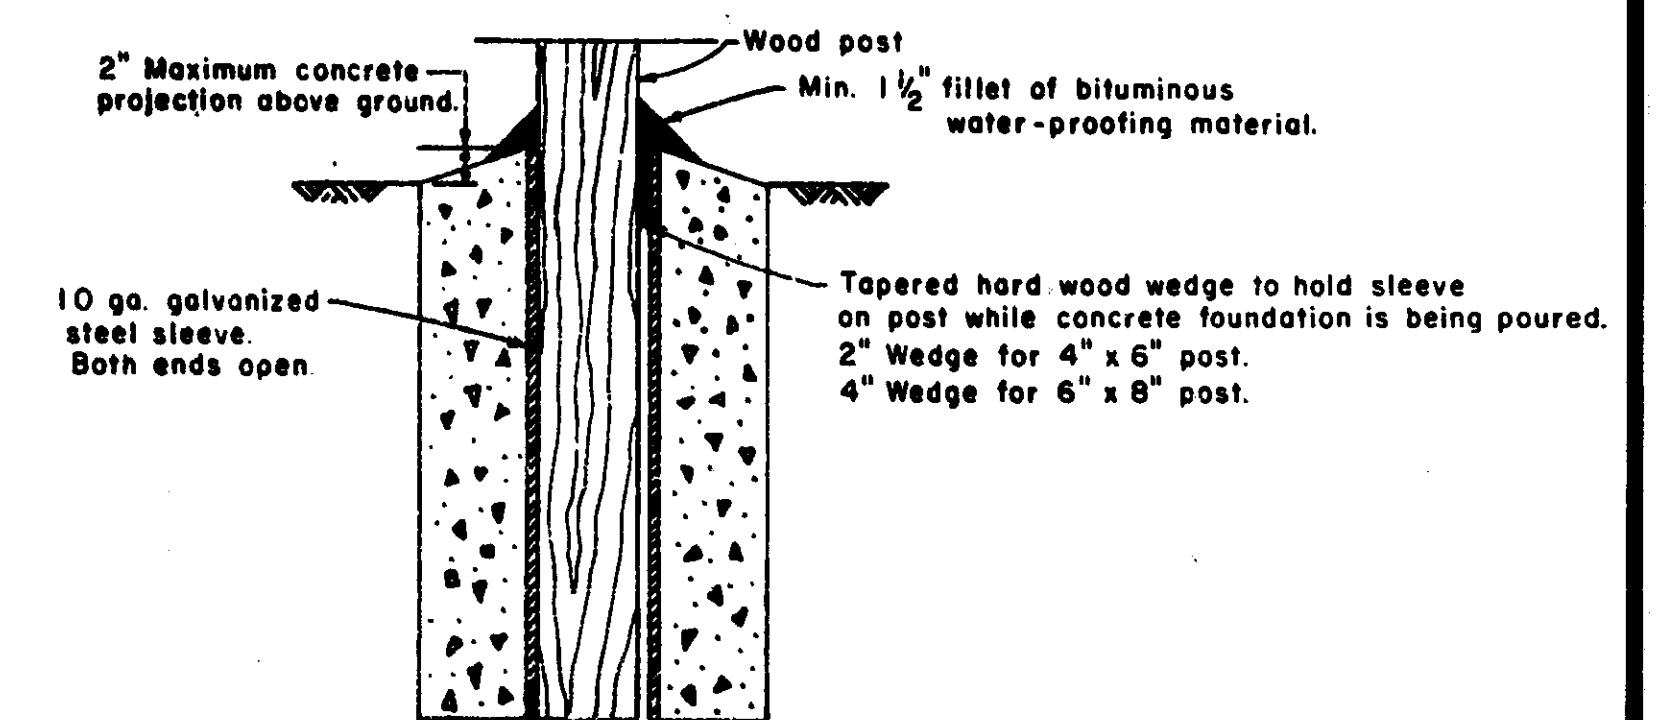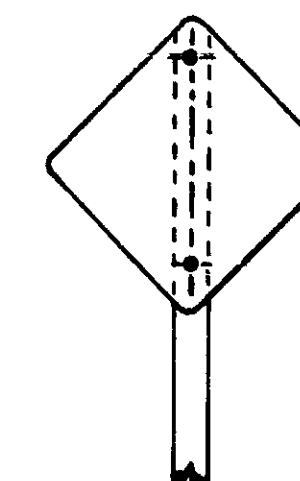

SECTION C-C

NOTES:


- 1.) All connections are incidental to "SIGN".

MICHIGAN DEPARTMENT OF STATE HIGHWAYS


WOOD POSTS

REVISIONS			
NO.	DESCRIPTION	DATE	BY
1	Revised 12/11/77 Mich. Hqs. - 4" x 6" post	5/78	W.C.G.


DESIGNED BY	W.C.G.
DRAWN BY	
CHECKED BY	
DATE	
S3.30	

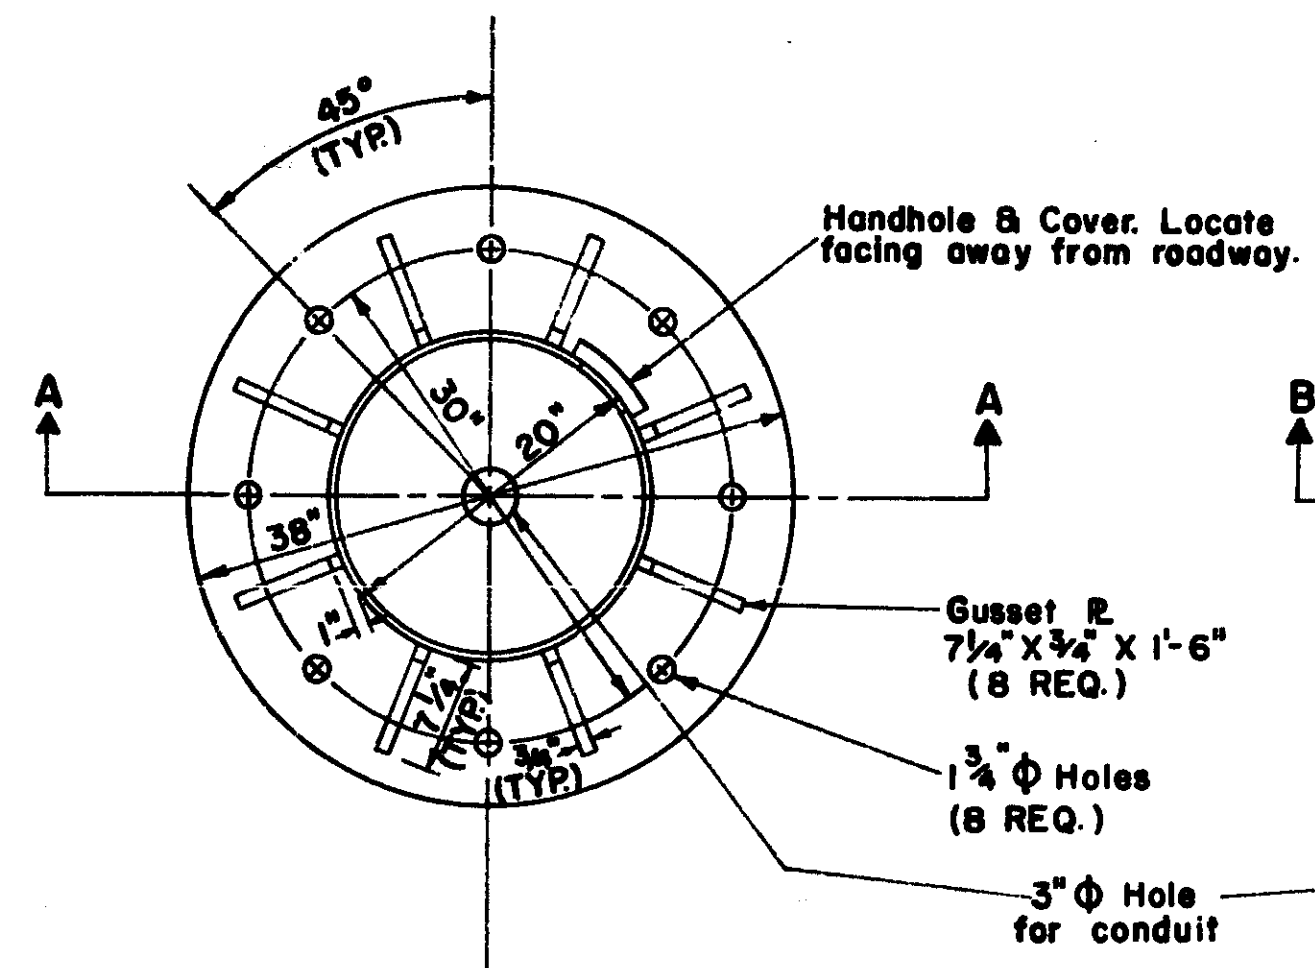


BASE R DETAIL
TYPE G

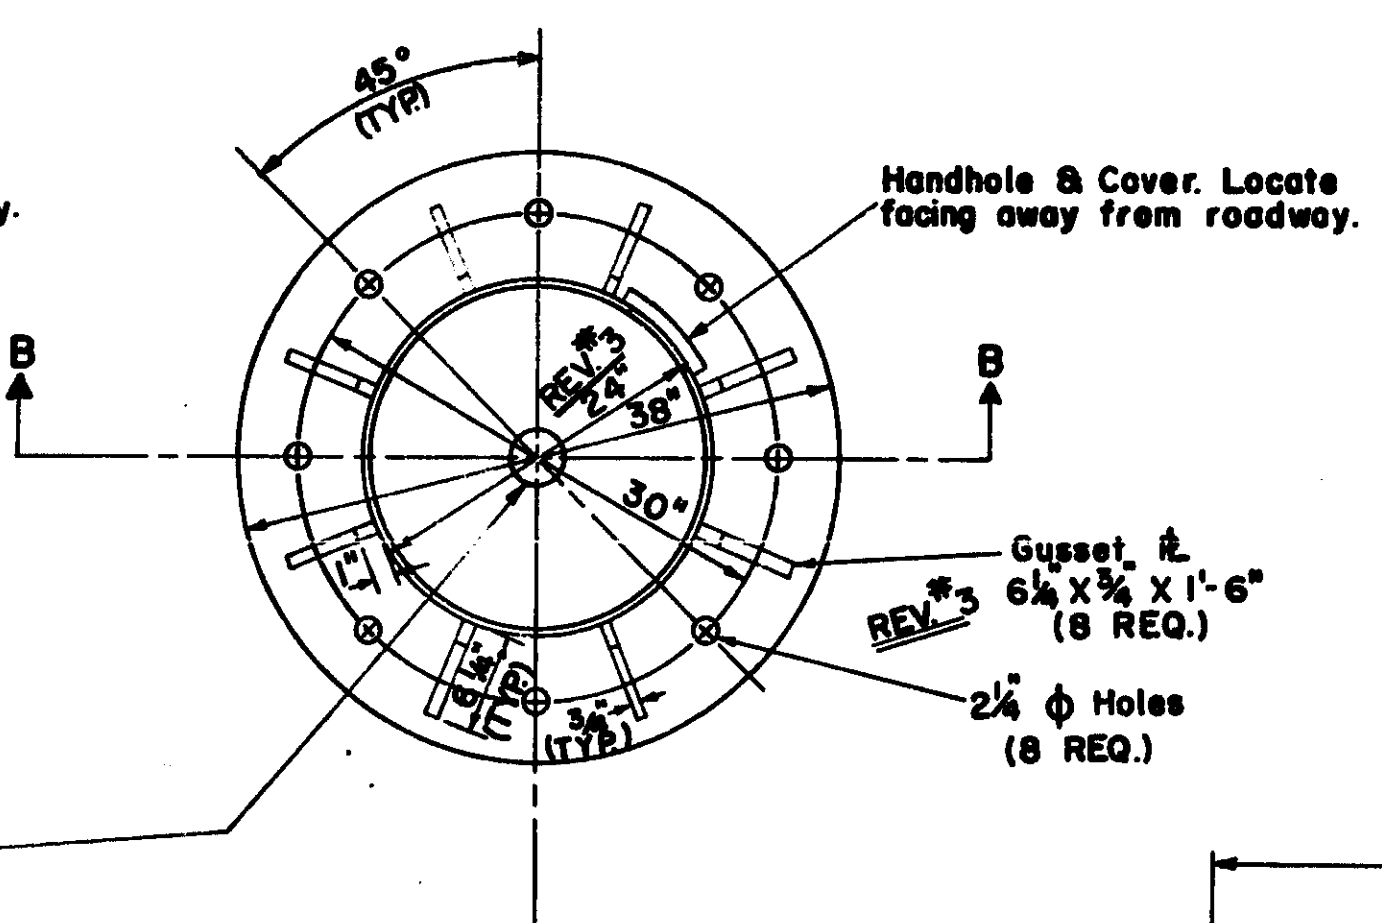


BASE R DETAIL
TYPE H

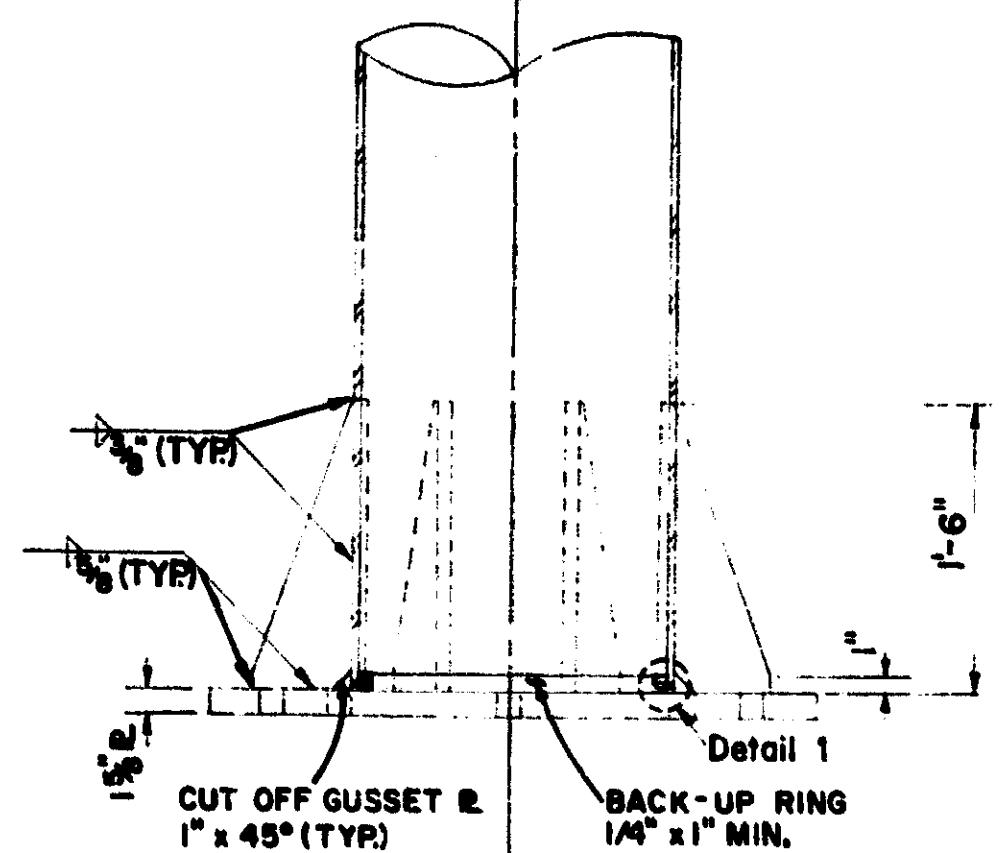


SECTION A-A

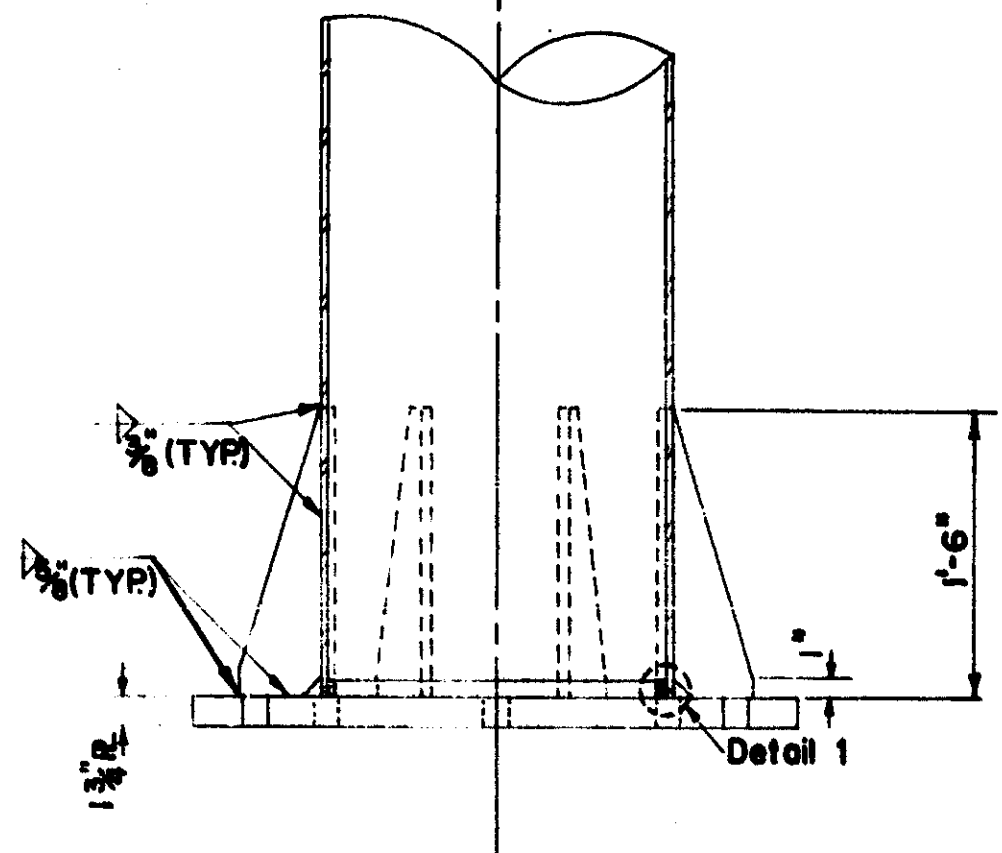


SECTION B-B

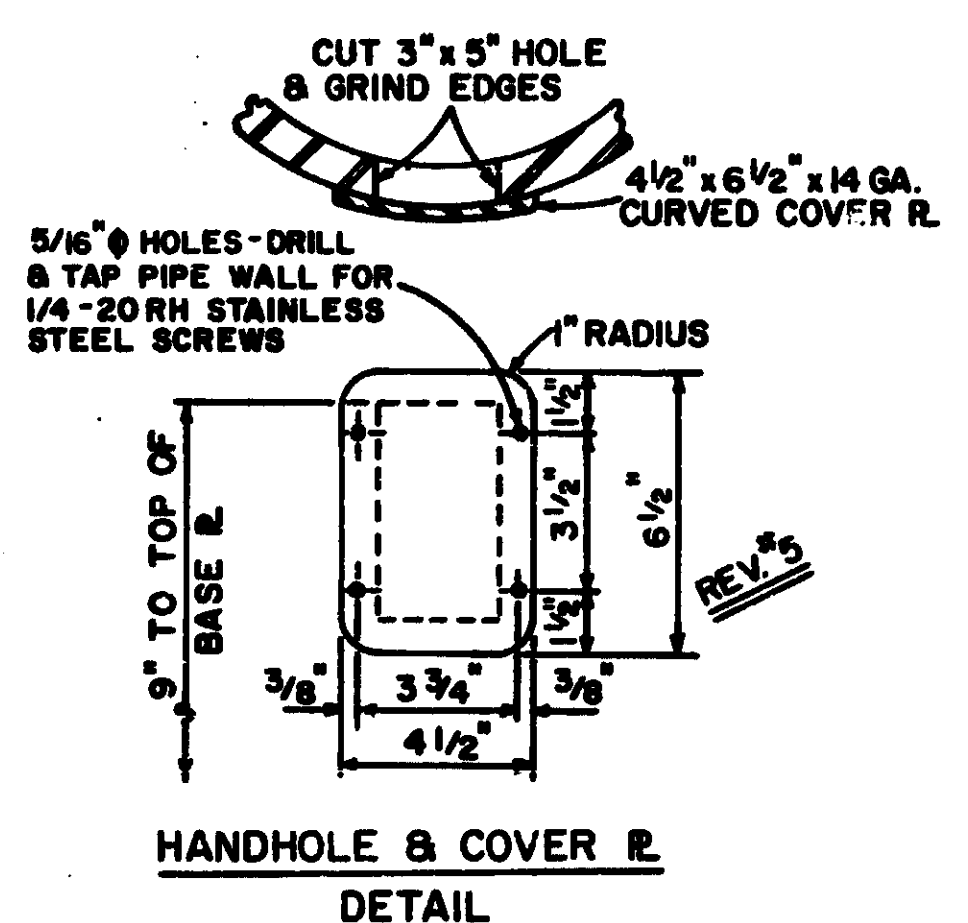

HANDHOLE & COVER R
DETAIL

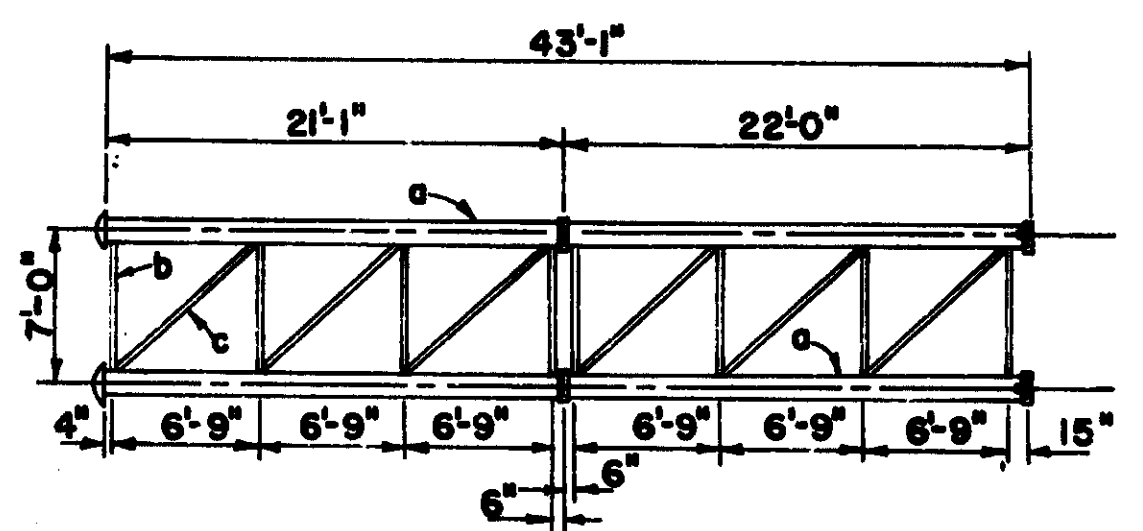

OPTIONAL TYPE "H" WITH
MID-SPAN SPLICE

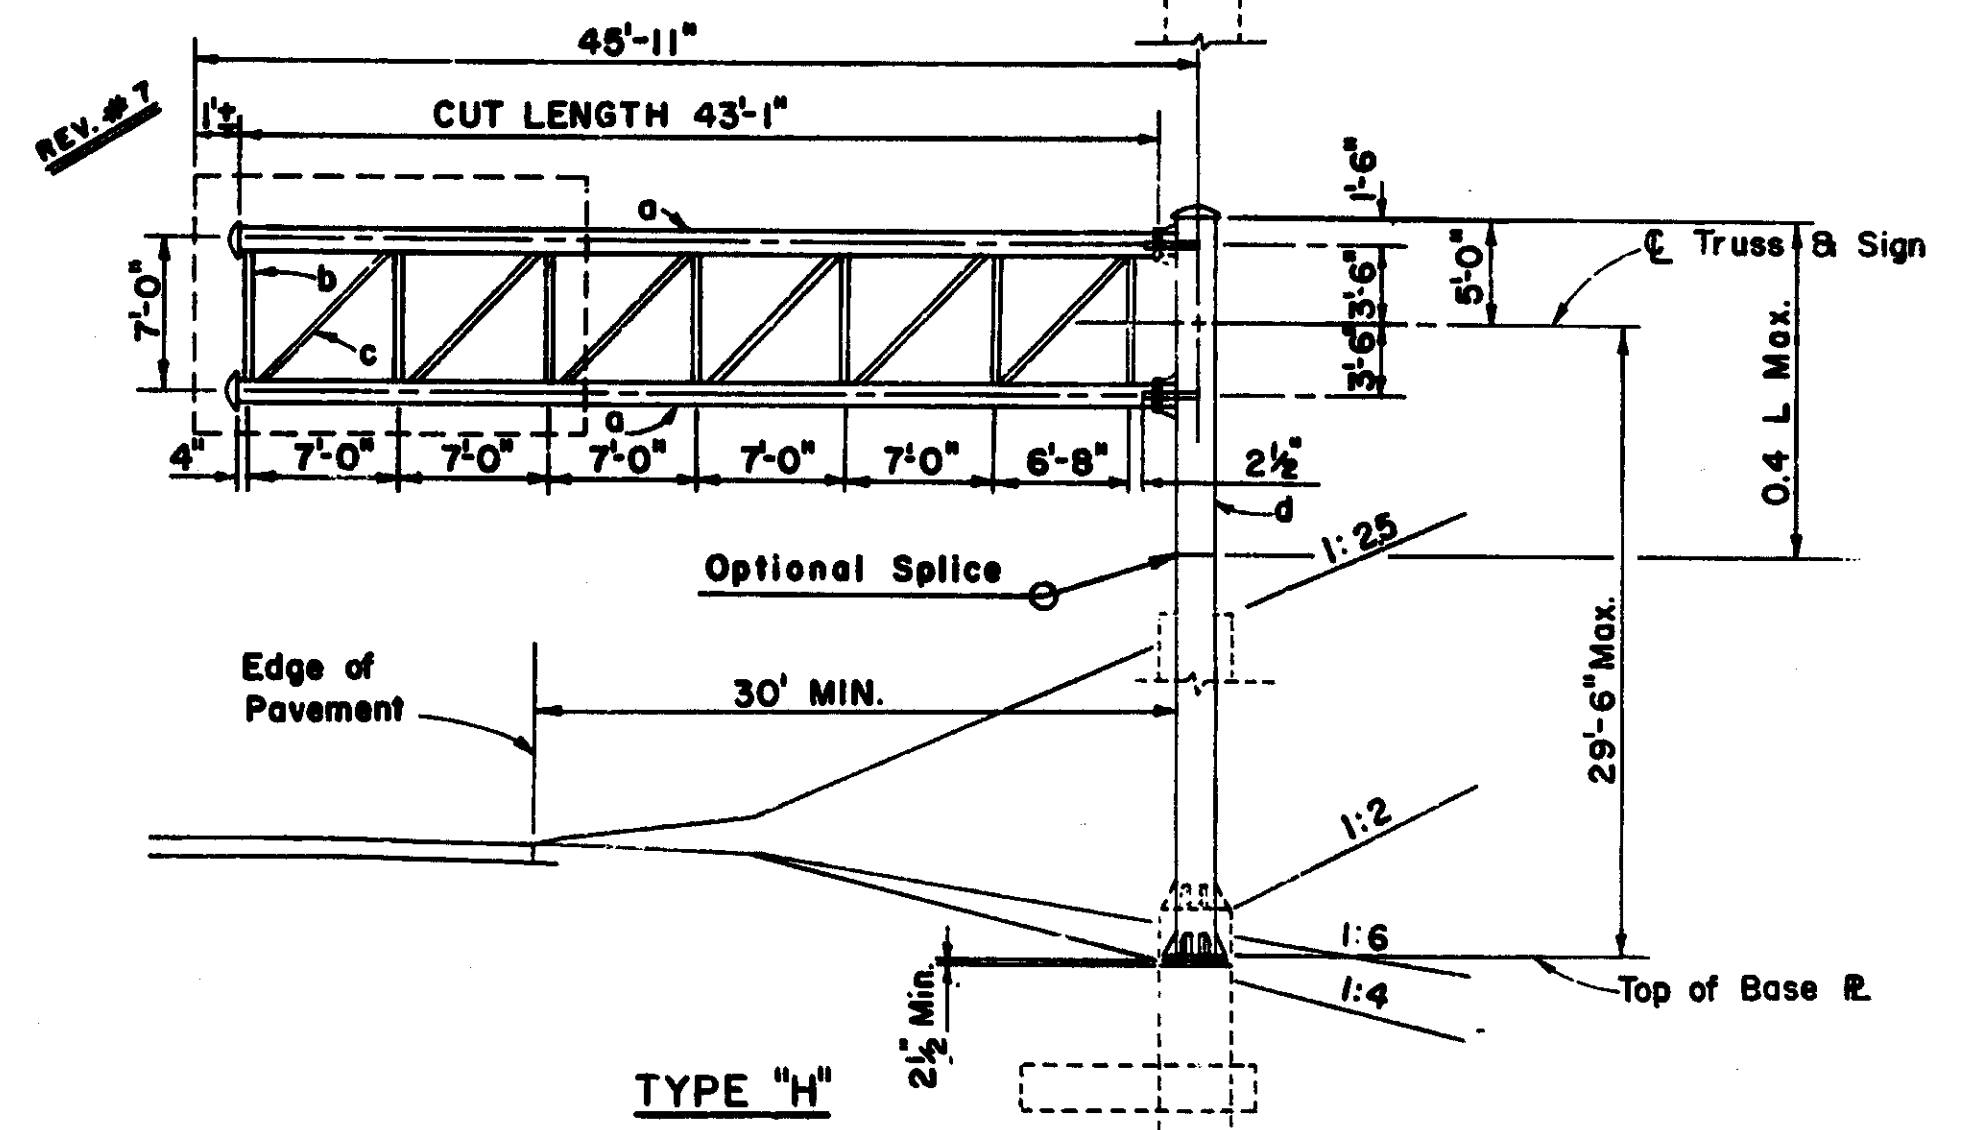


TYPE "G"

TYPE "H"

CANTILEVER SCHEDULE

MEMBER	TYPE "G"	TYPE "H"	STEEL
a	10" ϕ x 4.38 x 48.19	12" ϕ x 4.38 x 57.53	A-441 or API 5L, Grade X52
b	4" ϕ x 2.37 x 10.79	4" ϕ x 2.37 x 10.79	API 5L, Grade X52
c	do	do	API 5L, Grade X52
d	20" ϕ x 3.75 x 78.60	24" ϕ x 3.75 x 94.61	A-441 or API 5L, Grade X52
Base R	38" DIA. x 1 1/2"	38" DIA. x 1 1/2"	A-36
Flange R	20" DIA. x 1 1/2"	22" DIA. x 1 1/2"	A-441
Truss & Sign			A-441

- NOTES:
- 1) Weld at truss members - use $\frac{3}{8}$ " fillet weld on all vertical & diagonal member connections to the horizontal pipes.
 - 2) See S9.10 for sign connection details.



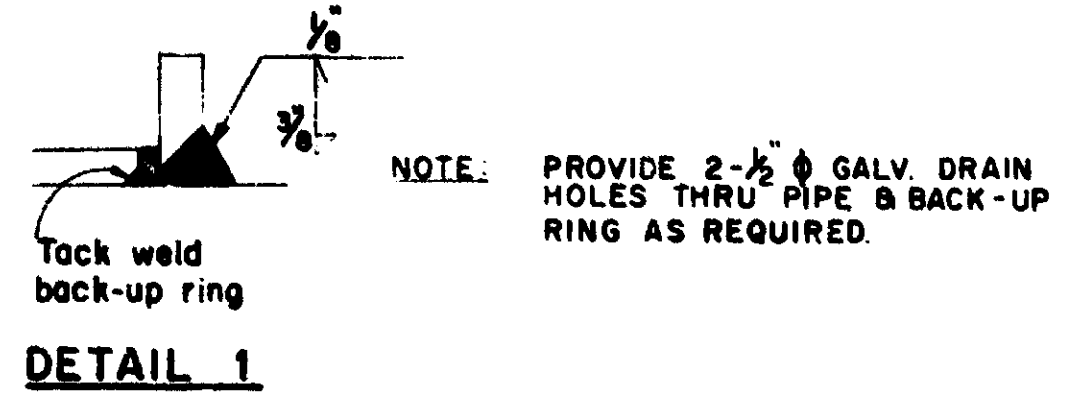


DETAIL 1

MICHIGAN DEPARTMENT OF STATE HIGHWAYS
STEEL CANTILEVER
TYPE G,H

REVISIONS	DATE	BY
4 ALTERNATE CANTILEVER SCHEDULE ADDED 11/74 LRP		
5 HANDHOLE DETAIL ADDED NOTE 3 DELETED 4/78 TFW		
6 NOTES FOR SECTION A-A ADD.		
7 REVISION #4 DELETED		
8 MAX. SIGN SIZE DELETED		
1 OPTIONAL TYPE "H" W/ MID-SPAN SPLICE	10/89	TFW
2 ADDITION TO CANTILEVER SCHEDULE		
3 SIZE & STEEL CHANGES (MEMBERS) B		
WELD SIZE CHANGE	1/70	TFW

DRYAN BOSS
DRAWN BY
CHECKED BY
SHEET 1 OF 3
S5.40

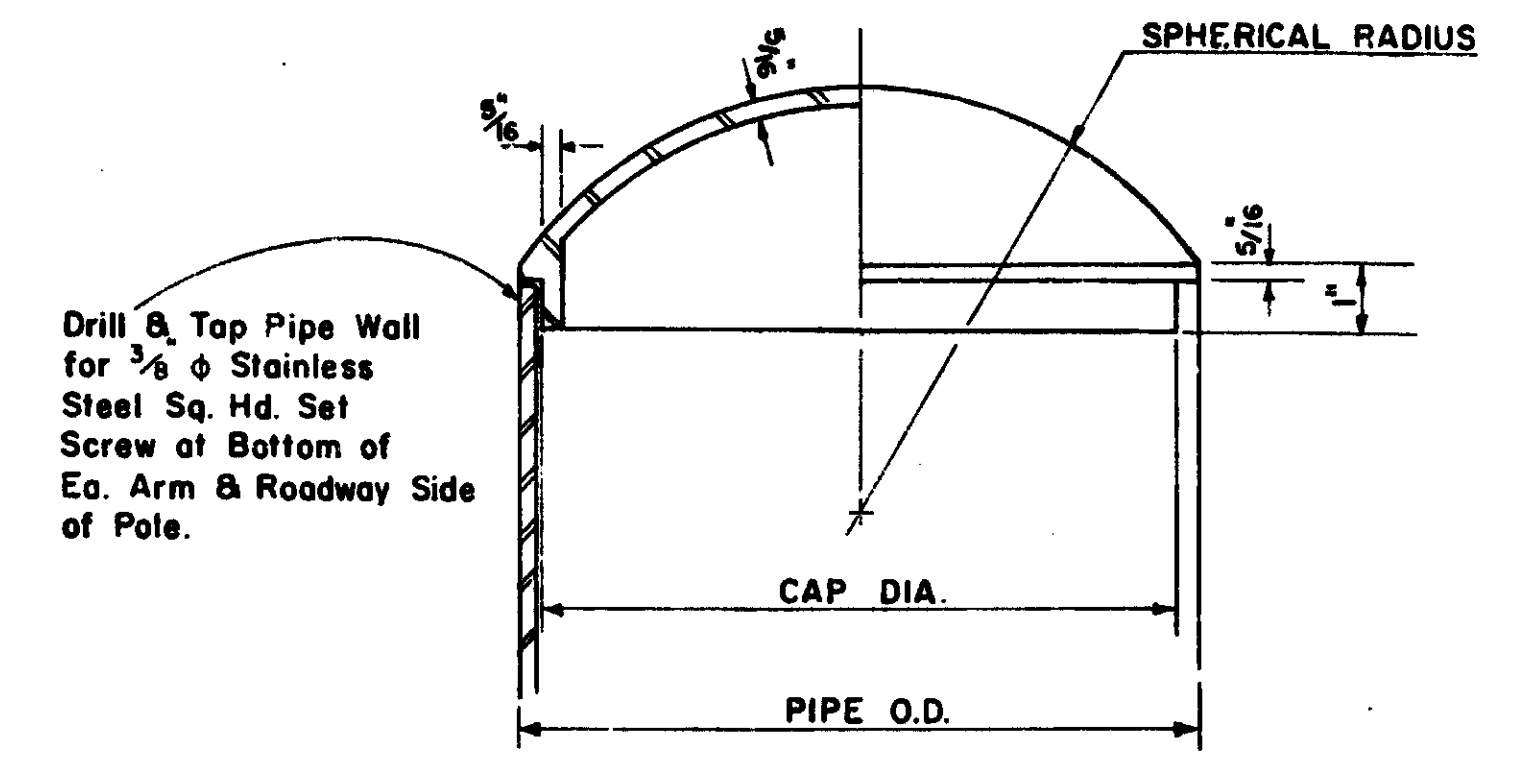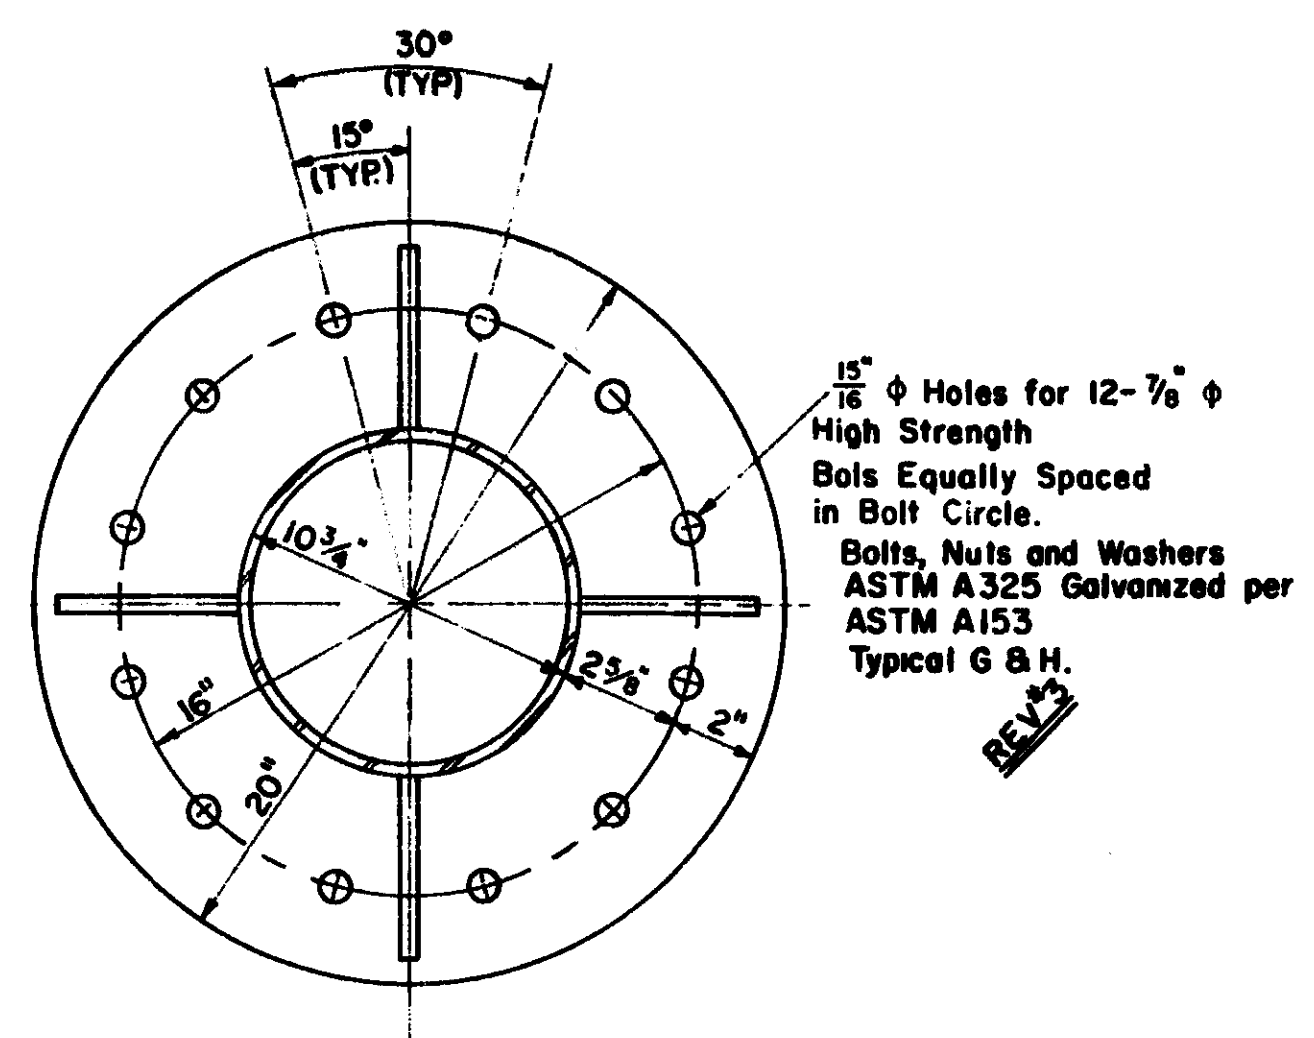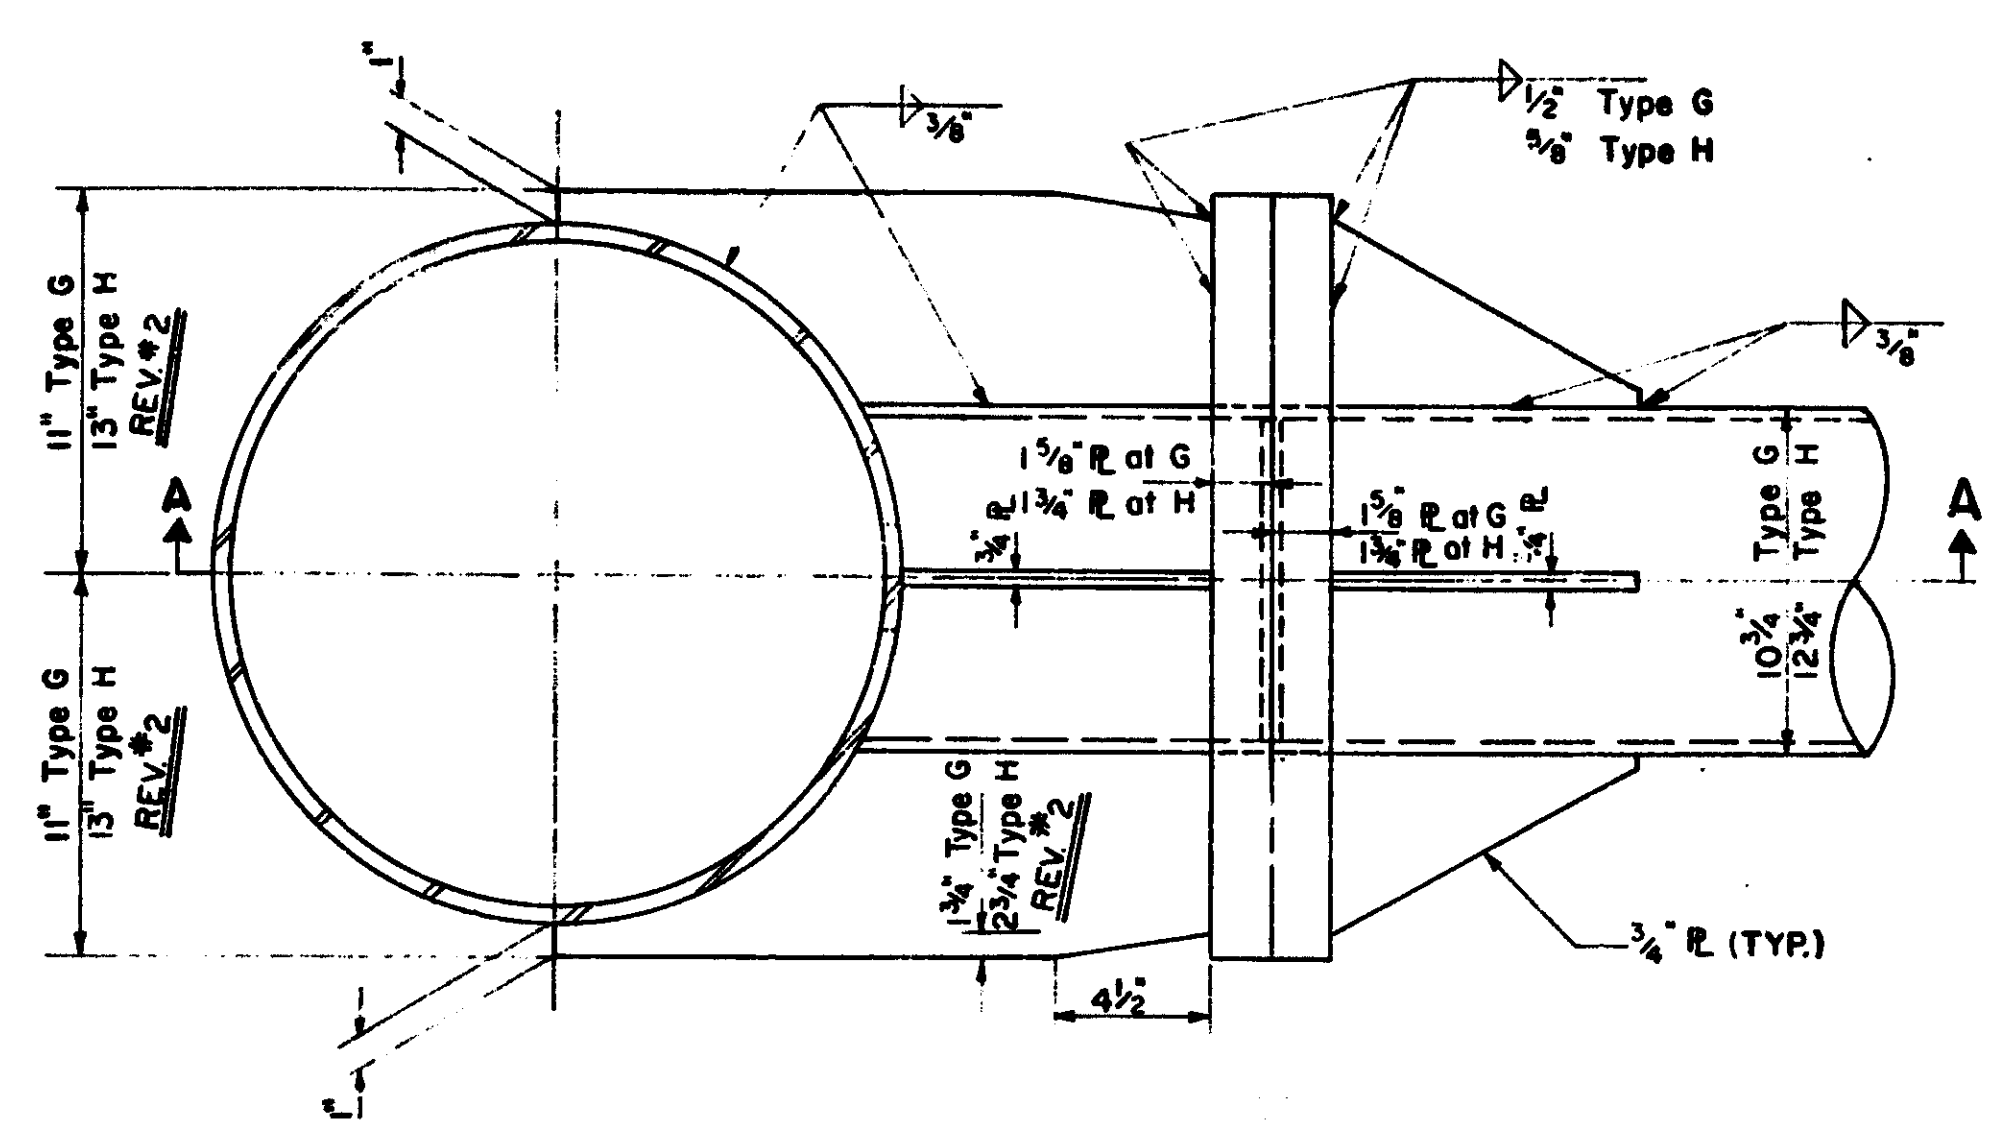


**PIPE CAST DETAILS
(CAST IRON)**


CAP DIMENSIONS		
PIPE O.D.	CAP DIA.	SPHERICAL RADIUS
10 3/4"	9 13/16"	6 3/8"
12 3/4"	11 13/16"	7 3/8"
20"	19 3/16"	11 3/4"
24"	23 13/16"	14 3/16"

TYPE G


FOR ALTERNATE CANTILEVER DIMENSIONING
SEE SCHEDULE ON (SHEET 1 of 3) S5.40

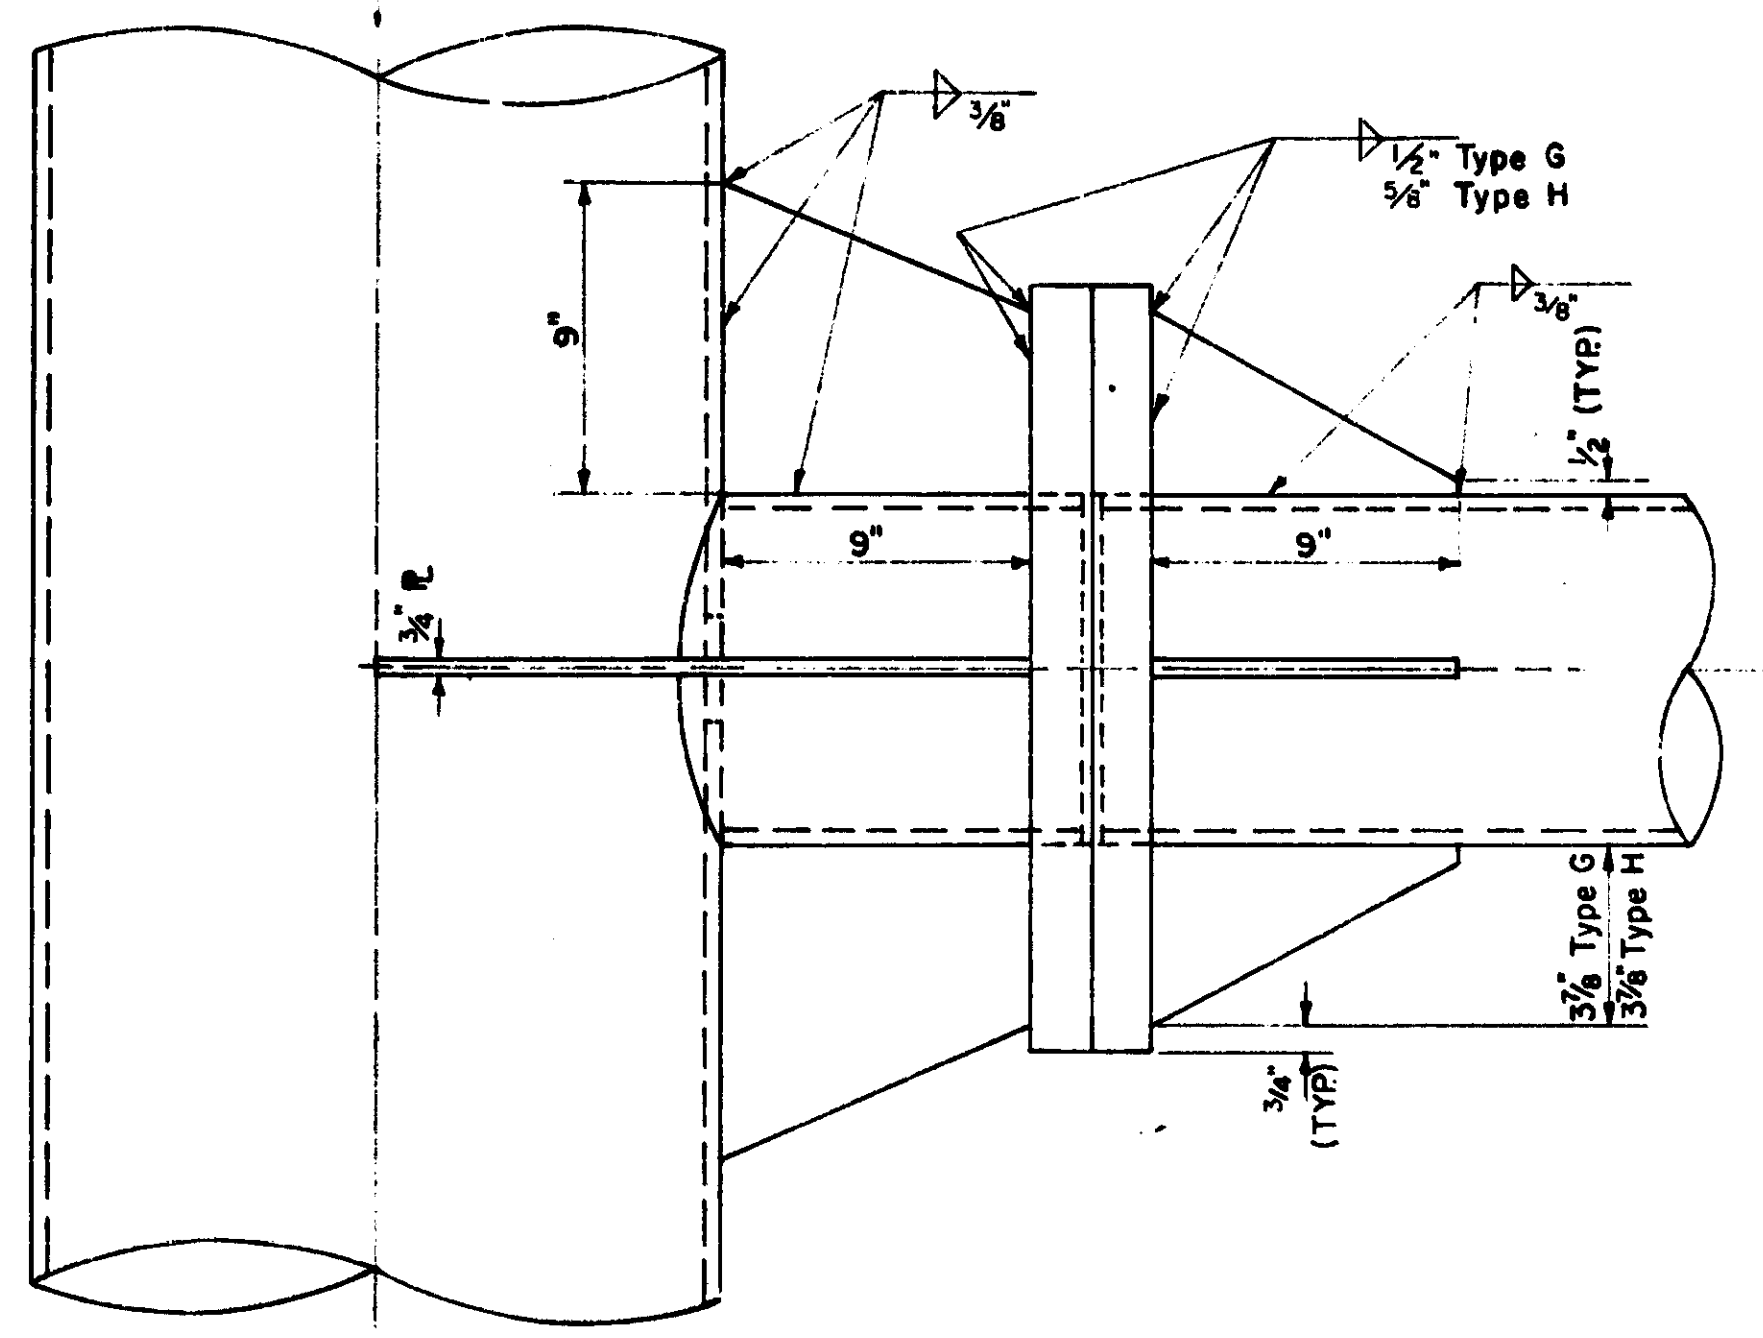

ARM CONNECTION

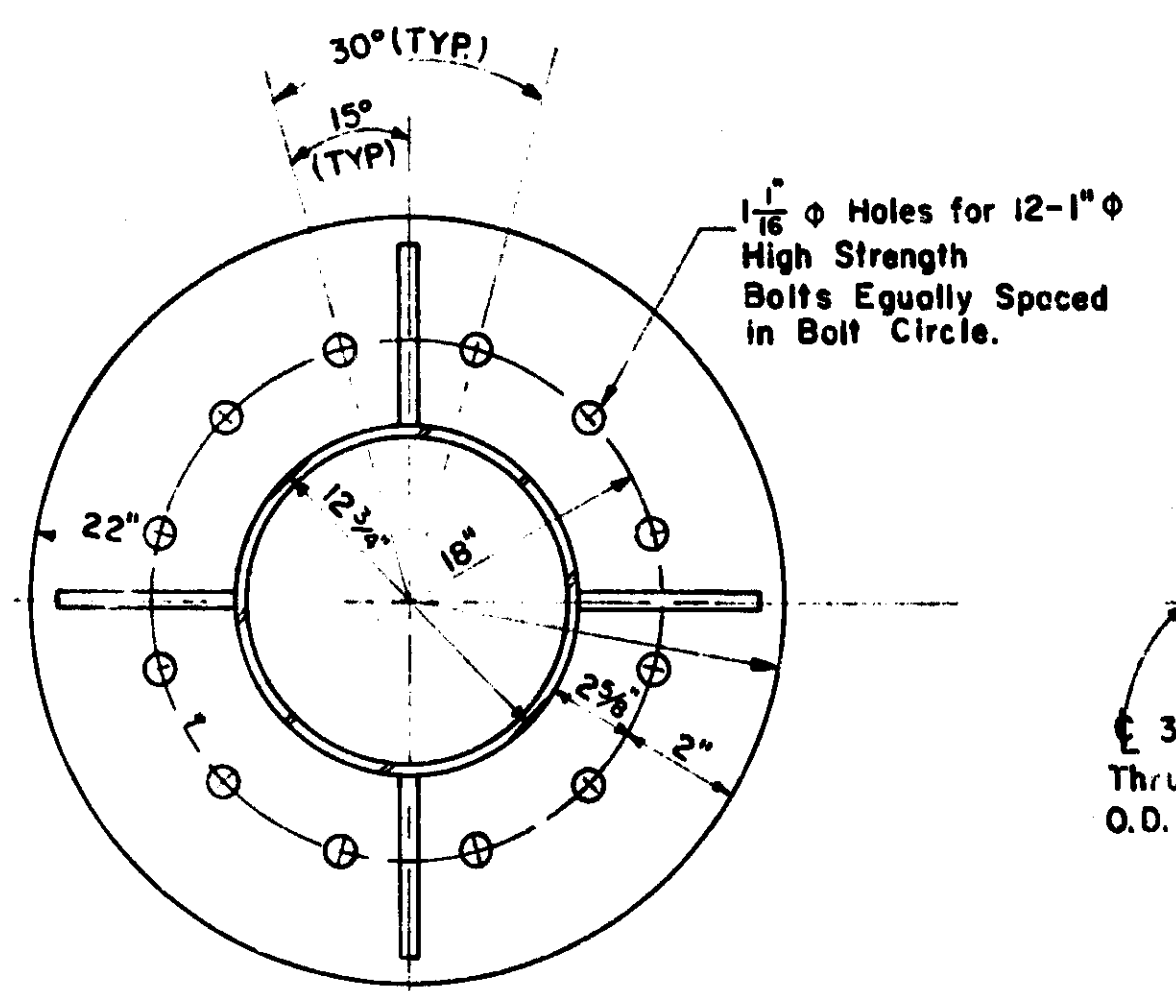


TYPE H

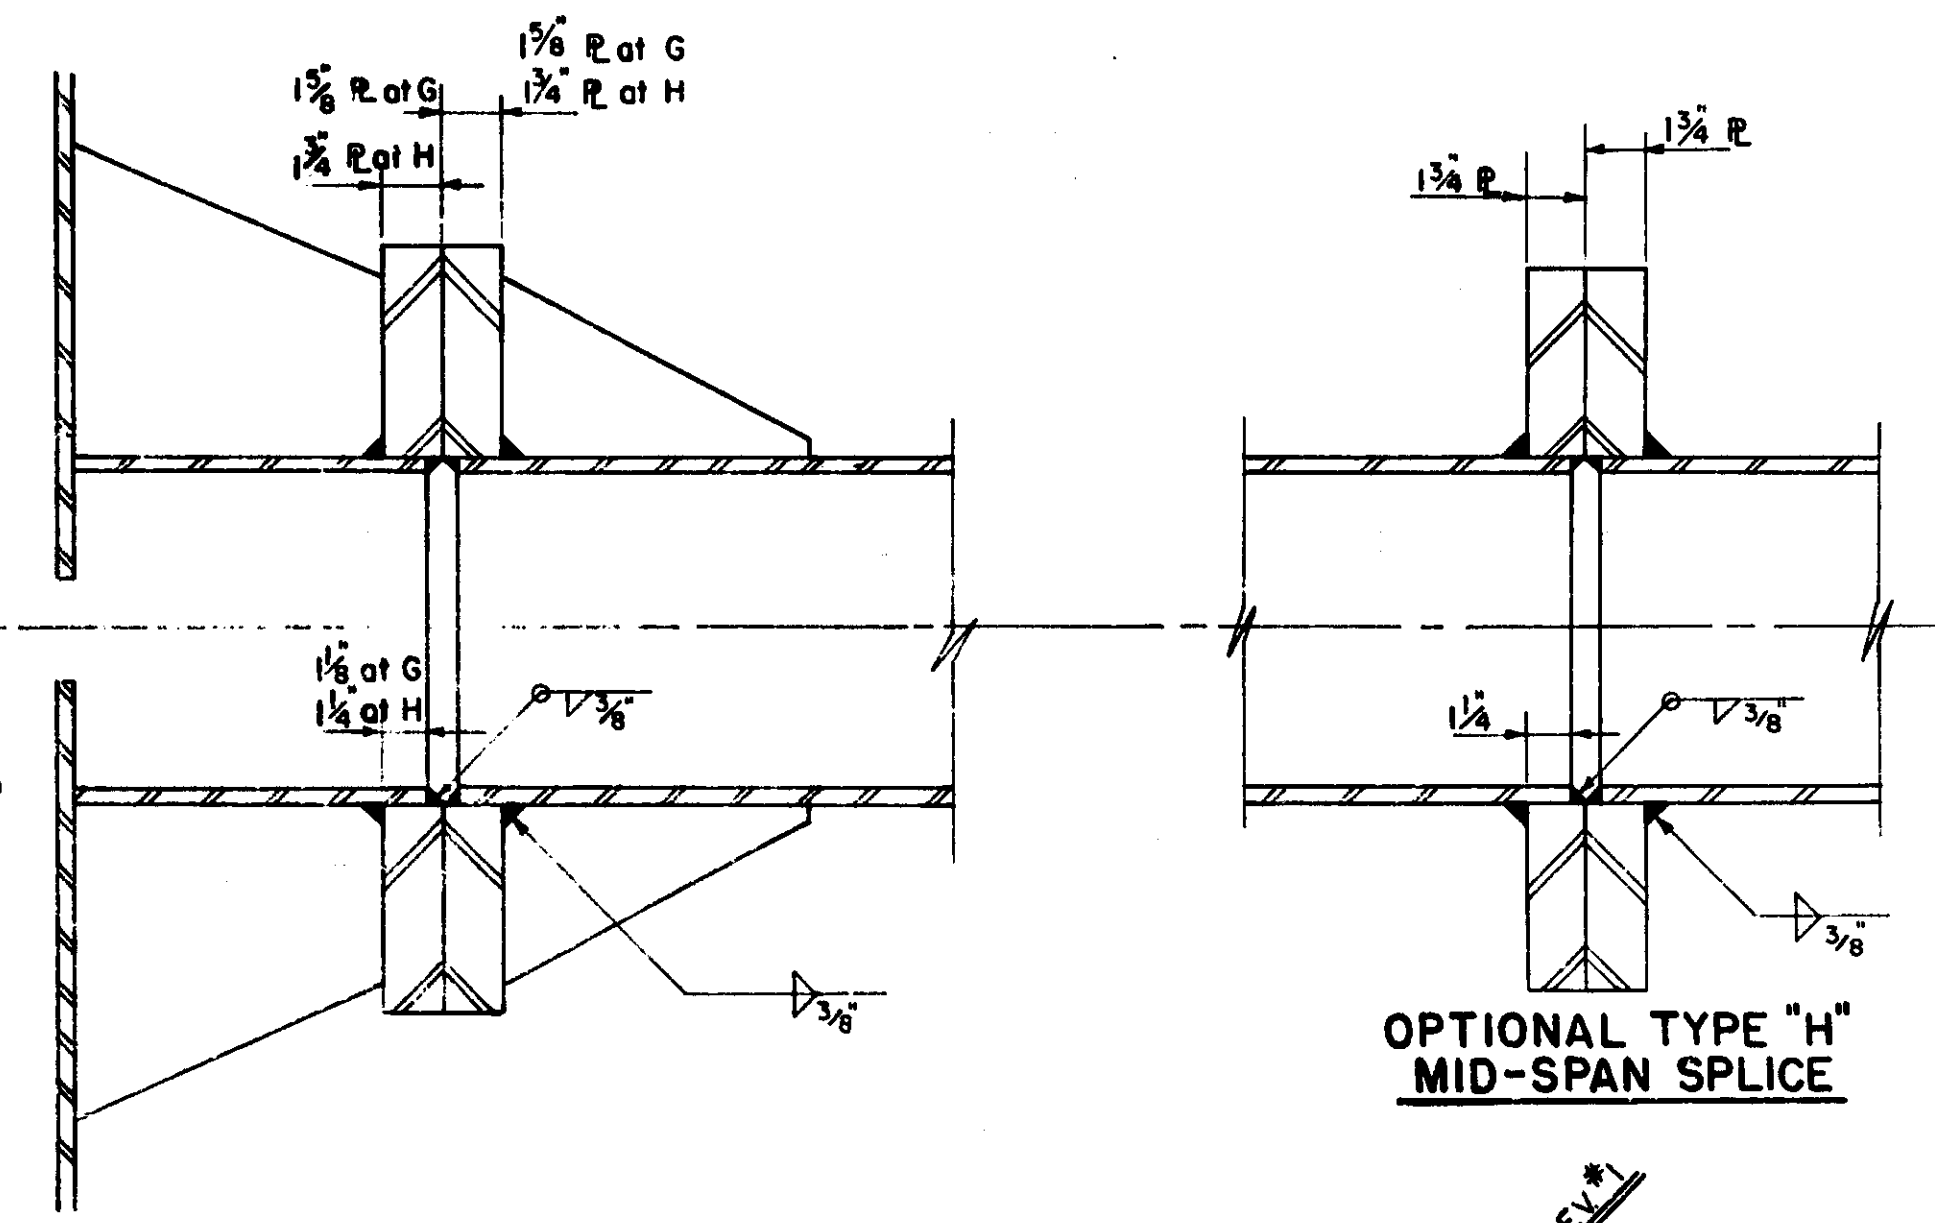

SECTION A-A

**OPTIONAL TYPE "H"
MID-SPAN SPLICE**

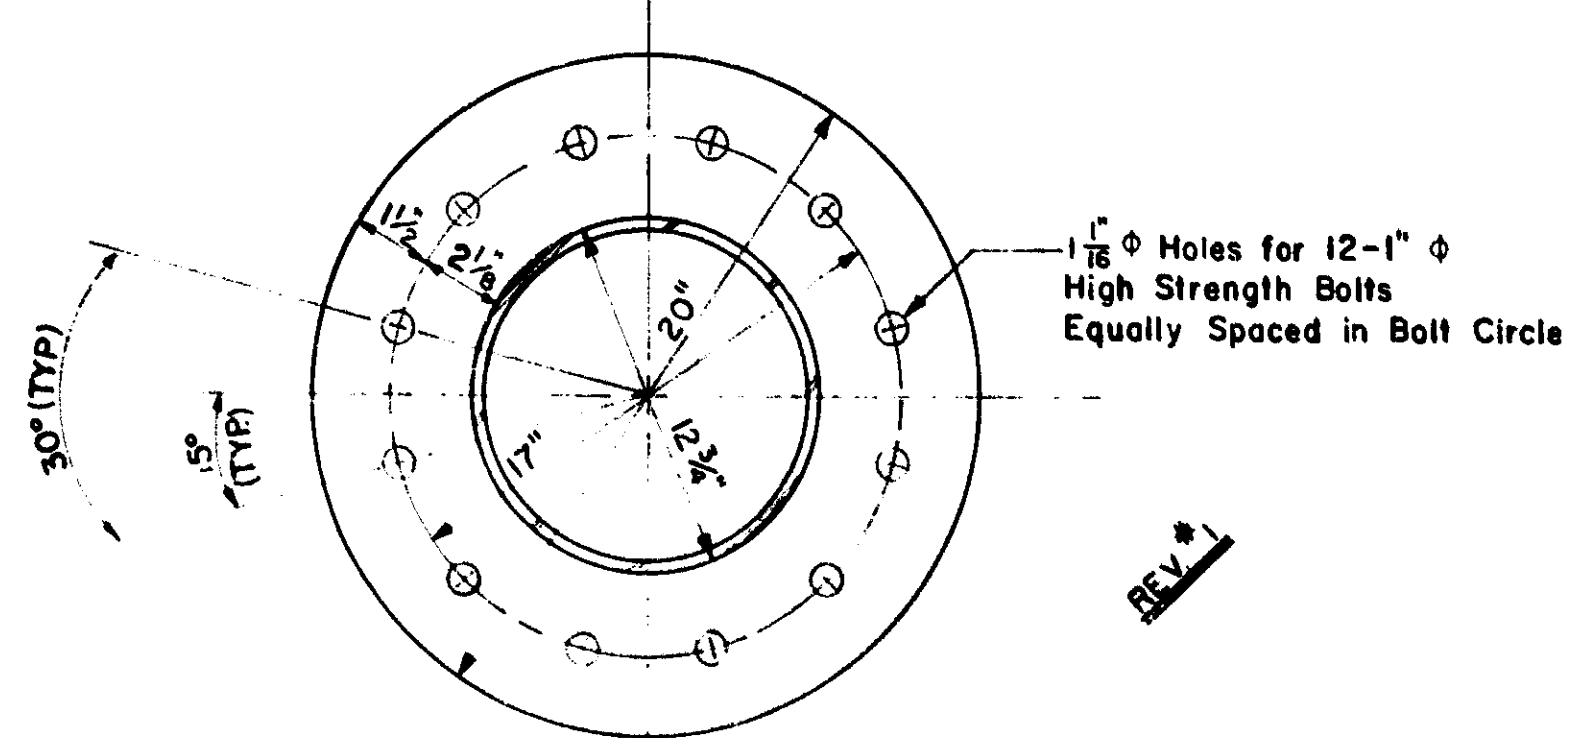


OPTIONAL TYPE "H" MID-SPAN SPLICE

**MICHIGAN DEPARTMENT OF STATE HIGHWAYS
STEEL CANTILEVER DETAILS
TYPE G, H**


REVISIONS			
NO.	DESCRIPTION	DATE	BY
1	OPTIONAL TYPE "H" MID-SPAN SPLICE ADDED	3/69	T.M.W.
2	DIMENSION CHANGES	1/70	T.M.W.
3	ASTM SPEC ADDED	2/76	J.D.B.

DESIGNED BY: _____
 DRAWN BY: _____
 CHECKED BY: _____
 SHEET 2 OF 3
S5.50

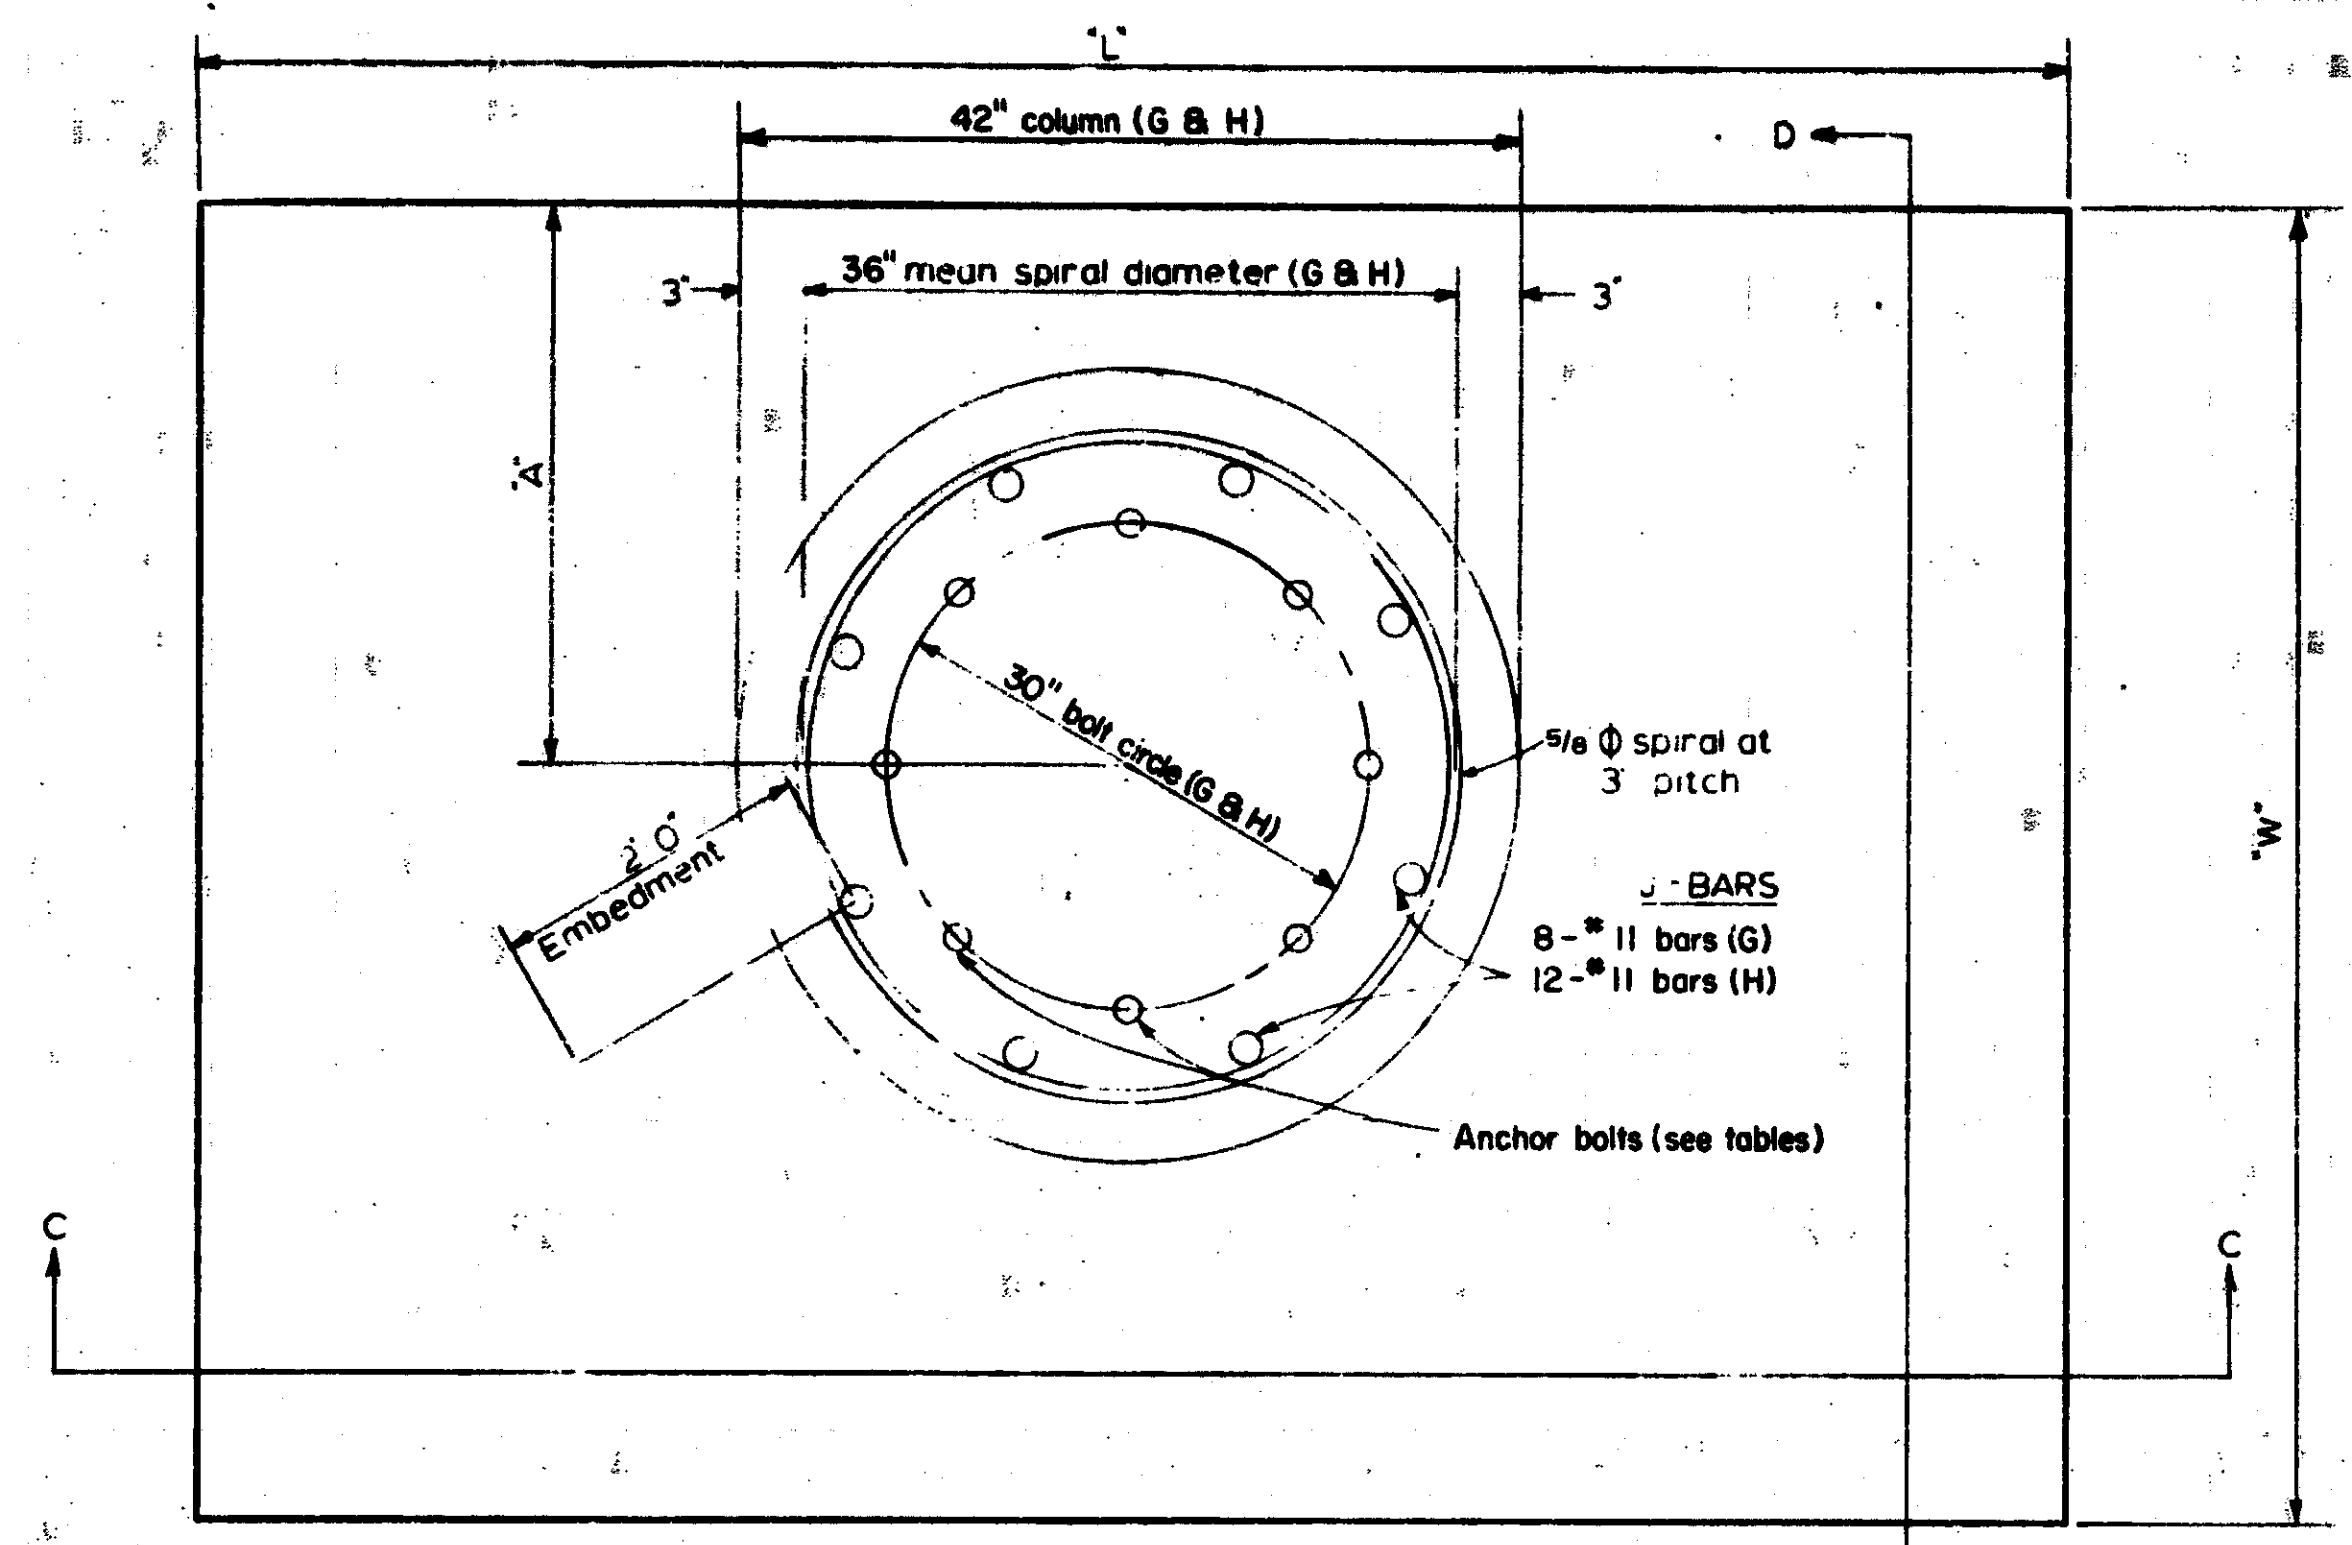

TYPE	SOIL CONDITIONS		FOOTING SIZE		"A" DISTANCE	ANCHOR BOLT	LONGITUDINAL FOOTING REINFORCEMENT TOP & BOTTOM	TRANSVERSE FOOTING REINFORCEMENT TOP & BOTTOM	CONCRETE CU. YD. (FOOTING & PEDESTAL)	REIN. STEEL WT. (FOOTING & PEDESTAL)
	Sc	N	"W"	"L"						
G-1	> 500	> 15	9'	10'	2'-9"	8 - 1 1/2" ϕ	#6 Bars 7 Spa. ϕ 1'-2" = 8'-2"	#6 Bars 14 Spa. ϕ 8" = 9'-4"	8.4	1185.4*
G-2	$\geq 250 \leq 500$	$\geq 10 \leq 15$	9'	11'	2'-9"	8 - 1 1/2" ϕ	#5 Bars 10 Spa. ϕ 10" = 8'-4"	#5 Bars 14 Spa. ϕ 9" = 10'-6"	9.1	1079.7*
G-3	$\geq 100 < 250$	$\geq 5 < 10$	11'	16'	2'-9"	8 - 1 1/2" ϕ	#5 Bars 11 Spa. ϕ 11 1/2" = 10'-6 1/2"	#5 Bars 13 Spa. ϕ 1'-2 1/4" = 15'-5 1/4"	14.8	1267.4*
H-1	> 500	> 15	10'	11'	2'-9"	8 - 2" ϕ	#7 Bars 8 Spa. ϕ 1'-2" = 9'-4"	#7 Bars 18 Spa. ϕ 7" = 10'-6"	9.9	1882.6*
H-2	$\geq 250 \leq 500$	$\geq 10 \leq 15$	10'	12'	2'-9"	8 - 2" ϕ	#6 Bars 10 Spa. ϕ 11" = 9'-2"	#6 Bars 18 Spa. ϕ 7 1/2" = 11'-3"	10.7	1678.6*
H-3	$\geq 100 < 250$	$\geq 5 < 10$	14'	16'	2'-9"	8 - 2" ϕ	#6 Bars 10 Spa. ϕ 1'-4 1/4" = 13'-6 1/2"	#6 Bars 16 Spa. ϕ 11 1/2" = 15'-4"	18.4	1957.5*

Sc = Allowable shear in cohesive soils $\frac{lb}{ft^2}$
 N = Blows/foot of penetration (ASTM testing procedure)


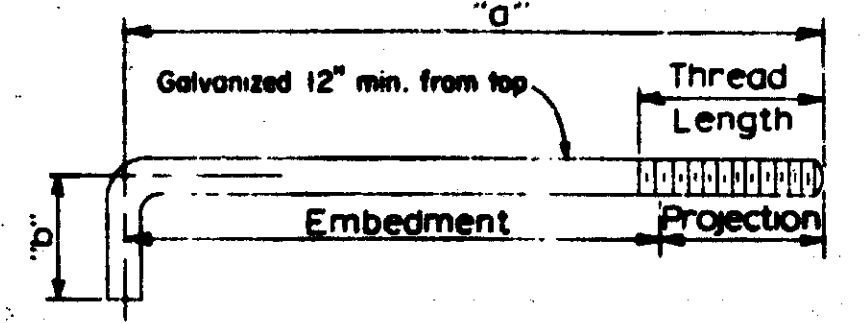


Cont. Type	a	b	Thread Length	Projection
G	4'-6"	6'-3/4"	6 1/2"	6 1/4"
H	4'-6"	6'-3/4"	7"	6 7/8"

ANCHOR BOLT TABLE

ANCHOR BOLTS: Minimum tensile strength 85,000 psi. and galvanized in accordance with ASTM A153.
 NUTS: Extra heavy hex. head galvanized. 16 Req'd. ASTM A307.
 WASHERS: 1 1/2" ϕ Type G; 2" ϕ Type H. Two per anchor bolt, Standard flat galvanized. 16 Req'd.


NOTES: (1) All reinforcing steel shall conform to standard specifications 8.05.03. Deformed bars shall be ASTM A615-Grade 60. Spirals shall be ASTM A306-Grade 80.
 (2) Deformed bars shall be ASTM A615-Grade 60. Spirals shall be ASTM A306-Grade 60.

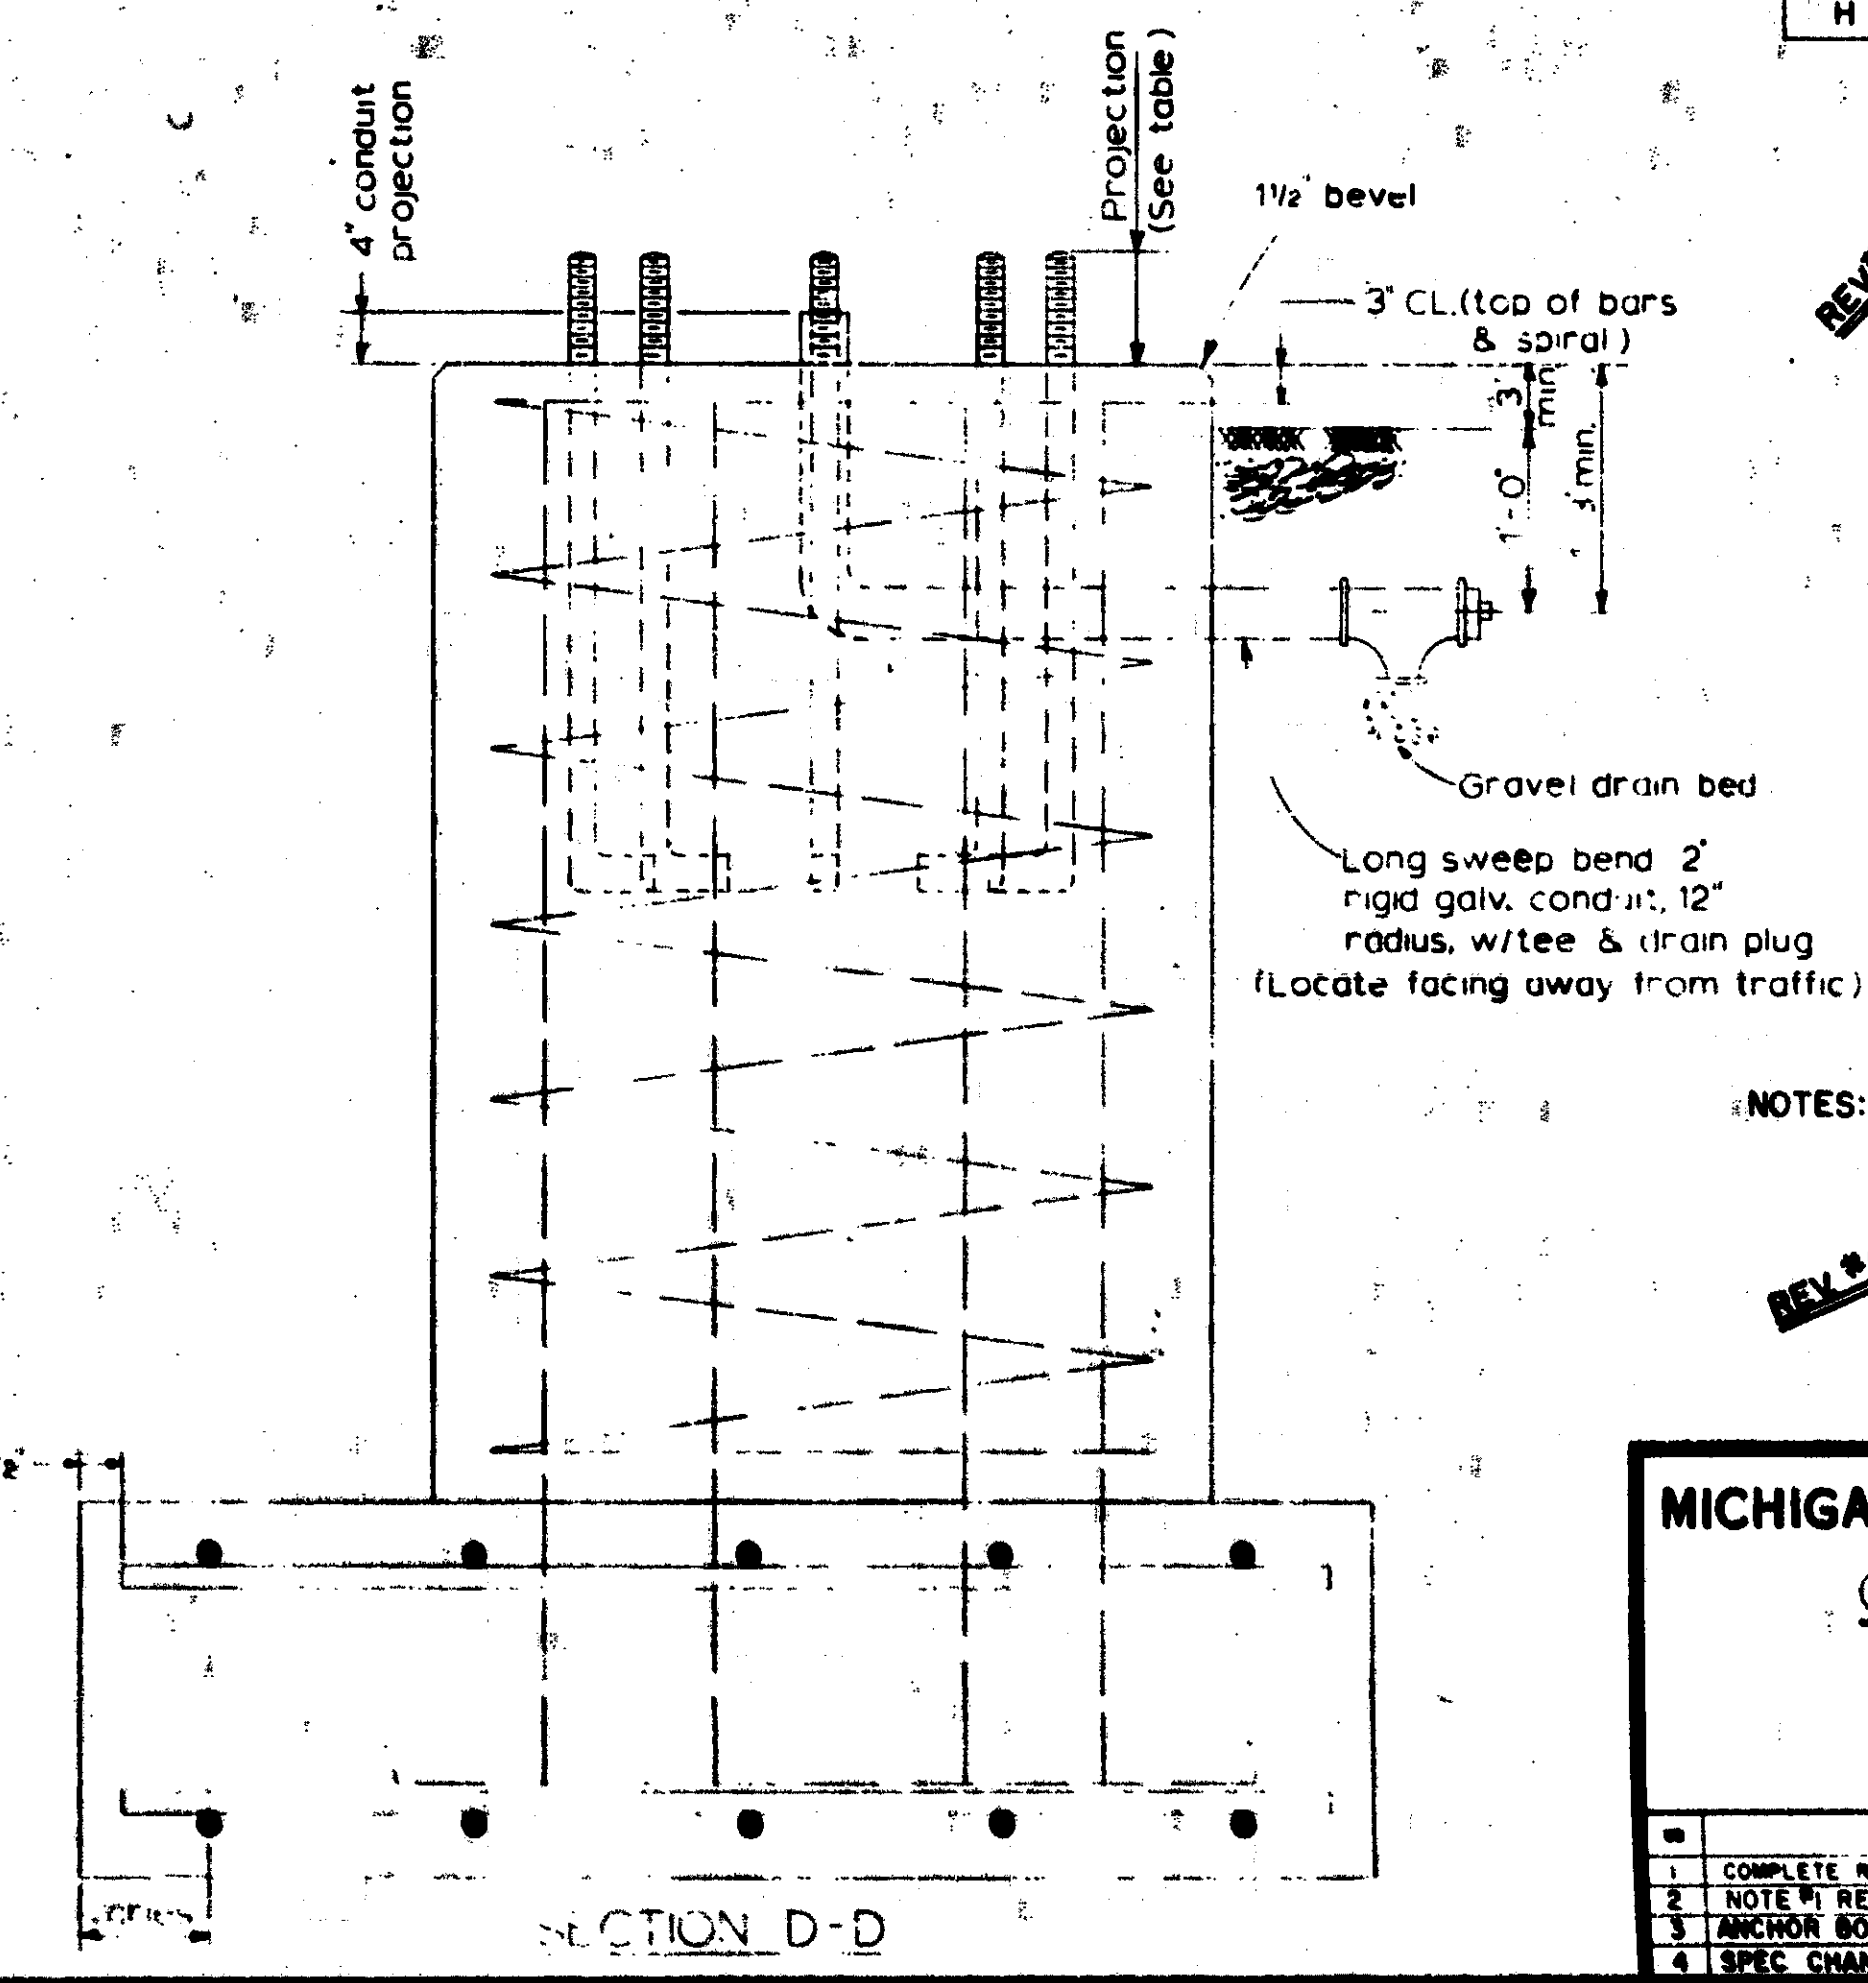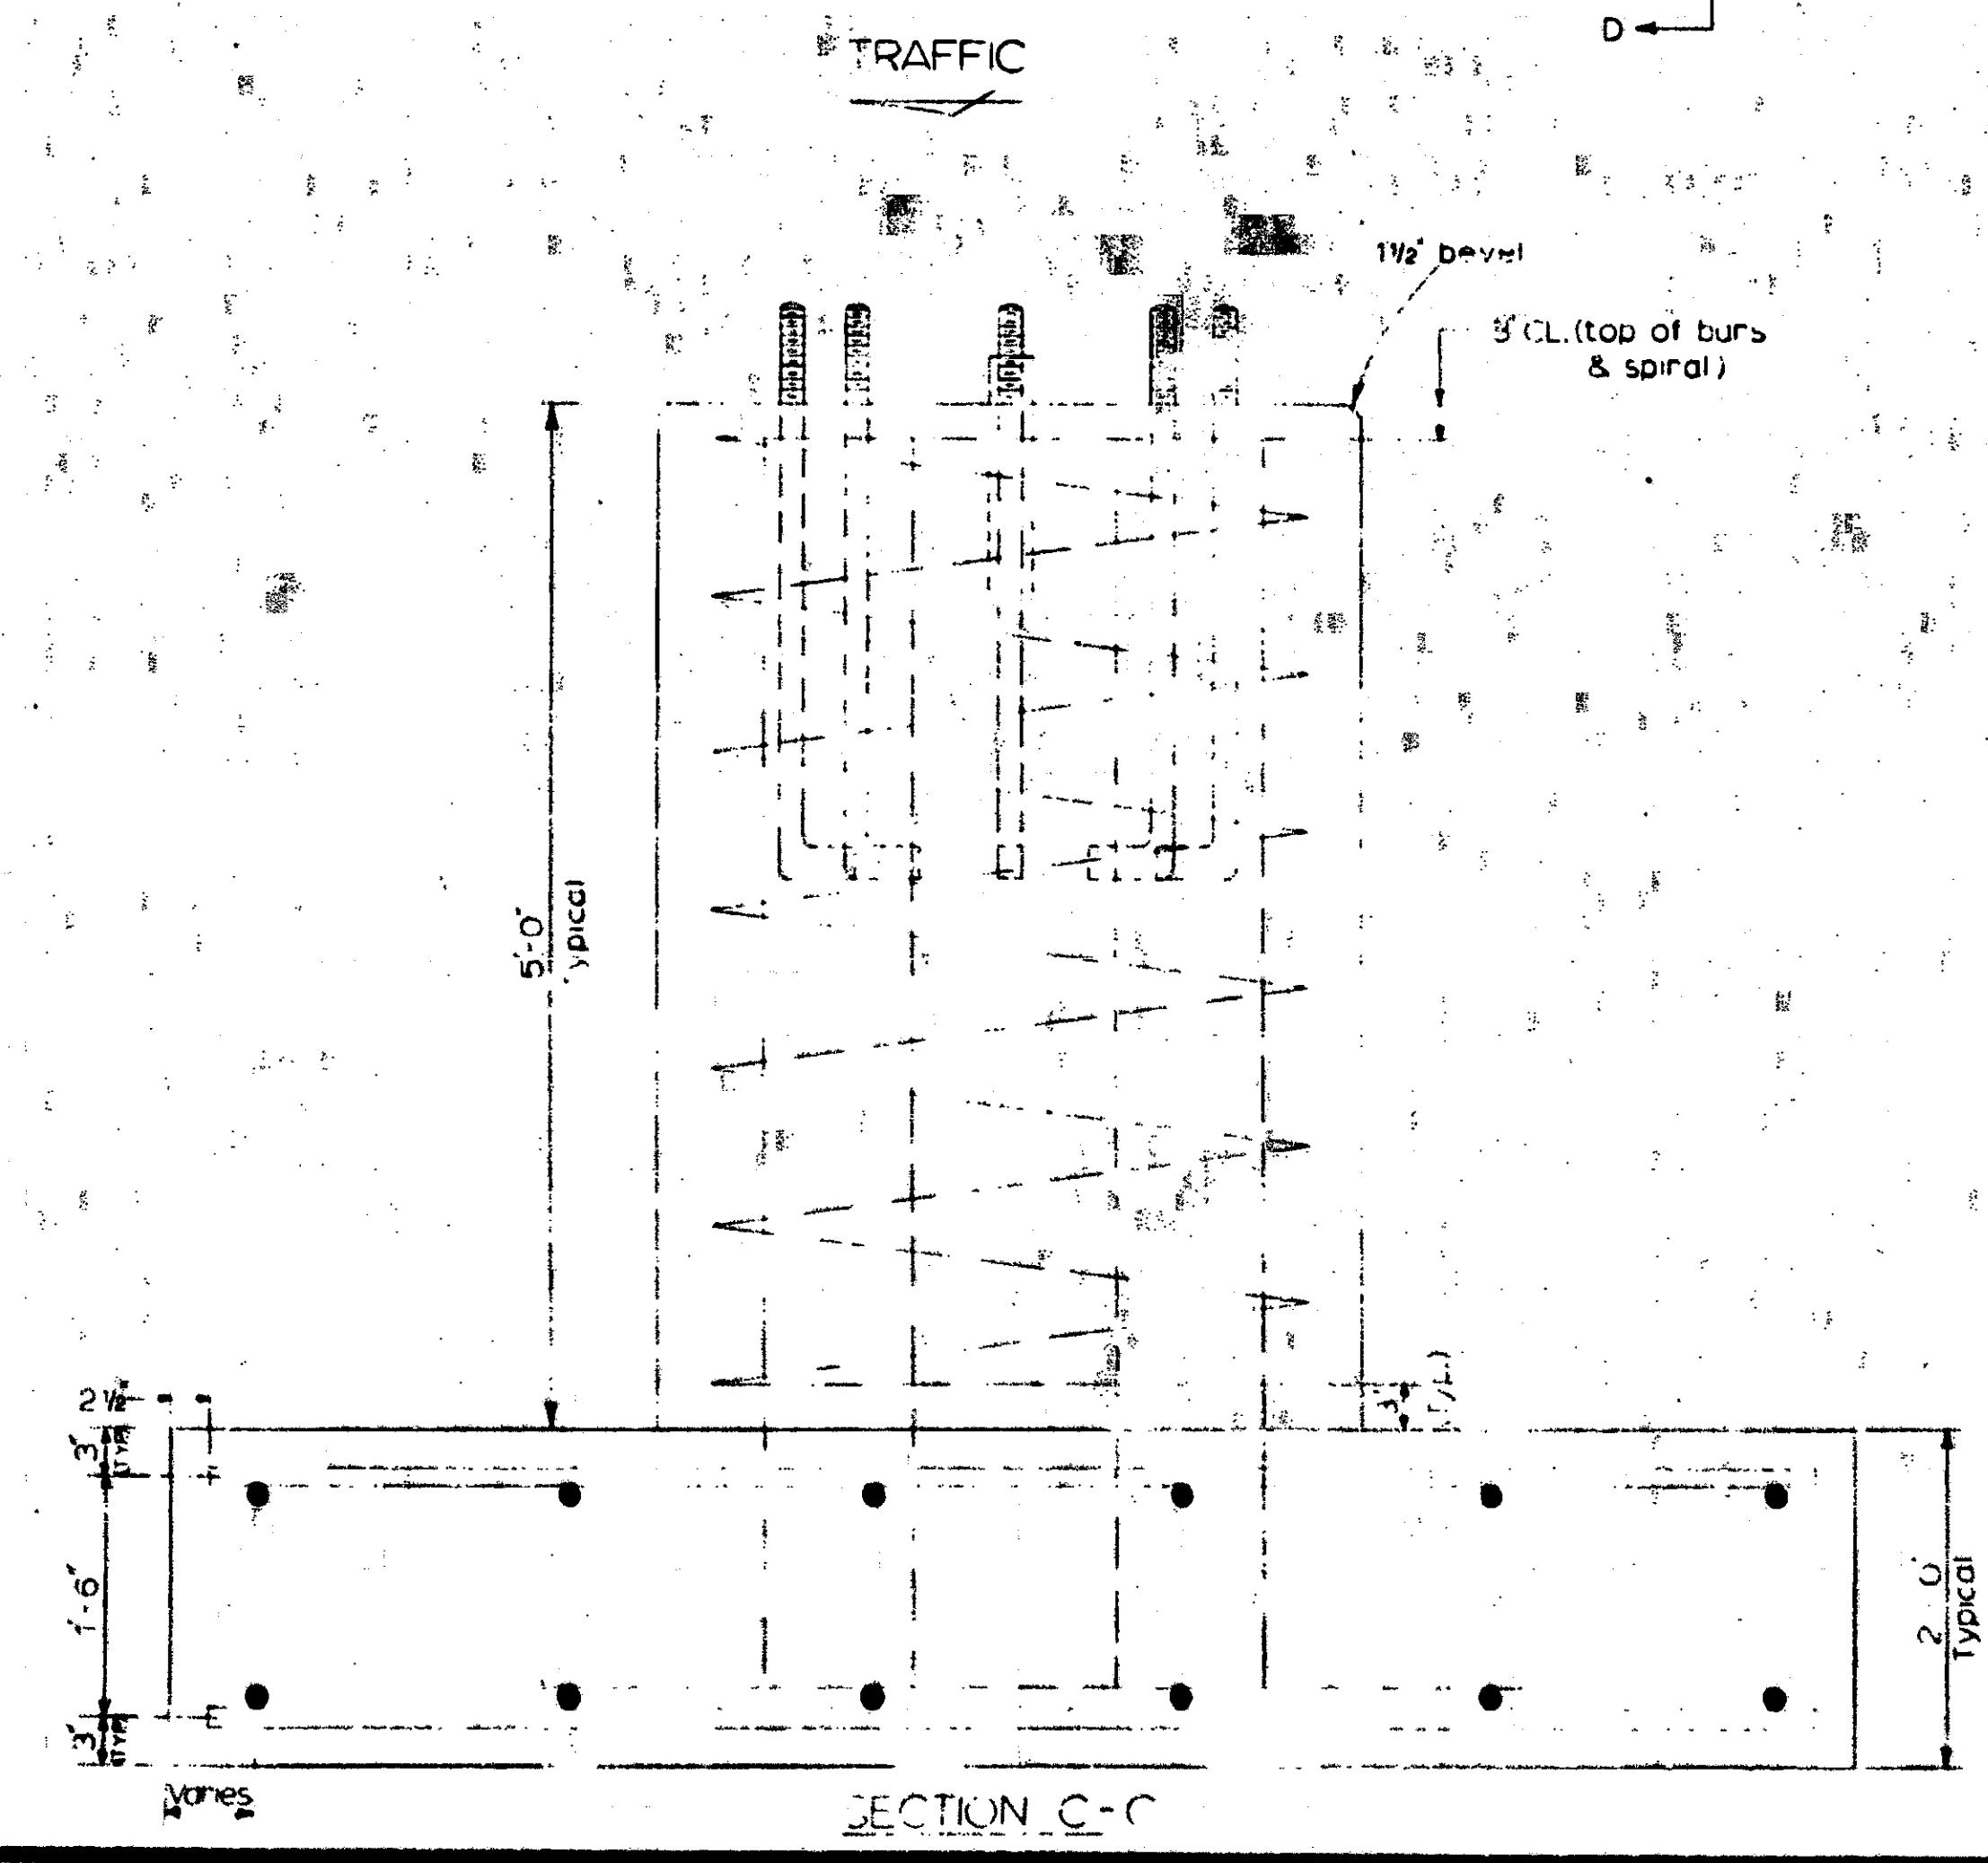

MICHIGAN DEPARTMENT OF STATE HIGHWAYS
CANTILEVER FOUNDATIONS
TYPE G & H

NO.	DESCRIPTION	DATE	BY
1	COMPLETE REVISION	7/71	KJO
2	NOTE #1 REVISED	4/72	YMW
3	ANCHOR BOLT TABLE REVISED	6/73	
4	SPEC CHANGED	1/78	JDB

Sheet 56 of 96
 S5.60

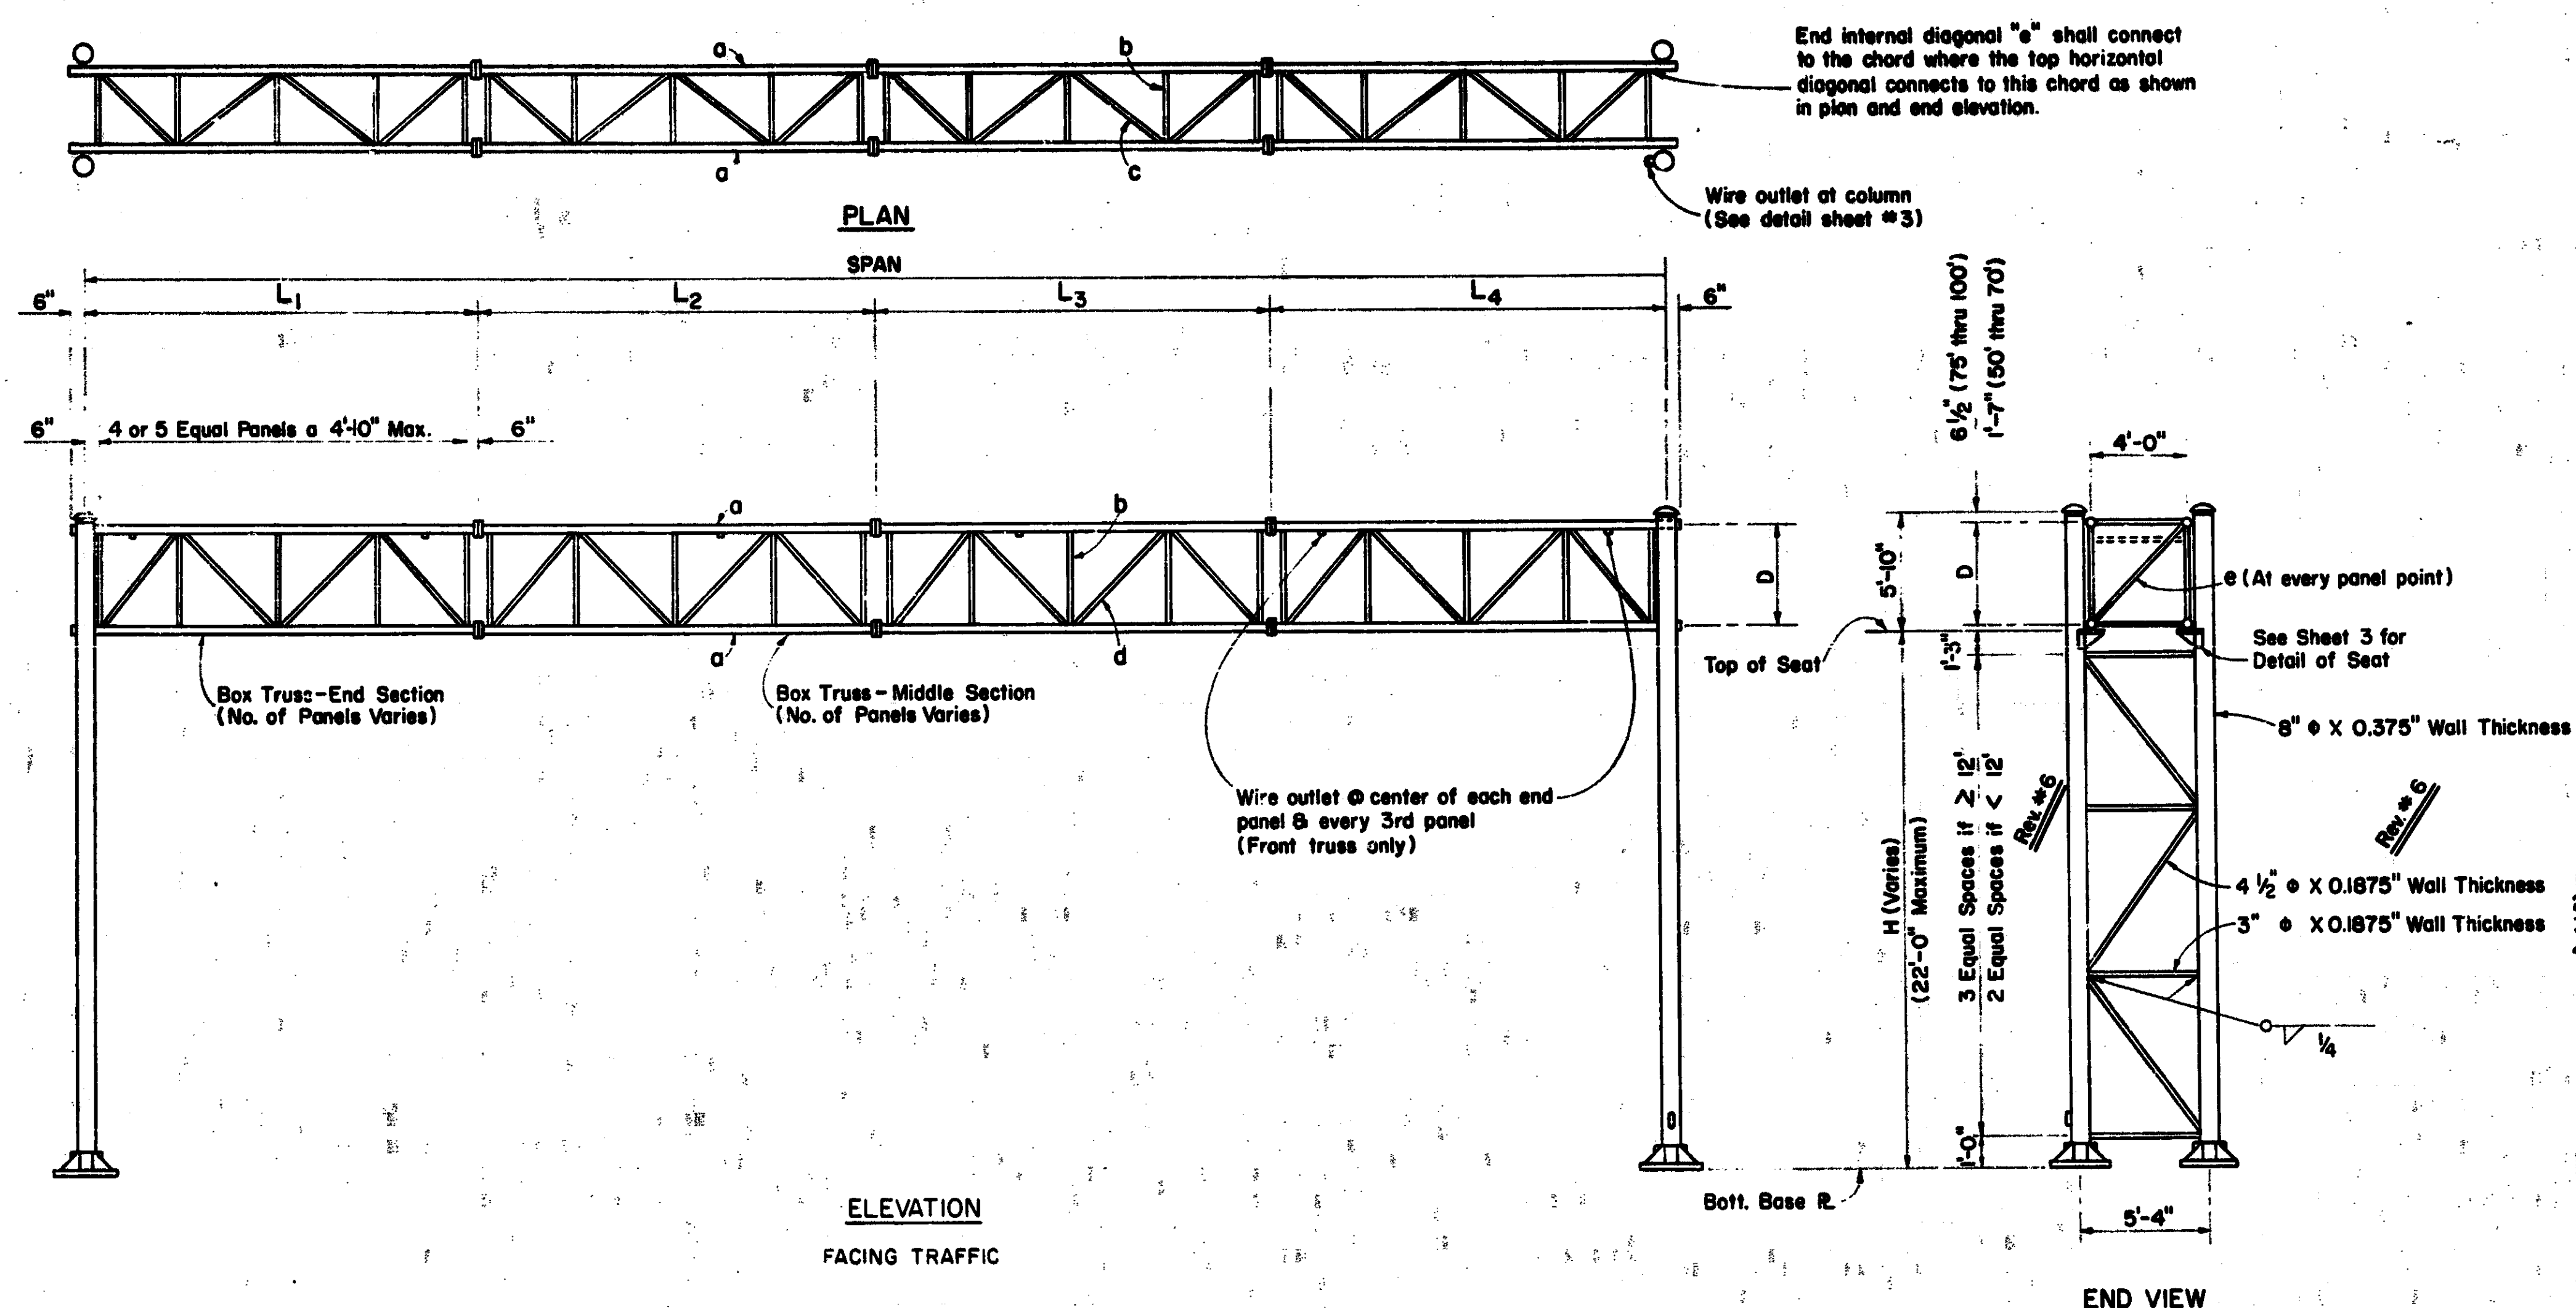

- Notes:**
- All columns and chord members shall be aluminum alloy 6061-T6.
 - All web members shall be aluminum alloy 6063-T6.
 - Connections shall be welded with filler alloy 5356.
 - The design of this structure is based on the American Association of State Highway Officials' Specifications for the Design and Construction of Structural Supports for Highway Signs. (1961 Edition)
- Max. projection of sign beyond chord is 4 ft.
- Design based on a wind load of 35 psf. on sign area.
- All U-Bolts and accompanying washers shall be stainless steel - ASTM A 320, Grade B8 (AISI Type 304).
- See std. plan S9.10 for sign connection.
 - The cambering shall be provided in the fabrication so that the flanges are correctly sloped to assure obtaining full contact in the relaxed position prior to snugging up the flange bolts. The flange bolts shall not be torqued in an attempt to close any flange misalignment. Trusses shall not be lifted by the web members.
 - All other connecting bolts, nuts and washers shall be stainless steel AISI 300 series alloy. Bolts shall have a minimum yield strength of 30,000 psi. Nut shall be the self locking type.

TRUSS SCHEDULE												
SPAN	L ₁	L ₂	L ₃	L ₄	D	a	b	c	d	e *	Estimated Weight (Lbs./ft.)	Camber **
50'-0"	25'-0"			25'-0"	4'-0"	6" ø X .1875 Wall Thick.	2" ø X .125 Wall Thick.	3" ø X .1875 Wall Thick.	2" ø X .125 Wall Thick.	2" ø X .125 Wall Thick.	30	7/8"
55'-0"	20'-0"	15'-0"		20'-0"	do	do	do	do	do	do	do	1"
60'-0"	20'-0"	20'-0"		20'-0"	do	do	do	do	do	do	do	1 1/8"
65'-0"	20'-0"	25'-0"		20'-0"	do	do	do	do	do	do	do	1 1/4"
70'-0"	25'-0"	20'-0"		25'-0"	4'-0"	6" ø X .1875 Wall Thick.	do	3" ø X .1875 Wall Thick.	do	2" ø X .125 Wall Thick.	30	1 1/2"
75'-0"	25'-0"	25'-0"		25'-0"	5'-0"	7" ø X .1875 Wall Thick.	do	3 1/2" ø X .1875 Wall Thick.	do	2" ø X .125 Wall Thick.	31	1 1/2"
80'-0"	20'-0"	20'-0"	20'-0"	20'-0"	do	do	do	do	do	do	do	1 3/8"
85'-0"	20'-0"	25'-0"	20'-0"	20'-0"	do	do	do	do	do	do	do	1 7/8"
90'-0"	20'-0"	25'-0"	25'-0"	20'-0"	do	do	do	do	do	do	do	2 1/8"
95'-0"	25'-0"	20'-0"	25'-0"	25'-0"	do	do	do	do	do	do	do	2 1/2"
100'-0"	25'-0"	25'-0"	25'-0"	25'-0"	5'-0"	7" ø X .1875 Wall Thick.	2" ø X .125 Wall Thick.	3 1/2" ø X .1875 Wall Thick.	2" ø X .125 Wall Thick.	2" ø X .125 Wall Thick.	31	2 3/4"

* For transverse diagonals at panels adjacent to columns use 3 1/2" ø X .1875

** Ordinate at center of assembled truss prior to dead load deflection. Allowable camber tolerance for truss is ± 25%

- REVISIONS
1. MAX SIGN PROJECTION ABOVE TOP CHORD CHANGED 1-3-67
 2. END SUPPORT SCHEDULE REMOVED; MAXIMUM END SUPPORT LENGTH ADDED;
 3. BRACE SPACING & SIZES ADDED 7-6-67
 4. U-BOLT DESIGNATION ADDED 12-67
- NOTE #6 ADDED 3-70
- NOTE #7 ADDED 2-76
- NOTE #7 Revised 11-76

Work this sheet with Sheets 3 & 4

MICHIGAN DEPARTMENT OF STATE HIGHWAYS

ALUMINUM TRUSS TYPE B

NO.	DESCRIPTION	DATE	BY
1	DIMENSION CHANGES	11-26-64	
2	RELOCATE WIRE OUTLET	1-15-64	
3	QUALITY CHANGE	3-25-65	
4	U-BOLT CHANGED TO STAINLESS STEEL	12-25-65	

DESIGNED BY: WOB 12-12-63


DRAWN BY: []

TRACED BY: []

CHECKED BY: []

SHEET: []

S 6.10

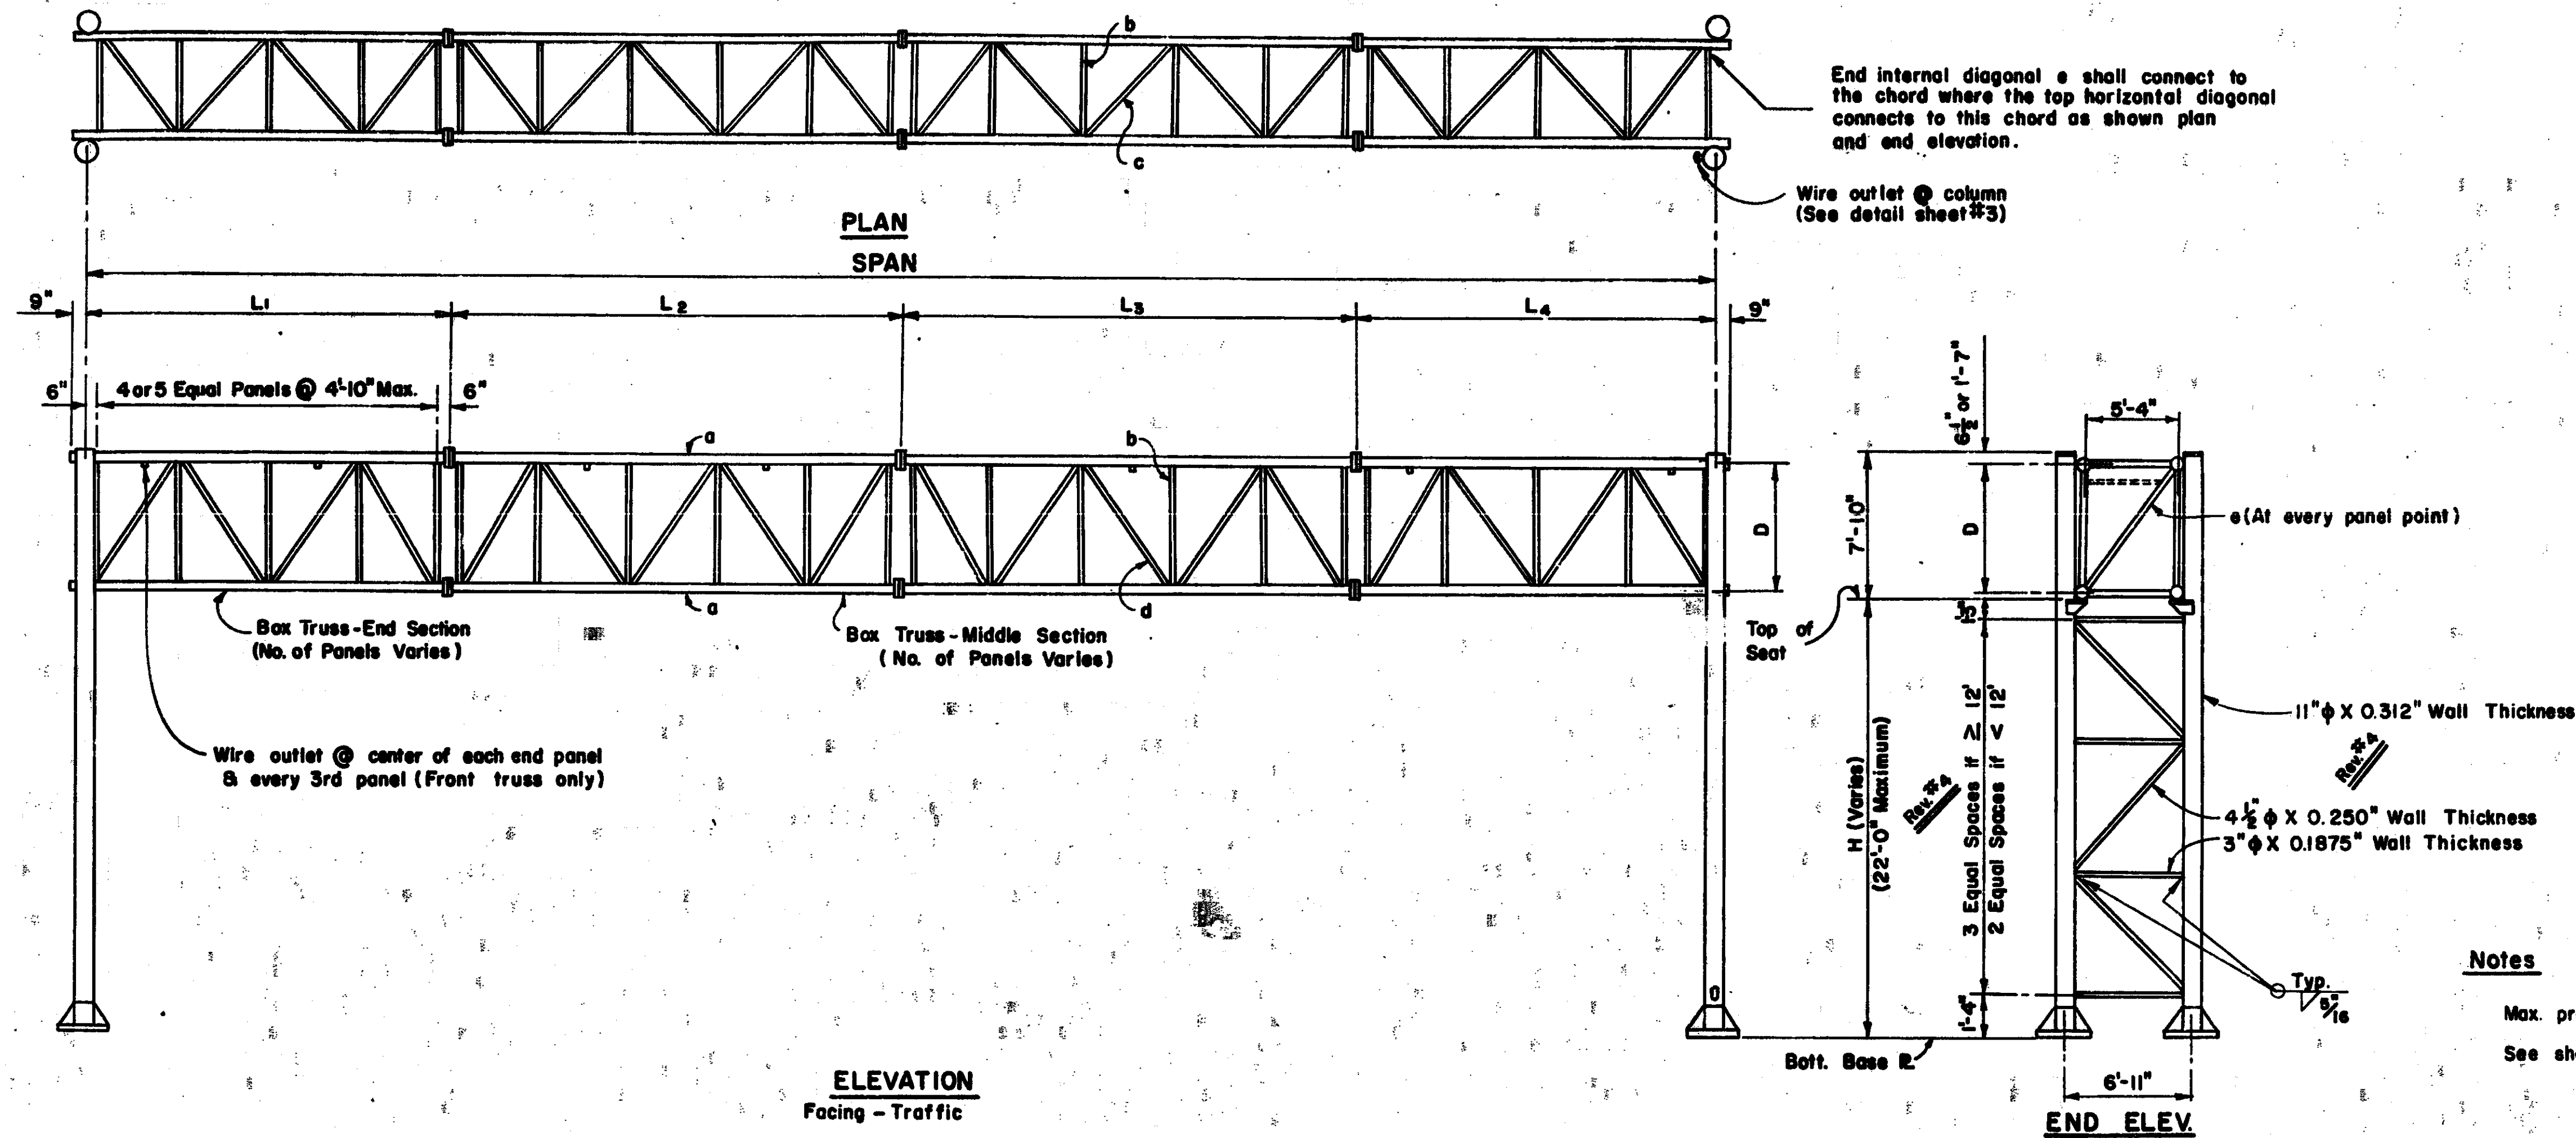

Notes

Max. projection of sign beyond chord is 6 ft.
See sheet 1 for additional notes.

ELEVATION
Facing - Traffic

TRUSS SCHEDULE

SPAN	L ₁	L ₂	L ₃	L ₄	D	a	b	c	d	e *	Estimated Weight (Lbs / Ft)	Camber **
50'-0"	25'-0"			25'-0"	6'-0"	6" φ X .1875" Wall Thick	2" φ X .125" Wall Thick	4 1/2" X .1875" Wall Thick	2 1/2" φ X .125" Wall Thick	2 1/2" φ X .125" Wall Thick	38	3/8"
55'-0"	20'-0"	15'-0"		20'-0"	do.	do.	do.	do.	do.	do.	do.	7/8"
60'-0"	20'-0"	20'-0"		20'-0"	do.	do.	do.	do.	do.	do.	do.	1"
65'-0"	20'-0"	25'-0"		20'-0"	do.	do.	do.	do.	do.	do.	do.	1 1/8"
70'-0"	25'-0"	20'-0"		25'-0"	6'-0"	6" φ X .1875" Wall Thick	2" φ X .125" Wall Thick	4 1/2" X .1875" Wall Thick	2 1/2" φ X .125" Wall Thick	2 1/2" φ X .125" Wall Thick	38	1 3/8"
75'-0"	25'-0"	25'-0"		25'-0"	7'-0"	7" φ X .250" Wall Thick	2" φ X .125" Wall Thick	4 1/2" X .250" Wall Thick	2 1/2" φ X .125" Wall Thick	2 1/2" φ X .125" Wall Thick	52	1 7/8"
80'-0"	20'-0"	20'-0"	20'-0"	20'-0"	do.	do.	do.	do.	do.	do.	do.	1 1/4"
85'-0"	20'-0"	25'-0"	20'-0"	20'-0"	do.	do.	do.	do.	do.	do.	do.	1 1/2"
90'-0"	20'-0"	25'-0"	25'-0"	20'-0"	do.	do.	do.	do.	do.	do.	do.	1 7/8"
95'-0"	25'-0"	20'-0"	25'-0"	25'-0"	do.	do.	do.	do.	do.	do.	do.	1 3/4"
100'-0"	25'-0"	25'-0"	25'-0"	25'-0"	7'-0"	7" φ X .250" Wall Thick	2" φ X .125" Wall Thick	4 1/2" X .250" Wall Thick	2 1/2" φ X .125" Wall Thick	2 1/2" φ X .125" Wall Thick	52	2"

* Use 4 1/2" φ X .250" Wall thick panels adjacent to Columns.

** Ordinate at center of assembled truss prior to dead load deflection. Allowable camber tolerance for truss is ± 25 %.


Work this sheet with sheets 3 & 4

MICHIGAN DEPARTMENT OF STATE HIGHWAYS
ALUMINUM TRUSS
TYPE C



NO.	DESCRIPTION	DATE	BY
1	DIMENSION CHANGES	11-28	
2	RELOCATE WIRE OUTLET	9-1-63	
3	Max. Sign projection above top chord changed	2-3-67	T.M.W.

ROAD DES.	WDB	2-12-63
DRAWN BY	HBS	2-6-63
TRACED BY		
CHECKED BY	JDB	2-12-63
SHEET 2 OF 4		
S6.20		


5. NOTE # 3 Revised 11-16-76 R.M. End support schedule removed; Max. end support length added; Brace spacing & sizes added.

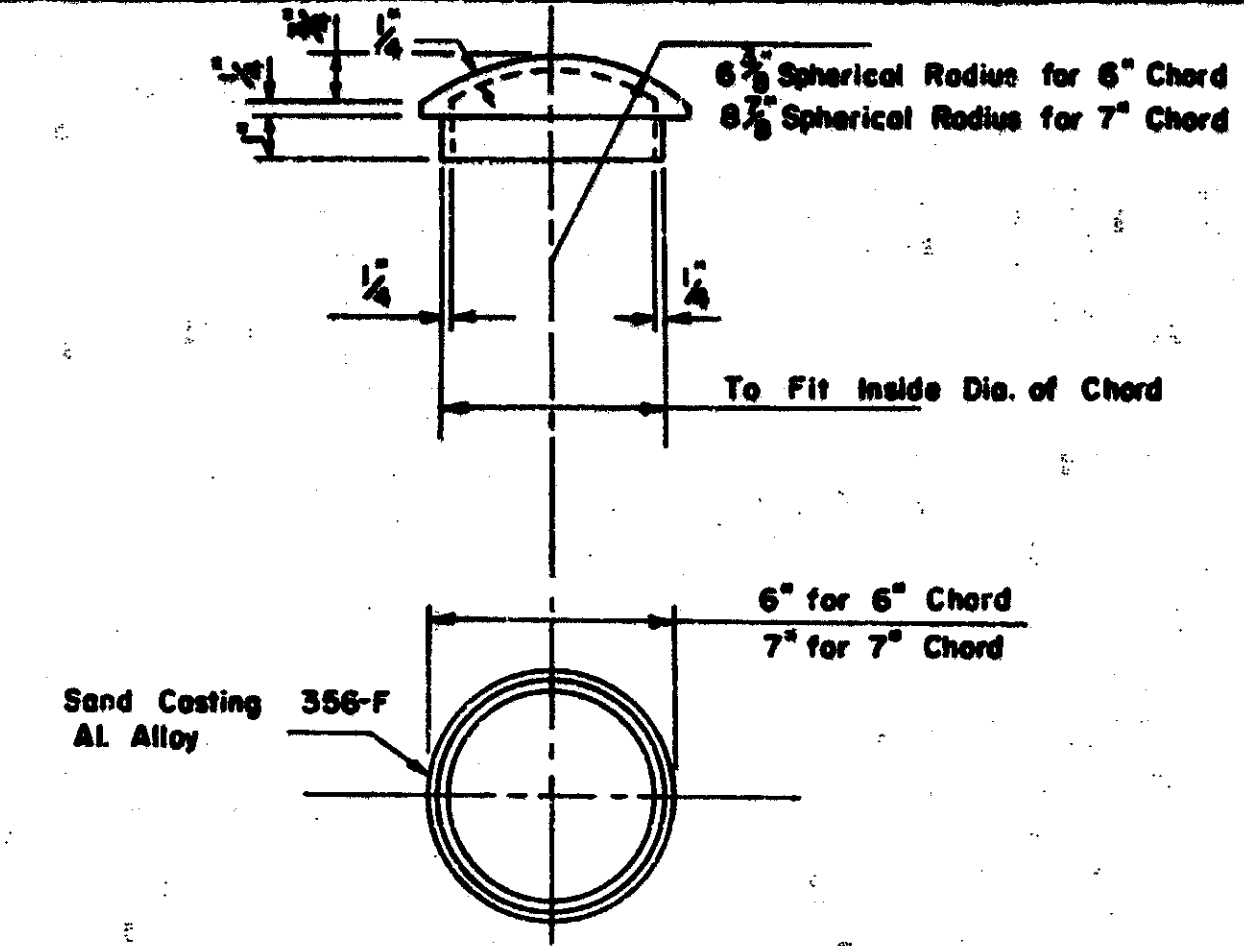


Detail of End Cap
For Horiz. Members
8 Req'd

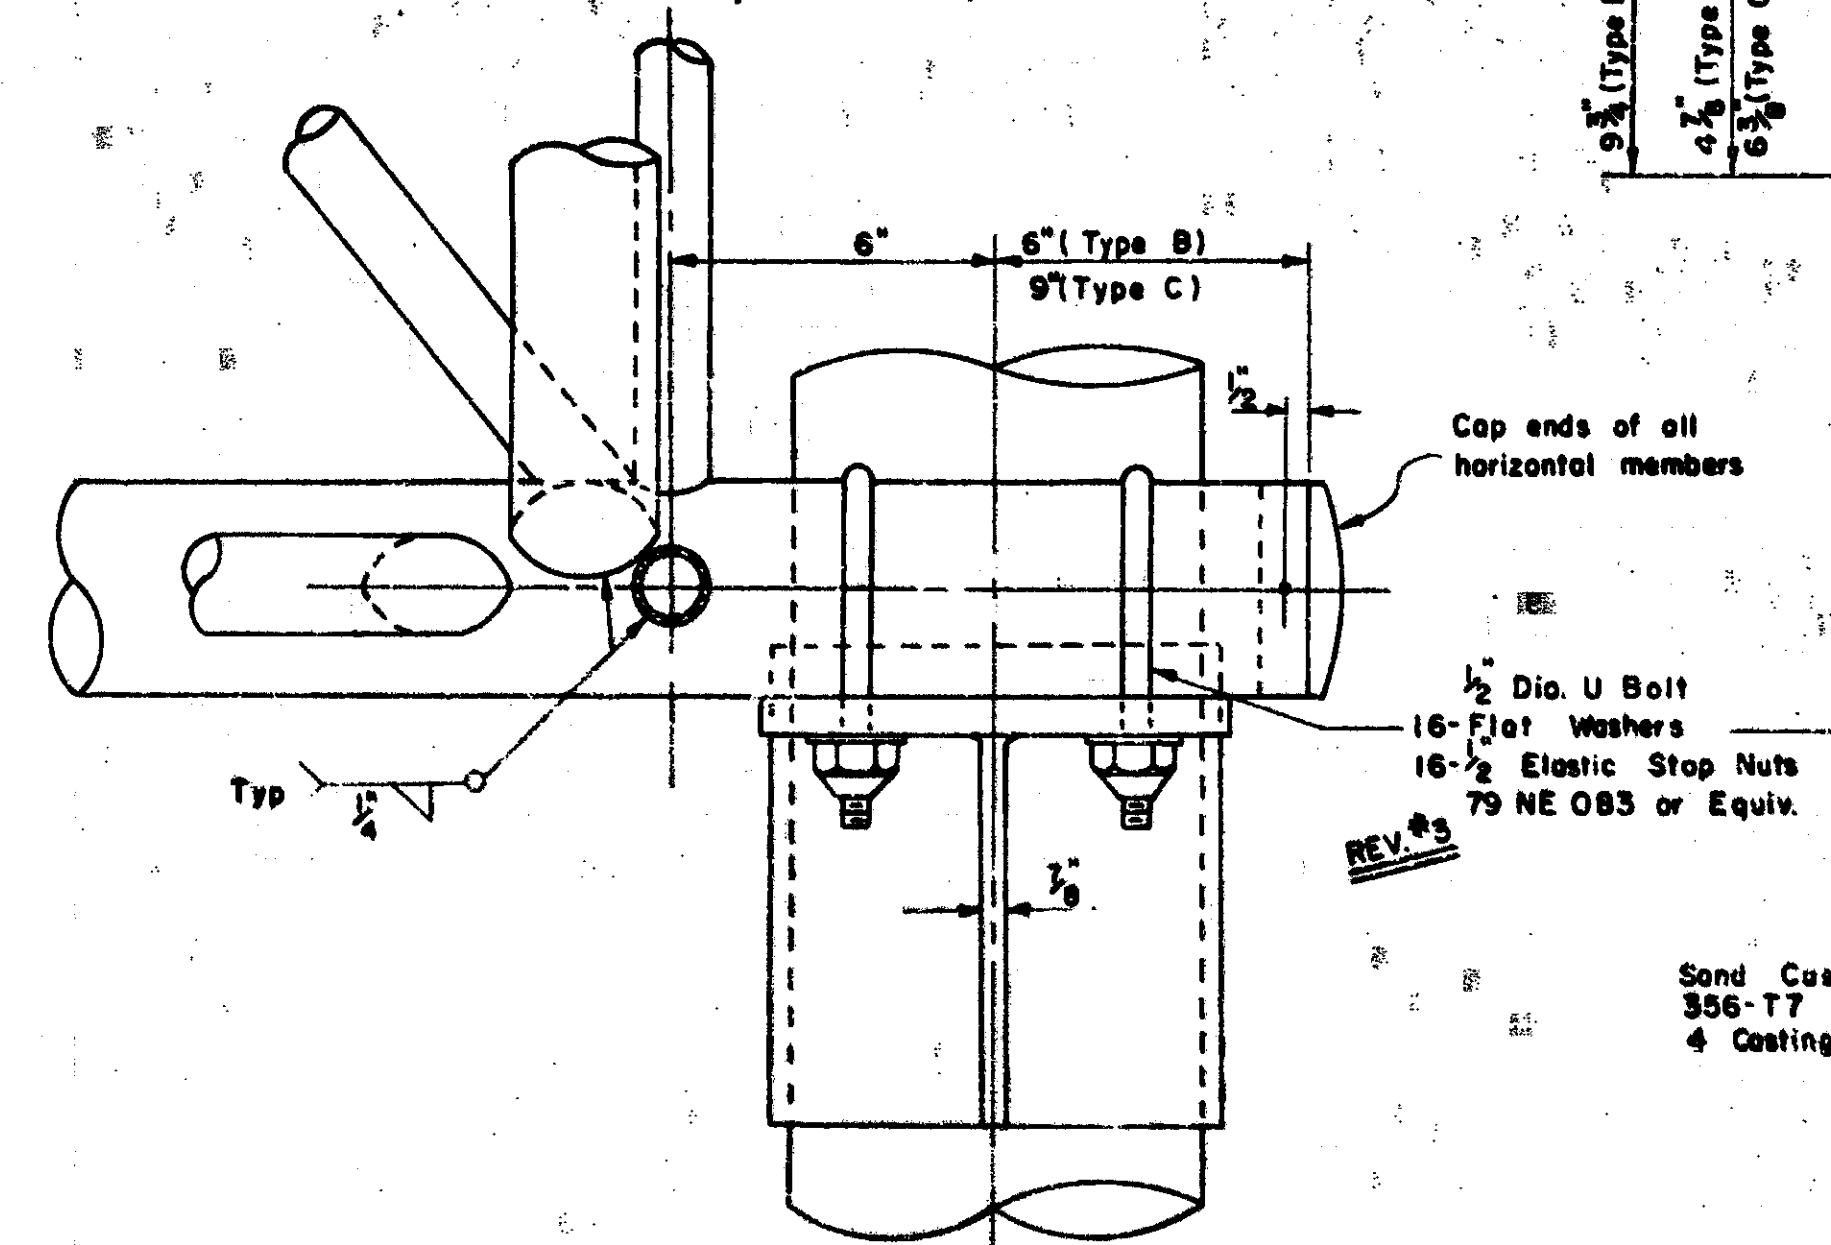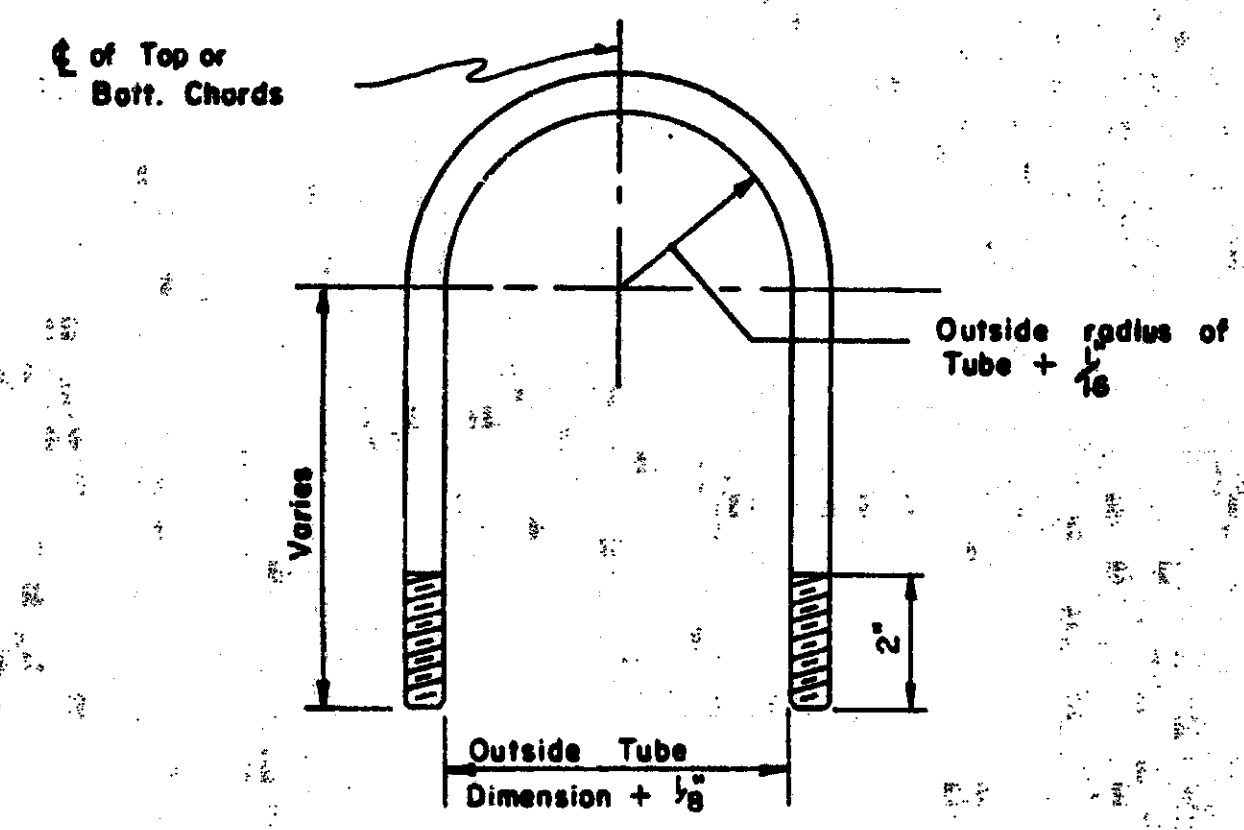


Detail of Seat

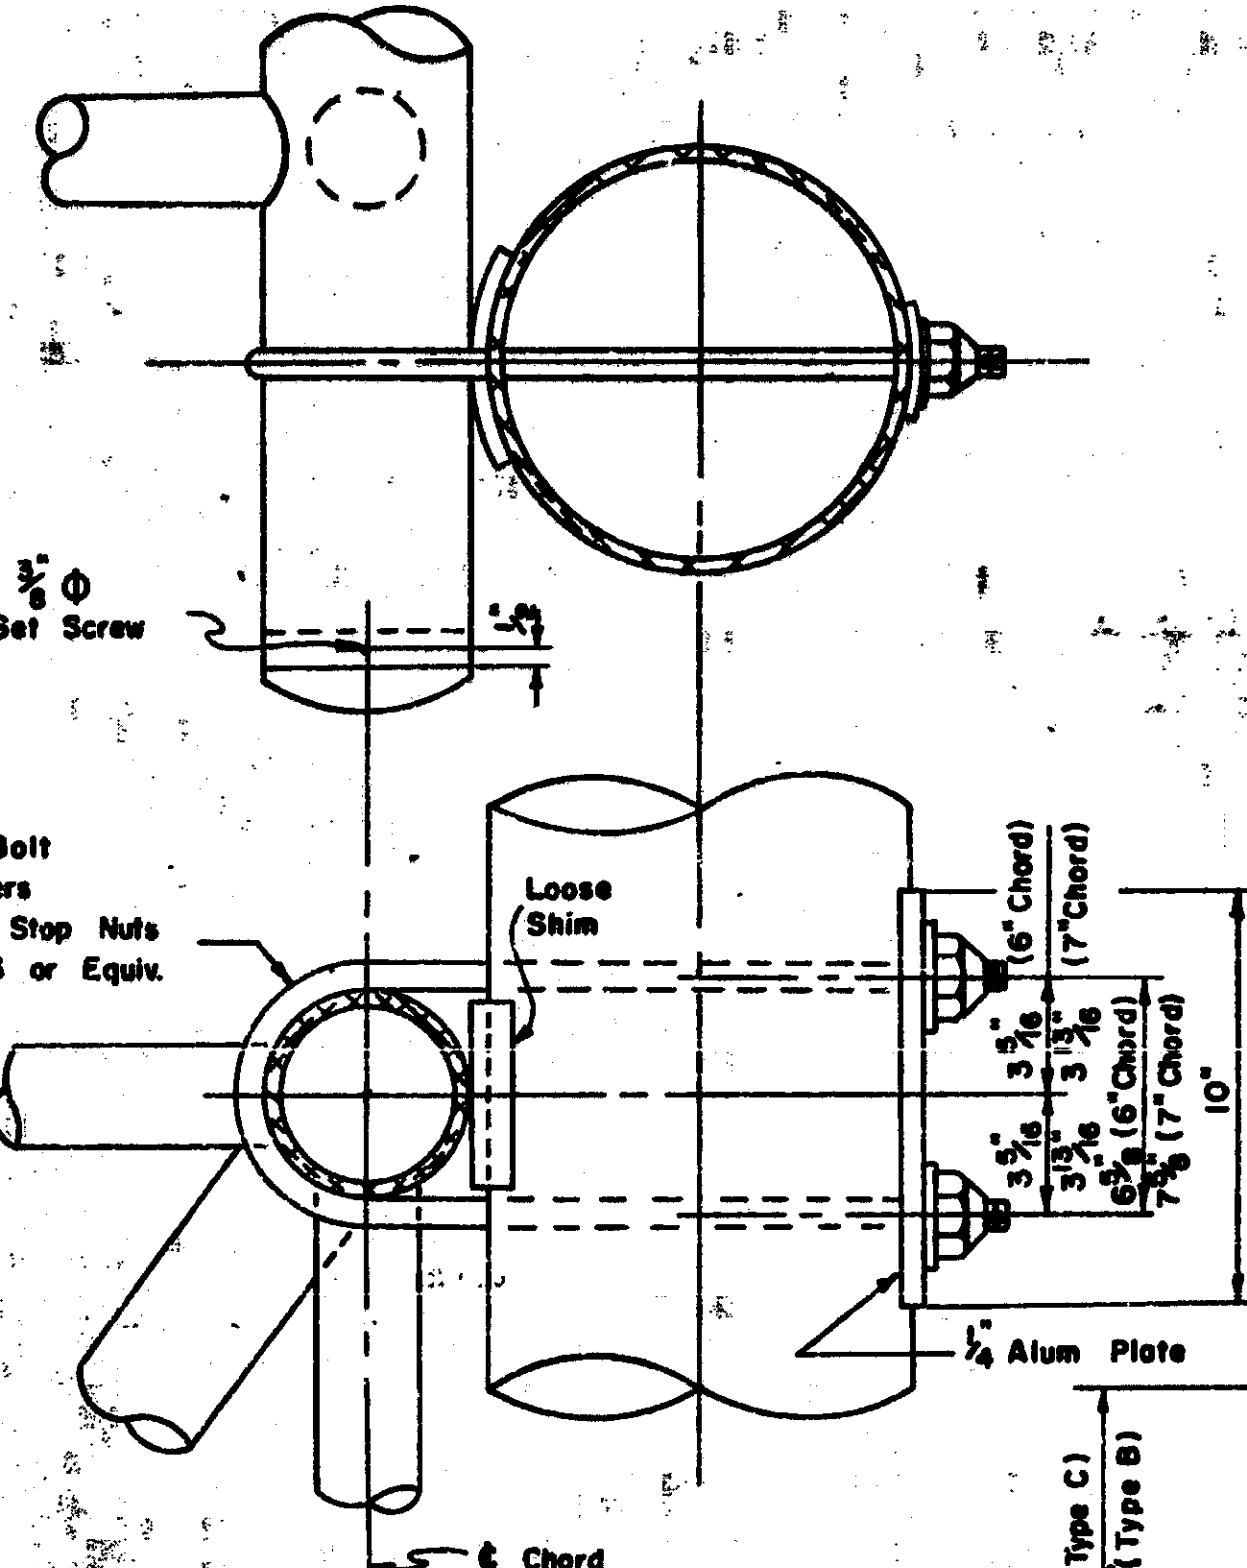


Detail of Upper Clamp

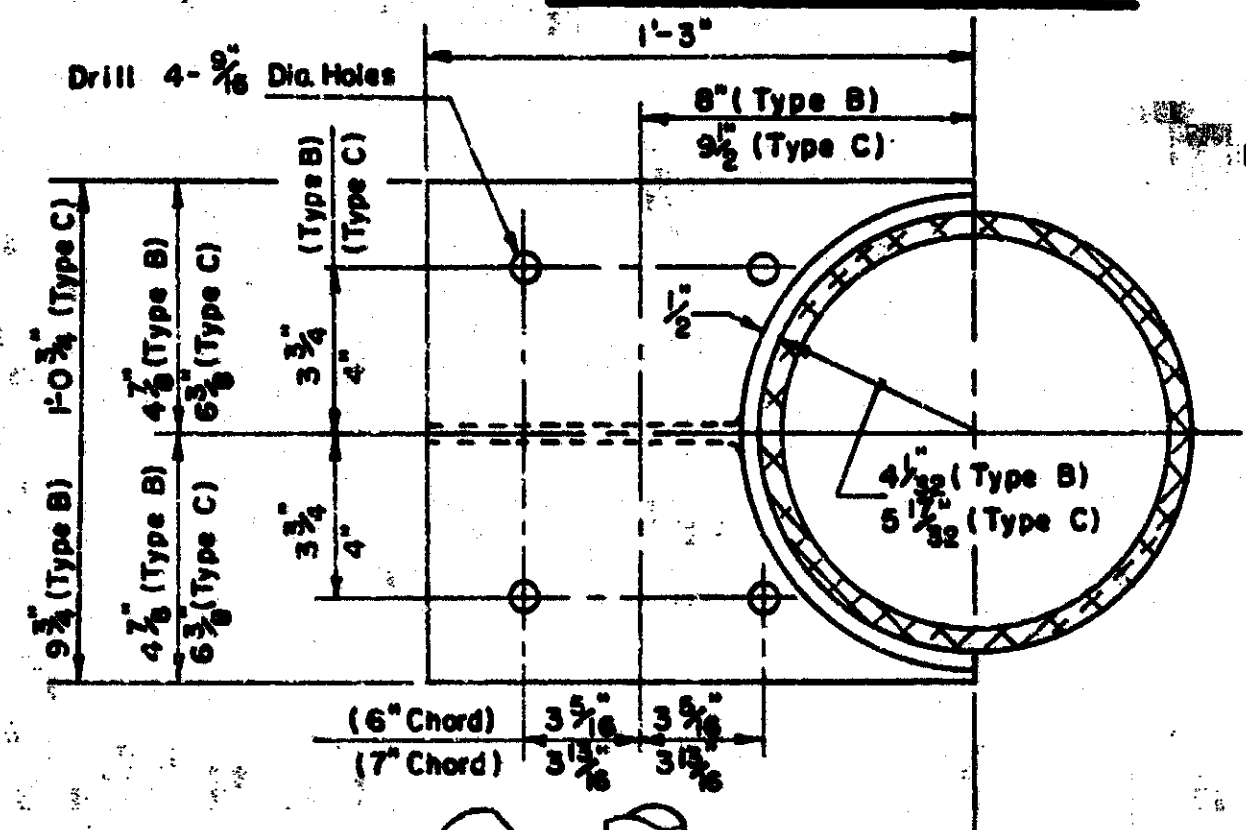


Detail of Pole Cap
4 Req'd

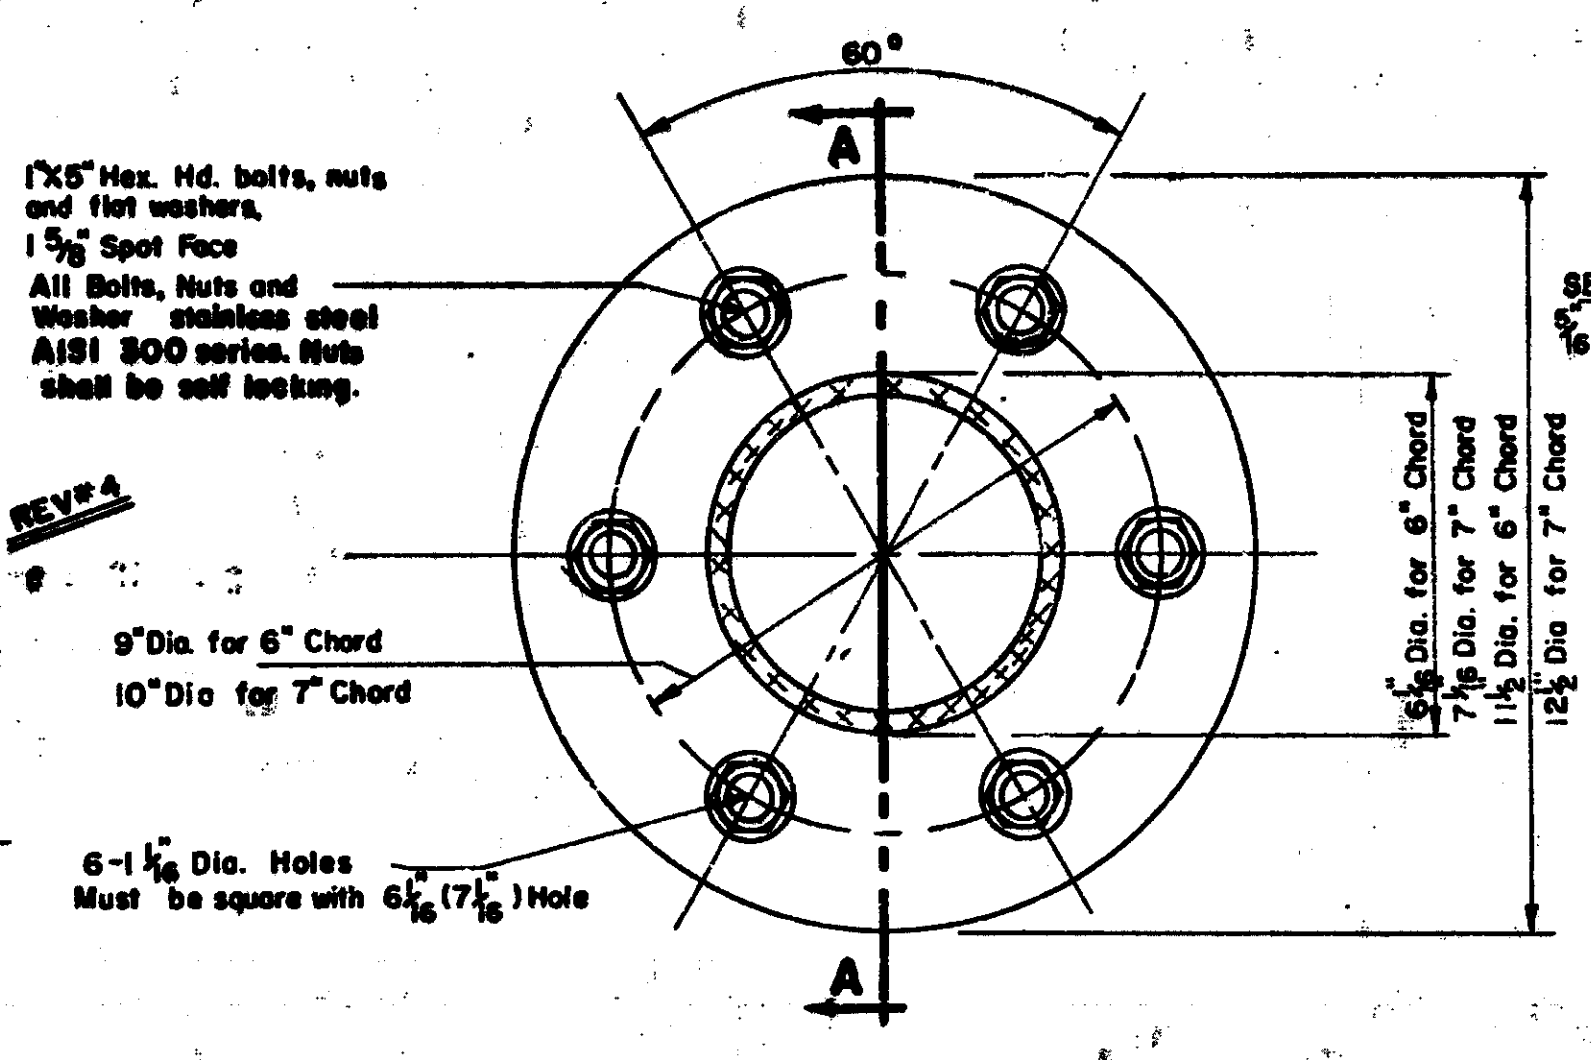


Chord Connection Detail

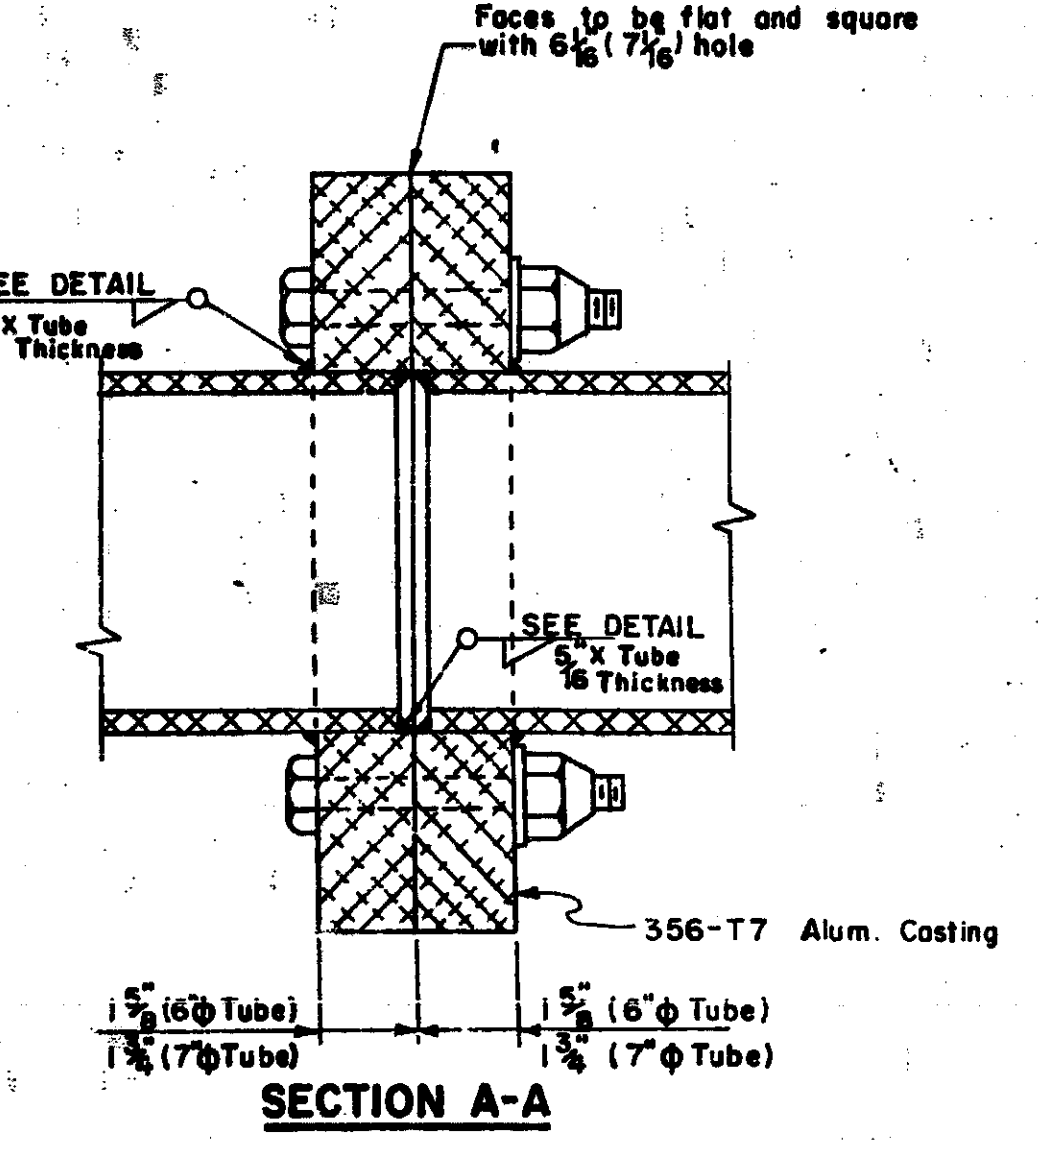

WELD DETAIL CHORD CONNECTION

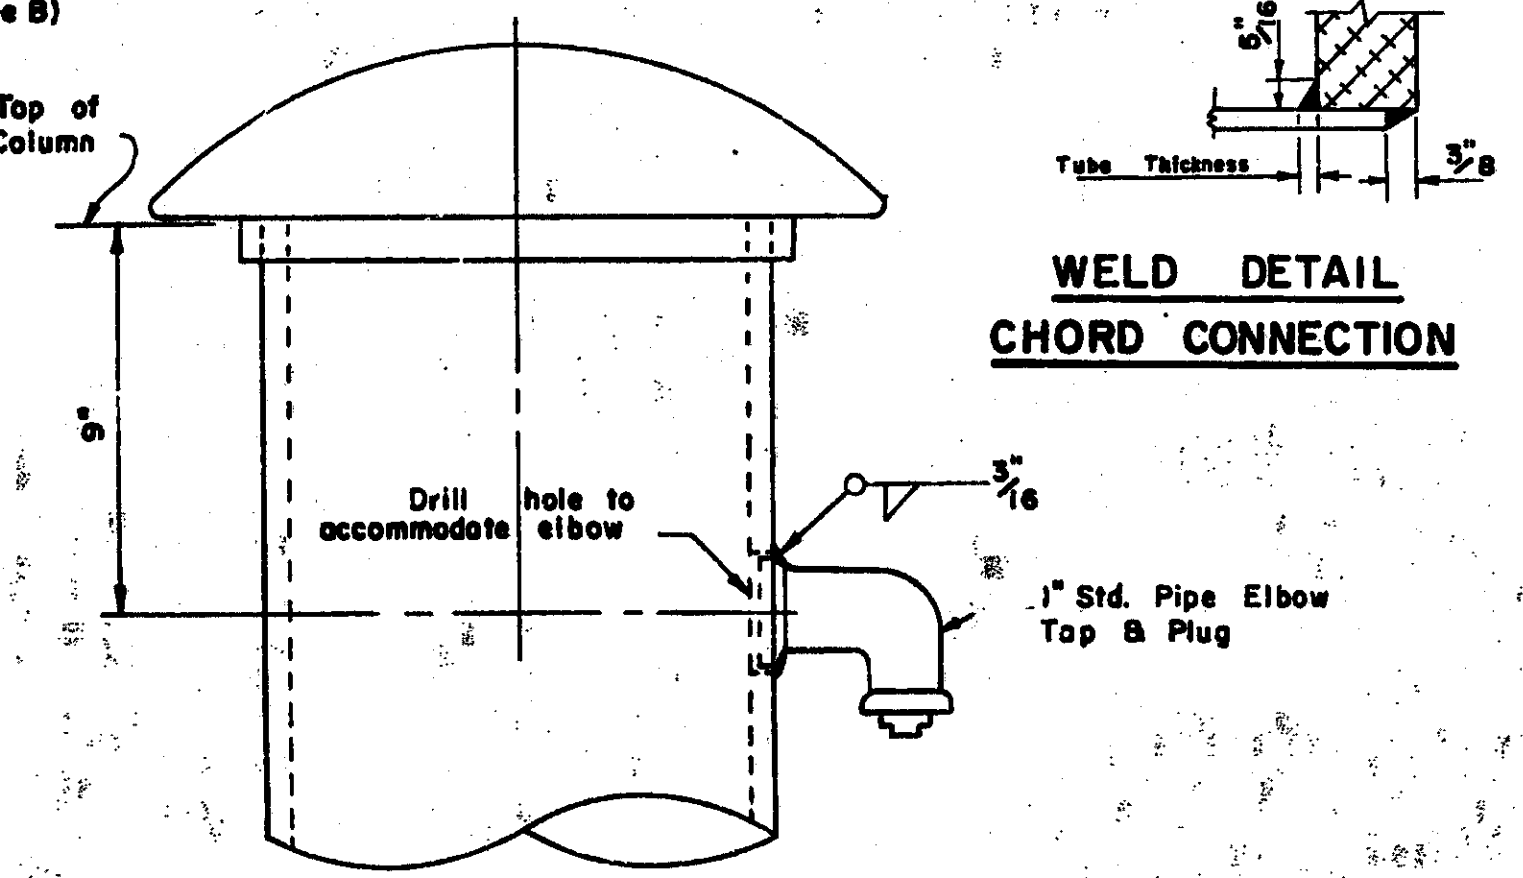

Detail of Electrical Outlet At Column

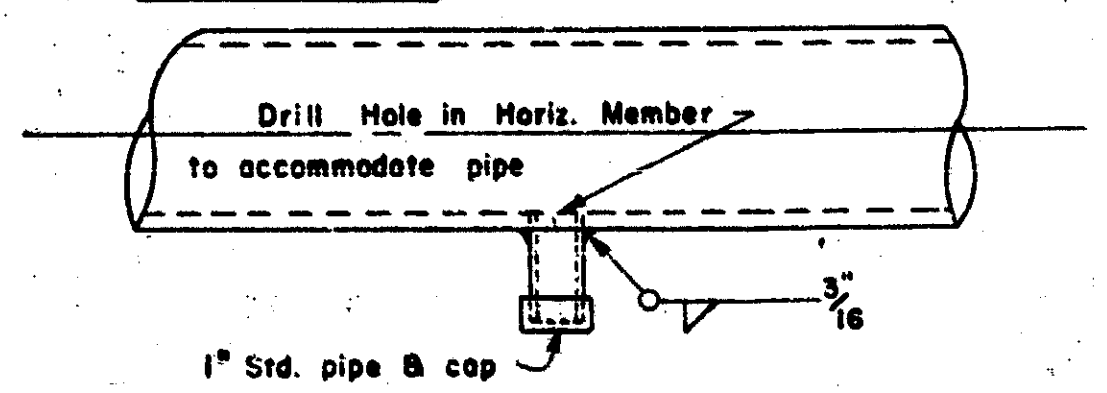

Detail of Electrical Outlet At Chord

Work this sheet with sheets 1 & 2

MICHIGAN DEPARTMENT OF STATE HIGHWAYS
ALUMINUM TRUSS DETAILS
TYPE B,C




REVISIONS			
NO.	DESCRIPTION	DATE	BY
1	Weld Detail	11-25-63	
2	Revise electrical outlet	8-1-64	
3	U-Bolt & Nut changed to stainless steel	3-25-68	
4	SPEC CHANGED	2/78	JOB

ISSUED BY	WOB	2-12-63
DESIGNED BY	JOB	2-9-63
CHECKED BY	HBE	2-12-63
DRAWN BY	JOB	2-12-63
S 6.30		




NOTE 4 Revised 11-78 RJM

CS 63174 NO.59

Job No. 14824A

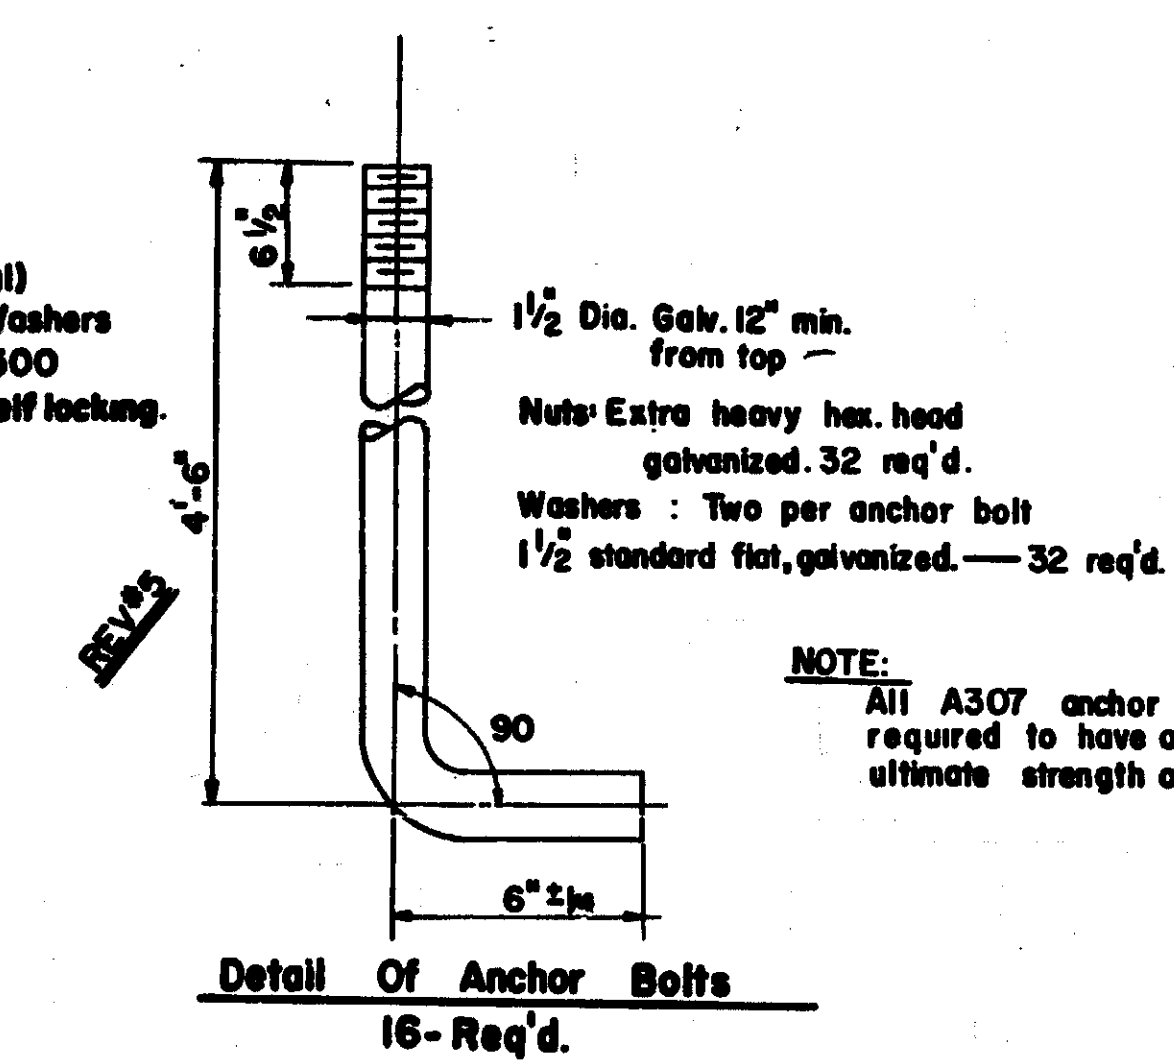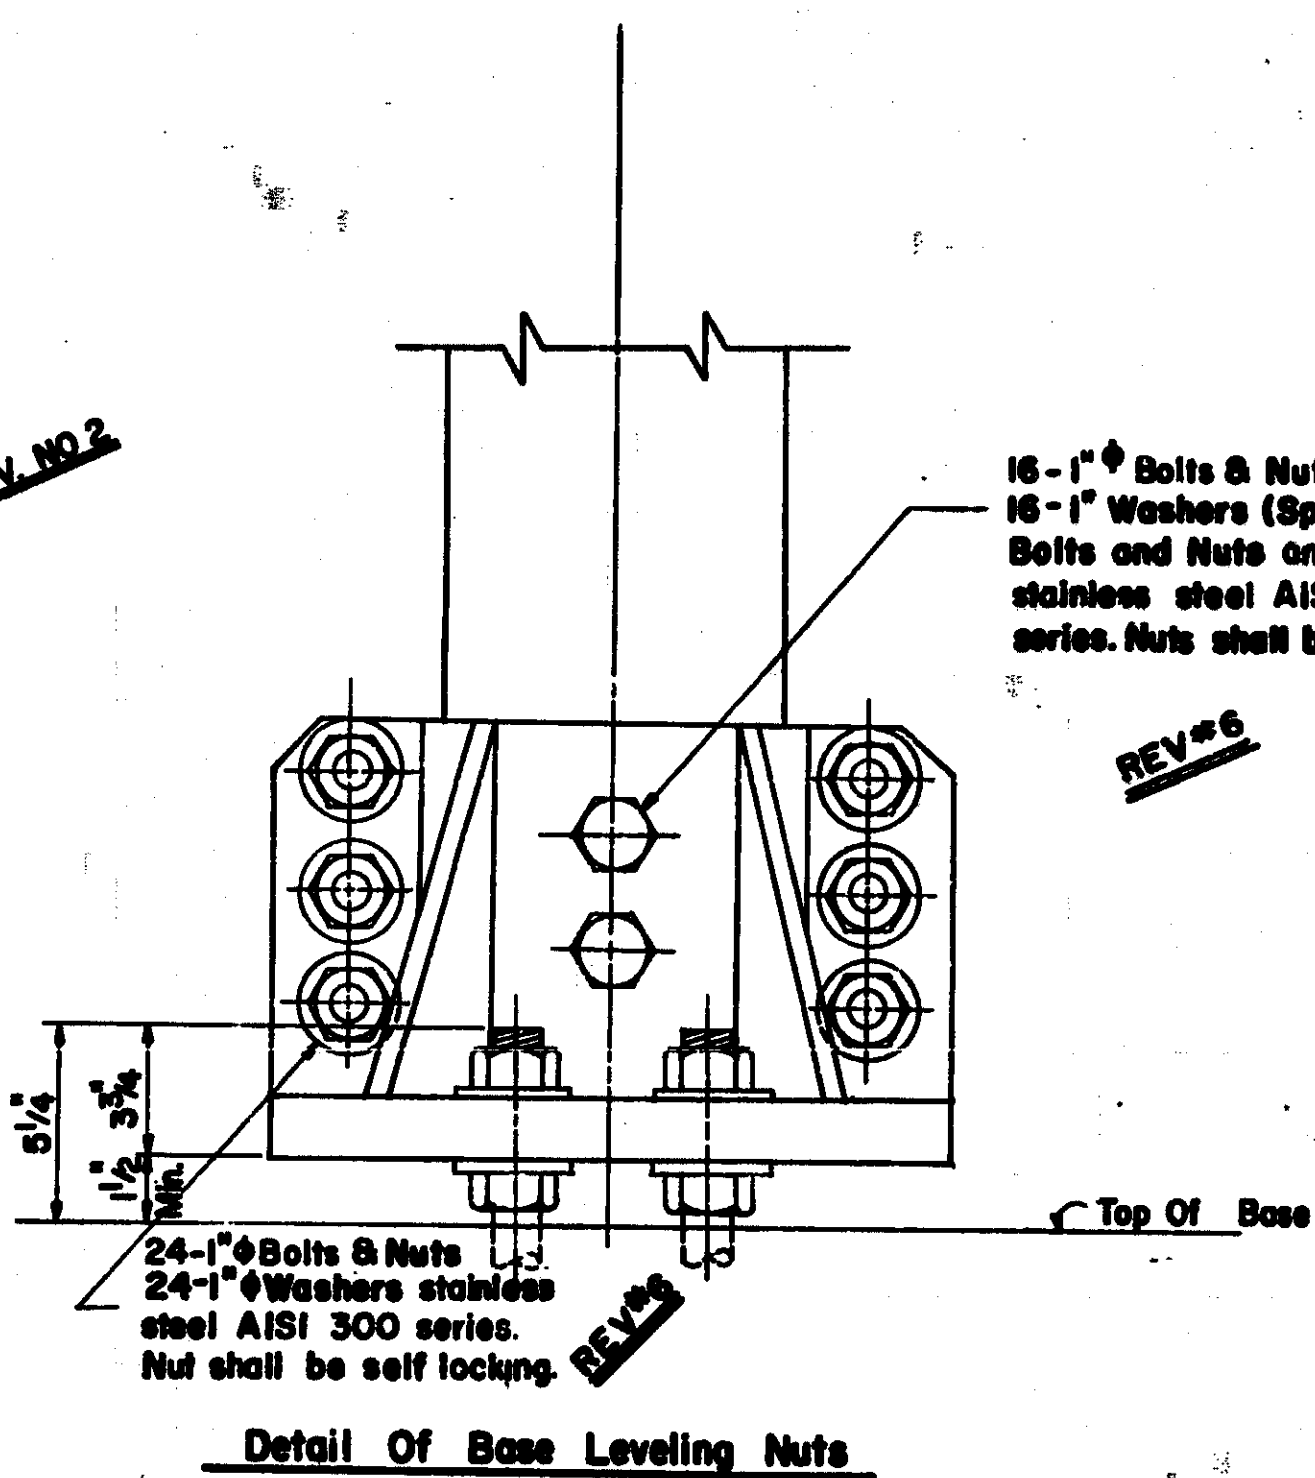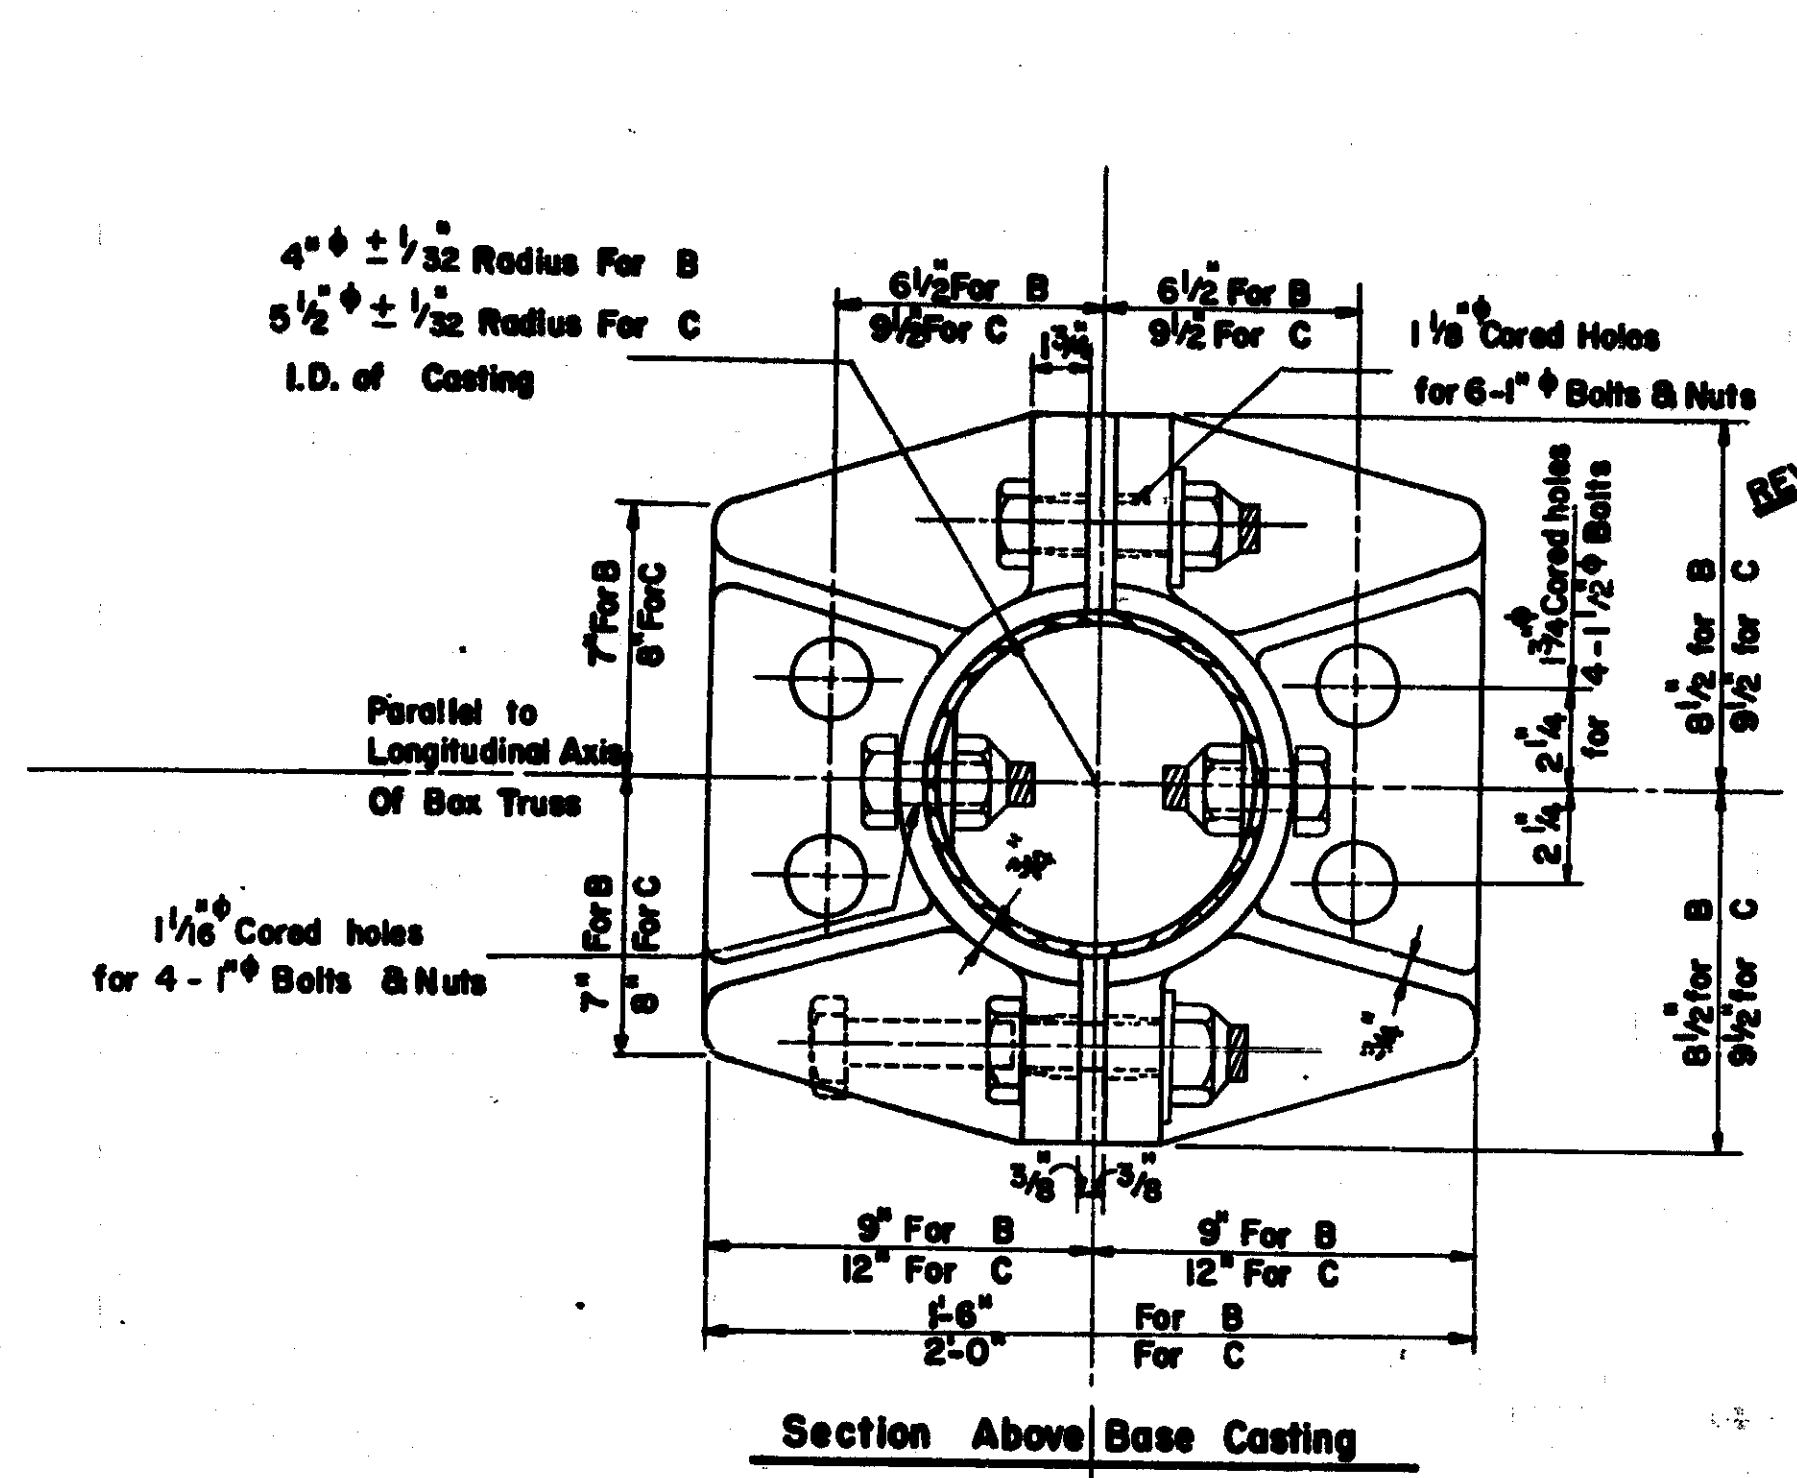

NOTE:
All A307 anchor bolts shall be required to have a minimum ultimate strength of 85,000 psi.

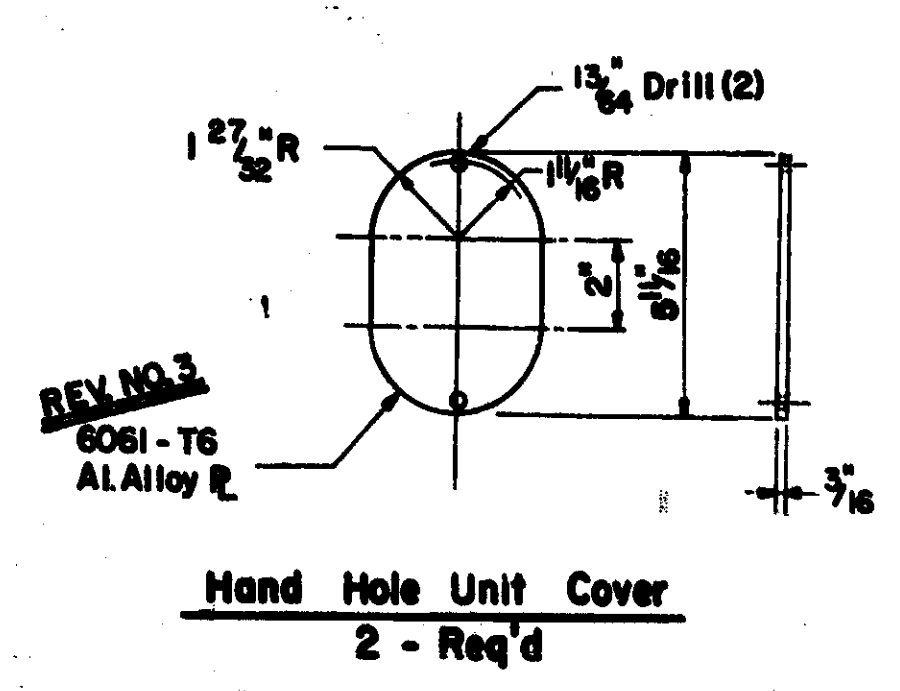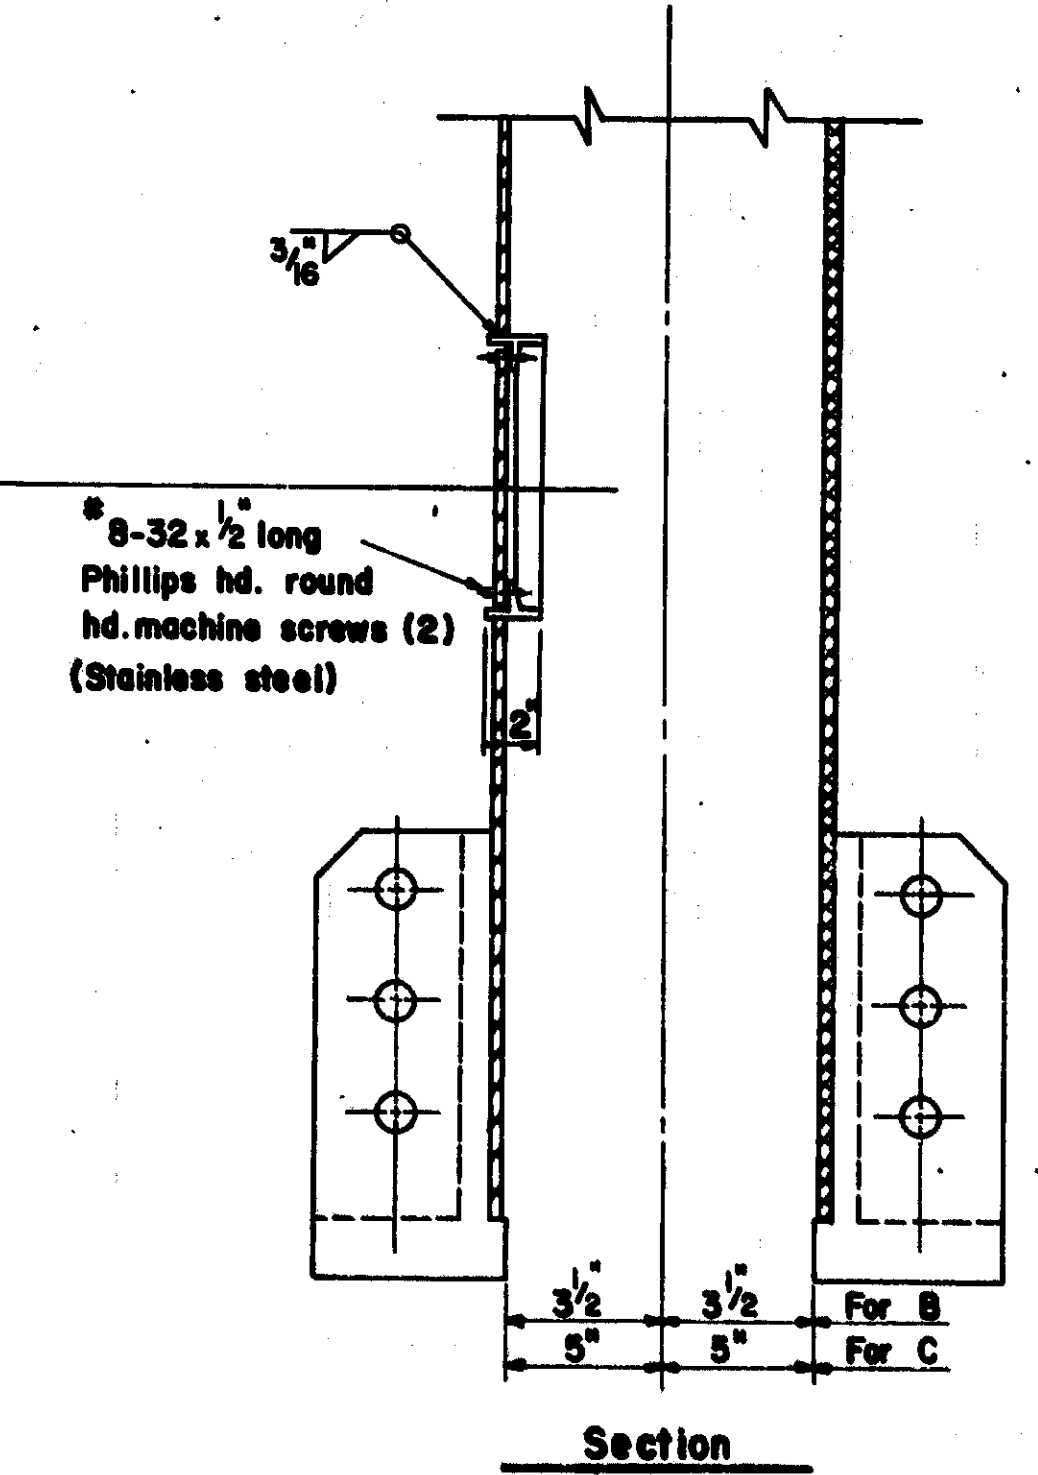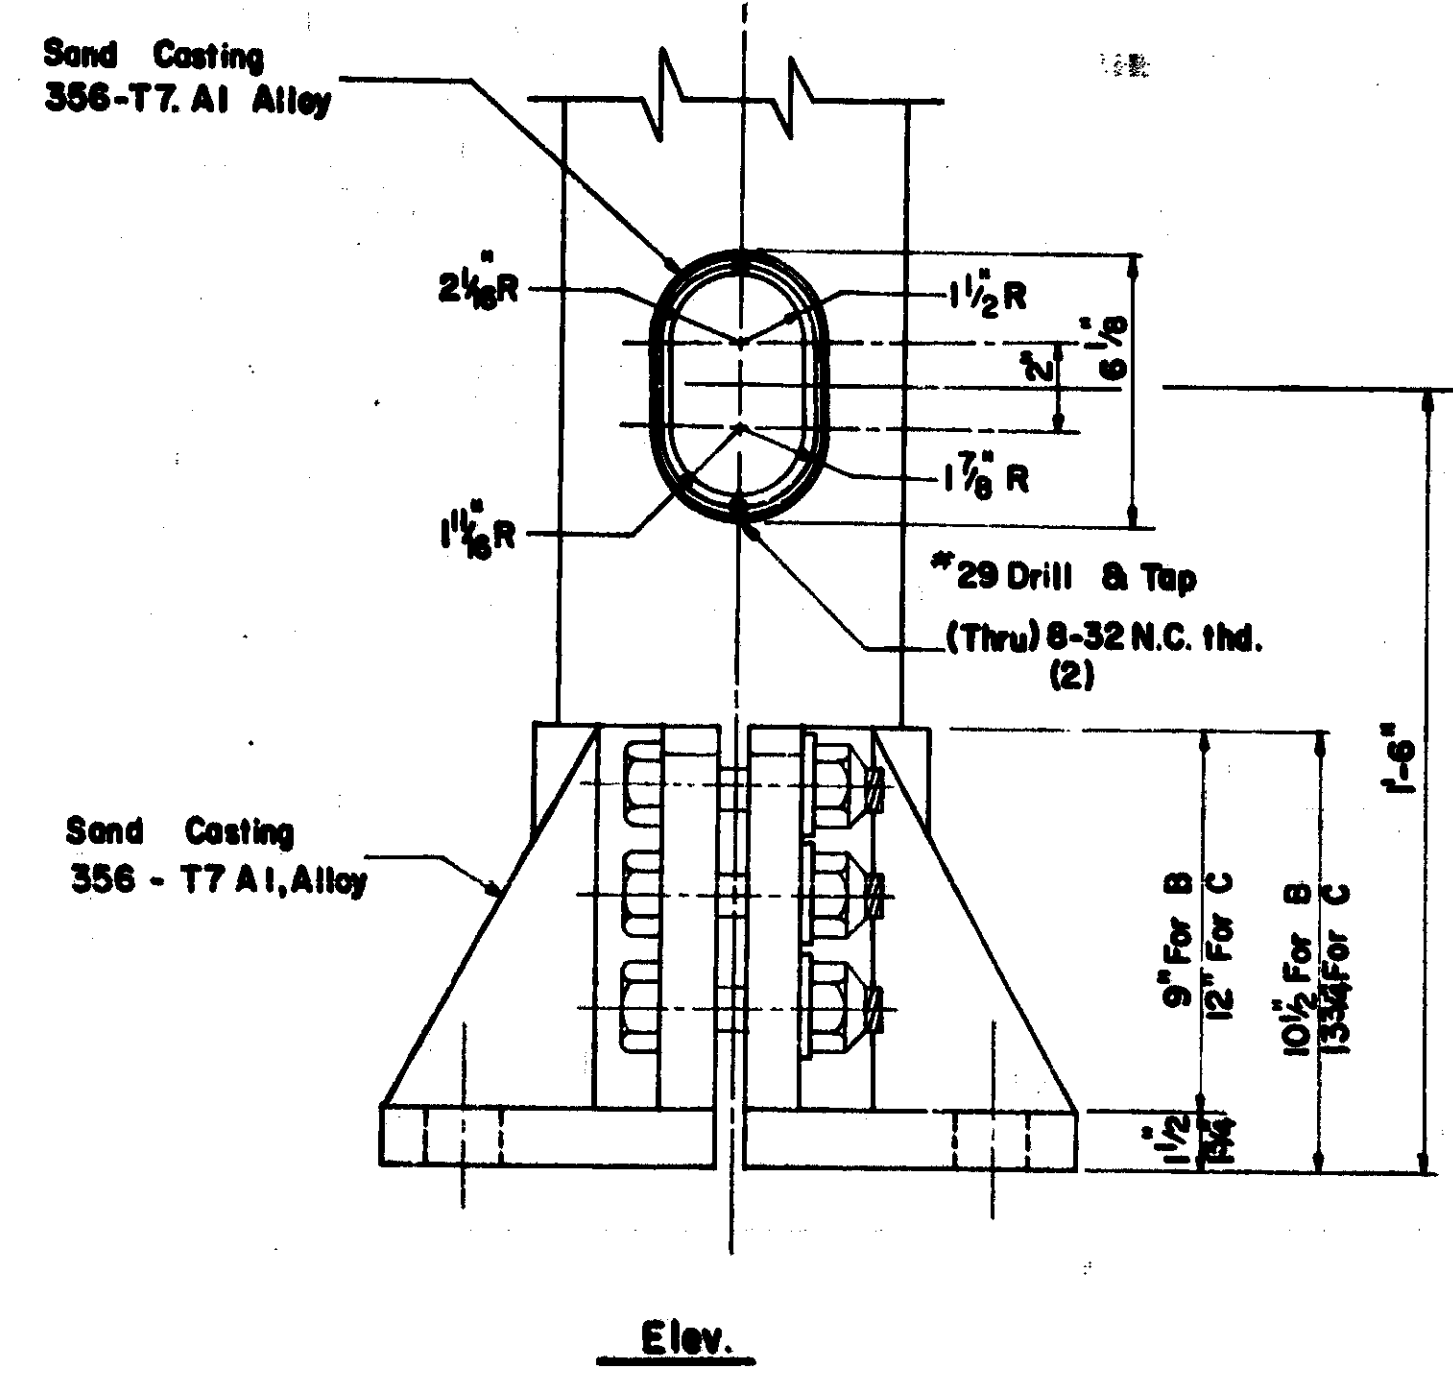

Detail Of Base And Hand Hole Units
Req'd. - 2 Hand hole units - One each tower.
" - 4 Bases. Complete


Work this sheet with sheets 1,2 & 3

MICHIGAN DEPARTMENT OF STATE HIGHWAYS
ALUMINUM END SUPPORT DETAILS
TYPE B,C


REVISIONS			
No.	DESCRIPTION	DATE	BY
1	GALVANIZED	1/64	RDS
2	DIMENSION OF BASE CASTING	8/65	RLD
3	ALLOY CHANGE		
4	ANCHOR BOLT STRENGTH NOTE	3-3-67	YMW

DRAWN BY	W.D.S.	2-12-63
DESIGNED BY	H.B.S.	2-6-63
TRACED BY	J.D.B.	2-12-63
CHECKED BY		
SHEET 4 OF 4		
\$6.40		

5 ANCHOR BOLT DETAIL REVISED 2/76 JDB
6 SPEC CHANGED 2/76 JDB
7 NOTE #6 Revised 11-76 RJM
CS 63174 NO.60
JCC No 14824A

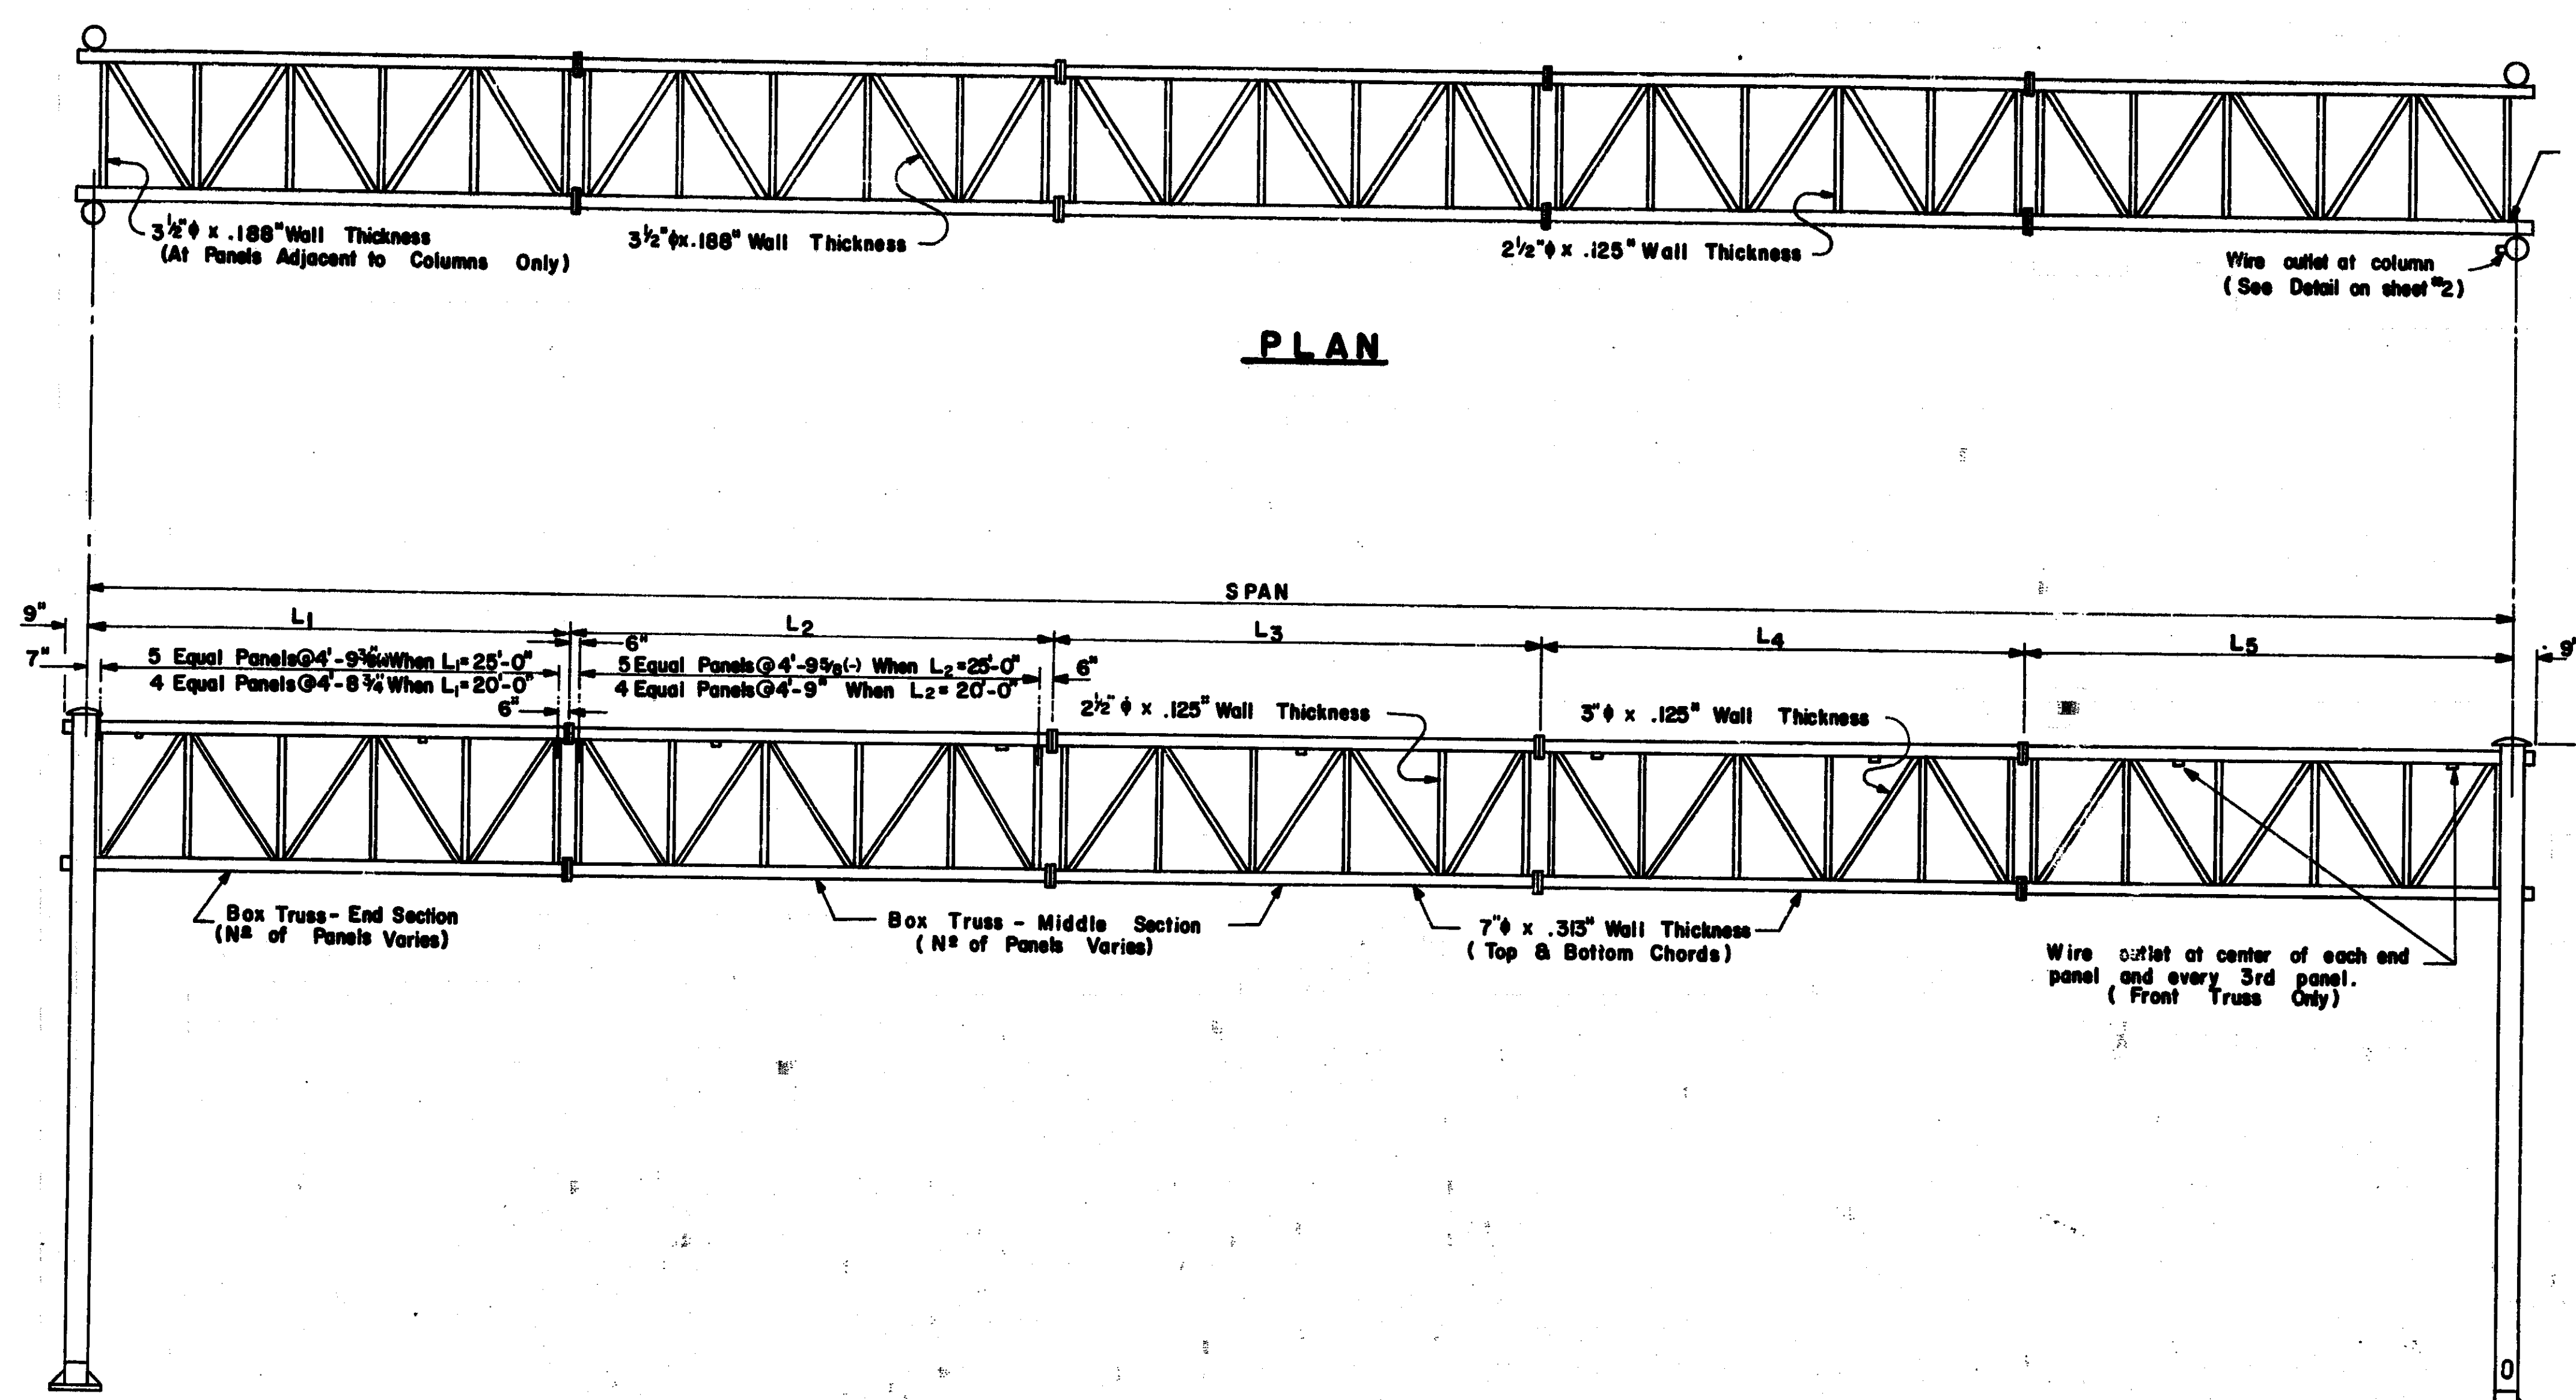

The end internal diagonal shall connect to the chord where the top horizontal diagonal connects to this chord as shown in plan and end elevation.

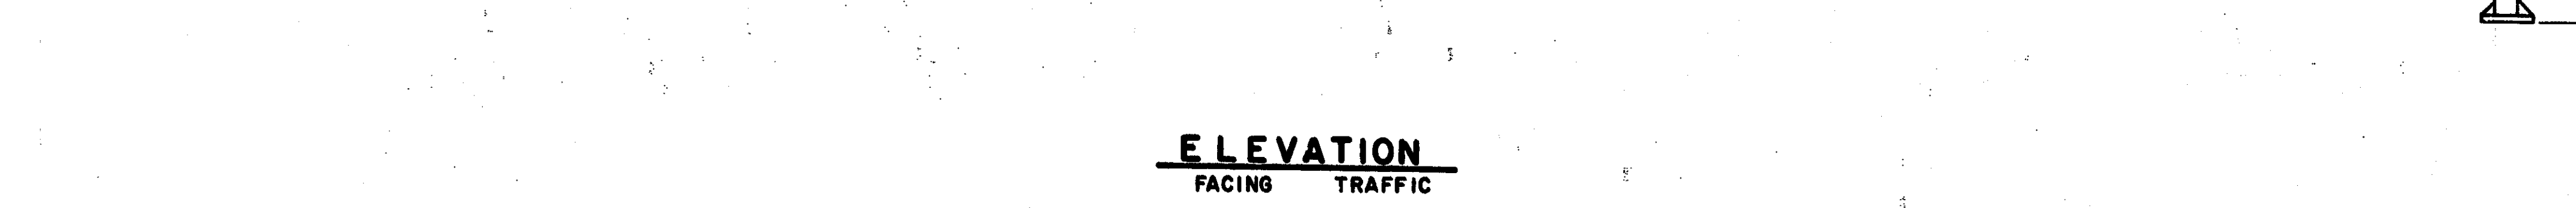

END ELEVATION

Truss		Data					CAMBER
SPAN	L_1	L_2	L_3	L_4	L_5		
105'-0"	20'-0"	20'-0"	25'-0"	20'-0"	20'-0"	$2\frac{1}{4}"$	
110'-0"	20'-0"	25'-0"	20'-0"	25'-0"	20'-0"	$2\frac{1}{2}"$	
115'-0"	20'-0"	25'-0"	25'-0"	25'-0"	20'-0"	$2\frac{3}{4}"$	
120'-0"	25'-0"	25'-0"	20'-0"	25'-0"	25'-0"	$3\frac{1}{8}"$	
125'-0"	25'-0"	25'-0"	25'-0"	25'-0"	25'-0"	$3\frac{3}{8}"$	

CAMBER: The camber given in the above table is the ordinate at the center of the assembled truss prior to dead load deflection. Allowable camber tolerance for truss is $\pm 25\%$.

NOTES:
 All columns and chord members shall be aluminum alloy 6061-T6.
 All web members shall be aluminum alloy 6063-T6.
 Connections shall be welded with filler alloy 5356.
 The design of this structure is based on the American Association of State Highway Officials' Specifications for the Design and Construction of Structural Supports for Highway Sign (1961 Edition)

Max. projection of sign beyond chord is 6ft.
 The design is based on a wind load of 35 p.s.f. on sign area. All connecting bolts, nuts and washers shall be stainless steel AISI 300 series alloy. Bolts shall have a minimum yield strength of 30,000 PSI. Nuts shall be of the self locking type. See standard plan S9.10 for sign connection.
 The cambering shall be provided in the fabrication so that the flanges are correctly sloped to assure obtaining full contact in the relaxed assembled position prior to snugging up the flange bolts. The flange bolts shall not be torqued in an attempt to close any flange misalignment. Truss shall not be lifted by the web member.

* The internal diagonal shall be $4\frac{1}{2}\phi \times .188$ Wall thickness at panels adjacent to columns.

Work this sheet with sheets 2 & 3

MICHIGAN DEPARTMENT OF STATE HIGHWAYS

ALUMINUM TRUSS


TYPE D

REVISIONS		DATE	BY
1	BRACKS SPECIFIED	7-7-67	J.M.W.
2	ITEM ADDED	3-18-70	W.J.H.
3	SPEC. CHANGED	3/76	J.D.B.
4	INSTEAD OF 3 REVISION	11-76	R.J.H.


SQUAD	W.O.B.	DATE
1	J.D.B.	11-22-66
2	F.H.	1-31-67

SHEET 1 OF 3


S6.50

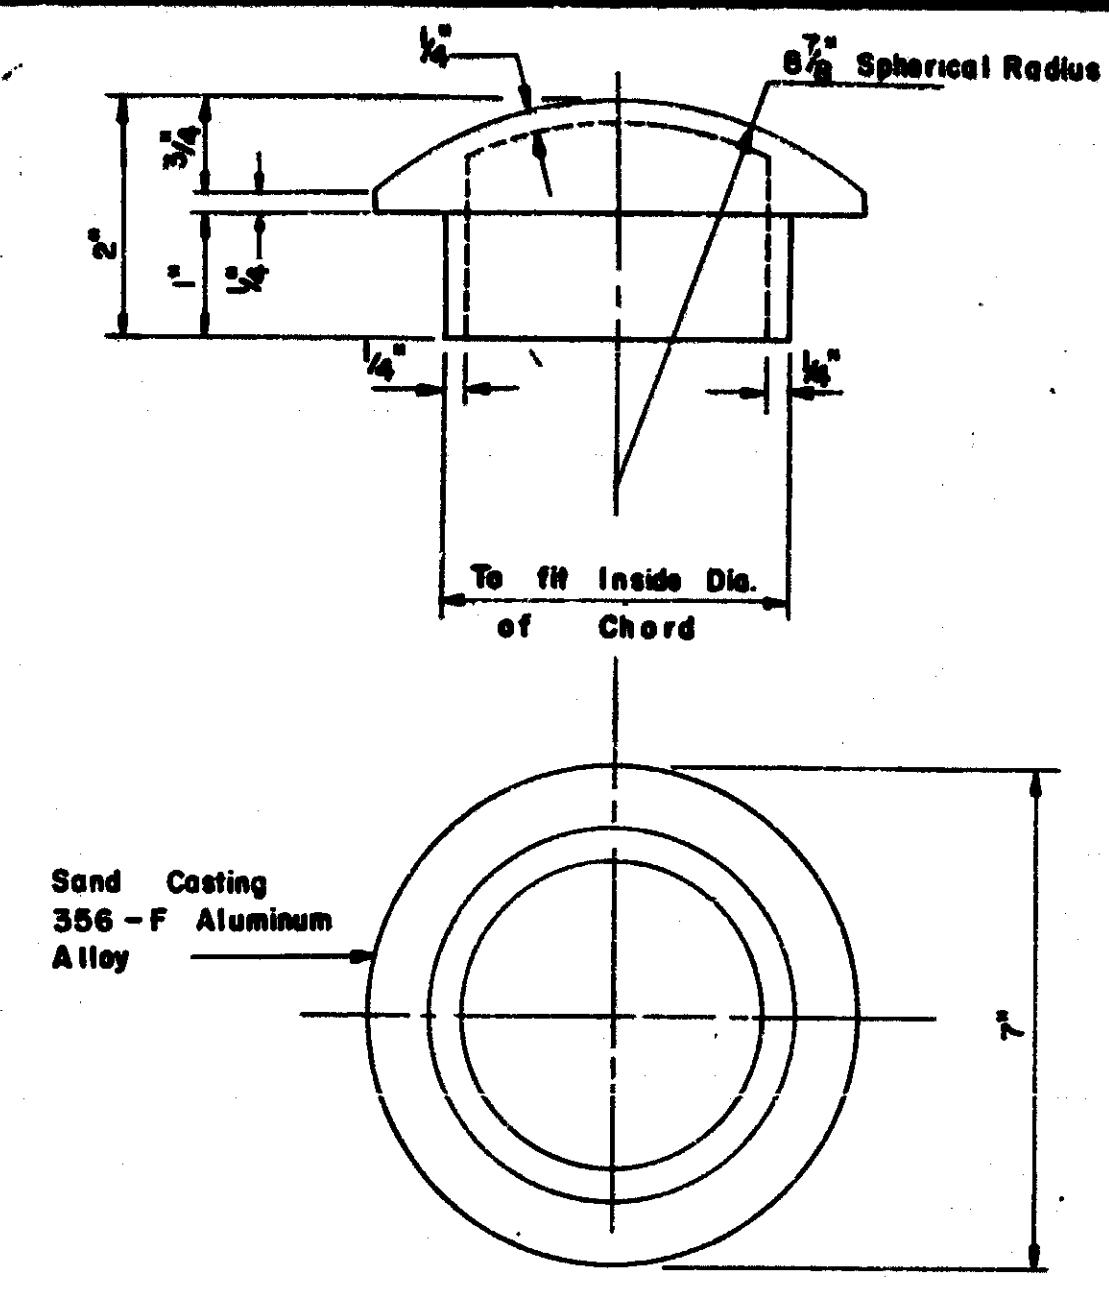


Detail of End Cap
For Horizontal members
8 Required

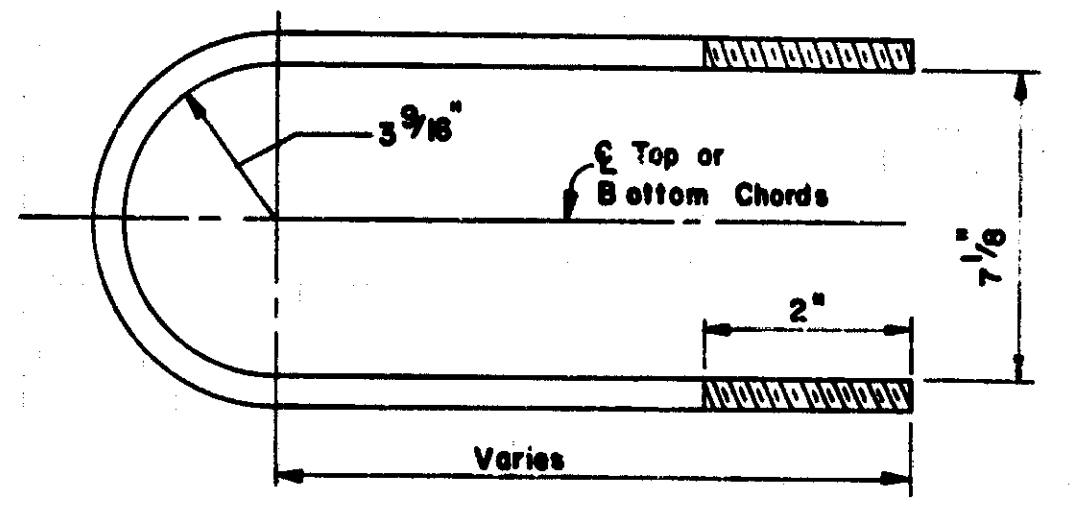


Detail of Stainless Steel U Bolt
4 Req'd Upper Clamp
8 Req'd Lower Clamp

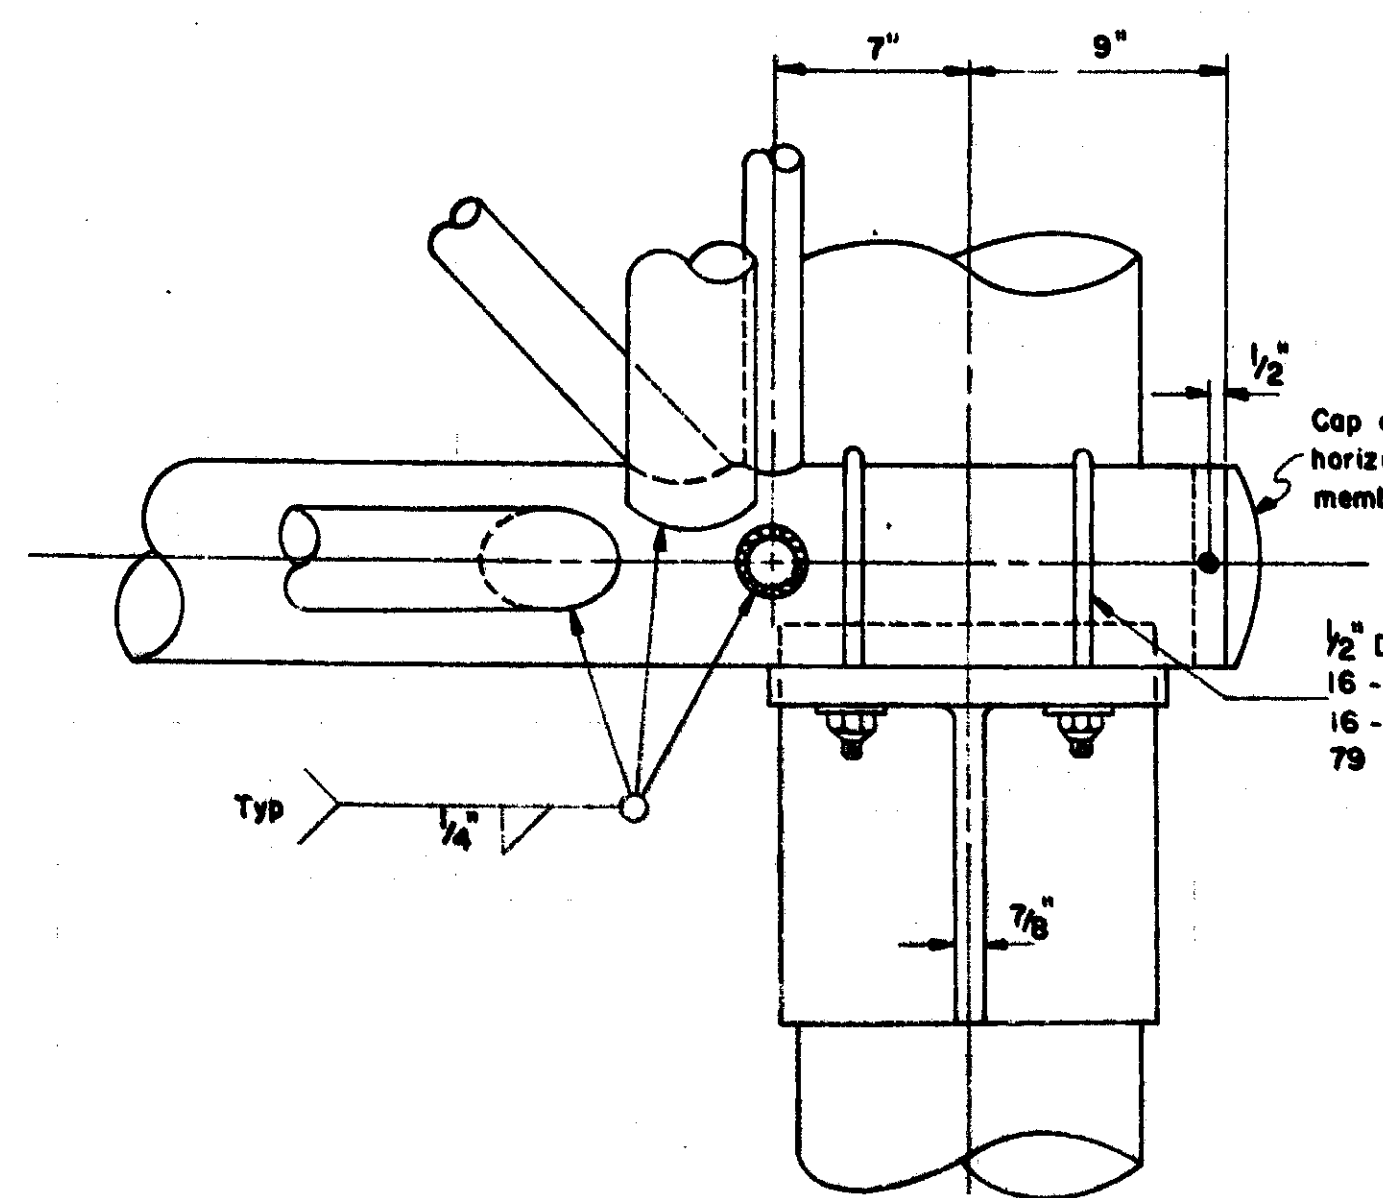

Detail of Seat

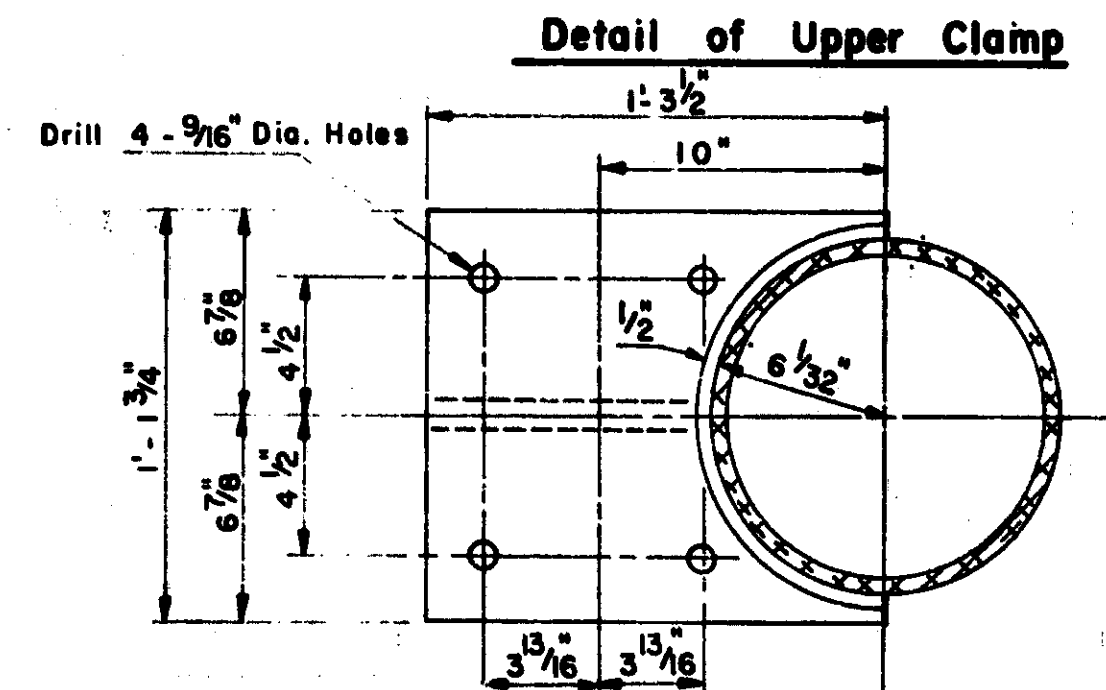

Detail of Upper Clamp

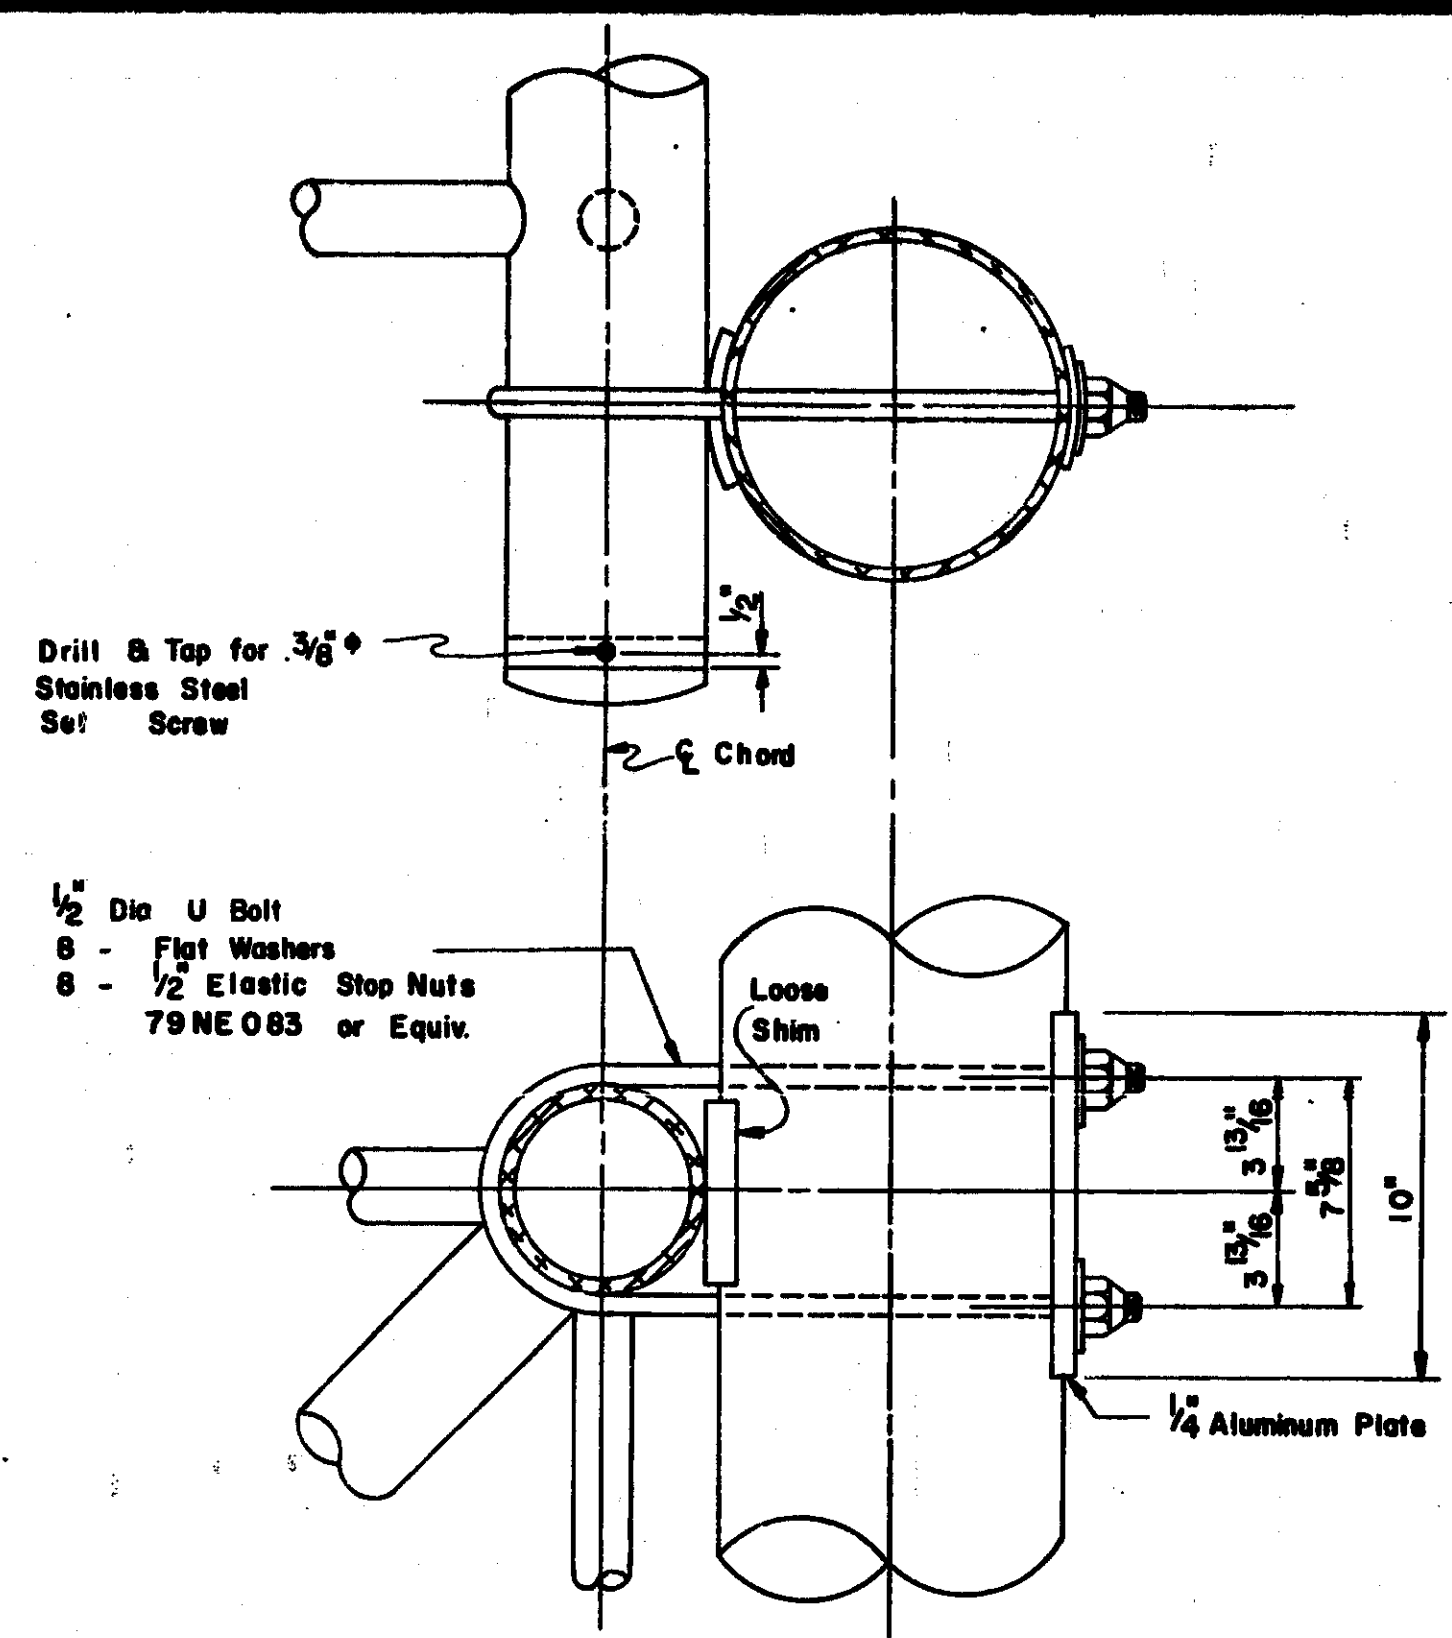


Drill & Tap for 3/8" Stainless Steel Set Screw

1/2" Dia U Bolt
8 - Flat Washers
8 - 1/2" Elastic Stop Nuts
79 NE 083 or Equiv.



1/4" Aluminum Plate

1" x 6" Hex. Hd. bolts, nuts and flat washers stainless steel AISI 300 series. Nuts shall be self locking.


6 - 1 7/16" Diameter Holes Must be square with 7/16" holes.

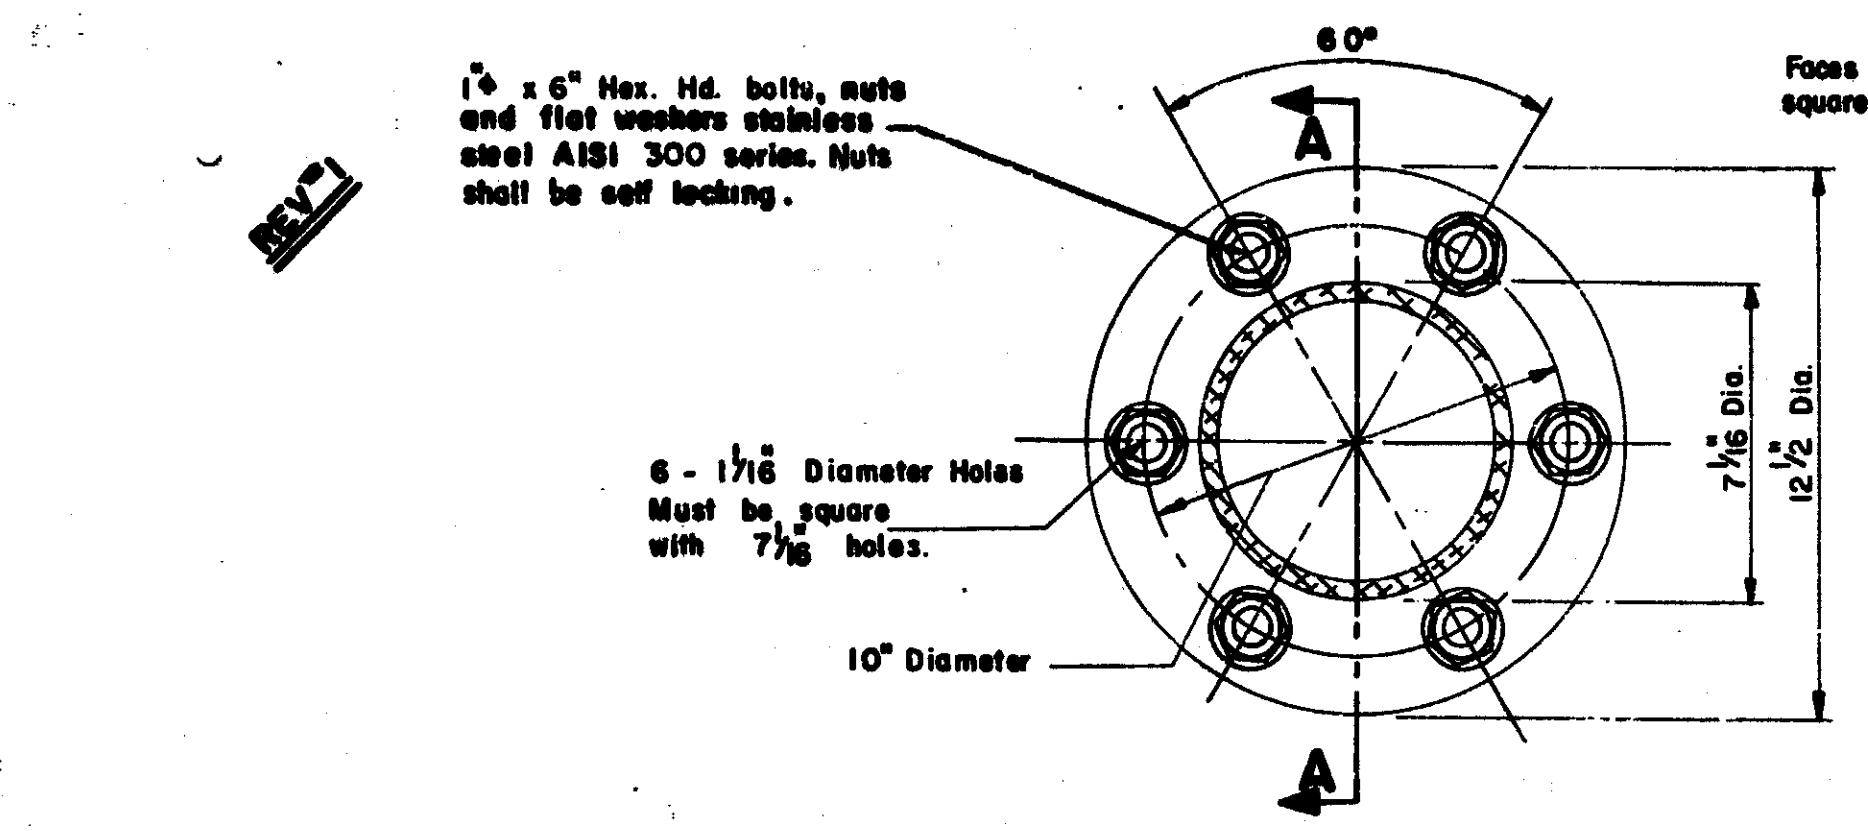


Detail of Chord Connection

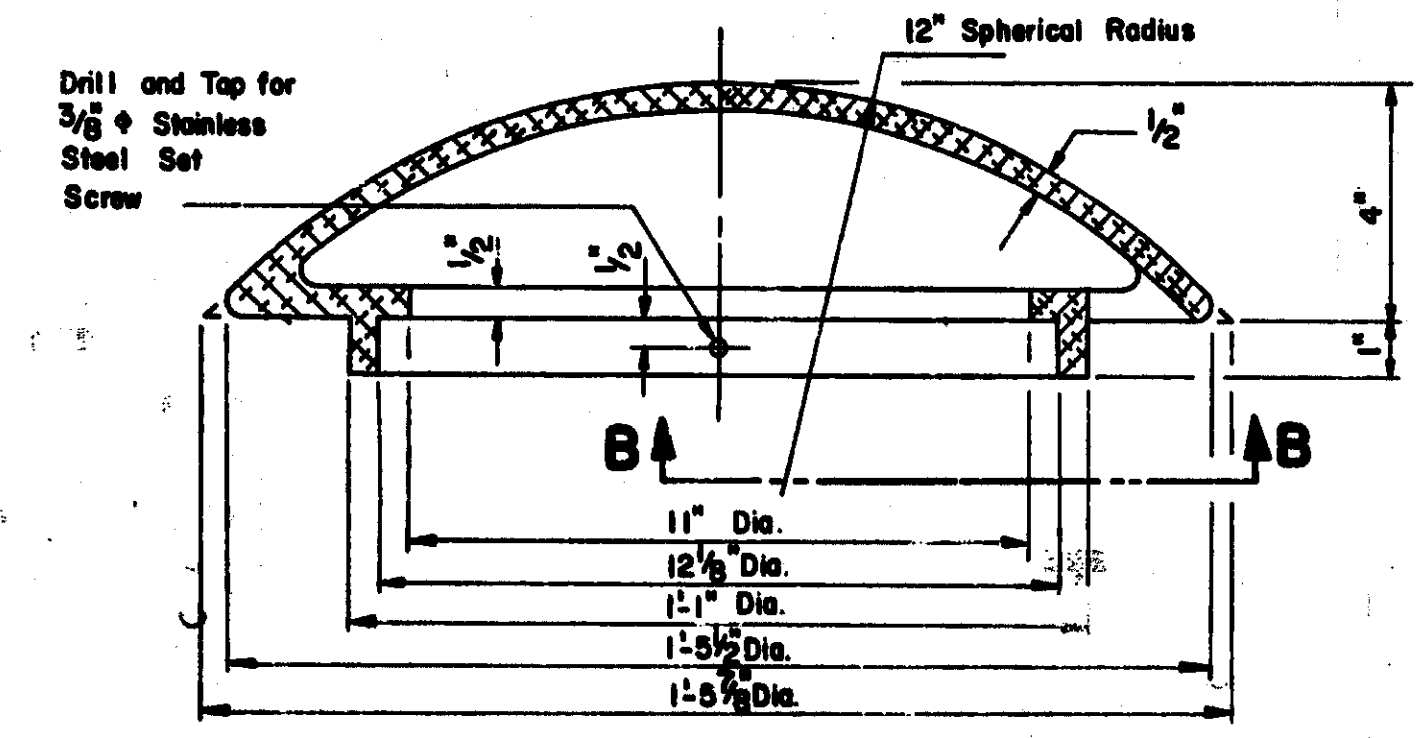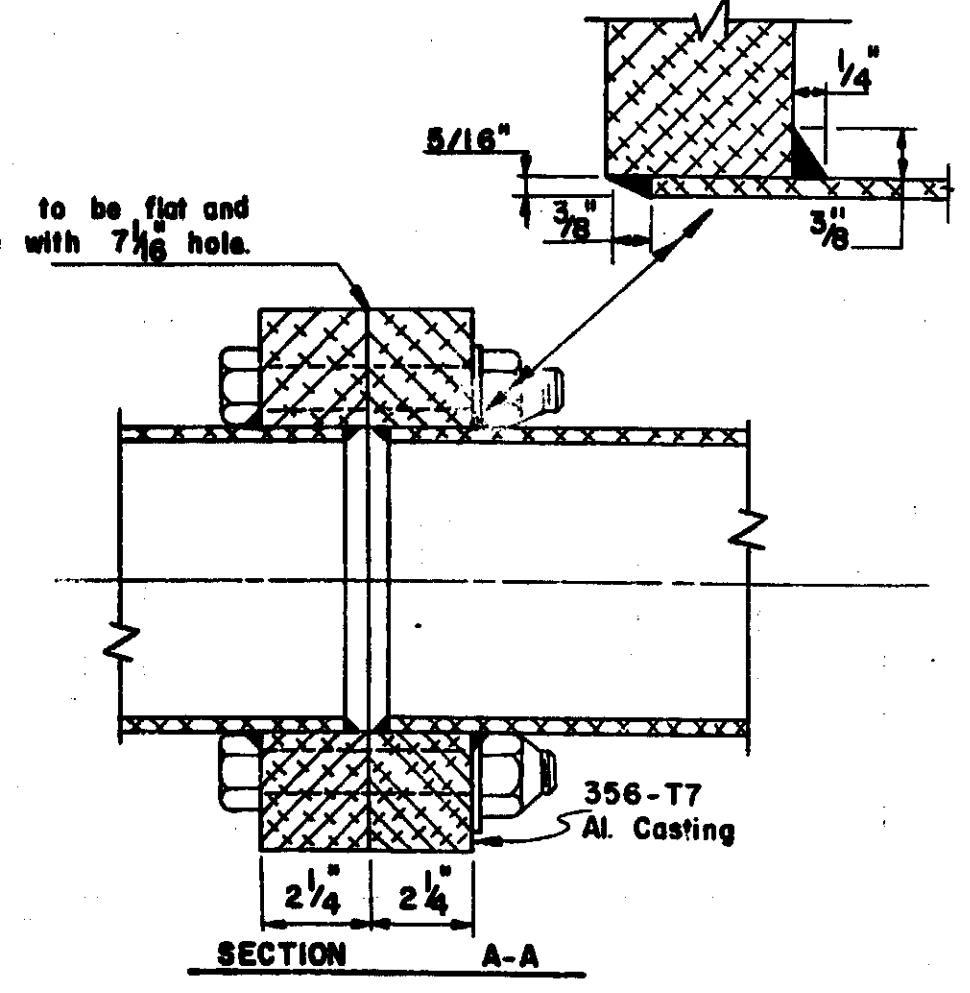


Detail of Pole Cap

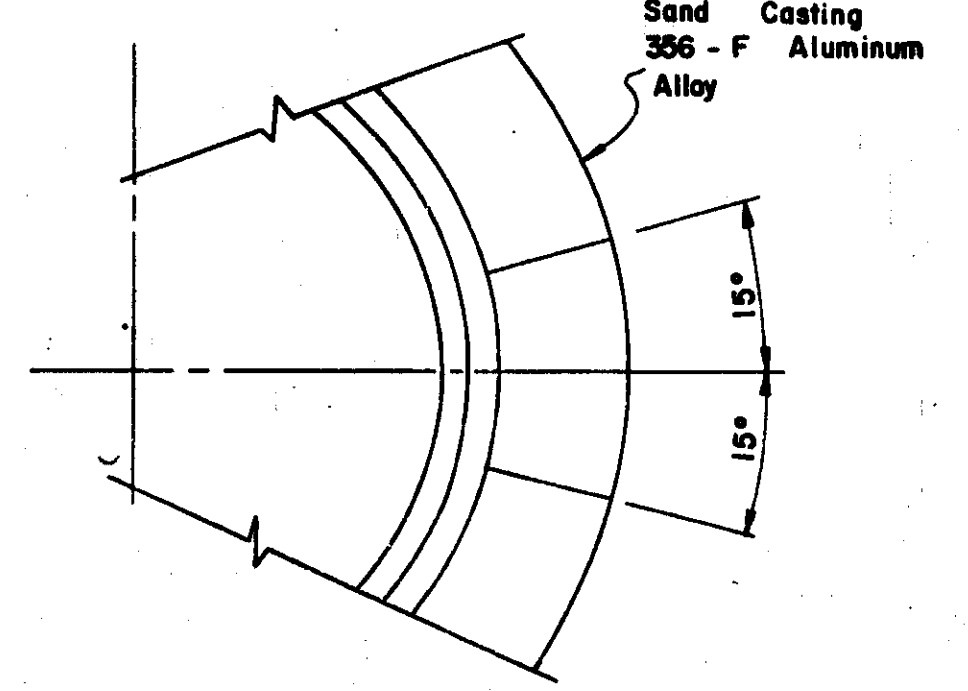

View B-B

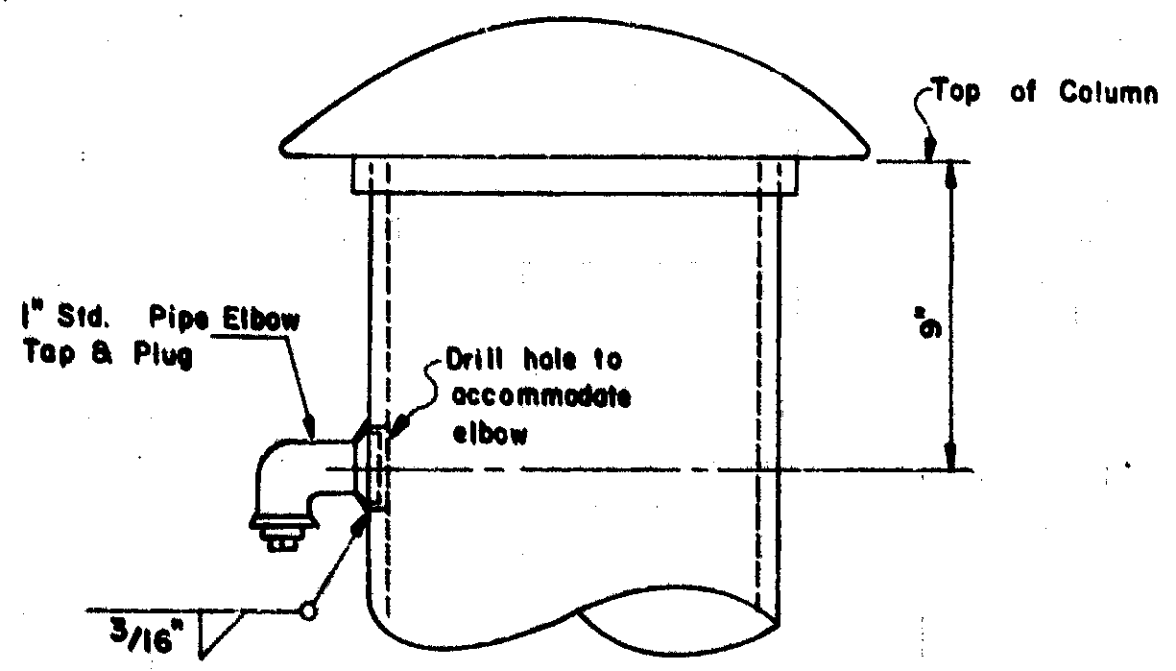

Detail of Electrical Outlet at Column

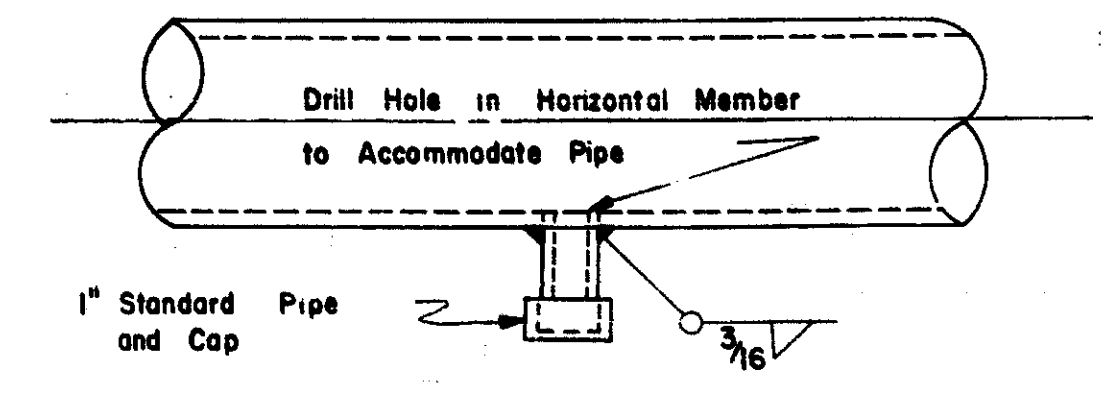

Detail of Electrical Outlet at Chord

Work the sheet with sheet 1

MICHIGAN DEPARTMENT OF STATE HIGHWAYS


ALUMINUM TRUSS DETAILS

TYPE D


NO.	DESCRIPTION	DATE	BY
1	CHANGE IN DETAIL OF CHORD CONNECTION	2/78	JDB
2	NOTE #1 Revised	11-78	RJM

REVISIONS	DATE	BY
1	2-7-67	W.D.R.
2	11-29-66	J.D.B.
3	1-28-67	F.H.


DESIGNED BY: W.D.R. DATE: 2-7-67
DRAWN BY: J.D.B. DATE: 11-29-66
CHECKED BY: F.H. DATE: 1-28-67
SHEET 2 OF 3
S6.60

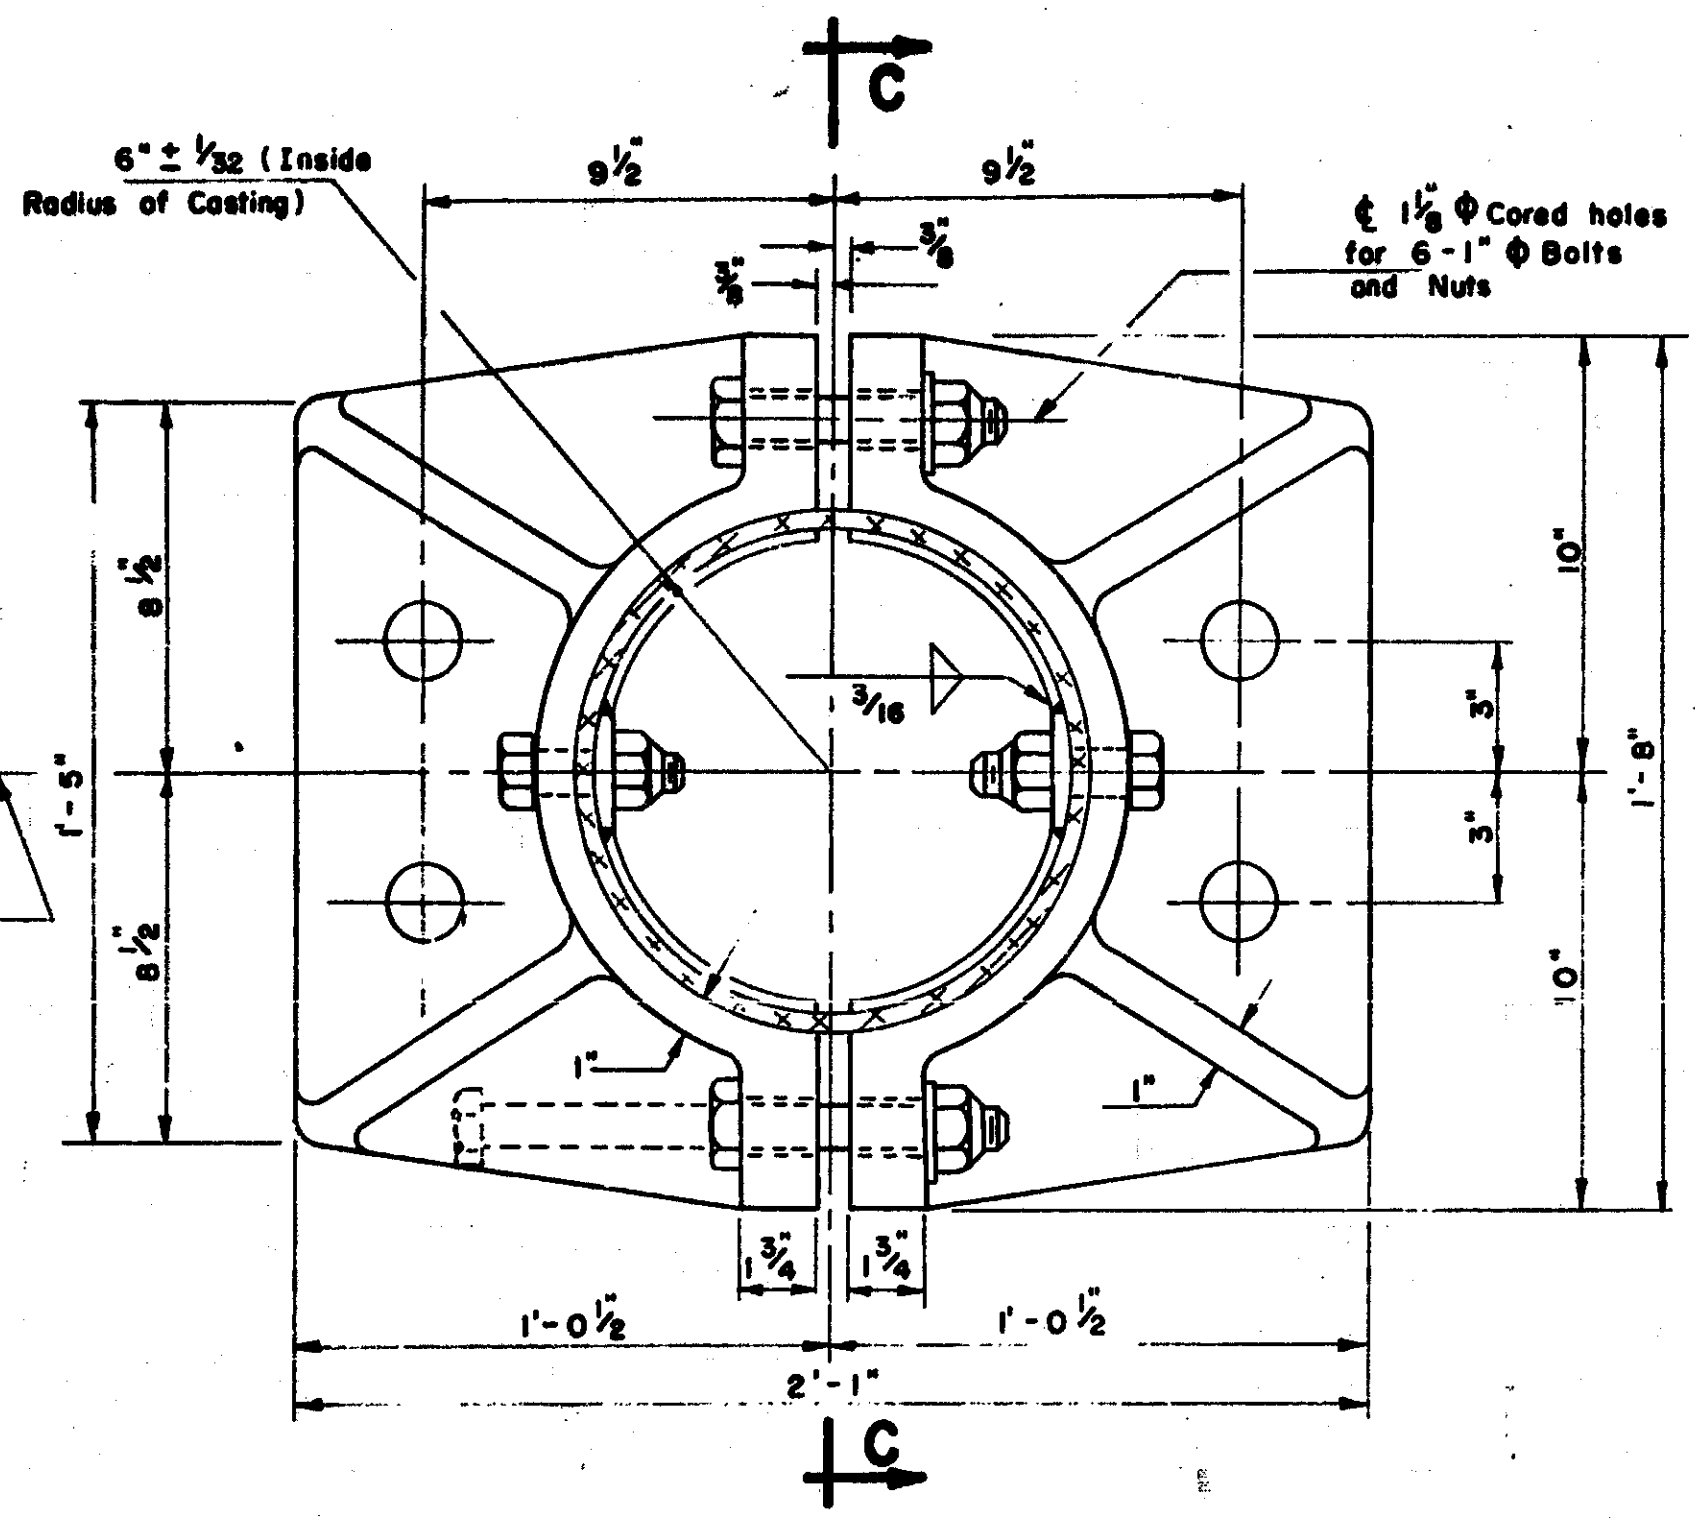


Section D-D

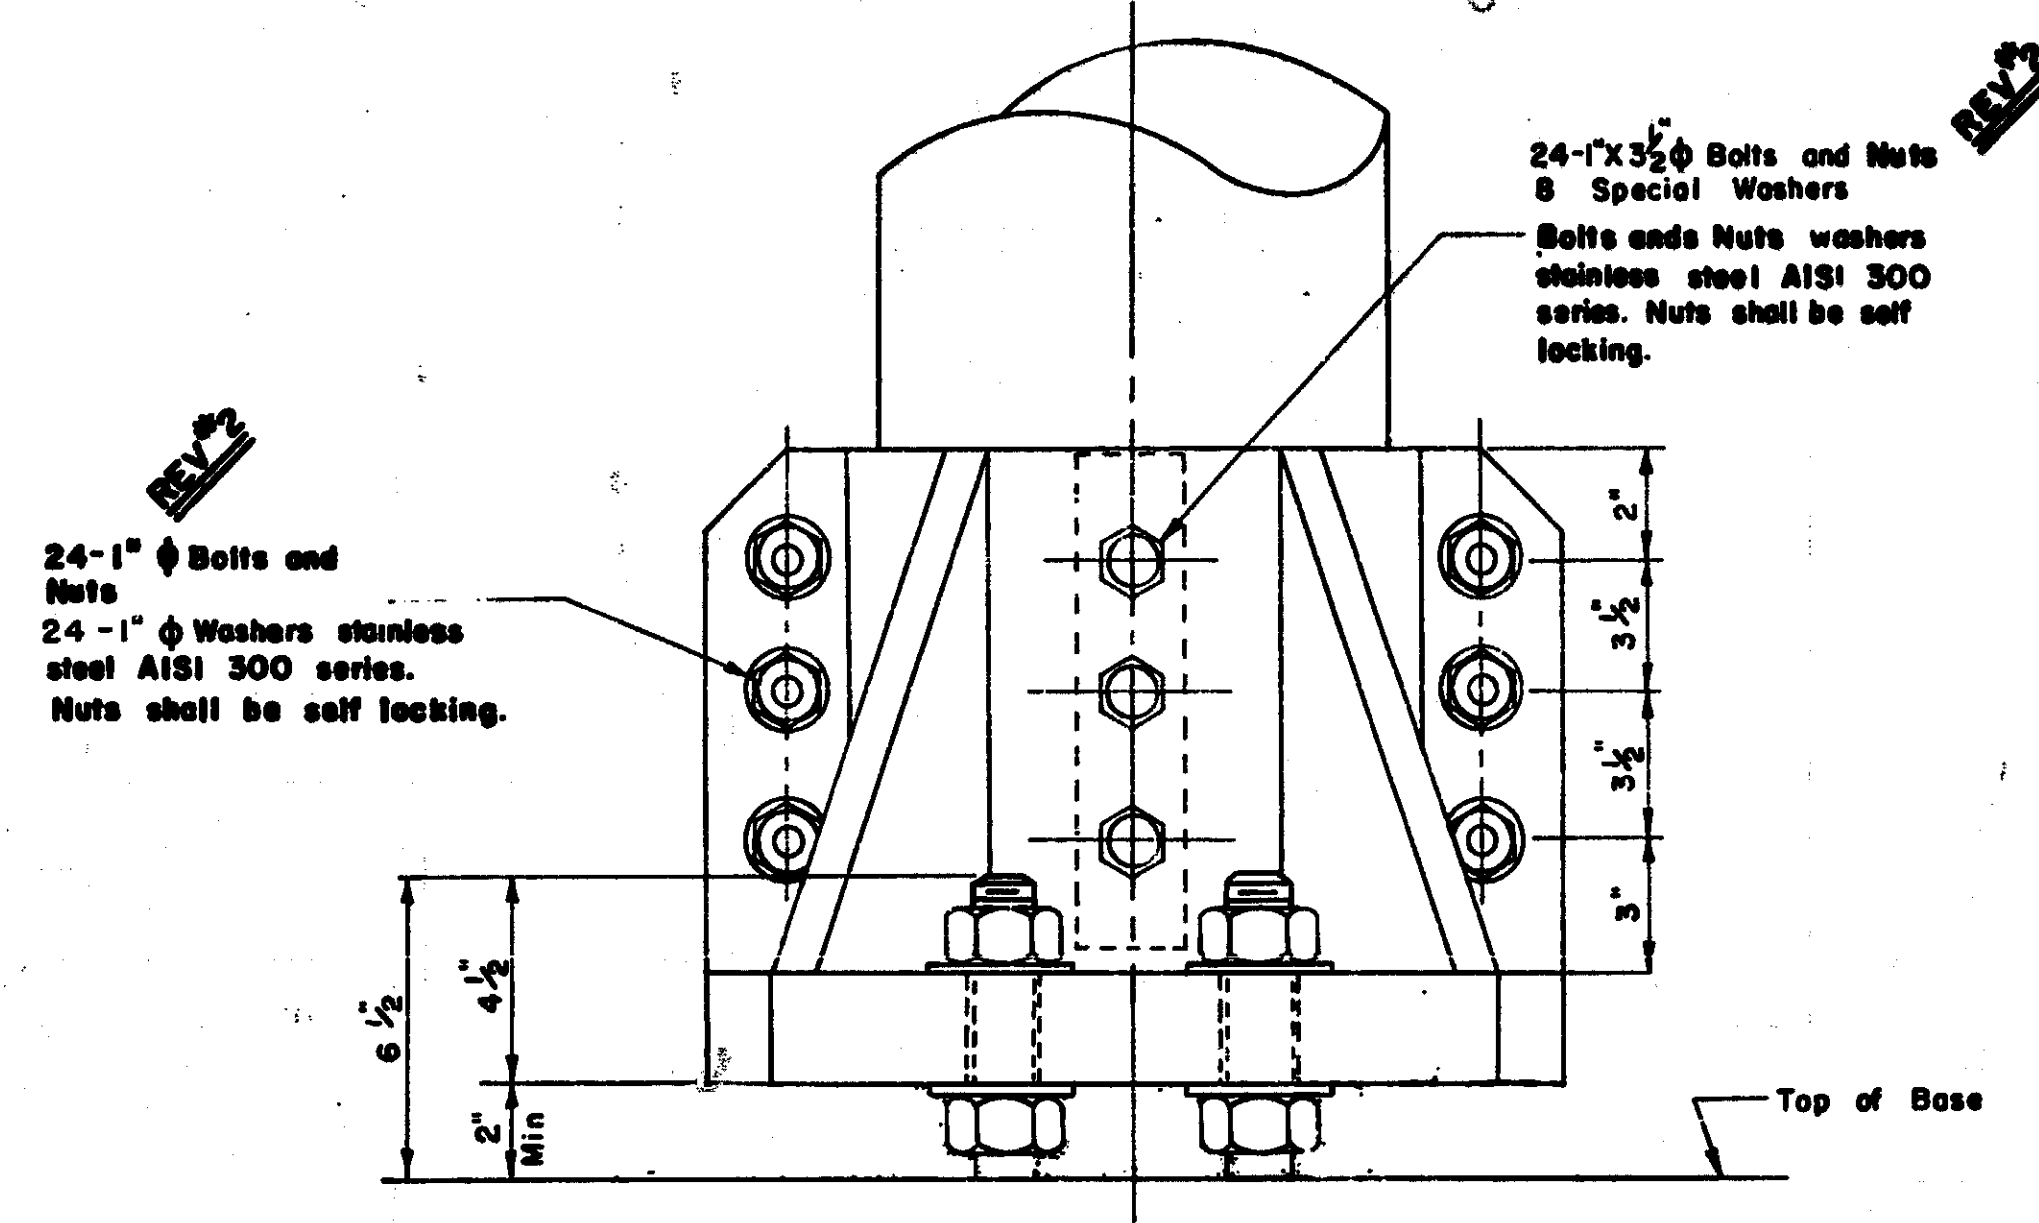

Side Elevation

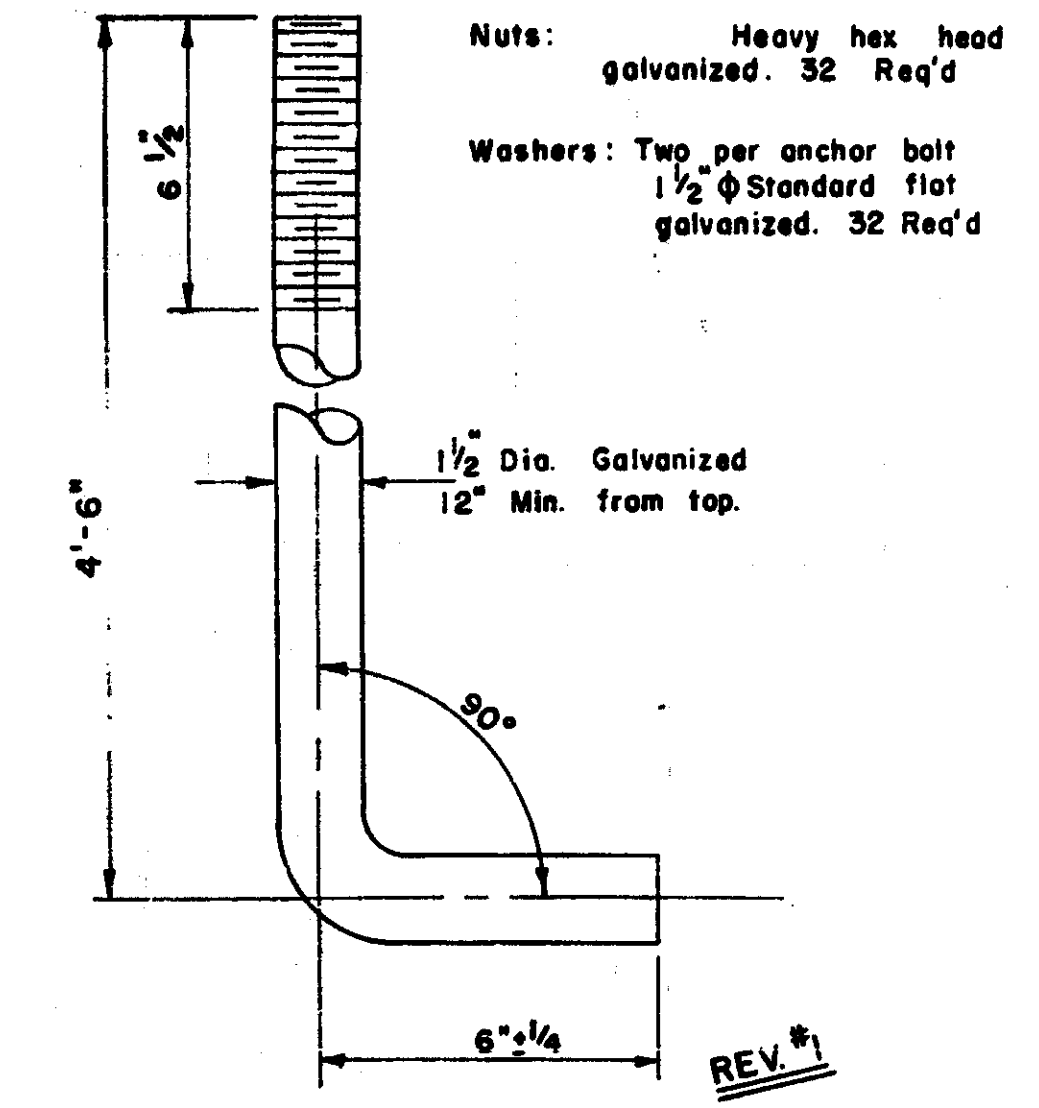


Detail of Anchor Bolt
16 Required
Anchor Bolts are to be A 307 Steel
With an Ultimate Strength of 85,000 P.S.I.

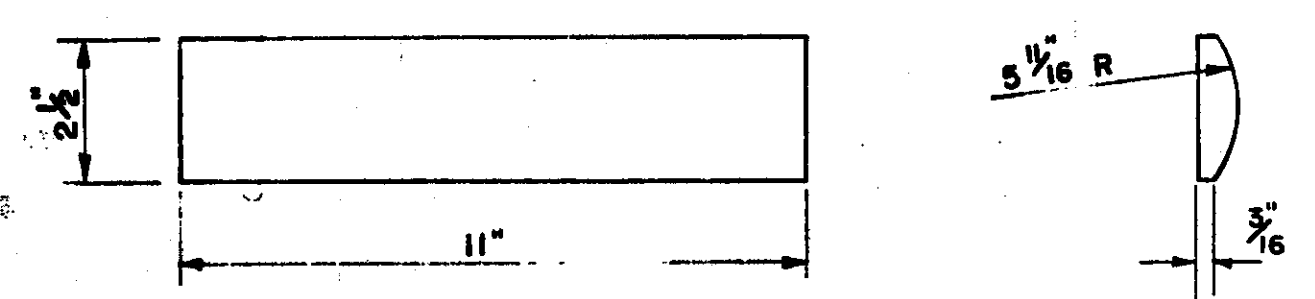


Detail of Special Washer


Washer to be welded to inside of column prior to drilling 1 1/8 inch holes through column and washer.

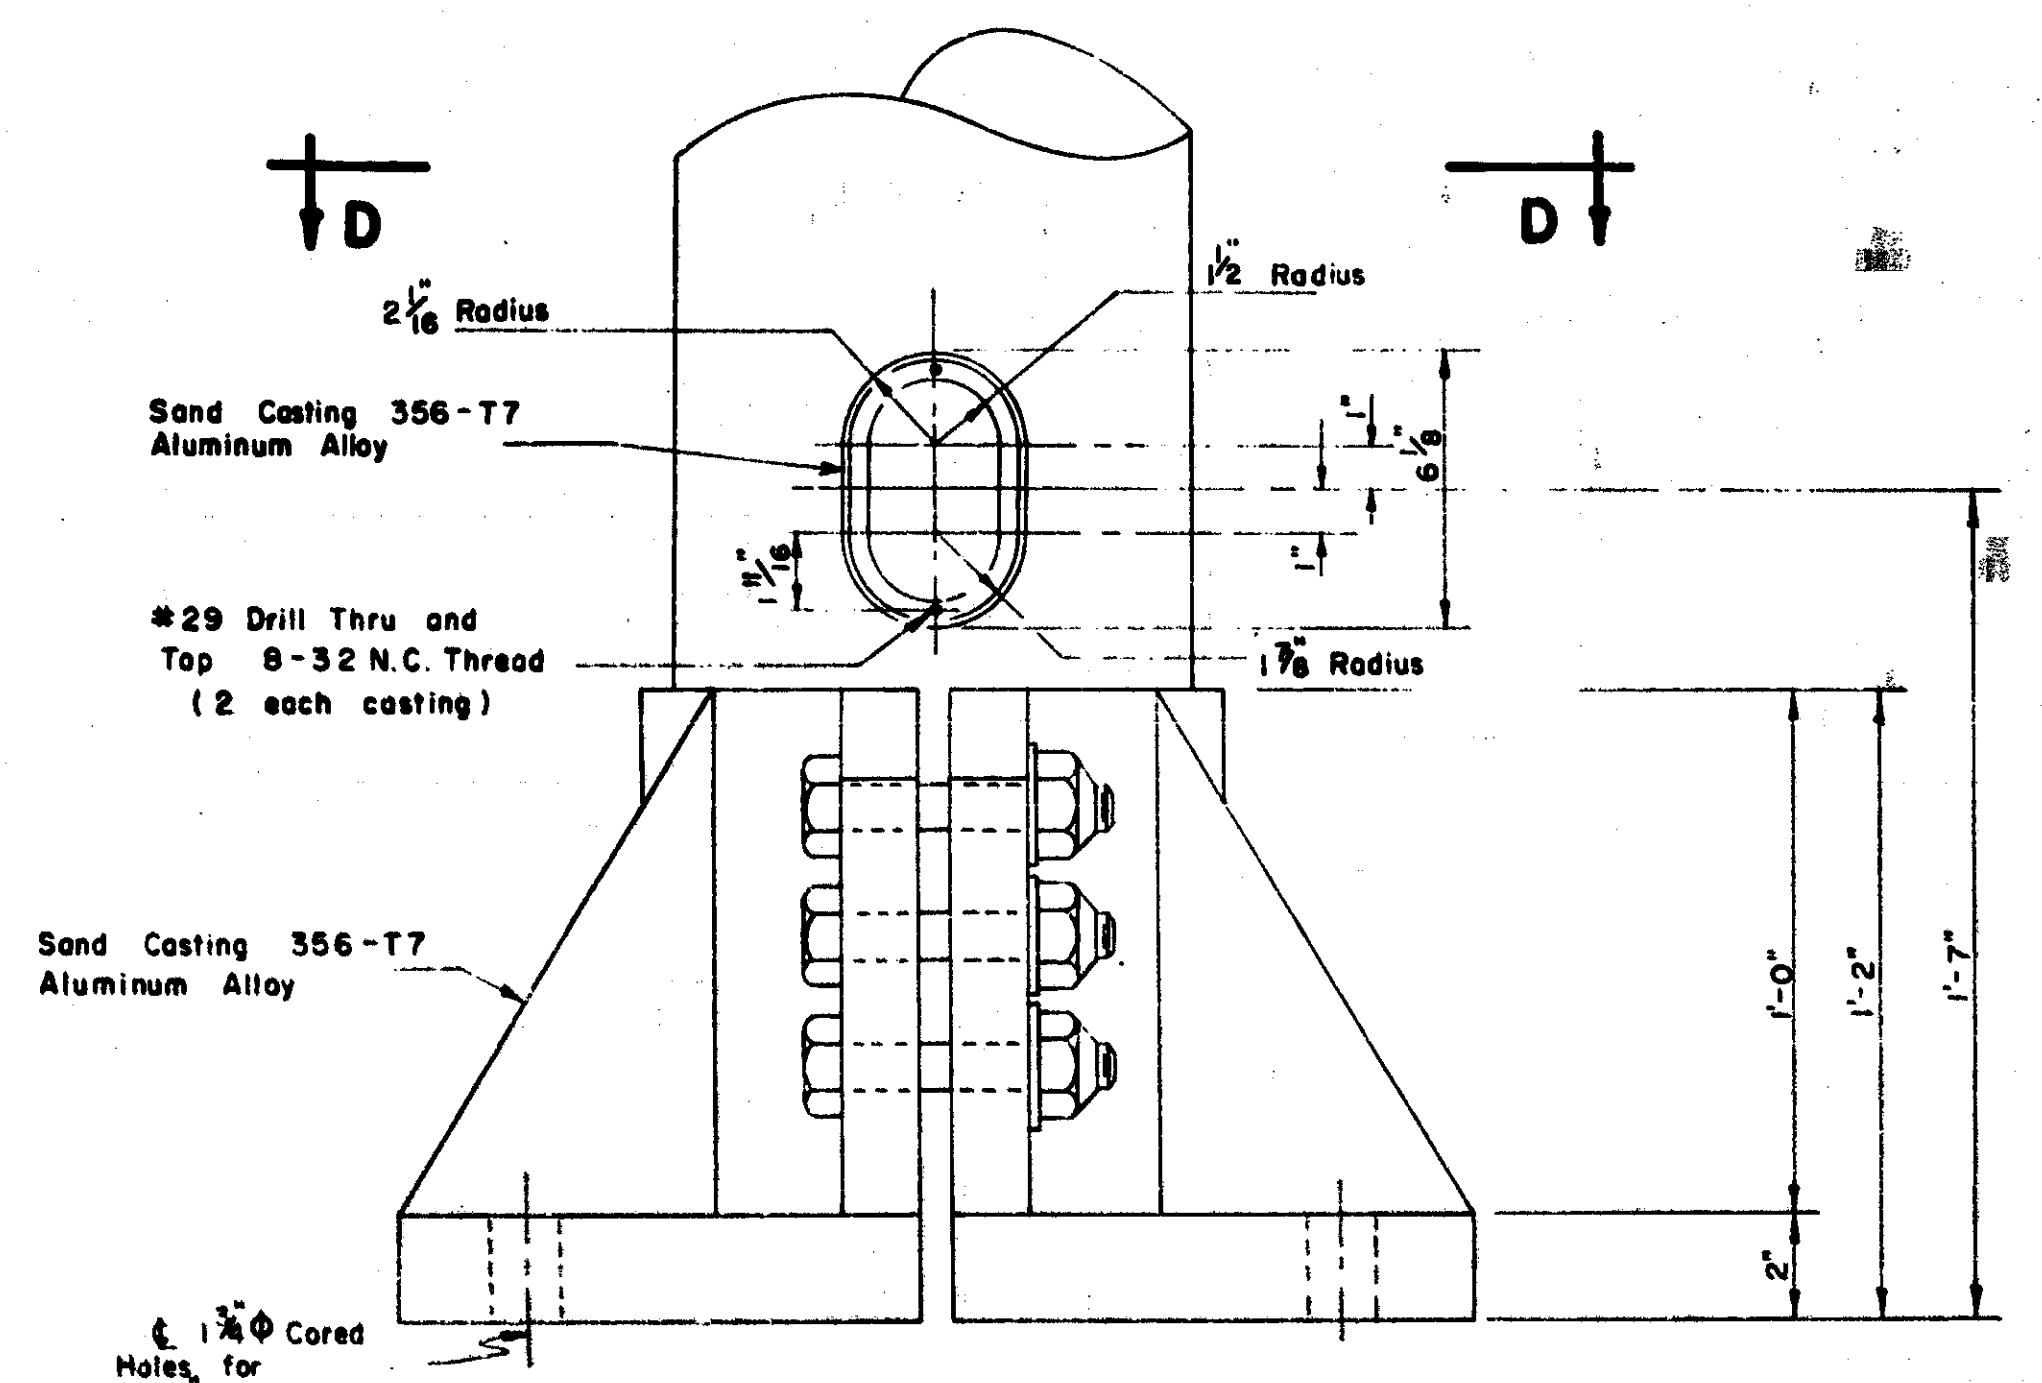

Front Elevation

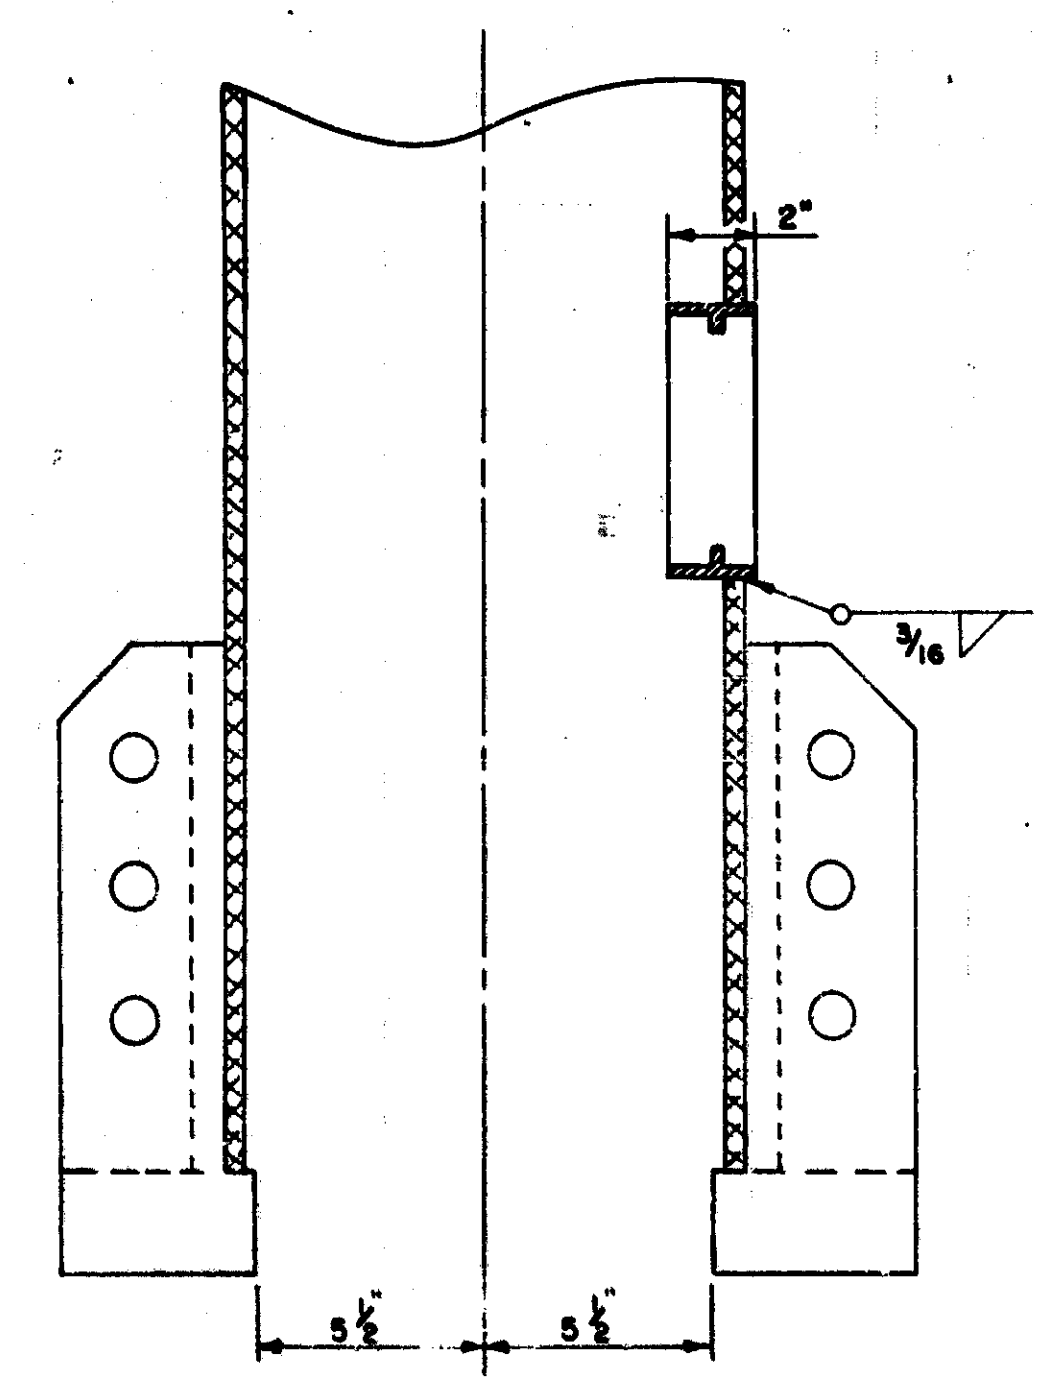

Section C-C

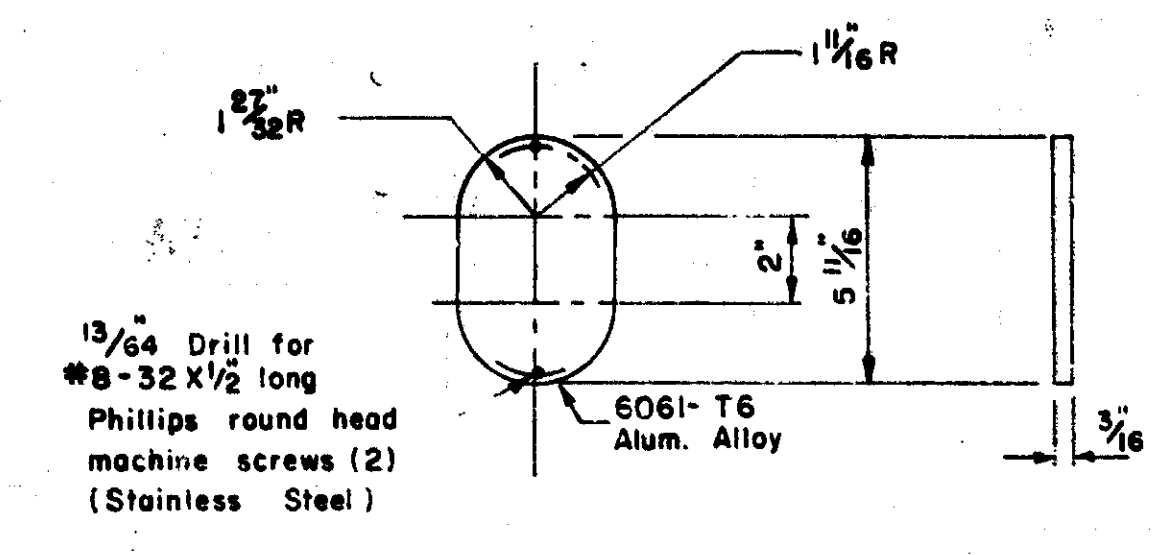

Hand Hole Unit Cover
2 Required

Detail of Base and Hand Hole Units
2 Handhole units req'd - One each tower
4 Bases req'd - Complete

MICHIGAN DEPARTMENT OF STATE HIGHWAYS
ALUMINUM TRUSS DETAILS
TYPE D

NO.	DESCRIPTION	DATE	BY
1	ANCHOR BOLT DETAIL REVISED	6/73	TNW
2	SPEC CHANGED	2/78	JOB
3	NOTE # 2 REVISED	11/78	NJM

DATE	BY	APP'D
2-7-67	WOB	
11-29-66	JOB	
1-31-67	F.H.	
3		

S670

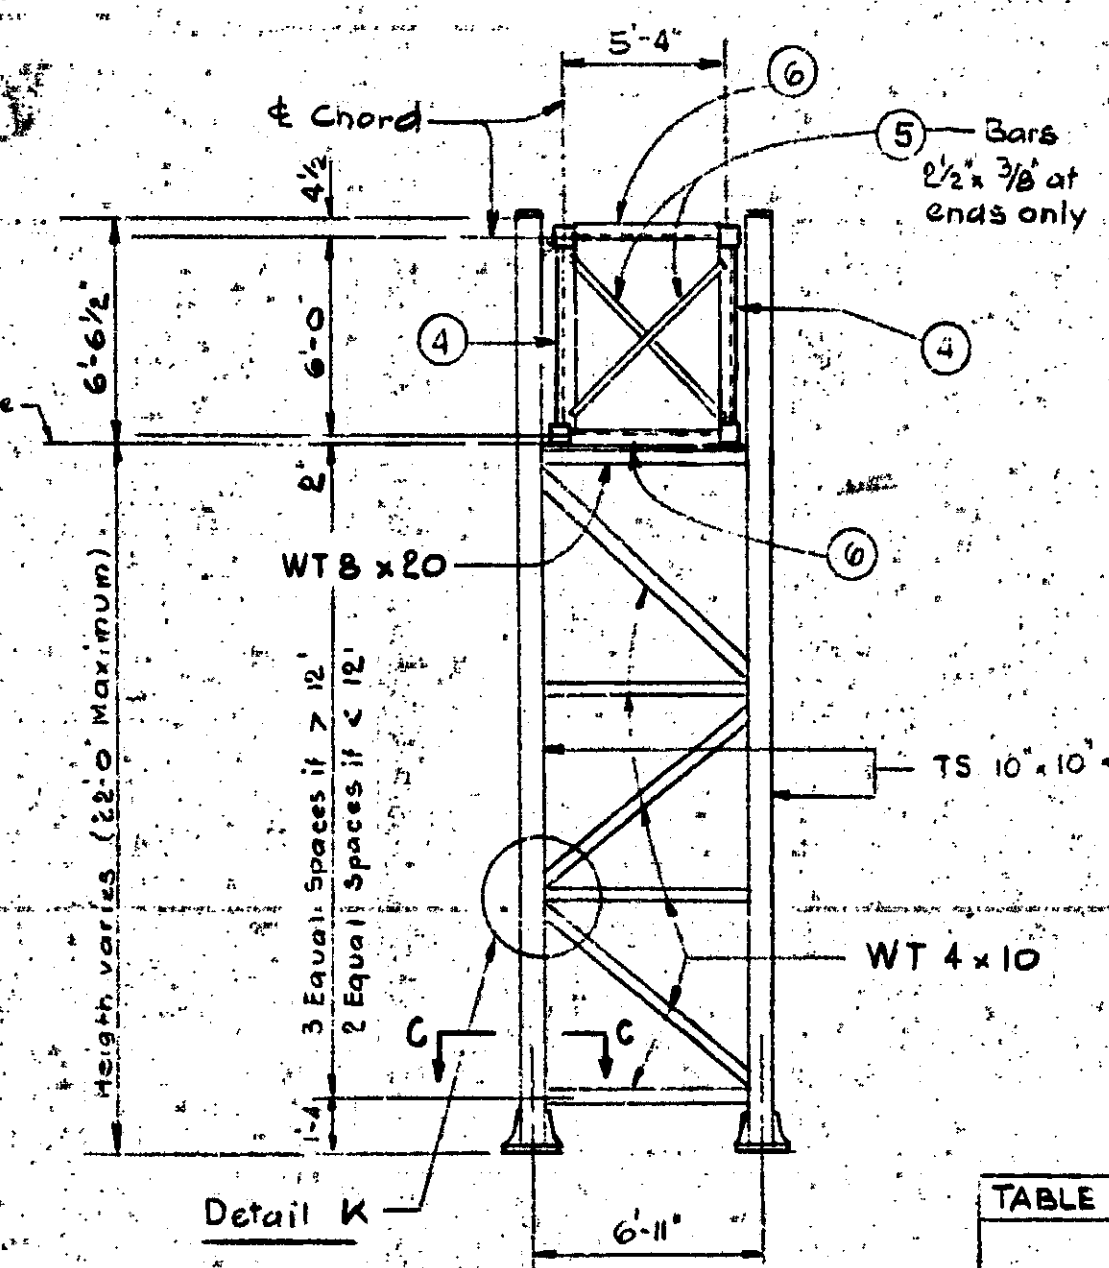
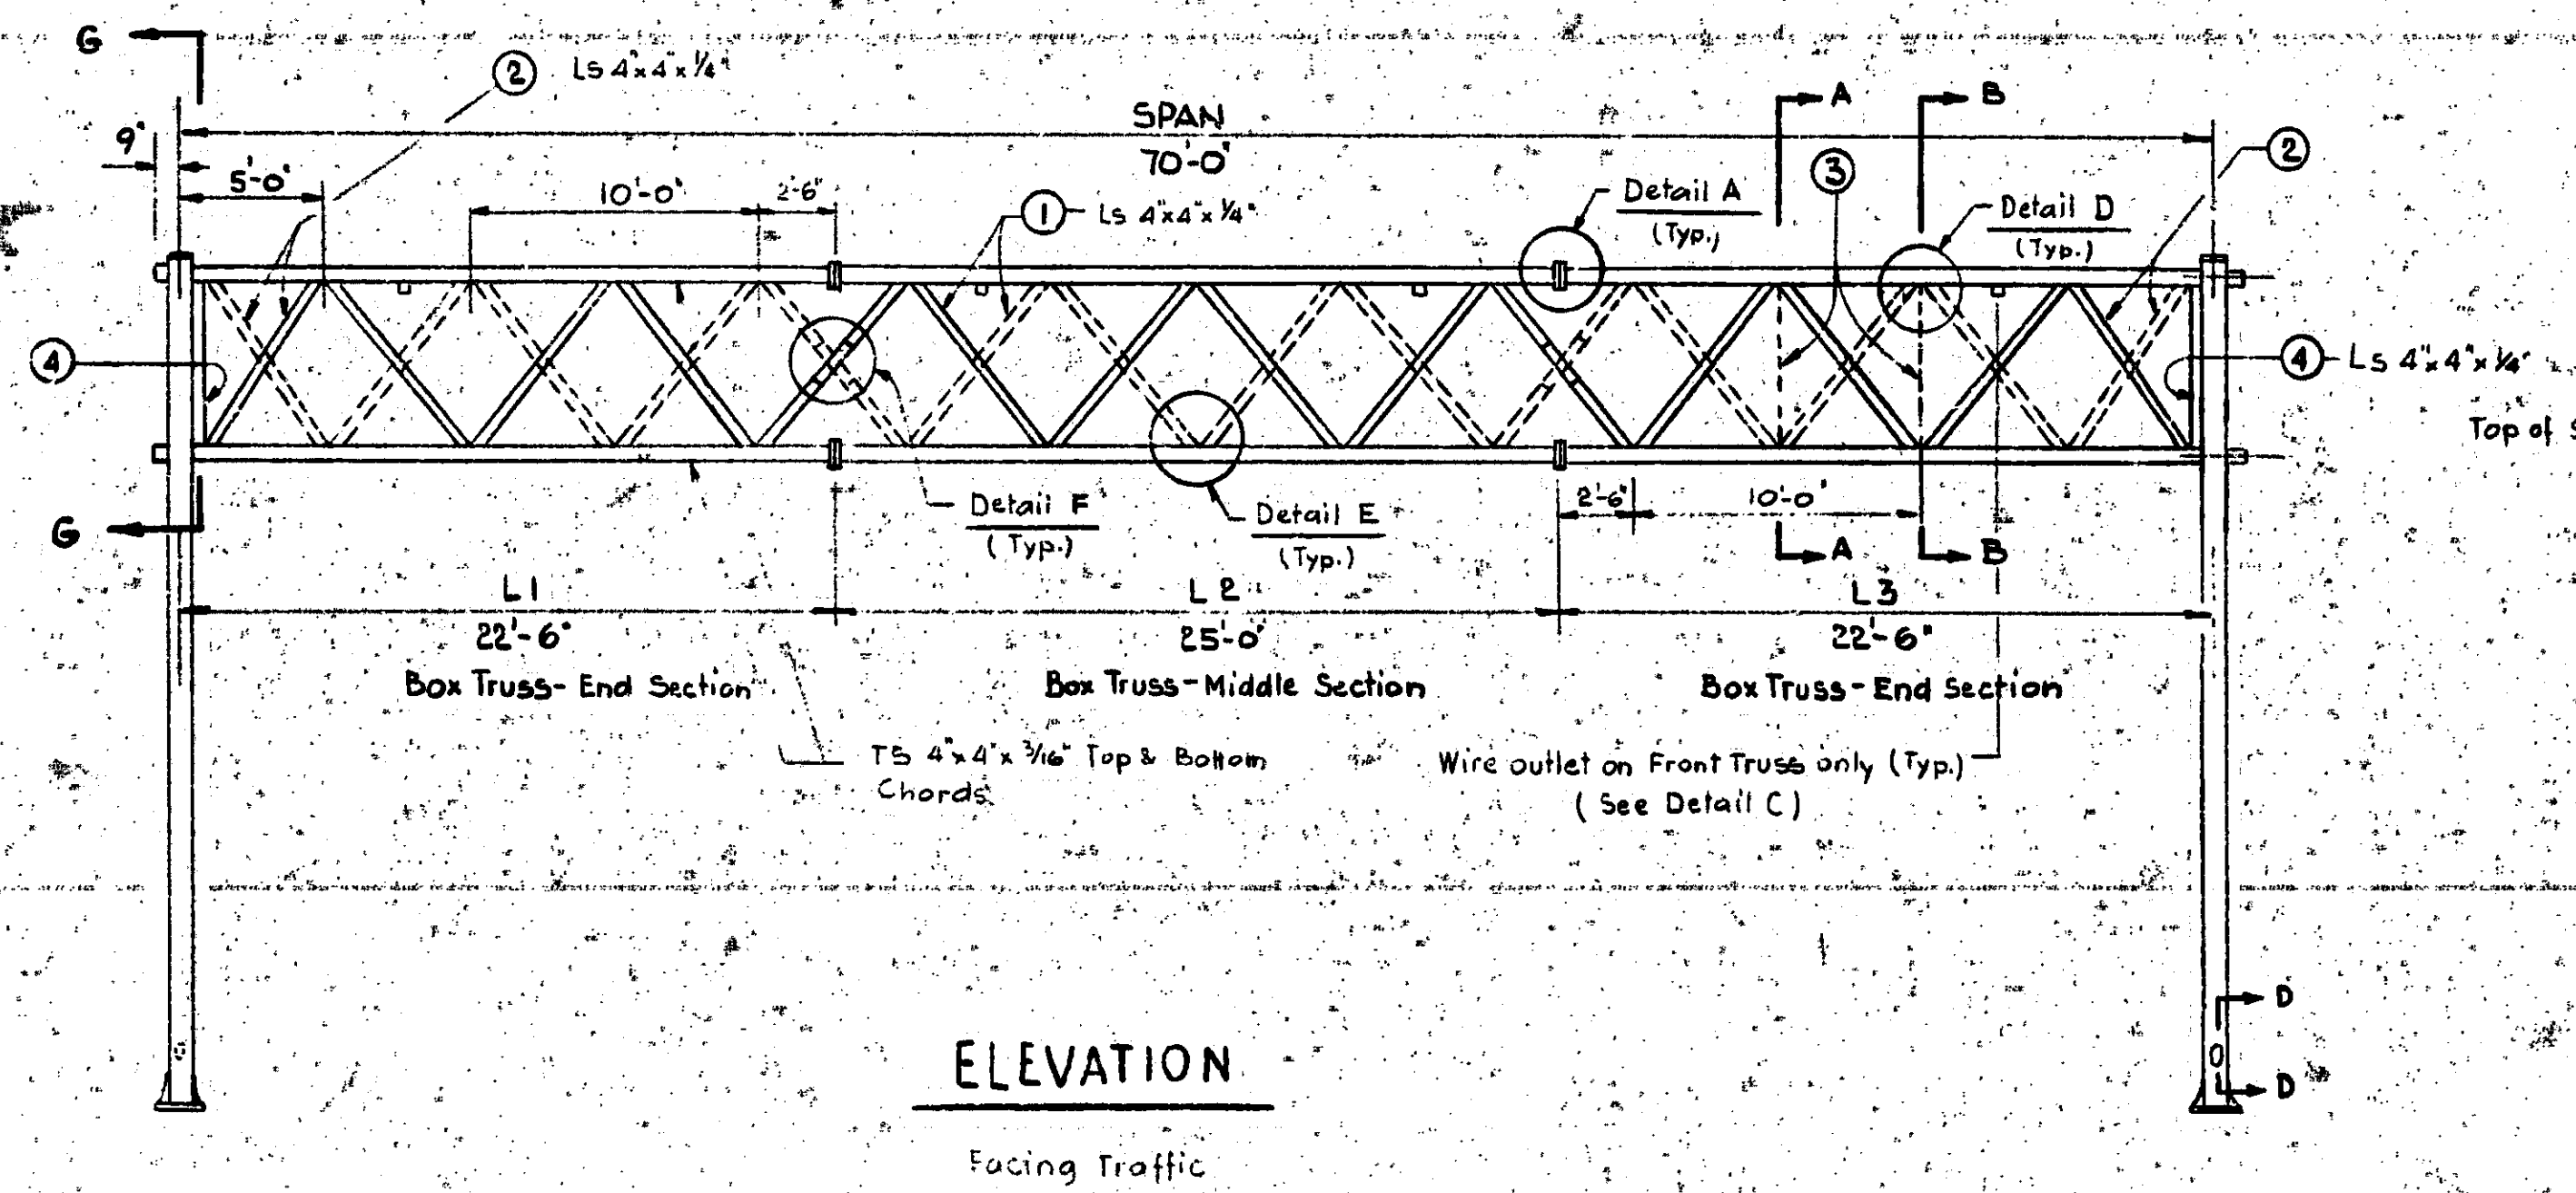
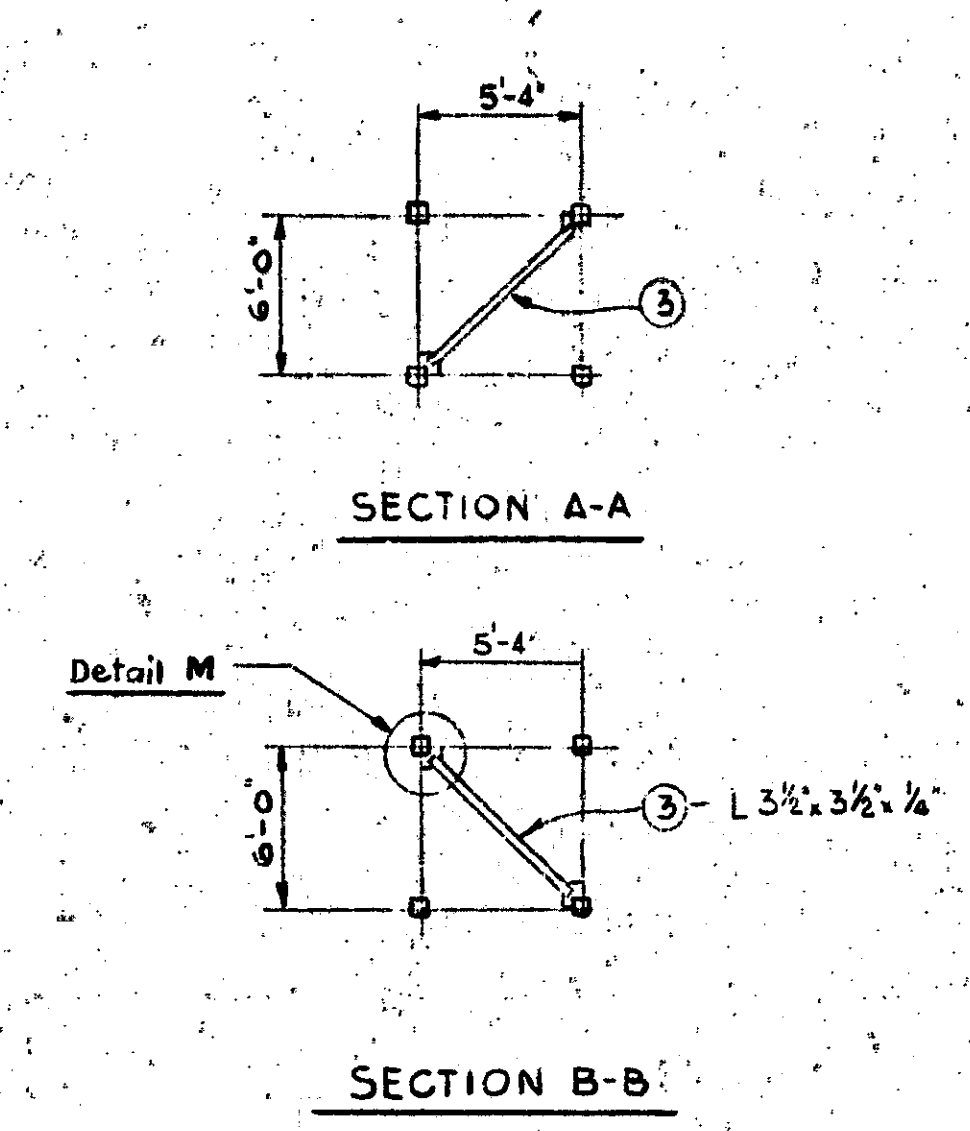
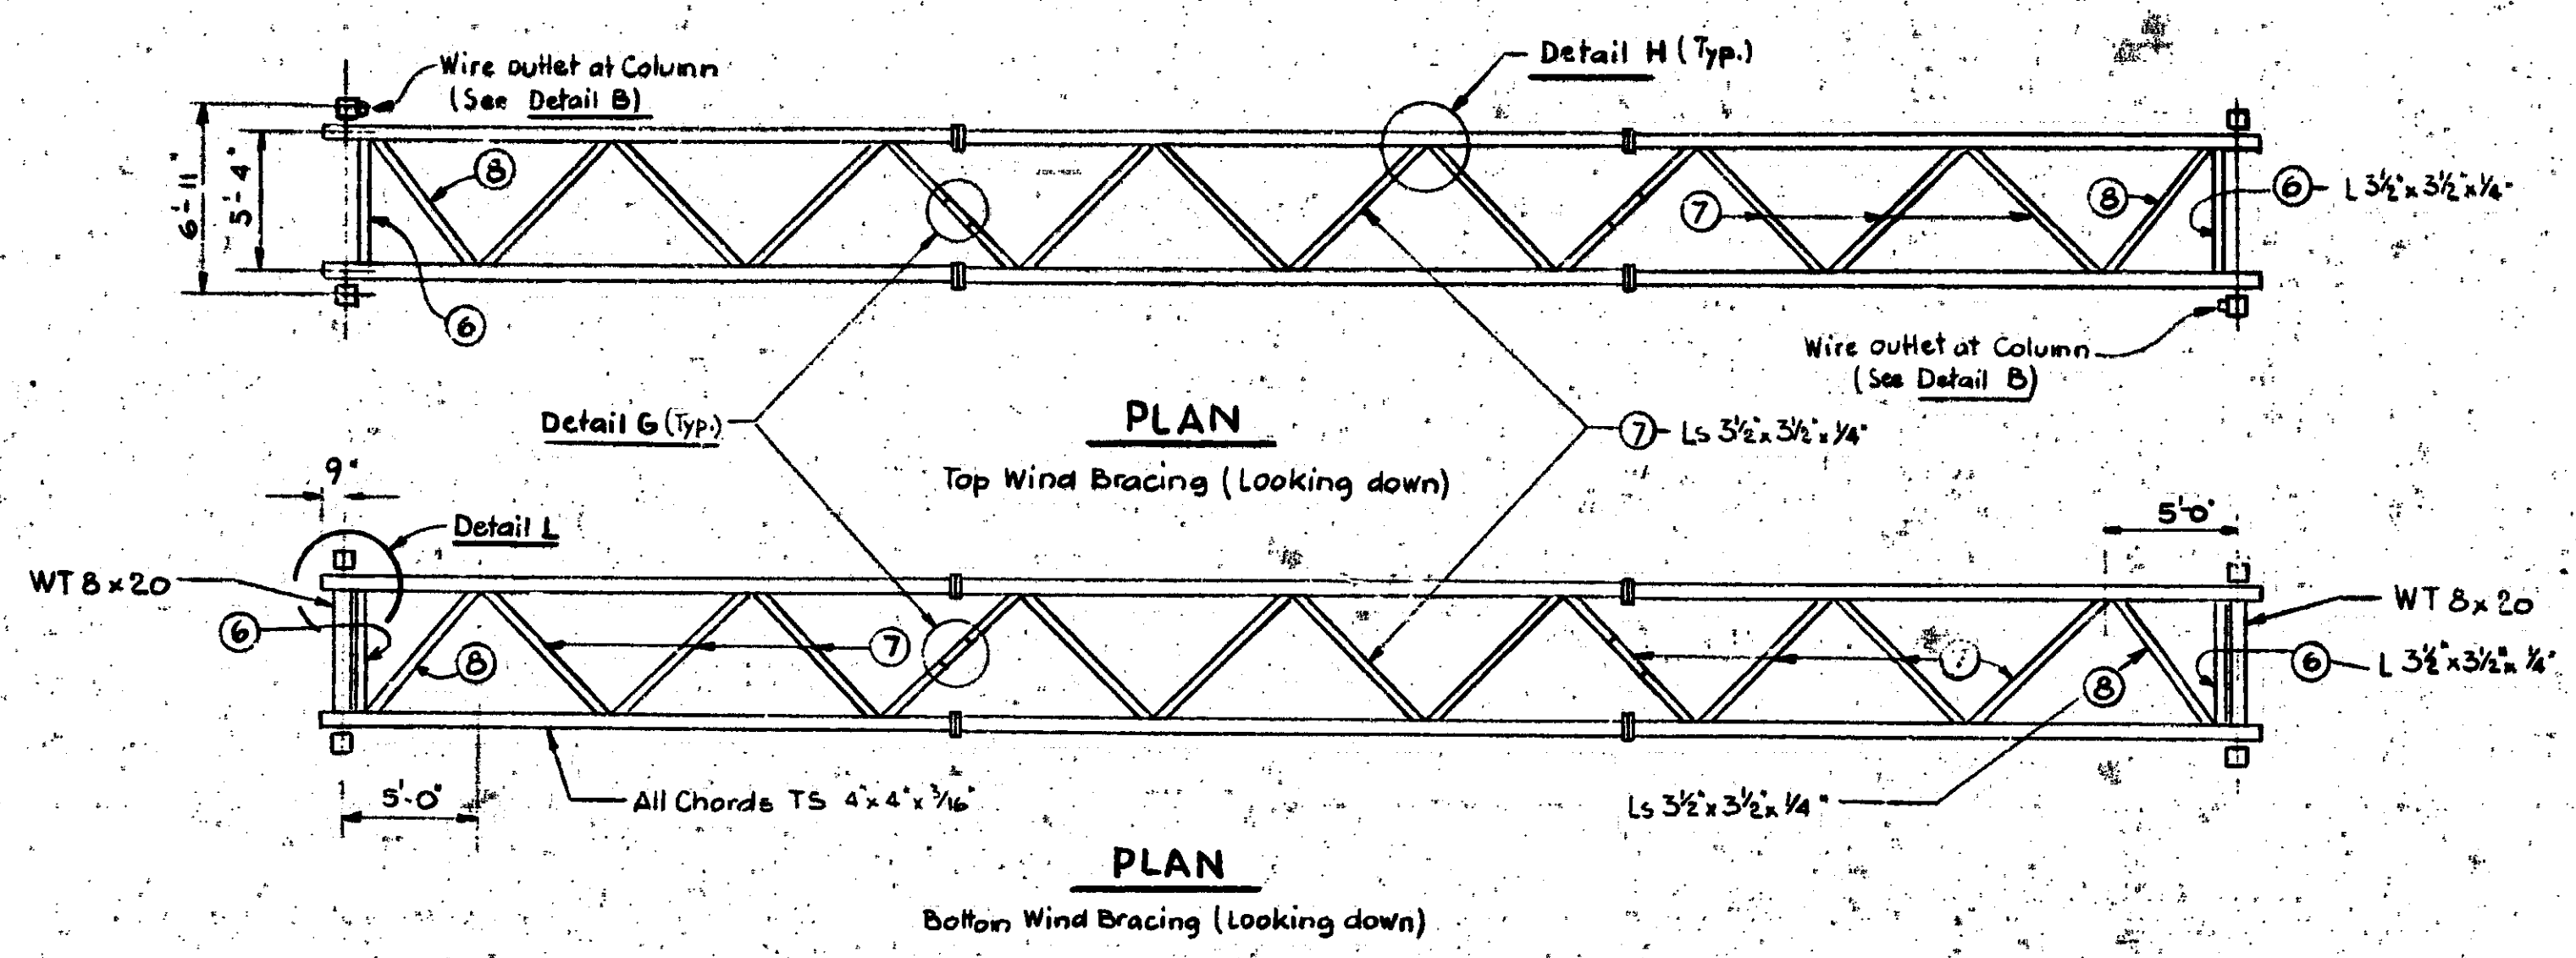


TABLE OF SECTIONS & DETAILS SHOWN ON SHEET

For	See
Section C-C	Type D sheet 7
Section D-D	
Hand Hole Cover	
Detail of Anchor Bolts	
Front Elevation of Base	
Base-Leveling nuts	
Detail B	
Detail C	Type D sheet 7
Detail G	Type C sheet 5
Detail R	Type D sheet 7


NOTES

- The design of this structure is based on the AASHTO Standard Specifications for Structural Supports for Highway Signs, Luminaires and Traffic Signals (1975 Edition). Sign area = 500 Sq. Ft. maximum. Maximum projection of sign beyond chord is 6 ft. Design is based on a wind load of 35 p.s.f. on sign area.
- All square tubes, angles, plates, bars and WT shapes shall be ASTM A-588 Structural Steel. All connection bolts, except U-bolts, anchor bolts, and bolts used in the upper clamp connection, shall conform to ASTM A-325, Type 3. U-bolts and bolts in the upper clamp connection and washers shall conform to ASTM A-307 Grade A.
- Welding shall conform to the requirements as specified under Structural Steel Construction, 504 of the Standard Specifications for Highway Construction 1976.
- Bolts, U-bolts, nuts & washers shall be zinc coated in conformance with the requirements of ASTM A-153.
- The cambering shall be provided in the fabrication so that the flanges are correctly sloped to assure obtaining full contact in the relaxed assembled position prior to strutting up the flange bolts. The flange bolts shall not be torqued in an attempt to close any flange misalignment. Trusses shall not be lifted by the web members.
- See Standard Spec 5.9.10 for sign connection.

TRUSS DATA - A 588 STEEL

SPAN	L1	L2	L3	CAMBER	BOX TRUSS	Approx. Weight of Truss, lbs/ft.
50'-0"	17'-6"	15'-0"	17'-6"	5/8"	6'-0" x 5'-4"	82
55'-0"	17'-6"	20'-0"	17'-6"	3/4"	6'-0" x 5'-4"	
60'-0"	22'-6"	15'-0"	22'-6"	7/8"	6'-0" x 5'-4"	
65'-0"	22'-6"	10'-0"	22'-6"	1"	6'-0" x 5'-4"	
70'-0"	22'-6"	25'-0"	22'-6"	1 1/8"	6'-0" x 5'-4"	82

CAMBER: The camber given in the above table is the ordinate at the center of the assembled truss prior to dead load deflection. Allowable camber tolerance for truss is ±5%.

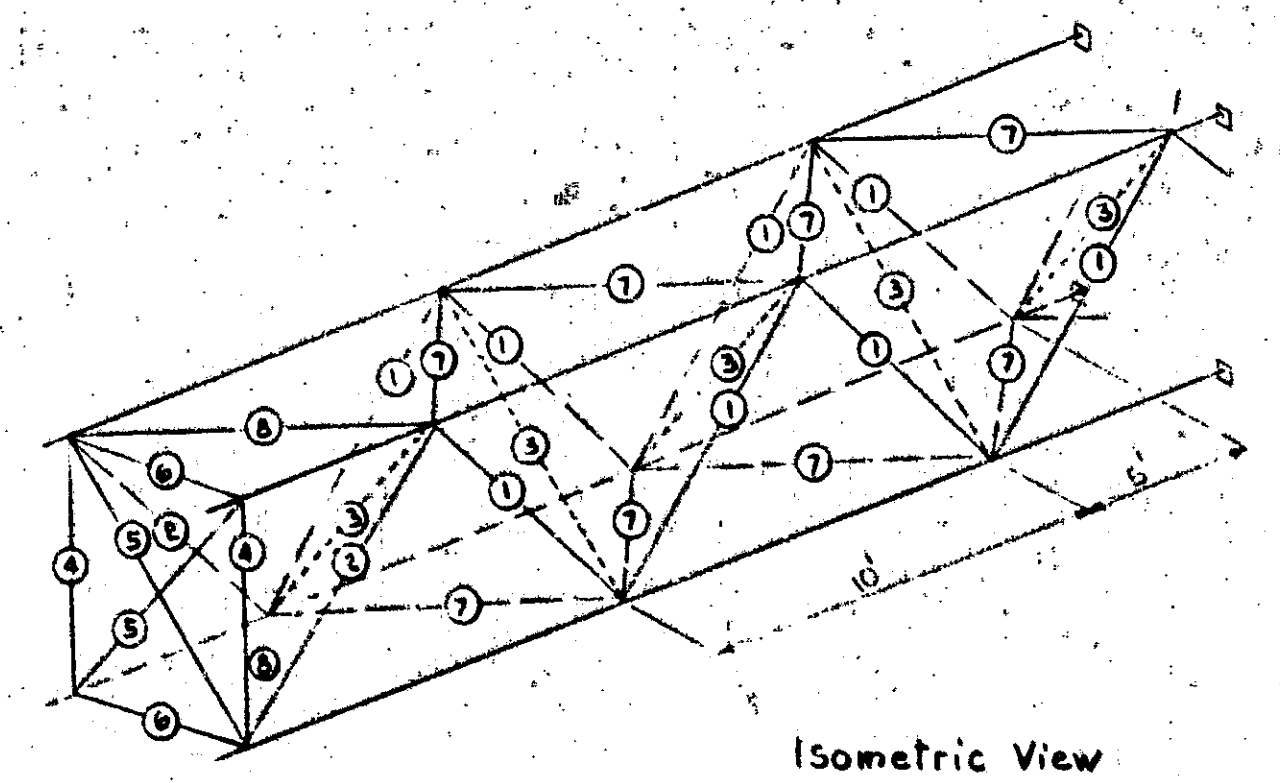

Isometric View
Showing end Section of Truss

Work this sheet with sheets 2, 3, 5, 7

MICHIGAN DEPARTMENT OF STATE HIGHWAYS

STEEL TRUSS


TYPE C (70 FT.)

A-588 STEEL


NO.	REVISION	DATE	BY

DESIGN BY	Bullen	2-16-77
DRAWN BY	P.R.N.	12-23-76
CHECKED BY	J.W.	1-17-77
DATE		
SHEET		
OF		


S 7.10

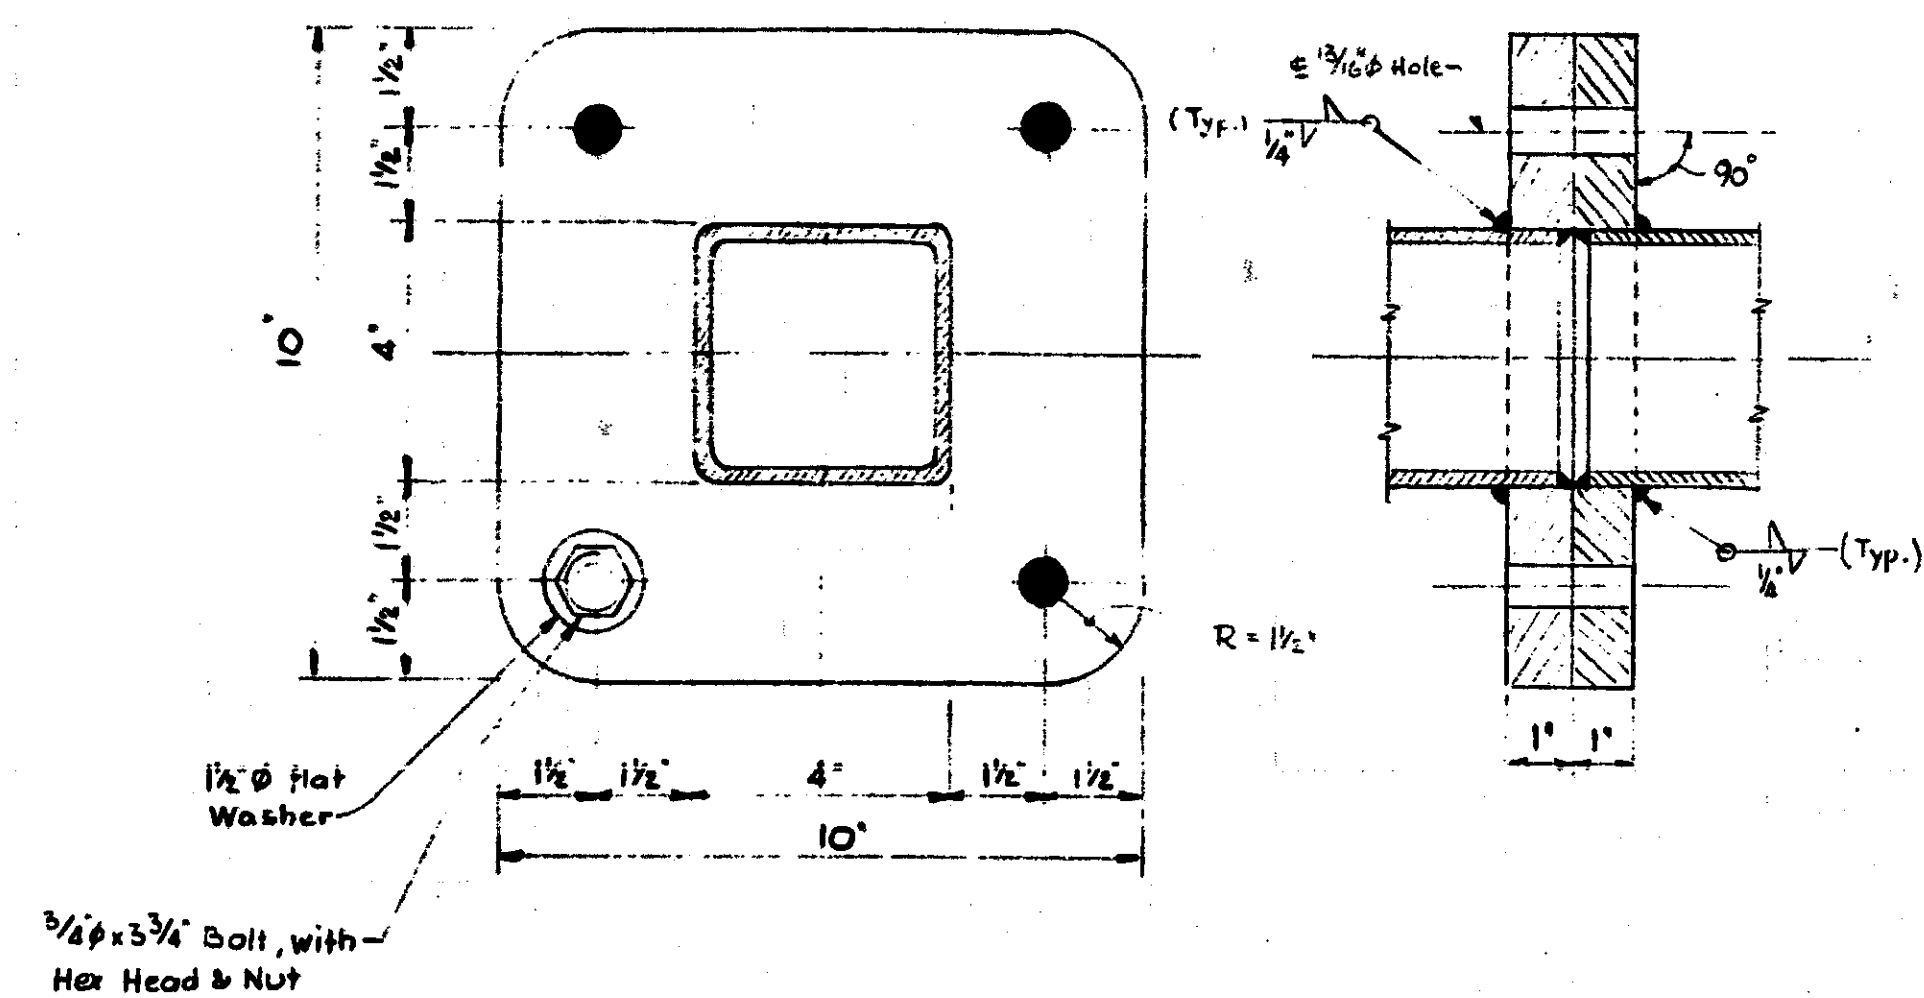

DETAIL A
Chord Connection Details

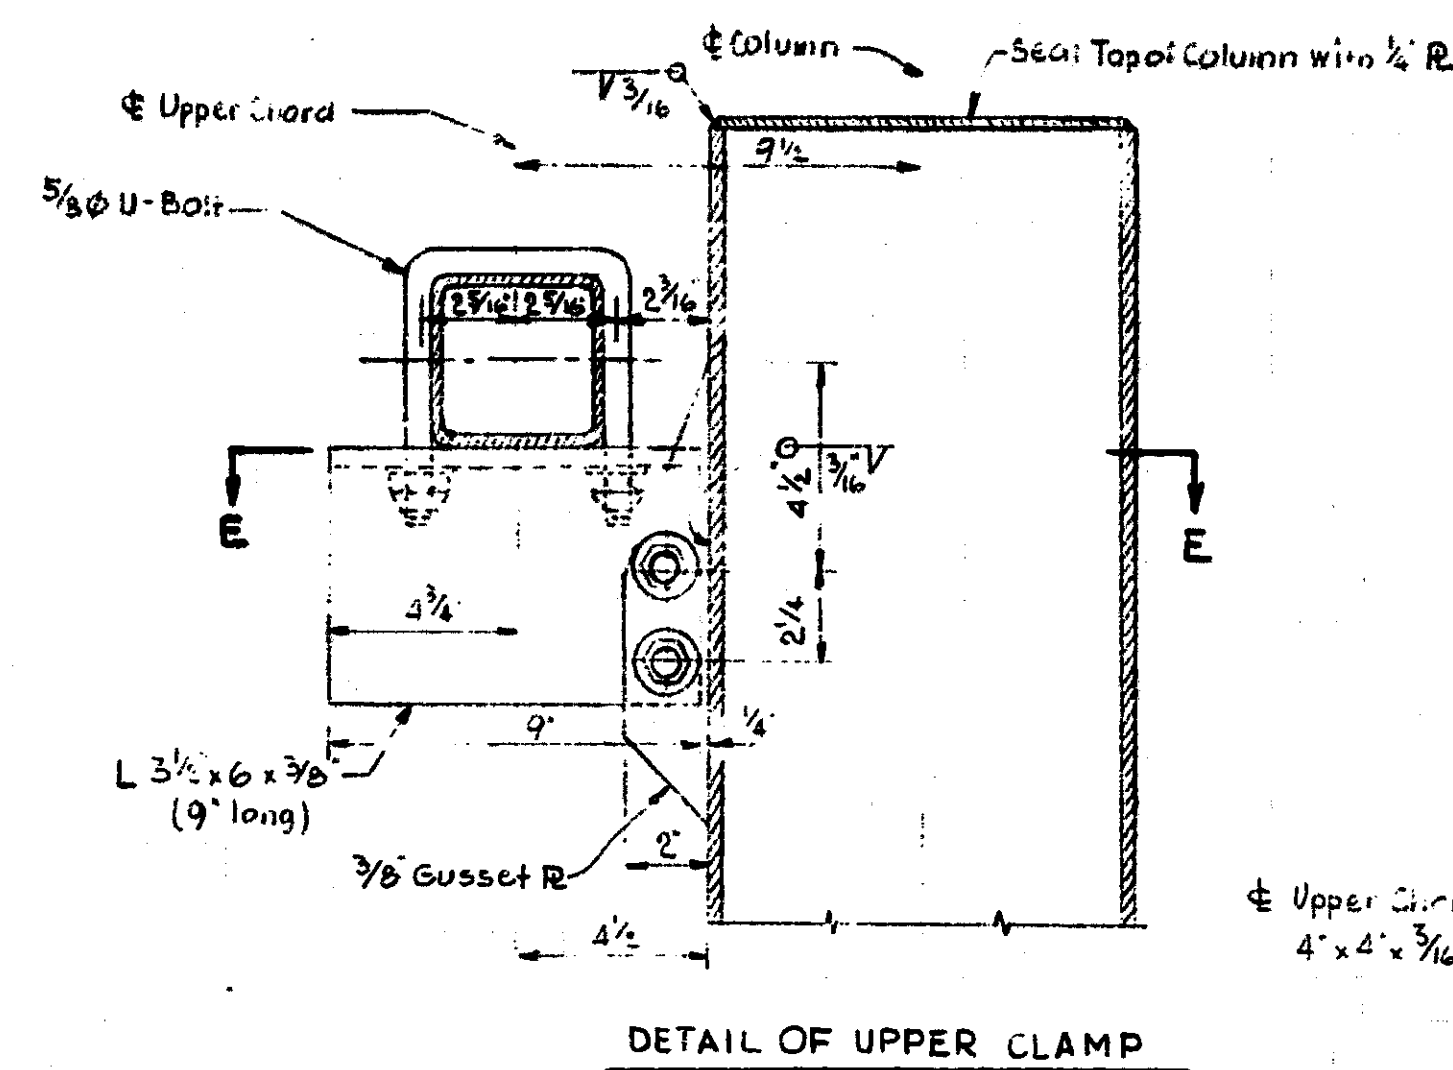


DETAIL OF UPPER CLAMP

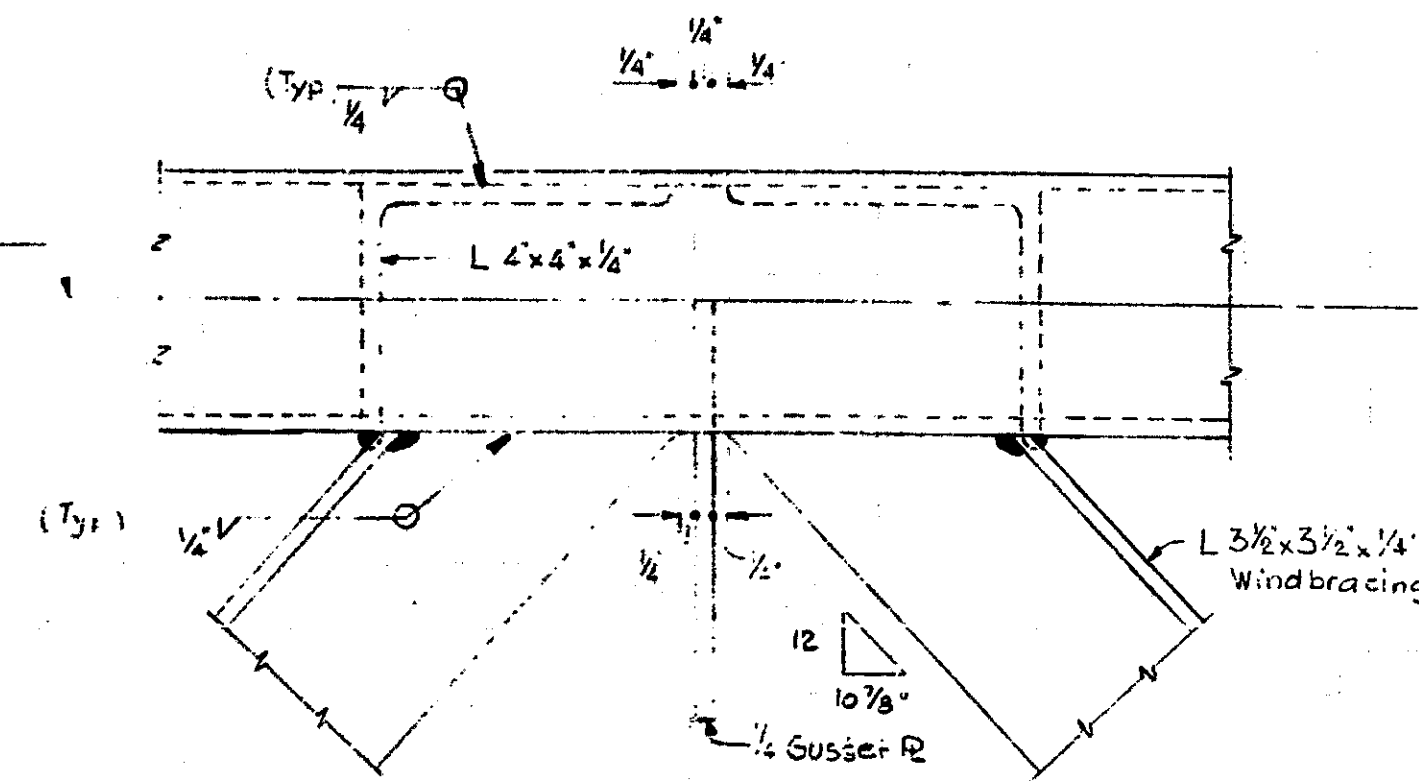


DETAIL H

View of top windbracing looking from the top down.
Note: The slope shown is typical only in the interior bays. It is different in the end bays due to the horizontal end column.

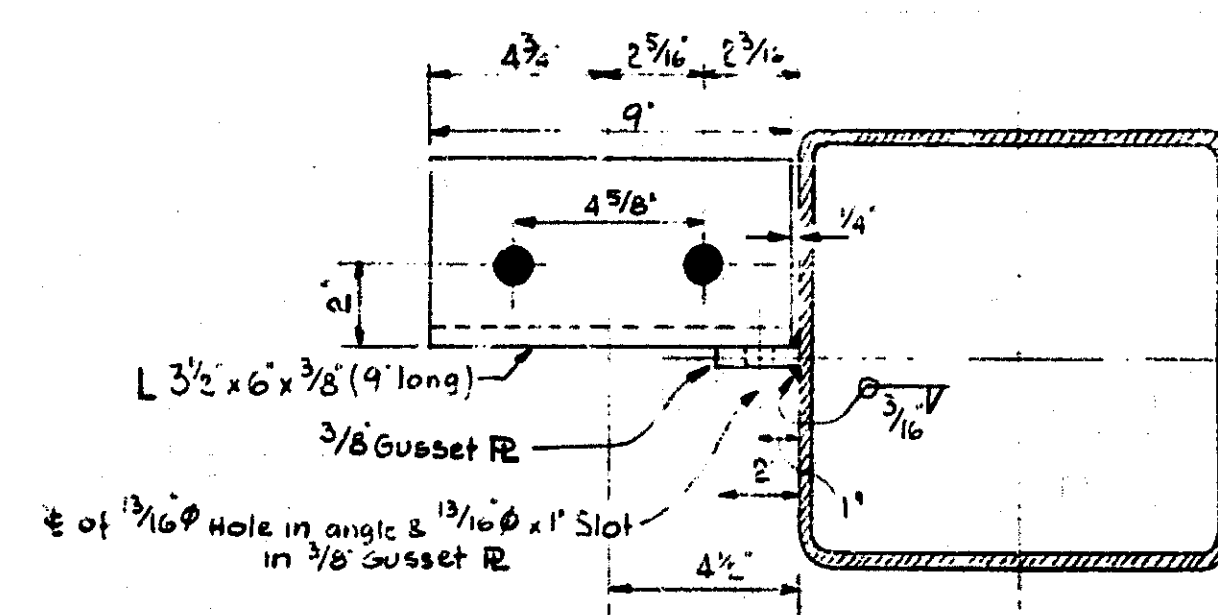


SECTION E-E

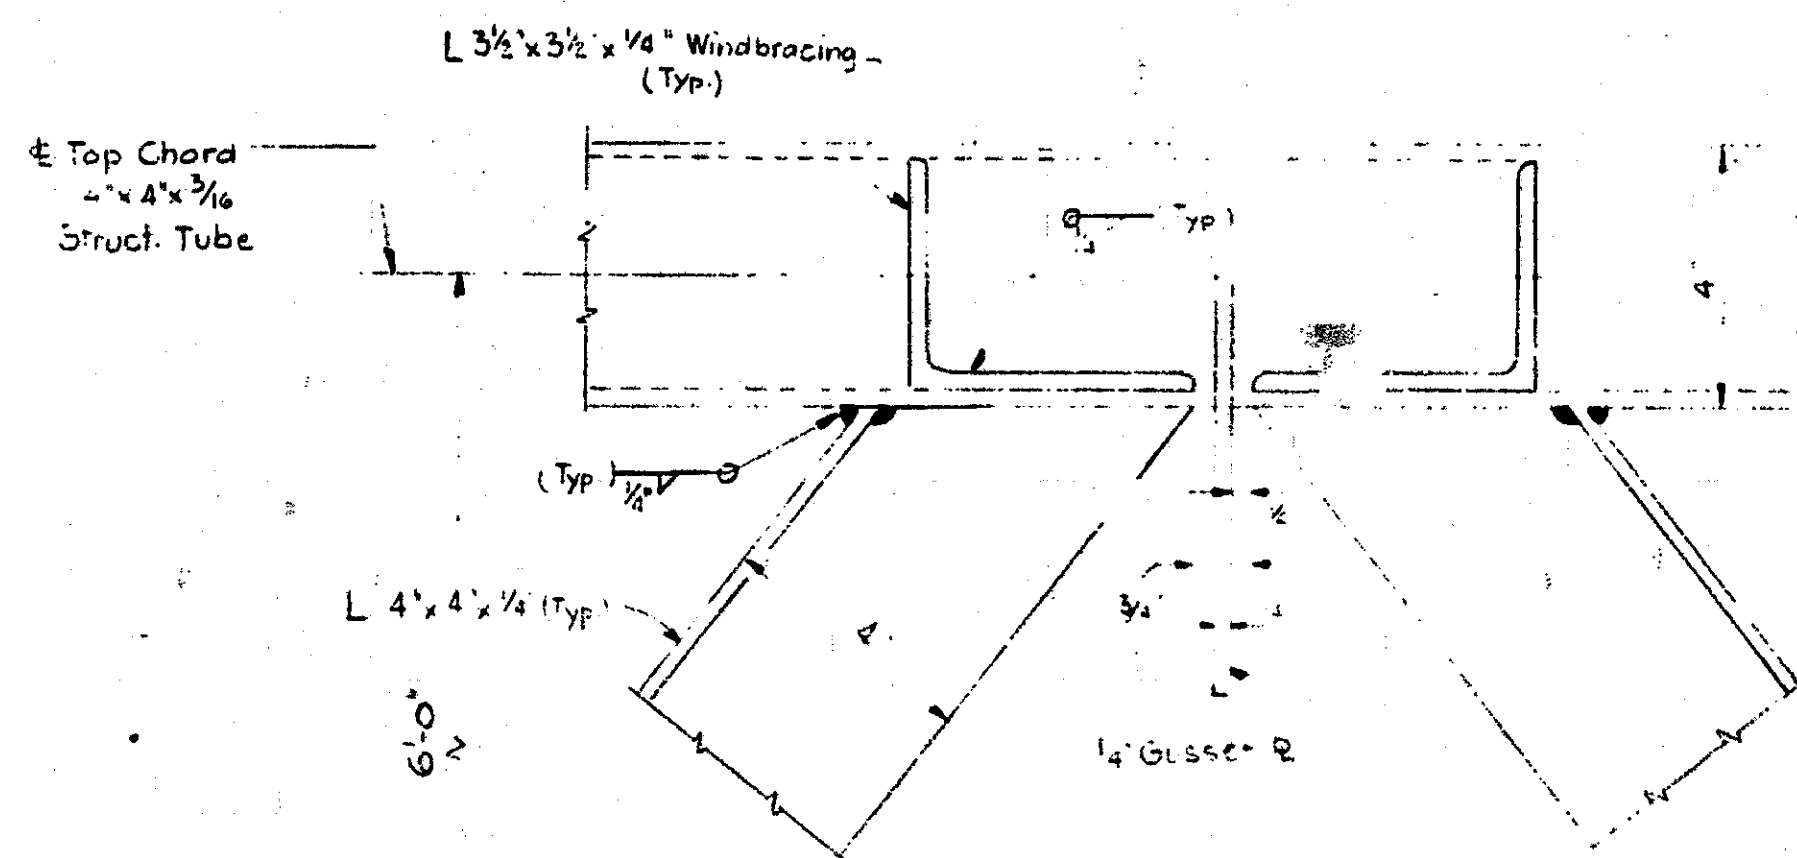


DETAIL D


Crossbracing and not shown for crossbracing see Detail M.

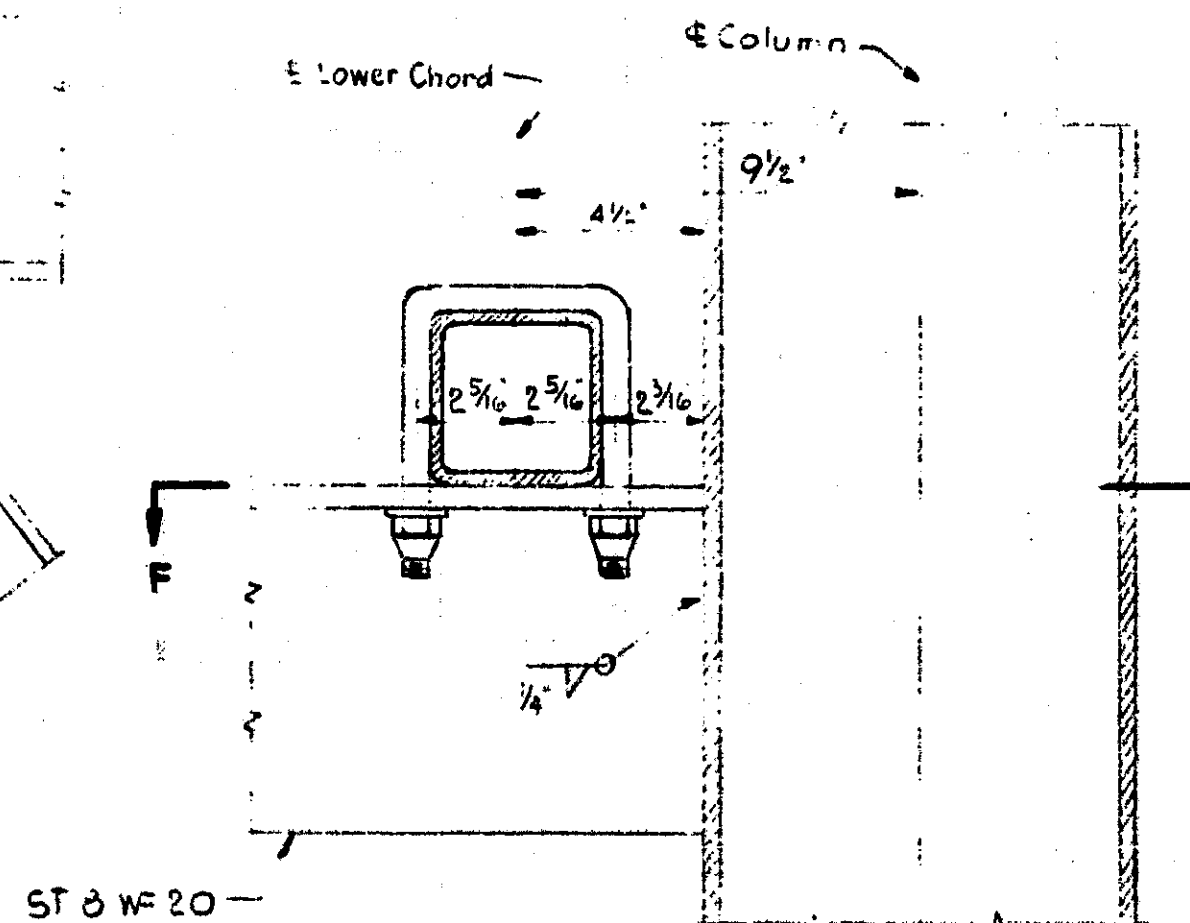


DETAIL OF SEAT

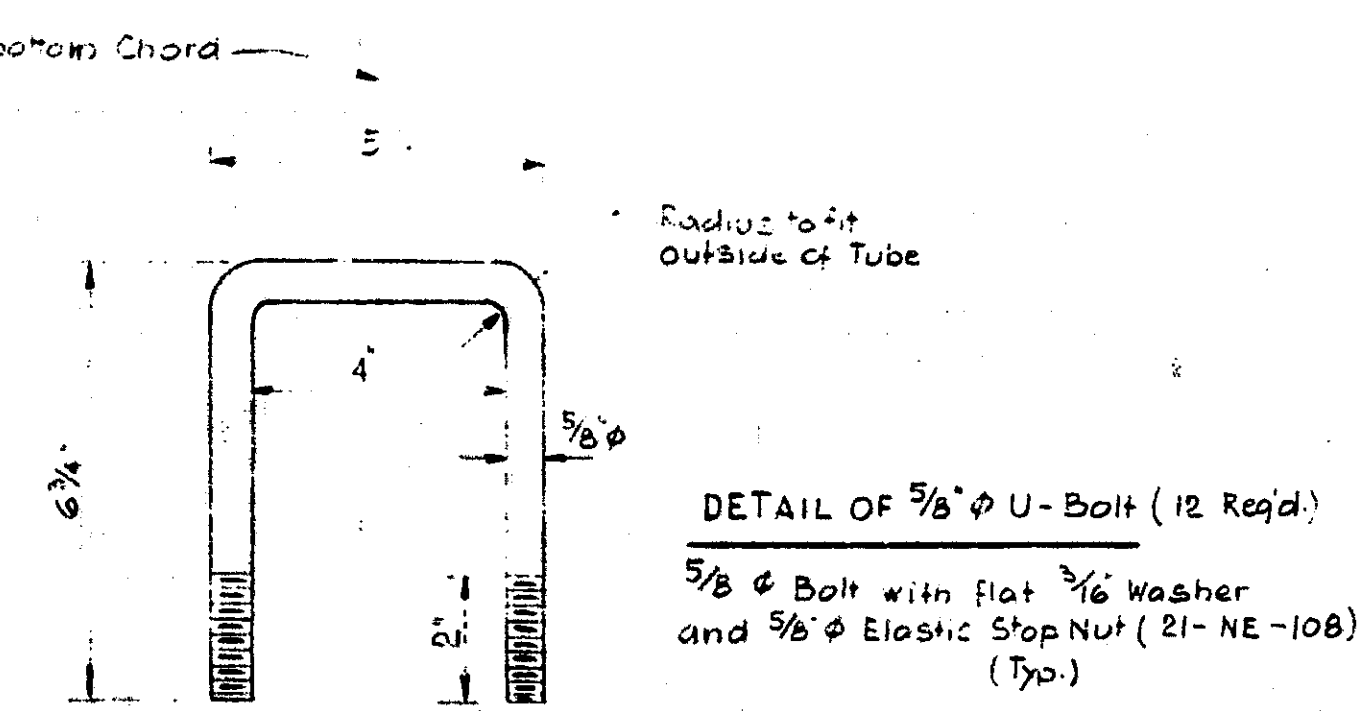

DETAIL OF 5/8" U-Bolt (12 Req'd)
5/8" Bolt with flat 3/16" Washer and 5/8" Elastic Stop Nut (21-NE-108) (Typ.)

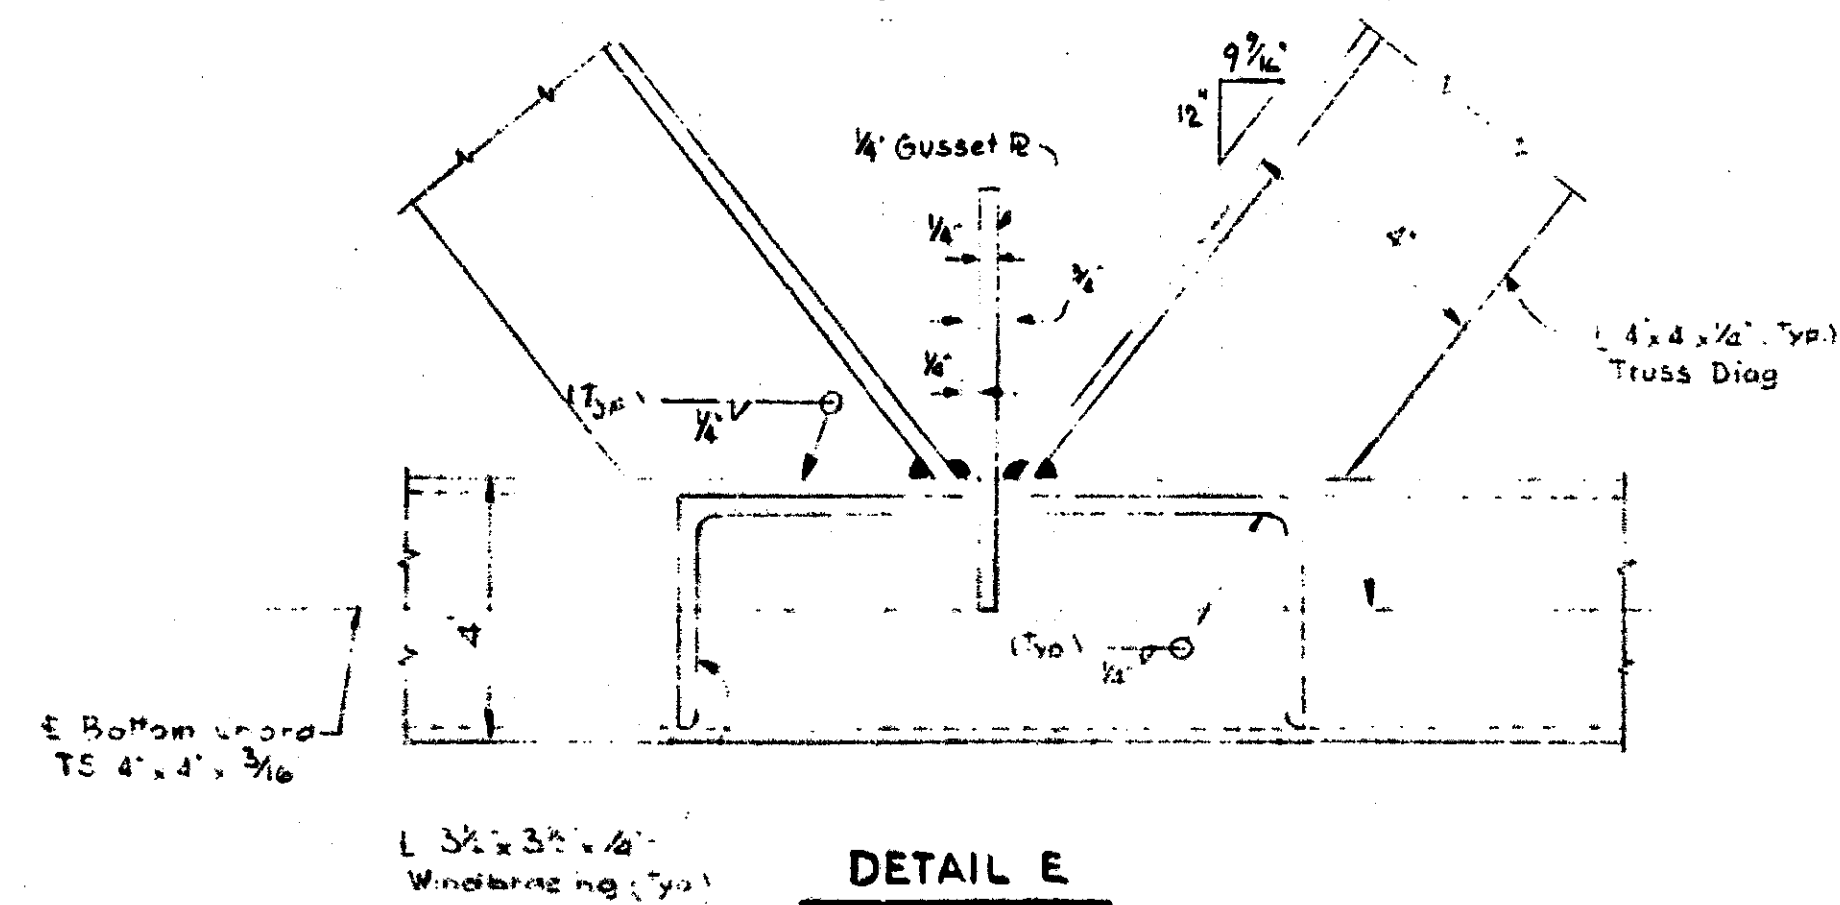

DETAIL E

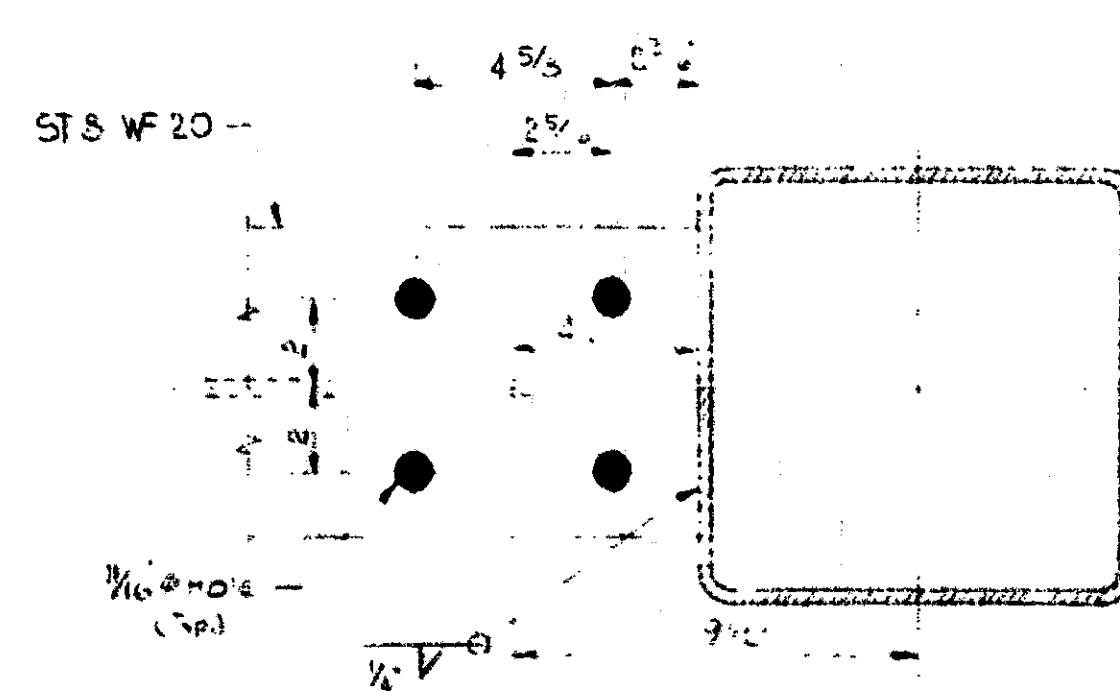

SECTION F-F

Work This Sheet With Sheets 1 & 3


MICHIGAN DEPARTMENT OF STATE HIGHWAYS

STEEL TRUSS


TYPE C (70 Ft.)
A-508 Steel

NO.	REVISIONS	DATE	BY

DESIGNED BY	SKN	DATE	12-27-76
CHECKED BY	FW	DATE	1-2-77
SHEET 5 OF 5			
S 72.			

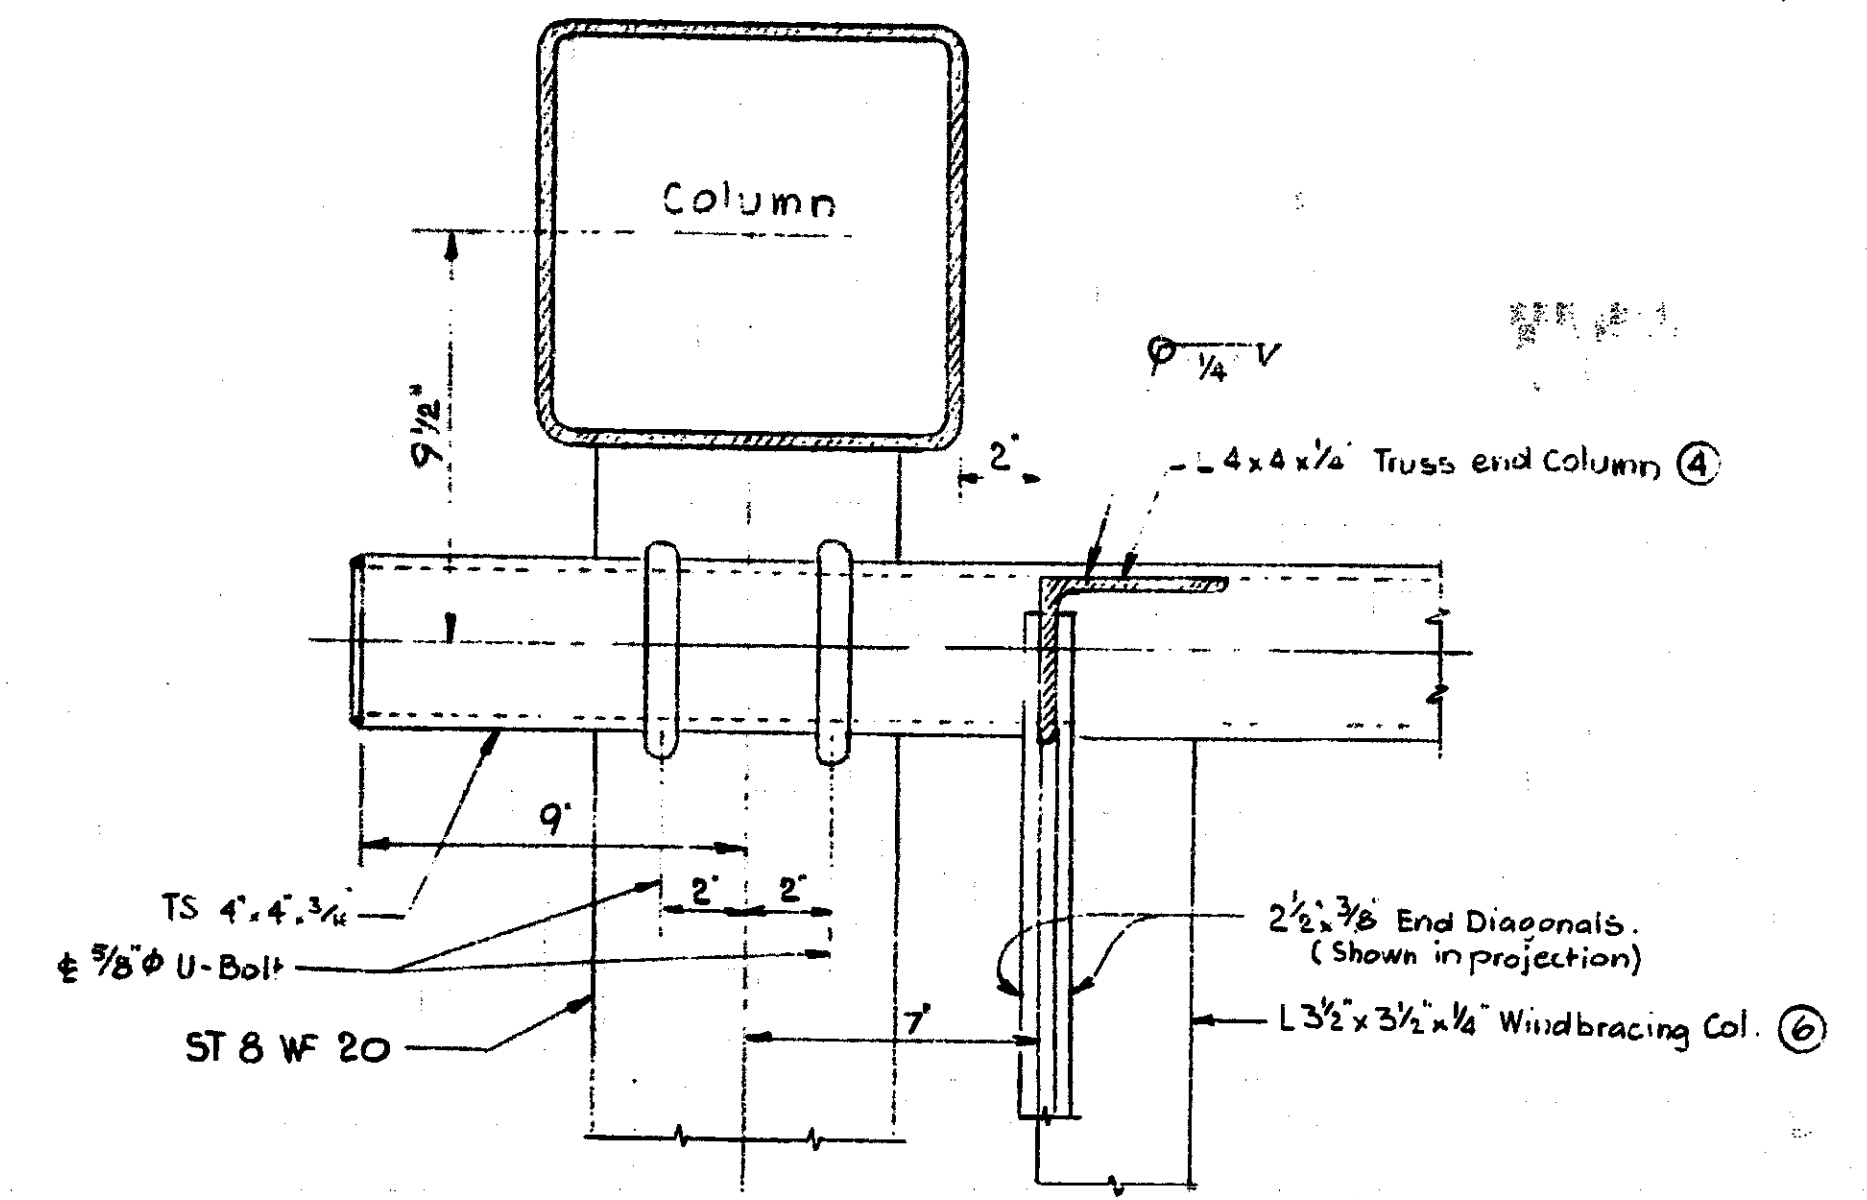


DETAIL L

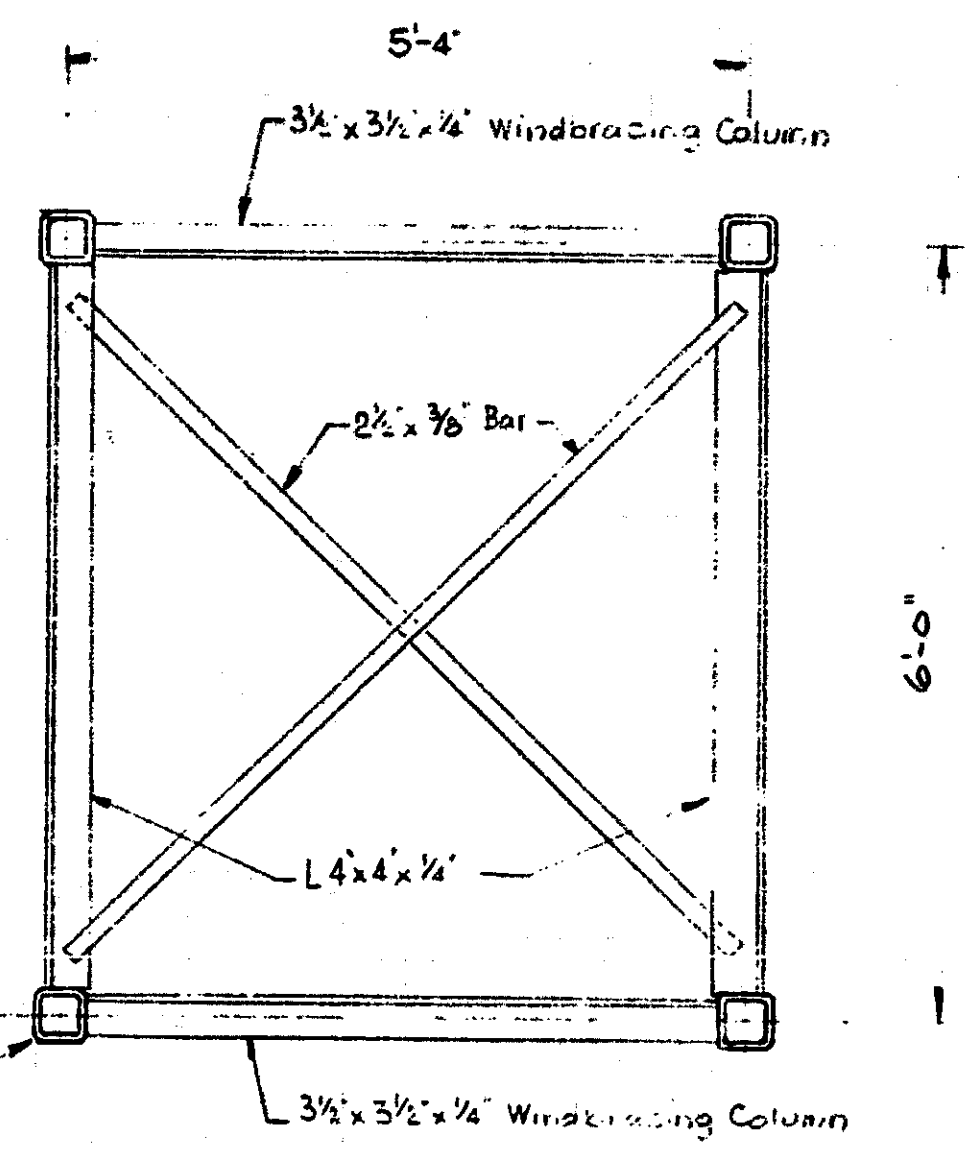


SECTION G-G

View of end crossframe looking from inside the truss outside.

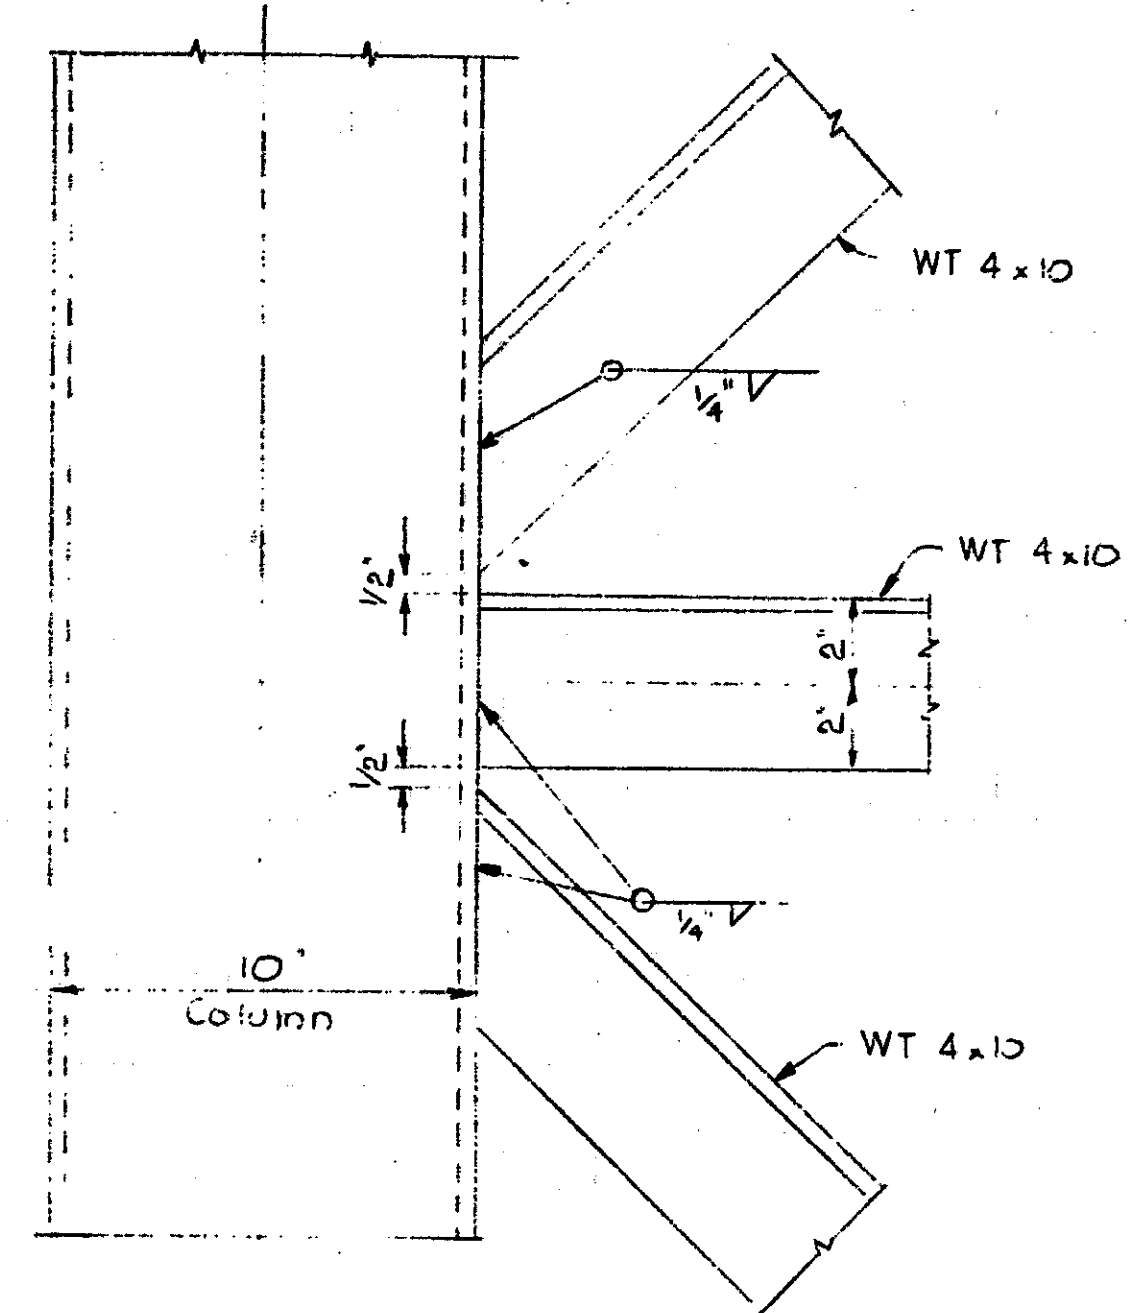


DETAIL K

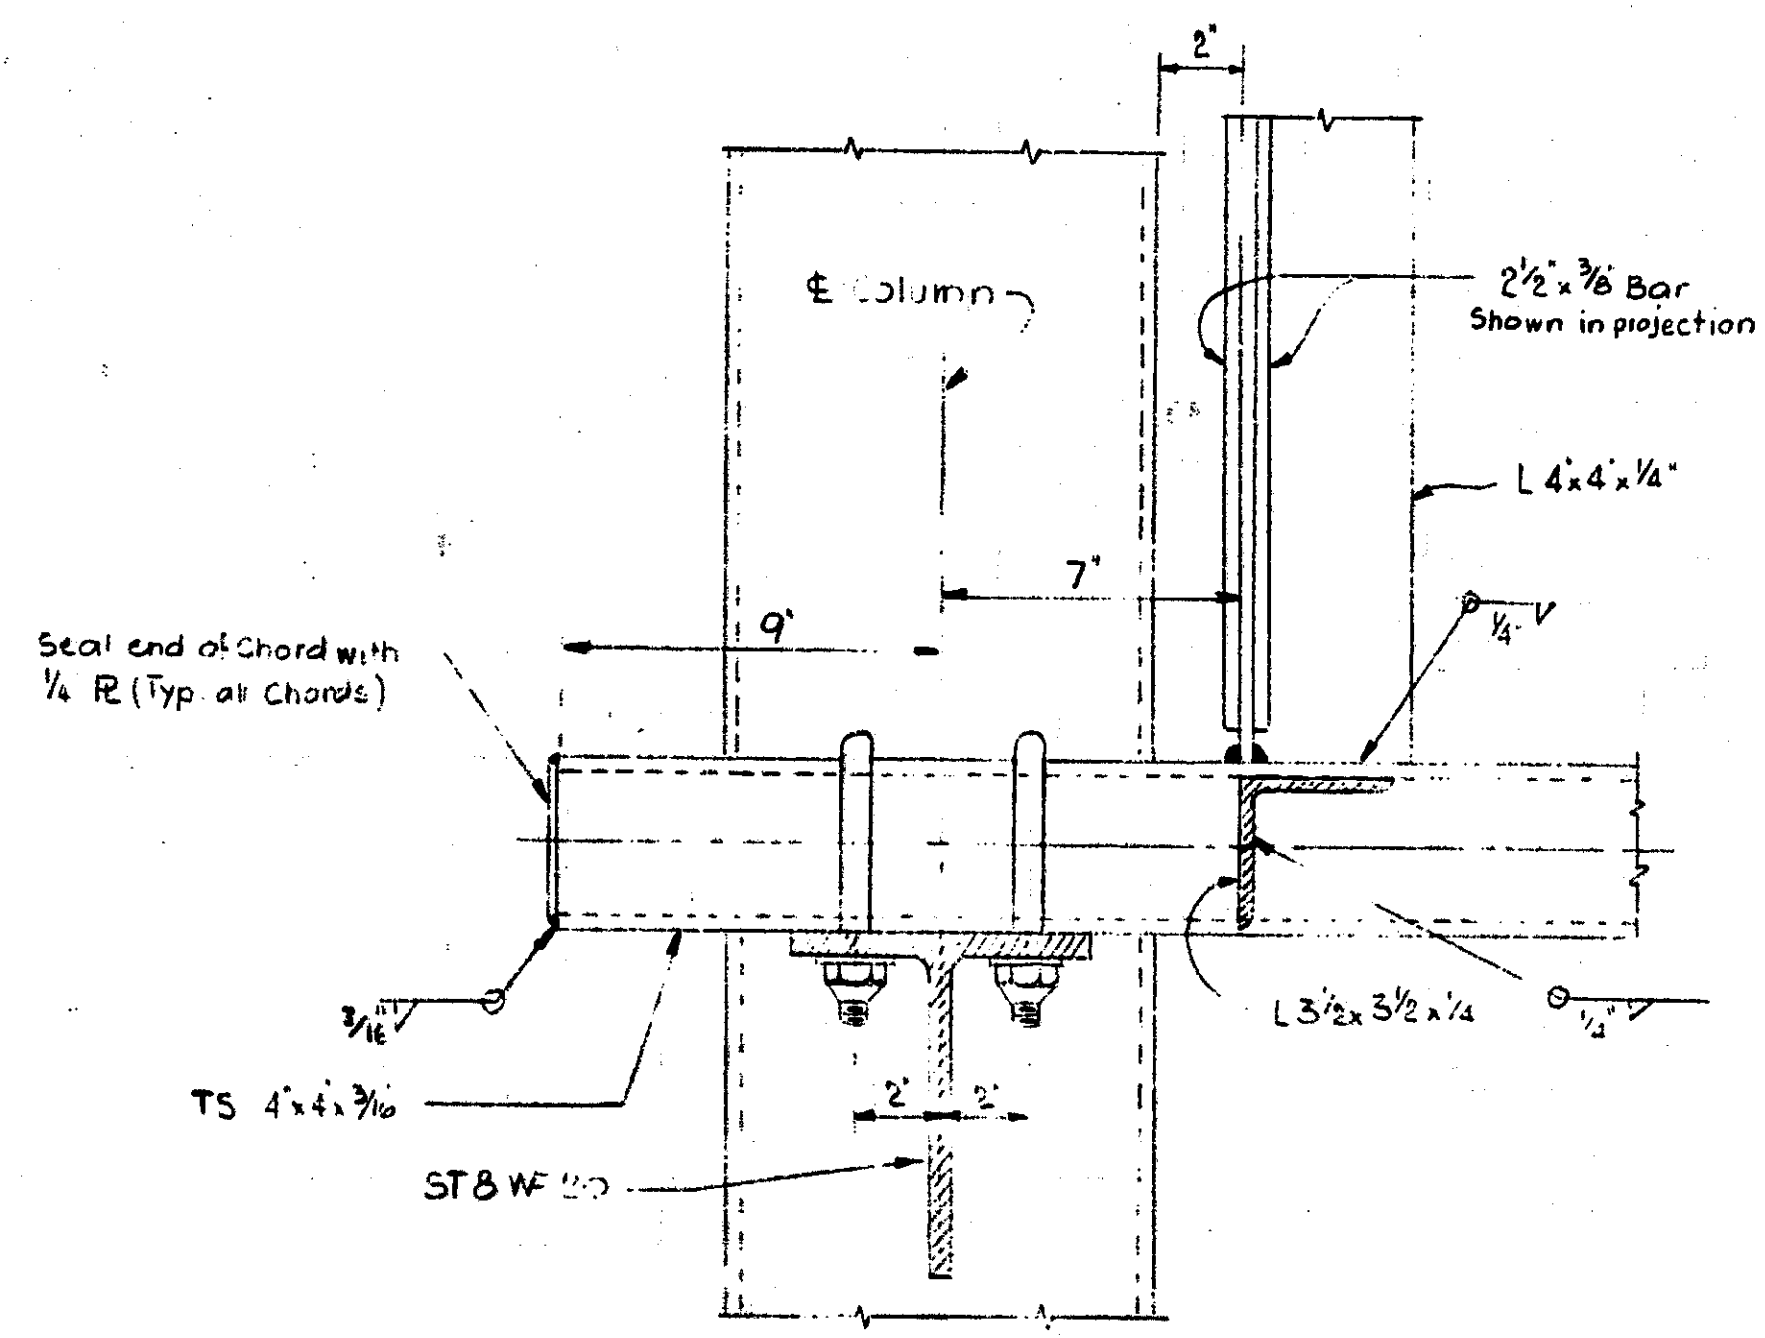

ELEVATION


End connection and end frame details

Note: All bolt holes are 3/16" (Typ) except as noted.

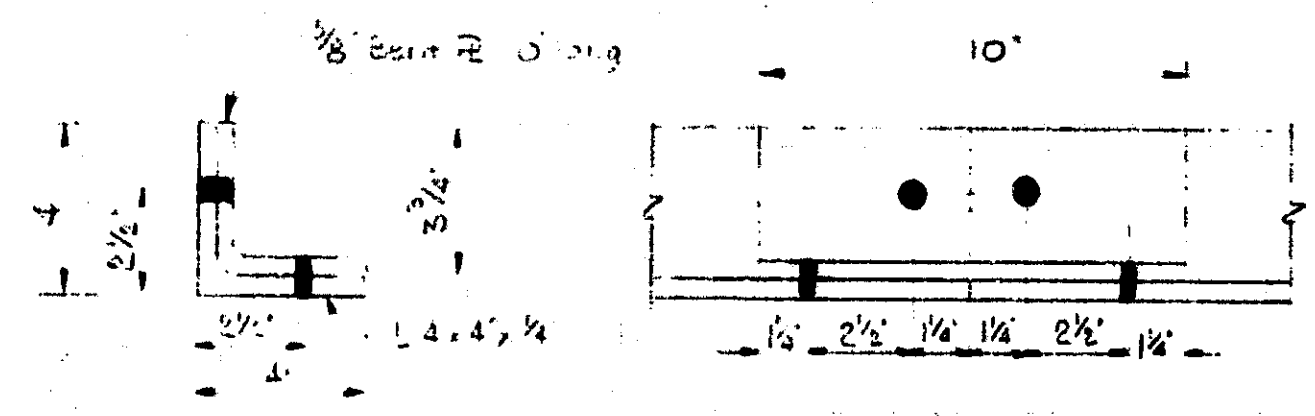

DETAIL F

Splice for Truss Diagonal

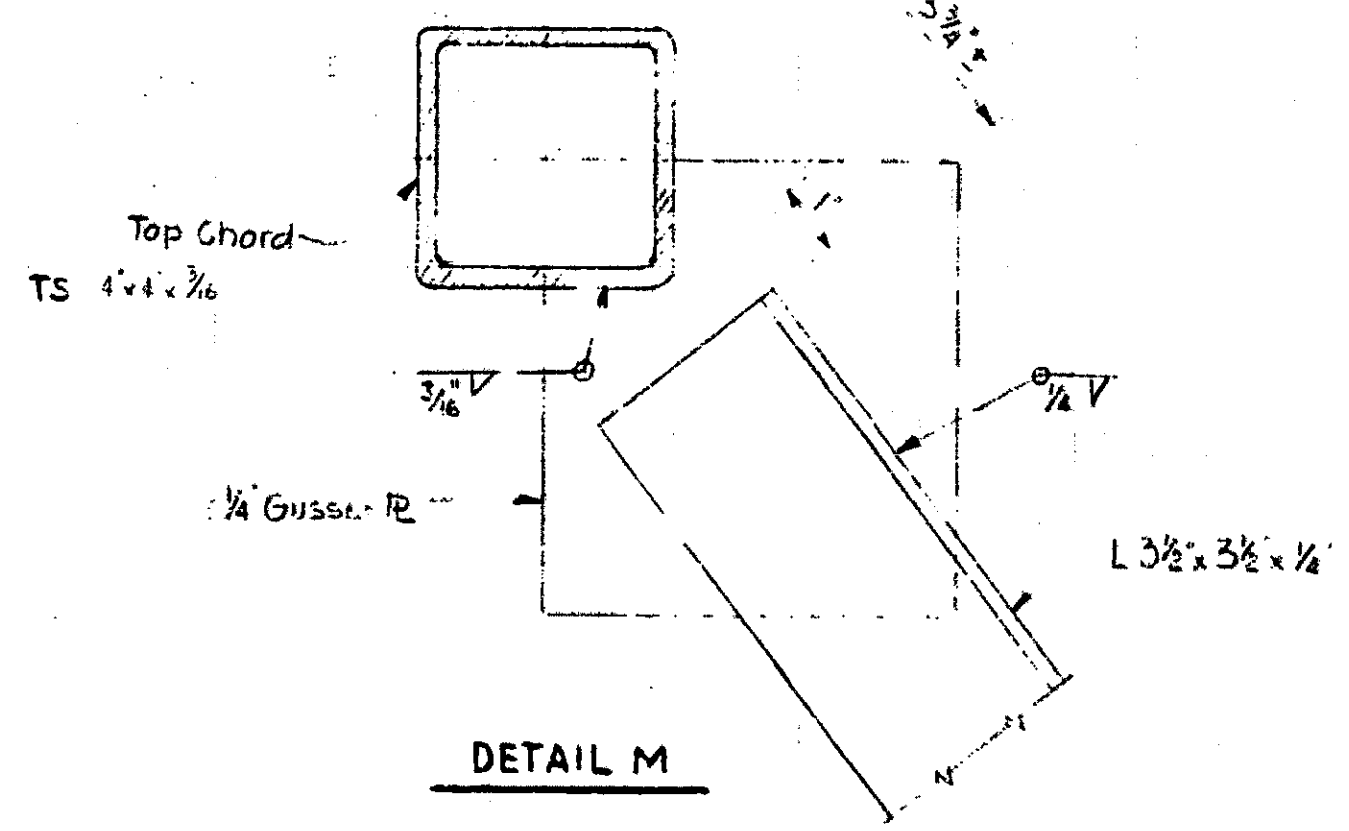

DETAIL M

Work this sheet with sheet 65 & 67

MICHIGAN DEPARTMENT OF STATE HIGHWAYS

STEEL TRUSS

TYPE C

A-588 STEEL

REVISIONS			
NO.	DESCRIPTION	DATE	BY

DESIGNED BY	B. Allen	DATE	11-1-77
DRAWN BY	J. S. N.	DATE	11-1-77
CHECKED BY	J. S. N.	DATE	11-1-77
SHEET	3	OF	3

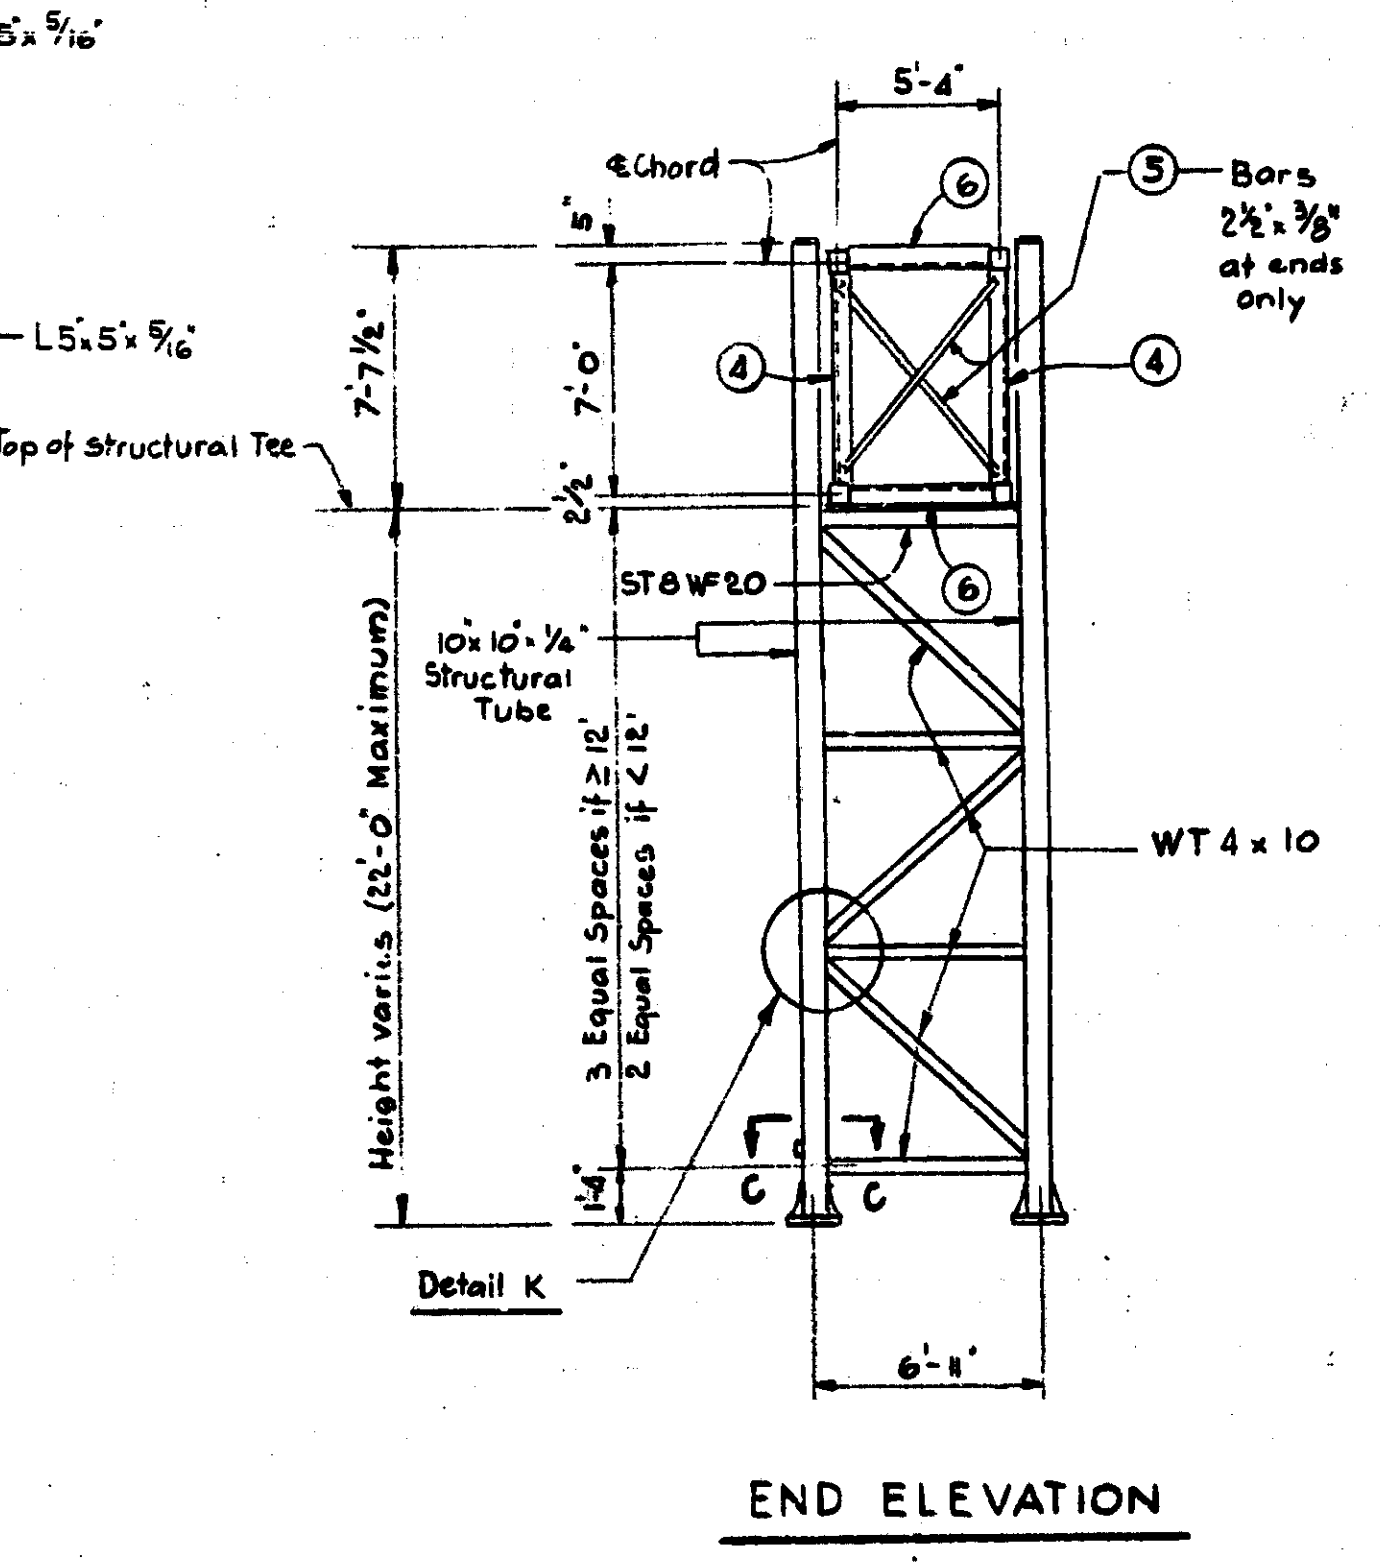
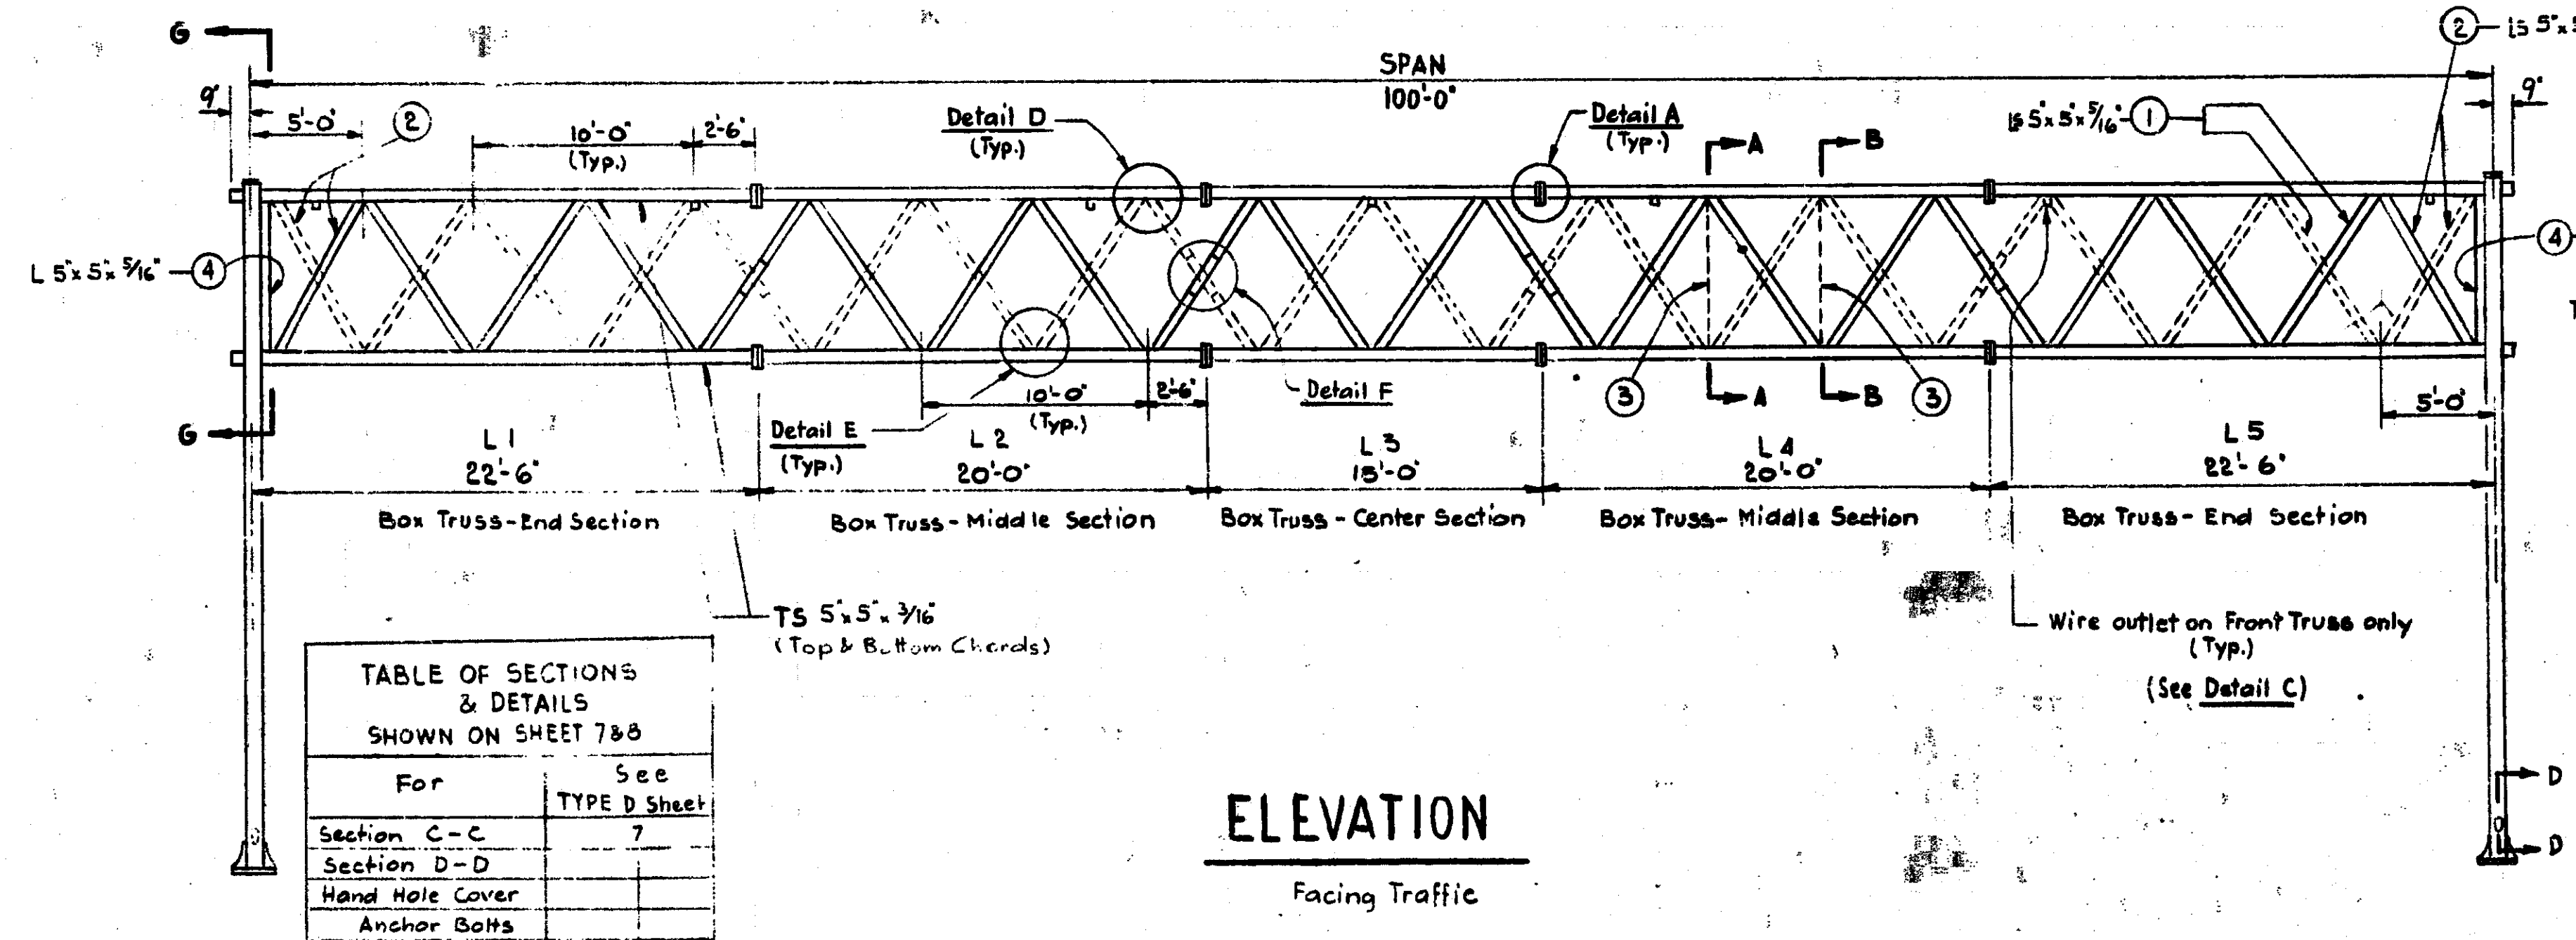
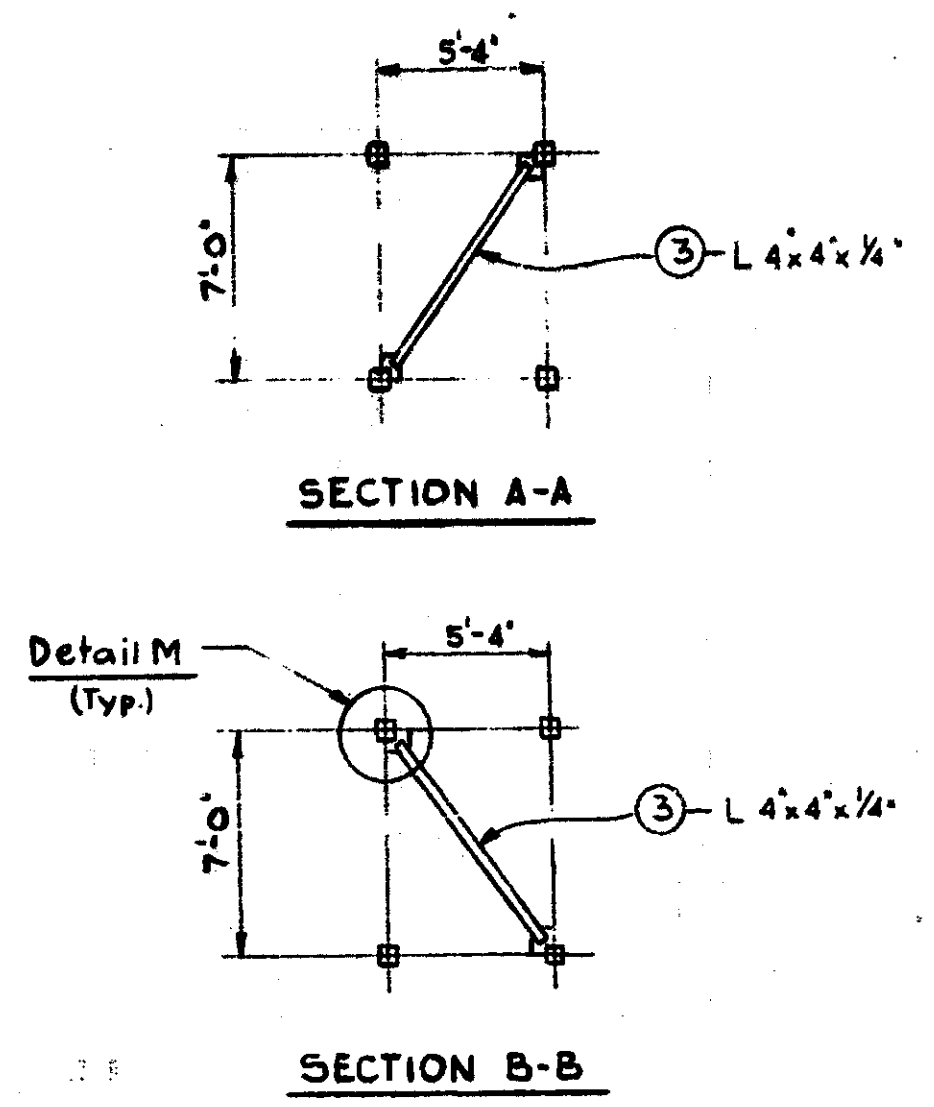
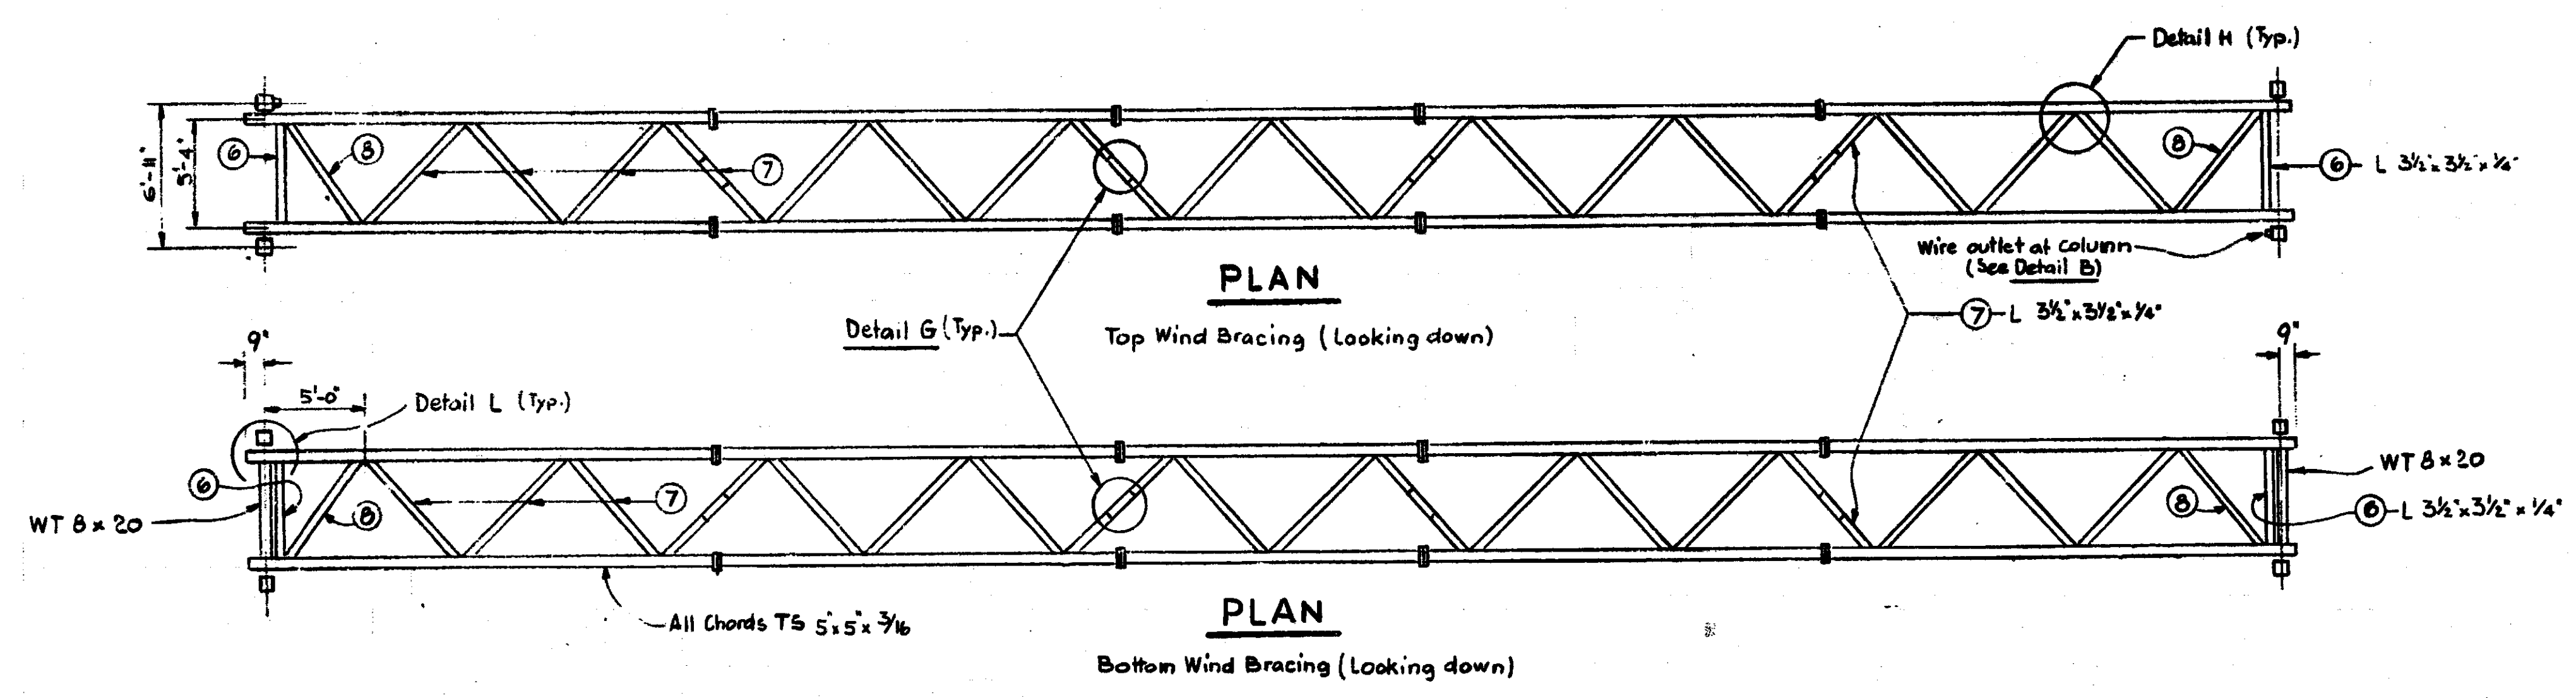


TABLE OF SECTIONS & DETAILS SHOWN ON SHEET 788


For	See TYPE D Sheet
Section C-C	7
Section D-D	
Hand Hole Cover	
Anchor Bolts	
Front Elev of Base	
Base-Leveling Nuts	
Detail A	
Detail B	
Detail C	7
Detail E	8
Detail K	8
Detail R	7

TRUSS DATA - A-588 Steel

SPAN	L1	L2	L3	L4	L5	CAMBER	BOX TRUSS	APPROX. WEIGHT OF TRUSS lbs./ft.
75'-0"	12'-6"	5'-0"	20'-0"	15'-0"	12'-6"	1 1/8"	7'-0" x 5'-4"	108
80'-0"	17'-6"	15'-0"	15'-0"	15'-0"	17'-6"	1 1/4"	7'-0" x 5'-4"	
85'-0"	17'-6"	15'-0"	20'-0"	15'-0"	17'-6"	1 3/8"	7'-0" x 5'-4"	
90'-0"	22'-6"	15'-0"	15'-0"	15'-0"	22'-6"	1 3/8"	7'-0" x 5'-4"	
95'-0"	17'-6"	20'-0"	20'-0"	20'-0"	17'-6"	1 3/4"	7'-0" x 5'-4"	
100'-0"	22'-6"	20'-0"	15'-0"	20'-0"	22'-6"	2"	7'-0" x 5'-4"	108

CAMBER The camber given in the above table is the ordinate at the center of the assembled truss prior to dead load deflection. Allowable camber tolerance for Truss is 25%.

For Notes See sheet No 1

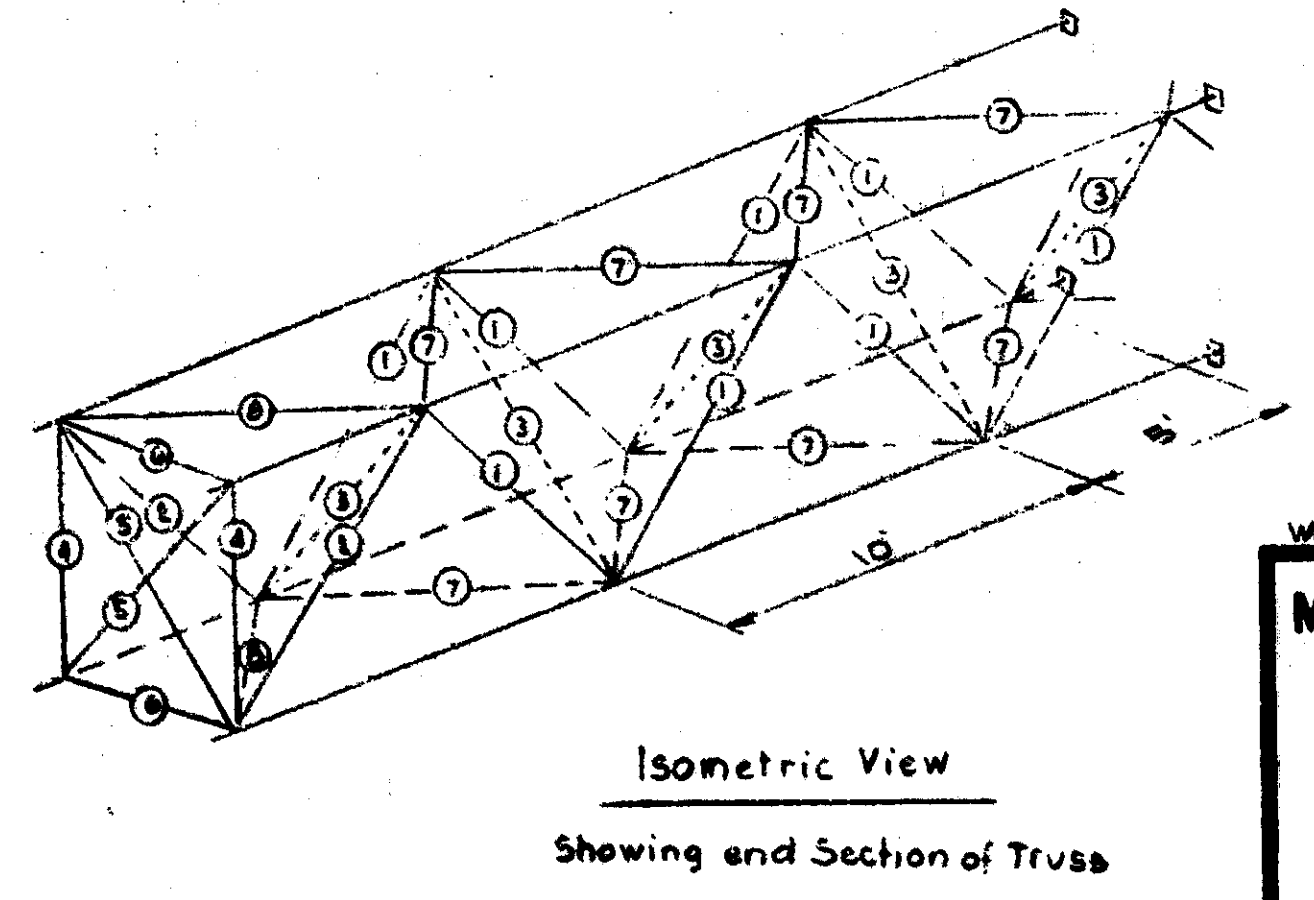

Work this sheet with sheets # 1, 2 & 3

MICHIGAN DEPARTMENT OF STATE HIGHWAYS

STEEL TRUSS


TYPE C (100 Ft.)

A-588 STEEL

NO.	DESCRIPTION	DATE	BY


DESIGNED BY	Sullen	2-16-77
DRAWN BY	P.R.N.	12-15-76
CHECKED BY	F.H.	1-10-77
APPROVED BY		

S 7

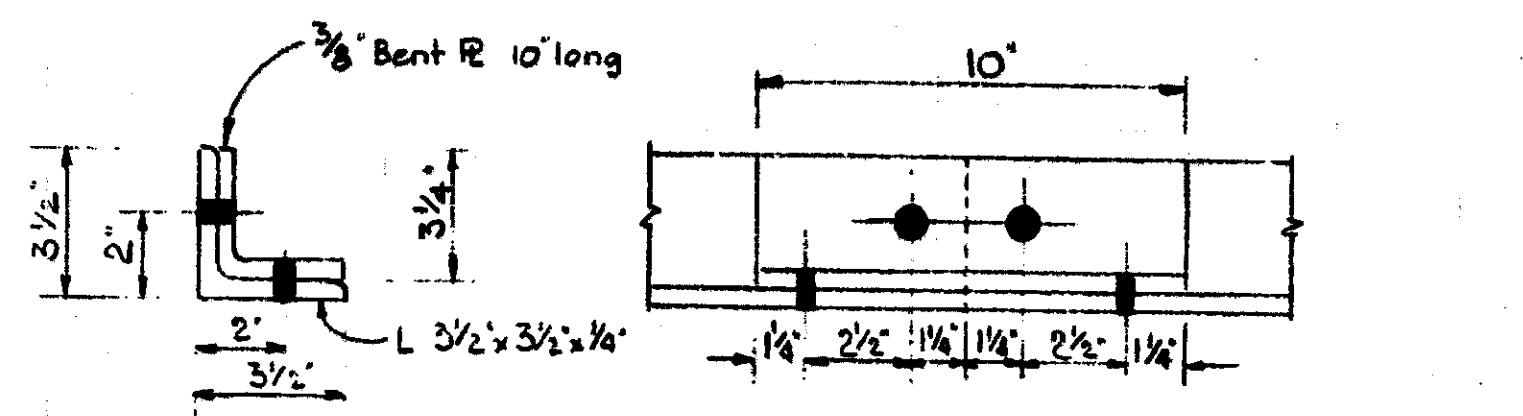

DETAIL G


Splice for Windbracing Diag.
All holes 1 3/16 phi for splices only.

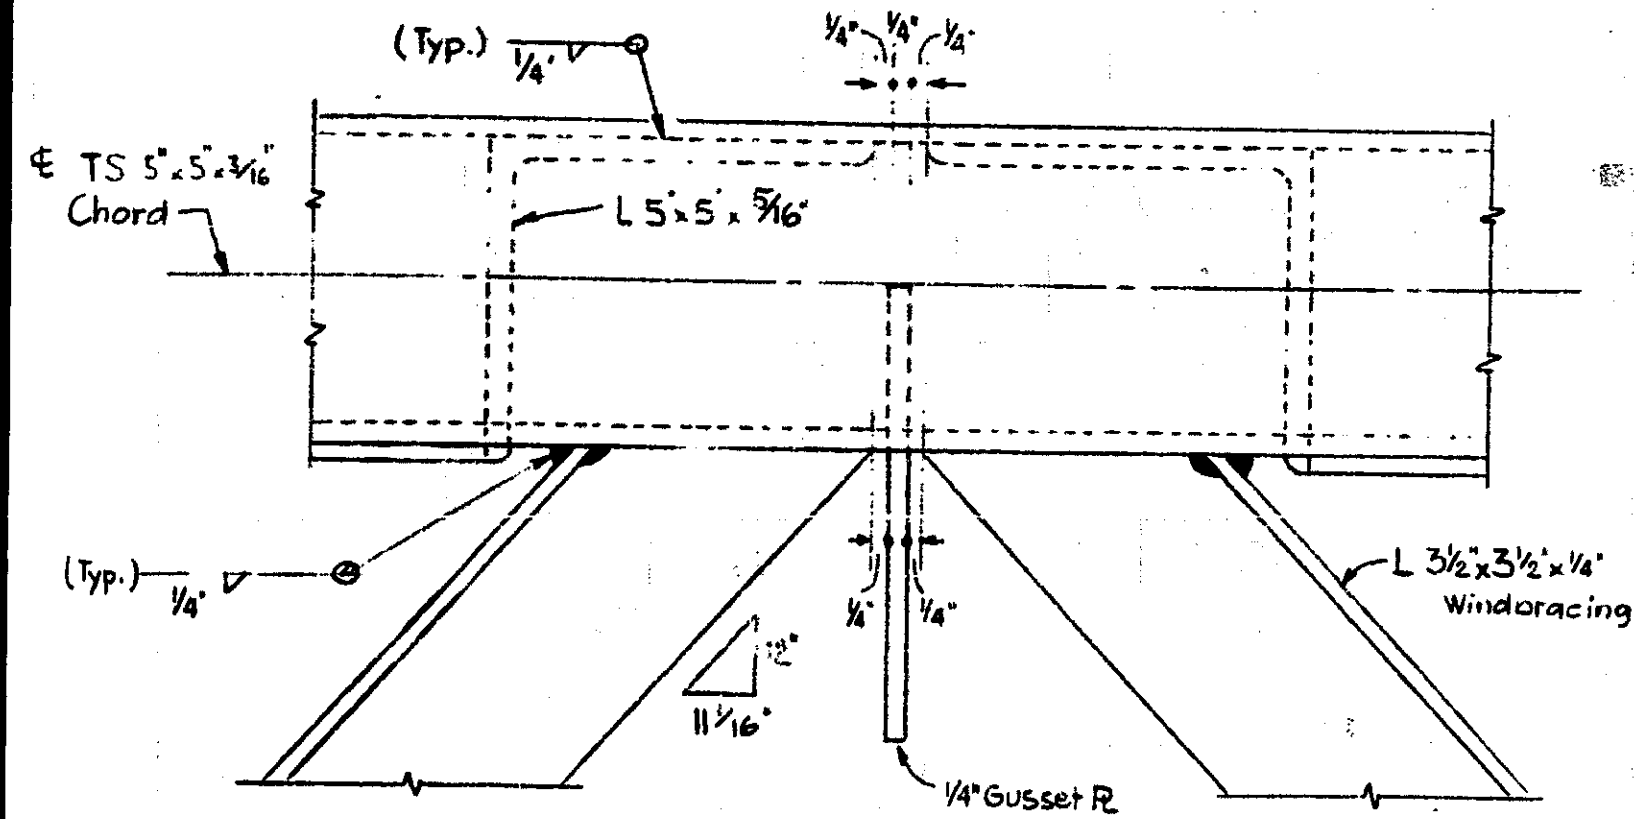

DETAIL H


View of top windbracing looking from the top down.

Note: The angle shown is typical only in the interior bays. It is different in the end bays due to the horizontal end column.

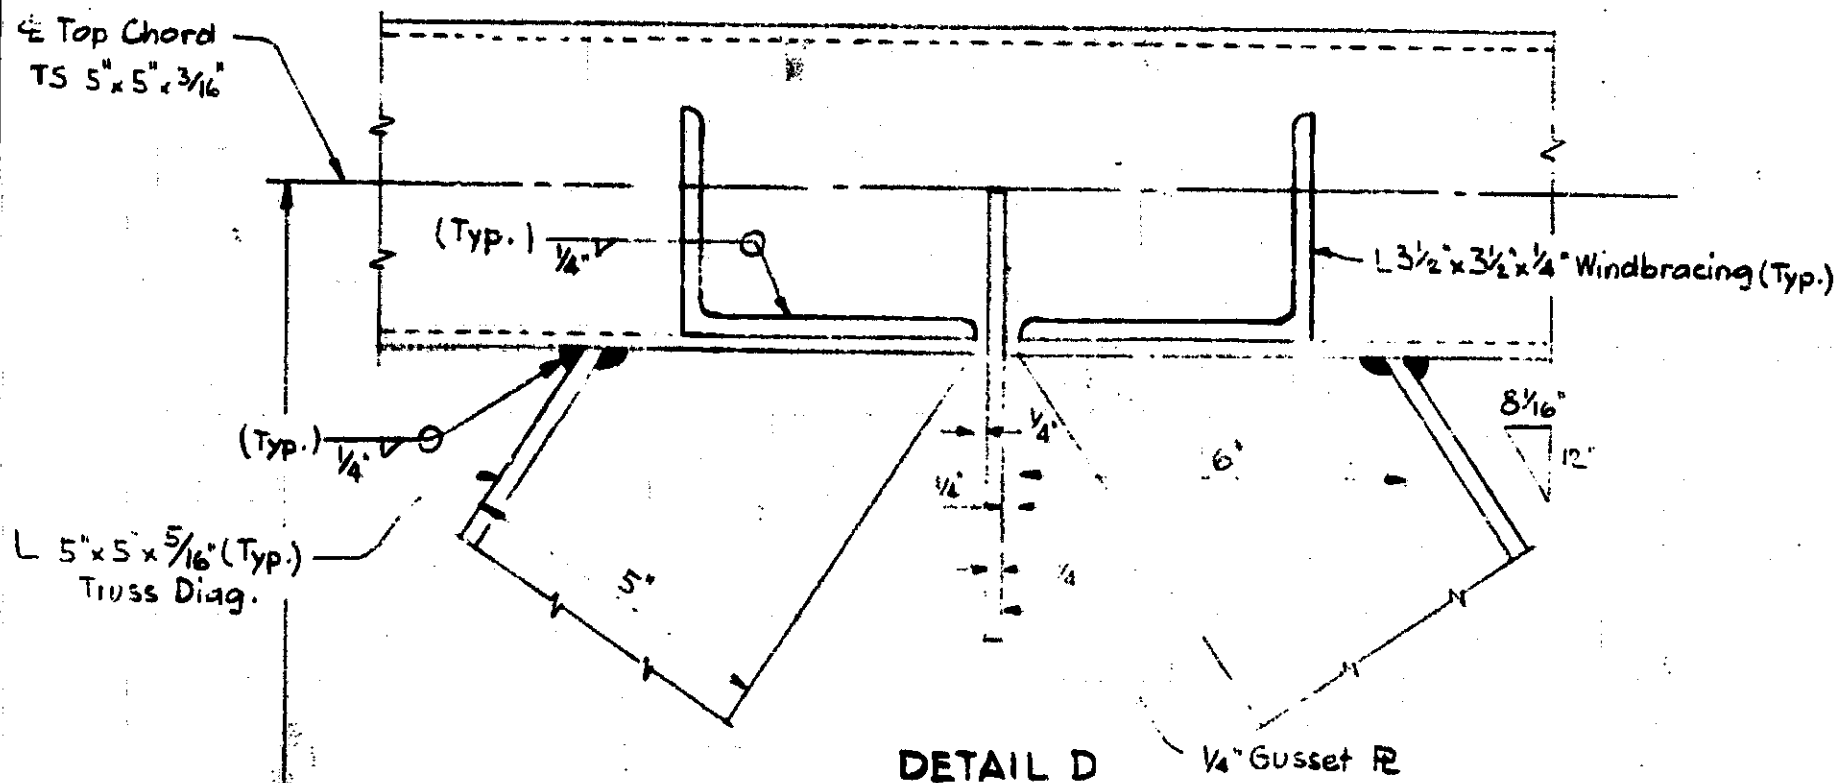


DETAIL D


Crossbracing angle not shown
For crossbracing see Detail M

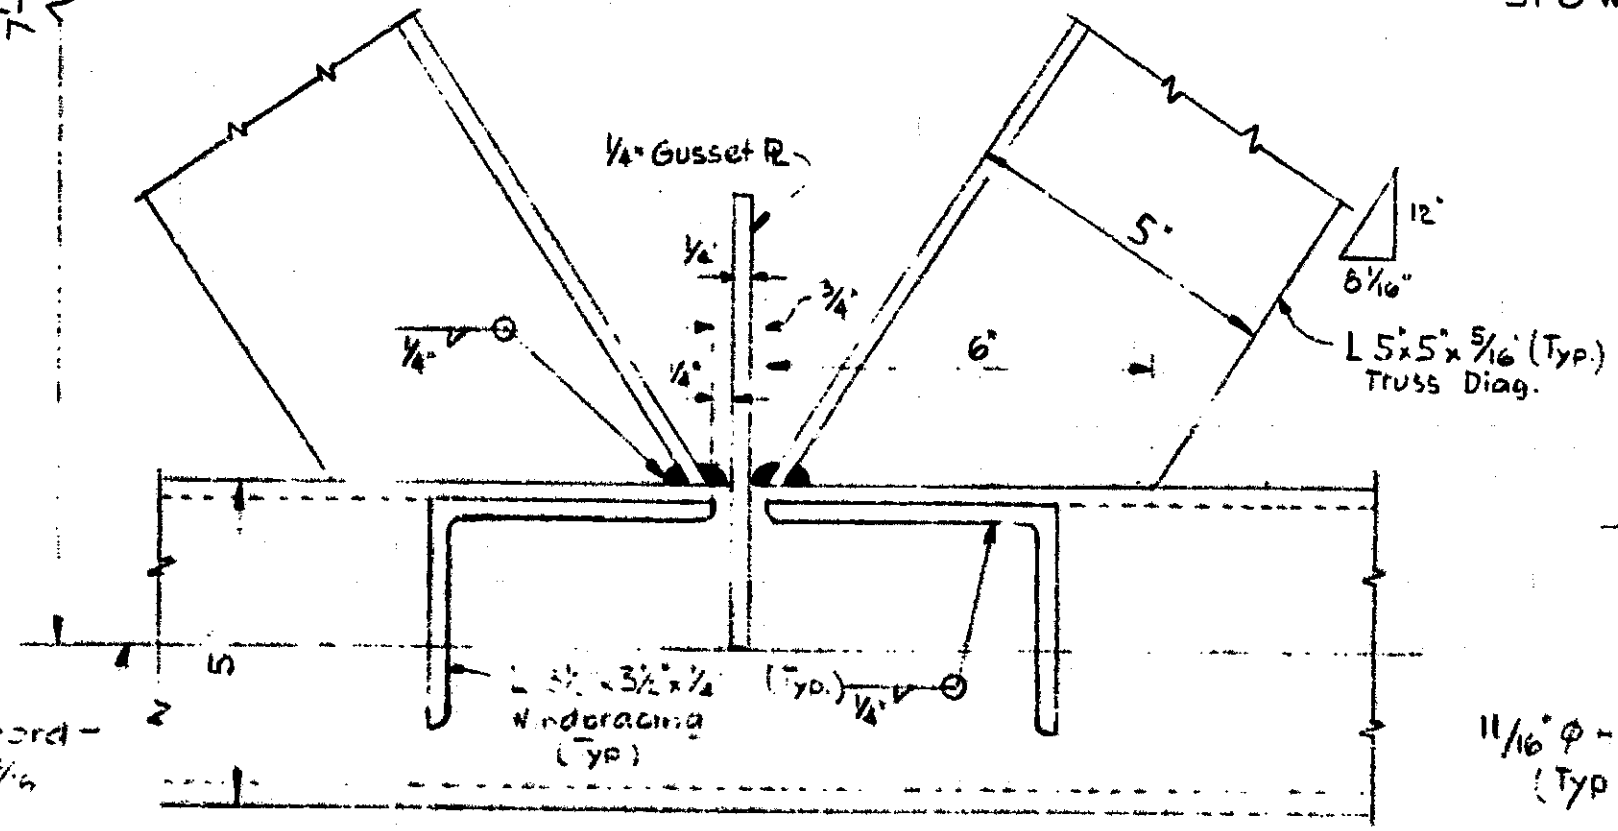


DETAIL E

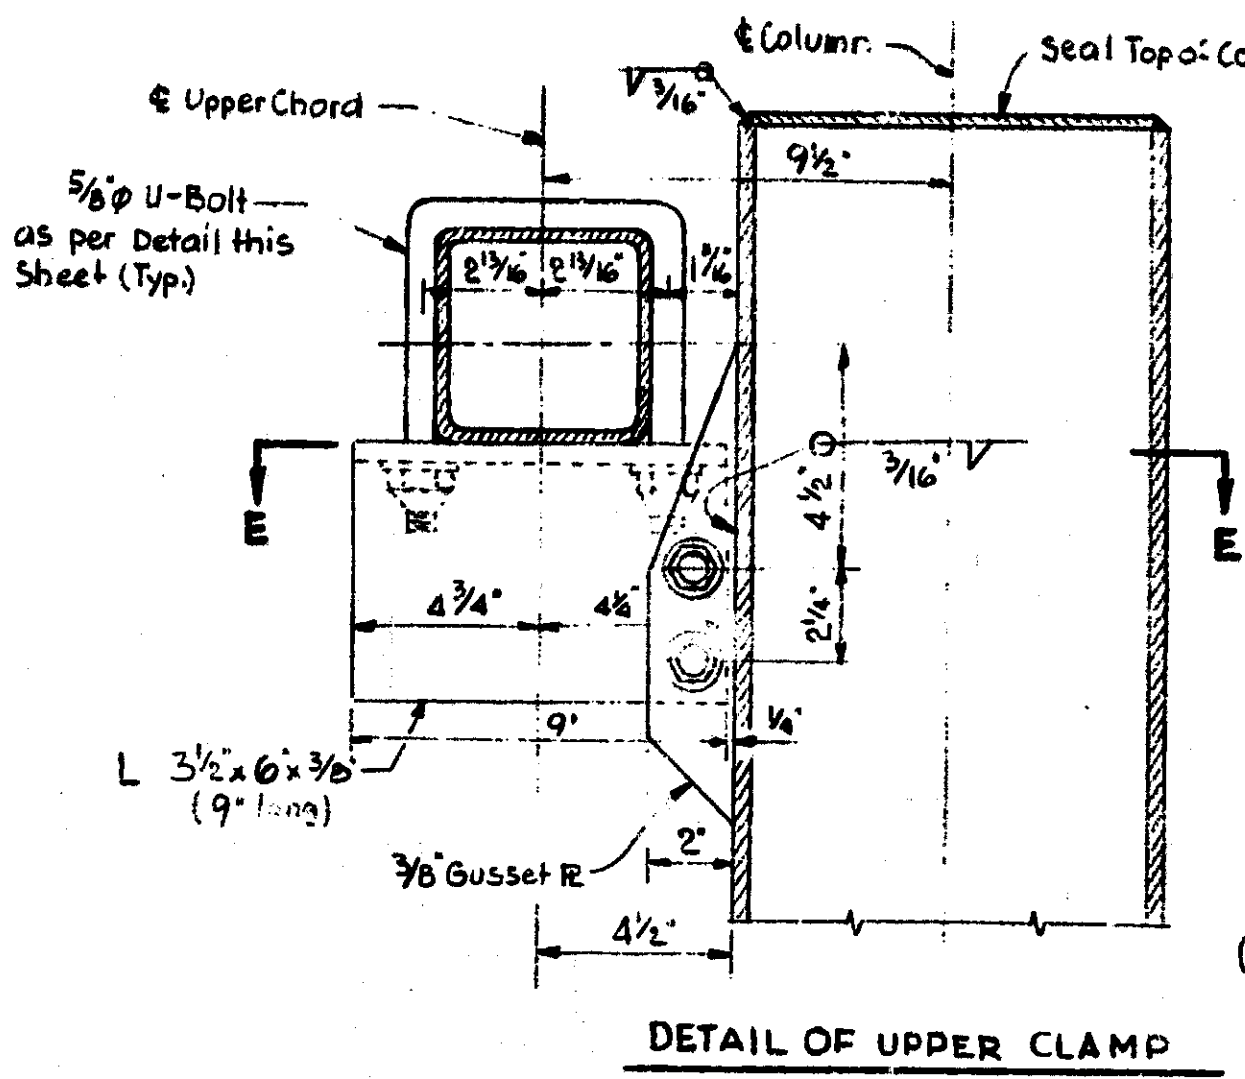

DETAIL OF UPPER CLAMP

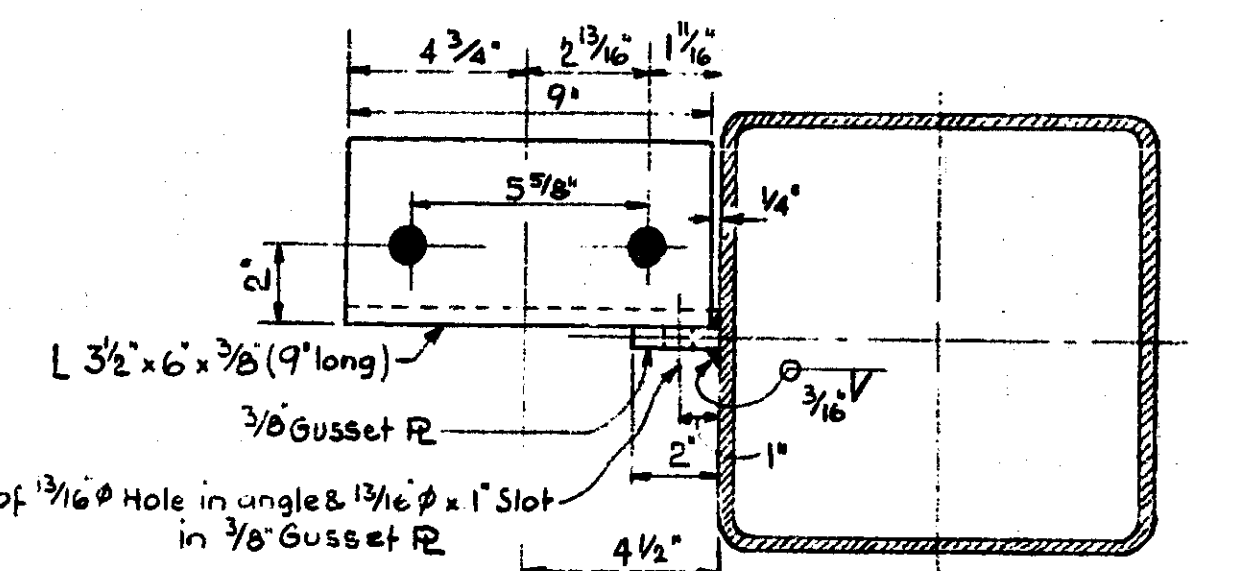


SECTION E-E

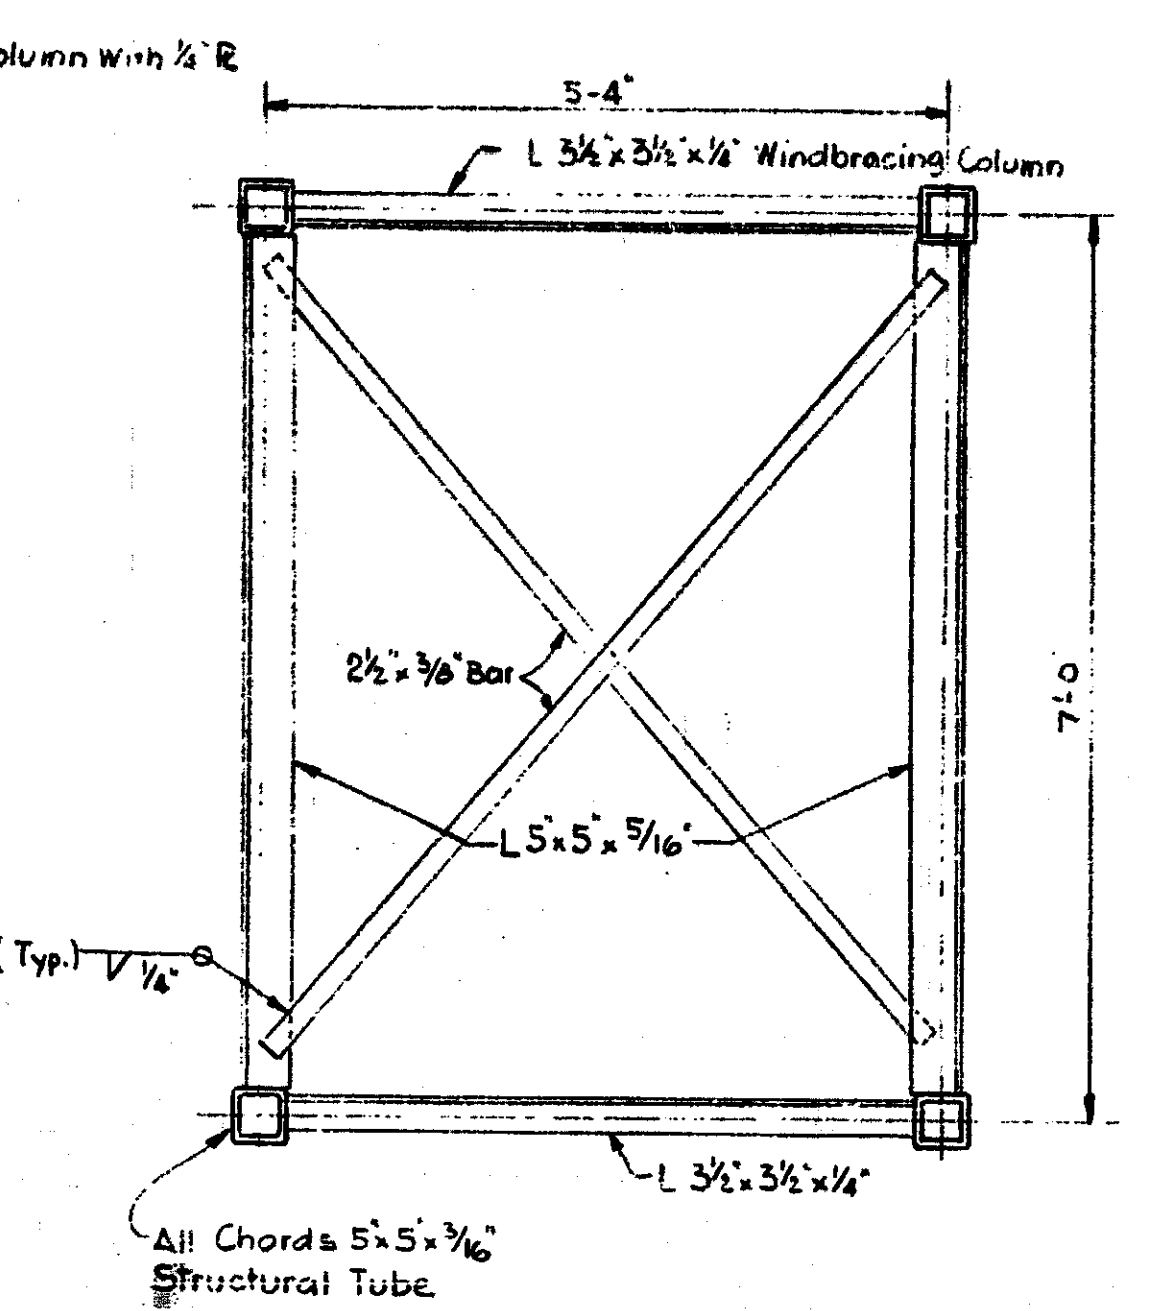


SECTION G-G


View of end crossframe looking from inside of the truss outside

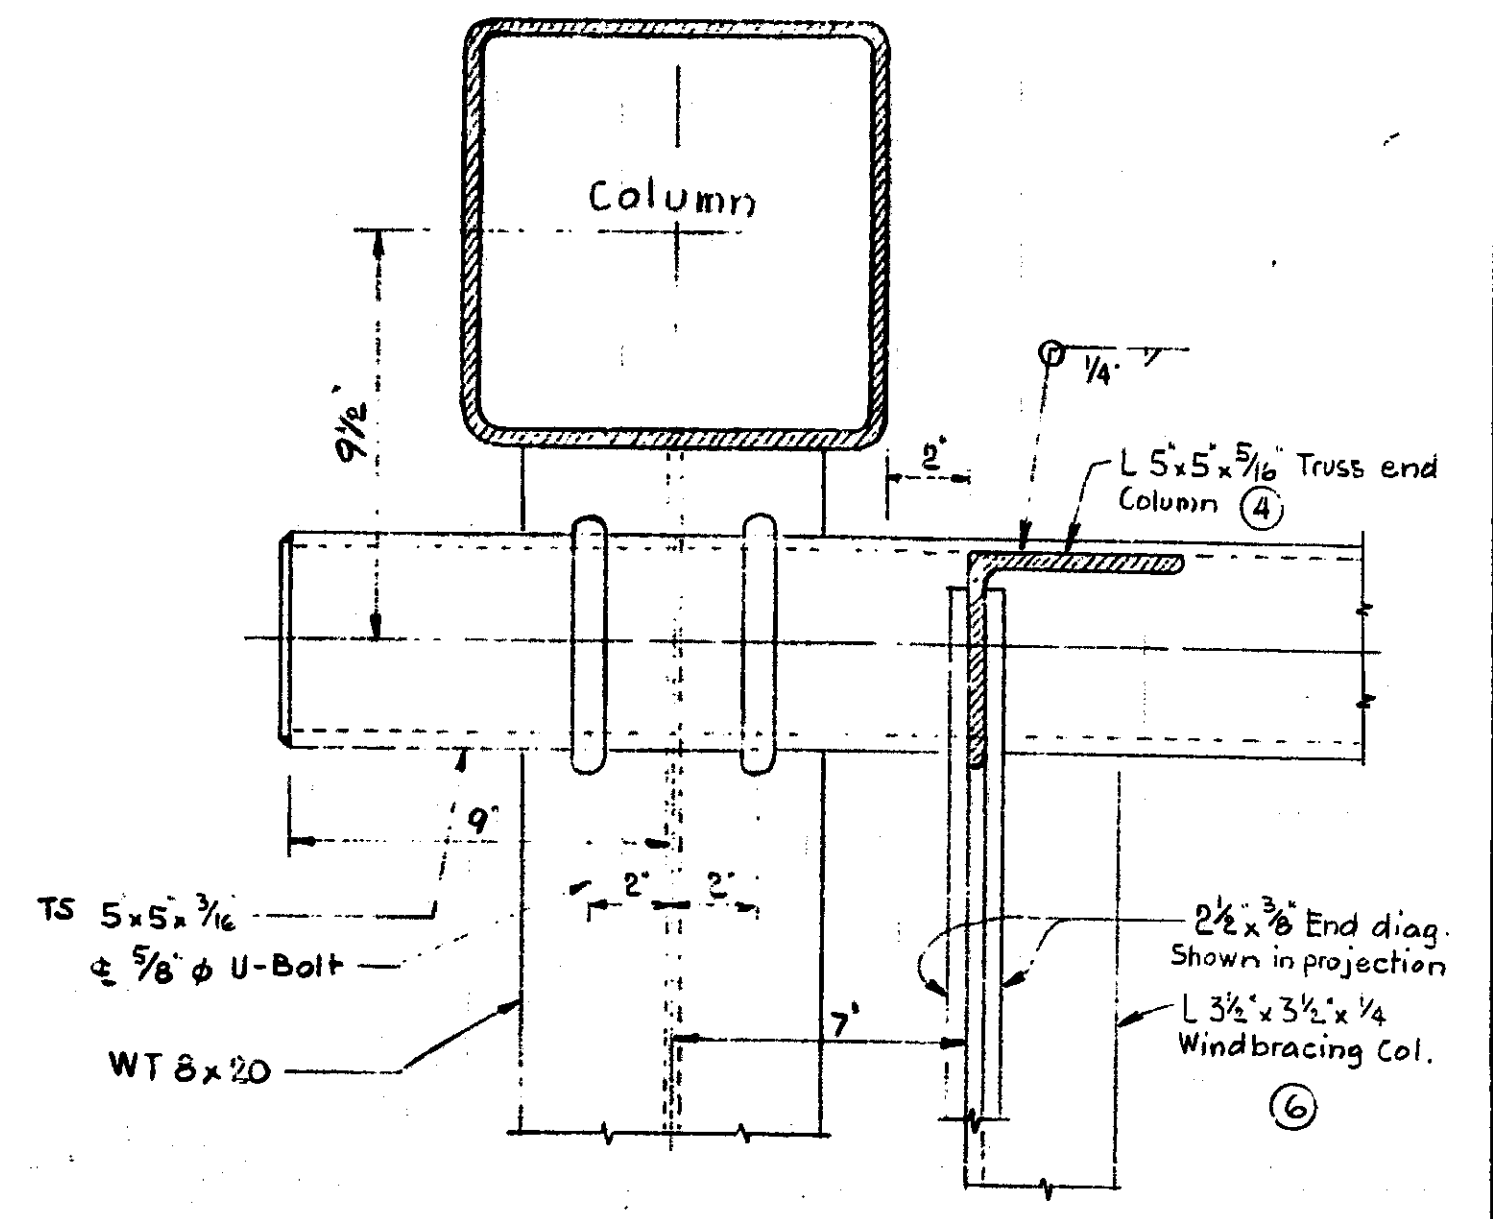


DETAIL L

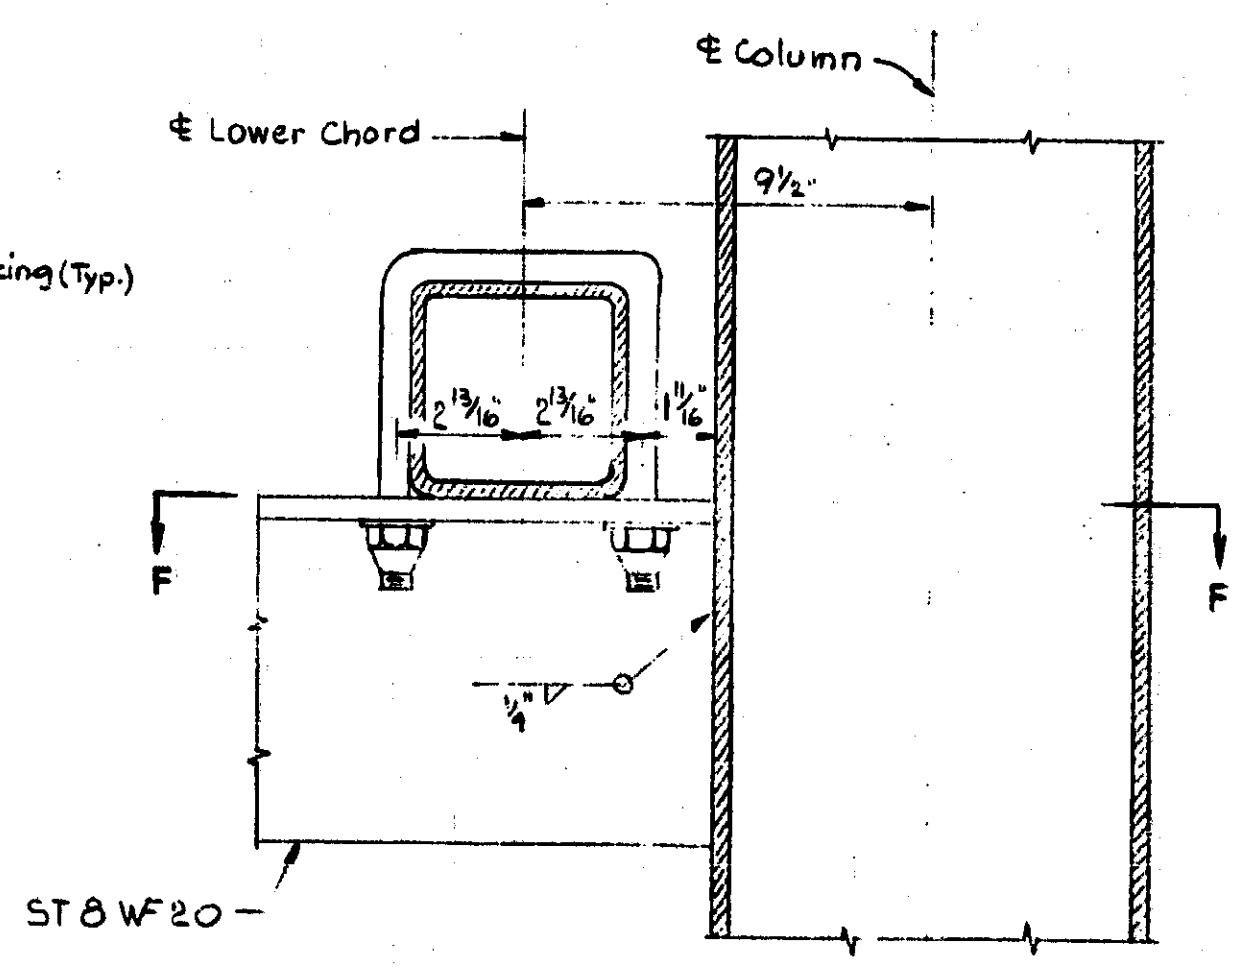

DETAIL OF SEAT

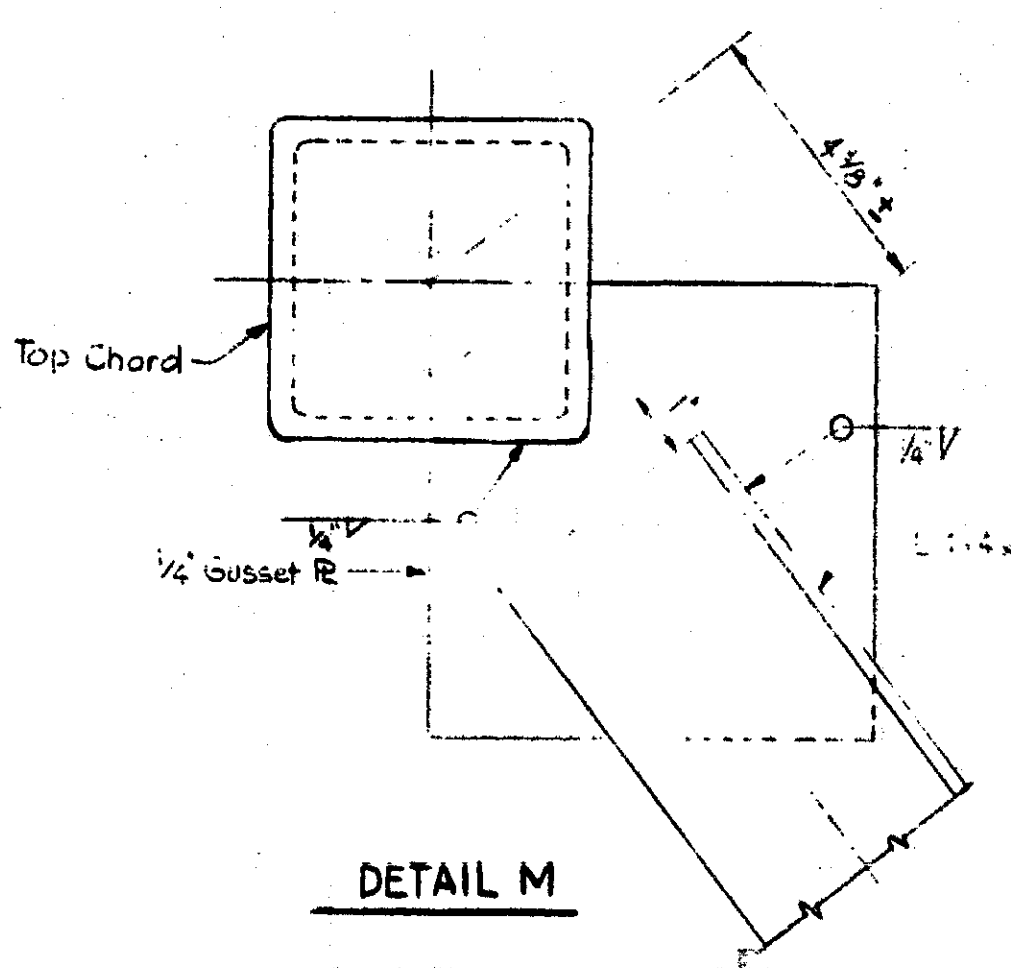


DETAIL M

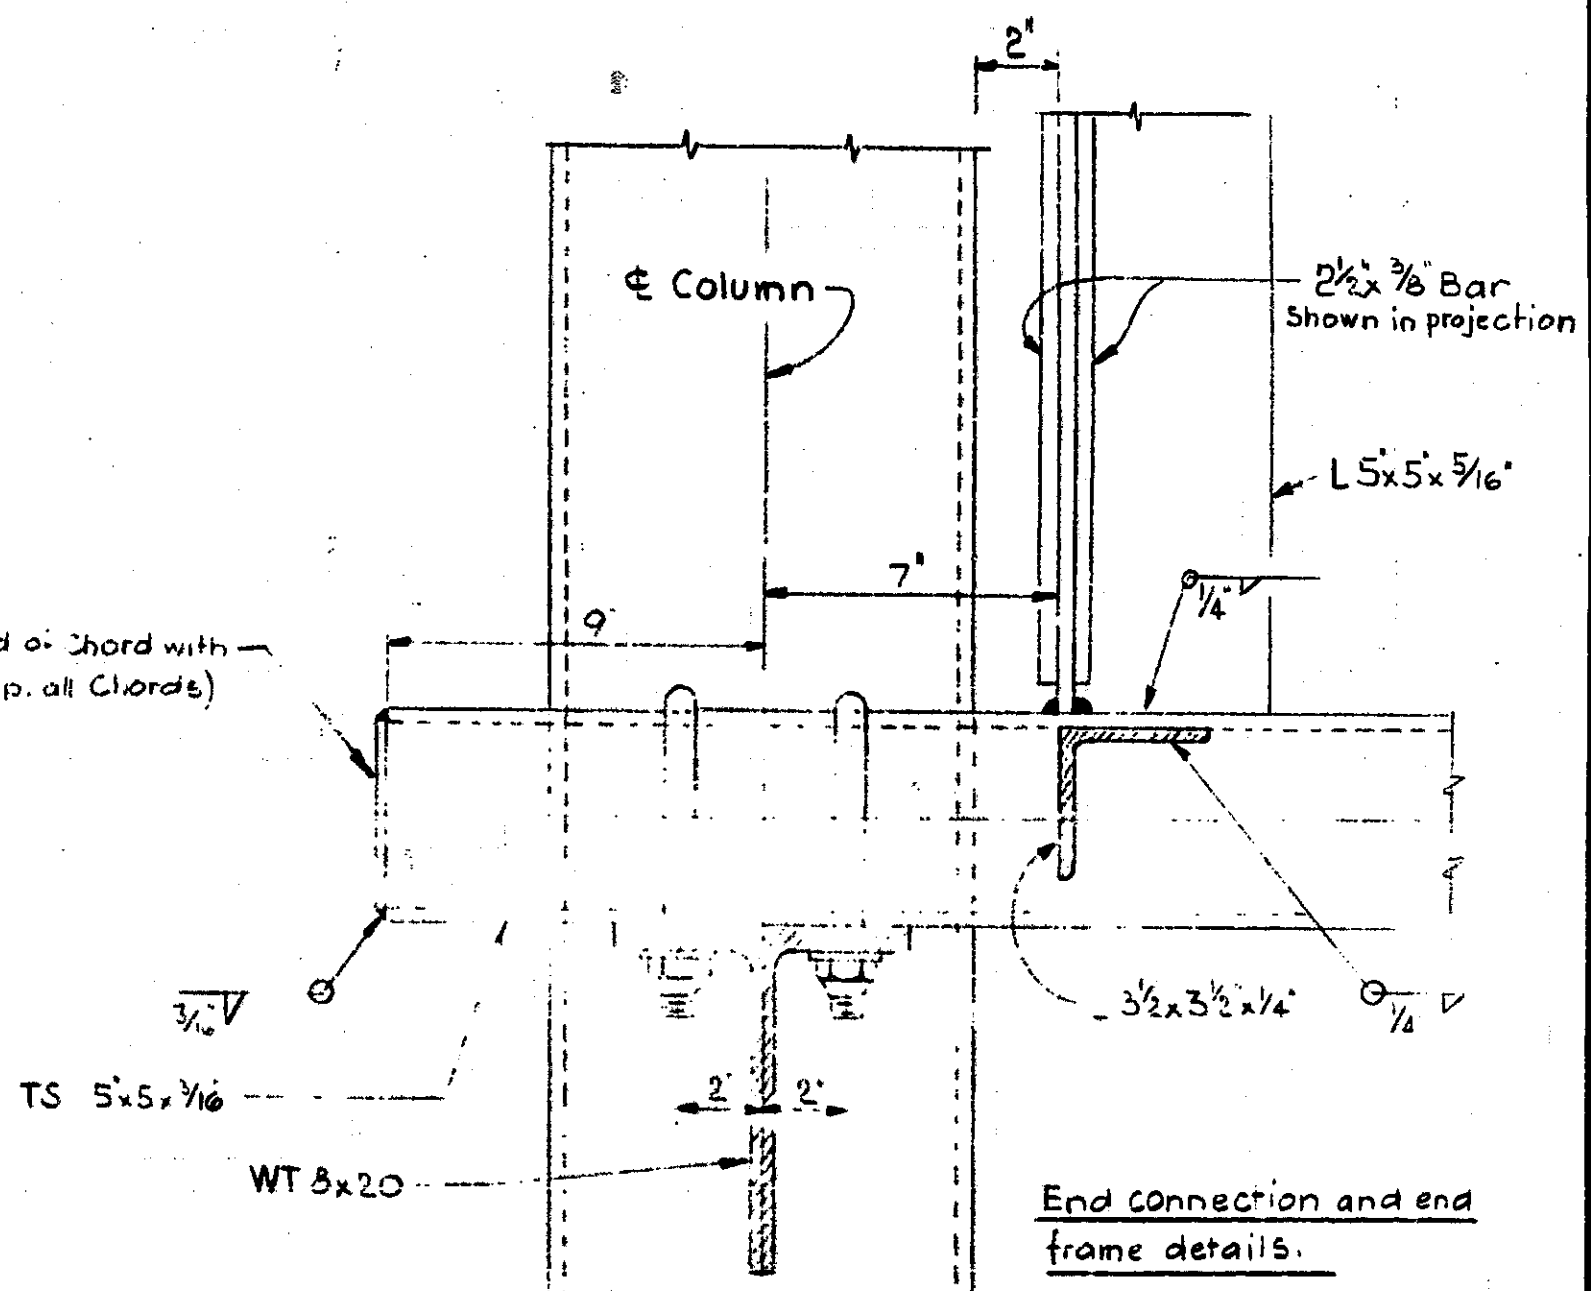


ELEVATION

NOTE All bolt holes are 1 3/16 phi (Typ.) except as noted.

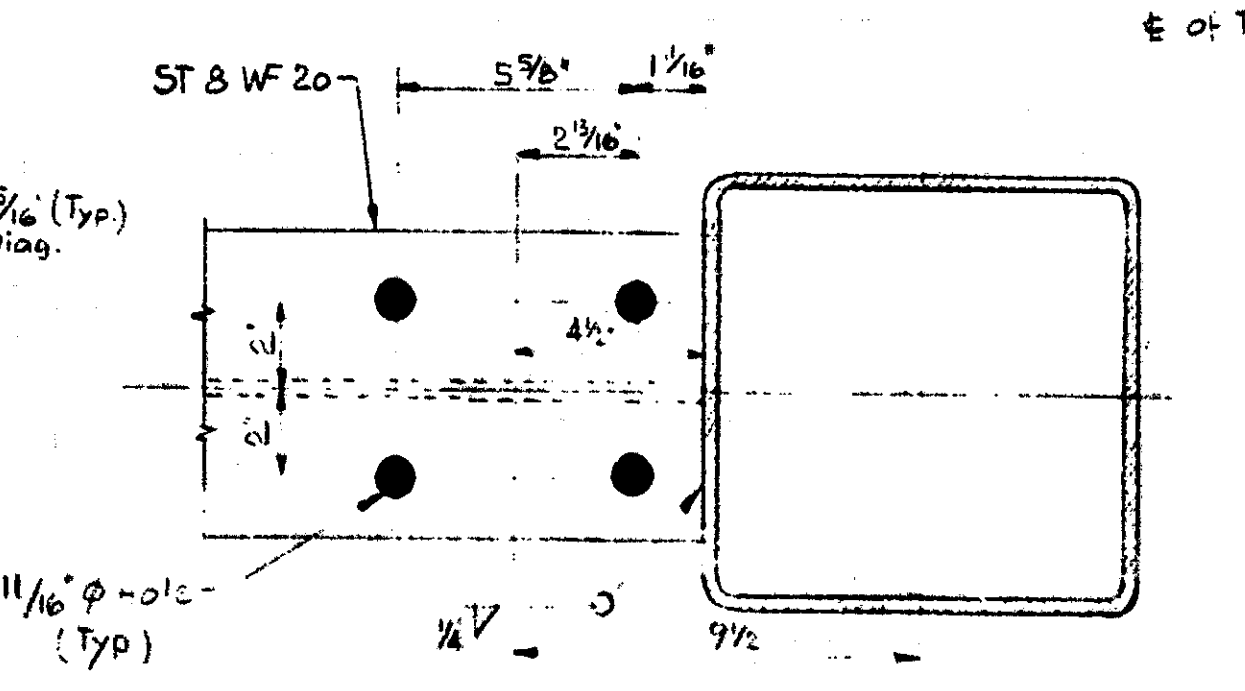

SECTION F-F

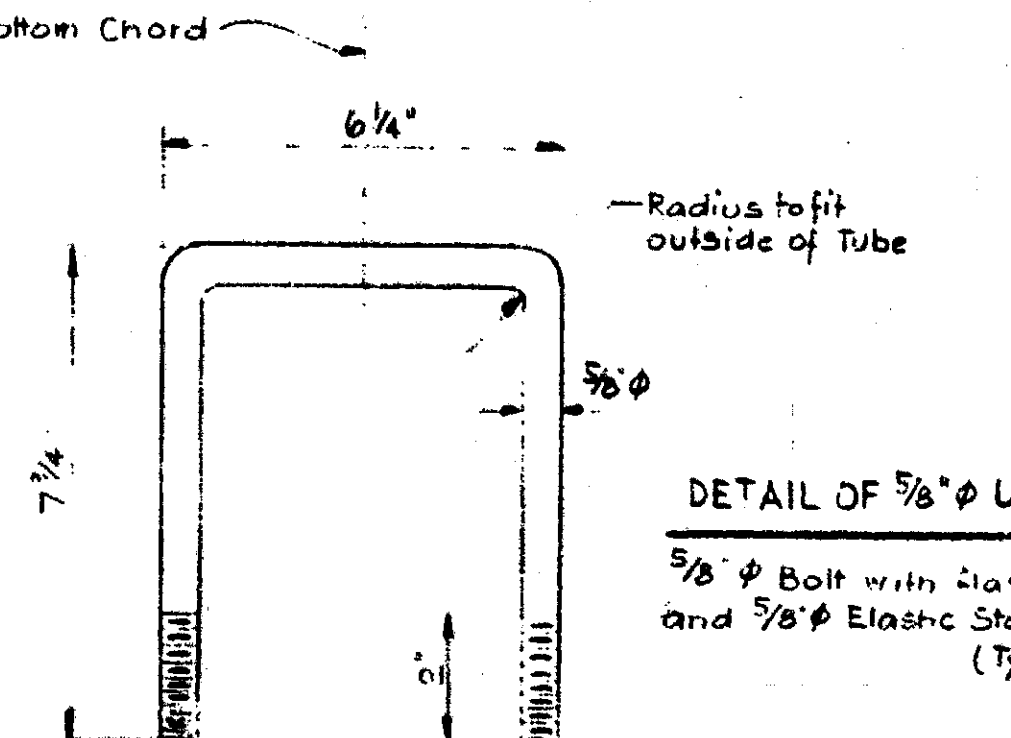

DETAIL OF 5/8 phi U-BOLT (12 Req'd)
5/8 phi Bolt with dia. 3/16 Washer
and 7/8 phi Elastic Stop Nut (21-NE-108)
(Typ.)

Work this sheet with sheet 67

MICHIGAN DEPARTMENT OF STATE HIGHWAYS

STEEL TRUSS

TYPE C

A-500 STEEL

NO.	DESCRIPTION	DATE	BY

REVISIONS	DATE	BY





DESIGNED BY: B. J. N. 2-16-77

DRAWN BY: B. J. N. 12-26-76

CHECKED BY: F. W. 1-11-77

SHEET 68 OF 96

S 7.0

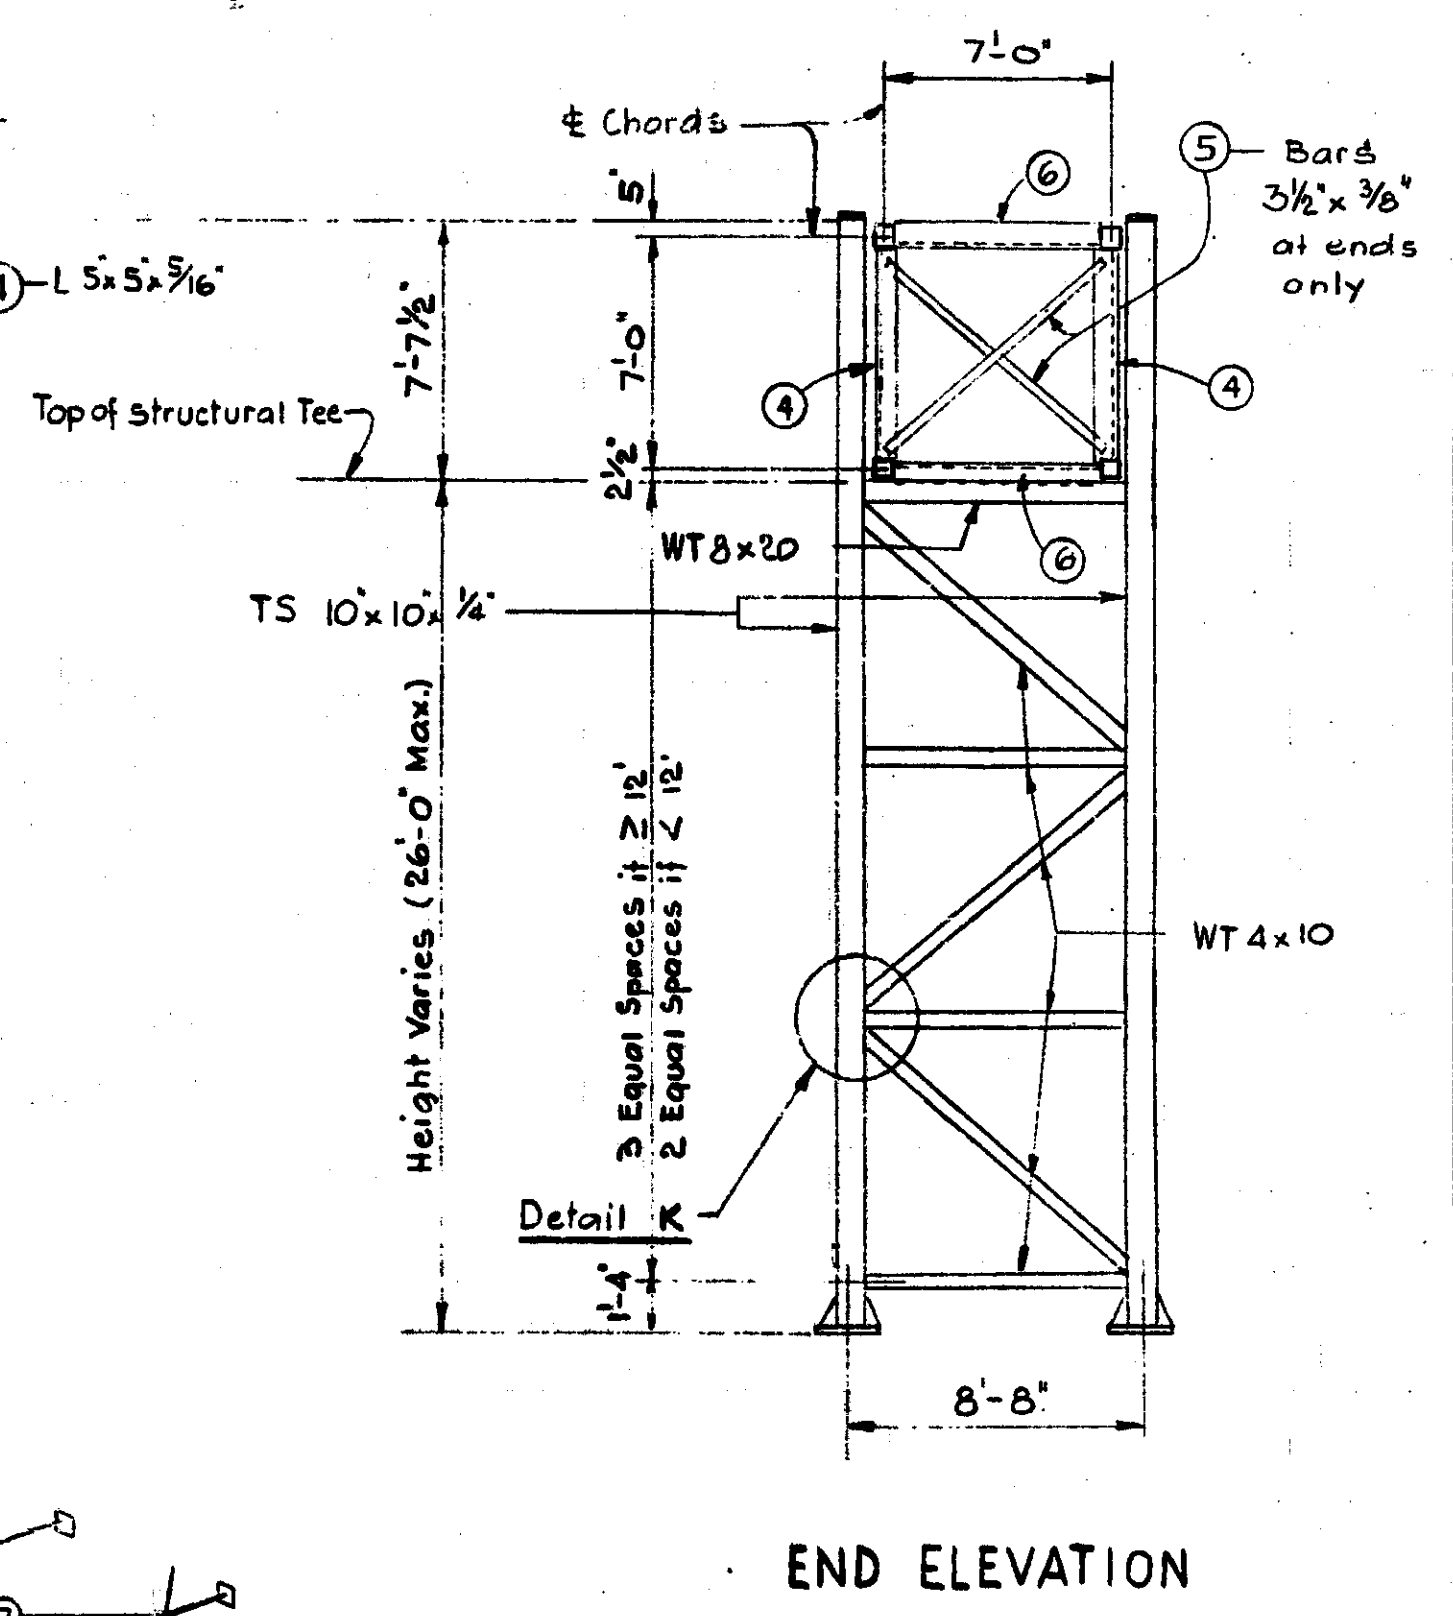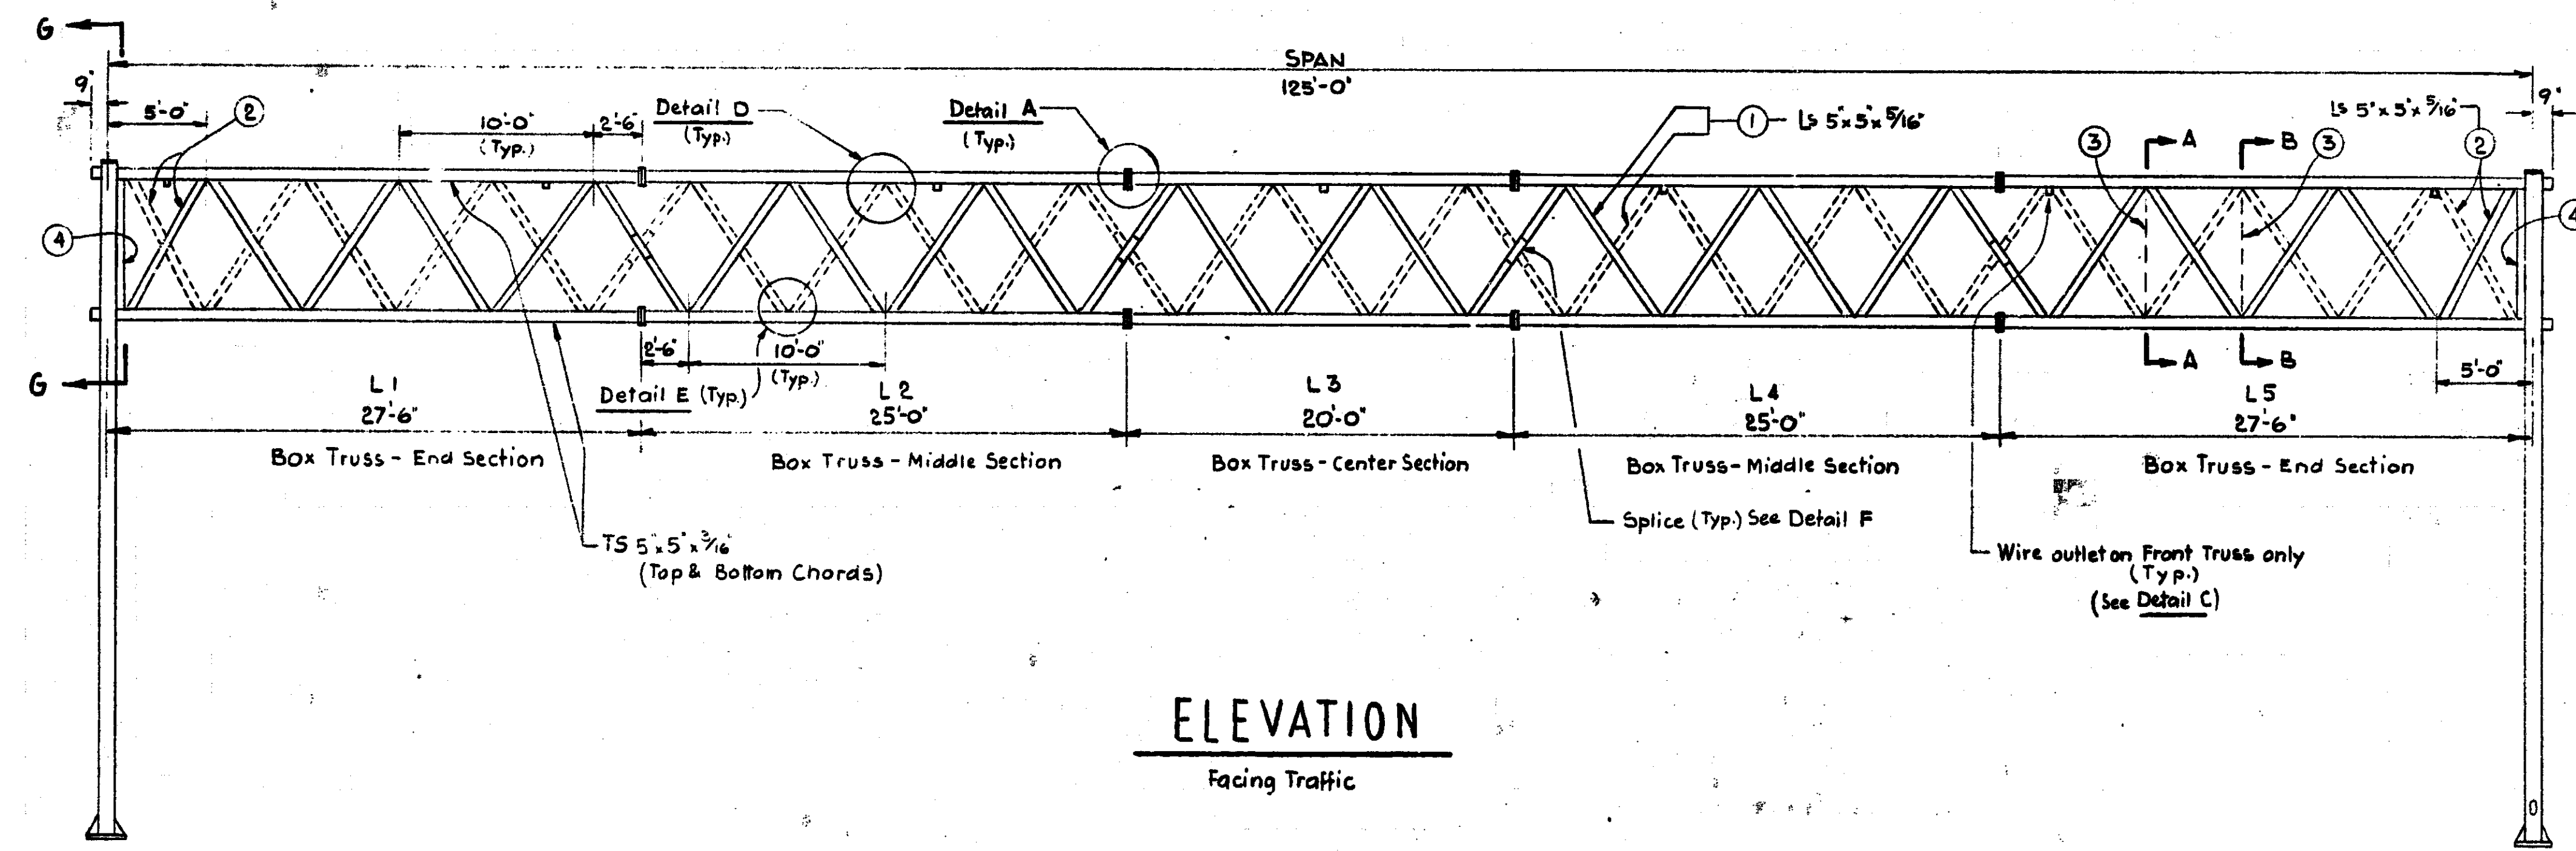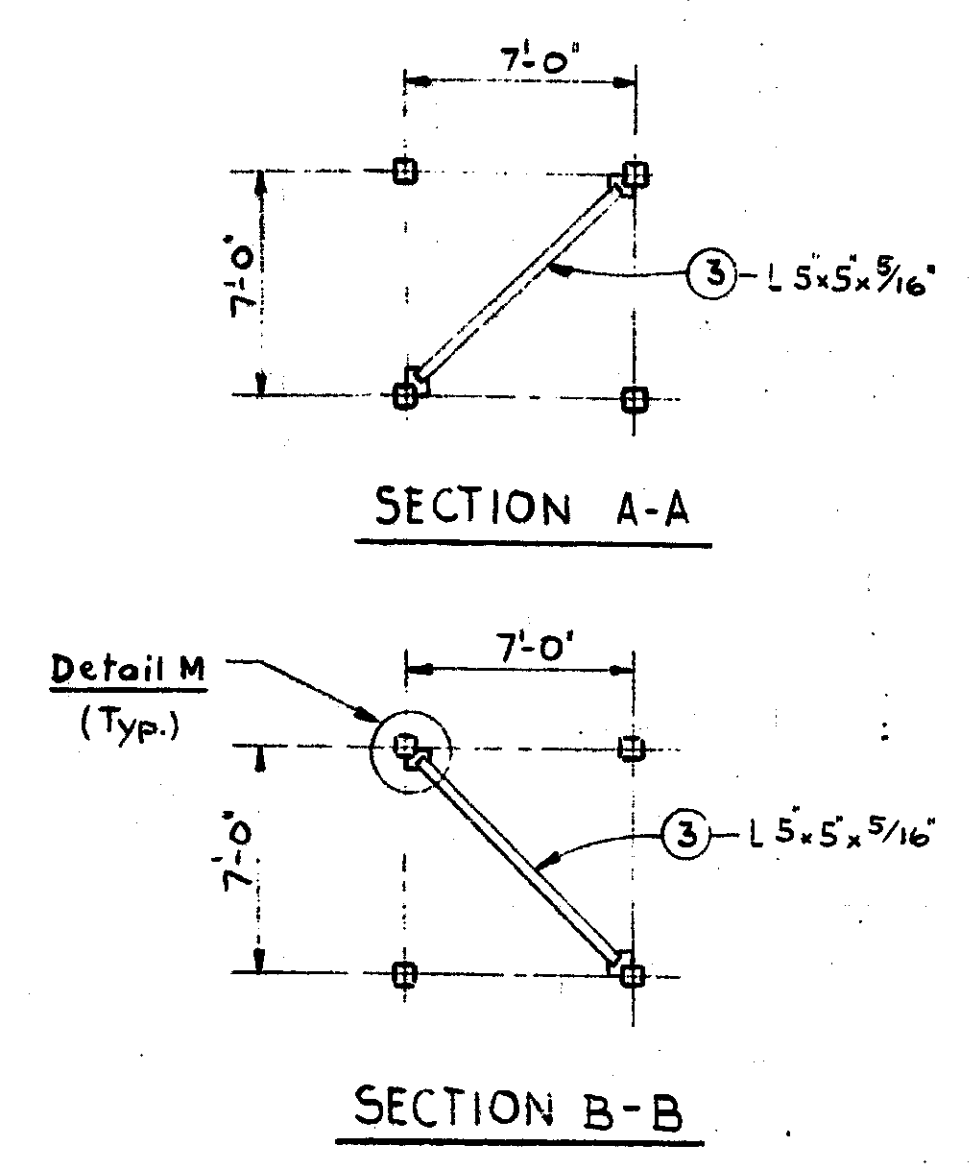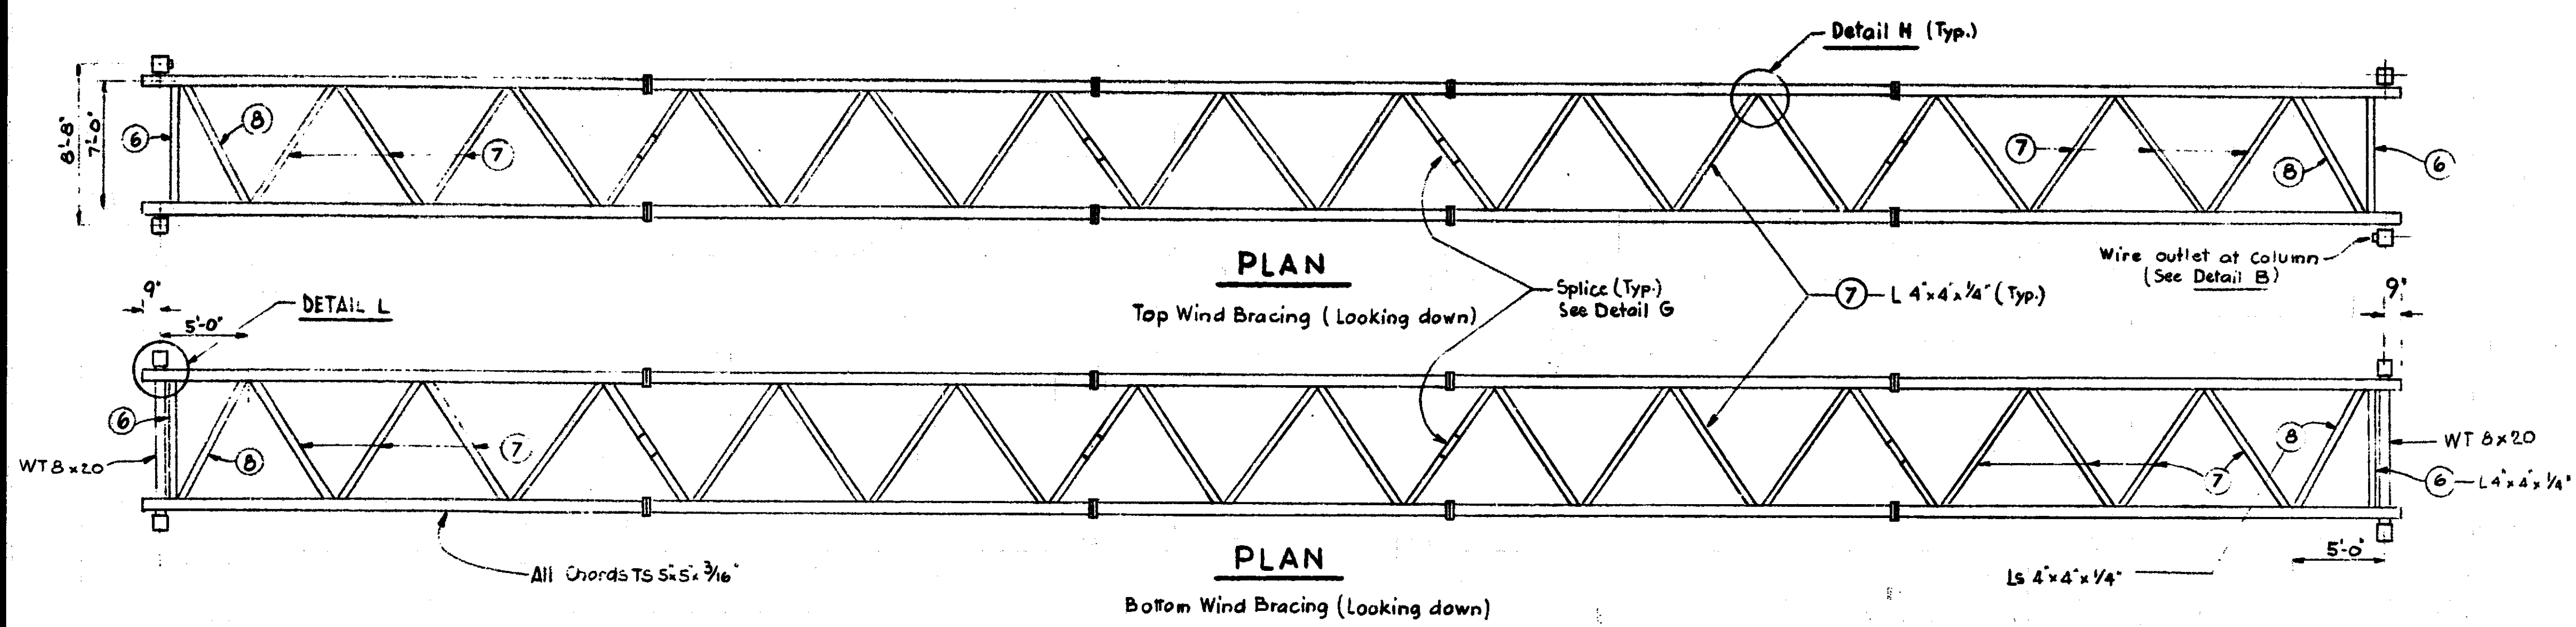


For Notes see sheet No 1

TRUSS DATA - A-588 Steel							APPROX. WEIGHT OF TRUSS lbs./ft.
SPAN	L1	L2	L3	L4	L5	CAMBER	
105'-0"	22'-6"	20'-0"	20'-0"	20'-0"	22'-6"	2 1/4"	123
110'-0"	22'-6"	20'-0"	25'-0"	20'-0"	22'-6"	2 1/2"	123
115'-0"	22'-6"	25'-0"	20'-0"	25'-0"	22'-6"	2 3/4"	123
120'-0"	27'-6"	20'-0"	25'-0"	20'-0"	27'-6"	3"	123
125'-0"	27'-6"	25'-0"	20'-0"	25'-0"	27'-6"	3 1/4"	123

CAMBER The camber given in the above table is the Ordinate at the center of the assembled truss prior to dead load deflection. Allowable camber tolerance for truss is 25%.

ADDITIONAL NOTES

(Type D only)
For proper damping characteristics the Minimum Size of sign for this structure is 6'x12'.

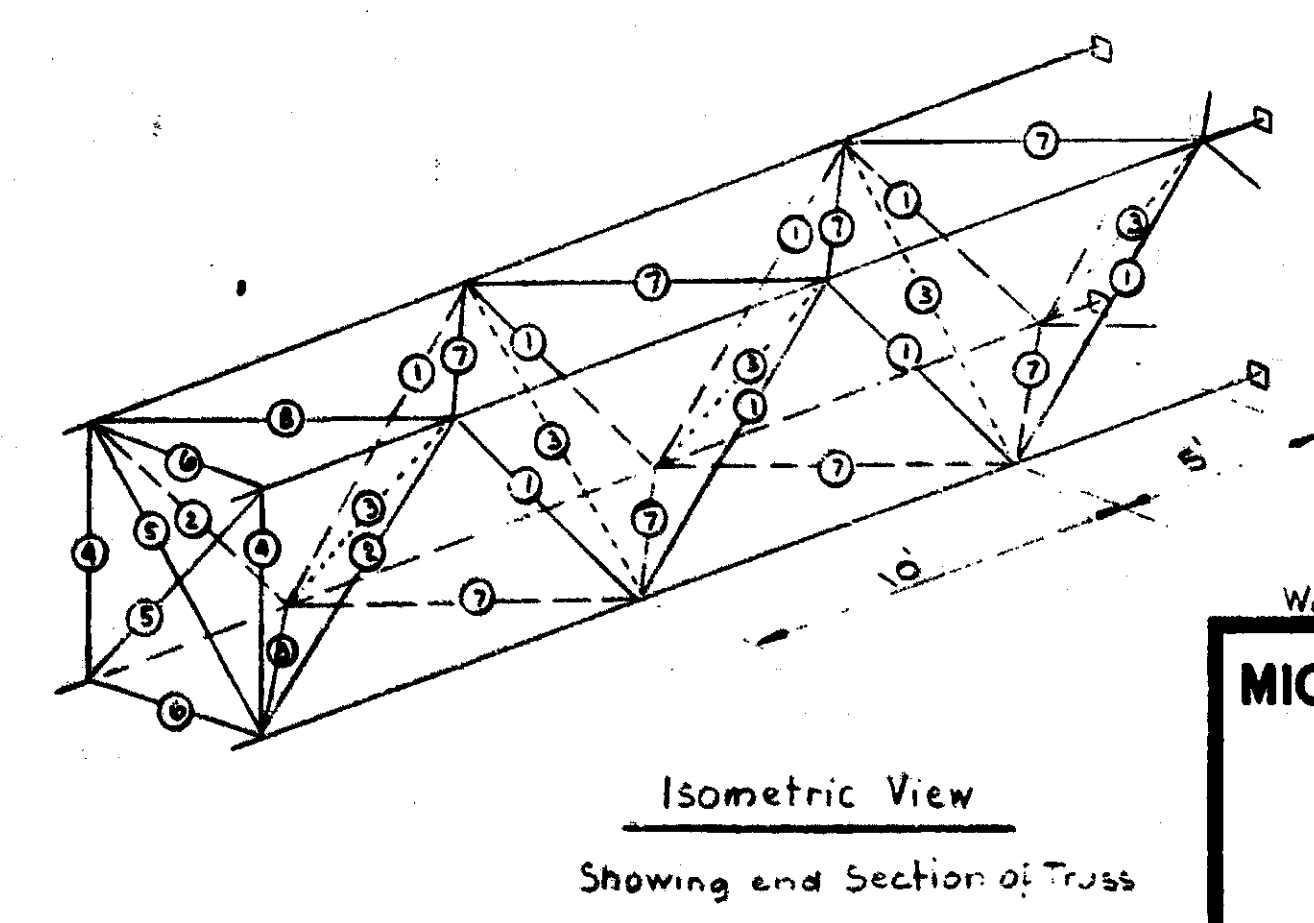

Work this sheet with sheets # 1, 7 & 8

MICHIGAN DEPARTMENT OF STATE HIGHWAYS

STEEL TRUSS


TYPE D (125 FT.)

A-588 STEEL


NO.	DESCRIPTION	DATE	BY

DESIGNED BY	Bullen	2-14-77
DRAWN BY	P. R. N.	10-20-76
TRACED BY		
CHECKED BY		


S 7.6C

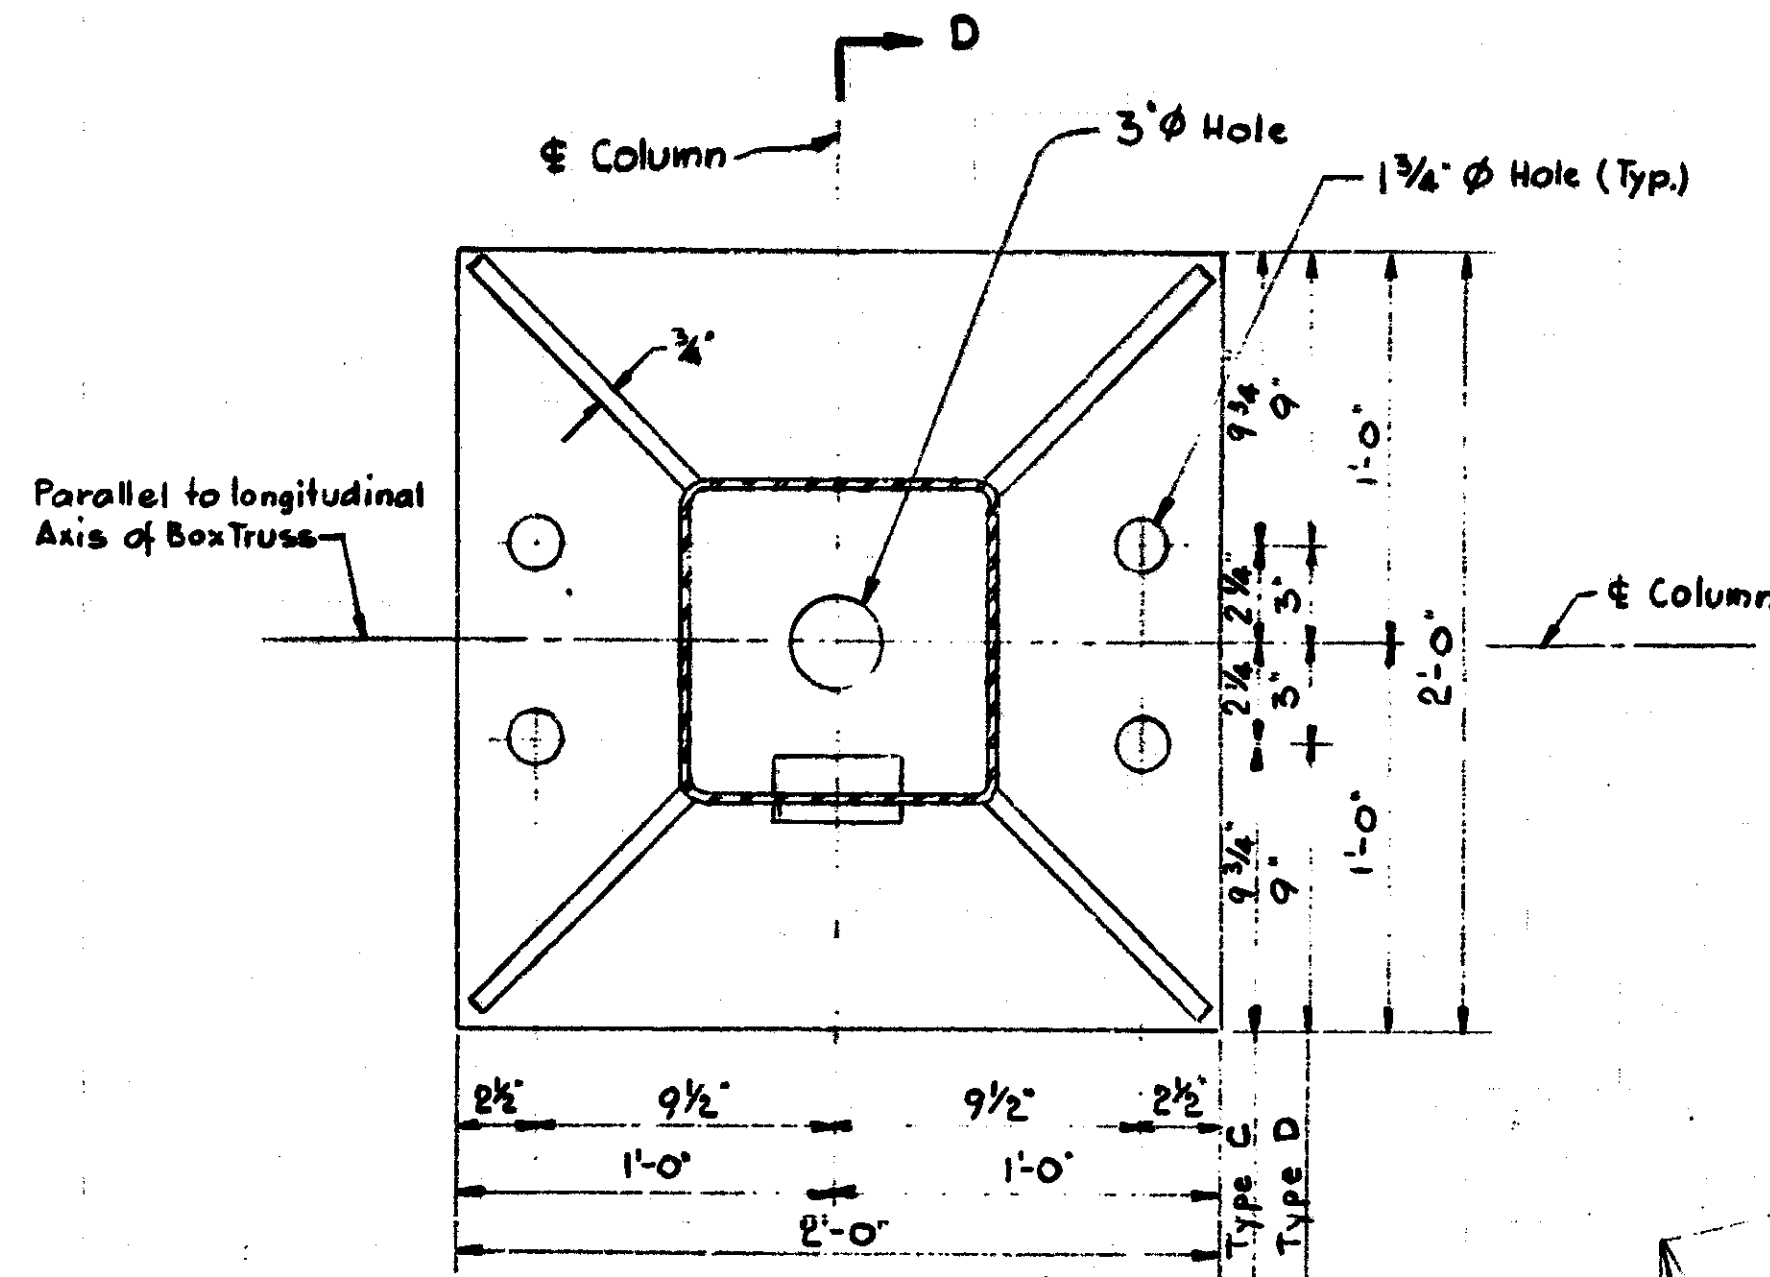


SECTION C-C

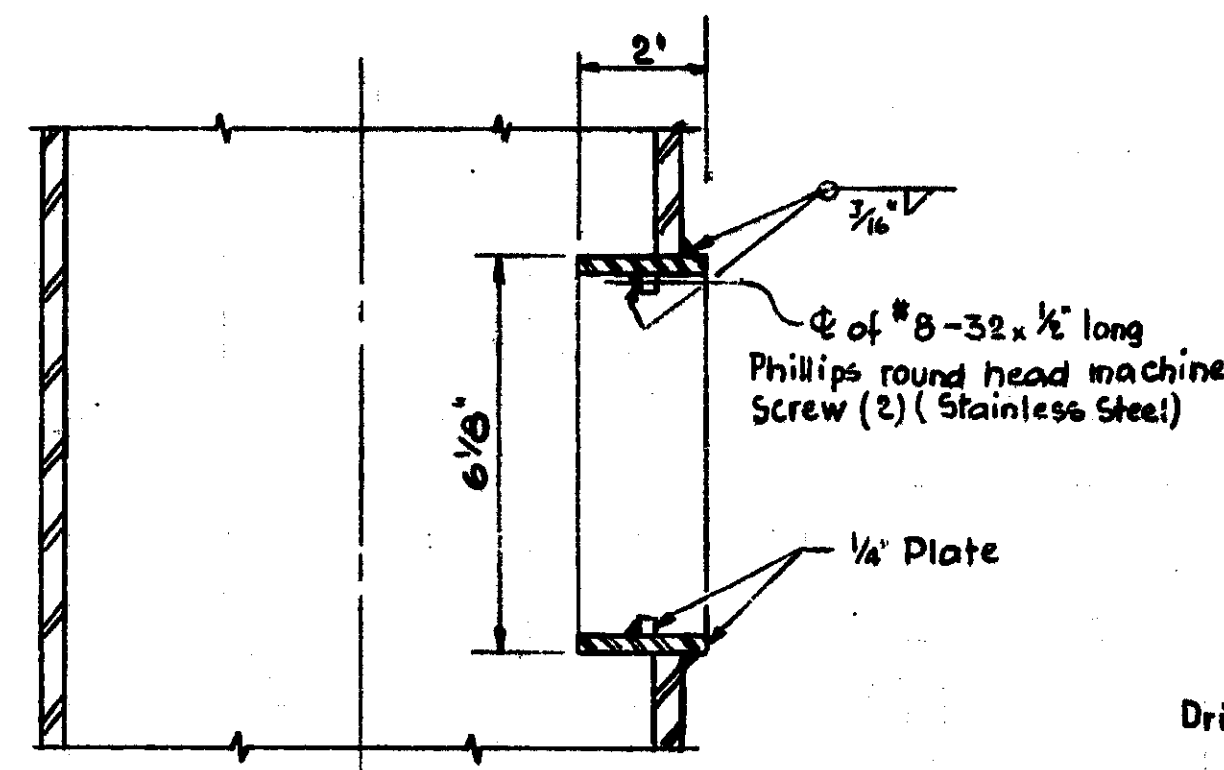


SECTION D-D

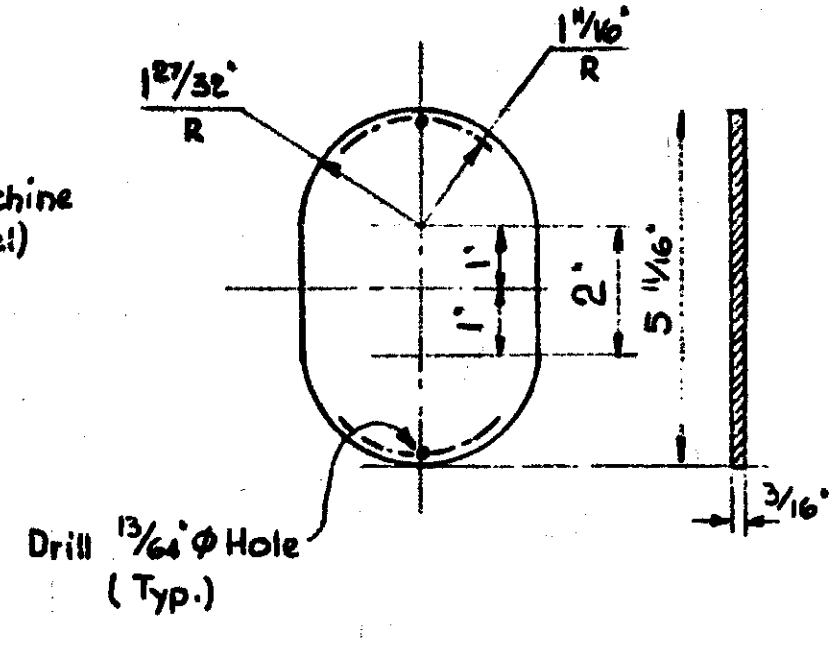


HAND HOLE COVER

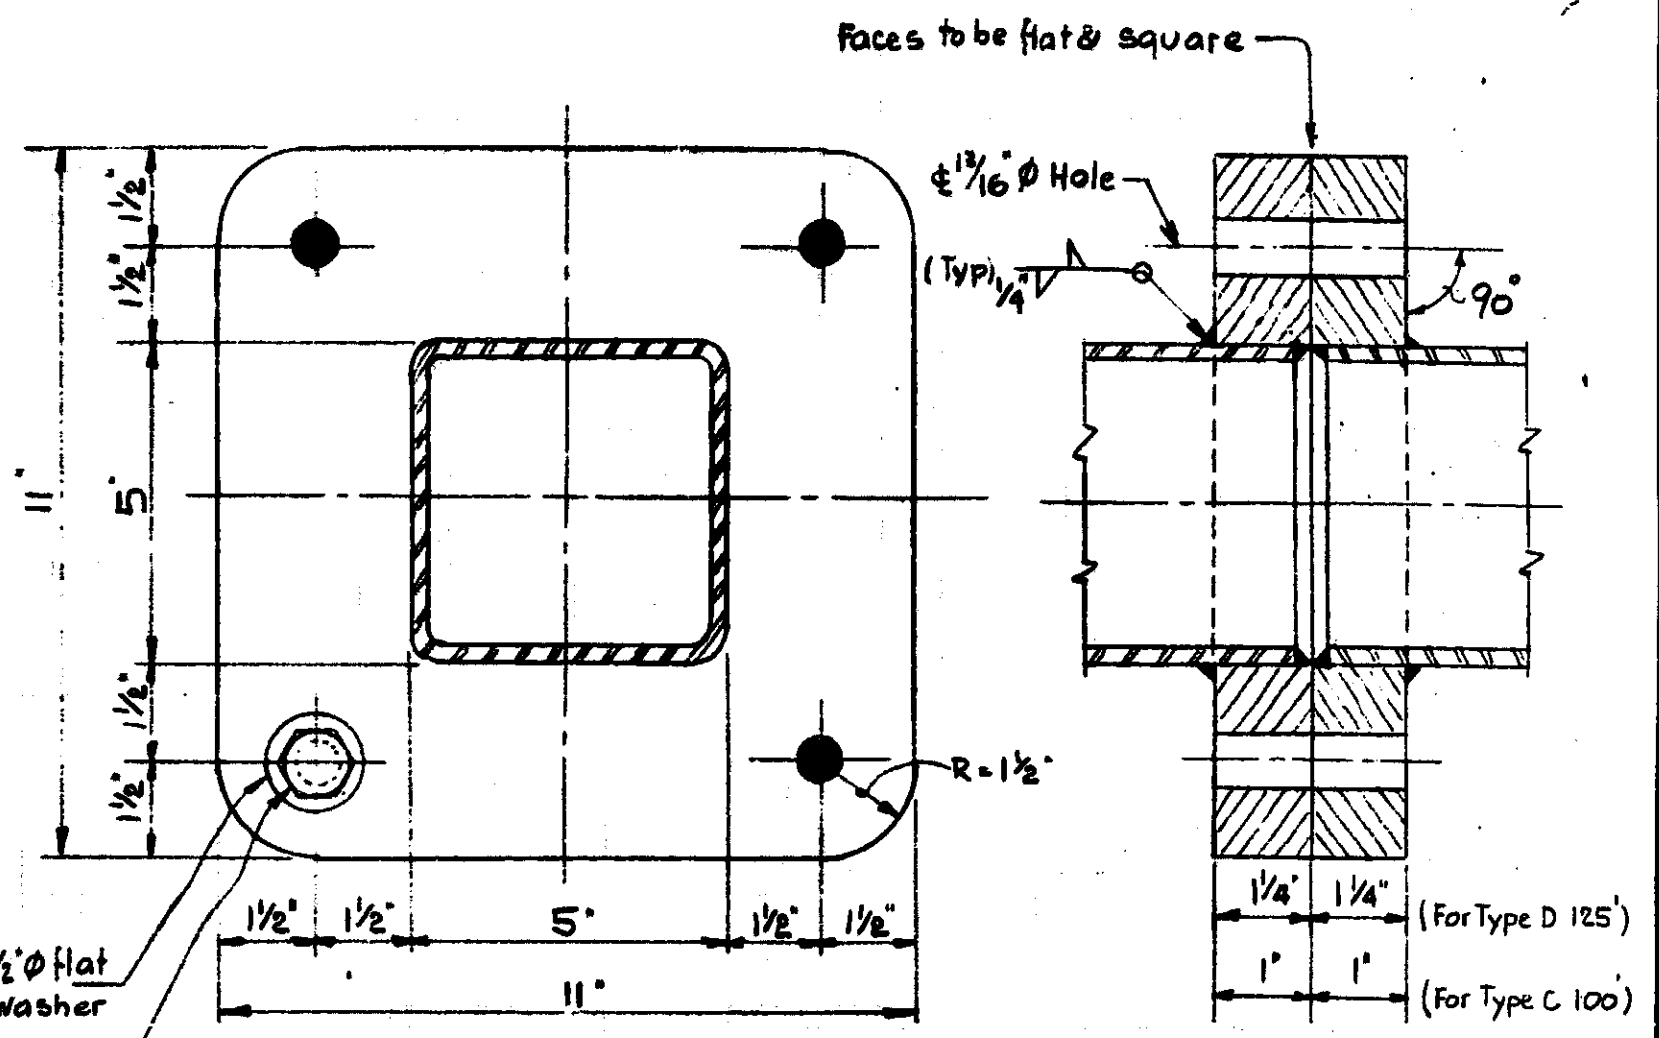


DETAIL A
Chord Connection Details

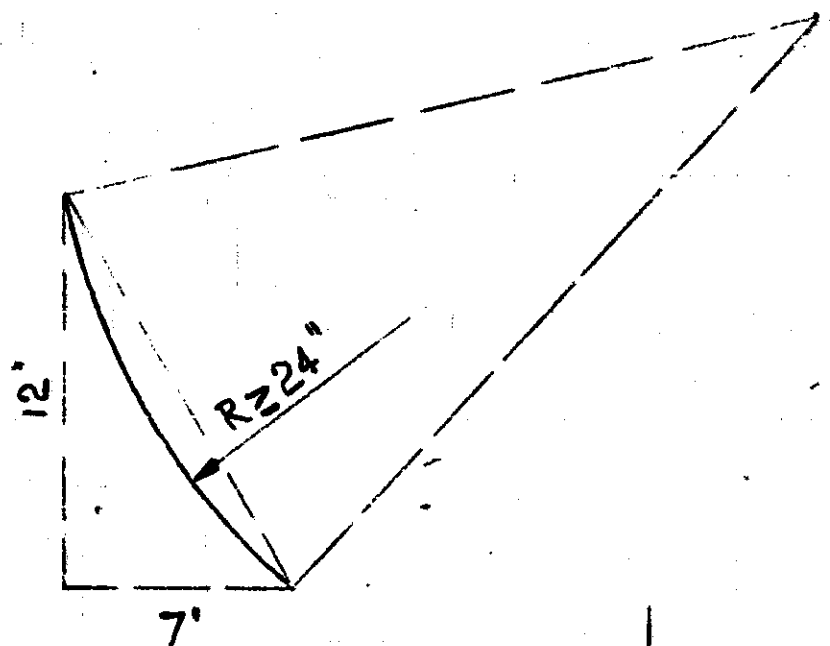


DETAIL R

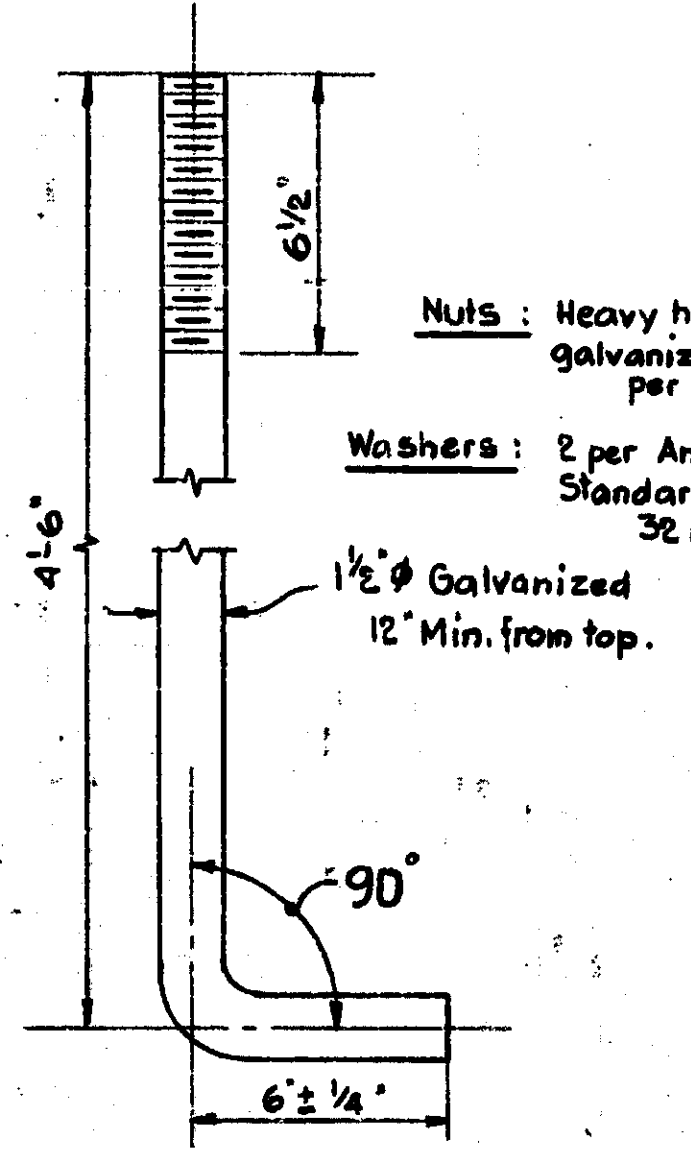


DETAIL OF ANCHOR BOLT (16 Req'd.)
Anchor Bolts shall be in accordance with Art. B. 07. 14 of the Std. Spec.

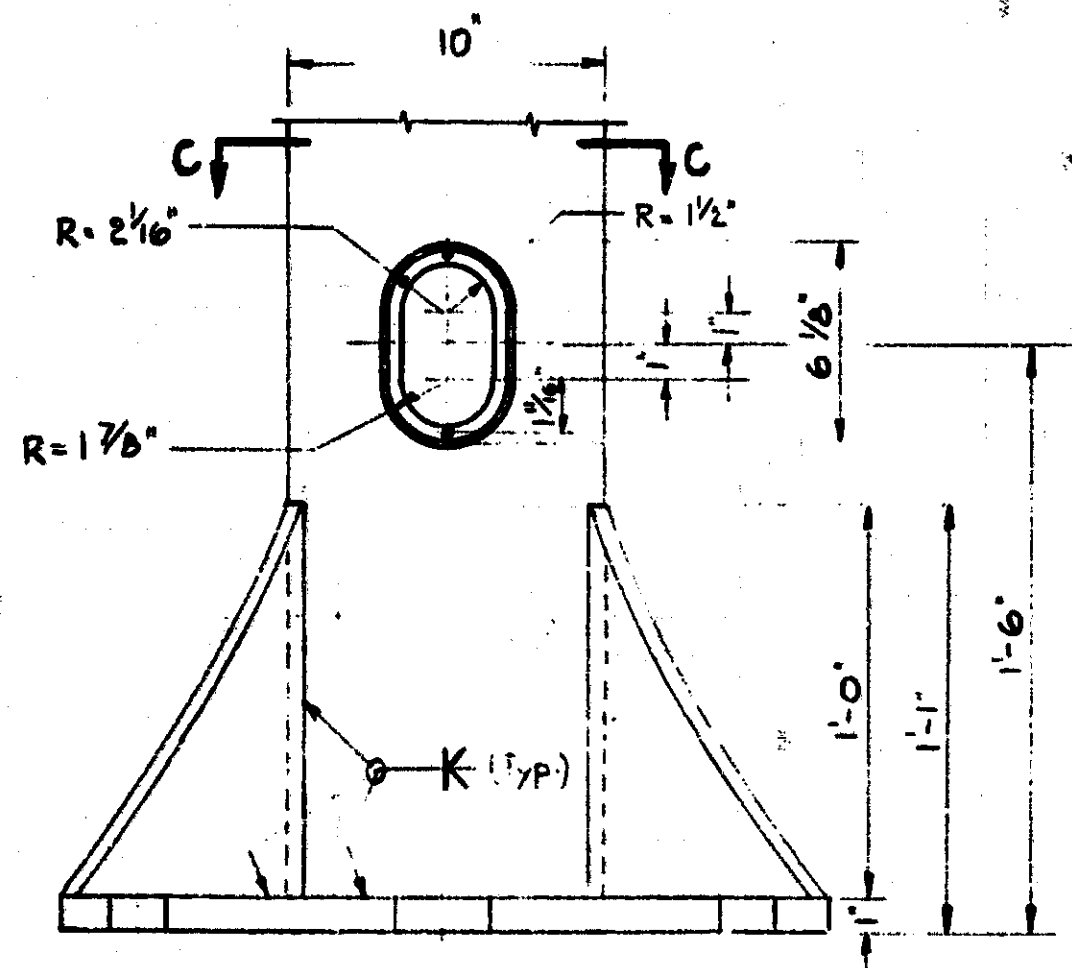

FRONT ELEVATION

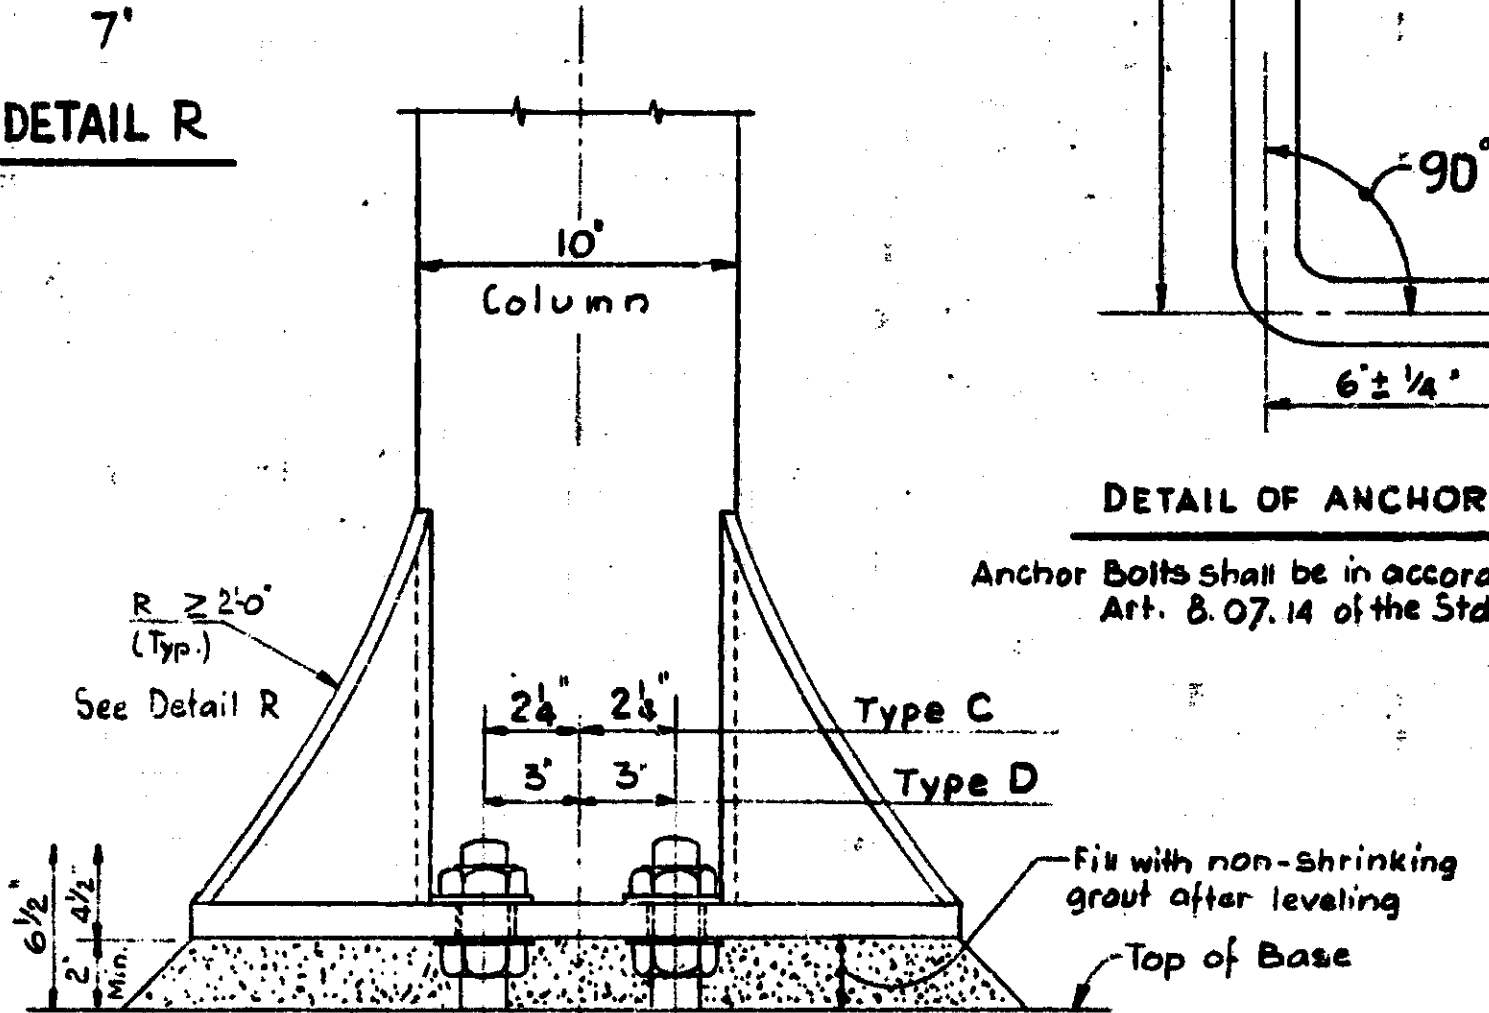


DETAIL OF BASE-LEVELING NUTS

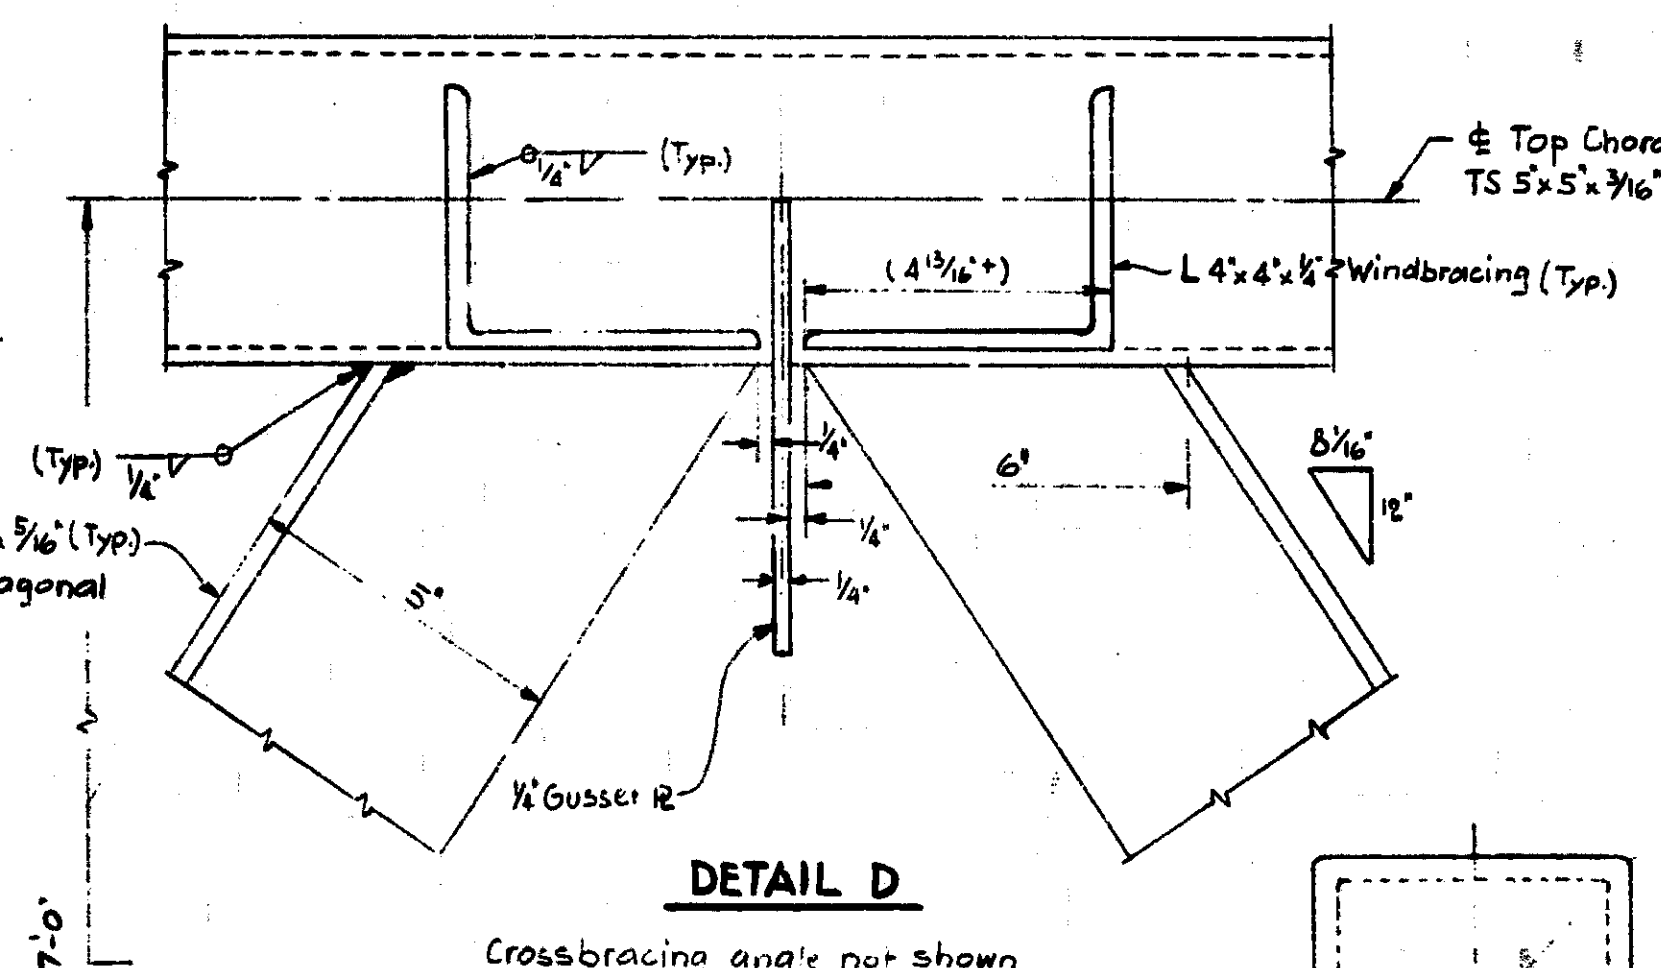


DETAIL D


NOTE
All bolts holes are 3/16\"/>

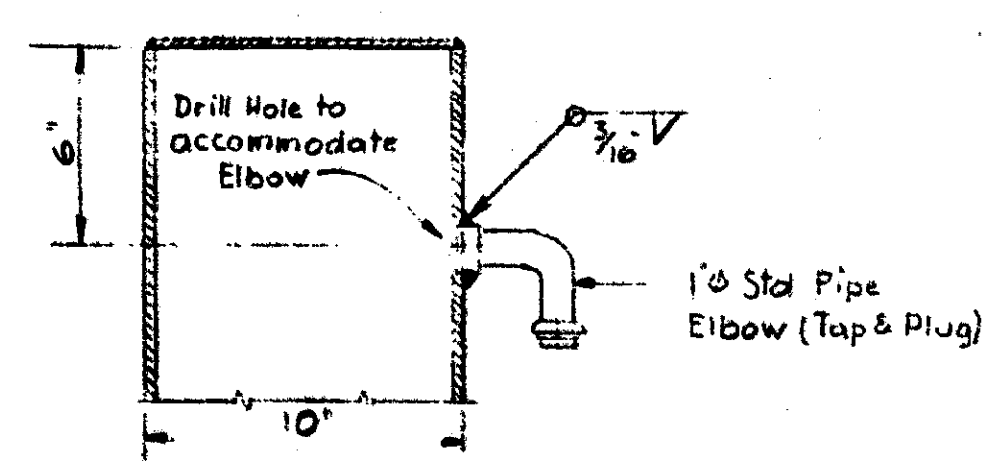


DETAIL B
Detail of electrical outlet at column

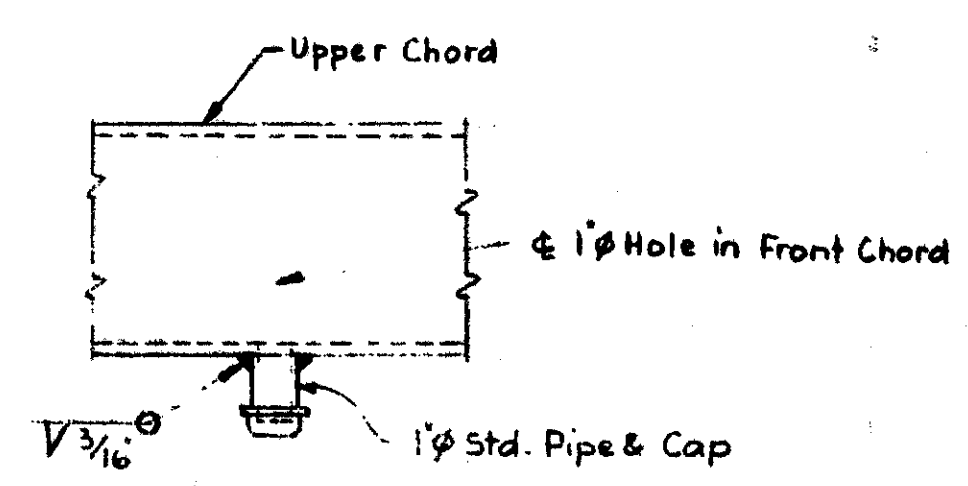

DETAIL C
Detail of electrical outlet at upper chord only

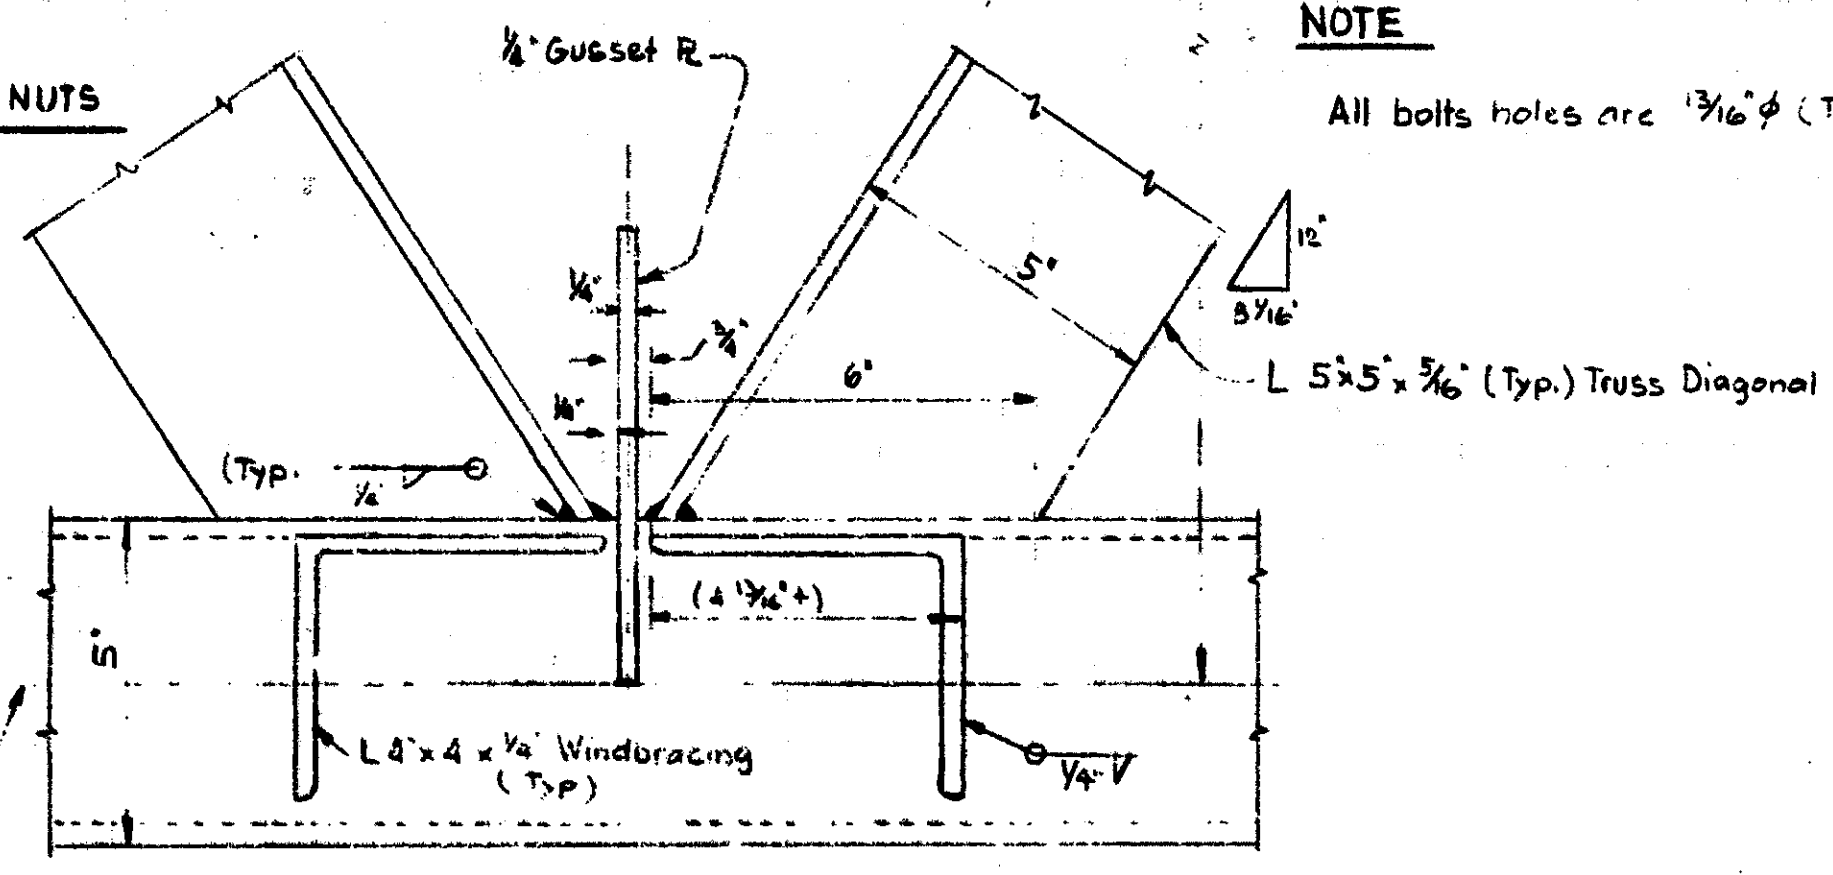

DETAIL E

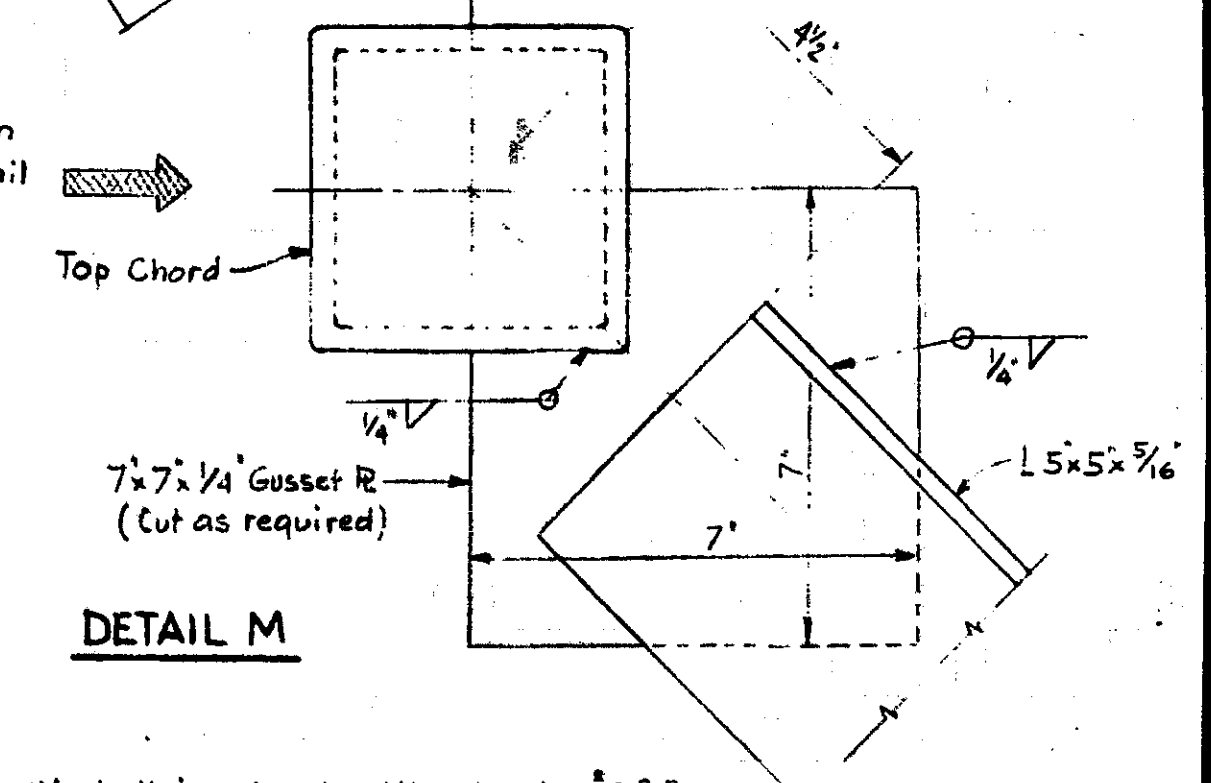

DETAIL M

Work this sheet with sheets 6&8

MICHIGAN DEPARTMENT OF STATE HIGHWAYS

STEEL TRUSS

TYPE D (125 FT.)


A-588 STEEL

NO.	DESCRIPTION	DATE	BY
C	Anchor bolt spacing	6-24-77	WDB


DRAWN BY	DATE
Bullen	2-16-77
PER N	10-21-76
FW	1-5-77

SHEET 7 OF 8


S 7.70

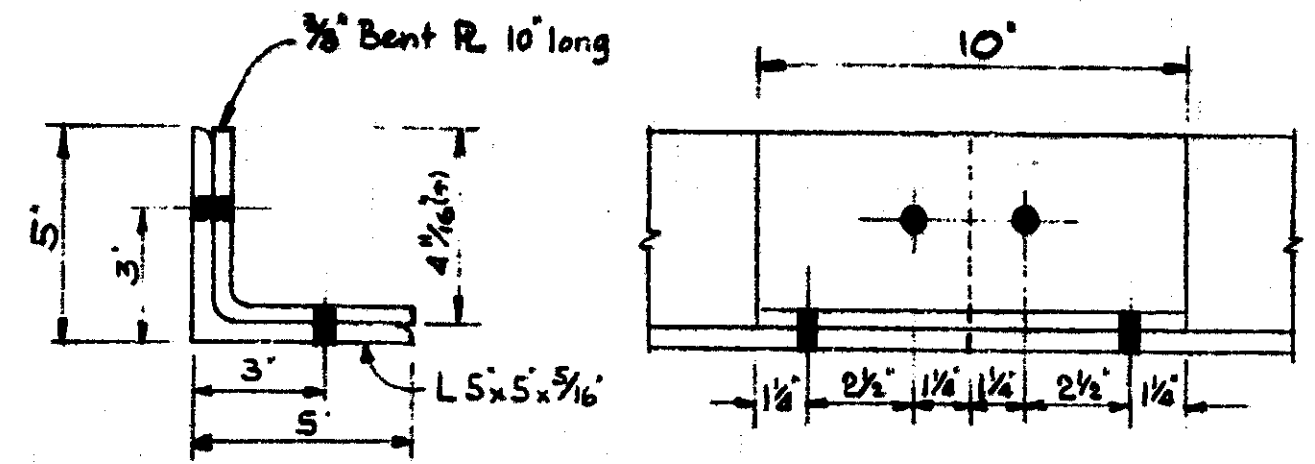


DETAIL F
Splice for Truss Web Member
All holes 15/16" ϕ for splice only.

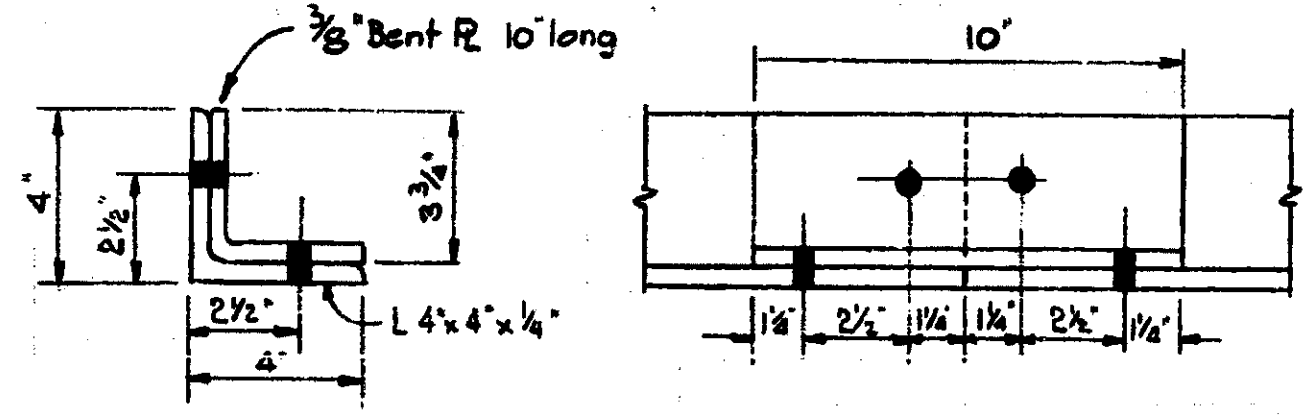


DETAIL G
Splice for Windbracing Diag.
All holes 15/16" ϕ for splice only.

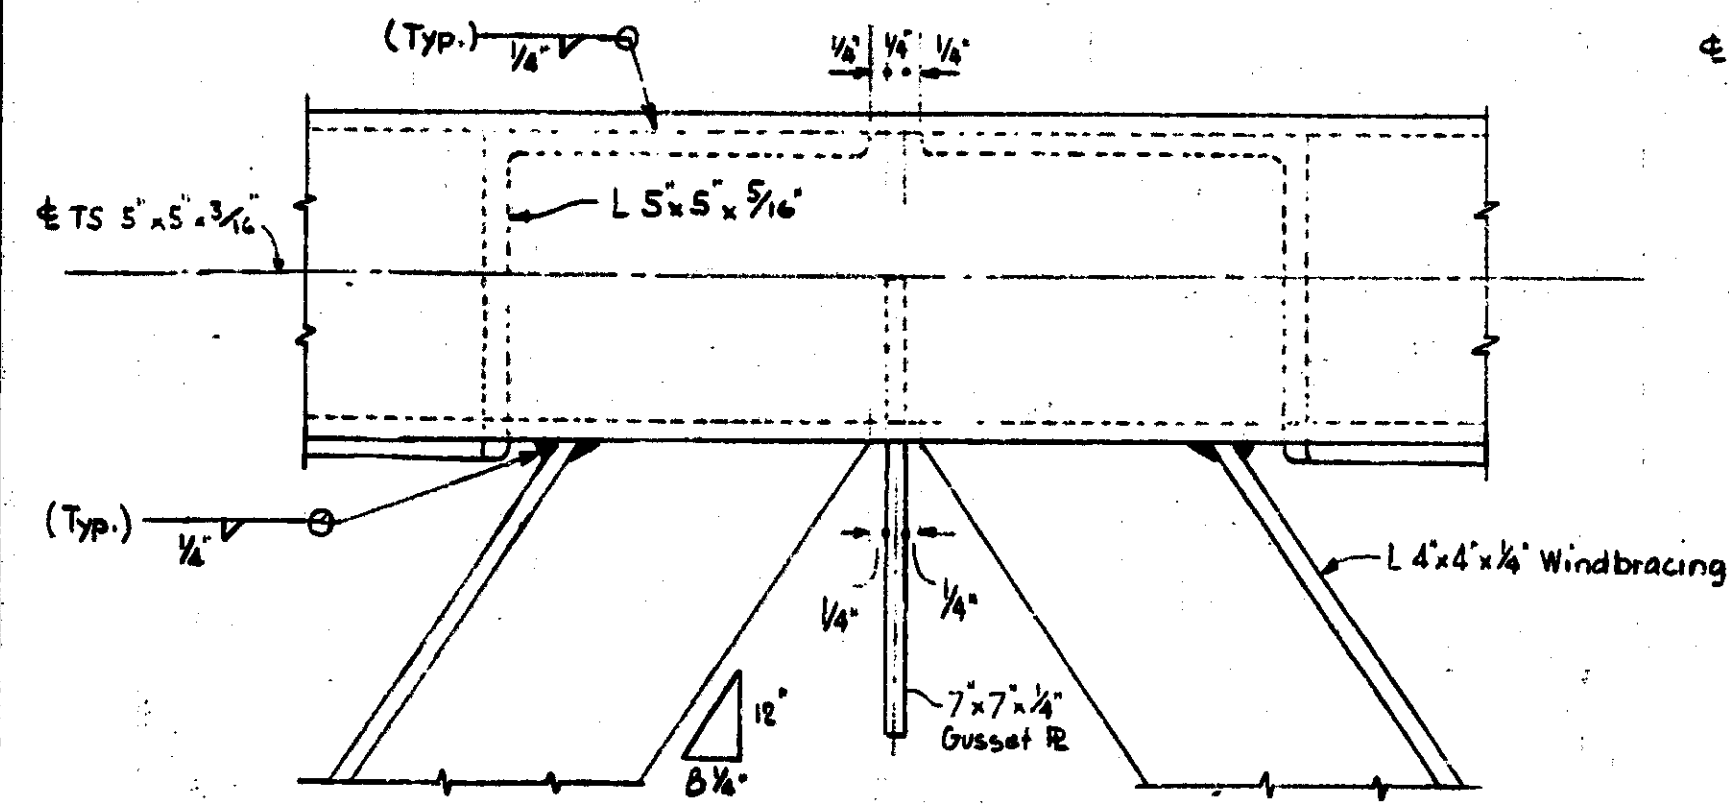


DETAIL H
View of top windbracing looking from the top down.
Note: The angle shown is typical only in the interior bays. It is different in the end bays due to the horizontal end column.

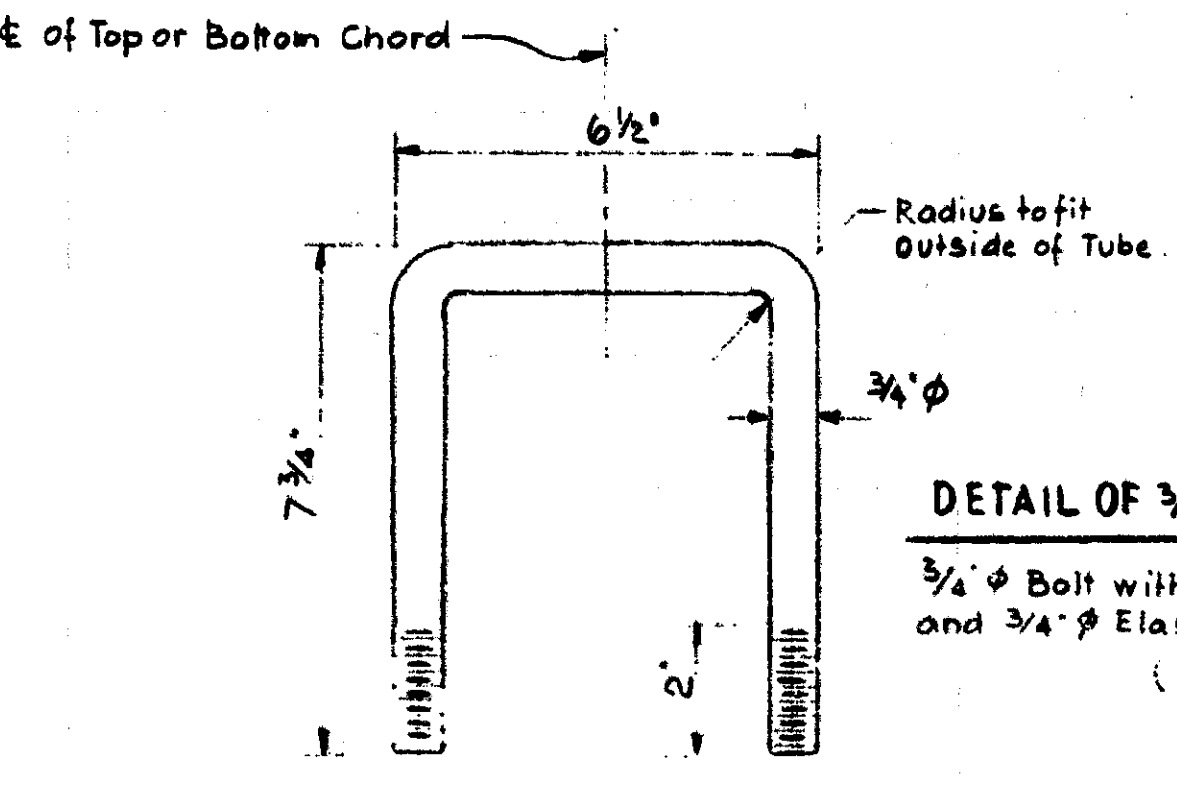


DETAIL OF 3/4" U-BOLT (12 Req'd.)
3/4" ϕ Bolt with flat 3/16" Washer and 3/4" ϕ Elastic Stop Nut (41-NE-120) (Typ.)

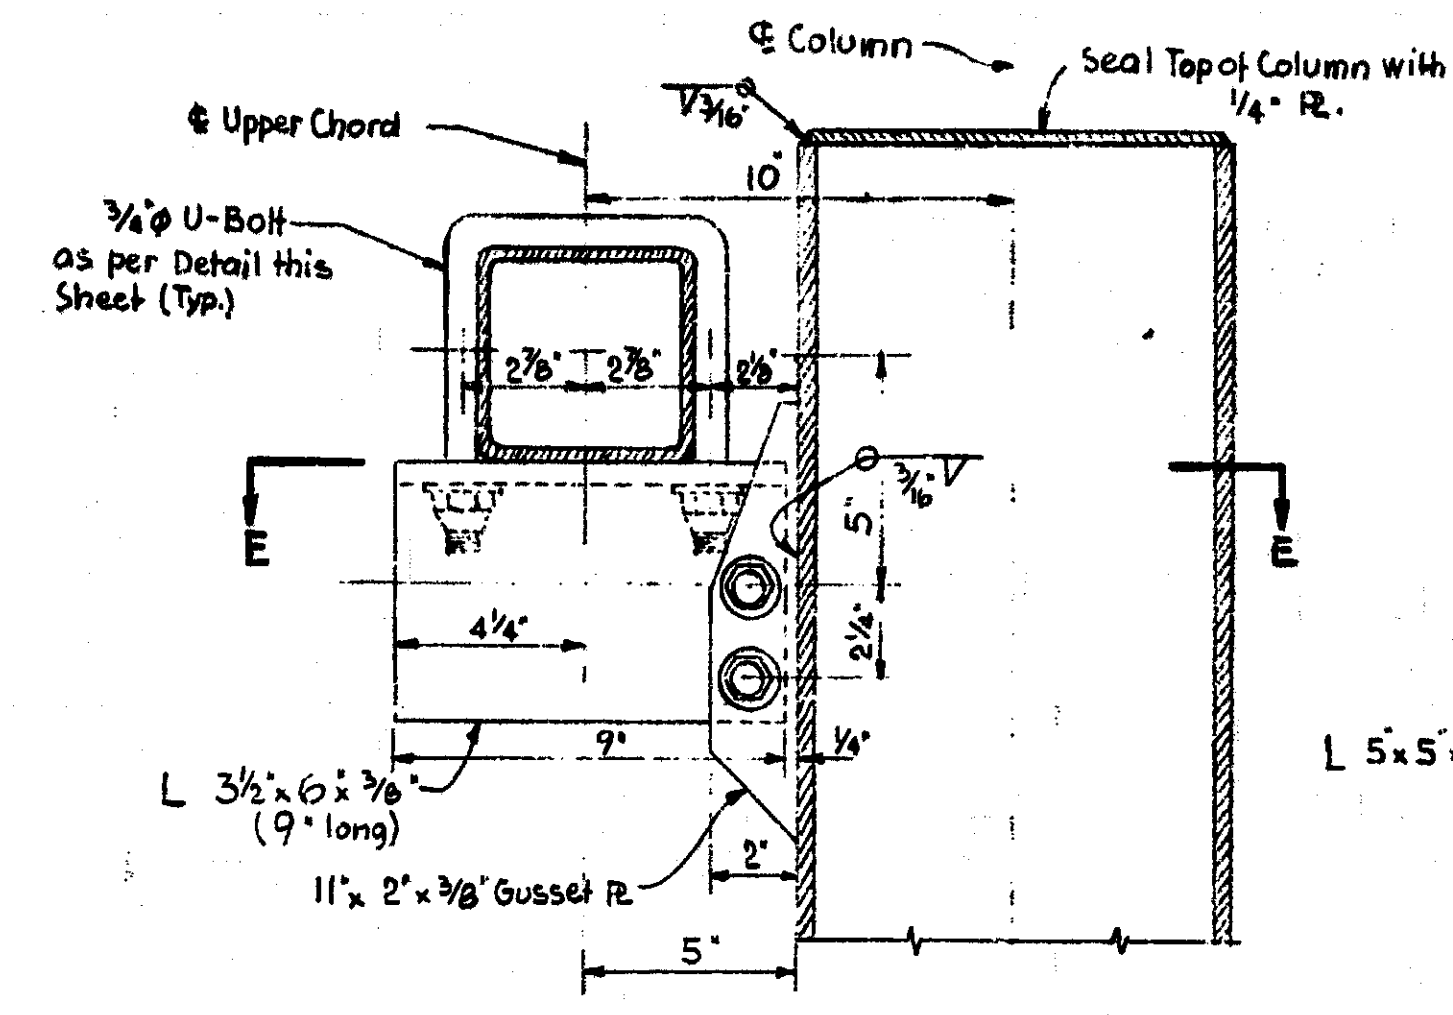


DETAIL OF UPPER CLAMP

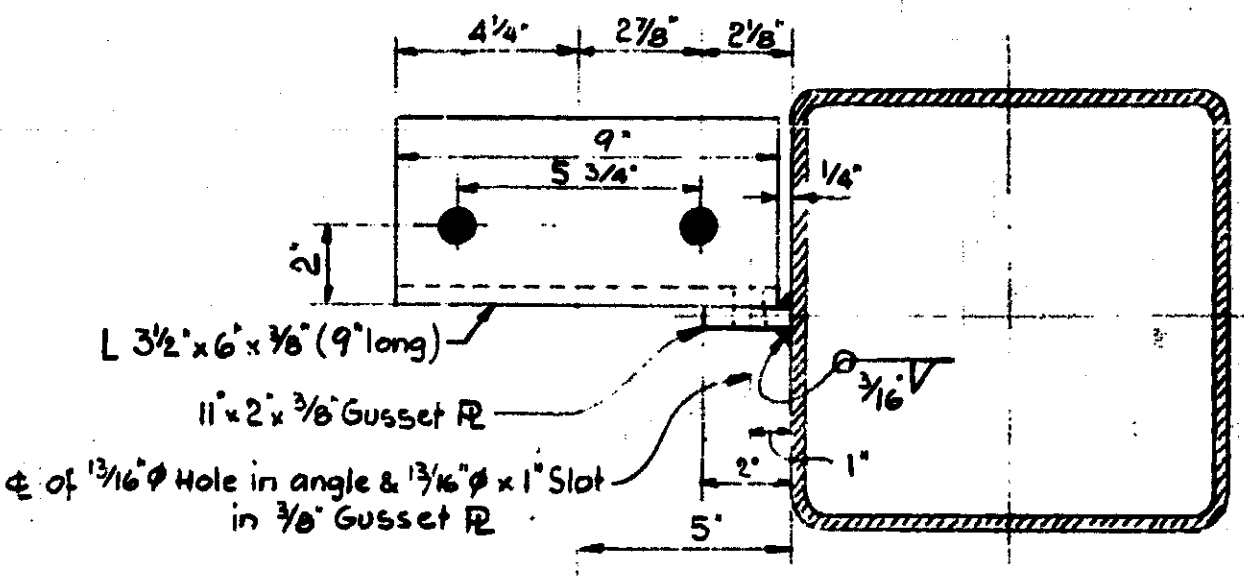


SECTION E-E

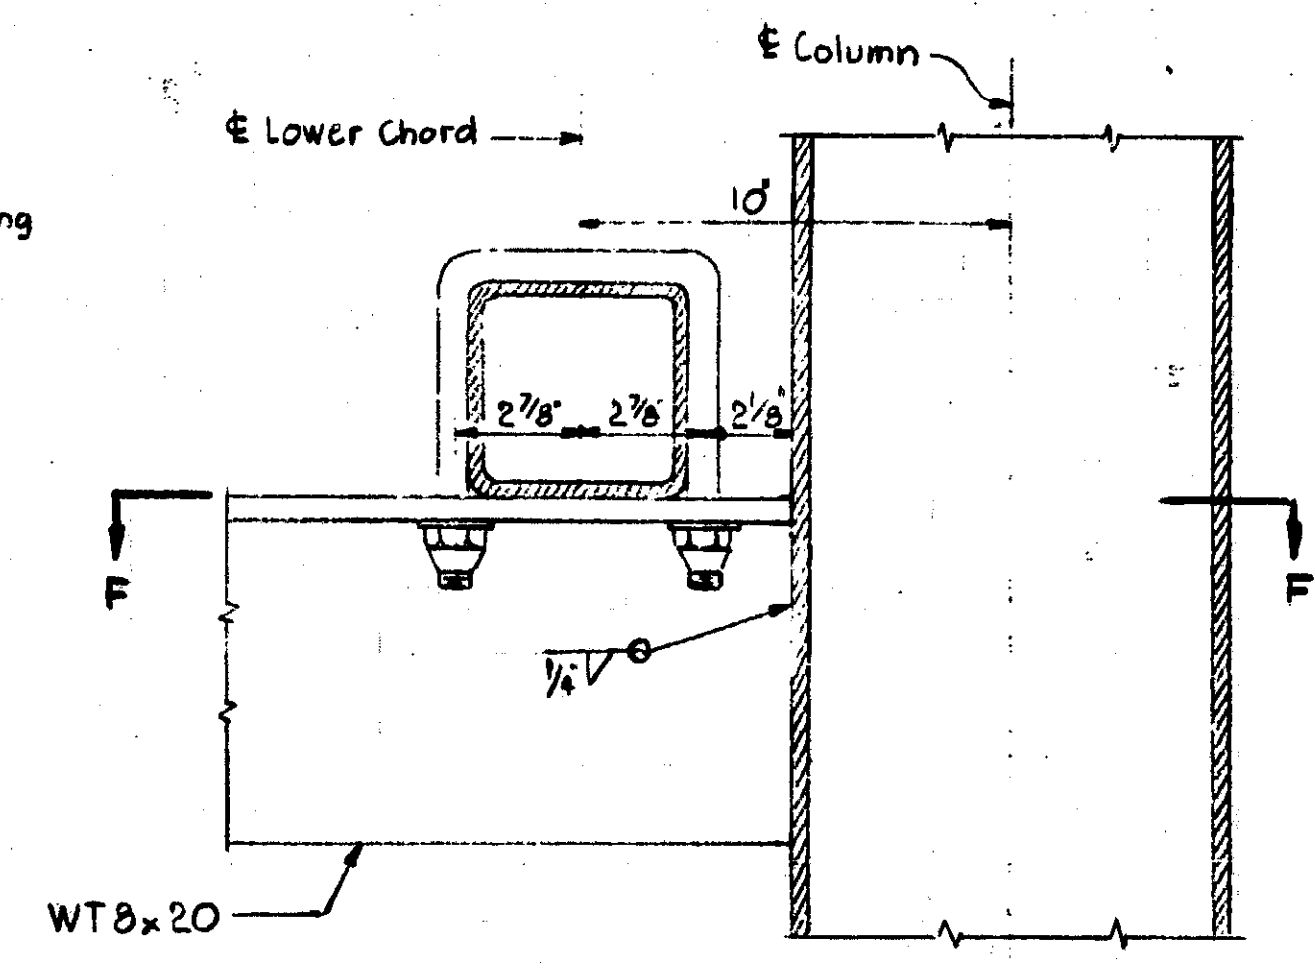


DETAIL OF SEAT

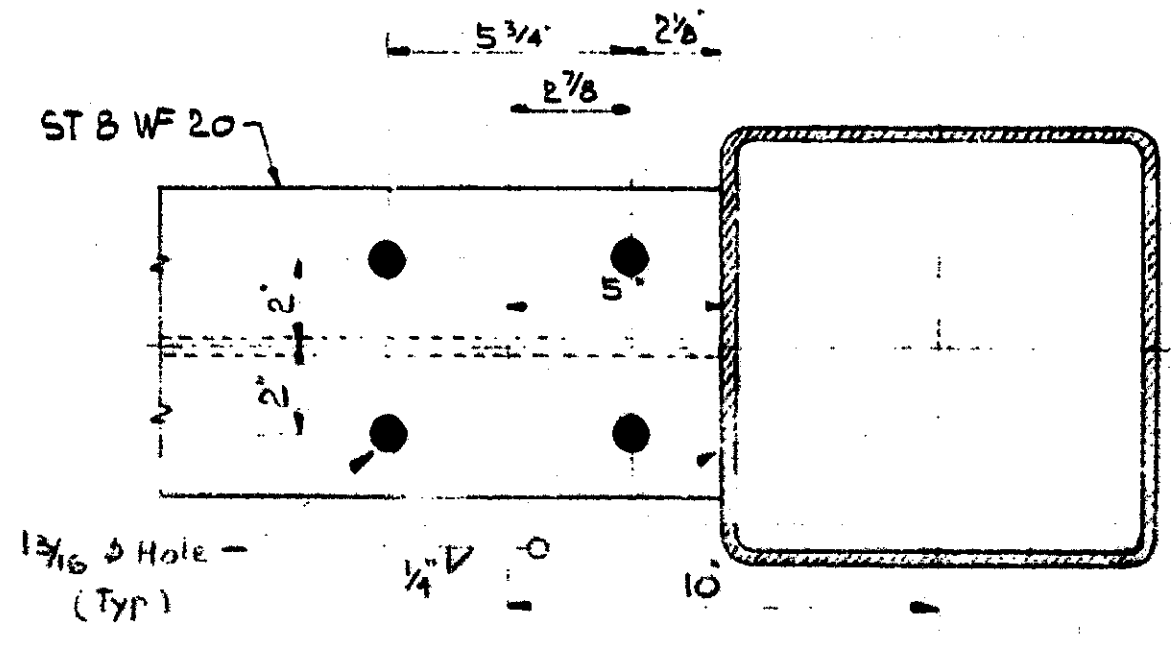


SECTION F-F

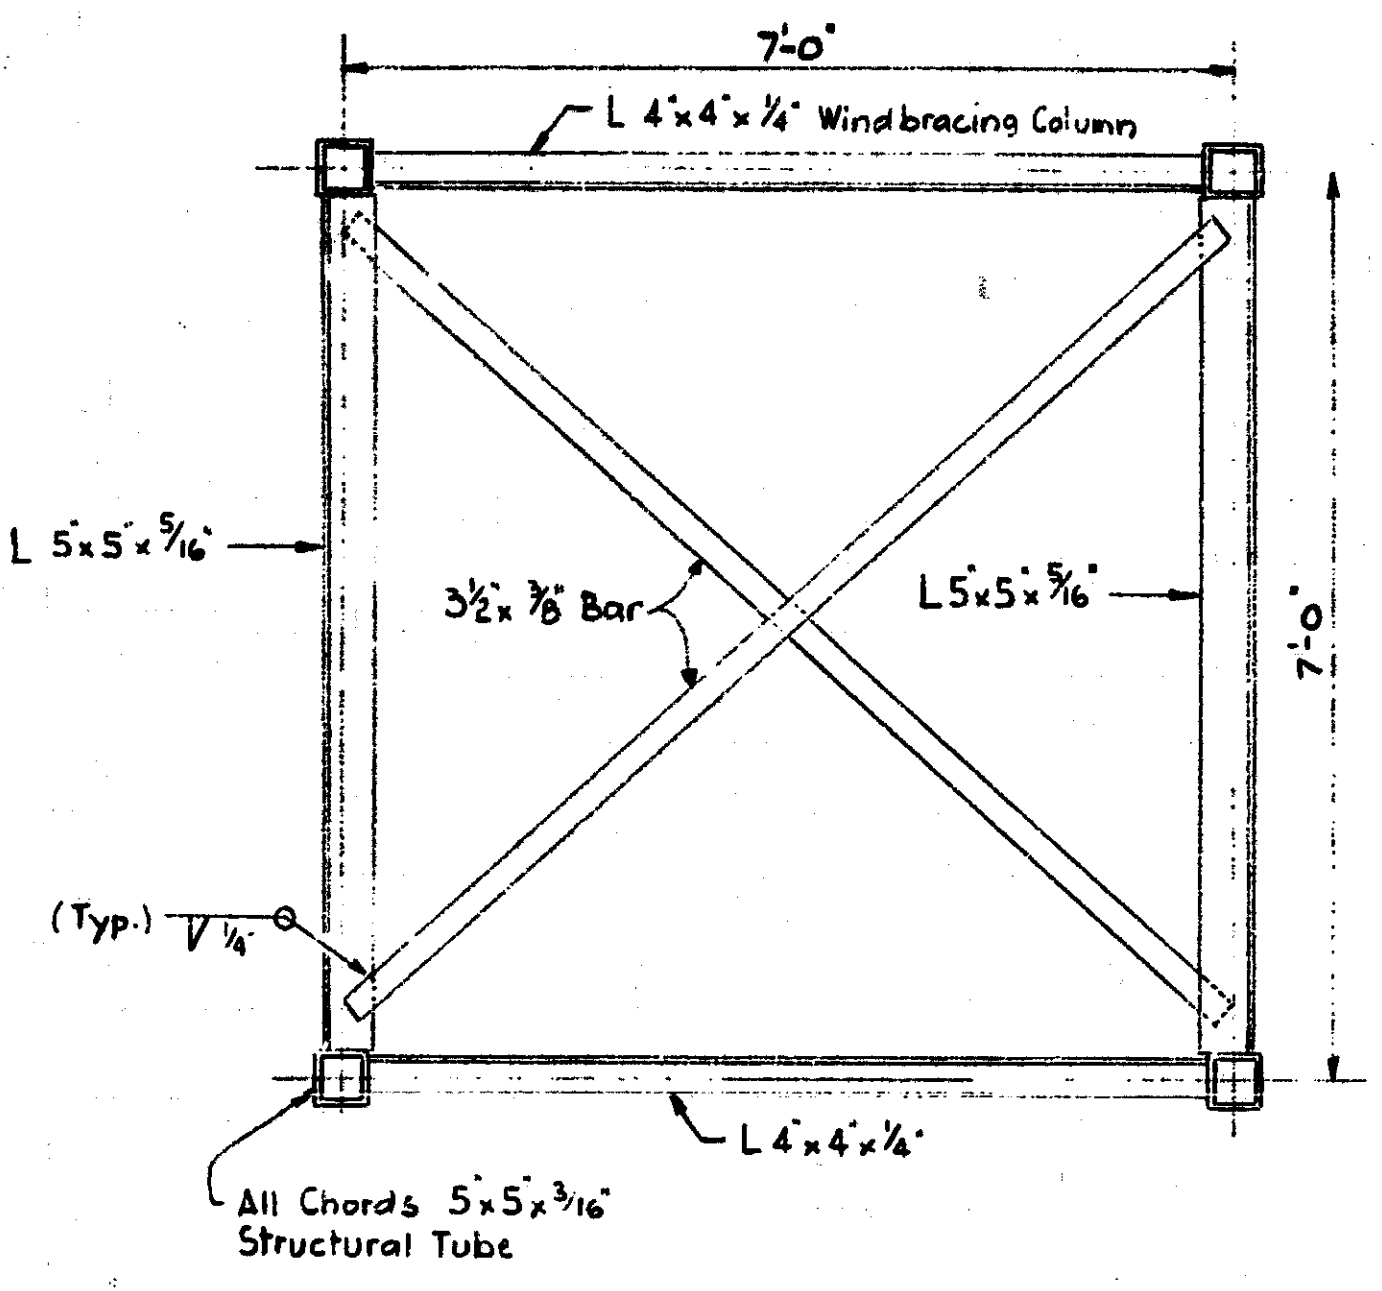


SECTION G-G
View of end crossframe looking from inside of the truss outside.

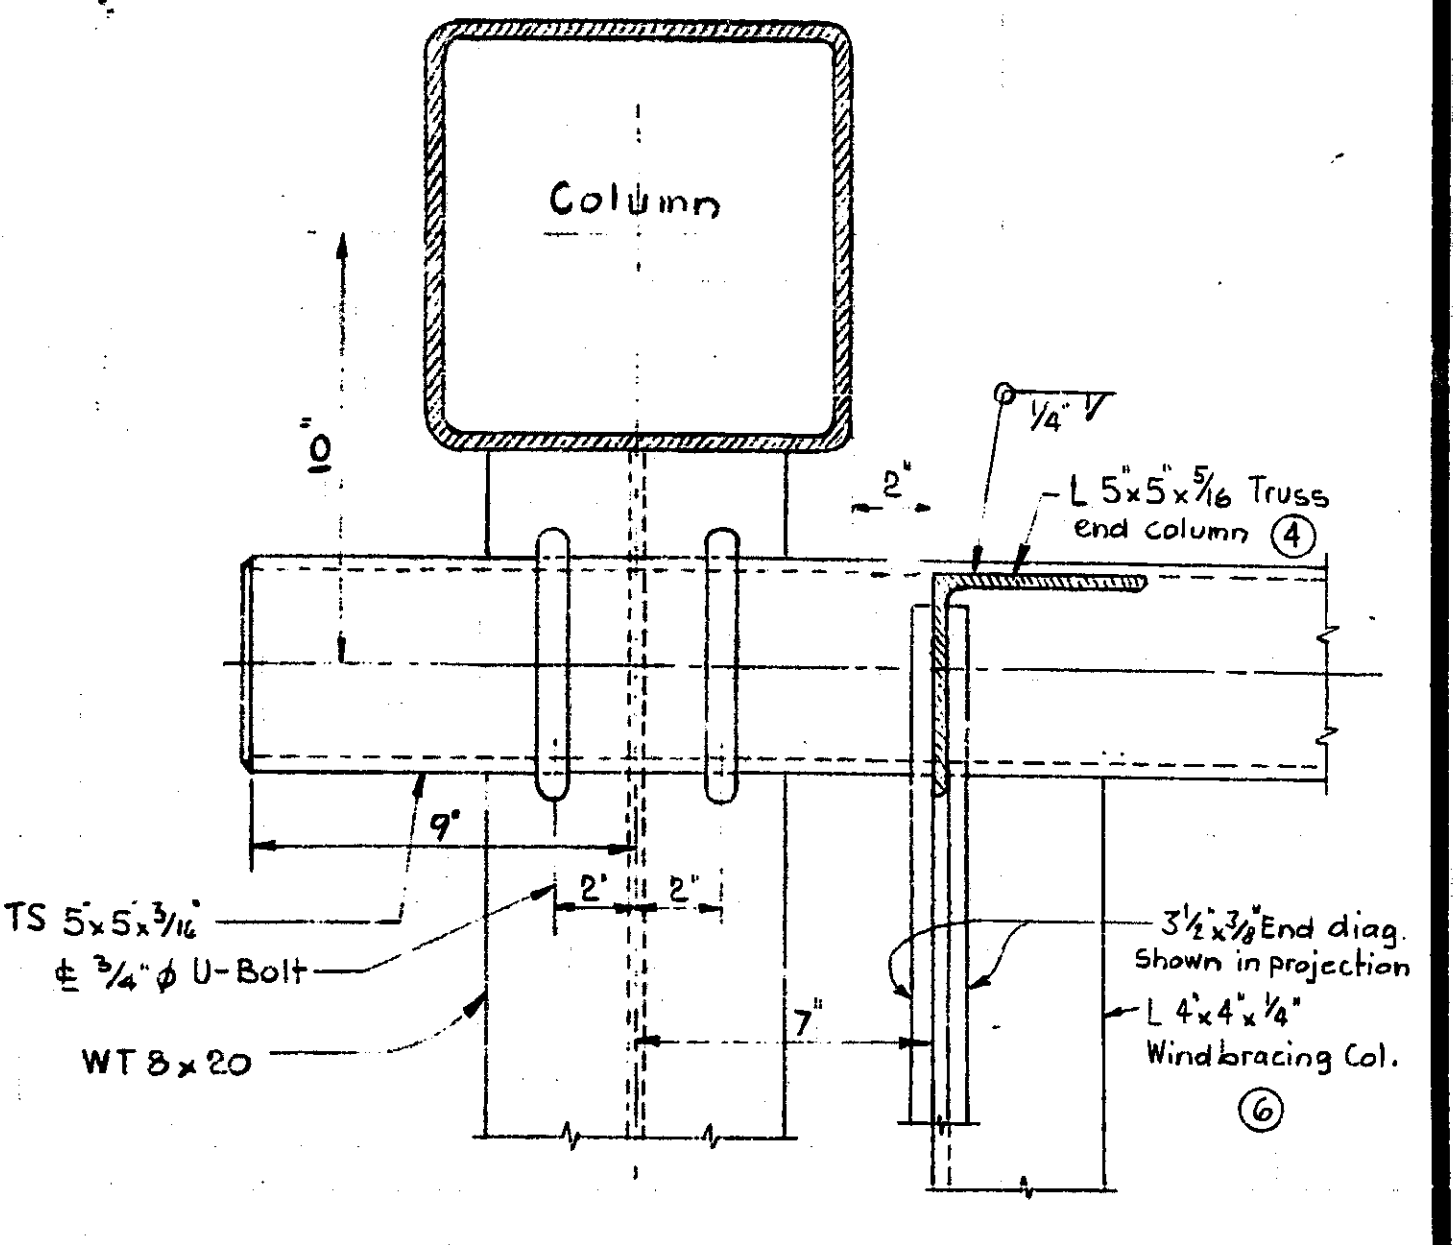

DETAIL L

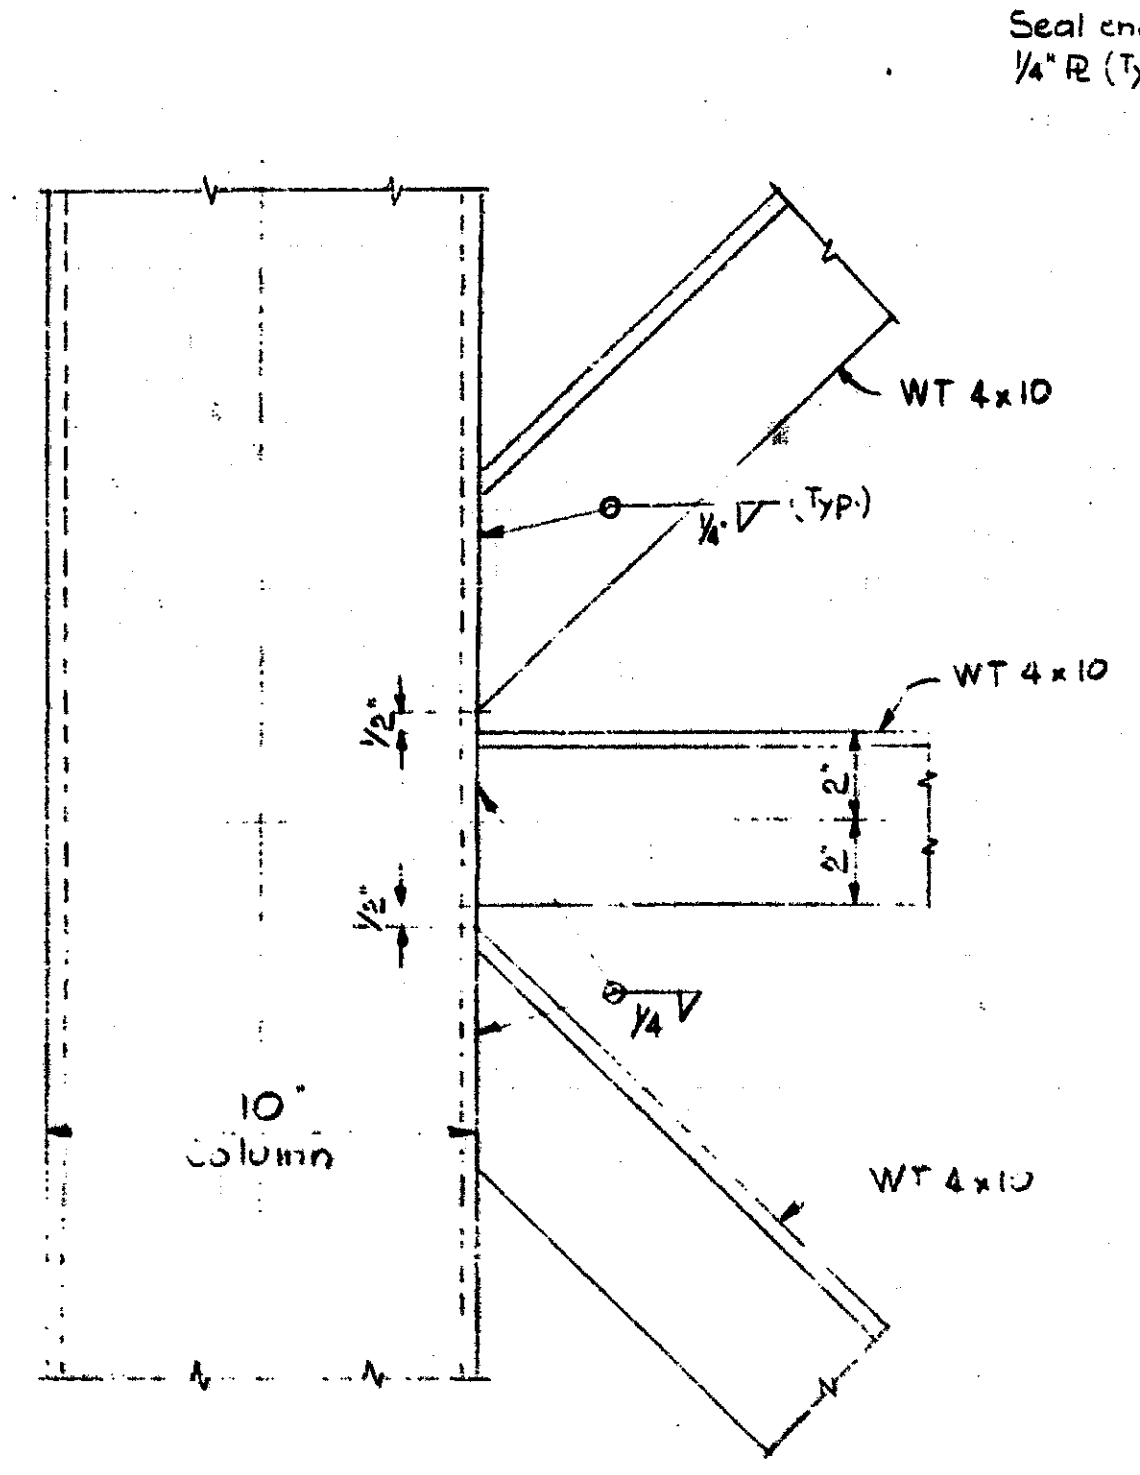

DETAIL K

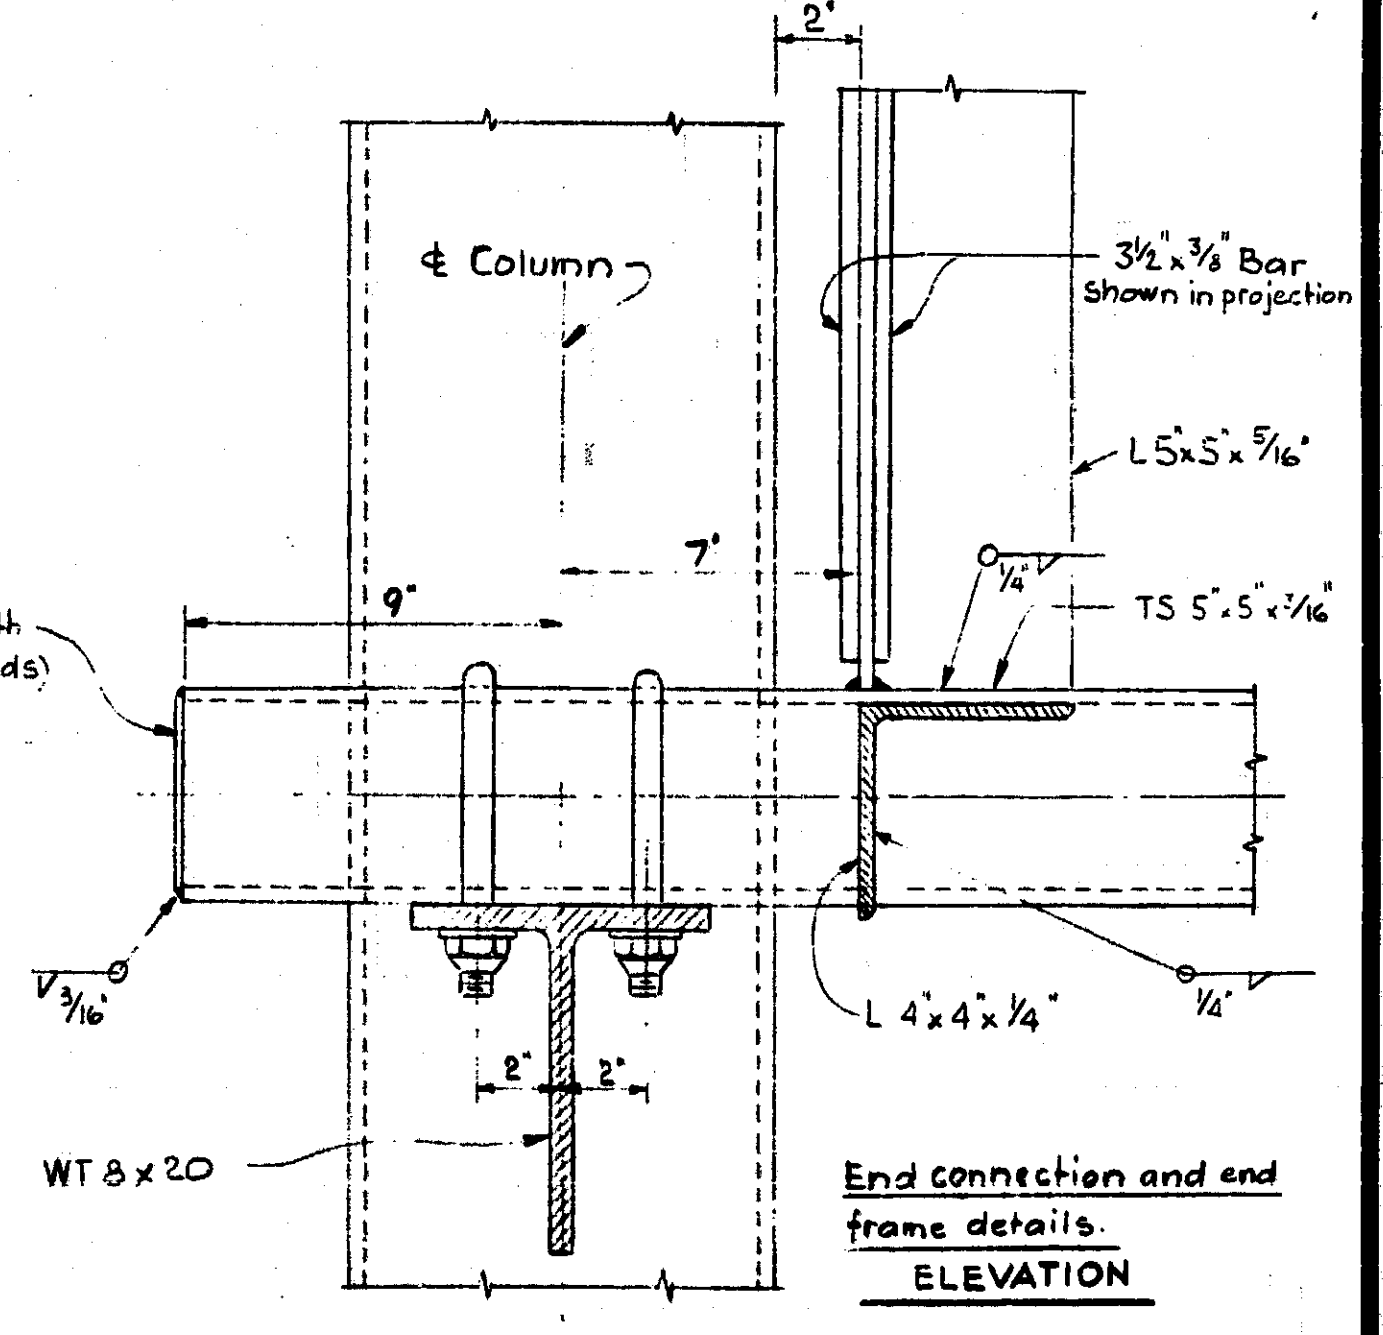

End connection and end frame details. ELEVATION


NOTE All bolt holes are 13/16" ϕ (Typ.)

MICHIGAN DEPARTMENT OF STATE HIGHWAYS
STEEL TRUSS
TYPE D (125H)
A-588 STEEL

NO.	REVISIONS	DATE	BY

DESIGNED BY	Bullen	3-10-77
DRAWN BY	PERN	11-1-76
TRACED BY	FJI	7-3-77
CHECKED BY	S	5

S 7.

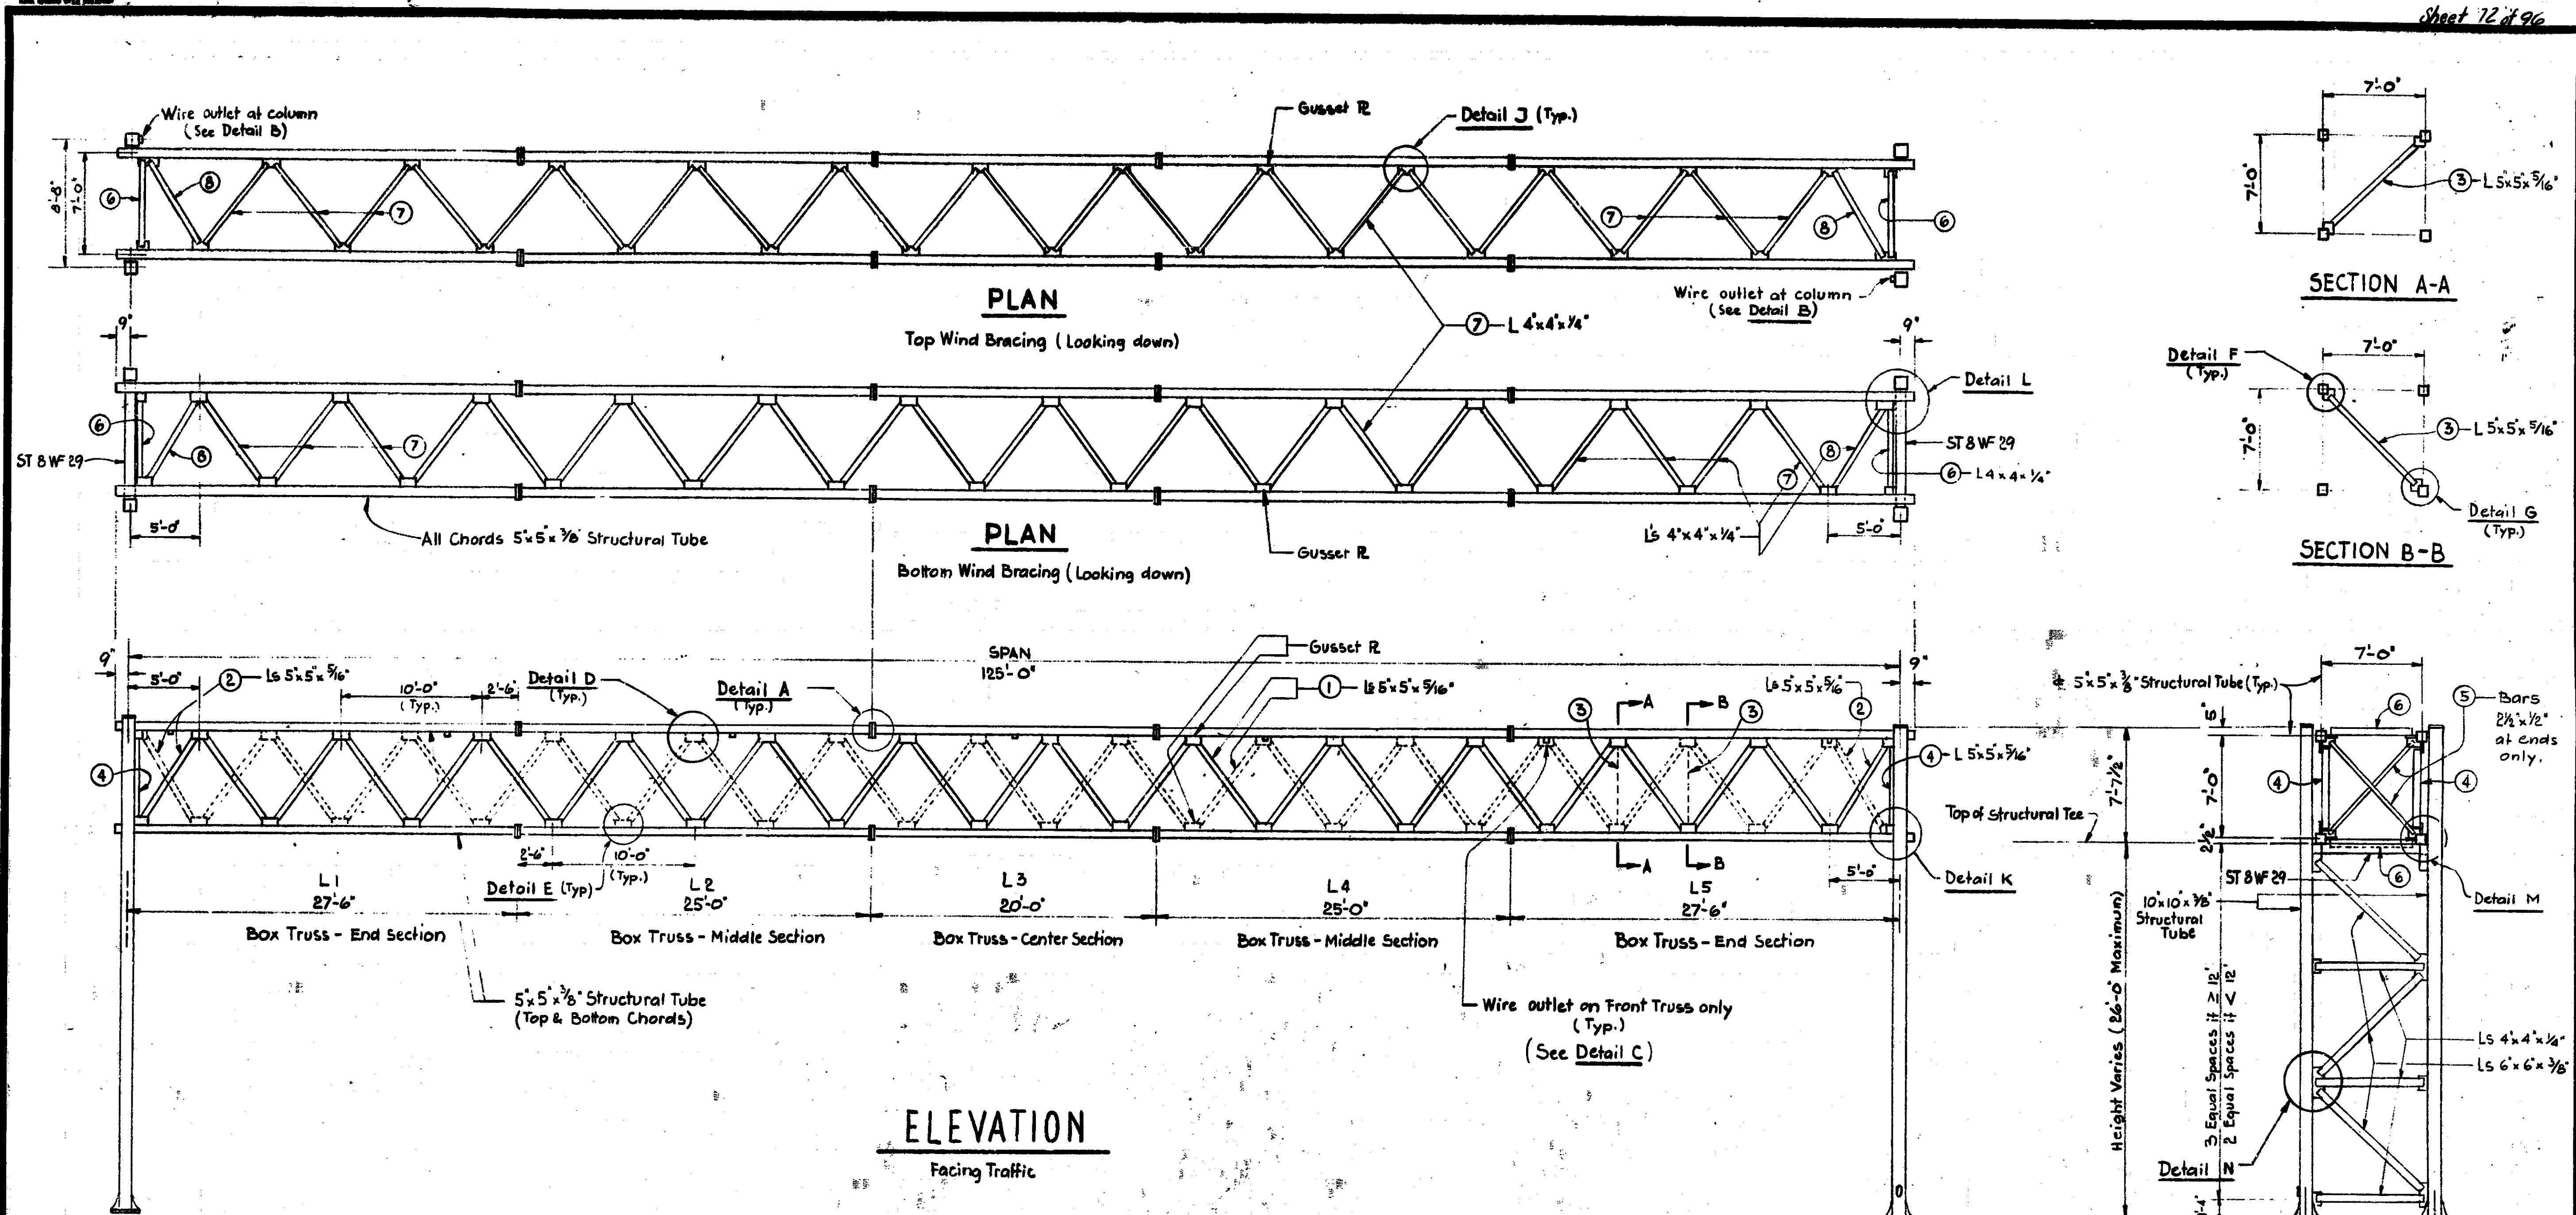

ELEVATION

Facing Traffic

NOTES


The design of this structure is based on the AASHTO Standard Specifications for Structural Supports for Highway Signs, Luminaires and Traffic Signals (1975 Edition). Sign area = 500 Sq. Ft. maximum. Maximum projection of sign beyond chord is 6 ft. Design is based on a wind load of 35 p.s.f. on sign area.

All structural steel, bolts, welding & galvanizing shall be according to Art. 8.26.08 b of Standard Specifications for Highway Construction. All truss components shall be hot-dip galvanized prior to bolted assembly. The cambering shall be provided in the fabrication so that the flanges are correctly sloped to assure obtaining full contact in the relaxed assembled position prior to snugging up the flange bolts. The flange bolts shall not be torqued in an attempt to close any flange misalignment. Trusses shall not be lifted by the web members.

See Standard plan S 9.10 for sign connection.

TRUSS DATA - A-36 Galv.							
SPAN	L1	L2	L3	L4	L5	CAMBER	BOX TRUSS
105'-0"	22'-6"	20'-0"	20'-0"	20'-0"	22'-6"	1 7/8"	7'-0" x 7'-0"
110'-0"	22'-6"	20'-0"	25'-0"	20'-0"	22'-6"	2"	7'-0" x 7'-0"
115'-0"	22'-6"	25'-0"	20'-0"	25'-0"	22'-6"	2 1/4"	7'-0" x 7'-0"
120'-0"	27'-6"	20'-0"	25'-0"	20'-0"	27'-6"	2 1/2"	7'-0" x 7'-0"
125'-0"	27'-6"	25'-0"	20'-0"	25'-0"	27'-6"	2 5/8"	7'-0" x 7'-0"

CAMBER The camber given in the above table is the ordinate at the center of the assembled truss prior to dead load deflection. Allowable camber tolerance for truss is 25%.

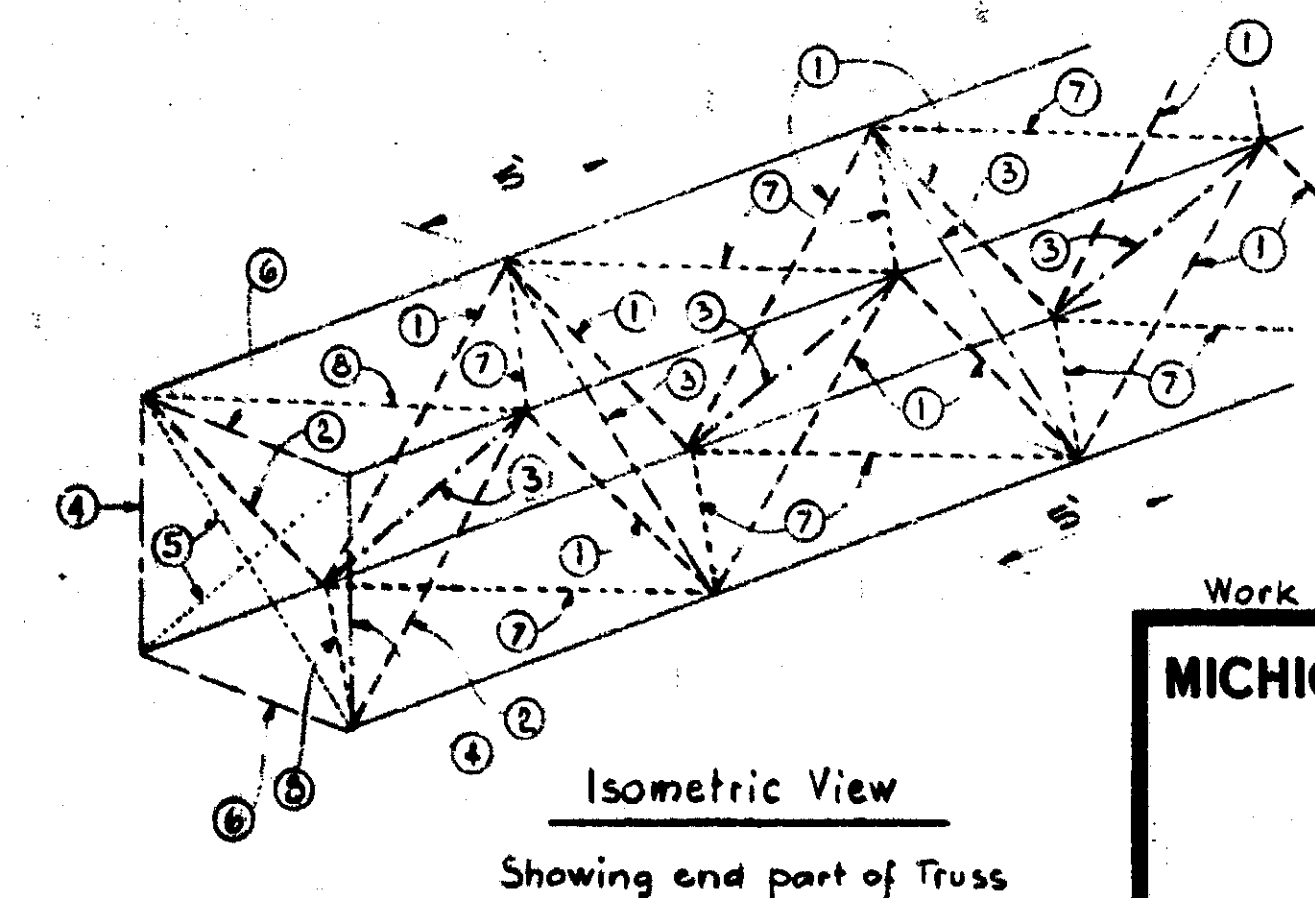

Work this sheet with sheets 2 & 3

MICHIGAN DEPARTMENT OF STATE HIGHWAYS


STEEL TRUSS TYPE D (125')

A-36 Galv.


REVISIONS			
NO.	DESCRIPTION	DATE	BY

DATE: BULLETIN 15-4-77
 DRAWN BY: P. B. N.
 CHECKED BY: P. B. N.
 7-18-76


SHEET NO. 72

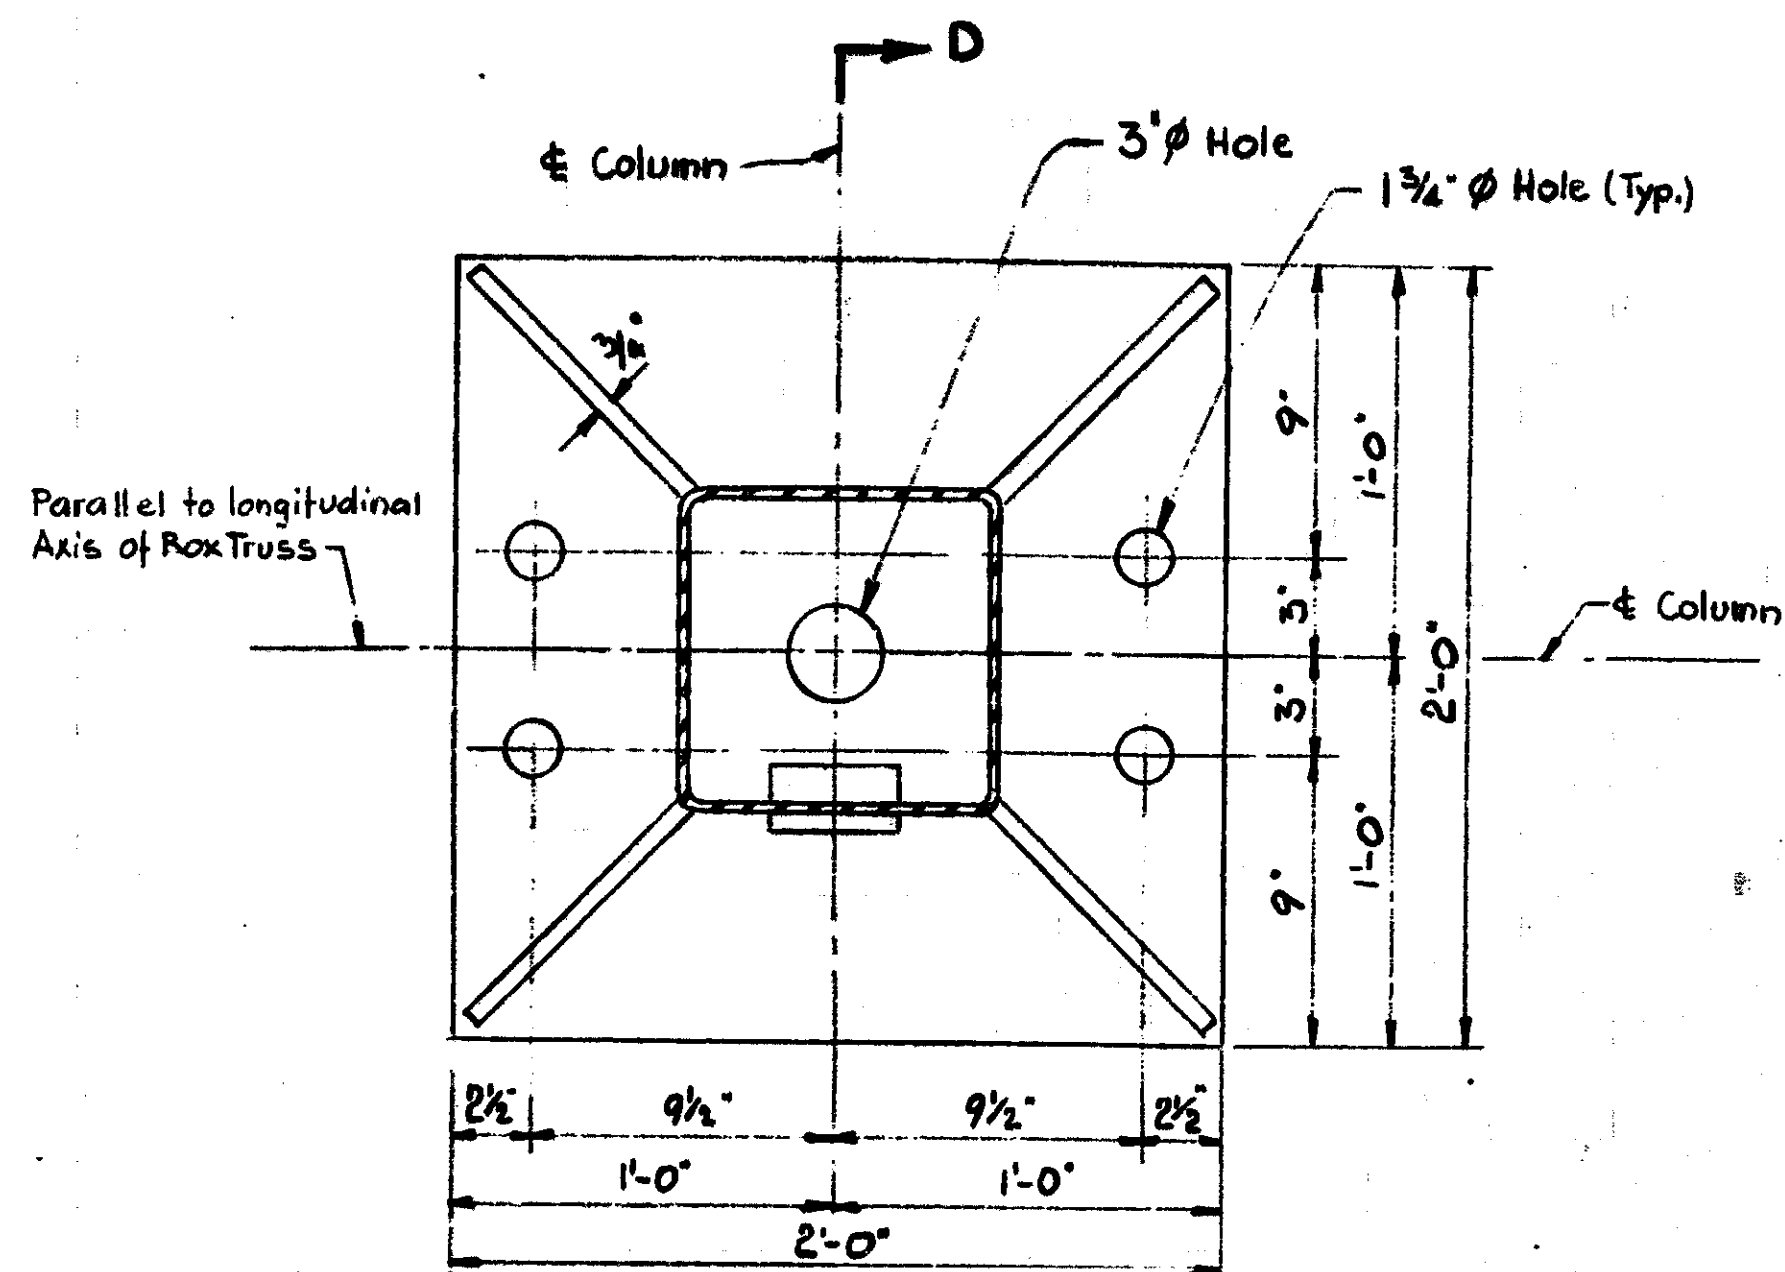


SECTION C-C

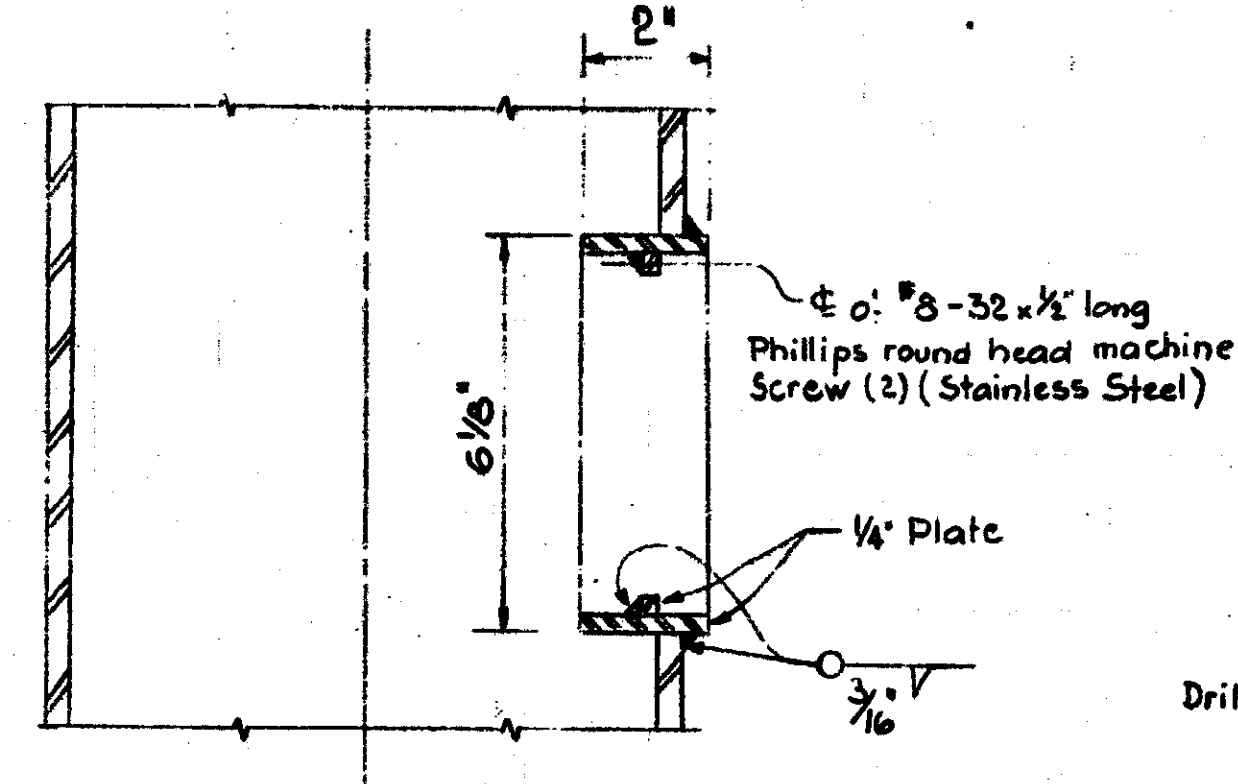


SECTION D-D

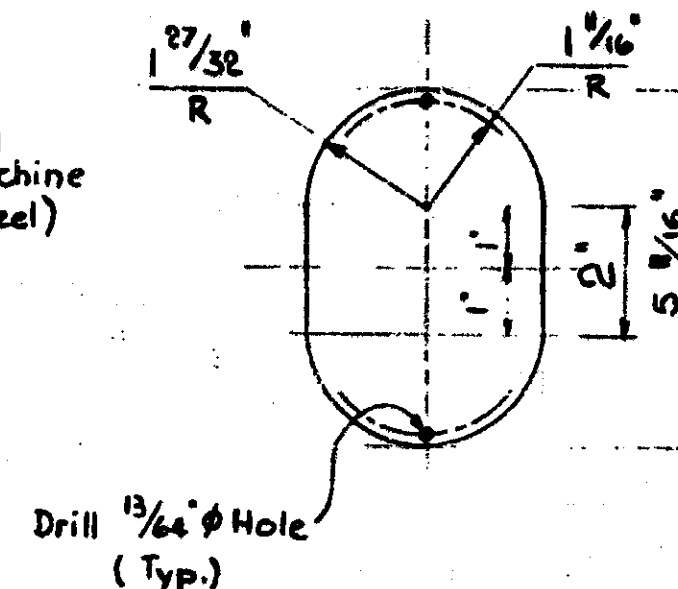


HAND HOLE COVER
(2 req'd per Truss)

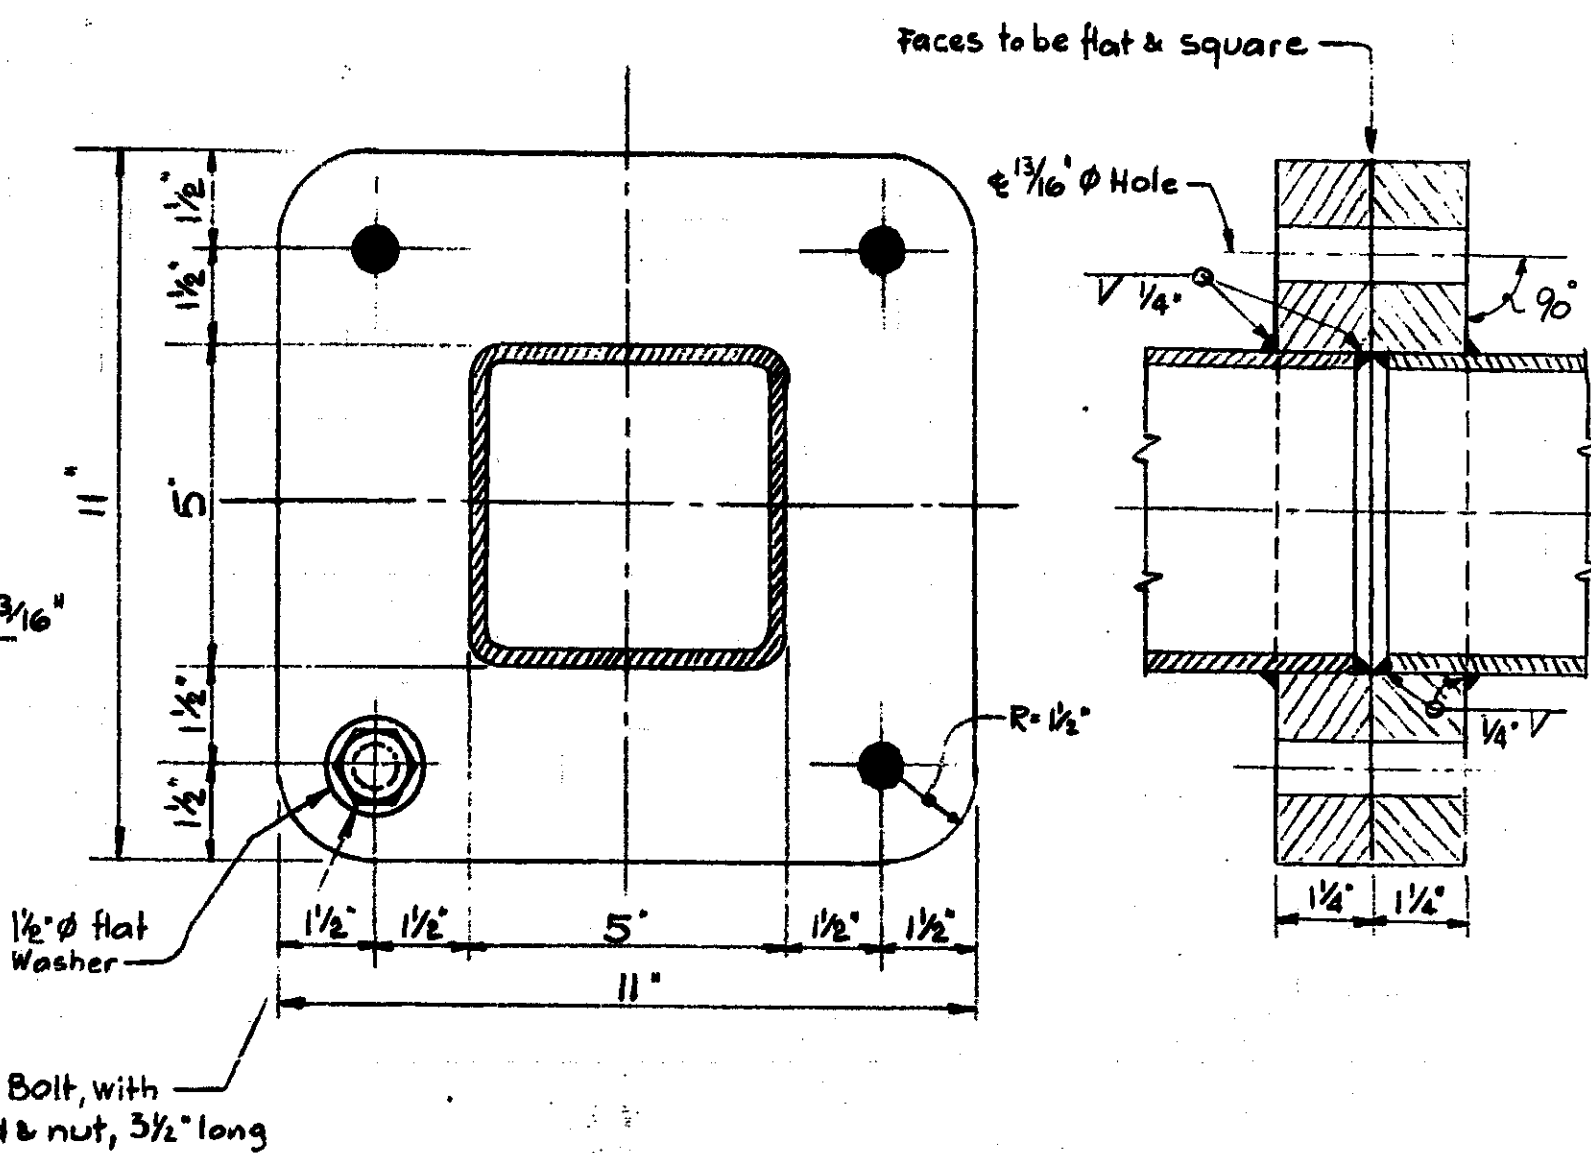


DETAIL A
Chord Connection Details

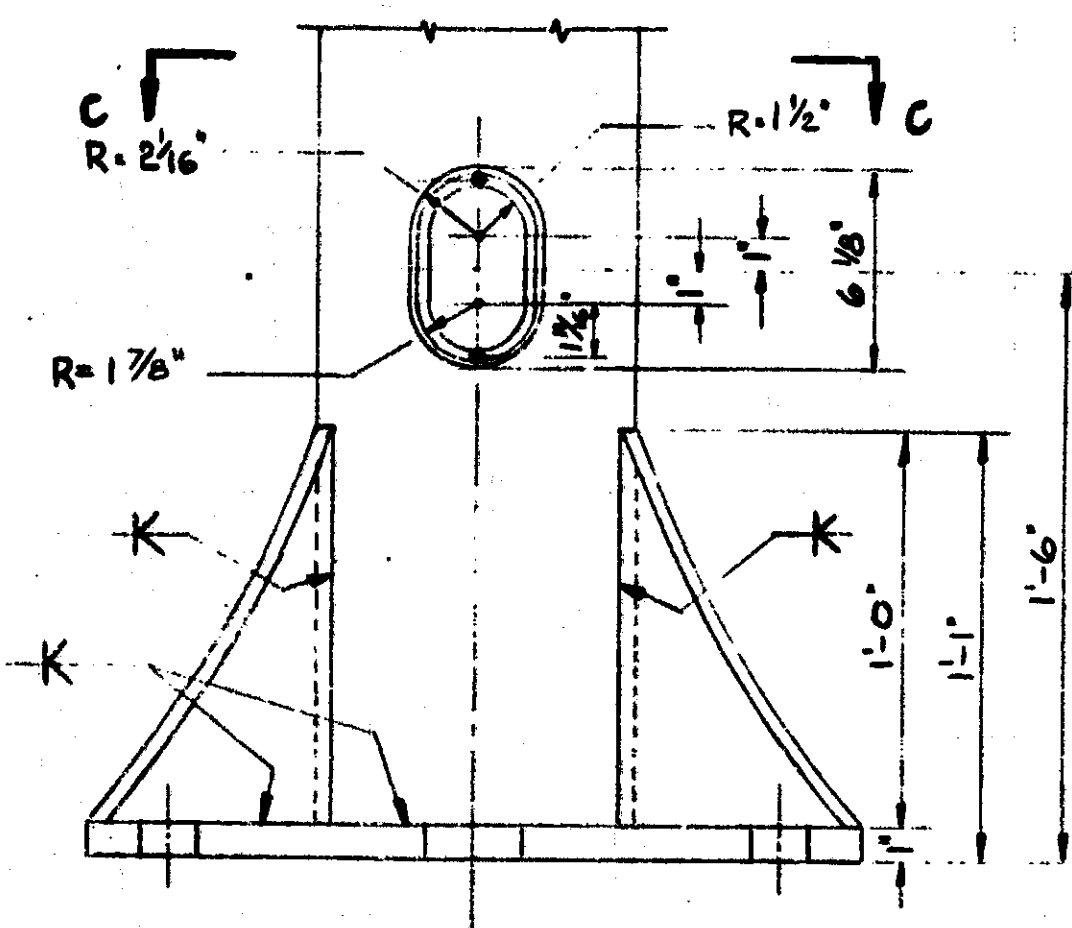


FRONT ELEVATION

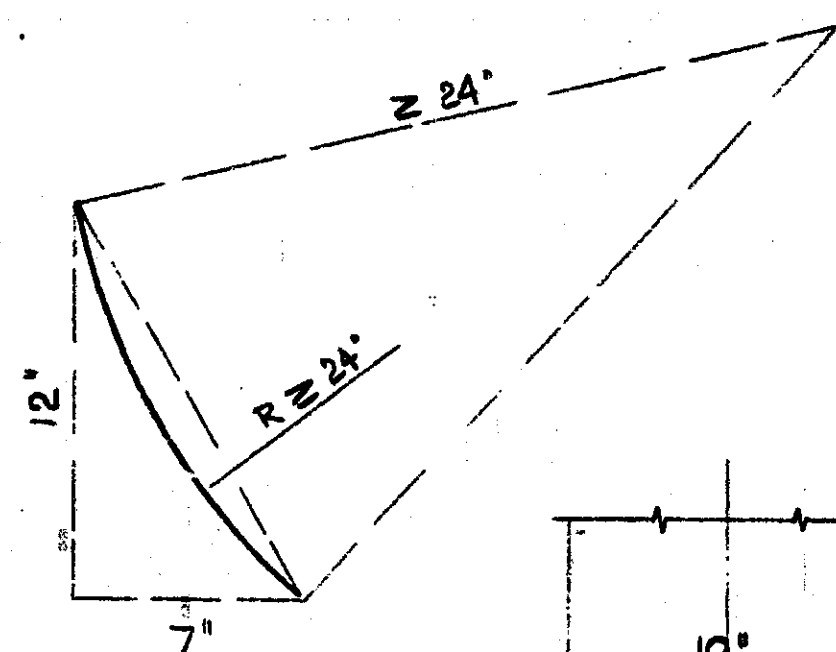

DETAIL R

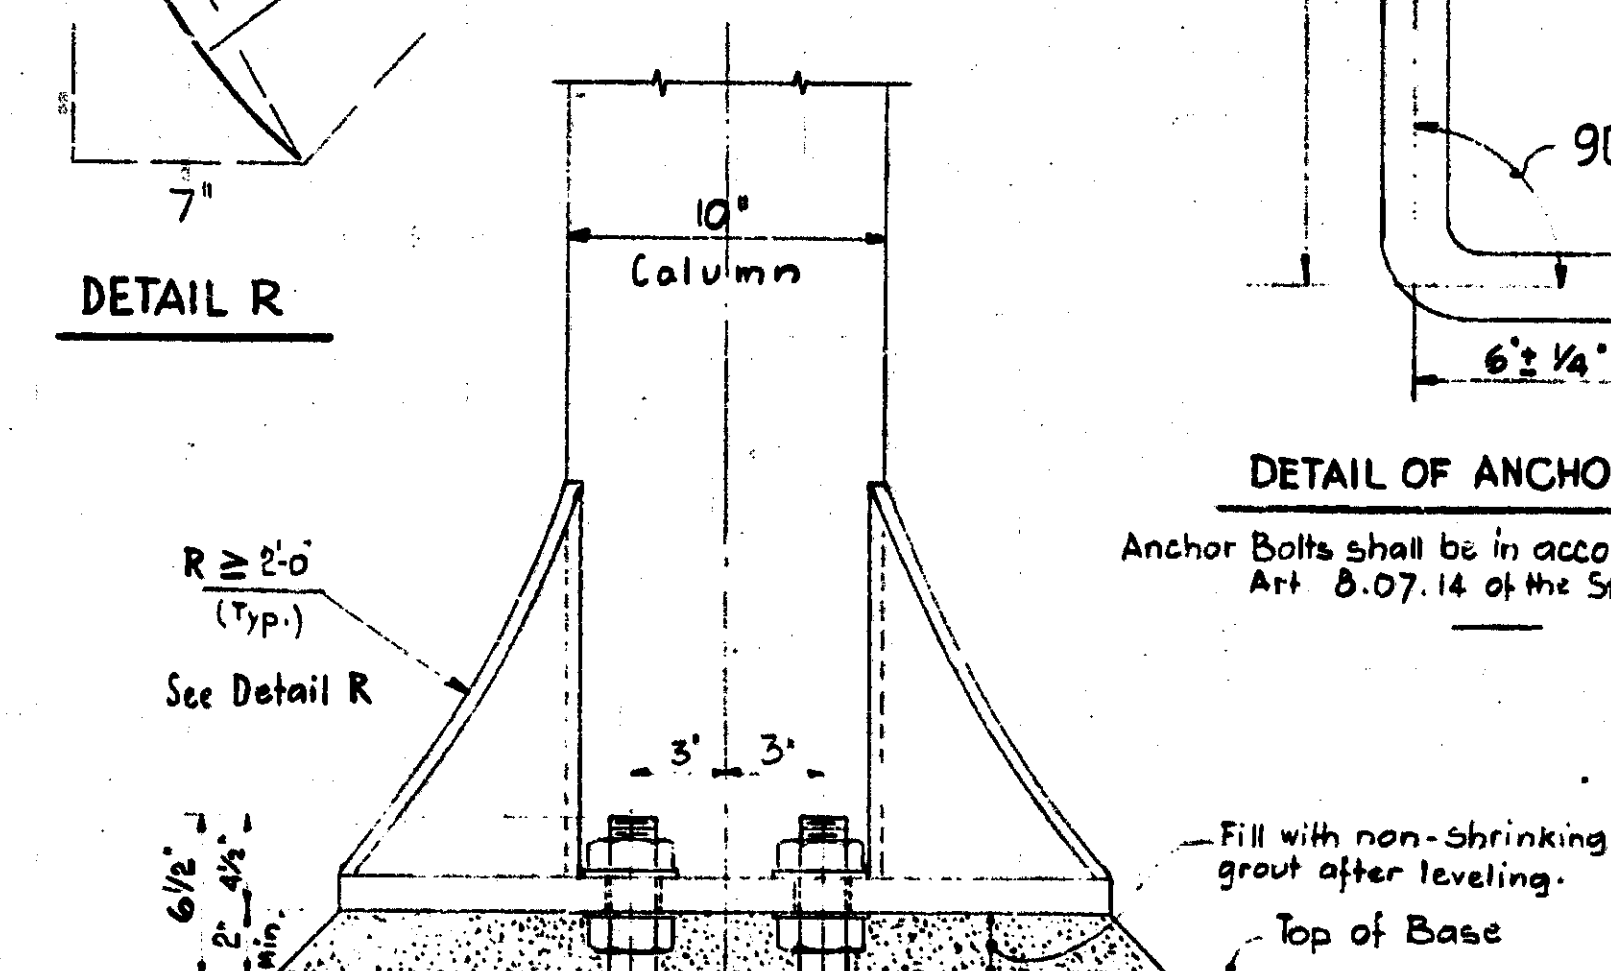


DETAIL OF BASE-LEVELING NUTS

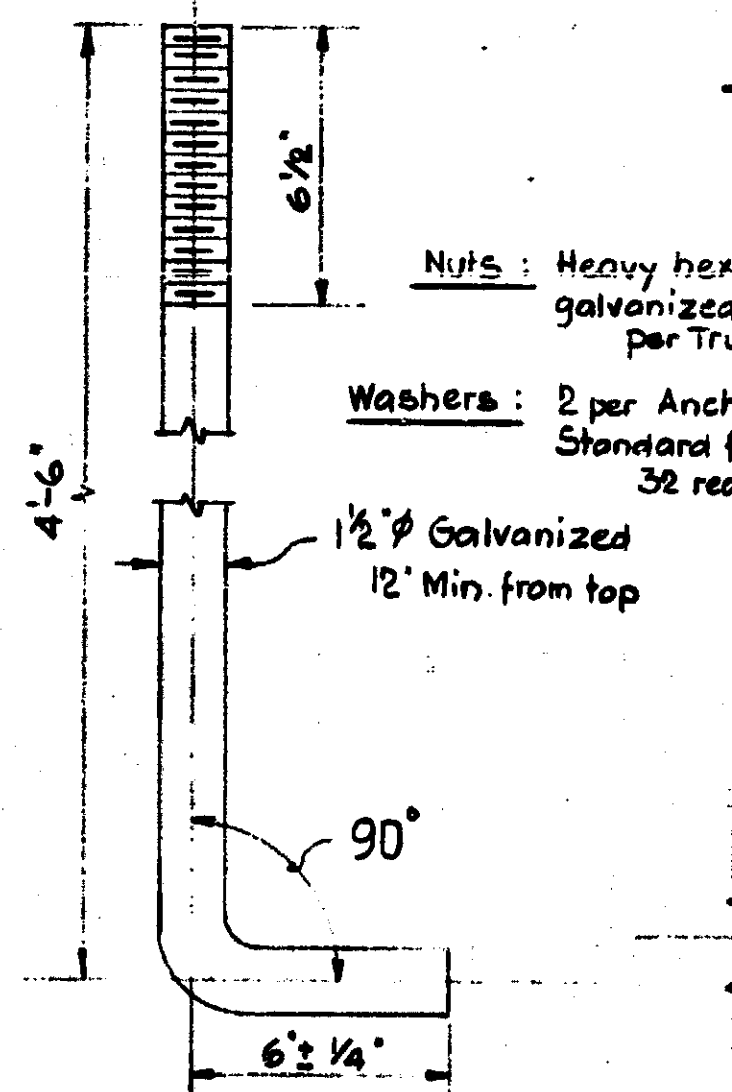


DETAIL OF ANCHOR BOLT (16 Req'd.)

Anchor Bolts shall be in accordance with Art. 8.07.14 of the Std. Spec.

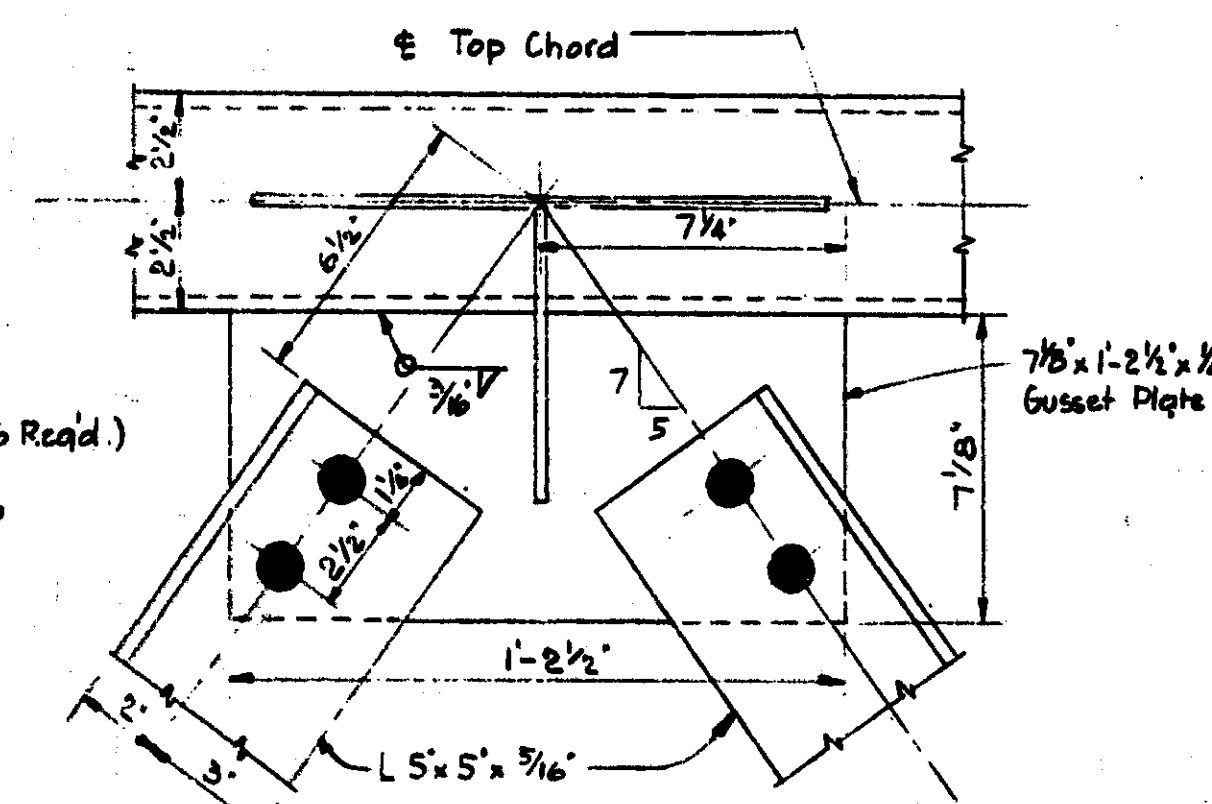


DETAIL D

NOTES: All bolts holes are 13/16 inch (Typ.)
Gusset Plate size shown in Detail N will vary with different column heights.

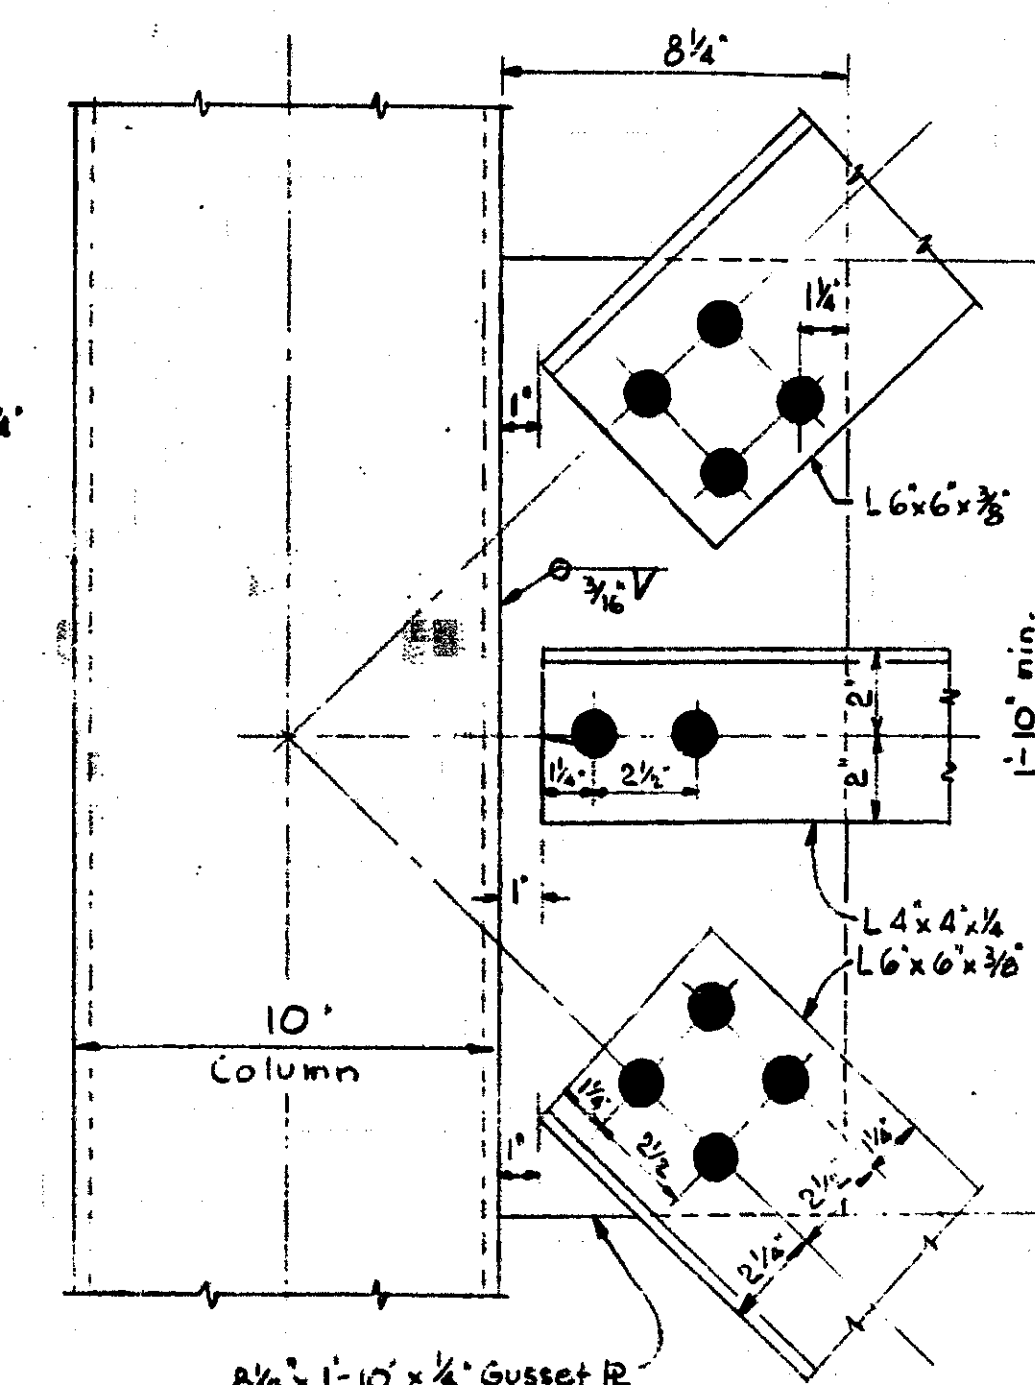


DETAIL N

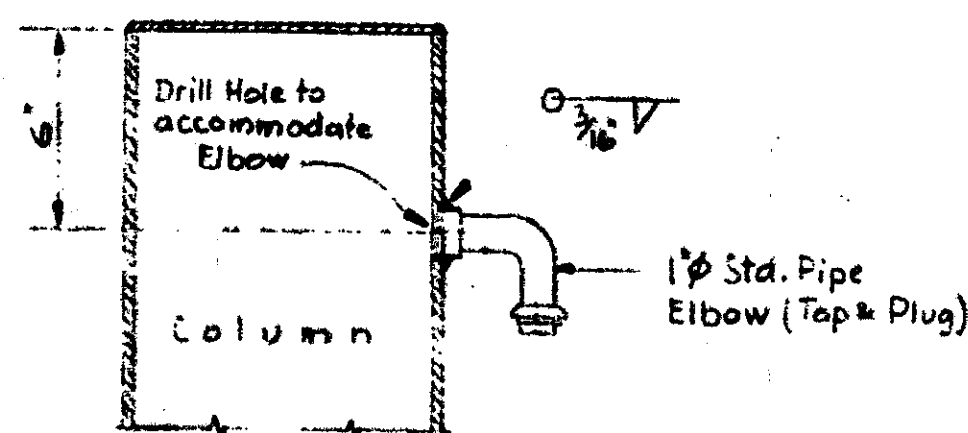


DETAIL B

Detail of electrical outlet at Column

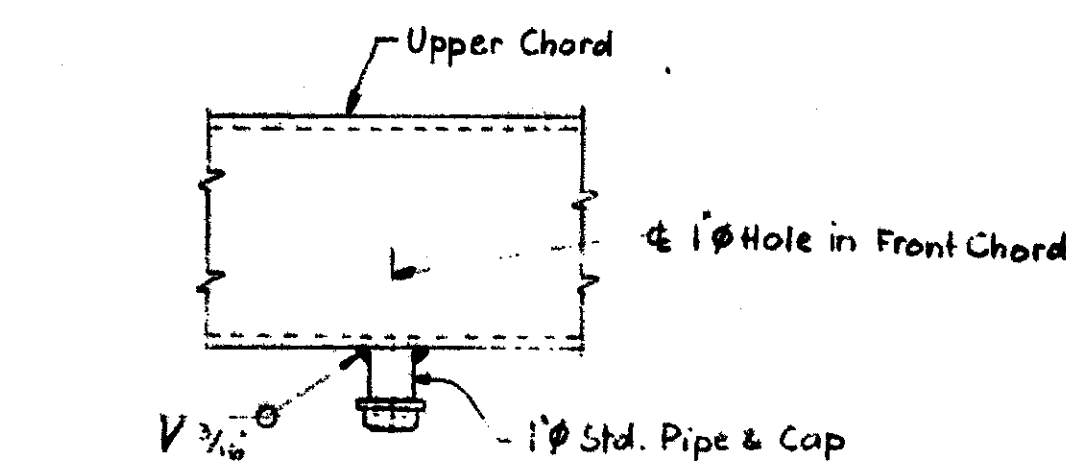

DETAIL C

Detail of electrical outlet at upper Chord only.

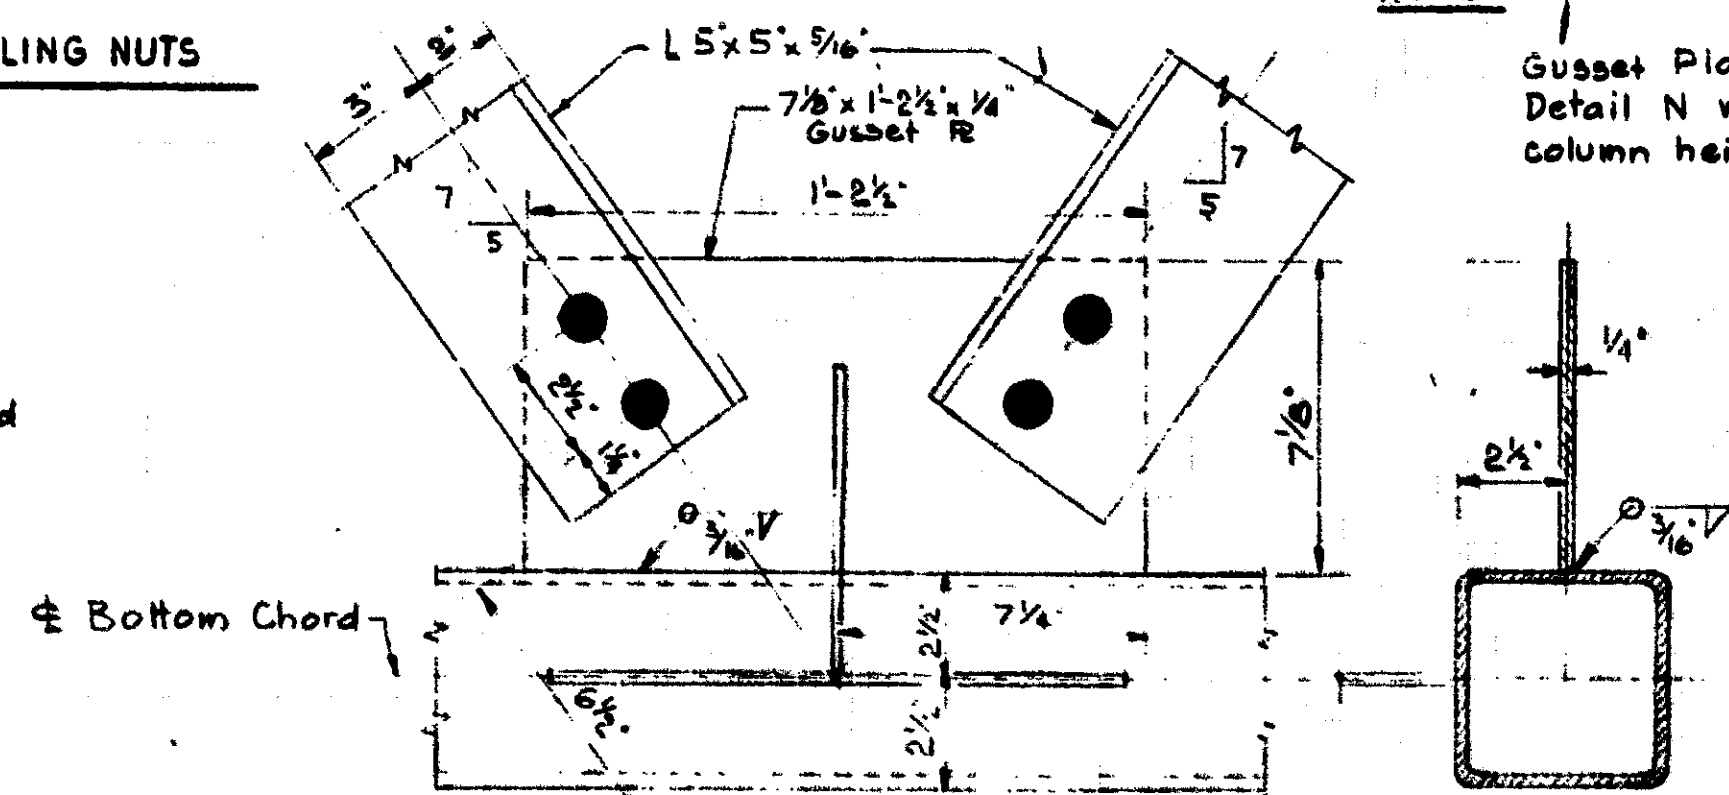

DETAIL E

Section at Panel Point (Ls not shown)

Work this sheet with sheets 1 & 3


MICHIGAN DEPARTMENT OF STATE HIGHWAYS

STEEL TRUSS TYPE D (25')


A-36 Galv.

NO.	REVISIONS	DATE	BY


57.82

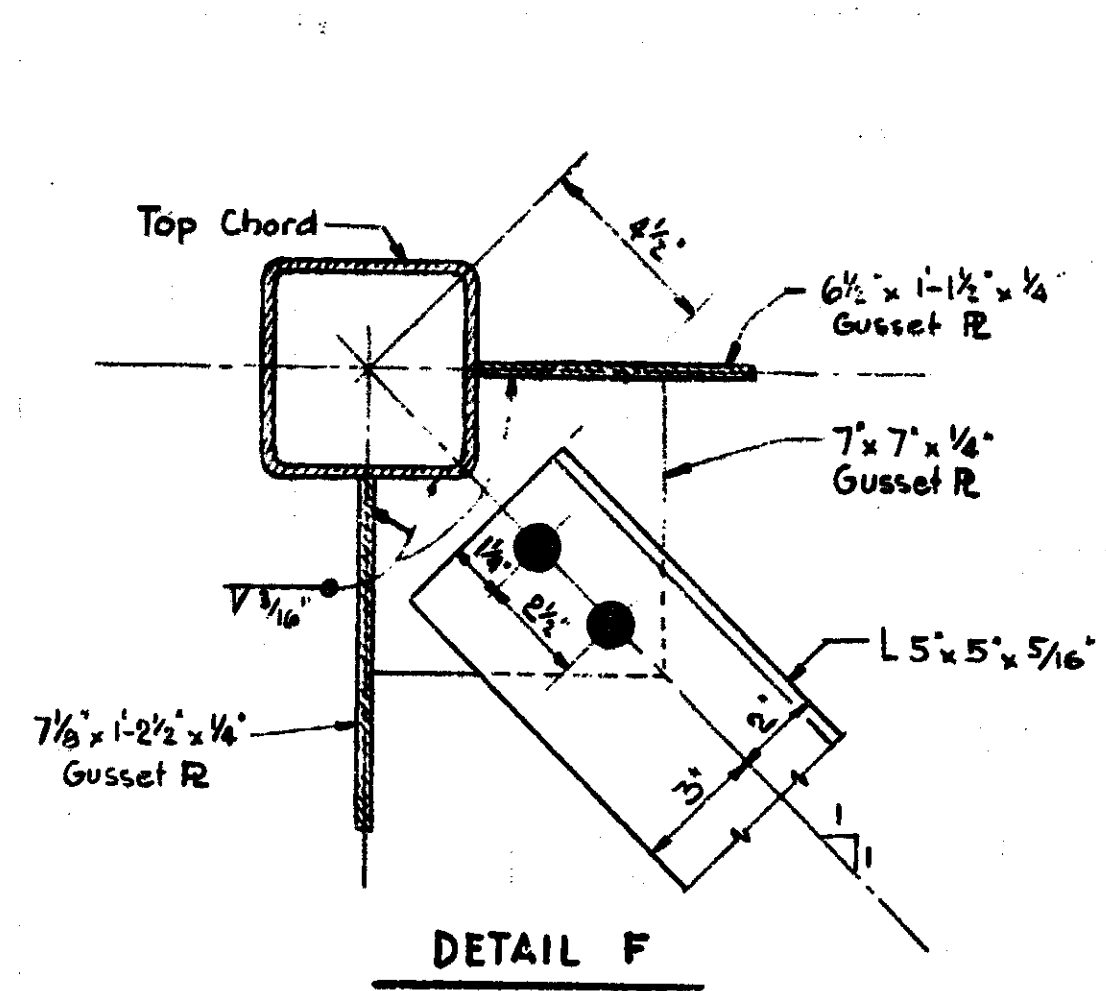


DETAIL F

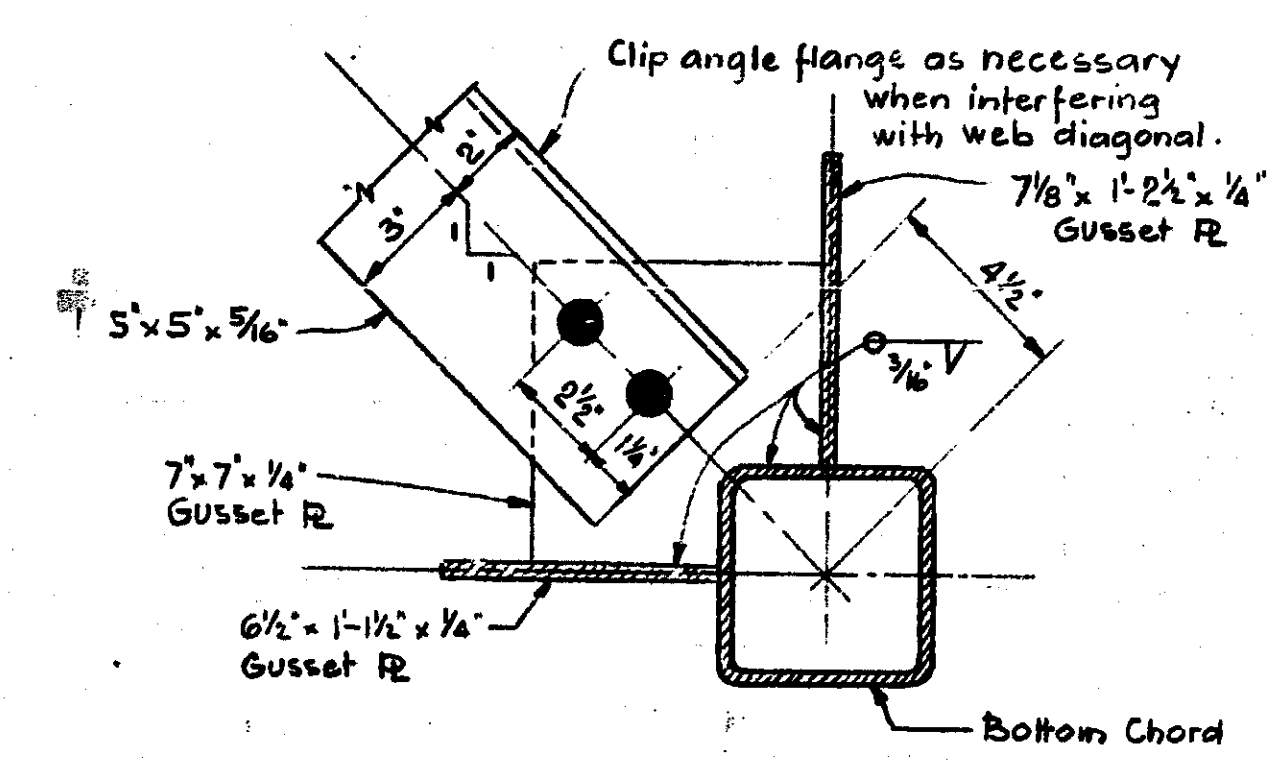


DETAIL G

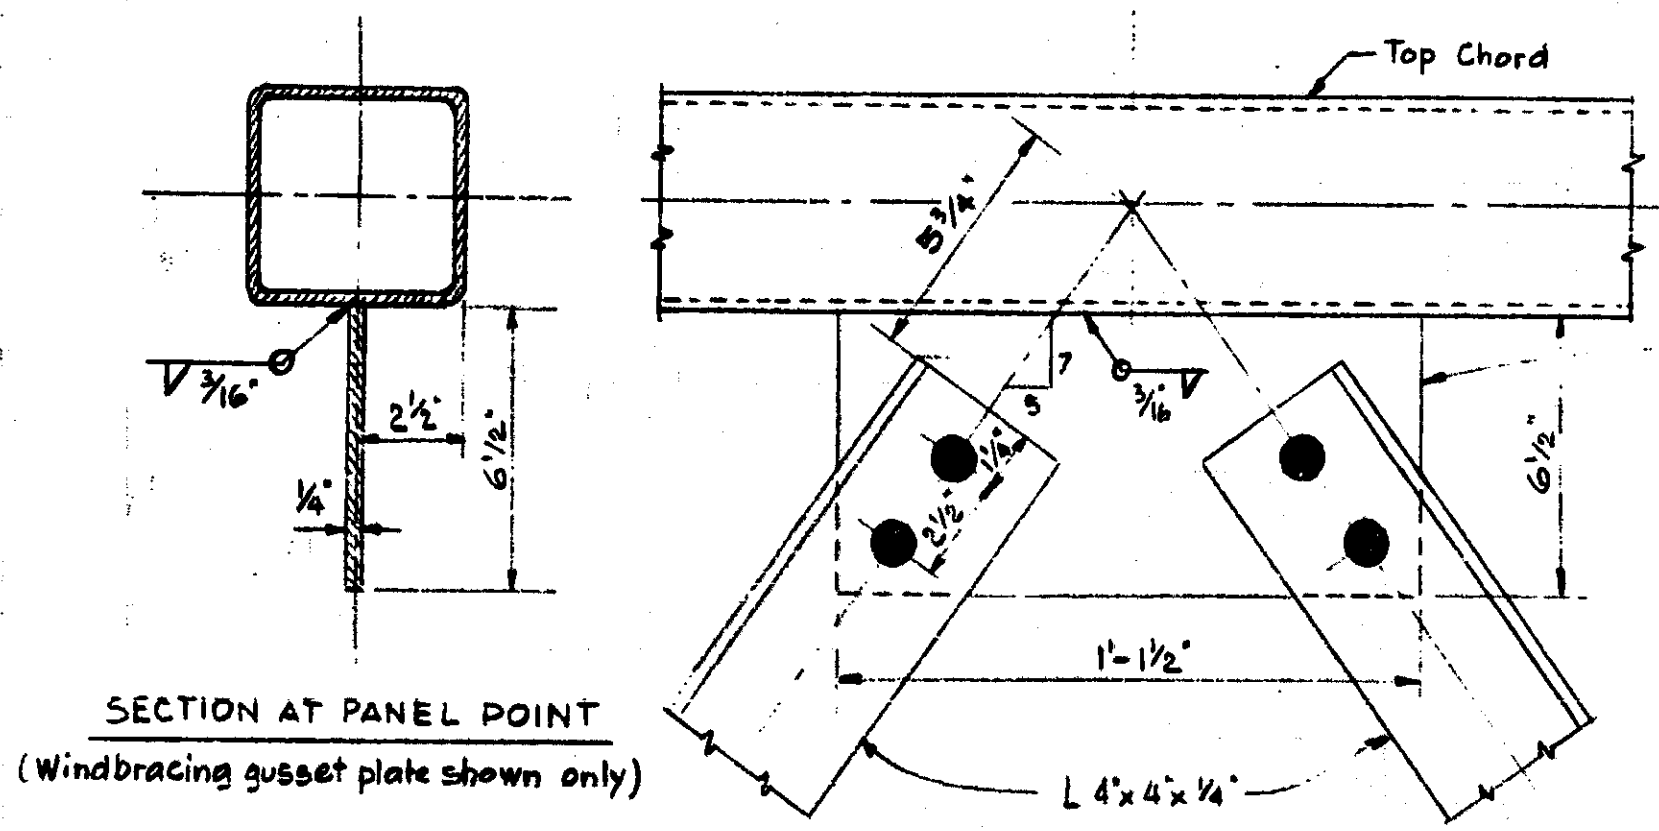


SECTION AT PANEL POINT
(Windbracing gusset plate shown only)

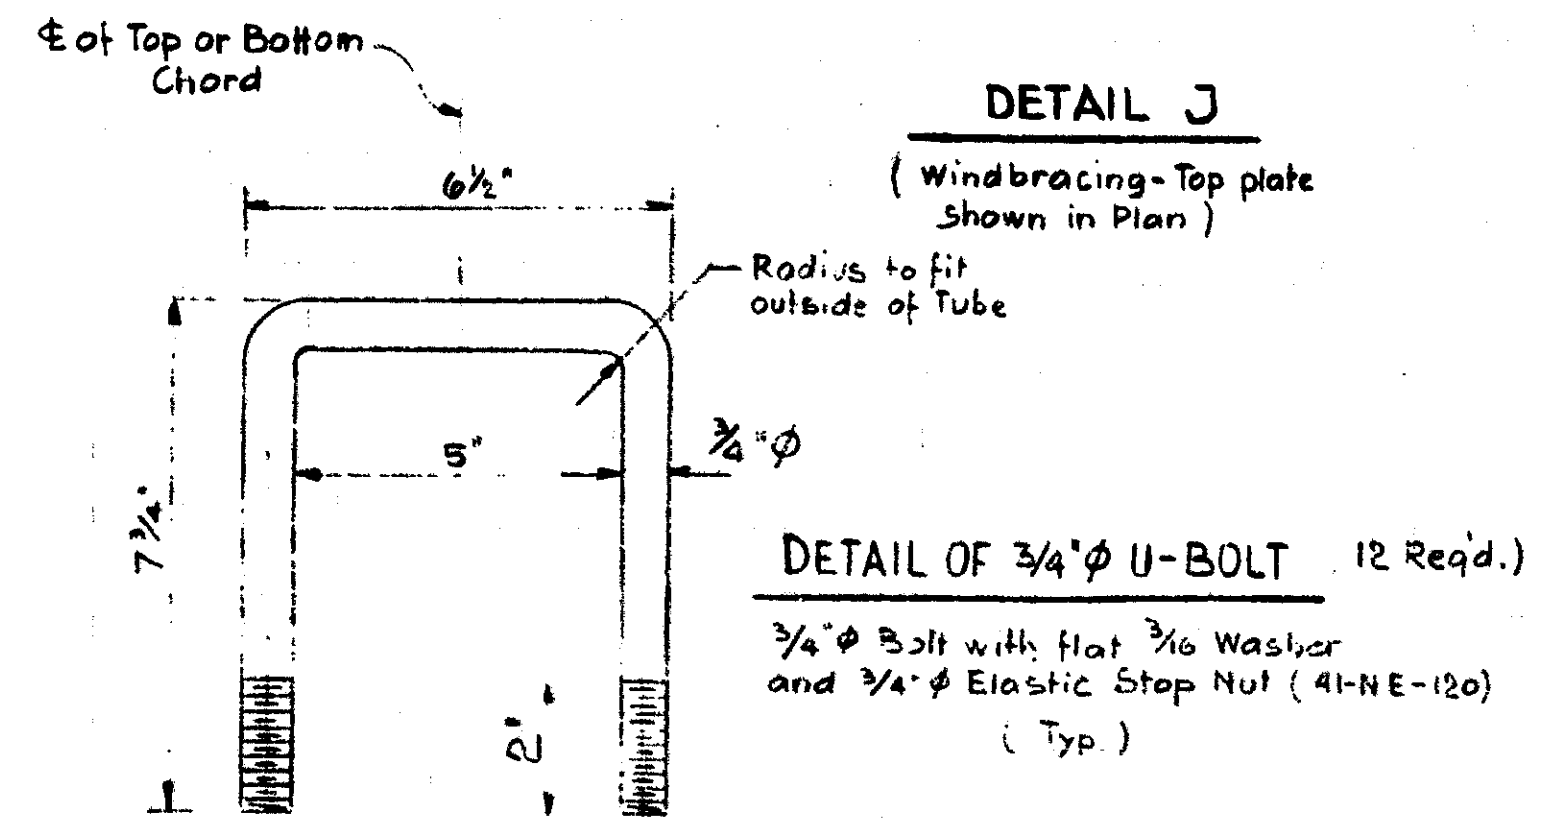


DETAIL J
(Windbracing - Top plate shown in Plan)
DETAIL OF 3/4" ϕ U-BOLT (12 Req'd.)
3/4" ϕ Bolt with Flat 3/16" Washer and 3/4" ϕ Elastic Stop Nut (41-NE-120) (Typ.)

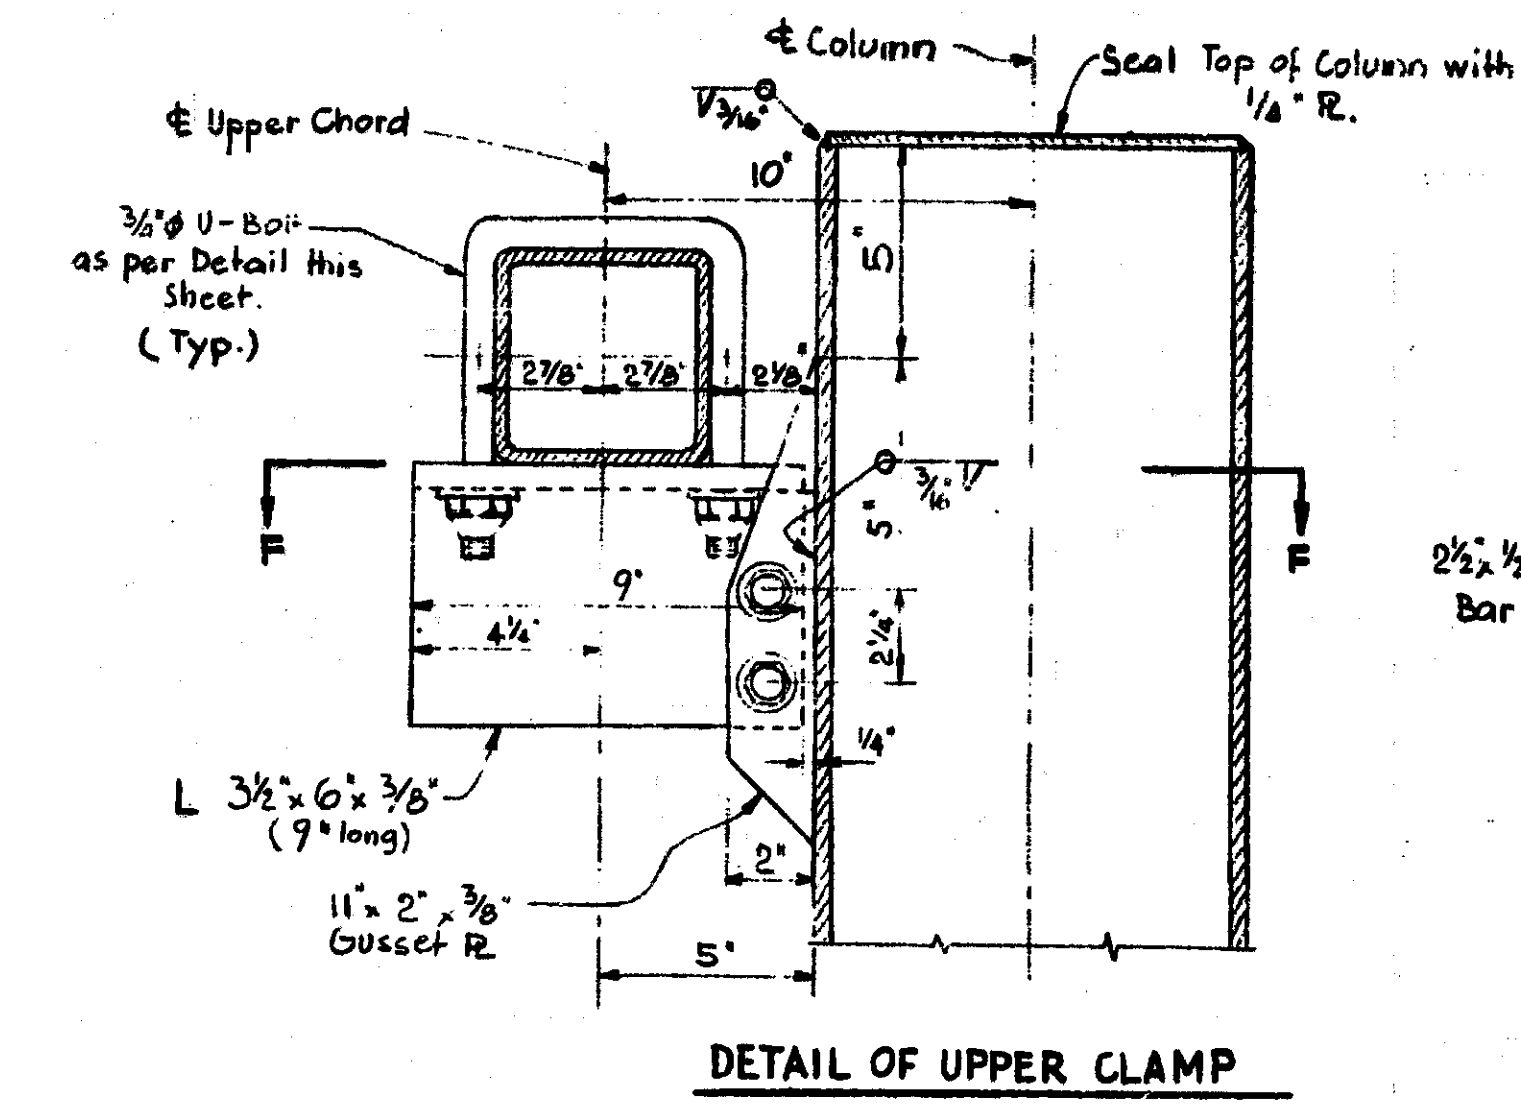


DETAIL OF UPPER CLAMP

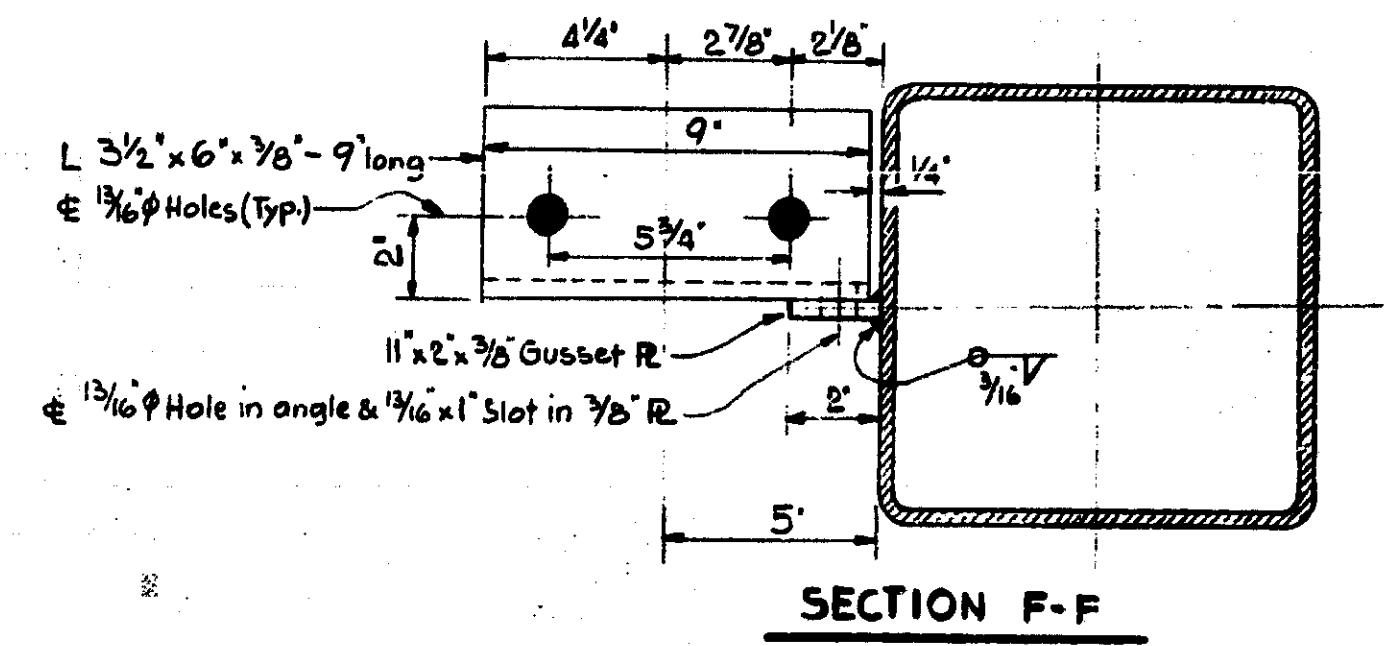


SECTION F-F

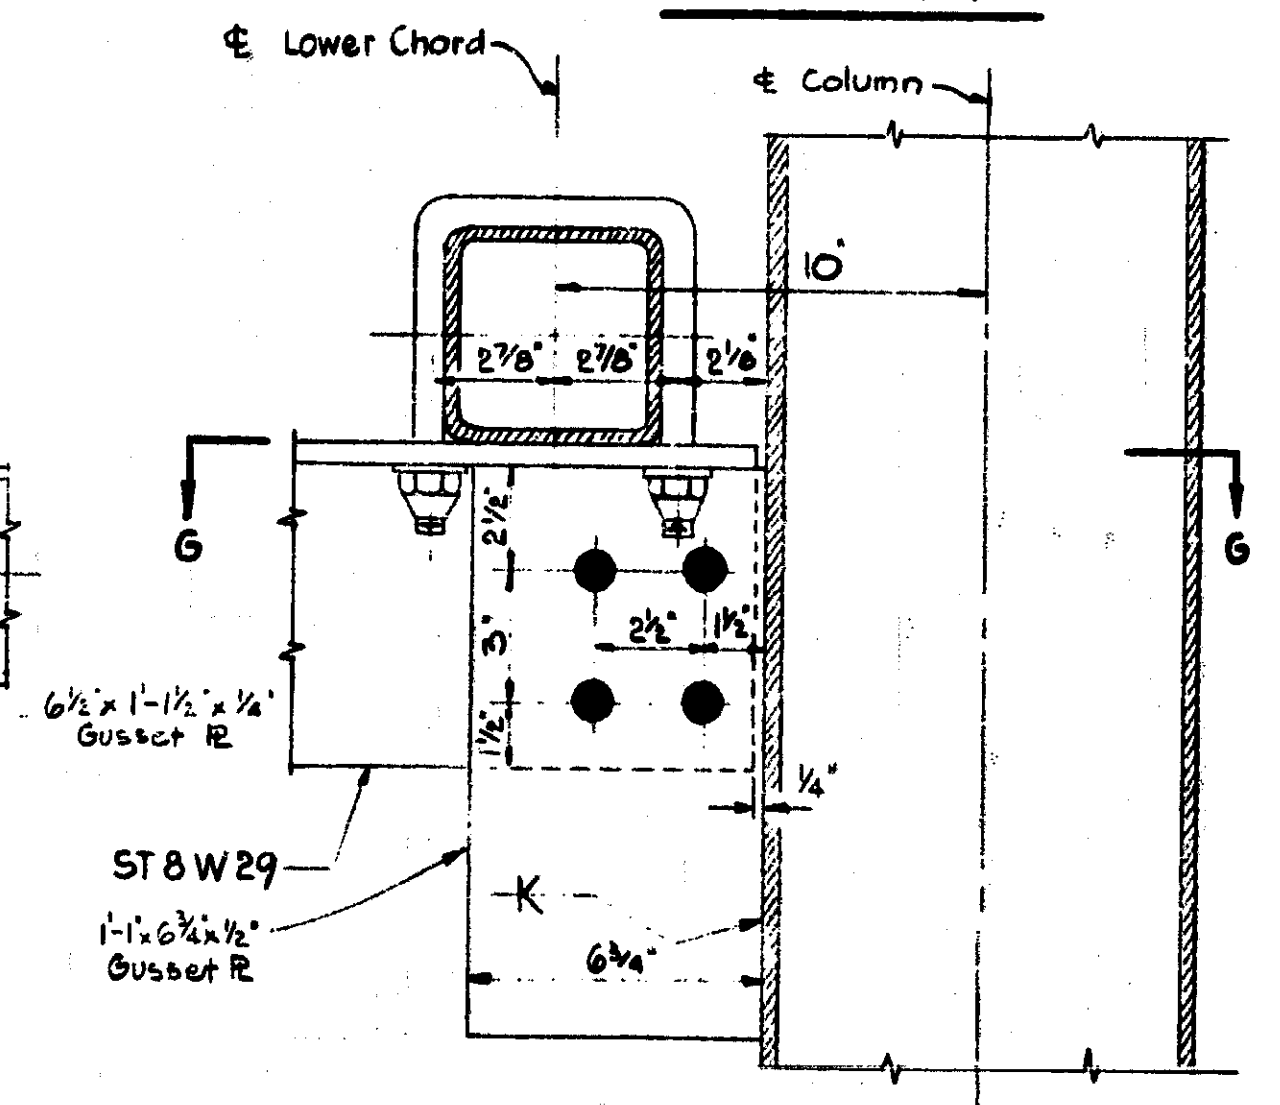

DETAIL OF SEAT (With no Diagonal shown)

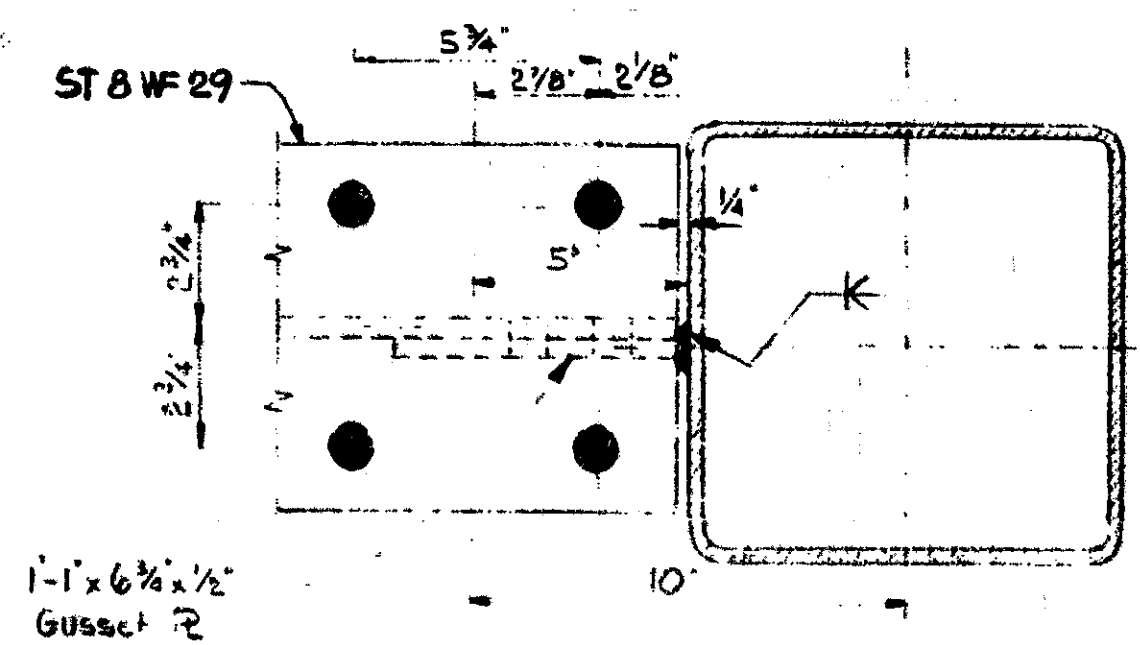


SECTION G-G

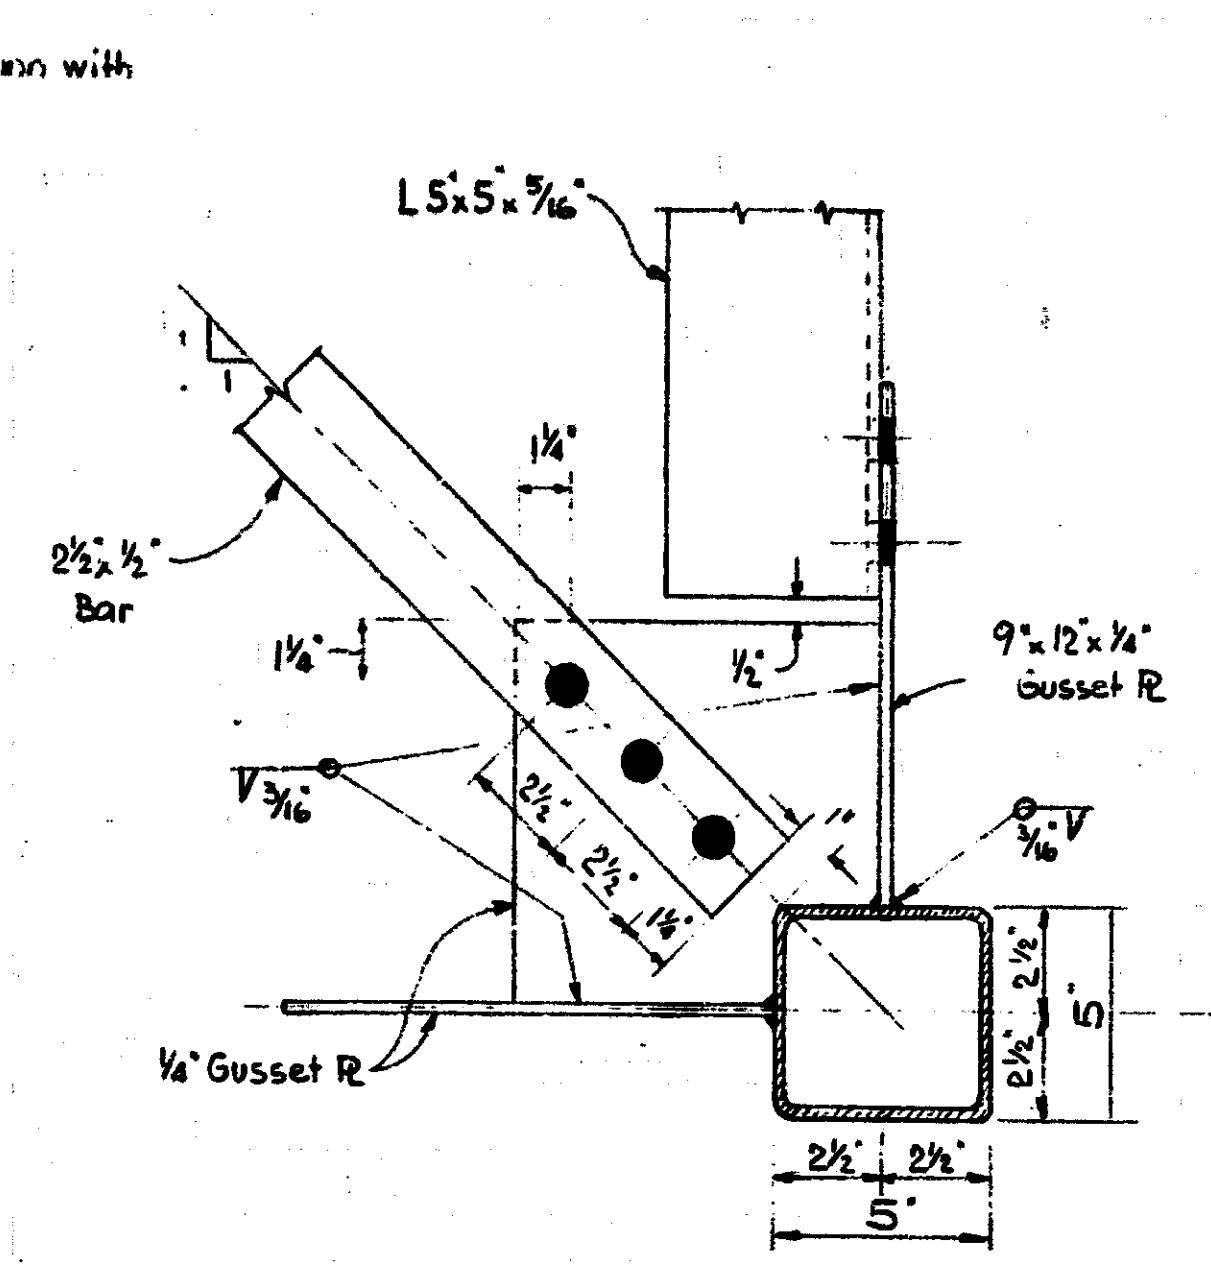


DETAIL M

NOTE All bolt holes are 13/16" ϕ .

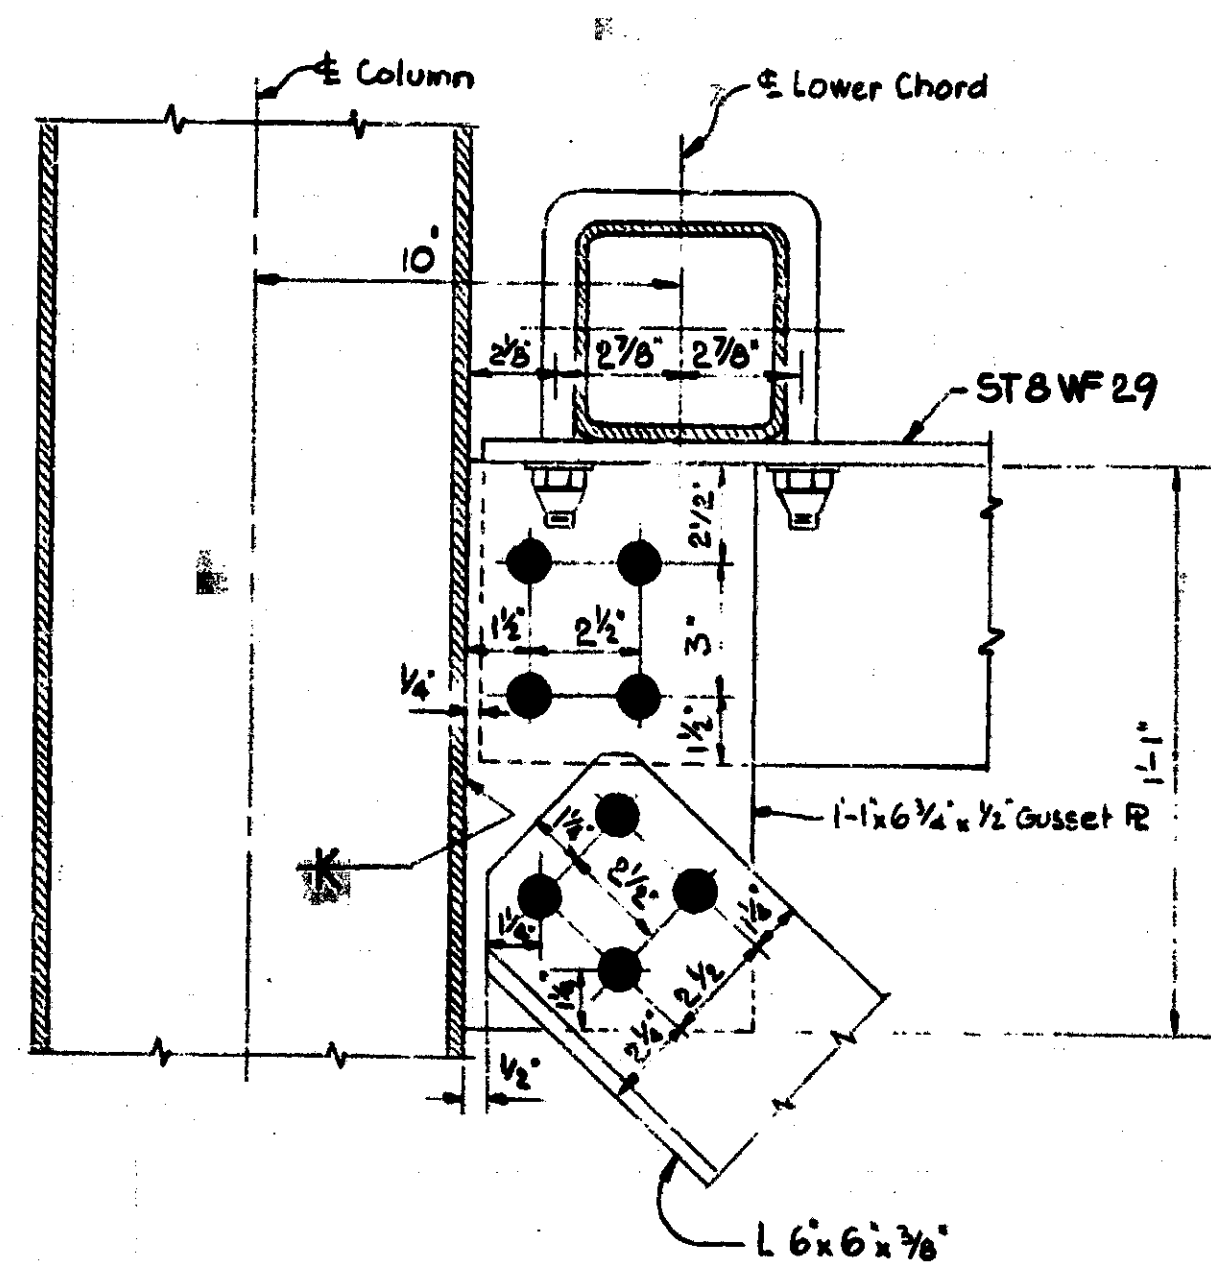


DETAIL OF SEAT (With Diagonal shown)

NOTE Gusset Plate size shown in the Detail above for the seat with diagonals will vary with different column height.

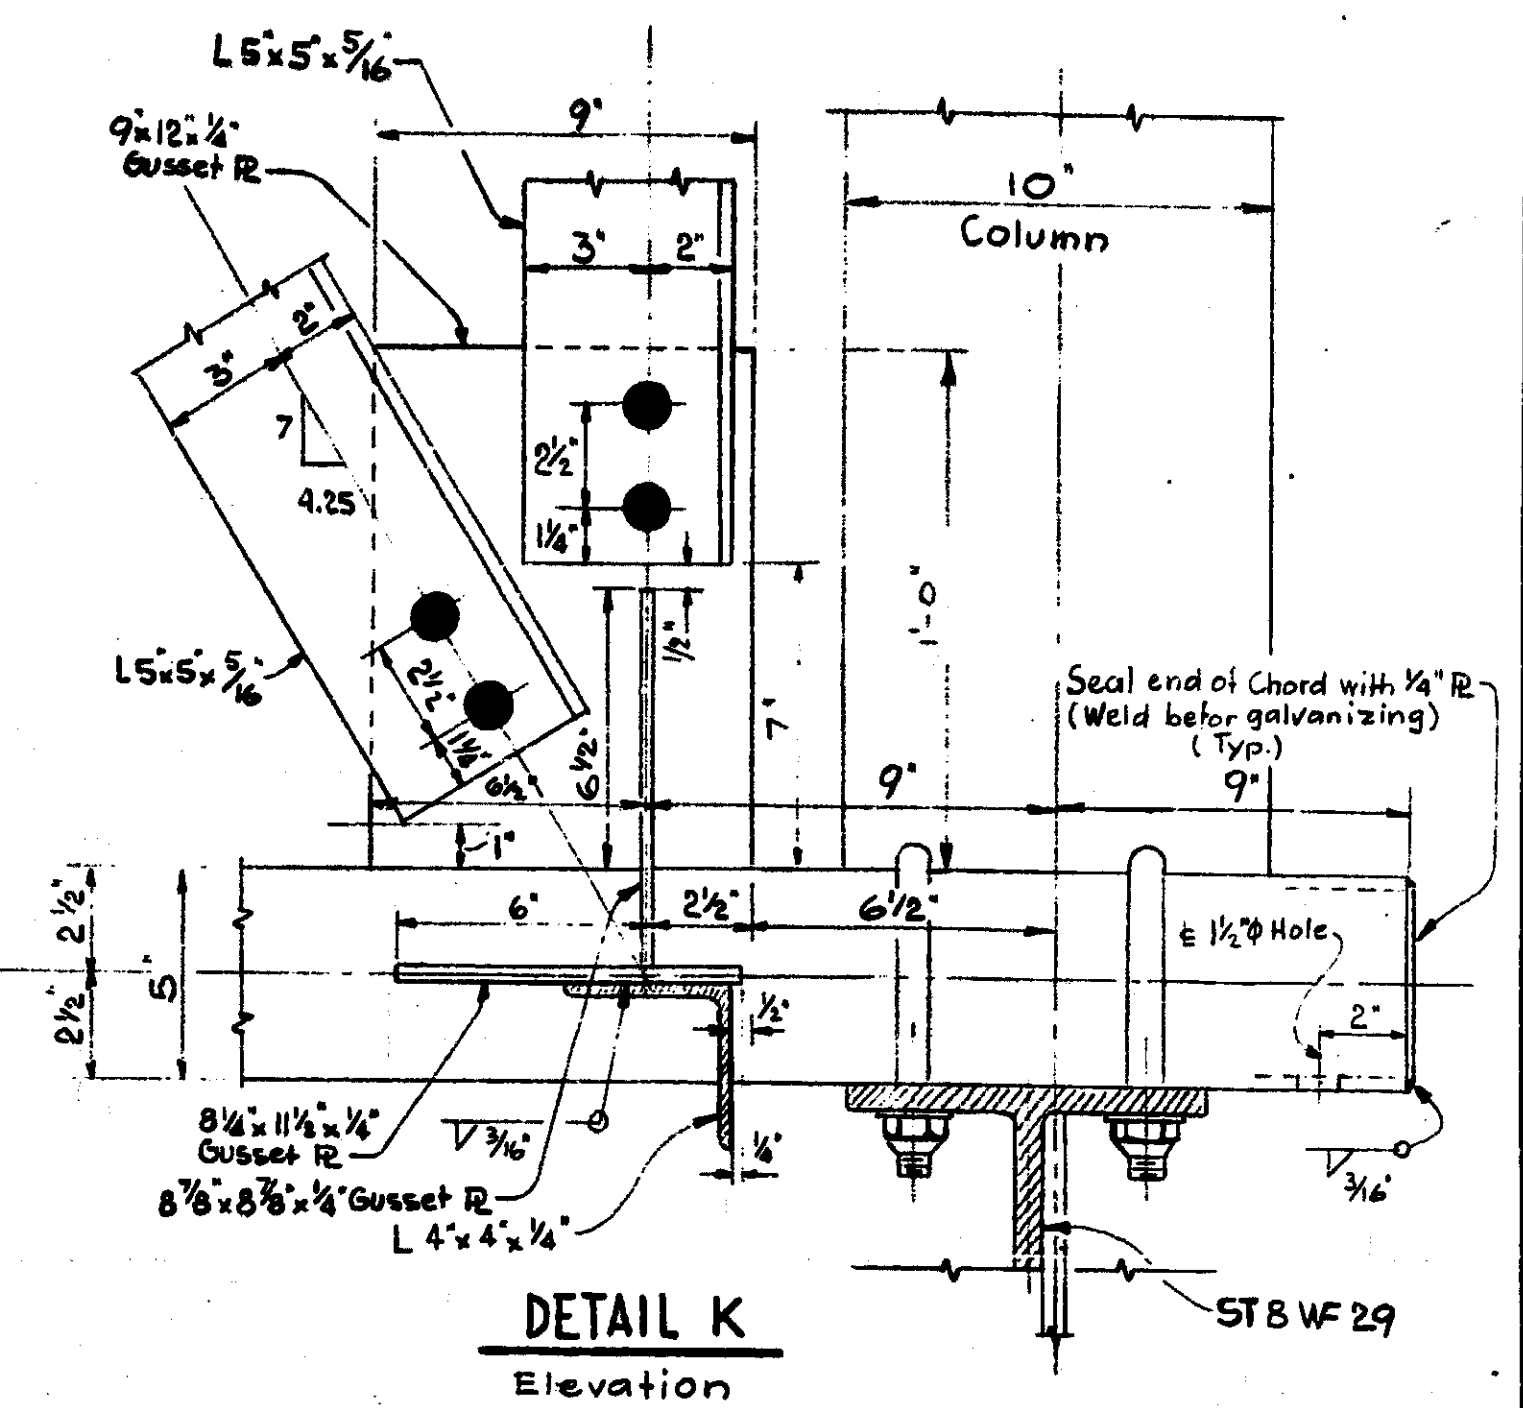

DETAIL K
Elevation

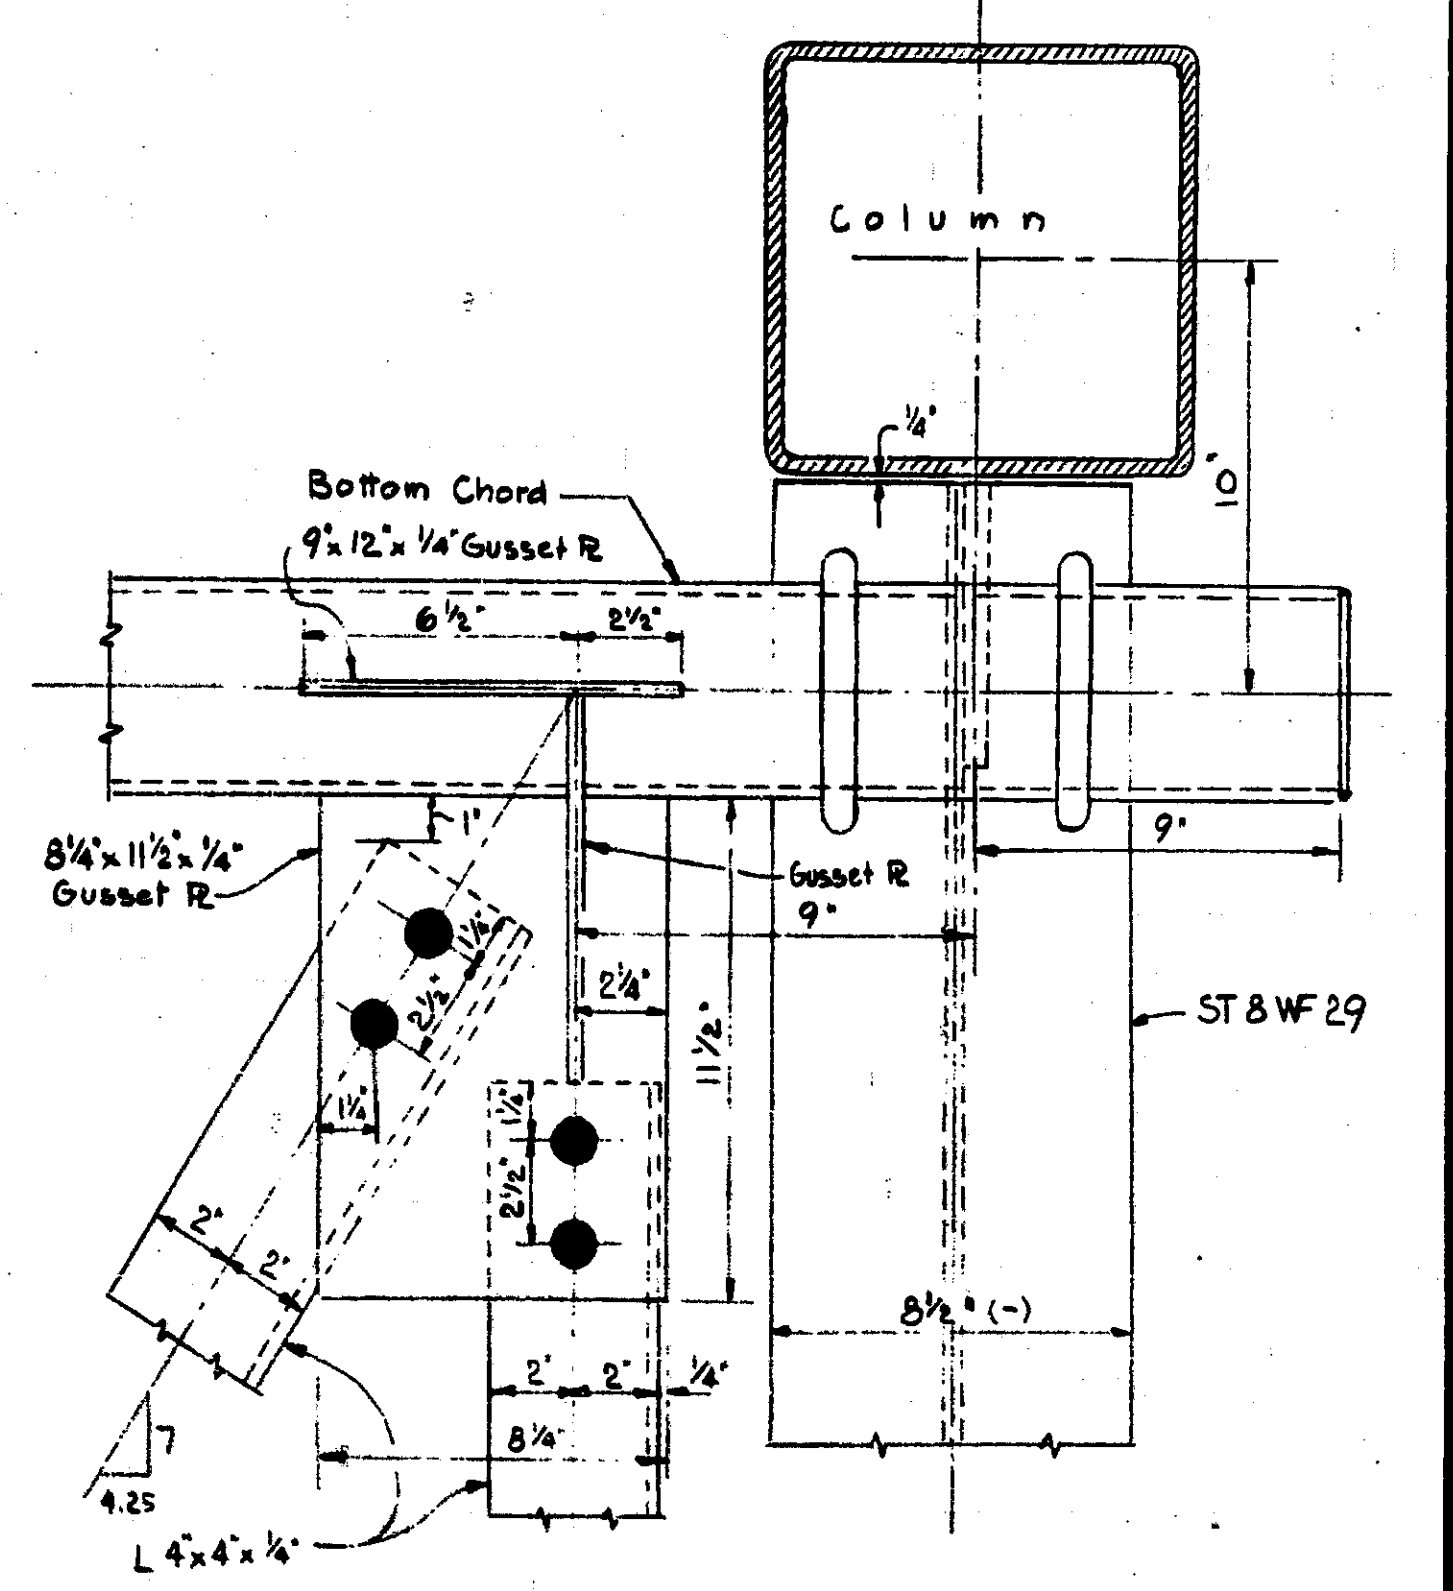

DETAIL L
Bottom Windbracing Plan

Work this sheet with sheets 1 & 2

MICHIGAN DEPARTMENT OF STATE HIGHWAYS





STEEL TRUSS TYPE D (125')

A-36 Galv.

NO.	REVISIONS	DATE	BY

DESIGNED BY	CHECKED BY	DATE

S7.43

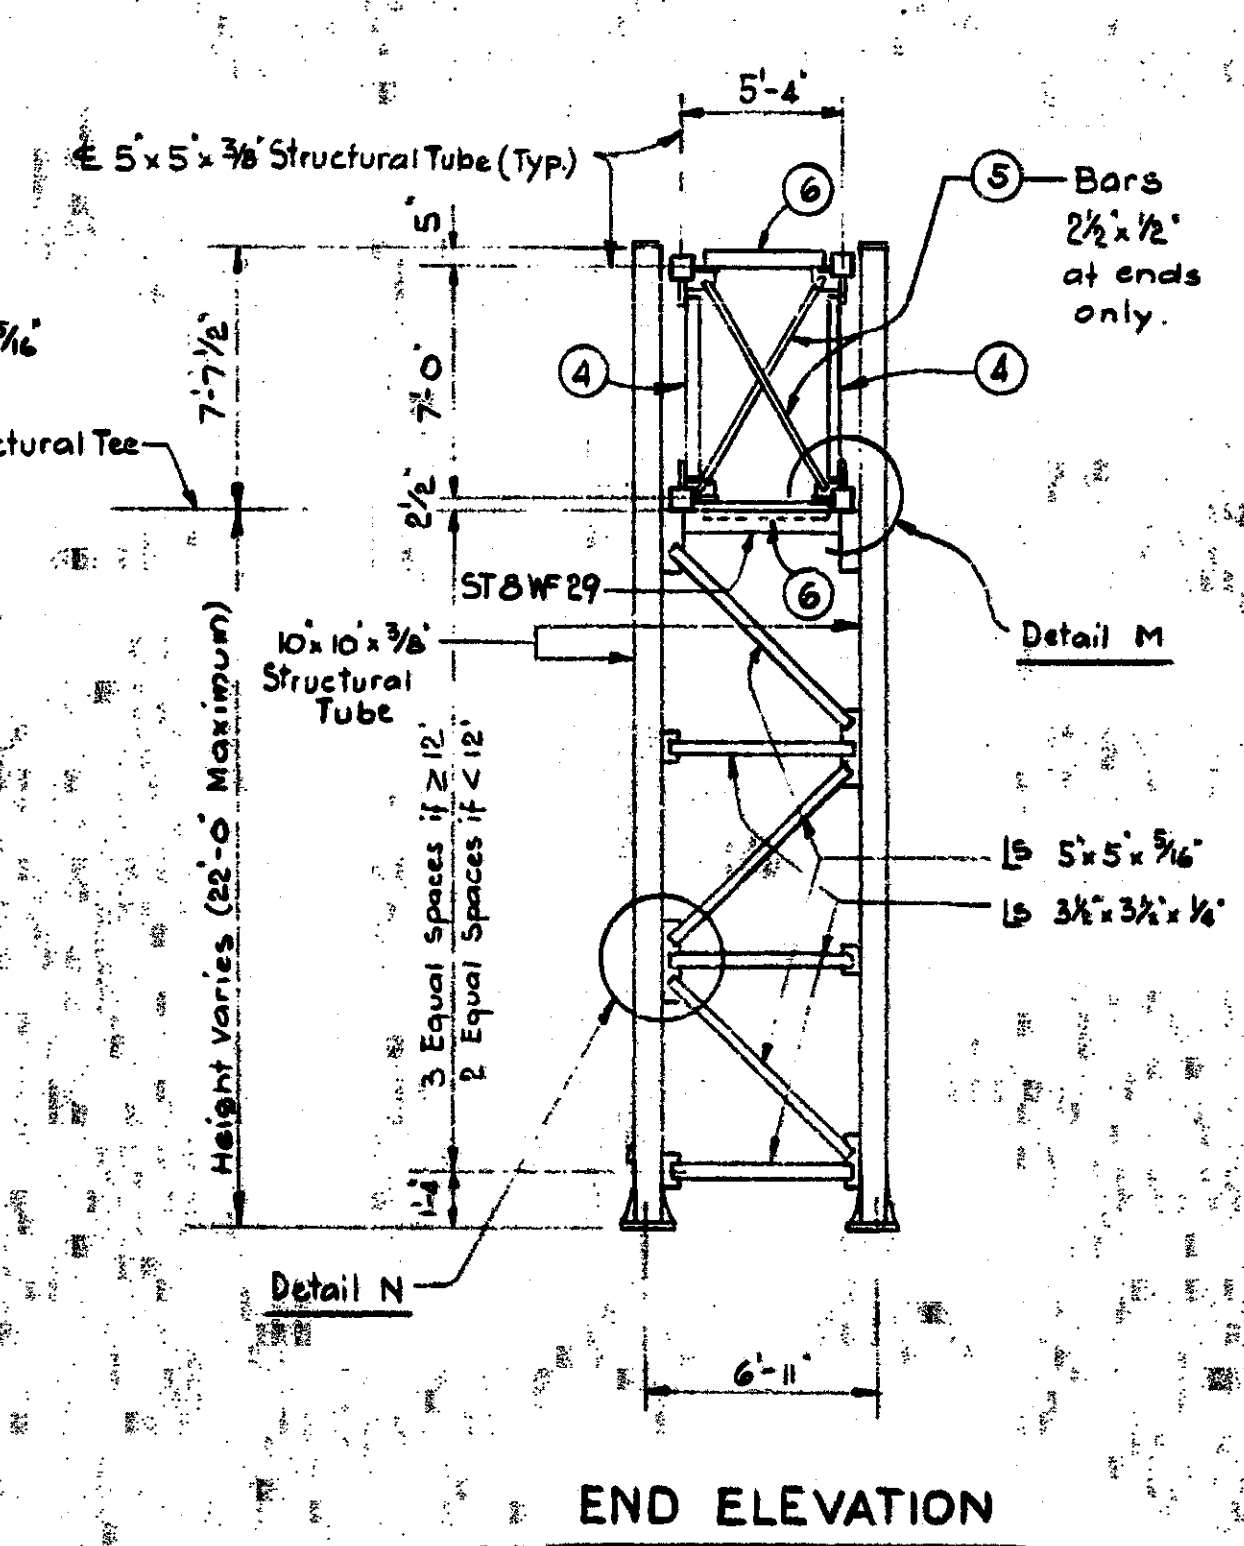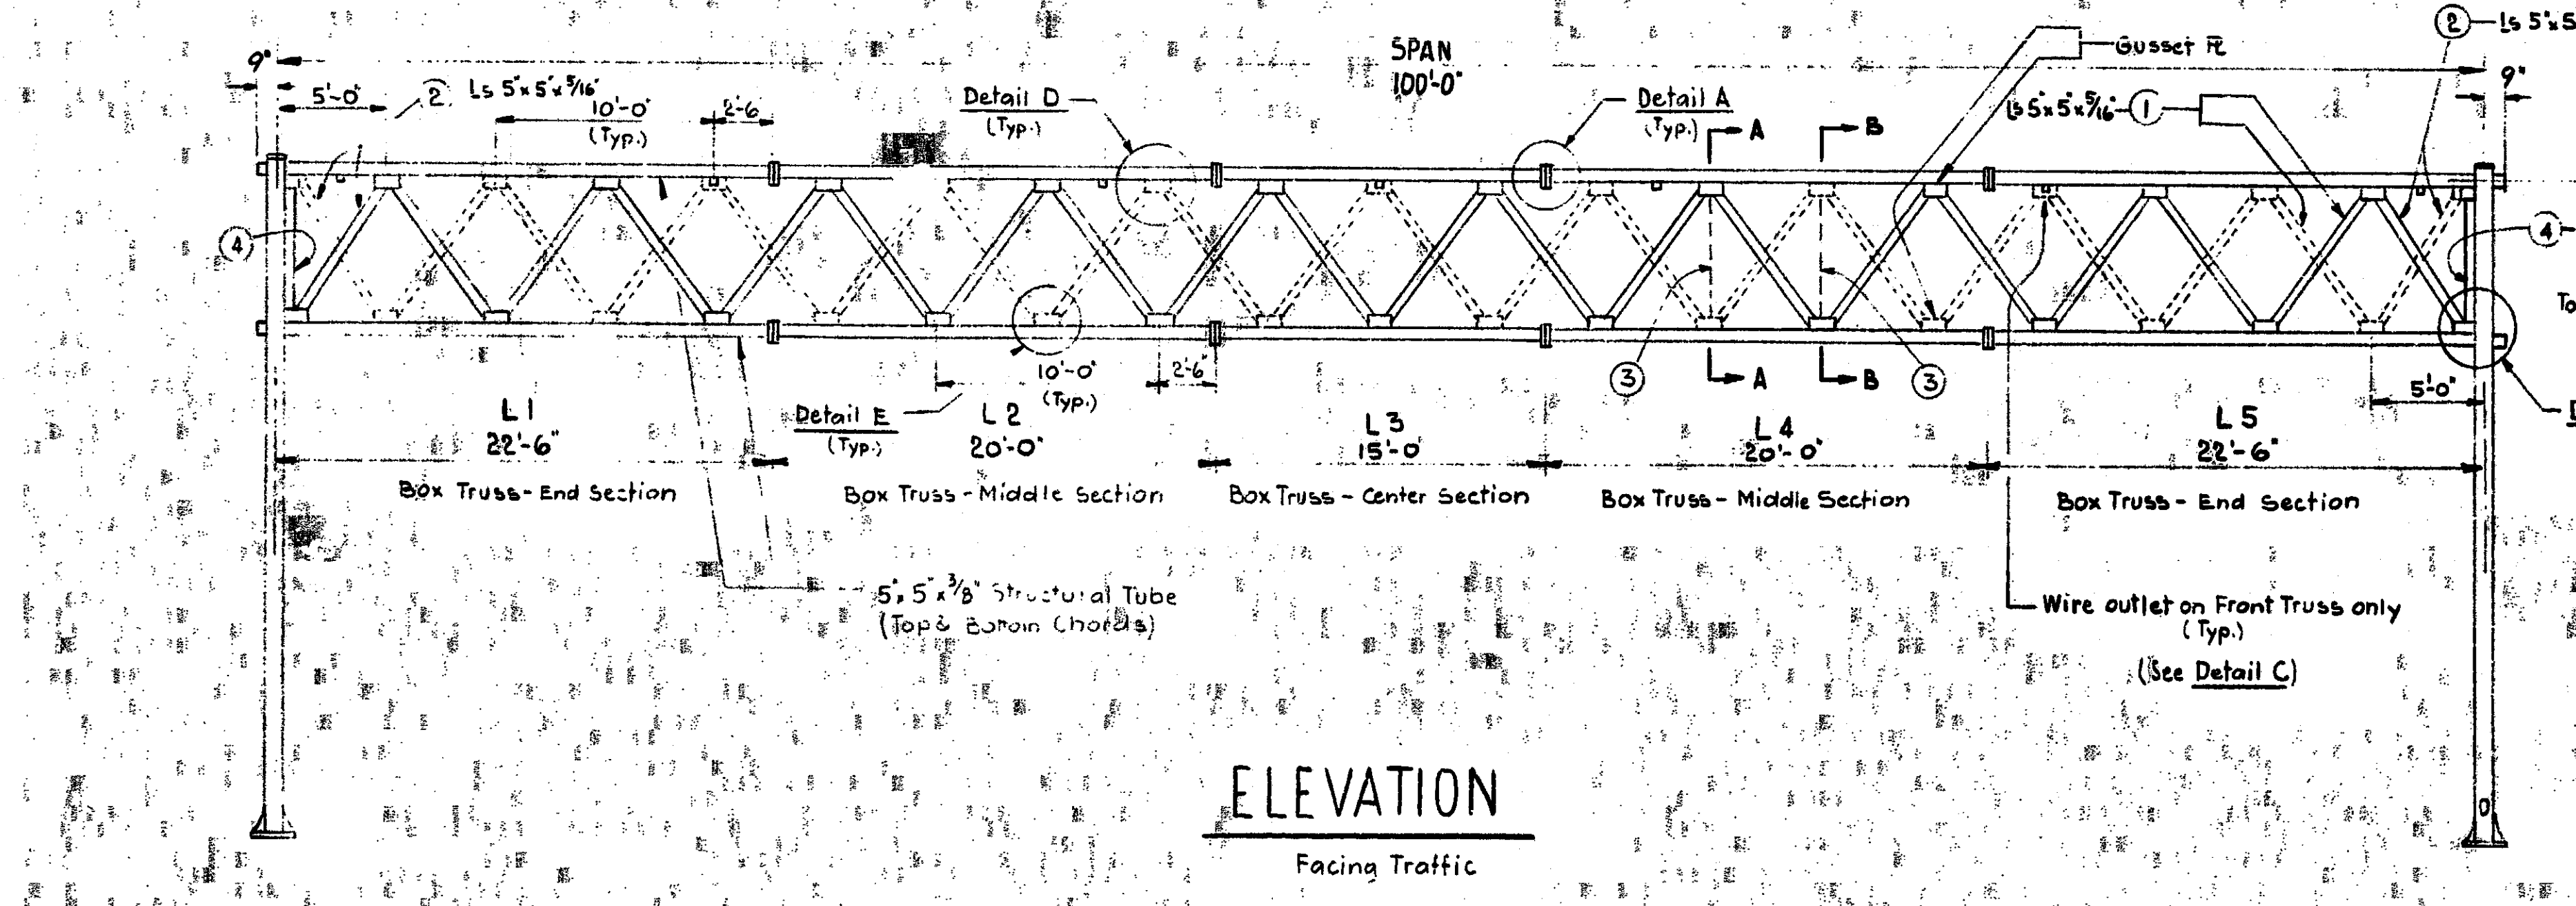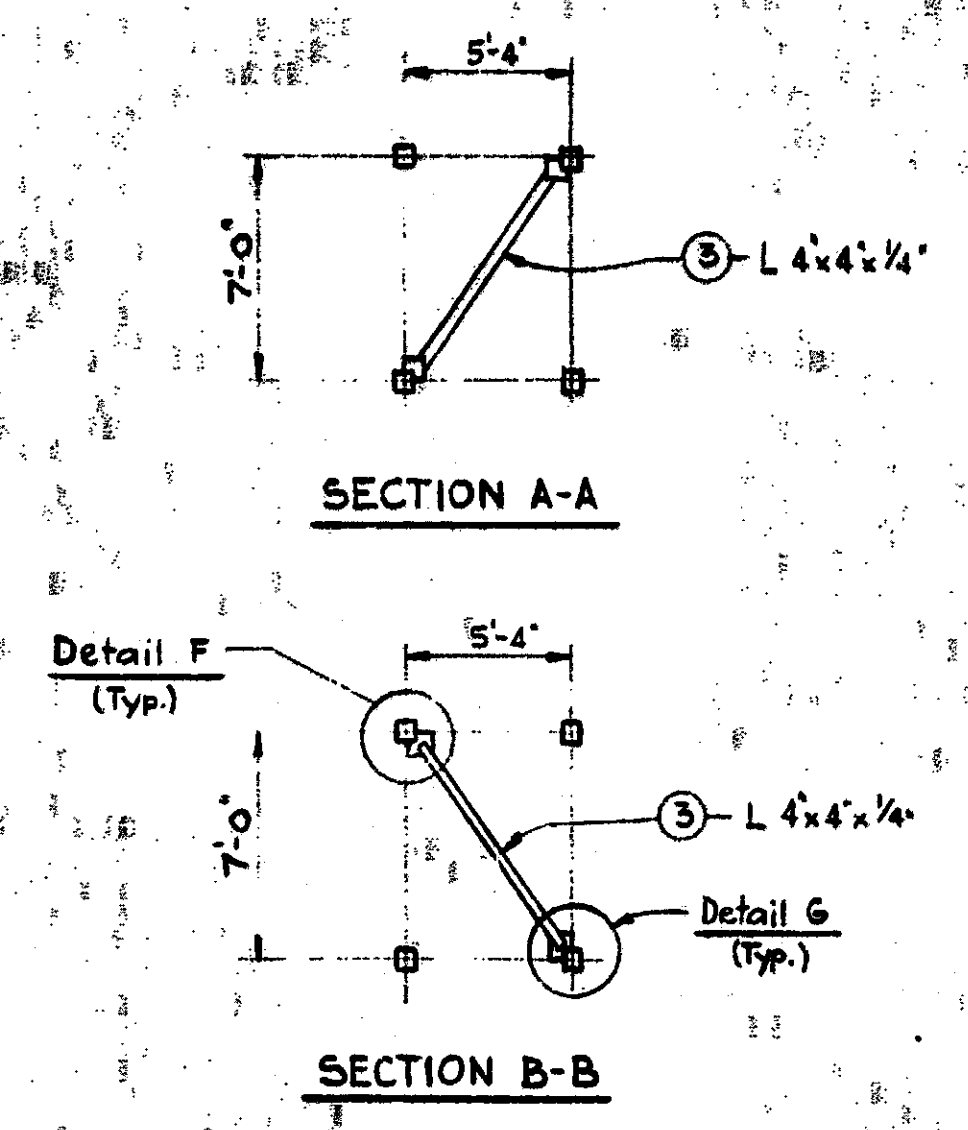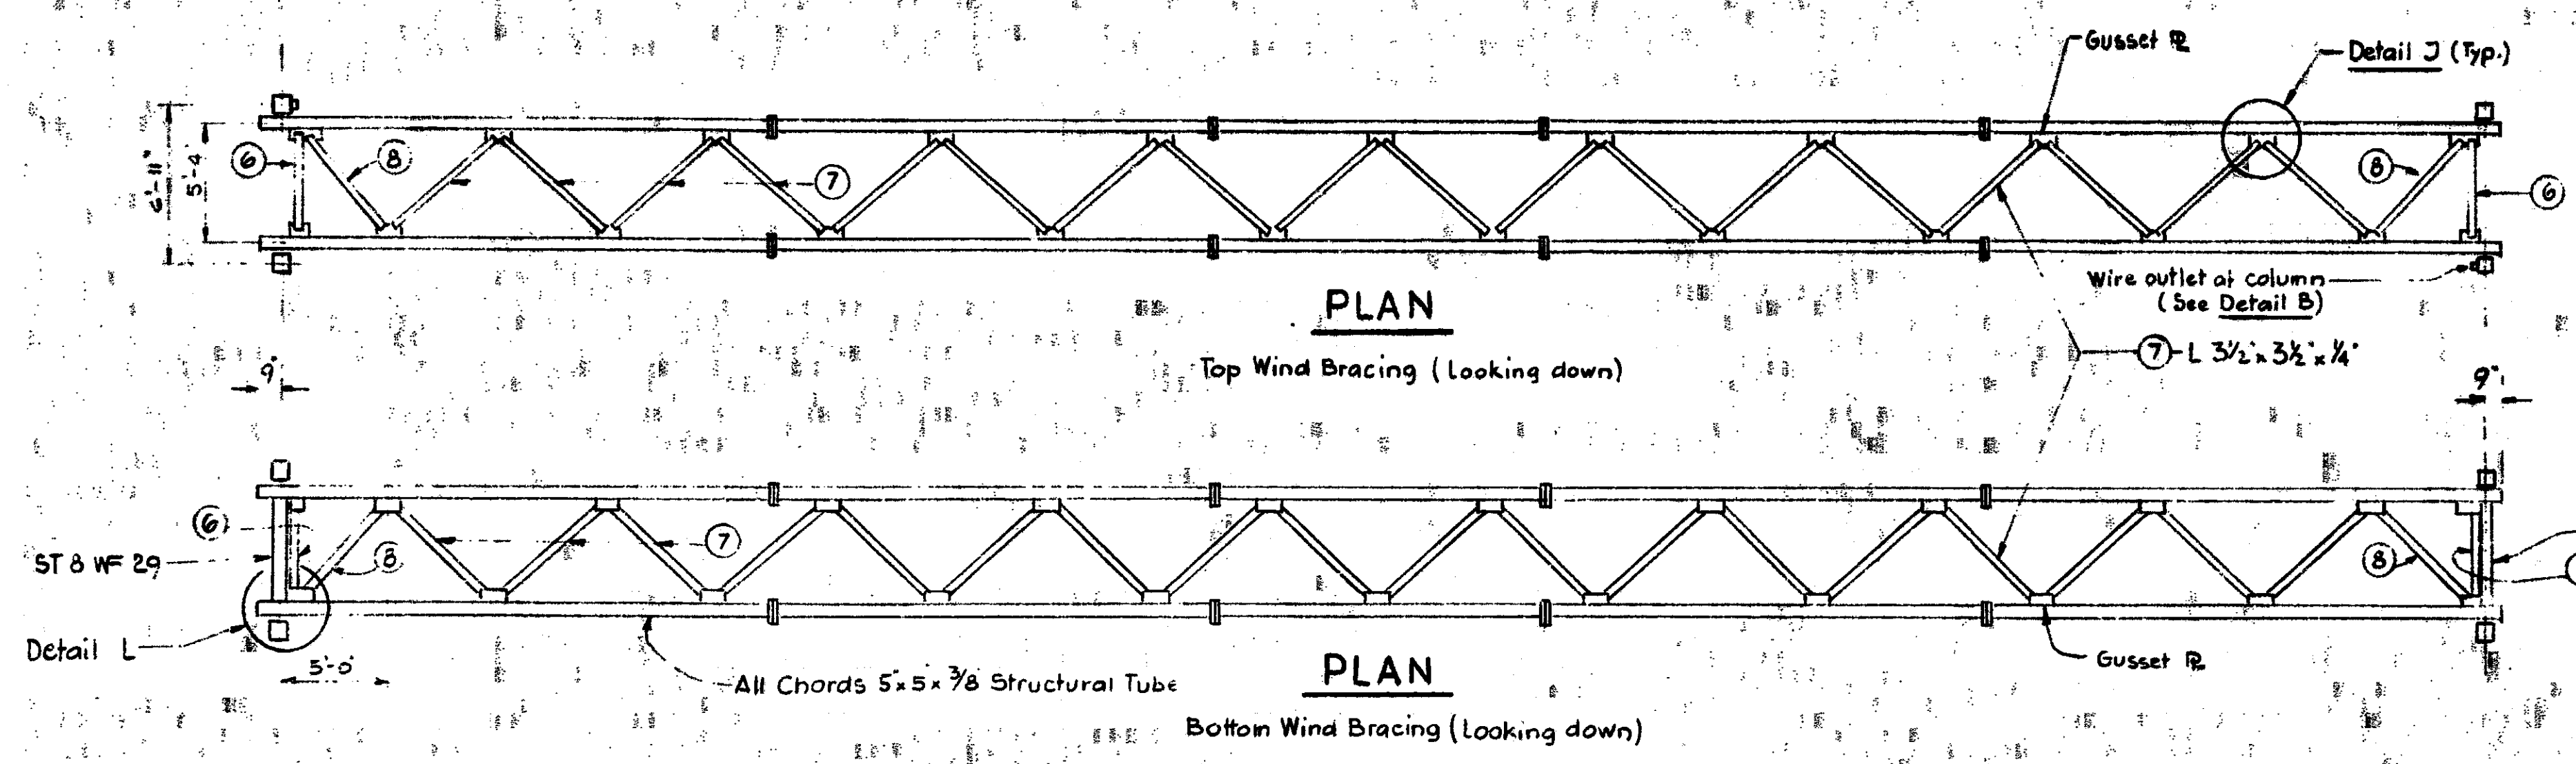

SPAN	TRUSS DATA - A-36					CAMBER	BOX TRUSS	APPROX. WT. OF TRUSS (LBS/4')
	L1	L2	L3	L4	L5			
75'-0"	22'-6"	15'-0"	20'-0"	15'-0"	12'-6"	1"	7'-0" x 5'-4"	123
80'-0"	17'-6"	15'-0"	15'-0"	15'-0"	17'-6"	1 3/8"	7'-0" x 5'-4"	
85'-0"	17'-6"	15'-0"	20'-0"	15'-0"	17'-6"	1 1/4"	7'-0" x 5'-4"	
90'-0"	22'-6"	15'-0"	15'-0"	15'-0"	22'-6"	1 3/8"	7'-0" x 5'-4"	
95'-0"	17'-6"	20'-0"	20'-0"	20'-0"	17'-6"	1 1/2"	7'-0" x 5'-4"	
100'-0"	22'-6"	20'-0"	15'-0"	10'-0"	22'-6"	1 3/4"	7'-0" x 5'-4"	123

CAMBER The camber given in the above table is the ordinate at the center of the assembled truss prior to dead load deflection.
Allowable camber tolerance for truss is 25%

Isometric View
Shipping and Section of Truss











For Notes see sheet 1 of Steel Truss Type D
Work this sheet with sheets 5 & 6

MICHIGAN DEPARTMENT OF STATE HIGHWAYS

STEEL TRUSS TYPE C (100')
A-36 Galv.

REVISIONS			
NO.	DESCRIPTION	DATE	BY

ORDER NO. BULLETIN 5-9-76
ORDER BY PRN 11-4-76
DESIGNED BY
DRAWN BY
CHECKED BY
DATE 5-9-76

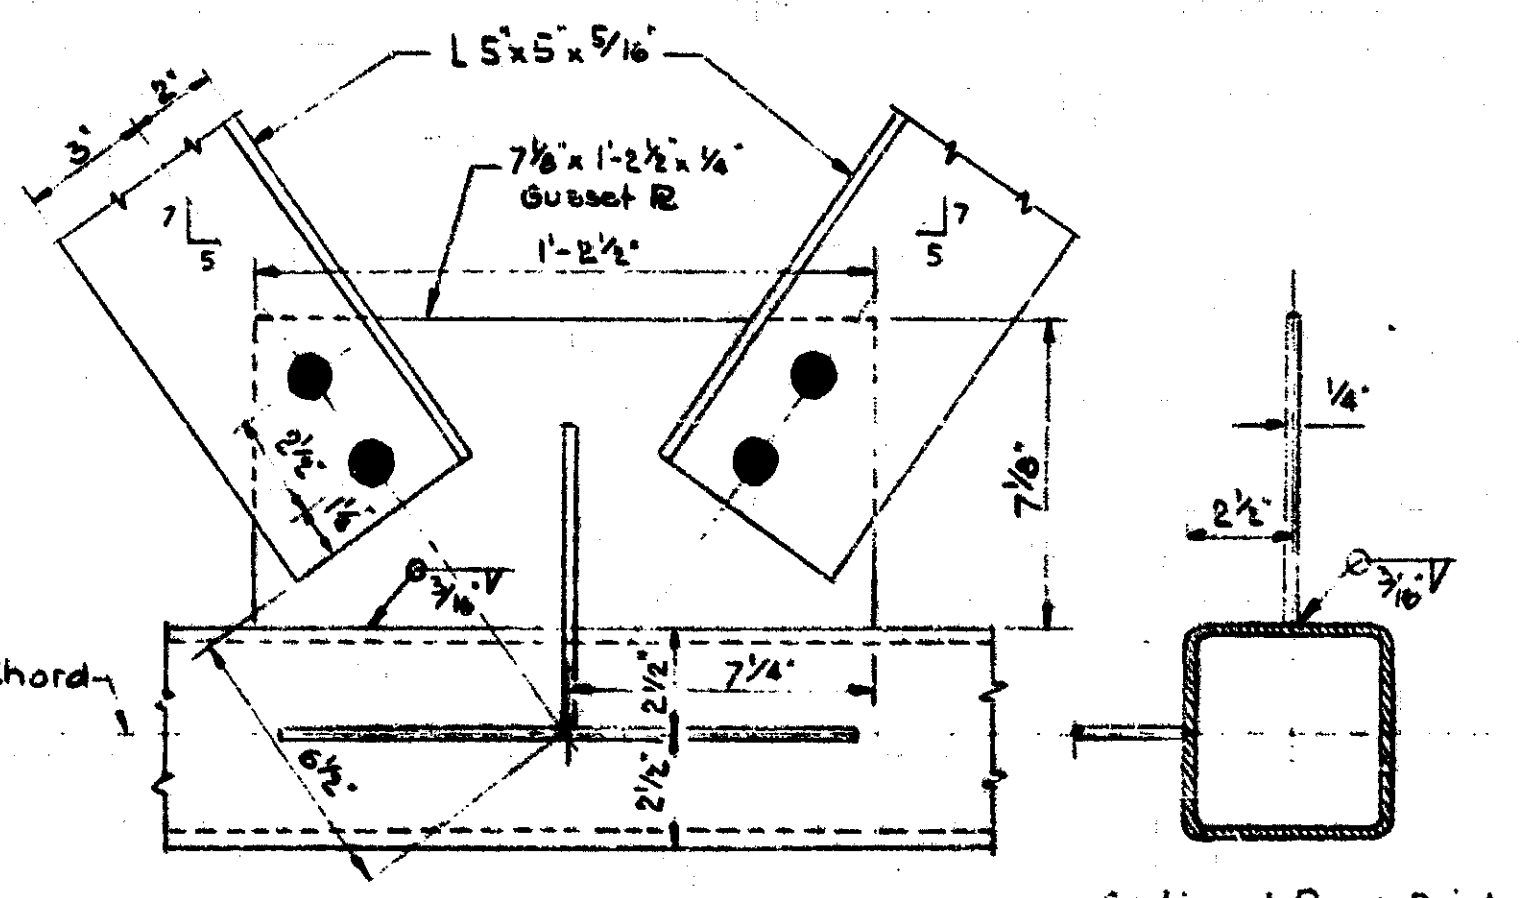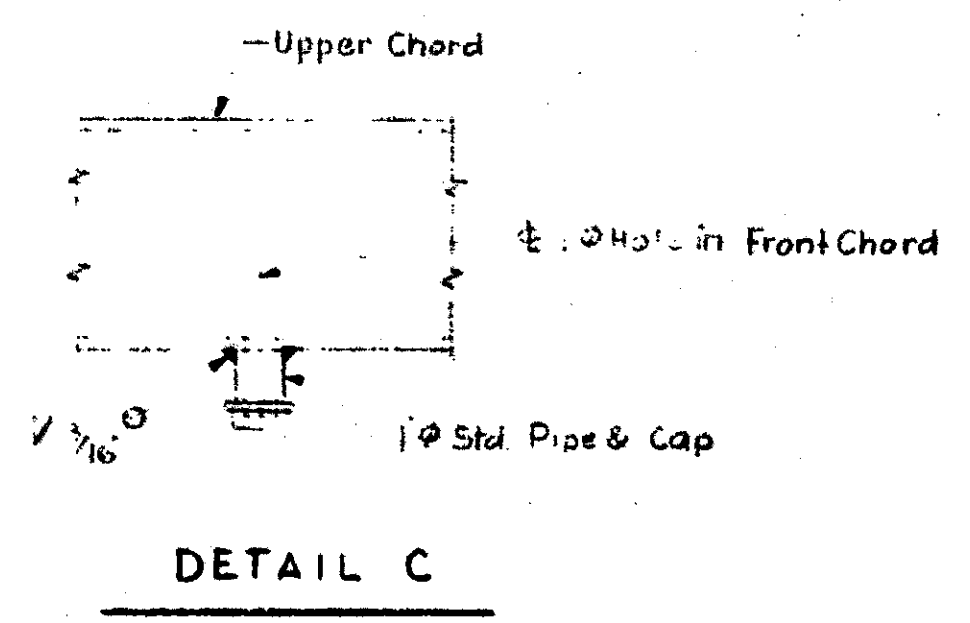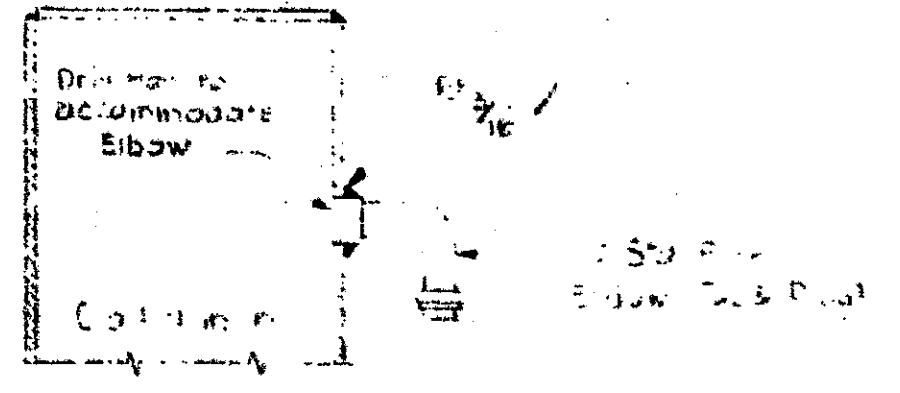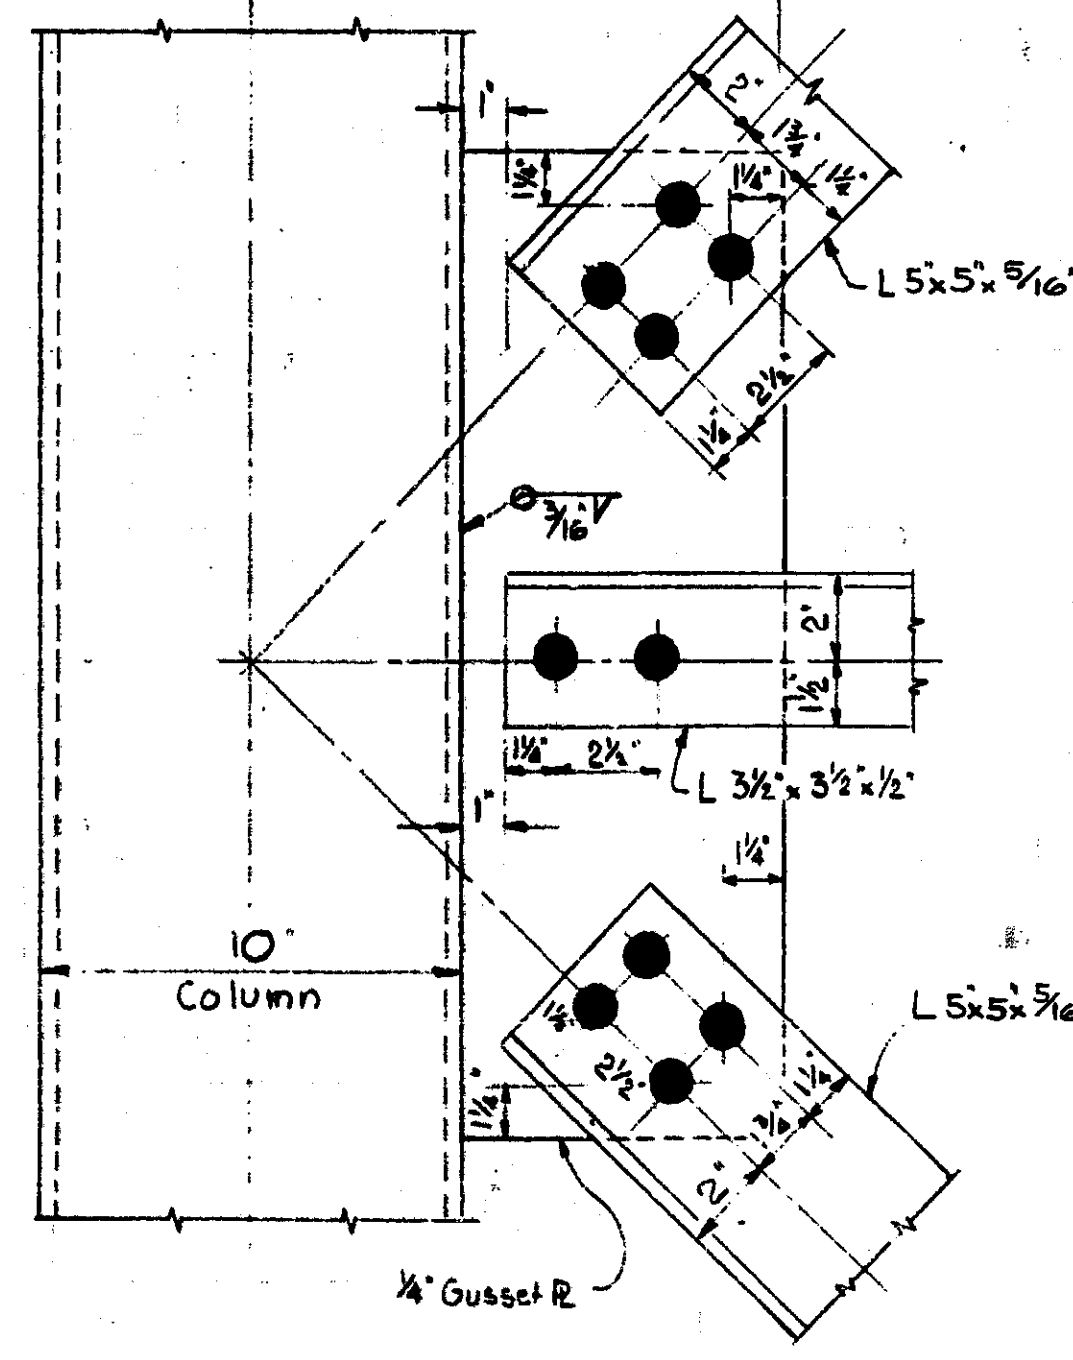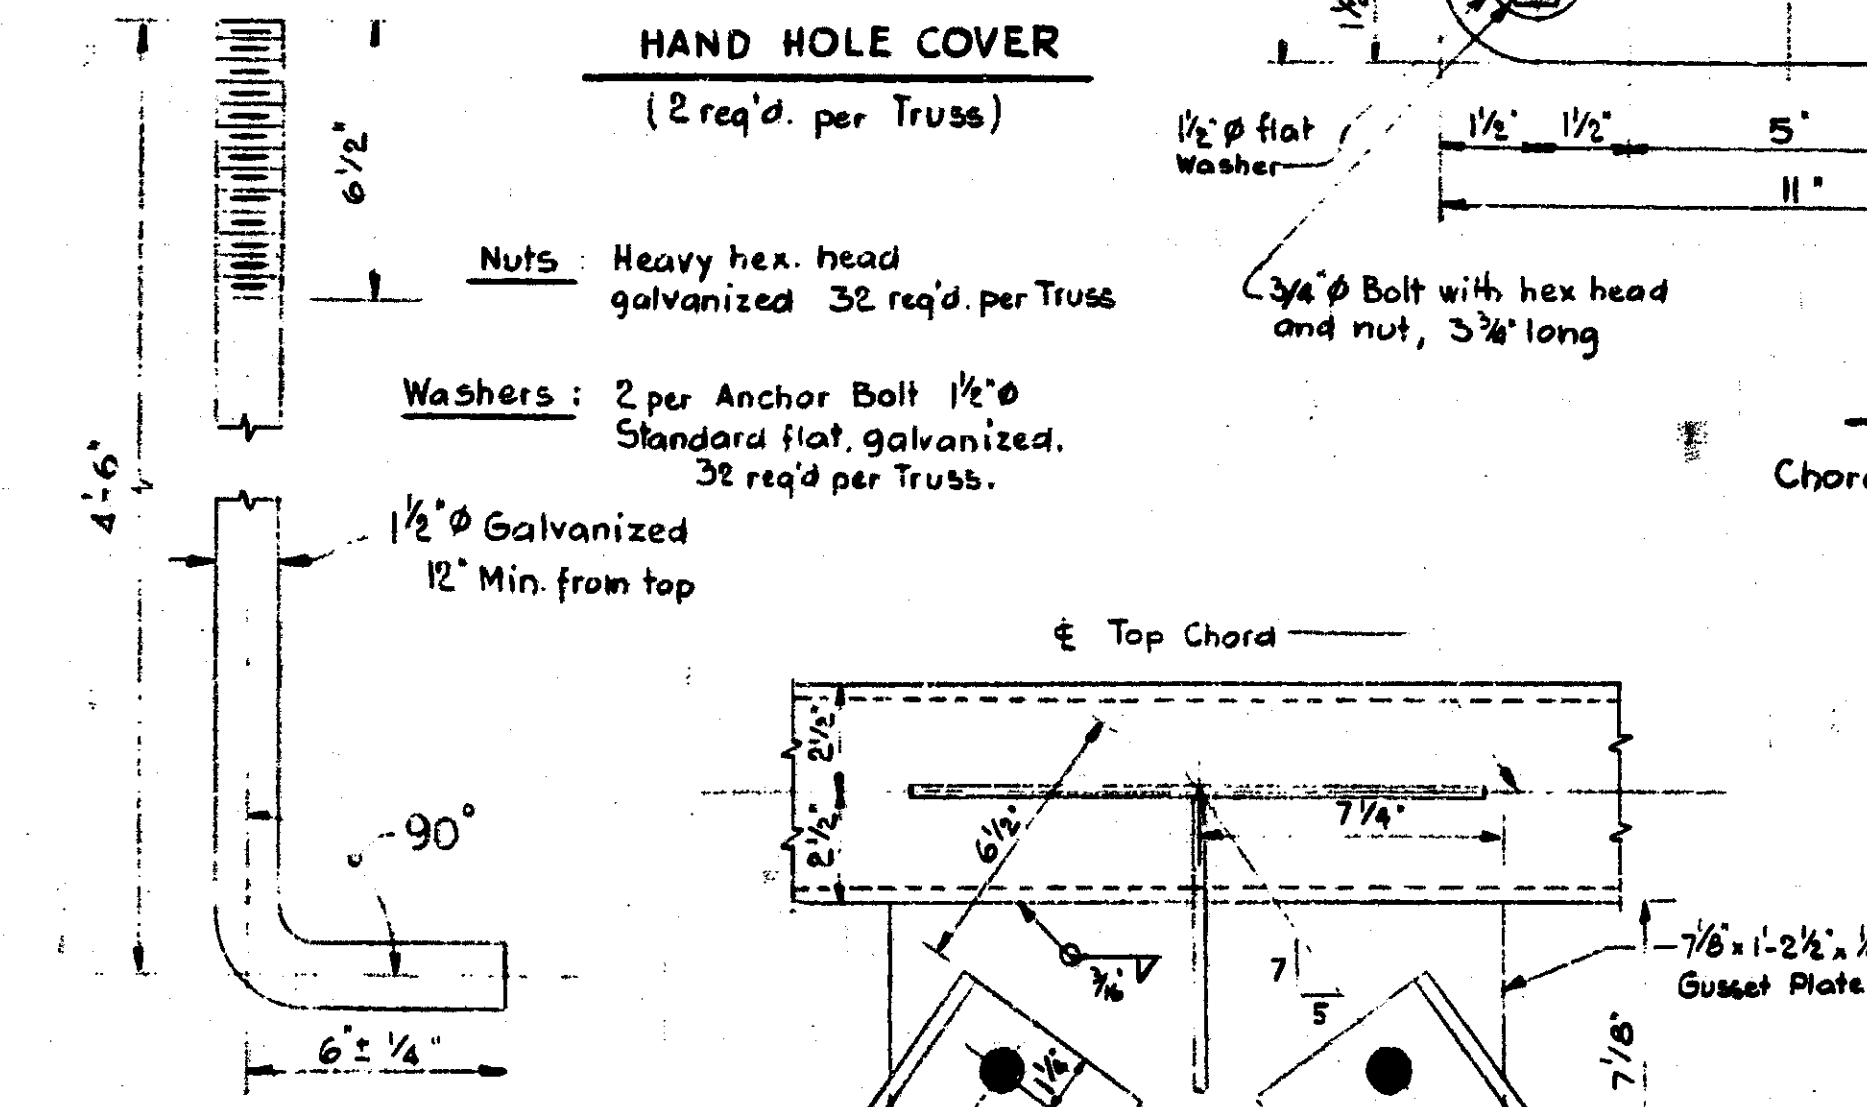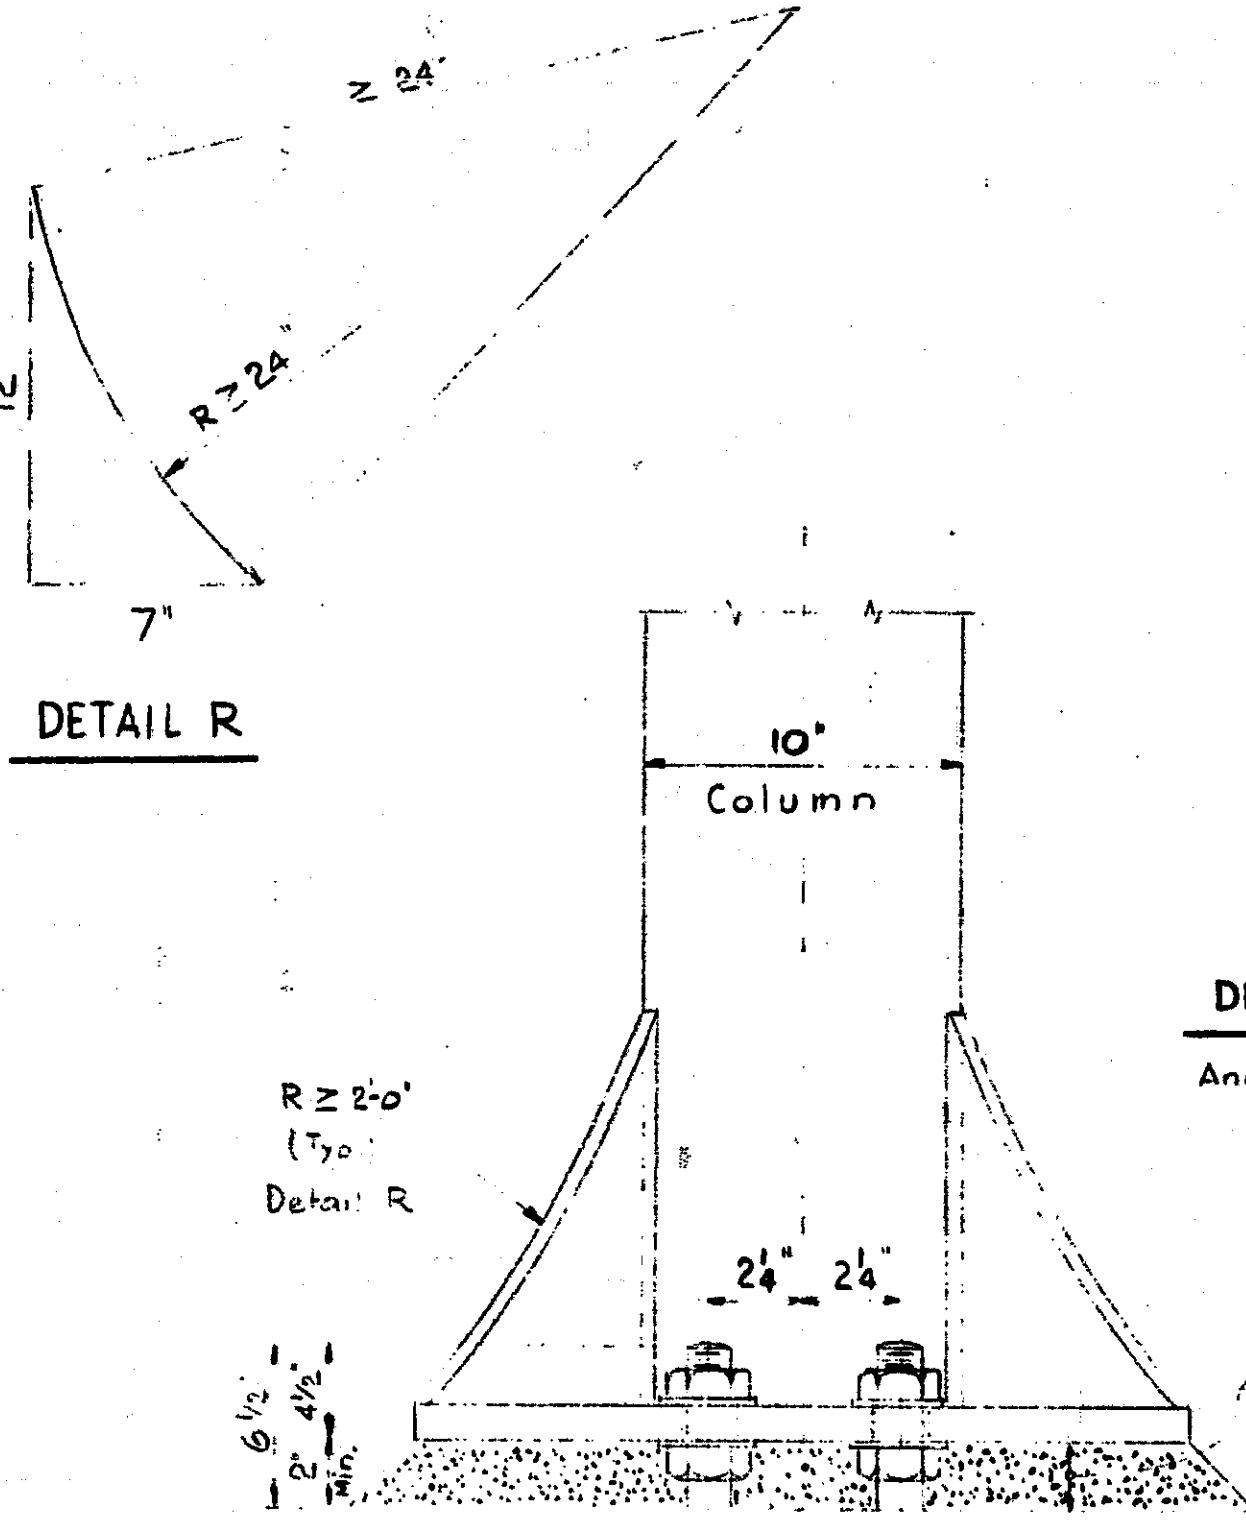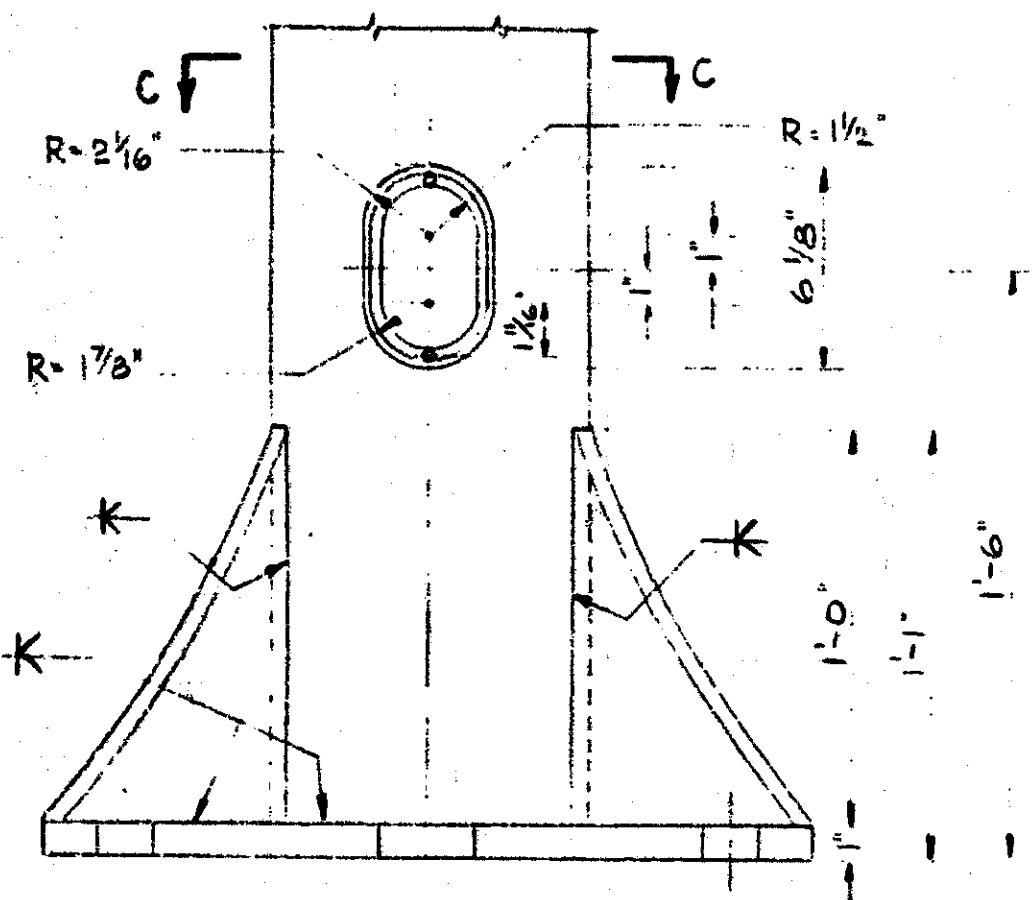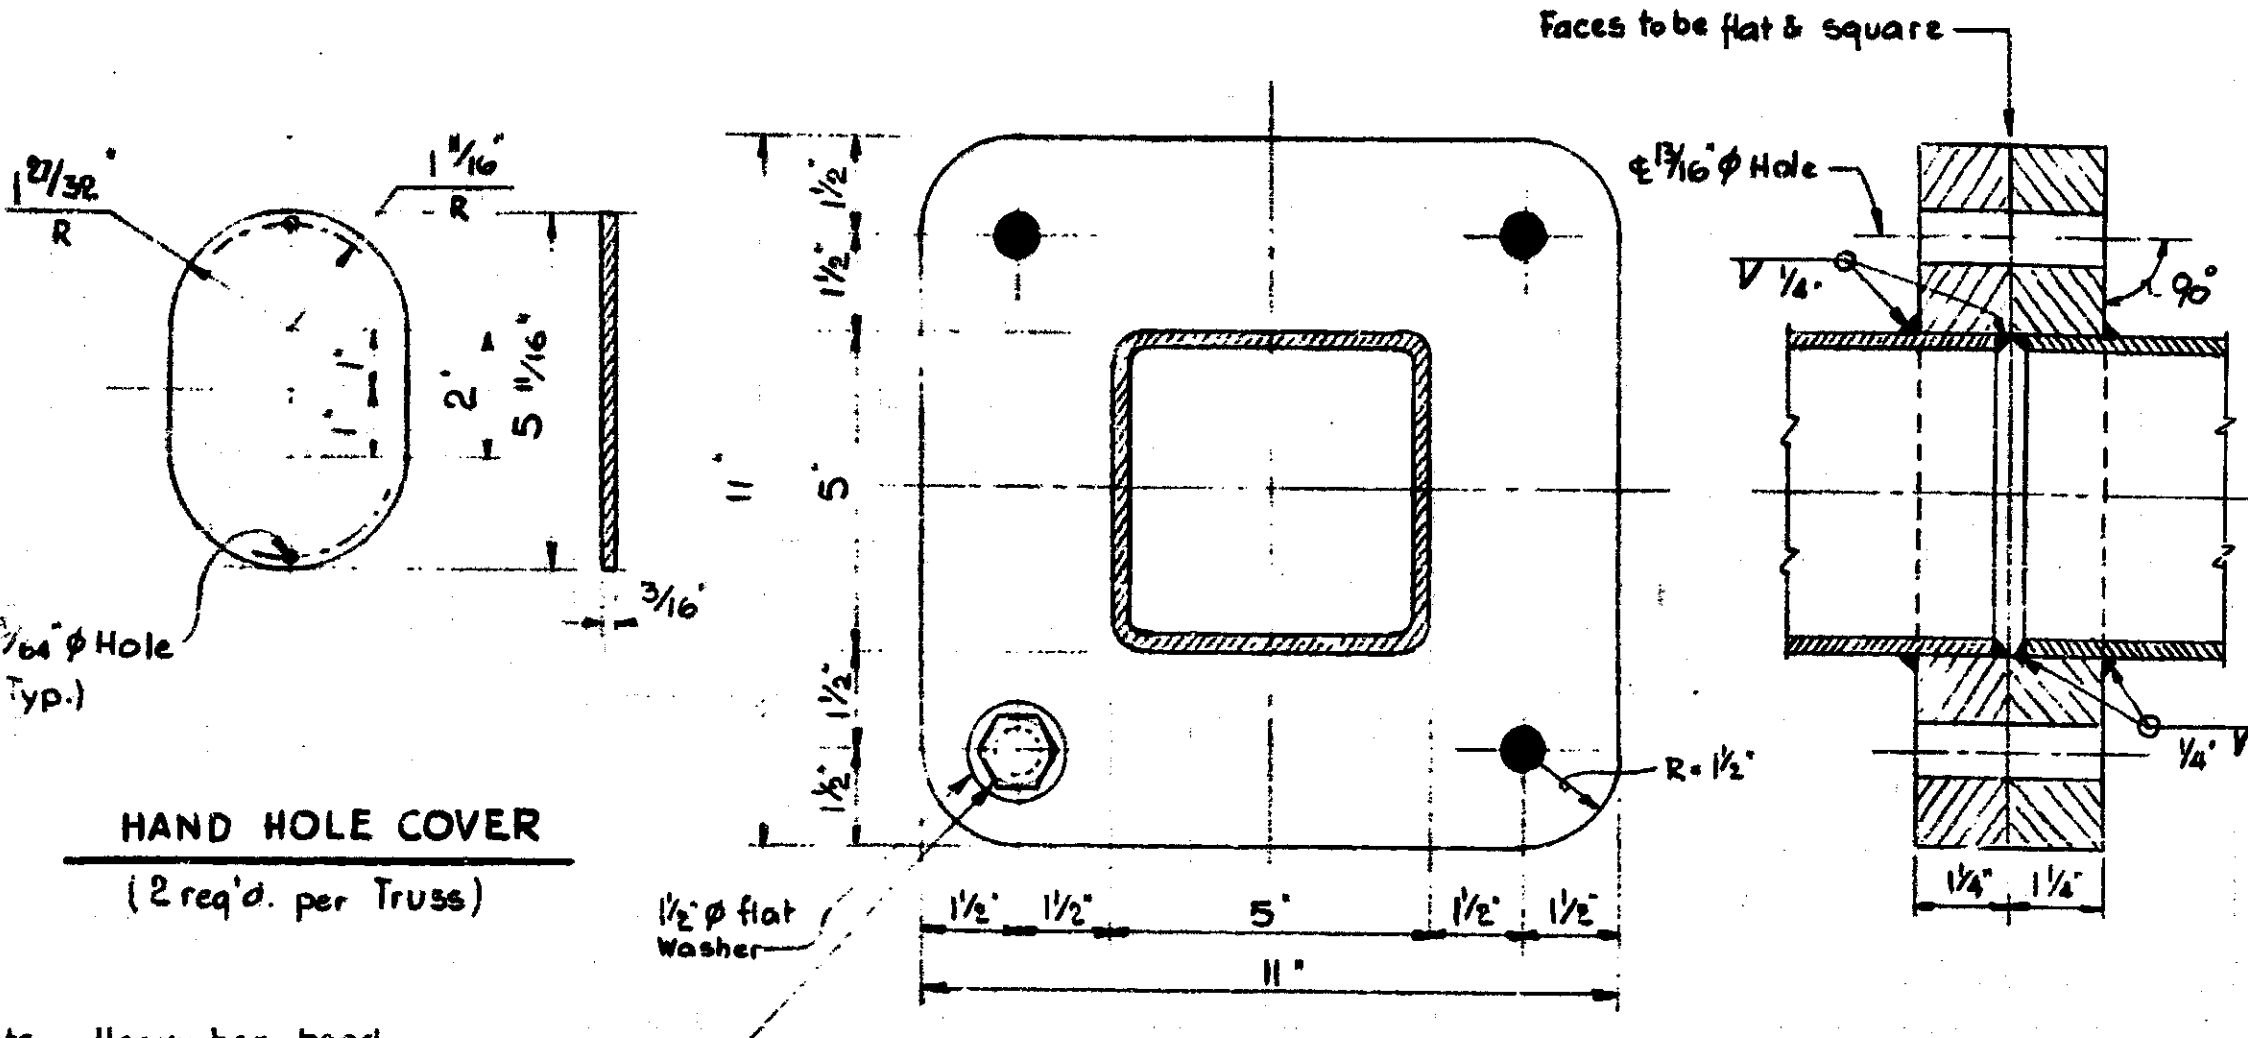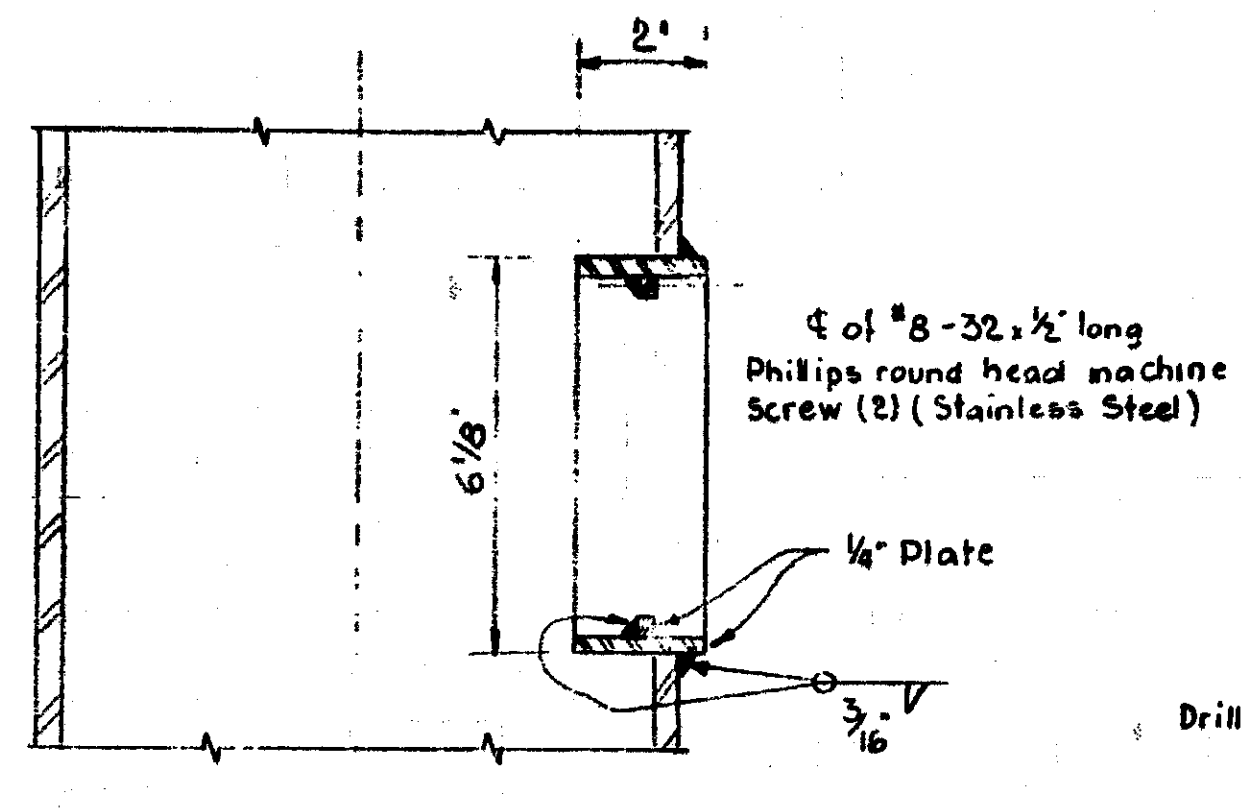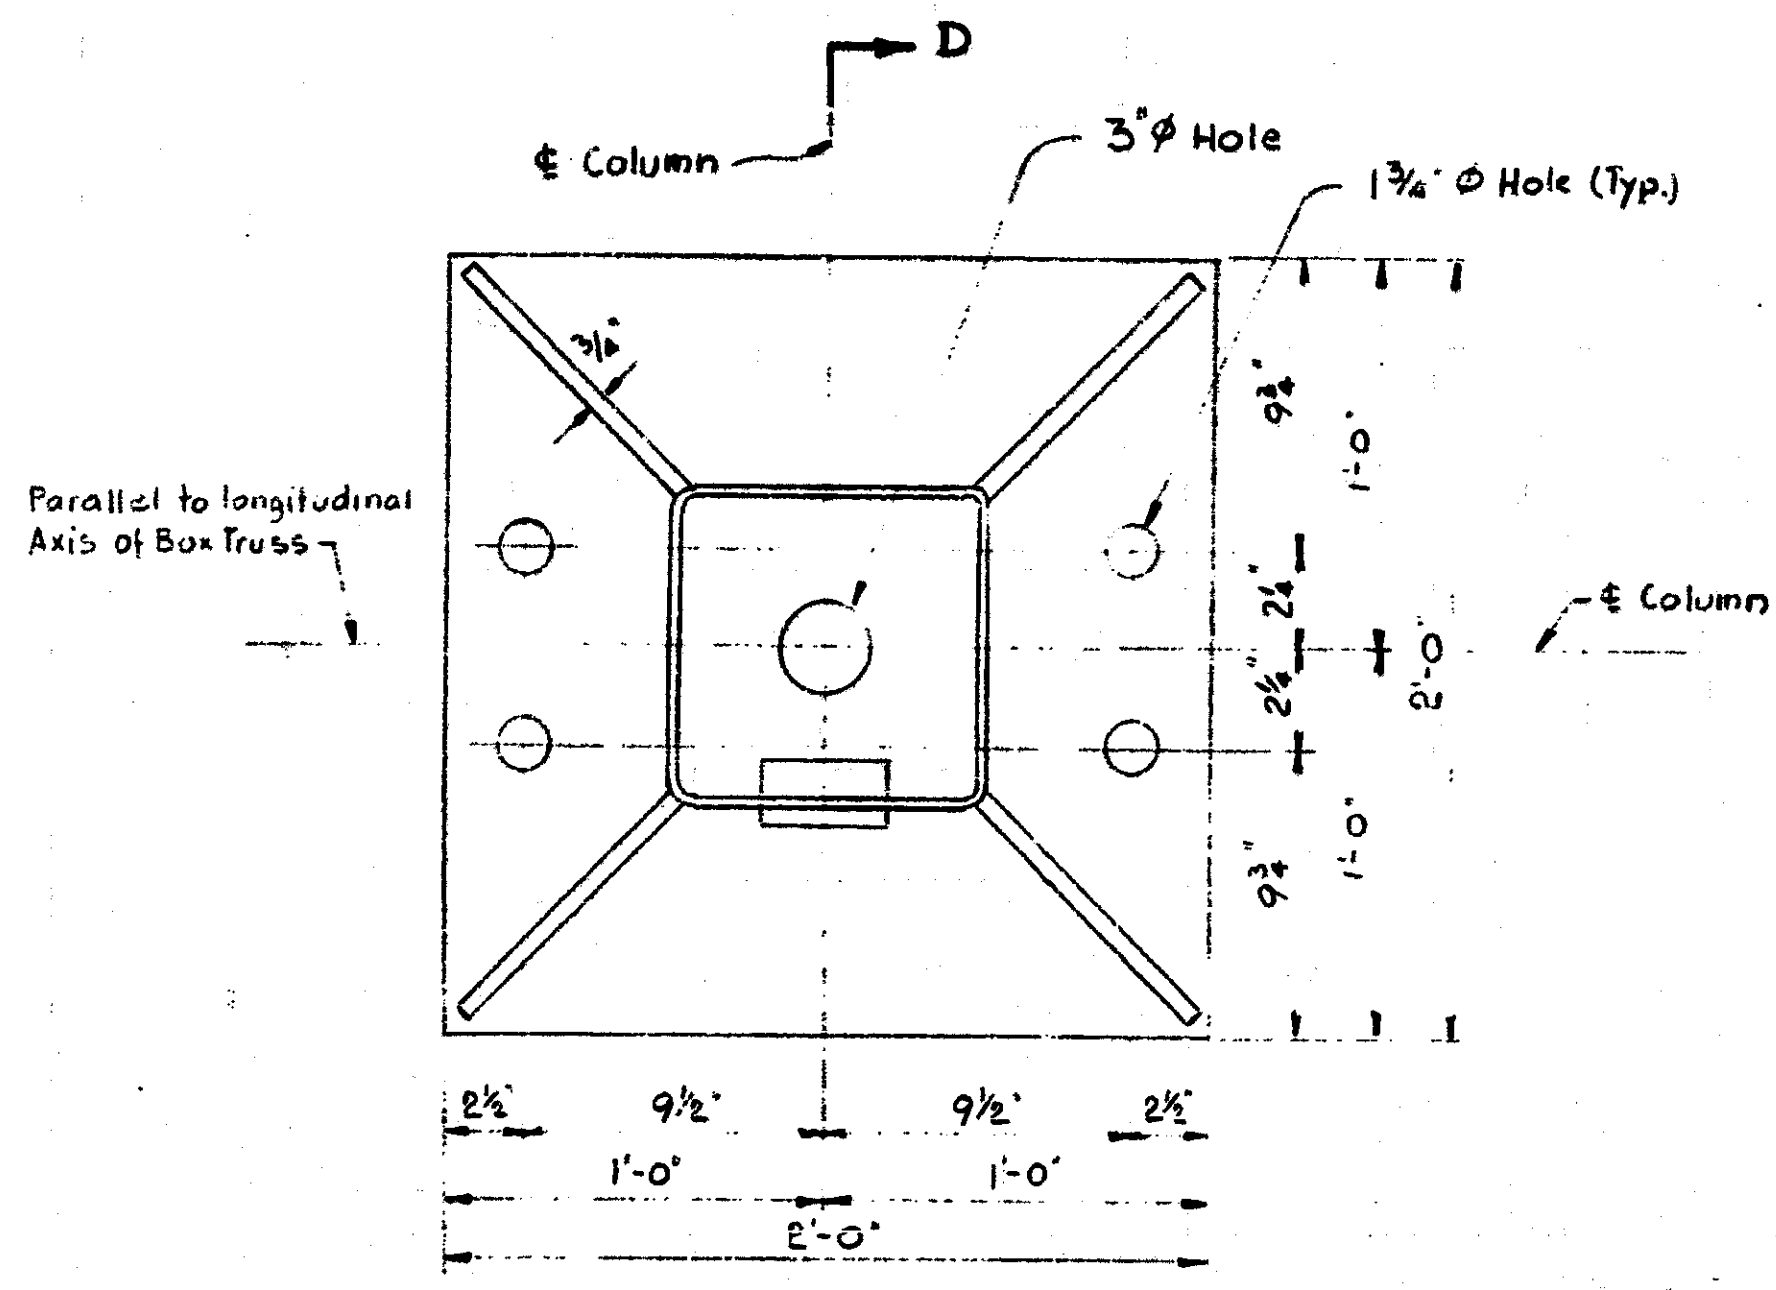

Work this sheet with sheets 4 & 6

MICHIGAN DEPARTMENT OF STATE HIGHWAYS


STEEL TRUSS TYPE C (100')

A-36 Galv.


NO.	REVISIONS	DATE	BY

ISSUED BY	BULLEN	5-9-77
DESIGNED BY	P. R. N.	11-10-76
CHECKED BY		


S785 11

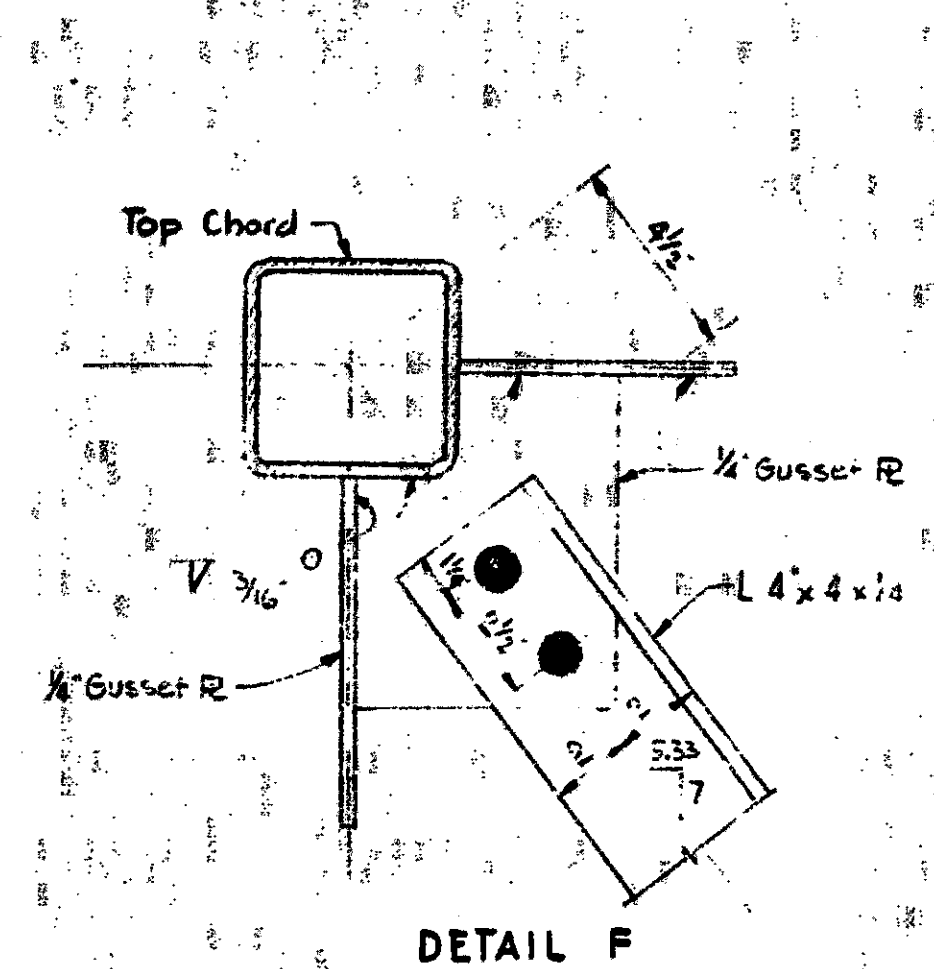


DETAIL F

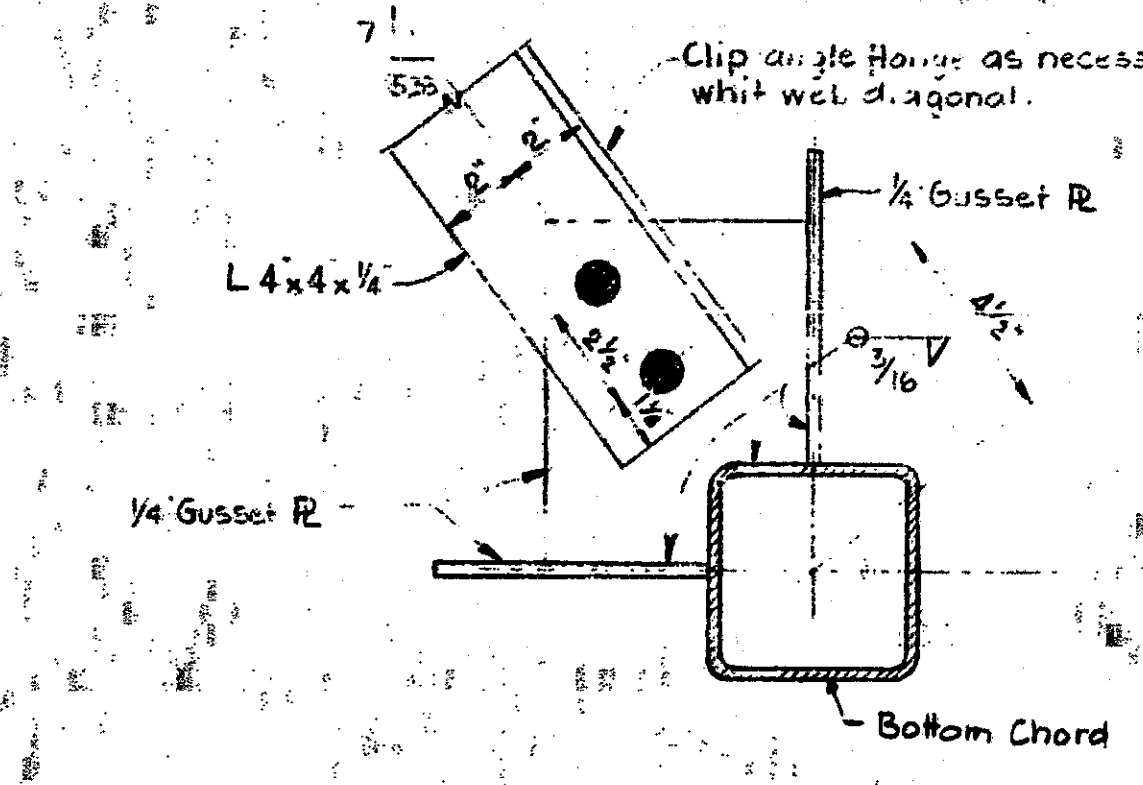


DETAIL G

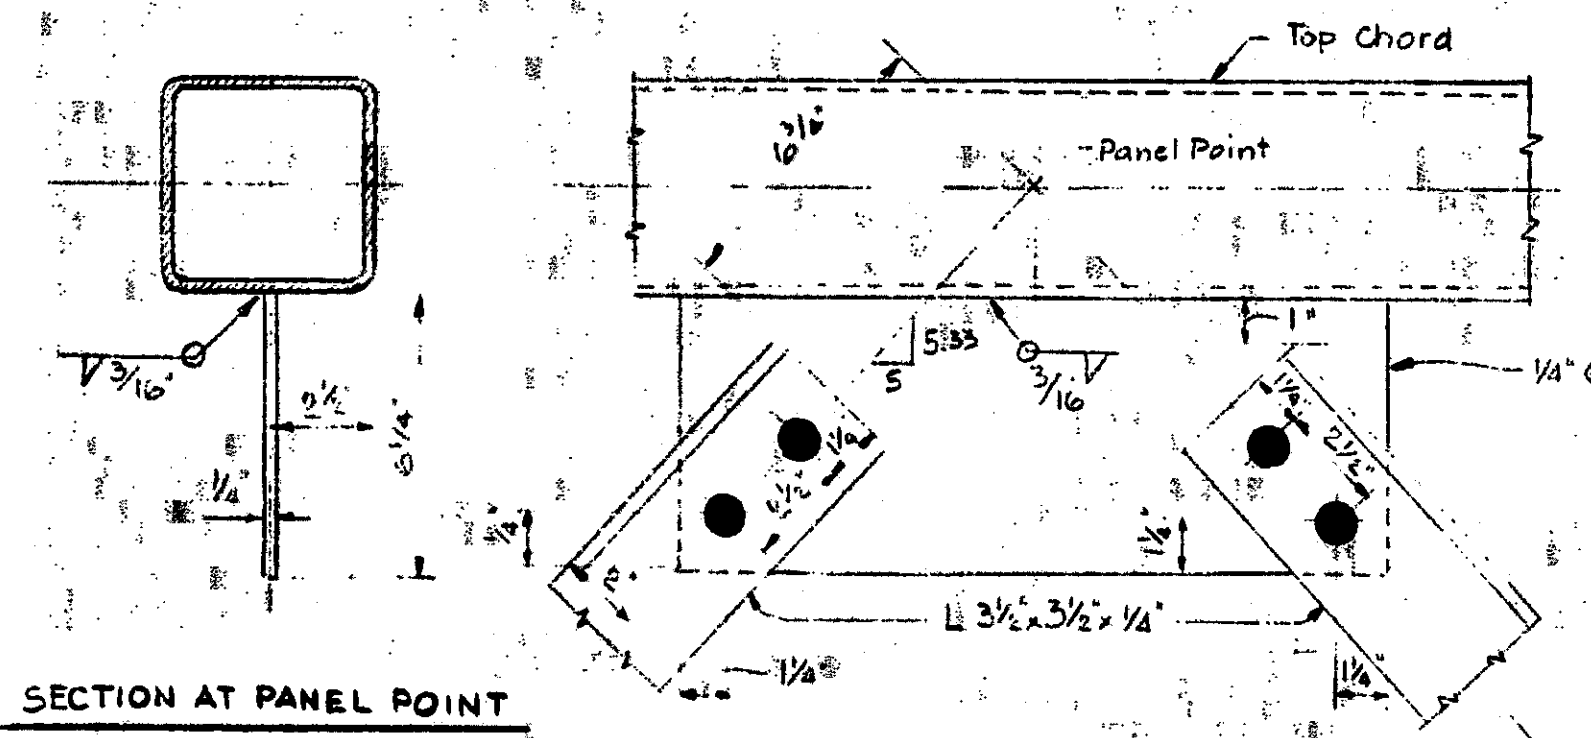


SECTION AT PANEL POINT
(Wind bracing gusset plate shown only)

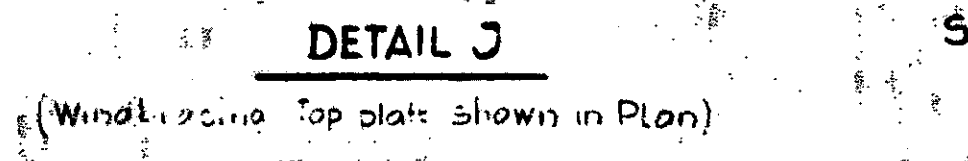


DETAIL J

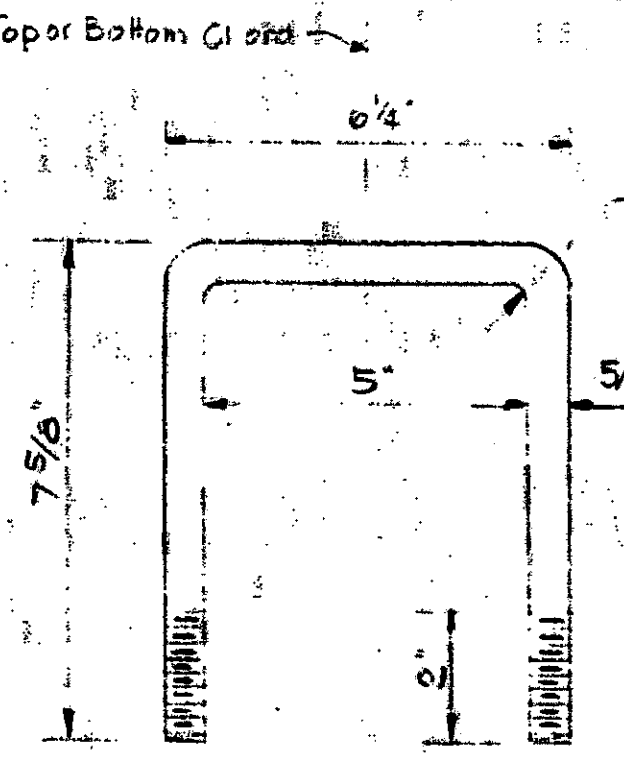


DETAIL OF 5/8" ϕ U-BOLT (12 Req'd.)
5/8" ϕ Bolt with flat 3/16" Washer and 3/8" ϕ Elastic Stop Nut (41-N2-120) (Typ)

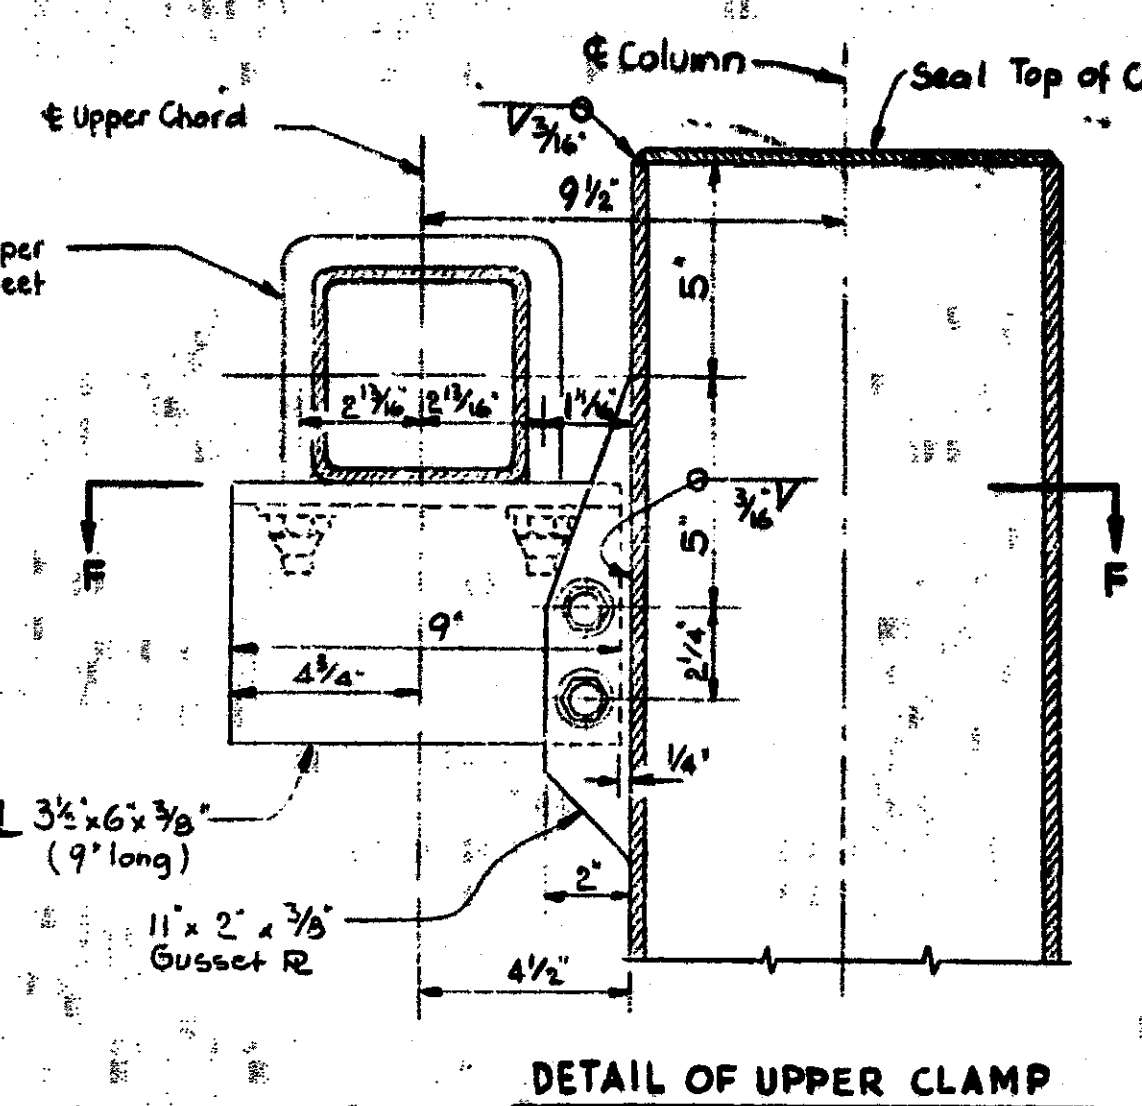


DETAIL OF UPPER CLAMP

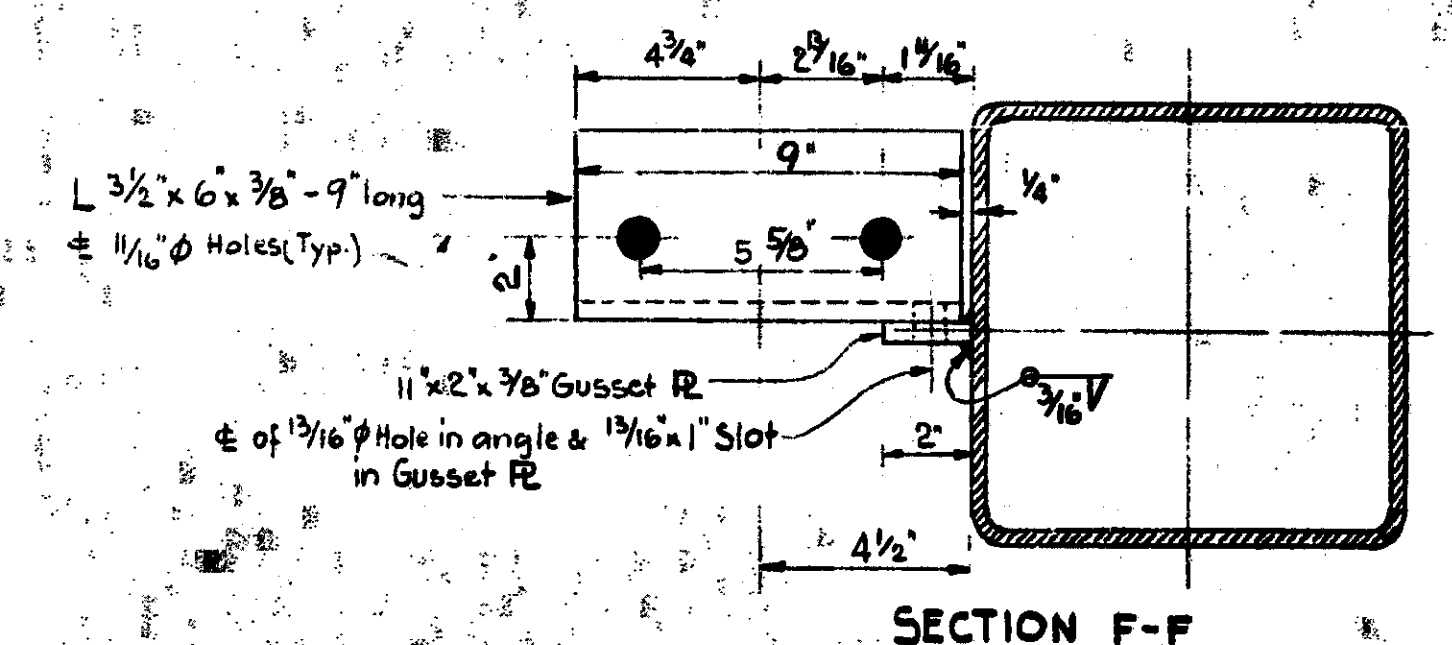


SECTION F-F

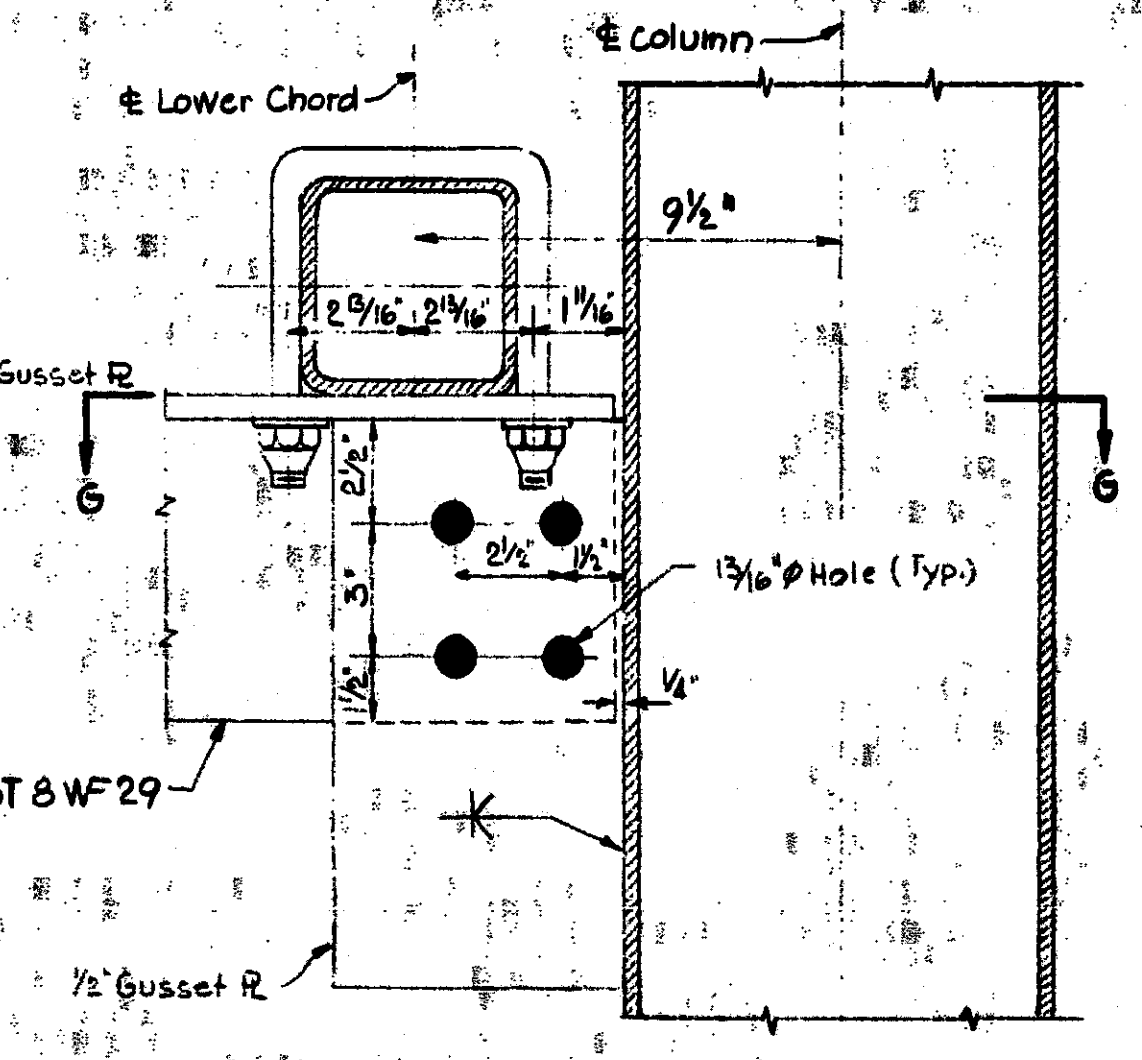


DETAIL OF SEAT (With no Diagonal shown)

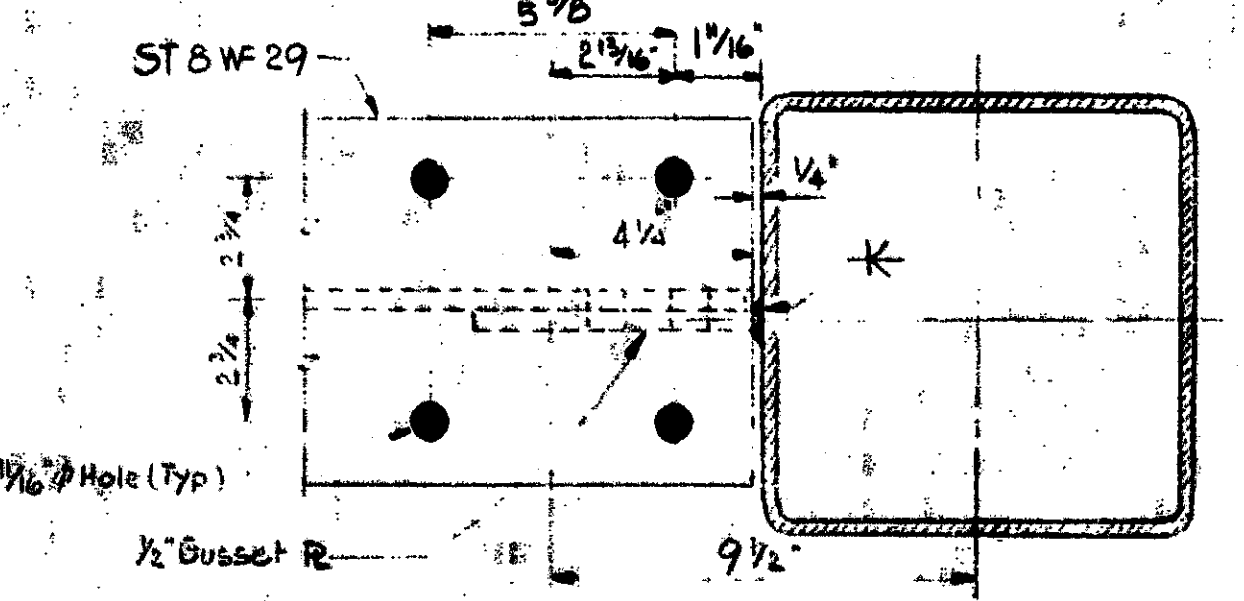


SECTION G-G

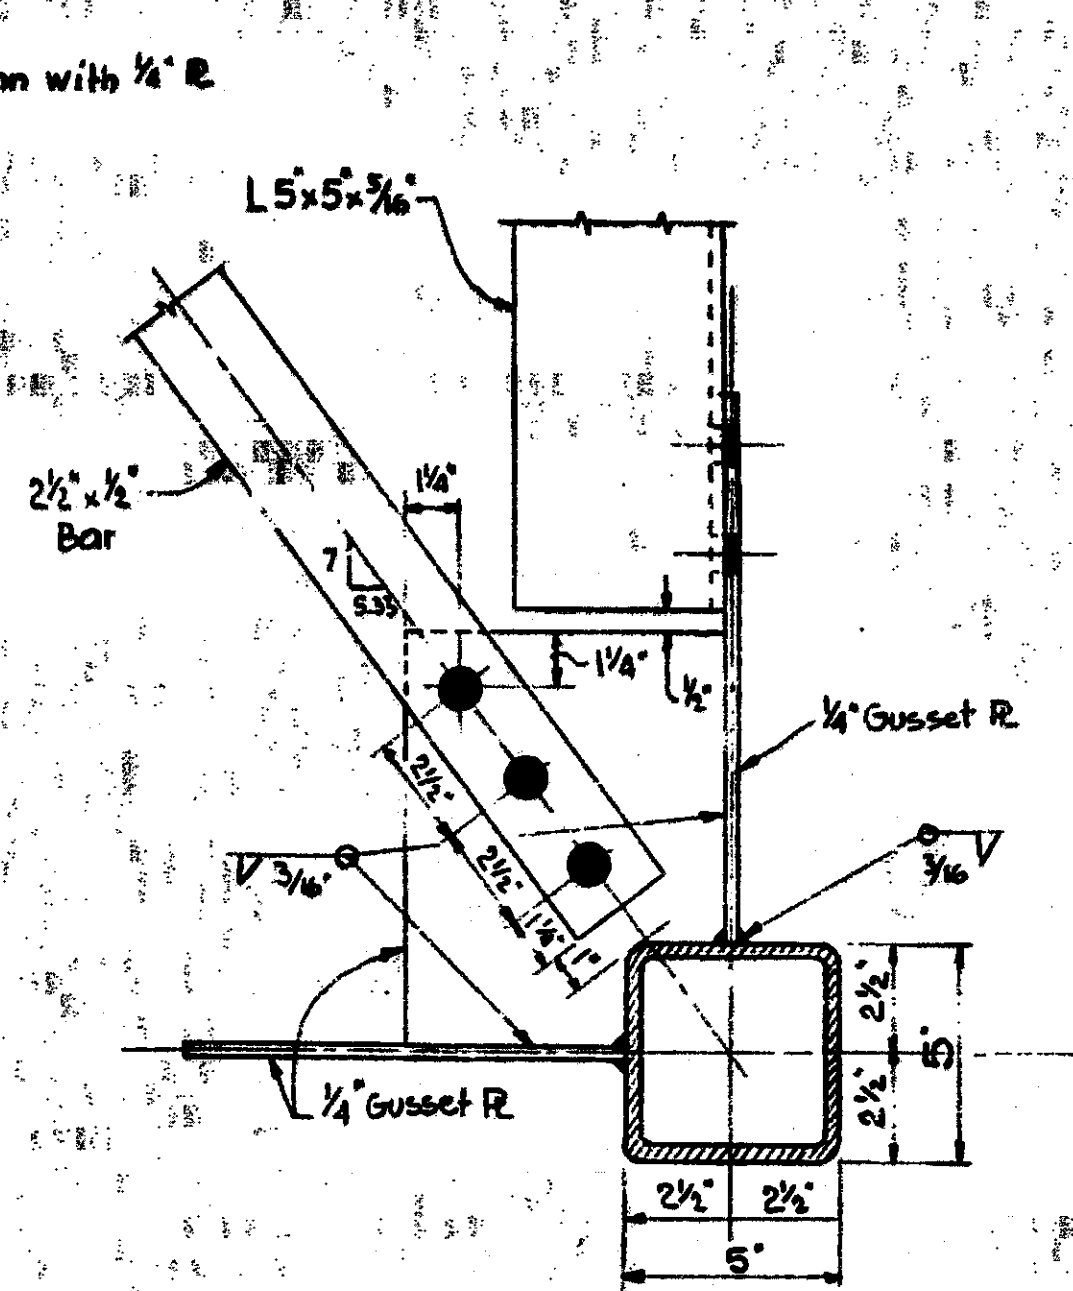


DETAIL M

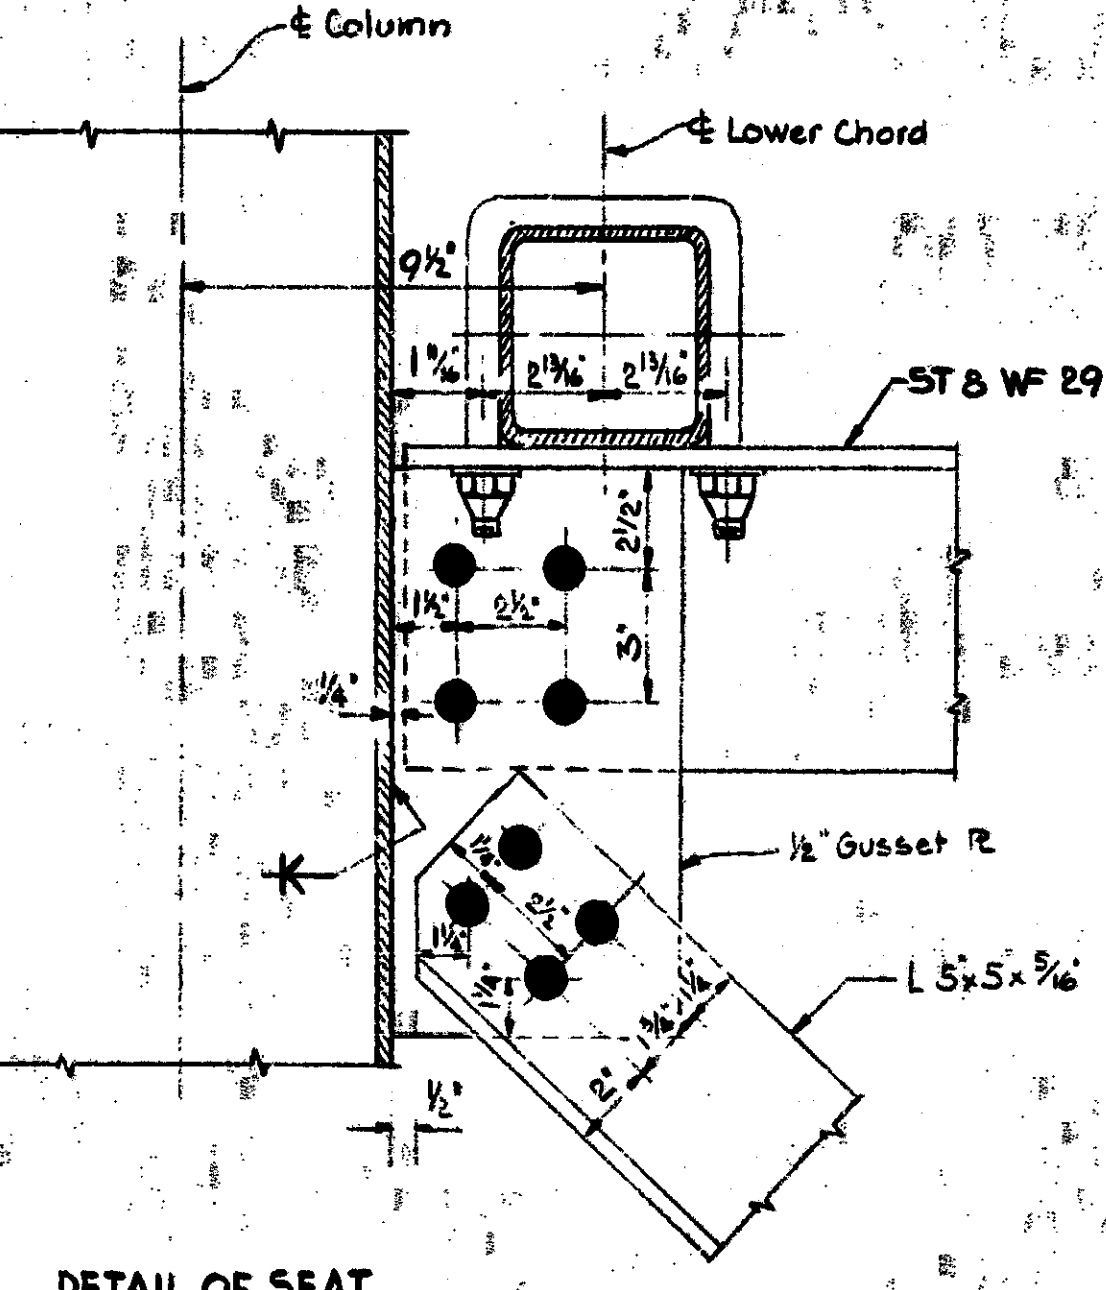

DETAIL OF SEAT (With Diagonal shown)

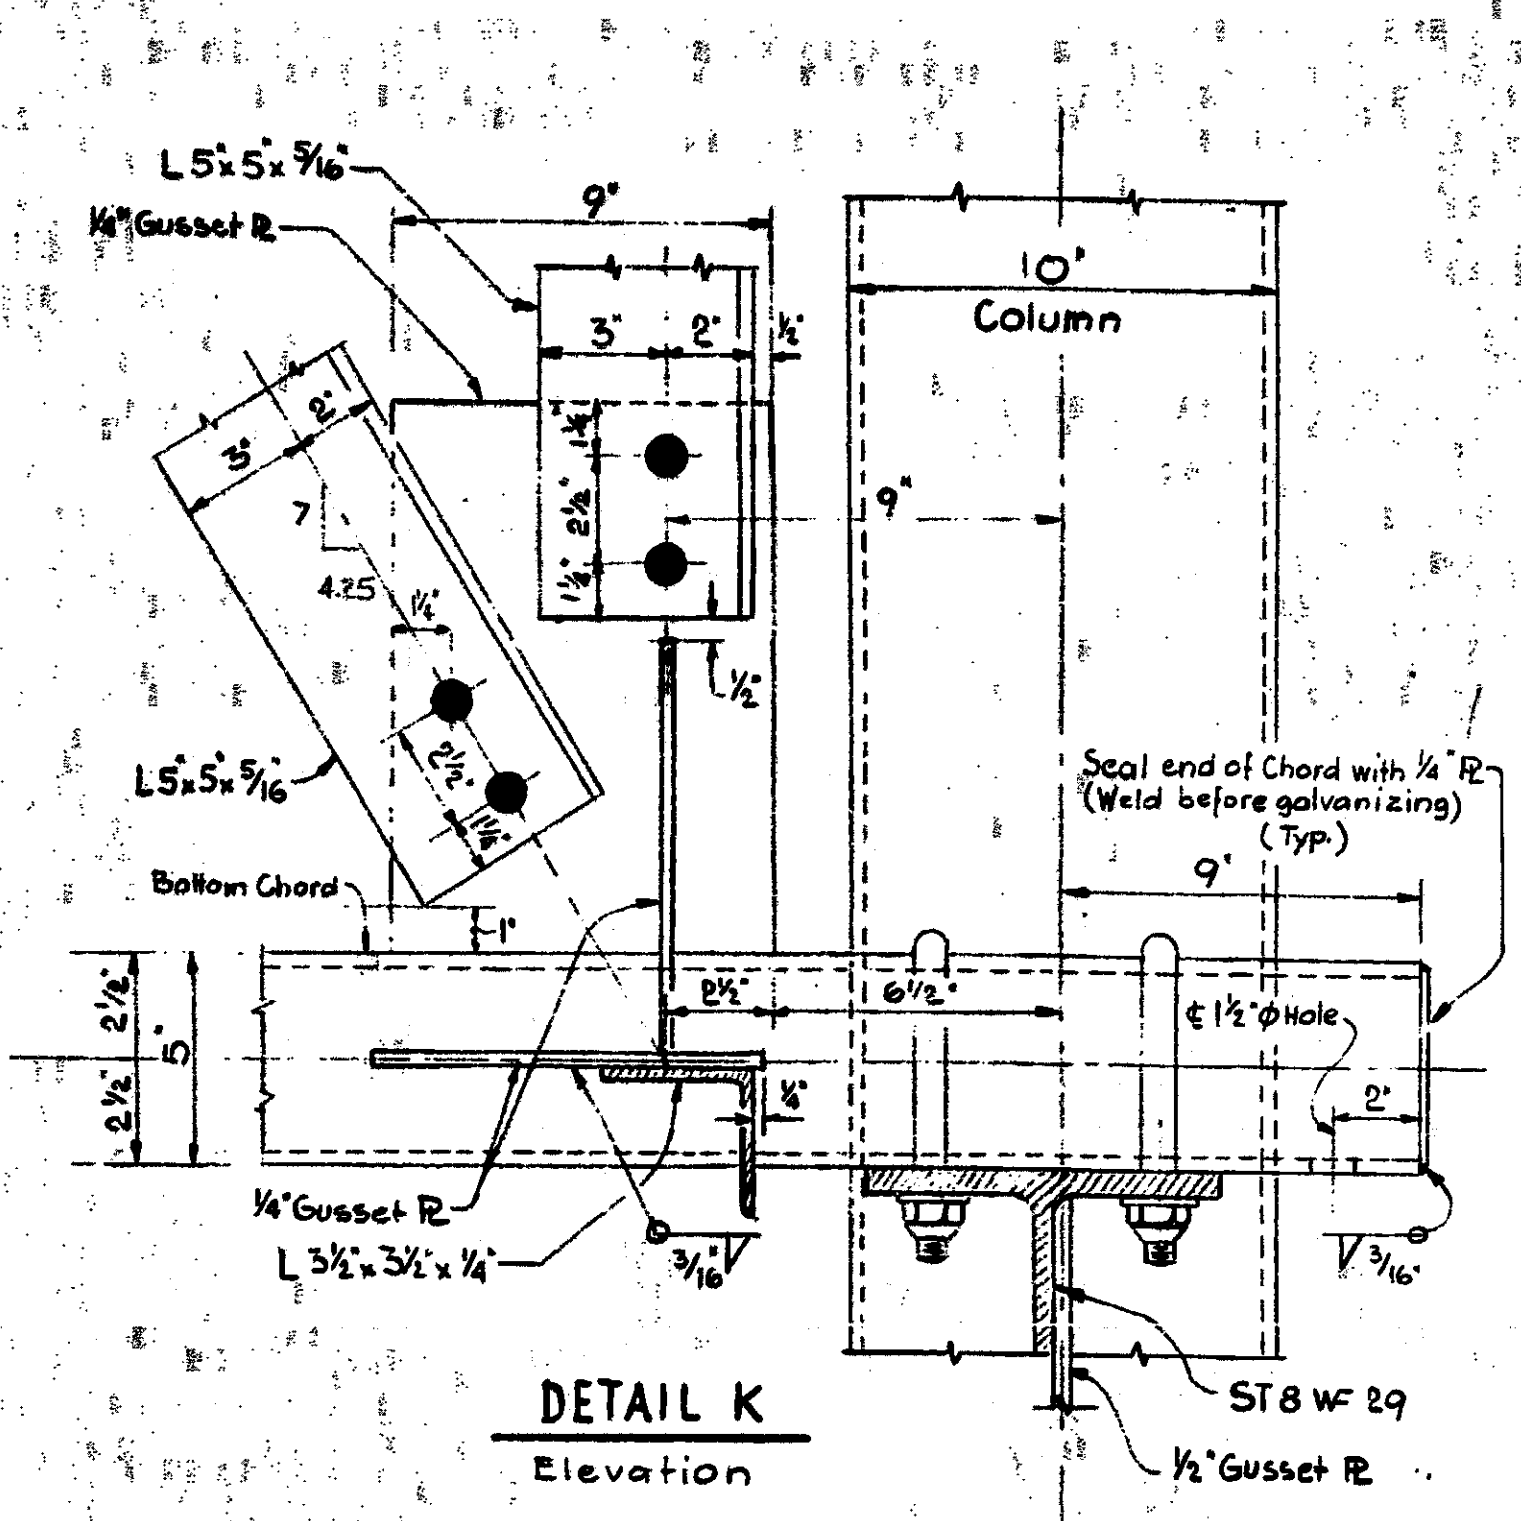

DETAIL K
Elevation

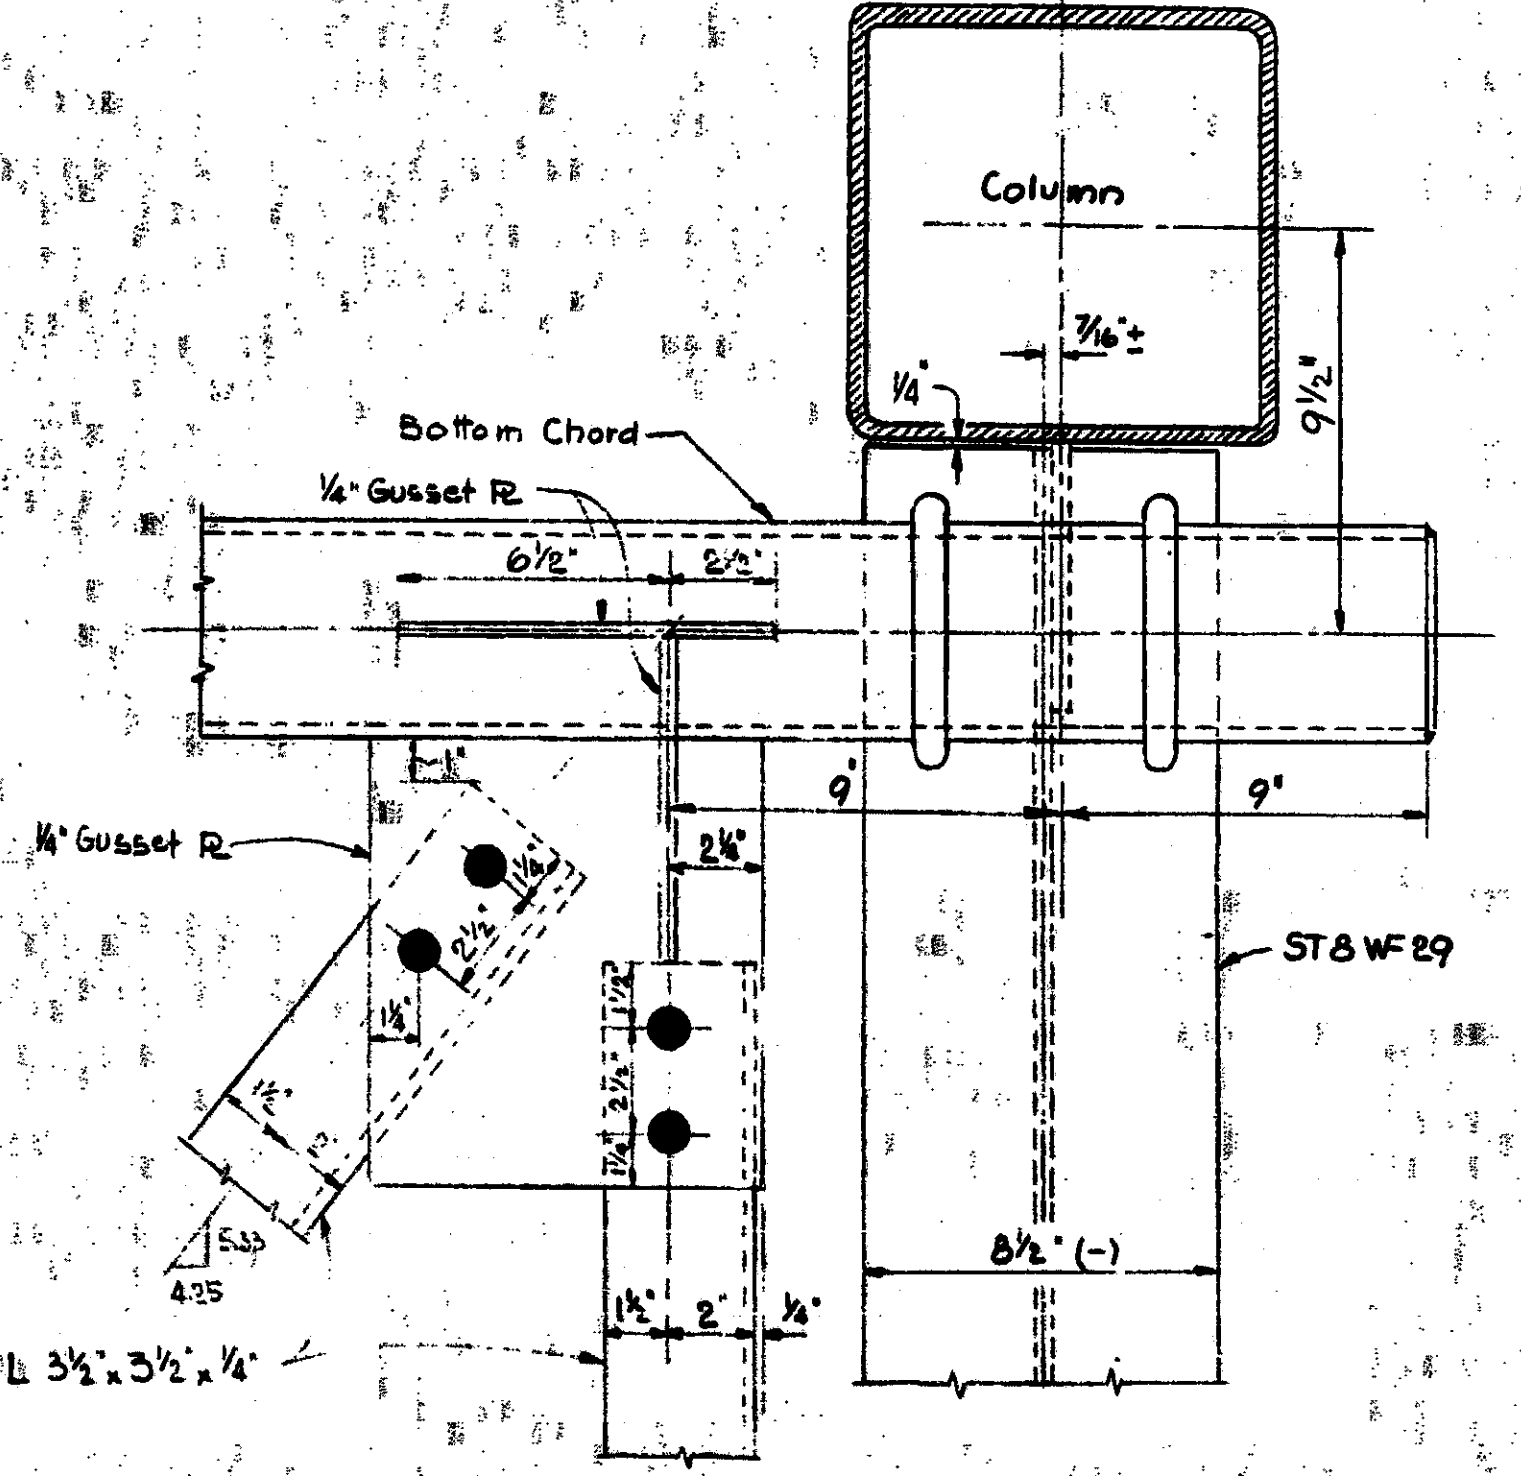

DETAIL L
Bottom Wind bracing Plan

NOTE All bolt holes are 13/16" ϕ except as indicated.

Work this sheet with sheets 84 & 5

MICHIGAN DEPARTMENT OF STATE HIGHWAYS

STEEL TRUSS TYPE C (100')





A-36 Galv.

NO.	REVISIONS	DATE	BY

ISSUED BY: PRN 11-15-76


DESIGNED BY: G. W. P. 6-1-76

5786 35

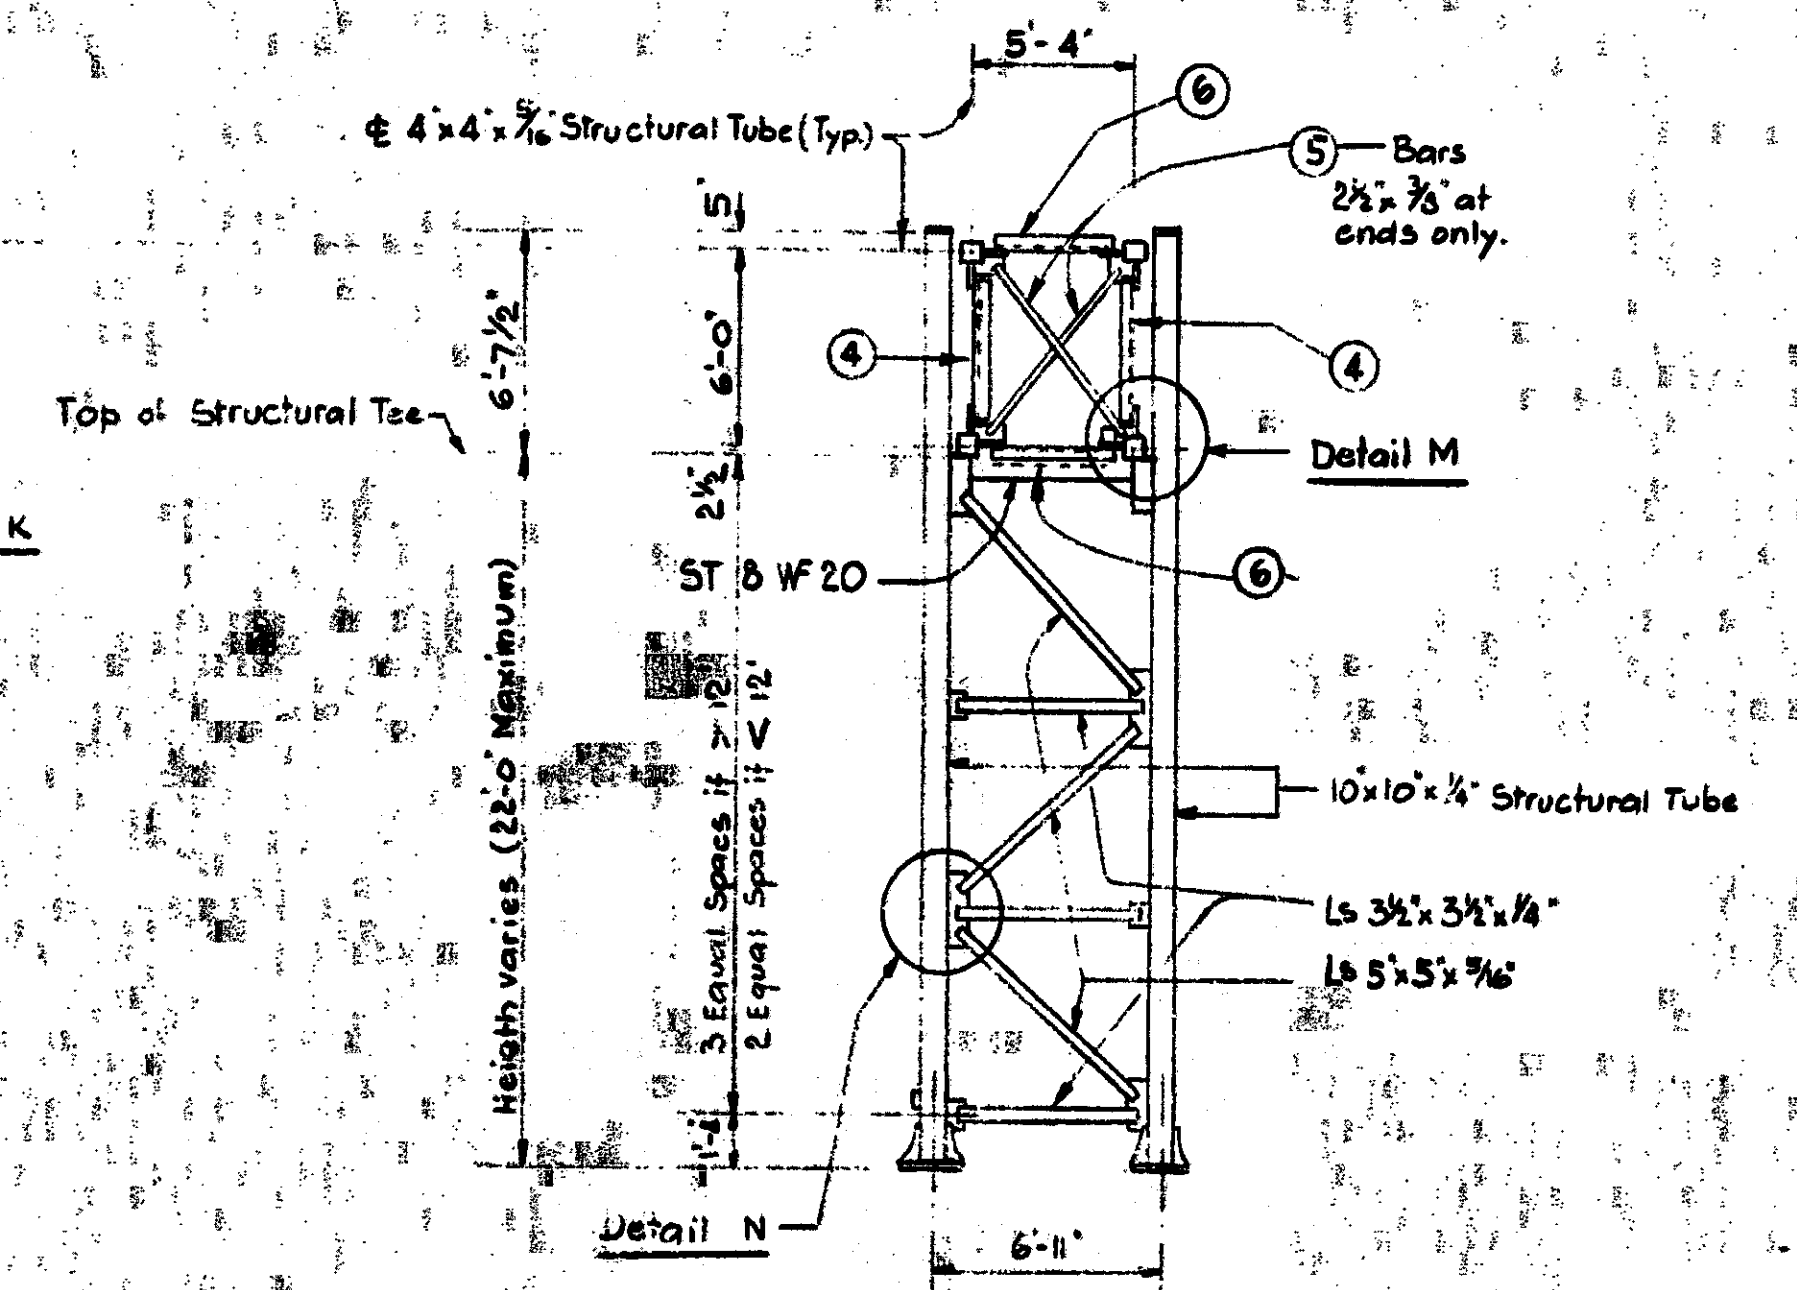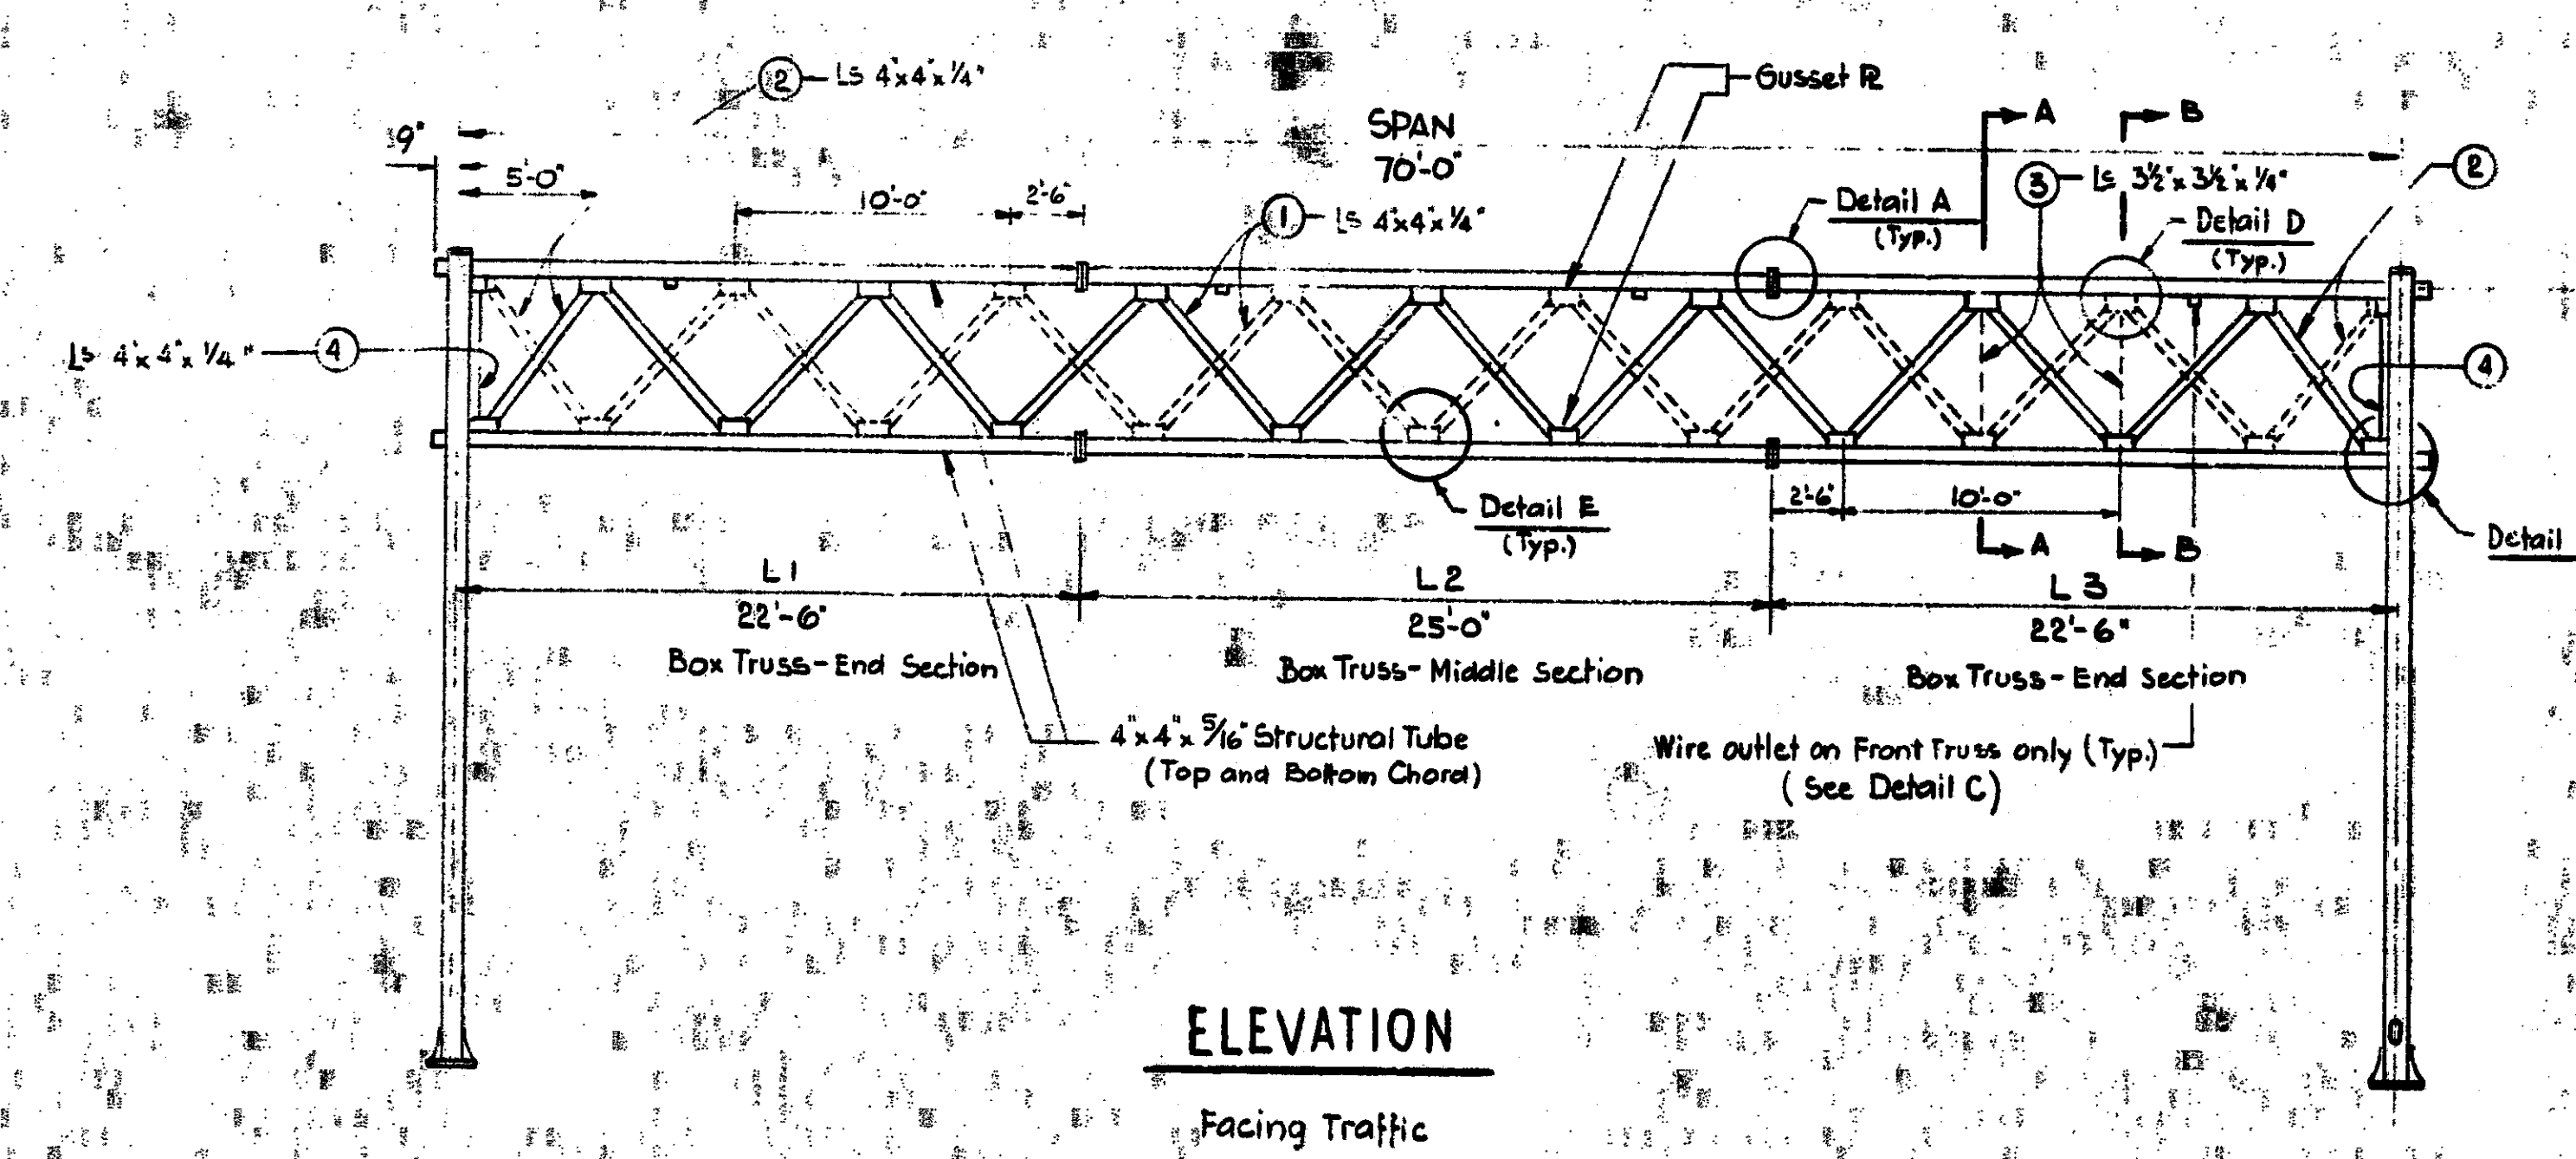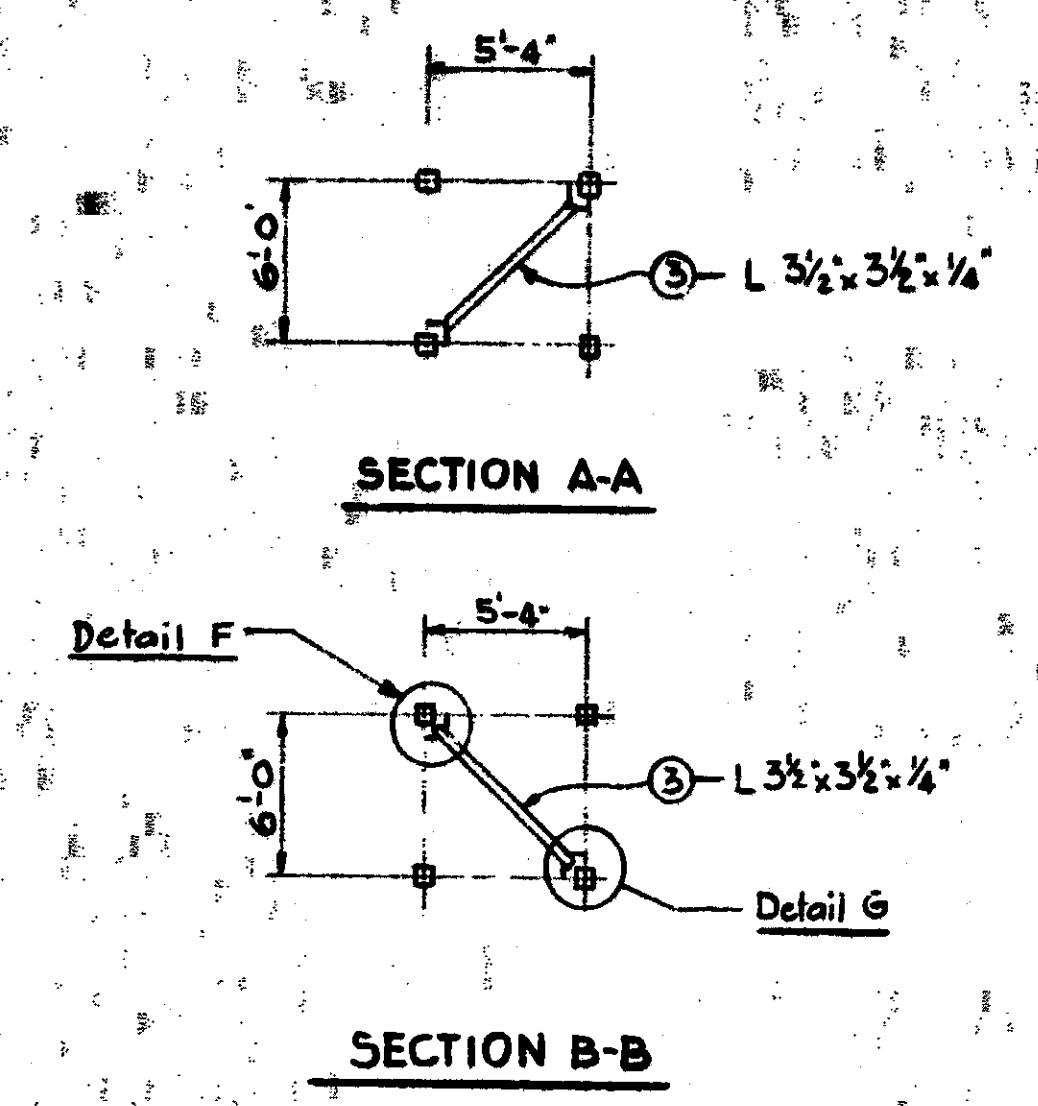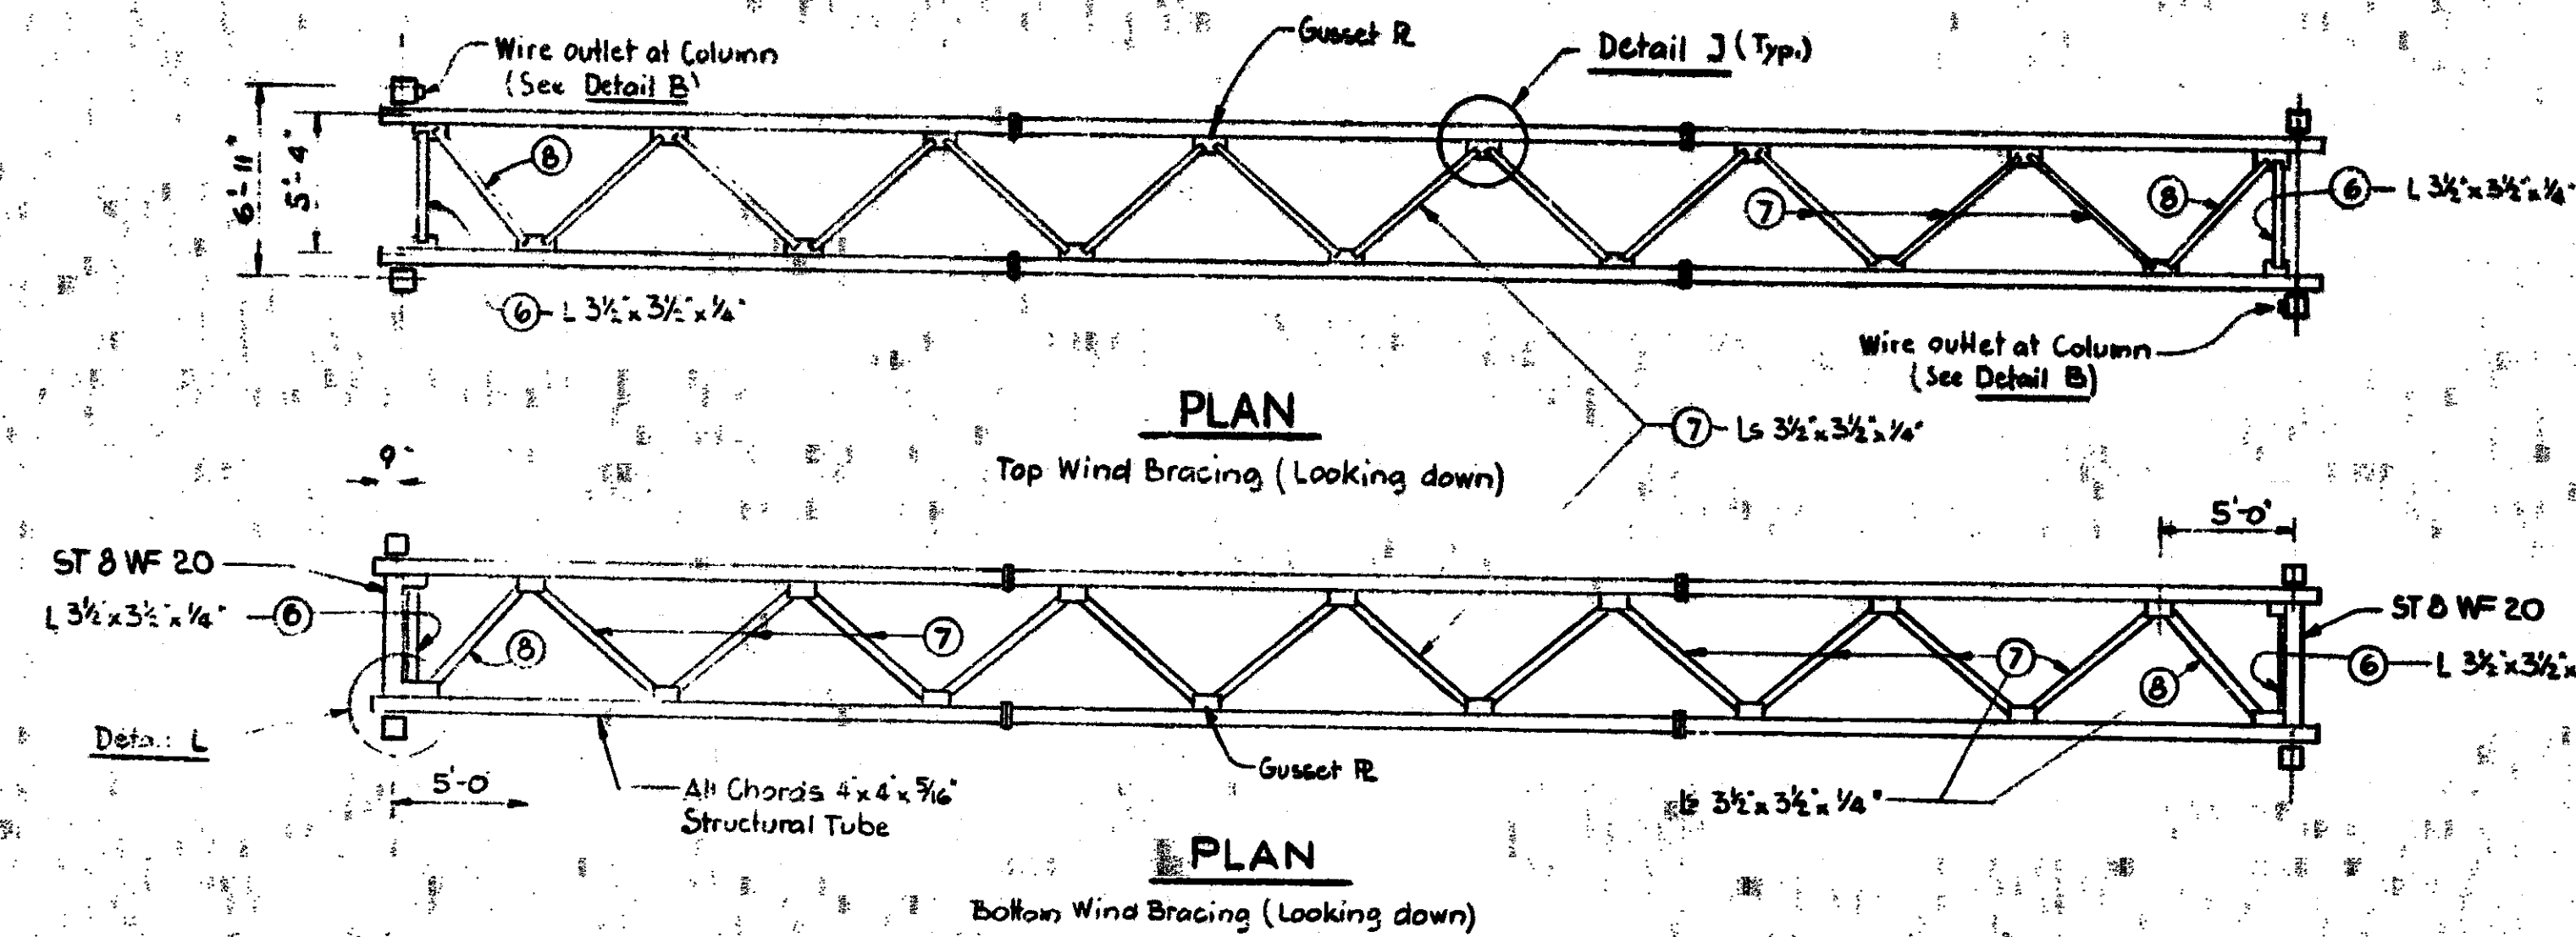

TRUSS DATA - A-36 Galv.					
SPAN	L1	L2	L3	CAMBER	BOX TRUSS
50'-0"	17'-6"	15'-0"	17'-6"	5/8"	6'-0" x 5'-4"
55'-0"	17'-6"	20'-0"	17'-6"	3/4"	6'-0" x 5'-4"
60'-0"	22'-6"	15'-0"	22'-6"	7/8"	6'-0" x 5'-4"
65'-0"	22'-6"	20'-0"	22'-6"	1"	6'-0" x 5'-4"
70'-0"	22'-6"	25'-0"	22'-6"	1"	6'-0" x 5'-4"


CAMBER The camber given in the above table is the ordinate at the center of the assembled truss prior to dead load deflection. Allowable camber tolerance for truss is 25%.

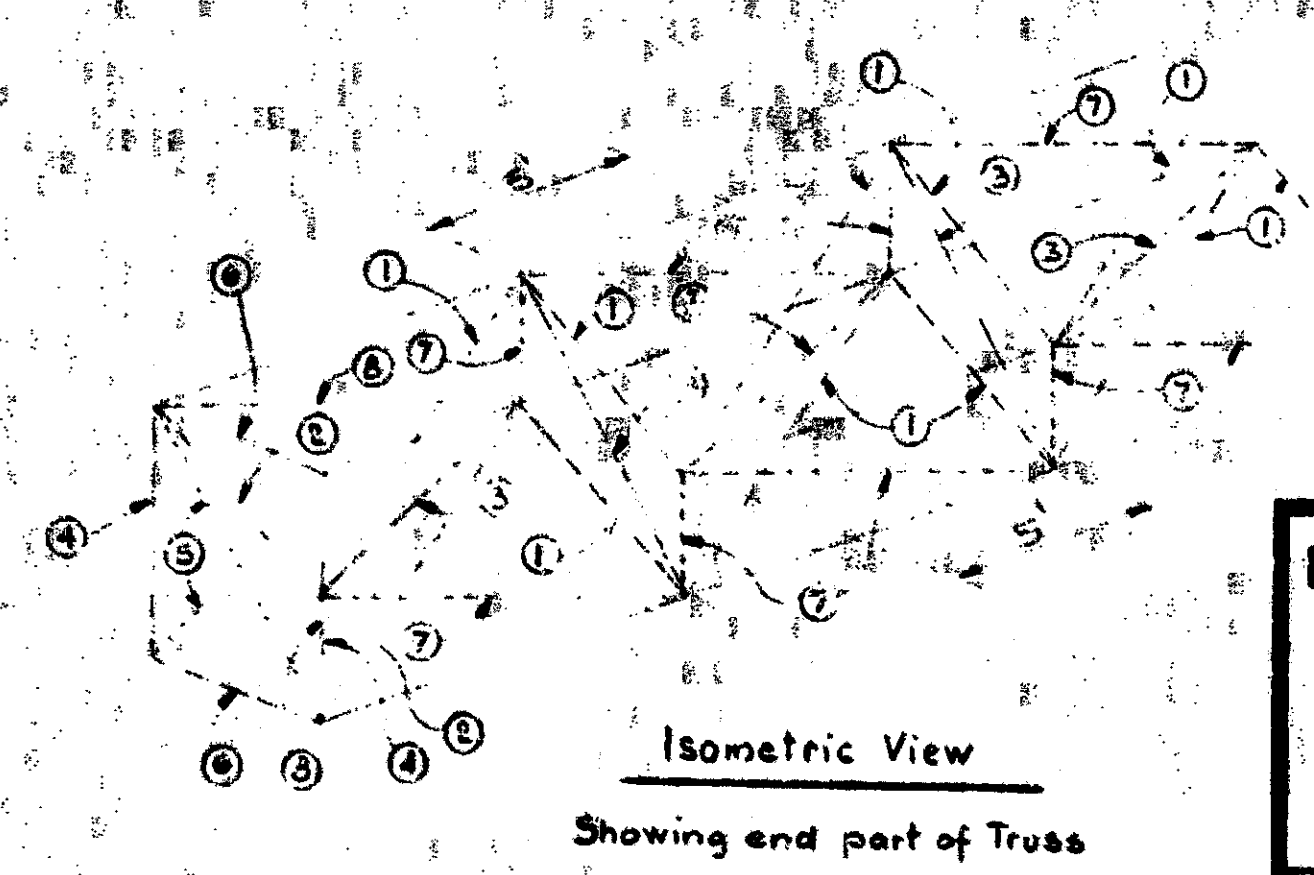


For Notes see sheet 1 of Steel Truss Type D
Work this sheet with sheet a 3 9

MICHIGAN DEPARTMENT OF STATE HIGHWAYS
STEEL TRUSS TYPE C (10)
A-36 Galv.


REVISIONS		
NO.	DESCRIPTION	DATE

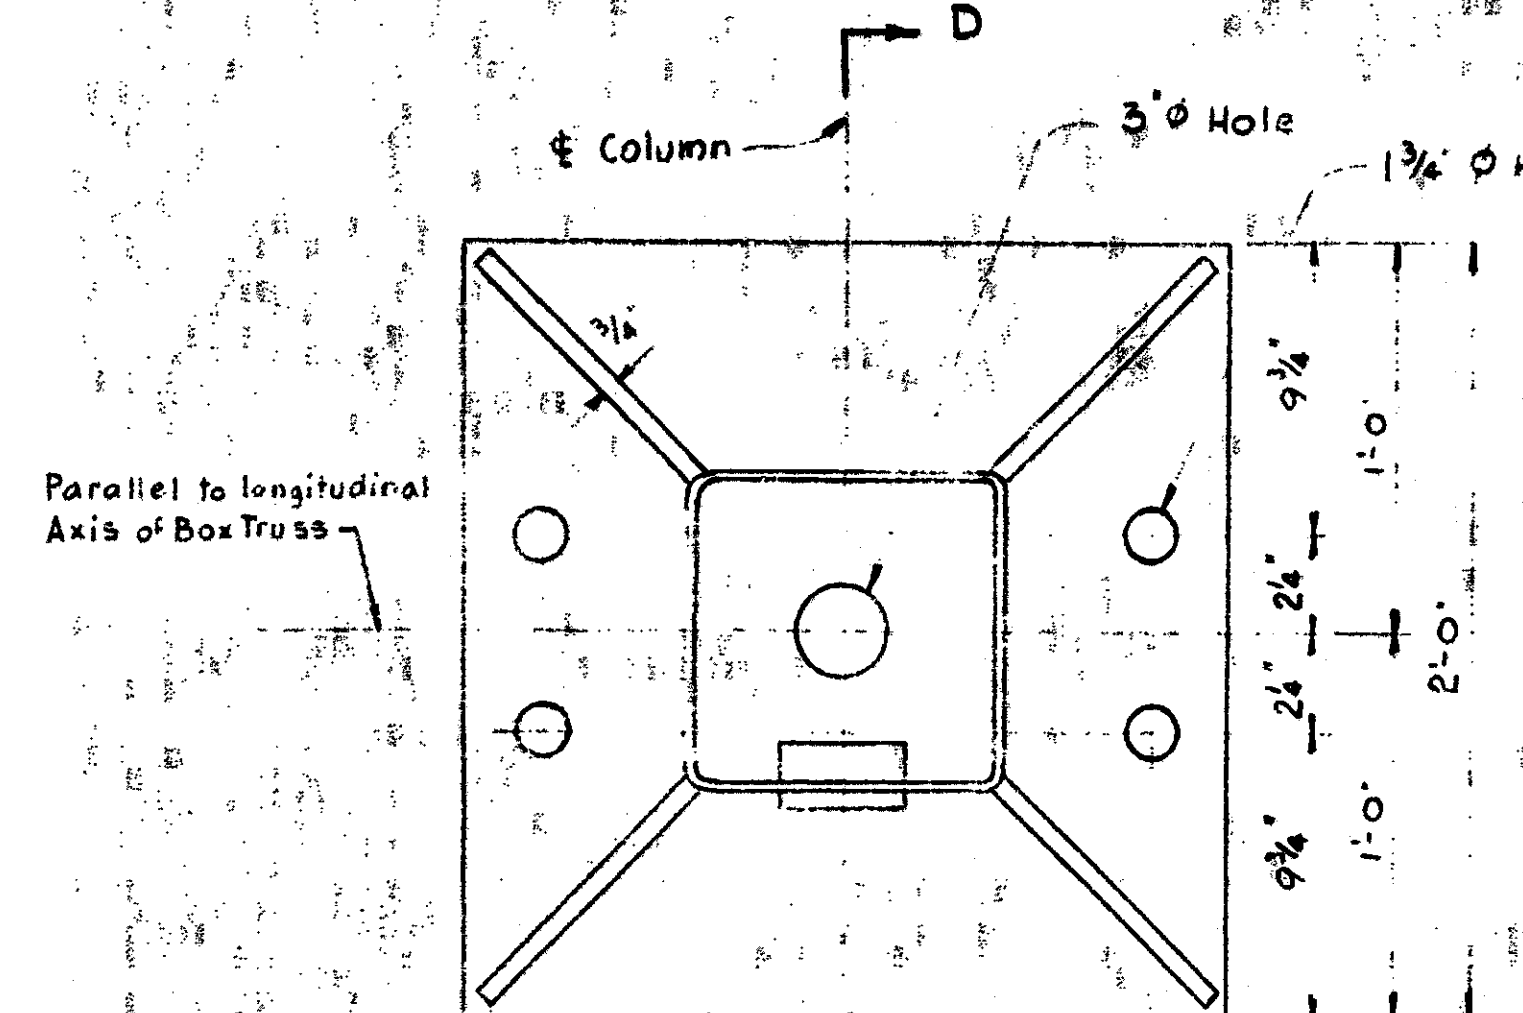


SECTION C-C

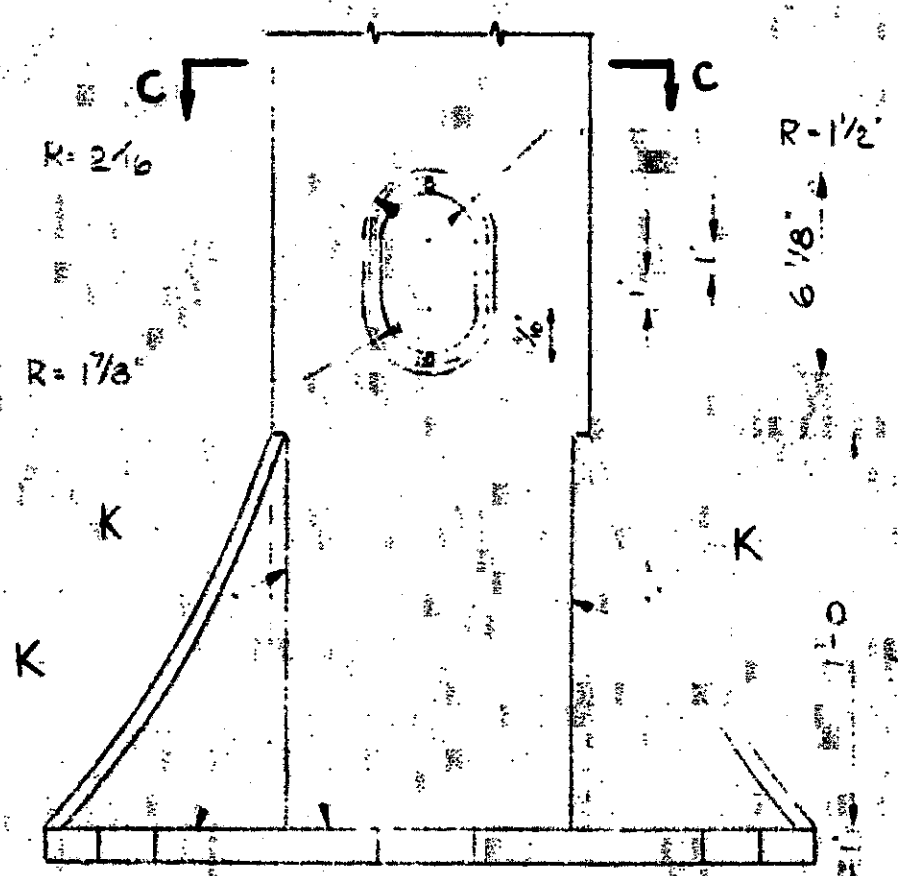


FRONT ELEVATION

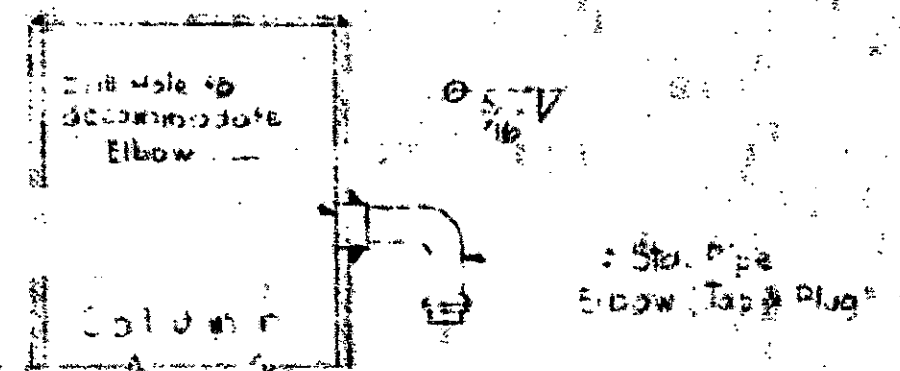


DETAIL B

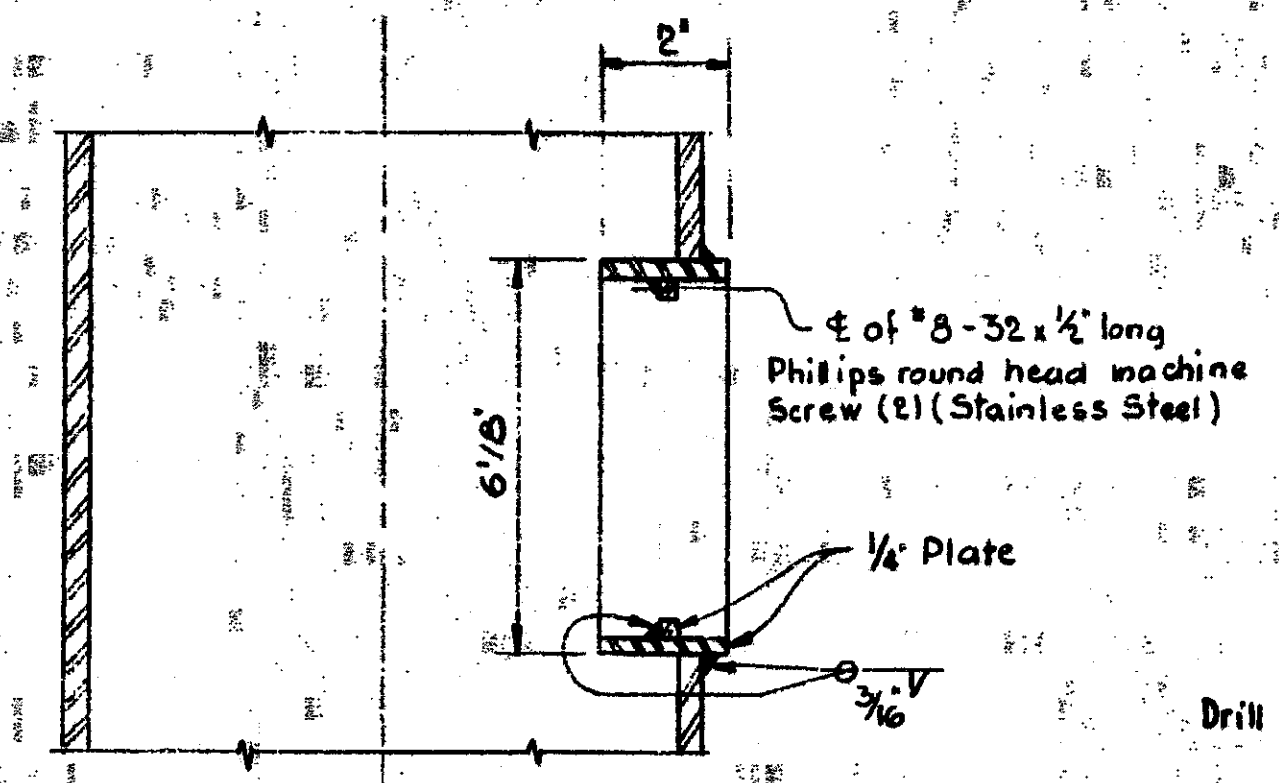


SECTION D-D

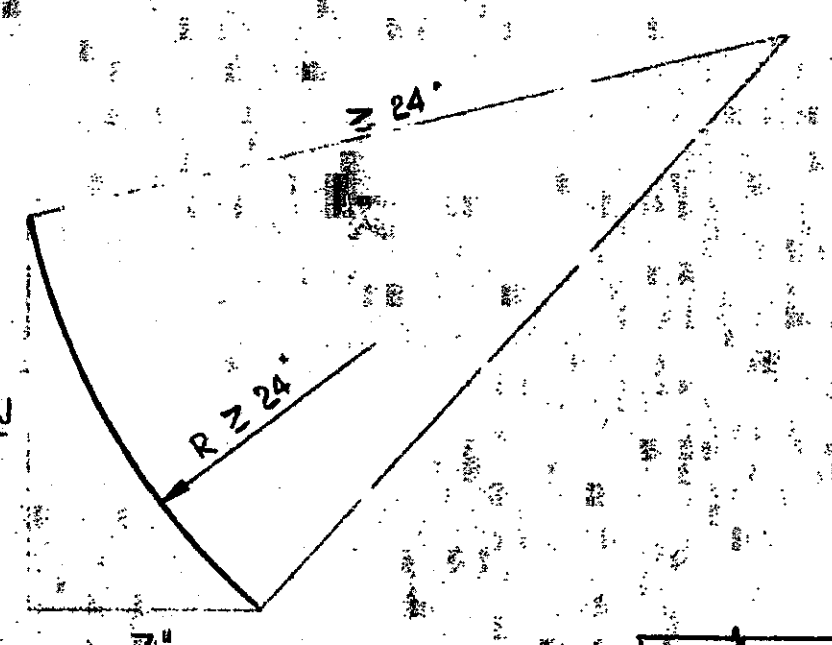

DETAIL R

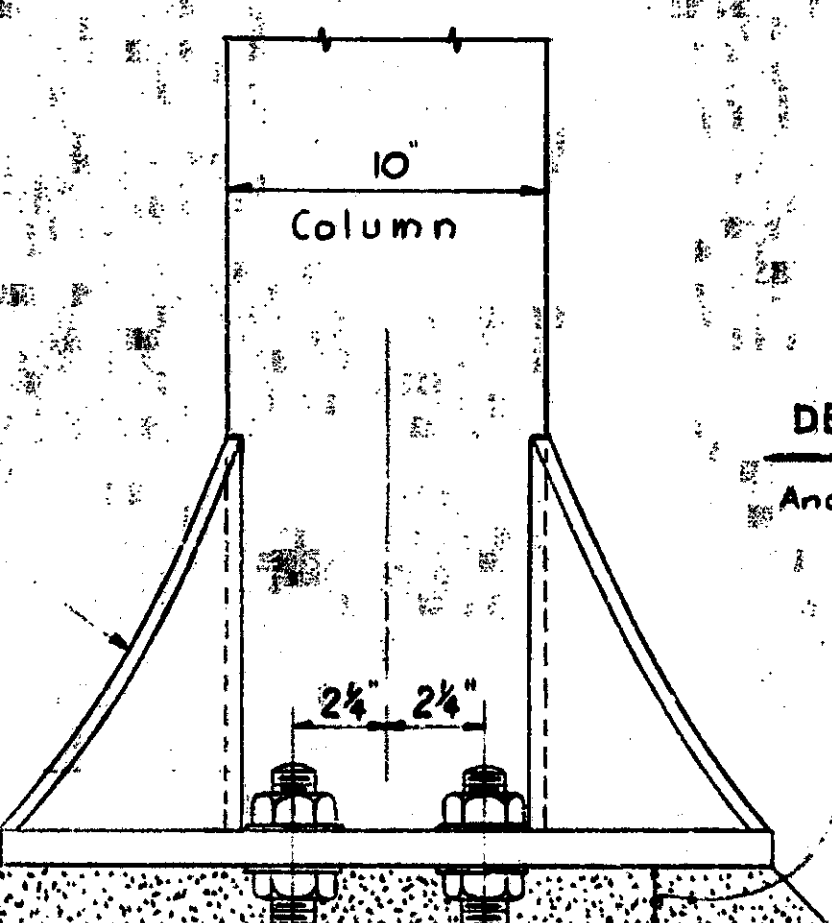


DETAIL OF BASE-LEVELING NUTS

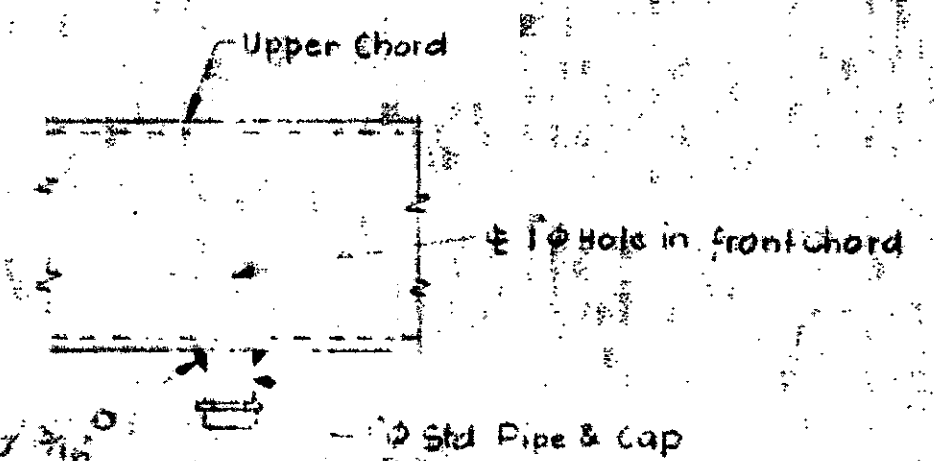


DETAIL C

Detail of electrical outlet at upper chord only

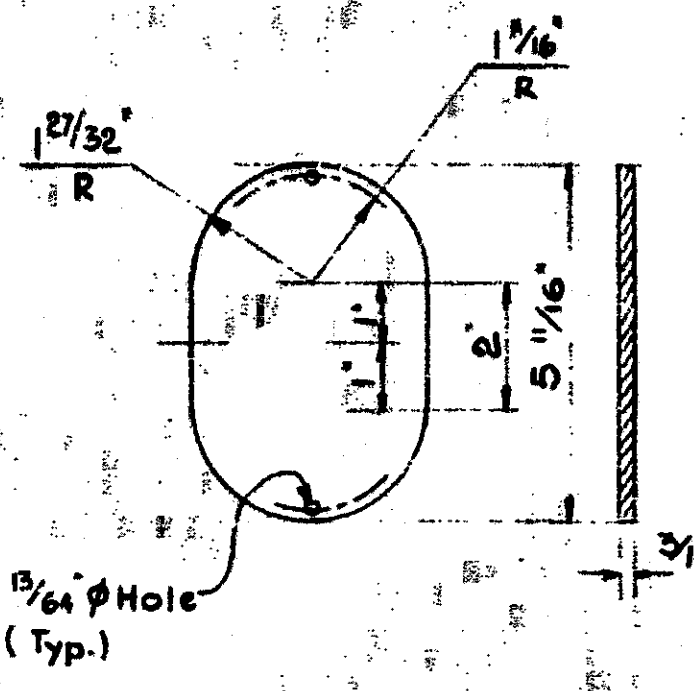


HAND HOLE COVER
(2 req'd. per Truss)

Nuts: Heavy hex head galvanized 32 req'd per Truss.
Washers: 2 per Anchor Bolt 1/2 inch diameter Standard flat galvanized 32 req'd per Truss.

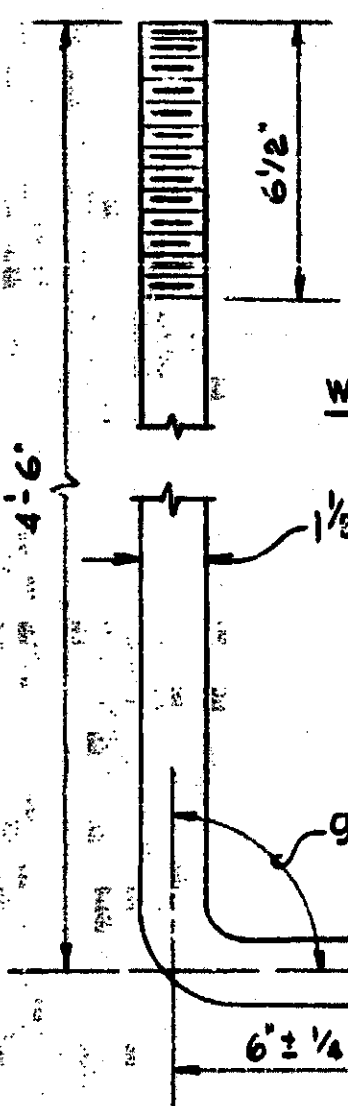


DETAIL OF ANCHOR BOLT (16 Req'd.)
Anchor Bolts shall be in accordance with Art. 5.07.14 of the Std. Spec.

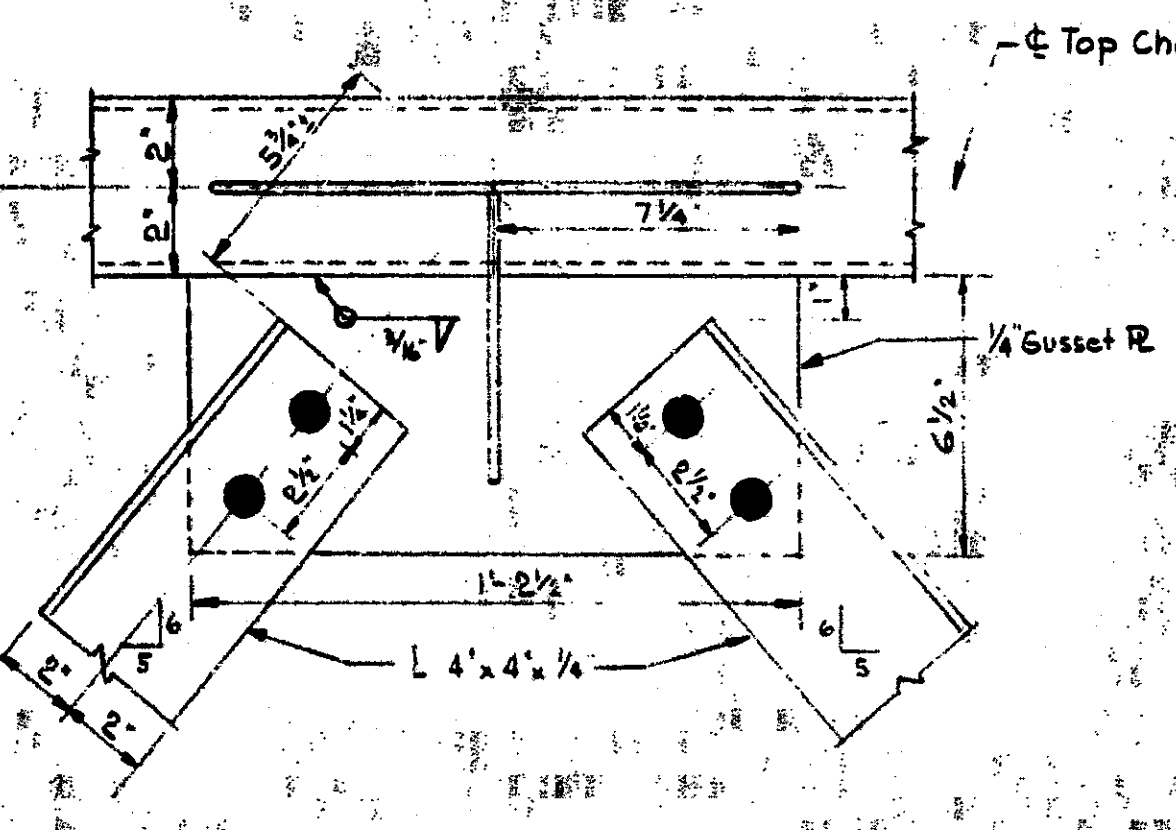


DETAIL D


NOTES
All bolts holes are 13/16" (Typ.)
Gusset Plate size shown in Detail N will vary with different Column heights.

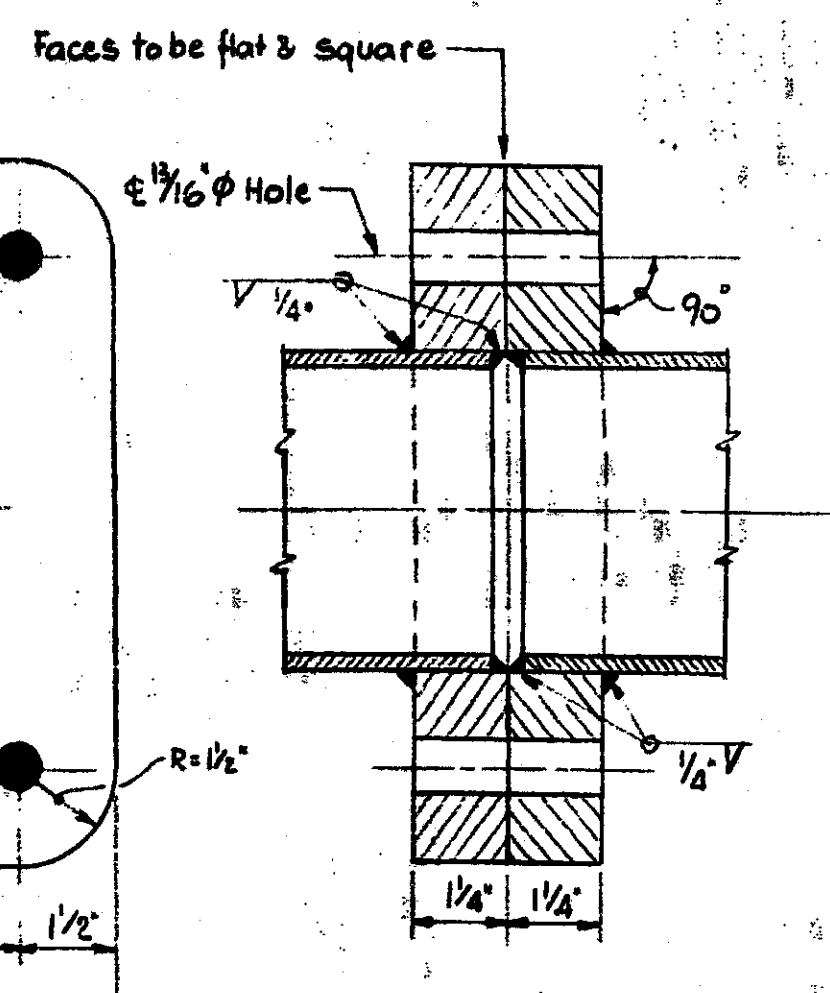

DETAIL A
Chord Connection Details

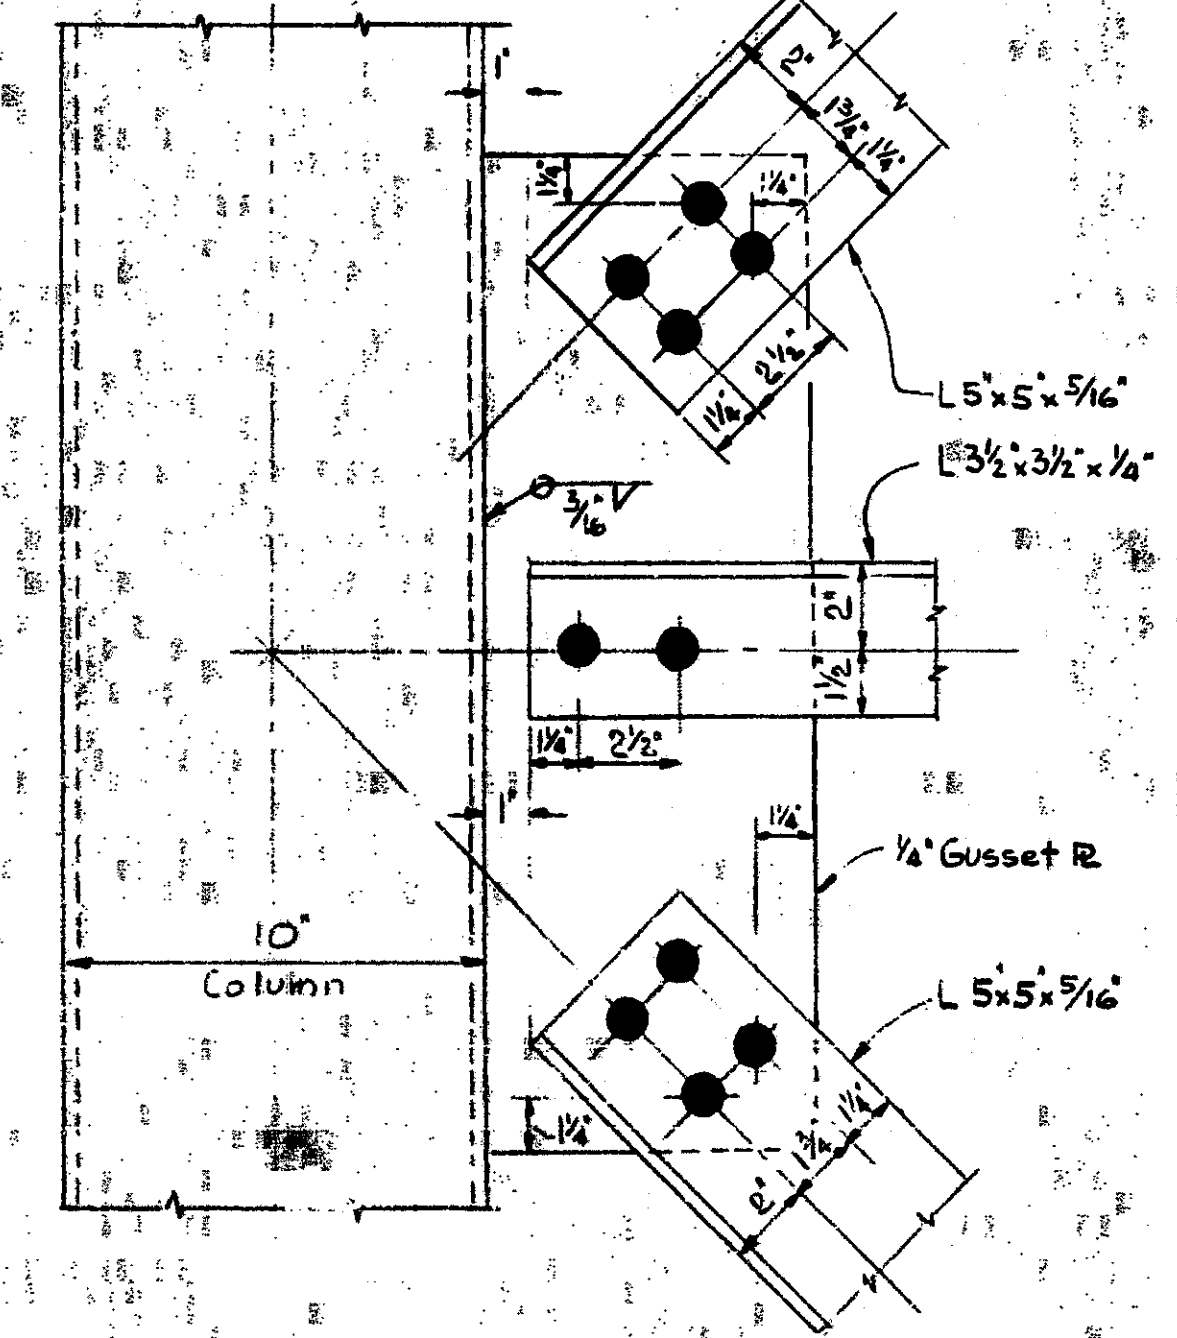

DETAIL N

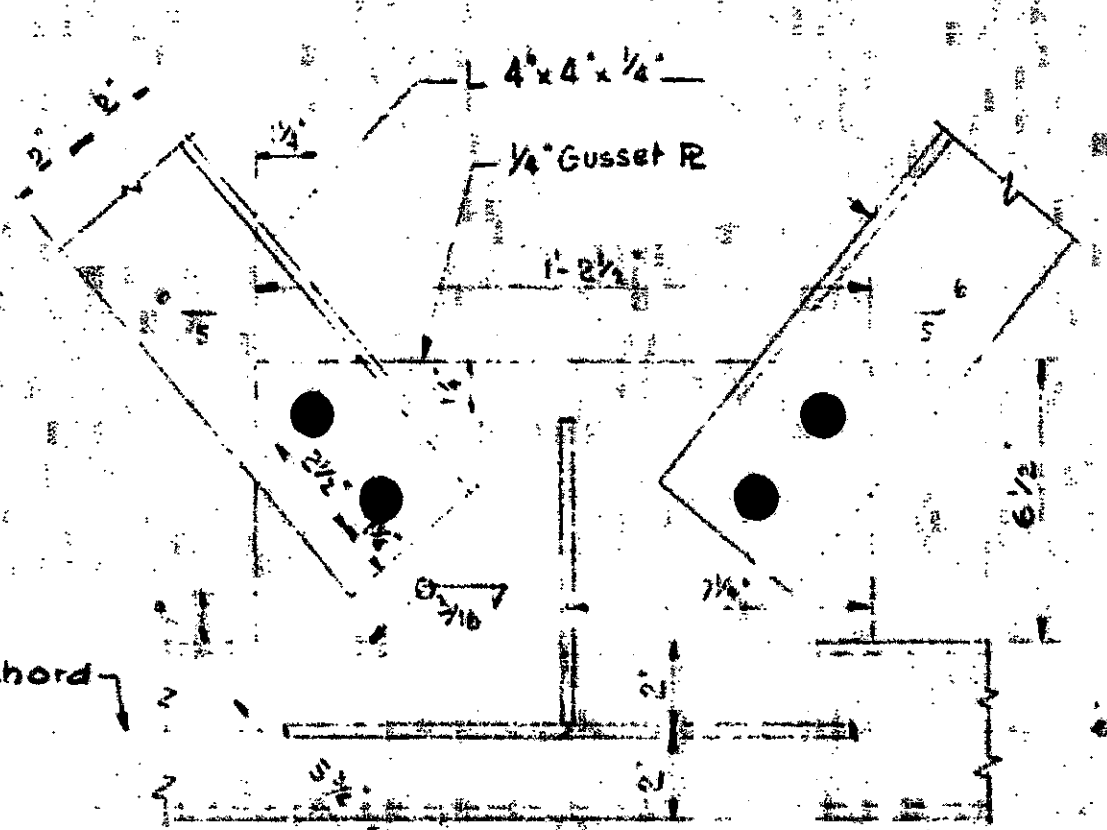

DETAIL E


Section at Panel Point
(LS not shown)

Work this sheet with sheets 1 & 3


MICHIGAN DEPARTMENT OF STATE HIGHWAYS
STEEL TRUSS TYPE C (70')
A-36 Galv.

NO.	REVISIONS	DATE	BY


DATE: JULY 5-4-77
DRAWN BY: P.R.N.
CHECKED BY: S.7.98

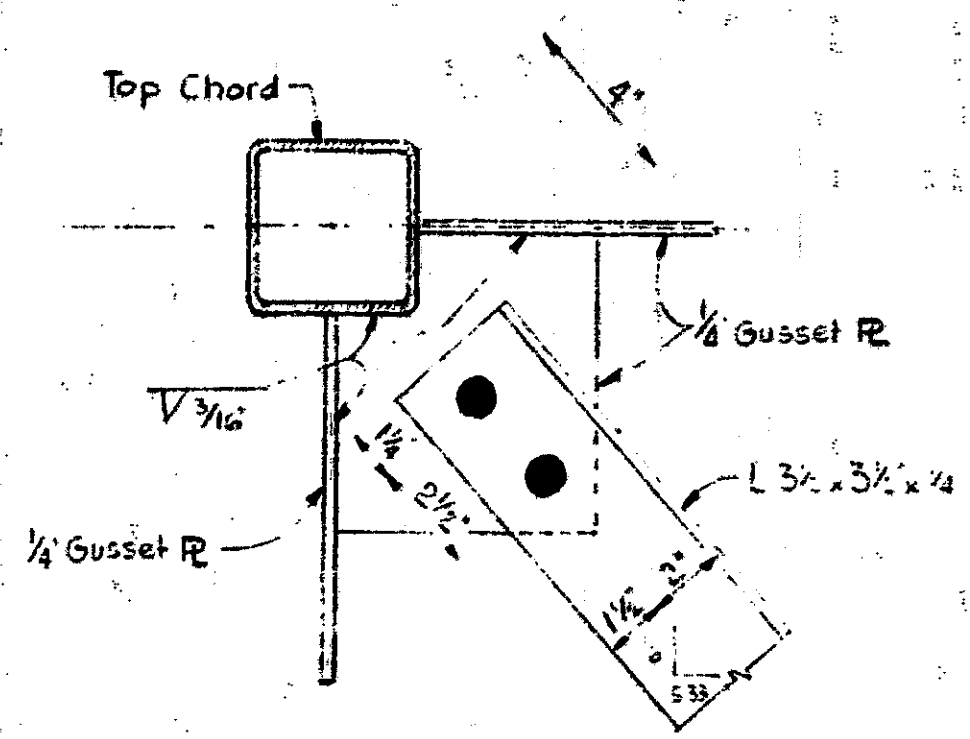


DETAIL F

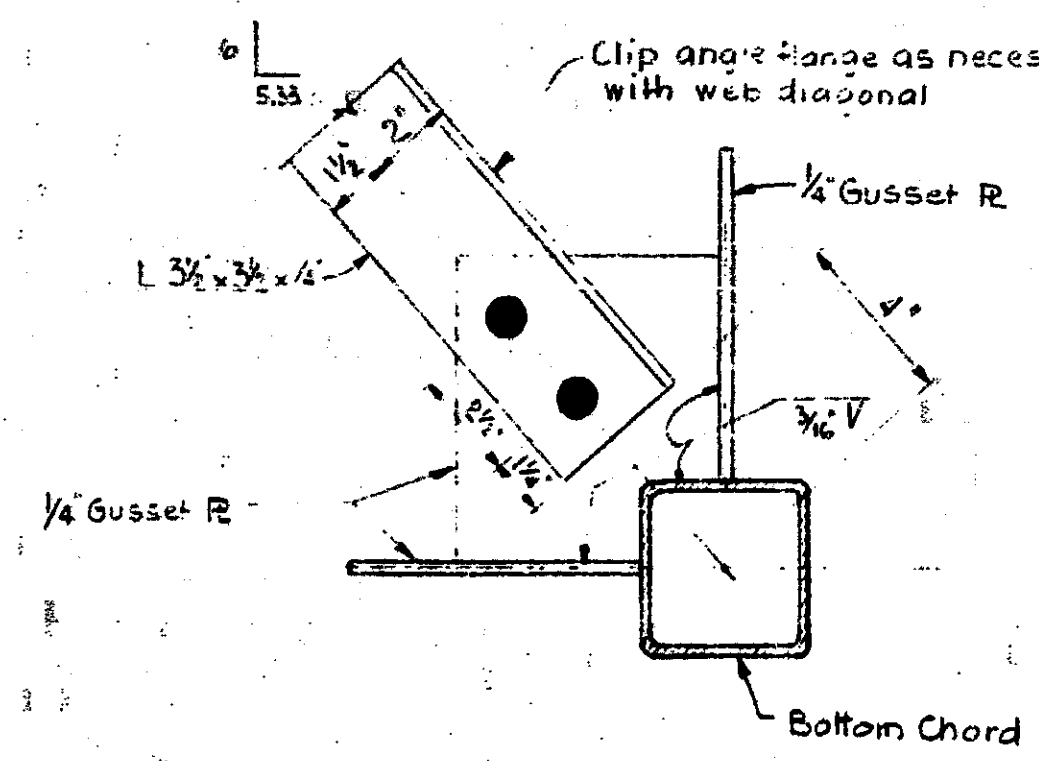


DETAIL G

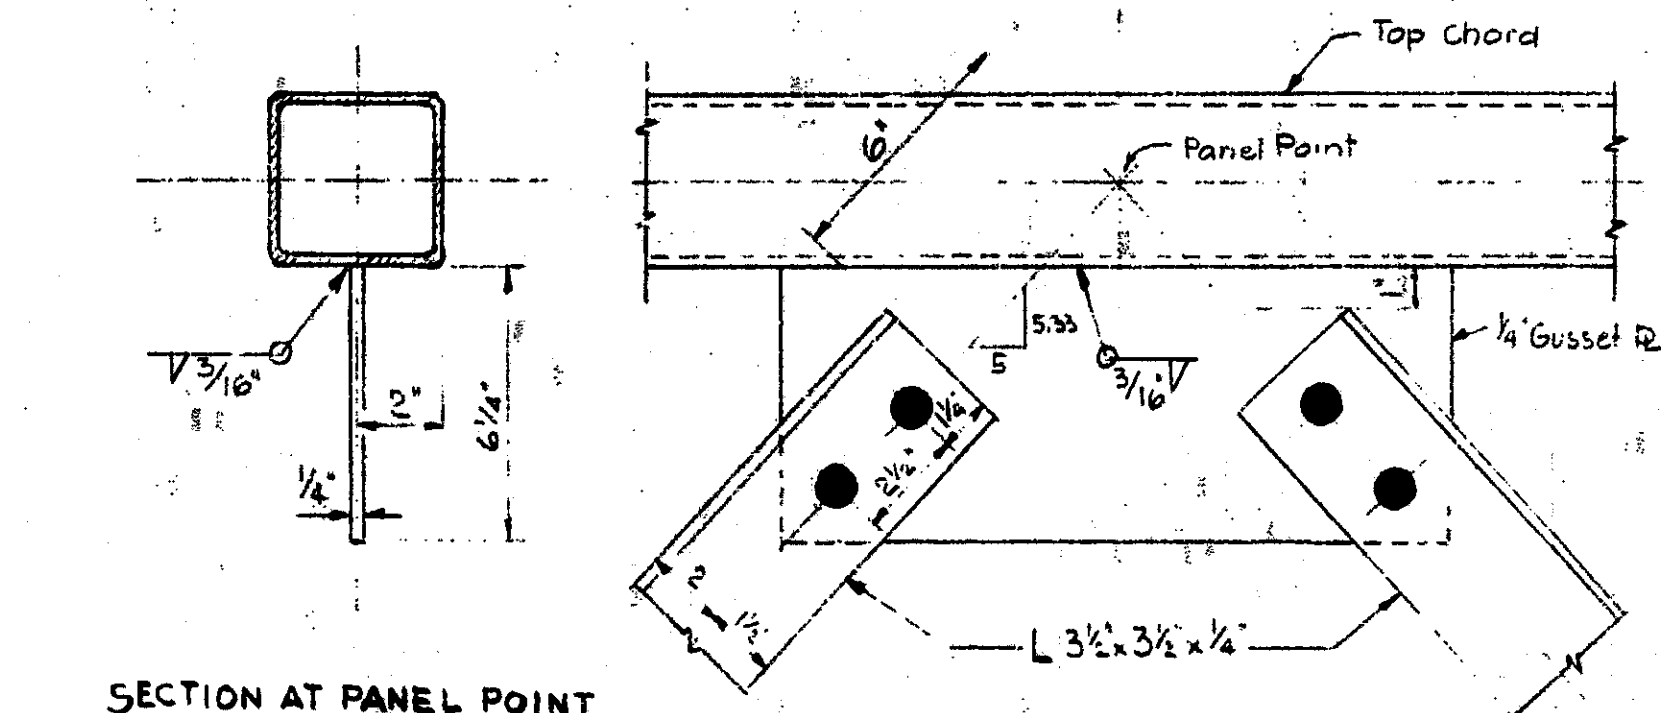


SECTION AT PANEL POINT
(Windbracing gusset plates shown only)

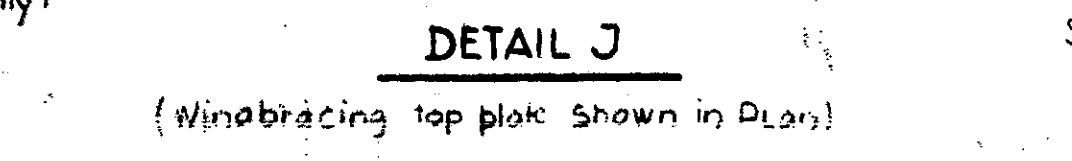


DETAIL J
(Windbracing top plate shown in plan)

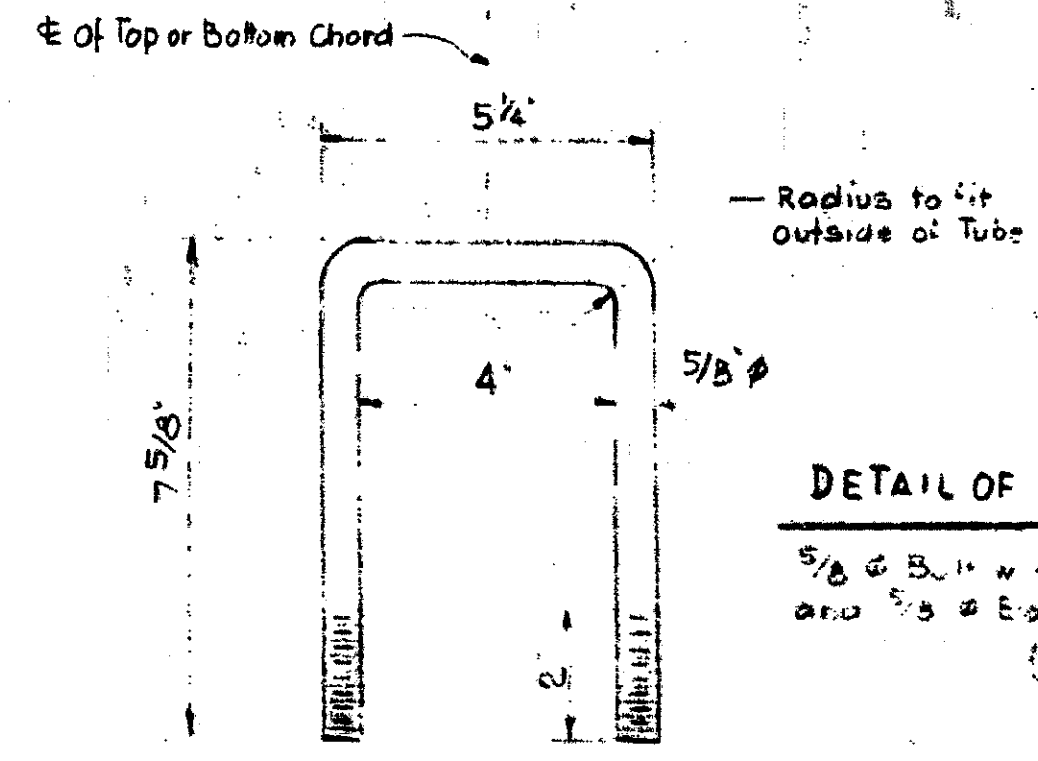


DETAIL OF 5/8" U-BOLT
5/8" U-Bolt with 2" Dia. Washer and 5/8" Elastic Stop Nut, 4-WAY-20 (Typ.)

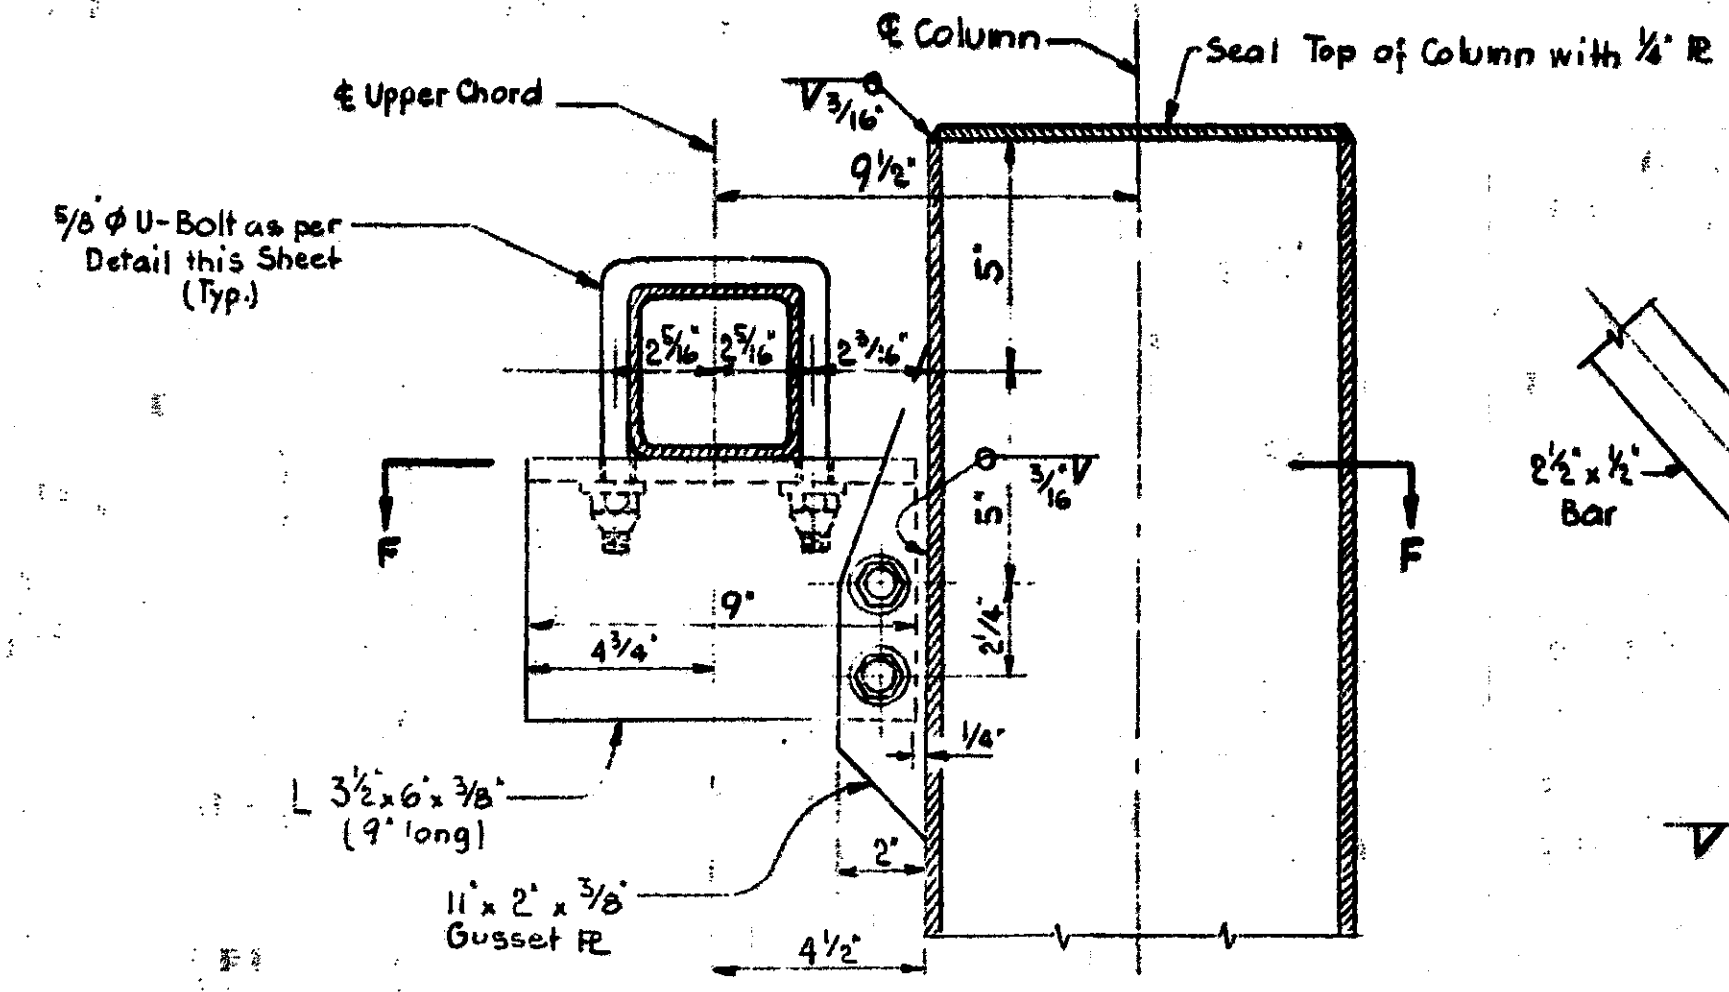


DETAIL OF UPPER CLAMP

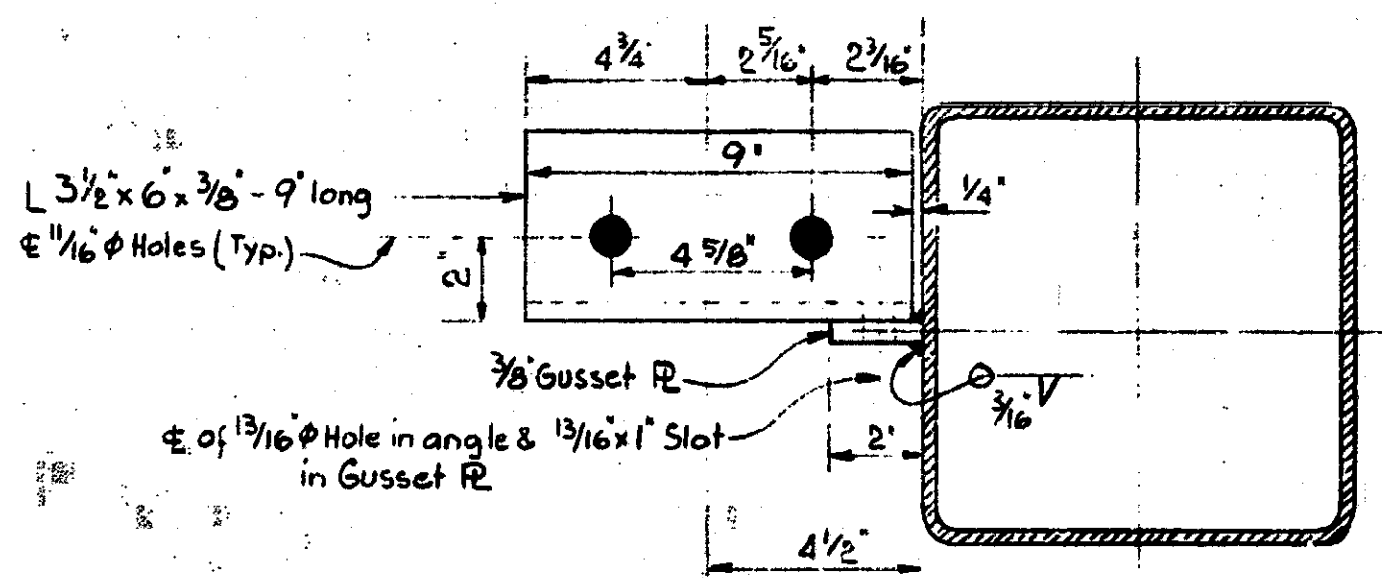


SECTION F-F

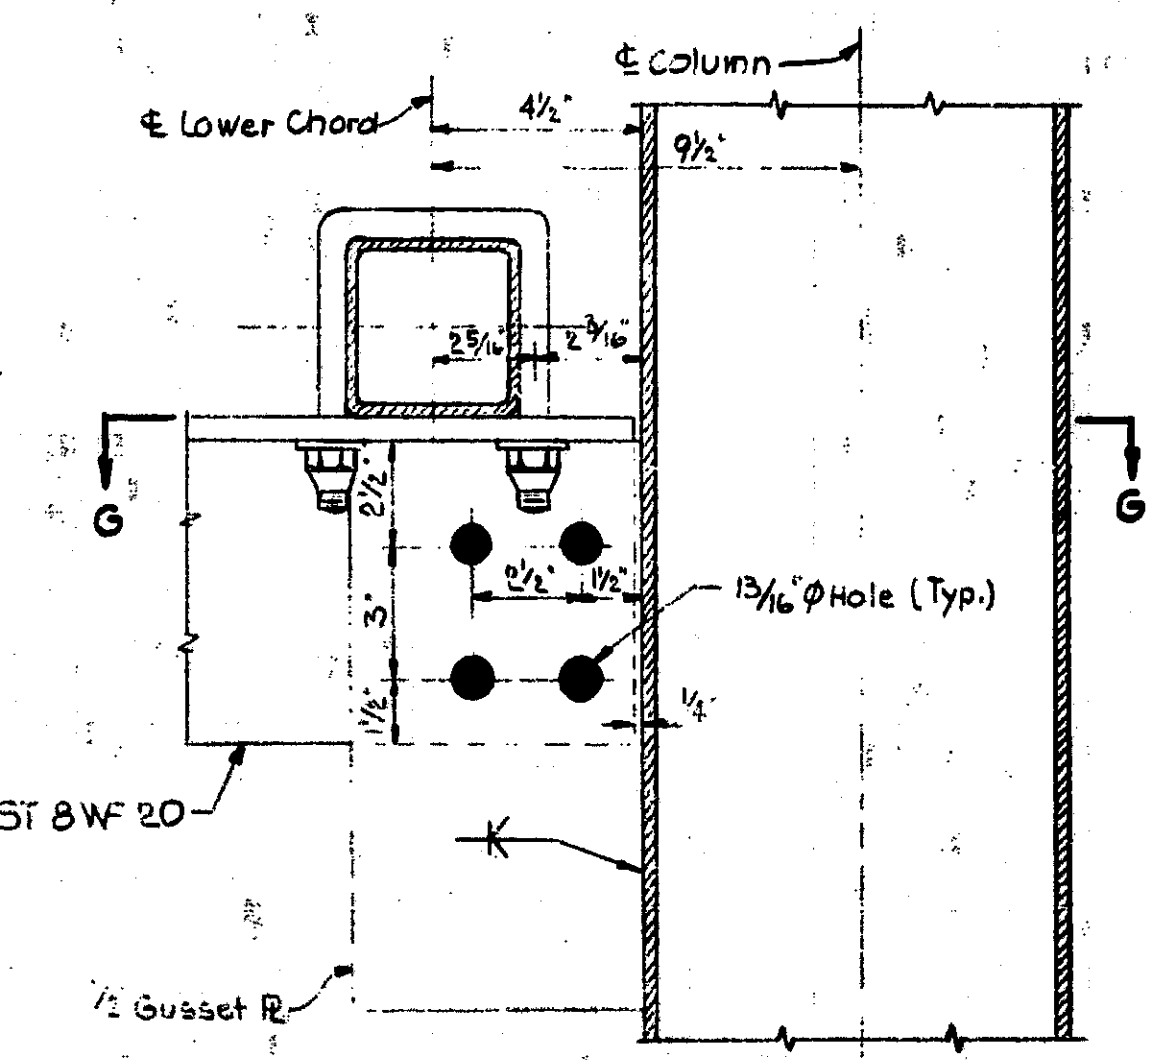

DETAIL OF SEAT (With no Diagonal shown)

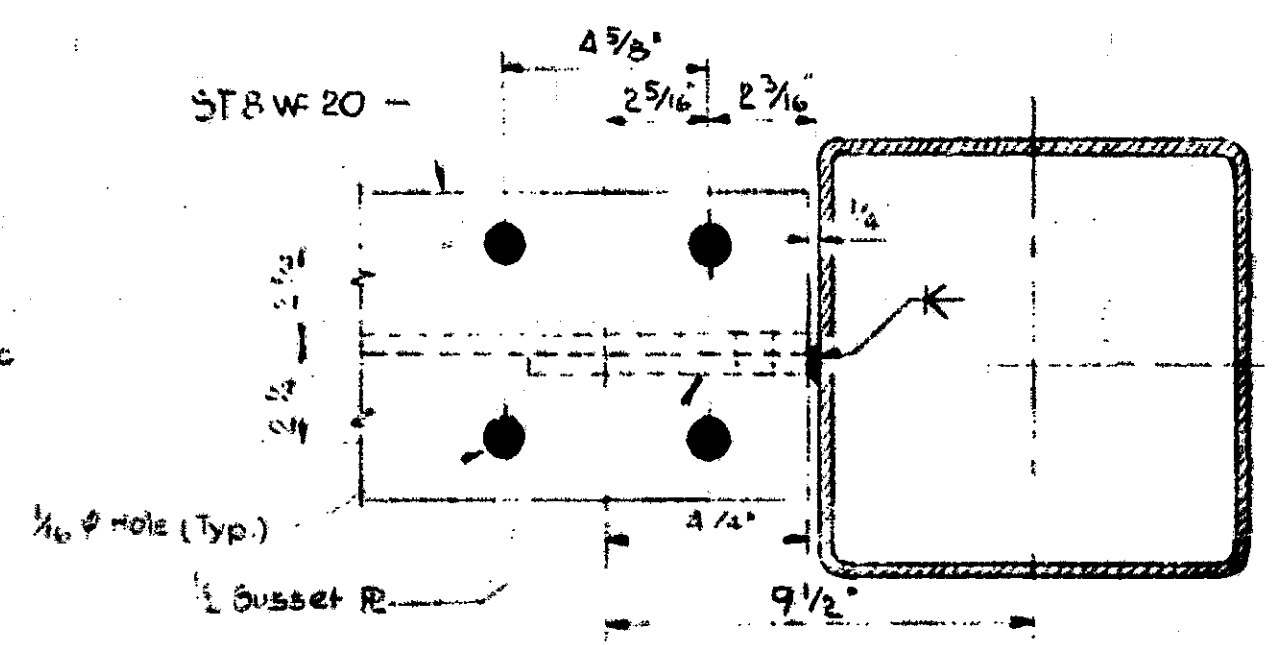


SECTION G-G

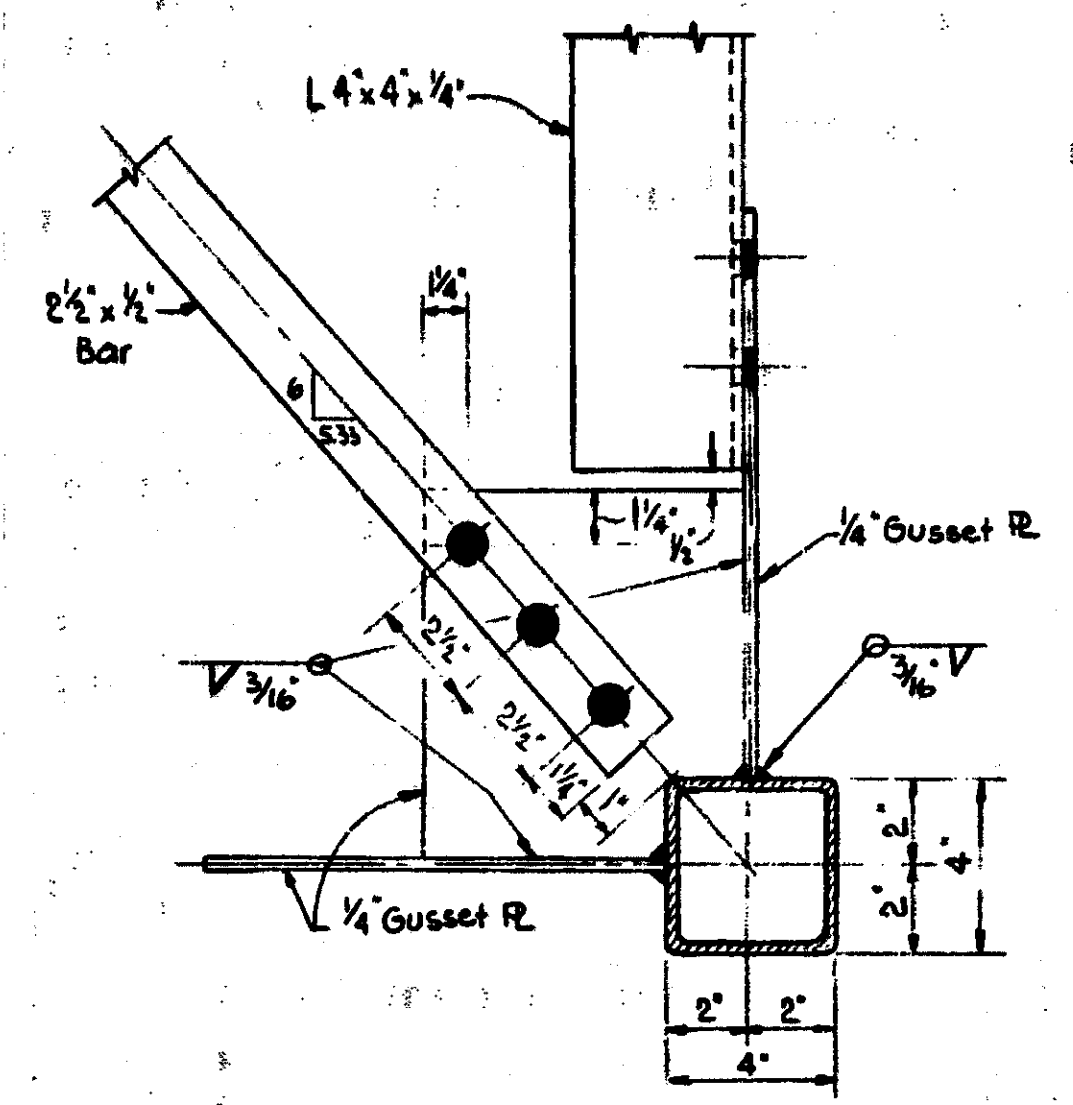


DETAIL M


NOTE All bolt holes are 13/16" except as indicated.

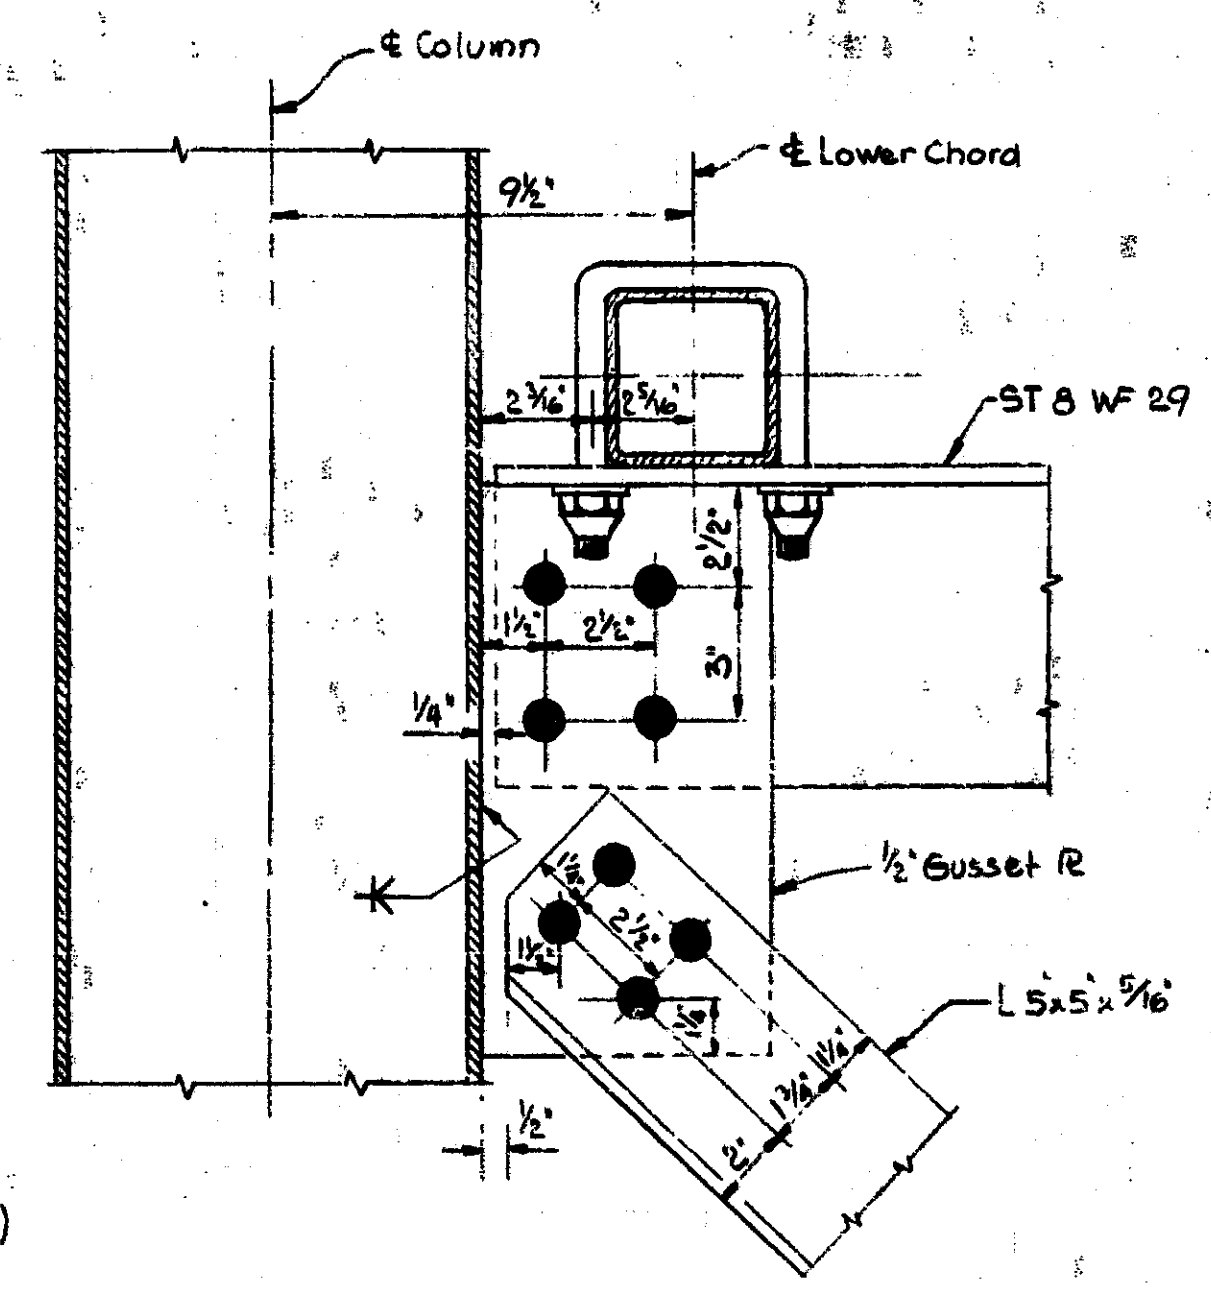

DETAIL OF SEAT (With Diagonal shown)

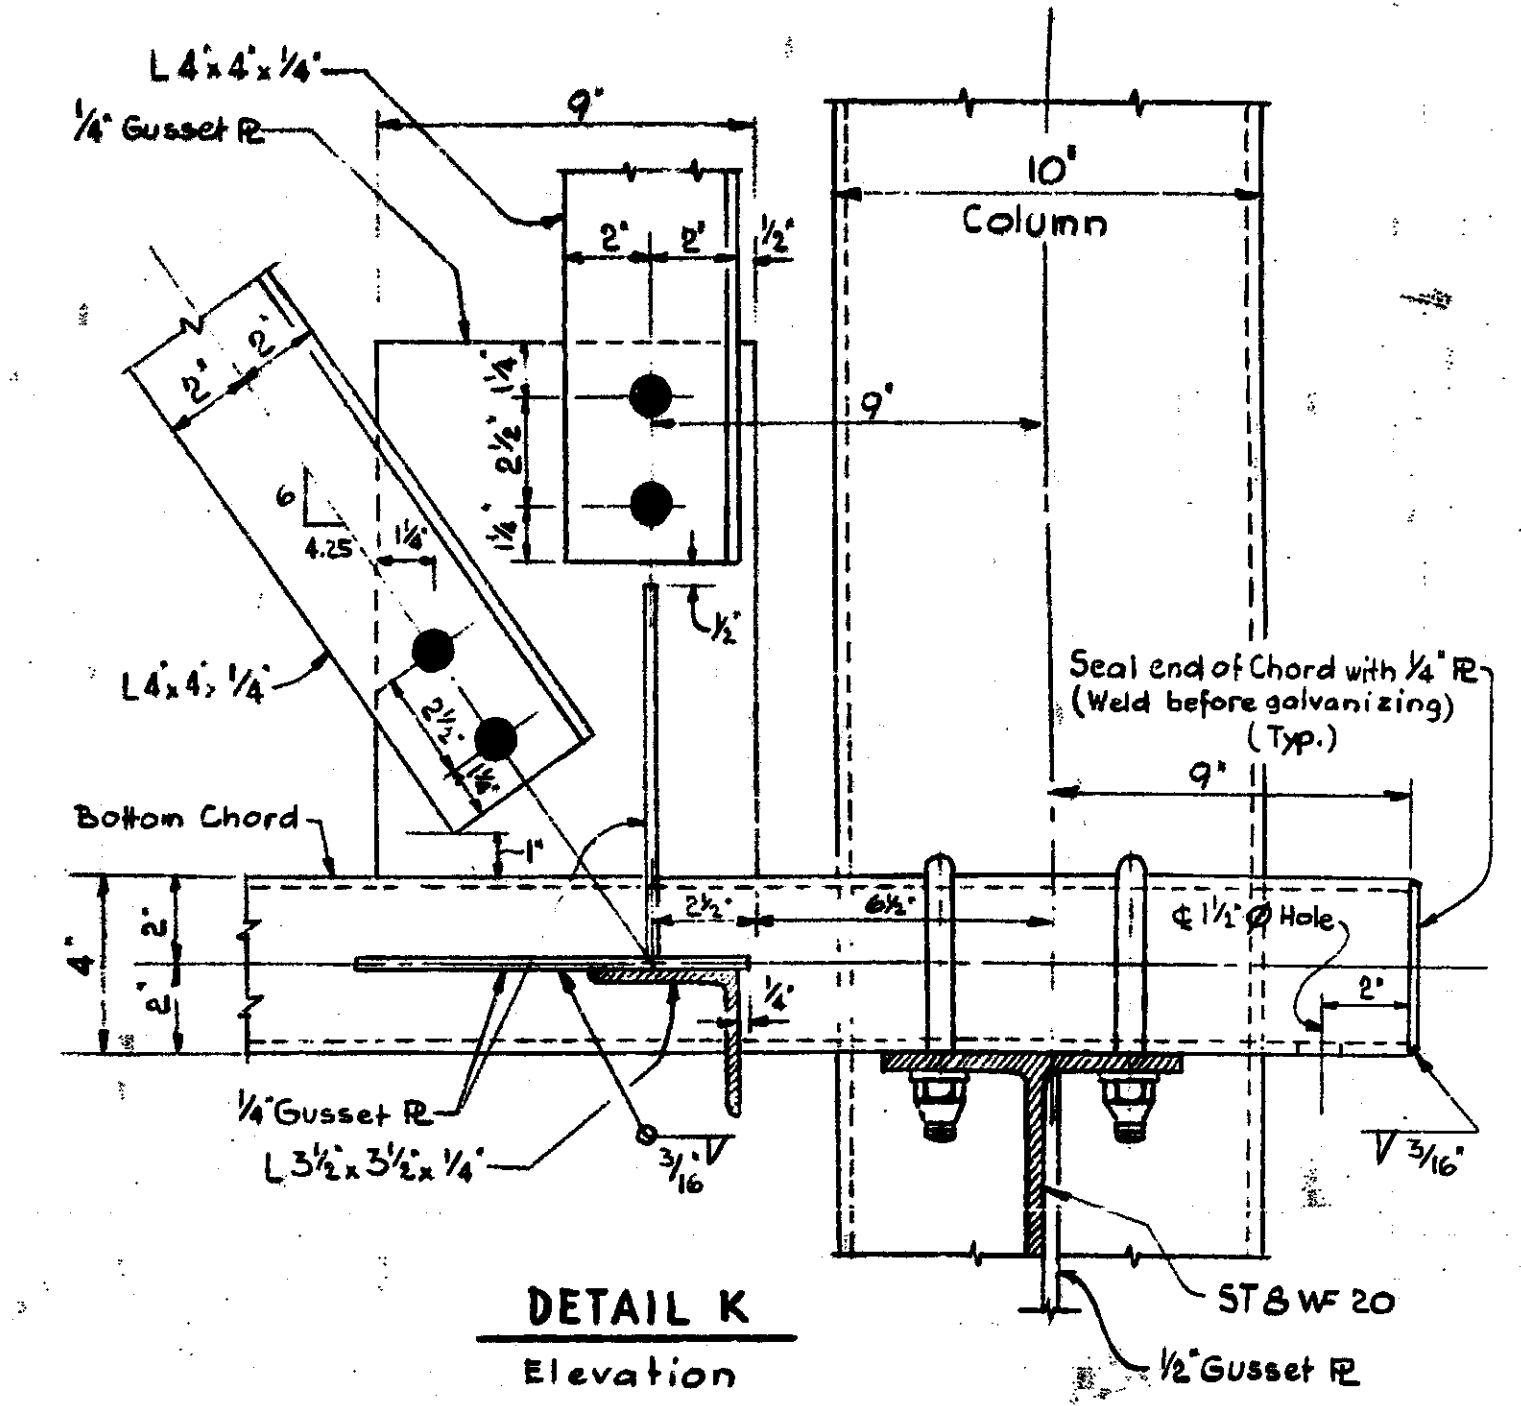

DETAIL K
Elevation

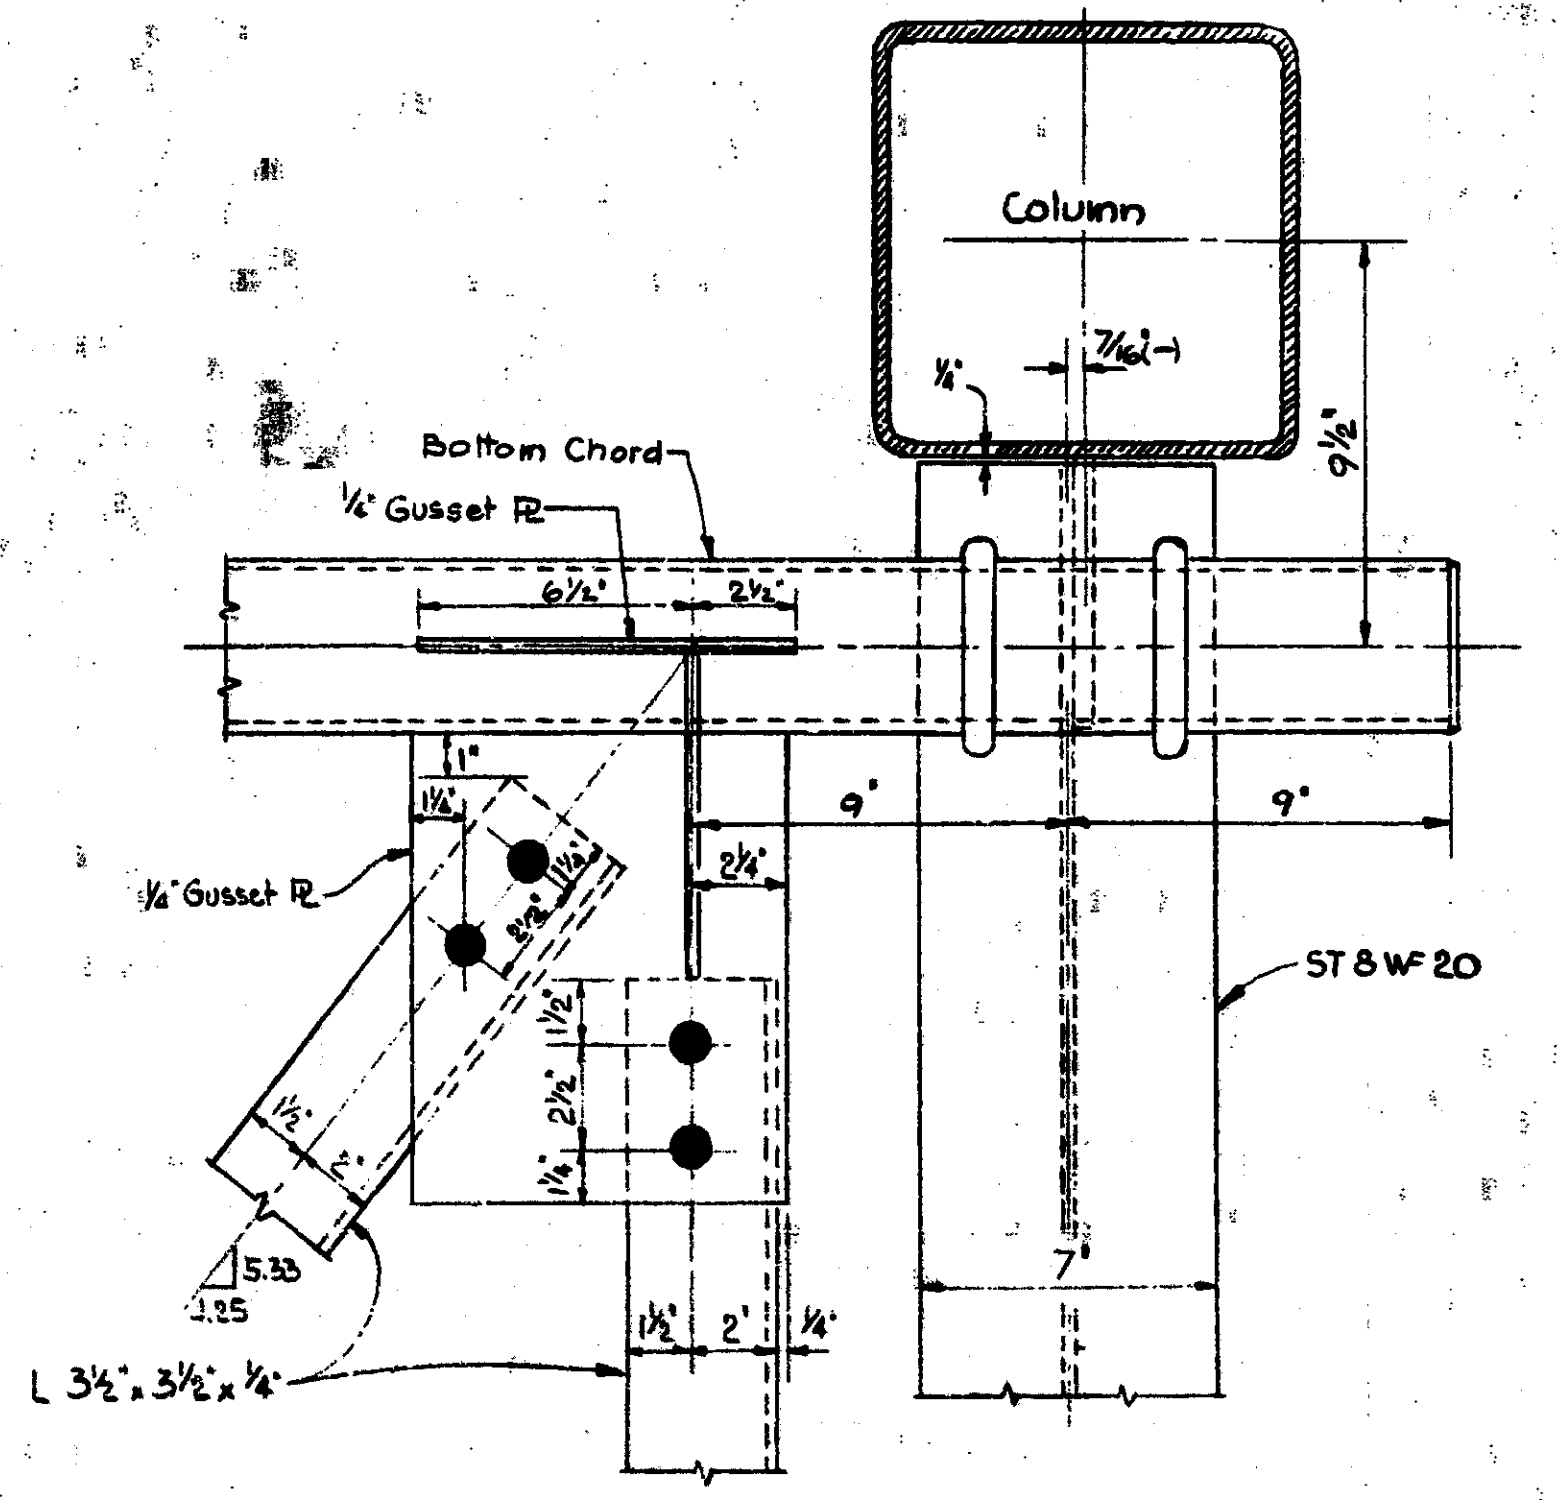

DETAIL L
Bottom Windbracing Plan

Work this sheet with sheets 73 & 74

MICHIGAN DEPARTMENT OF STATE HIGHWAYS


STEEL TRUSS TYPE C (70')

A-36 Galv.


NO.	REVISIONS	DATE	BY

DESIGNED BY	BULLEN	5-9-77
DRAWN BY	PRN	11-10-76
CHECKED BY		


5780

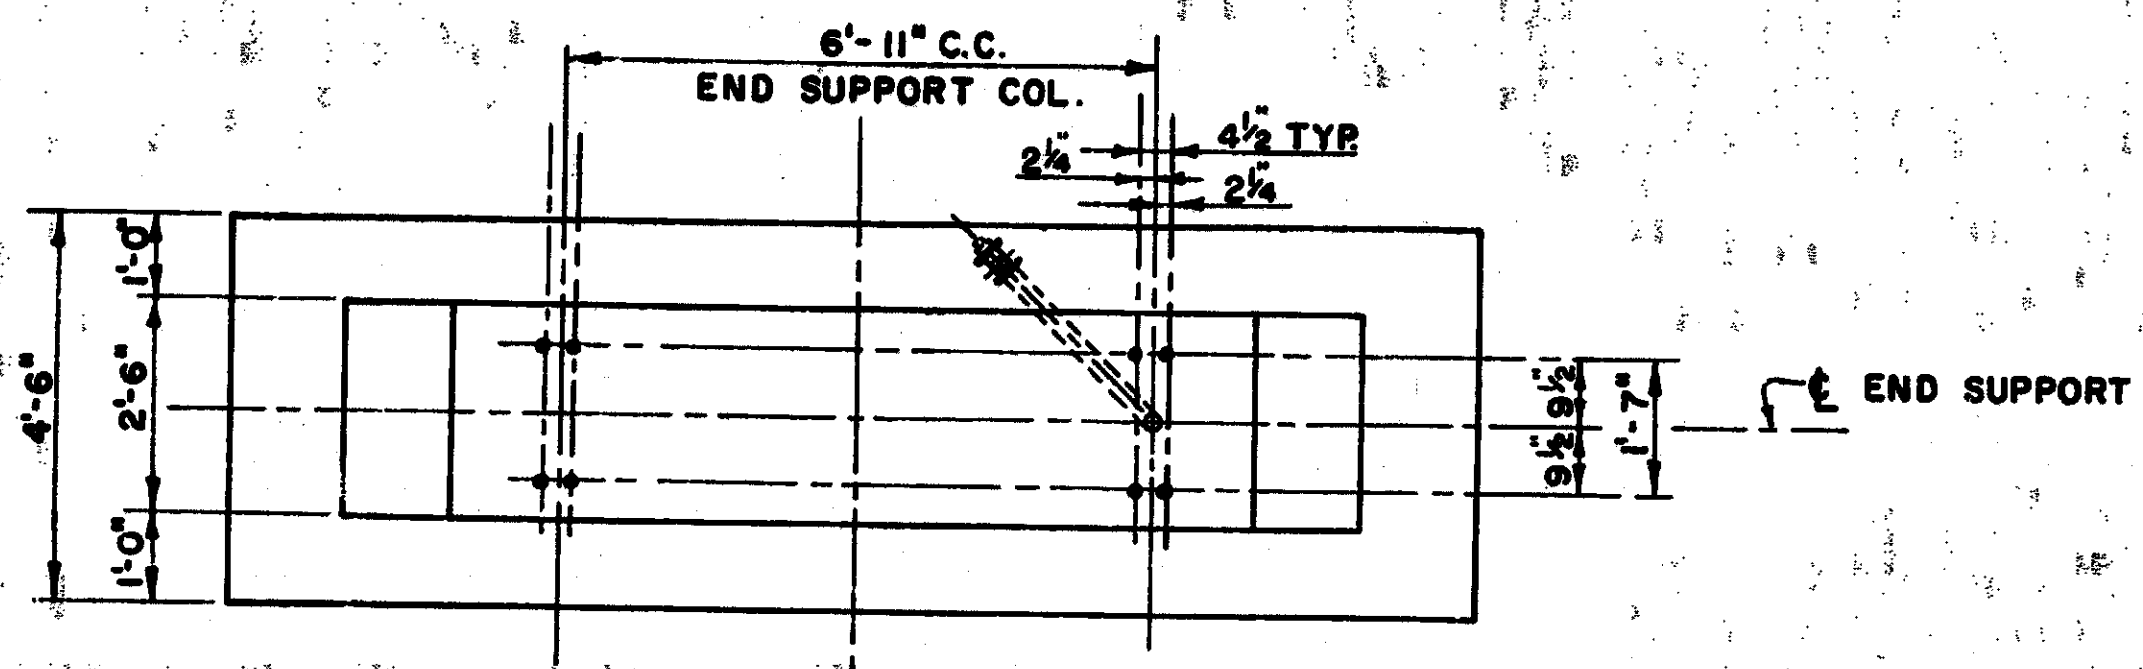


PLAN

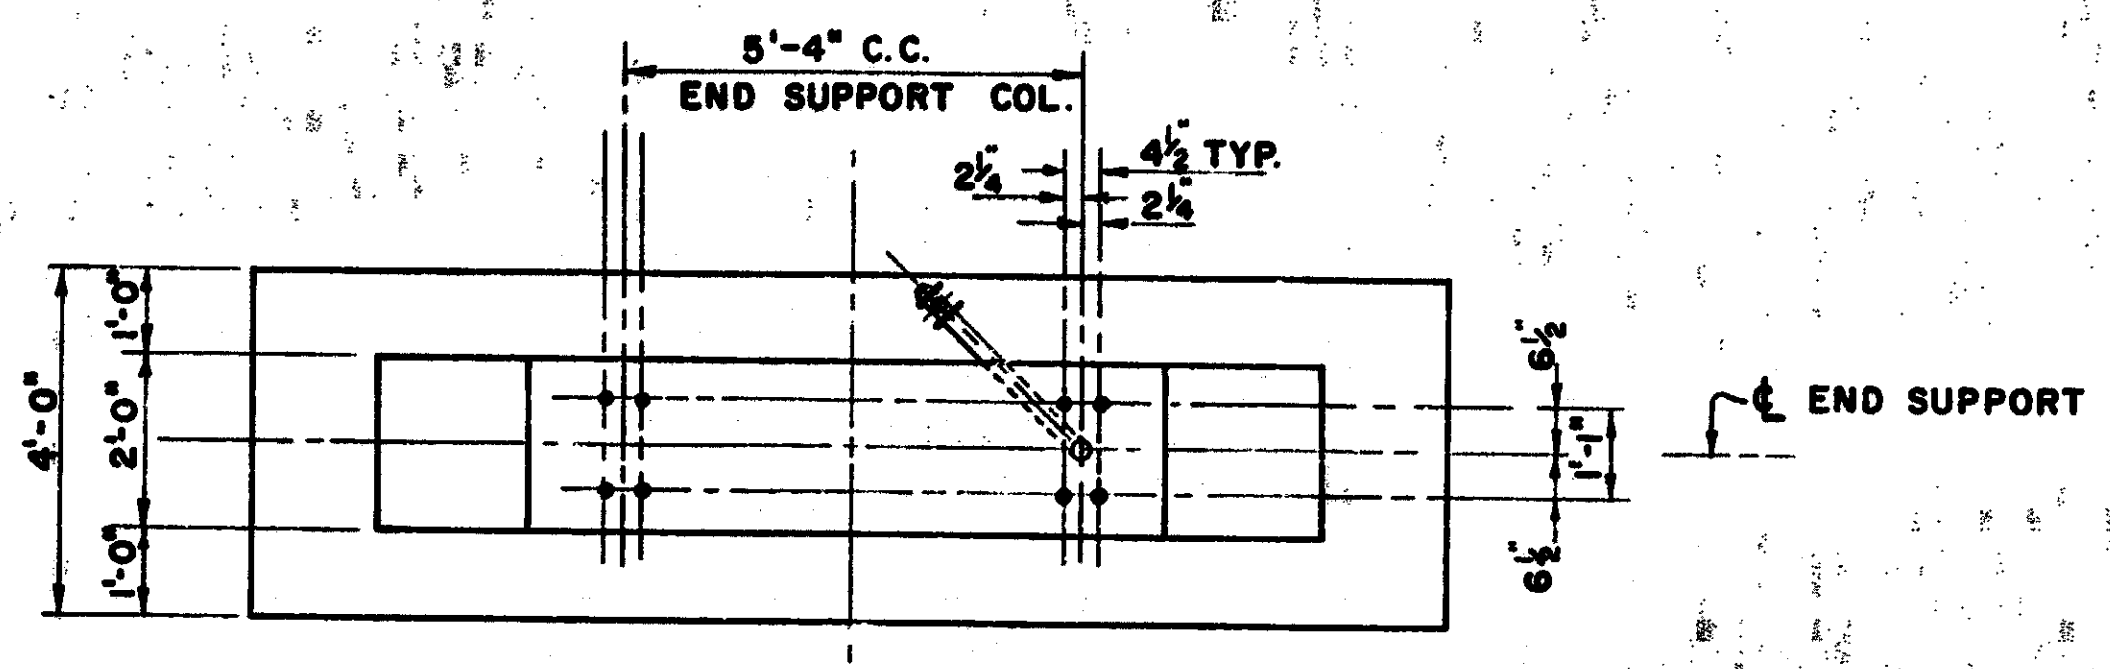


PLAN

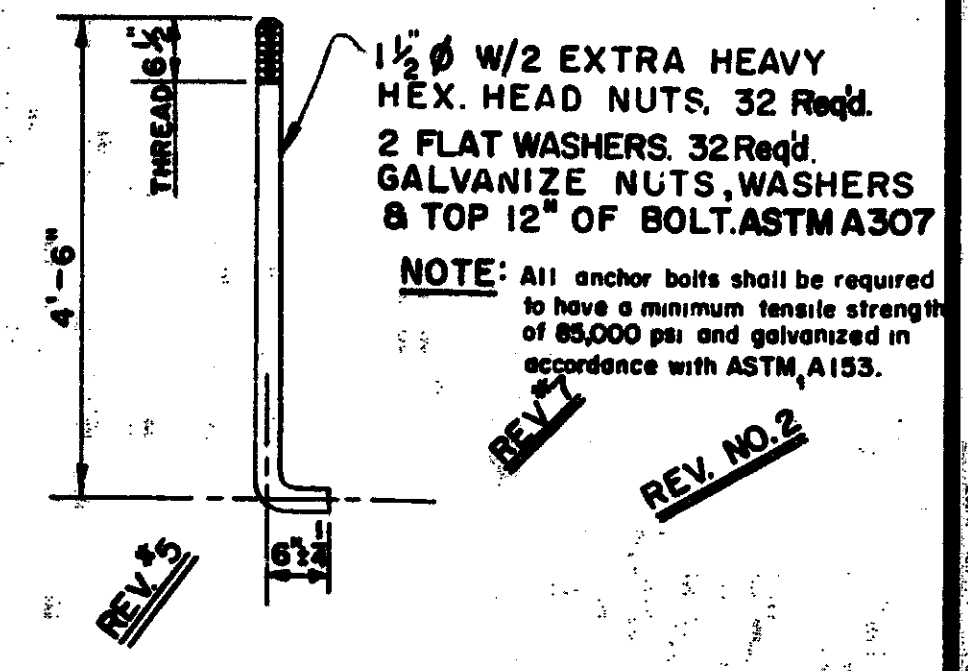


ANCHOR BOLT DETAIL

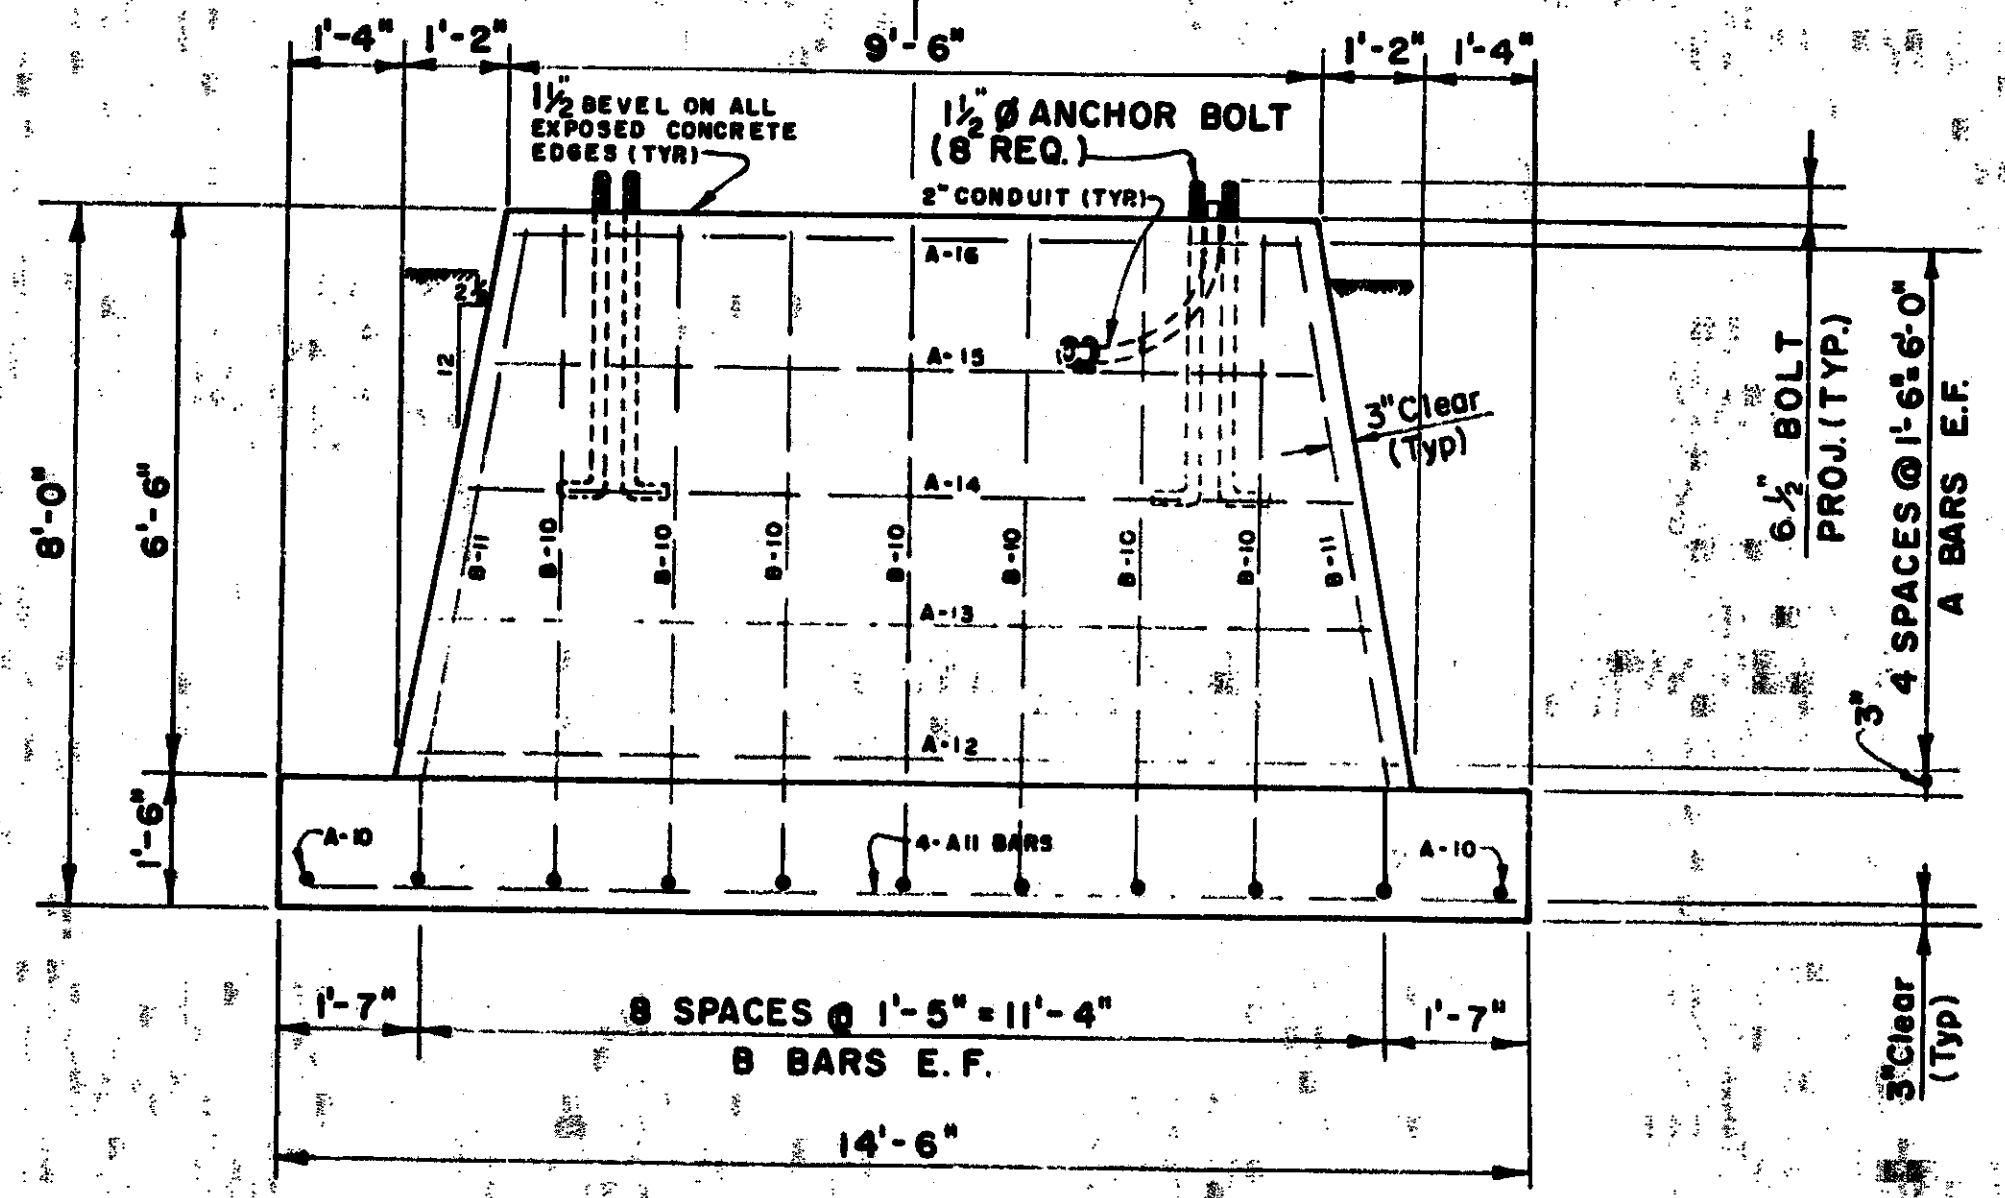

ELEVATION

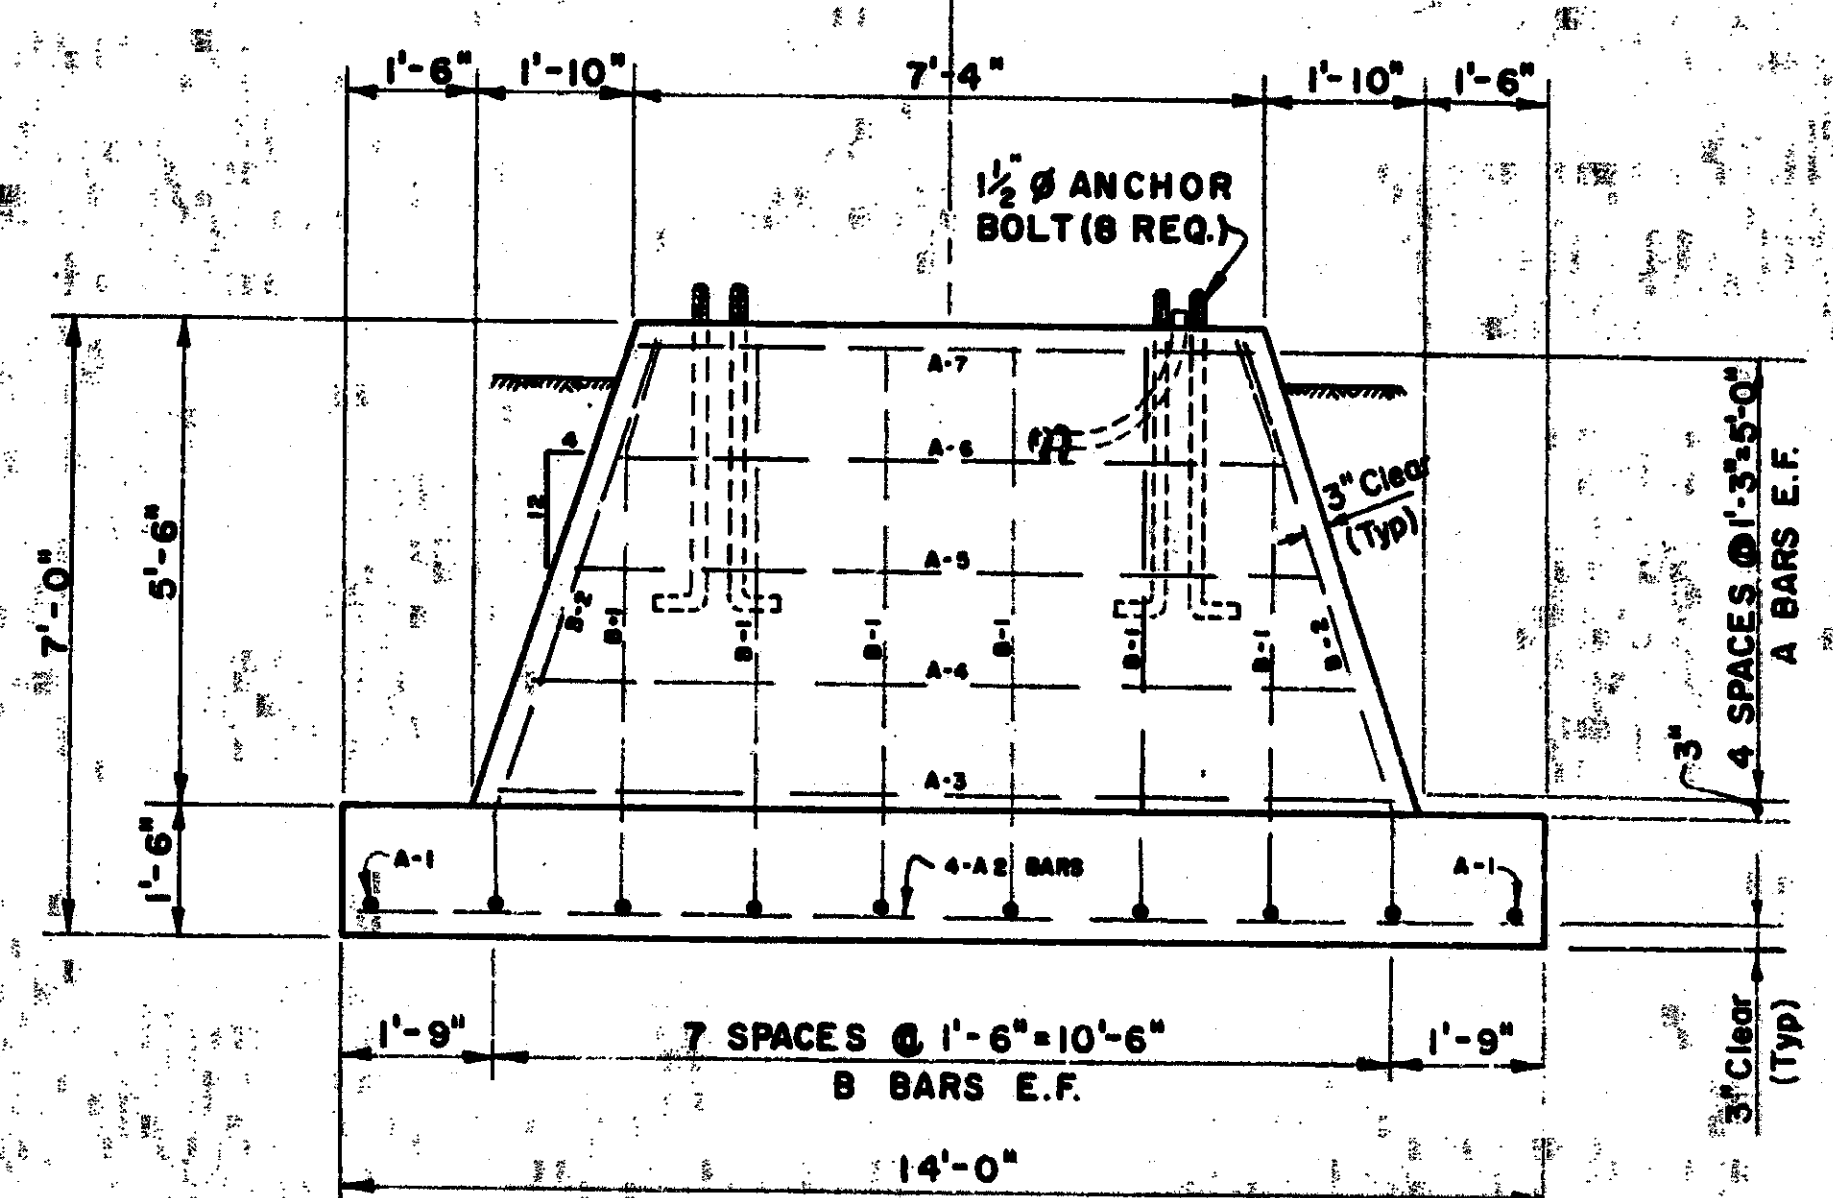

ELEVATION

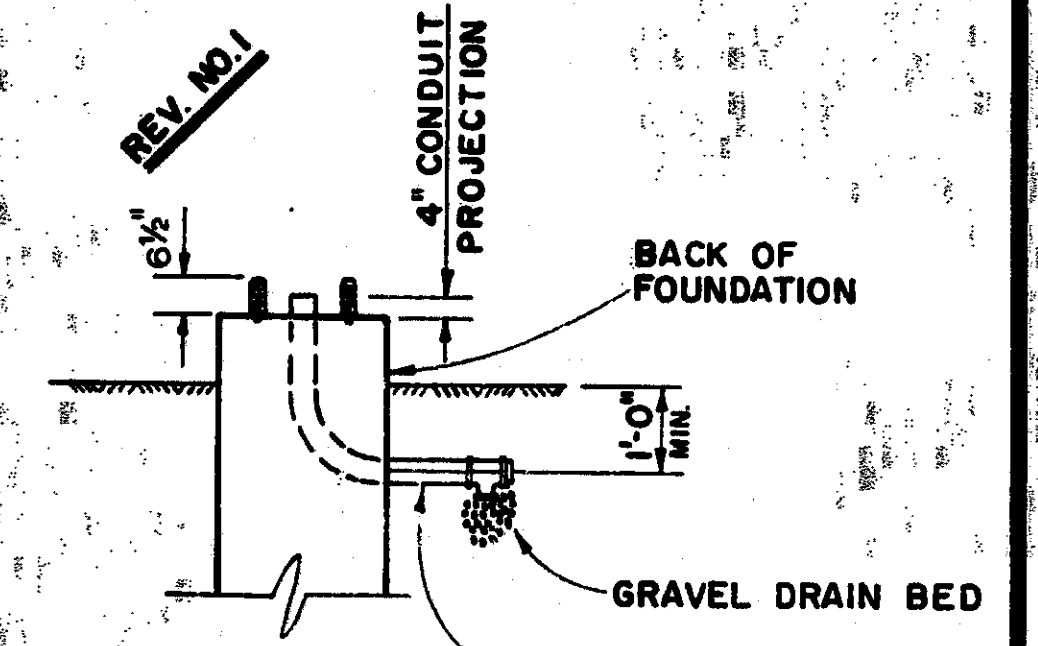

CONDUIT DETAIL

- NOTES:
- 1) CONDUIT SHALL BE INSTALLED IN RIGHT FOUNDATION OR AS OTHERWISE SPECIFIED BY THE ENGINEER.
 - 2) TOP OF CONC. SHALL BE 3" MIN. ABOVE GROUND (DESIRABLE)
 - 3) ANCHOR BOLTS SHALL BE CAREFULLY SET AND HELD VERTICAL AT THE CORRECT LOCATION AND AT THE PROPER ELEVATION UNTIL CONCRETE HAS SET, IF DESIRED, EACH SET OF FOUR BOLTS MAY BE TIED TOGETHER NEAR THE TOP AND BOTTOM BY WELDING INTO A BASKET WITH BAR STOCK OR EQUIVALENT MATERIAL.

BAR SIZE	DIMENSIONS	REQ.
A-10 #4	4'-0"	2
A-11 #4	14'-0"	4
A-12 #4	11'-3"	2
A-13 #4	10'-8"	2
A-14 #4	10'-2"	2
A-15 #4	9'-7"	2
A-16 #4	9'-1"	2
B-10 #4	7'-5" 3'-0"	14
B-11 #4	7'-7" 3'-0"	4

10.0 CU. YDS. CONC.
237 # REINF. STEEL

TYPE C
SCALE 1/2" = 1'-0"

BAR SIZE	DIMENSIONS	NO. REQ.
A-1 #4	3'-6"	2
A-2 #4	13'-6"	4
A-3 #4	10'-4"	2
A-4 #4	9'-6"	2
A-5 #4	8'-8"	2
A-6 #4	7'-10"	2
A-7 #4	7'-0"	2
B-1 #4	6'-0" 2'-6"	12
B-2 #4	6'-0" 2'-6"	4

6.82 CU. YDS. CONC.
196 # REINF. STEEL


TYPE B
SCALE 1/2" = 1'-0"

MICHIGAN DEPARTMENT OF STATE HIGHWAYS

TRUSS FOUNDATION
TYPE B, C


NO.	DESCRIPTION	DATE	BY
1	WIRE ENTRANCE	11/7/66	TMW
2	Anchor bolt strength note	3-9-67	TMW
3	Re-bar dimension change	5/20/67	TMW
4	NOTE ADDED	5-26-68	TMW
5	ANCHOR BOLT DETAIL REVISED	6/73	TMW
6	QUANTITIES ADDED TO ANCHOR BOLT DETAIL	2/74	JDB

88.10

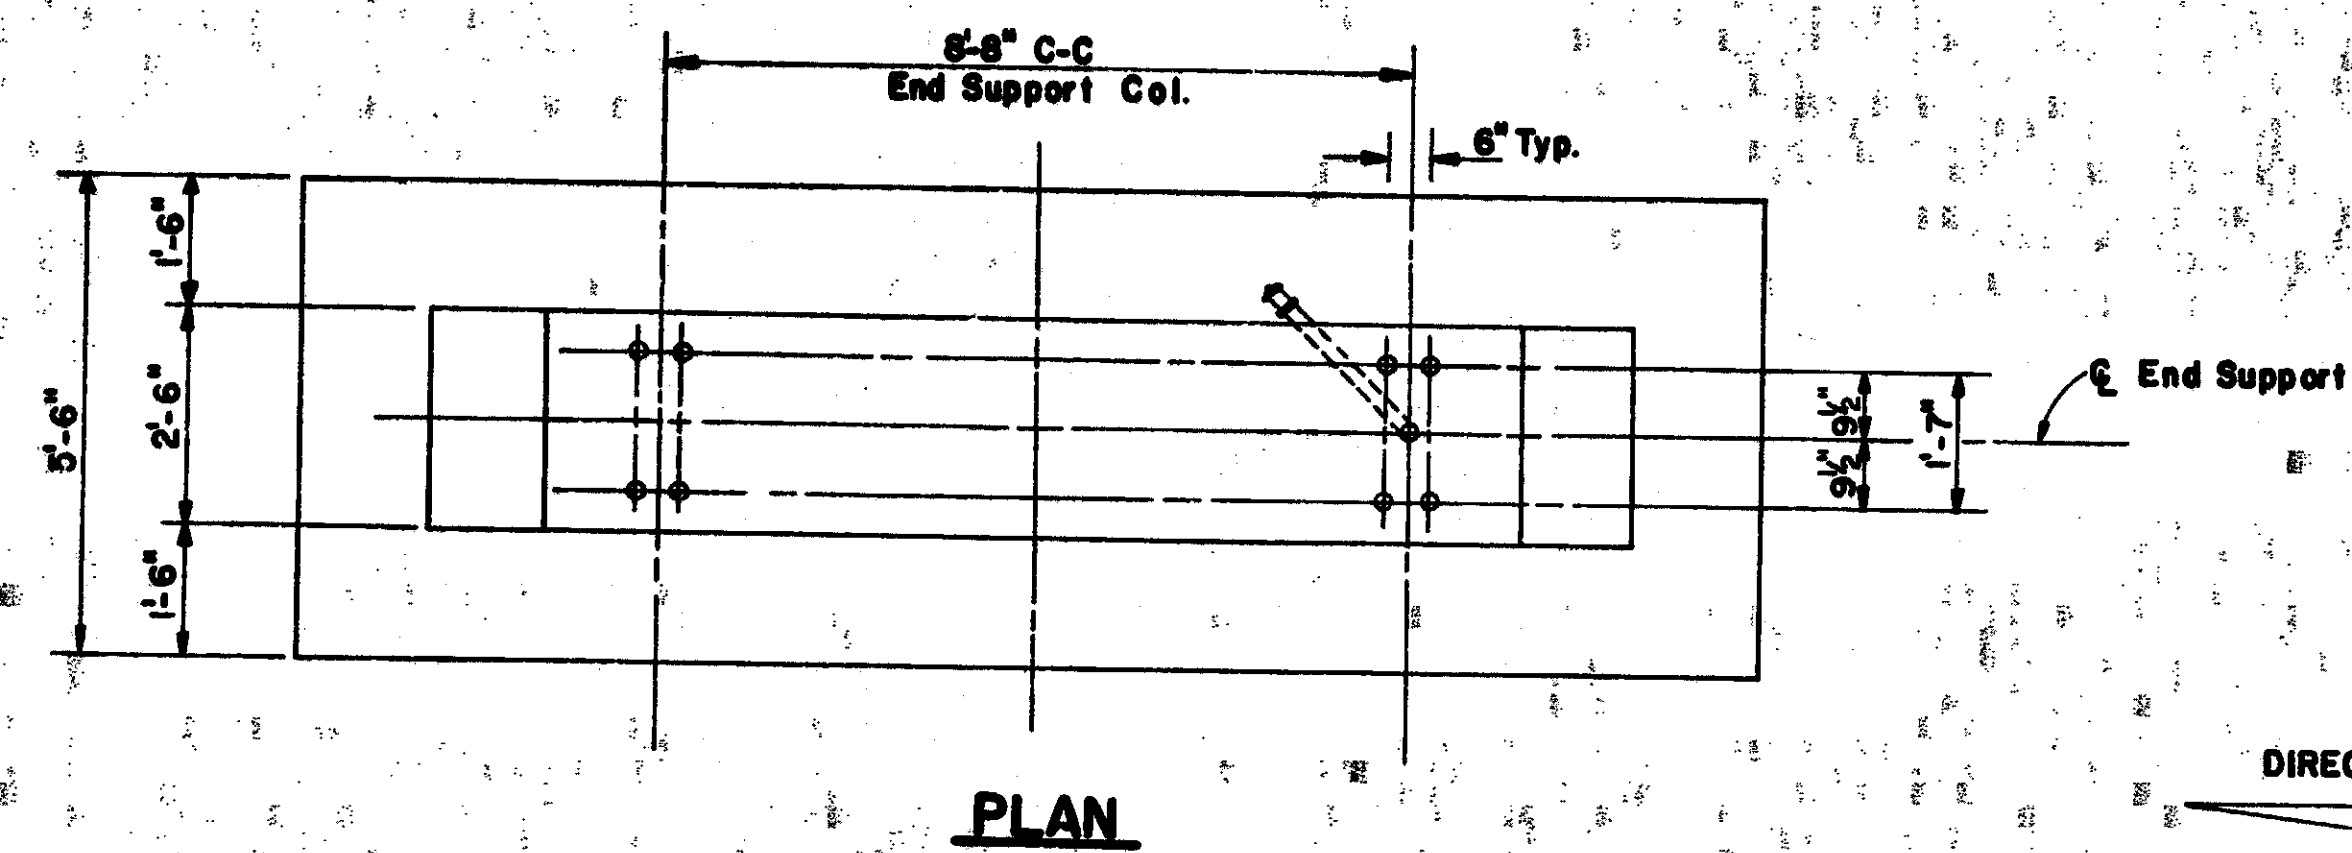

PLAN

DIRECTION OF TRAFFIC

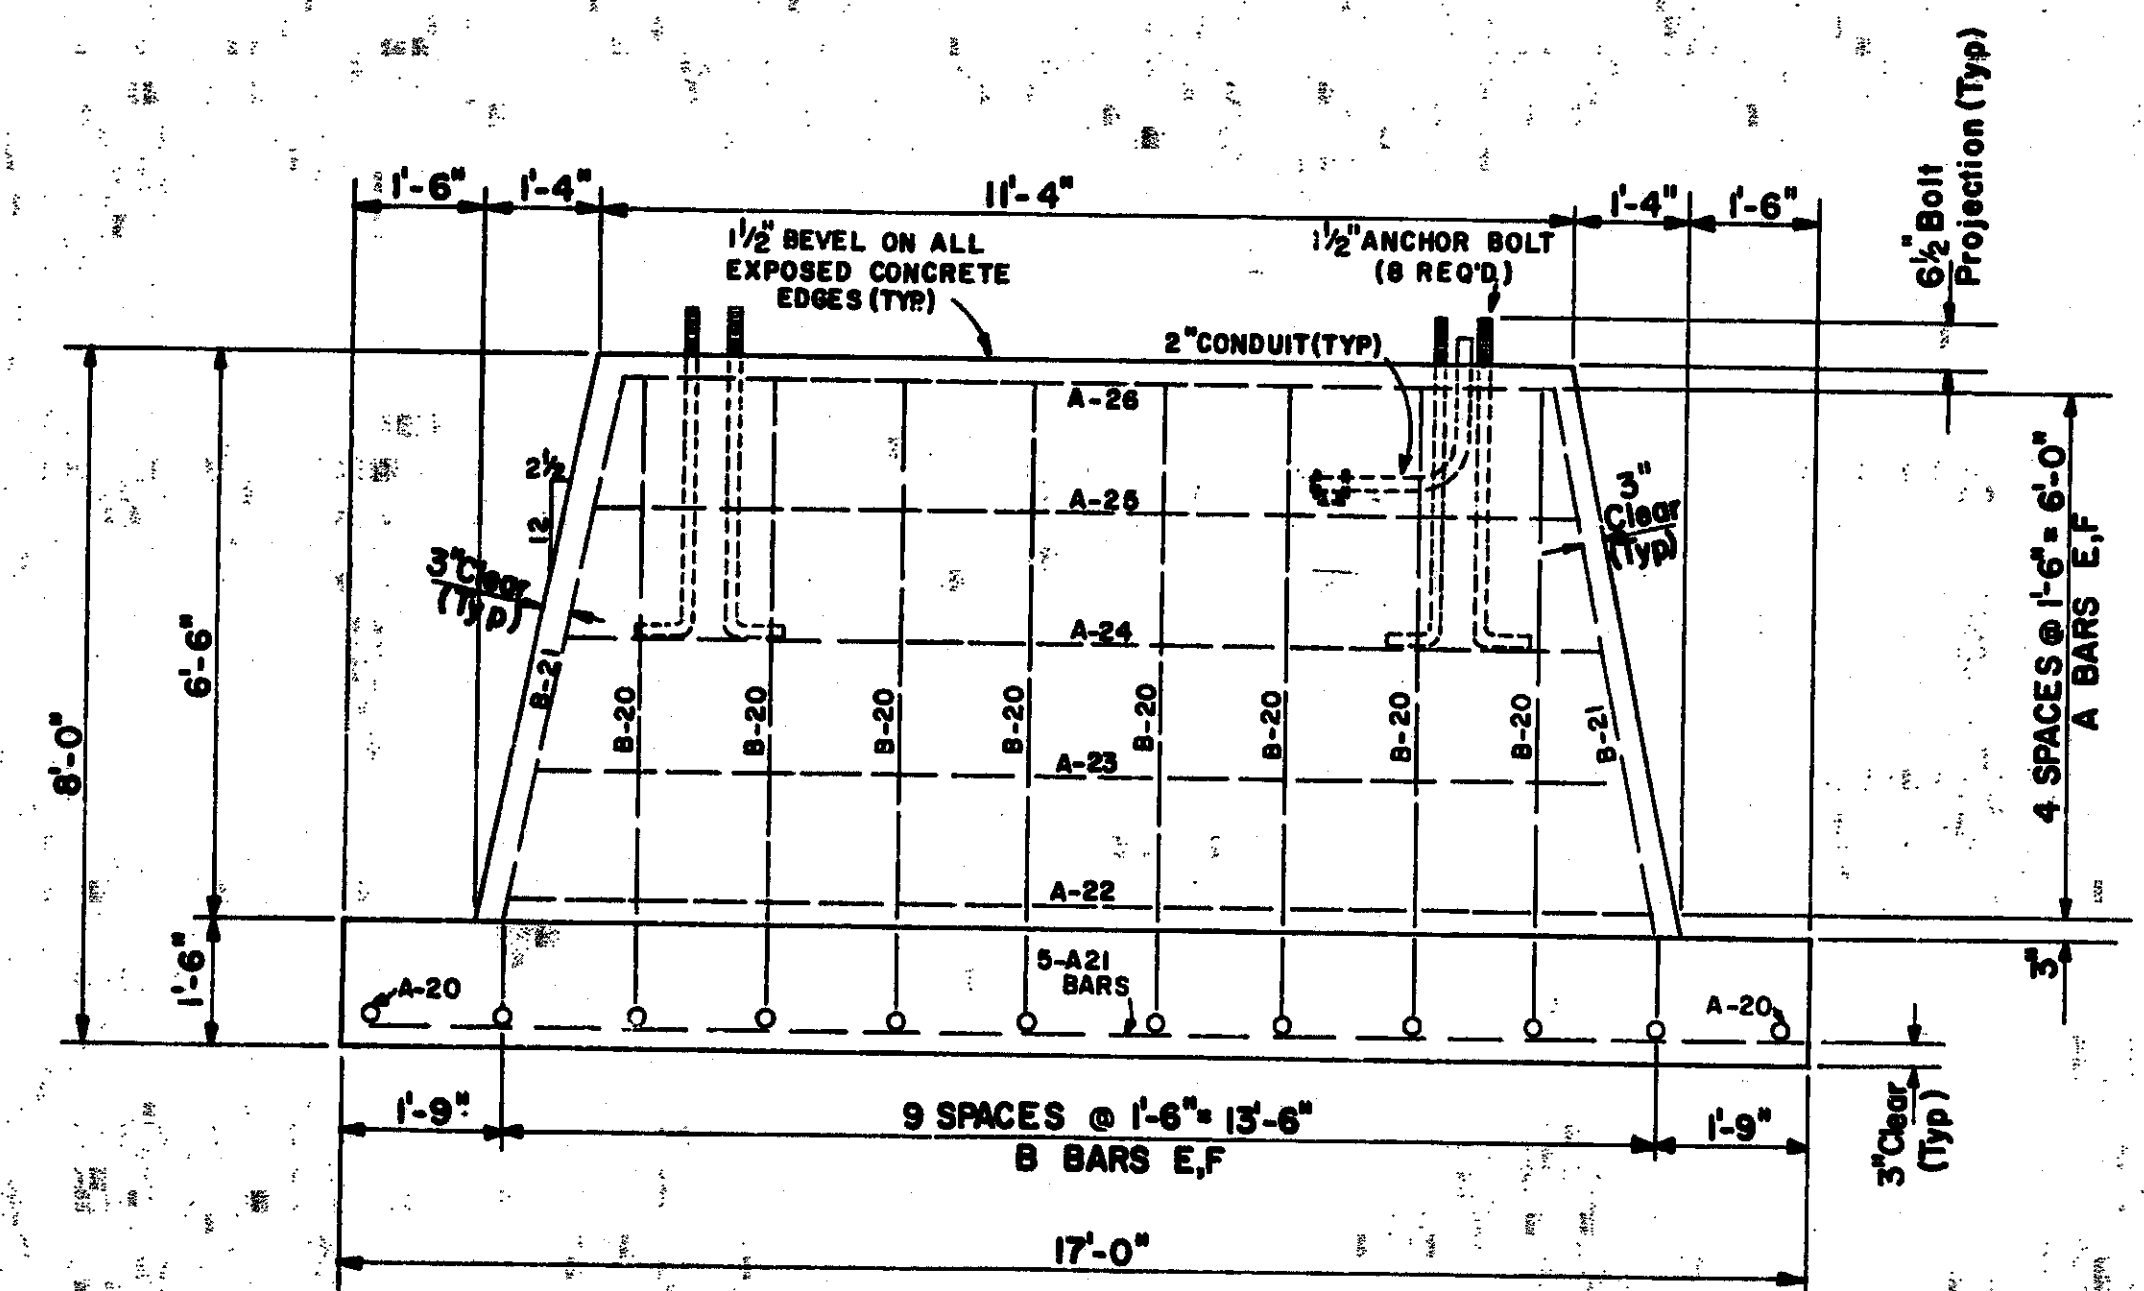


ELEVATION

STEEL REINFORCEMENT			
BAR	SIZE	DIMENSIONS	NO. REQ.
A-20	#4	5'-0"	2
A-21	#4	16'-6"	5
A-22	#4	13'-5"	2
A-23	#4	12'-9"	2
A-24	#4	12'-2"	2
A-25	#4	11'-6"	2
A-26	#4	10'-11"	2
B-20	#5	3'-6"	16
B-21	#5	3'-6"	4


12.82 Cu. Yds. Conc.
373# Reinf. Steel

SCALE: 1/2" = 1'-0"

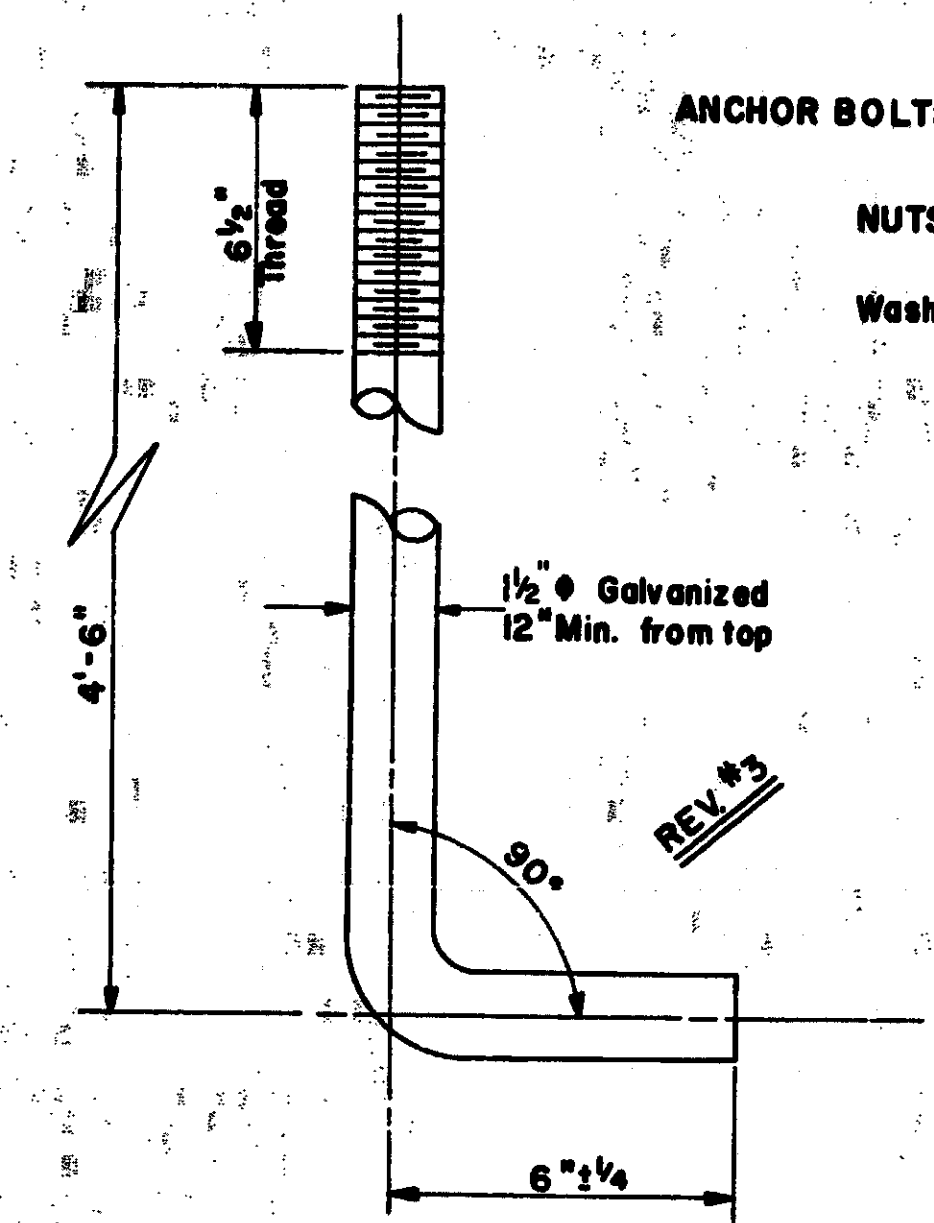

DETAIL of ANCHOR BOLT
16 Required

ANCHOR BOLTS: Steel with a minimum tensile strength of 85,000 psi and galvanized in accordance with ASTM A153.
NUTS: Heavy hex. head galvanized, 3/2 Req'd. ASTM A307
Washers: Two per anchor bolt, 1 1/2" Standard flat galvanized, 3/2 Req'd.

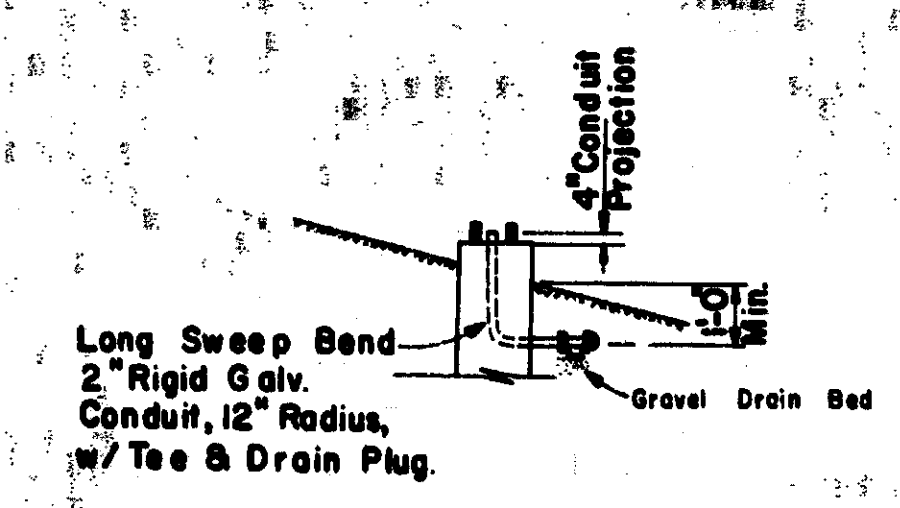


CONDUIT DETAIL

- NOTES
- 1) Conduit shall be installed in the right foundation or as otherwise specified by the engineer.
 - 2) Top of conc. shall be 3" min. above ground (desirable).
 - 3) Anchor bolts shall be carefully set and held vertical at the correct location and at the proper elevation until concrete has set. If desired, each set of four bolts may be tied together near the top and bottom by welding into a basket with bar stock or equivalent material.


MICHIGAN DEPARTMENT OF STATE HIGHWAYS
TRUSS FOUNDATION
TYPE D

REVISIONS			
NO.	DESCRIPTION	DATE	BY
1	NUMBER OF ANCHOR BOLTS CHANGED	2-5-68	T.M.W.
2	NOTE ADDED	5-26-68	T.M.W.
3	ANCHOR BOLT DETAIL REVISED	6/73	T.M.W.
4	QUANTITIES CHANGED-ANCHOR BOLT DETAIL	2/74	J.D.B.
5	ANCHOR BOLT SPEC. CHANGED	2/76	J.D.B.


DESIGNED BY	T.M.W.	3-67
CHECKED BY	J.D.B.	3-67
S8.20		

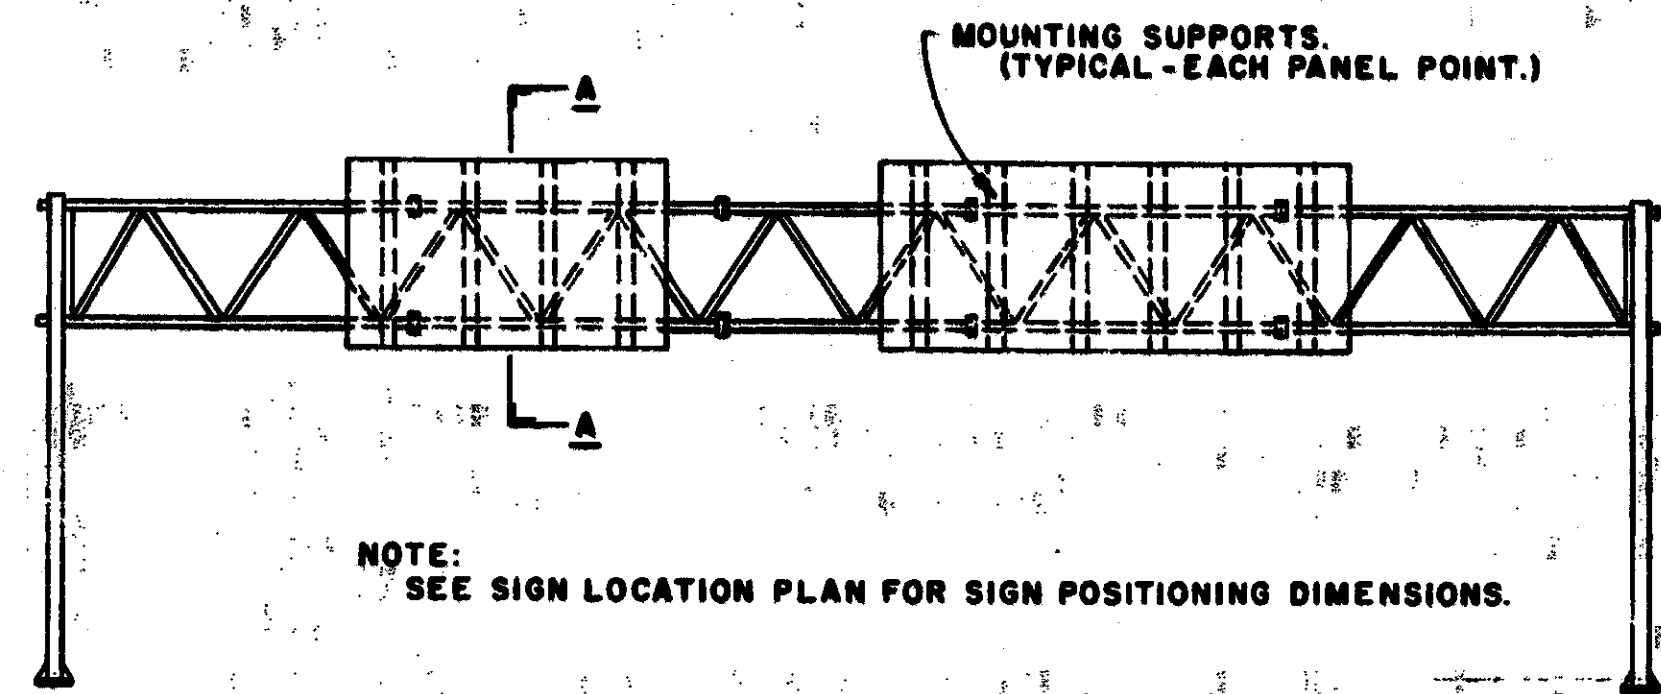

ELEVATION TRUSS

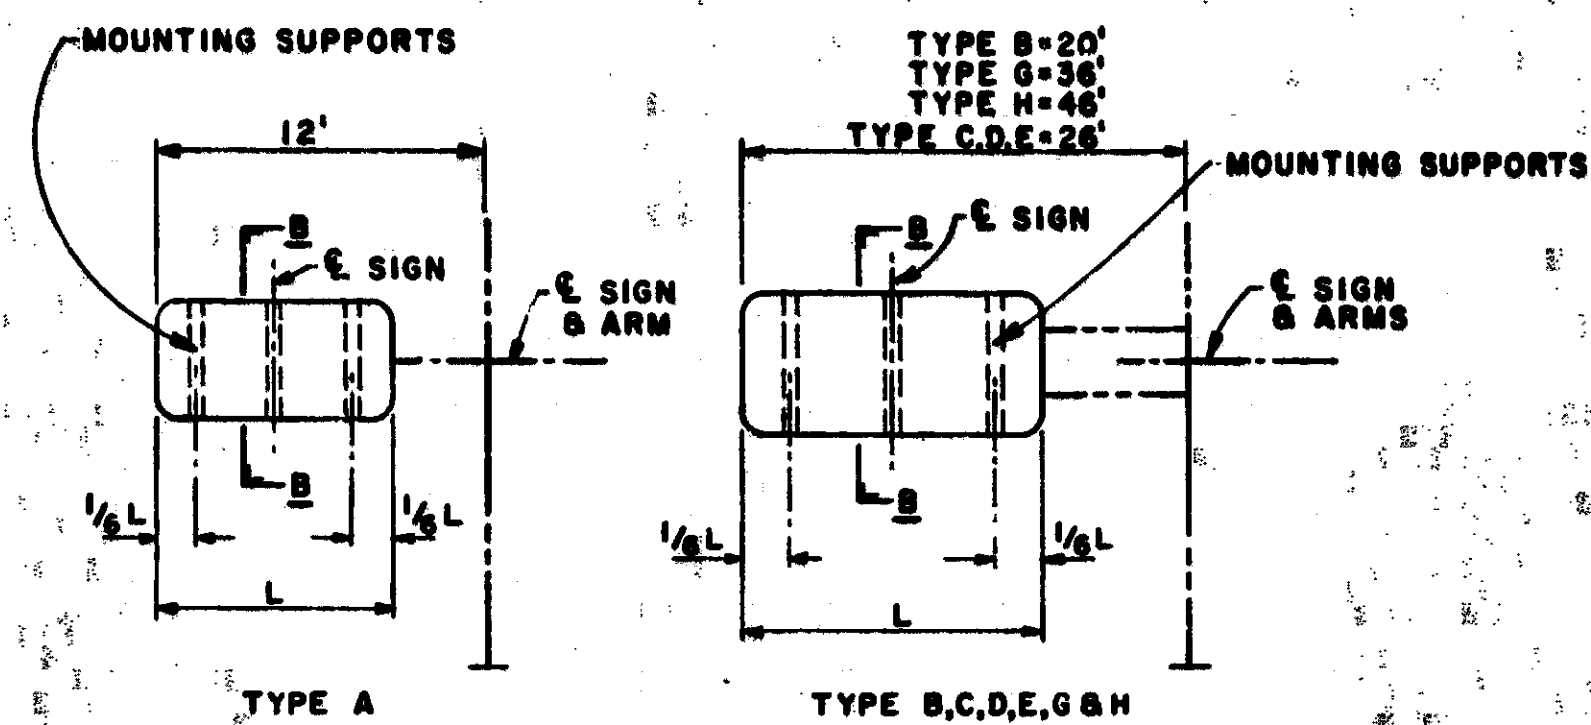


ELEVATION CANTILEVER

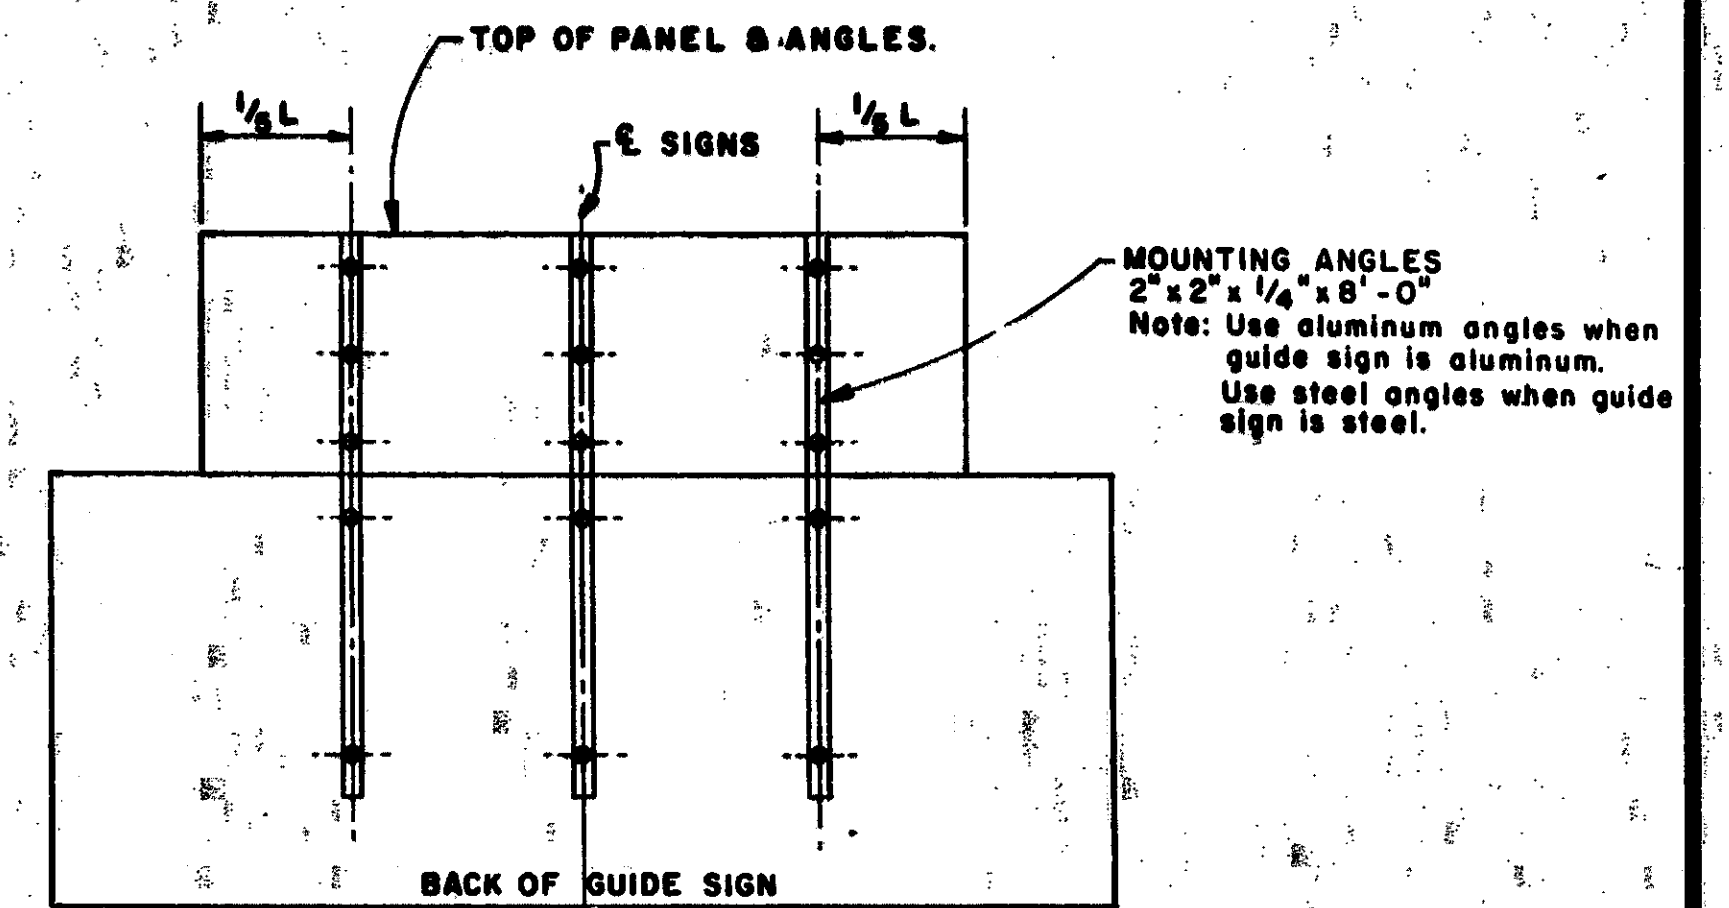


DETAIL OF EXIT NUMBER PANEL ERECTION TO OVERHEAD SIGNS


- NOTES:**
- All mounting angles and connections are incidental to "sign".
 - Shift the mounting angles a minimal distance to avoid conflict with guide sign supports.
 - Where guide sign is less than 6' in height, shorten mounting angles to match bottom of guide sign.
 - Exit Number Panel shall be direct bolted at top, middle and bottom to mounting angle (3 bolts req'd. per mounting angle). For attaching mounting angles to parent guide sign, use direct bolting at top of parent guide sign and at bottom of mounting angles (2 bolts req'd. per mounting angle). Sign support clips or direct bolting shall be used on each intermediate panel point. For bolting, use 1/2" Rectangular Flat Head bolts w/lock nut and flat washers. Physical properties of direct bolts and sign support clips shall be as defined in MDS&T SPECIFICATIONS.

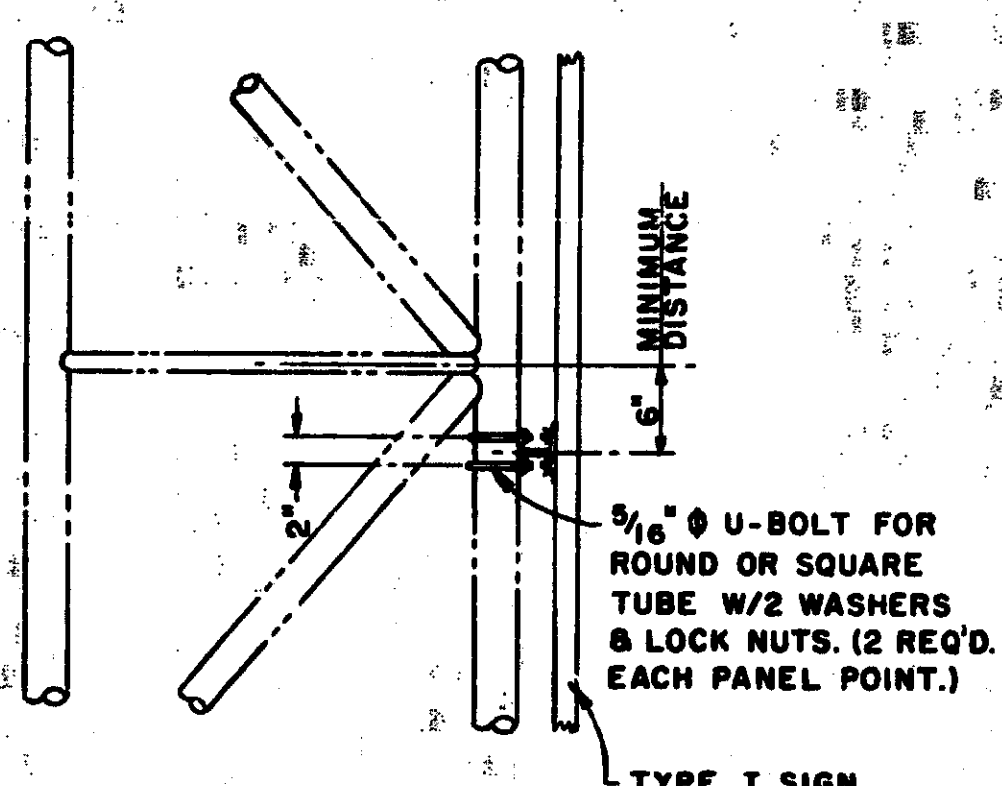


PLAN - TRUSS CONNECTION
TYP. - EACH PANEL PT.

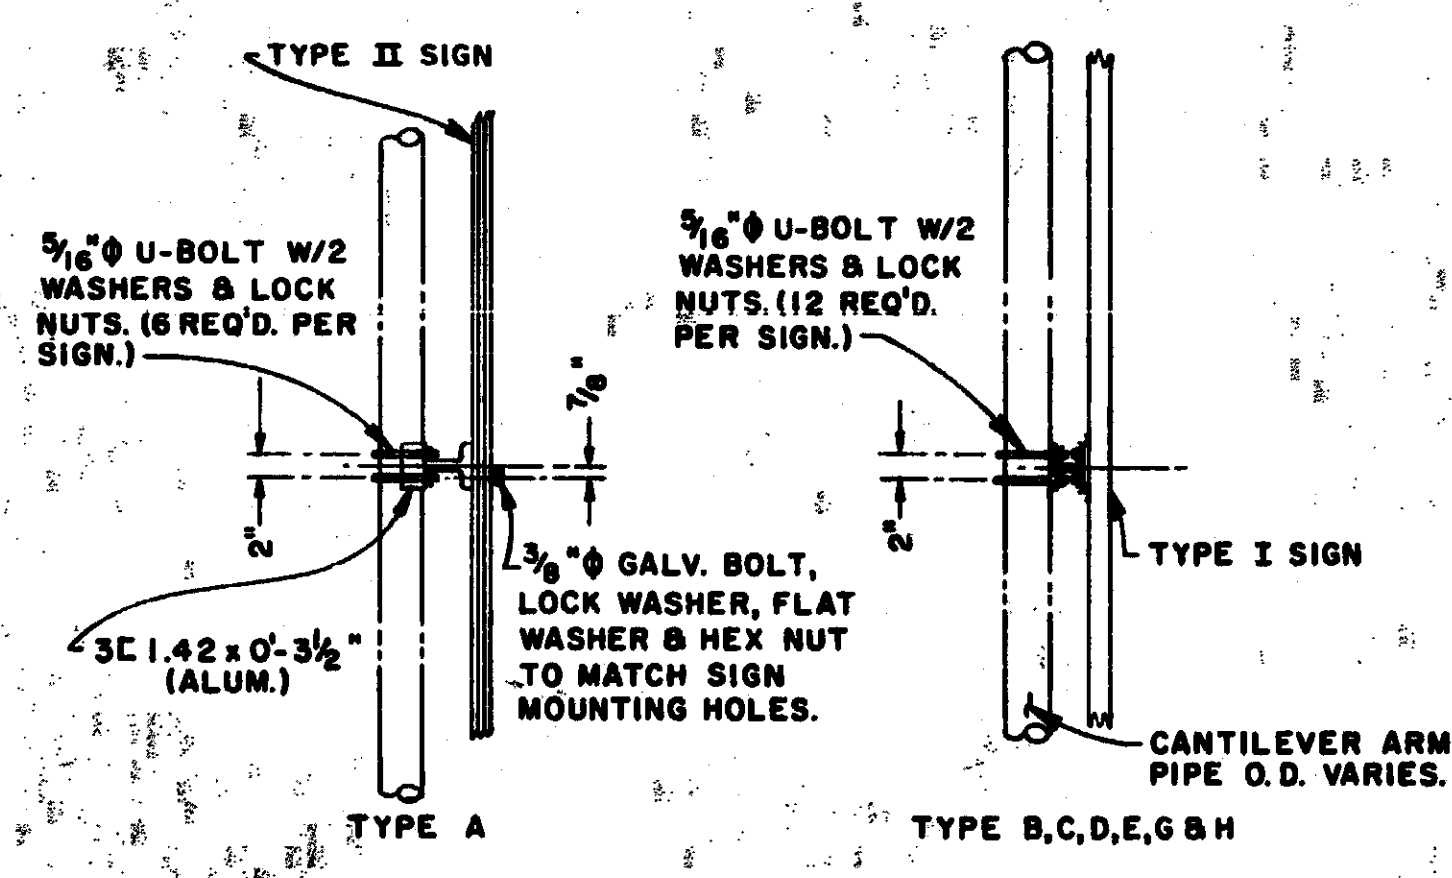

PLAN - CANTILEVER CONNECTION
TYP. - 3 PLACES

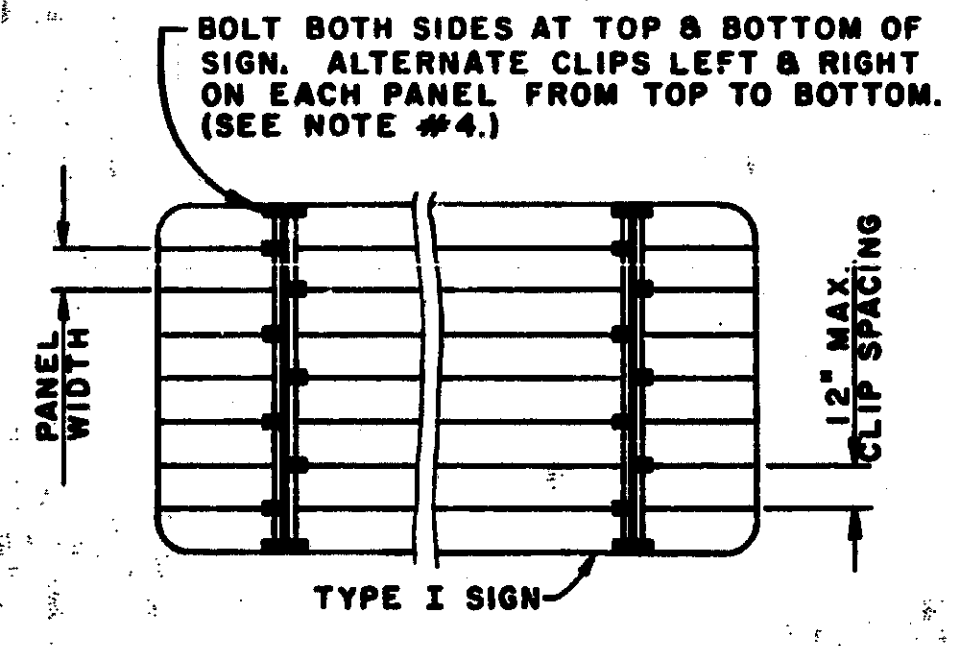


SIGN SUPPORT - CLIP OR BOLT ARRANGEMENT FOR OVERHEAD SIGNS

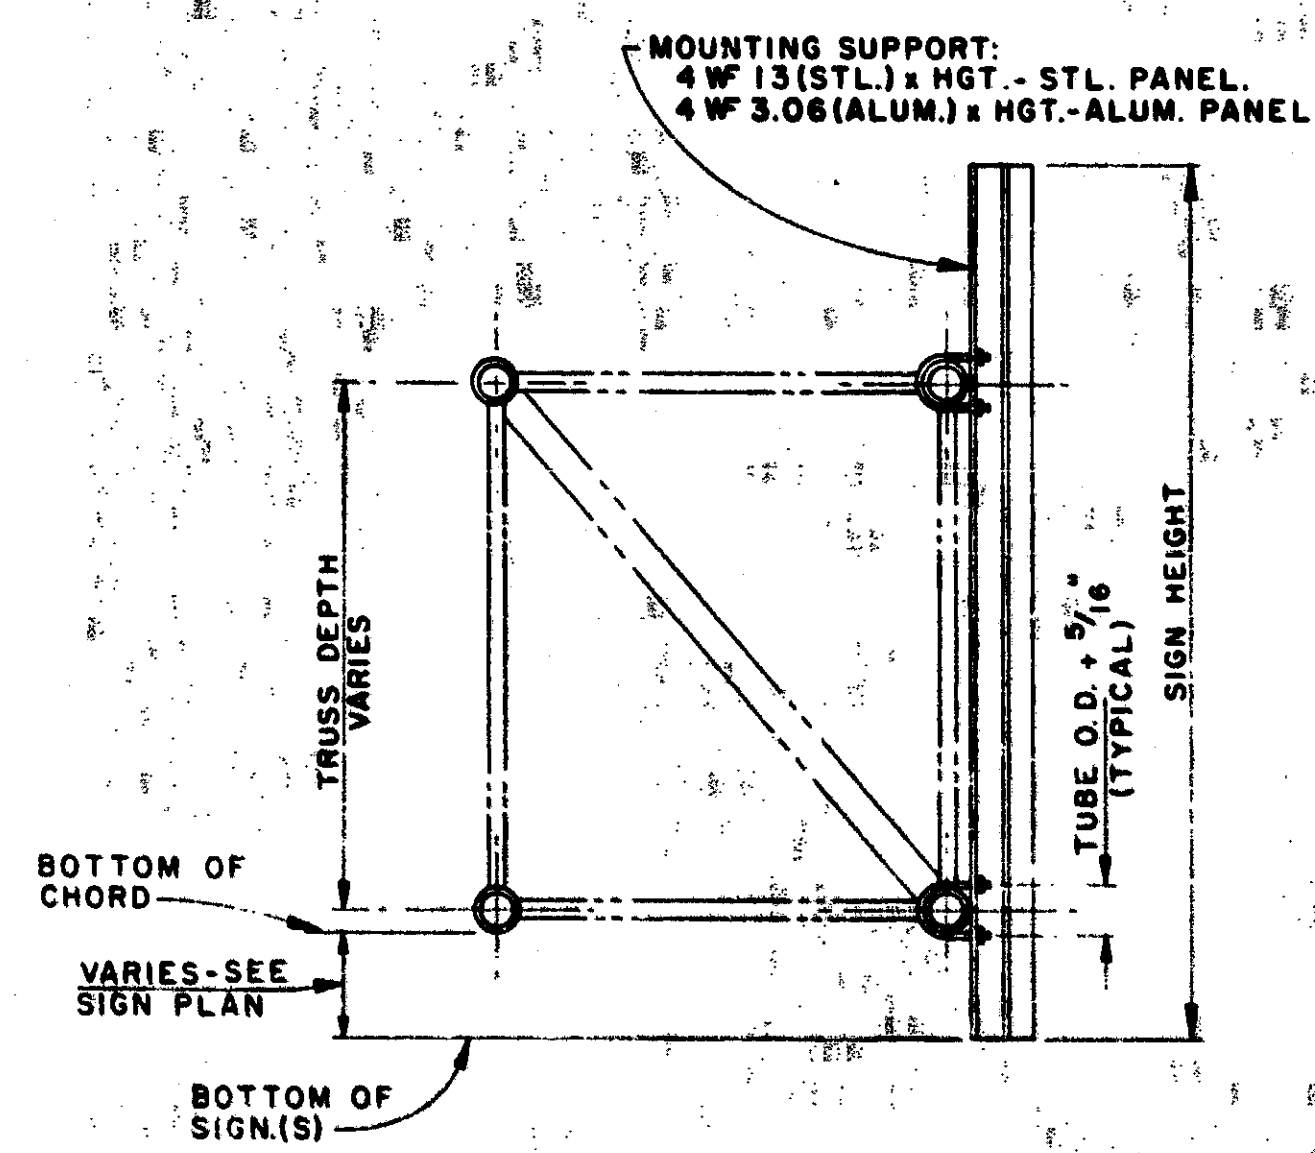

SECTION A-A

TRUSS

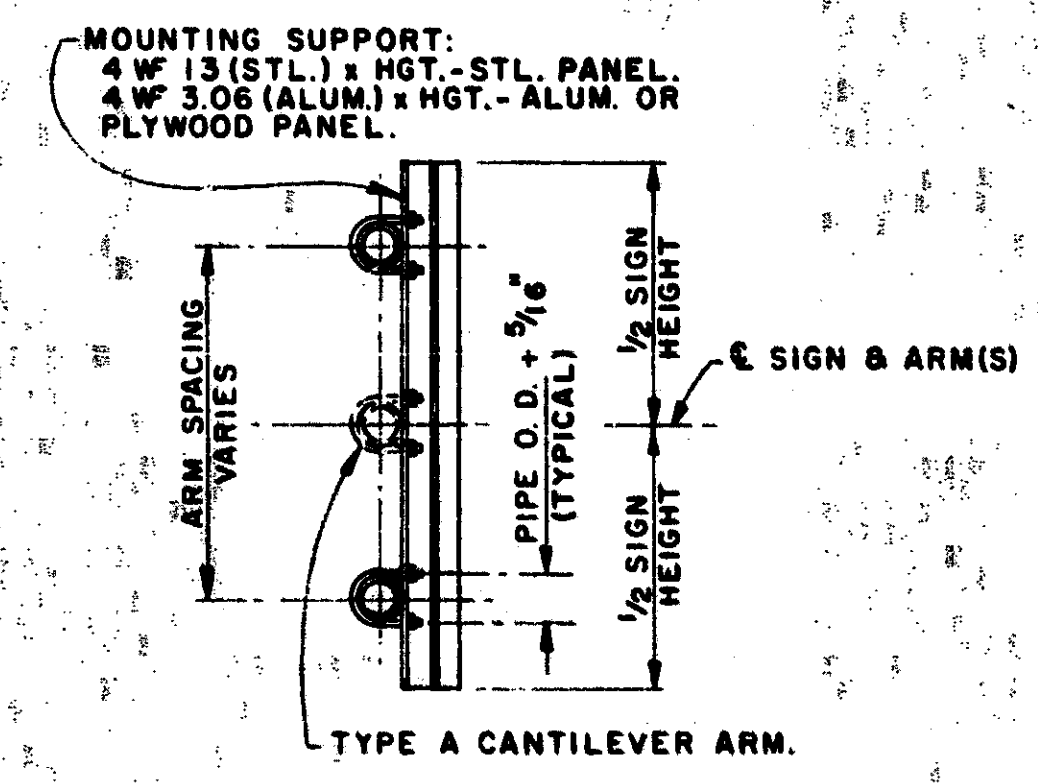


SECTION B-B

CANTILEVER

TRUSS TYPE	"U" - BOLT DIMENSIONS			U-BOLT LENGTH
	CANTILEVER TYPE	INSIDE BEND DIAMETER (D)	INSIDE BEND RADIUS (R)	
C (70') A-588		4"	3/8"	1'-2 5/8"
C (100') A-588		5"	3/8"	1'-5 5/8"
D (125') A-588		5"	3/8"	1'-5 5/8"
C (70') A-36		4"	3/8"	1'-2 3/8"
C (100') A-36		5"	7/8"	1'-5 1/4"
D (125') A-36		5"	7/8"	1'-5 1/4"
B (Alum.)		6" or 7"	3" or 3 1/2"	1'-5 1/2" or 1'-8"
C (Alum.)		6" or 7"	3" or 3 1/2"	1'-5 1/2" or 1'-8"
D (Alum.)		7"	3 1/2"	1'-8"
A		4 1/2"	2 1/4"	1'-3 1/2"
B		6 5/8"	3 5/8"	1'-7 1/2"
C		8 5/8"	4 5/8"	2'-1"
D & E		10 3/8"	5 3/8"	2'-8"
G		10 3/8"	5 3/8"	2'-8"
H		12 3/8"	6 3/8"	2'-11 1/2"

NOTE:
ALL U-BOLTS SHALL HAVE 1/4" THREAD LENGTH. (MIN.)
ALL U-BOLTS AND ACCOMPANYING LOCKNUTS AND FLAT WASHERS SHALL BE STAINLESS STEEL - ASTM A320, GRADE B6 (AISI TYPE 304) FOR U-BOLTS AND WASHERS, AND GRADE B8F (AISI TYPE 303) FOR LOCKNUTS.

- NOTES:**
- ERECTION ANGLES & WF MOUNTING SUPPORTS SHALL BE SHOP CONNECTED BEFORE HANDLING FINISHED SIGN. (INCIDENTAL TO SIGN.)
 - ALL CONNECTIONS ARE INCIDENTAL TO "SIGN".
 - SIGN PANEL CONNECTIONS - BOLTS - 3/8" BOLT & HEX. NUT @ 24" O.C. FOR ALUMINUM & STEEL PANELS. RIVETS - 1/4" @ 24" O.C. FOR ALUMINUM PANELS ONLY.
 - FOR ATTACHMENT OF TYPE I SIGN TO OVERHEAD SIGN MOUNTING SUPPORTS, USE 3/8" RECTANGULAR FLAT HEAD BOLTS W/LOCK NUT AND FLAT WASHER AT THE TOP & BOTTOM. (4 REQ'D PER MOUNTING SUPPORT.) SUPPORT CLIPS MAY BE USED INTERMEDIATELY.

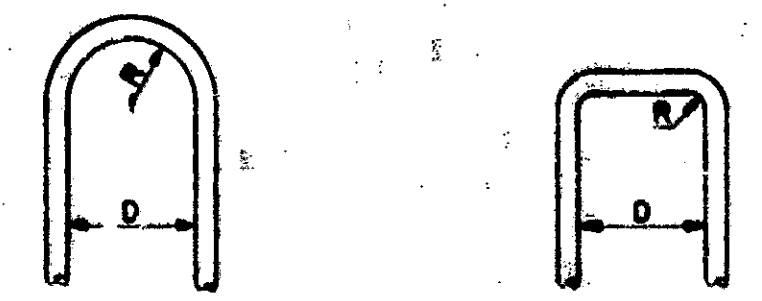

MICHIGAN DEPARTMENT OF STATE HIGHWAYS AND TRANSPORTATION

SIGN CONNECTION DETAILS
TRUSS - CANTILEVER - EXIT NUMBER


NO.	DESCRIPTION	DATE	BY

DESIGNED BY: W.C.G. 5/77


CHECKED BY: []

SHEET NO. 9


S 9.10

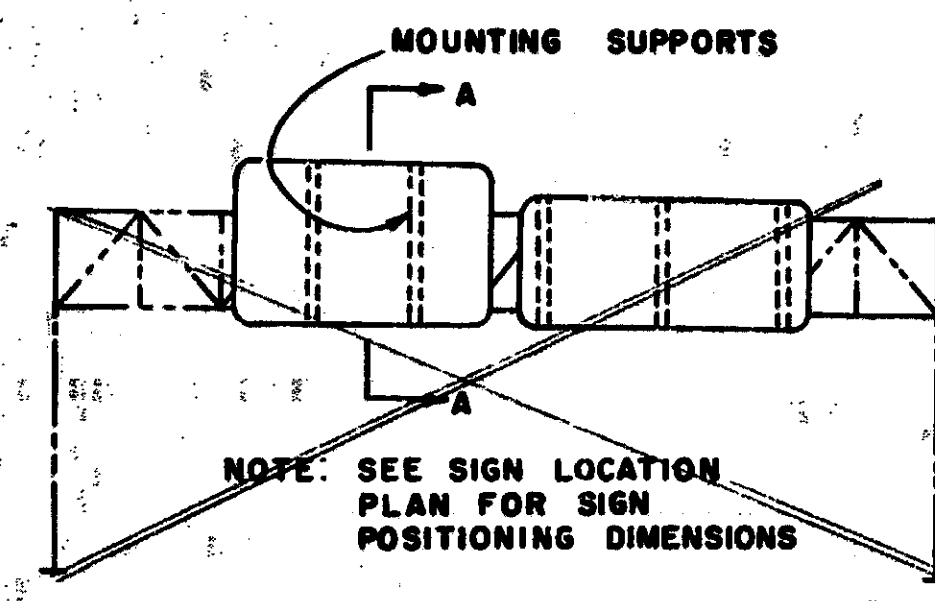


ELEVATION TRUSS

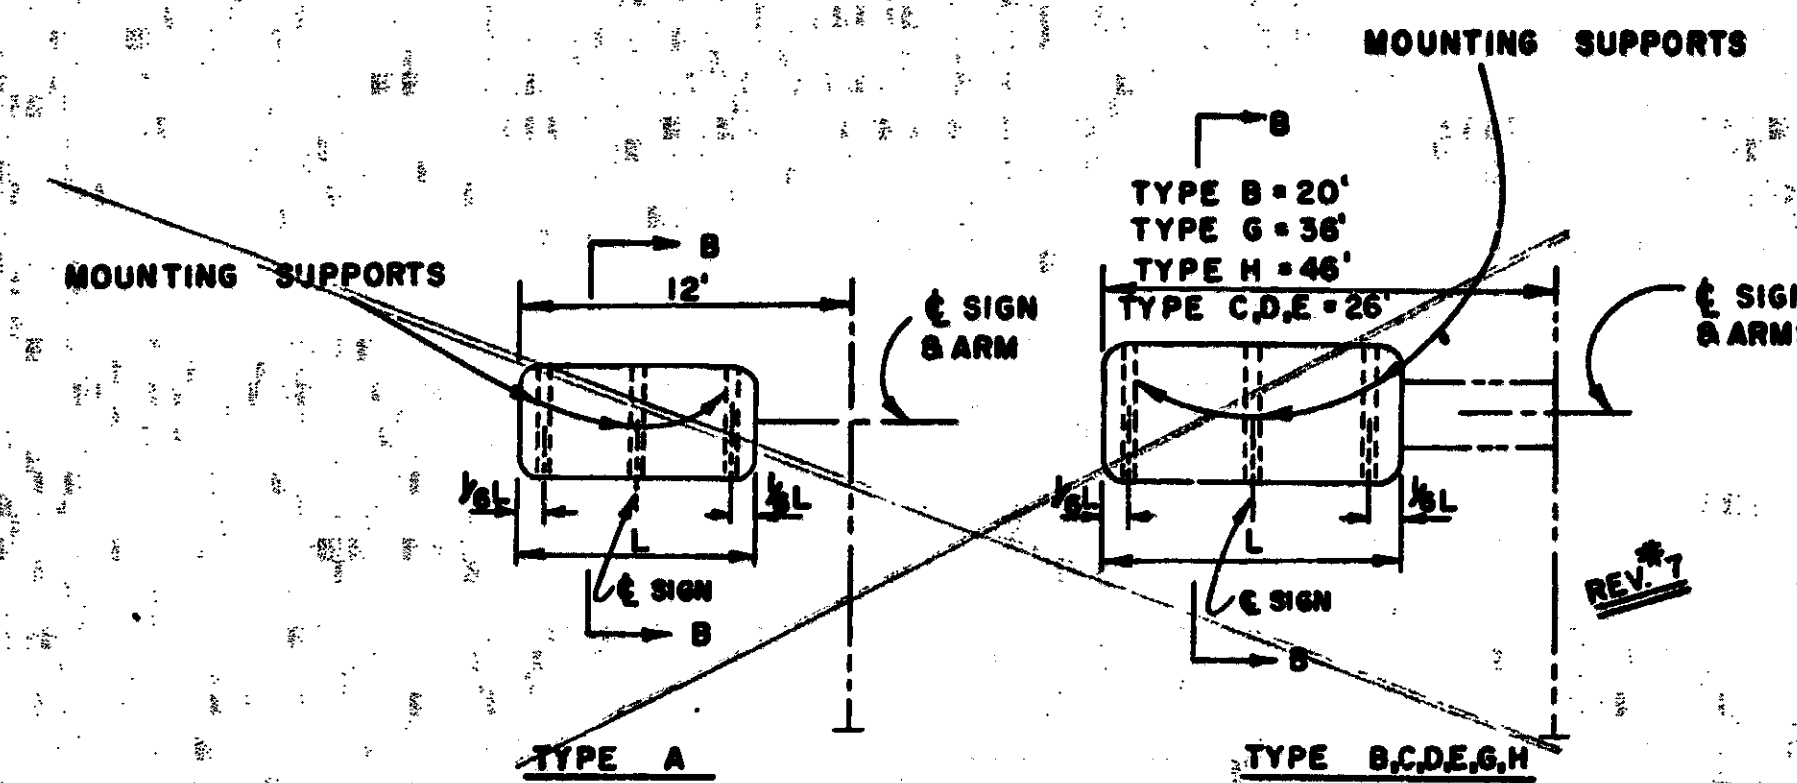


ELEVATION CANTILEVER

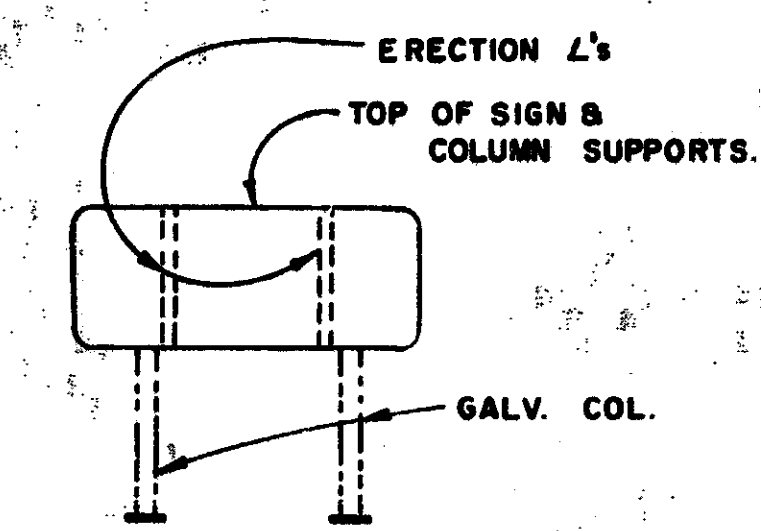


ELEVATION STEEL COLUMN BREAKAWAY

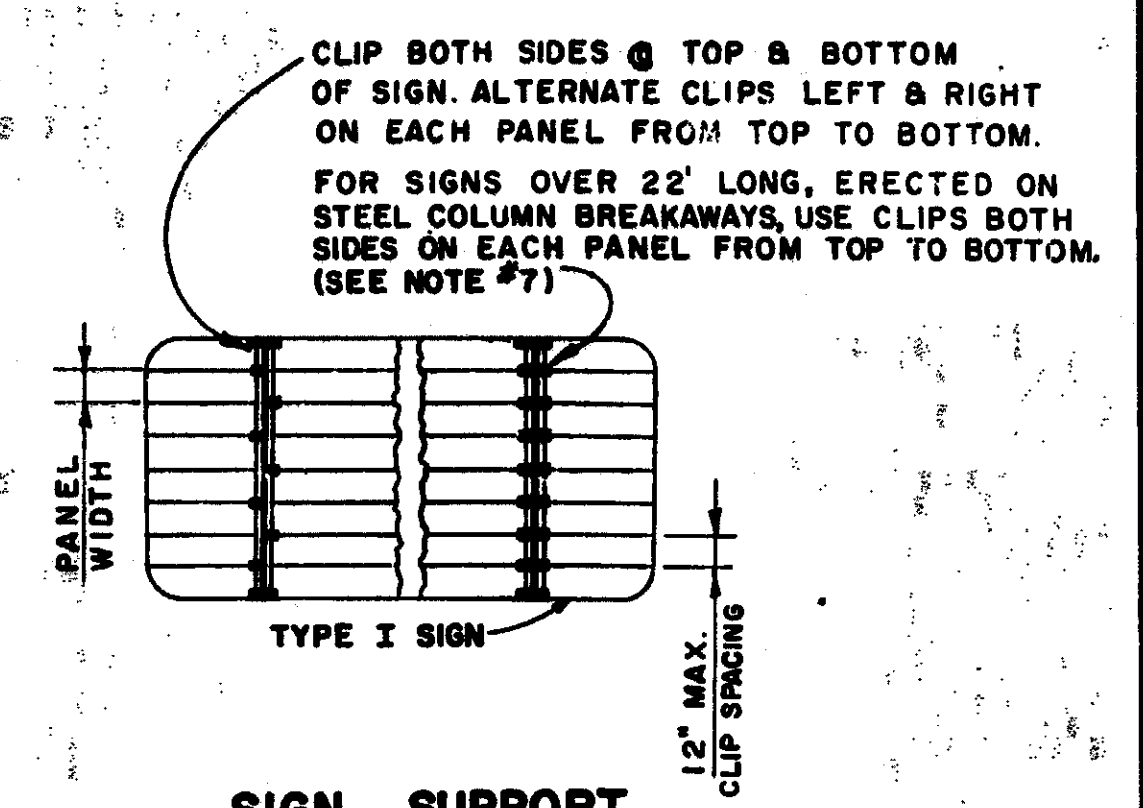


SIGN SUPPORT CLIP OR BOLT ARRANGEMENT

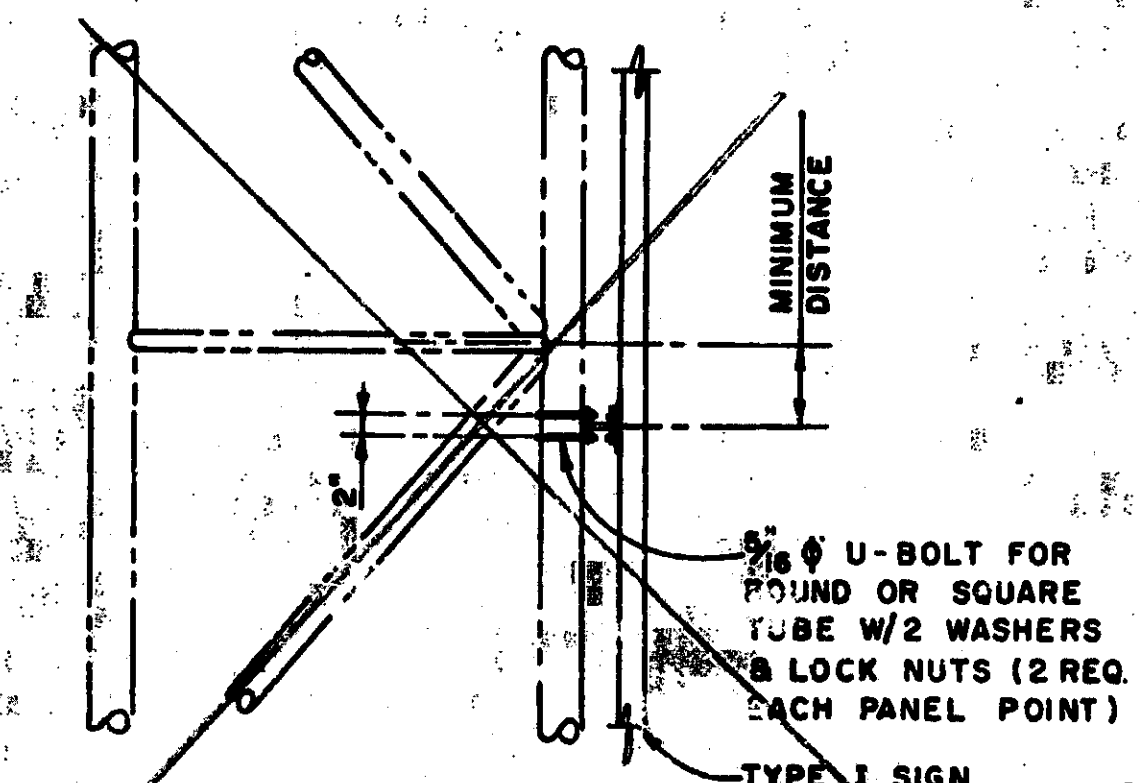

PLAN-TRUSS CONNECTION
TYR - EACH PANEL PT.

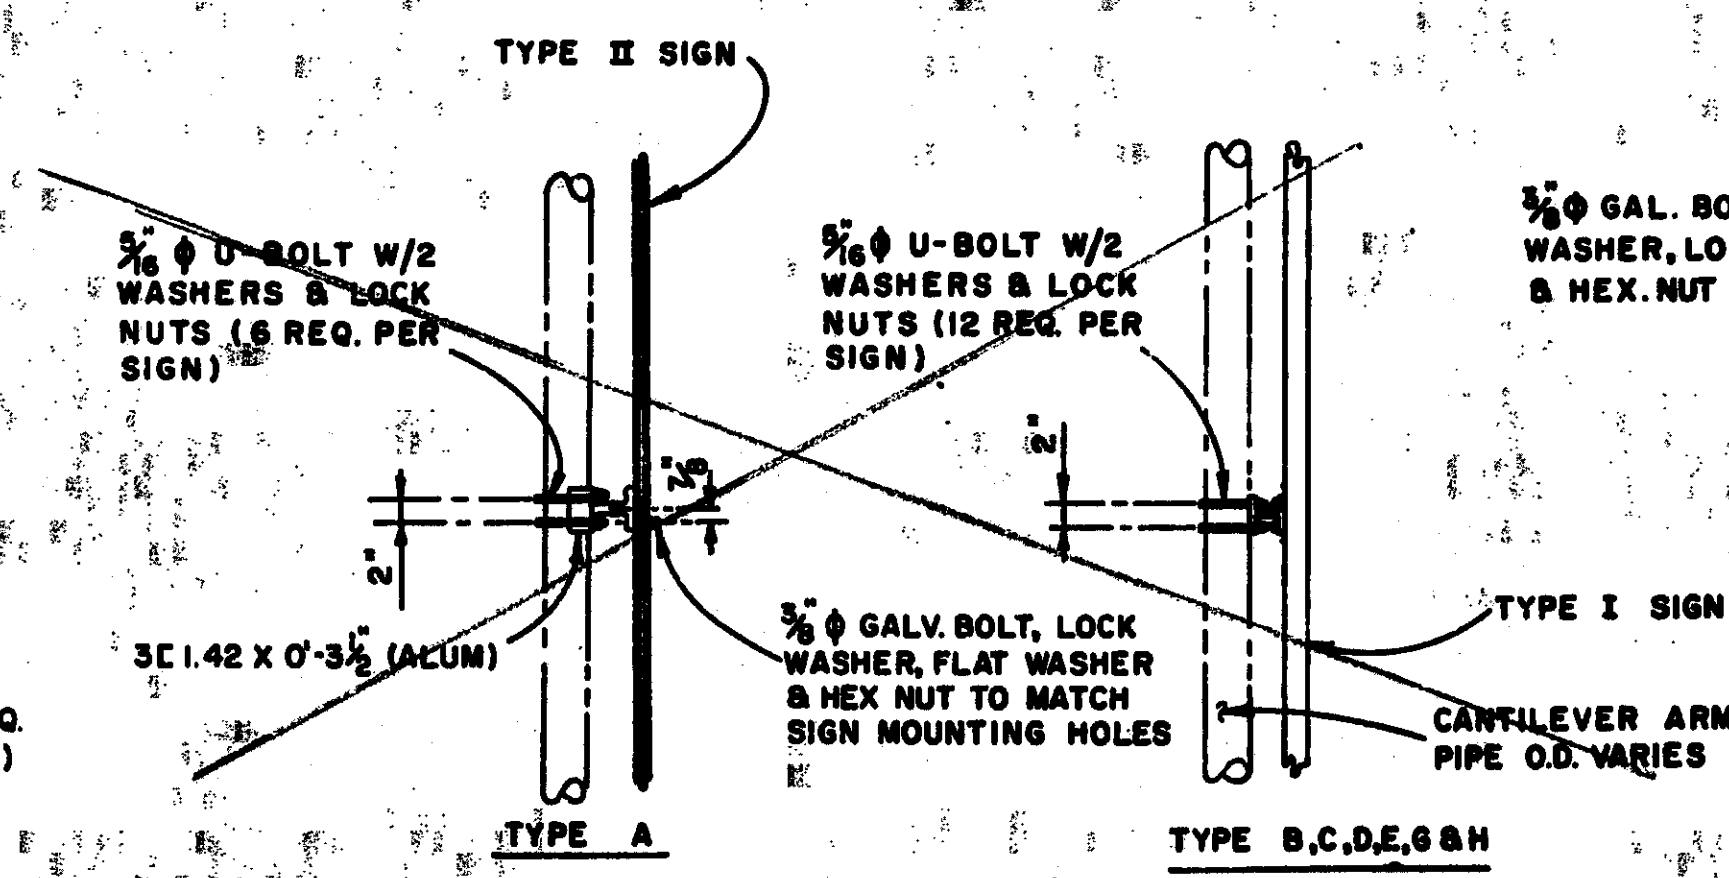


PLAN-CANTILEVER CONNECTION
TYR - 3 PLACES

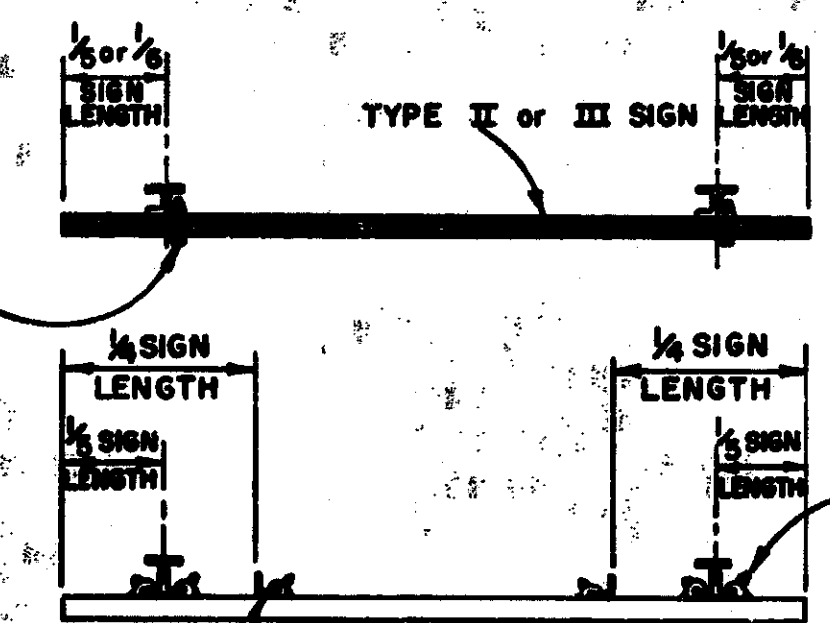


PLAN STEEL COLUMN BREAKAWAY

ATTACHMENT OF EXIT NUMBER PANELS TO OTHER HIGHWAY GUIDE SIGNS

WHERE AN EXIT NUMBER PANEL IS TO BE ERRECTED ABOVE A COLUMN-SUPPORTED SIGN, THE SIGN'S ERECTION ANGLE SHALL BE EXTENDED TO THE TOP OF THE EXIT NUMBER PANEL. WHERE AN EXIT NUMBER PANEL IS TO BE ERRECTED ABOVE AN OVERHEAD SIGN, ERECTION ANGLES SHALL BE ADDED TO THE SIGN AND EXTENDED TO THE TOP OF THE EXIT NUMBER PANEL. WHERE NECESSARY, SIGN ERECTION ANGLES MAY BE SHIED TOWARD THE CENTER OF A SIGN TO PROVIDE SUPPORT FOR THE EXIT NUMBER PANEL. ALL ERECTION ANGLES ADDED TO OVERHEAD SIGNS SHALL BE THE SAME AS THOSE SPECIFIED FOR COLUMN-SUPPORTED SIGNS.

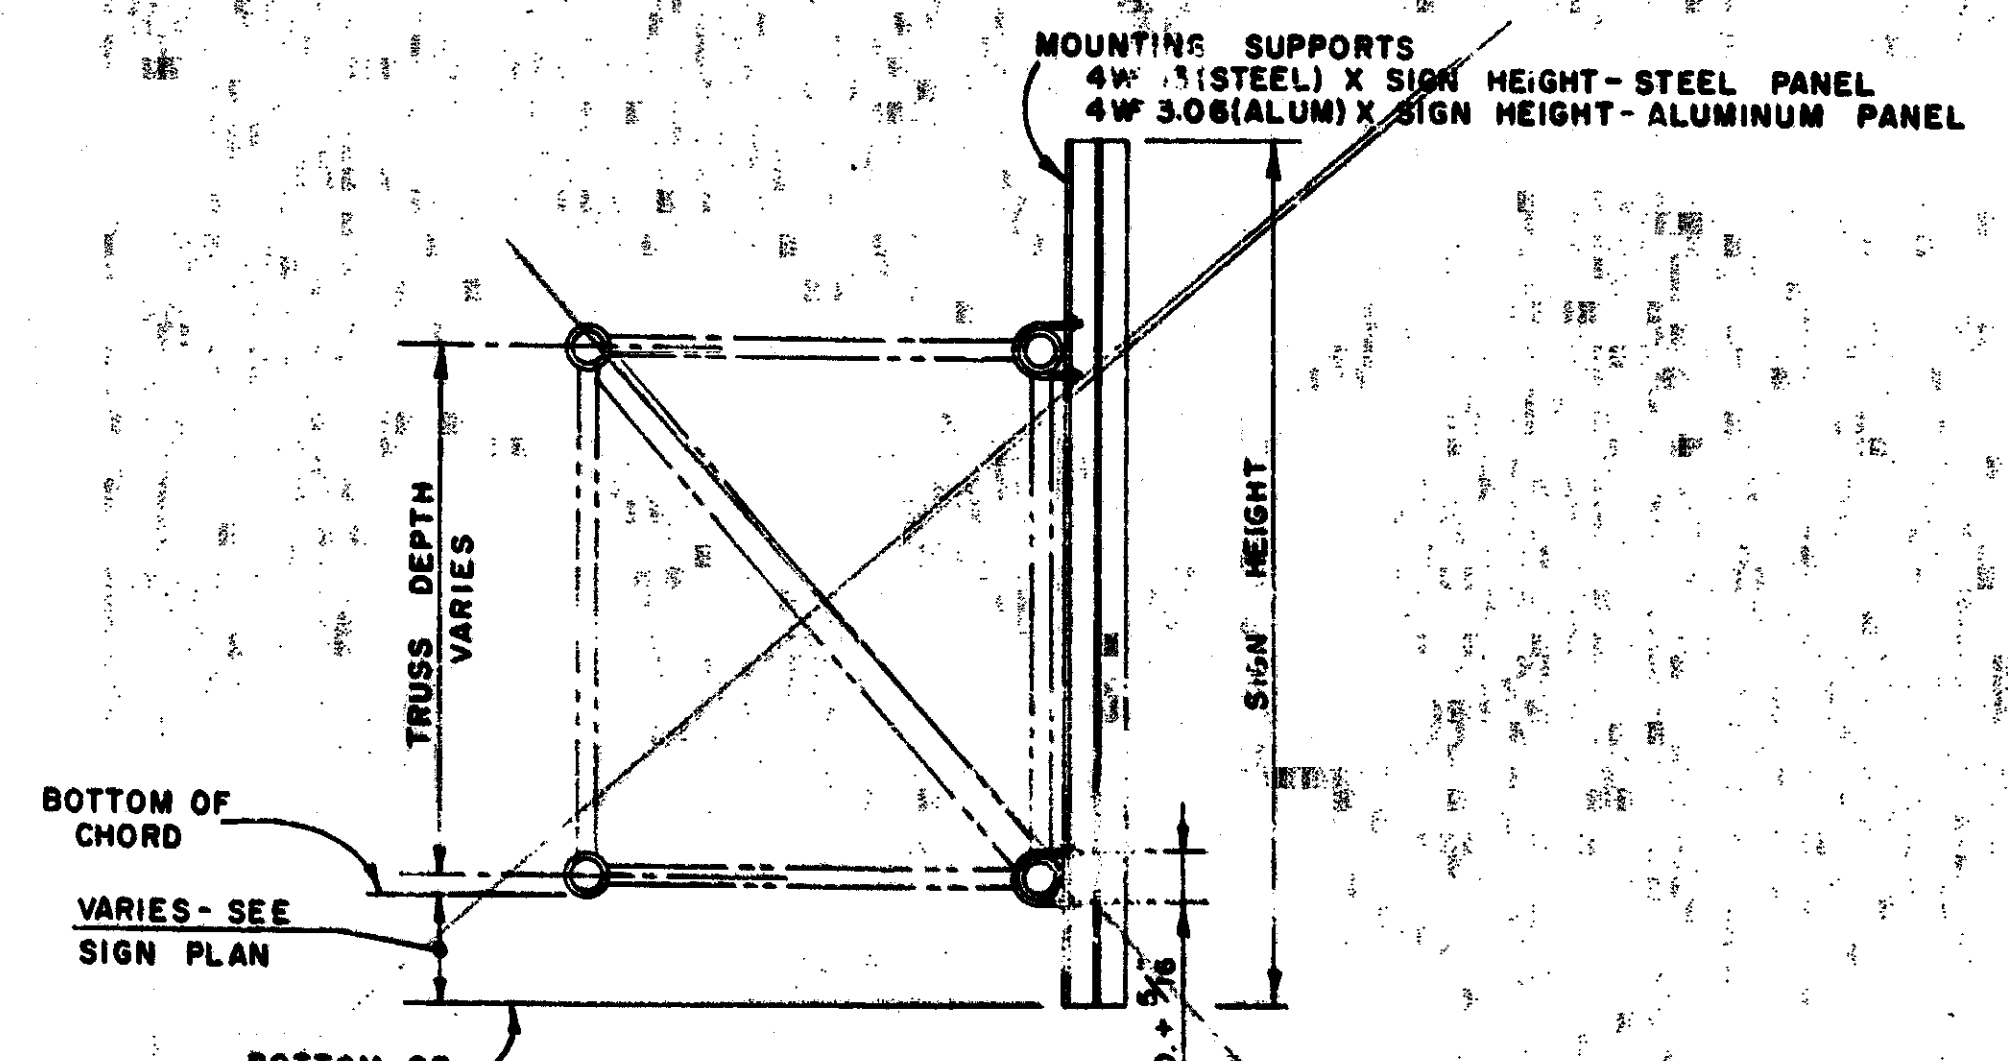

SECTION A-A TRUSS

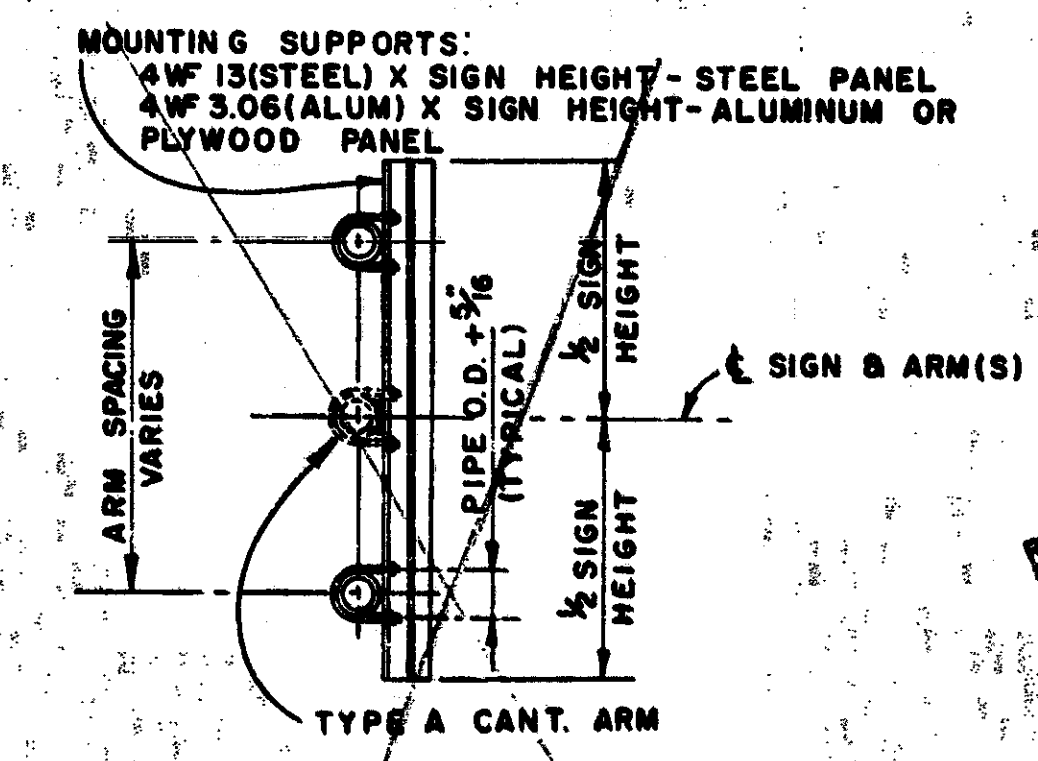

SECTION B-B CANTILEVER

U-BOLT DIMENSIONS			
ALUM TRUSS TYPE	CANTILEVER TYPE	INSIDE BEND-DIA.	U-BOLT LENGTH
B		6" or 7"	1'-5" or 1'-8"
C		6" or 7"	1'-5" or 1'-8"
D		7"	1'-8"
	A	4 1/2"	1'-3 1/2"
	B	6 5/8"	1'-7 1/2"
	C	8 3/8"	2'-1"
	D, E	10 3/8"	2'-5 1/2"
	G	10 3/8"	2'-5 1/2"
	H	12 3/8"	2'-11 1/2"


NOTE: ALL U-BOLTS SHALL HAVE 1 1/4" THREAD LENGTH (MIN.)

ALL U-BOLTS AND ACCOMPANYING LOCKNUTS AND WASHERS SHALL BE STAINLESS STEEL - ASTM A 320, GRADE B.8 (AISI TYPE 304) FOR U-BOLTS AND WASHERS, AND GRADE B.8 (AISI TYPE 303) FOR LOCKNUTS.

- NOTE:**
- ERECTION ANGLES & WF MOUNTING SUPPORTS SHALL BE SHOP CONNECTED BEFORE HANDLING FINISHED SIGN. (INCIDENTAL TO SIGN)
 - ALL CONNECTIONS ARE INCIDENTAL TO "SIGN".
 - SIGN PANEL CONNECTIONS - BOLTS - 3/8" Ø BOLT & HEX. NUT @ 24" O.C. FOR ALUMINUM & STEEL PANELS. RIVETS - 1/4" Ø @ 24" O.C. FOR ALUMINUM PANELS ONLY.
 - TORQUE ALUMINUM CLIP BOLTS TO 225 INCH POUNDS.
 - WHEN AN EXIT NUMBER PANEL IS CALLED FOR ON THE PLANS FOR AN OVERHEAD SIGN, THE MOUNTING CLIP OR BOLT SHALL BE EXTENDED TO THE TOP OF THE EXIT NUMBER PANEL.
 - ON GROUND MOUNTS, SIGN ERECTION ANGLES SHALL BE EXTENDED TO THE TOP OF AN EXIT NUMBER PANEL. IF NECESSARY, THE LOCATION OF ERECTION ANGLES MAY BE ADJUSTED TOWARD THE CENTER OF THE SIGN TO SUPPORT THE EXIT NUMBER PANEL.
 - SIGN SUPPORT CLIPS TO BE USED ONLY FOR TYPE I SIGN ATTACHMENTS TO ROADSIDE STEEL COLUMN BREAKAWAYS. FOR ATTACHMENT OF TYPE I SIGN TO OVERHEAD SIGN MOUNTING SUPPORTS, USE 3/8" Ø RECTANGULAR FLAT HEAD BOLTS W/ CON. NUT AND FLAT WASHER, AT TOP & BOTTOM. (4 REQ'D PER MOUNTING SUPPORTS). SUPPORT CLIPS MAY BE USED INTERMEDIATELY.



MICHIGAN DEPARTMENT OF STATE HIGHWAYS
SIGN CONNECTION DETAILS
TRUSS - CANTILEVER - COLUMN

REVISIONS			REVISIONS		
NO.	DESCRIPTION	DATE	NO.	DESCRIPTION	DATE
1	DELETE NOTES B3 AND B4	4-71	1	DIMENSION CHANGE	7-15-85 S.R.H.
2	ADD OF ATTACHMENT OF EXIT NUMBER PANELS	4-71	2	CONNECTION PLAN ADDED	4-66 R.L.D.
3	DELETE REV. #10	10-7	3	ADD OF STEEL SIGN PANEL	10-68 T.M.W.
4	DELETE OVERHEAD SUPPORT CLIPS, NOTE #7 ADDED	3-72	4	U-BOLT DESIGNATION ADDED	12-87 D.A.P.
5	ADDITIONS MADE TO NOTES #1 & #7	7-78 LWP	5	NOTES 5 & 6 ADDED	10-88
			6	U-BOLT CHART CHANGED	10-89
			7	8 IN DIMENSIONS ADDED	10-89
			8	DELETE NOTE #4	3-71

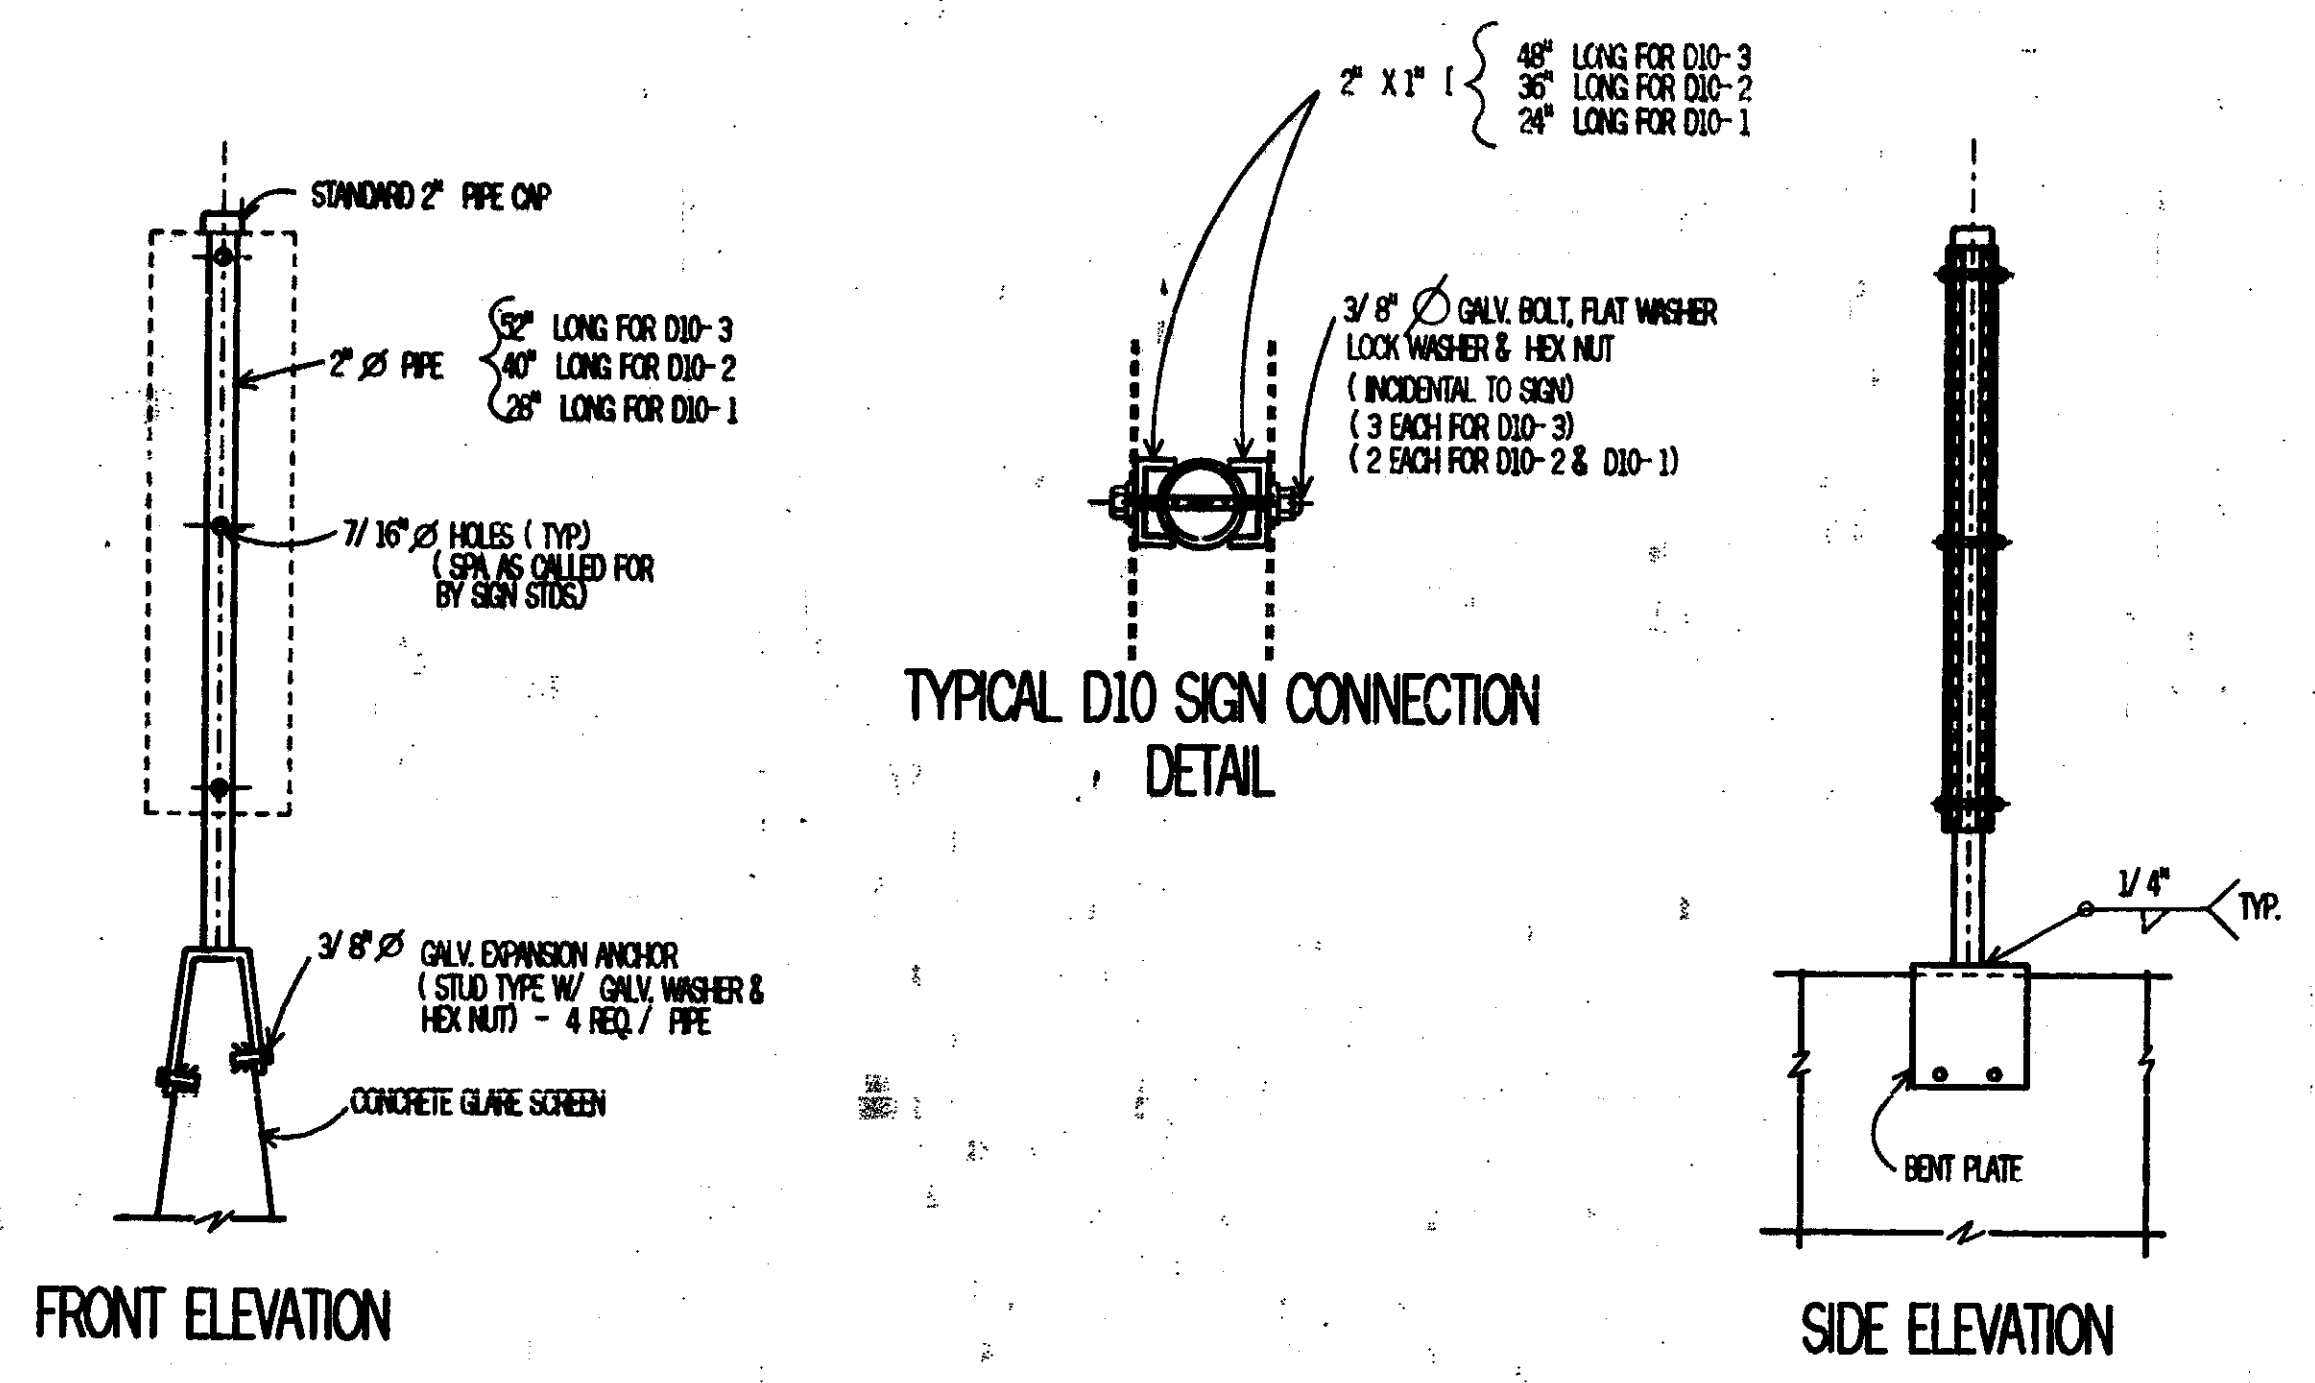


GLARE SCREEN CONNECTION - TYPE I

MILE POST SIGN

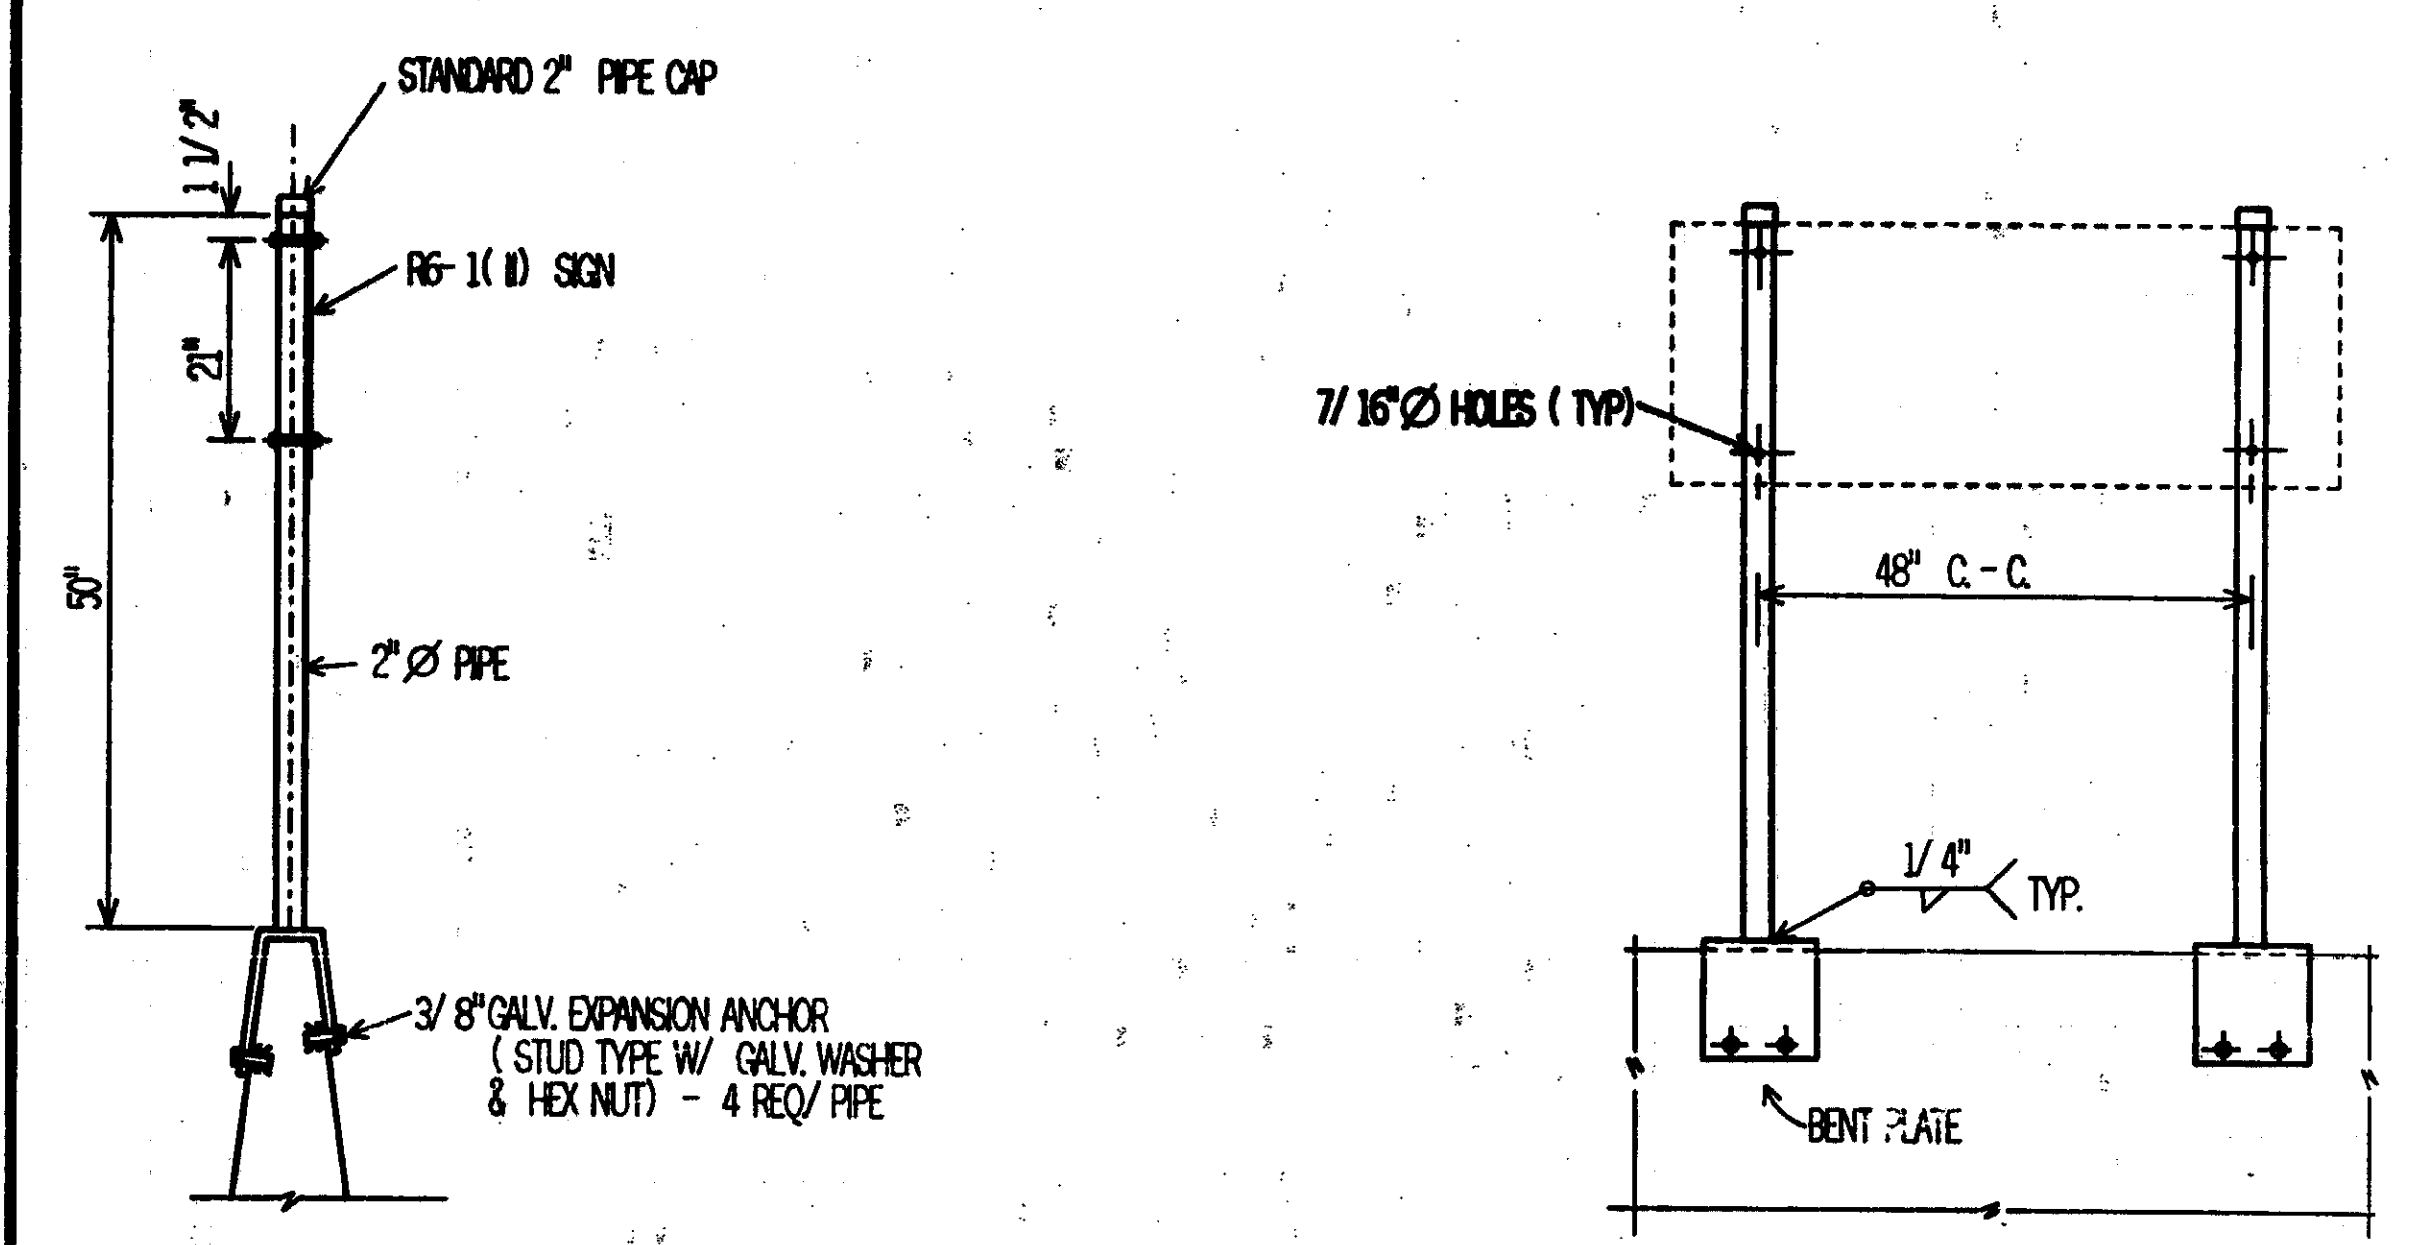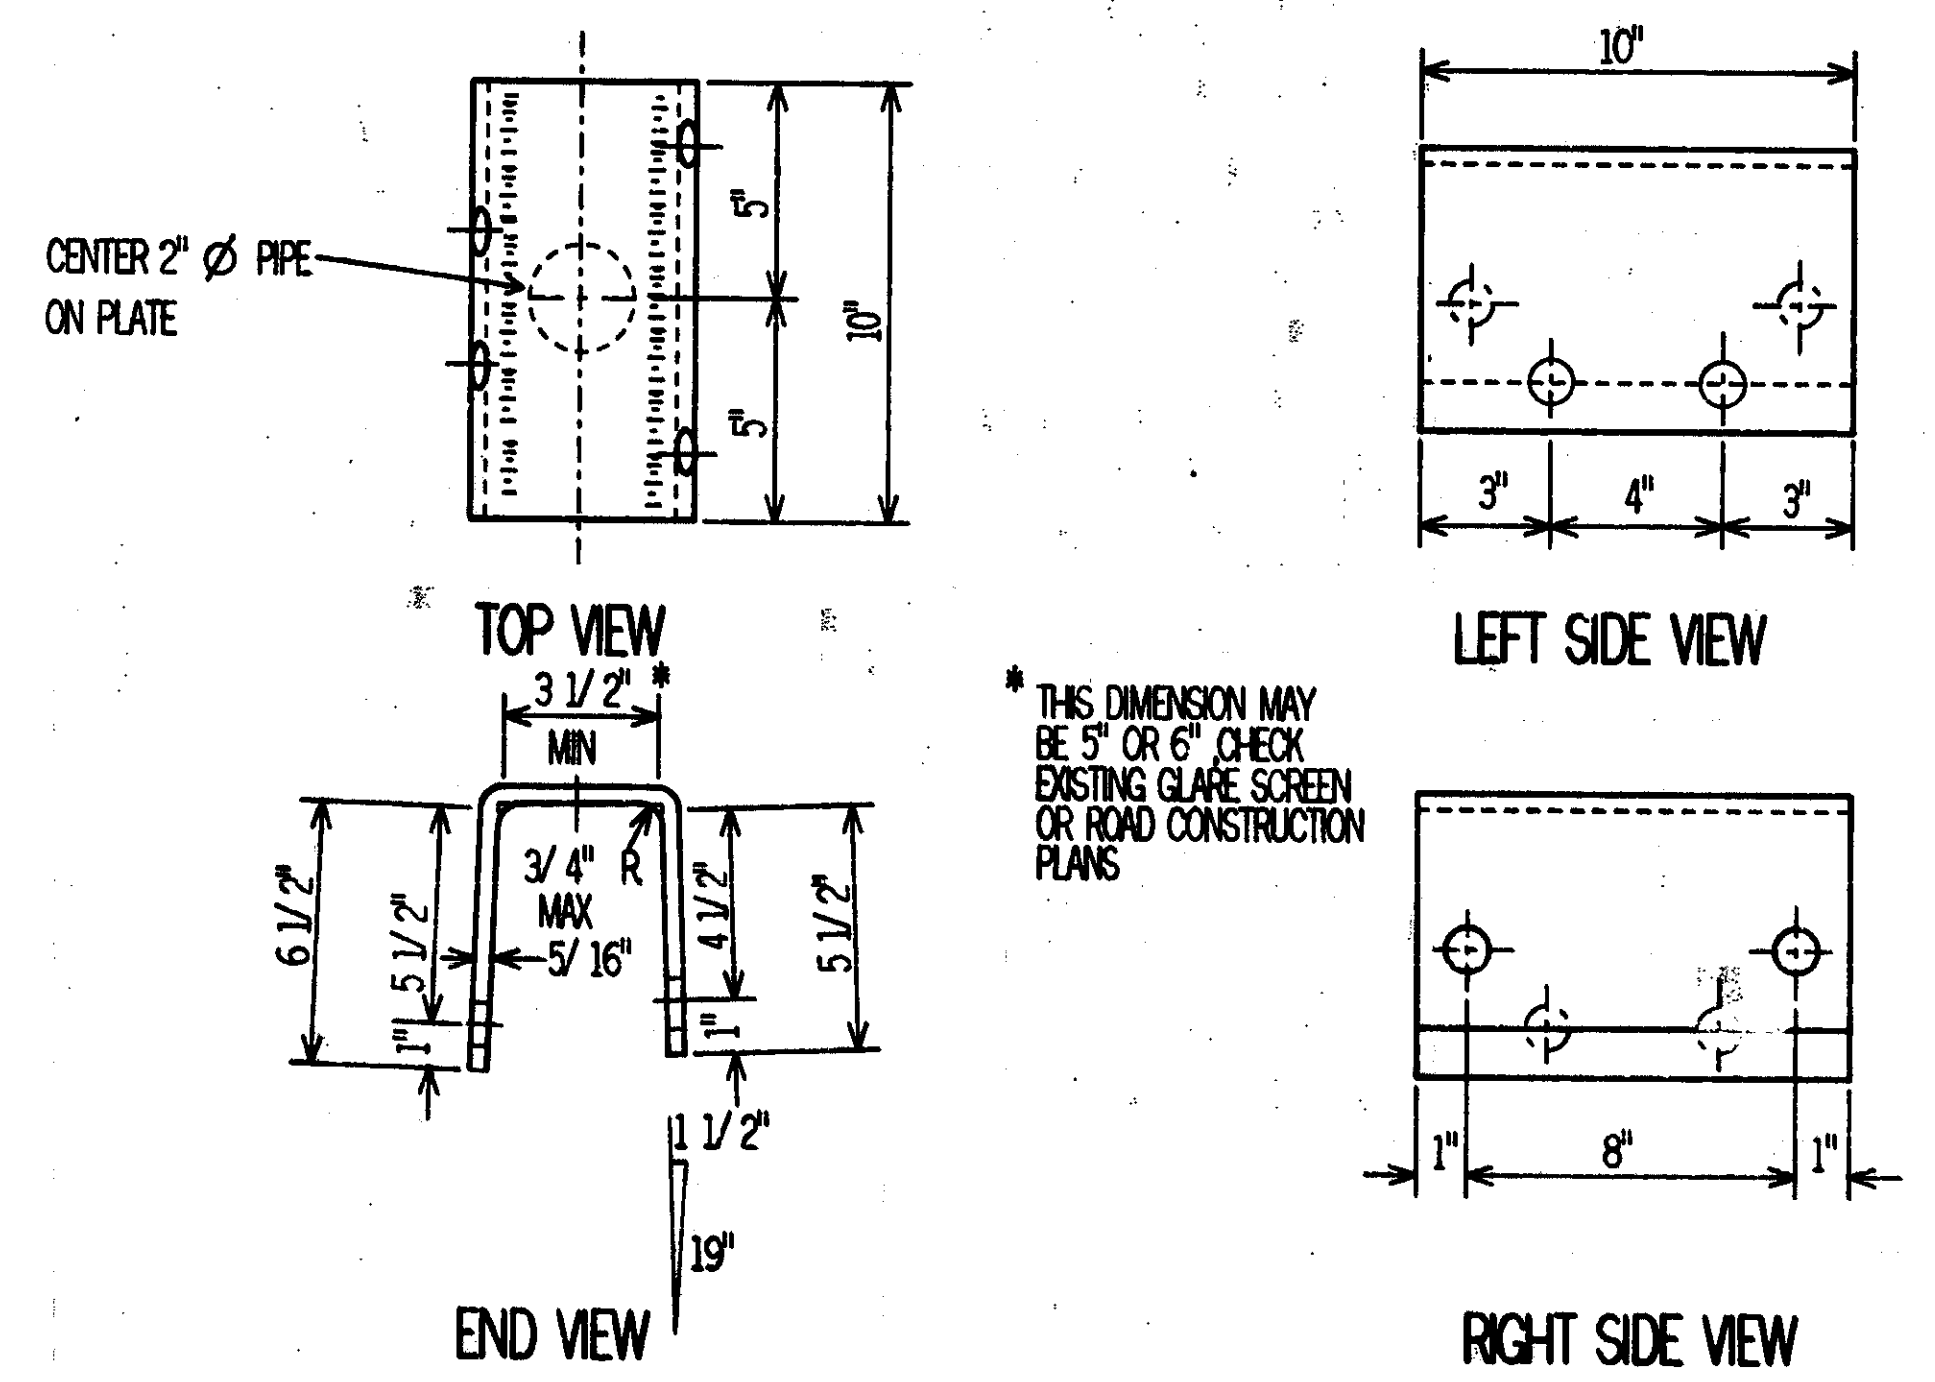

GLARE SCREEN CONNECTION - TYPE II










ONE-WAY ARROW SIGN

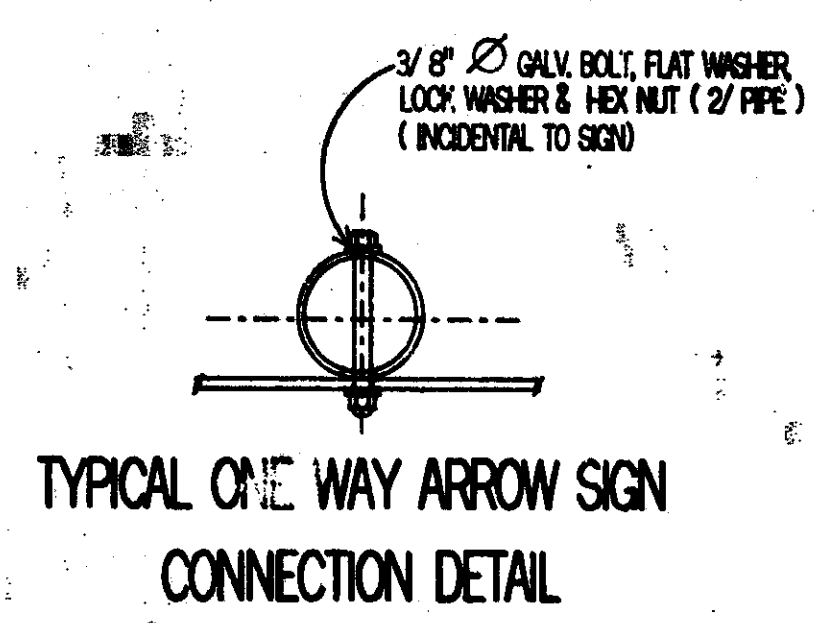

- NOTES:
- ENTIRE SECTION (PIPE & PLATE) TO BE HOT DIP GALVANIZED IN ACCORDANCE WITH ASTM A 123 AFTER FABRICATION.
 - ALL CHANNELS, BOLTS, NUTS AND WASHERS TO BE GALVANIZED.
 - STEEL PIPES SHALL BE OF " STANDARD WEIGHT" AND CONFORM TO ASTM A 53 (GRADE B)
 - ALL PLATES AND CHANNELS TO BE STRUCTURAL STEEL ASTM A 36.

PREPARED BY ENG. DEV. T&S DIV.	ENGINEER OF DESIGN	ENGINEER OF TRAFFIC & SAFETY	MICHIGAN DEPARTMENT OF STATE HIGHWAYS AND TRANSPORTATION STANDARD PLAN FOR	
CHECKED BY REFL. DEV.	ENGINEER OF CONSTRUCTION	DEPARTMENT DIRECTOR JOHN P. WOODFORD	TYPE I & II SIGN CONNECTIONS TO CONCRETE GLARE SCREEN	
DRAWN BY		BY	DATE	DATE
CHECKED BY A.E.	ENGINEER OF TESTING & RESEARCH	DEPUTY DIRECTOR-HIGHWAYS	DATE	DATE
			S9-12A	SHEET 1 OF 2

S9-12A SHEET 2 OF 2

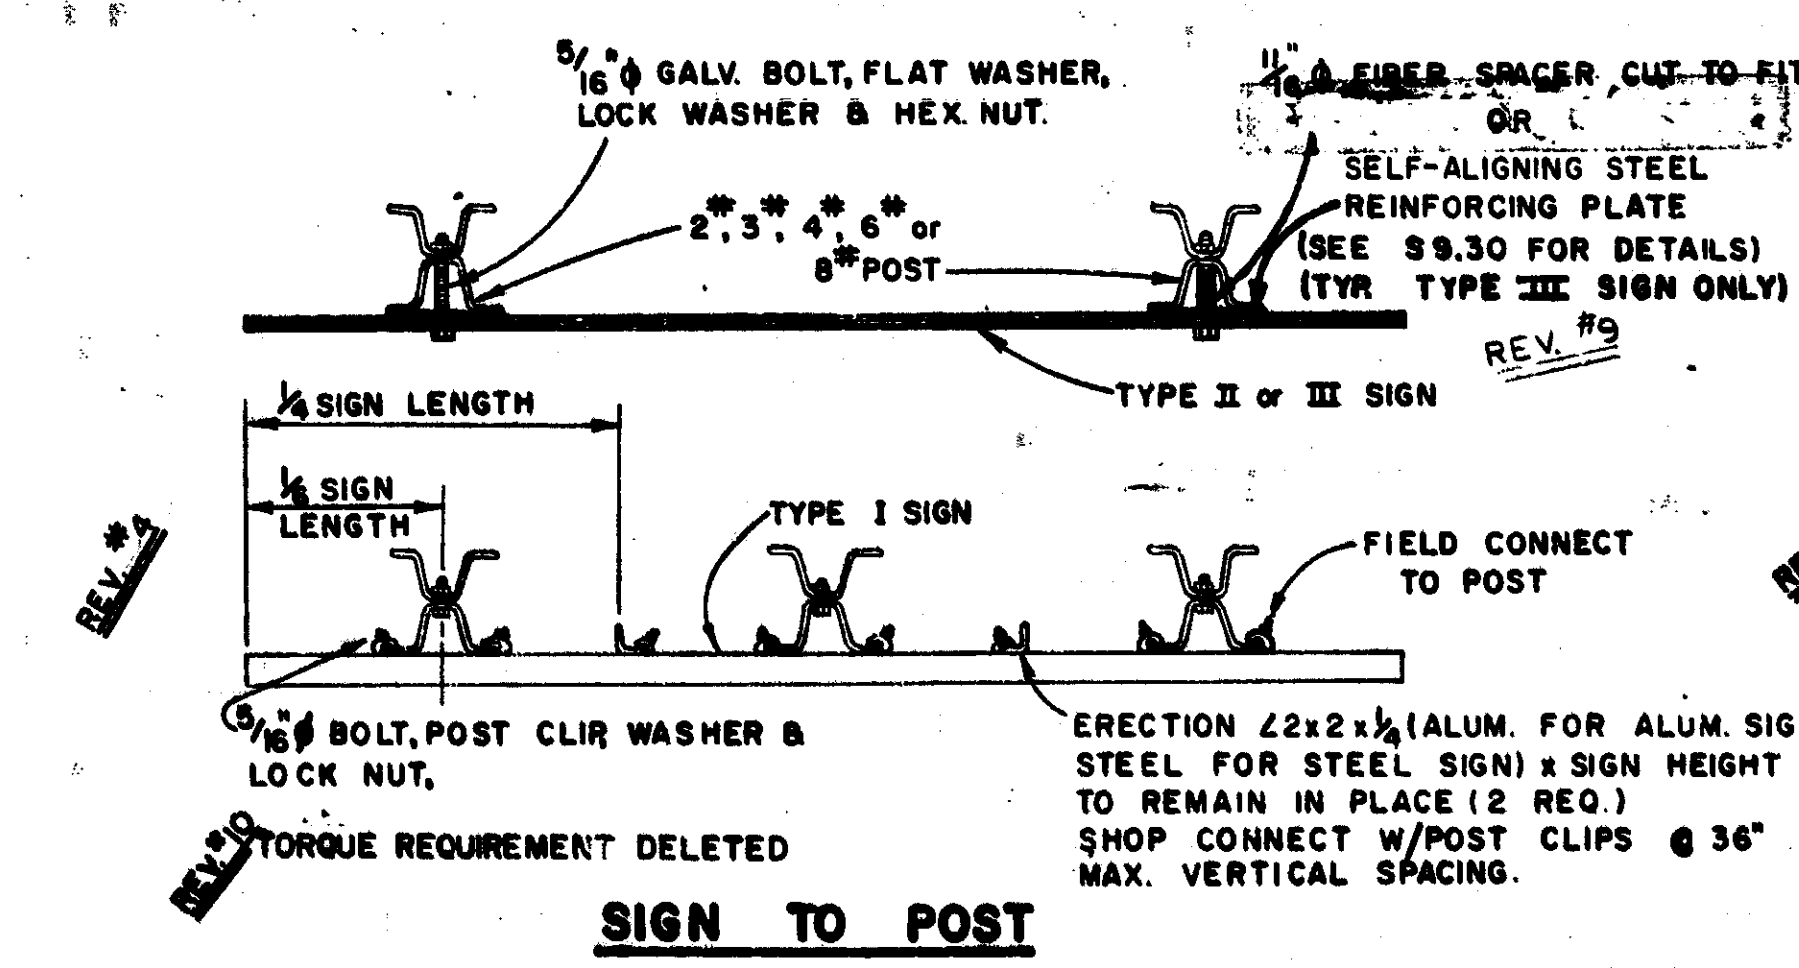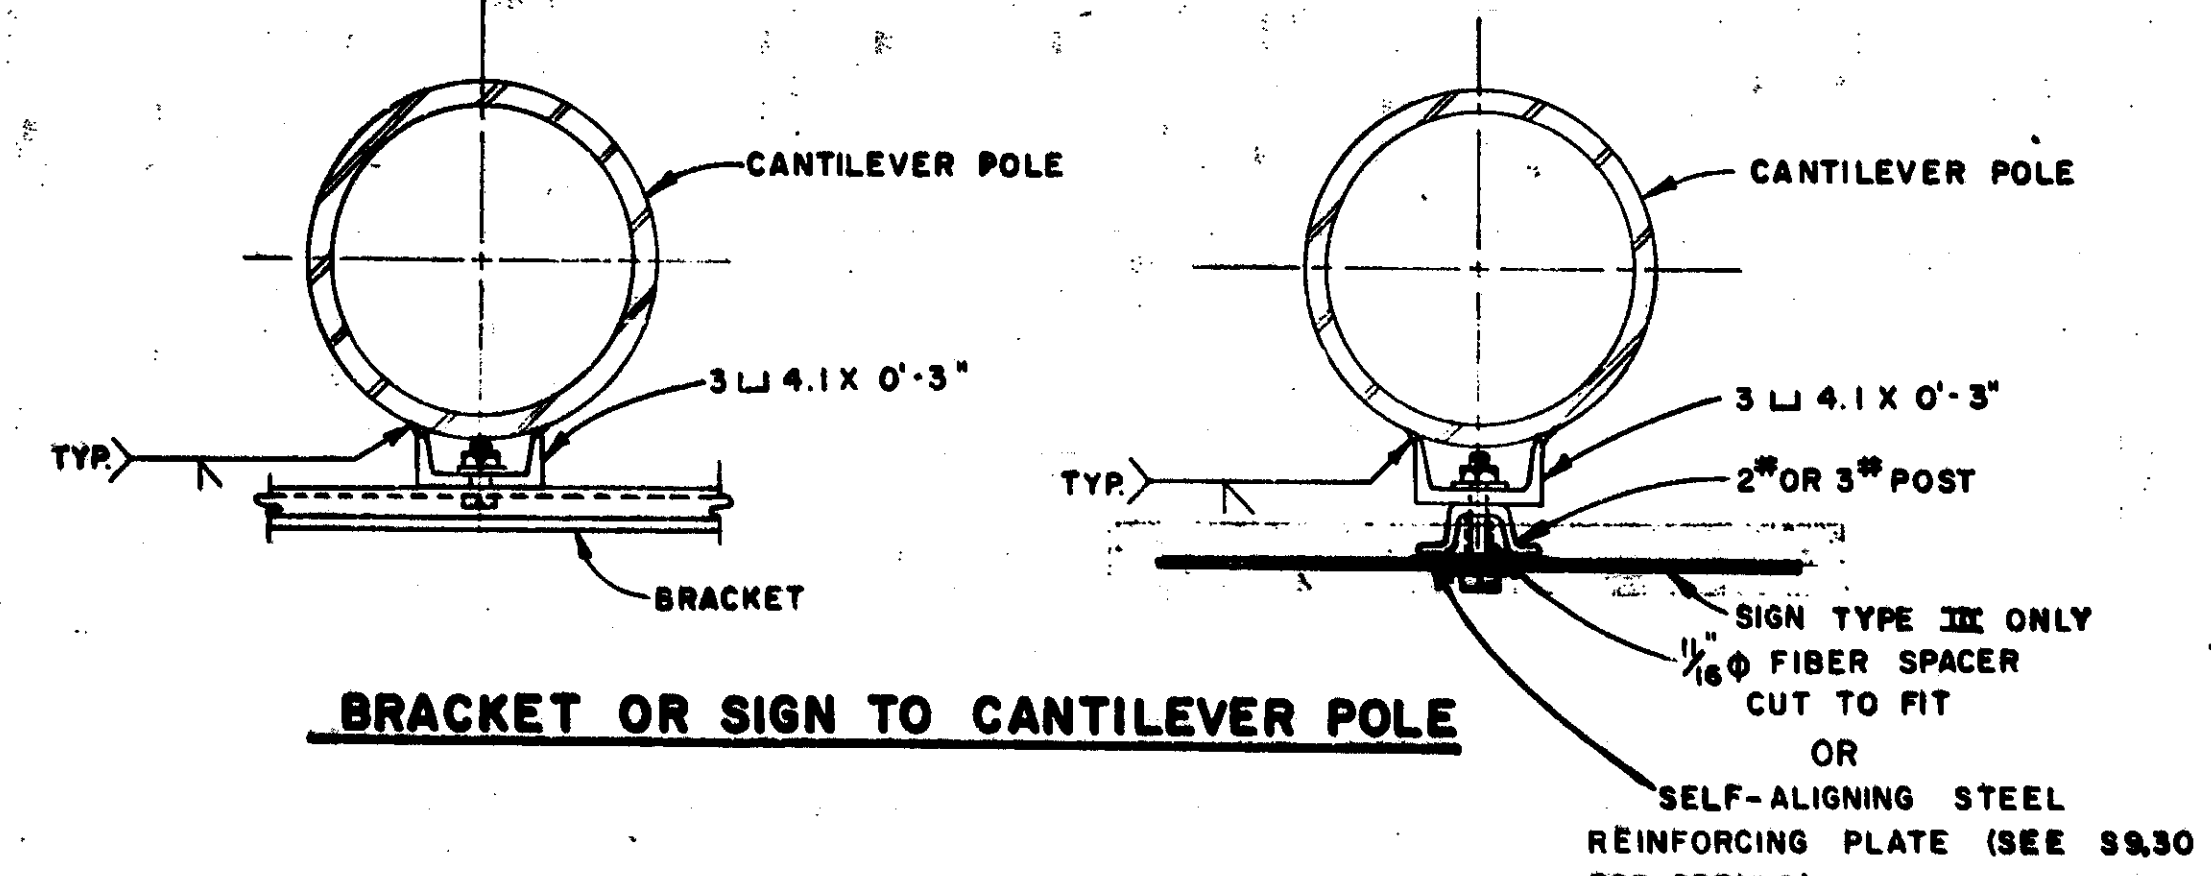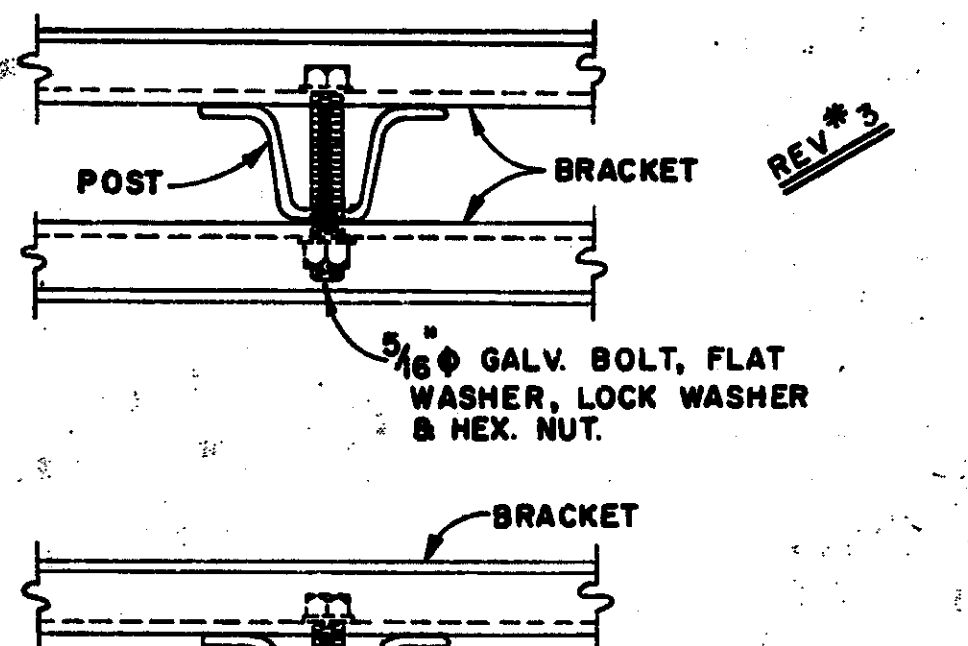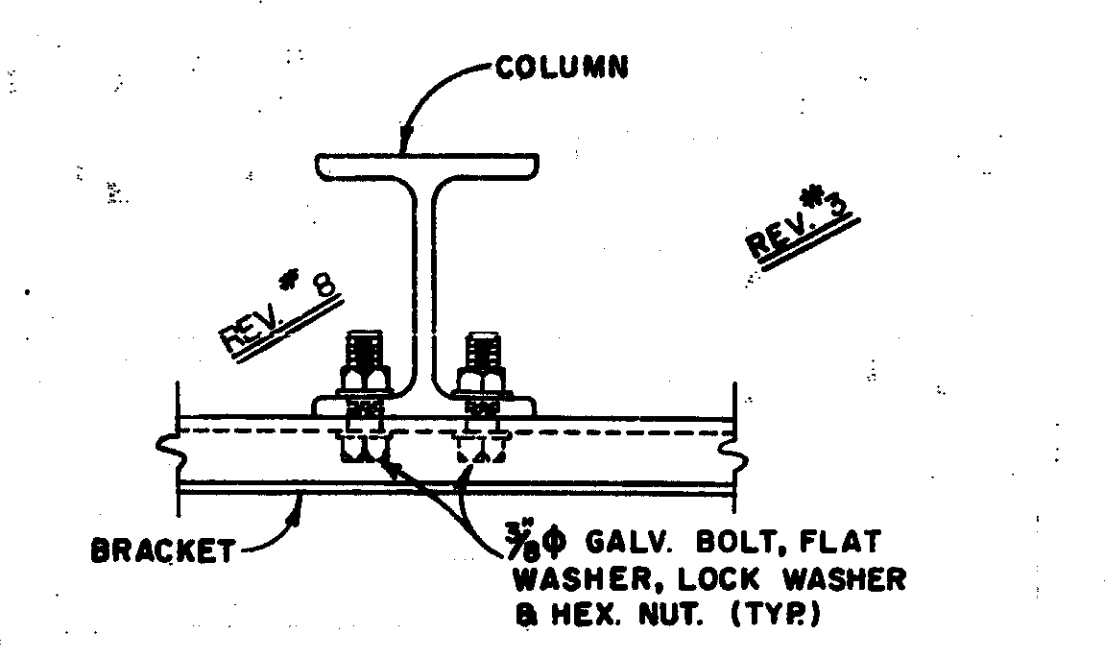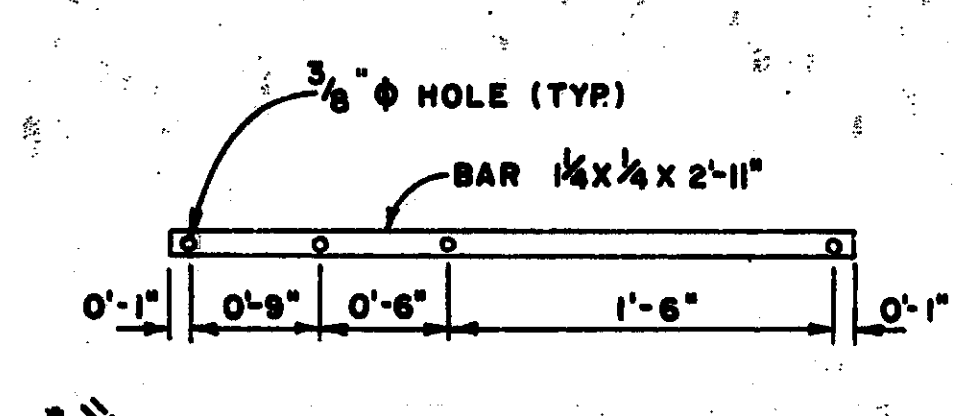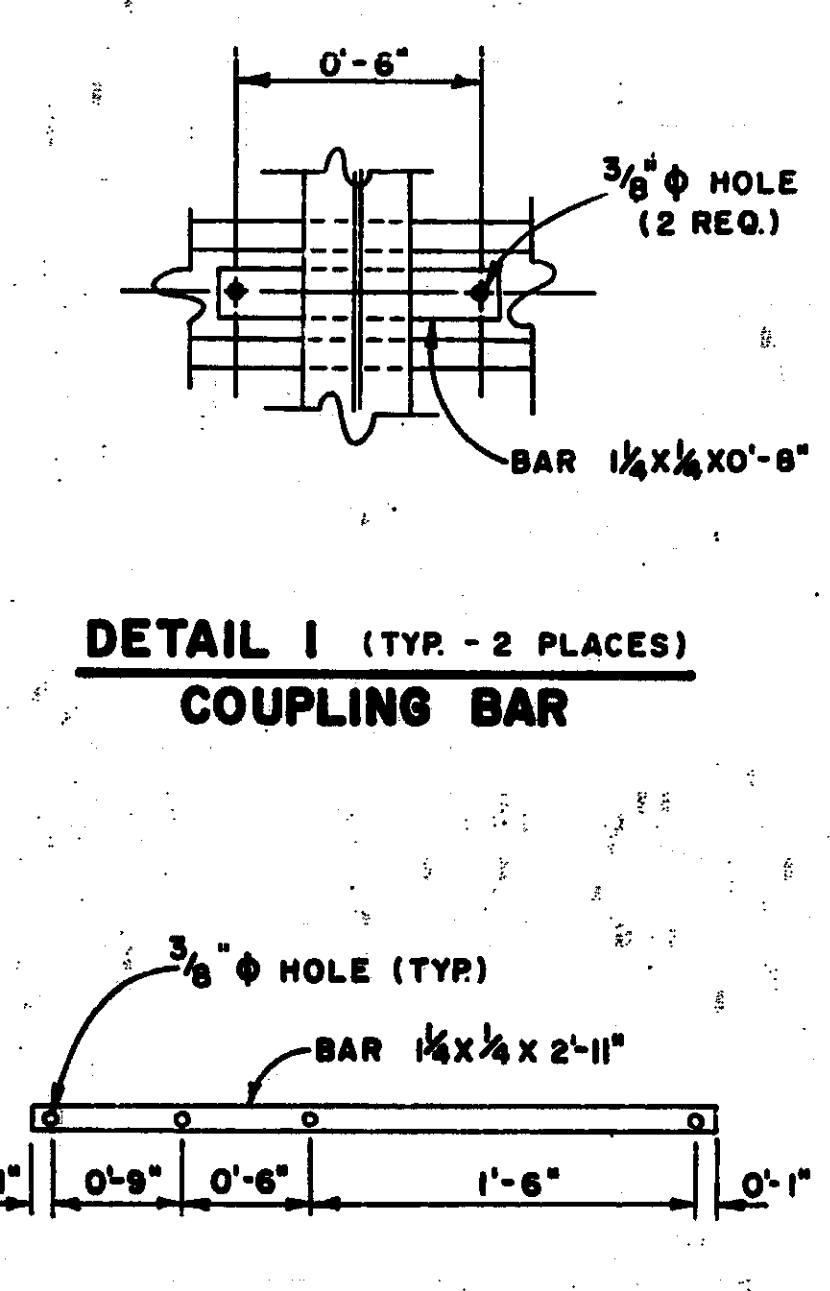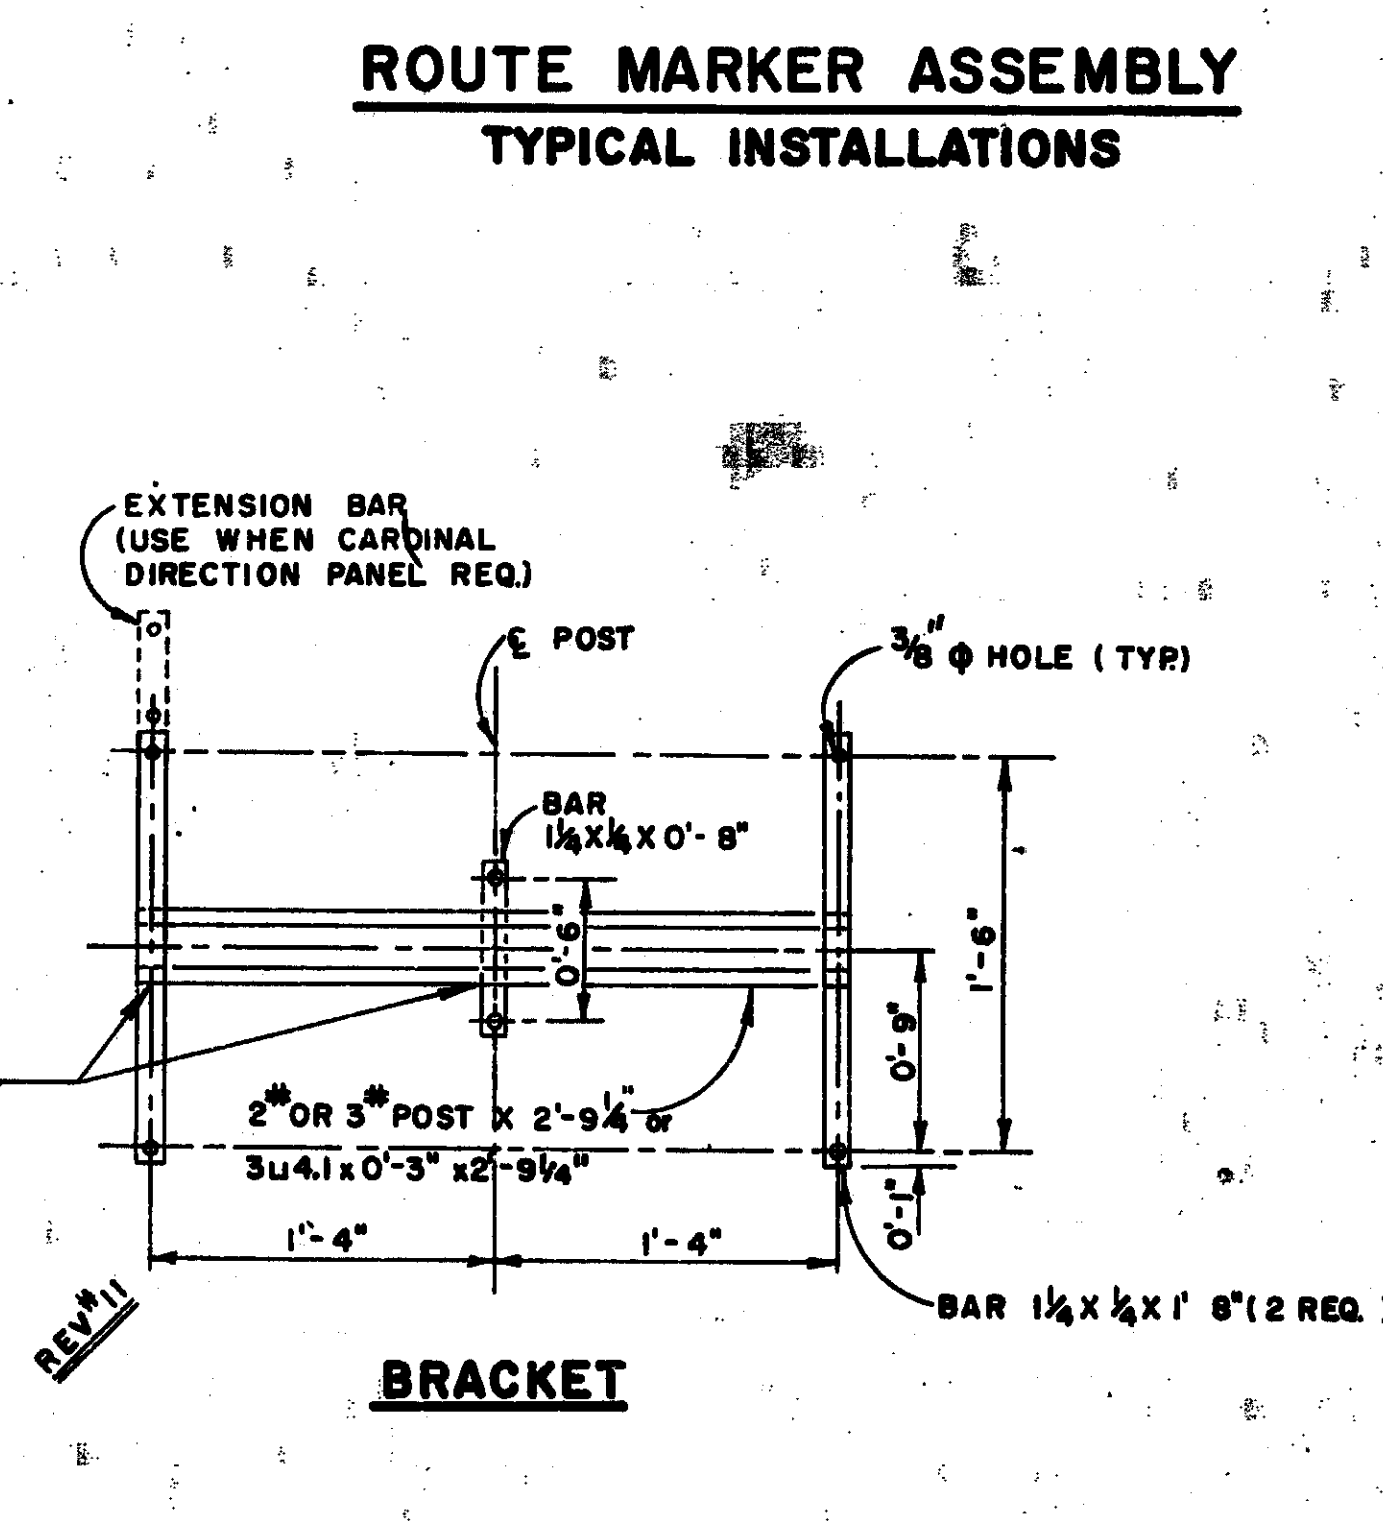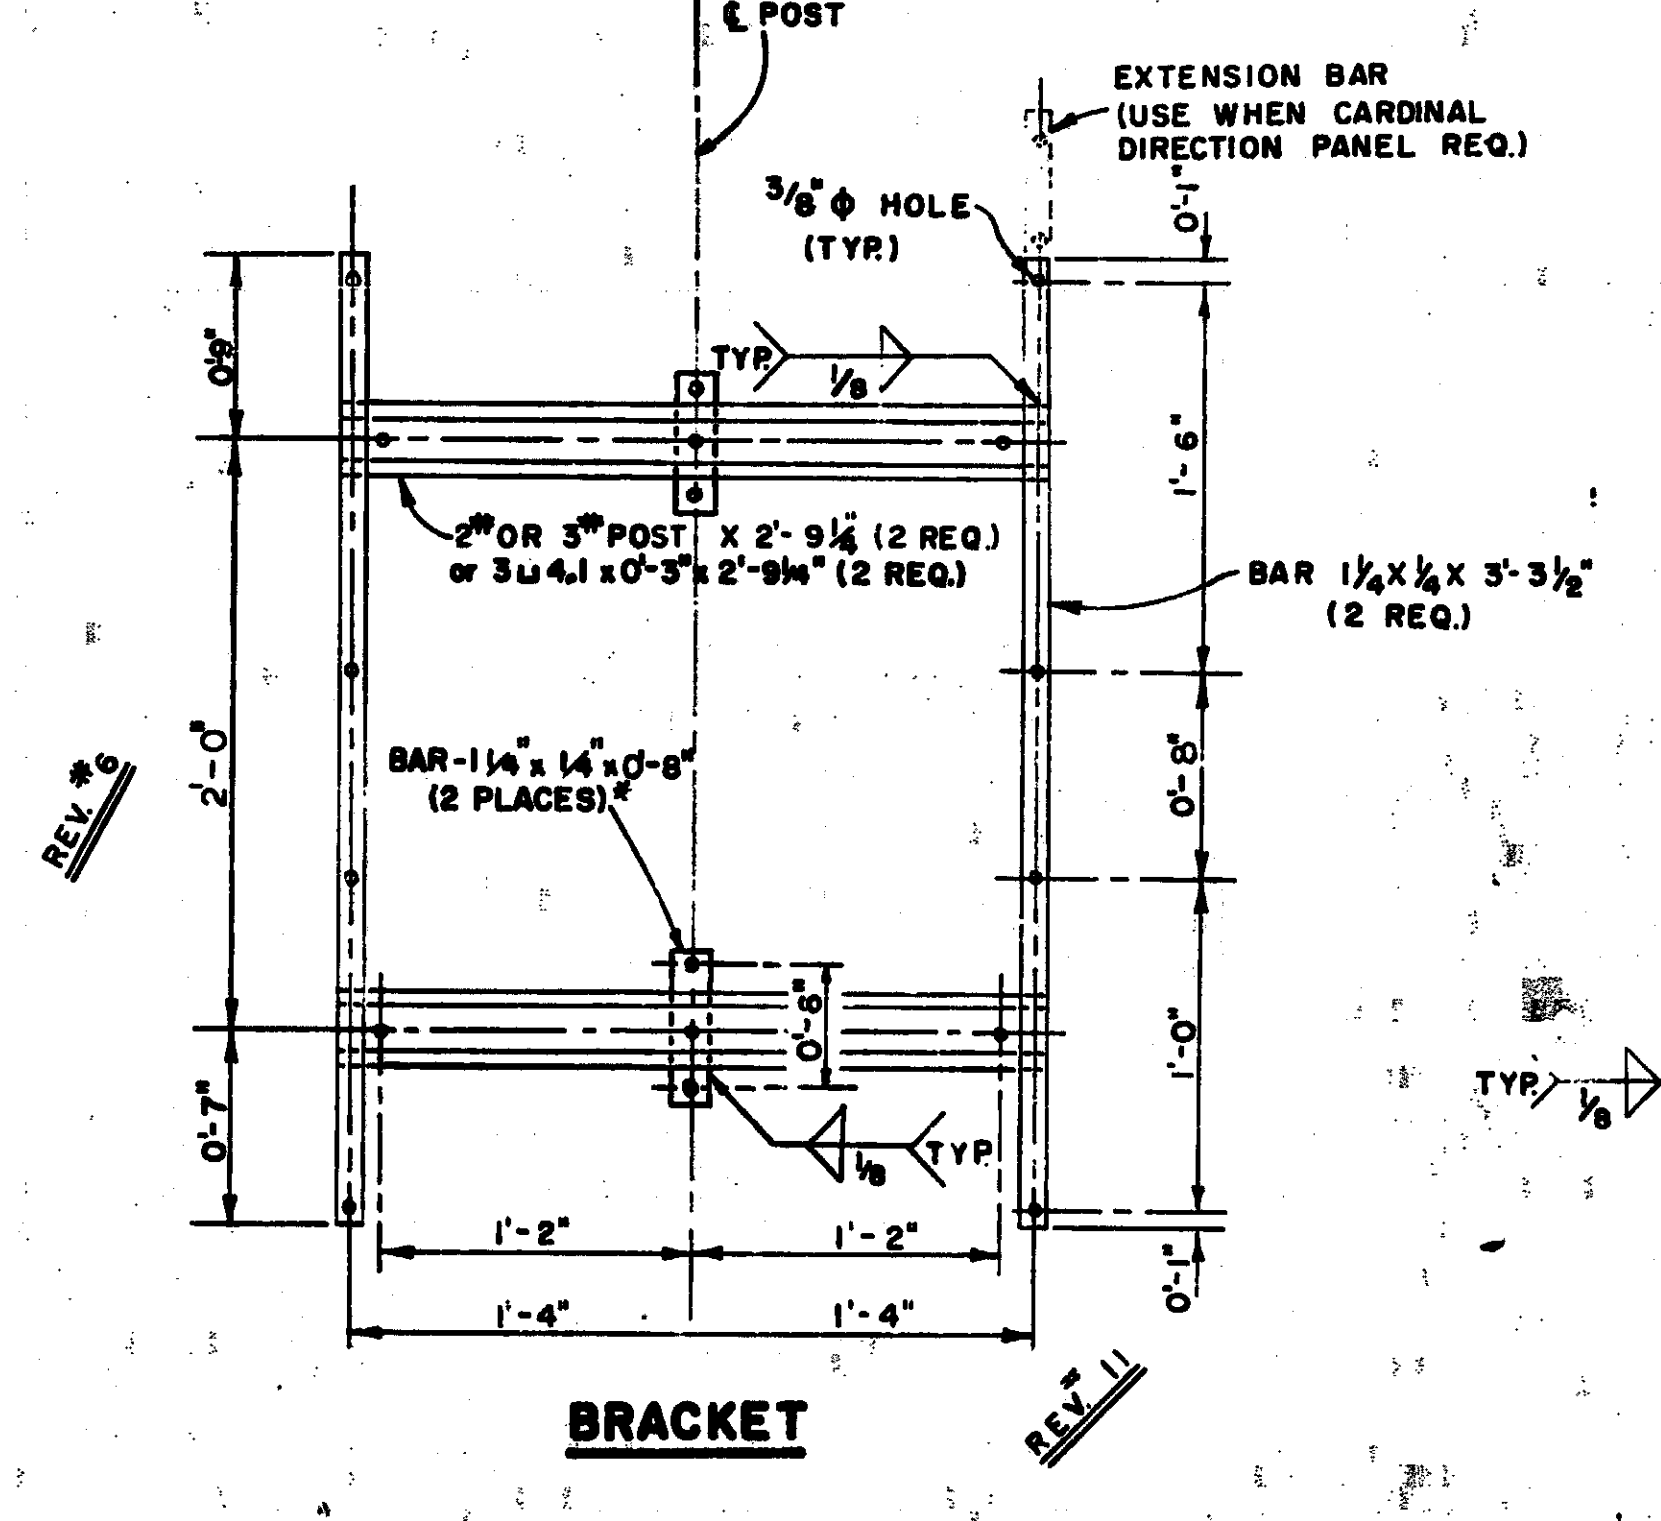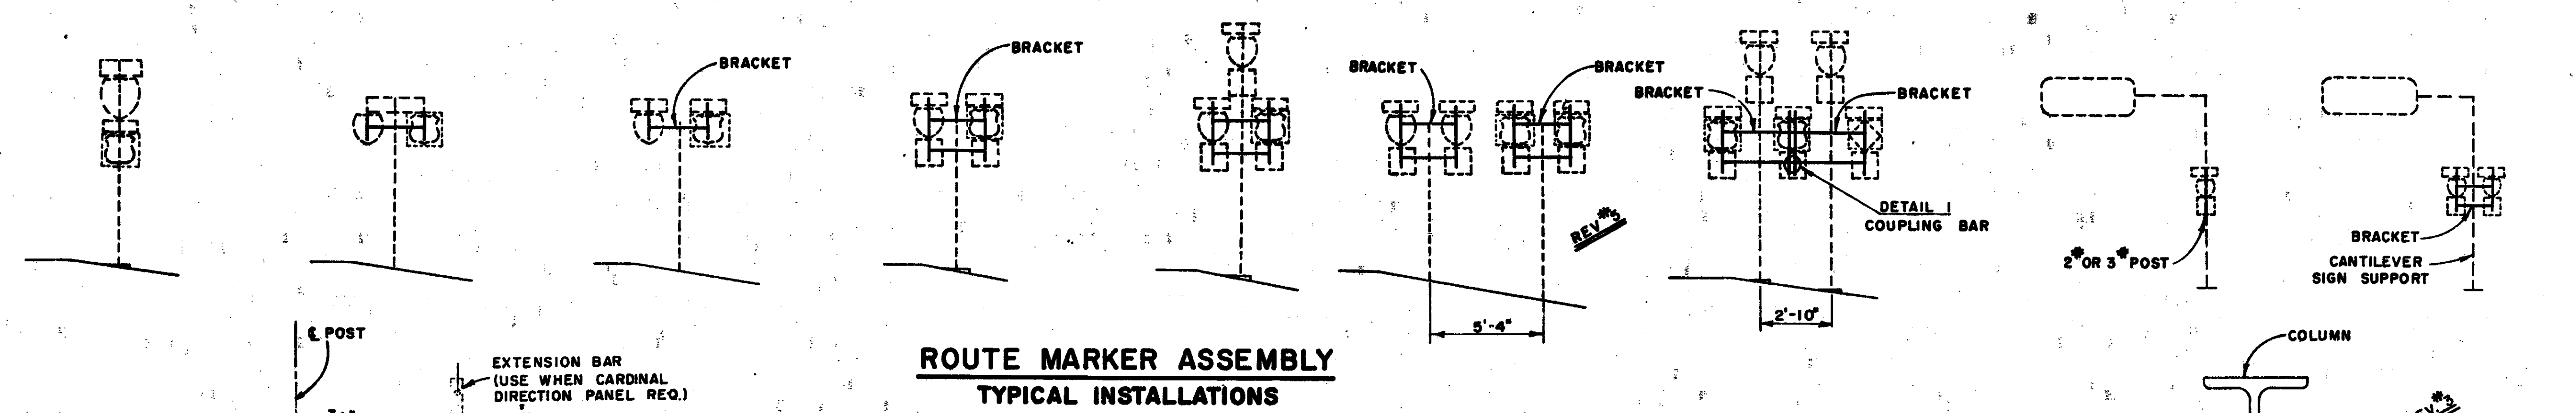

NOTE:
 1. ALL CONNECTIONS ARE INCIDENTAL TO "SIGN".
 2. ALL STEEL PARTS SHALL BE GALVANIZED.
 3. FOR SIGN CONNECTIONS TO WOOD SUPPORTS SEE PLAN S330.
 4. USE BAR FOR BRACKET WHEN "STRAPPING CONNECTION TO POLE" (\$9.30) IS USED.

BRACKET OR SIGN TO CANTILEVER POLE

SIGN TO POST

MICHIGAN DEPARTMENT OF STATE HIGHWAYS
 MISCELLANEOUS
 SIGN CONNECTION DETAILS


NO.	DESCRIPTION	DATE	BY
1		1-64	
2		6-64	
3	PIGGYBACK CONN. DELETED, VIEWS ADD.	4-14-66	G.R.H.
4	2\"/>		

\$9.20


TYPICAL CONNECTIONS

CS 63174
 Job No. 14-24A


1. HOLES CHANGED TO 3/8"
 2. BRACKET REINFORCING, NOTE #4 ADDED, EXTENSION BAR CHANGED, ALTERNATE BRACKET MATERIAL PROVIDED
 3. CHANGE 2-SIGN CLUSTER MOUNTING ARRANGEMENT
 4. BRACKET DIMENSIONS CHANGED
 5. NOTE #3 ADDED
 6. SECOND BOLT ADDED
 7. STEEL REINFORCING PLATE ADDED
 8. 10 TORQUE REQUIREMENT DELETED
 9. SHEET NO. 7

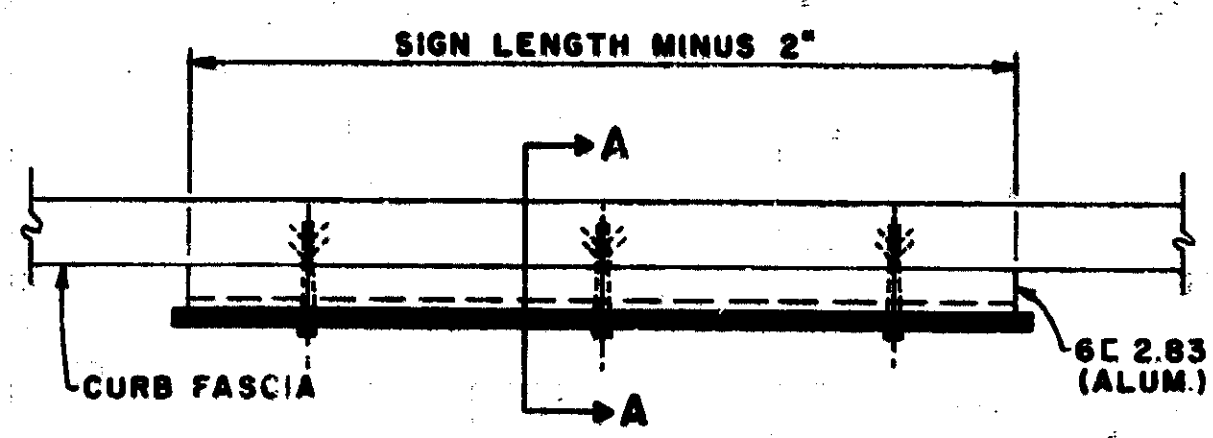


PLAN (TYPE A)
0° CONNECTION

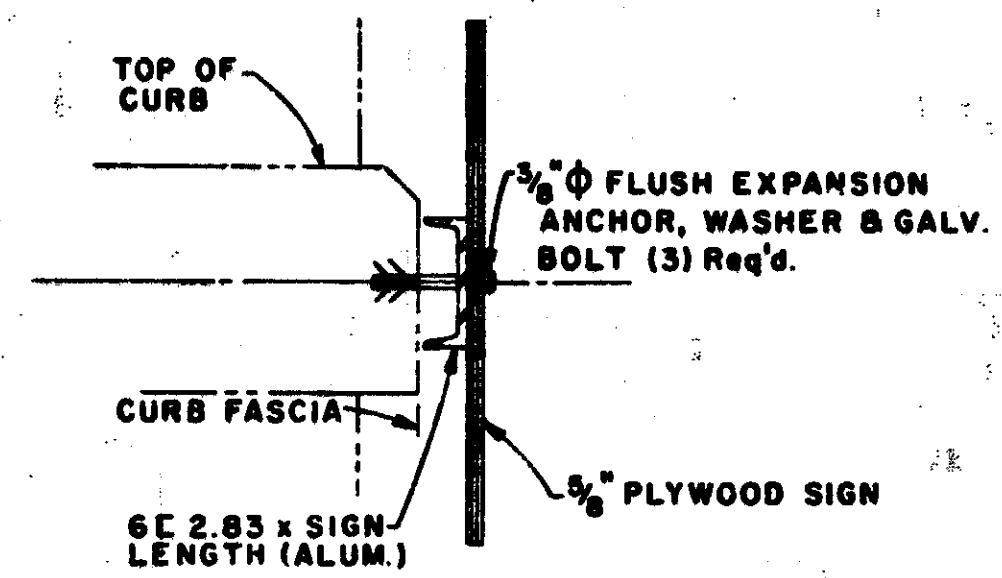


SECTION A-A

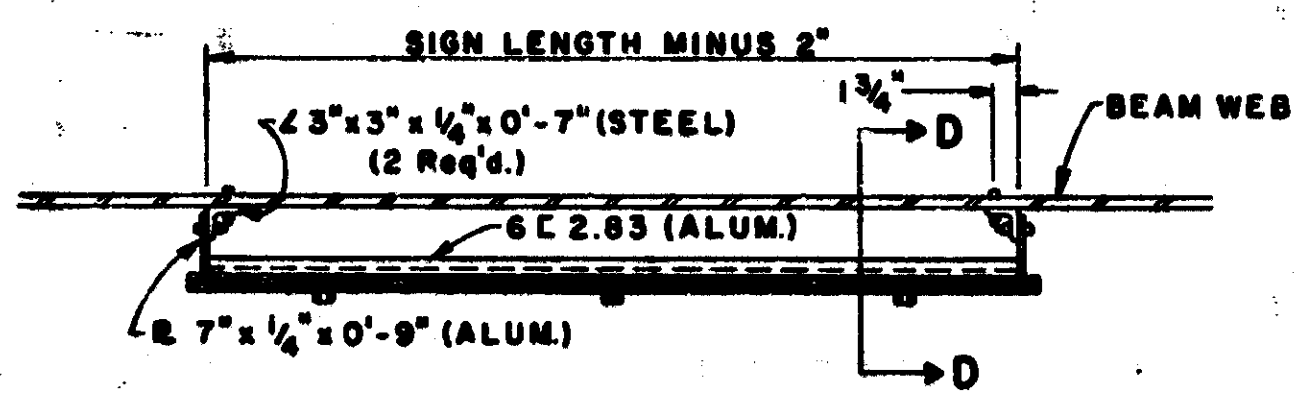


PLAN (TYPE B)
0° CONNECTION

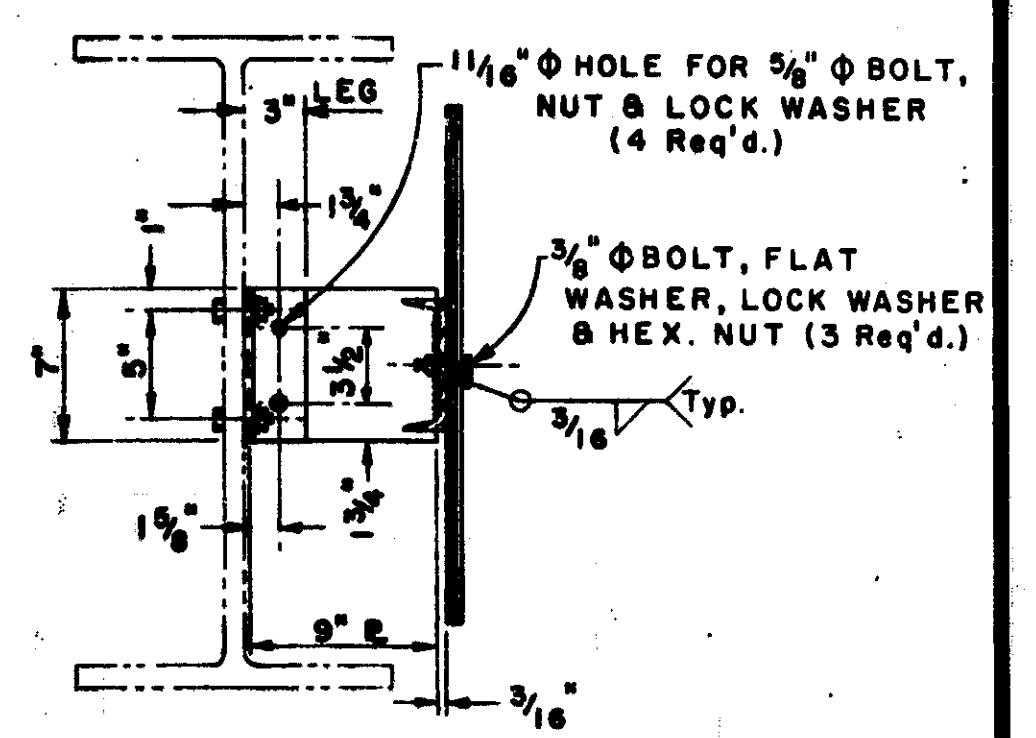


SECTION D-D

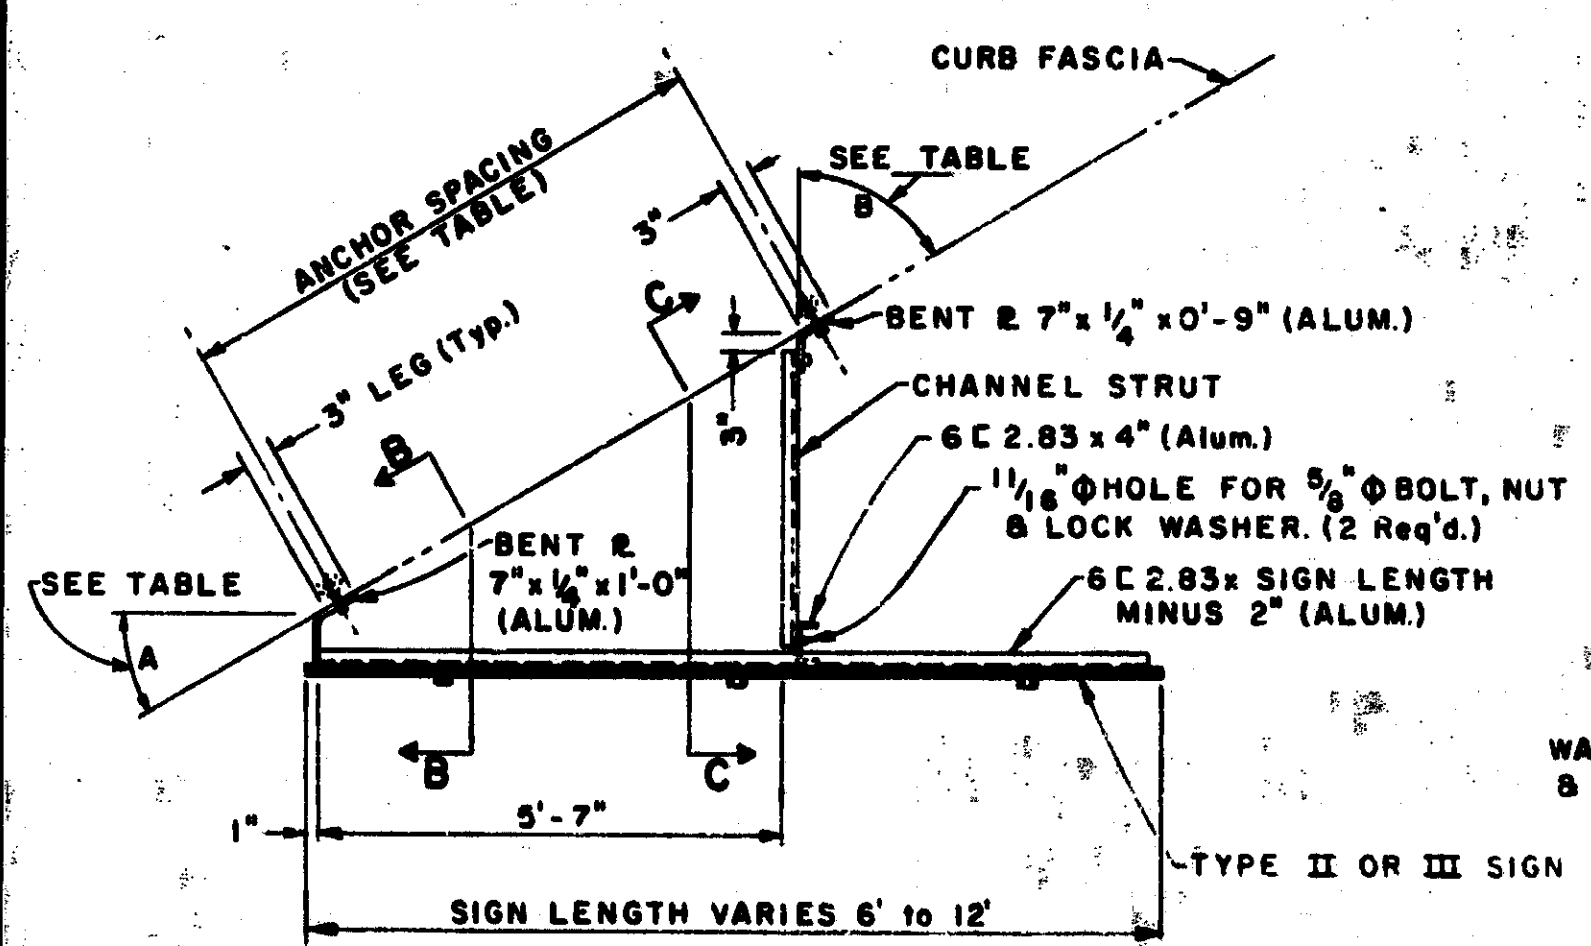


PLAN (TYPE A)
10°, 20°, 30° & 40° CONNECTIONS

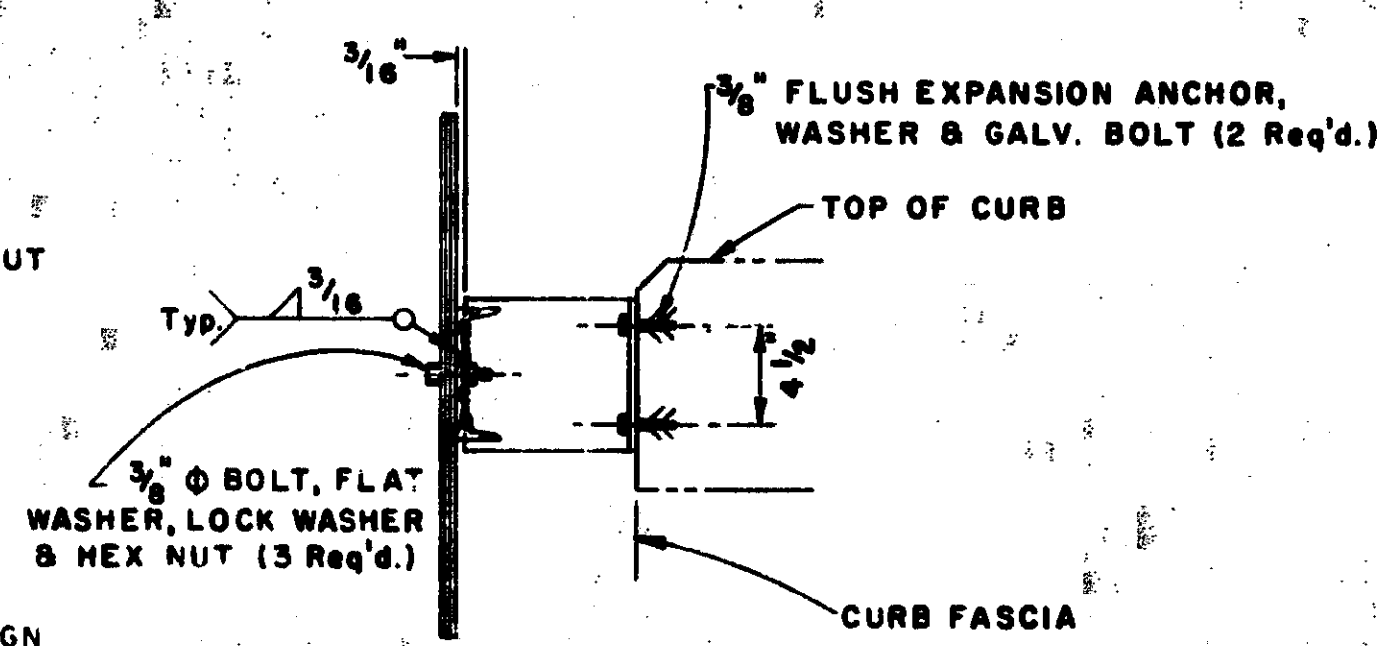


SECTION B-B

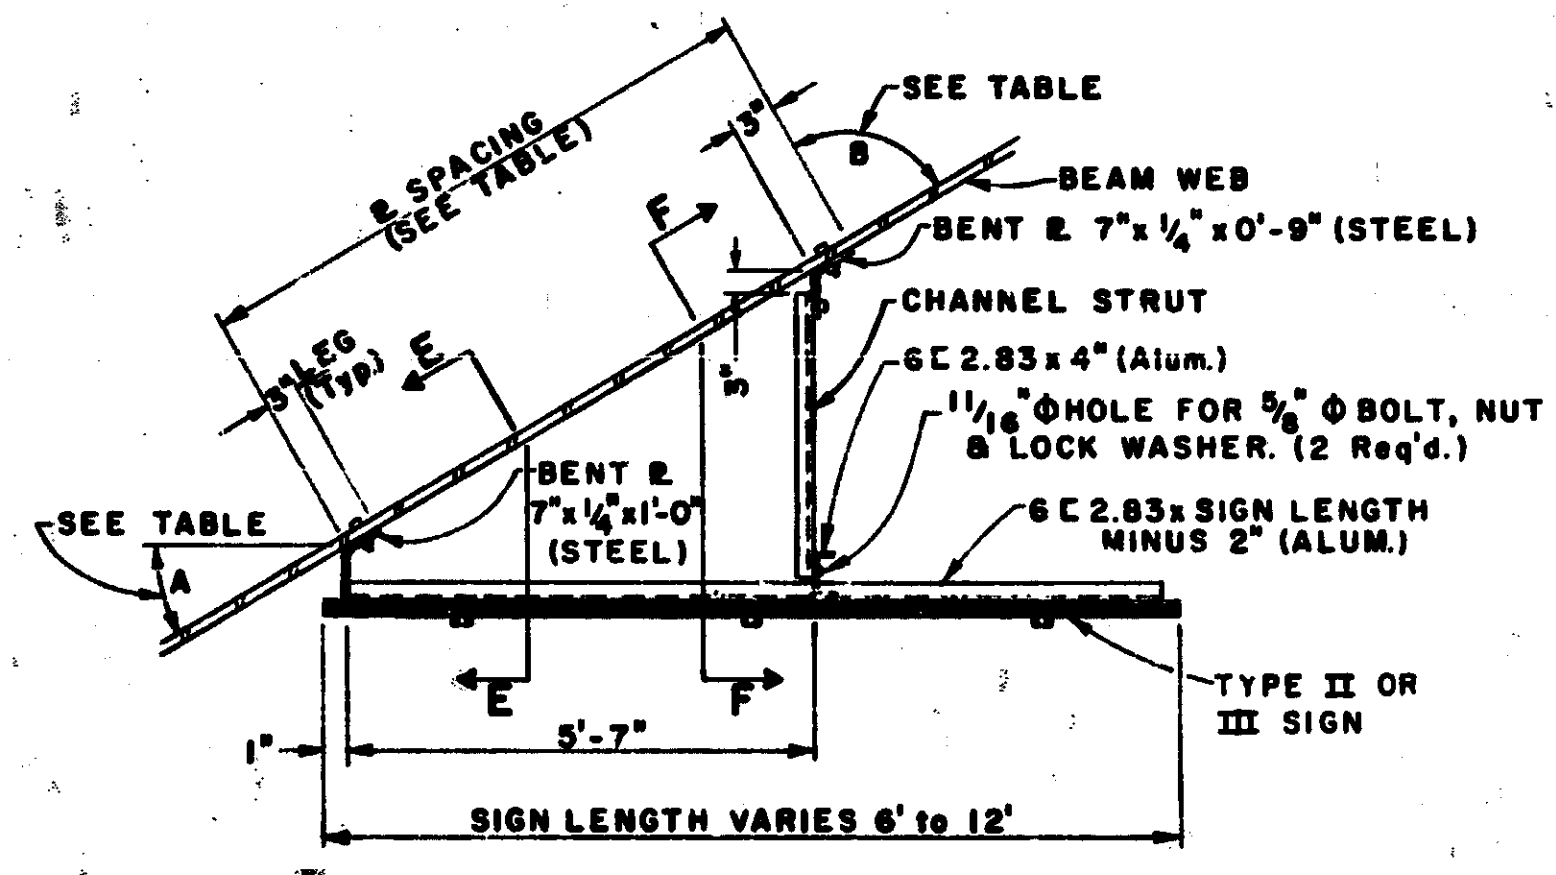

PLAN (TYPE B)
10°, 20°, 30° & 40° CONNECTIONS

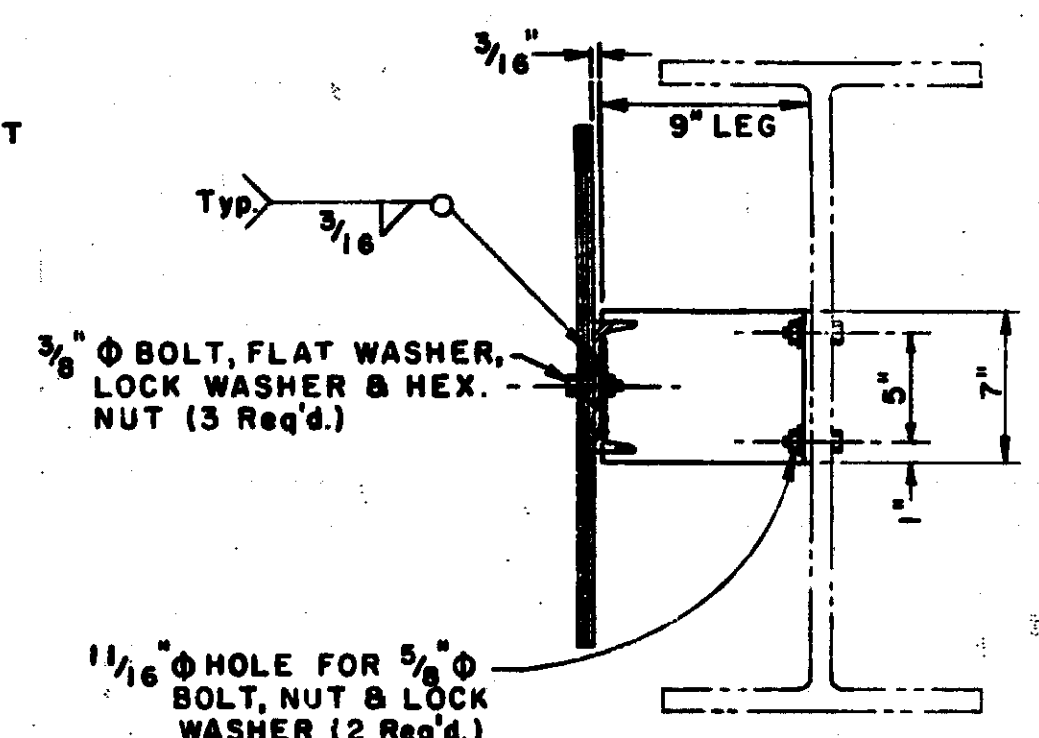

SECTION E-E

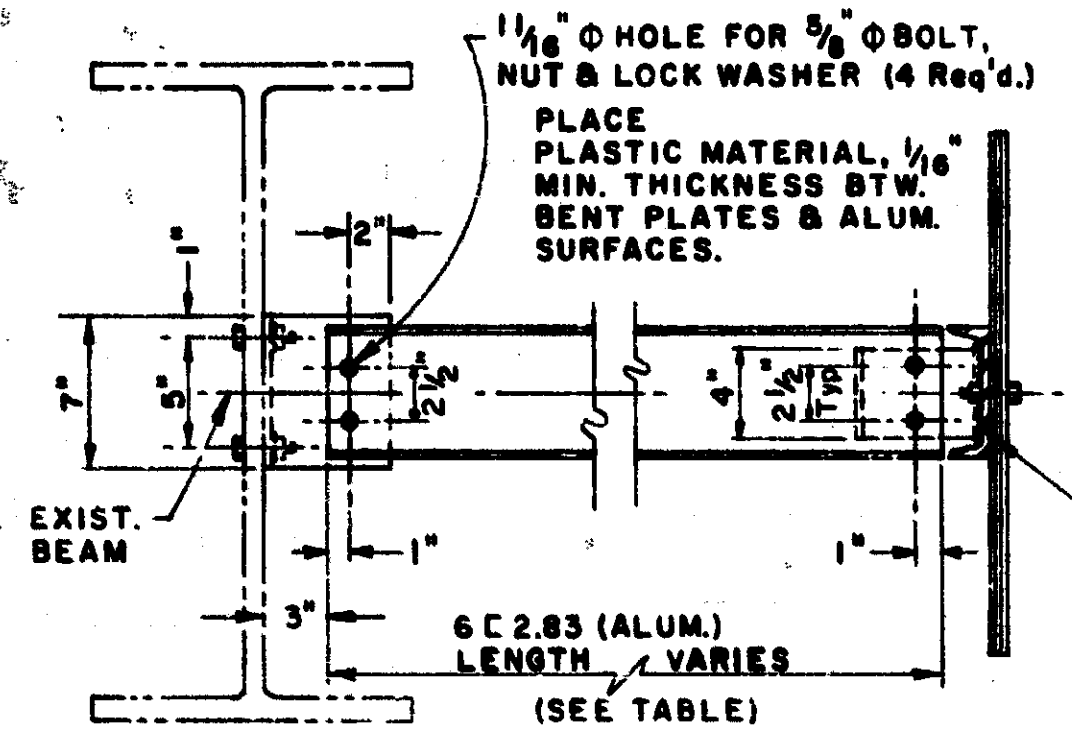


SECTION F-F

- NOTES:**
- 1.) All bolts, nuts and washers shall be galvanized steel. Nuts shall be topped 0.015 oversize.
 - 2.) All aluminum components shall be 6061-T6 aluminum alloy. All steel components shall be A-36 and shall be hot-dip galvanized according to ASTM A-123. A-588 steel components may be used as an alternate on existing A-588 Fascia beams.
 - 3.) Sign location may be shifted to avoid joints or stiffeners.
 - 4.) Threads on all bolts shall be burred after final torquing.
 - 5.) Bottom edge of sign shall be horizontal when erected and shall be a minimum of 1'-6" above the bridge beam flange at all points.

TYPE A BRIDGE CONNECTION TABLE

SKEW	CONNECTION (ANGLE A)	ANGLE B	CHANNEL STRUT LENGTH	ANCHOR SPACING
0°-10°	0°	80°	6 C 2.83 x 1'-4 3/4"	MATCH SIGN HOLES
10°-20°	10°	70°	do x 2'-5 1/4"	5'- 6"
20°-30°	20°	60°	do x 3'- 7 1/2"	5'- 11 1/2"
30°-40°	30°	50°	6 C 2.83 x 5'- 1 1/4"	6'- 5 1/2"
40°-50°	40°	40°		7'- 3 1/4"

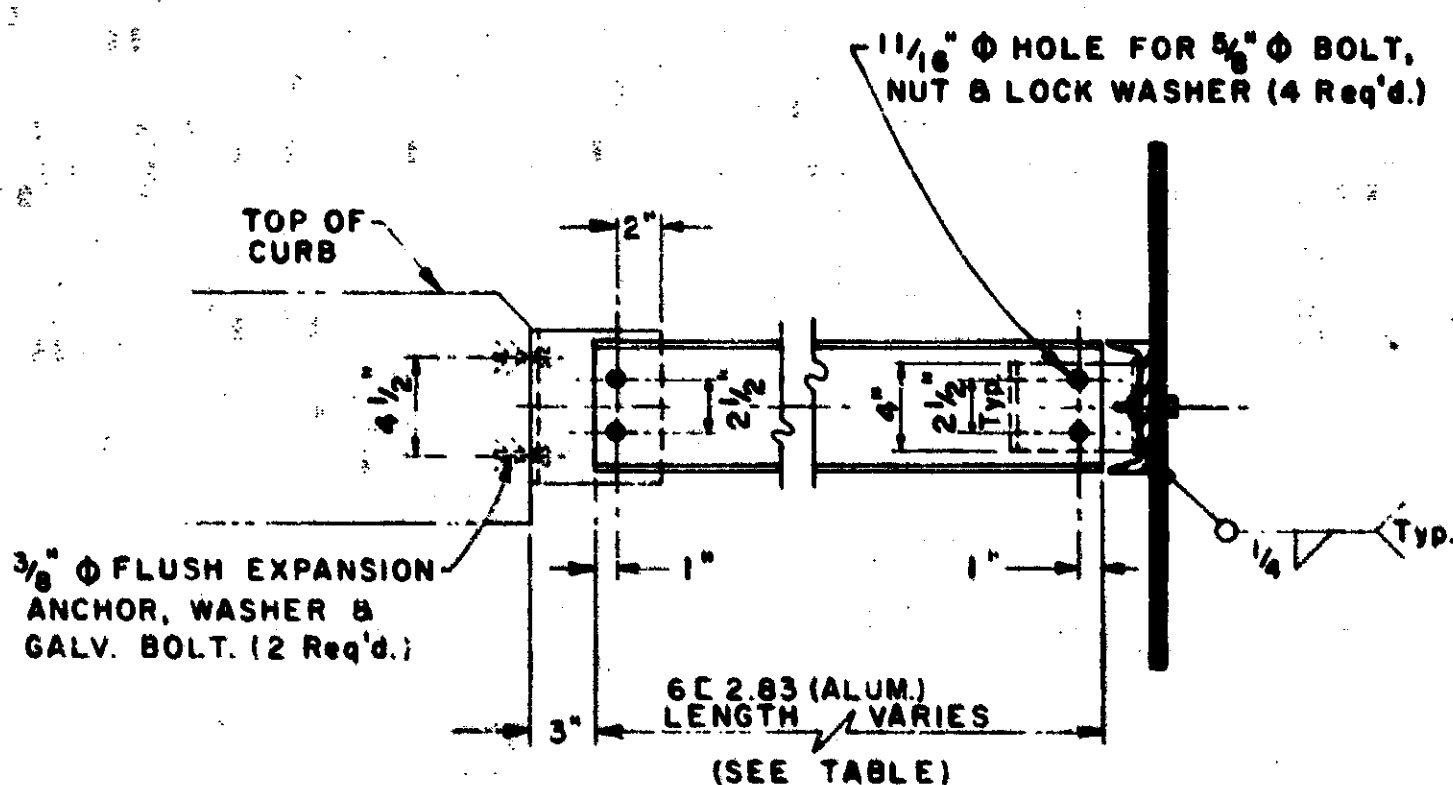

SECTION C-C

TYPE B BRIDGE CONNECTION TABLE

SKEW	CONNECTION (ANGLE A)	ANGLE B	CHANNEL STRUT LENGTH	R SPACING
0°-10°	0°	80°	6 C 2.83 x 1'-4 3/4"	5'- 11"
10°-20°	10°	70°	do x 2'-5 1/4"	6'- 2 1/2"
20°-30°	20°	60°	do x 3'- 7 1/2"	6'- 8 1/2"
30°-40°	30°	50°	6 C 2.83 x 5'- 1 1/4"	7'- 6 1/2"


BRIDGE CONNECTION
TYPE A

BRIDGE CONNECTION
TYPE B


MICHIGAN DEPARTMENT OF STATE HIGHWAYS AND TRANSPORTATION
BOLTED BRIDGE CONNECTION
TYPE A & B

NO.	REVISIONS	DATE	BY
1	Notes Revised	4/78	JDB


W.C.G.
S 10.50

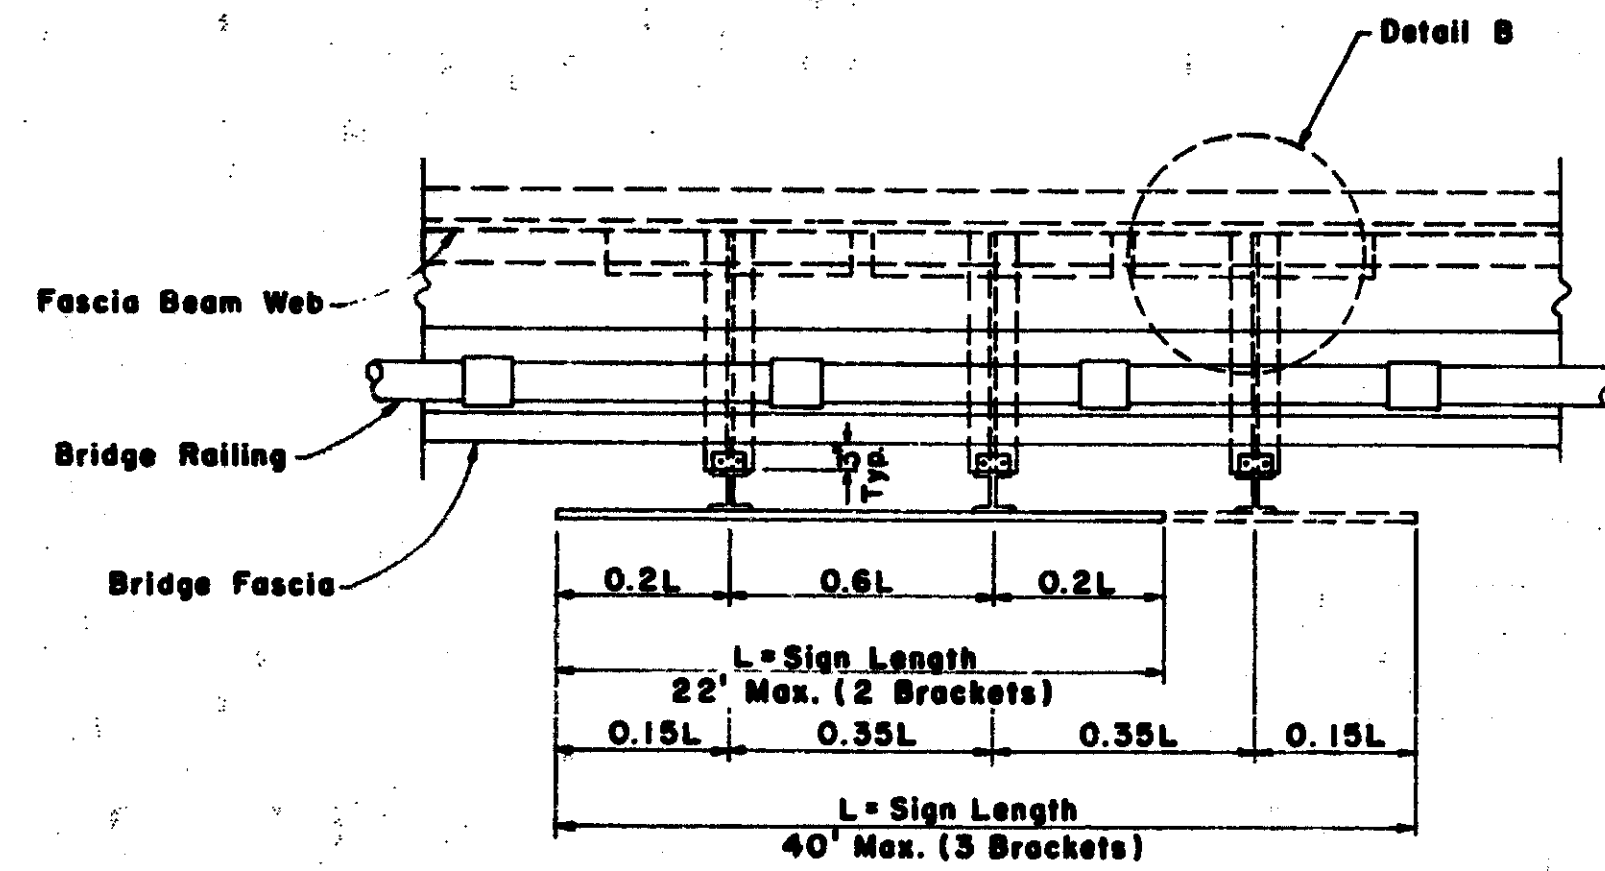

PLAN

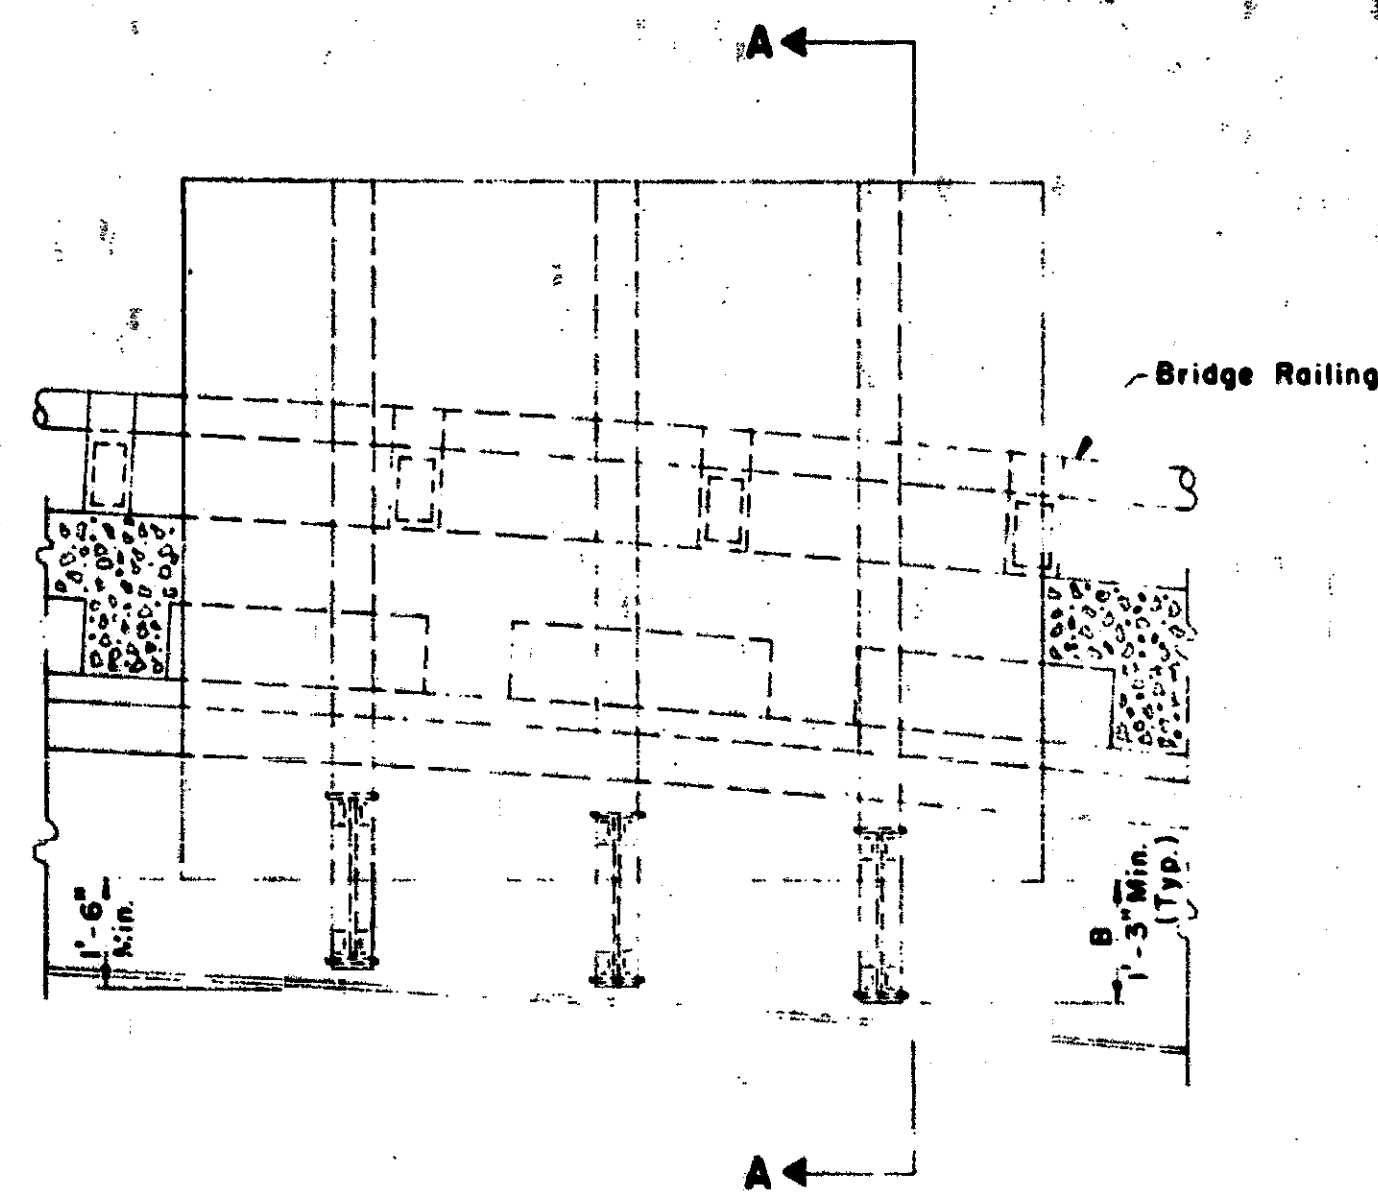


ELEVATION

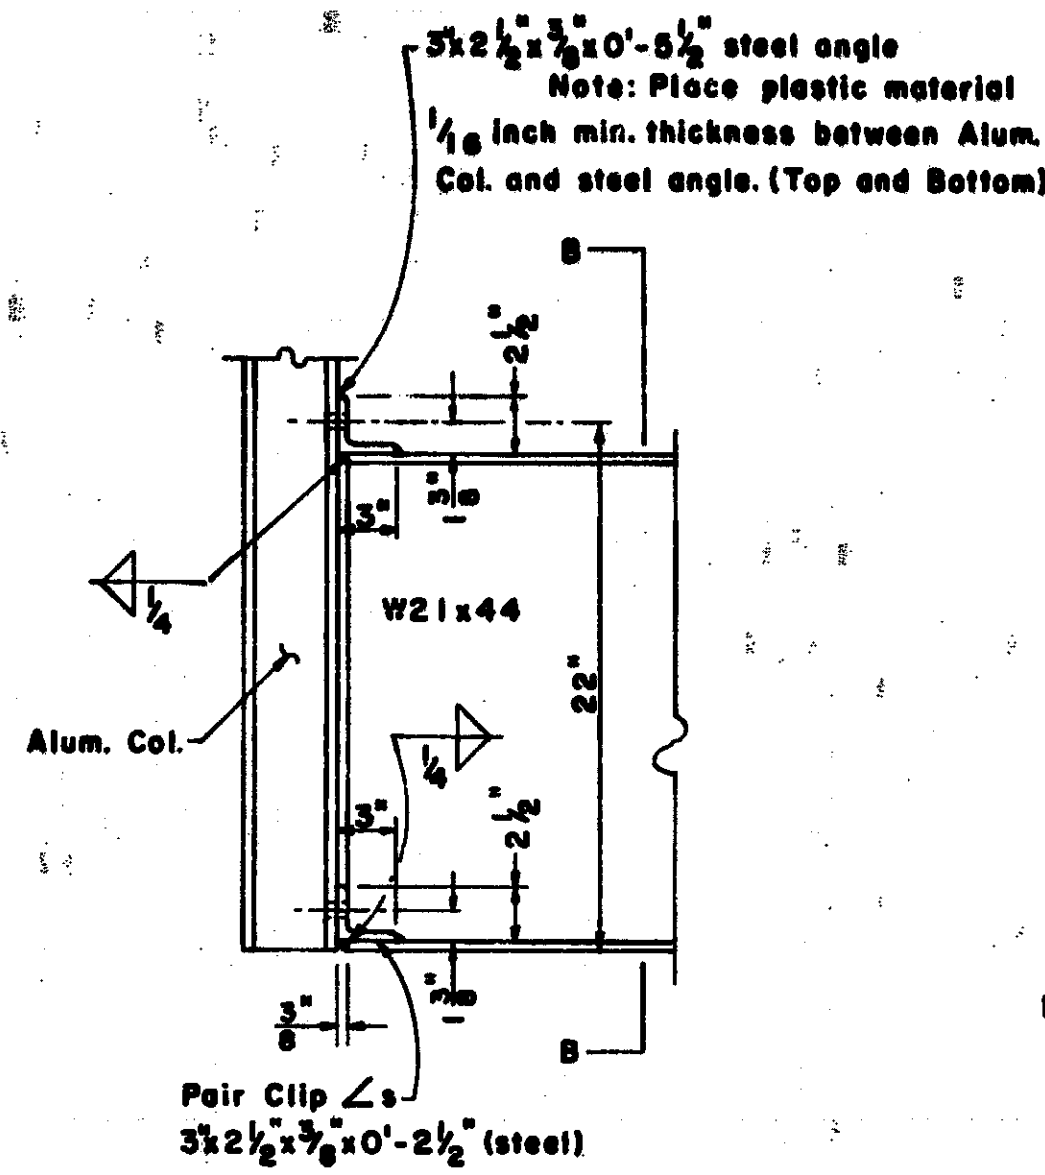


DETAIL A

COLUMN SELECTION PROCEDURE


- 1.) Determine B using the longest required column.
- 2.) $L_b = 1/2$ of the distance between the top of the sign and the top clip angle bolt. $L_b = 1/2 [(H+B)-2.0]$
- 3.) Determine the sign area. (Sq. ft.)
- 4.) Using the chart determine the size and number of columns required.

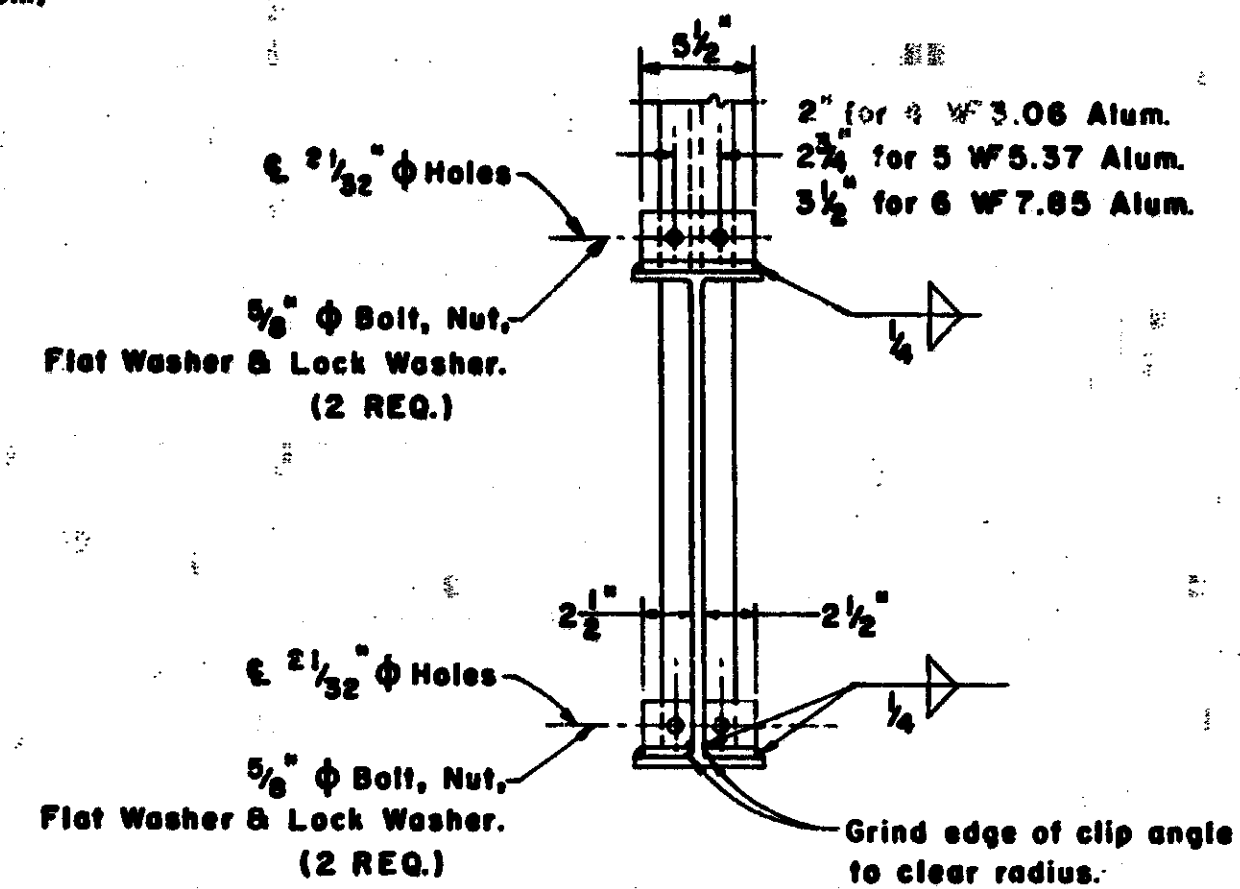


SECTION B-B

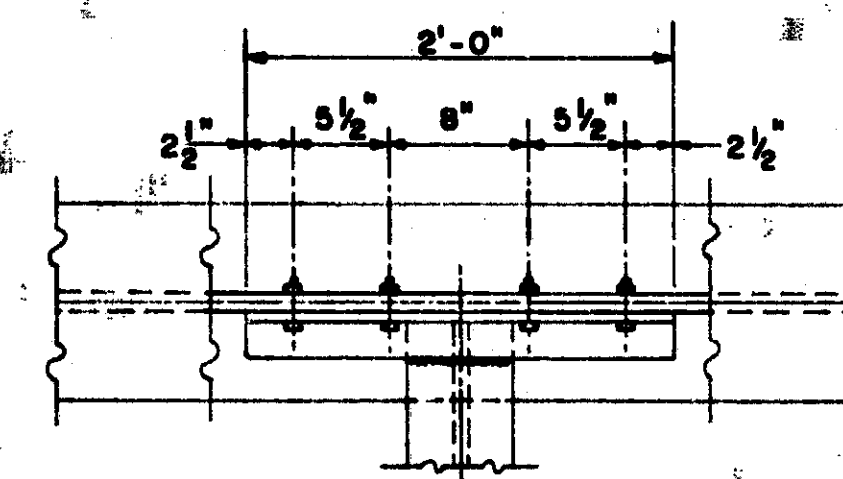


DETAIL B

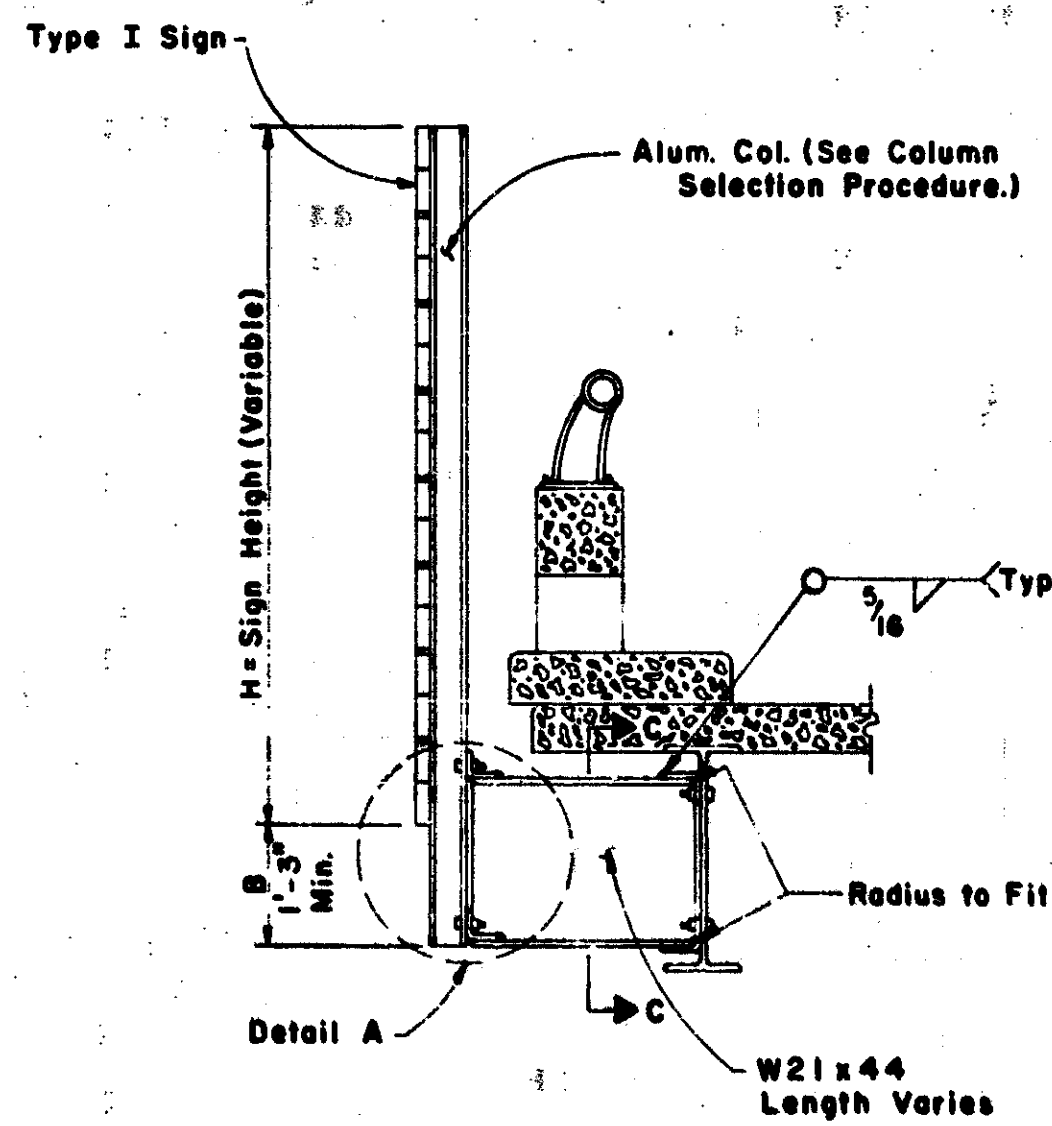

SECTION A-A

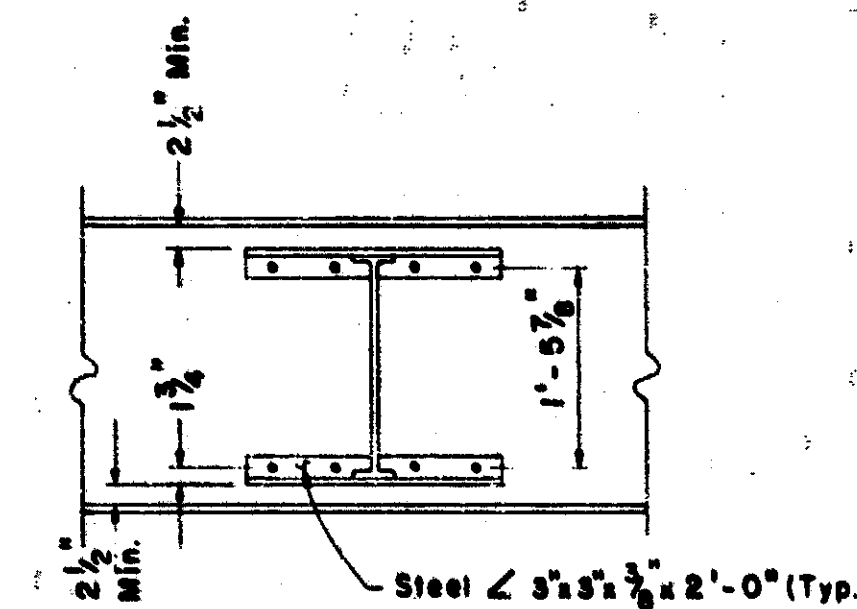

SECTION C-C

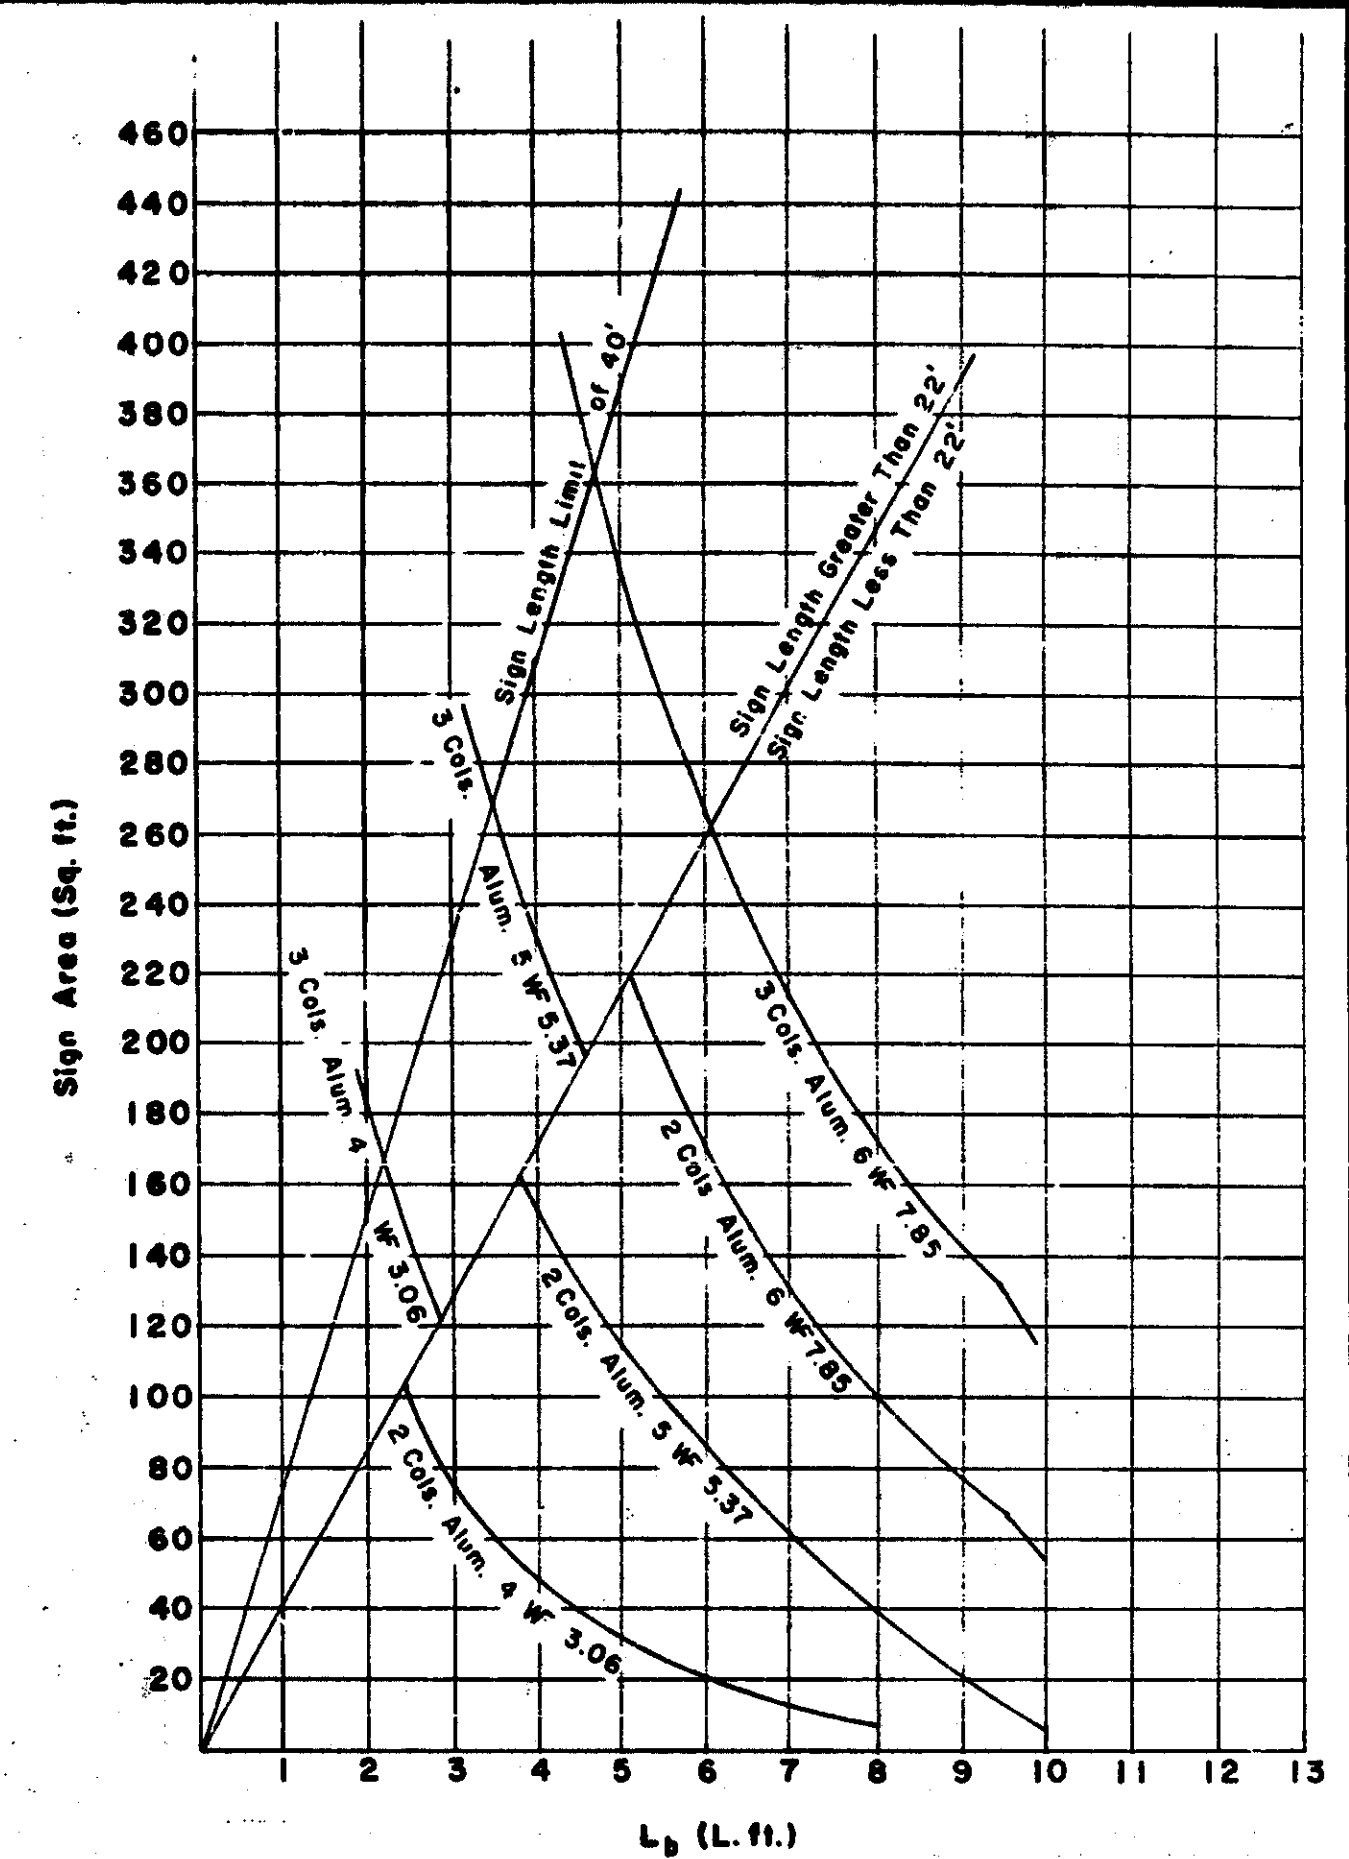

NOTES:

- 1.) All bolts shall be galvanized high strength bolts (ASTM A325). All bolts, nuts and washers shall be hot dip galvanized according to ASTM A-153. Nuts shall be topped 0.015 oversize.
- 2.) All alum. components shall be 6061-T6 alum. alloy. All steel components shall be A-36 and shall be hot-dip galvanized according to ASTM A-123. A-588 steel components may be used as an alternate on existing A-588 Fascia beams.
- 3.) Sign location may be shifted to avoid joints or stiffeners.
- 4.) Threads on all bolts shall be burred after final torquing.
- 5.) Bottom edge of sign shall be horizontal when erected and shall be a minimum of 1'-6" above the lower bridge beam flange at all points.
- 6.) Type C connection denotes a two-bracket sign connection.
- 7.) Type D connection denotes a three-bracket sign connection.
- 8.) Sign connections to mounting support columns shall have the same bolt arrangement as shown for connections for sign to mounting supports for cantilevers and trusses. (Standard Plan S 9.10.)

MICHIGAN DEPARTMENT OF STATE HIGHWAYS AND TRANSPORTATION
BOLTED BRIDGE CONNECTION
TYPES C & D ($\phi = 0^\circ$)


REVISIONS				DATE	BY	W.C.G.
1.	Notes Revised			4/76	JDB	
2.	Added Flat Washers to Drawg.			4/77	WCG	

NO. 10100
CHECKED BY: _____
DATE: _____
SHEET: _____ OF _____
S10.60

SIGN DETAIL SHEET


PANEL NO.	STATE	FEDERAL PROJECT	P.L. NO.	SHEET NO.	TOTAL SHEETS
				91	96
NAME	COUNTY	CONTR. SECTION	JOB NO.		

E6-2 SIGNS

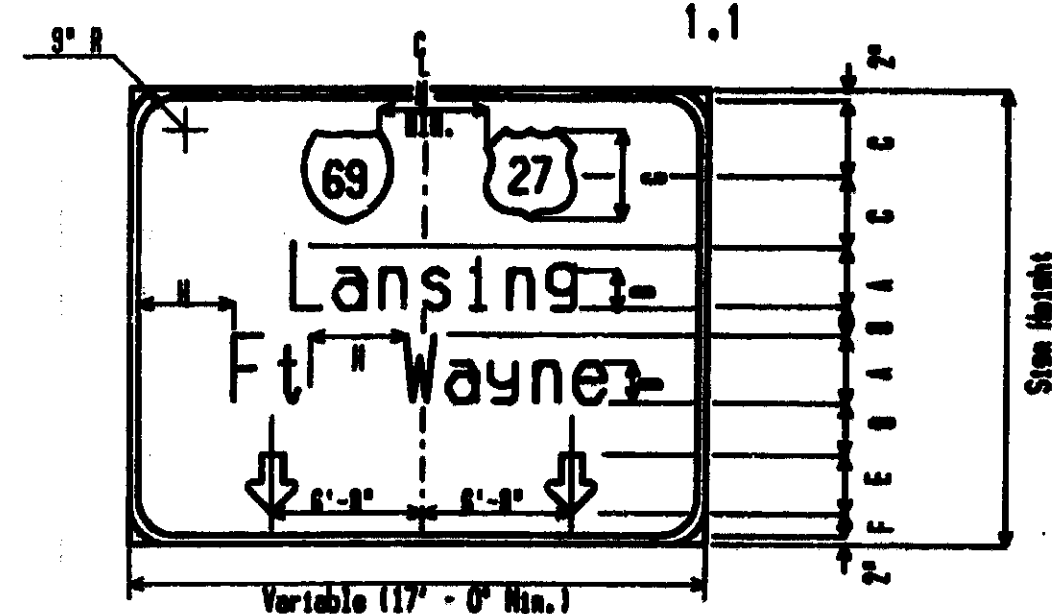


PANEL	LEGEND SIZE	DIMENSION (INCHES)							SIGN HEIGHT
		A	B	C	D	E	F	G	
I	16"HC 12"LC	16	12	27	12	22	8	28	10'-0"
II	20"HC 15"LC	20	15	30	14	24	8	30	11'-0"
III	18.3"HC 10"LC	19.3	10	24	8	22	7.4	28	10'-0"

E6-2 SIGNS

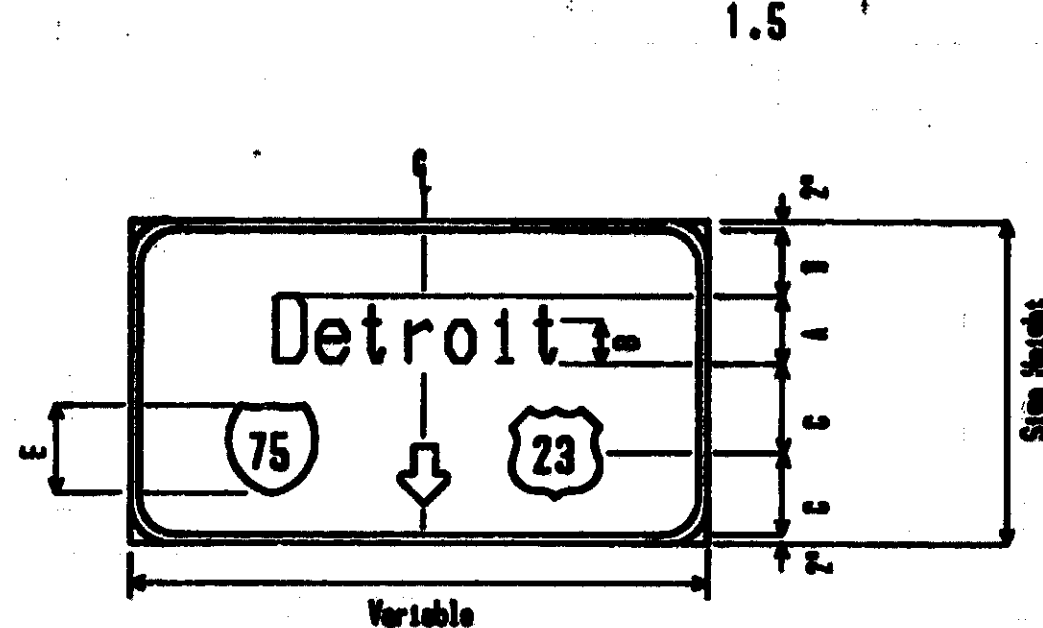


PANEL	LEGEND SIZE	DIMENSION (INCHES)							SIGN HEIGHT
		A	B	C	D	E	F	G	
I	16"HC 12"LC	16	12	28	14	20	8	28	10'-0"
II	20"HC 15"LC	20	15	32	14	20	8	30	11'-0"
III	18.3"HC 10"LC	19.3	10	26	10.7	20	8	28	10'-0"

E6-2 SIGNS

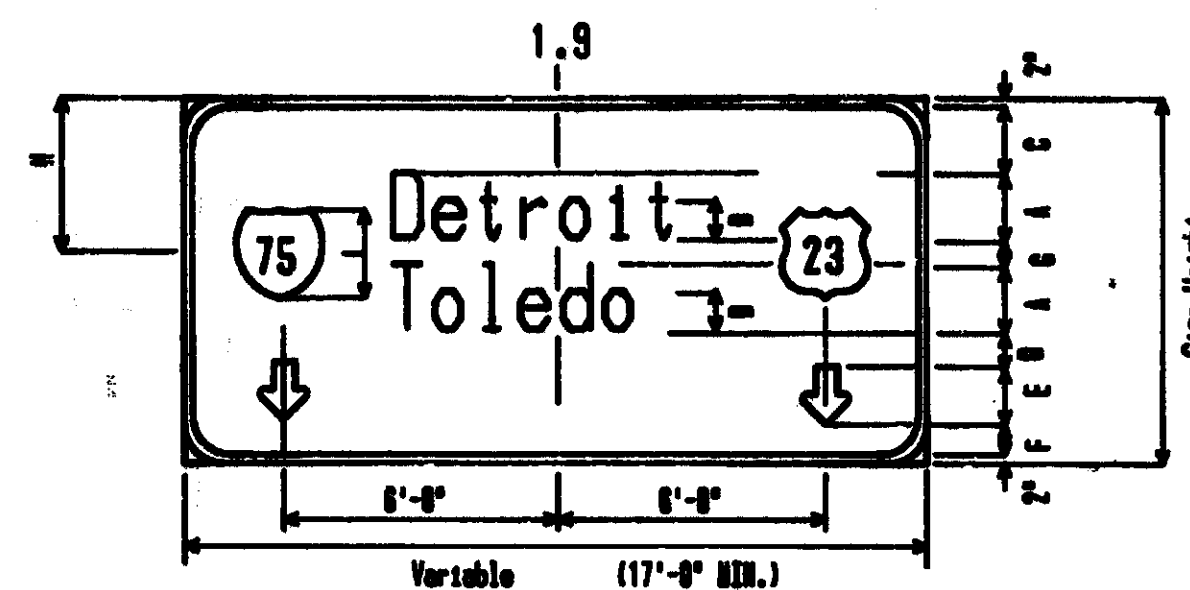


PANEL	LEGEND SIZE	DIMENSION (INCHES)									SIGN HEIGHT
		A	B	C	D	E	F	G	H	J	
I	16"HC 12"LC	16	12	12	12	22	8	12	30	30	11'-0"
II	20"HC 15"LC	20	15	14	12	22	8	14	41	30	13'-0"
III	18.3"HC 10"LC	19.3	10	10	10	22	8	8.4	32	30	11'-0"

1.2

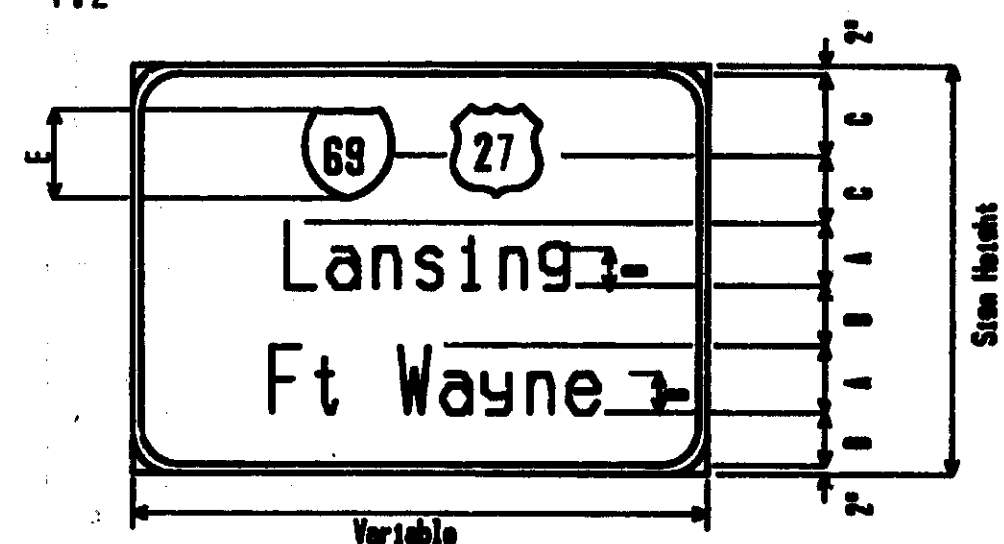


PANEL	LEGEND SIZE	DIMENSION (INCHES)							SIGN HEIGHT
		A	B	C	D	E	F	G	
I	16"HC 12"LC	16	12	27	12	22	8	28	10'-0"
II	20"HC 15"LC	20	15	30	14	24	8	30	11'-0"
III	18.3"HC 10"LC	19.3	10	25.5	10.7	20	8	28	10'-0"

1.3

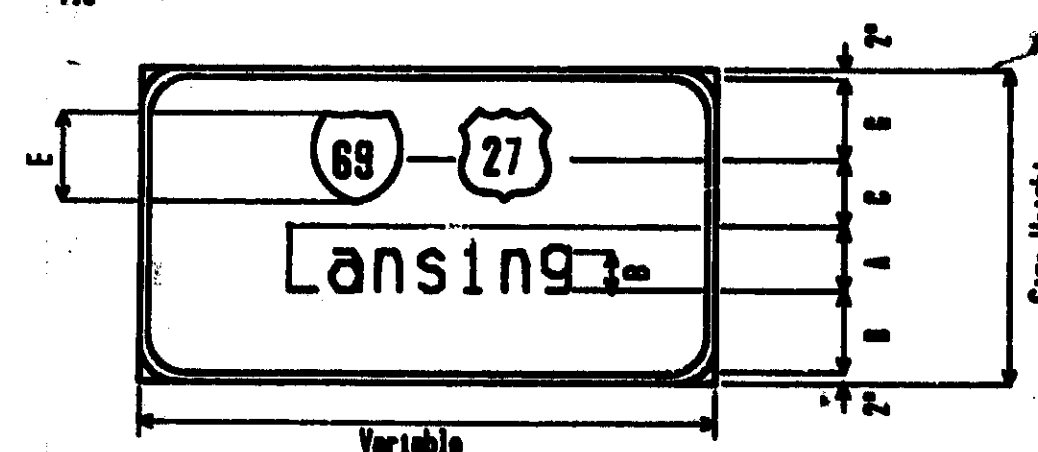


PANEL	LEGEND SIZE	DIMENSION (INCHES)							SIGN HEIGHT
		A	B	C	D	E	F	G	
I	16"HC 12"LC	16	12	28	14	20	8	28	10'-0"
II	20"HC 15"LC	20	15	32	14	20	8	30	11'-0"
III	18.3"HC 10"LC	19.3	10	26	10.7	20	8	28	10'-0"

1.4

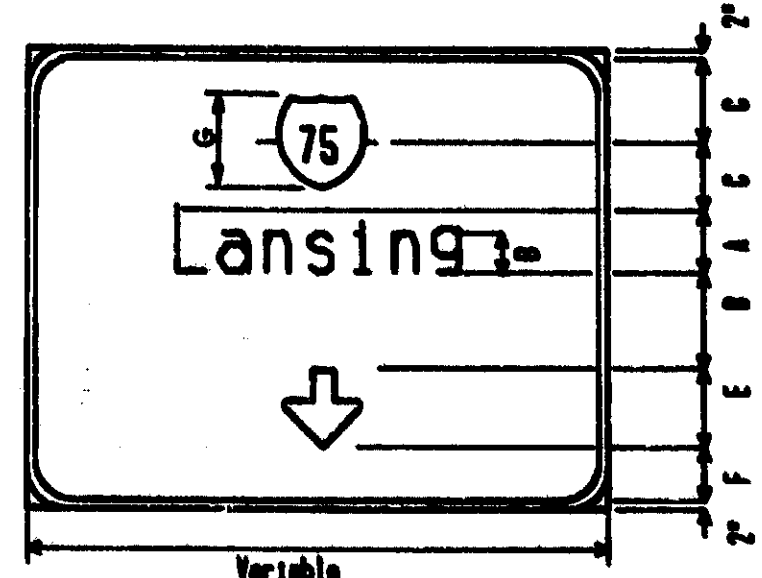


PANEL	LEGEND SIZE	DIMENSION (INCHES)							SIGN HEIGHT
		A	B	C	D	E	F	G	
I	16"HC 12"LC	16	12	27	10	22	8	28	10'-0"
II	20"HC 15"LC	20	15	30	14	22	8	30	11'-0"
III	18.3"HC 10"LC	19.3	10	25	10.7	22	8	28	10'-0"

1.6

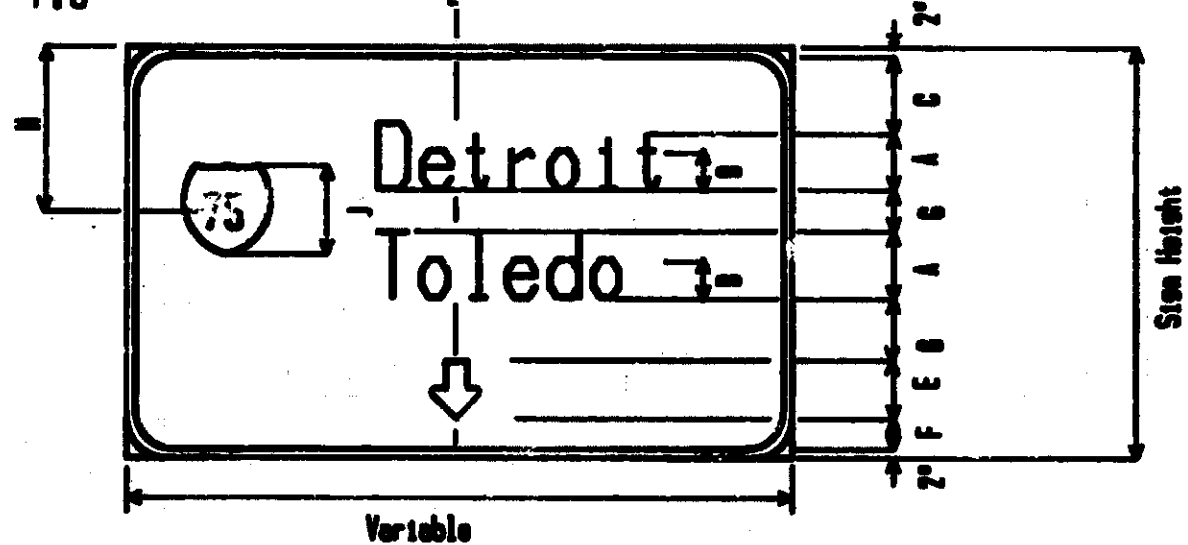


PANEL	LEGEND SIZE	DIMENSION (INCHES)							SIGN HEIGHT
		A	B	C	D	E	F	G	
I	16"HC 12"LC	16	12	28	14	20	8	28	10'-0"
II	20"HC 15"LC	20	15	32	14	20	8	30	11'-0"
III	18.3"HC 10"LC	19.3	10	26	10.7	20	8	28	10'-0"

1.7

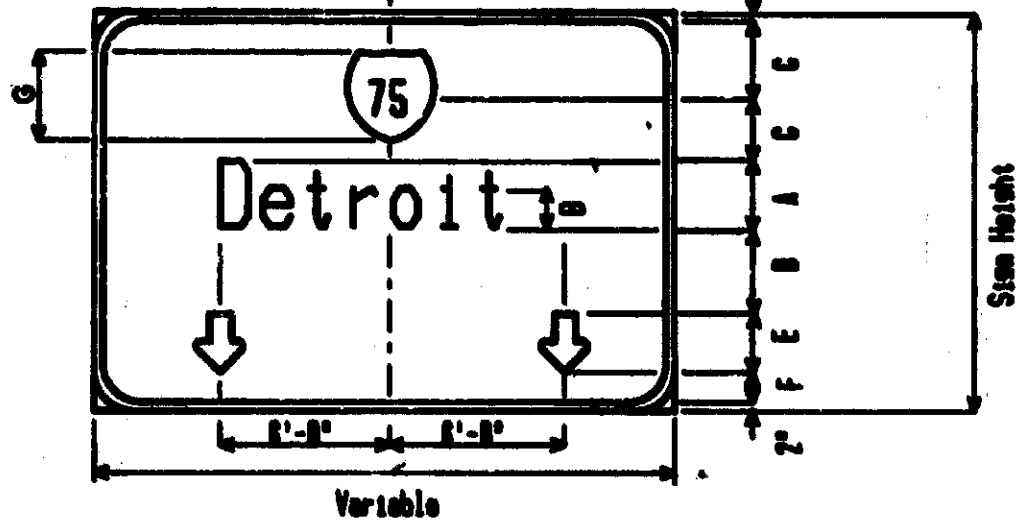


PANEL	LEGEND SIZE	DIMENSION (INCHES)							SIGN HEIGHT
		A	B	C	D	E	F	G	
I	16"HC 12"LC	16	12	27	10	22	8	28	10'-0"
II	20"HC 15"LC	20	15	30	14	22	8	30	11'-0"
III	18.3"HC 10"LC	19.3	10	25	10.7	22	8	28	10'-0"

1.8

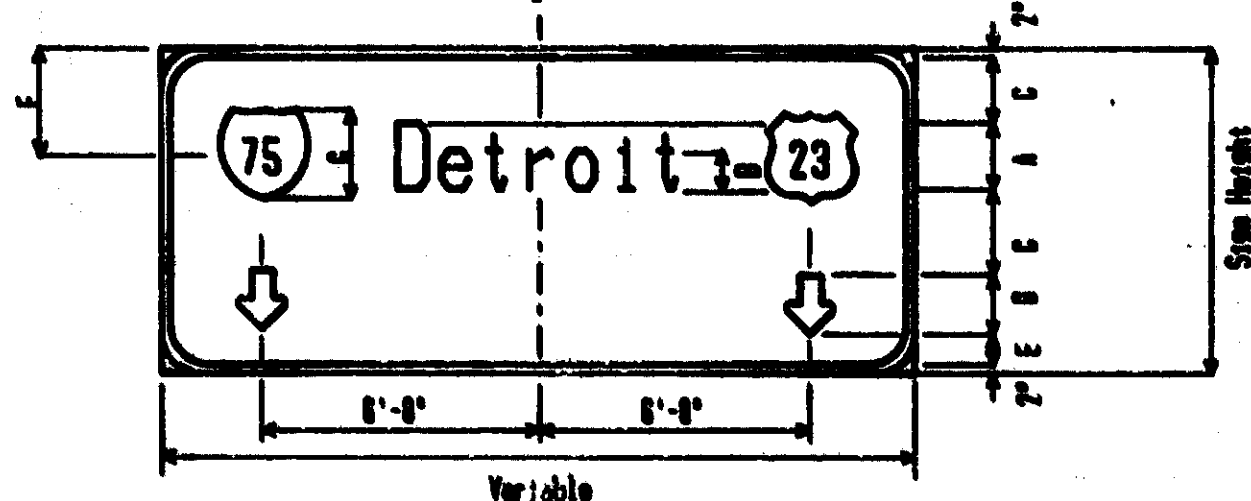

PANEL	LEGEND SIZE	DIMENSION (INCHES)							SIGN HEIGHT
		A	B	C	D	E	F	G	
I	16"HC 12"LC	16	12	28	14	20	8	28	10'-0"
II	20"HC 15"LC	20	15	32	14	20	8	30	11'-0"
III	18.3"HC 10"LC	19.3	10	26	10.7	20	8	28	10'-0"

DETAIL 1

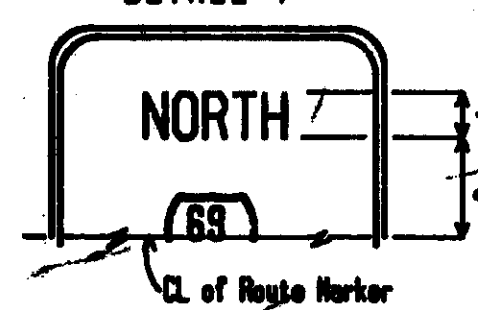

When cardinal direction is placed above route marker, it shall be positioned as shown with stem height increased. 18" for Panel I & III; 24" for Panel II.


PANEL	LEGEND SIZE	DIMENSION (INCHES)	
		A	B
I	16"HC 12"LC	12	24
II	20"HC 15"LC	15	24
III	18.3"HC 10"LC	10	21

DETAIL 2




PANEL	LEGEND SIZE	DIMENSION (INCHES)	
		A	B
I	16"HC 12"LC	15	7
II	20"HC 15"LC	18	7
III	18.3"HC 10"LC	12	8

TRIPLE DOWN ARROW DETAIL

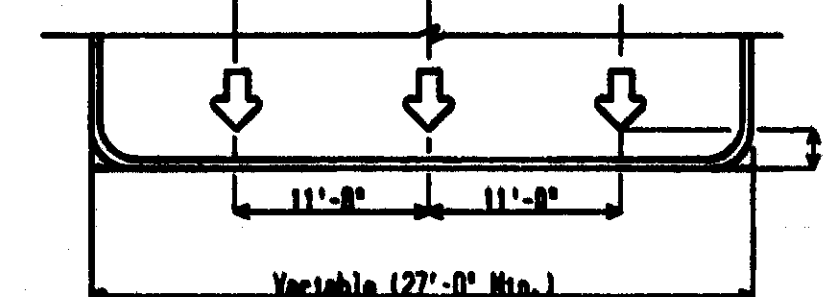

CURVED ARROW DETAIL

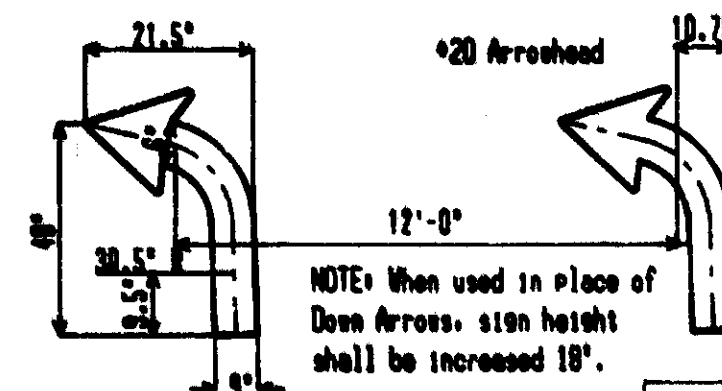

NOTE:
All lines of Legends are to be optically centered.







NOTE: When used in place of Down Arrows, sign height shall be increased 18".

S13.30

CONTROL SECTION	63174	NO.	14824A	FEDERAL PROJECT	P.L. NO.	SHEET NO.	TOTAL SHEETS
						91	96

ROUTE MARKER DETAILS 30" FOR 13.3" & 10" GUIDE SIGN USE

FEDERAL PROJECT	SHEET NO.	DATE
92	96	
DIVISION	SECTION	JOB NO.

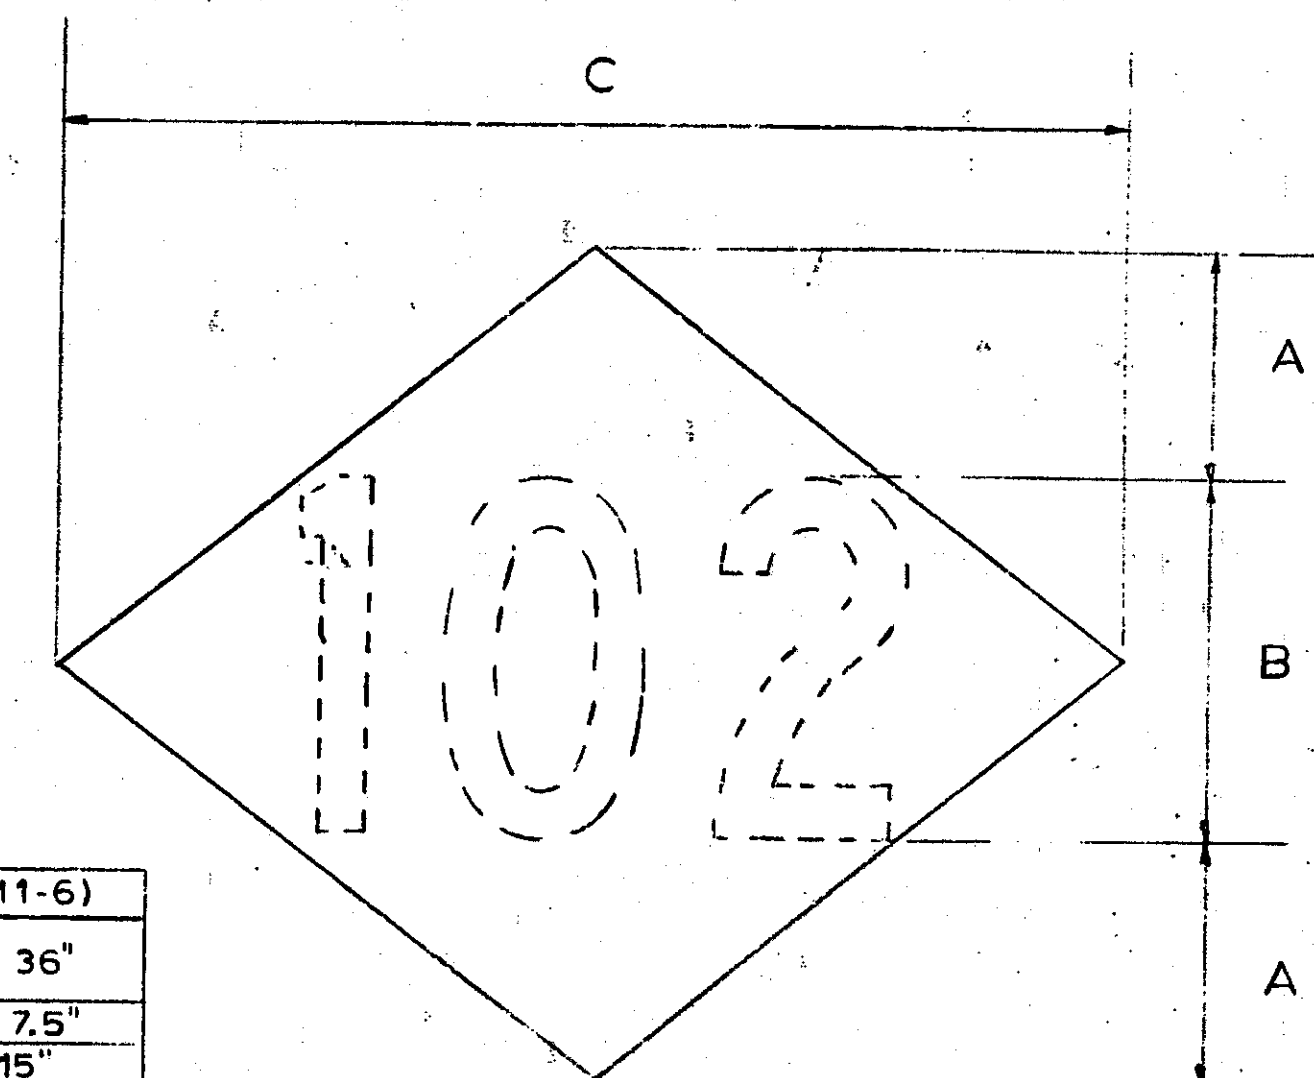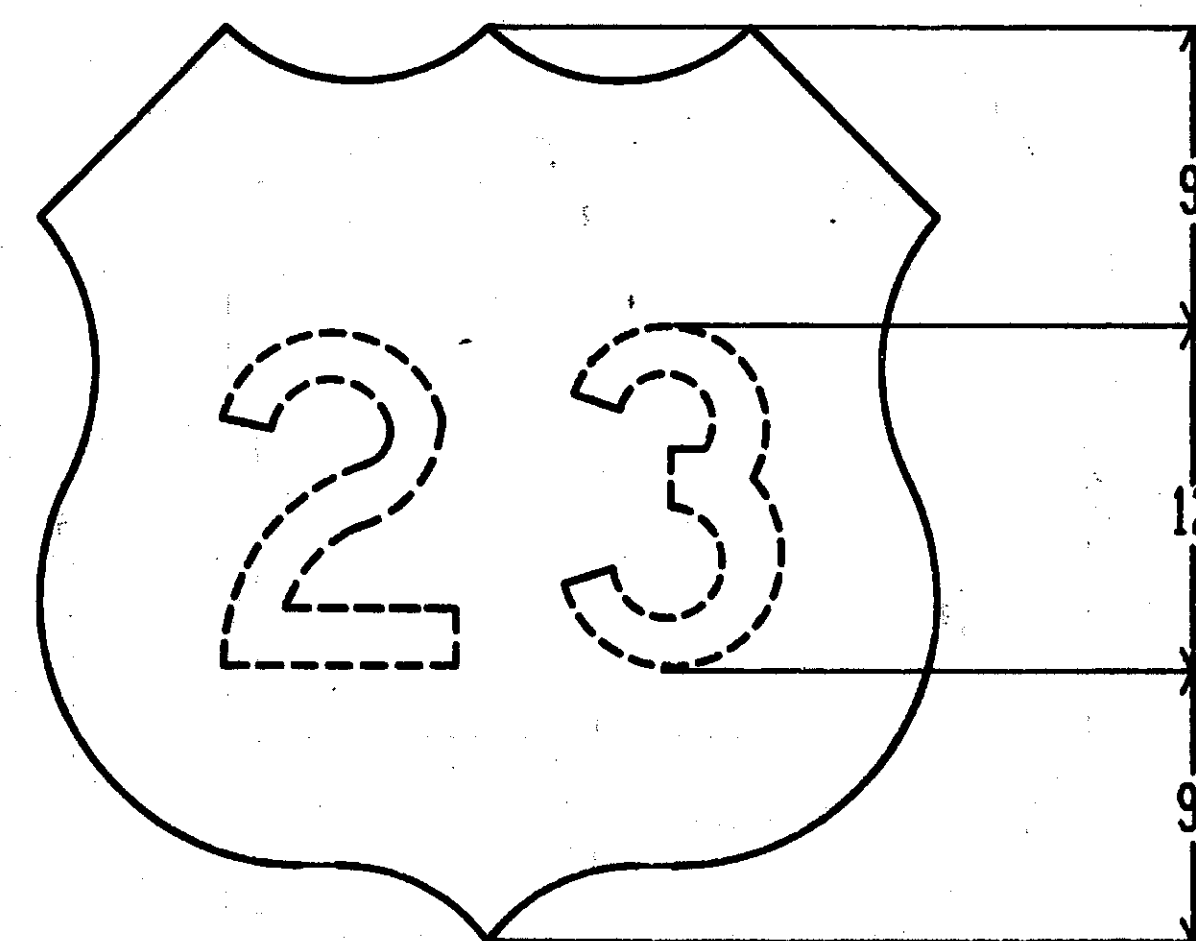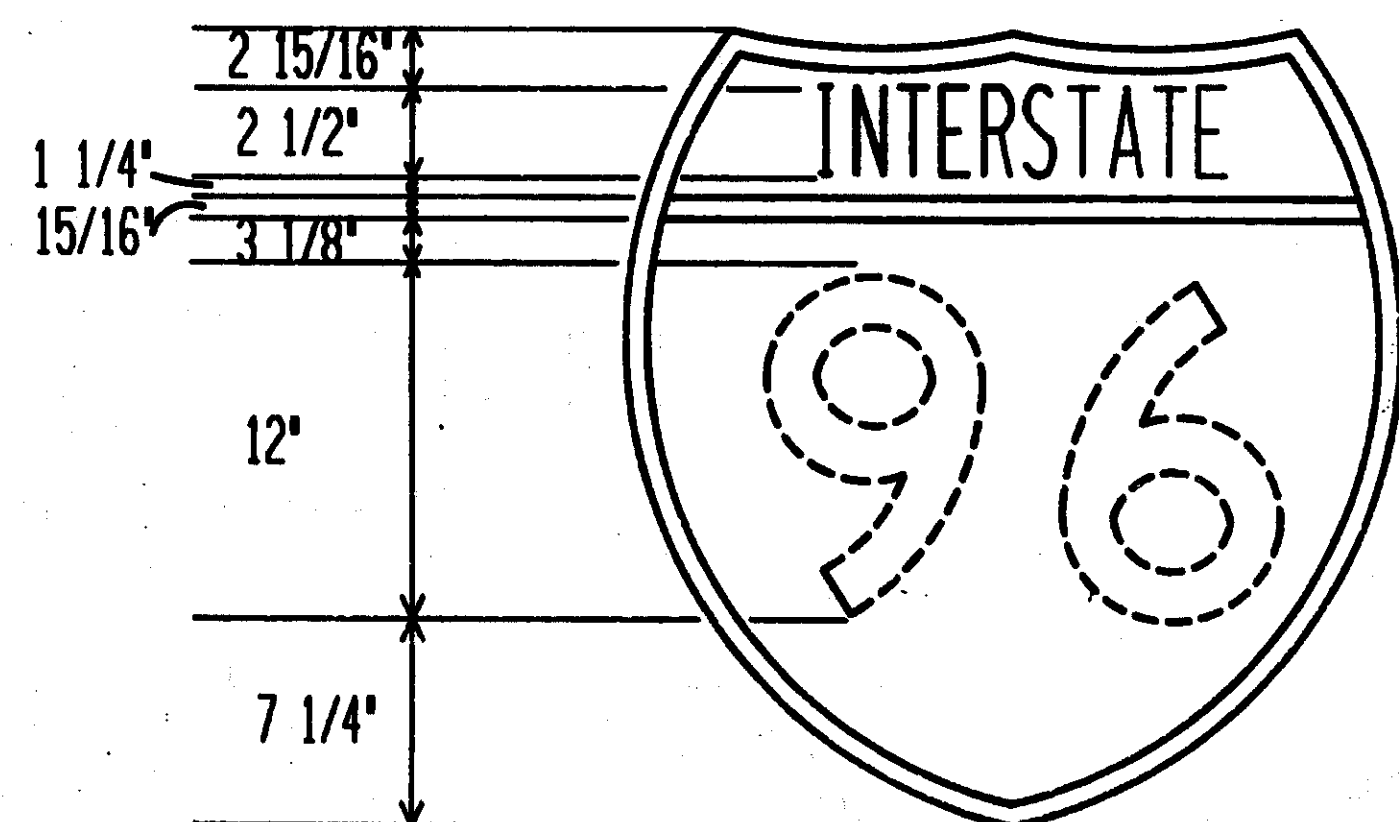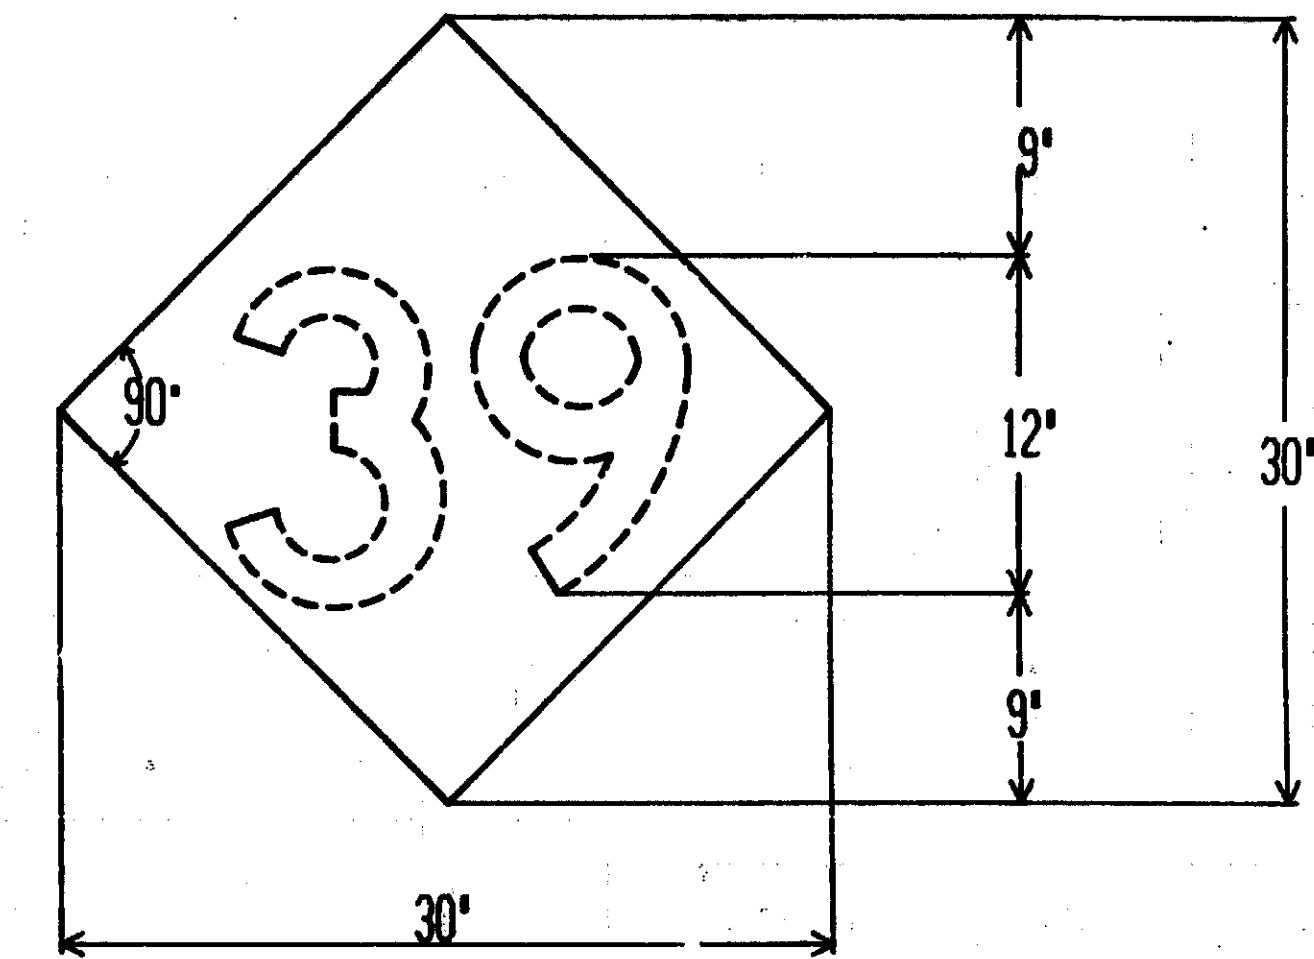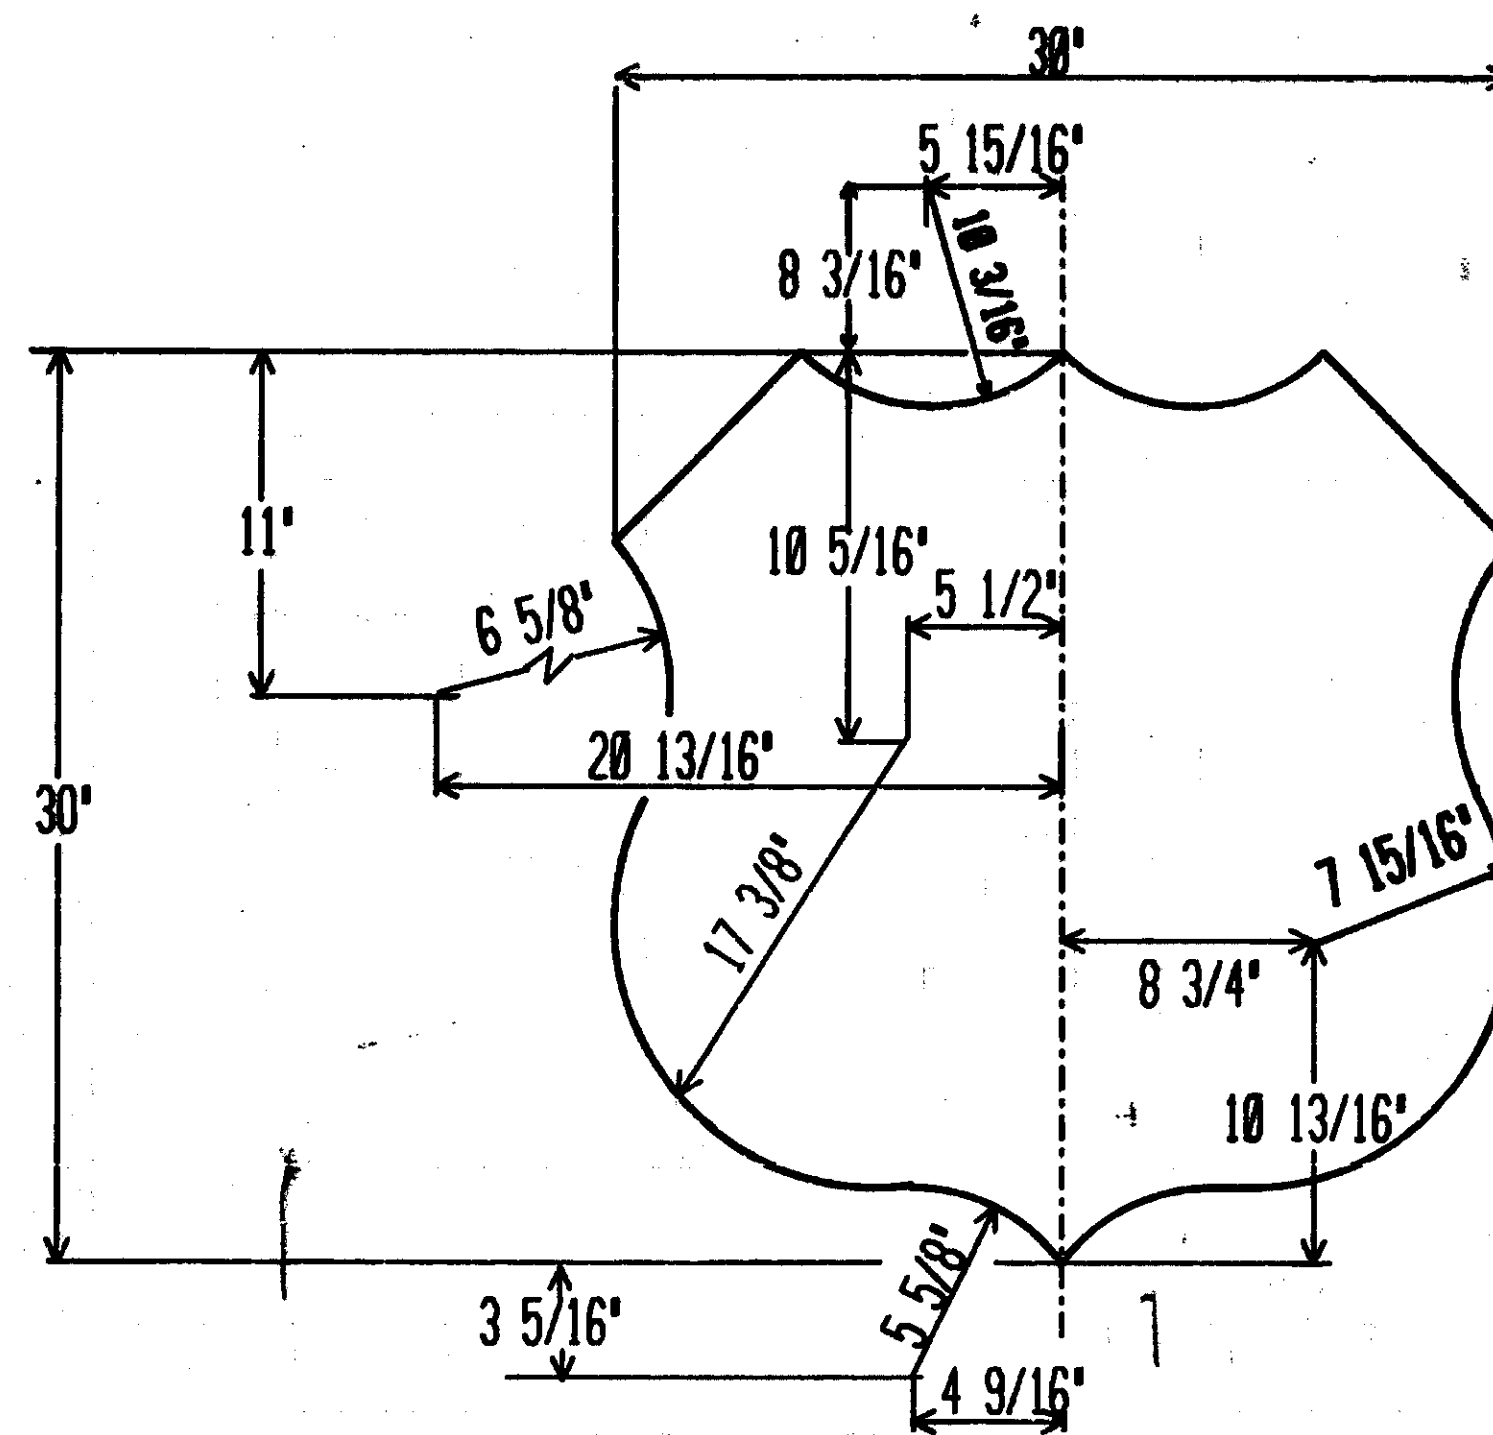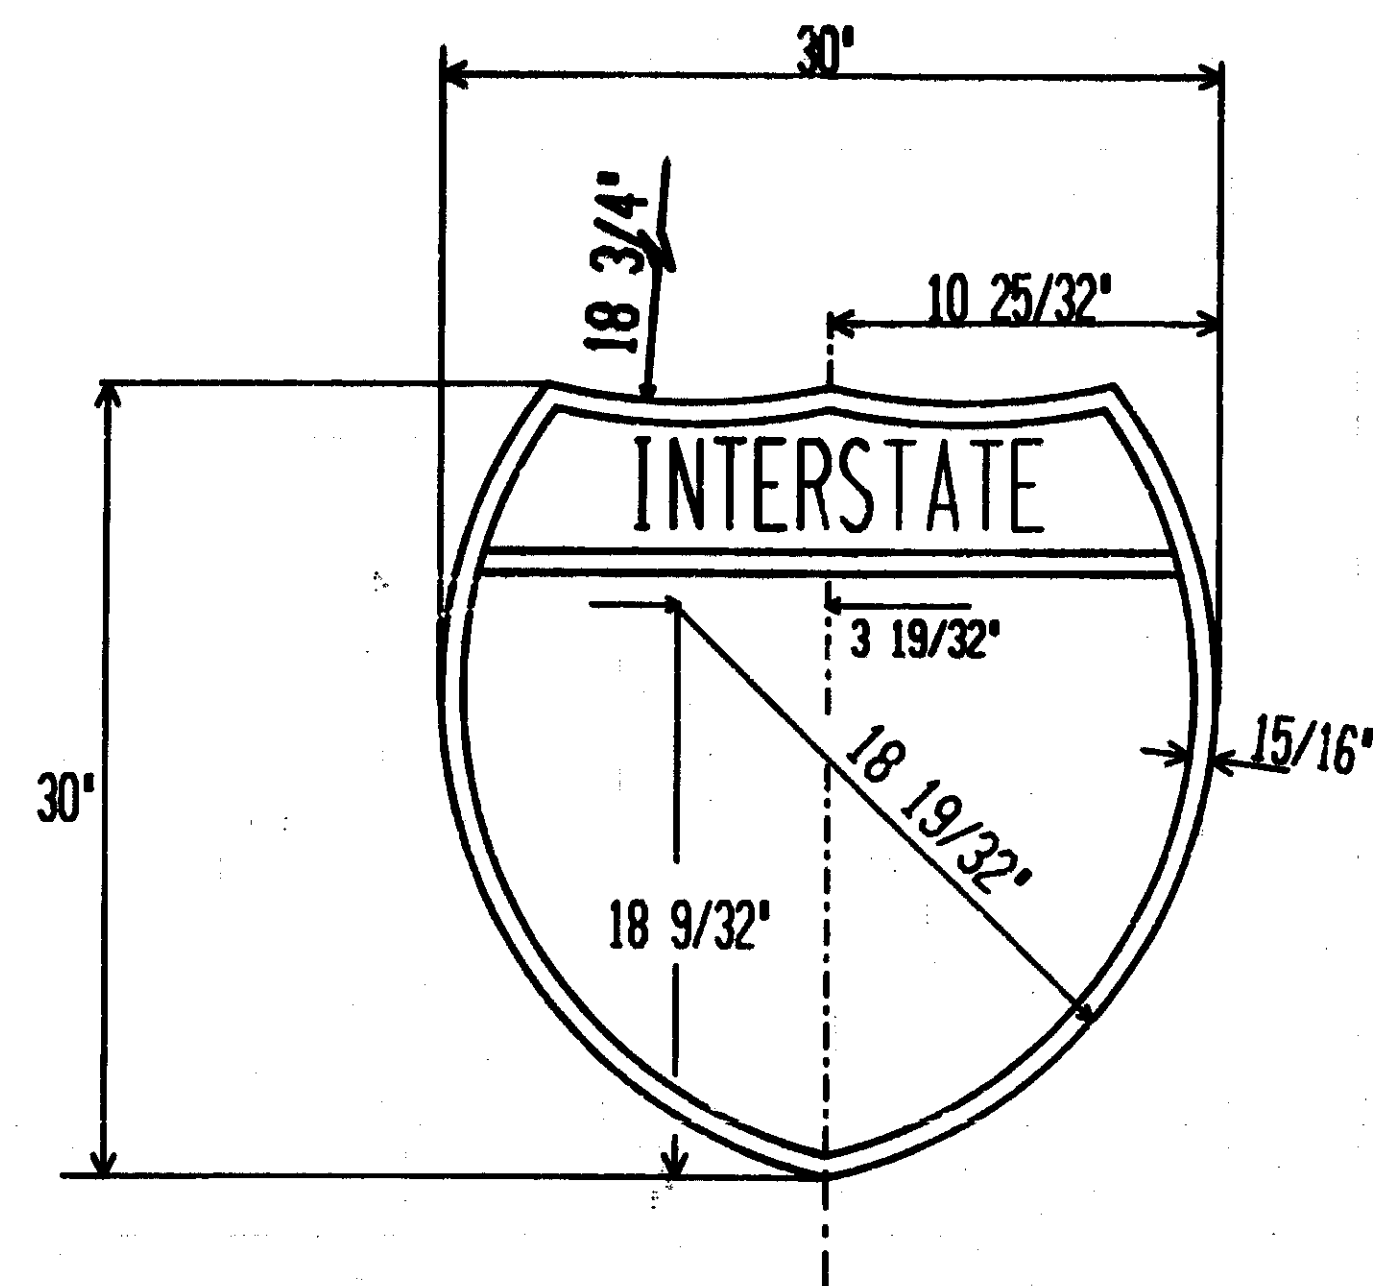

3 DIGIT (M1-6)		
	30"	36"
A	9"	7.5"
B	12"	15"
C	36"	45"

SPECIFICATIONS

1. Sign Panel: Type III, Sheet aluminum or approved equal (for demountable route markers only).
2. Sign Face: Type A.
 - (a) Legend: As indicated.
 - (b) Color: Silver letters, numerals and border on an Interstate Red and Interstate Blue background.
 - (c) Reflectization: Letters, numerals and border - Silver sheeting or demountable. Background - Interstate Red and Interstate Blue transparent screened on silver sheeting.

NOTE: Letters, numerals and spacings between letters and numerals shall be in accordance with standards prepared by the FHWA. All lines of legend shall be optically centered horizontally on the sign.

SPECIFICATIONS

1. Sign Panel: Type III, Sheet aluminum or approved equal (for demountable route markers only).
 2. Sign Face: Type B.
 - (a) Legend: Series "D" numerals of the height indicated
 - (b) Color: Black numerals on a silver background.
 - (c) Reflectization: Silver sheeting.
- NOTE: Numerals, and spacings between numerals, shall be in accordance with standards prepared by the FHWA. The route number shall be optically centered horizontally on the sign.


SPECIFICATIONS

1. Sign Panel: Type III, Sheet aluminum or approved equal (for demountable route markers only).
 2. Sign Face: Type B.
 - (a) Legend: As indicated (See notes below).
 - (b) Color: Black numerals on a silver background.
 - (c) Reflectization: Silver sheeting.
- NOTES: 1. All 1 and 2 digit designations Series "D" of the height indicated except the combination "22" which shall be Series "C". All 3 digit designations shall be either Series "C" or Series "B". (Use the wider series whenever possible).
2. Where necessary, spacing between numerals may be somewhat less than that specified by FHWA standards. The route number shall be optically centered horizontally on the sign.

S13.40

SECTION	63174	JOB NO.	1482 4A	FEDERAL PROJECT	SHEET NO.	DATE
					92	96


STATE	PROJECT NO.	SHEET NO.	TOTAL SHEETS
5 MICH.		93	96
DATE	DESIGNER	CHECKED	BY

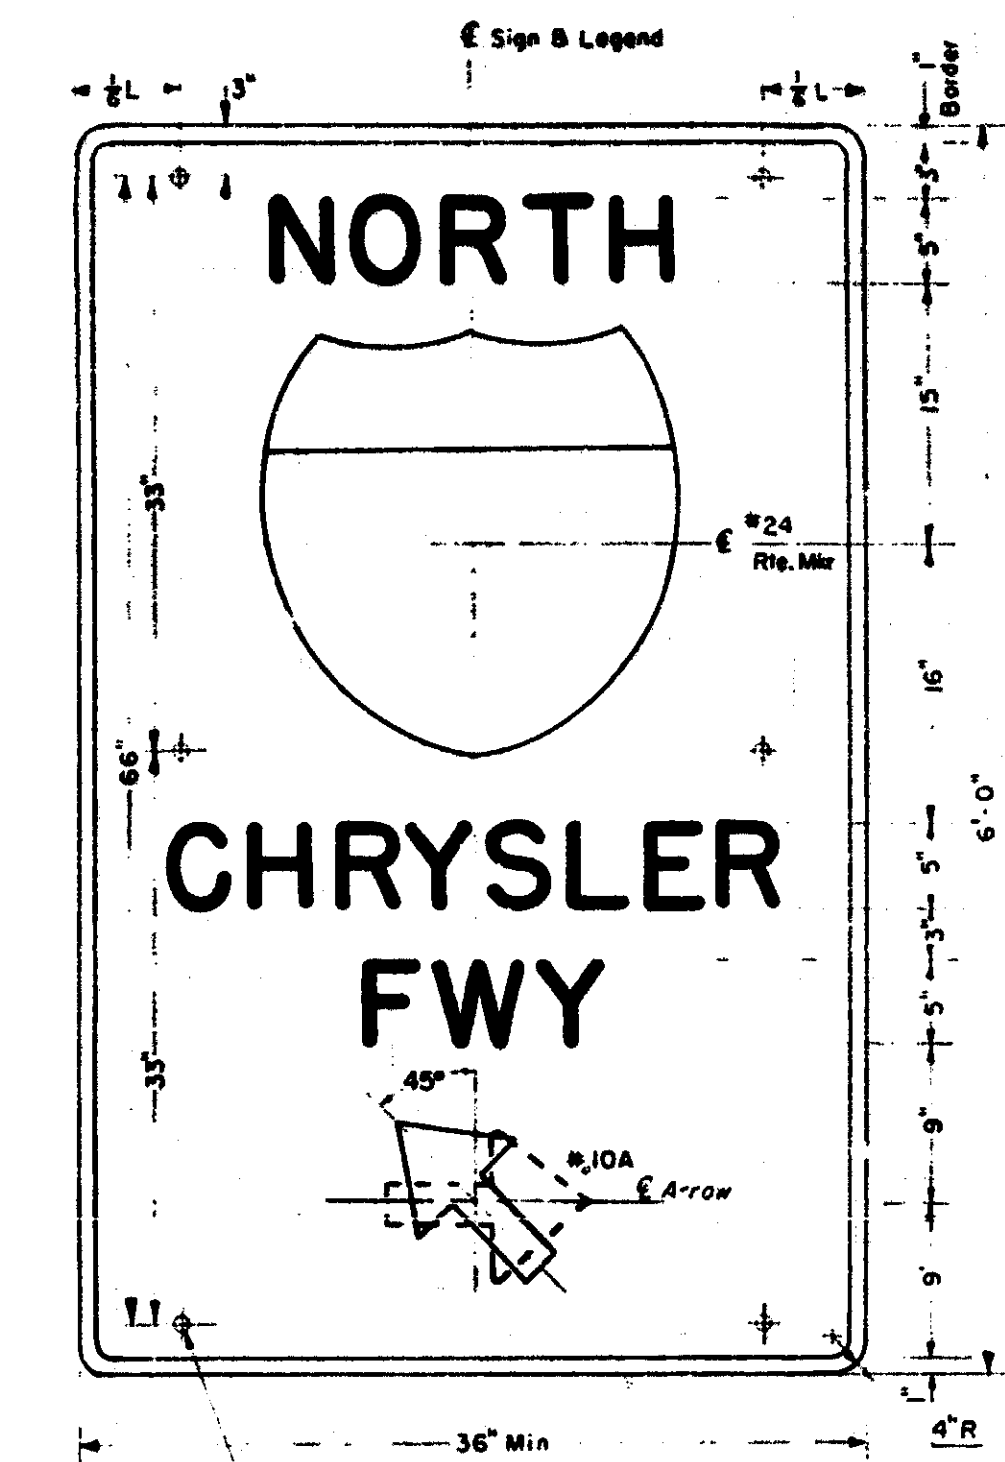

DETAIL OF SIGN
Scale: None

- SPECIFICATIONS**
1. Sign Panel: Type D 1/2" Plywood or approved equal
 2. Sign Face: Type A
 - (a) Legend: 5" Series "D" letters, M.S.H.D. standard alphabet with a no.24 Route marker overlay. (SB-36)
 - (b) Color: Silver letters and border on a green background
 - (c) ReflectORIZATION: Full

Type II A Sign			
AUTH. NO.	DATE	DRAWN	
CONF. SEC.	DATE	DATE	
REV.	SCALE	SCALE	
SHEET 1 OF 1	PLAN	85-126	

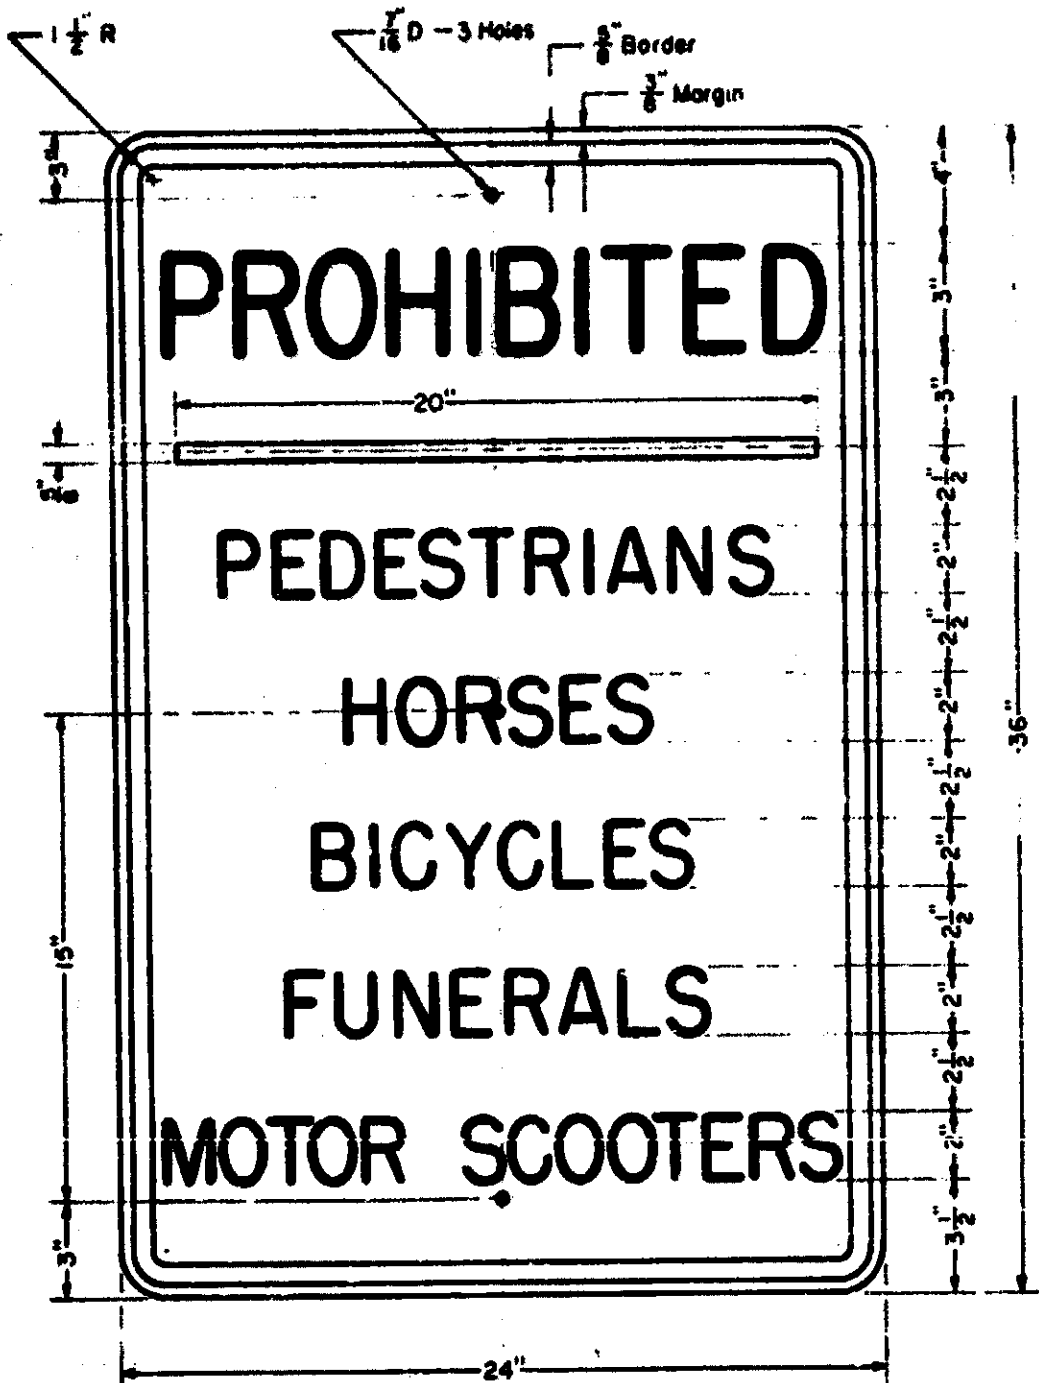


DETAIL OF SIGN
Scale: None

NO.	REVISIONS DESCRIPTIONS	DATE

- SPECIFICATIONS**
1. Sign Panel: Type III, Sheet aluminum or approved equal
 2. Sign Face: Type B
 - (a) Legend: 2" and 3" Series "C" modified letters - M.S.H.D. standard alphabet
 - (b) Color: Black letters, divider bar and border on a silver background
 - (c) ReflectORIZATION: Silver sheeting
- Note: Letter spacing shall be in accordance with spacing charts prepared by Traffic Division.


Type III B Sign			
R3-32-24D			
AUTH. NO.	DATE	DRAWN M.S.G.	
CONF. SEC.	DATE	DATE 2/28/66	
REV.	SCALE	SCALE NONE	
SHEET 2 OF 2	PLAN	R3-32-24D	

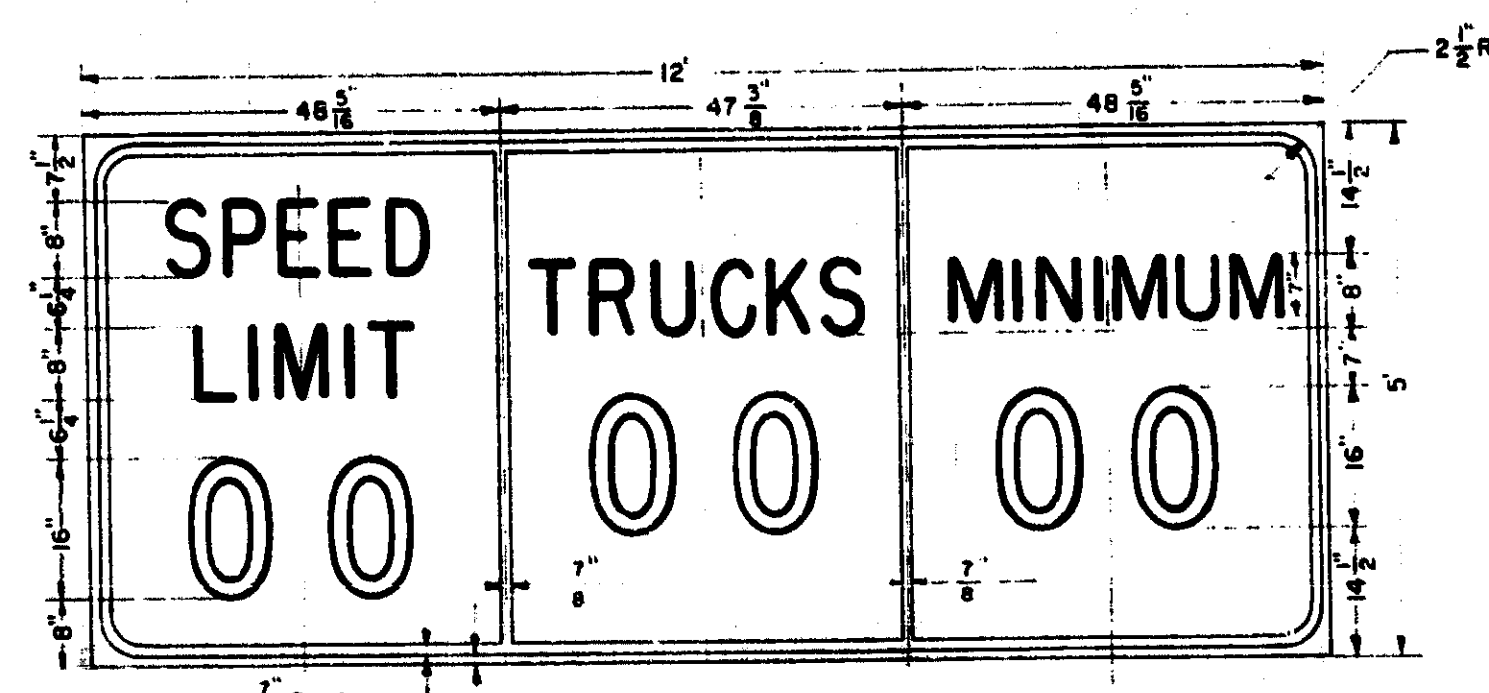

DETAIL OF SIGN
Scale: None


- SPECIFICATIONS**
1. Sign Panel: Type I Aluminum extrusions or approved equal
 2. Sign Face: Type "b"

Legend: SPEED LIMIT, TRUCKS, 8" series "O" modified letters
MINIMUM, 7" Series "C" modified letters.
M.S.H.D. Standard Alphabet
Color: Black legend, border and silver background
ReflectORIZATION: Silver sheeting

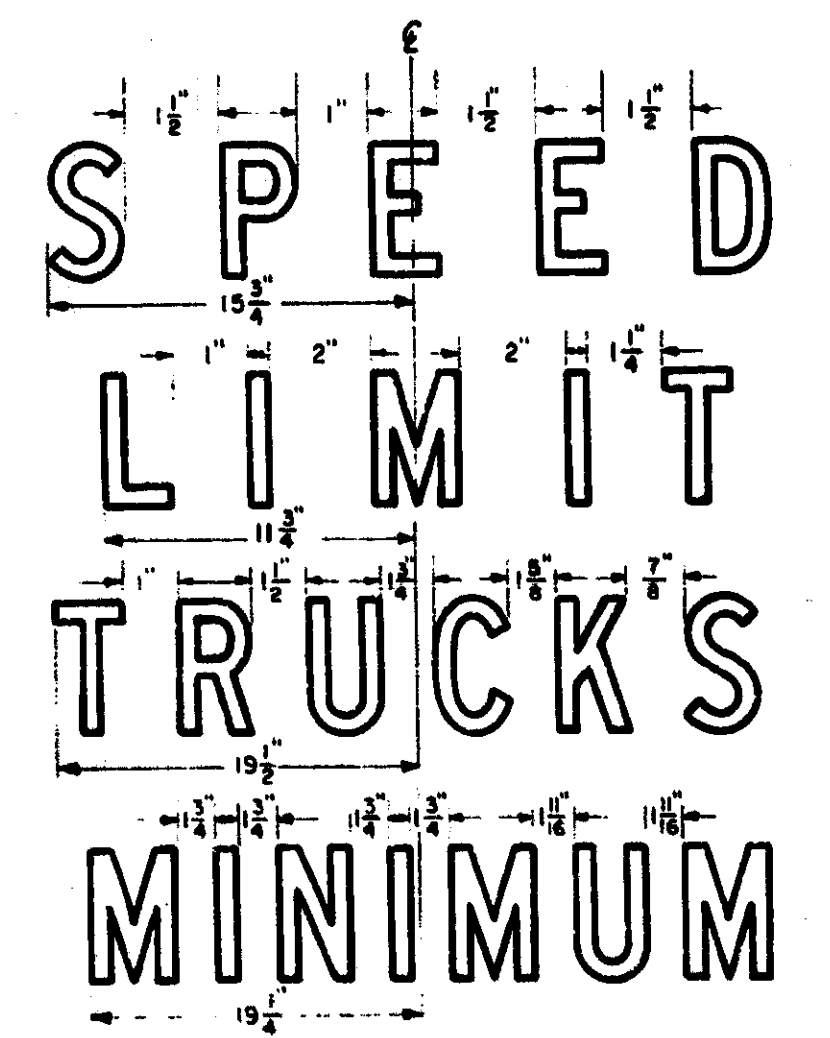

DETAIL OF LETTER SPACING
Scale: None

Type IB Sign			
SPEED LIMIT SIGN FOR FREEWAY ENTRANCES TO STATE			
AUTH. NO.	DATE	DRAWN W.P.B.	
CONF. SEC.	DATE	DATE 12-16-65	
REV.	SCALE	SCALE NONE	
SHEET 1 OF 1	PLAN	B-281	

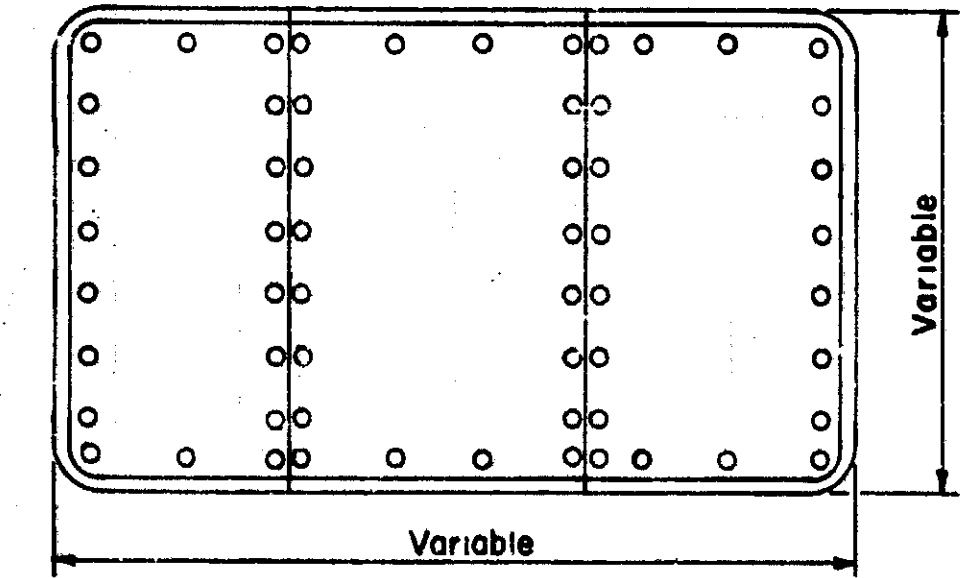

- NOTES:**
1. Use 10-16 x 3/4" Hex Washer Head, Teks #3 with long pilot, Teks #634-101280-02-0200 Cad. plated (or equivalent) to fasten sign overlay to sign face.
 2. Allow 9" maximum spacing between self-tapping screws and 3/4" minimum - 1/2" maximum from edge of sign overlay along outside edge. Allow 1" maximum from cut to interior screws.
 3. Care shall be exercised in attaching overlays to ensure a flat surface.

- SPECIFICATIONS**
1. Sign Panel: Type IV, 0.040" sheet aluminum.
 2. Sign Face: Type A,
 - (a) Legend: None, unless otherwise specified on sign location plans.
 - (b) Color: As specified on sign standard appropriate to overlay layout.
 - (c) ReflectORIZATION: Sheeting as required by the appropriate sign standard.

REVISIONS		
NO.	DESCRIPTION	DATE

AUTH. NO.	DATE	DRAWN TMW	
CONF. SEC.	DATE	DATE 6-72	
REV.	SCALE	SCALE NONE	
SHEET 1 OF 1	PLAN	G5-17 SIGN OVERLAY PANEL	

S13.EC

63174-18874A

CS: 63174

ID: 18874A

✓

MICHIGAN
DEPARTMENT OF TRANSPORTATION
PLANS OF PROPOSED

MICHIGAN PROJECT IR-75-2(266)
CONTROL SECTION IR 63174
JOB NUMBER 18874A
I-75
OAKLAND COUNTY
BLOOMFIELD AND PONTIAC TOWNSHIPS
CITIES OF MADISON HEIGHTS AND TROY


ROUTE	JOB NUMBER	FEDERAL NUMBER	SHEET NO.	TOTAL SHEETS
I-75	18874A	IR-75-2(266)	1	

THE IMPROVEMENTS COVERED BY THESE PLANS SHALL BE DONE IN ACCORDANCE WITH THE MICHIGAN DEPARTMENT OF TRANSPORTATION 1979 STANDARD SPECIFICATIONS AND SUPPLEMENTAL SPECIFICATIONS

YEAR 1977

A.D.T. _____
D.H.V. _____
COMM. % 10 %
DESIGN SPEED _____

ROAD PLANS	SHEET NOS.
TITLE	1
TYPICAL CROSS SECTION	
NOTE SHEET	2
PLANS	3-9
SPECIAL DETAILS	
MASS DIAGRAMS	
QUANTITY SHEETS	2
<i>Note - Sheet 5 Deleted</i>	
<i>As Const. Sheets - 2A, 2B, 3A, 5A, 6A, 7A, 8A</i>	
BRIDGE PLANS	
SIGNING PLANS	

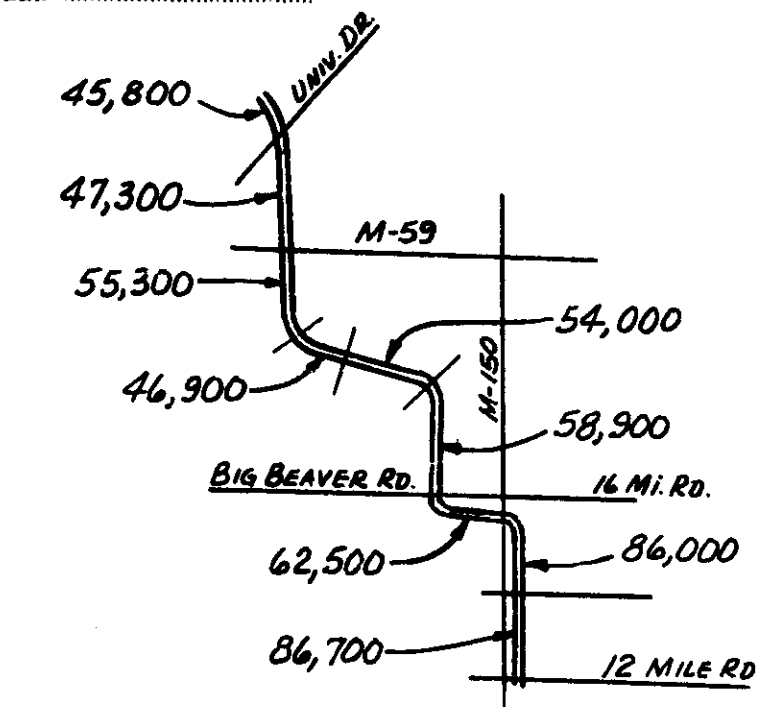


MICH. PROJ. IR-75-2(266)
Cont. Sect. IR 63174
Job Number 18874A
Ends Sta. 180+00

STATION EQUATION
Sta. 838+87.65 Back =
Sta. 38+87.65 Ahead

STATION EQUATION
Sta. 1326+20.19 Back =
Sta. 518+61.05 Ahead

MICH. PROJ. IR-75-2(266)
Cont. Sect. IR 63174
Job Number 18874A
Begins Sta. 946+00

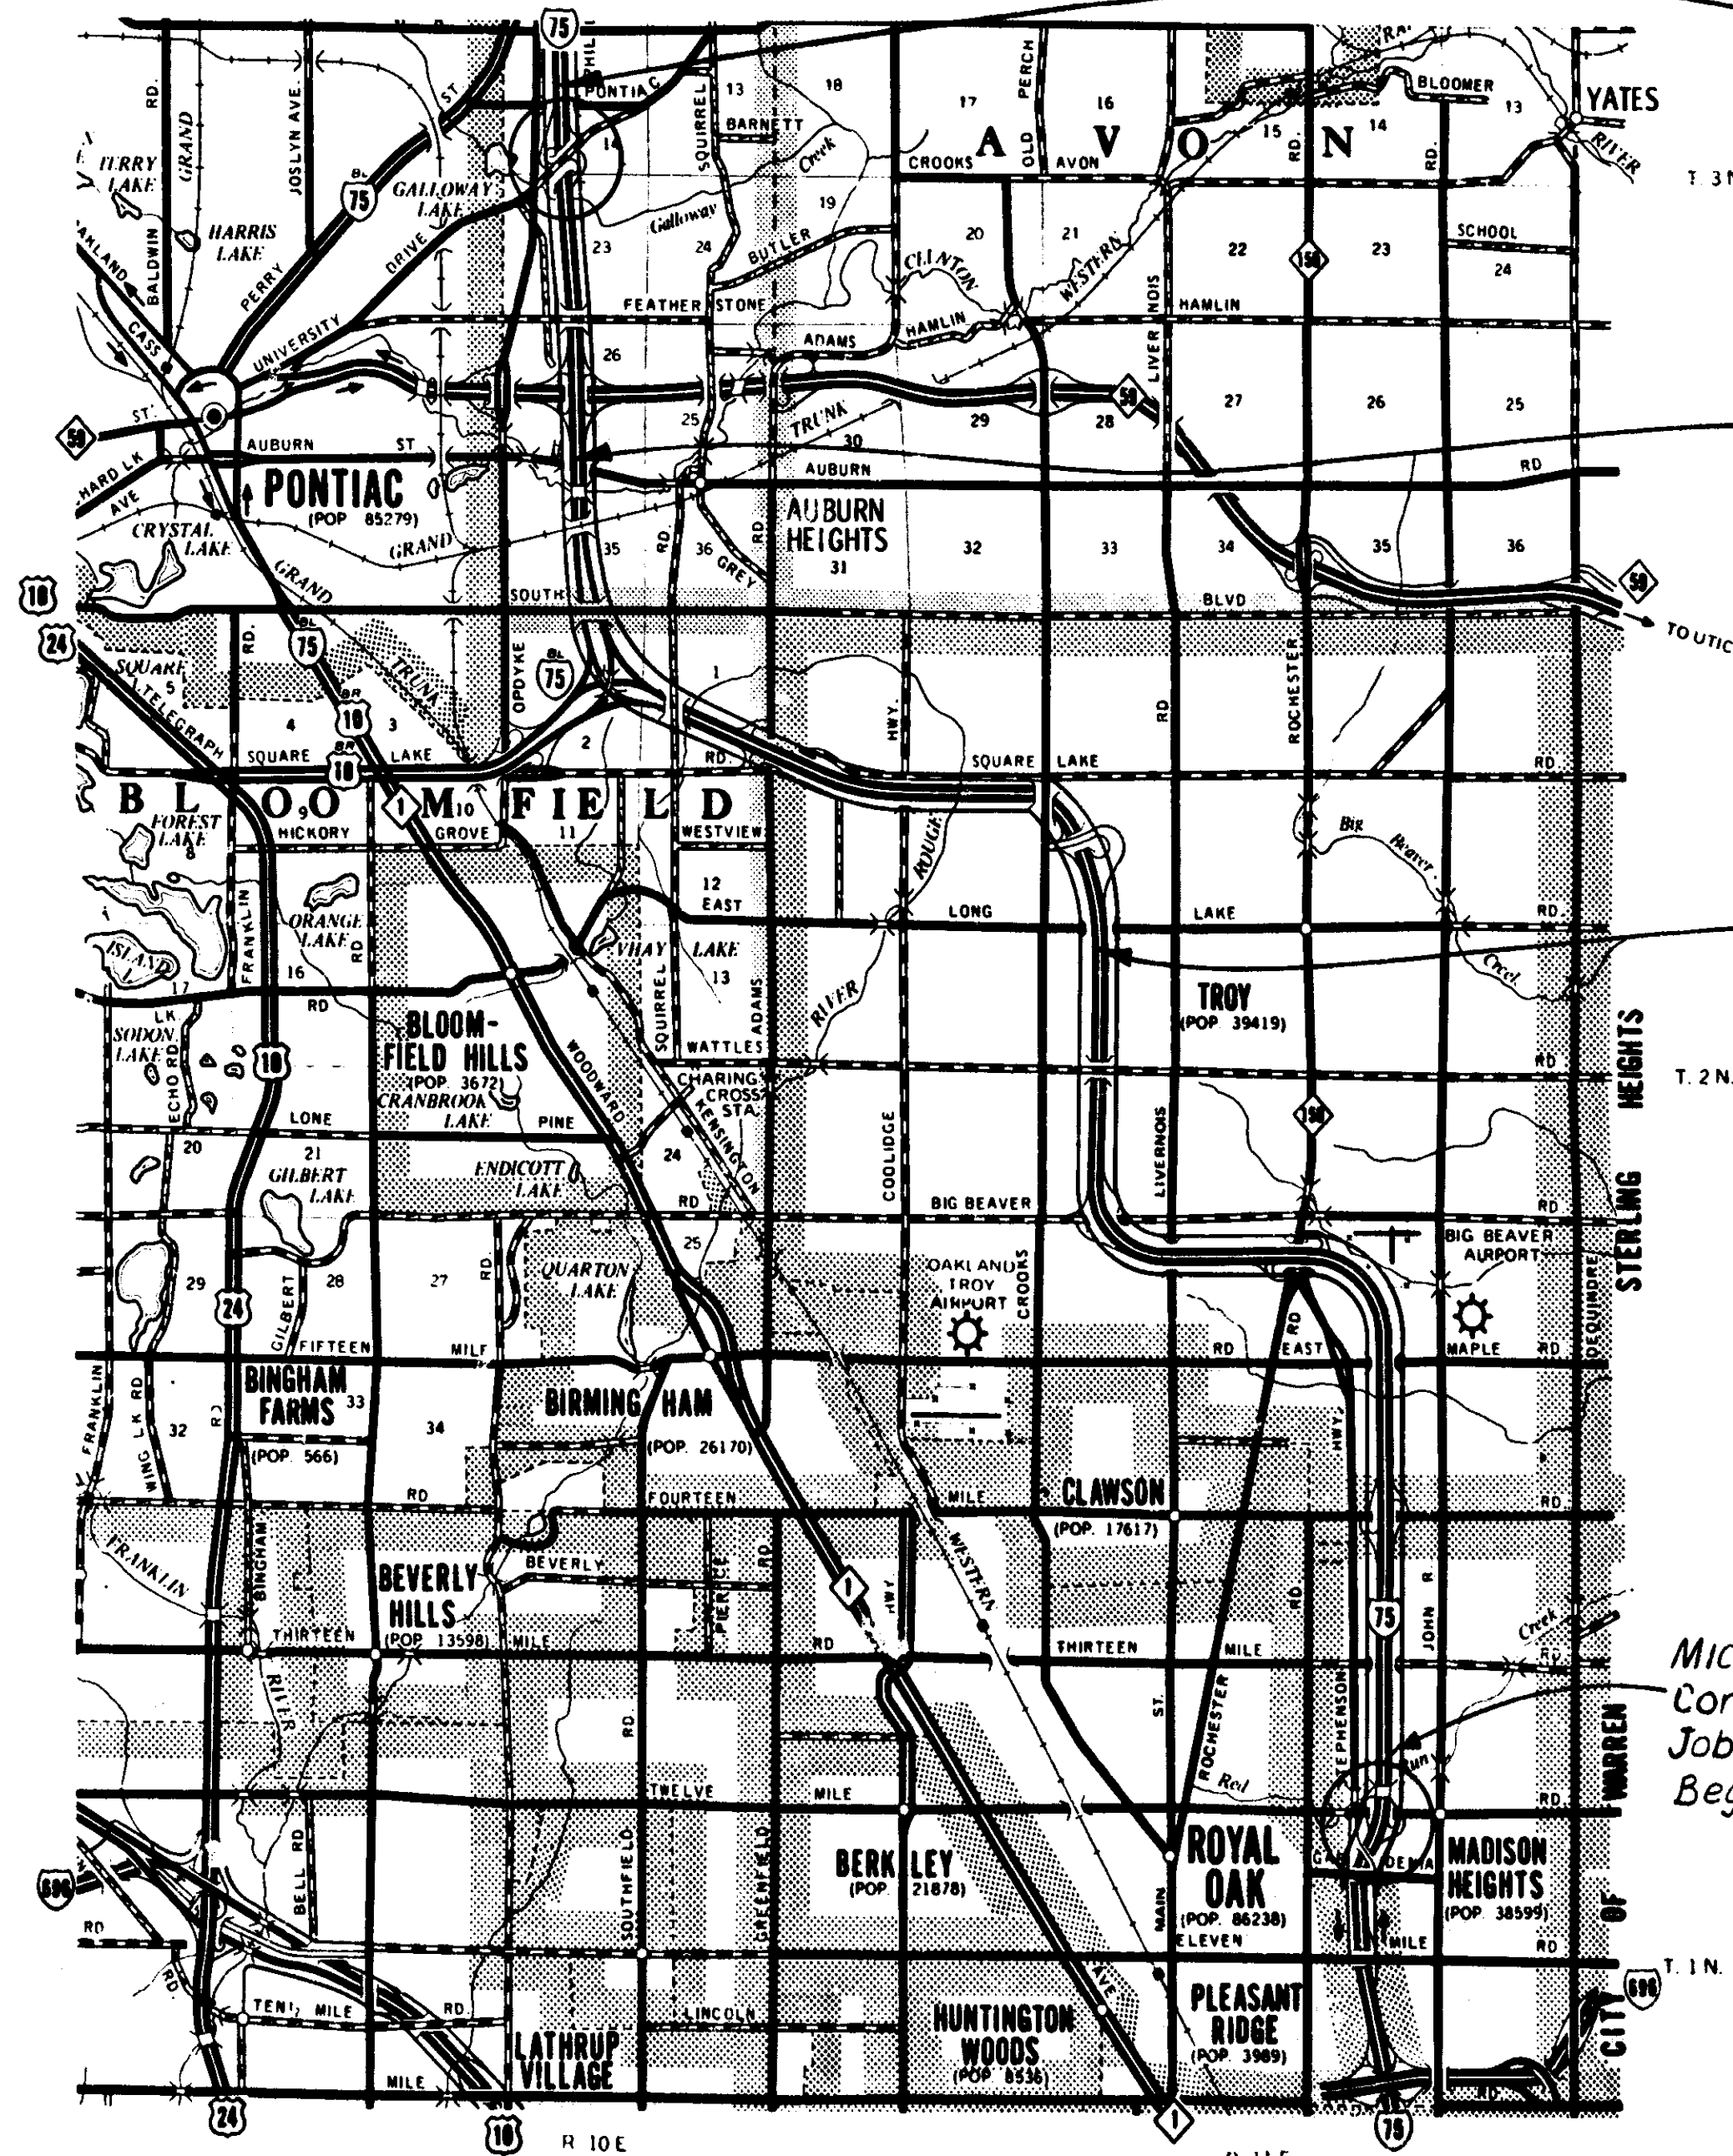

TITLE SHEET LEGEND

PROPOSED PROJECT	—————
EXISTING ROADS	—————
PAVED	—————
BITUMINOUS	—————
GRAVEL	—————
UNIMPROVED OR CITY STREET	—————
SECTION LINE	—————
TOWNSHIP LINE	—————
COUNTY LINE	—————
CITY OR VILLAGE LIMITS	—————
RAILROADS	—————

NP Length = 15.74 Mile

CONTRACT FOR CONC. PAV'T. JOINT REPAIR ON I-75

APPROVALS

CHECKED	<i>J. Williams</i>	9-13-82
RECOMMENDED FOR APPROVAL	<i>W. Peery</i>	9/19/82
RECOMMENDED FOR APPROVAL	<i>M. W. Hester</i>	9/13/82
RECOMMENDED FOR APPROVAL	<i>Robert Hester</i>	9-14-82

MICHIGAN DEPARTMENT OF TRANSPORTATION
JOHN P. WOODFORD - DIRECTOR

APPROVED BY *D. G. Cash* 9/14/82

PLANS PREPARED BY
CHRISTY
DIVISION UNIT

U.S. DEPARTMENT OF TRANSPORTATION
FEDERAL HIGHWAY ADMINISTRATION

CONTROL SECTION	JOB NUMBER	FEDERAL NUMBER	PROJECT	SHEET NO.
IR 63174	18874A	IR-75-2(266)	NP-175	1

CONTROL SECTION - JOB NUMBER - 18874A

NOTE SHEET

DESCRIPTION OF WORK:

SAW DETERIORATED JOINTS AND PAVEMENT SECTIONS, AS SHOWN ON PLANS, PLACE PRESSURE RELIEF JOINTS AS SHOWN ON THE PLANS OR AS DIRECTED BY THE ENGINEER, AND REPAIR WITH FAST SETTING CONCRETE PAVEMENT PATCHING AND JOINT FILLER. PLACE JOINT FILLER AS SHOWN ON THE PLANS OR AS DESIGNATED BY THE ENGINEER. PAVEMENT REPAIRS SHALL BE DONE IN CONFORMANCE WITH SPECIAL DETAILS X & Y ON SHEET NO. 10. MAINTAIN TRAFFIC THROUGHOUT THE ENTIRE PROJECT.

NOTES:

STATIONING ON THIS PROJECT WAS MEASURED BY A FOOTMETER AND TAKEN FROM OLD PLANS, AND IS NOT NECESSARILY CORRECT.

IT IS THE INTENT THAT ALL GOVERNMENT CORNERS OCCURRING ON THIS PROJECT BE PRESERVED AND THAT, WHERE NECESSARY, MONUMENT BOXES BE PLACED OR ADJUSTED, WHETHER SHOWN OR NOT.

SIZES SHOWN FOR SLAB REPAIR ARE ESTIMATES ONLY. ACTUAL SIZES ARE TO BE DETERMINED BY THE ENGINEER ON CONSTRUCTION WITH NO EXTRA COMPENSATION ABOVE CONTRACT UNIT PRICES TO BE ALLOWED FOR SIZE DIFFERENTIAL.

WASTE CONCRETE OR CONCRETE FRAGMENTS SHALL NOT BE BURIED IN THE SHOULDER BECAUSE OF POTENTIAL DAMAGE TO SHOULDER STABILIZATION EQUIPMENT.

THE PLANS FOR JOINT REPAIR MAY CONTAIN SOME JOINTS WHICH HAVE ALREADY BEEN REPAIRED PRIOR TO CONSTRUCTION OF THIS PROJECT.

JOINT TYPE SHALL BE X&Y UNLESS OTHERWISE CALLED FOR ON PLANS OR AS DIRECTED BY THE ENGINEER.

ANY BITUMINOUS OVERLAY OCCURRING ADJACENT TO AREAS TO BE REPAIRED SHALL BE REMOVED INCIDENTAL TO CONSTRUCTION.

FOR THE PROTECTION OF UNDERGROUND UTILITIES, THE CONTRACTOR SHALL DIAL 1-800-492-7171 A MINIMUM OF 48 HOURS PRIOR TO EXCAVATING IN THE VICINITY OF UTILITY LINES. ALL "MISS DIG" PARTICIPATING MEMBERS WILL BE ROUTINELY NOTIFIED. THIS DOES NOT RELIEVE THE CONTRACTOR OF THE RESPONSIBILITY OF NOTIFYING UTILITY OWNERS WHO MAY NOT BE A PART OF THE "MISS DIG" ALERT SYSTEM.

KEY:

TYPE X- CONCRETE PAVEMENT REPAIR OF THE LENGTH, WIDTH, AND JOINT TYPE SPECIFIED

TYPE Y- CONCRETE PAVEMENT REPAIR OF THE LENGTH, WIDTH, AND JOINT TYPE SPECIFIED

Note: Ramp repairs less than 12' wide may be undoweled repairs. In 16' ramp repairs, the spacing of dowels or tie bars shall be the same as for 12' wide patches, with the center of the spacing coinciding with the centerline of the 16' wide ramp.

PUBLIC UTILITIES

The existing utilities listed below and shown on these plans represent the best information as obtained on our G.I. dated 2-28-80. This information does not relieve the Contractor of the responsibility to satisfy himself as to their accuracy or of his responsibility in case utilities have been constructed or removed since the above G.I. date.

NAME AND ADDRESS OF OWNER	KIND OF UTILITY
Detroit Edison Co.	Electricity
Consumers Power Co.	Gas
Michigan Bell Telephone Co.	Telephone

Owners of public utilities will not be required by the Department to move additional poles and structures that are not within grading or structure limits in order to facilitate the operation of construction equipment, unless it is determined by the Engineer that such pole line or structures constitute a hazard to the public or are extraordinarily dangerous to the Contractor's operations.

DATE OF REPAIR

The Contractor will be required to stencil the month and year of repair in each patch, incidental to the item of "Fixed Cost for Patches".

NOTES APPLYING TO STANDARD PLANS

WHERE THE FOLLOWING ITEMS ARE CALLED FOR ON PLANS, THEY ARE TO BE CONSTRUCTED ACCORDING TO THE STANDARD PLAN GIVEN BELOW OPPOSITE EACH ITEM UNLESS OTHERWISE INDICATED.

CONCRETE PAVEMENT REPAIR	11-44E
JOINT REPAIRS - TYPES "X" & "Y"	SPECIAL DETAIL 11-45C
PAVEMENT REINFORCEMENT	
TYPES II & III BARRICADES AND LIGHTED ARROWS	VI-125E
TRANSVERSE PAVEMENT JOINTS	II-39G
LOAD TRANSFER ASSYS FOR TRANSVERSE JOINTS	II-40D
LONGITUDINAL PAVEMENT JOINTS	II-41D
LOCATION OF TRANSVERSE JOINTS IN CONC. PAV'T.	II-43C

MISCELLANEOUS ESTIMATES

The following items of work shall be done as they apply throughout the project. These items are not detailed or included on the plan and profile sheets.

MOBILIZATION	1 L.SUM
MINOR TRAFFIC DEVICES	1 L.SUM
SIGNS - TYPE B TEMPORARY	932 S.FT
LIGHTED ARROW, TYPE A - FURNISHED	4 EACH
LIGHTED ARROW, TYPE A - OPERATED	4 EACH
BARRICADES, TYPE II LIGHTED - FURNISHED	350 EACH
BARRICADES, TYPE II LIGHTED - OPERATED	280 EACH
ON THE JOB TRAINING	3 EACH
REMOVING PAVEMENT MARKINGS	500 LFT
TEMPORARY PAVEMENT MARKINGS - NR	100 LFT

QUANTITY SHEET

AS PER PLANS

AS CONSTRUCTED

ITEM DESCRIPTION	UNIT	ITEM CODE	TOTAL	AS PER PLANS									AS CONSTRUCTED								
				SHEET 2	SHEET 3	SHEET 4	SHEET 5	SHEET 6	SHEET 7	SHEET 8	SHEET 9	TOTAL	SHEET 2	SHEET 3	SHEET 4	SHEET 5	SHEET 6	SHEET 7	SHEET 8	SHEET 9	
REMOVING OLD PAVEMENT - PATCHING	SYD	4520001	23592	4651	3011	2251	2919	5640	3545	4515											
CONCRETE PAVEMENT PATCHING TYPE FS																					
10" REINFORCED	SYD	4520044	23592	4651	3011	2251	2919	5640	3545	4515											
FIXED COST FOR PATCHES - TYPE X	EACH	4527003	1028	186	104	124	172	224	142	76											
FIXED COST FOR PATCHES - TYPE Y	EACH	4527005	1528	280	168	119	169	438	245	107											
LIGHTED ARROW, TYPE A, FURNISHED	EACH	6310011	4	4																	
LIGHTED ARROW, TYPE A, OPERATED	EACH	6310012	4	4																	
SIGN, TYPE B TEMPORARY	SFT	6310057	932	932																	
Mobilization	SFT																				
MINOR TRAFFIC DEVICES	LSUM	6230001	1	1																	
BARRICADE, TYPE II LIGHTED - FURNISHED	LSUM	6310054	1	1																	
BARRICADE, TYPE II LIGHTED - OPERATED	EACH	6310026	350	350																	
REMOVING PAVEMENT	EACH	6310027	280	280																	
MISCELLANEOUS CONCRETE PAV'T., REINF. 9"	SYD	2070002	1949	639	87	240	162	591	162	68											
CEMENT	TONS	4500033	1949	639	87	240	162	591	162	68											
INTERMEDIATE SAW CUTS	LFT	4520090	24	8	1	3	2	7	2	1											
REMOVING PAVEMENT MARKINGS	LFT	4520004	5080	1510	1468	228	396	612	744	72											
TEMP. PAVEMENT MARKING - NR	LFT	6310003	500	500																	
TEMP. PAVEMENT MARKING - NR	LFT	6310061	100	100																	
HOOB BOLT LANE TIES	EACH	4507001	148	52	71		8	17													
ON THE JOB TRAINING	EACH	6320000	3	3																	
* Concrete, Grade 35P - Additional 94 Lbs of Cement per cubic yard of concrete.																					



I-75 CONC. PAV'T. JOINT REPAIR

DATE 2/ 8/82 SCALE 1" = NONE CONT. SEC. IR 63174

N.B. - SQUARE LK. RD. N. TO UNIV. DR.


S.B. - 12 MILE RD. N. TO UNIV. DR. JOB NO. 19874 A DESIGN UNIT CRISTY SHEET NO. 2

NBD POB to STA 685+00

RD WRN PDR STA

L STA

RD WRN STA 119 - L STA

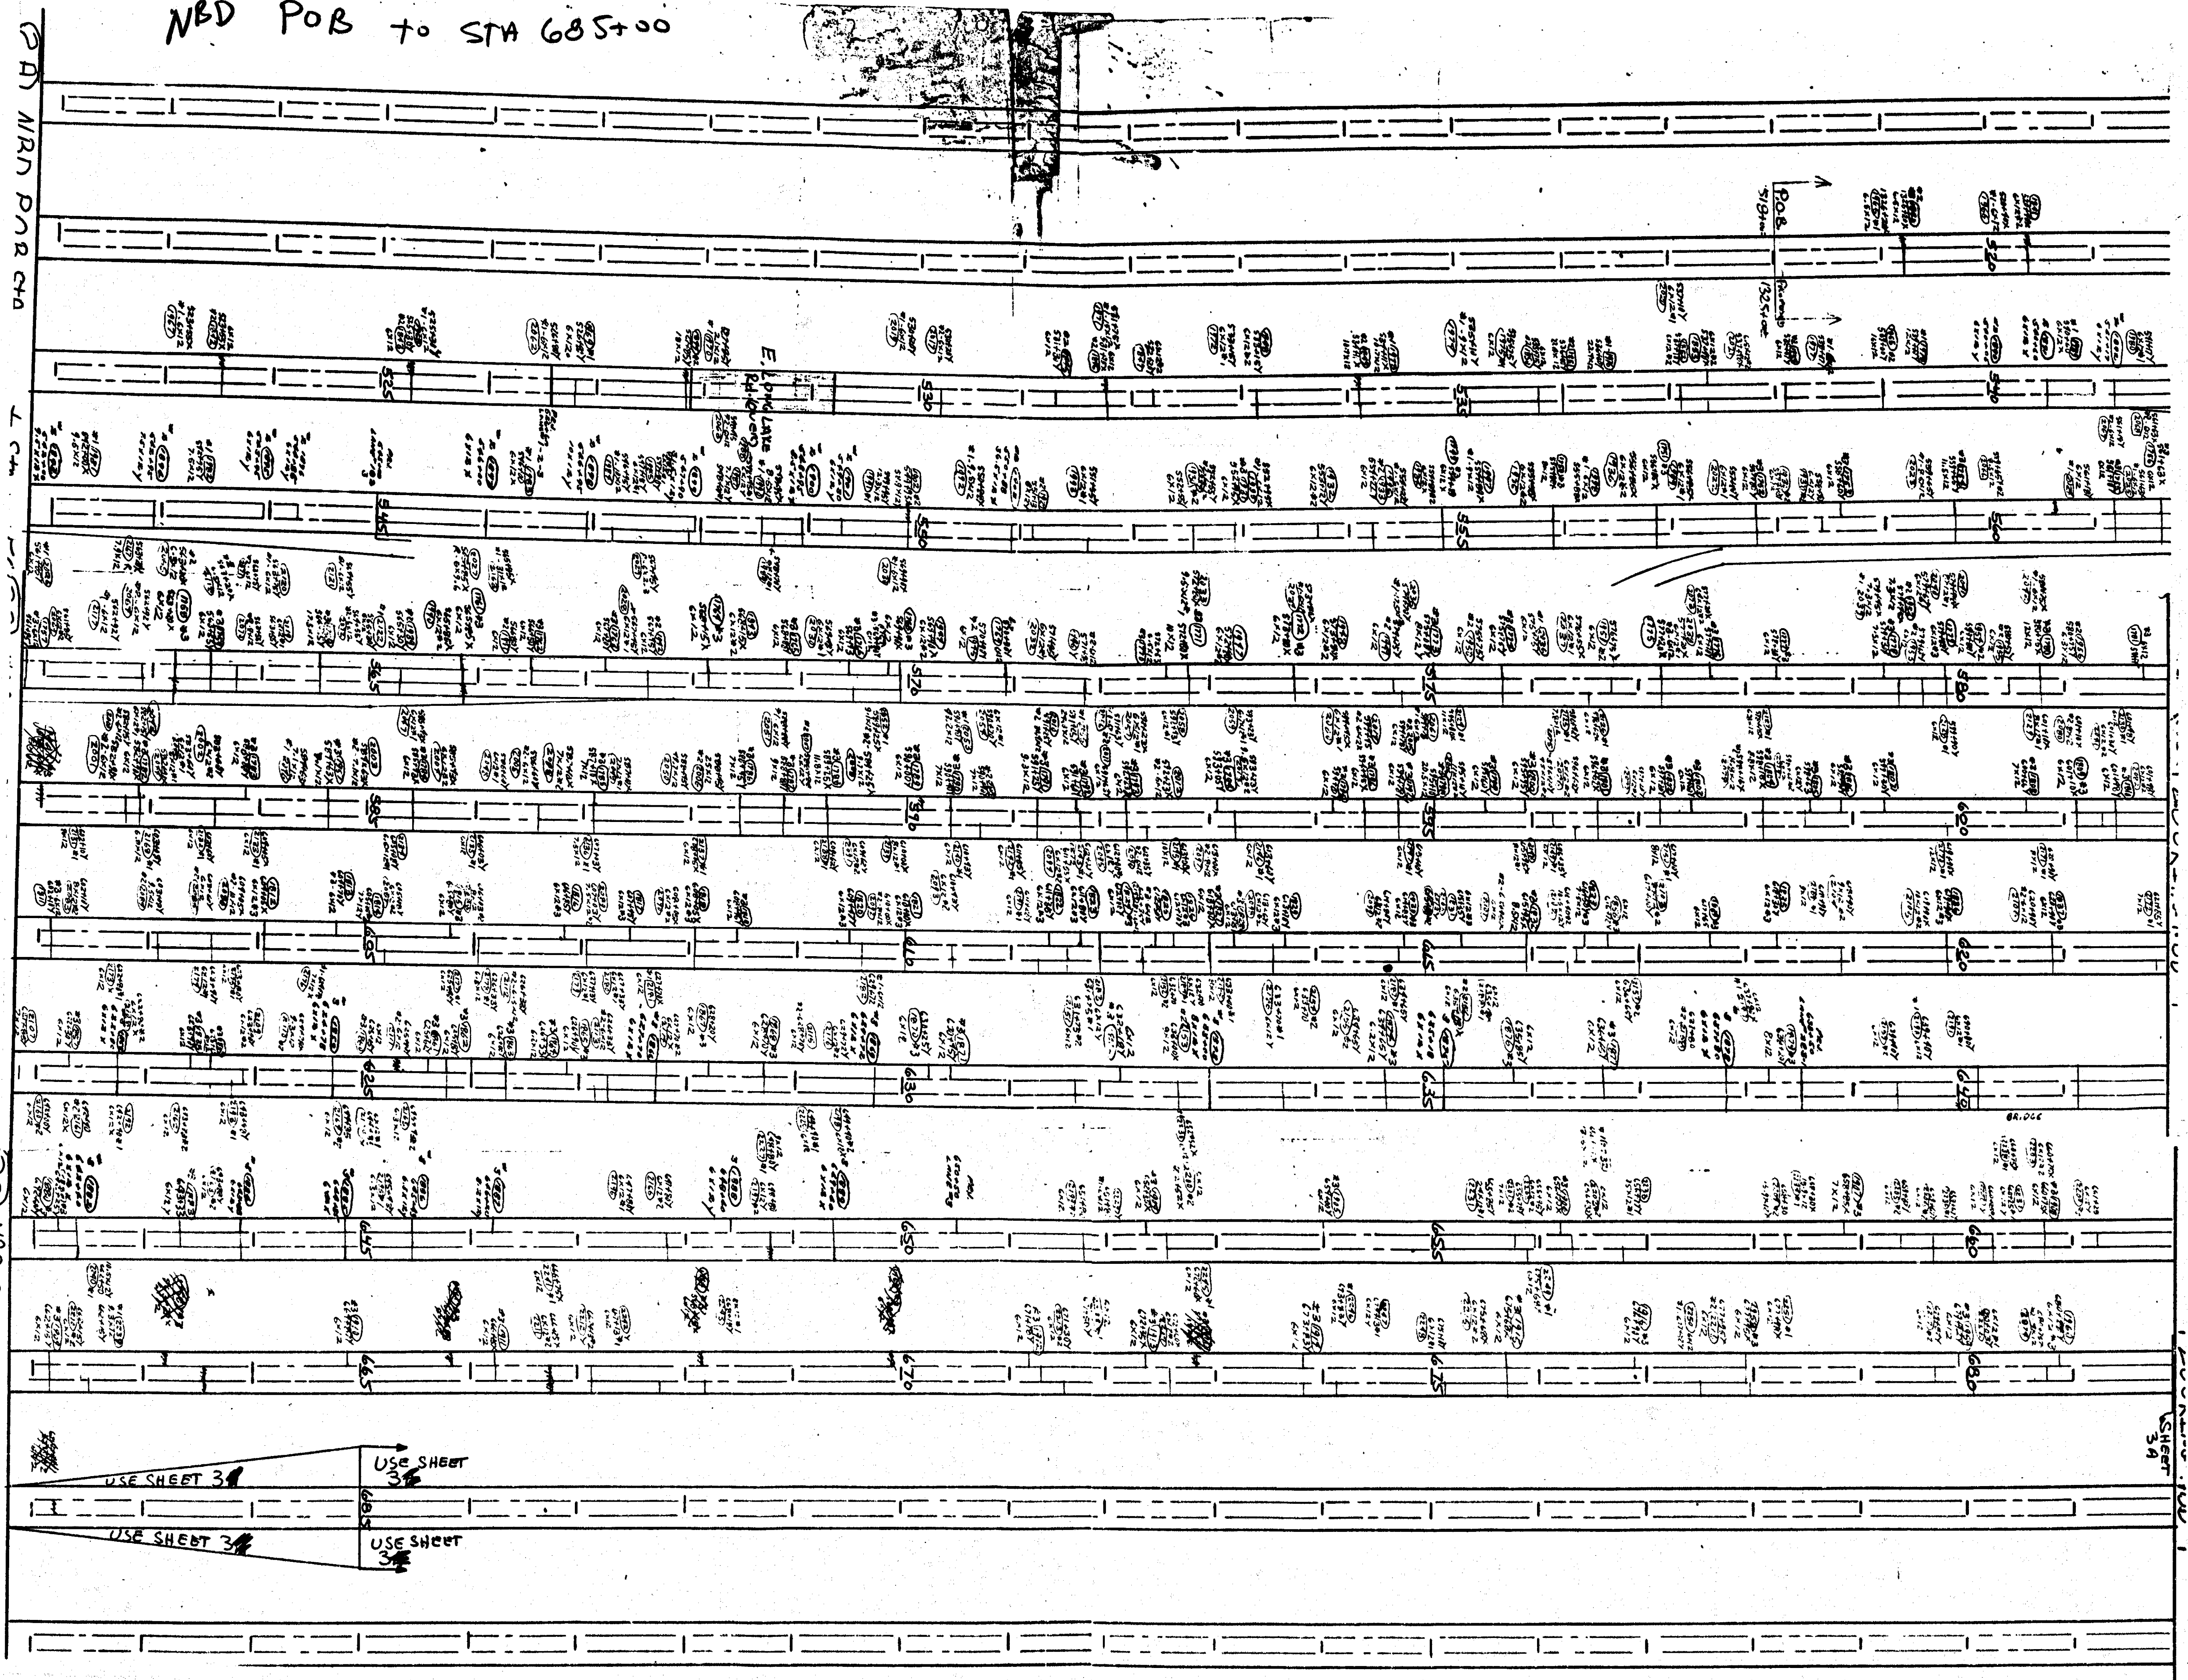

USE SHEET 3
 USE SHEET 3
 USE SHEET 3
 USE SHEET 3

SHEET 3A

3A NBD STA 682- to STA. 714

3B NBD STA 722- to STA 404

3C NBD STA 41- to STA 80+3



LOOKING NBD


LOOKING NBD

LOOKING NBD

USE SHEET 4A FROM STA BOT
Sheet 28

SHEET 4A

JAN 1 1952 SQUAD: P. M. CHRISTY S.Y. C.R.K.

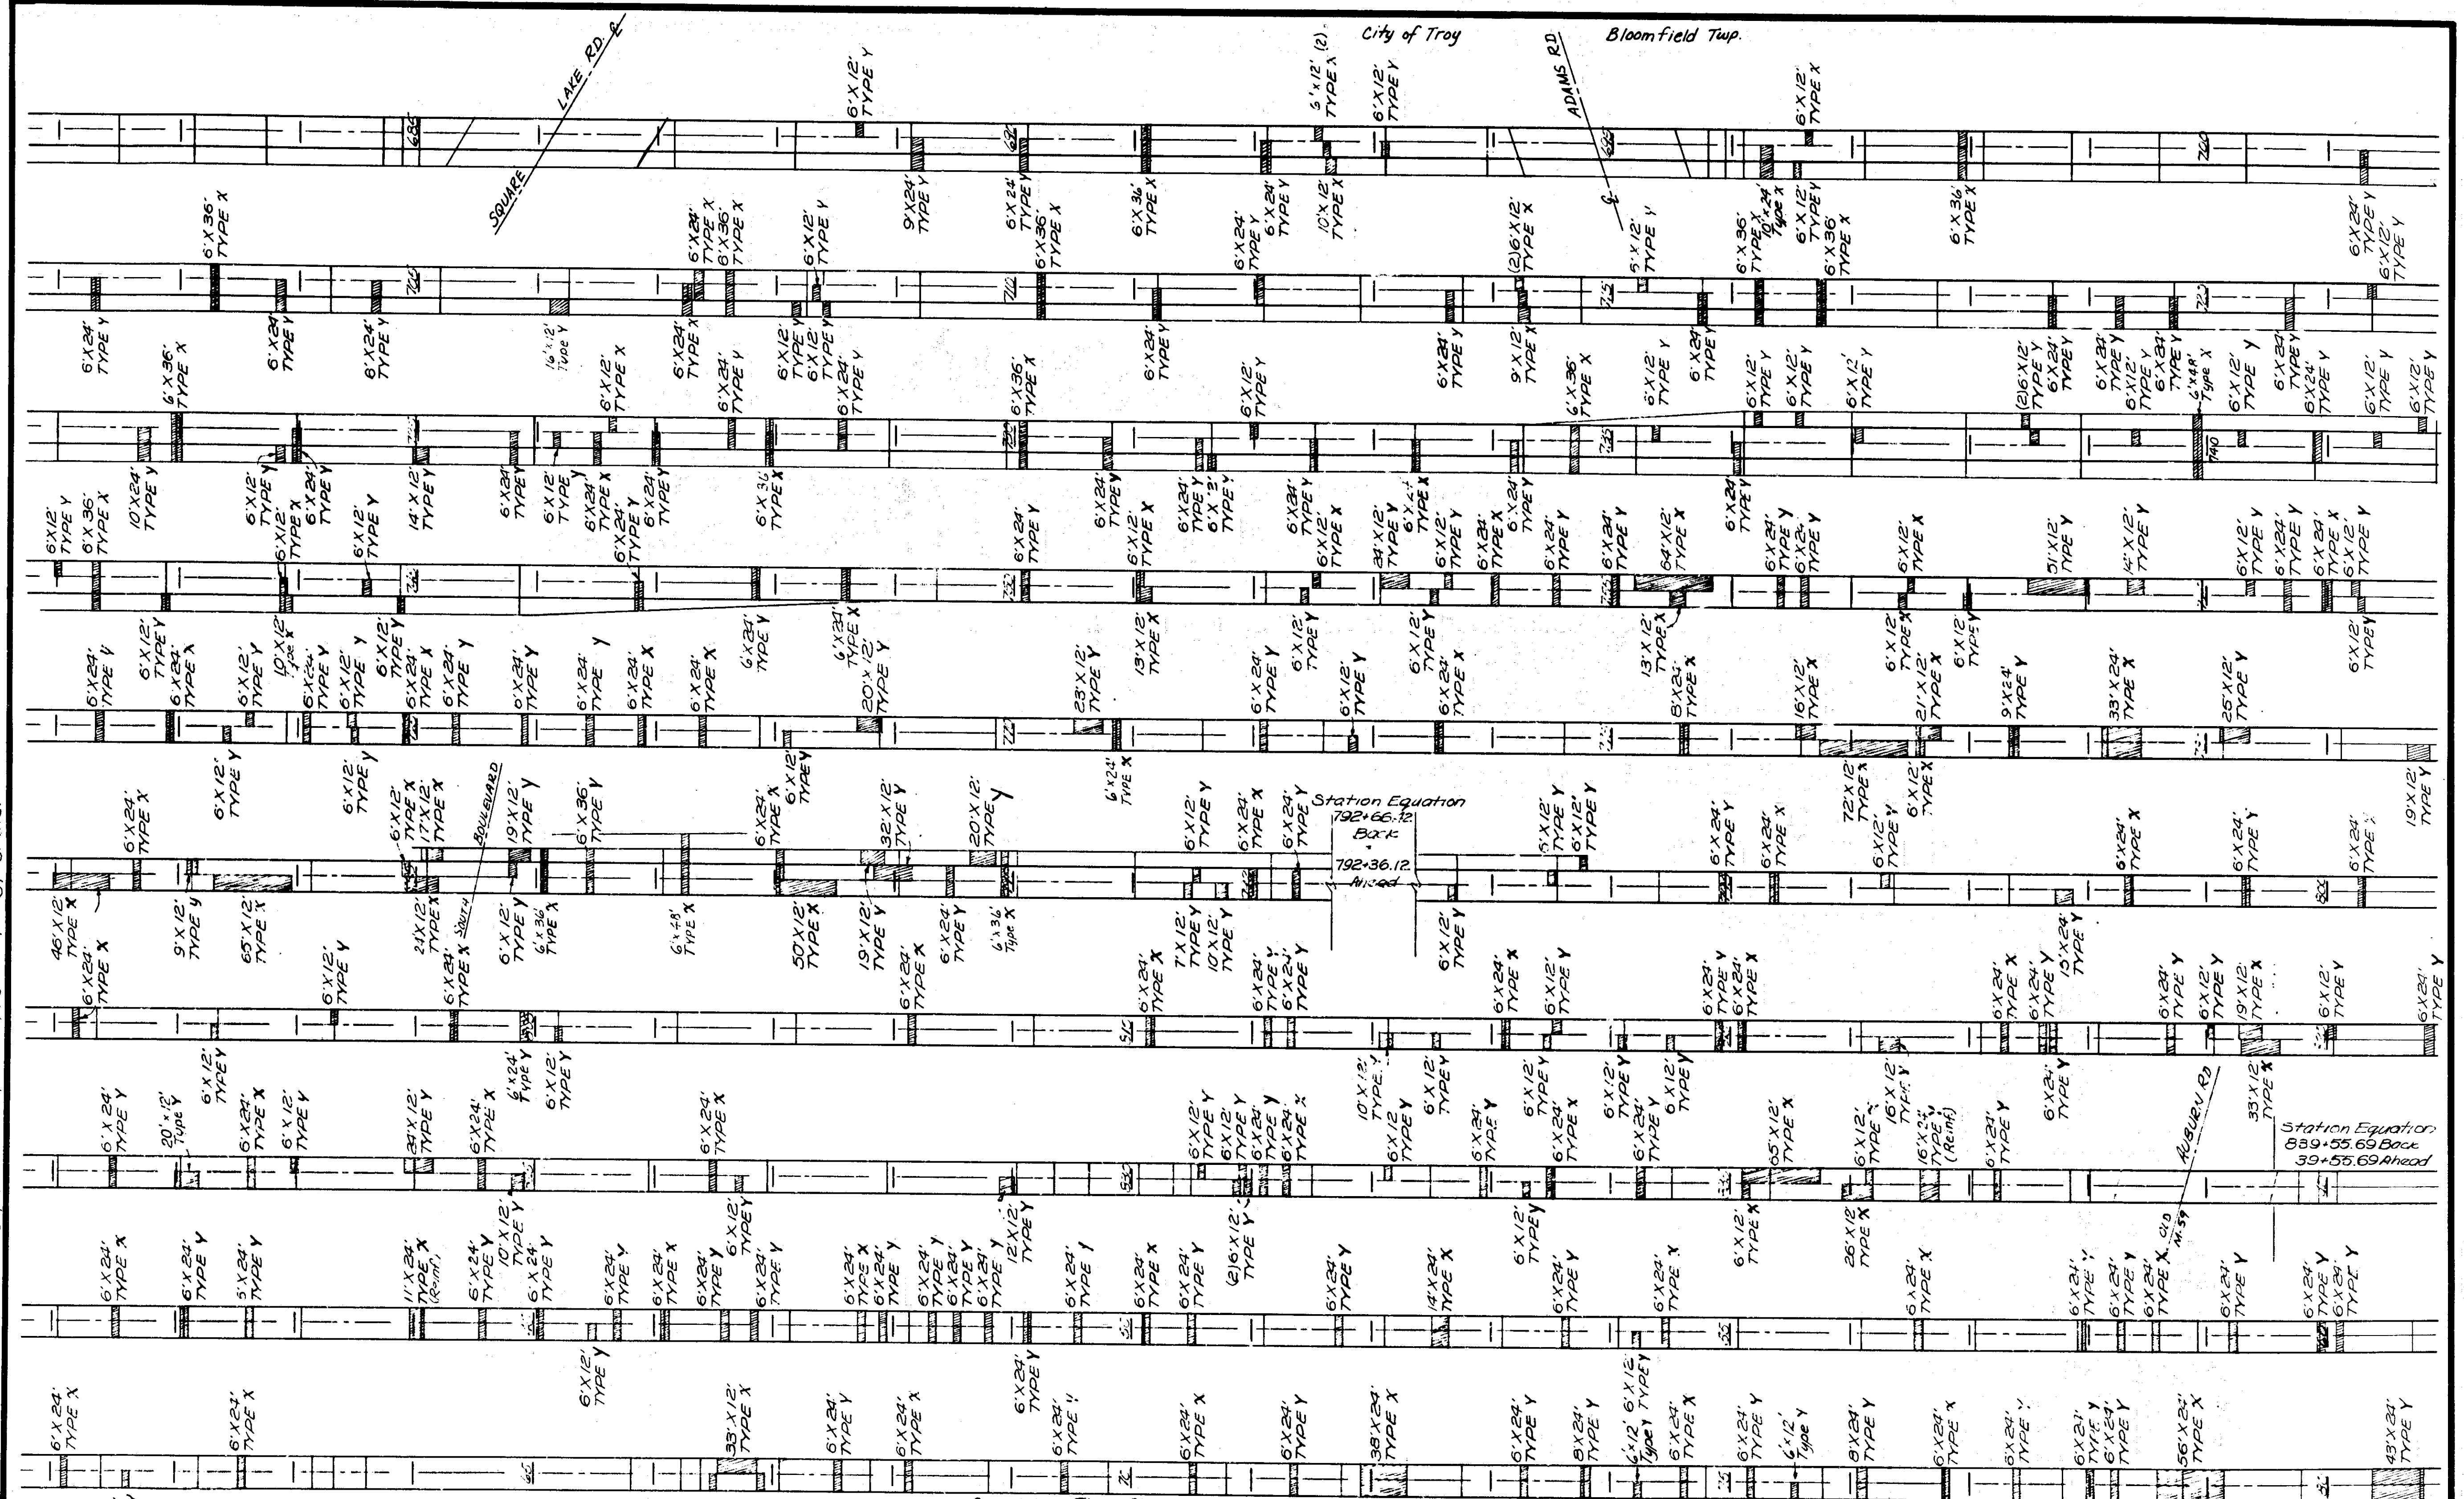

Quantities This Sheet
 4651 Syd Removing Old Pavement (Patching)
 52 Each Hook Bolt Lane Ties
 4651 Syd Conc. Pavt Patching-Type F.S. 10" Reint'
 639 Syd Removing Pavement
 639 Syd Misc. Concrete Pavement Reint 9"
 1560 L.F.T Intermediate Saw Cuts
 136 Each Fixed Cost for Patches - Type X
 280 Each Fixed Cost for Patches - Type Y
 8 Tons Cement

SCALE 1" = 60'

THIS SHEET: STA 686+00 to STA. 792+66.42
 STA 792+66.42 Back = STA. 792+36.12 Ahead
 STA 792+36.12 to STA. 839+55.69
 STA 839+55.69 Back = STA. 39+55.69 Ahead
 STA. 39+55.69 to STA. 81+00

STATE OF MICHIGAN
 DEPARTMENT OF STATE HIGHWAYS AND TRANSPORTATION

RESEARCH LAB. TESTING AND RESEARCH DIVISION

CONC. JOINT REPAIR LOCATION SHEET

LOCATION I-75 NORTHBOUND from SQUARE LAKE RD
 NORTHERLY TO UNIVERSITY DRIVE

STATE PROJECT 1R 63174 MAINT PROJECT 18872A


ROUTE I-75


SHEET NO. 3

4B NBD STA. 81 - to STA 1607

4B NBD STA. 161 - to STA.

POE

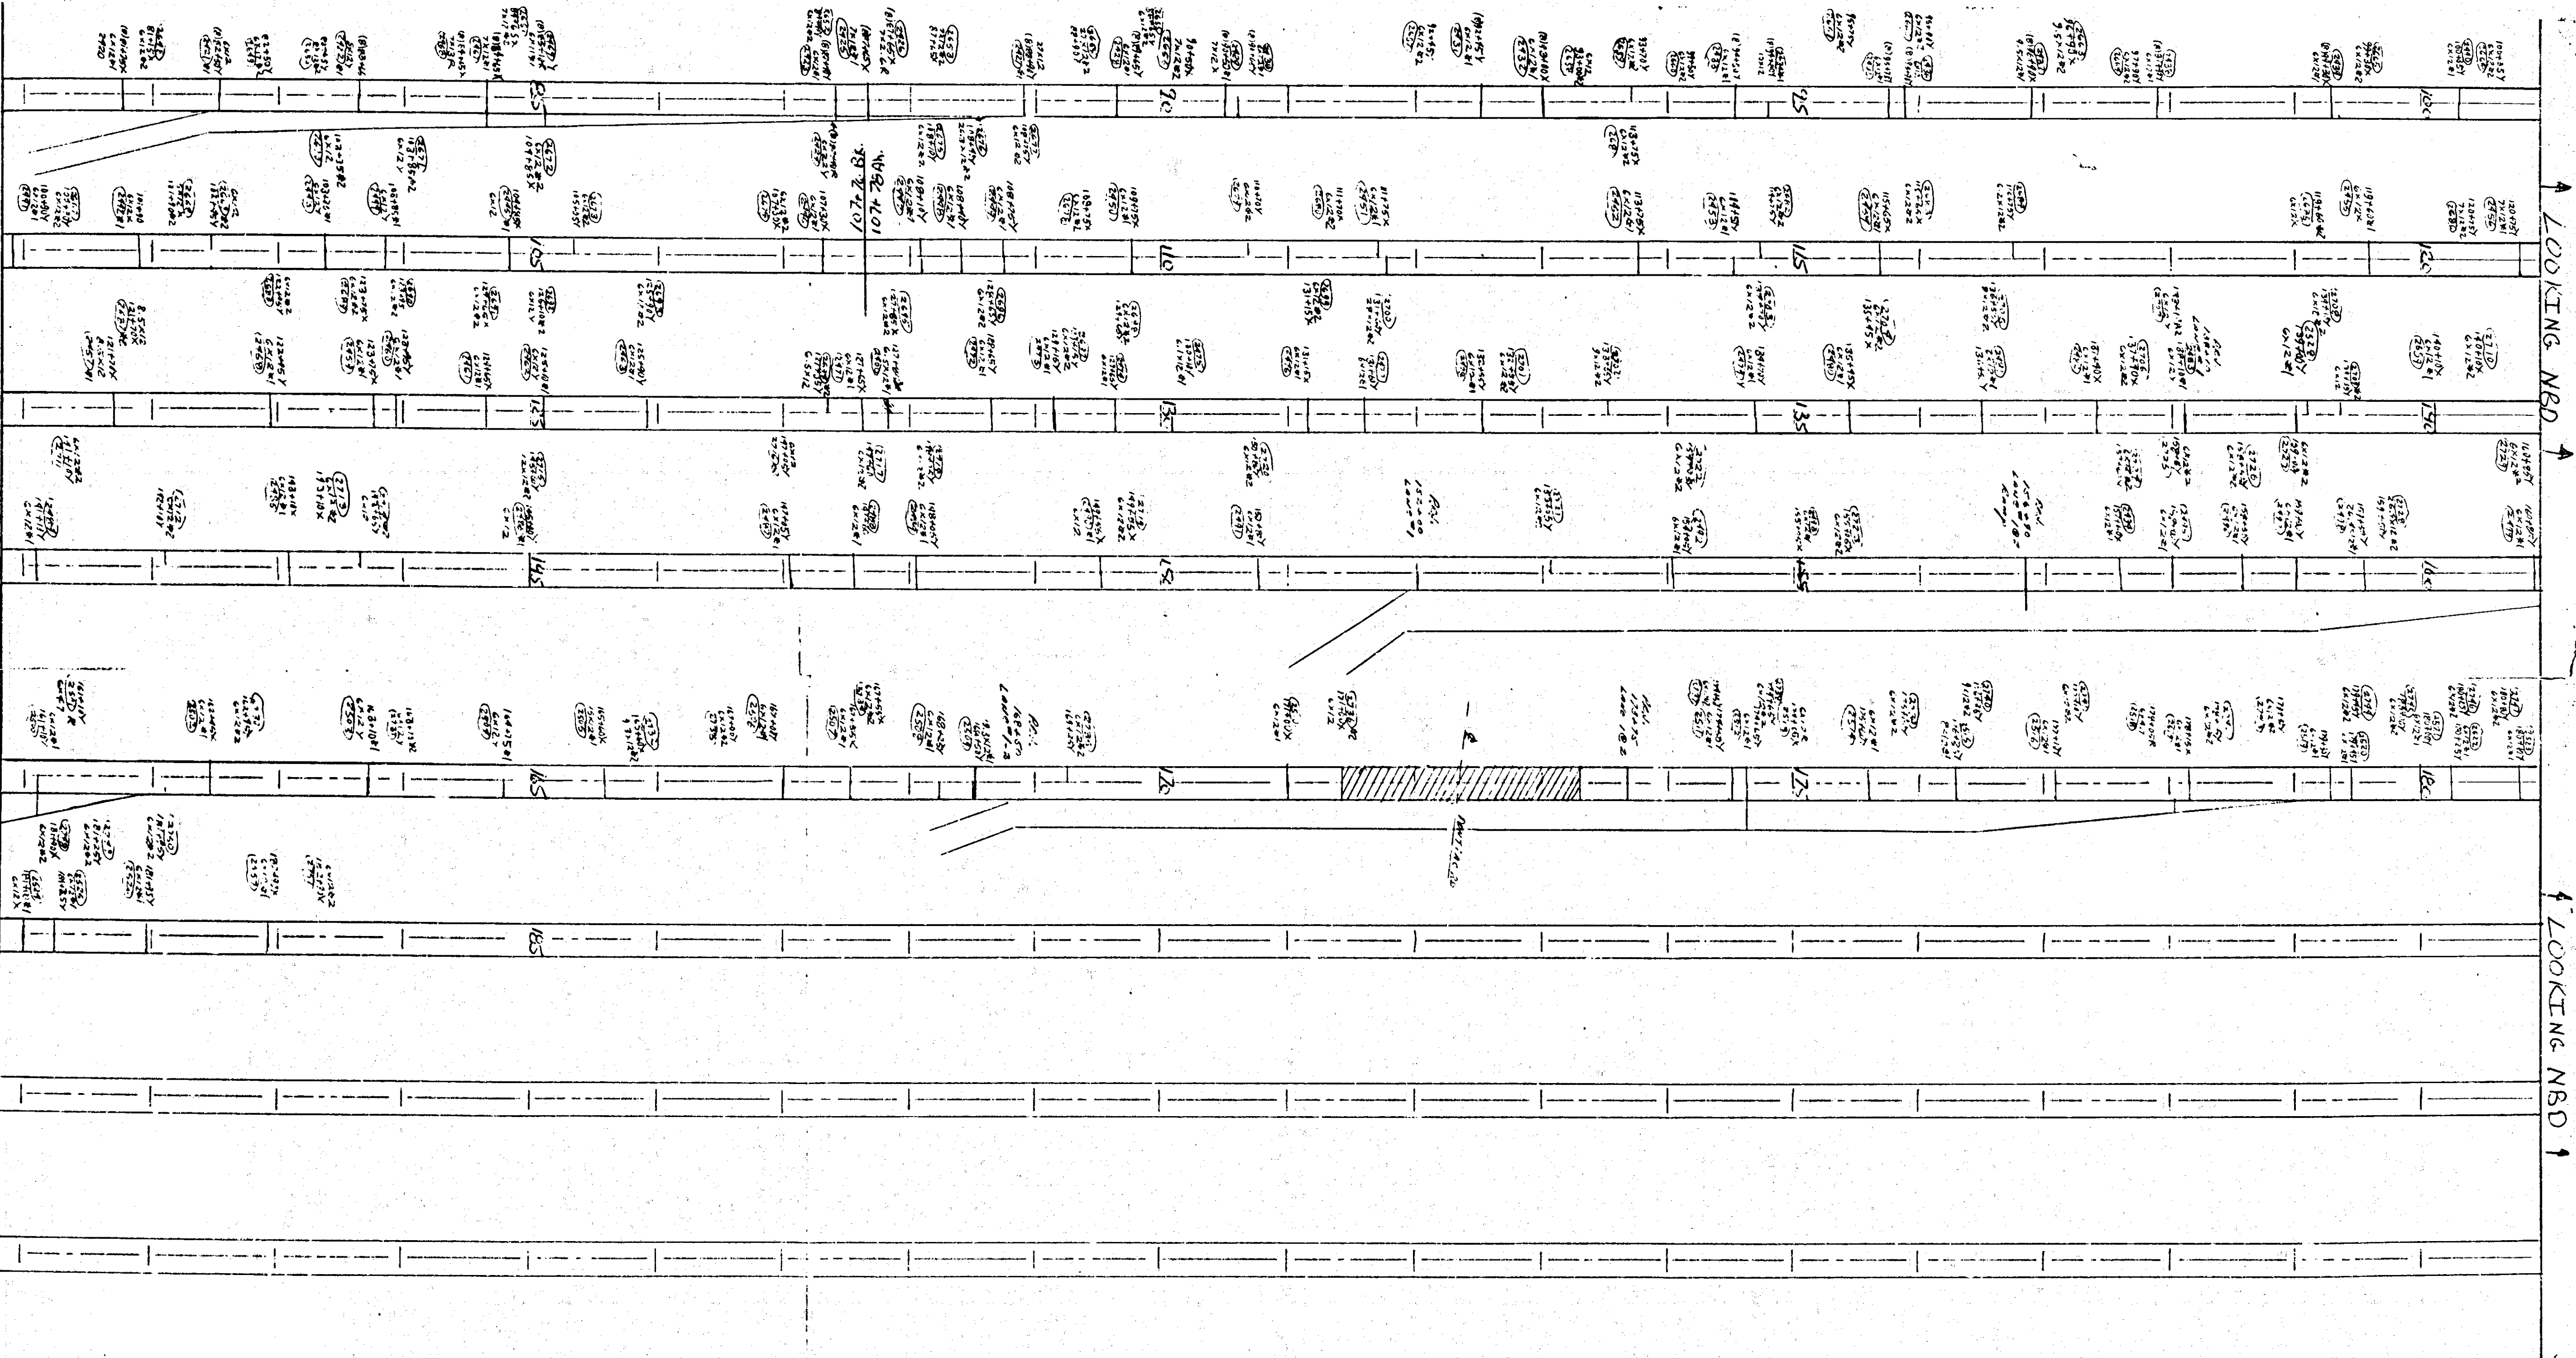

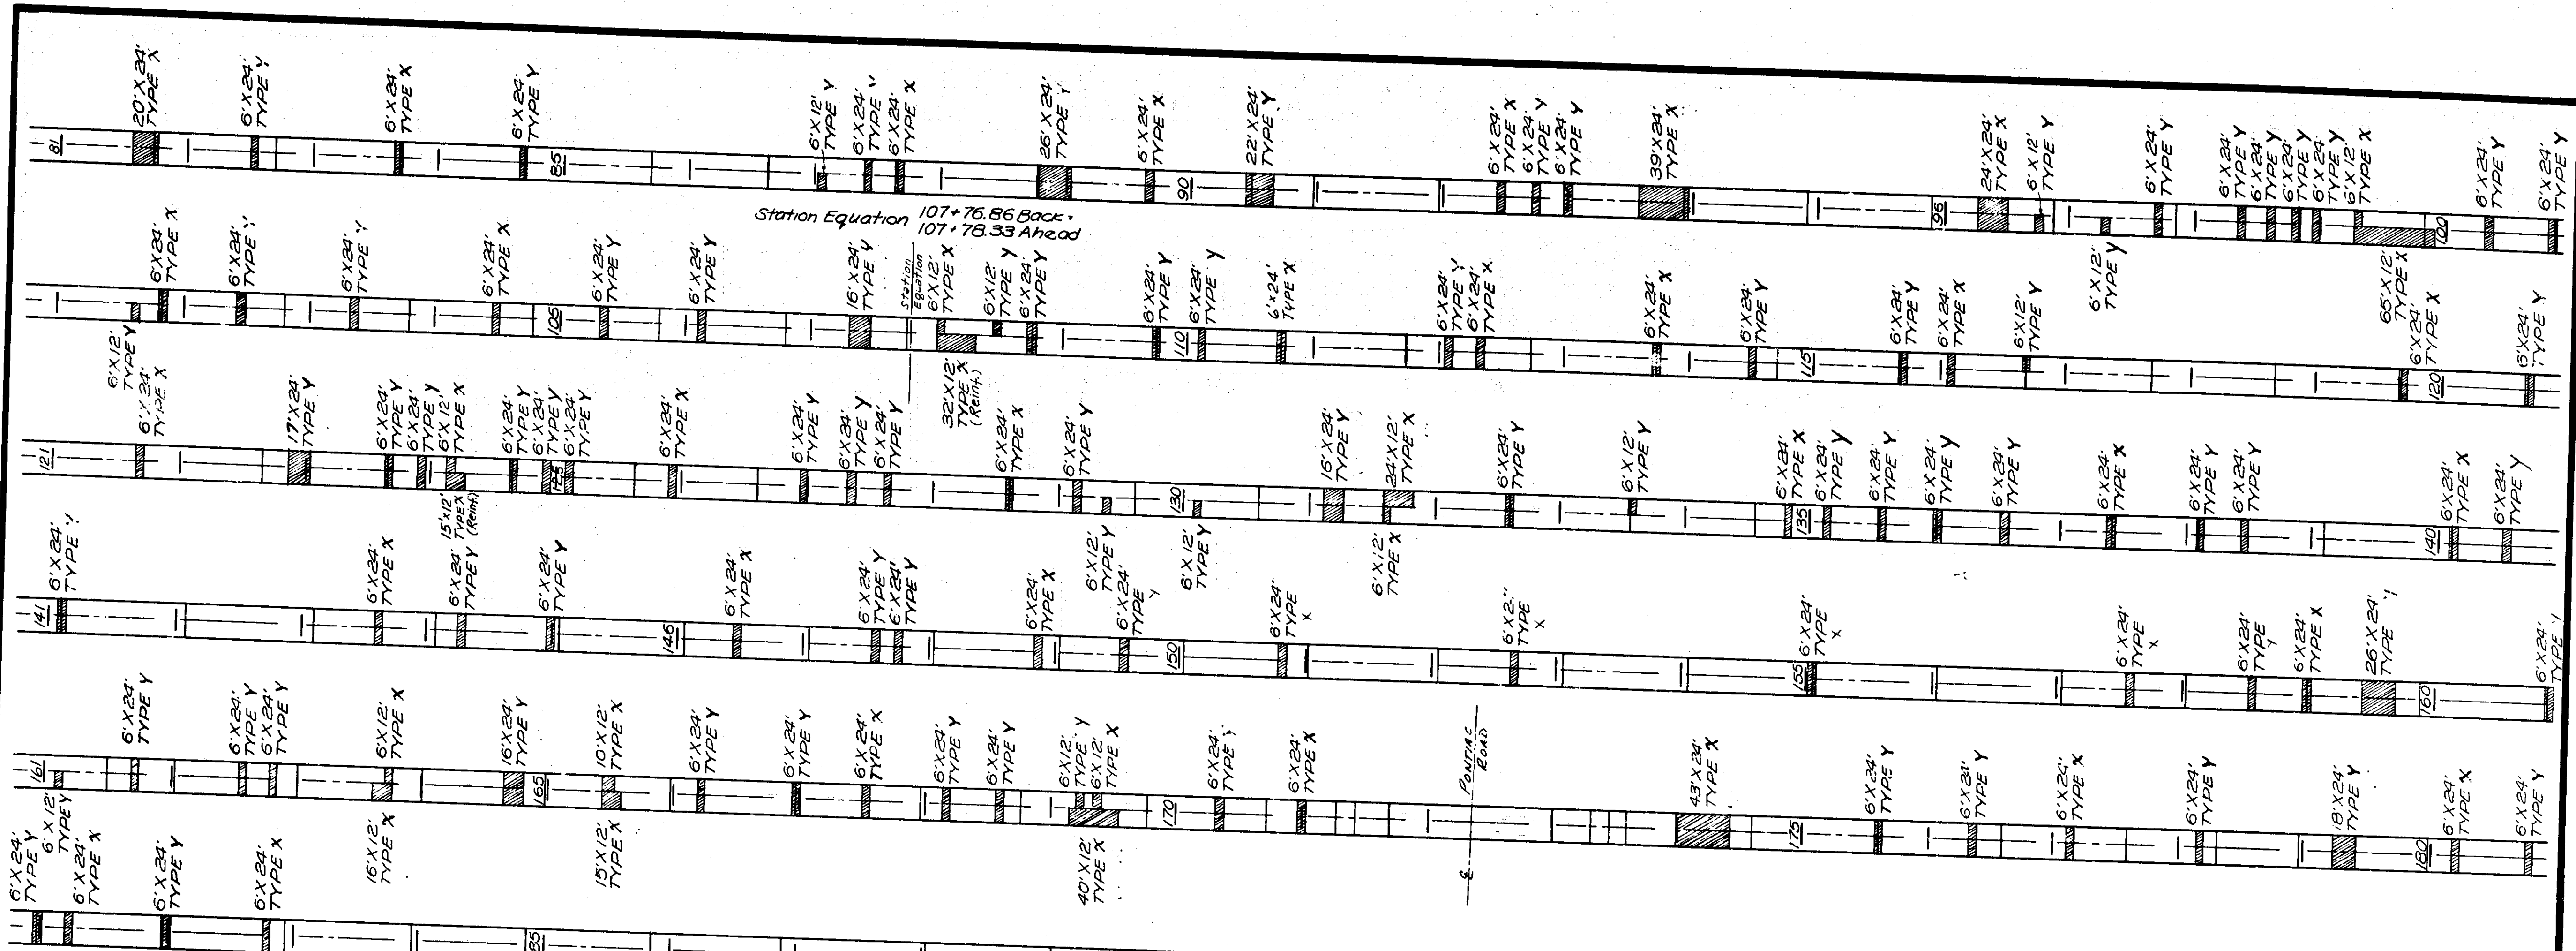


P.O.E. I-75 N.B.
C.S. 63174, J.N. 18874A

QUANTITIES
THIS SHEET
I-75 Mainline:

3011 Syd. Removing Old Patching (Patching)
71 Each Hook Bolt Lane Ties
3011 Syd. Conc. Pavt. Patching - Type F.S.10 (Reinf.)
87 Syd. Removing Pavement
87 Syd. Misc. Concrete Pavement Reinf. 9"

14.68 LFT. Intermediate Saw Cuts
104 Each Fixed Cost For Patches - Type X
168 Each Fixed Cost For Patches - Type Y
1 Ton Cement

**PROPOSED CONC. RAMP
PAV'T JOINT REPAIR:**

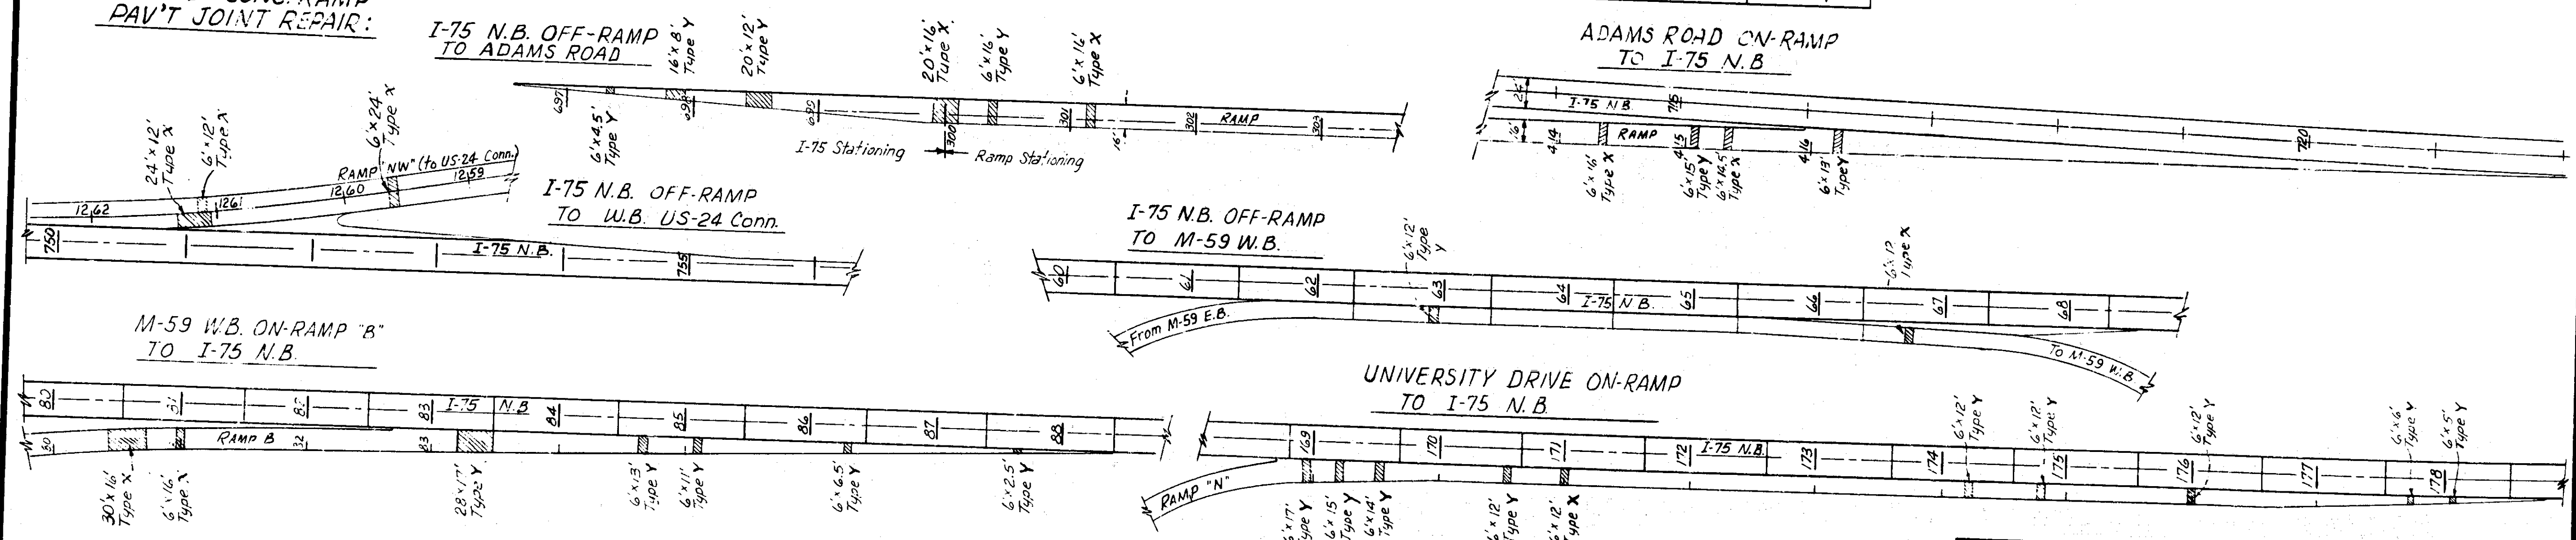

STATE OF MICHIGAN
DEPARTMENT OF STATE HIGHWAYS AND TRANSPORTATION

RESEARCH LAB.
TESTING AND
RESEARCH DIVISION

CONC. JOINT REPAIR LOCATIONS

LOCATION I-75 NORTHBOUND from SQUARE LAKE RD
NORTHERLY TO UNIVERSITY DRIVE
CONTROL SECTION IR 63174 JOB NUMBER 18874A

ROUTE
I-75

SHEET
NO. 4


THIS SHEET: STA 81+00 to 107+76.86
STA 107+76.86 Back = 107+78.33 ahead
STA. 107+78.33 to 183+00

SCALE 1" = 60'

Quantities This Sheet

2251 Syd. Removing Old Pavement (Patching)
 2251 Syd. Conc. Pavt. Patching - Type F.S., 10" (Reinf.)
 240 Syd. Removing Pavement
 240 Syd. Misc. Concrete Pavement Reinf. 9"

228 L.F. Intermediate Saw Cuts
 124 Each Fixed Cost for Patches - Type X
 119 Each Fixed Cost for Patches - Type Y
 3 Tons Cement

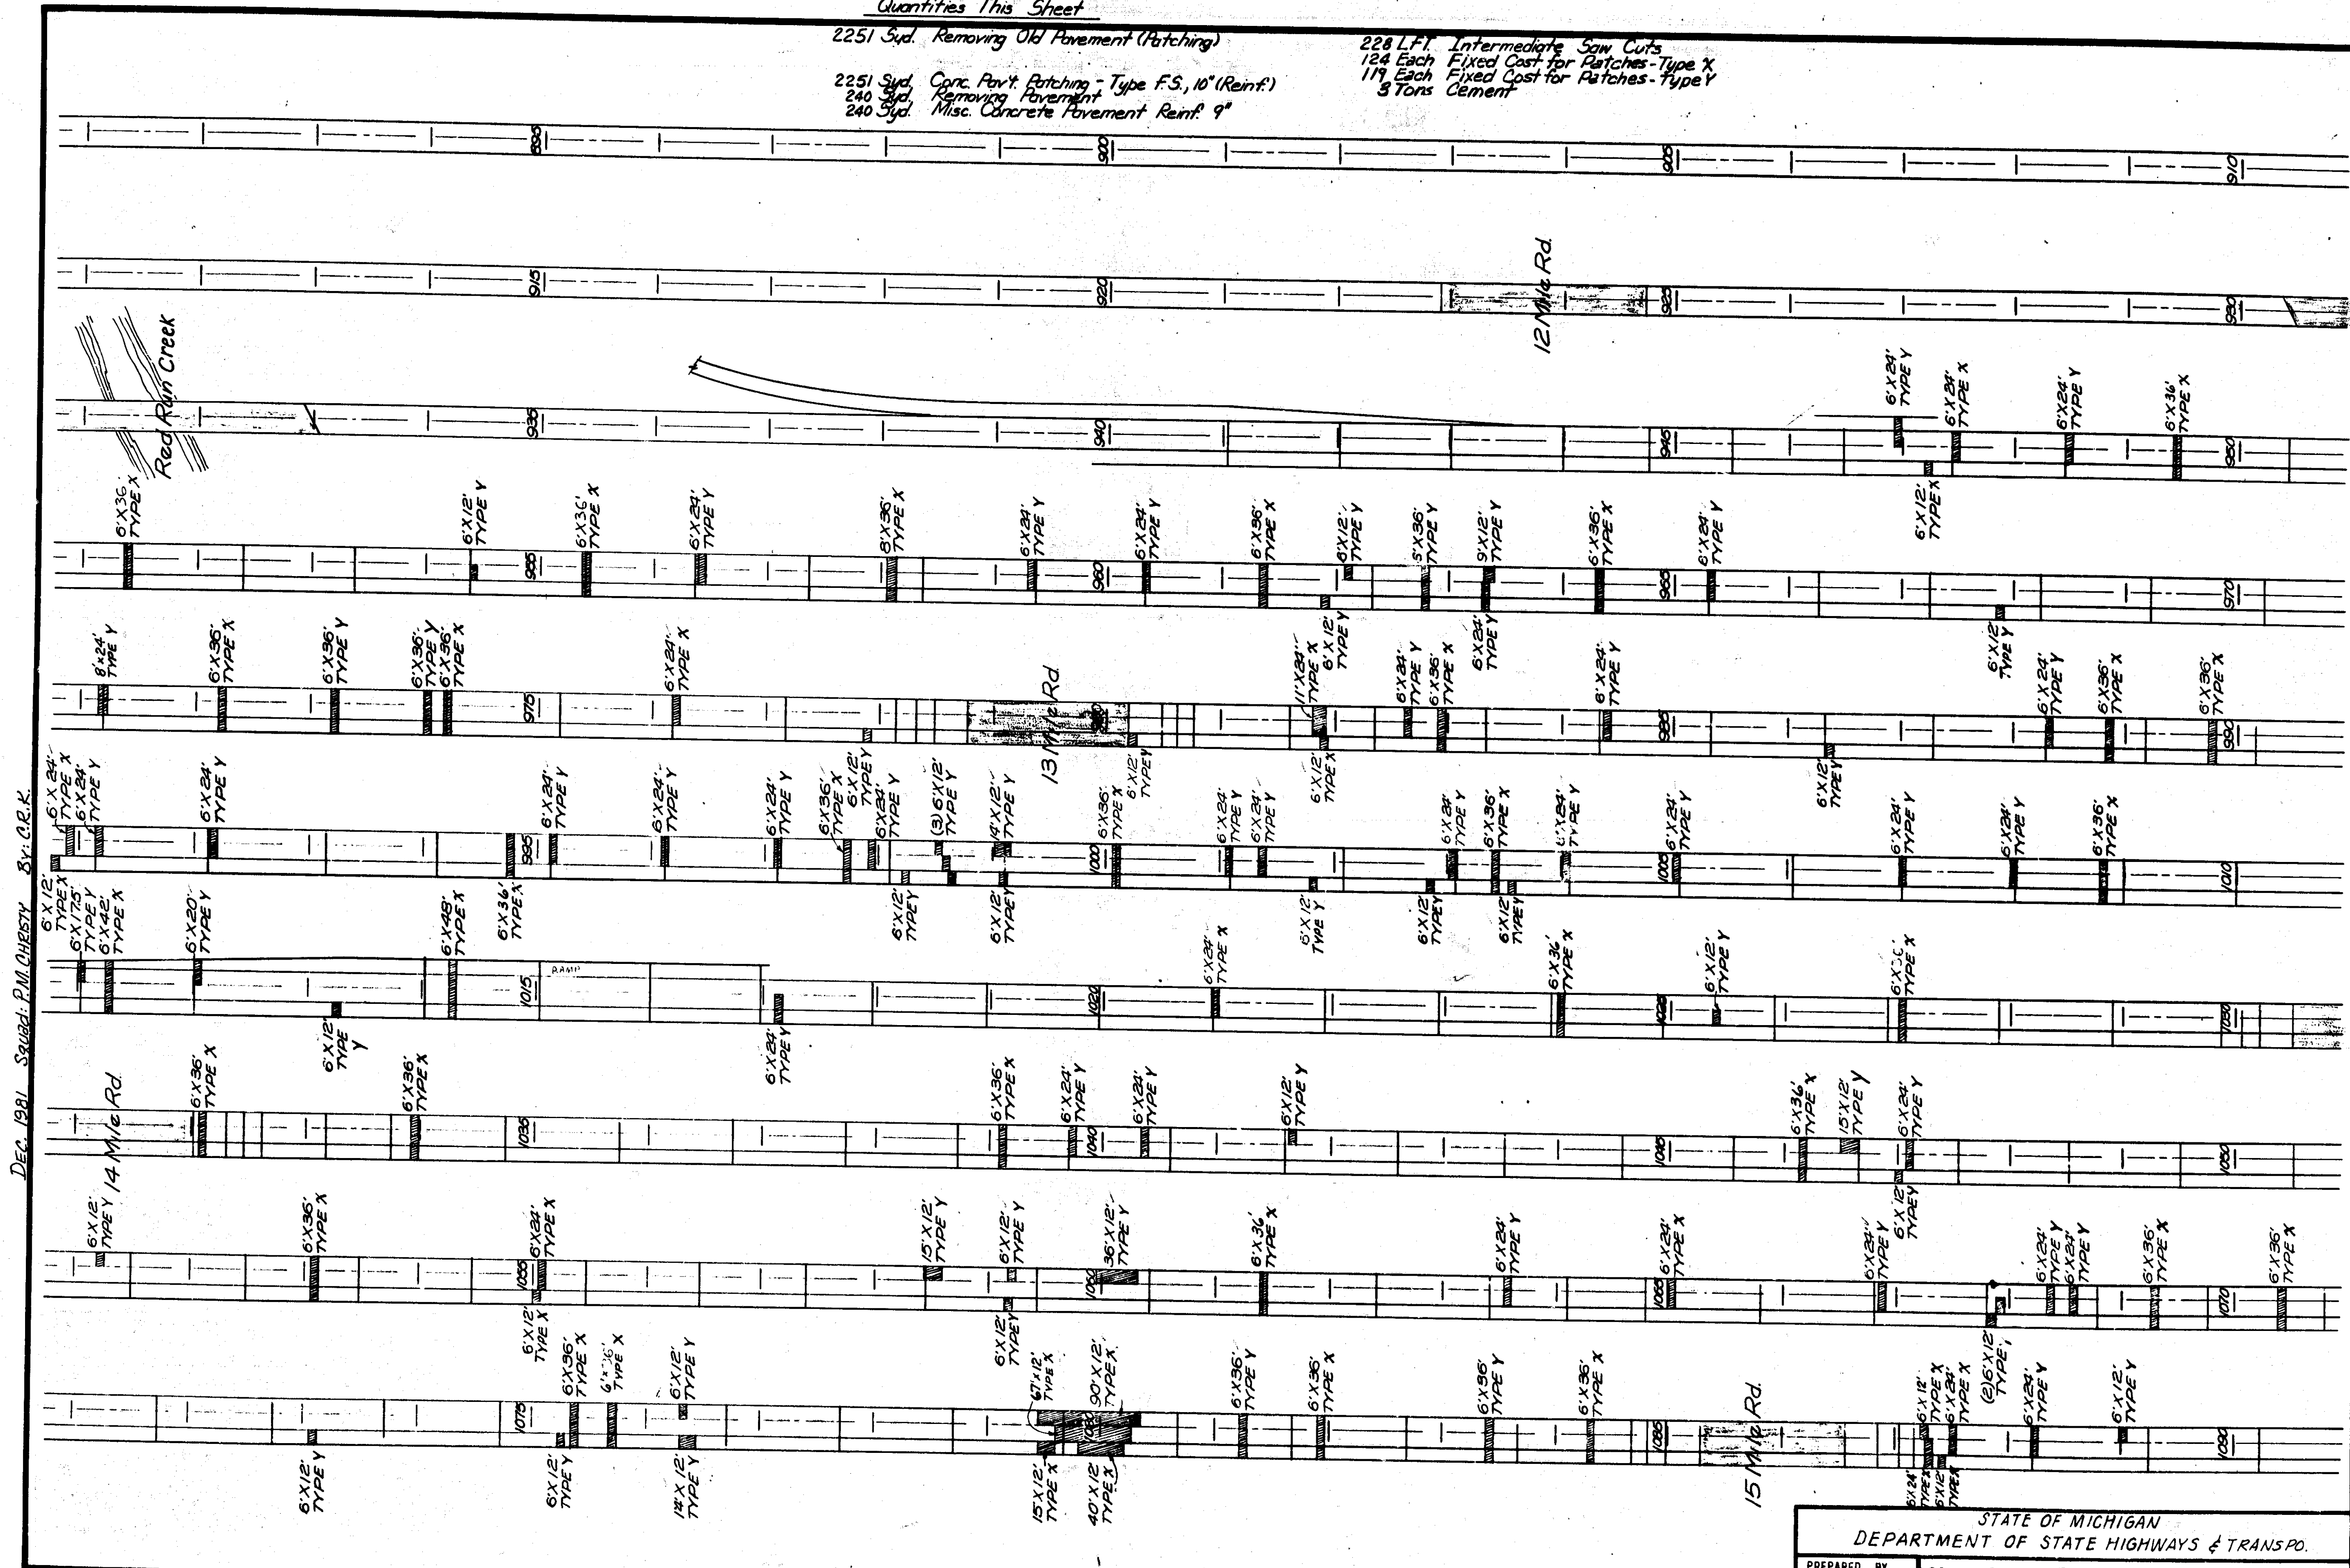


DEC. 1981 Squad: P.M. CHESTY 84-C.R.K.

SCALE 1" = 60'

THIS SHEET: Sta. 946+00 to Sta. 1024+00 (S.B.)
 (12 Mi. Rd north to 15 Mi. Rd)

STATE OF MICHIGAN DEPARTMENT OF STATE HIGHWAYS & TRANSP.		
PREPARED BY DESIGN DIVISION	CONC. JOINT REPAIR LOCATION SHEET	
LOCATION I-75 SOUTHBOUND from 12 MILE RD NORTH'LY TO UNIVERSITY DRIVE		
CONTROL SECTION IR 63174	JOB NO. 18874 A	ROUTE I-75 SHEET NO. 5


LOOKING S&D

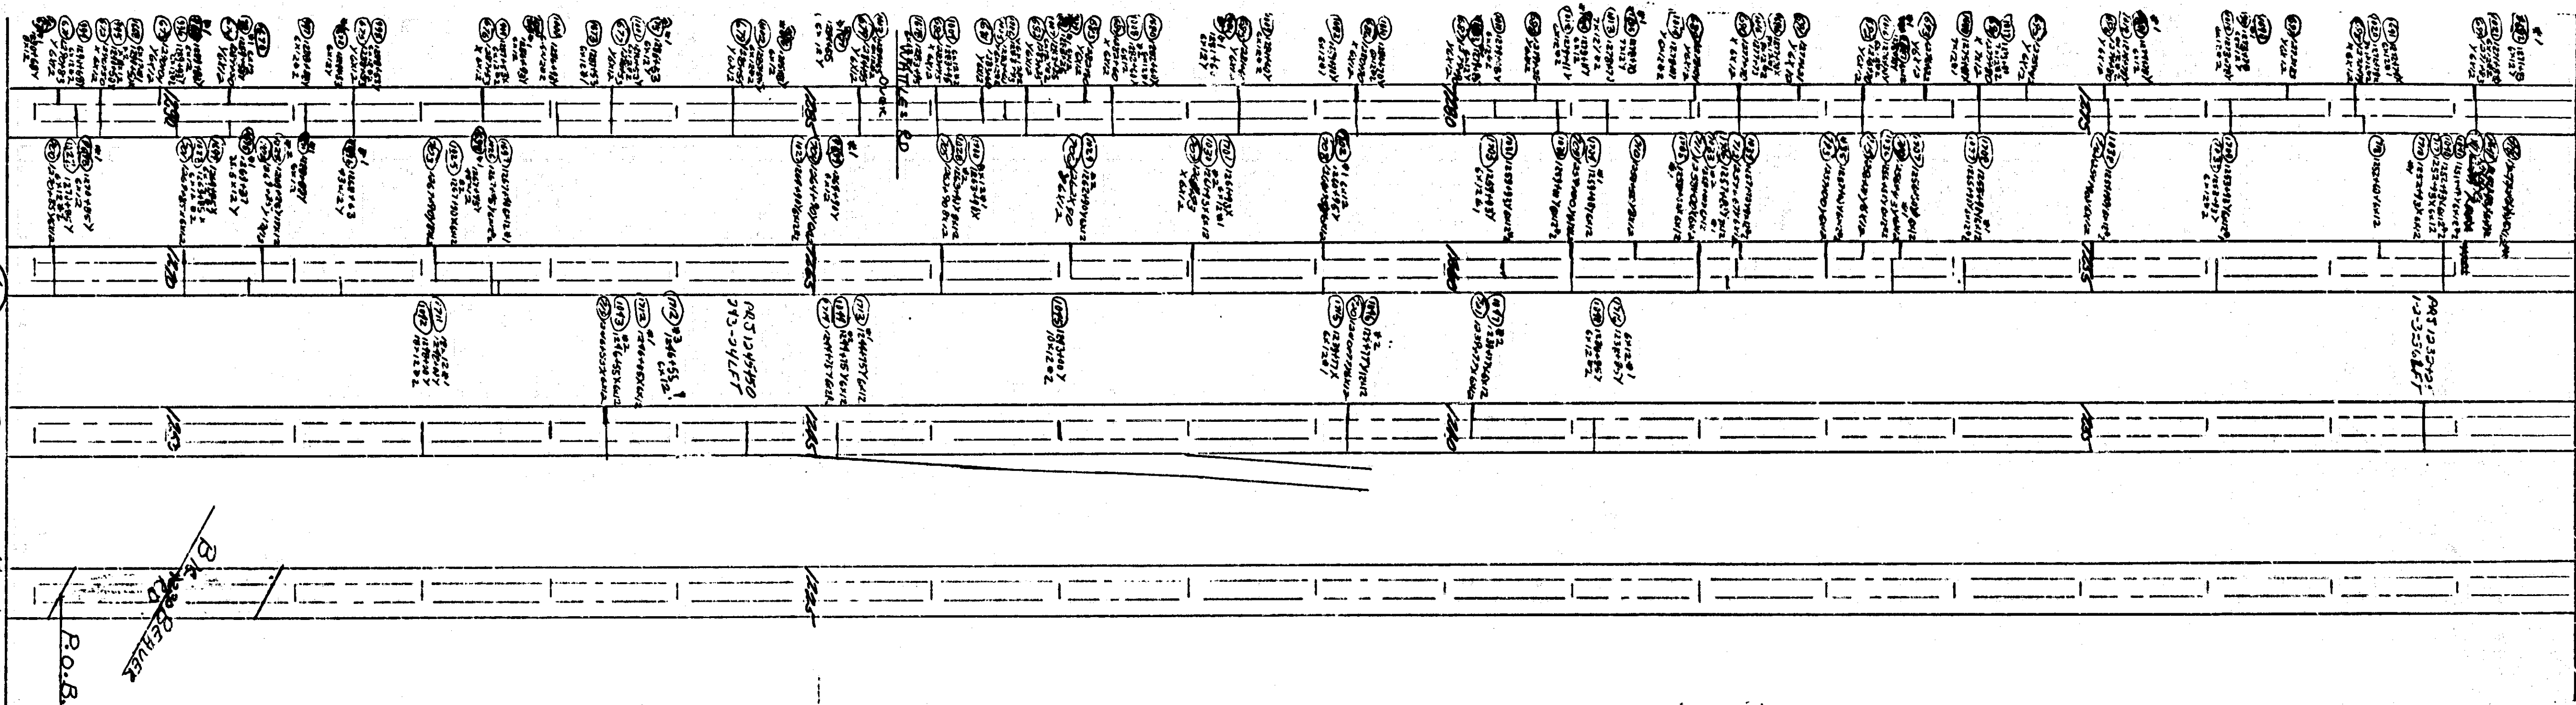

58 STA 1291 (61) to 118 STA 1308.25

B.L. REPAIR
P.O.B.

DEC. 1961 SQUAD P. M. CHRISTY 57-C-22

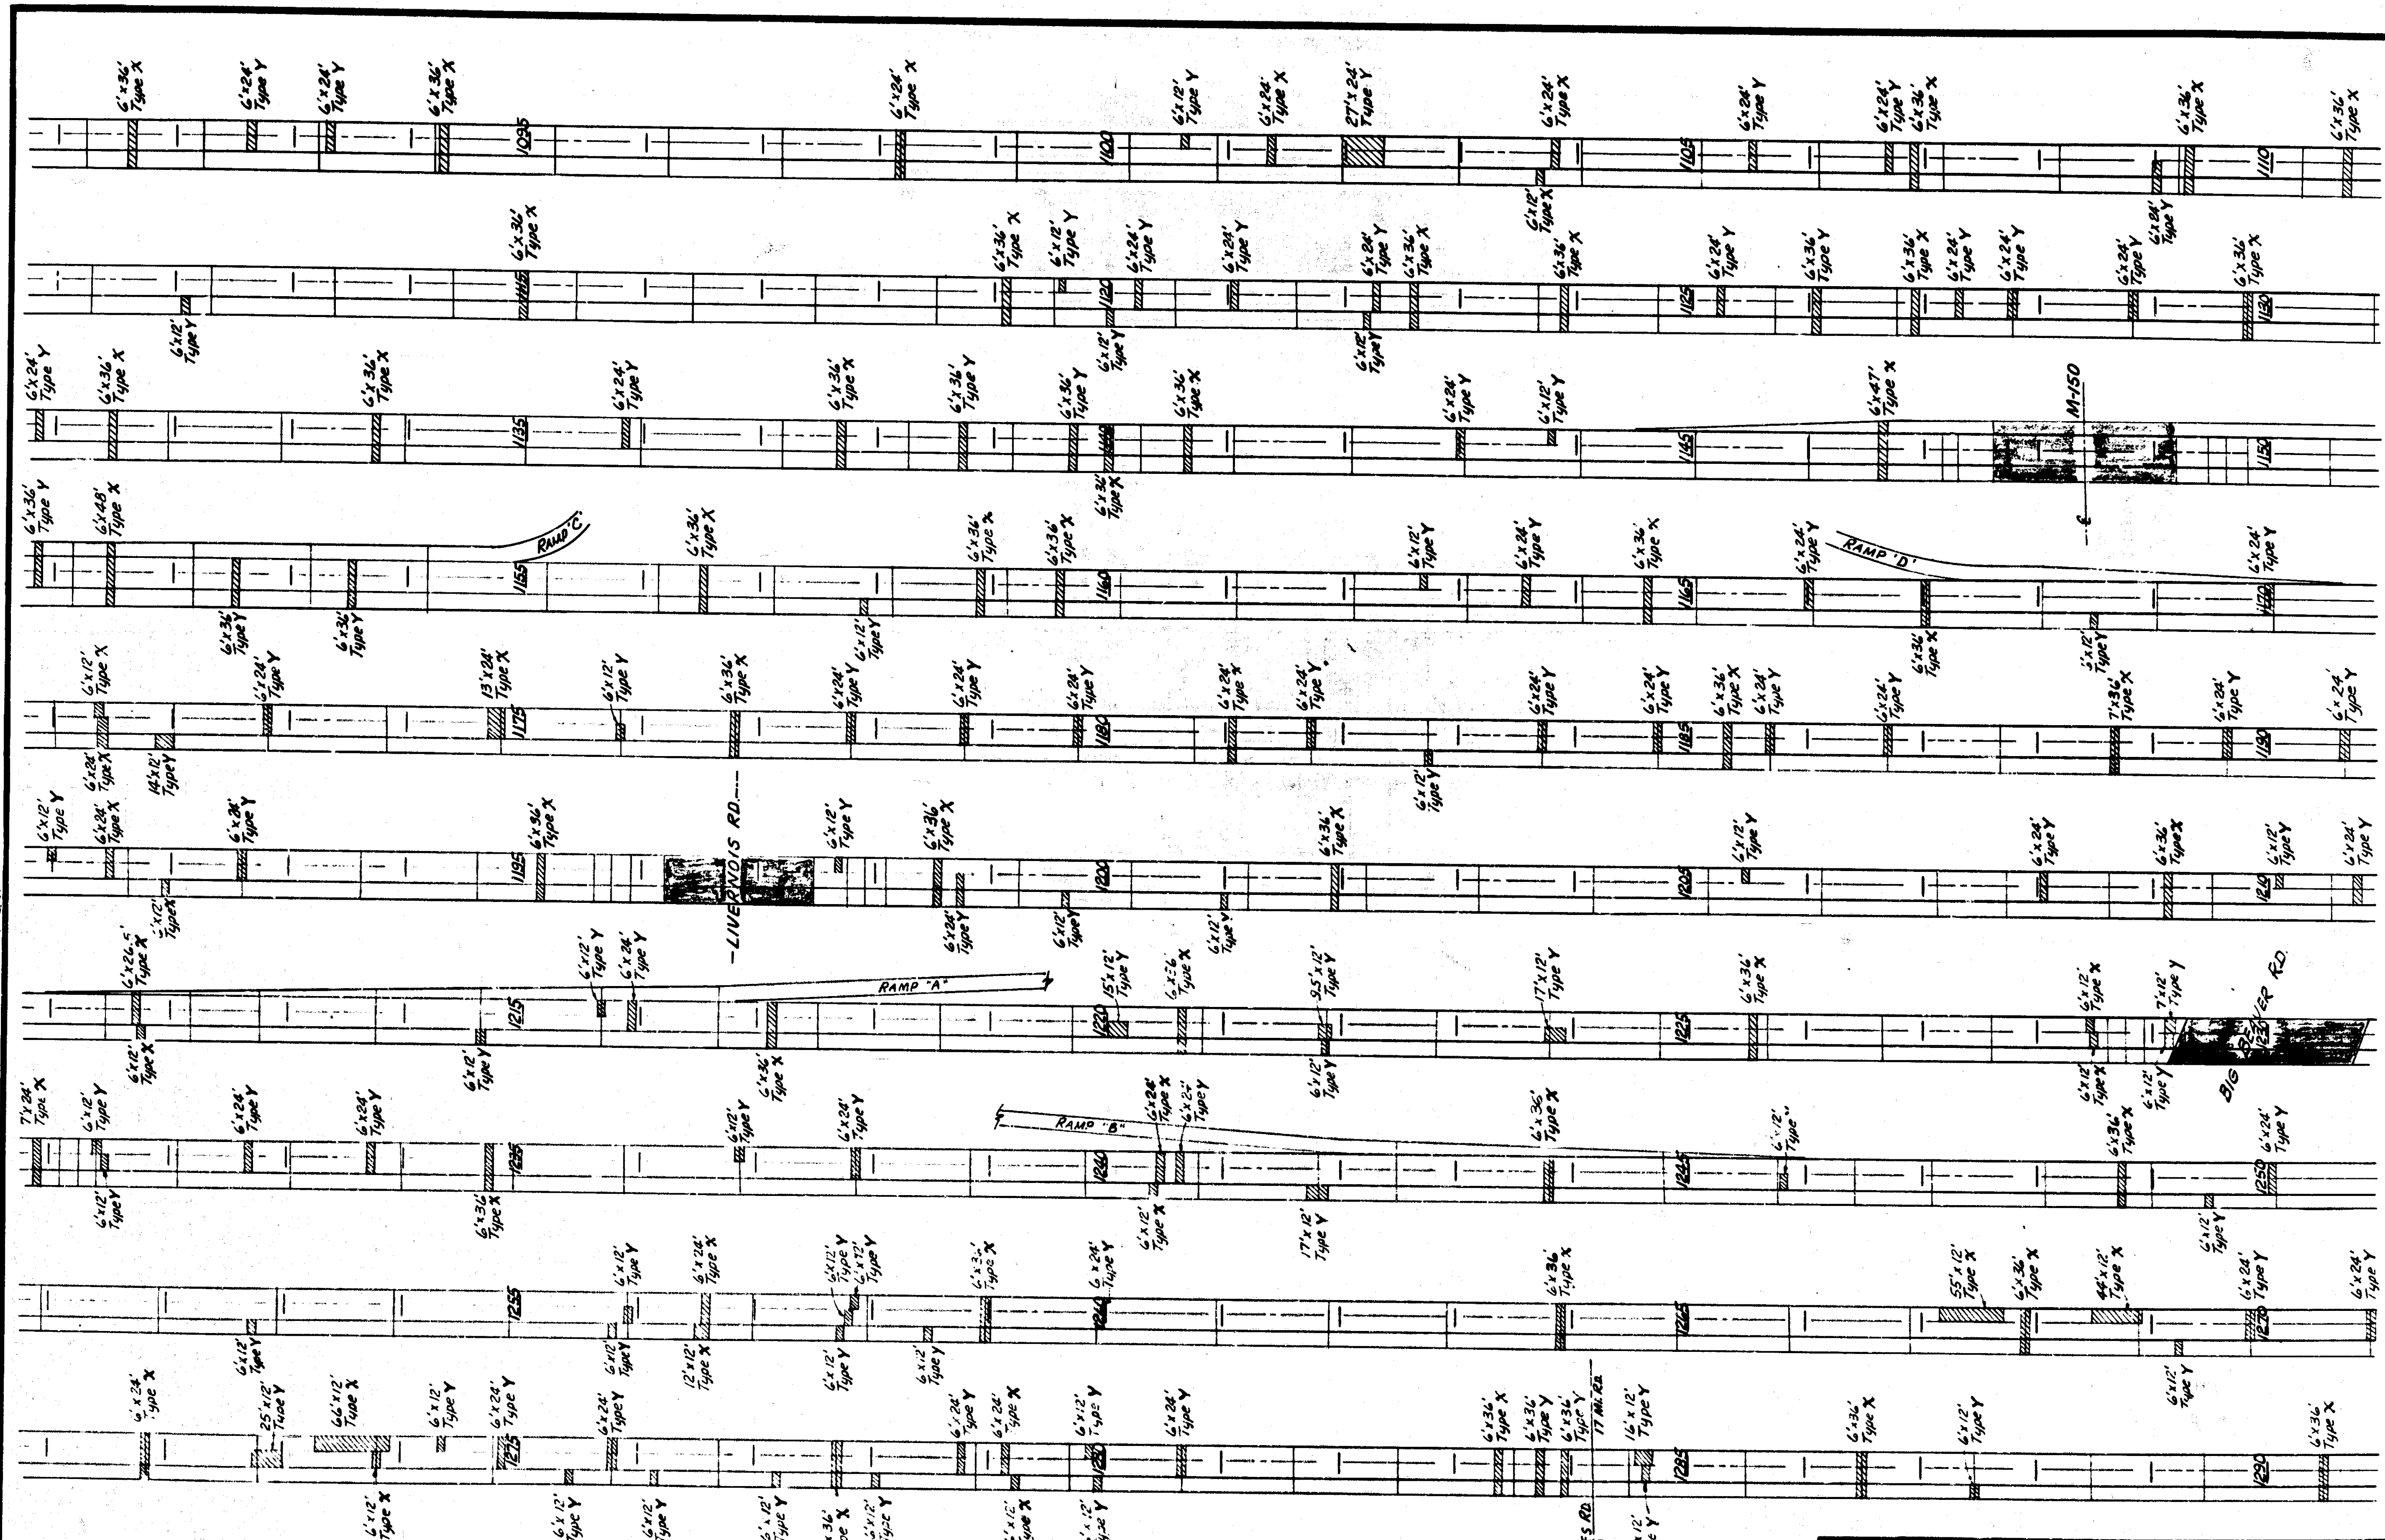

Quantities This Sheet

2919 Syd Removing Old Pavement (Patching)

6 Each 700k Bolt Lane Ties

2919 Syd Conc Pav't Patching-Type F.S. 10" (Reinf)

156 Syd Removing Pavement

162 Syd Misc Concrete Pavement Reinf 9"

396 LFT Intermediate Sawy Cuts

172 Each Fixed Cost For Patches-Type X

169 Each Fixed Cost For Patches-Type Y

2 Tons Cement

SCALE 1" = 60'

THIS SHEET: Sta 1091+00 to Sta 1290+00

STATE OF MICHIGAN		DEPARTMENT OF STATE HIGHWAYS AND TRANSPORTATION	
PREPARED BY	DESIGN DIVISION	CONC. JOINT REPAIR LOCATION SHEET	
LOCATION I-75 SOUTHBOUND from 12 MILE RD. NORTHLY TO UNIVERSITY DRIVE			
CONTROL SECTION	TR 63174	JOB No.	18874 A
			ROUTE I-75 SHEET NO. 6

56 STA 682

71 to STA 685

56 STA 602

78 to STA 583

56 STA 522

72 to STA 1001


USE SHEET 64

LOOKING S&D


LOOKING S&D

LOOKING S&D

Sheet 64

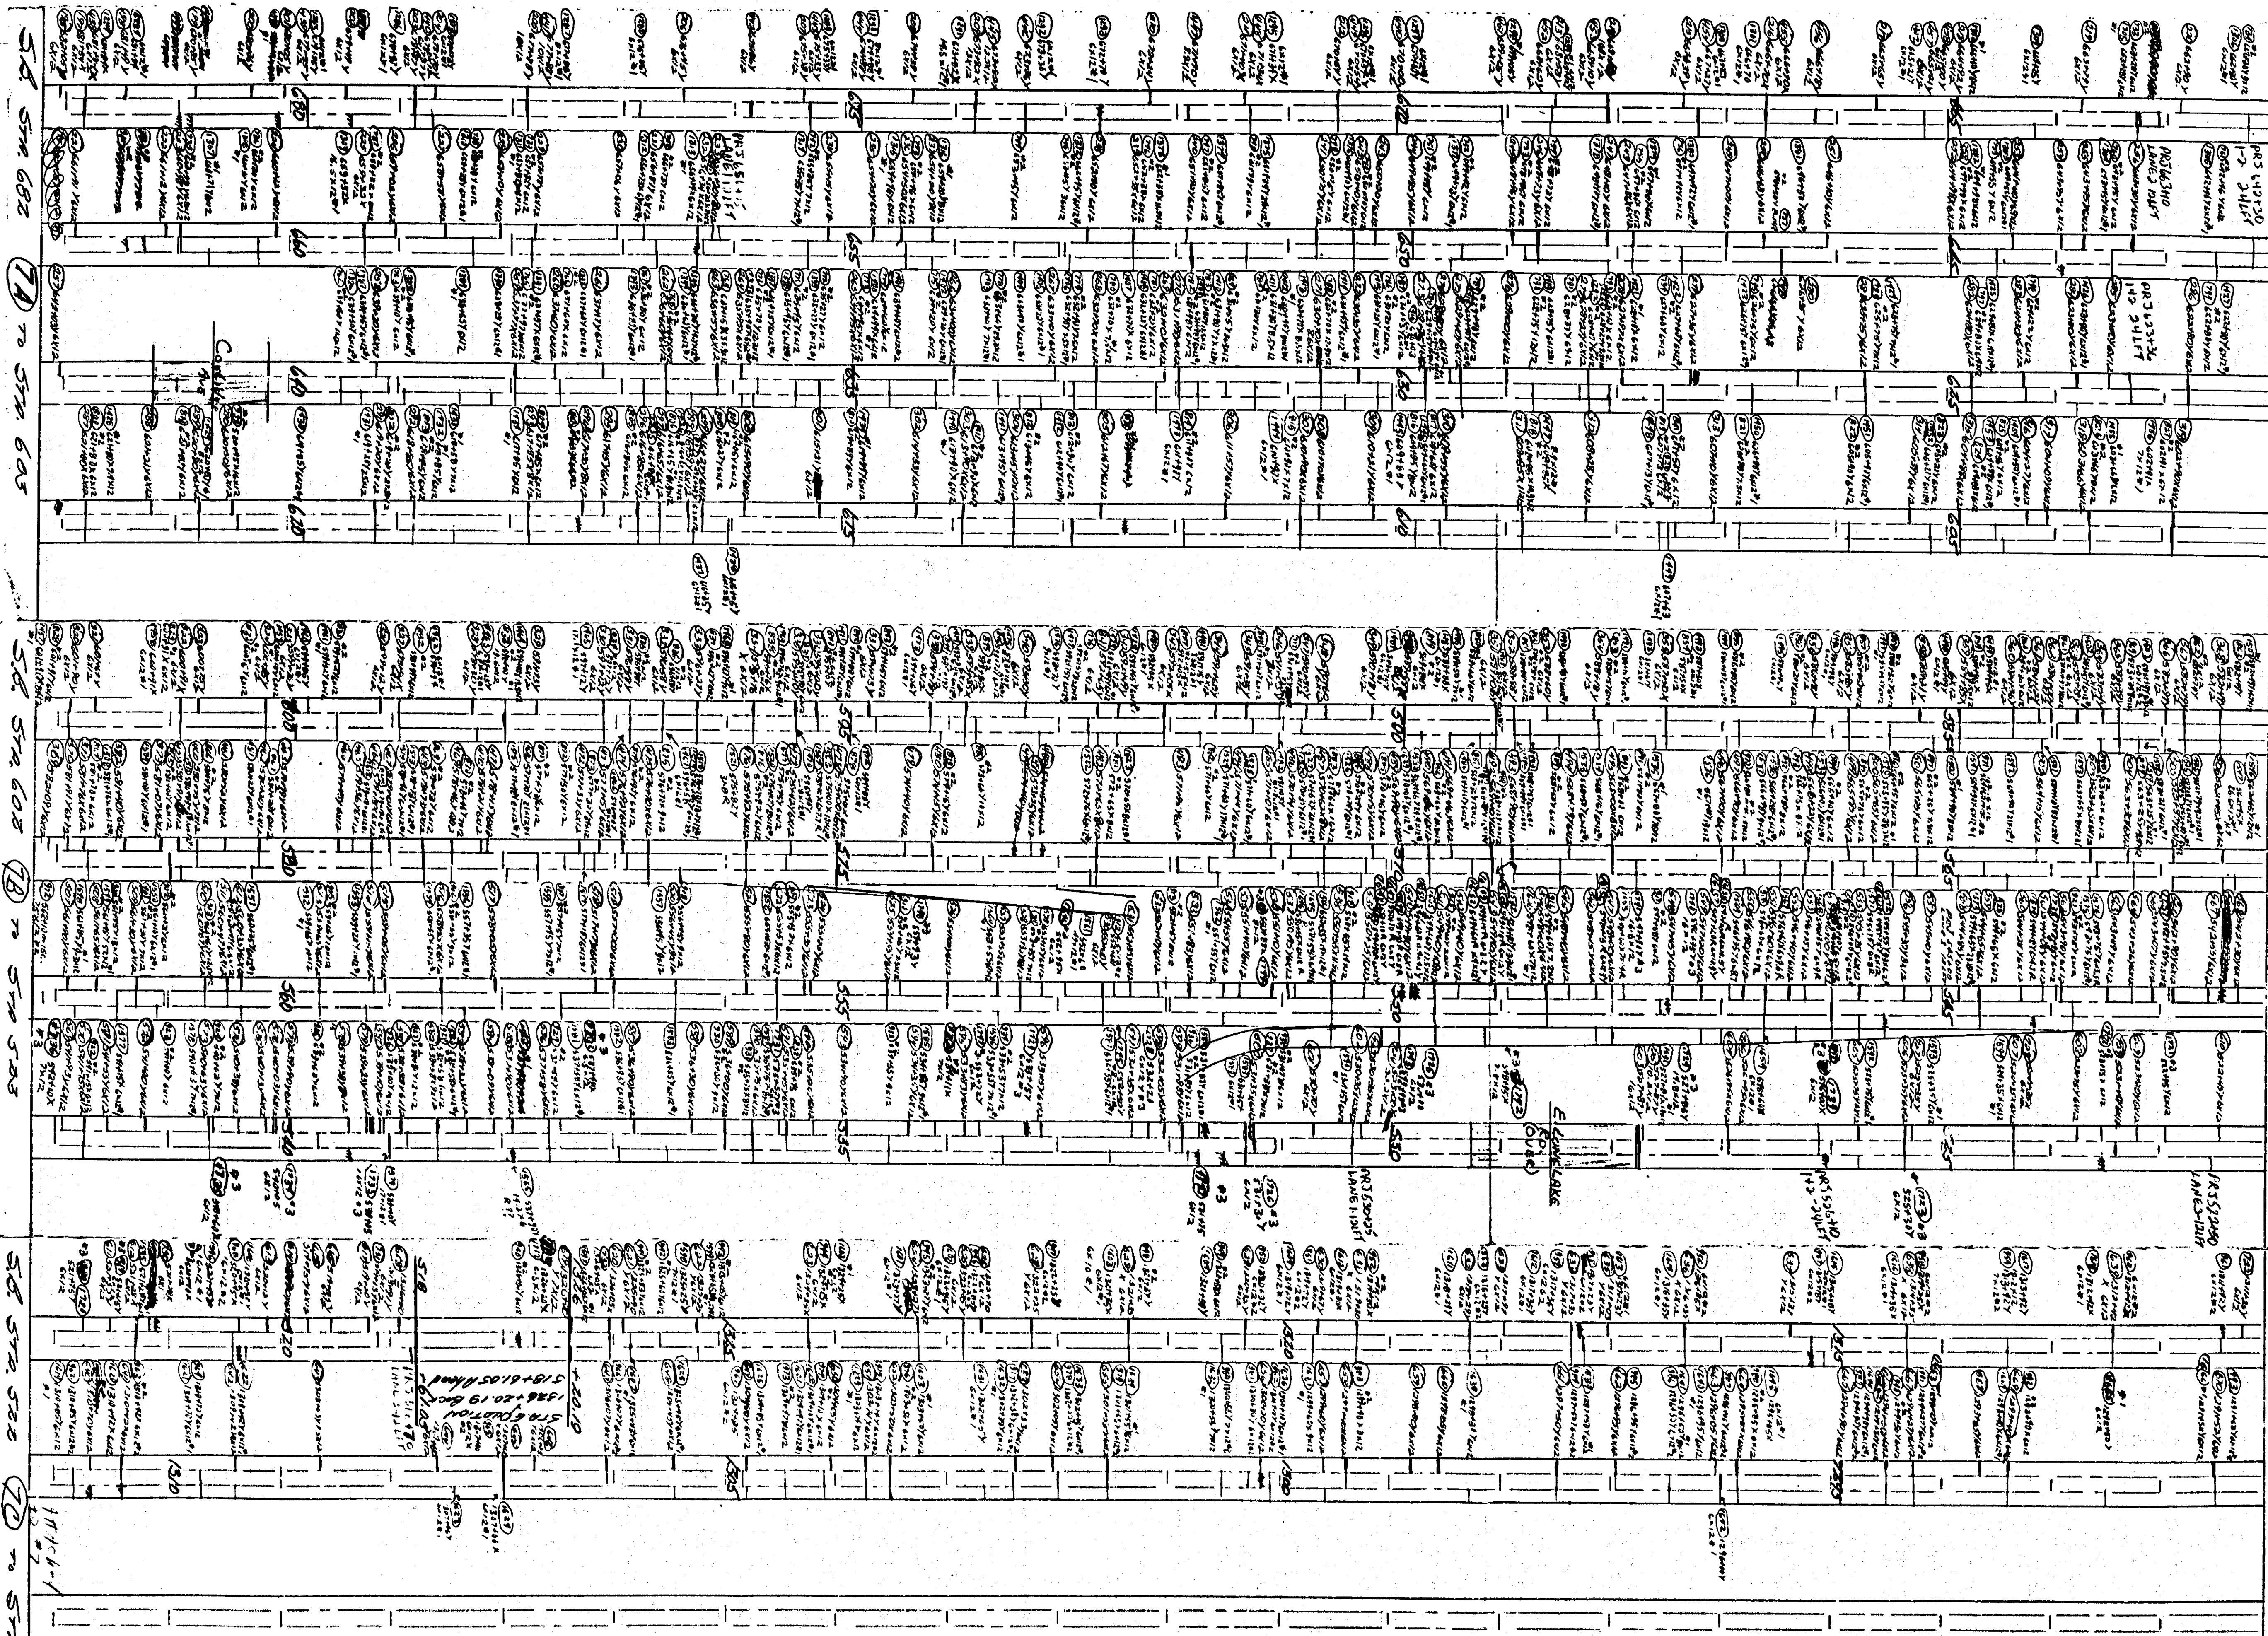

DEC. 1981 Squad: P.M. CHESTY B.Y.C.R.K.

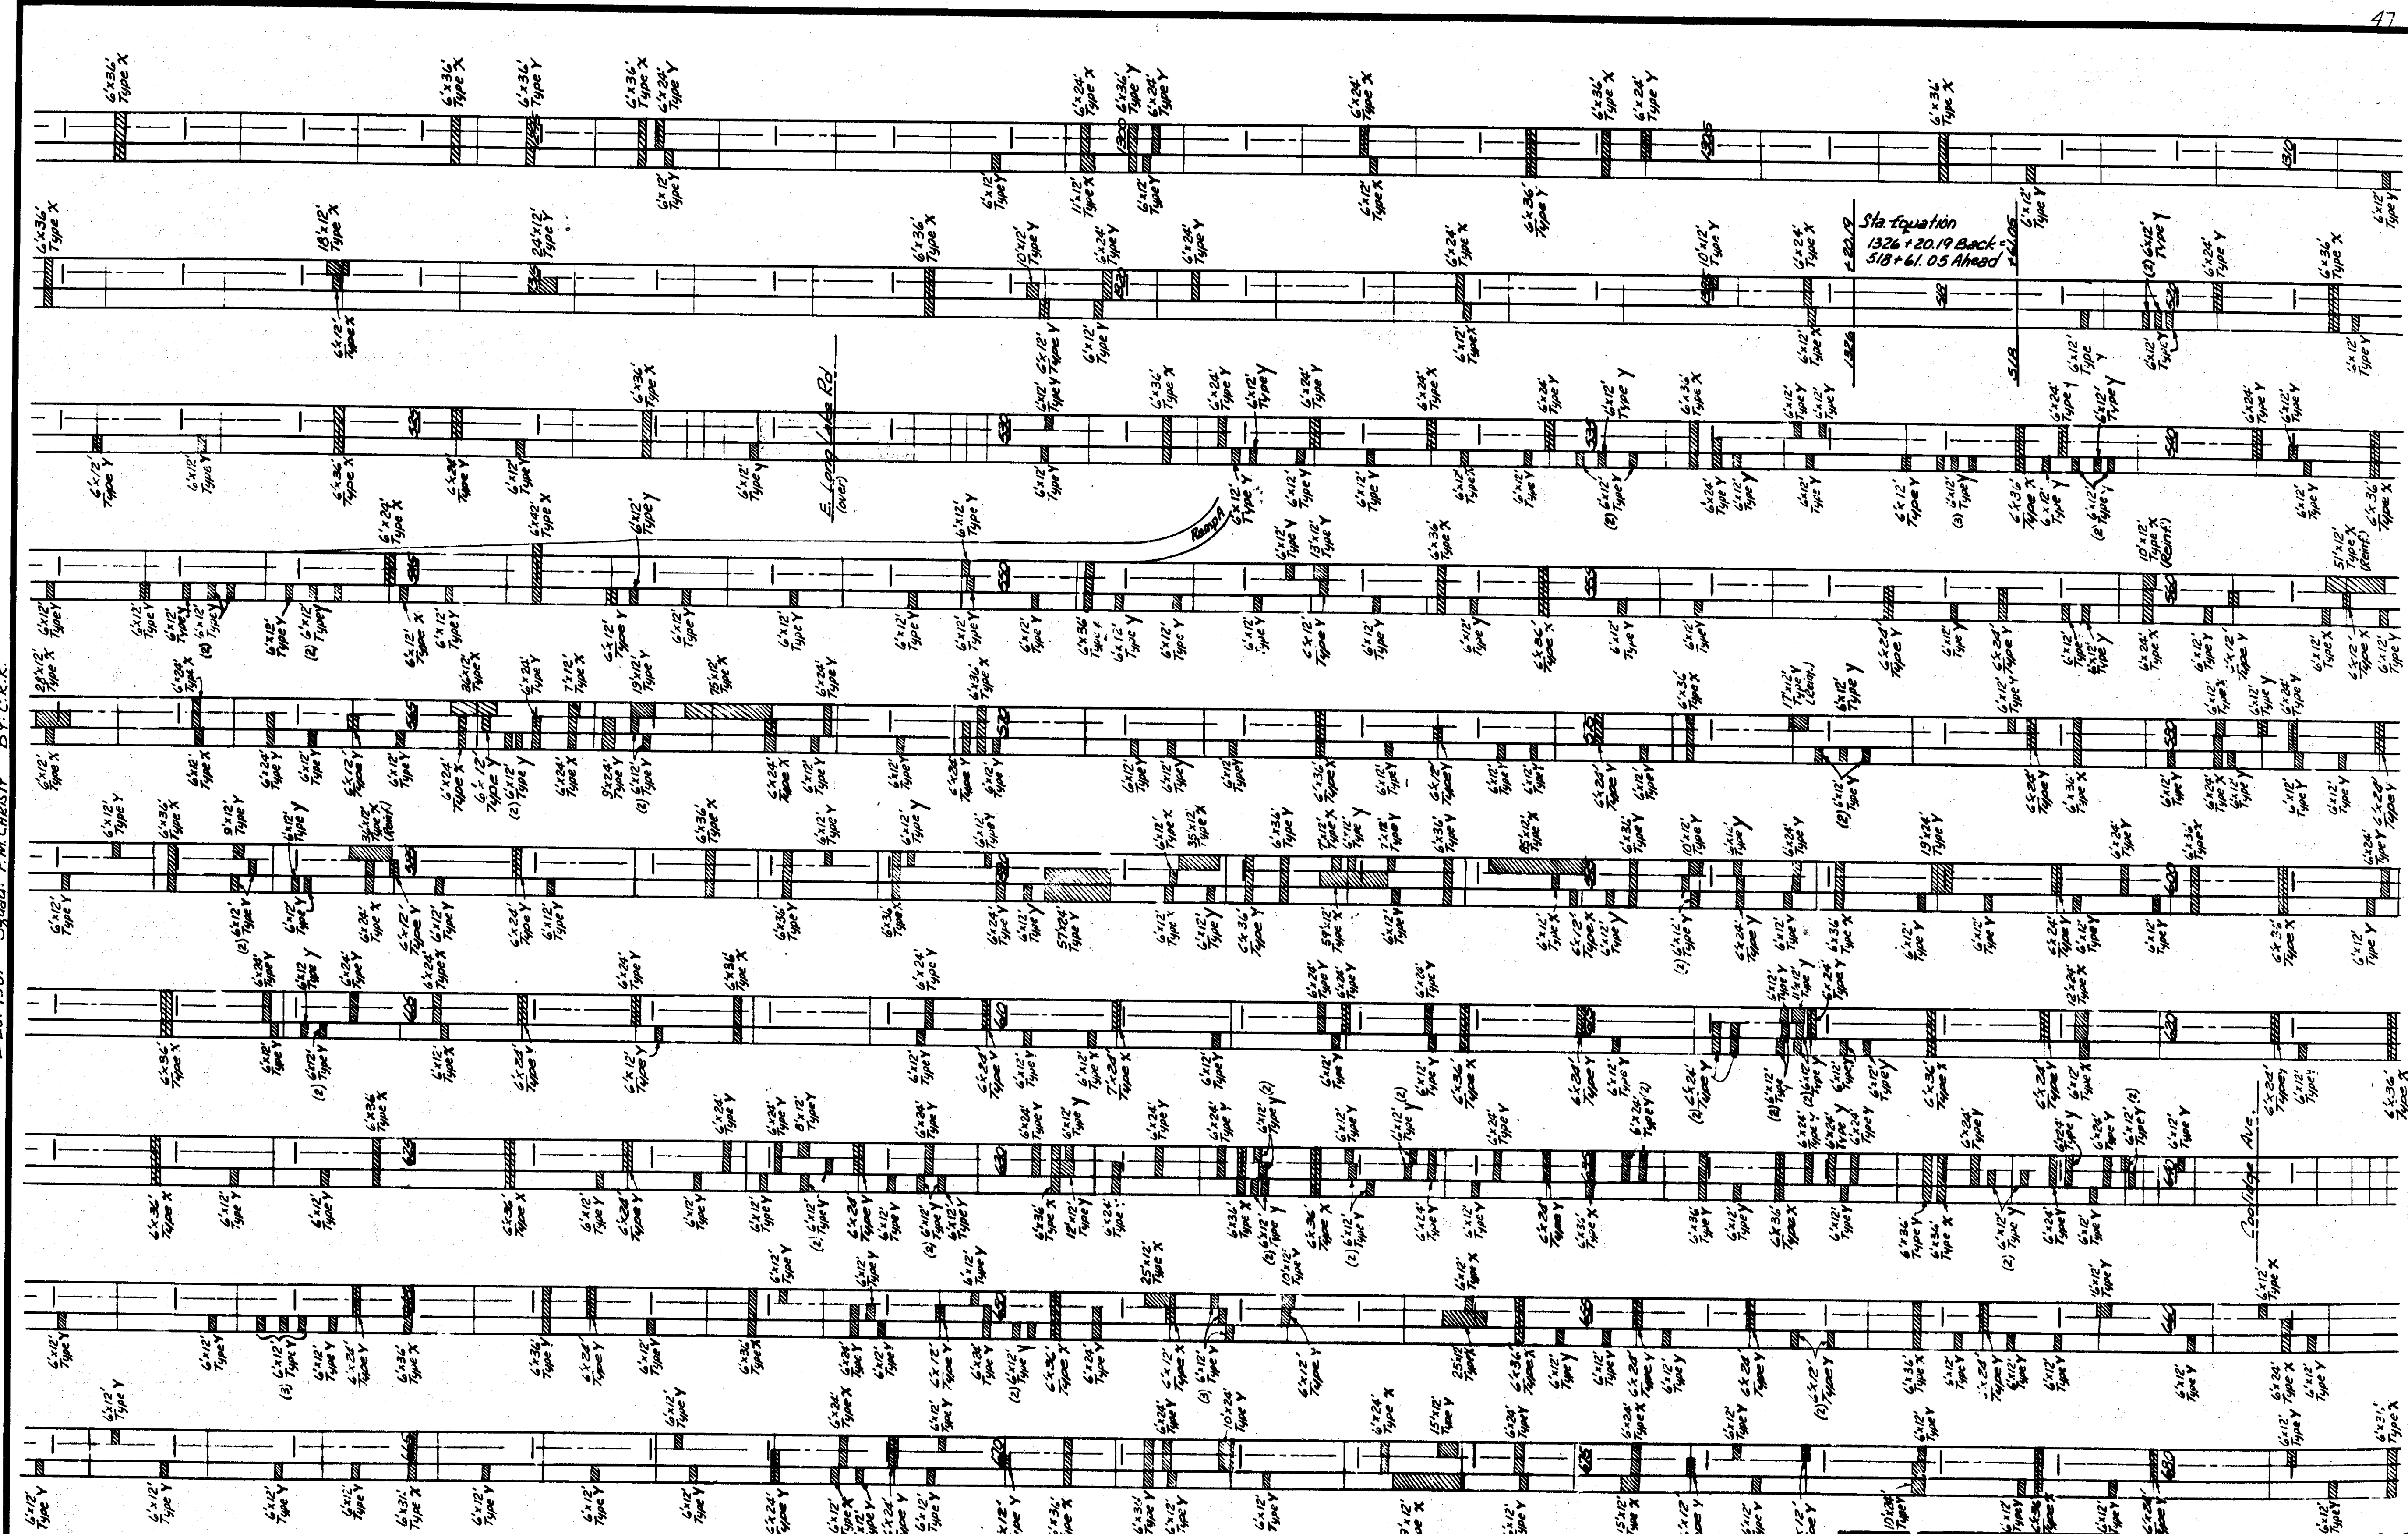

Quantities This Sheet
 5640 Syd Removing Old Pavement (Patching)
 17 Each Hook Back Lane Ties
 5640 Syd Conc. Part Patching - Type F.S., 10" (Reinf.)
 5640 Syd Removing Pavement
 391 Syd Misc. Concrete Pavement Reinf. 9"
 612 LFT. Intermediate Saw Cuts
 224 Each Fixed Cost for Patches - Type X
 138 Each Fixed Cost for Patches - Type Y
 7 Tons Cement

This Sheet:
 Sta. 1291+00 to 1326+20.19
 Sta. 1326+20.19 Back = Sta. 518+61.05 (Station Equation)
 Sta. 518+61.05 to Sta. 681+00

SCALE 1" = 60'

STATE OF MICHIGAN			
DEPARTMENT OF STATE HIGHWAYS AND TRANSPORTATION			
RESEARCH LAB. TESTING AND RESEARCH DIVISION	CONC. JOINT REPAIR LOCATION SHEET		
LOCATION I-75 SOUTHBOUND FROM 12 MILE RD. NORTHERLY TO UNIVERSITY DRIVE SHEET OF _____			
STATE PROJECT	MAINT PROJECT		ROUTE I-75
CONTROL SECTION IR 63174	JOB NO. 18874 A	SHEET NO. 7	

LOOKING S80

LOOKING S80

LOOKING S80


58. STA 77 8A to STA 798

58. STA 797


8B to STA 760

56. STA 760

8C to STA 685

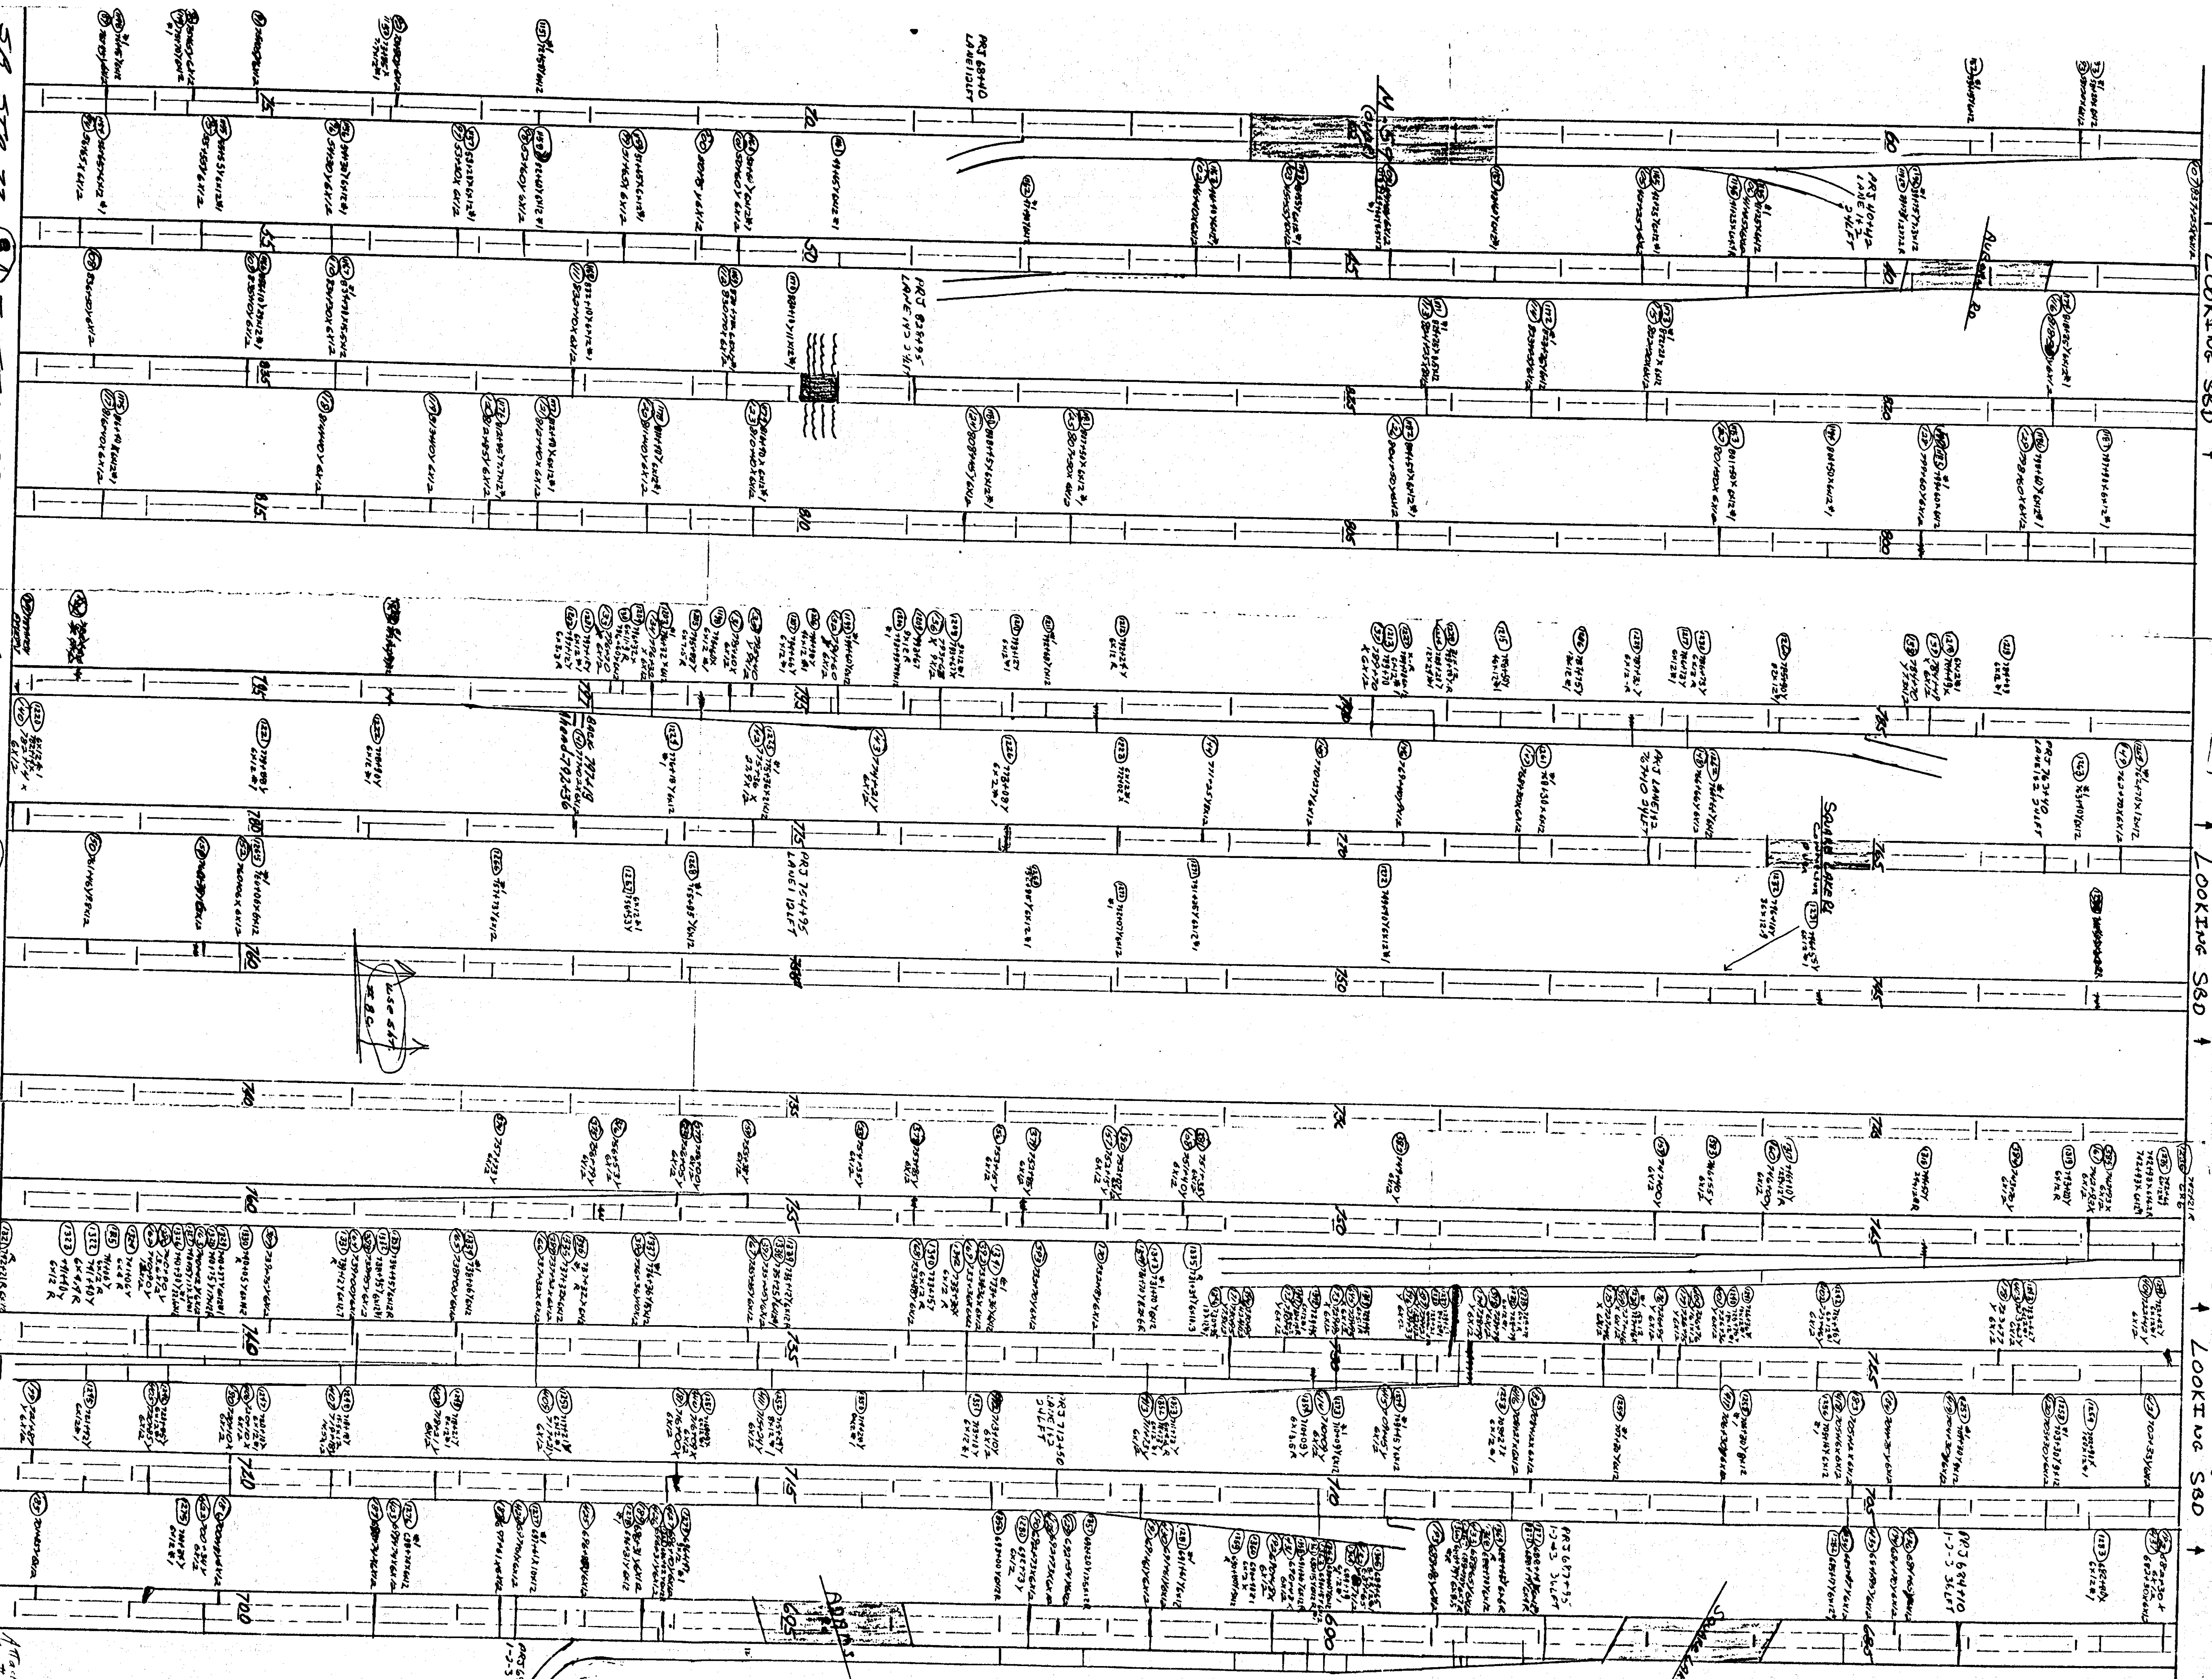

DEC. 1981 Squad P.M. CHRISTY BY: CRK

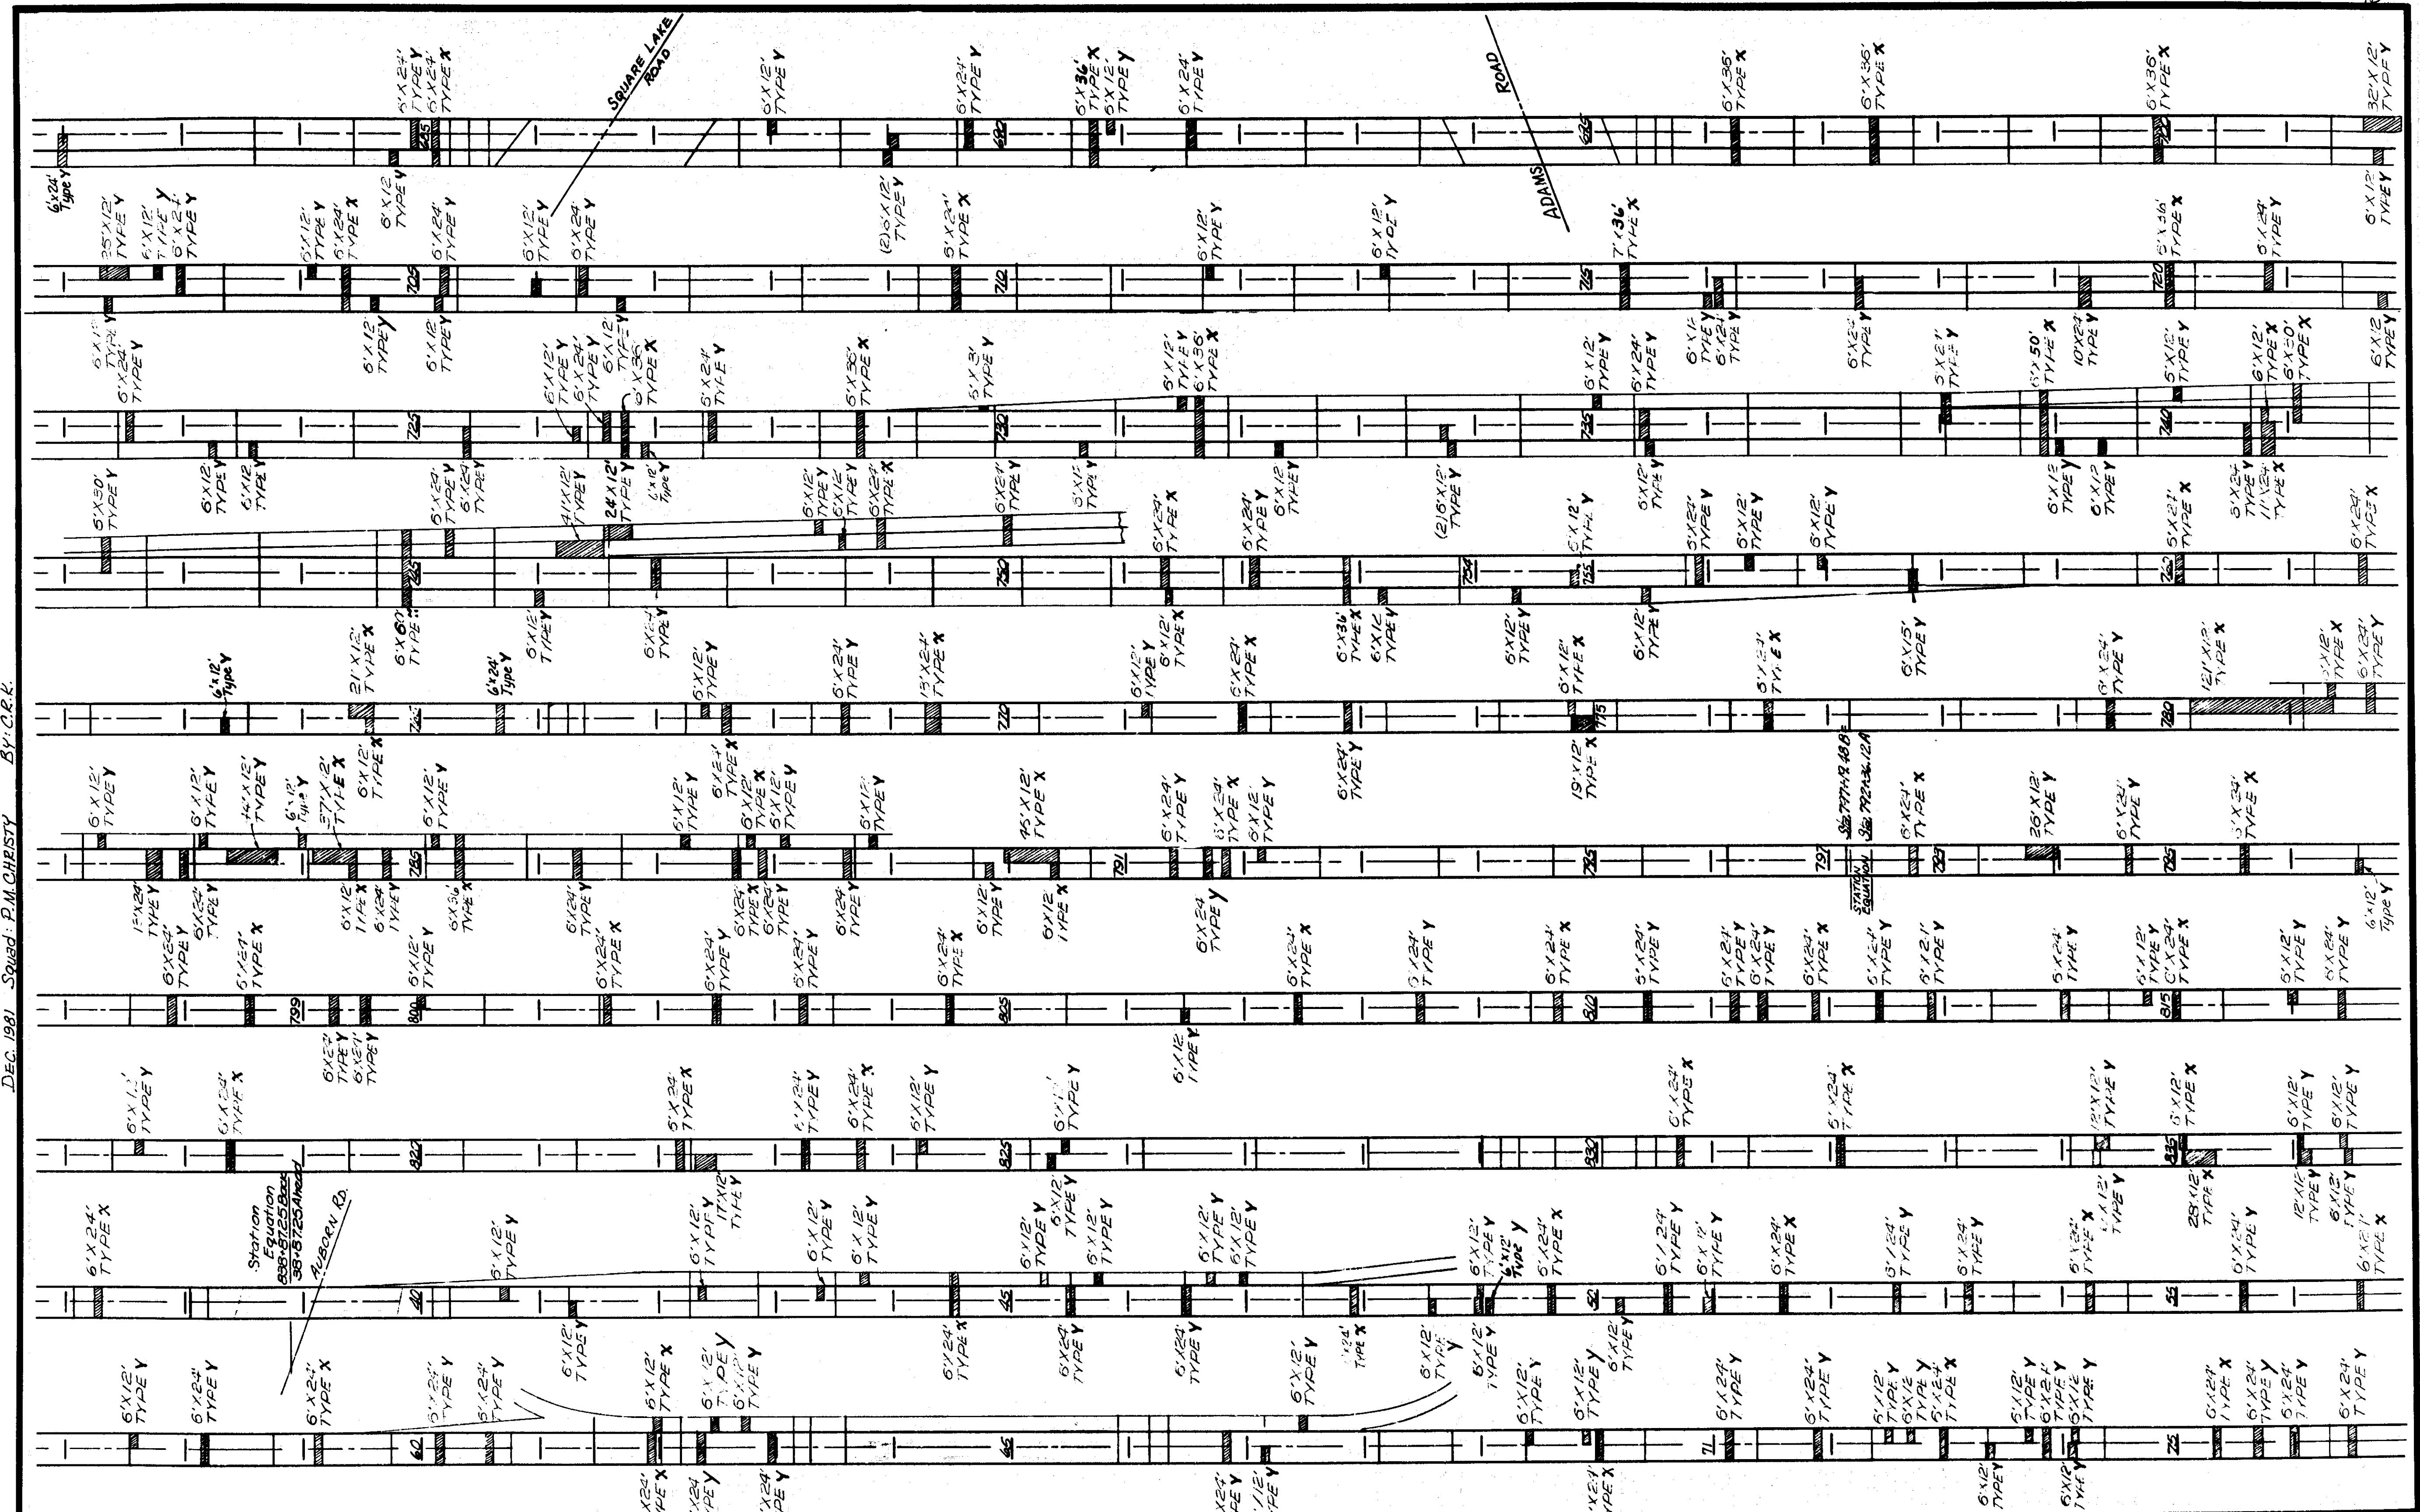


Quantities This Sheet
 3545 Syd Removing Old Pavement (Patching)
 2 Tons Cement
 3545 Syd Conc. Pavt. Patching - Type FS, 10'(Reinf.)
 162 Syd Removing Pavement
 162 Syd Misc. Concrete Pavement Reinf. 9'

744 LFT Intermediate Saw Cuts
 142 Each Fixed Cost for Patches - Type X
 245 Each Fixed Cost for Patches - Type Y


THIS SHEET: Sta 682+00 to Sta 838+87.25
 Sta 838+87.25 B = Sta 38+87.25 A. (STATION EQUATION)
 Sta 38+87.25 to Sta 76+50

SCALE 1" = 60'

STATE OF MICHIGAN	
DEPARTMENT OF STATE HIGHWAYS AND TRANSPORTATION	
RESEARCH LAB. TESTING AND RESEARCH DIVISION	CONC. JOINT REPAIR LOCATION SHEET
LOCATION: I-75 SOUTHBOUND from 12 MILE RD. NORTHERLY TO UNIVERSITY DRIVE SHEET OF _____ ROUTE I-75	
STATE PROJECT	MAINT. PROJECT
CONTROL SECTION	IR 63174
JOB NO.	18874 A
SHEET NO.	8

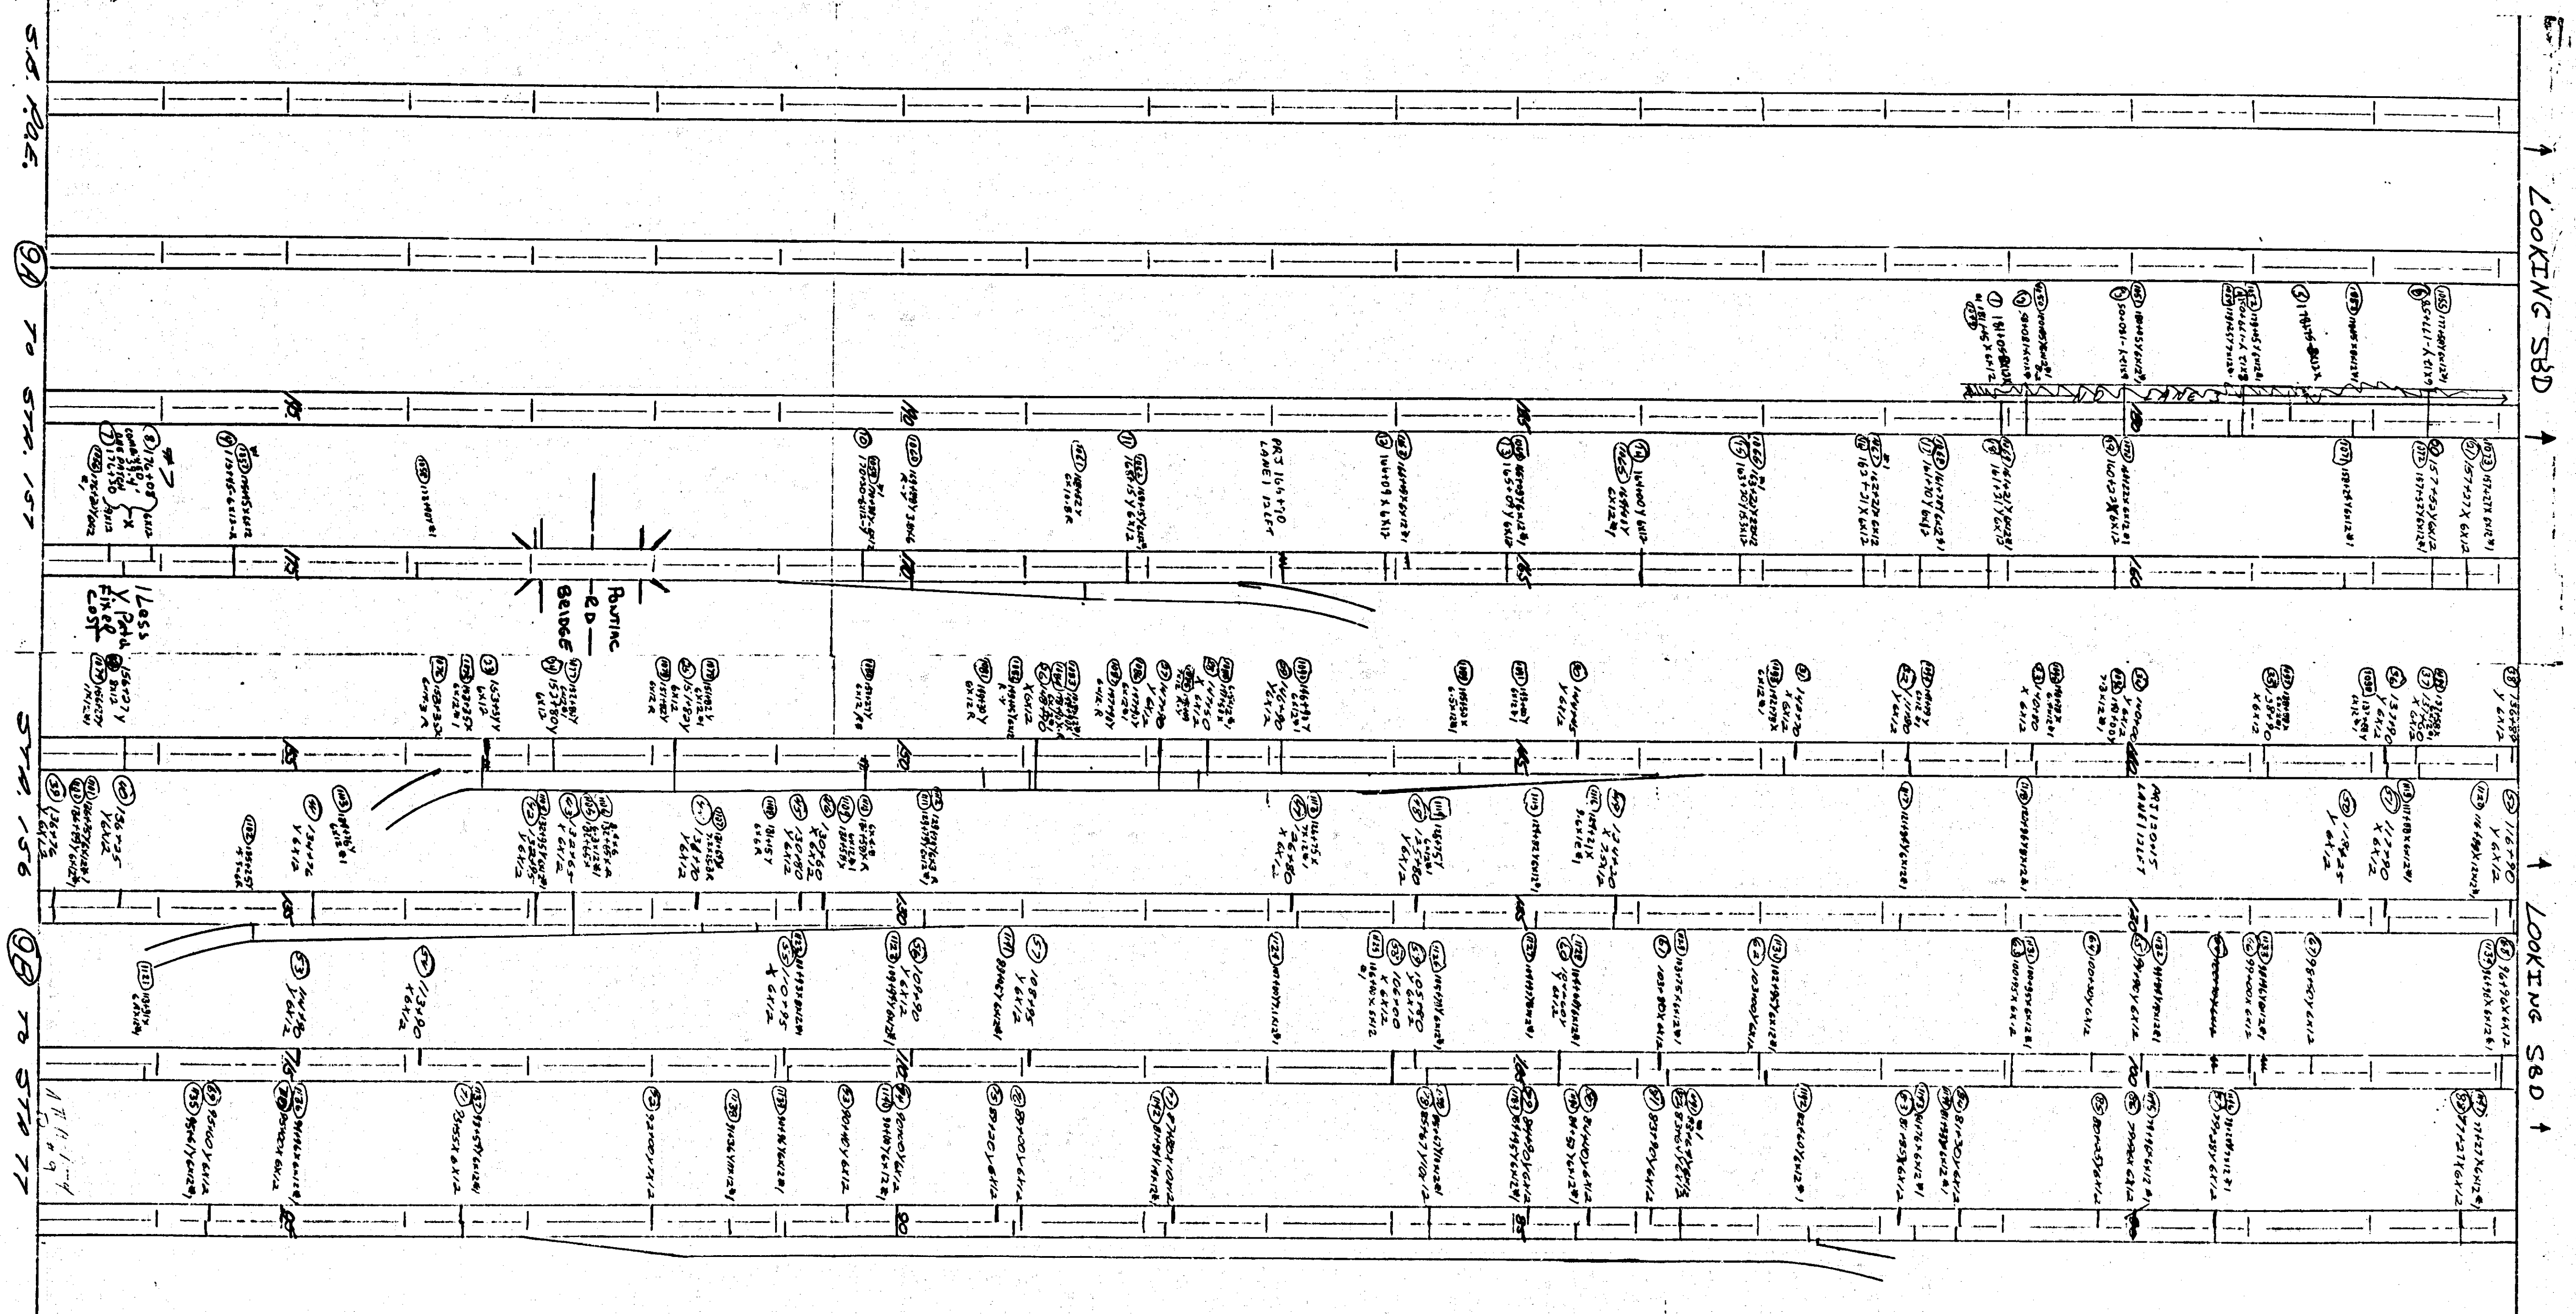

Dec. 1981 Squad: P.M. CHRISTY By: C.R.K.

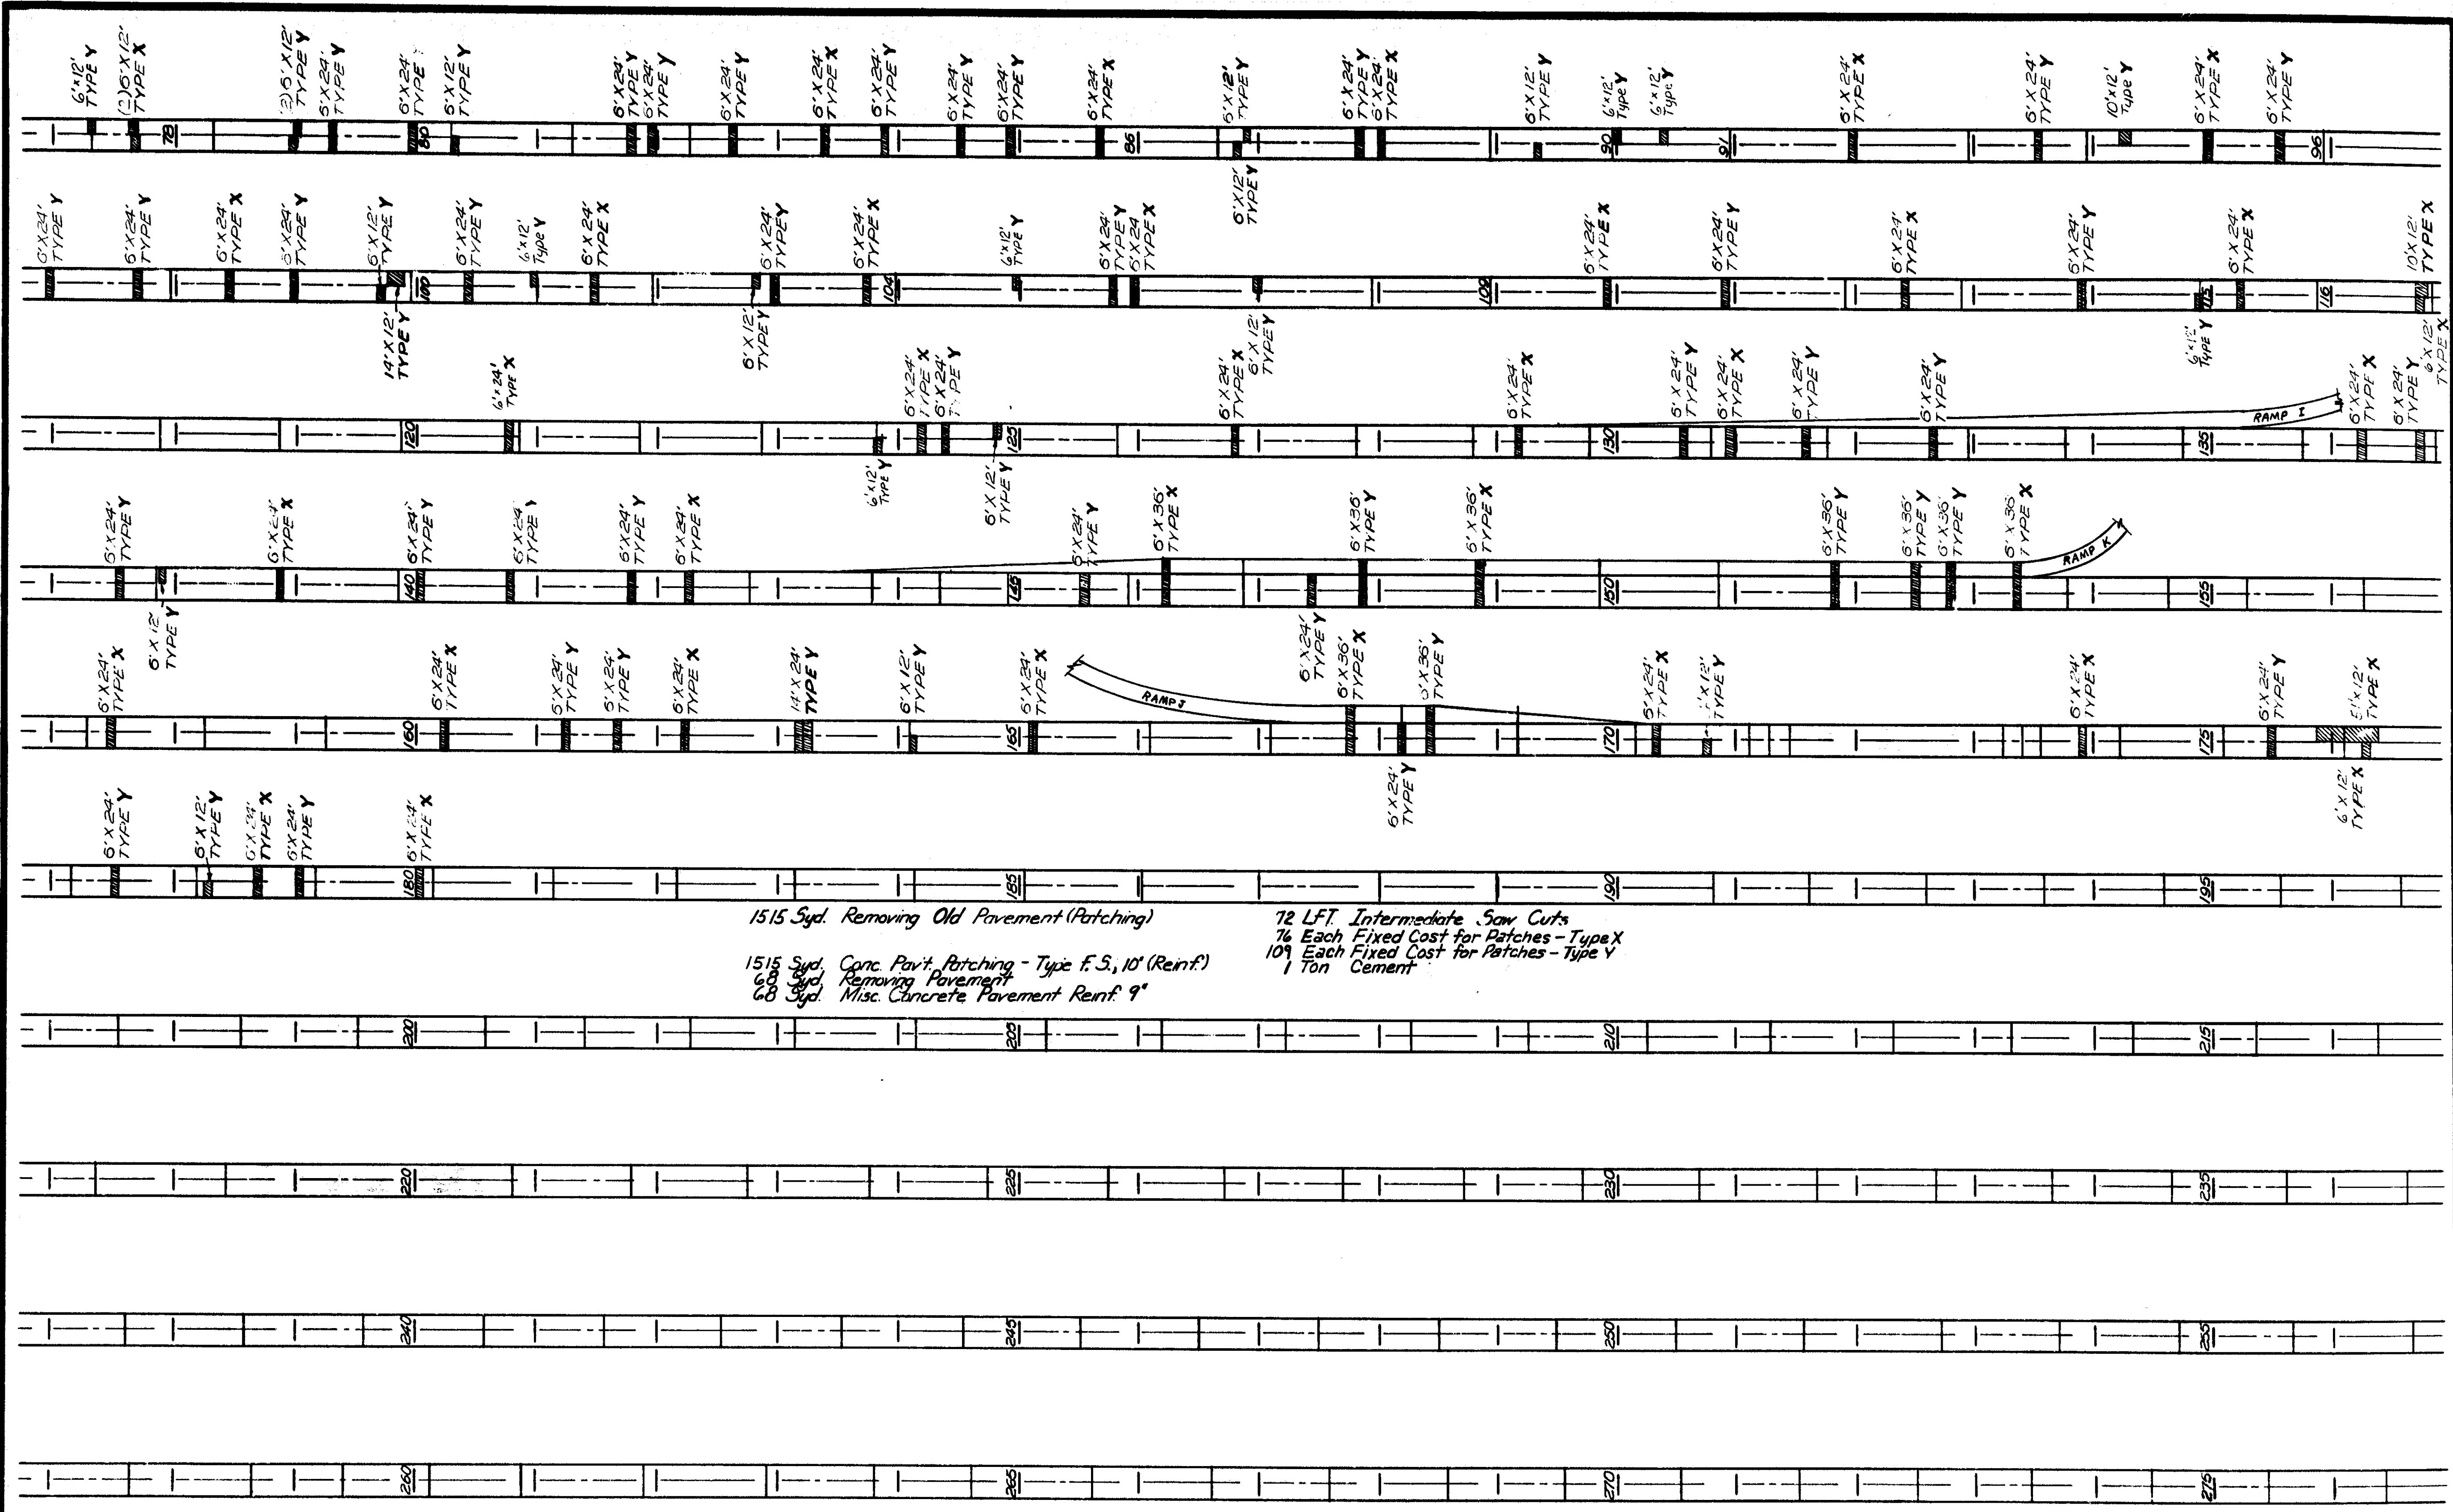

1515 Syd. Removing Old Pavement (Patching)
 1515 Syd. Conc. Pav't. Patching - Type F.S., 10' (Reinf.)
 68 Syd. Removing Pavement
 68 Syd. Misc. Concrete Pavement Reinf. 9"




72 LFT Intermediate Saw Cuts
 76 Each Fixed Cost for Patches - Type X
 109 Each Fixed Cost for Patches - Type Y
 1 Ton Cement

SCALE 1" = 60'

THIS SHEET: Sta 77+00 to Sta 180+50 (P.O.E.)
 (University Drive)


STATE OF MICHIGAN			
DEPARTMENT OF STATE HIGHWAYS AND TRANSPORTATION			
RESEARCH LAB. TESTING AND RESEARCH DIVISION	CONC. JOINT REPAIR LOCATION SHEET		
LOCATION I-75 SOUTHBOUND from 12 MILE RD. NORTHEASTLY TO UNIVERSITY DRIVE			
ROUTE I-75			SHEET NO. 9
CONTRACT SECTION IR 63174	JOB NO. 18874 A		

FINAL R.O.V.			
AUTH.	DATE	NO.	REVISION

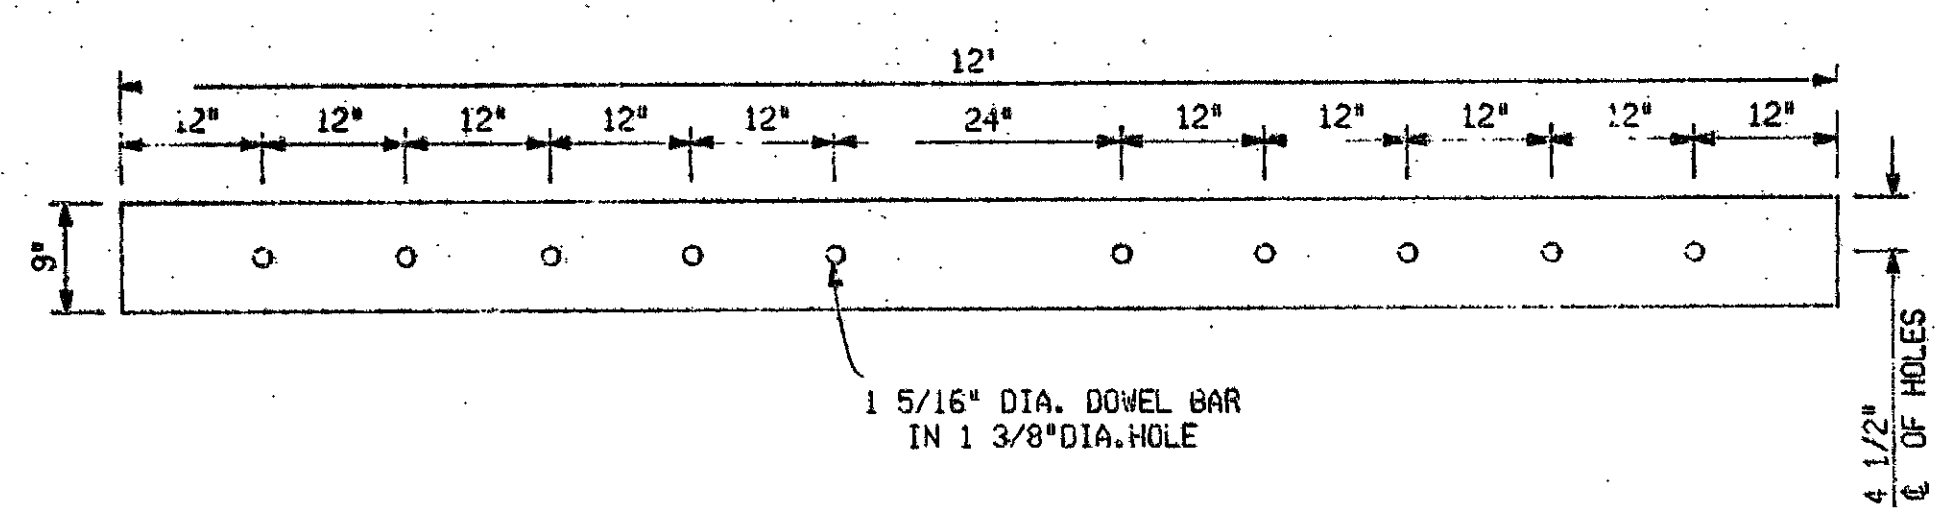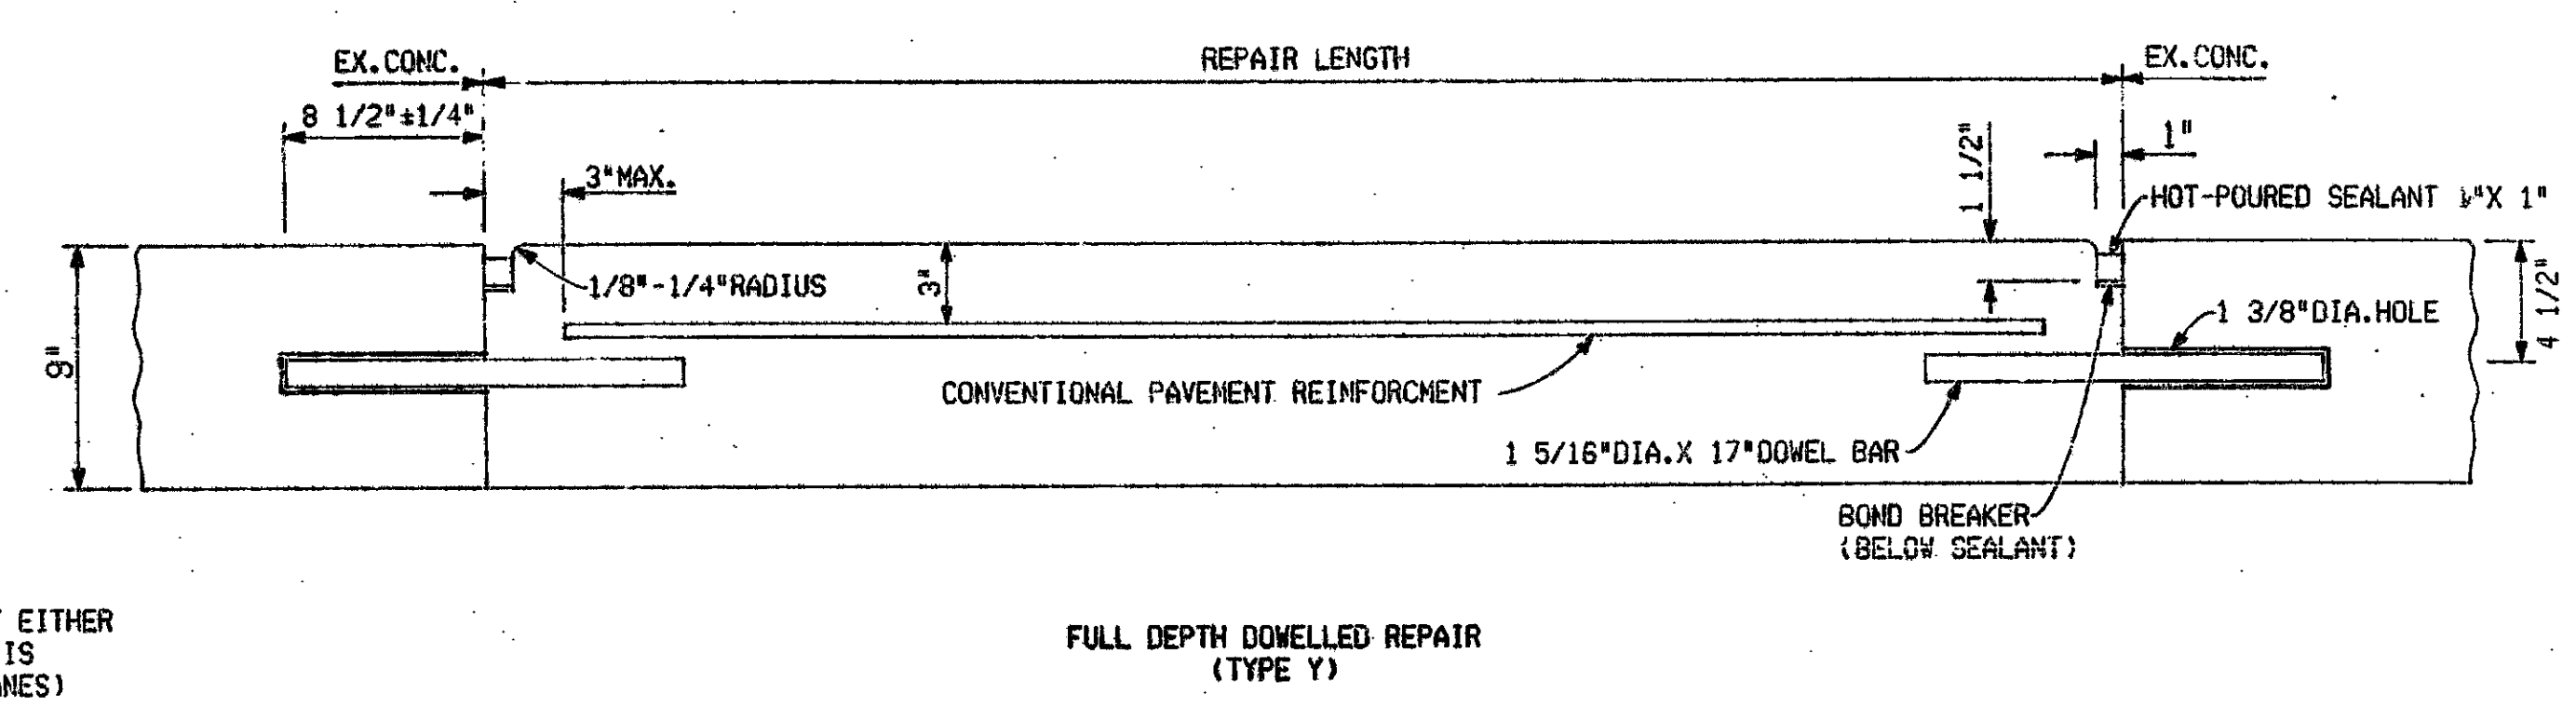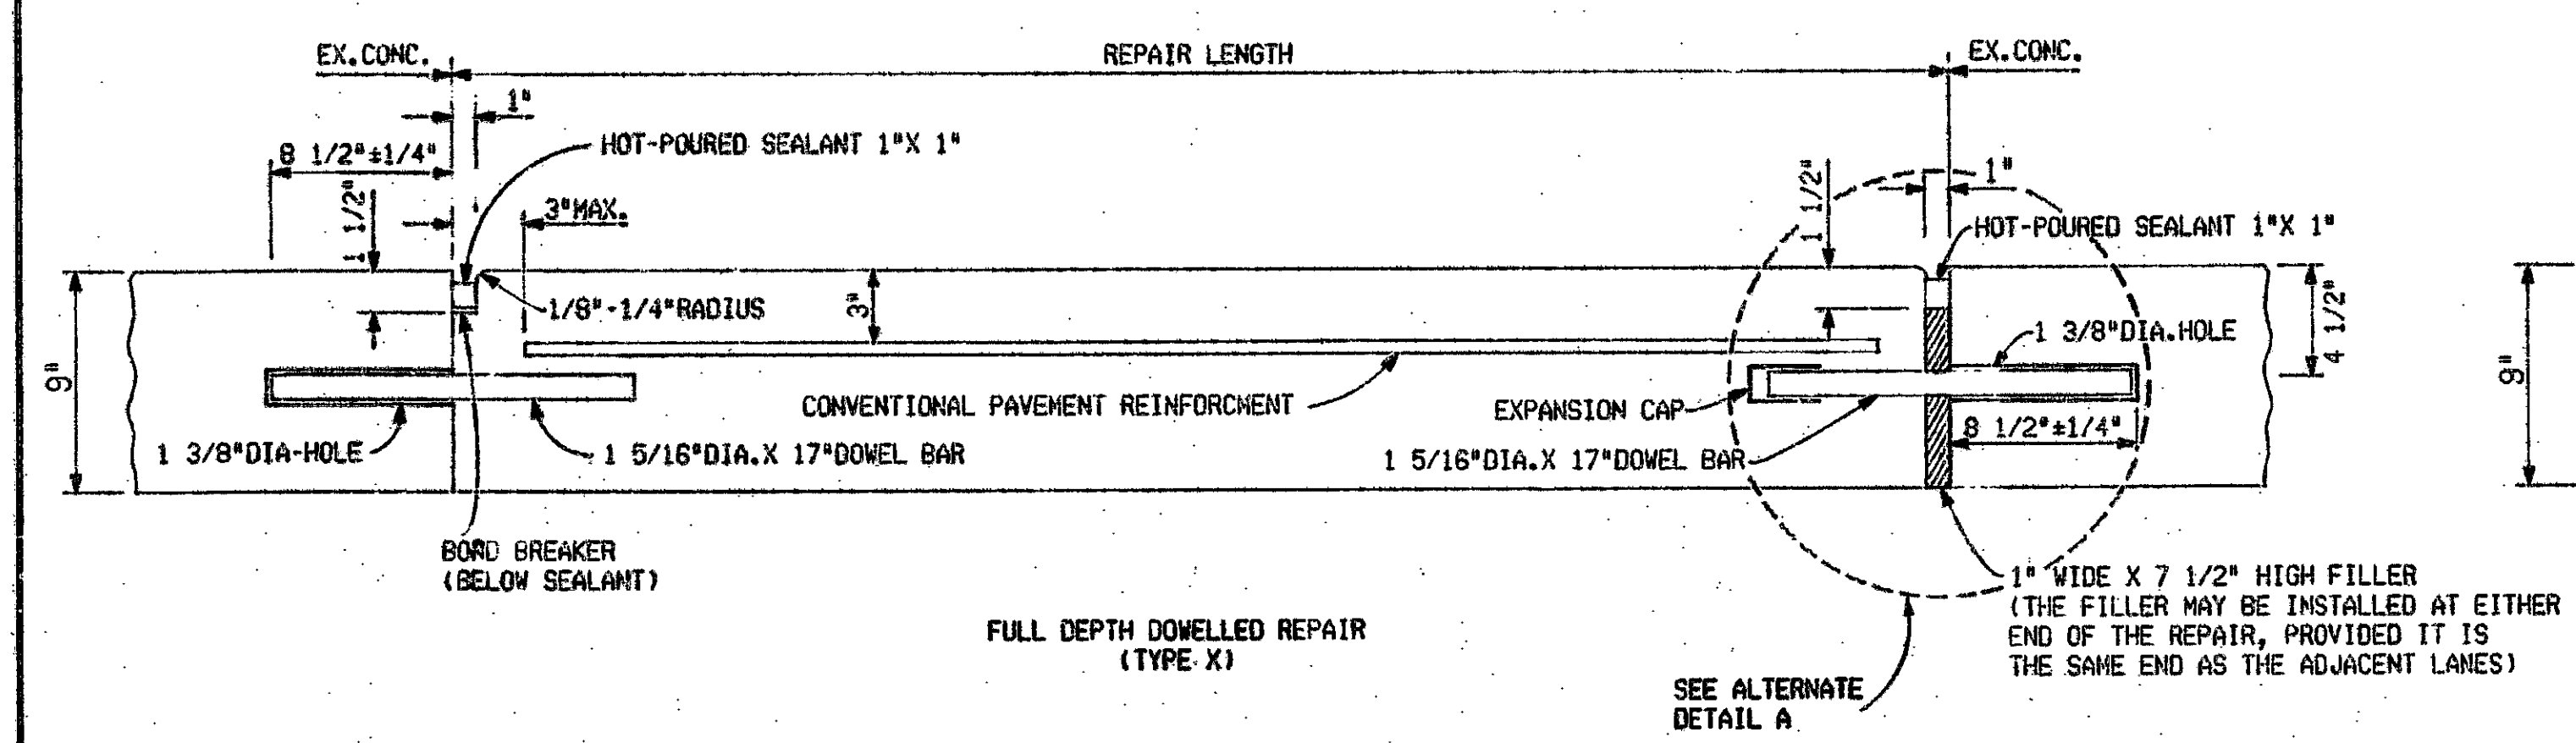


NOTE: THE HOLE SPACING MAY BE ADJUSTED 1" HORIZONTALLY, RAISED 1/2", OR LOWERED 1" FROM THE ABOVE LOCATIONS TO AVOID DRILLING INTO THE REINFORCEMENT.

DOWEL BAR SPACING FOR TYPE X AND TYPE Y REPAIRS

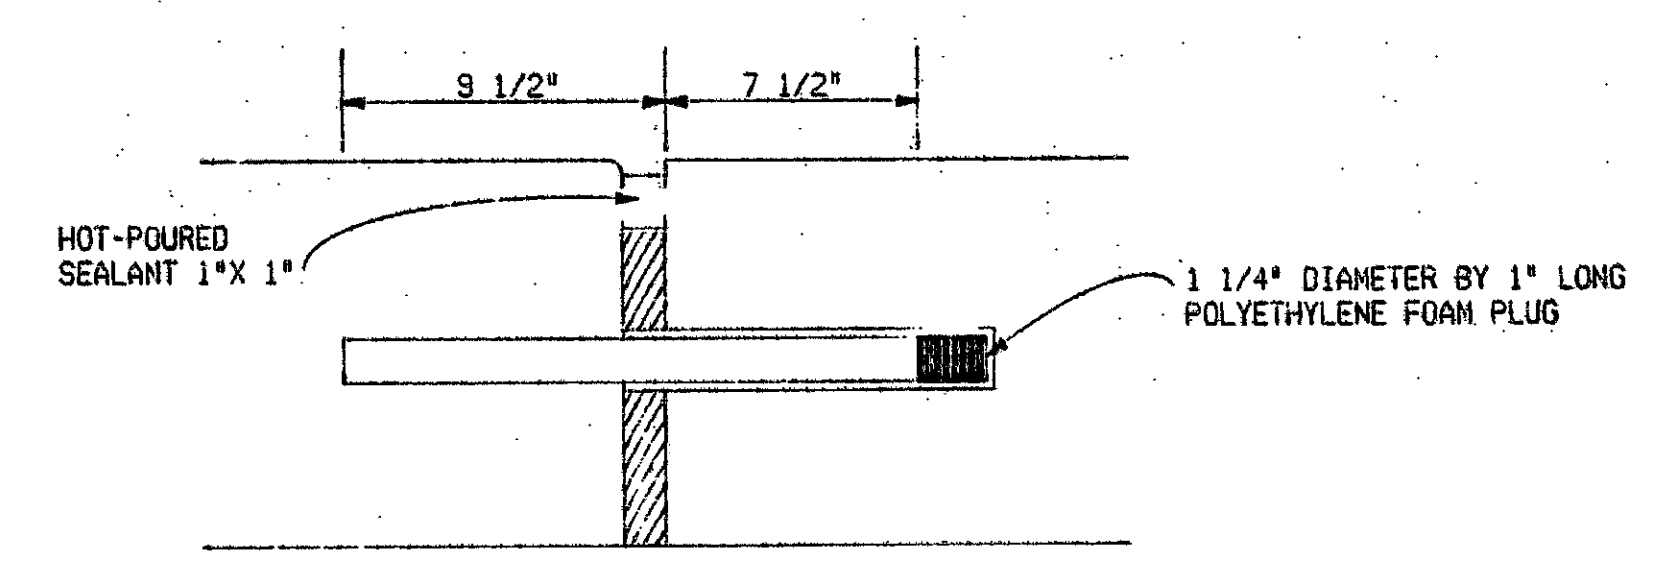


ALTERNATE DETAIL A

NOTE: FOR ADDITIONAL INFORMATION ON THE EXPANSION JOINT DETAIL AND ALTERNATE DETAIL A, REFER TO THE SPECIAL PROVISION FOR FULL DEPTH DOWELLED REPAIRS TYPE X AND TYPE Y.
 A BOND BREAKING COAT OF LIQUID ASPHALT (NGDT RC-250) IS REQUIRED ON THE PORTION OF THE DOWEL BAR EXTENDING INTO THE NEW CONCRETE WHEN EXPANSION CAPS ARE USED.


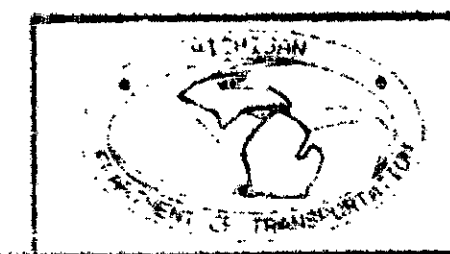


SPECIAL DETAIL - JOINT REPAIR SHEET						
DATE	SCALE	CONT. SEC.	JOB NO.	DESIGN UNIT	SHEET NO.	
11/29/82	1" =	63174	18874A	CHRISTY	R.O.V. CONST.	10

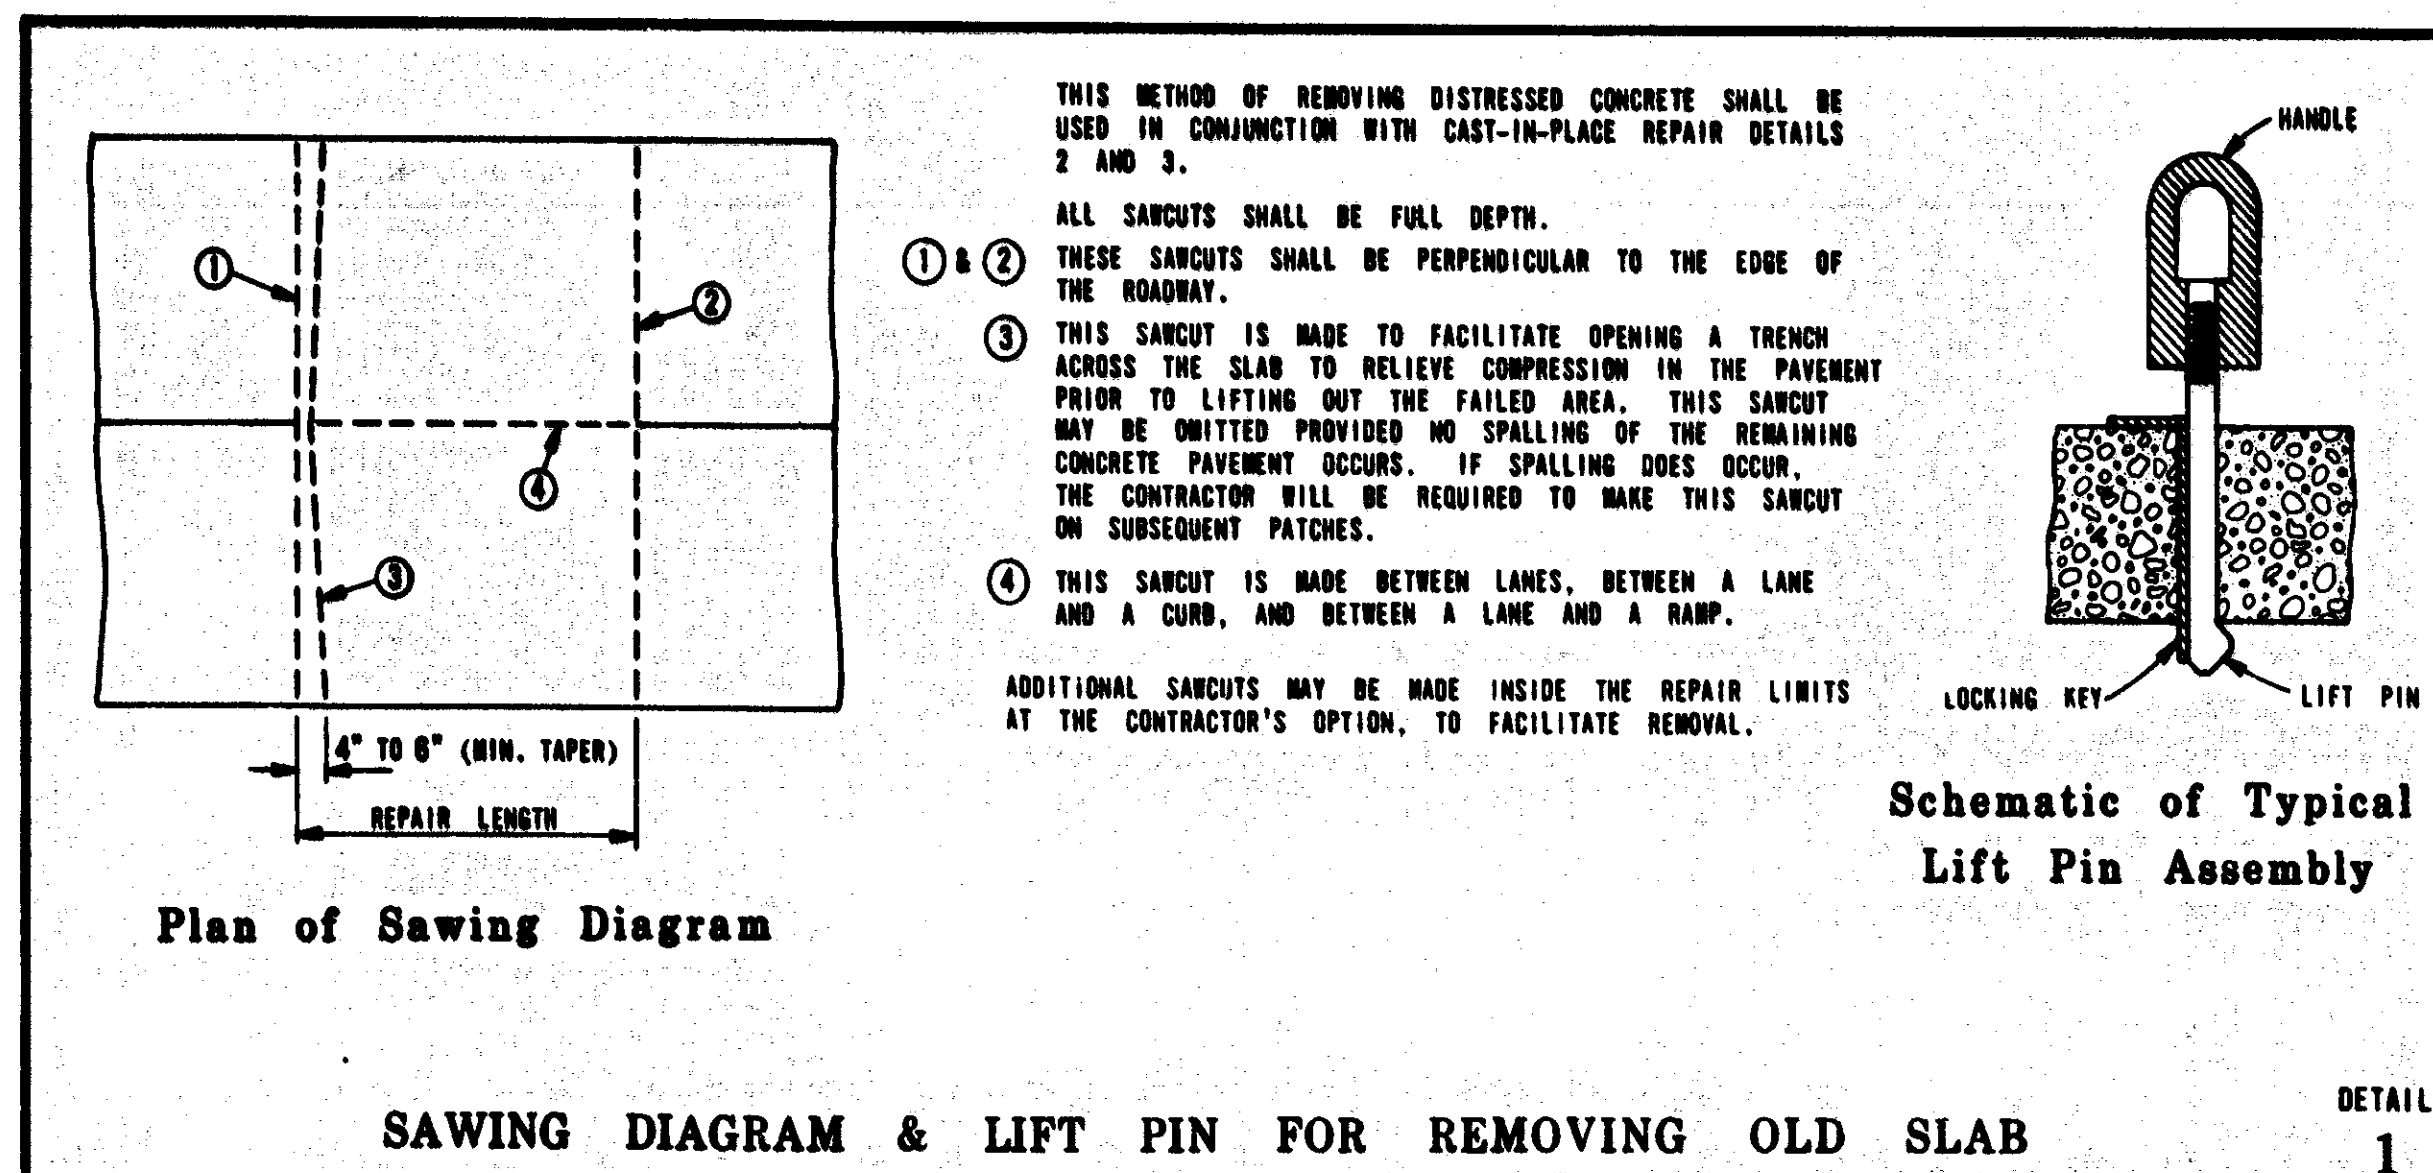

SAWING DIAGRAM & LIFT PIN FOR REMOVING OLD SLAB

DETAIL 1


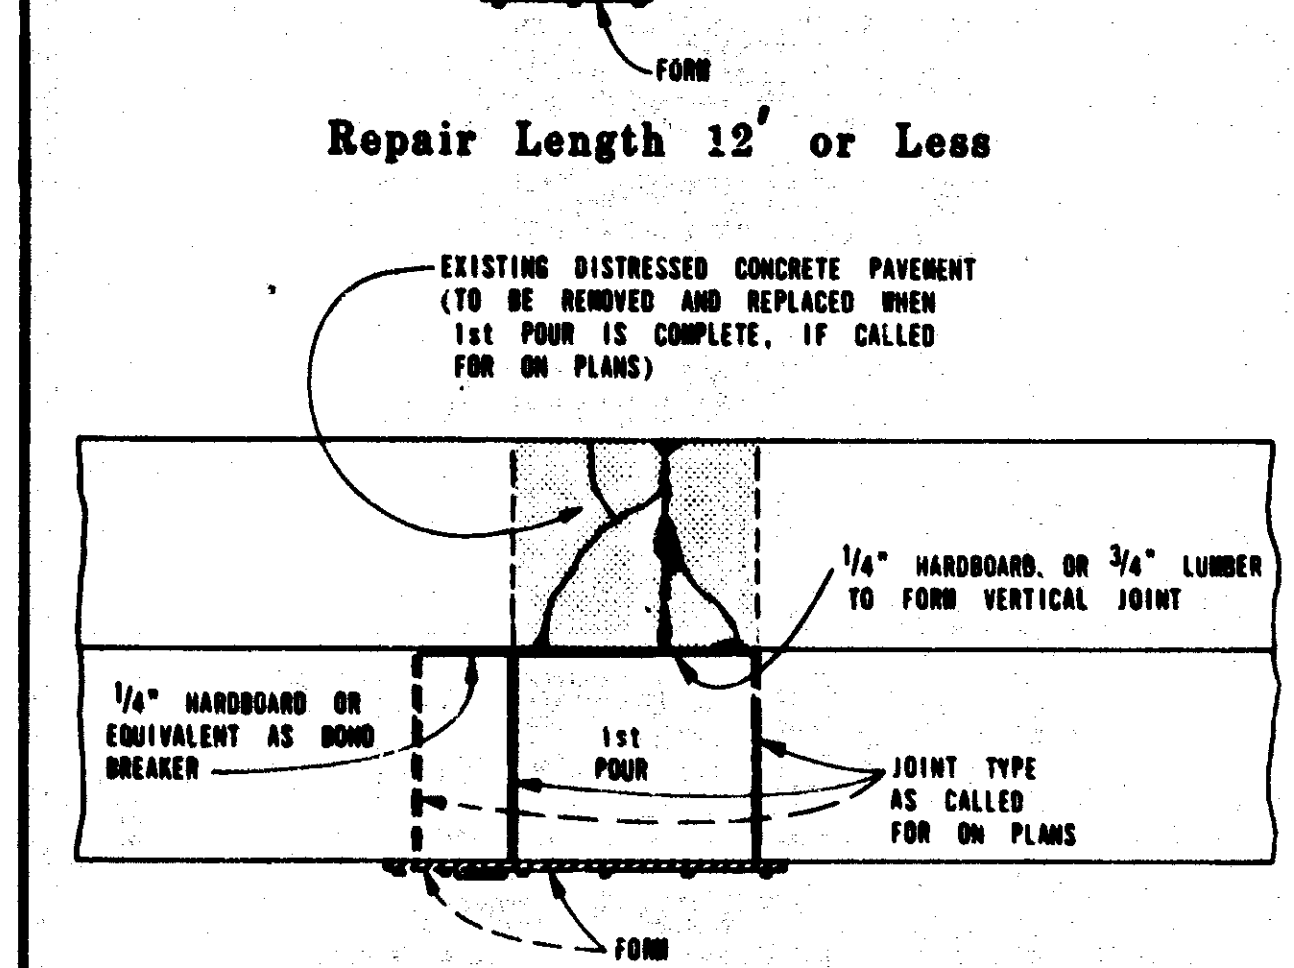
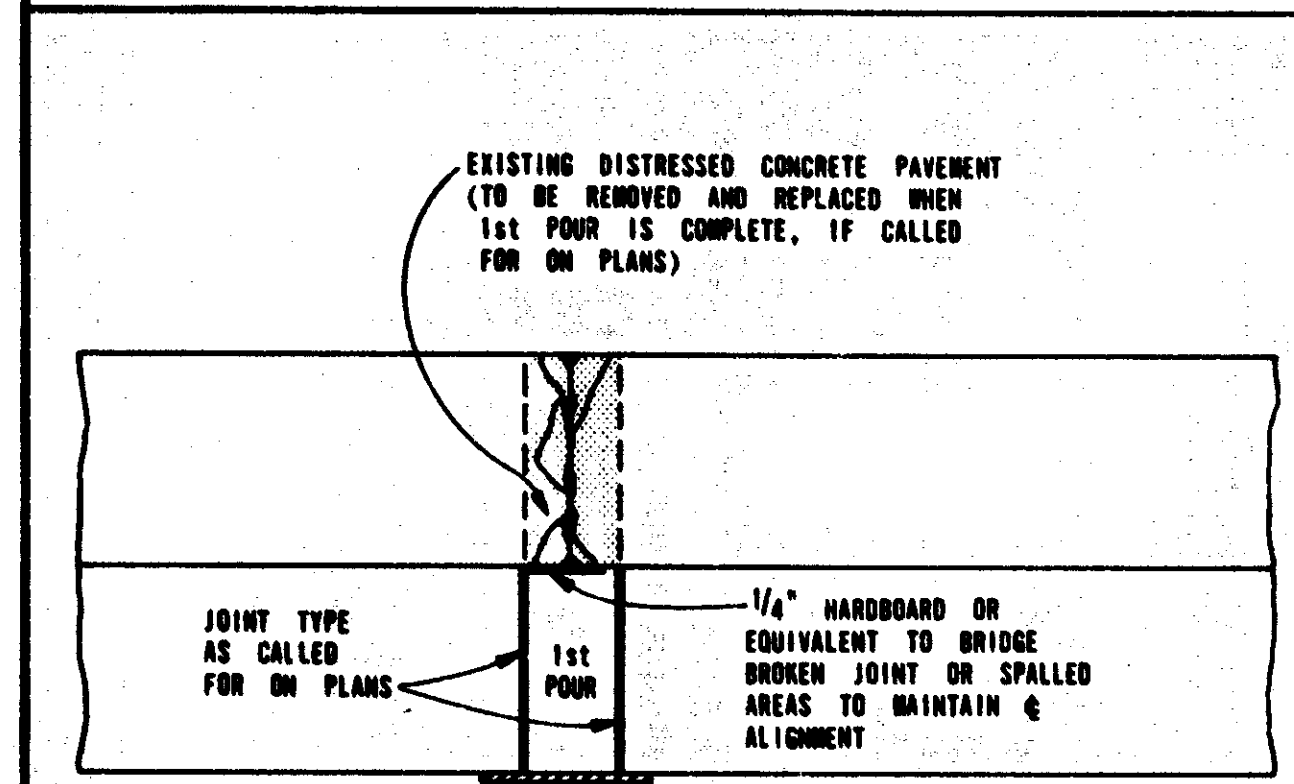


WHERE REPAIRS LONGER THAN 12 FEET ARE REQUIRED, A NEW GRADE MUST BE ESTABLISHED ALONG THE OLD PAVEMENT INNER JOINT LINE INDEPENDENT OF THE OLD PAVEMENT SURFACE, SO THAT SCREEDING MAY BE DONE PERPENDICULAR TO THE CENTERLINE.

NOTE: STAKES USED TO HOLD BITUMINOUS FILLER OR HARDBOARD IN PLACE DURING CONCRETE PLACEMENT SHALL BE REMOVED BEFORE SCREEDING THE CONCRETE.

FORMING REQUIREMENTS FOR CAST-IN-PLACE REPAIR


DETAIL 2

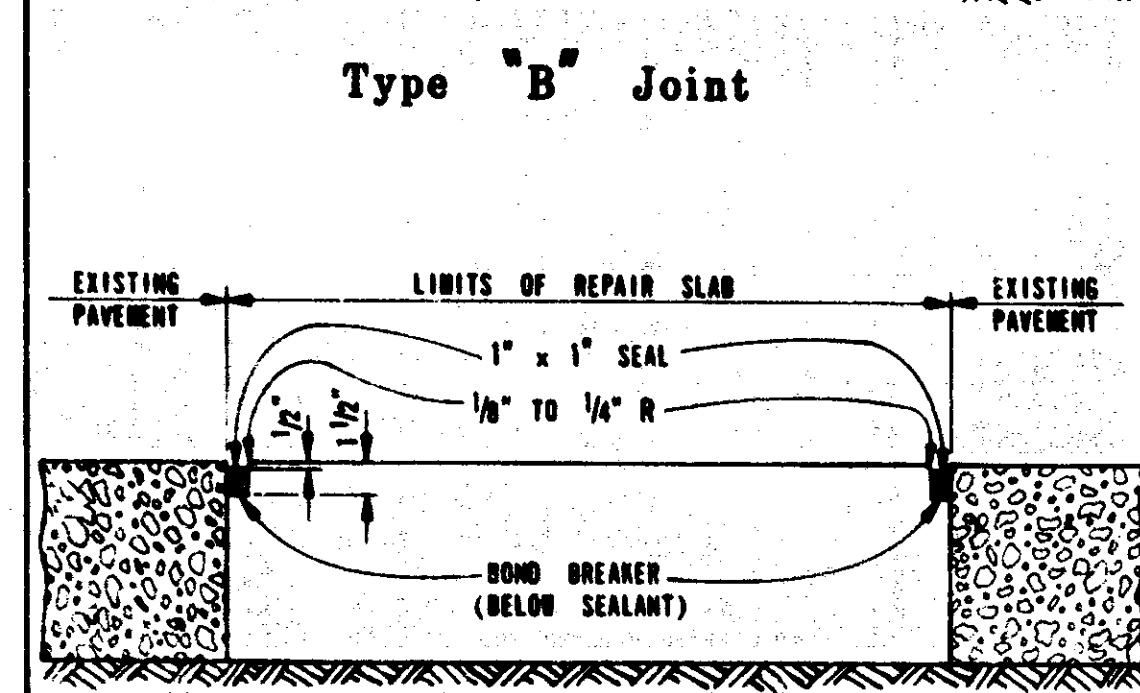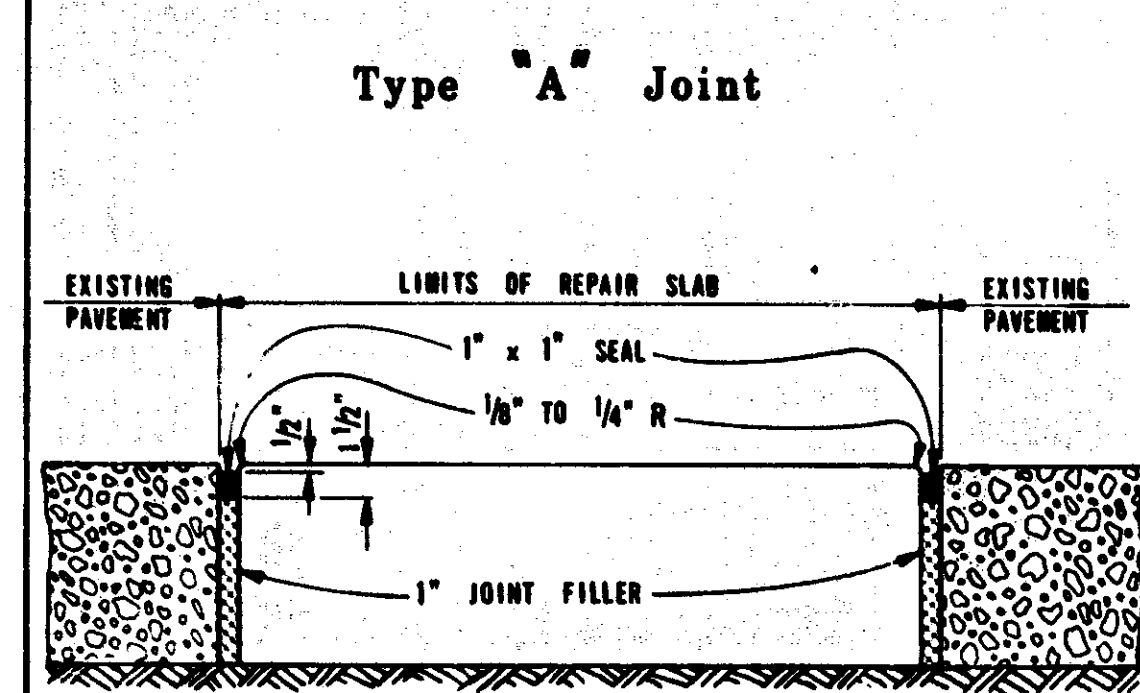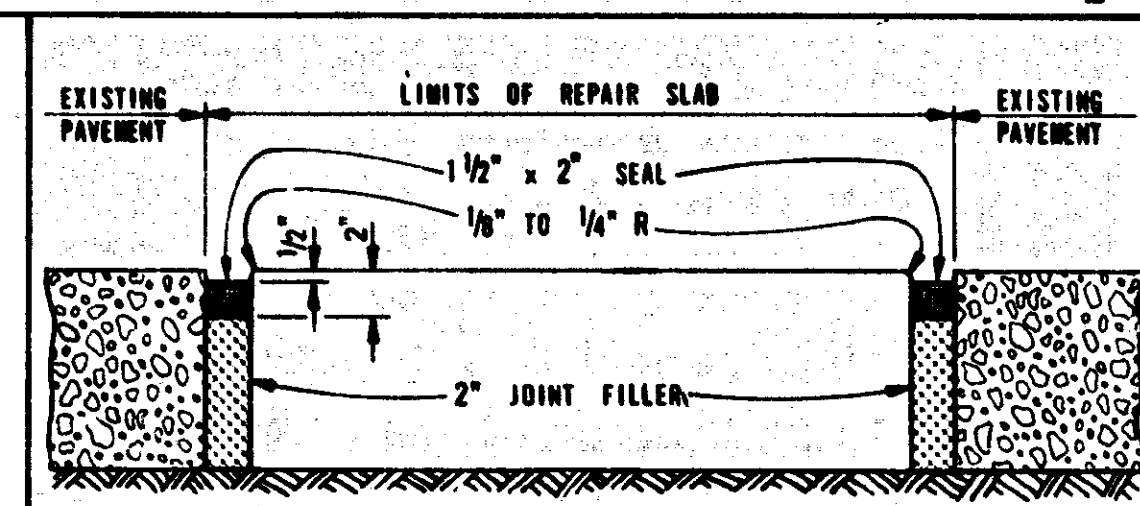

NOTE: WHEN PLACING CONCRETE PAVEMENT PATCHES IN BITUMINOUS OVER CONCRETE PAVEMENTS, THE PATCH SHALL BE CONSTRUCTED AS SHOWN ABOVE WITH TOP OF PATCH LEVEL WITH TOP OF EXISTING BITUMINOUS SURFACE.


CAST-IN-PLACE REPAIR JOINTS

DETAIL 3

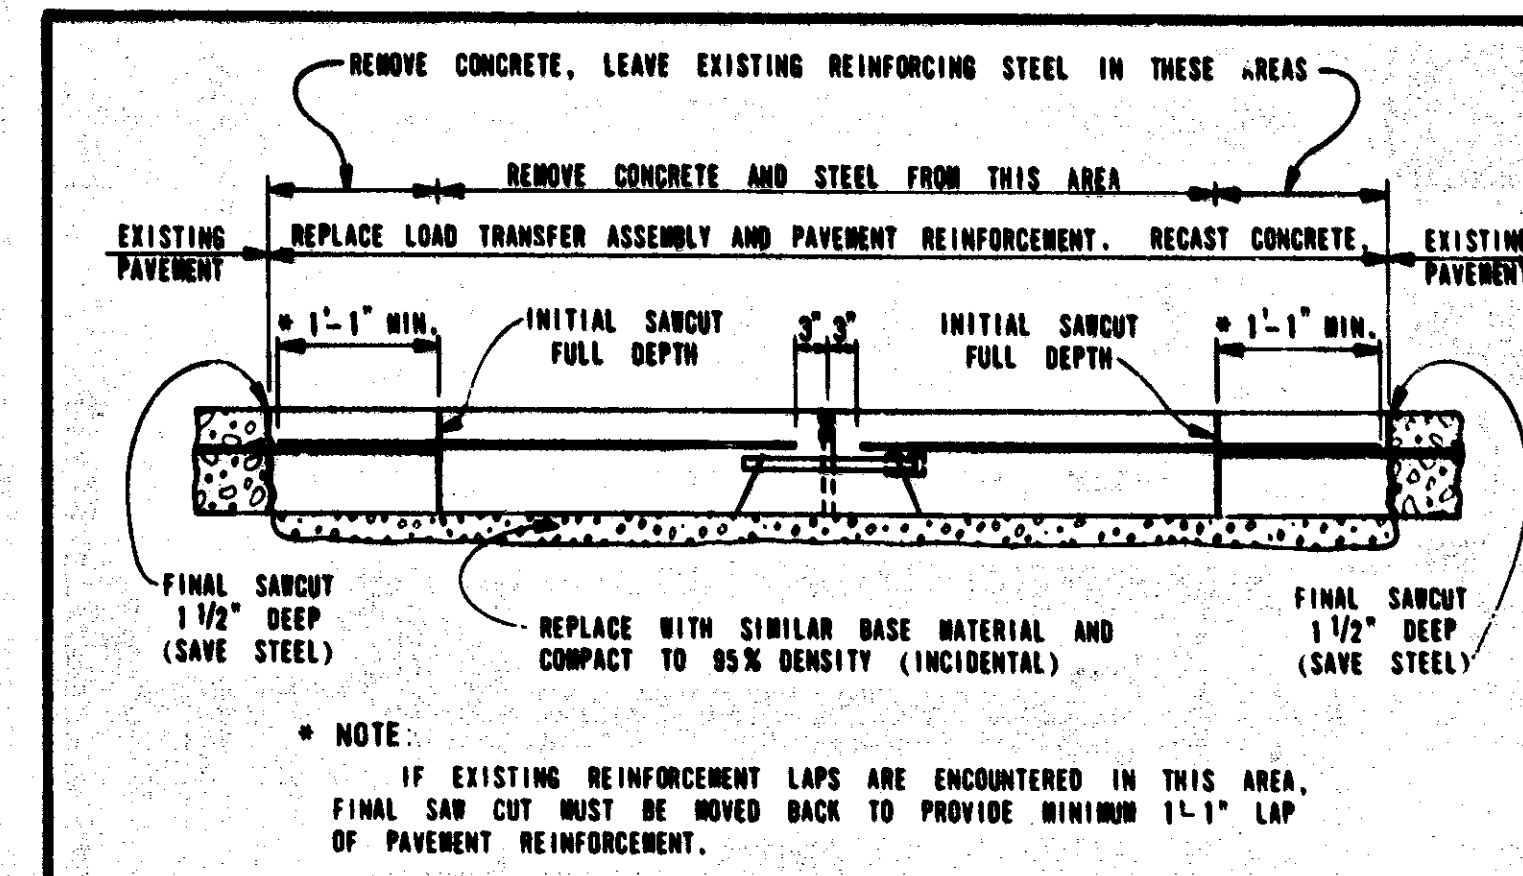



TRANSVERSE JOINT REPAIR USING LOAD TRANSFER ASSEMBLY

(CONTRACTION JOINT) 4
(EXPANSION JOINT) 4A

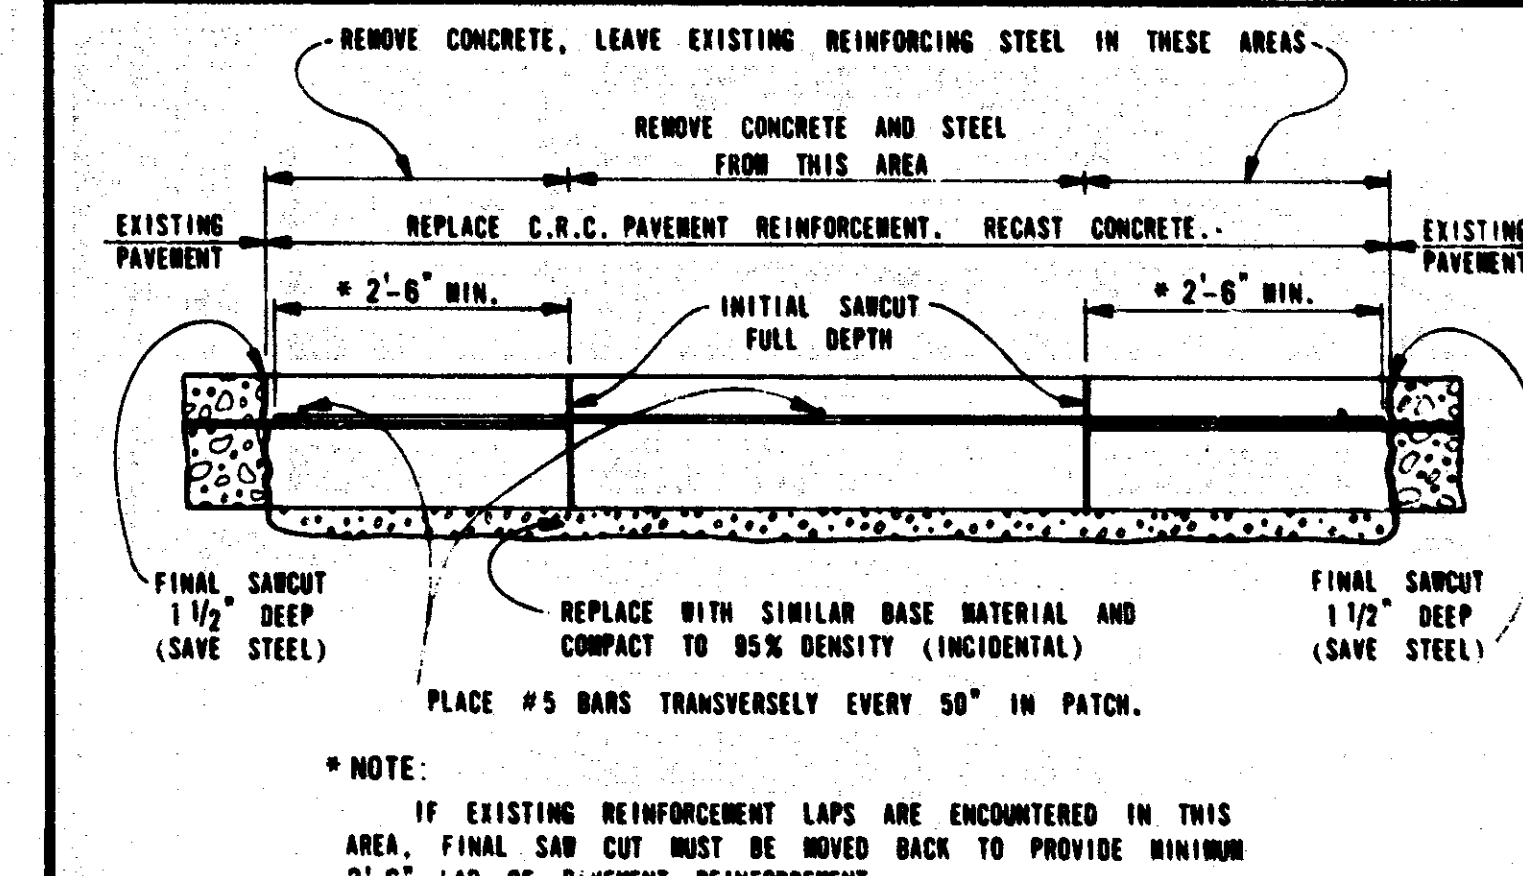


PATCHING CONTINUOUSLY REINFORCED CONCRETE

DETAIL 5

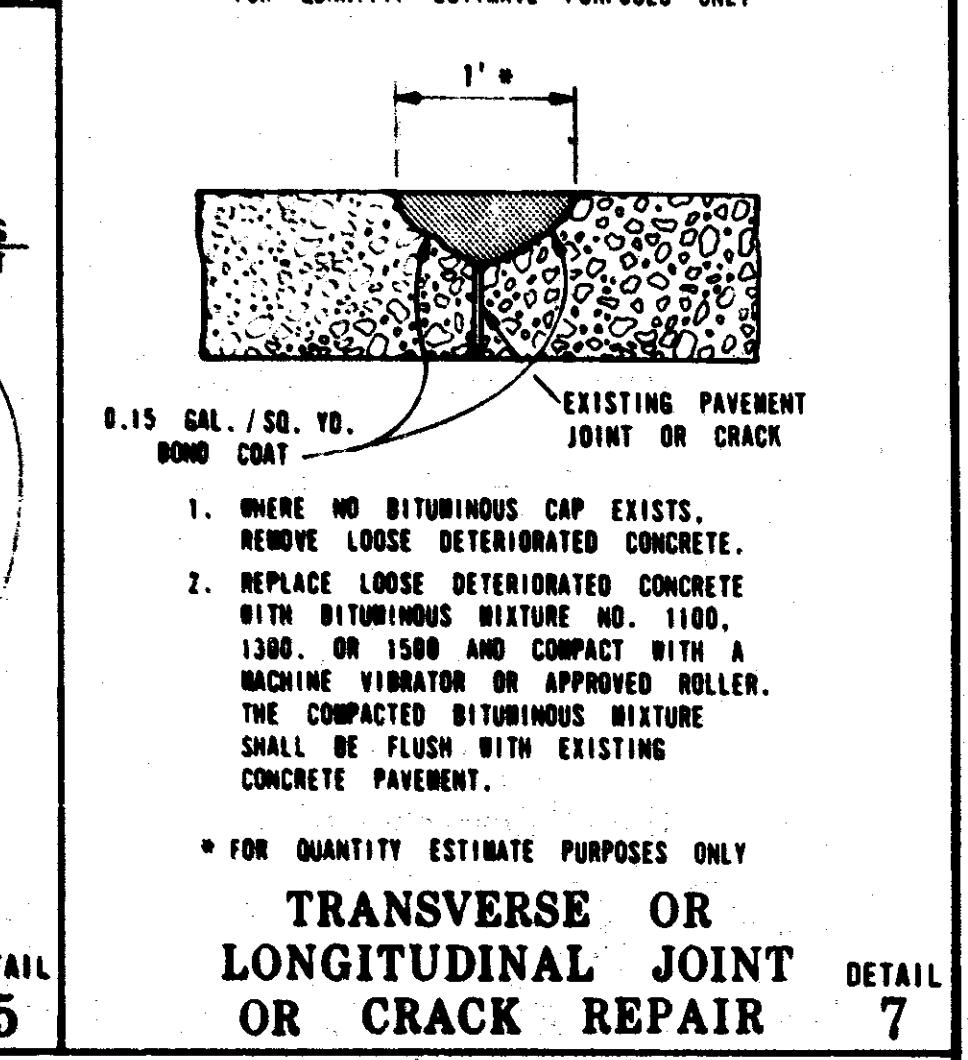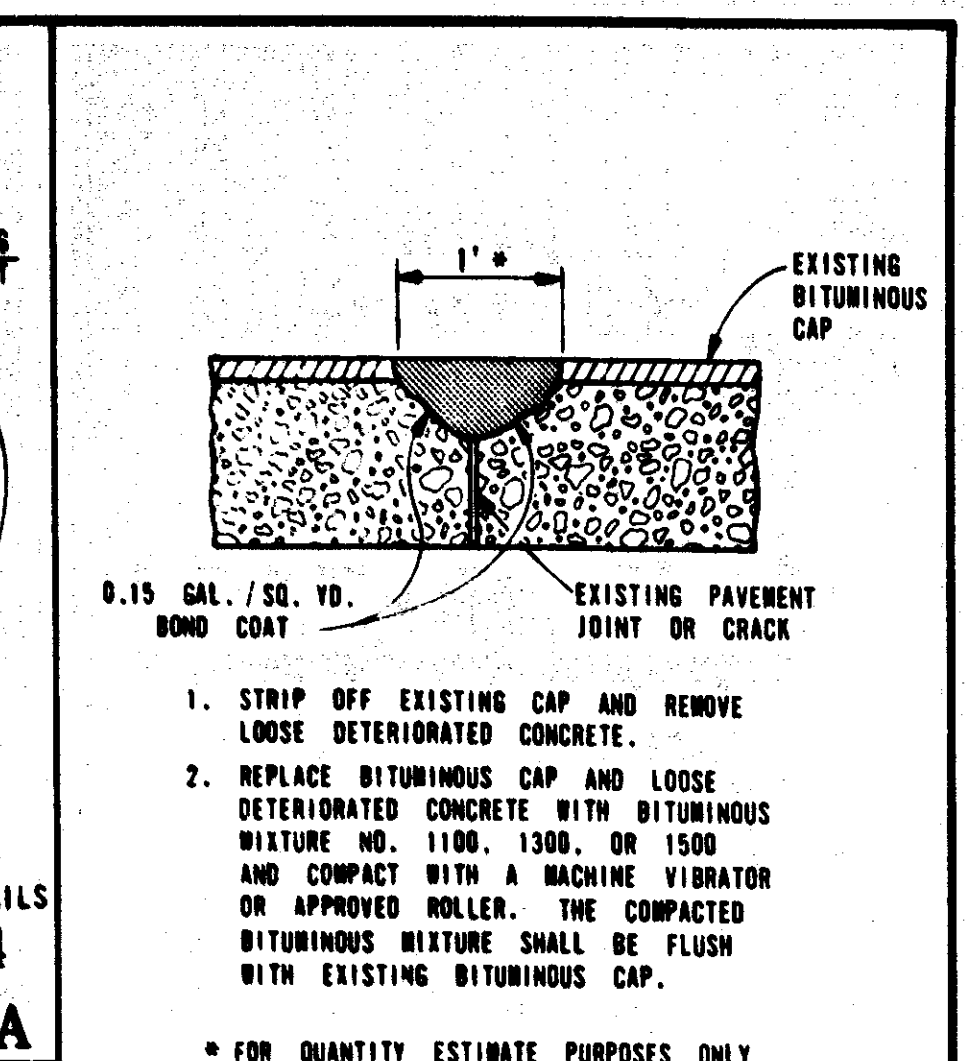


DETAIL 7

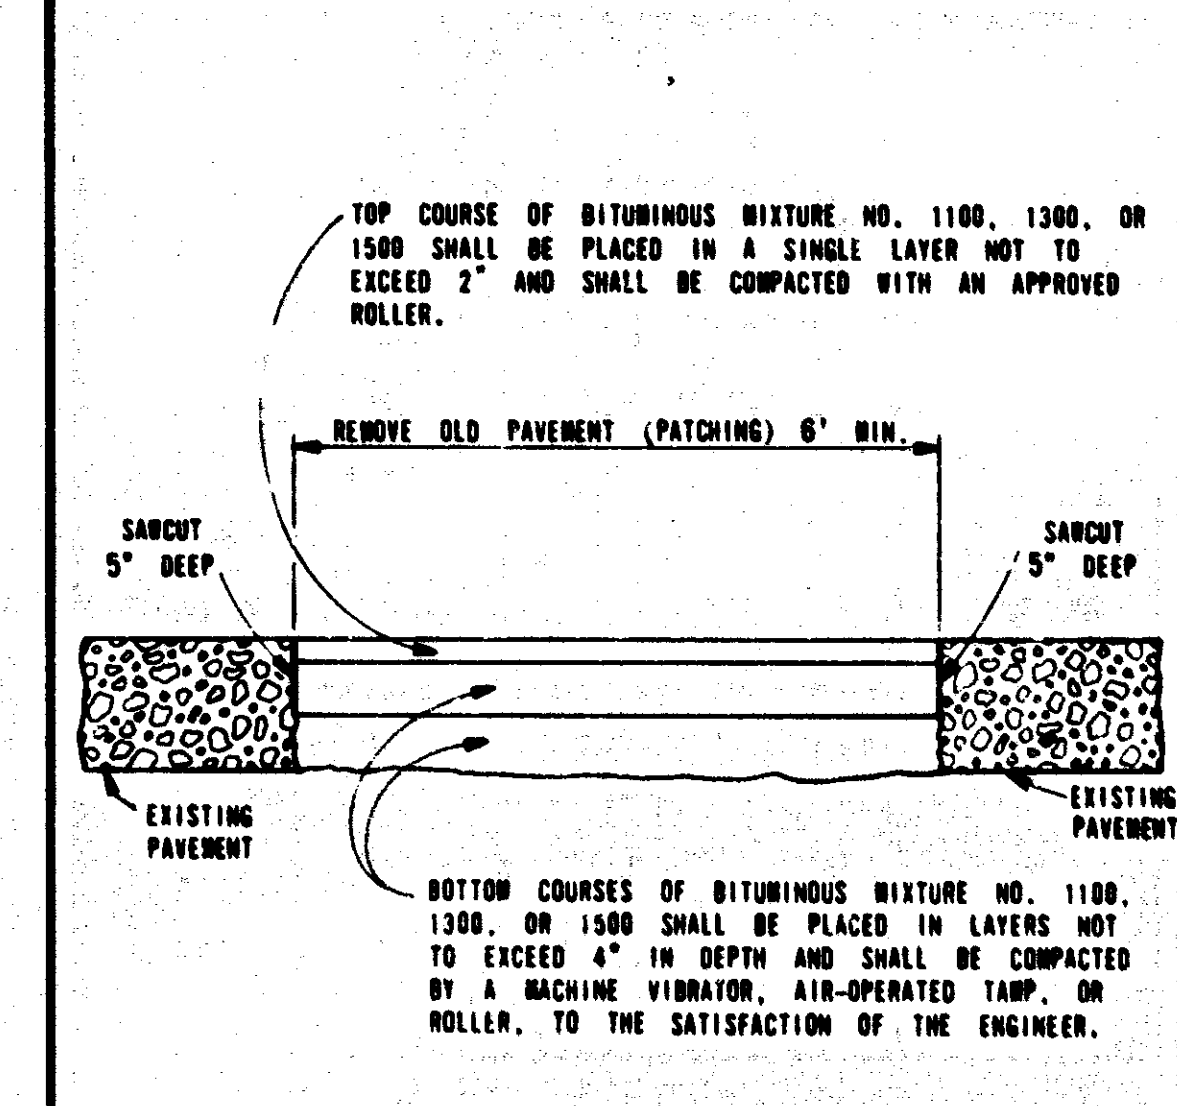

PATCHING WITH BITUMINOUS MATERIAL

DETAIL 6

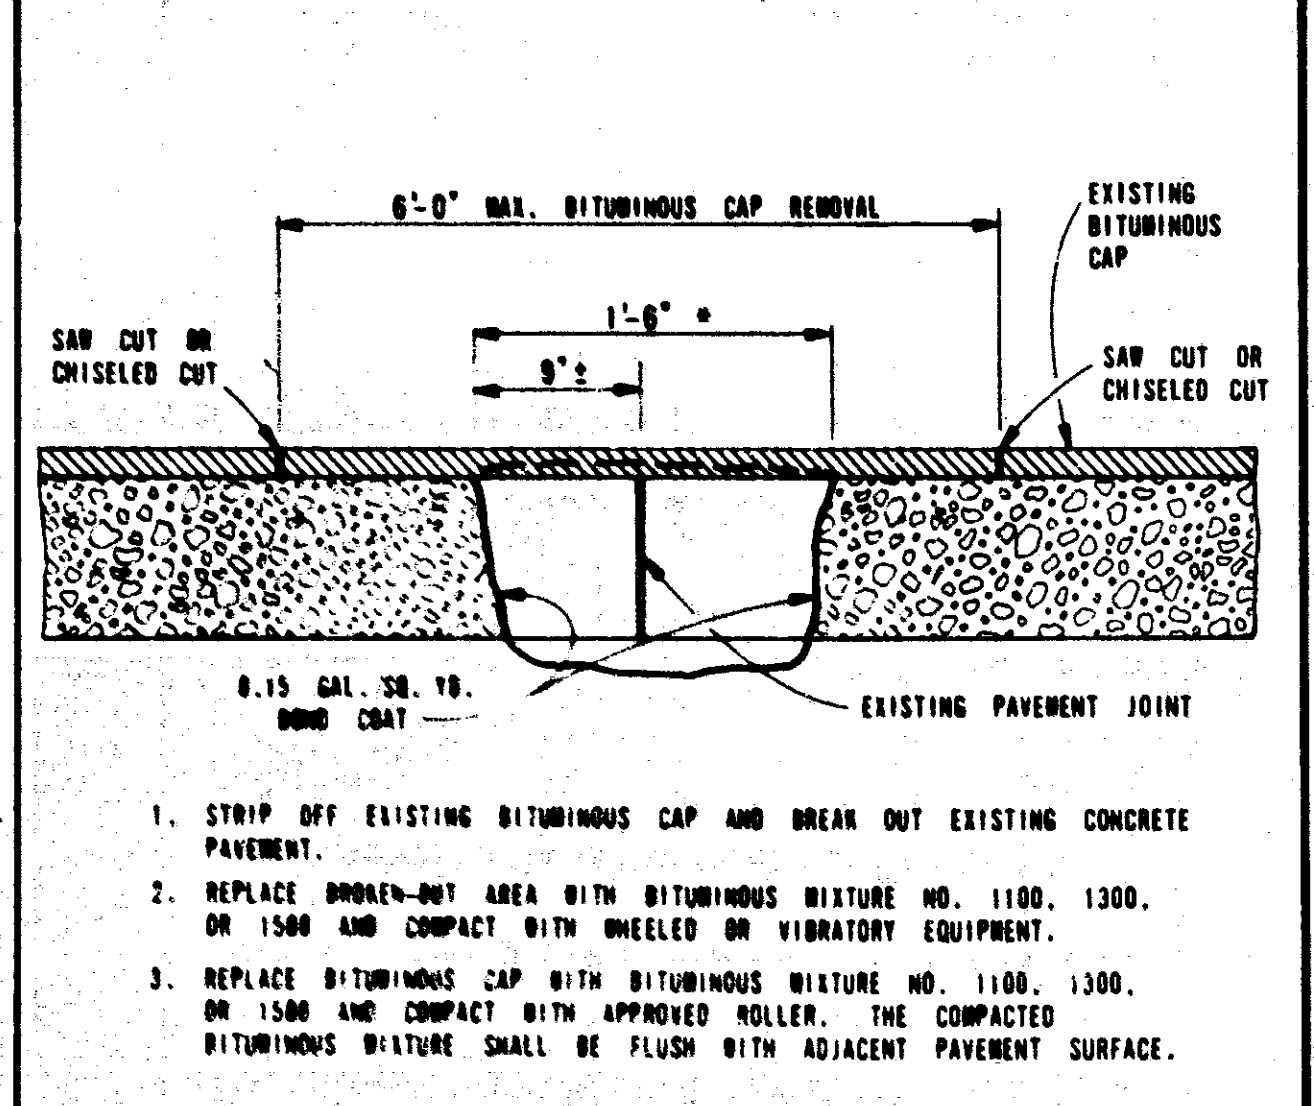

TRANSVERSE JOINT REPAIR

DETAIL 8

PREPARED BY DESIGN DIVISION

ENGINEER OF CONSTRUCTION: *H. B. Le... & ...*

ENGINEER OF MAINTENANCE: *Donald E. ...*

ENGINEER OF DESIGN: *W. J. Mac... & ...*

ENGINEER OF TESTING AND RESEARCH: *K. A. Allen...*

ENGINEER OF TRAFFIC AND SAFETY: *M. W. ...*

DEPARTMENT DIRECTOR: *JOHN P. WOODFORD*

DEPUTY DIRECTOR - HIGHWAYS: *...*

DRAWN BY: H.A.W.

CHECKED BY: V.R.

MICHIGAN DEPARTMENT OF TRANSPORTATION
BUREAU OF HIGHWAYS STANDARD PLAN FOR

CONCRETE PAVEMENT REPAIR

8-6-82

II-44E

SHEET 1 OF 3

F.N.B.A. APPROVAL

PLAN DATE

PREPARED BY DESIGN DIVISION

ENGINEER OF CONSTRUCTION: *H. B. Le... & ...*

ENGINEER OF MAINTENANCE: *Donald E. ...*

ENGINEER OF DESIGN: *W. J. Mac... & ...*

ENGINEER OF TESTING AND RESEARCH: *K. A. Allen...*

ENGINEER OF TRAFFIC AND SAFETY: *M. W. ...*

DEPARTMENT DIRECTOR: *JOHN P. WOODFORD*

DEPUTY DIRECTOR - HIGHWAYS: *...*

DRAWN BY: H.A.W.

CHECKED BY: V.R.

MICHIGAN DEPARTMENT OF TRANSPORTATION
BUREAU OF HIGHWAYS STANDARD PLAN FOR

CONCRETE PAVEMENT REPAIR


8-6-82

II-44E

SHEET 2 OF 3


F.N.B.A. APPROVAL

PLAN DATE

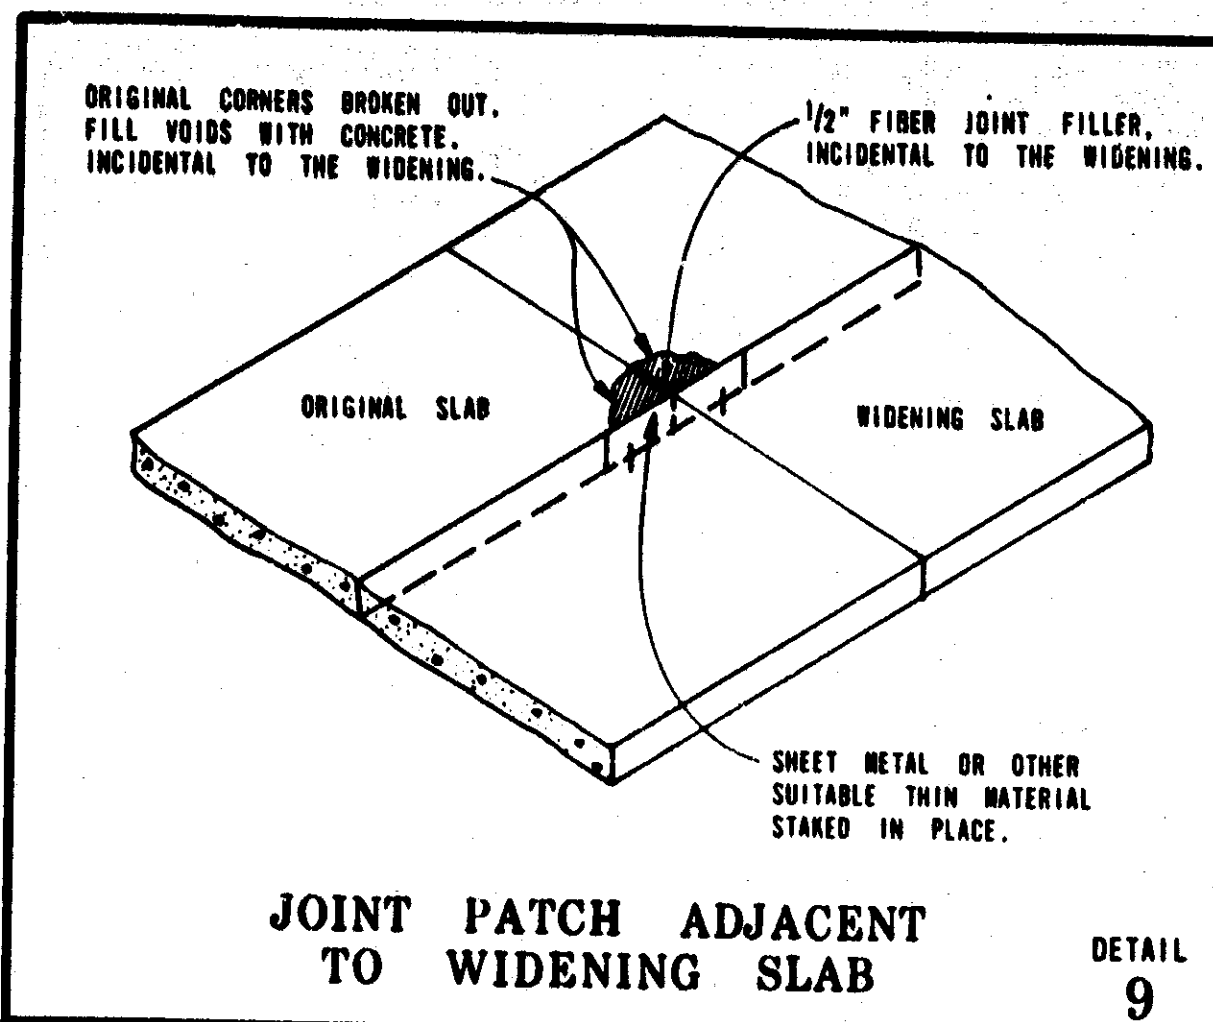


JOINT PATCH ADJACENT TO WIDENING SLAB

DETAIL 9

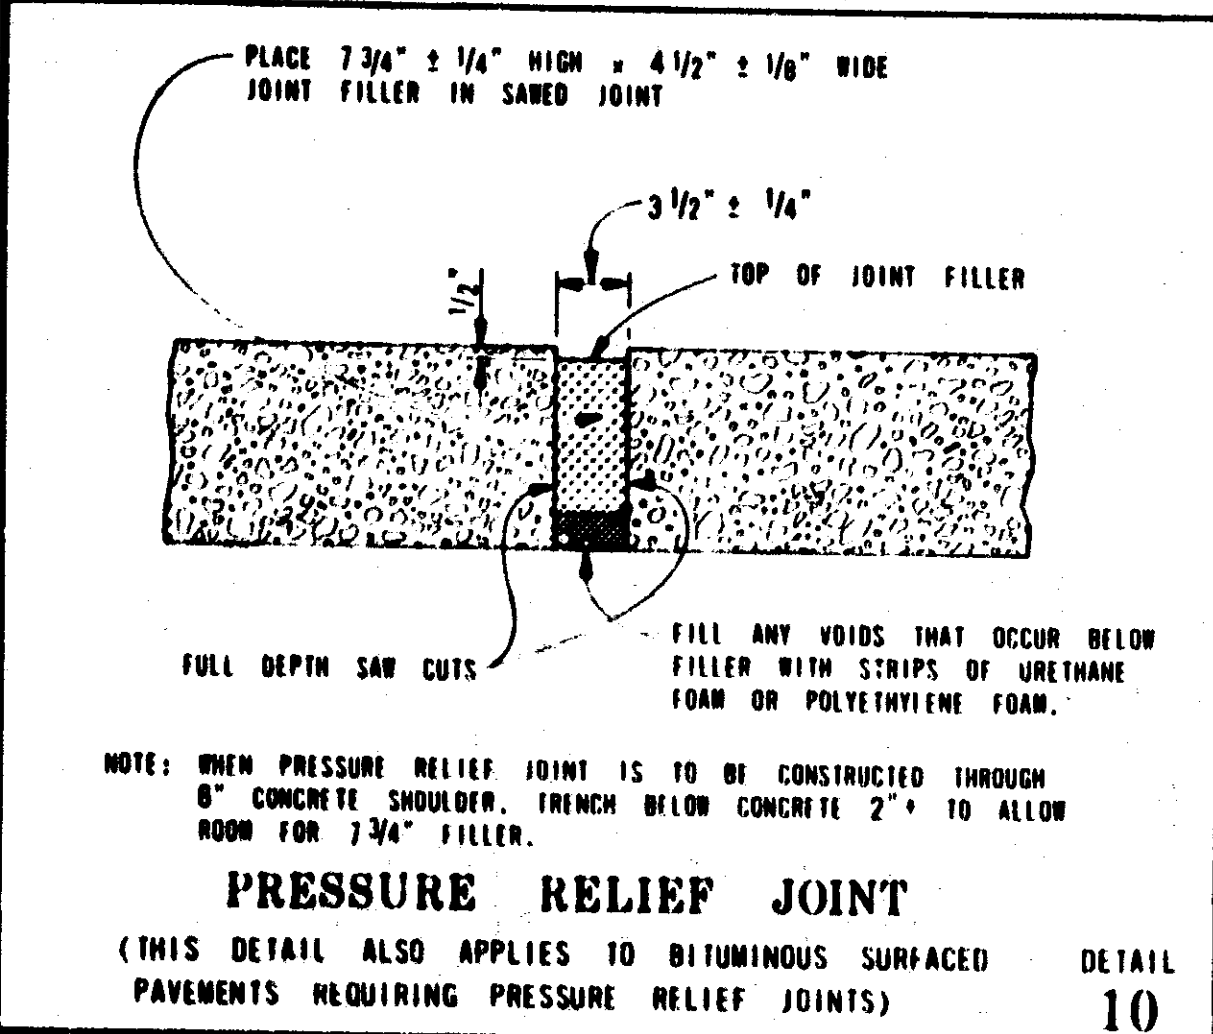

PRESSURE RELIEF JOINT

DETAIL 10

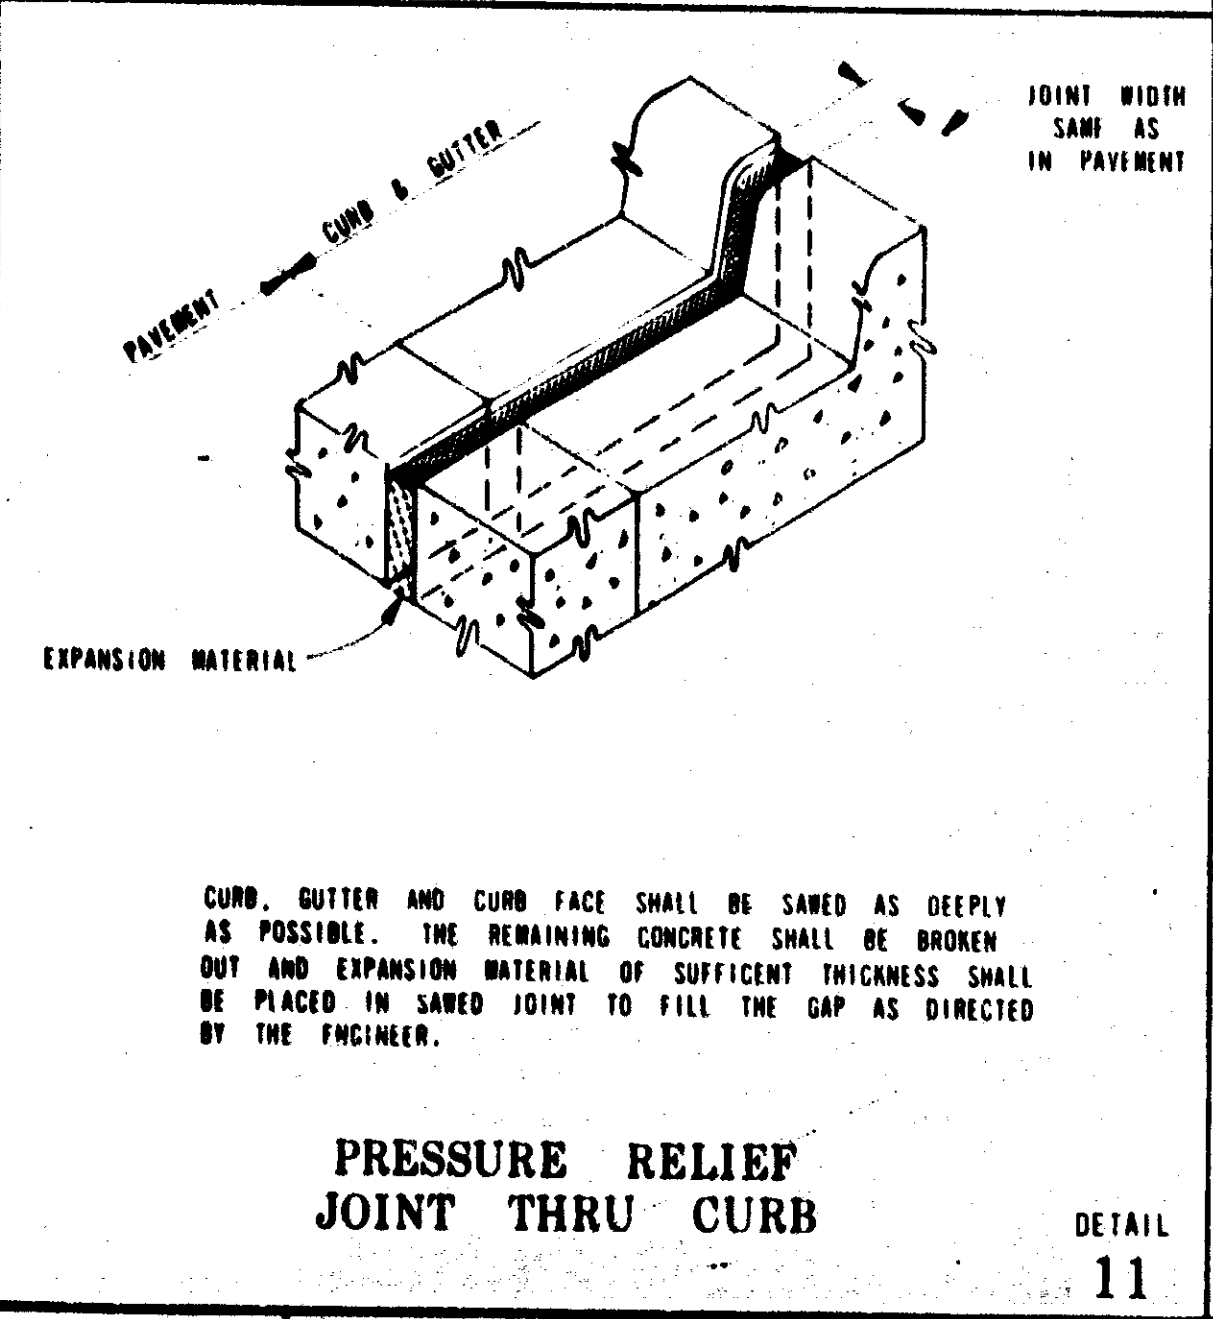

PRESSURE RELIEF JOINT THRU CURB

DETAIL 11

NOTES APPLYING TO STANDARD PLAN II-44E:

CONCRETE PAVEMENT REPAIR OR EXPANSION RELIEF DETAIL WILL BE AS CALLED FOR ON PLANS OR IN LOG OF PROJECT.

IF EXISTING PAVEMENT HAS AN ASPHALT SURFACE, THE SAW CUTS SHALL EXTEND THE DEPTH SHOWN INTO THE PORTLAND CEMENT CONCRETE.

WHEN CONCRETE PAVEMENT PATCHES ARE LONGER THAN 20' AND ARE TO BE RESURFACED, TRANSVERSE PLANE OF WEARNESS JOINTS, SYMBOL (U), SHALL BE PLACED IN LINE WITH EXISTING TRANSVERSE JOINTS, WORKING CRACKS, OR AT 20-FOOT MAX., 8-FOOT MIN. INTERVALS. TRANSVERSE PLANE OF WEARNESS JOINTS, SYMBOL (D1), SHALL BE PLACED IN CONCRETE PAVEMENT PATCHES NOT TO BE RESURFACED AS SHOWN IN (DETAIL 12). FOR SYMBOL (U) AND SYMBOL (D1) JOINTS, SEE STANDARD PLAN II-39 SERIES.

WHEN CAST-IN-PLACE REPAIRS ARE MADE IN JOINTED PAVEMENT, STANDARD PAVEMENT REINFORCEMENT SHALL BE USED TO REINFORCE CONCRETE PATCHES 10' OR LONGER.

WHEN PATCHING PAVEMENTS WITH CAST-IN-PLACE REPAIR JOINTS (DETAIL 3), THE JOINT TYPES SELECTED SHOULD PROVIDE FOR NO MORE EXPANSION SPACE THAN 4" IN 850' FOR PAVEMENTS WITH 90' JOINT SPACING, OR 2" IN 850' FOR PAVEMENTS WITH 71' JOINT SPACING AND NEOPRENE SEALS.

EXPANSION SPACE SHOULD BE DISTRIBUTED THROUGHOUT THE SECTION RATHER THAN INSTALLING IT ALL AT ONE LOCATION. TO ALLOW FOR DISTRIBUTION OF PAVEMENT EXPANSION, CAST-IN-PLACE PATCHES MAY HAVE A TYPE "C" JOINT ON ONE END AND A TYPE "A" OR "B" JOINT ON THE OTHER END. TYPE "A" JOINTS SHOULD NOT BE USED IN PATCHES ON NEOPRENE SEALED PAVEMENTS.

WHEN THERE ARE NO REPAIR LOCATIONS WITHIN AN 850' LENGTH, NO EXPANSION SPACE WILL BE REQUIRED.

EQUAL EXPANSION SPACE SHOULD BE PROVIDED IN ADJACENT LANES. TYPE "C" JOINTS SHOULD BE USED IN PATCHES WHICH DO NOT EXTEND ACROSS ALL LANES.

WHEN CAST-IN-PLACE REPAIR JOINT TYPES "A" AND "B" ARE PLACED ADJACENT TO CONCRETE CURB AND GUTTER AND WHERE REMOVAL OF CURB AND GUTTER IS NOT NECESSARY AS DETERMINED BY THE ENGINEER, AN EQUIVALENT EXPANSION JOINT WIDTH PER PATCH SHALL BE PROVIDED IN THE CURB AND GUTTER.


TRANSVERSE JOINTS (DETAIL 3) SHALL BE SANDBLASTED FOLLOWED BY A FINAL CLEANING WITH OIL-FREE COMPRESSED AIR PRIOR TO SEALING WITH HOT-POURED RUBBER-ASPHALT JOINT SEALER. BOND BREAKER (ALSO SHOWN IN DETAIL 3) SHALL BE PRESSURE SENSITIVE SILICONE BACKED TAPE OR AN EQUIVALENT APPROVED BY THE ENGINEER.

THE PAVEMENT REINFORCEMENT SHALL BE PLACED 3" BELOW FINISHED SURFACE.

TRANSVERSE JOINTS (DETAIL 4 AND 4A) SHALL BE SEALED IN ACCORDANCE WITH STANDARD PLAN II 30 SERIES.

SAWING OVERCUTS OCCURRING IN ADJACENT SLAB, GUTTER, OR SHOULDER, WHICH WILL REMAIN IN PLACE, SHALL BE SEALED.

THE DATE OF CASTING SHALL BE STENCILLED ON EACH CONCRETE PATCH.

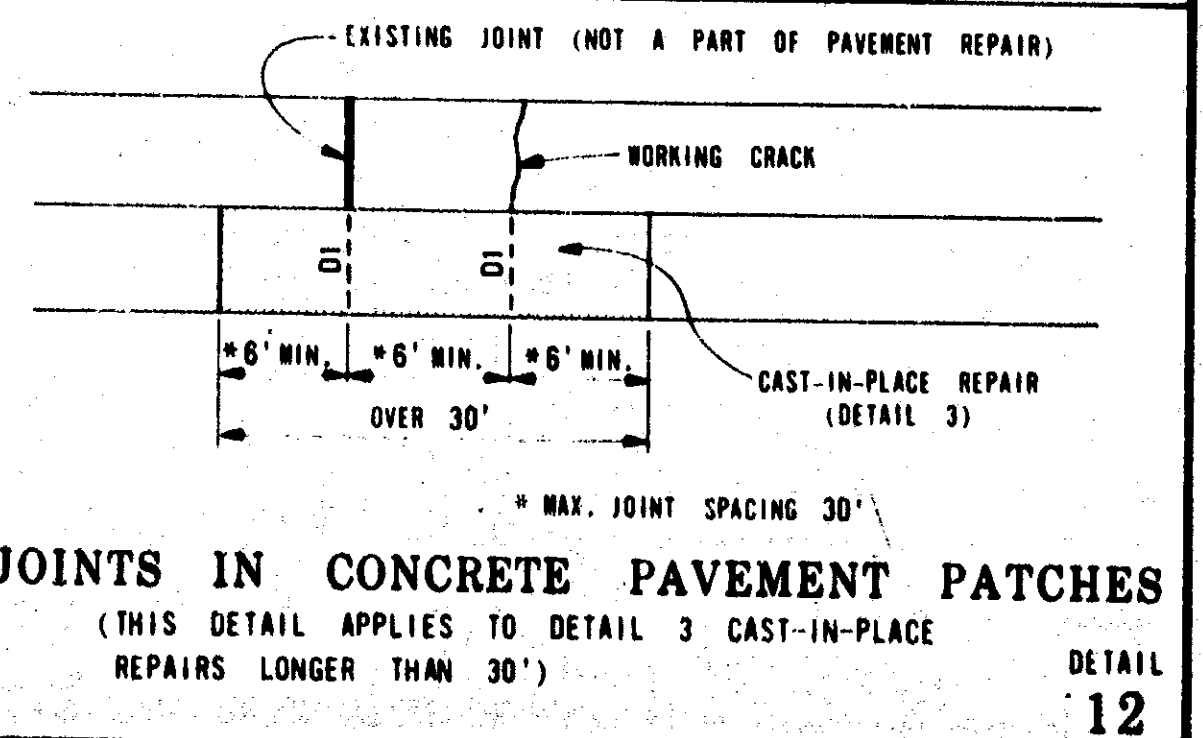


JOINTS IN CONCRETE PAVEMENT PATCHES

DETAIL 12

 PREPARED BY DESIGN DIVISION DRAWN BY: H.A.W. CHECKED BY: V.R.	 W.B. Thomas ENGINEER OF CONSTRUCTION	 J. Woodruff ENGINEER - ROAD DESIGN
	 Donald E. Jones ENGINEER OF MAINTENANCE	 W. Woodruff ENGINEER OF DESIGN
	 J.A. McCombs ENGINEER OF TESTING AND RESEARCH	DEPARTMENT DIRECTOR JOHN P. WOODFORD
	 M. R. Williams ENGINEER OF TRAFFIC AND SAFETY	 J. Woodruff DEPUTY DIRECTOR - HIGHWAYS

MICHIGAN DEPARTMENT OF TRANSPORTATION BUREAU OF HIGHWAYS STANDARD PLAN FOR CONCRETE PAVEMENT REPAIR		
F.H.W.A. APPROVAL	8-6-82 PLAN DATE	II-44E
		SHEET 3 OF 3

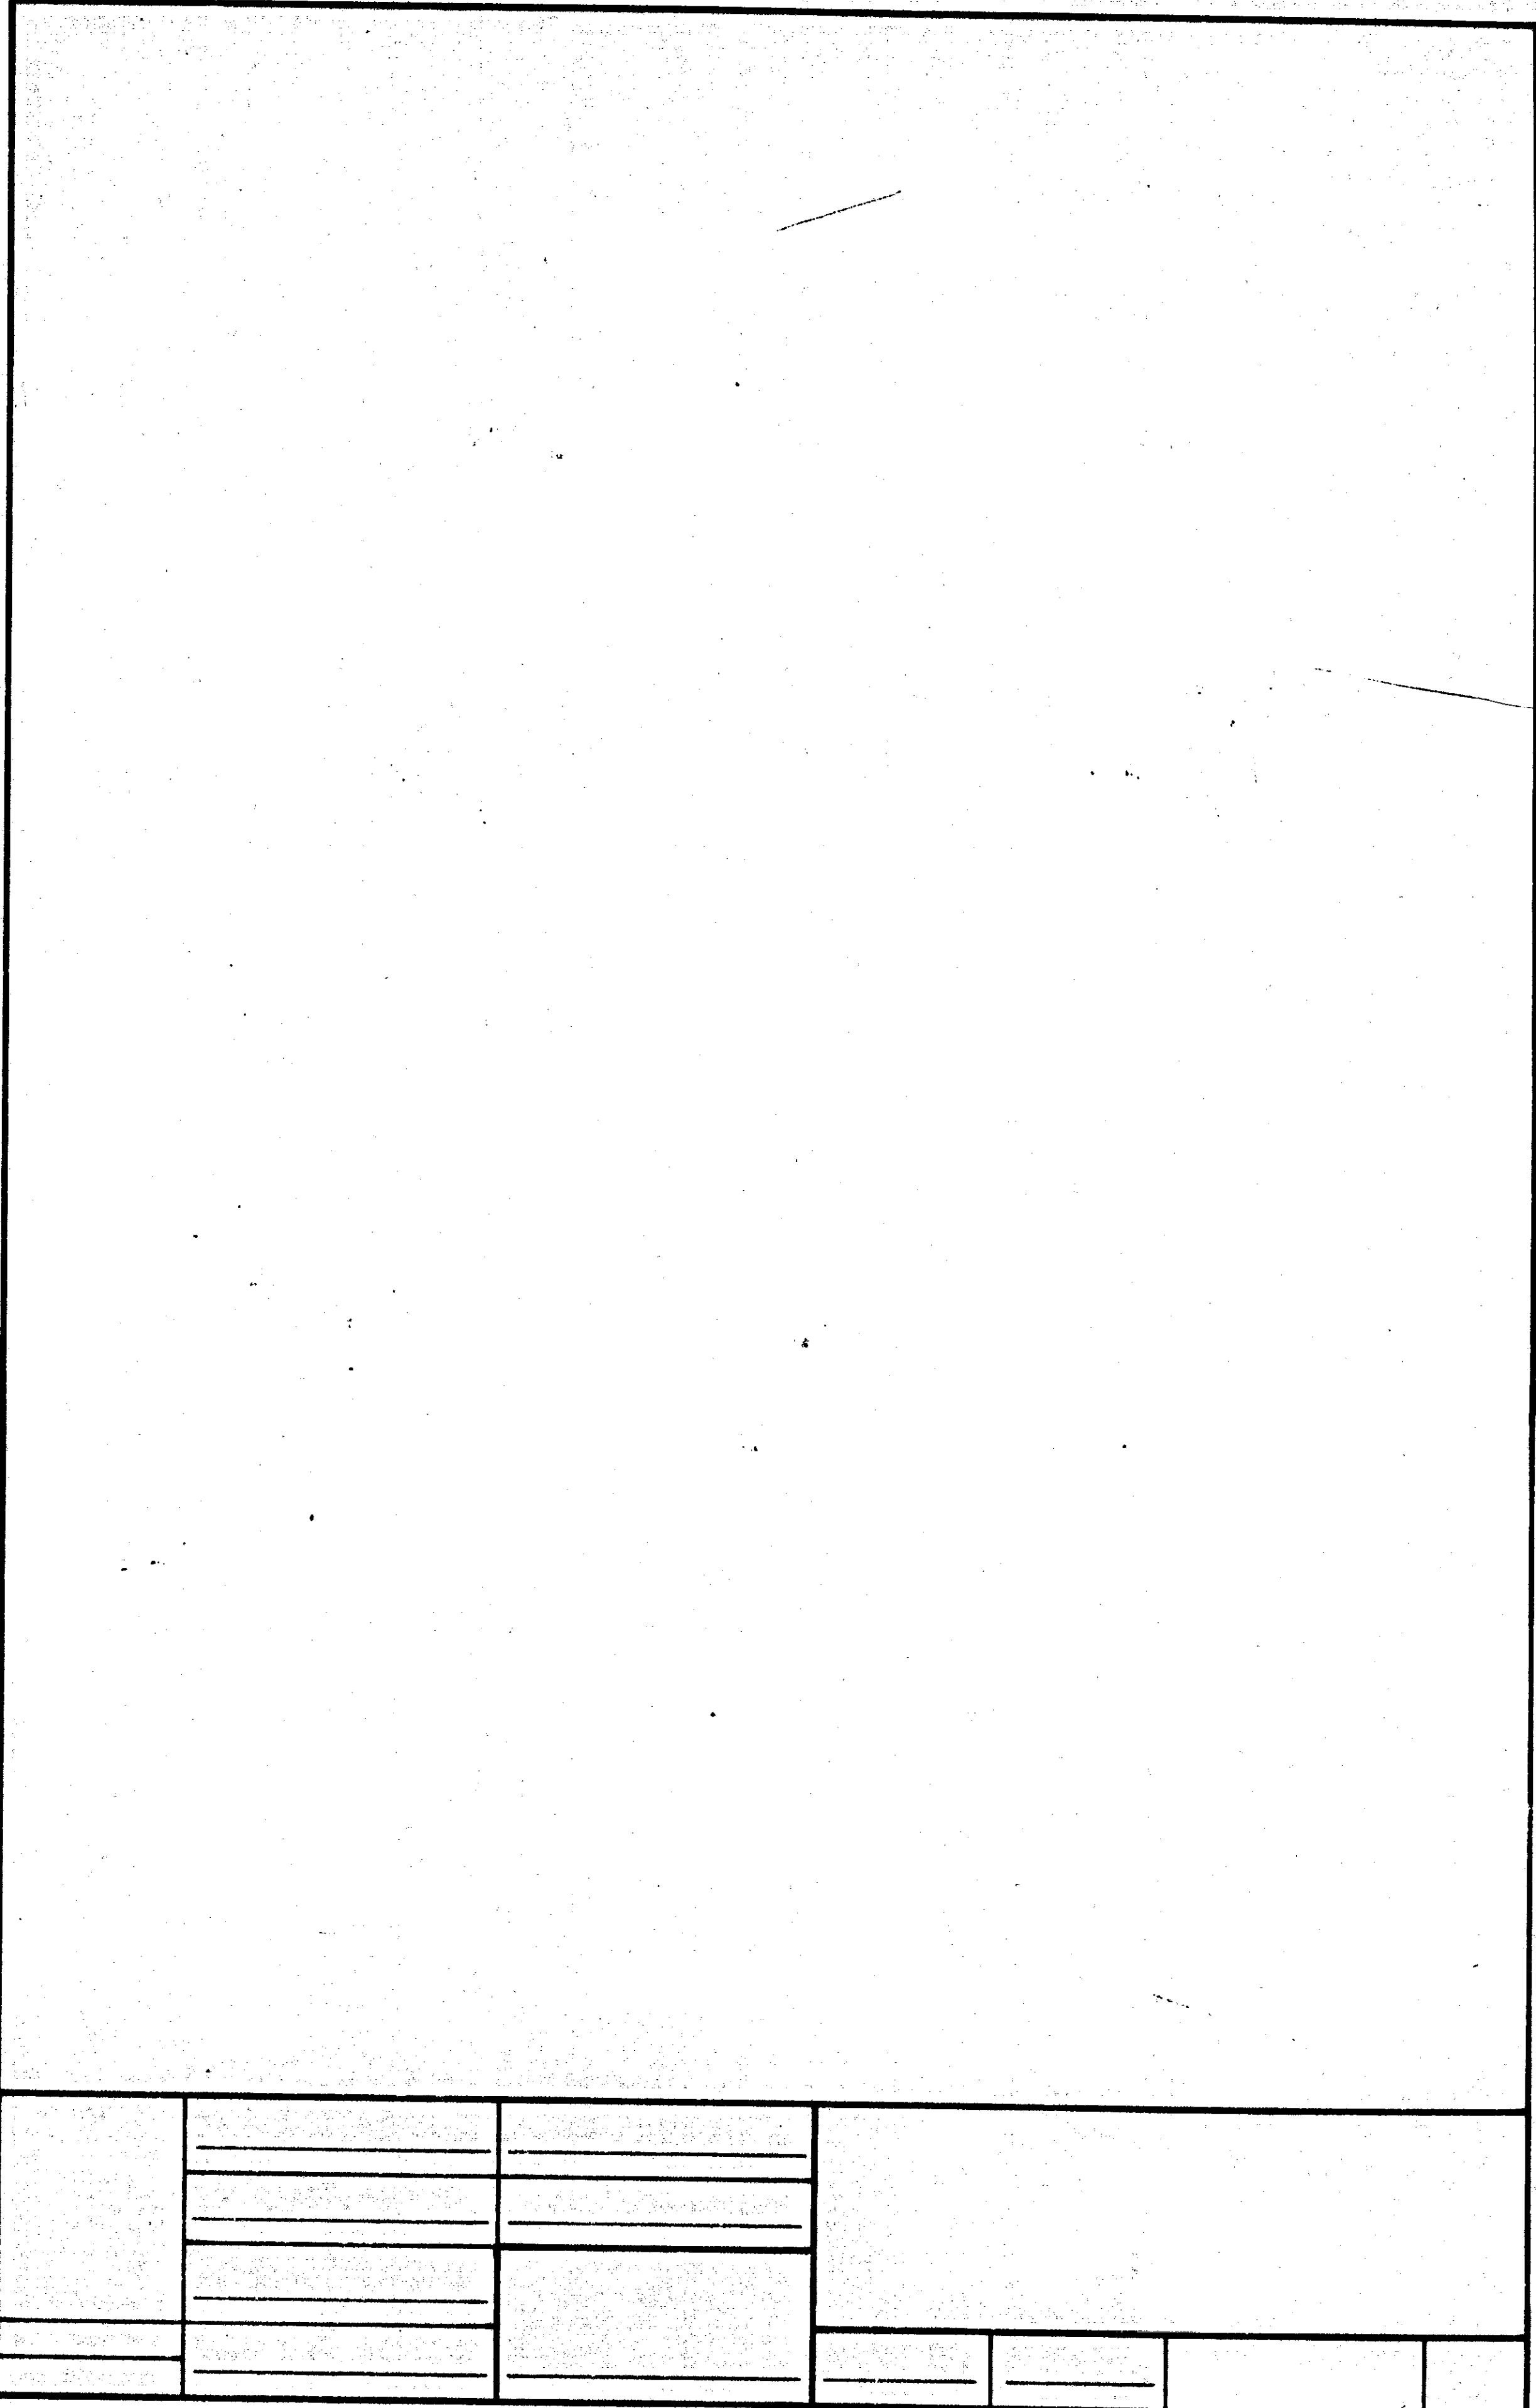

CS: 63174

ID: 23749A 25091A

63174-23749A
25091A
~~XXXXXXXXXX~~

CONTROL SECTION NHI 63174
 JOB NO. 23749A 25091A
 SHEET NO. 1

**PART 1
ROAD
PLANS**

**SHEET
NUMBERS**

TITLE	1
TYPICAL CROSS SECTIONS	2-3
MISCELLANEOUS DETAIL	4-5
NOTE SHEET	6
STANDARD SYMBOLS	7
WALL ALIGNMENTS	8-11
PLAN & PROFILE	12-32
PLANTING DETAIL	33
LOG OF BORINGS	34-39
SPECIAL DETAILS	40-44

MICHIGAN DEPARTMENT OF TRANSPORTATION

PLANS OF PROPOSED

MICHIGAN PROJECT NH9663076, IM9663077

CONTROL SECTION NHI 63174

JOB NUMBER 23749A, 25091A

I=75


OAKLAND COUNTY
CITY OF ROYAL OAK
CITY OF MADISON HEIGHTS

THE IMPROVEMENTS COVERED BY THESE PLANS SHALL BE DONE IN ACCORDANCE WITH THE MICHIGAN DEPARTMENT OF TRANSPORTATION 1990 STANDARD SPECIFICATIONS AND SUPPLEMENTAL SPECIFICATIONS.

	1993	YEAR
A.D.T.	288862	
D.H.V.	28074	
COMM. %	4%	
DESIGN SPEED	N/A	

MICHIGAN PROJECT IM9663077
 CONTROL SECTION NH9663076
 JOB NUMBER 23749A
 P.O.B. STA 307+00
 M.P. 3.900

MICHIGAN PROJECT IM9663077
 CONTROL SECTION NH9663076
 JOB NUMBER 23749A
 P.O.E. STA 831+00
 M.P. 2.590

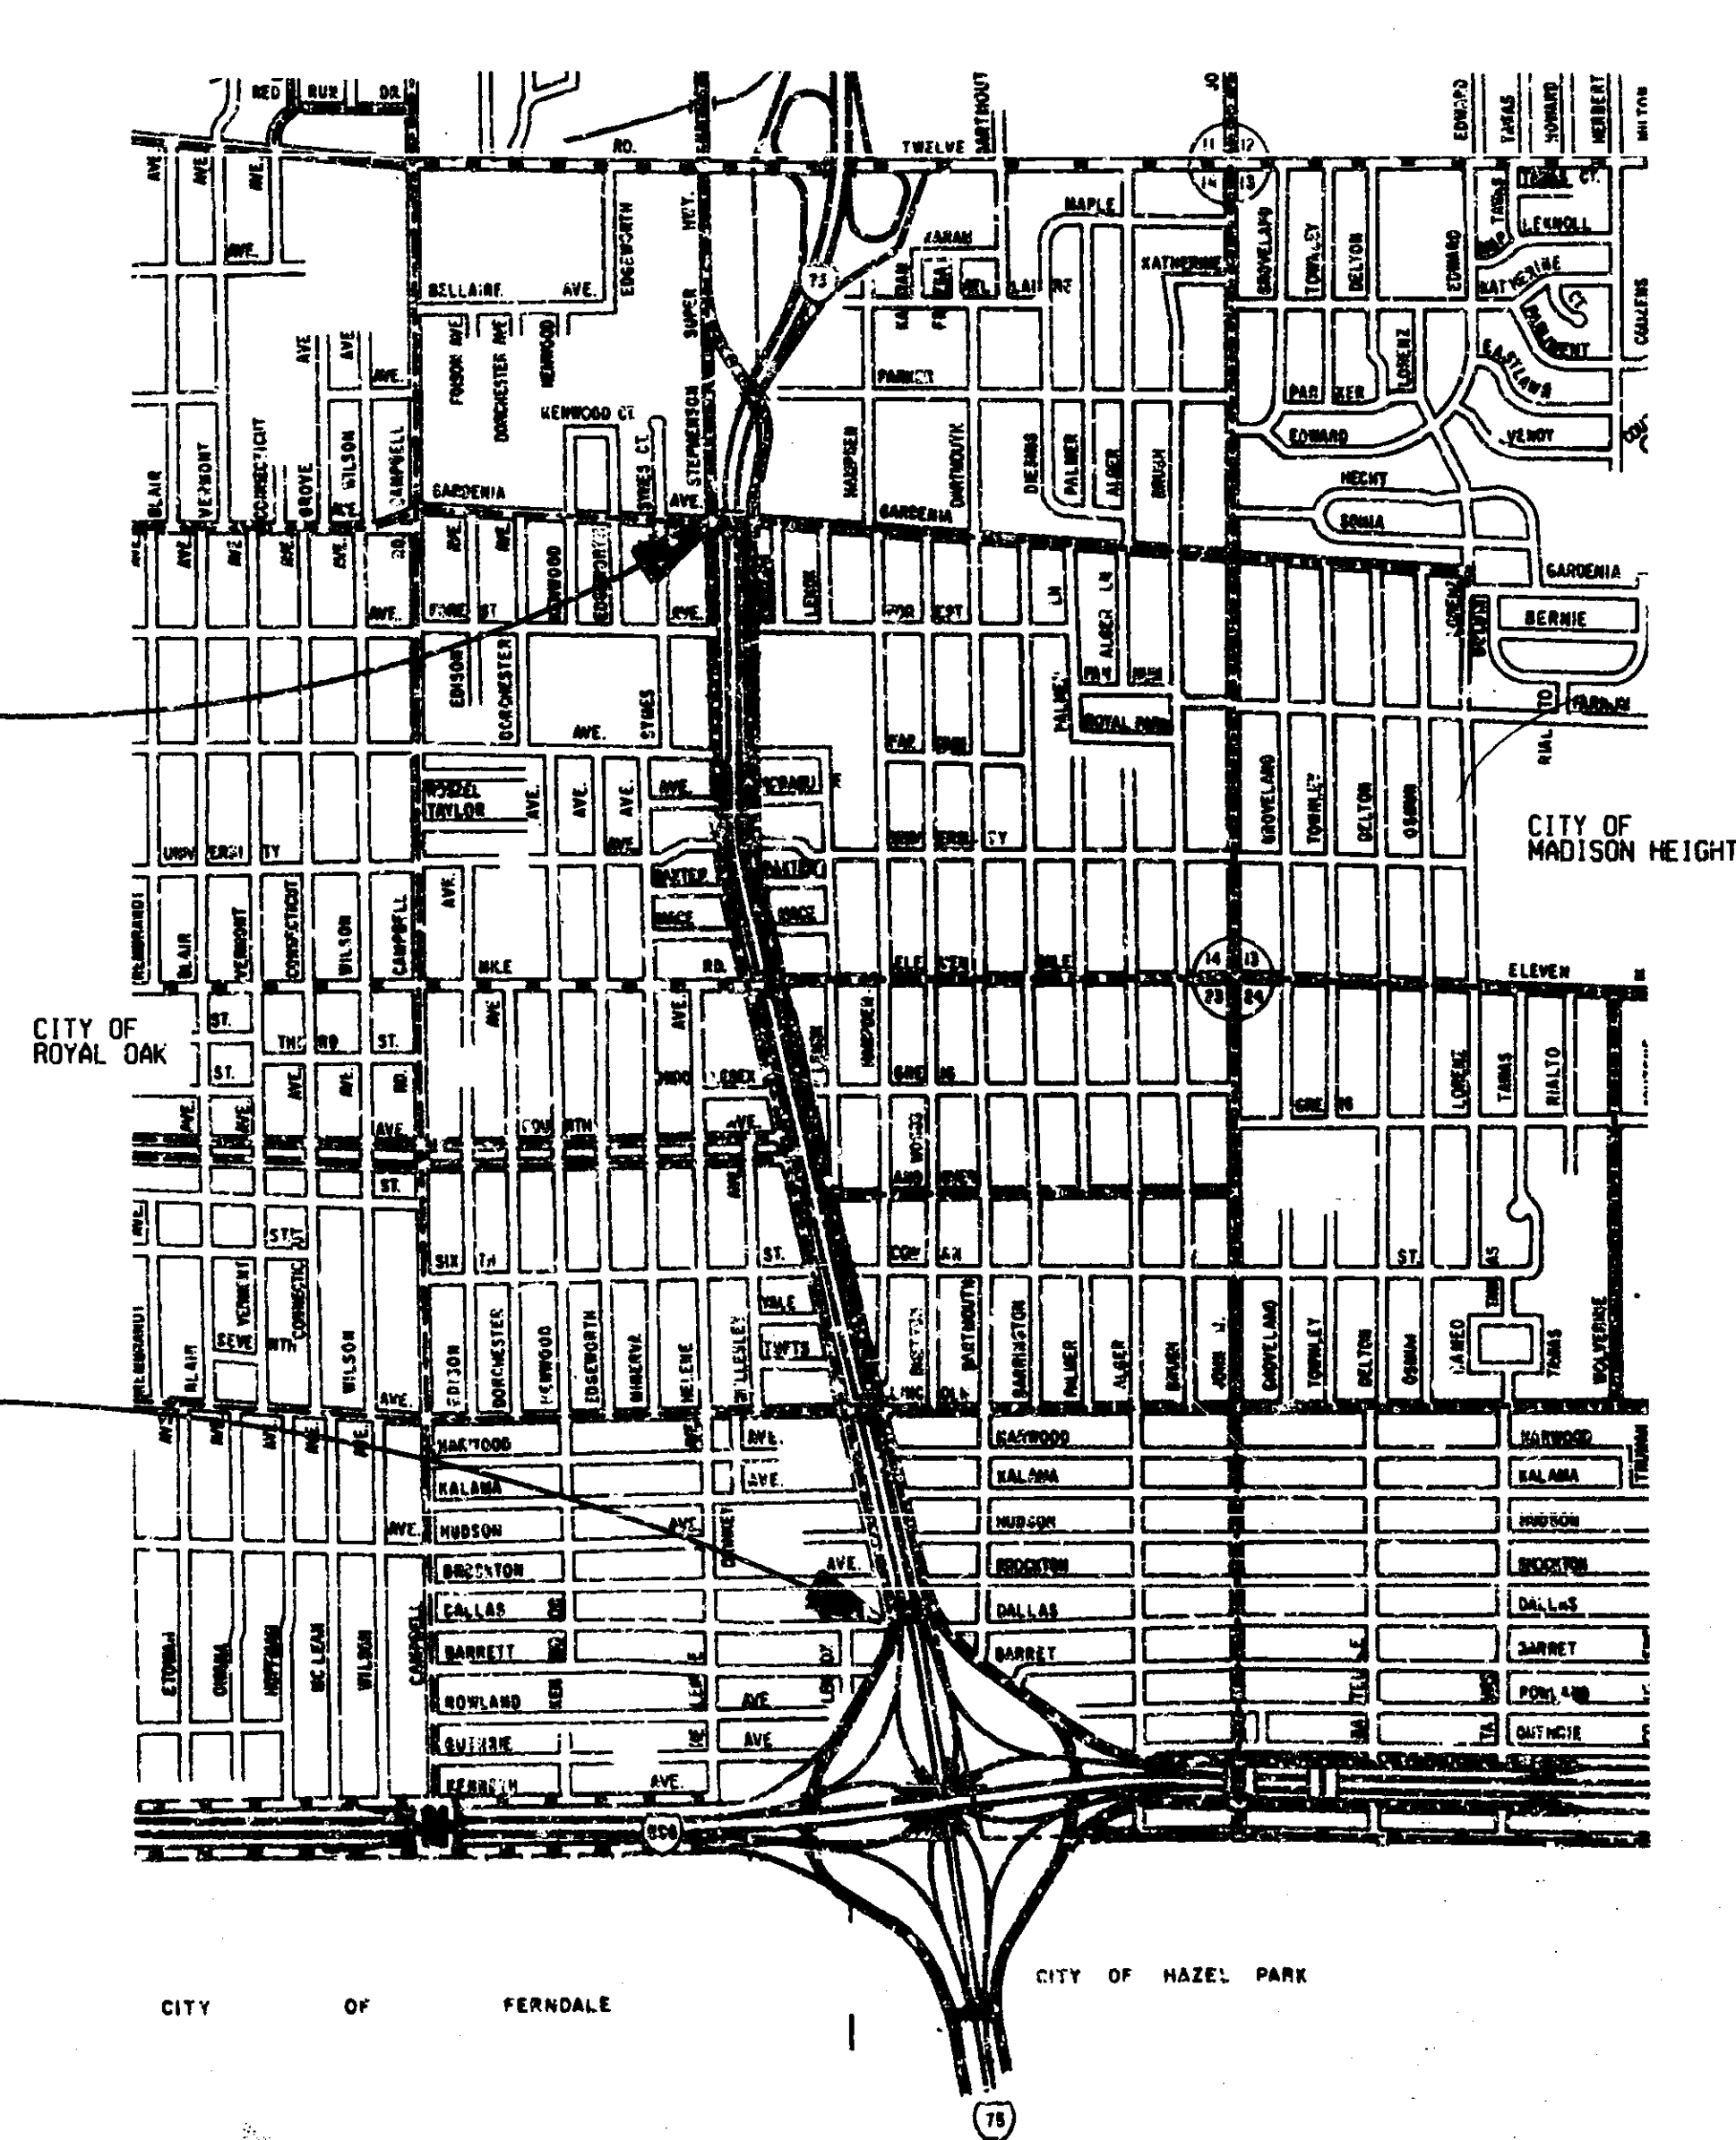

TITLE SHEET LEGEND

PROPOSED PROJECT	=====
EXISTING ROADS	
PAVED	=====
BITUMINOUS	=====
GRAVEL	=====
UNIMPROVED OR CITY STREET	=====
SECTION LINE	=====
TOWNSHIP LINE	=====
COUNTY LINE	=====
CITY OR VILLAGE LIMITS	=====
RAILROADS	=====

As Constructed

4-99

Plan Revision R-1

CONTRACT FOR: SOUNDWALL CONSTRUCTION 1.31 MI.2S (23749A)
LANDSCAPING (25091A)

APPROVALS		
RECOMMENDED FOR APPROVAL	<i>James A. Fiedor</i>	9/10/96
	ENGINEER - ROAD DESIGN	DATE
RECOMMENDED FOR APPROVAL	<i>R. G. Arnold</i>	9/10/96
	ENGINEER OF DESIGN	DATE
RECOMMENDED FOR APPROVAL	<i>James D. Crisp</i>	9/10/96
	ENGINEER OF TRAFFIC & SAFETY	DATE
RECOMMENDED FOR APPROVAL	<i>J. J. [Signature]</i>	8/2/96
	ENGINEER OF CONSTRUCTION	DATE

MICHIGAN
DEPARTMENT OF TRANSPORTATION
 ROBERT A. WELFE - DIRECTOR

APPROVED BY *George D. [Signature]* 9/10/96
DEPUTY DIRECTOR - HIGHWAYS DATE



PLANS PREPARED BY: PENA
DESIGN UNIT

CONTROL SECTION	JOB NUMBER	FEDERAL NUMBER	SHEET NO.
NHI 63174	23749A 25091A	IM9663076 NH9663077	KKO445 KKO446
			1

CONTROL SECTION NHI 63174 J.N. 23749A, 25091A


DATE: 9-13-93
 DATE: 07/21/96
 DATE: 07/21/96

EXISTING BY: NB
 FOR CORRECTION BY: WALTER
 LAST CORRECTION BY: WALTER


CONSTRUCTED AS PER PLANS APRIL 1999

FILE NAME: 23749.TY1
 1 2 3


FINAL R.O.W.			
AUTH	DATE	NO.	REVISION

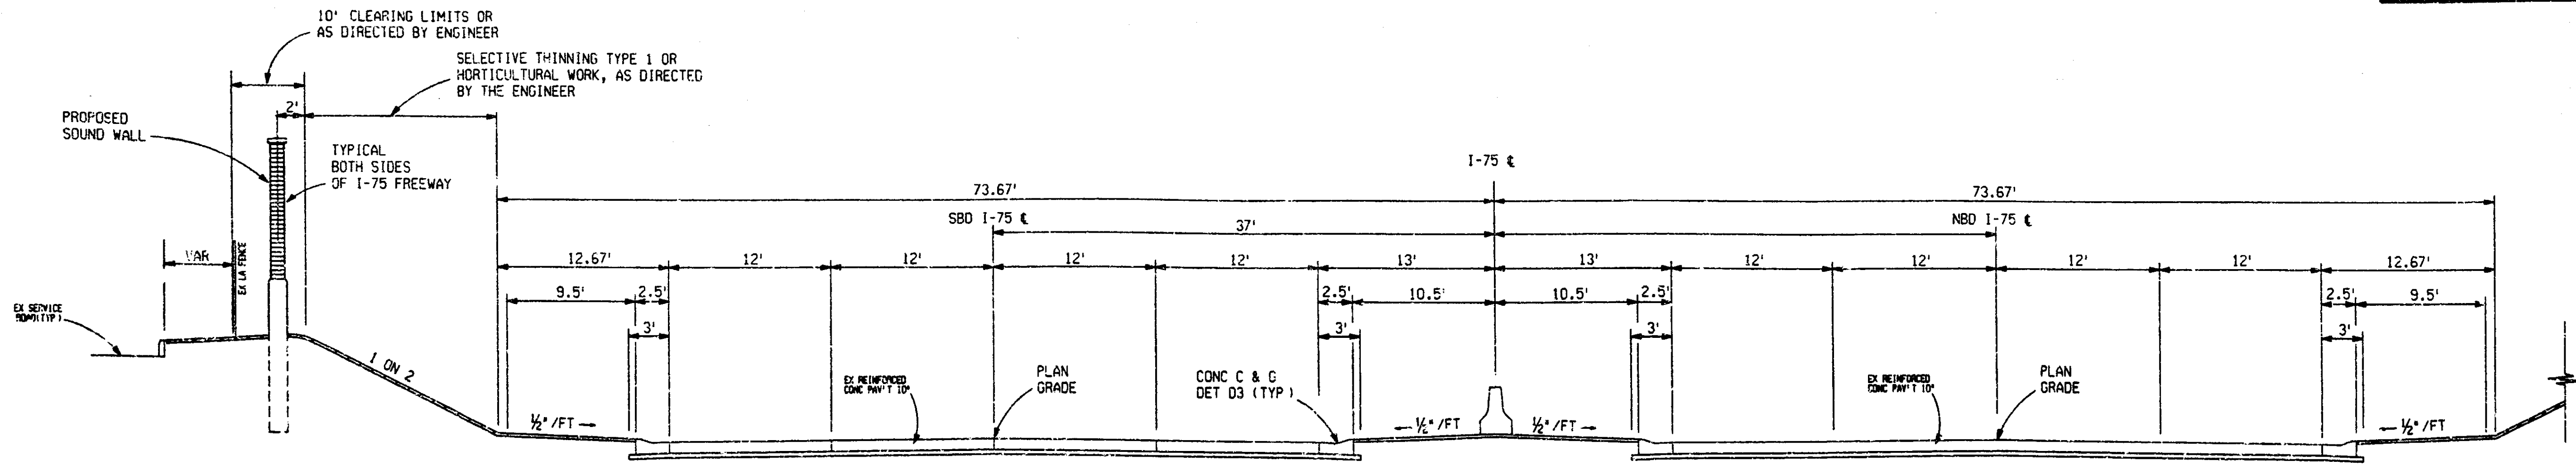

I-75 TYPICAL CROSS SECTION
 TO APPLY:
 STA 831+00 TO STA 857+00

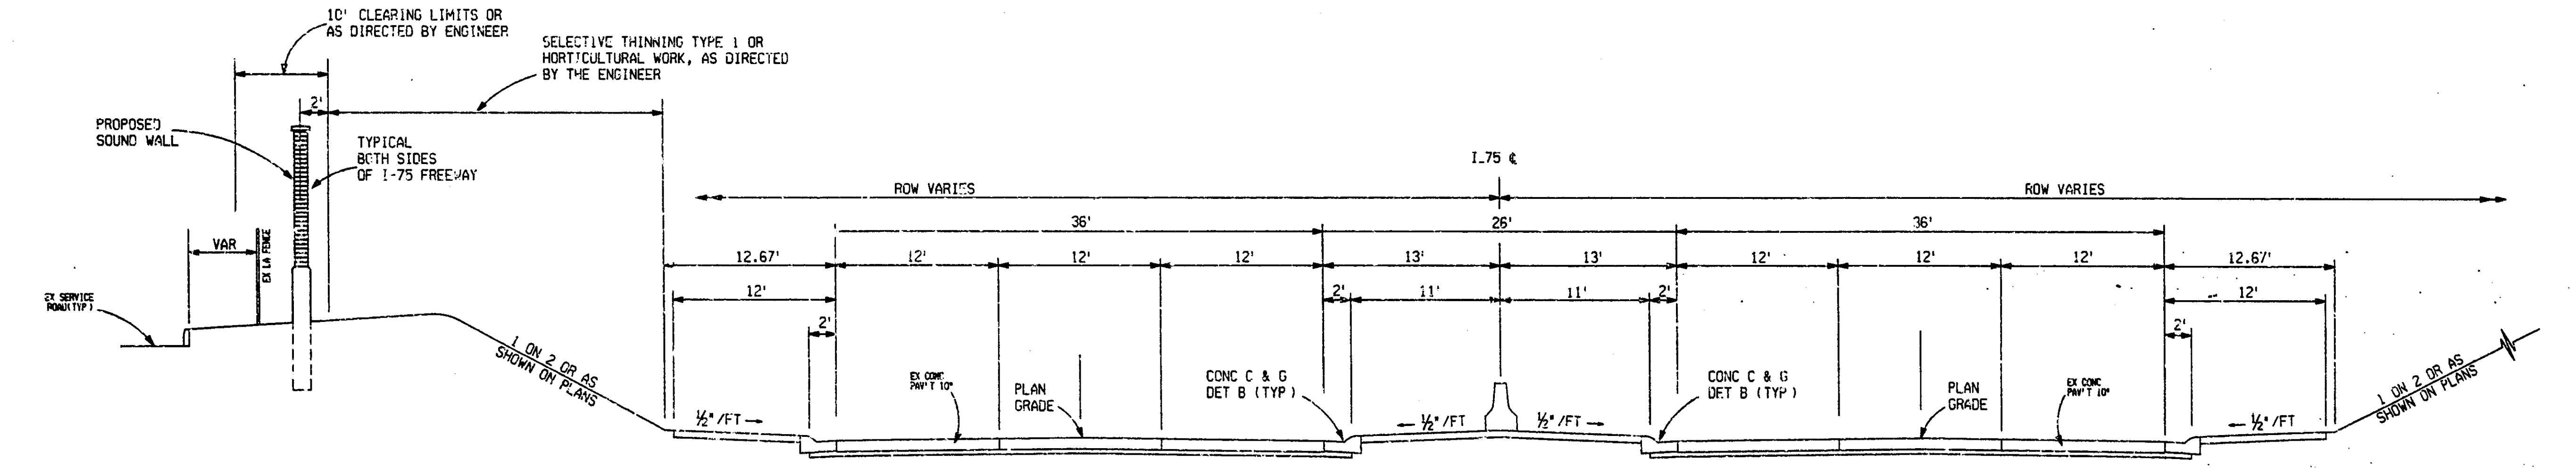

I-75 TYPICAL CROSS SECTION
 TO APPLY:
 STA 857+00 TO STA 900+00

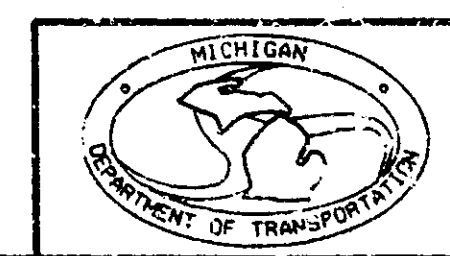


I-75 EXISTING TYPICAL CROSS SECTION					
DATE	SCALE	CONT. SEC.	JOB NO.	DESIGN UNIT	SHEET NO.
07/21/96	1" = 6'	63174	23749 A	PENA	2


1878796 Engineering Print

FINAL R.O.W.			
AUTH	DATE	NO.	REVISION

DATE: 07/12/96
 DATE: 07/12/96
 EXISTING BY: WALTER
 PROPOSED BY: WALTER
 L&ST CORRECTION BY: WALTER

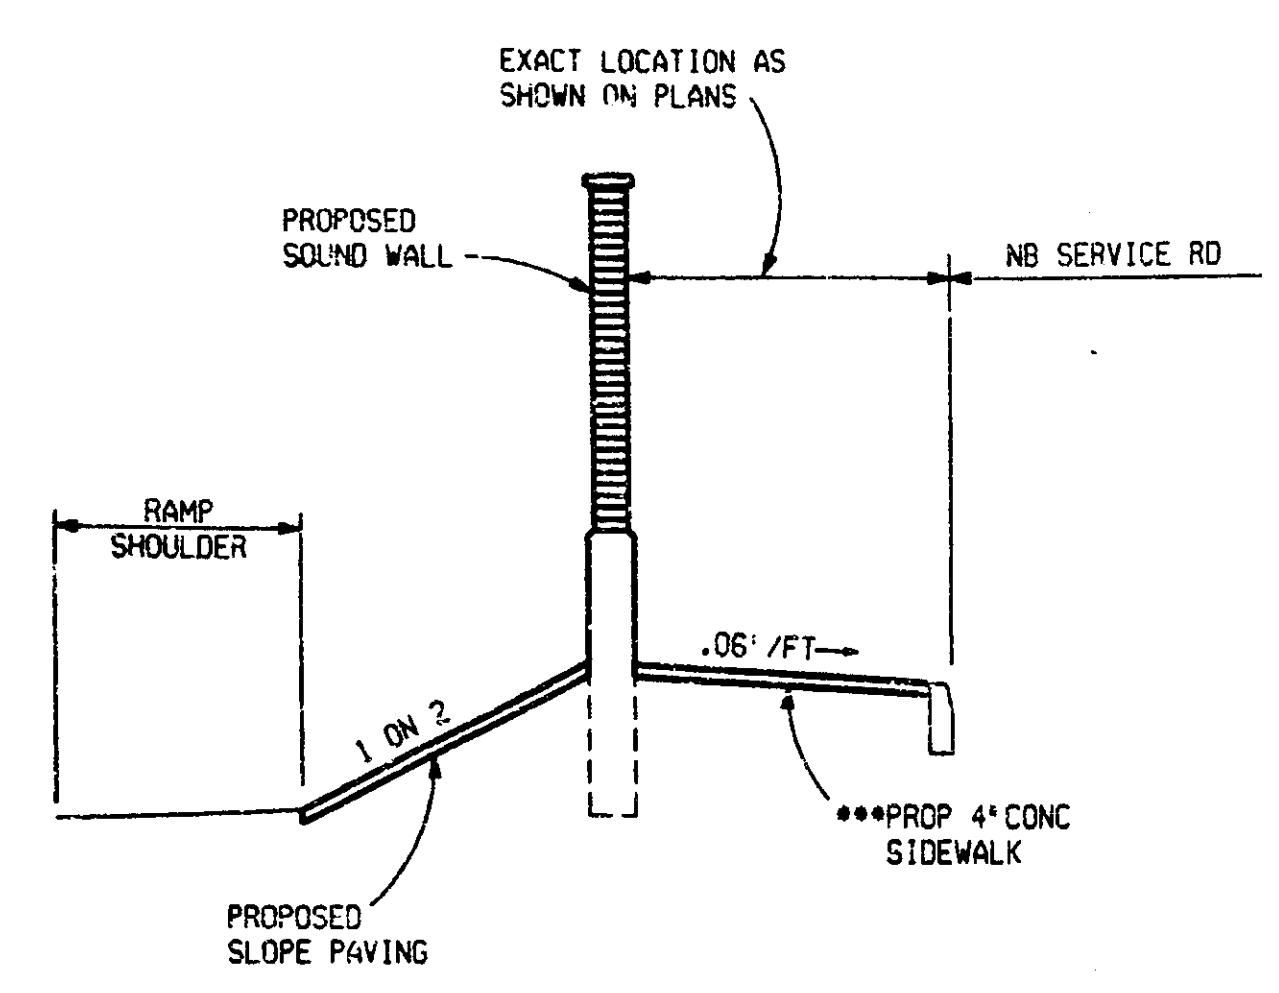


TYPICAL CROSS SECTION
 TO APPLY:
 STA 851+30 TO STA 855+00 (NB SERVICE RD)

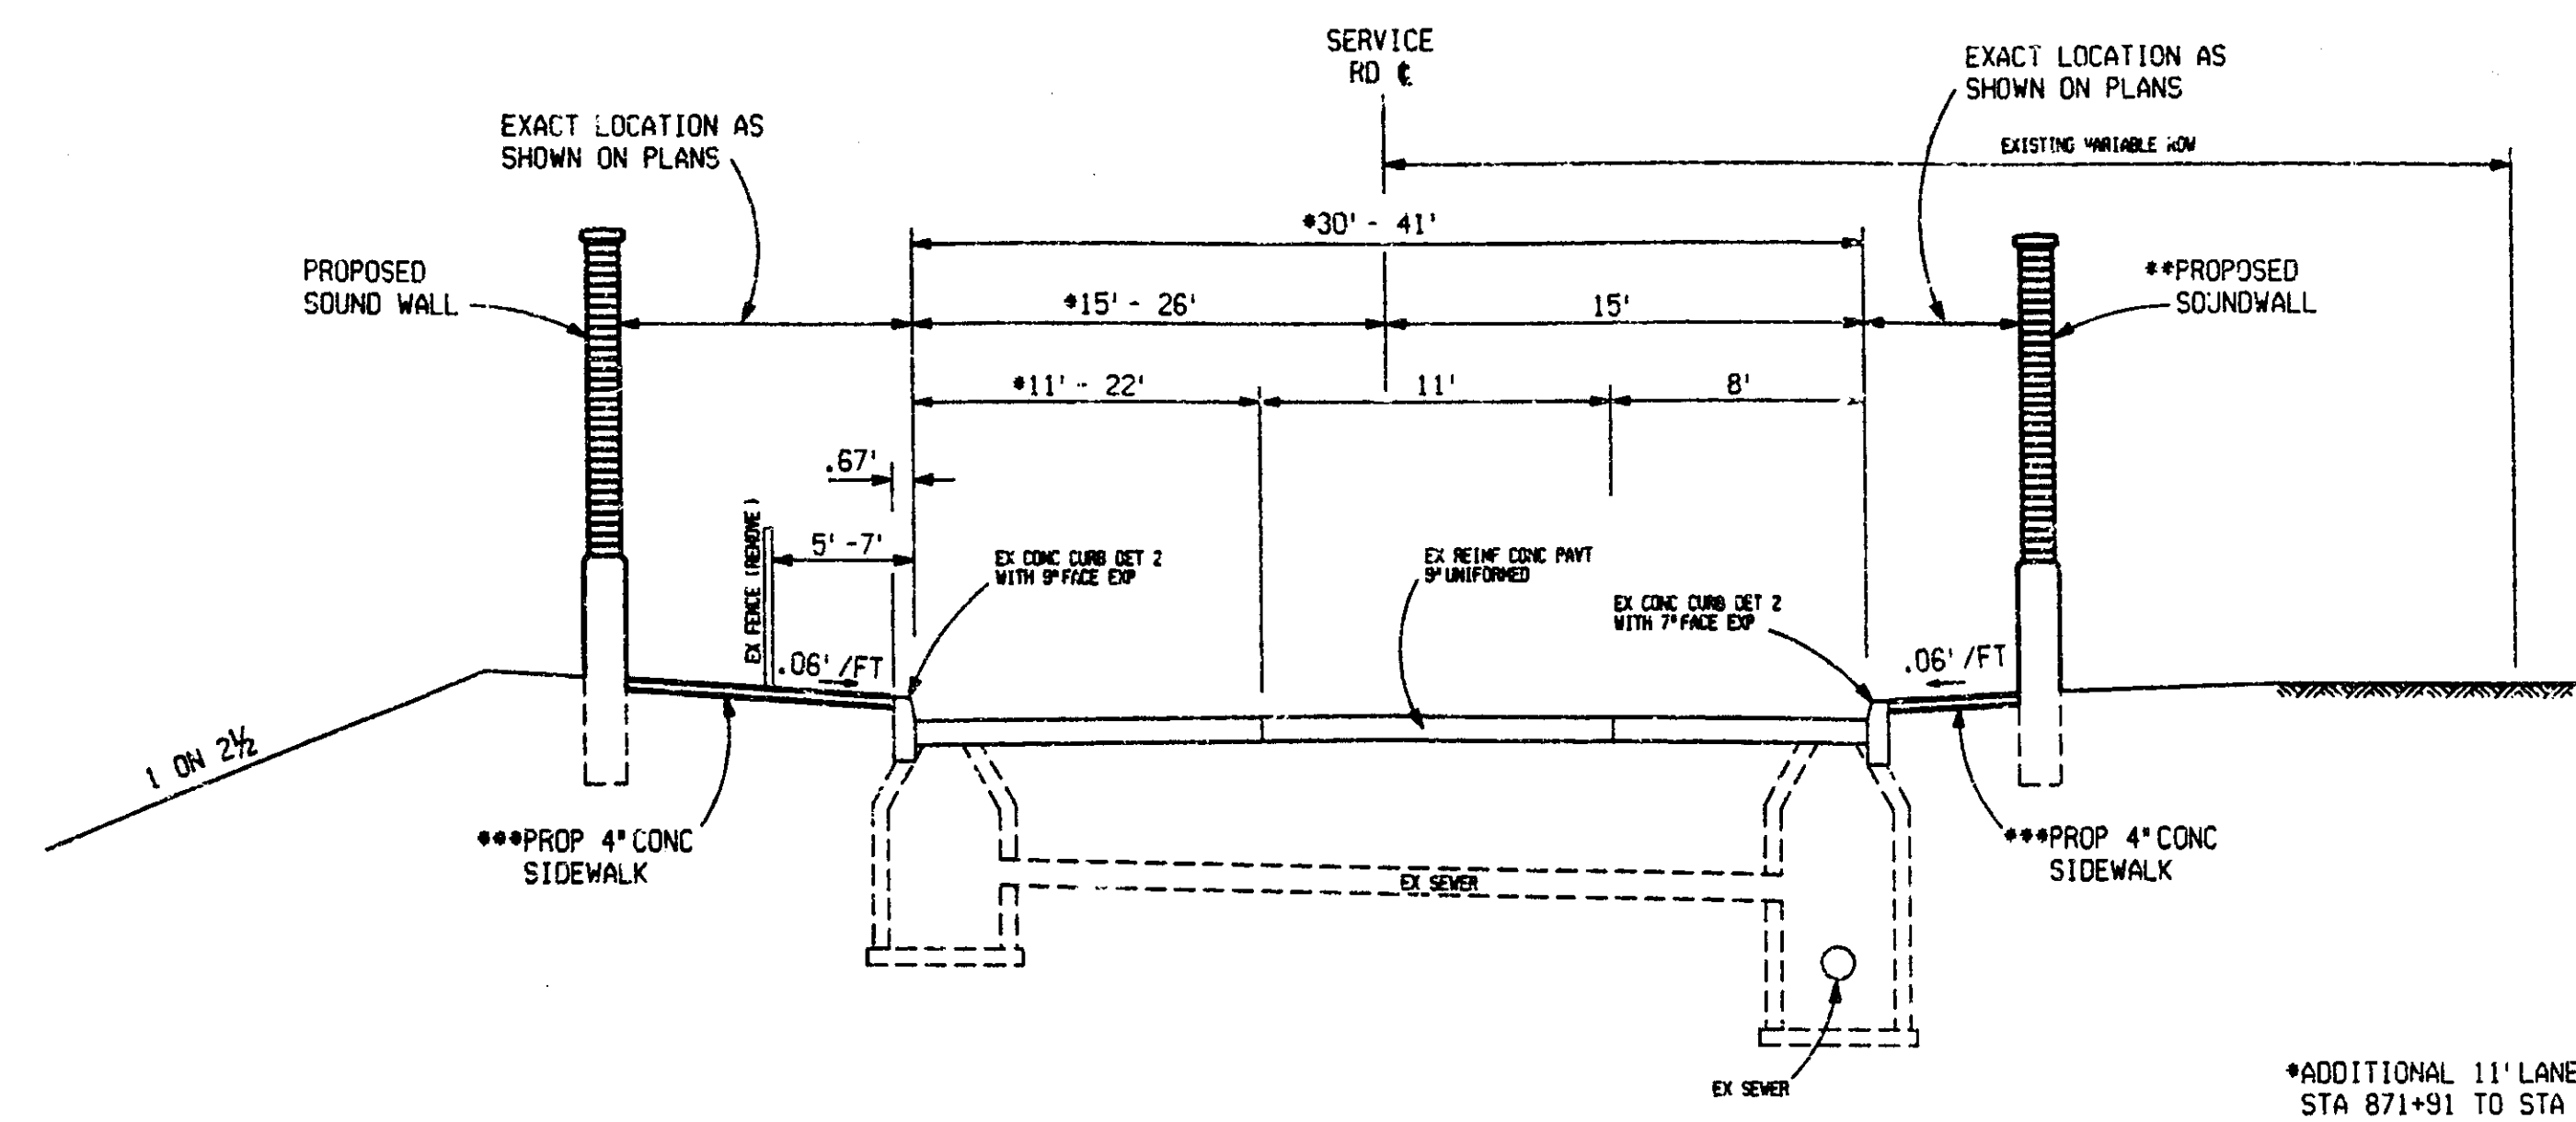


TYPICAL CROSS SECTION
 TO APPLY:
 NBD AND SBD SERVICE ROAD

*ADDITIONAL 11' LANE AT
 STA 871+91 TO STA 878+00 SBD
 **APPLIES STA 859+00 TO 868+72
 EAST SIDE OF NORTHBOUND ROADWAY
 ***APPLIES TO WALLS
 A, *B*, *C*, *E* AND *F* ONLY

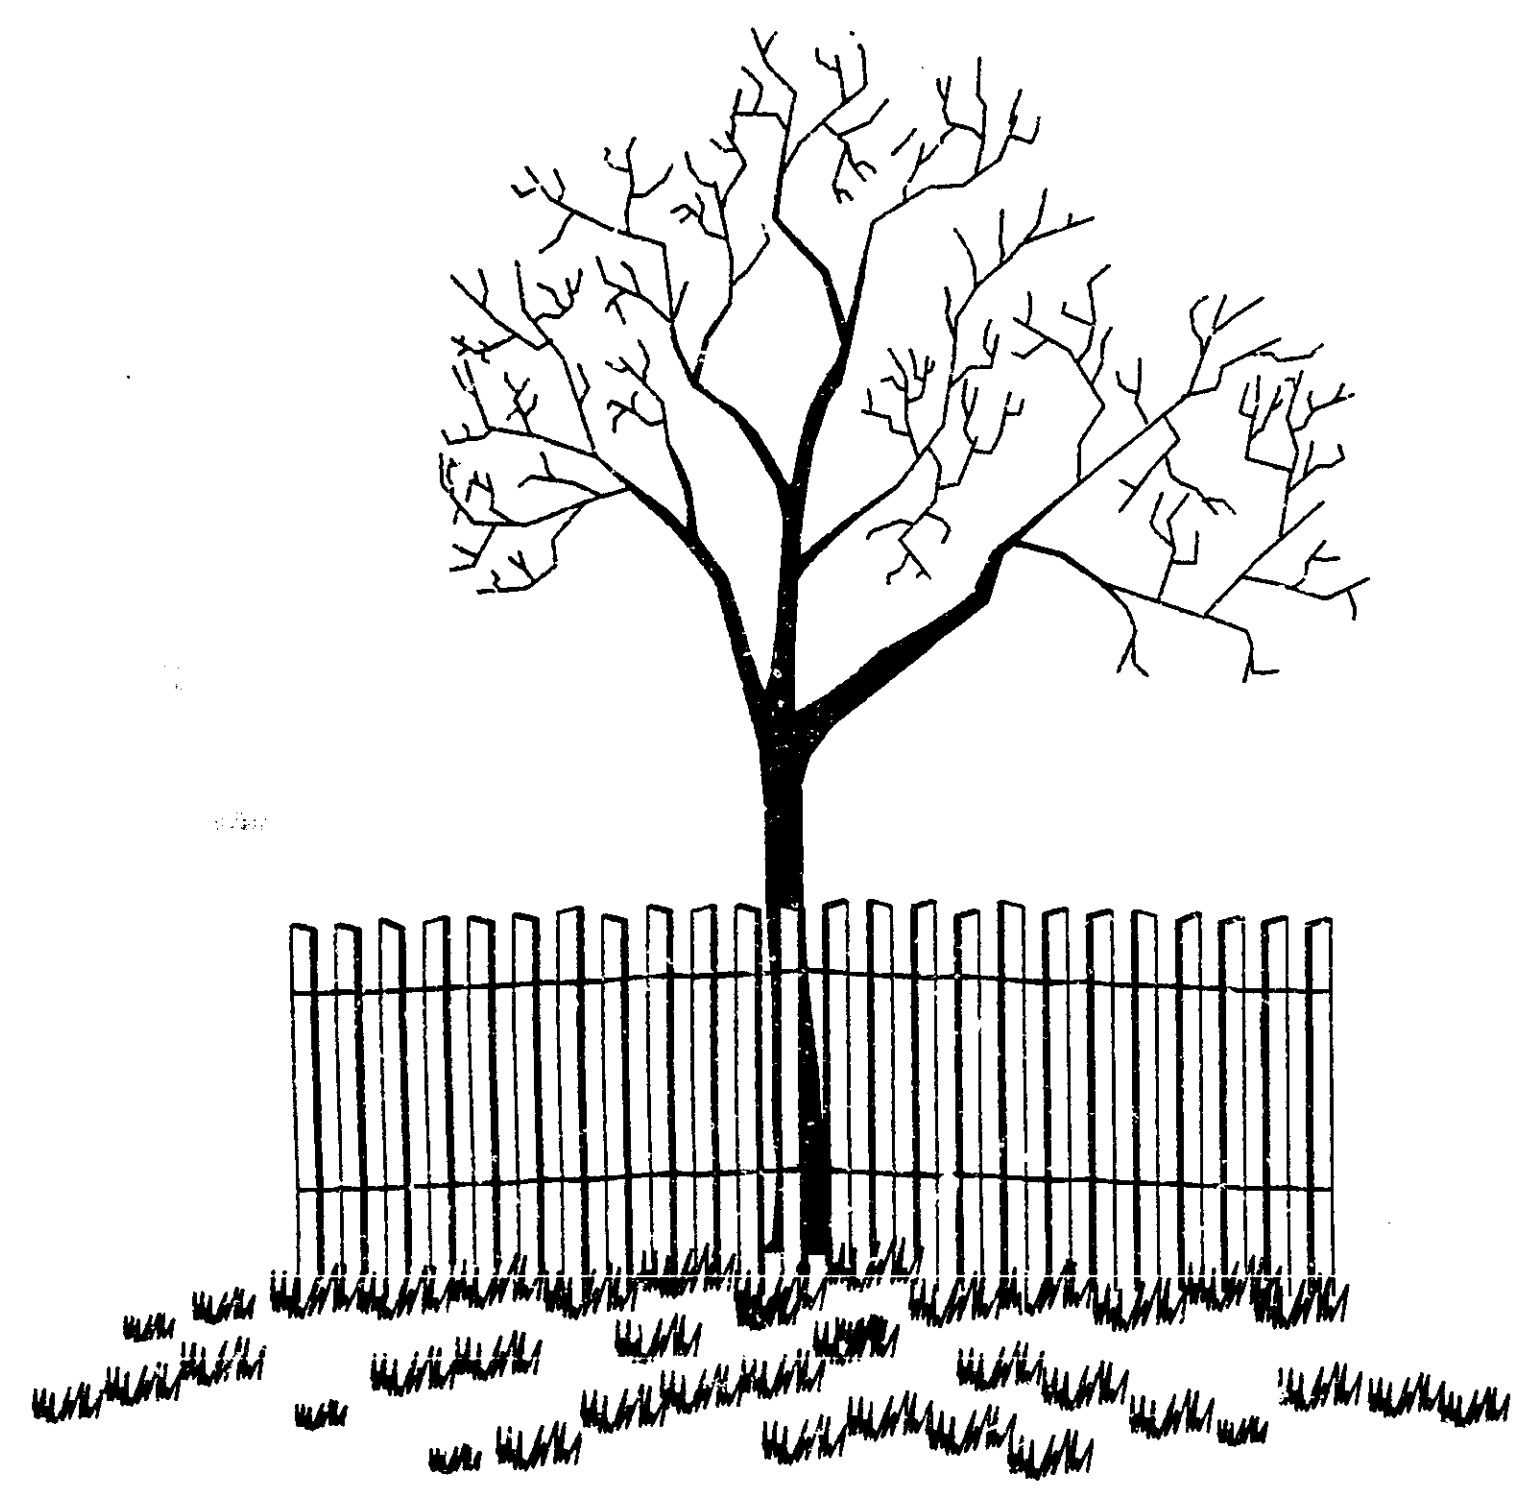


TEMPORARY TREE PROTECTION
 DETAIL

TEMPORARY TREE PROTECTION SHALL BE PROVIDED AS DIRECTED BY THE ENGINEER TO PREVENT DAMAGE TO VALUABLE EXISTING TREES ENDANGERED BY CONSTRUCTION OPERATIONS. FENCING SHALL BE PLACED PRIOR TO THE START OF ANY CONSTRUCTION ACTIVITY AND REMOVED ONLY WHEN ALL WORK IS COMPLETED. LOWER BRANCHES OF TREES SHALL NOT BE REMOVED.

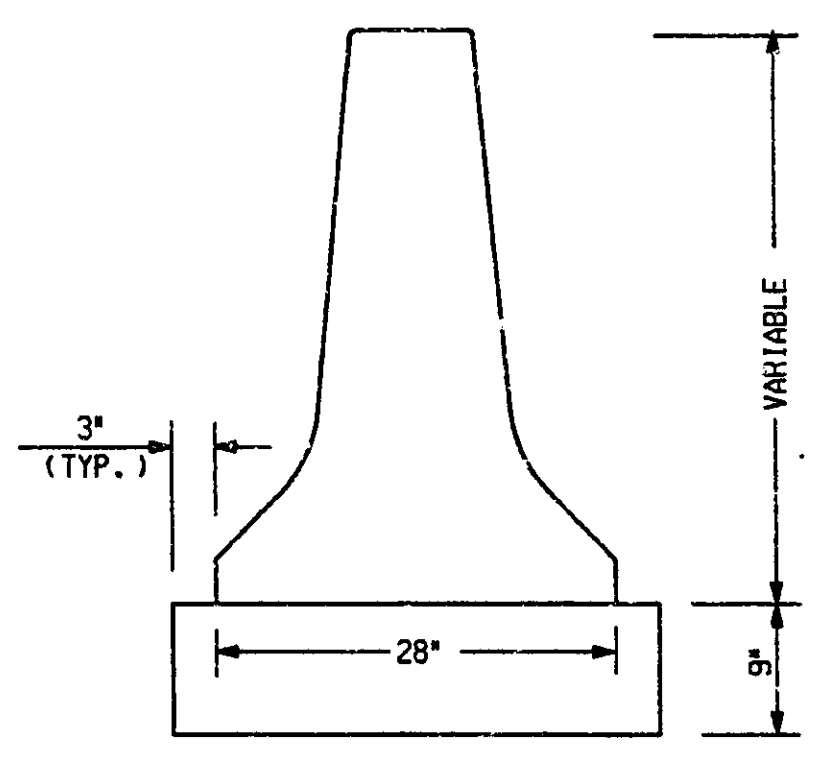


SLOPED END TREATMENT
 TO APPLY:
 NBD SERVICE DR. STA 532+50 (LEFT)
 545+30 (LEFT)
 859+00 (RIGHT)
 SBD SERVICE DR. STA 858+00 (LEFT)

NOT TO SCALE

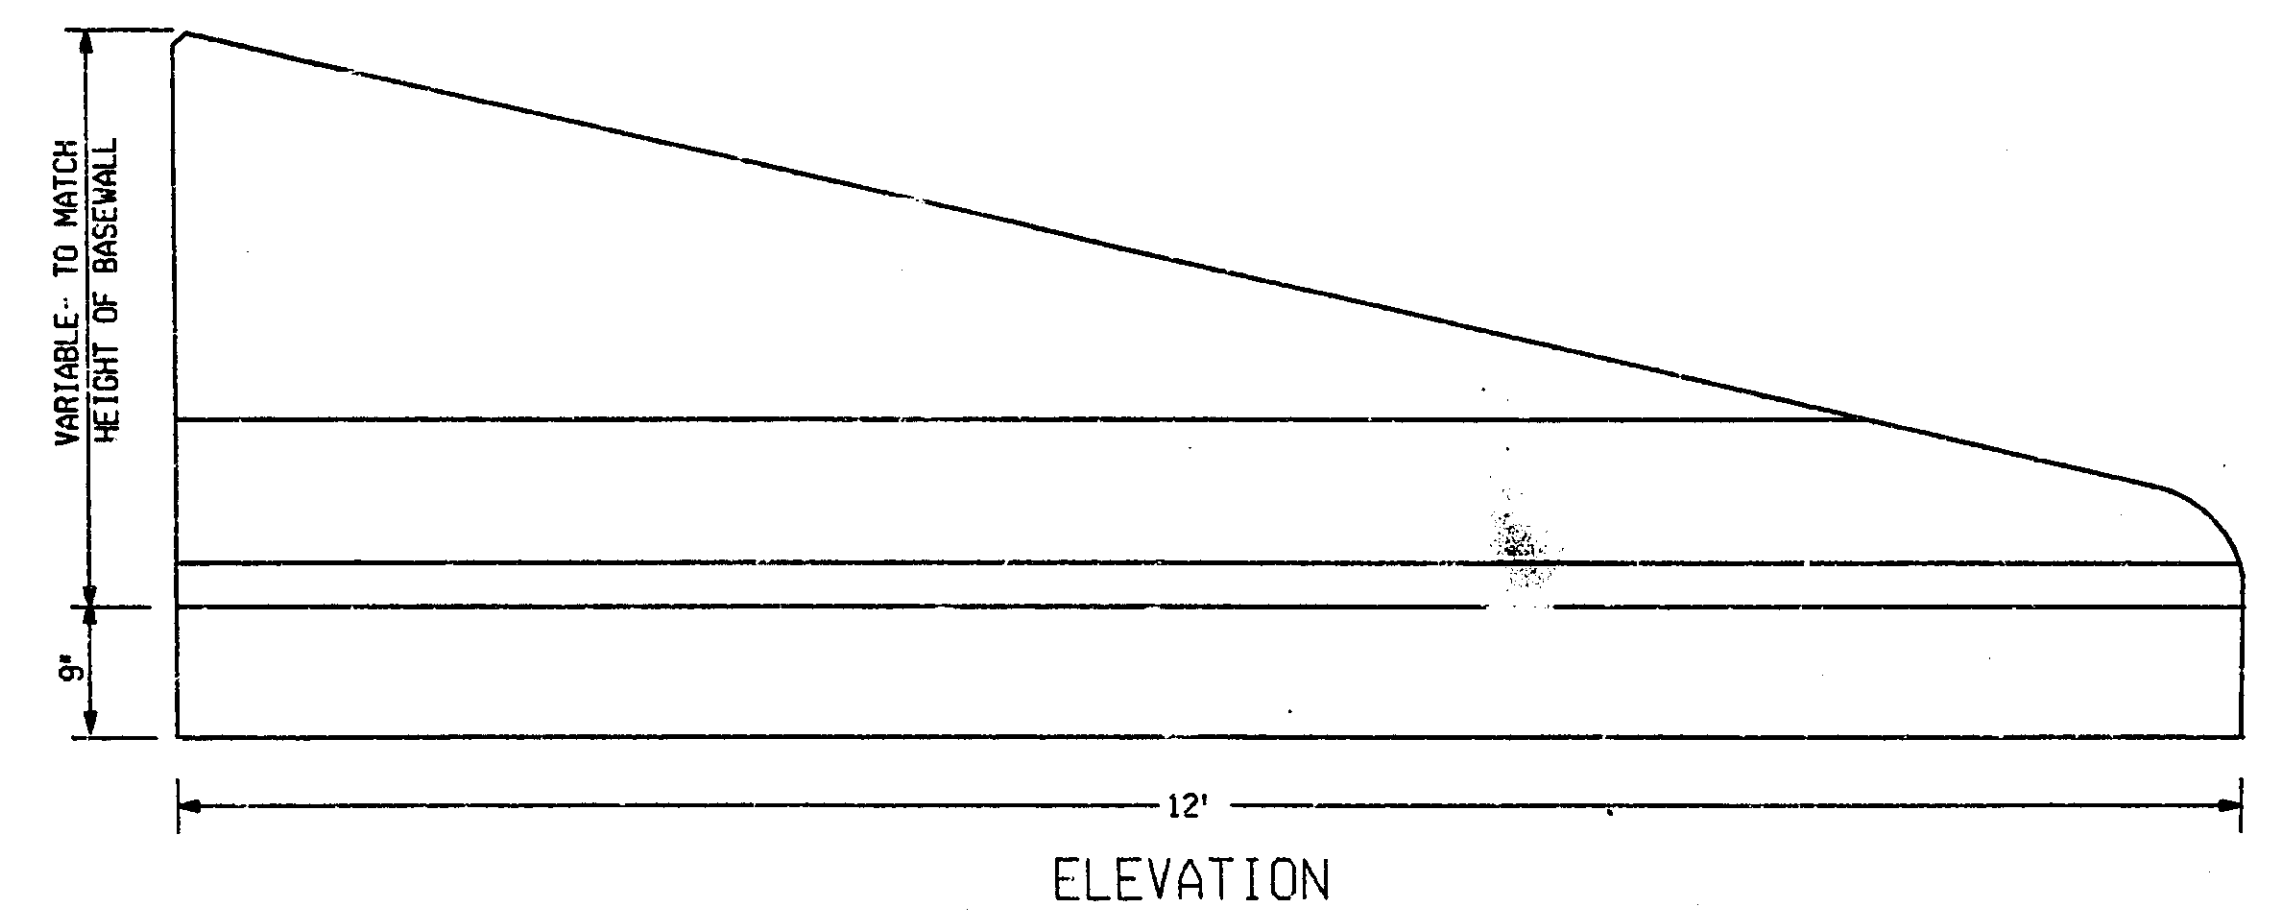

ELEVATION

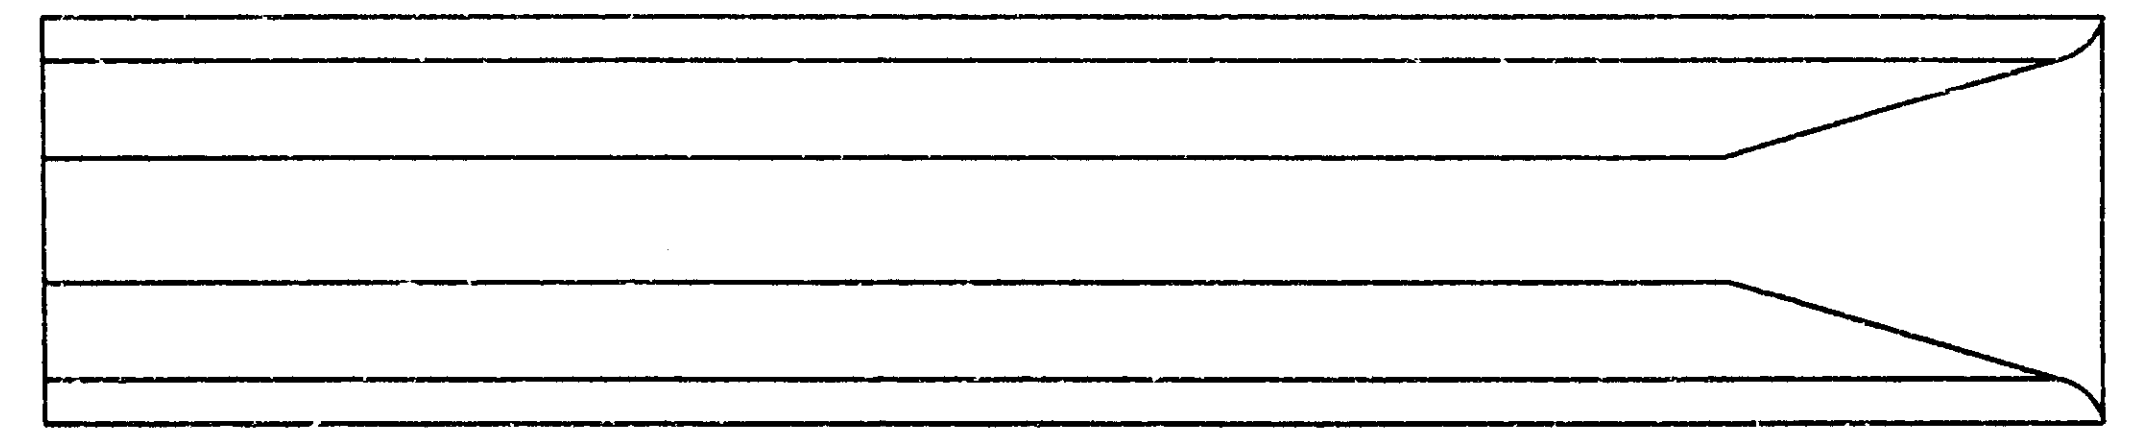


TOP VIEW

CONSTRUCTED AS PER PLANS APRIL 1989

FILE NAME: 23749.dwg
 1 2 3


TYPICAL CROSS SECTION						
DATE	SCALE	CONT. SEC.	JOB NO.	DESIGN UNIT	SHEET NO.	
08/22/96	1" = 5'	63174	23749 A	PENA	R.O.W	CONST.
						3

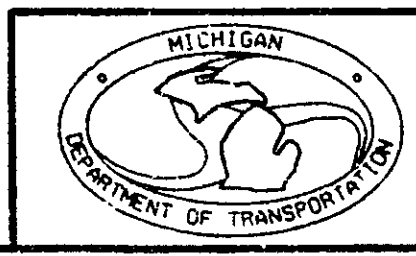


CONSTRUCTED AS PER PLANS, APRIL 1999

DATE: 11/20/96


DRAWN BY: DAN J
 LAST CORRECTION BY: DAN J
 FILE NAME: 23749det.dgn

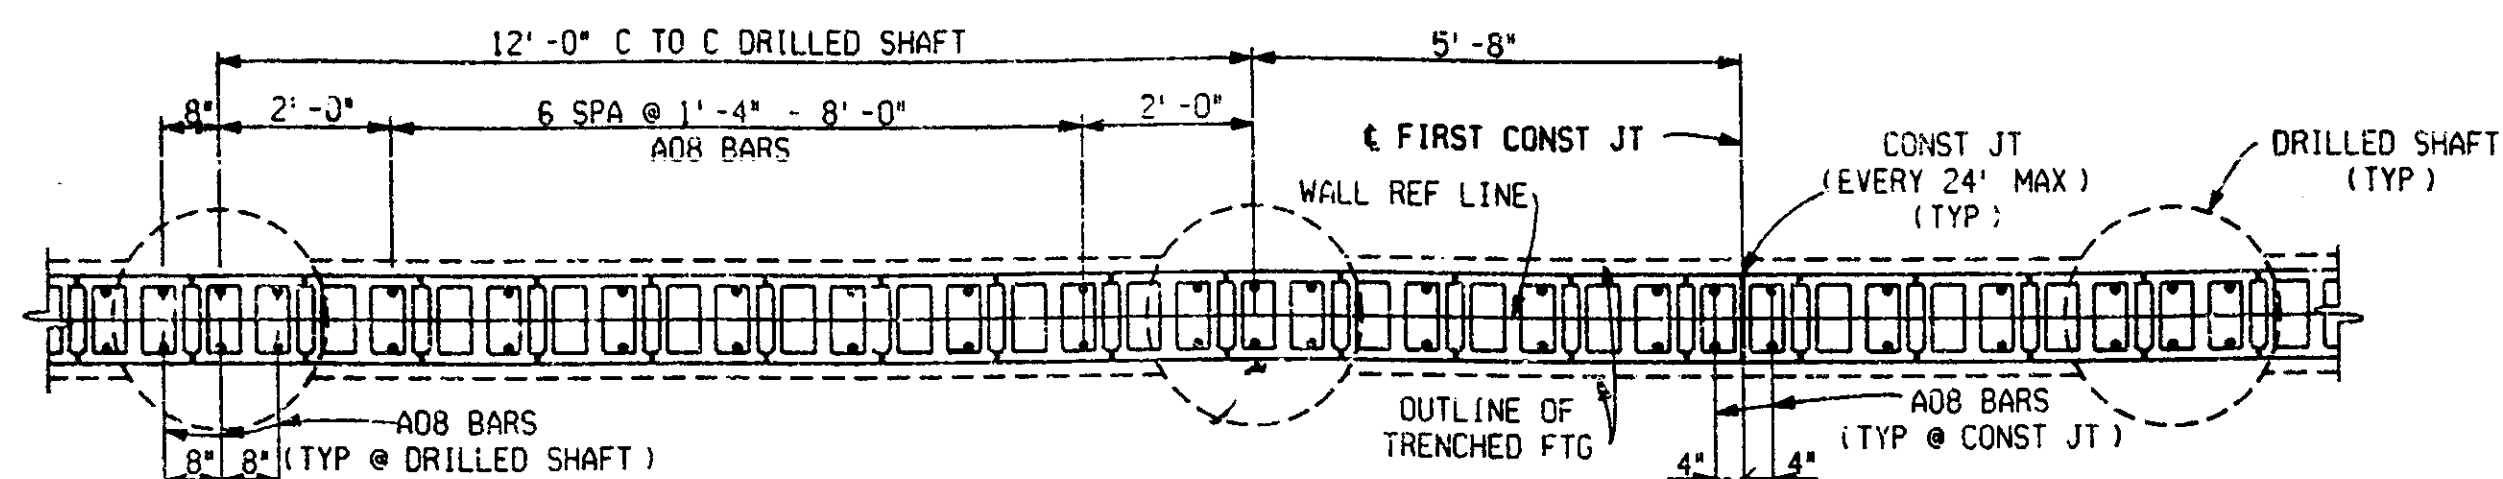

PLAN OF BLOCK WALL

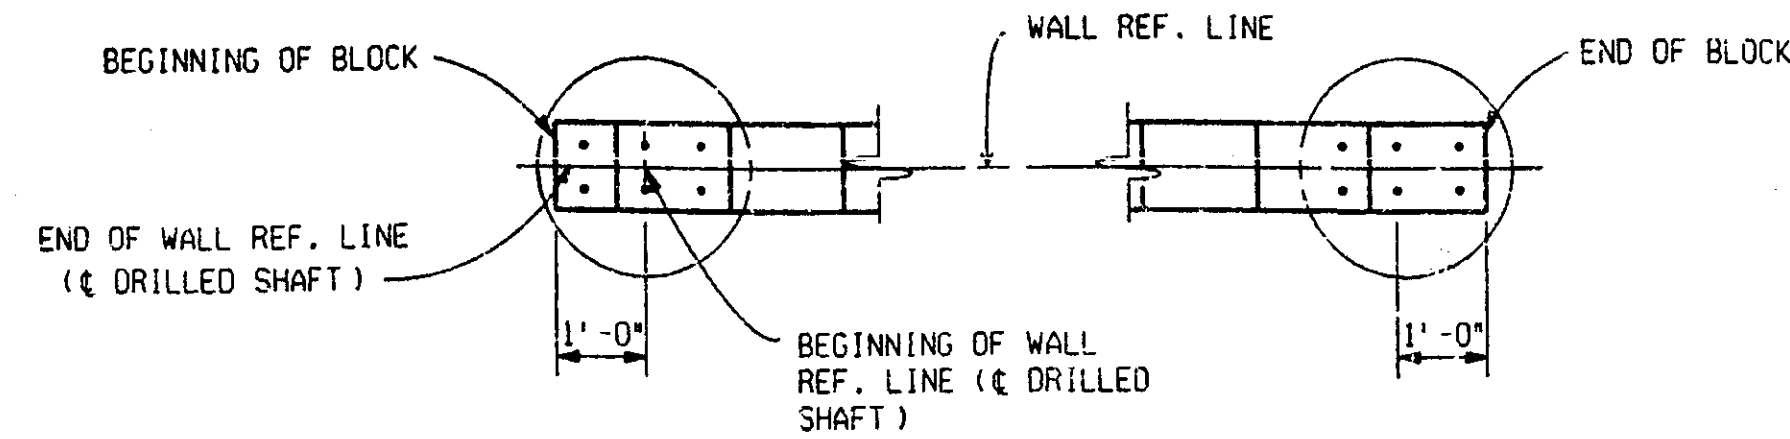


BEGINNING AND END OF WALL DETAILS

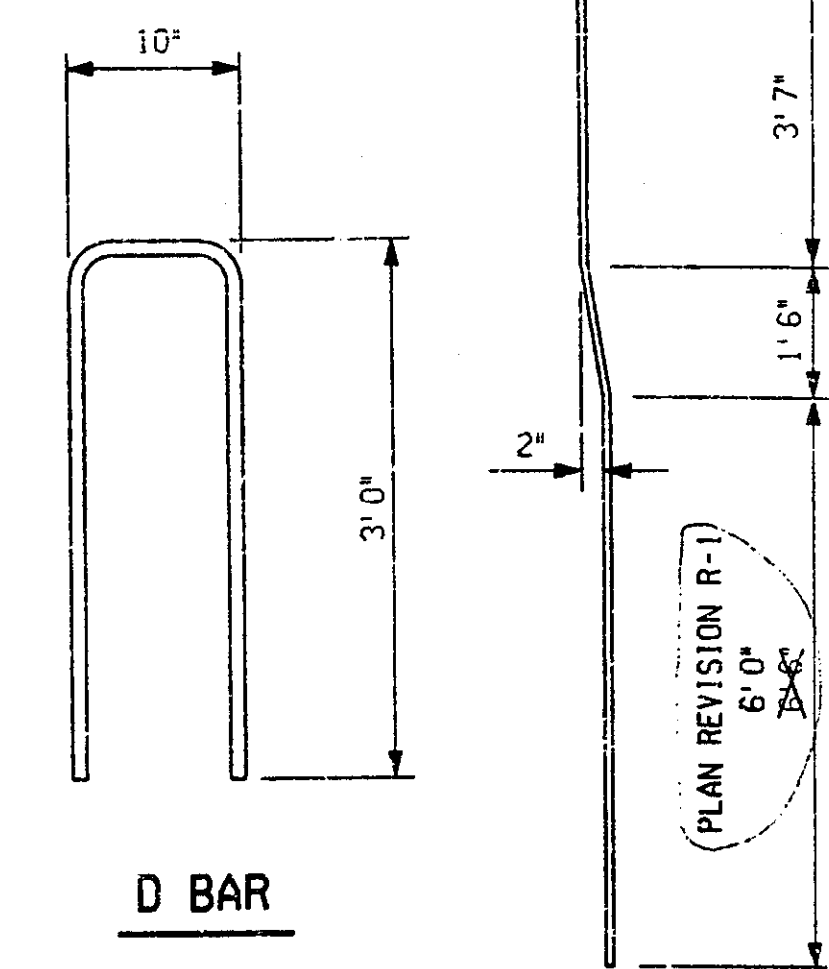


D BAR

Z BAR

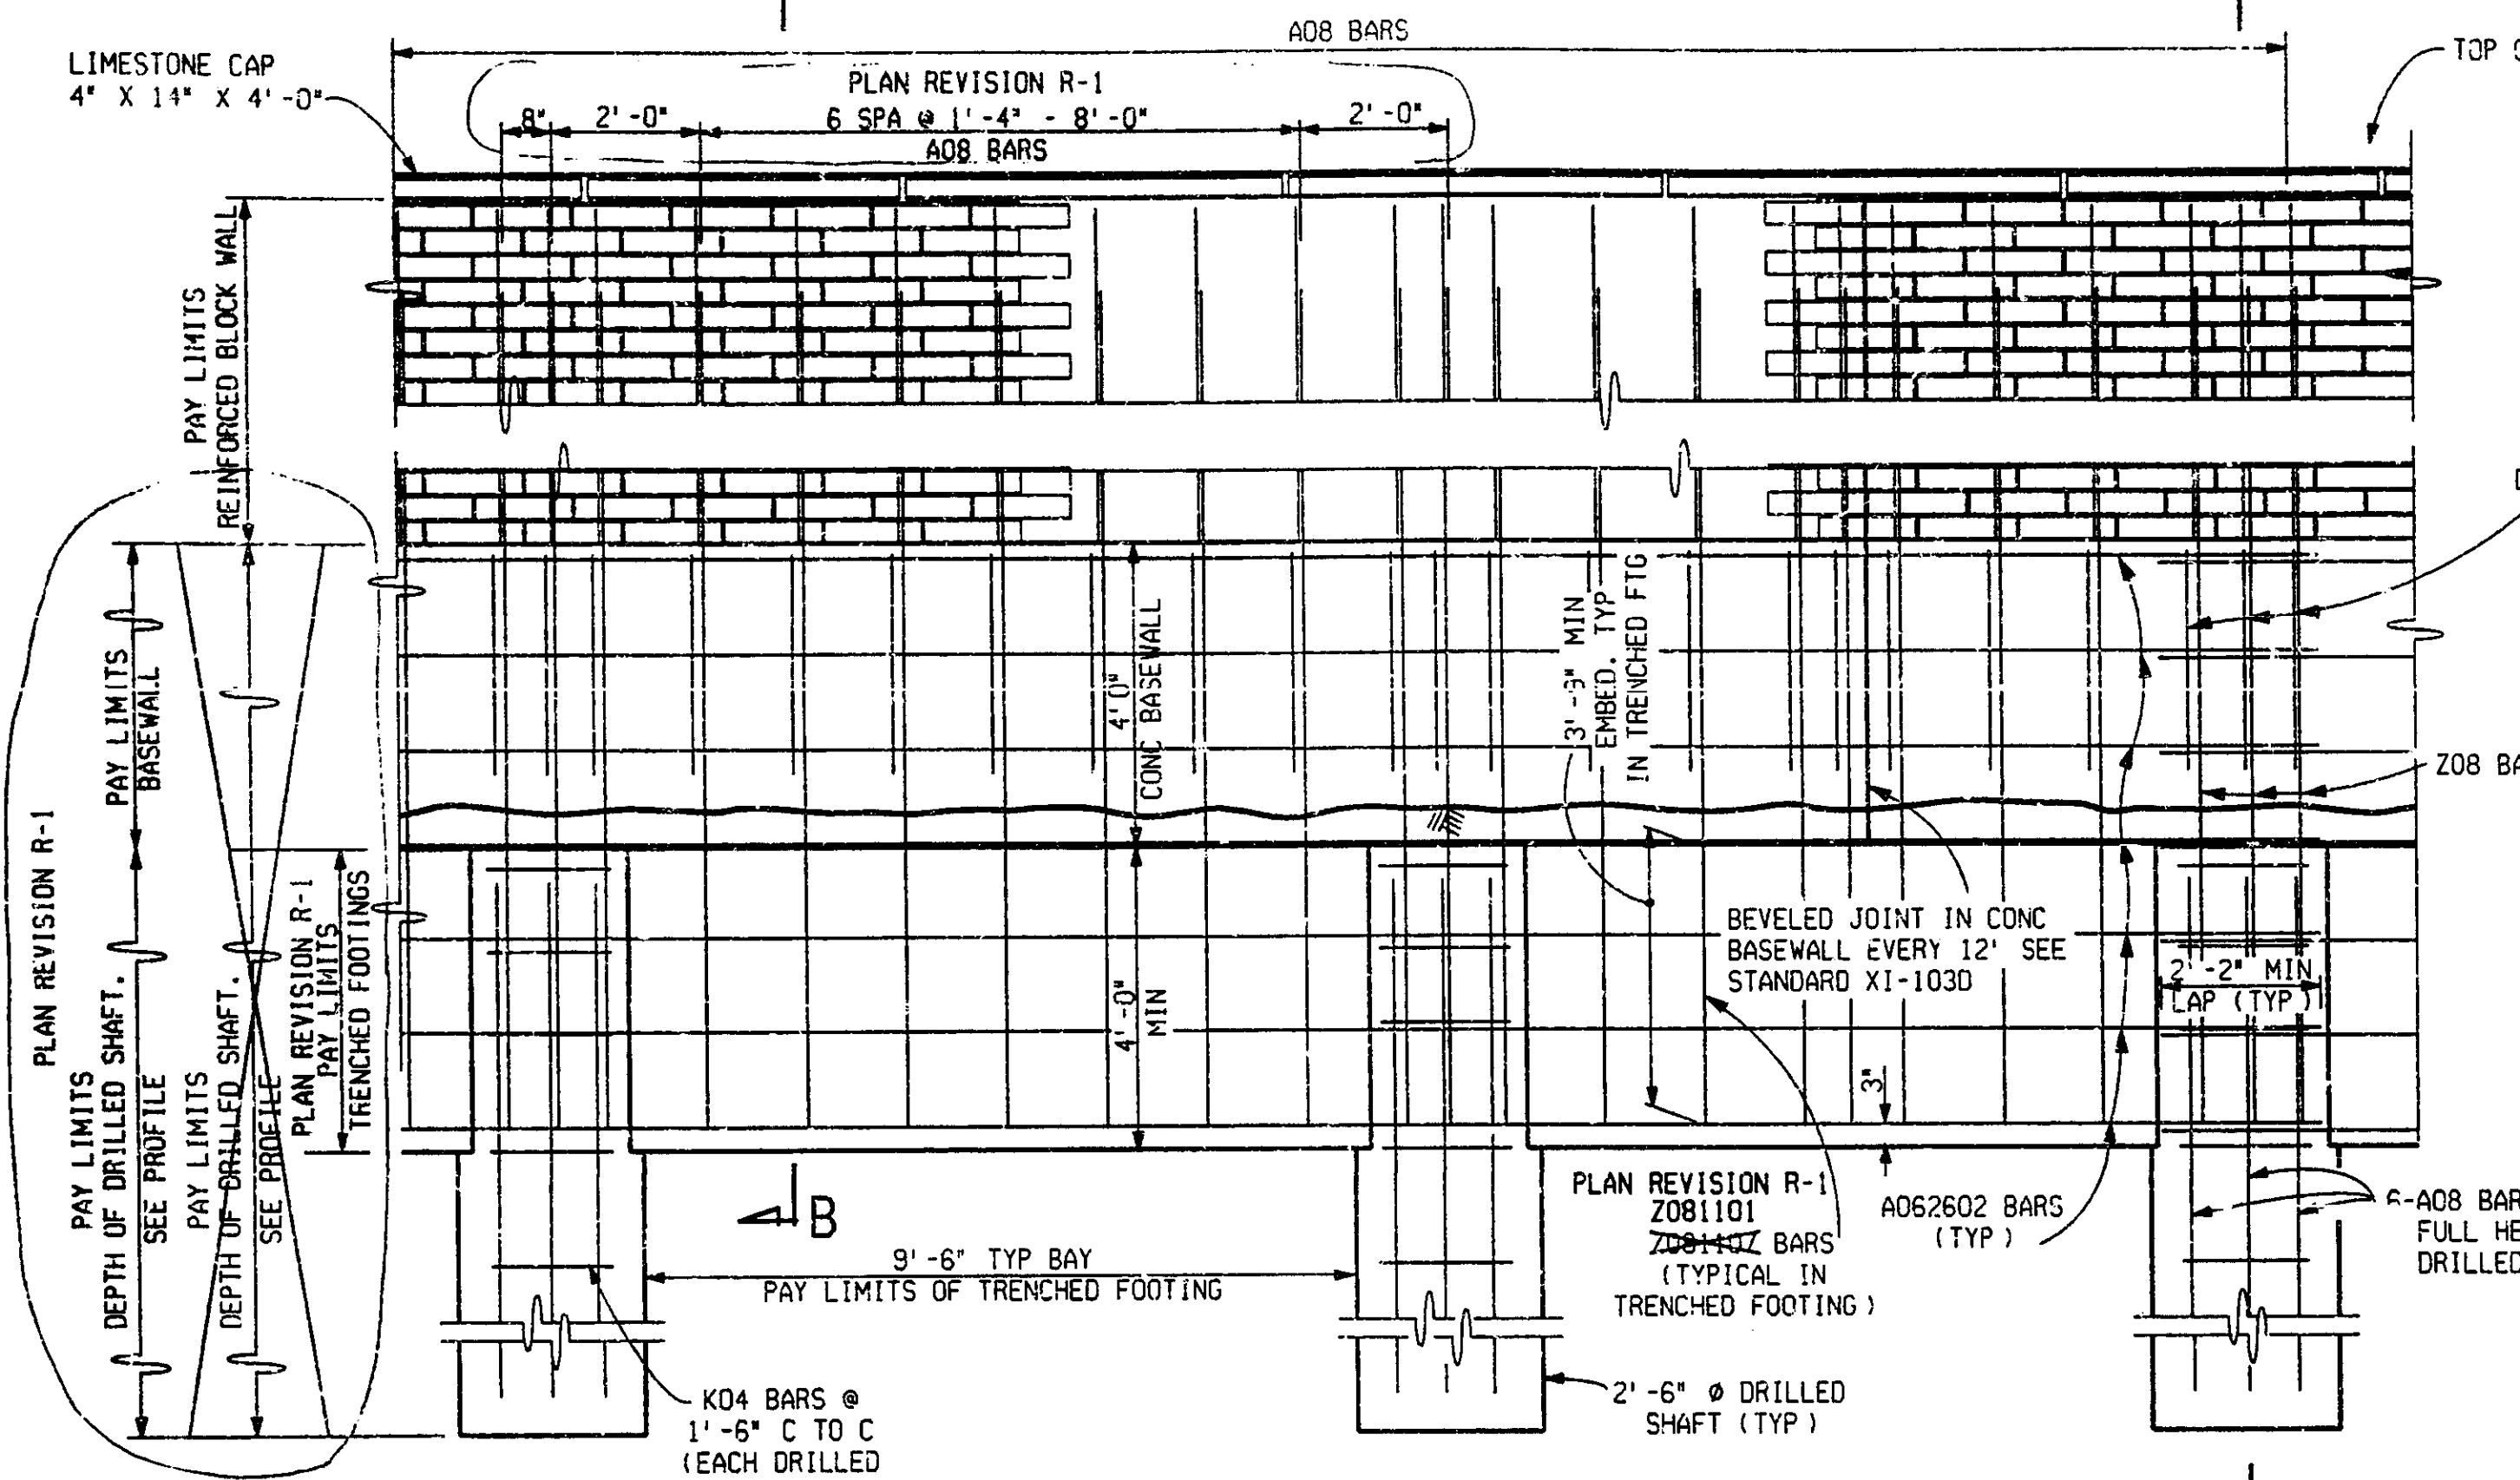


ELEVATION

(TYPICAL 24' SECTION)

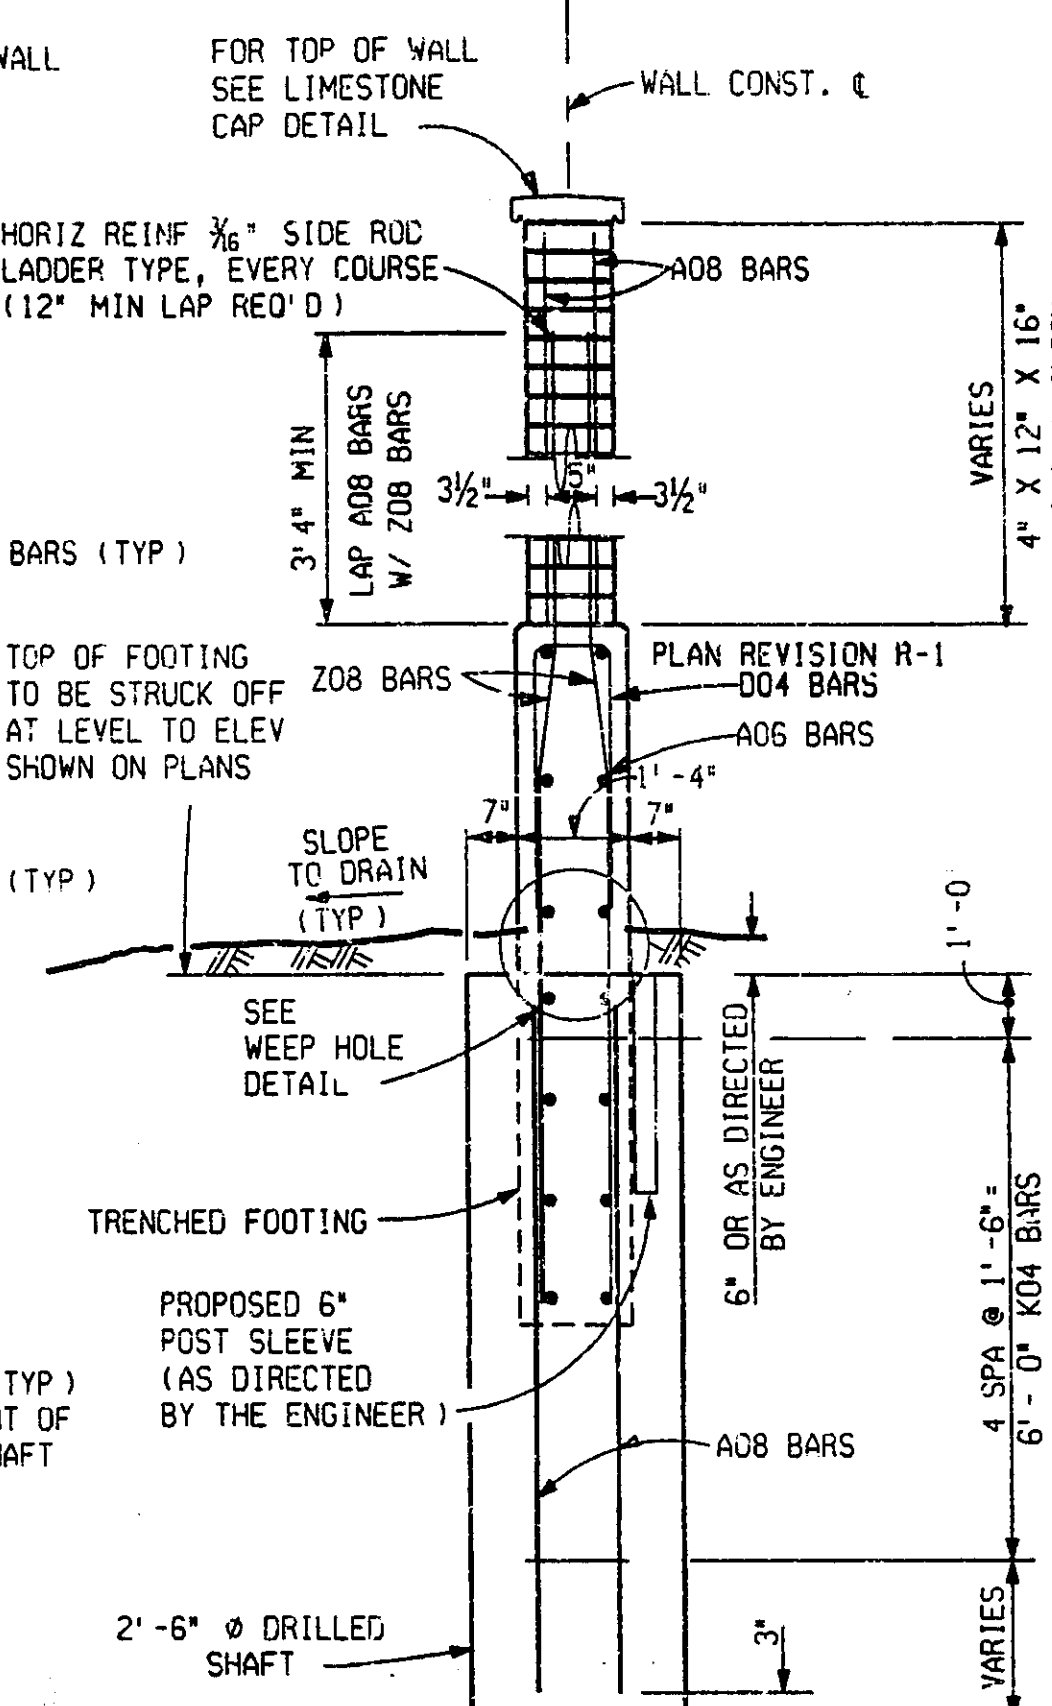


SECTION A-A

AT DRILLED SHAFT

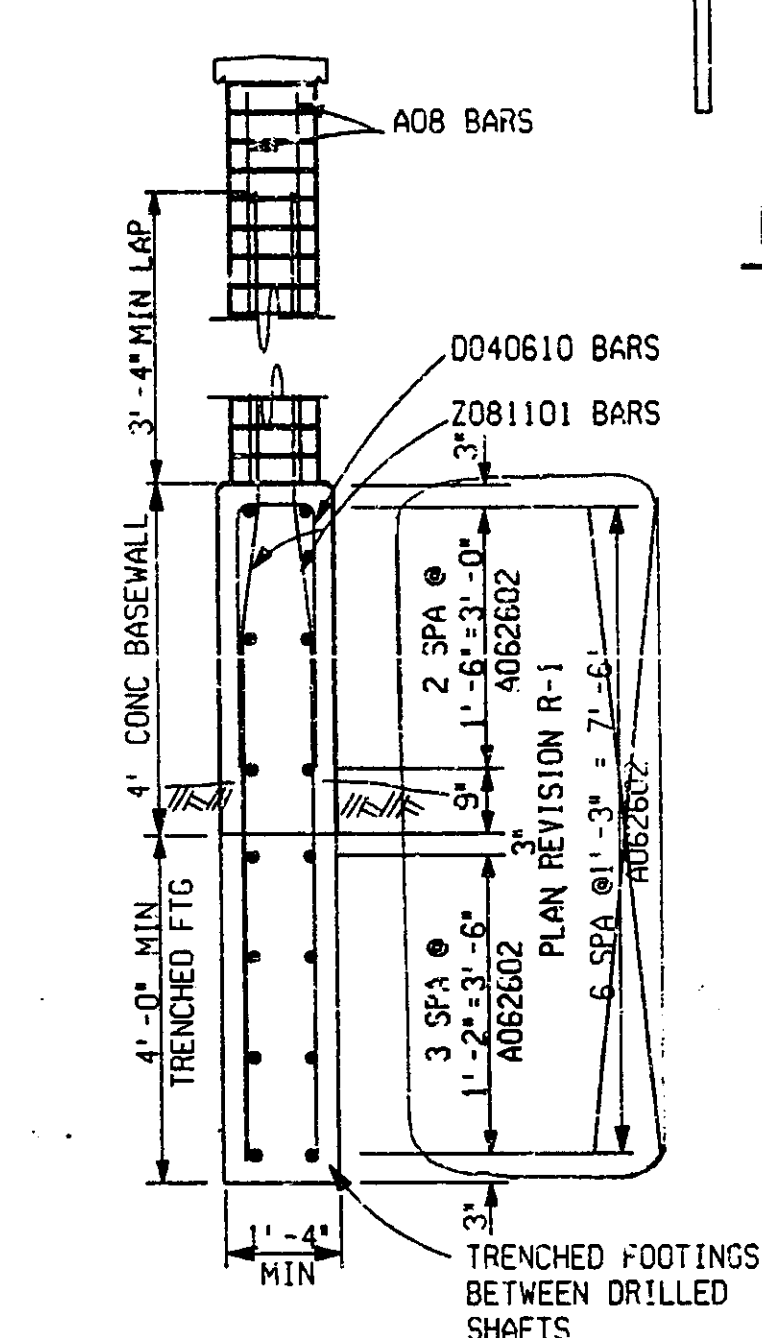


SECTION B-B

AT TRENCHED FOOTING

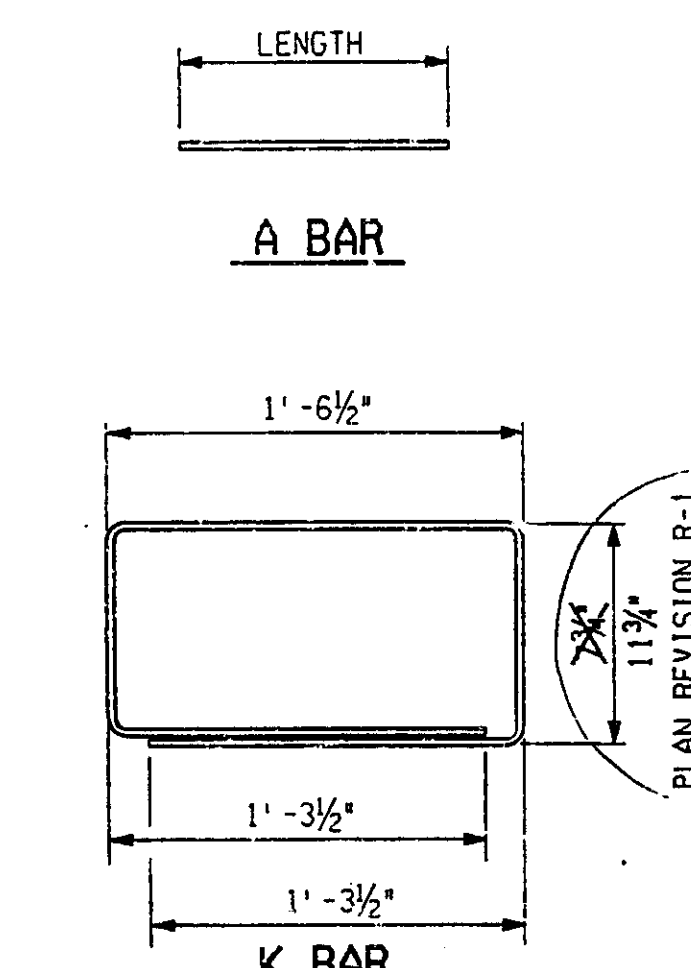


A BAR

K BAR

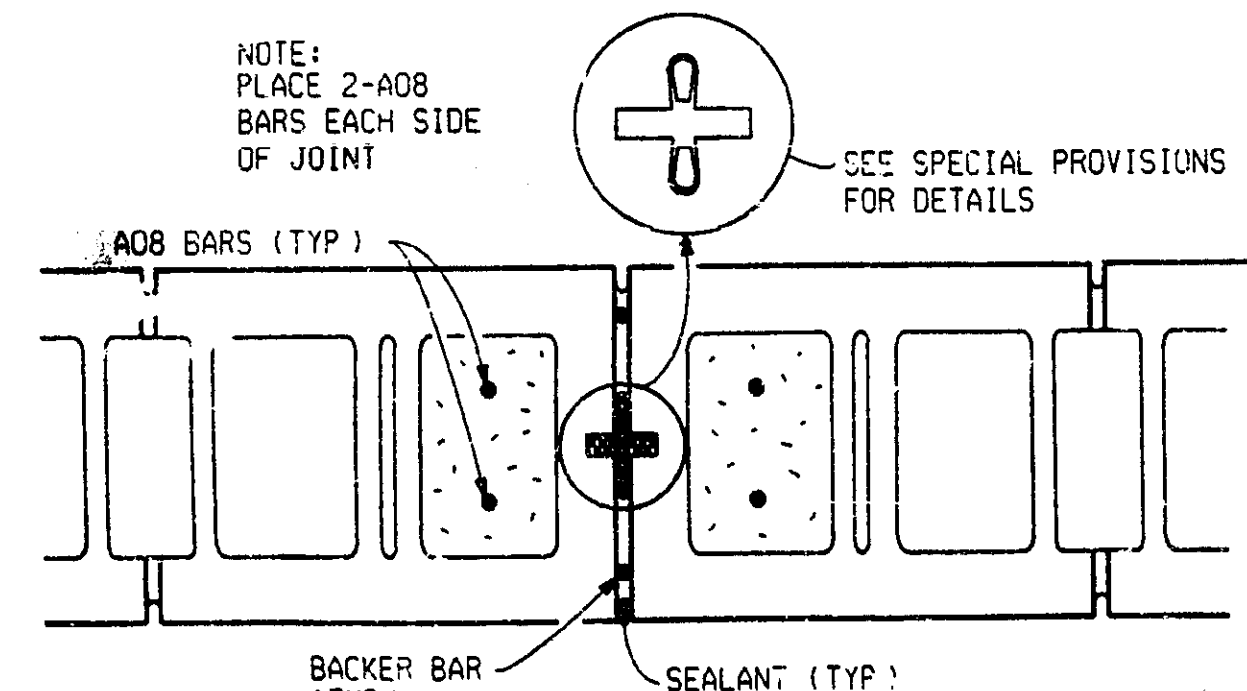


EXPANSION JOINT

(EVERY 4TH JOINT, 95' MAX.)
 (MAY BE USED AS CONSTRUCTION JOINT)
 (SHALL EXTEND THROUGH LIMESTONE CAP)

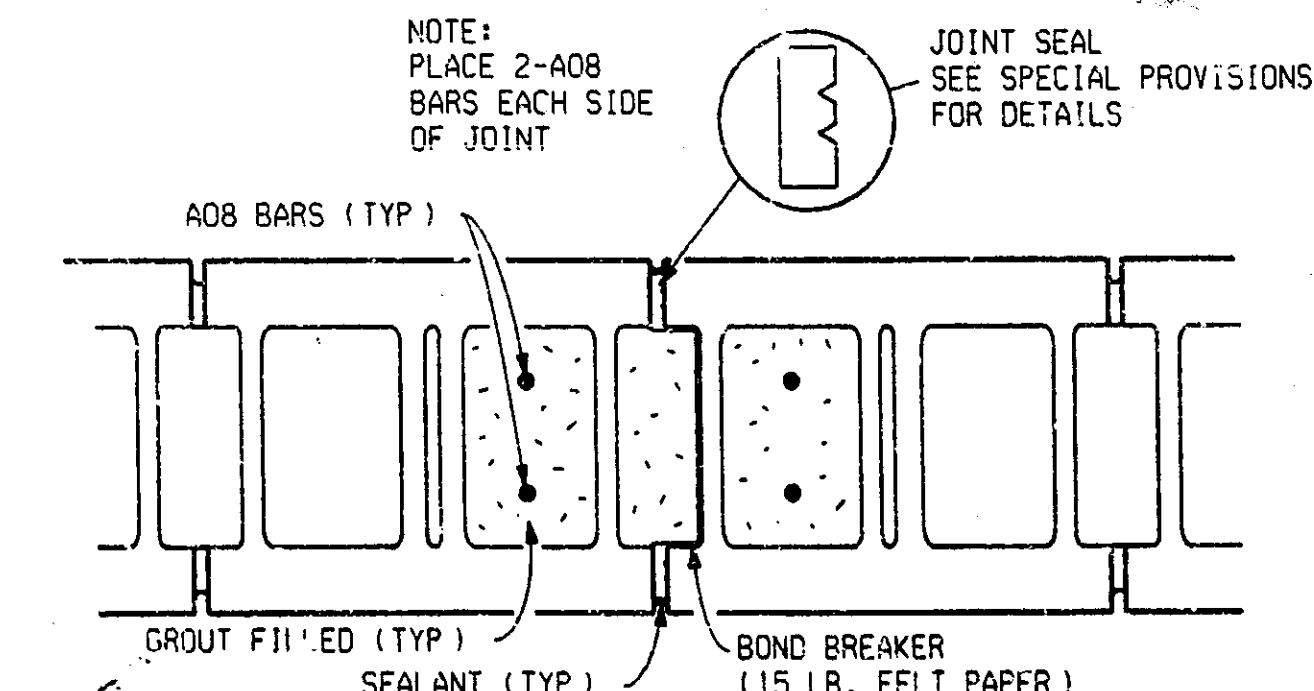


CONSTRUCTION JOINT

(EVERY 24'-0" MAX.)

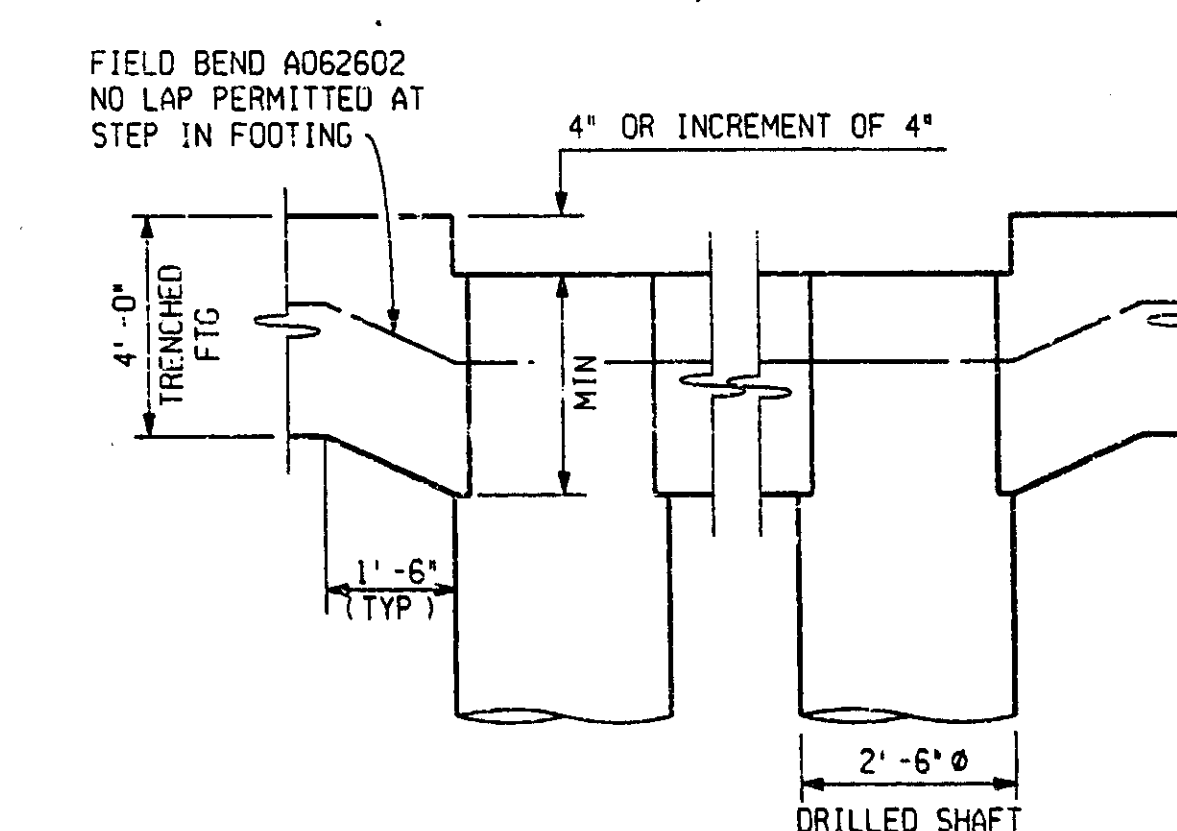


STEP IN FOOTING

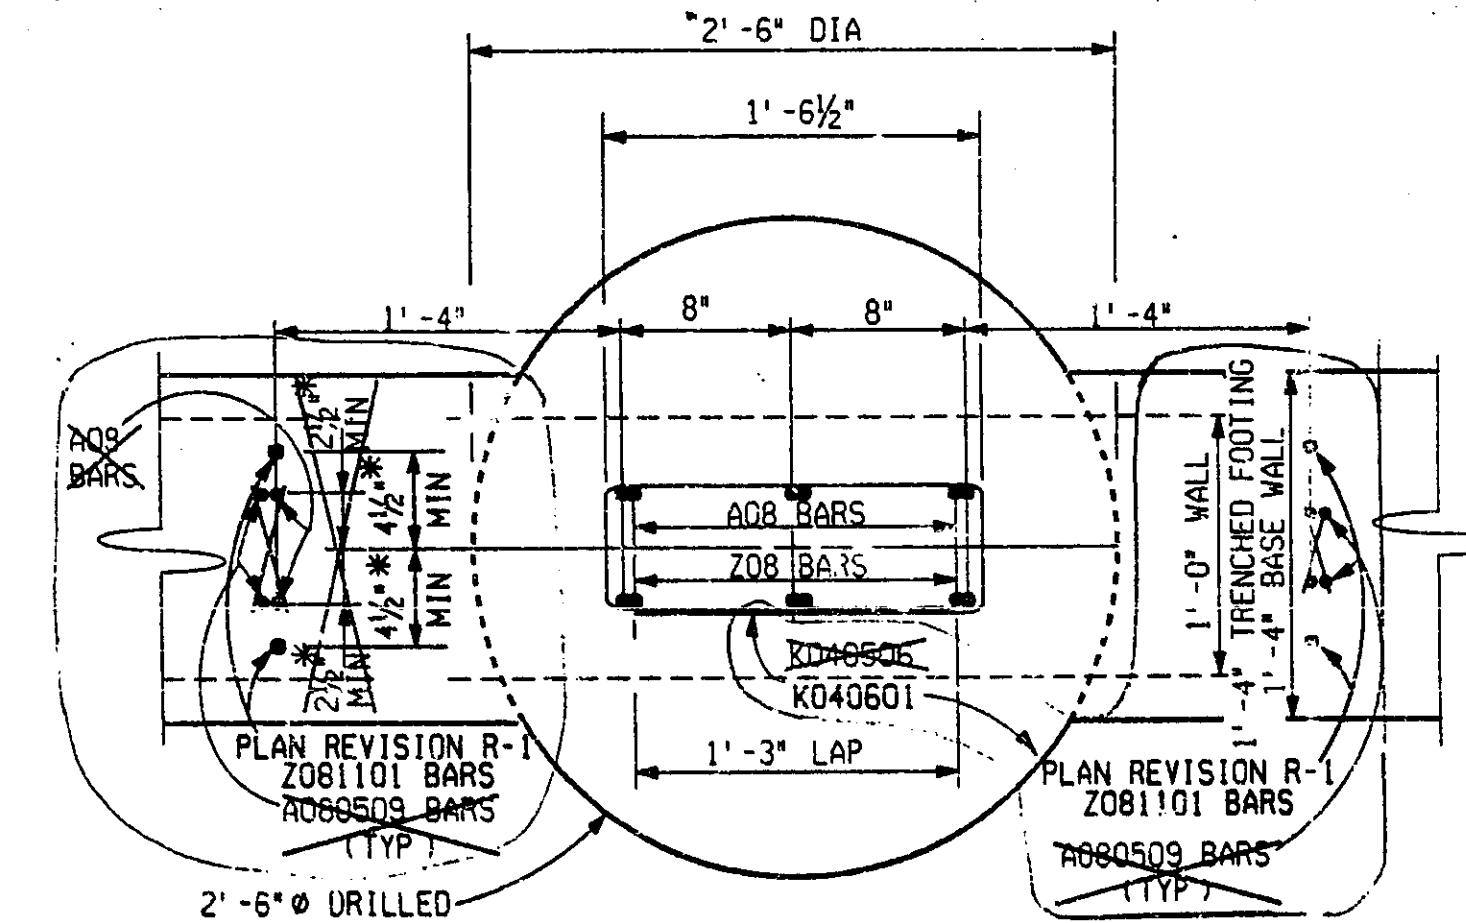

PLAN OF DRILLED SHAFT

*CONTRACTOR SHALL VERIFY BLOCK CORE WIDTH PRIOR TO PLACEMENT OF VERTICAL BARS IN TRENCHED FOOTING.
 *BLOCK SHALL NOT BE CUT TO FIT OVER REBAR.
 WHERE WALL HEIGHT EXCEEDS 18'-0", ENGINEER SHALL PROVIDE ALTERNATE SPACING FOR VERTICAL BARS IN TRENCHED FOOTING (A08509) OF 8" MAXIMUM.

MAXIMUM DESIGN WALL HEIGHT IS 25'.

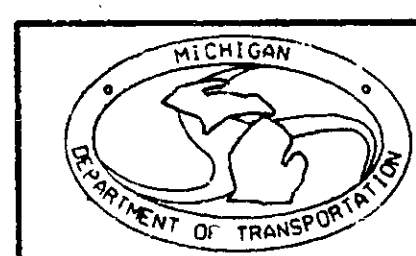


PROPOSED 4" REINFORCED BLOCK WALL


DATE	SCALE	CONT. SEC.	JOB NO.	DESIGN UNIT	SHEET NO.
11/20/96		63174	23749A	PENA	4

CONTRACTED AS PER PLANS APRIL 1999


DATE: 11/20/96
DRAWN BY: DAVID
FILE NAME: 23749det.dgn

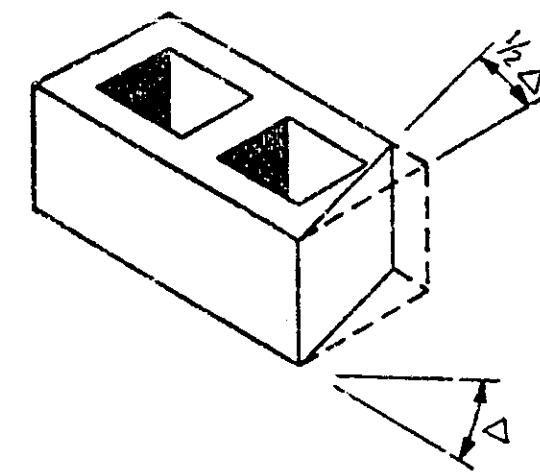


NOTE:
NOTE: Δ IS THE DEFLECTION ANGLE AT THE CHANGE IN DIRECTION OF WALL. THE BLOCK SHALL BE SAW-CUT AT $\frac{1}{2} \Delta$.

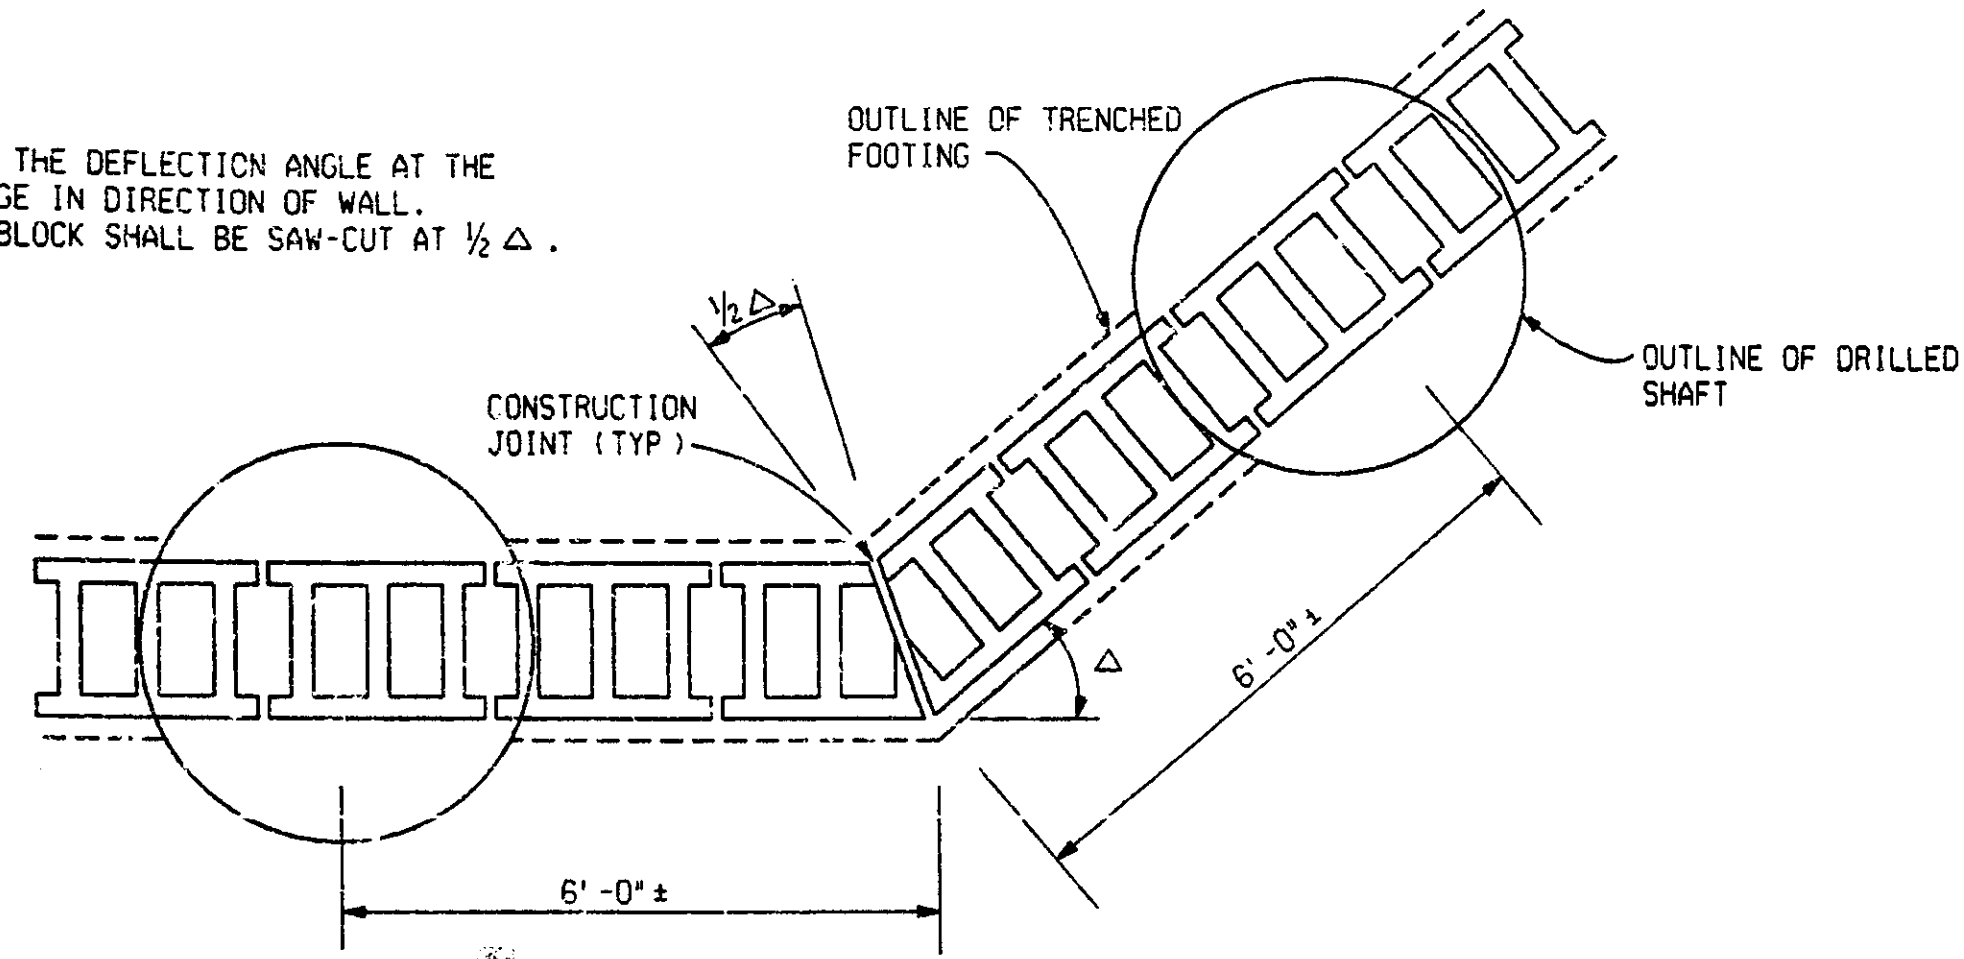

BLOCK DETAIL AT DEFLECTIONS IN WALL ALIGNMENT

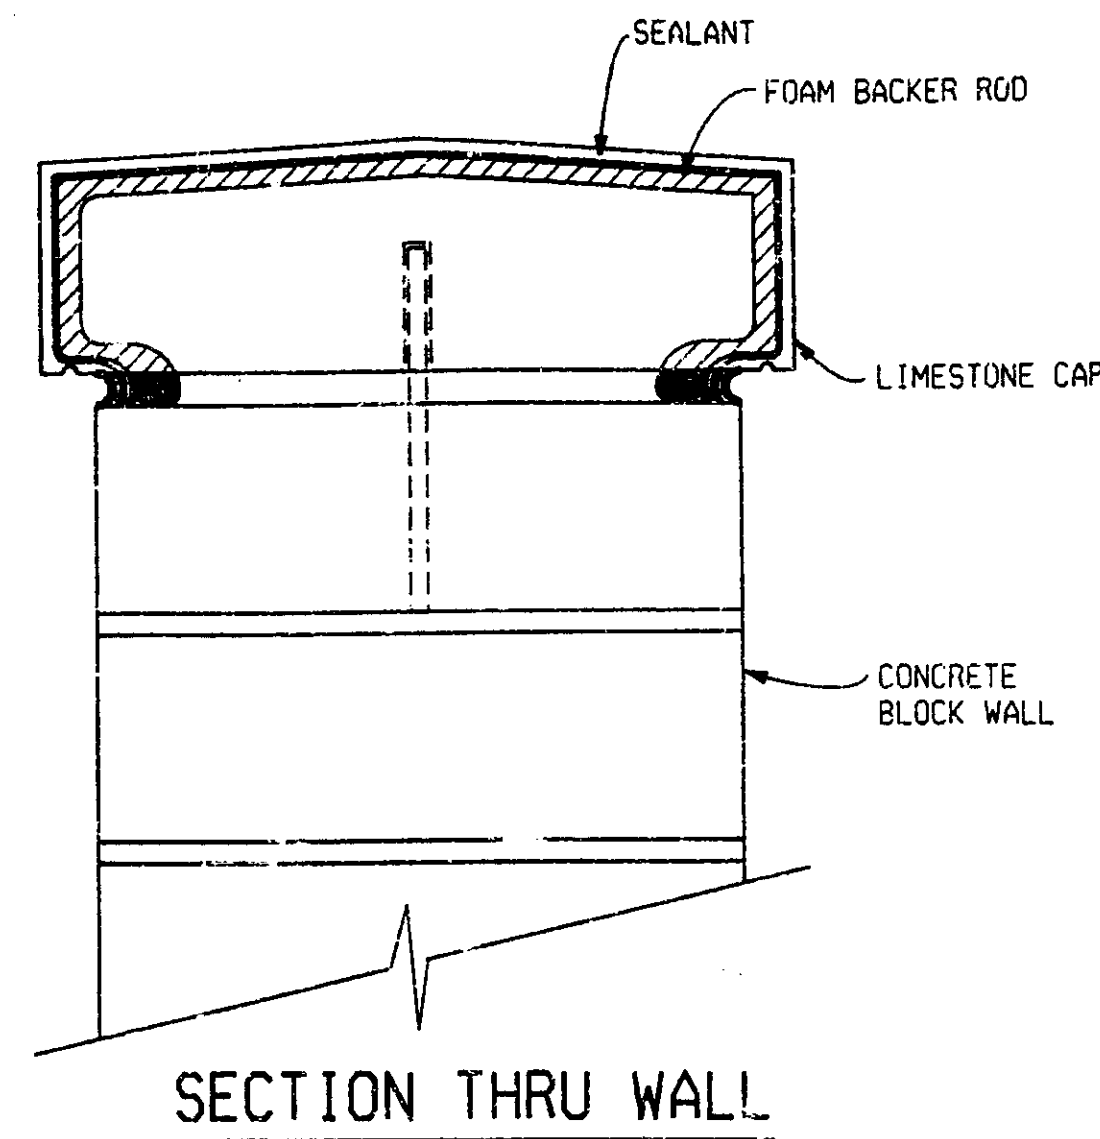

SECTION THRU WALL

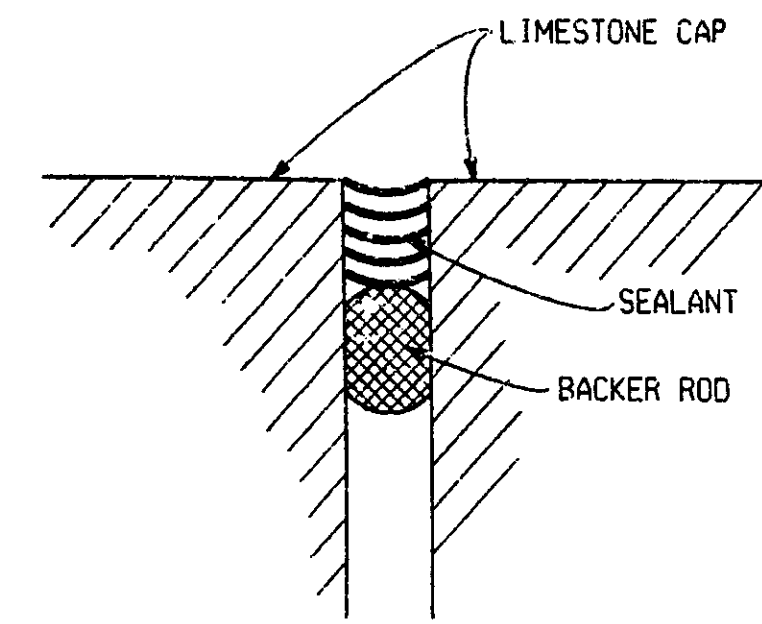


JOINT SECTION

VERTICAL JOINT DETAILS


NOTE:

VERTICAL JOINT IN LIMESTONE CAP SHALL NOT CONcide WITH THE EXPANSION JOINTS IN THE WALL. CAP JOINT SHALL BE OFFSET TO INSURE CONTINUOUS MOISTURE BARRIER FOR THE LENGTH OF THE WALL.

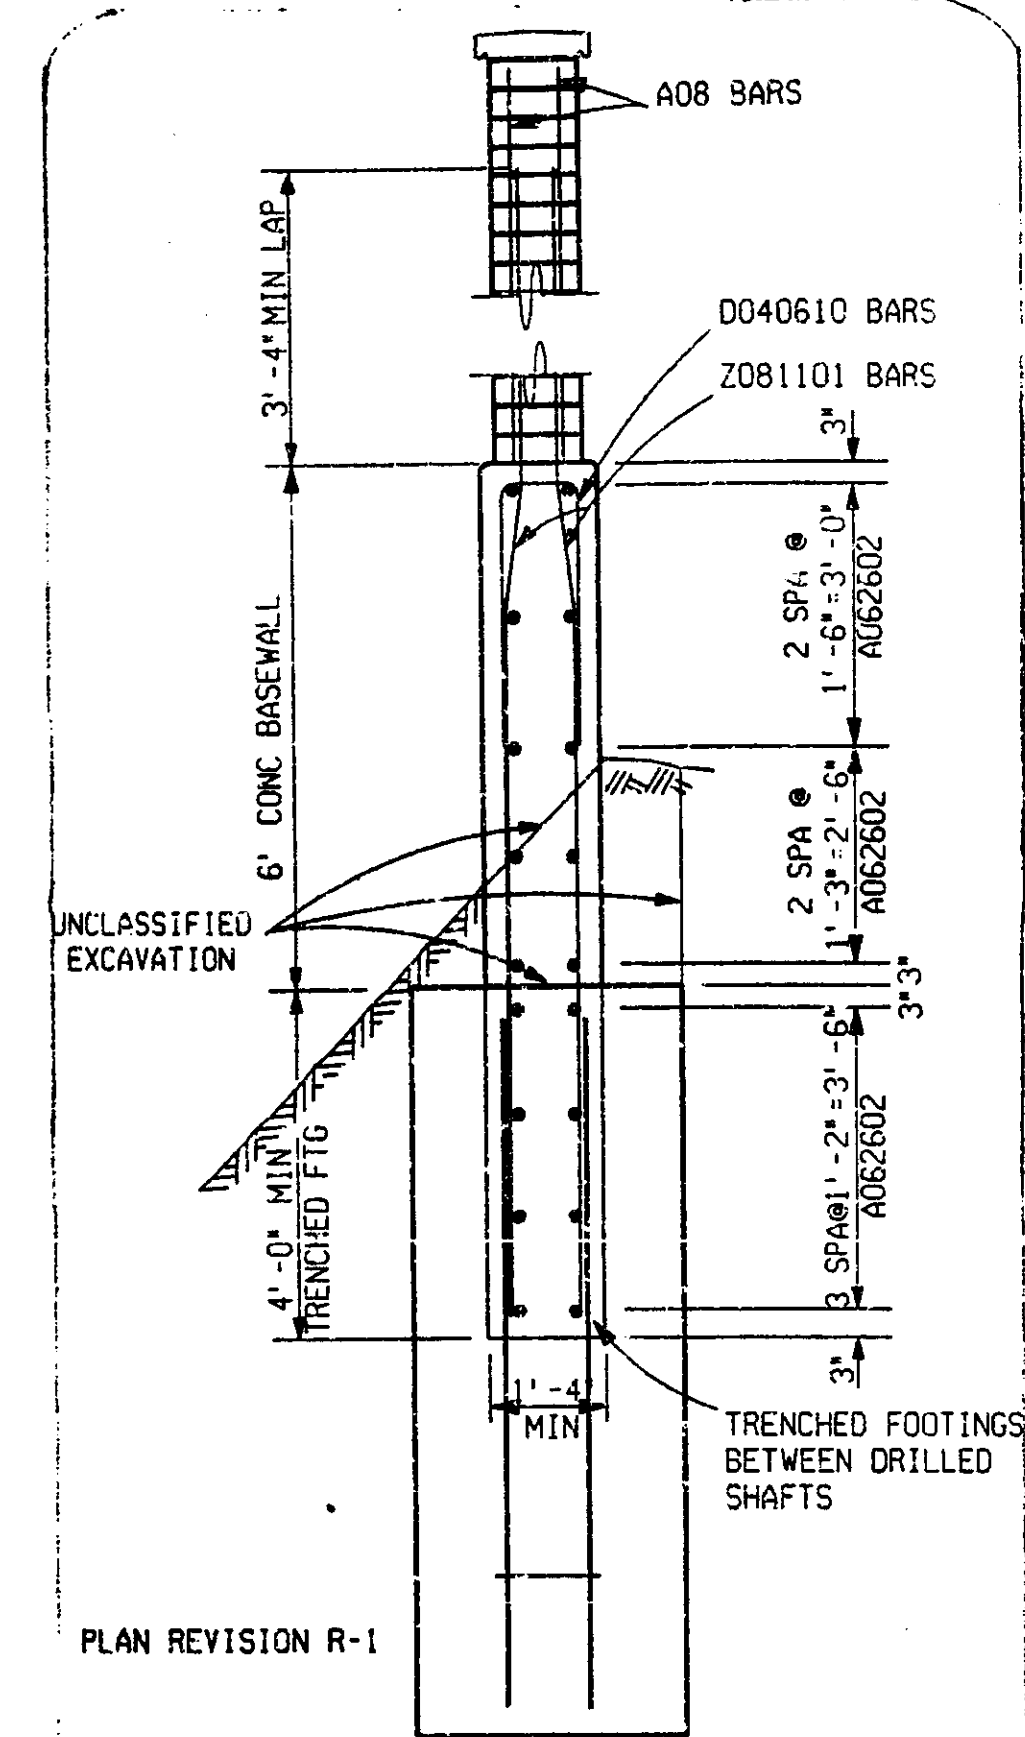

SECTION A-A


SECTION APPLIES TO:
STA 529+25 TO STA 855+06 NB
STA 554+24 TO STA 834+82 SB
*SHOWS 6' HIGH CONC BASEWALL

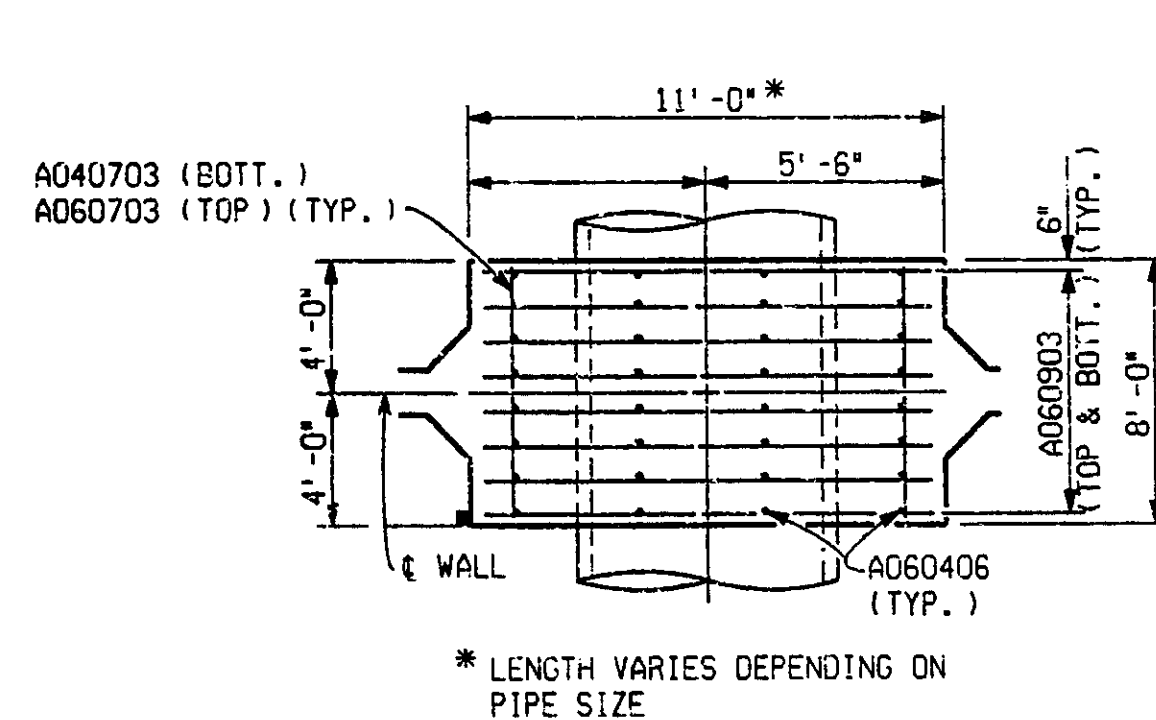

PLAN


FOOTING CROSSING UTILITY DETAILS

LOCATE UTILITY BEFORE DRILLING DRILLED SHAFT. USE WHERE DRILLED SHAFT OCCURS AT UTILITY. LOCATION TO BE DETERMINED BY THE ENGINEER. NOT TO BE PAID FOR SEPERATELY BUT INCLUDED IN PAY ITEM "DRILLED SHAFT"

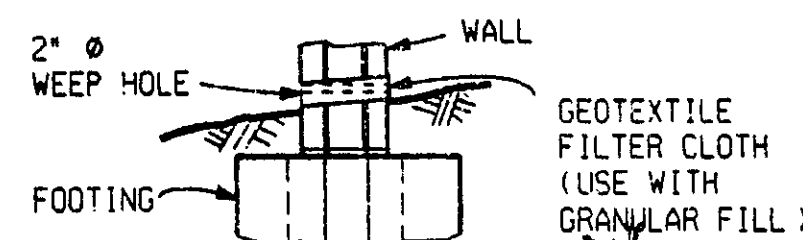


WEEP HOLE DETAIL

PROVIDE WEEP HOLE WHERE FINISH GRADE SLOPES TOWARD THE WALL. LOCATION TO BE DETERMINED BY THE ENGINEER.

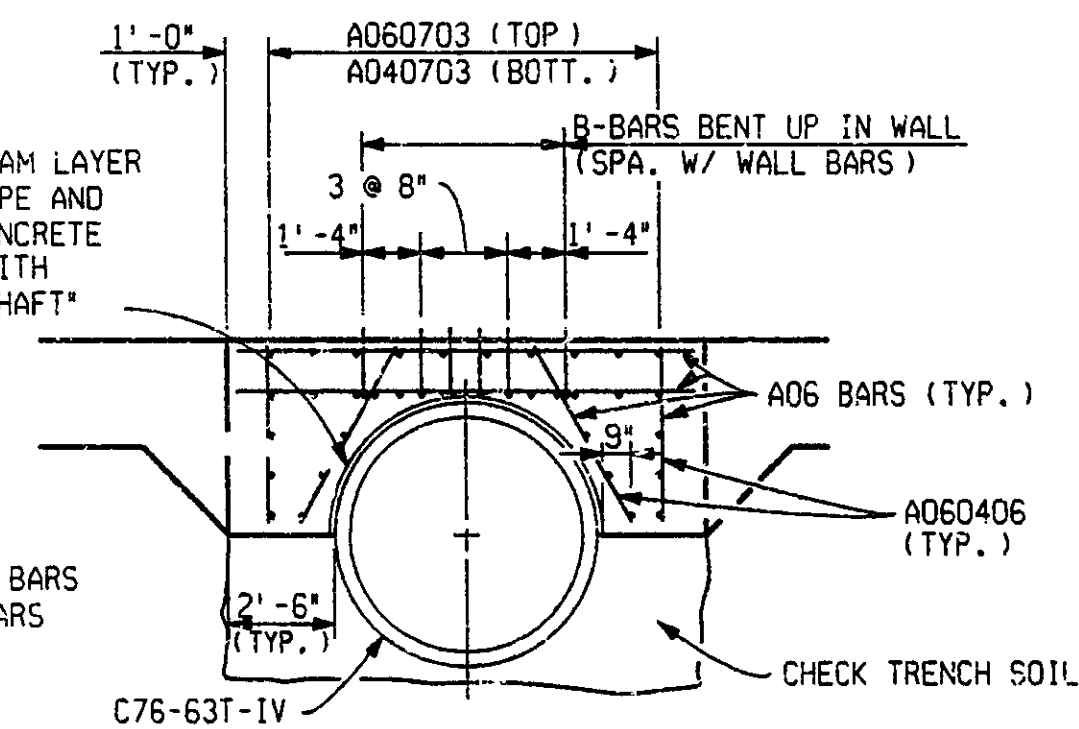

ELEVATION

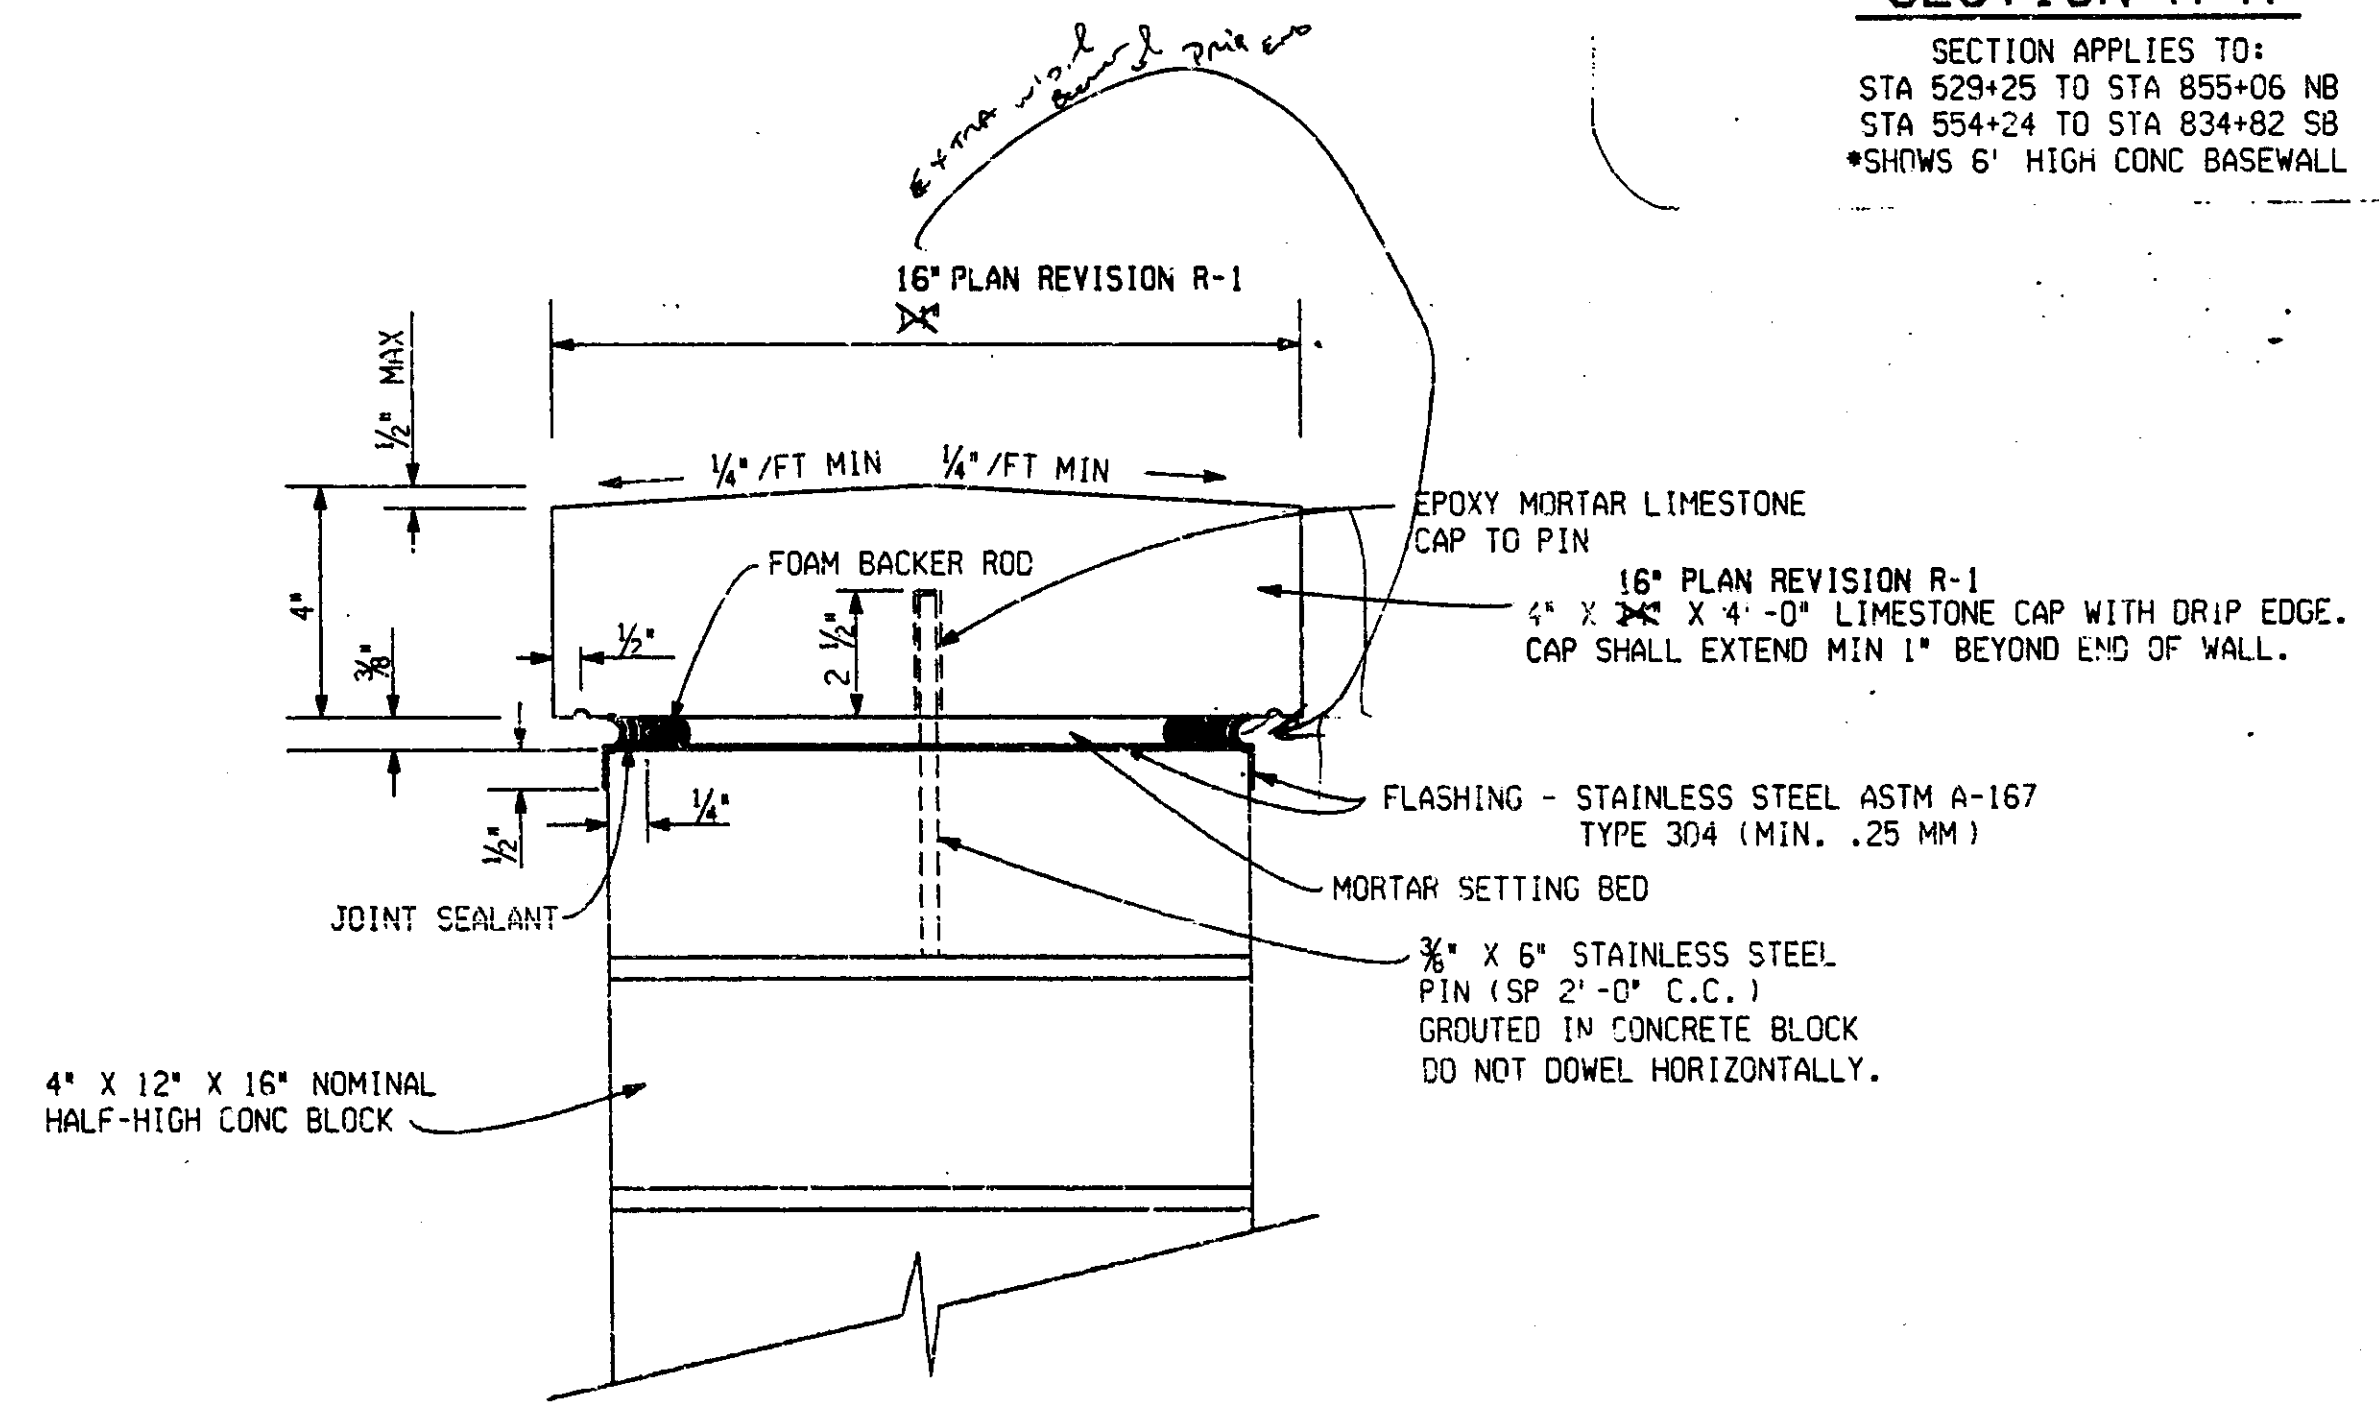

LIMESTONE CAP DETAIL

PLAN REVISION R-1

	PROPOSED 4" REINFORCED BLOCK WALL					SHEET NO. R.O.W CONST. 5
	DATE 11/20/96	SCALE	CONT. SEC. 63174	JOB NO. 23749A	DESIGN UNIT PENA	

FILE NAME: 23749leg.dwg
 1 2 3 4 5 6 7 8 9 10 11 12 13 14 15 16 17 18 19 20 21 22 23 24 25 26 27 28 29 30 31 32 33 34 35 36 37 38 39 40 41 42 43 44 45 46 47 48 49 50 51 52 53 54 55 56 57 58 59 60 61 62 63

EXISTING BY:
 PROPOSED BY:
 LAST CO. SECTION BY:

CONTRACT AS PER PLANS APRIL 1999

WATER & DRAINAGE SYMBOLS

- EXISTING CATCH BASIN
- ◐ PROPOSED CATCH BASIN
- EXISTING MANHOLE
- ◌ PROPOSED MANHOLE
- ▲ EXISTING CULVERT END SECTION
- ▲ PROPOSED CULVERT END SECTION
- EXISTING HEADWALL
- PROPOSED HEADWALL
- WATER SHUTOFF (Service Valve)
- GATE VALVE
- ⊙ GATEWELL
- ⊙ WATER METER
- WATER MANHOLE
- EXISTING FIRE HYDRANT
- PROPOSED FIRE HYDRANT
- (ADJ-HYD) ADJUST FIRE HYDRANT
- (ADJ) ADJUST DRAINAGE STRUCTURE
- (ADJ-K) ADJUST DRAINAGE STRUCTURE W/COVER
- (ADJ-B/P) ADJUST DRAINAGE STRUCTURE BY OTHERS
- (REC) RECONSTRUCT DRAINAGE STRUCTURE
- (REC-K) RECONSTRUCT DRAINAGE STRUCTURE W/COVER
- (REL-B/O) RELOCATE - BY OTHERS
- (SR-1) SIDEWALK RAMP TYPE
- ^ CHECK DAM (PROFILES)
- ^ DIKE (PROFILES)
- W.T. WATER TABLE (PROFILES)
- GUARD POST
- WATER WELL

REAL ESTATE SYMBOLS

- PROPERTY OWNERSHIP ARROW
- ↗ CONTIGUOUS PROPERTY SYMBOL
- 123456 PARCEL NUMBER BOX
- PARCEL LINES

UTILITIES SYMBOLS

- POWER POLE
- TELEPHONE POLE
- GUY POLE
- LIGHT POLE
- POWER LIGHT POLE
- TELEPHONE MANHOLE
- ⊗ POWER TOWER
- ⊠ GAS VALVE
- WALK/NO-WALK
- DEADMAN FOR GUYWIRE
- RAILROAD SIGNAL
- ELECTRICAL MANHOLE
- ELECTRICAL HANDHOLE
- TELEPHONE PEDESTAL/RISER

MISCELLANEOUS SYMBOLS

- RIPRAP
- ↑ SIGN
- ^ STUMP
- SWAMP
- ☆ DECIDUOUS TREE
- ★ EVERGREEN TREE
- MAIL BOX
- ◆ QUARTER CORNER
- ◇ SECTION CORNER
- ▲ HALF QUARTER SECTION
- ⊙ TEST HOLE NO.
- ◁ 123 BEAM G. R. RUN NUMBER (EXISTING)
- ▷ 123 BEAM G. R. RUN NUMBER (PROPOSED)

HAZARDOUS OR FLAMMABLE MATERIAL USED WITH UNDERGROUND GAS & ELECTRICAL LINES

CAUTION - CRITICAL UNDERGROUND UTILITY USED WITH FIBER OPTICS LINES

--- PROP 36" --- PROPOSED CULVERT/SEWER

.... EX 12" CMP EXISTING CULVERT/SEWER

UTILITY PATTERNS

- 6" ELEC --- ELECTRICAL LINE
- 24" GAS --- GAS LINE
- 12" OIL --- OIL LINE
- TEL --- TELEPHONE LINE
- 30" W --- WATER LINE
- CTV --- AERIAL CABLE ONLY
- TEL FO --- FIBER OPTICS
- PTL --- POWER TRANSMISSION LINE

R.O.W. PATTERNS

- XX --- EX. LIMITED ACCESS R.O.W.
- --- EXISTING R.O.W.
- XX XX --- PROP LIMITED ACCESS R.O.W.
- --- PROP FREE ACCESS R.O.W.
- --- SECTION LINE

TOPO PATTERNS

- HEDGE LINE
- TREE LINE
- X X --- EXISTING FENCE
- X X --- PROPOSED FENCE
- EXISTING GUARD RAIL
- PROPOSED GUARD RAIL
- DRAINAGE CRS/EDGE OF WATER
- WETLANDS AREA
- ABANDON ANY UTILITY
- CITY LIMITS
- RAILROAD
- SOUND ABATEMENT WALL
- CONCRETE MEDIAN BARRIER
- SLOPE STAKE LINE

DRIVE/APPROACH LEGEND


- CONCRETE
- BITUMINOUS
- AGGREGATE

REMOVAL LEGEND

- REMOVING BITUMINOUS
- REMOVING SIDEWALK
- REMOVING PAVEMENT
- REMOVING CURB & GUTTER
- REMOVING
- ABANDONING
- SAVE
- BULKHEAD
- CLEARING

SPECIAL SYMBOLS THIS PROJECT:

- TWELVE TOWNS DRAIN
- GROUTED FLAGSTONE

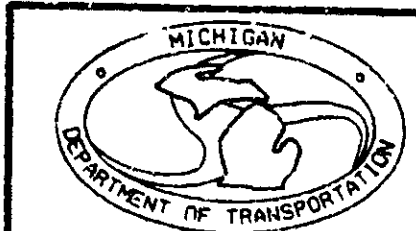

STANDARD SYMBOLS


DATE	SCALE	CONT. SEC.	JOB NO.	DESIGN UNIT	SHEET NO.
08/03/95	1" = 50'	63174	23749 A	PENA	7

DATE: 07/08/96
 DATE: 07/08/96
 EXISTING BY: WALTER
 PROPOSED BY: WALTER
 LAST CORRECTION BY: WALTER


CONSTRUCTED AS PER PLANS APRIL 1999

FILE NAME: 23749wall.dwg
 10
 1 2


FINAL R.O.W.		
AUTH	DATE	REVISION

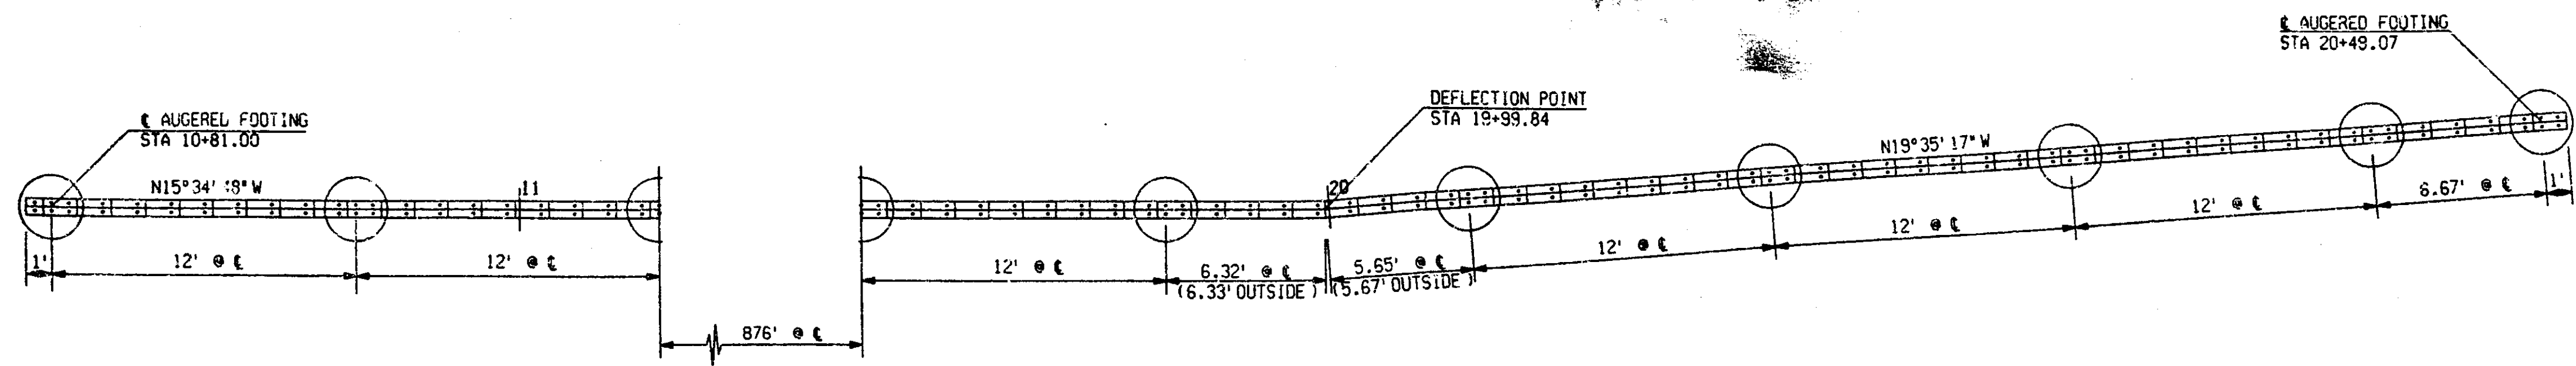


WALL "A"

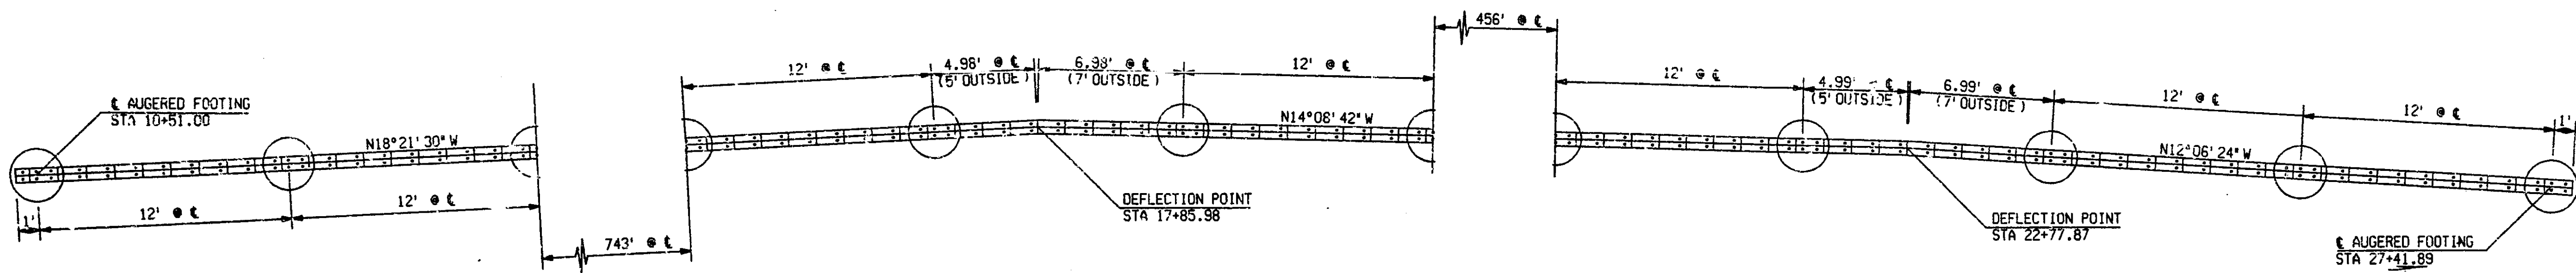

WALL "B"

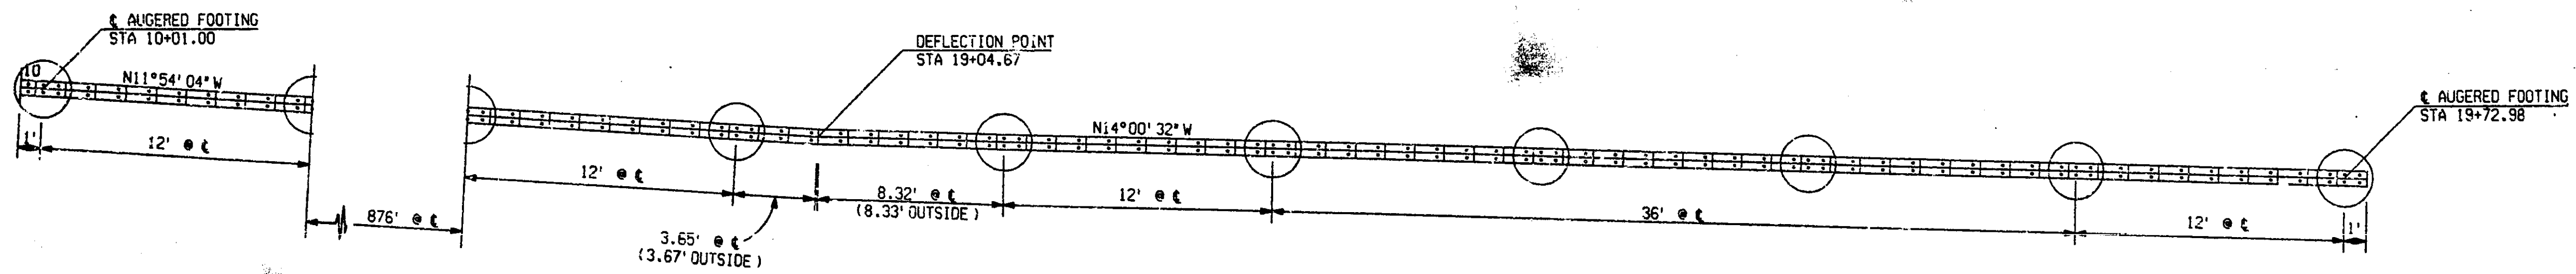

WALL "C"

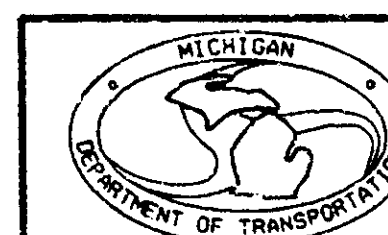

WALL "A", "B" AND "C" ALIGNMENT SHEET					
DATE	SCALE	CONT. SEC.	JOB NO.	DESIGN UNIT	SHEET NO.
07/08/96	1" = 4'	63174	23749	PENA	8



16/07/96 Engineering Print

FINAL R.O.W.			
AUTH.	DATE	NO.	REVISION


DATE: 07/08/96
 DATE: 07/08/96
 EXISTING BY: WALTER
 PROPOSED BY:
 LAST CORRECTION BY:

CONSTRUCTED AS PER PLANS, APRIL 1999

16/87/96 Engineering Print

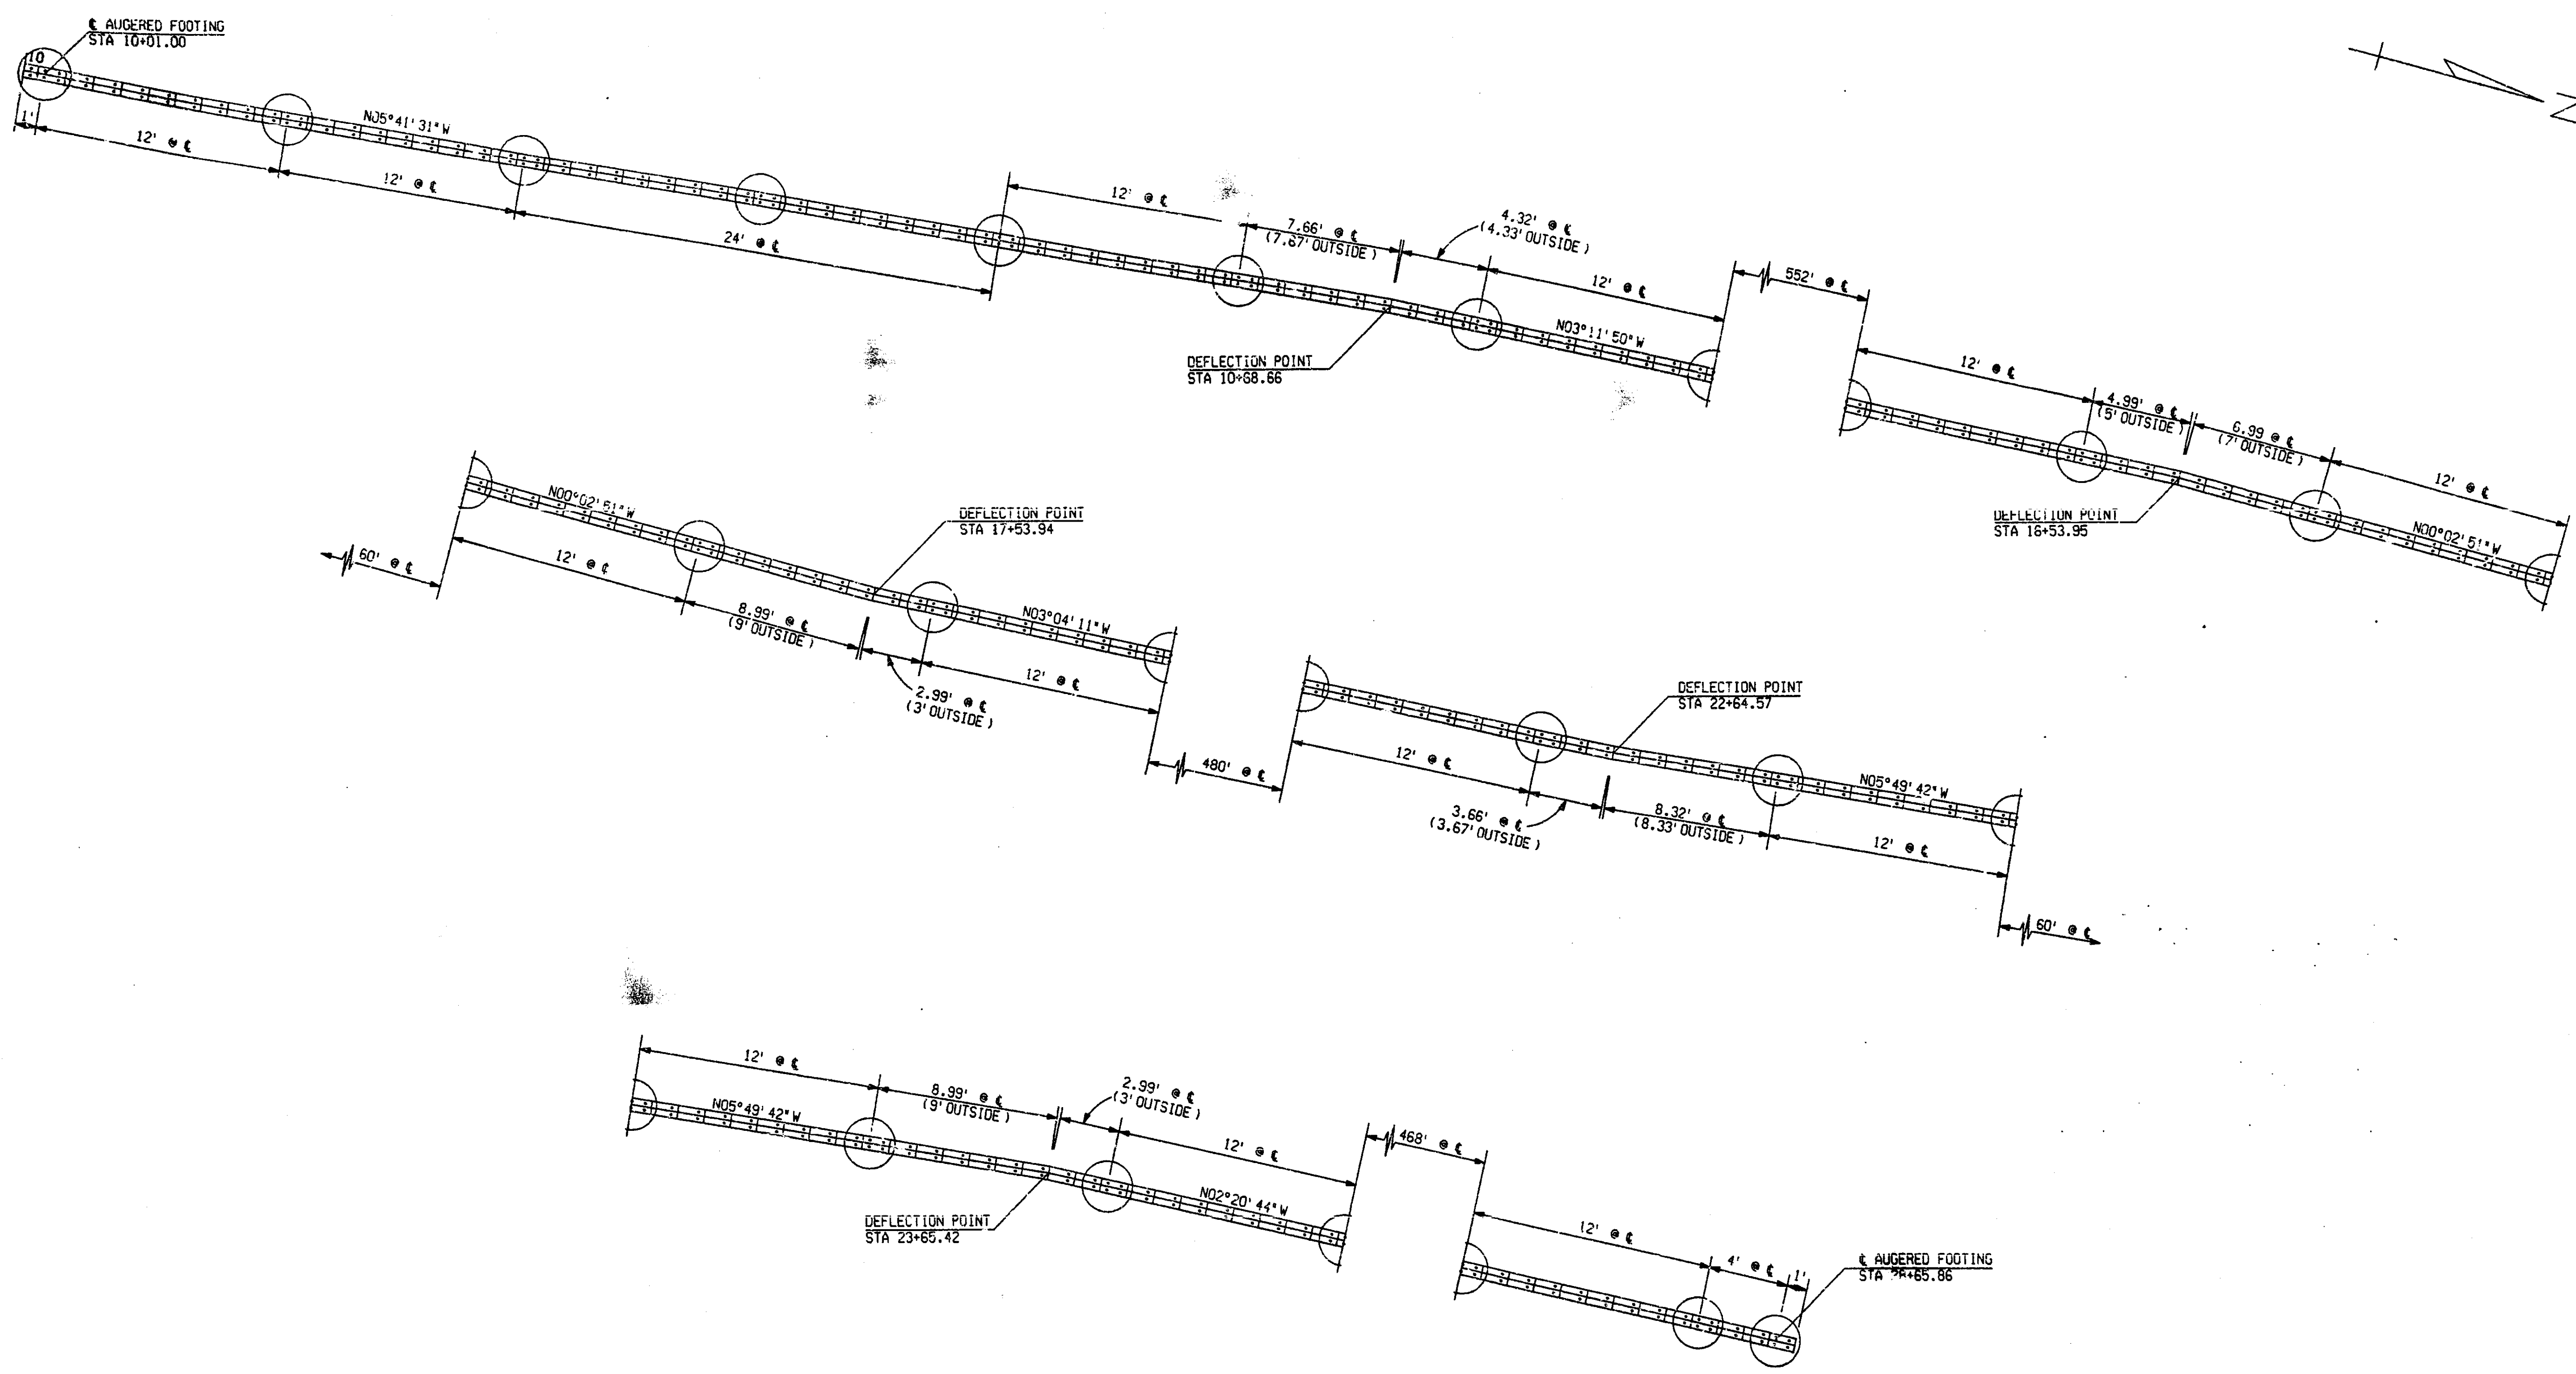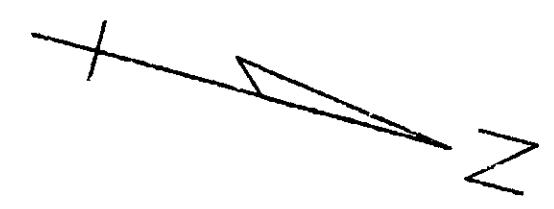

WALL "D"

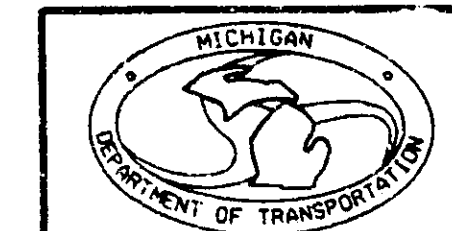

WALL "D" ALIGNMENT SHEET					
DATE	SCALE	CONT. SEC.	JOB NO.	DESIGN UNIT	SHEET NO.
07/08/96	1" = 4'	63174	23749	PENA	9


FILE NAME: 23749wall.e12
 1 2

DATE: 08/21/96
 DA: F
 DATE: 08/21/96
 EXISTING BY: DAVID
 PROPOSED BY: DAVID
 LAST CORRECTION BY: DAVID


CONSTRUCTED AS PER PLANS APRIL 1990

FILE NAME: 23749wall.dwg
 10
 1 2


FINAL R.O.W.		
AUTH	DATE	REVISION

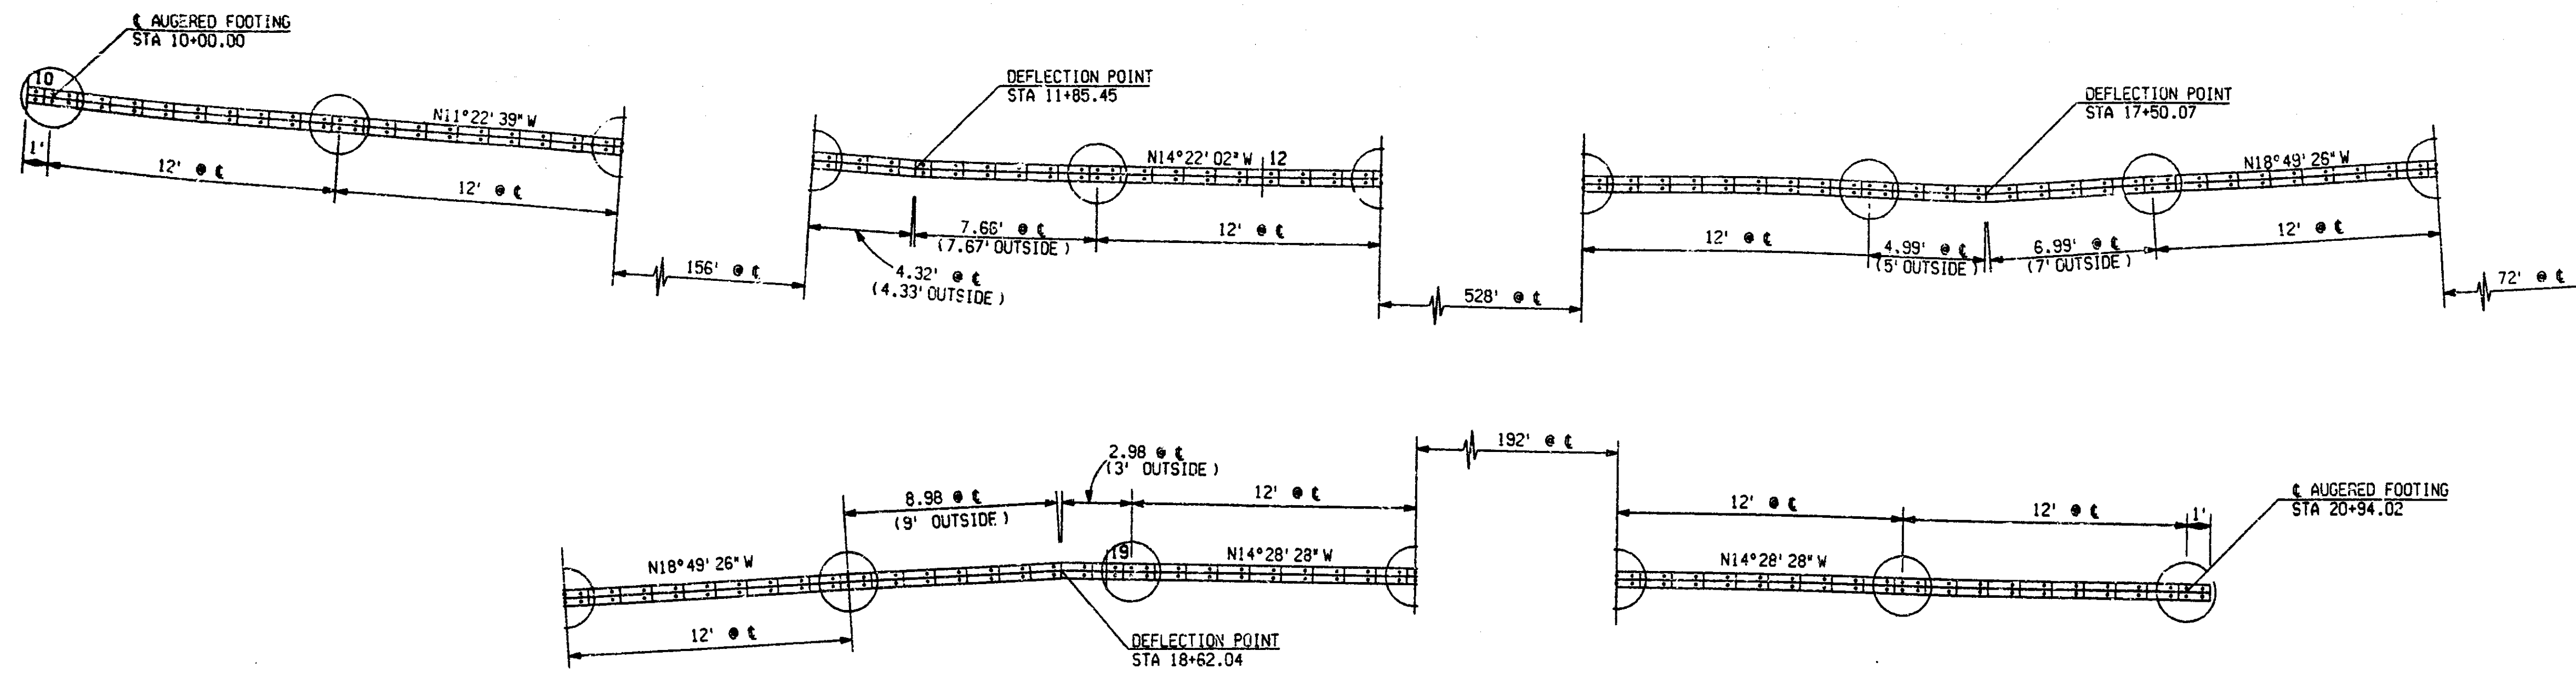

WALL "E"

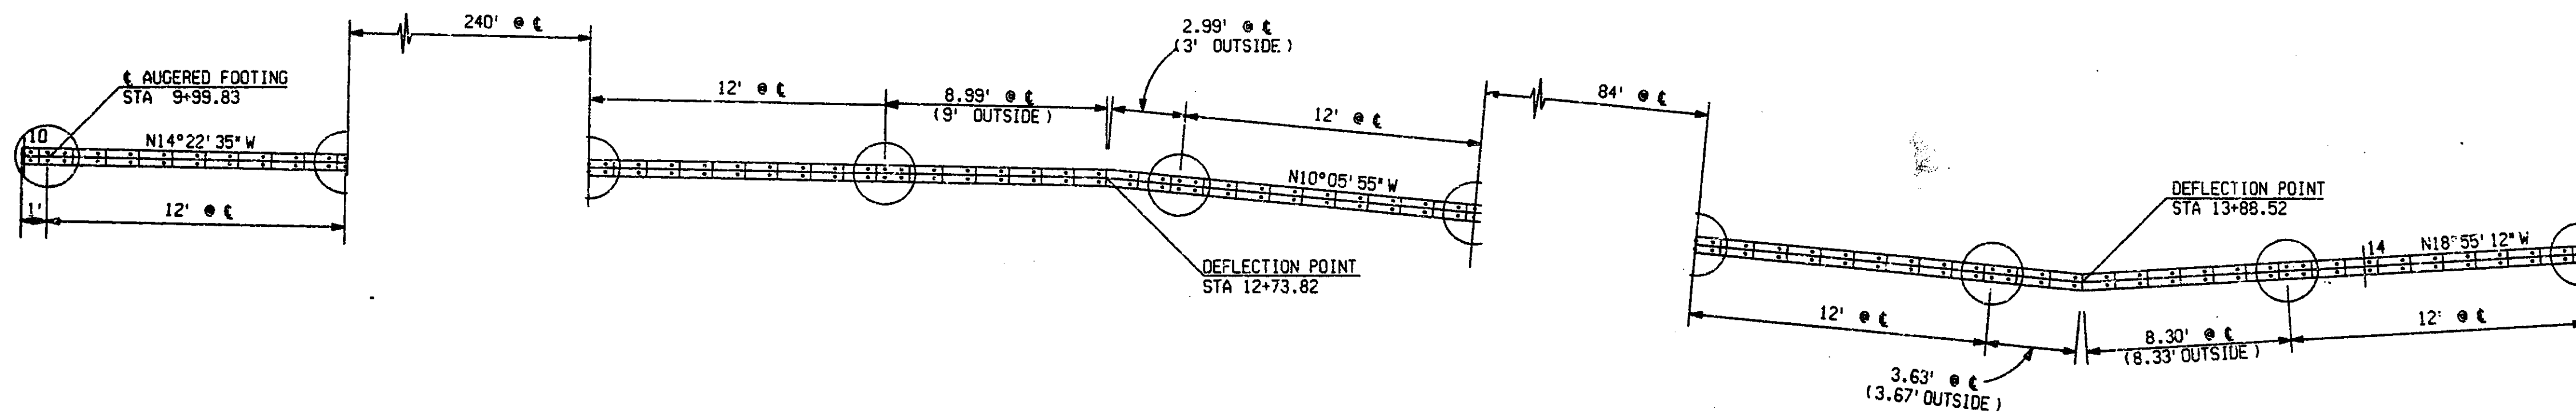

WALL "F"




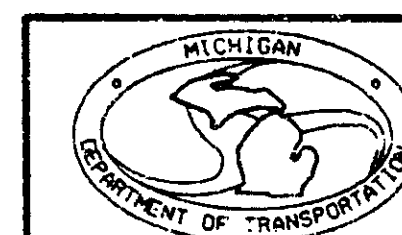


WALL "E" AND "F" ALIGNMENT SHEET

DATE	SCALE	CONT. SEC.	JOB NO.	DESIGN UNIT	SHEET NO.
08/21/96	1" = 4'	63174	23749	PENA	10

1076796 Engineering Print

FINAL R.O.W.			
AUTH	DATE	NO.	REVISION

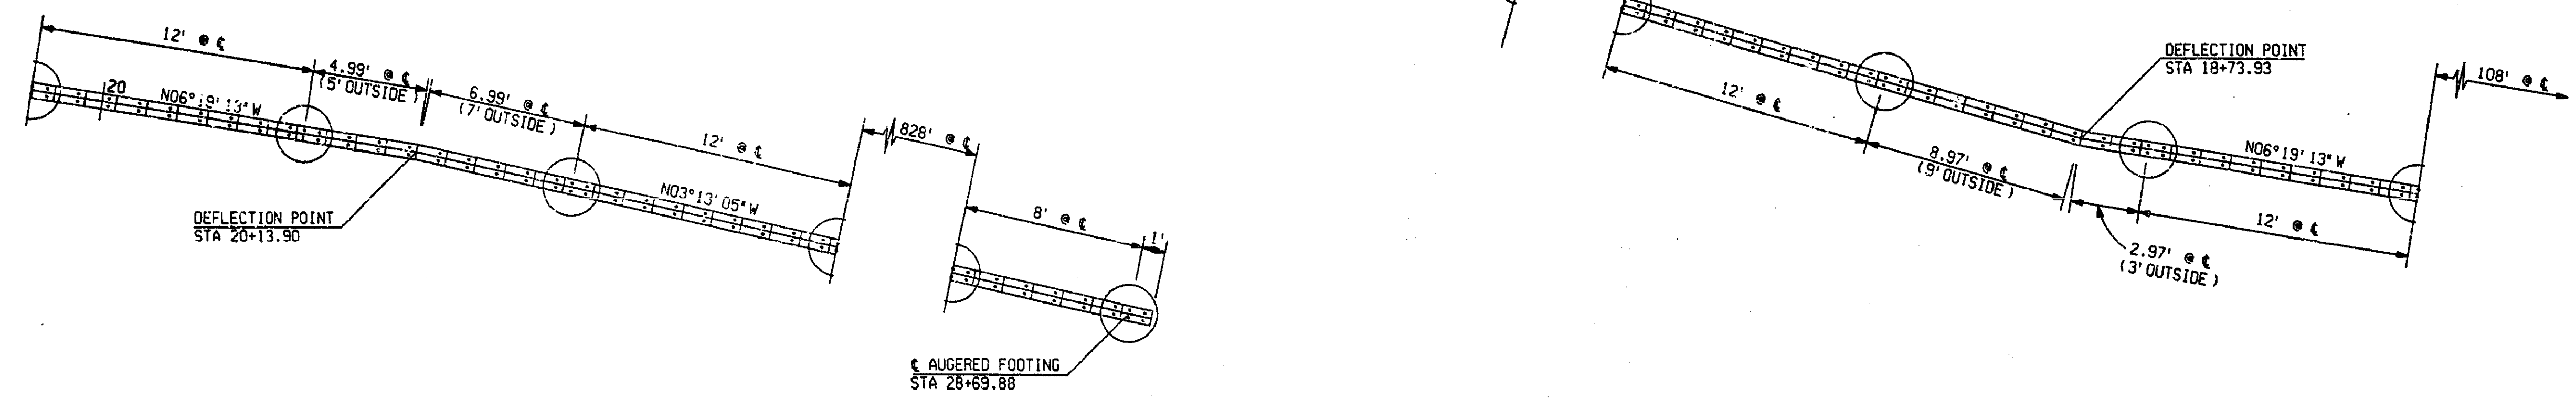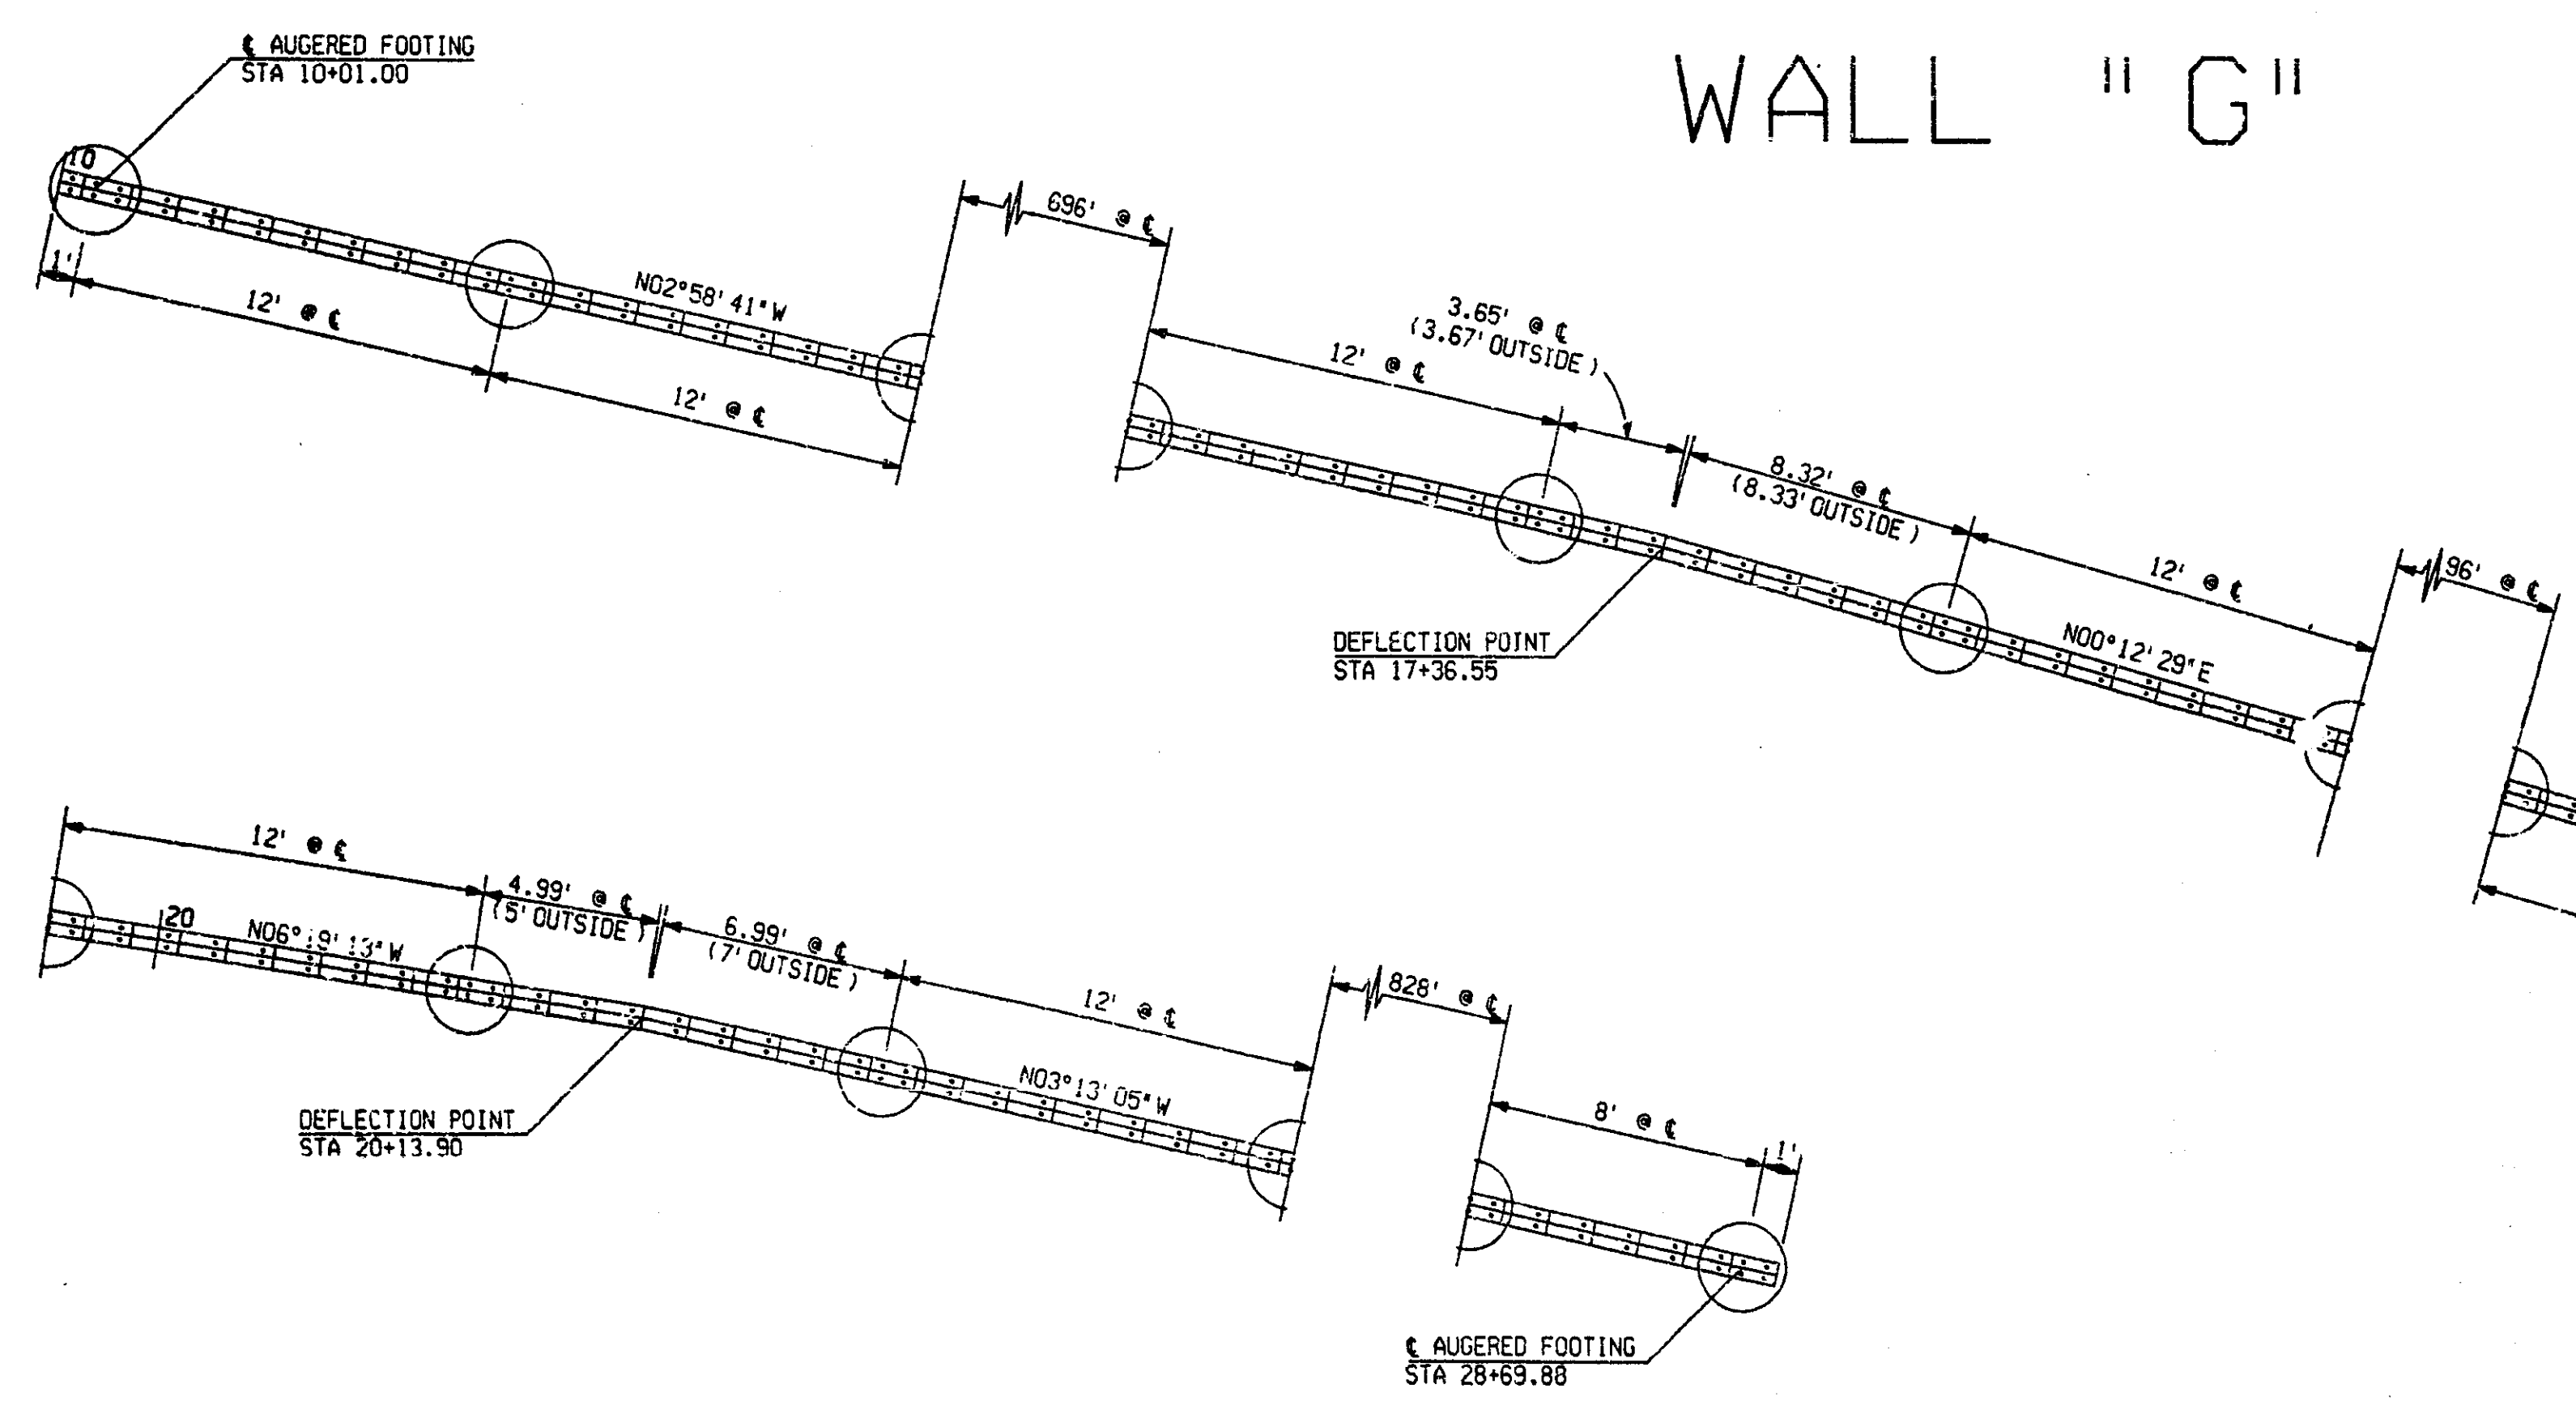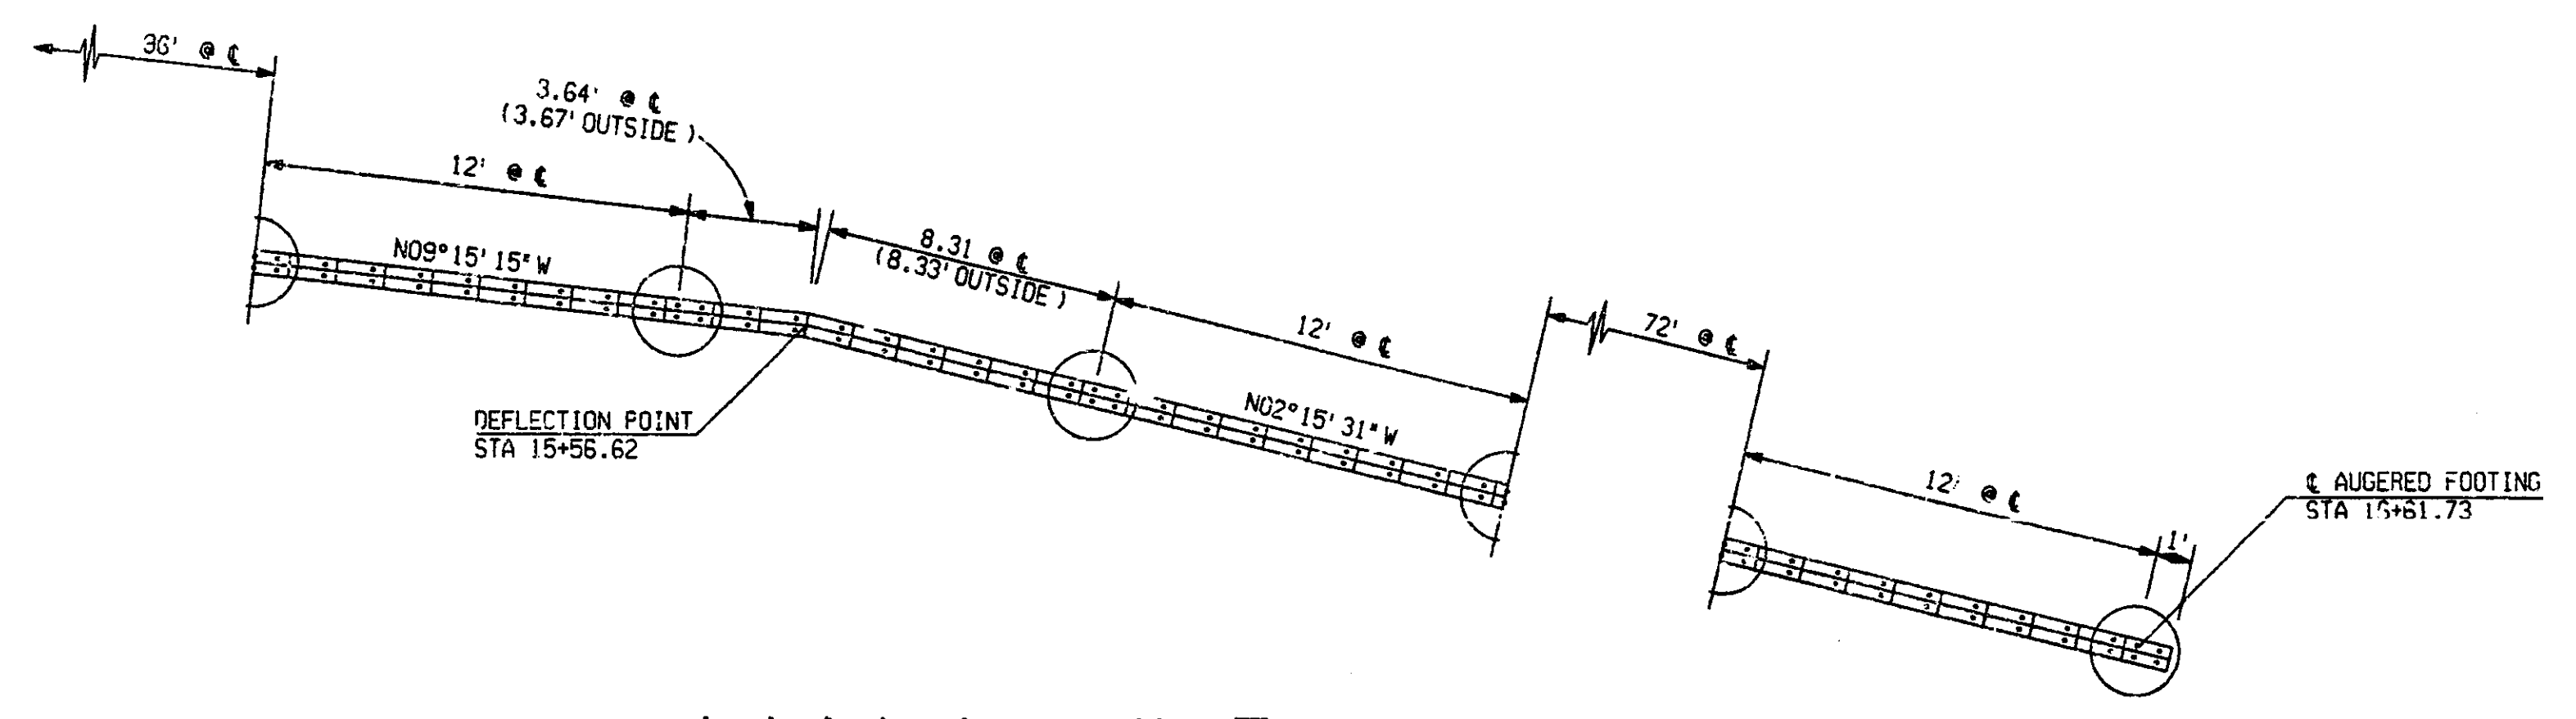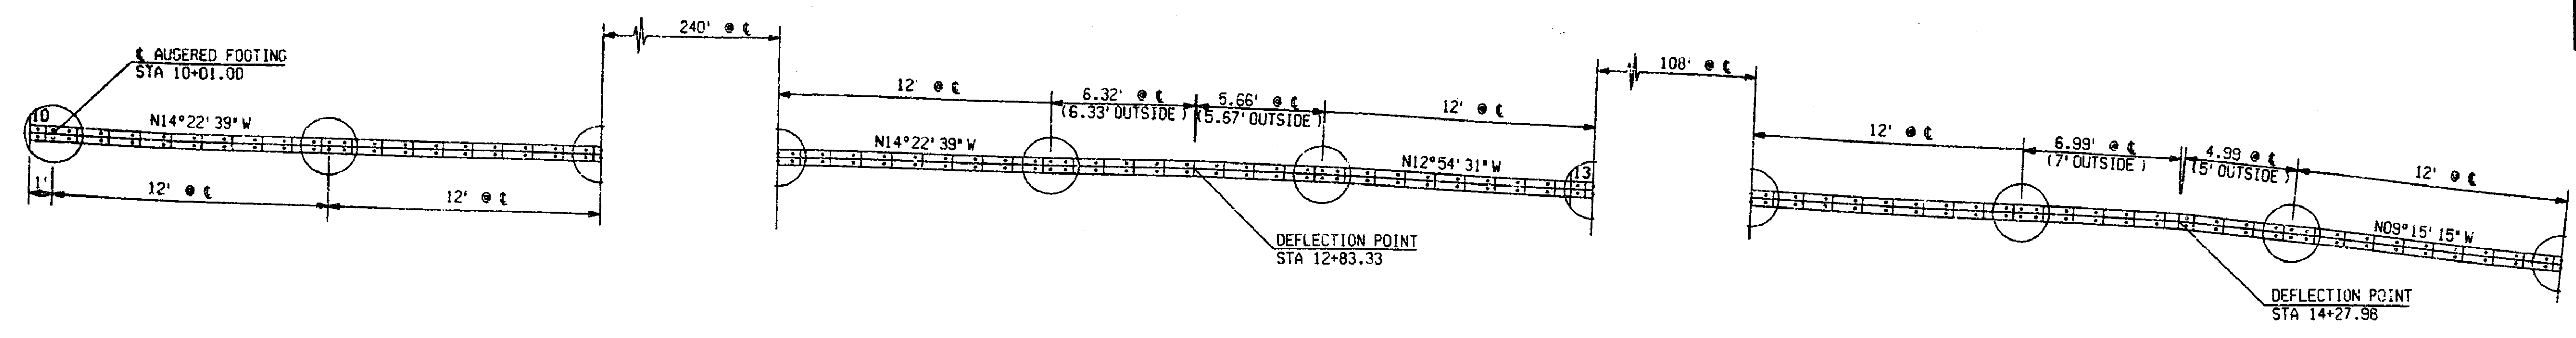

WALL "G"

WALL "H"

DATE: 07/08/96
 PROPOSED BY: WALTER
 LAST CORRECTION BY: WALTER

6001 TRIMWAY PLAN APRIL 1995

FILE NAME: 23749wall1.d12
 10

16/07/96 Engineering Print

		WALL "G" AND "H" ALIGNMENT SHEET			
		DATE 07/08/96	SCALE 1" = 4'	CONT. SEC. 63174	JOB NO. 23749

CONTRACT NO. 23749
SECTION 63174

CONSTRUCTION PERMITS APRIL 1999

DATE: 11/20/96
EXISTING BY: FEMA'S UNIT
PROPOSED BY: DAVID
LAST CORRECTION BY: DAVID


FILE NAME: 23749R29.DWG
1 2 3 4 5 6 7 8 9 10 11 12 13 14 15 16 17 18 19 20 21 22 23 24 25 26 27 28 29 30 31 32 33 34 35

BROCKTON AVE

HUDSON AVE

KALAMA AVE

FINAL R.O.W.			
AUTH	DATE	NO.	REVISION

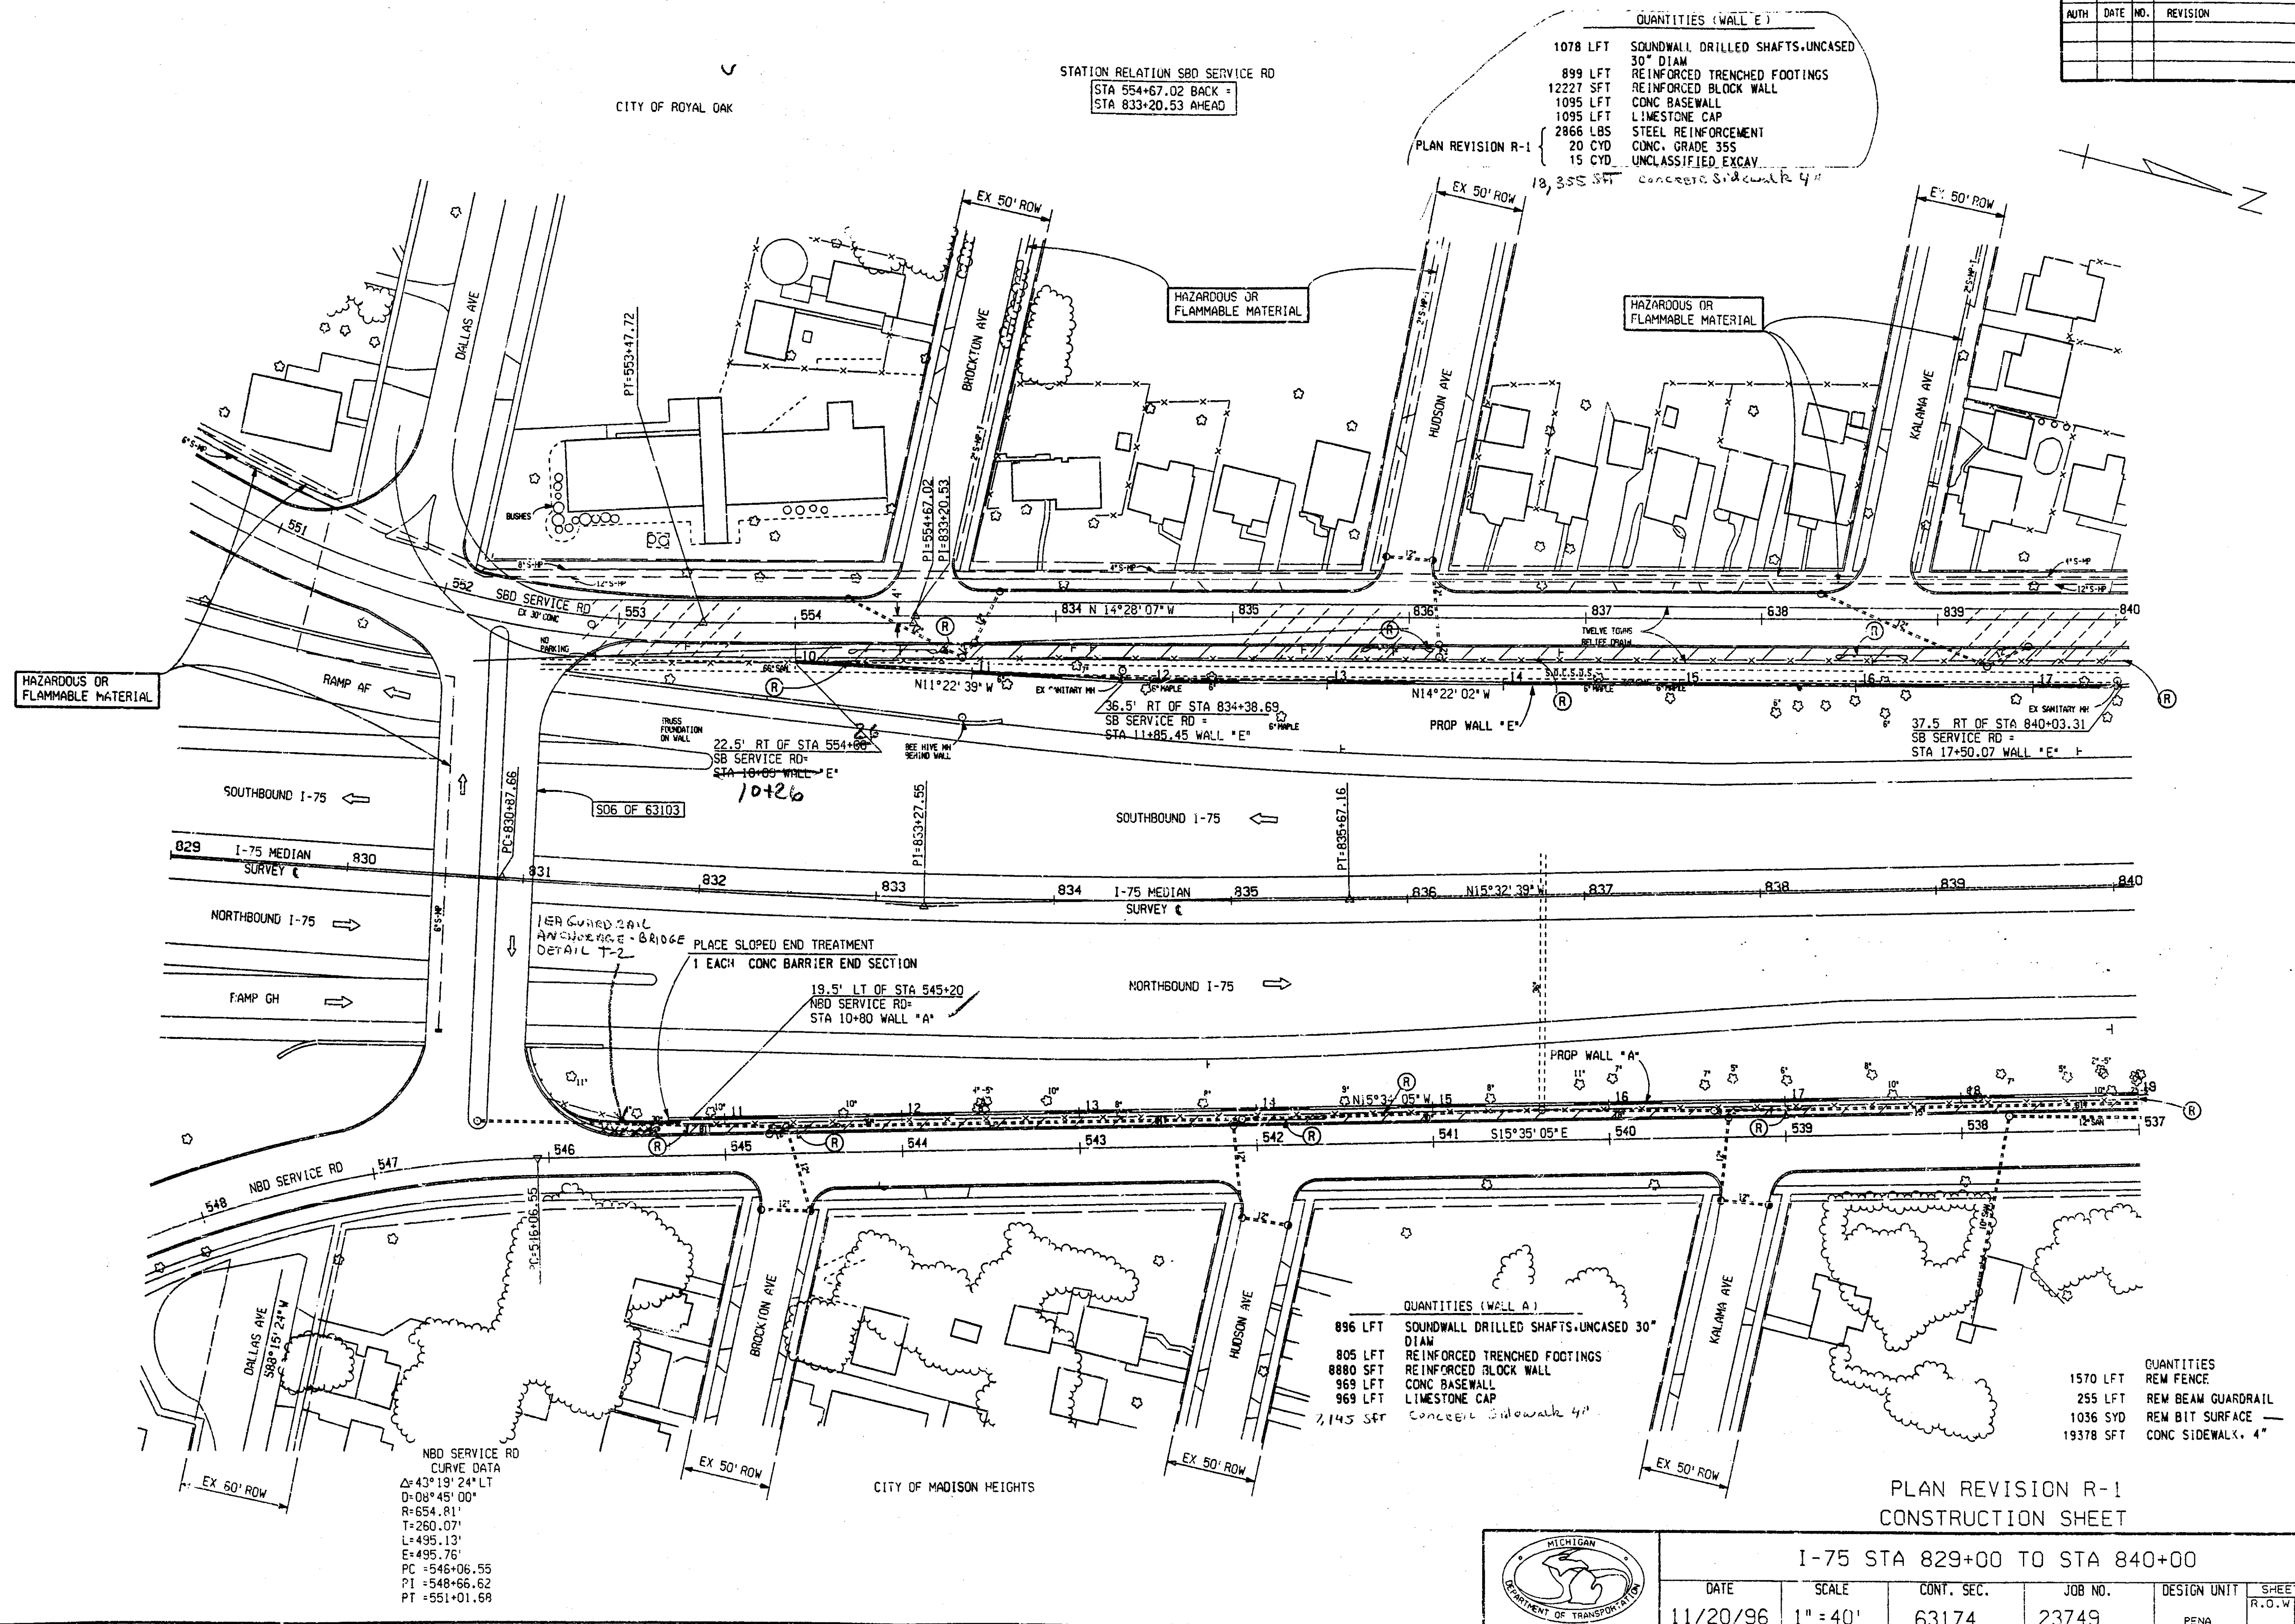

QUANTITIES (WALL E)

- 1078 LFT SOUNDWALL DRILLED SHAFTS, UNCASED 30" DIAM
- 899 LFT REINFORCED TRENCHED FOOTINGS
- 12227 SFT REINFORCED BLOCK WALL
- 1095 LFT CONC BASEWALL
- 1095 LFT LIMESTONE CAP
- 2866 LBS STEEL REINFORCEMENT
- 20 CYD CONC. GRADE 355
- 15 CYD UNCLASSIFIED EXCAV
- 18,355 SFT Concrete Sidewalk 4"


QUANTITIES (WALL A)

- 896 LFT SOUNDWALL DRILLED SHAFTS, UNCASED 30" DIAM
- 805 LFT REINFORCED TRENCHED FOOTINGS
- 8880 SFT REINFORCED BLOCK WALL
- 969 LFT CONC BASEWALL
- 969 LFT LIMESTONE CAP
- 2,145 SFT Concrete Sidewalk 4"

QUANTITIES

- 1570 LFT REM FENCE
- 255 LFT REM BEAM GUARDRAIL
- 1036 SYD REM BIT SURFACE
- 19378 SFT CONC SIDEWALK, 4"

NBD SERVICE RD CURVE DATA
 $\Delta = 43^\circ 19' 24" \text{ LT}$
 $D = 08^\circ 45' 00"$
 $R = 654.81'$
 $T = 260.07'$
 $L = 495.13'$
 $E = 495.76'$
 $PC = 548+06.55$
 $PI = 548+66.62$
 $PT = 551+01.69$

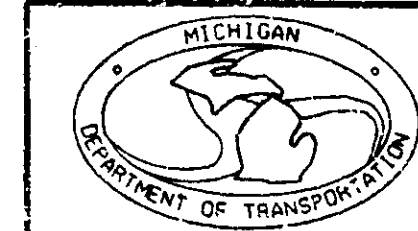


I-75 STA 829+00 TO STA 840+00					
DATE	SCALE	CONT. SEC.	JOB NO.	DESIGN UNIT	SHEET NO.
11/20/96	1" = 40'	63174	23749	PENA	R.O.W. CONST. 12

PLAN REVISION R-1
CONSTRUCTION SHEET

CONSTRUCTED AS PER PLANS APRIL 1989

23749BPF.DGN

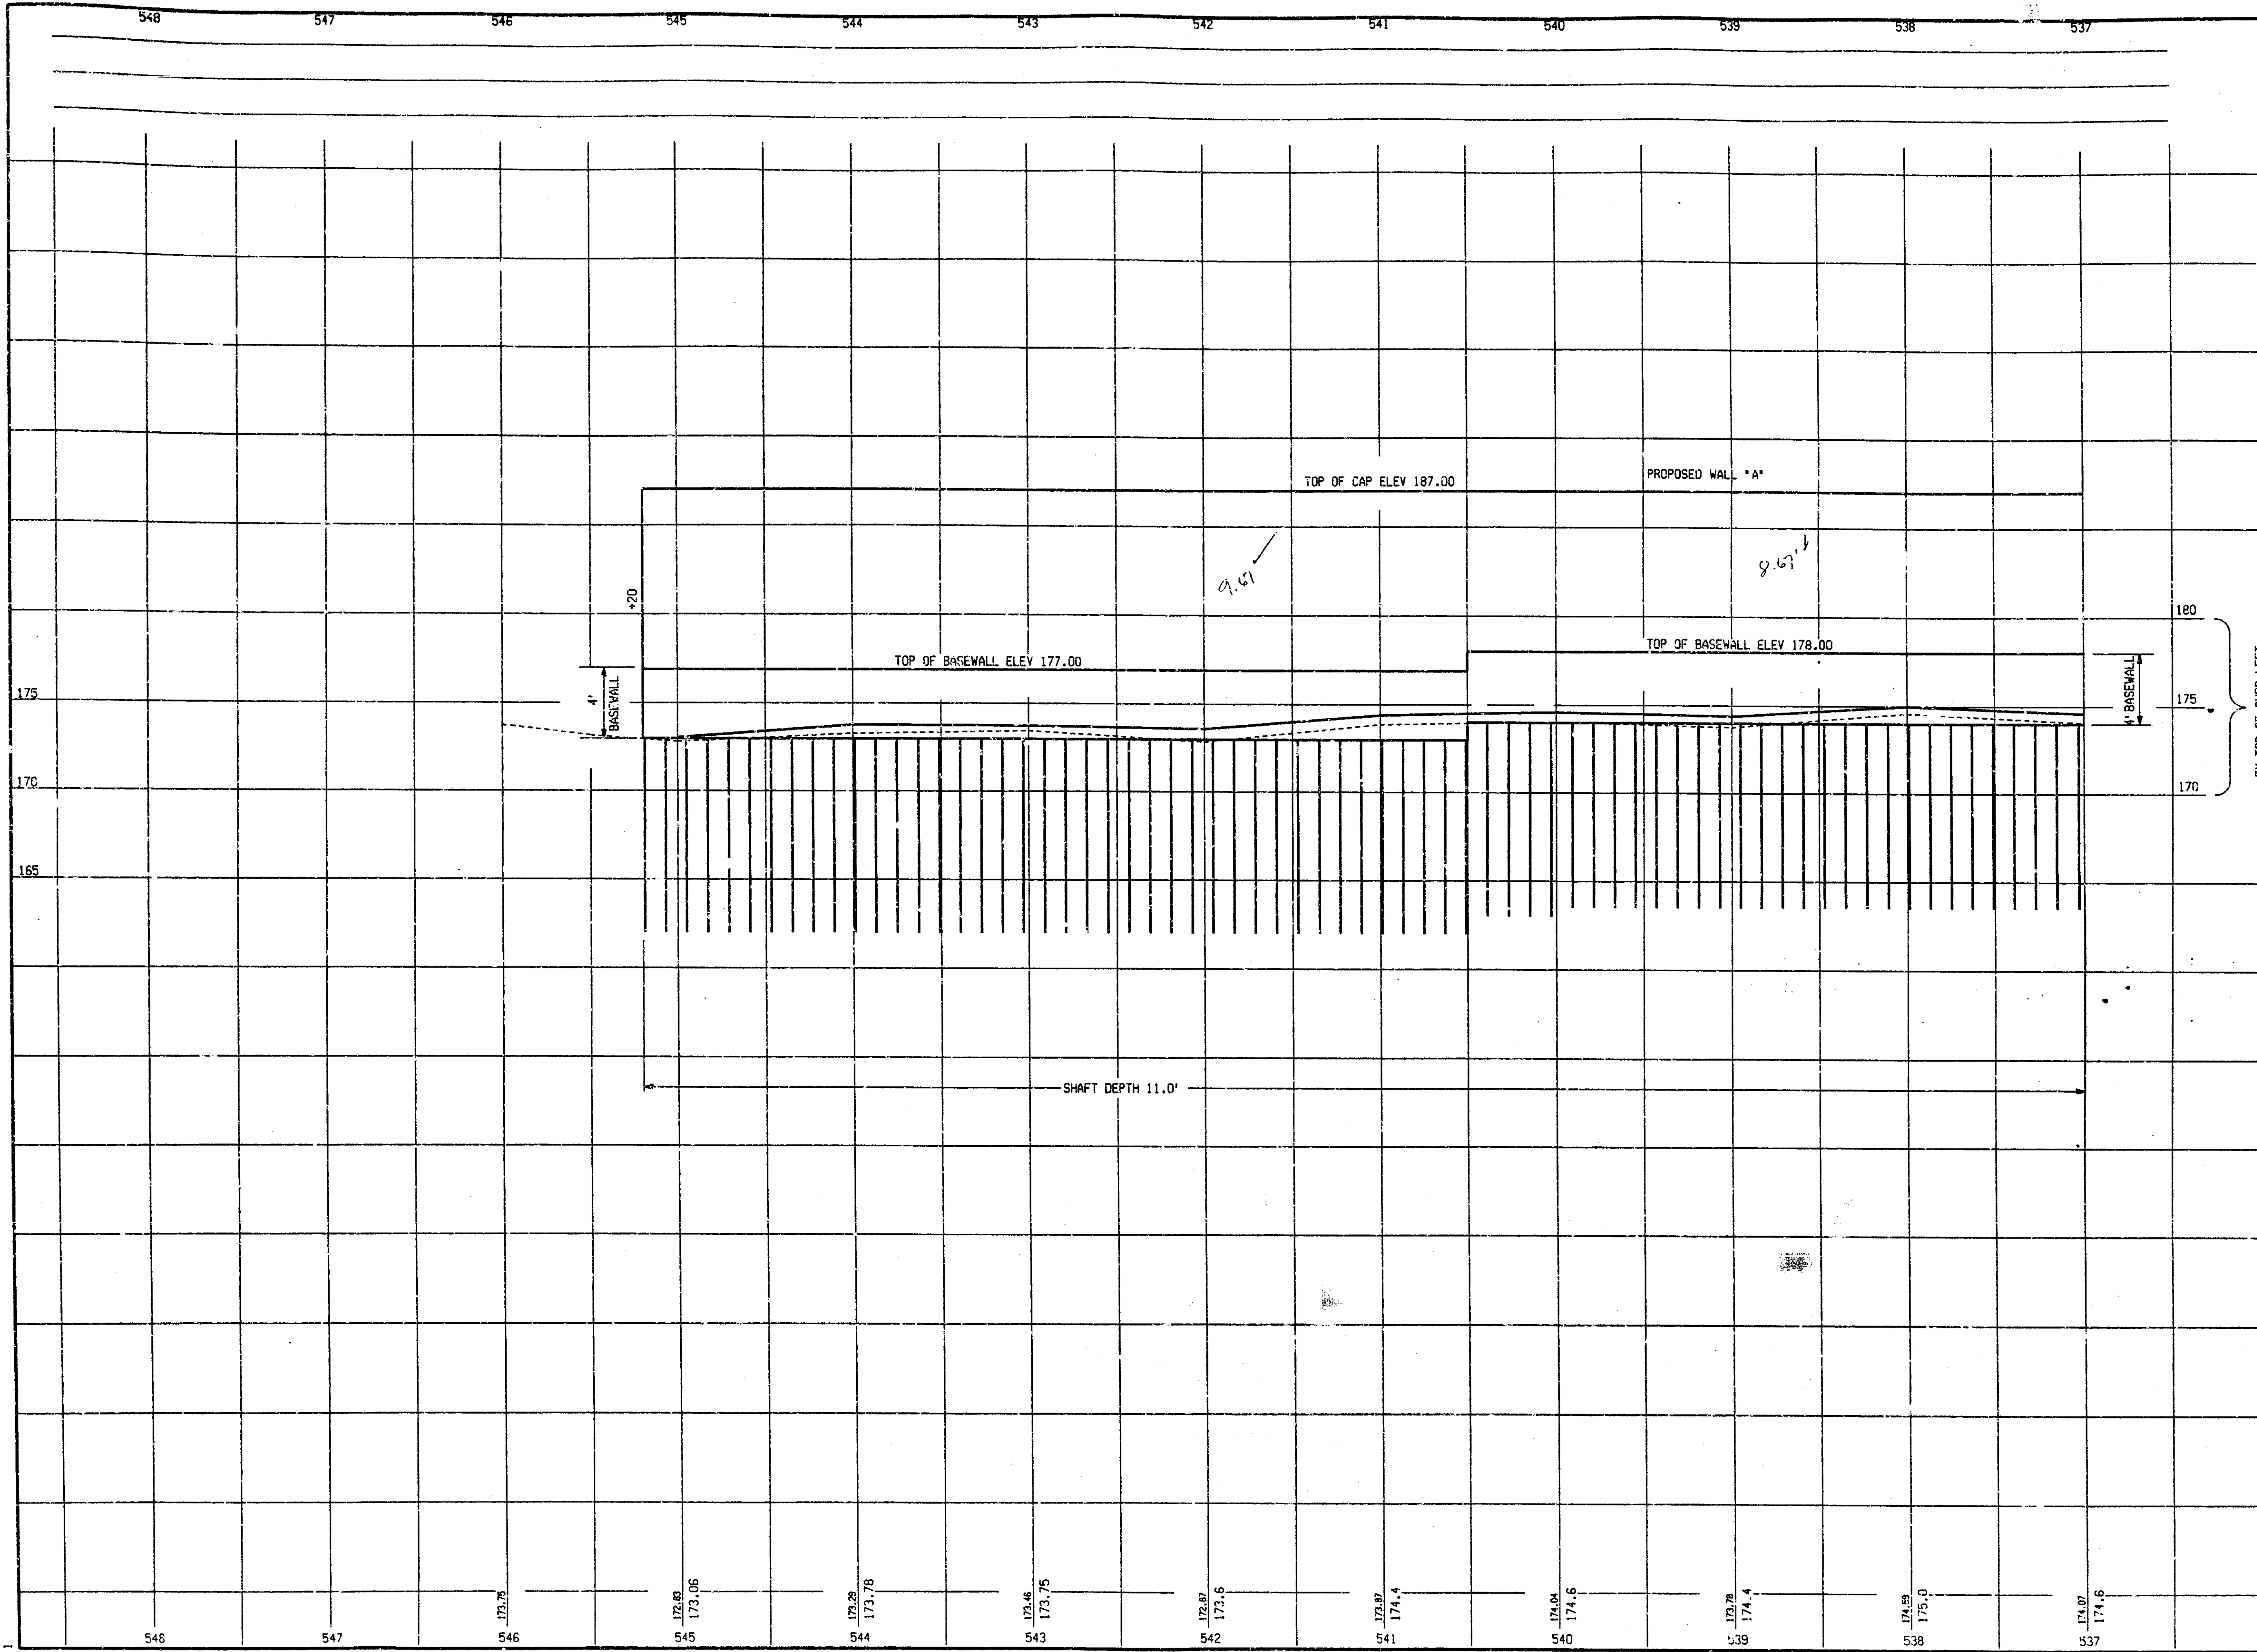

DATE	NO.	REVISION

EX TOP OF CURB LEFT
PROP SOUND WALL PROFILE-LEFT

N.B. SERVICE RD STA 548+00 TO STA 537+00
 DATE 07/13/96
 SCALE HORIZ. 1" = 40' VERT. 1" = 4'
 CONT. SEC. 63174
 JOB NO. 23749
 DESIGN UNIT PENA




SHEET NO. 13
 R.O.W CONST.

10/07/96 ENGINEERING PERM

SECTION 631/4

CONTRACTED TO PER PLANS APRIL 1998

3/749bpf.dgn
3 7 41

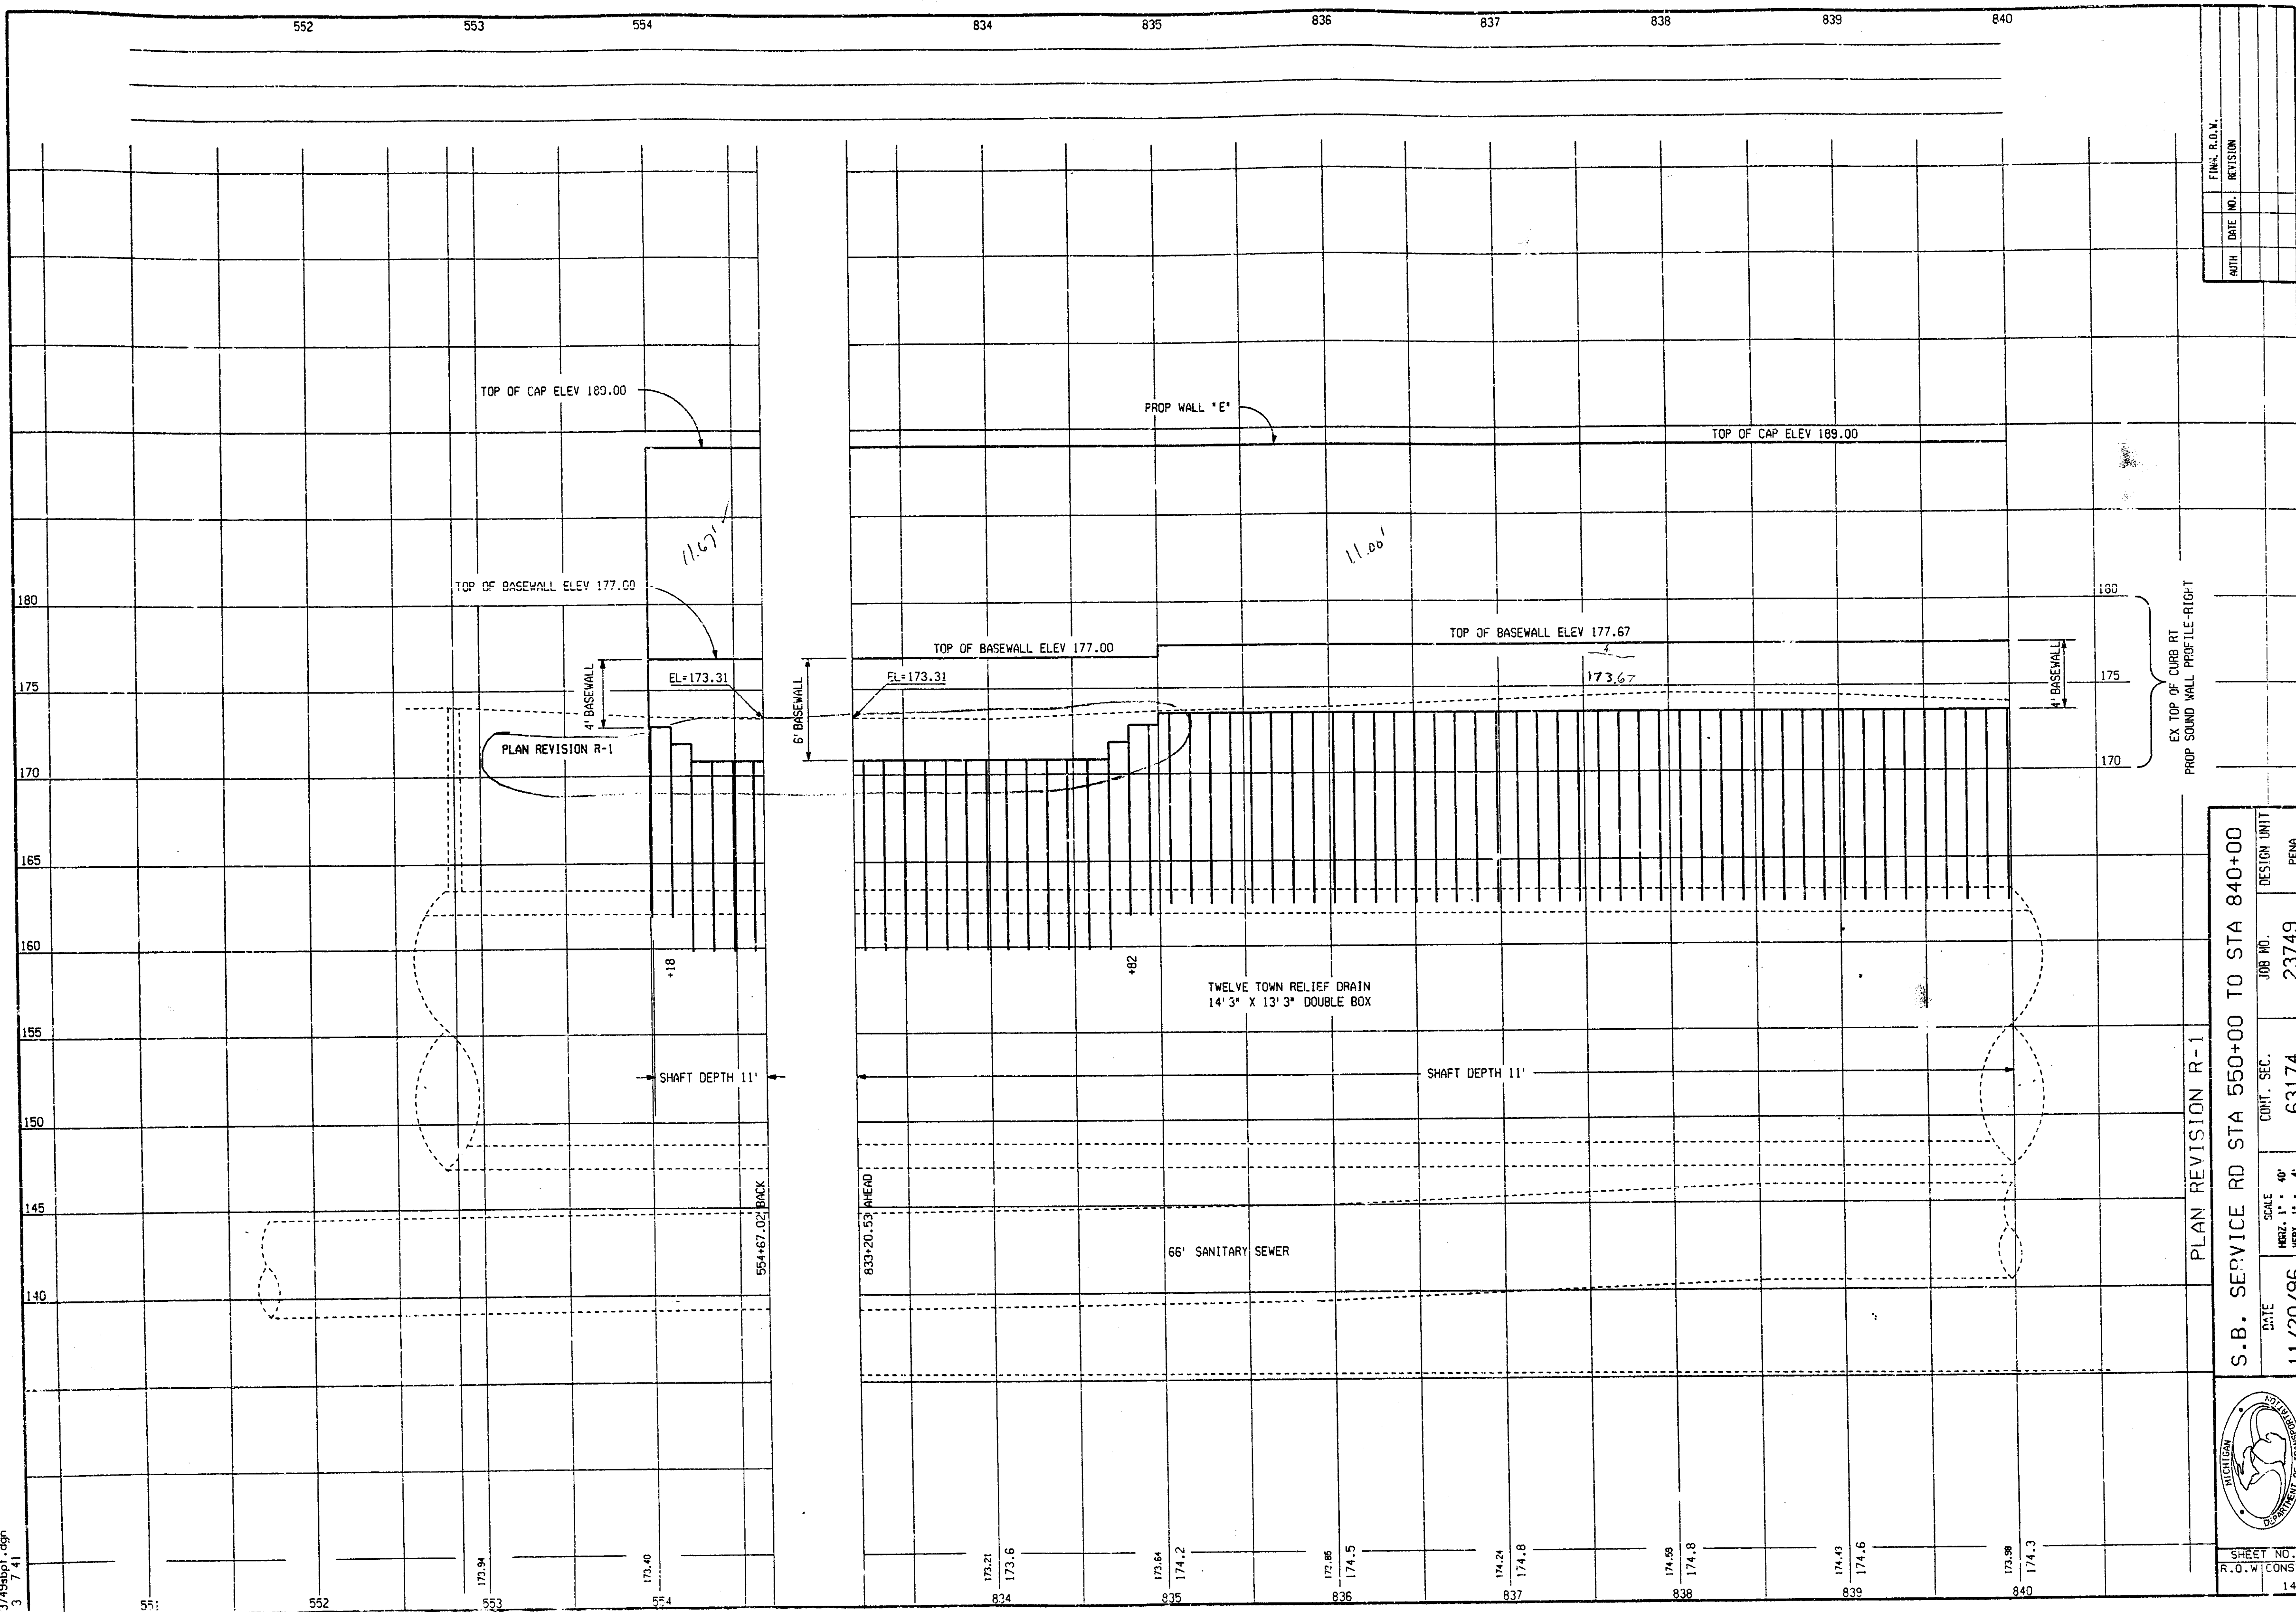

DATE	NO.	REVISION

PLAN REVISION R-1	
DATE	11/20/96
SCALE	HORIZ. 1" = 40' VERT. 1" = 4'
CONT. SEC.	63174
JOB NO.	23749
DESIGN UNIT	PENA



SHEET NO.
R.O.W. CONST.
14

CURTAIN SECTION 63174

EXISTING BY: PENNA'S UNIT
PROPOSED BY: PENNA'S UNIT
DATE: 11/20/96
LAST CORRECTION BY: DAVID

CONSTRUCTION PERMITS APRIL 1999

FILE NAME: 23749940.DWG
1 2 3 4 5 6 7 8 9 10 11 12 13 14 15 16 17 18 19 21 22 23 24 25 26 27 28 29 30 31 32 33 34 35 36

LINCOLN AVE

TUFTS AVE

YALE AVE

FINAL R.O.W.			
AUTH	DATE	NO.	REVISION

SBD SERVICE RD
CURVE DATA
 $\Delta = 00^{\circ}05'28''$ RT
NO CURVE


STATION EQUATION SBD SERVICE RD
STA 843+89.55 BACK = STA 843+89.11 AHEAD
LINE LENGTHENS 1.69'

STATION EQUATION MEDIAN ϵ
STA 850+86.90 BACK = STA 850+85.22 AHEAD
LINE LENGTHENS 1.68'

FOR QUANTITIES ON WALL F
SEE SHEET #18

FOR QUANTITIES ON WALL E
SEE SHEET #12

CITY OF ROYAL OAK
SECTION 23
T1N, R11E
ROYAL OAK TWP

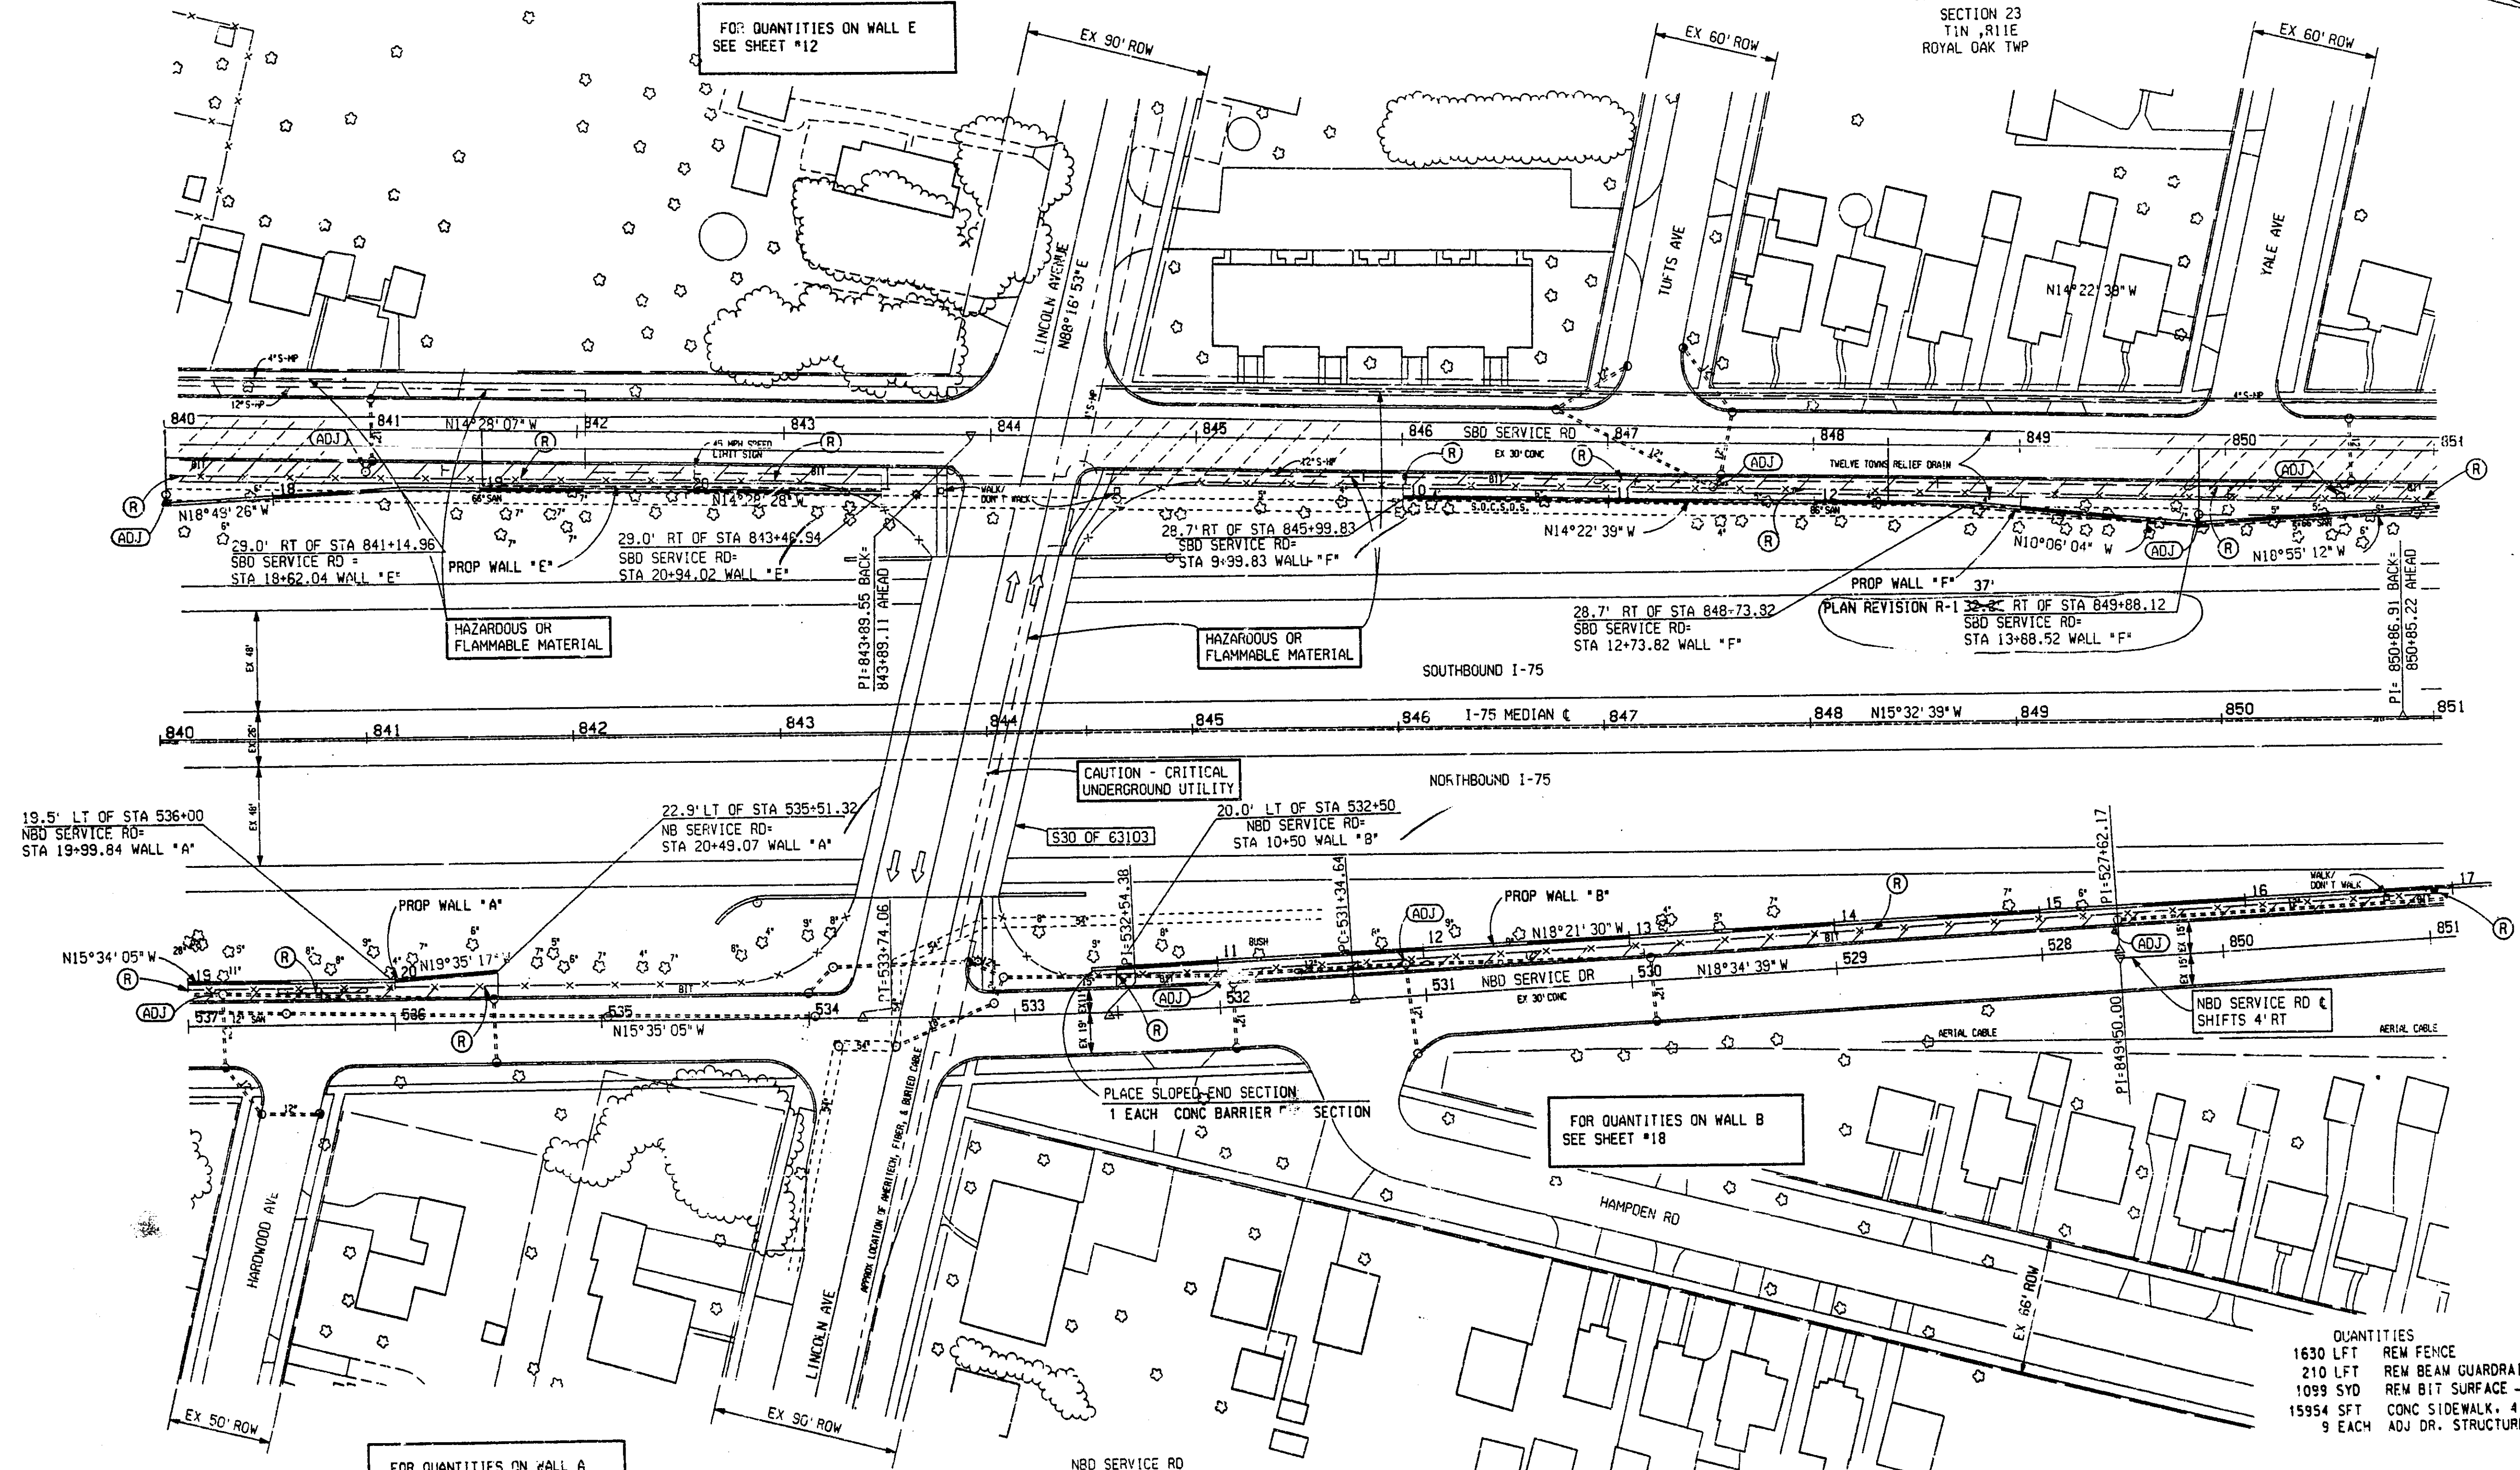

19.5' LT OF STA 536+00
NBD SERVICE RD =
STA 19+99.84 WALL "A"

22.9' LT OF STA 535+51.32
NB SERVICE RD =
STA 20+49.07 WALL "A"

20.0' LT OF STA 532+50
NBD SERVICE RD =
STA 10+50 WALL "B"


FOR QUANTITIES ON WALL A
SEE SHEET #12

NBD SERVICE RD
CURVE DATA
 $\Delta = 02^{\circ}59'34''$ RT
D = 01'15'00"
R = 4583.66'
T = 119.74'
L = 239.42'
E = 1.56'
PC = +531+34.64
PI = +532+54.38
PT = +533+74.06

FOR QUANTITIES ON WALL B
SEE SHEET #18

- QUANTITIES
- 1630 LFT REM FENCE
 - 210 LFT REM BEAM GUARDRAIL
 - 1099 SYD REM BIT SURFACE
 - 15954 SFT CONC SIDEWALK, 4"
 - 9 EACH ADJ DR. STRUCTURE COVER, CASE 2


PLAN REVISION R-1
CONSTRUCTION SHEET

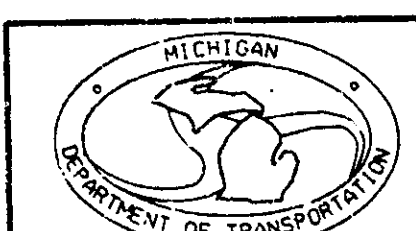

I-75 STA 840+00 TO STA 851+00					
DATE	SCALE	CONT. SEC.	JOB NO.	DESIGN UNIT	SHEET NO.
11/20/96	1" = 40'	63174	23749 A	PENA	15

CONTRACT PLANS APRIL 1988

23749BPF.DGN
2.4

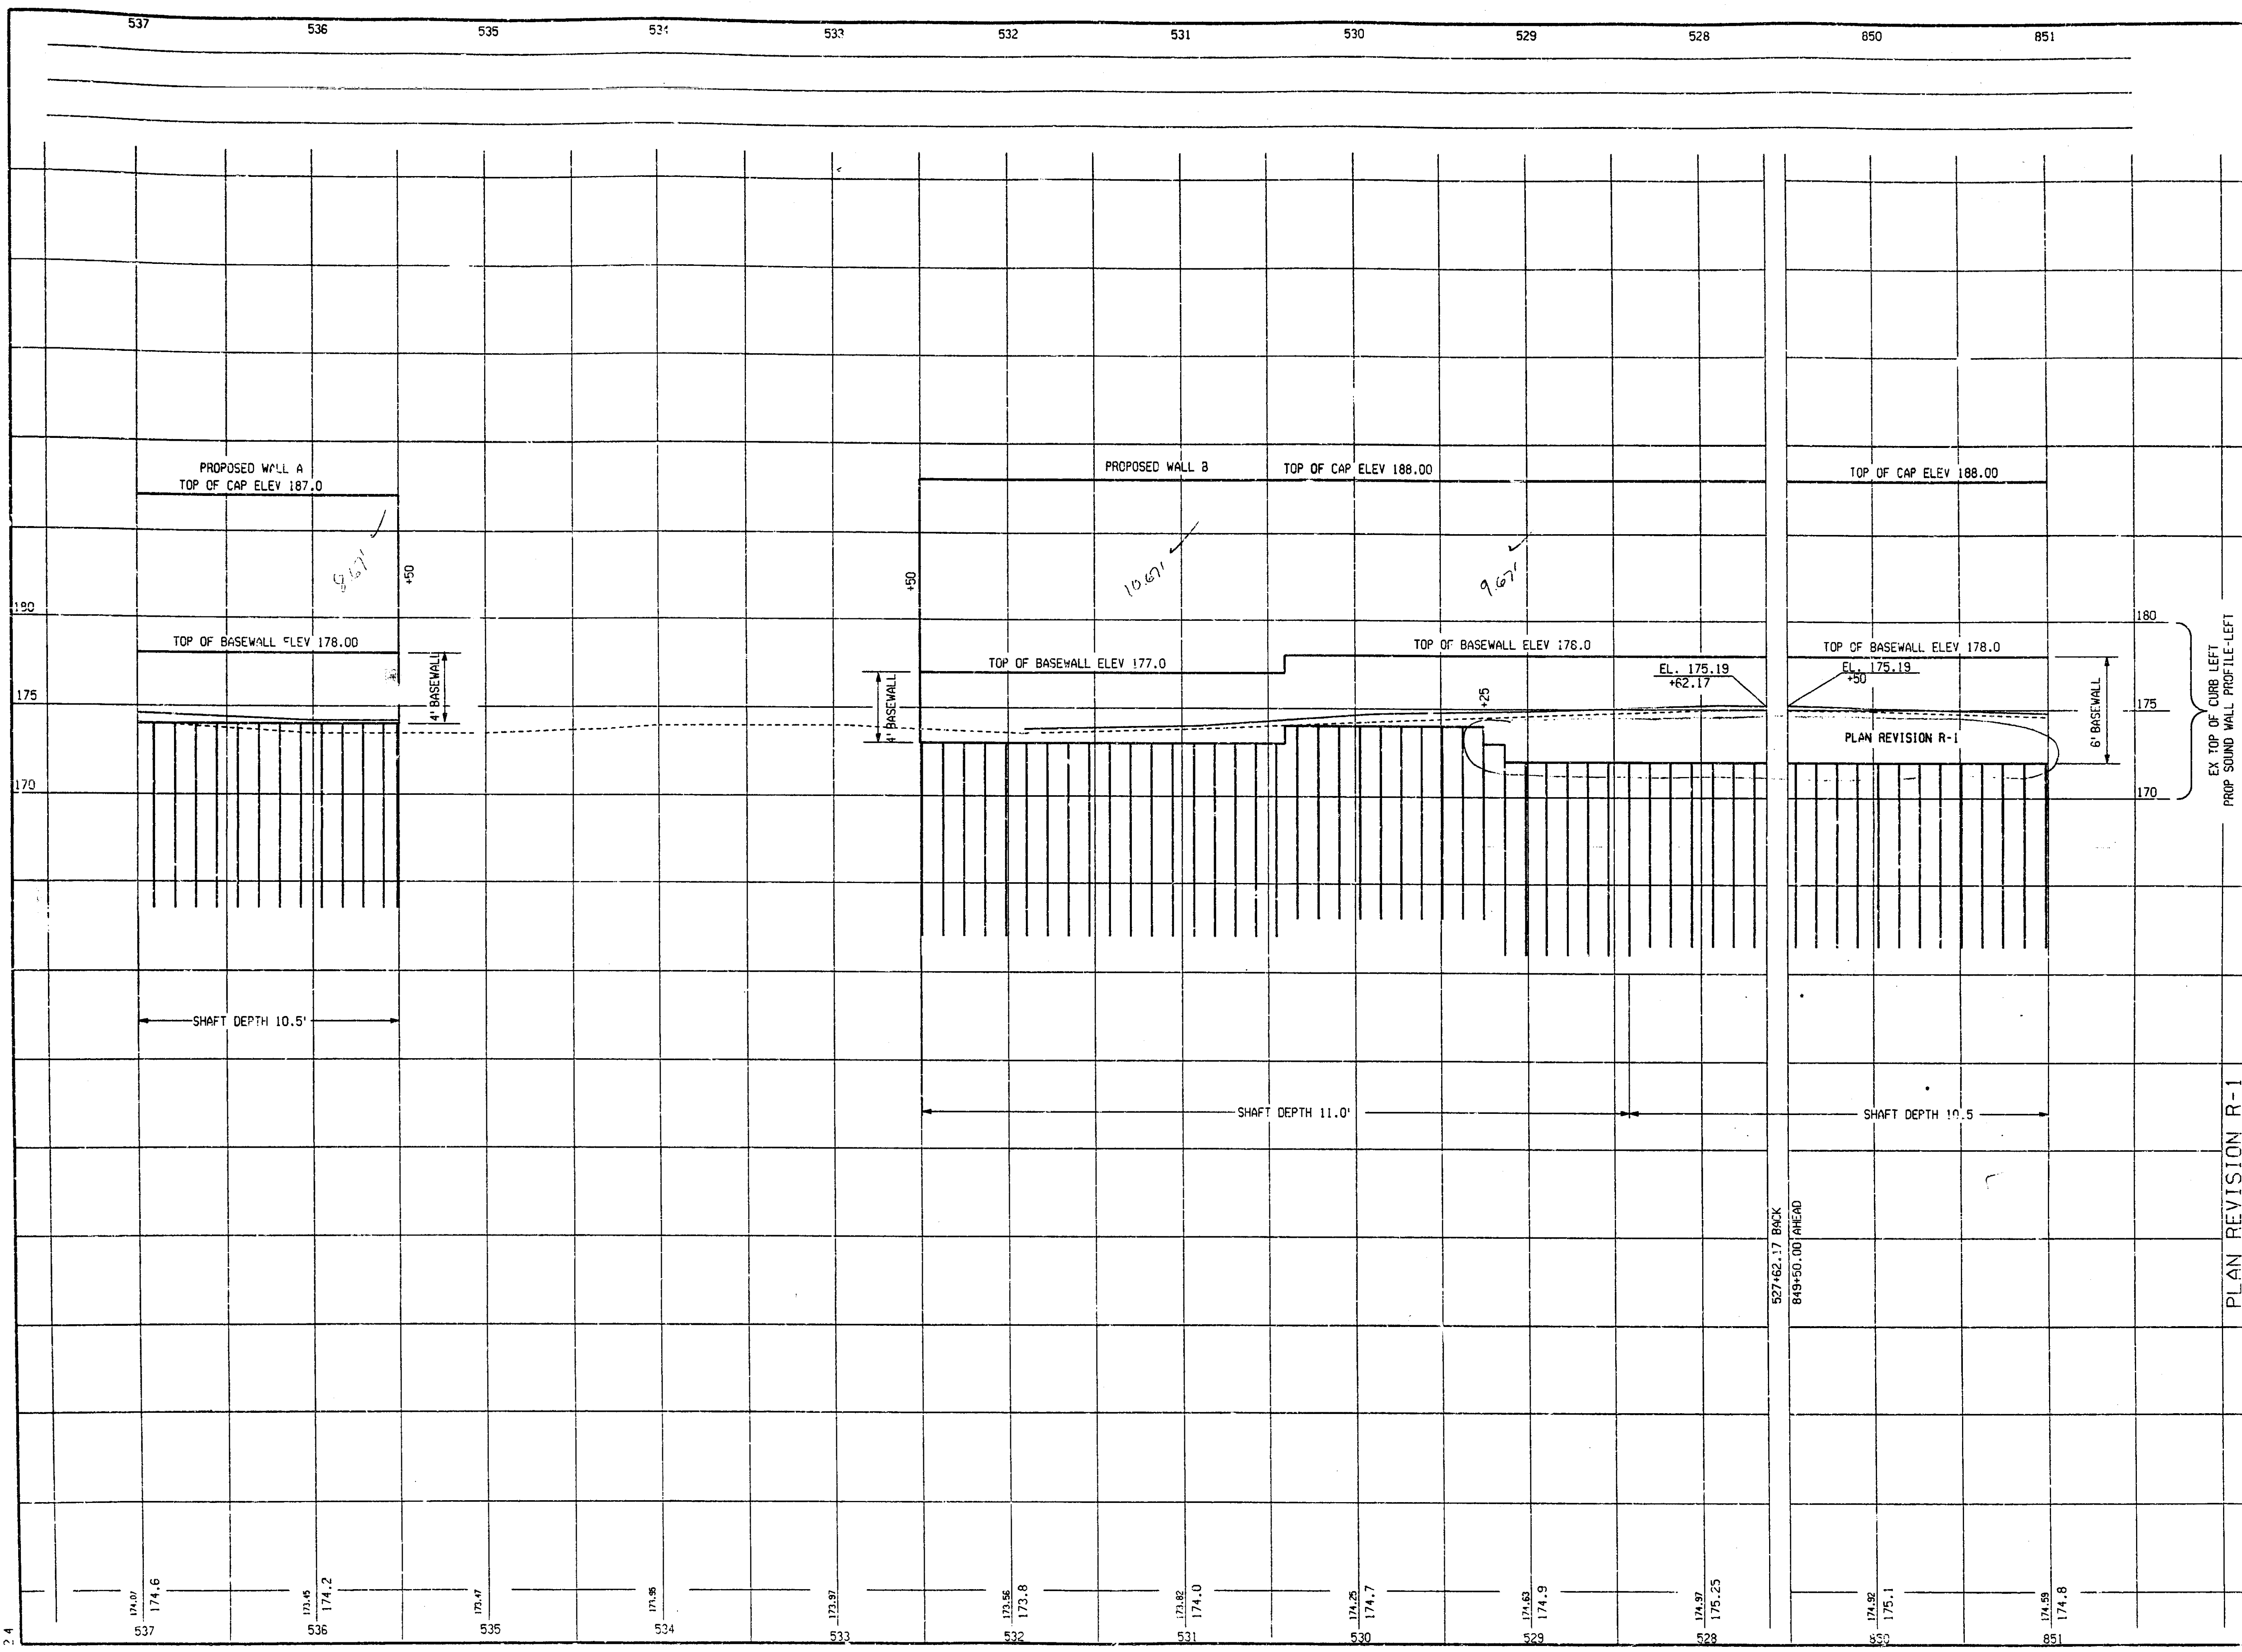

FINN. R.O.W.	
DATE	
NO.	
REVISION	

PLAN REVISION R-1

N.B. SERVICE RD STA 537+00 TO STA 851+00


DATE	11/20/96	SCALE	HORIZ. 1" = 40'	VERT. 1" = 4'
CONT. SEC.	63174	JOB NO.	23749	DESIGN UNIT
			PEN#	

SHEET NO. 16

P.O. & CONST.

6661 HRAV SANITARY SEWER PLAN APRIL 1999

23749sbf.dgn
2 4 6 42

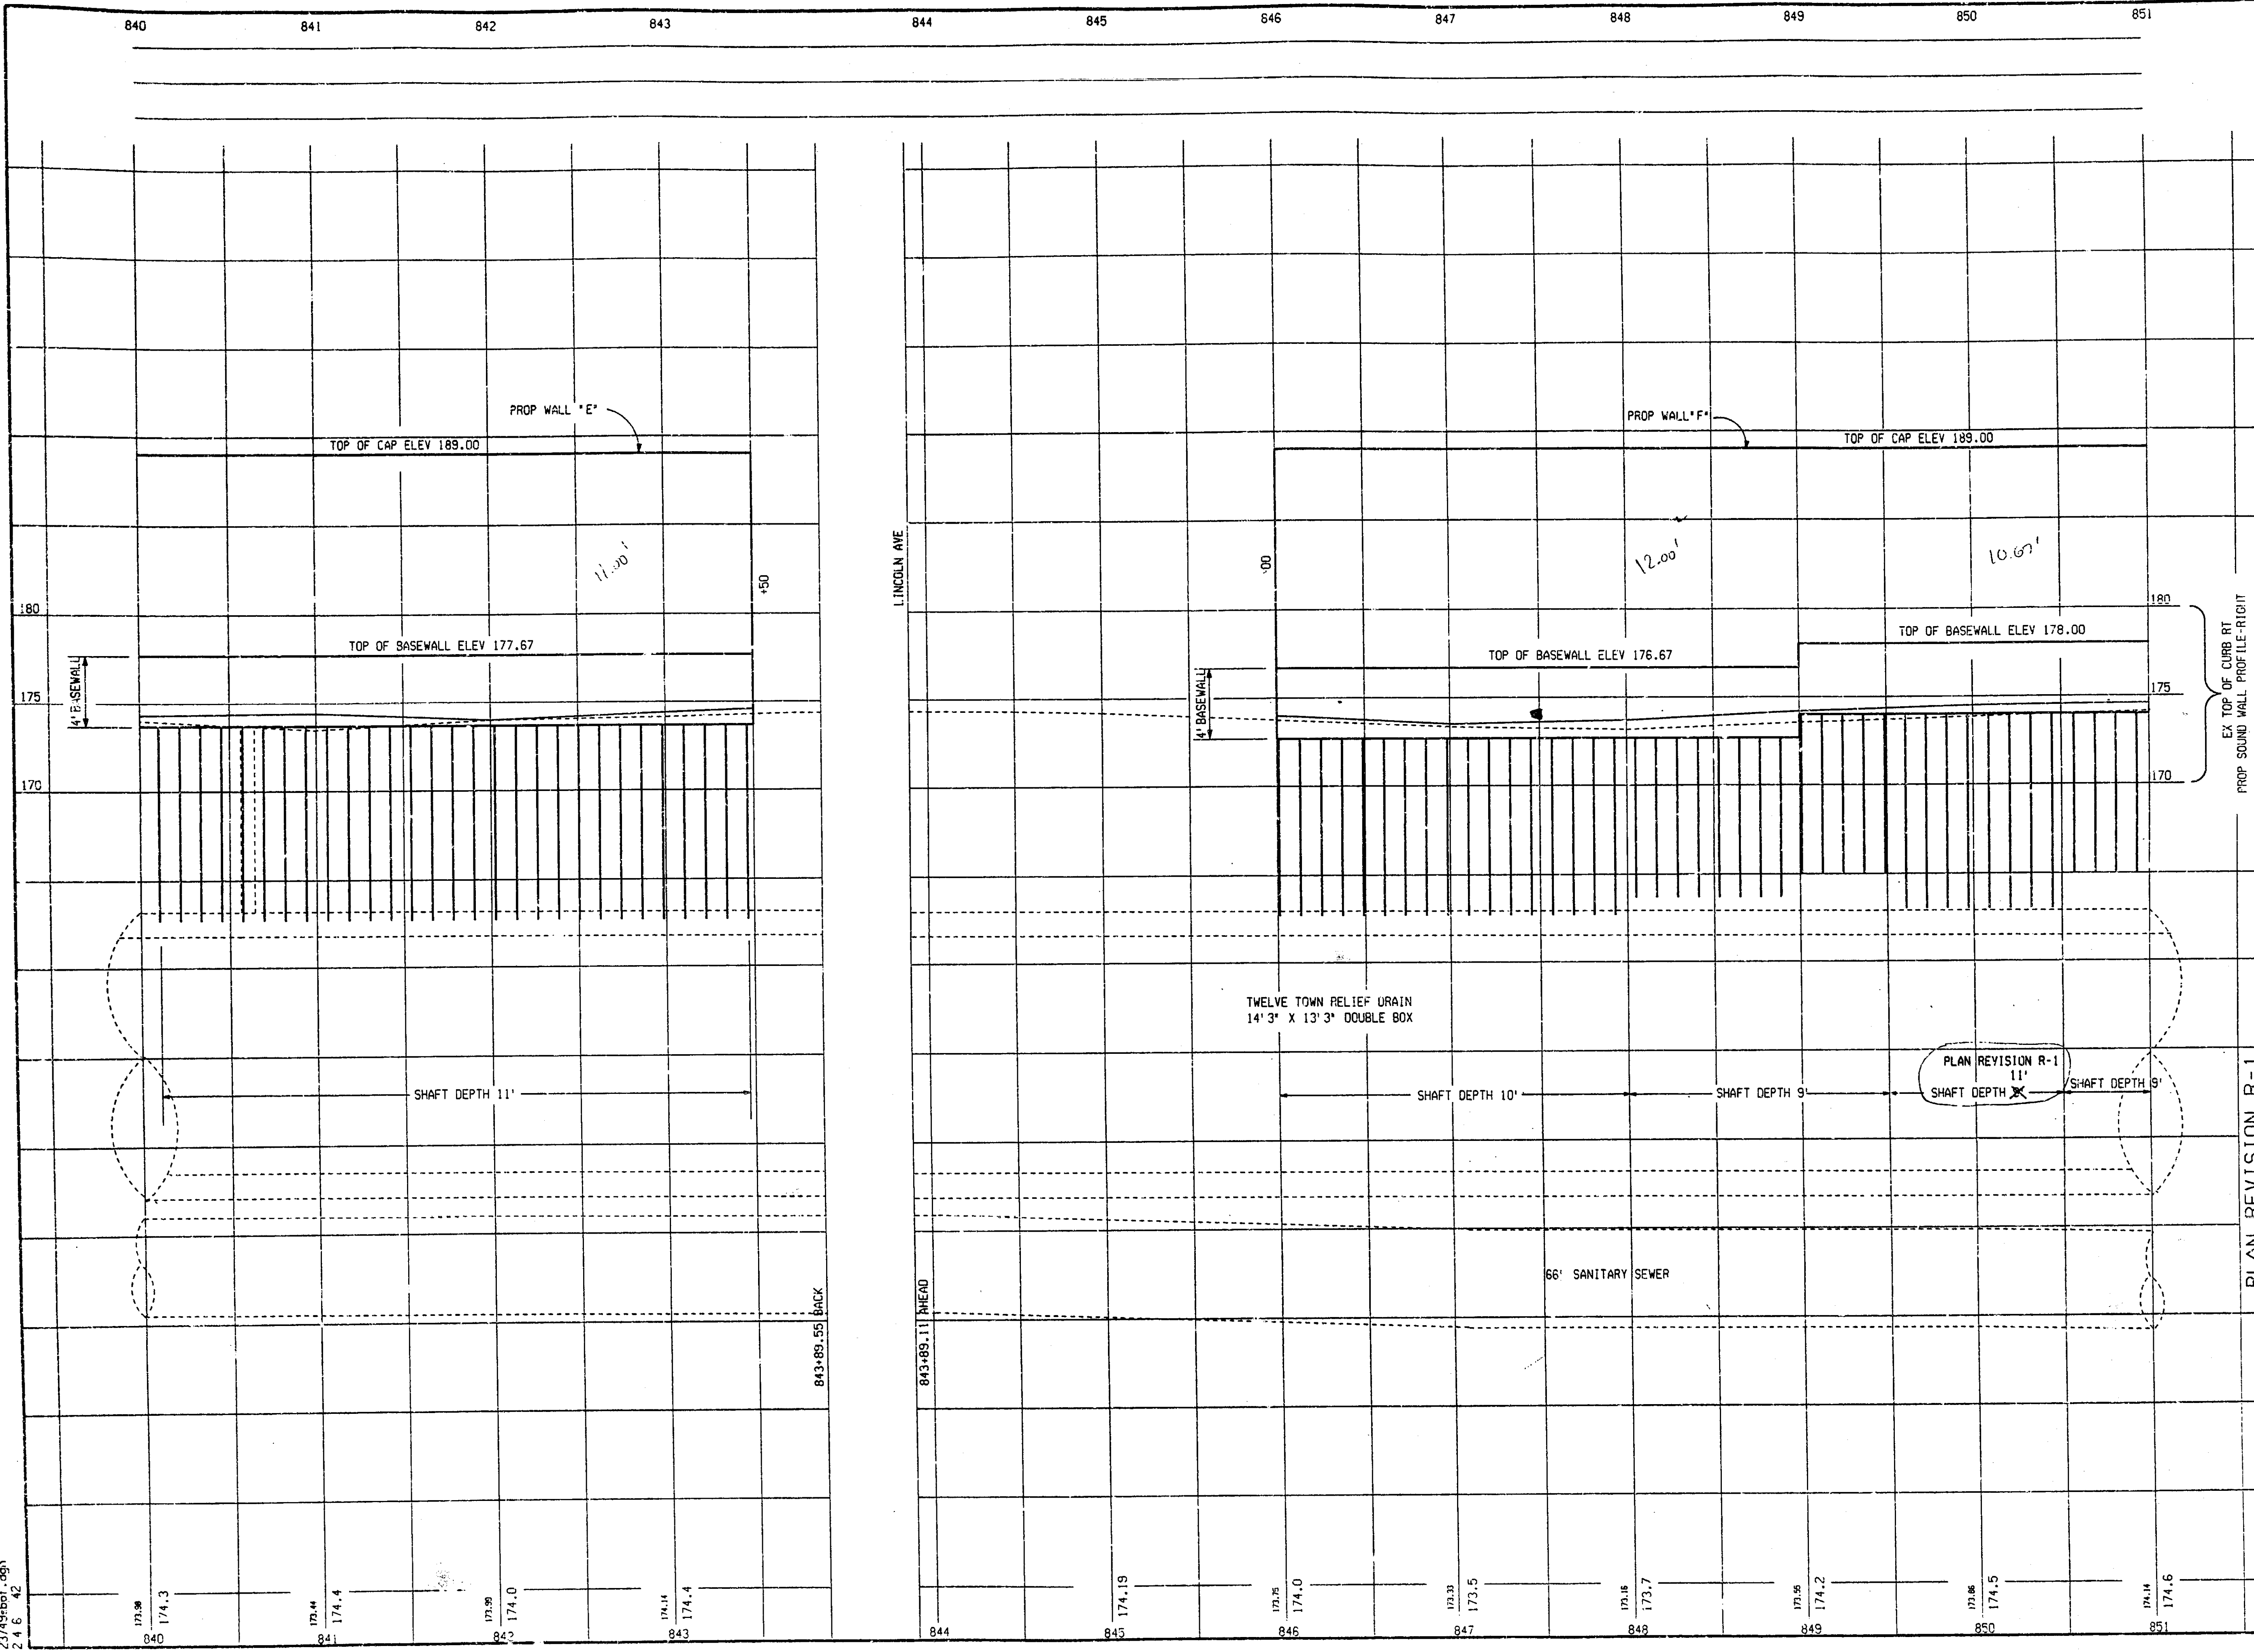

DATE	REVISION

PLAN REVISION R-1	
DATE	11/20/96
SCALE	HORIZ. 1" = 40' VERT. 1" = 4'
CONT. SEC.	63174
JOB NO.	23749
DESIGN UNIT	PENA
S.B. SERVICE RD STA 840+00 TO STA 851+00	



 SHEET NO. 17
 R.O.V. CONST.

SIXTH ST

FOURTH ST






AUTH	DATE	NO.	REVISION	FINAL R.O.W.

DATE: 11/22/96
 EXISTING BY: FELSING'S UNIT
 PROPOSED BY: DAVID
 LAST CORRECTION BY: DAVID
 SECTION 03174
 6687 TRIP PLANS APRIL 1999
 FILE NAME: 23749851.DWG
 1 2 3 4 5 6 7 8 9 11 12 13 14 15 16 17 18 19 20 21 22 23 24 25 27 28 29 30 31 32 33 34 35 36 37 38 39 40 41 42 43 44 45 46 47 48 49 50 51 52 53 54 55 56 57 58 59 60 61 62 63

NBD SERVICE RD
 CURVE DATA
 $\Delta=04^{\circ}12'00''$ RT
 $PI=852+47.80$ BACK
 $=852+46.61$ AHEAD
 NO CURVE

I-75 MEDIAN C
 CURVE DATA
 $\Delta=02^{\circ}20'00''$ RT
 $D=00^{\circ}12'00''$
 $R=28647.89'$
 $T=583.41'$
 $L=1166.67'$
 $E=05.94'$
 $PC=851+81.77$
 $PI=857+65.18$
 $PT=863+48.44$


QUANTITIES (WALL F)
 PLAN REVISION R-1
 897 LFT SOUNDWALL DRILLED SHAFTS, UNCASED 30" DIAM
 1001 LFT REINFORCED TRENCHED FOOTINGS
 13809 SFT REINFORCED BLOCK WALL
 1203 LFT CONC BASEWALL
 1203 LFT LIMESTONE CAP

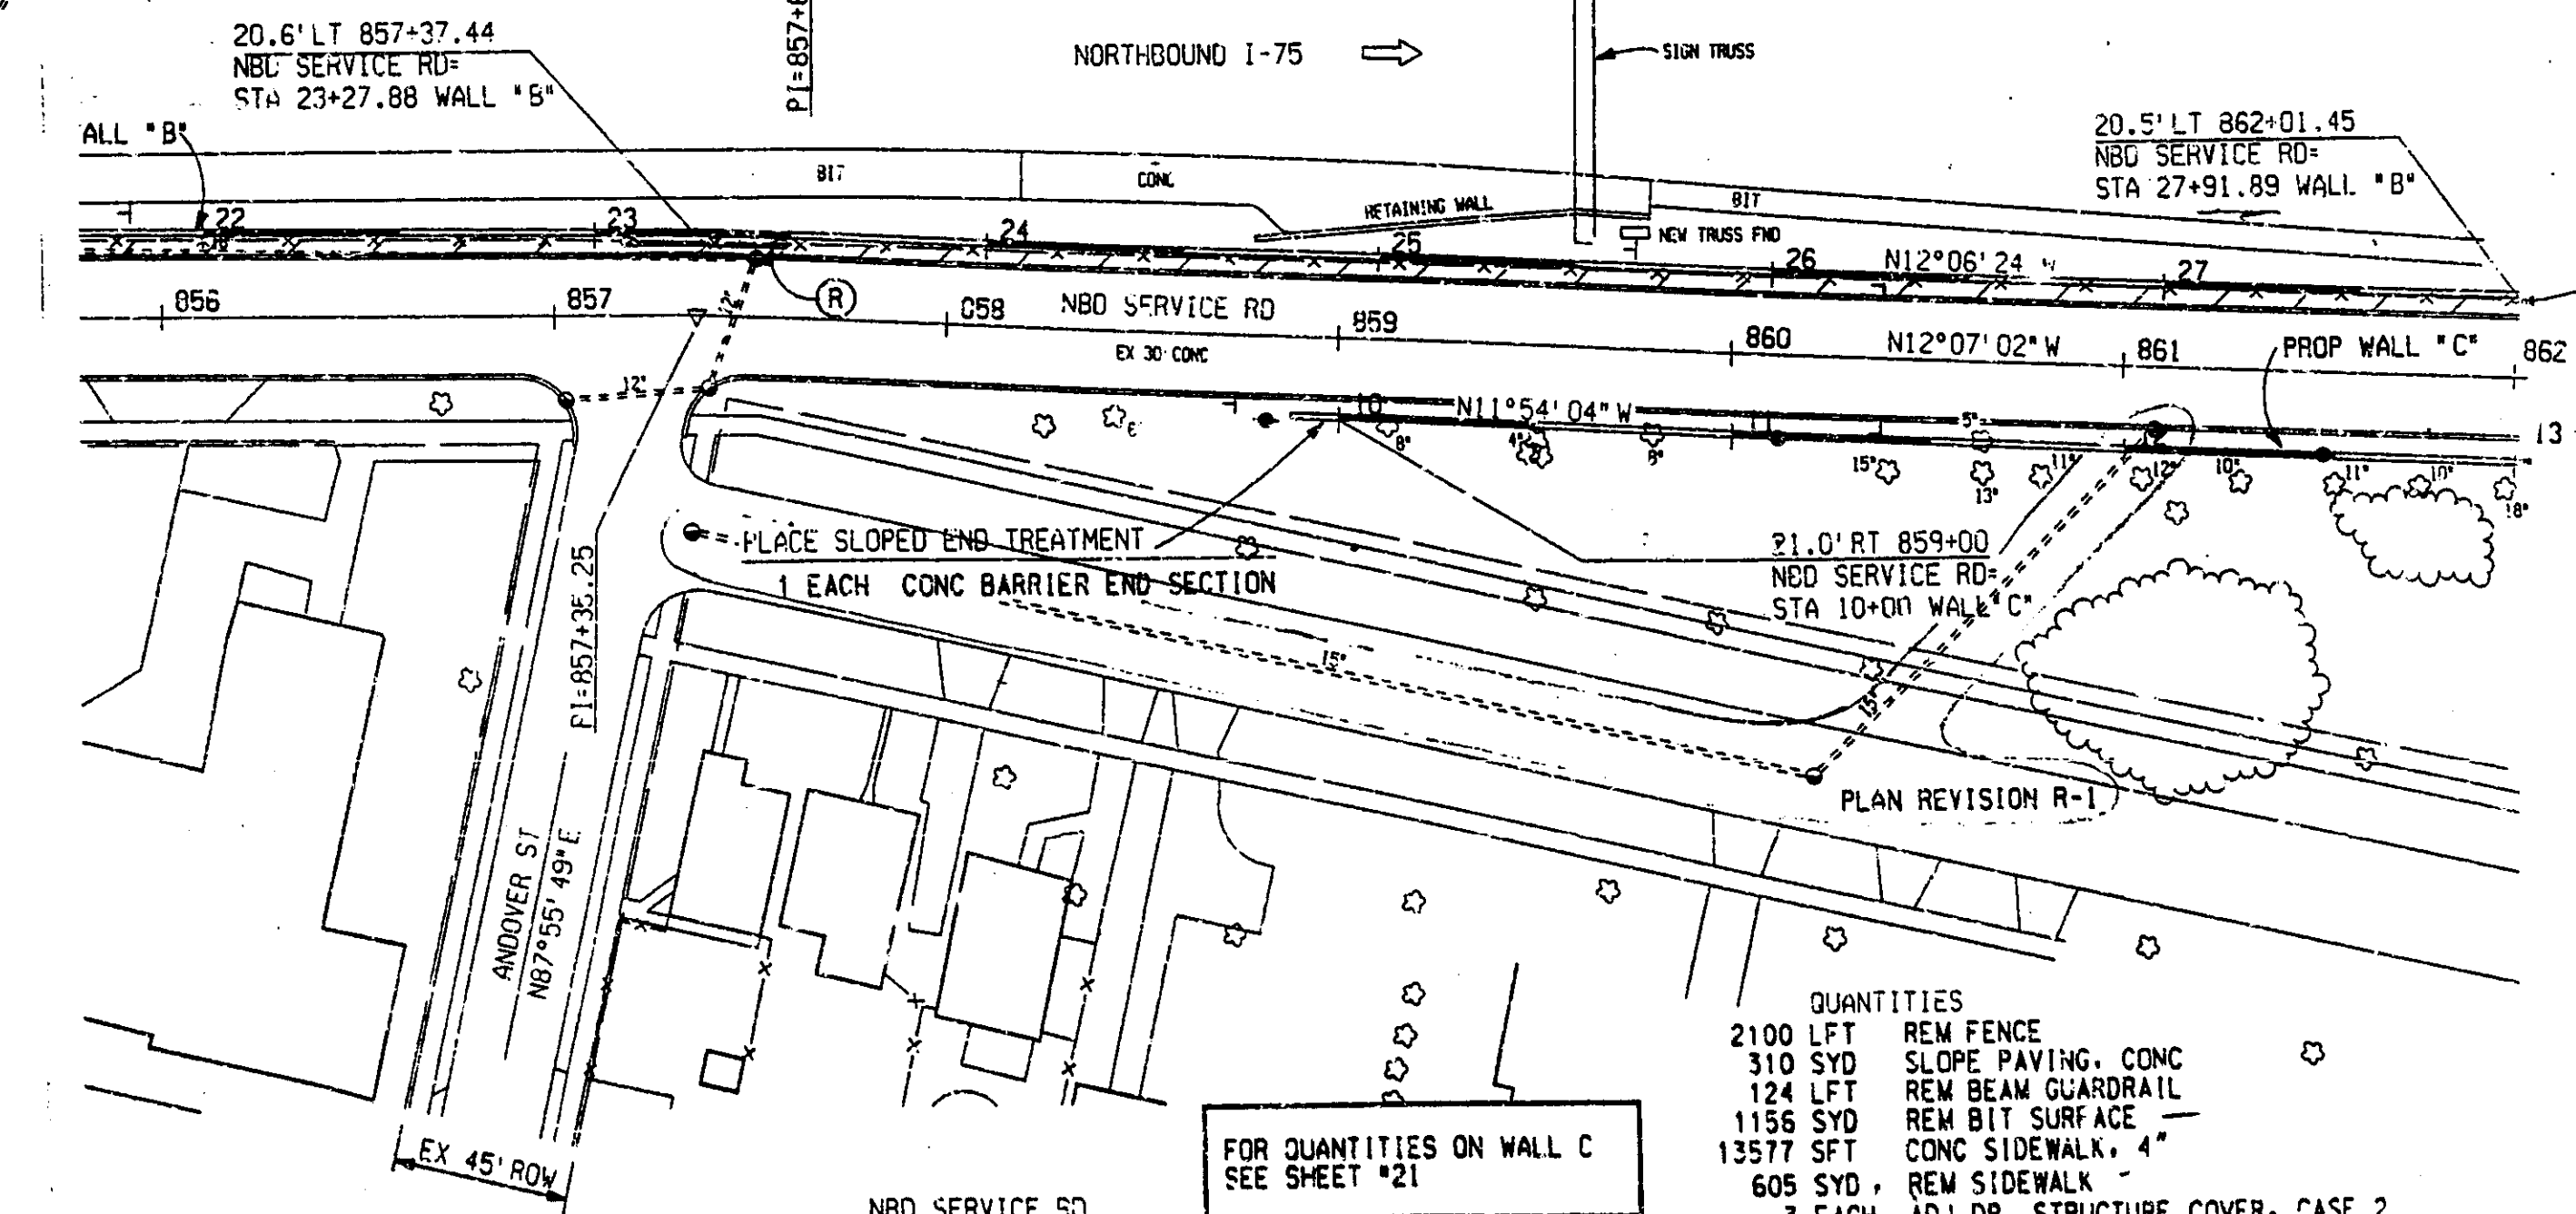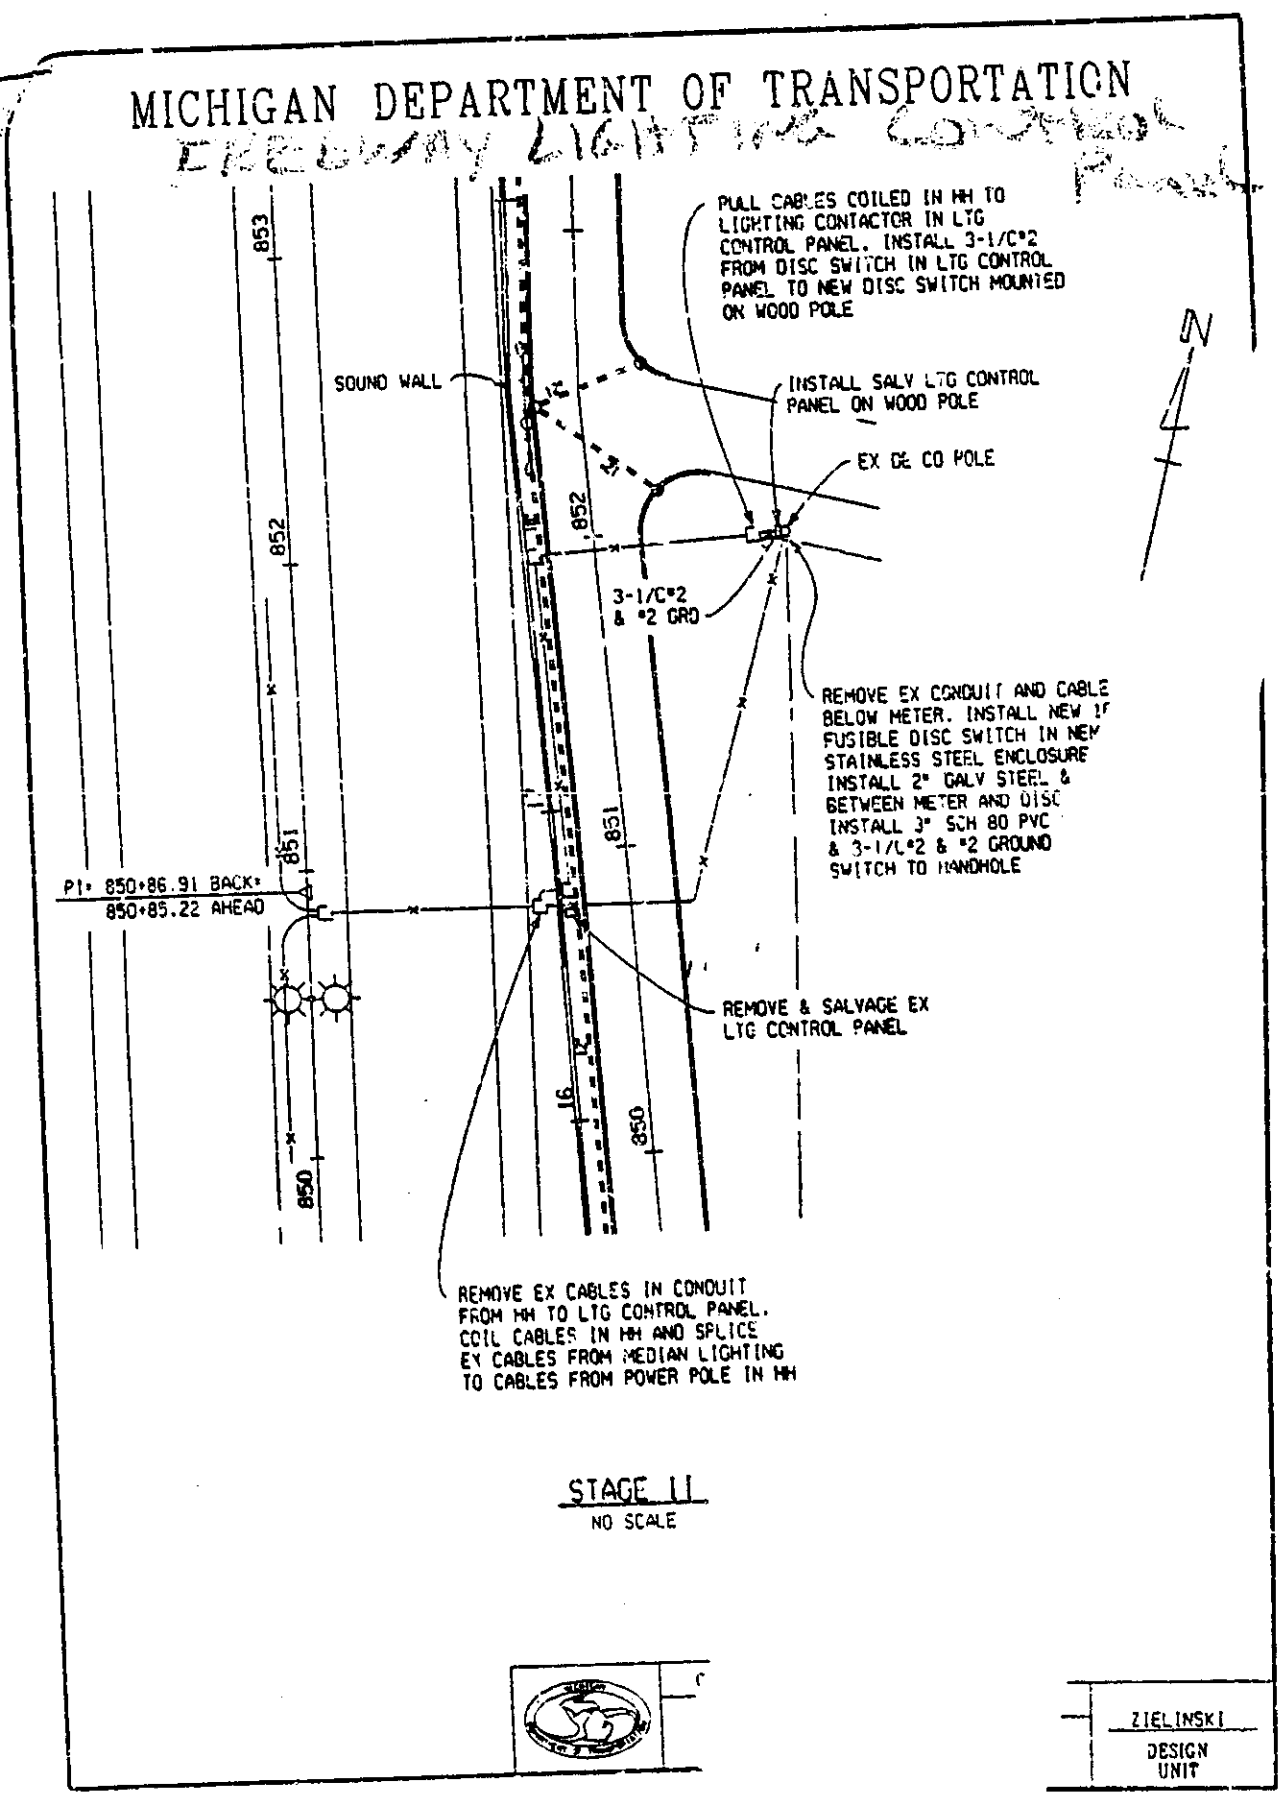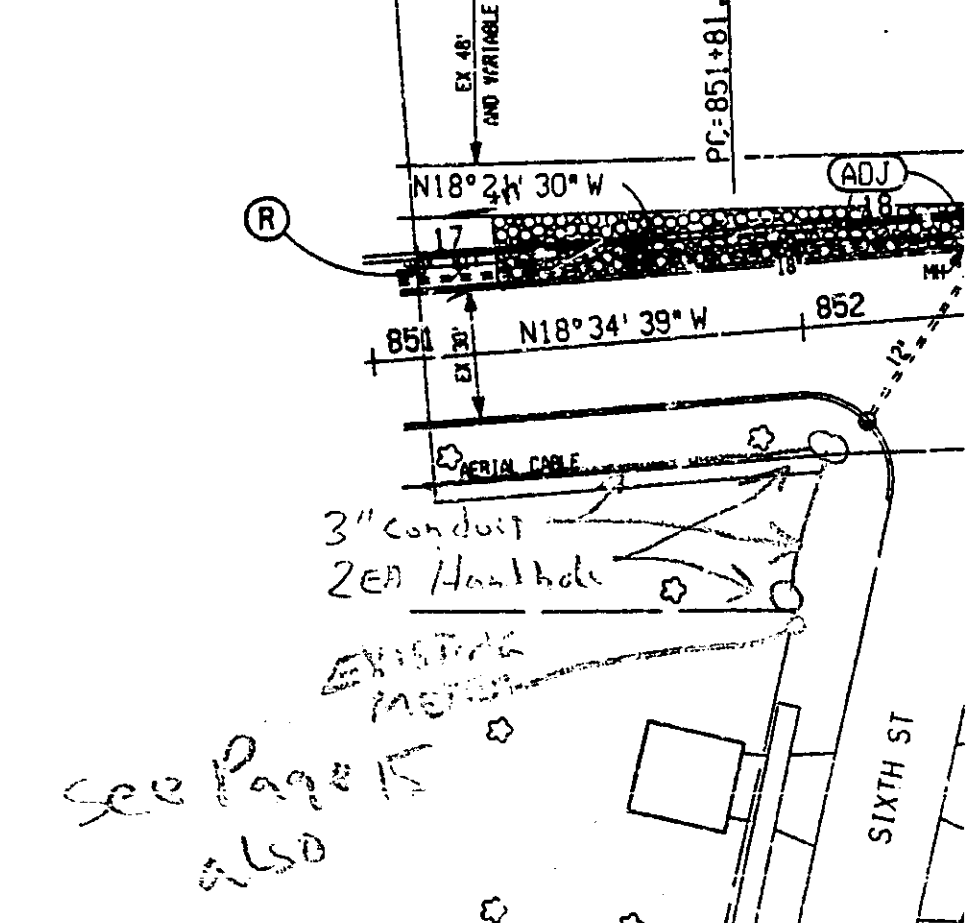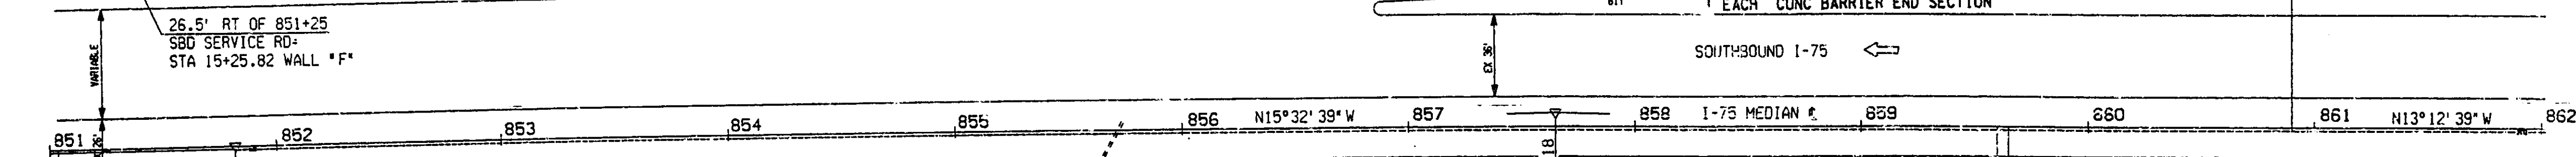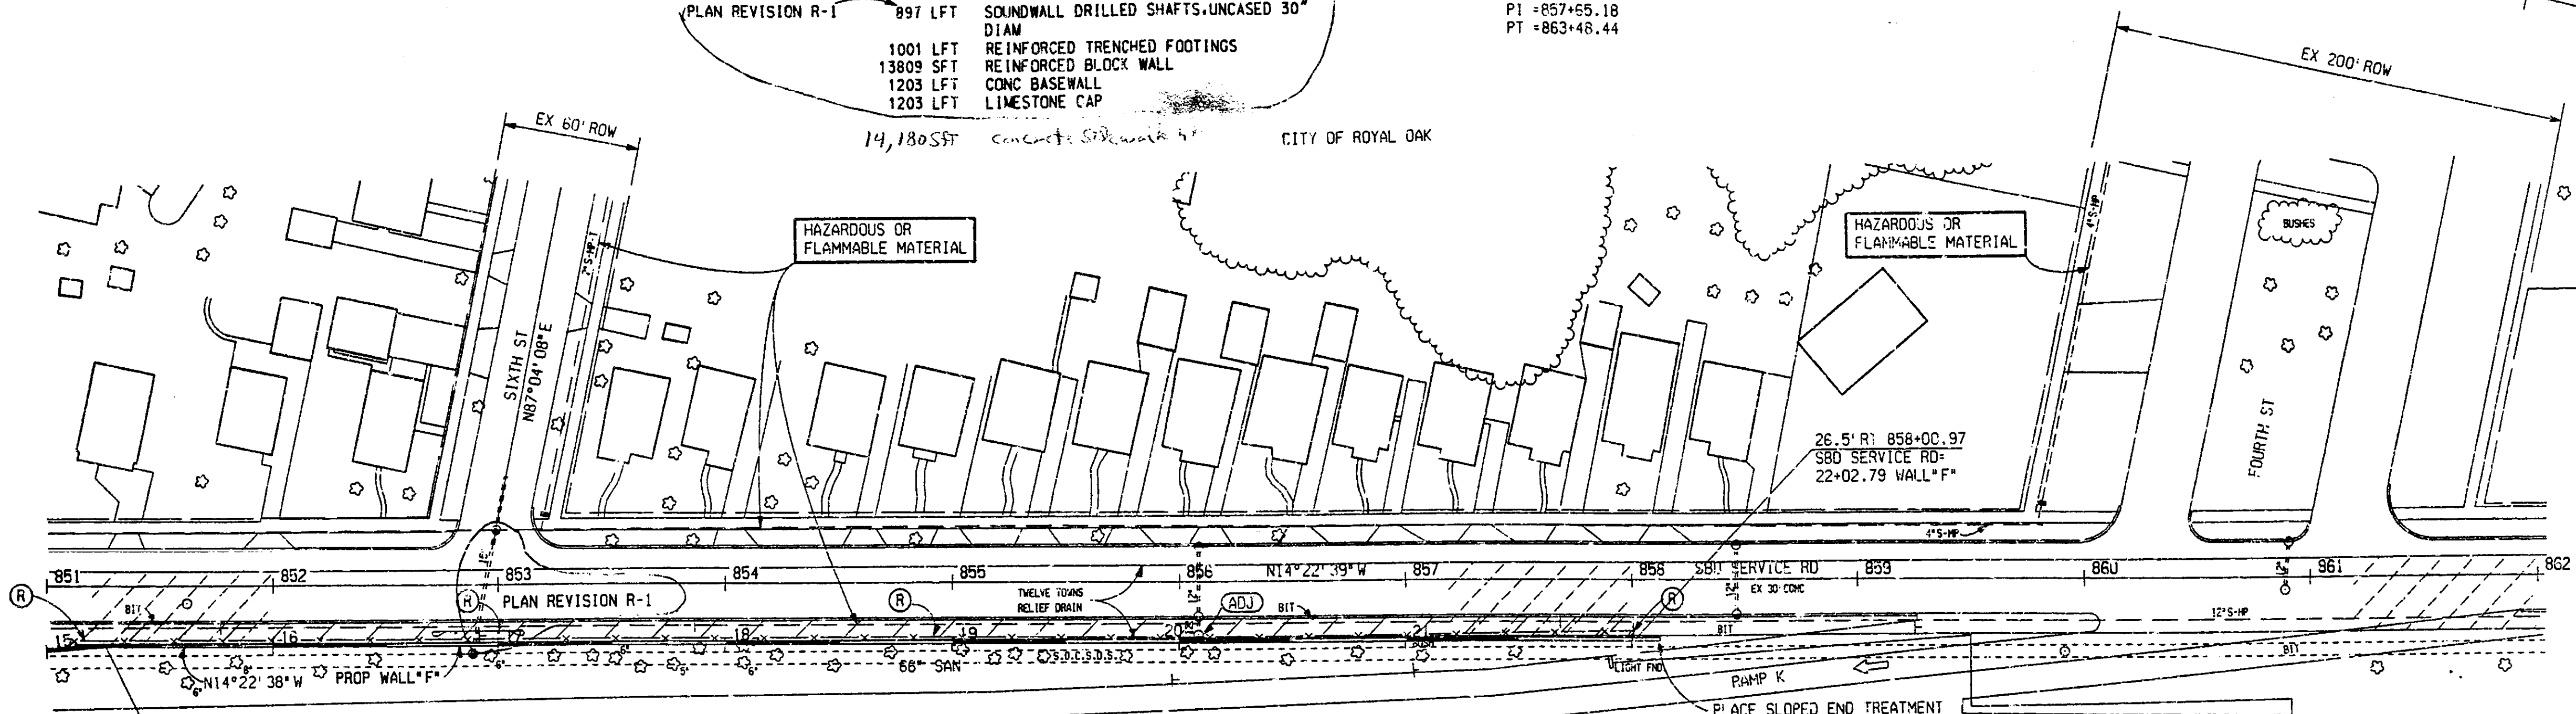

QUANTITIES
 2100 LFT REM FENCE
 310 SYD SLOPE PAVING, CONC
 124 LFT REM BEAM GUARDRAIL
 1156 SYD REM BIT SURFACE
 13577 SFT CONC SIDEWALK, 4"
 605 SYD, REM SIDEWALK
 3 EACH ADJ DR. STRUCTURE COVER, CASE 2

FOR QUANTITIES ON WALL C
 SEE SHEET #21


PLAN REVISION R-1
 CONSTRUCTION SHEET

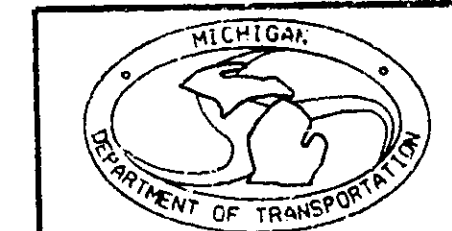

I-75 STA 851+00 TO STA 862+00				
DATE	SCALE	CONT. SEC.	JOB NO.	DESIGN UNIT
11/22/96	1" = 40'	63174	23749 A	PENA
				SHEET NO. R.O.W. CONST.
				18

SECTION 231.171

656 TYPICAL PLAN VIEW

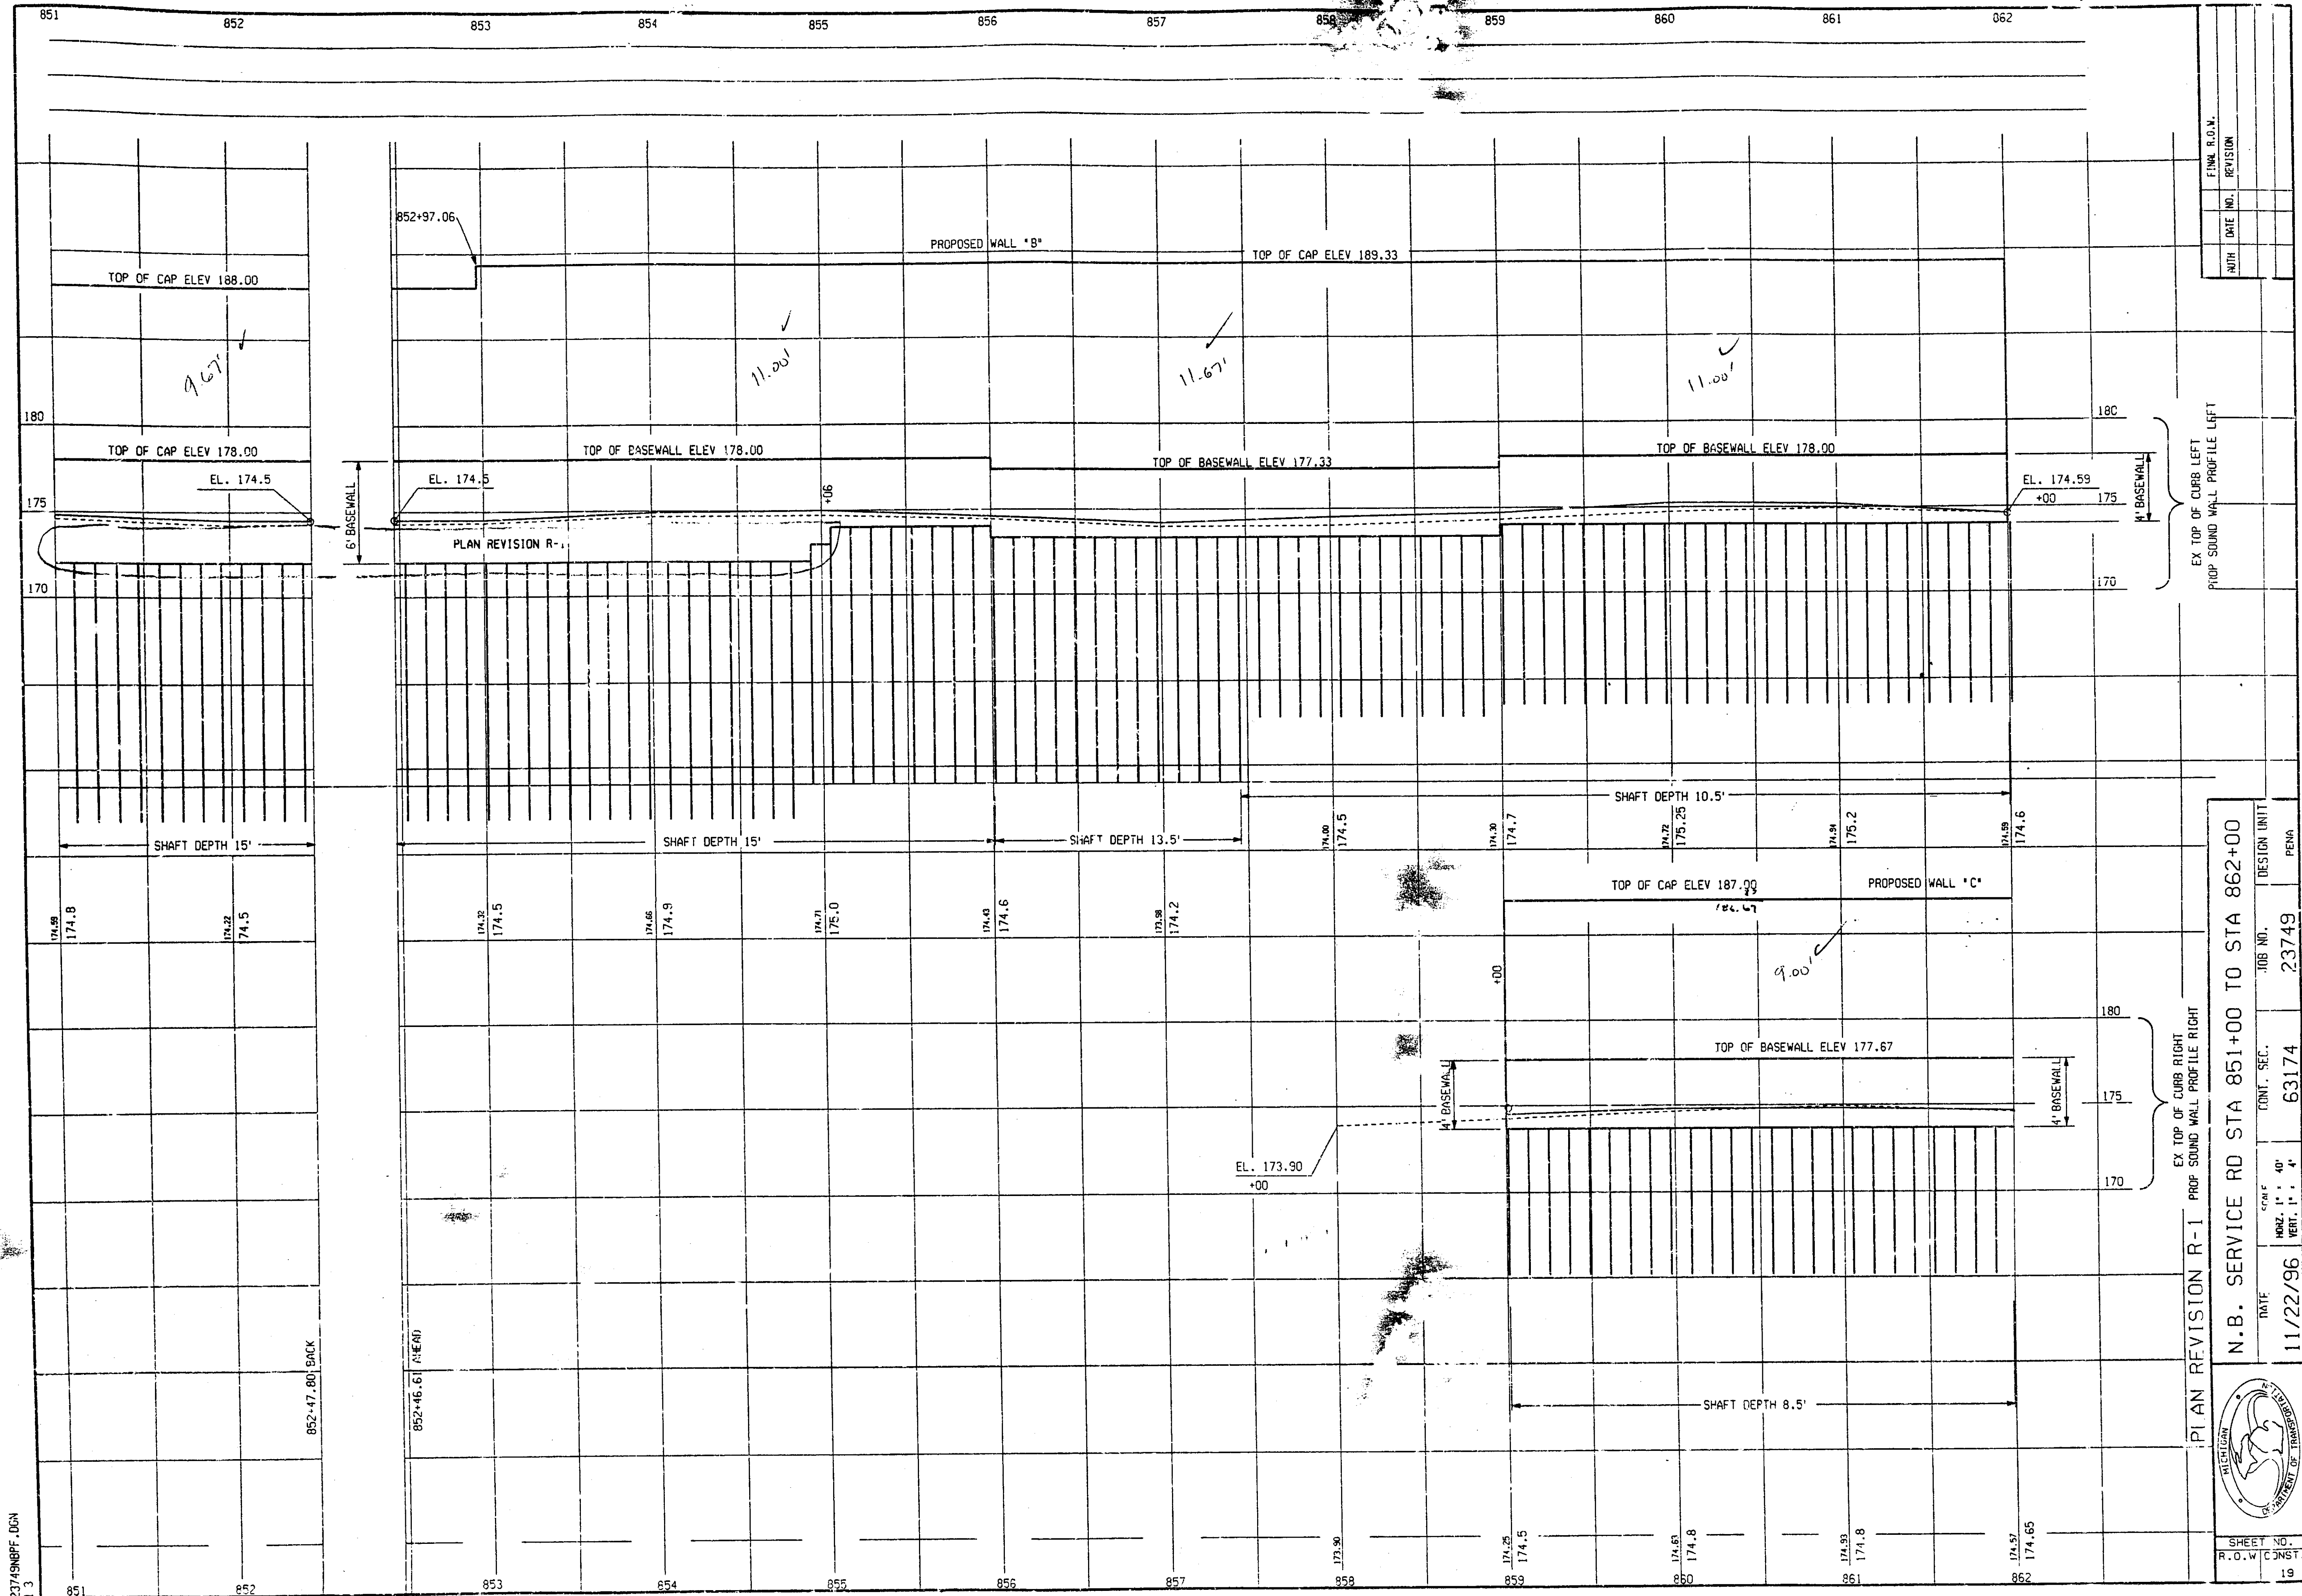

23749BPF.DGN
1 3

852+47.80 BACK

852+46.61 AHEAD

NO.	DATE	REVISION

DATE	11/22/96	SCALE	HORIZ. 1" = 40' VERT. 1" = 4'	CONT. SEC.	63174	JOB NO.	23749	DESIGN UNIT	PERA
------	----------	-------	----------------------------------	------------	-------	---------	-------	-------------	------



SHEET NO. 19
R.O.W. CONST.


EX TOP OF CURB LEFT
PROP SOUND WALL PROFILE LEFT

EX TOP OF CURB RIGHT
PROP SOUND WALL PROFILE RIGHT

PLAN REVISION R-1
N.B. SERVICE RD STA 851+00 TO STA 862+00

CONSTRUCTION PERMITS APRIL 1999

2374989P.06N
1, 3, 7-41

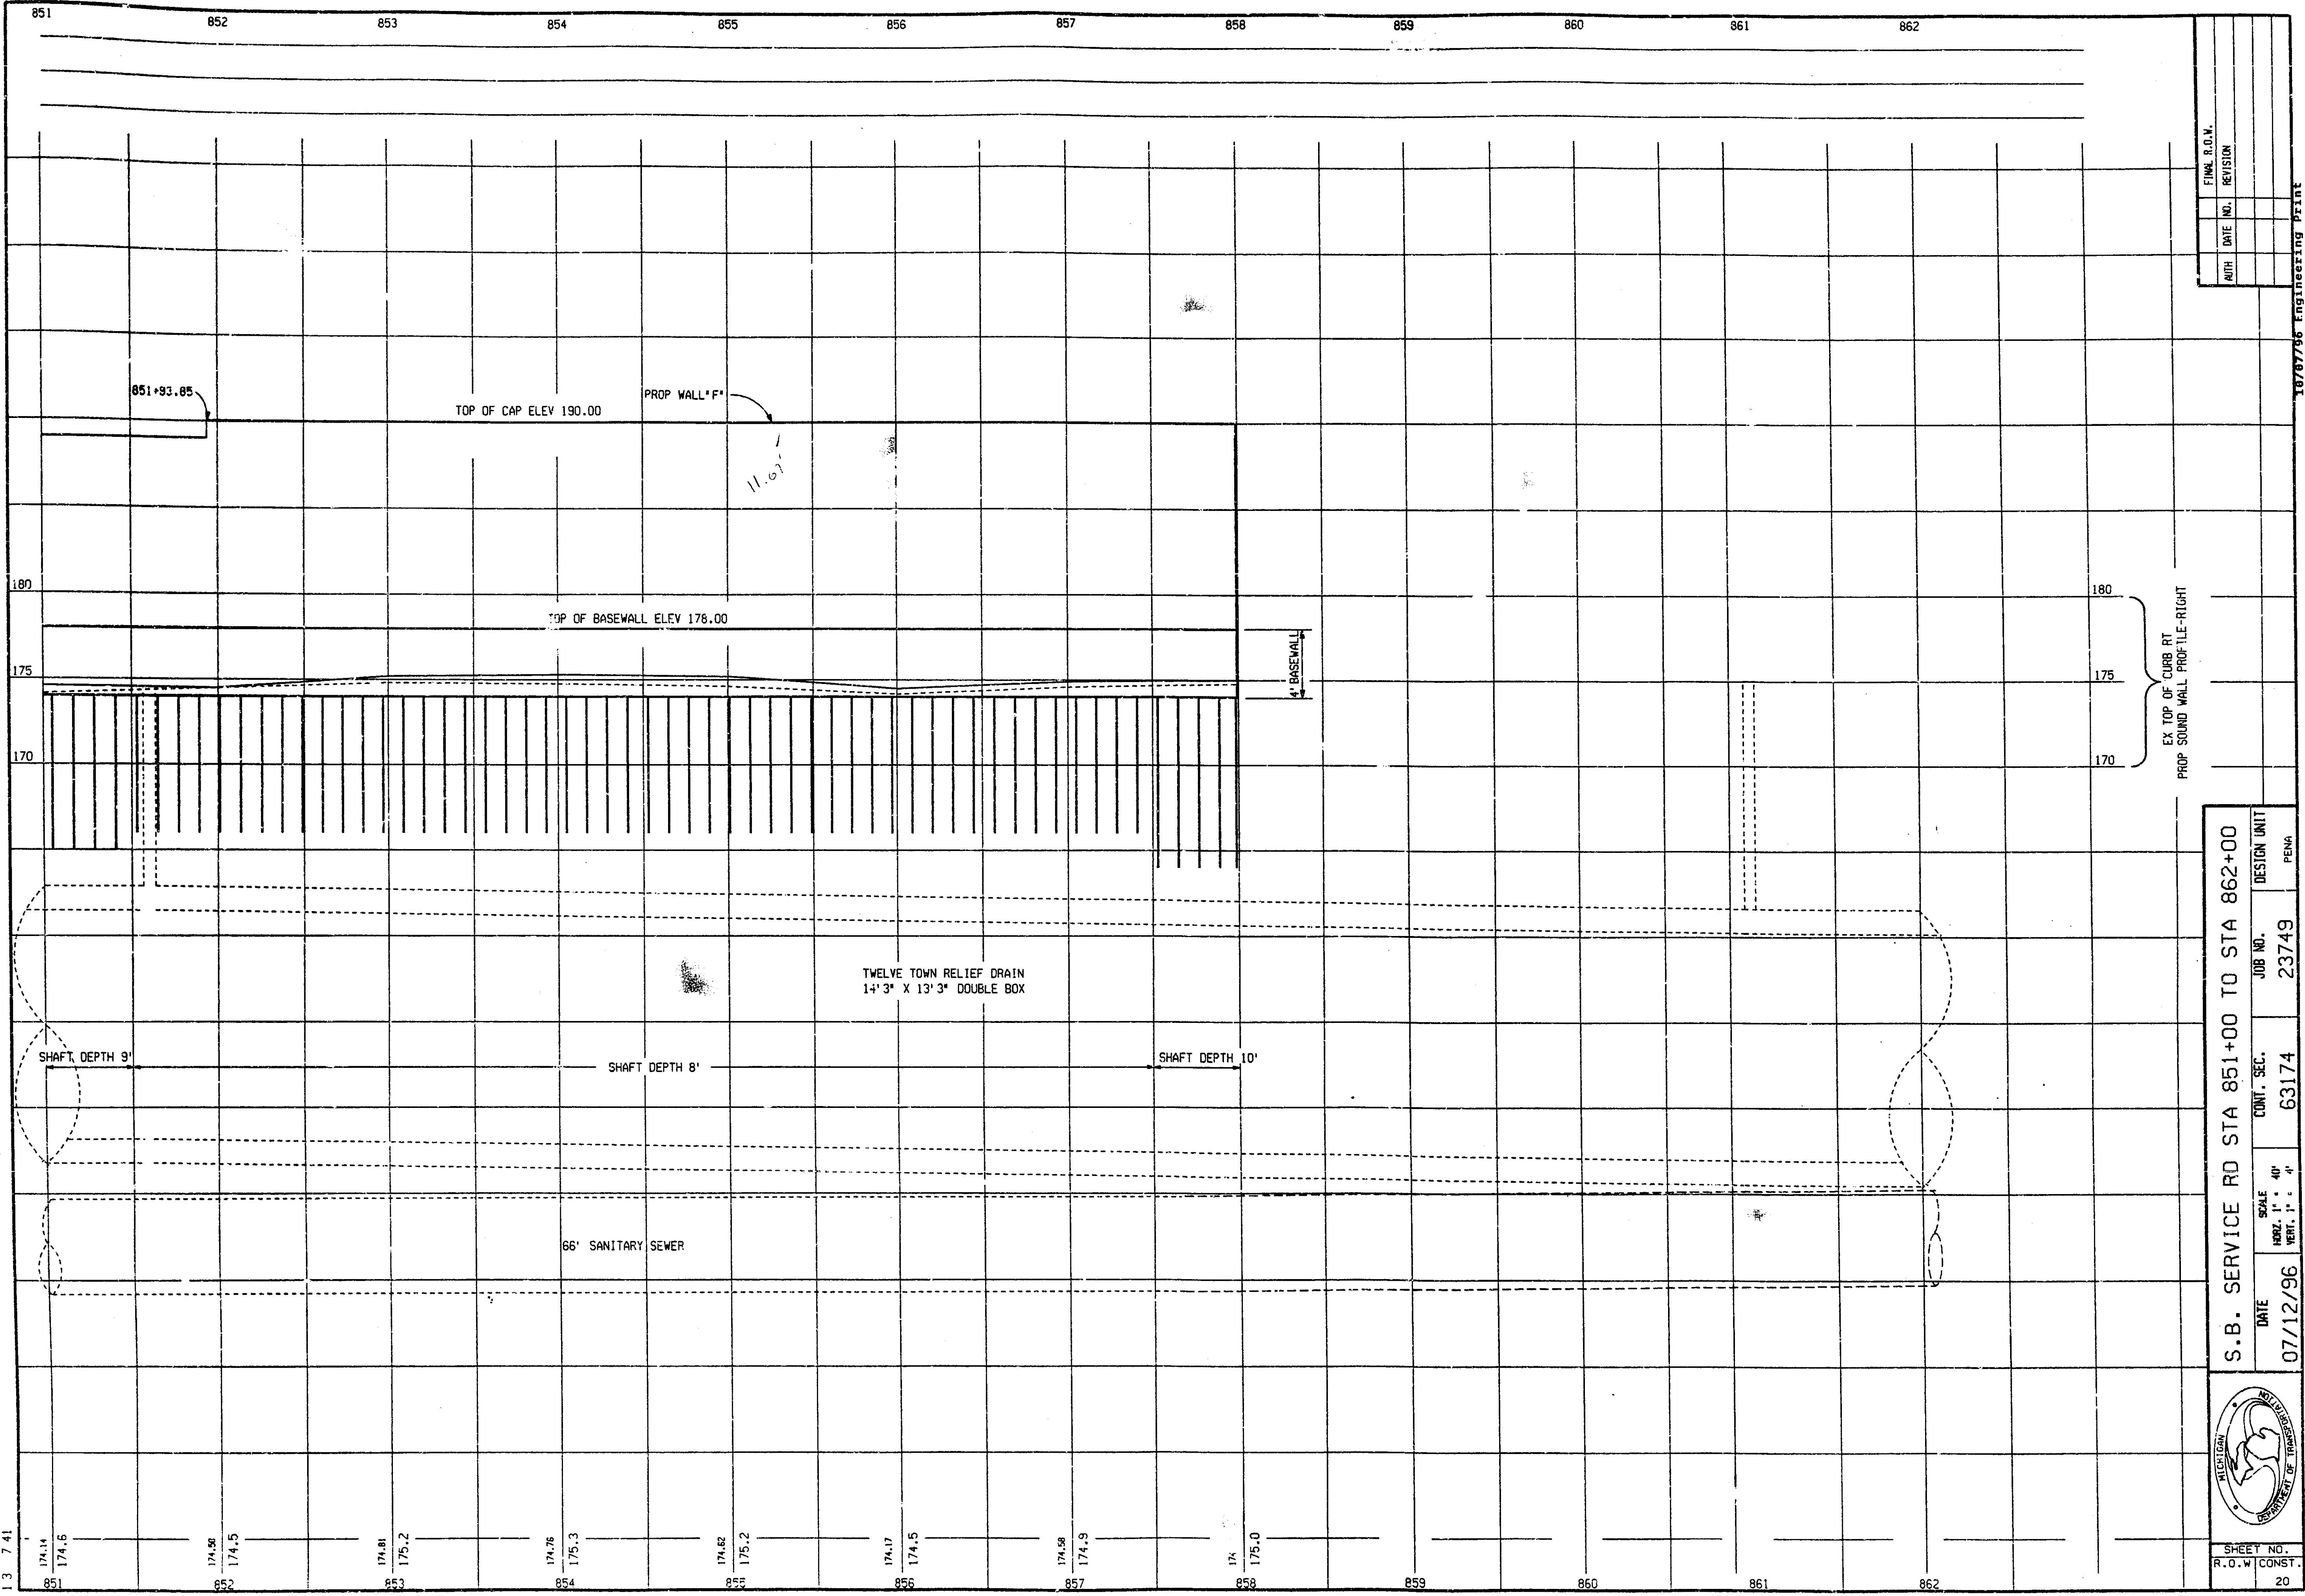

DATE	NO.	REVISION

S.B. SERVICE RD STA 851+00 TO STA 862+00	
DATE	07/12/96
SCALE	HORIZ. 1" = 40'
CONT. SEC.	63174
JOB NO.	23749
DESIGN UNIT	PENNA



SHEET NO.	20
R.O.W. CONST.	


10/07/96 ENGINEERING PRINT

DATE: 11/20/96
 EXISTING BY: FELSING'S UNIT
 PROPOSED BY: DAVID
 LAST CORRECTION BY: DAVID

GREIG ST

11 MILE RD

FINAL R.O.W.		
AUTH	DATE	REVISION

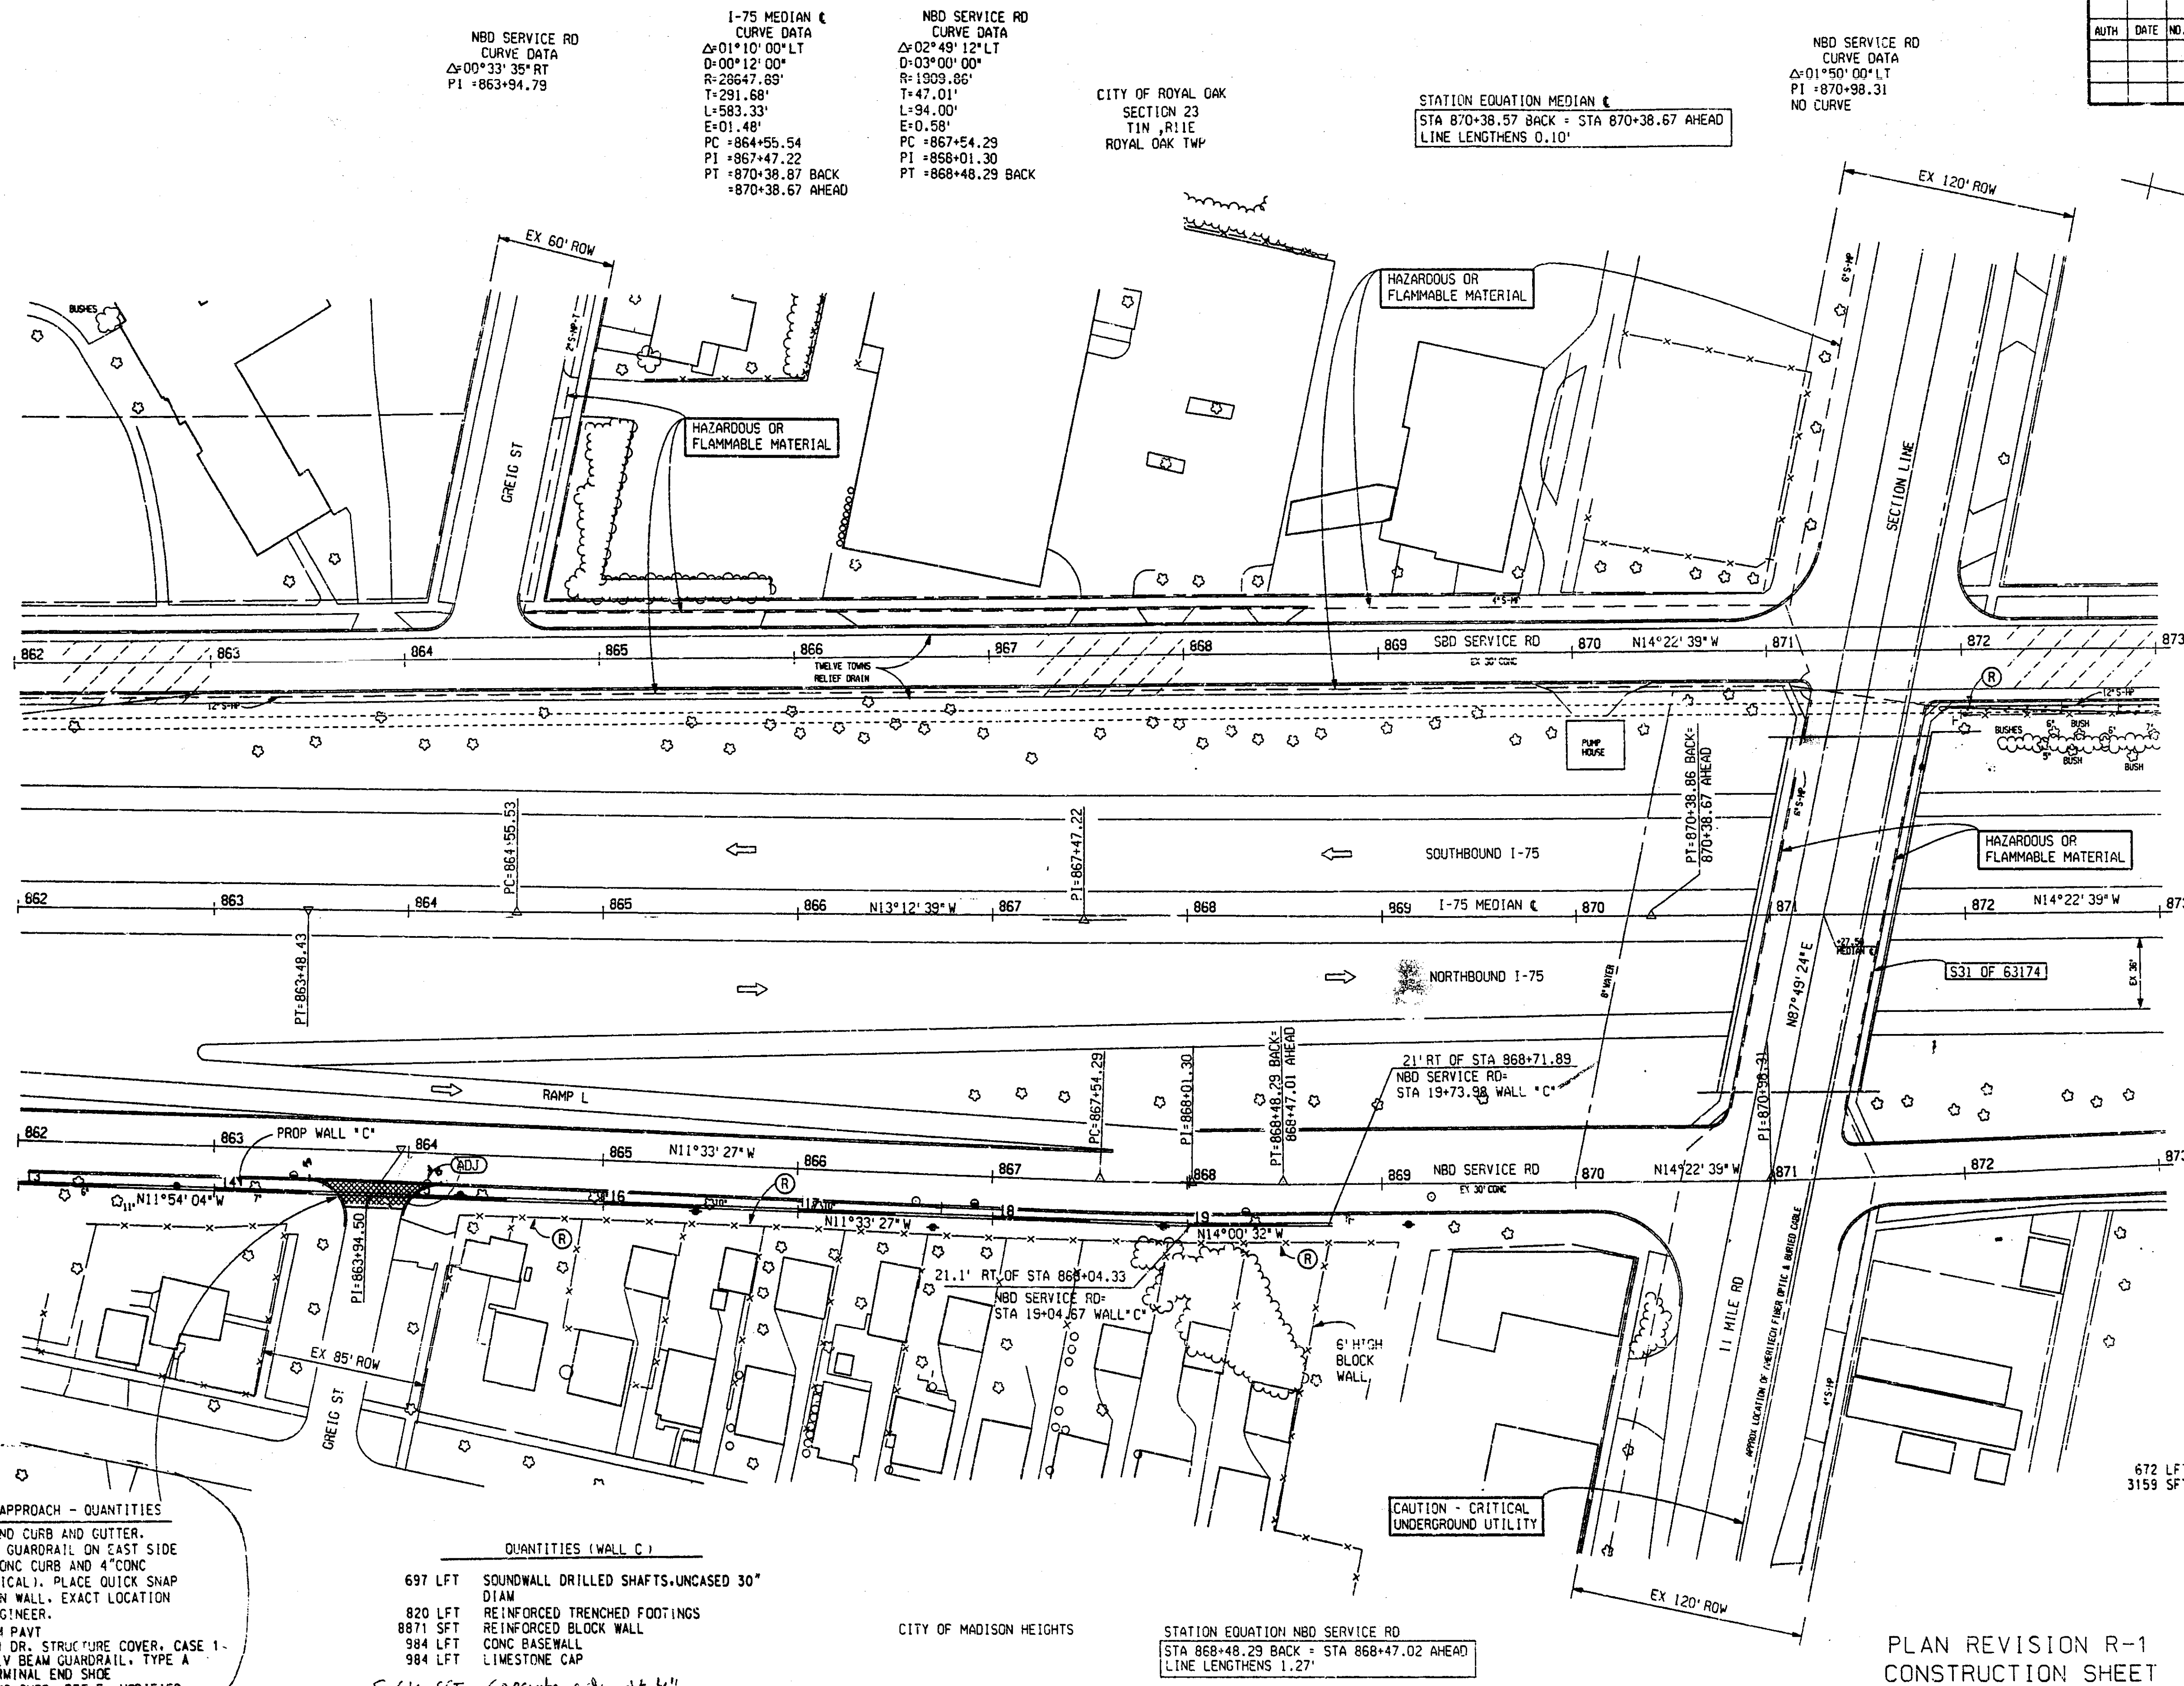

PLAN REVISION R-1
 CLOSING GREIG ST APPROACH - QUANTITIES
 REMOVE PAVEMENT AND CURB AND GUTTER.
 PLACE TYPE A BEAM GUARDRAIL ON EAST SIDE OF WALL. PLACE CONC CURB AND 4" CONC SIDEWALK (SEE TYPICAL). PLACE QUICK SNAP HYDRANT HOOK-UP IN WALL. EXACT LOCATION AS DIRECTED BY ENGINEER.
 59 SYD REM PAVT
 1 EACH ADJ DR. STRUCTURE COVER, CASE 1-
 32 LFT CALV BEAM GUARDRAIL, TYPE A
 2 EACH TERMINAL END SHOE
 68 LFT CONC CURB, OCT E, MODIFIED
 1 EACH QUICK SNAP HYDRANT HOOK-UPS

QUANTITIES (WALL C)


697 LFT	SOUNDWALL DRILLED SHAFTS, UNCASED 30" DIAM
820 LFT	REINFORCED TRENCHED FOOTINGS
8871 SFT	REINFORCED BLOCK WALL
984 LFT	CONC BASEWALL
984 LFT	LIMESTONE CAP

5,416 SFT Concrete sidewalk 4"

QUANTITIES

672 LFT	REM FENCE
3159 SFT	CONC SIDEWALK, 4"


PLAN REVISION R-1
 CONSTRUCTION SHEET

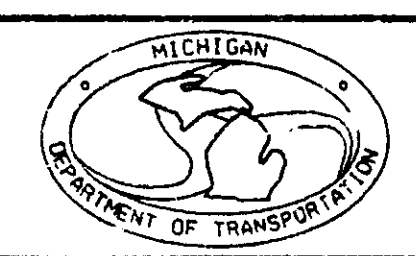

I-75 STA 862+00 TO STA 873+00					
DATE	SCALE	CONT. SEC.	JOB NO.	DESIGN UNIT	SHEET NO.
11/20/96	1" = 40'	63174	23743 A	PENA	21


CONSTRUCTION PERMITS APRIL 1999

23749MBP.DGN
2 4 6

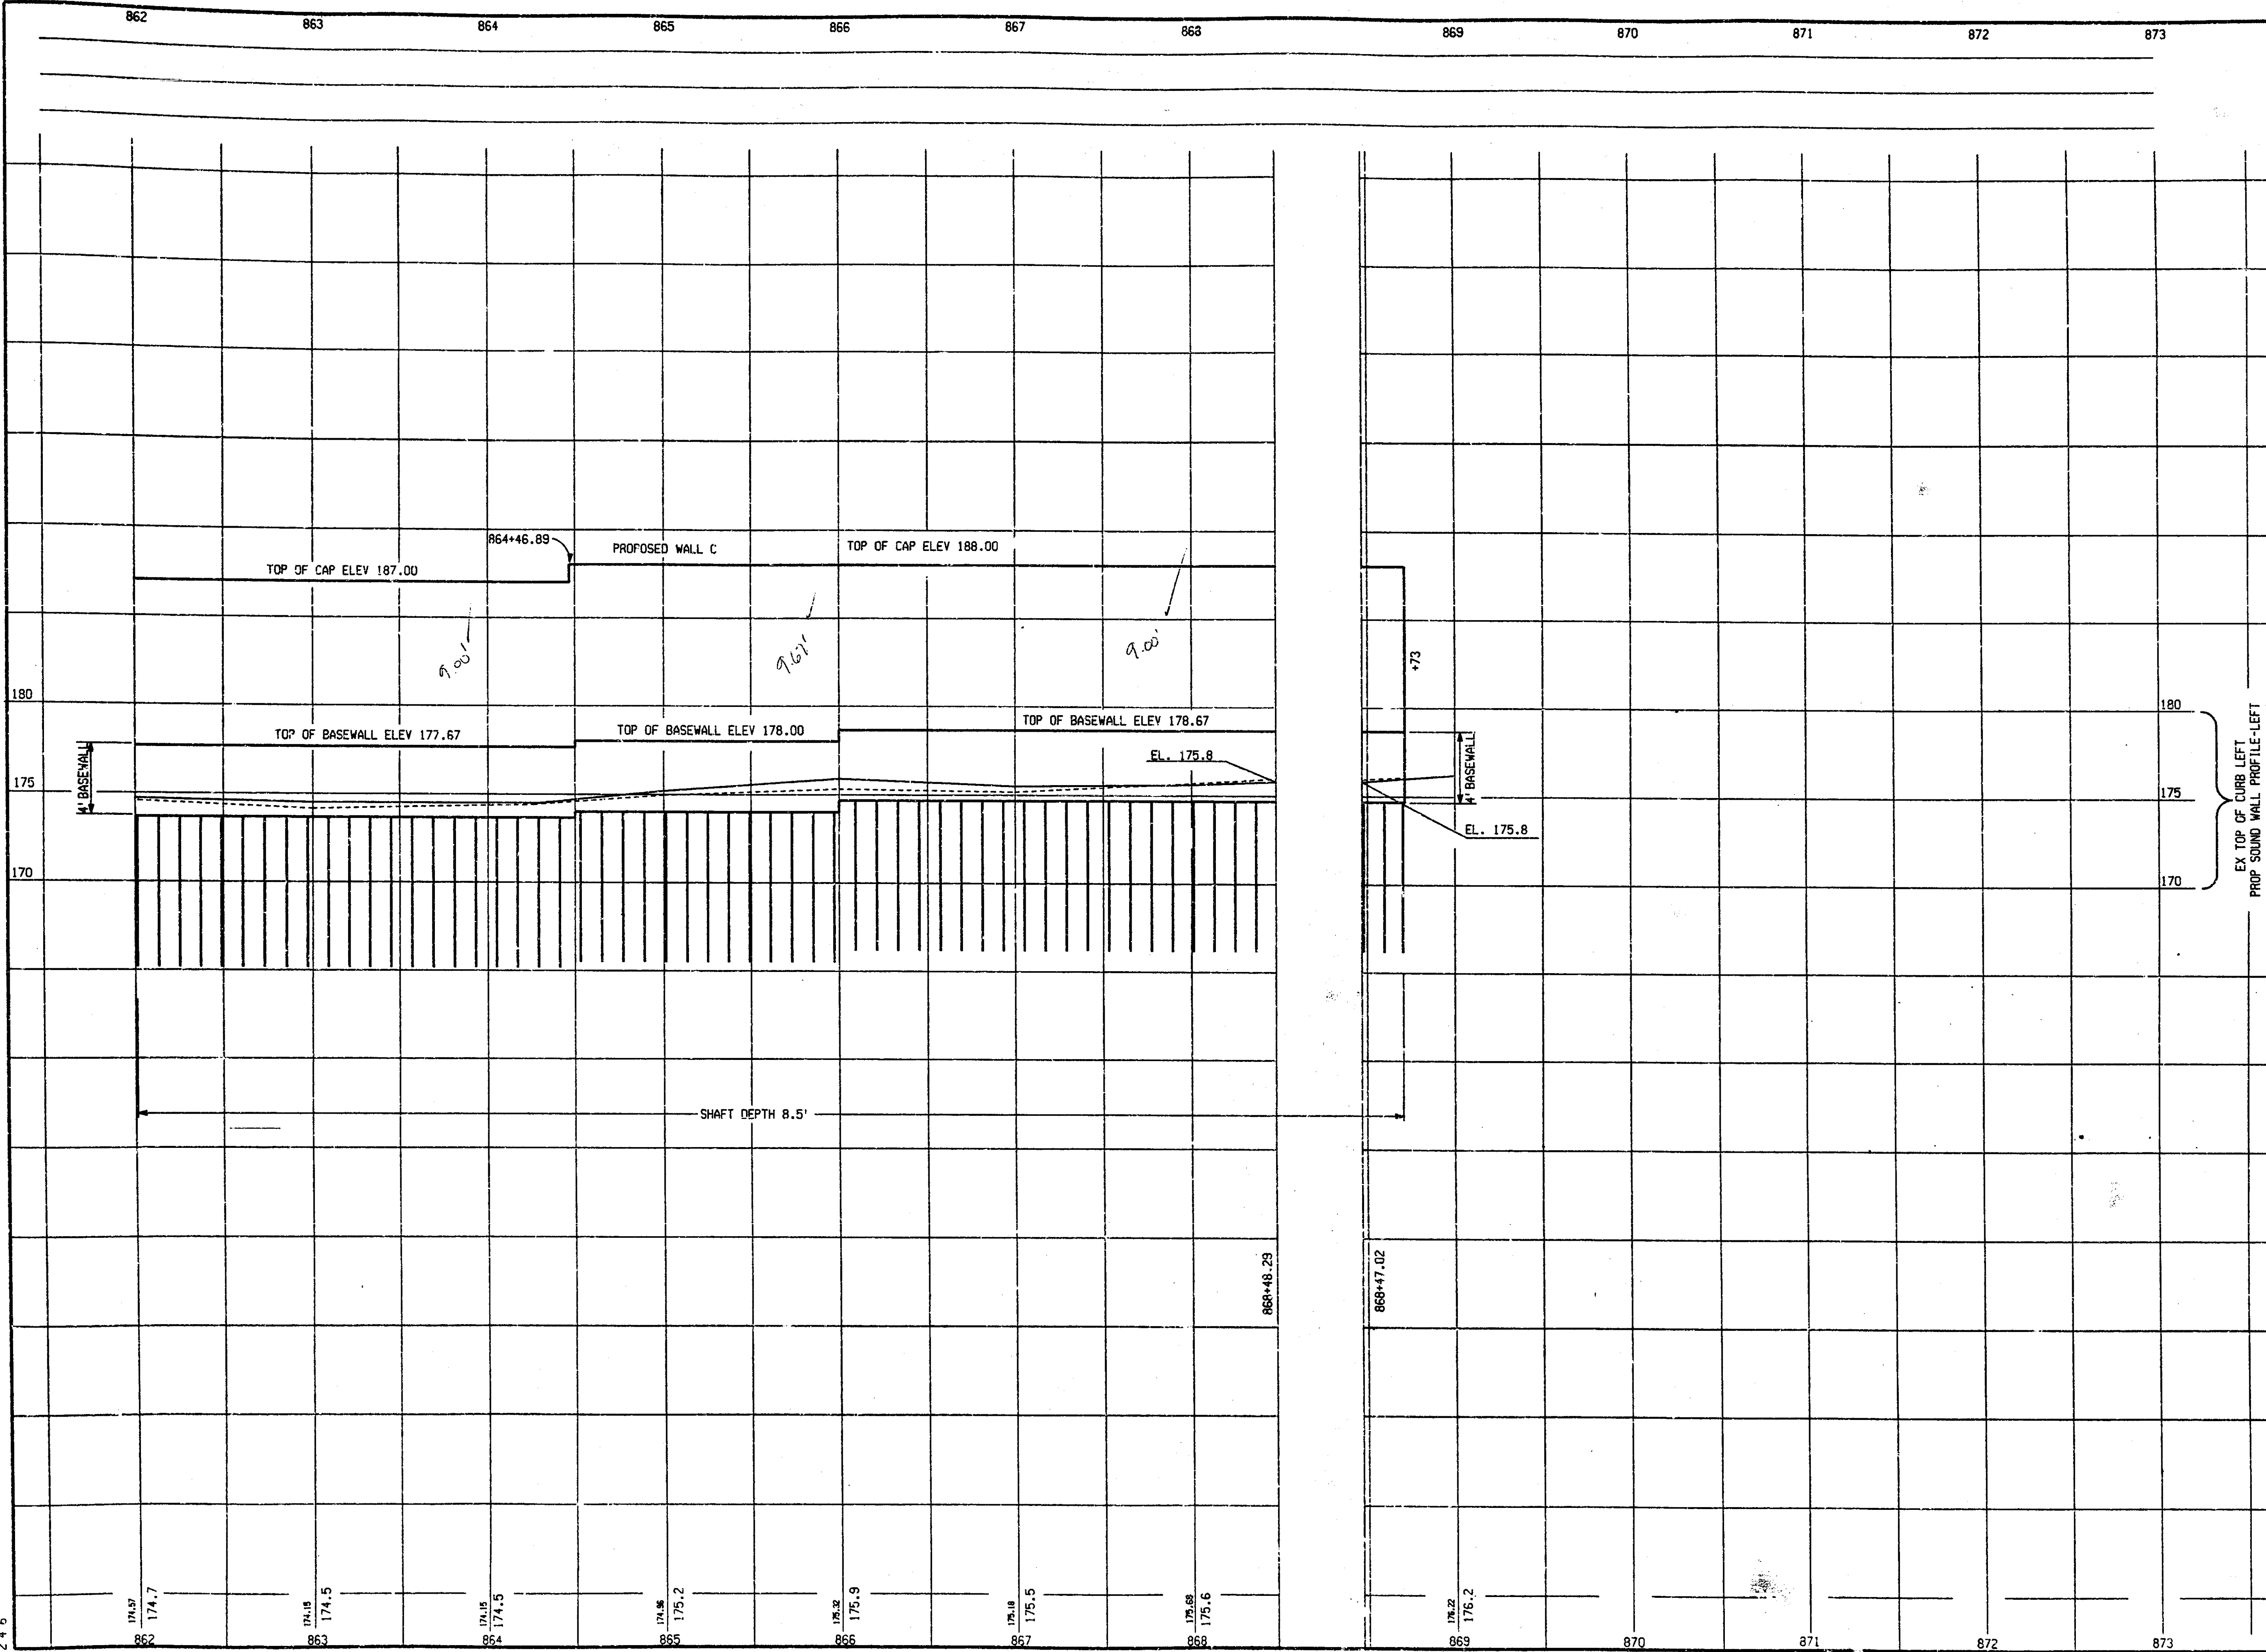

DATE	NO.	REVISION


N.B. SERVICE RD STA 862+00 TO STA 873+00
 DATE 07/11/96
 SCALE HORIZ. 1" = 40' VERT. 1" = 4'
 CONT. SEC. 63174
 JOB NO. 23749
 DESIGN UNIT .PENA

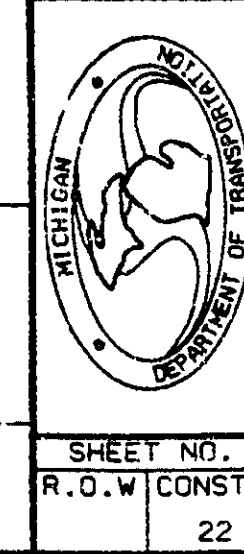

10787796 Engineering Print

CONSTRUCTED AS PER PLANS, APRIL 1999

23749bpf.dgn
2 4 6 42

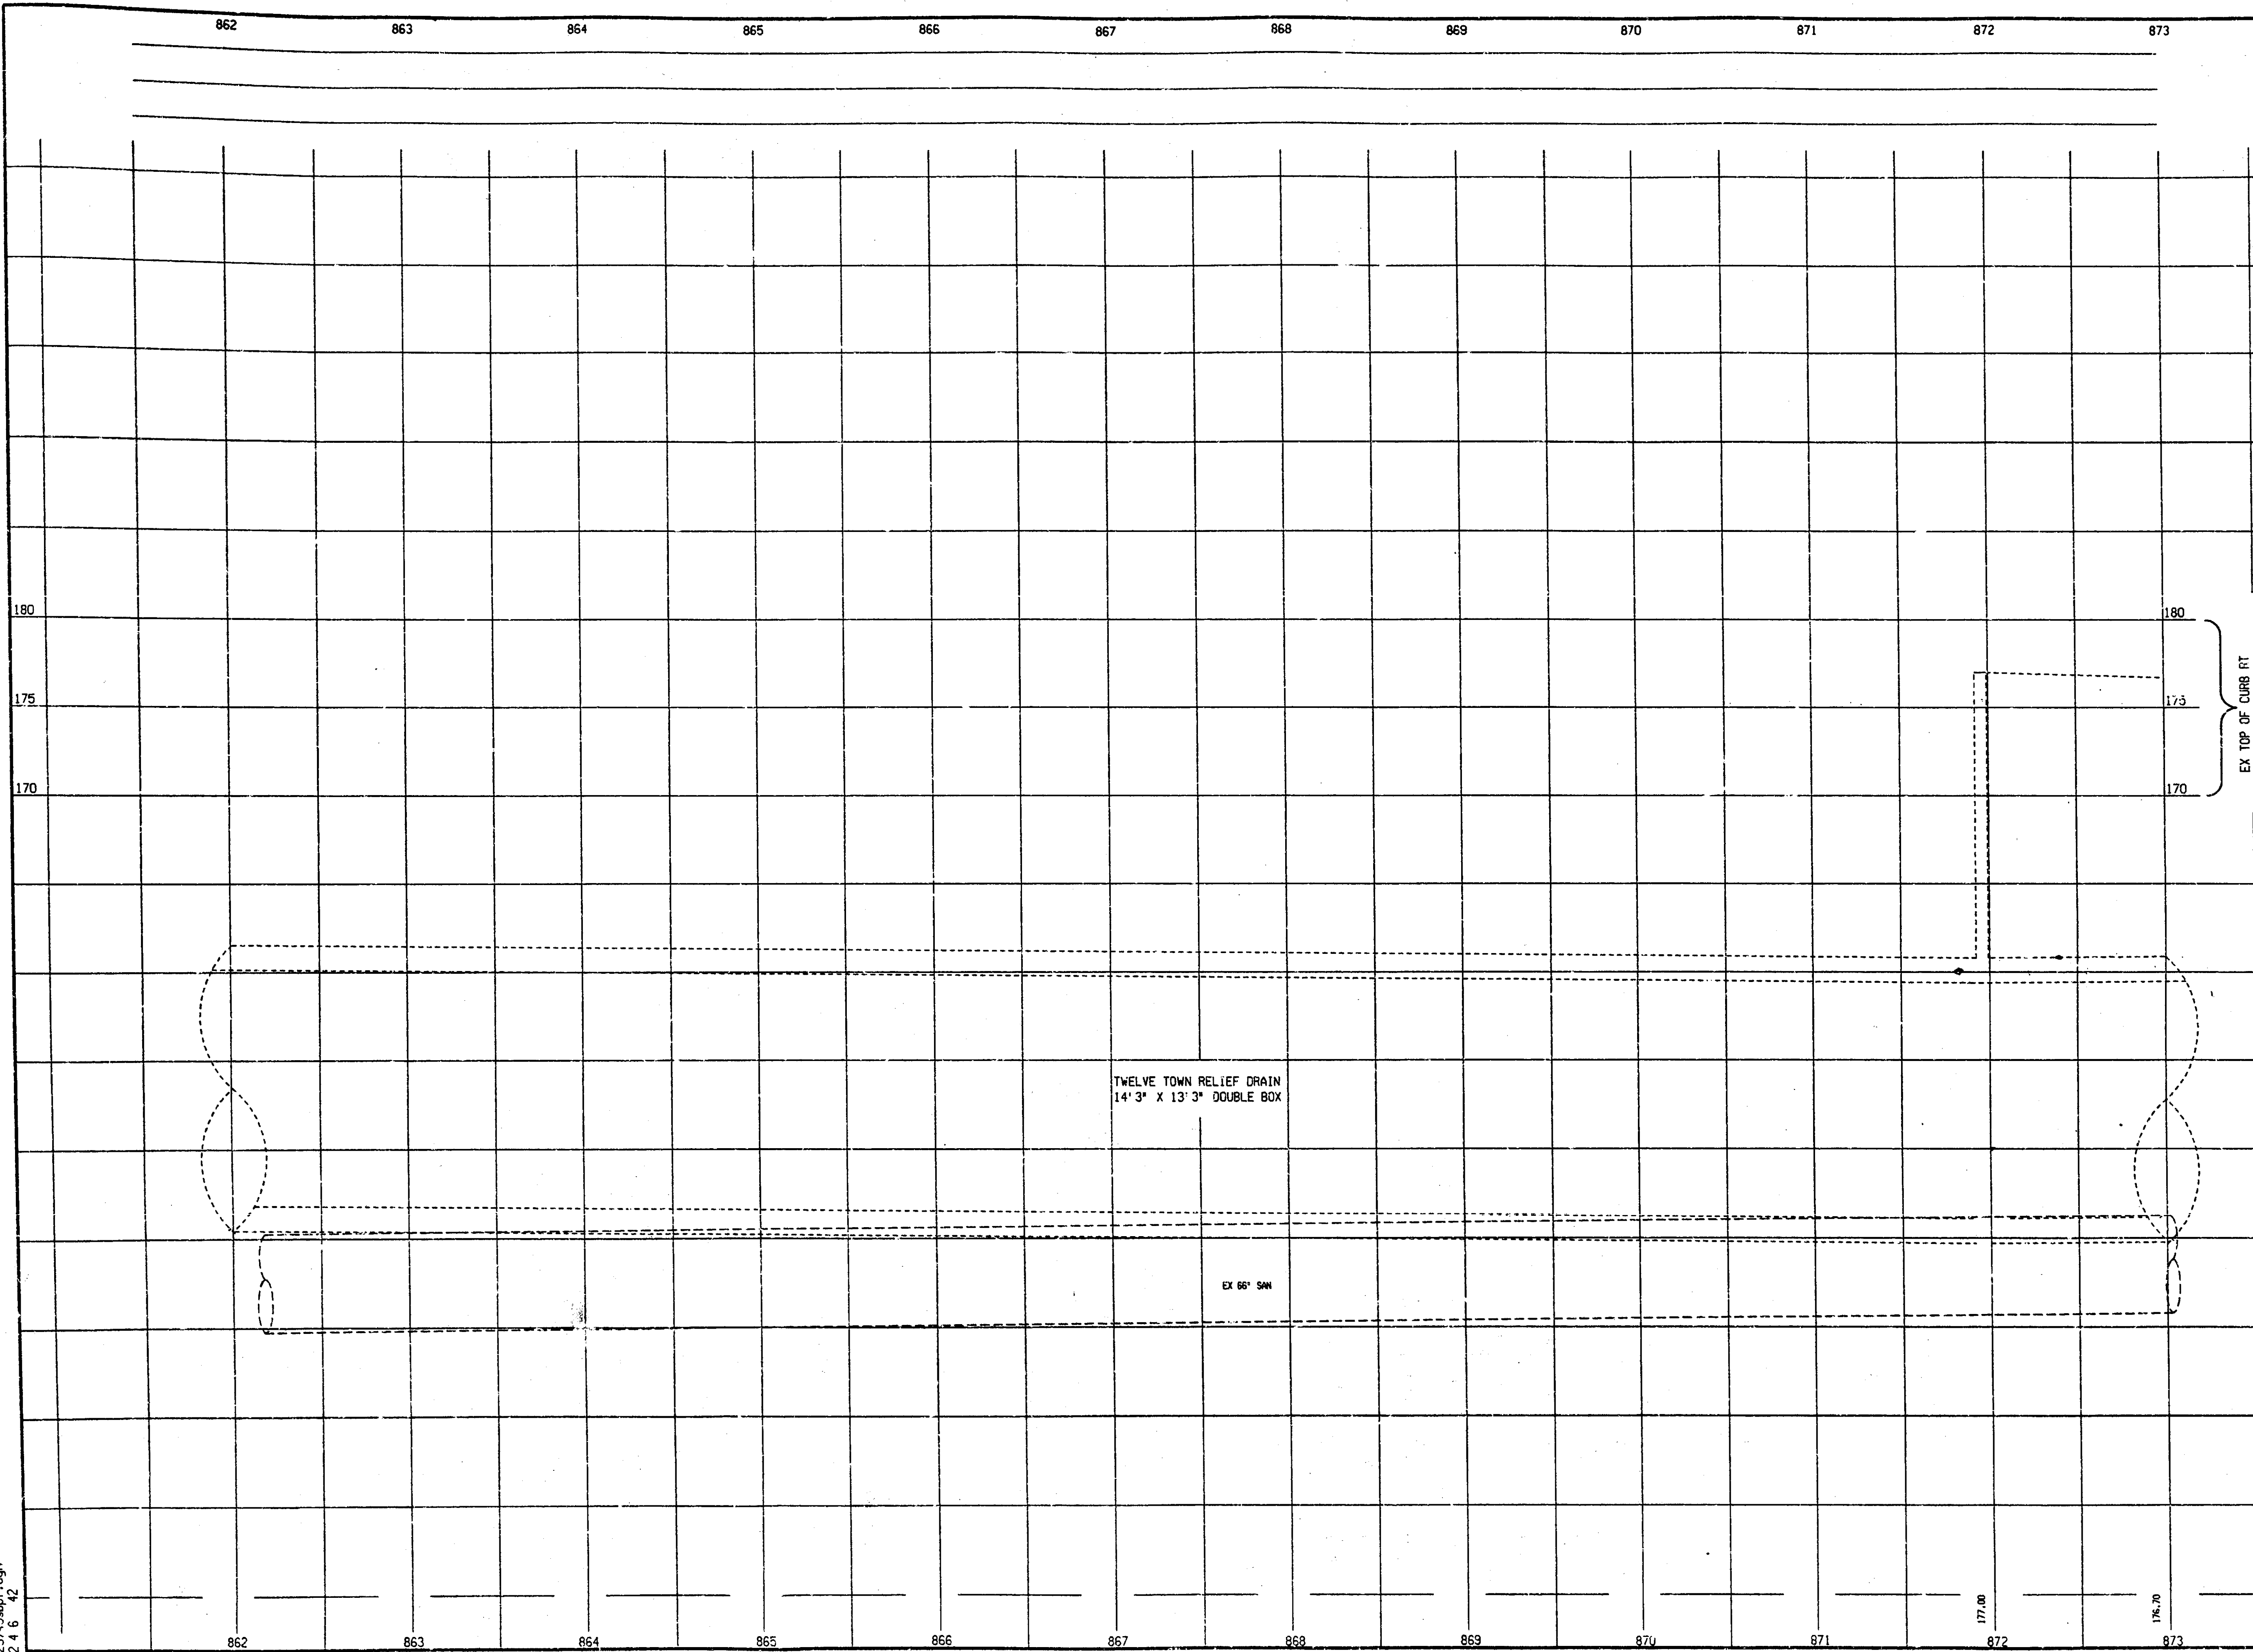

DATE	NO.	REVISION

S.B. SERVICE RD STA 862+00 TO STA 873+00
 DATE 07/12/96
 SCALE HORIZ. 1" = 40' VERT. 1" = 4'
 CONT. SEC. 63174
 JOB NO. 23749
 DESIGN UNIT PERMS



SHEET NO. R.O.W. CONST. 23

18787/96 ENGINEER'S PRINT

MACE RD

BAXTER RD

UNIVERSITY AVE

FINAL R.O.W.			
AUTH	DATE	NO.	REVISION

- QUANTITIES (WALL G)
- 546 LFT SOUNDWALL DRILLED SHAFTS-UNCASED 30" DIAM
 - 531 LFT REINFORCED TRENCHED FOOTINGS
 - 8367 SFT REINFORCED BLOCK WALL
 - 661 LFT CONC BASEWALL
 - 661 LFT LIMESTONE CAP

CITY OF ROYAL OAK


SBD SERVICE RD
 CURVE DATA
 $\Delta=11^{\circ}35'11''$ RT
 $D=02^{\circ}00'00''$
 $R=2864.79'$
 $T=292.33'$
 $L=582.65'$
 $E=14.88'$
 $PC=876+23.25$
 $PI=879+15.58$
 $PT=882+05.90$

I-75 MEDIAN &
 CURVE DATA
 $\Delta=11^{\circ}25'10''$ RT
 $D=01^{\circ}40'00''$
 $R=3437.75'$
 $T=343.72'$
 $L=685.17'$
 $E=17.14'$
 $PC=875+69.33$
 $PI=879+13.05$
 $PT=882+54.50$

- PLACE 6-BAY ATTENUATOR
- 1 EACH G.R.E.A.T. ATTENUATOR (6-BAY WIDE), FURN
 - 1 EACH INSTALL IMPACT ATTENUATOR
 - 2 EACH EPOXY ANCHORED BOLT, 3/4"
 - 200 LFT REM CURB AND GUTTER
 - 200 LFT CONC VALLEY GUTTER
 - 10 SYD MISC CONC PAVT - NONREINF 8"

REM & REPLACE GUARDRAIL AND ANCHOR TO CONC BASEWALL

- 350 LFT RLW BEAM GUARDRAIL
- 100 LFT GALV BEAM GUARDRAIL, TYPE B
- 1 EACH GUARDRAIL ANCH - CABLE - DEPARTING END
- 1 EACH GUARDRAIL ANCH - BRIDGE, DET T-2

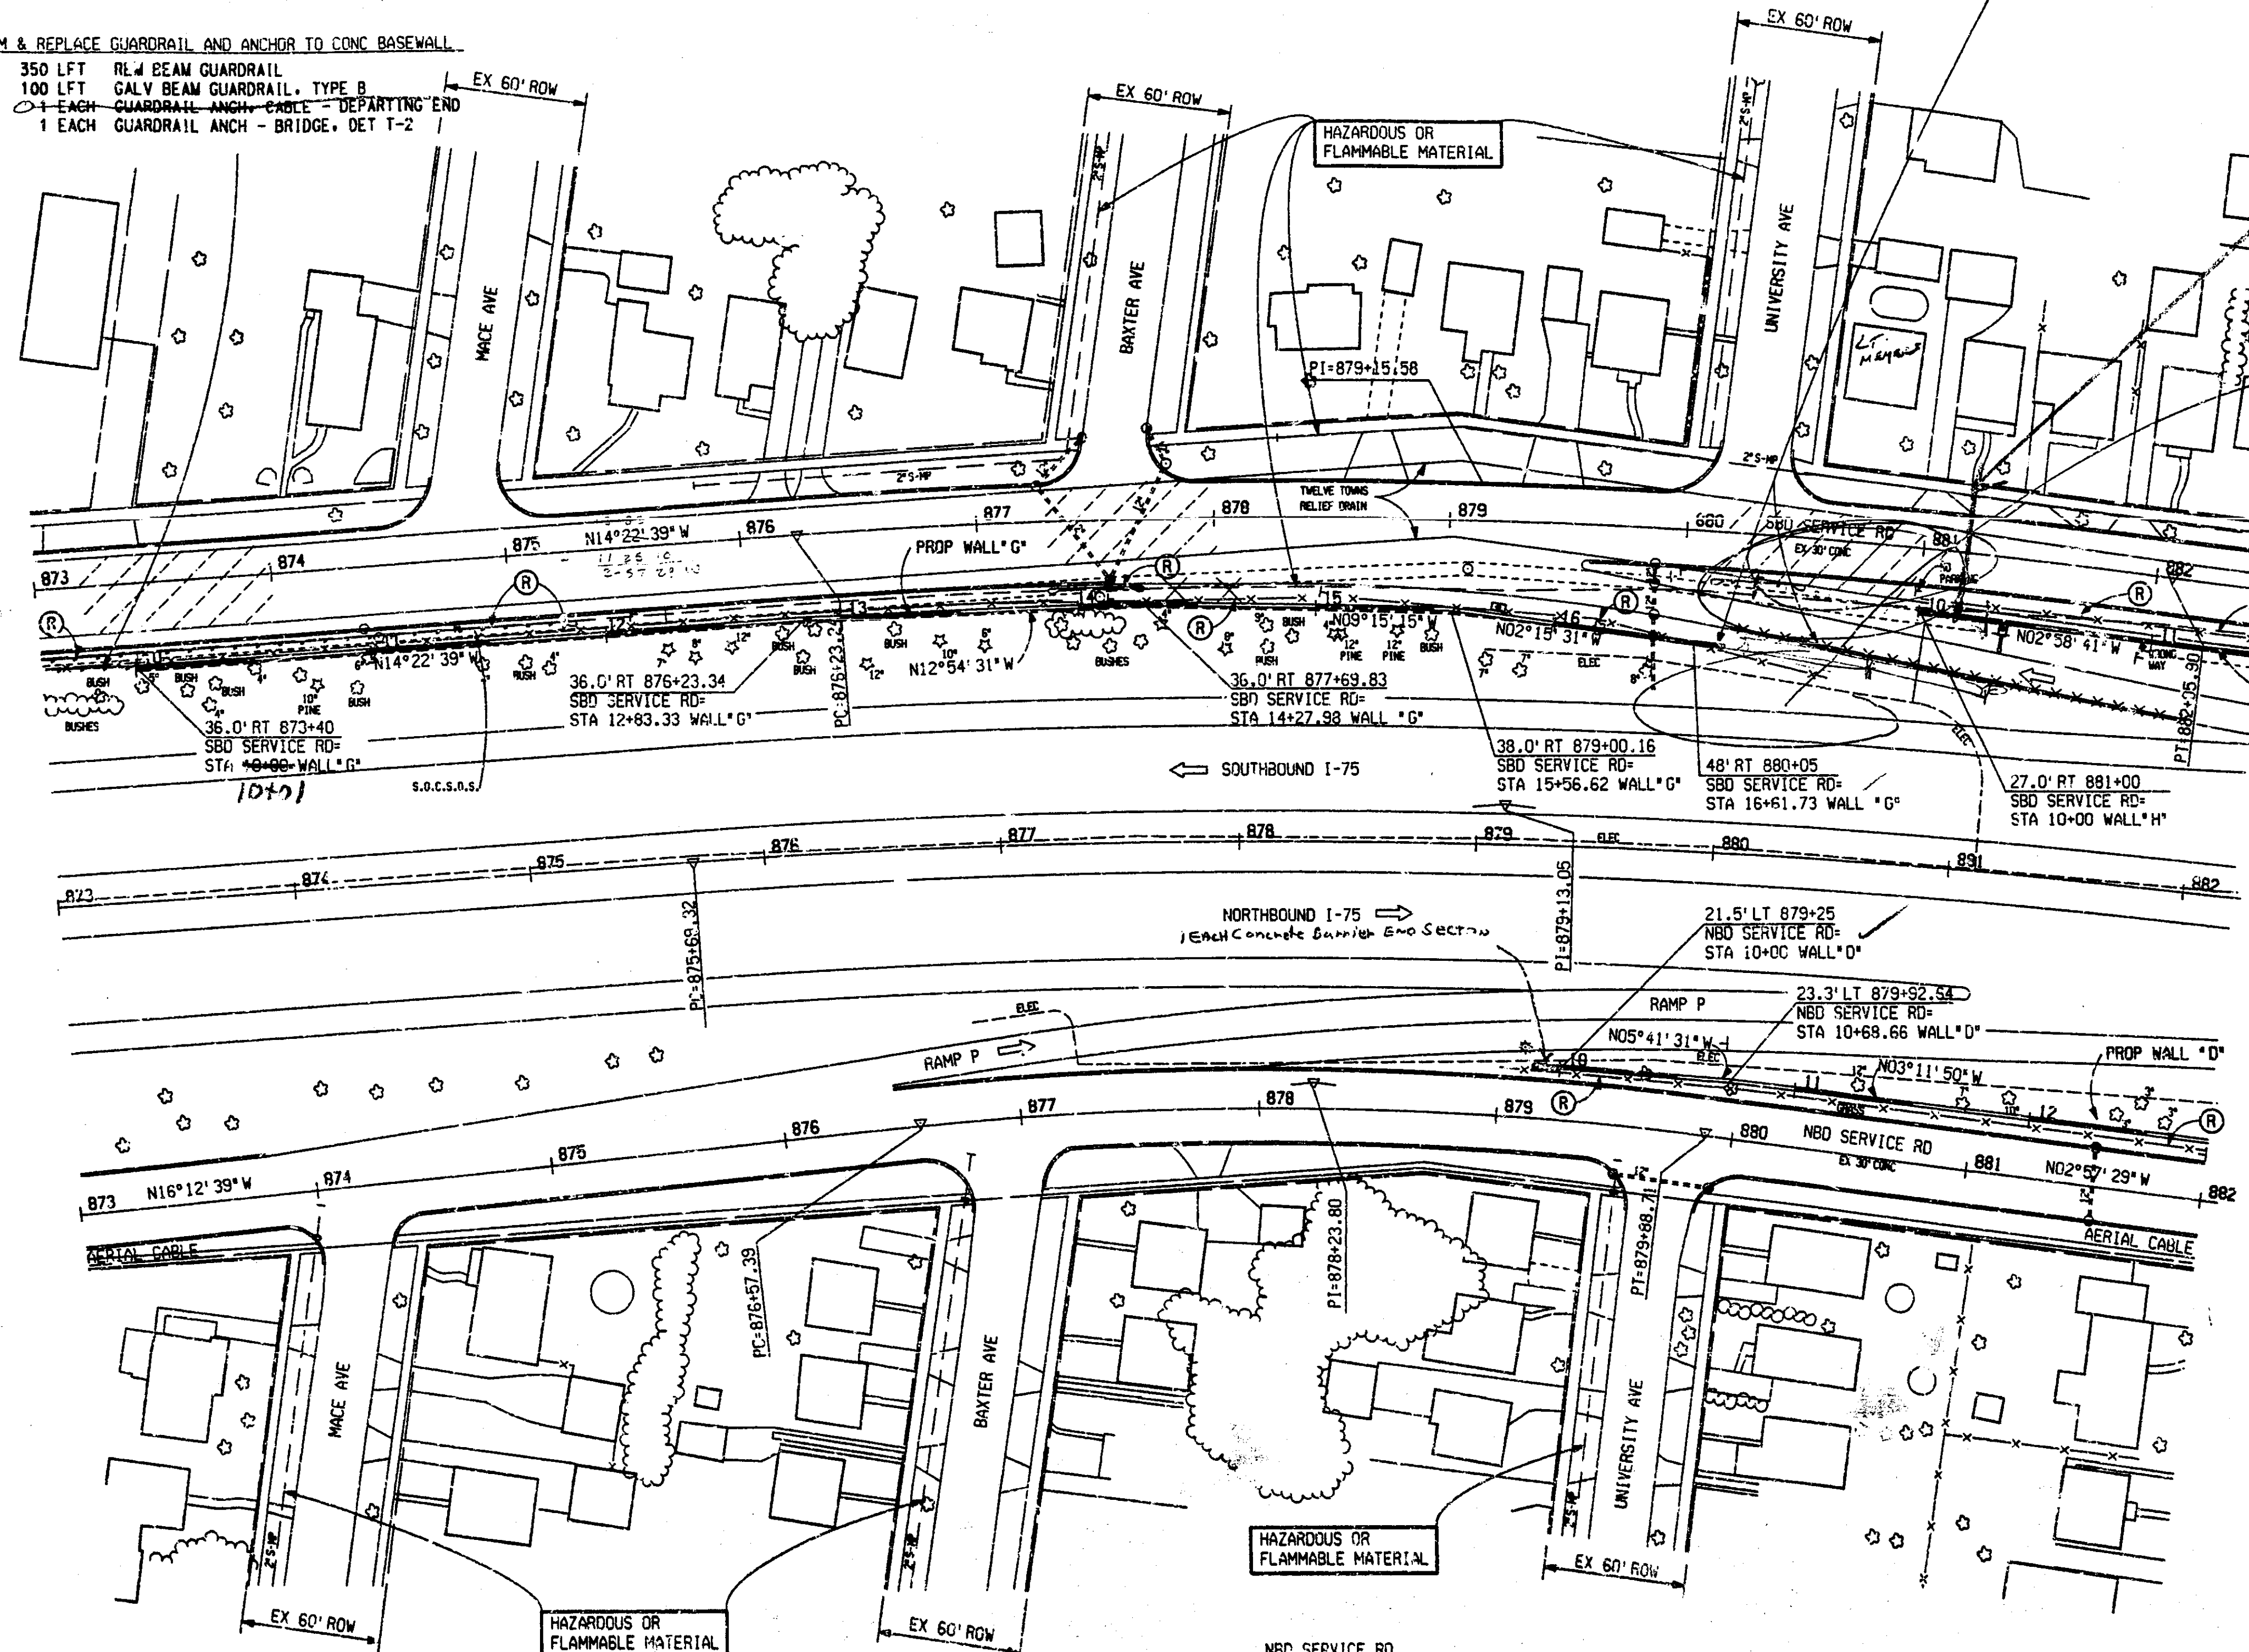

WALL H ends
 at Sta 881+37 SBD S.D.
 Sta 10+57 WALL H
 as per Traffic Safety
 for Sight Distance

Prop trees
 shows
 in this
 area

FOR QUANTITIES ON WALL H
 SEE SHEET #27


FOR QUANTITIES ON WALL D
 SEE SHEET #27

QUANTITIES
 1090 LFT REM FENCE
 33 LFT REM BEAM GUARDRAIL

CITY OF MADISON HEIGHTS

NBD SERVICE RD
 CURVE DATA
 $\Delta=13^{\circ}15'10''$ RT
 $D=04^{\circ}00'00''$
 $R=1432.40'$
 $T=166.40'$
 $L=331.32'$
 $E=9.63'$
 $PC=876+57.40$
 $PI=878+23.80$
 $PT=879+88.72$

CONSTRUCTION SHEET

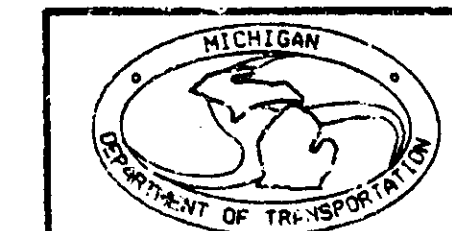


I-75 STA 873+00 TO STA 882+00					
DATE	SCALE	CONT. SEC.	JOB NO.	DESIGN UNIT	SHEET NO.
08/26/96	1" = 40'	631.74	23749	PENA	R.O.W CONST. 24

DATE: 08/26/96
 EXISTING BY: FELSING'S UNIT
 PROPOSED BY: DAVID
 LAST CORRECTION BY: DAVID
 FILE NAME: 23749873.DWG
 1 2 3 4 5 6 7 8 9 10 11 12 13 14 15 16 17 18 19 21 22 23 24 25 26 27 28 29 33 34 35
 CONSTRUCTION AS PER PLANS, APRIL 1999

1078796 Engineering Print

CONSTRUCTED AS PER PLANS APRIL 1999

23749BPF.DGN
1 3 7

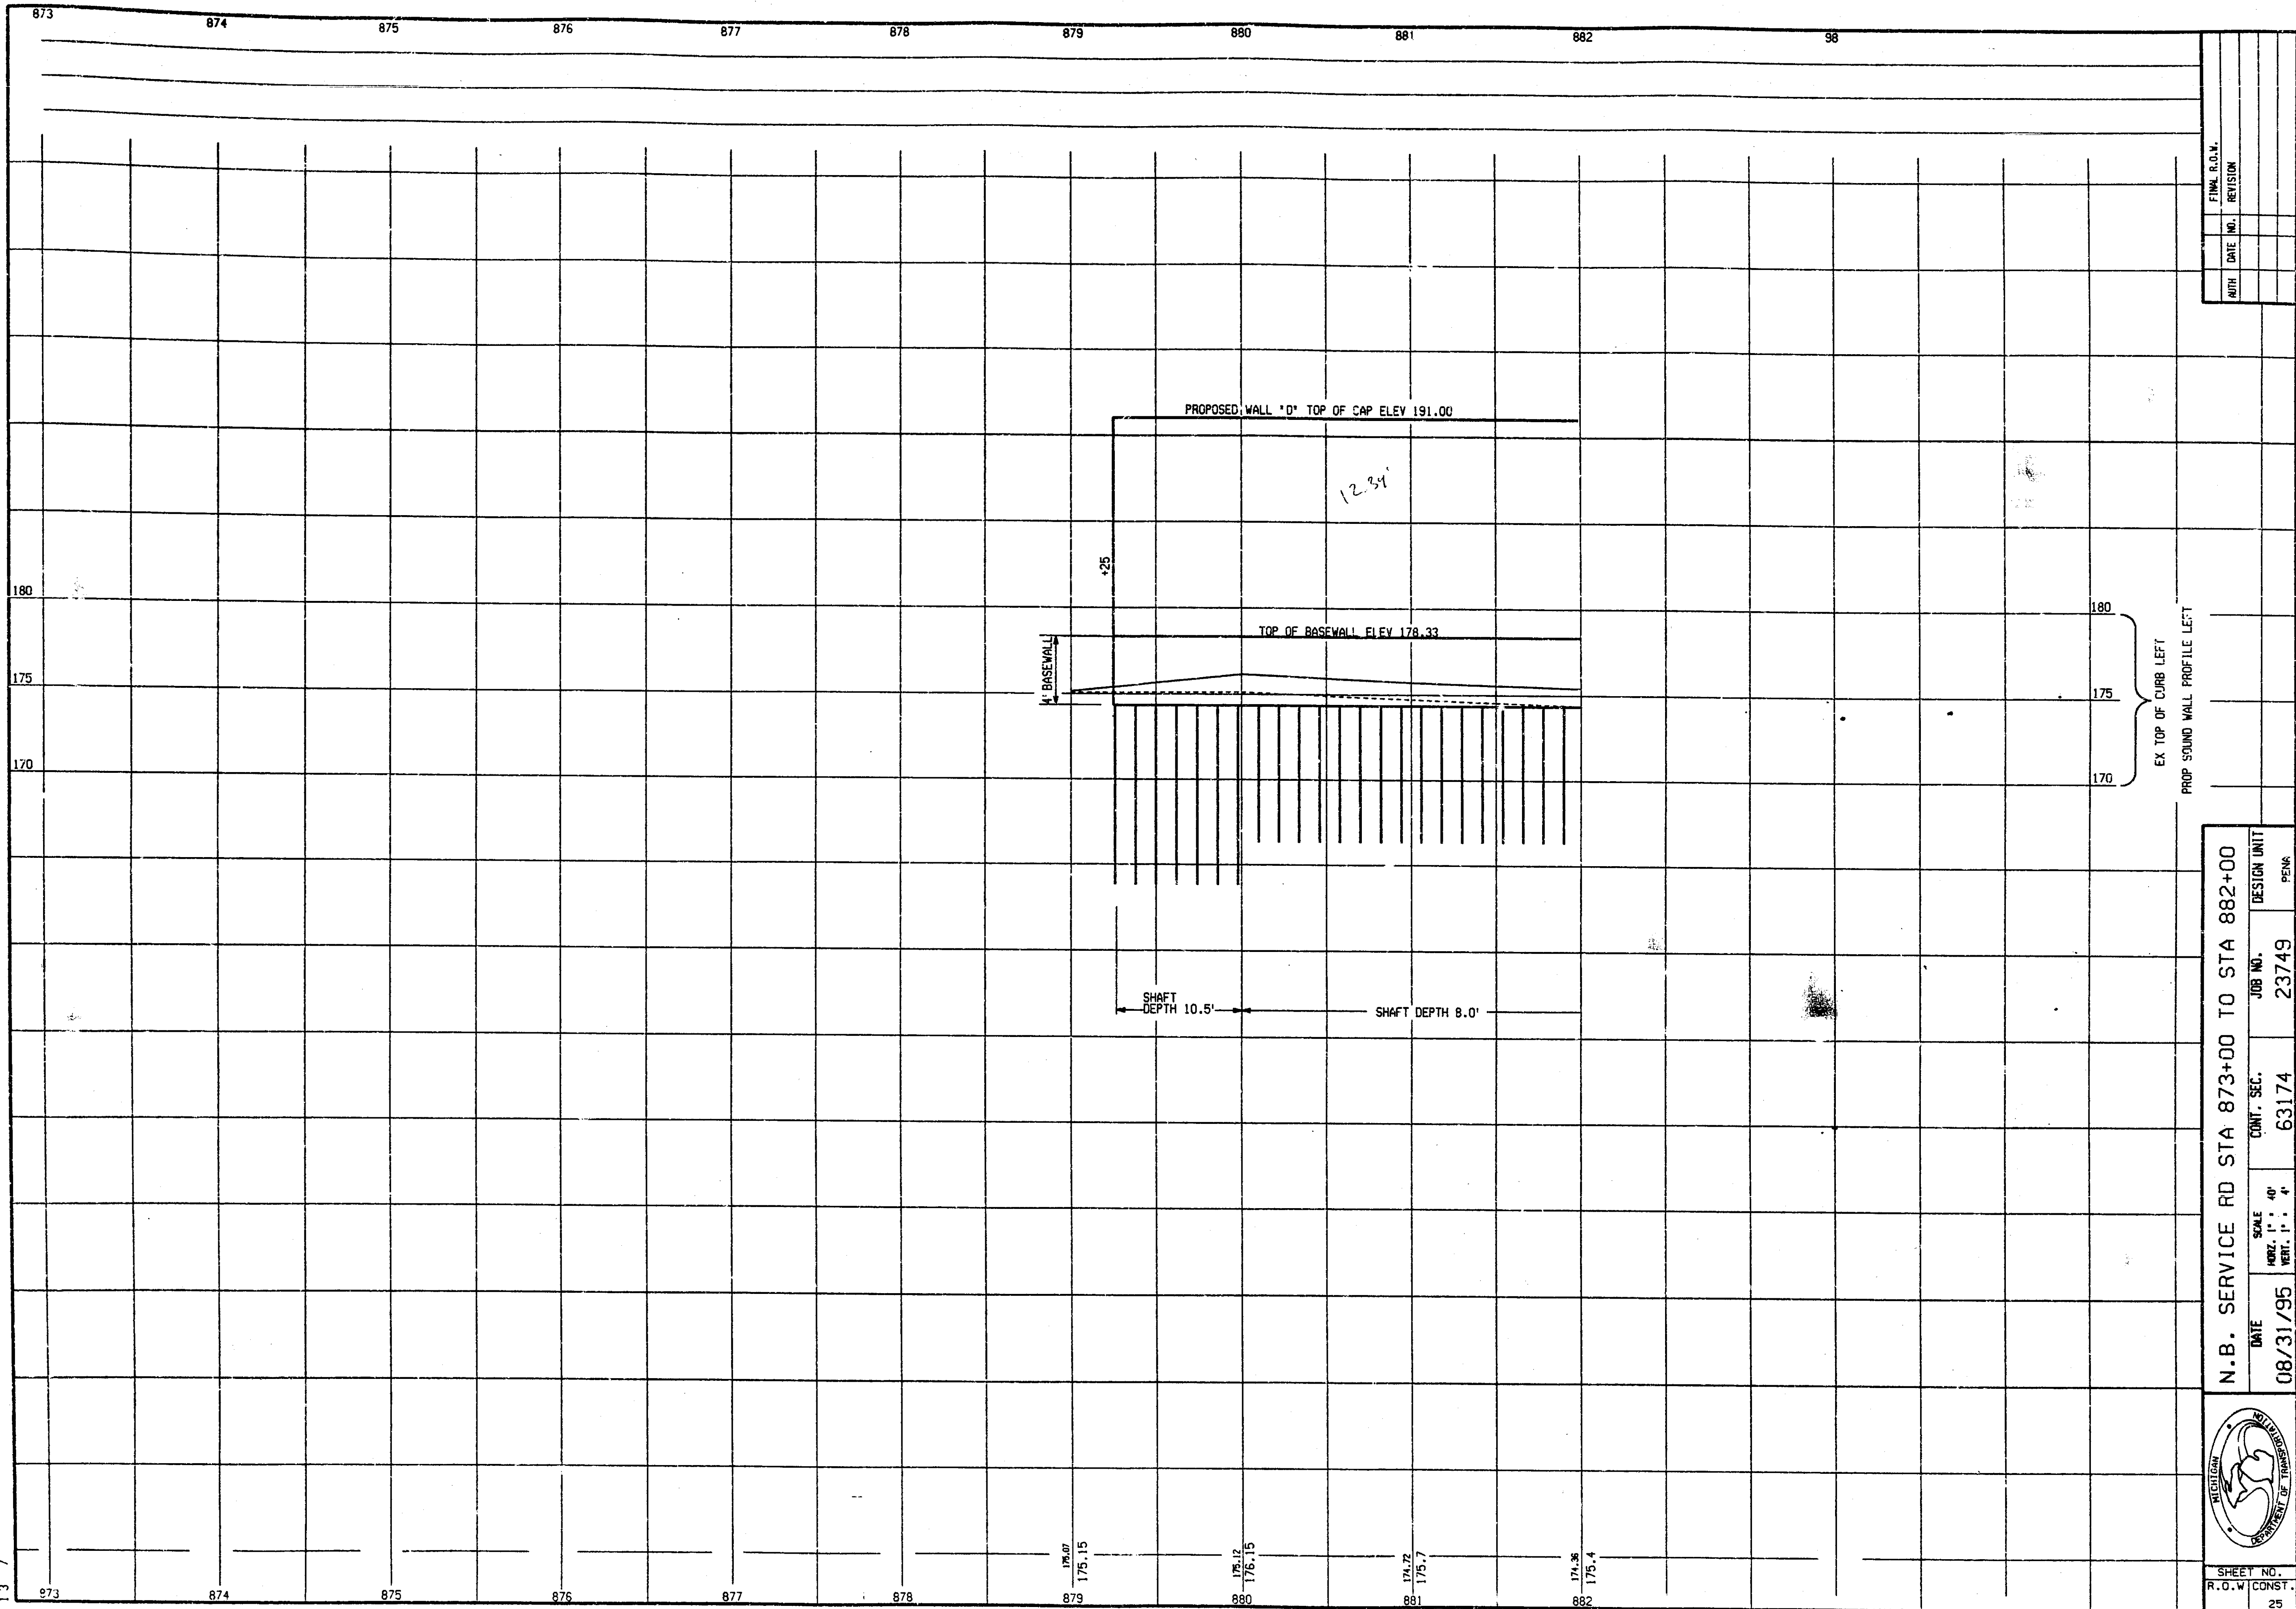

DATE	NO.	REVISION

N.B. SERVICE RD STA 873+00 TO STA 882+00			
DATE	SCALE	CNT. SEC.	JOB NO.
08/31/95	HORIZ. 1" = 40' VERT. 1" = 4'	63174	23749
DESIGN UNIT		PENK	




SHEET NO.
R.O.W. CONST.
25

10/07/96 Engineering Print

CONSTRUCTED AS PER PLANS APRIL 1999

237495BPF.DGN
1-3
41

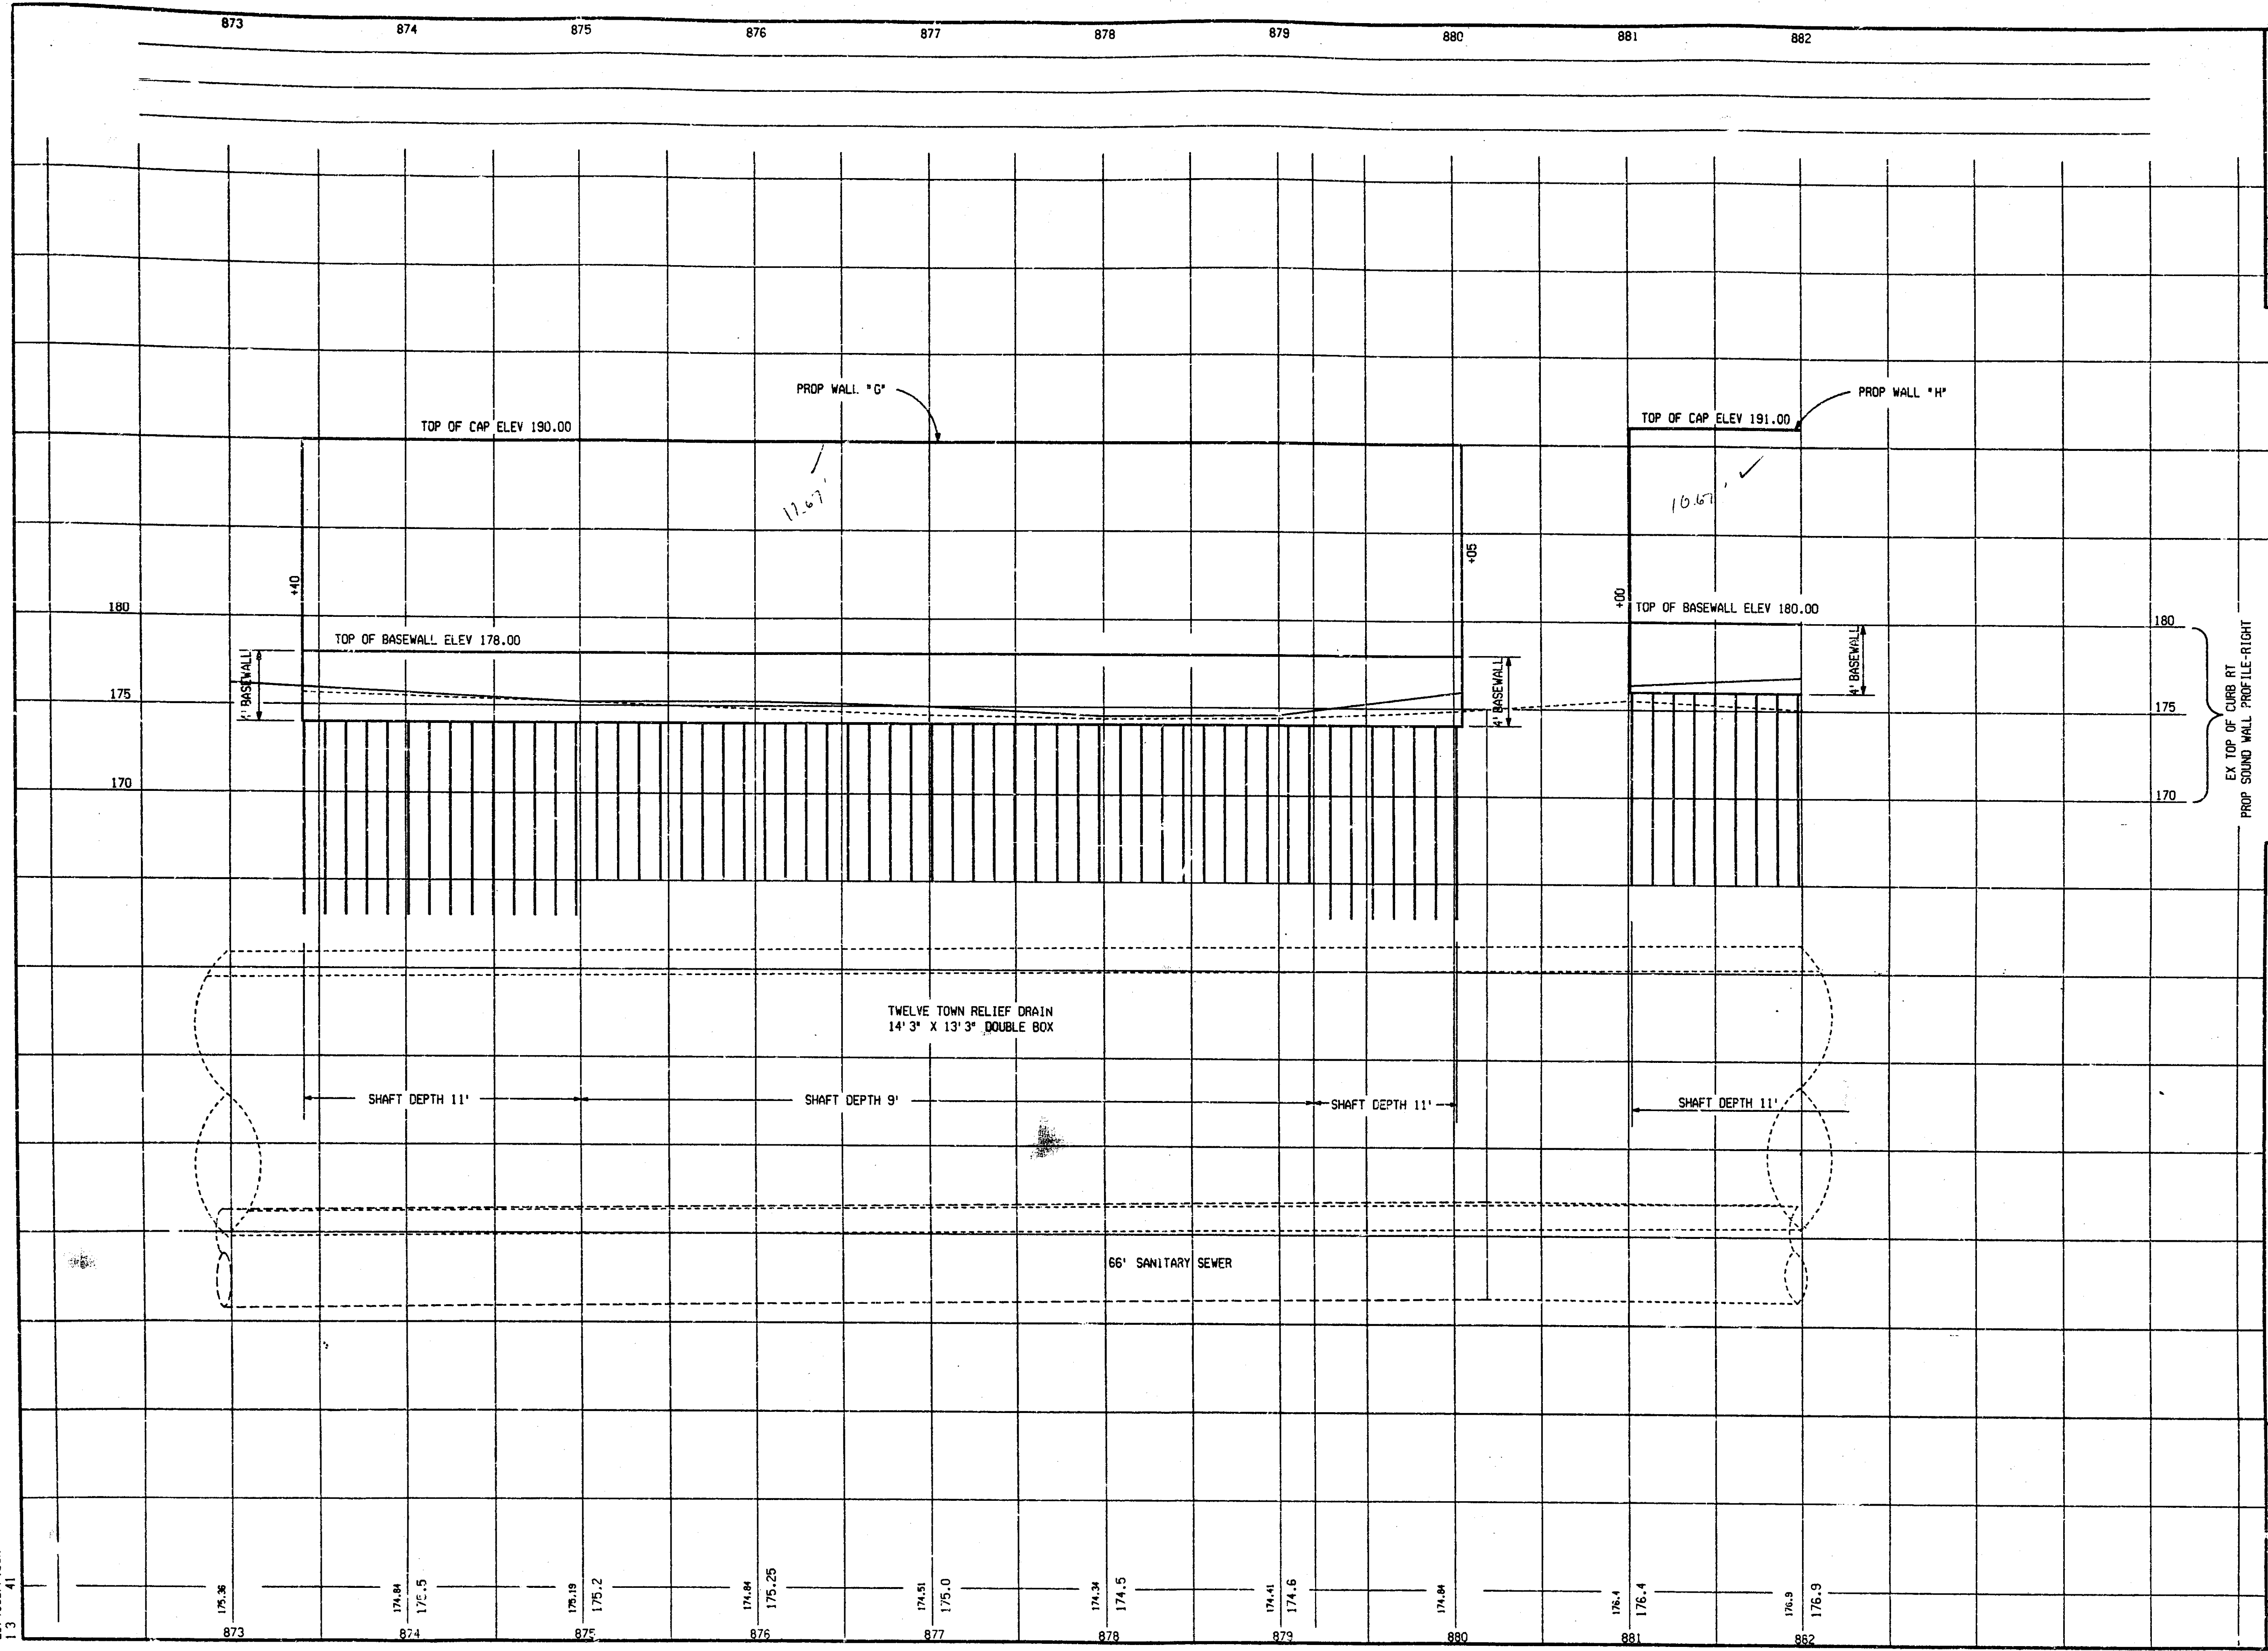

FINAL R.O.W.	
REVISION	
AUTH	
DATE	
NO.	

18787786 ENGINEERING PRINT

S.B. SERVICE RD STA 873+00 TO STA 882+00	
DATE	07/12/96
SCALE	HORIZ. 1" = 40'
VERT. 1" = 4'	
CONT. SEC.	63174
JOB NO.	23749
DESIGN UNIT	PENA


 SHEET NO.
 R.O.W. CONST.
 26

SPRAGUE AVE

FARNUM AVE

FINAL R.O.W.		
AUTH	DATE	REVISION

STATION RELATION SBD SERVICE RD
 STA 883+03.18 BACK =
 STA 102+71.97 AHEAD


SBD SERVICE RD
 CURVE DATA
 $\Delta = 00^{\circ}13'13''$ LT
 NO CURVE

QUANTITIES (WALL H)

1493 LFT SOUNDWALL DRILLED SHAFTS-UNCASED 30" DIAM
 1556 LFT REINFORCED TRENCHED FOOTINGS
 26496 SF REINFORCED BLOCK WALL
 1870 LFT CONC BASEWALL
 1870 LFT LIMESTONE CAP

STATION RELATION MEDIAN
 STA 882+74.77 BACK =
 STA 882+81.58 AHEAD

CITY OF ROYAL OAK

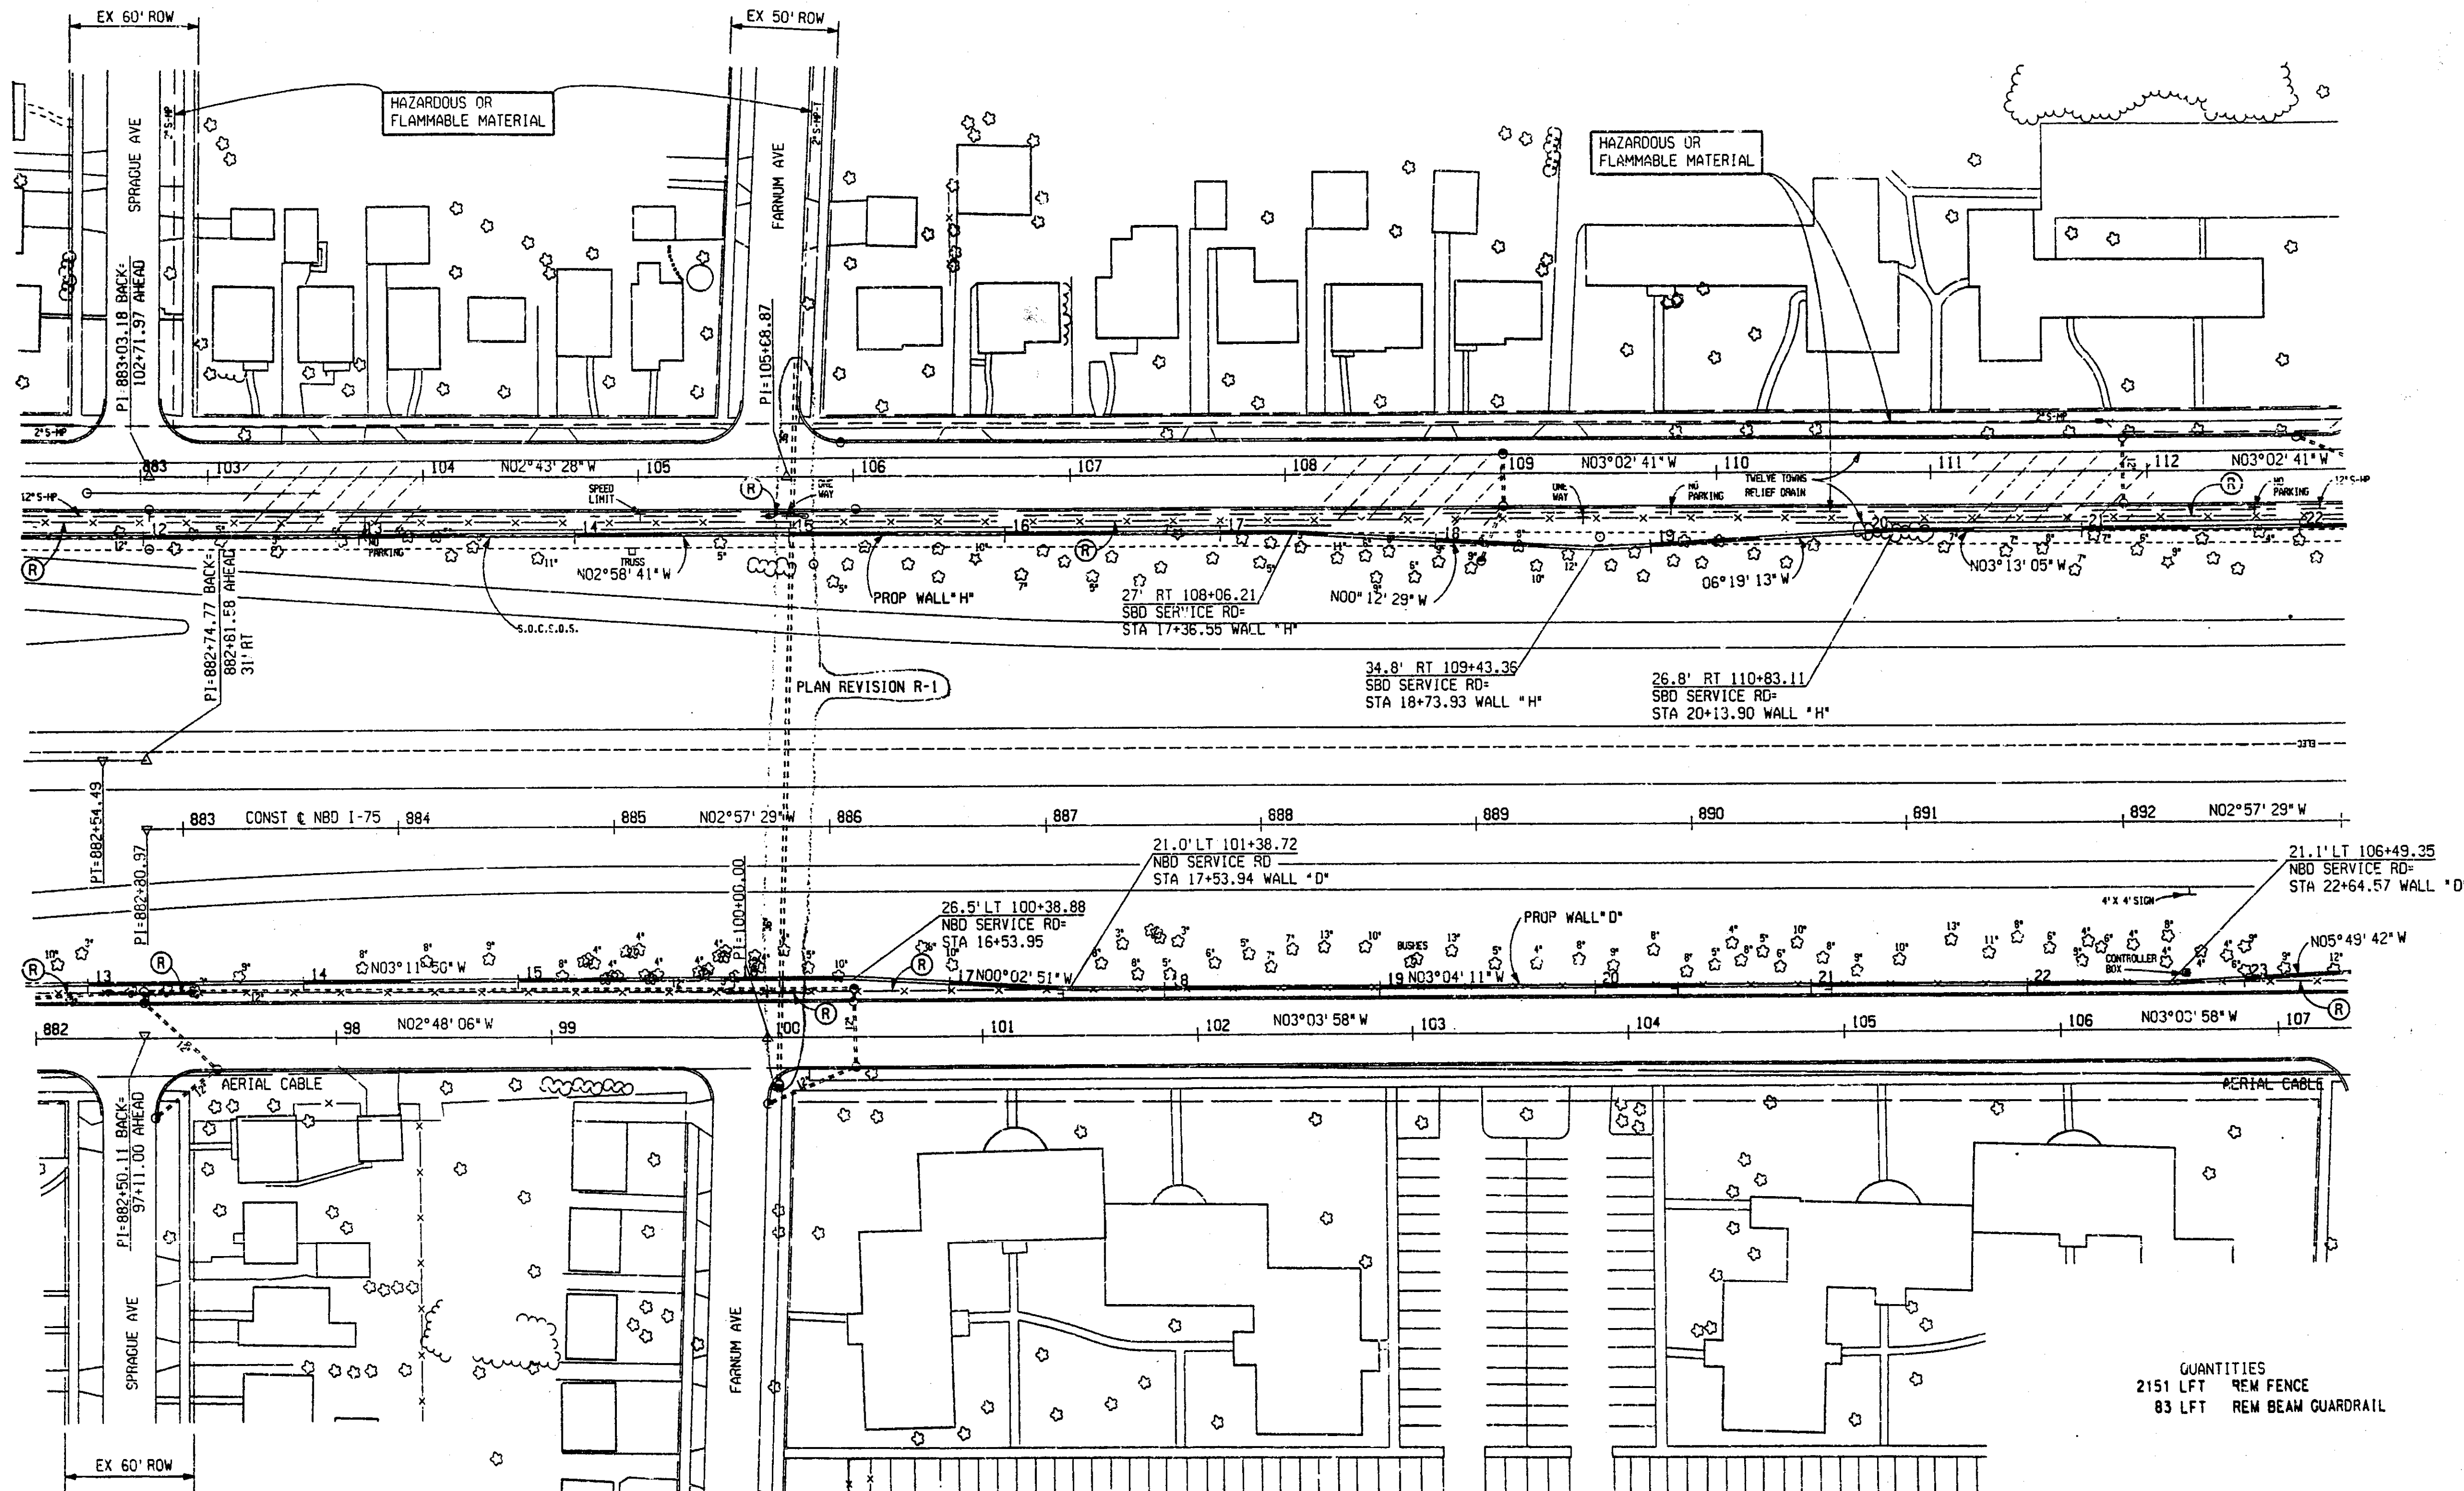

STATION RELATION NBD SERVICE RD
 STA 882+50.11 BACK =
 STA 97+11.00 AHEAD


NBD SERVICE RD
 CURVE DATA
 $\Delta = 00^{\circ}09'23''$ RT
 PI = 882+50.11 BACK
 = 97+11.00 AHEAD
 NO CURVE

NBD SERVICE RD
 CURVE DATA
 $\Delta = 00^{\circ}15'52''$ LT
 PI = 100+00.00
 NO CURVE

QUANTITIES (WALL D)
 1305 LFT SOUNDWALL DRILLED SHAFTS-UNCASED 30" DIAM
 1554 LFT REINFORCED TRENCHED FOOTINGS
 24238 SF REINFORCED BLOCK WALL
 1866 LFT CONC BASEWALL
 1866 LFT LIMESTONE CAP
 2,433 SF Concrete sidewalk

QUANTITIES
 2151 LFT REM FENCE
 83 LFT REM BEAM GUARDRAIL

PLAN REVISION R-1
 CONSTRUCTION SHEET

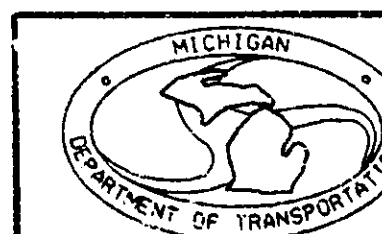

I-75 STA 882+00 TO STA 893+00

DATE	SCALE	CONT. SEC.	JOB NO.	DESIGN UNIT	SHEET NO.	R.O.W. CONST.
11/22/96	1" = 40'	63174	23749	PENA	27	

SECTION 63174
 NO. 27


EXISTING BY: FELSING'S UNIT
 PROPOSED BY: DAVID
 LAST CORRECTION BY: DAVID

CONSTRUCTION PERMITS - APRIL 1999

FILE NAME: 23749882.DWG
 1 2 3 4 5 6 7 8 9 10 11 12 13 14 15 16 17 18 19 21 22 23 24 25 26 27 28 29 30 33 34 35

CONSTRUCTED AS PER PLANS APRIL 1999


2374NBPF.DGN
2 4

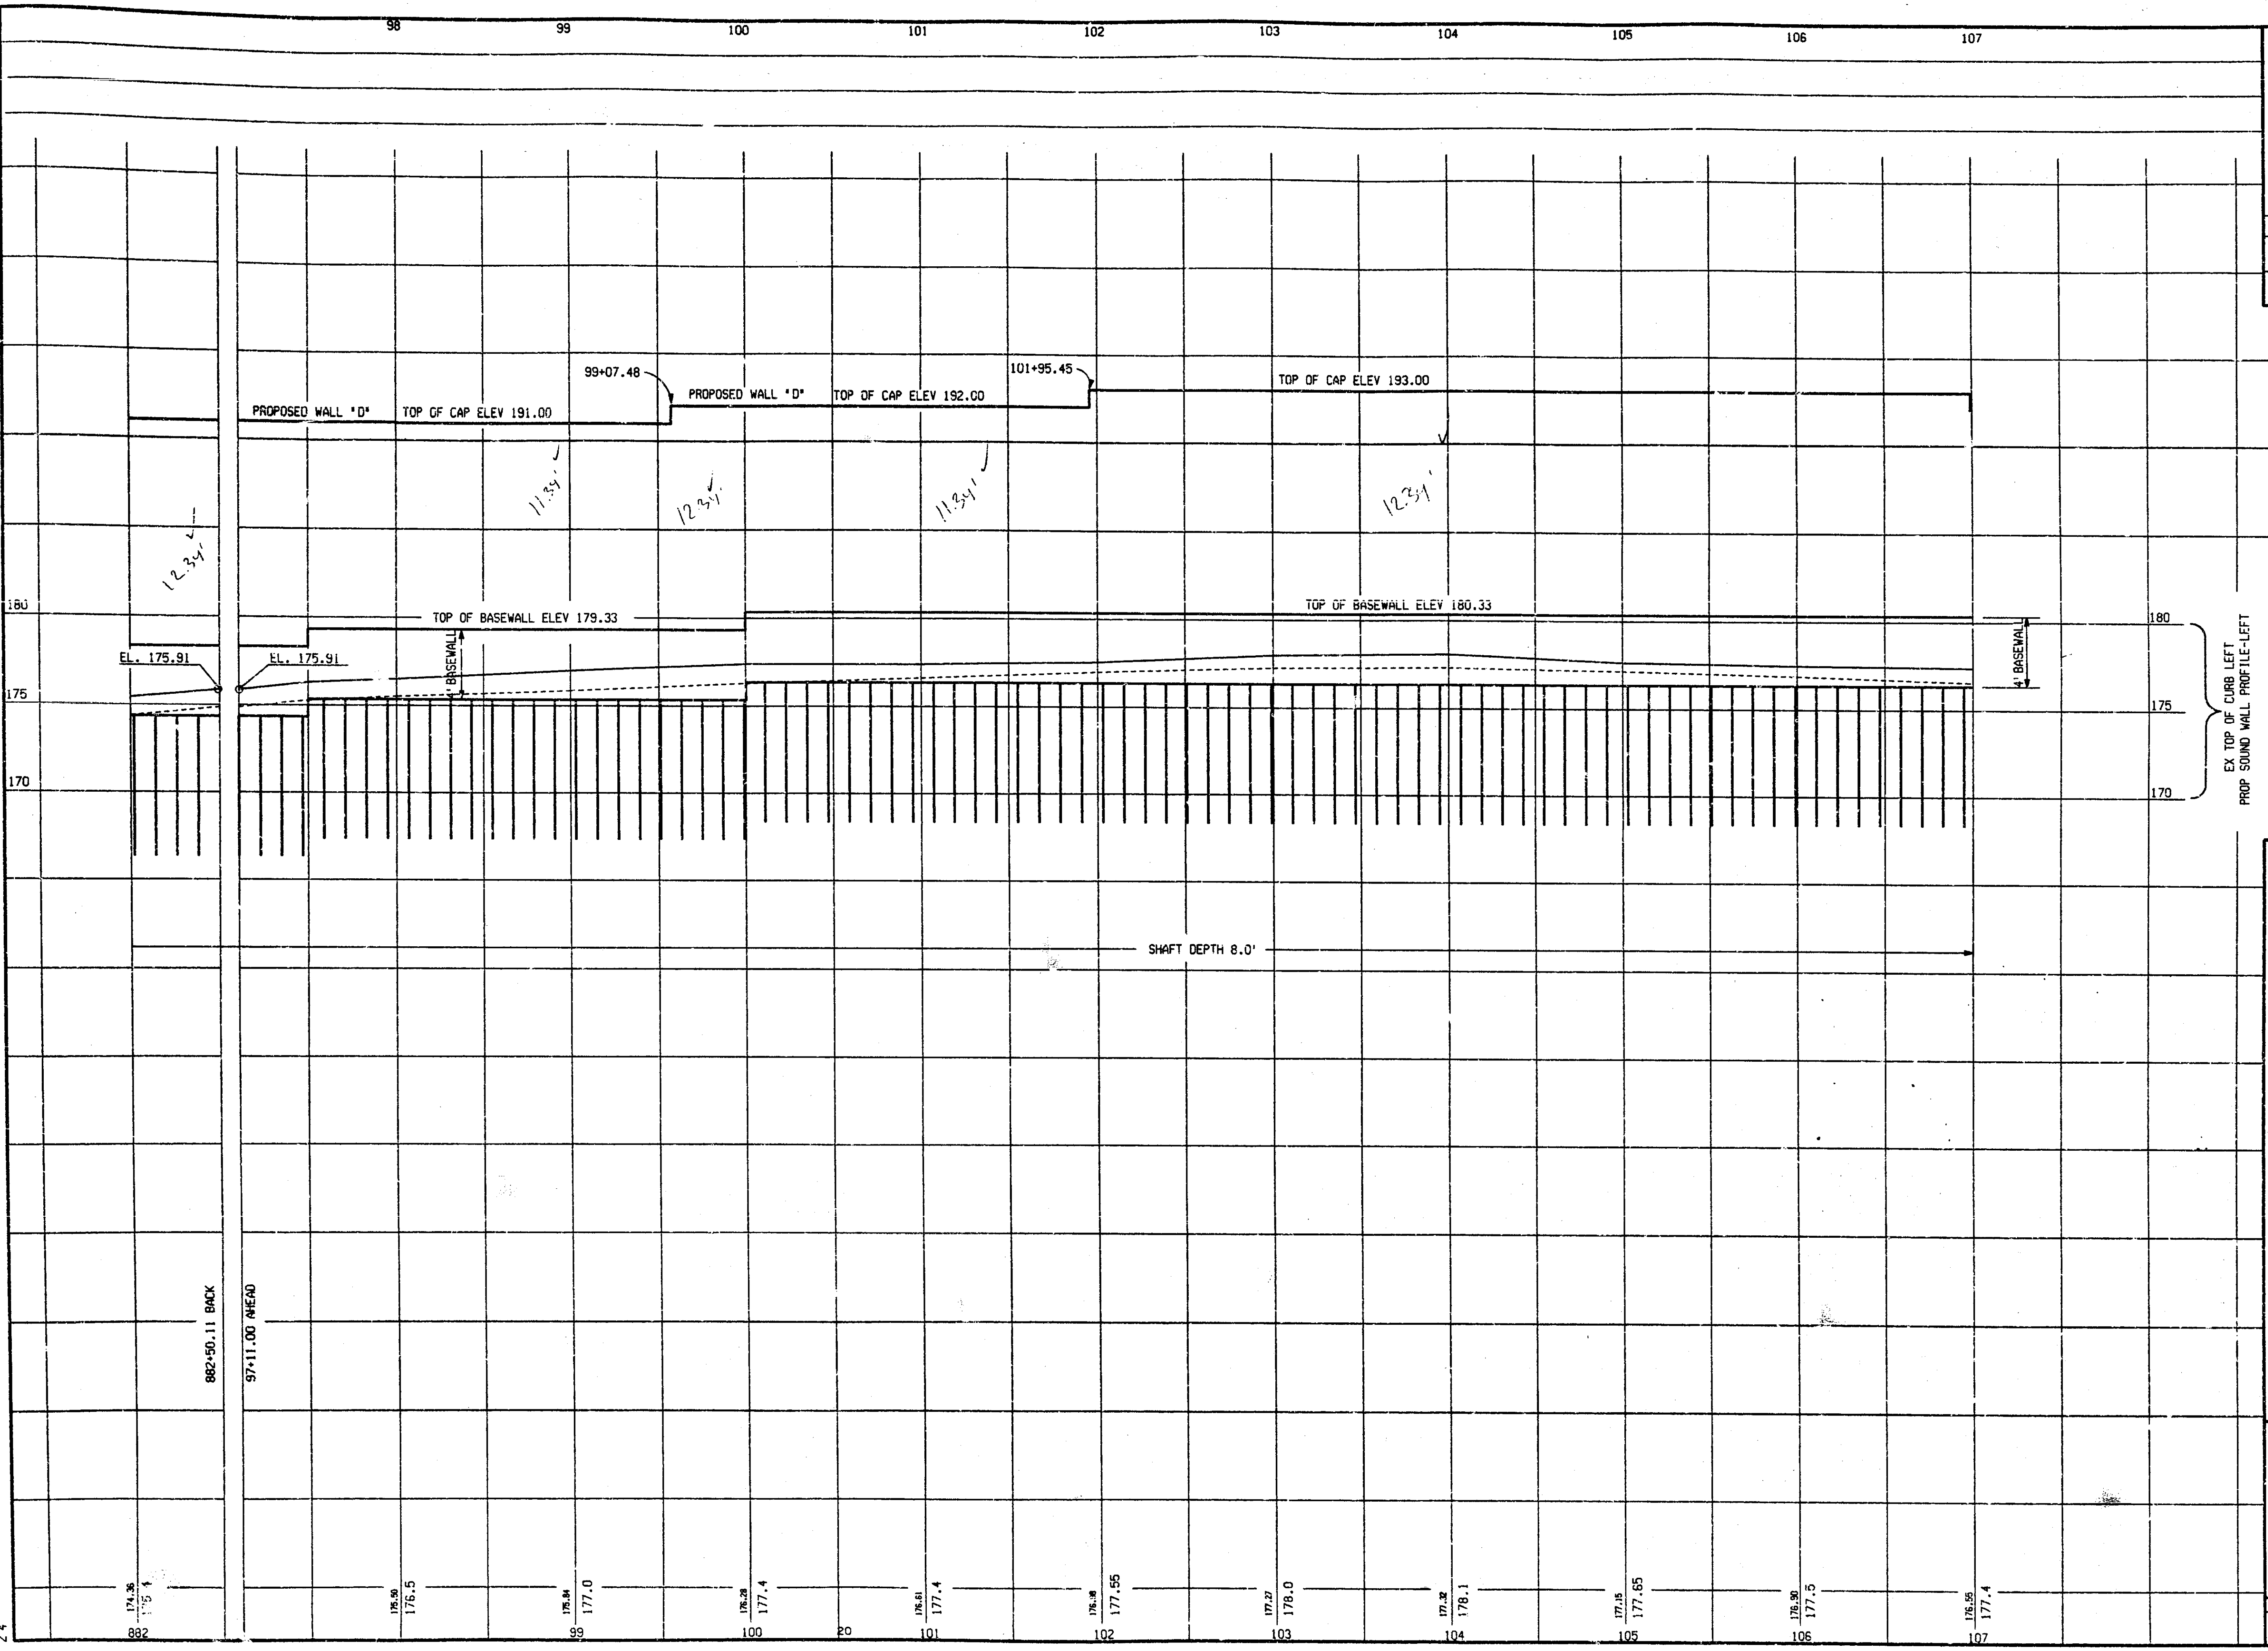

REV.	DATE	REVISION

N.B. SERVICE RD STA 882+00 TO STA 107+00


DATE: 07/11/96
 SCALE: HORIZ. 1" = 40' VERT. 1" = 4'
 CONT. SEC. 63174
 JOB NO. 23749
 DESIGN UNIT: PENS.

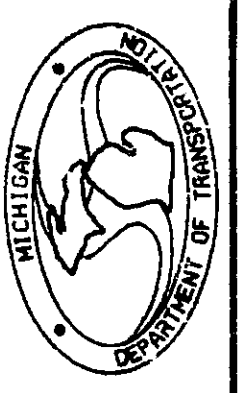

SHEET NO. 28
 P.O.W. CONST.

18787796 ENGINEERING FIRM

CONSTRUCTED AS PER PLANS APRIL 1999

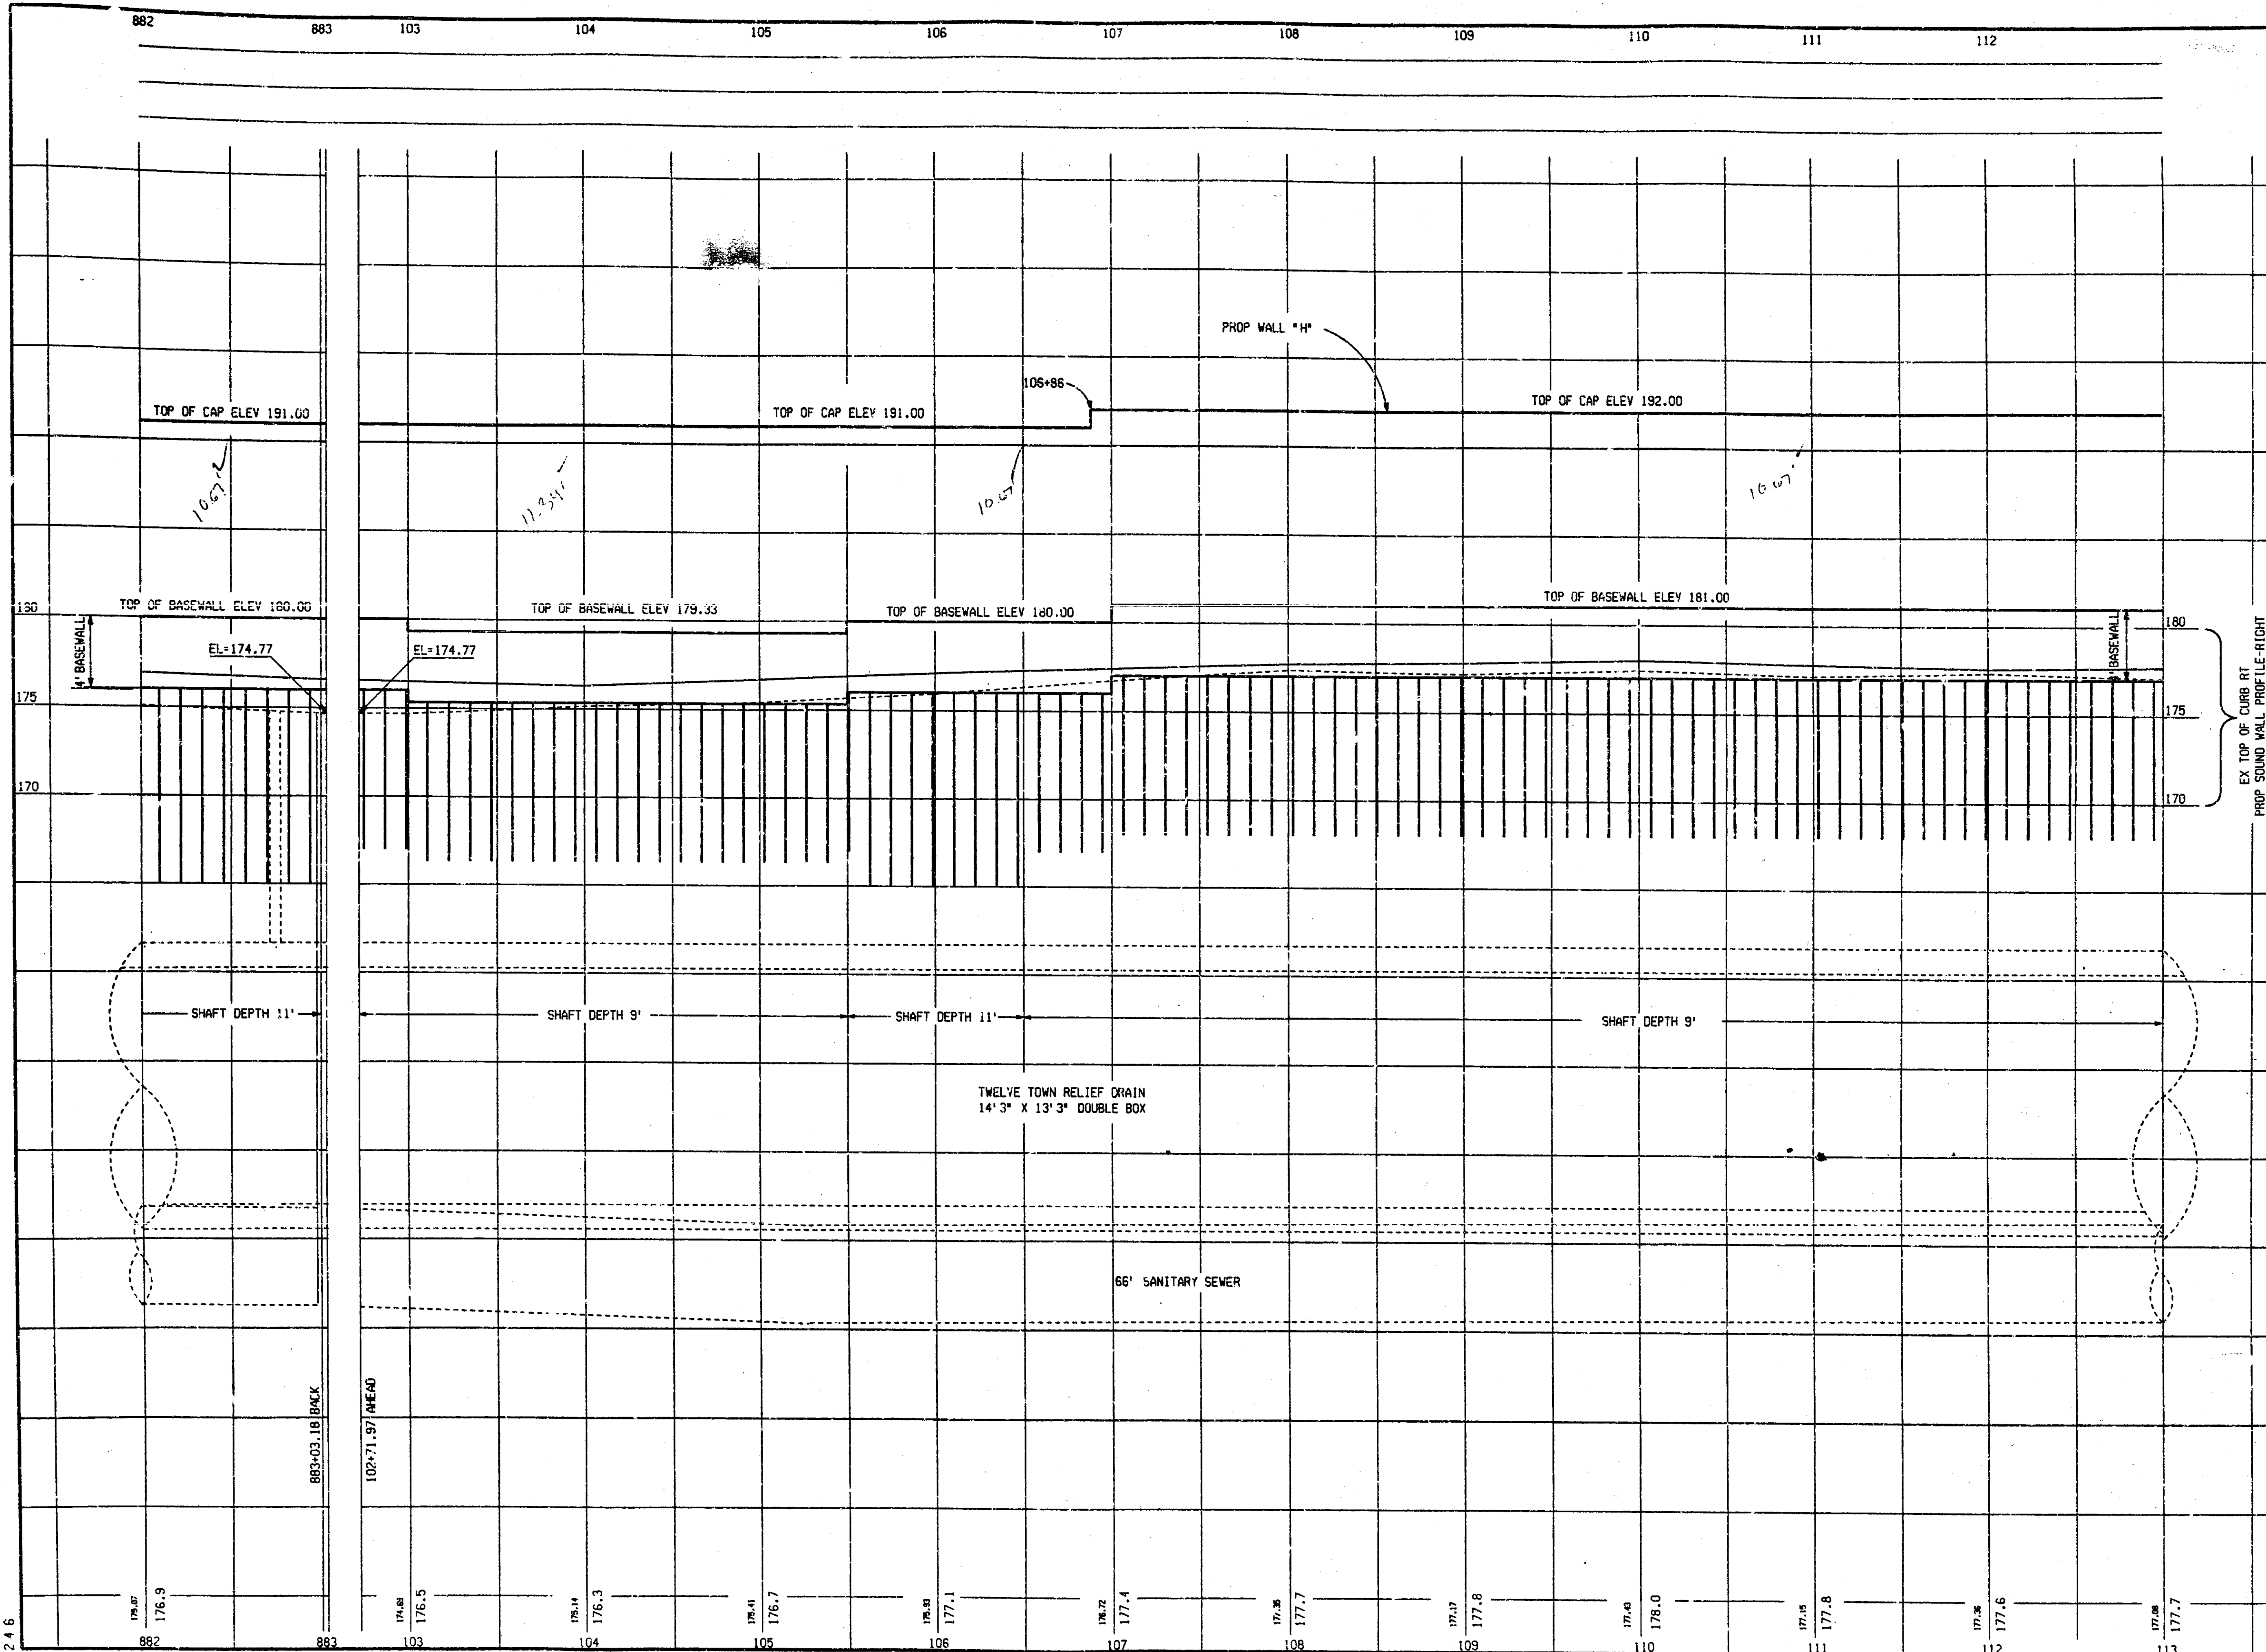

REVISED	DATE	BY

S.B. SERVICE RD STA 882+00 TO STA 112+00	
DATE	07/12/96
SCALE	HORIZ. 1" = 40' VERT. 1" = 4'
CONT. SEC.	63174
JOB NO.	23749
DESIGN UNIT	PENNA



SHEET NO.	29
R.O.W. CONST.	

10787796 ENGINEERING PRINT

FOREST AVE

GARDENIA AVE

FINAL R.I.W.			
AUTH	DATE	NO.	REVISION

JOB NO. 23749 A

CONTROL SECTION 63174

RESTRICTED AS PER PLANS APRIL 1999

DATE: 11/22/96
 DATE: 11/22/96
 EXISTING BY: PENNA'S UNIT
 PROPOSED BY:
 LAST CORRECTION BY: DAVID

33 34 35

21 22 23 24 25 26 27 28

15 16 17 18 19

FILE NAME: 23749832.DWG
2 3 4 5 6 7 8 9 10 11 12 13 14

SBD SERVICE RD
 CURVE DATA
 $\Delta = 00^{\circ}14'14''$ LT
 NO CURVE

CITY OF ROYAL OAK
 SECTION 14
 TIN #111
 ROYAL OAK TWP

FOR QUANTITIES ON WALL H
 SEE SHEET #27

CAUTION - CRITICAL
 UNDERGROUND UTILITY

HAZARDOUS OR
 FLAMMABLE MATERIAL

HAZARDOUS OR
 FLAMMABLE MATERIAL

SOUTHBOUND I-75

NORTHBOUND I-75

S01 OF 63174

26.0' RT 107+90.25
 NBD SERVICE RD
 STA 23+65.42 WALL *D*

PROP WALL *D*

26.0' RT 112+90.20
 NBD SERVICE RD
 STA 28+65.86 WALL *D*

PLAN REVISION R-1


FOR QUANTITIES ON WALL J
 SEE SHEET #27

QUANTITIES
 1159 LFT REM FENCE

PLAN REVISION R-1
 CONSTRUCTION SHEET

NBD SERVICE RD
 CURVE DATA
 $\Delta = 00^{\circ}43'06''$ RT
 PI = 107+48.08
 NO CURVE

CITY OF MADISON HEIGHTS

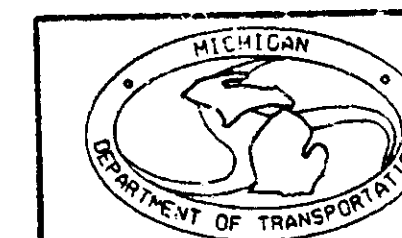


I-75 STA 893+00 TO STA 900+00

DATE	SCALE	CONT. SEC.	JOB NO.	DESIGN UNIT	SHEET R.O.W.C.C.
11/22/96	1" = 40'	63174	23749 A	PENA	30

CONSTRUCTED SHEET PLANS APRIL 1999

23749BPF.DGN
1 3 7

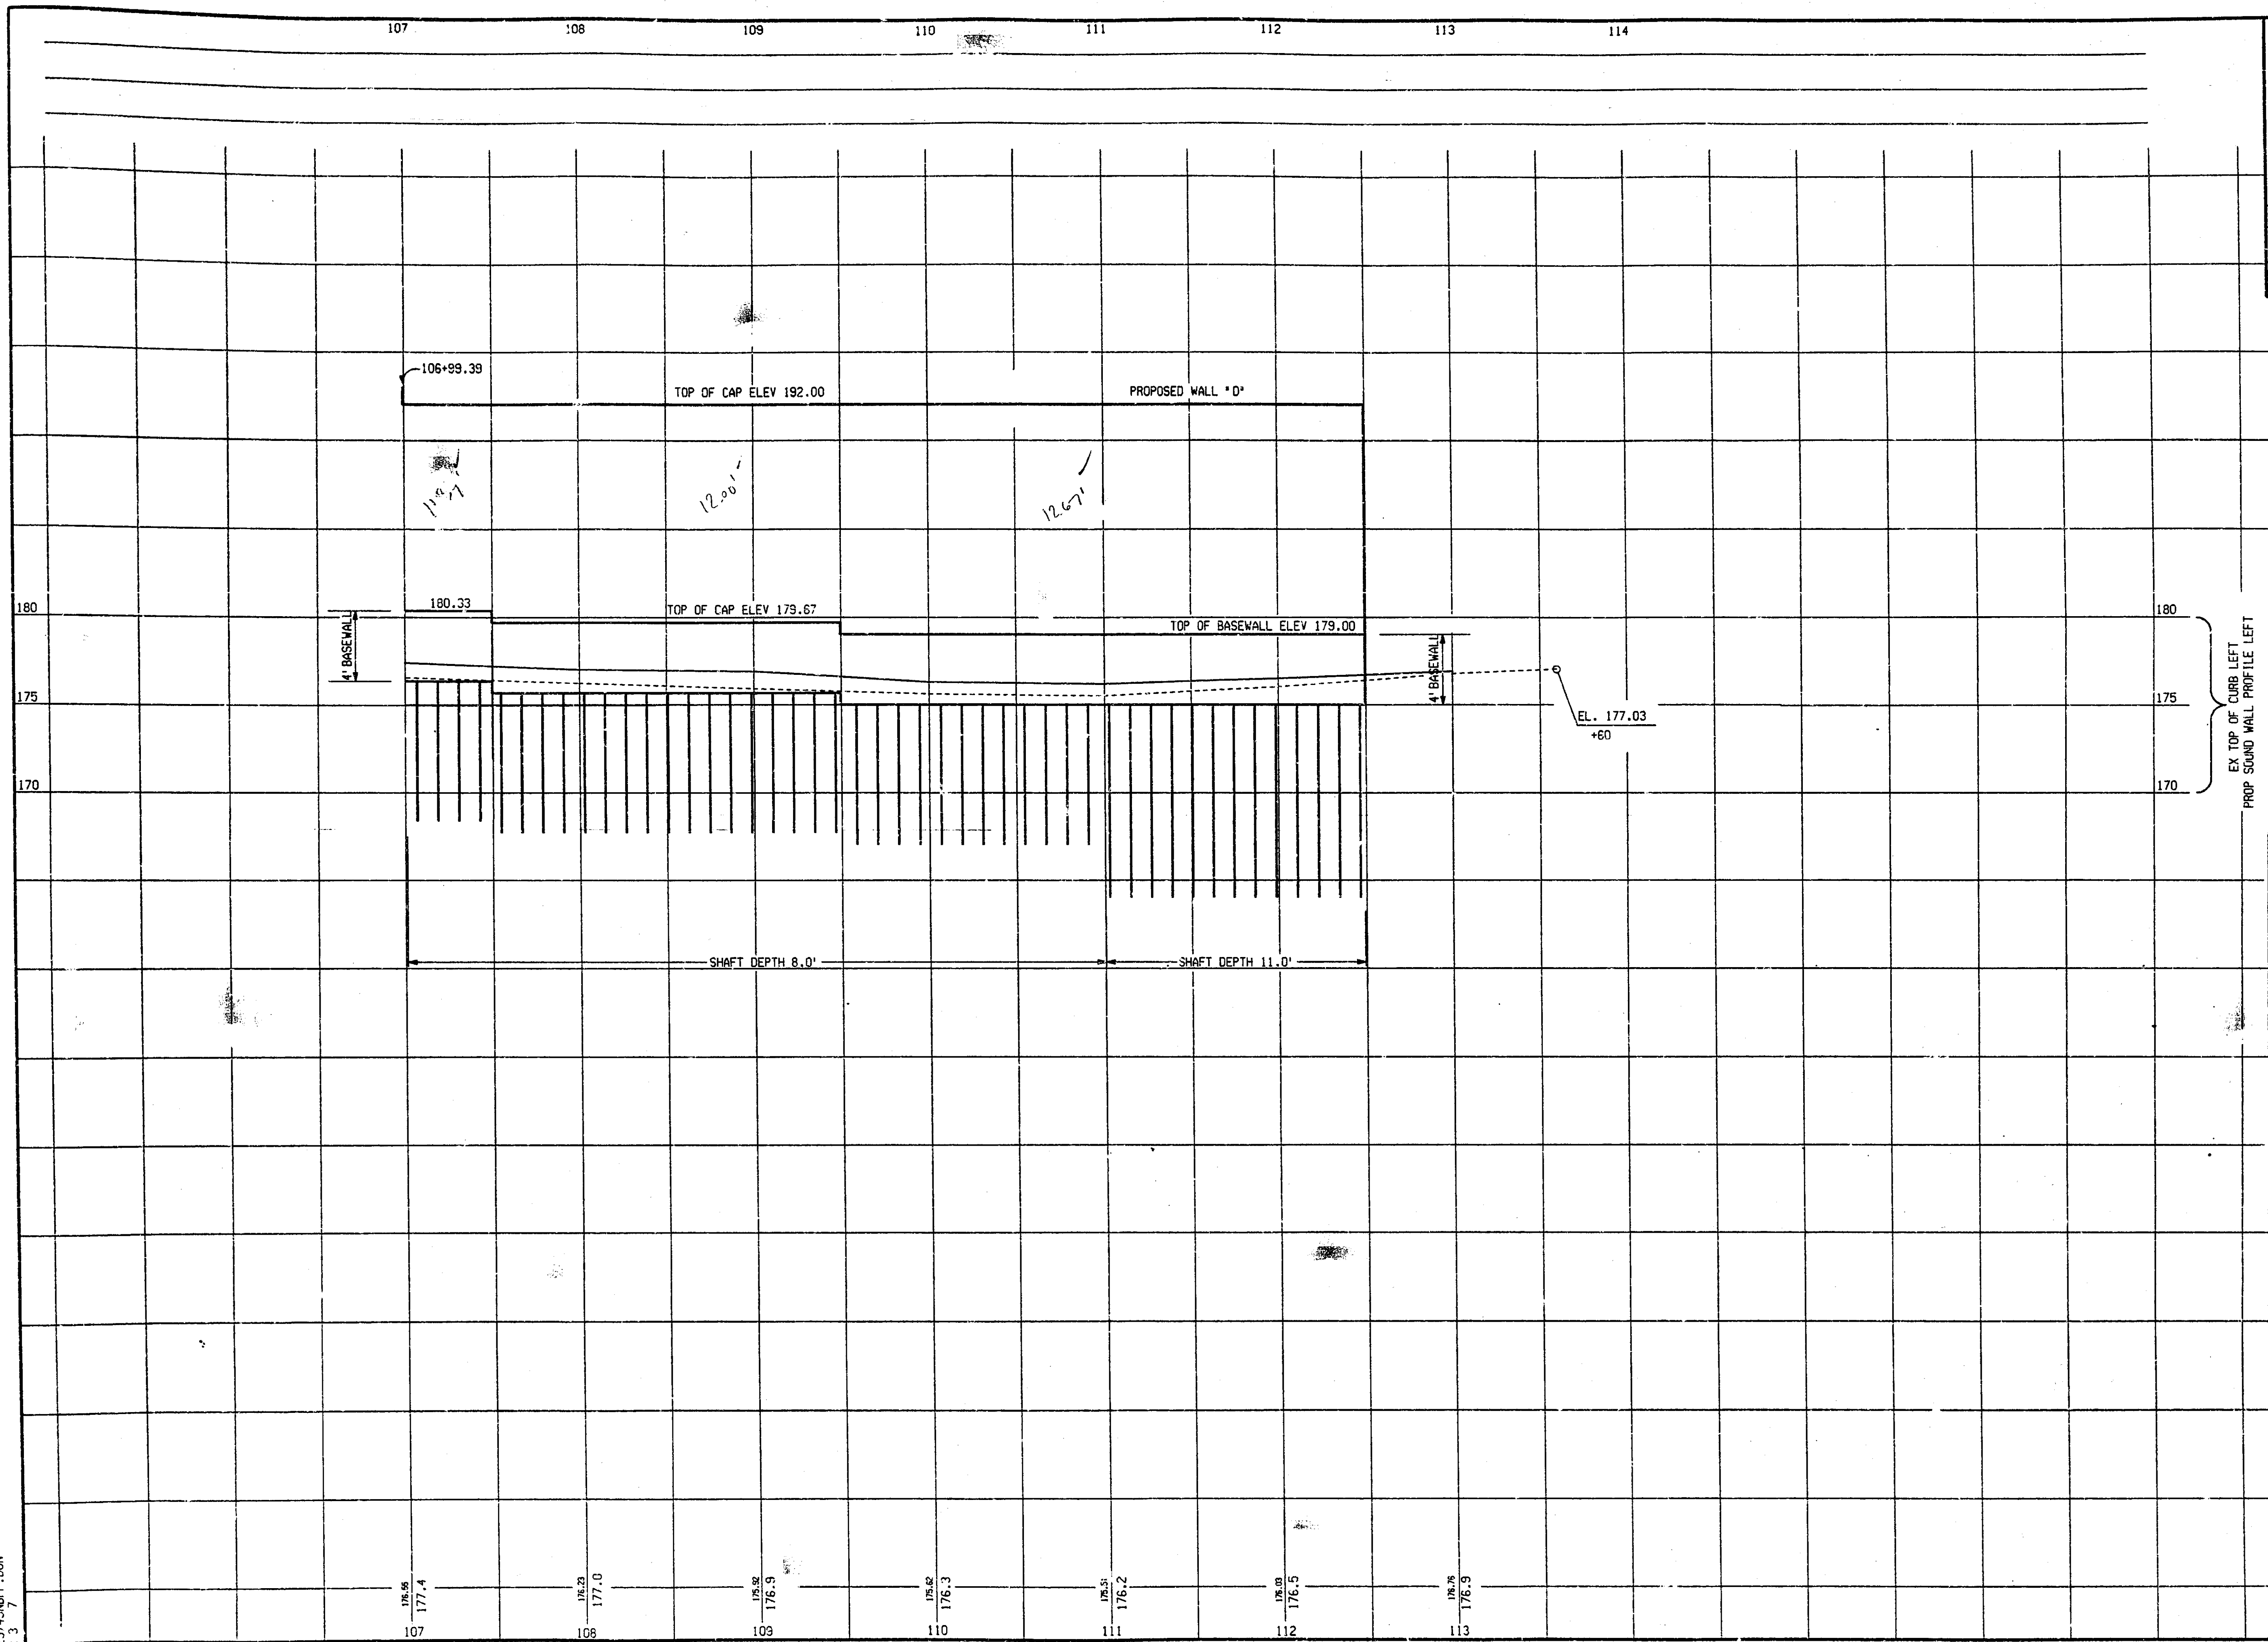

AUTH	DATE	NO.	REVISION

N.B. SERVICE RD S 107+00 TO STA 114+00
 DATE 09/06/96
 SCALE HORIZ. 1" = 40' VERT. 1" = 4'
 CONT. SEC. 63174
 JOB NO. 23749
 DESIGN UNIT PENN




SHEET NO.
R.O.W. CONST.
31

10/07/96 Engineering Print

CONSTRUCTED AS PER PLANS, APRIL 1999


237459RPF.DGN
1.3 41

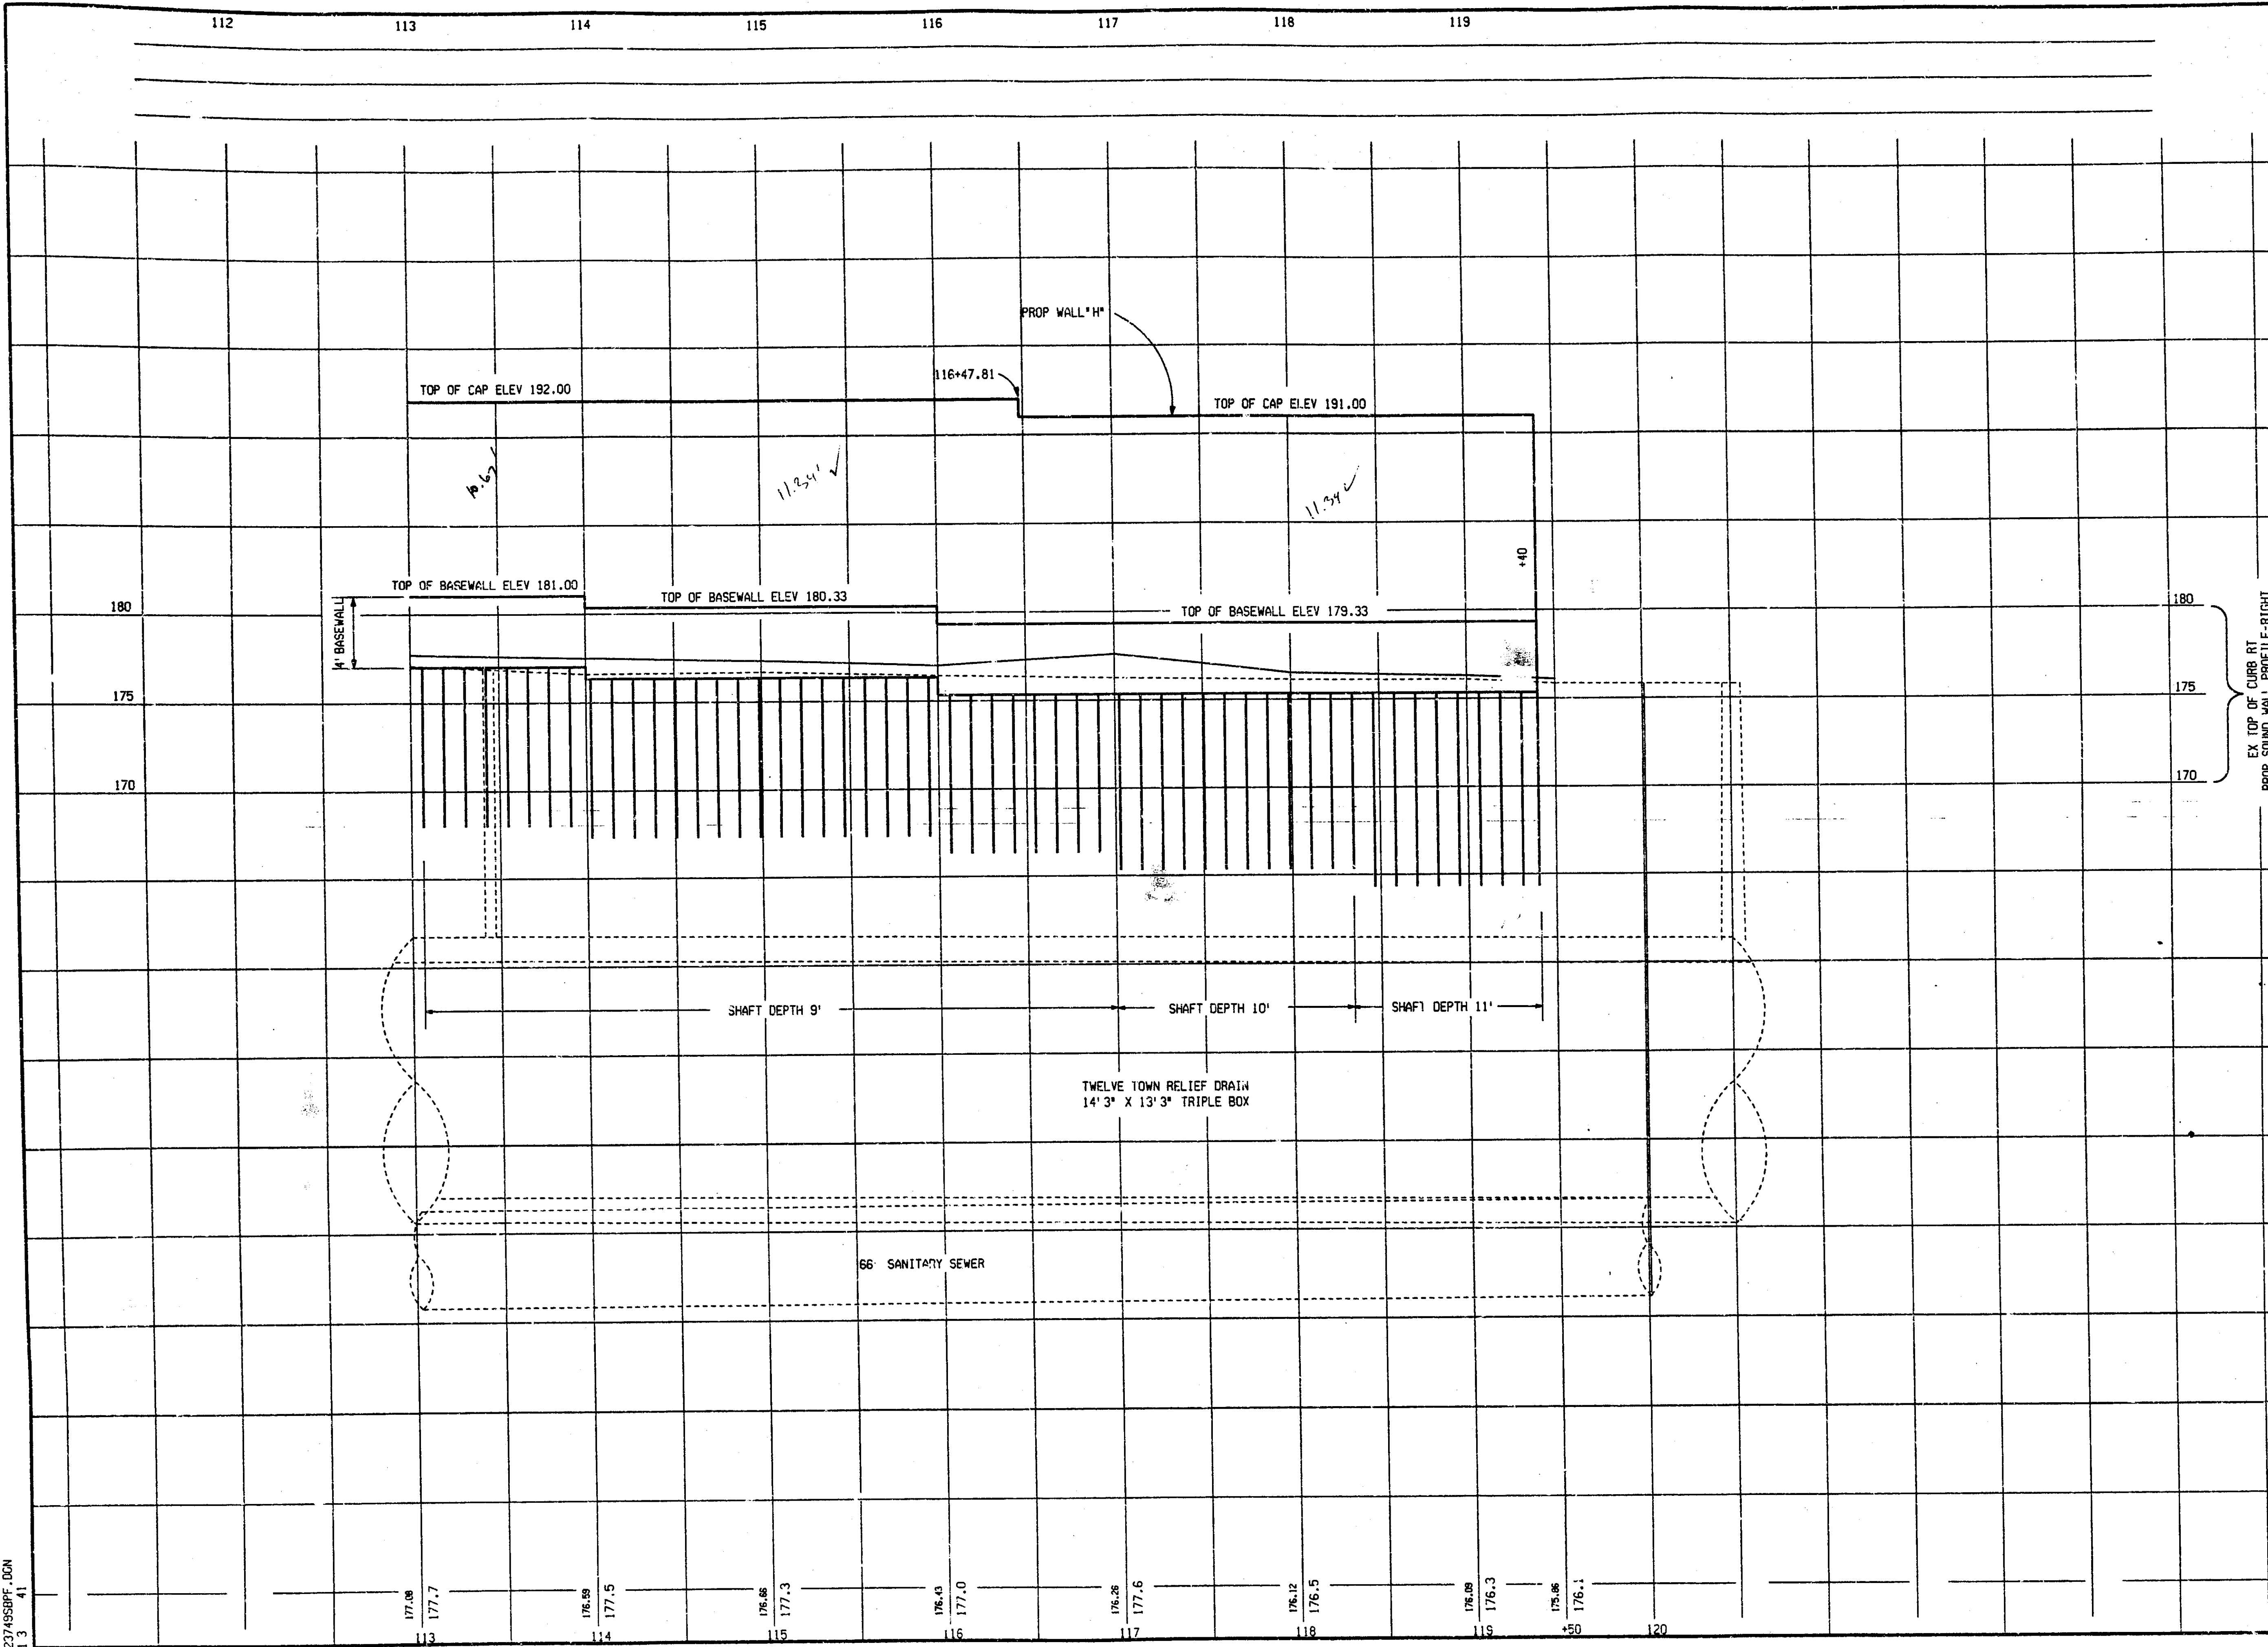

DATE	10/20/95
JOB NO.	23749
CONT. SEC.	63174
DESIGN UNIT	PENNA

EX TOP OF CURB RT
PROP SOUND WALL PROFILE-RIGHT


S.B. SERVICE RD. STA 112+00 TO STA 120+00
DATE 09/20/95
SCALE
HORZ. 1" = 40'
VERT. 1" = 4'JOB NO. 23749
CONT. SEC. 63174
DESIGN UNIT PENNA




SHEET NO.
R.O.W. CONST.
32

FINAL R.O.V.			
AUTH	DATE	NO.	REVISION


DATE: 08/02/96
 DWT: DAVID
 EXISTING BY: DAVID
 PROPOSED BY: DAVID
 LAST CORRECTION BY: DAVID
 FILE NAME: 237491.mcd.dgn
 1 2 3 100

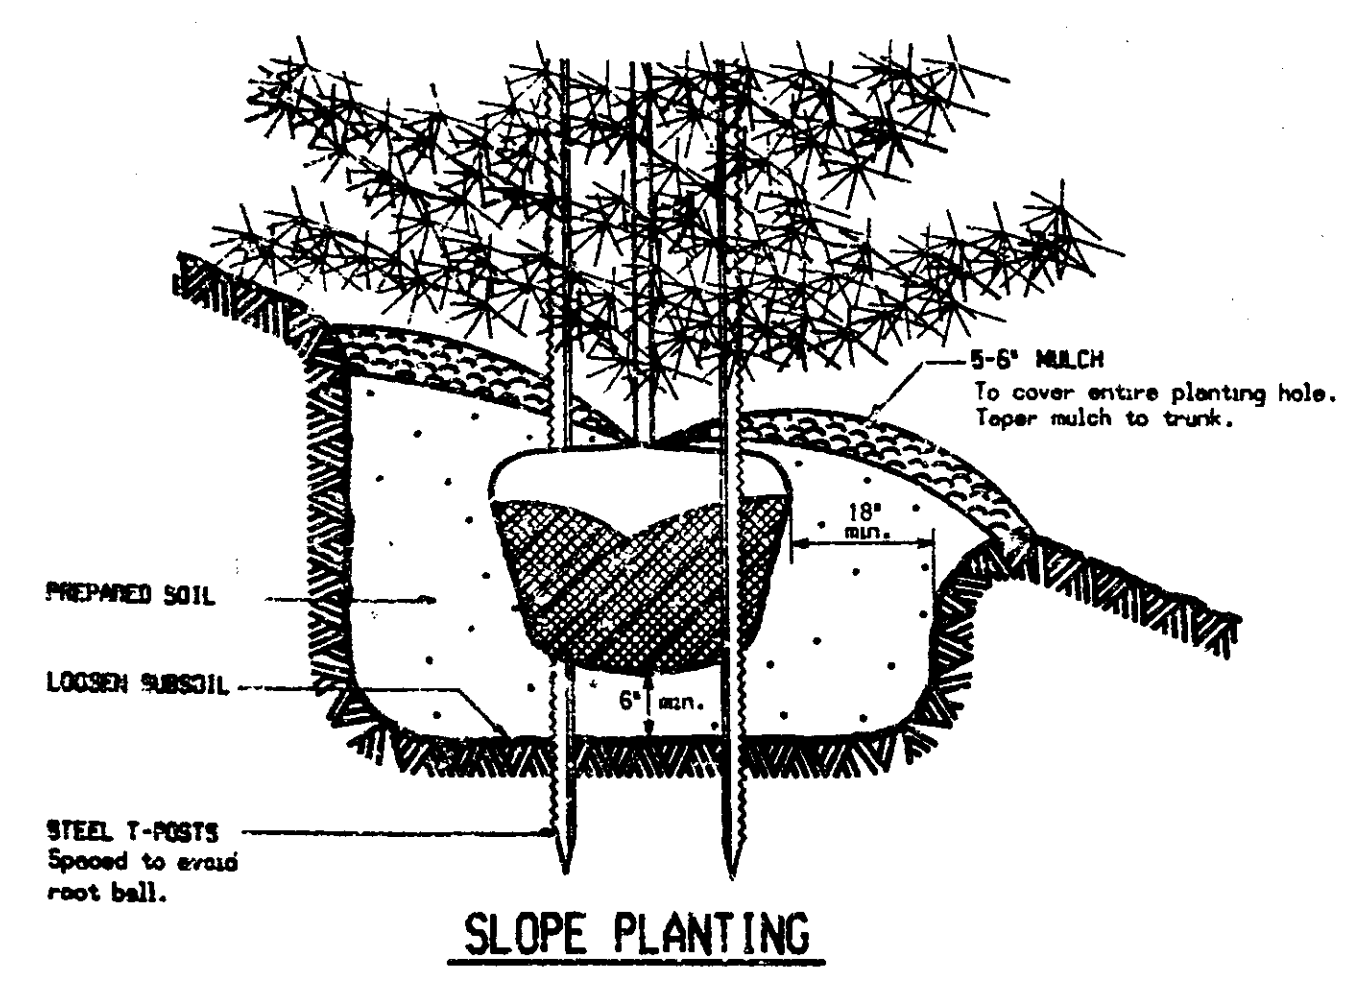


SLOPE PLANTING

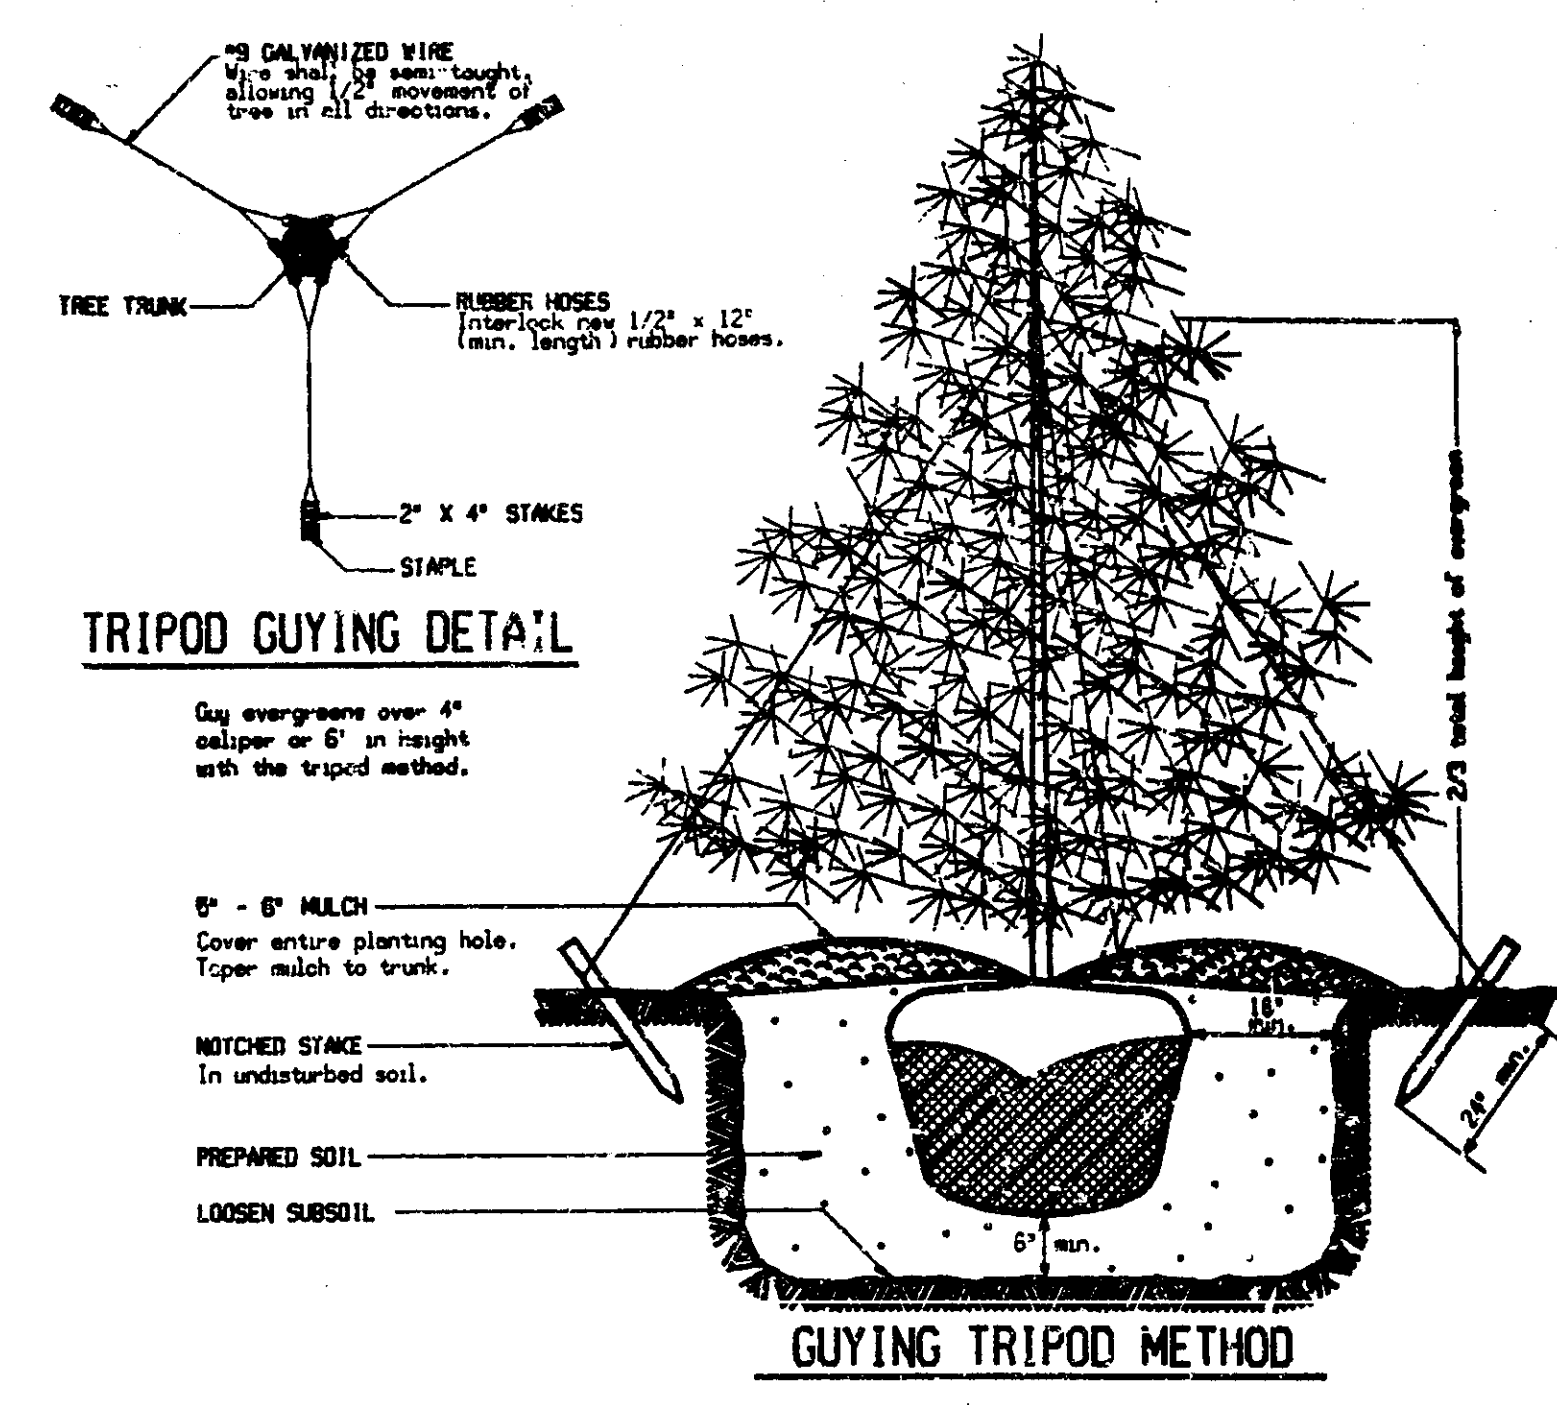

TRIPOD GUYING DETAIL

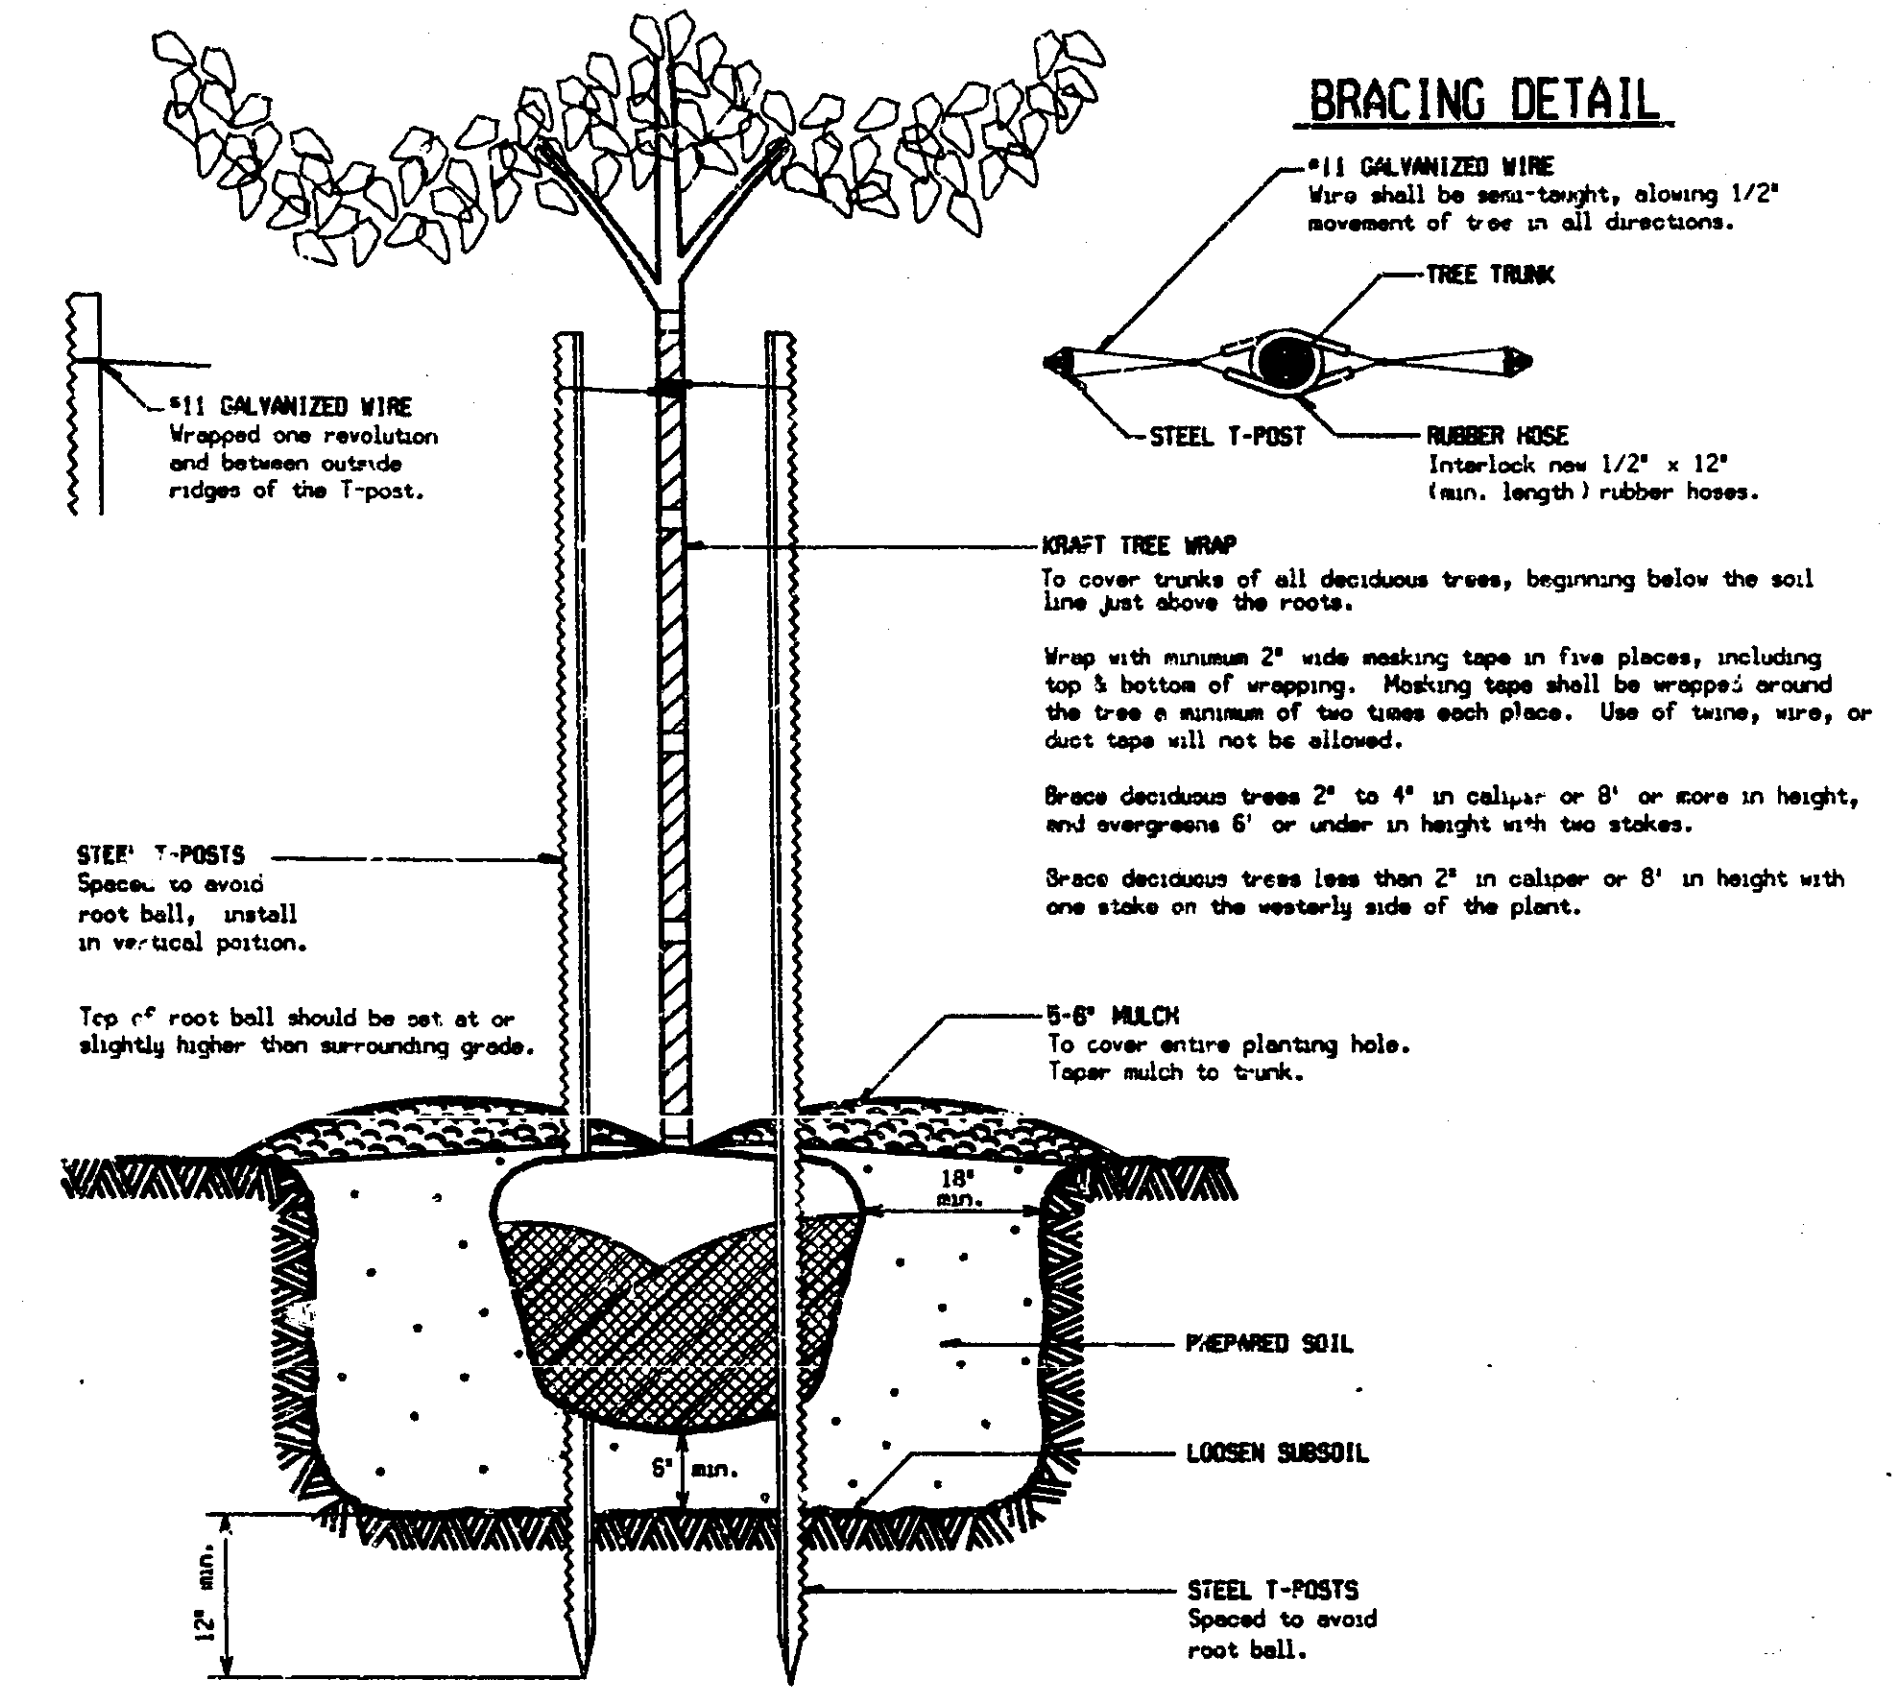


BRACING DETAIL

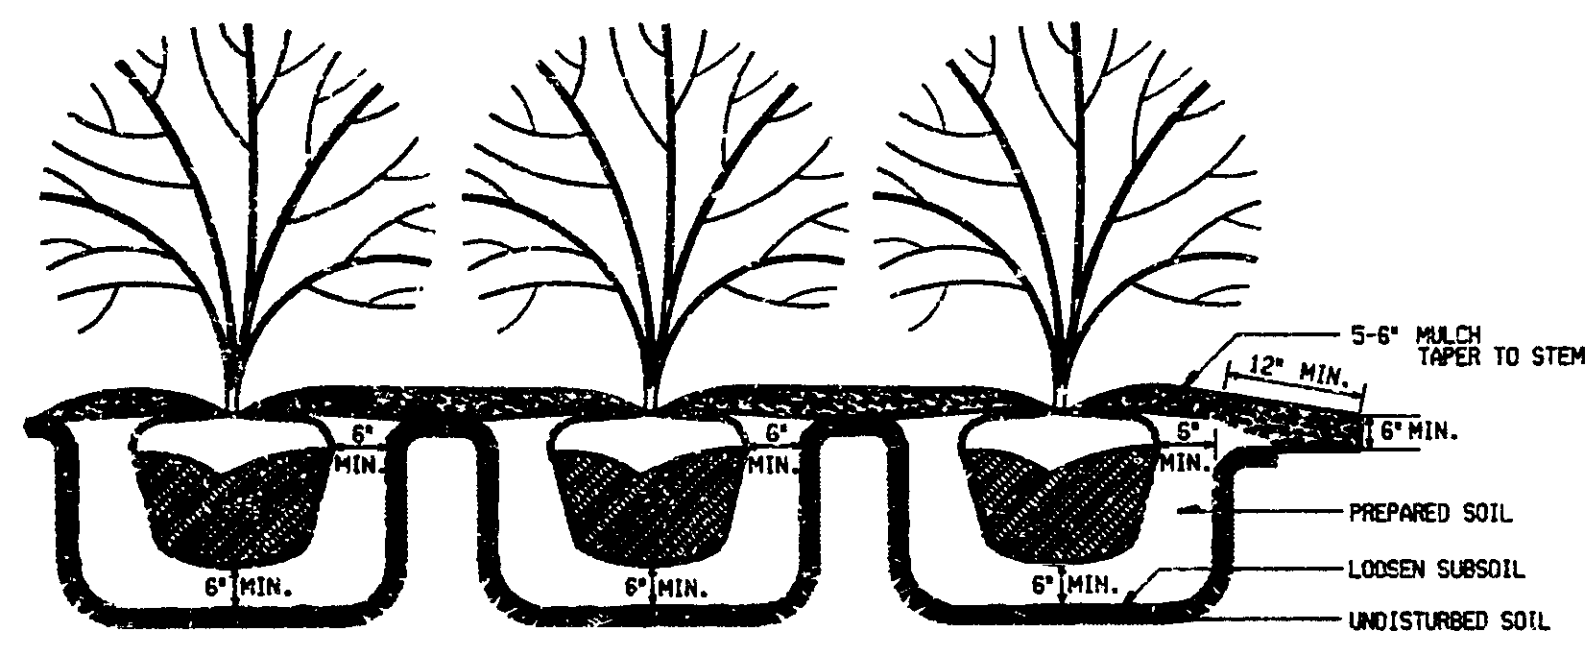


SHRUB BED DETAIL N.T.S.

-FIRST AND SECOND WATERING AND CULTIVATION SHALL INCLUDE SHRUB BEDS.
 -CUT 6" X 12" (MIN.) EDGING AROUND THE PERIMETER OF ALL SHRUB BEDS SHOWN ON THE PLANS. SPRAY A NON-PERSISTANT GLYPHOSATE HERBICIDE TO ENTIRE SHRUB BEDS PRIOR TO PLANTING AND BARK PLACEMENT.
 -SHRUB BEDS ARE TO BE PAID FOR BY THE PAY ITEM 'SITE PREPARATION'.
 -ALL PLANTS SHALL BE SET PLUMB AND HAVE THE BEST SIDE OF PLANT FACING THE MAIN VIEWING DIRECTION.

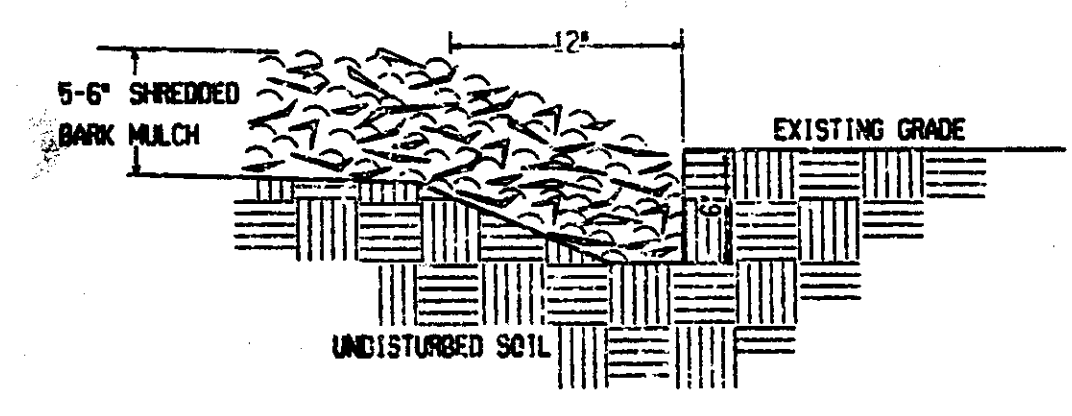

PLANTING BED EDGE DETAIL

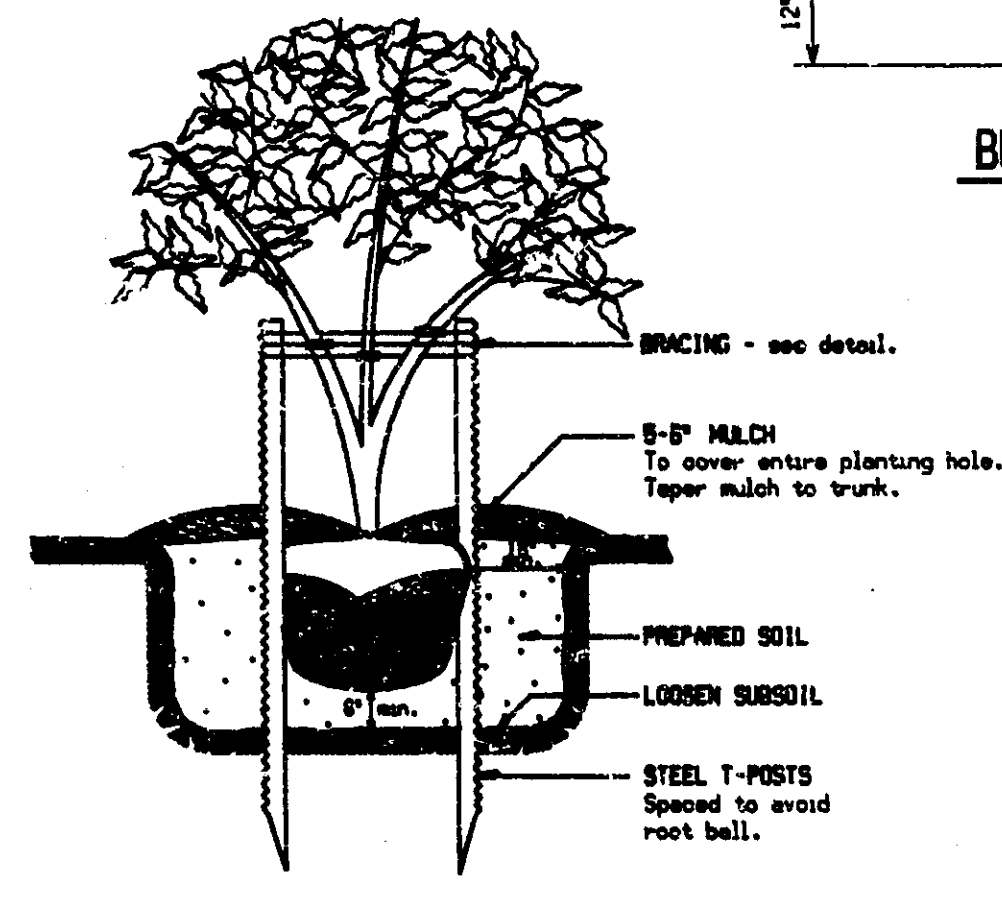


MULTIPLE STEM TREES

PLANTING TREES, SHRUBS, AND EVERGREENS


1. Dig plant pocket for deciduous and evergreen trees a minimum of 36" wide and 6" deeper than root ball, unless otherwise specified.
2. Dig plant pocket for shrubs a minimum of 12" wide and 6" deeper than the root ball, unless otherwise specified.
3. Loosen subsoil to a depth of 4". Loosen north on sides of plant pocket to break any glazing caused by digging.
4. Set plants at the same or slightly higher depth than at the nursery.
5. Fill prepared soil to 1/2 the depth of the root ball, pack firmly, and puddle with water.
6. Loosen and remove burlap and oil lacing from upper half of root ball.
7. Backfill with prepared soil slowly, after compaction, to flush with surrounding ground level.
8. Cover entire plant pocket area with 5 - 6" mulch. Prune, wrap, and brace & guy as specified.

GENERAL NOTES

When plants are furnished in containers, the containers shall be completely removed at the time of planting.
 All excavated material shall be removed from the site - immediately.
 All heights are shown before pruning.
 All depths are shown after settling.
 Trees and shrubbery shall not be planted within 50' and 30' respectively of the nearest edge of metal - except near structures or guardrails, and where inaccessible to vehicles.

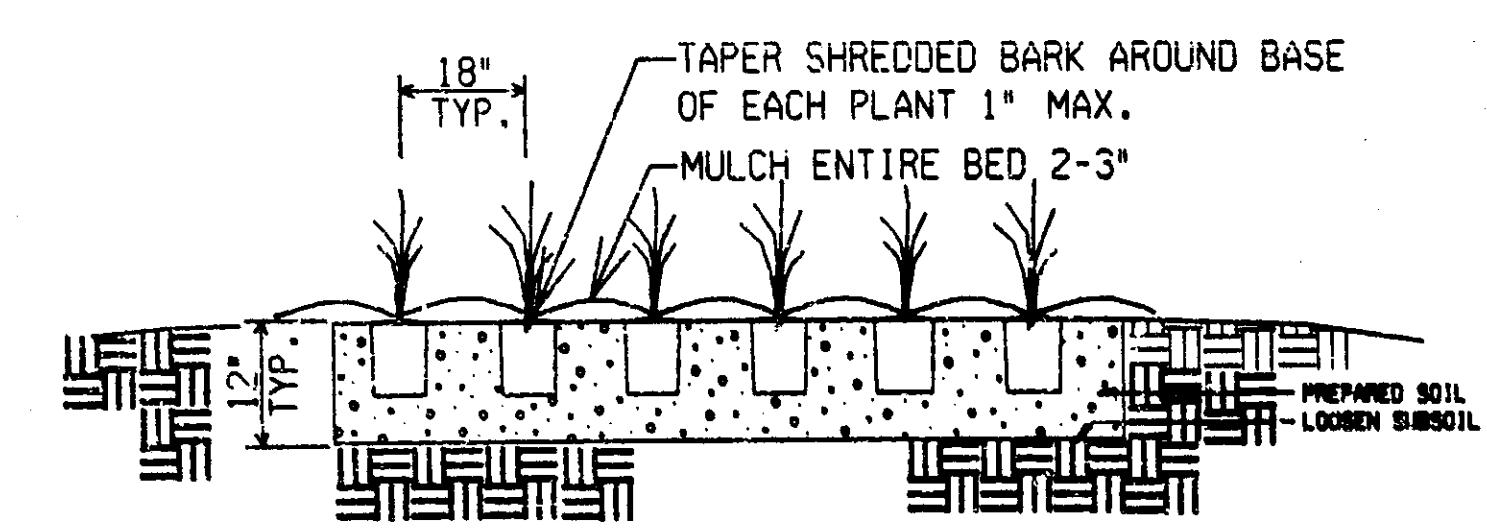

-FIRST AND SECOND WATERING AND CULTIVATION SHALL INCLUDE DAYLILY BEDS.
 -DAYLILIES ARE TO BE FULLY DEVELOPED TWO YEAR #2 CONTAINER PLANTS.
 -VARIETIES OF DAYLILIES SHALL BE EVENLY MIXED IN THE BEDS.
 -ENTIRE DAYLILY BED SHALL BE EXCAVATED DOWN 12" AND REPLACED WITH 12" OF PREPARED SOIL.
 -DAYLILY BEDS ARE TO BE PAID FOR BY THE PAY ITEM 'SITE PREPARATION'.


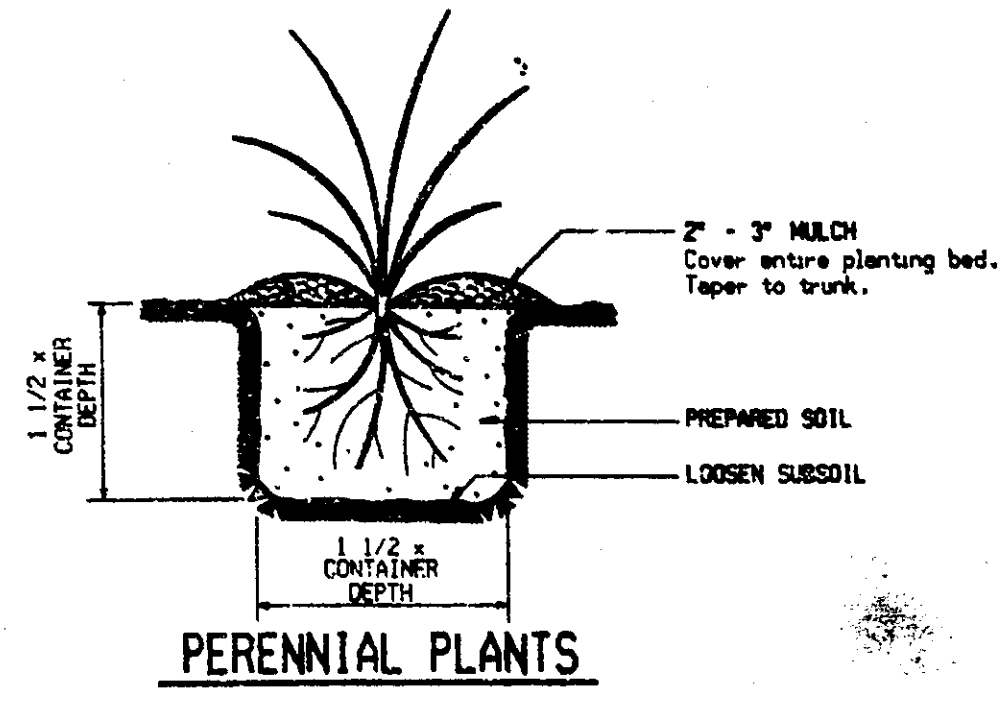


PERENNIAL PLANTS

MICHIGAN DEPARTMENT OF TRANSPORTATION					
PLANTING DETAIL					
DATE	SCALE	CONT. SEC.	JOB NO.	DESIGN UNIT	SHEET NO.
08/02/96	N.T.S.	63174	25191 A	MULLER	R.O.V CONST. 33

DATE: DATE: DATE:
 EXISTING BY: PROPOSED BY: LAST CORRECTION BY:

FILE NAME: 1 2 3 4 5 6 7 8 9 10 11 12 13 14 15 16 17 18 19 20 21 22 23 24 25 26 27 28 29 30 31 32 33 34 35 36 37 38 39 40 41 42 43 44 45 46 47 48 49 50 51 52 53 54 55 56 57 58 59 60 61 62 63
 (6061 TRIP PLAN APRIL 1999)

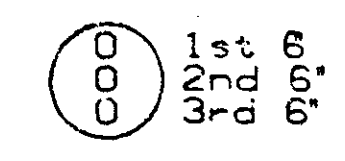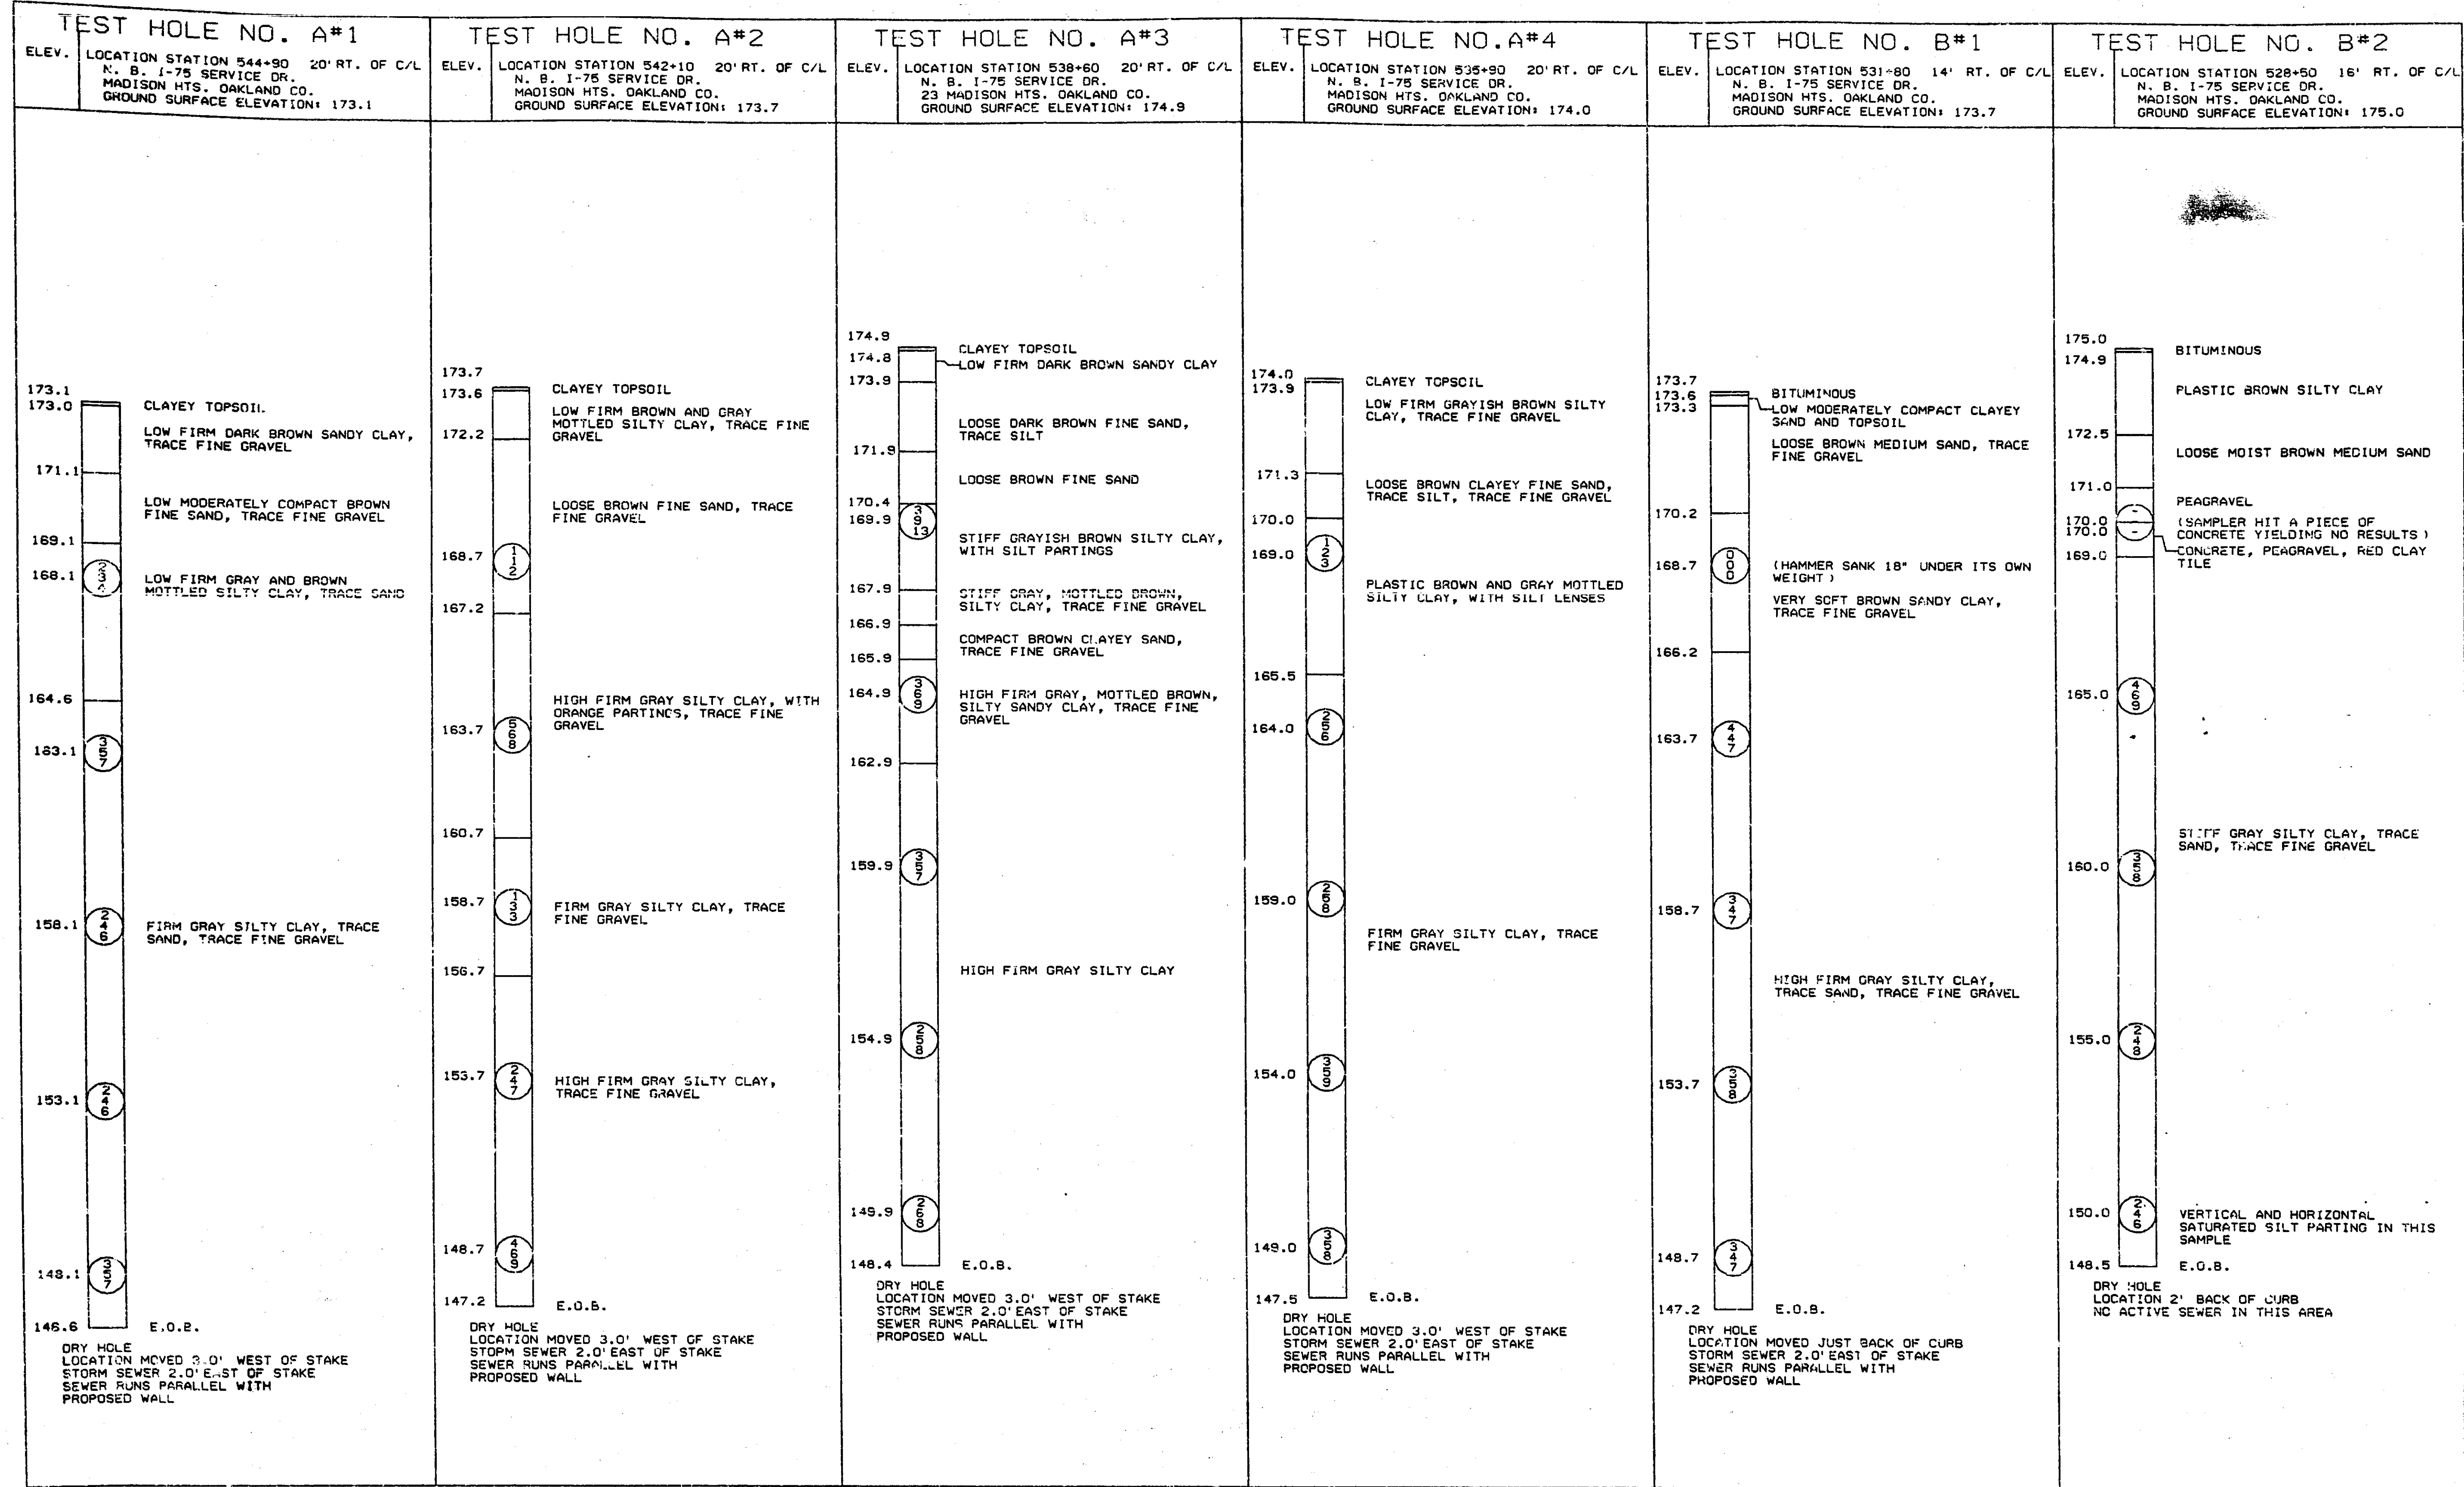


NUMBERS IN CIRCLES DENOTE NUMBER OF BLOWS REQUIRED TO DRIVE A 2.00" O.D. X 1.50" I.D. SPLIT SPOON SAMPLER 3 SUCCESSIVE 6" INCREMENTS USING A 140# HAMMER FALLING 30".

CONSISTENCY DETERMINED BY INSPECTION OF SAMPLES AND BY SOIL RESISTANCE TO PENETRATION BY JET ROD AND CASING OR AUGER.

WATER LEVELS MAY BE INFLUENCED BY RESIDUAL BORING WATER

THE SOIL BORING LOGS REPRESENT POINT INFORMATION. PRESENTATION OF THIS INFORMATION IN NO WAY IMPLIES THAT THE SUBSURFACE CONDITIONS ARE THE SAME AT LOCATIONS OTHER THAN THE EXACT LOCATION OF THE BORING.

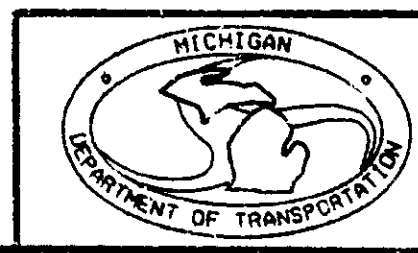

SOIL BORING SHEET


DATE	SCALE	CONT. SEC.	JOB NO.	DESIGN UNIT	SHEET NO.
06/21/95	1" =	63174	23749 A	PENA	R.O.W. CONST. 34

16787796 ENGINEERING PLANS

SECTION: 0-11/11

DATE: 06/20/95
 DRAWN BY: J. J. J.
 CHECKED BY: J. J. J.
 EXISTING BY: J. J. J.
 PROPOSED BY: J. J. J.
 LAST CORRECTION BY: J. J. J.

FILE NAME: 1 2 3 4 5 6 7 8 9 10 11 12 13 14 15 16 17 18 19 20 21 22 23 24 25 26 27 28 29 30 31 32 33 34 35 36 37 38 39 40 41 42 43 44 45 46 47 48 49 50 51 52 53 54 55 56 57 58 59 60 61 62 63

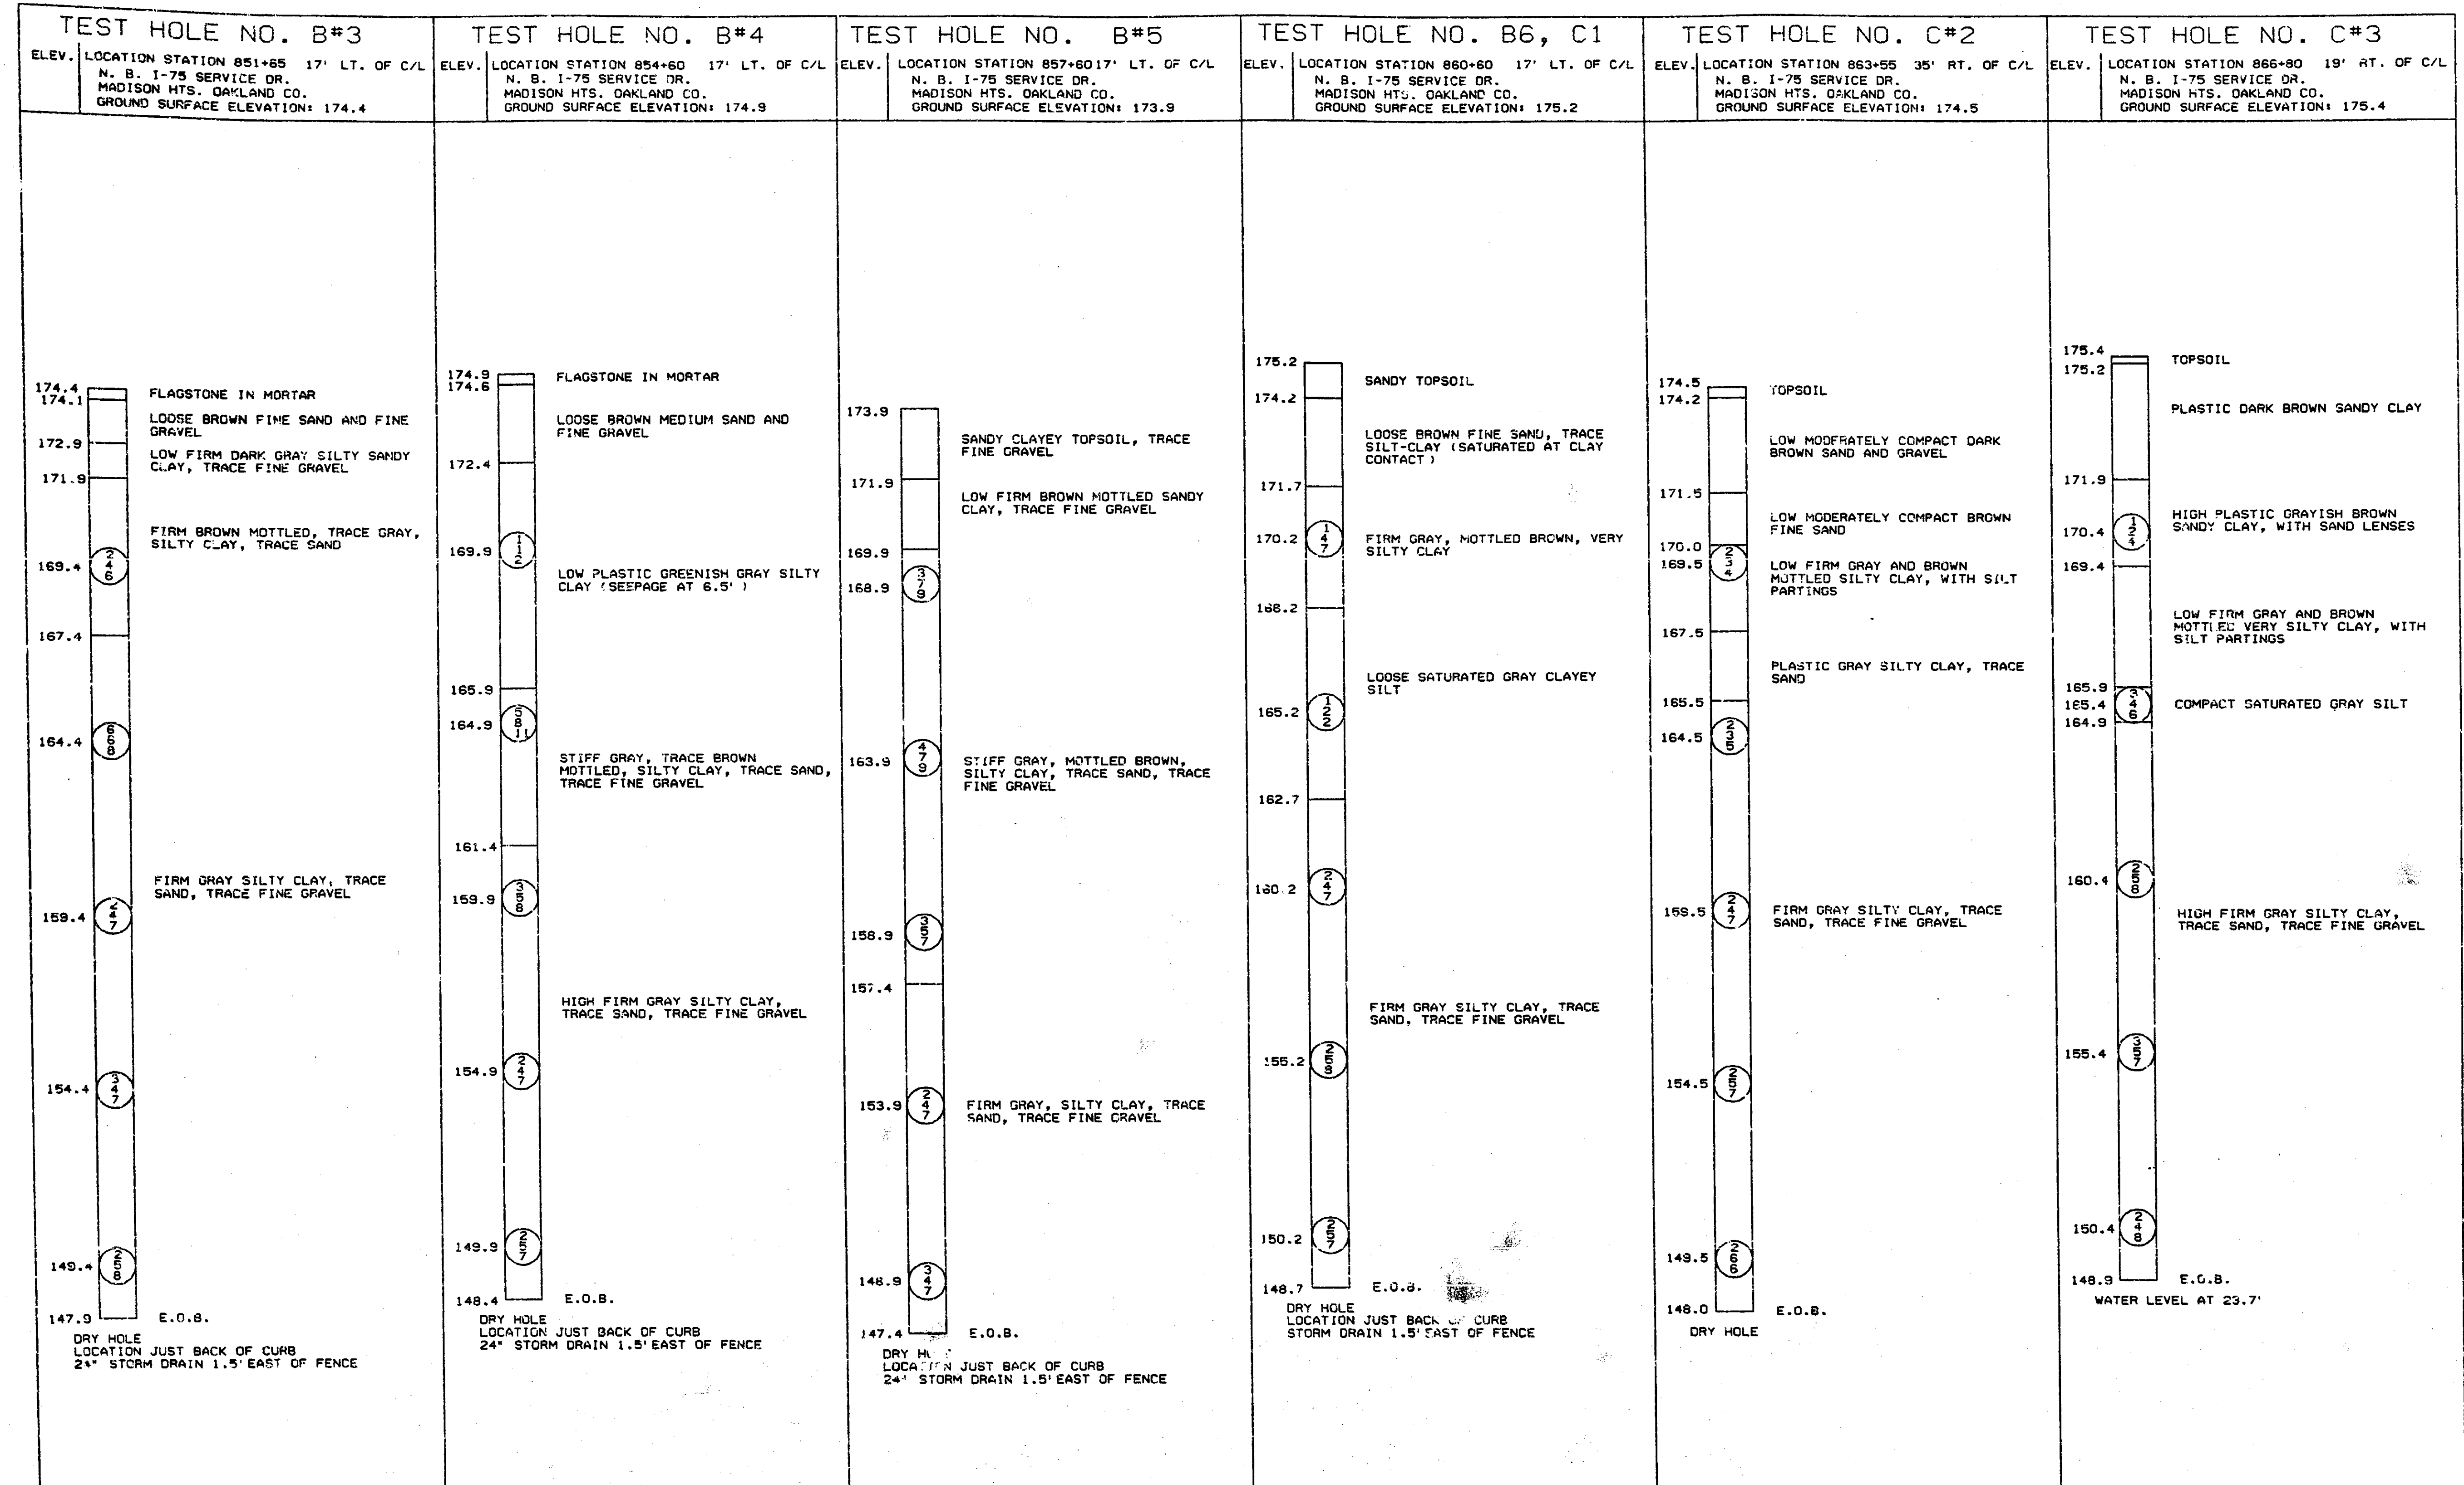


NUMBERS IN CIRCLES DENOTE NUMBER OF BLOWS REQUIRED TO DRIVE A 2.00" O.D. X 1.50" I.D. SPLIT SPOON SAMPLER 3 SUCCESSIVE 6" INCREMENTS USING A 140# HAMMER FALLING 30".

WATER LEVELS MAY BE INFLUENCED BY RESIDUAL BORING WATER

THE SOIL BORING LOGS REPRESENT POINT INFORMATION. PRESENTATION OF THIS INFORMATION IN NO WAY IMPLIES THAT THE SUBSURFACE CONDITIONS ARE THE SAME AT LOCATIONS OTHER THAN THE EXACT LOCATION OF THE BORING.



CONSISTENCY DETERMINED BY INSPECTION OF SAMPLES AND BY SOIL RESISTANCE TO PENETRATION BY JET ROD AND CASING OR AUGER.

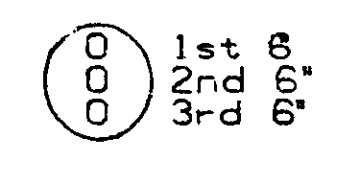

	SOIL BORING SHEET					
	DATE	SCALE	CONT. SEC.	JOB NO.	DESIGN UNIT	SHEET NO.
	06/20/95	1" =	63174	23749 A	PENA	R.O.W CONST. 35

1978/95 ENGINEERING PRINT

DATE: DATE: DATE:
 EXISTING BY: PROPOSED BY: LAST CORRECTION BY:
 FILE NAME: 1 2 3 4 5 6 7 8 9 10 11 12 13 14 15 16 17 18 19 20 21 22 23 24 25 26 27 28 29 30 31 32 33 34 35 36 37 38 39 40 41 42 43 44 45 46 47 48 49 50 51 52 53 54 55 56 57 58 59 60 61 62 63
 6601 TRITON AS PER PLANS, APRIL 1999

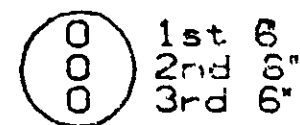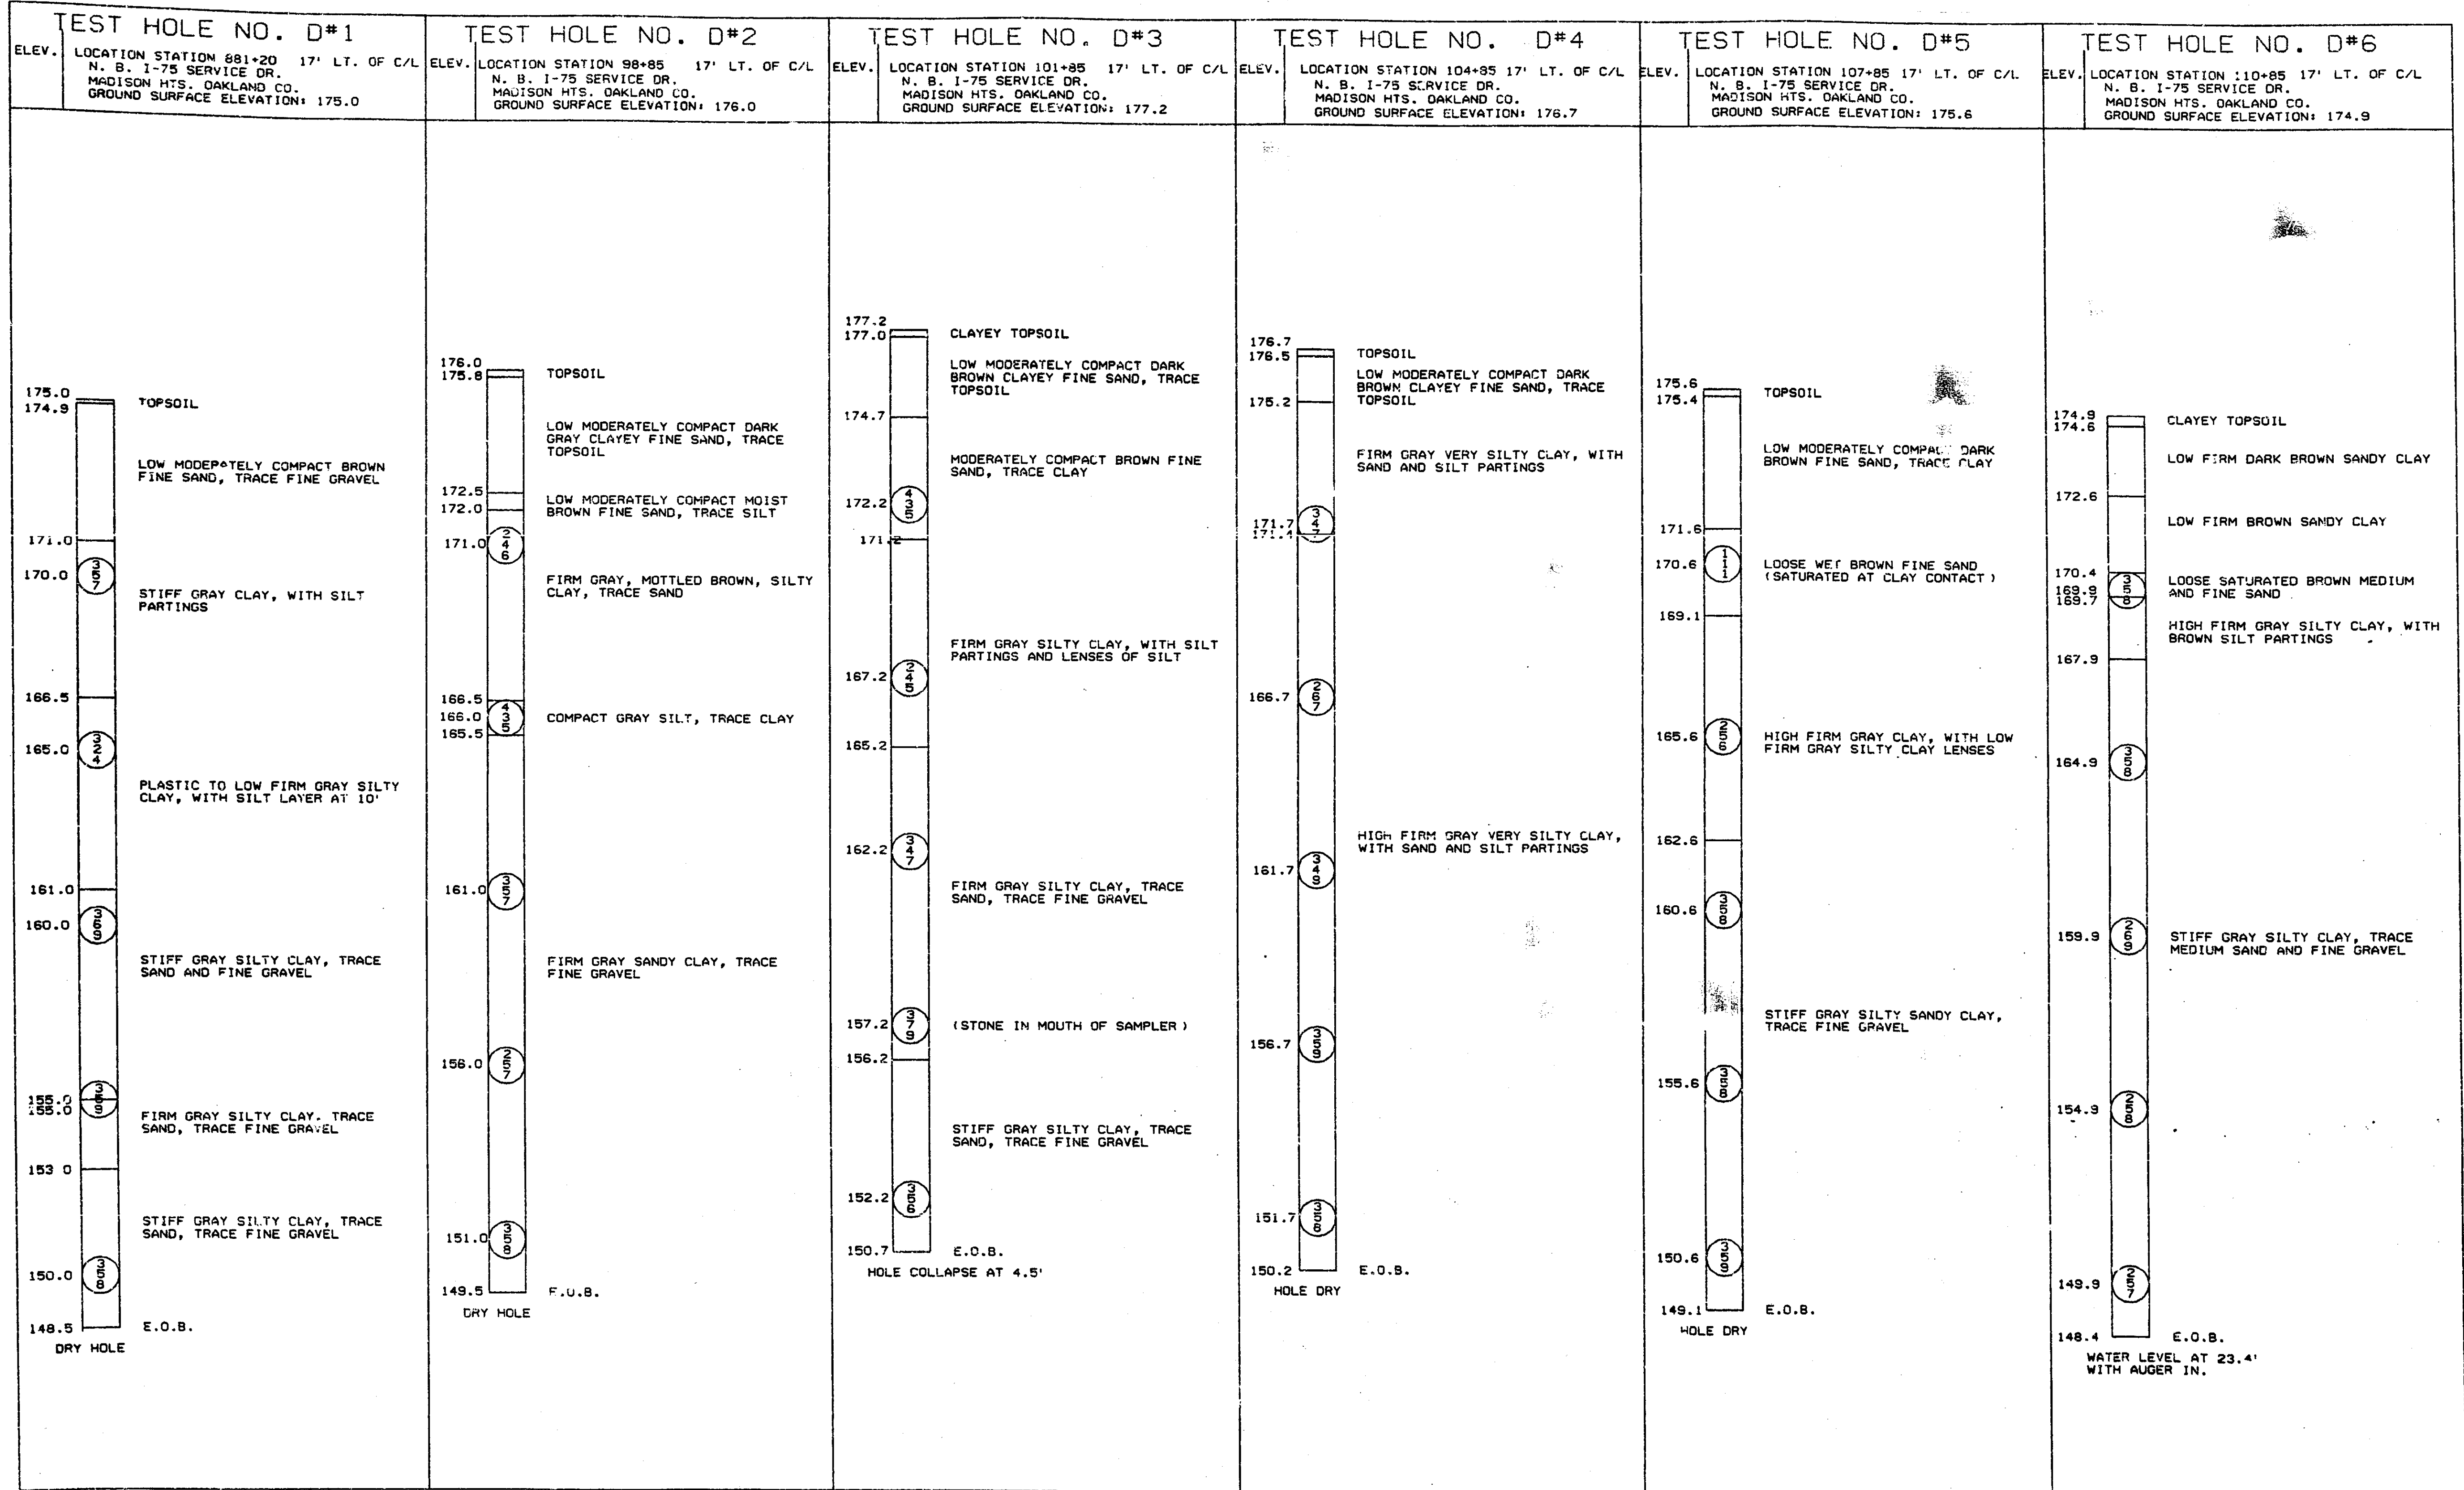


NUMBERS IN CIRCLES DENOTE NUMBER OF BLOWS REQUIRED TO DRIVE A 2.00" O.D. X 1.50" I.D. SPLIT SPOON SAMPLER 3 SUCCESSIVE 6" INCREMENTS USING A 140# HAMMER FALLING 30"

CONSISTENCY DETERMINED BY INSPECTION OF SAMPLES AND BY SOIL RESISTANCE TO PENETRATION BY JET ROD AND CASING OR AUGER.

WATER LEVELS MAY BE INFLUENCED BY RESIDUAL BORING WATER

THE SOIL BORING LOGS REPRESENT POINT INFORMATION. PRESENTATION OF THIS INFORMATION IN NO WAY IMPLIES THAT THE SUBSURFACE CONDITIONS ARE THE SAME AT LOCATIONS OTHER THAN THE EXACT LOCATION OF THE BORING.

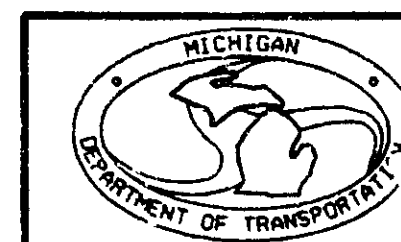

SOIL BORING SHEET

DATE	SCALE	CONT. SEC.	JOB NO.	DESIGN UNIT	SHEET NO.
06/20/95	1" =	63174	23749 A	PENA	R.O.W CONST. 36


1878796 ENGINEERING PERM

SECTION 03110 - EROSION CONTROL

DATE: _____
 DATE: _____
 DATE: _____
 EXISTING BY:
 PROPOSED BY:
 LAST CORRECTION BY:

CONSTRUCTED AS PER PLANS APRIL 1999

FILE NAME: 23749sb1.dgn
 1 2 3 4 5 6 7 8 9 10 11 12 13 14 15 16 17 18 19 20 21 22 23 24 25 26 27 28 29 30 31 32 33 34 35 36 37 38 39 40 41 42 43 44 45 46 47 48 49 50 51 52 53 54 55 56 57 58 59 60 61 62 63


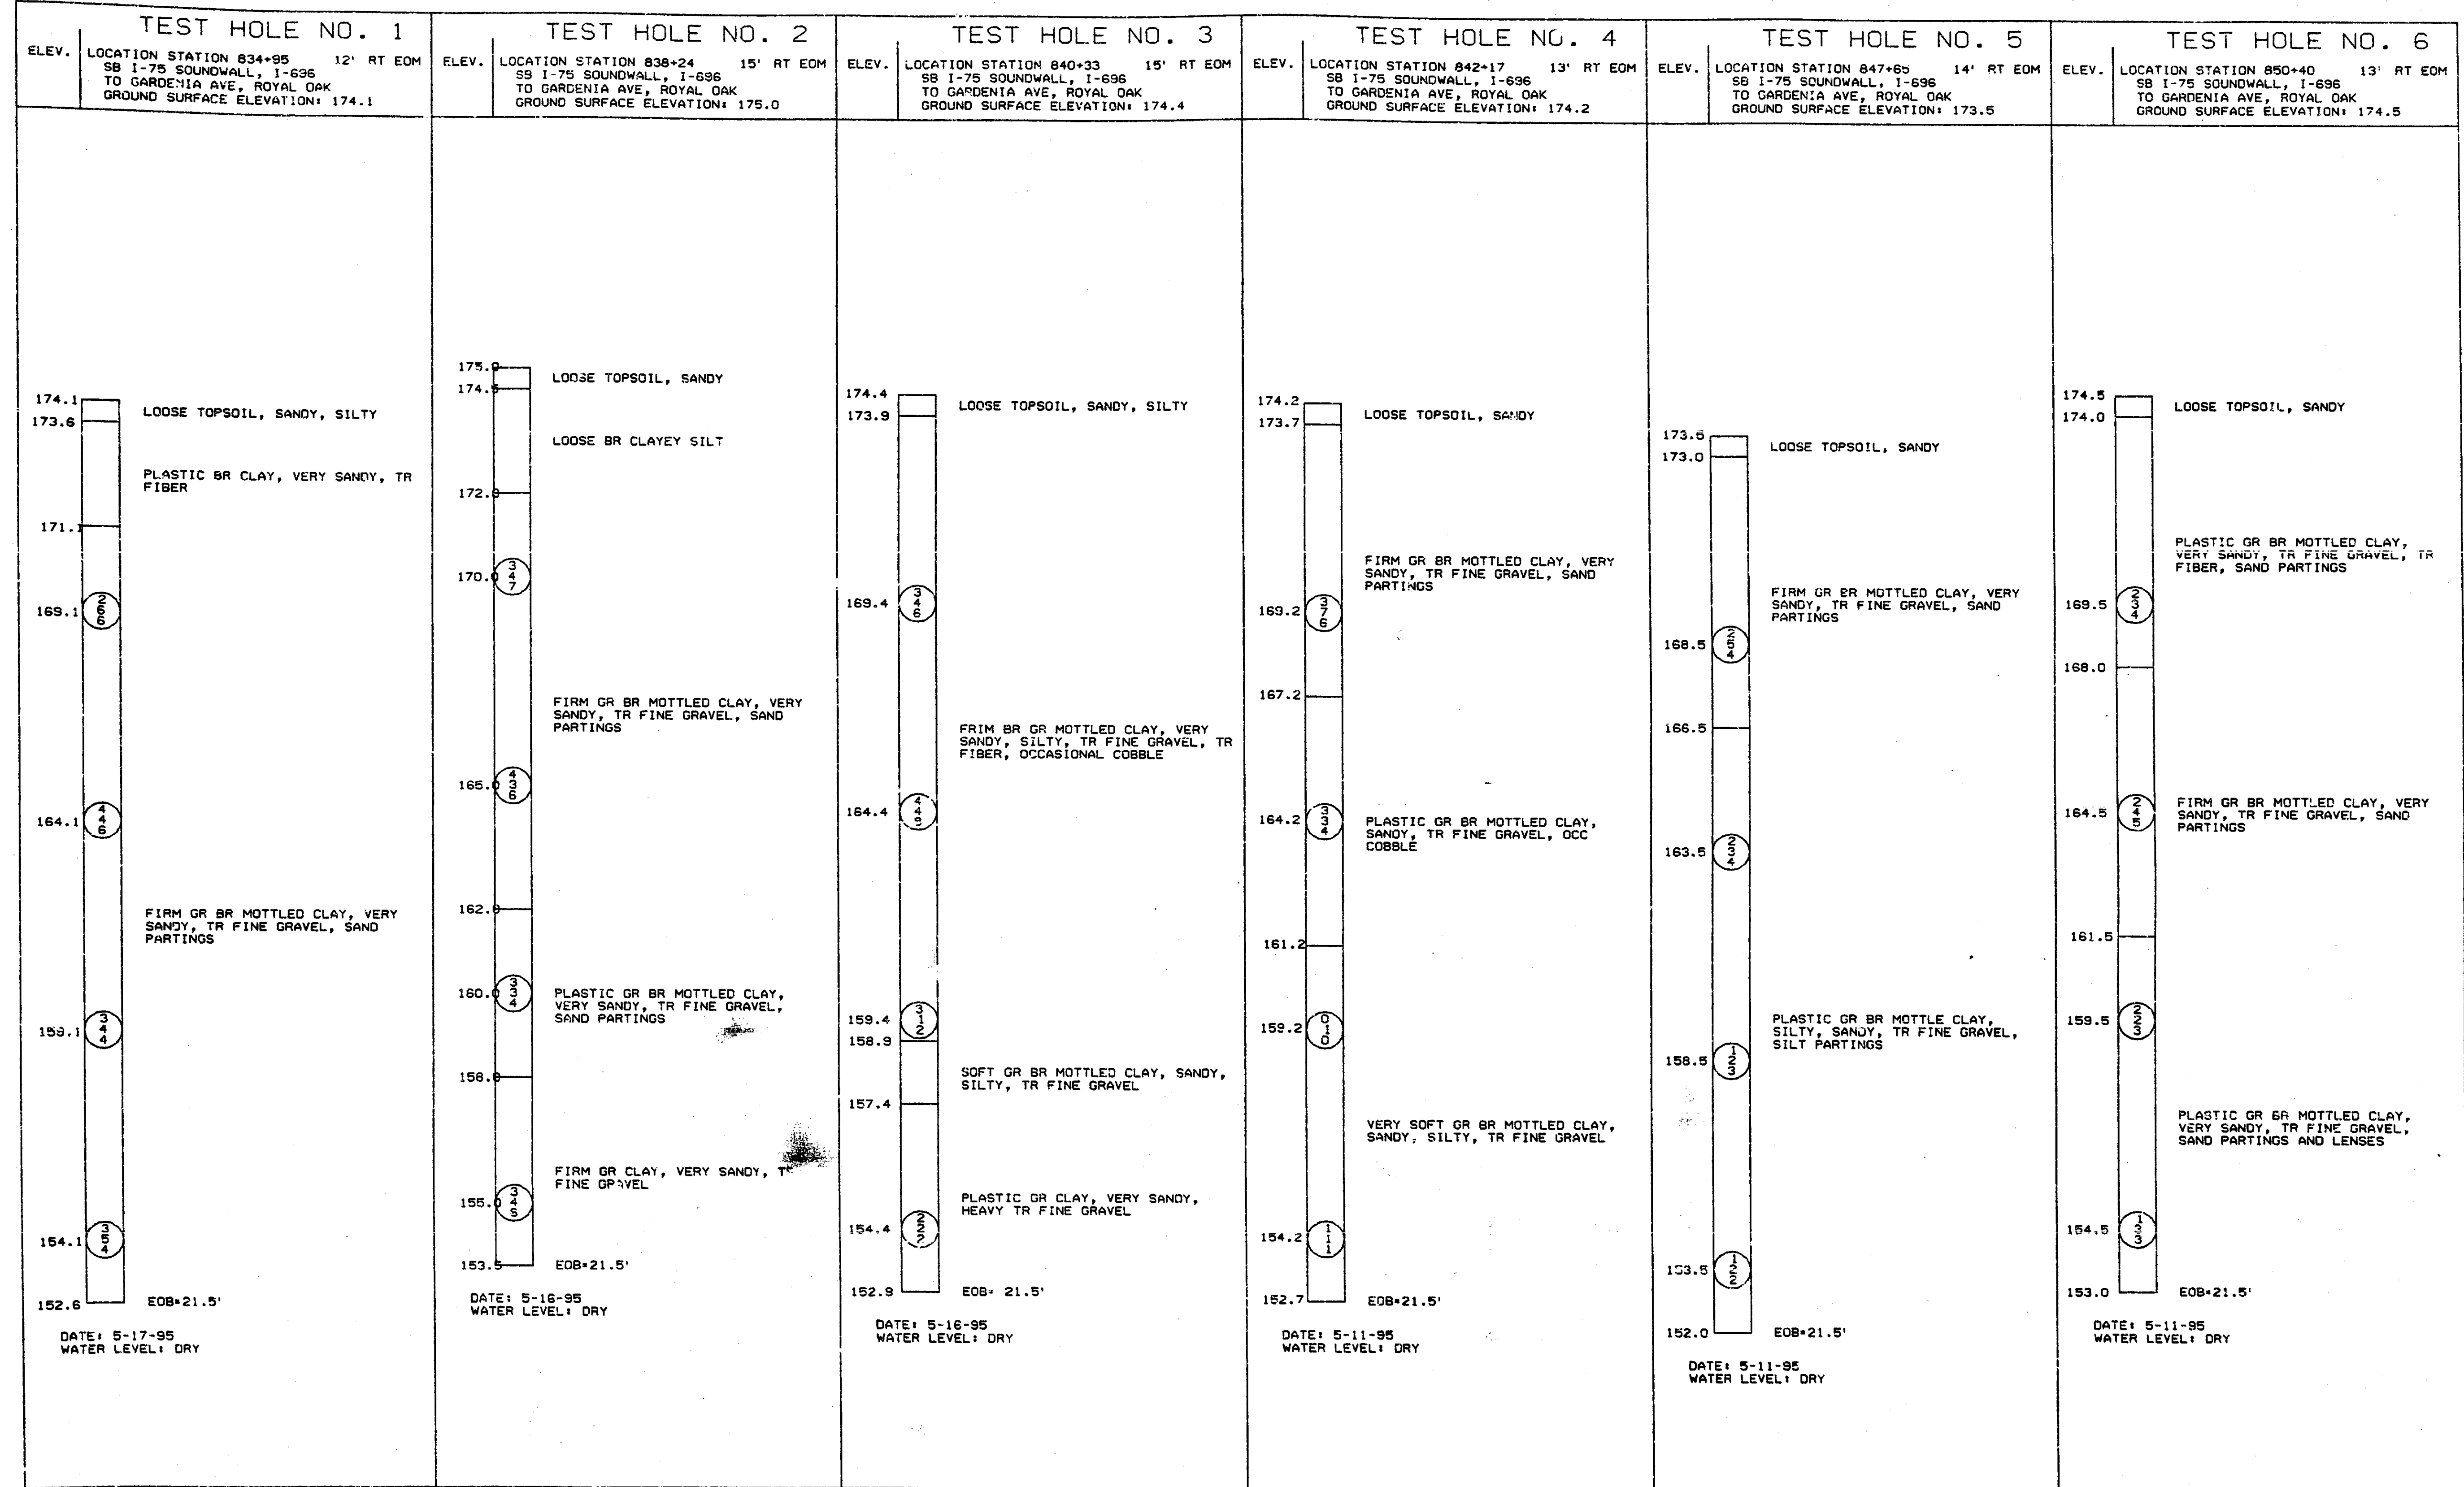


NUMBERS IN CIRCLES DENOTE NUMBER OF BLOWS REQUIRED TO DRIVE A 2.00" O.D. X 1.50" I.D. SPLIT SPOON SAMPLER 3 SUCCESSIVE 6" INCREMENTS USING A 140# HAMMER FALLING 30".

WATER LEVELS MAY BE INFLUENCED BY RESIDUAL BORING WATER

THE SOIL BORING LOGS REPRESENT POINT INFORMATION. PRESENTATION OF THIS INFORMATION IN THIS WAY IMPLIES THAT THE SUBSURFACE CONDITIONS ARE THE SAME AT LOCATIONS OTHER THAN THE EXACT LOCATION OF THE BORING.

CONSISTENCY DETERMINED BY INSPECTION OF SAMPLES AND BY SOIL RESISTANCE TO PENETRATION BY JET ROD AND CASING OR AUGER.

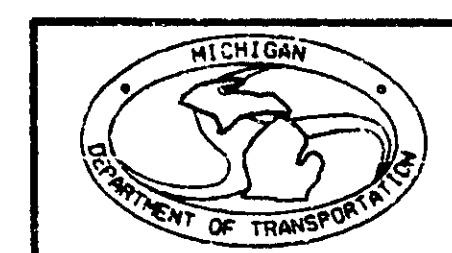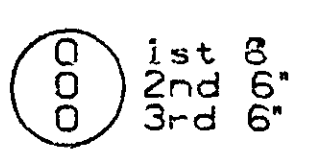

SOIL BORING SHEET					
DATE	SCALE	CONT. SEC.	JOB NO.	DESIGN UNIT	SHEET NO.
06/20/95	1" =	63174	23749 A	PENA	R.O.W CONST. 37

18/87/96 Engineering Print


DATE:
DATE:

EXISTING BY:
PROPOSED BY:
LAST CORRECTION BY:

CONTRACT NO. 1-100-100-0000
APRIL 1999

FILE NAME: 1 2 3 4 5 6 7 8 9 10 11 12 13 14 15 16 17 18 19 20 21 22 23 24 25 26 27 28 29 30 31 32 33 34 35 36 37 38 39 40 41 42 43 44 45 46 47 48 49 50 51 52 53 54 55 56 57 58 59 60 61 62 63

18/07/96 Engineering Print


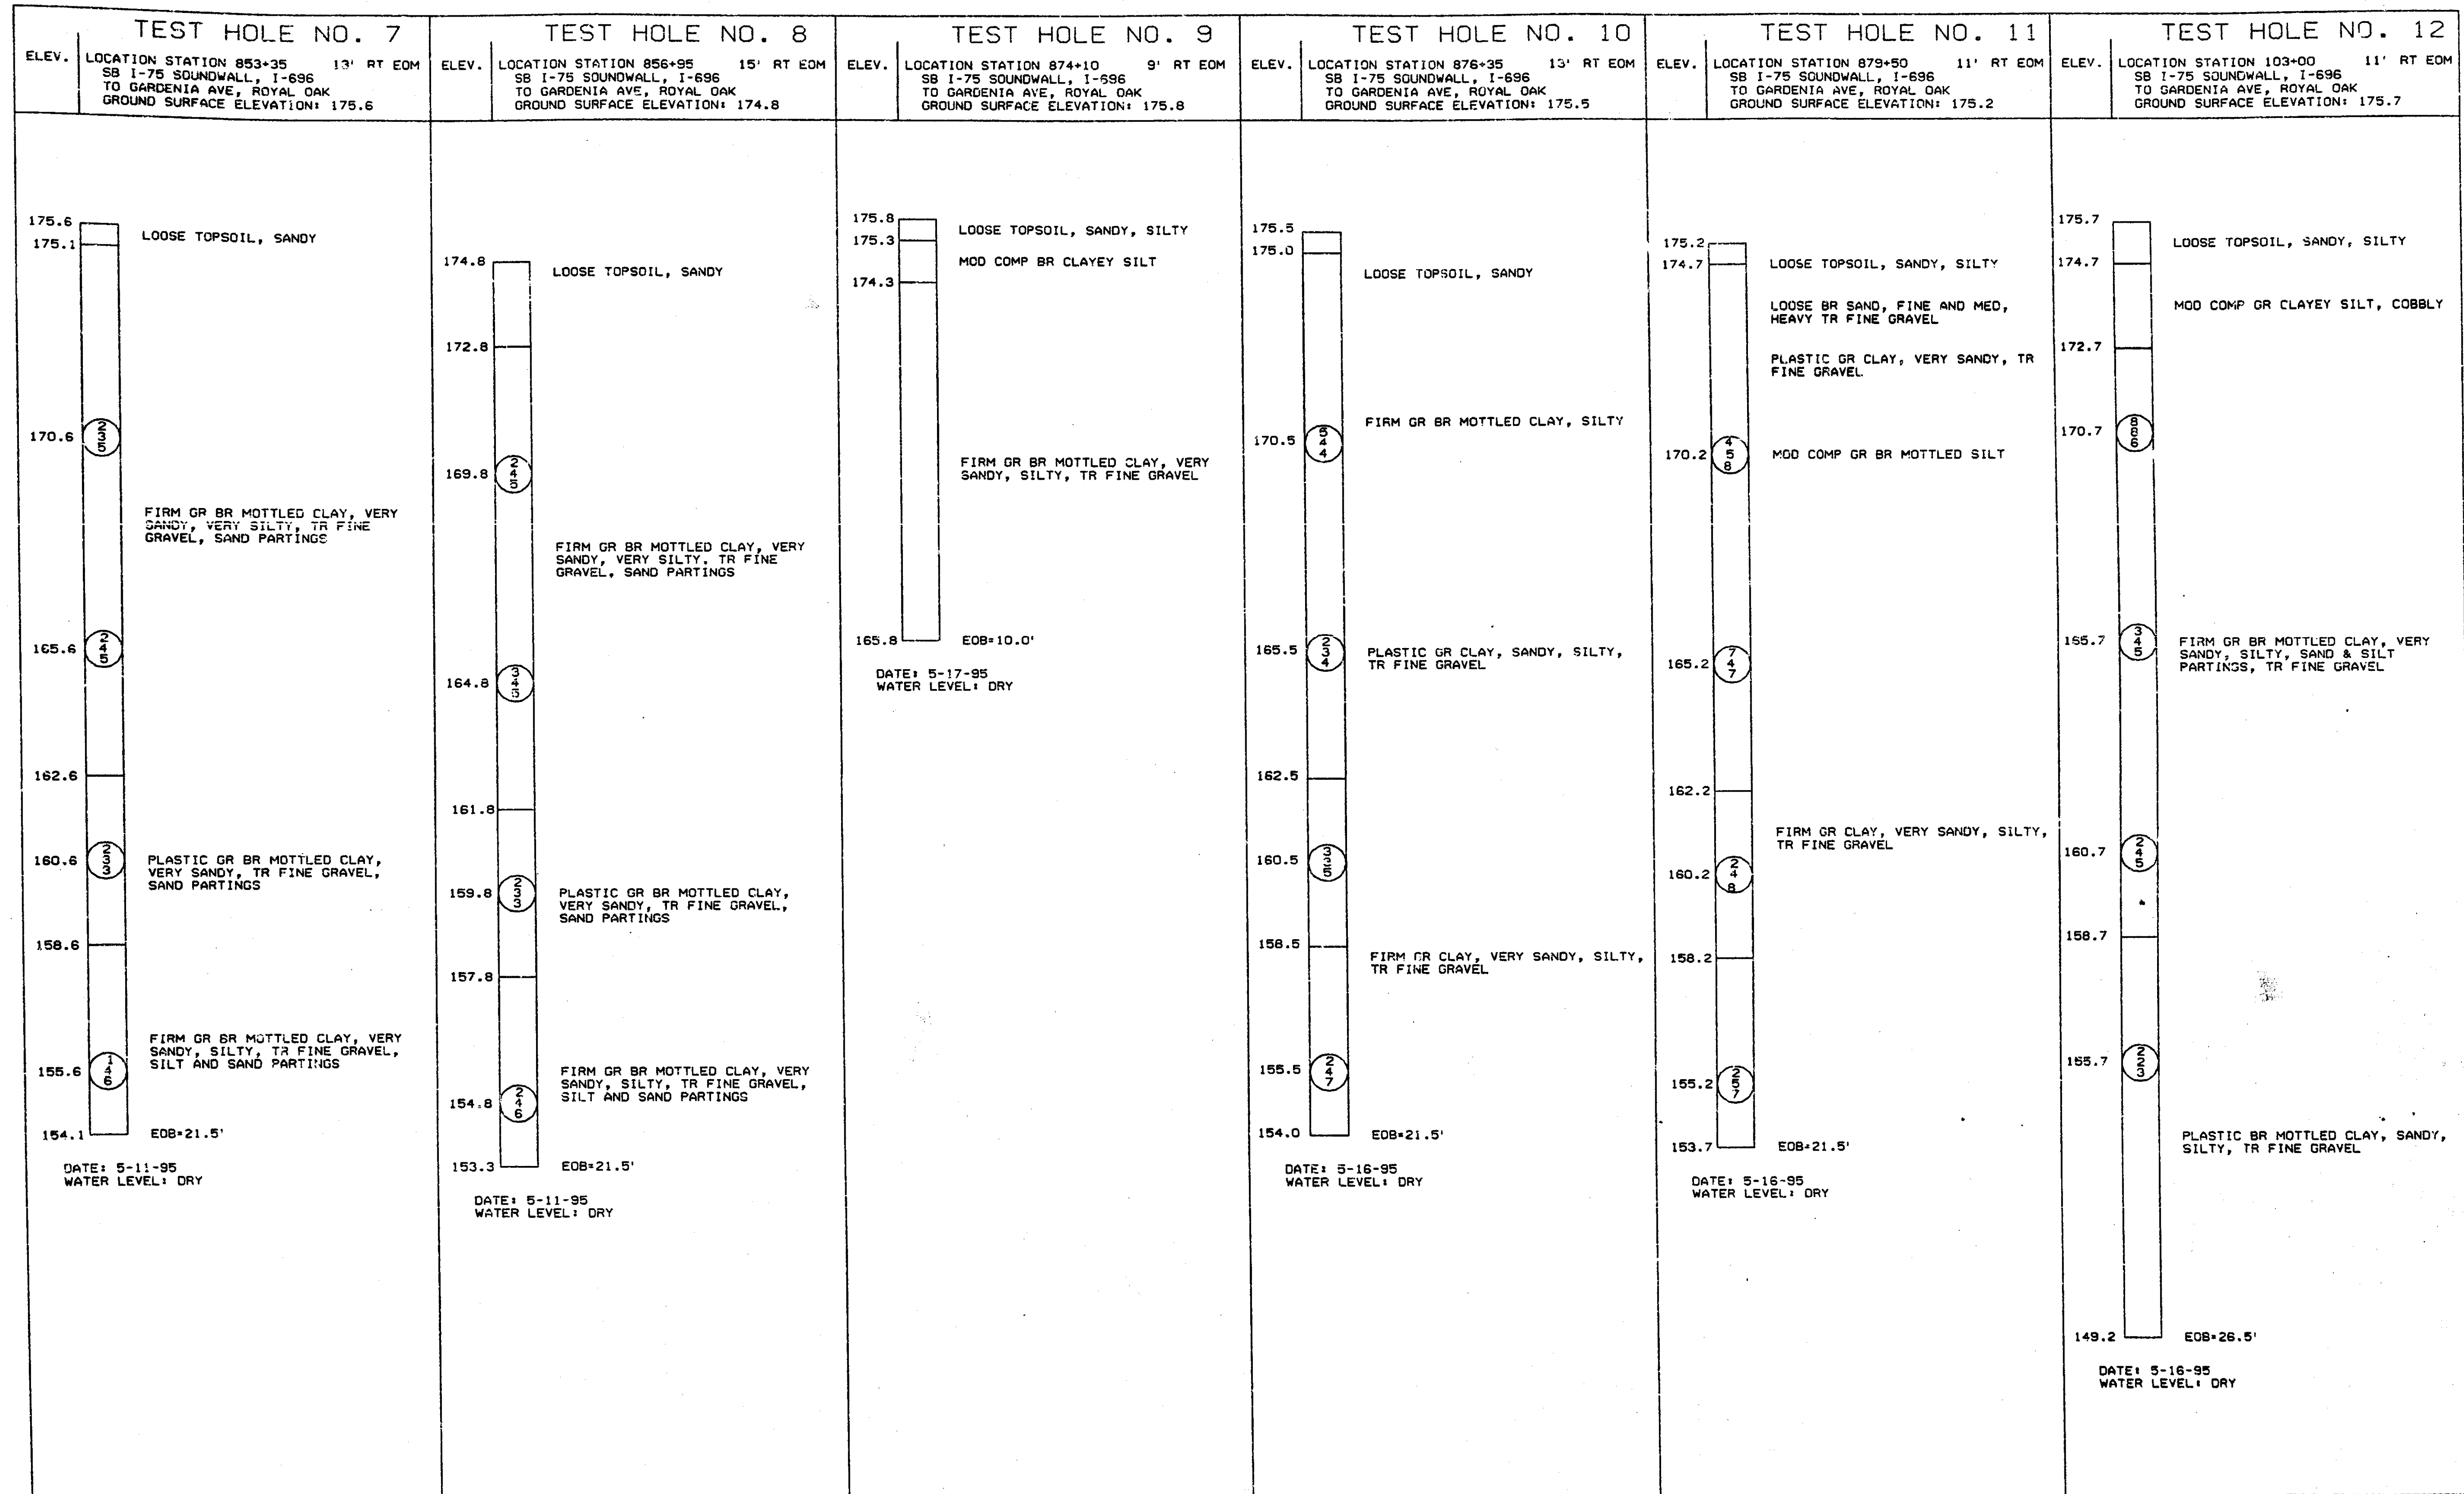


NUMBERS IN CIRCLES DENOTE NUMBER OF BLOWS REQUIRED TO DRIVE A 2.00" O.D. X 1.50" I.D. SPLIT SPOON SAMPLER 3 SUCCESSIVE 6" INCREMENTS USING A 140# HAMMER FALLING 30".

WATER LEVELS MAY BE INFLUENCED BY RESIDUAL BORING WATER

THE SOIL BORING LOGS REPRESENT POINT INFORMATION. PRESENTATION OF THIS INFORMATION IN NO WAY IMPLIES THAT THE SUBSURFACE CONDITIONS ARE THE SAME AT LOCATIONS OTHER THAN THE EXACT LOCATION OF THE BORING.

CONSISTENCY DETERMINED BY INSPECTION OF SAMPLES AND BY SOIL RESISTANCE TO PENETRATION BY JET ROD AND CASING OR AUGER.

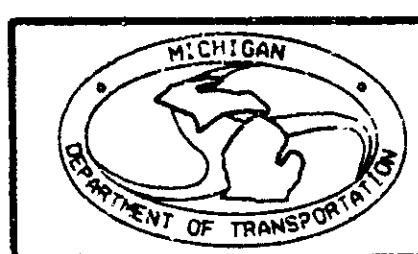
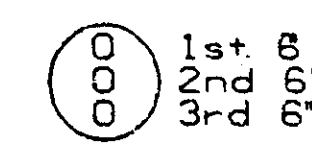


SOIL BORING SHEET					
DATE	SCALE	CONT. SEC.	JOB NO.	DESIGN UNIT	SHEET NO.
06/20/95	1" =	63174	23749 A	PENA	R.O.W. CONST. 39


DATE: DATE:
DATE: DATE:

EXISTING BY:
PROPOSED BY:
LAST CORRECTION BY:

FILE NAME: 1 2 3 4 5 6 7 8 9 10 11 12 13 14 15 16 17 18 19 20 21 22 23 24 25 26 27 28 29 30 31 32 33 34 35 36 37 38 39 40 41 42 43 44 45 46 47 48 49 50 51 52 53 54 55 56 57 58 59 60 61 62 63
 6661 TRGV SWVI RUP ST CILCUMLSO
 1997 APR 11 10 55 AM

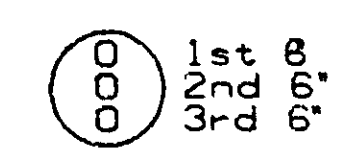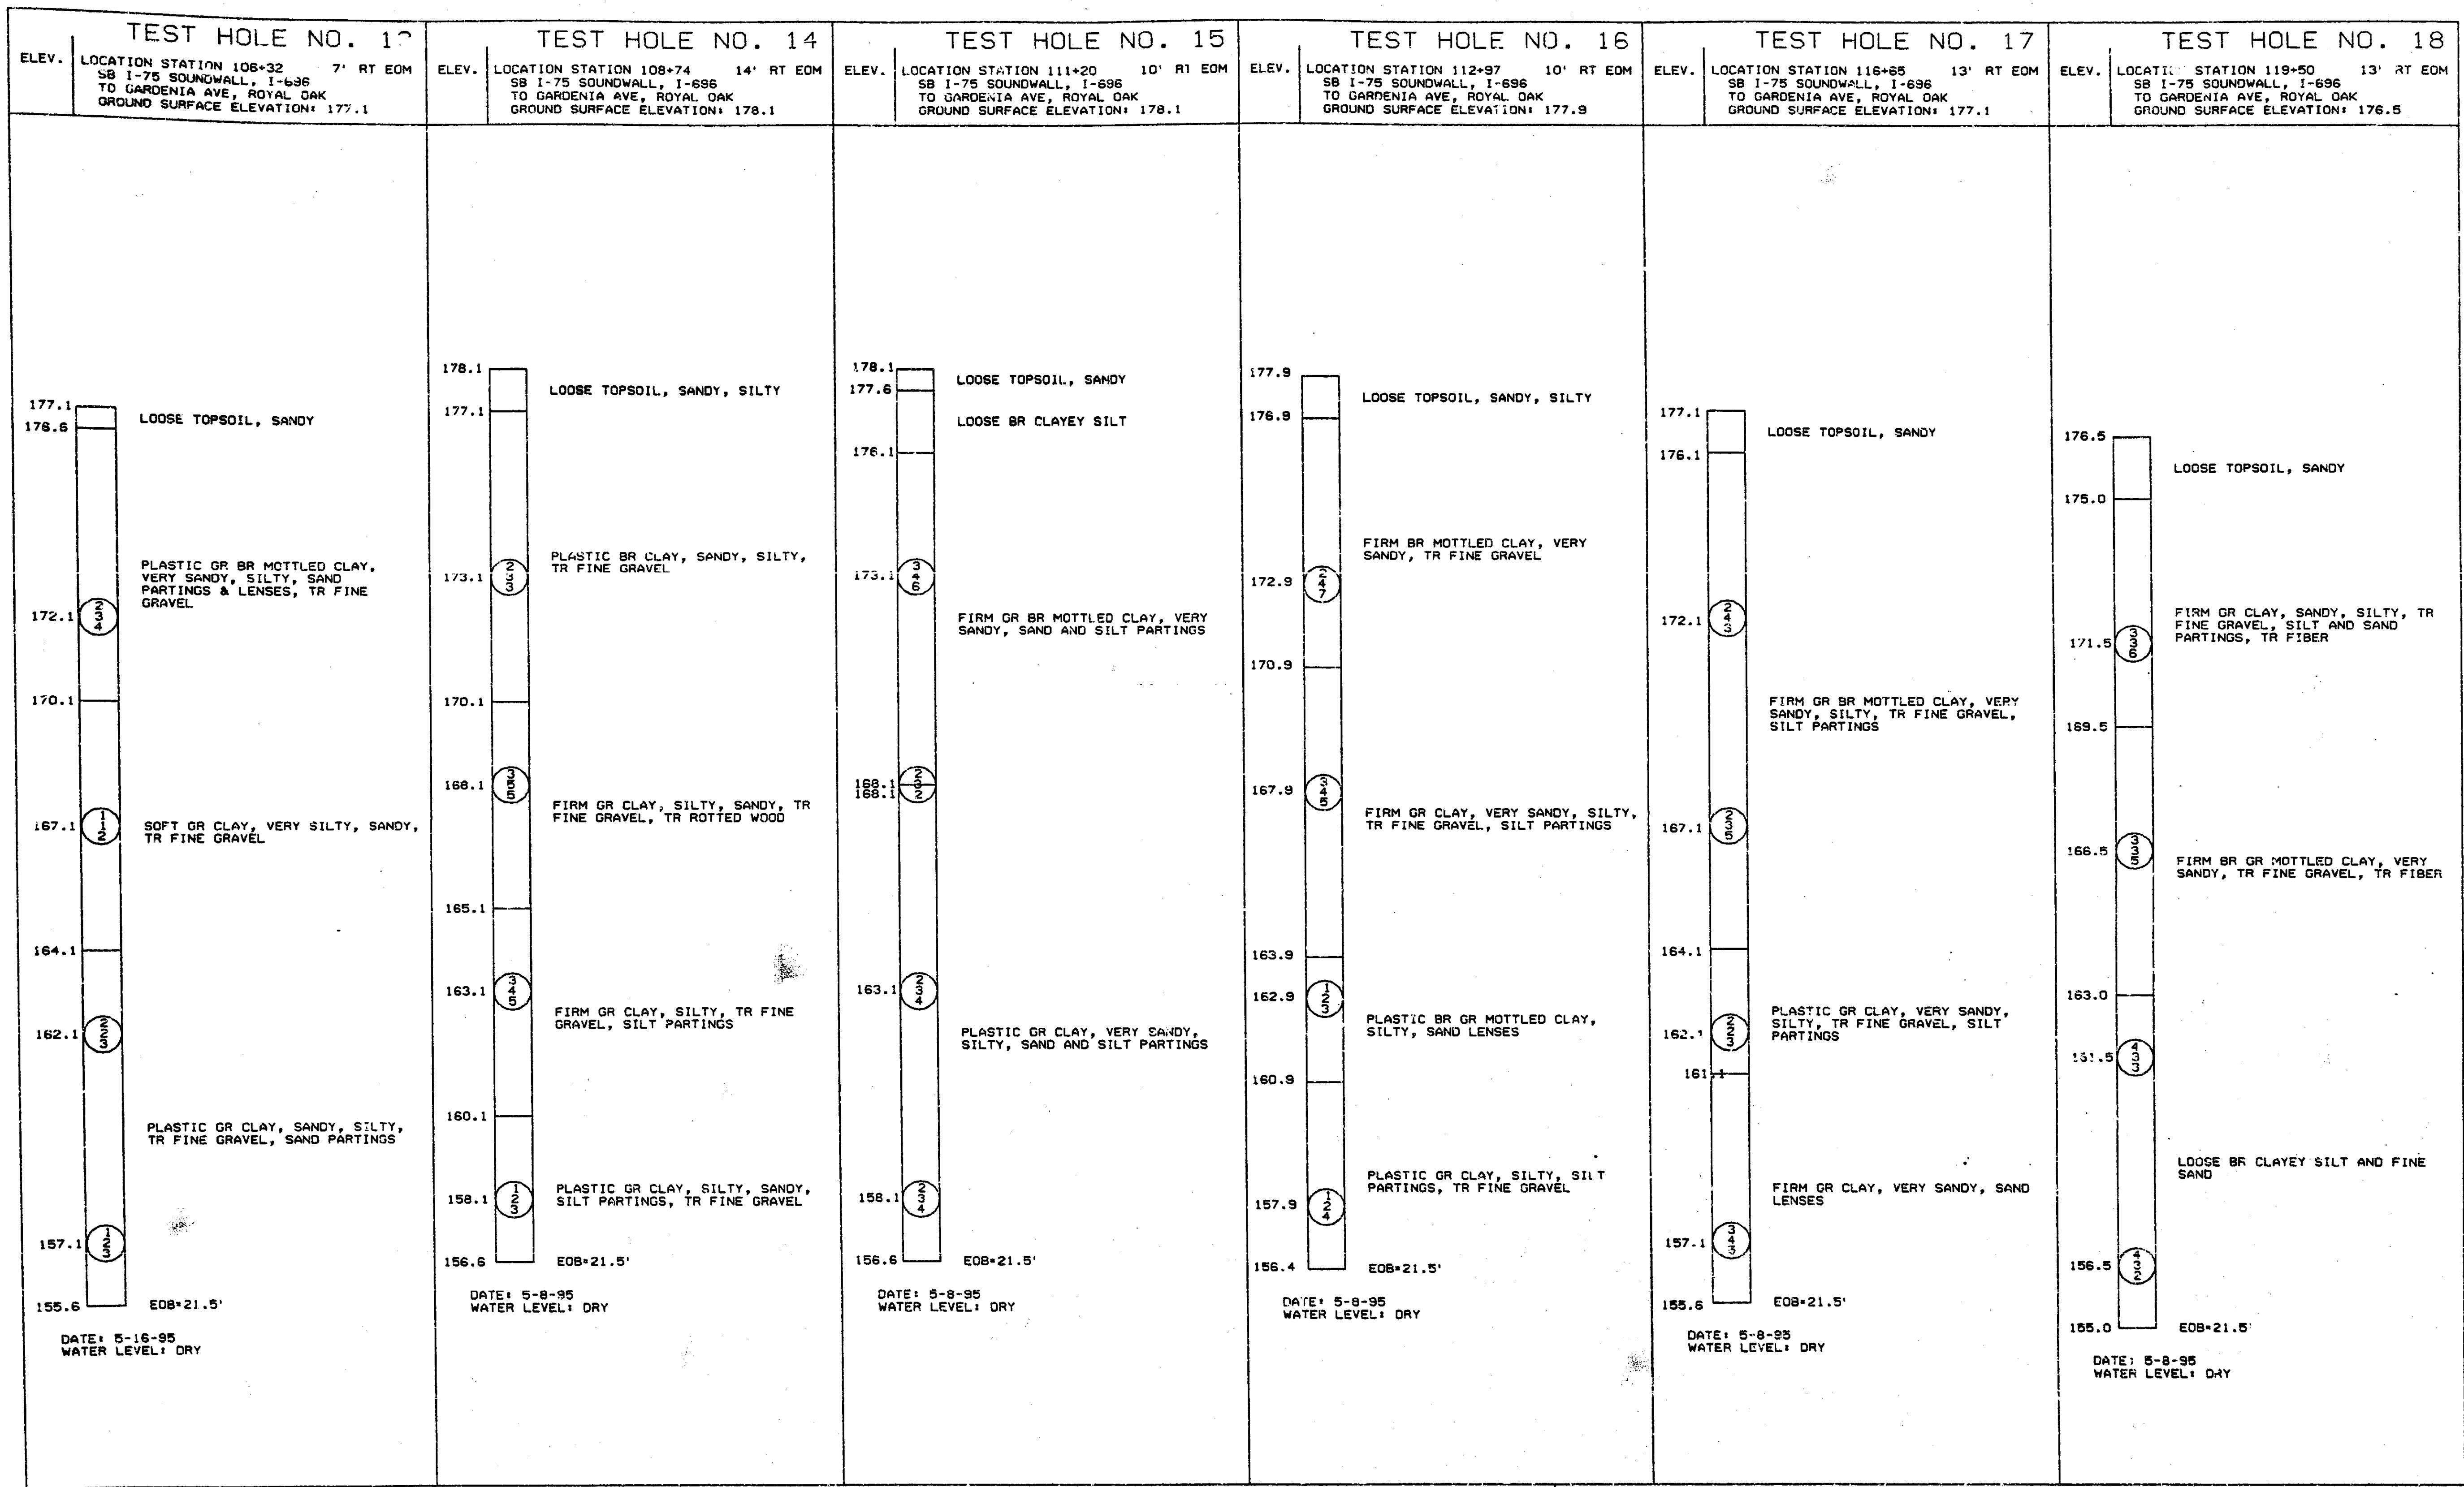

NUMBERS IN CIRCLES DENOTE NUMBER OF BLOWS REQUIRED TO DRIVE A 2.00" O.D. X 1.50" I.D. SPLIT SPOON SAMPLER 3 SUCCESSIVE 6" INCREMENTS USING A 140# HAMMER FALLING 30".
 CONSISTENCY DETERMINED BY INSPECTION OF SAMPLES AND BY SOIL RESISTANCE TO PENETRATION BY JET ROD AND CASING OR AUGER.
 WATER LEVELS MAY BE INFLUENCED BY RESIDUAL BORING WATER
 THE SOIL BORING LOGS REPRESENT POINT INFORMATION. PRESENTATION OF THIS INFORMATION IN NO WAY IMPLIES THAT THE SUBSURFACE CONDITIONS ARE THE SAME AT LOCATIONS OTHER THAN THE EXACT LOCATION OF THE BORING.

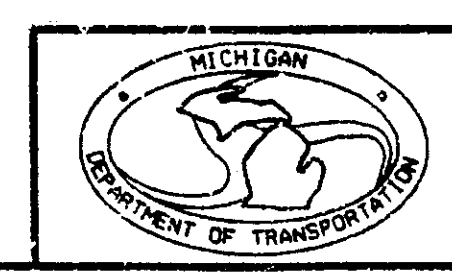



SOIL BORING SHEET					
DATE	SCALE	CONT. SEC.	JOB NO.	DESIGN UNIT	SHEET NO.
06/20/95	1" =	63174	23749 A	PENA	39

10/8/96 Engineering Print

UNRESTRICTED AS PER PLANS APRIL 1989

THE POST OFFSET DIMENSIONS ARE GIVEN TO THE CENTER OF THE TRAFFIC FACE OF THE WOOD OFFSET BLOCKS. EXCEPT FOR THE FIRST AND SECOND POSTS WHICH ARE GIVEN TO THE CENTER OF THE TRAFFIC FACE OF THE POST. OFFSET POINTS ARE TO BE LOCATED BY CHORD MEASUREMENTS AT THE BACK OF THE RAIL EQUAL TO THE NOMINAL POST SPACINGS SPECIFIED. POSTS ARE TO BE SET APPROXIMATELY TANGENT TO THE BEAM ELEMENT AT EACH POST LOCATION.

POST	POST OFFSET DISTANCE
1	4.0'
2	2.8'
3	1.8'
4	1.4'
5	1.0'
6	0.7'
7	0.5'
8	0.25'
9	0.1'
10	0.04'
11	0
12	0

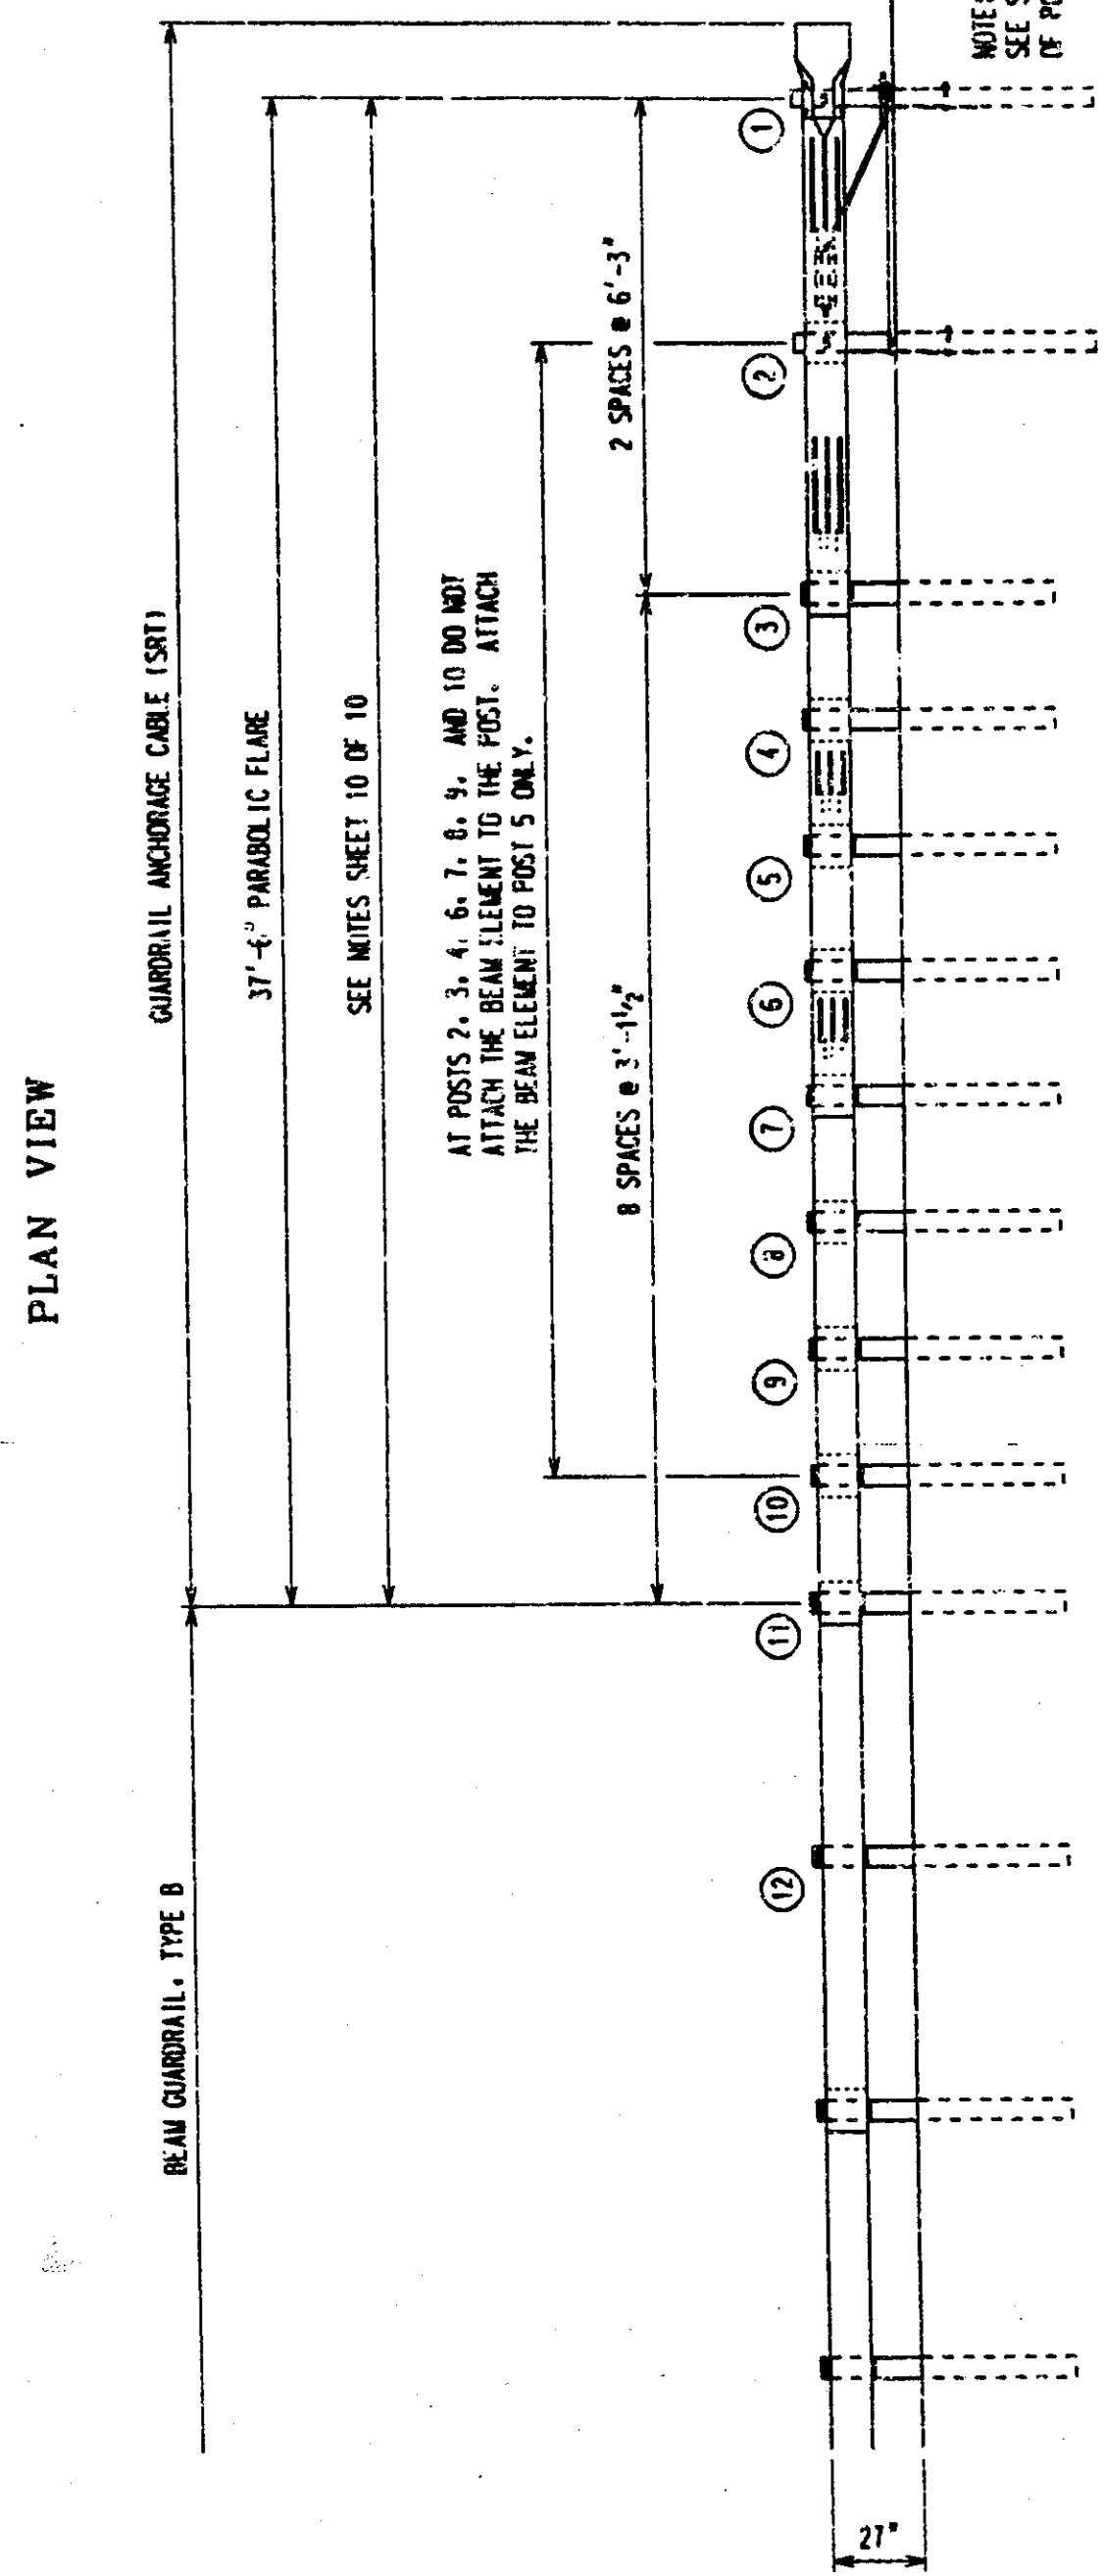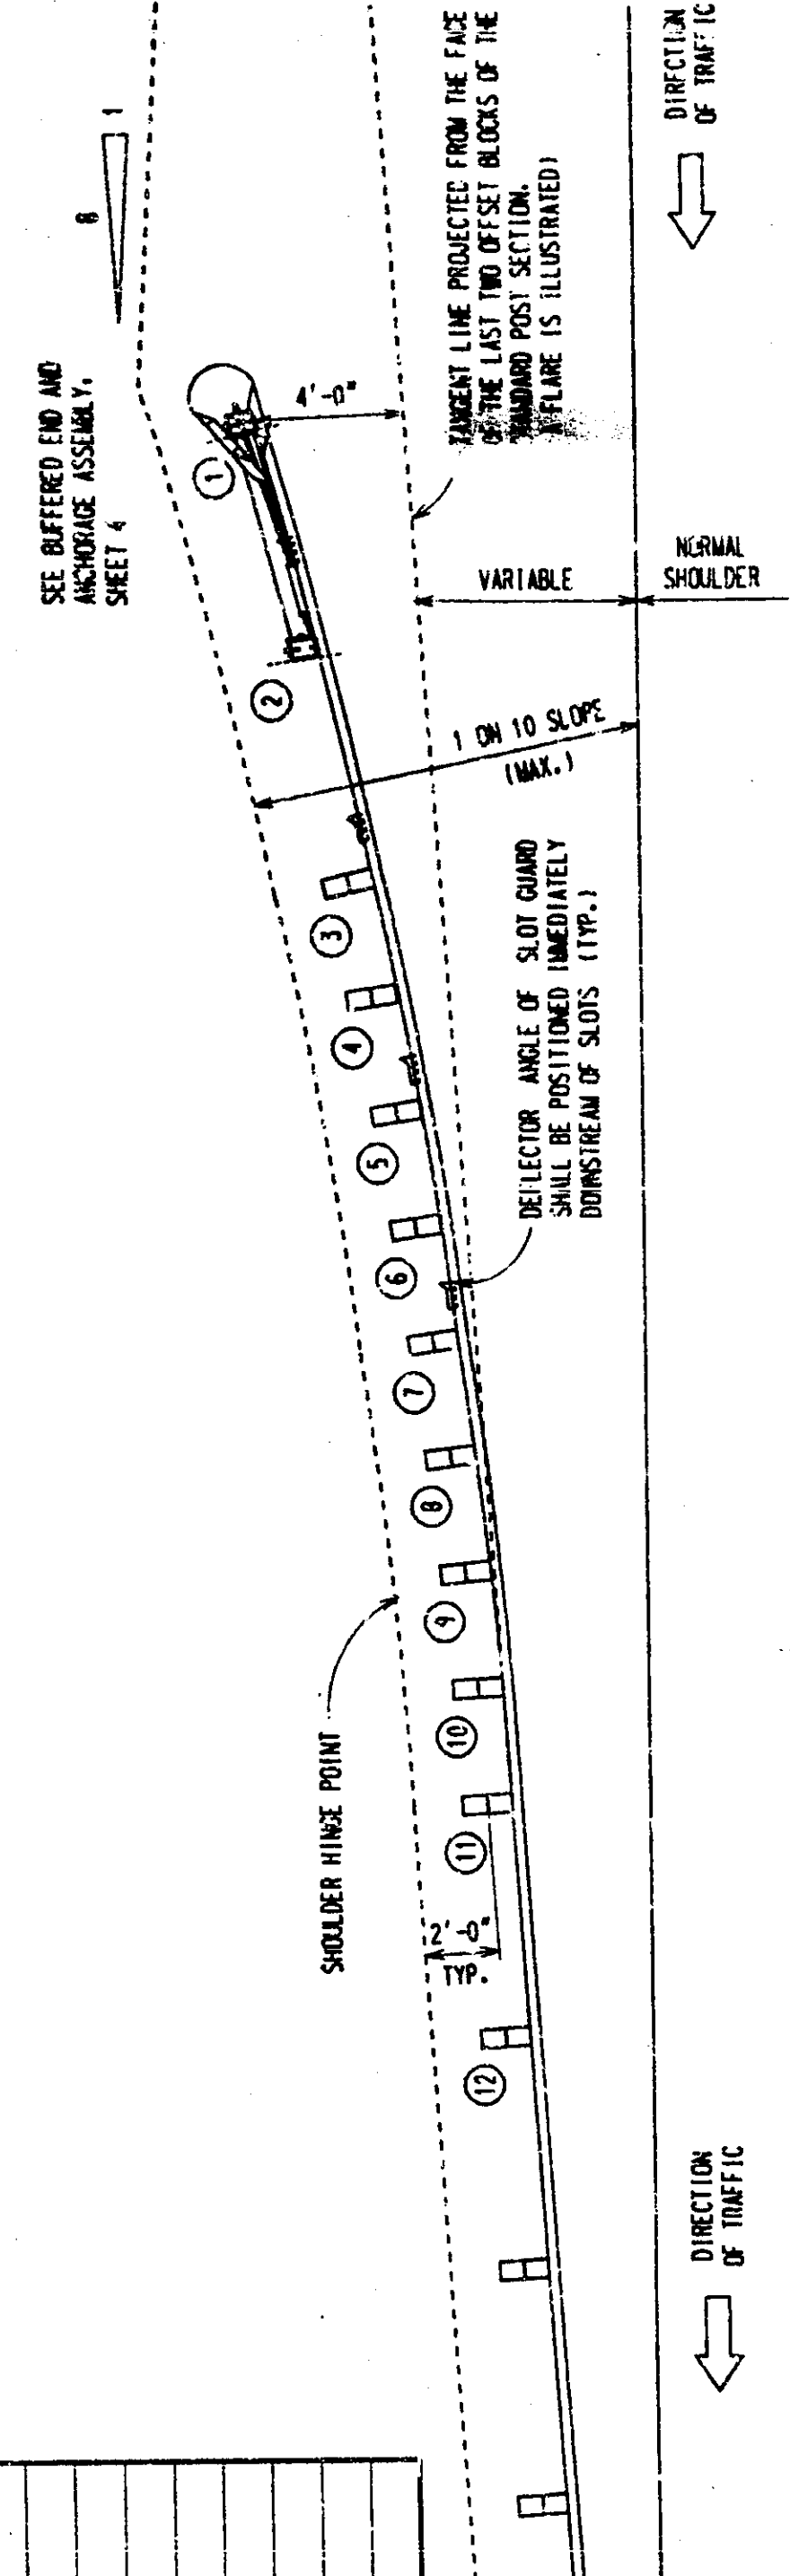

APPROACH END OF GUARDRAIL ANCHORAGE, CABLE FOR BEAM GUARDRAIL, TYPE B

<p>PREPARED BY DESIGN DIVISION</p> <p>DRAWN BY: B.L.T.</p> <p>CHECKED BY: W.K.P.</p>	ENGINEER OF CONSTRUCTION	ENGINEER - ROAD DESIGN
	ENGINEER OF MAINTENANCE	ENGINEER OF DESIGN
	ENGINEER OF MATERIALS & TECHNOLOGY	DEPARTMENT DIRECTOR ROBERT A. WELKE
	ENGINEER OF TRAFFIC AND SAFETY	BY: BUREAU DIRECTOR HIGHWAY TECHNICAL SERVICES

MICHIGAN DEPARTMENT OF TRANSPORTATION
BUREAU OF HIGHWAY TECHNICAL SERVICES STANDARD PLAN FOR

GUARDRAIL ENDING WITH CABLE ANCHORAGE (SRT)

F.H.W.A. APPROVAL



4-22-96
PLAN DATE

III-58N

SHEET 1 OF 10

THE POST OFFSET DIMENSIONS ARE GIVEN TO THE CENTER OF THE TRAFFIC FACE OF THE WOOD OFFSET BLOCKS. EXCEPT FOR THE FIRST AND SECOND POSTS WHICH ARE GIVEN TO THE CENTER OF THE TRAFFIC FACE OF THE POST. OFFSET POINTS ARE TO BE LOCATED BY CHORD MEASUREMENTS AT THE BACK OF THE RAIL EQUAL TO THE NOMINAL POST SPACINGS SPECIFIED. POSTS ARE TO BE SET APPROXIMATELY TANGENT TO THE BEAM ELEMENT AT EACH POST LOCATION.


POST	POST OFFSET DISTANCE
1	4.0'
2	2.8'
3	1.8'
4	1.4'
5	1.0'
6	0.7'
7	0.5'
8	0.25'
9	0.1'
10	0.04'
11	0
12	0

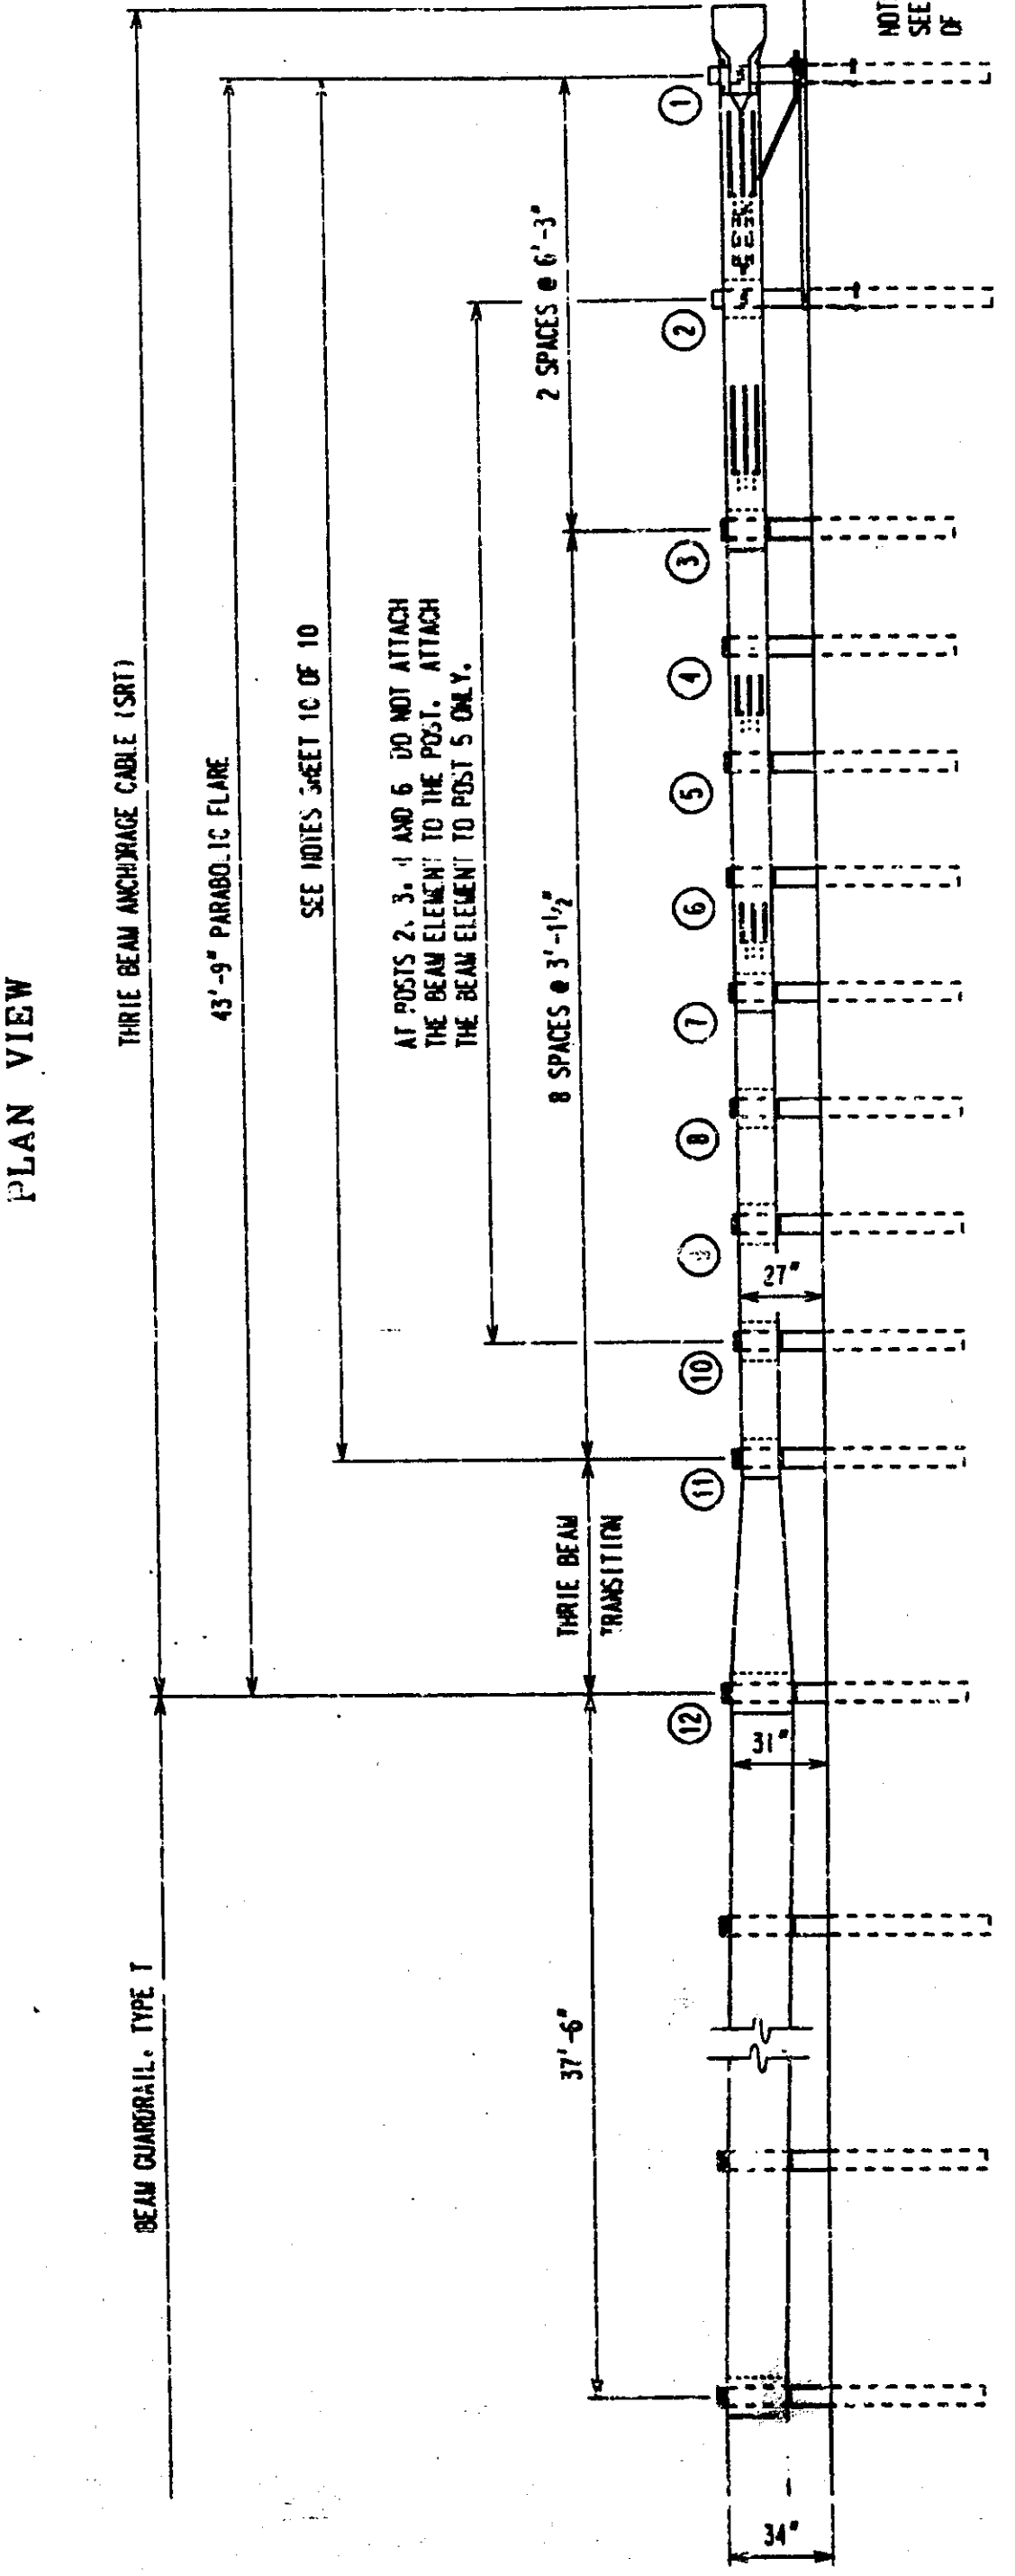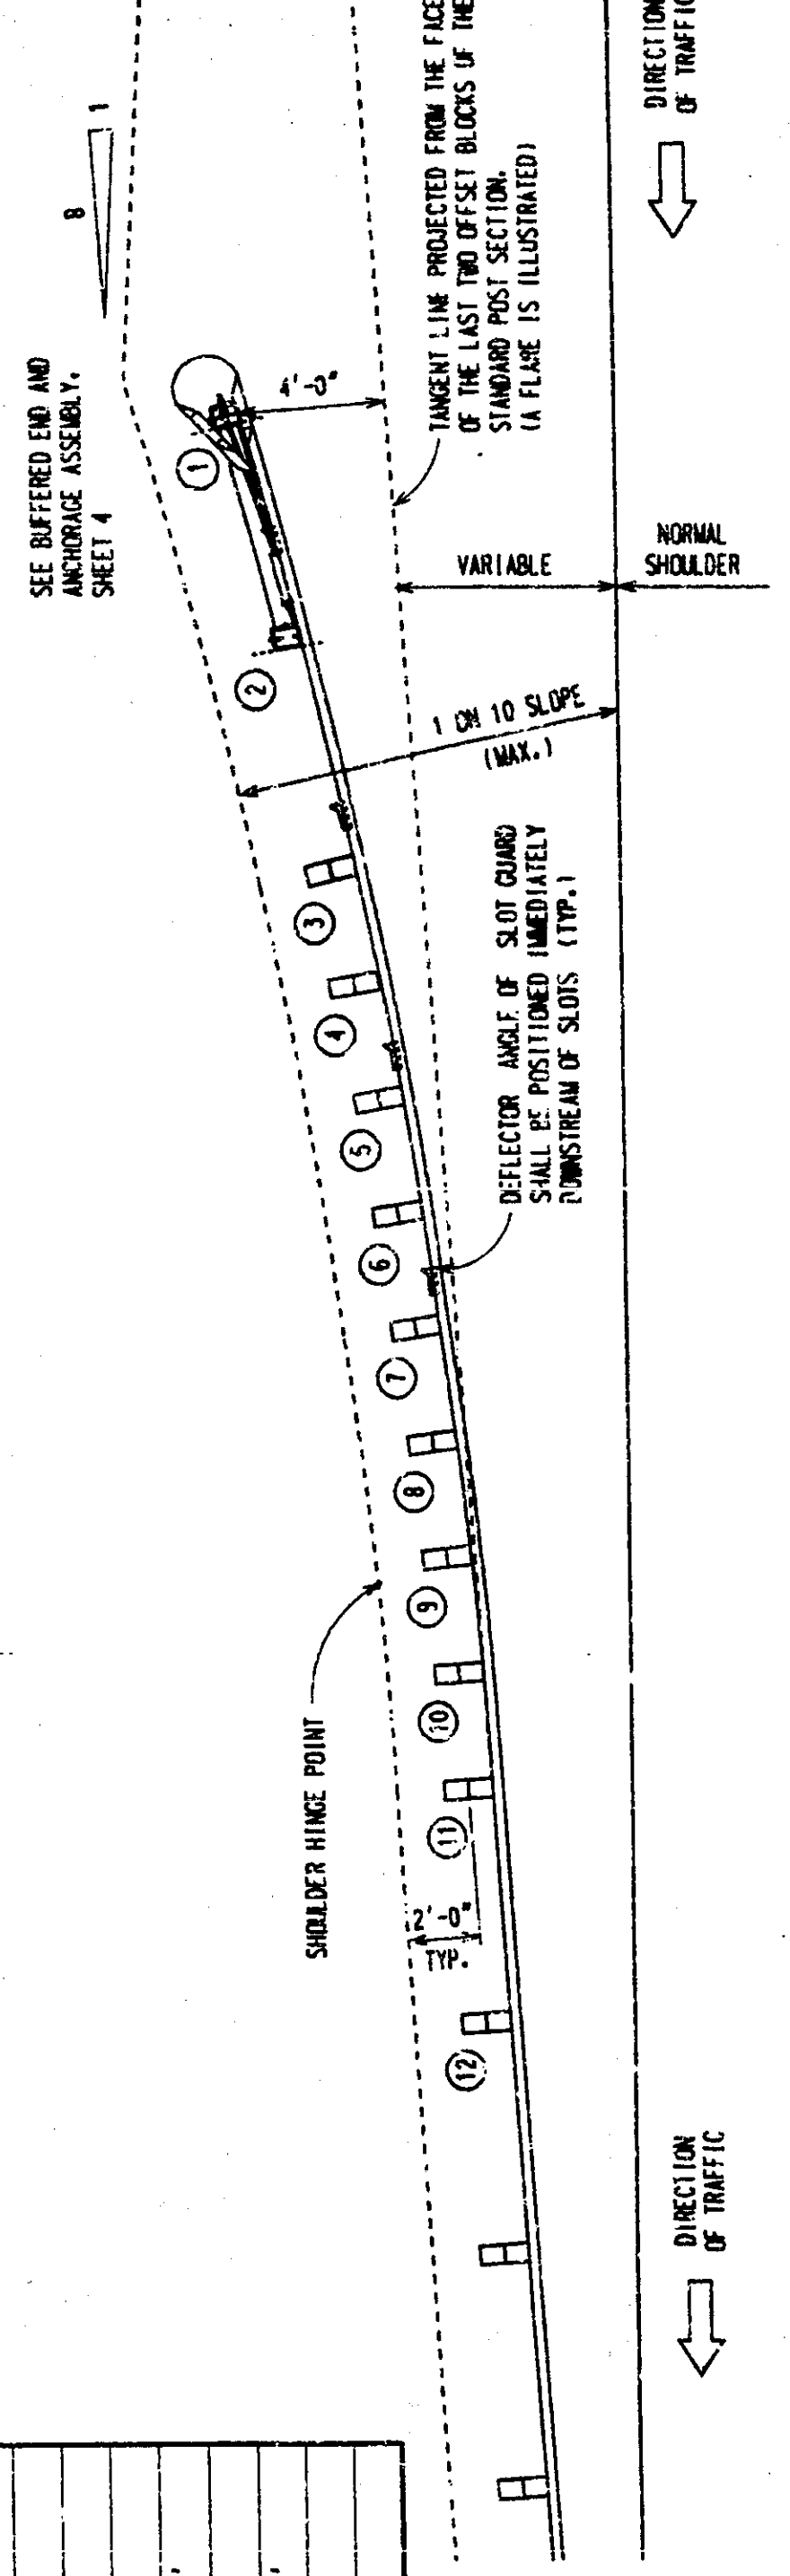


APPROACH END OF THRIE BEAM ANCHORAGE, CABLE FOR BEAM GUARDRAIL, TYPE T

MICHIGAN DEPARTMENT OF TRANSPORTATION BUREAU OF HIGHWAY TECHNICAL SERVICES STANDARD PLAN FOR			
GUARDRAIL ENDING WITH CABLE ANCHORAGE (SRT)			
F.H.W.A. APPROVAL	4-22-96 PLAN DATE	III-58N	SHEET 2 OF 10
CONTROL SECTION 63174	JOB NO. 23749A	SHEET NO. 40	

CORRECTED AS PER PLAN APRIL 1999

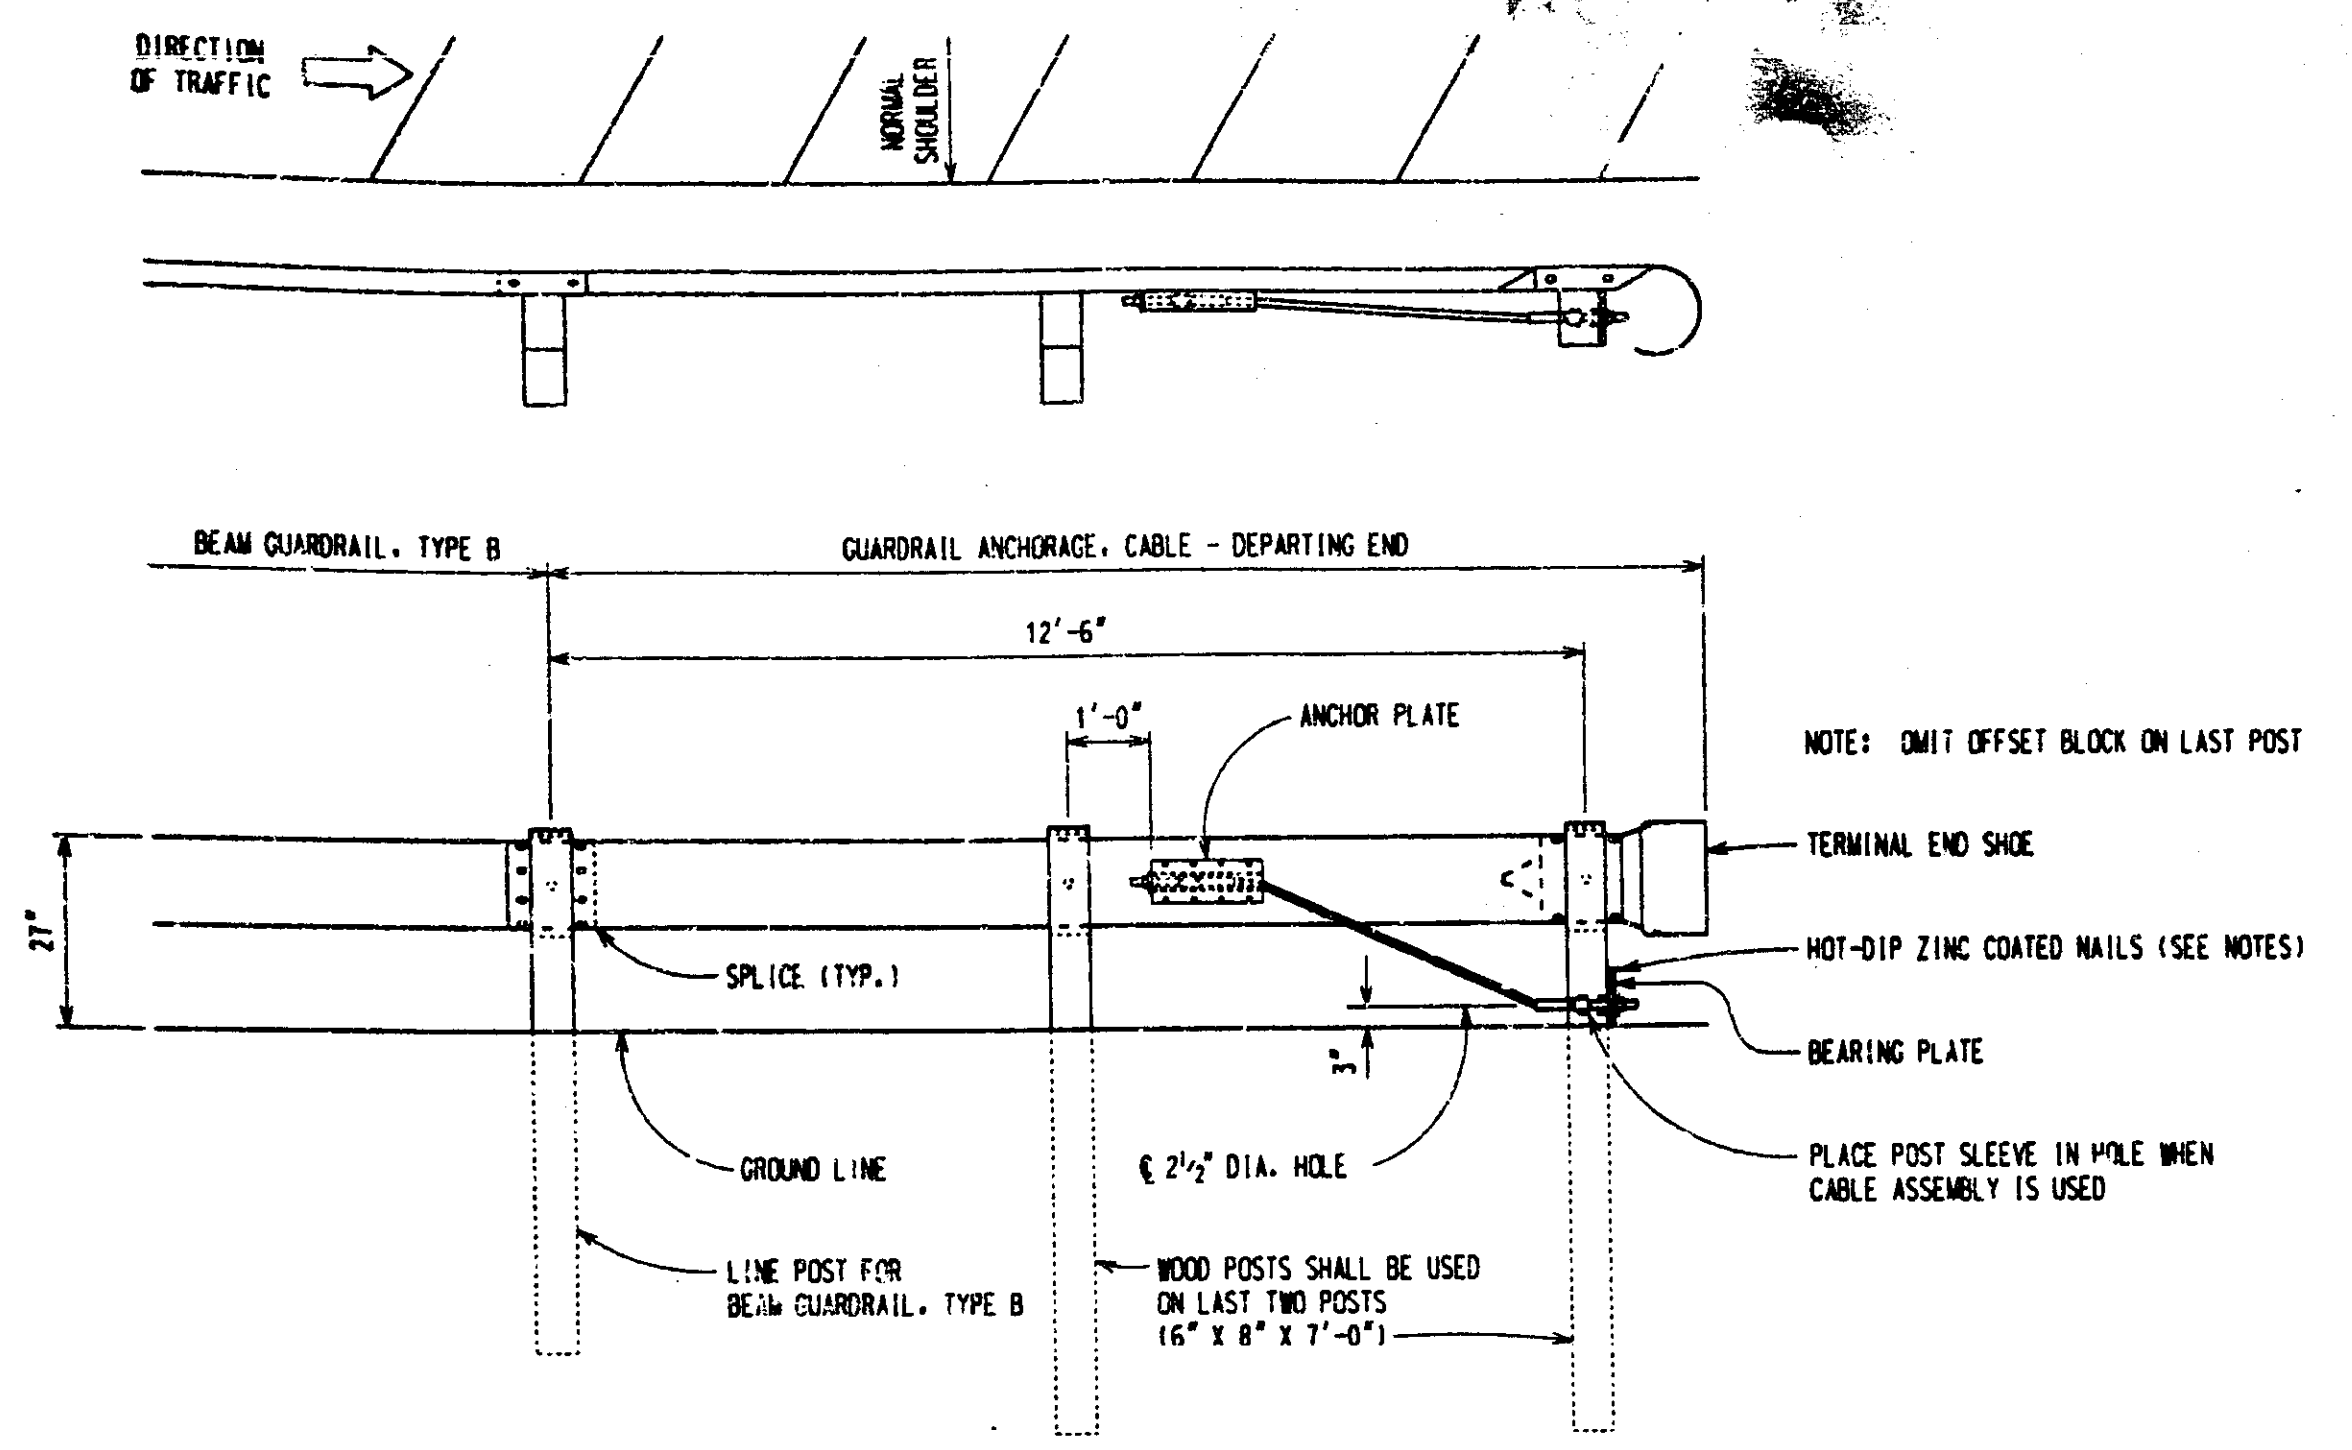

GUARDRAIL ANCHORAGE, CABLE - DEPARTING END
(ONE-WAY ROADWAYS ONLY)

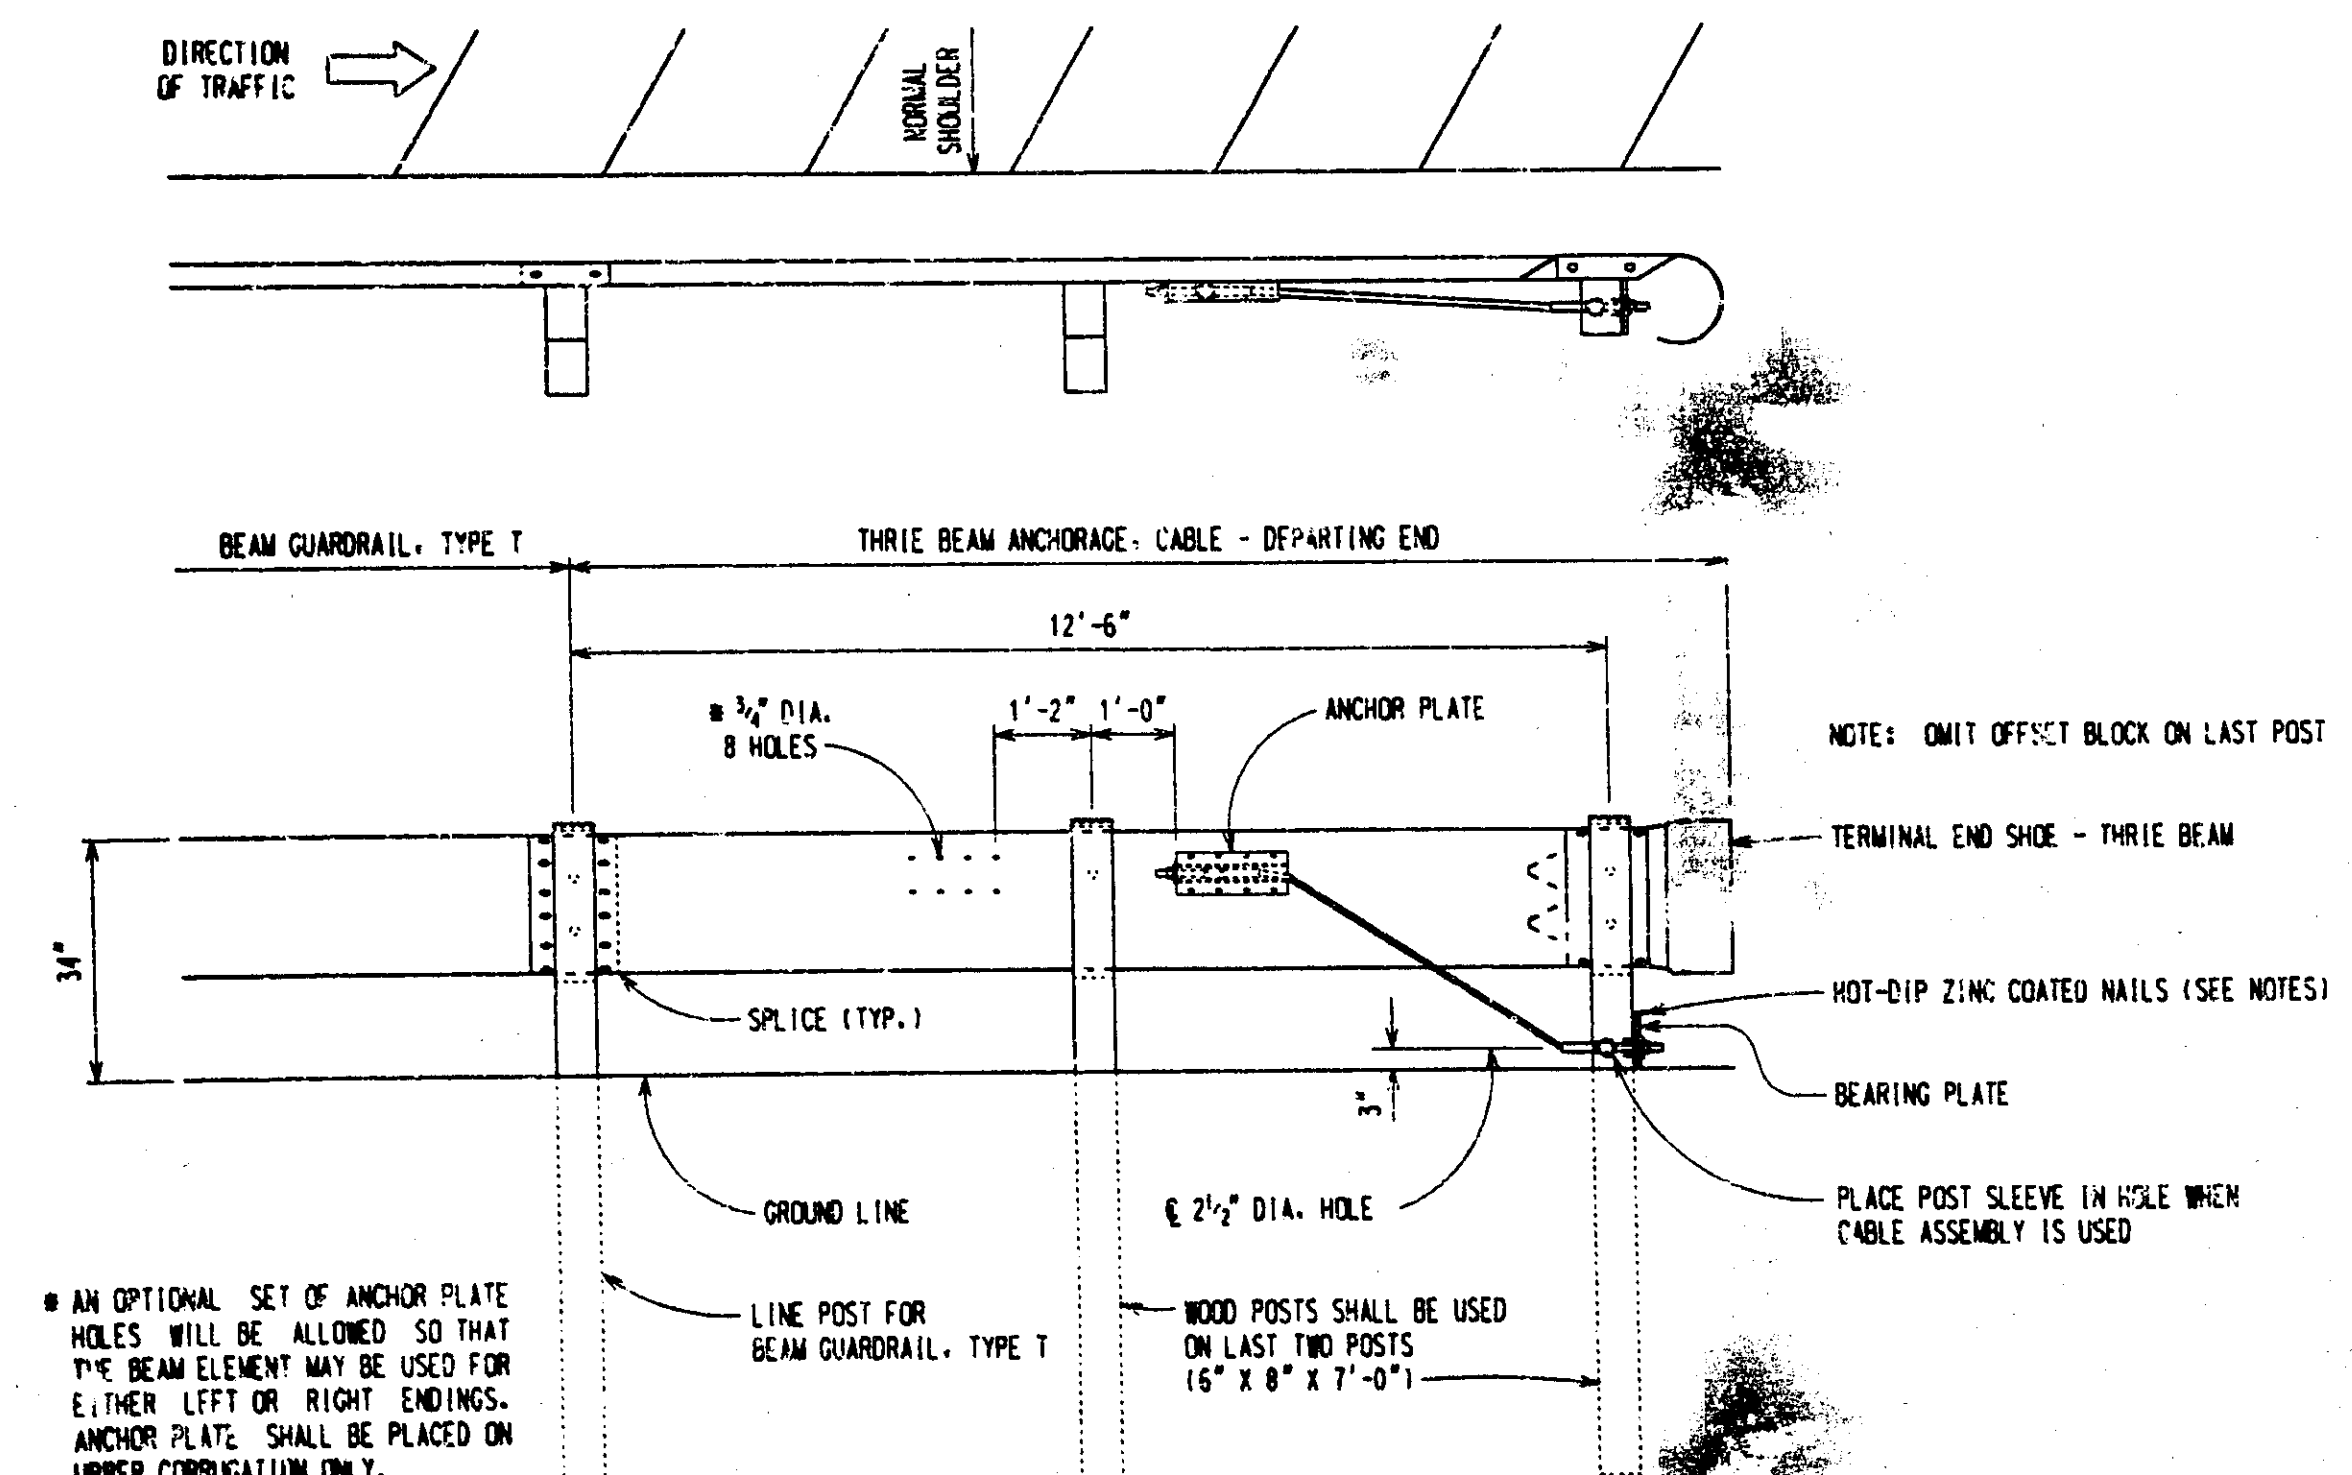


THRIE BEAM ANCHORAGE, CABLE - DEPARTING END
(ONE-WAY ROADWAYS ONLY)


MICHIGAN DEPARTMENT OF TRANSPORTATION
BUREAU OF HIGHWAY TECHNICAL SERVICES STANDARD PLAN FOR

GUARDRAIL ENDING WITH CABLE ANCHORAGE (SRT)

F.H.W.A. APPROVAL	4-22-96 PLAN DATE	III-58N	SHEET 3 OF 10
-------------------	----------------------	---------	------------------

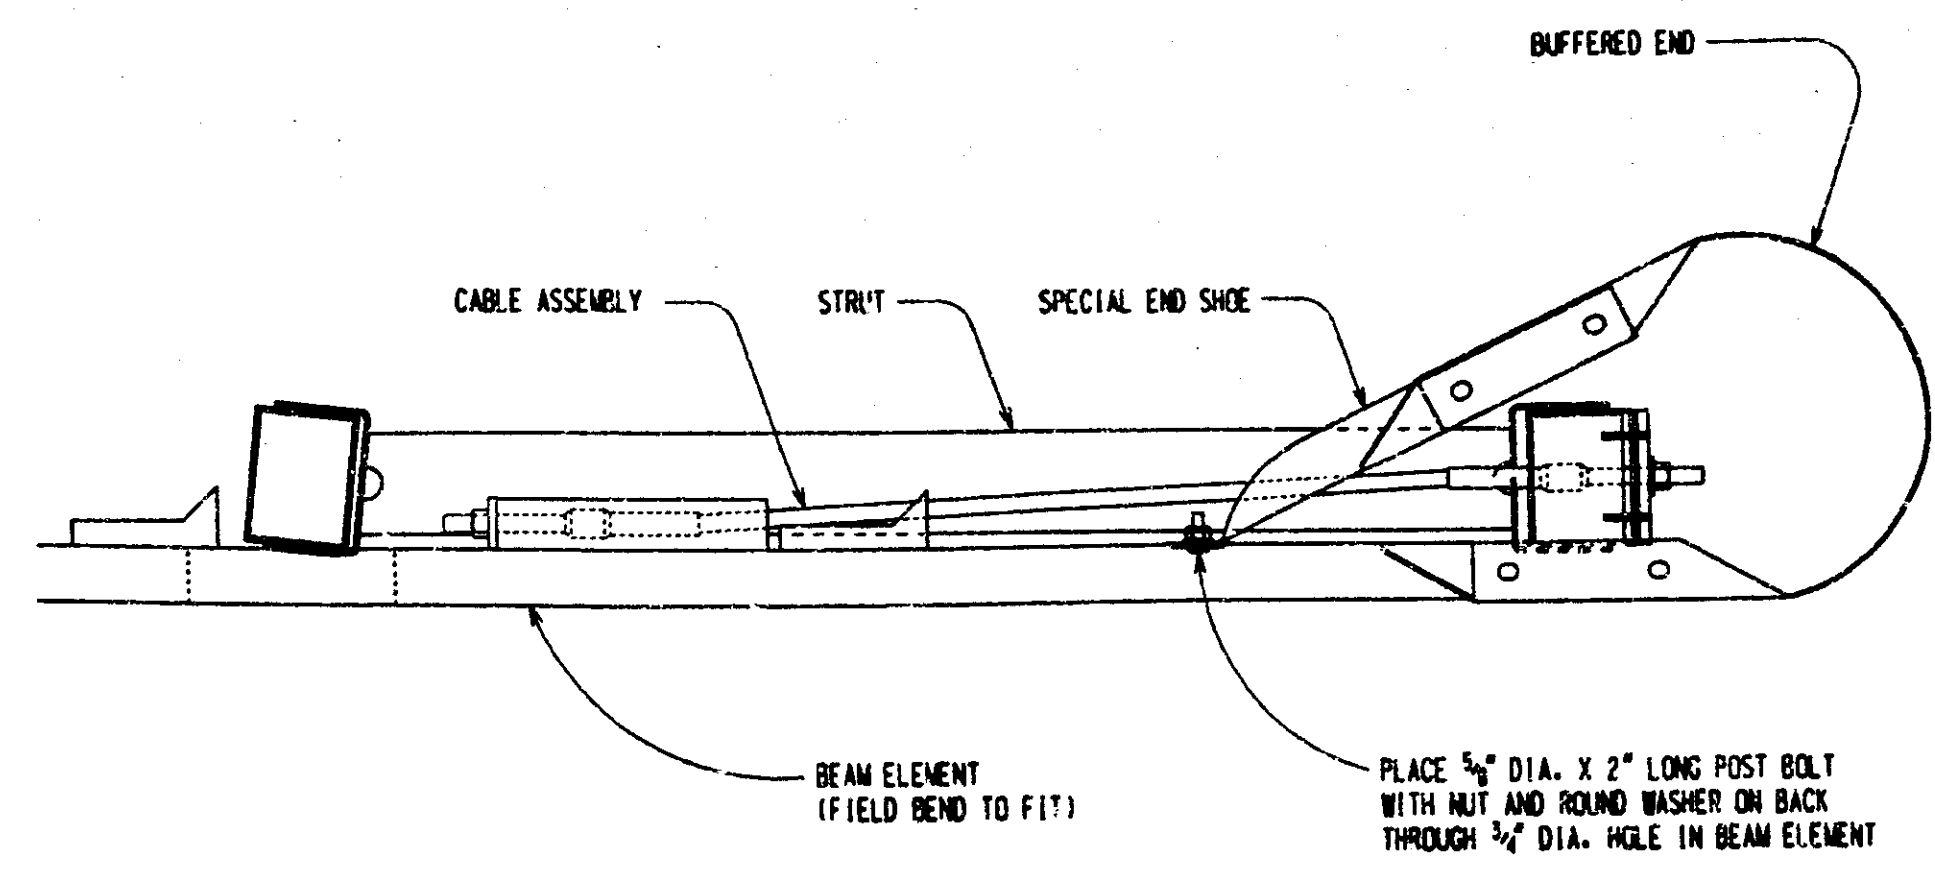

PLAN VIEW

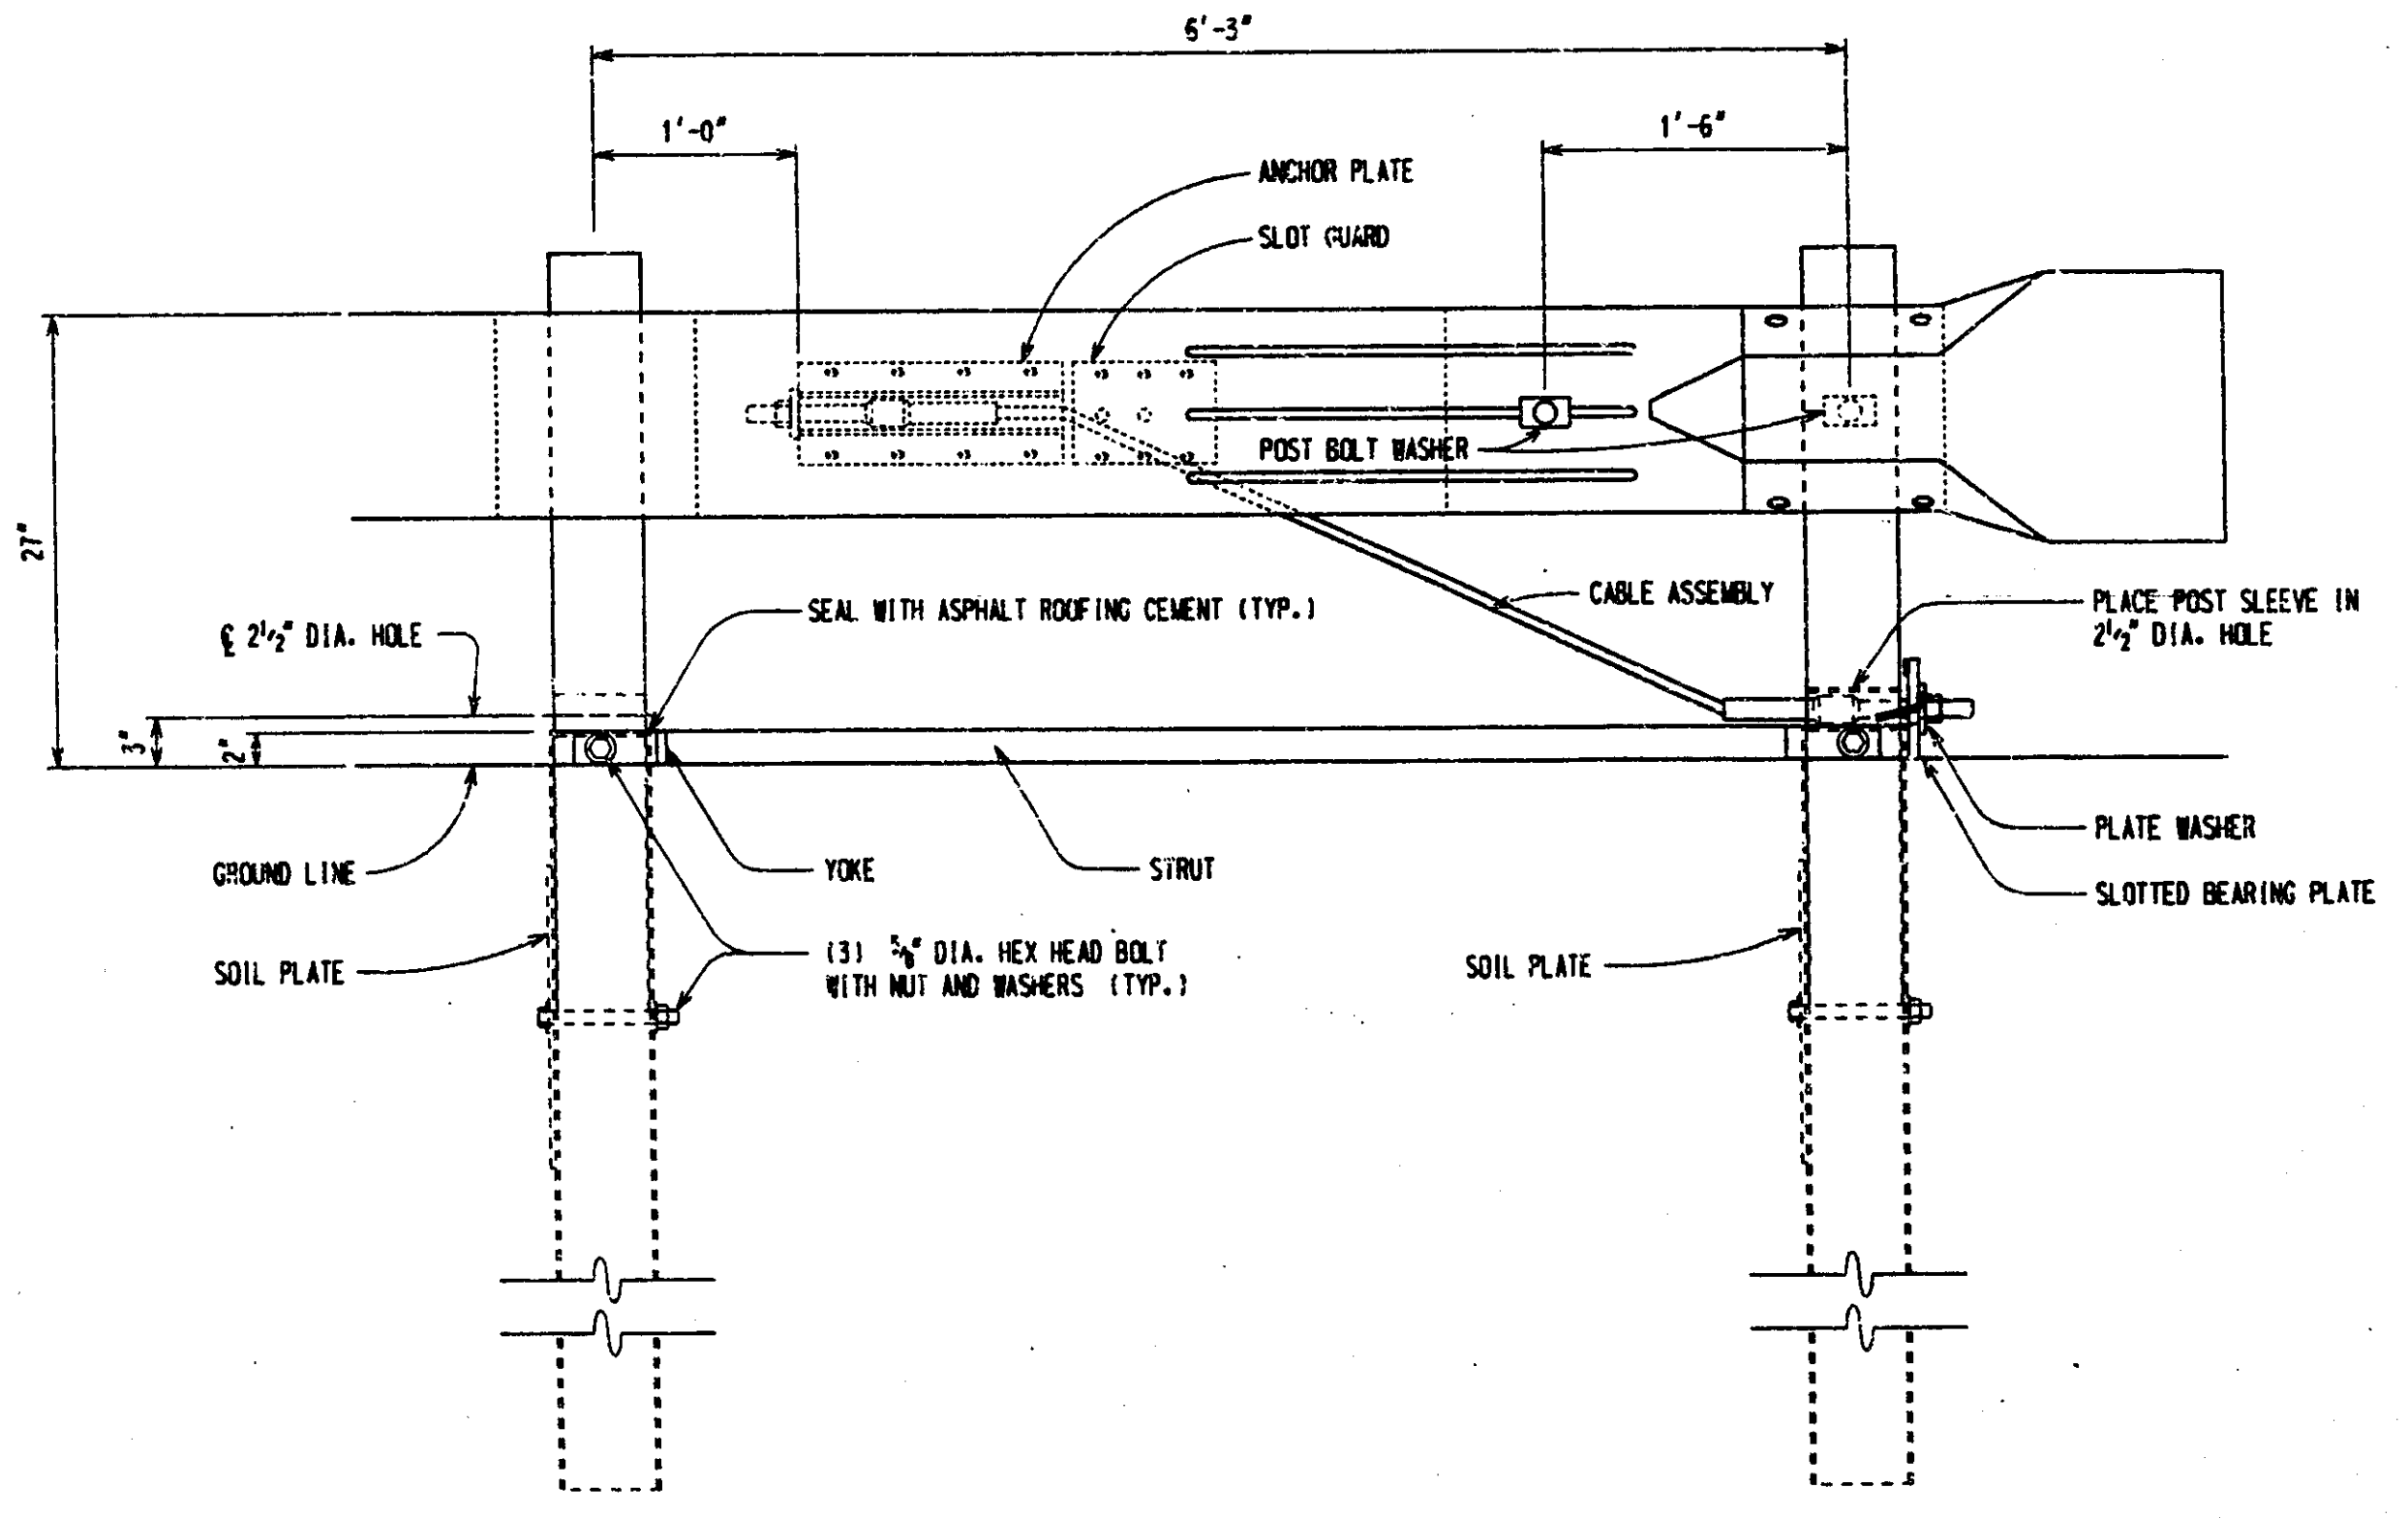

ELEVATION

BUFFERED END AND ANCHORAGE ASSEMBLY


MICHIGAN DEPARTMENT OF TRANSPORTATION
BUREAU OF HIGHWAY TECHNICAL SERVICES STANDARD PLAN FOR

GUARDRAIL ENDING WITH CABLE ANCHORAGE (SRT)


F.H.W.A. APPROVAL	4-22-96 PLAN DATE	III-58N	SHEET 4 OF 10
CONTROL SECTION 63174	JOB NO. 23749A	SHEET NO. 41	

10/07/96 Engineering Print


CONSTRUCTED FROM PLANS APRIL 1999

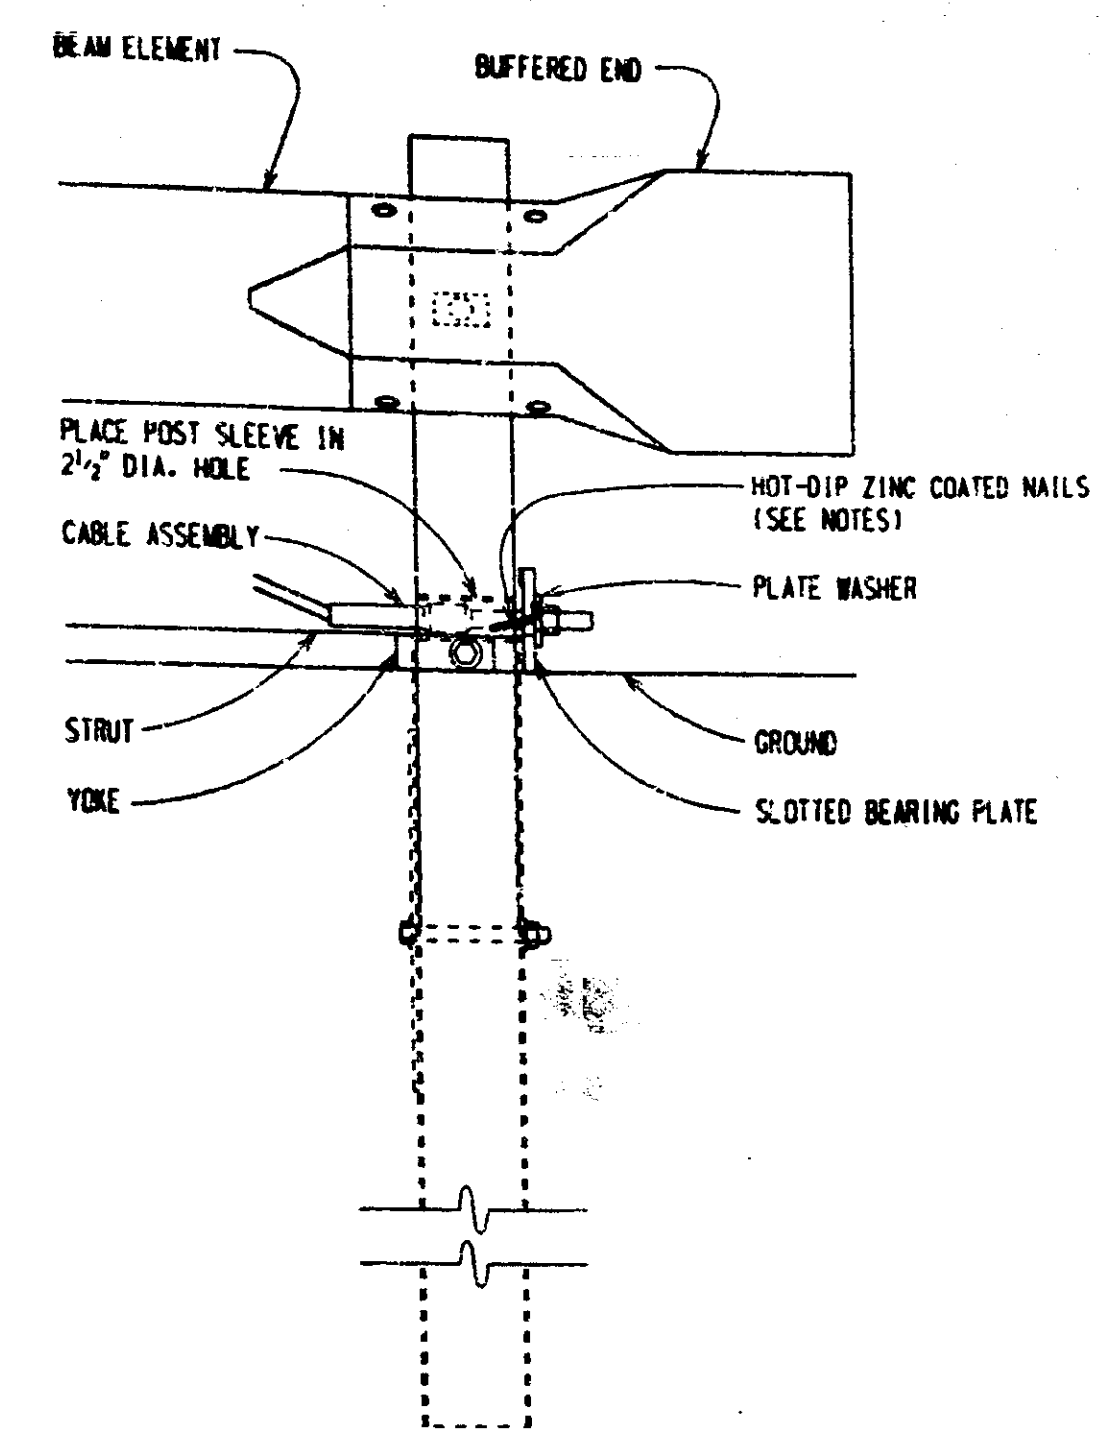

ELEVATION

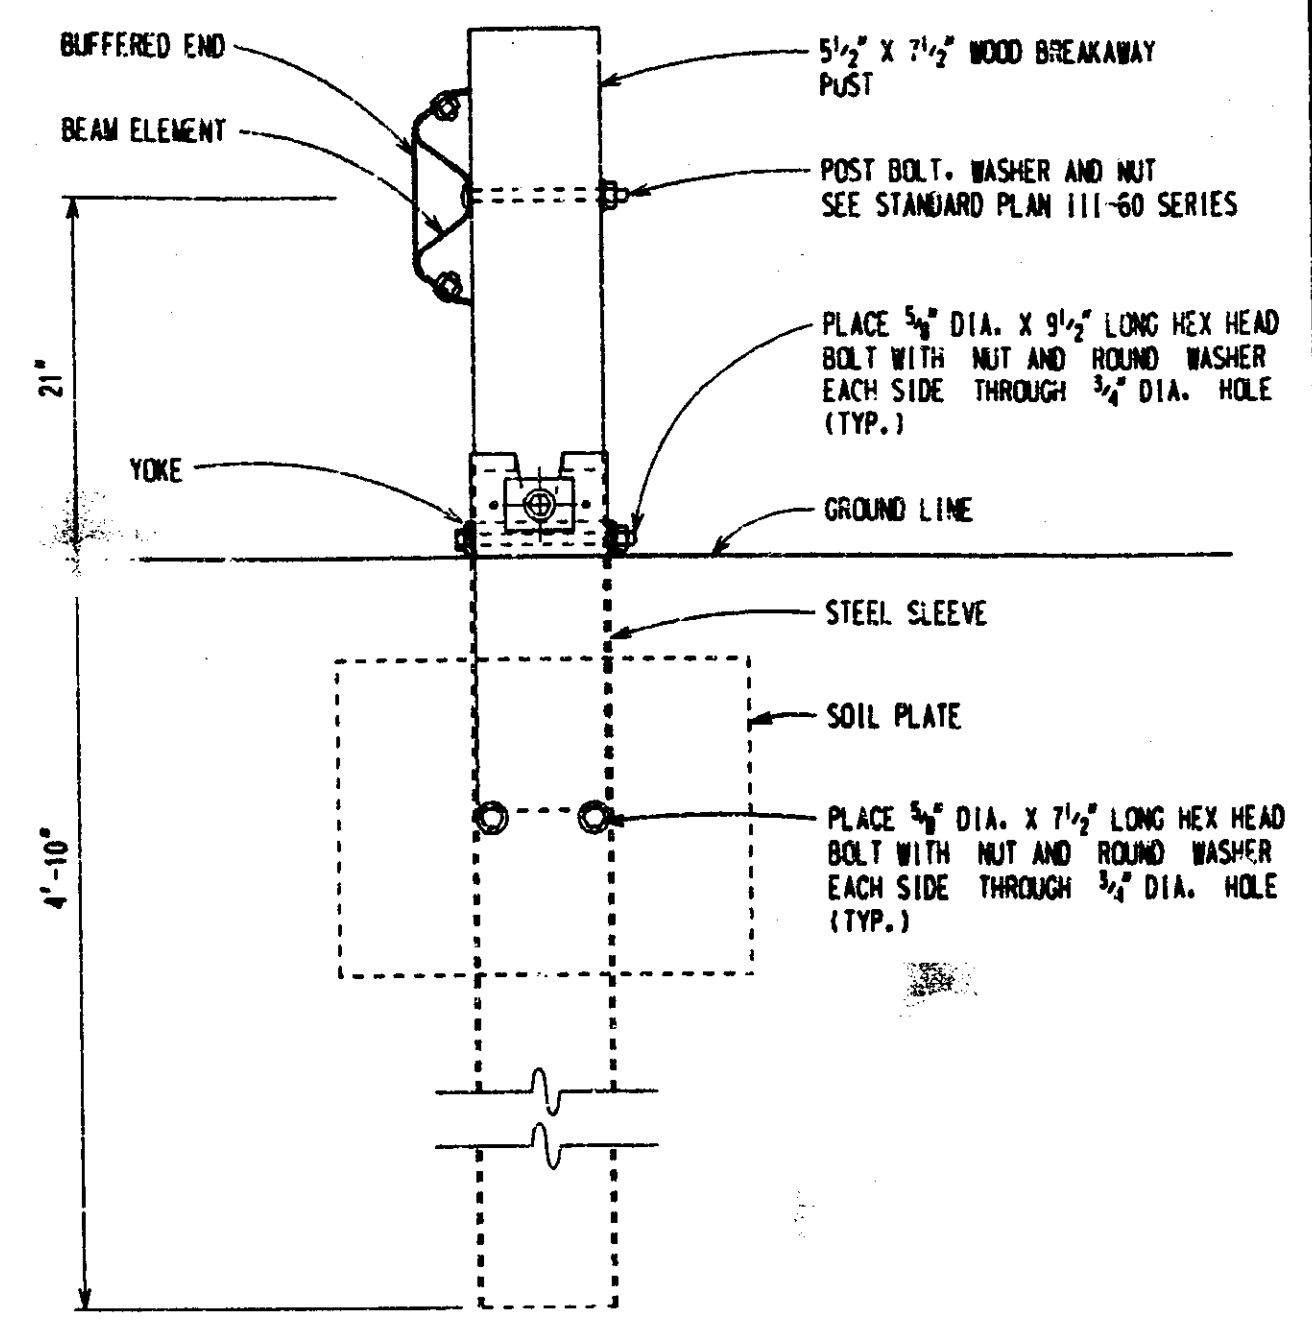

POST 1 DETAIL

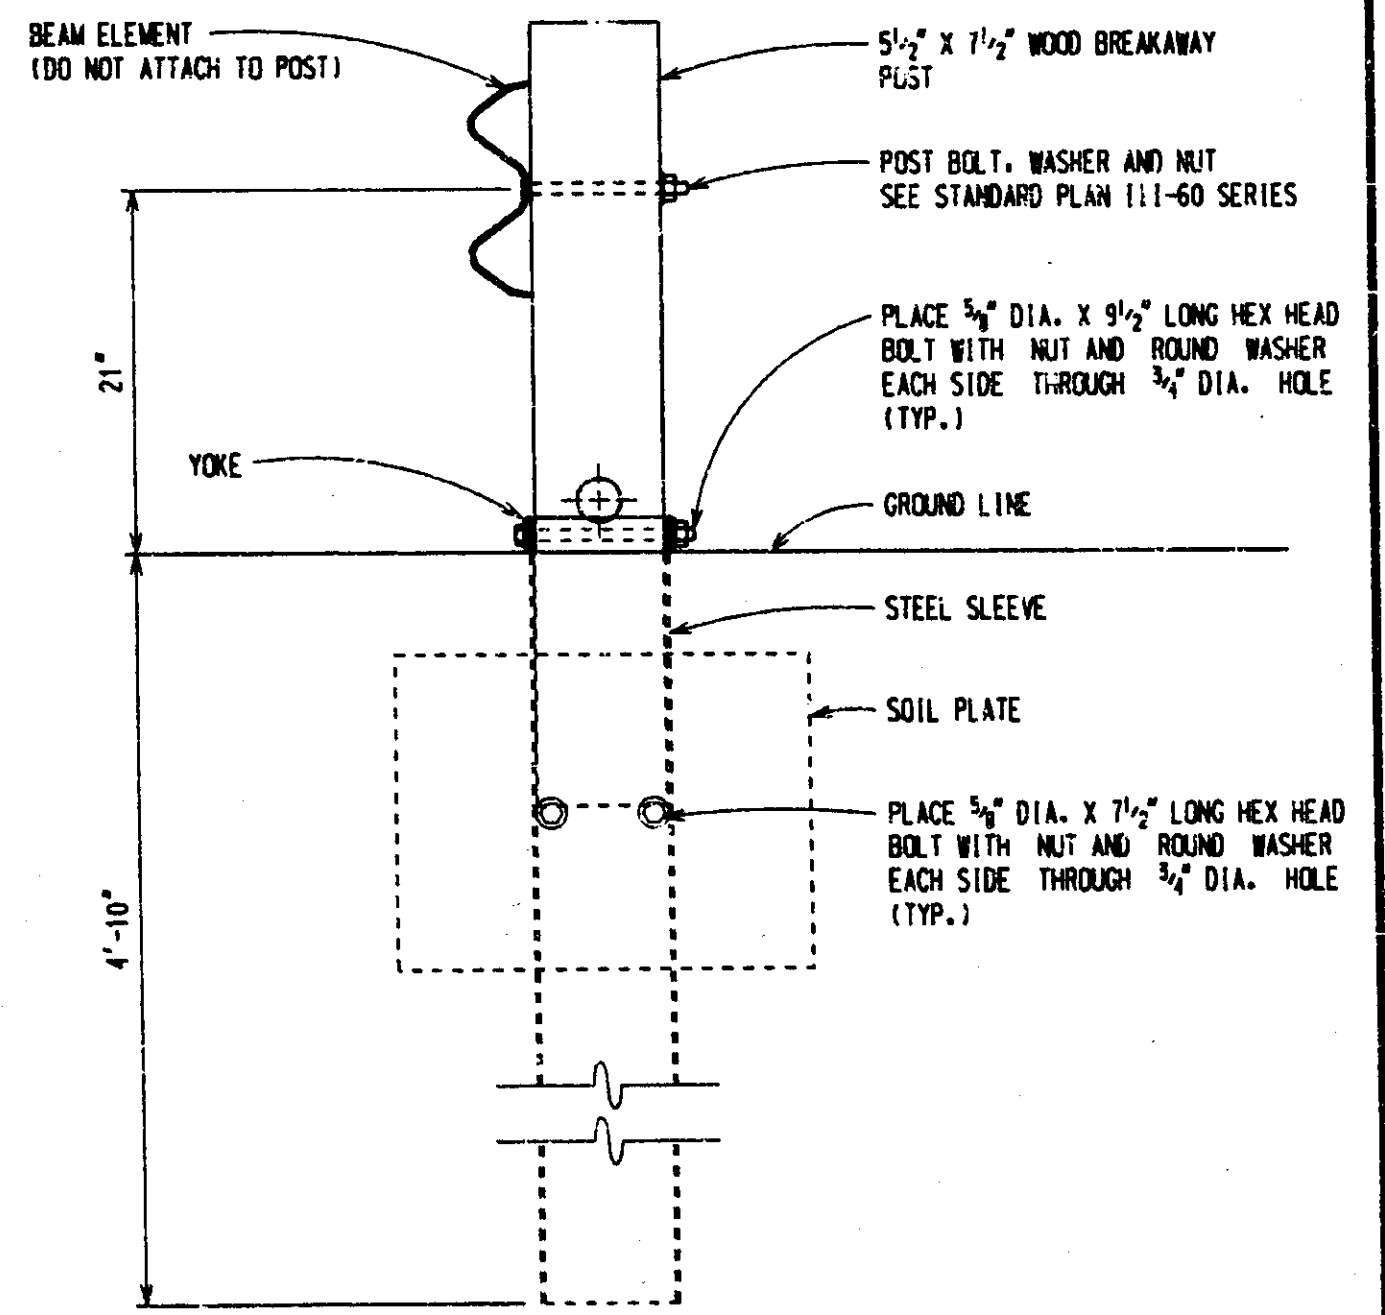


POST 2 DETAIL


BACK-UP ELEMENT REQUIRED, SEE STANDARD PLAN 111-60 SERIES

MICHIGAN DEPARTMENT OF TRANSPORTATION
BUREAU OF HIGHWAY TECHNICAL SERVICES STANDARD PLAN FOR
**GUARDRAIL ENDING WITH
CABLE ANCHORAGE (SRT)**

F.H.W.A. APPROVAL	4-22-96 PLAN DATE	III-58N	SHEET 5 OF 10
-------------------	----------------------	---------	------------------

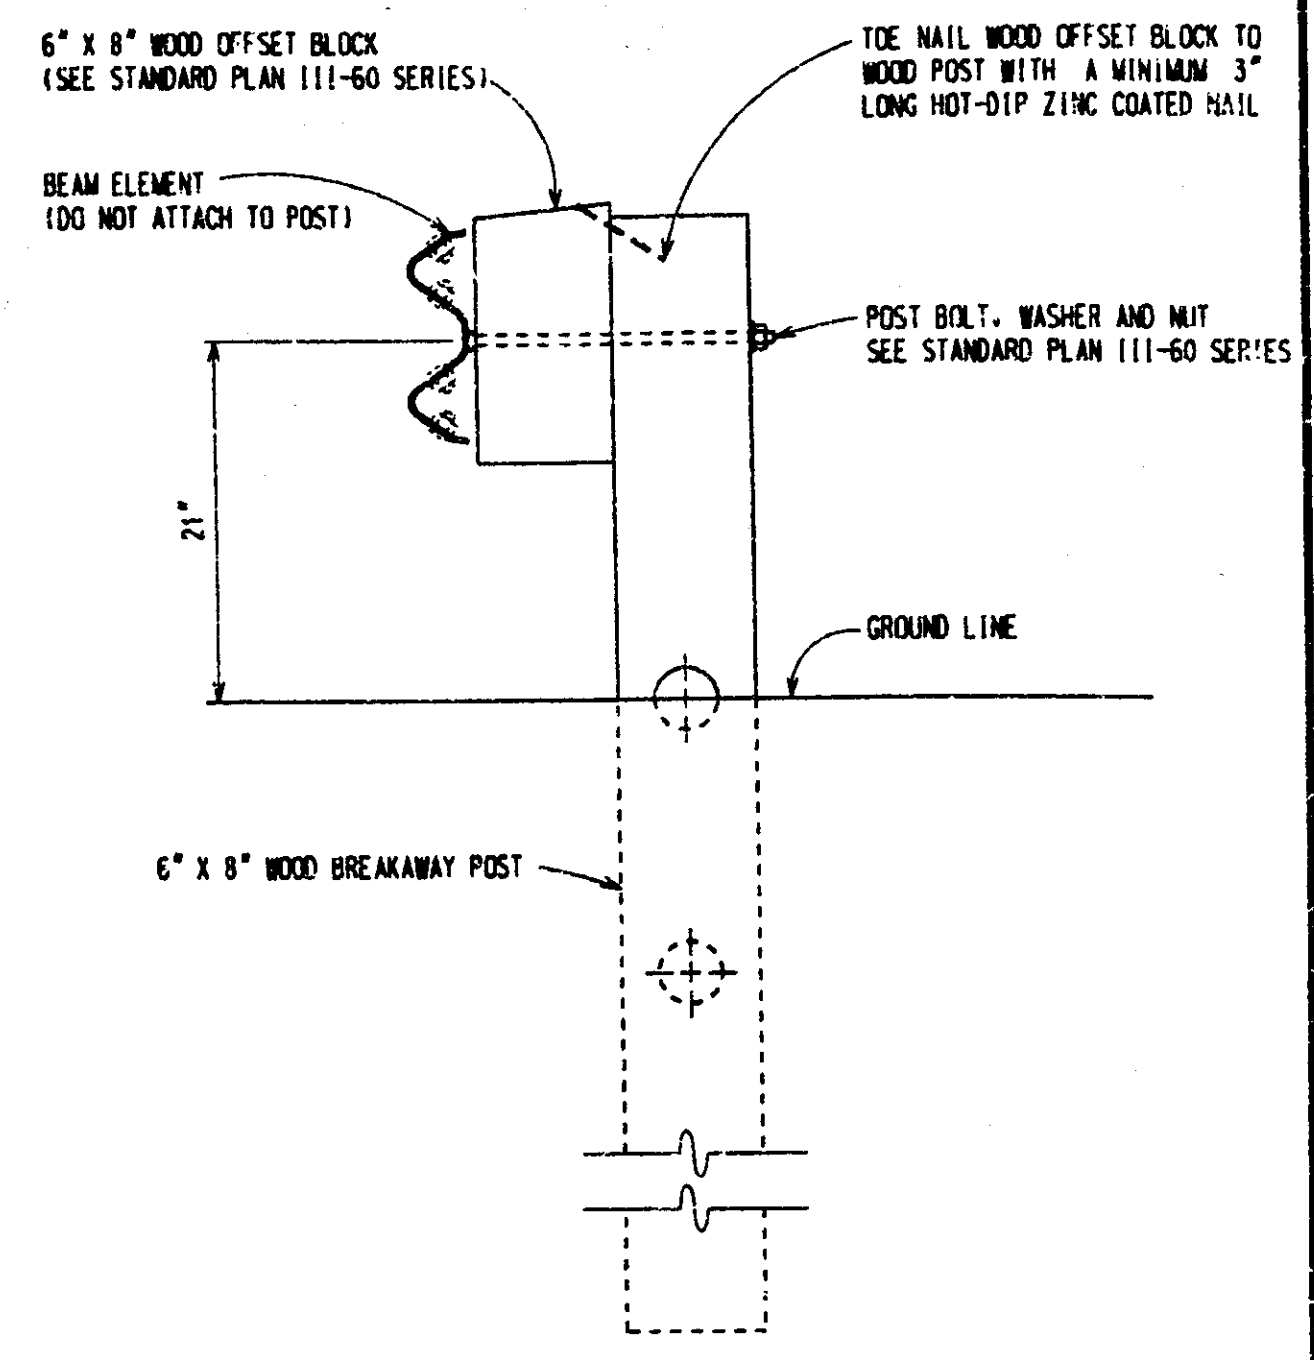


POST 3 DETAIL

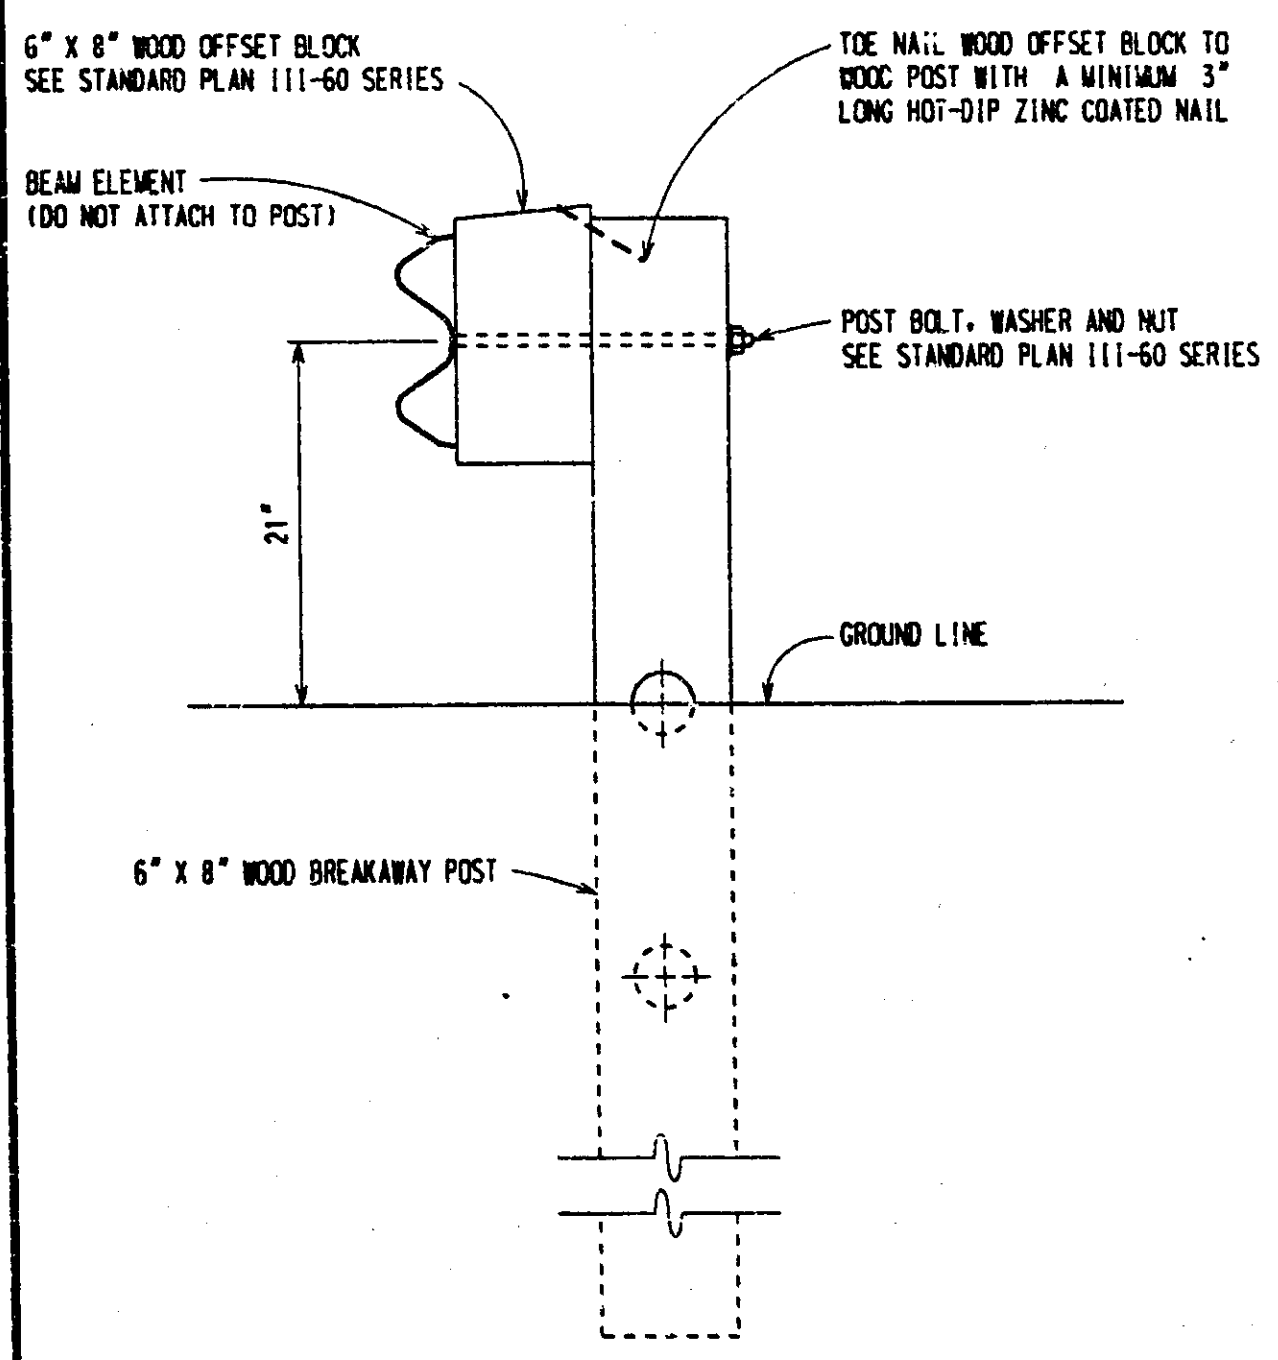

POST 4, 6, 7, 8, 9, 10 DETAIL

BACK-UP ELEMENT REQUIRED AT ALL POSTS EXCEPT POST 7, SEE STANDARD PLAN 111-60 SERIES

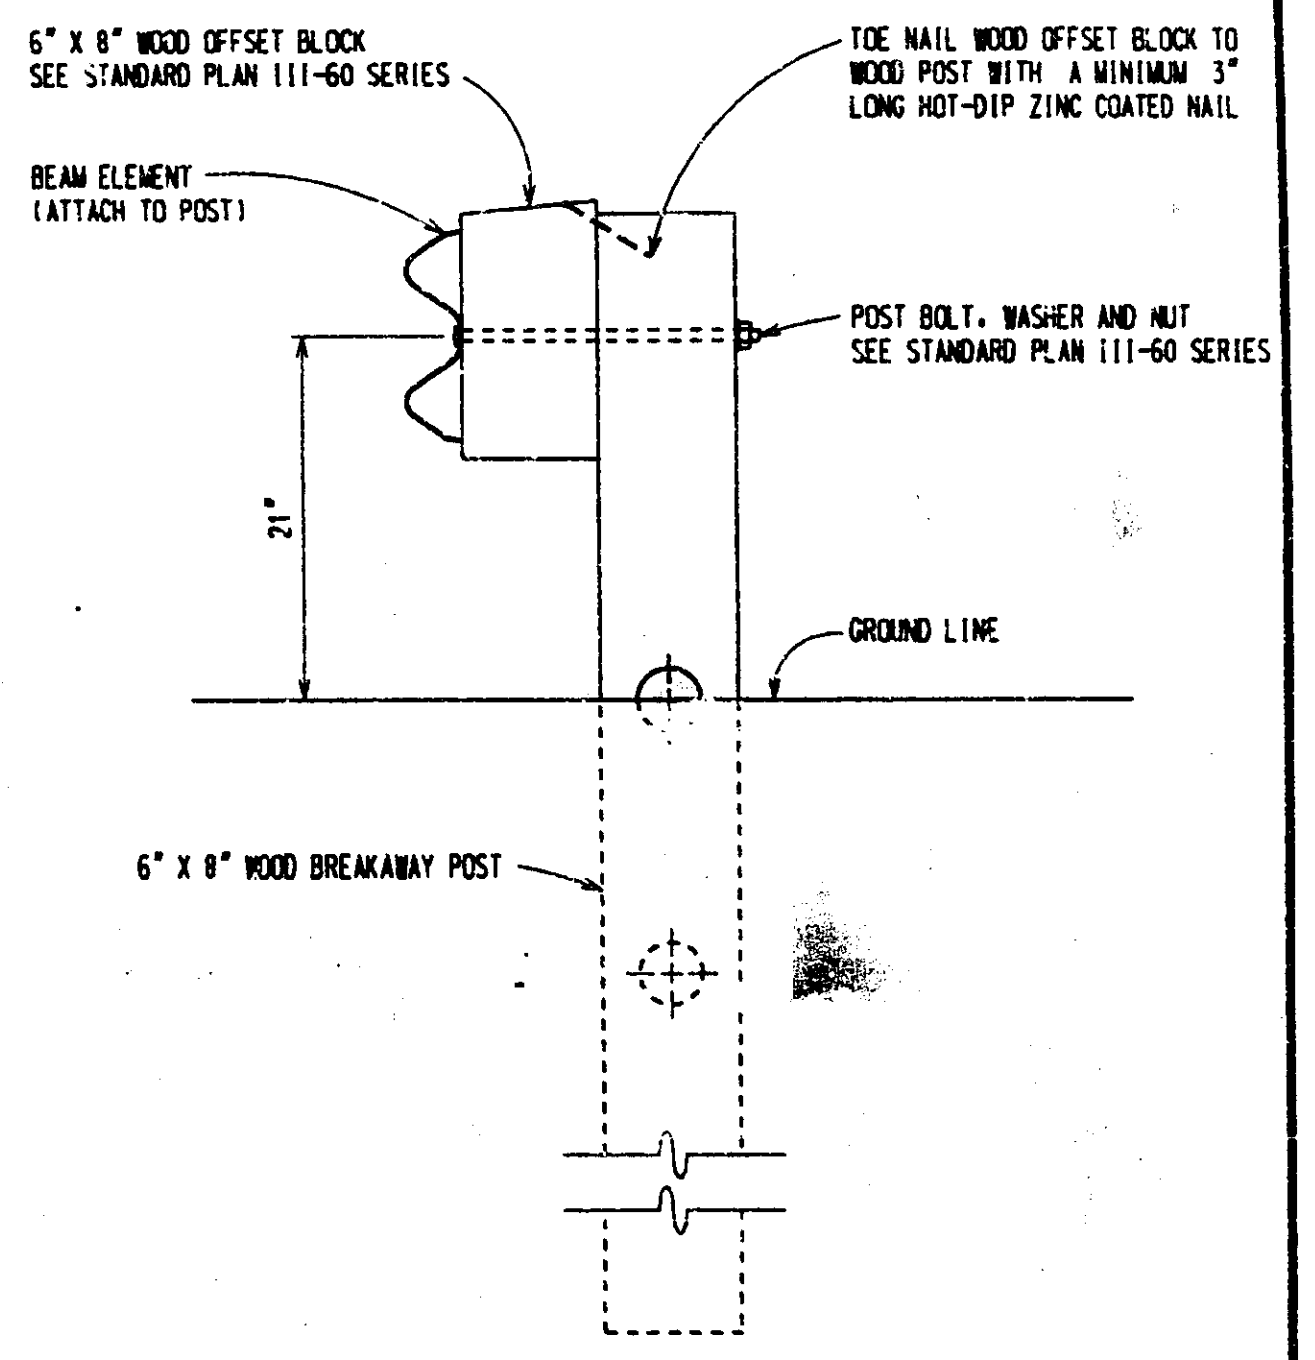

POST 5 DETAIL

BACK-UP ELEMENT REQUIRED, SEE STANDARD PLAN 111-60 SERIES


MICHIGAN DEPARTMENT OF TRANSPORTATION
BUREAU OF HIGHWAY TECHNICAL SERVICES STANDARD PLAN FOR
**GUARDRAIL ENDING WITH
CABLE ANCHORAGE (SRT)**

F.H.W.A. APPROVAL	4-22-96 PLAN DATE	III-58N	SHEET 6 OF 10
-------------------	----------------------	---------	------------------


CONTROL SECTION 63174	JOB NO. 23749A	SHEET NO. 42
-----------------------	----------------	--------------

10/07/96 Engineering Print

CONSTRUCTED AS PER PLANS APRIL 1999

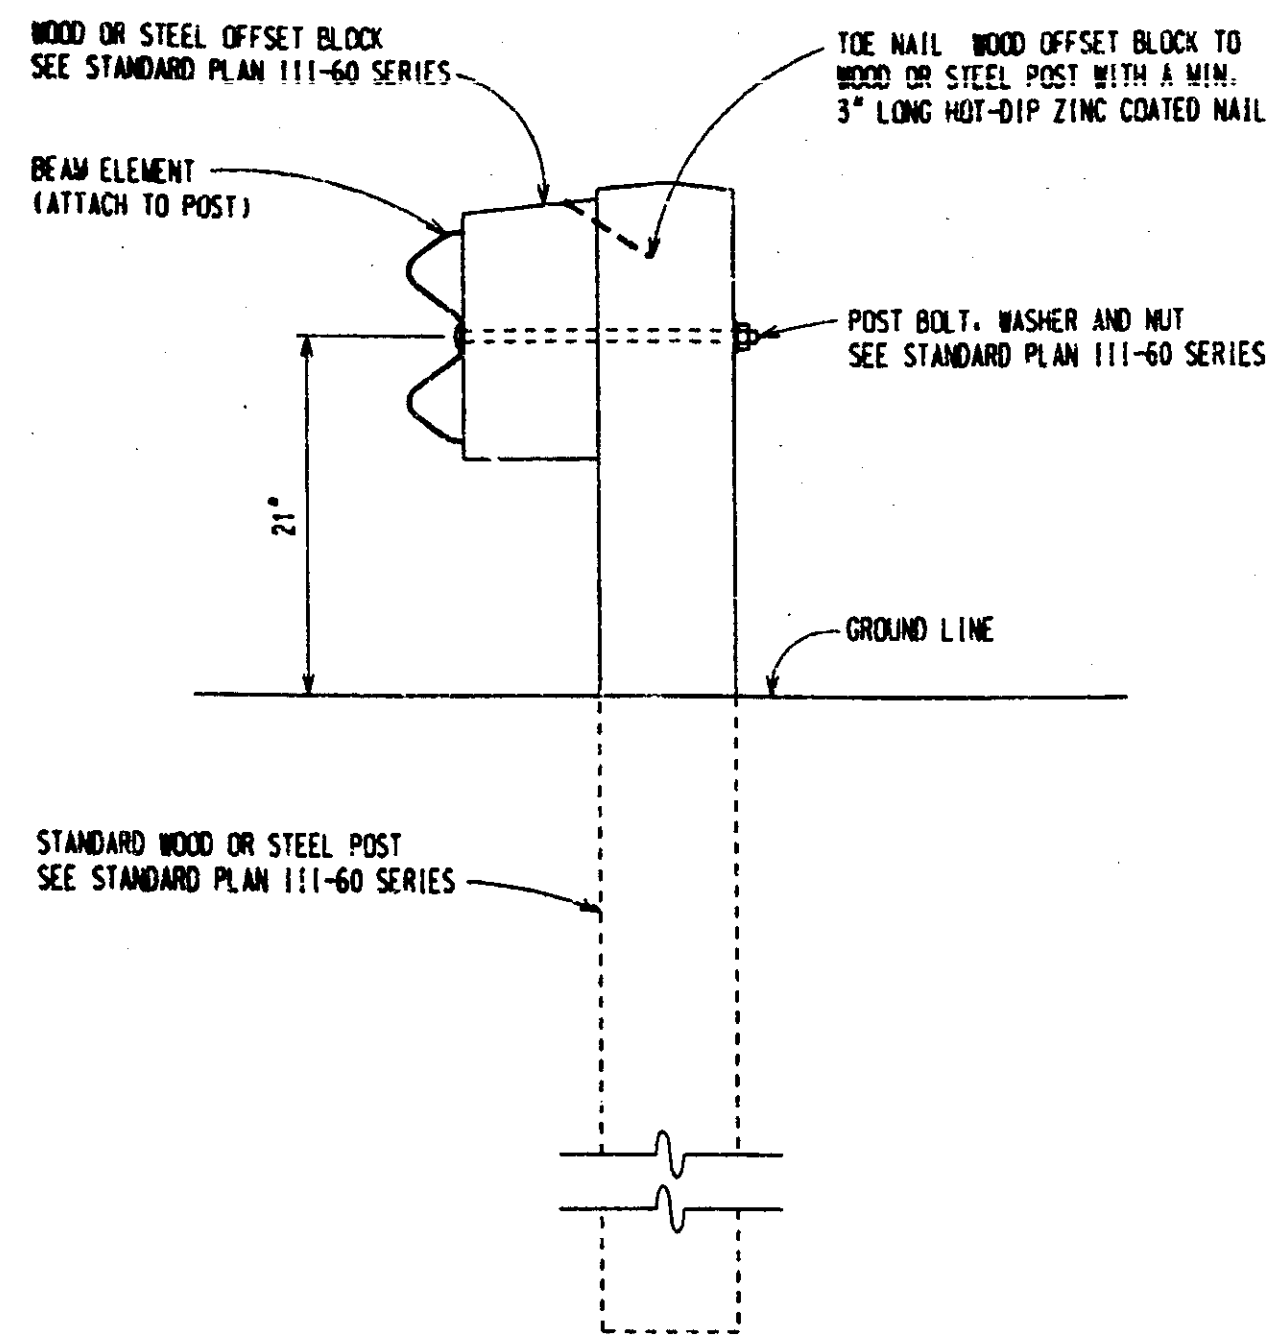


POST 11 DETAIL
WOOD POST AND OFFSET BLOCK ILLUSTRATED

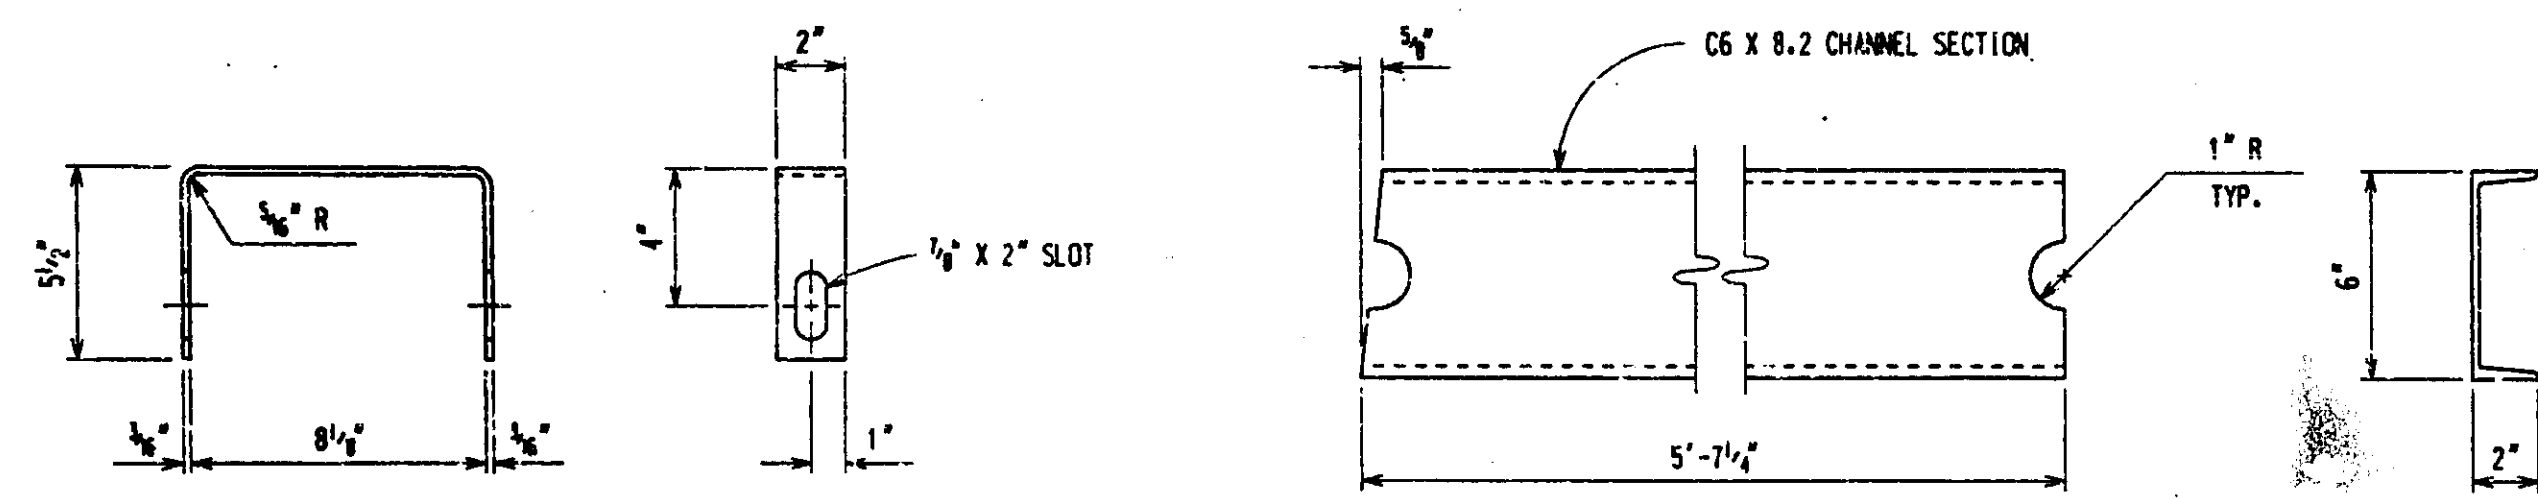

YOKE DETAIL


STRUT DETAIL

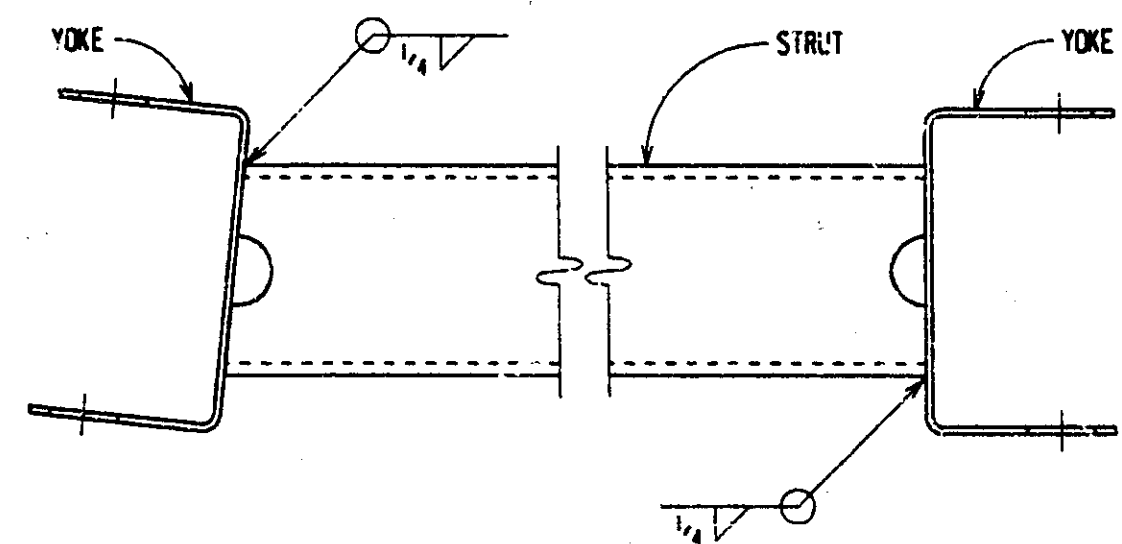


ASSEMBLY DETAIL
STRUT AND YOKE ASSEMBLY

MICHIGAN DEPARTMENT OF TRANSPORTATION
BUREAU OF HIGHWAY TECHNICAL SERVICES STANDARD PLAN FOR
**GUARDRAIL ENDING WITH
CABLE ANCHORAGE (SRT)**


F.H.W.A. APPROVAL	4-22-96 PLAN DATE	III-58N	SHEET 7 OF 10
-------------------	----------------------	---------	------------------

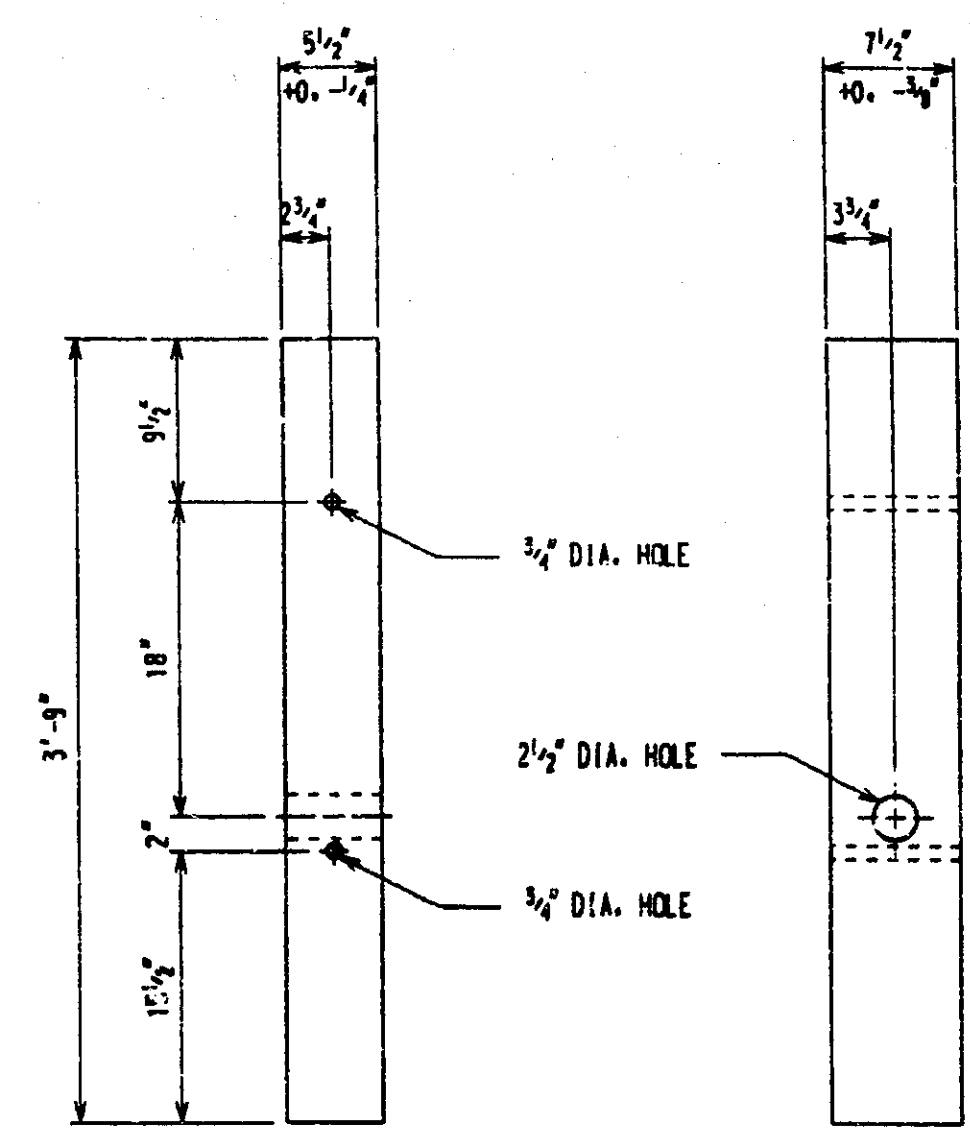


WOOD BREAKAWAY POST
(POSTS 1 AND 2)

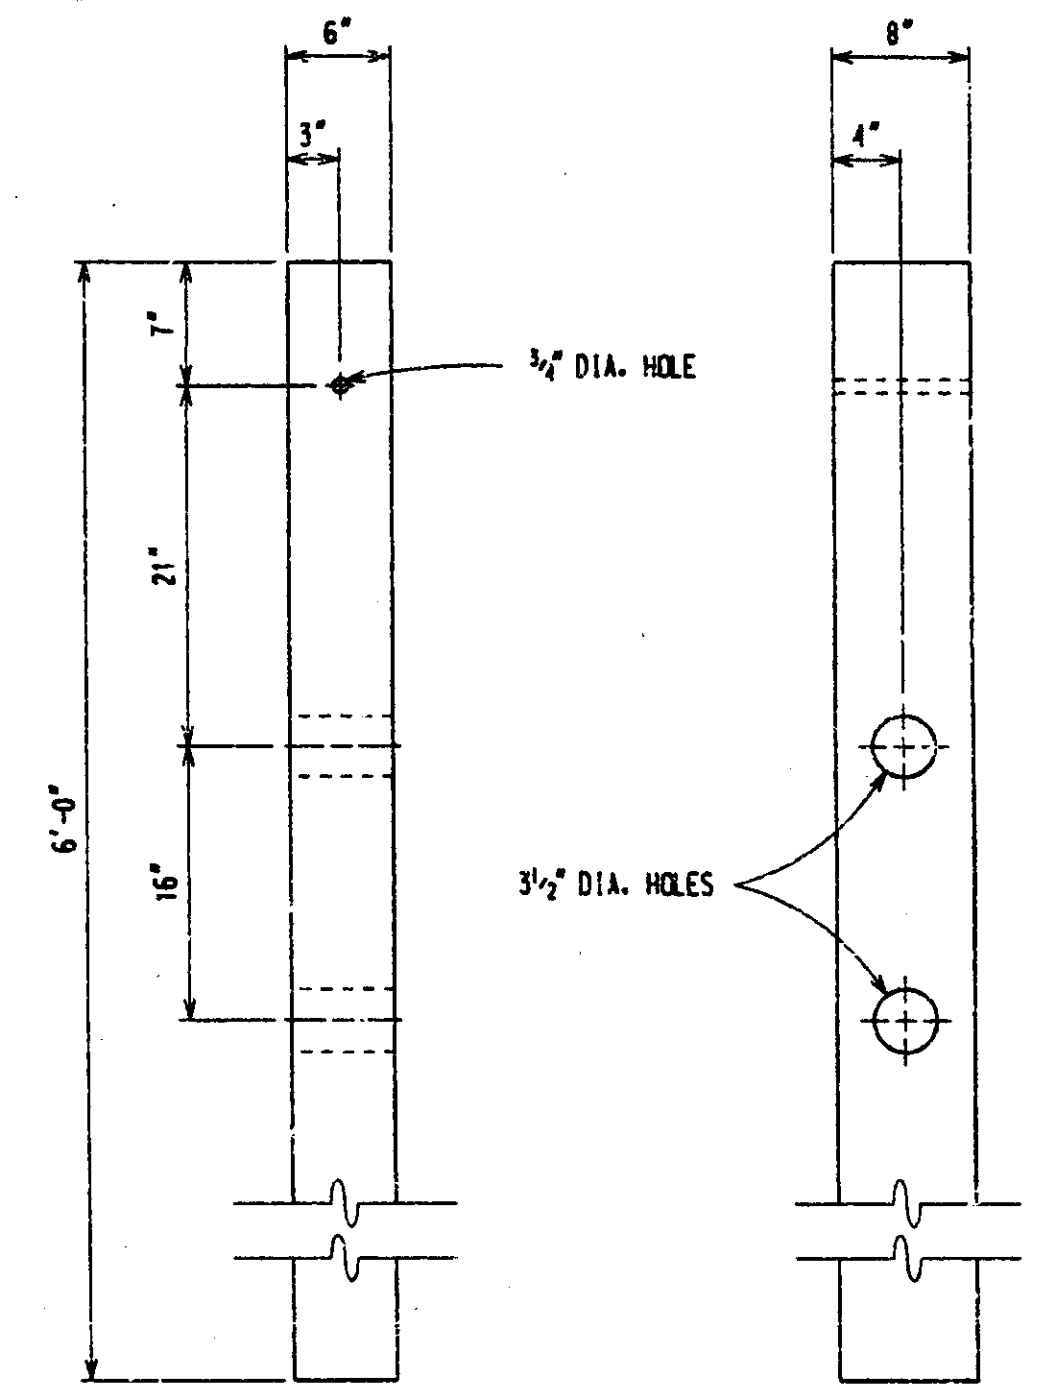


WOOD BREAKAWAY POST
(POSTS 3 THROUGH 10)

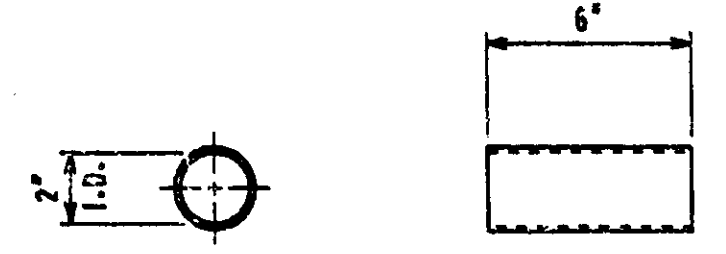


POST SLEEVE
(FOR POST 1)

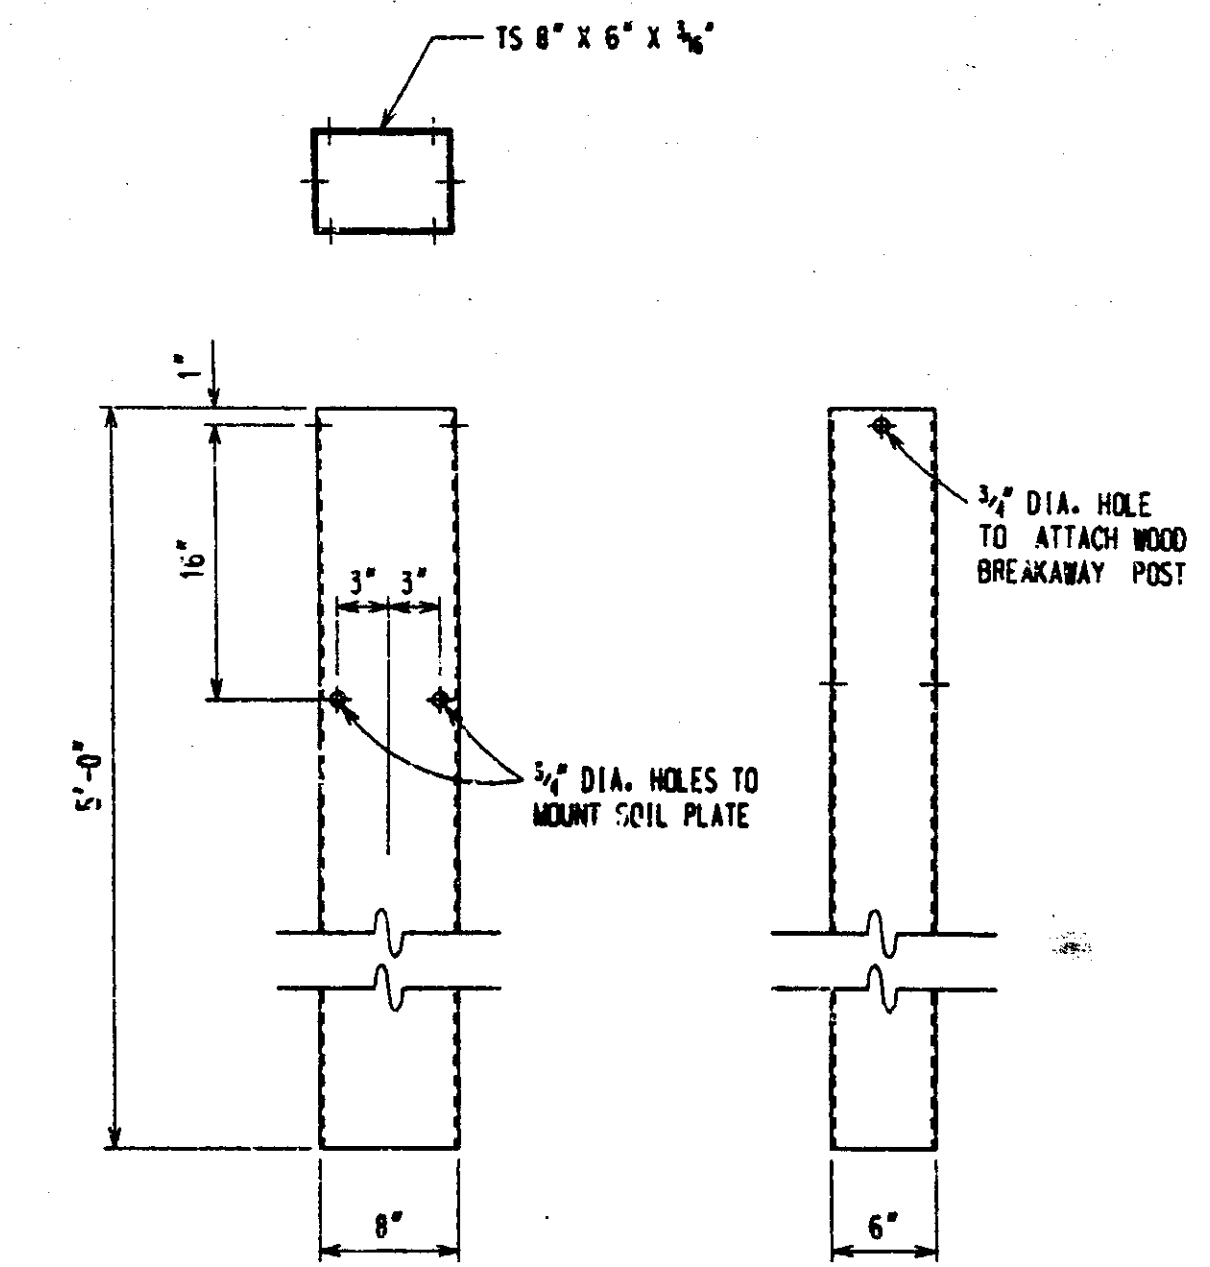

STEEL SLEEVE

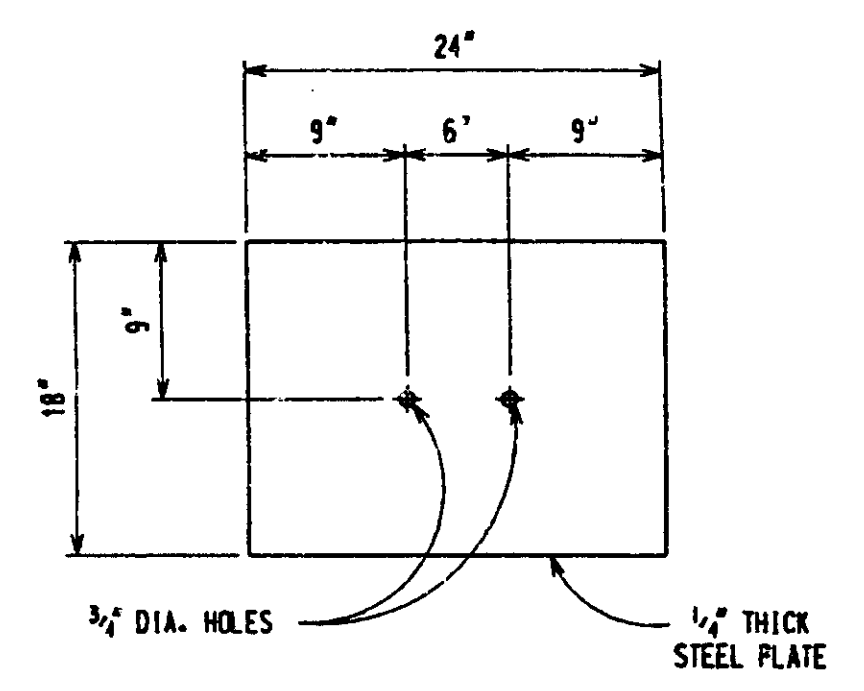

SOIL PLATE

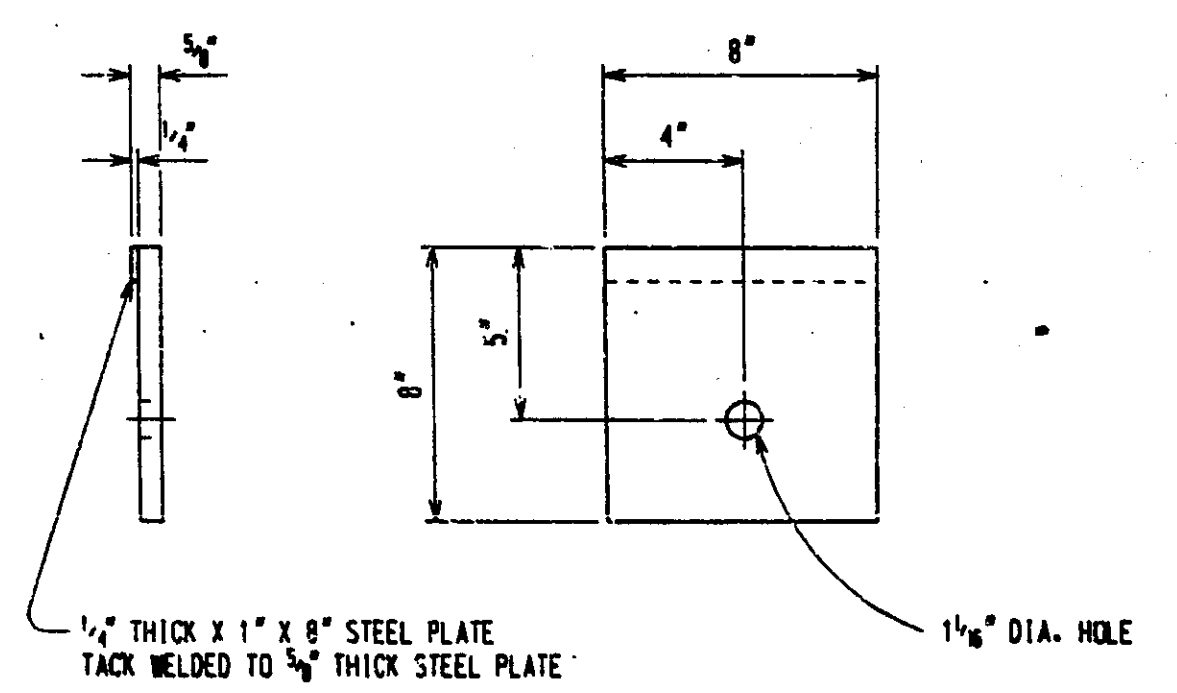

BEARING PLATE
FOR USE ON DEPARTING END ANCHORAGES ON ONE WAY ROADWAYS ONLY

MICHIGAN DEPARTMENT OF TRANSPORTATION
BUREAU OF HIGHWAY TECHNICAL SERVICES STANDARD PLAN FOR
**GUARDRAIL ENDING WITH
CABLE ANCHORAGE (SRT)**



F.H.W.A. APPROVAL	4-22-96 PLAN DATE	III-58N	SHEET 8 OF 10
-------------------	----------------------	---------	------------------

CONTROL SECTION 63174	JOB NO. 23749 A	SHEET NO. 43
-----------------------	-----------------	--------------



10/07/96 Engineering Print

SECTION 63174


CONSTRUCTED AS PER PLANS APRIL 1999

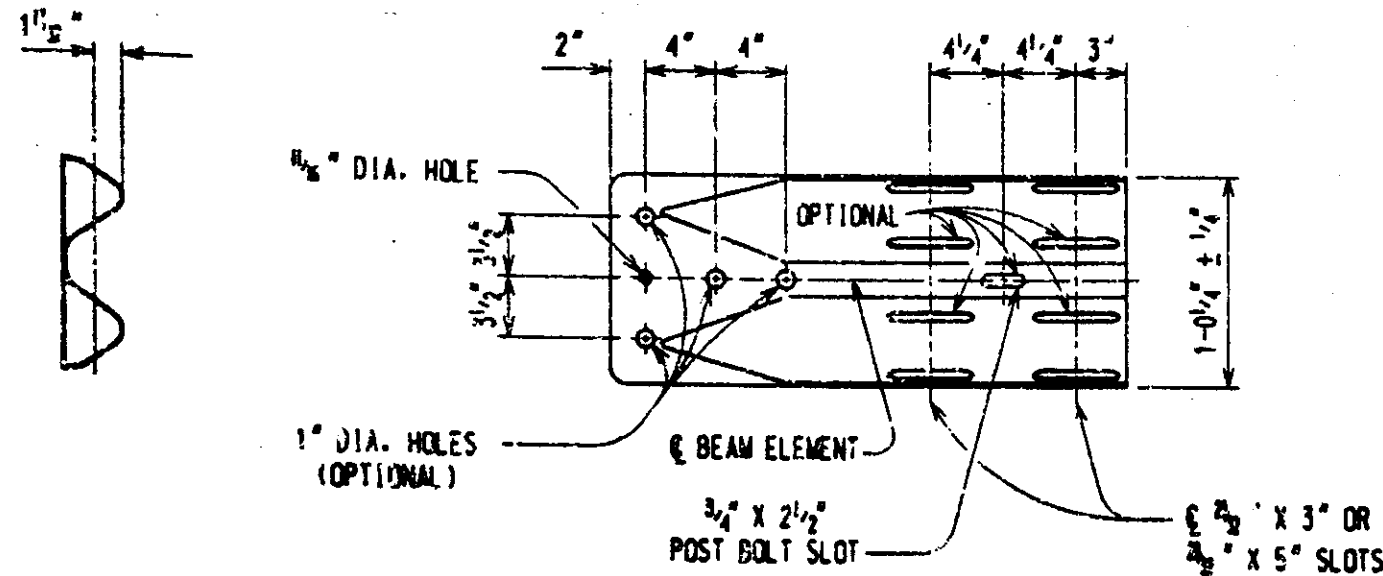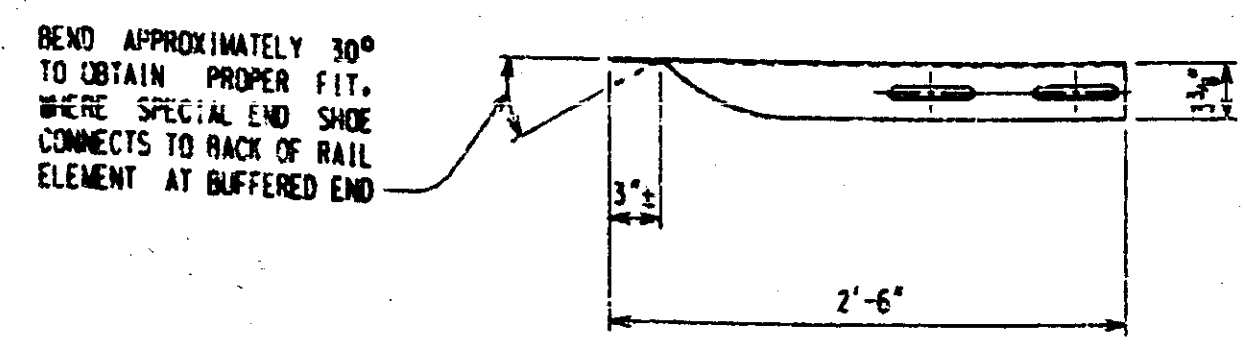


SPECIAL END SHOE
(FOR BUFFERED END)

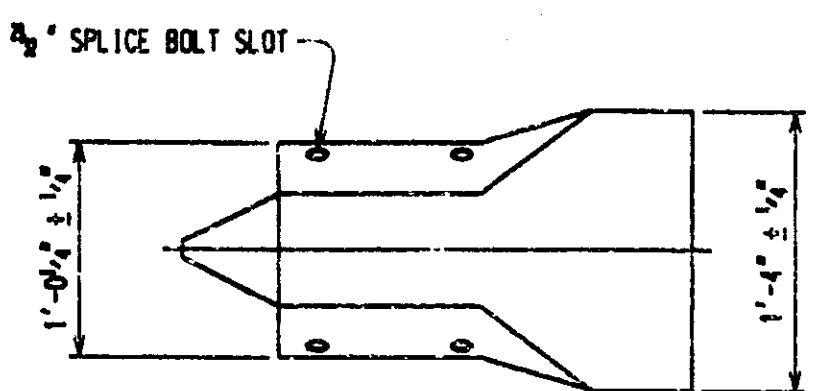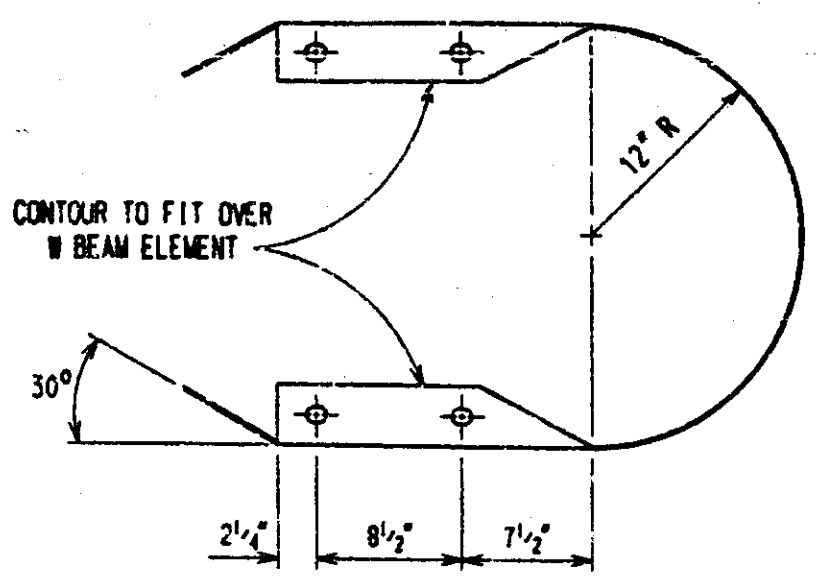



BUFFERED END
(FOR W BEAM ELEMENT)

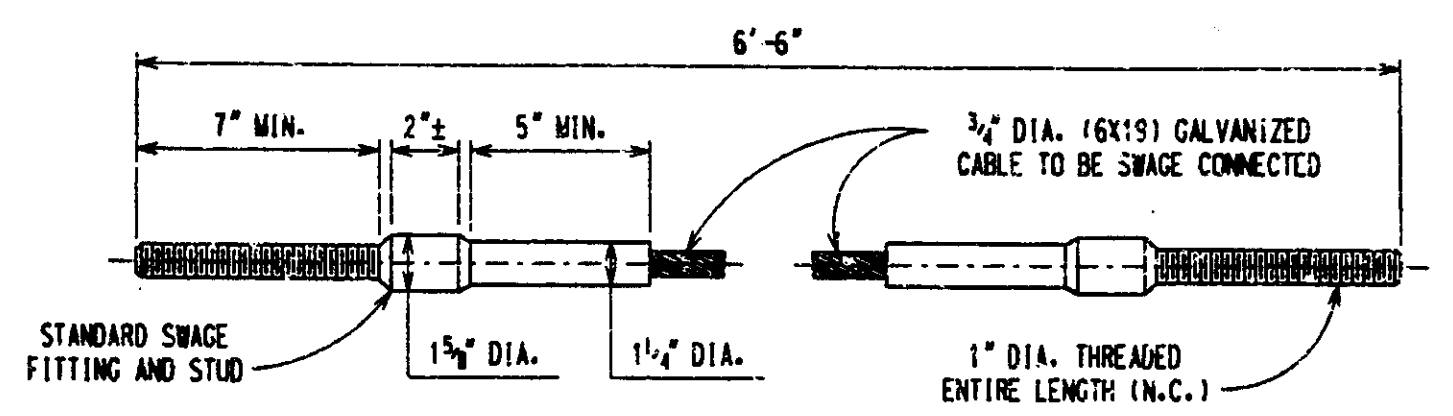

CABLE ASSEMBLY

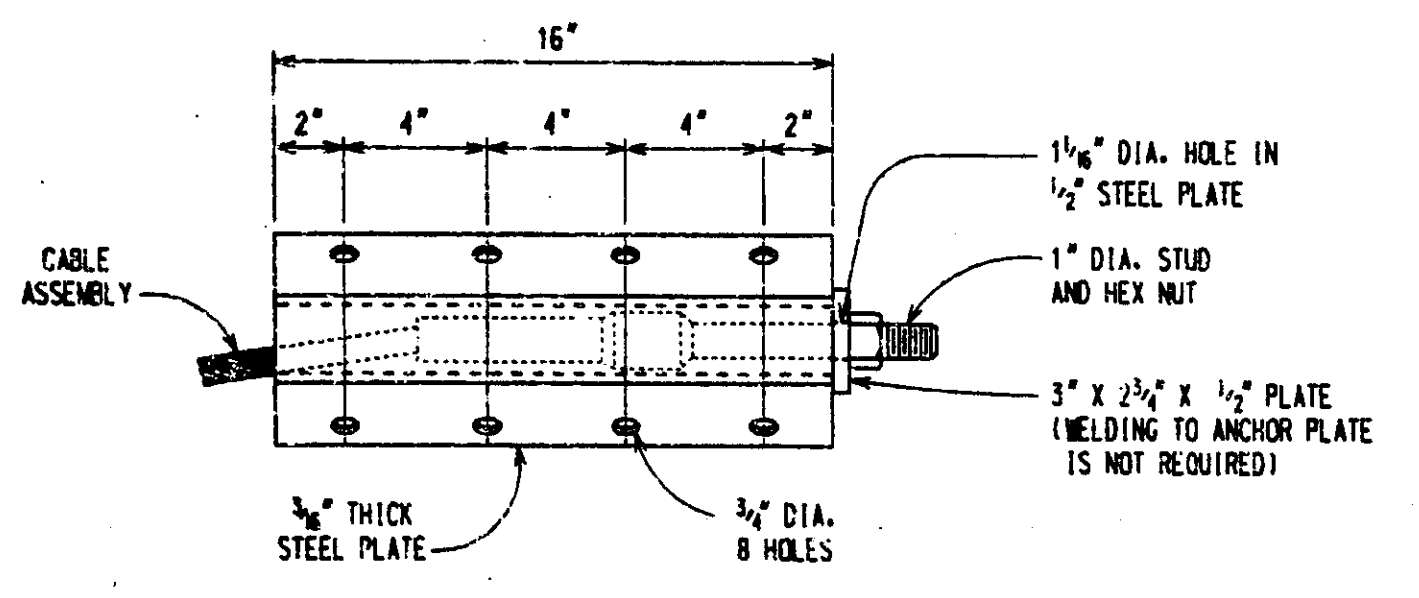

ANCHOR PLATE DETAILS

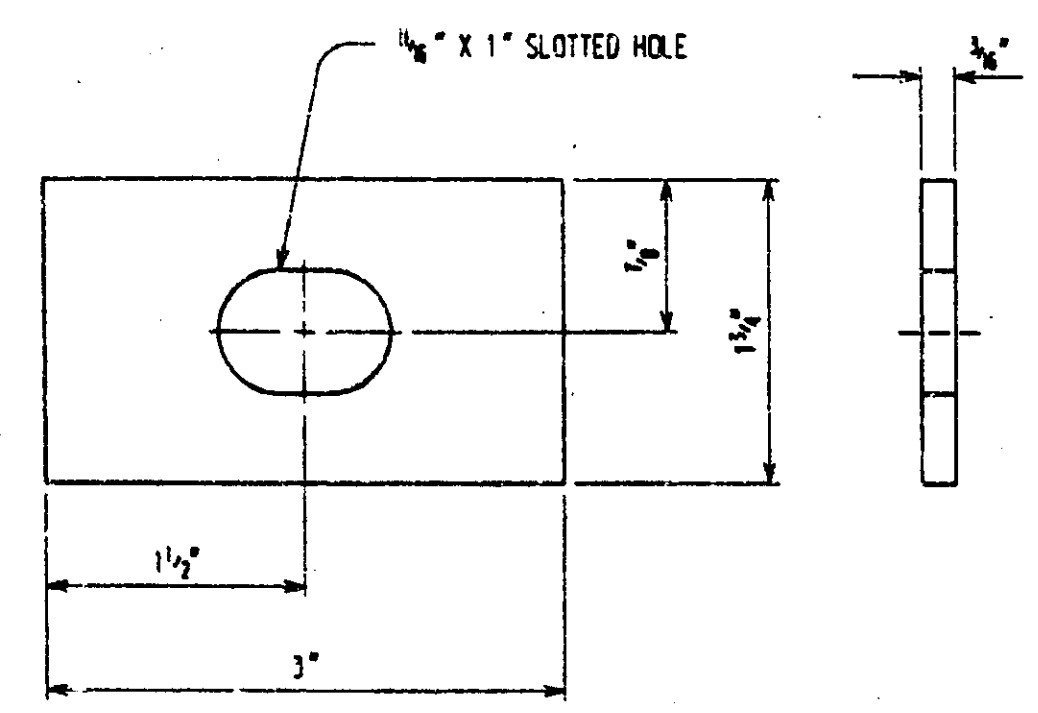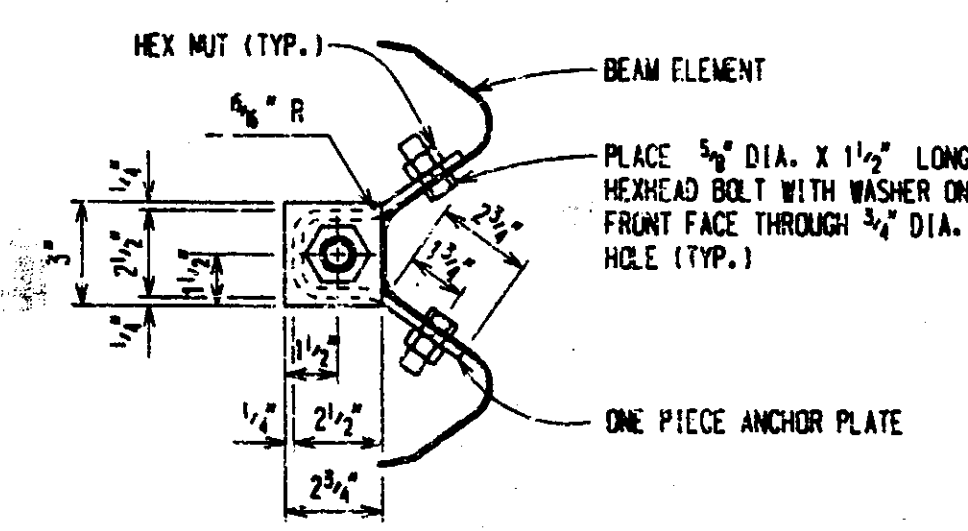


POST BOLT WASHER


MICHIGAN DEPARTMENT OF TRANSPORTATION
BUREAU OF HIGHWAY TECHNICAL SERVICES STANDARD PLAN FOR

GUARDRAIL ENDING WITH CABLE ANCHORAGE (SRT)


F.H.W.A. APPROVAL	4-22-96 PLAN DATE	III-58N	SHEET 9 OF 10
-------------------	----------------------	---------	------------------

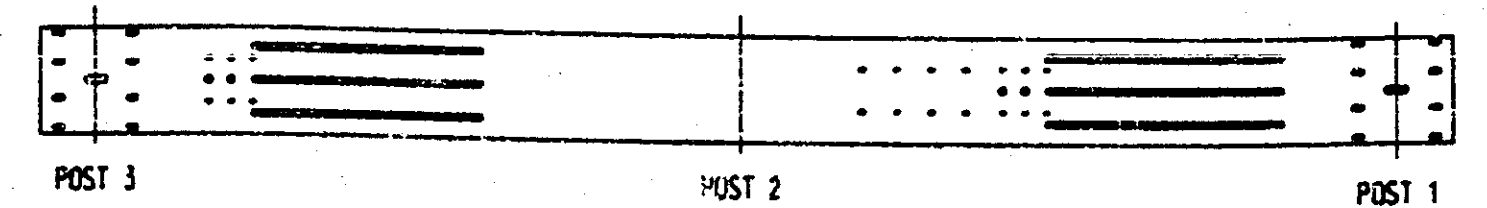


SLOTTED RAIL BEAM ELEMENT
(POST 1 THROUGH 3)

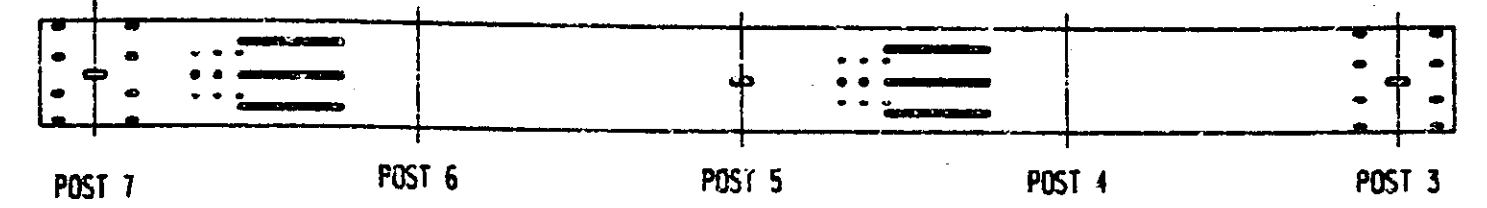


SLOTTED RAIL BEAM ELEMENT
(POST 3 THROUGH 7)

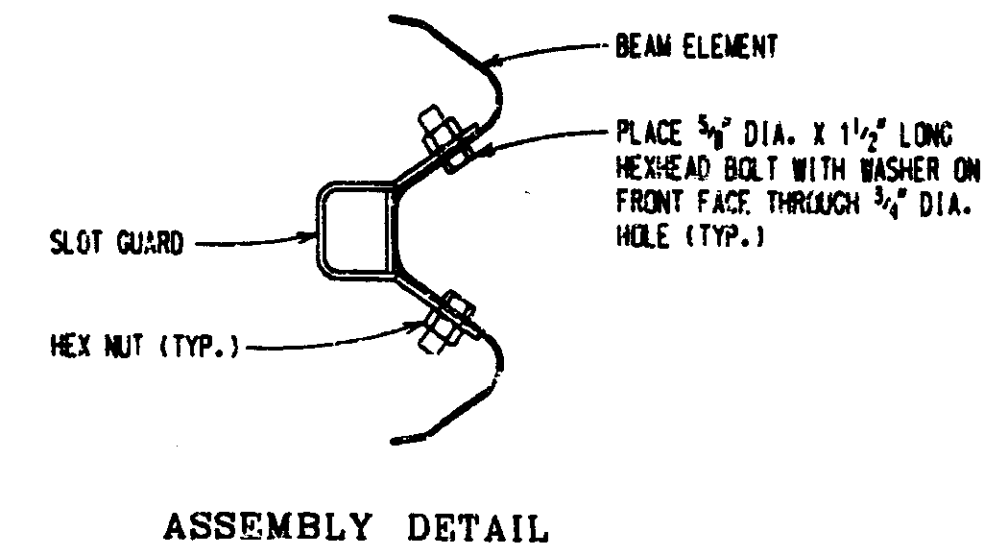

ASSEMBLY DETAIL

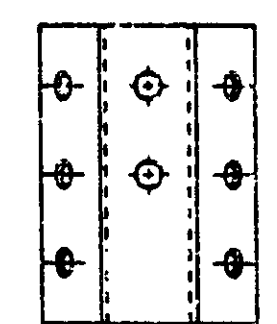

SLOTTED BEARING PLATE

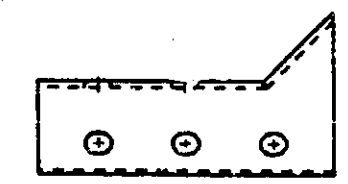

SLOT GUARD DETAILS

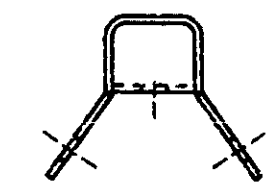


PLATE WASHER

NOTE: ALL ITEMS ILLUSTRATED WITHOUT DIMENSIONS SHALL BE ACCORDING TO THE MANUFACTURERS SPECIFICATION.

- NOTES:
- ALL POSTS, OFFSET BLOCKS, BEAM AND BACK-UP ELEMENTS, AND HARDWARE (INCLUDING BOLTS, NUTS, AND WASHERS) SHALL CONFORM TO THE CURRENT STANDARD SPECIFICATIONS AND TO THE CURRENT STANDARD PLAN III-60 SERIES, WHERE APPLICABLE, EXCEPT AS SPECIFIED ON THIS STANDARD.
 - STEEL SLEEVE WELDS SHALL BE MADE FULL LENGTH.
 - THE BUFFERED END AND SPECIAL END SHOE SHALL BE MADE OF A MINIMUM 0.109" THICK STEEL SHEET.
 - ALL 1 ON 10 SLOPES SHALL BE GRADED TO CLASS A SLOPE TOLERANCES.
 - FOR DETAILS OF GUARDRAIL PLACEMENT, SEE STANDARD PLAN III-59 SERIES.
 - AFTER THE CABLE ASSEMBLY HAS BEEN TIGHTENED, THE THREADS OUTSIDE THE NUTS SHALL BE BURIED SLIGHTLY SO THE NUTS WILL NOT LOOSEN.
 - ON THE GUARDRAIL ANCHORAGE, CABLE - DEPARTING END TWO HOT-DIP ZINC COATED NAILS SHALL BE DRIVEN INTO THE WOOD POST AT THE TOP OF THE BEARING PLATE TO KEEP THE BEARING PLATE FROM ROTATING.
 - ON THE GUARDRAIL ANCHORAGE CABLE (SRT) TWO HOT-DIP ZINC COATED NAILS SHALL BE DRIVEN THROUGH THE HOLES IN THE SLOTTED BEARING PLATE TO KEEP THE PLATE FROM ROTATING.
 - WHEN ADDITIONAL POST BOLT SLOTS ARE REQUIRED, THEY SHALL BE DRILLED OR PUNCHED AND REGALVANIZED. BURNING WILL NOT BE ALLOWED.
 - BACK-UP ELEMENTS SHALL NOT BE USED ON DEPARTING END ANCHORAGES.
 - BACK-UP ELEMENTS ARE REQUIRED ON POSTS 2, 4, 5, 6, 8, 9, AND 10 OF THE GUARDRAIL APPROACH ANCHORAGE. SEE STANDARD PLAN III-60 SERIES.
 - HARDWARE BETWEEN POST 1 AND POST 11 ARE PROPRIETARY ITEMS OF THE SRT AND MUST BE PURCHASED FROM AN AUTHORIZED DISTRIBUTOR.

MICHIGAN DEPARTMENT OF TRANSPORTATION
BUREAU OF HIGHWAY TECHNICAL SERVICES STANDARD PLAN FOR

GUARDRAIL ENDING WITH CABLE ANCHORAGE (SRT)

F.H.W.A. APPROVAL	4-22-96 PLAN DATE	III-58N	SHEET 10 OF 10
CONTROL SECTION 63174	JOB NO. 23749A	SHEET NO. 44	

10/07/96 Engineering Print

MICROFILM CONTENT SHEET

BATCH 07-8G

OUT TO MICROFILM 8/31/2007

Control Section	Structure	Job Number	Sheet Number	Let Date	Region	Total Sheets	Plan Set	Box
63174		28991	(ONE ROLL)	11/14/1990	METRO	23		3
			AS LET					
	63174-28991 BIT SURF AND SAFETY UP GRADING							

CONTROL SECTION IR 63174 JOB NO. 28991A SH. NO. 1

MICHIGAN DEPARTMENT OF TRANSPORTATION

PLANS OF PROPOSED

MICHIGAN PROJECT IR 75-2(384)63
CONTROL SECTION IR 63174
JOB NUMBER 28991 A

I-75

OAKLAND CO.
BLOOMFIELD TWP.

CITIES OF TROY & MADISON HEIGHTS


ROUTE	JOB NUMBER	FEDERAL NUMBER	SHEET NO.	TOTAL SHEETS
I-75	28991 A	IR 75-2(384)63	1	1

THE IMPROVEMENT COVERED BY THESE PLANS SHALL BE DONE IN ACCORDANCE WITH THE MICHIGAN DEPARTMENT OF TRANSPORTATION 1984 STANDARD SPECIFICATIONS AND SUPPLEMENTAL SPECIFICATIONS.

ROAD PLANS	SHEET NOS.
TITLE	1
TYPICAL CROSS SECTION	2-3
NOTE SHEET	4
PLANS & PROFILES	5-17
SPECIAL DETAILS	18-22
QUANTITY SHEETS	23

A.D.T.	159700
D.H.V.	8827
COMM. %	9%
DESIGN SPEED	70MPH
YEAR	1990

BRIDGE PLANS
SIGNING PLANS

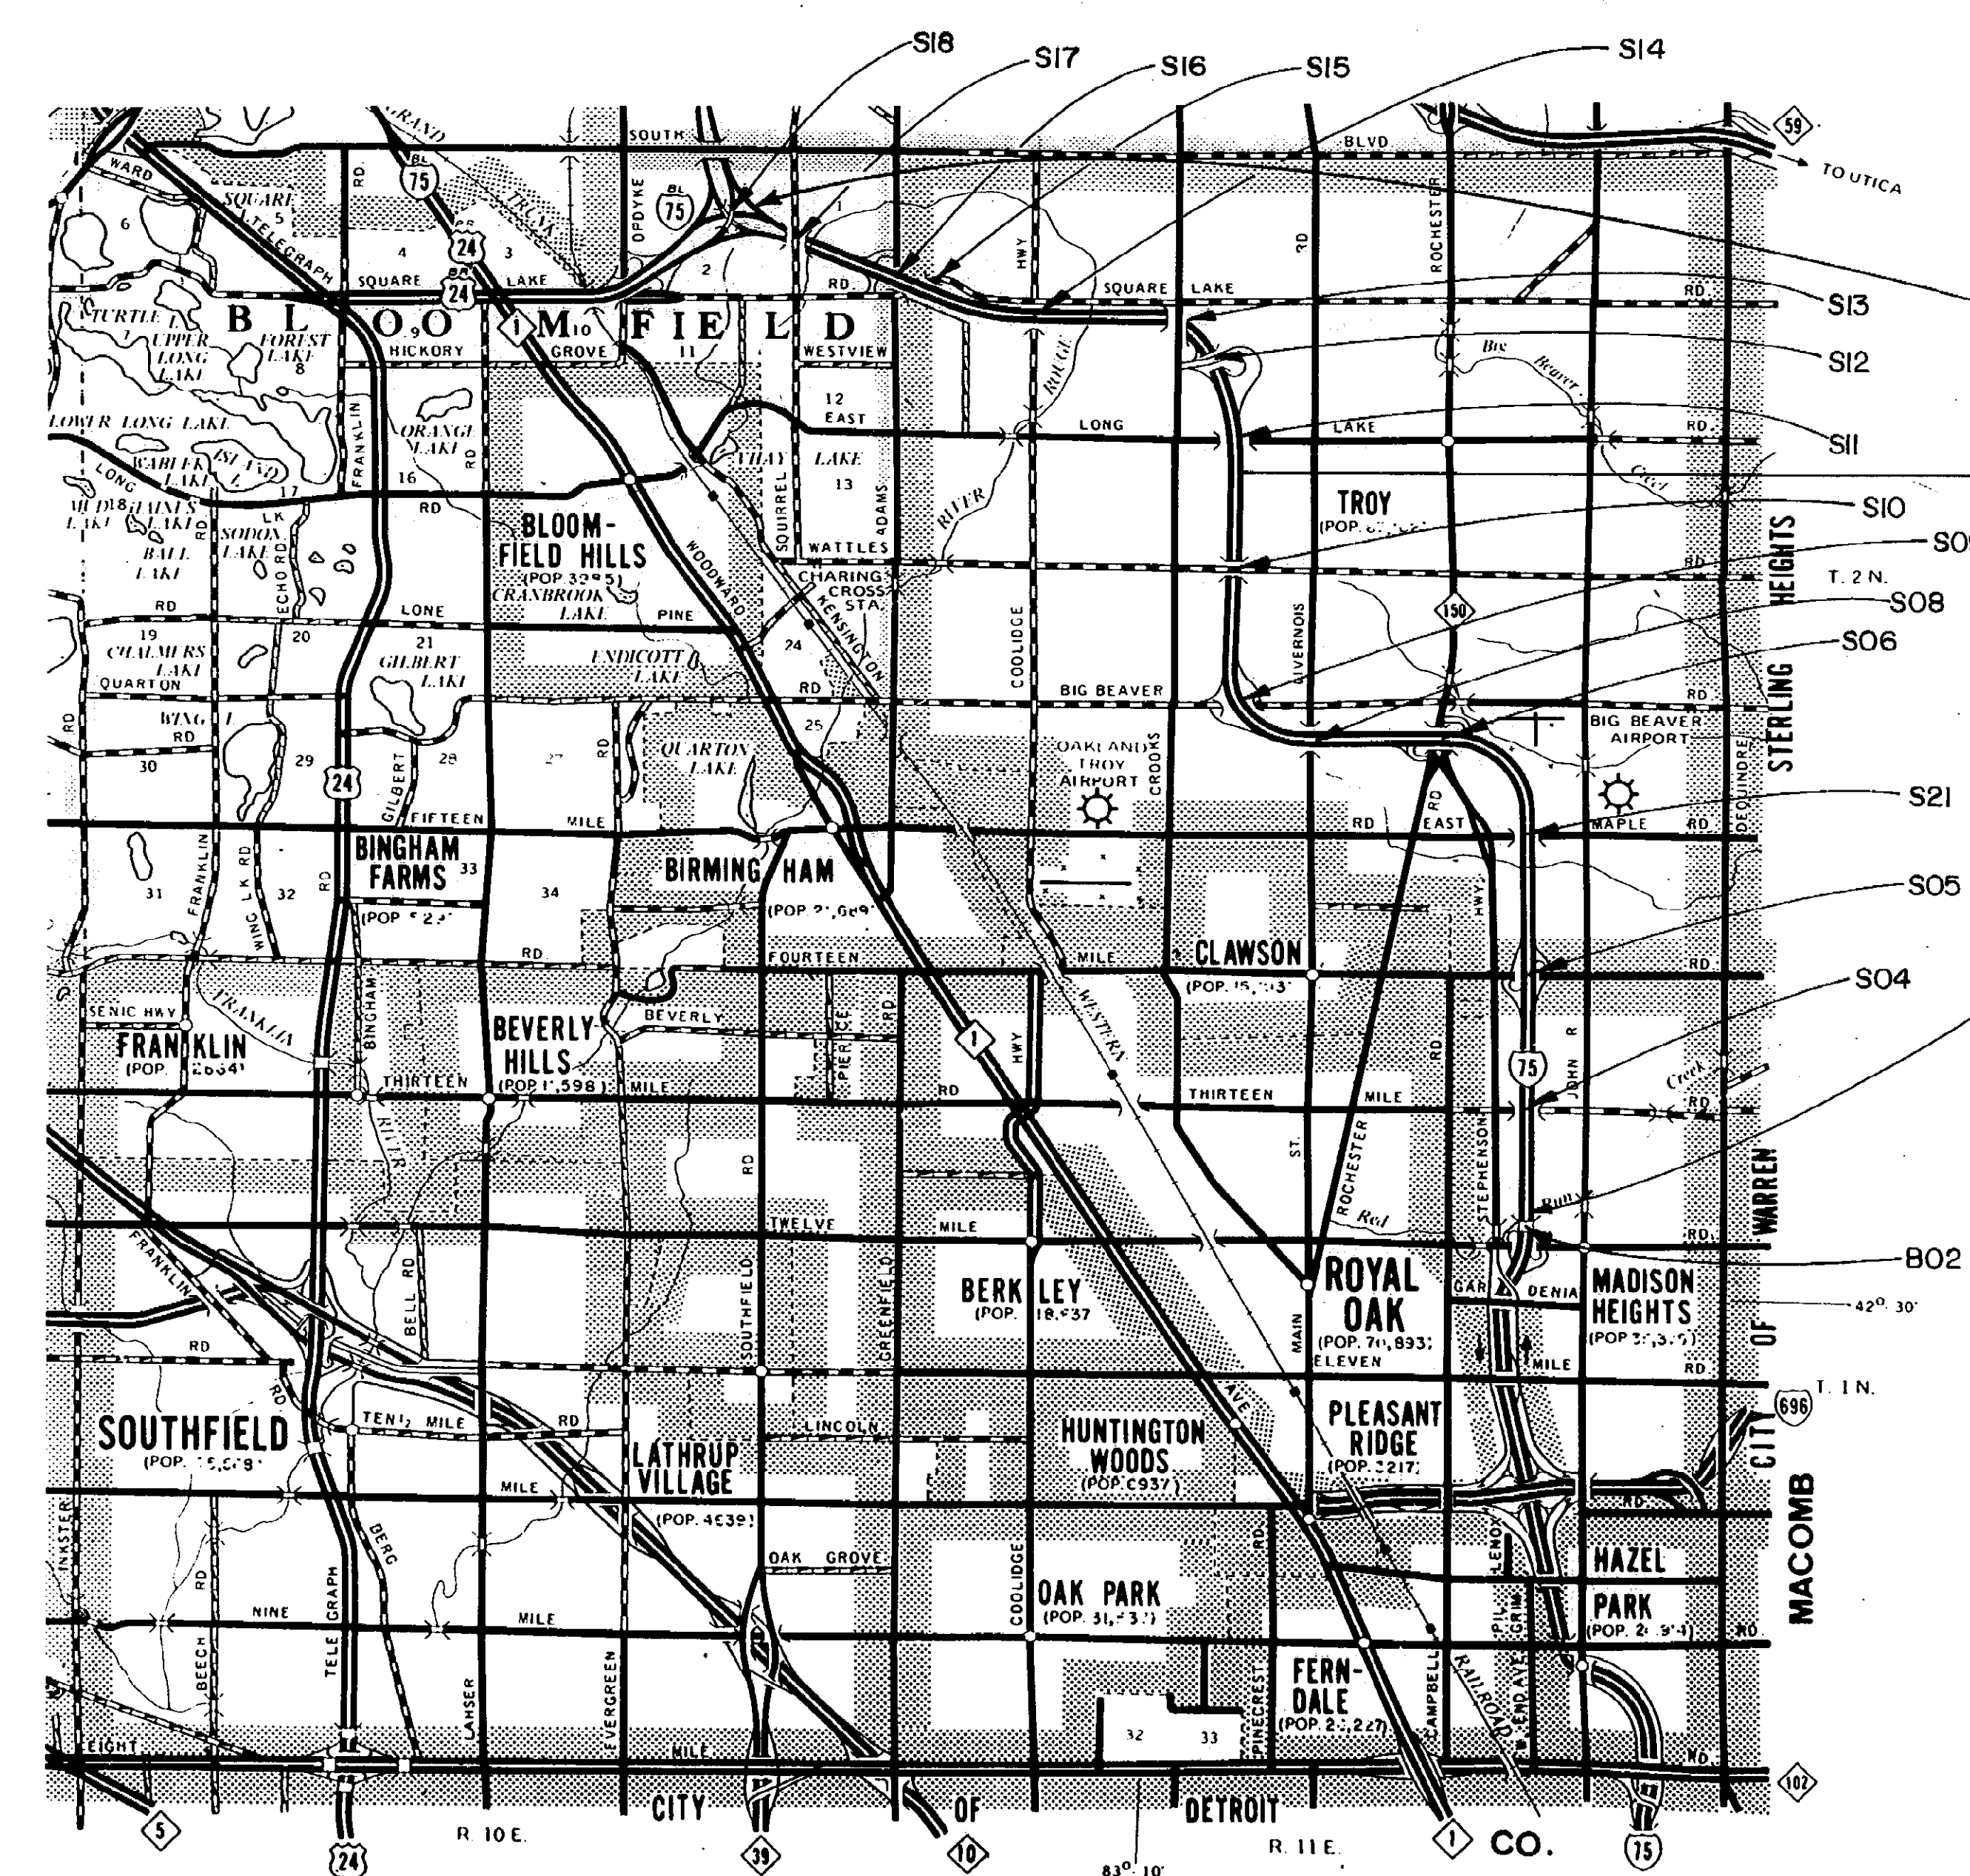

P.O.E. STA. 782+50.00
MICHIGAN PROJECT IR 75-2(384)63
CONTROL SECTION IR 63174
JOB NO. 28991 A
M.P. = 16.949

STA. EQUATION
STA. 1326+20.20 BACK =
STA. 318+61.05 AHEAD

P.O.B. STA. 935+00.00
MICHIGAN PROJECT IR 75-2(384)63
CONTROL SECTION IR 63174
JOB NO. 28991 A
M.P. = 4.542

TITLE SHEET LEGEND

PROPOSED PROJECT	
EXISTING ROADS	
PAVED	
BITUMINOUS	
GRAVEL	
UNIMPROVED OR CITY STREET	
SECTION LINE	
TOWNSHIP LINE	
COUNTY LINE	
CITY OR VILLAGE LIMITS	
RAILROADS	

CONTRACT FOR: BIT. SURFACING & SAFETY UPGRADING

APPROVALS

RECOMMENDED FOR APPROVAL		9-13-90
	ENGINEER ROAD DESIGN	DATE
RECOMMENDED FOR APPROVAL		9-14-90
	ENGINEER OF DESIGN	DATE
RECOMMENDED FOR APPROVAL		9/24/90
	ENGINEER OF TRAFFIC & SAFETY	DATE
RECOMMENDED FOR APPROVAL		10/11/90
	FOR ENGINEER OF CONSTRUCTION	DATE

**MICHIGAN
DEPARTMENT OF TRANSPORTATION**

JAMES P. FITZ - DIRECTOR

APPROVED BY

PLANS PREPARED BY

U. S. DEPARTMENT OF TRANSPORTATION
FEDERAL HIGHWAY ADMINISTRATION

CONTROL SECTION	JOB NUMBER	FEDERAL NUMBERS	SHEET NO.
IR 63174	28991 A	IR 75-2(384)63 NPI137	1




AS LET PLANS

IR 63174-28991 A

JOB NUMBER CONTROL SECTION


FINAL R.O.V.			
AUTH	DATE	NO.	REVISION

SH. NO. 2
 JOB NO. 28991A
 CONTROL SECTION 63174

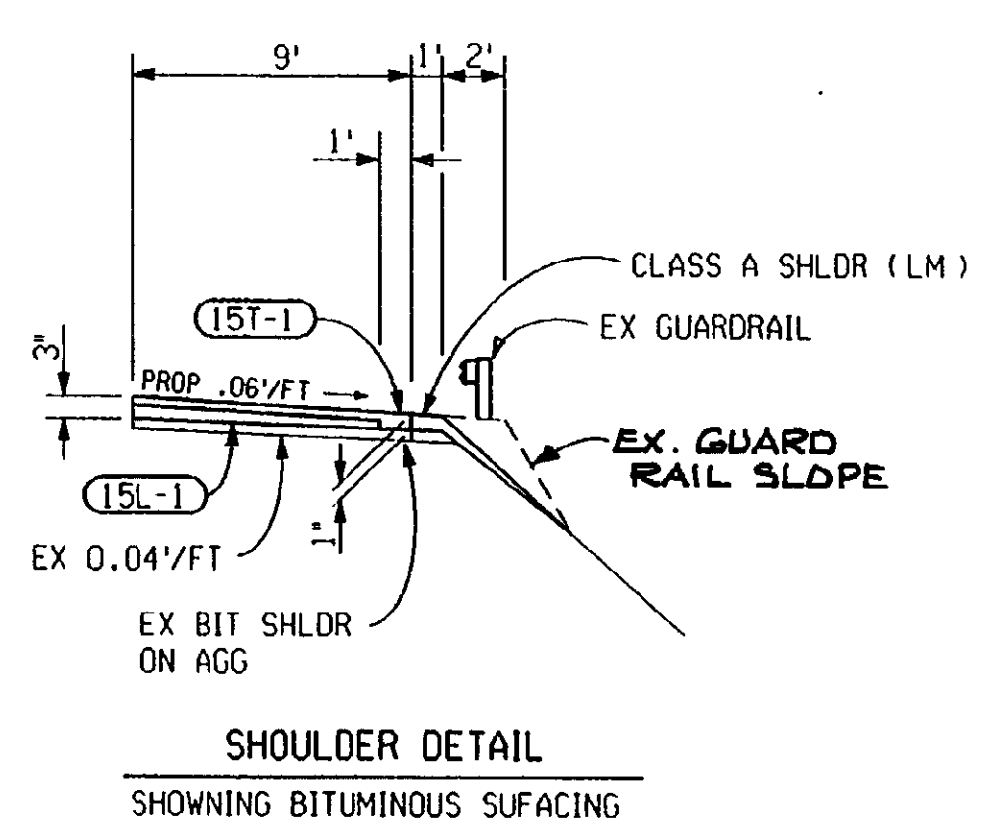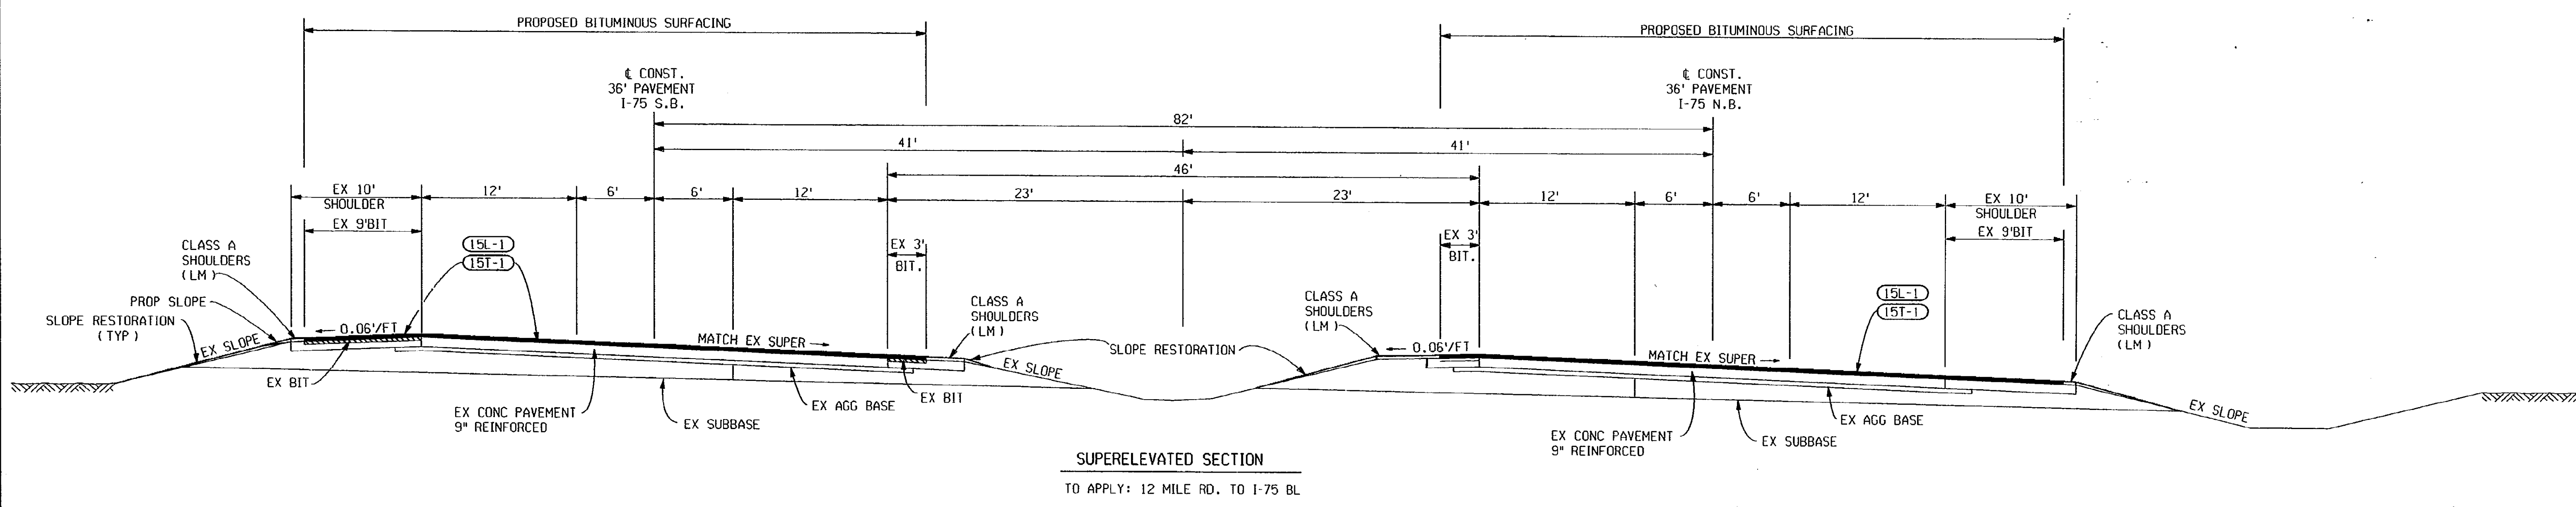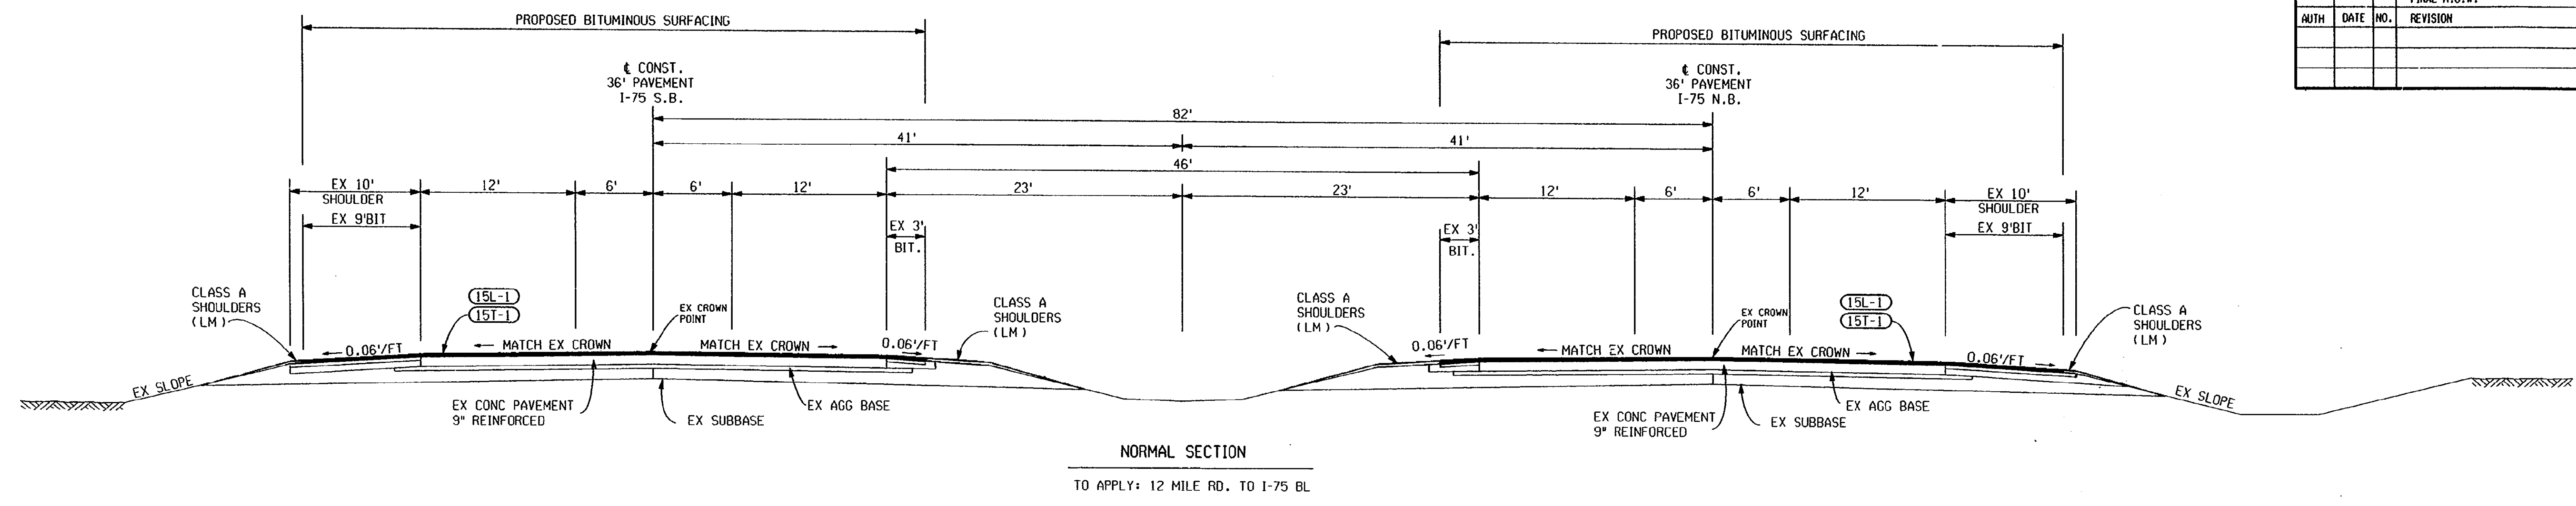

IDENT NO.	ITEM	RATE PER SYD	ESTIMATED THICKNESS	ASPHALT PENETRATION	REMARKS
15T-1	BITUMINOUS MIXTURE #1500T, 20AAA-RUBBER	160"	1 1/2"	85-100	I-75 ROADWAY & RAMPS
15L-1	BITUMINOUS MIXTURE #1500L, 20AAA-RUBBER	170"	1 1/2"	85-100	I-75 ROADWAY & SHLDRS
** BA	BITUMINOUS MIXTURE #1500T, 20AAA	330"	3"	85-100	TURNAROUNDS
*** 15L-2	BITUMINOUS MIXTURE #1500L, 20AAA-RUBBER	250"	2 1/2"	85-100	EX CONC PATCH REPAIR
* BITUMINOUS BOND COAT		0-0.10 GAL			

*FOR INFORMATION ONLY
 ** TO BE PAID FOR AS BITUMINOUS APPROACHES
 *** TO BE PAVED IN TWO LIFTS


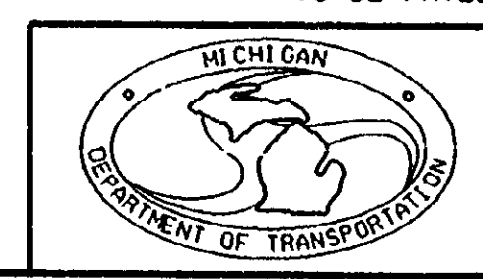


DATE	SCALE	CONT. SEC.	JOB NO.	DESIGN UNIT	SHEET NO.
09/10/90	1"=6'	63174	28991A	PALMER	R.O.W CONST. 2





EXIS. PROPOSED BY: DATE: 09-10-90
 LAST CORRECTION BY: DATE: 09-10-90
 FILE NAME: 28991.TY1
 1 3 4

FINAL R.O.W.			
AUTH	DATE	NO.	REVISION

CONTROL SECTION 63174 SH. NO. 3
 JOB NO. 28991A

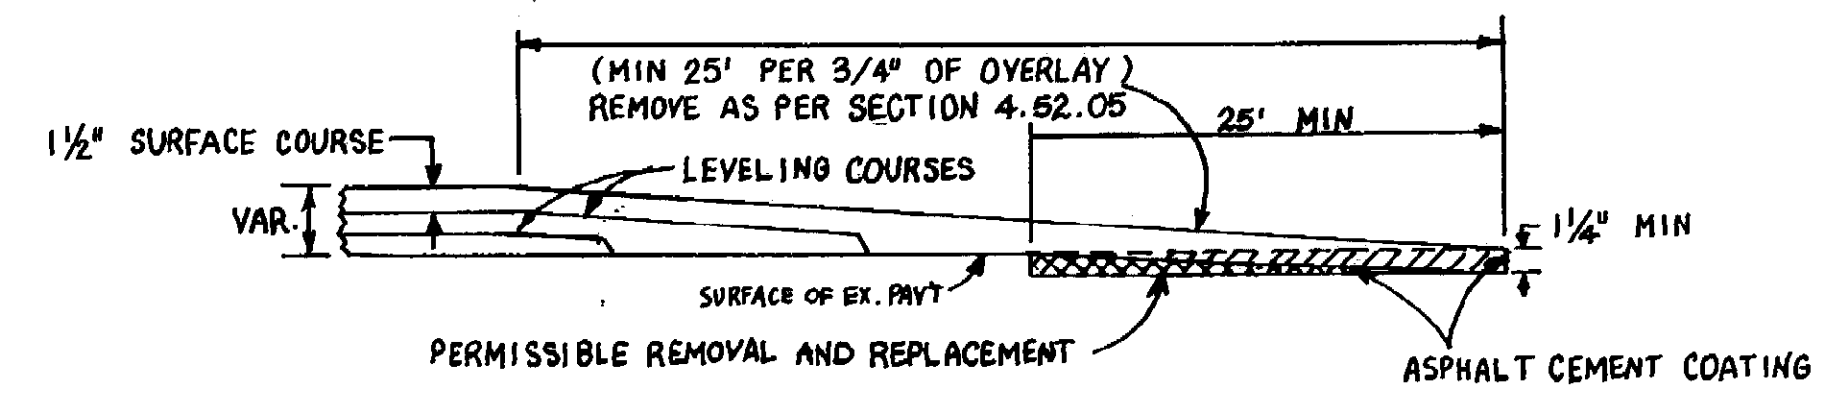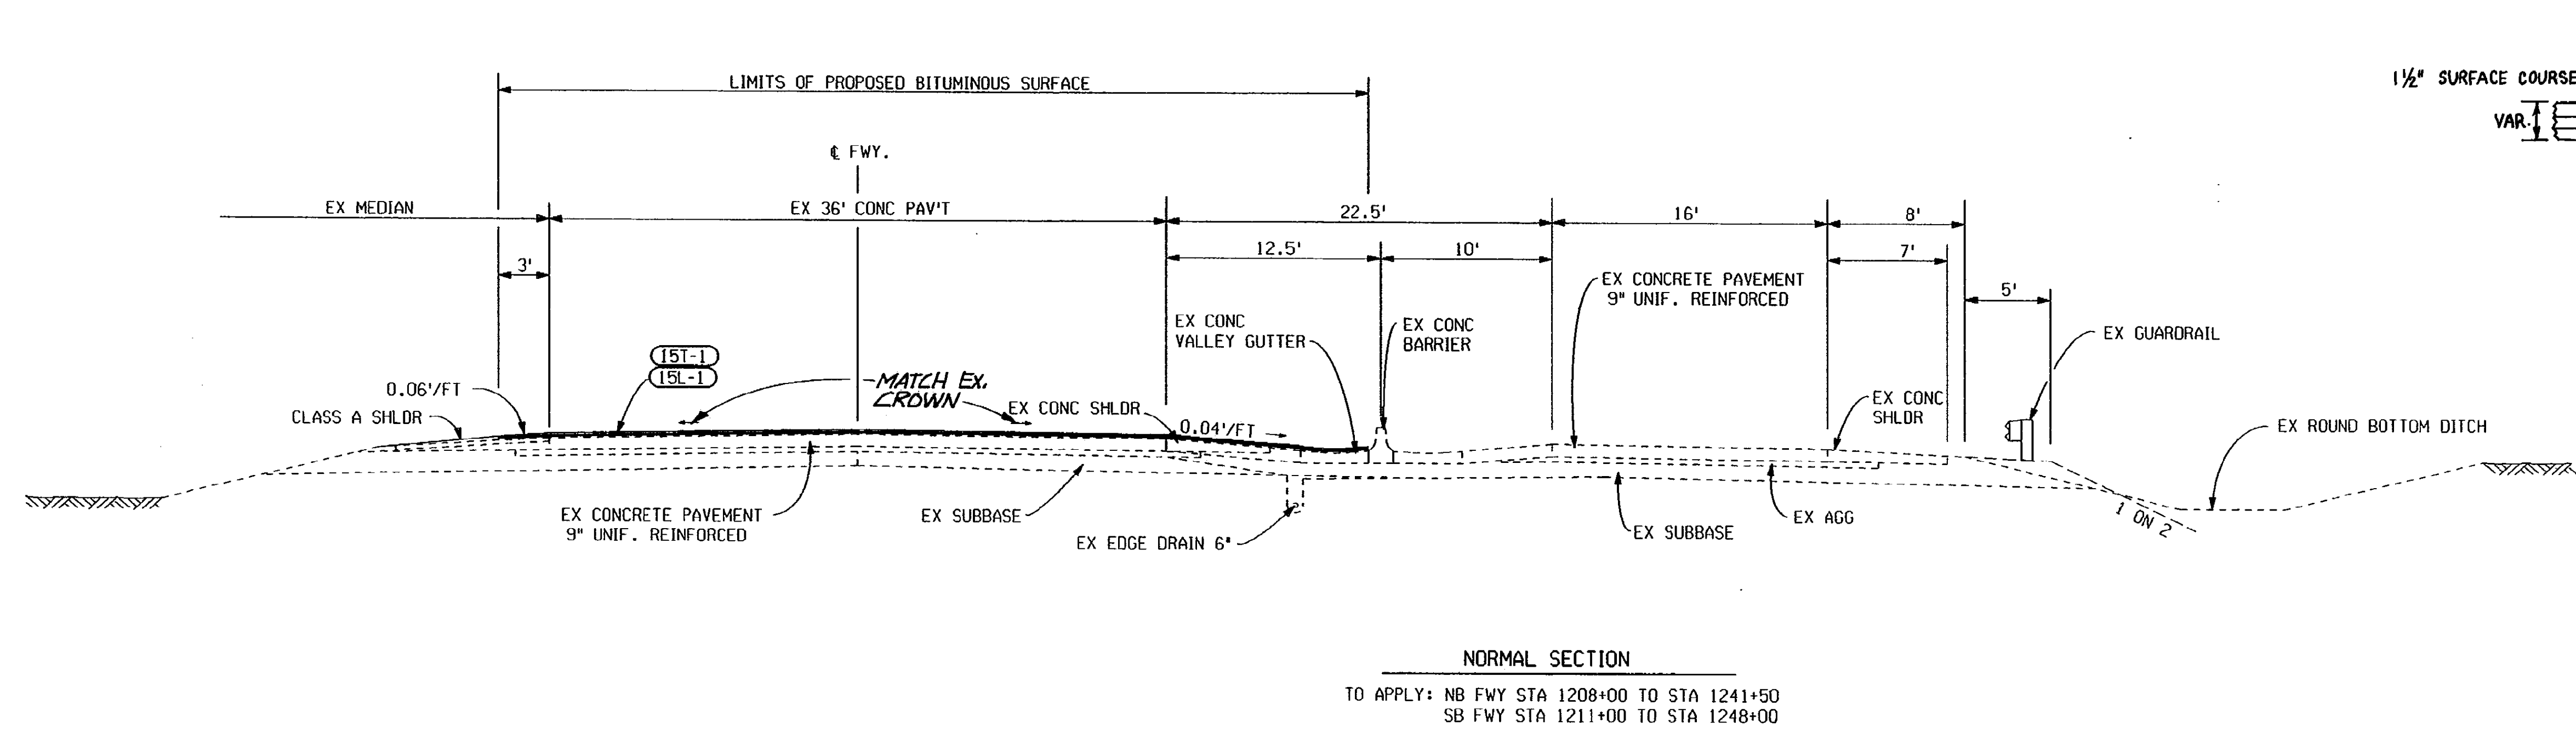

FEATHERING DETAIL-BUTT JOINT TYPE
 TO APPLY: POB, ALL RAMP, SO4, SO5, S21, SO6, SO8, SO9, S11, S14, S15, S16, S18, & POE.

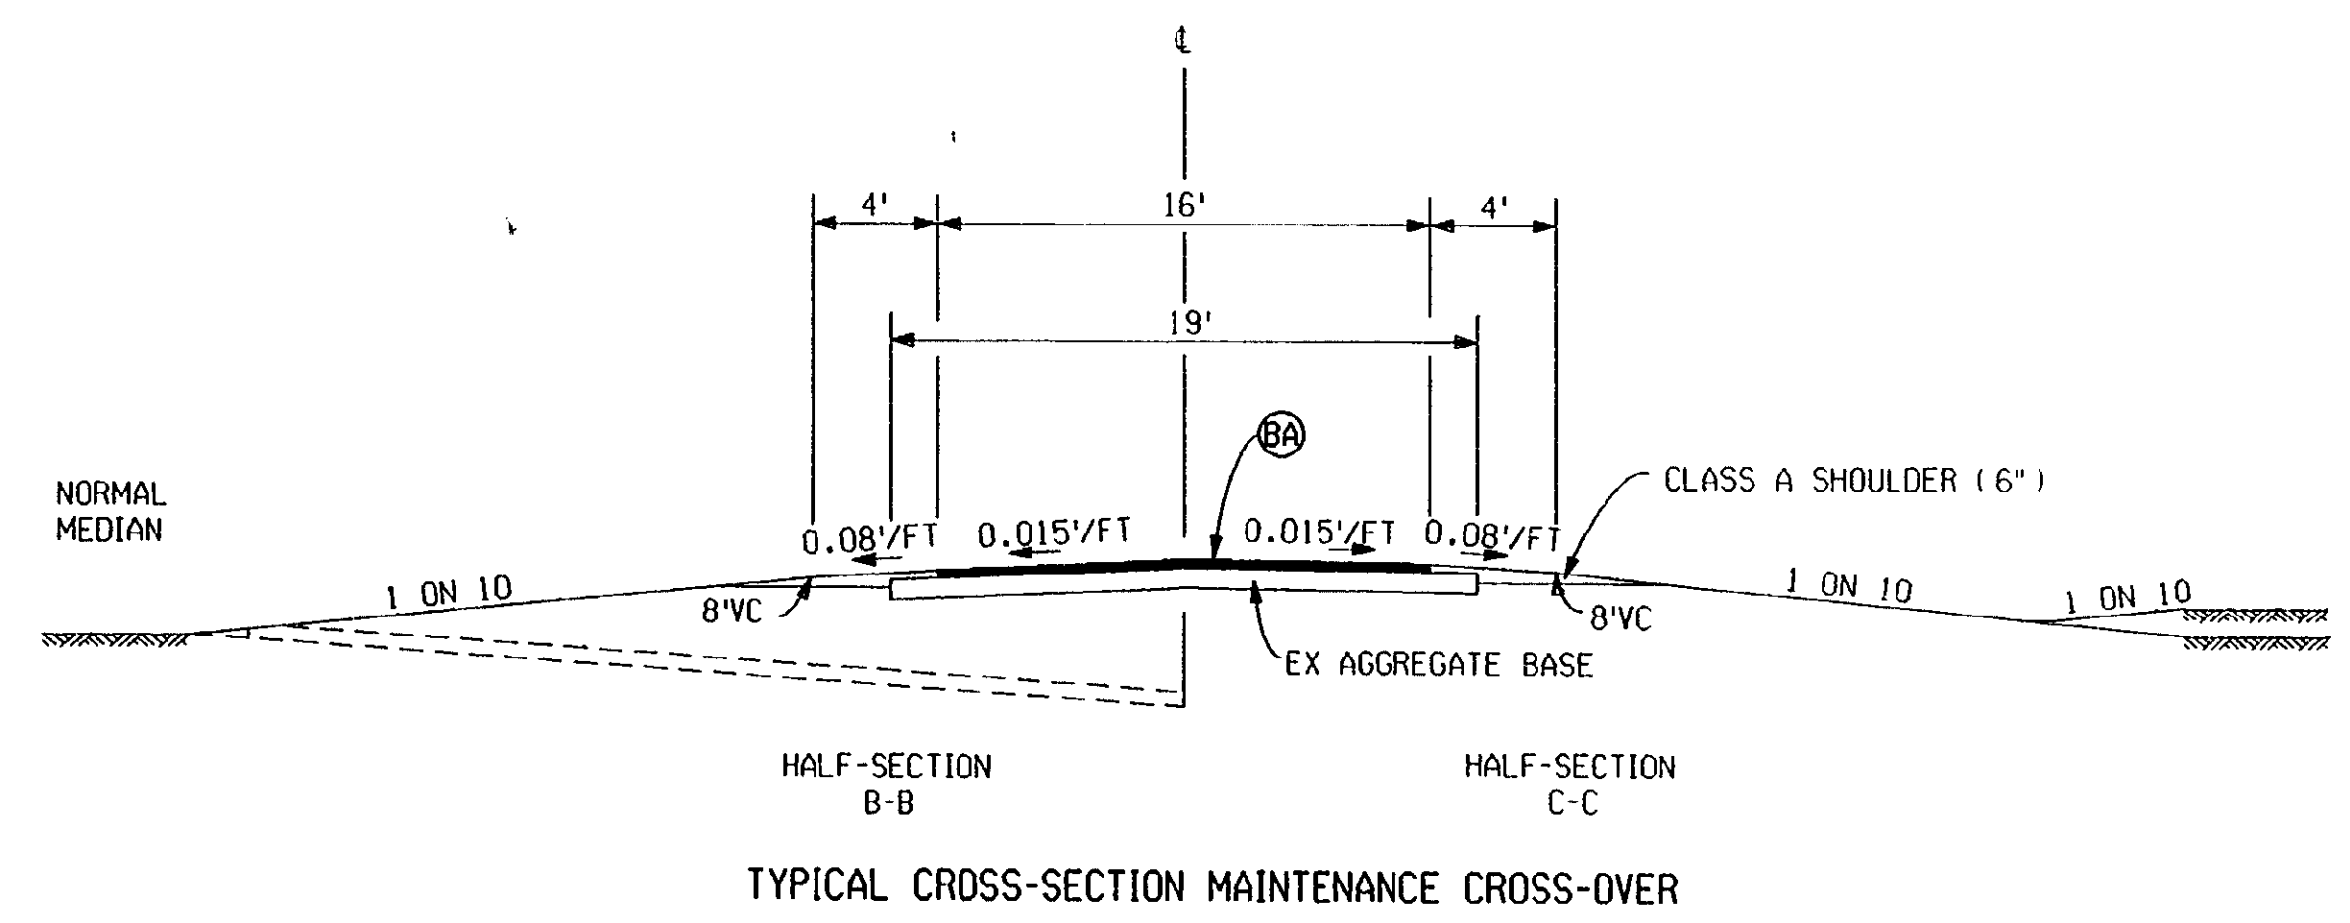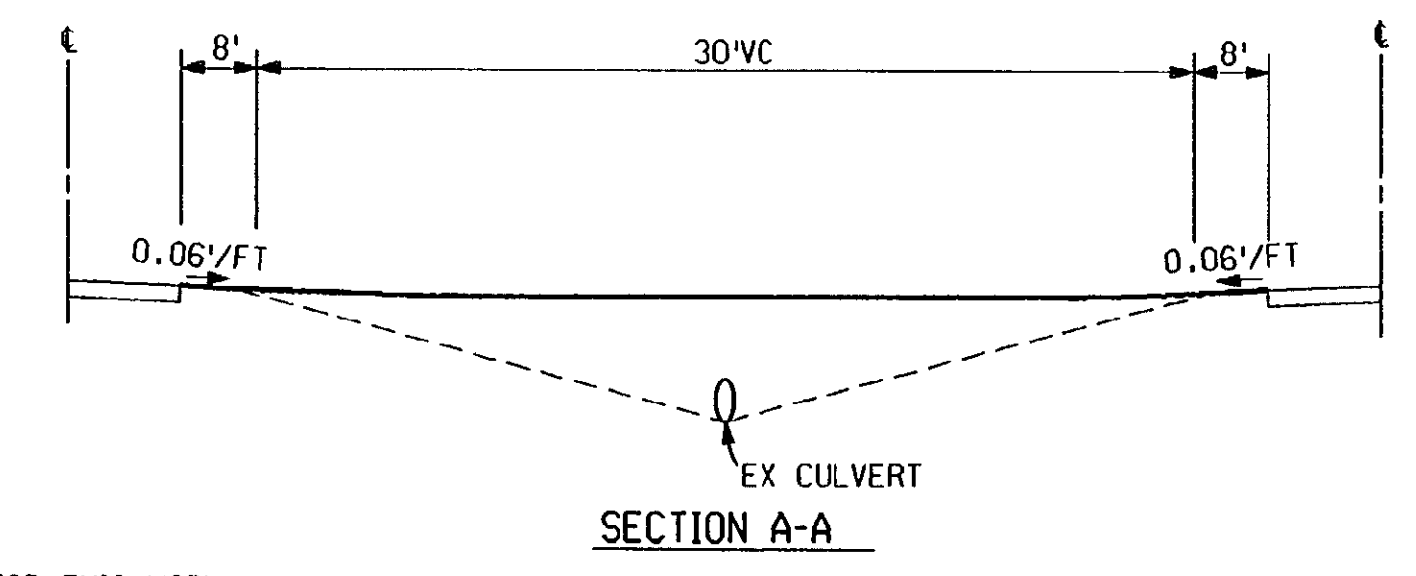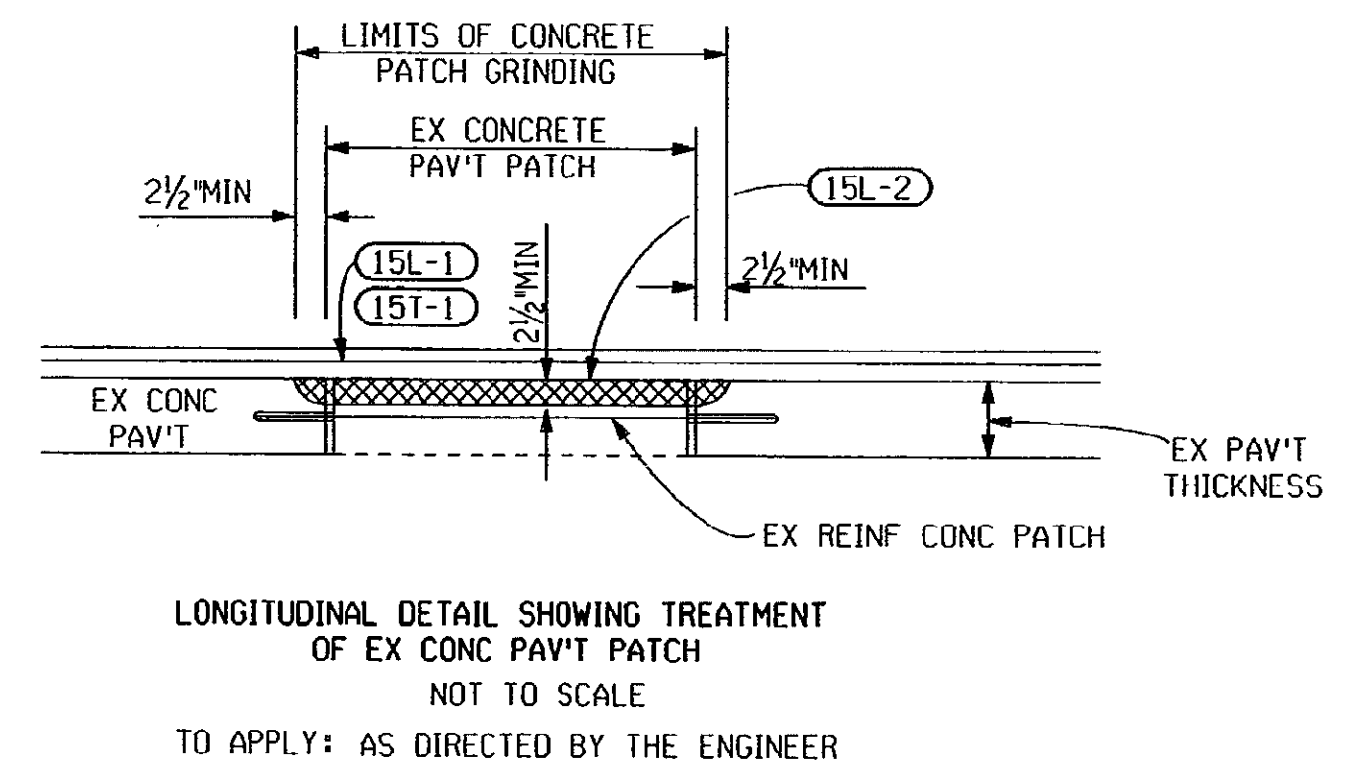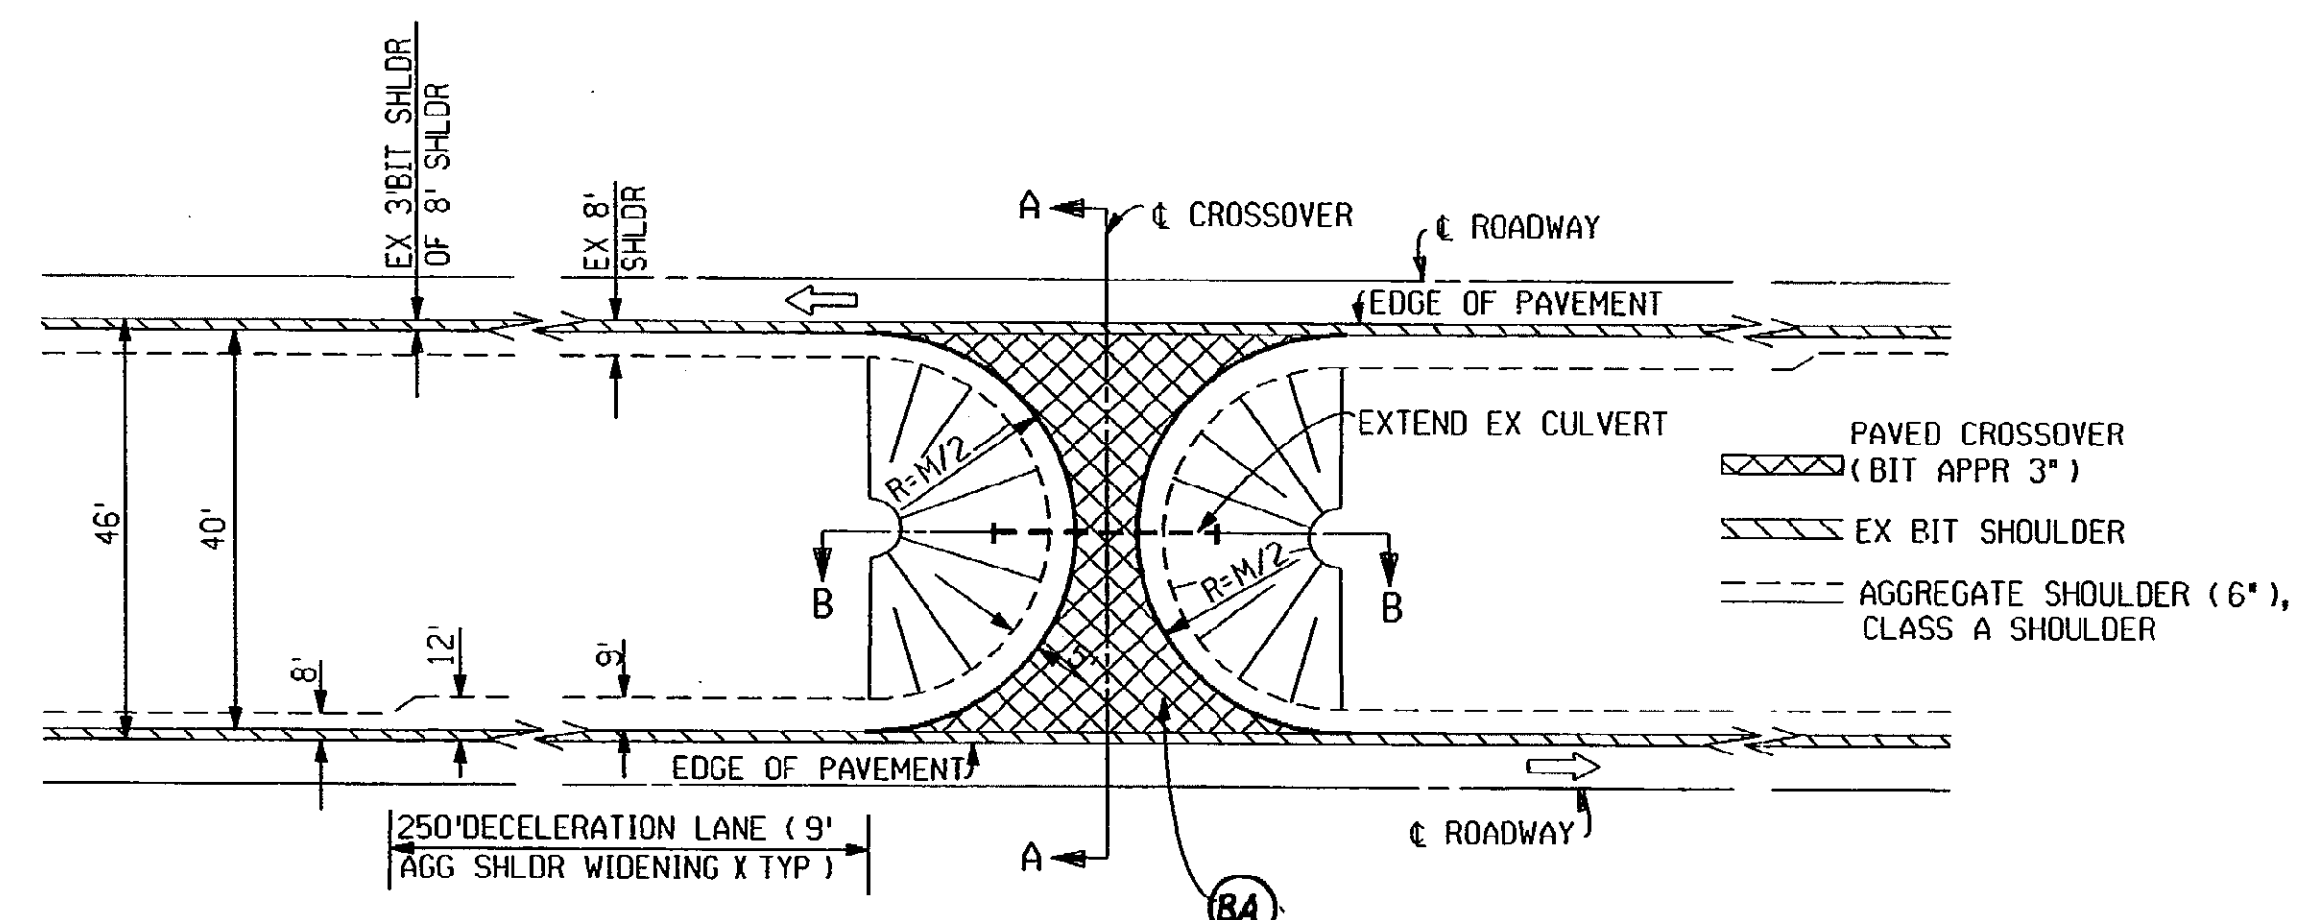

DATE: 09-10-90
 DATE: 09-10-90
 EXIS. PROPOSED BY:
 LAST CORRECTION BY:
 FILE NAME: 28991.TY1
 3 4

	TYPICAL CROSS SECTION					
	DATE	SCALE	CONT. SEC.	JOB NO.	DESIGN UNIT	SHEET NO.
	09/10/90	1"=6'	63174	28991	PALMER	R.O.W CONST. 3

CONTROL SECTION 63174 JOB NO. 28991A SH. NO. 4

ENGINEERING REPORT NO.	ENVIRON IMPACT STMT
METHOD OF SURVEY	YEAR
SURVEY ORDER	SURVEY CHIEF
AERIAL SURVEY NO.	YEAR
HORIZ DATUM	VERT DATUM
ROAD DESIGN INITIATED 5-5-88	COMPLETED 9-90
PRELIMINARY PLANS BY D.VAUGHN	FINAL PLANS BY T.PALMER
FIELD INSPECTION (CI) BY K.KRUGER	M. FISHER DATE 12-7-88
PLANS-IN-HAND BY (FHWA) M. HOVEL	AND (MDOT) D. HILL DATE 1-30-89

GENERAL PLAN NOTES

UNDERGROUND UTILITIES

FOR PROTECTION OF UNDERGROUND UTILITIES, THE CONTRACTOR SHALL DIAL 1-800-482-7171 A MINIMUM OF 48 HOURS PRIOR TO EXCAVATING IN THE VICINITY OF UTILITY LINES. ALL "MISS DIG" PARTICIPATING MEMBERS WILL BE ROUTINELY NOTIFIED. THIS DOES NOT RELIEVE THE CONTRACTOR OF THE RESPONSIBILITY OF NOTIFYING UTILITY OWNERS WHO MAY NOT BE PART OF THE "MISS DIG" ALERT SYSTEM.

ADJUSTING MONUMENT BOXES

IT IS THE INTENT THAT ALL GOVERNMENT CORNERS ON THIS PROJECT BE PRESERVED AND THAT, WHERE NECESSARY, MONUMENT BOXES BE PLACED OR ADJUSTED, WHETHER SHOWN OR NOT.

OLD PLANS

THE FOLLOWING OLD PLANS WERE REFERRED TO IN THE DESIGN OF THIS PROJECT.
 63174- C2,3,4,5,8,14
 JN'S 08386A, 19958A, 25414A
 63103 - 030

IN ADDITION, OTHER OLD PLANS THAT PREDATE THIS PROJECT MAY BE AVAILABLE. THESE PLANS MAY BE REVIEWED IN THE LANSING DESIGN OFFICE DURING NORMAL WORKING HOURS.

SHOULDER CORES

THE CORING LOGS REPRESENT POINT INFORMATION. PRESENTATION OF THIS INFORMATION IN NO WAY INFERS THAT SUBSURFACE CONDITIONS ARE THE SAME OTHER THAN THE EXACT LOCATION OF THE CORINGS.

STATIONING

STATIONING ON THIS PROJECT WAS TAKEN FROM OLD PLANS AND PAVEMENT STENCILED STATIONING AND IS NOT NECESSARILY CORRECT.

SIGNS

ALL SIGNS REQUIRING RELOCATION DUE TO CONSTRUCTION OPERATIONS SHALL BE SALVAGED AND RESET BY THE CONTRACTOR AT LOCATIONS DESIGNATED BY THE ENGINEER. THIS WORK WILL BE CONSIDERED AS INCIDENTAL TO CONSTRUCTION OF THE PROJECT.

GUARDRAIL MATERIAL

ONLY GALVANIZED BEAM GUARDRAIL WILL BE USED ON THIS PROJECT.

BRIDGE UNDERCLEARANCES

UNDERCLEARANCES FOR EXISTING BRIDGES OVER I-75 SHALL NOT BE REDUCED BY NEW BITUMINOUS SURFACING BELOW 16'-0".

JOINT AND CRACK CLEANOUT

JOINT AND CRACK CLEANOUT IS ONLY FOR THE REMOVAL OF PRESSURE RELIEF JOINTS BEFORE OVERLAYING WITH BITUMINOUS, AS DIRECTED BY THE ENGINEER. THE SEALING OF THESE JOINTS WILL CONSIST OF A BITUMINOUS MIXTURE AS APPROVED BY THE ENGINEER. THIS WILL BE PAID FOR BY THE TON AS "HAND PATCHING."

COOLING OF BITUMINOUS MAT

IT WILL BE THE CONTRACTORS RESPONSIBILITY TO MAKE SURE THE BITUMINOUS MAT IS PROPERLY COOLED BEFORE OPENING TO TRAFFIC. THIS OPERATION IS INCLUDED IN THE COST OF THE BITUMINOUS.

SLOPE RESTORATION

ALL GRADED SLOPES SHALL BE MULCHED AND SEEDDED AS DESCRIBED UNDER THE PAY ITEM "SLOPE RESTORATION".

STAGING SEQUENCE

CENTER LANE JOINT REPAIRS SHALL BE DONE HALF AT A TIME. TRAFFIC WILL NOT BE ALLOWED TO DRIVE ON THE SHOULDER. TAPER JOINTS MUST BE USED AND AT THE TIME OF PAVING THE CENTER LANE, TRAFFIC MUST BE SHIFTED TO A PREVIOUSLY PAVED LANE.

BITUMINOUS CONSTRUCTION JOINTS

BIT. CONST. JOINTS MUST BE AT LEAST 4'-0" LONG FOR A 1 1/2" COURSE. THIS SHALL BE IN PLACE BEFORE TRAFFIC CAN BE SHIFTED. BITUMINOUS TAPER JOINTS ARE REQUIRED ON THIS PROJECT. SEE THE SPECIAL PROVISION FOR DETAILS.

PUBLIC UTILITIES

THE EXISTING UTILITIES LISTED BELOW AND SHOWN ON THESE PLANS REPRESENT THE BEST INFORMATION AVAILABLE. THIS INFORMATION DOES NOT RELIEVE THE CONTRACTOR OF THE RESPONSIBILITY TO BE SATISFIED AS TO ITS ACCURACY AND THE LOCATION OF EXISTING UTILITIES.

NAME OF OWNER	KIND OF UTILITY
CITY OF MADISON HEIGHTS 300 W. 13 MILE RD. MADISON HEIGHTS, MICHIGAN 48071 ATTN: MR. PETER CONNERS, PUBLIC WORKS	SEWER, WATER
CITY OF TROY 500 W. BIG BEAVER TROY, MICHIGAN 48064-5285 ATTN: ROBERT QUIGLEY, ENGINEER	SEWER, WATER
CONSUMERS POWER COMPANY 1955 FARNALL RD., ROOM JSC-202A JACKSON, MICHIGAN 49201 ATTN: W. ZIMMERMAN, LAND & ROY DEPT.	GAS
DETROIT EDISON COMPANY 2000 SECOND AVE., ROOM 6605B DETROIT, MICHIGAN 48226 ATTN: PAUL NORMANDIN	ELECTRIC
MICHIGAN BELL TELEPHONE COMPANY 444 MICHIGAN AVE., ROOM 635 DETROIT, MICHIGAN 48226 ATTN: KEITH REGAN	TELEPHONE
OAKLAND COUNTY DRAIN COMMISSION PUBLIC WORKS DRIVE PONTIAC, MICHIGAN 48054 ATTN: D. SNYDER, DEPUTY & CHIEF ENGINEER	SEWER
BUCKEYE PIPELINE COMPANY P.O. BOX 368 EMMAUS, PA. 18049-0368 ATTN: GEORGE FOX	OIL

NOTES APPLYING TO STANDARD PLANS

WHERE THE FOLLOWING ITEMS ARE CALLED FOR ON PLANS, THEY ARE TO BE CONSTRUCTED ACCORDING TO THE STANDARD PLAN GIVEN BELOW OPPOSITE EACH ITEM UNLESS OTHERWISE INDICATED.

CONCRETE PAVEMENT REPAIR	II-44G (SPECIAL DET)
GUARDRAIL BULLNOSE	III-56B (SPECIAL DET)
GUARDRAIL ENDINGS WITH CABLE ANCHORAGE	III-58K (SPECIAL DET)
GUARDRAIL AT BRIDGES AND EMBANKMENTS	III-59G
SOIL EROSION & SEDIMENTATION CONTROL MEASURES	V-96C
SODDING AND SEEDING	V-100
SHOULDERS - FREEWAYS	V-112K
LIGHTED ARROWS AND BARRICADES	VI-125G

MISCELLANEOUS ESTIMATES

THE FOLLOWING ITEMS OF WORK SHALL BE DONE AS THEY APPLY THROUGHOUT THE PROJECT. THESE ITEMS ARE NOT DETAILED OR INCLUDED ON THE PLAN AND PROFILE SHEETS:

	A	B	MDOT	TOTAL	UNIT
CLEANING EXISTING PAVEMENT	.15	.72	.13	1	LSUM
FLAG CONTROL	.15	.72	.13	1	LSUM
MINOR TRAFFIC DEVICES	.15	.72	.13	1	LSUM
LIGHTED ARROW, TYPE A - FURNISHED	2	4	2	8	EACH
LIGHTED ARROW, TYPE A - OPERATED	2	4	2	8	EACH
BARRICADE, TYPE II, LIGHTED - FURNISHED	217	1044	189	1450	EACH
BARRICADE, TYPE II, LIGHTED - OPERATED	126	605	109	840	EACH
SIGN, TYPE A, TEMPORARY	12	58	10	80	SFT
SIGN, TYPE B, TEMPORARY	450	2160	390	3000	SFT
TEMPORARY PAVEMENT MARKING, TYPE R 4" WHITE	12510	60048	10842	83400	LFT
TEMPORARY PAVEMENT MARKING, TYPE R 4" YELLOW	2358	11318	2044	15720	LFT
THERMOPLASTIC PAVEMENT MARKING, 4" WHITE				314500	314500 LFT
THERMOPLASTIC PAVEMENT MARKING, 4" YELLOW				157000	157000 LFT
THERMOPLASTIC PAVEMENT MARKING, 6" CROSS WALK LINE				6000	6000 LFT
THERMOPLASTIC PAVEMENT MARKING, 12" CROSS WALK LINE				20000	20000 LFT
TEMPORARY PAVEMENT MARKING, TYPE NR (TAPE M) WHITE	11898	57110	10312	79320	LFT
TEMPORARY PAVEMENT MARKING, TYPE NR (TAPE M) YELLOW	2358	11318	2044	15720	LFT
BARRICADE, TYPE III, LIGHTED-FURNISHED	5	21	4	30	EACH
BARRICADE, TYPE III, LIGHTED-OPERATED	4	17	3	24	EACH
STRAW MULCH BLANKET		6259	5146	11405	SYD
SLOPE RESTORATION		6259	5146	11405	SYD
CEREAL RYE SEEDING	146	698	126	970	LBS
BIT. MIX. NO. 1500L-20AAA-RUBBER (PATCH GRINDING AREA)	2250	10800	1950	15000	TON
HAND PATCHING	82	396	72	550	TON
LONGITUDINAL JOINT REPAIR	1500	7200	1300	10000	LFT
CONCRETE PATCH GRINDING	9150	43820	7930	61000	SYD
JOINT AND CRACK CLEANOUT	375	1800	325	2500	LFT
ON-THE-JOB TRAINING	450	2160	390	3000	HR
REPAIRING PAV'T JOINTS AND CRACKS DETAIL 7	750	3600	650	5000	LFT
MOBILIZATION	.15	.72	.13	1	LSUM
REMOVAL OF SIGN, TYPE II	1	2	1	4	EACH
LIGHTING FOR NIGHT PAVING	.15	.72	.13	1	LSUM


EROSION AND SEDIMENTATION CONTROL QUANTITIES

HAY OR STRAW BALES	9	43	8	60	EACH
SEDIMENT TRAPS	1	4	1	6	EACH
SEDIMENT EXCAVATION-MAINTENANCE	2	9	1	12	CYD

A - CITY OF MADISON HEIGHTS

B - CITY OF TROY

EXIS :
 PROP. BY: RHO48BECK/1
 LAST CORRECTION BY: RHO48BECK/1
 FILE NAME: 28991.MT1
 DATE: 9-4-90
 DATE: 9-4-90

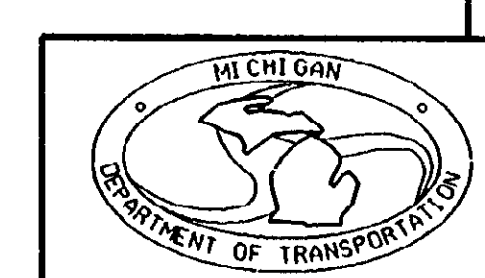

NOTE SHEET

DATE	CONT. SEC.	JOB NO.	DESIGN UNIT	SHEET NO.
9/ 4/90	63174	28991A	PALMER	R.O.W CONST. 4

CONTROL SECTION NO. 63174

DATE: 9-88
 DATE: 07-10-90
 EXISTING BY:
 PROPOSED BY:
 LAST CORRECTION BY:

FILE NAME: 289910525.DGN
 1 3 4 5 6 7 8 9 10 11 12 13 14 15 16 17 18 19 20 21 22 23 24 25 26 27 28 29 30 31 32 33 34 35 37 38 39 40 41 42 43 44 45 46 47 48 49

I-75 CONST. CURVE DATA
 $\Delta = 29^{\circ}02'20''$
 $D = 03^{\circ}00'00''$
 $R = 1909.86'$
 $T = 494.61'$
 $L = 967.36'$
 $E = 63.01'$
 $PC = 915+39.22$
 $PI = 920+33.83$
 $PT = 925+07.18$

RED RUN DRAIN

CITY OF MADISON HEIGHTS

RAMP E CURVE DATA
 $\Delta = 18^{\circ}24'21''$
 $D = 5^{\circ}00''$
 $R = 1145.92'$
 $T = 185.66'$
 $L = 368.12'$
 $E = 14.94'$
 $PC = 6+27.41$ (STA 938+27.41 SB ROW)
 $PI = 8+13.07$
 $PT = 9+95.53$
 $EX SUPER = 0.07\%FT$


FINAL R.O.W.			
AUTH	DATE	NO.	REVISION

MICHIGAN PROJECT: IR 75-2(384)63
 P.O.B STA. 935+00 NBD I-75
 CONTROL SECTION IR63174
 JOB NO. 28991A

LOCATION OF CROSSOVERS

STA 953+00	STA 1317+70
STA 997+00	STA 532+00
STA 1068+00	STA 597+00
STA 1114+80	STA 632+00
STA 1185+20	STA 678+50
STA 1269+20	STA 728+00

EX. CROSSOVER GRADE AND SURFACE (FOR DETAILS SEE TYPICAL CROSS-SECTION)
 18 TON BIT APPROACHES
 36 CYD AGG BASE - BIT (LM)
 125 CYD CLASS A SHOULDERS (LM)
 270 CYD EMBANKMENT (LM)

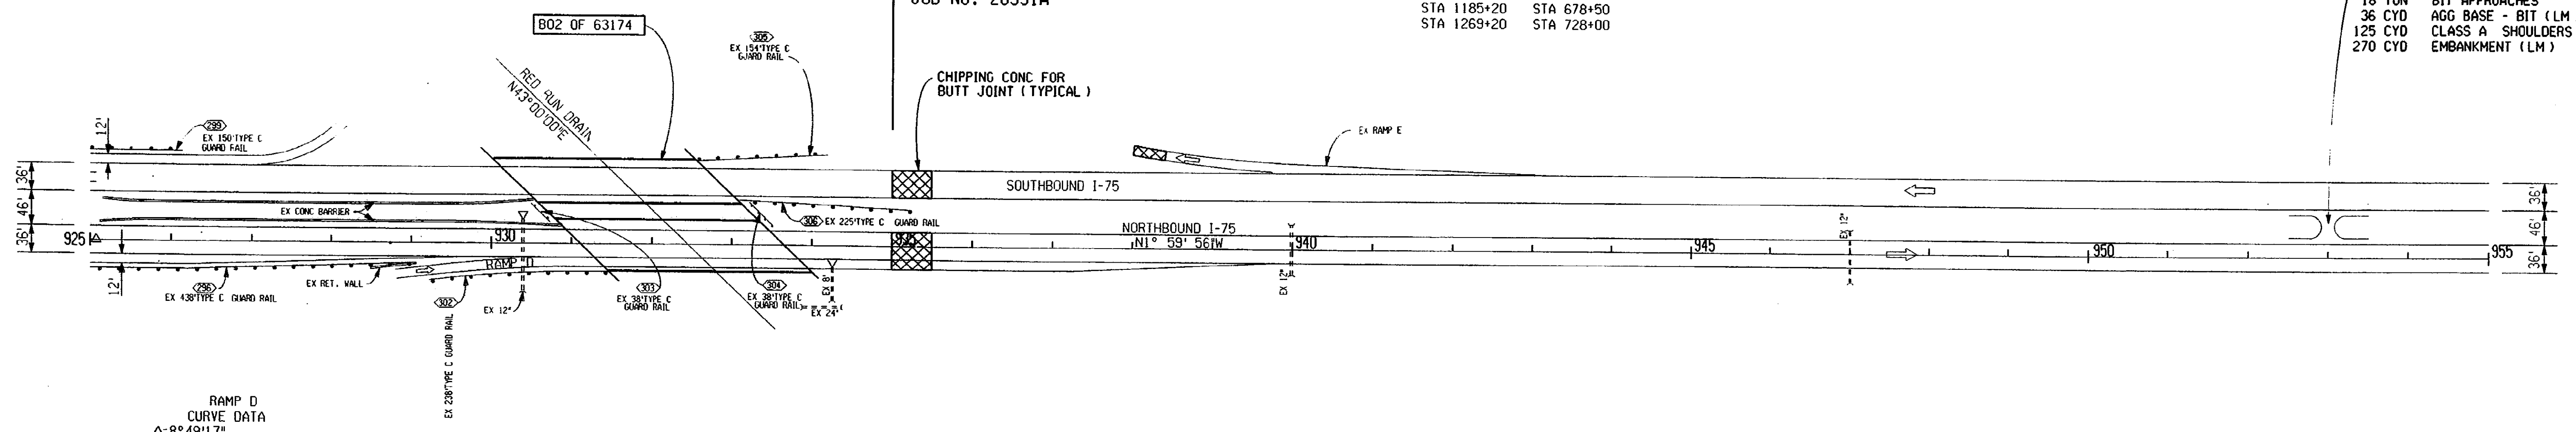

RAMP D CURVE DATA
 $\Delta = 8^{\circ}49'17''$
 $D = 7^{\circ}00''$
 $R = 818.51'$
 $T = 63.13'$
 $L = 126.02'$
 $E = 2.43'$
 $PC = 6+43.81$
 $PI = 7+06.94$
 $PT = 7+69.83$
 (30' RT STA 930+00 N.B. ROW)

CITY OF MADISON HEIGHTS

QUANTITIES


720 CYD	CLASS A SHOULDERS (LM)
1307 SYD	CHIPPING CONC PAVT FOR JOINTS
4487 TON	BIT MIXTURE NO.1500L, 20AAA-RUBBER
4223 TON	BIT MIXTURE NO.1500T, 20AAA-RUBBER

THURBY DRAIN

LAWSON DRAIN


13 MILE RD.

CITY OF MADISON HEIGHTS

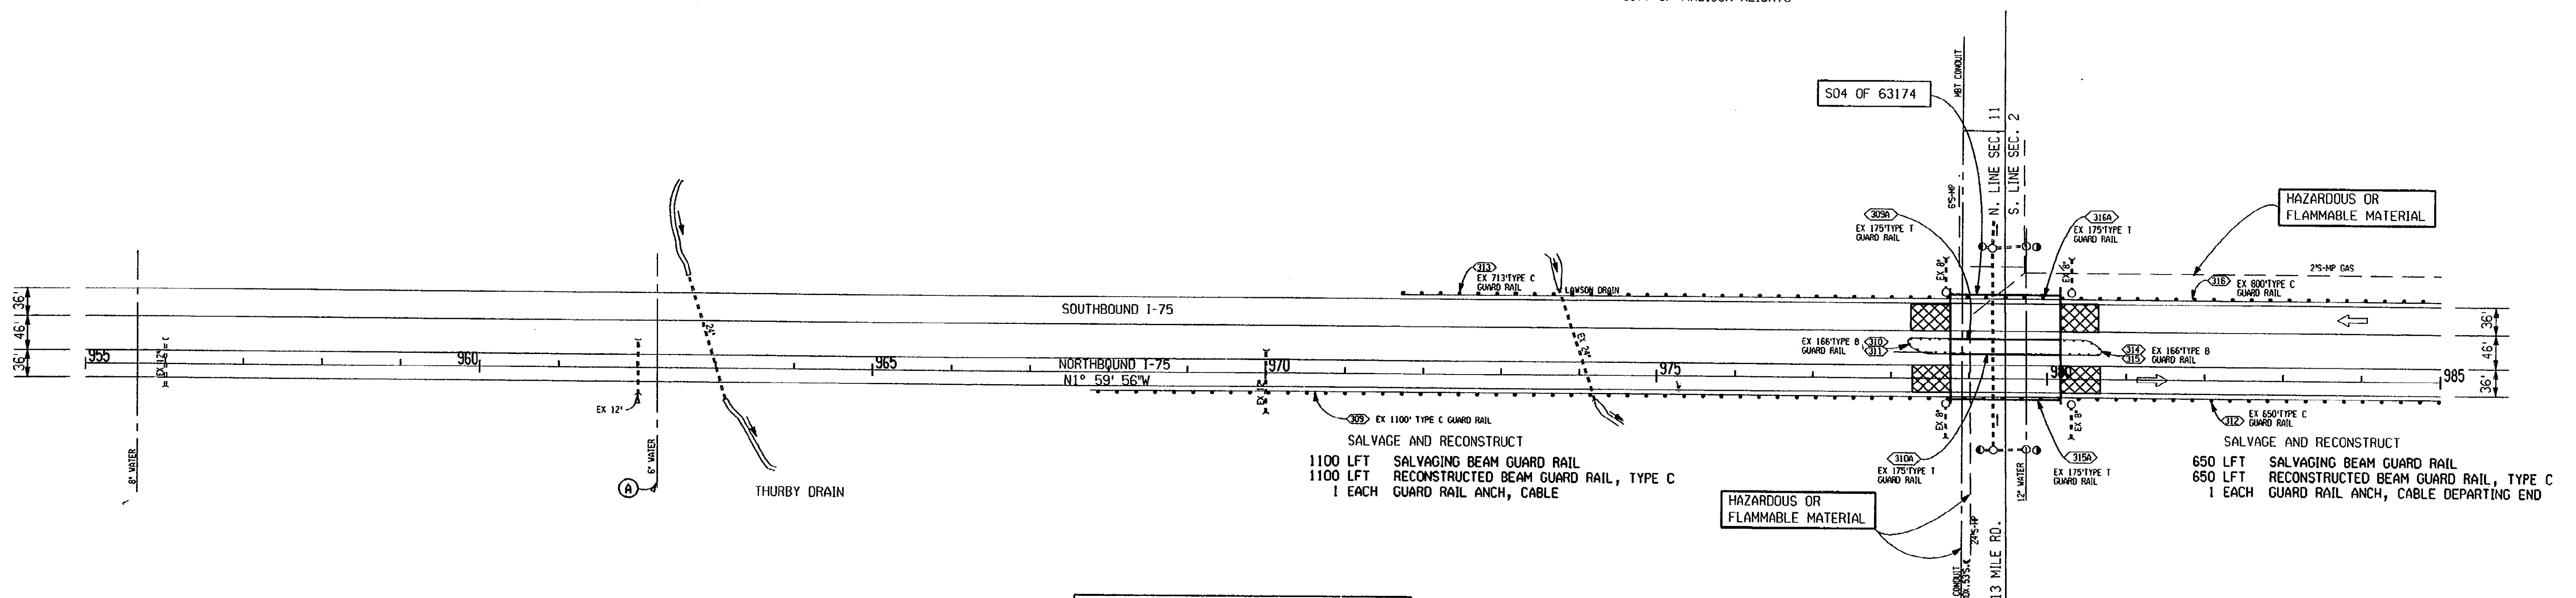


LEGEND

	CHIPPING CONC PAVT FOR JOINTS
	ABANDON

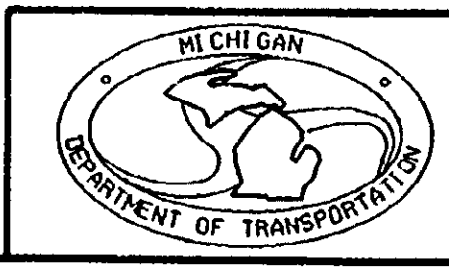

I-75 STA 925+00 TO STA 985+00					
DATE	SCALE	CONT. SEC.	JOB NO.	DESIGN UNIT	SHEET NO.
07/10/90	1"=100'	63174	28991 A	PALMER	R.O.W CONST. 5


FINAL R.O.V.			
AUTH	DATE	NO.	REVISION

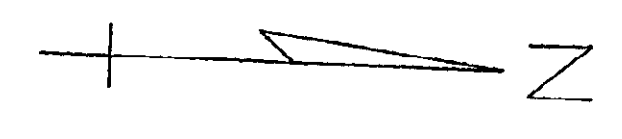

CITY OF MADISON HEIGHTS

SH. NO. 28991A
JOB NO. 63174
DATE: 07-10-90
DATE: 07-10-90

EXISTING BY:
PROPOSED BY:
LAST CORRECTION BY:

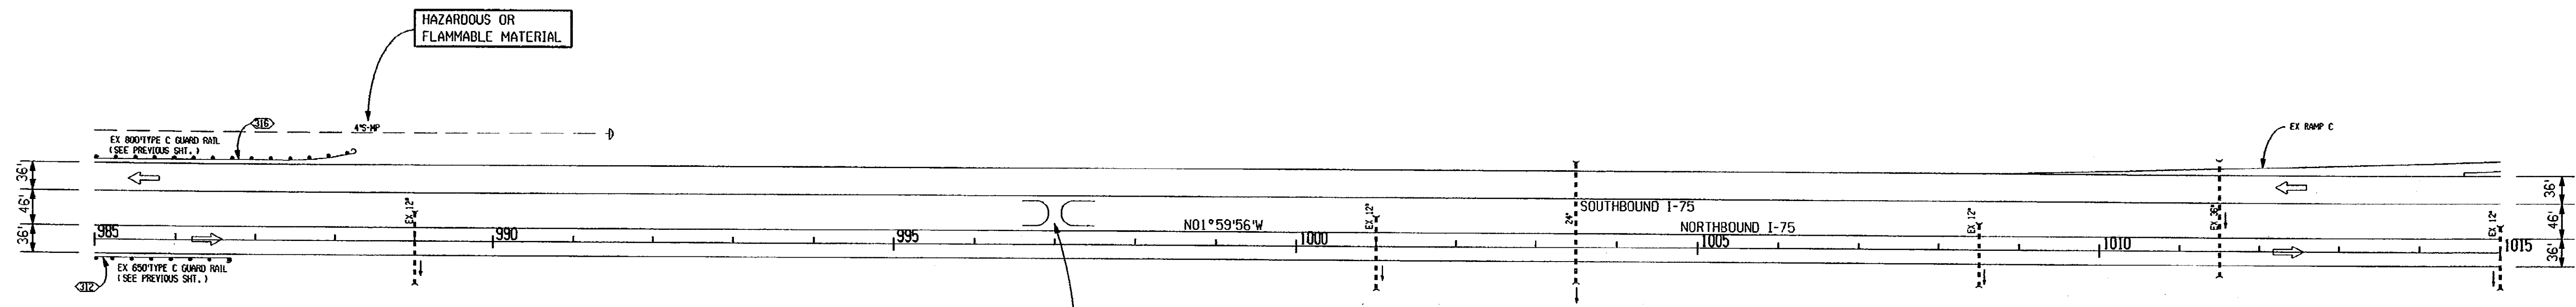

RAMP E
CURVE DATA
 $\Delta = 88^{\circ}19'46''$
 $D = 24^{\circ}54'40''$
 $R = 230.00'$
 $T = 223.39'$
 $L = 354.38'$
 $E = 90.63'$
 $PC = 0+00.00$
 $PI = 2+23.39$
 $PT = 3+54.58$
 (30'LT - STA 1028+48.89 @ S.BD RDWY)
 EX SUPER = 0.07'/FT

EX. CROSSOVER
GRADE AND SURFACE
CROSS-OVER
CITY OF MADISON HEIGHTS
 18 TON BIT APPROACHES
 36 CYD AGG BASE - BIT (LM)
 125 CYD CLASS A SHOULDERS (LM)
 270 CYD EMBANKMENT (LM)

CITY OF TROY	CITY OF MADISON HEIGHTS	QUANTITIES - THIS SHEET
1376 TON	4380 TON	BIT MIXTURE NO. 1500L, 20AAA-RUBBER
1295 TON	4122 TON	BIT MIXTURE NO. 1500T, 20AAA-RUBBER
654 SYD	654 SYD	CHIPPING CONC PAYT FOR JOINTS
192 CYD	674 CYD	CLASS A SHOULDERS (LM)


RAMP C
CURVE DATA
 $\Delta = 3^{\circ}15'00''$
 $D = 2^{\circ}00'00''$
 $R = 2864.79'$
 $T = 81.27'$
 $L = 162.50'$
 $E = 1.15'$
 $PC = 0+00.00$
 $PI = 0+81.27$
 $PT = 1+62.50$
 (RT - STA 1014+97.42 N.BD. RDWY)
 EX SUPER = 0.05'/FT

14 MILE RD.

CITY OF MADISON HEIGHTS

CITY OF TROY

RAMP D
CURVE DATA
 $\Delta = 3^{\circ}15'00''$
 $D = 2^{\circ}00'00''$
 $R = 2864.79'$
 $T = 81.27'$
 $L = 162.50'$
 $E = 1.15'$
 $PC = 0+00.00$
 $PI = 0+81.27$
 $PT = 1+62.50$
 (100'LT - STA 1047+53.70 N.BD. RDWY)
 EX SUPER = 0.05'/FT

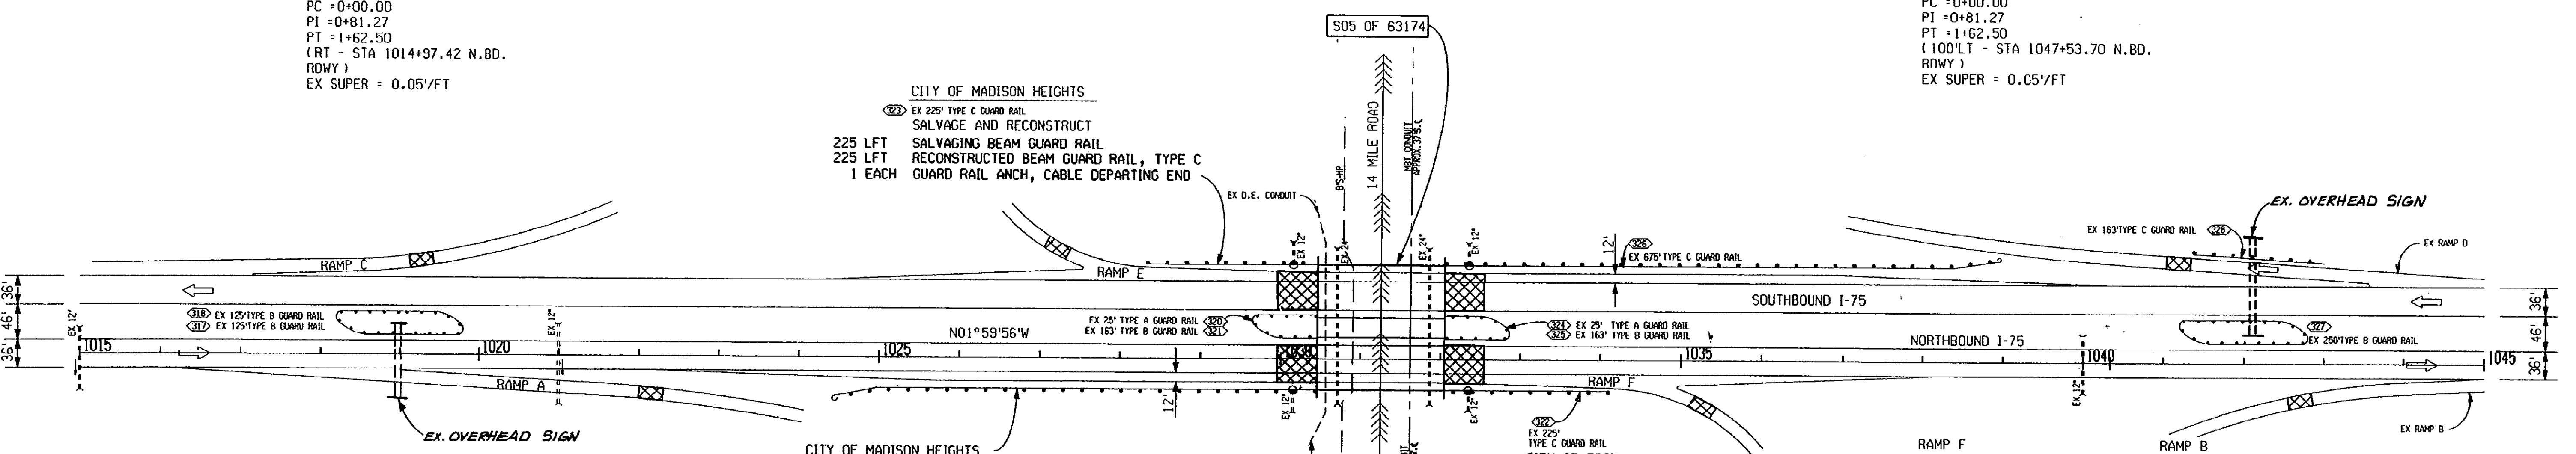

CITY OF MADISON HEIGHTS
 EX 225' TYPE C GUARD RAIL
 SALVAGE AND RECONSTRUCT
 225 LFT SALVAGING BEAM GUARD RAIL
 225 LFT RECONSTRUCTED BEAM GUARD RAIL, TYPE C
 1 EACH GUARD RAIL ANCH, CABLE DEPARTING END


CITY OF MADISON HEIGHTS
 EX 588' TYPE C GUARD RAIL
 SALVAGE AND RECONSTRUCT
 588 LFT SALVAGING BEAM GUARD RAIL
 588 LFT RECONSTRUCTED BEAM GUARD RAIL, TYPE C
 1 EACH GUARD RAIL ANCH, CABLE

CITY OF TROY
 EX 225' TYPE C GUARD RAIL
 SALVAGE AND RECONSTRUCT
 225 LFT SALVAGING BEAM GUARD RAIL
 225 LFT RECONSTRUCTED BEAM GUARD RAIL, TYPE C
 1 EACH GUARD RAIL ANCH, CABLE DEPARTING END

RAMP F
CURVE DATA
 $\Delta = 88^{\circ}19'46''$
 $D = 24^{\circ}54'40''$
 $R = 230.00'$
 $T = 223.39'$
 $L = 354.58'$
 $E = 90.63'$
 $PI = 2+23.39$
 $PCC = 3+54.58$
 $PC = 0+00.00$
 (30'RT - STA 1034+02.23 N.BD. RDWY)
 EX SUPER = 0.07'/FT

RAMP B
CURVE DATA
 $\Delta = 46^{\circ}20'32''$
 $D = 7^{\circ}00'00''$
 $R = 818.51'$
 $T = 350.33'$
 $L = 662.03'$
 $E = 71.82'$
 $PC = 7+65.81$
 $PI = 11+16.14$
 $PT = 14+27.84$
 (40'RT - STA 1043+75.24 N.BD. RDWY)
 EX SUPER = 0.07'/FT

RAMP A
CURVE DATA
 $\Delta = 7^{\circ}20'44''$
 $D = 3^{\circ}00'00''$
 $R = 1909.86'$
 $T = 122.59'$
 $L = 244.85'$
 $E = 3.93'$
 $PC = 6+27.41$
 $PI = 7+50.00$
 $PT = 8+72.26$
 EX SUPER = 0.06'/FT

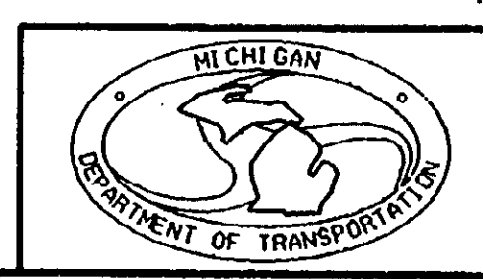


I-75 STA 985+00 TO STA 1045+00

DATE	SCALE	CONT. SEC.	JOB NO.	DESIGN UNIT	SHEET NO.
07/16/90	1"=100'	63174	28991 A	PALMER	6


33
26
24
21.22
17
15
11
3
FILE NAME: 289910985.DMI

FINAL R.O.W.			
AUTH	DATE	NO.	REVISION


SPENCER DRAIN

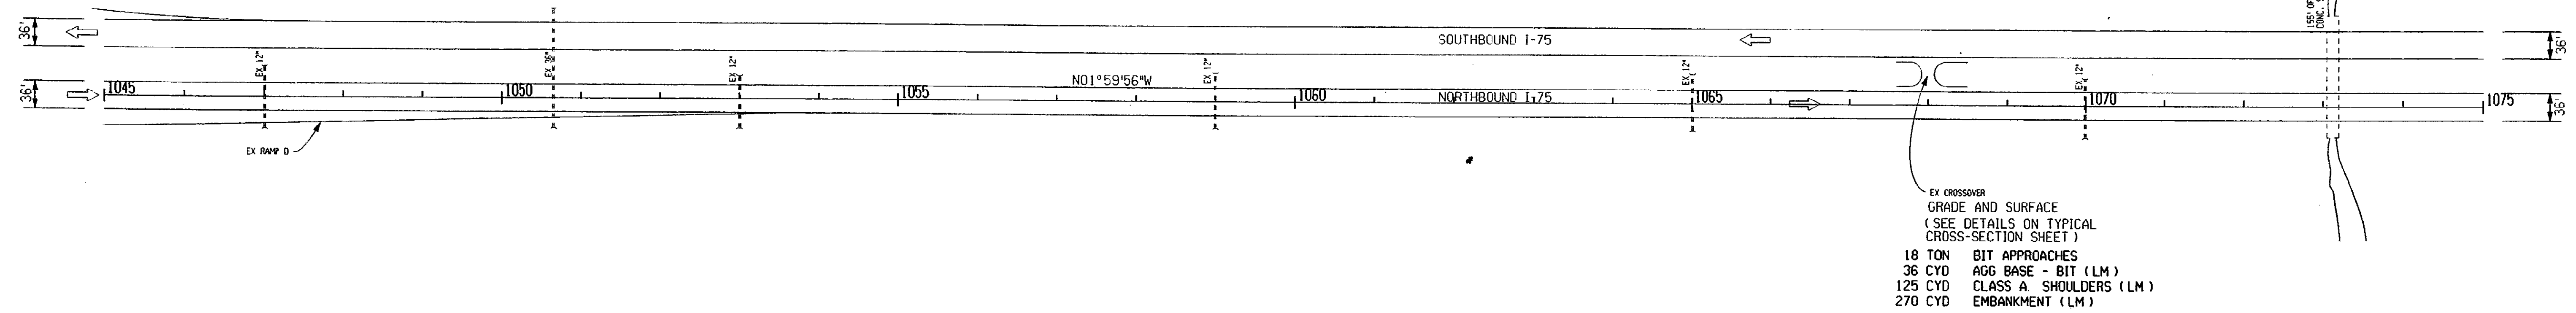

15 MILE RD.

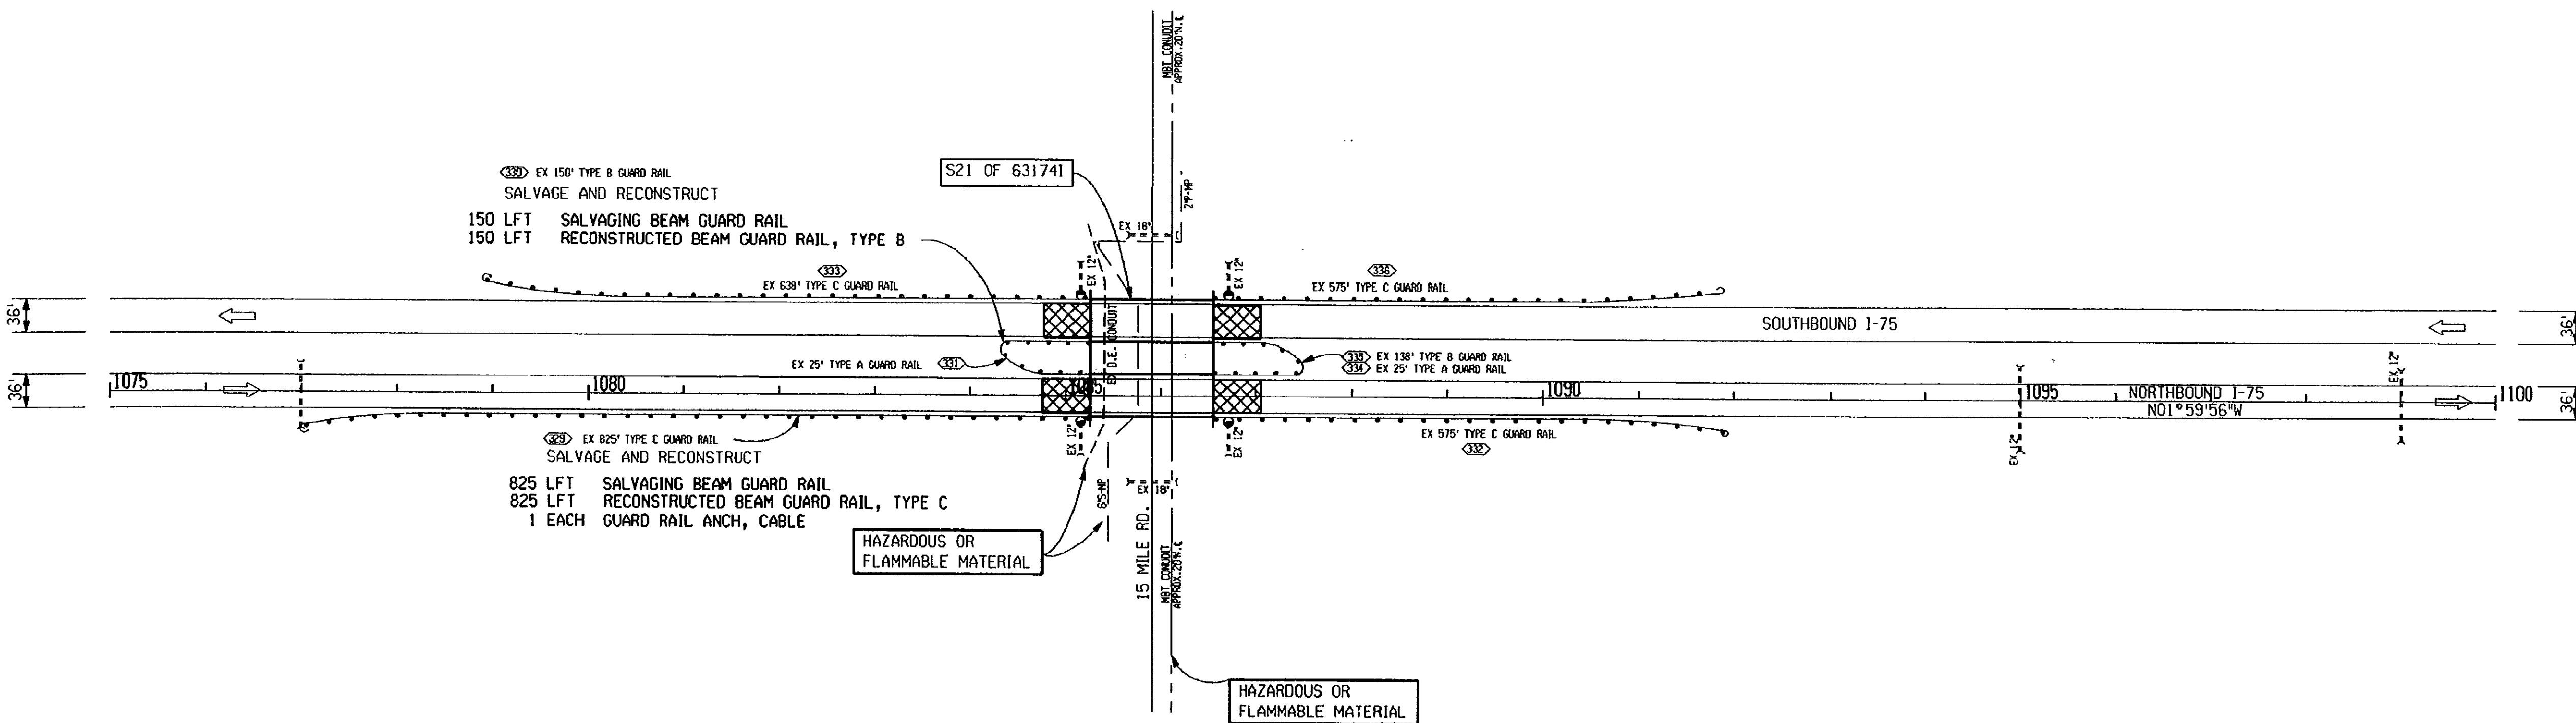

CITY OF TROY	QUANTITIES
4915 TON	BIT MIXTURE NO.1500L, 20AAA-RUBBER
4626 TON	BIT MIXTURE NO.1500T, 20AAA-RUBBER
797 CYD	CLASS A SHOULDERS (LM)
600 SYD	CHIPPING CONC PAVT FOR JOINTS

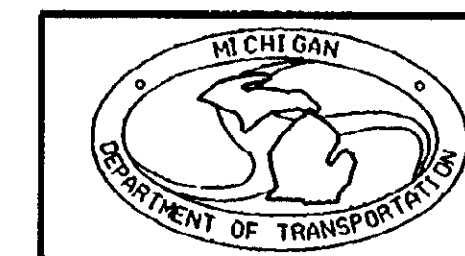

I-75 STA 1045+00 TO STA 1100+00					
DATE	SCALE	CONT. SEC.	JOB NO.	DESIGN UNIT	SHEET NO.
07/16/90	1"=100'	63174	28991 A	PALMER	R.O.W CONST. 7


CONTROL SECTION 63174

FILE NAME: 289911100.DWG
1 3

DATE: 07-10-90
DATE: 07-10-90
EXISTING BY:
PROPOSED BY:
LAST CORRECTION BY:

I-75 CONST. &
CURVE DATA
Δ=90°00'26" LT
D=02°15'00"
R=2546.48'
T=2546.80'
L=4000.32'
E=1055.01'
PC = 1100+16.38
PT = 1125+63.18
PI = 1140+16.70
EX SUPER = 0.05'/FT

FINAL R.O.W.			
AUTH	DATE	NO.	REVISION

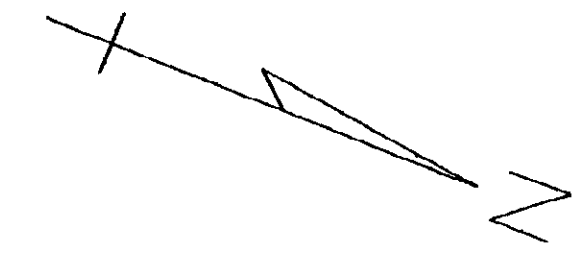

CITY OF TROY
QUANTITIES - THIS SHEET
40 SYD CHIPPING CONC PAYT FOR JOINTS
3701 TON BIT MIXTURE NO.1500L, 20AAA - RUBBER
3483 TON BIT MIXTURE NO.1500T, 20AAA - RUBBER
593 CYD CLASS A SHOULDERS (LM)

EX CROSSOVER
GRADE AND SURFACE
(FOR DETAILS SEE
TYPICAL CROSS-SECTION SHEET.)
18 TON BIT APPROACHES
36 CYD AGG BASE - BIT (LM)
125 CYD CLASS A SHOULDERS (LM)
270 CYD EMBANKMENT (LM)


RAMP B
CURVE DATA
Δ=11°27'27"
D=3°00'00"
R=1909.86'
T=191.60'
L=381.92'
E=9.59'
PC = 1+46.46
PI = 3+38.06
PT = 5+28.38
(34'RT - STA 1132+24.47 N.BD.
RDWY)
EX SUPER = 0.06'/FT

HAWTHORN DRAIN

CITY OF TROY

15 17
11 15
17 15
15 17

33
29
26
24
21
22

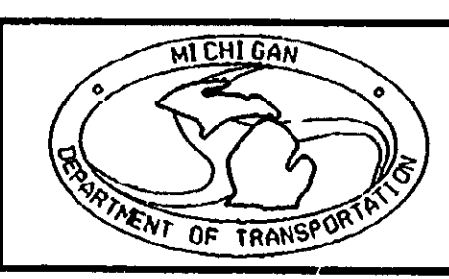

I-75 STA 1100+00 TO STA 1140+00					
DATE	SCALE	CONT. SEC.	JOB NO.	DESIGN UNIT	SHEET NO.
07/16/90	1"=100'	63174	28991 A	PALMER	5

CONTROL SECTION 63174 JOB NO. 28991A SH. NO.

DATE: 07-10-90
 EXISTING BY:
 PROPOSED BY:
 LAST CORRECTION BY:


STATION EQUATION
 PI STA 1140+16.72 BACK-
 PI STA 1140+15.78 AHEAD

ROCHESTER RD.

RAMP C
 CURVE DATA
 $\Delta = 2^{\circ}58'00''$
 $D = 1^{\circ}45'00''$
 $R = 3274.04'$
 $T = 84.78'$
 $L = 169.52'$
 $E = 1.10'$
 $PC = 12+69.11$
 $PI = 13+53.89$
 $PT = 14+38.63$
 (112'LT - STA 1152+50 N.B.D.
 RDWY)
 EX SUPER = 0.03'/FT

RAMP D
 CURVE DATA
 $\Delta = 3^{\circ}15'00''$
 $D = 2^{\circ}00'00''$
 $R = 2864.79'$
 $T = 81.27'$
 $L = 162.50'$
 $E = 1.15'$
 $PC = 0+00$
 (100'LT - STA 1171+77.82 N.B.D.
 RDWY)
 EX SUPER = 0.05'/FT

FINAL R.O.W.			
AUTH	DATE	NO.	REVISION

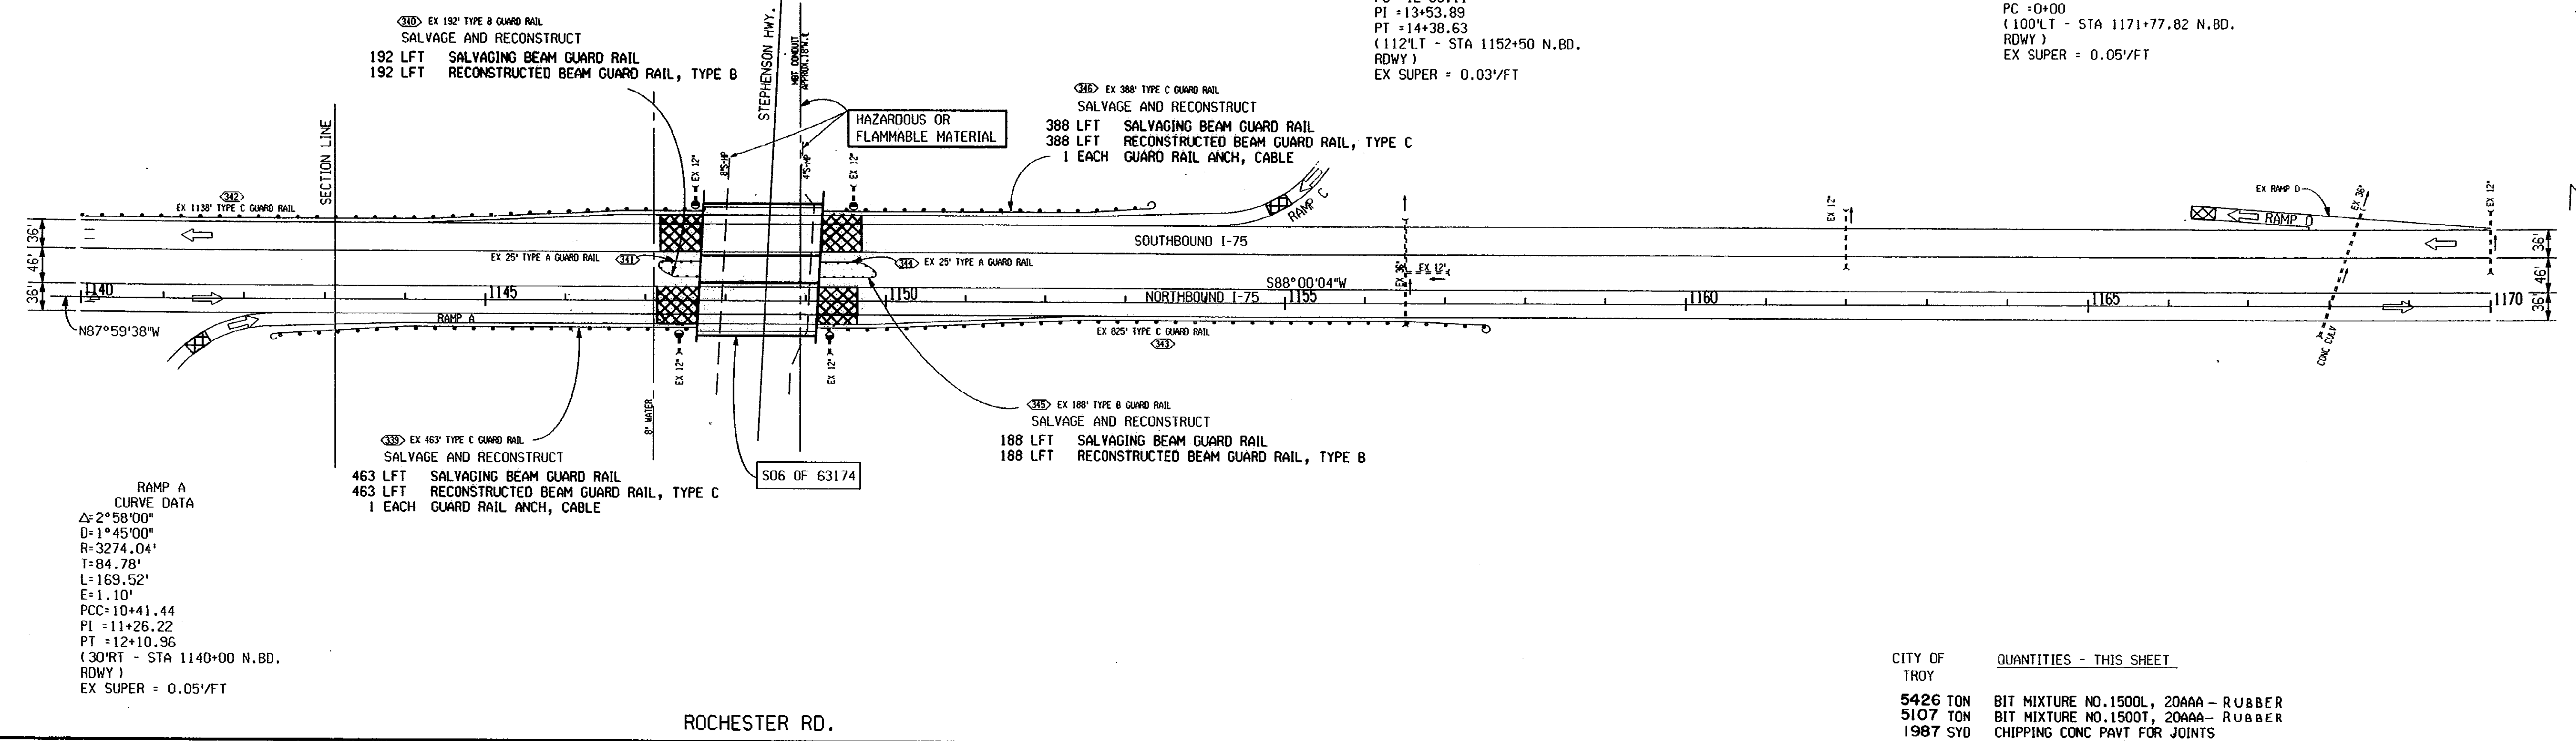


CITY OF TROY
 QUANTITIES - THIS SHEET
 5426 TON BIT MIXTURE NO.1500L, 20AAA - RUBBER
 5107 TON BIT MIXTURE NO.1500T, 20AAA - RUBBER
 1987 SYD CHIPPING CONC PAVT FOR JOINTS
 889 CYD CLASS A SHOULDERS (LM)


ROCHESTER RD.

CITY OF TROY

EX. CROSSOVER
 GRADE AND SURFACE EX CROSSOVER (FOR
 DETAILS SEE TYPICAL CROSS-SECTIONS SHEET)
 18 TON BIT APPROACHES
 36 CYD AGG BASE - BIT (LM)
 125 CYD CLASS A SHOULDERS (LM)
 270 CYD EMBANKMENT (LM)

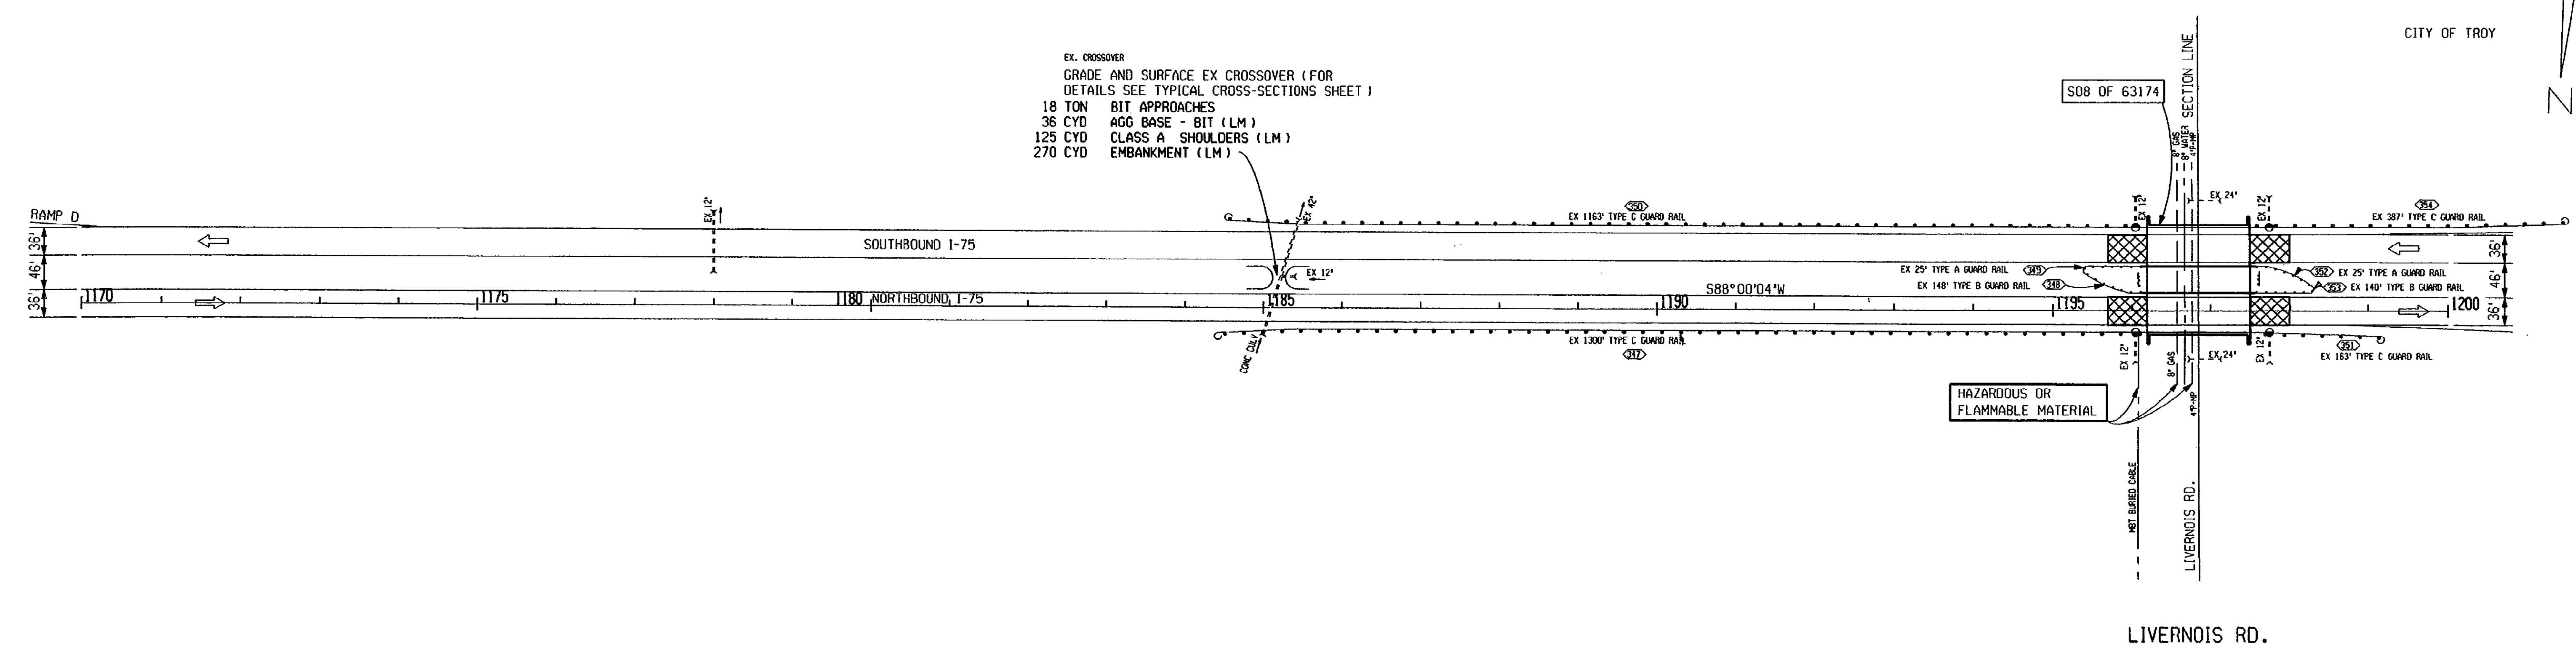

LIVERNOIS RD.

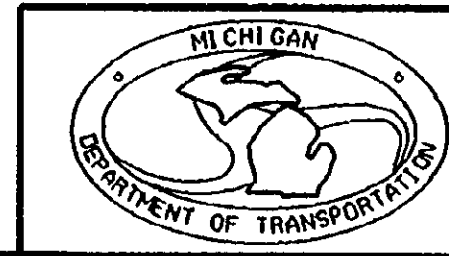


I-75 STA 1140+00 TO STA 1200+00					
DATE	SCALE	CONT. SEC.	JOB NO.	DESIGN UNIT	SHEET NO.
07/16/90	1"=100'	63174	28991 A	PALMER	R.O.W CONST. 9

CONTROL NO. 28991A
 JOB NO. 28991A
 SHEET NO. 10
 DATE: 07-16-90
 DATE: 10-25-89
 DATE: 10-25-89

MASTIN CO. DRAIN

FINAL R.O.W.			
AUTH	DATE	NO.	REVISION

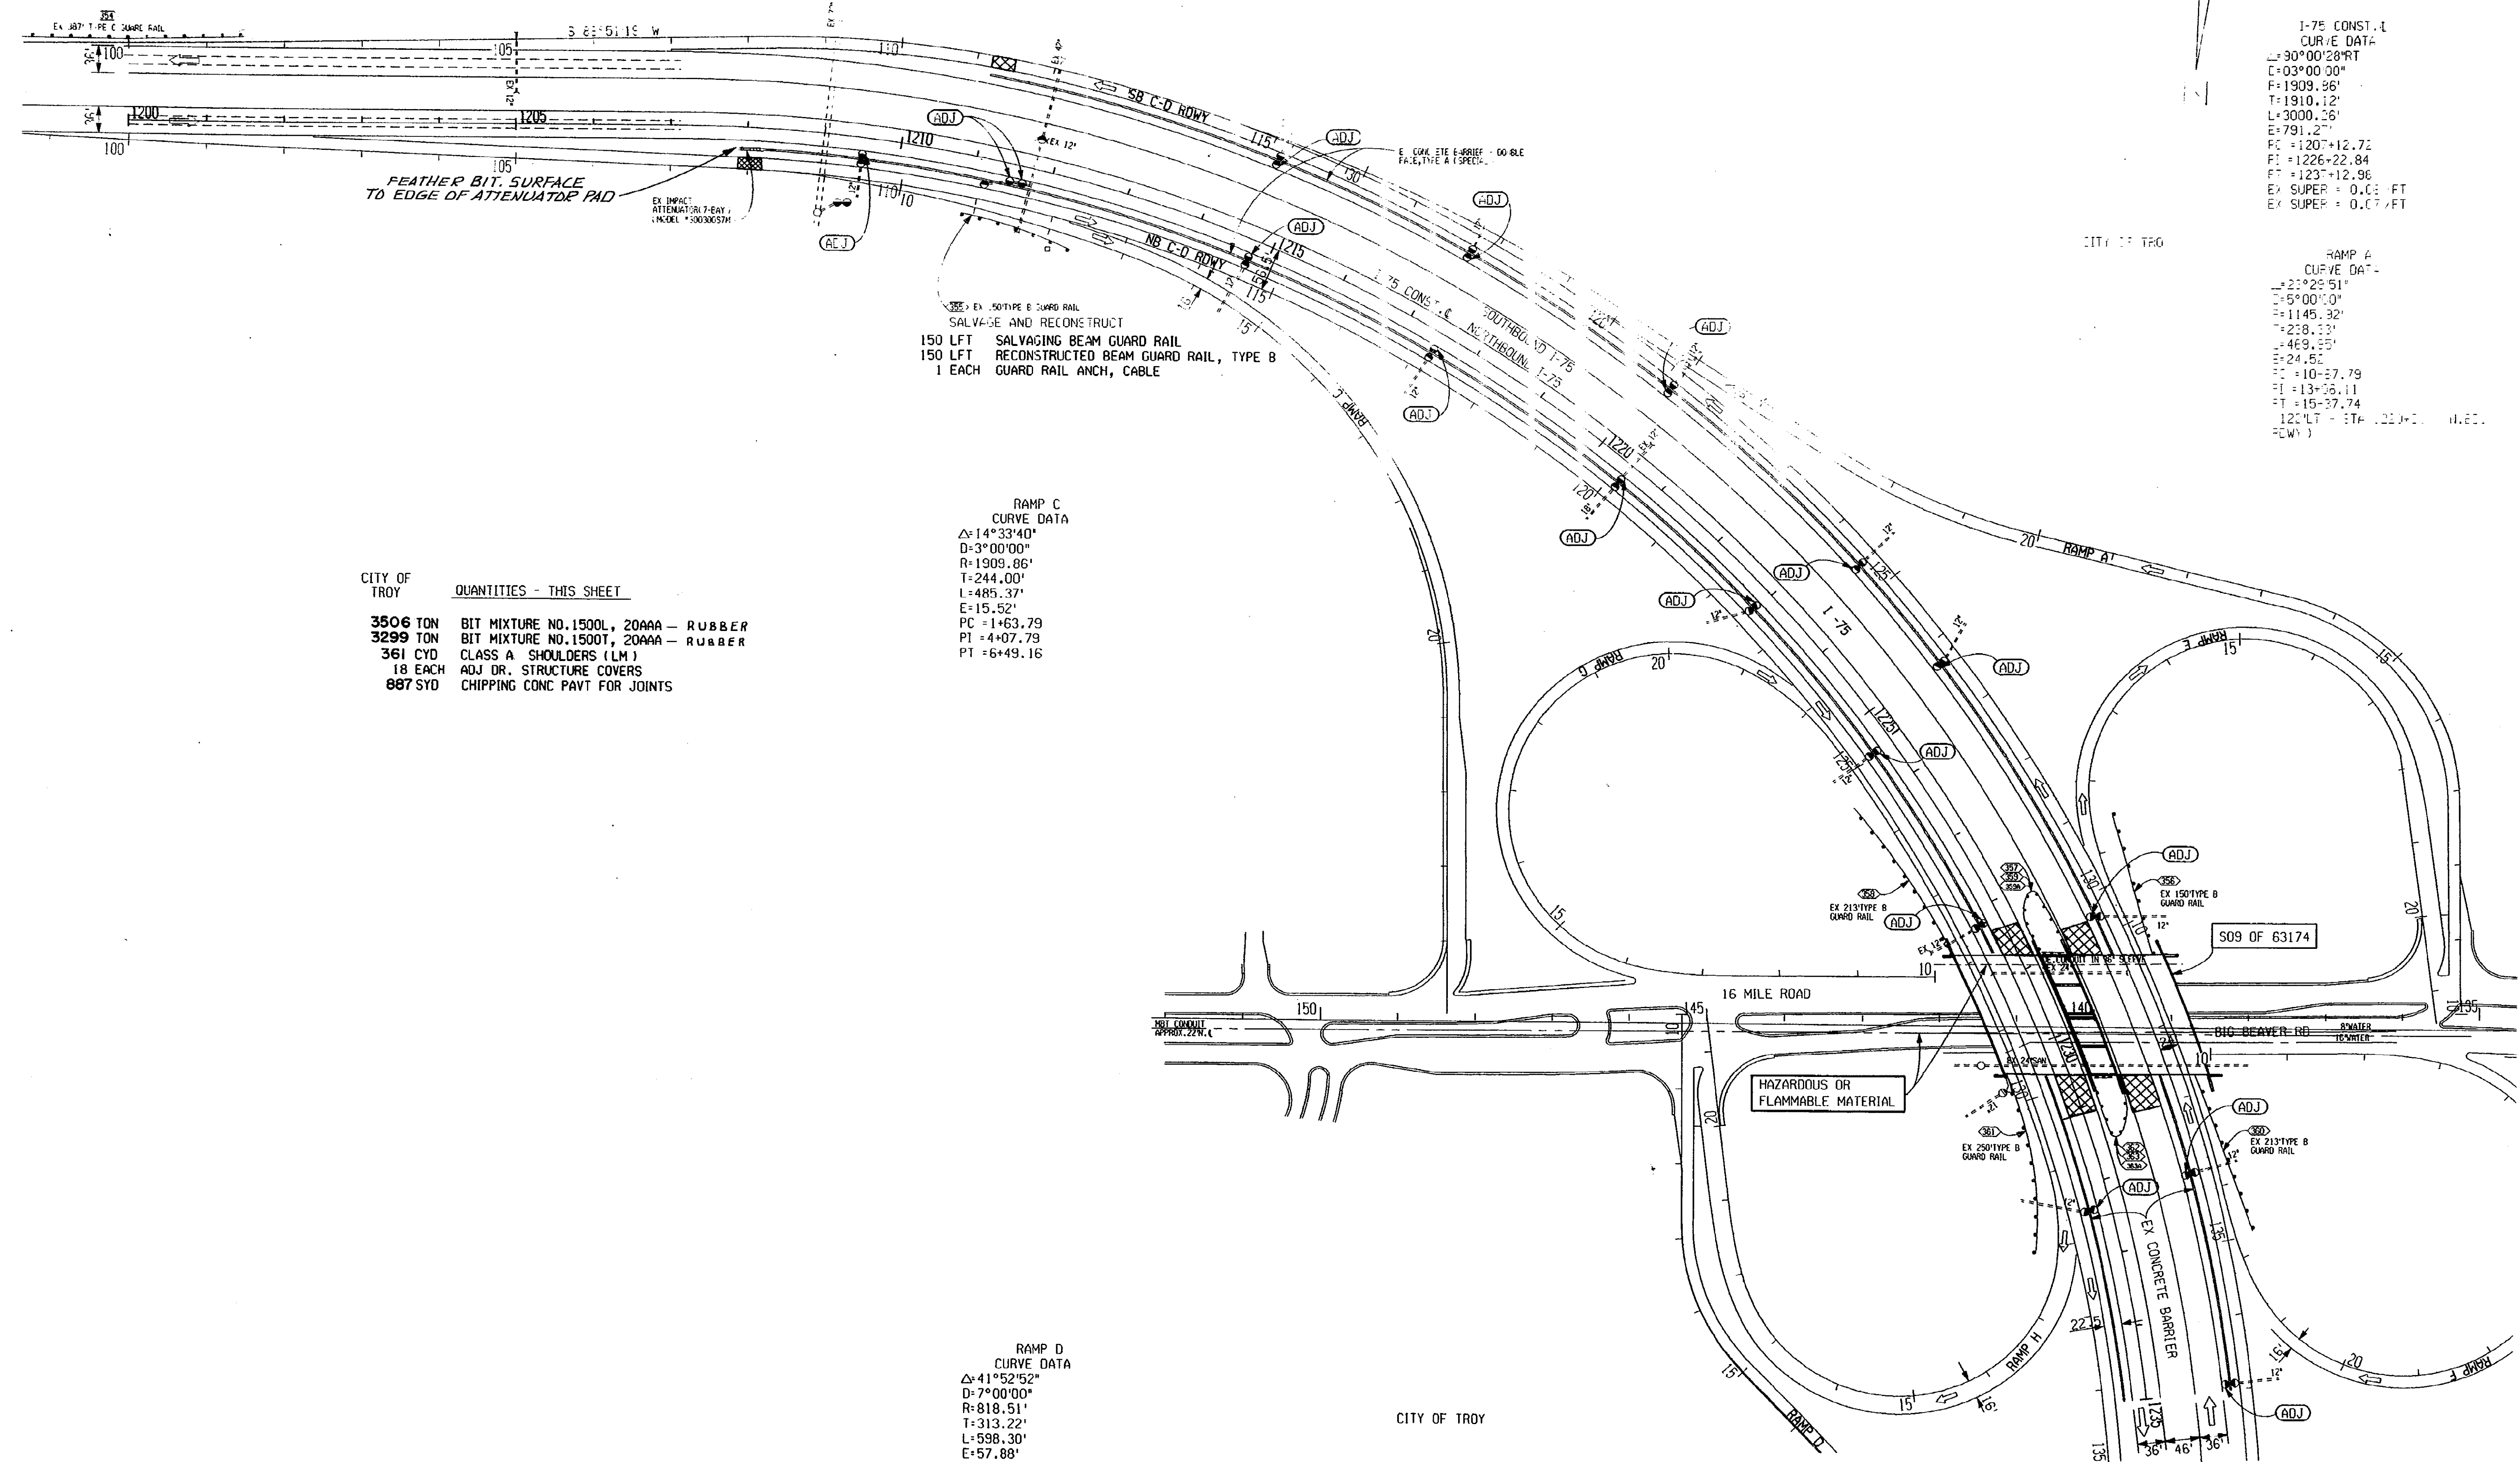

I-75 CONST. 1
 CURVE DATA
 $\Delta=30^{\circ}00'28''$
 $D=3^{\circ}00'00''$
 $R=1909.86'$
 $T=1910.12'$
 $L=3000.36'$
 $E=791.27'$
 $PC=1207+12.72$
 $PT=1226+22.84$
 $PI=1237+12.98$
 $EX\ SUPER=0.03\ FT$
 $EX\ SUPER=0.07\ FT$


RAMP A
 CURVE DATA
 $\Delta=23^{\circ}25'51''$
 $D=5^{\circ}00'00''$
 $R=1145.32'$
 $T=238.13'$
 $L=469.55'$
 $E=24.56'$
 $PC=10+37.79$
 $PT=13+36.11$
 $PI=15+37.74$
 $12\% LT - 1\% SUPER - 11.6\%$
 $=CWY$

RAMP C
 CURVE DATA
 $\Delta=14^{\circ}33'40''$
 $D=3^{\circ}00'00''$
 $R=1909.86'$
 $T=244.00'$
 $L=485.37'$
 $E=15.32'$
 $PC=1+63.79$
 $PT=4+07.79$
 $PI=6+49.16$

RAMP D
 CURVE DATA
 $\Delta=41^{\circ}52'52''$
 $D=7^{\circ}00'00''$
 $R=818.51'$
 $T=313.22'$
 $L=598.30'$
 $E=57.88'$
 $PC=8+97.08$
 $PT=12+10.30$
 $PI=14+35.30$
 $(40\% RT - STA 1243+00 / N.BD. RDWY)$

CITY OF TROY

QUANTITIES - THIS SHEET	
3506 TON	BIT MIXTURE NO.1500L, 20AAA - RUBBER
3299 TON	BIT MIXTURE NO.1500T, 20AAA - RUBBER
361 CYD	CLASS A SHOULDERS (LM)
18 EACH	ADJ DR. STRUCTURE COVERS
887 SYD	CHIPPING CONC PAVT FOR JOINTS

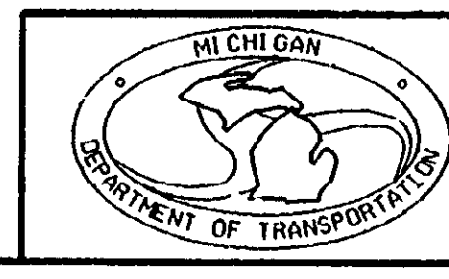

I-75 STA 1200+00 TO STA 1235+00					
DATE	SCALE	CONT. SEC.	JOB NO.	DESIGN UNIT	SHEET NO. / R.O.W CONST.
07/16/90	1"=100'	63174	28991 A	PALMER	10


CONTROL SECTION 63174 JOB NO. 28991A

EXISTING BY: DATE: 07-10-90
 PROPOSED BY: DATE:
 LAST CORRECTION BY: DATE:


FILE NAME: 289911235.DWG

1 3 11 15 17 21 22 24 26 33

I-75 CONST. & CURVE DATA
 $\Delta = 90^{\circ}00'28''$
 $D = 03^{\circ}00'00''$
 $R = 1909.86'$
 $T = 1910.12'$
 $L = 3000.26'$
 $E = 791.27'$
 $PC = 1207+12.72$
 $PI = 1226+22.84$
 $PT = 1237+12.98$
 $EX SUPER = 0.061/FT$

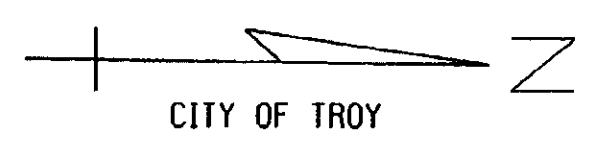

FINAL R.O.W.			
AUTH	DATE	NO.	REVISION

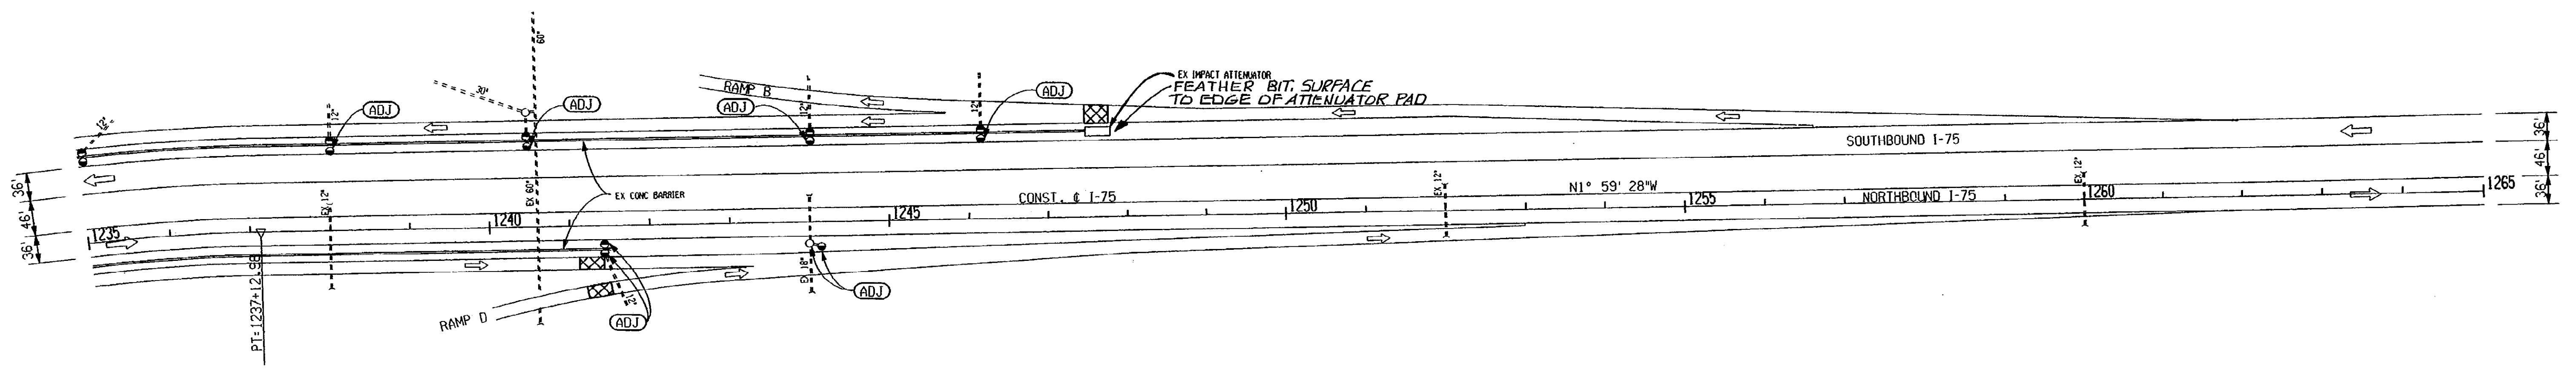


CITY OF TROY

QUANTITIES - THIS SHEET

- 6449 TON BIT MIXTURE NO. 1500L, 20AAA - RUBBER
- 6070 TON BIT MIXTURE NO. 1500T, 20AAA - RUBBER
- 187 SYD CHIPPING CONC PAVT FOR JOINTS
- 835 CYD CLASS A SHOULDERS (LM)
- 8 EACH ADJ DR. STRUCTURE COVERS


I-75 CONST. & CURVE DATA
 $\Delta = 05^{\circ}56'01''$
 $D = 00^{\circ}45'00''$
 $R = 7639.44'$
 $T = 395.93'$
 $L = 791.15'$
 $E = 10.25'$
 $PC = 1273+15.08$
 $PI = 1277+11.01$
 $PT = 1281+06.23$
 $EX SUPER = 0.011/FT$

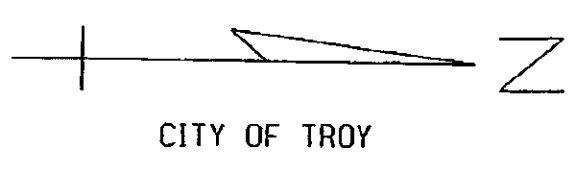


17 MILE RD.

I-75 CONST. & CURVE DATA
 $\Delta = 06^{\circ}07'11''$
 $D = 00^{\circ}45'00''$
 $R = 7639.44'$
 $T = 408.37'$
 $L = 815.96'$
 $E = 10.91'$
 $PC = 1290+11.68$
 $PI = 1294+20.05$
 $PT = 1298+27.65$
 $EX SUPER = 0.011/FT$

- EX CROSSOVER GRADE AND SURFACE (SEE DETAILS ON TYPICAL CROSS-SECTION SHEET)
- 18 TON BIT APPROACHES
- 36 CYD AGG BASE - BIT (LM)
- 125 CYD CLASS A SHOULDERS (LM)
- 270 CYD EMBANKMENT (LM)

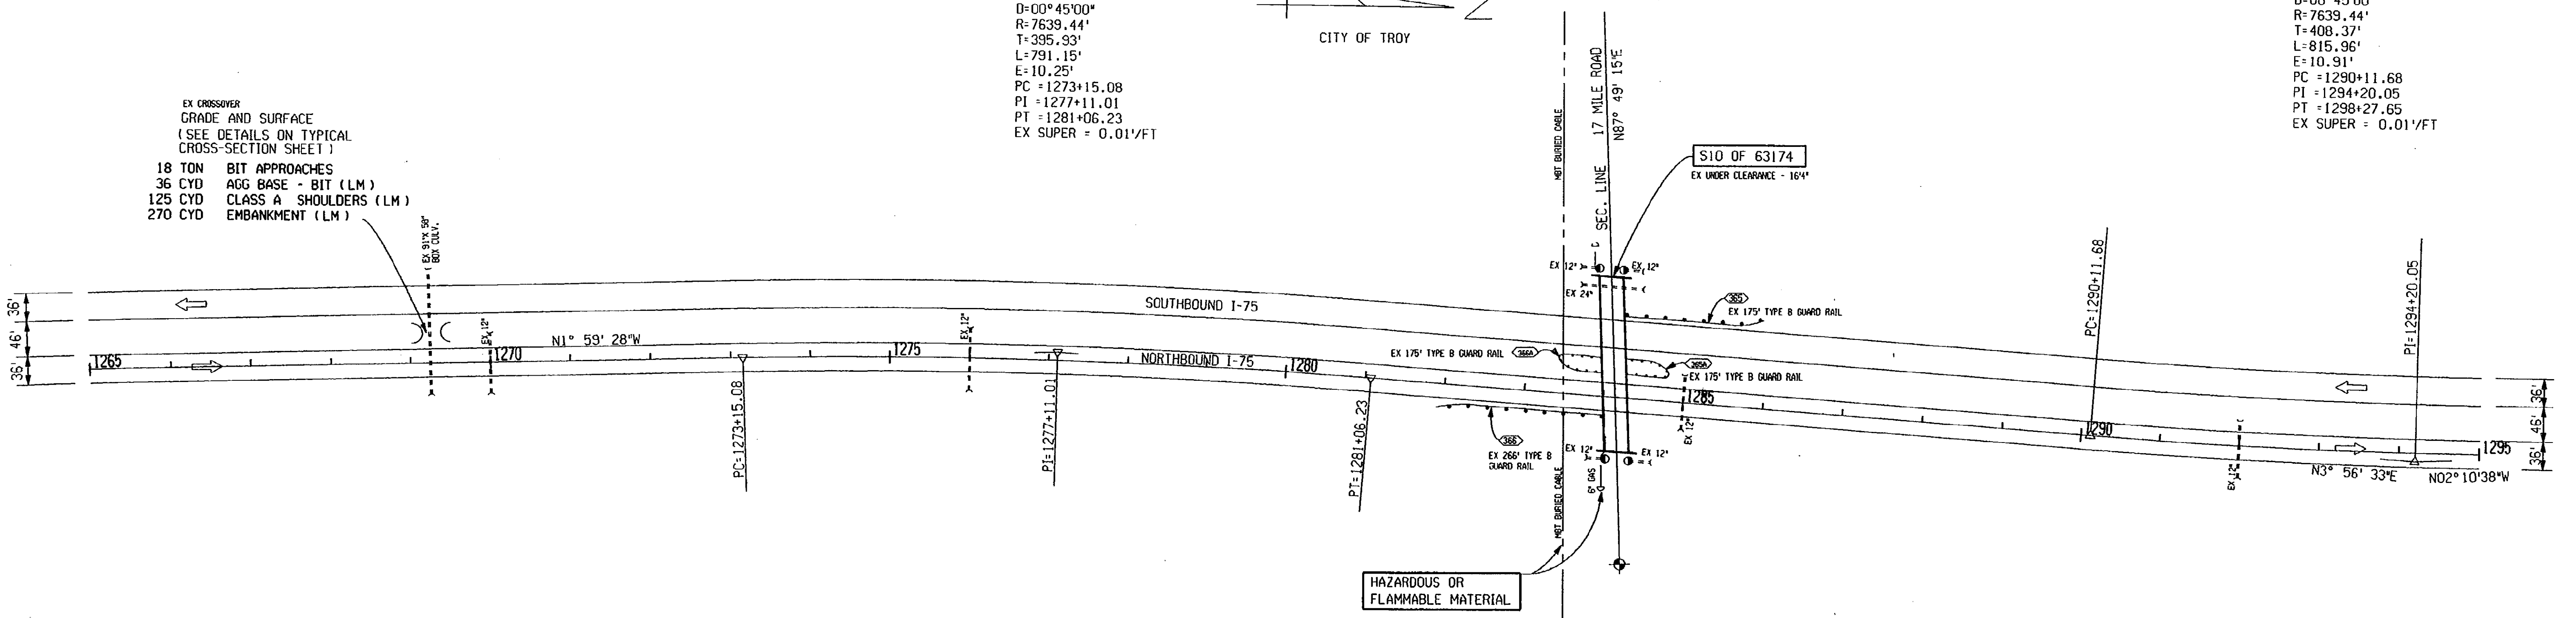

HAZARDOUS OR FLAMMABLE MATERIAL

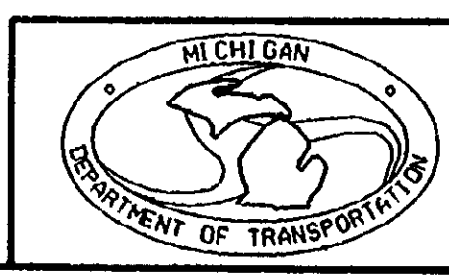

I-75 STA 1235+00 TO STA 1295+00

DATE	SCALE	CONT. SEC.	JOB NO.	DESIGN UNIT	SHEET NO.
07/16/90	1"=100'	63174	28991 A	PALMER	R.O.W CONST. //


17 MILE RD.

CONTROL SECTION 63174 JOB NO. 28991A SH. NO.


EXISTING BY: DATE: 07-10-90
 PROPOSED BY: DATE: 07-10-90
 LAST CORRECTION BY:

I-75 CONST. & CURVE DATA
 $\Delta=06^{\circ}07'11''$ LT
 $D=00^{\circ}45'00''$
 $R=7639.44'$
 $T=408.37'$
 $L=815.96'$
 $E=10.91'$
 $PC=1290+11.68$
 $PI=1294+20.05$
 $PT=1298+27.65$

CITY OF TROY

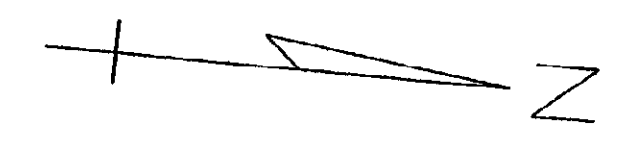

FINAL R.O.V.			
AUTH	DATE	NO.	REVISION

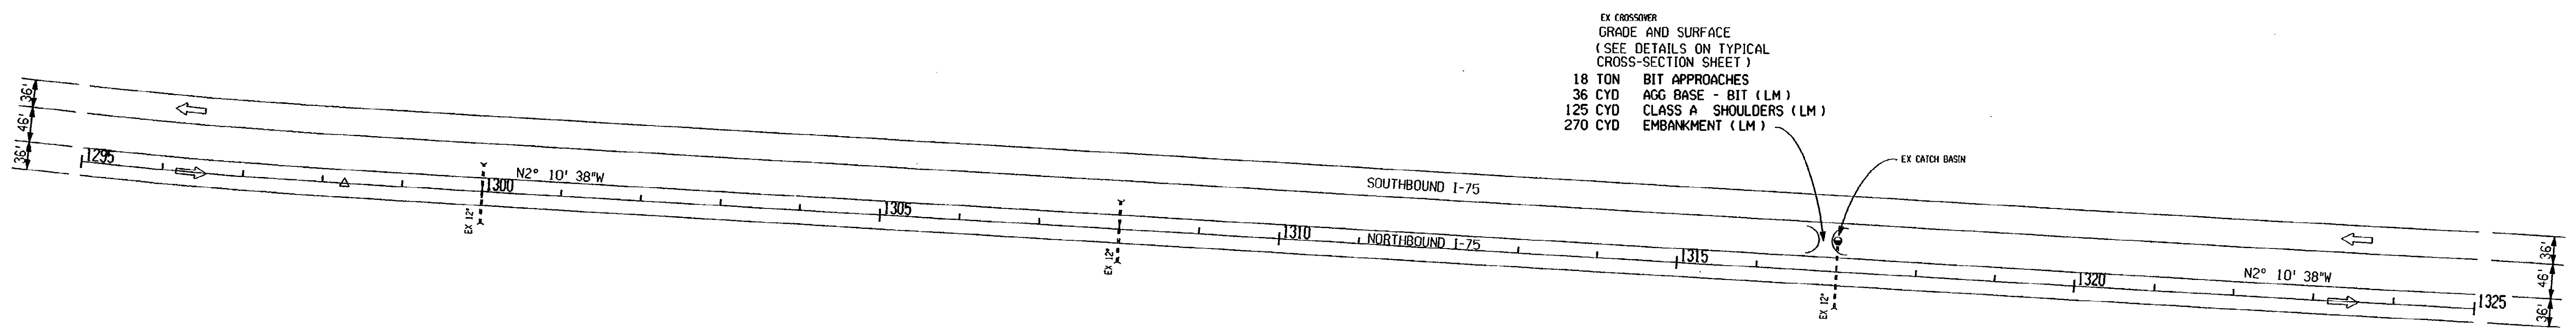

EX CROSSOVER
 GRADE AND SURFACE
 (SEE DETAILS ON TYPICAL CROSS-SECTION SHEET)
 18 TON BIT APPROACHES
 36 CYD AGG BASE - BIT (LM)
 125 CYD CLASS A SHOULDERS (LM)
 270 CYD EMBANKMENT (LM)


CITY OF TROY QUANTITIES - THIS SHEET
 5724 TON BIT MIXTURE NO.1500L, 20AAA - RUBBER
 5387 TON BIT MIXTURE NO.1500T, 20AAA - RUBBER
 854 SYD CHIPPING CONC PAVT FOR JOINTS
 908 CYD CLASS A SHOULDERS (LM)

EAST LONG LAKE RD.


CITY OF TROY

I-75 CONST. & CURVE DATA
 $\Delta=22^{\circ}37'20''$ LT
 $D=02^{\circ}00'00''$
 $R=2864.79'$
 $T=573.02'$
 $L=1131.11'$
 $E=56.75'$
 $PC=534+71.28$
 $PI=540+44.30$
 $PT=546+02.39B$
 EX SUPER = 0.05'/FT

RAMP A CURVE DATA
 $\Delta=70^{\circ}44'17''$
 $D=7^{\circ}10'00''$
 $R=799.48'$
 $T=567.51'$
 $L=987.05'$
 $E=180.95'$
 $PC=211+23.49$
 $PI=216+91.00$
 $PT=221+10.54$
 (STA 552+15.77 S.BD. RDWY)
 EX SUPER = 0.07'/FT

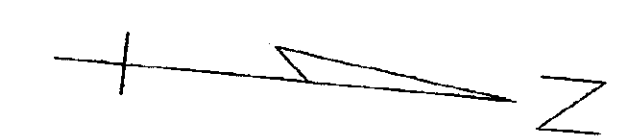


STATION EQUATION
 STA 1326+20.20 BACK-
 STA 518+61.05 AHEAD

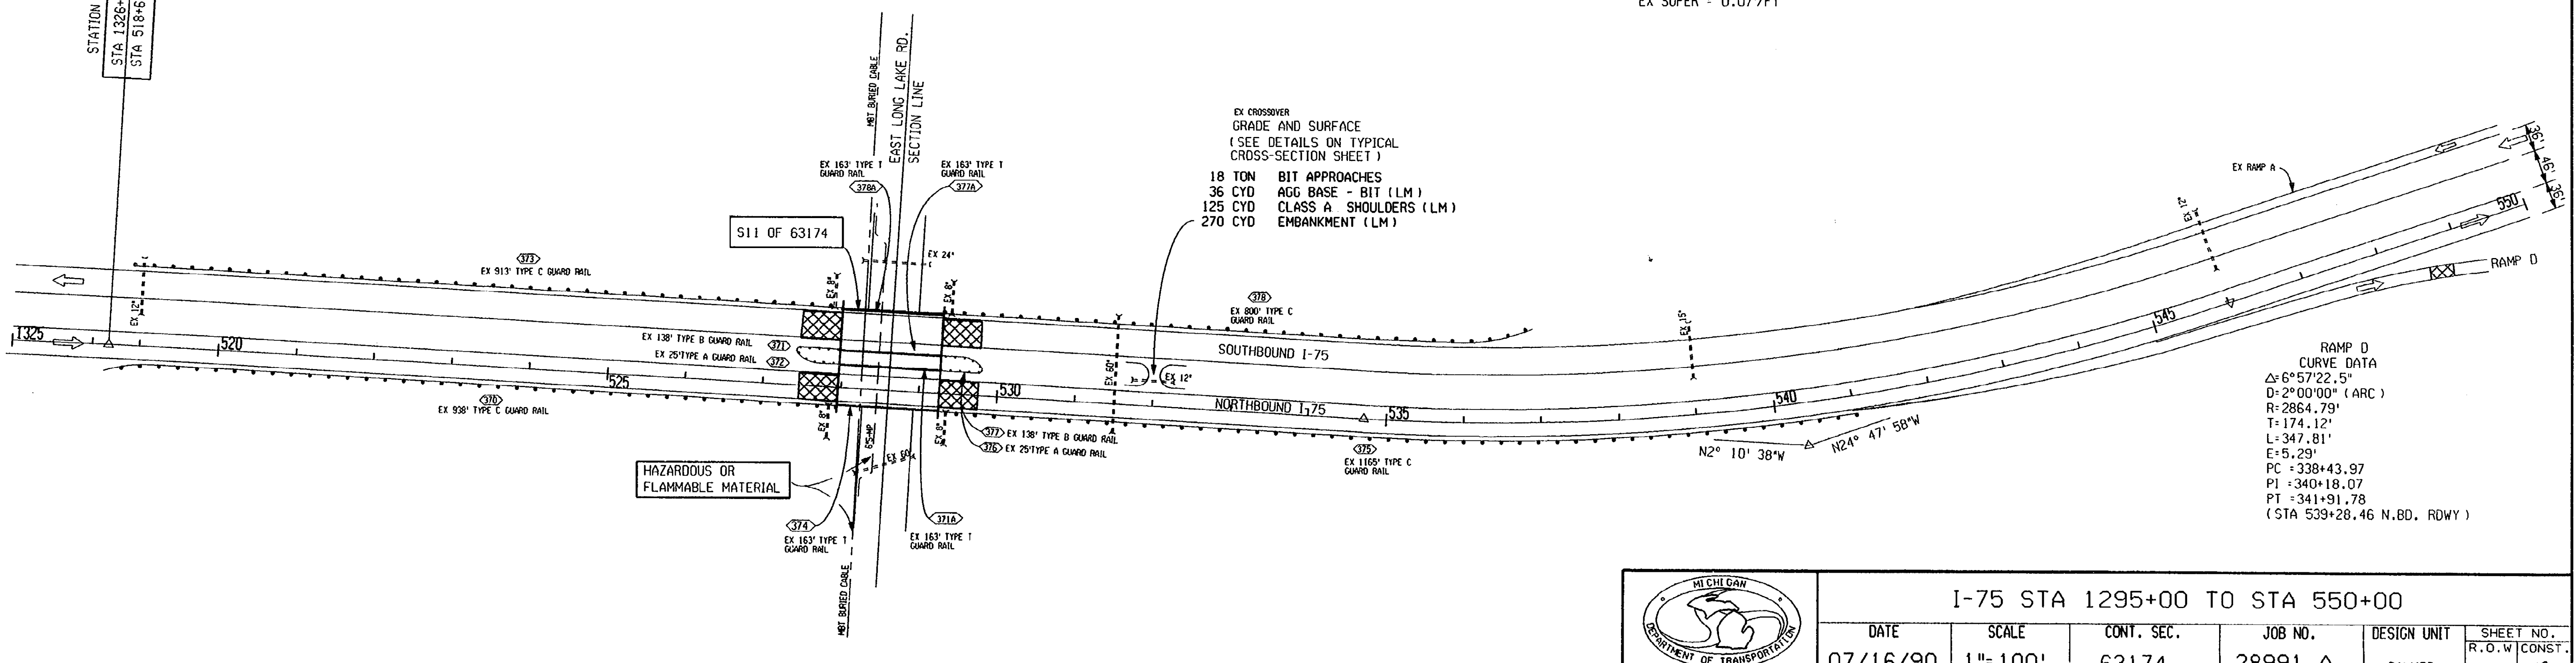

EX CROSSOVER
 GRADE AND SURFACE
 (SEE DETAILS ON TYPICAL CROSS-SECTION SHEET)
 18 TON BIT APPROACHES
 36 CYD AGG BASE - BIT (LM)
 125 CYD CLASS A SHOULDERS (LM)
 270 CYD EMBANKMENT (LM)

RAMP D CURVE DATA
 $\Delta=6^{\circ}57'22.5''$
 $D=2^{\circ}00'00''$ (ARC)
 $R=2864.79'$
 $T=174.12'$
 $L=347.81'$
 $E=5.29'$
 $PC=338+43.97$
 $PI=340+18.07$
 $PT=341+91.78$
 (STA 539+28.46 N.BD. RDWY)

FILE NAME: 28991.1295.DWG
 1 3

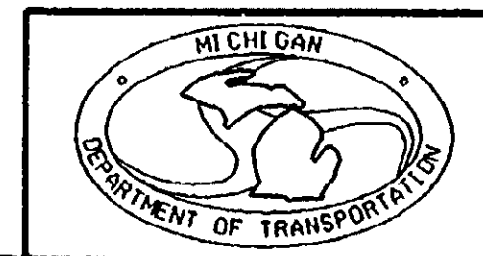


I-75 STA 1295+00 TO STA 550+00

DATE	SCALE	CONT. SEC.	JOB NO.	DESIGN UNIT	SHEET NO.
07/16/90	1"=100'	63174	28991 A	PALMER	R.O.W CONST. /2

CROOKS RD CONNECTOR

FINAL R.O.W.			
AUTH	DATE	NO.	REVISION

RAMP B
 CURVE DATA
 $\Delta = 10^{\circ}10'19''$
 $D = 2^{\circ}00'4'' \text{ ARC}$
 $R = 2864.79'$
 $T = 254.97'$
 $L = 508.60'$
 $E = 111.32'$
 $PCC = 22+22.91$
 $PI = 24+77.88$
 $PCI = 27+31.57 (576+30.35 \text{ I-75 SBD})$

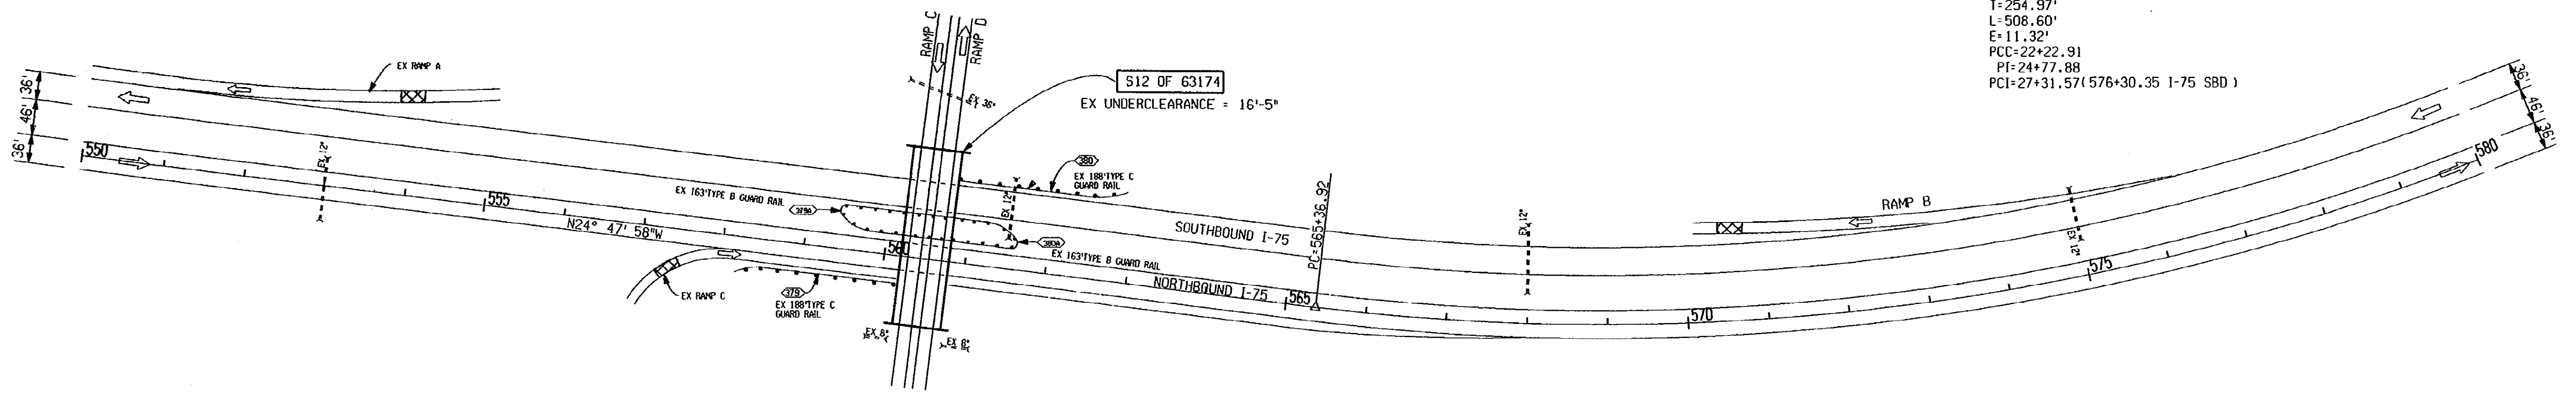

EX RAMP C
 CURVE DATA
 $\Delta = 2^{\circ}58'00''$
 $D = 1^{\circ}45'00'' \text{ ARC}$
 $R = 3274.04'$
 $T = 84.78'$
 $L = 169.52'$
 $E = 1.10'$
 $PC = 131+09.12$
 $PI = 131+93.90$
 $PT = 132+78.64 (STA 559+58.78 \text{ NBD RDWY})$



CITY OF TROY

QUANTITIES - THIS SHEET	
5649 TON	BIT MIXTURE NO. 1500L, 20AAA - RUBBER
5317 TON	BIT MIXTURE NO. 1500T, 20AAA - RUBBER
160 SYD	CHIPPING CONC PAVT FOR JOINTS
889 CYD	CLASS A SHOULDERS (LM)

CROOKS RD.

I-75 CONST. C
 CURVE DATA
 $\Delta = 67^{\circ}14'30'' \text{ LT}$
 $D = 02^{\circ}00'00''$
 $R = 2864.79'$
 $T = 1904.86'$
 $L = 3362.08'$
 $E = 575.49'$
 $PC = 565+36.92$
 $PI = 584+41.78$
 $PT = 598+99.00$
 $EX \text{ SUPER} = 0.05\% \text{ FT}$

EX CROSS-OVER
 GRADE AND SURFACE
 (FOR DETAILS SEE
 TYPICAL CROSS-SECTION SHEET.)
 18 TON BIT APPROACHES
 36 CYD AGG BASE - BIT (LM)
 125 CYD CLASS A SHOULDERS (LM)
 270 CYD EMBANKMENT (LM)

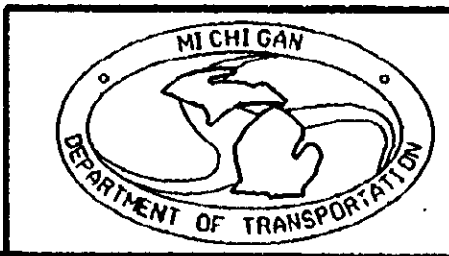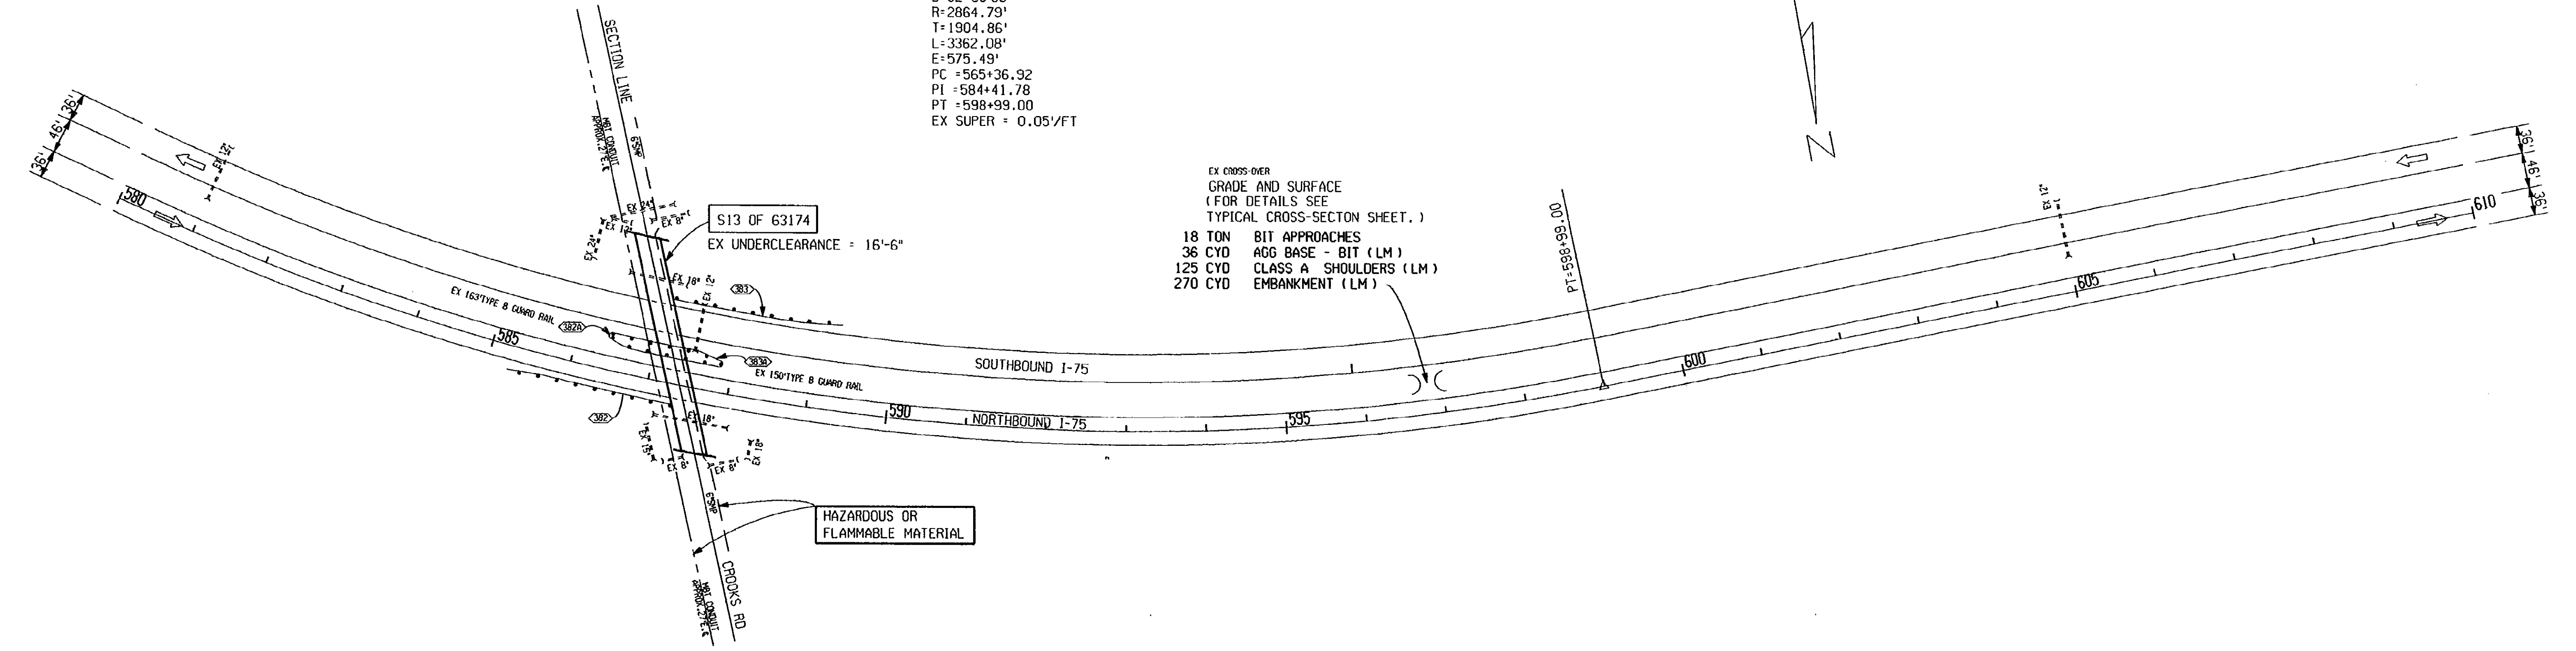

I-75 STA 550+00 TO STA 610+00					
DATE	SCALE	CONT. SEC.	JOB NO.	DESIGN UNIT	SHEET NO.
07/16/90	1" = 100'	63174	28991 A	PALMER	R.O.W CONST. / 3

SH. NO. 28991A
 CONTROL SECTION 63174
 EXISTING BY: DATE: 07-11-90
 PROPOSED BY: DATE: 07-11-90
 LAST CORRECTION BY: DATE: 07-11-90
 FILE NAME: 289915500.DWI
 1 3
 15 17 21 22 24 26 33

CONTROL SECTION 63174 JOB NO. 28991A SH. NO.


EXISTING BY: DATE: PROPOSED BY: DATE: LAST CORRECTION BY: DATE: 07-11-90

SPRAGUE DRAIN

CITY OF TROY

FINAL R.O.V.		
AUTH	DATE	REVISION

EX CROSSOVER
GRADE AND SURFACE
(SEE DETAILS ON TYPICAL
CROSS-SECTION SHEET)
18 TON BIT APPROACHES
36 CYD AGG BASE - BIT (LM)
125 CYD CLASS A SHOULDERS (LM)
270 CYD EMBANKMENT (LM)

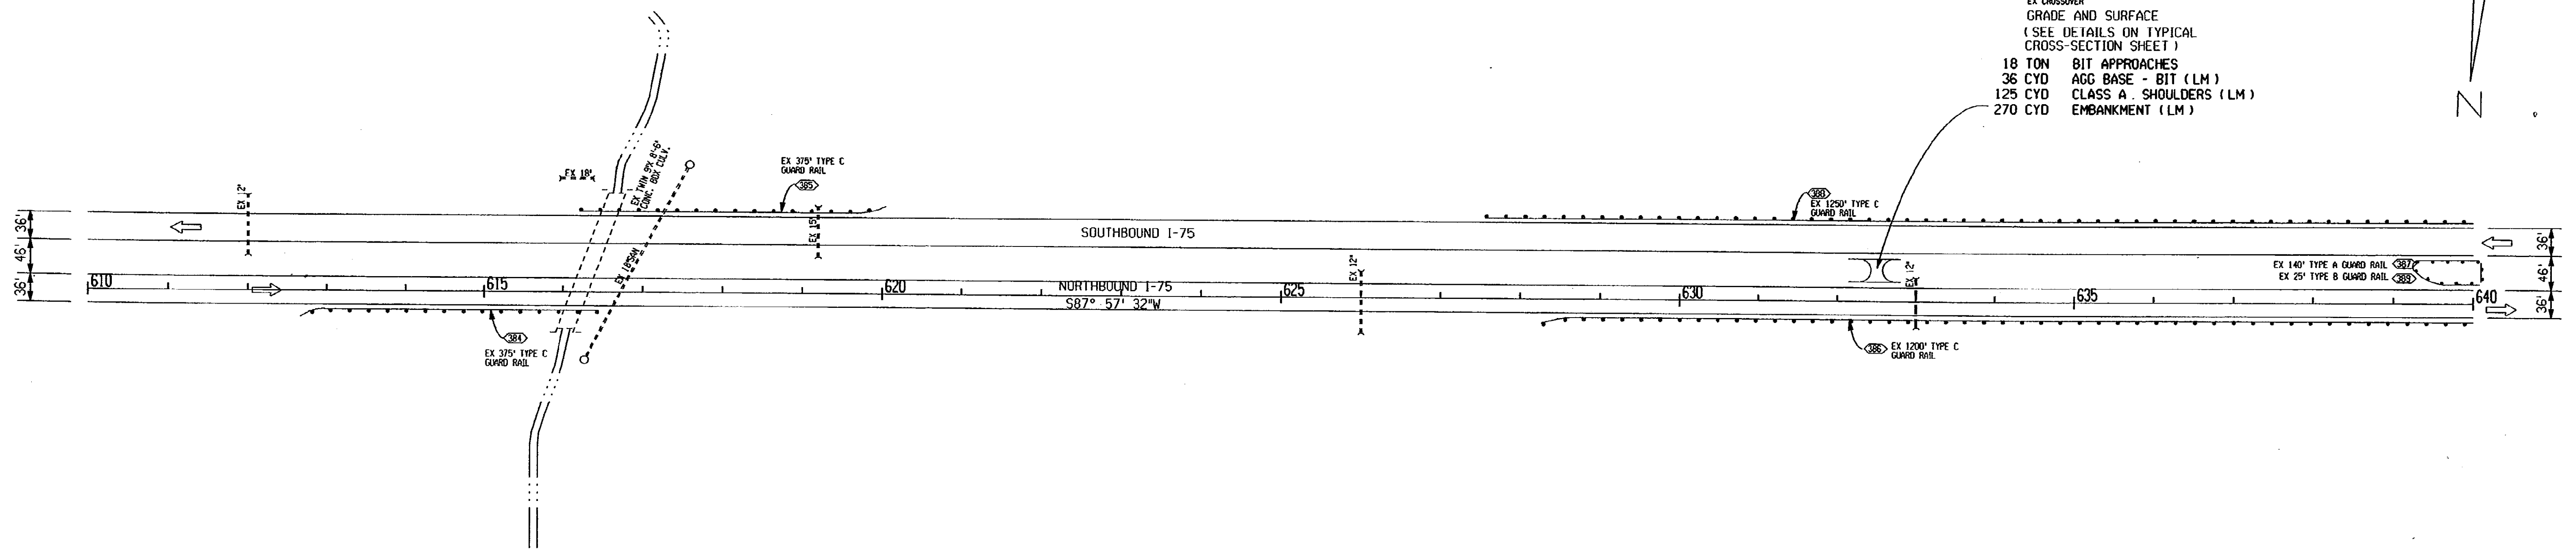


CITY OF TROY QUANTITIES - THIS SHEET
5341 TON BIT MIXTURE NO.1500L, 20AAA - RUBBER
5027 TON BIT MIXTURE NO.1500T, 20AAA - RUBBER
800 SYD CHIPPING CONC PAVT FOR JOINTS
873 CYD CLASS A SHOULDERS (LM)

I-75 CONST. &
CURVE DATA
Δ=17°52'21"RT
D=02°00'00"
R=2864.79'
T=450.47'
L=893.63'
E=35.20'
PC =663+41.26
PI =667+91.73
PT =672+34.88
EX SUPER= 0.05/FT


COOLIDGE RD.

BEACH RD.

CITY OF TROY

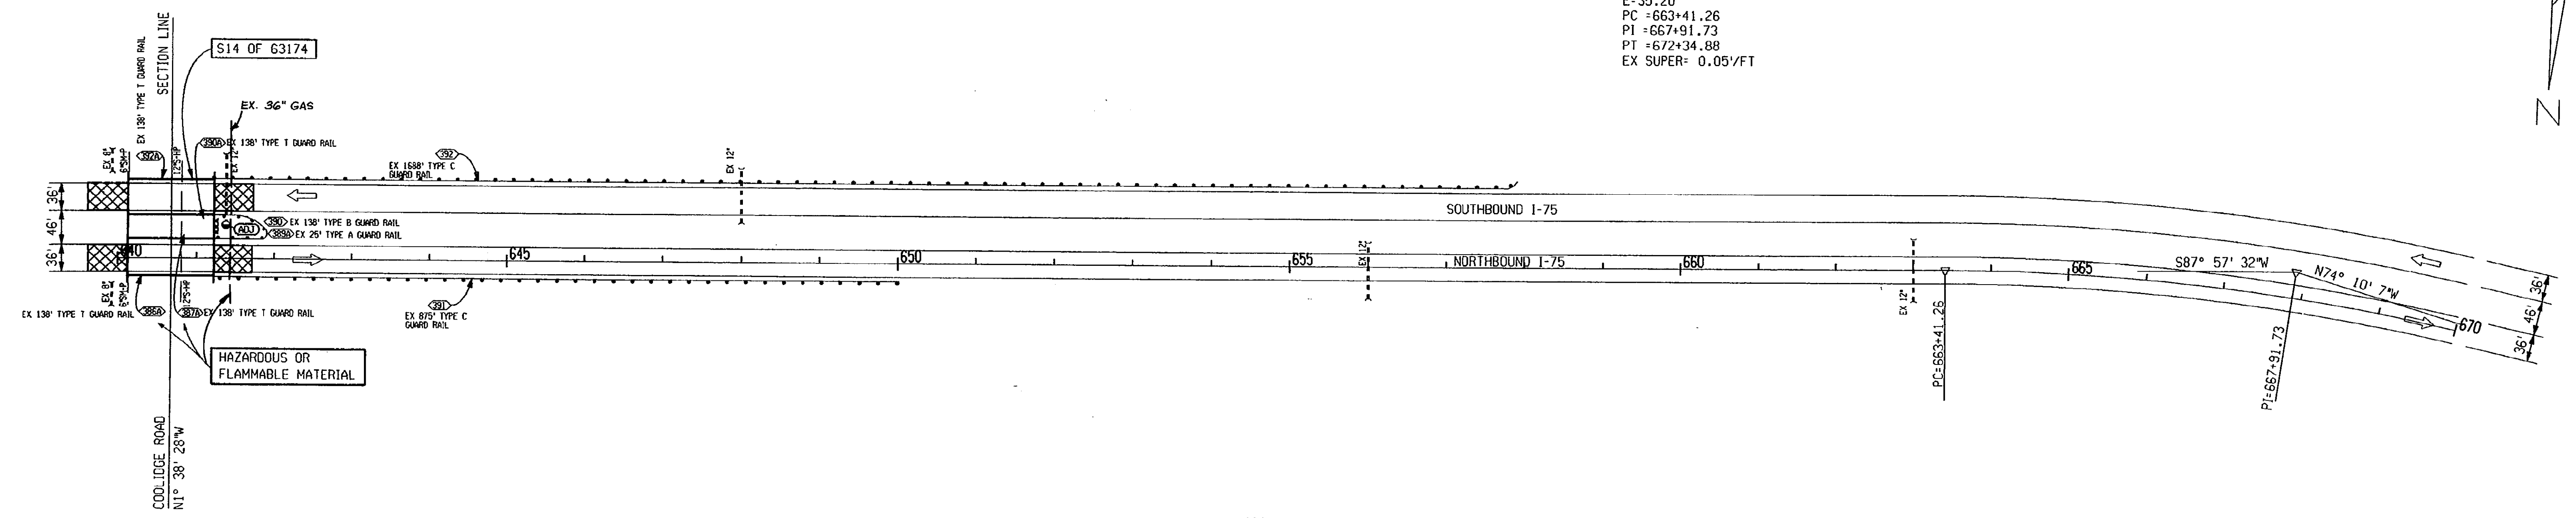

FILE NAME: 289916100.DWG 1 3 11

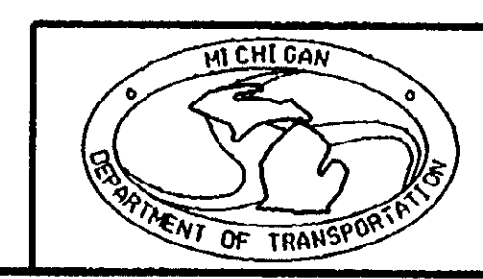

I-75 STA 610+00 TO STA 670+00

DATE	SCALE	CONT. SEC.	JOB NO.	DESIGN UNIT	SHEET NO.
07/16/90	1"=100'	63174	28991 A	PALMER	R.O.W CONST. 1/4

DATE: 07-11-90
 DATE: 07-11-90
 DATE: 07-11-90

EXISTING BY:
 PROPOSED BY:
 LAST CORRECTION BY:

I-75 CONST. & CURVE DATA
 $\Delta = 17^\circ 52' 21''$ RT
 $D = 02^\circ 00' 00''$
 $R = 2864.79'$
 $T = 450.47'$
 $L = 893.63'$
 $E = 35.20'$
 $PC = 653+41.26$
 $PI = 667+91.73$
 $PT = 672+34.88$
 $EX SUPER = 0.05/FT$


CITY OF TROY

RELOCATED SQUARE LAKE RD

I-75 CONST. & CURVE DATA
 $\Delta = 03^\circ 52' 08''$ RT
 $D = 00^\circ 15' 00''$
 $R = 22918.31'$
 $T = 774.07'$
 $L = 1547.56'$
 $E = 13.07'$
 $PC = 686+77.68$
 $PI = 694+51.75$
 $PT = 702+25.23$
 NO SUPER

ADAMS RD.

FINAL R.O.W.		
AUTH	DATE	REVISION

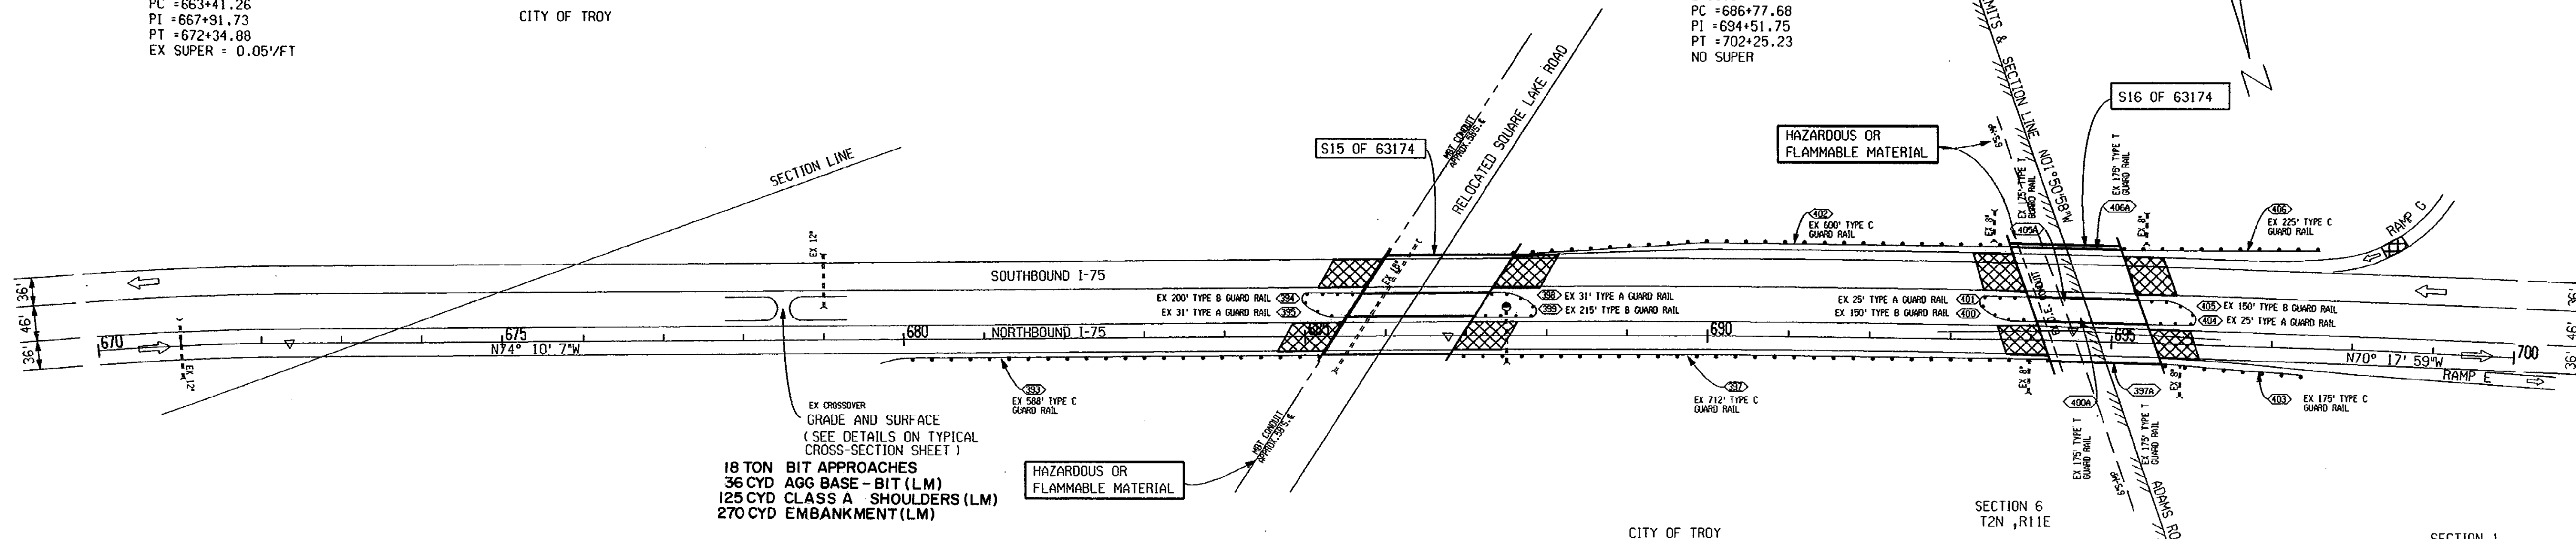

18 TON BIT APPROACHES
 36 CYD AGG BASE - BIT (LM)
 125 CYD CLASS A SHOULDERS (LM)
 270 CYD EMBANKMENT (LM)


HAZARDOUS OR FLAMMABLE MATERIAL

RAMP G
 CURVE DATA
 $\Delta = 2^\circ 58'$
 $D = 1^\circ 45' 00''$
 $R = 3274.04'$
 $T = 84.70'$
 $L = 169.52'$
 $E = 1.10'$
 $PC = 95+63.44$
 $PI = 96+48.22$
 $PCC = 97+32.96$ (STA 697+32.96 SBD RDWY)

RAMP E
 CURVE DATA
 $\Delta = 1^\circ 08' 41''$
 $D = 0^\circ 15' 00.7''$
 $R = 22900.32'$
 $T = 228.77'$
 $L = 457.53'$
 $E = 1.14'$
 $PC = 297+51.00$
 $PI = 299+79.77$
 $PCC = 302+08.53$ (STA 702+08.53 NBD RDWY)

MDOT	CITY OF TROY	QUANTITIES - THIS SHEET
3408 TON	2088 TON	BIT MIXTURE NO.1500L, 20AAA - RUBBER
3208 TON	1965 TON	BIT MIXTURE NO.1500T, 20AAA - RUBBER
660 SYD	1267 SYD	CHIPPING CONC PAVT FOR JOINTS
513 CYD	332 CYD	CLASS A SHOULDERS (LM)


SECTION 1
 T2N ,R10E
 BLOOMFIELD TWP.

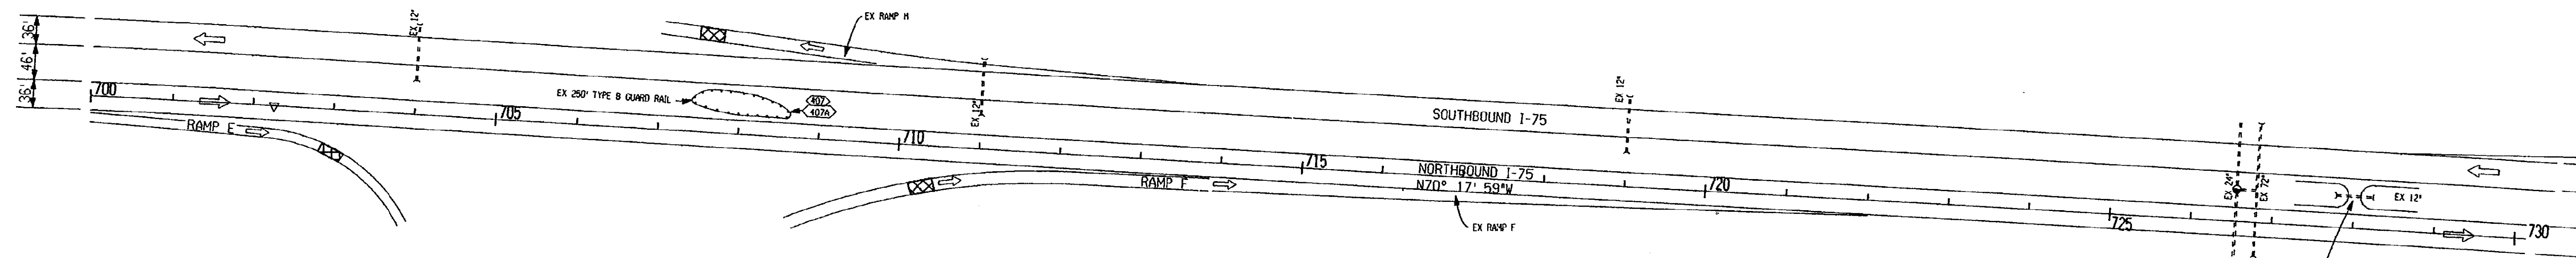

RAMP H
 CURVE DATA
 $\Delta = 64^\circ 59' 41''$
 $D = 6^\circ 00'$
 $R = 954.93'$
 $T = 608.30'$
 $L = 1083.25'$
 $E = 177.29'$
 $PC = 96+17.49$
 $PI = 102+25.79$
 $PT = 107+00.74$ (STA 707+00.74 SBD RDWY)

RAMP F
 CURVE DATA
 $\Delta = 39^\circ 21' 14''$
 $D = 7^\circ 15' 00''$
 $R = 799.48'$
 $T = 285.89'$
 $L = 549.13'$
 $E = 49.58'$
 $PC = 406+50.60$
 $PI = 409+36.49$
 $PT = 411+99.73$ (STA 711+99.73 NBD RDWY)

EX CROSSOVER
 GRADE AND SURFACE
 (SEE DETAILS ON TYPICAL
 CROSS-SECTION SHEET)
 18 TON BIT APPROACHES
 36 CYD AGG BASE - BIT (LM)
 125 CYD CLASS A SHOULDERS (LM)
 270 CYD EMBANKMENT (LM)

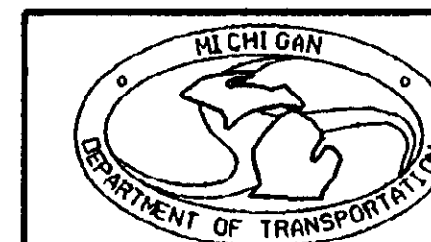

I-75 STA 670+00 TO STA 730+00

DATE	SCALE	CONT. SEC.	JOB NO.	DESIGN UNIT	SHEET NO.
07/16/90	1" = 100'	63174	28991 A	PALMER	R.O.W CONST. 15

DATE: 07-11-90
 PROPOSED BY:
 LAST CORRECTION BY:

FILE NAME: 289917300.DMI
 1 3 11 15 17 21.22 24 26 30 33

FINAL R.O.W.		
AUTH	DATE	REVISION

I-75 NB CONST. CURVE DATA
 $\Delta = 57^{\circ}53'36''$ RT
 $D = 01^{\circ}00'00''$
 $R = 5729.57'$
 $T = 3168.99'$
 $L = 5789.33'$
 $E = 817.98'$
 $PC = 734+24.54$
 $PI = 765+93.53$
 $PT = 792+13.88$
 EX SUPER = 0.02'/FT

I-75 SB CONST. CURVE DATA
 $\Delta = 57^{\circ}53'36''$ RT
 $D = 03^{\circ}00'00''$
 $R = 1909.86'$
 $T = 1056.33'$
 $L = 1929.78'$
 $E = 272.66'$
 $PC = 755+79.09$ AHEAD
 $PI = 766+35.42$
 $PT = 775+08.87$
 EX SUPER = 0.06'/FT


RAMP ES - CURVE DATA
CURVE DATA
 $\Delta = 1^{\circ}01'52''$
 $D = 0^{\circ}31'00''$
 $R = 11459.16'$
 $T = 103.11'$
 $L = 205.19'$
 $E = 0.46'$
 $PC = 361+18.57$
 $PI = 362+21.68$
 $PT = 363+23.76$ (STA 737+86.84 SB ROWAY)

STATION EQUATION
 STA 755+82.56 BACK-
 PC STA 755+79.09 AHEAD


QUANTITIES - THIS SHEET
 3372 TON BIT MIXTURE NO. 1500L, 20AAA - RUBBER
 3174 TON BIT MIXTURE NO. 1500T, 20AAA - RUBBER
 460 CYD CLASS A SHOULDERS (LM)
 160 SYD CHIPPING CONC PAVT FOR JOINTS

SECTION 1
 T2N, R10E
 BLOOMFIELD TOWNSHIP

SECTION 2
 T2N, R10E
 BLOOMFIELD TOWNSHIP

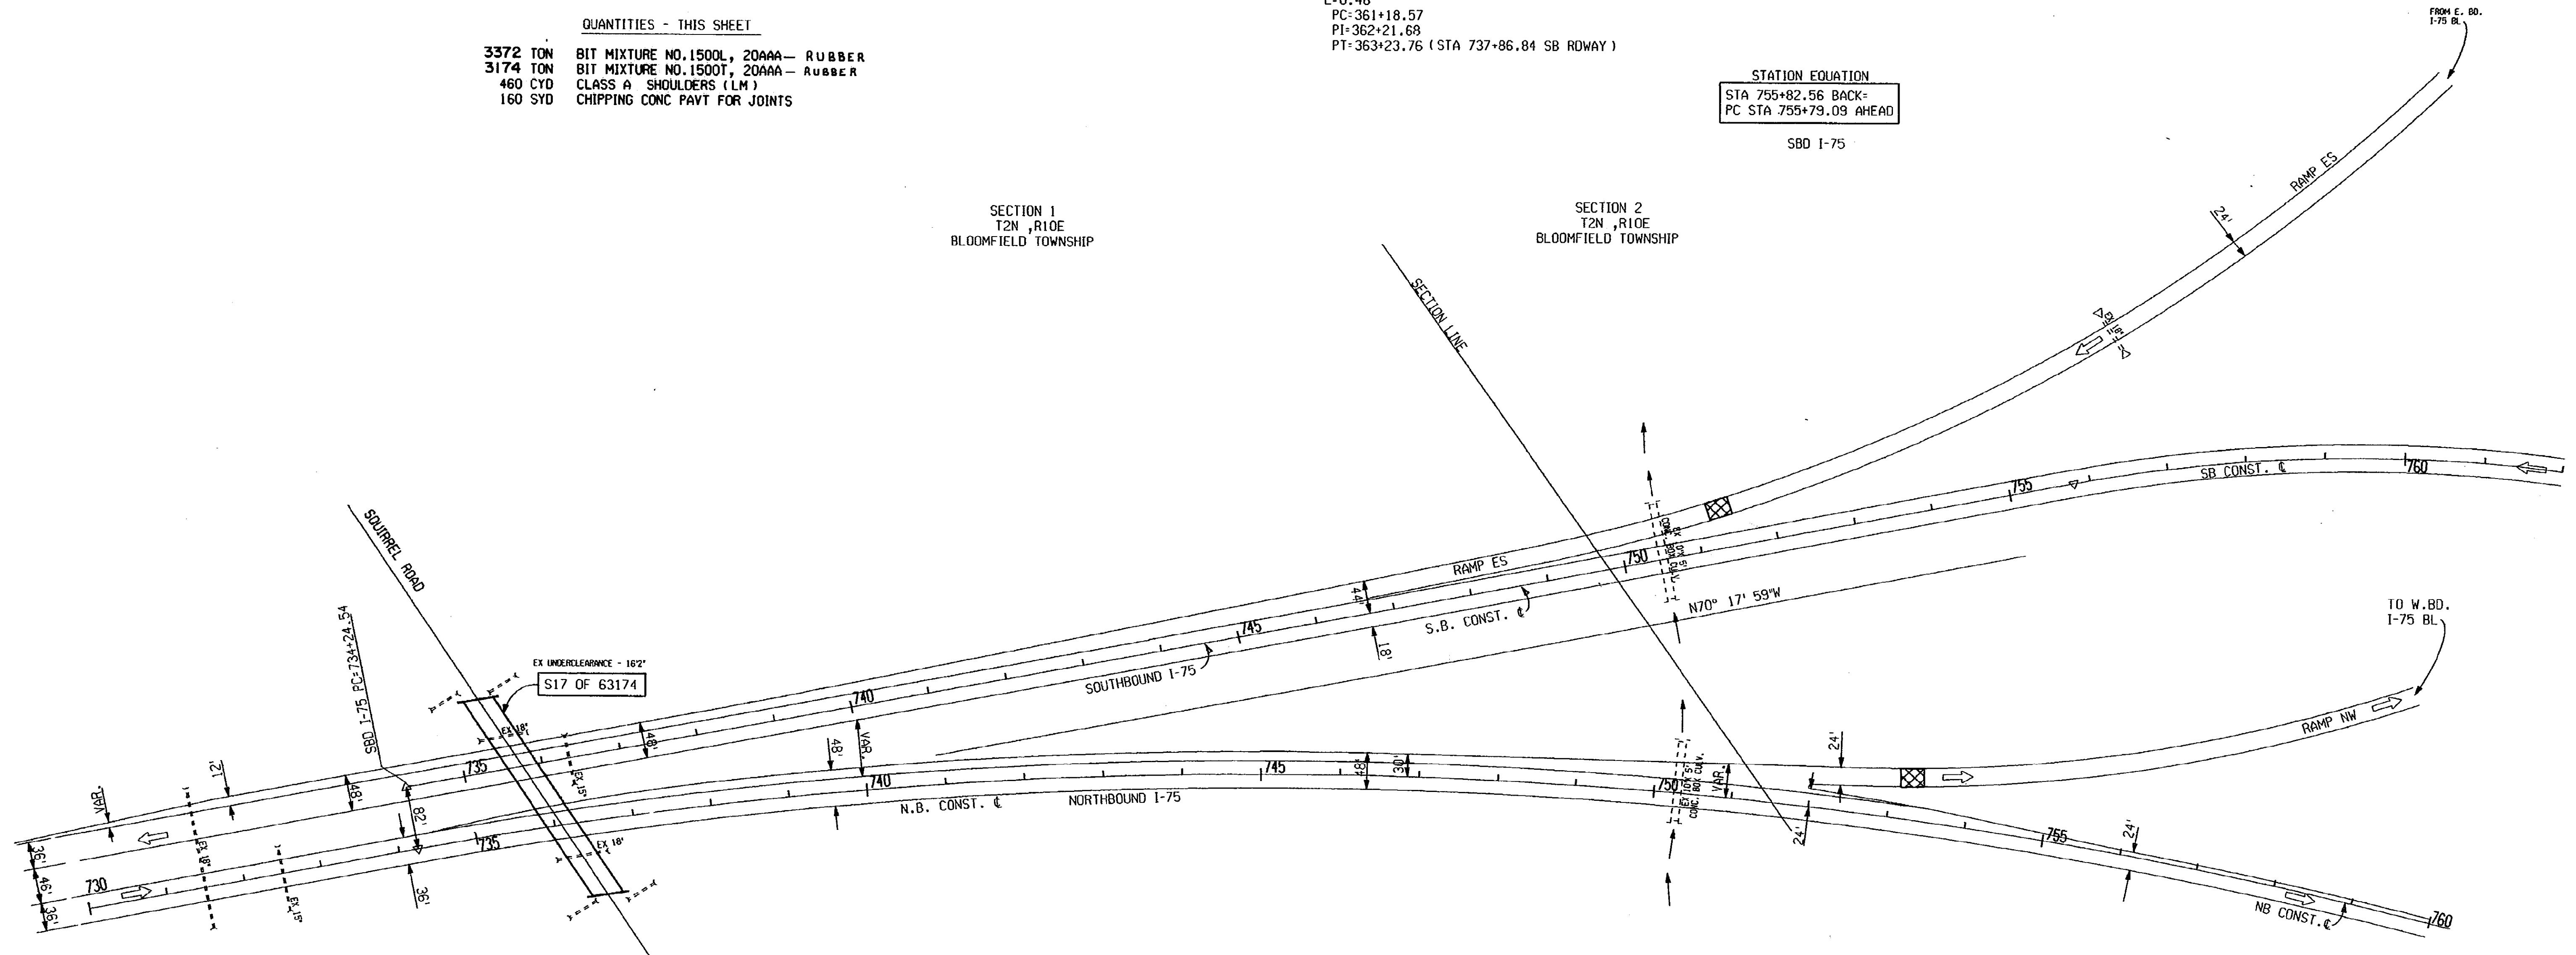

RAMP NW CURVE DATA
 $\Delta = 91^{\circ}22'30.3''$
 $D = 3^{\circ}00''$
 $R = 1909.86'$
 $T = 1959.26'$
 $L = 3045.84'$
 $E = 824.09'$
 $PC = 1229+11.28$
 $PI = 1248+67.54$
 $PT = 1259+57.11$ (STA 746+76.46 NB ROWAY)
 EX SUPER = 0.06'/FT

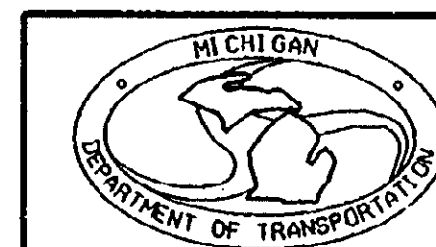

I-75 STA 730+00 TO N. BD. STA 760+00

DATE	SCALE	CONT. SEC.	JOB NO.	DESIGN UNIT	SHEET NO.
07/16/90	1"=100	63174	28991 A	PALMER	16


FINAL R.O.W.			
AUTH	DATE	NO.	REVISION

I-75 NB CONST. CURVE DATA
 $\Delta = 57^{\circ}53'36"RT$
 $D = 01^{\circ}00'00"$
 $R = 5729.57'$
 $T = 3168.99'$
 $L = 5769.33'$
 $E = 817.98'$
 $PC = 734+24.54$
 $PI = 765+33.53$
 $PT = 792+13.88$
 $EX\ SUPER = 0.02/FT$

I-75 SB CONST. CURVE DATA
 $\Delta = 57^{\circ}53'36"RT$
 $D = 03^{\circ}00'00"$
 $R = 1909.86'$
 $T = 1055.33'$
 $L = 1929.78'$
 $E = 272.66'$
 $PC = 755+79.09$
 $PI = 766+35.42$
 $PT = 775+08.87$
 $EX\ SUPER = 0.06/FT$

RAMP EN CURVE DATA
 $\Delta = 73^{\circ}16'05.5"$
 $D = 3^{\circ}30'$
 $R = 1637.02'$
 $T = 1217.27'$
 $L = 2093.37'$
 $E = 402.98'$
 $PC = 2333+79.92$
 $PI = 2345+97.19$
 $PT = 2354+73.30$

RAMP NE CURVE DATA
 $\Delta = 42^{\circ}13'09"LT$
 $D = 1^{\circ}45'00"$
 $R = 3274.04'$
 $T = 1263.98'$
 $L = 2412.52'$
 $E = 235.52'$
 $PC = 237+15.48$
 $PI = 249+79+.46$
 $PT = 261+28.00 (STA 787+62.97 SB ROW)$

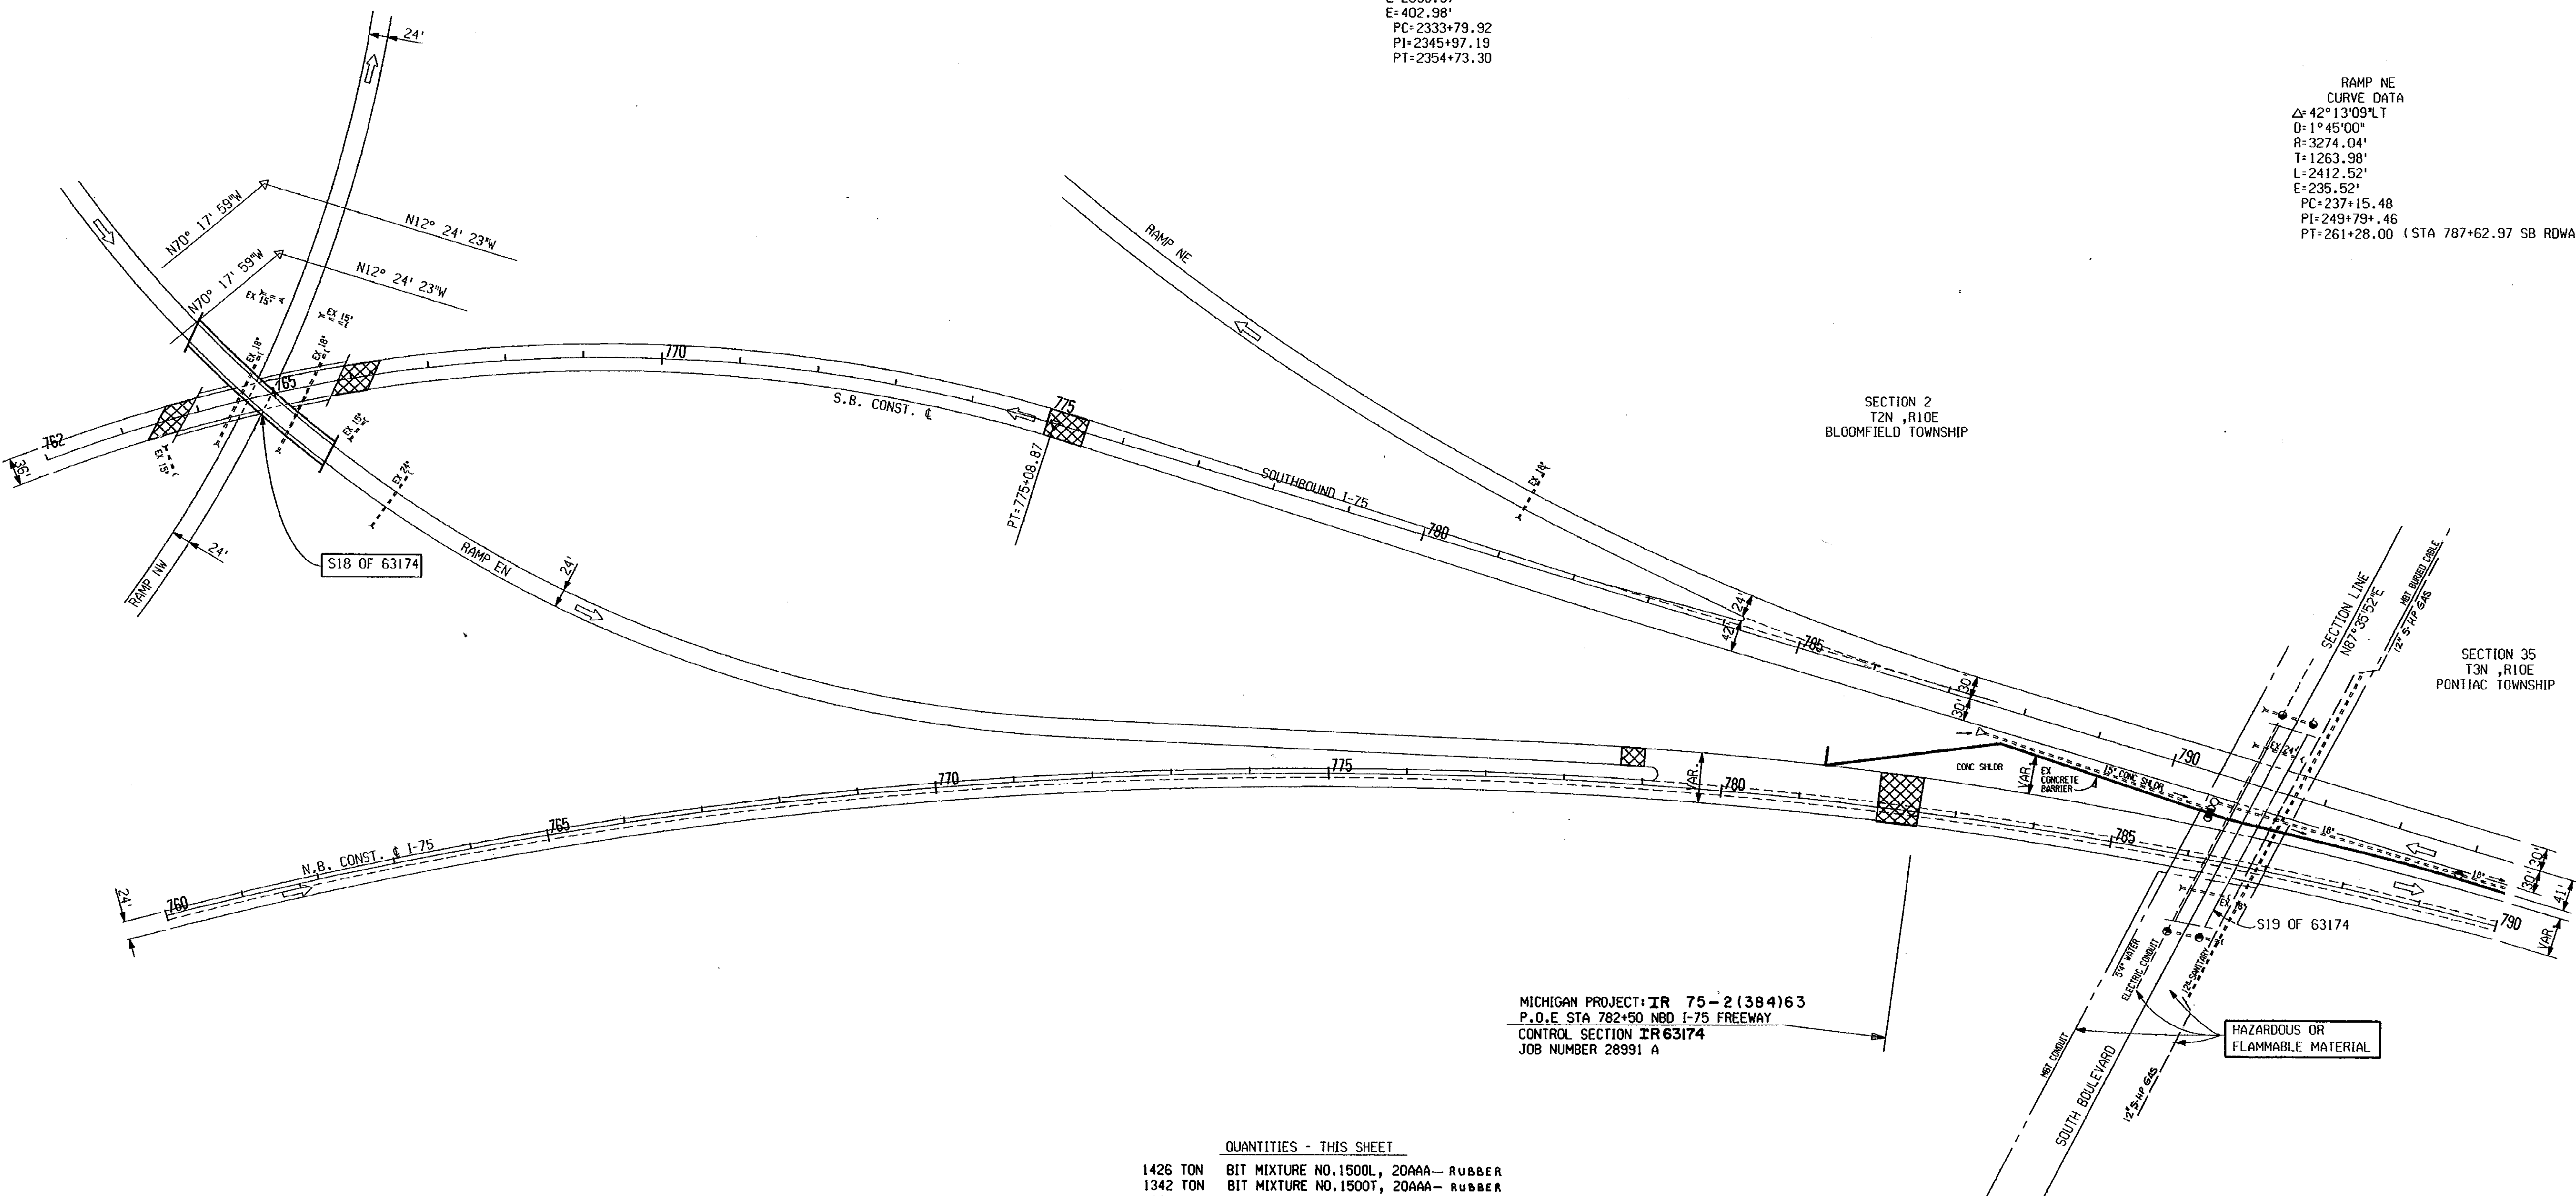


MICHIGAN PROJECT: IR 75-2(384)63
 P.O.E STA 782+50 NBD I-75 FREEWAY
 CONTROL SECTION IR 63174
 JOB NUMBER 28991 A

QUANTITIES - THIS SHEET
 1426 TON BIT MIXTURE NO.1500L, 20AAA- RUBBER
 1342 TON BIT MIXTURE NO.1500T, 20AAA- RUBBER
 1036 SYD CHIPPING CONC PAVT FOR JOINTS
 252 CYD CLASS A SHOULDERS (LM)

SOUTH BOULEVARD

NB I-75 STA 760+00 TO STA 790+00					
DATE	SCALE	CONT. SEC.	JOB NO.	DESIGN UNIT	SHEET NO.
07/16/90	1" = 100'	63174	28991 A	PALMER	R.O.W CONST. 17

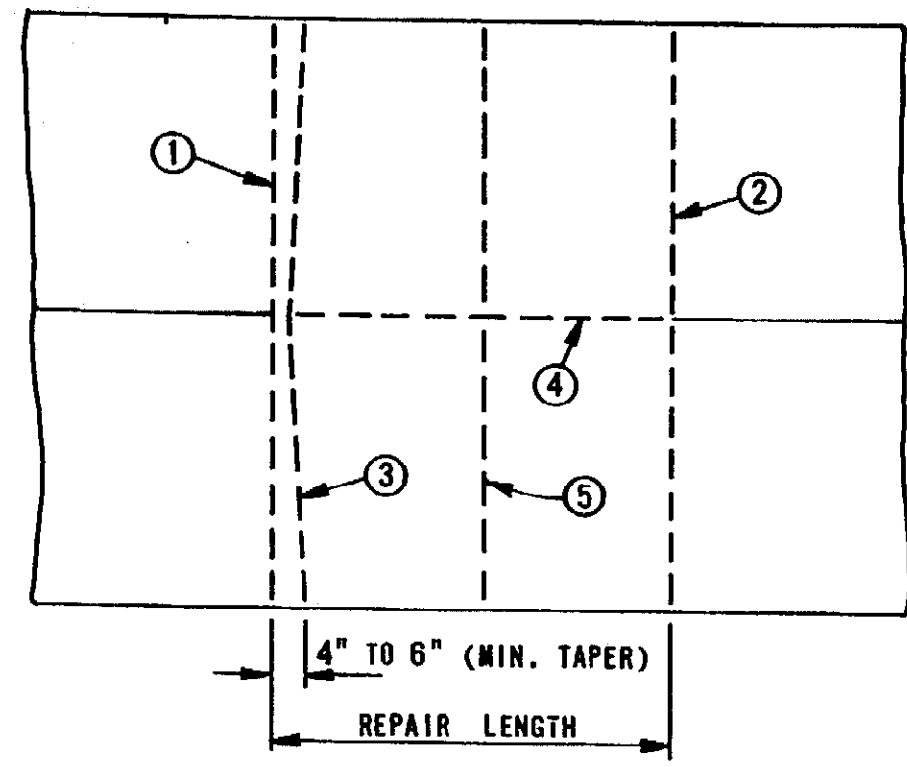


Plan of Sawing Diagram

THIS METHOD OF REMOVING DISTRESSED CONCRETE SHALL BE USED IN CONJUNCTION WITH FULL DEPTH CAST-IN-PLACE REPAIRS (DETAILS 3 & 3A) LESS THAN 50' LONG, AND IS OPTIONAL FOR REPAIRS OVER 50' IN LENGTH.

- 1 & 2 THESE SAW CUTS SHALL BE FULL DEPTH AND PERPENDICULAR TO THE EDGE OF THE ROADWAY, WITH A TOLERANCE OF 1".
- 3 THIS FULL DEPTH SAW CUT IS MADE TO FACILITATE OPENING A TRENCH ACROSS THE SLAB TO RELIEVE COMPRESSION IN THE PAVEMENT PRIOR TO LIFTING OUT THE FAILED AREA. THIS SAW CUT MAY BE OMITTED PROVIDED NO SPALLING OF THE REMAINING CONCRETE PAVEMENT OCCURS. IF SPALLING DOES OCCUR, THE CONTRACTOR WILL BE REQUIRED TO MAKE THIS SAW CUT ON SUBSEQUENT REPAIRS. WHEN THIS SAW CUT IS USED AND THE ADJACENT LANE IS NOT REPAIRED, NO OVERCUTTING INTO THAT LANE SHALL BE MADE.
- 4 THIS SAW CUT IS MADE FULL DEPTH BETWEEN LANES, BETWEEN A LANE AND A CURB, AND BETWEEN A LANE AND A RAMP.
- 5 IF REQUIRED, INTERMEDIATE SAW CUTS MAY BE MADE TO REMOVE A SECTION OF PAVEMENT LANE WHICH IS OVER 6 FEET IN LENGTH, TO PERMIT LOADING INTO THE HAULING UNITS.


ADDITIONAL SAW CUTS, AT CONTRACTOR'S EXPENSE, MAY BE MADE INSIDE THE REPAIR LIMITS TO REDUCE 6-FOOT BY 12-FOOT SLABS INTO SMALLER PIECES TO FACILITATE REMOVAL.

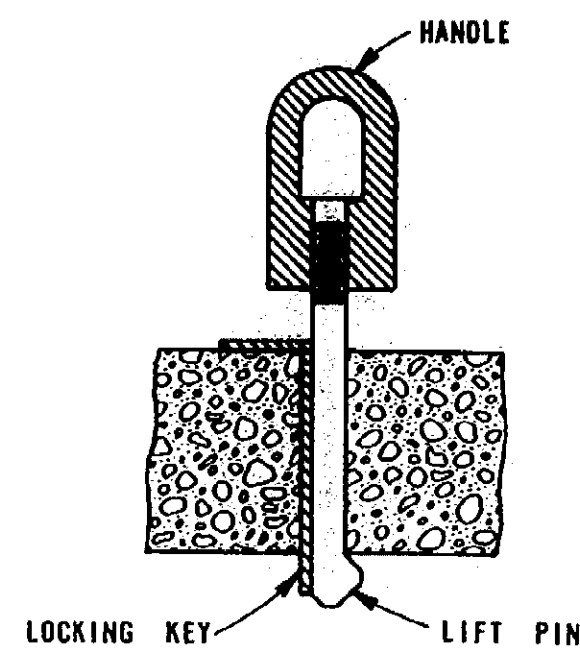


Schematic of Typical Lift Pin Assembly

SAWING DIAGRAM & LIFT PIN FOR REMOVING OLD SLAB

DETAIL 1

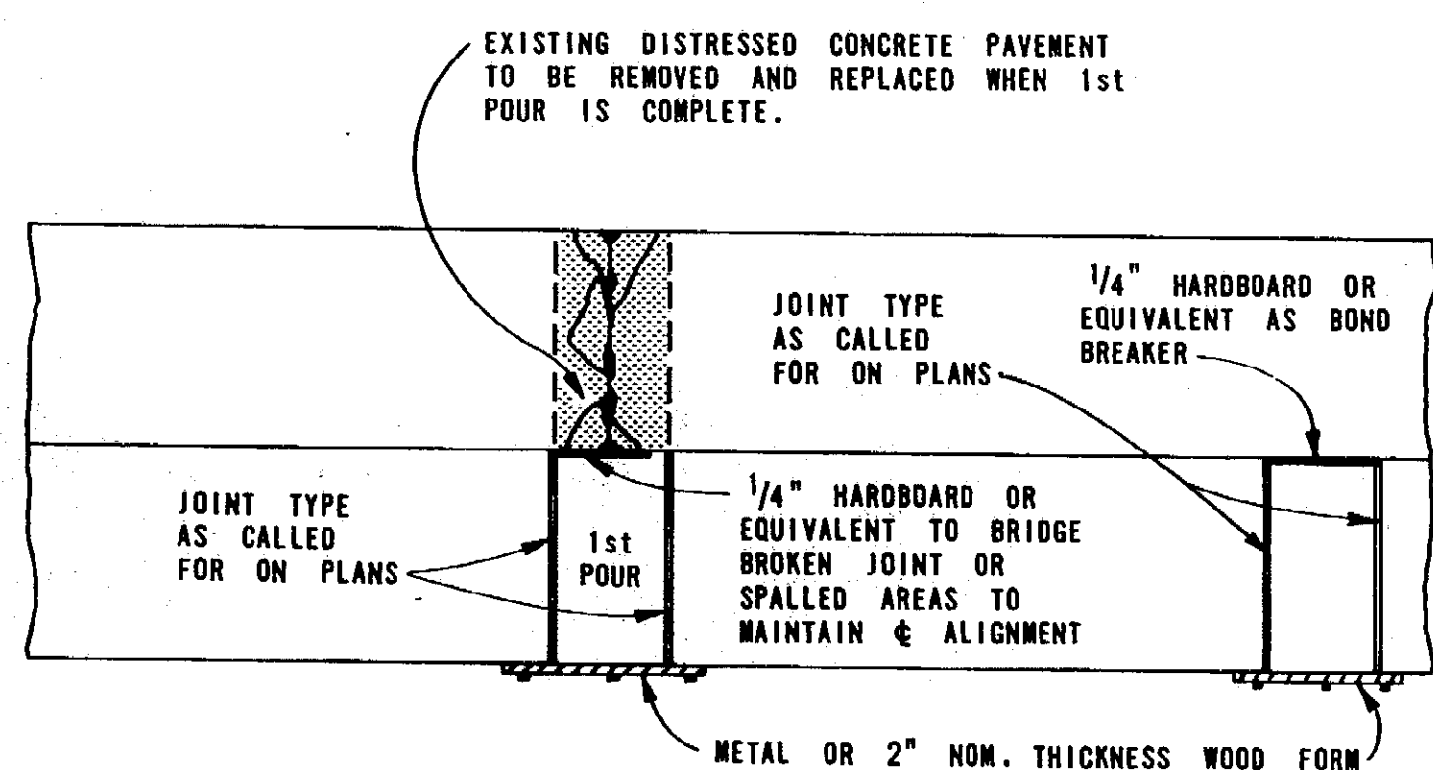


Repair Length 12' or Less

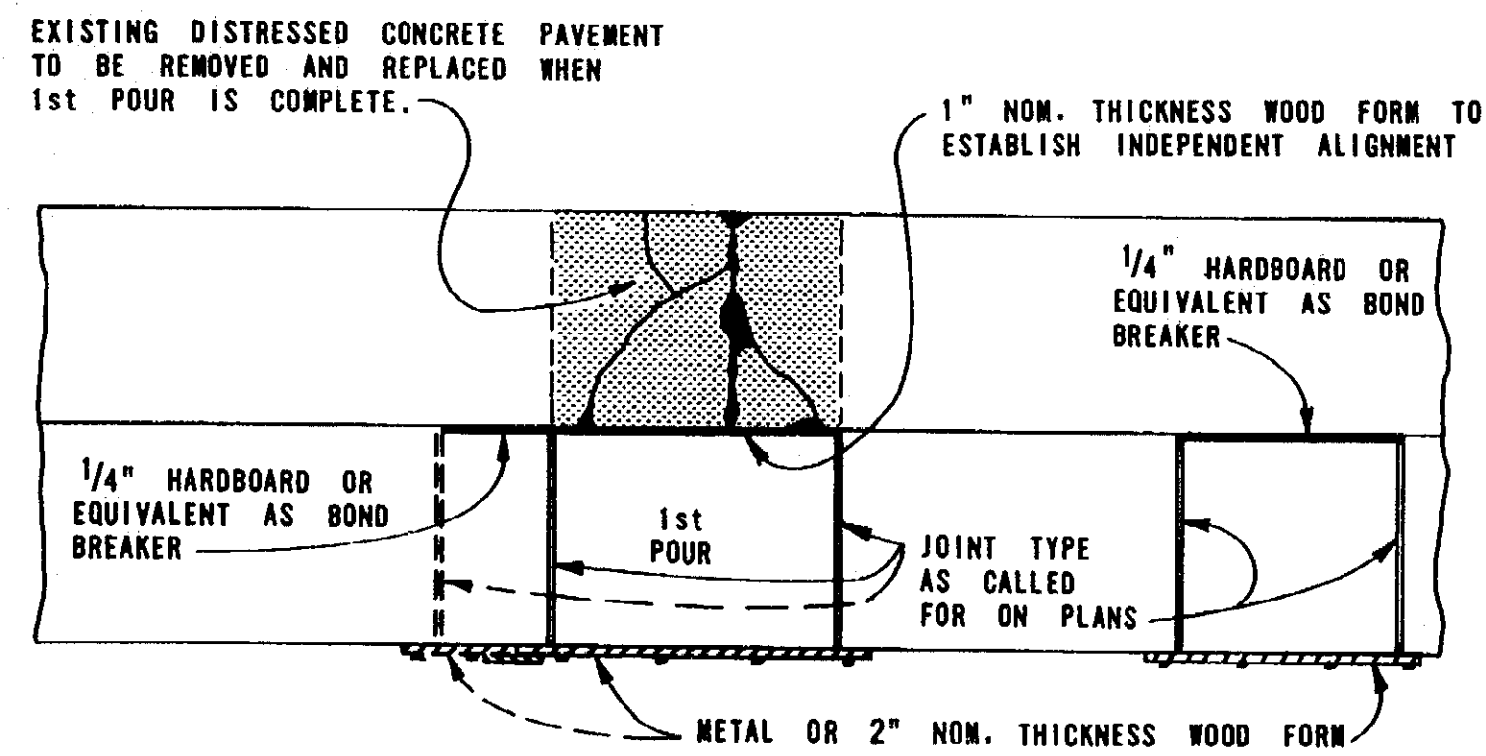


FORMING REQUIREMENTS FOR CAST-IN-PLACE REPAIR

DETAIL 2

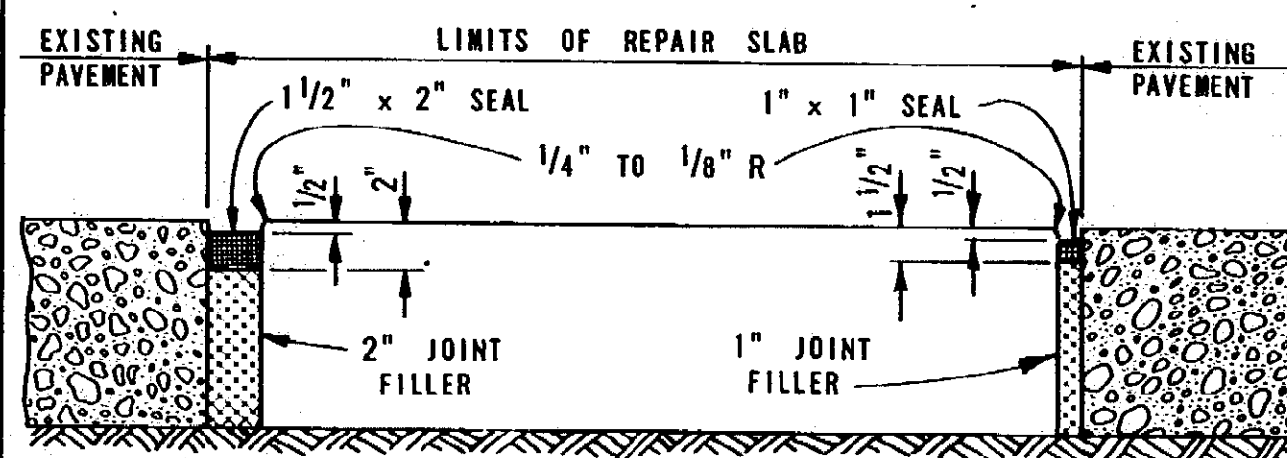

Expansion Joint Type "A"

Expansion Joint Type "B"

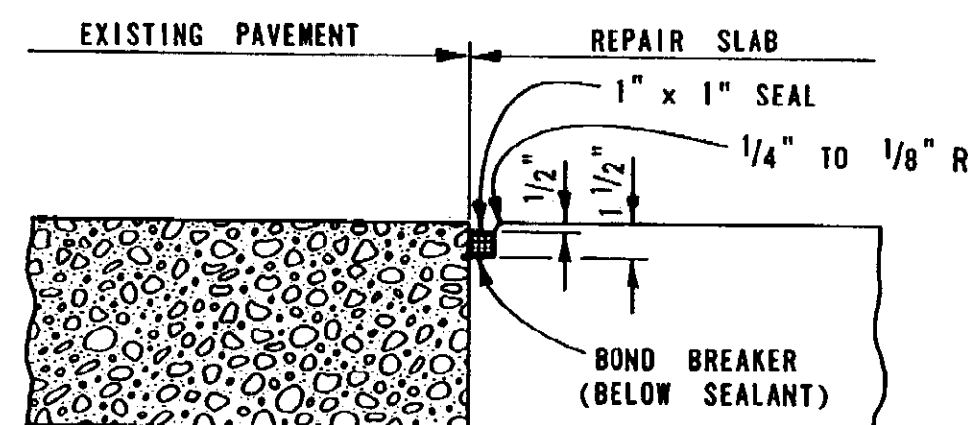


Contraction Joint Type "C"

NOTE: WHEN PLACING CONCRETE PAVEMENT REPAIRS IN CONCRETE PAVEMENTS WITH BITUMINOUS OVERLAYS, THE REPAIR SHALL BE CONSTRUCTED AS SHOWN ABOVE EXCEPT THE SURFACE OF THE CONCRETE REPAIR SHALL BE CONSTRUCTED LEVEL WITH THE TOP OF THE EXISTING BITUMINOUS SURFACE.


UNDOWELED CAST-IN-PLACE REPAIR JOINTS U_r

DETAIL 3

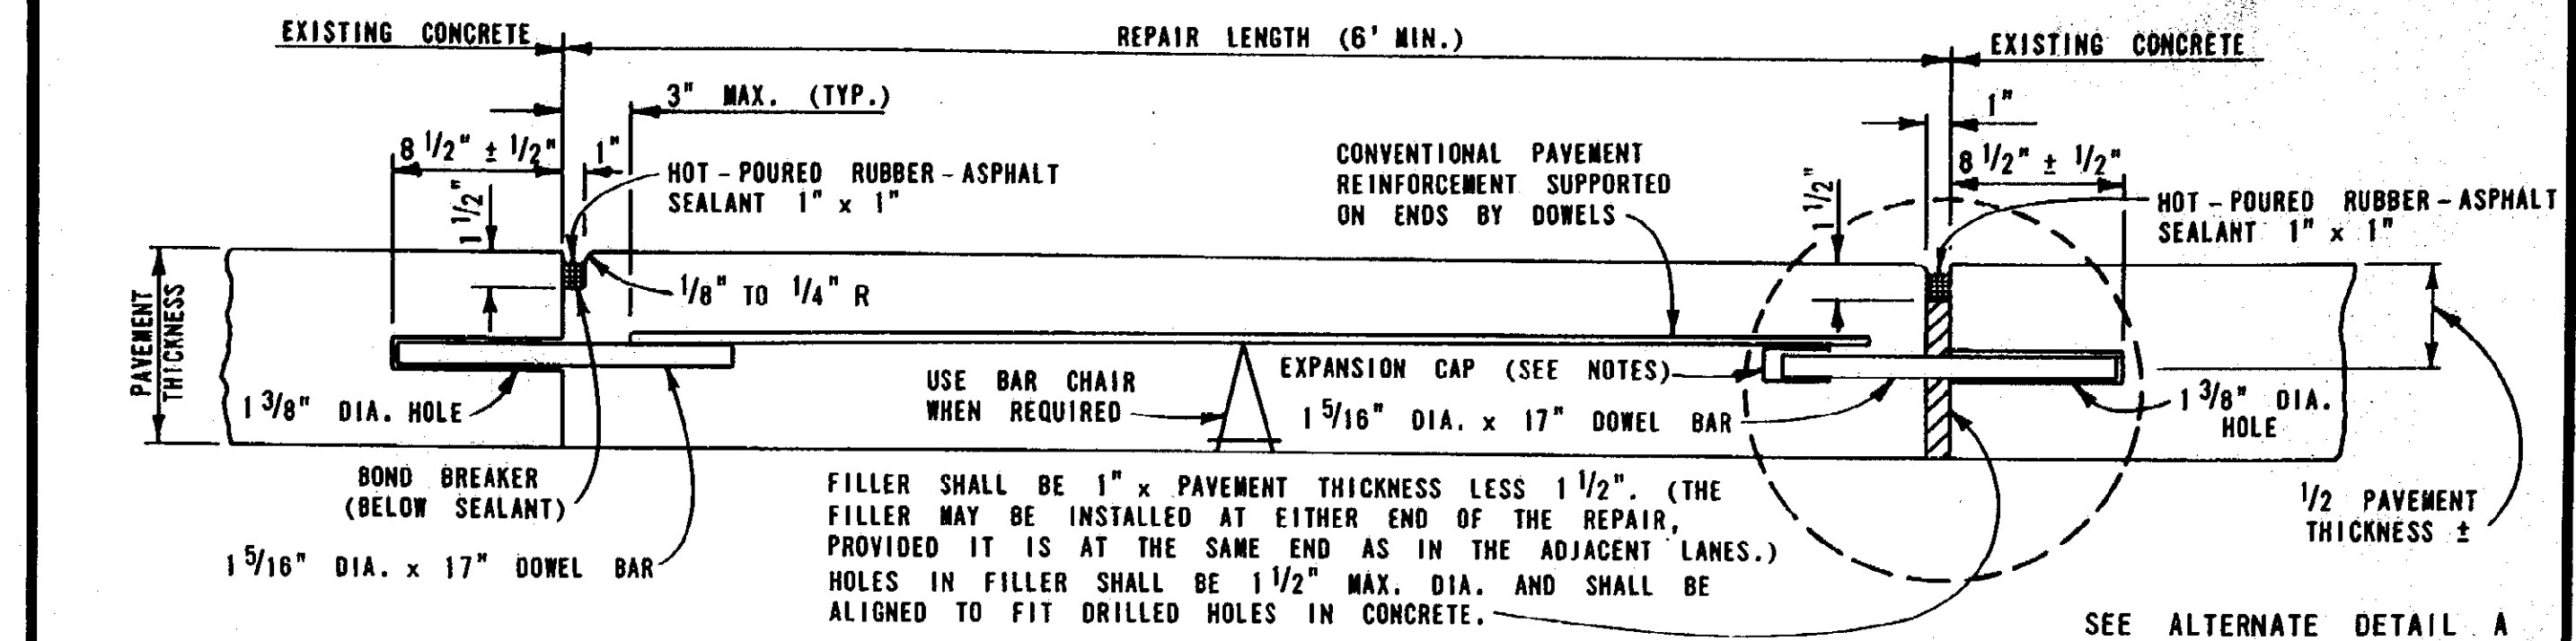


CONTRACTION JOINT Cr

EXPANSION JOINT Er

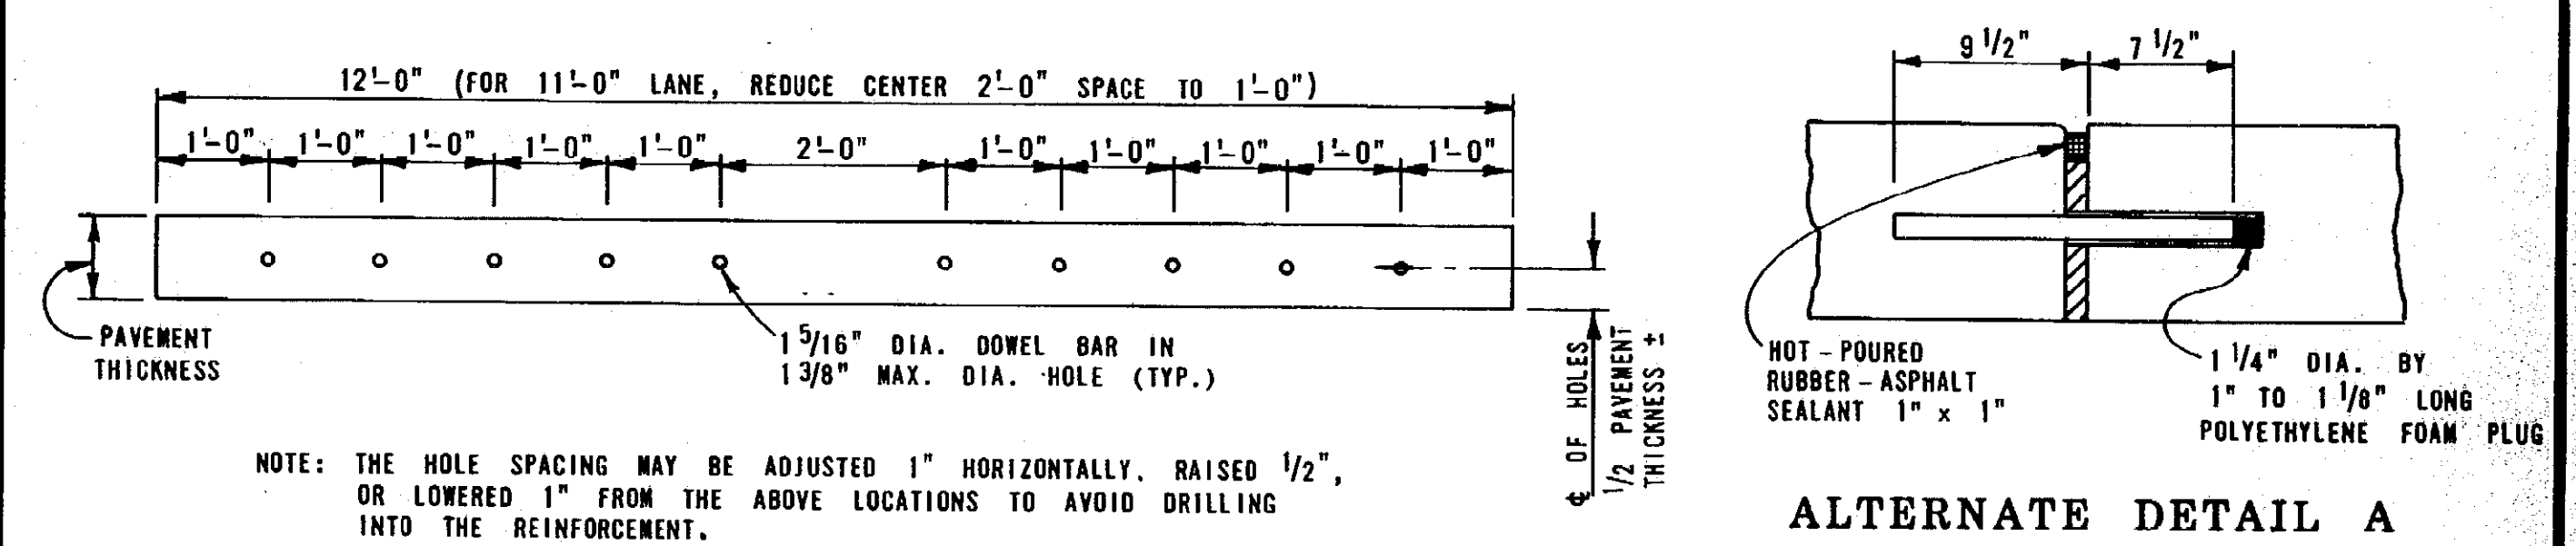


DOWEL BAR SPACING FOR REPAIRS

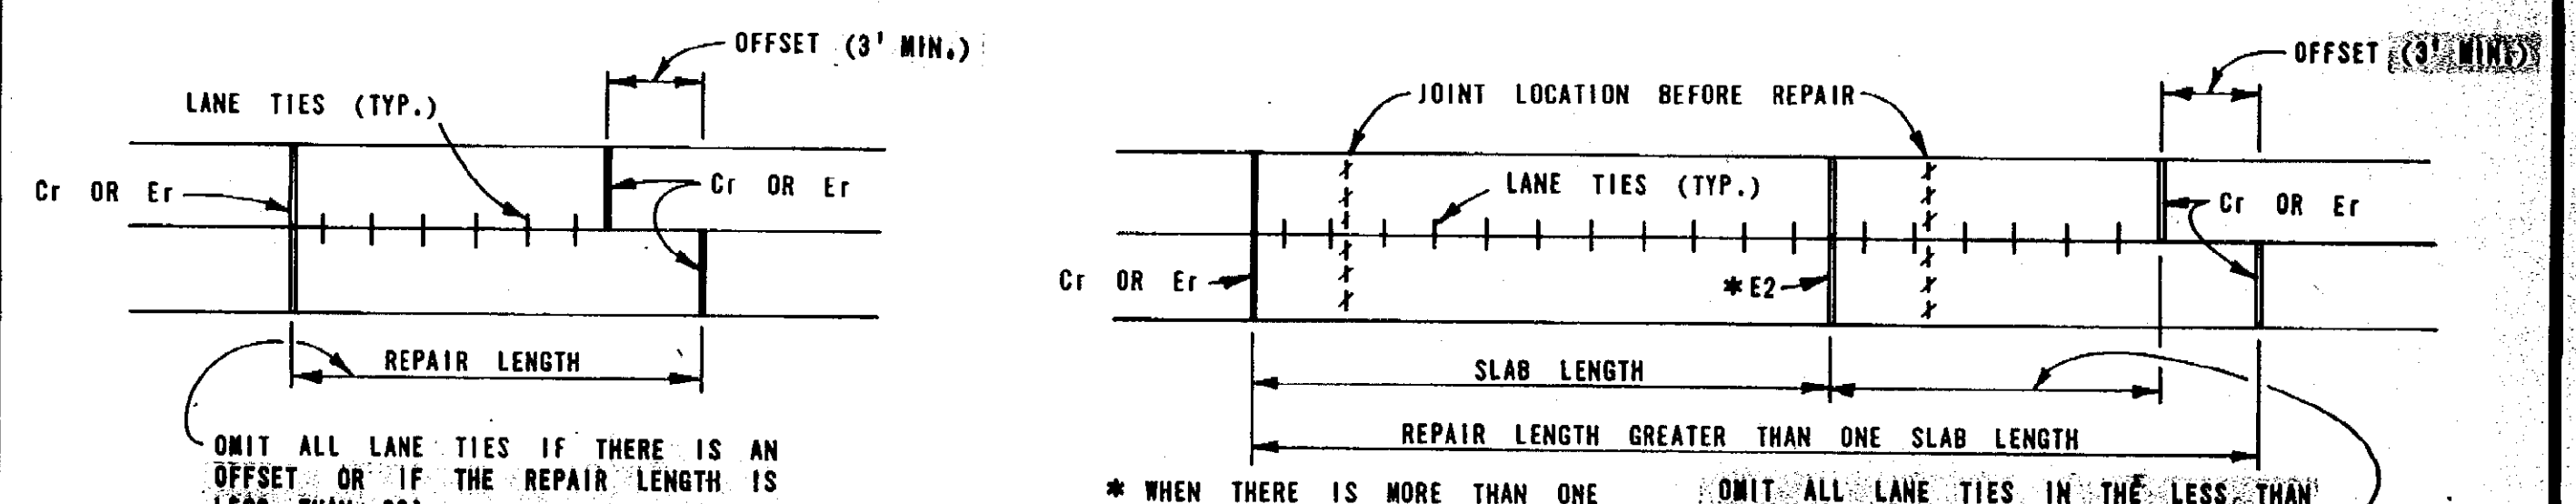

Repair Length Less Than One Slab Length

Repair Length Greater Than One Slab Length

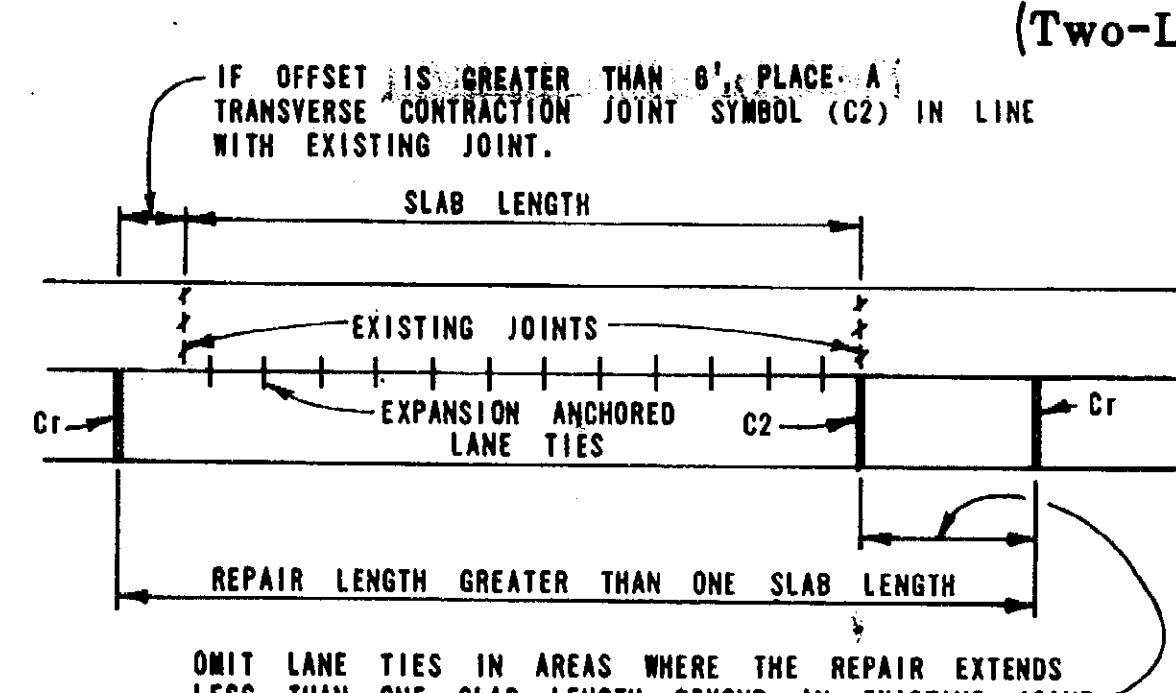

Repair Length Greater Than One Slab Length (One-Lane Repairs)

LANE TIES FOR DOWELED REPAIRS

DOWELED CAST-IN-PLACE REPAIR JOINTS


DETAIL 3A

<p>PREPARED BY DESIGN DIVISION</p> <p>DRAWN BY: H.A.W.</p> <p>CHECKED BY: C.A.L.</p>	ENGINEER OF CONSTRUCTION	ENGINEER - ROAD DESIGN
	ENGINEER OF MAINTENANCE	ENGINEER OF DESIGN
	ENGINEER OF MATERIALS & TECHNOLOGY	DEPARTMENT DIRECTOR JAMES P. PITZ
	ENGINEER OF TRAFFIC AND SAFETY	DEPUTY DIRECTOR - HIGHWAYS


MICHIGAN DEPARTMENT OF TRANSPORTATION BUREAU OF HIGHWAYS STANDARD PLAN FOR CONCRETE PAVEMENT REPAIR			
F.H.W.A. APPROVAL	6-30-89 PLAN DATE	II-44G	SHEET 1 OF 4

<p>PREPARED BY DESIGN DIVISION</p> <p>DRAWN BY: H.A.W.</p> <p>CHECKED BY: C.A.L.</p>	ENGINEER OF CONSTRUCTION	ENGINEER - ROAD DESIGN
	ENGINEER OF MAINTENANCE	ENGINEER OF DESIGN
	ENGINEER OF MATERIALS & TECHNOLOGY	DEPARTMENT DIRECTOR JAMES P. PITZ
	ENGINEER OF TRAFFIC AND SAFETY	DEPUTY DIRECTOR - HIGHWAYS


MICHIGAN DEPARTMENT OF TRANSPORTATION BUREAU OF HIGHWAYS STANDARD PLAN FOR CONCRETE PAVEMENT REPAIR			
F.H.W.A. APPROVAL	6-30-89 PLAN DATE	II-44G	SHEET 2 OF 4

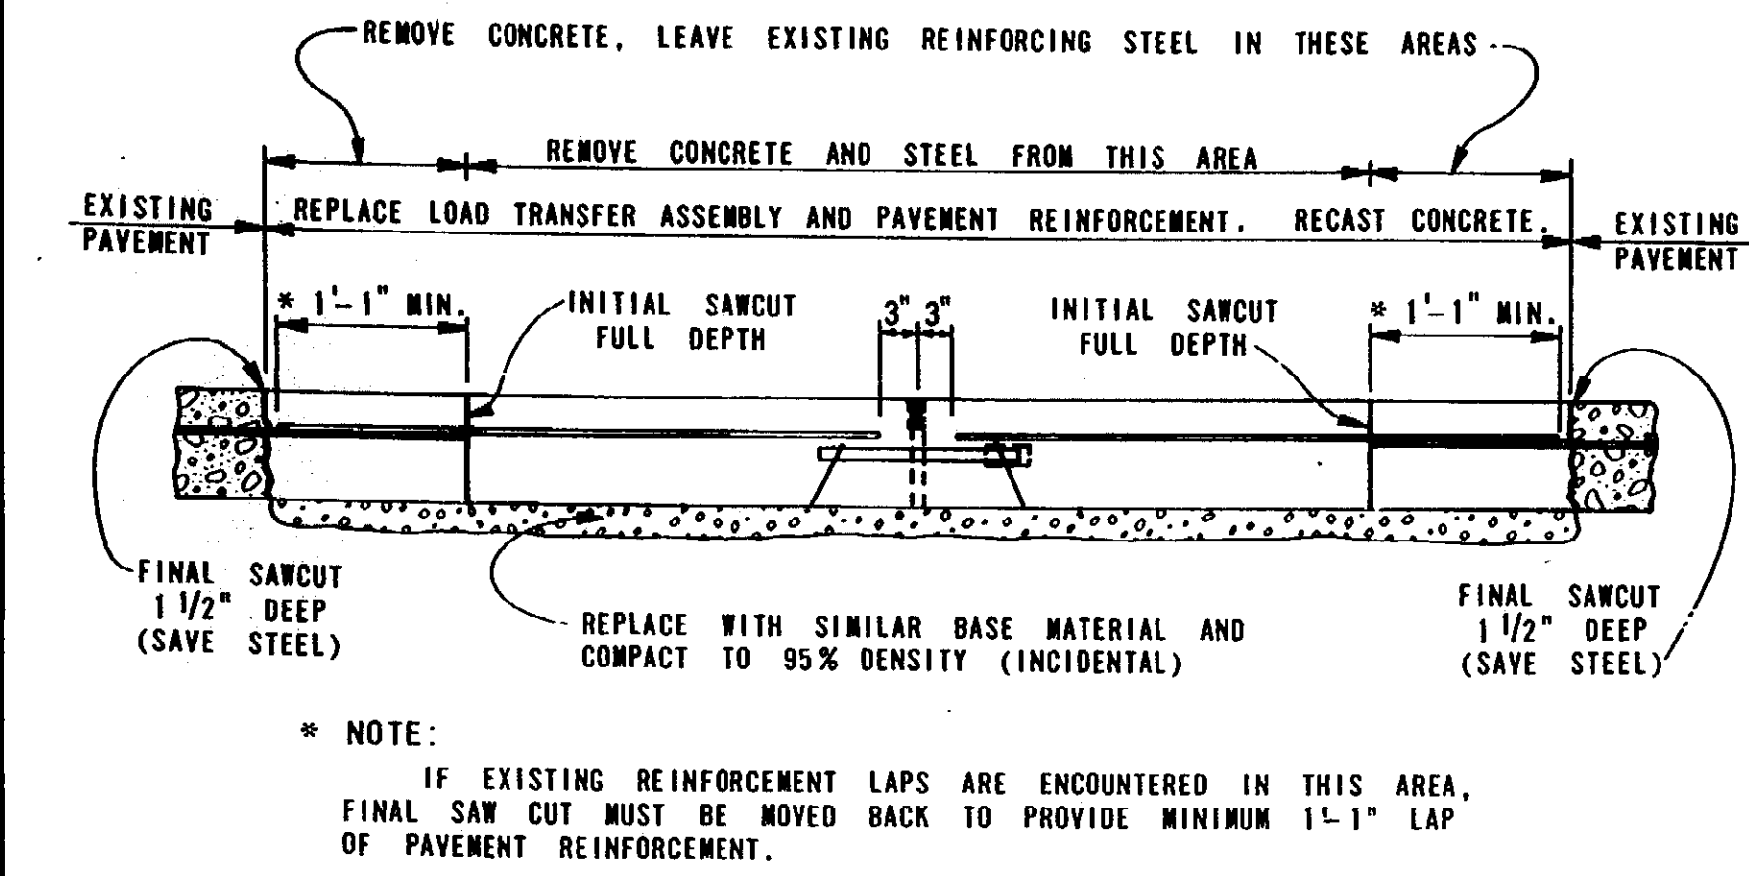


TRANSVERSE JOINT REPAIR USING LOAD TRANSFER ASSEMBLY (CONTRACTION JOINT) **4** (EXPANSION JOINT) (SHOWN DASHED) **4A**

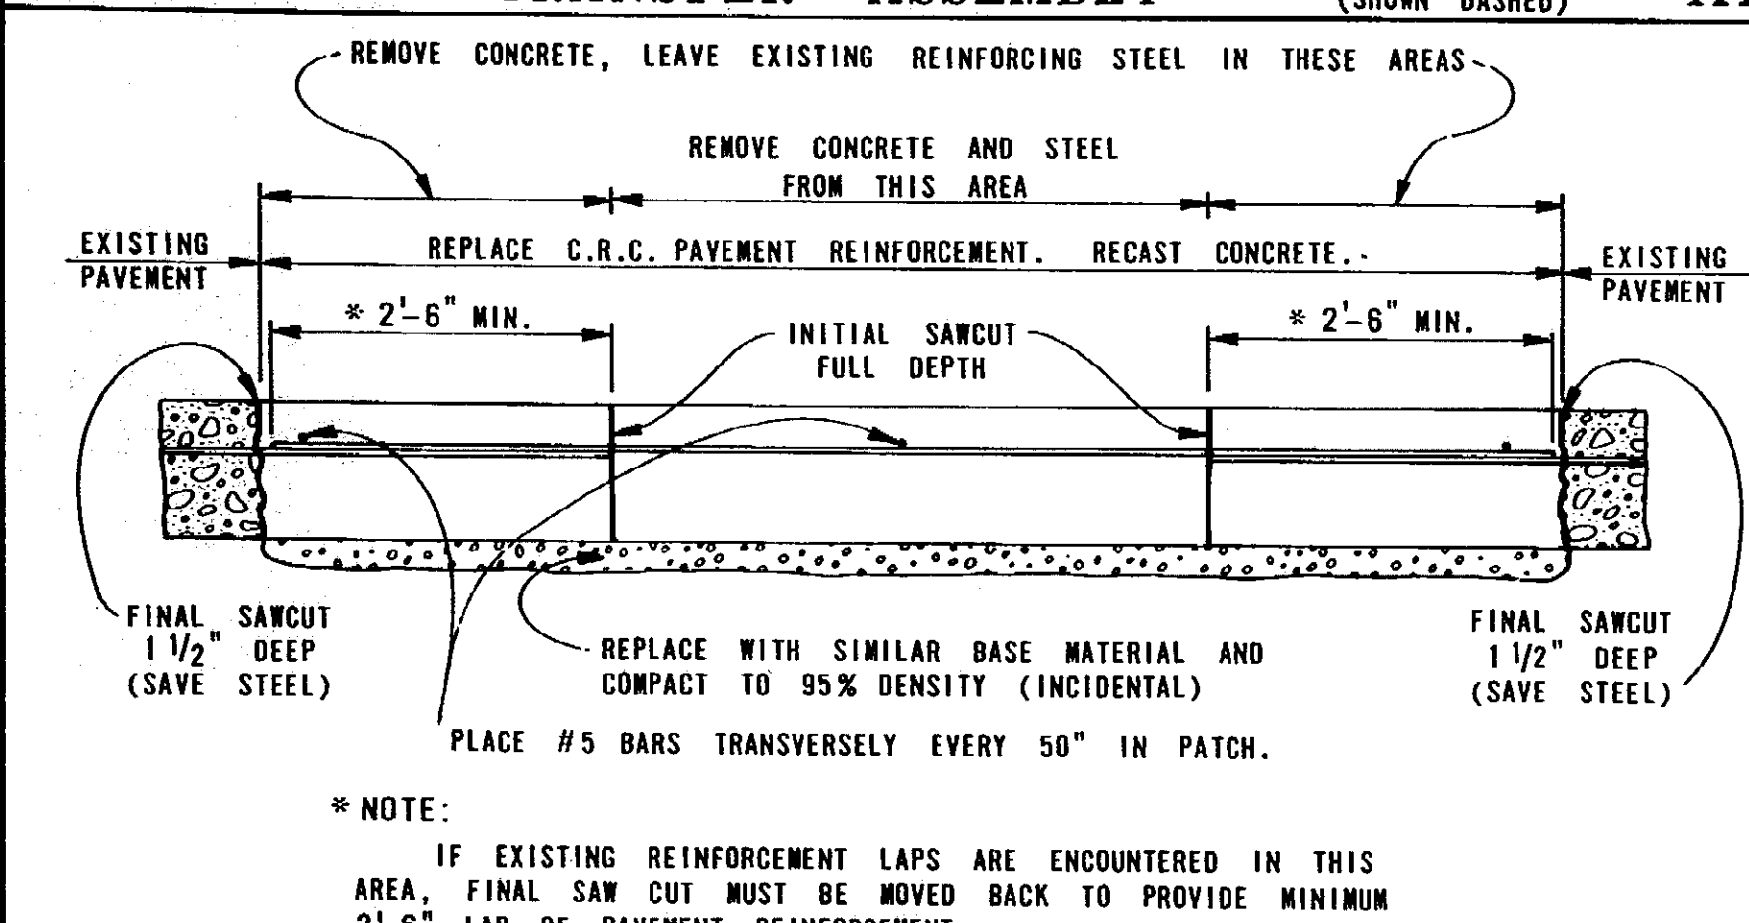


REPAIRING CONTINUOUSLY REINFORCED CONCRETE **5**

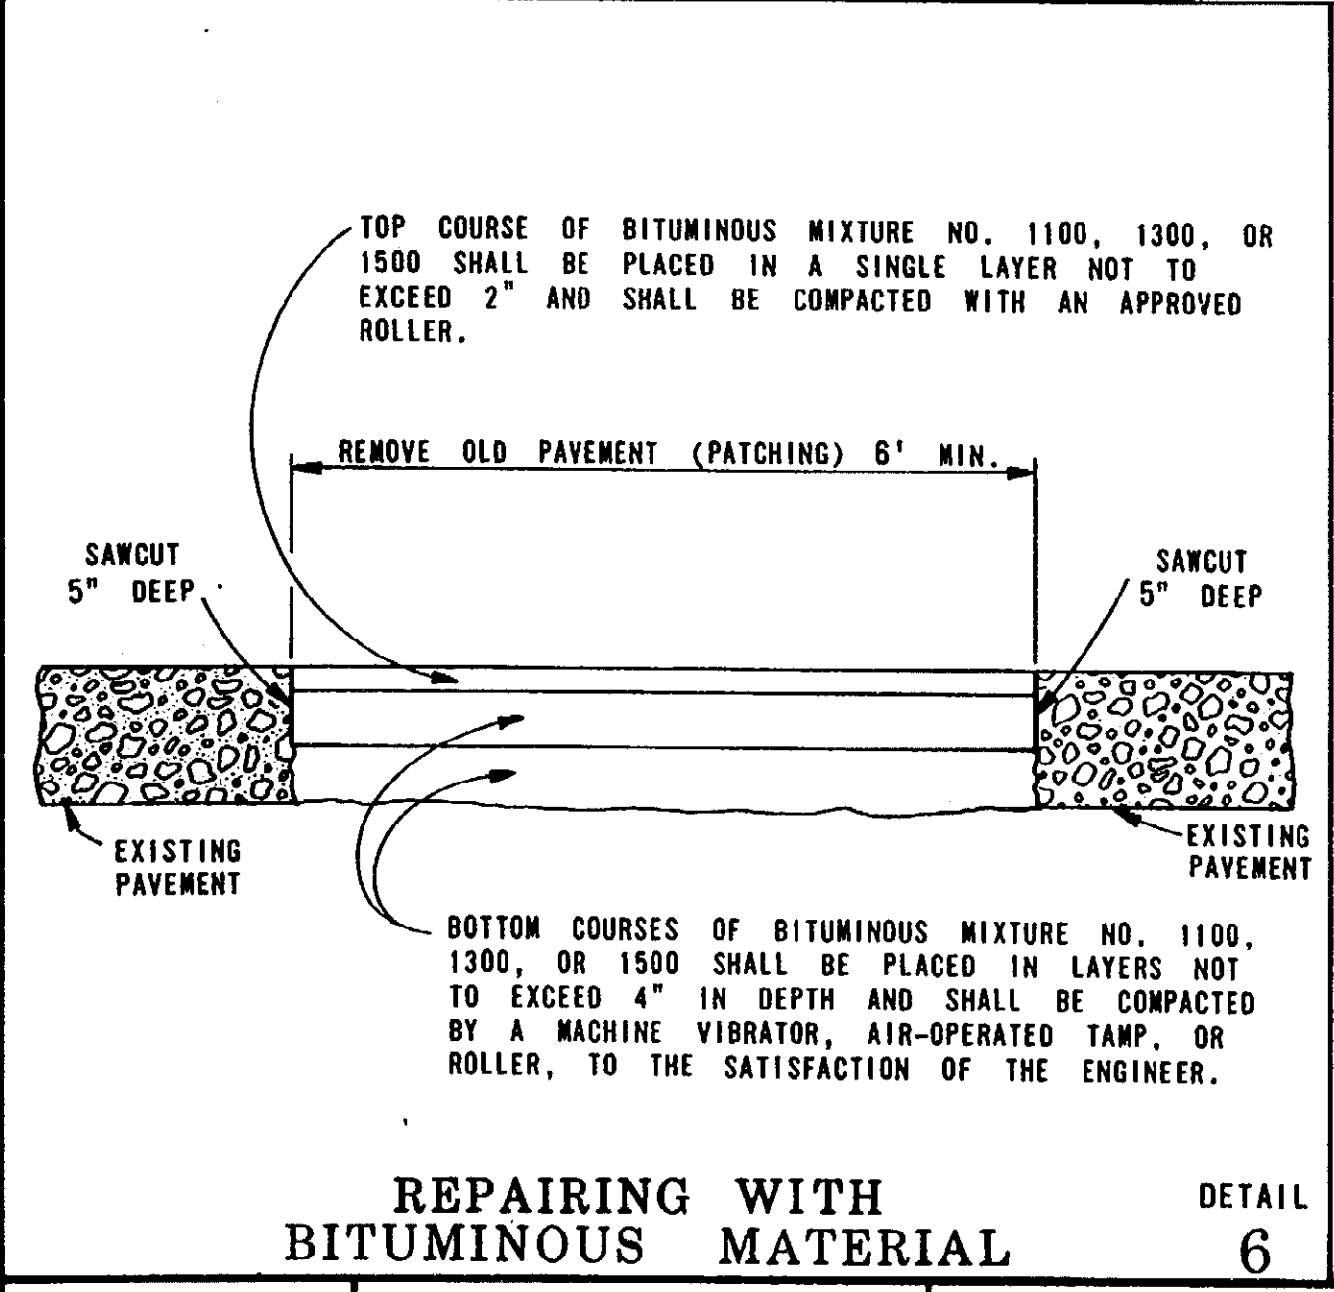


REPAIRING WITH BITUMINOUS MATERIAL **6**

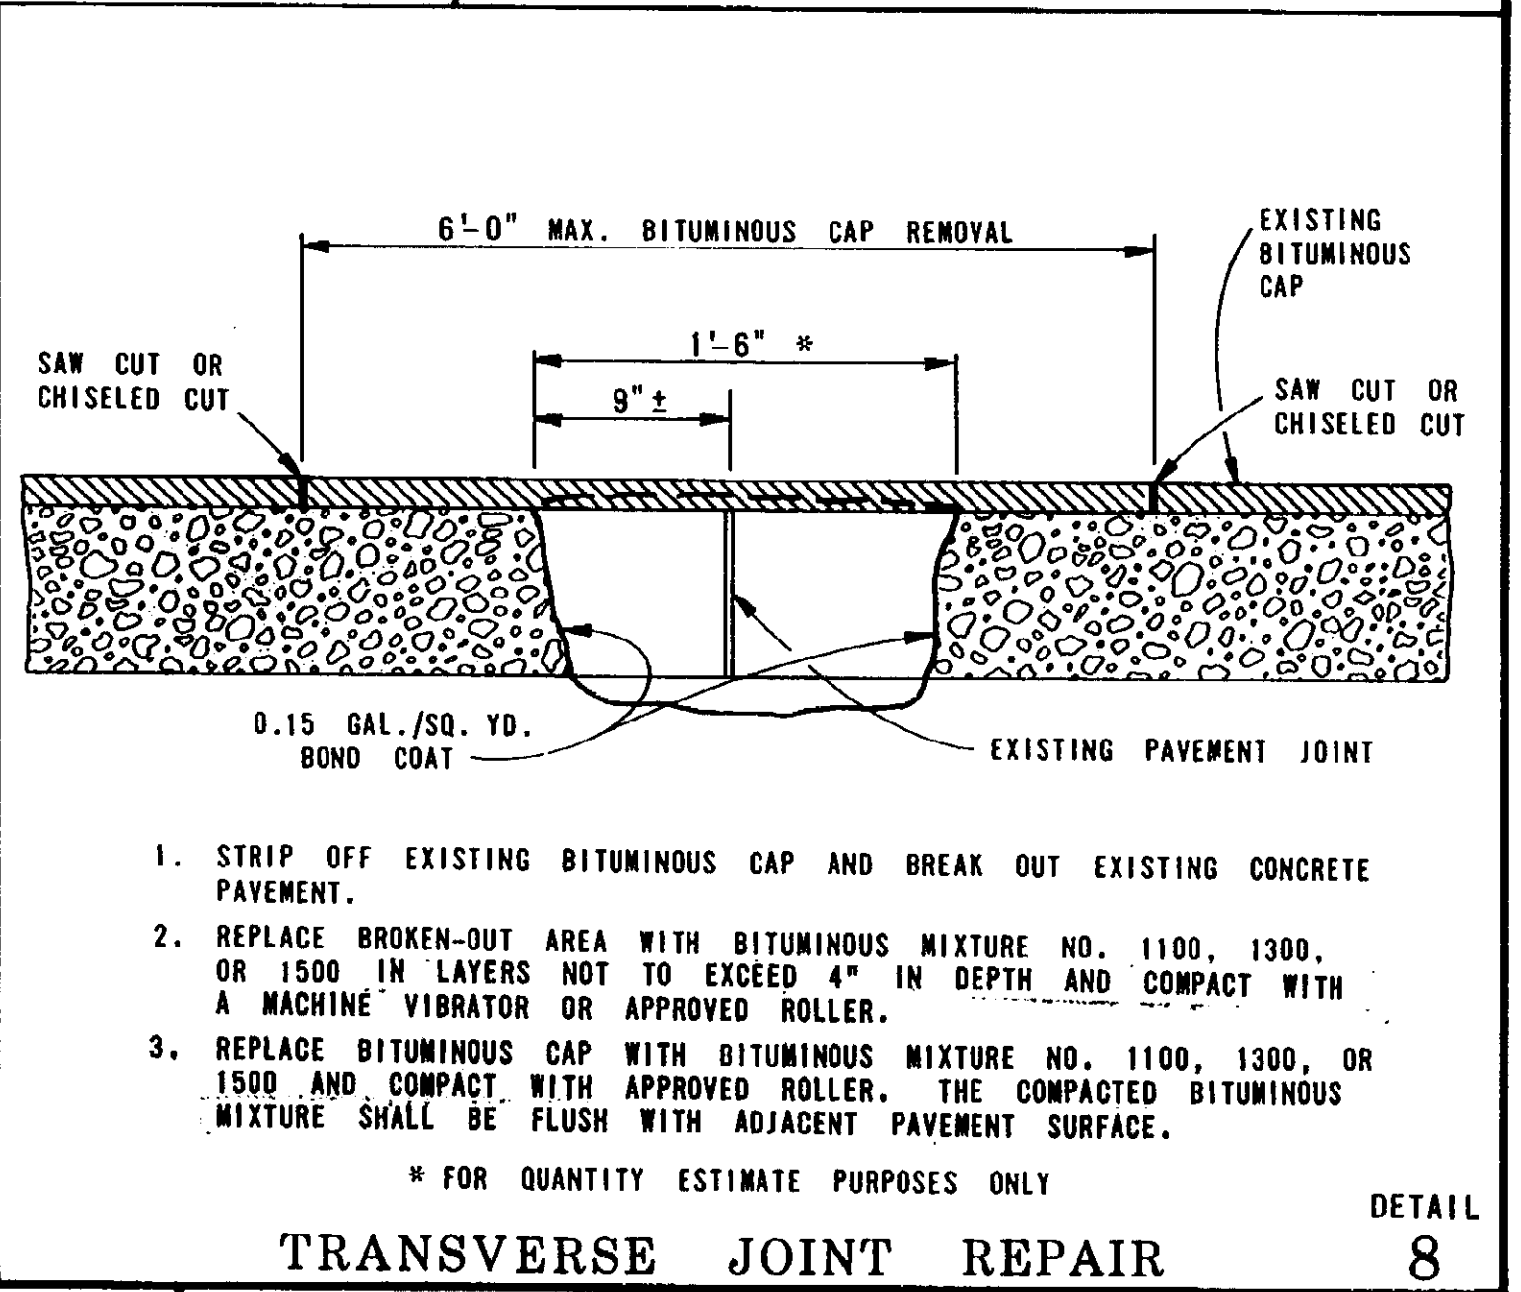


TRANSVERSE JOINT REPAIR **8**

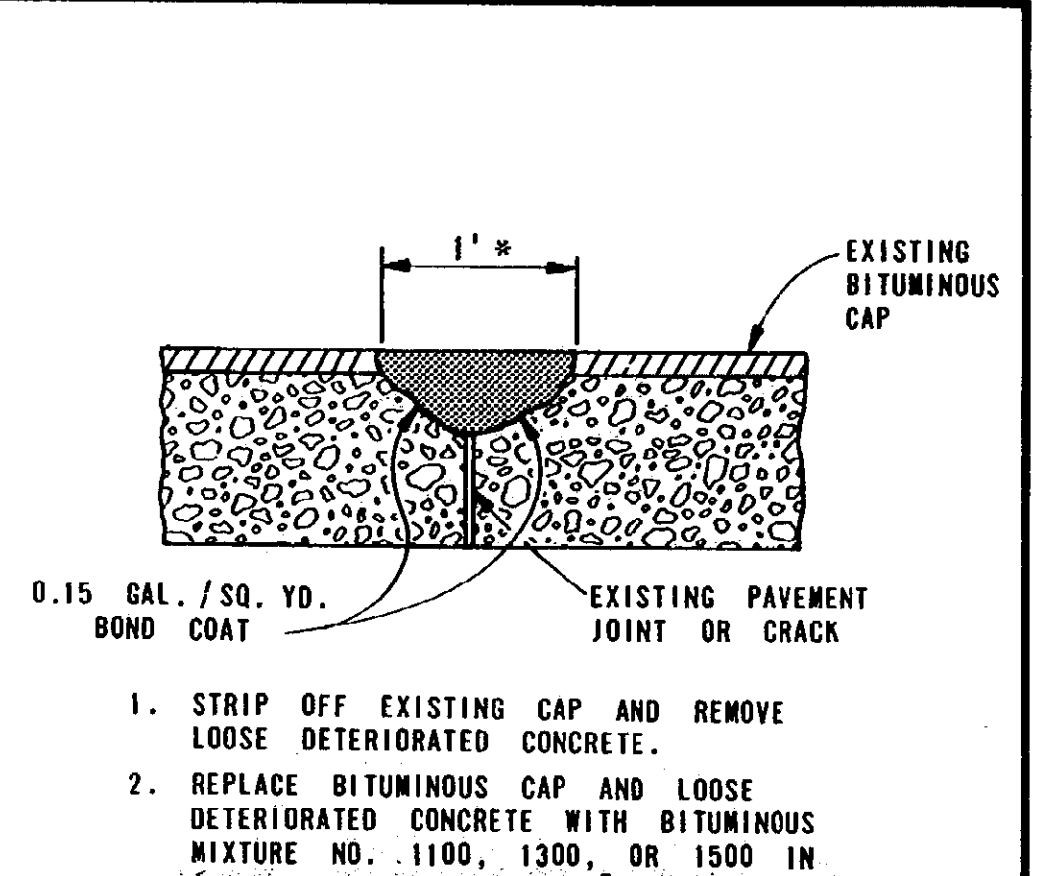


JOINT PATCH ADJACENT TO WIDENING SLAB **9**

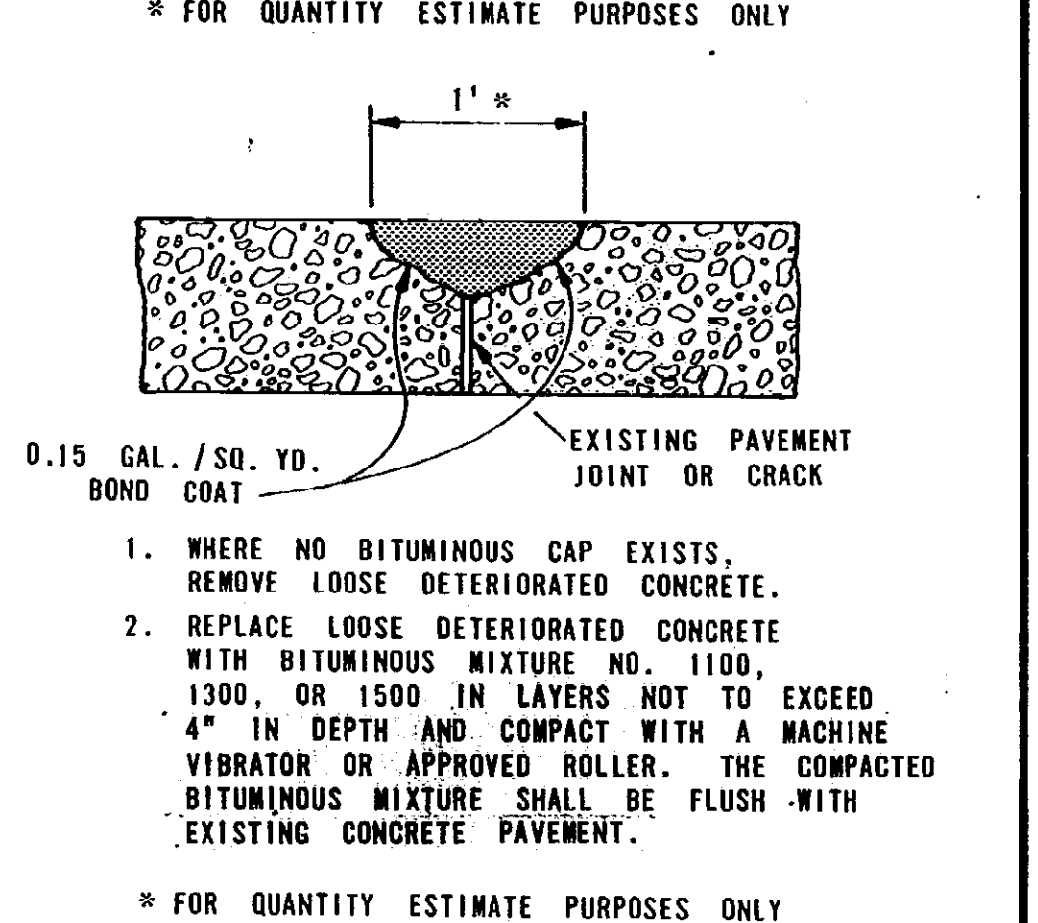


PRESSURE RELIEF JOINT (THIS DETAIL ALSO APPLIES TO BITUMINOUS SURFACED PAVEMENTS REQUIRING PRESSURE RELIEF JOINTS) **10**

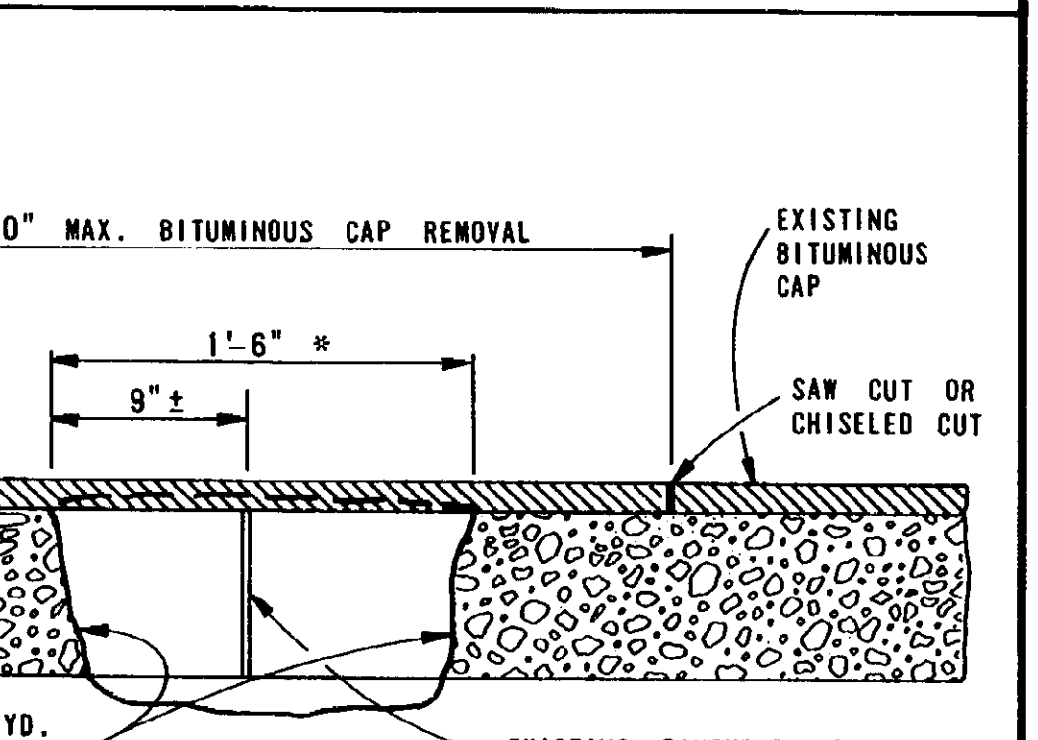


EXPANSION JOINT Esc **11**

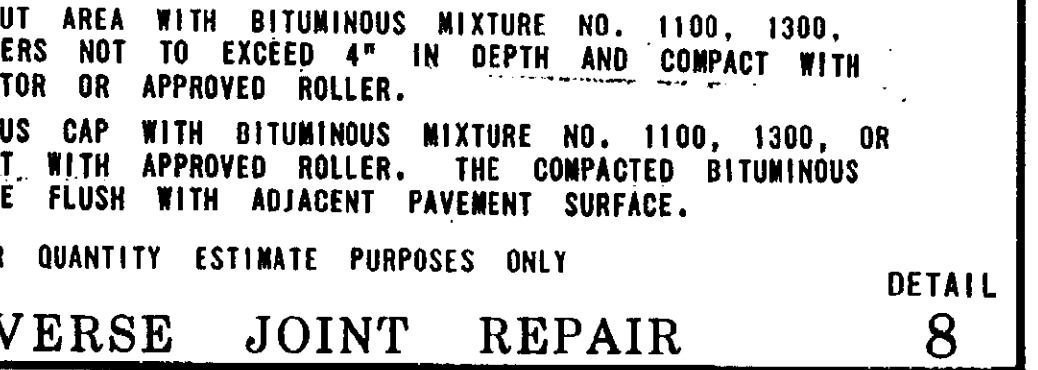

OVERNIGHT CONSTRUCTION JOINT IN FAST-SET REPAIR **12**

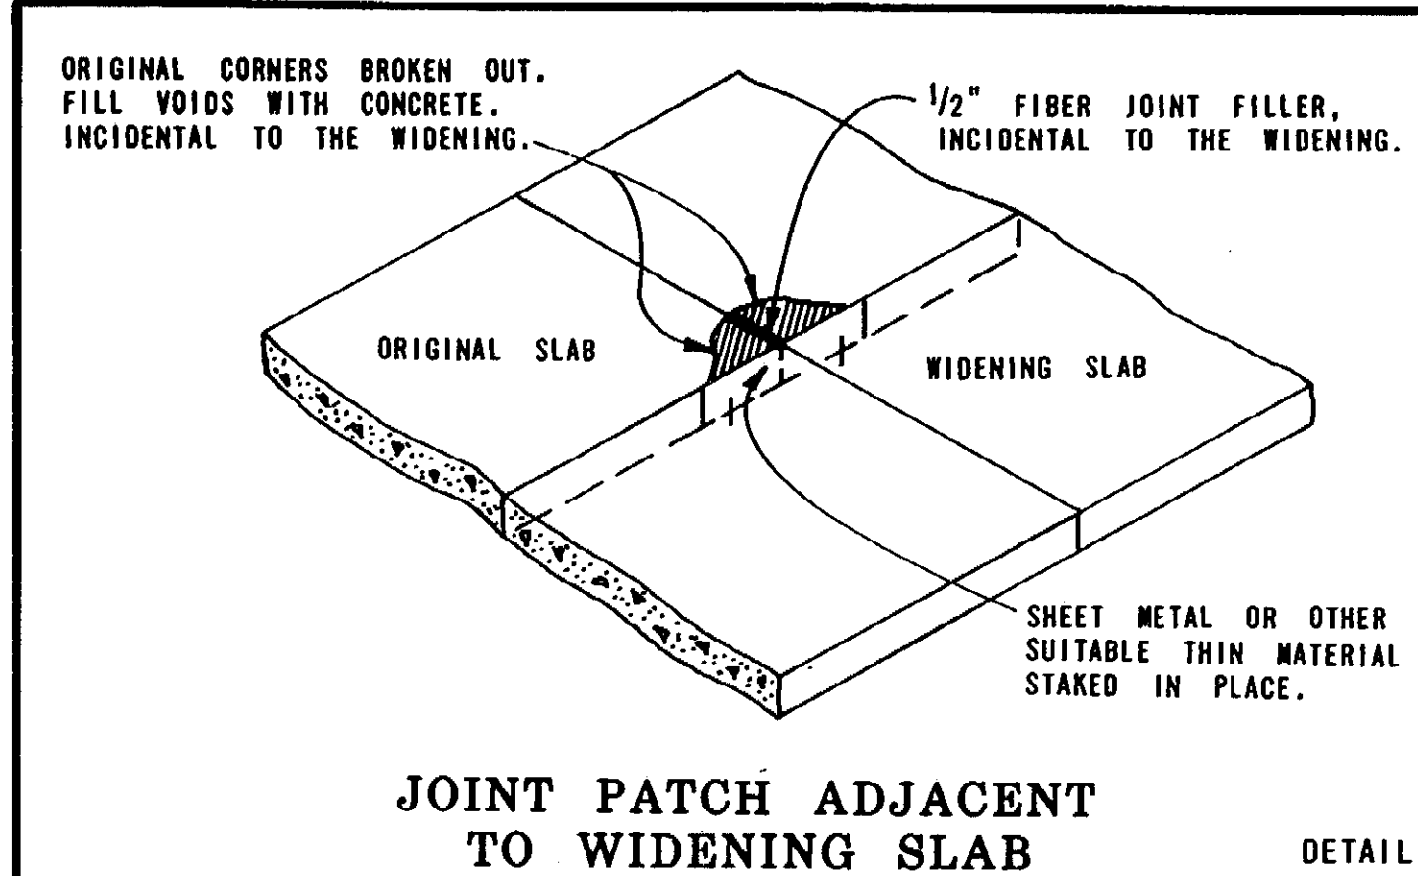

EXPANSION JOINT Esc **11**

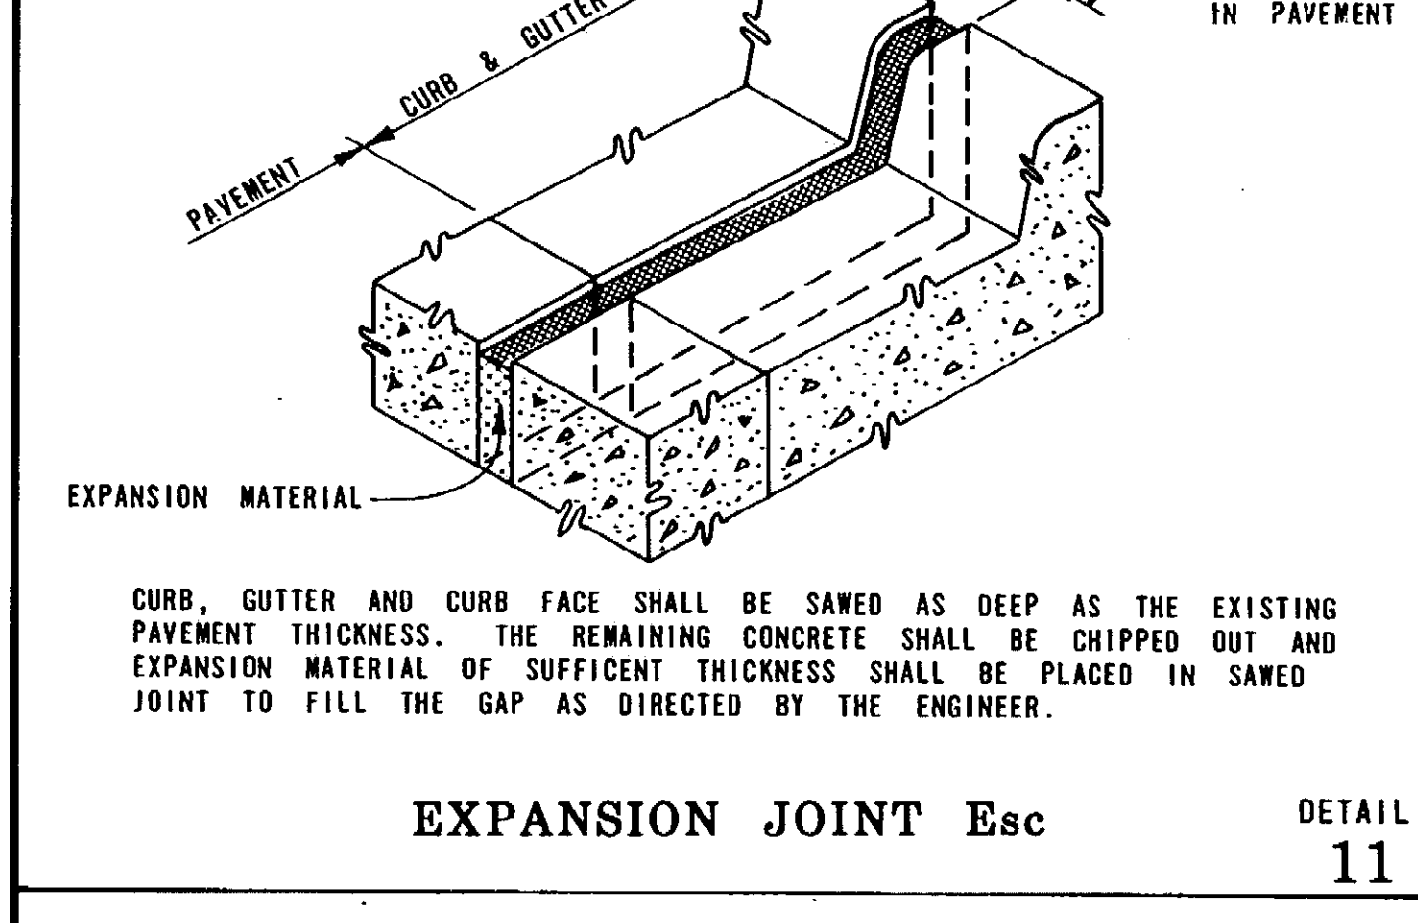

Spacing Layout for Hook Bolts **12**

NOTES APPLYING TO STANDARD PLAN II-44G:

CONCRETE PAVEMENT REPAIRS OR PRESSURE RELIEF JOINT DETAILS WILL BE AS CALLED FOR ON PLANS OR IN LOG OF PROJECT.

IF EXISTING PAVEMENT HAS AN ASPHALT SURFACE, THE SAW CUTS SHALL EXTEND THRU THE UNDERLYING PORTLAND CEMENT CONCRETE.

WHEN CONCRETE PAVEMENT REPAIRS ARE TO BE RESURFACED, REINFORCEMENT WILL BE OMITTED. IF THE REPAIR IS LONGER THAN 20', TRANSVERSE PLANE OF WEAKNESS JOINTS, SYMBOL (U), SHALL BE PLACED IN LINE WITH EXISTING TRANSVERSE JOINTS, WORKING CRACKS, OR AT 20-FOOT MAX., 8-FOOT MIN. INTERVALS. FOR SYMBOL (U) JOINTS, SEE STANDARD PLAN II-39 SERIES.

WHEN REPAIRING PAVEMENTS WITH CAST-IN-PLACE REPAIR JOINTS (DETAILS 3 & 3A), THE JOINT TYPES SELECTED SHOULD PROVIDE FOR NO MORE EXPANSION SPACE THAN 4" IN 900' FOR PAVEMENTS WITH 99' JOINT SPACING, OR 2" IN 900' FOR PAVEMENTS WITH 72' JOINT SPACING AND NEOPRENE SEALS.

WHEN THERE ARE NO REPAIR LOCATIONS WITHIN A 900' LENGTH, NO EXPANSION SPACE WILL BE PROVIDED.

EQUAL EXPANSION SPACE SHOULD BE PROVIDED IN ADJACENT LANES. NO EXPANSION SPACE SHALL BE PROVIDED IN REPAIRS WHICH DO NOT EXTEND ACROSS ALL LANES.

TRANSVERSE CONTRACTION JOINTS TYPE "C" AND C_r JOINT GROOVES (DETAIL 3 & 3A) SHALL BE SANDBLASTED FOLLOWED BY A FINAL CLEANING WITH OIL-FREE COMPRESSED AIR PRIOR TO SEALING WITH HOT-POURED RUBBER-ASPHALT JOINT SEALER. A BOND BREAKER (ALSO SHOWN IN DETAILS 3 & 3A) SHALL CONSIST OF A PRESSURE-SENSITIVE SILICONE-BACKED TAPE OR AN EQUIVALENT APPROVED BY THE ENGINEER.


THE PAVEMENT REINFORCEMENT SHALL BE PLACED 3" BELOW FINISHED SURFACE IN UNDOVELED REPAIRS OR AS SHOWN IN DETAIL 3A FOR DOVELED REPAIRS.

WHEN UNDOVELED REPAIRS ARE MADE IN JOINTED PAVEMENT, STANDARD PAVEMENT REINFORCEMENT SHALL BE USED TO REINFORCE CONCRETE REPAIRS 10' OR LONGER.


FOR ALL REPAIRS, EXPANSION SPACE SHOULD BE DISTRIBUTED THROUGHOUT THE SECTION RATHER THAN INSTALLING IT ALL AT ONE LOCATION. TO ALLOW FOR DISTRIBUTION OF PAVEMENT EXPANSION, REPAIRS MAY HAVE A CONTRACTION JOINT ON ONE END AND AN EXPANSION JOINT ON THE OTHER END. THE TYPE "A" JOINT SHOULD NOT BE USED IN REPAIRS OF NEOPRENE SEALED PAVEMENTS.

WHEN TRANSVERSE EXPANSION JOINTS ARE PLACED ADJACENT TO CONCRETE CURB AND GUTTER AND WHERE REMOVAL OF CURB AND GUTTER IS NOT NECESSARY AS DETERMINED BY THE ENGINEER, AN EQUIVALENT WIDTH OF EXPANSION JOINT Esc SHALL BE EXTENDED THRU THE CURB AND GUTTER.

TRANSVERSE JOINTS (DETAIL 4 AND 4A) SHALL BE SEALED IN ACCORDANCE WITH STANDARD PLAN II-39 SERIES.

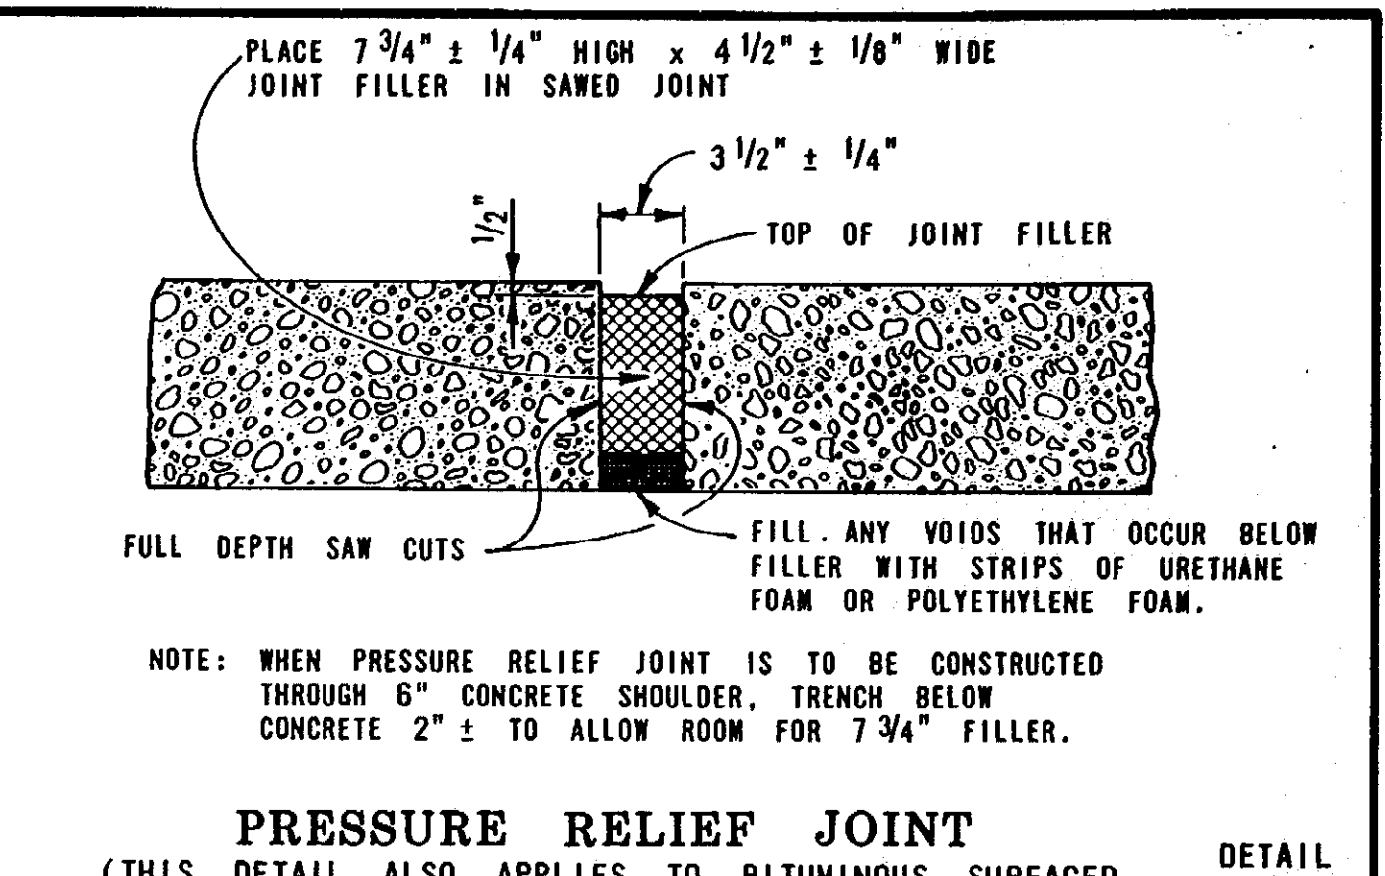

Section A-A **15**

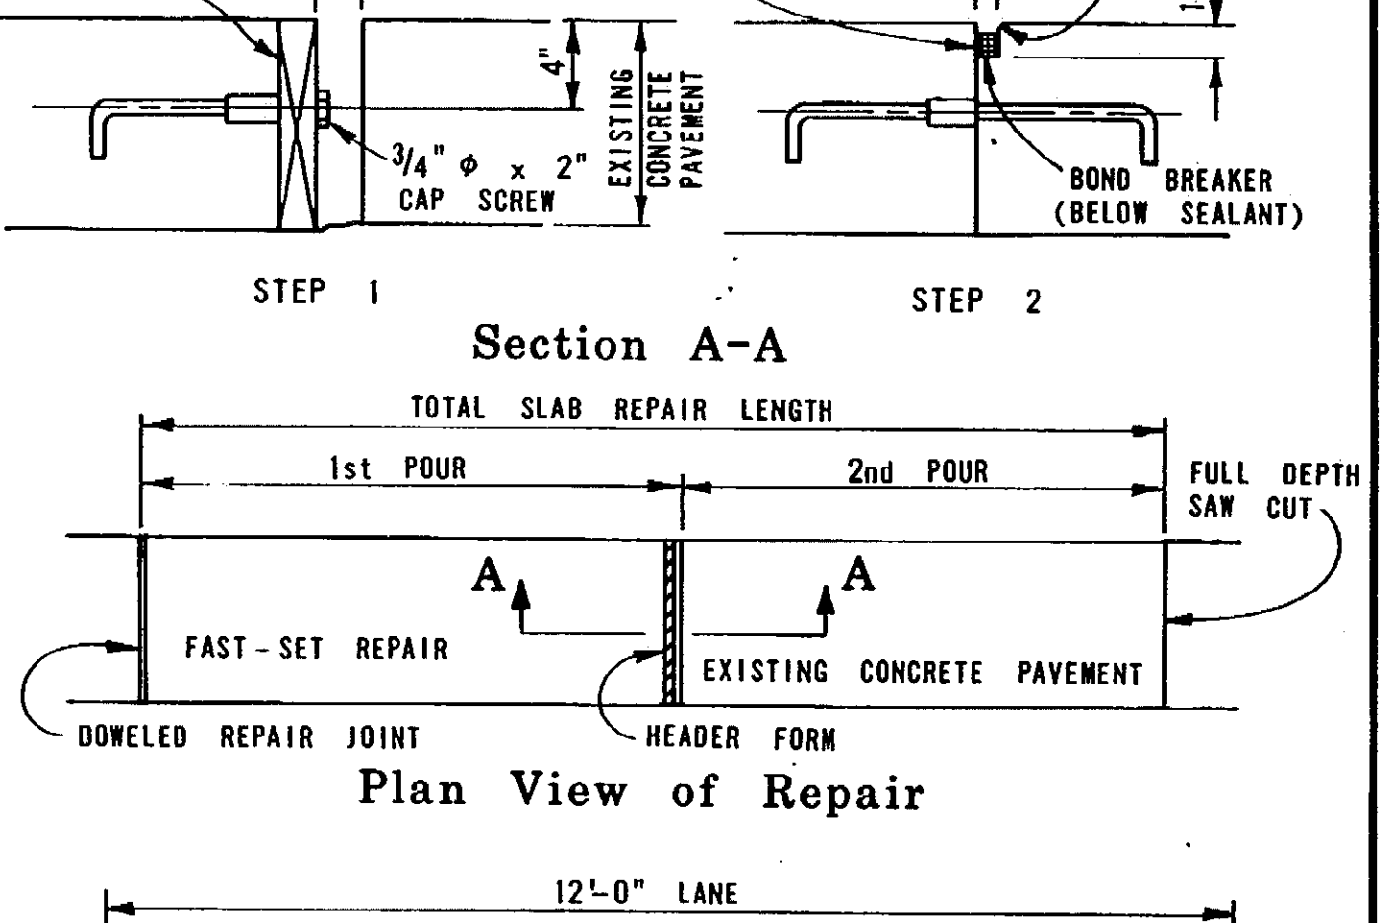

Plan View of Repair **16**

NOTES (CONTINUED)

SAWED OVERCUTS OCCURRING IN ADJACENT SLAB, GUTTER, OR SHOULDER, WHICH WILL REMAIN IN PLACE, SHALL BE SEALED.


THE MONTH AND YEAR OF CASTING AND STATION NUMBER (IF REMOVED) SHALL BE STENCILED ON EACH CONCRETE REPAIR.

MICHIGAN DEPARTMENT OF TRANSPORTATION BUREAU OF HIGHWAYS	ENGINEER OF CONSTRUCTION	ENGINEER - ROAD DESIGN
	ENGINEER OF MAINTENANCE	ENGINEER OF DESIGN
	ENGINEER OF MATERIALS & TECHNOLOGY	DEPARTMENT DIRECTOR JAMES P. PITZ
	BY: ENGINEER OF TRAFFIC AND SAFETY	DEPUTY DIRECTOR - HIGHWAYS

MICHIGAN DEPARTMENT OF TRANSPORTATION BUREAU OF HIGHWAYS STANDARD PLAN FOR			
CONCRETE PAVEMENT REPAIR			
6-30-89	II-44G	SHEET	3 OF 4
PLAN DATE			


MICHIGAN DEPARTMENT OF TRANSPORTATION BUREAU OF HIGHWAYS	ENGINEER OF CONSTRUCTION	ENGINEER - ROAD DESIGN
	ENGINEER OF MAINTENANCE	ENGINEER OF DESIGN
	ENGINEER OF MATERIALS & TECHNOLOGY	DEPARTMENT DIRECTOR JAMES P. PITZ
	BY: ENGINEER OF TRAFFIC AND SAFETY	DEPUTY DIRECTOR - HIGHWAYS

MICHIGAN DEPARTMENT OF TRANSPORTATION BUREAU OF HIGHWAYS STANDARD PLAN FOR			
CONCRETE PAVEMENT REPAIR			
6-30-89	II-44G	SHEET	4 OF 4
PLAN DATE			

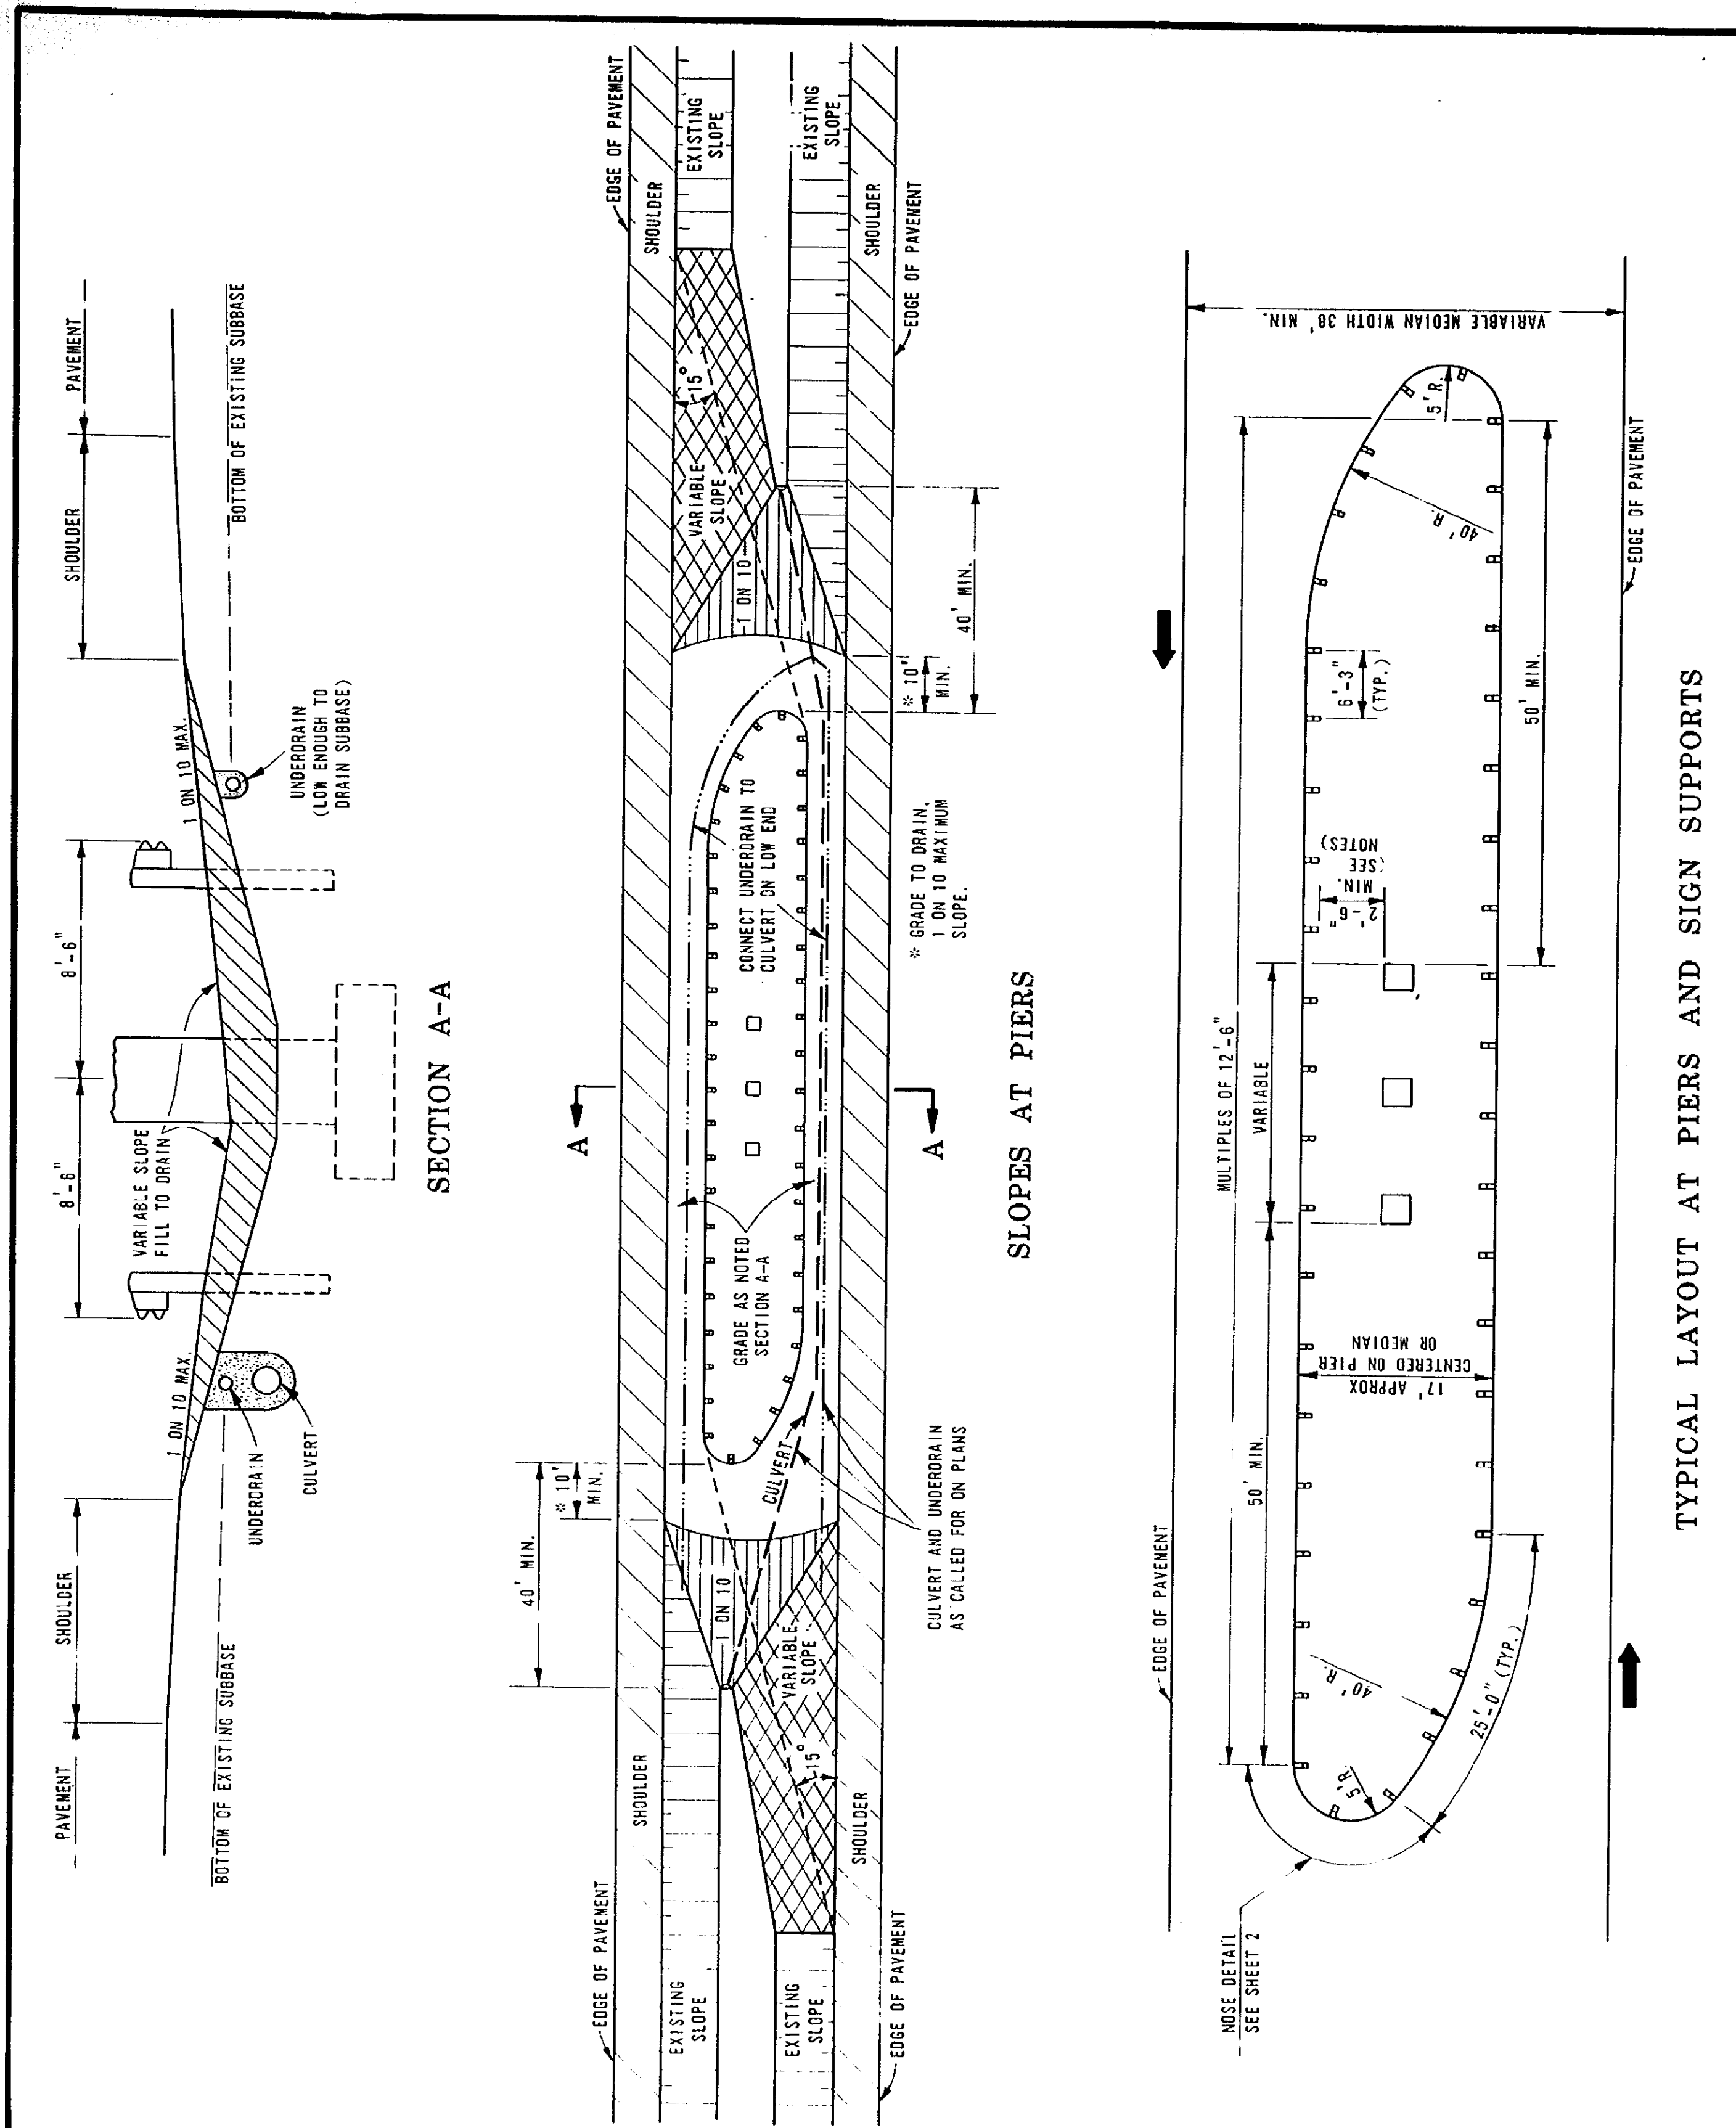


<p>PREPARED BY DESIGN DIVISION</p> <p>DRAWN BY D.F.M.</p> <p>CHECKED BY C.A.L.</p>	ENGINEER OF CONSTRUCTION	ENGINEER - ROAD DESIGN
	ENGINEER OF MAINTENANCE	ENGINEER OF DESIGN
	ENGINEER OF MATERIALS & TECHNOLOGY	DEPARTMENT DIRECTOR JAMES P. PITZ
	BY: ENGINEER OF TRAFFIC AND SAFETY	DEPUTY DIRECTOR - HIGHWAYS



MICHIGAN DEPARTMENT OF TRANSPORTATION BUREAU OF HIGHWAYS STANDARD PLAN FOR GUARDRAIL BULLNOSE			
F.H.W.A. APPROVAL	12-8-88 PLAN DATE	III-56B	SHEET 1 OF 2

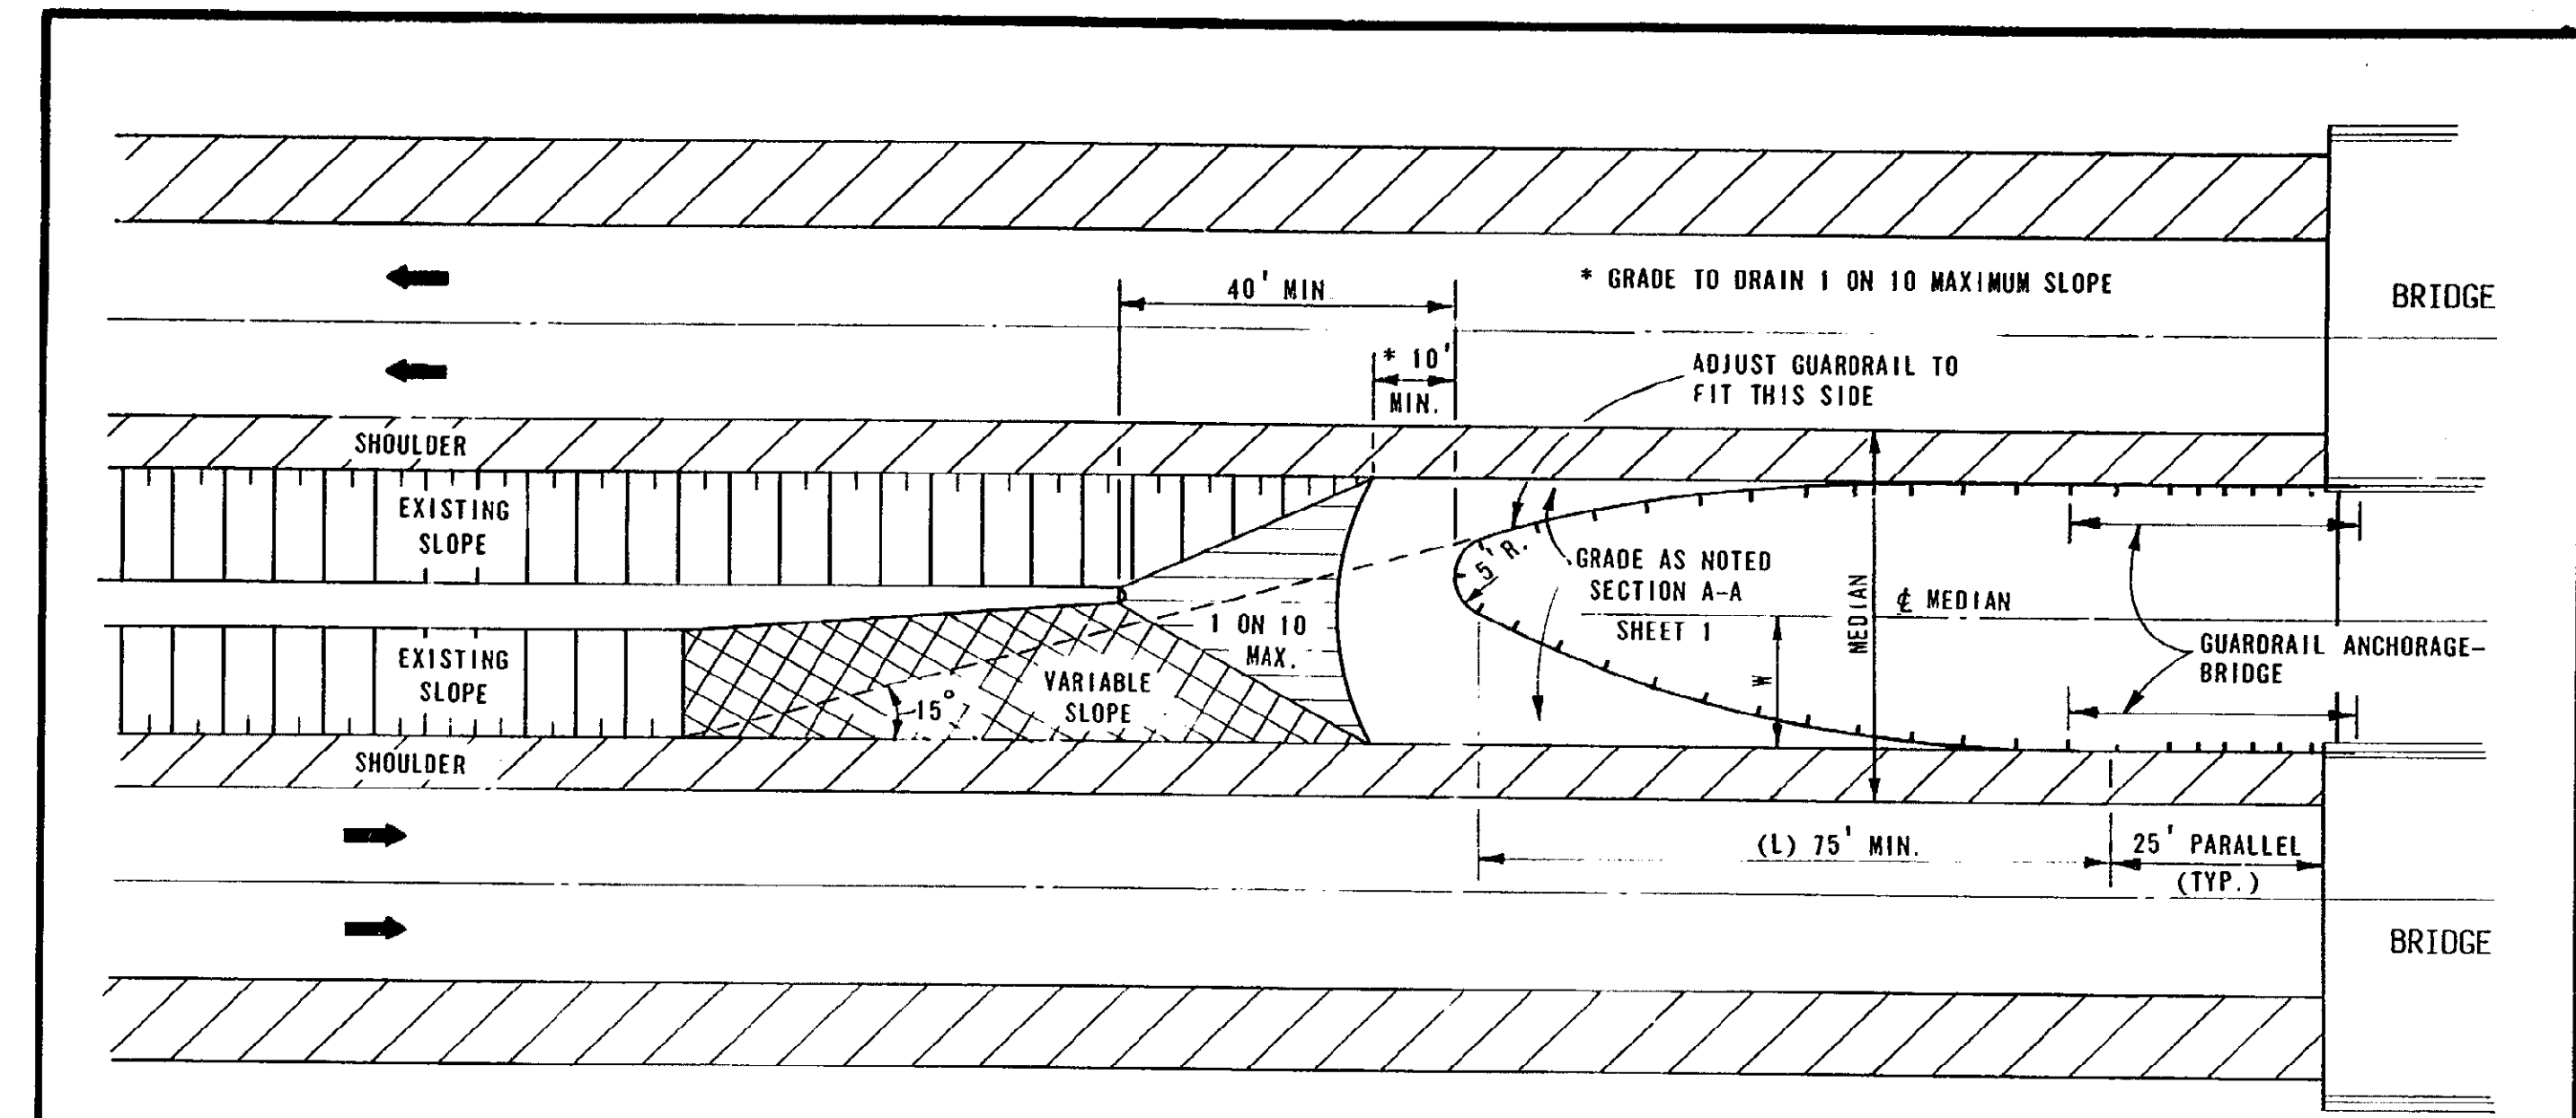

X = INTERMEDIATE DISTANCES Y = INTERMEDIATE OFFSETS
 L = TOTAL LENGTH OF FLARE W = WIDTH OF FINAL OFFSET

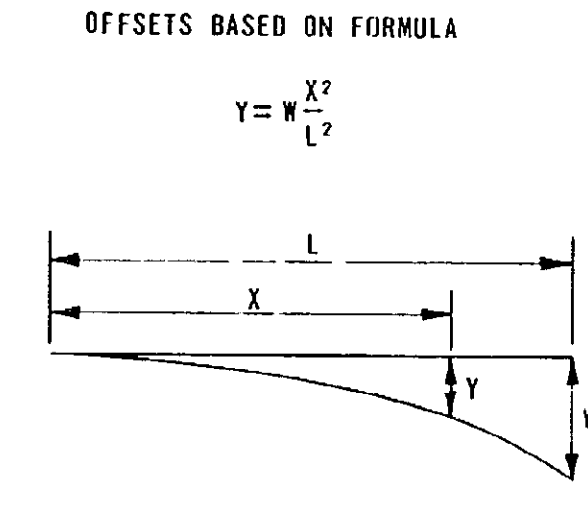

OFFSET FORMULA

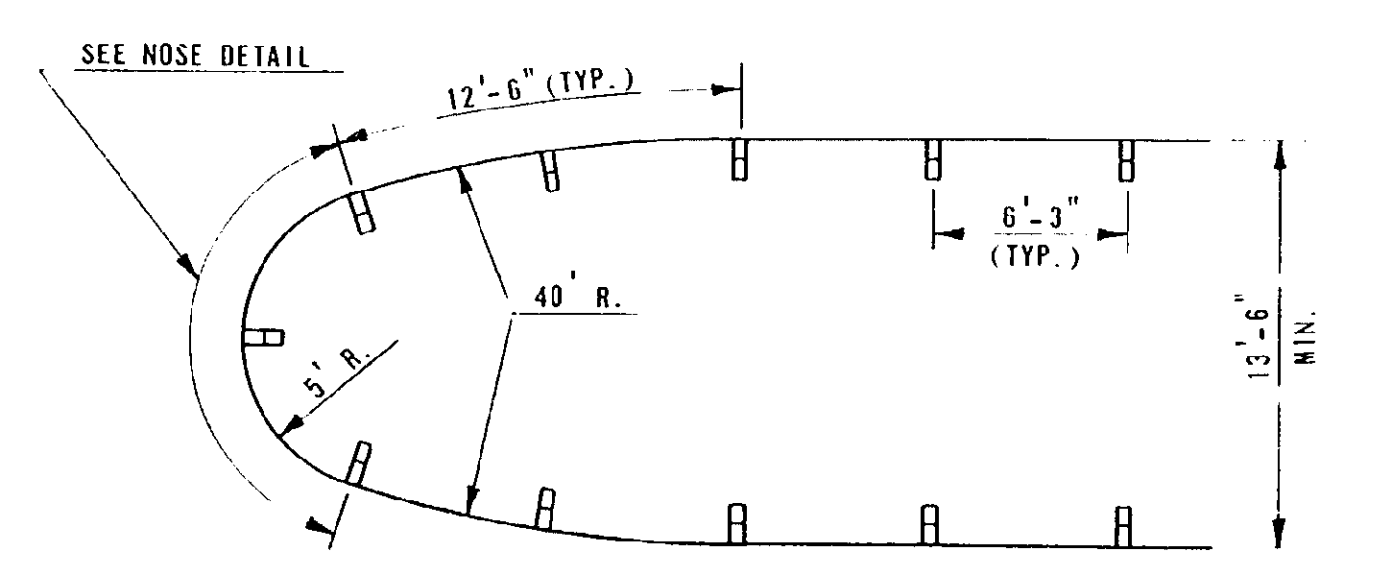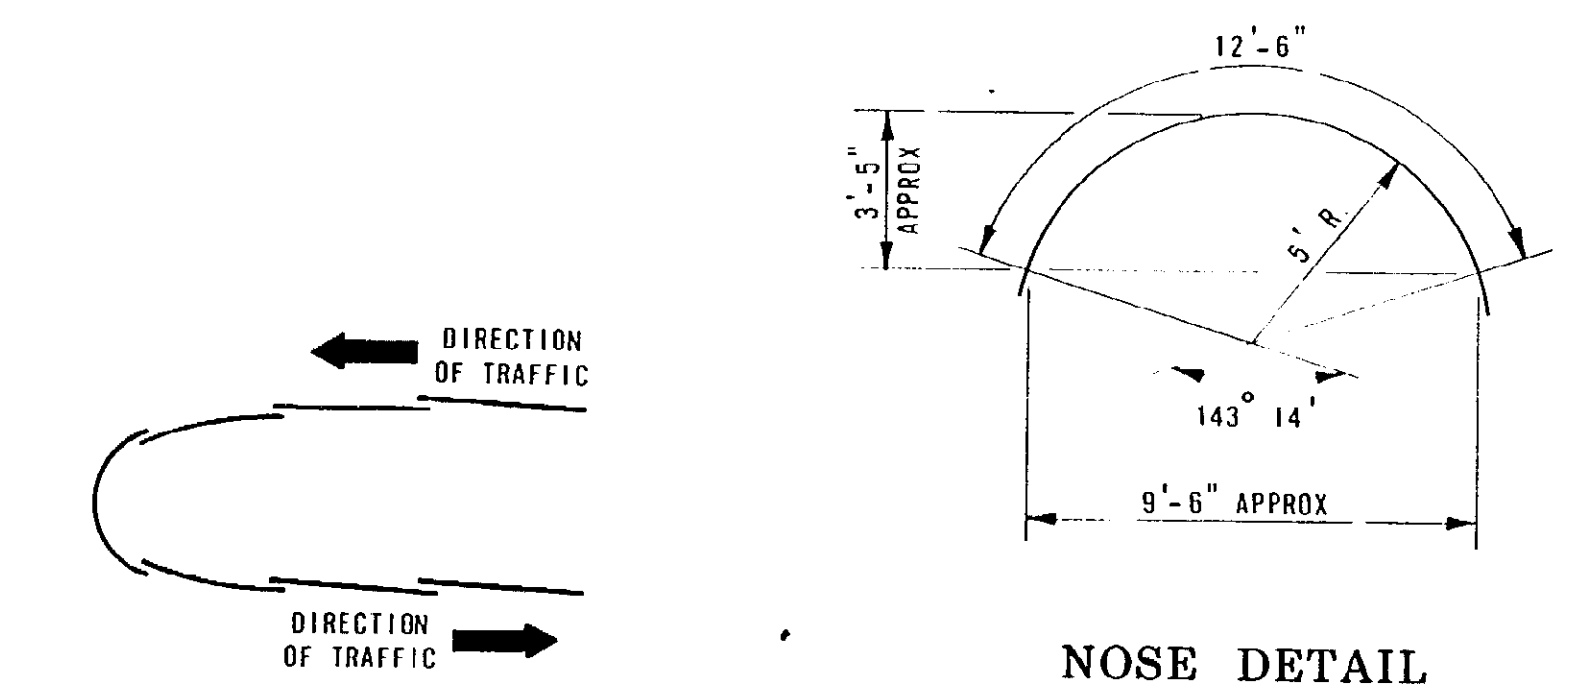

ALTERNATE INSTALLATION
 FOR USE WHERE NARROW MEDIAN PROHIBITS USE OF CONVENTIONAL TREATMENT

NOTES:

ALL POSTS AND BLOCKS, BEAM AND BACK UP ELEMENTS AND FITTINGS, INCLUDING BOLTS, NUTS AND WASHERS, SHALL CONFORM TO THE DIMENSIONS AND SPECIFICATIONS SHOWN ON CURRENT STANDARD PLAN III-60 AND III-67 SERIES, WHERE APPLICABLE, EXCEPT AS SHOWN ON THIS STANDARD PLAN.

ONLY BEAM GUARDRAIL TYPE B SHALL BE USED FOR GUARDRAIL BULLNOSE INSTALLATIONS, EXCEPT IN "GUARDRAIL ANCHORAGE - BRIDGE, DETAIL".

WOOD POSTS WILL BE REQUIRED WHENEVER THE GUARDRAIL RADIUS IS 50' OR LESS, AND FOR ALL OF THE POSTS IN THE "GUARDRAIL AT TWIN BRIDGE APPROACH" EXCEPT THOSE IN THE GUARDRAIL ANCHORAGE - BRIDGE.




REMOVE CURB FROM 150' IN ADVANCE AND ALONG TOTAL LENGTH OF THE GUARDRAIL INSTALLATION UNLESS ONE FOOT OR LESS FROM FACE OF CURB TO FACE OF RAIL.

ADEQUATE DRAINAGE MUST BE PROVIDED WHEN EXISTING MEDIANS OR DITCHED AREAS ARE FILLED.

ANY PART OF THE GUARDRAIL SYSTEM SHOULD BE NO CLOSER THAN 2'-6" TO THE BRIDGE PIER COLUMNS. IF THIS MINIMUM IS IMPOSSIBLE TO OBTAIN, STIFFEN THE RAIL SYSTEM AS DIRECTED BY THE ENGINEER, SO ITS THEORETICAL DEFLECTION WILL NOT EXCEED THE AVAILABLE CLEARANCE. IF ADDITIONAL GUIDANCE IS NEEDED, CONTACT THE ROAD STANDARDS UNIT OF THE DESIGN DIVISION.

<p>PREPARED BY DESIGN DIVISION</p> <p>DRAWN BY D.F.M.</p> <p>CHECKED BY C.A.L.</p>	ENGINEER OF CONSTRUCTION	ENGINEER - ROAD DESIGN
	ENGINEER OF MAINTENANCE	ENGINEER OF DESIGN
	ENGINEER OF MATERIALS & TECHNOLOGY	DEPARTMENT DIRECTOR JAMES P. PITZ
	BY: ENGINEER OF TRAFFIC AND SAFETY	DEPUTY DIRECTOR - HIGHWAYS

MICHIGAN DEPARTMENT OF TRANSPORTATION BUREAU OF HIGHWAYS STANDARD PLAN FOR GUARDRAIL BULLNOSE			
F.H.W.A. APPROVAL	12-8-88 PLAN DATE	III-56B	SHEET 2 OF 2

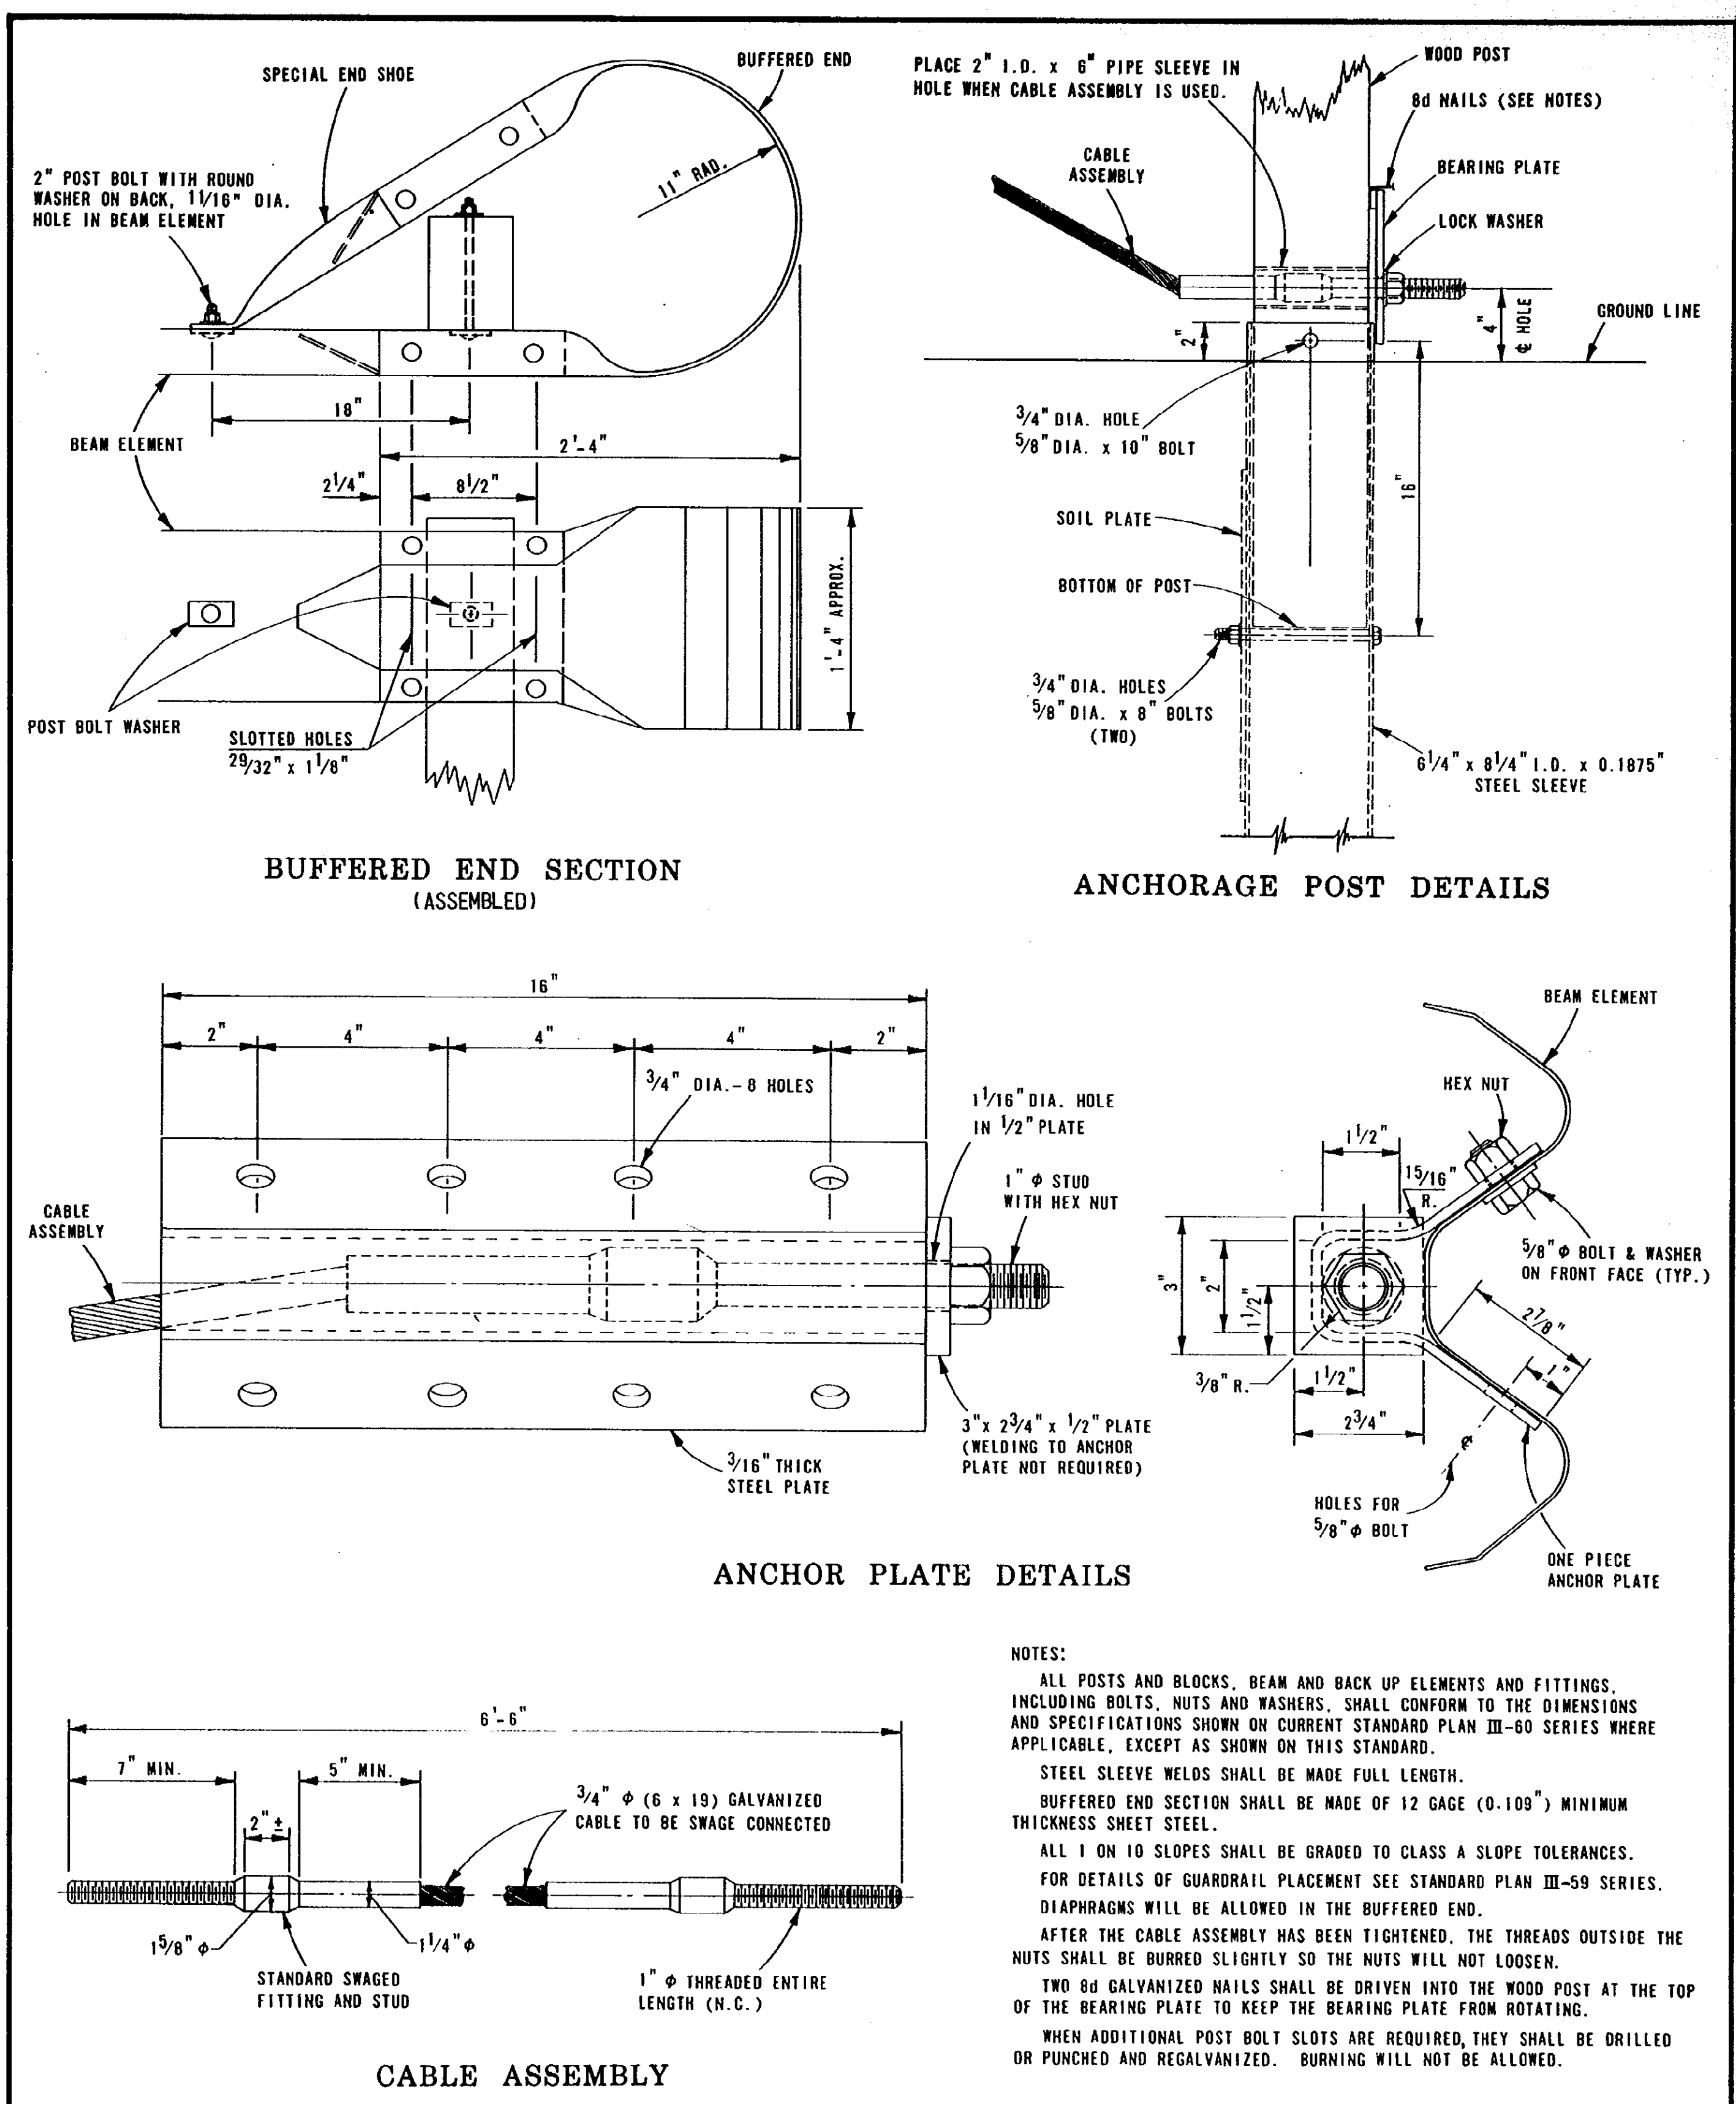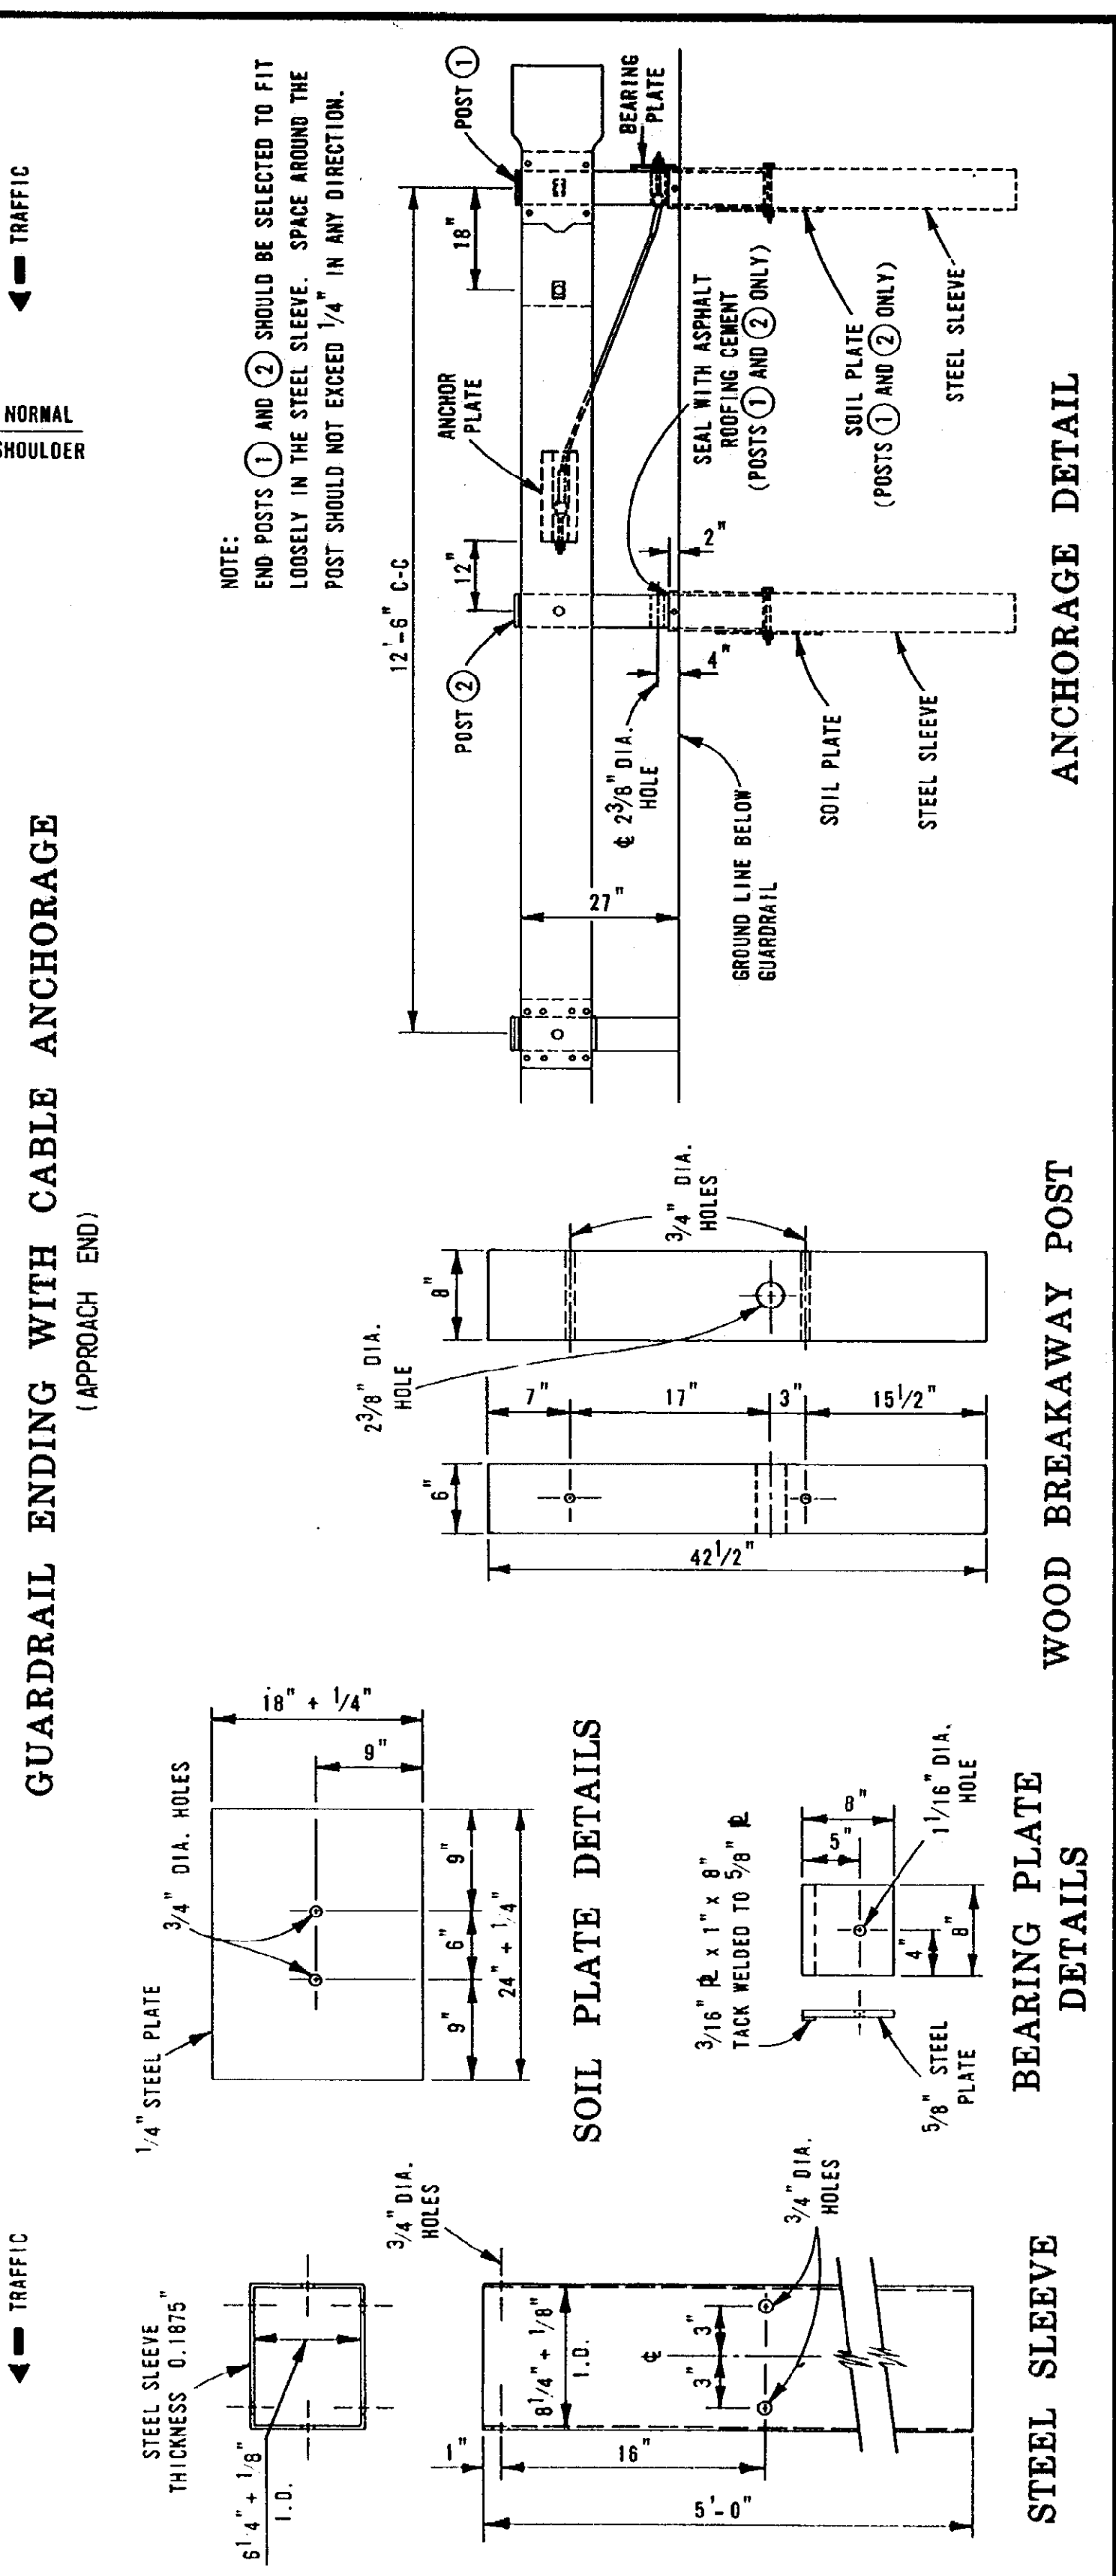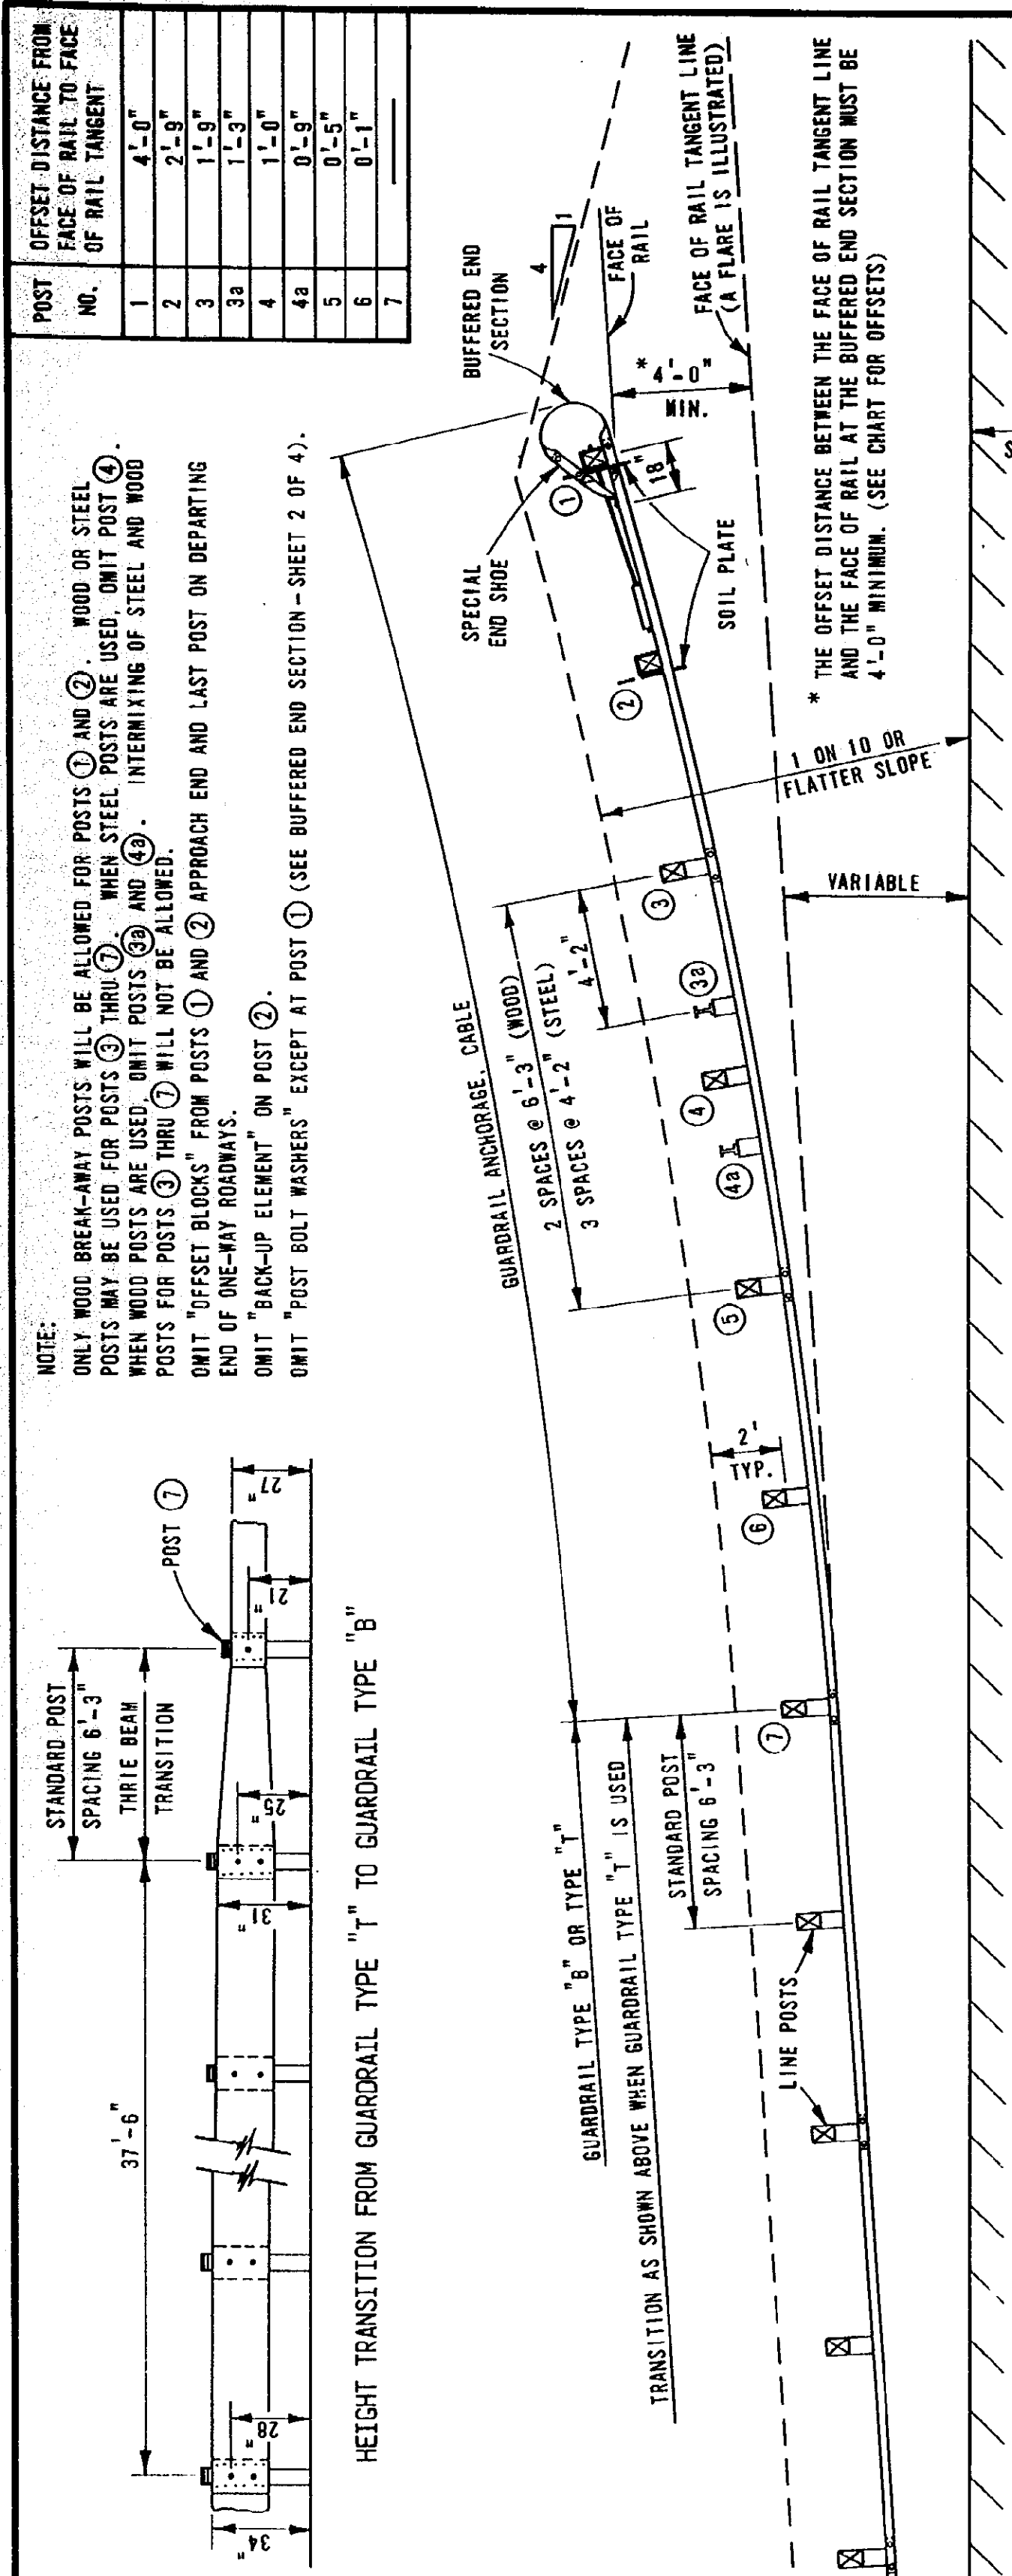


<p>PREPARED BY DESIGN DIVISION</p>	ENGINEER OF CONSTRUCTION	<i>J. H. Williams</i> ENGINEER - ROAD DESIGN
	ENGINEER OF MAINTENANCE	<i>William L. ...</i> ENGINEER OF DESIGN
<p>DRAWN BY: D.F.M.</p> <p>CHECKED BY: C.A.L.</p>	ENGINEER OF MATERIALS & TECHNOLOGY	DEPARTMENT DIRECTOR JAMES P. PITZ
	ENGINEER OF TRAFFIC AND SAFETY	DEPUTY DIRECTOR - HIGHWAYS


MICHIGAN DEPARTMENT OF TRANSPORTATION BUREAU OF HIGHWAYS STANDARD PLAN FOR GUARDRAIL ENDINGS WITH CABLE ANCHORAGE			
F.H.W.A. APPROVAL	6-1-90 PLAN DATE	III-58K	SHEET 1 OF 4

<p>PREPARED BY DESIGN DIVISION</p>	ENGINEER OF CONSTRUCTION	<i>J. H. Williams</i> ENGINEER - ROAD DESIGN
	ENGINEER OF MAINTENANCE	<i>William L. ...</i> ENGINEER OF DESIGN
<p>DRAWN BY: D.F.M.</p> <p>CHECKED BY: C.A.L.</p>	ENGINEER OF MATERIALS & TECHNOLOGY	DEPARTMENT DIRECTOR JAMES P. PITZ
	ENGINEER OF TRAFFIC AND SAFETY	DEPUTY DIRECTOR - HIGHWAYS


MICHIGAN DEPARTMENT OF TRANSPORTATION BUREAU OF HIGHWAYS STANDARD PLAN FOR GUARDRAIL ENDINGS WITH CABLE ANCHORAGE			
F.H.W.A. APPROVAL	6-1-90 PLAN DATE	III-58K	SHEET 2 OF 4

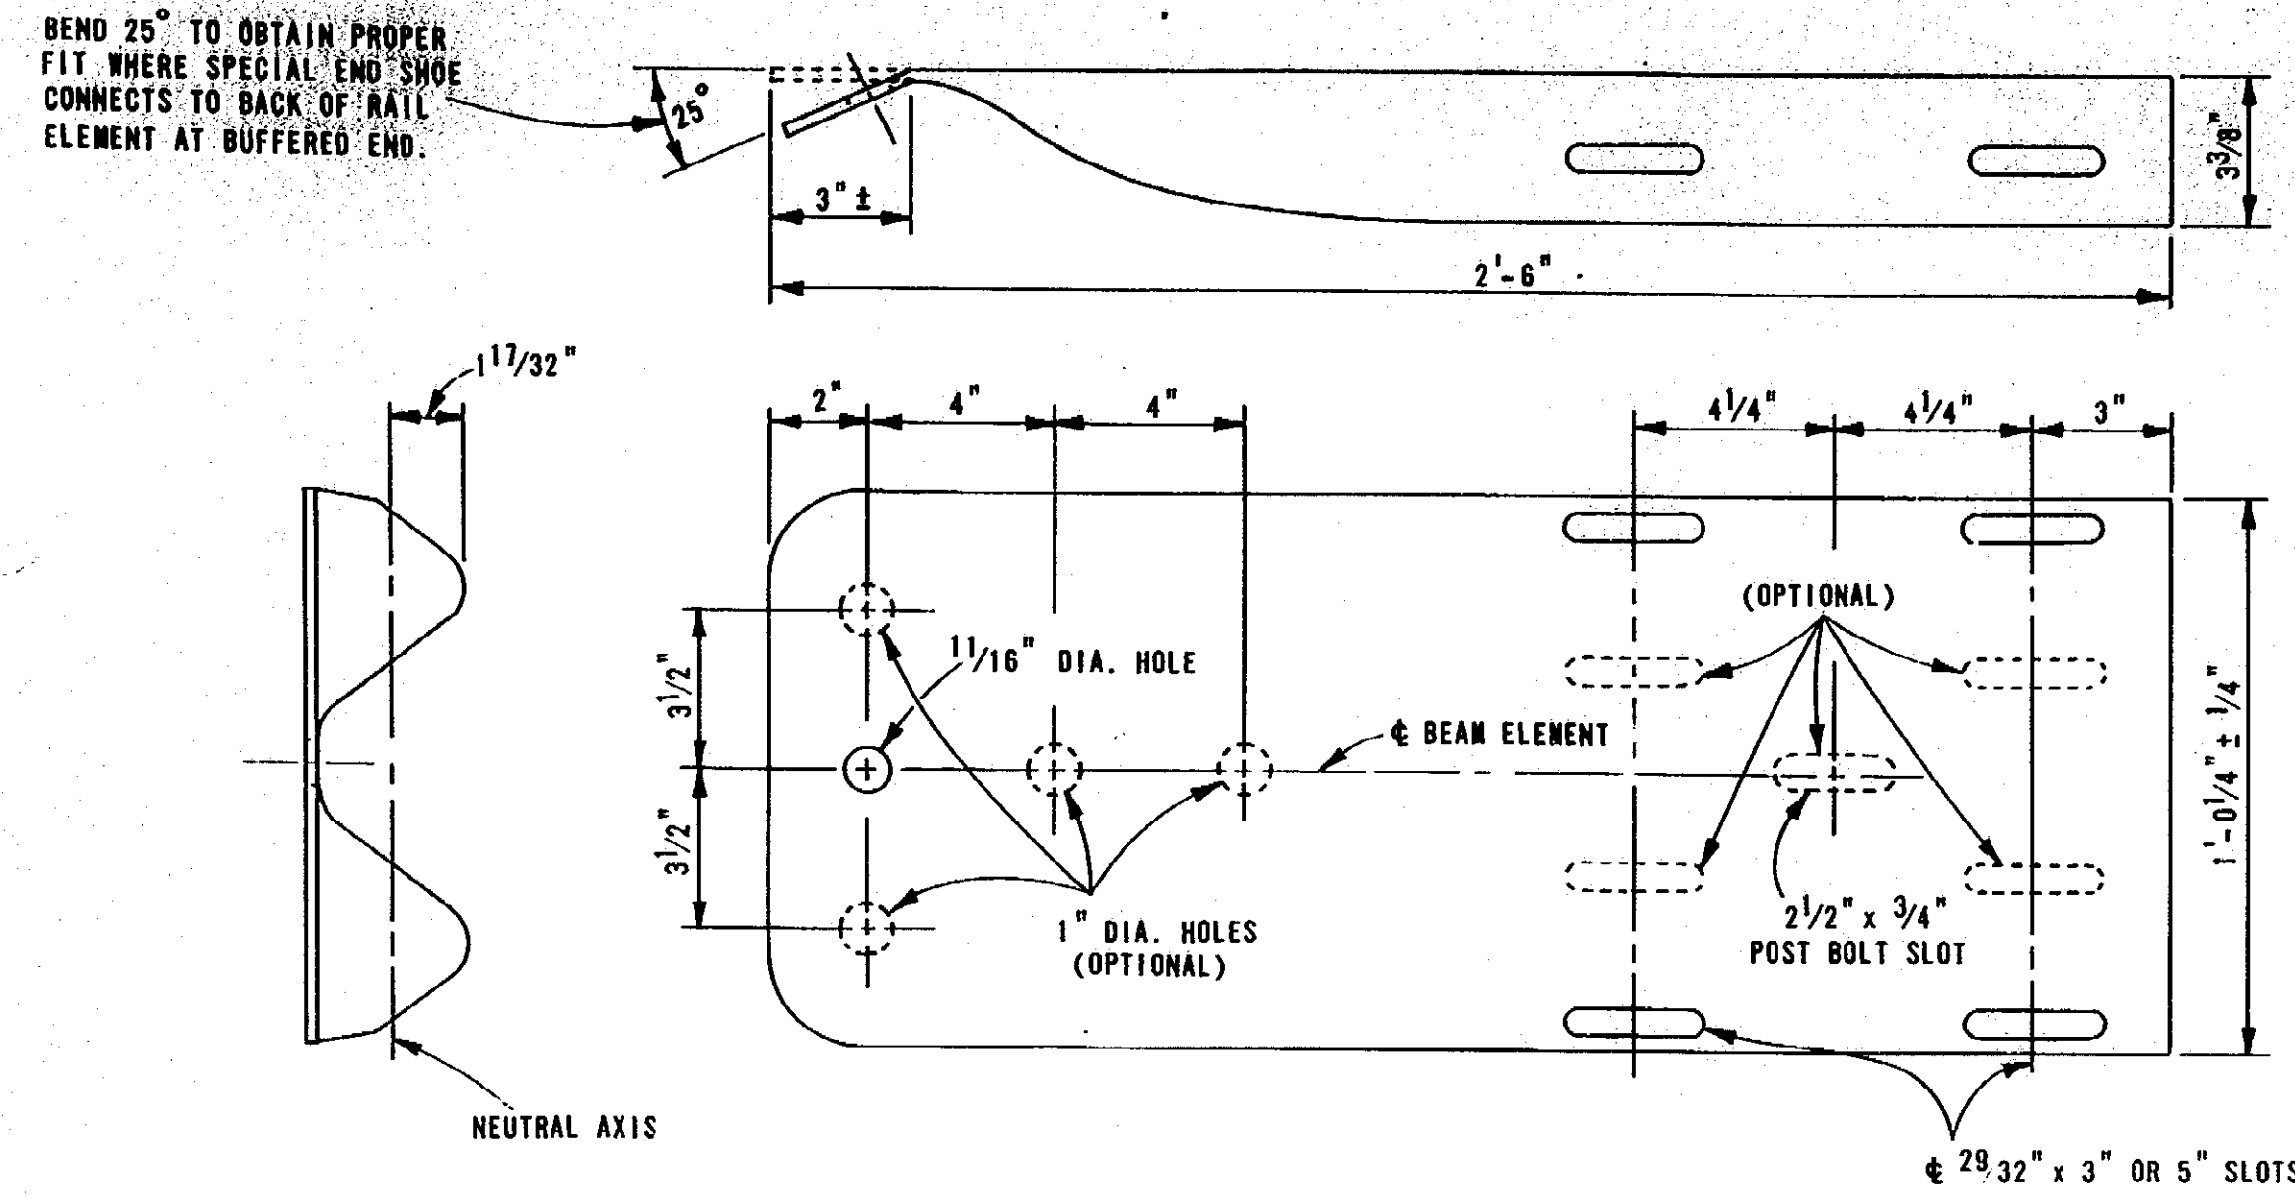



SPECIAL END SHOE
(FOR BUFFERED END)

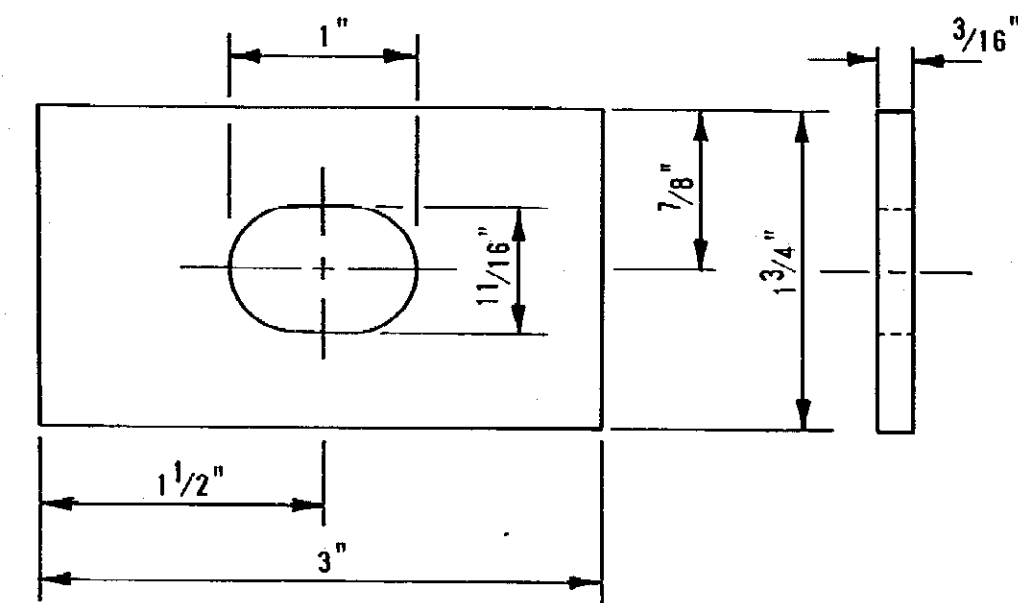


POST BOLT WASHER

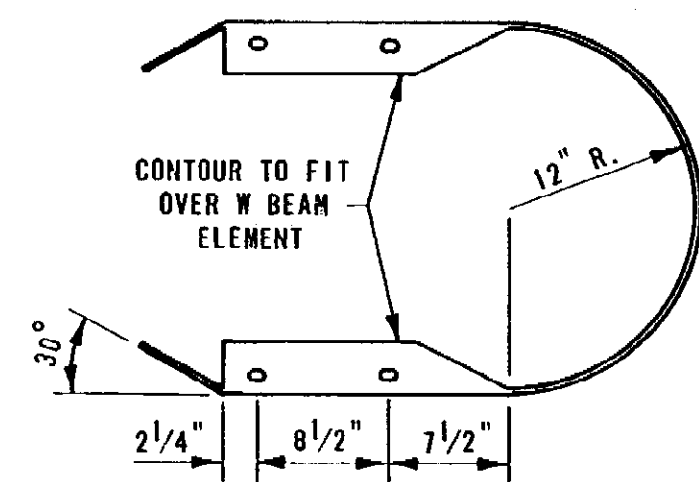

BUFFERED END
(FOR W BEAM ELEMENT)

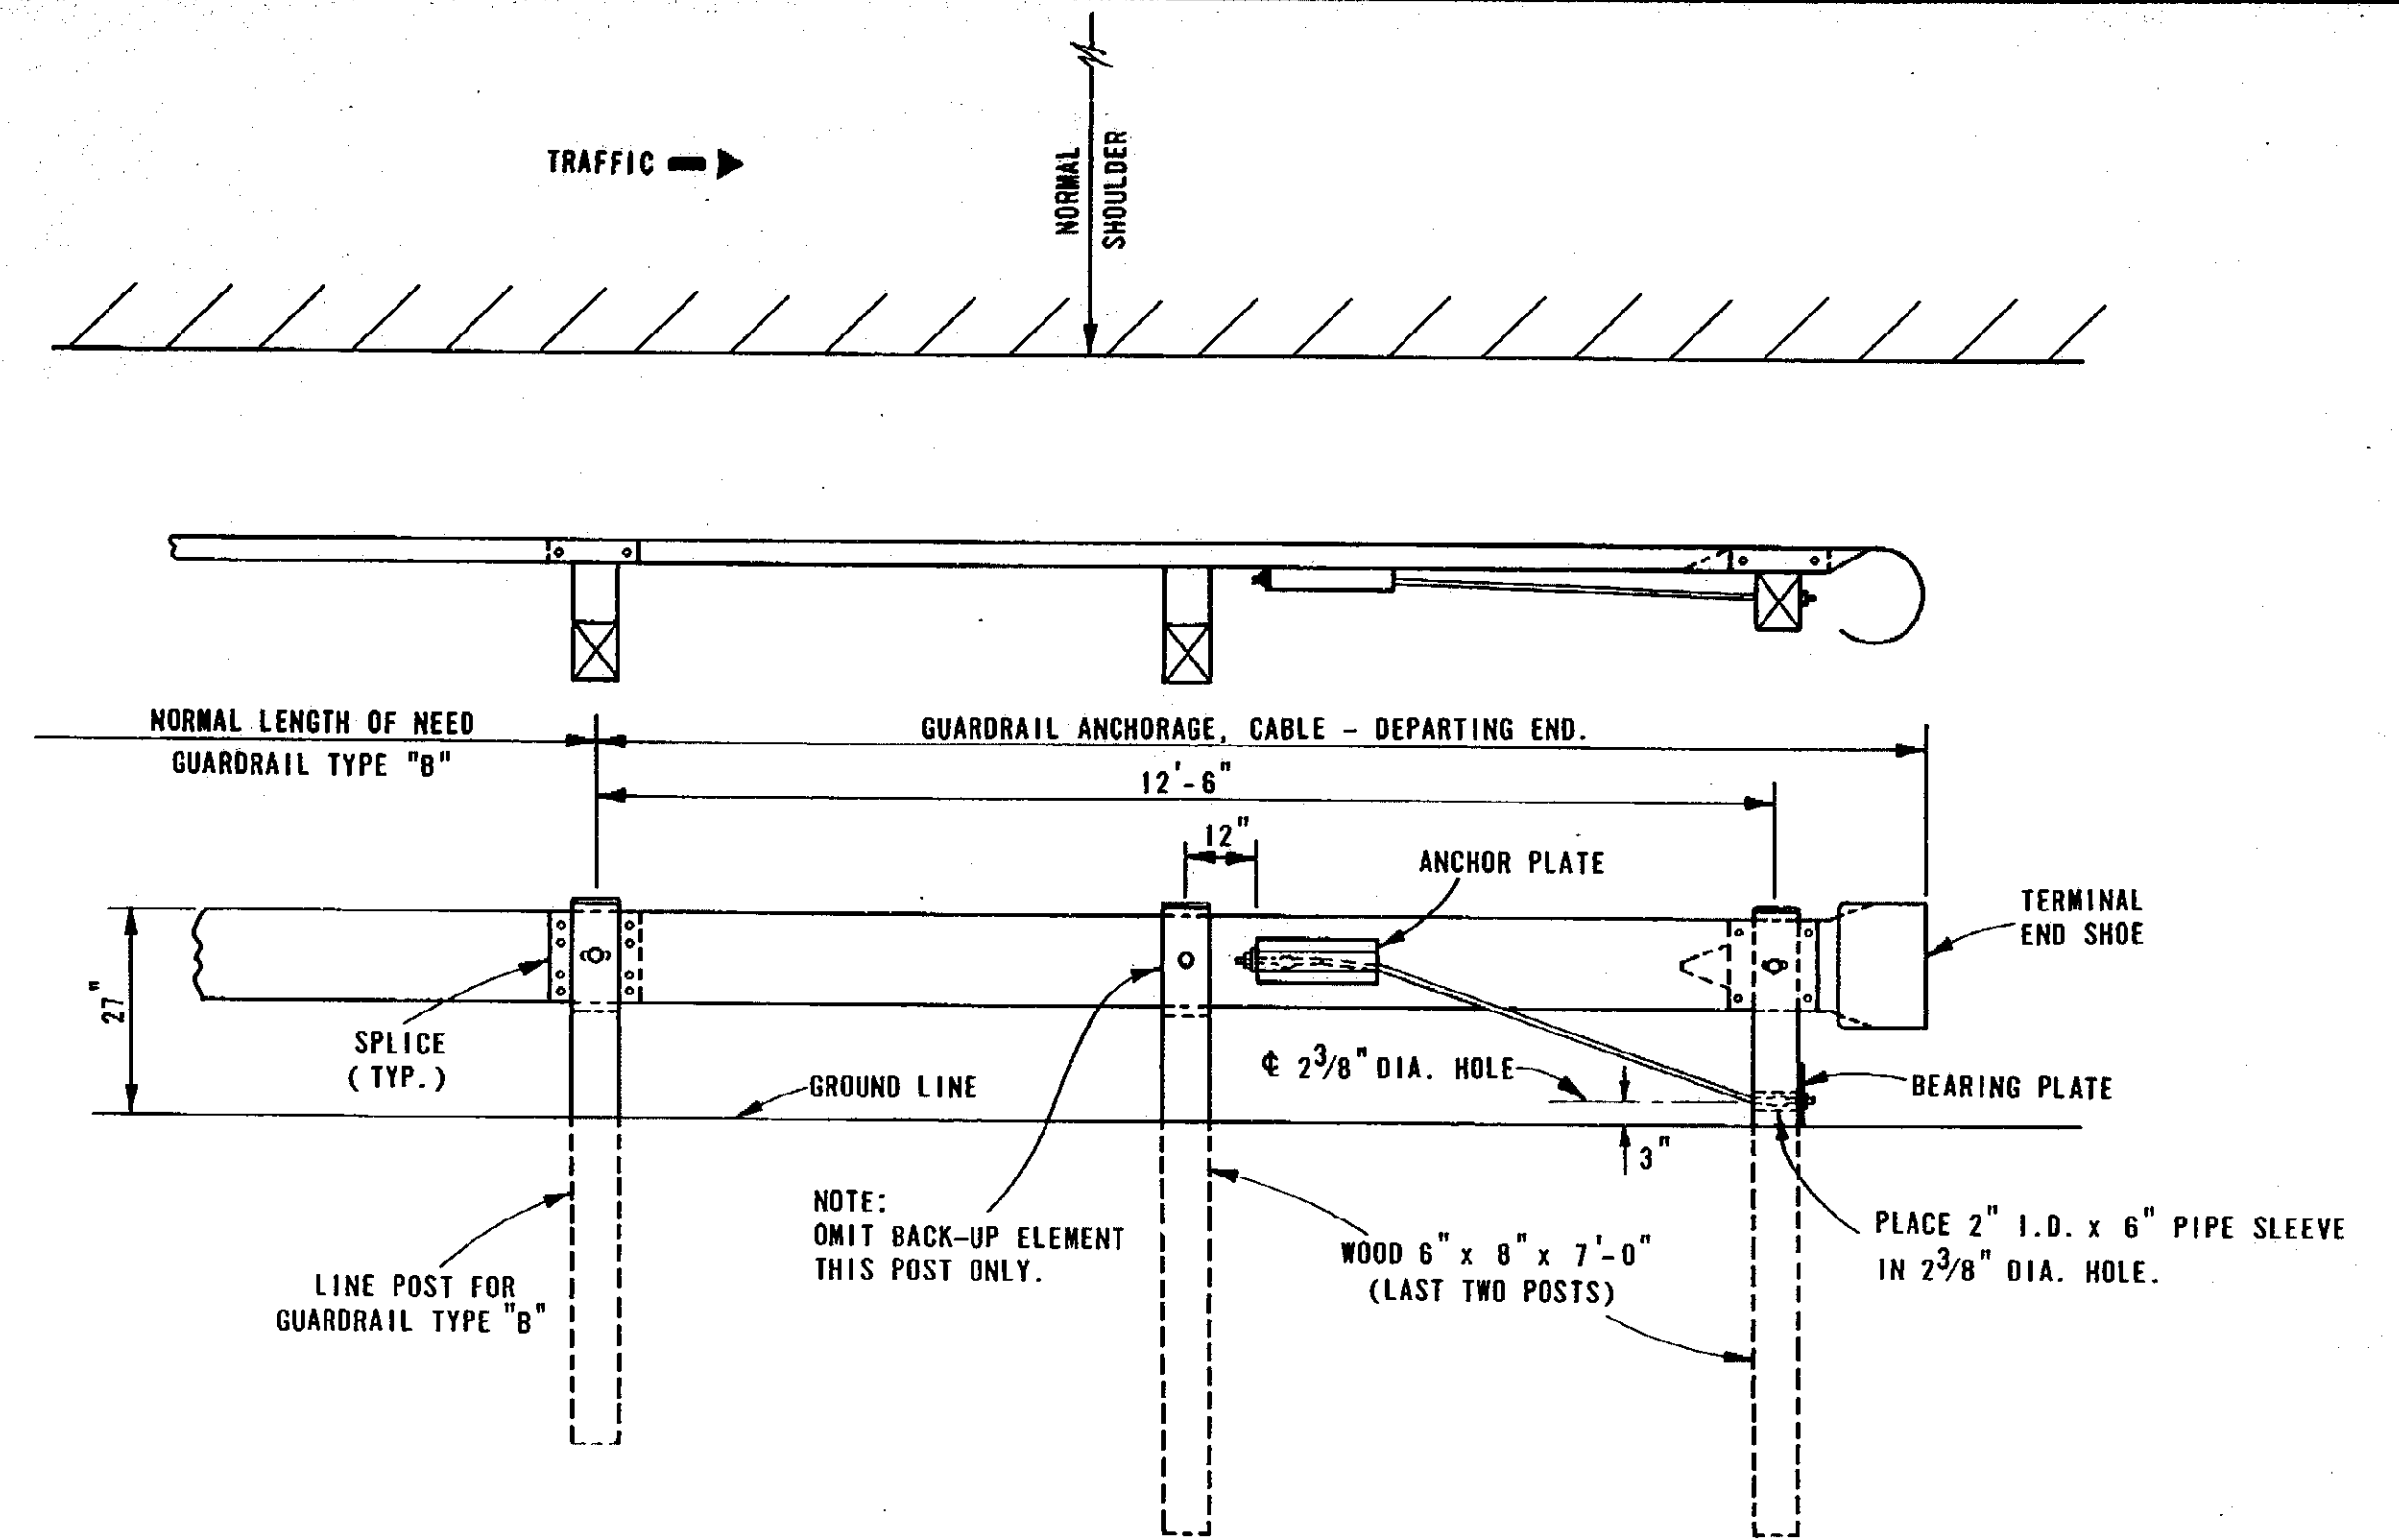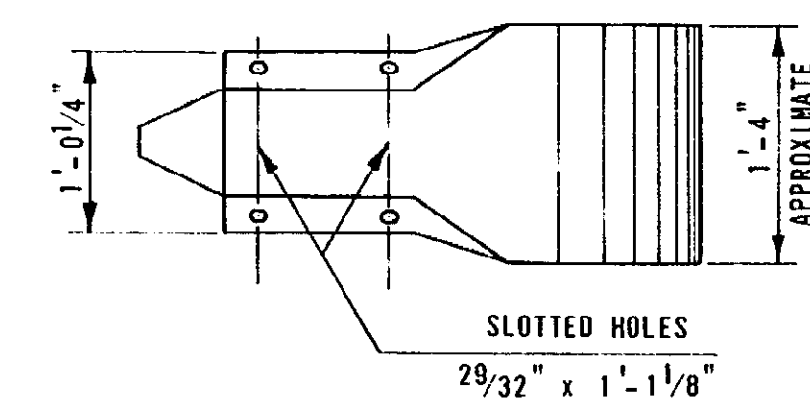

GUARDRAIL ANCHORAGE, CABLE - DEPARTING END
(ONE-WAY ROADWAYS ONLY)

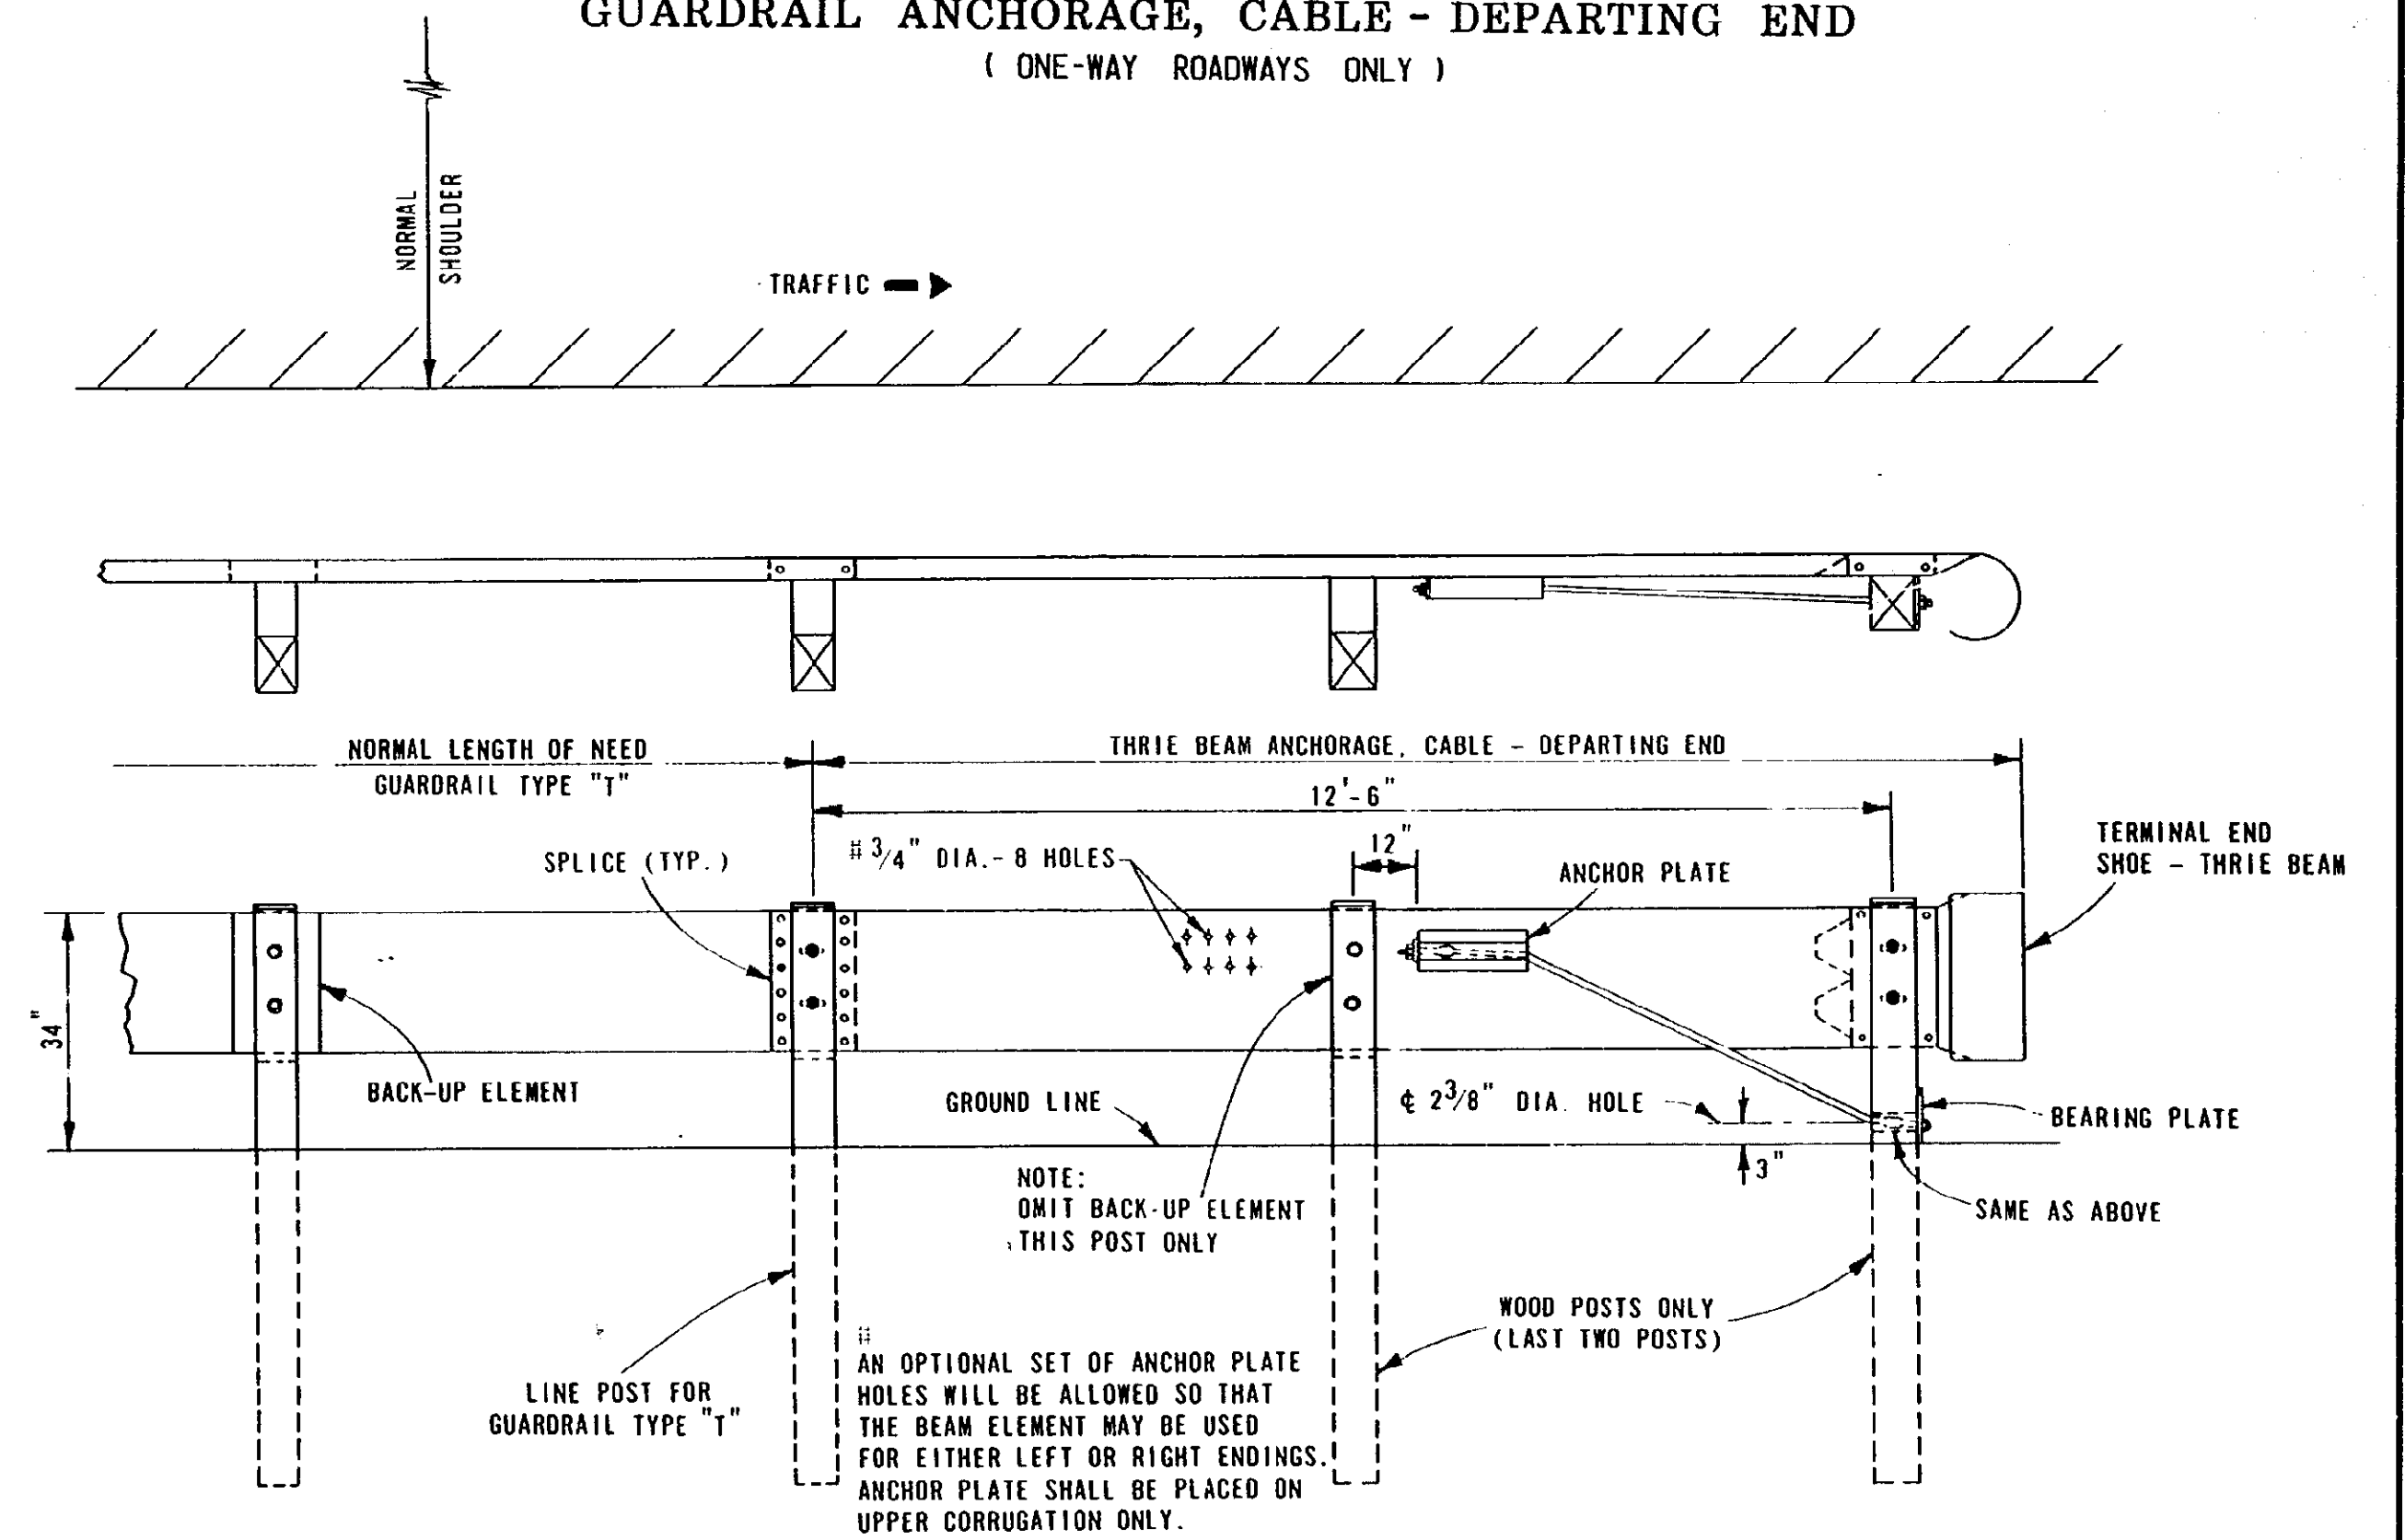

THRIE BEAM ANCHORAGE, CABLE - DEPARTING END
(ONE-WAY ROADWAYS ONLY)

 PREPARED BY DESIGN DIVISION DRAWN BY: D.F.M. CHECKED BY: C.A.L.	ENGINEER OF CONSTRUCTION	<i>J.H. Williams</i> ENGINEER - ROAD DESIGN
	ENGINEER OF MAINTENANCE	<i>James P. Pitz</i> ENGINEER OF DESIGN
	ENGINEER OF MATERIALS & TECHNOLOGY	DEPARTMENT DIRECTOR JAMES P. PITZ
	ENGINEER OF TRAFFIC AND SAFETY	DEPUTY DIRECTOR - HIGHWAYS

MICHIGAN DEPARTMENT OF TRANSPORTATION BUREAU OF HIGHWAYS STANDARD PLAN FOR GUARDRAIL ENDINGS WITH CABLE ANCHORAGE			
F.H.W.A. APPROVAL	6-1-90 PLAN DATE	III-58K	SHEET 3 OF 4

 PREPARED BY DESIGN DIVISION DRAWN BY: D.F.M. CHECKED BY: C.A.L.	ENGINEER OF CONSTRUCTION	<i>J.H. Williams</i> ENGINEER - ROAD DESIGN
	ENGINEER OF MAINTENANCE	<i>James P. Pitz</i> ENGINEER OF DESIGN
	ENGINEER OF MATERIALS & TECHNOLOGY	DEPARTMENT DIRECTOR JAMES P. PITZ
	ENGINEER OF TRAFFIC AND SAFETY	DEPUTY DIRECTOR - HIGHWAYS

MICHIGAN DEPARTMENT OF TRANSPORTATION BUREAU OF HIGHWAYS STANDARD PLAN FOR GUARDRAIL ENDINGS WITH CABLE ANCHORAGE			
F.H.W.A. APPROVAL	6-1-90 PLAN DATE	III-58K	SHEET 4 OF 4

MICROFILM CONTENT SHEET

BATCH 07-8G

OUT TO MICROFILM 8/31/2007

Control Section	Structure	Job Number	Sheet Number	Let Date	Region	Total Sheets	Plan Set	Box
63174		28991	(ONE ROLL)	11/14/1990	METRO	23		3
			AS LET					
	63174-28991 BIT SURF AND SAFETY UP GRADING							

SHEET NO. 1
 JOB NO. 28992A
 CONTROL SECTION IR 63174

MICHIGAN DEPARTMENT OF TRANSPORTATION

PLANS OF PROPOSED

MICHIGAN PROJECT **FIR 75-2(387)58**
CONTROL SECTION **FUIR 63174**
JOB NUMBER **28992A**

I-75

OAKLAND CO.
CITIES OF HAZEL PARK,
MADISON HEIGHTS AND ROYAL OAK

ROUTE	JOB NUMBER	FEDERAL NUMBER	SHEET NO.	TOTAL SHEETS
I-75	28992A	FIR 75-2(387)58	1	


THE IMPROVEMENT COVERED BY THESE PLANS SHALL BE DONE IN ACCORDANCE WITH THE MICHIGAN DEPARTMENT OF TRANSPORTATION 1984 STANDARD SPECIFICATIONS AND SUPPLEMENTAL SPECIFICATIONS.

ROAD PLANS	SHEET NOS.
TITLE	1
TYPICAL CROSS SECTION	2-4
NOTE SHEET	5
PLANS & PROFILES	6-9
SPECIAL DETAILS	10-15
MASS DIAGRAMS	
QUANTITY SHEETS	16

BRIDGE PLANS

SIGNING PLANS

A.D.T.	159700
D.H.V.	8827
COMM. %	9%
DESIGN SPEED	70 MPH

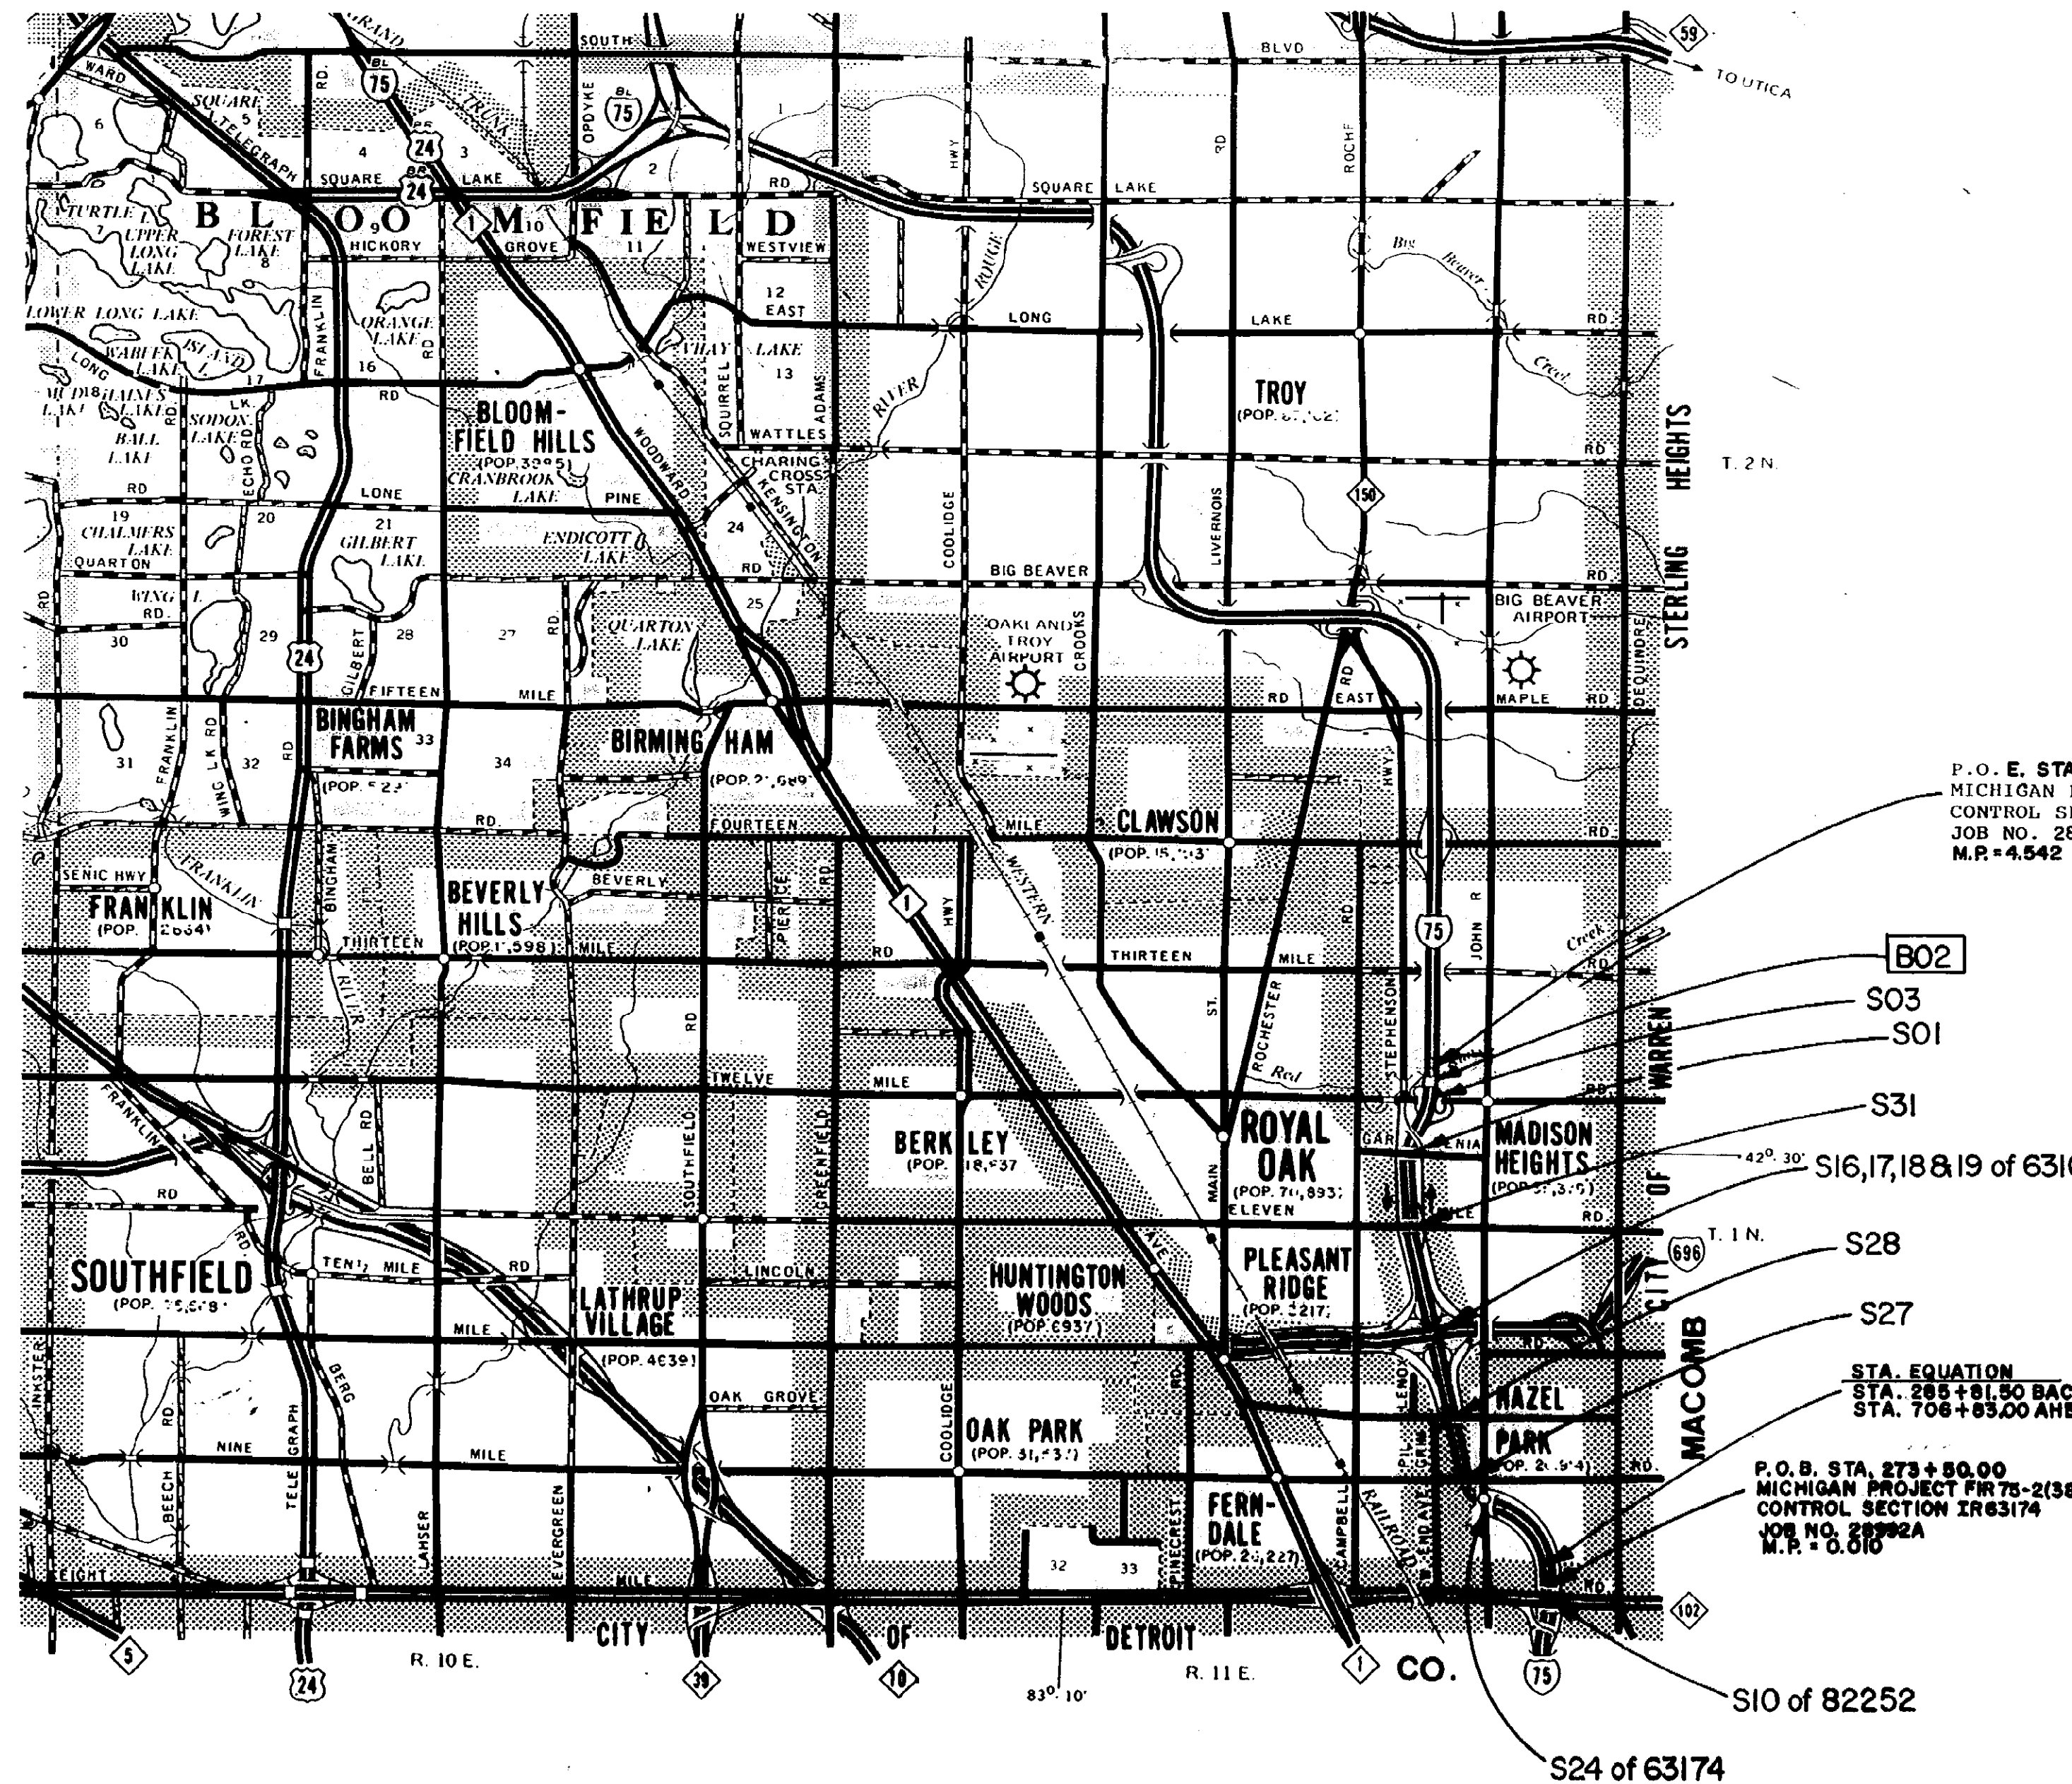

TITLE SHEET LEGEND

PROPOSED PROJECT	
EXISTING ROADS	
PAVED	
BITUMINOUS	
GRAVEL	
UNIMPROVED OR CITY STREET	
SECTION LINE	
TOWNSHIP LINE	
COUNTY LINE	
CITY OR VILLAGE LIMITS	
RAILROADS	

CONTRACT FOR - BIT. OVERLAY			
APPROVALS			
RECOMMENDED FOR APPROVAL		10/28/90	DATE
		ENGINEER ROAD DESIGN	
RECOMMENDED FOR APPROVAL		10/29/90	DATE
		ENGINEER OF DESIGN	
RECOMMENDED FOR APPROVAL		11/5/90	DATE
		ENGINEER OF TRAFFIC & SAFETY	
RECOMMENDED FOR APPROVAL		11/6/90	DATE
		ENGINEER OF CONSTRUCTION	
MICHIGAN			
DEPARTMENT OF TRANSPORTATION			
JAMES P. FITZ - DIRECTOR			
APPROVED BY		11/14/90	DATE
		DEPUTY DIRECTOR - HIGHWAYS	
PLANS PREPARED BY		U. S. DEPARTMENT OF TRANSPORTATION	
PALMER		FEDERAL HIGHWAY ADMINISTRATION	
DESIGN UNIT		APPROVED	
		DIVISION ADMINISTRATOR	
CONTROL SECTION	JOB NUMBER	FEDERAL NUMBERS	SHEET NO.
IR 63174	28992A	FIR 75-2(387)58 NP1145	1



AS LET PLANS

IR 63174--28992A


JOB NUMBER 1

FINAL R.O.V.			
AUTH	DATE	NO.	REVISION

CONTROL SECTION 63174
 JOB NO. 28992A
 SH. NO. 2

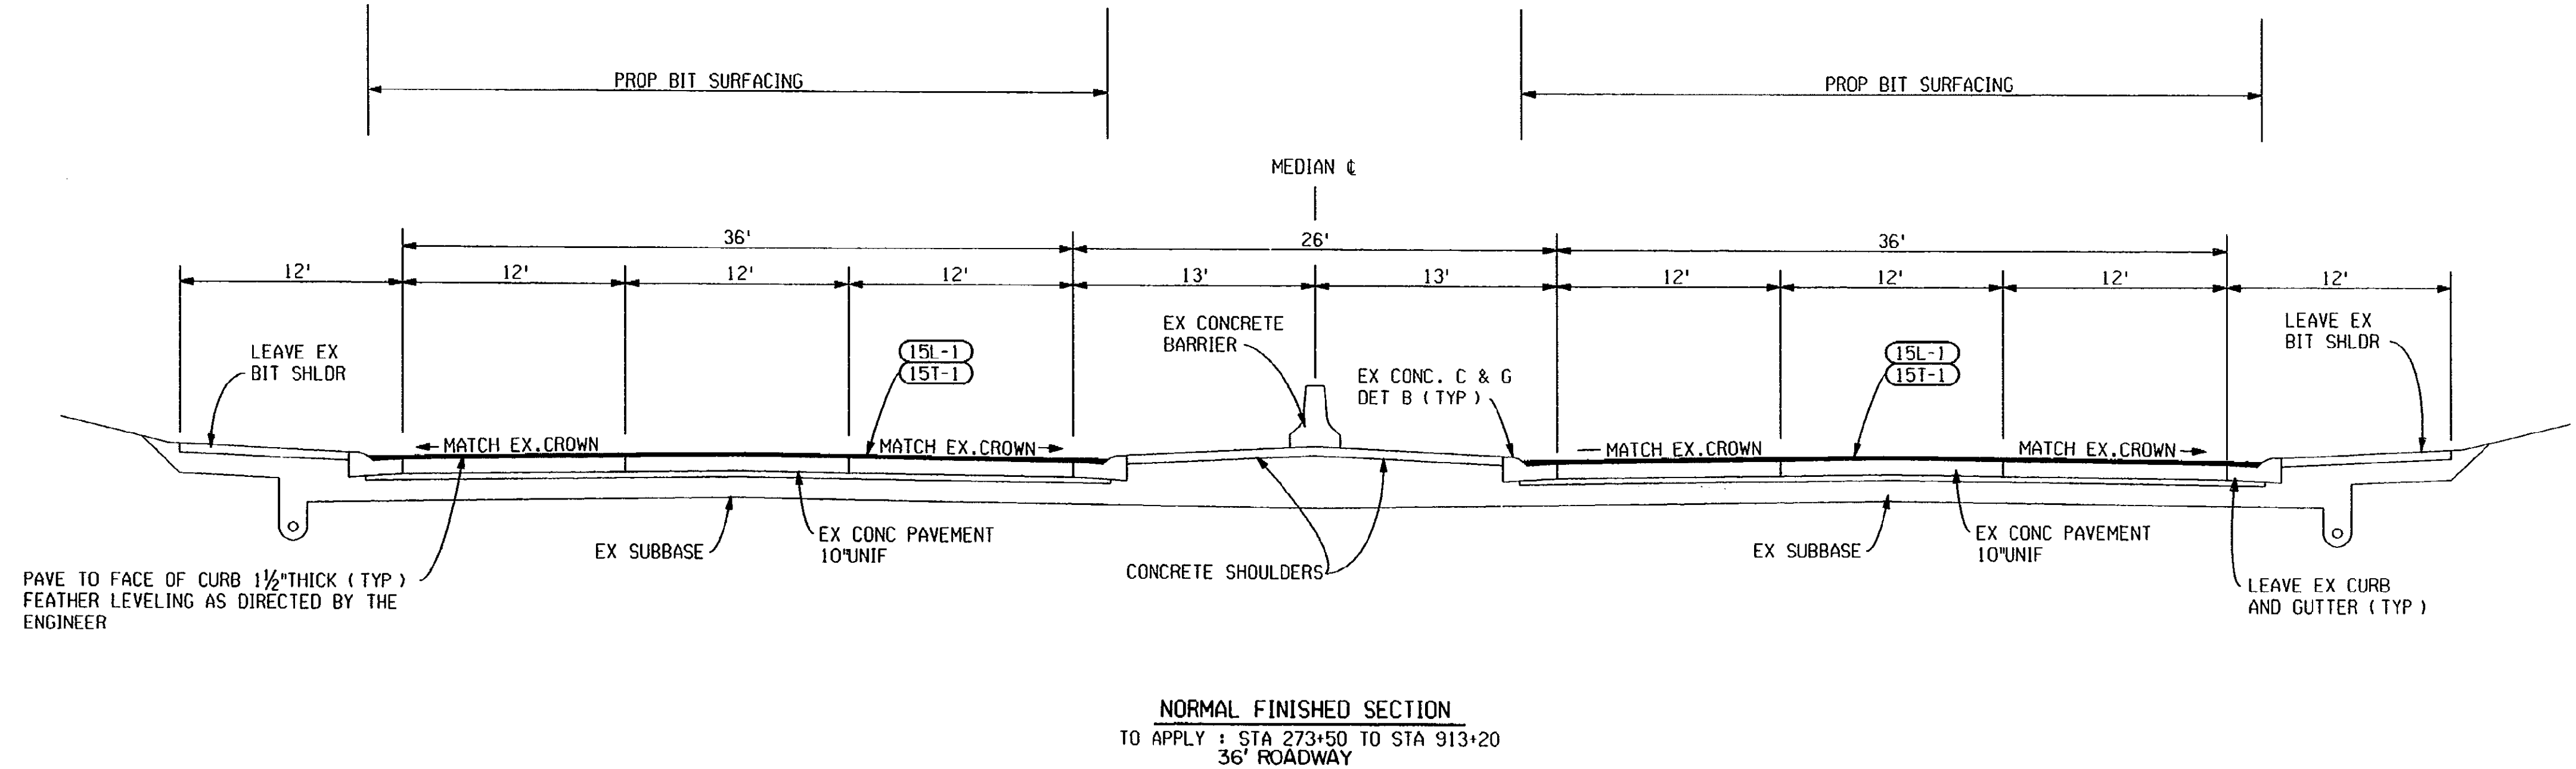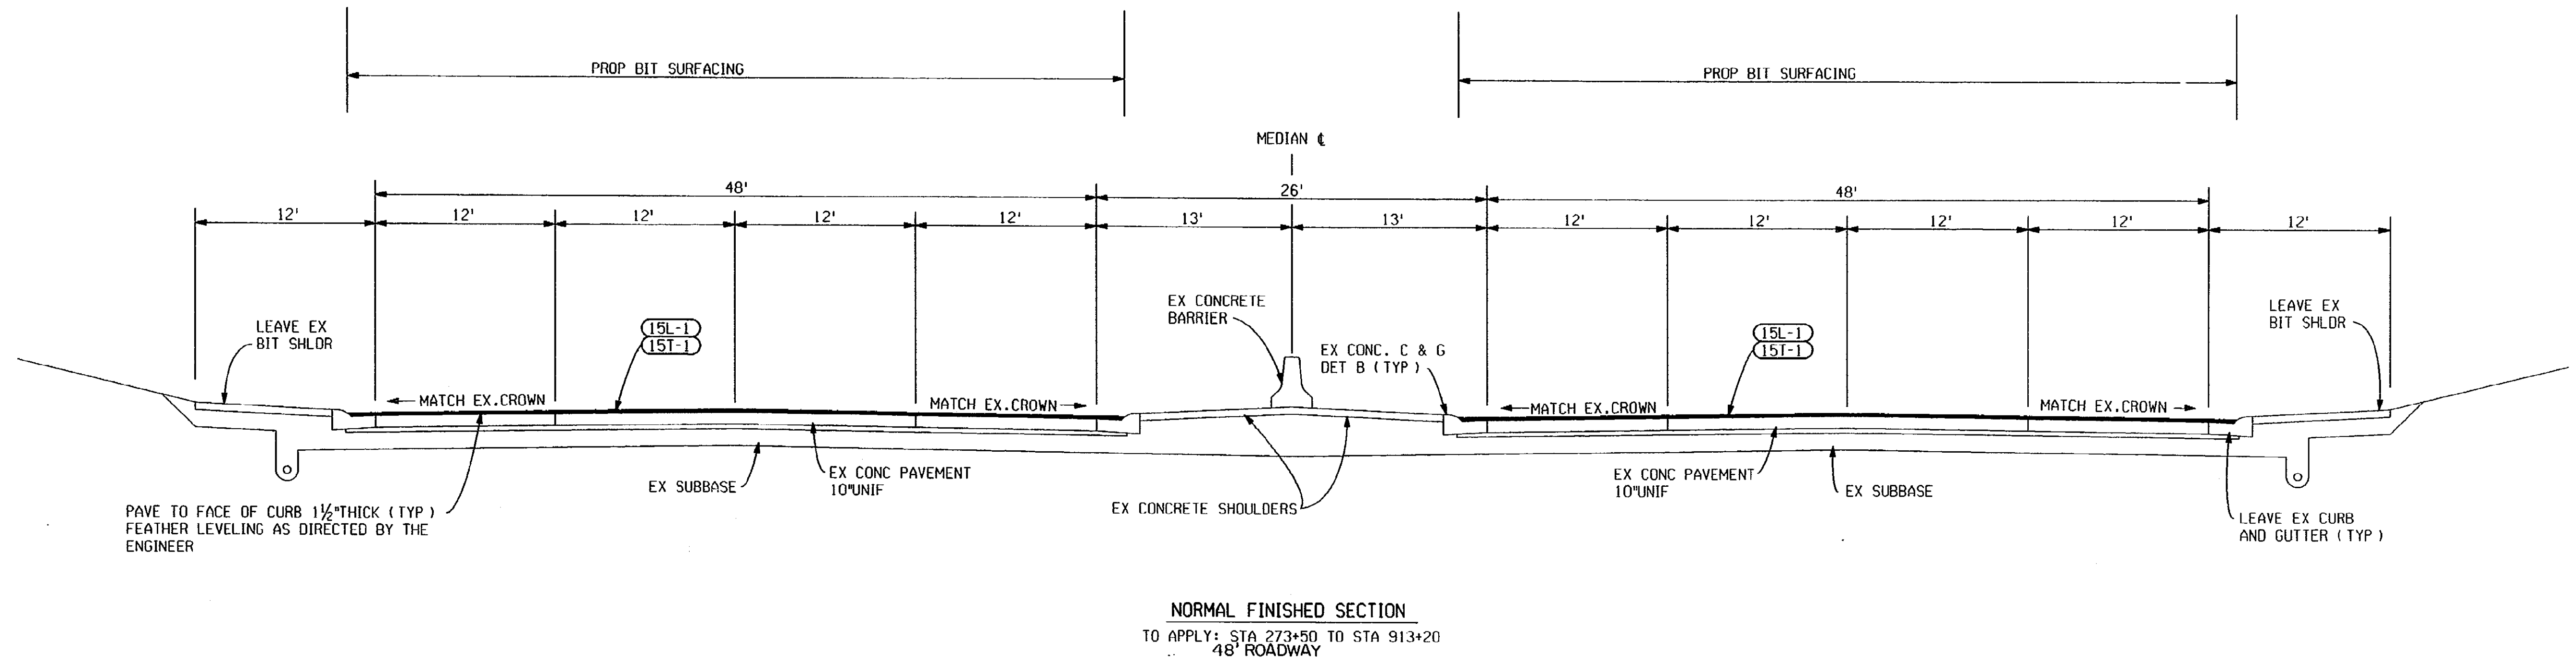


EXIS: 1 3 4
 PROPOSED BY: M. MCCARTHY
 LAST CORRECTION BY: M. MCCARTHY
 FILE NAME: 28992-111
 DATE: 10-16-90

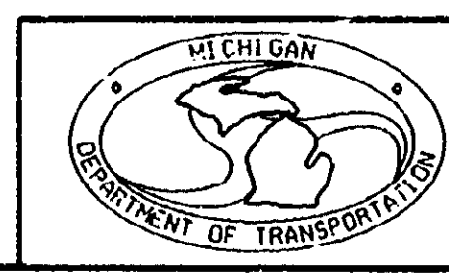


TYPICAL CROSS SECTION					
DATE	SCALE	CONT. SEC.	JOB NO.	DESIGN UNIT	SHEET NO.
10/16/90	1"=6'	63174	28992 A	FALMER	R.O.W CONST. 2

FINAL R.O.W.		
AUTH	DATE	REVISION

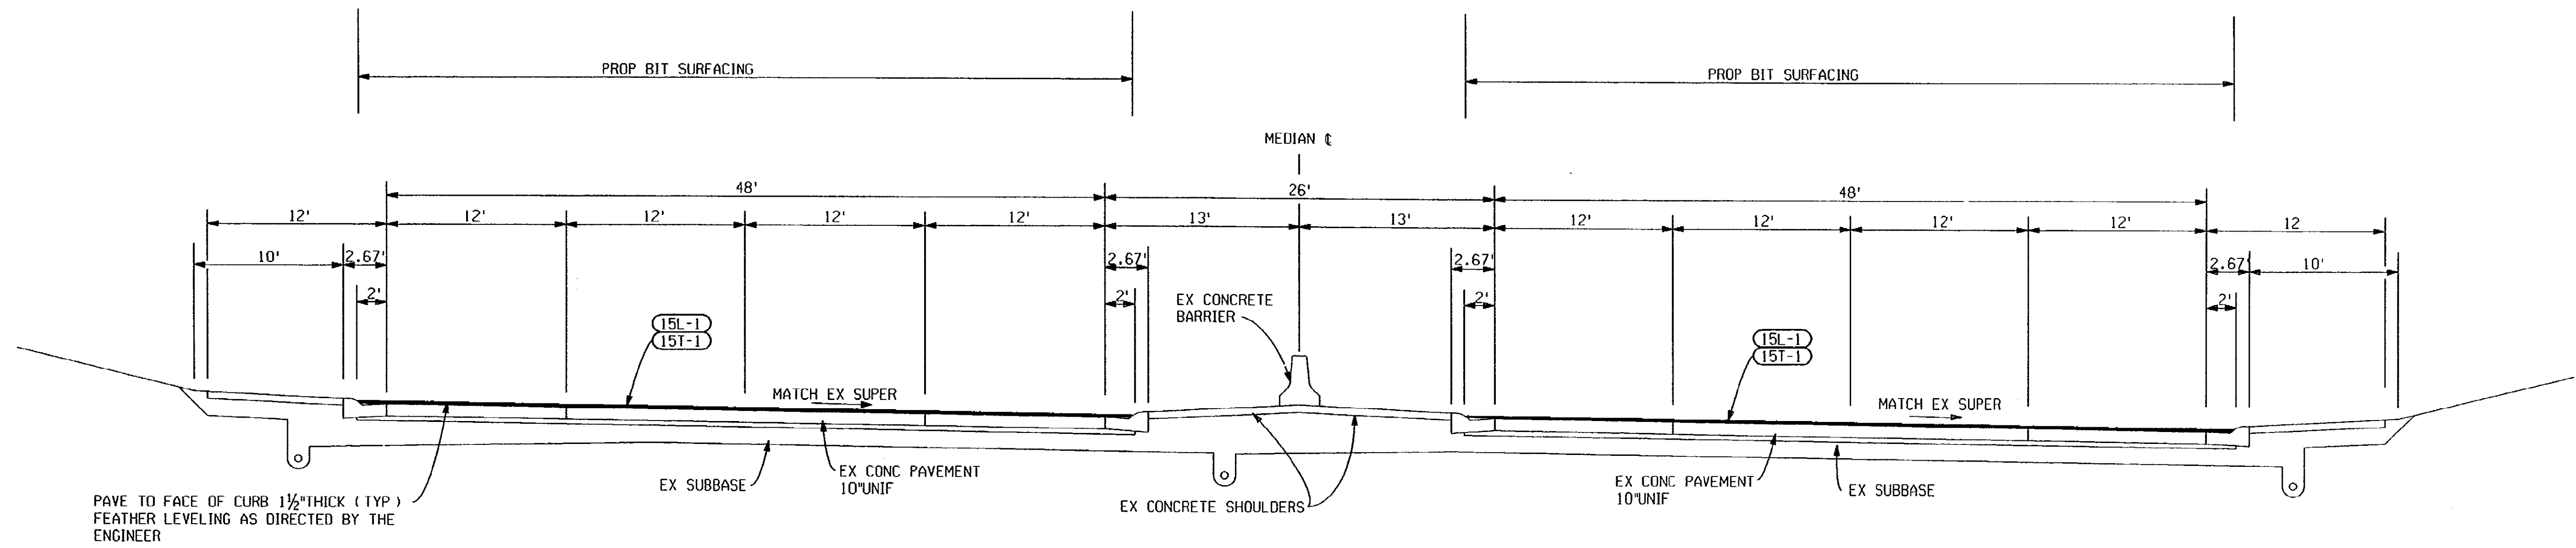


SUPERELEVATED SECTION
 TO APPLY: STA 273+50 TO STA 913+20
 48' ROADWAY

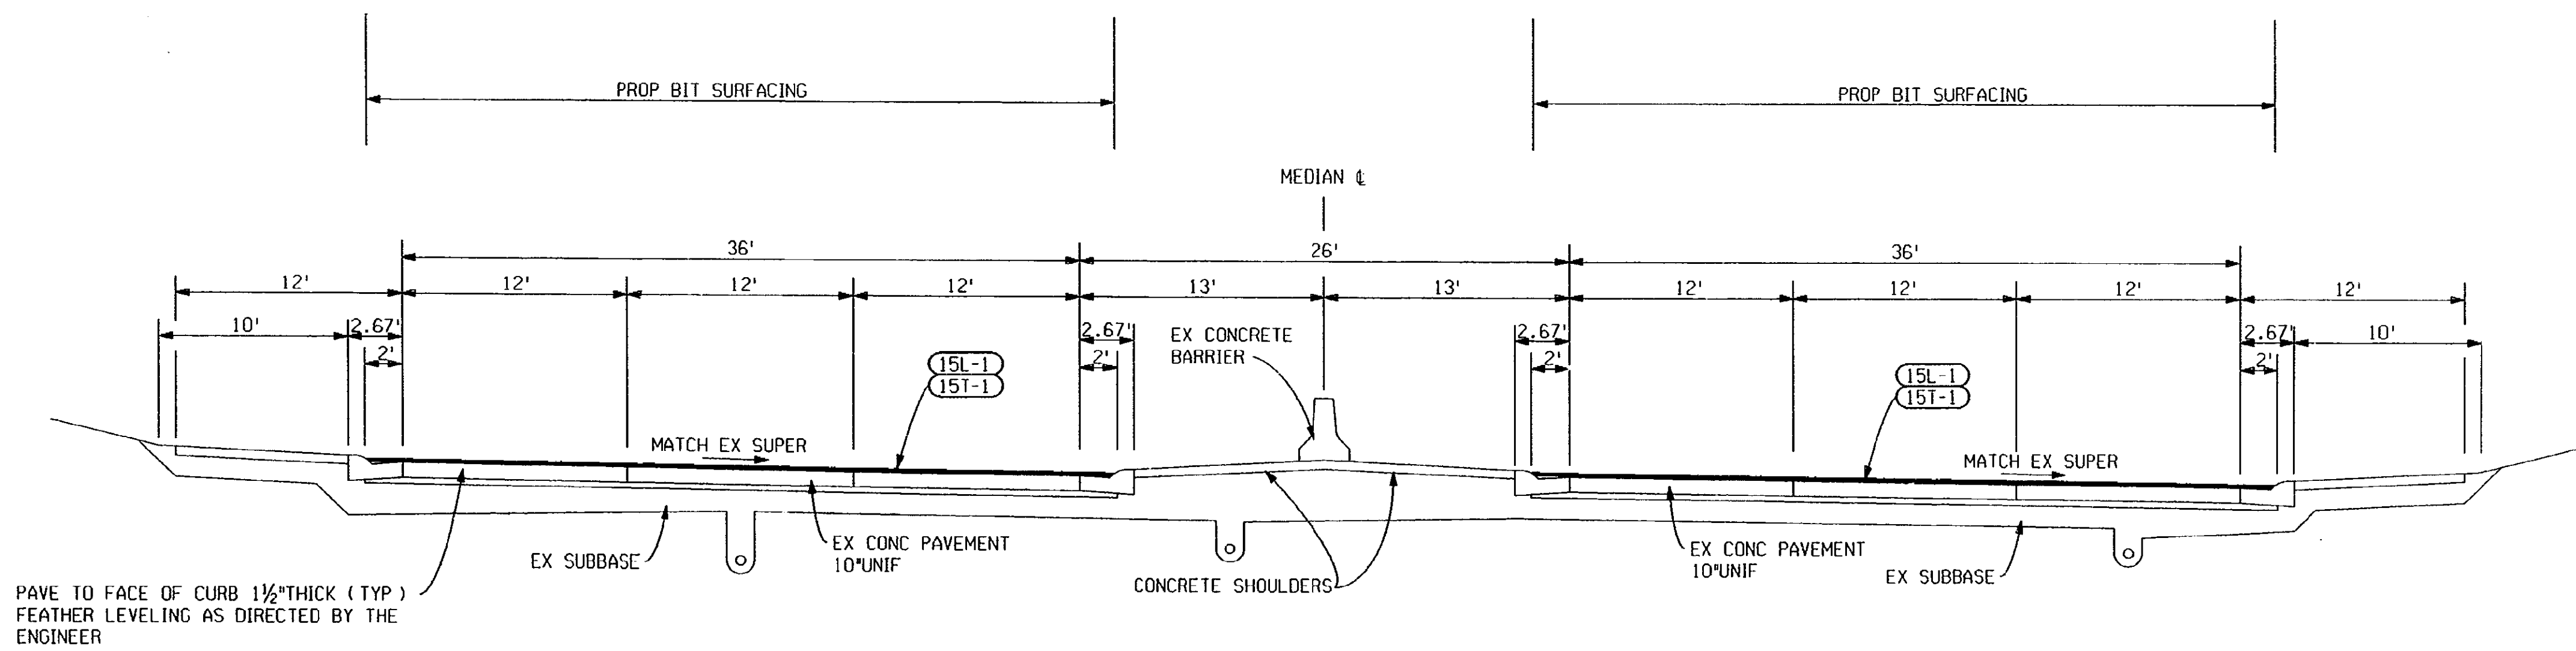

SUPERELEVATED SECTION
 TO APPLY: STA 273+50 TO STA 913+20
 36' ROADWAY

PAVE TO FACE OF CURB 1 1/2" THICK (TYP)
 FEATHER LEVELING AS DIRECTED BY THE
 ENGINEER

PAVE TO FACE OF CURB 1 1/2" THICK (TYP)
 FEATHER LEVELING AS DIRECTED BY THE
 ENGINEER

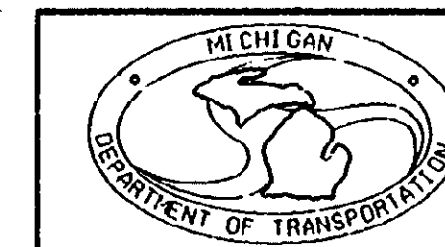

TYPICAL CROSS SECTION


DATE	SCALE	CONT. SEC.	JOB NO.	DESIGN UNIT	SHEET NO.
10/19/90	1"=6'	63174	28992 A	PALMER	3

EXL
 PROPOSED BY: M. MCCARTHY
 LAST CORRECTION BY: M. MCCARTHY
 FILE NAME: 28992.TY1
 1 3 4


DATE: 10-16-90

CONTROL SECTION 63174 JOB NO. 28992A SHEET NO. 3


FINAL R.O.W.			
AUTH	DATE	NO.	REVISION

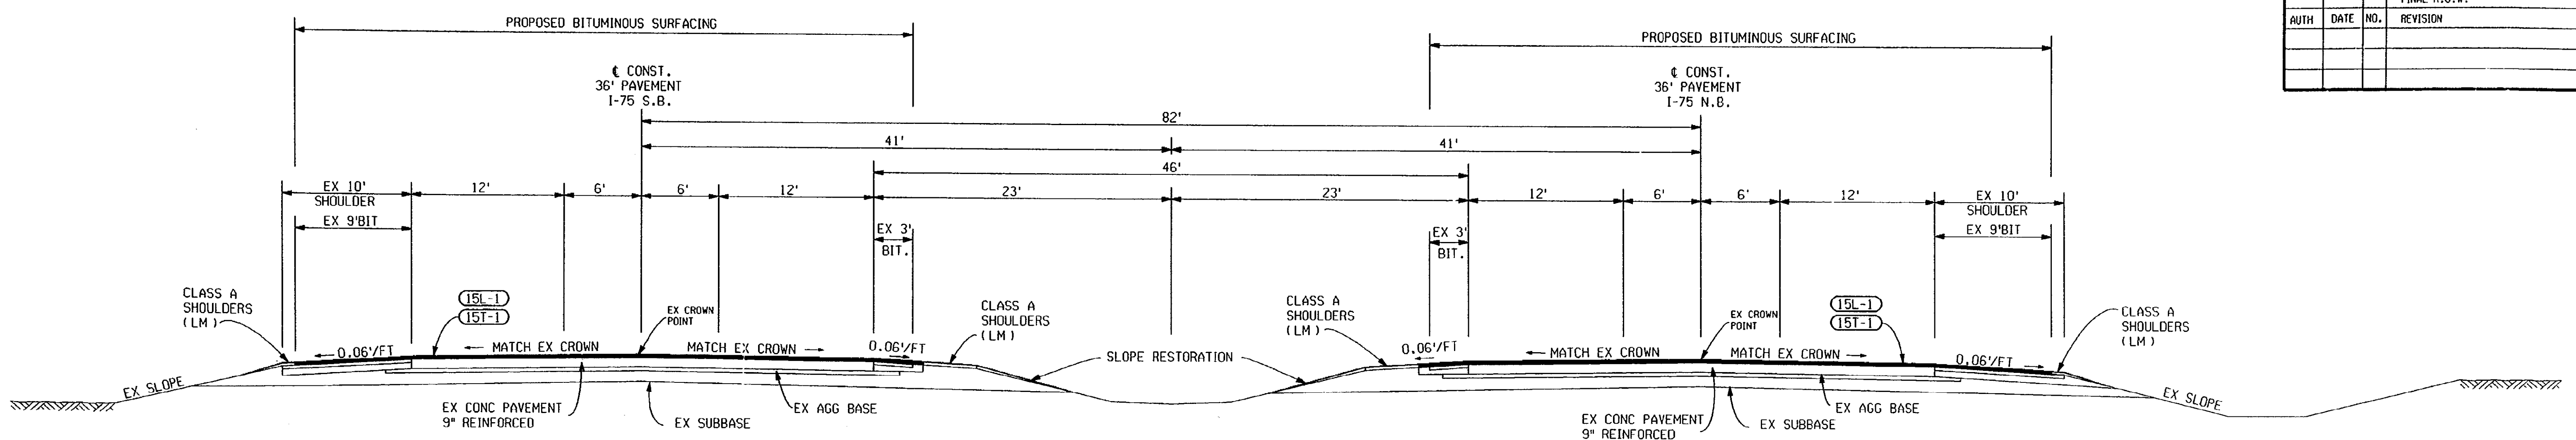


NORMAL SECTION
TO APPLY: B02 TO STA 935+00

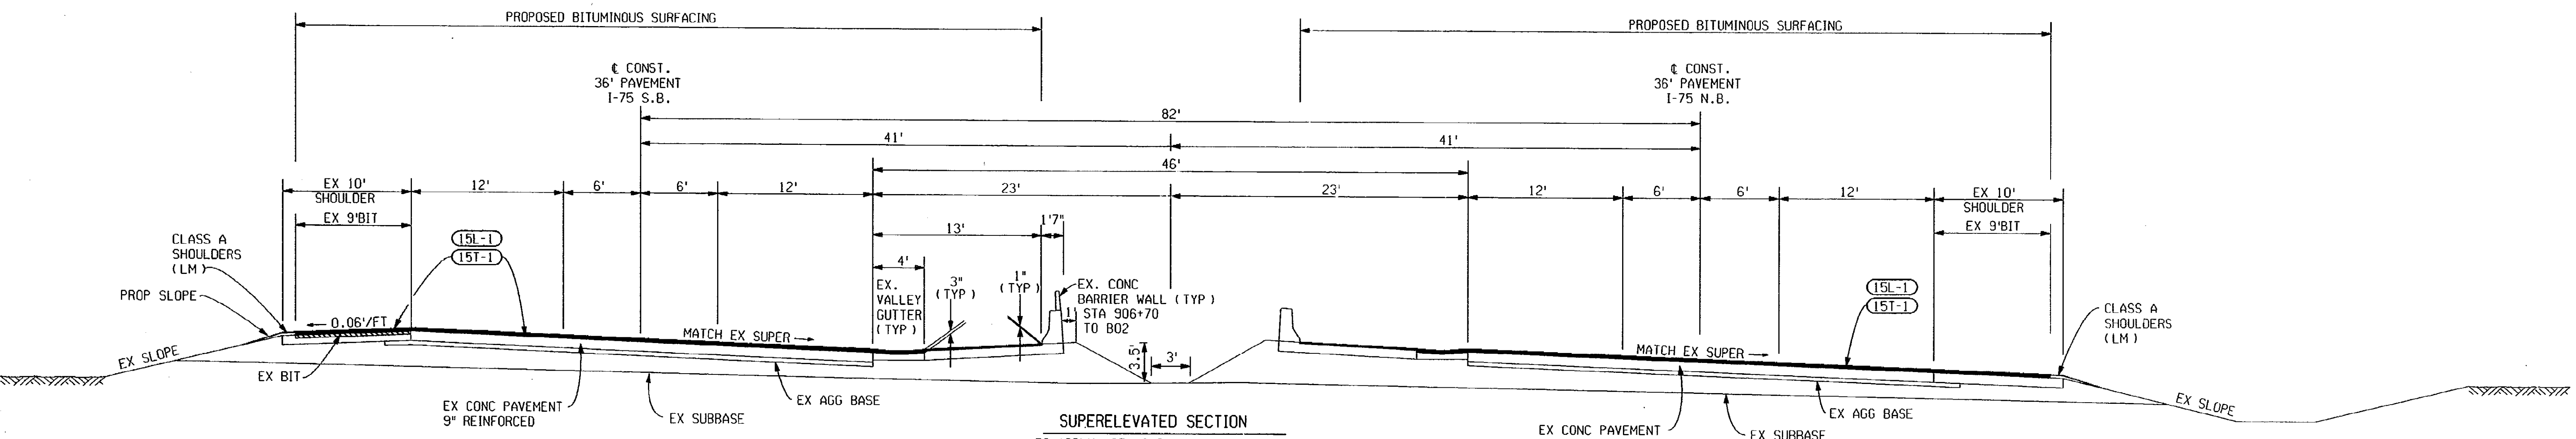


SUPERELEVATED SECTION
TO APPLY: STA 913+20 TO STA 931+15

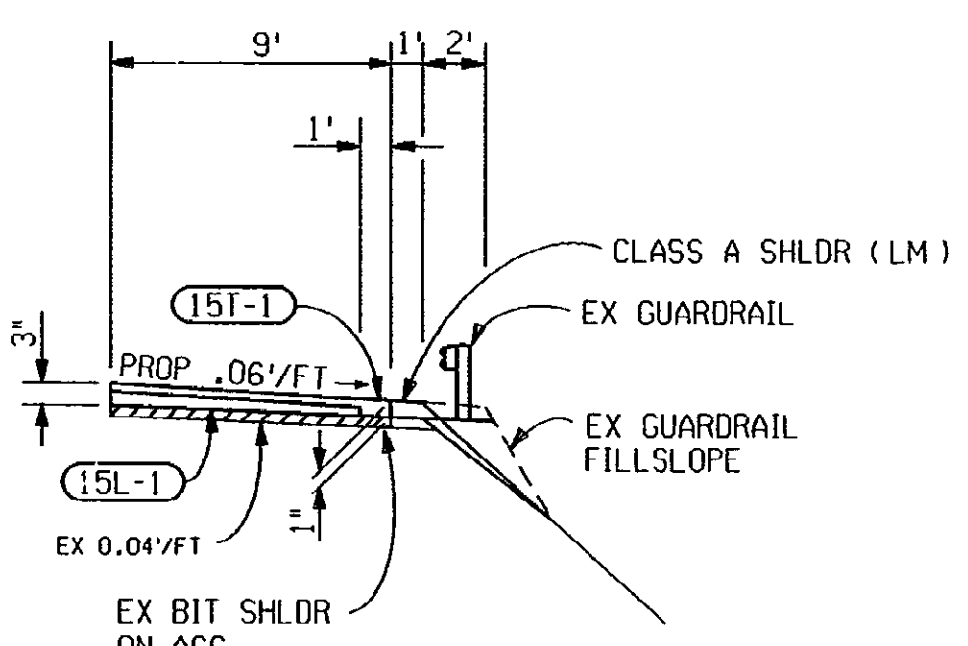


SHOULDER DETAIL
SHOWING BITUMINOUS SURFACING

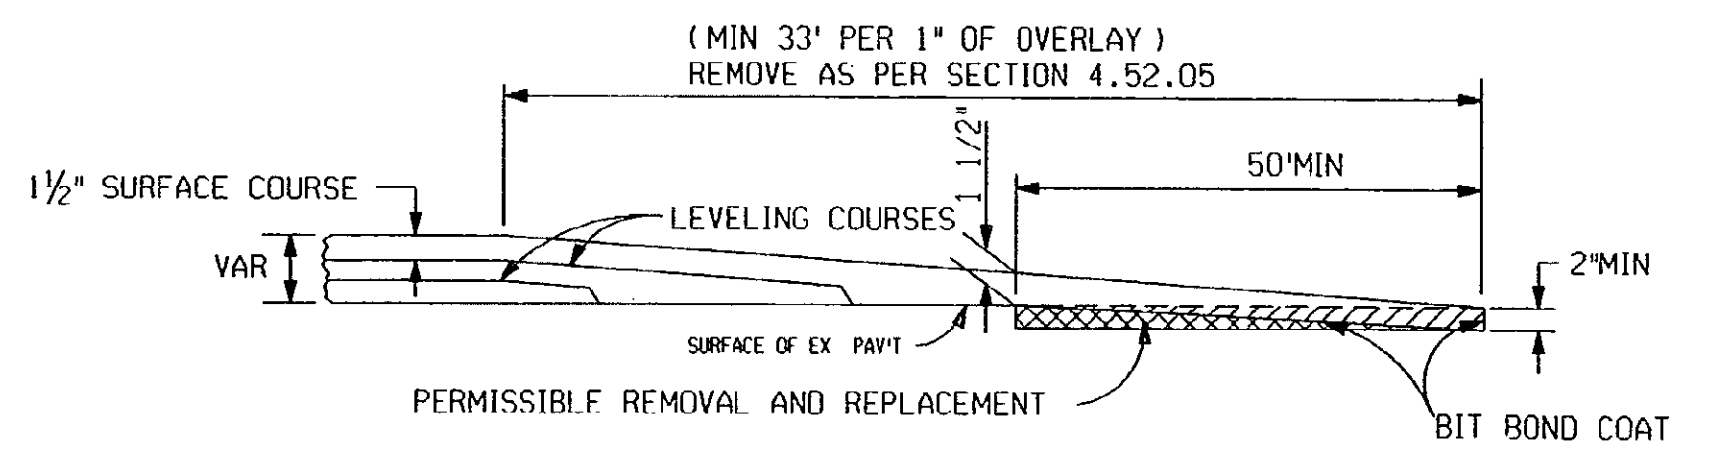

FEATHERING DETAIL-BUTT JOINT TYPE
TO APPLY: ALL RAMP, POB, SO3, B02, POE & UNDER BRIDGES WHERE SHOWN
NOTE: BUTT JOINTS WILL ONLY BE CUT ON THE DAY THAT THE OVERLAY WILL BE PLACED.

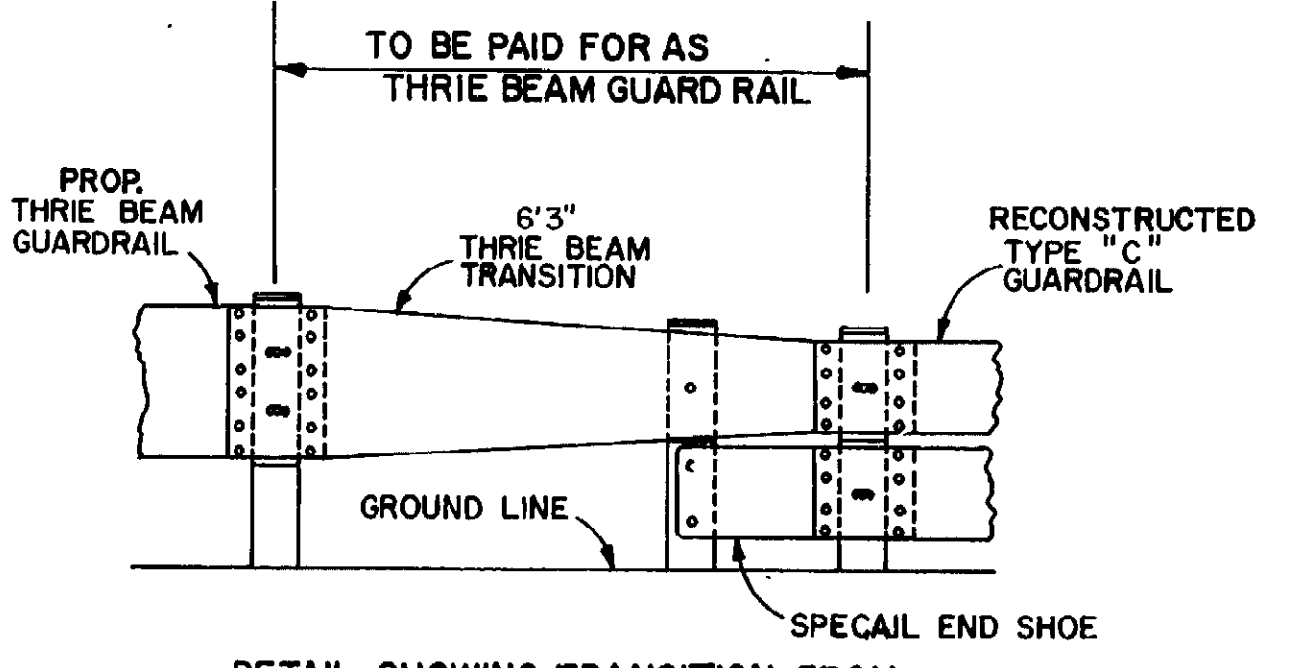

DETAIL SHOWING TRANSITION FROM TYPE 'C' TO THRIE BEAM GUARDRAIL

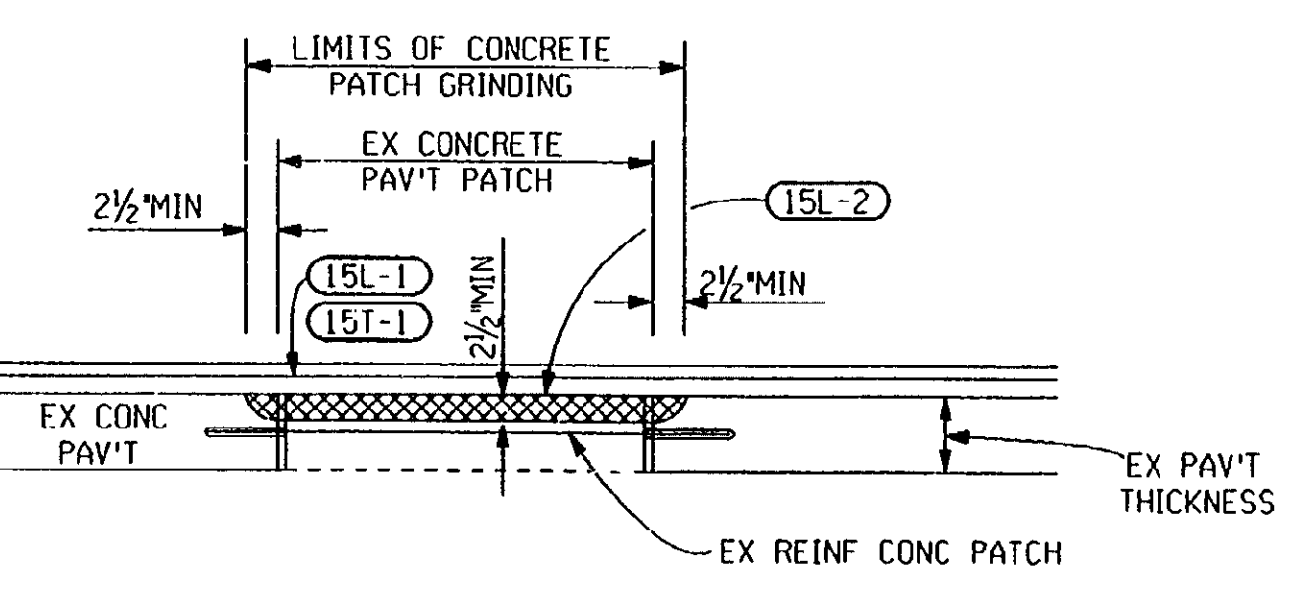


LONGITUDINAL DETAIL SHOWING TREATMENT OF EX CONC PAV'T PATCH
NOT TO SCALE
TO APPLY: AS DIRECTED BY THE ENGINEER

BITUMINOUS APPLICATION ESTIMATE

IDENT NO.	ITEM	RATE PER SYD	ESTIMATED THICKNESS	ASPHALT PENETRATION	REMARKS
15T-1	BITUMINOUS MIXTURE #1500T, 20AAA - RUBBER	160*	1 1/2"	85-100	1-75 ROADWAY & RAMPS
15L-1	BITUMINOUS MIXTURE #1500L, 20AAA - RUBBER	170*	1 1/2"	85-100	1-75 ROADWAY & SHLDRS
15L-2	BITUMINOUS MIXTURE #1500L, 20AAA	250*	2 1/2"	85-100	EX CONC PATCH REPAIR
* BITUMINOUS BOND COAT		0-0.10 GAL			

*FOR INFORMATION ONLY
*** TO BE PAVED IN TWO LIFTS

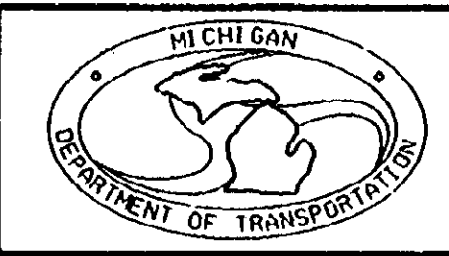

TYPICAL CROSS SECTION

DATE	SCALE	CONT. SEC.	JOB NO.	DESIGN UNIT	SHEET NO.
10/19/90	1"=6'	63174	28992A	PALMER	4

PROPOSED BY: DATE: 10-16-90
LAST CORRECTION BY: M. MCCARTHY
FILE NAME: 28992.TY1
1 3 4

SH. 5
JOB NO. 28992A
CONTROL SECTION 63174

ENGINEERING REPORT NO	ENVIRON IMPACT STMT
METHOD OF SURVEY	
SURVEY ORDER	YEAR
AERIAL SURVEY NO	SURVEY CHIEF
HORIZ DATUM	YEAR
ROAD DESIGN INITIATED 5-5-88	VERT DATUM
PRELIMINARY PLANS BY D. VAUGHN	COMPLETED 9-90
FIELD INSPECTION (GI) BY K. KRUGER	FINAL PLANS BY T. PALMER
PLANS-IN-HAND BY (FHWA) M. HOVEL	M. FISHER DATE 12-7-88
J. PATTEN	D. HILL DATE 1-30-89
	T. PALMER DATE 9-27-90
	J. KALMBACH

GENERAL PLAN NOTES

UNDERGROUND UTILITIES

FOR PROTECTION OF UNDERGROUND UTILITIES, THE CONTRACTOR SHALL DIAL 1-800-482-7171 A MINIMUM OF 72 HOURS PRIOR TO EXCAVATING IN THE VICINITY OF UTILITY LINES. ALL "MISS DIG" PARTICIPATING MEMBERS WILL THUS BE ROUTINELY NOTIFIED. THIS DOES NOT RELIEVE THE CONTRACTOR OF THE RESPONSIBILITY OF NOTIFYING UTILITY OWNERS WHO MAY NOT BE PART OF THE "MISS DIG" ALERT SYSTEM.

ADJUSTING MONUMENT BOXES

IT IS THE INTENT THAT ALL GOVERNMENT CORNERS ON THIS PROJECT BE PRESERVED AND THAT, WHERE NECESSARY, MONUMENT BOXES BE PLACED OR ADJUSTED, WHETHER SHOWN OR NOT.

OLD PLANS

THE FOLLOWING OLD PLANS WERE REFERRED TO IN THE DESIGN OF THIS PROJECT.
82252-142 63174-C14
63174-C61 63174-C66
63174-C70

IN ADDITION, OTHER OLD PLANS THAT PREDATE THIS PROJECT MAY BE AVAILABLE. THESE PLANS MAY BE REVIEWED IN THE LANSING DESIGN OFFICE DURING NORMAL WORKING HOURS.

SHOULDER CORES

THE CORING LOGS REPRESENT POINT INFORMATION. PRESENTATION OF THIS INFORMATION IN NO WAY INFERS THAT SUBSURFACE CONDITIONS ARE THE SAME OTHER THAN THE EXACT LOCATION OF THE CORINGS.

STATIONING

STATIONING ON THIS PROJECT WAS TAKEN FROM OLD PLANS AND PAVEMENT STENCILED STATIONING AND IS NOT NECESSARILY CORRECT.

SIGNS

ALL SIGNS REQUIRING RELOCATION DUE TO CONSTRUCTION OPERATIONS SHALL BE SALVAGED AND RESET BY THE CONTRACTOR AT LOCATIONS DESIGNATED BY THE ENGINEER. THIS WORK WILL BE CONSIDERED AS INCIDENTAL TO CONSTRUCTION OF THE PROJECT.

GUARDRAIL MATERIAL

ONLY GALVANIZED BEAM GUARDRAIL WILL BE USED ON THIS PROJECT.

BRIDGE UNDERCLEARANCES

EXISTING UNDECLEARANCES ON STRUCTURES OVER I-75 SHALL BE MAINTAINED AS NOTED ON PLANS OR DIRECTED BY THE ENGINEER.

SLOPE RESTORATION

ALL GRADED SLOPES SHALL BE MULCHED AND SEEDED AS DESCRIBED UNDER THE PAY ITEM "SLOPE RESTORATION".

JOINT & CRACK CLEANOUT

JOINT AND CRACK CLEANOUT IS ONLY FOR THE REMOVAL OF PRESSURE RELIEF JOINTS BEFORE OVERLAYING WITH BITUMINOUS AS DIRECTED BY THE ENGINEER. THE SEALING OF THESE JOINTS WILL CONSIST OF A BITUMINOUS MIXTURE AS APPROVED BY THE ENGINEER, THIS WILL BE PAID FOR BY THE TON AS "HAND PATCHING."

COOLING OF BITUMINOUS MAT

IT WILL BE THE CONTRACTORS RESPONSIBILITY TO MAKE SURE BITUMINOUS MAT IS PROPERLY COOLED BEFORE OPENING TO TRAFFIC. THIS OPERATION IS INCLUDED IN THE COST OF THE BITUMINOUS.

STAGING SEQUENCE

CENTER LANE JOINT REPAIRS SHALL BE DONE HALF AT A TIME. TRAFFIC WILL NOT BE ALLOWED TO DRIVE ON THE SHOULDER TAPER JOINTS MUST BE USED AND AT THE TIME OF PAVING THE CENTER LANE, TRAFFIC MUST BE SHIFTED TO A PREVIOUSLY PAVED LANE.

BITUMINOUS CONSTRUCTION JOINTS

BITUMINOUS CONSTRUCTION JOINTS MUST BE AT LEAST 4-1/2' LONG FOR A 1-1/2" COURSE, THIS SHALL BE IN PLACE BEFORE TRAFFIC CAN BE SHIFTED. BITUMINOUS TAPER JOINTS ARE REQUIRED ON THIS PROJECT. SEE THE SPECIAL PROVISION FOR DETAILS.

SHOULDER PATCHING

A MISCELLANEOUS QUANTITY OF HAND PATCHING HAS BEEN SET UP FOR REPAIRING THE EXISTING SHOULDER AS DIRECTED BY THE ENGINEER.

GUARD RAIL ANCHORAGE - BRIDGE

THE EXISTING GUARDRAIL ANCHORAGES THAT ATTACH TO THE EXISTING BRIDGES SHALL BE PAID FOR AS SALVAGED AND RECONSTRUCTED BEAM GUARDRAIL. TWO EXTRA POSTS SHALL BE ADDED TO THE ANCHORS OF THESE AND ALL OTHER EXISTING BRIDGE ANCHORS AND WILL BE PAID FOR SEPARATELY. DRILLING OF HOLES IN GUARDRAIL BEAMS, ALL HARDWARE AND INSTALLATION OF THE POST WILL BE MEASURED AS UNITS OF GUARD RAIL POST FURNISHED AND INSTALLED, 6".

PUBLIC UTILITIES

THE EXISTING UTILITIES LISTED BELOW AND SHOWN ON THESE PLANS REPRESENT THE BEST INFORMATION AVAILABLE. THIS INFORMATION DOES NOT RELIEVE THE CONTRACTOR OF THE RESPONSIBILITY TO BE SATISFIED AS TO IT'S ACCURACY AND THE LOCATION OF EXISTING UTILITIES.

NAME OF OWNER	KIND OF UTILITY
CITY OF MADISON HEIGHTS 300 W. 13 MILE RD. MADISON HEIGHTS, MICHIGAN 48071 ATTN: MR. PETER CONNERS, PUBLIC WORKS	SEWER, WATER
CITY OF ROYAL OAK 211 WILLIAM ST. ROYAL OAK, MICHIGAN 48067	SEWER, WATER
CONSUMERS POWER COMPANY 1955 PARWALL RD., ROOM JSC-202A JACKSON, MICHIGAN 49201 ATTN: W. ZIMMERMAN, LAND & ROW DEPT.	GAS
DETROIT EDISON COMPANY 2000 SECOND AVE. ROOM 6605B DETROIT, MICHIGAN 48226 ATTN: PAUL NORMANDIN	ELECTRIC
MICHIGAN BELL TELEPHONE COMPANY 444 MICHIGAN AVE. ROOM 635 DETROIT, MICHIGAN 48226 ATTN: KEITH REGAN	TELEPHONE
OAKLAND COUNTY DRAIN COMMISSION PUBLIC WORKS DRIVE PONTIAC, MICHIGAN 48054 ATTN: D. SNYDER, DEPUTY & CHIEF ENGINEER	SEWER
BUCKEYE PIPELINE COMPANY P.O. BOX 368 EMMAUS, PA. 18049-0368 ATTN: GEORGE FOX	OIL

NOTES APPLYING TO STANDARD PLANS

WHERE THE FOLLOWING ITEMS ARE CALLED FOR ON PLANS, THEY ARE TO BE CONSTRUCTED ACCORDING TO THE STANDARD PLAN GIVEN BELOW OPPOSITE EACH ITEM UNLESS OTHERWISE INDICATED.

CONCRETE PAVEMENT REPAIR	II-44G (SPECIAL DET)
GUARDRAIL BULLNOSE	III-56B (SPECIAL DET)
GUARDRAIL ENDINGS WITH CABLE ANCHORAGE	III-58K (SPECIAL DET)
SOIL EROSION & SEDIMENTATION CONTROL MEASURES	V-96C
SODDING AND SEEDING	V-100B
* SHOULDERS - FREEWAYS	V-112K
LIGHTED ARROWS AND BARRICADES	VI-125G
** SUPER ELEVATION AND PAVEMENT CROWNS	V-107D
* INCLUDED FOR SHOULDER CORRUGATIONS ONLY	
** INCLUDED FOR SHOULDER SLOPE AND SUPER TRANSITION ONLY (SUPER IN ACCORDANCE WITH AASHTO STRAIGHT LINE FRICTION TABLE)	
<u>ROAD SPECIAL DETAIL</u>	
BRIDGE RAILING THRIE BEAM RETROFIT	X-23A (SPEC. DET.)

MISCELLANEOUS ESTIMATES

THE FOLLOWING ITEMS OF WORK SHALL BE DONE AS THEY APPLY THROUGHOUT THE PROJECT. THESE ITEMS ARE NOT DETAILED OR INCLUDED ON THE PLAN AND PROFILE SHEETS:


	A	B	MOOT	TOTAL	UNIT
CLEANING EXISTING PAVEMENT	.12	.39	.49		1 LSUM
FLAG CONTROL	.12	.39	.49		1 LSUM
MINOR TRAFFIC DEVICES	.12	.39	.49		1 LSUM
LIGHTING FOR NIGHT PAVING	.12	.39	.49		1 LSUM
LIGHTED ARROW, TYPE A - FURNISHED	1	2	3		6 EACH
LIGHTED ARROW, TYPE A - OPERATED	1	2	3		6 EACH
BARRICADE, TYPE II, LIGHTED - FURNISHED	68	220	277		565 EACH
BARRICADE, TYPE II, LIGHTED - OPERATED	39	127	159		325 EACH
SIGN, TYPE A, TEMPORARY	2	8	10		20 SFT
SIGN, TYPE B, TEMPORARY	144	468	588		1200 SFT
TEMPORARY PAVEMENT MARKING, TYPE R 4" WHITE	5345	17375	21830		44550 LFT
TEMPORARY PAVEMENT MARKING, TYPE R 4" YELLOW	696	2262	2842		5800 LFT
THERMOPLASTIC PAVEMENT MARKING 4" WHITE			137240		137240 LFT
THERMOPLASTIC PAVEMENT MARKING 4" YELLOW			57800		57800 LFT
THERMOPLASTIC PAVEMENT MARKING 6" CROSS WALK LINE			2300		2300 LFT
THERMOPLASTIC PAVEMENT MARKING 12" CROSS WALK LINE			19815		19815 LFT
TEMPORARY PAVEMENT MARKING, TYPE NR (TAPE M*WHITE)	10692	34749	43659		89100 LFT
TEMPORARY PAVEMENT MARKING, TYPE NR (TAPE M*YELLOW)	1392	4524	5684		11600 LFT
BARRICADE, TYPE III, LIGHTED-FURNISHED	1	2	3		6 EACH
BARRICADE, TYPE III, LIGHTED-OPERATED	1	2	3		6 EACH
STRAW MULCH BLANKET	500				500 SYD
SLOPE RESTORATION	500				500 SYD
CEREAL RYE SEEDING	6				6 LBS
BIT. MIXNO. 1500L, 20AAA (PATCH GRINDING AREA)	48	156	196		400 TON
HAND PATCHING	10	40	50		100 TON
JOINT AND CRACK CLEANOUT	149	487	612		1248 LFT
CONCRETE PATCH GRINDING	383	1248	1568		3199 SYD
LONGITUDIAL JOINT REPAIR	240	780	980		2000 LFT
ON-THE-JOB TRAINING	180	285	285		750 HOUR
RECONSTRUCT DRAINAGE STRUCTURE	4	12	14		30 EACH
DRAINAGE STRUCTURE COVERS	1854	6026	7570		15450 LBS
MOBILIZATION	.12	.39	.49		1 LSUM
REPAIRING PAVEMENT JOINTS AND CRACKS, DET. 7	120	390	490		1000 LFT
REMOVAL OF SIGN, TYPE II			1		1 EACH
GUARD RAIL POST FURNISHED AND INSTALLED, 6"	8				8 EACH

EROSION AND SEDIMENTATION CONTROL QUANTITIES

HAY OR STRAW BALES	4	16	20		40 EACH
--------------------	---	----	----	--	---------

A - CITY OF MADISON HEIGHTS

B - CITY OF ROYAL OAK

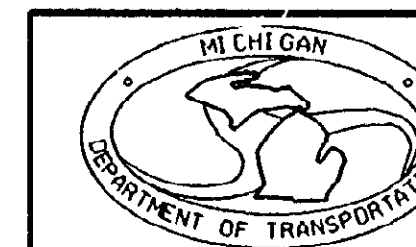

NOTE SHEET

DATE	CONT. SEC.	JOB NO.	DESIGN UNIT	SHEET NO.
10/19/90	63174	28992A	PALMER	R.O.W CONST. 5

DATE: 10-19-90
DATE: 10-19-90
DATE: 10-19-90
PROPOSED BY: M. MCCARTHY
LAST CORRECTION BY: M. MCCARTHY
FILE NAME: 28991.NTI
1 2

CONTROL SECTION 63174 JOB NO. 28992A

EXISTING BY: HAGERMAN
 PROPOSED BY: RHOBACK/1
 DATE: 10-16-90

FINAL R.O.W.			
AUTH	DATE	NO.	REVISION

I-75 CONST. &
 CURVE DATA
 $\Delta = 08^{\circ}20'23''$ L
 $D = 01^{\circ}15'00''$
 $R = 4583.66'$
 $T = 334.18'$
 $L = 667.18'$
 $E = 12.17'$
 $PC = 263+04.29$
 $PI = 266+38.47$
 $PT = 269+71.47$
 NO SUPER

CITY OF DETROIT
 WAYNE COUNTY
 T1S - R11E

8 MILE RD.

CITY OF HAZEL PARK

CITY OF DETROIT

S10 OF 82252

CITY LIMITS

MICHIGAN PROJECT FIR 75-2(387)58
 P.O.B. STA 273+50+
 CONTROL SECTION 63174
 JOB NO. 28992A

QUANTITIES THIS SHEET

4167 TON	BIT MIXTURE NO. 1500T, 20AAA - RUBBER
4427 TON	BIT MIXTURE NO. 1500L, 20AAA - RUBBER
665 SYD	CHIPPING CONC PAVT FOR JOINTS
64 EACH	ADJ DR. STRUCTURE COVERS
2934 SYD	COLD-MILLING CONC SURFACE

I-75 CONST. &
 CURVE DATA
 $\Delta = 72^{\circ}59'28''$ L
 $D = 02^{\circ}40'00''$
 $R = 2148.59'$
 $T = 1589.62'$
 $L = 2737.17'$
 $E = 524.11'$
 $PC = 715+67.06$
 $PI = 731+56.68$
 $PT = 743+04.23$
 EX & PROP SUPER = 0.05'/FT


CITY OF HAZEL PARK

MAINTAIN 14'-8"
 PO4 OF 63174A
 CLEARANCE 14'-8"

MAINTAIN 14'-7"
 PO3 OF 63174A
 CLEARANCE 14'-7"

LEGEND

	COLD-MILL EX CONC PAVT
	CHIPPING CONC PAVT FOR JOINTS
	ADJUST

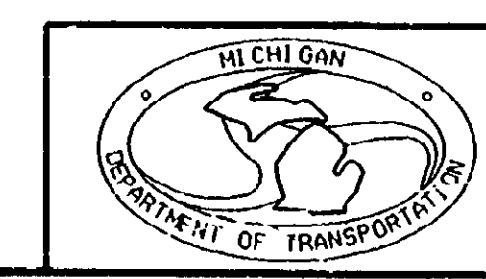

I-75 STA 260+00 TO STA 745+00					
DATE	SCALE	CONT. SEC.	JOB NO.	DESIGN UNIT	SHEET NO.
10/19/88	1" = 100'	63174	28992 A	PALMER	6


FILE NAME: 289220260.DWG
 1 2 3

EXISTING BY: DATE: 10-16-90
 PROPOSED BY: RHOBACK/1
 LAST CORRECTION BY: RHOBACK/1

FINAL R.O.W.			
AUTH	DATE	NO.	REVISION

I-75 CONST. CURVE DATA
 $\Delta = 60^\circ 20' 44'' \text{RT}$
 $D = 04^\circ 20' 00''$
 $R = 1322.21'$
 $T = 768.70'$
 $L = 1392.59'$
 $E = 207.22'$
 $PC = 747+58.00$
 $PI = 755+26.70$
 $PT = 751+50.59$
 EX & PROP SUPER = 0.05/FT


I-75 CONST. CURVE DATA
 $\Delta = 03^\circ 50' 16'' \text{LT}$
 $D = 00^\circ 30' 00''$
 $R = 11459.16'$
 $T = 383.92'$
 $L = 767.56'$
 $E = 6.43'$
 $PC = 769+76.08$
 $PI = 773+60.00$
 $PT = 777+43.63$
 EX & PROP SUPER = 0.01/FT

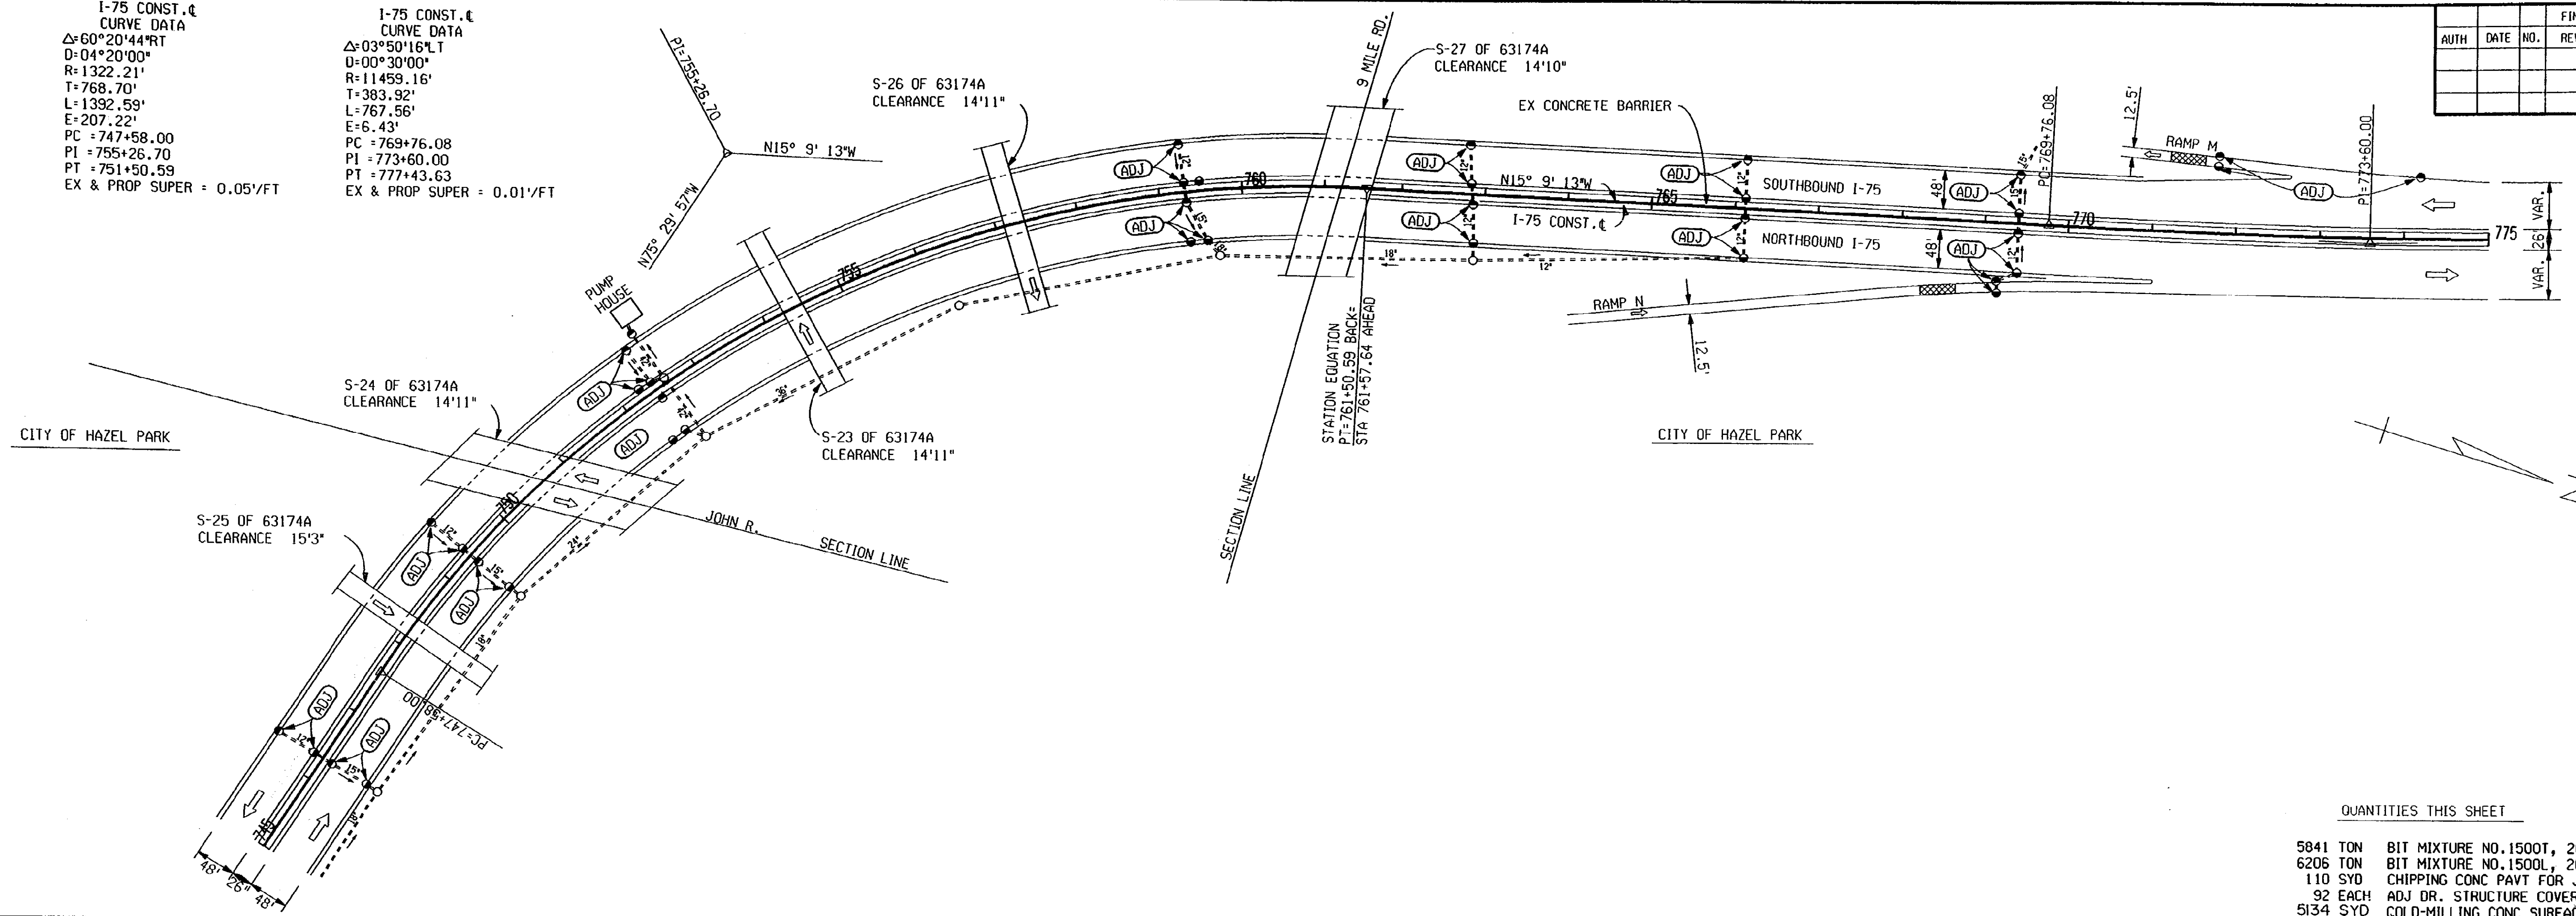

QUANTITIES THIS SHEET


5841 TON	BIT MIXTURE NO. 1500T, 20AAA - RUBBER
6206 TON	BIT MIXTURE NO. 1500L, 20AAA - RUBBER
110 SYD	CHIPPING CONC PAVT FOR JOINTS
92 EACH	ADJ DR. STRUCTURE COVERS
5134 SYD	COLD-MILLING CONC SURFACE

I-75 CONST. CURVE DATA
 $\Delta = 08^\circ 14' 32'' \text{RT}$
 $D = 00^\circ 15' 25''$
 $R = 22298.90'$
 $T = 1606.66'$
 $L = 3207.70'$
 $E = 57.81'$
 $PC = 782+20.00$
 $PI = 798+26.66$
 $PT = 814+27.78$
 NO SUPER

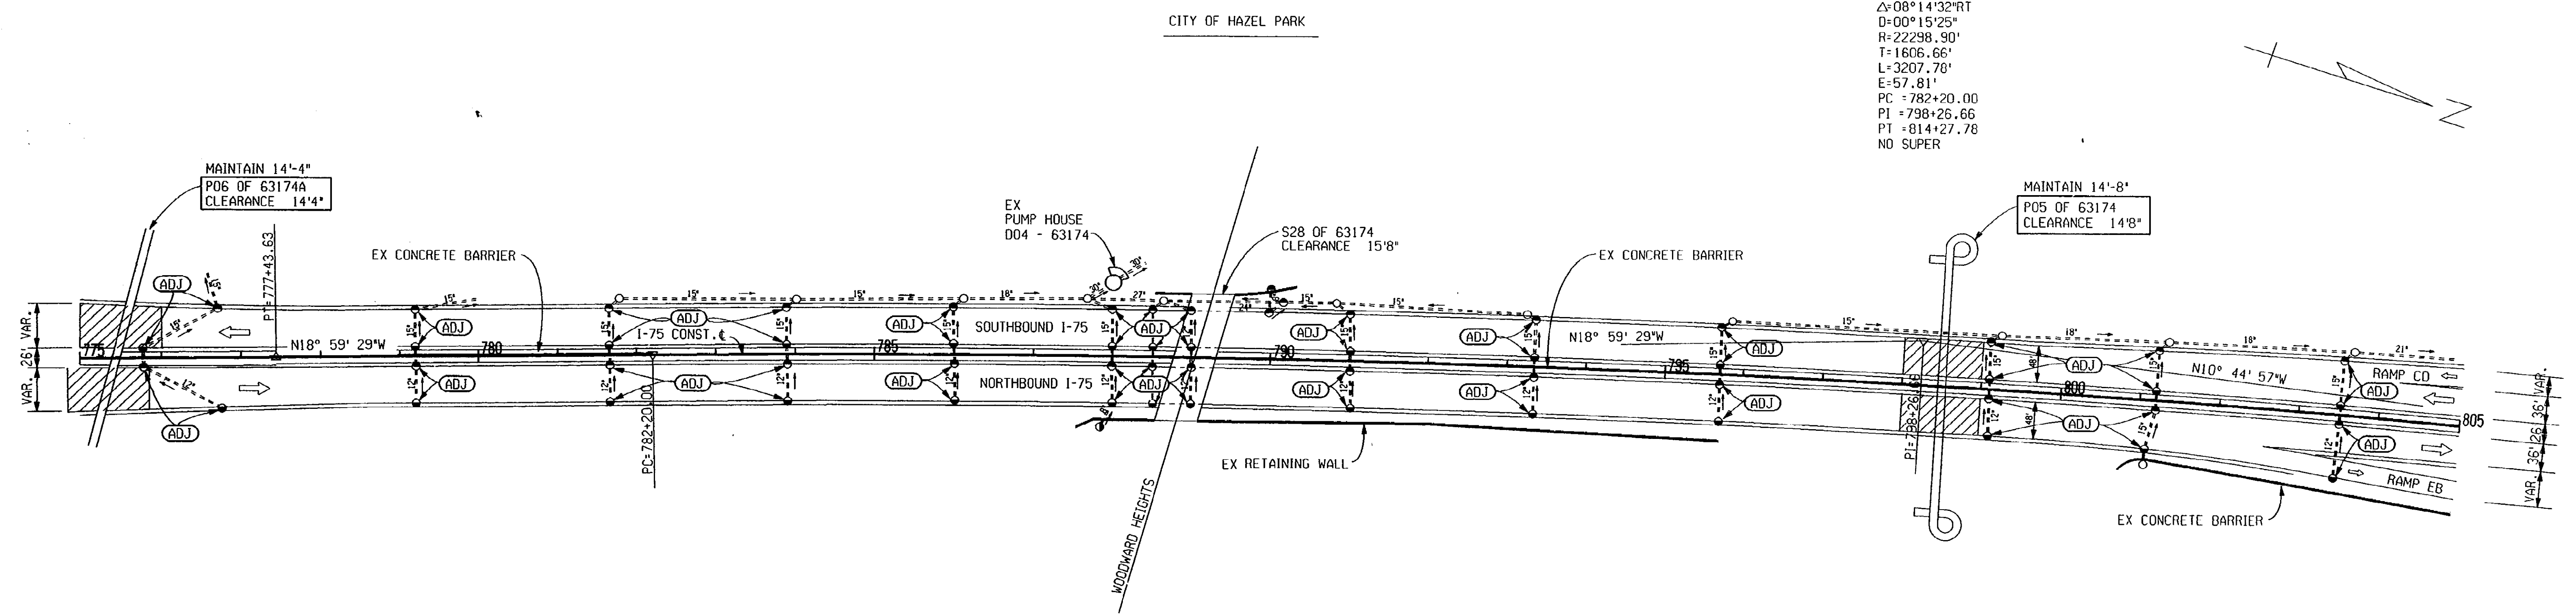

33
24 25 26
21 22
17
FILE NAME: 289920745.DWG
1 2 3



	I-75 STA 745+00 TO STA 805+00					
	DATE	SCALE	CONT. SEC.	JOB NO.	DESIGN UNIT	SHEET NO.
	10/19/88	1"=100'	63174	28992 A	PALMER	R.O.W CONST. 7

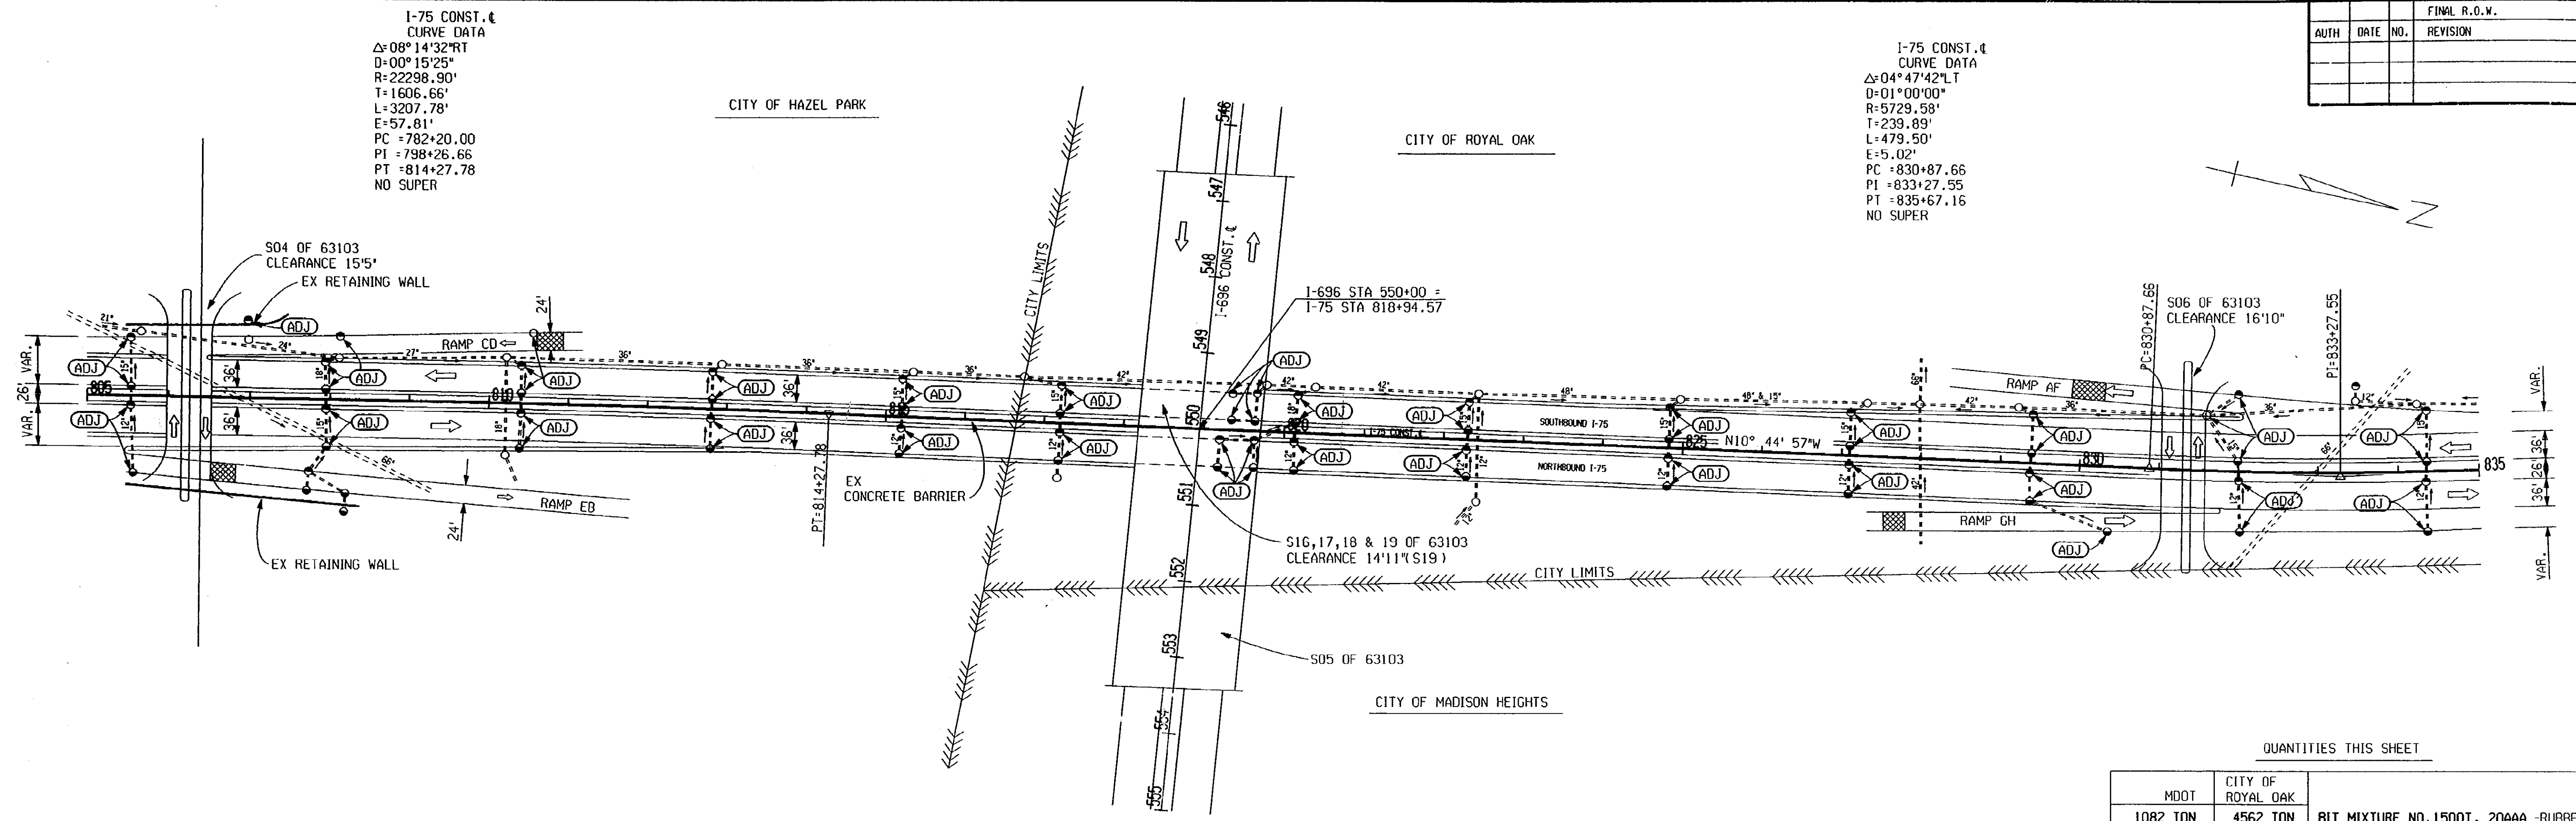

FINL R.O.W.			
AUTH	DATE	NO.	REVISION

QUANTITIES THIS SHEET

MDOT	CITY OF ROYAL OAK	
1082 TON	4562 TON	BIT MIXTURE NO. 1500T, 20AAA - RUBBER
1150 TON	4847 TON	BIT MIXTURE NO. 1500L, 20AAA - RUBBER
160 SYD	270 SYD	CHIPPING CONC PAYT FOR JOINTS
22 EACH	83 EACH	ADJ DR. STRUCTURE COVERS

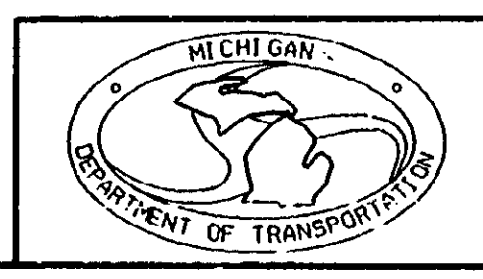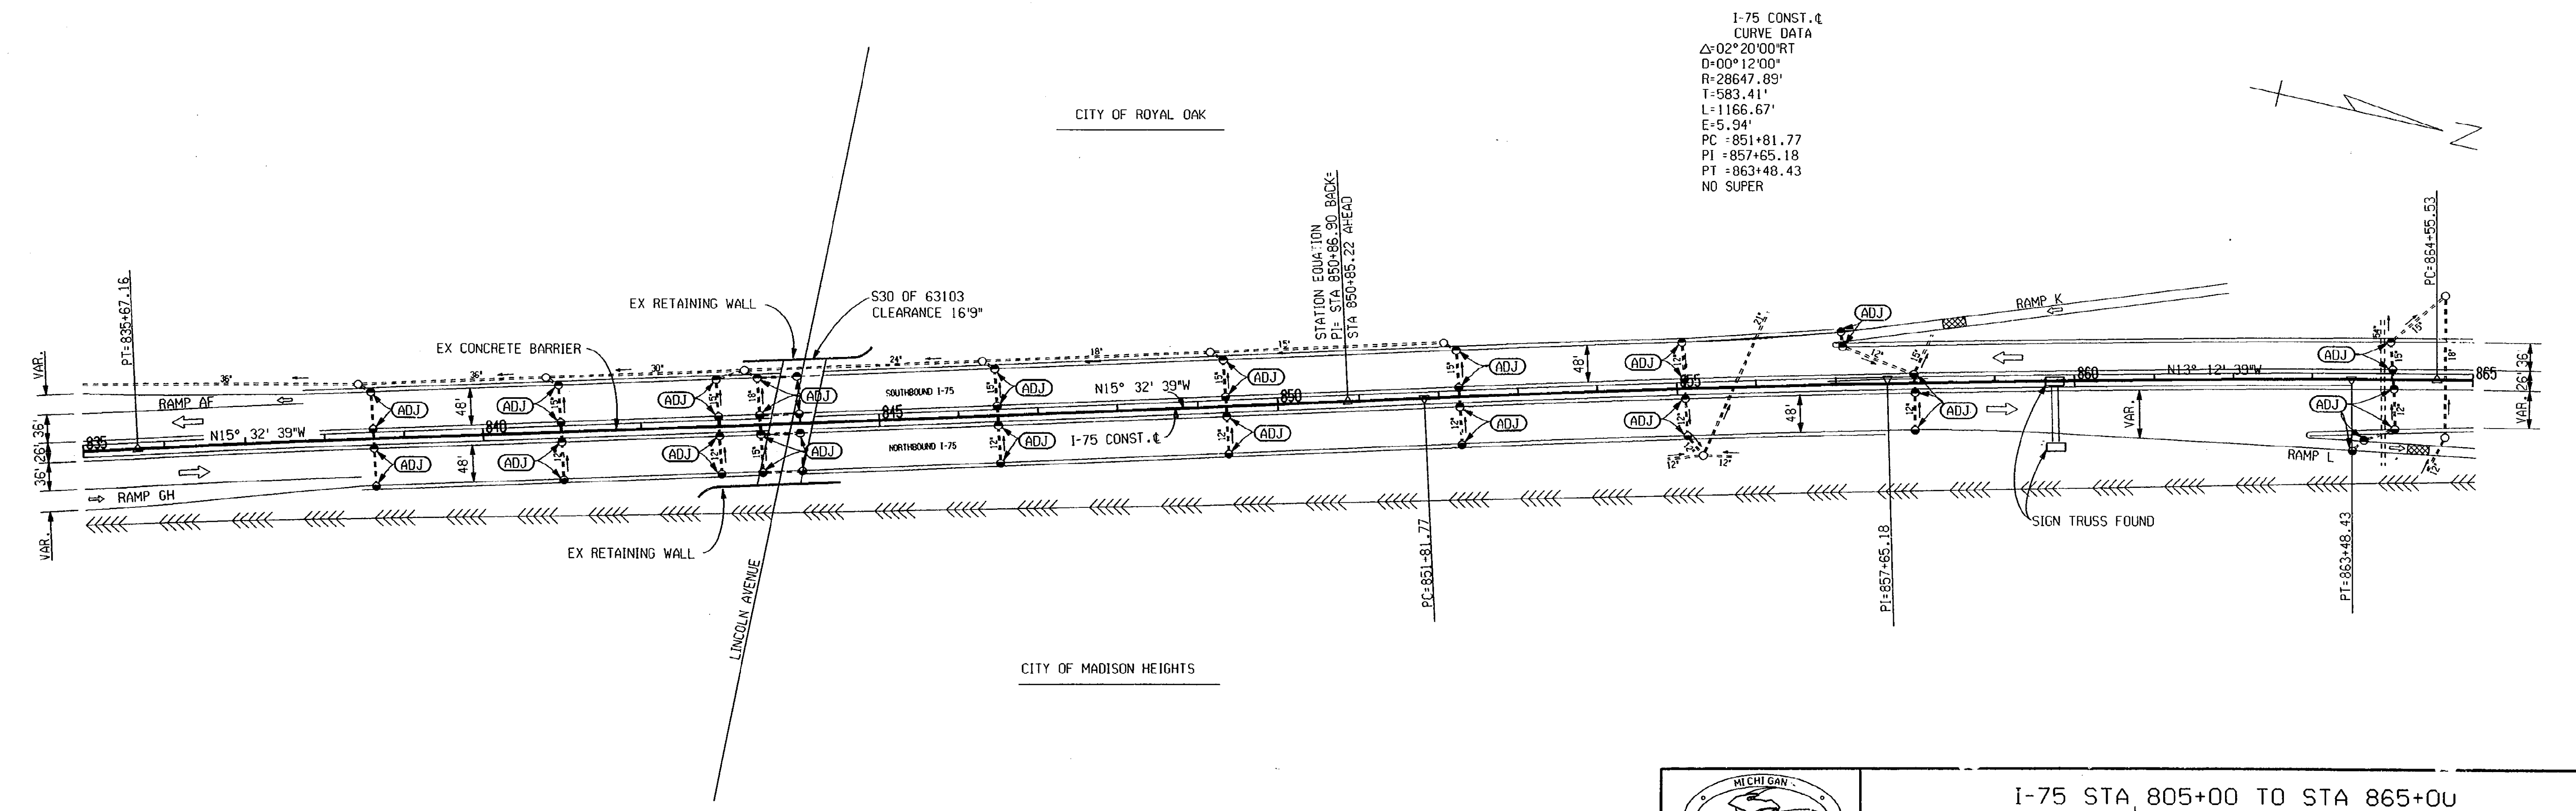

I-75 STA 805+00 TO STA 865+00


DATE	SCALE	CONT. SEC.	JOB NO.	DESIGN UNIT	SHEET NO.
10/19/90	1" = 100'	63174	28992 A	PALMER	R.O.W. CONST. 8

CONTROL SECTION 63174 JOB NO. 28992 A SHEET NO. 9
 EXISTING BY: DATE: 10/19/90
 PROPOSED BY: M. MCCARTHY
 LAST CORRECTION BY: M. MCCARTHY DATE: 10-19-90

FINAL R.O.W.			
AUTH	DATE	NO.	REVISION

I-75 CONST. & CURVE DATA
 $\Delta = 01^{\circ}10'00''$ LT
 $D = 00^{\circ}12'00''$
 $R = 28647.89'$
 $T = 291.68'$
 $L = 583.33'$
 $E = 1.48'$
 $PC = 864+55.53$
 $PI = 867+47.21$
 $PT = 870+36.78$ BACK = 870+36.67 AHEAD

I-75 CONST. & CURVE DATA
 $\Delta = 11^{\circ}25'10''$ RT
 $D = 01^{\circ}40'00''$
 $R = 3437.75'$
 $T = 343.72'$
 $L = 685.17'$
 $E = 17.14'$
 $PC = 875+69.33$
 $PI = 879+13.05$
 $PT = 882+54.50$
 EX & PROP SUPER = 0.05'/FT

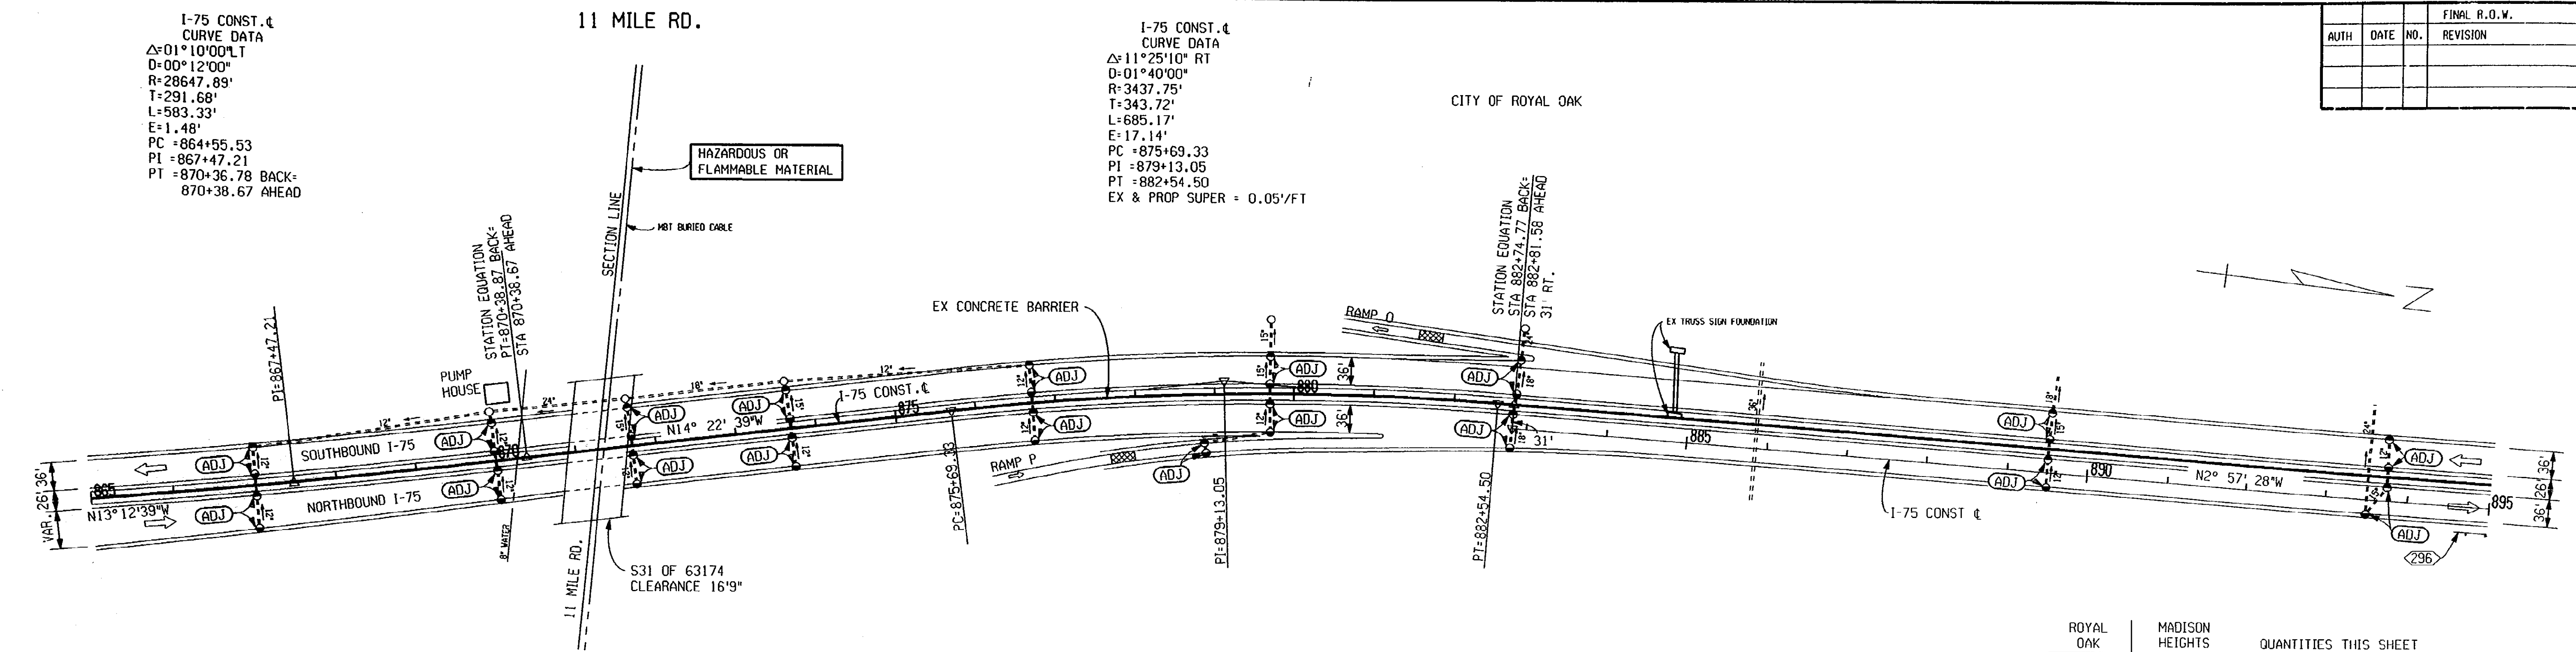


ROYAL OAK	MADISON HEIGHTS	QUANTITIES THIS SHEET
3212 TON	3040 TON	BIT MIXTURE NO. 1500T, 20AAA - RUBBER
3412 TON	2653 TON	BIT MIXTURE NO. 1500L, 20AAA - RUBBER
107 SYD	2356 SYD	CHIPPING CONC PAVT FOR JOINTS
60 EACH	12 EACH	ADJ. DR. STRUCTURE COVERS
	1040 LFT	BRIDGE RAILING THRIE BEAM RETROFIT
	1156 SYD	COLD-MILLING CONC SURFACE
	225 LFT	REMOVING BEAM GUARD RAIL

GARDENIA AVE.

I-75 SB CONST. & CURVE DATA
 $\Delta = 29^{\circ}59'53''$ RT
 $D = 02^{\circ}52'35''$
 $R = 1991.86'$
 $T = 533.68'$
 $L = 1042.87'$
 $E = 70.26'$
 $PC = 899+80.93$
 $PI = 905+14.61$
 $PT = 910+23.80$
 EX & PROP SUPER = 0.05'/FT

I-75 CONST. & CURVE DATA
 $\Delta = 29^{\circ}02'20''$ LT
 $D = 03^{\circ}00'00''$
 $R = 1909.86'$
 $T = 494.61'$
 $L = 967.96'$
 $E = 63.01'$
 $PC = 915+39.22$
 $PI = 920+33.83$
 $PT = 925+07.18$
 EX & PROP SUPER = 0.57'/FT

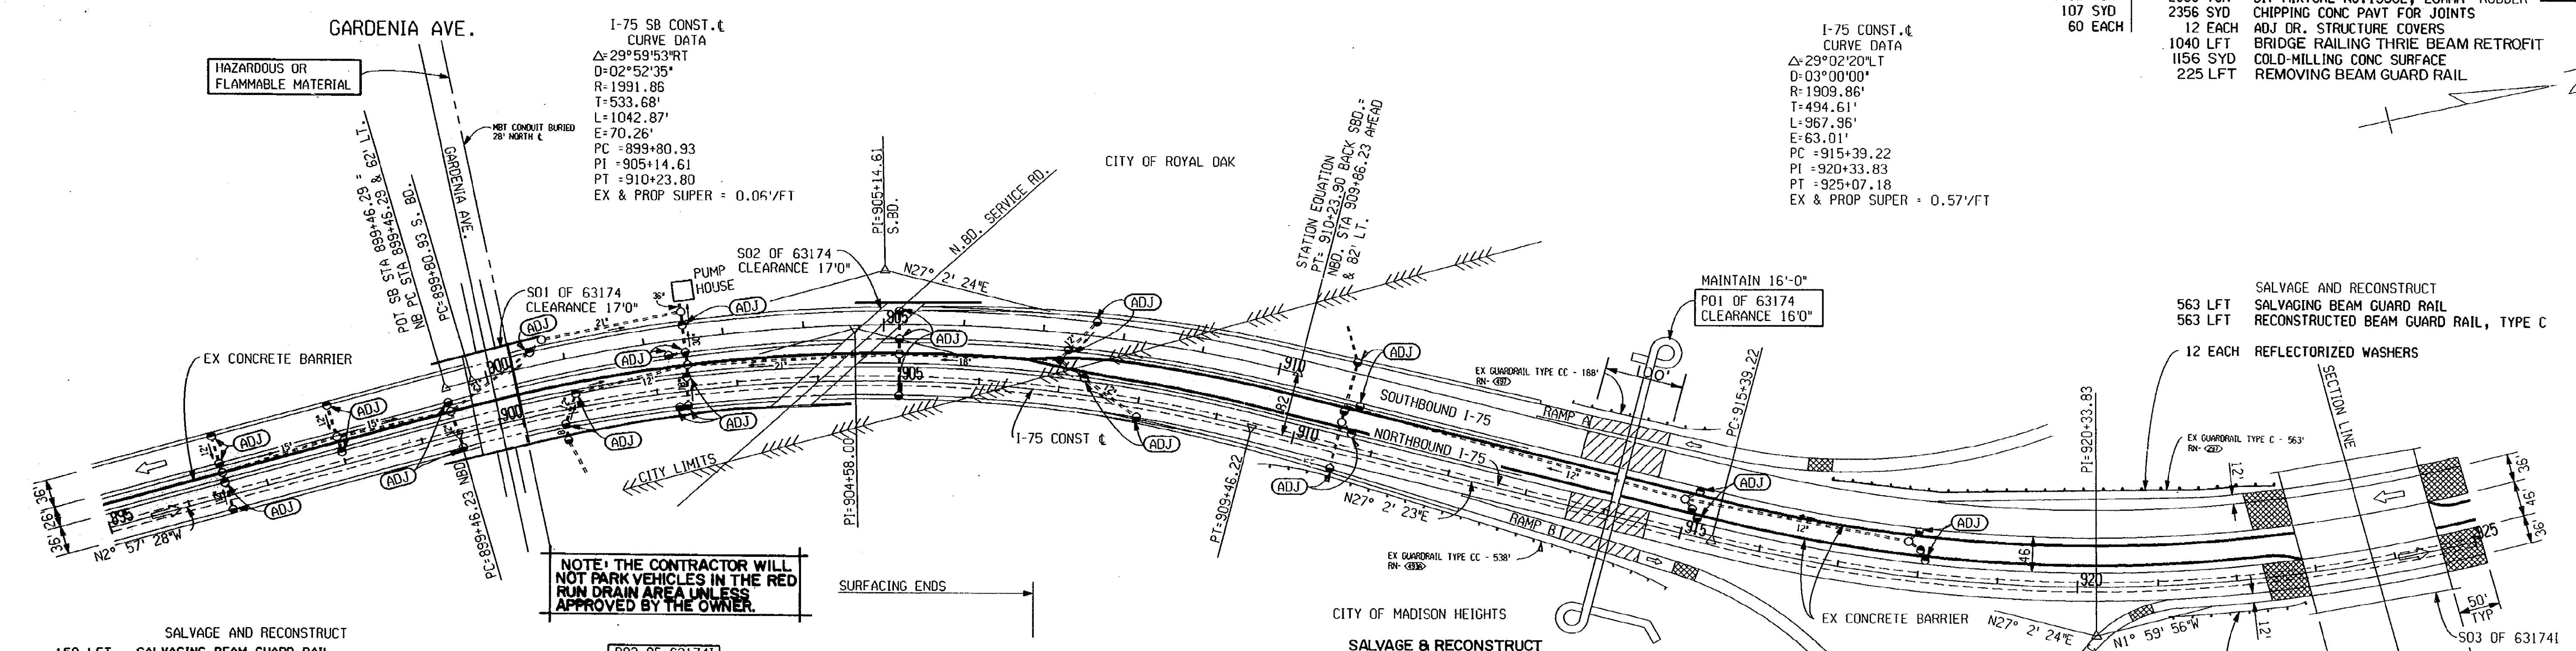

NOTE: THE CONTRACTOR WILL NOT PARK VEHICLES IN THE RED RUN DRAIN AREA UNLESS APPROVED BY THE OWNER.

- SALVAGE AND RECONSTRUCT
- 150 LFT SALVAGING BEAM GUARD RAIL
- 150 LFT RECONSTRUCTED BEAM GUARD RAIL, TYPE C
- 1 EACH GUARD RAIL ANCH, CABLE
- 7 EACH REFLECTORIZED WASHERS

PROP. BRIDGE RAILING THRIE BEAM RETROFIT (SEE SPEC. DETAIL X-23A & TYP. SHEET)


MICHIGAN PROJ FIR 75-2(387)58
 P.O.E STA. 935+00 NBD I-75
 CONTROL SECTION 63174
 JOB NO. 28992A

- SALVAGE & RECONSTRUCT
- 154 LFT EX. 154' TYPE C GUARD RAIL
- 154 LFT SALVAGING BEAM GUARD RAIL
- 110 LFT RECONST. BEAM GUARD RAIL, TYPE C
- 1 EACH GUARD RAIL ANCH, CABLE
- 7 EACH REFLECTORIZED WASHERS
- 44 LFT GALV. BEAM GUARD RAIL, TYPE T


- SALVAGE AND RECONSTRUCT
- 438 LFT SALVAGING BEAM GUARD RAIL
- 438 LFT RECONSTRUCTED BEAM GUARD RAIL, TYPE C
- 14 EACH REFLECTORIZED WASHERS

- SALVAGE AND RECONSTRUCT
- 238 LFT SALVAGING BEAM GUARD RAIL
- 194 LFT RECONSTRUCTED BEAM GUARD RAIL, TYPE C
- 1 EACH GUARD RAIL ANCH, CABLE
- 10 EACH REFLECTORIZED WASHERS
- 44 LFT GALV. BEAM GUARD RAIL, TYPE T

- PLACE NEW GUARD RAIL BULLNOSE
- 100 LFT GALV. BEAM GUARD RAIL, TYPE B
- 62.5 LFT GALV. CURVED BEAM GUARD RAIL, TYPE B
- 6 EACH REFLECTORIZED WASHERS
- 50 CYD EMBANKMENT (LM)
- 88 LFT GALV. BEAM GUARD RAIL, TYPE T

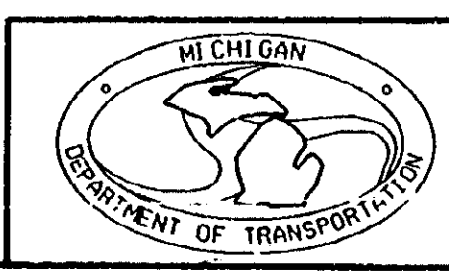

I-75 STA 865+00 TO STA 935+00 (P.O.E.)					
DATE	SCALE	CONT. SEC.	JOB NO.	DESIGN UNIT	SHEET NO.
10/19/90	1"=100'	63174	28992 A	PALMER	R.O.W. CONST. 9

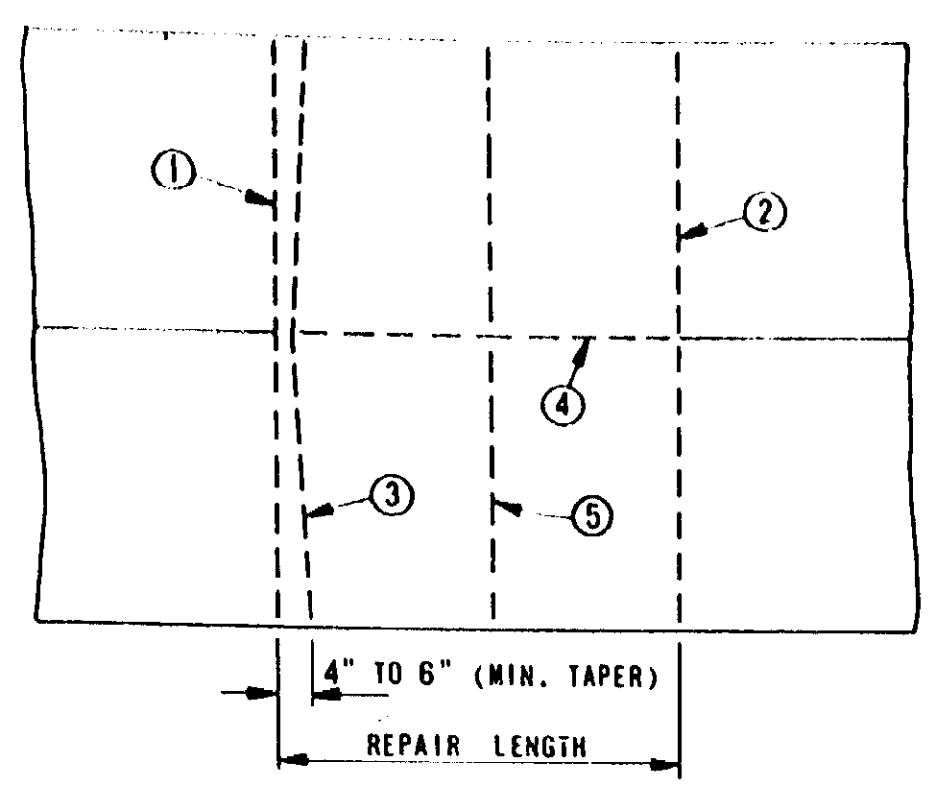

THIS METHOD OF REMOVING DISTRESSED CONCRETE SHALL BE USED IN CONJUNCTION WITH FULL DEPTH CAST-IN-PLACE REPAIRS (DETAILS 3 & 3A) LESS THAN 50' LONG, AND IS OPTIONAL FOR REPAIRS OVER 50' IN LENGTH.


① & ② THESE SAW CUTS SHALL BE FULL DEPTH AND PERPENDICULAR TO THE EDGE OF THE ROADWAY, WITHIN A TOLERANCE OF 1".

③ THIS FULL DEPTH SAW CUT IS MADE TO FACILITATE OPENING A TRENCH ACROSS THE SLAB TO RELIEVE COMPRESSION IN THE PAVEMENT PRIOR TO LIFTING OUT THE FAILED AREA. THIS SAW CUT MAY BE OMITTED PROVIDED NO SPALLING OF THE REMAINING CONCRETE PAVEMENT OCCURS. IF SPALLING DOES OCCUR, THE CONTRACTOR WILL BE REQUIRED TO MAKE THIS SAW CUT ON SUBSEQUENT REPAIRS. WHEN THIS SAW CUT IS USED AND THE ADJACENT LANE IS NOT REPAIRED, NO OVERCUTTING INTO THAT LANE SHALL BE MADE.

④ THIS SAW CUT IS MADE FULL DEPTH BETWEEN LANES, BETWEEN A LANE AND A CURB, AND BETWEEN A LANE AND A RAMP.

⑤ IF REQUIRED, INTERMEDIATE SAW CUTS MAY BE MADE TO REMOVE A SECTION OF PAVEMENT LANE WHICH IS OVER 6 FEET IN LENGTH, TO PERMIT LOADING INTO THE HAULING UNITS.


ADDITIONAL SAW CUTS, AT CONTRACTOR'S EXPENSE, MAY BE MADE INSIDE THE REPAIR LIMITS TO REDUCE 6-FOOT BY 12-FOOT SLABS INTO SMALLER PIECES TO FACILITATE REMOVAL.

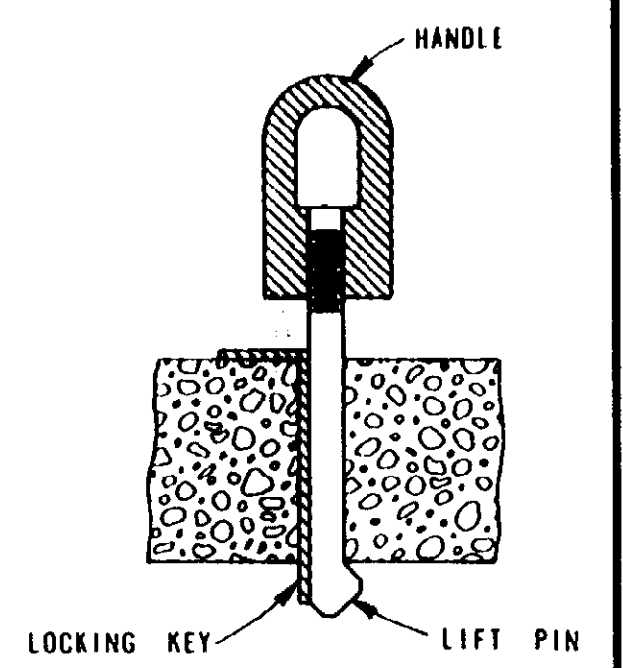


Schematic of Typical Lift Pin Assembly

SAWING DIAGRAM & LIFT PIN FOR REMOVING OLD SLAB

DETAIL 1

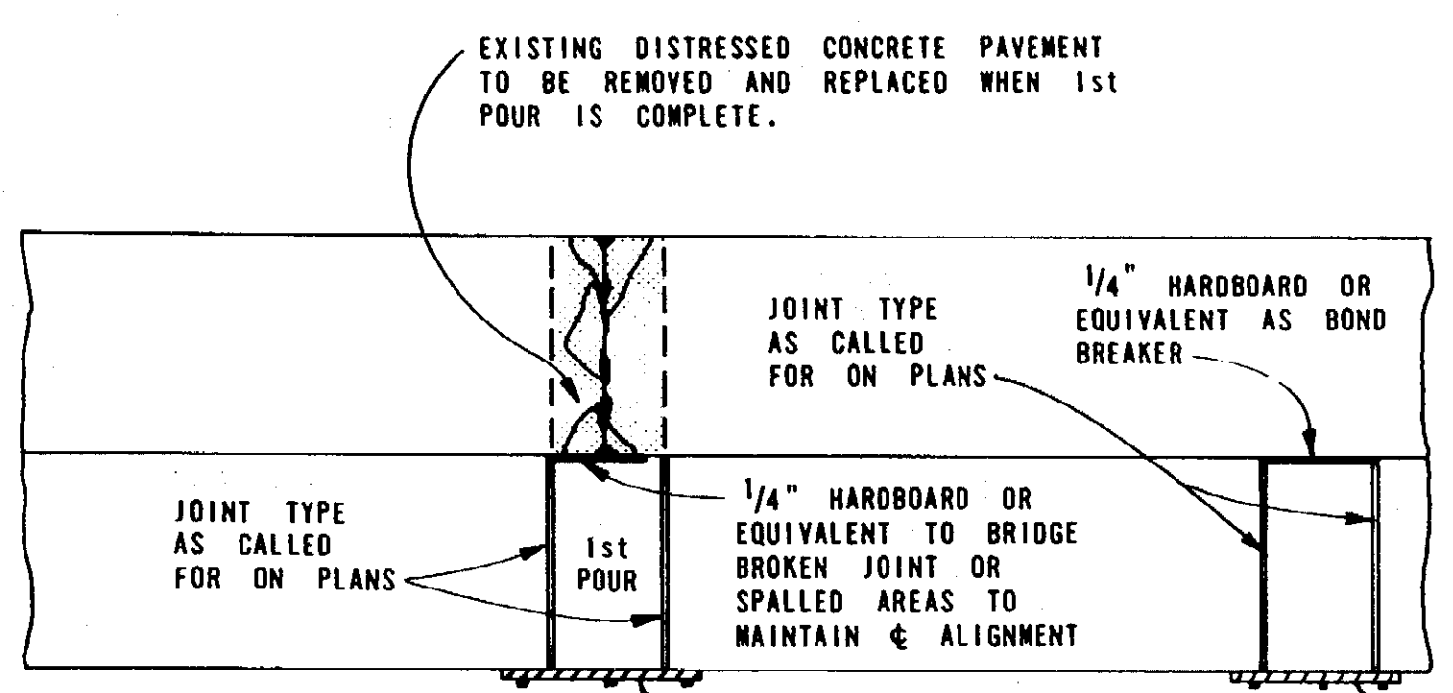

Repair Length 12' or Less

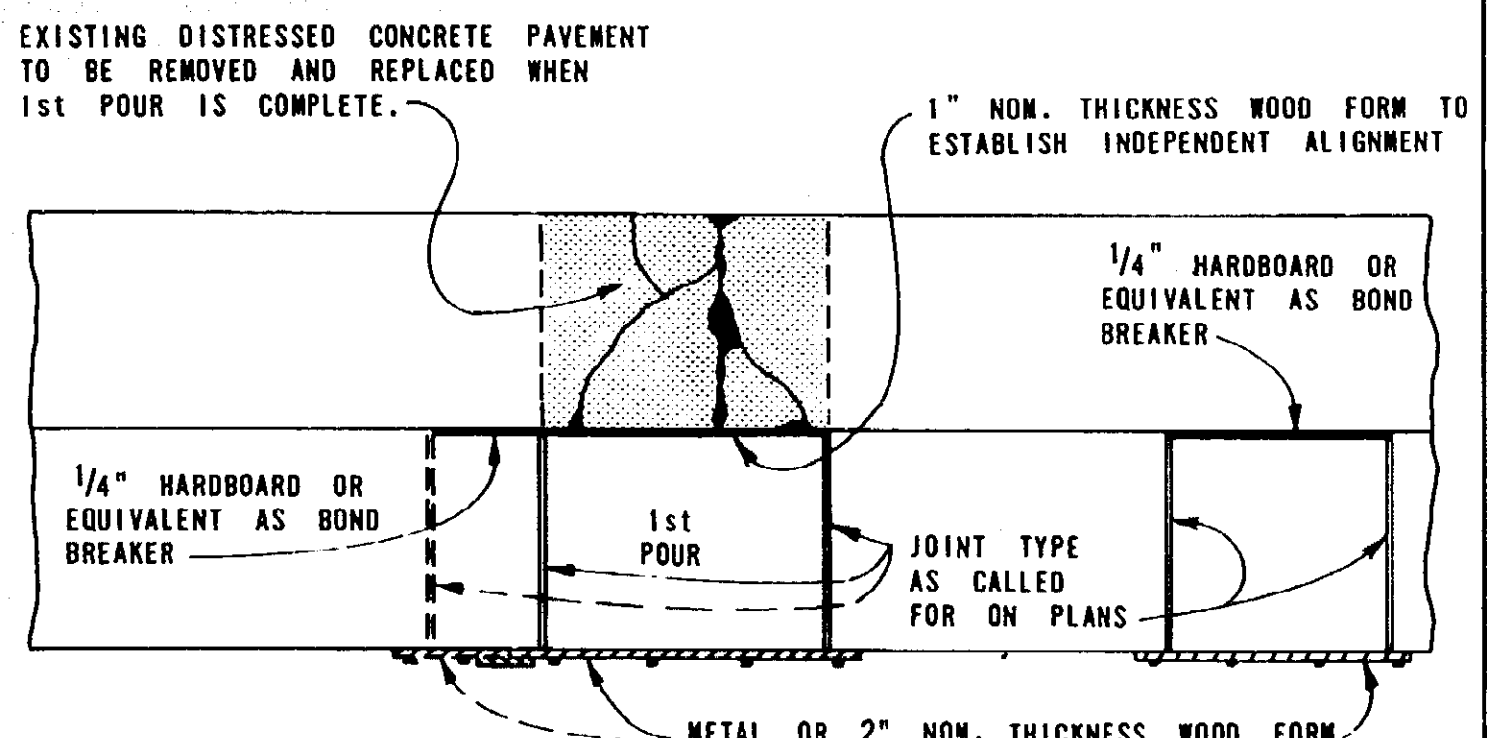


Repair Length More Than 12'

NOTE: STAKES USED TO HOLD BITUMINOUS FILLER OR HARDBOARD IN PLACE DURING CONCRETE PLACEMENT SHALL BE REMOVED BEFORE SCREEDING THE CONCRETE.


FORMING REQUIREMENTS FOR CAST-IN-PLACE REPAIR

DETAIL 2

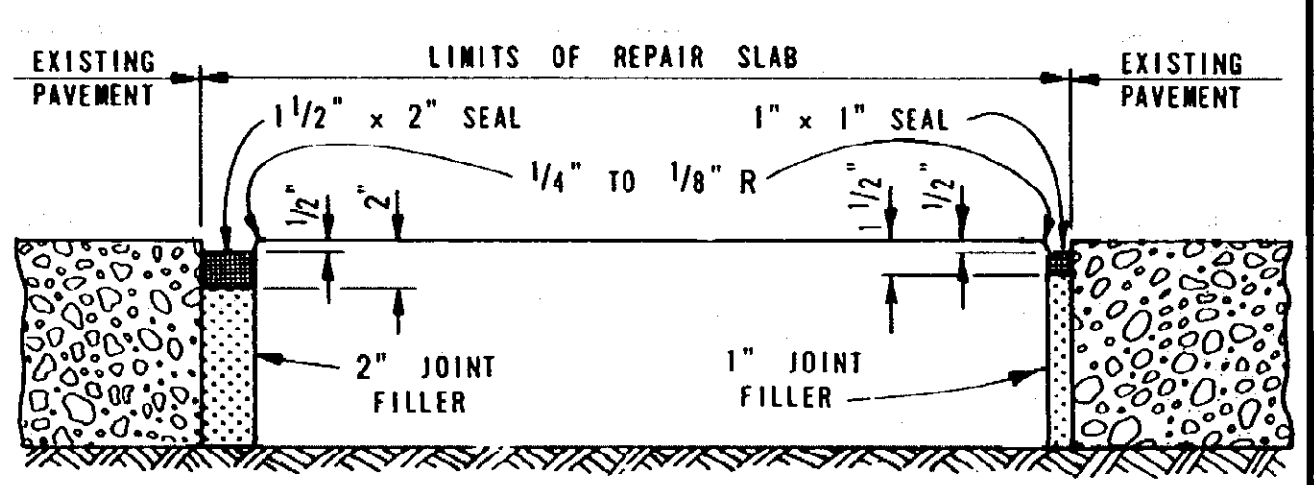

Expansion Joint Type "A"

Expansion Joint Type "B"

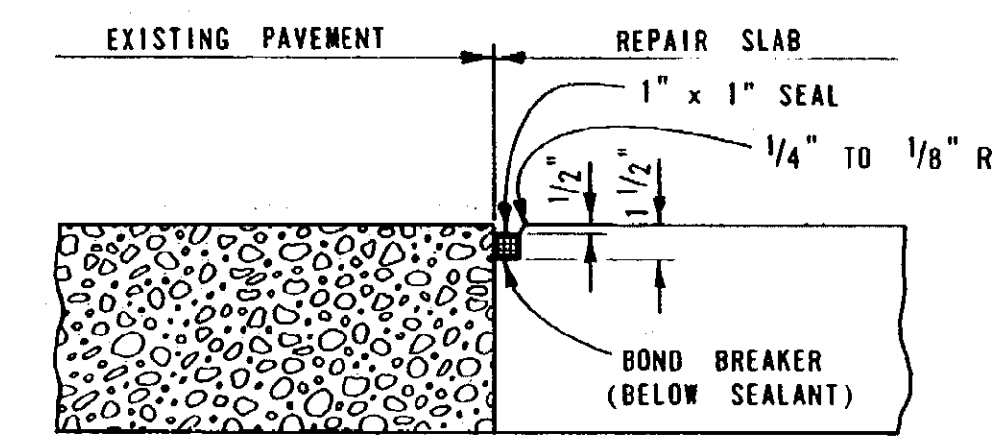

Contraction Joint Type "C"


NOTE: WHEN PLACING CONCRETE PAVEMENT REPAIRS IN CONCRETE PAVEMENTS WITH BITUMINOUS OVERLAYS, THE REPAIR SHALL BE CONSTRUCTED AS SHOWN ABOVE EXCEPT THE SURFACE OF THE CONCRETE REPAIR SHALL BE CONSTRUCTED LEVEL WITH THE TOP OF THE EXISTING BITUMINOUS SURFACE.

UNDOWELED CAST-IN-PLACE REPAIR JOINTS Ur

DETAIL 3


<p>PREPARED BY DESIGN DIVISION</p> <p>DRAWN BY: H.A.W.</p> <p>CHECKED BY: C.A.L.</p>	ENGINEER OF CONSTRUCTION	ENGINEER - ROAD DESIGN
	ENGINEER OF MAINTENANCE	ENGINEER OF DESIGN
	ENGINEER OF MATERIALS & TECHNOLOGY	DEPARTMENT DIRECTOR JAMES P. PITZ
	ENGINEER OF TRAFFIC AND SAFETY	DEPUTY DIRECTOR - HIGHWAYS

MICHIGAN DEPARTMENT OF TRANSPORTATION BUREAU OF HIGHWAYS STANDARD PLAN FOR	
CONCRETE PAVEMENT REPAIR	
F.W.A. APPROVAL	6-30-89 PLAN DATE
II-44G	SHEET 1 OF 4

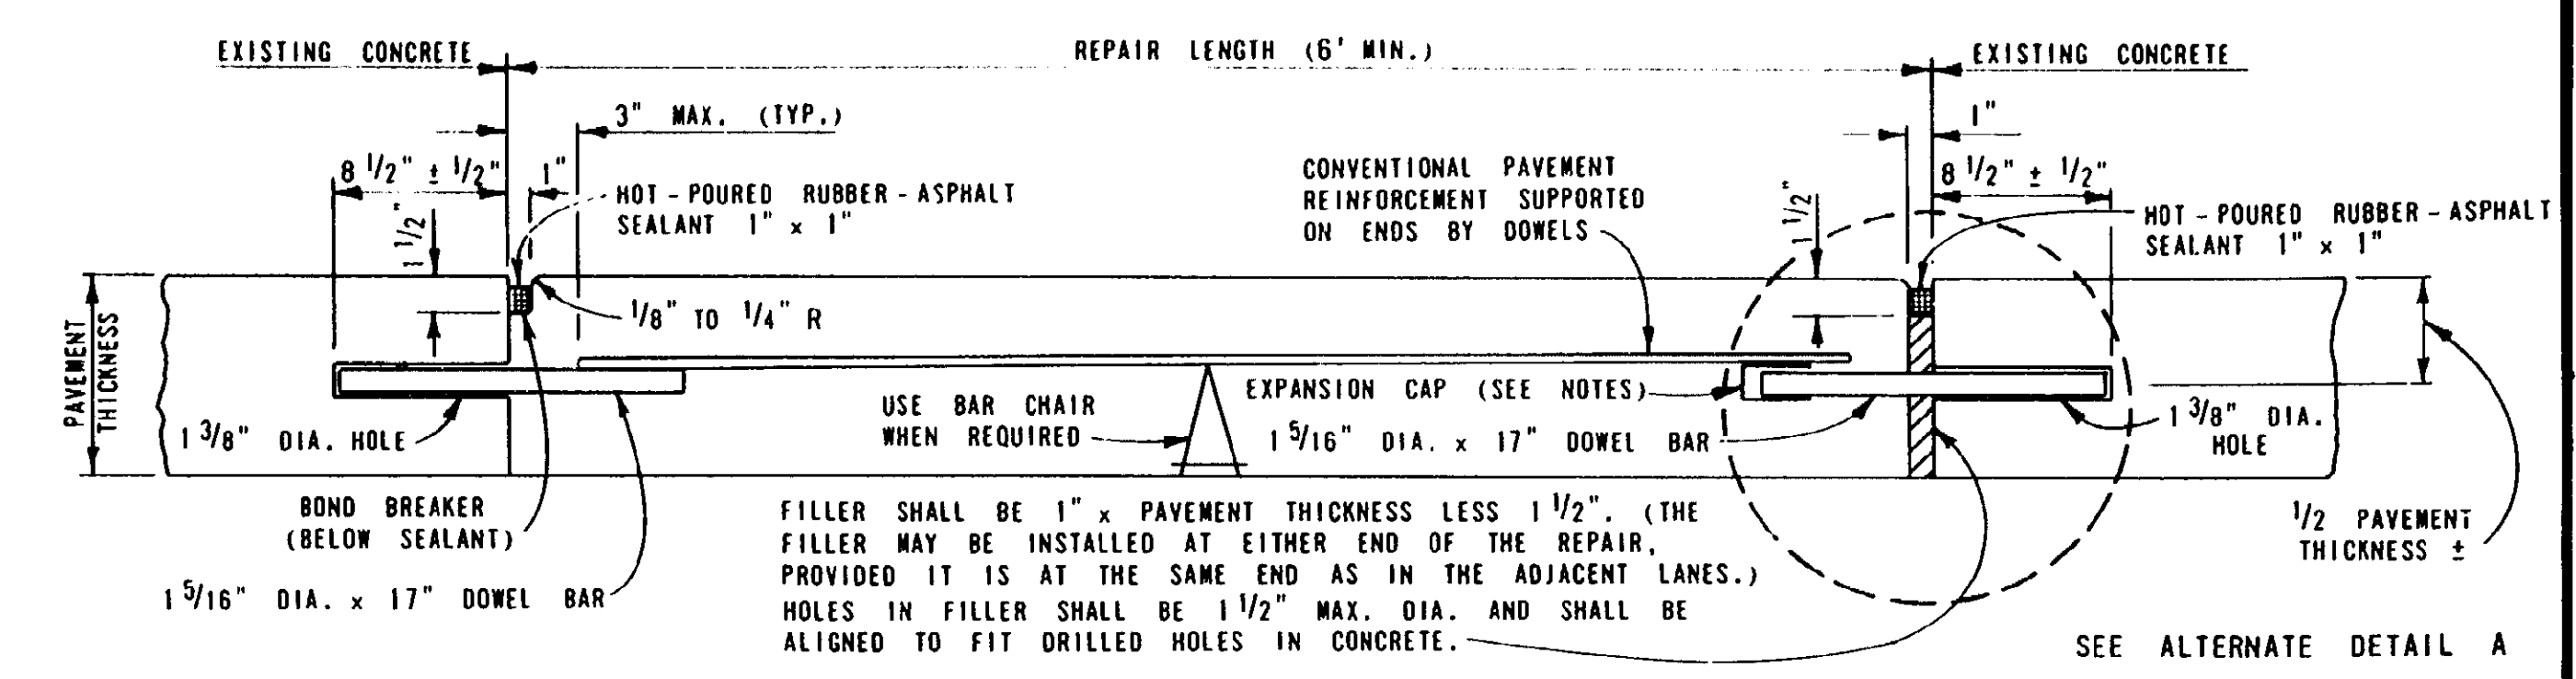


CONTRACTION JOINT Cr


EXPANSION JOINT Er

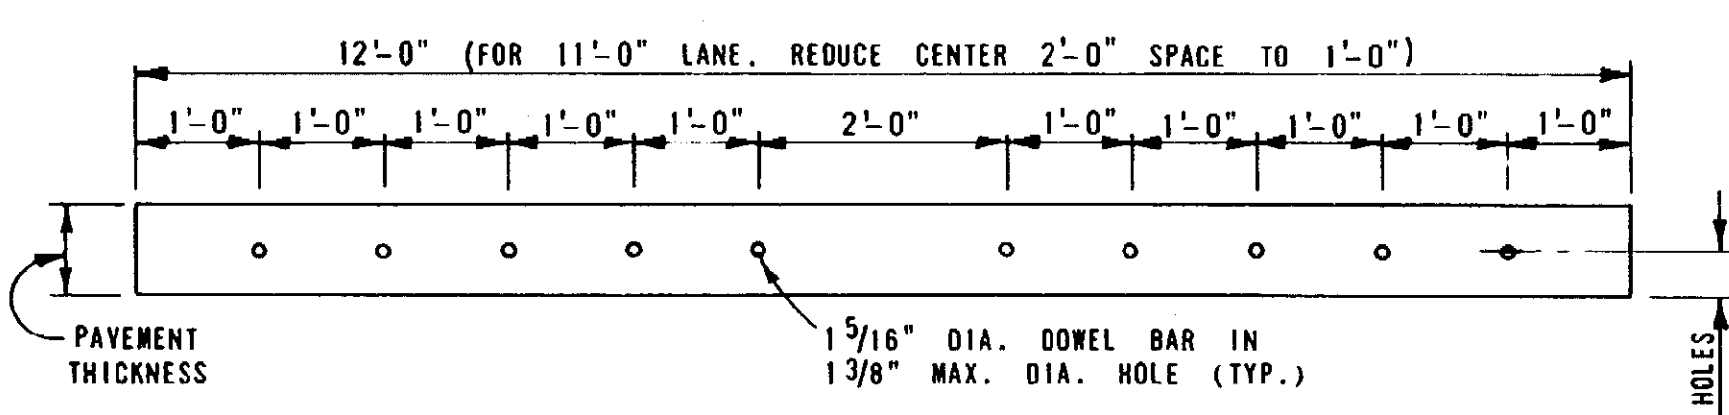


DOWEL BAR SPACING FOR REPAIRS

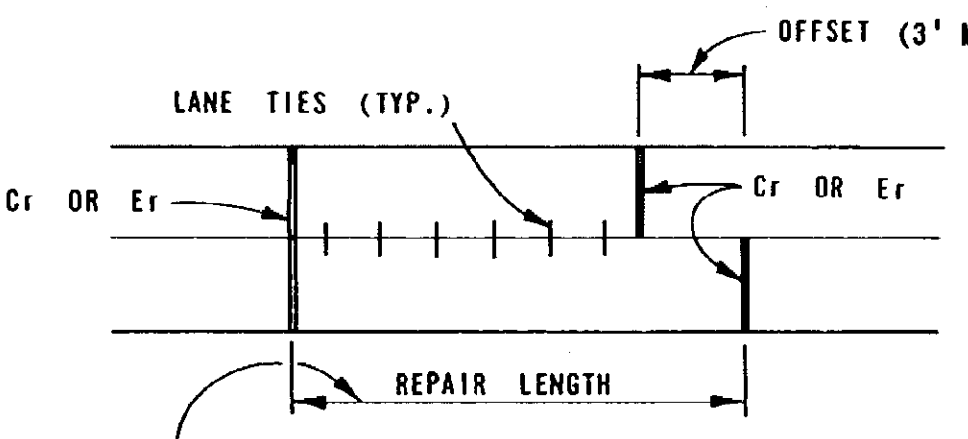

Repair Length Less Than One Slab Length (Two-Lane Repairs)

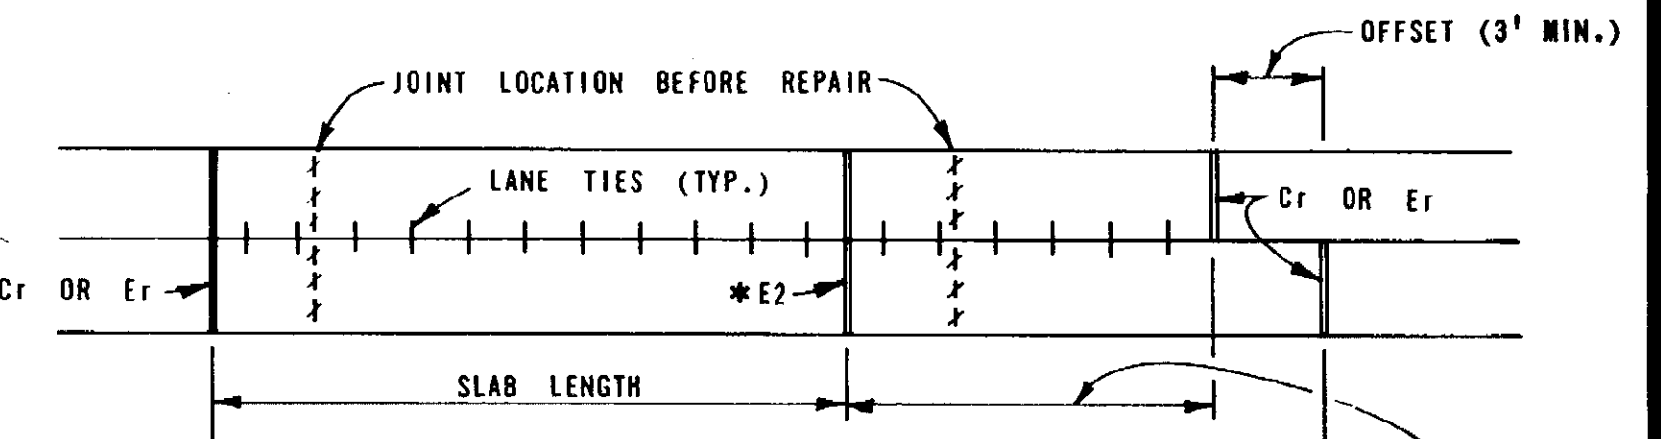

Repair Length Greater Than One Slab Length (One-Lane Repairs)

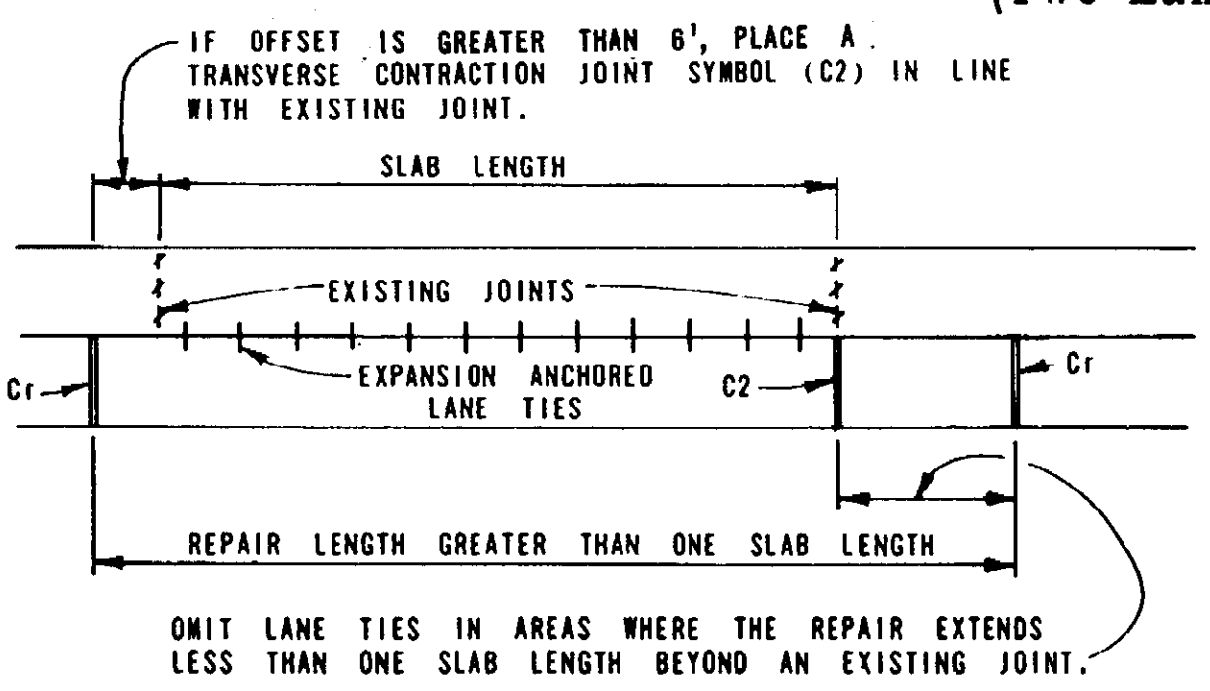

LANE TIES FOR DOWELED REPAIRS

NOTES:

LONGITUDINAL LANE TIES, WHEN REQUIRED, SHALL BE SPACED IN ACCORDANCE WITH STANDARD PLAN II-41 SERIES, EXCEPT THE FIRST LANE TIE ADJACENT TO A TRANSVERSE JOINT SHALL BE INSTALLED AT A DISTANCE OF 1'-8".

EXPANSION CAPS SHALL BE FABRICATED FROM A MINIMUM 28 GAGE SHEET STEEL AND SHALL BE SIZED SO AS TO PROVIDE A SLIP FIT ON THE SHOP PAINTED DOWEL BAR. THE EXPANSION CAP SHALL CONTAIN A SINGLE LONGITUDINAL TIGHTLY ROLLED "S" SEAM, WITH A SUITABLE STOP TO MAINTAIN THE END OF THE CAP A MINIMUM DISTANCE OF 1" FROM THE END OF THE DOWEL DURING CONCRETE PLACEMENT AND TO PROVIDE A MINIMAL EXPANSION RESISTANCE FOR SUBSEQUENT MOVEMENT OF THE BAR IN THE CAP. THE EXPANSION CAP SHALL BE COMPLETELY CLOSED AT THE END BY CRIMPING AND SHALL BE OF A UNIFORM DIAMETER FOR A MINIMUM LENGTH OF 4". A SAMPLE OF EACH DESIGN OF EXPANSION CAP SHALL BE SUBMITTED TO THE ENGINEER OF TESTING AND RESEARCH ALONG WITH A SHOP DRAWING FOR APPROVAL PRIOR TO USE. CAPS MADE OF OTHER MATERIALS AND/OR DESIGNS, IF TESTED AND APPROVED BY THE ENGINEER, MAY BE USED AT THE OPTION OF THE CONTRACTOR.

A BOND-BREAKING COAT OF LIQUID ASPHALT (MDOF RC-250) IS REQUIRED ON THE PORTION OF THE DOWEL BAR EXTENDING INTO THE NEW CONCRETE WHEN EXPANSION CAPS ARE USED.

SEE STANDARD PLAN II-39 SERIES FOR TRANSVERSE PAVEMENT JOINTS SYMBOLS (C2) AND (E2).





DOWELED CAST-IN-PLACE REPAIR JOINTS

DETAIL 3A

<p>PREPARED BY DESIGN DIVISION</p> <p>DRAWN BY: H.A.W.</p> <p>CHECKED BY: C.A.L.</p>	ENGINEER OF CONSTRUCTION	ENGINEER - ROAD DESIGN
	ENGINEER OF MAINTENANCE	ENGINEER OF DESIGN
	ENGINEER OF MATERIALS & TECHNOLOGY	DEPARTMENT DIRECTOR JAMES P. PITZ
	ENGINEER OF TRAFFIC AND SAFETY	DEPUTY DIRECTOR - HIGHWAYS





MICHIGAN DEPARTMENT OF TRANSPORTATION BUREAU OF HIGHWAYS STANDARD PLAN FOR	
CONCRETE PAVEMENT REPAIR	
F.W.A. APPROVAL	6-30-89 PLAN DATE
II-44G	SHEET 2 OF 4

CONTROL SECTION 63174 FOR 28992A

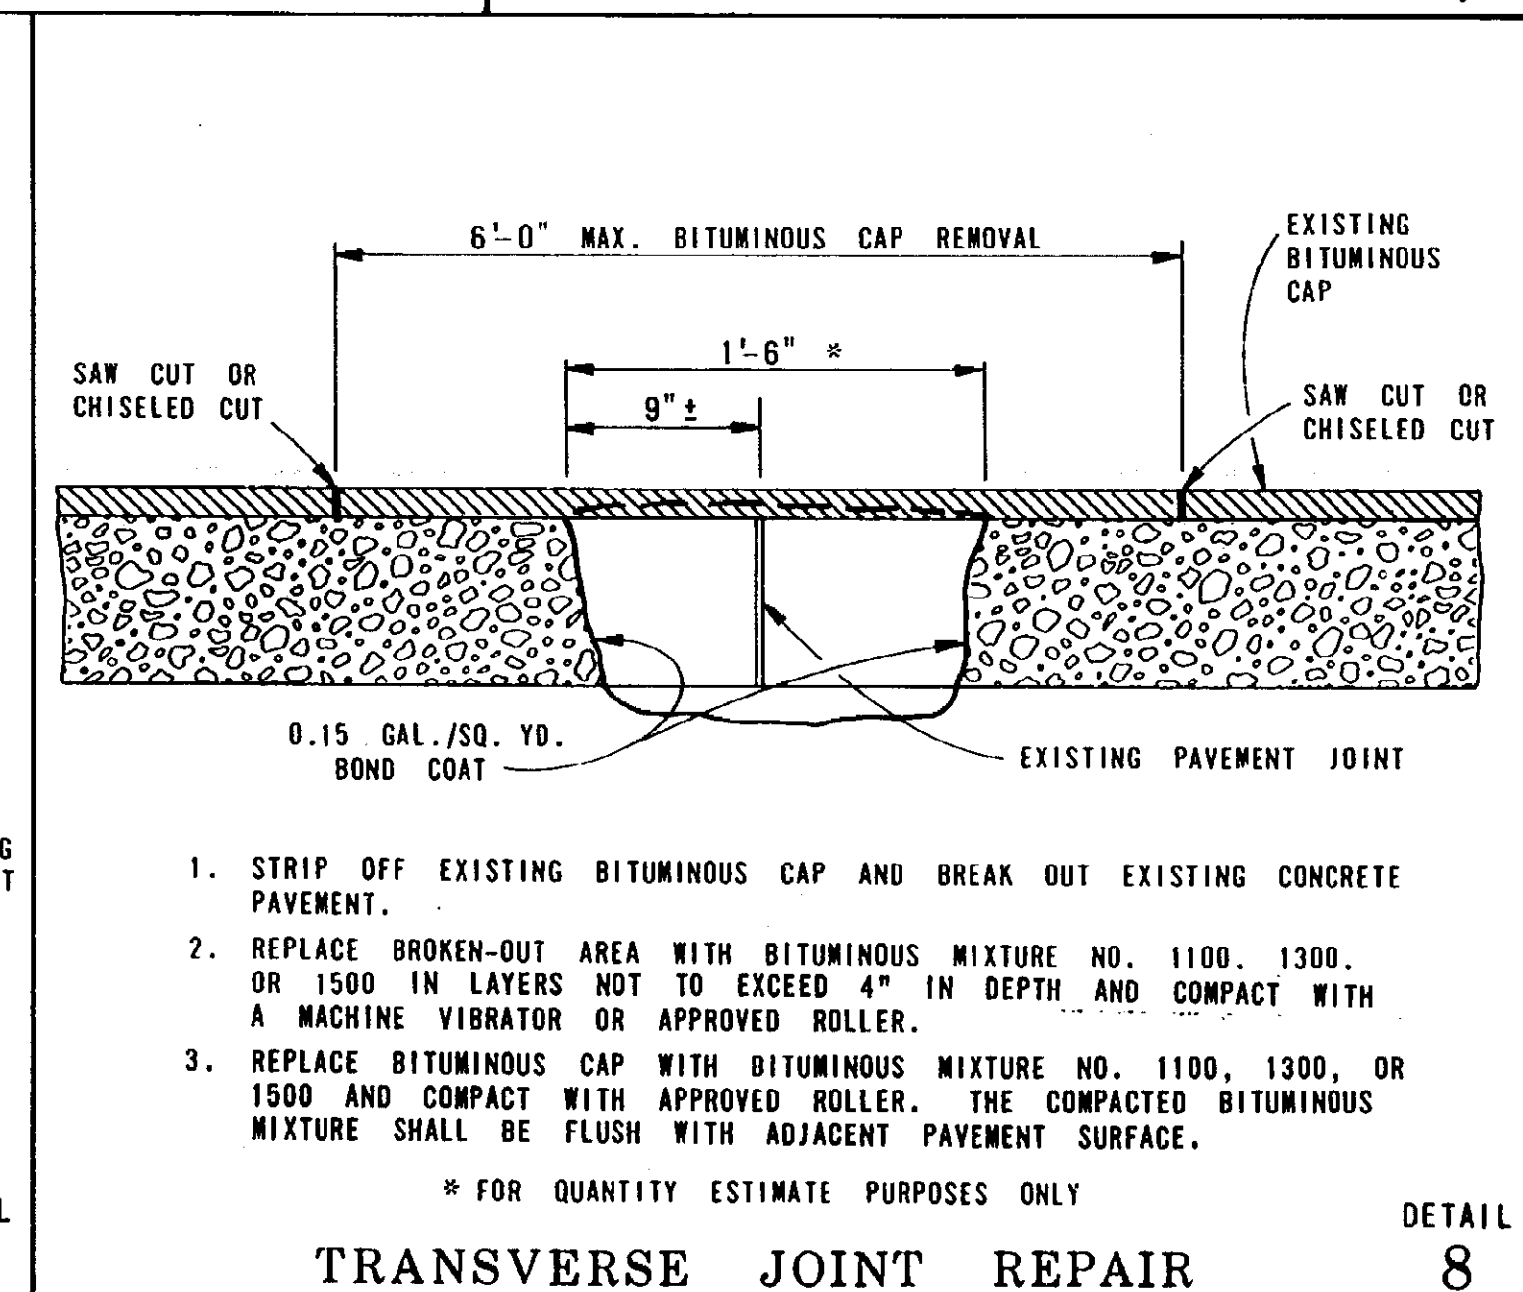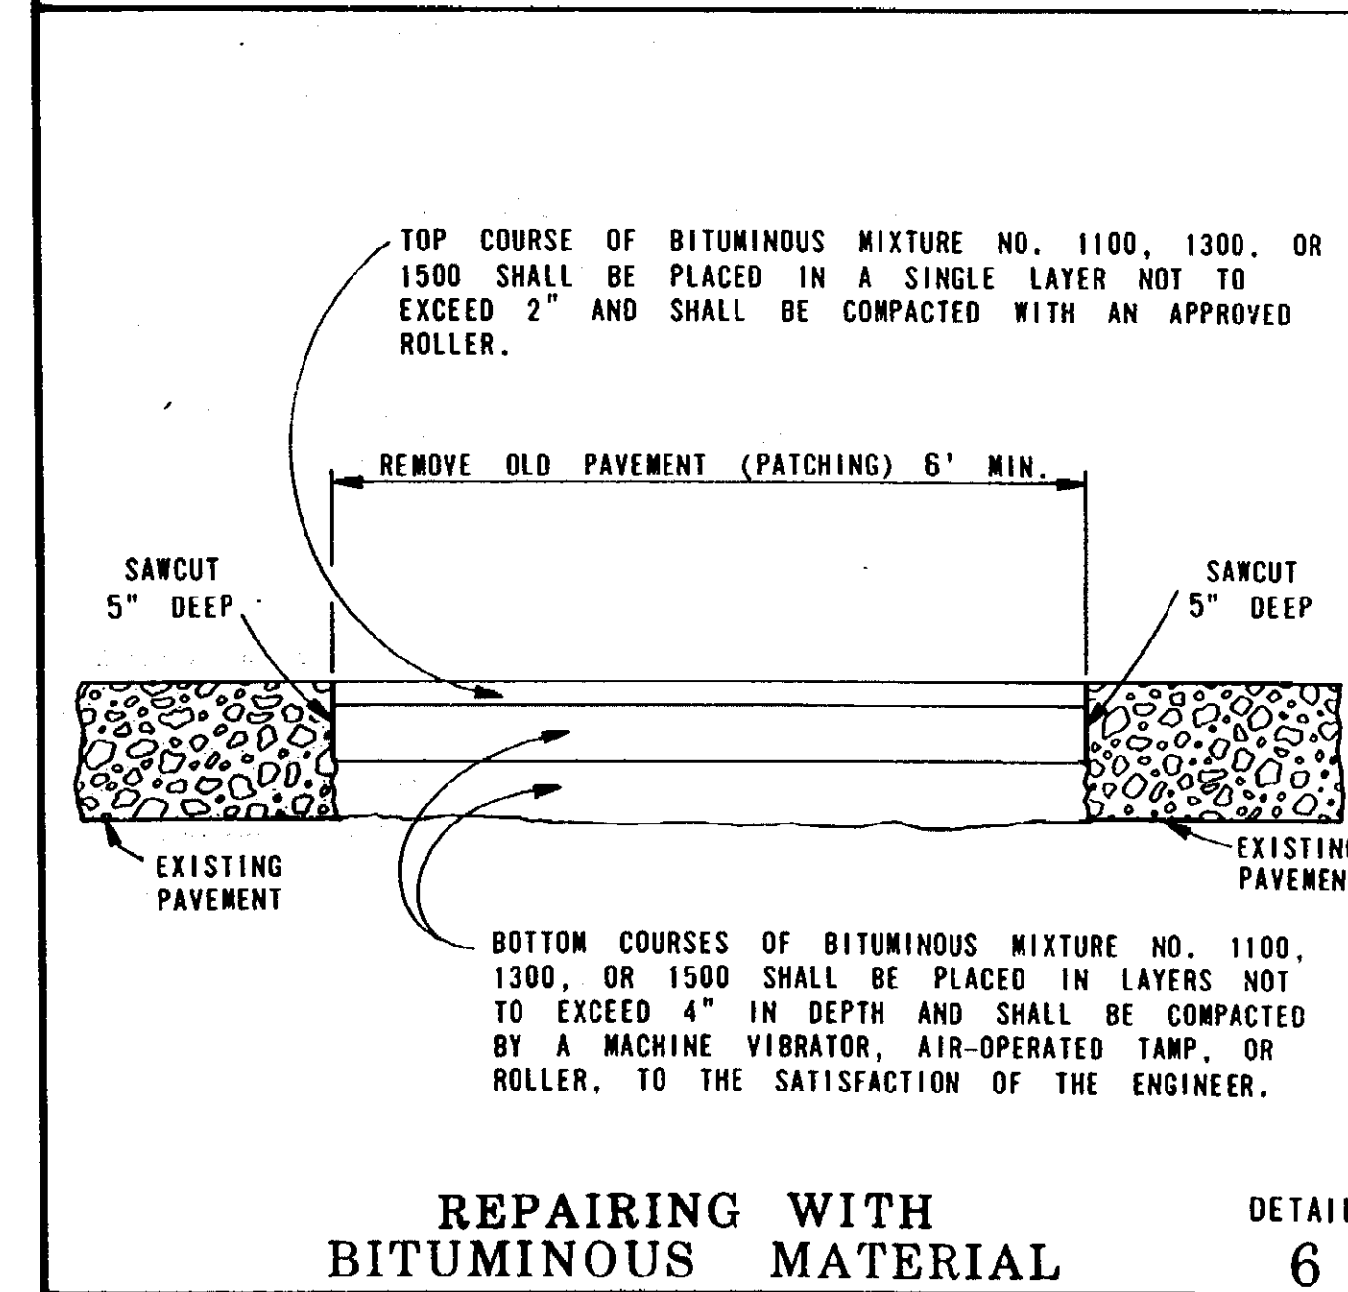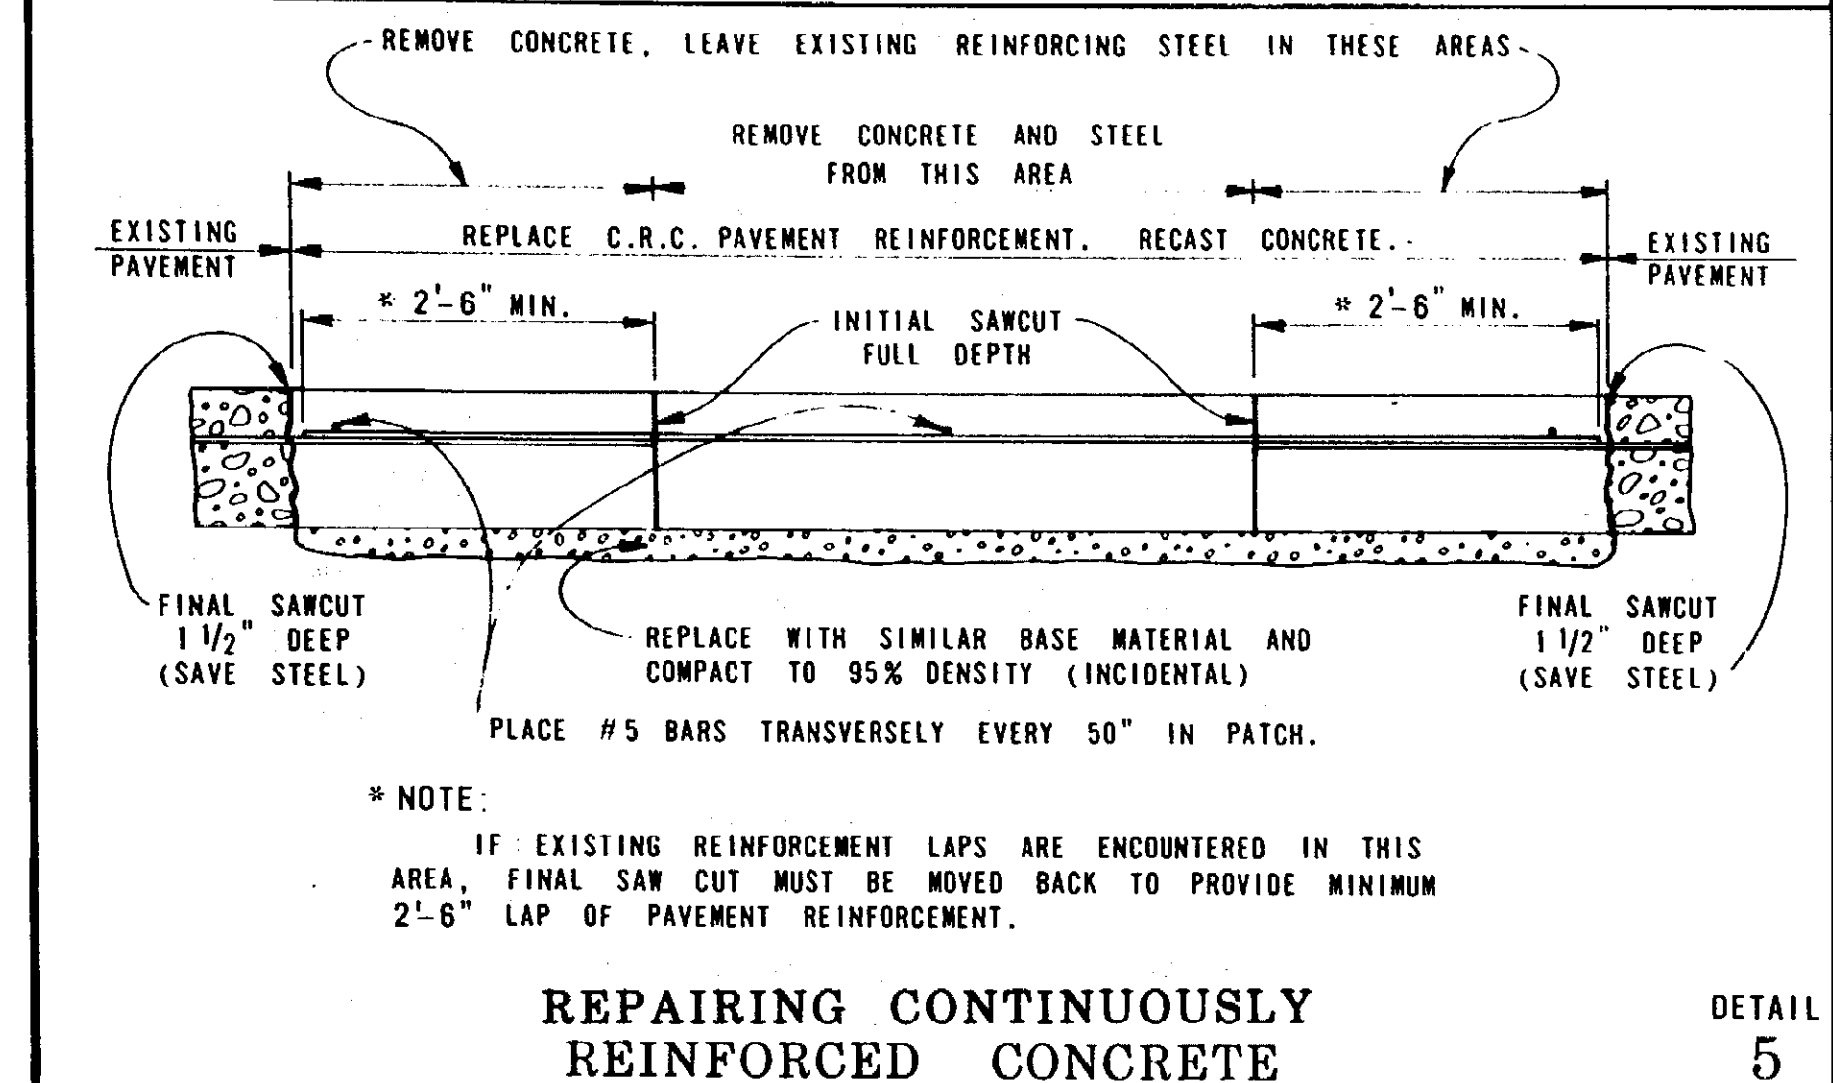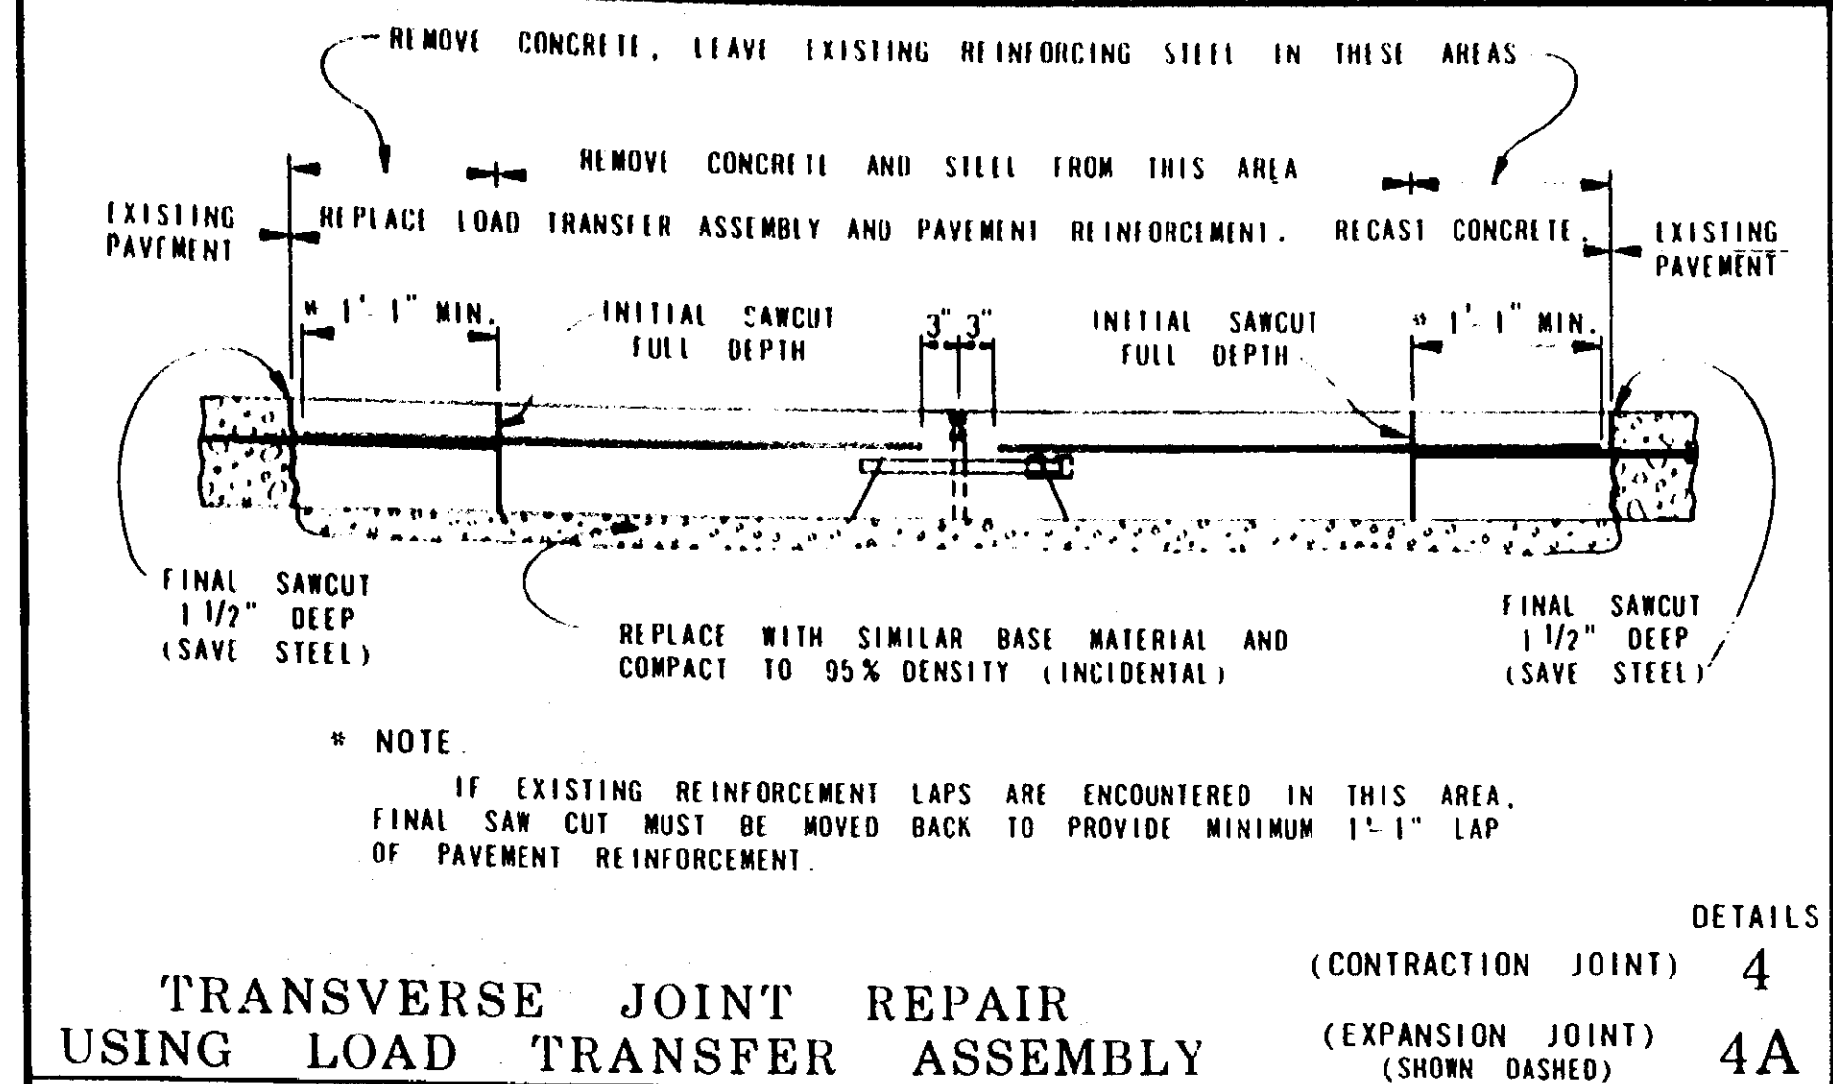

<p>PREPARED BY DESIGN DIVISION</p> <p>DRAWN BY: H.A.W.</p> <p>CHECKED BY: C.A.L.</p>	ENGINEER OF CONSTRUCTION	ENGINEER - ROAD DESIGN
	ENGINEER OF MAINTENANCE	ENGINEER OF DESIGN
	ENGINEER OF MATERIALS & TECHNOLOGY	DEPARTMENT DIRECTOR JAMES P. PITZ
	ENGINEER OF TRAFFIC AND SAFETY	DEPUTY DIRECTOR - HIGHWAYS

MICHIGAN DEPARTMENT OF TRANSPORTATION BUREAU OF HIGHWAYS STANDARD PLAN FOR			
CONCRETE PAVEMENT REPAIR			
F.H.W.A. APPROVAL	6-30-89 PLAN DATE	II-44G	SHEET 3 OF 4

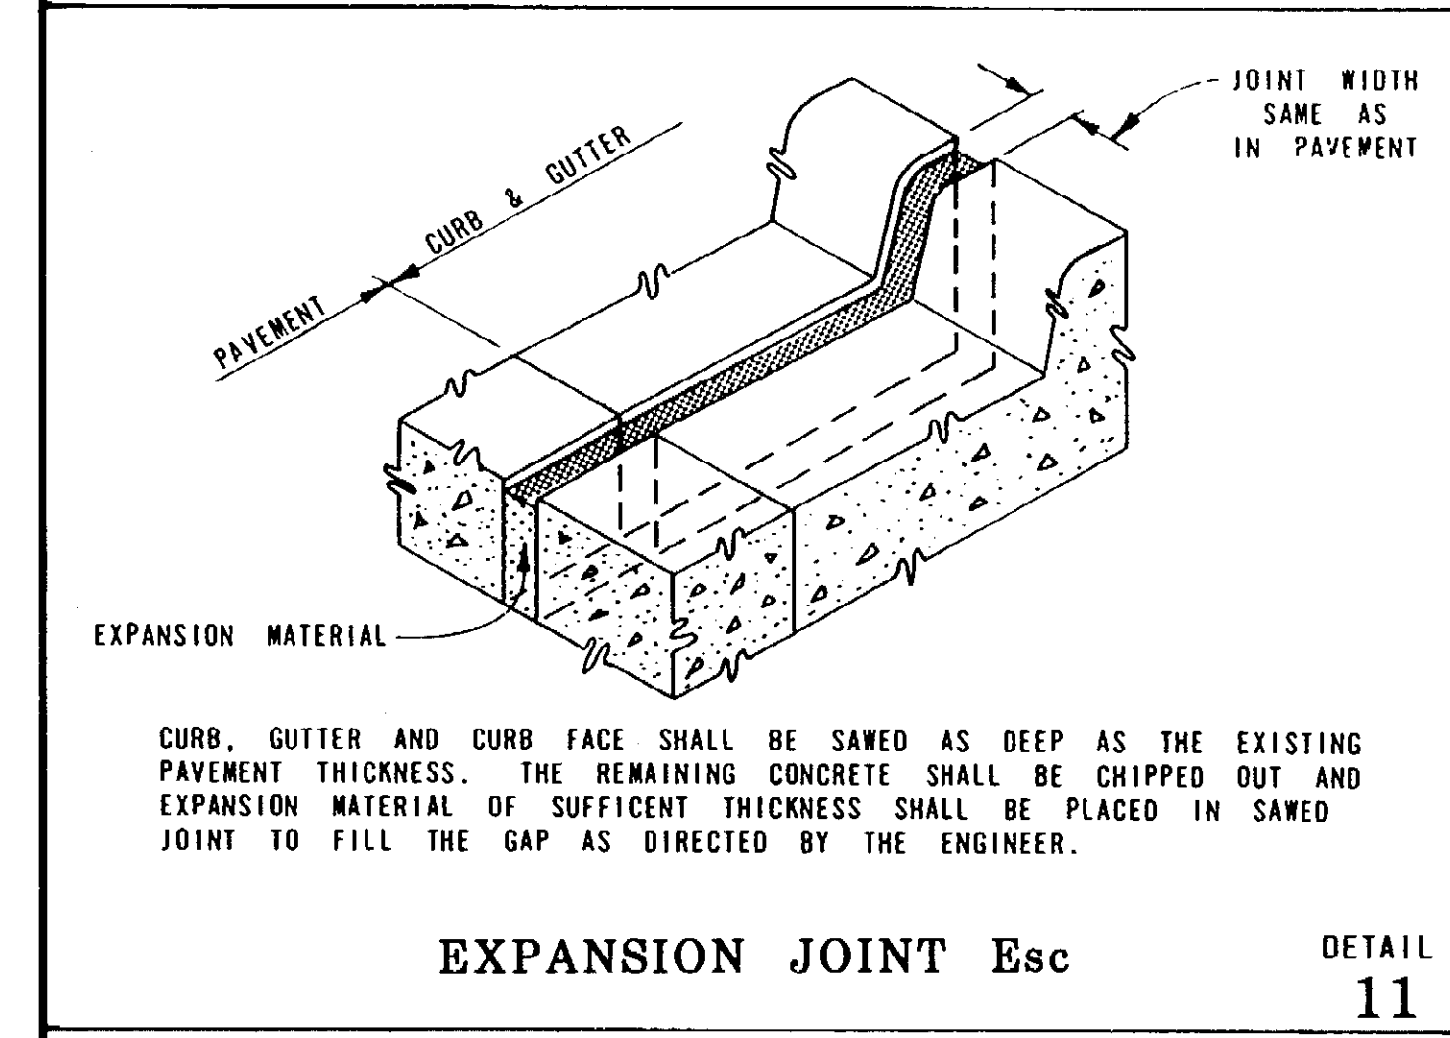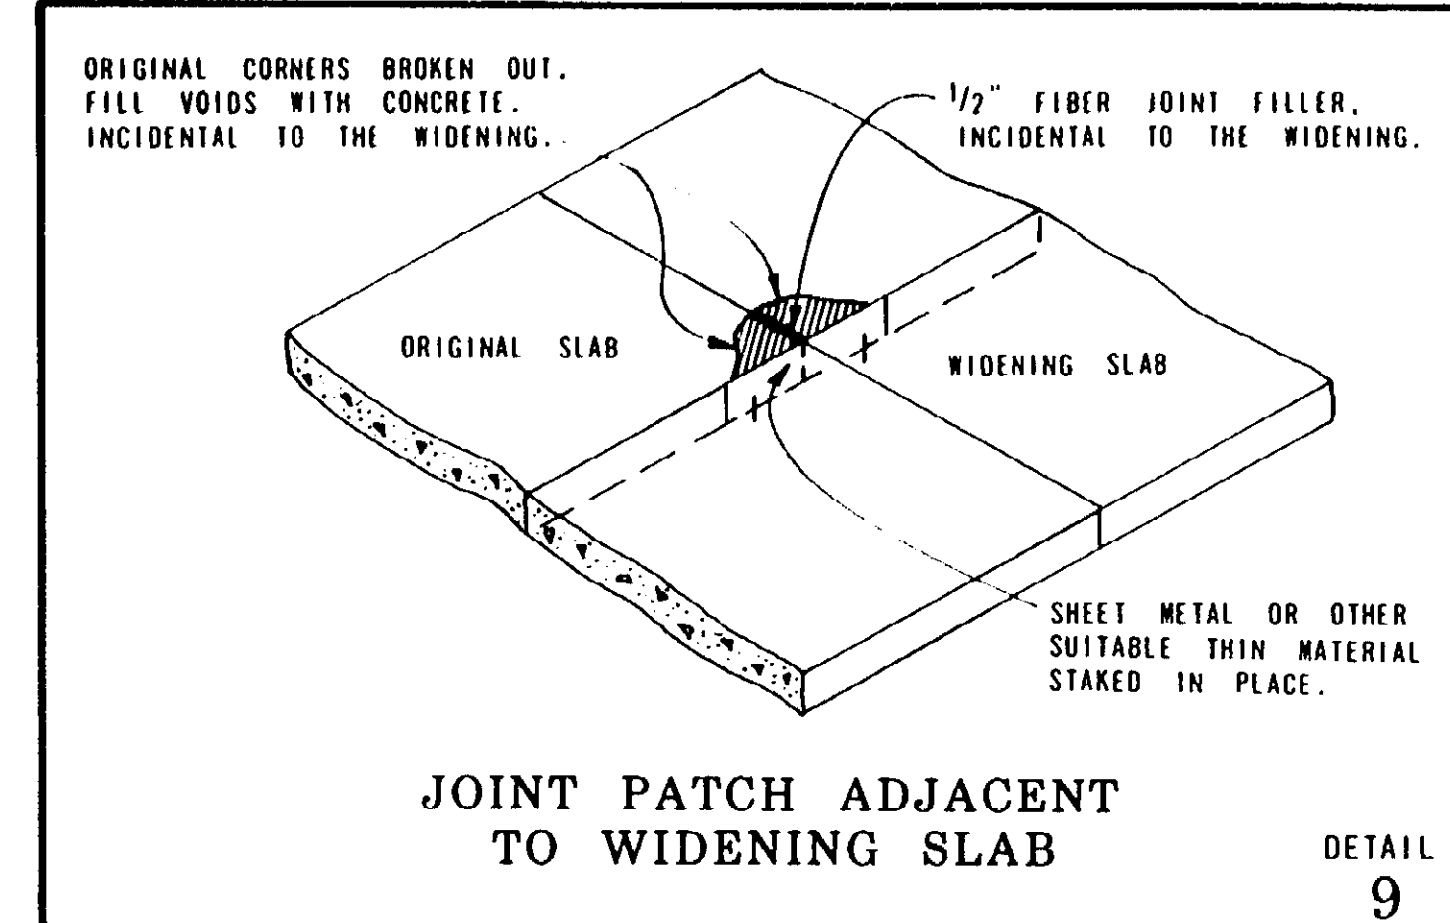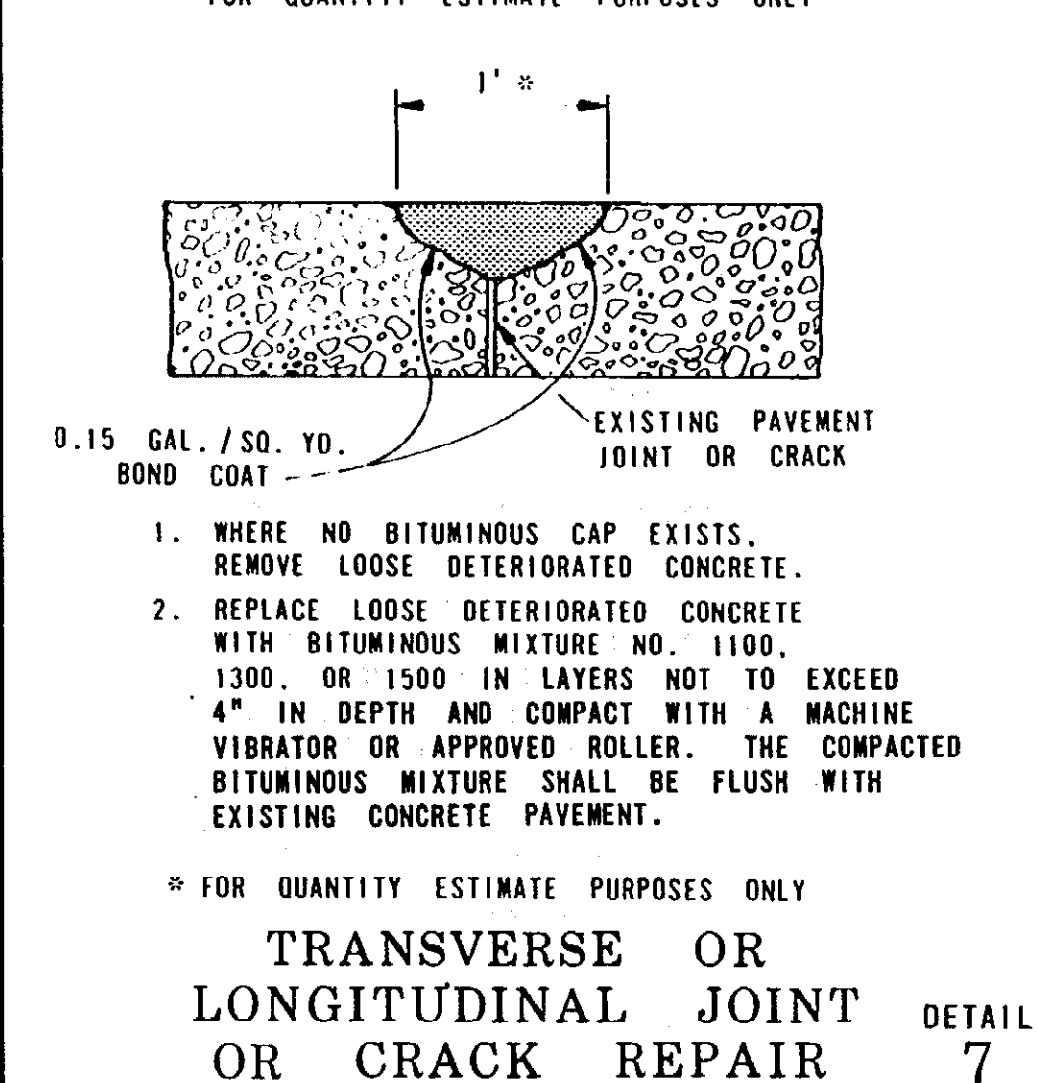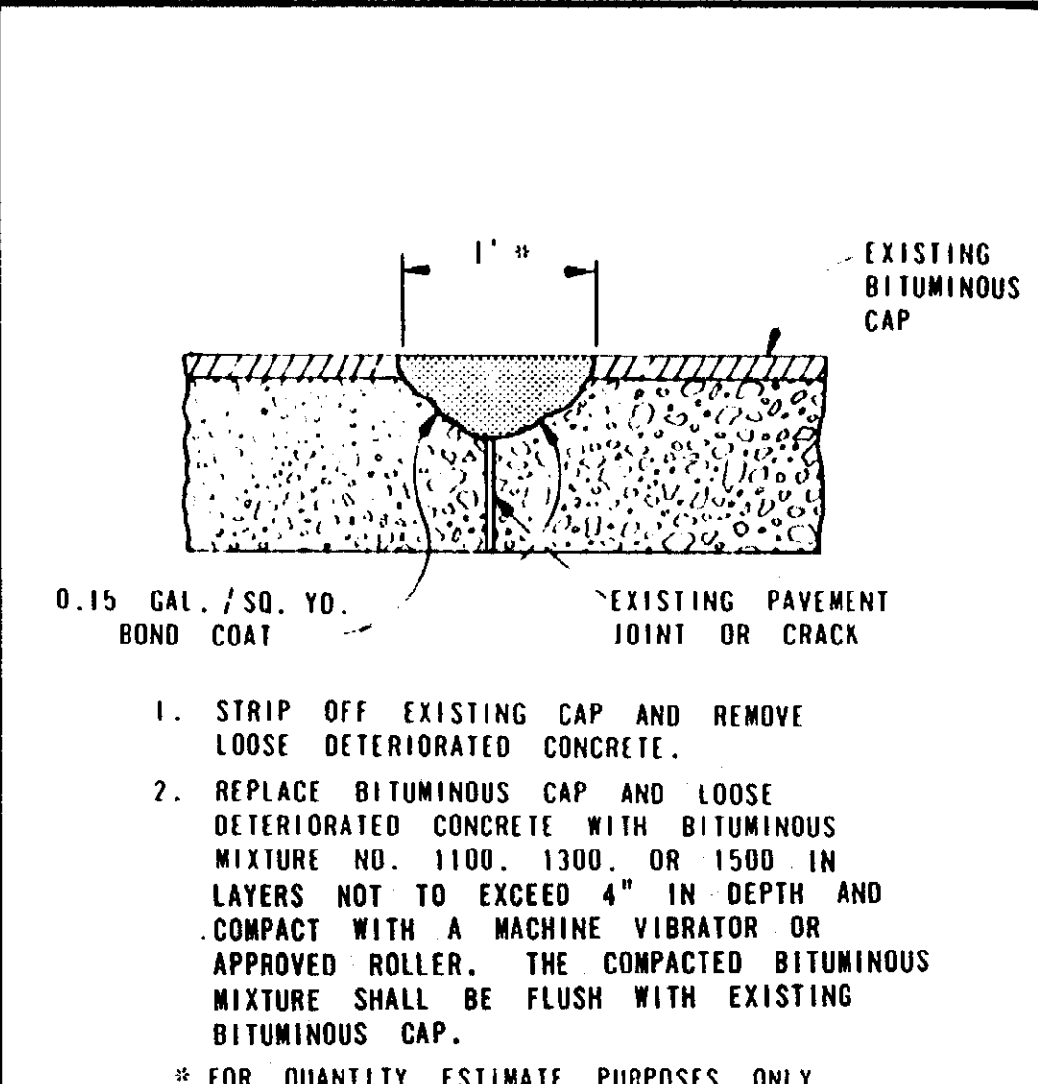

NOTES APPLYING TO STANDARD PLAN II-44G:

CONCRETE PAVEMENT REPAIRS OR PRESSURE RELIEF JOINT DETAILS WILL BE AS CALLED FOR ON PLANS OR IN LOG OF PROJECT.

IF EXISTING PAVEMENT HAS AN ASPHALT SURFACE, THE SAW CUTS SHALL EXTEND THRU THE UNDERLYING PORTLAND CEMENT CONCRETE.

WHEN CONCRETE PAVEMENT REPAIRS ARE TO BE RESURFACED, REINFORCEMENT WILL BE OMITTED. IF THE REPAIR IS LONGER THAN 20', TRANSVERSE PLANE OF WEAKNESS JOINTS, SYMBOL (U), SHALL BE PLACED IN LINE WITH EXISTING TRANSVERSE JOINTS, WORKING CRACKS, OR AT 20-FOOT MAX., 8-FOOT MIN. INTERVALS. FOR SYMBOL (U) JOINTS, SEE STANDARD PLAN II-39 SERIES.

WHEN REPAIRING PAVEMENTS WITH CAST-IN-PLACE REPAIR JOINTS (DETAILS 3 & 3A), THE JOINT TYPES SELECTED SHOULD PROVIDE FOR NO MORE EXPANSION SPACE THAN 4" IN 900' FOR PAVEMENTS WITH 99" JOINT SPACING, OR 2" IN 900' FOR PAVEMENTS WITH 72" JOINT SPACING AND NEOPRENE SEALS.

WHEN THERE ARE NO REPAIR LOCATIONS WITHIN A 900' LENGTH, NO EXPANSION SPACE WILL BE PROVIDED.

EQUAL EXPANSION SPACE SHOULD BE PROVIDED IN ADJACENT LANES. NO EXPANSION SPACE SHALL BE PROVIDED IN REPAIRS WHICH DO NOT EXTEND ACROSS ALL LANES.

TRANSVERSE CONTRACTION JOINTS TYPE "C" AND C₁ JOINT GROOVES (DETAIL 3 & 3A) SHALL BE SANDBLASTED FOLLOWED BY A FINAL CLEANING WITH OIL-FREE COMPRESSED AIR PRIOR TO SEALING WITH HOT-POURED RUBBER-ASPHALT JOINT SEALER. A BOND BREAKER (ALSO SHOWN IN DETAILS (3 & 3A) SHALL CONSIST OF A PRESSURE-SENSITIVE SILICONE-BACKED TAPE OR AN EQUIVALENT APPROVED BY THE ENGINEER.

THE PAVEMENT REINFORCEMENT SHALL BE PLACED 3" BELOW FINISHED SURFACE IN UNDOWELED REPAIRS OR AS SHOWN IN DETAIL 3A FOR DOWELED REPAIRS.




WHEN UNDOWELED REPAIRS ARE MADE IN JOINTED PAVEMENT, STANDARD PAVEMENT REINFORCEMENT SHALL BE USED TO REINFORCE CONCRETE REPAIRS 10' OR LONGER.

FOR ALL REPAIRS, EXPANSION SPACE SHOULD BE DISTRIBUTED THROUGHOUT THE SECTION RATHER THAN INSTALLING IT ALL AT ONE LOCATION. TO ALLOW FOR DISTRIBUTION OF PAVEMENT EXPANSION, REPAIRS MAY HAVE A CONTRACTION JOINT ON ONE END AND AN EXPANSION JOINT ON THE OTHER END. THE TYPE "A" JOINT SHOULD NOT BE USED IN REPAIRS OF NEOPRENE SEALED PAVEMENTS.

WHEN TRANSVERSE EXPANSION JOINTS ARE PLACED ADJACENT TO CONCRETE CURB AND GUTTER AND WHERE REMOVAL OF CURB AND GUTTER IS NOT NECESSARY AS DETERMINED BY THE ENGINEER, AN EQUIVALENT WIDTH OF EXPANSION JOINT Esc SHALL BE EXTENDED THRU THE CURB AND GUTTER.

TRANSVERSE JOINTS (DETAIL 4 AND 4A) SHALL BE SEALED IN ACCORDANCE WITH STANDARD PLAN II-39 SERIES.

<p>PREPARED BY DESIGN DIVISION</p> <p>DRAWN BY: H.A.W.</p> <p>CHECKED BY: C.A.L.</p>	ENGINEER OF CONSTRUCTION	ENGINEER - ROAD DESIGN
	ENGINEER OF MAINTENANCE	ENGINEER OF DESIGN
	ENGINEER OF MATERIALS & TECHNOLOGY	DEPARTMENT DIRECTOR JAMES P. PITZ
	ENGINEER OF TRAFFIC AND SAFETY	DEPUTY DIRECTOR - HIGHWAYS

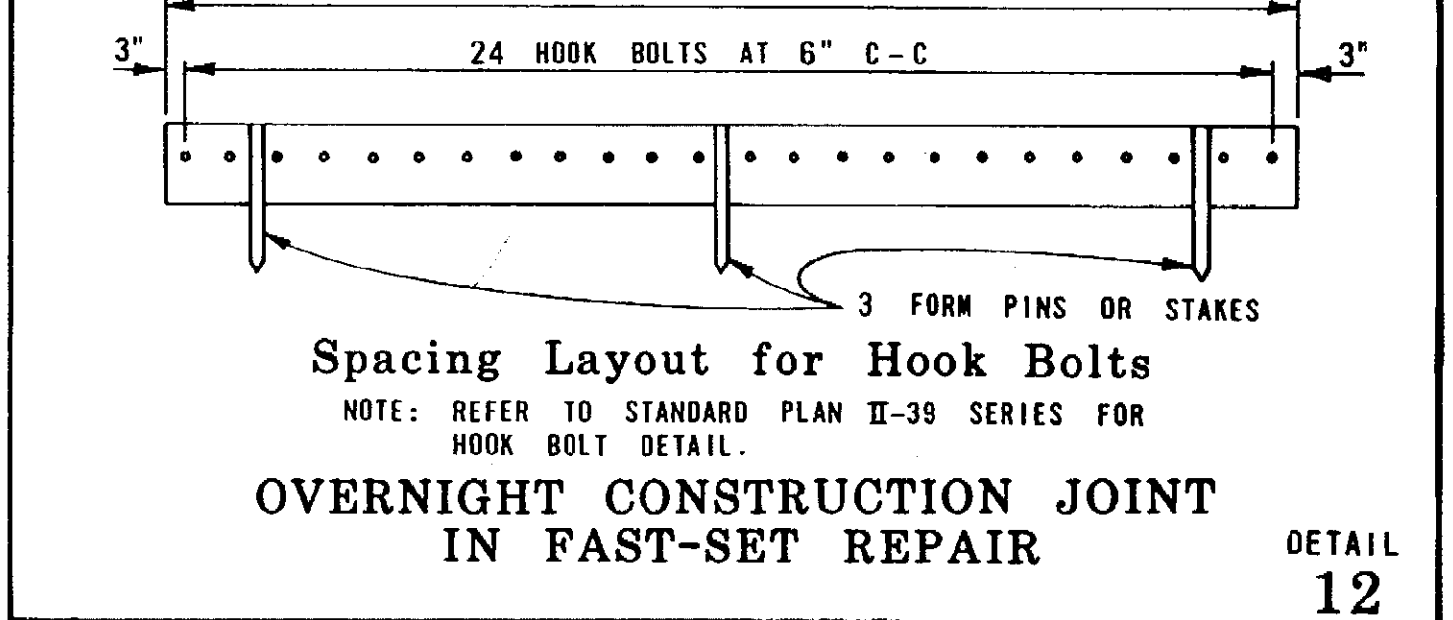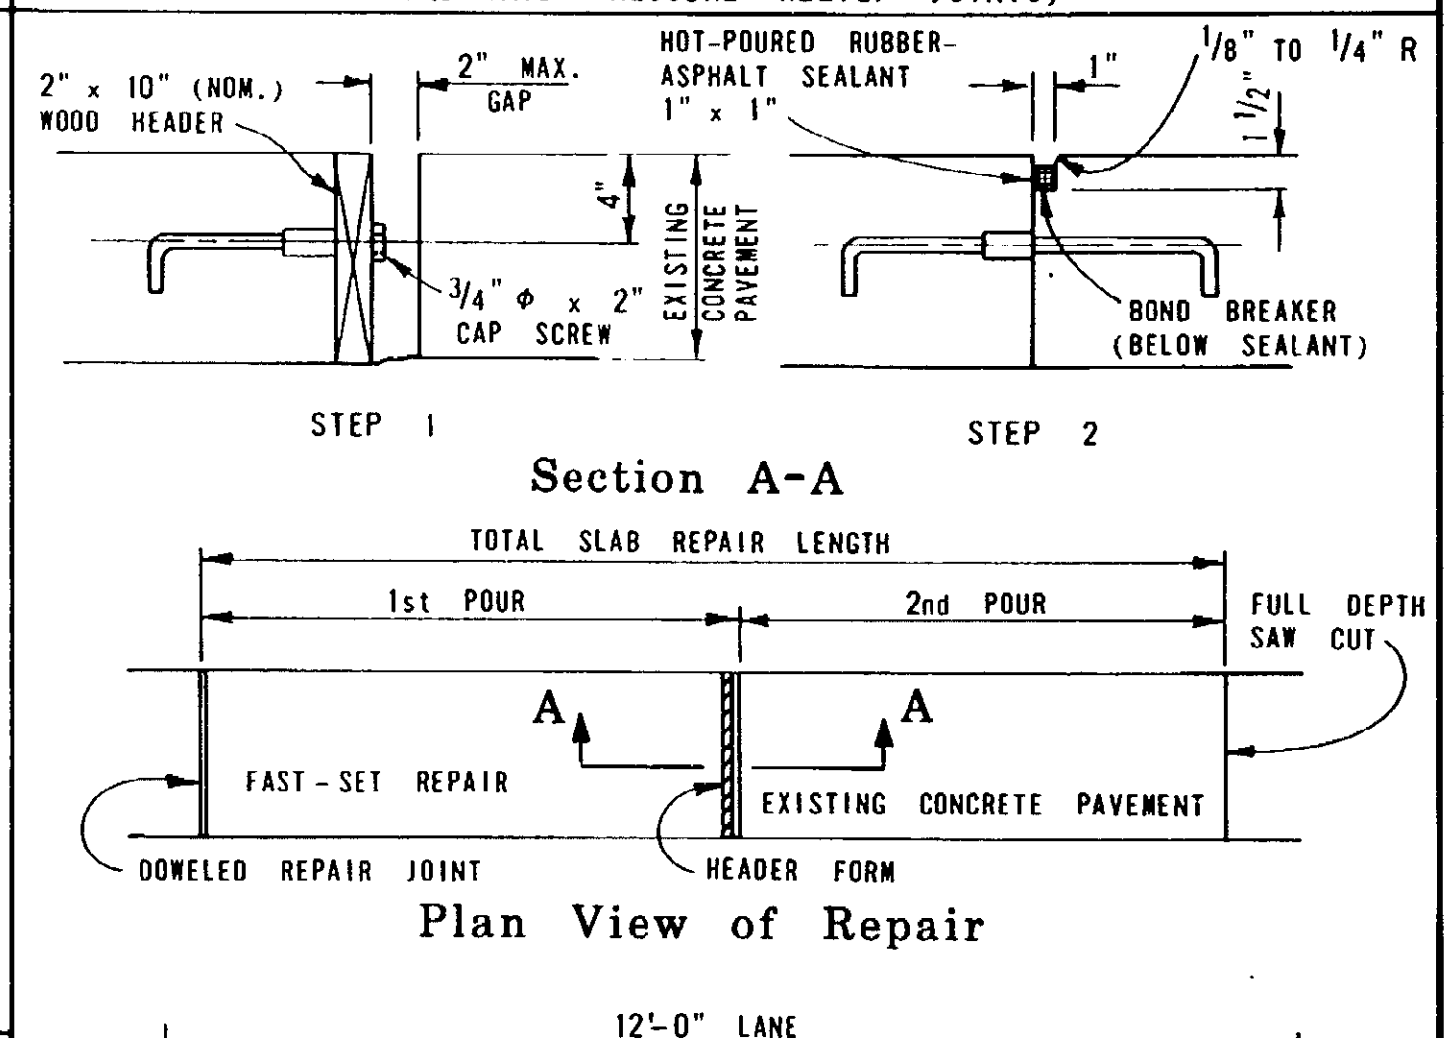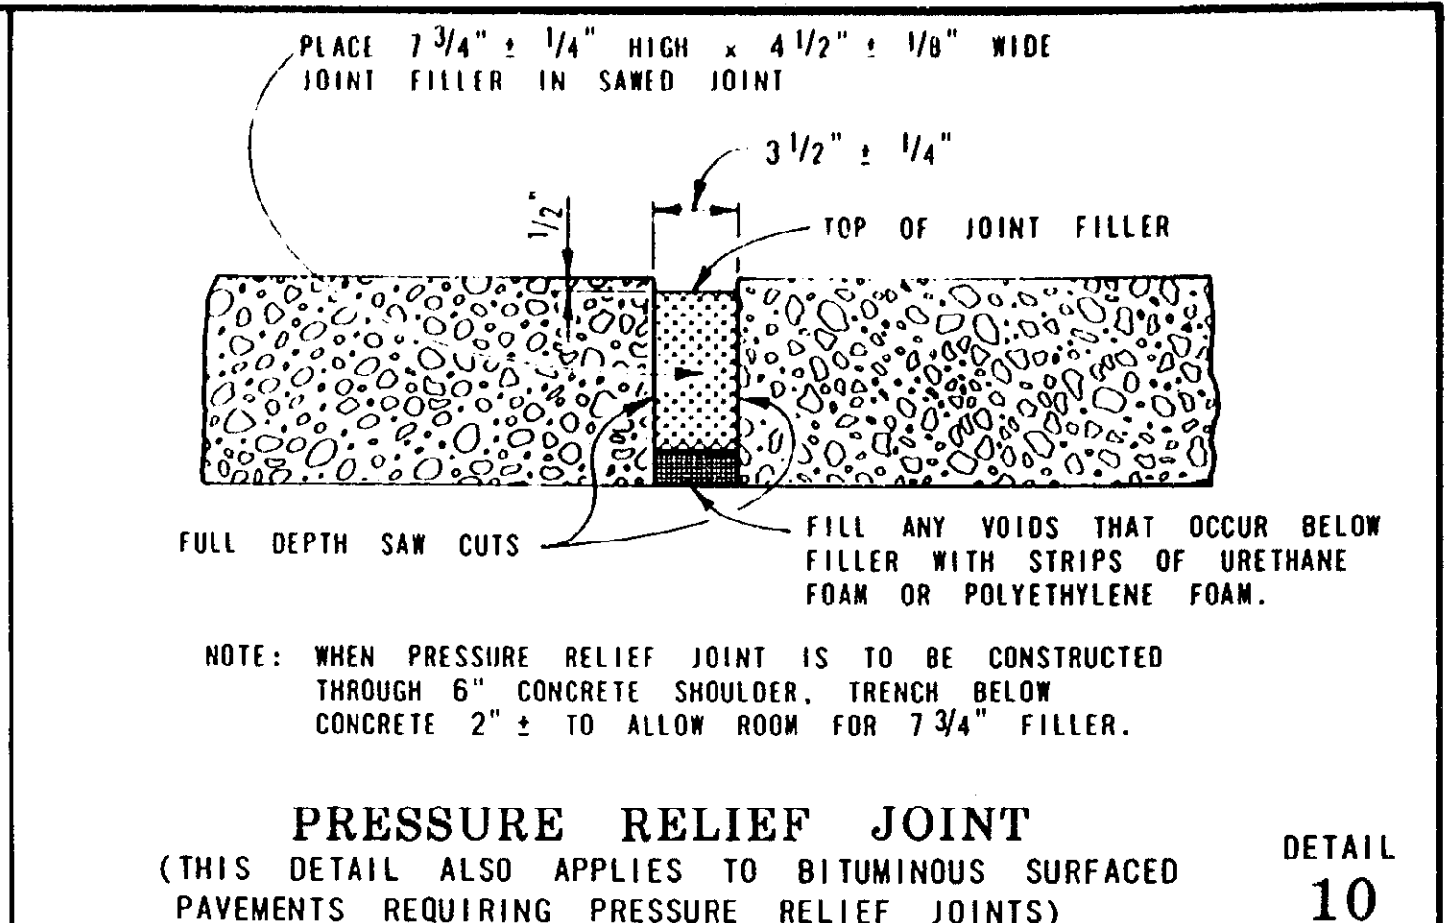


NOTES: (CONTINUED)

SAWED OVERCUTS OCCURRING IN ADJACENT SLAB, GUTTER, OR SHOULDER, WHICH WILL REMAIN IN PLACE, SHALL BE SEALED.


THE MONTH AND YEAR OF CASTING AND STATION NUMBER (IF REMOVED) SHALL BE STENCILED ON EACH CONCRETE REPAIR.

MICHIGAN DEPARTMENT OF TRANSPORTATION BUREAU OF HIGHWAYS STANDARD PLAN FOR			
CONCRETE PAVEMENT REPAIR			
F.H.W.A. APPROVAL	6-30-89 PLAN DATE	II-44G	SHEET 4 OF 4

CONTROL SECTION 63174 FOR 28992A SHEET NO. //

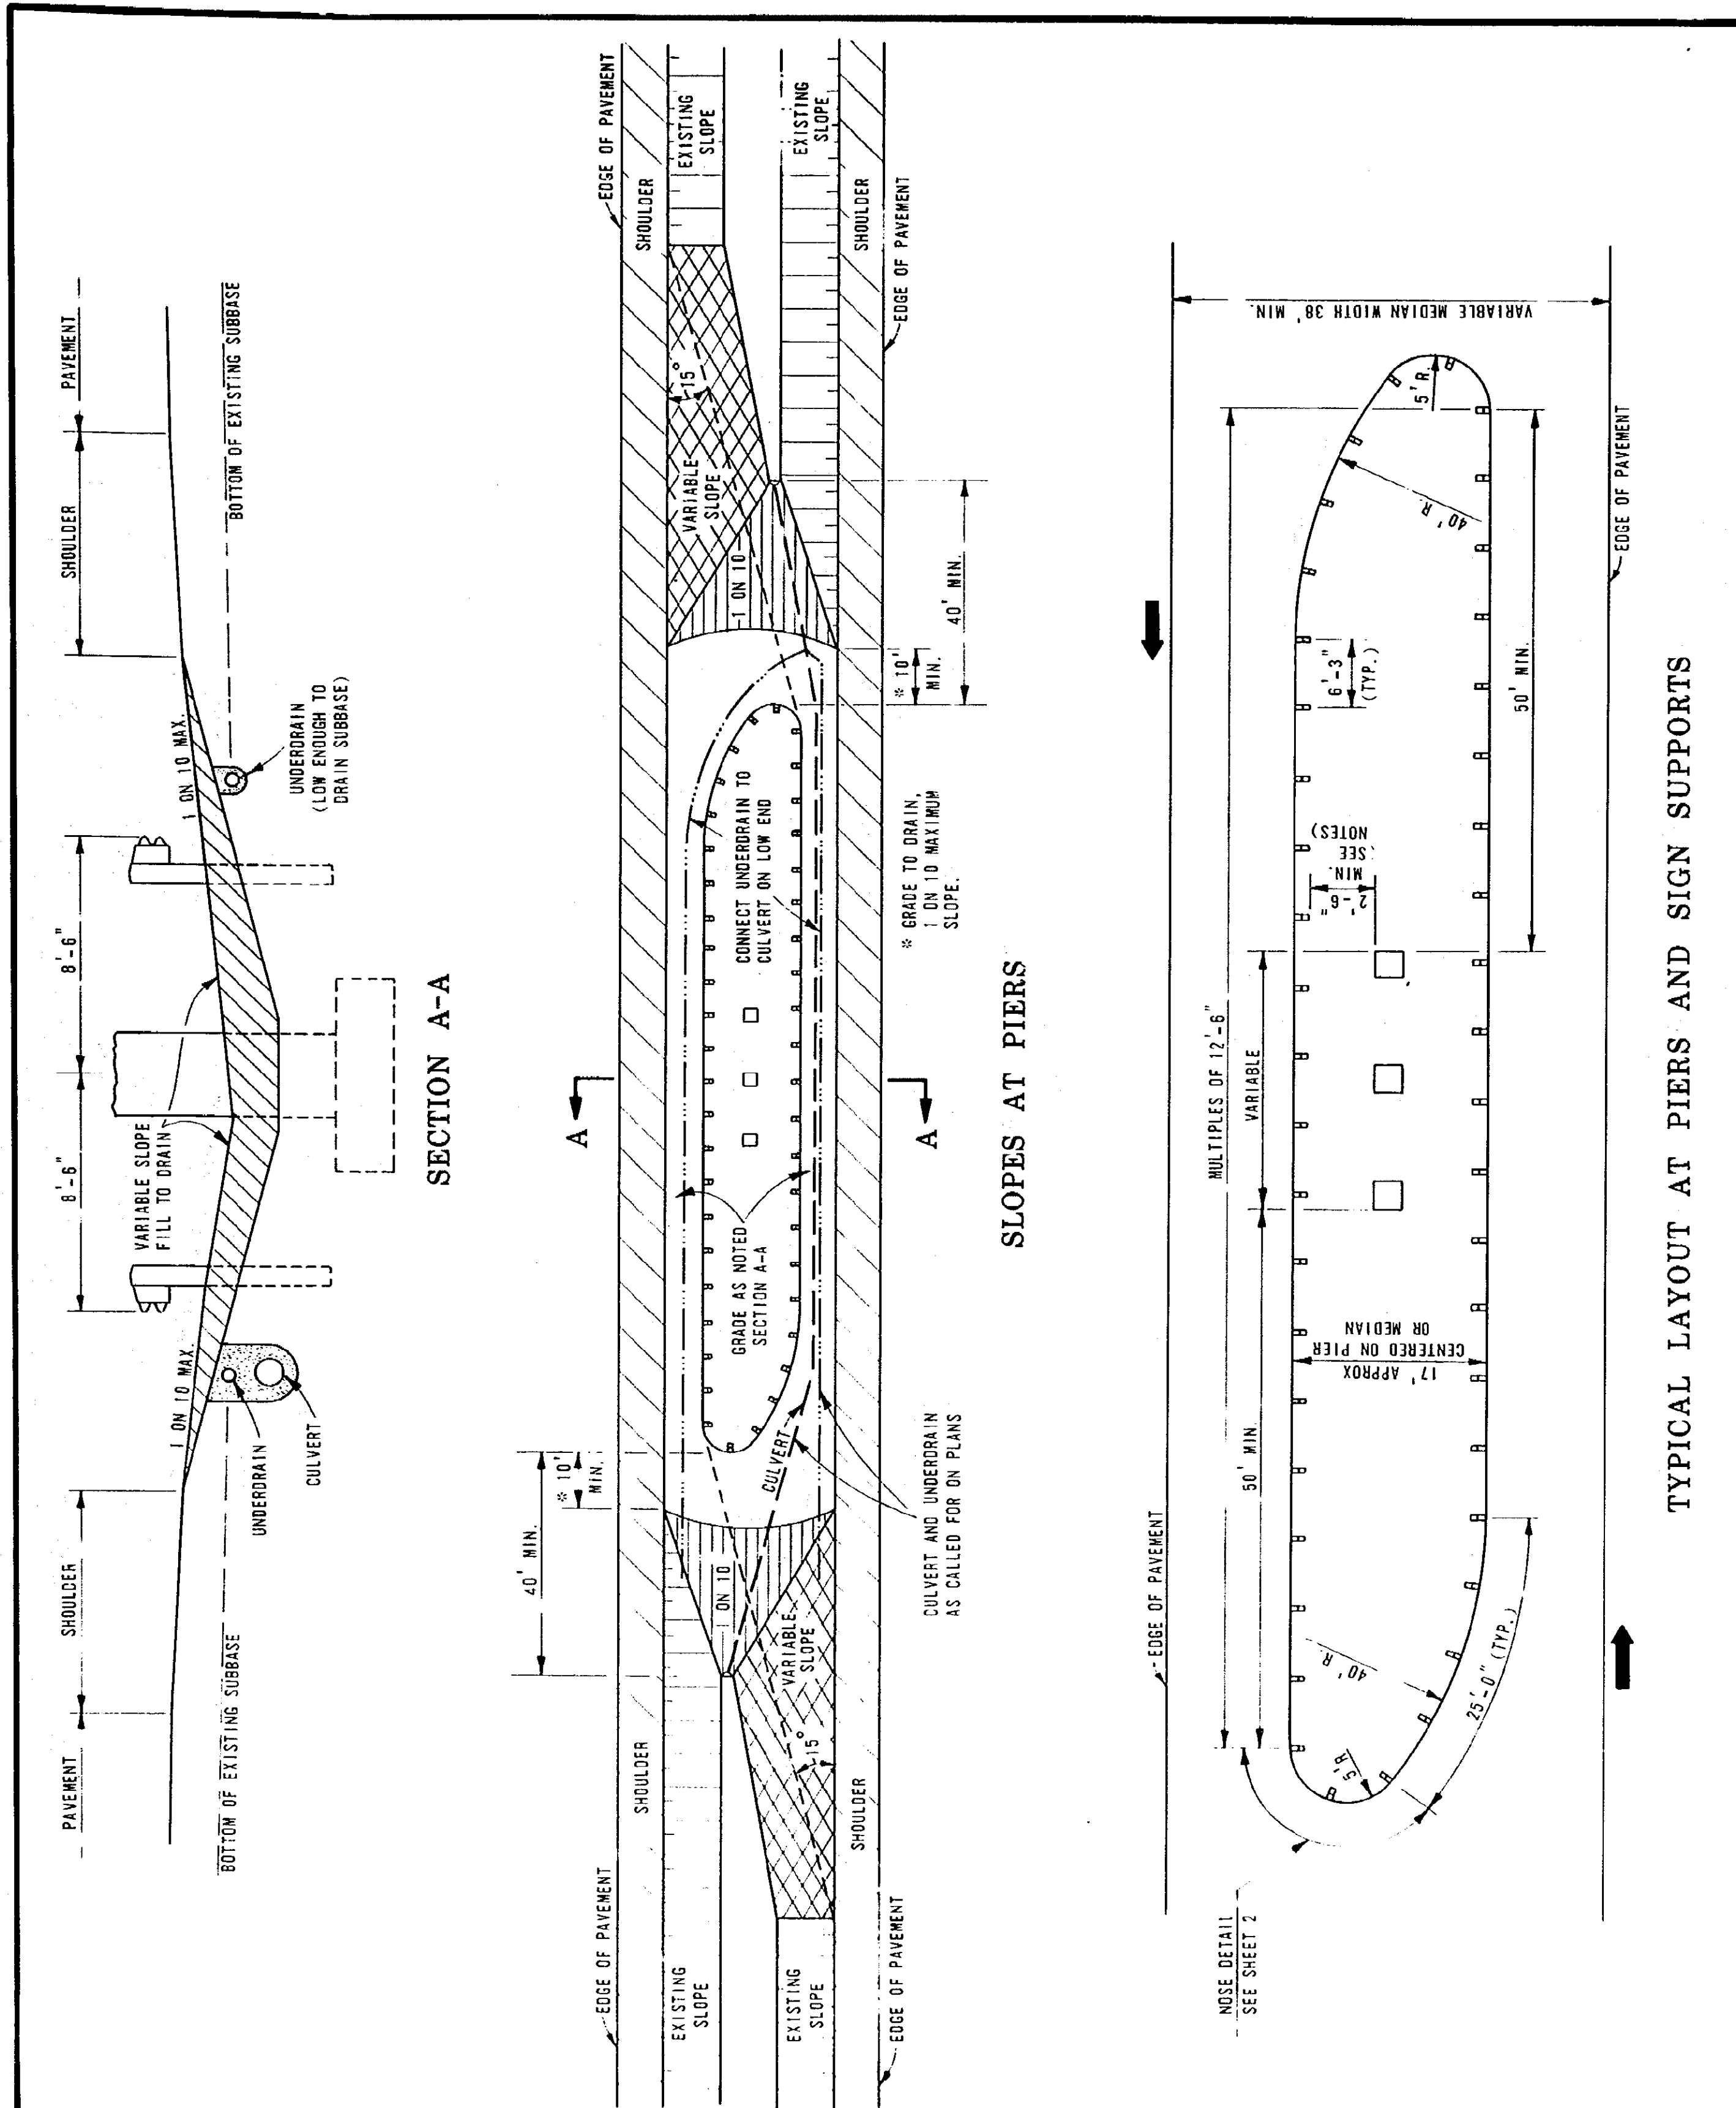


		MICHIGAN DEPARTMENT OF TRANSPORTATION BUREAU OF HIGHWAYS STANDARD PLAN FOR	
PREPARED BY DESIGN DIVISION	ENGINEER OF CONSTRUCTION ENGINEER OF MAINTENANCE ENGINEER OF MATERIALS & TECHNOLOGY	ENGINEER - ROAD DESIGN ENGINEER OF DESIGN DEPARTMENT DIRECTOR JAMES P. PITZ	GUARDRAIL BULLNOSE
DRAWN BY D.F.M. CHECKED BY C.A.L.	ENGINEER OF TRAFFIC AND SAFETY	BY: DEPUTY DIRECTOR - HIGHWAYS	F.H.W.A. APPROVAL 12-8-88 PLAN DATE III-56B SHEET 1 OF 2

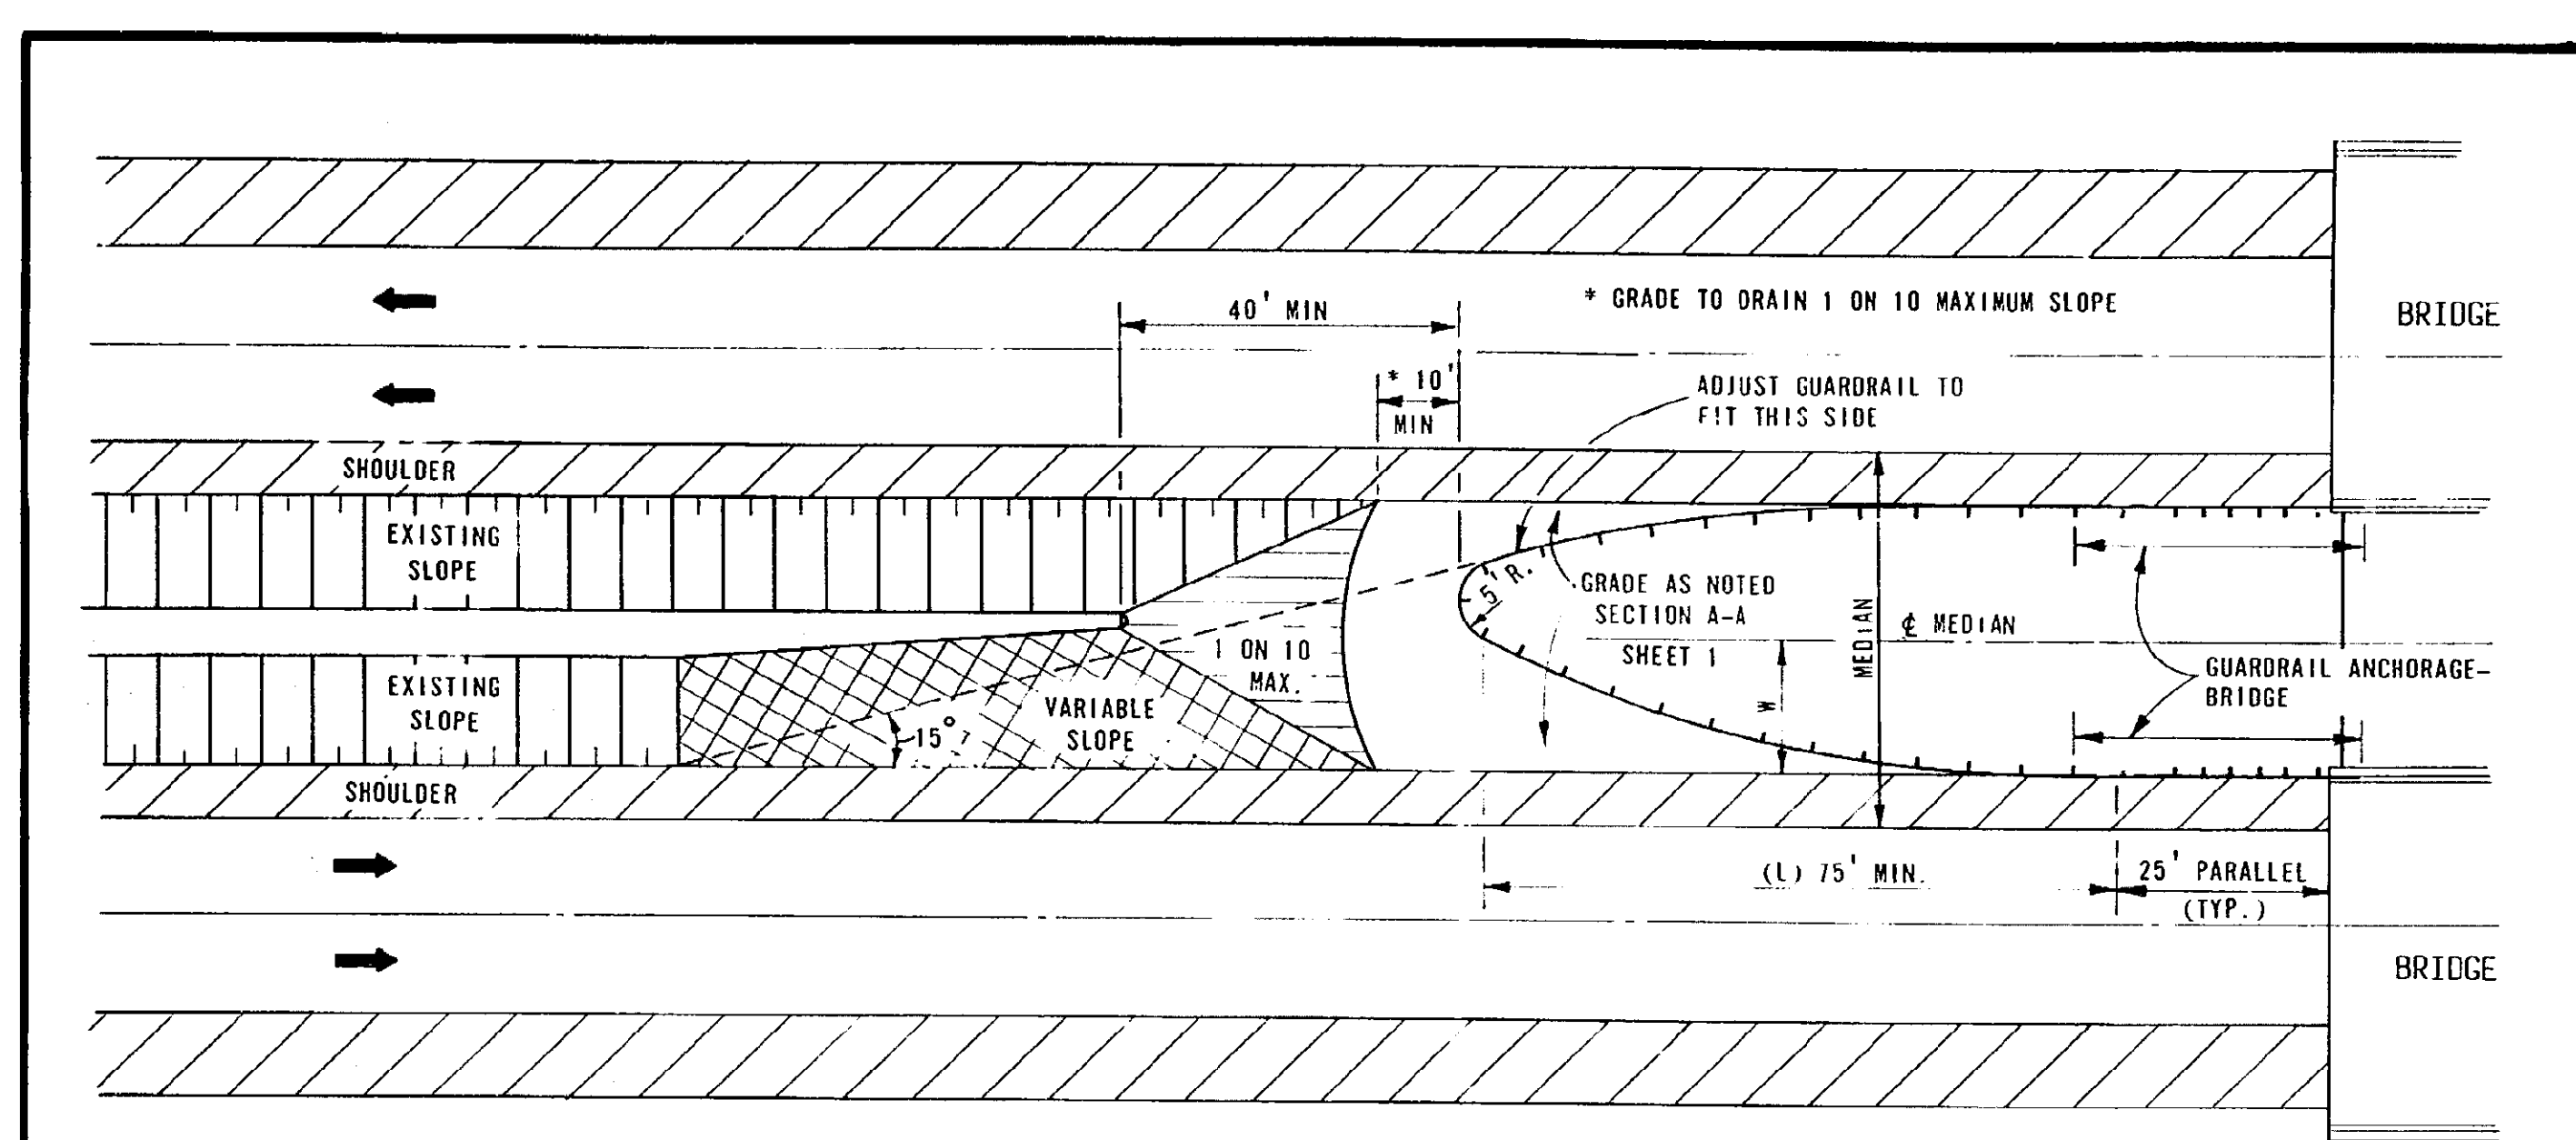


GUARDRAIL AT TWIN BRIDGE APPROACH
(FOR MEDIANS 46' OR LESS IN WIDTH)

X = INTERMEDIATE DISTANCES Y = INTERMEDIATE OFFSETS
 L = TOTAL LENGTH OF FLARE W = WIDTH OF FINAL OFFSET

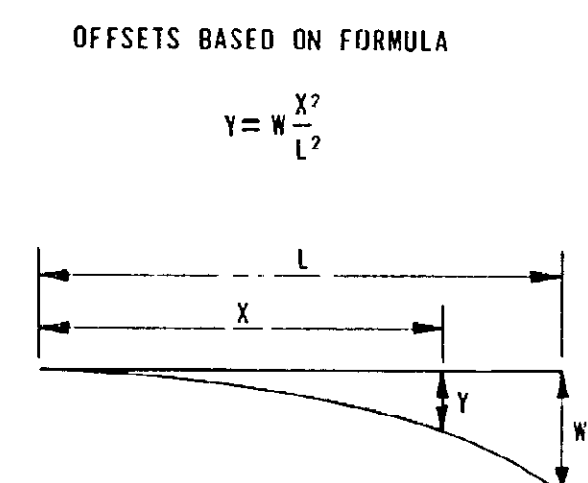


OFFSET FORMULA

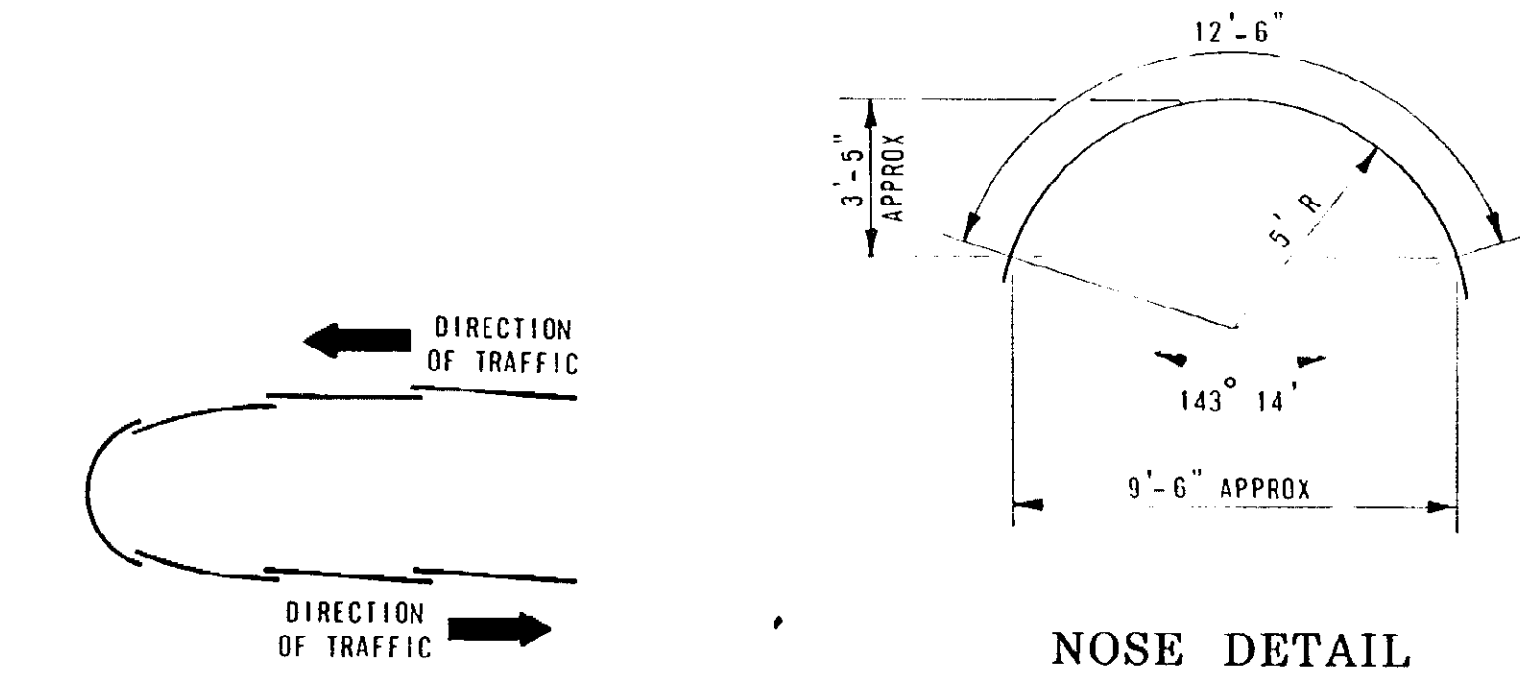

NOSE DETAIL











DETAIL OF RAIL LAP

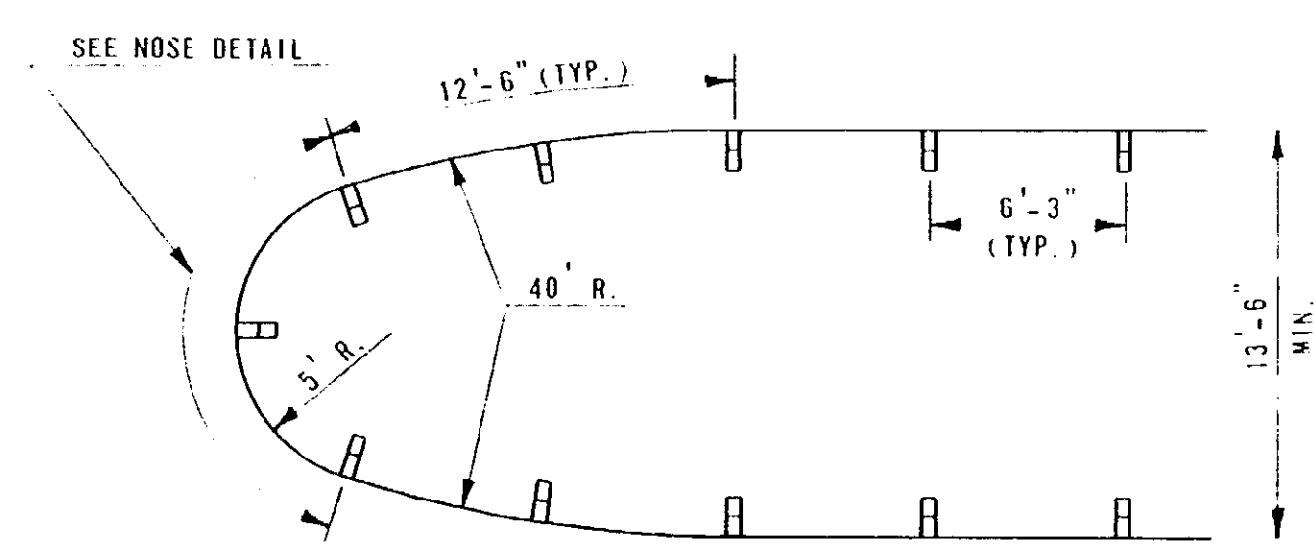

ALTERNATE INSTALLATION
 FOR USE WHERE NARROW MEDIAN PROHIBITS
 USE OF CONVENTIONAL TREATMENT

NOTES:
 ALL POSTS AND BLOCKS, BEAM AND BACK UP ELEMENTS AND FITTINGS, INCLUDING BOLTS, NUTS AND WASHERS, SHALL CONFORM TO THE DIMENSIONS AND SPECIFICATIONS SHOWN ON CURRENT STANDARD PLAN III - 60 AND III - 67 SERIES, WHERE APPLICABLE, EXCEPT AS SHOWN ON THIS STANDARD PLAN.
 ONLY BEAM GUARDRAIL TYPE B SHALL BE USED FOR GUARDRAIL BULLNOSE INSTALLATIONS, EXCEPT IN "GUARDRAIL ANCHORAGE - BRIDGE, DETAIL".
 WOOD POSTS WILL BE REQUIRED WHENEVER THE GUARDRAIL RADIUS IS 50' OR LESS, AND FOR ALL OF THE POSTS IN THE "GUARDRAIL AT TWIN BRIDGE APPROACH" EXCEPT THOSE IN THE GUARDRAIL ANCHORAGE - BRIDGE.
 REMOVE CURB FROM 150' IN ADVANCE AND ALONG TOTAL LENGTH OF THE GUARDRAIL INSTALLATION UNLESS ONE FOOT OR LESS FROM FACE OF CURB TO FACE OF RAIL.
 ADEQUATE DRAINAGE MUST BE PROVIDED WHEN EXISTING MEDIANS OR DITCHED AREAS ARE FILLED.
 ANY PART OF THE GUARDRAIL SYSTEM SHOULD BE NO CLOSER THAN 2'-6" TO THE BRIDGE PIER COLUMNS. IF THIS MINIMUM IS IMPOSSIBLE TO OBTAIN, STIFFEN THE RAIL SYSTEM AS DIRECTED BY THE ENGINEER, SO ITS THEORETICAL DEFLECTION WILL NOT EXCEED THE AVAILABLE CLEARANCE. IF ADDITIONAL GUIDANCE IS NEEDED, CONTACT THE ROAD STANDARDS UNIT OF THE DESIGN DIVISION.

		MICHIGAN DEPARTMENT OF TRANSPORTATION BUREAU OF HIGHWAYS STANDARD PLAN FOR	
PREPARED BY DESIGN DIVISION	ENGINEER OF CONSTRUCTION ENGINEER OF MAINTENANCE ENGINEER OF MATERIALS & TECHNOLOGY	ENGINEER - ROAD DESIGN ENGINEER OF DESIGN DEPARTMENT DIRECTOR JAMES P. PITZ	GUARDRAIL BULLNOSE
DRAWN BY D.F.M. CHECKED BY C.A.L.	ENGINEER OF TRAFFIC AND SAFETY	BY: DEPUTY DIRECTOR - HIGHWAYS	F.H.W.A. APPROVAL 12-8-88 PLAN DATE III-56B SHEET 2 OF 2

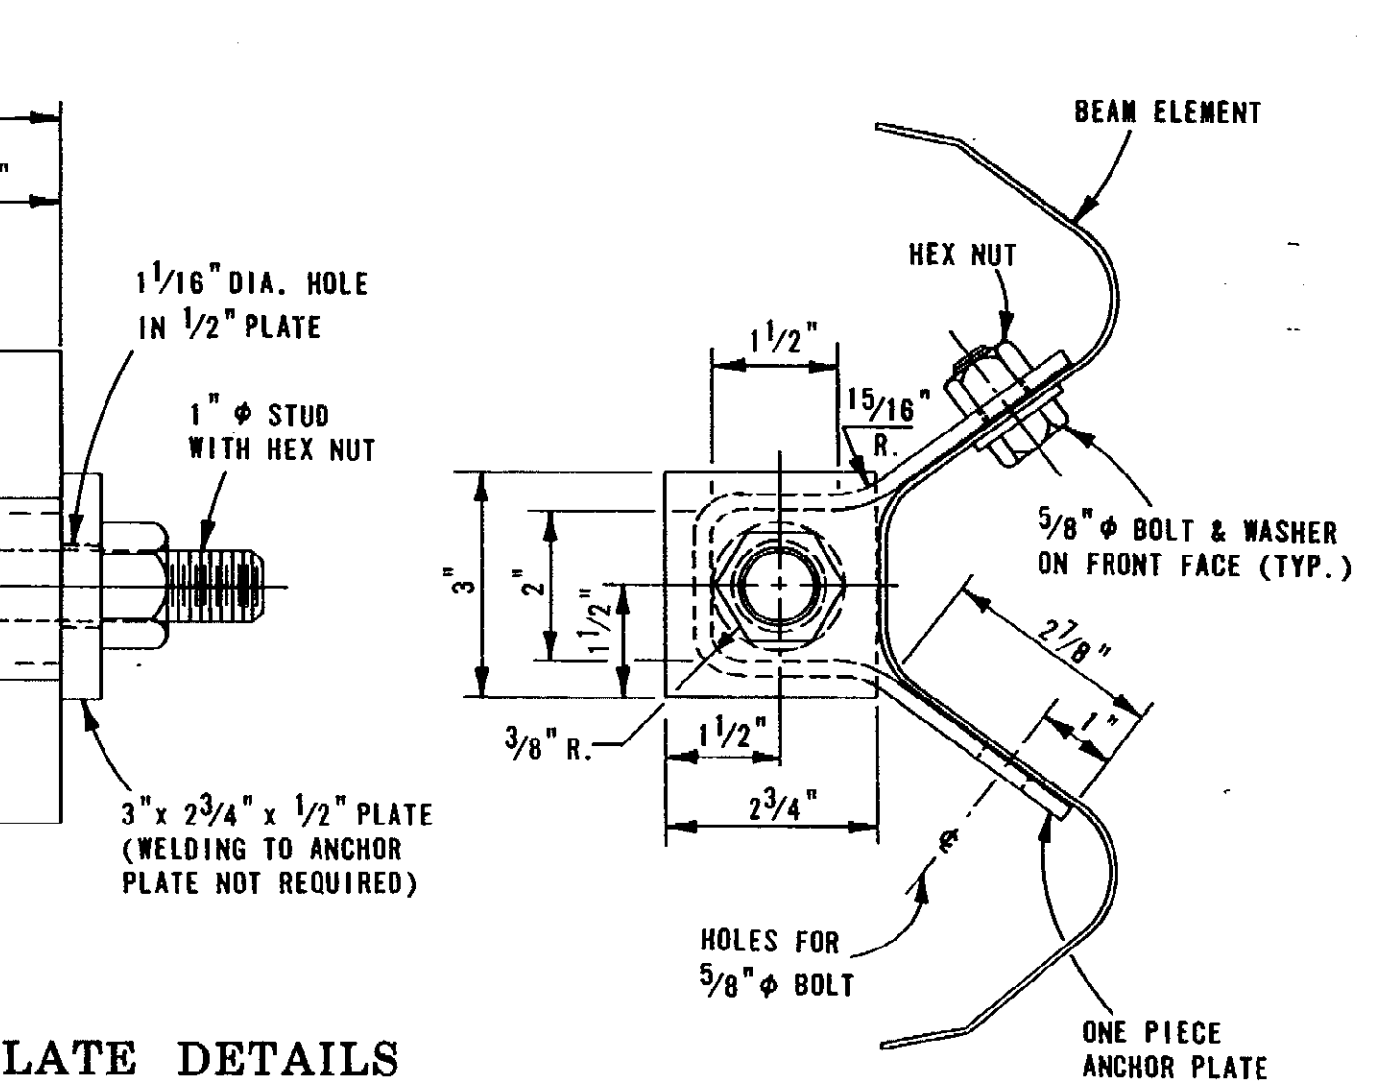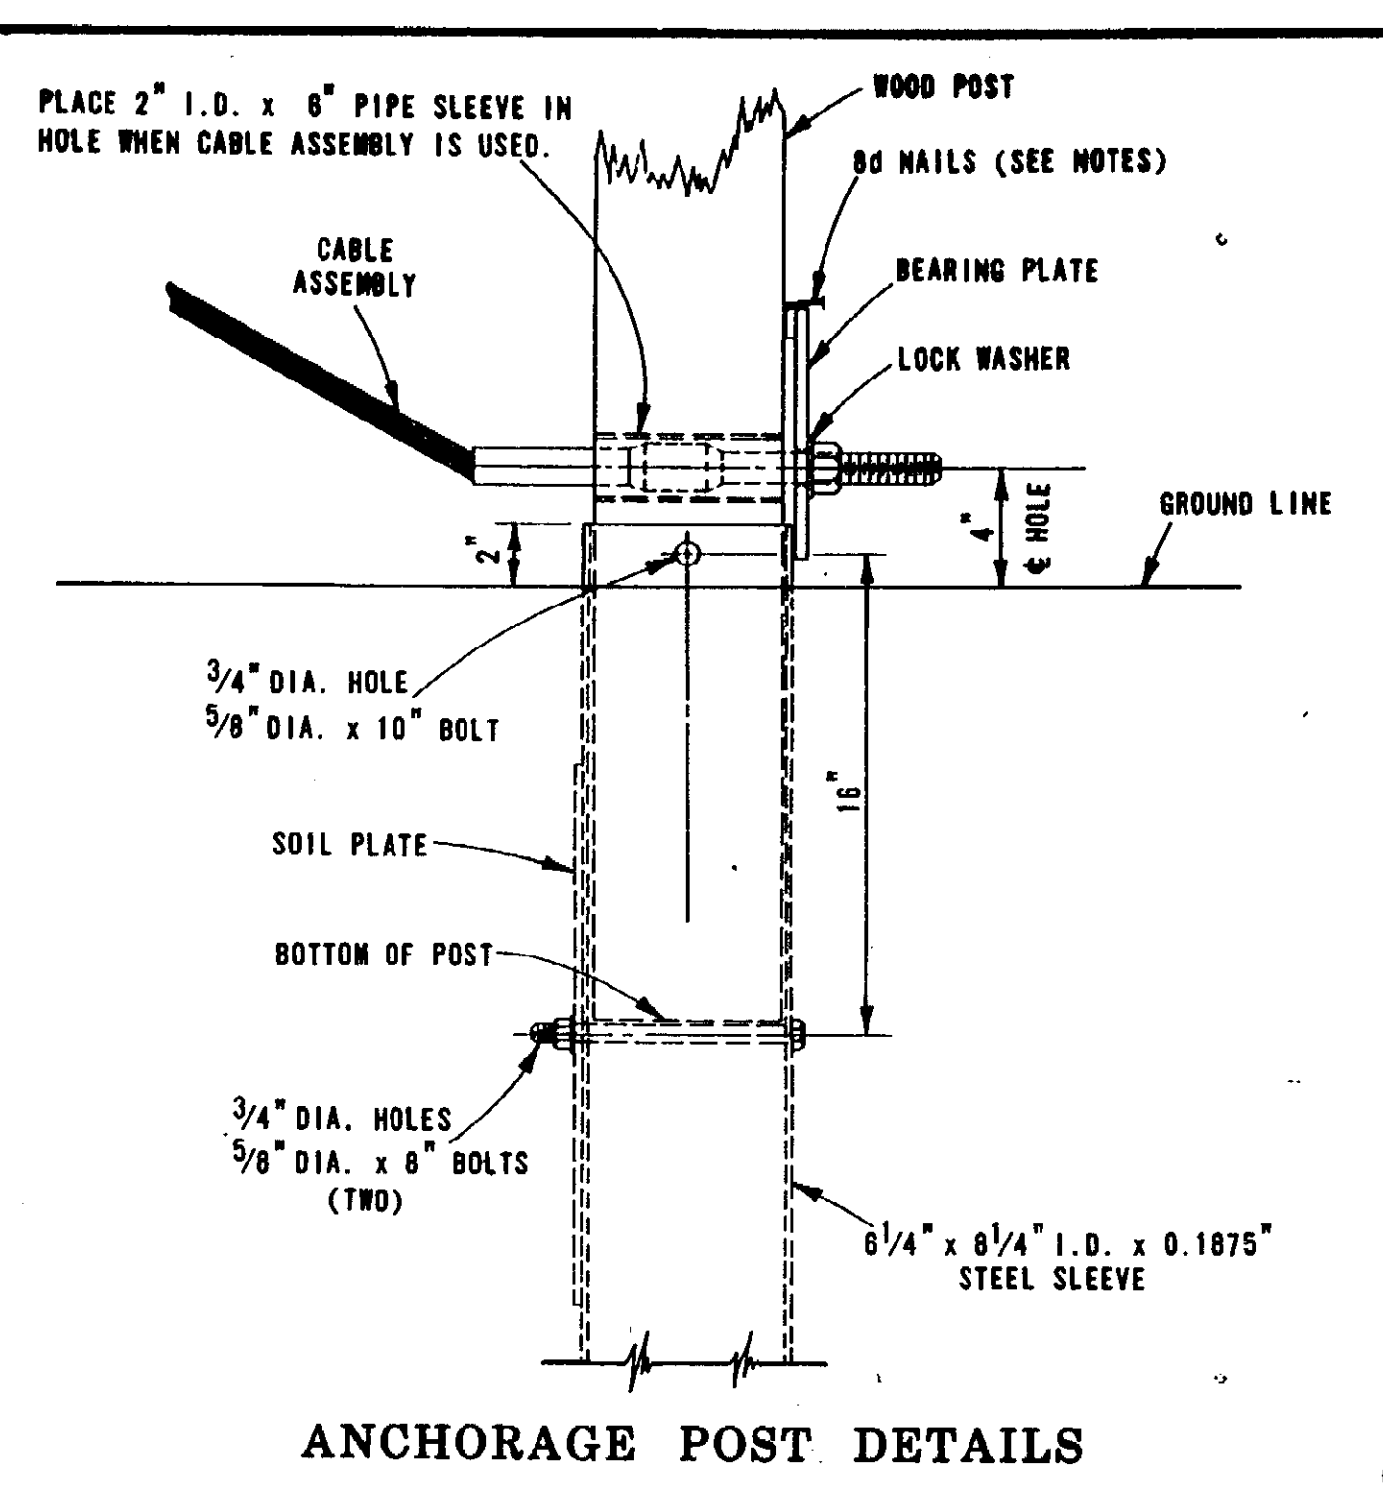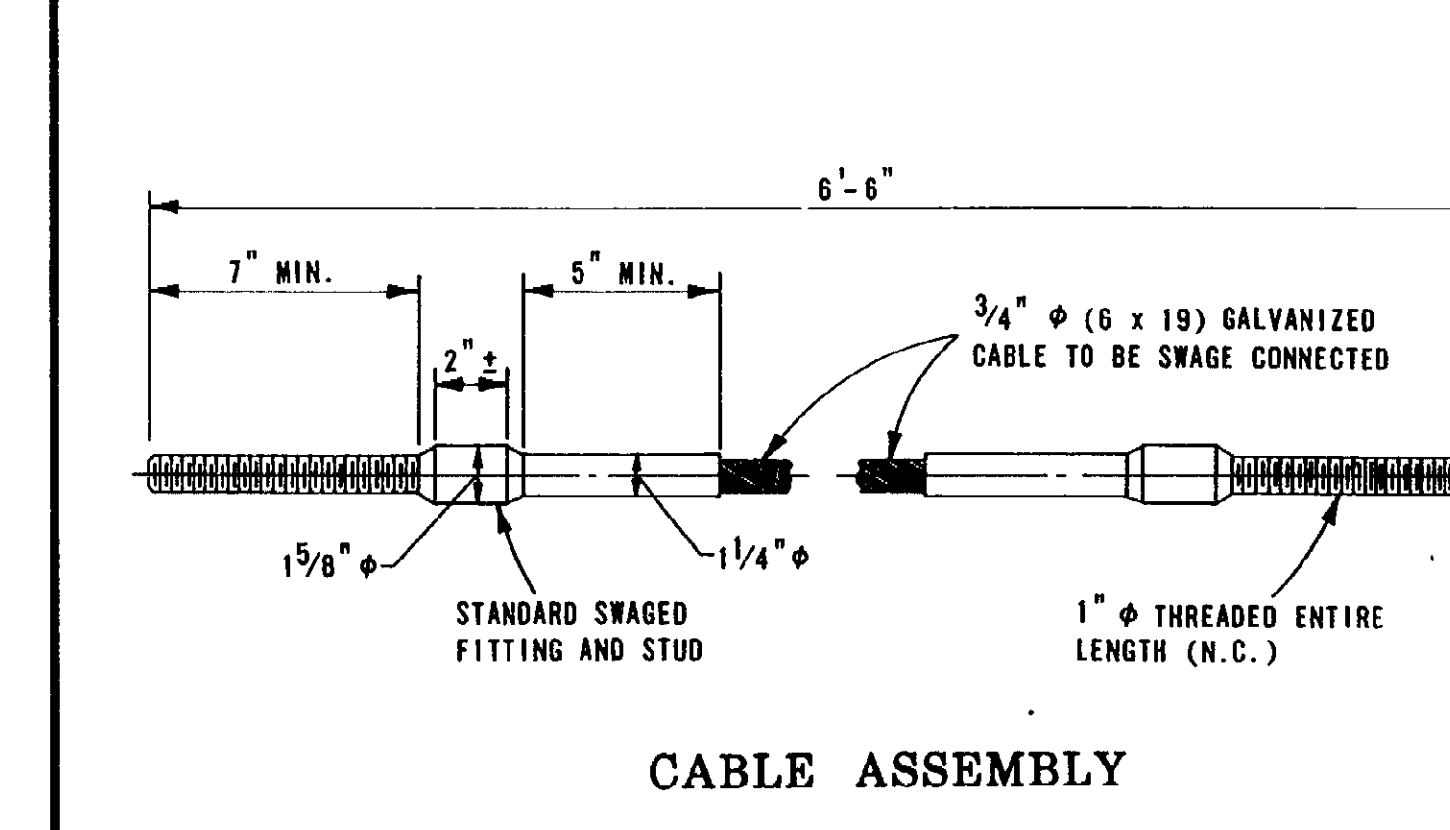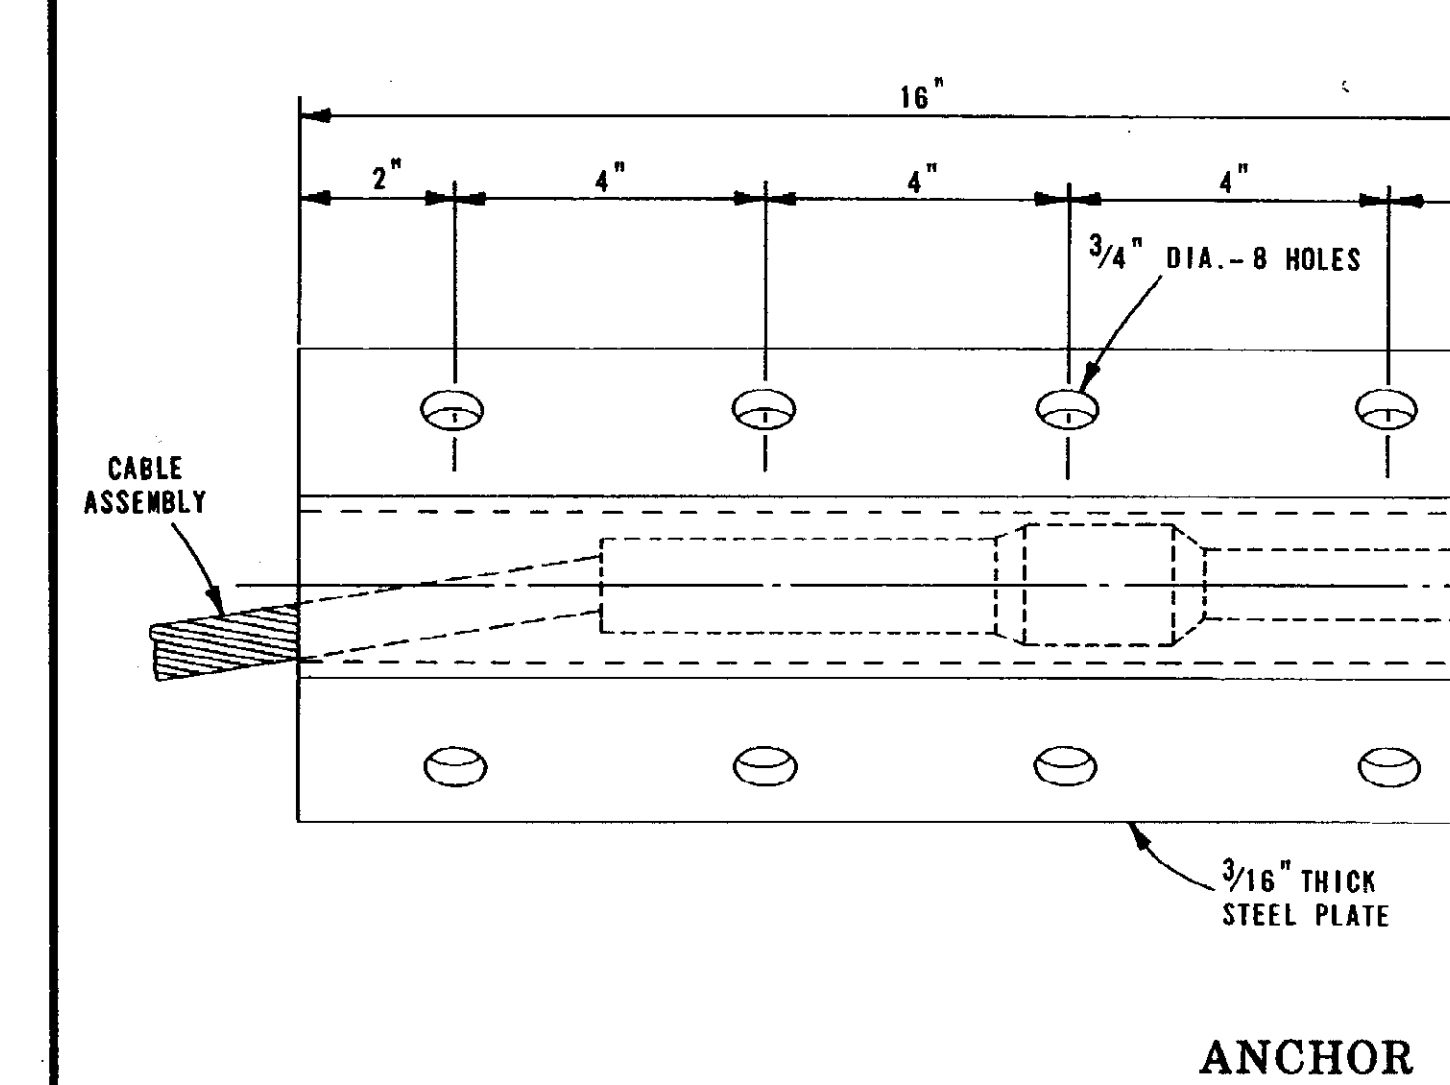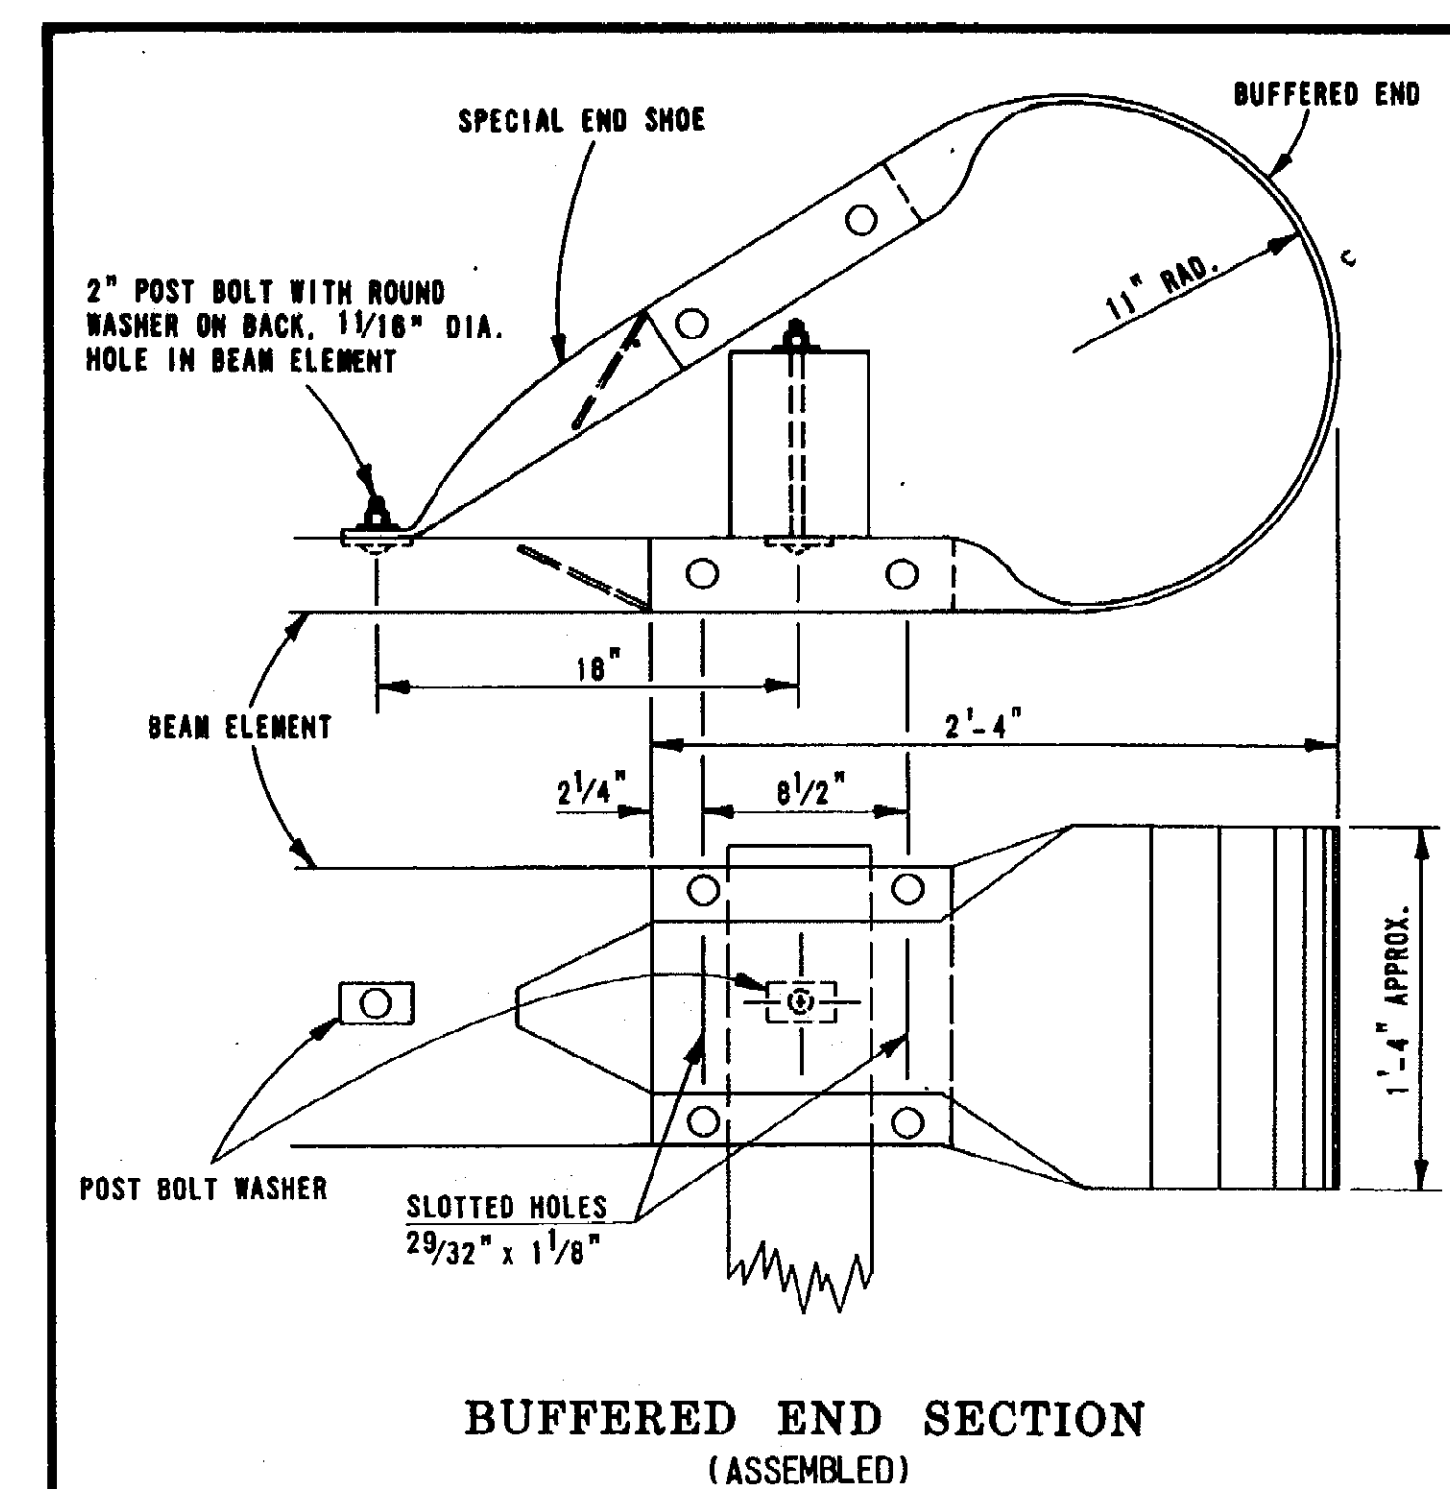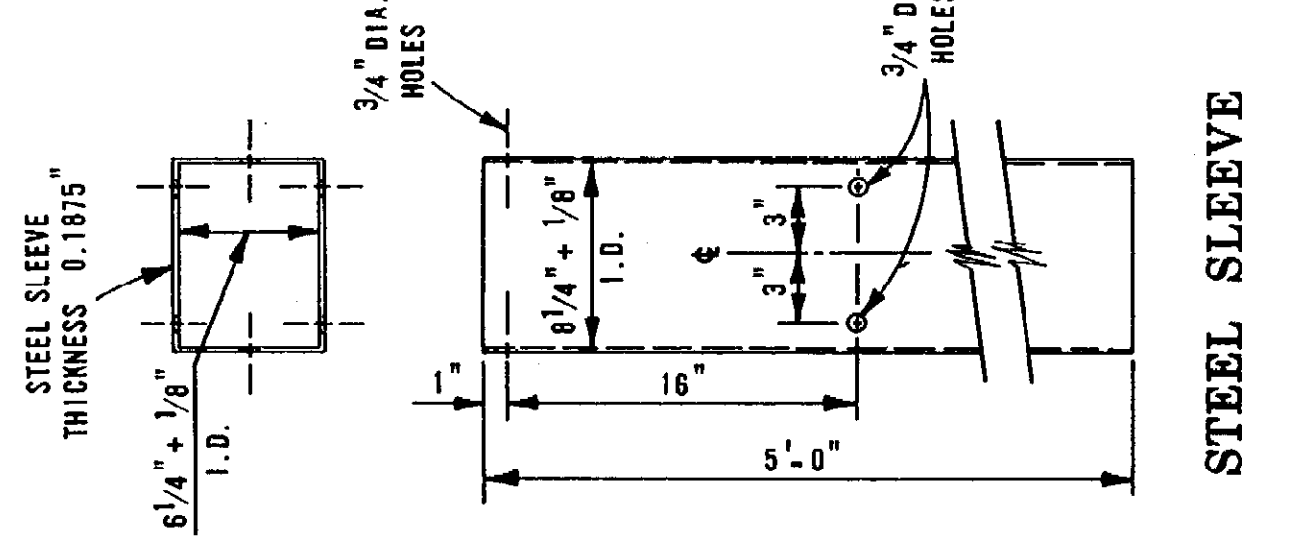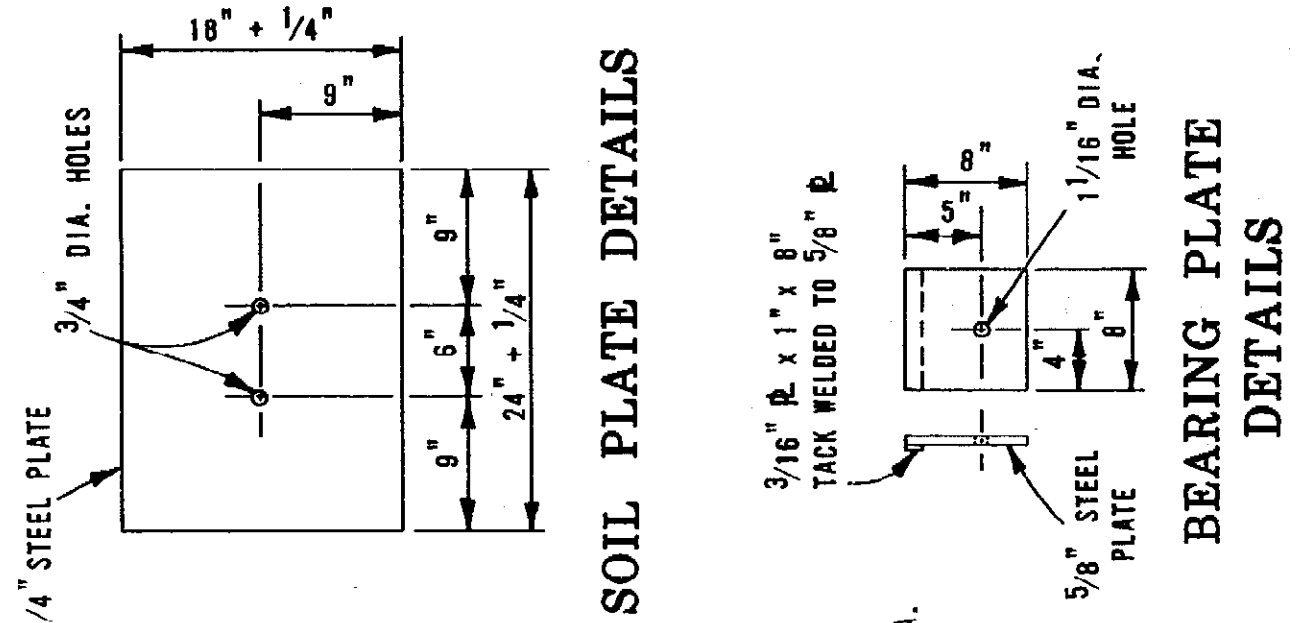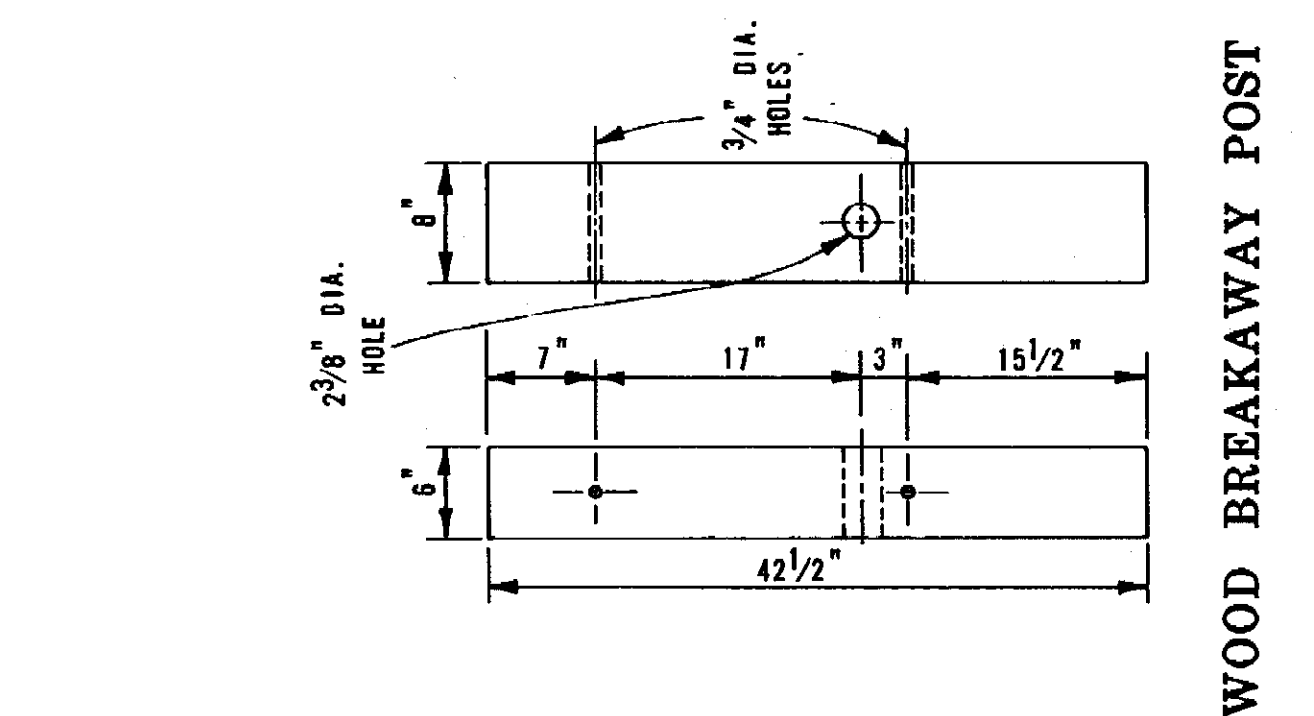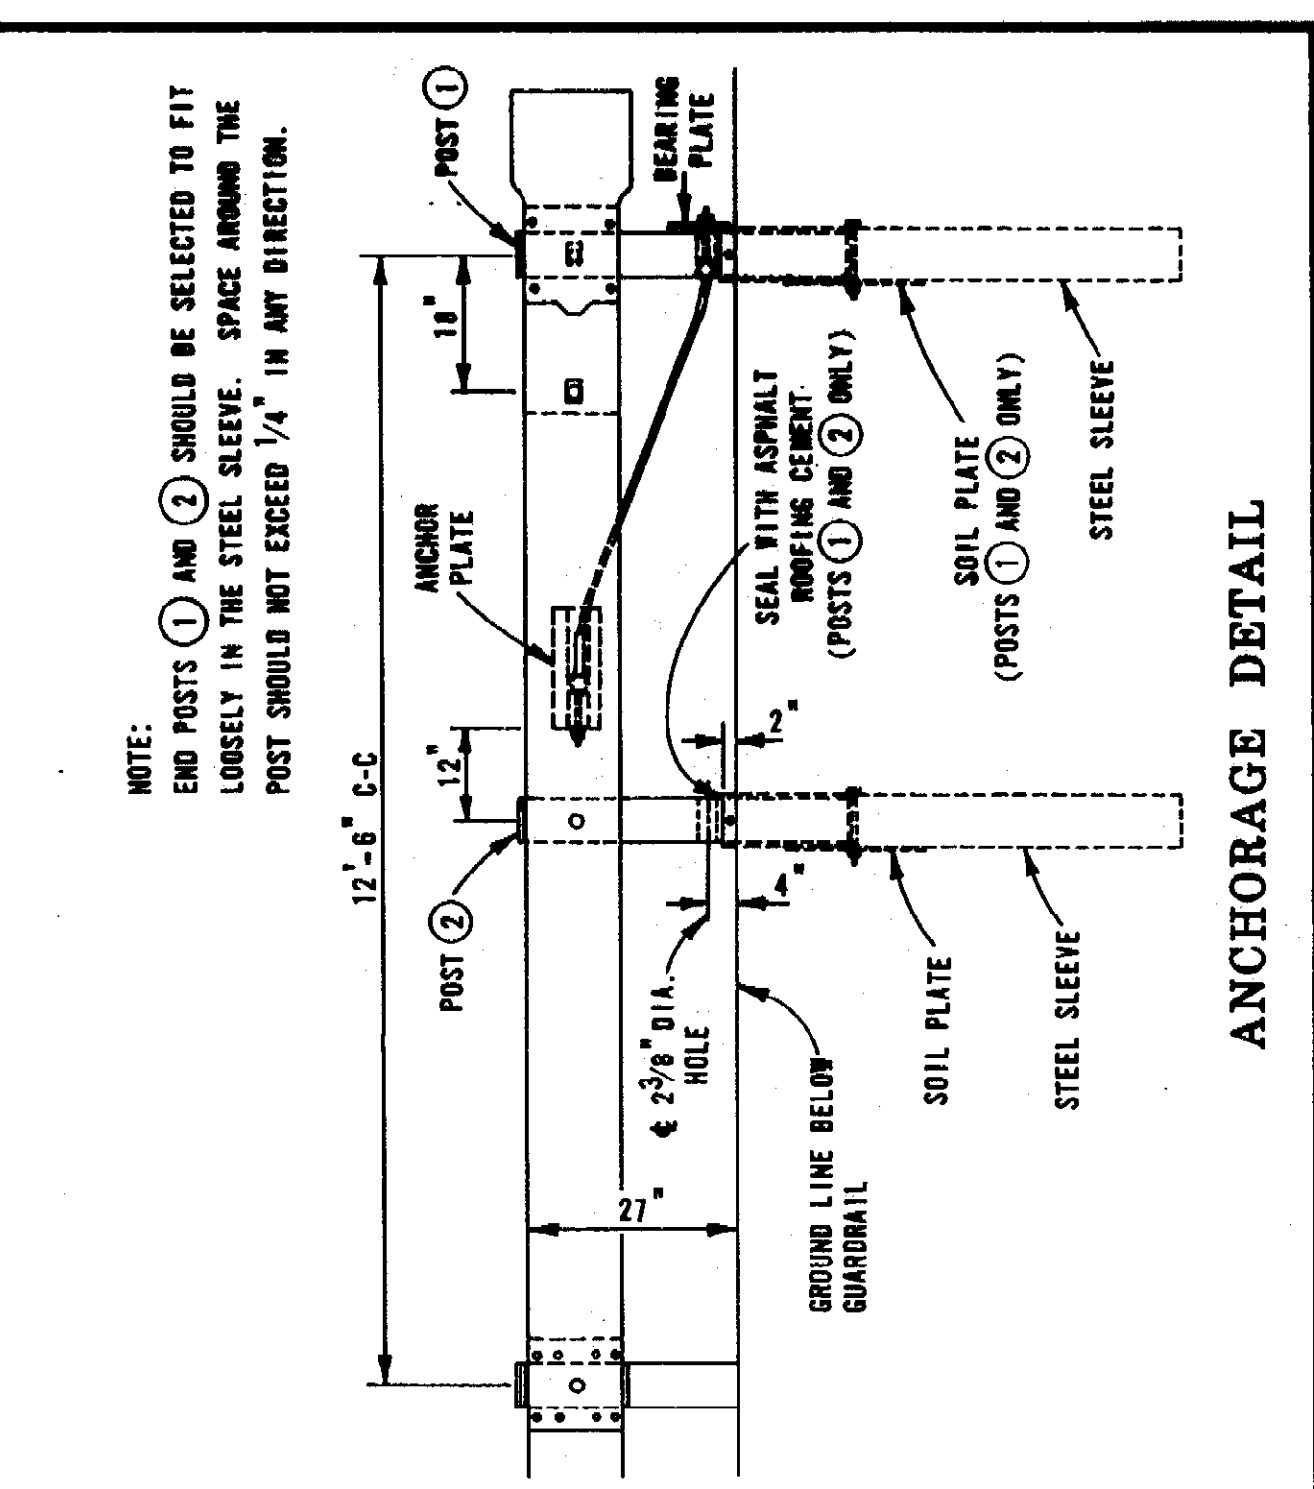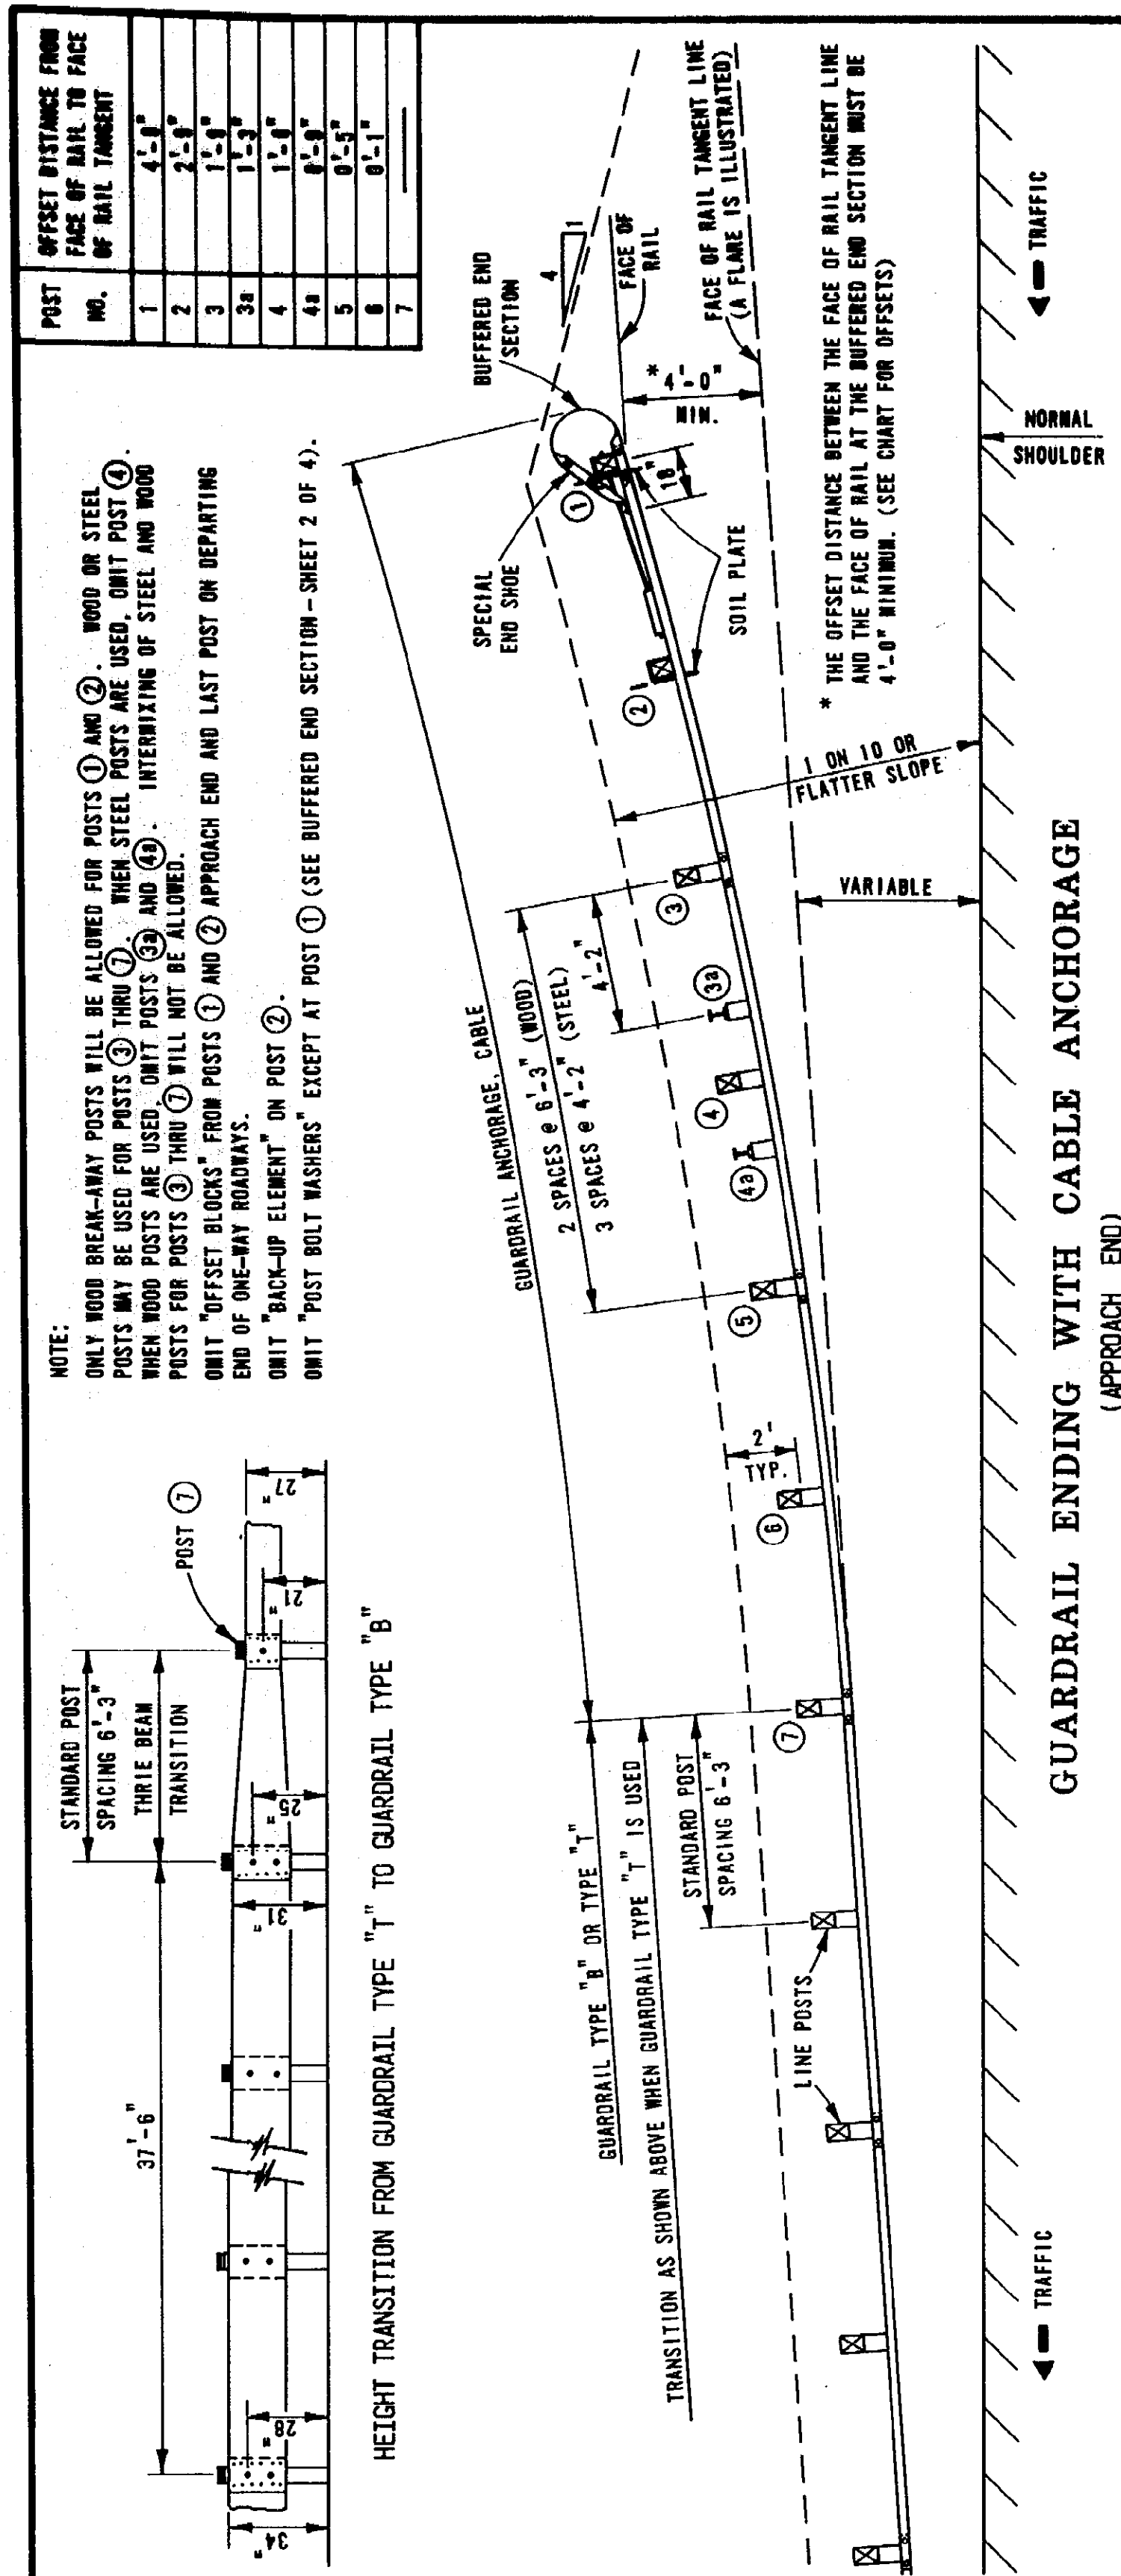


NOTES:
 ALL POSTS AND BLOCKS, BEAM AND BACK UP ELEMENTS AND FITTINGS, INCLUDING BOLTS, NUTS AND WASHERS, SHALL CONFORM TO THE DIMENSIONS AND SPECIFICATIONS SHOWN ON CURRENT STANDARD PLAN III-50 SERIES WHERE APPLICABLE, EXCEPT AS SHOWN ON THIS STANDARD.
 STEEL SLEEVE WELDS SHALL BE MADE FULL LENGTH.
 BUFFERED END SECTION SHALL BE MADE OF 12 GAGE (0.109") MINIMUM THICKNESS SHEET STEEL.
 ALL 1 ON 10 SLOPES SHALL BE GRADED TO CLASS A SLOPE TOLERANCES. FOR DETAILS OF GUARDRAIL PLACEMENT SEE STANDARD PLAN III-50 SERIES. DIAPHRAGMS WILL BE ALLOWED IN THE BUFFERED END.
 AFTER THE CABLE ASSEMBLY HAS BEEN TIGHTENED, THE THREADS OUTSIDE THE NUTS SHALL BE BURRED SLIGHTLY SO THE NUTS WILL NOT LOOSEN.
 TWO 8d GALVANIZED NAILS SHALL BE DRIVEN INTO THE WOOD POST AT THE TOP OF THE BEARING PLATE TO KEEP THE BEARING PLATE FROM ROTATING.
 WHEN ADDITIONAL POST BOLT SLOTS ARE REQUIRED, THEY SHALL BE DRILLED OR PUNCHED AND REGALVANIZED. BURNING WILL NOT BE ALLOWED.

 PREPARED BY DESIGN DIVISION DRAWN BY: D.F.M. CHECKED BY: C.A.L.	ENGINEER OF CONSTRUCTION	<i>J. P. Williams</i> ENGINEER - ROAD DESIGN
	ENGINEER OF MAINTENANCE	<i>James P. Pitz</i> ENGINEER OF DESIGN
	ENGINEER OF MATERIALS & TECHNOLOGY	DEPARTMENT DIRECTOR JAMES P. PITZ
	ENGINEER OF TRAFFIC AND SAFETY	DEPUTY DIRECTOR - HIGHWAYS


MICHIGAN DEPARTMENT OF TRANSPORTATION BUREAU OF HIGHWAYS STANDARD PLAN FOR GUARDRAIL ENDINGS WITH CABLE ANCHORAGE			
F.H.W.A. APPROVAL	6-1-90 PLAN DATE	III-58K	SHEET 1 OF 4

 PREPARED BY DESIGN DIVISION DRAWN BY: D.F.M. CHECKED BY: C.A.L.	ENGINEER OF CONSTRUCTION	<i>J. P. Williams</i> ENGINEER - ROAD DESIGN
	ENGINEER OF MAINTENANCE	<i>James P. Pitz</i> ENGINEER OF DESIGN
	ENGINEER OF MATERIALS & TECHNOLOGY	DEPARTMENT DIRECTOR JAMES P. PITZ
	ENGINEER OF TRAFFIC AND SAFETY	DEPUTY DIRECTOR - HIGHWAYS


MICHIGAN DEPARTMENT OF TRANSPORTATION BUREAU OF HIGHWAYS STANDARD PLAN FOR GUARDRAIL ENDINGS WITH CABLE ANCHORAGE			
F.H.W.A. APPROVAL	6-1-90 PLAN DATE	III-58K	SHEET 2 OF 4

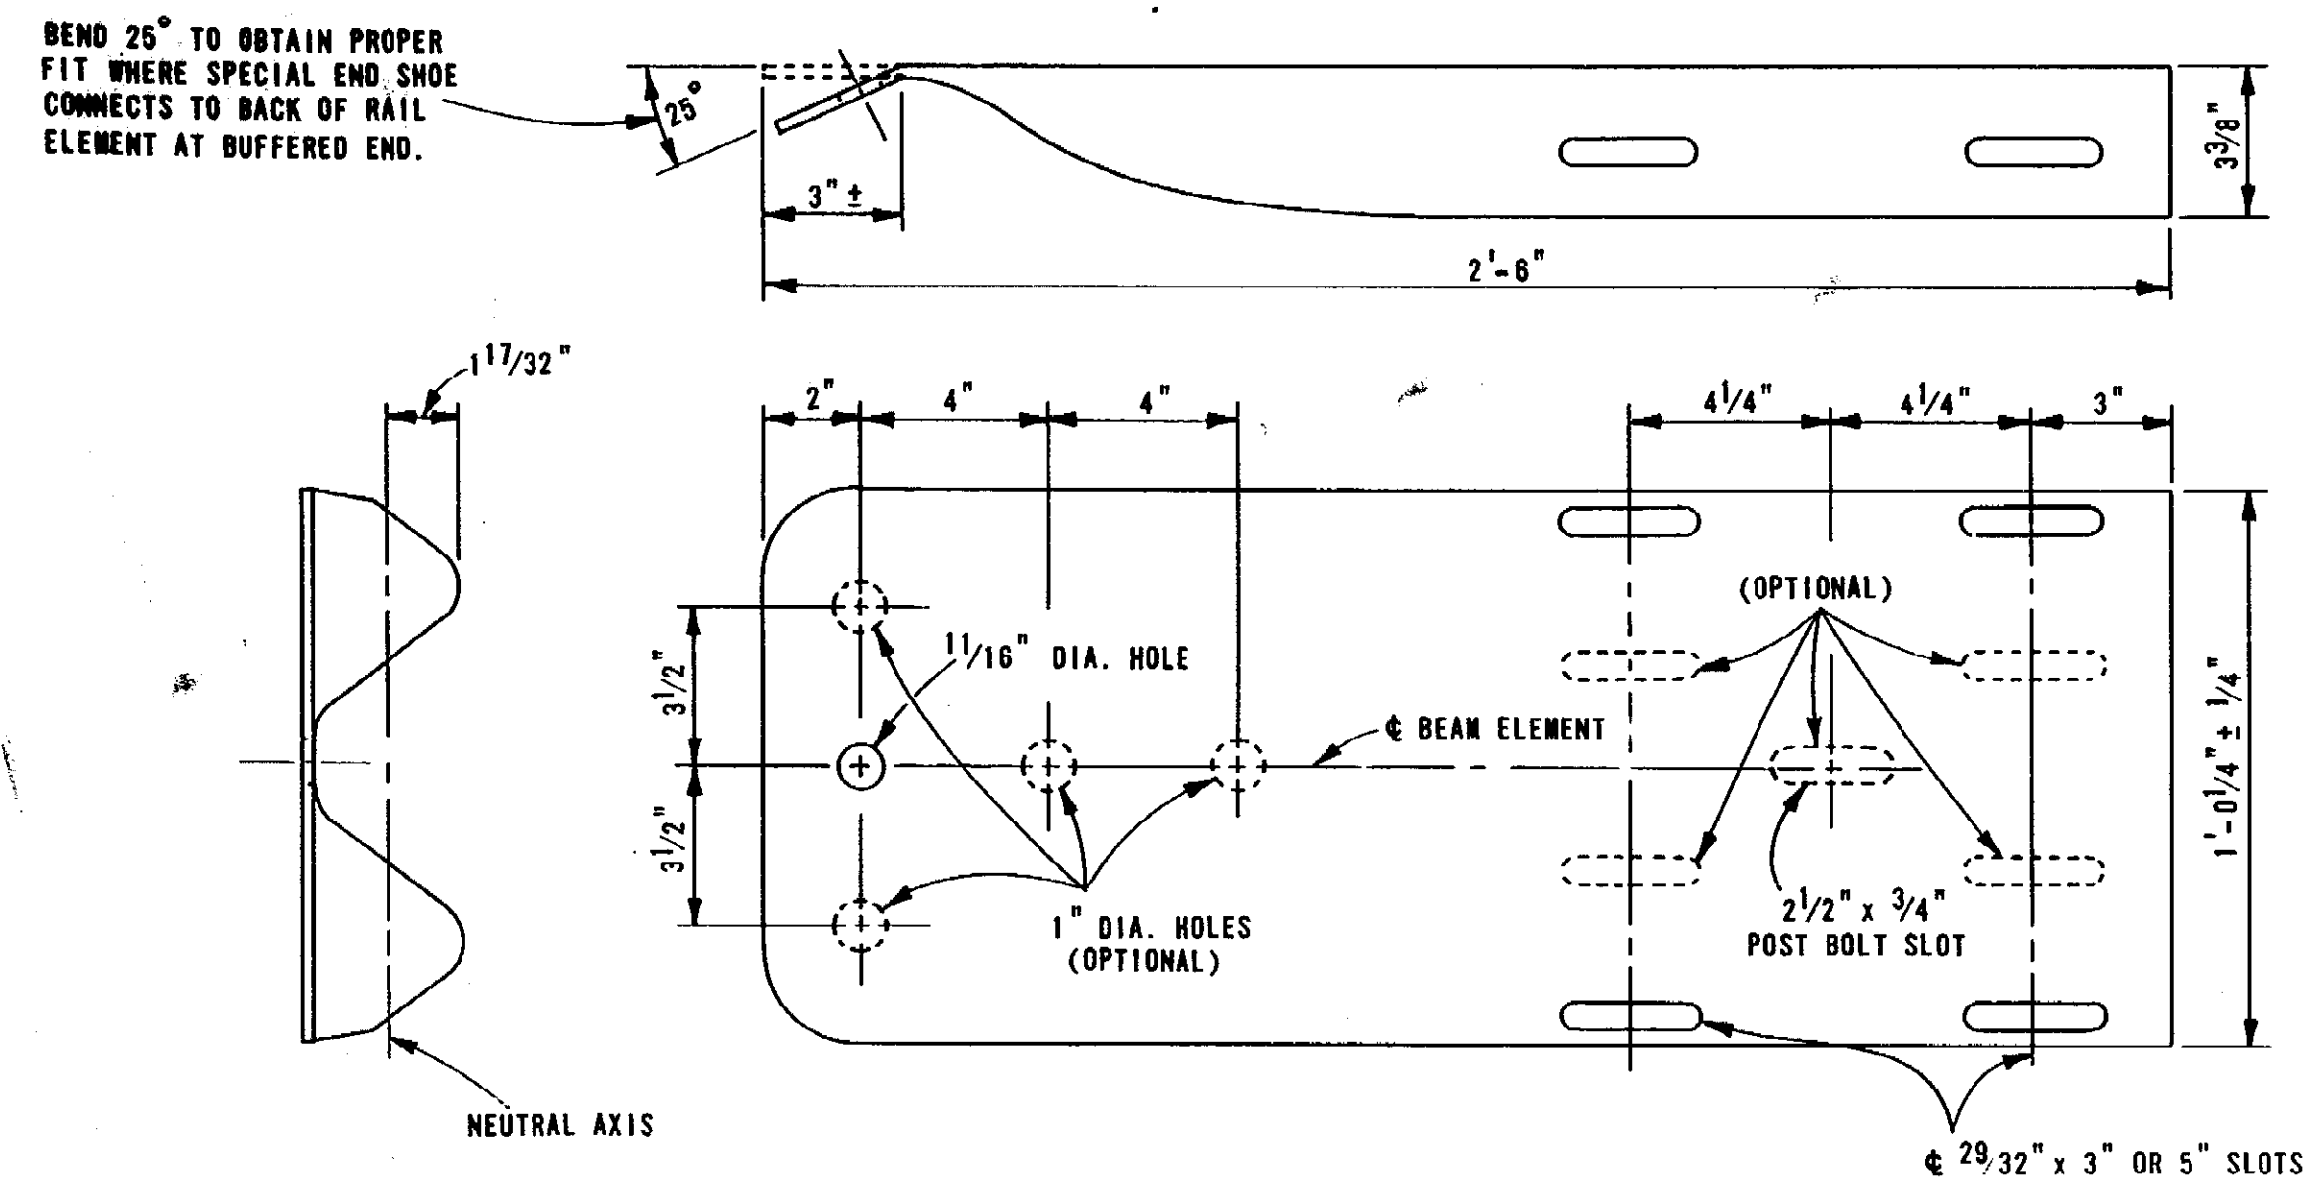


SPECIAL END SHOE
(FOR BUFFERED END)

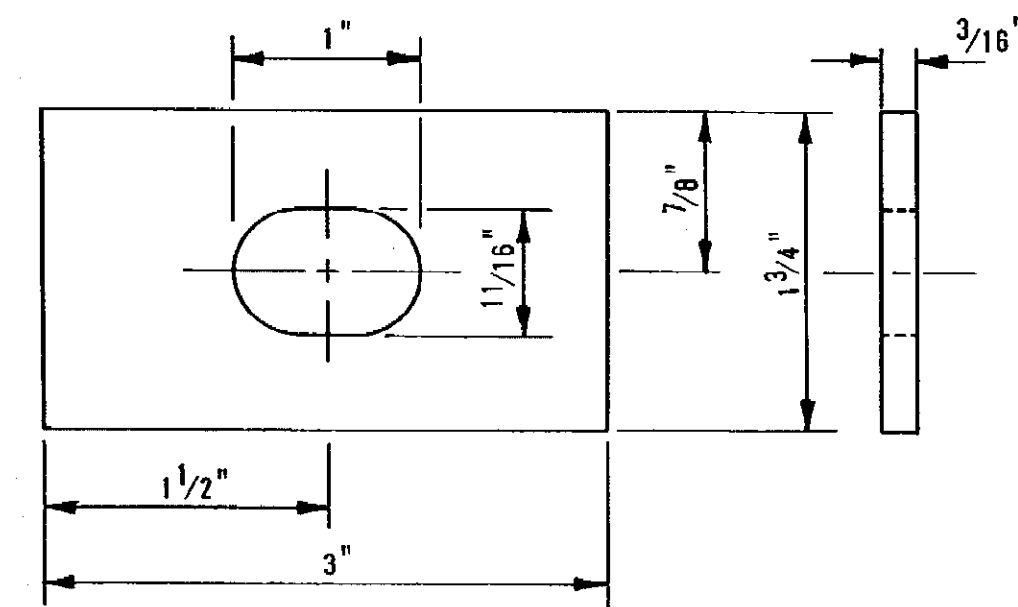

POST BOLT WASHER

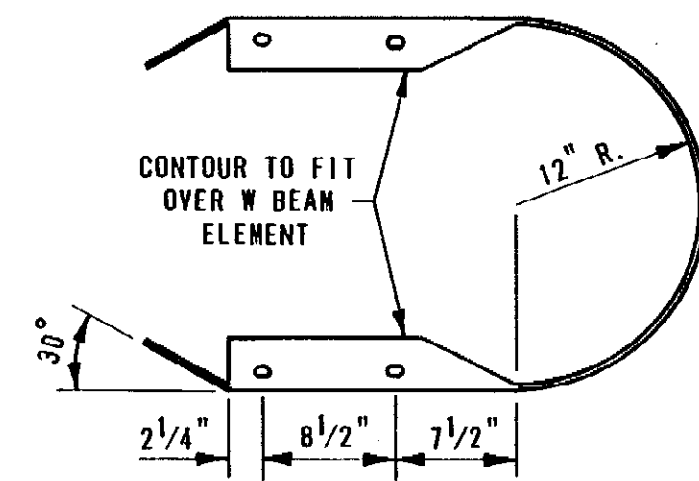


BUFFERED END
(FOR W BEAM ELEMENT)

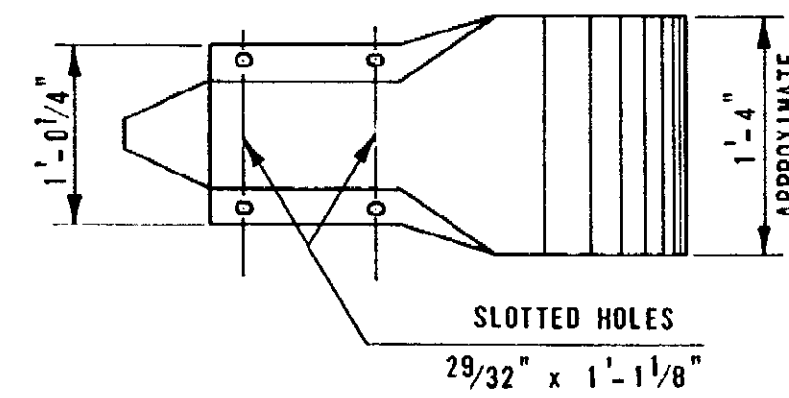


MICHIGAN DEPARTMENT OF TRANSPORTATION
BUREAU OF HIGHWAYS STANDARD PLAN FOR
**GUARDRAIL ENDINGS
WITH CABLE ANCHORAGE**

 PREPARED BY DESIGN DIVISION DRAWN BY: D.F.M. CHECKED BY: C.A.L.	ENGINEER OF CONSTRUCTION	<i>J.H. Williams</i> ENGINEER - ROAD DESIGN
	ENGINEER OF MAINTENANCE	<i>James P. Pitz</i> ENGINEER OF DESIGN
	ENGINEER OF MATERIALS & TECHNOLOGY	DEPARTMENT DIRECTOR JAMES P. PITZ
	ENGINEER OF TRAFFIC AND SAFETY	DEPUTY DIRECTOR - HIGHWAYS

F.H.W.A. APPROVAL	DATE	6-1-90 PLAN DATE	III-58K	SHEET 3 OF 4
-------------------	------	---------------------	----------------	--------------

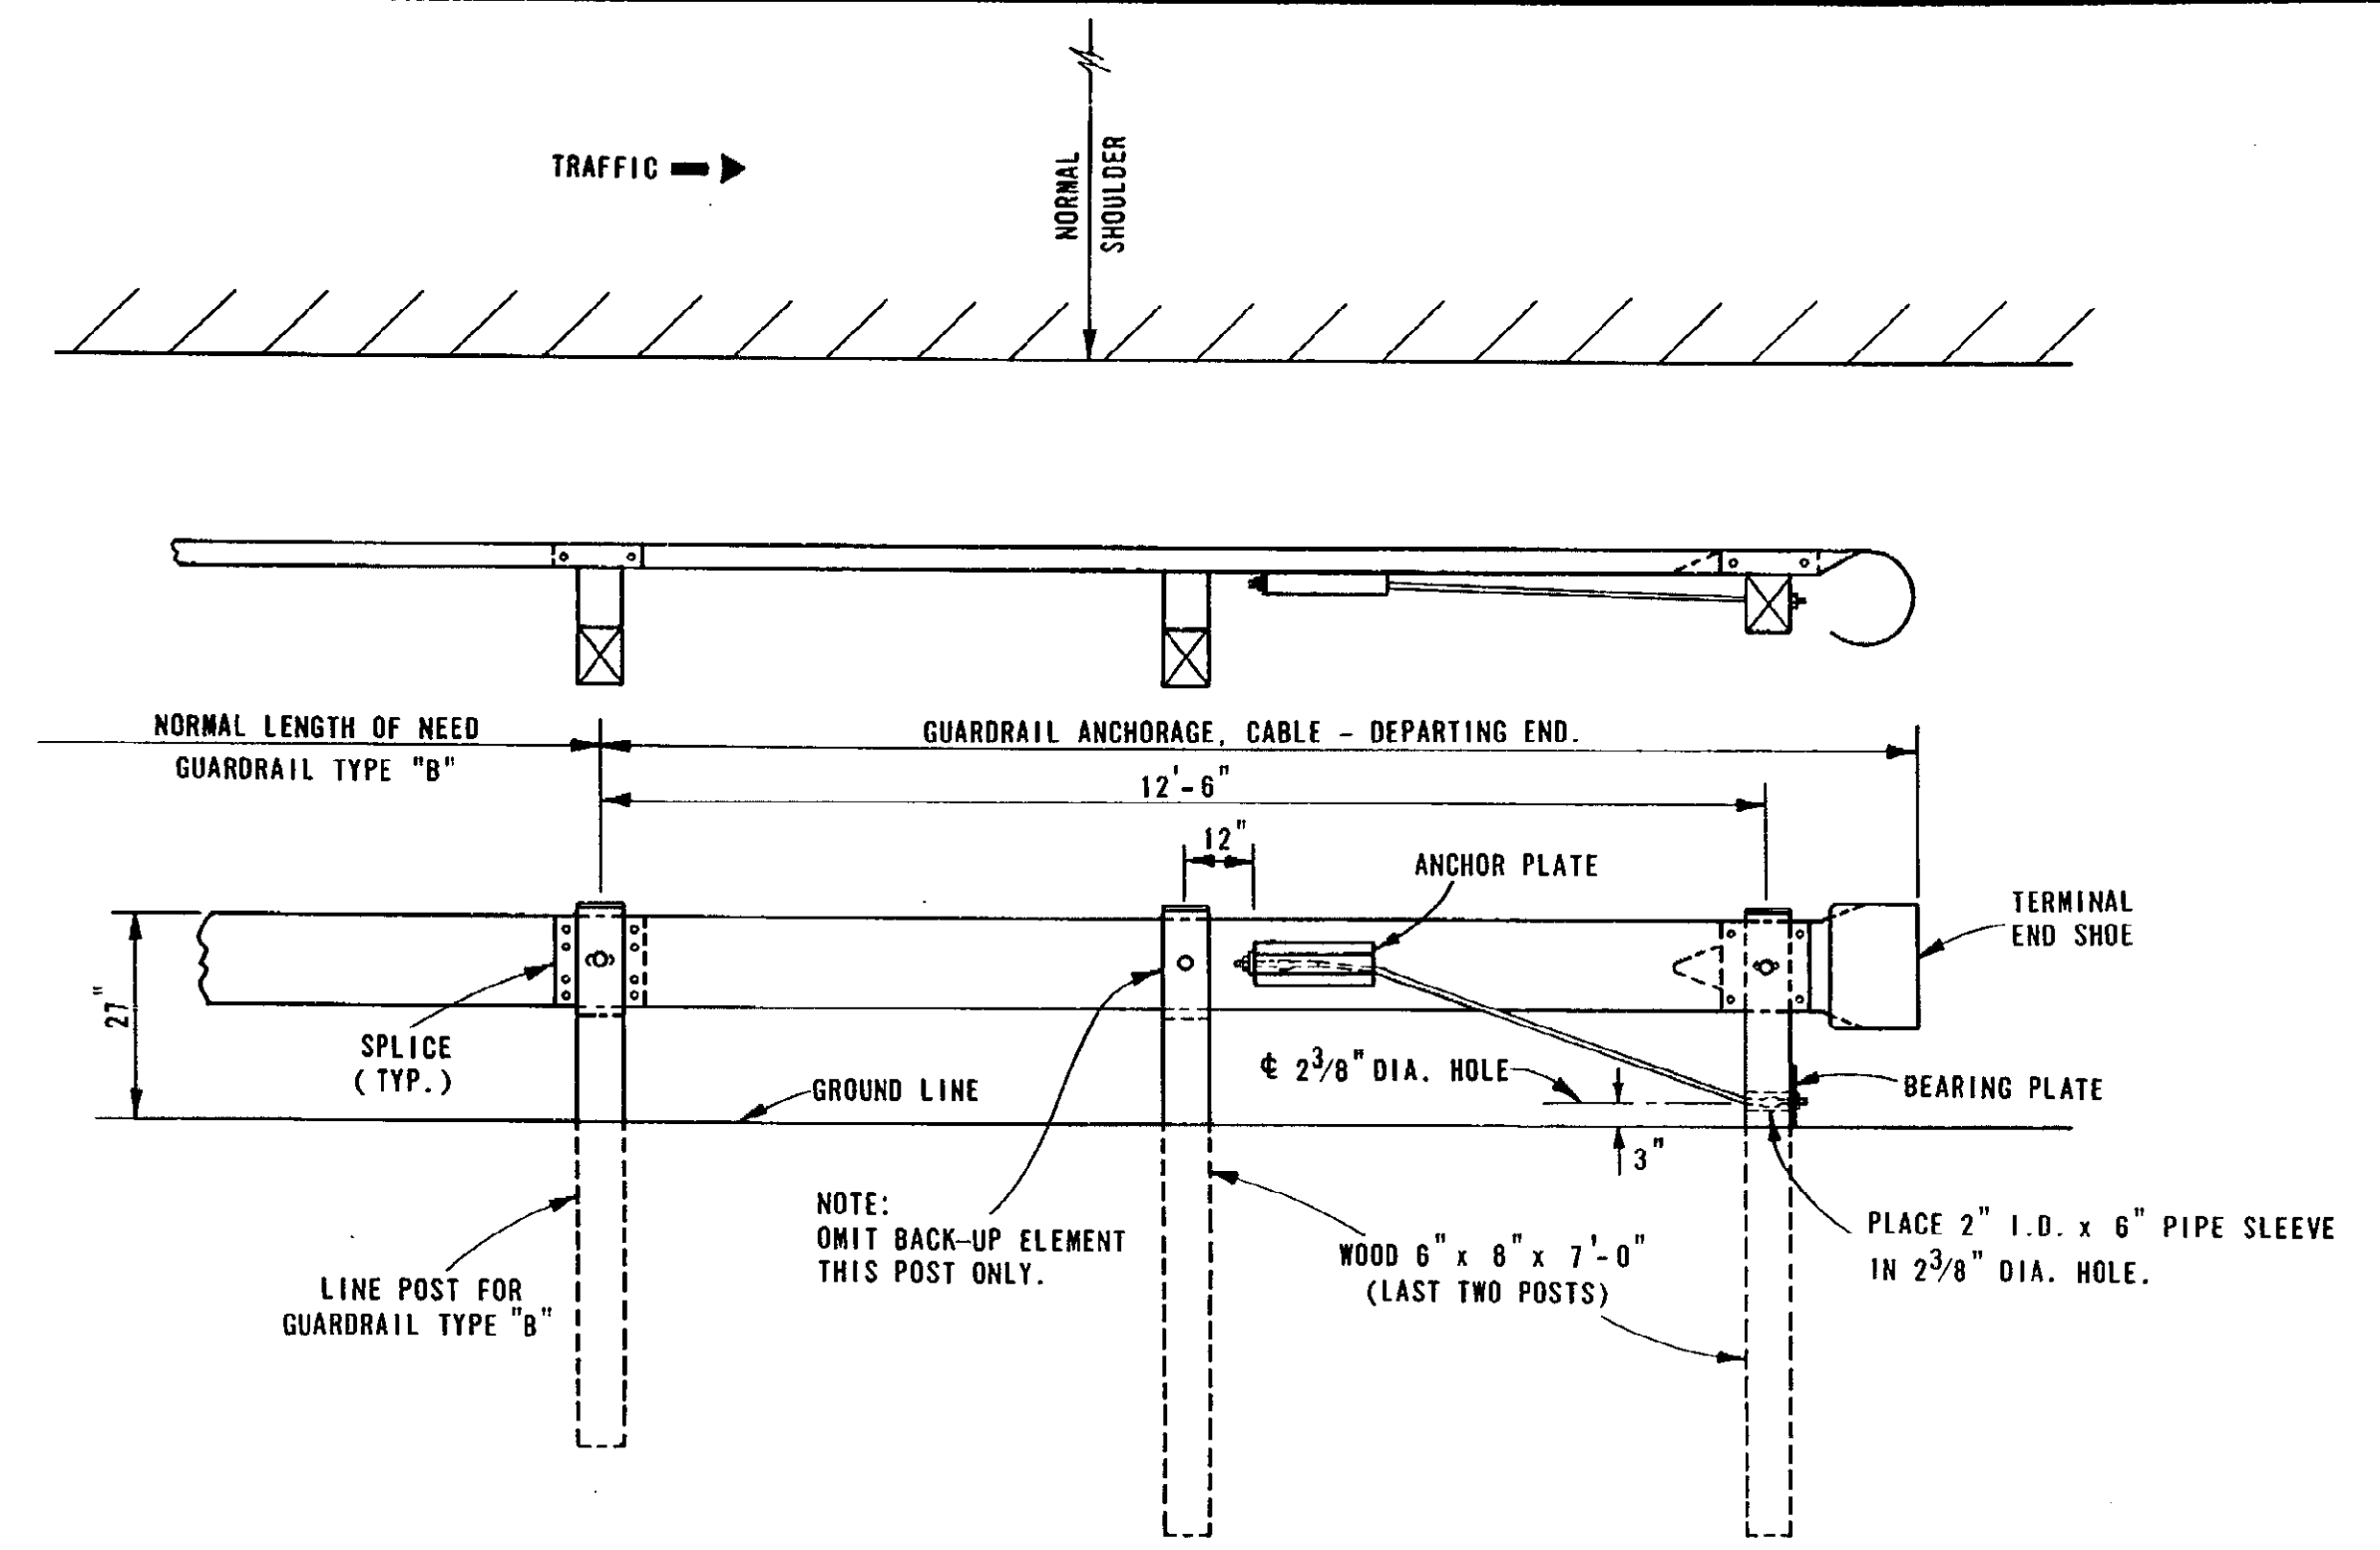




GUARDRAIL ANCHORAGE, CABLE - DEPARTING END
(ONE-WAY ROADWAYS ONLY)

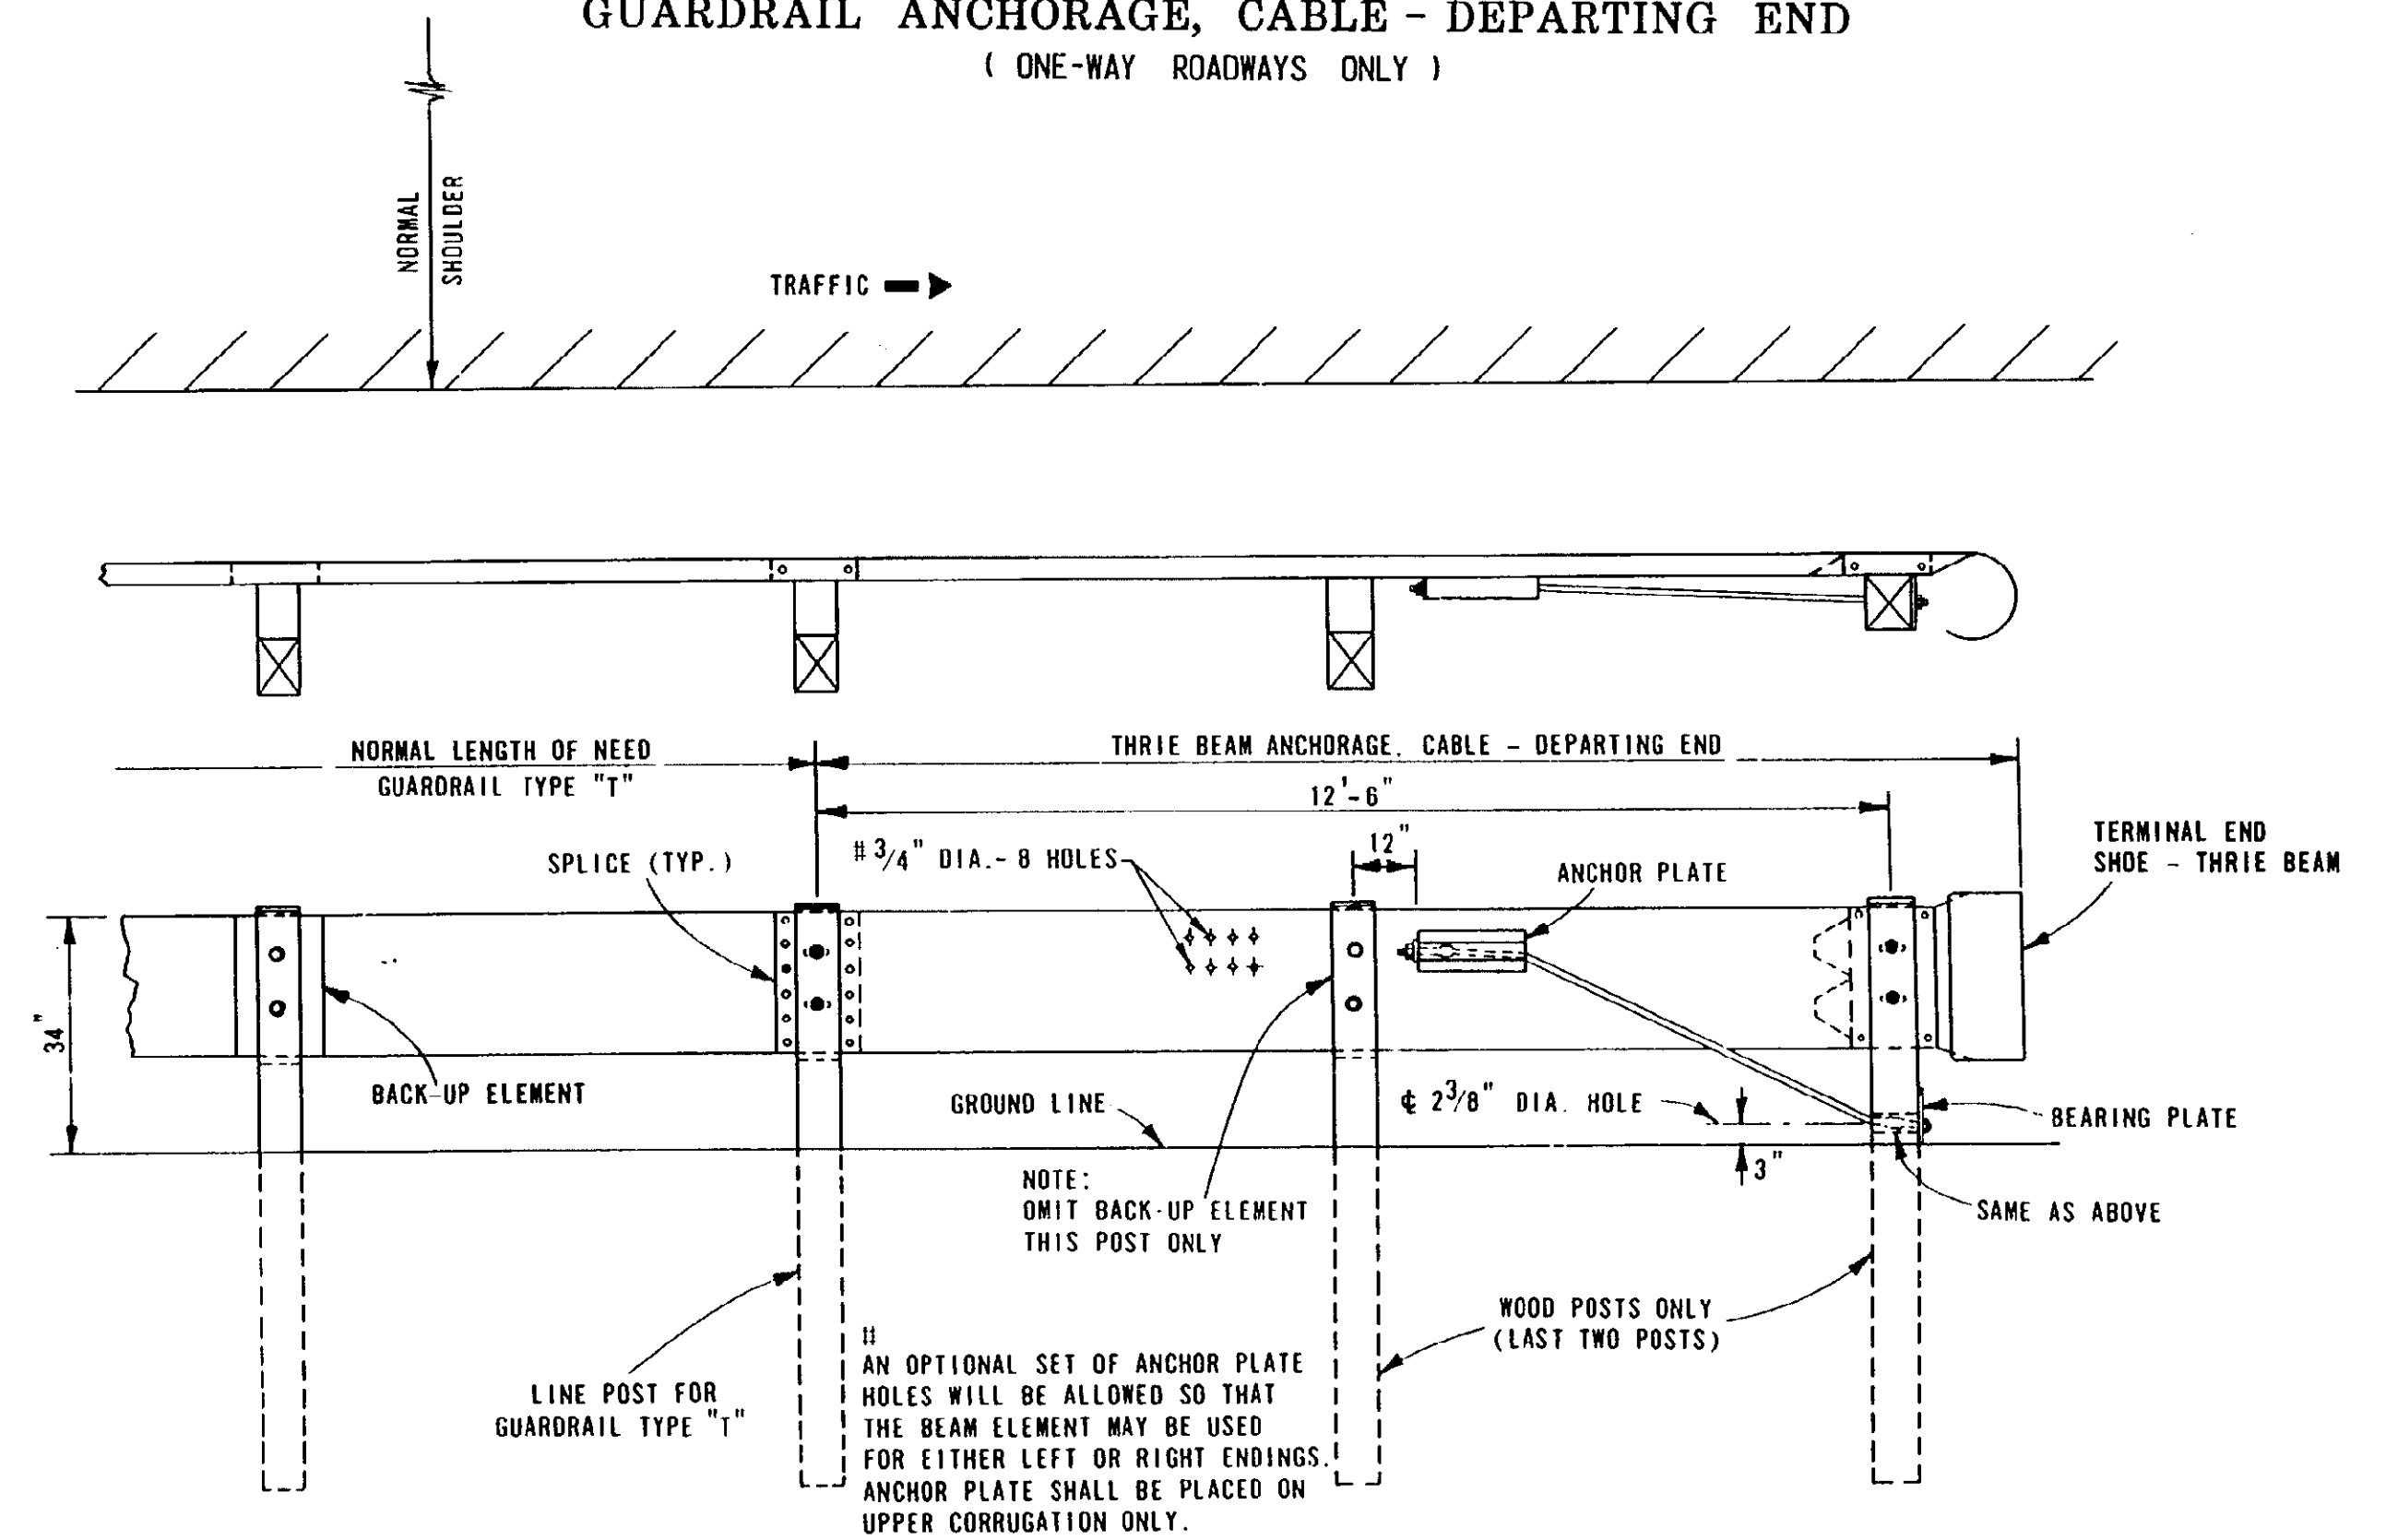

THRIE BEAM ANCHORAGE, CABLE - DEPARTING END
(ONE-WAY ROADWAYS ONLY)

 PREPARED BY DESIGN DIVISION DRAWN BY: D.F.M. CHECKED BY: C.A.L.	ENGINEER OF CONSTRUCTION	<i>J.H. Williams</i> ENGINEER - ROAD DESIGN
	ENGINEER OF MAINTENANCE	<i>James P. Pitz</i> ENGINEER OF DESIGN
	ENGINEER OF MATERIALS & TECHNOLOGY	DEPARTMENT DIRECTOR JAMES P. PITZ
	ENGINEER OF TRAFFIC AND SAFETY	DEPUTY DIRECTOR - HIGHWAYS

MICHIGAN DEPARTMENT OF TRANSPORTATION BUREAU OF HIGHWAYS STANDARD PLAN FOR GUARDRAIL ENDINGS WITH CABLE ANCHORAGE				
F.H.W.A. APPROVAL	DATE	6-1-90 PLAN DATE	III-58K	SHEET 4 OF 4

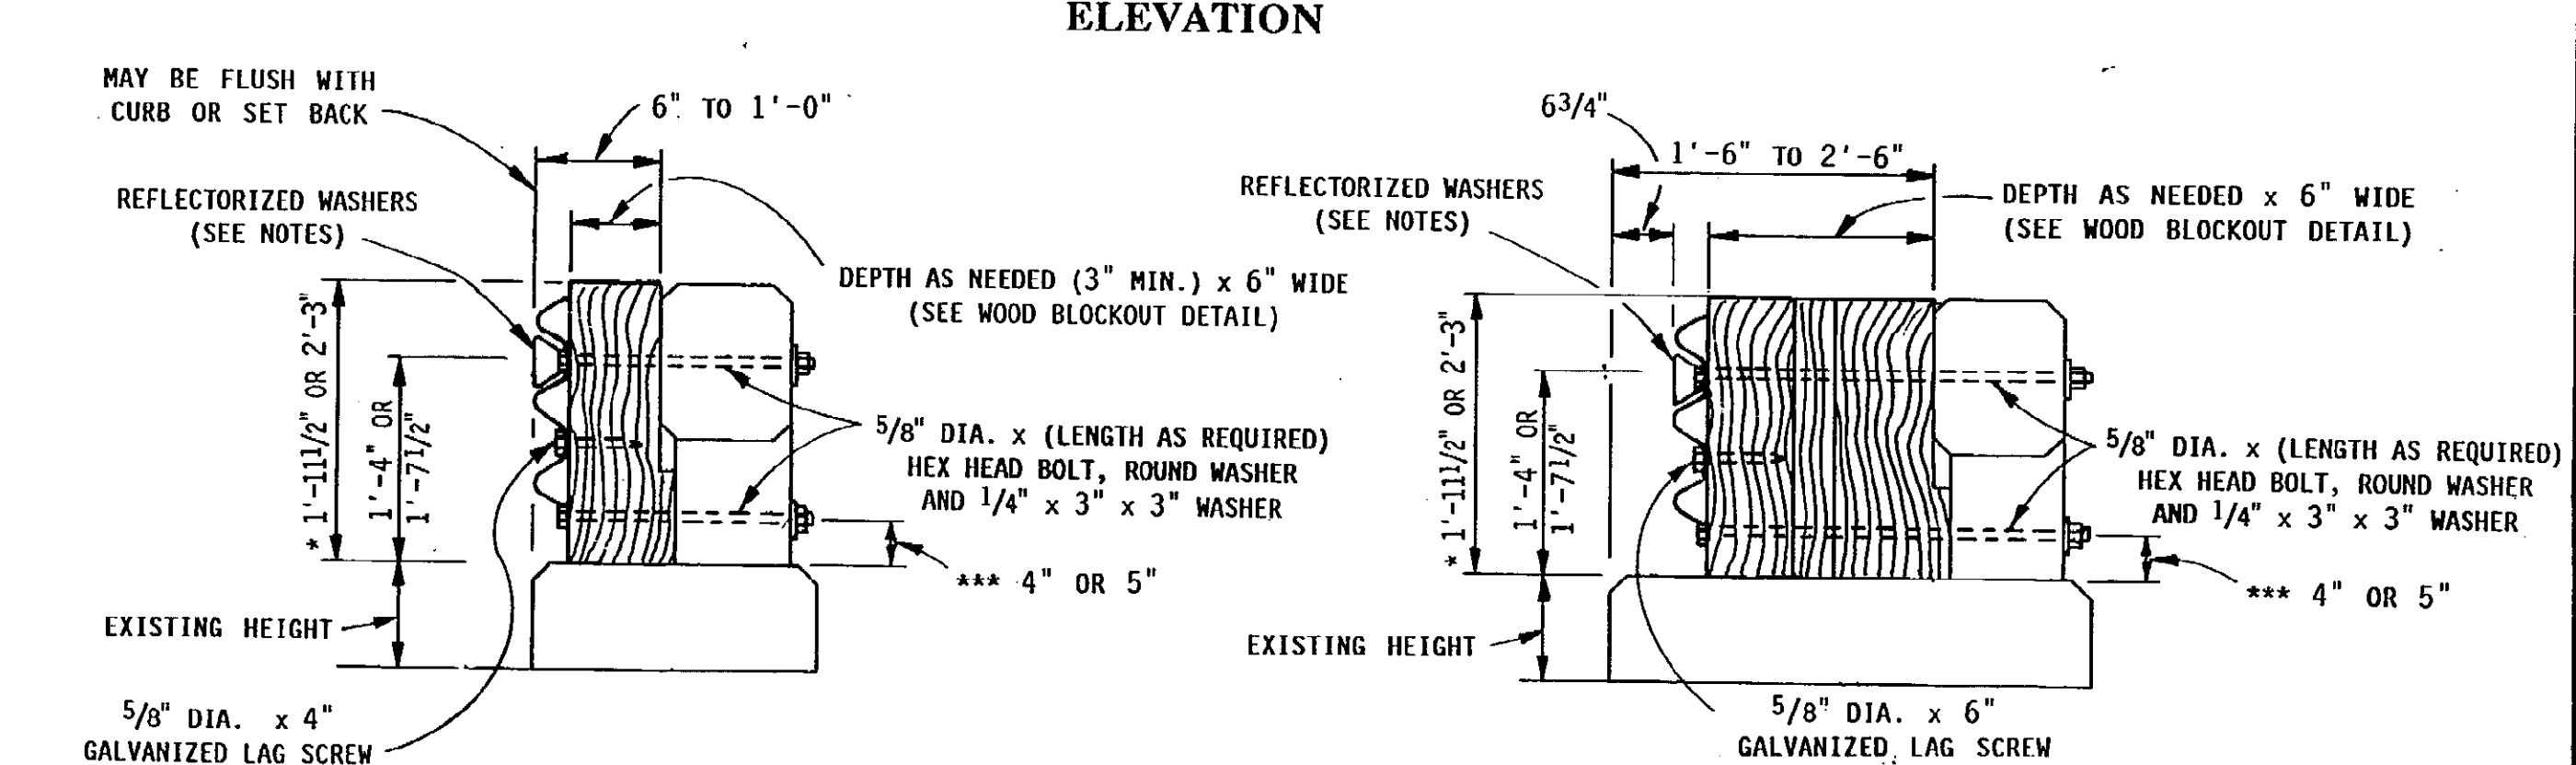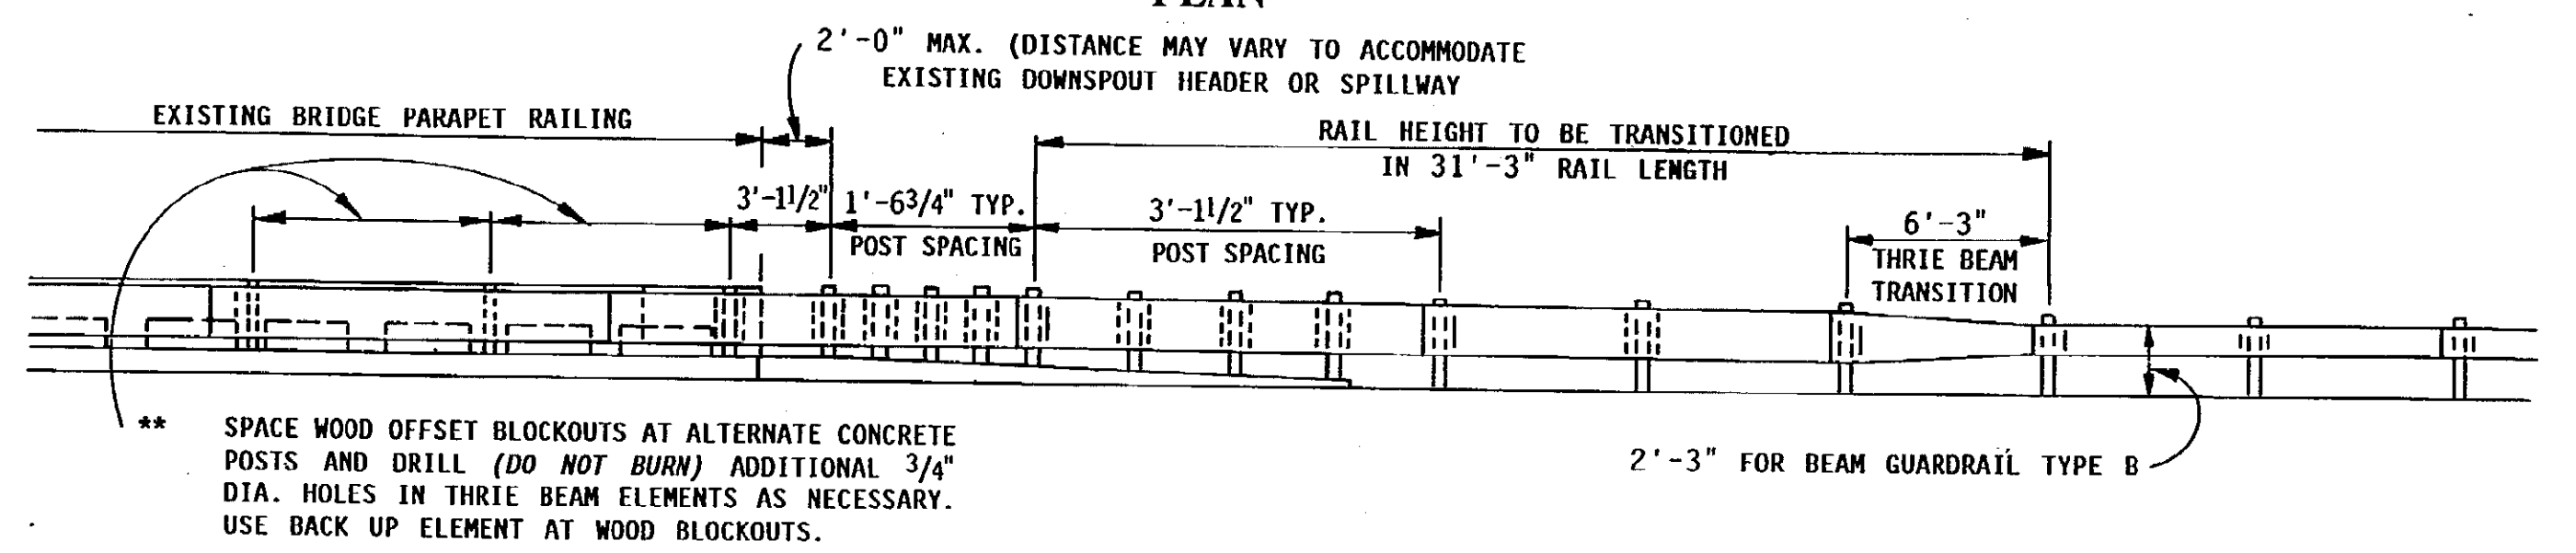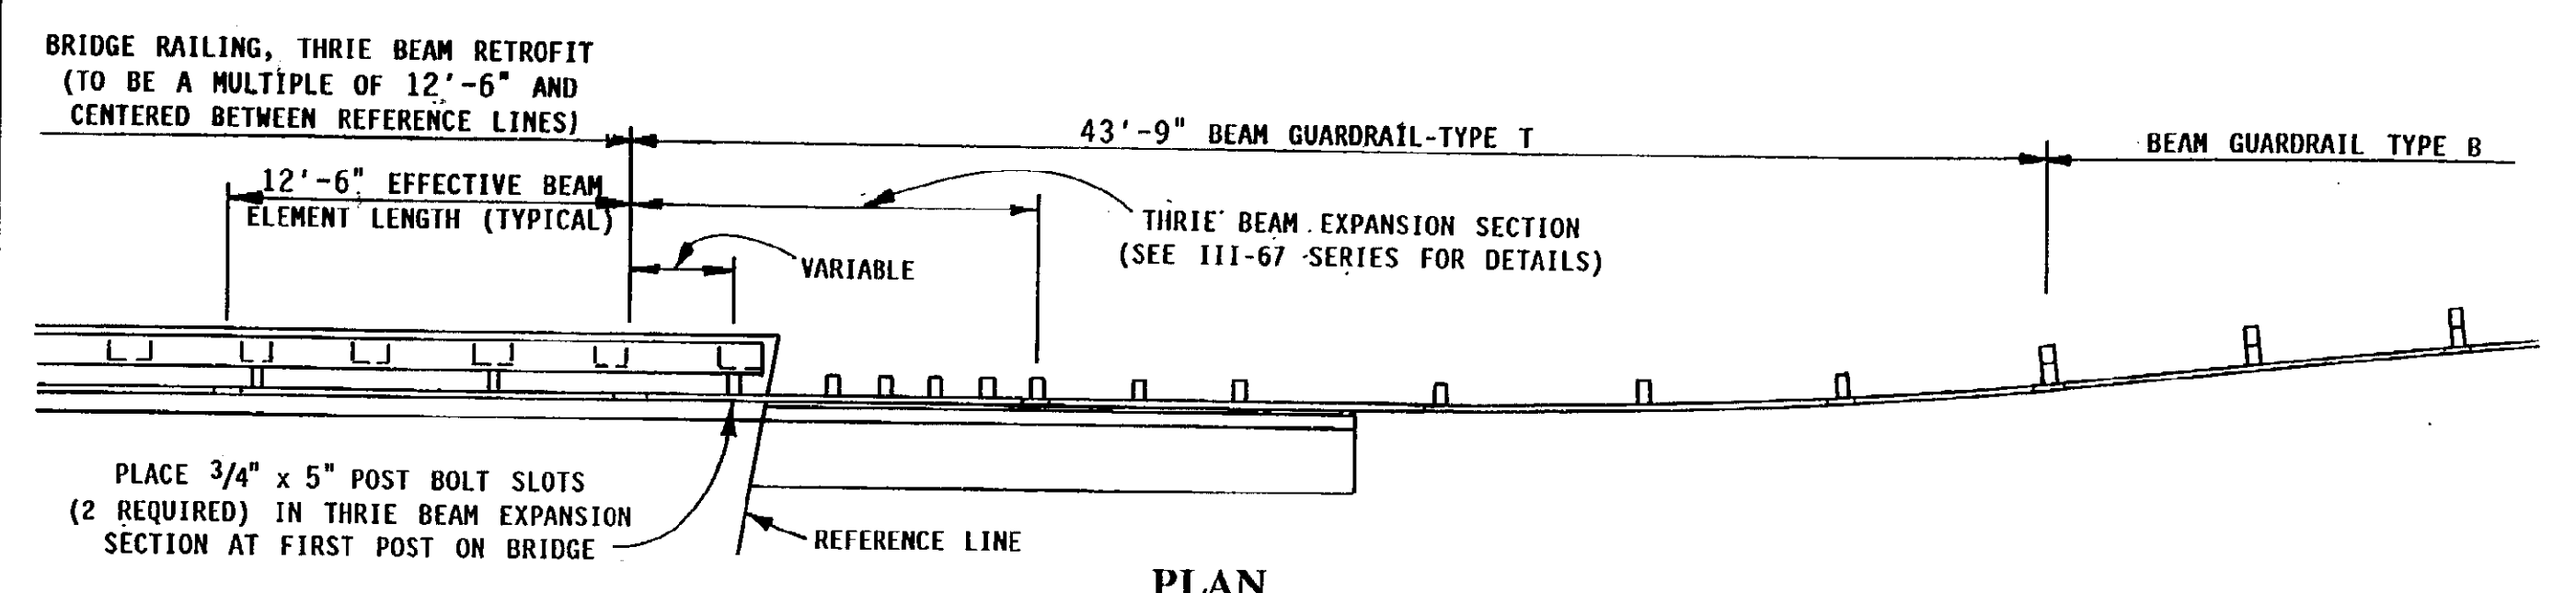

NOTE: A 32" MINIMUM HEIGHT FROM TOP OF THE THRIE BEAM TO BRIDGE DECK AT THE BOTTOM OF BRUSH BLOCK IS REQUIRED.

- * EXISTING RAILING MAY BE EITHER OF TWO HEIGHTS.
- ** A 2" OFFSET FROM THE CENTERLINE OF THE CONCRETE RAILING POST FOR THE WOOD BLOCKOUT AND THE DRILLING OF THE 3/4" DIA. HOLE IN THE CONCRETE RAILING POST IS REQUIRED TO CLEAR EXISTING REINFORCEMENT.
- *** 4" WHEN OVERALL HEIGHT 2'-3", 5" WHEN OVERALL HEIGHT 1'-11 1/2"

NOTES:

THIS SPECIAL DETAIL IS INTENDED FOR USE IN UPGRADING OF EXISTING OPEN-PARAPET TYPE BRIDGE RAILINGS AND APPROACH GUARDRAIL. FOR NEW CONSTRUCTION AND FOR DETAILS OF GUARDRAIL HARDWARE, SEE STANDARD PLANS.

BRIDGE RAILING, THRIE BEAM RETROFIT WILL BE PAID FOR AT THE CONTRACT UNIT PRICE PER LINEAR FOOT. THIS PRICE INCLUDES PAYMENT IN FULL FOR ALL WORK AND MATERIAL REQUIRED TO PLACE THE RAILING TO THE LIMITS SHOWN. ALL WORK AND MATERIAL REQUIRED TO ATTACH APPROACH GUARDRAIL ELEMENT TO BRIDGE RAILING END POST IS INCLUDED IN THE BID ITEM "BRIDGE RAILING, THRIE BEAM RETROFIT". REFLECTORIZED WASHERS WILL BE PAID FOR SEPARATELY.

ADDITIONAL GUARDRAIL POSTS, HARDWARE, THRIE BEAM ELEMENTS, TRANSITIONS ELEMENTS AND ALL OTHER WORK AND MATERIALS REQUIRED TO CONSTRUCT APPROACH GUARDRAIL AS DETAILED, IS INCLUDED IN THE BID ITEM "BEAM GUARDRAIL-TYPE T".


ALL POSTS, OFFSET BLOCKS, THRIE BEAM, TRANSITIONS, BACK-UP ELEMENTS AND FITTINGS (INCLUDING NUTS, BOLTS, AND WASHERS) SHALL CONFORM TO THE REQUIREMENTS OF THE CURRENT STANDARD SPECIFICATIONS AND TO THE DIMENSIONS SHOWN ON THE CURRENT STANDARD PLAN III-60 SERIES, WHERE APPLICABLE, EXCEPT AS SHOWN ON THIS PLAN.

THRIE BEAM ELEMENTS USED FOR GUARDRAIL-BRIDGE (THRIE BEAM) SHALL BE FORMED FROM SHEETS HAVING A NOMINAL THICKNESS OF NOT LESS THAN 0.138" (10 GAGE). REFLECTORIZED WASHERS ARE TO BE PLACED ON UPPER POST BOLT AND SPACED AT EVERY THIRD OFFSET BLOCKOUT.

BEAM ELEMENTS SHALL BE LAPPED IN THE DIRECTION OF TRAFFIC.

WHEN PRESENT, REMOVE EXISTING ALUMINUM POSTS AND TUBE FROM TOP OF OPEN-PARAPET RAILING.

STANDARD SPLICE BOLTS SHALL BE USED WHEN SPLICING THRIE BEAM ELEMENT TO THRIE BEAM EXPANSION SECTION. NUTS SHALL BE INSTALLED FINGERTIGHT AND SHALL FULLY ENGAGE BOLTS WITH A MINIMUM OF ONE BOLT THREAD EXTENDING BEYOND THE NUTS. THE FIRST THREAD ON THE OUTSIDE OF THE NUTS SHALL BE UPSET WITH A CENTER PUNCH OR A COLD CHISEL TO PREVENT LOOSENING.

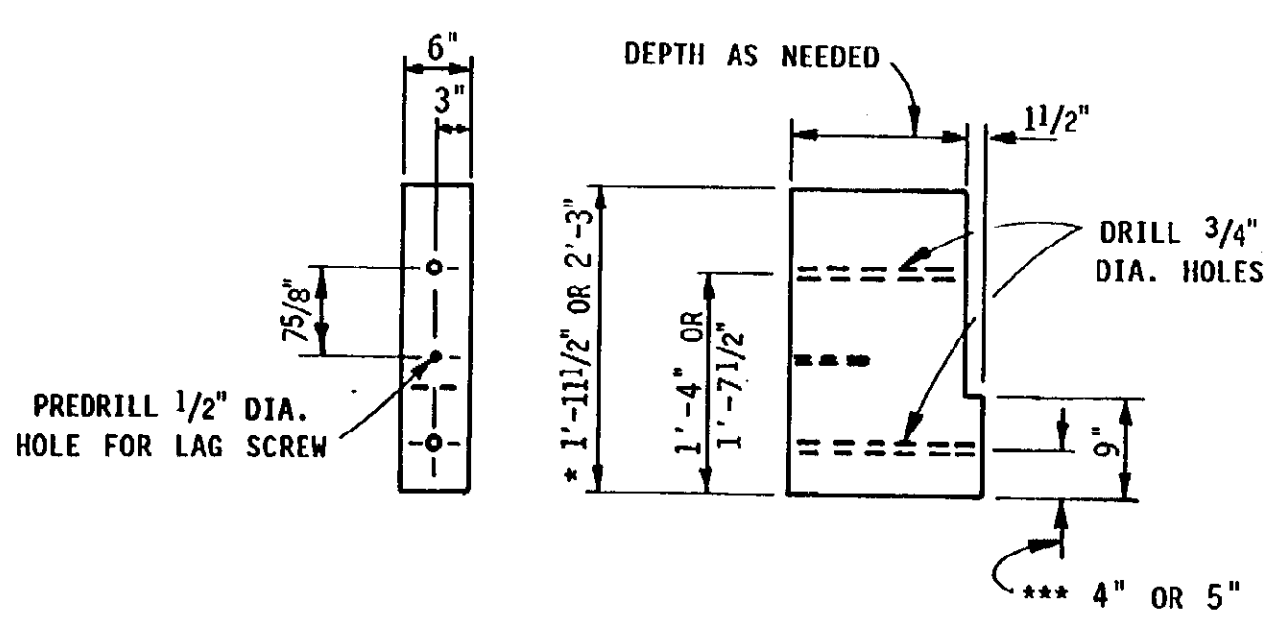

ENGINEER-BRIDGE DESIGN		ENGINEER-ROAD DESIGN		ENGINEER OF DESIGN	
ENGINEER OF MAINTENANCE		ENGINEER OF CONSTRUCTION		DEPARTMENT DIRECTOR	
ENGINEER OF MATERIALS & TECHNOLOGY		DEPARTMENT DIRECTOR		JAMES P. PITZ	
ENGINEER OF TRAFFIC AND SAFETY		DEPUTY DIRECTOR-HIGHWAYS		BY:	
PREPARED BY DESIGN DIVISION		DRAWN BY: H.A.M.		CHECKED BY: C.A.L.	
MICHIGAN DEPARTMENT OF TRANSPORTATION BUREAU OF HIGHWAYS STANDARD PLAN FOR		BRIDGE RAILING, THRIE BEAM RETROFIT (OPEN PARAPET TYPE BRIDGE RAILING)		X-23A	
APPROVAL		PLAN DATE		SHEET 1 OF 1	
SECTION 63174		NO. 28992A		SHEET NO. 15	

MICROFILM CONTENT SHEET

BATCH 07-8F

OUT TO MICROFILM 8/24/2007

Control Section	Structure	Job Number	Sheet Number	Let Date	Region	Total Sheets	Plan Set	Box
63174		32616	(ONE ROLL)	9/9/1992	METRO	3		3
			AS LET					
	LANDSCAPING							

MICHIGAN
DEPARTMENT OF TRANSPORTATION

PLANS OF PROPOSED
MICHIGAN PROJECT I-75-2(409) 59
CONTROL SECTION IR 63174
JOB NUMBER 32616A


I-75
OAKLAND CO.
CITY OF HAZEL PARK

ROUTE	JOB NUMBER	FEDERAL NUMBER	SHEET NO.	TOTAL SHEETS
I-75	32616A	NP 1270	1	3

THE IMPROVEMENT COVERED BY THESE PLANS SHALL BE DONE IN ACCORDANCE WITH THE MICHIGAN DEPARTMENT OF TRANSPORTATION 1990 STANDARD SPECIFICATIONS AND SUPPLEMENTAL SPECIFICATIONS

A.D.T.....
D.H.V.....
COMM. %.....
DESIGN SPEED.....

INDEX SHEET NO'S.
TITLE SHEET
SPECIFICATIONS.....
PLAN SHEETS.....
QUANTITY SHEET.....

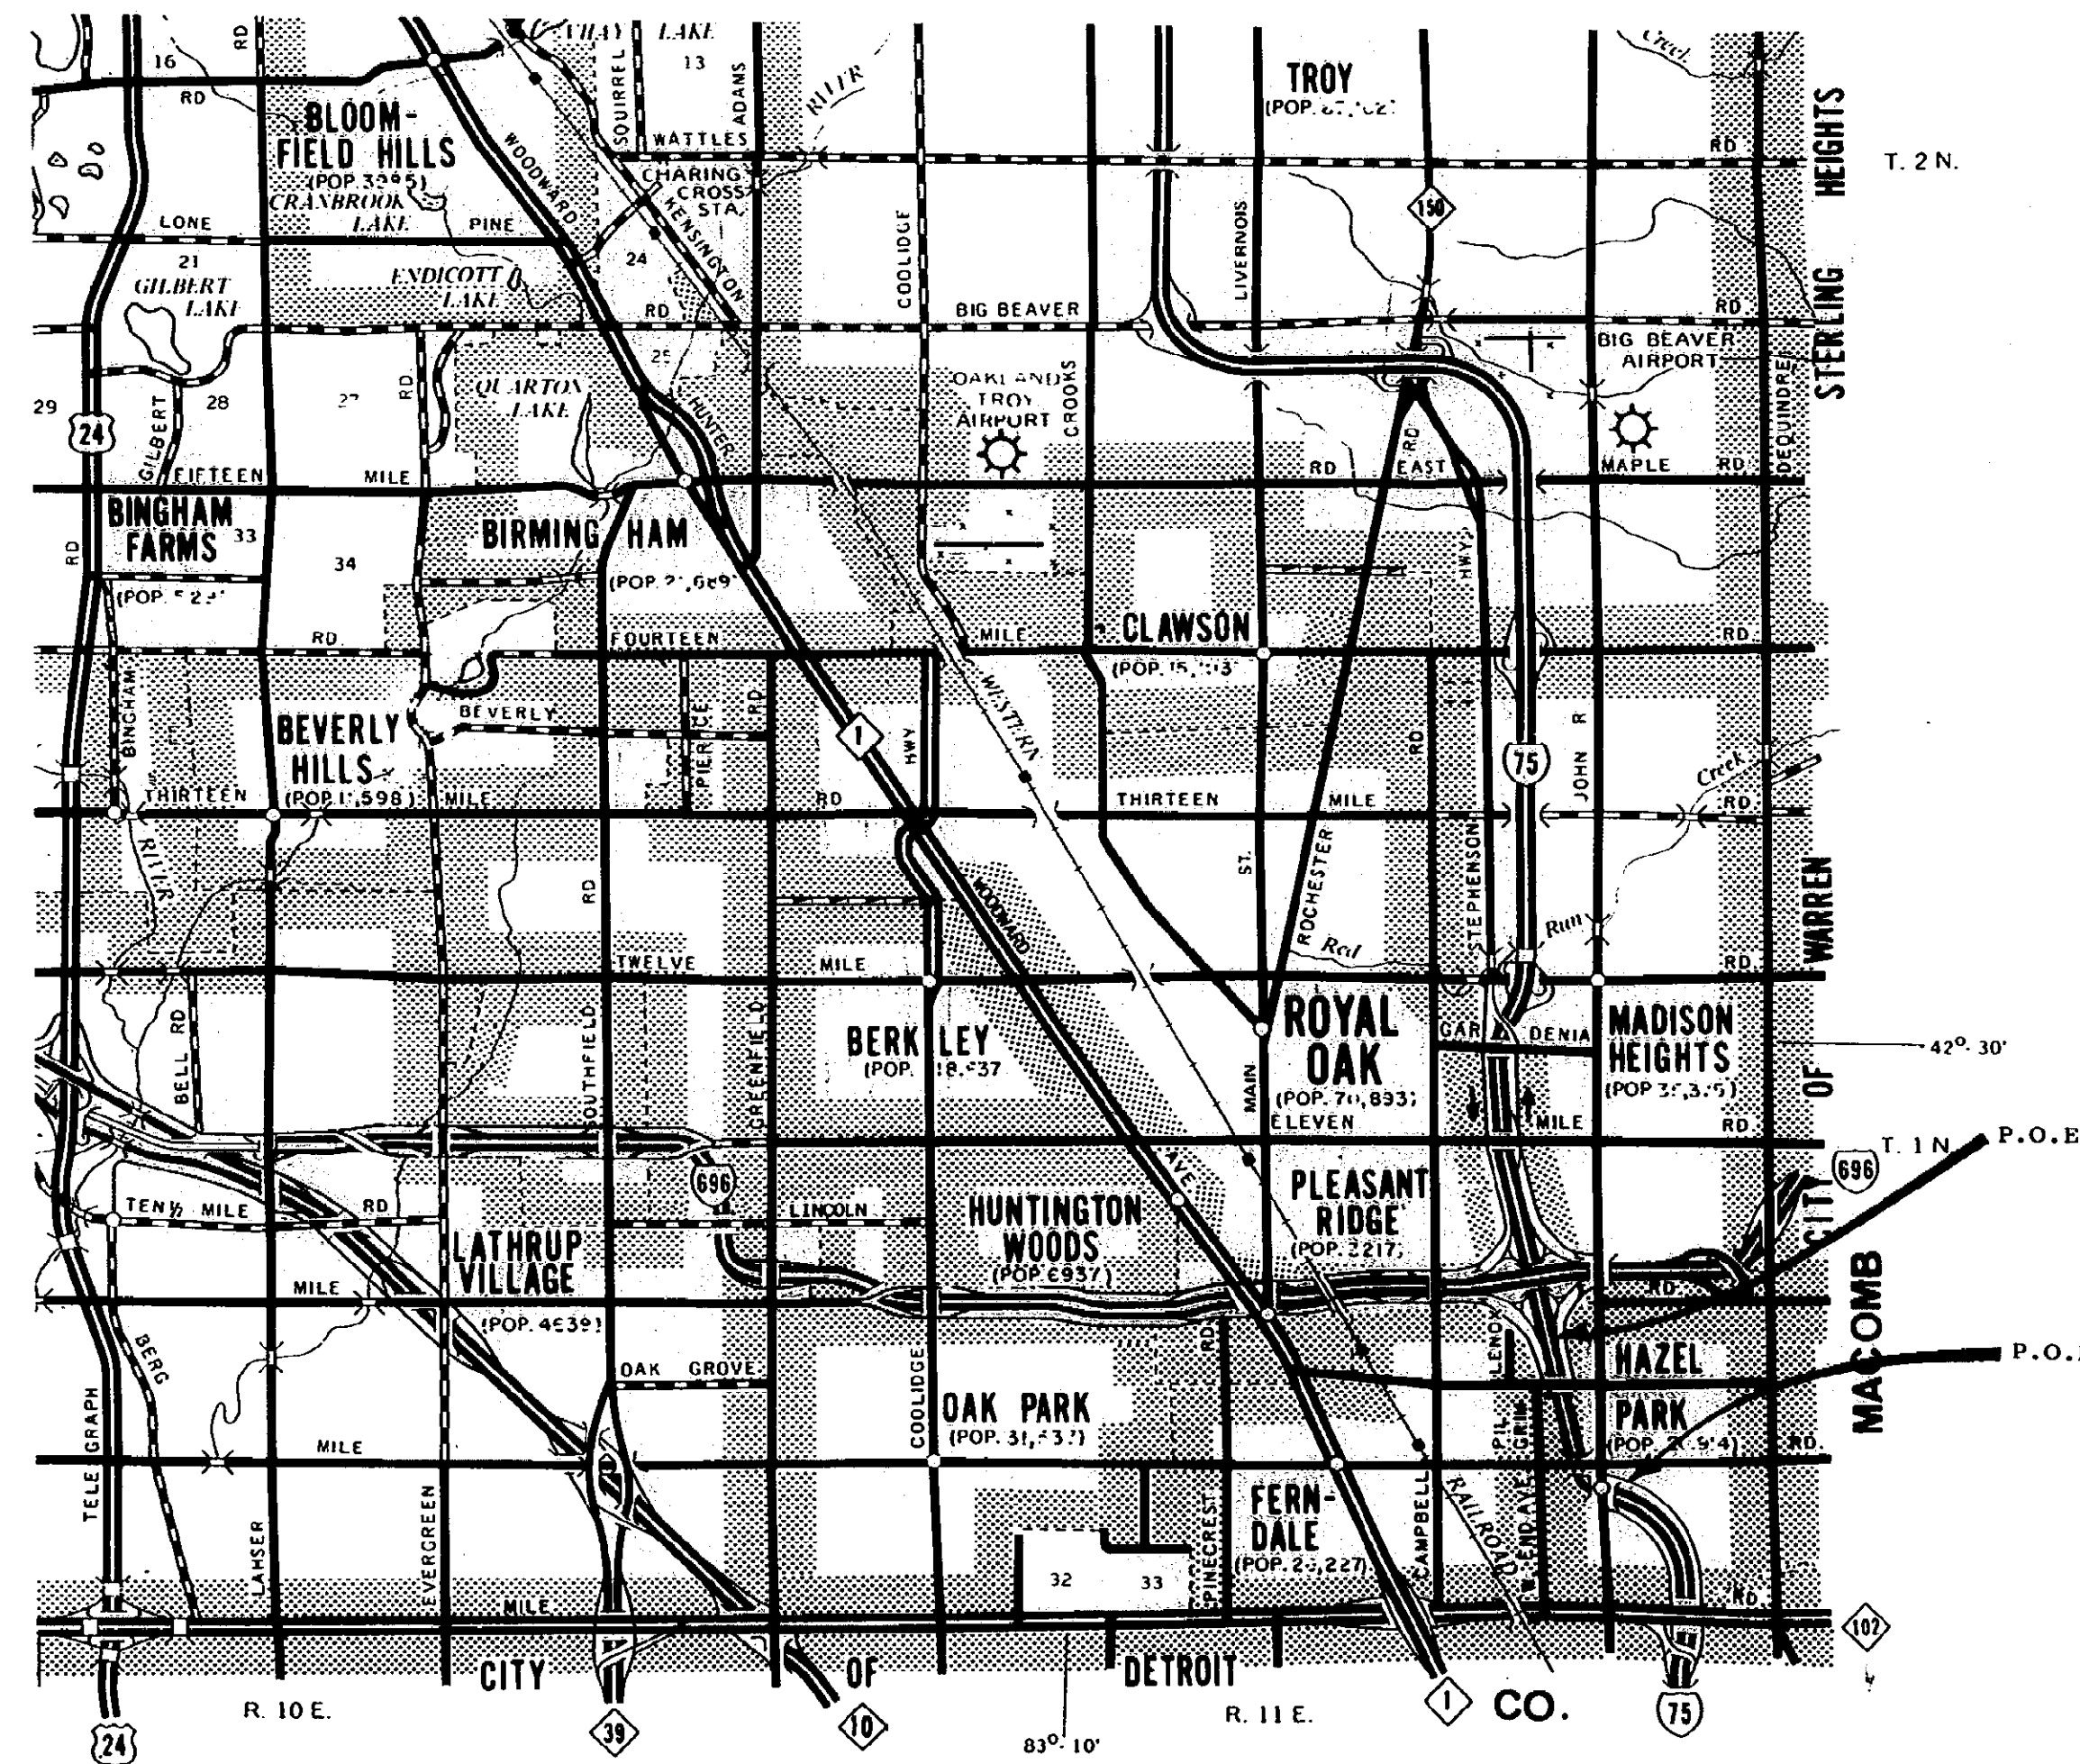

TITLE SHEET LEGEND

	EXISTING CONDITION
PAVED	
BITUMINOUS	
GRAVEL	
UNIMPROVED OR CITY STREET	
SECTION LINE	
TOWNSHIP LINE	
COUNTY LINE	
CITY OR VILLAGE LIMITS	
RAILROADS	

AS LET PLANS

CONTRACT FOR LANDSCAPE DEVELOPMENT			
APPROVALS			
RECOMMENDED FOR APPROVAL	<i>C. J. Arnold</i> ENGINEER OF DESIGN	7/27/92	DATE
RECOMMENDED FOR APPROVAL	<i>John J. Williams</i> FOR ENGINEER OF TRAFFIC & SAFETY	7/17/92	DATE
RECOMMENDED FOR APPROVAL	<i>Robert J. Summers</i> FOR ENGINEER OF CONSTRUCTION	7/17/92	DATE
MICHIGAN DEPARTMENT OF TRANSPORTATION PATRICK M. NOWAK, DIRECTOR			
APPROVED BY	<i>Henry D. Taylor</i> DEPUTY DIRECTOR - HIGHWAYS	7-9-92	DATE
PLANS PREPARED BY		U.S. DEPARTMENT OF TRANSPORTATION FEDERAL HIGHWAY ADMINISTRATION	
MULLER DESIGN UNIT		APPROVED	
IR 63174	JOB NUMBER 32616A	PROJECT NUMBER I-75-2(409) 59	ITEM NUMBER NP 1270
			SHEET NO. 1

IR 63174--32616A


JOB NUMBER
CONTROL SECTION

SHEET NO. 32016 A
 CONTROL SECTION



QTY.	KEY	BOTANICAL NAME	COMMON NAME	SPACING	PLANT SIZE	BALL SIZE	BALL DEPTH	SIZE	ROOT
1621	302E	ELIPHOBA CYPRISSIA	CYPRESS SPURLE	18"	1'-2"				OWN
204	91Y	JUNIPERUS PLUMBERGIANA	YANDEEA JUNIPER	4'	3'-4"	10"	8"	18"	BB
159	77A	LIQUIDUM O. REGLANUM	REGLA FENET	4'	5'-6"	10"	8"	24"	BB
155	78M	MYRTA PENNSYLVANICA	NORTHERN BAYBERRY	5'	5'-6"	11"	9"	30"	BB
27	93C	PINKS MUGO	MUGO PINE	5'	5'-6"	12"	9"	24"	BB
273	83D	RHUS AROMATICA	FRAGRANT SUMAC	5'	5'-6"			18"	#2 ct.
337	85DD	RHUS AROMATICA 200-LOW	GR-LW FRAG. SUMAC	4'	5'-6"			15"	#2 ct.
208	83C	ROSA RUGOSA	RUGED ROSE	4'	5'-6"			15"	#2 ct.
110	61C	VIBURNUM L. MEXICANUM	MEXICAN VIBURNUM	4'	5'-6"	11"	9"	30"	BB
287	79Y	TILIA F. GOLDEN SWOED	GOLDEN SWOED TILIA	*	1'-2"			12"	#2 ct.

FINAL R.O.W.			
AUTH.	DATE	NO.	REVISION

DRAWN BY S. ESKOY DATE
 DESIGNED BY S. ESKOY START
 DESIGN UNIT E. MULLER COMP.

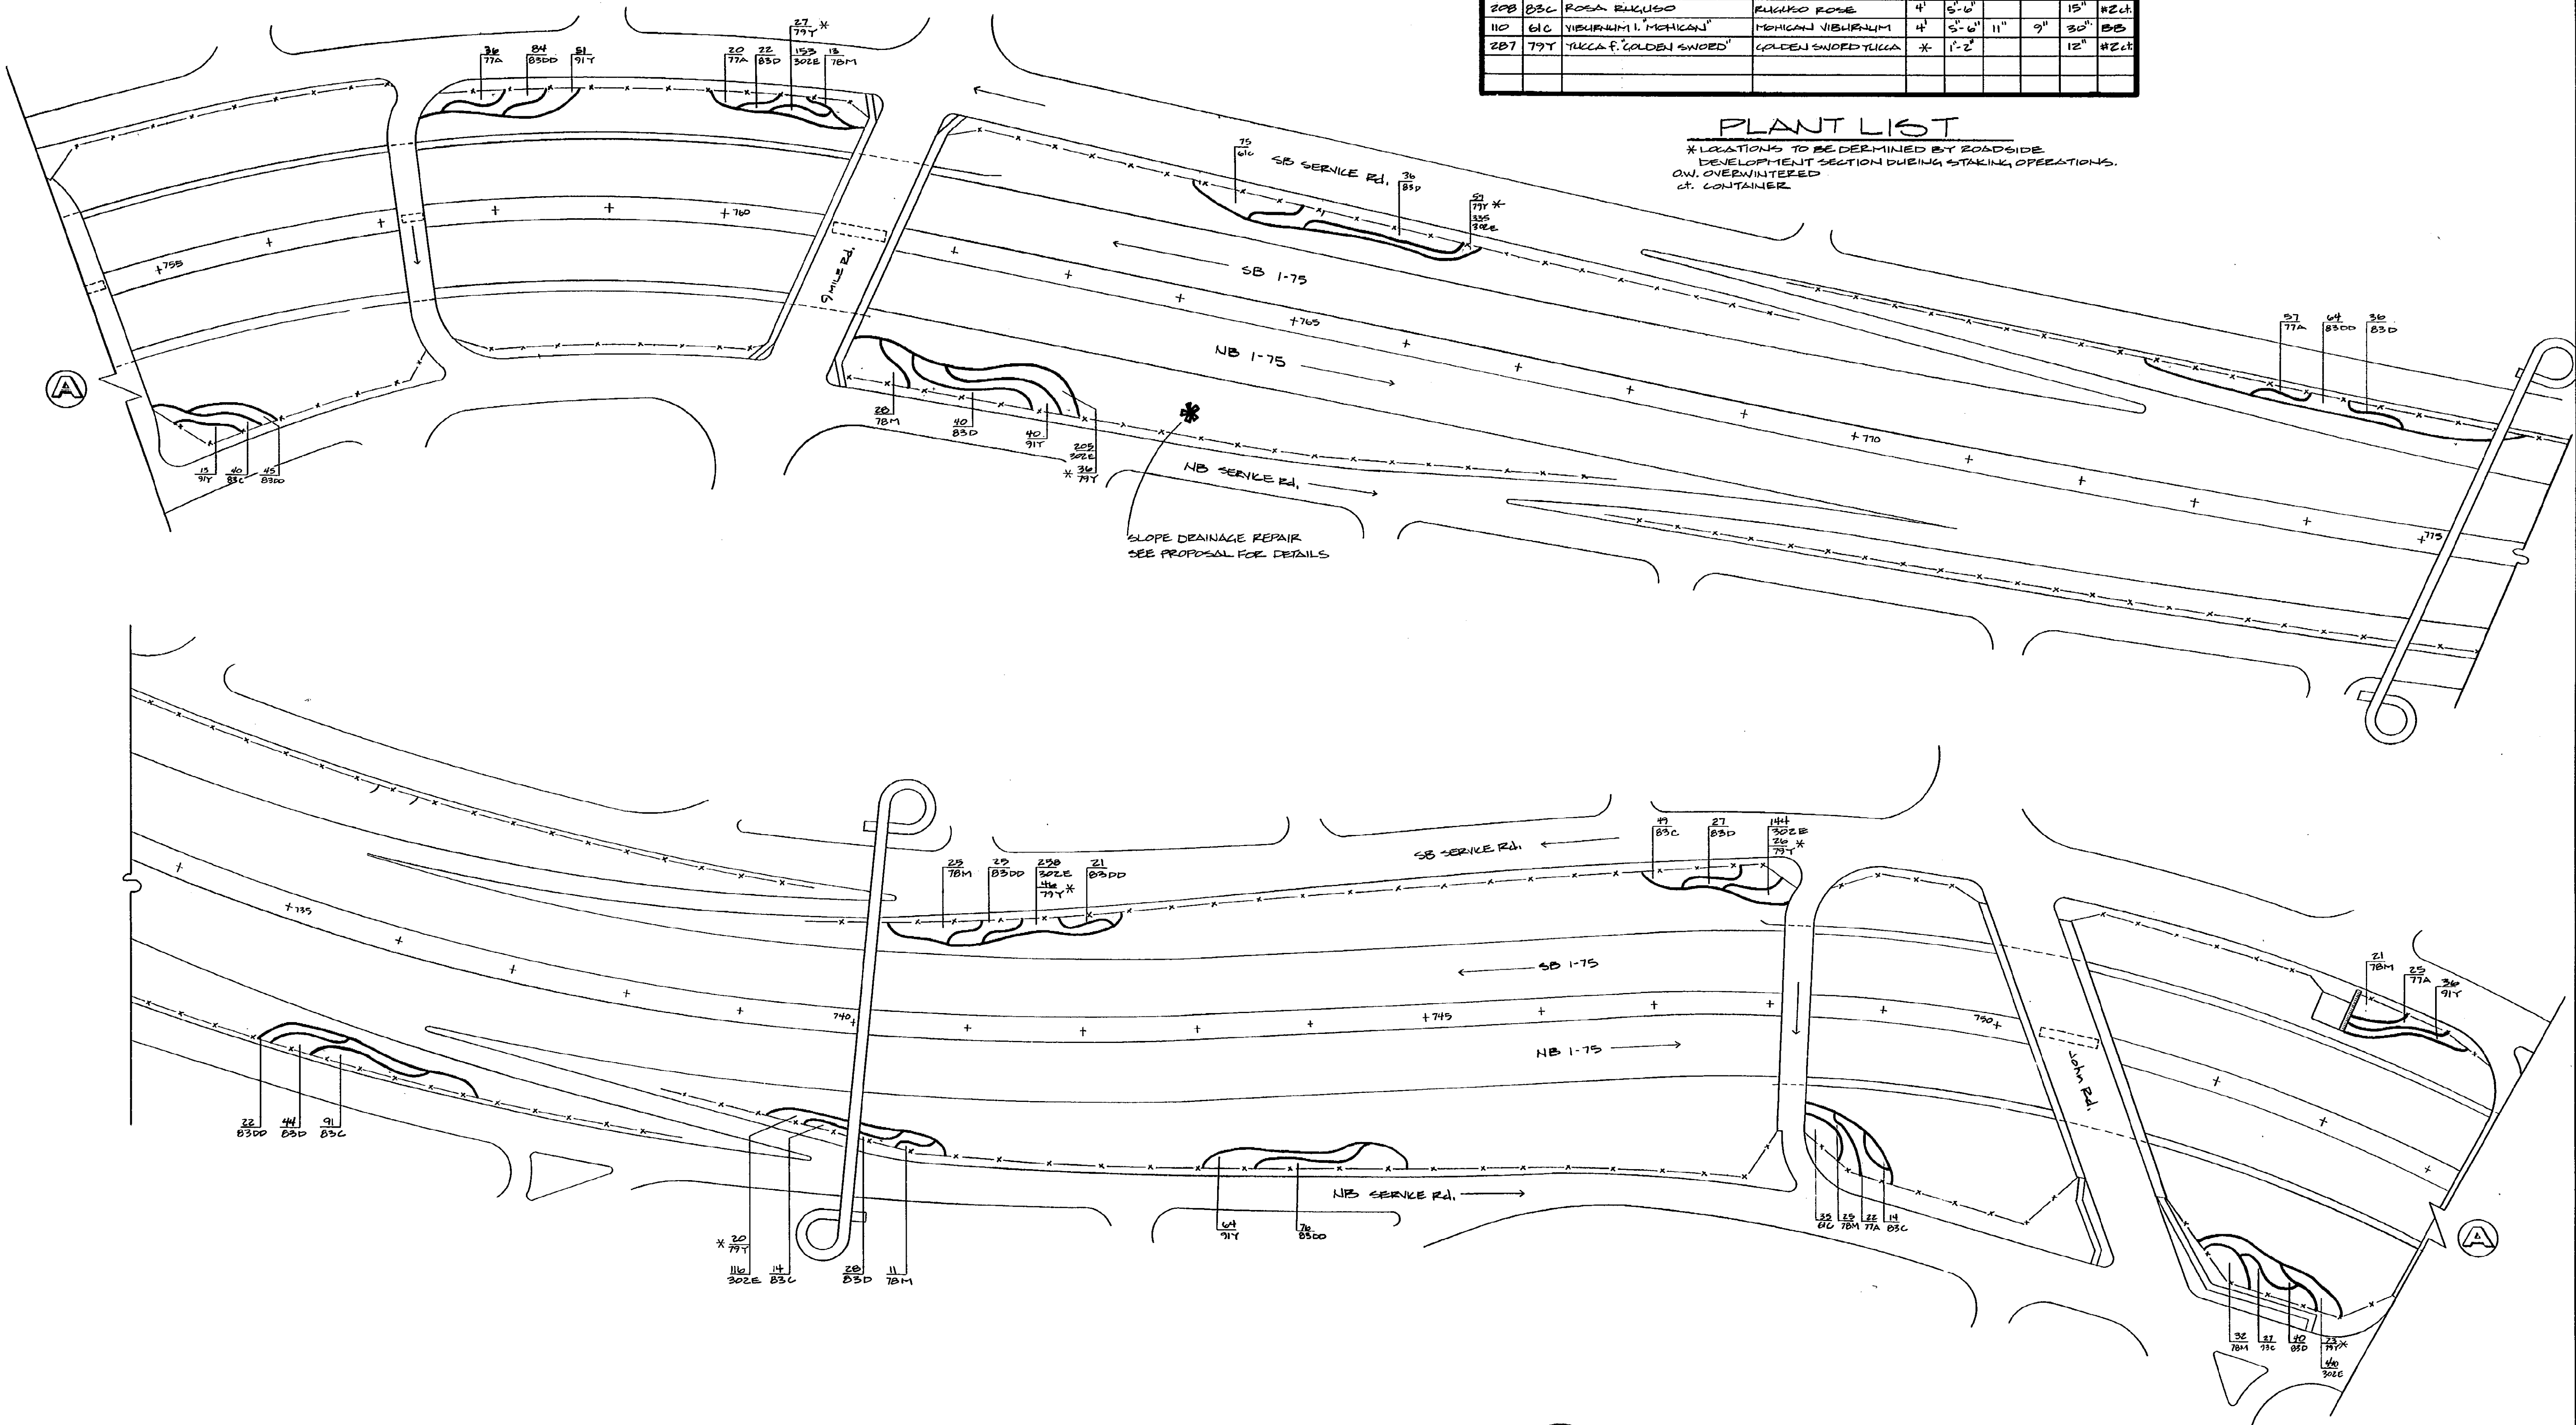

PLANT LIST
 * LOCATIONS TO BE DETERMINED BY ROADSIDE DEVELOPMENT SECTION DURING STAKING OPERATIONS.
 OW. OVERWINTERED
 CT. CONTAINER

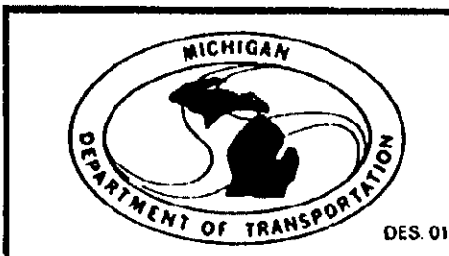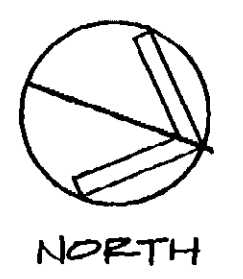

I-75 & NINE MILE LANDSCAPING					
DATE	SCALE	CONT. SEC.	JOB NO.	DESIGN UNIT	SHEET NO. 2
7/1/92	1"=205'0"	1R 63174	32016 A	MULLER	R.O.W. CONST.

032616A

ROAD TOTAL

SUMMARY OF QUANTITIES

SH. NO.

JOB NO. 32616A

63174

CONTROL SECTION

ITEM DESCRIPTION

ITEM CODE

UNIT

PROJECT TOTAL

JOB SUBTOTAL

SHEET 001

AGGREGATE BASE UNDER CONCRETE (4" IN PLACE)	3010021	SYD	10
CONCRETE SHOULDERS - NONREINFORCED	4500253	SYD	10
REMOVING PAVEMENT (REPAIR)	4520002	SYD	10
SEWER TAP, 4"	5130620	EACH	1
UNDERDRAIN OUTLET, 4"	6020136	LFT	175
CONCRETE CURB AND GUTTER, DETAIL B2	6090018	LFT	6
LIGHTED ARROW, TYPE A - FURNISHED	6310011	EACH	2
LIGHTED ARROW, TYPE A - OPERATED	6310012	EACH	2
BARRICADE, TYPE 11, LIGHTED - FURNISHED	6310026	EACH	150
BARRICADE, TYPE 11, LIGHTED - OPERATED	6310027	EACH	75
SIGN, TYPE B TEMPORARY	6310057	SFT	64
JUNIPERUS HORIZONTALIS PLUMOSA 'YOUNGSTOWN' 18"	6500496	EACH	204
LIOUSTRUM OBTUSIFOLIUM REGALIANUM 18"	6500526	EACH	159
MYRICA PENNSYLVANICA 24"	6500621	EACH	155
PINUS MUCHO 24"	6500682	EACH	27
RHUS AROMATICA 18"	6500776	EACH	273
RHUS AROMATICA GRO-LOW 18"	6500780	EACH	337
EUPHORBIA CYPARISSIA OVERWINTERED	6507000	EACH	1621
CYPRESS SPURGE MATURE PLANT 6"POT	6507002	EACH	208
ROSA RUGOSA 15"	6507002	EACH	208
VIBURNUM LANTANA MOHICAN 24"	6507004	EACH	110
YUCCA FILAMETOSA GOLDEN SWORD 12"	6507006	EACH	287
SITE PREPARATION (MAX. \$35,900)	6507008	LSUM	1
WATERING AND CULTIVATING 1ST SEASON (MINIMUM \$15,250)	6507010	LSUM	1
WATERING AND CULTIVATING 2ND SEASON (MINIMUM \$14,350)	6507012	LSUM	1
TRUCK MOUNTED ATTENUATOR FURNISHED	6507030	EACH	2
TRUCK MOUNTED ATTENUATOR, OPERATED	6507031	EACH	2
TOPSOIL SURFACE, 5"	6530016	SYD	90
SLOPE RESTORATION	6537001	SOYD	90
EXPLORATORY TRENCHING	6537002	LFT	50
BANK UNDERDRAIN, 4"-MODIFIED	6537003	LFT	40

JOB NUMBER 32616A
CONTROL SECTION 63174

QUANTITY SHEET

DATE	CONT. SEC.	JOB NO.	DESIGN UNIT	SHEET NO.
5/20/92	63174	32616A		3

MICROFILM CONTENT SHEET

BATCH 07-8F

OUT TO MICROFILM 8/24/2007

Control Section	Structure	Job Number	Sheet Number	Let Date	Region	Total Sheets	Plan Set	Box
63174		32616	(ONE ROLL)	9/9/1992	METRO	3		3
			AS LET					
	LANDSCAPING							

SH. NO. 1
 JOB. 48404A
 LUNIRUL S04 OF 63103, P01, S02,
 SECTION S30, S31 OF 63174

MICHIGAN DEPARTMENT OF TRANSPORTATION

PLANS OF PROPOSED BRIDGE REHABILITATION

MICHIGAN PROJECT **BHI 0063(169)**

CONTROL SECTION **BHI 63174**

JOB NUMBER **48404A**

I-75

CITIES OF HAZEL PARK, MADISON HEIGHTS, & ROYAL OAK
 OAKLAND COUNTY

GENERAL NOTES

THE RECONSTRUCTION DESIGN IS BASED ON CURRENT AASHTO STANDARD SPECIFICATIONS FOR HIGHWAY BRIDGES MS18 LOADING. LIVE LOAD PLUS IMPACT DEFLECTION DOES NOT EXCEED 1/1000 OF SPAN LENGTH AND 1/300 OF CANTILEVER ARM. THE LOAD FACTOR METHOD OF DESIGN WAS USED FOR THIS DESIGN.

EXCEPT WHERE OTHERWISE INDICATED ON THESE PLANS, OR IN THE PROPOSAL AND SUPPLEMENTAL SPECIFICATIONS CONTAINED HEREIN, ALL MATERIALS AND WORKMANSHIP SHALL BE ACCORDING TO THE MICHIGAN DEPARTMENT OF TRANSPORTATION STANDARD SPECIFICATIONS FOR CONSTRUCTION 1996 EDITION.

THE STATIONING AS SHOWN ON THESE PLANS FOR THE INTERSECTION OF THE CENTERLINE OF BRIDGE AND ROADWAY CENTERLINE IS BELIEVED TO BE CORRECT. IT SHALL, HOWEVER, BE CHECKED AT THE TIME OF STARTING CONSTRUCTION, AND IF THE STATIONING SHOWN ON THE PLANS IS INCORRECT, IT SHALL BE REPORTED TO THE DESIGN OFFICE IN LANSING, AND THE STRUCTURE SHALL BE STAKED OUT USING THE ACTUAL INTERSECTION OF THE CENTERLINE OF BRIDGE AND ROADWAY CENTERLINE AS THE CONTROL POINT.

THE DESIGN OF THE STRUCTURAL MEMBERS IS BASED ON MATERIAL OF THE FOLLOWING GRADES AND STRESSES:

CONCRETE, GRADE S2	f'c = 21 MPa
CONCRETE, GRADE D	f'c = 28 MPa
STEEL REINFORCEMENT	f _y = 400 MPa
STRUCTURAL STEEL: AASHTO M270 Grade 250	f _y = 250 MPa
STRUCTURAL STEEL: AASHTO M270 Grade 345	f _y = 345 MPa
STRUCTURAL STEEL PINS: ASTM A276	
UNS DESIGNATION S20161 OR S21800	f _y = 345 MPa

PROPOSED PLAN SHEET DIMENSIONS ARE IN MILLIMETERS UNLESS OTHERWISE SHOWN. ELEVATIONS, COORDINATES AND CURVE ALIGNMENT DATA ARE IN METERS. STATIONS ARE IN KILOMETERS + METERS. EXISTING PLAN SHEET DIMENSIONS ARE IN CUSTOMARY U. S. UNITS.

THE REGULATED WASTE ACTIVITY IDENTIFICATION NUMBERS FOR THIS PROJECT ARE AS FOLLOWS:

CONTROL SECTION	NUMBER
S04 OF 63103	MIR000039164
S02 OF 63174	MIR000039156
S30 OF 63174	MIR000039180
S31 OF 63174	MIR000039198
P01 OF 63174	MIR000039206

2020 ESTIMATED TRAFFIC DISTRIBUTION

194500 AVERAGE DAILY TRAFFIC
 8% COMMERCIAL

CONTRACT FOR: DECK REPLACEMENT, OVERLAY, SUSPENDER REPLACEMENT, STEEL REPAIR, SUBSTRUCTURE REPAIR, PAINTING, AND APPROACH WORK


APPROVALS

RECOMMENDED FOR APPROVAL	<i>J. Mahdavi</i>	10-18-99
	PROJECT MANAGER	DATE
RECOMMENDED FOR APPROVAL	<i>Steve W. Cooper</i>	10-7-99
	RESIDENT ENGINEER	DATE

**MICHIGAN
 DEPARTMENT OF TRANSPORTATION**
 JAMES R. DESANA - DIRECTOR

APPROVED BY *Gay D. Taylor* 11/3/99
 DEPUTY DIRECTOR - HIGHWAYS DATE

MDOT Michigan Department of Transportation		MDOT DESIGN COORDINATOR MAHDAVI DESIGN UNIT	
CONTROL SECTION	JOB NUMBER	FEDERAL NUMBERS	SHEET NO.
S04 OF 63103, P01, S02, S03, S15, S30, S31 OF 63174	48404A	BHI0063(169) RR2232	1

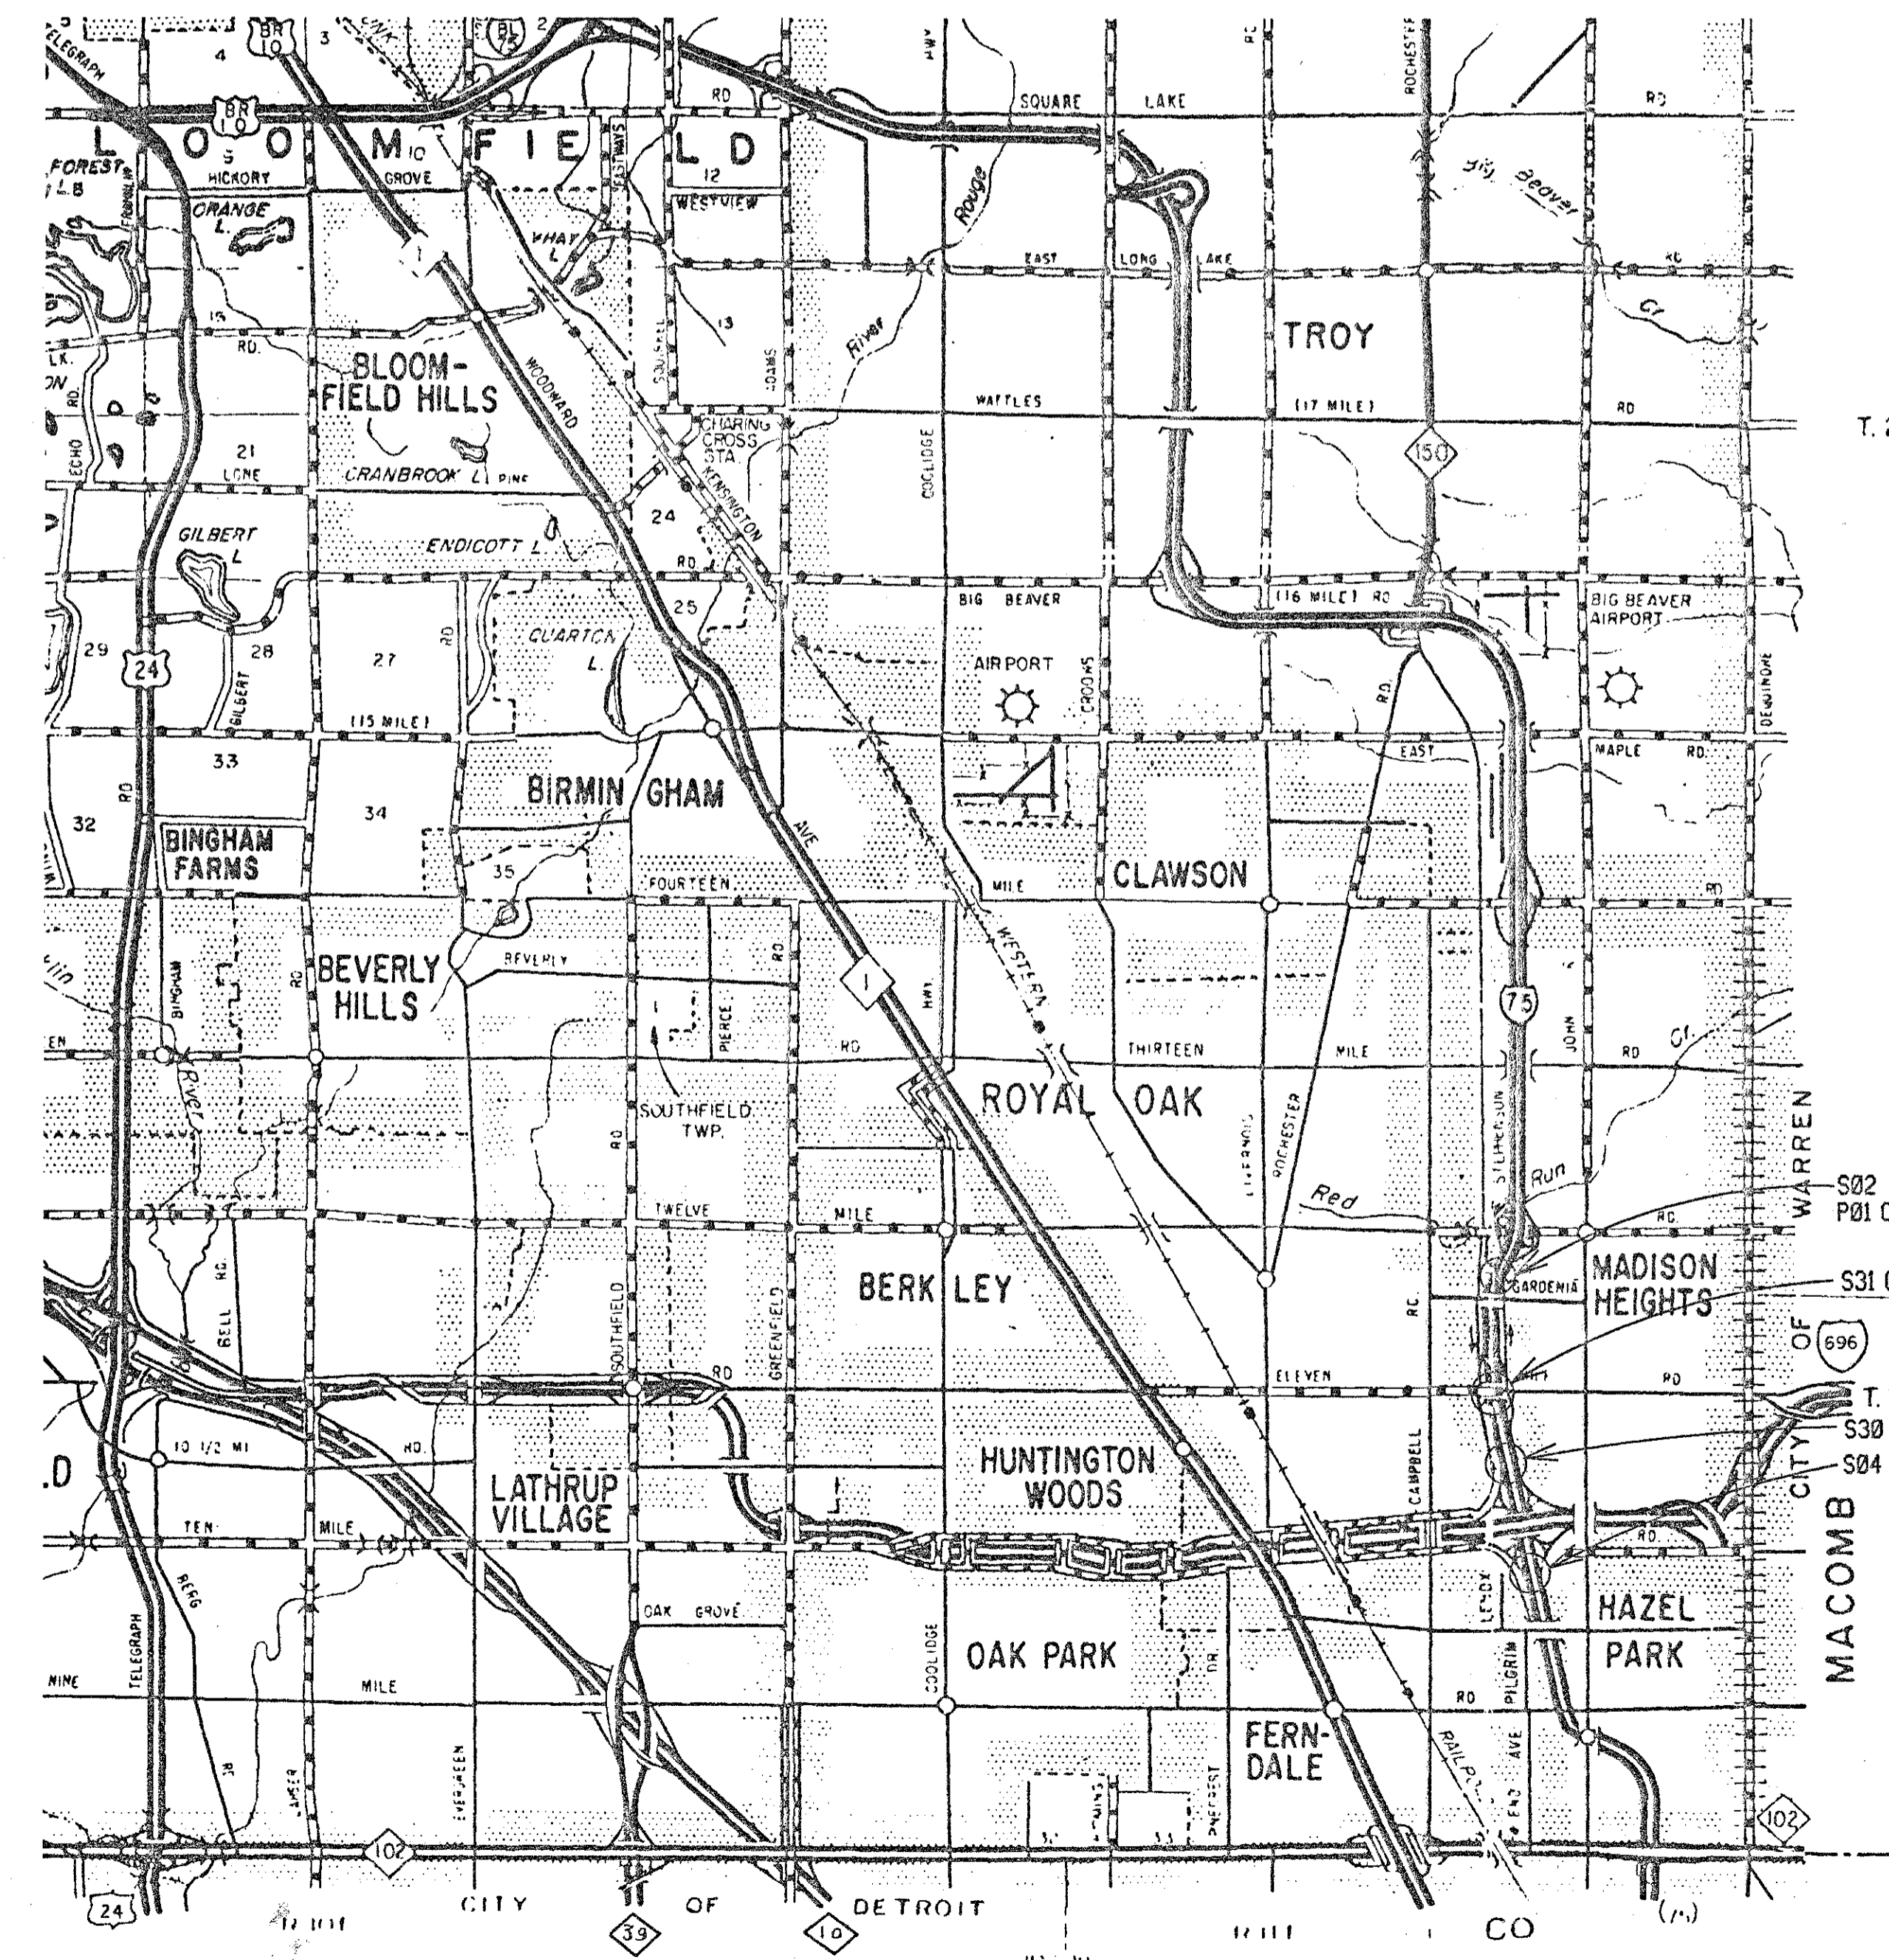

STANDARD PLANS

WHERE THE FOLLOWING ITEMS ARE CALLED FOR ON THE PLANS THEY ARE TO BE CONSTRUCTED ACCORDING TO THE STANDARD PLAN GIVEN BELOW OPPOSITE EACH ITEM UNLESS OTHERWISE INDICATED.

- B-25-A BRIDGE RAILING, AESTHETIC PARAPET TUBE
- B-32-A FENCING FOR PEDESTRIAN STRUCTURE, EXISTING OPEN PARAPET
- B-103-B MOLDING, BEVEL, LIGHT STANDARD ANCHOR BOLT ASSEMBLY, AND NAME PLATE DETAILS

TITLE SHEET LEGEND

PROPOSED PROJECT	=====
EXISTING ROADS	=====
PAVED	=====
BITUMINOUS	=====
GRAVEL	=====
UNIMPROVED OR CITY STREET	=====
SECTION LINE	=====
TOWNSHIP LINE	=====
COUNTY LINE	=====
CITY OR VILLAGE LIMITS	=====
RAILROADS	=====

DATE: 11-19-98
 DATE: 10-6-99
 DATE:
 DRAWN BY: CASLER
 CHECKED BY: CASLER
 CORRECTED BY: CASLER
 FILE NAME: S0263174.t

JOB NUMBER
 SECTION
 CONTROL SECTION
 S04 OF 63103, P01, S02, S30, S31 OF 63174-48404A
 S0263174.t

1 2 3 4 5 6 7 8 9 10 11 12 13 14 15 16 17 18 19 20 21 22 23 24 25 26 27 28 29 30 31 32 33 34 35 36 37 38 39 40 41 42 43 44 45 46 47 48 49 50 51 52 53 54 55 56 57 58 59 60 61 62 63

REVISIONS			
NO.	DESCRIPTION	DATE	BY

PLAN INDEX	
SHEET NO.	DESCRIPTION
1	TITLE SHEET
1A	PLAN INDEX SHEET
1B-7B	APPROACH ROAD DETAILS
1C-7C	SPECIAL DETAILS
1D-31D	TEMPORARY AND PERMANET TRAFFIC SIGNAL DETAILS
1E-10E	ELECTRICAL DETAILS


S02 OF 63174	
SHEET NO.	DESCRIPTION
2-3	GENERAL PLAN OF STRUCTURE
4	EXISTING GENERAL PLAN OF SITE - FOR INFORMATION ONLY
5	EXISTING GENERAL PLAN OF STRUCTURE- REMOVAL PORTIONS
6-20	EXISTING DETAILS-FOR INFORMATION ONLY
21	EXPANSION JOINT DETAILS
22-25	SUPERSTRUCTURE DETAILS
26-27	FENCING DETAILS
28	SLAB AND SCREED DETAILS
29	STEEL REINFORCEMENT DETAILS

S04 OF 63103	
SHEET NO.	DESCRIPTION
2	EXISTING GENERAL PLAN OF SITE-FOR INFORMATION ONLY
3	EXISTING GENERAL PLAN OF STRUCTURE-FOR INFORMATION ONLY
4-17	EXISTING DETAILS-FOR INFORMATION ONLY
18-19	ABUTMENT A REPAIR DETAILS
20	SUSPENDER REPLACEMENT DETAILS
21	EXPANSION JOINT DETAILS
22-23	DECK OVERLAY DETAILS
24	FENCING DETAILS

P01 OF 63174	
SHEET NO.	DESCRIPTION
2	GENERAL PLAN OF STRUCTURE
3	EXISTING GENERAL PLAN OF SITE - FOR INFORMATION ONLY
4	EXISTING GENERAL PLAN OF STRUCTURE AND REMOVAL PORTIONS
5-14	EXISTING DETAILS-FOR INFORMATION ONLY
15-16	SUPERSTRUCTURE DETAILS

S30 OF 63174	
SHEET NO.	DESCRIPTION
2-3	GENERAL PLAN OF STRUCTURE
4	EXISTING GENERAL PLAN OF SITE - FOR INFORMATION ONLY
5	EXISTING GENERAL PLAN OF STRUCTURE- REMOVAL PORTIONS
6-12	EXISTING DETAILS-FOR INFORMATION ONLY
13	SUSPENDER REPLACEMENT DETAILS
14	EXPANSION JOINT DETAILS
15-18	SUPERSTRUCTURE DETAILS
19-20	FENCING DETAILS
21	SLAB AND SCREED DETAILS
22	STEEL REINFORCEMENT DETAILS

S31 OF 63174	
SHEET NO.	DESCRIPTION
2-3	GENERAL PLAN OF STRUCTURE
4	EXISTING GENERAL PLAN OF SITE- FOR INFORMATION ONLY
5	EXISTING GENERAL PLAN OF STRUCTURE- REMOVAL PORTIONS
6-10	EXISTING DETAILS-FOR INFORMATION ONLY
12	SUSPENDER REPLACEMENT DETAILS
13	EXPANSION JOINT DETAILS
14-16	SUPERSTRUCTURE DETAILS
17-18	FENCING DETAILS
19	SLAB AND SCREED DETAILS
20	STEEL REINFORCEMENT DETAILS

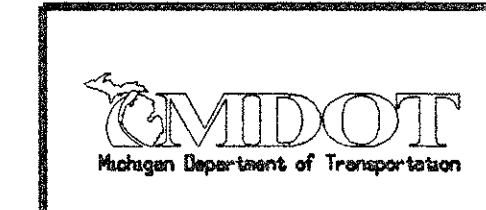

PLAN INDEX				
DATE	CONT. SEC.	JOB NO.	DESIGN UNIT	SHEET
10-13-99	S04 OF 63103 & P01, S02, S30 & S31 OF 63174	48404A	MAHDAVI	1A OF


FILE NAME: s3063174.dwg
 DRAWN BY: INDER
 CHECKED BY: DATE: 9-20-99
 CORRECTED BY: CASLER
 DATE: 9-23-99

DATE: 04-28-99
DATE: 10-11-99

EXISTING BY: TJM
PROPOSED BY: TJM
LAST CORRECTION BY:


FILE NAME: 48404TYP.DGN
1 2 3 4 5 6 7 8 9 10 11 12 13 14 15 16 17 18 19 20 21 22 23 24 25 26 27 28 29 30 31 32 33 34 35 36 37 38 39 40 41 42 43 44 45 46 47 48 49 50 51 52 53 54 55 56 57 58 59 60 61 62 63

FINAL R.O.W.			
AUTH	DATE	NO.	REVISION

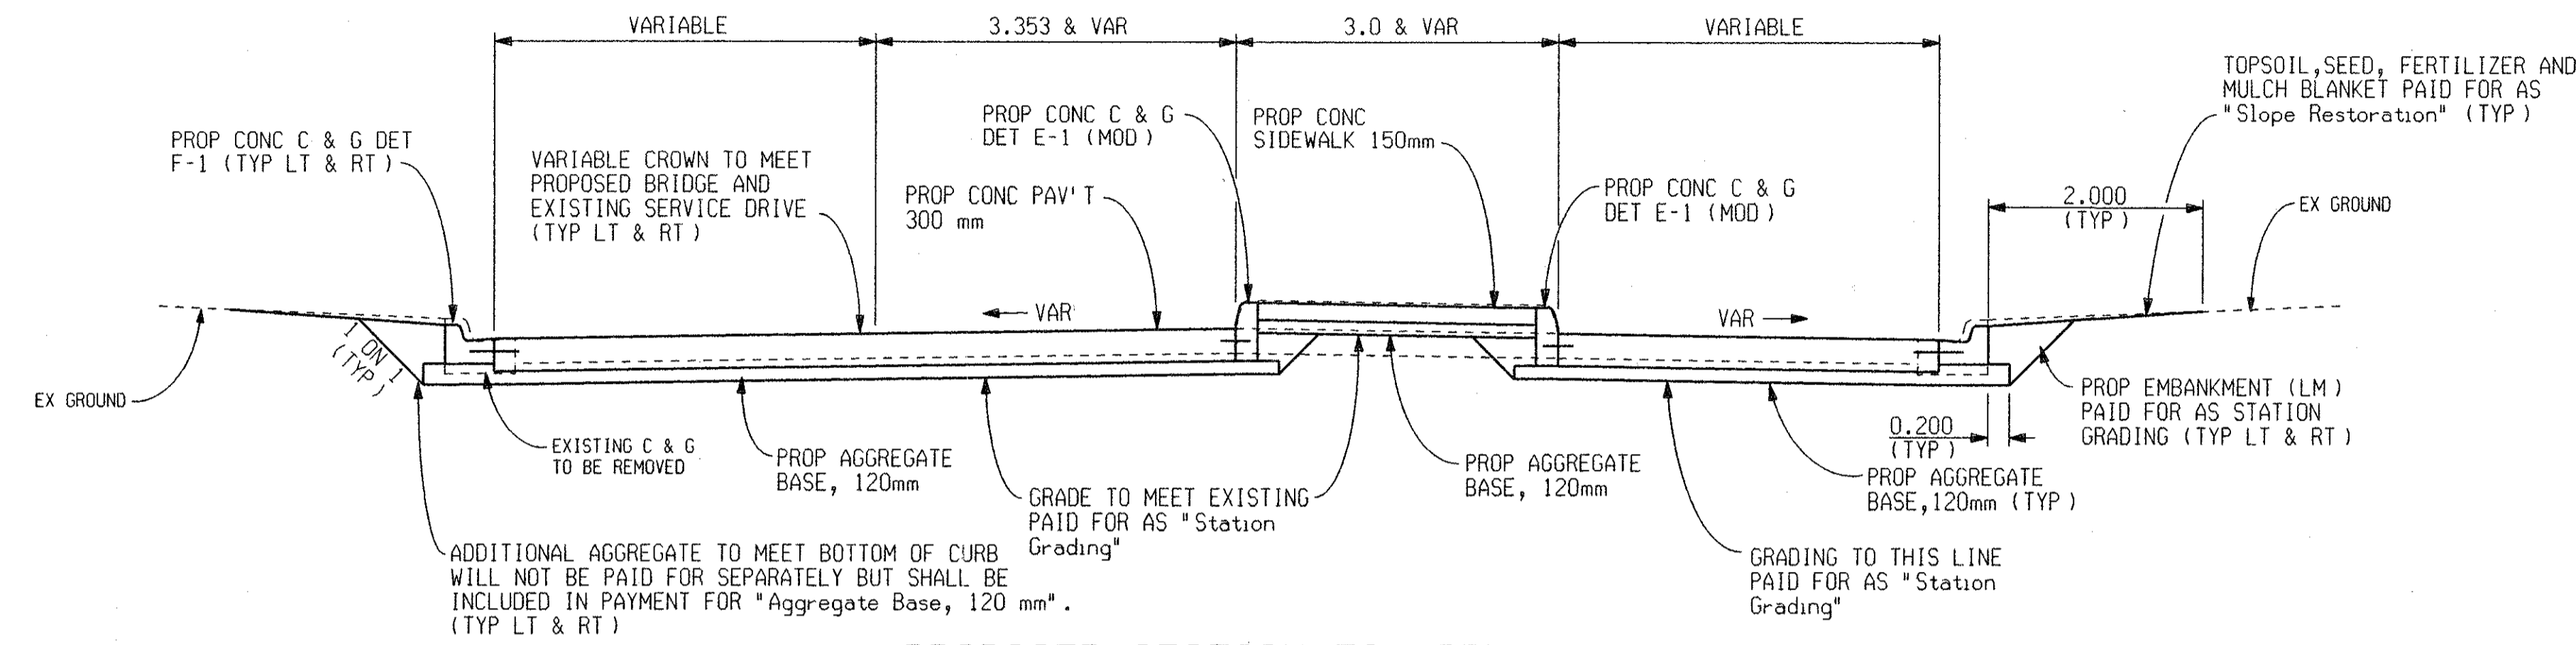

PROPOSED SECTION TO APPLY:

S04 OF 63174
STA 0+310.684 TO STA 0+324.487
STA 0+388.194 TO STA 0+397.119

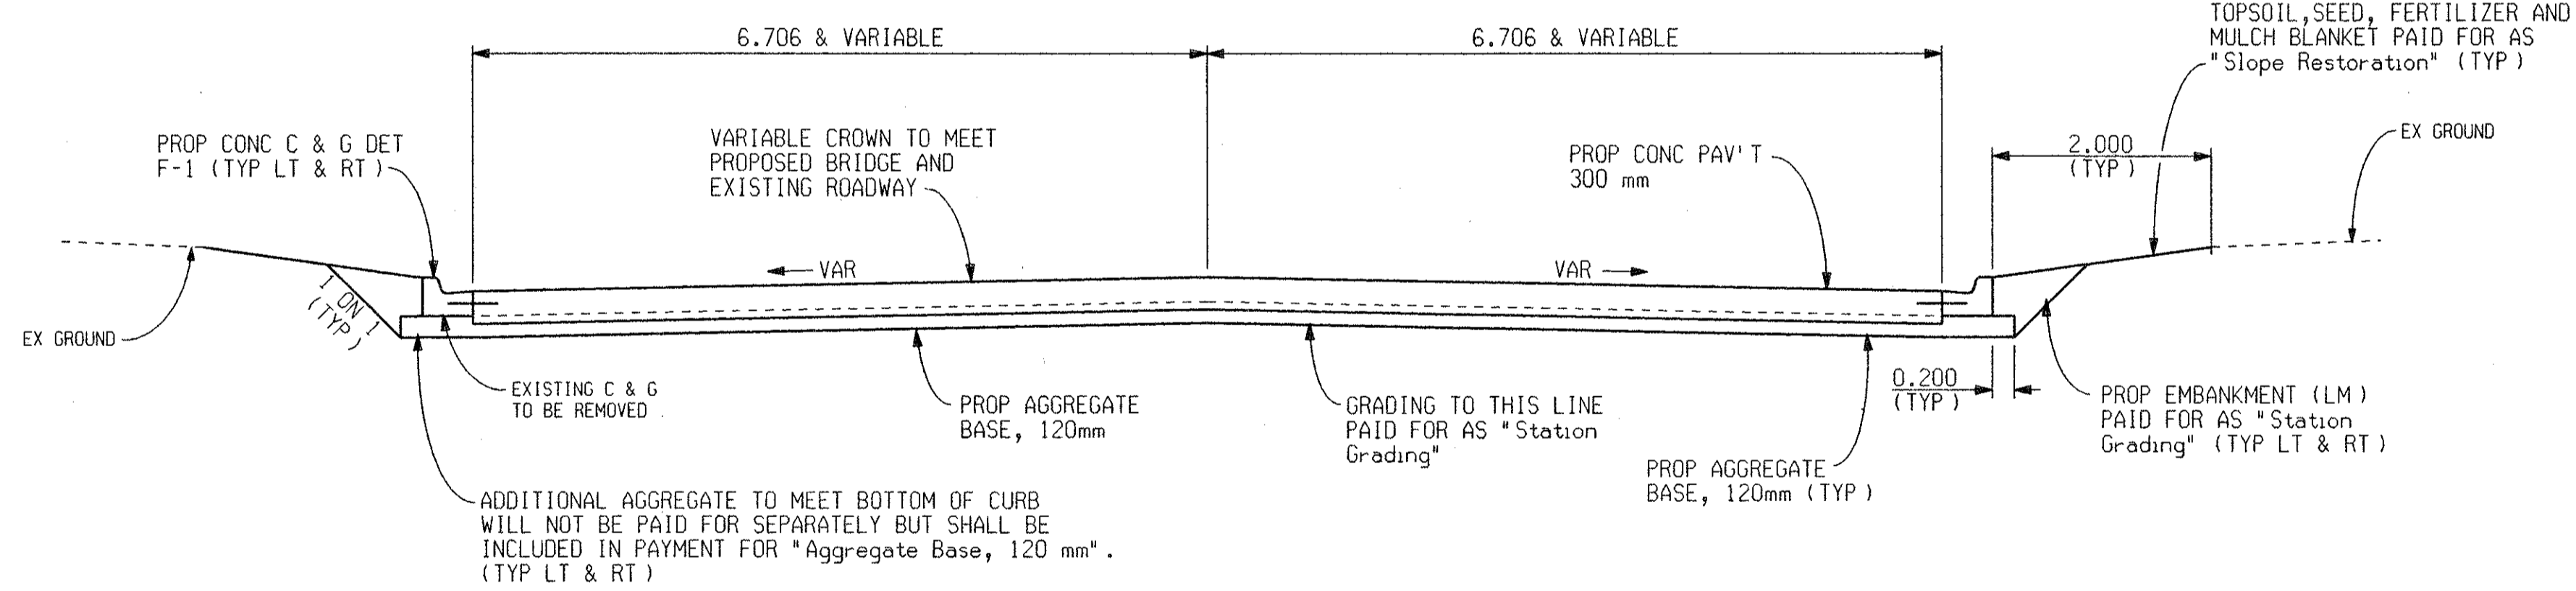


PROPOSED SECTION TO APPLY:

S31 OF 63174
STA 0+416.468 TO STA 0+431.119
STA 0+483.077 TO STA 0+498.286
S30 OF 63174
STA 0+572.432 TO STA 0+587.883
STA 0+637.055 TO STA 0+651.350
S02 OF 63174
STA 3+547.041 TO STA 3+595.761
STA 3+653.496 TO STA 3+701.944

TYPICAL CROSS SECTIONS					
DATE	SCALE	CONT. SEC.	JOB NO.	DESIGN UNIT	SHEET NO.
10/11/99	1:50	63174,63103	48404	RICK	R.O.W. 1B




FINAL R.O.W.			
AUTH	DATE	NO.	REVISION

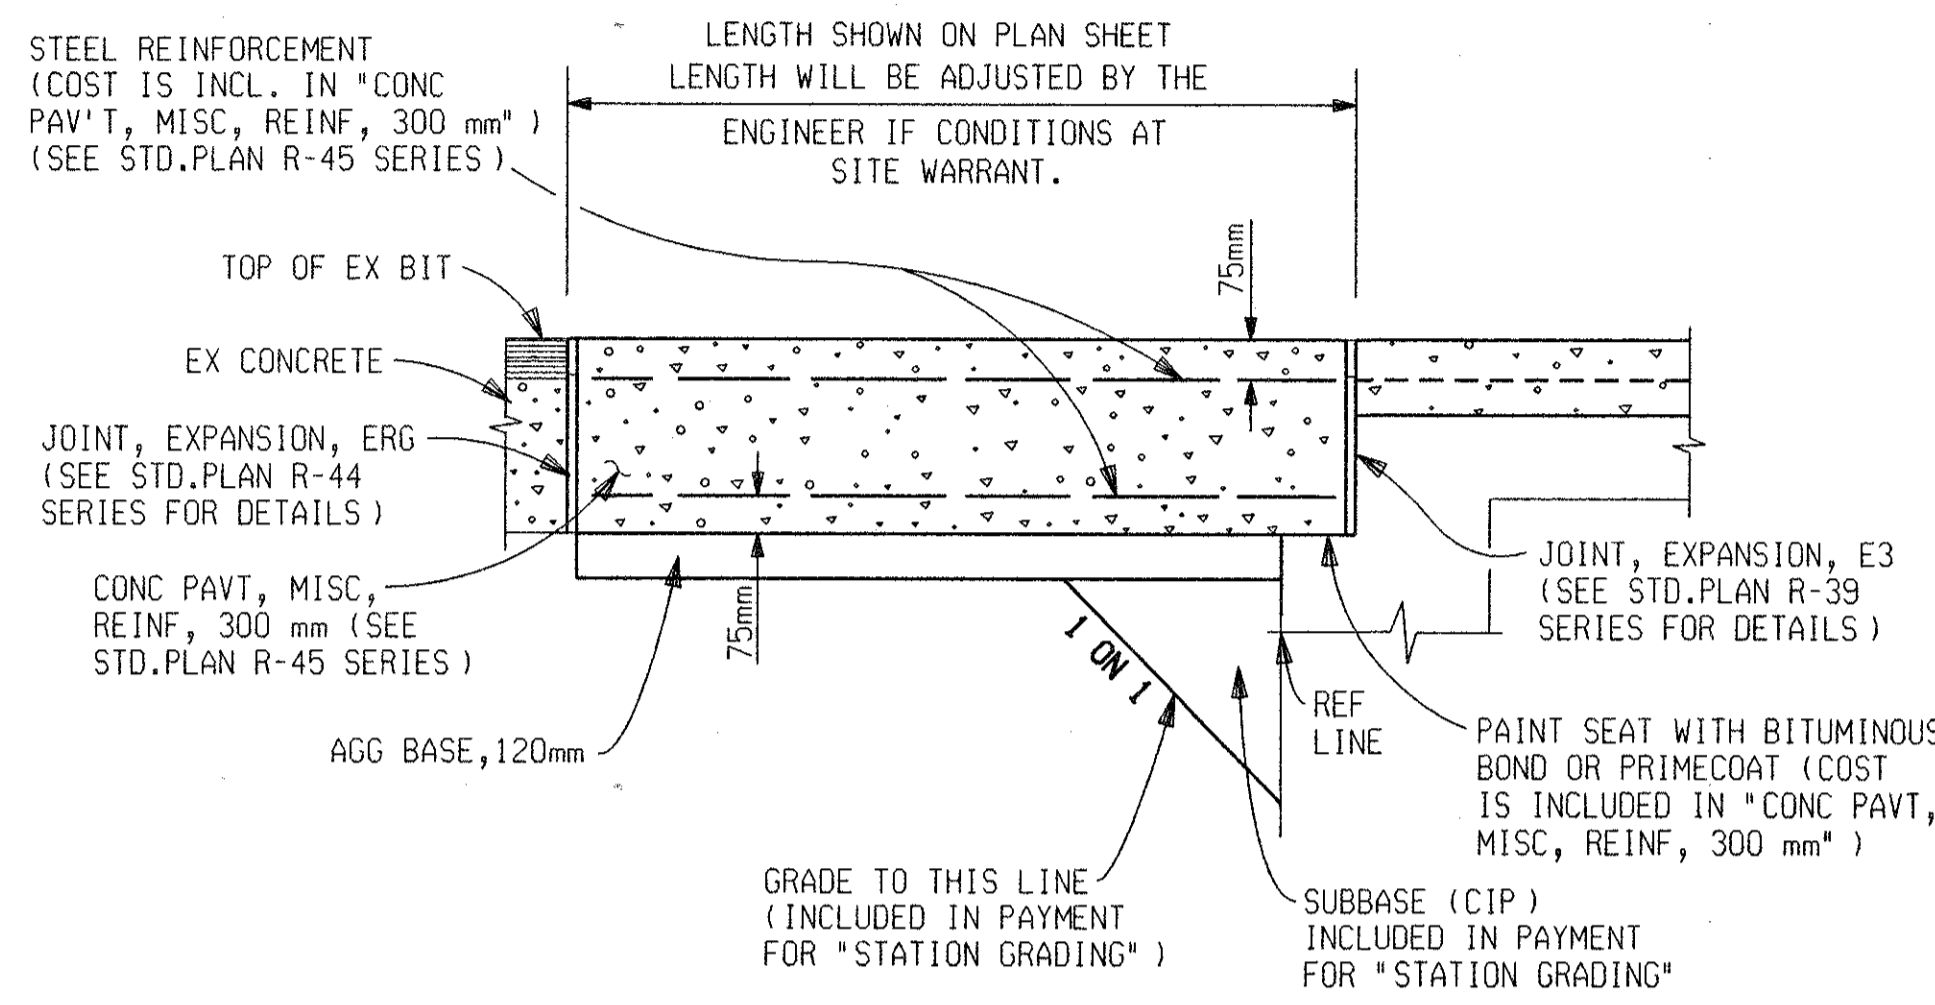


CONCRETE APPROACH DETAIL-EXISTING COMPOSITE SECTION

NOT TO SCALE

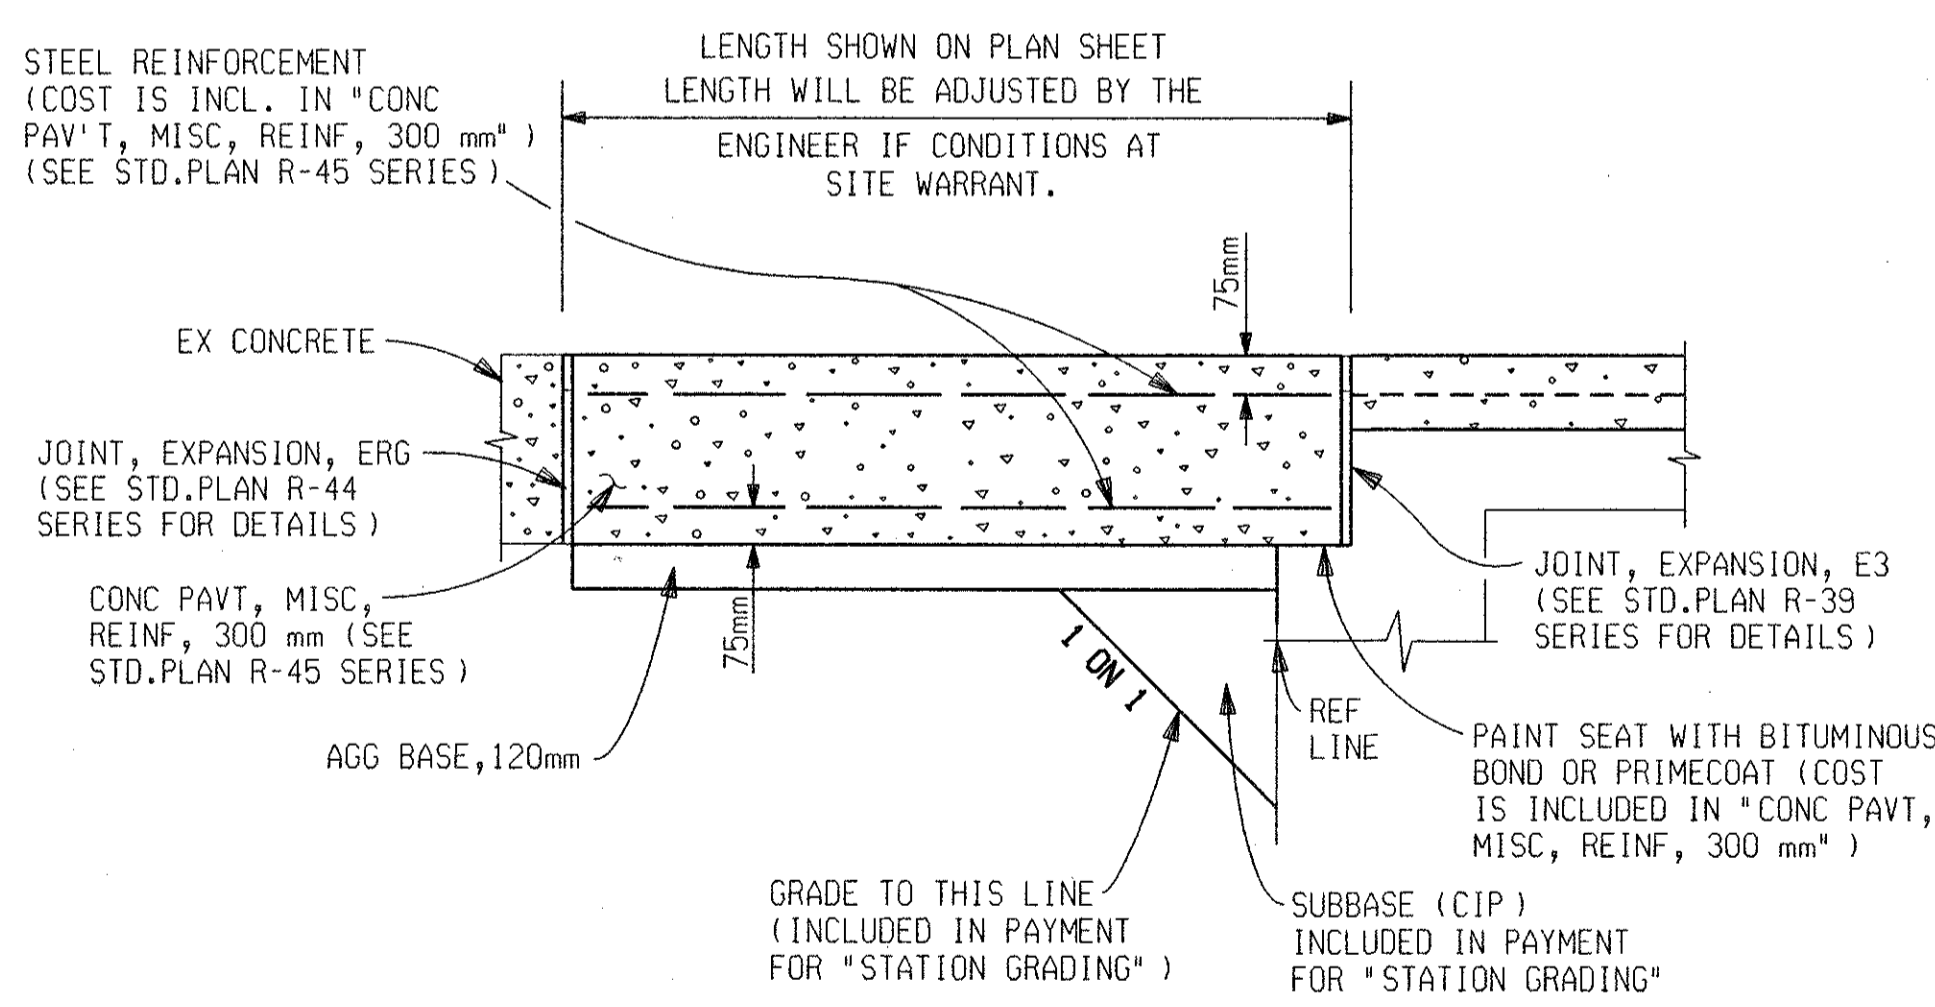


CONCRETE APPROACH DETAIL-EXISTING CONCRETE SECTION

NOT TO SCALE

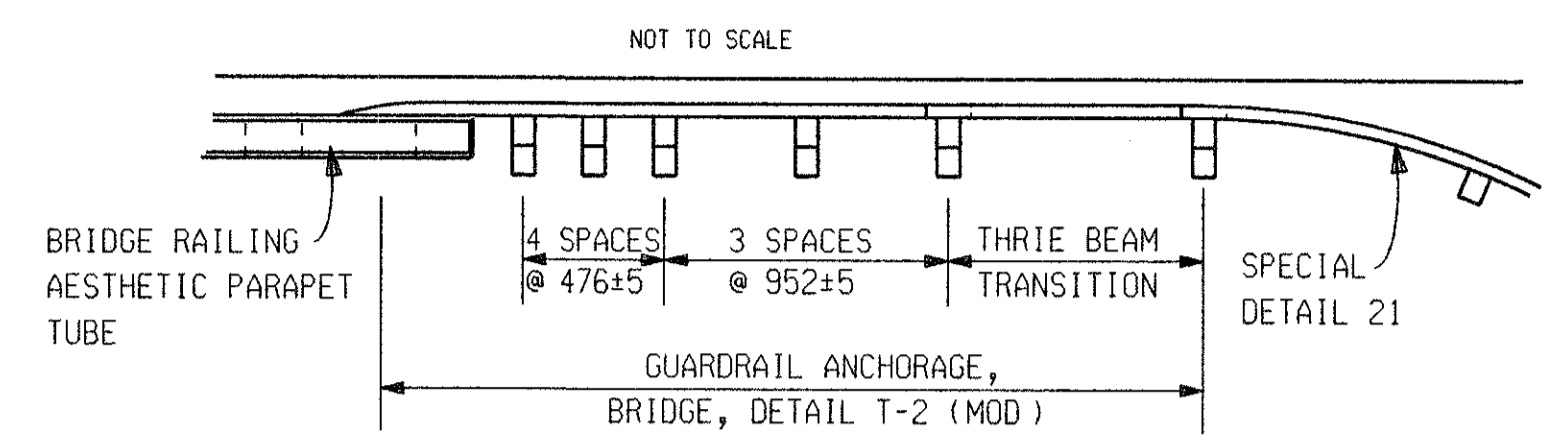

PROPOSED GUARDRAIL ANCHORAGE, BRIDGE, DETAIL T-2 (MOD) (TYP)


DETAIL 1

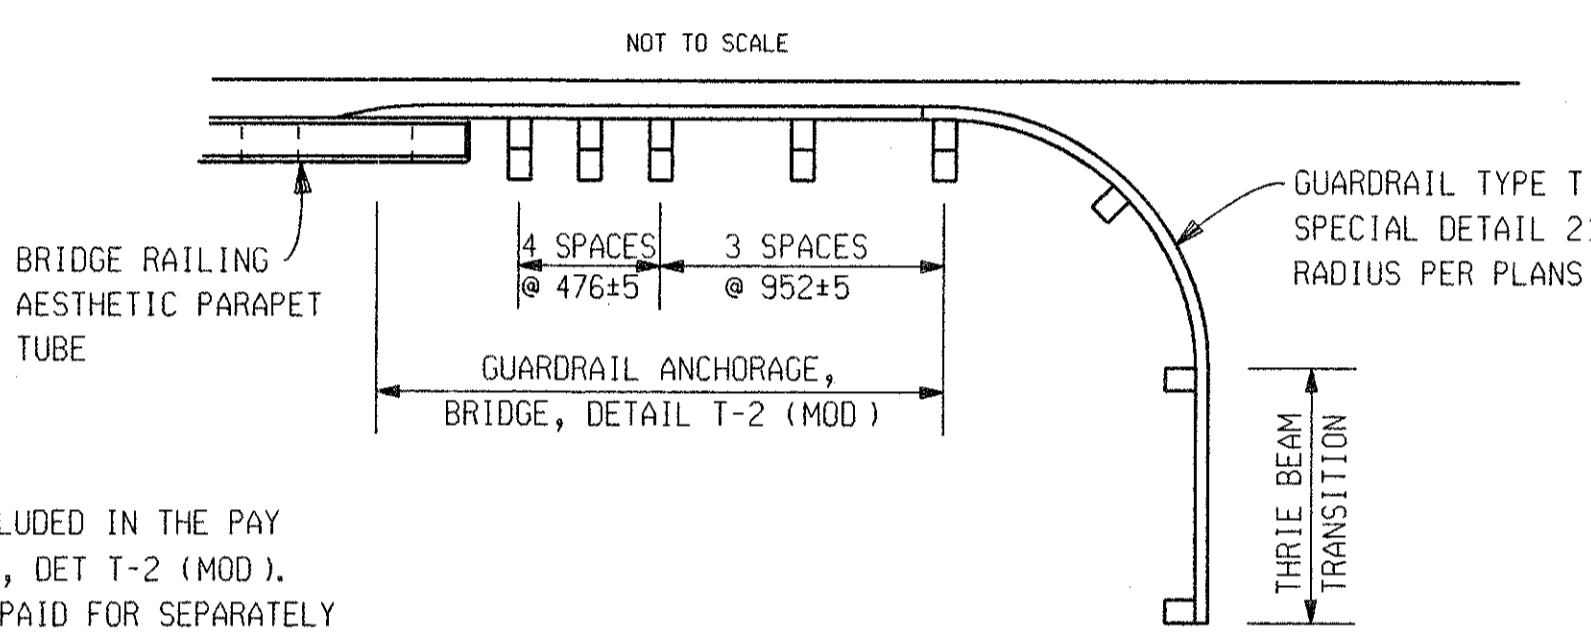

PROPOSED GUARDRAIL ANCHORAGE, BRIDGE, DETAIL T-2 (MOD) (TYP)

DETAIL 2

NOTE:
 THRIE BEAM TRANSITION IS INCLUDED IN THE PAY ITEM *GUARDRAIL ANCH, BRIDGE, DET T-2 (MOD).
 GUARDRAIL, CURVED, TYPE T PAID FOR SEPARATELY

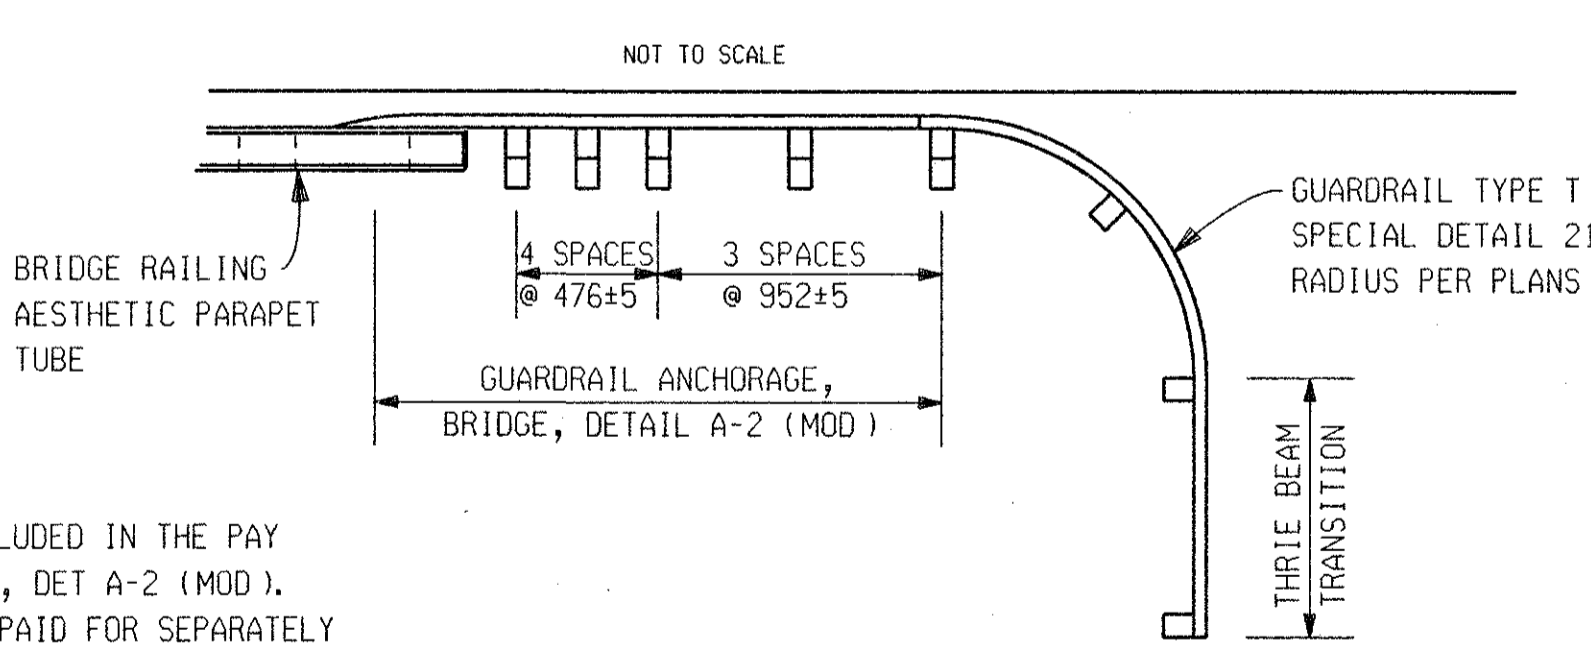

PROPOSED GUARDRAIL ANCHORAGE, BRIDGE, DETAIL A-2 (MOD) (TYP)

DETAIL 3

NOTE:
 THRIE BEAM TRANSITION IS INCLUDED IN THE PAY ITEM *GUARDRAIL ANCH, BRIDGE, DET A-2 (MOD).
 GUARDRAIL, CURVED, TYPE T PAID FOR SEPARATELY

MISC DETAILS

	DATE	SCALE	CONT. SEC.	JOB NO.	DESIGN UNIT	SHEET NO.
	10/11/99	1:300	63174,63103	48404A	RICK	R.O.W 2B

ENGINEERING REPORT NO	ENVIRON IMPACT STMT
METHOD OF SURVEY	YEAR
SURVEY ORDER	SURVEY CHIEF
AERIAL SURVEY NO	YEAR
HORIZ DATUM	VERT DATUM
ROAD DESIGN INITIATED 1999	COMPLETED 1999
PRELIMINARY PLANS BY RICK	FINAL PLANS BY RICK
FIELD INSPECTION (GI) BY TIM BARRY	DATE 6-22-99
PLANS-IN-HAND BY (FHWA)	AND (MDOT) DATE

GENERAL PLAN NOTES

UNDERGROUND UTILITIES
FOR PROTECTION OF UNDERGROUND UTILITIES AND IN CONFORMANCE WITH PUBLIC ACT 53, 1974, THE CONTRACTOR SHALL DIAL 1-800-482-7171 A MINIMUM OF THREE FULL WORKING DAYS, EXCLUDING SATURDAYS, SUNDAYS, AND HOLIDAYS PRIOR TO BEGINNING EACH EXCAVATION IN AREAS WHERE PUBLIC UTILITIES HAVE NOT BEEN PREVIOUSLY LOCATED. MEMBERS WILL THUS BE ROUTINELY NOTIFIED. THIS DOES NOT RELIEVE THE CONTRACTOR OF THE RESPONSIBILITY OF NOTIFYING UTILITY OWNERS WHO MAY NOT BE A PART OF THE "MISS DIG" ALERT SYSTEM.

MDOT'S FREEWAY LIGHTING SYSTEM, THE SCANDI SYSTEM AND OTHER MISCELLANEOUS ELECTRICAL SYSTEMS ARE NOT A PART OF MISS DIG.

CONTRACTORS WORKING OUTSTATE SHOULD CONTACT THE MAINTENANCE REPRESENTATIVE AT THE MDOT DISTRICT OFFICE TO HAVE LIGHTING SYSTEMS STAKED.

GRADES FOR INTERSECTIONS
ALL INTERSECTIONS ARE TO BE CONSIDERED AS COMPLETE UNITS AND THEIR GRADES DETERMINED BEFORE CONSTRUCTION IS STARTED.

OLD PLANS
THE FOLLOWING OLD PLANS WERE REFERRED TO IN THE DESIGN OF THIS PROJECT.
S31 OF 63174B
S02 OF 63174D
S30 OF 63174B
S04 OF 63103A
1-75-2 (75) 62
1-696-8 (24) 224
S03 OF 63174I
1-75-2 (137) 62
P01 OF 63174C
1-75-2 (78)-71
S15 OF 63174F
1-75-2 (92) 62

IN ADDITION, OTHER OLD PLANS THAT PREDATE THIS PROJECT MAY BE AVAILABLE. THESE PLANS MAY BE REVIEWED IN THE LANSING DESIGN OFFICE DURING NORMAL WORKING HOURS.

STATIONING
STATIONING ON THIS PROJECT WAS TAKEN FROM OLD PLANS AND PAVEMENT STENCILED STATIONING AND IS NOT NECESSARILY CORRECT.

SIGNS
ANY MDOT SIGNS REQUIRING RELOCATION DUE TO CONSTRUCTION OPERATIONS SHALL BE SALVAGED AND RESET BY THE CONTRACTOR AT LOCATIONS DESIGNATED BY THE ENGINEER. THIS WORK WILL BE CONSIDERED INCLUDED IN PAYMENT FOR OTHER CONTRACT ITEMS.

PAVEMENT REMOVAL QUANTITIES
PAVEMENT REMOVAL AS SHOWN ON THE PLANS SHALL BE AT THE DISCRETION OF THE ENGINEER. IF IN HIS/HER JUDGEMENT, AREAS OF PAVEMENT MAY BE LEFT IN PLACE, OR ADDITIONAL AREAS ADDED TO PROVIDE THE PROPER CROSS-SECTION AND BASE, CHANGES CAN BE MADE IN THE QUANTITIES.

MILLING PAVEMENT
PRIOR TO MILLING THE PAVEMENT, THE CONTRACTOR SHALL HAVE AN APPROVED MIX DESIGN AND AN ADEQUATE SUPPLY OF MATERIAL TO INSURE THAT THE FIRST LIFT OF THE SPECIFIED BITUMINOUS MIXTURE CAN BE PLACED ON ALL MILLED SURFACES

MITS
CALL MITS (313-256-9800) FOR LOCATION OF FIBER OPTIC LINES. IN CASE OF AN EMERGENCY CALL (313) 256-9800 EXT 310

GAS MAINS
A 4" STEEL GAS MAIN IS IN THE VICINITY OF THE LINCOLN AVE. STRUCTURE (S30 OF 63174). CONTRACTOR SHALL TAKE CAUTION DURING OPERATIONS NOT TO DISTURB THE GAS MAIN.

A 4" H.P. AND A 6" M.P. STEEL GAS MAIN ARE IN THE VICINITY OF THE ELEVEN MILE STRUCTURE (S31 OF 63174). CONTRACTOR SHALL TAKE CAUTION DURING OPERATIONS NOT TO DISTURB THE GAS MAINS.

PUBLIC UTILITIES		
THE EXISTING UTILITIES LISTED BELOW AND SHOWN ON THESE PLANS REPRESENT THE BEST INFORMATION AVAILABLE AS OBTAINED ON OUR SURVEYS. THIS INFORMATION DOES NOT RELIEVE THE CONTRACTOR OF THE RESPONSIBILITY TO BE SATISFIED AS TO IT'S ACCURACY AND THE LOCATION OF EXISTING UTILITIES.		
NAME OF OWNER	KIND OF UTILITY	
DEVEK BLOUNT AMERITECH PONTIAC/SOUTHFIELD ENGINEERING OFFICE 54 N MILL ST BOX 33 PH* (248) 456-0841 PONTIAC, MI 48342	PHONE	
COMCAST CABLEVISION OF PONTIAC, WATERFOR ATTN: JIM CHURCH 1300 CRESENT LAKE RD WATERFORD, MI 48327	CTV	
STEVE PLAWINSKI CONSUMERS ENERGY COMPANY 1030 HEATHERSTONE RD PONTIAC, MI 48342 PH* (248) 858-4448	GAS	
MEDIA ONE ATT STEVE S RUZDZINSKI 35155 INDUSTRIAL ROAD LIVONIA, MI 48150	PHONE/CTV	
MS. CINDY NORLIN PRINCIPAL AREA LEADER - PROJECT MANAGEMENT DETROIT EDISON COMPANY 2000 SECOND AVENUE, 410 SB DETROIT, MI 48226	ELECTRICAL	
SUN PIPE LINE COMPANY MR. ROBERT RYAN, SUPERINTENDENT 7155 INKSTER ROAD TAYLOR, MI 48180		
TCI CABLEVISION 720 N. BATES ST. SAGINAW, MI 48602-4868	CTV	
TCI CABLE OF OAKLAND COUNTY ATT: DAVID EADES 4500 DELEMERE ROYAL OAK, MI 48073	CTV	
UNITED CABLE TVC OF MID MICHIGAN 1070 TOWBRIDGE RD E LANSING, MI 48823	CTV	
MITS 1050 SIXTH ST. DETROIT, MI 48226		

NOTES APPLYING TO STANDARD PLANS

WHERE THE FOLLOWING ITEMS ARE CALLED FOR ON PLANS, THEY ARE TO BE CONSTRUCTED ACCORDING TO THE STANDARD PLAN GIVEN BELOW OPPOSITE EACH ITEM UNLESS OTHERWISE INDICATED.

DRAINAGE STRUCTURES	R-1-B
SIDEWALK RAMP DETAILS	R-28-B
DRIVEWAY OPENINGS & APPROACHES, AND CONCRETE SIDEWALKS	R-29-B
CONCRETE CURB AND CONCRETE CURB AND GUTTER	R-30-C
TRANSVERSE PAVEMENT JOINTS	R-39-D
LONGITUDINAL PAVEMENT JOINTS	R-41-C *
LOCATION OF TRANSVERSE JOINTS IN CONCRETE PAVEMENT	R-43-B
CONCRETE PAVEMENT REPAIR	R-44-B
CONVENTIONAL PAVEMENT REINFORCEMENT	R-45-C
GUARDRAIL AT STRUCTURES AND EMBANKMENTS	R-59-C
GUARDRAIL TYPES A, B, BD, T & TD	R-60-E *
GUARDRAIL DEPARTING TERMINAL TYPES B & T	R-66-C *
GUARDRAIL ANCHORAGE, BRIDGE, DETAILS	R-67-D
SODDING AND SEEDING	R-100-B
LIGHTED ARROWS AND BARRICADES	R-125-A

* SPECIAL DETAILS

MISCELLANEOUS ESTIMATES CONT.	
THE FOLLOWING ITEMS OF WORK ARE ESTIMATED FOR THE ENTIRE PROJECT FOR MAINTAINING TRAFFIC AS DETERMINED BY THE ENGINEER.	
50 m	Post, Steel, 4.5 kg
12 ea	Band, Sign
20 m2	Sign, Type IA
7.2 m2	Sign, Type IIA
3 m2	Sign, Type IIIA
7.2 m2	Sign, Type IB
7.2 m2	Sign, Type IIB
4 m2	Sign, Type IIIB
5 ea	Bridge Sign Connection, Bolt Replacement
2 ea	Sign, Type I, Rem
10 ea	Sign, Type II, Rem
23 ea	Sign, Type III, Rem
5 ea	Sign, Type I, Salv
4 ea	Sign, Type III, Salv
10 ea	Bridge Sign Connection, Type A, Rem
1 ea	Bridge Sign Connection, Type E, Rem
1 ea	Bridge Sign Connection, Type F, Rem
192 m	Pavt Mrkg, Overlay Cold Plastic, 600 mm, Stop Bar
440 m	Pavt Mrkg, Overlay Cold Plastic, 150 mm, Crosswalk
18 ea	Pavt Mrkg, Overlay Cold Plastic, Only
8 ea	Pavt Mrkg, Overlay Cold Plastic, Rt Turn Arrow Symb
14 ea	Pavt Mrkg, Overlay Cold Plastic, Lt Turn Arrow Symb
310 m	Pavt Mrkg, Overlay Cold Plastic, Pattern Tape, 100 mm, White
370 m	Pavt Mrkg, Overlay Cold Plastic, Pattern Tape, 100 mm, Yellow
475 m	Pavt Mrkg, Optional Material, 100 mm, White
450 m	Pavt Mrkg, Optional Material, 100 mm, Yellow

MISCELLANEOUS ESTIMATES

THE FOLLOWING ITEMS OF WORK SHALL BE DONE AS THEY APPLY THROUGHOUT THE PROJECT. THESE ITEMS ARE NOT DETAILED OR INCLUDED ON THE PLAN AND PROFILE SHEETS:

1 ea	Bridge Sign Connection, Steel, Type E	(15 degree)
1 ea	Bridge Sign Connection, Steel, Type F	(15 degree)
5 ea	Bridge Sign Connection, Steel, Type A	(0 degree)
2 ea	Bridge Sign Connection, Steel, Type A	(10 degree)
2 ea	Bridge Sign Connection, Steel, Type A	(15 degree)
1 ea	Bridge Sign Connection, Steel, Type A	(30 degree)
175 m2	Sign, Type B Temp, Prismatic, Special	

MISCELLANEOUS ESTIMATES			
THE FOLLOWING ITEMS OF WORK SHALL BE DONE AS THEY APPLY THROUGHOUT THE PROJECT. THESE ITEMS ARE NOT DETAILED OR INCLUDED ON THE PLAN AND PROFILE SHEETS:			
ROYAL OAK 43%	MADISON HTS. 6%	MDOT 51%	
0.43	0.06	0.51 LS	Project Cleanup
645	90	765 hr	On the Job Training
0.43	0.06	0.51 LS	Contractor Staking for Bridges
24	3	28 hr	Staking Plan Errors and Extras, One Person
9	1	12 hr	Staking Plan Errors and Extras, Two Person
14	2	17 hr	Staking Plan Errors and Extras, Three Person
641	89	761 m3	Conc Quality Assurance
2397	335	2843 dir	Conc Quality Initiative
6	1	8 m	Fence, Plastic, Temp
21	3	24 ea	Sand Module Impact Attenuator (Temp)
10	1	13 ea	Sand Module Impact Attenuator (Replace)
15	2	19 ea	Sand Module Impact Attenuator (Relocate)


MISCELLANEOUS ESTIMATES CONT.

THE FOLLOWING ITEMS OF WORK ARE ESTIMATED FOR THE ENTIRE PROJECT FOR MAINTAINING TRAFFIC AS DETERMINED BY THE ENGINEER.

ROYAL OAK 43%	MADISON HTS. 6%	MDOT 51%	
15	2	18 ea	Barricade, Type III, Lighted, Oper
4	1	5 ea	Truck Mtd Attenuator, Furn
4	1	5 ea	Truck Mtd Attenuator, Oper
215	30	255 m	Conc Barrier, Temp, Furn
215	30	255 m	Conc Barrier, Temp, Oper
95	13	114 m	Conc Barrier, Temp, Relocated
11	1	13 ea	Conc Barrier Reflector Replacement
3	0	4 ea	High Intensity Light, Type B, Furn
3	0	4 ea	High Intensity Light, Type B, Oper
0.43	0.06	0.51 LS	Minor Traf Devices
0.43	0.06	0.51 LS	Flag Control
2	0	3 m2	Sign, Type A Temp, Prismatic Retriflec Sheeting
129	18	153 m2	Sign, Type B Temp, Prismatic Retriflec Sheeting
4	1	5 ea	Sign Cover
2	0	2 ea	Sign, Portable, Changeable, Furn
2	0	2 ea	Sign, Portable, Changeable, Oper
387	54	459 m	Pavt Mrkg, Type R, 100 mm, White, Temp
1505	210	1785 m	Pavt Mrkg, Type R, 100 mm, Yellow, Temp
150	20	179 m	Pavt Mrkg, Longit, 125 mm or Less Width, Rem
43	6	51 m	Pavt Mrkg, Longit, 126 mm to 250 mm Width, Rem
291	41	345 m	Removing Curing Compound, for Longit Mrkg
58	8	69 m2	Removing Curing Compound, for Spec Mrkg
64	9	77 m2	Removing Spec Mrkg
6	1	7 ea	Lighted Arrow, Type C, Furn
6	1	7 ea	Lighted Arrow, Type C, Oper
0.43	0.06	0.51 ea	Lighted Arrow, Type C, Standby
602	84	714 ea	Plastic Drum with High Intensity Sheeting, Lighted, Furn
537	75	638 ea	Plastic Drum with High Intensity Sheeting, Lighted, Oper
15	2	18 ea	Barricade, Type III, Lighted, Furn

NOTE SHEET

DATE	CONT. SEC.	JOB NO.	DESIGN UNIT	SHEET NO.
10/19/99	63174	48404	RICK	R.O.W CONST. 3B

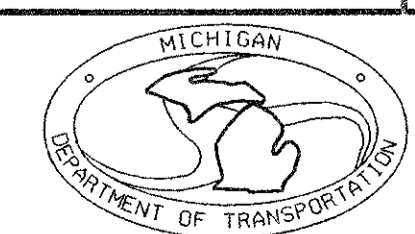


DATE: 05-04-99
 DATE: 10-11-99
 EXISTING BY: ZAMORAB
 PROPOSED BY:
 LAST CORRECTION BY: TJM

FILE NAME: 48404s02.dgn
 8 9 11 12 13 14 15 16 17 18 19 21 23 24 25 26 27 28 29 30 31 33

FINAL R.O.W.			
AUTH	DATE	NO.	REVISION

SECTION 14
 TIN, R11E
 ROYAL OAK TWP

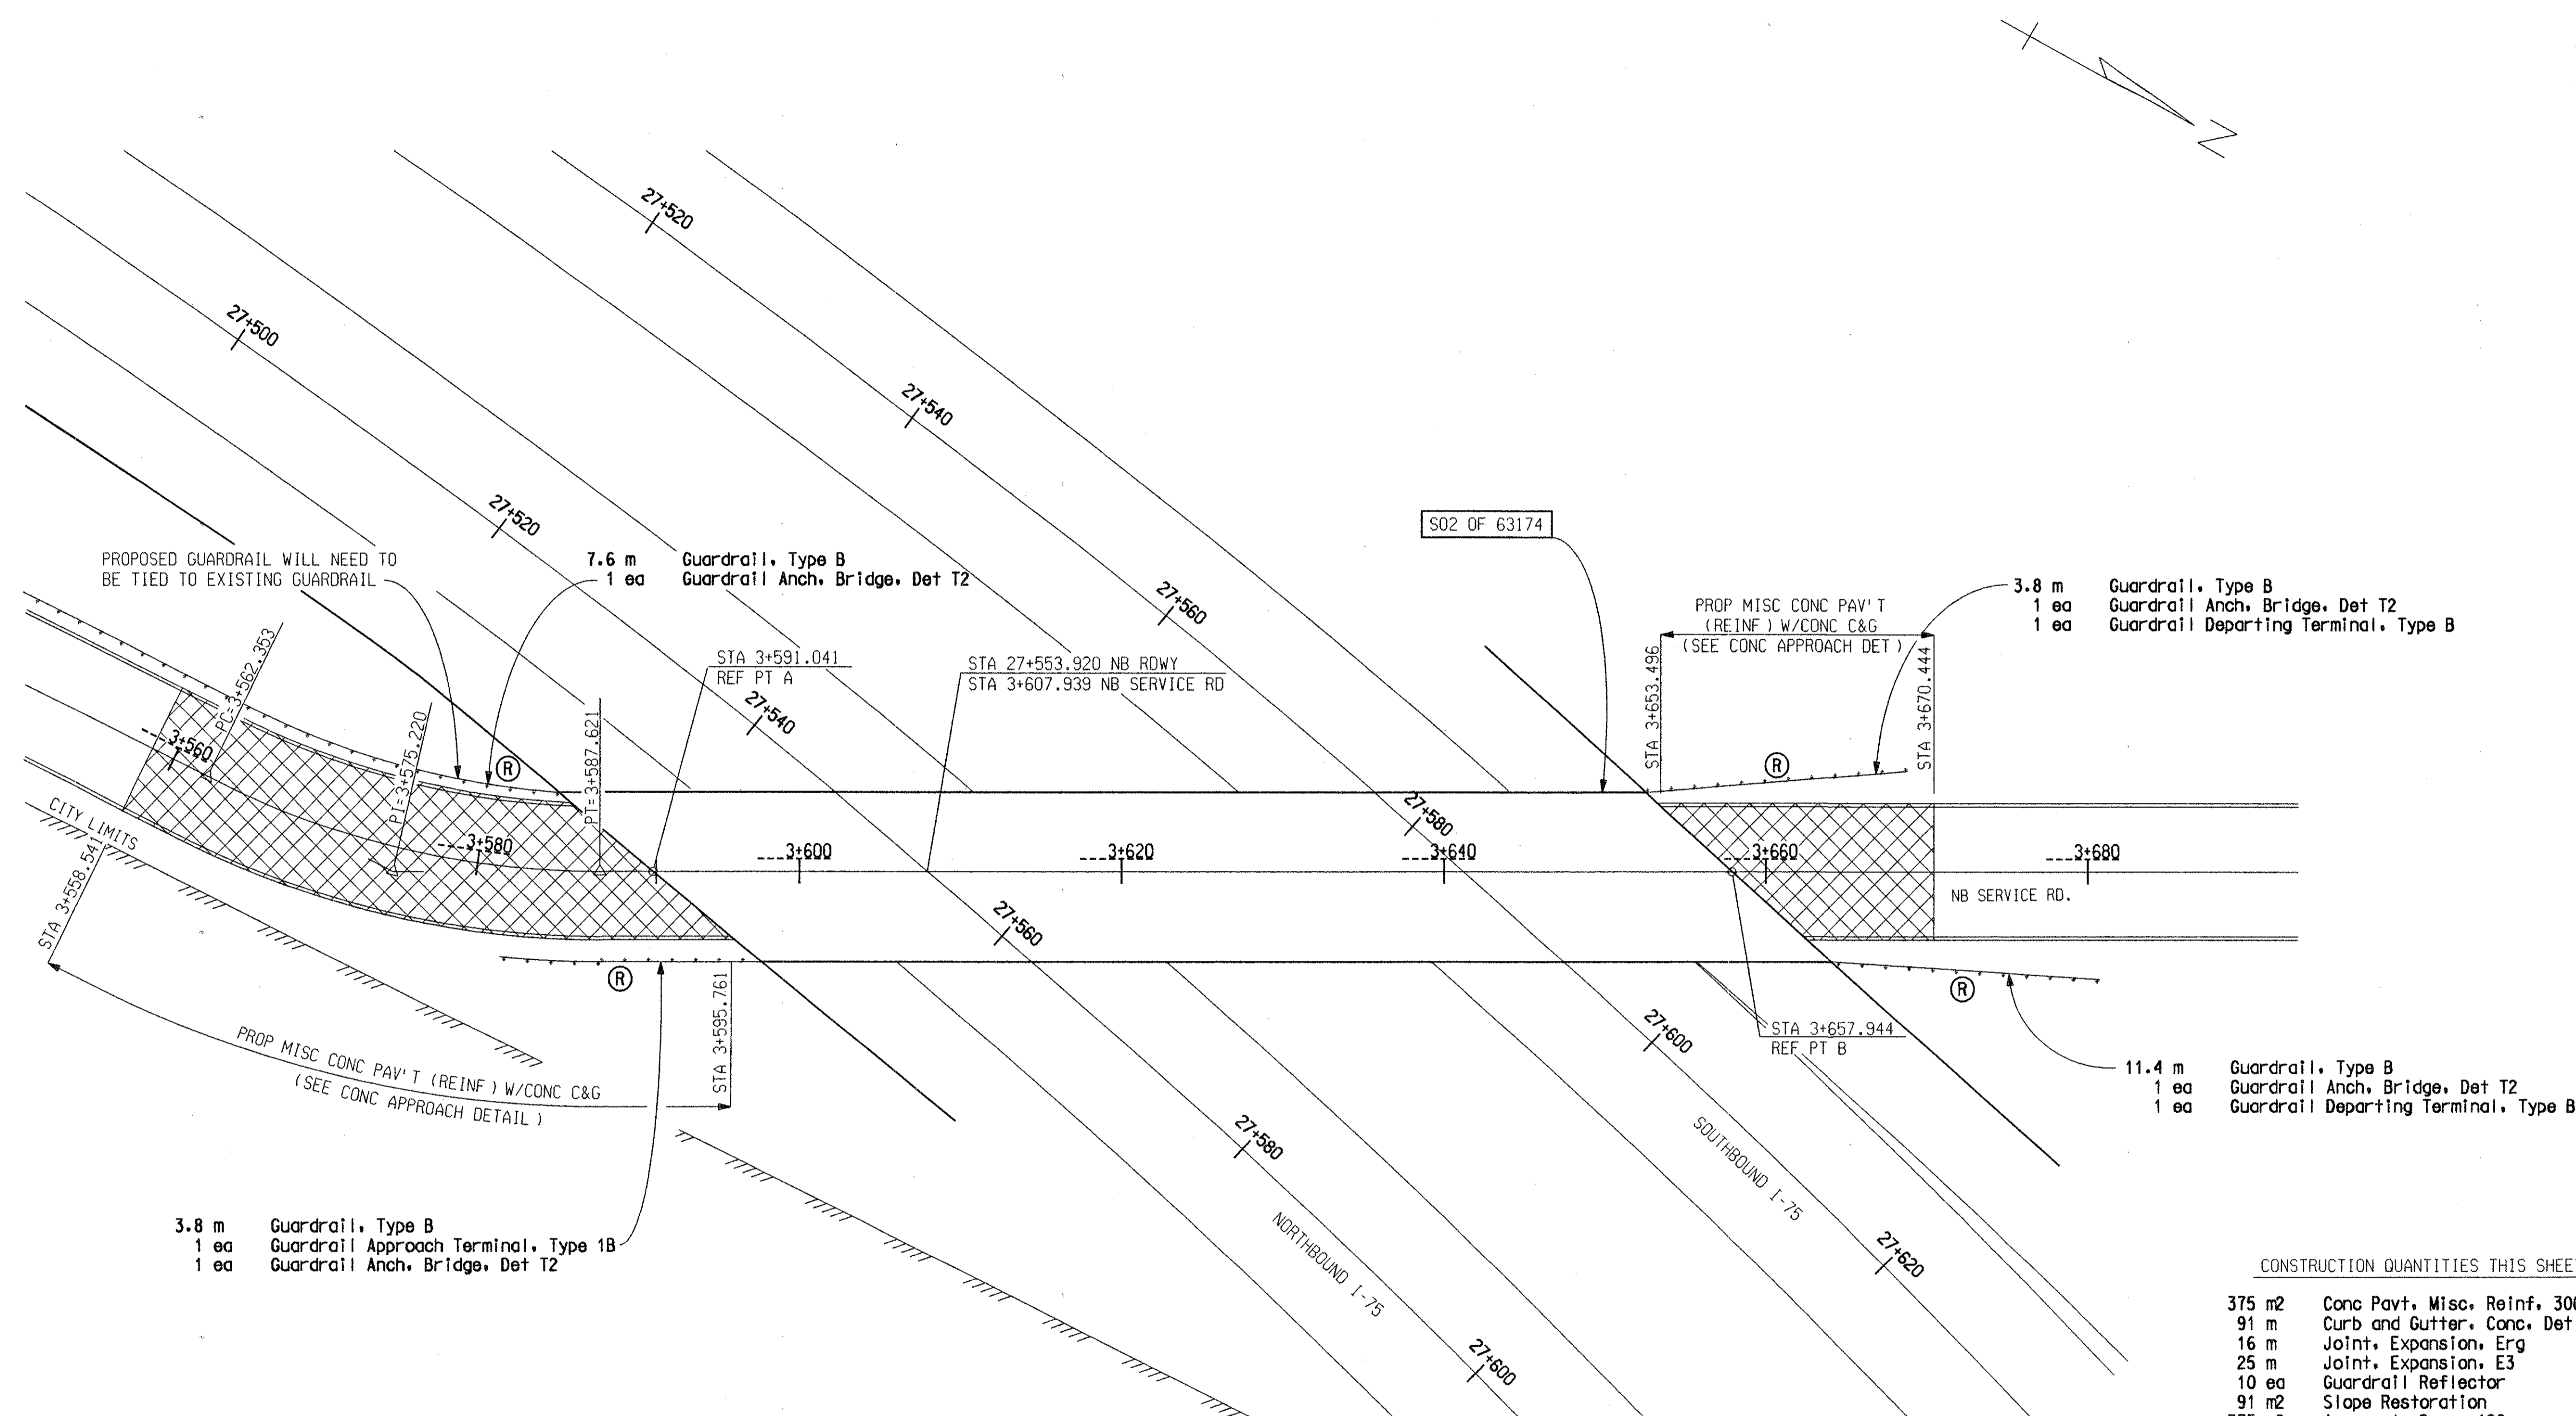

3.8 m Guardrail, Type B
 1 ea Guardrail Approach Terminal, Type 1B
 1 ea Guardrail Anch. Bridge, Det T2

3.8 m Guardrail, Type B
 1 ea Guardrail Anch. Bridge, Det T2
 1 ea Guardrail Departing Terminal, Type B

11.4 m Guardrail, Type B
 1 ea Guardrail Anch. Bridge, Det T2
 1 ea Guardrail Departing Terminal, Type B

CONSTRUCTION QUANTITIES THIS SHEET

375 m ²	Conc Pavt. Misc. Reinf. 300 mm
91 m	Curb and Gutter, Conc. Det F1
16 m	Joint. Expansion, Erg
25 m	Joint. Expansion, E3
10 ea	Guardrail Reflector
91 m ²	Slope Restoration
375 m ²	Aggregate Base, 120 mm

REMOVAL QUANTITIES THIS SHEET

66 m	Guardrail, Rem
375 m ²	Pavt. Rem
91 m	Station Grading

LEGEND

REMOVING PAVEMENT	XXXX
REMOVING	(R)

NOTE:
 ALL QUANTITIES ON THIS SHEET
 ARE ROYAL OAK PARTICIPATION

REMOVAL/CONSTRUCTION SHEET


	S02 OF 63174 NB SERVICE RD OVER I-75					
	DATE	SCALE	CONT. SEC.	JOB NO.	DESIGN UNIT	SHEET NO.
10/11/99	1:250	63174	48404	RICK	R.O.W.	4B

DATE: 10-11-98
 EXISTING BY: RICK'S UNIT
 PROPOSED BY: RICK'S UNIT
 LAST CORRECTION BY: RICK'S UNIT

FILE NAME: 48404s04.dgn
 8 9 10 11 12 13 14 15 16 17 18 19 20 21 22 23 24 25 26 27 28 29 30 31 32 33


FINAL R.O.W.			
AUTH	DATE	NO.	REVISION

SECTION
 TIN, R11E
 HAZEL PARK
 OAKLAND COUNTY

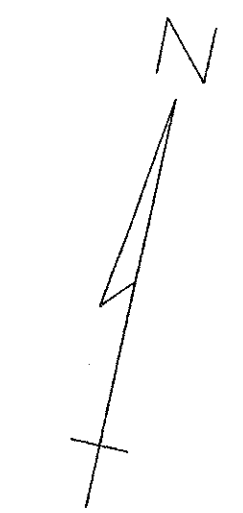

FOR LOCATION OF FIBER OPTIC LINE PLEASE CALL MDOT INTELLIGENT VEHICLE HIGHWAY SYSTEM AT (313) 256-9800

CAUTION - CRITICAL UNDERGROUND UTILITY

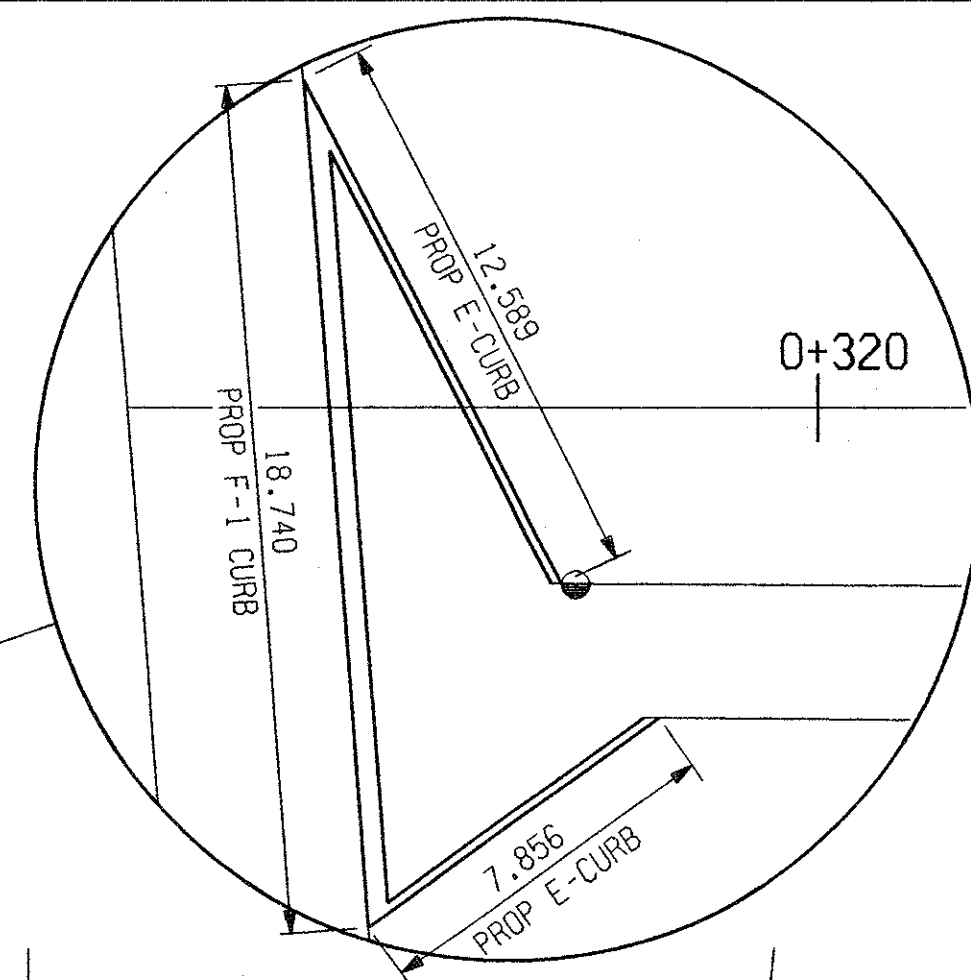

- 34.2 m Guardrail, Type B
- 1 ea Guardrail Approach Terminal, Type 1B
- 19 m Guardrail, Curved, Type T (17.8m R)
- 1 ea Guardrail Anch. Bridge, Det A2 (MOD) (SEE DET 3)

POB STA 0+304.800 BRIDGE =
 POT STA 16+900.224 SERVICE RD

POT STA 0+353.452 BRIDGE
 POC STA 24+578.764 I-75

PROP MISC CONC PAV'T (REINF) W/CONC C&G (SEE CONC APPROACH DET)

- 38 m Guardrail, Type B
- 1 ea Guardrail Departing Terminal, Type B
- 3.8 m Guardrail, Curved, Type T (12.7m R)
- 1 ea Guardrail Anch. Bridge, Det A2 (MOD) (SEE DET 3)

GRADE TO DRAIN TO EXISTING STRUCTURES

REF PT A STA 0+324.496

REF PT B STA 0+390.028

S04 OF 63103

PDE STA 0+399.333 BRIDGE =
 STA 16+663.973 SERVICE RD

- 68.4 m Guardrail, Type B
- 1 ea Guardrail Approach Terminal, Type 1B
- 7.6 m Guardrail, Curved, Type T (2.8m R)
- 1 ea Guardrail Anch. Bridge, Det A2 (MOD) (SEE DET 3)

- 1 ea Guardrail Departing Terminal, Type B
- 22.8 m Guardrail, Curved, Type T (12m R)
- 1 ea Guardrail Anch. Bridge, Det A2 (MOD) (SEE DET 3)

PROP MISC CONC PAV'T (REINF) W/CONC C&G (SEE CONC APPROACH DET)

CONSTRUCTION QUANTITIES THIS SHEET

406 m ²	Conc Pavt, Misc, Reinf, 300 mm
78 m	Curb and Gutter, Conc, Det F1
104 m	Joint, Expansion, Erg
48 m	Joint, Expansion, E3
102 m ²	Sidewalk, Conc, 150 mm
12 ea	Guardrail Reflector
5 ea	Dr Structure Cover, Adj, Case 1
78 m ²	Slope Restoration
508 m ²	Aggregate Base, 120 mm
69 m	Curb, Conc, Det E1
1135 kg	Dr Structure Cover L

REMOVAL QUANTITIES THIS SHEET

179 m	Guardrail, Rem
508 m ²	Pavt, Rem
78 m	Station Grading

LEGEND	
REMOVING PAVEMENT	
REMOVING SIDEWALK	

REMOVAL/CONSTRUCTION SHEET


MDOT Michigan Department of Transportation		S04 OF 63103		SHELVIN AVE OVER I-75	
DATE	SCALE	CONT. SEC.	JOB NO.	DESIGN UNIT	SHEET NO.
10/11/99	1:250	63103	48404	RICK	R.O.W. 5B

EXISTING BY: PROPOSED BY: LAST CORRECTION BY: RICK UNIT DATE: 10-11-99

FILE NAME: 48404\30_46p
 1 2 3 4 5 6 7 8 9 10 11 12 13 14 15 16 17 18 19 20 21 22 23 24 25 26 27 28 29 30 31 32 33 34 35 36 37 38 39 40 41 42 43 44 45 46 47 48 49 50 51 52 53 54 55 56 57 58 59 60 61 62 63

SECTION 23
 TIN, R11E
 OAKLAND COUNTY
 CITY OF ROYAL OAK

FINAL R.O.W.			
AUTH	DATE	NO.	REVISION

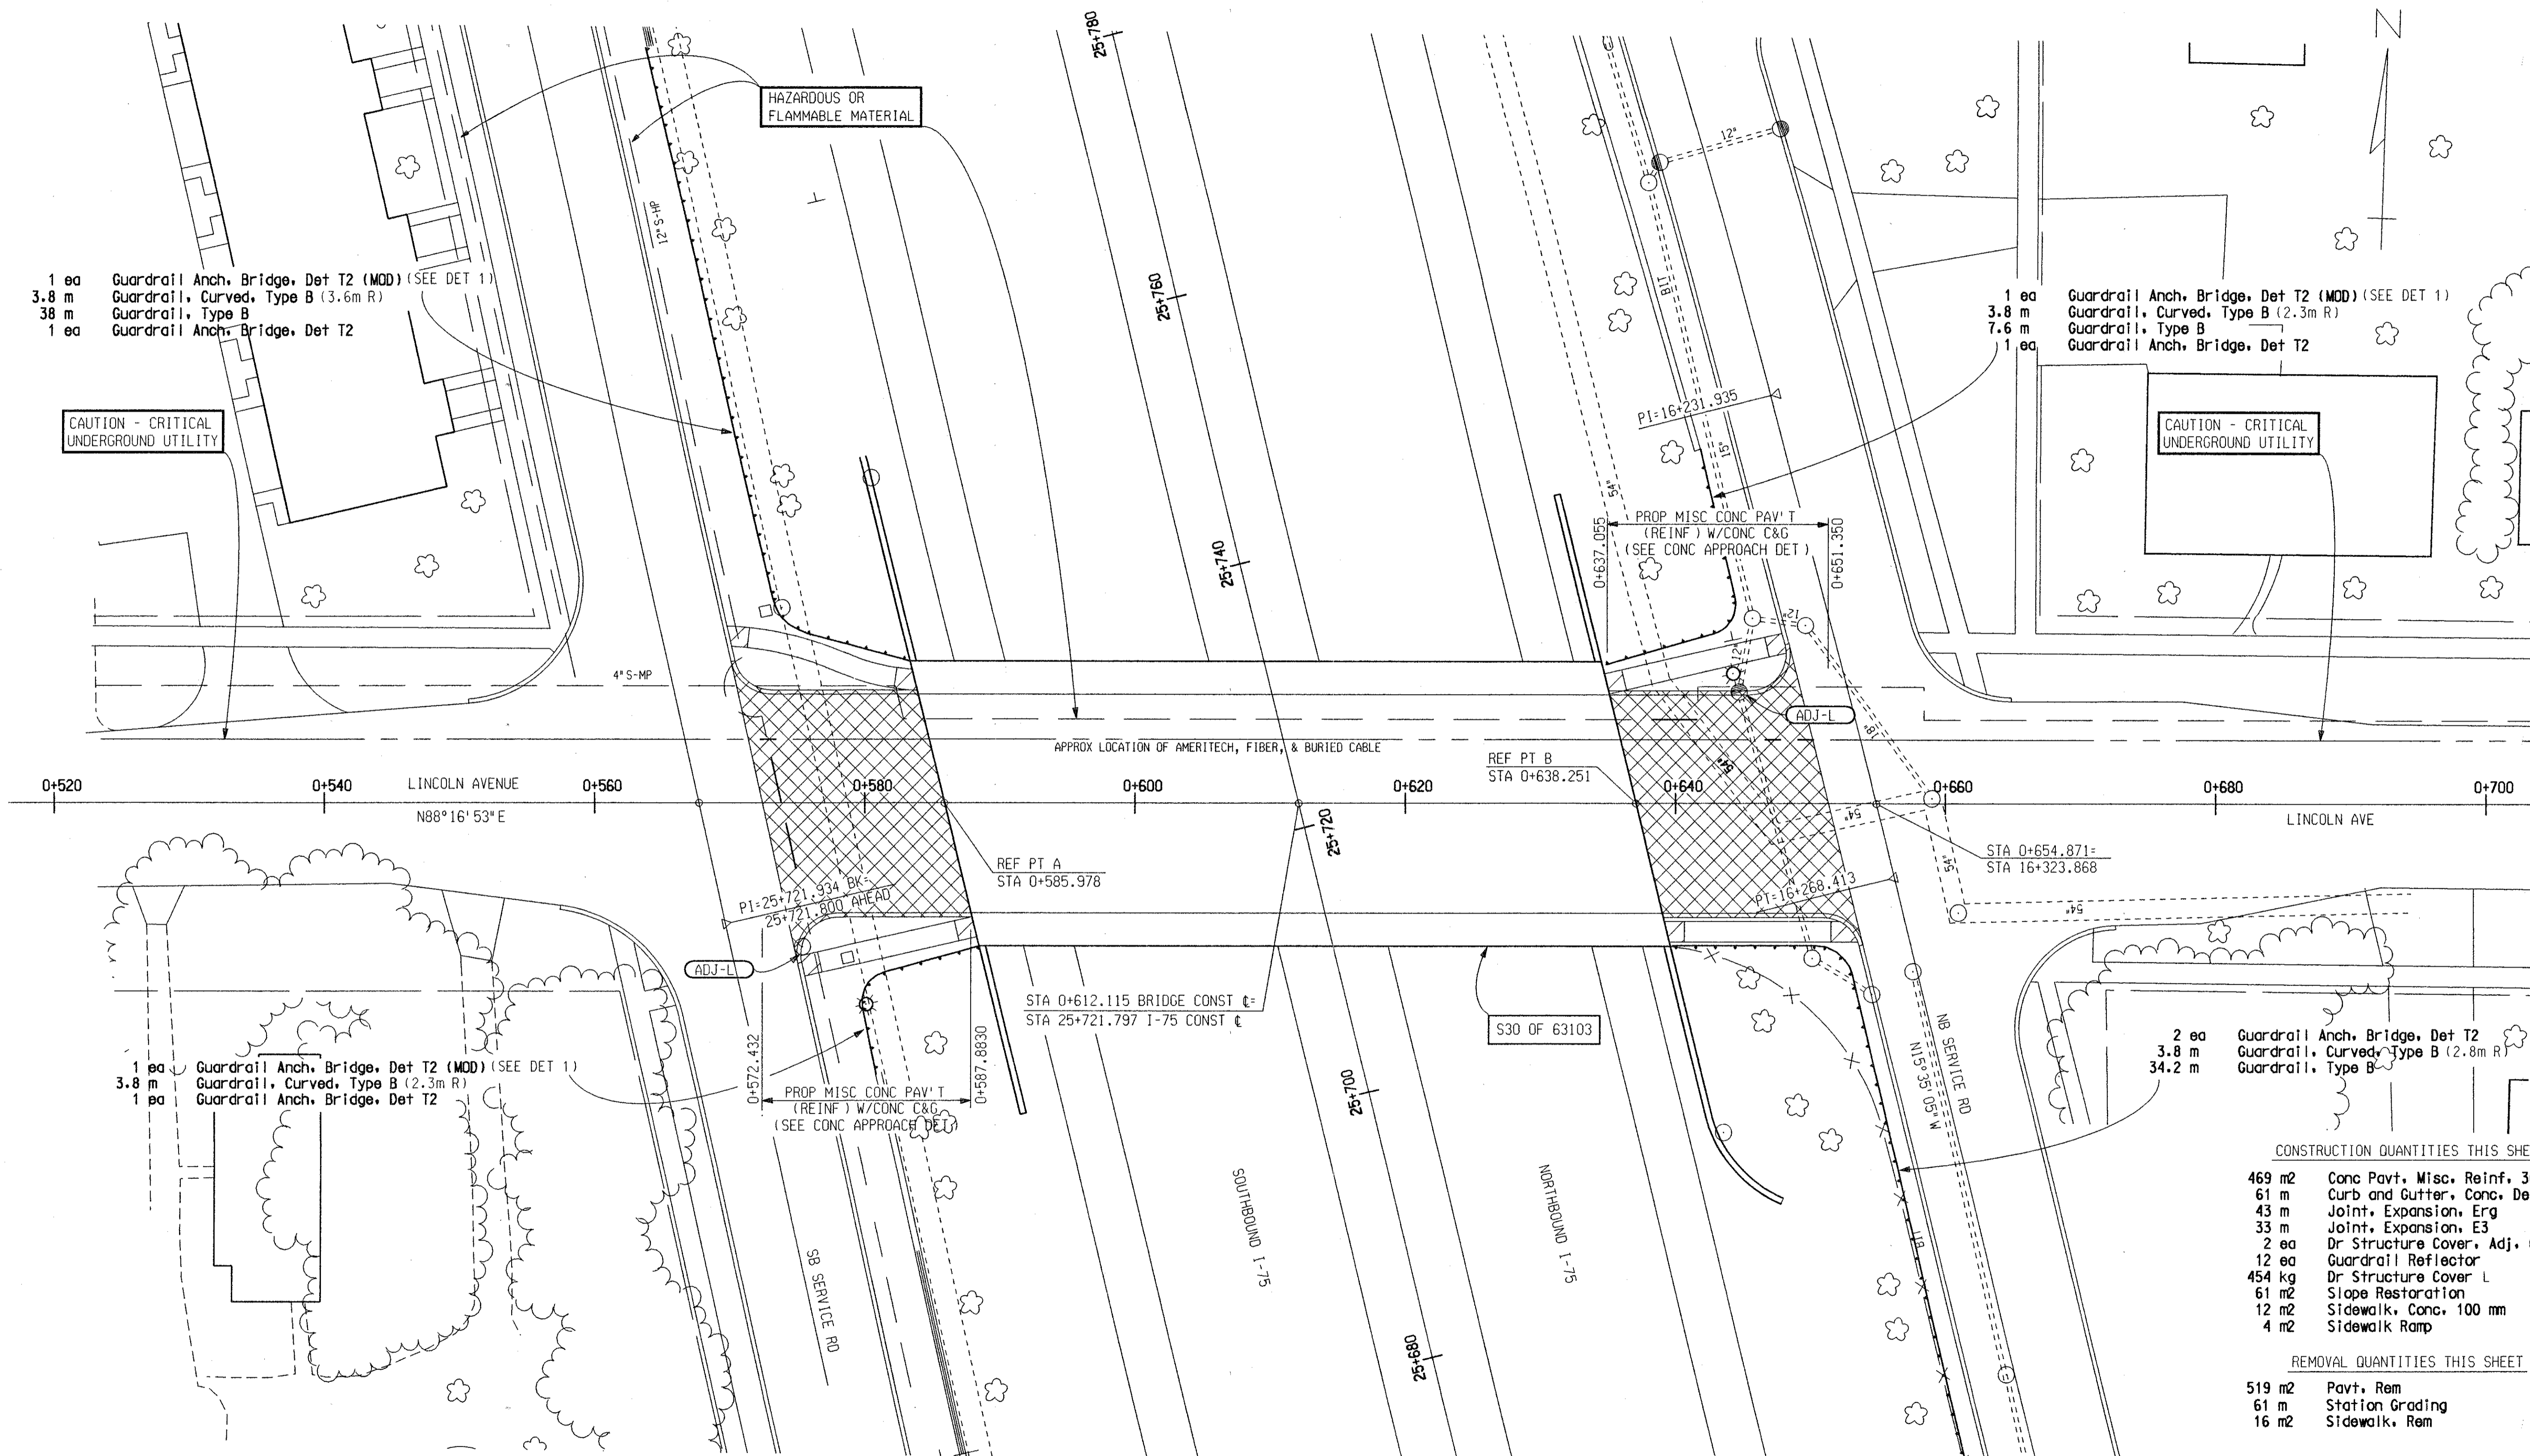

- 1 ea Guardrail Anch. Bridge, Det T2 (MOD) (SEE DET 1)
- 3.8 m Guardrail, Curved, Type B (3.6m R)
- 38 m Guardrail, Type B
- 1 ea Guardrail Anch. Bridge, Det T2

- 1 ea Guardrail Anch. Bridge, Det T2 (MOD) (SEE DET 1)
- 3.8 m Guardrail, Curved, Type B (2.3m R)
- 7.6 m Guardrail, Type B
- 1 ea Guardrail Anch. Bridge, Det T2

- 1 ea Guardrail Anch. Bridge, Det T2 (MOD) (SEE DET 1)
- 3.8 m Guardrail, Curved, Type B (2.3m R)
- 1 ea Guardrail Anch. Bridge, Det T2

- 2 ea Guardrail Anch. Bridge, Det T2
- 3.8 m Guardrail, Curved, Type B (2.8m R)
- 34.2 m Guardrail, Type B

CONSTRUCTION QUANTITIES THIS SHEET

- 469 m² Conc Pavt, Misc. Reinf, 300 mm
- 61 m Curb and Gutter, Conc, Det F1
- 43 m Joint, Expansion, Erg
- 33 m Joint, Expansion, E3
- 2 ea Dr Structure Cover, Adj, Case 1
- 12 ea Guardrail Reflector
- 454 kg Dr Structure Cover L
- 61 m² Slope Restoration
- 12 m² Sidewalk, Conc, 100 mm
- 4 m² Sidewalk Ramp

REMOVAL QUANTITIES THIS SHEET

- 519 m² Pavt. Rem
- 61 m Station Grading
- 16 m² Sidewalk, Rem

NOTE:
 ALL QUANTITIES ON THIS SHEET
 ARE ROYAL OAK PARTICIPATION

LEGEND	
REMOVING PAVEMENT	
REMOVING SIDEWALK	

REMOVAL/CONSTRUCTION SHEET


		S30 OF 63174 LINCOLN AVE OVER 1-75			
DATE	SCALE	CONT. SEC.	JOB NO.	DESIGN UNIT	SHEET NO.
10/11/99	1:250	63174	48404	RICK	R.O.W 6B

EXISTING BY: DATE: 10-11-99
 PROPOSED BY: DATE: 10-11-99
 LAST CORRECTION BY: TJM

FILE NAME: 48404s31.dgn
 8.9 11.12 13.14 15.16 17.18 19 21.22 23.24 25.26 27.28 29.30 31.32 33

SECTION 14
 TUN, R11E
 ROYAL OAK
 OAKLAND COUNTY

FINAL R.O.W.			
AUTH	DATE	NO.	REVISION

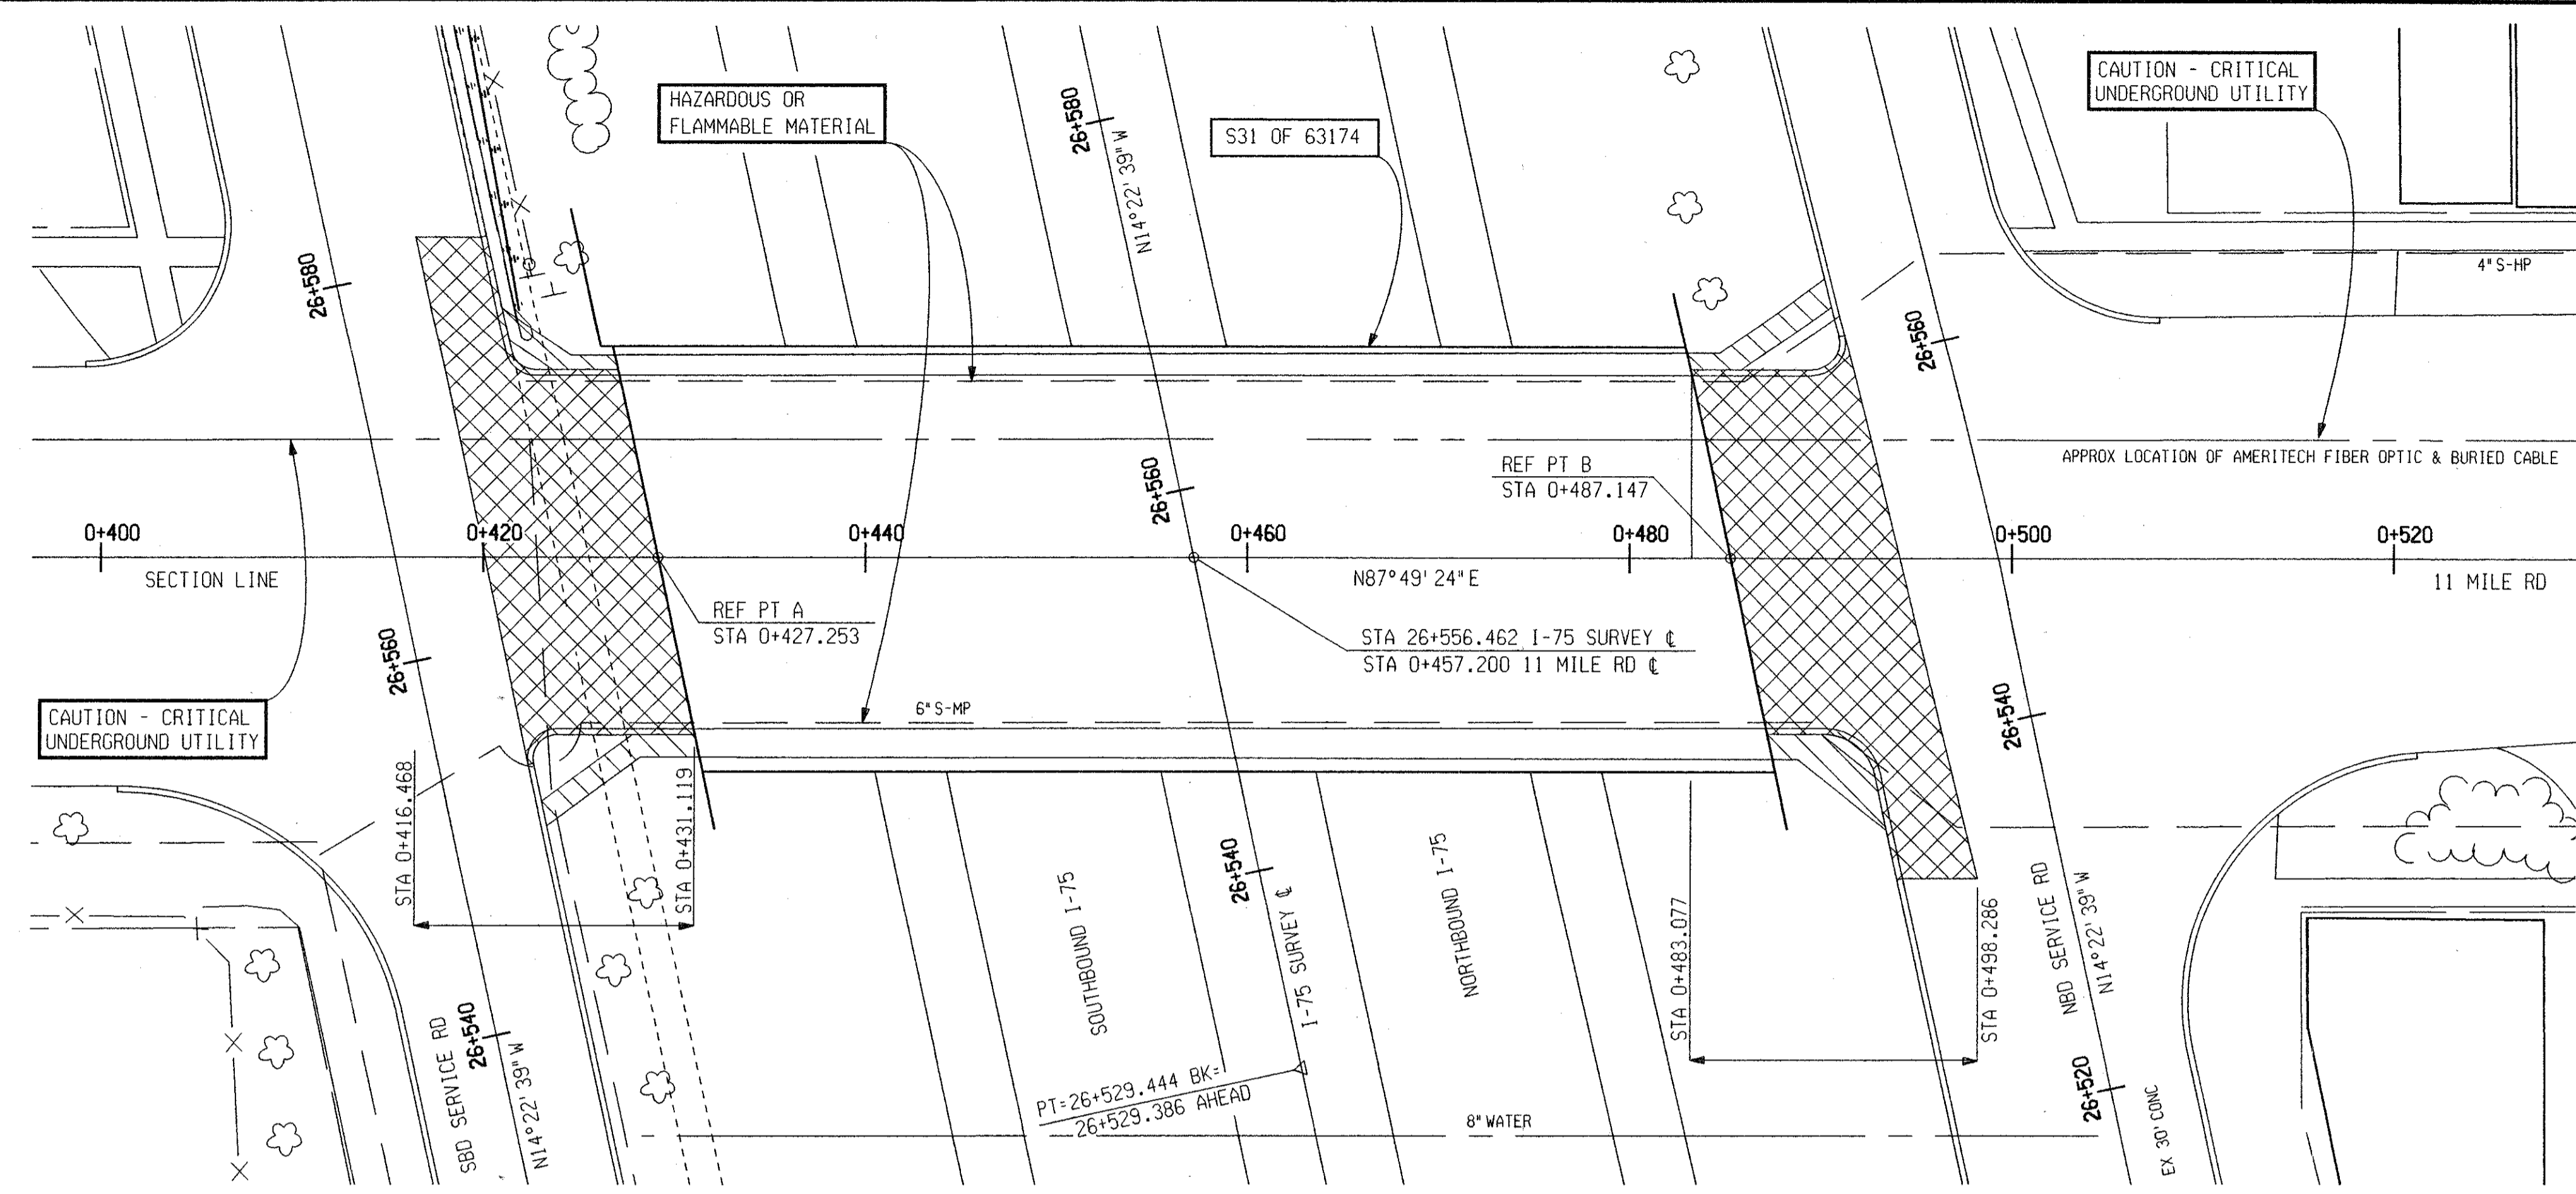


REMOVAL QUANTITIES THIS SHEET

30 m	Guardrail, Rem
398 m ²	Pavt. Rem
40 m ²	Sidewalk, Rem
28 m	Station Grading

1 ea Guardrail Anch. Bridge, Det T2 (MOD)
 (SEE DET 2) TIE TO EXISTING GUARDRAIL
 3.8 m Guardrail, Curved, Type T (2.2m R)

1 ea Guardrail Anch. Bridge, Det T2 (MOD)
 (SEE DET 2) TIE TO EXISTING GUARDRAIL
 3.8 m Guardrail, Type B
 3.8 m Guardrail, Curved, Type T (2.9m R)

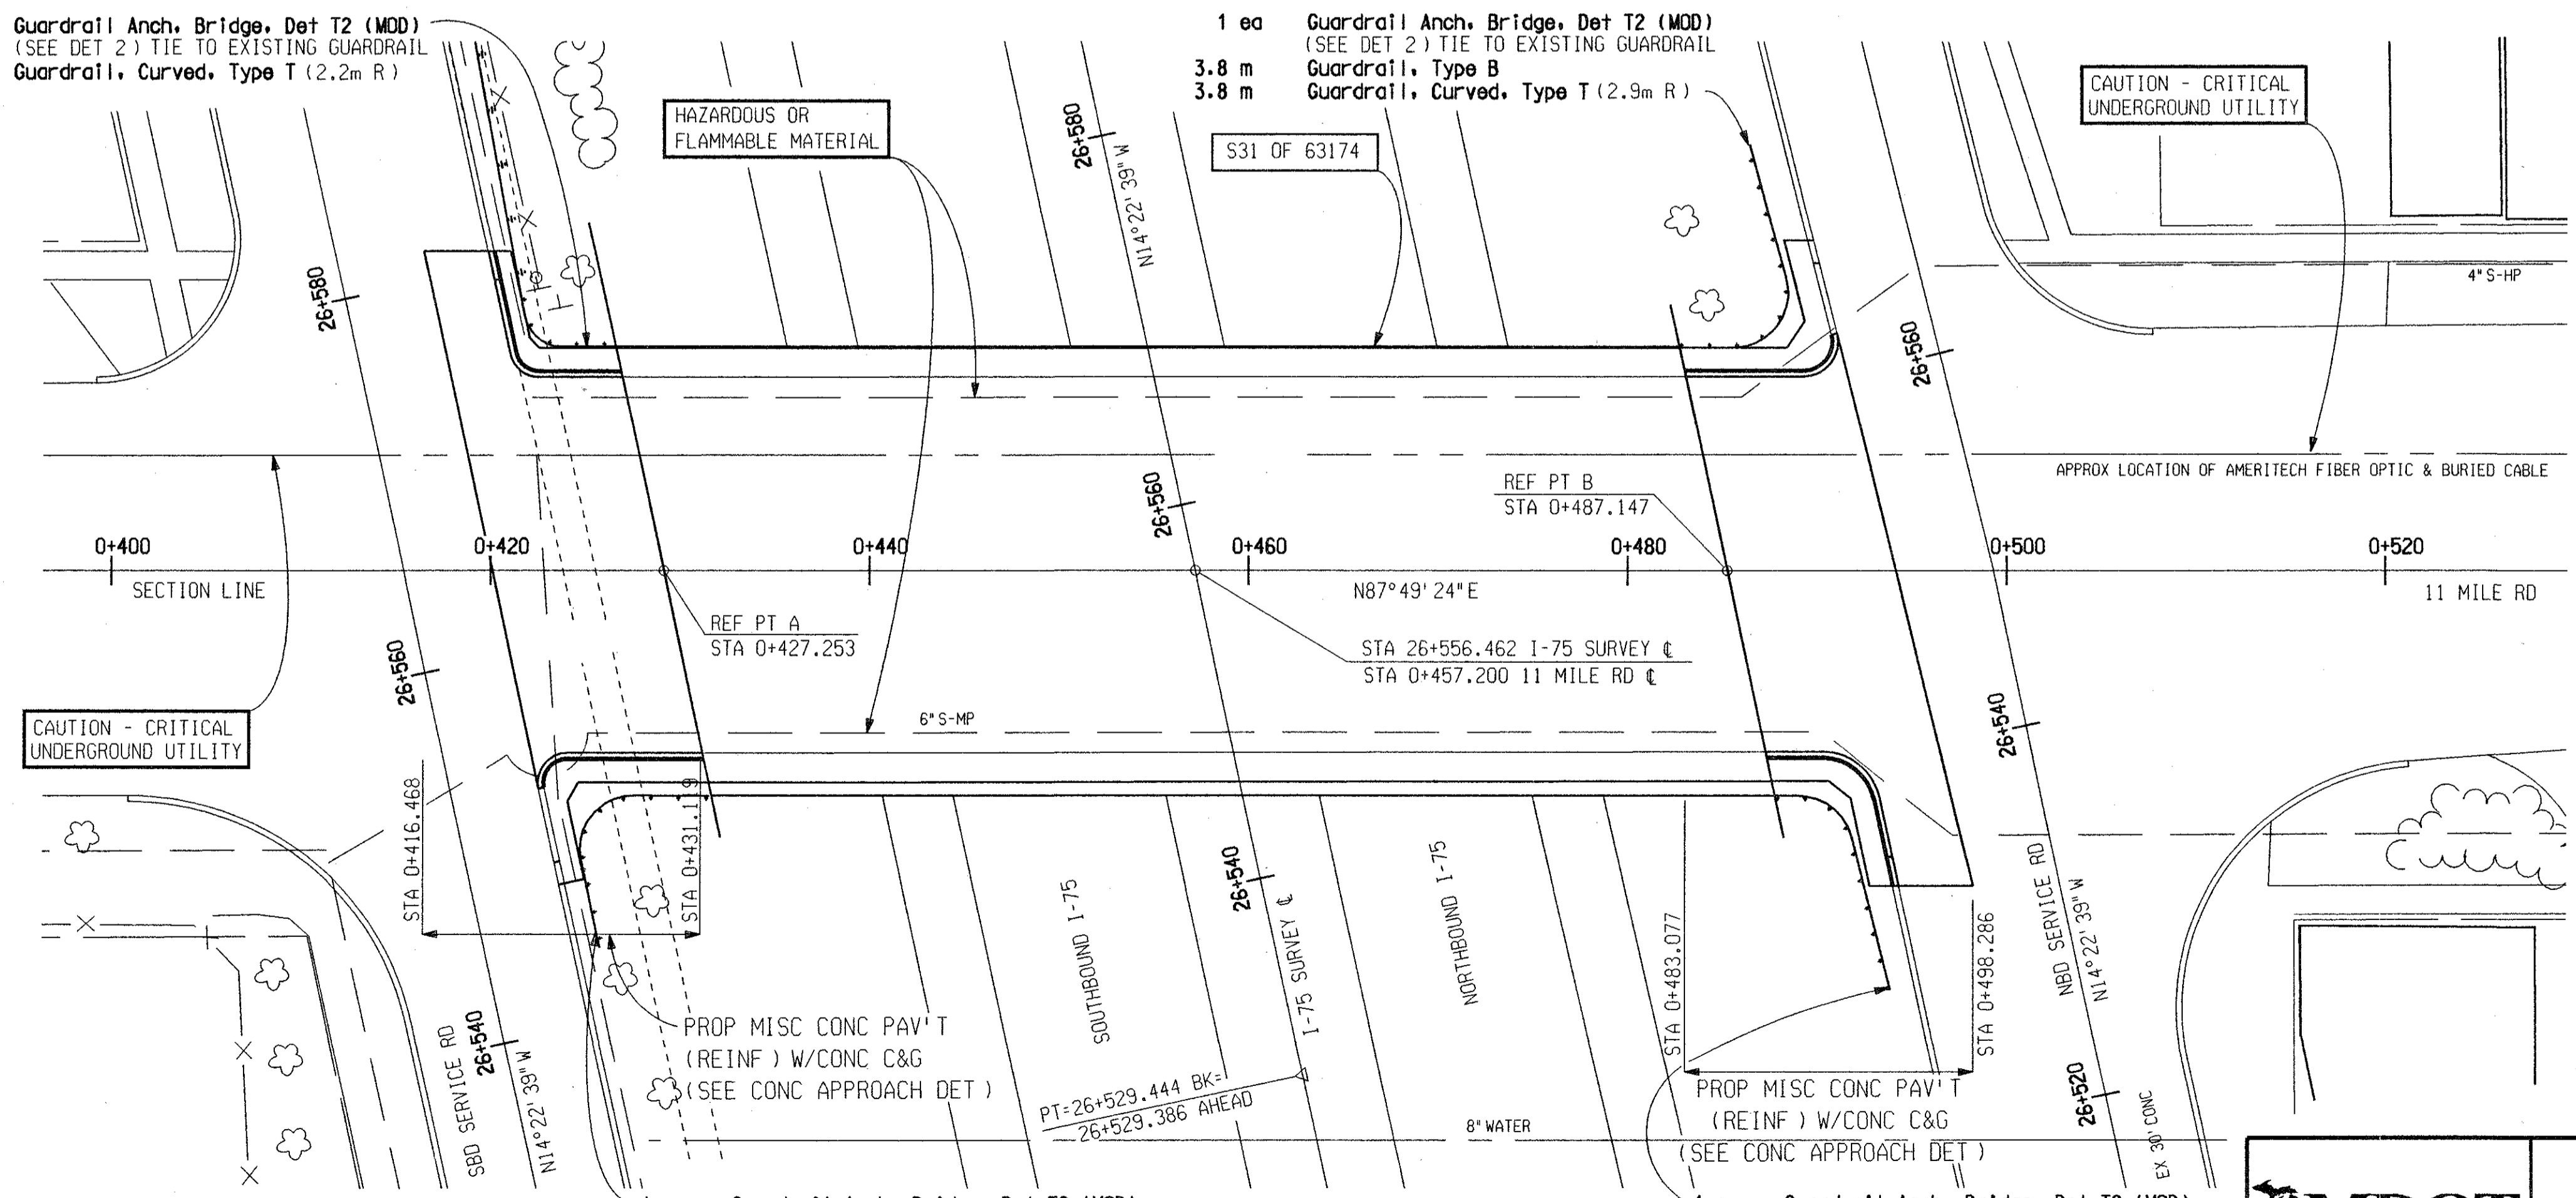

LEGEND

REMOVING PAVEMENT	
REMOVING BITUMINOUS	
REMOVING SIDEWALK	

CONSTRUCTION QUANTITIES THIS SHEET

340 m ²	Conc Pavt. Misc. Reinf. 300 mm
42 m	Curb and Gutter, Conc, Det F1
65 m	Joint, Expansion, Erg
41 m	Joint, Expansion, E3
35 m ²	Sidewalk, Conc, 100 mm
4 ea	Guardrail Reflector
15 m ²	Sidewalk Ramp
28 m ²	Slope Restoration
340 m ²	Aggregate Base, 120 mm


NOTE:
 ALL QUANTITIES ON THIS SHEET
 ARE ROYAL OAK PARTICIPATION

REMOVAL/CONSTRUCTION SHEET

S31 OF 63174		11 MILE RD OVER I-75			
DATE	SCALE	CONT. SEC.	JOB NO.	DESIGN UNIT	SHEET NO.
10/11/99	1:250	63174	48404	RICK	R.O.W 7B




SYMBOL (B)

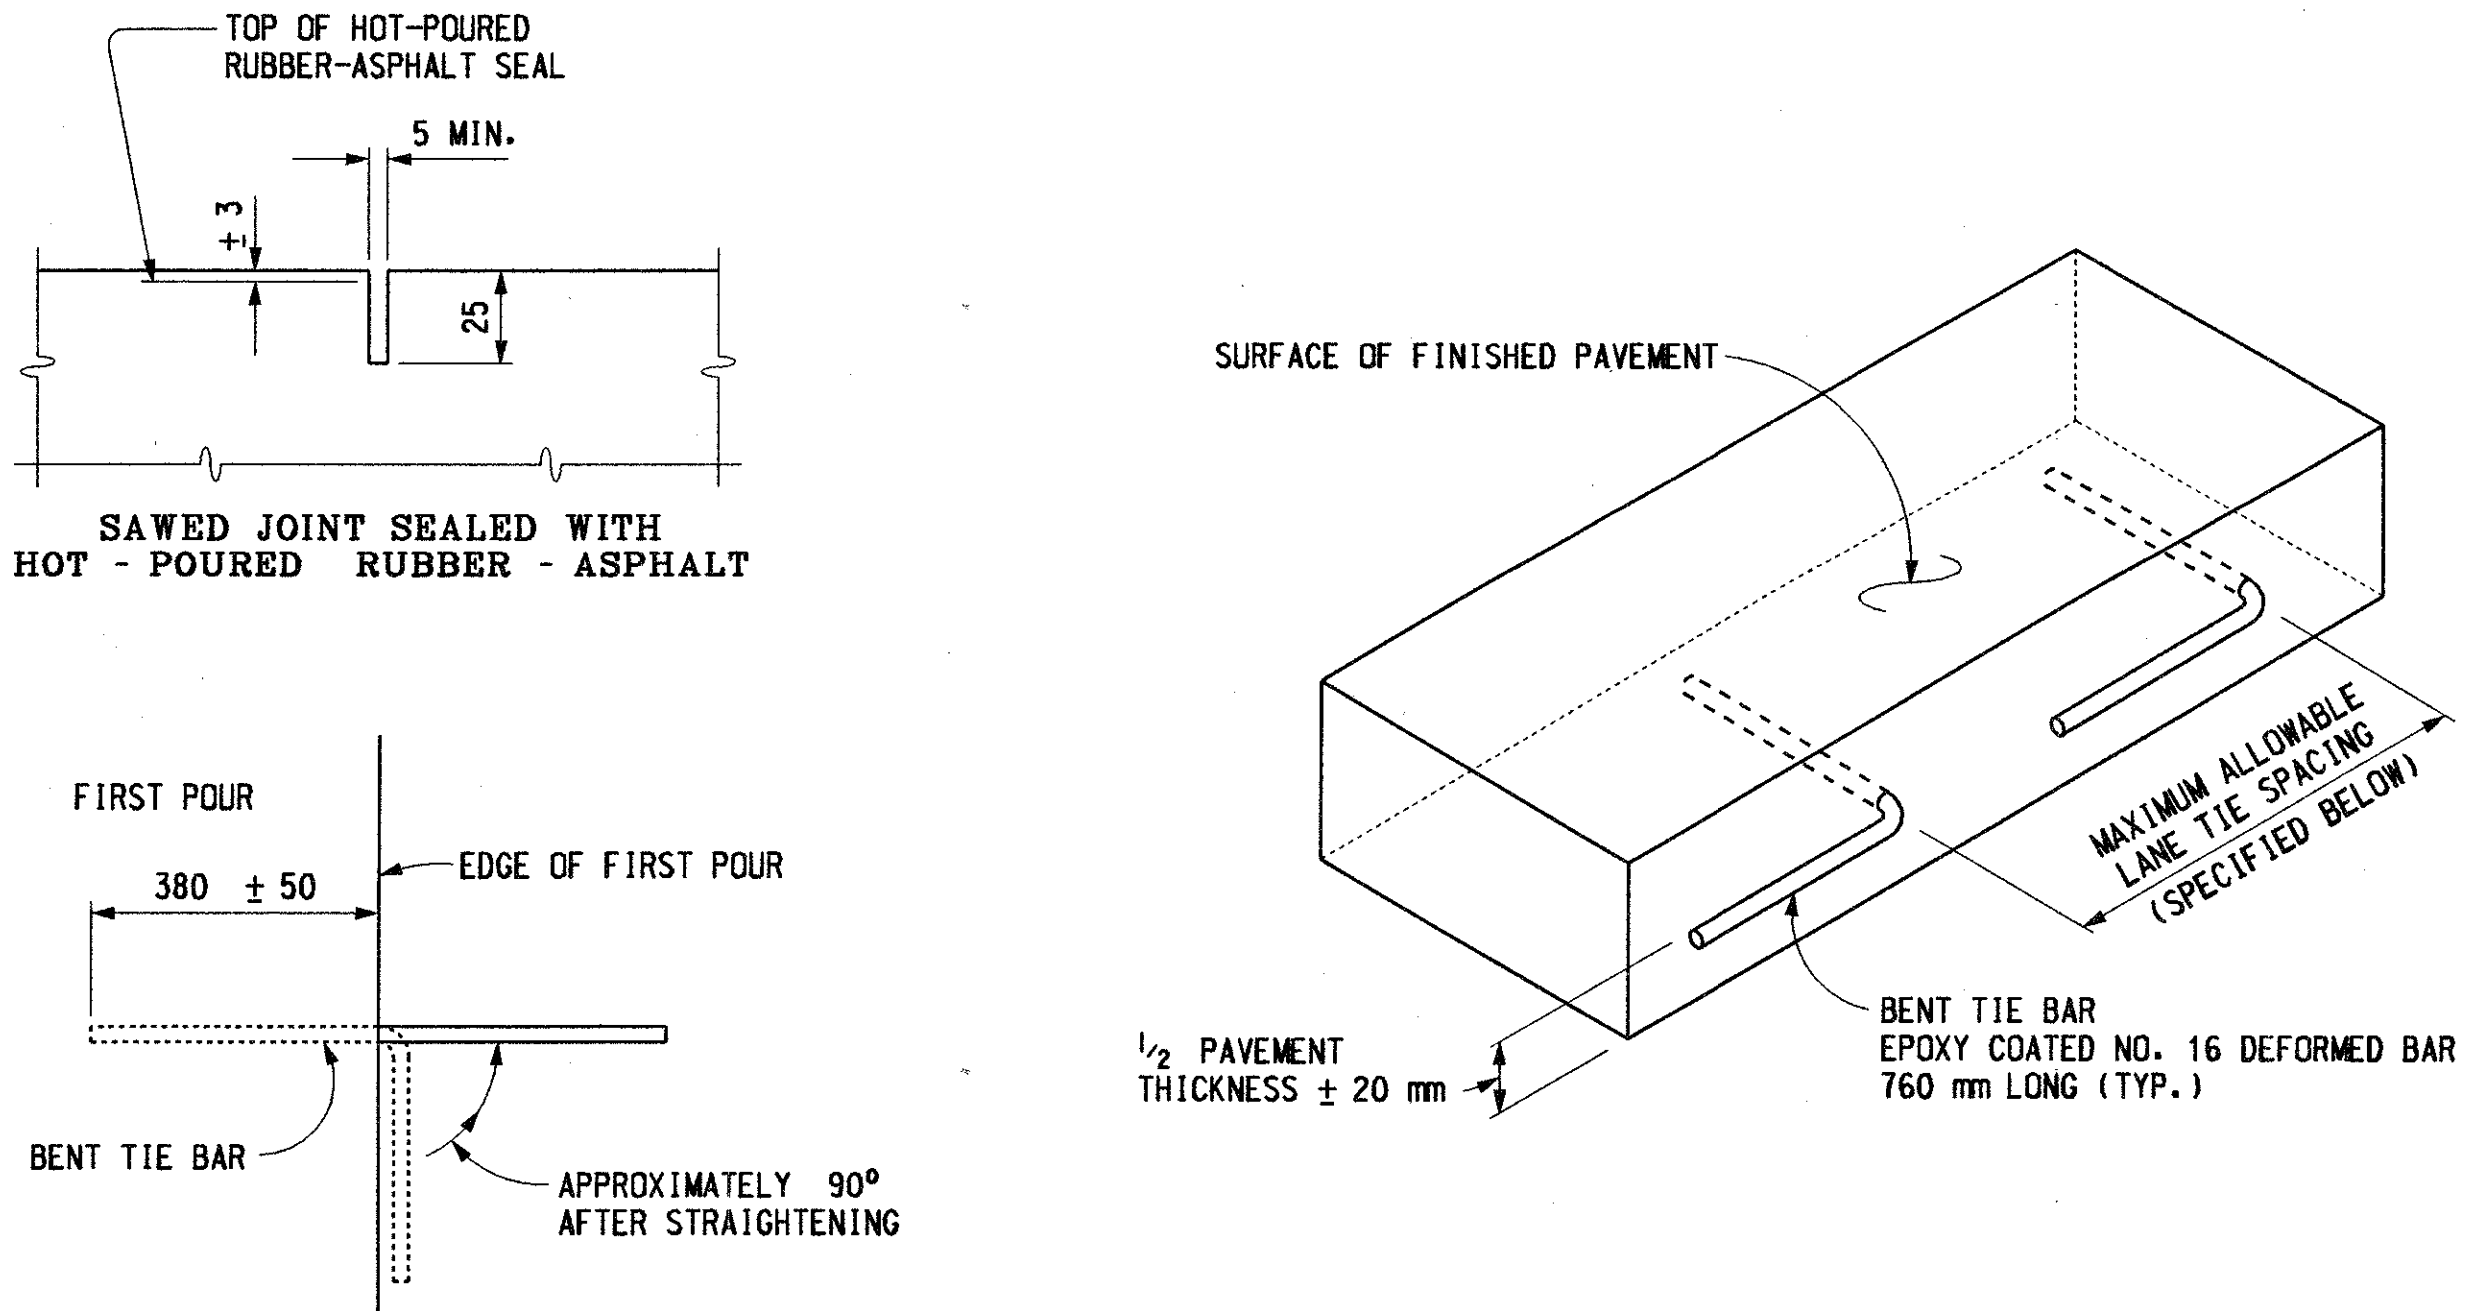

LONGITUDINAL BULKHEAD JOINT

ALL SYMBOL (B) JOINTS SHALL BE SAWS AND SEALED EXCEPT JOINTS WITHOUT LANE TIES AND JOINTS ADJACENT TO VERTICAL FACES WHICH WOULD PROHIBIT SAWING.

SYMBOL (D)

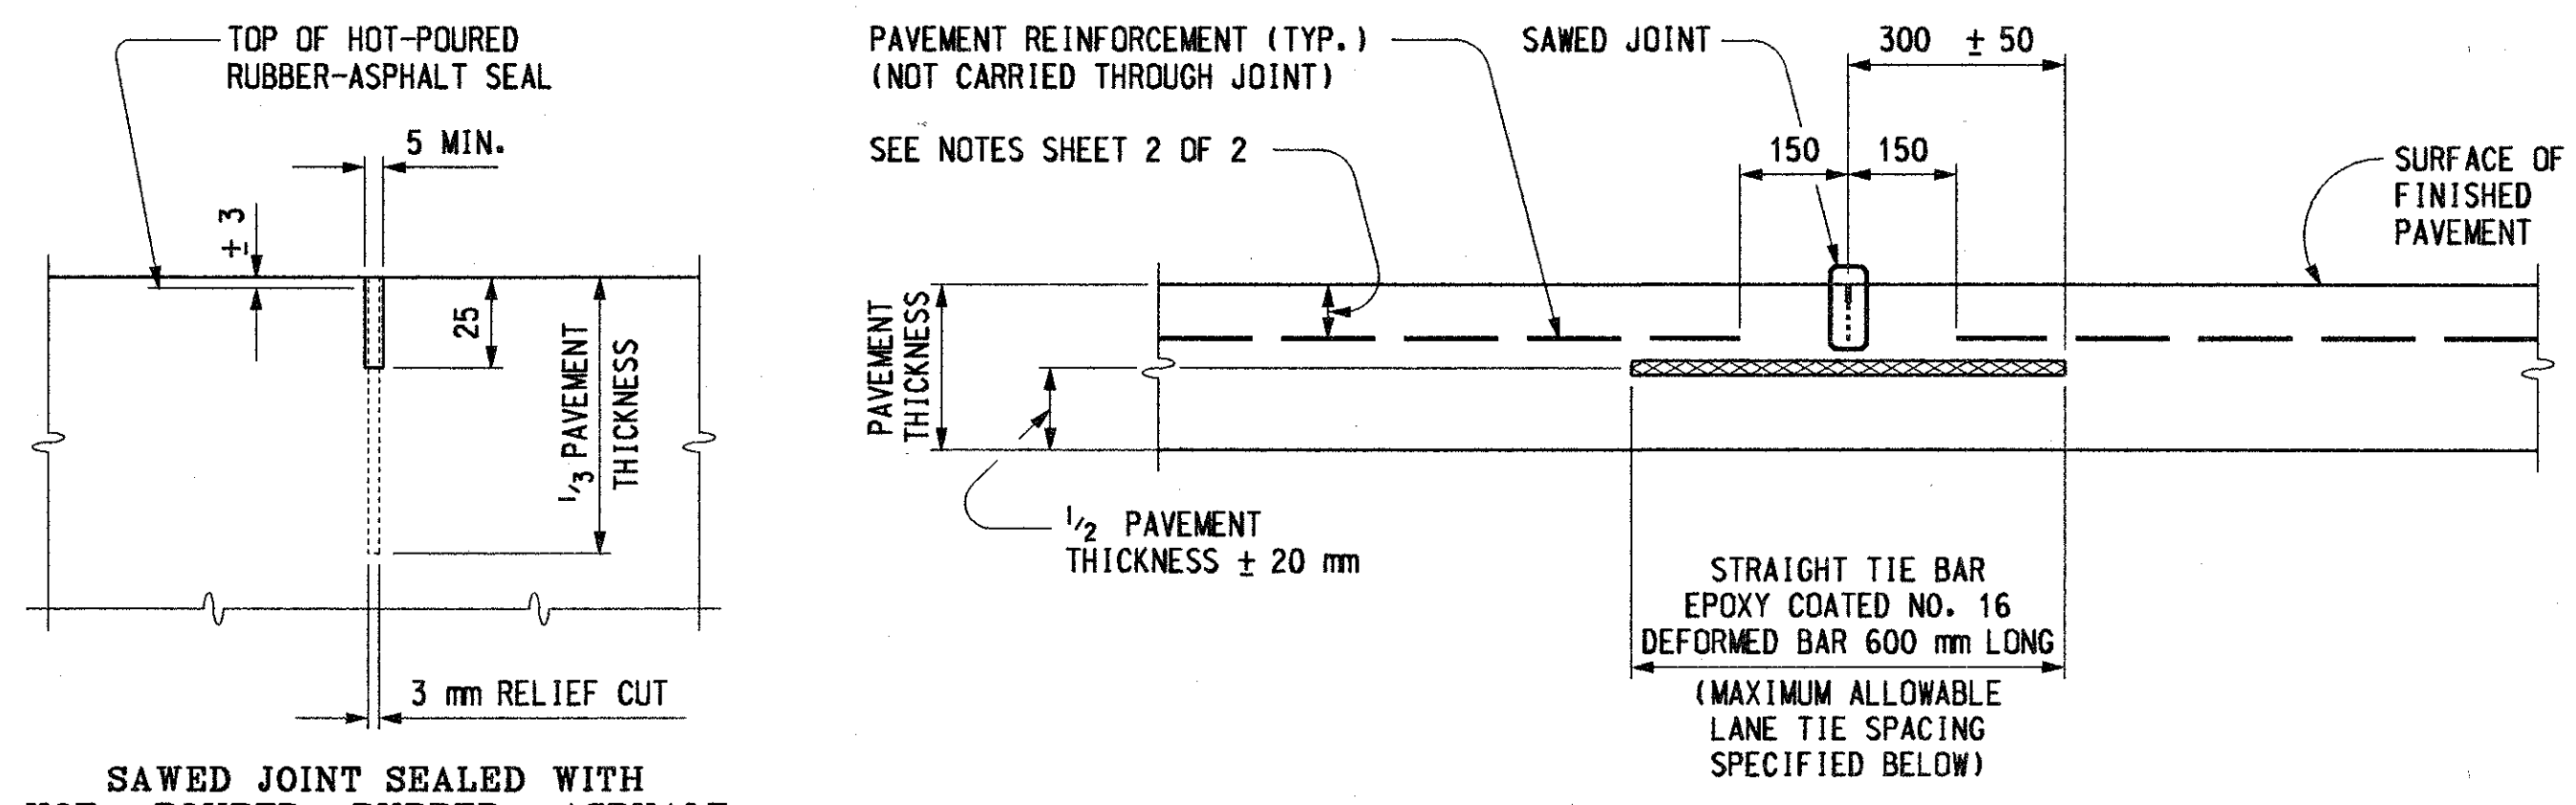

LONGITUDINAL LANE TIE JOINT


SYMBOL (D) TIE BARS SHALL BE PLACED AT THE PROPER SPACING LONGITUDINALLY, AND TRANSVERSELY AT 90° WITH THE JOINT.

MAXIMUM ALLOWABLE LANE TIE SPACING, SYMBOLS (B) AND (D) (mm)		* TOTAL DISTANCE OF TIED JOINT FROM NEAREST FREE EDGE
(B) GRADE 300	(D) GRADE 400	
860	1090	3.6 m OR LESS
585	790	3.6 m + THROUGH 5.1 m
430	585	5.1 m + THROUGH 7.2 m
355	530	7.2 m + THROUGH 8.4 m
355	405	8.4 m + THROUGH 10.8 m
330	330	10.8 m OR GREATER

* INCLUDES ANY TIED COMBINATION OF LANE WIDTH, VALLEY GUTTER, CURB & GUTTER, OR SHOULDER

MAXIMUM ALLOWABLE LANE TIE SPACING


SYMBOL (L2)

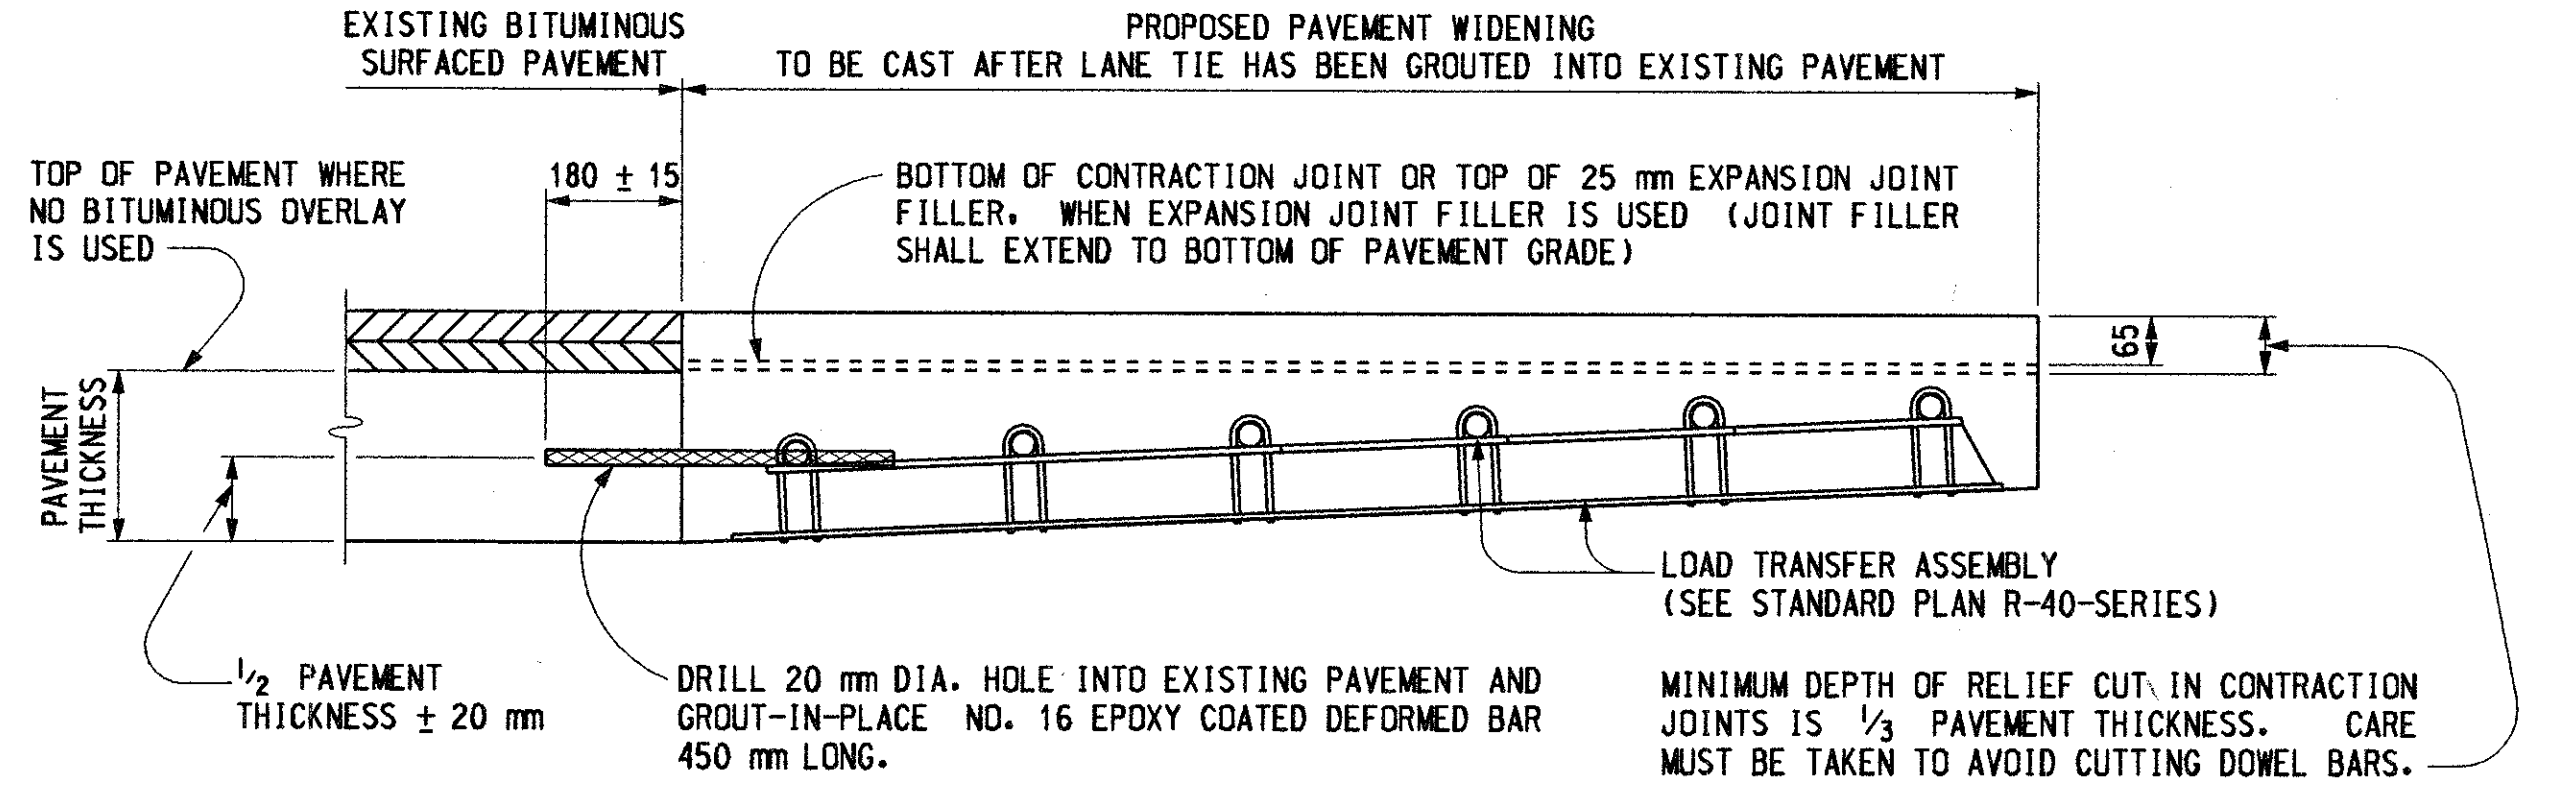

LONGITUDINAL BULKHEAD JOINT

FOR WIDENING EXISTING CONCRETE PAVEMENT OR CONCRETE BASE COURSE (USING EPOXY ANCHORED LANE TIES)

THE FIRST SLAB SHALL BE EDGED WITH AN EDGER HAVING A 20 mm LIP AND A RADIUS OF 3 mm TO 6 mm. EDGING TOOL SHALL BE 150 mm X 300 mm AND SHALL HAVE A 25 mm LIP WITH A RADIUS OF 3 mm TO 6 mm.

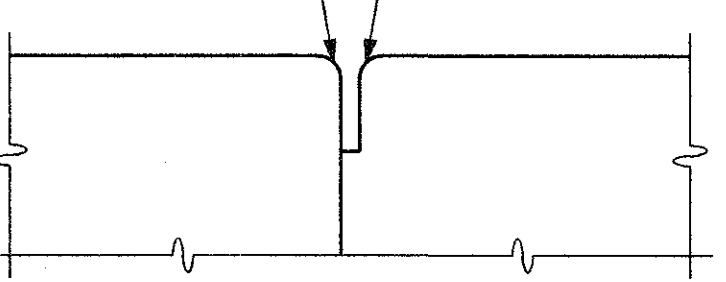

METHOD OF EDGING

NOTES:

- LANE TIE BARS SHALL BE DEFORMED.
- THE INSTALLATION OF LANE TIE BARS AND THE SAWING OF LONGITUDINAL JOINTS WILL NOT BE REQUIRED FOR TEMPORARY CONCRETE PAVEMENT UNLESS SPECIFIED ON PLANS OR IN THE PROPOSAL. THE EDGING OF TEMPORARY CONCRETE PAVEMENT WILL NOT BE REQUIRED.
- FOR JOINT LAYOUT DETAILS, SEE STANDARD PLAN R-42-SERIES.
- SAWING PROCEDURES AND RELATED OPERATIONS ARE DESCRIBED IN THE CURRENT STANDARD SPECIFICATIONS.
- NO SAWS OR SEALED JOINT SHALL BE CONSTRUCTED BETWEEN THE PAVEMENT AND CURB OR PAVEMENT AND CURB AND GUTTER, WHERE THESE ITEMS ARE CAST INTEGRALLY.
- ALL STRAIGHT TIE BARS SHALL BE EPOXY COATED ACCORDING TO THE CURRENT STANDARD SPECIFICATIONS FOR EPOXY COATED STEEL REINFORCEMENT FOR STRUCTURES.
- WHEN DEFORMED BARS ARE GROUTED INTO AN EXISTING PAVEMENT, THE GROUT SHALL BE SELECTED FROM THE PREQUALIFIED MATERIALS LISTED IN THE DEPARTMENT'S "MATERIALS SAMPLING GUIDE" FOR DEFORMED BARS.
- IN ORDER TO AVOID CONFLICT WITH THE LOAD TRANSFER ASSEMBLY, THE PLACEMENT OF THE END LANE TIE ADJACENT TO ANY TRANSVERSE JOINT SHALL BE AS FOLLOWS:
 - WHEN MAXIMUM ALLOWABLE LANE TIE SPACING EXCEEDS 1000 mm, PLACE FIRST AND LAST LANE TIE HALF THE MAXIMUM ALLOWABLE LANE TIE SPACING FROM JOINT.
 - WHEN MAXIMUM ALLOWABLE LANE TIE SPACING IS LESS THAN 1000 mm, PLACE FIRST AND LAST LANE TIE A MINIMUM OF 500 mm FROM JOINT.
- IT MAY BE NECESSARY TO ADJUST THE LAST THREE LANE TIE SPACINGS TO ENSURE UNIFORM LOADING RESISTANCE ALONG THE LONGITUDINAL JOINT.
- FOR THE USE AND PLACEMENT OF STEEL REINFORCEMENT, SEE STANDARD PLAN R-45-SERIES.
- ALL DIMENSIONS ARE IN MILLIMETERS (mm) UNLESS OTHERWISE NOTED.

MICHIGAN DEPARTMENT OF TRANSPORTATION
 BUREAU OF HIGHWAY TECHNICAL SERVICES STANDARD PLAN FOR

LONGITUDINAL PAVEMENT JOINTS

ENGINEER - ROAD DESIGN
 ENGINEER OF DESIGN
 DEPARTMENT DIRECTOR
 James R. DeSana

PREPARED BY DESIGN DIVISION
 DRAWN BY: B.L.T.
 CHECKED BY: W.K.P.

ENGINEER OF CONSTRUCTION & TECHNOLOGY
 ENGINEER OF MAINTENANCE
 ENGINEER OF TRAFFIC AND SAFETY

BY: CHIEF ENGINEER/DEPUTY DIRECTOR
 BUREAU OF HIGHWAY TECHNICAL SERVICES

F.H.W.A. APPROVAL

8-17-99
 PLAN DATE

R-41-C

SHEET 1 OF 2

MICHIGAN DEPARTMENT OF TRANSPORTATION
 BUREAU OF HIGHWAY TECHNICAL SERVICES STANDARD PLAN FOR





LONGITUDINAL PAVEMENT JOINTS

F.H.W.A. APPROVAL

8-17-99
 PLAN DATE

R-41-C


SHEET 2 OF 2

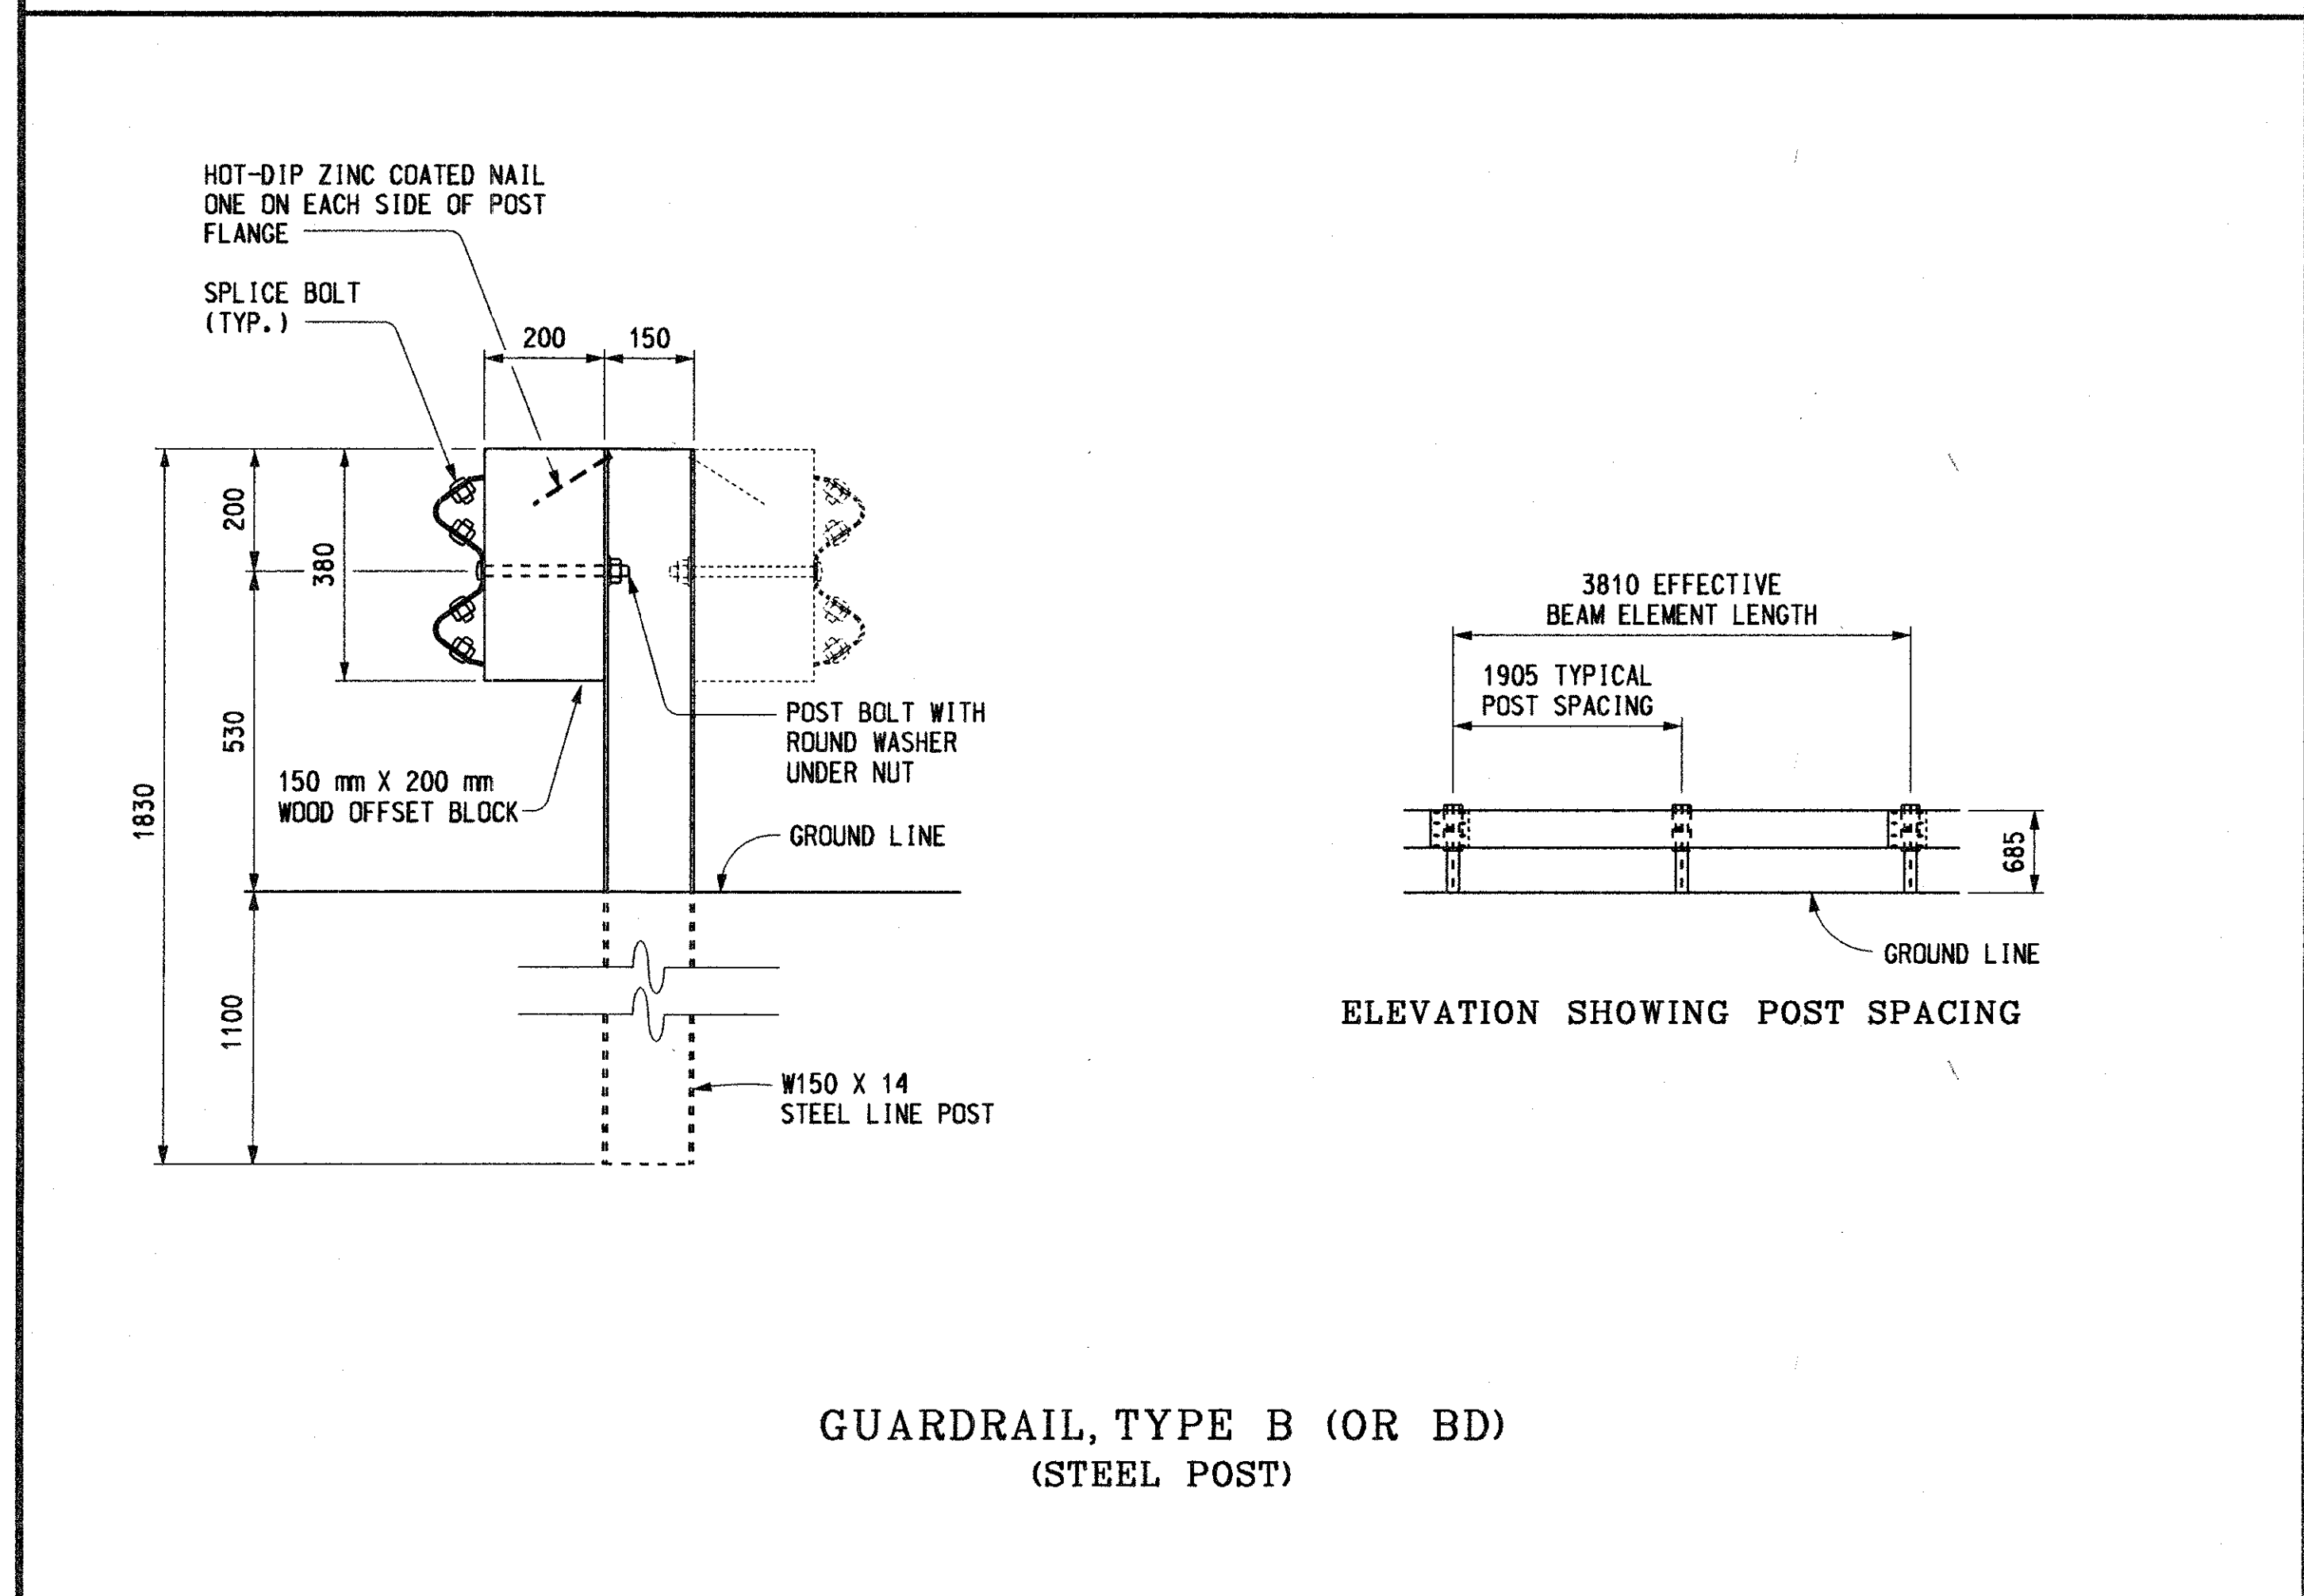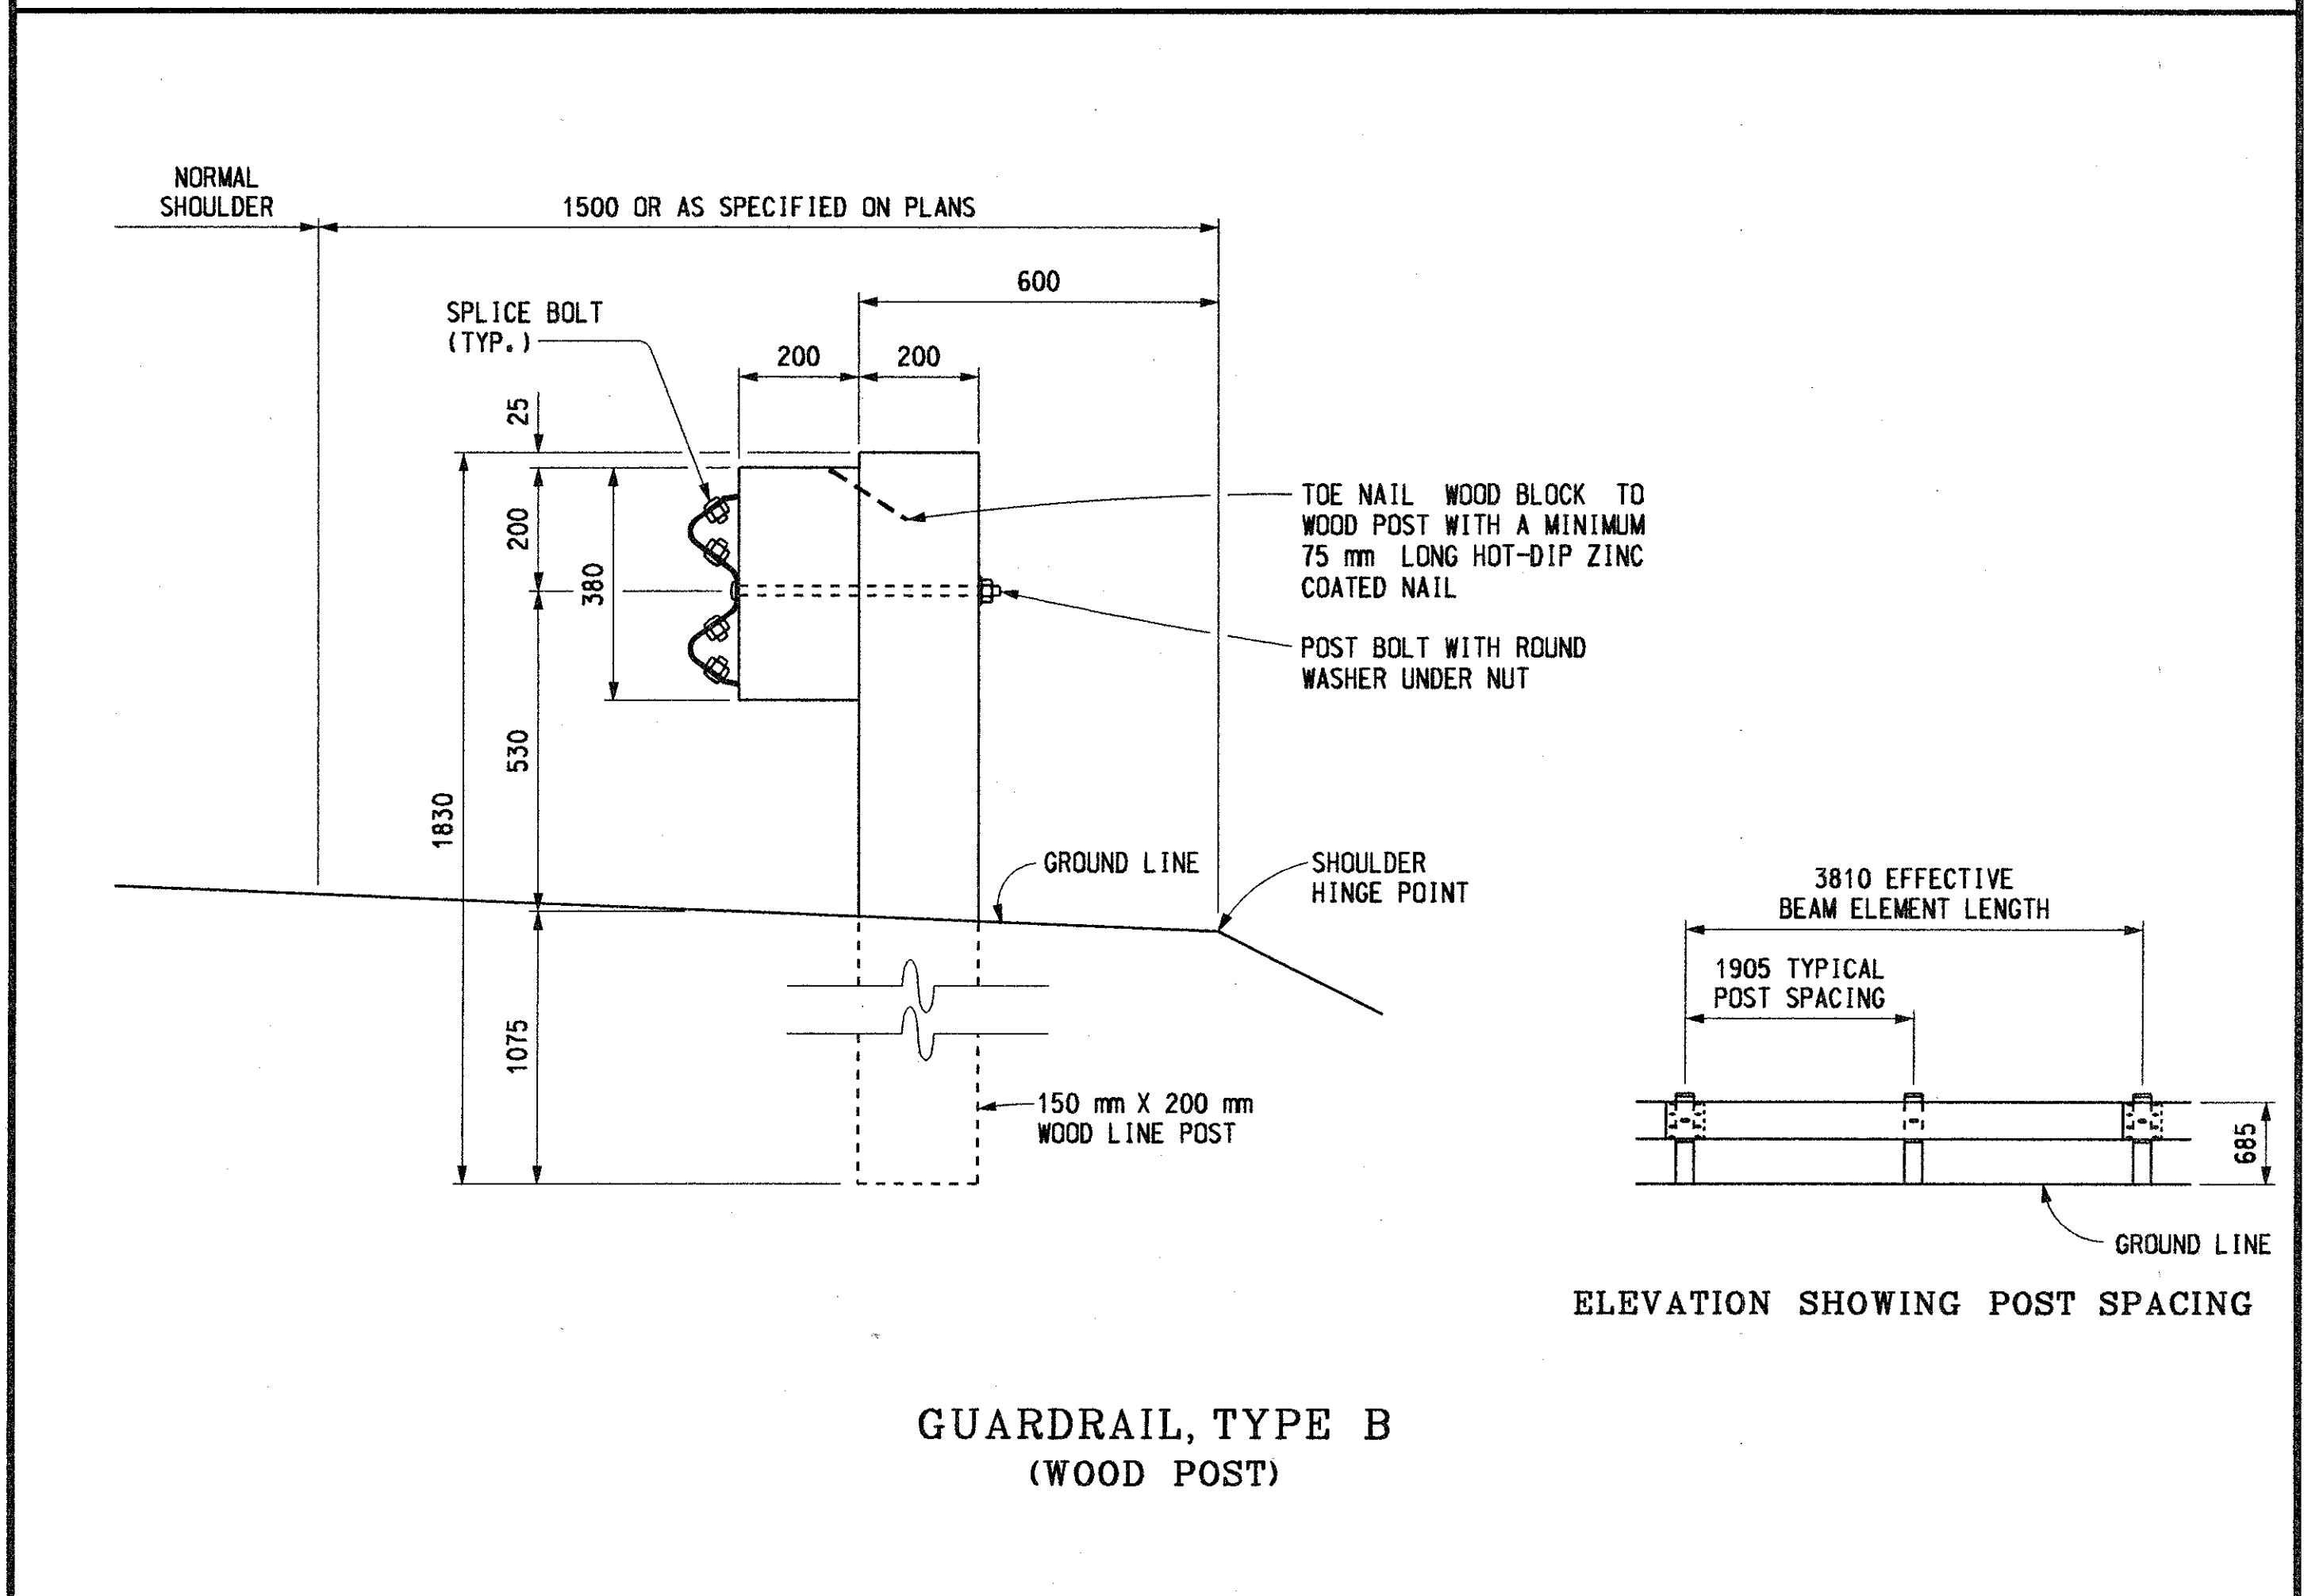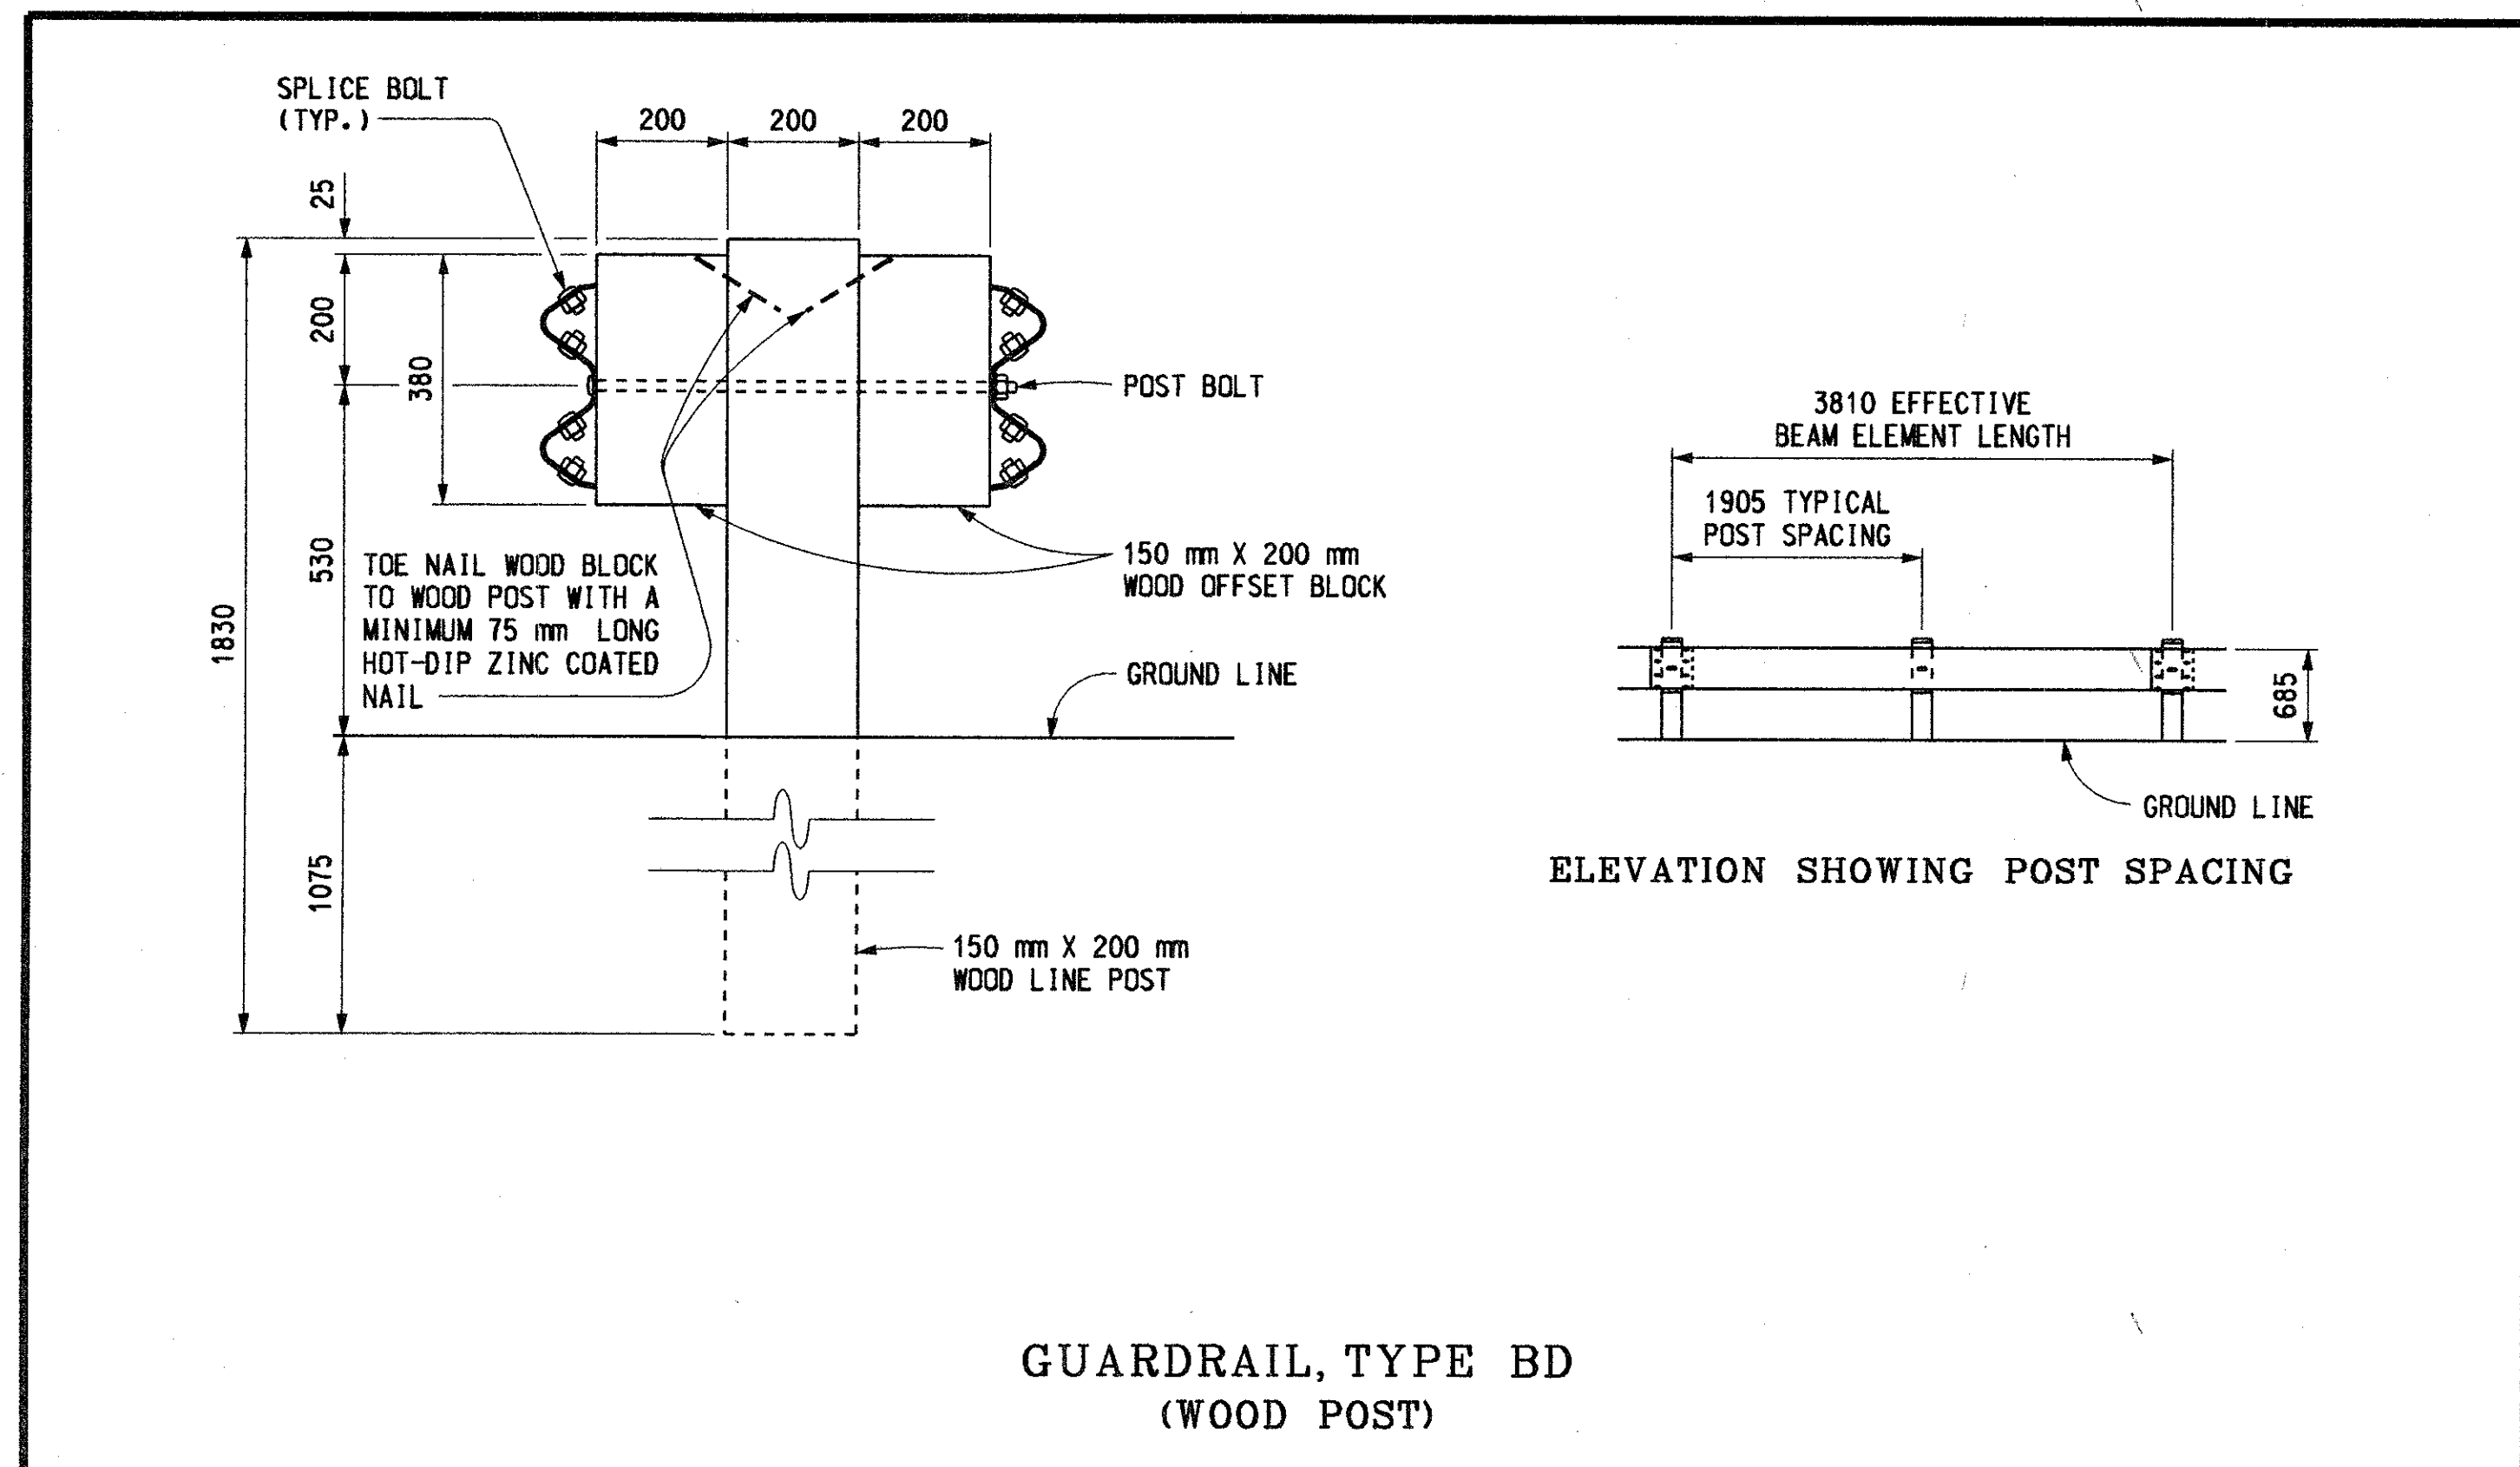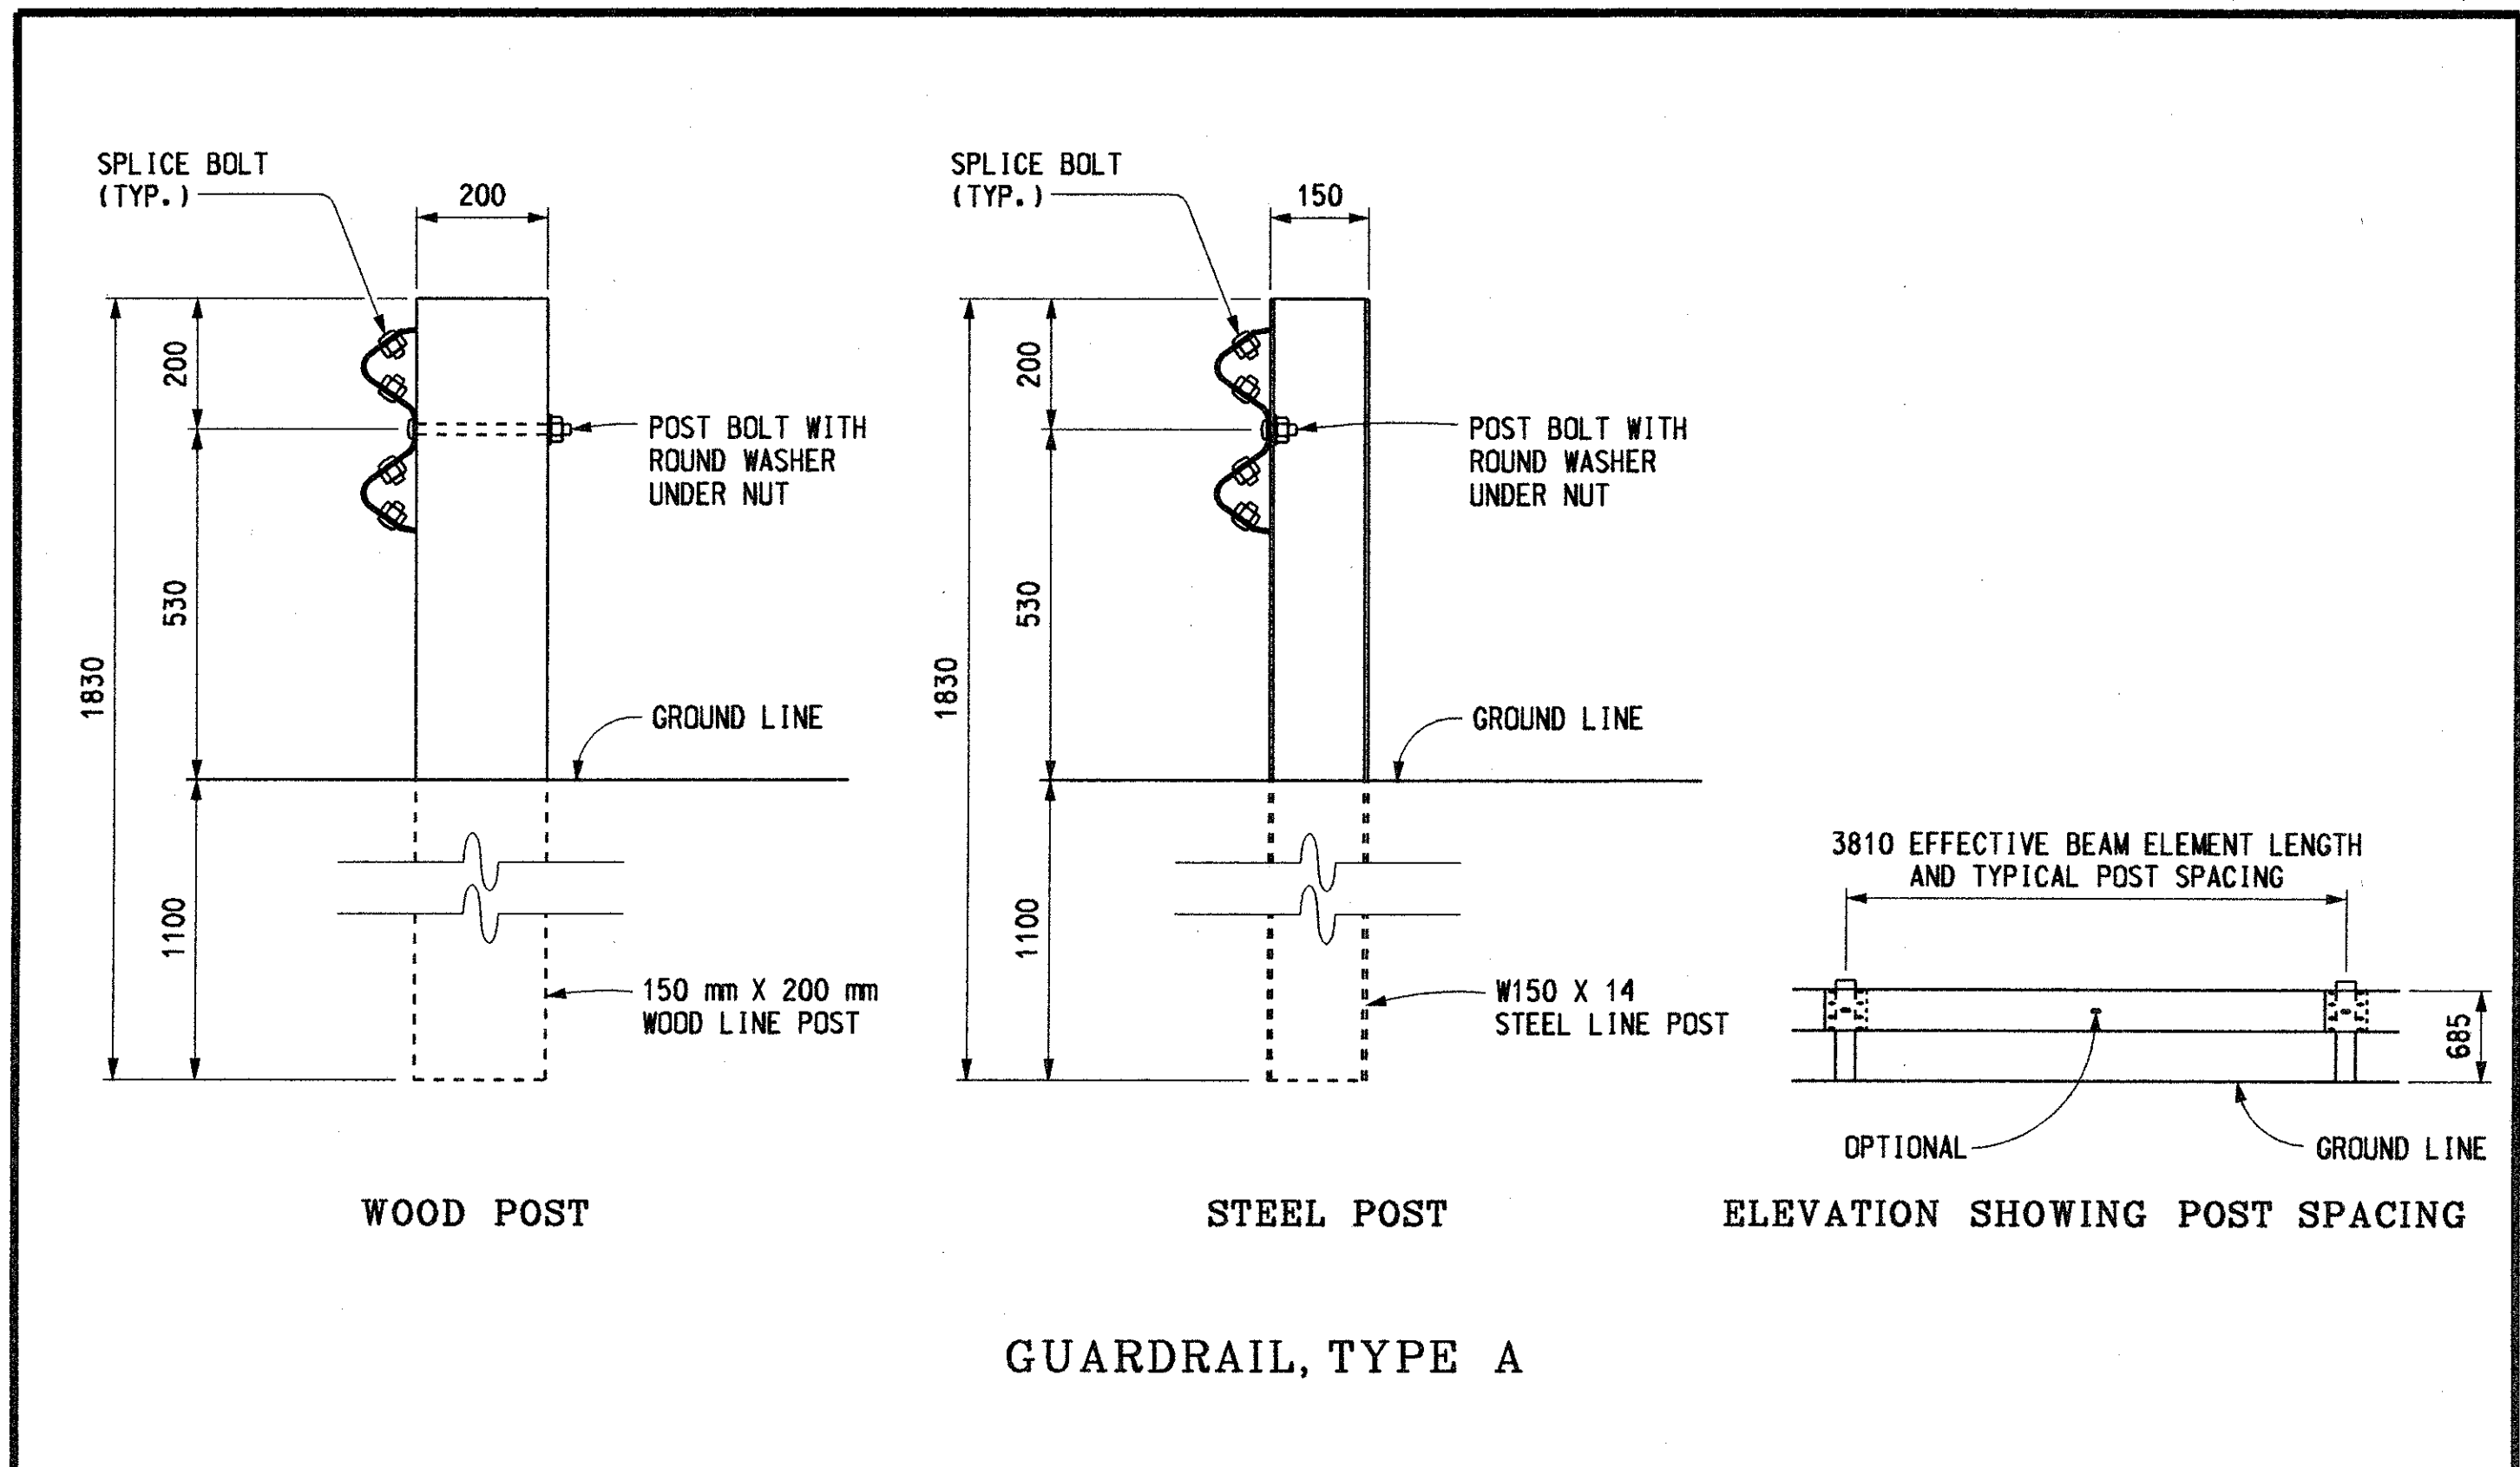


<p>PREPARED BY DESIGN DIVISION</p> <p>DRAWN BY: <u>B.L.T.</u></p> <p>CHECKED BY: <u>W.K.P.</u></p>	ENGINEER OF CONSTRUCTION & TECHNOLOGY	ENGINEER - ROAD DESIGN
	ENGINEER OF MAINTENANCE	ENGINEER OF DESIGN
	ENGINEER OF TRAFFIC AND SAFETY	DEPARTMENT DIRECTOR James R. DeSana
		BY: CHIEF ENGINEER/DEPUTY DIRECTOR BUREAU OF HIGHWAY TECHNICAL SERVICES

MICHIGAN DEPARTMENT OF TRANSPORTATION BUREAU OF HIGHWAY TECHNICAL SERVICES STANDARD PLAN FOR GUARDRAIL, TYPES A, B, BD, T, & TD		
F.H.W.A. APPROVAL	4-16-99 PLAN DATE	R-60-E
		SHEET 1 OF 10


MICHIGAN DEPARTMENT OF TRANSPORTATION BUREAU OF HIGHWAY TECHNICAL SERVICES STANDARD PLAN FOR GUARDRAIL, TYPES A, B, BD, T, & TD			
F.H.W.A. APPROVAL	4-16-99 PLAN DATE	R-60-E	SHEET 2 OF 10

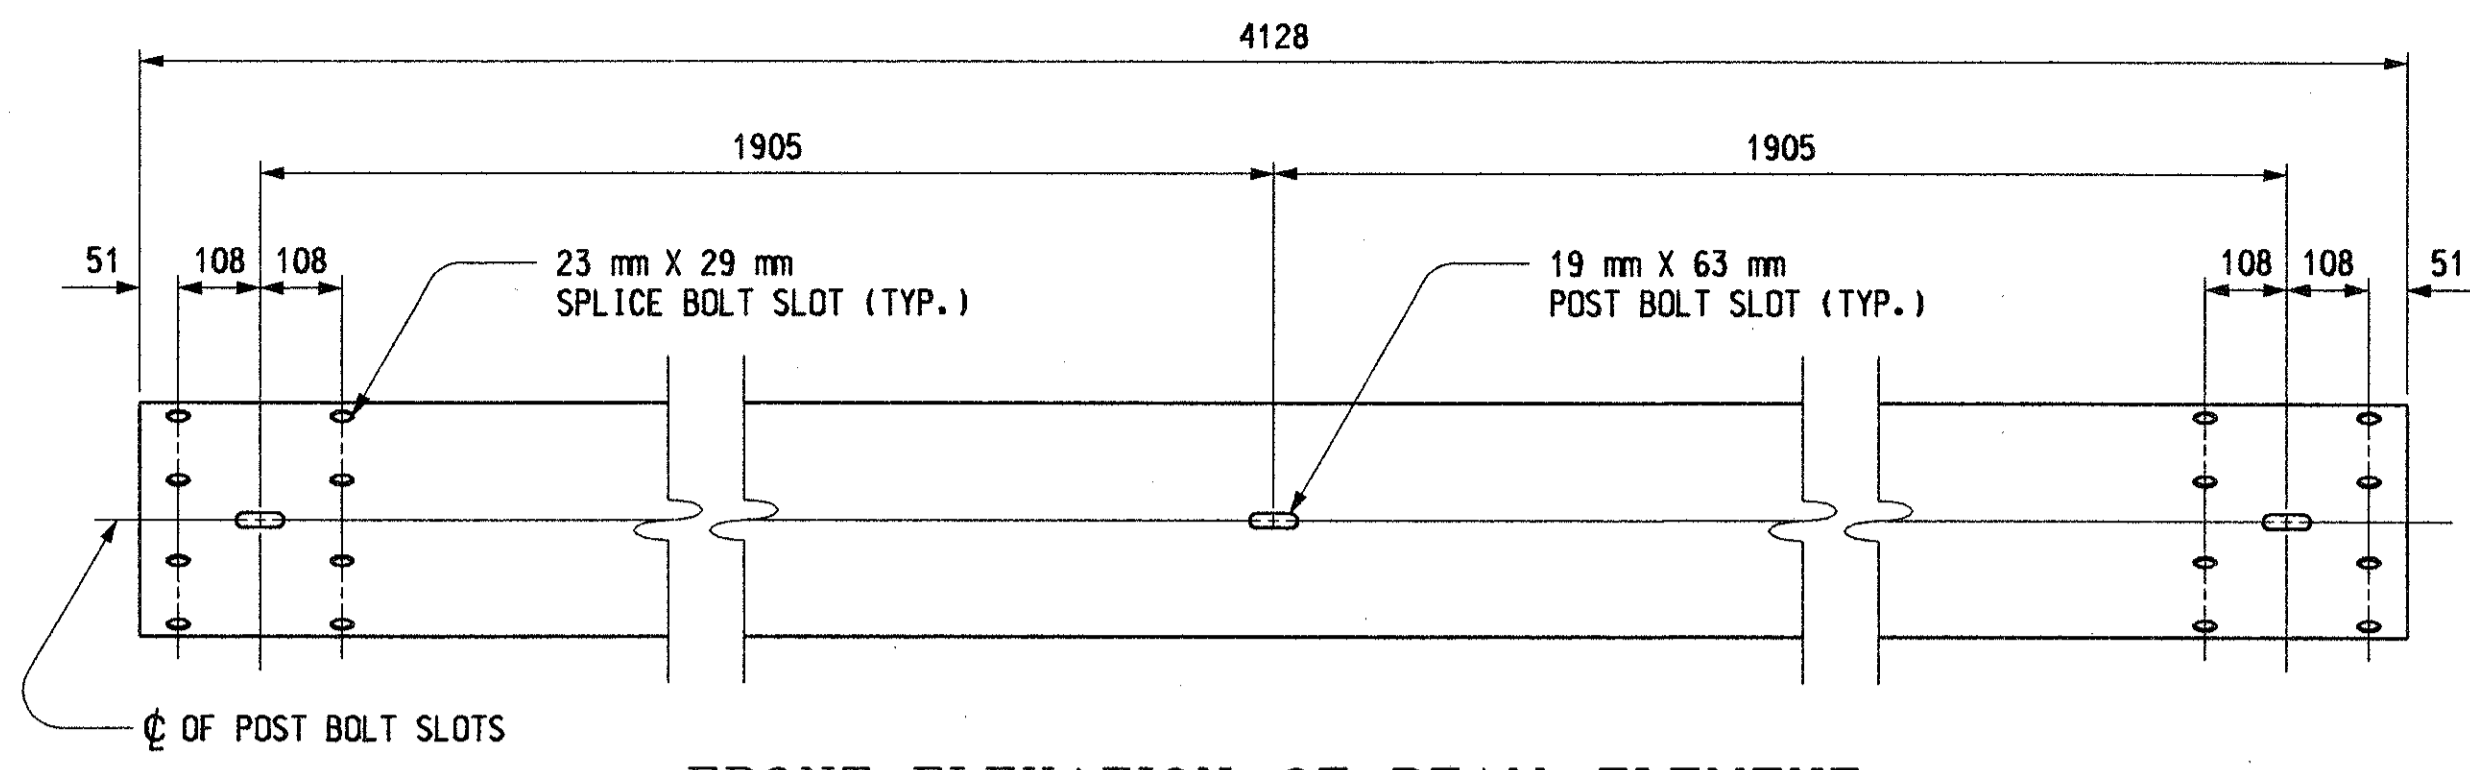

FRONT ELEVATION OF BEAM ELEMENT

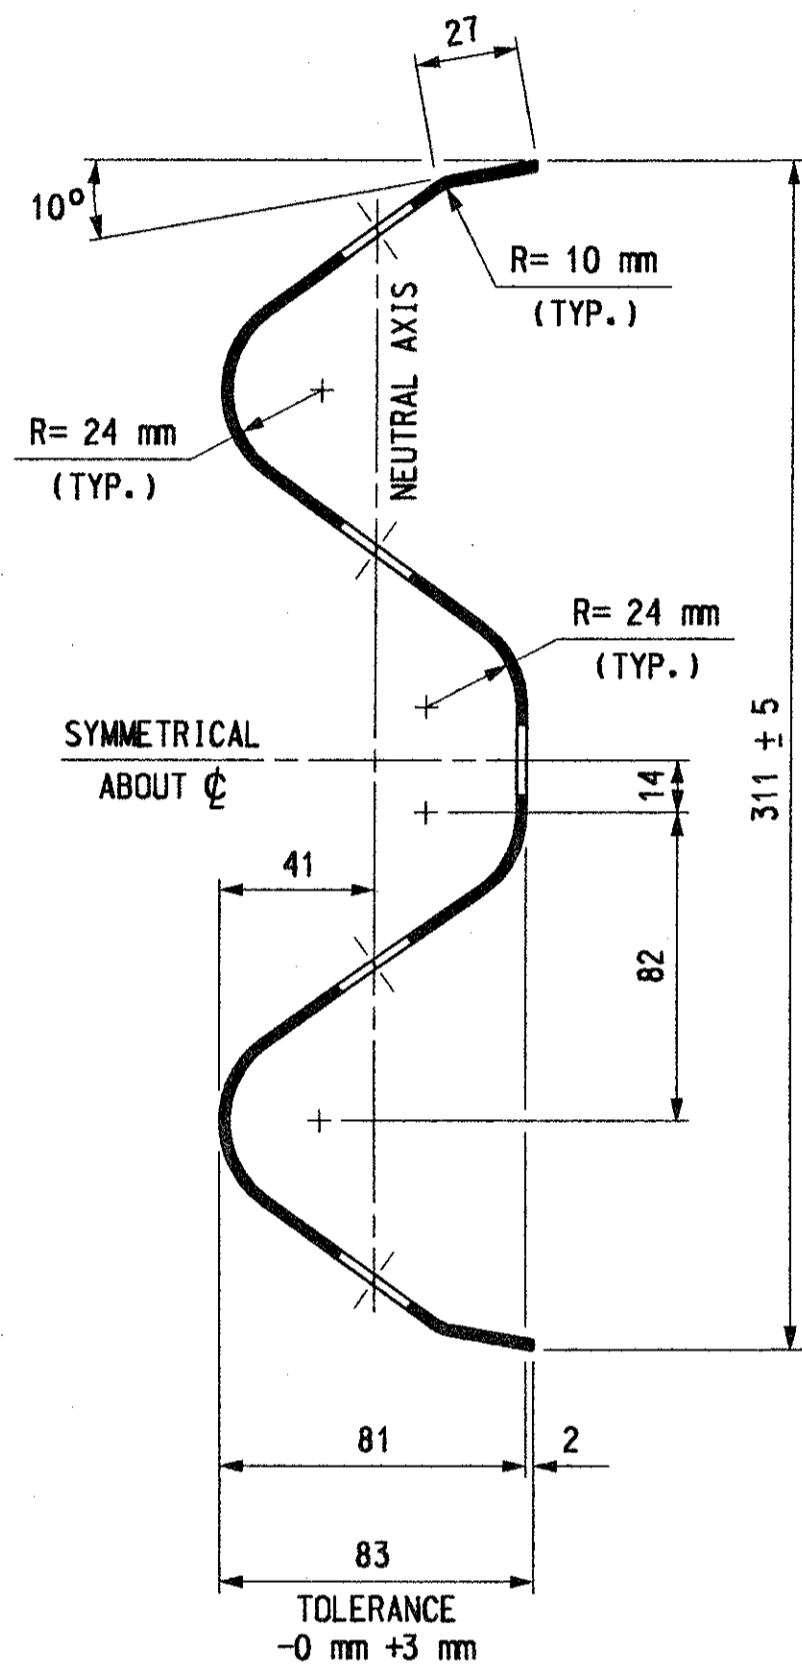

SECTION THROUGH BEAM ELEMENT
(FOR GUARDRAIL, TYPE A, TYPE B, AND TYPE BD)

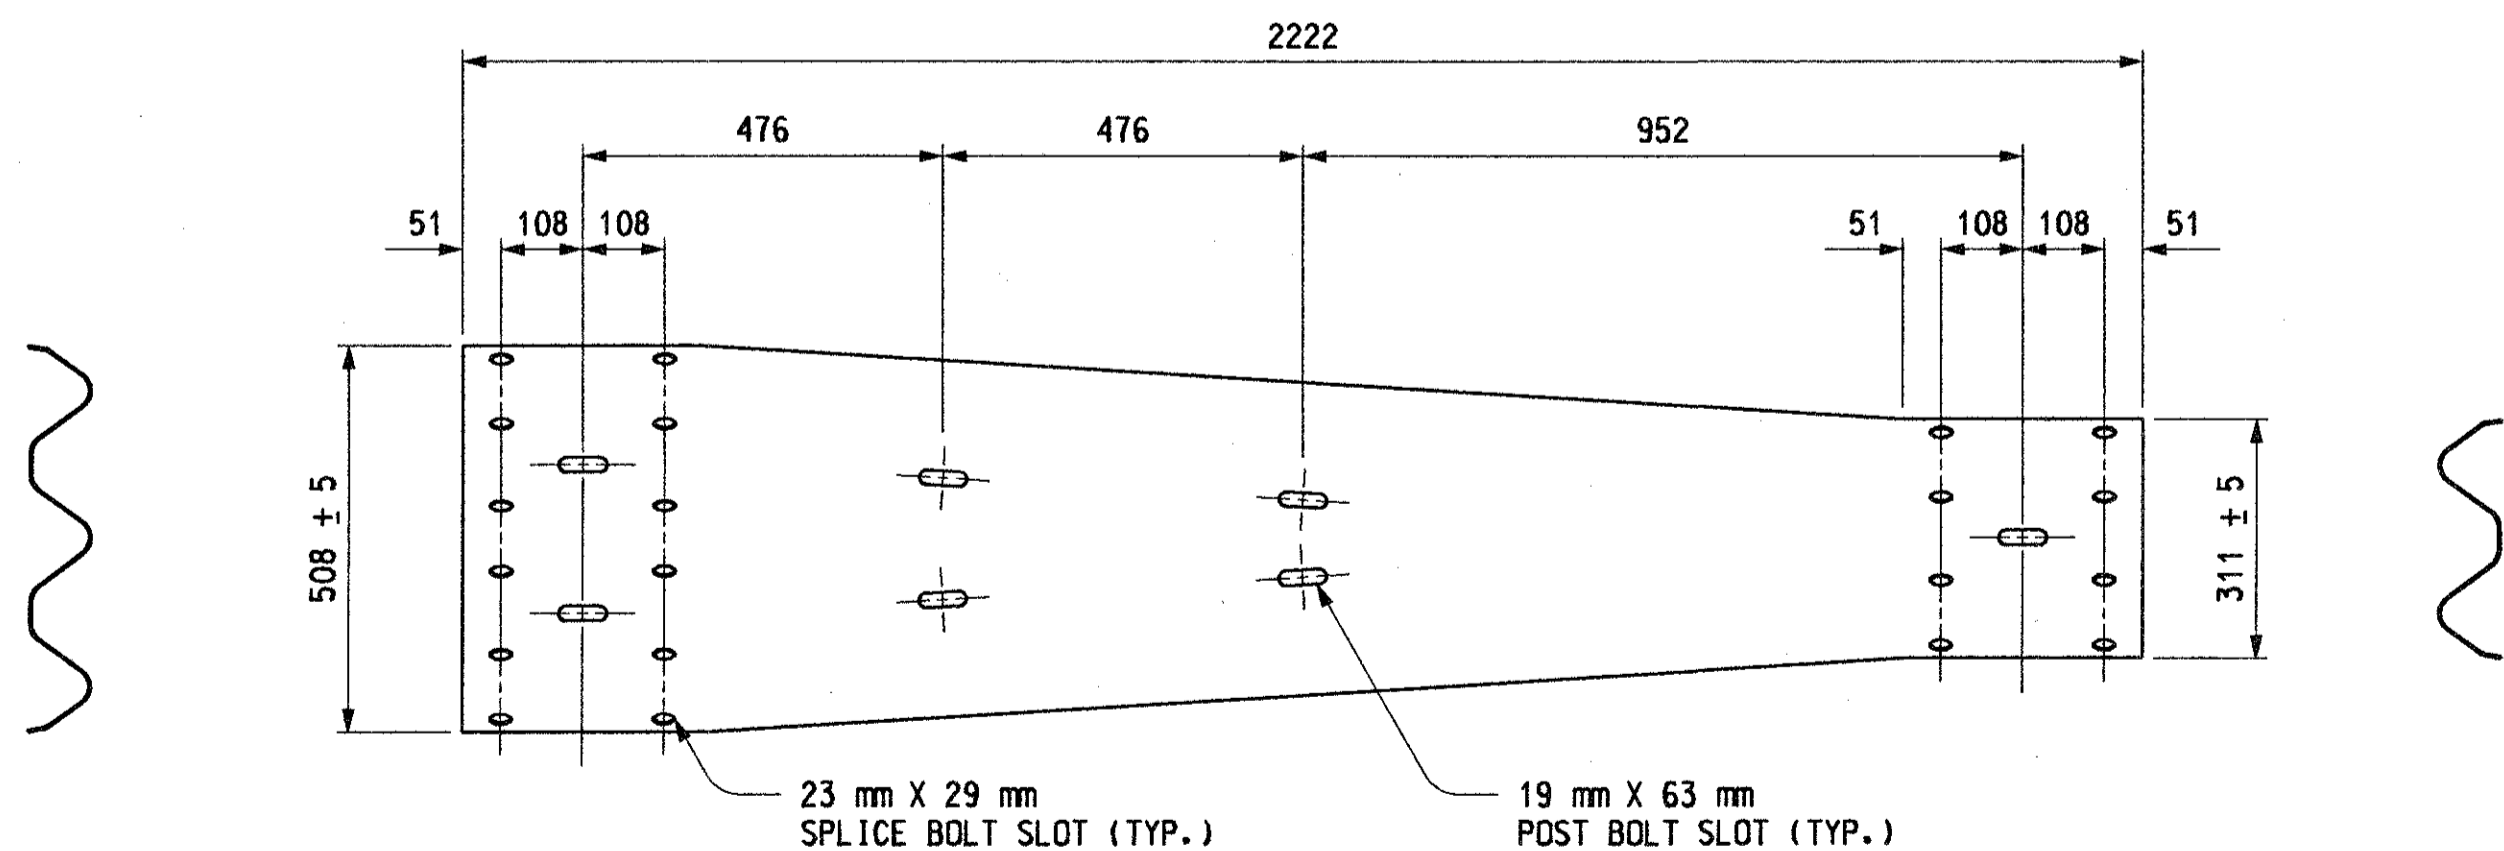


THREE BEAM TRANSITION

MICHIGAN DEPARTMENT OF TRANSPORTATION
BUREAU OF HIGHWAY TECHNICAL SERVICES STANDARD PLAN FOR

**GUARDRAIL,
TYPES A, B, BD, T, & TD**


F.H.W.A. APPROVAL	4-16-99 PLAN DATE	R-60-E	SHEET 3 OF 10
-------------------	----------------------	---------------	------------------

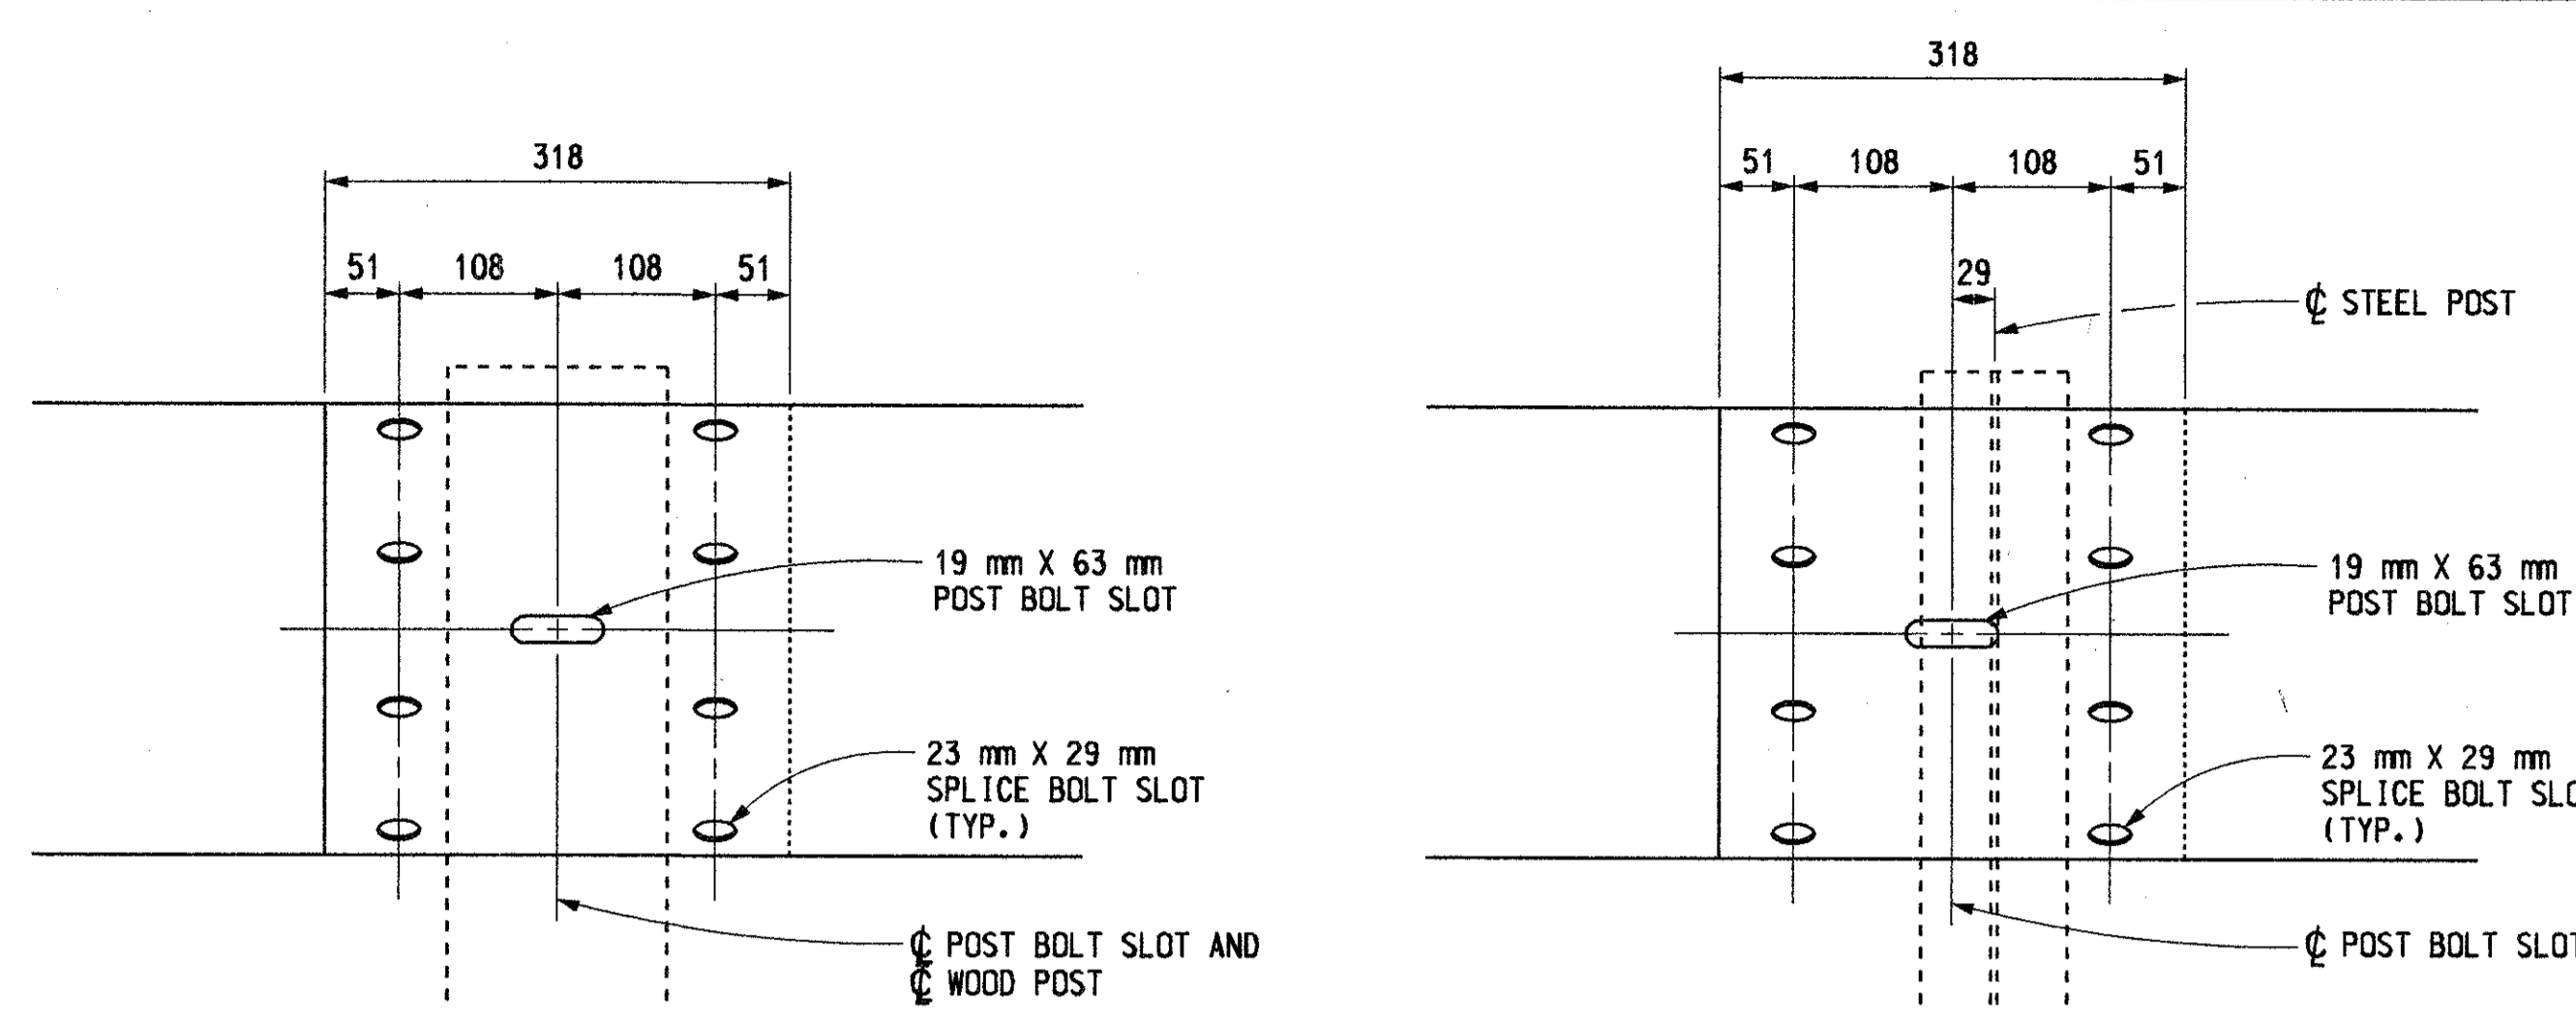


WOOD POST

STEEL POST


BEAM ELEMENT SPLICE DETAILS

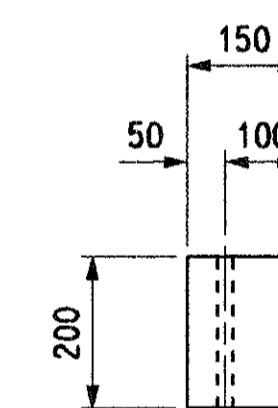

TOP

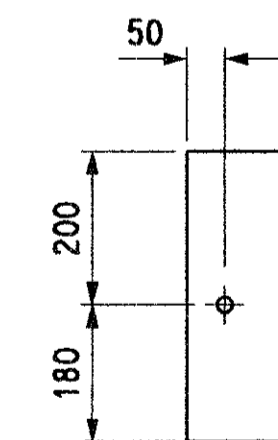


FRONT

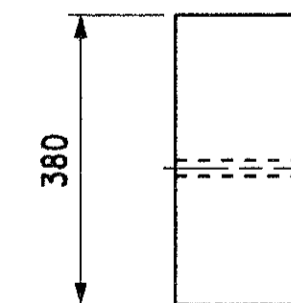


SIDE


FOR USE ON STEEL POSTS
(SEE NOTES ON SHEET 10 OF 10)

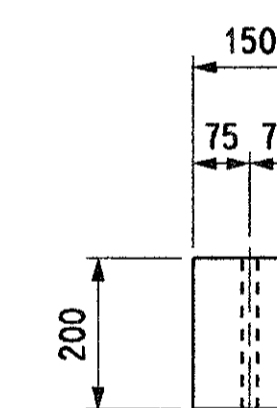

TOP

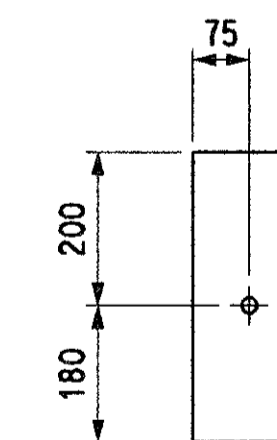

FRONT

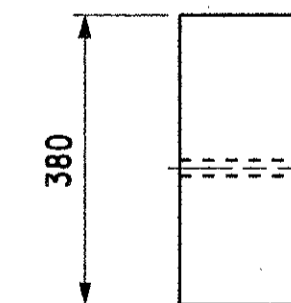

SIDE


FOR USE ON WOOD POSTS
(SEE NOTES ON SHEET 10 OF 10)

WOOD OFFSET BLOCKS FOR GUARDRAIL, TYPE B AND TYPE BD


MICHIGAN DEPARTMENT OF TRANSPORTATION
BUREAU OF HIGHWAY TECHNICAL SERVICES STANDARD PLAN FOR

**GUARDRAIL,
TYPES A, B, BD, T, & TD**

F.H.W.A. APPROVAL	4-16-99 PLAN DATE	R-60-E	SHEET 4 OF 10
-------------------	----------------------	---------------	------------------

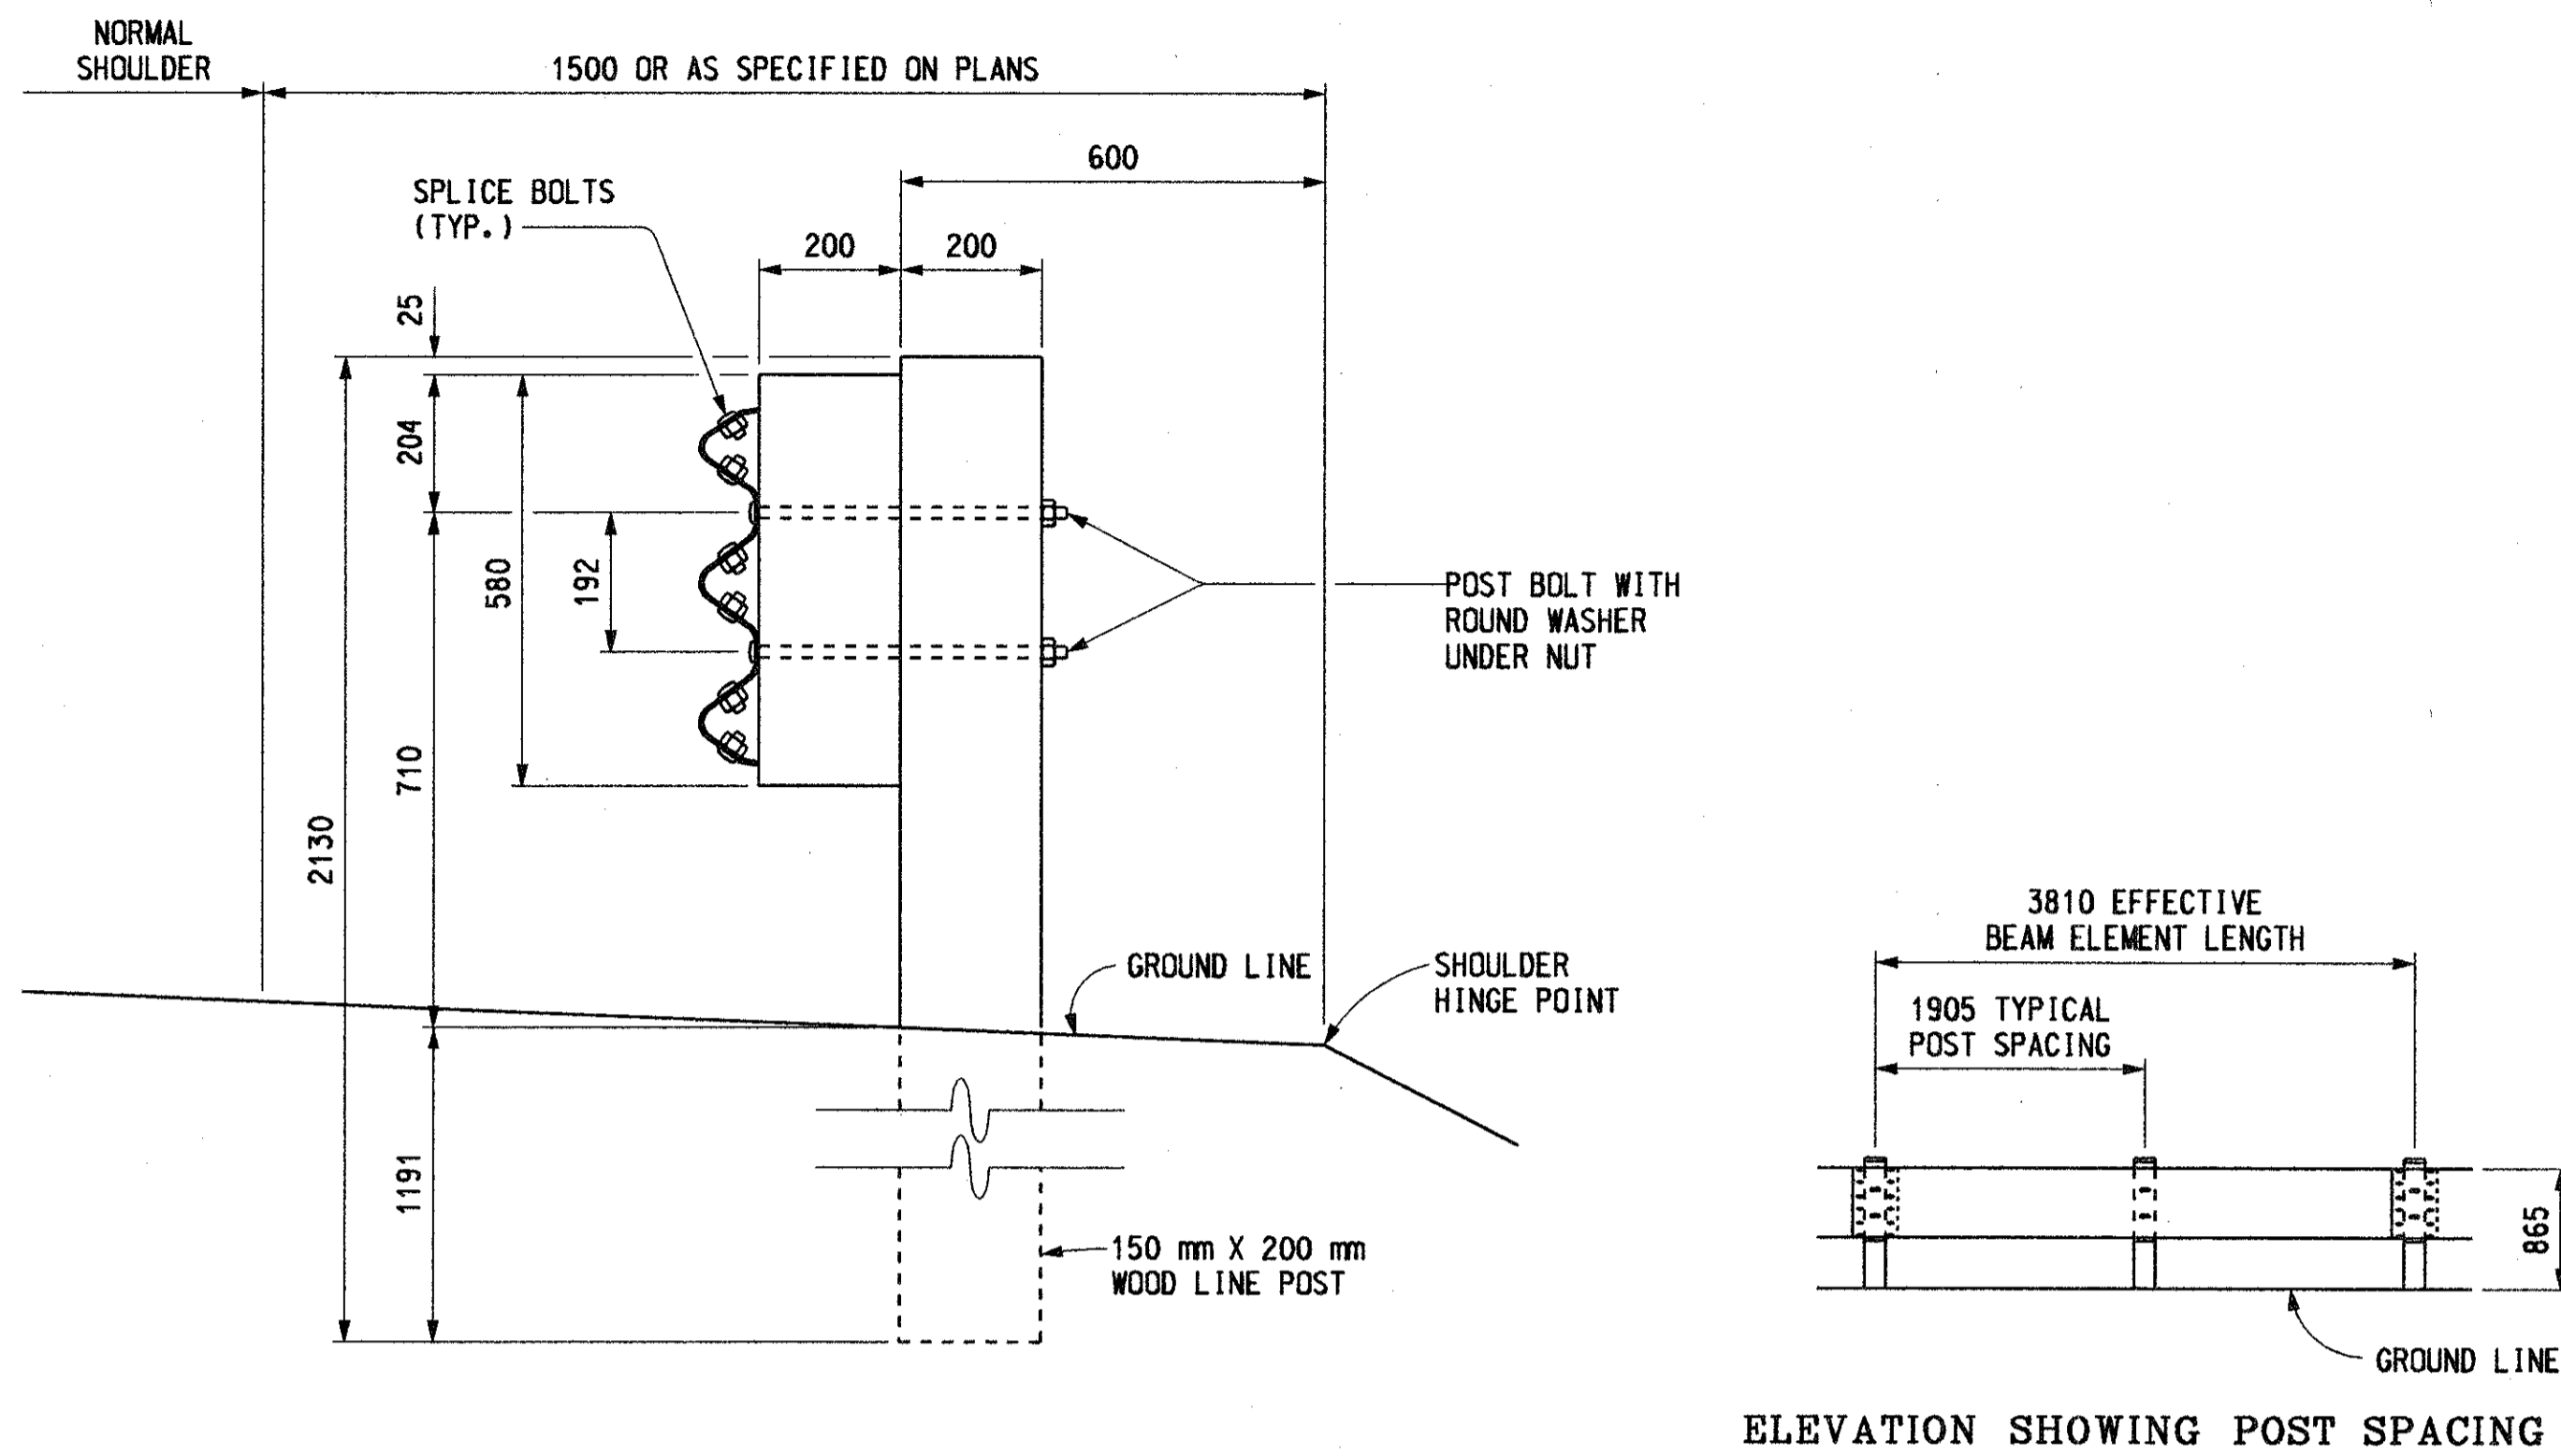

GUARDRAIL, TYPE T
 (WOOD POST)

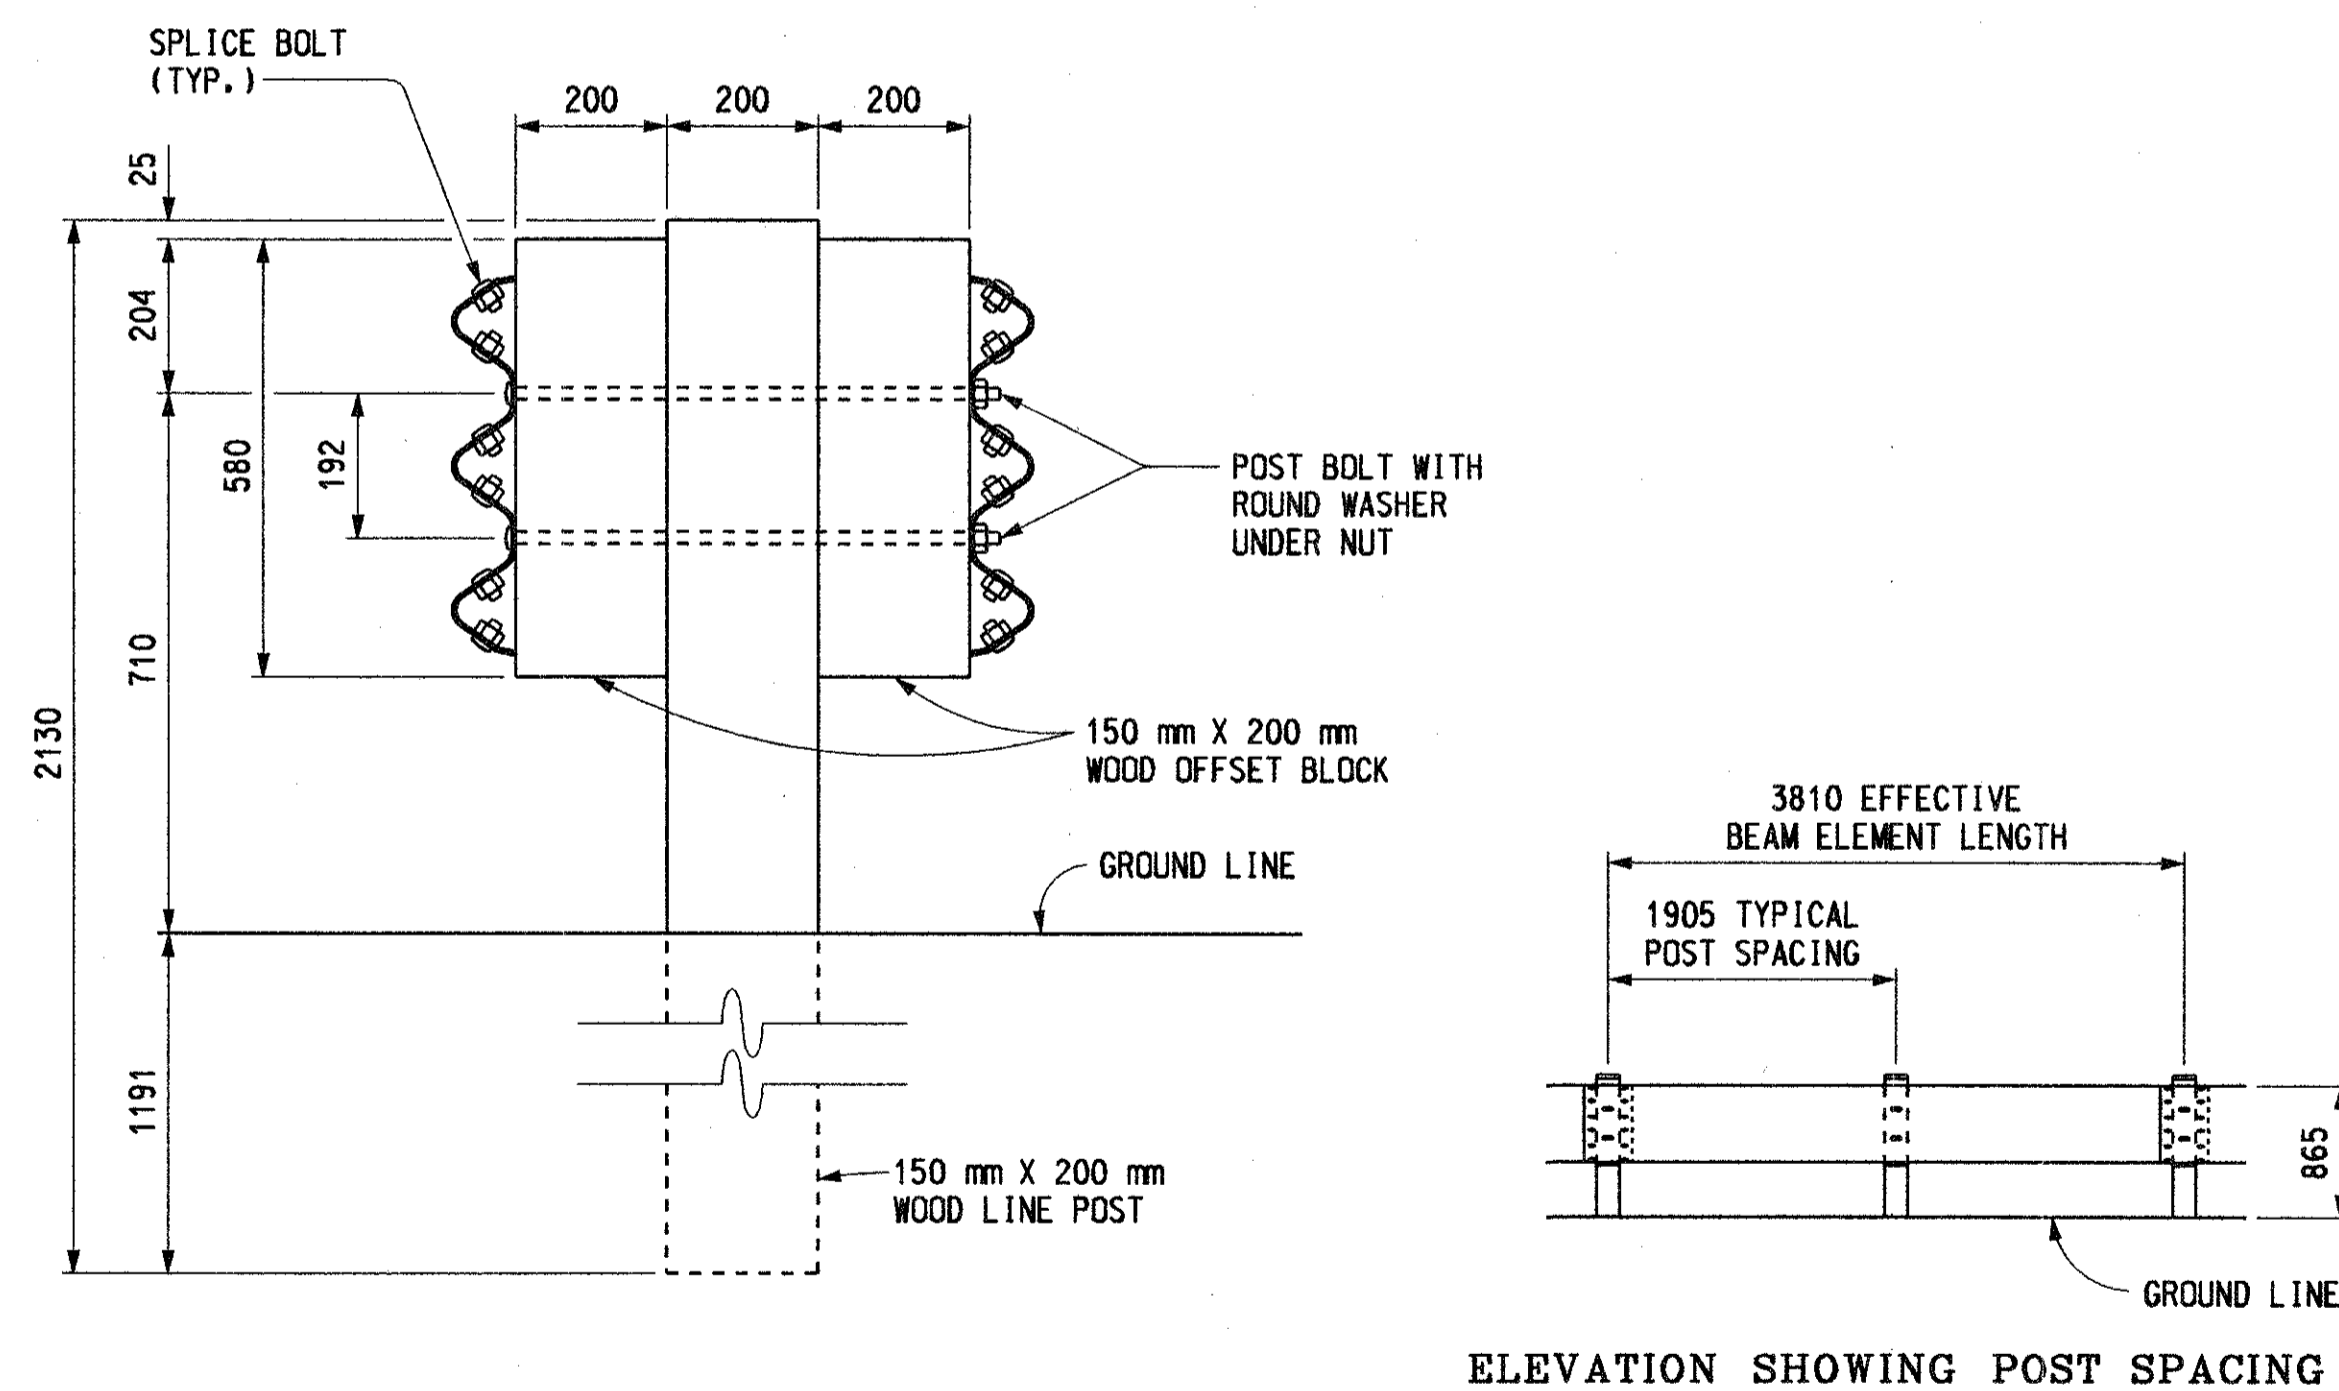


GUARDRAIL, TYPE TD
 (WOOD POST)


MICHIGAN DEPARTMENT OF TRANSPORTATION
 BUREAU OF HIGHWAY TECHNICAL SERVICES STANDARD PLAN FOR

GUARDRAIL,
 TYPES A, B, BD, T, & TD


F.H.W.A. APPROVAL	4-16-99 PLAN DATE	R-60-E	SHEET 5 OF 10
-------------------	----------------------	--------	------------------

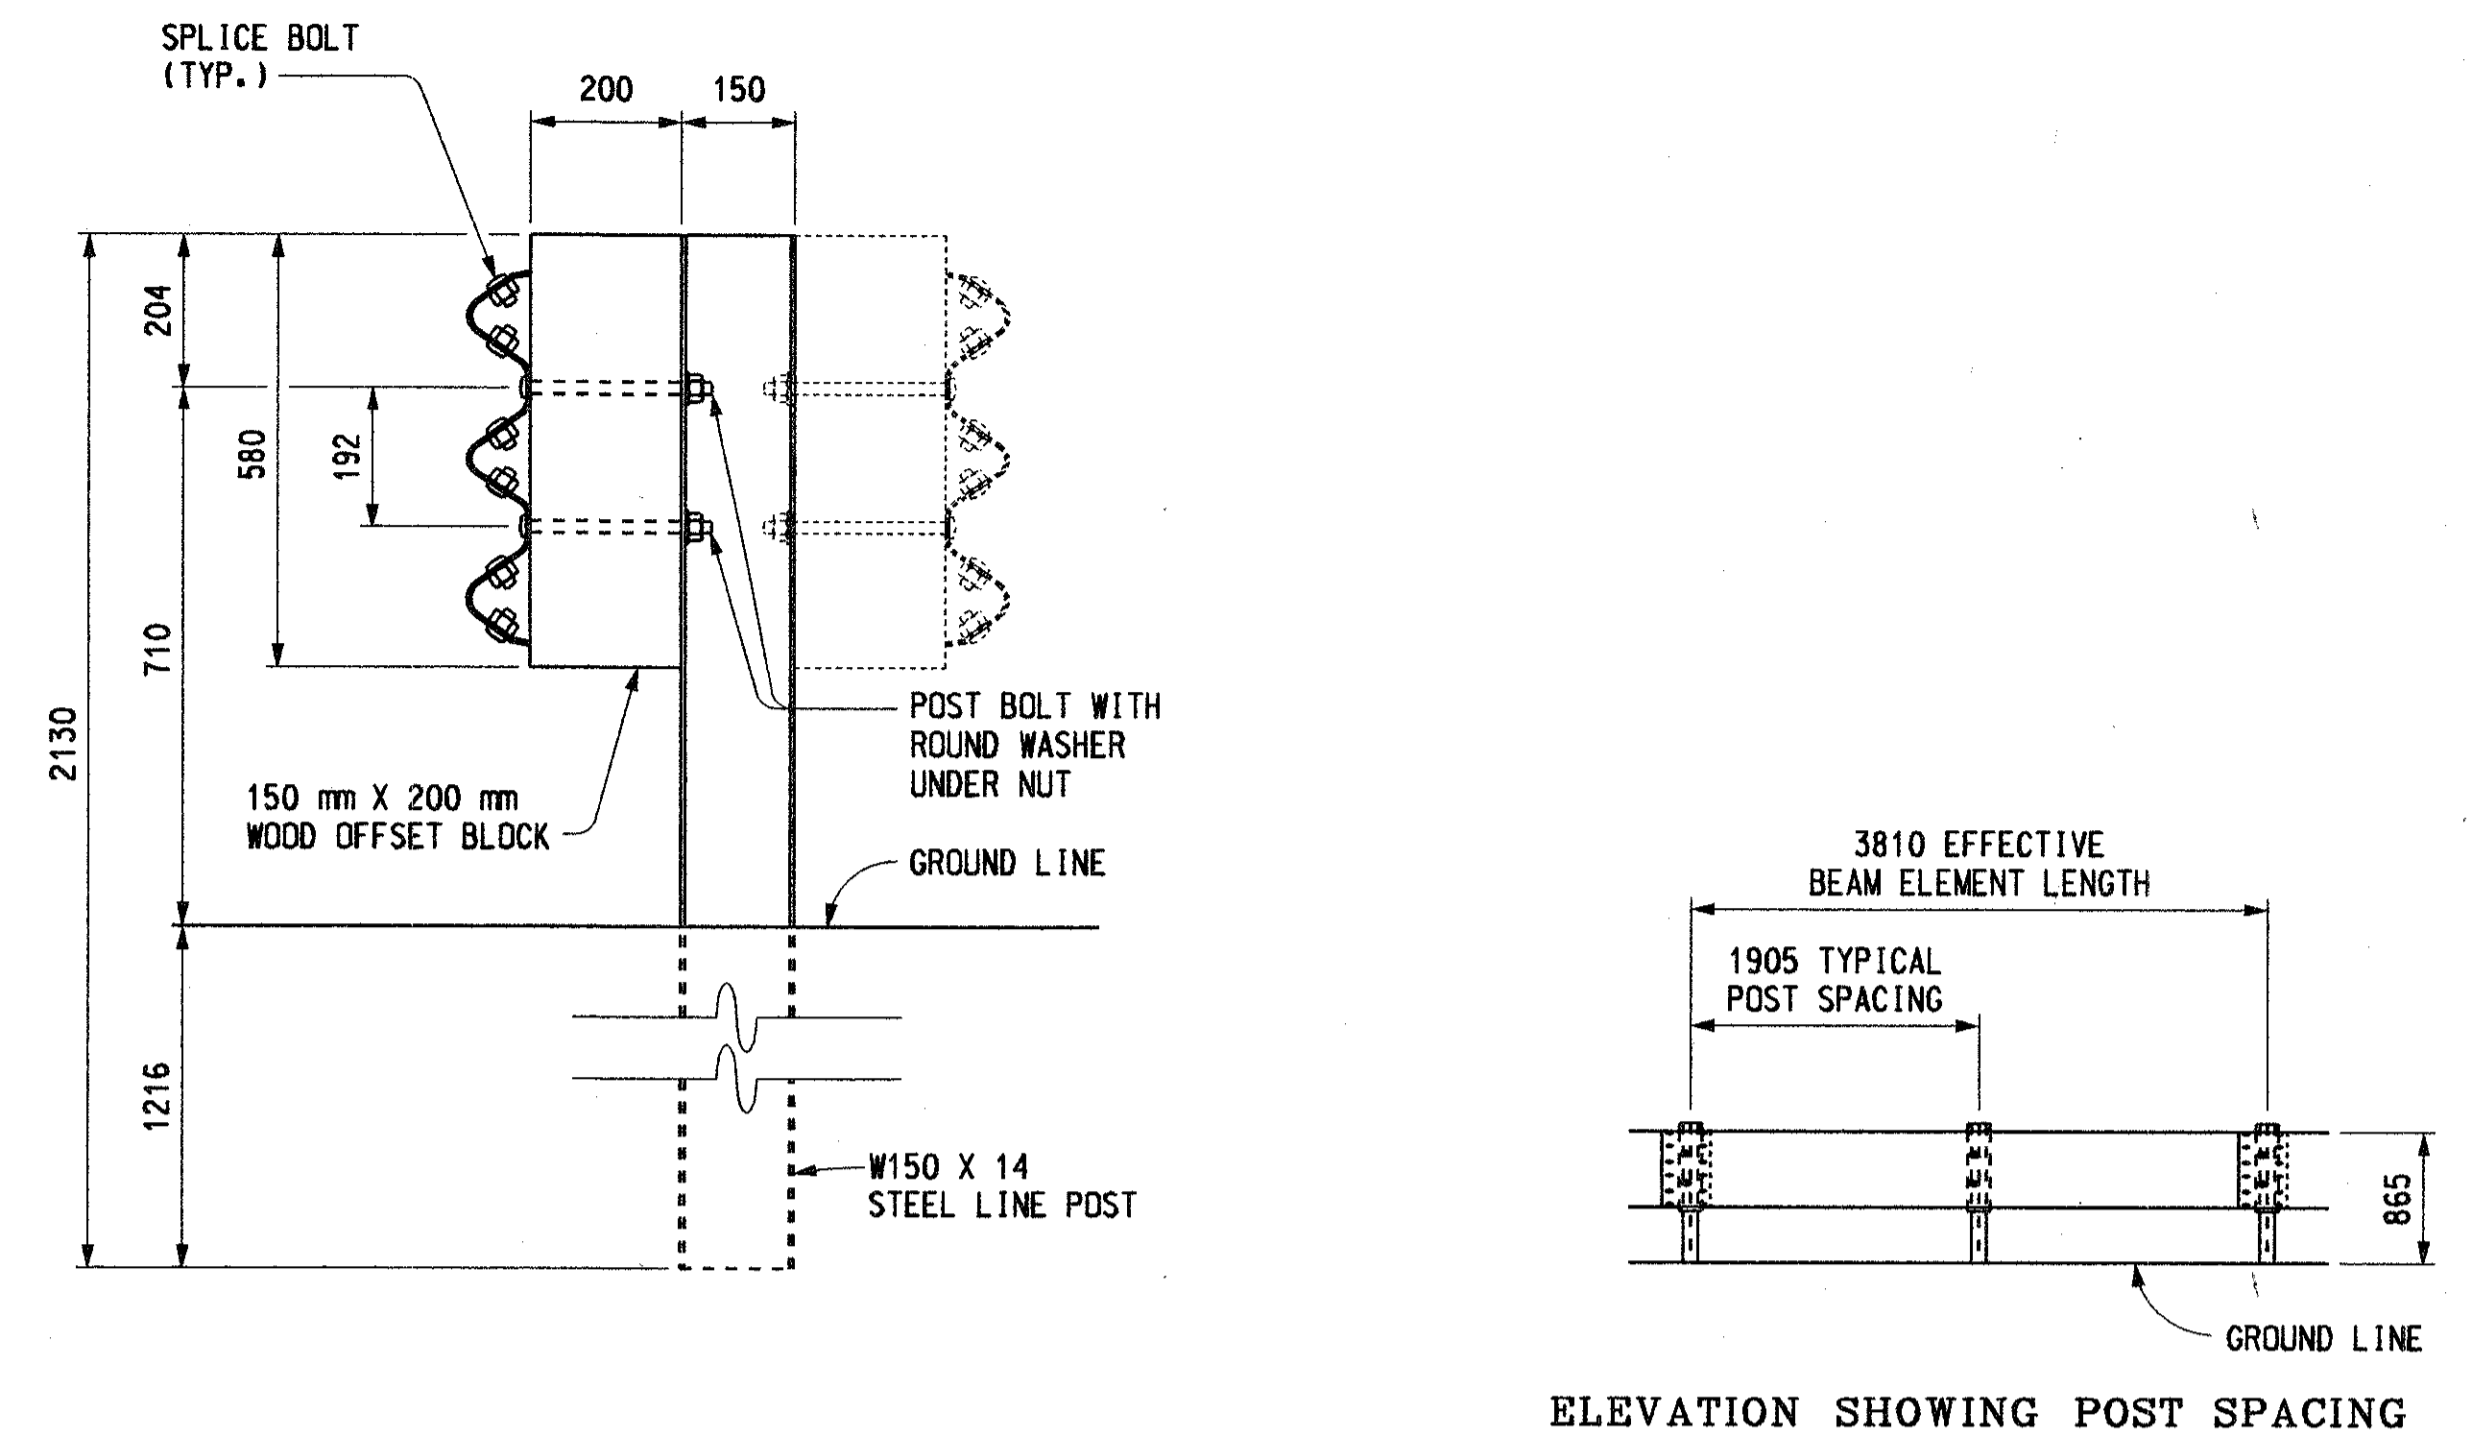


GUARDRAIL, TYPE T (OR TD)
 (STEEL POST)

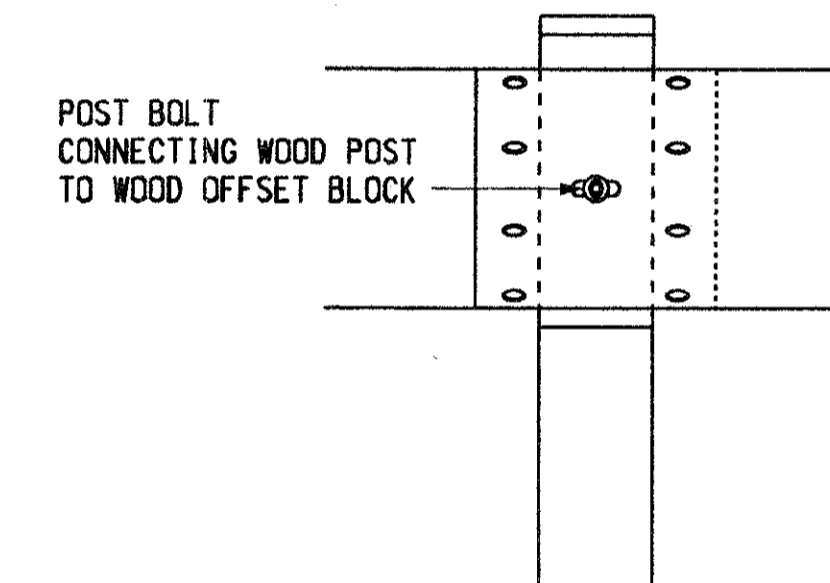


GUARDRAIL, TYPE B
 WOOD POST

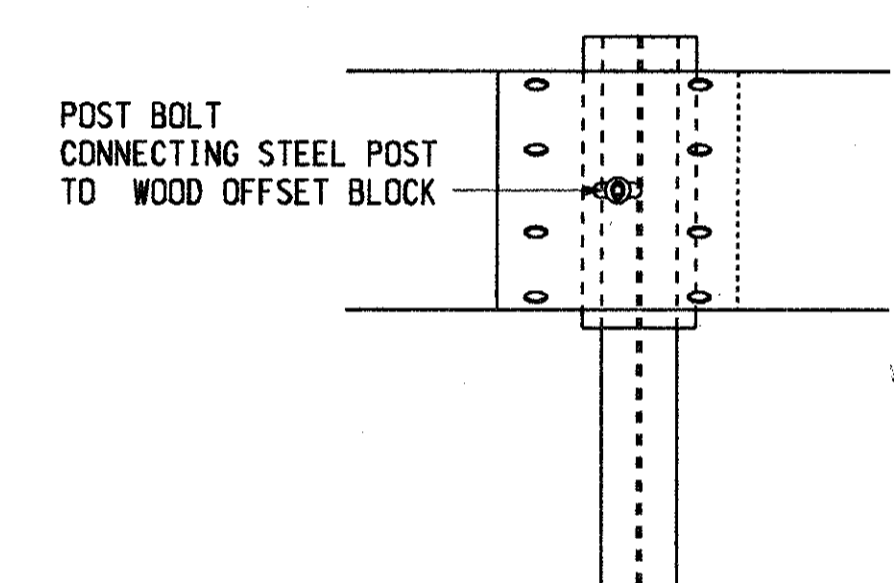

GUARDRAIL, TYPE B
 STEEL POST

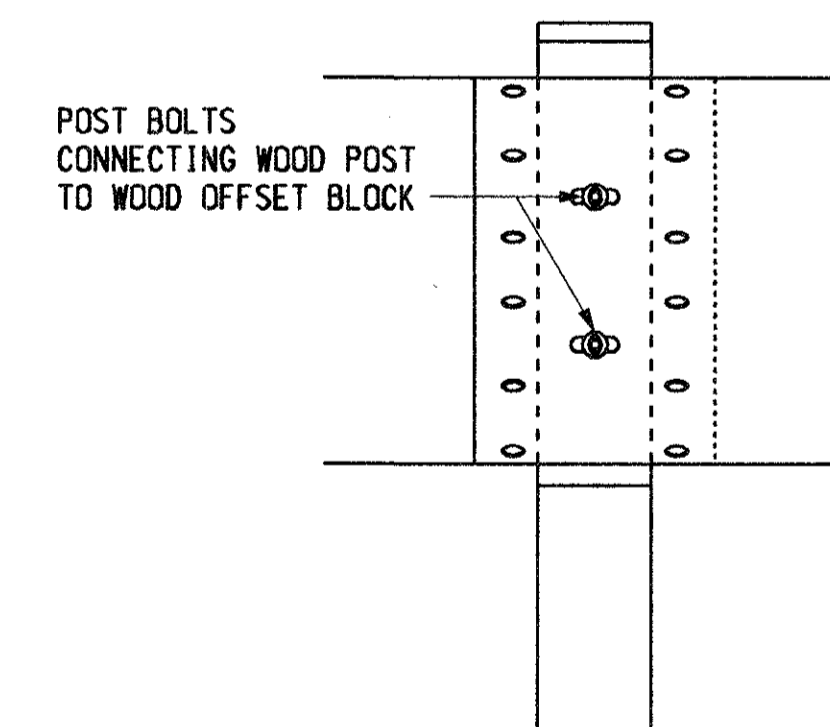

GUARDRAIL, TYPE T
 WOOD POST

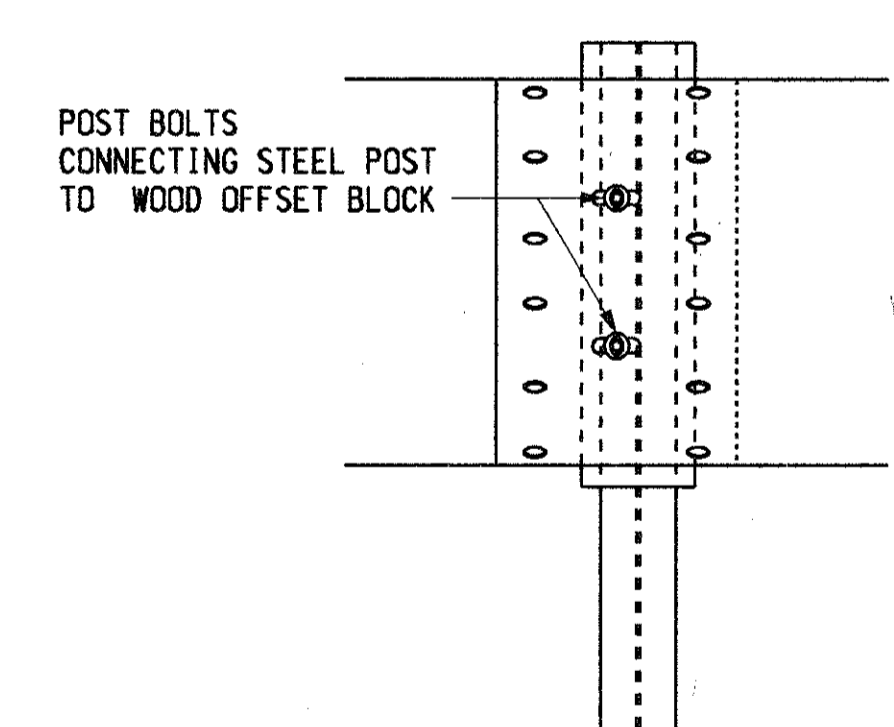


GUARDRAIL, TYPE T
 STEEL POST

BLOCK AND POST CONNECTION DETAILS


MICHIGAN DEPARTMENT OF TRANSPORTATION
 BUREAU OF HIGHWAY TECHNICAL SERVICES STANDARD PLAN FOR

GUARDRAIL,
 TYPES A, B, BD, T, & TD

F.H.W.A. APPROVAL	4-16-99 PLAN DATE	R-60-E	SHEET 6 OF 10
-------------------	----------------------	--------	------------------

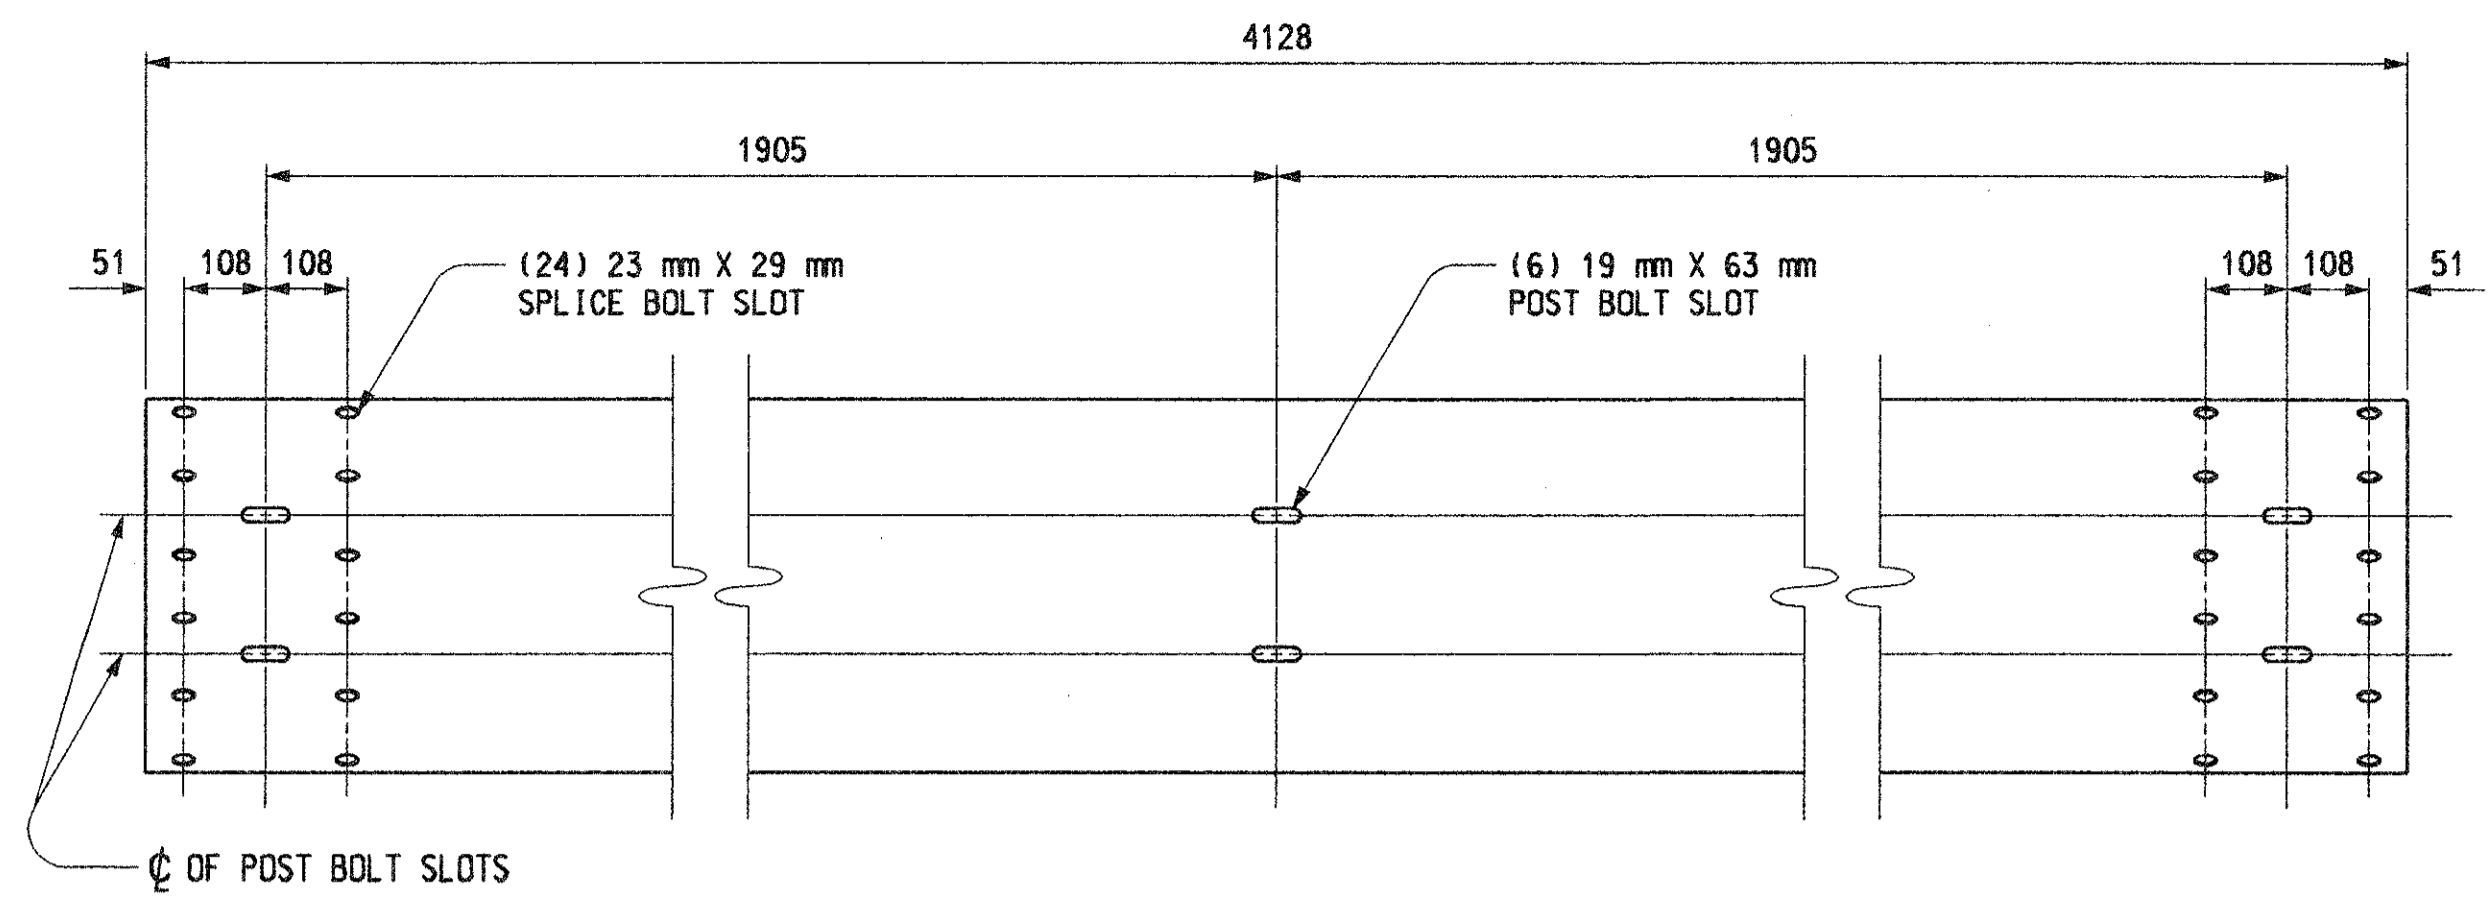

FRONT ELEVATION OF THRIE BEAM ELEMENT

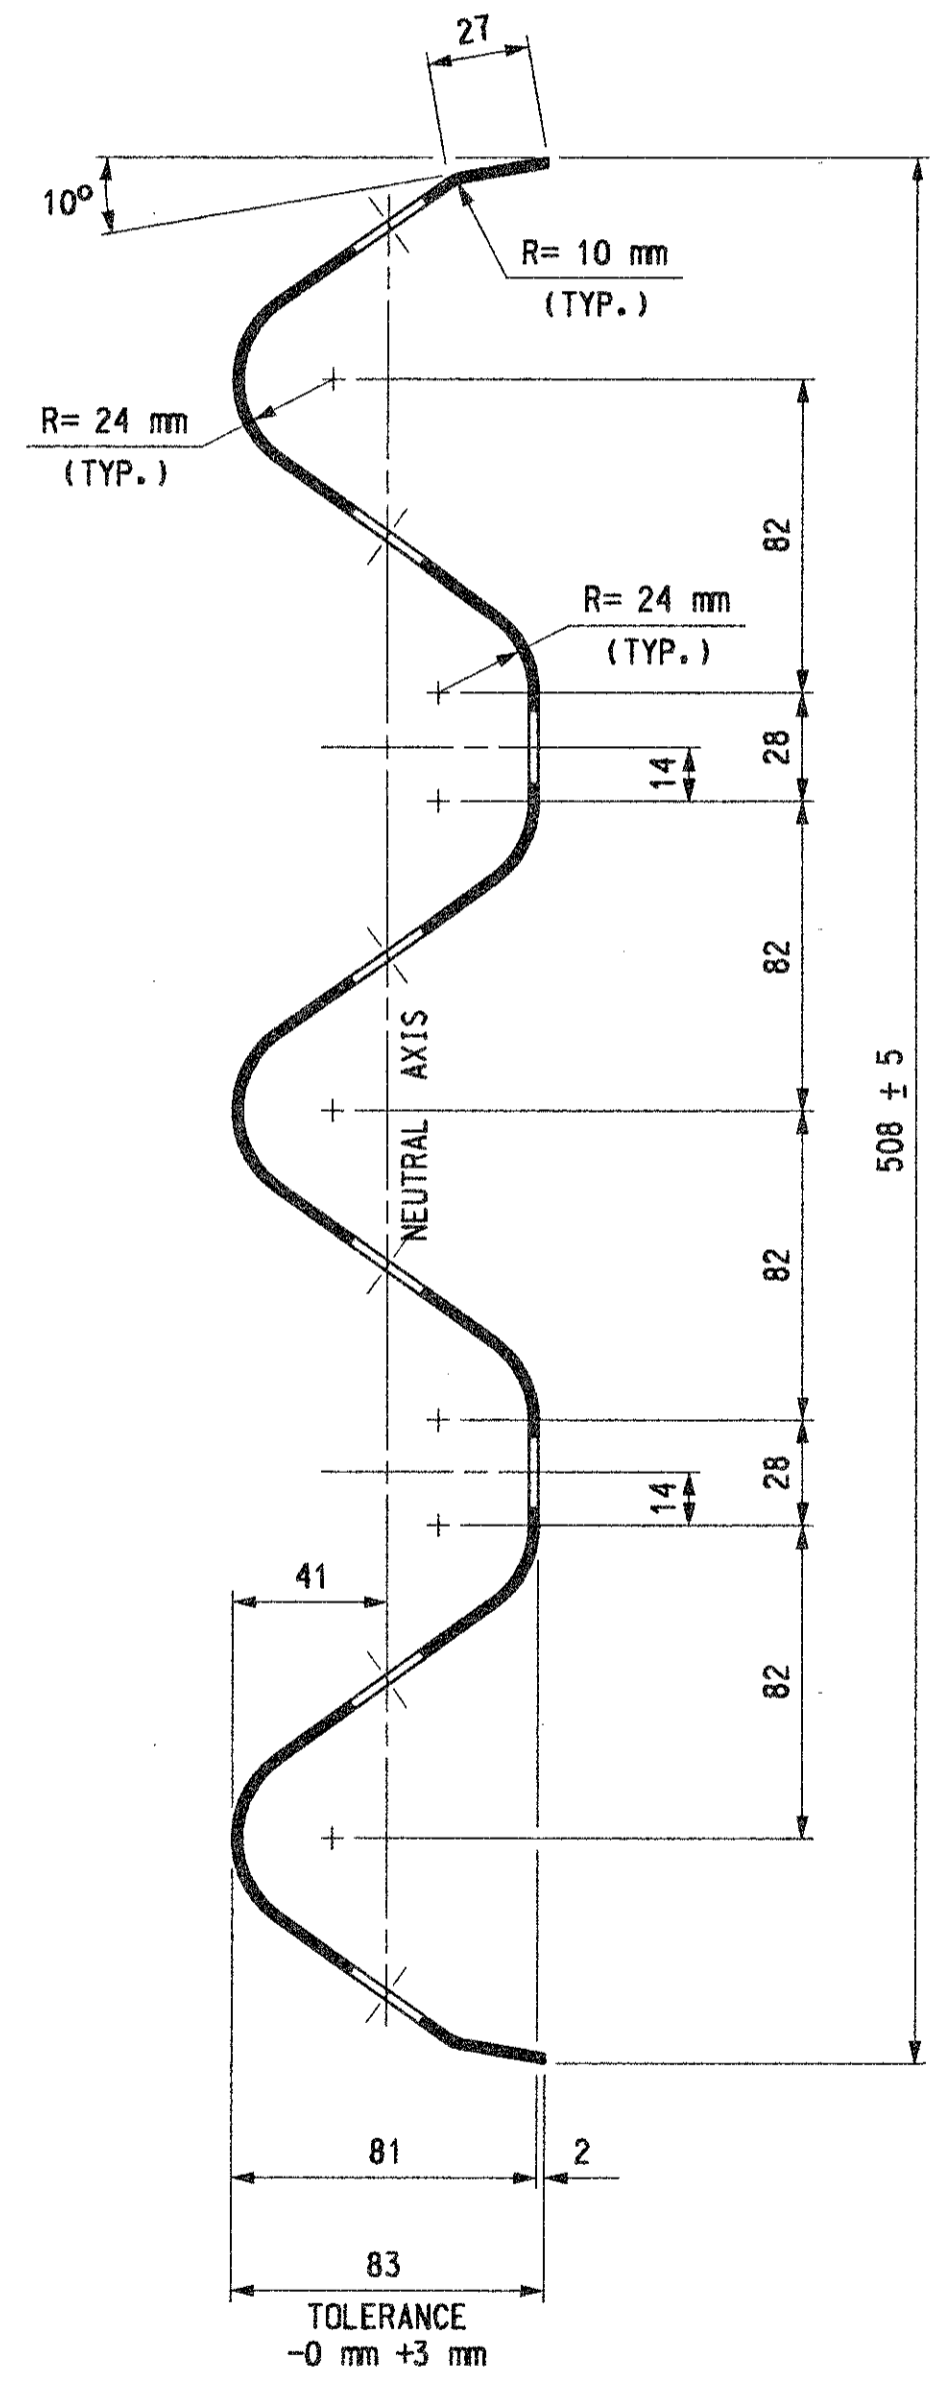


SECTION THROUGH THRIE BEAM ELEMENT
 (FOR GUARDRAIL, TYPE T AND TYPE TD)

MICHIGAN DEPARTMENT OF TRANSPORTATION
 BUREAU OF HIGHWAY TECHNICAL SERVICES STANDARD PLAN FOR


**GUARDRAIL,
 TYPES A, B, BD, T, & TD**

F.H.W.A. APPROVAL	4-16-99 PLAN DATE	R-60-E	SHEET 7 OF 10
-------------------	----------------------	--------	------------------

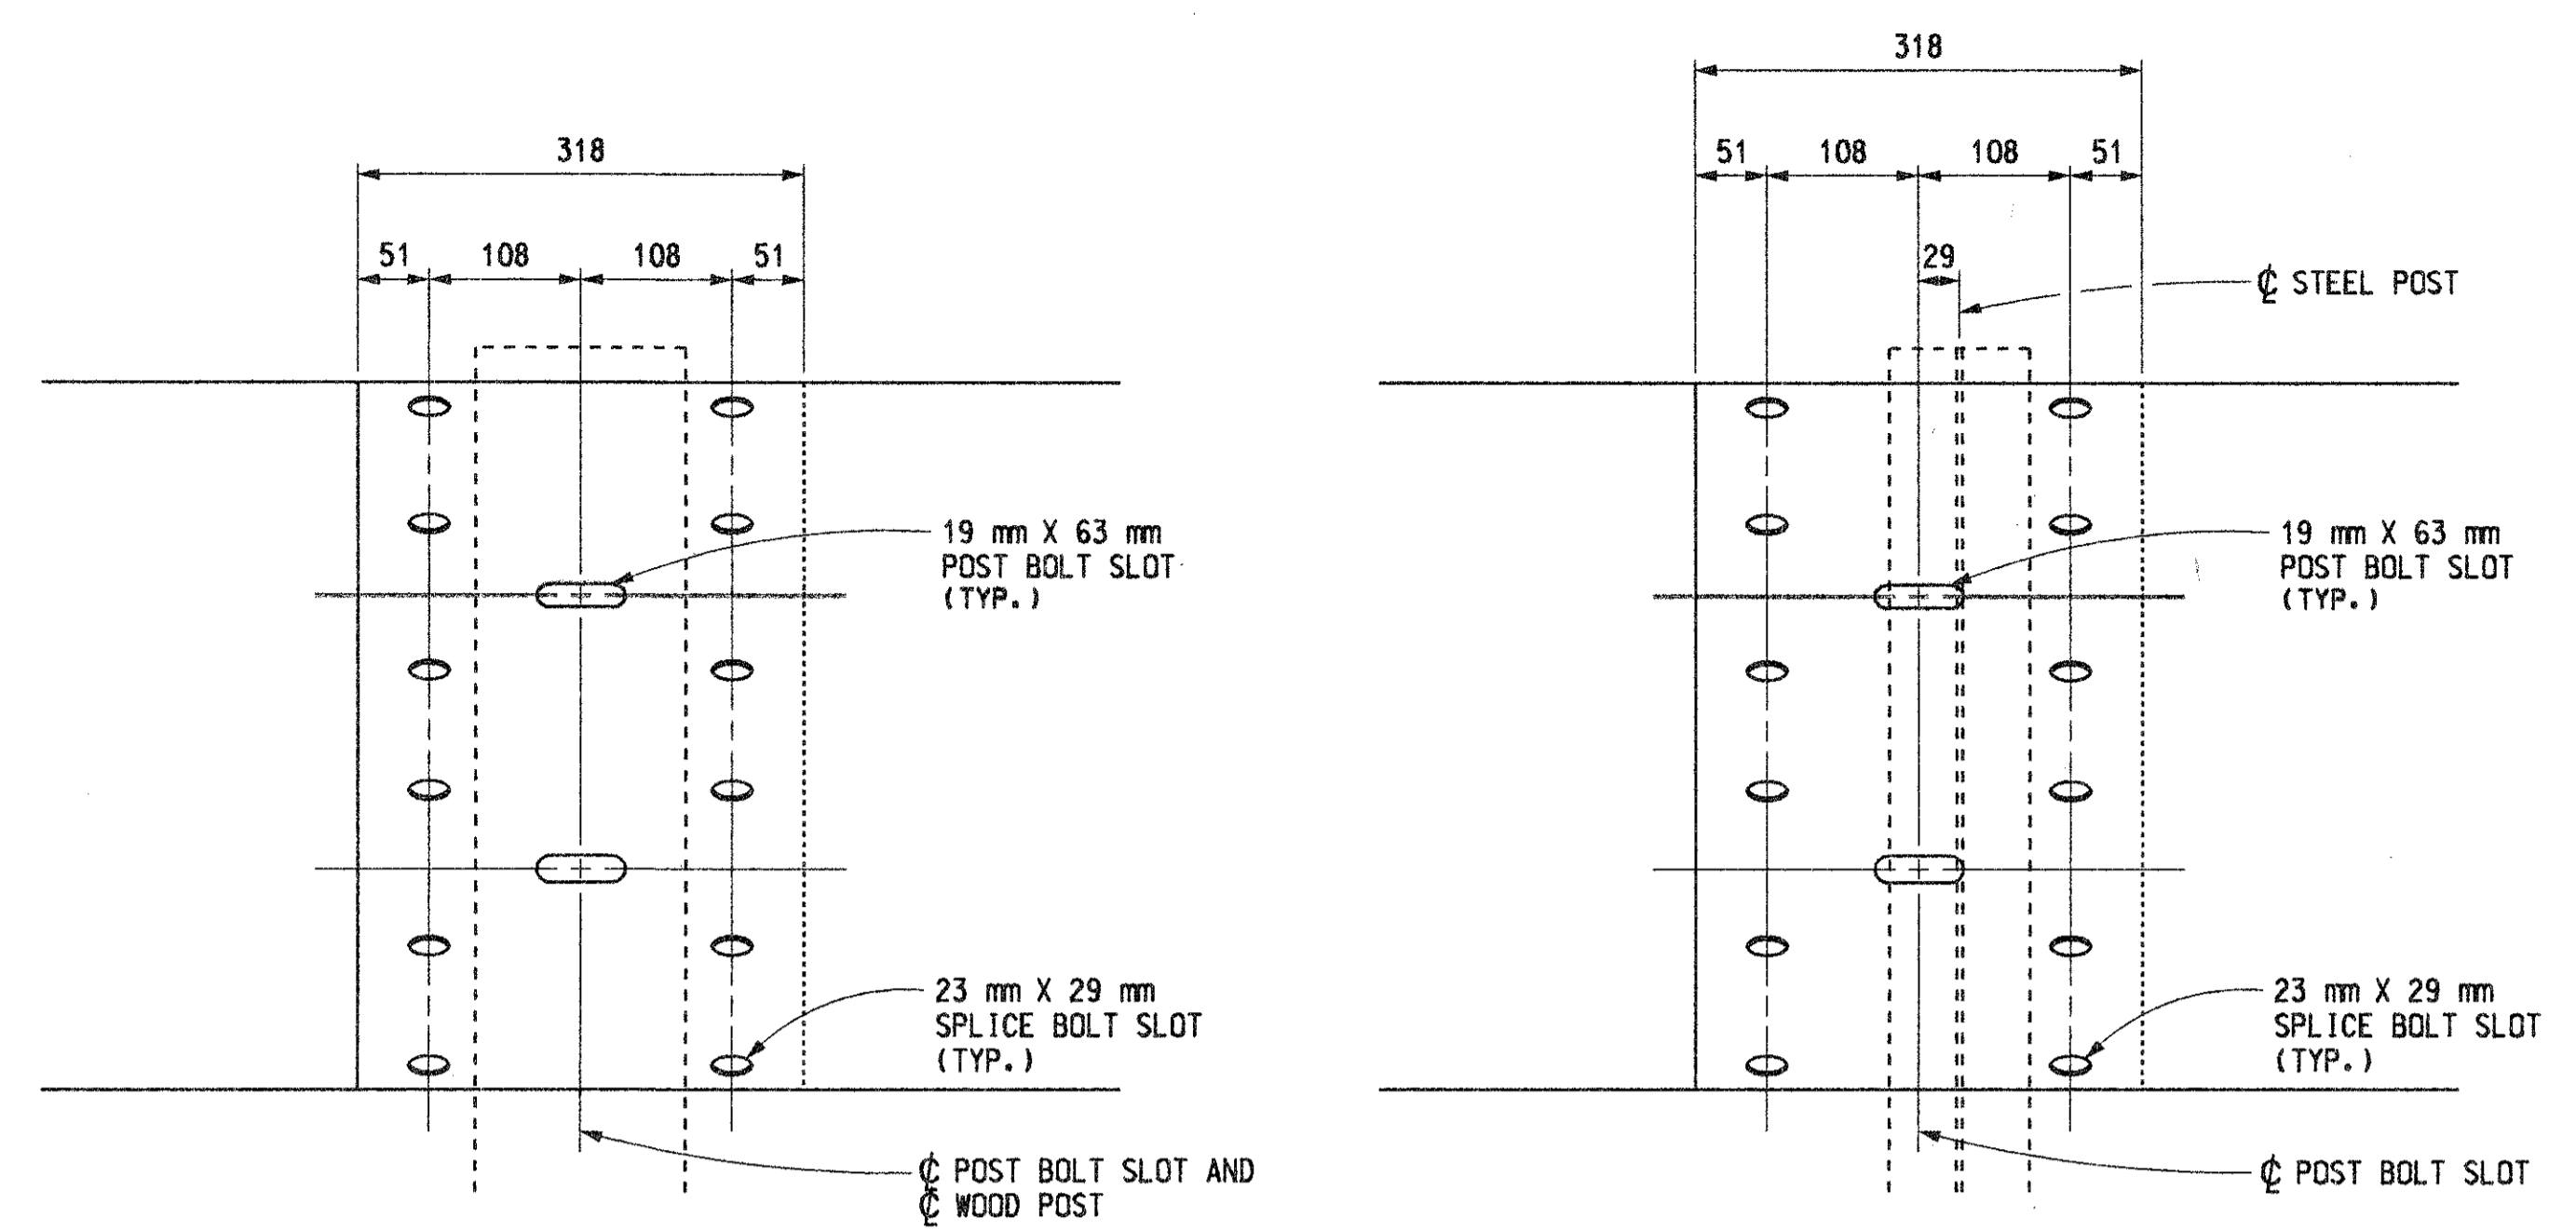

WOOD POST STEEL POST

THRIE BEAM ELEMENT SPLICE DETAILS

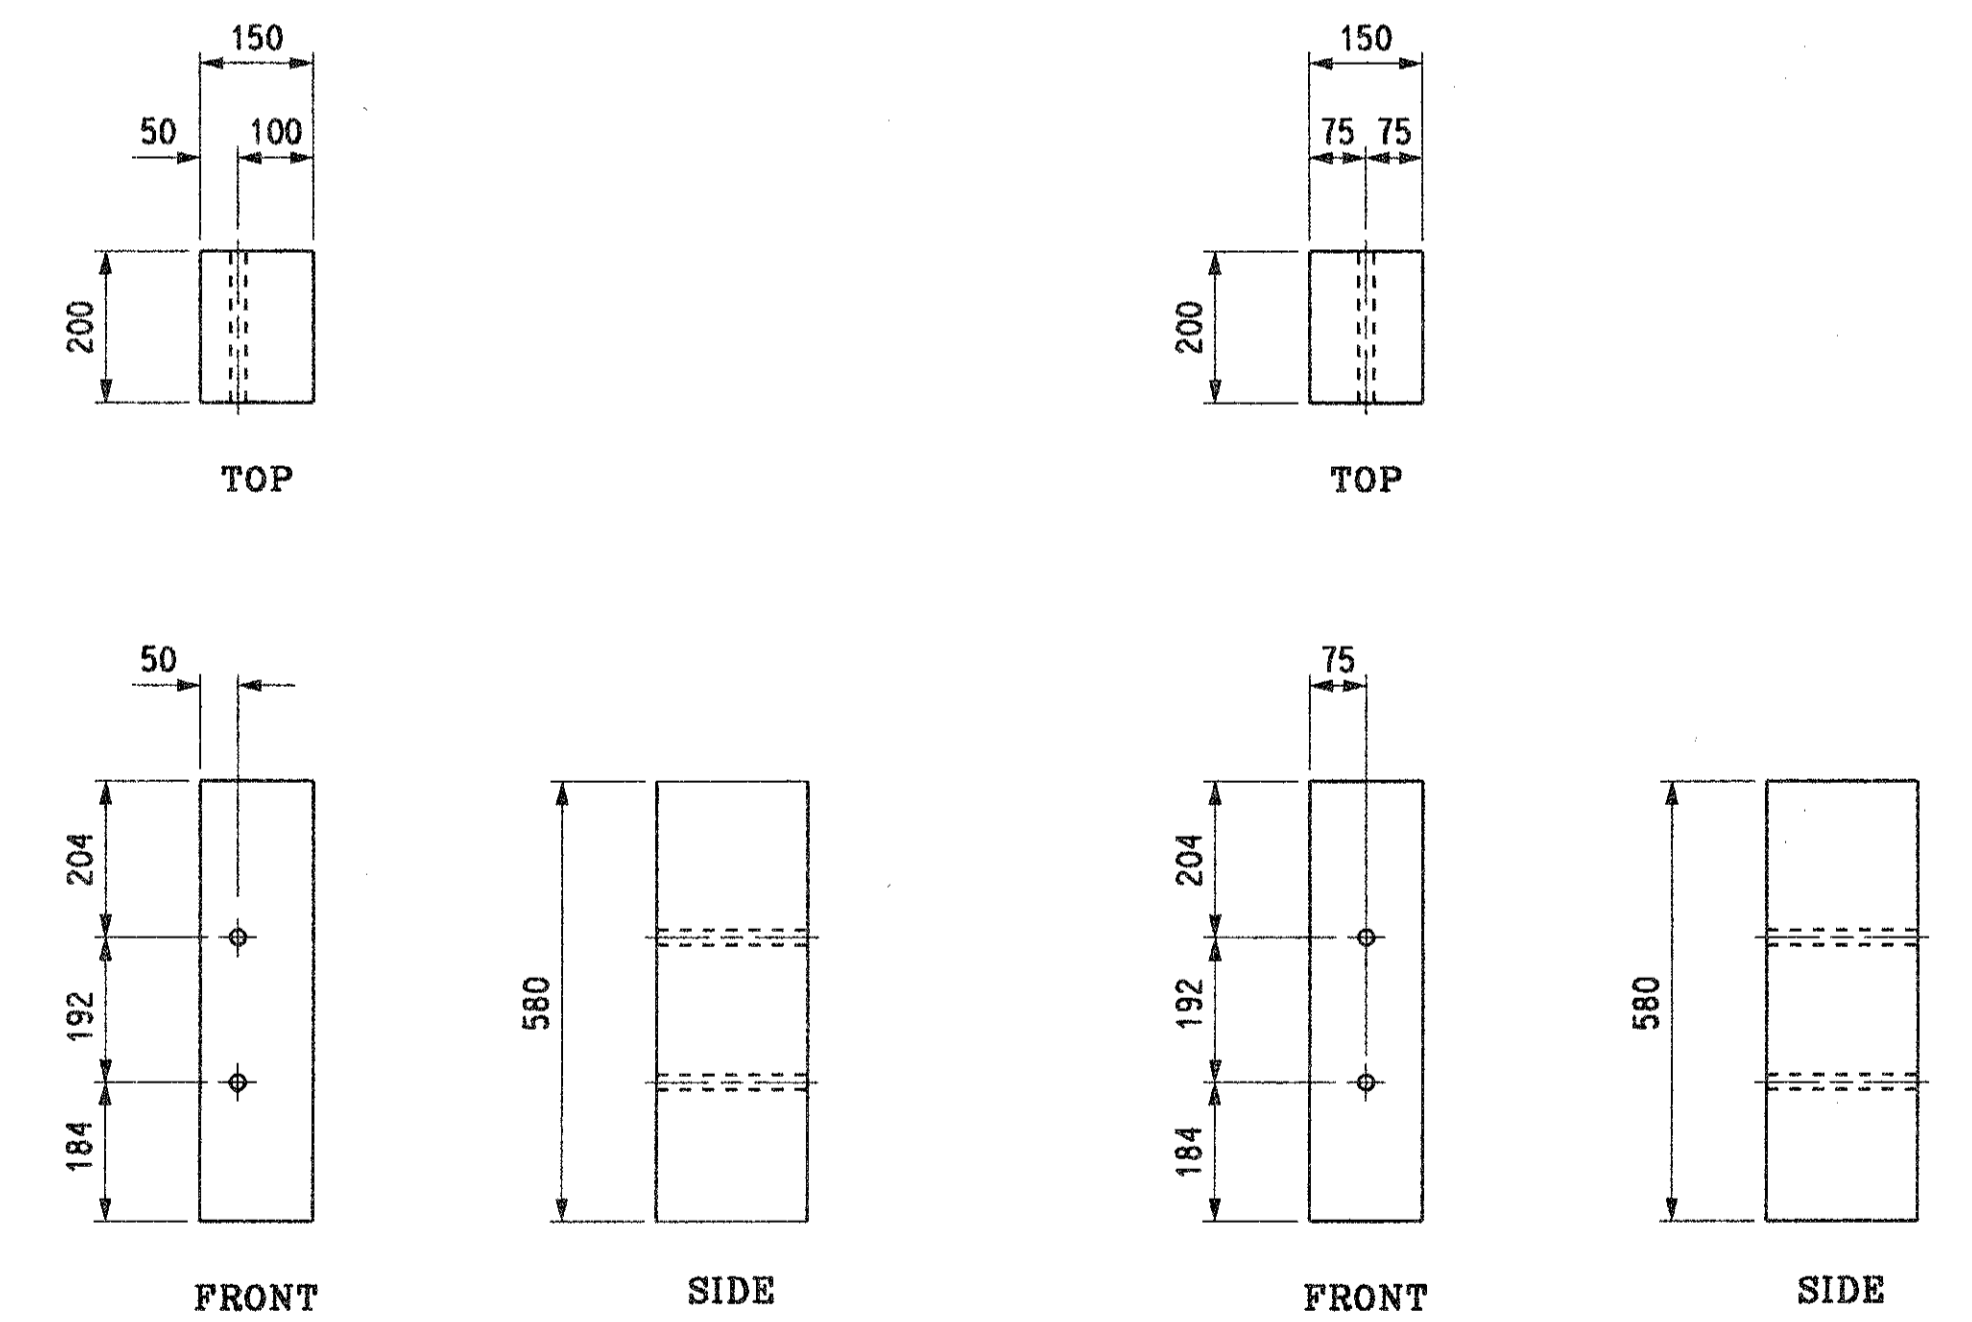


FOR USE ON STEEL POSTS (SEE NOTES ON SHEET 10 OF 10)
 FOR USE ON WOOD POSTS (SEE NOTES ON SHEET 10 OF 10)

WOOD OFFSET BLOCKS FOR GUARDRAIL, TYPE T AND TYPE TD

MICHIGAN DEPARTMENT OF TRANSPORTATION
 BUREAU OF HIGHWAY TECHNICAL SERVICES STANDARD PLAN FOR

**GUARDRAIL,
 TYPES A, B, BD, T, & TD**

F.H.W.A. APPROVAL	4-16-99 PLAN DATE	R-60-E	SHEET 8 OF 10
-------------------	----------------------	--------	------------------

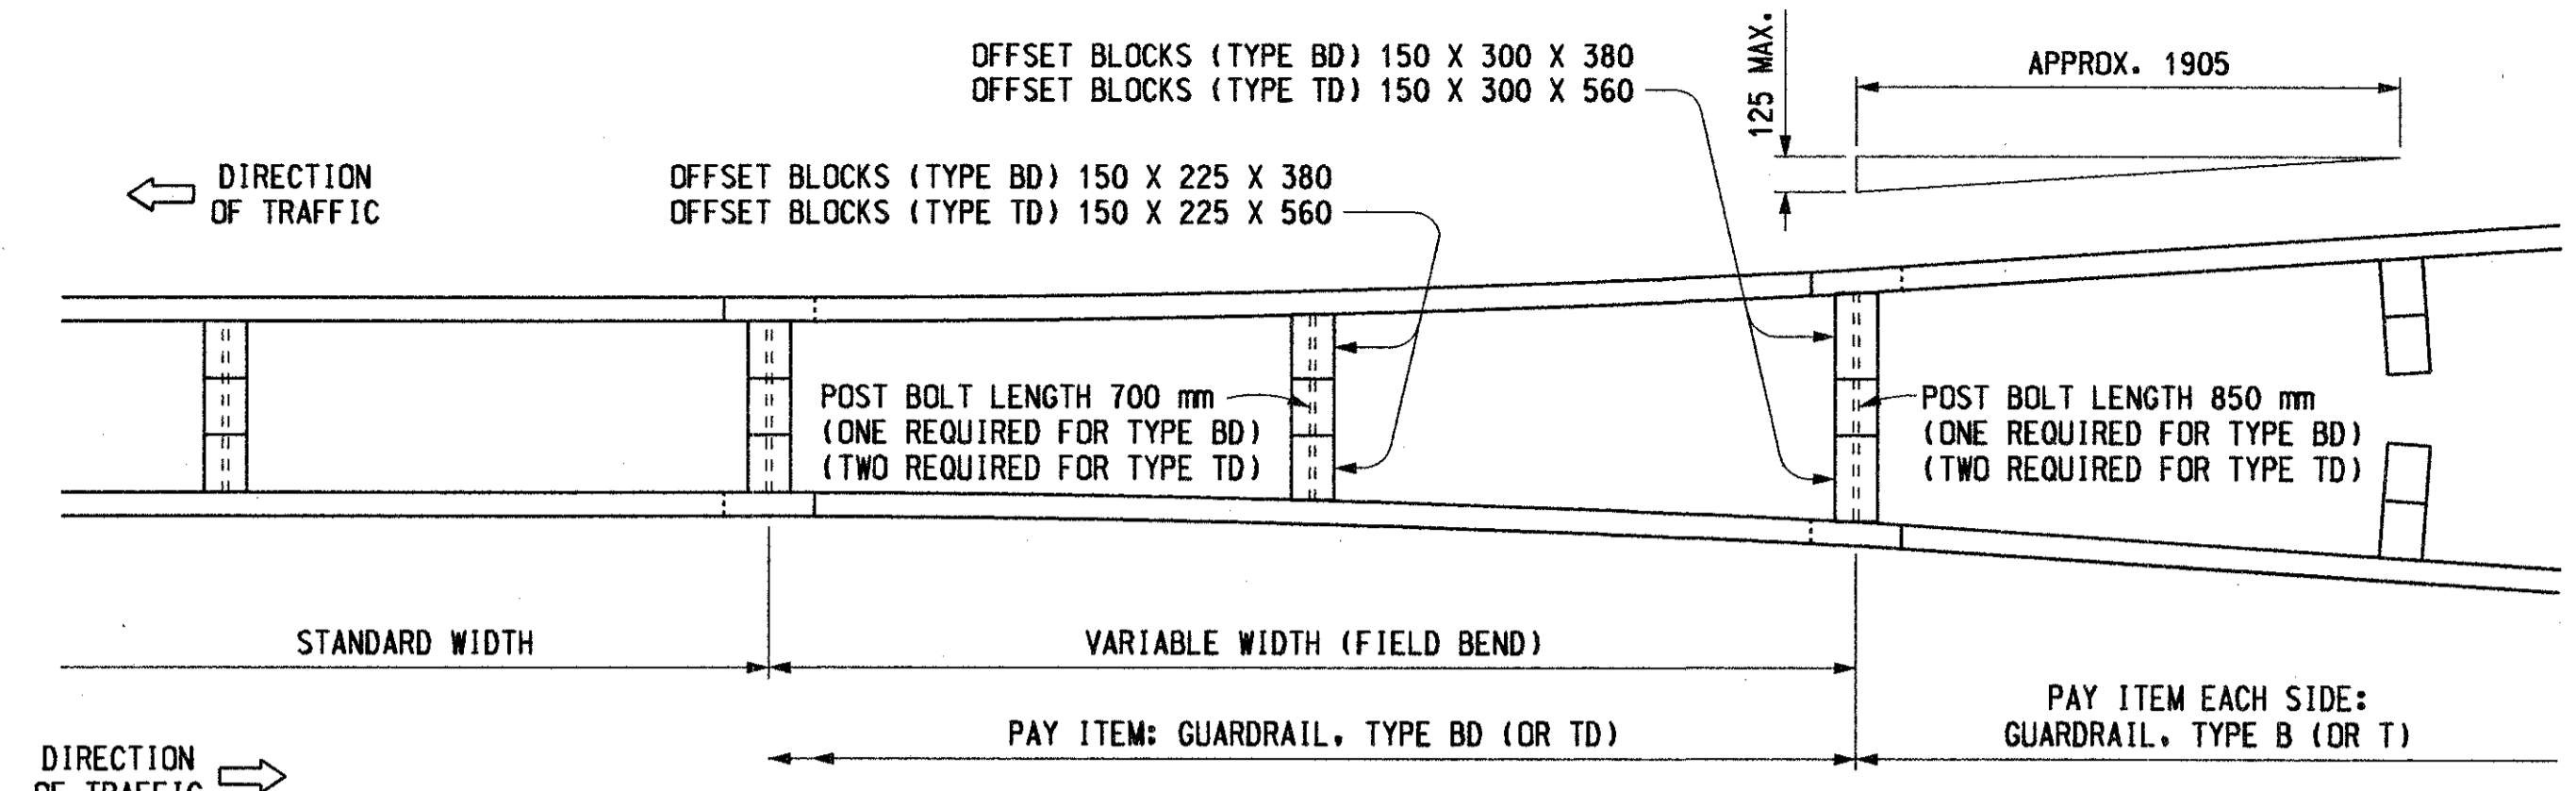


DETAIL SHOWING TRANSITION FROM GUARDRAIL, TYPE B (OR TYPE T) TO GUARDRAIL, TYPE BD (OR TYPE TD)

POST BOLTS, SPLICE BOLTS AND WASHERS AT BEAM ELEMENT SPLICE POSTS AND AT INTERMEDIATE POSTS							
GUARDRAIL TYPE	POST	OFFSET BLOCK	POST BOLTS		SPLICE BOLTS (32 mm LONG) (NO. REQ'D)	WASHERS (ROUND) (NO. REQ'D)	NOT NEEDED AT INTERMEDIATE POSTS
			NO. REQ'D	LENGTH (mm)			
A	WOOD	N/A	1	240	8	1	
	STEEL	N/A	1	50			
B	WOOD	WOOD	1	460	8	1	
	STEEL	WOOD	1	240			
BD	WOOD	WOOD	1	* 675	16	2	
	STEEL	WOOD	2	240			
T	WOOD	WOOD	2	460	12	2	
	STEEL	WOOD	2	240			
TD	WOOD	WOOD	2	* 675	24	4	
	STEEL	WOOD	4	240			


MINIMUM POST BOLT THREAD LENGTH	
BOLT LENGTH (mm)	MINIMUM THREAD LENGTH (mm)
240	45
460	65
675	75

THREE BEAM TRANSITIONS REQUIRE 20 SPLICE BOLTS EACH (12 ON TYPE T END AND 8 ON TYPE B END).


* EXCEPT AS SPECIFIED ON DETAIL SHOWING TRANSITION FROM GUARDRAIL, TYPE B (OR TYPE T) TO GUARDRAIL, TYPE BD (OR TYPE TD), POST BOLTS SHALL NOT EXTEND MORE THAN 15 mm BEYOND NUT.

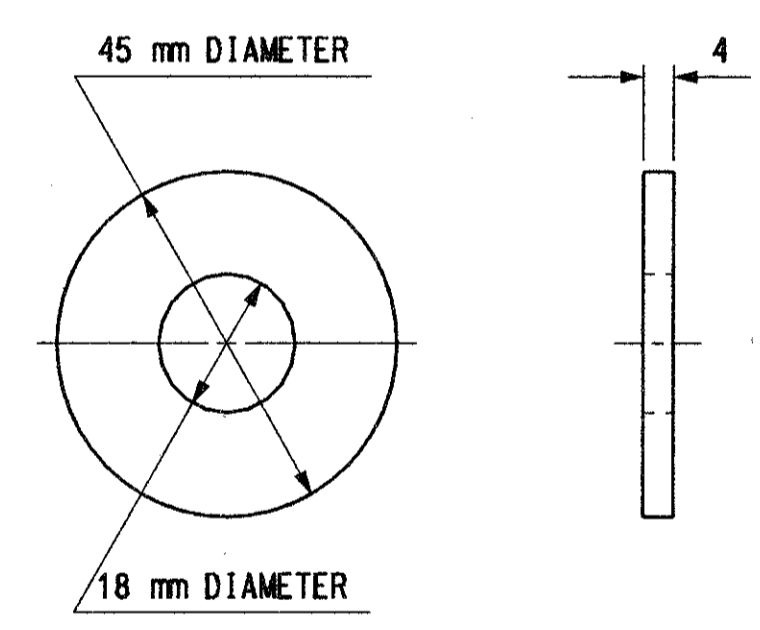

ROUND WASHER

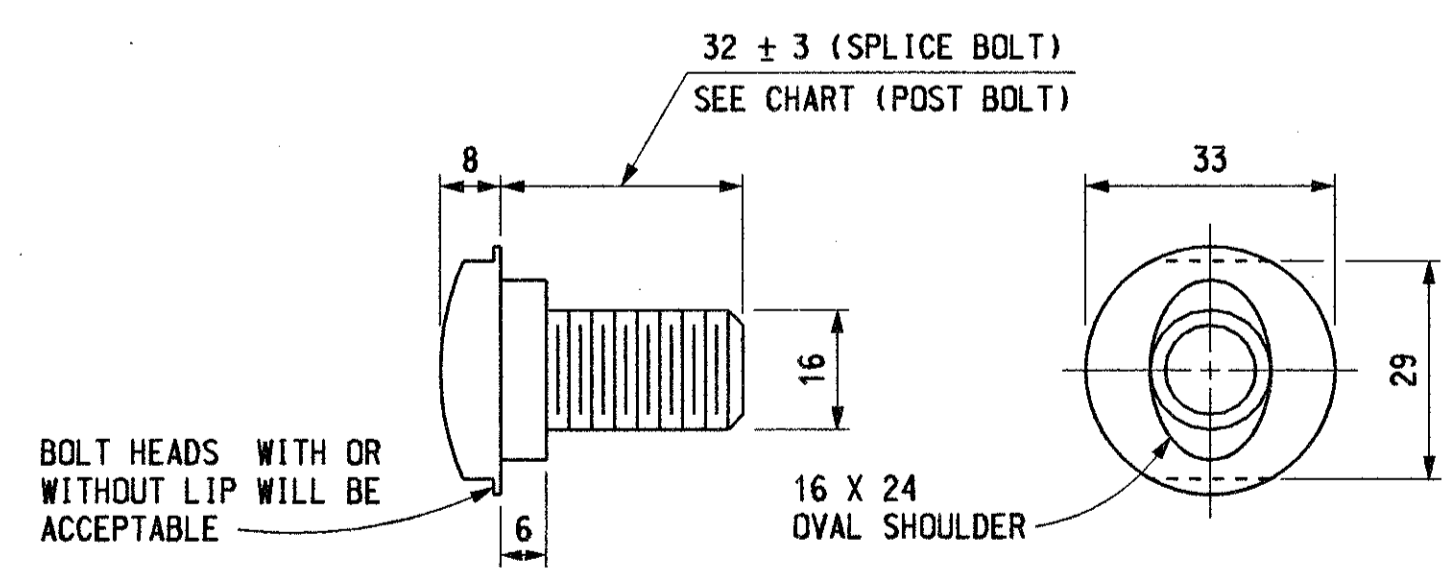

SPLICE BOLT AND POST BOLT

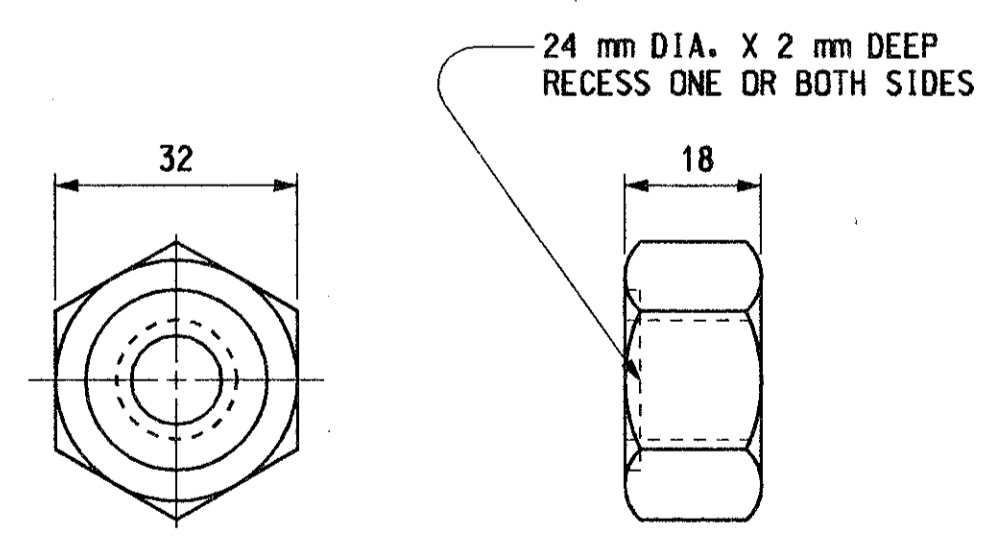


NUT


MICHIGAN DEPARTMENT OF TRANSPORTATION
BUREAU OF HIGHWAY TECHNICAL SERVICES STANDARD PLAN FOR

**GUARDRAIL,
TYPES A, B, BD, T, & TD**

F.H.W.A. APPROVAL _____ 4-16-99 PLAN DATE _____ R-60-E SHEET 9 OF 10

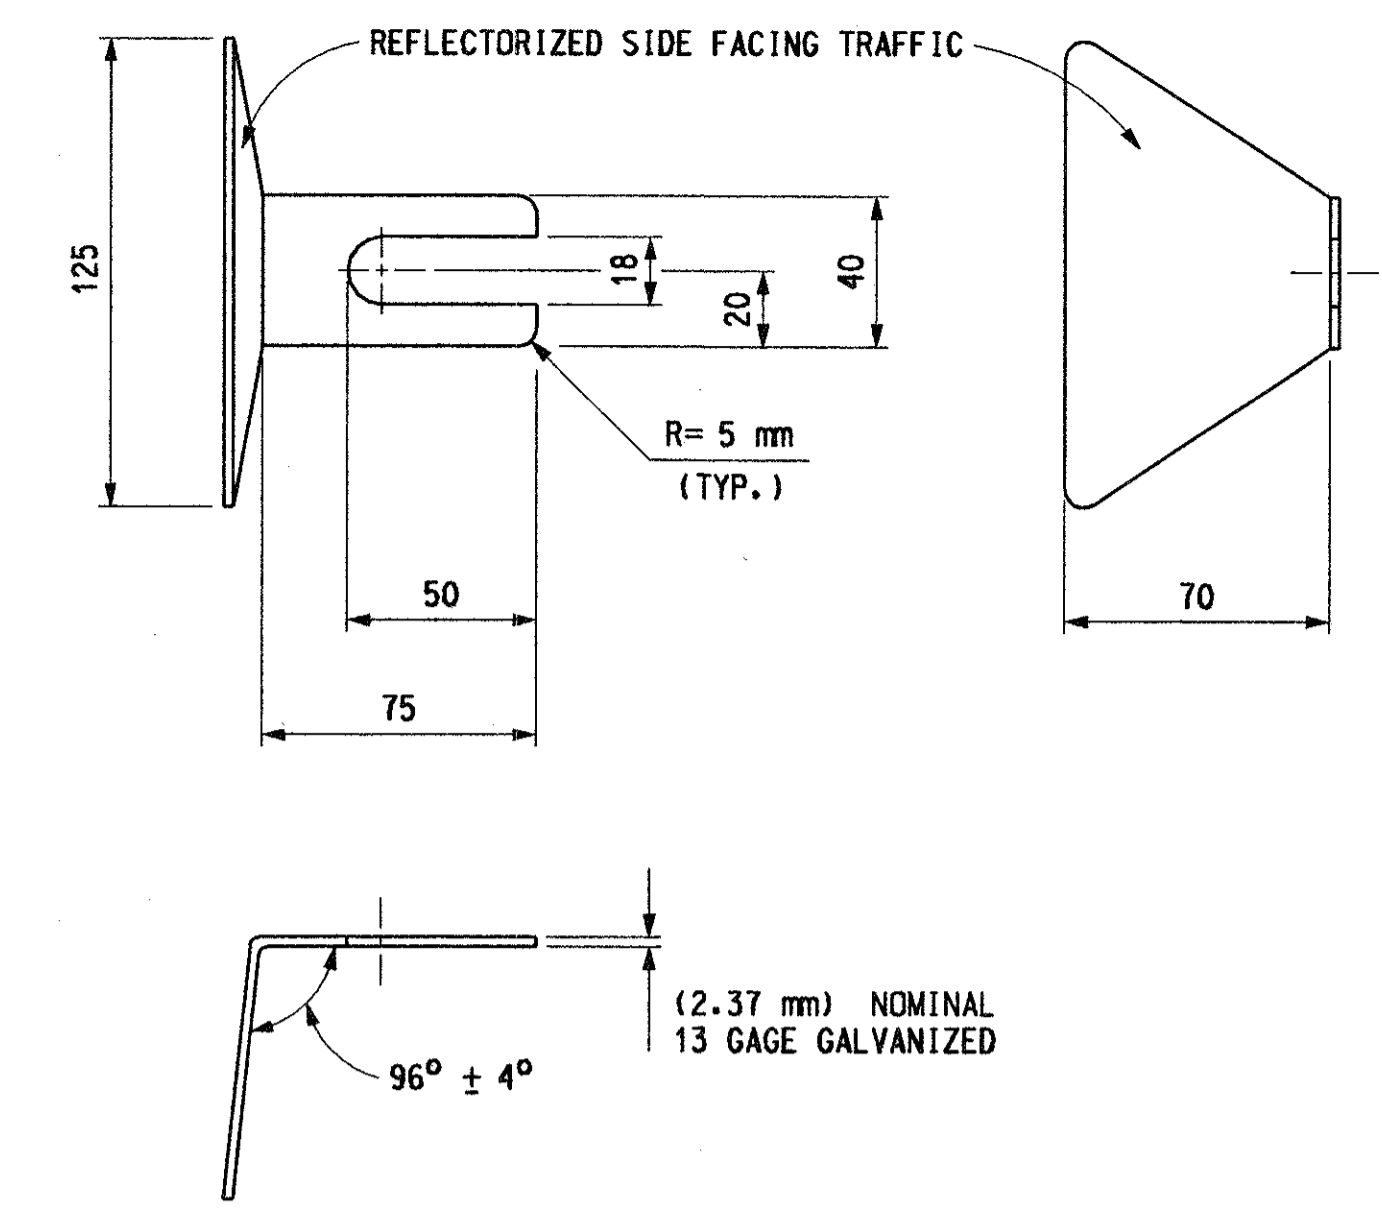



GUARDRAIL REFLECTOR

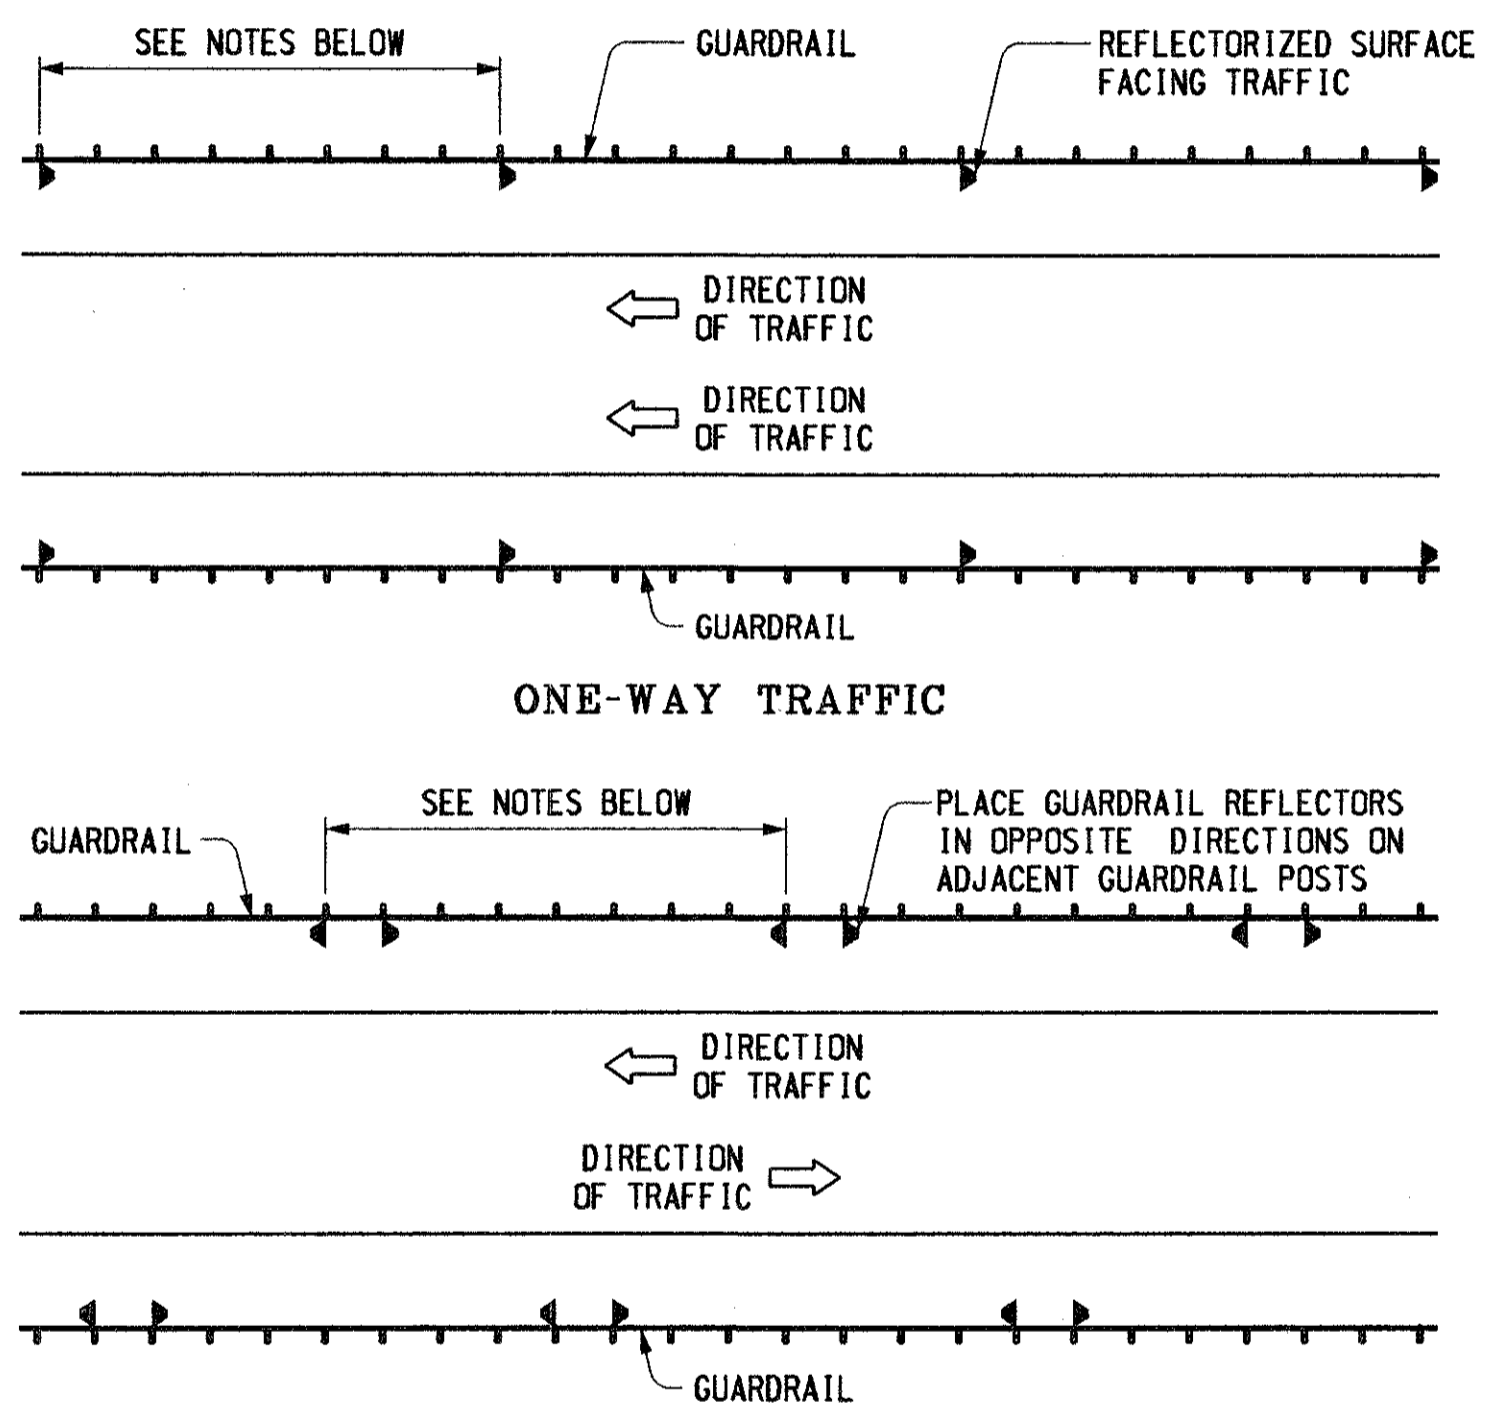

PLACEMENT OF GUARDRAIL REFLECTORS

NOTES GOVERNING THE USE OF GUARDRAIL REFLECTORS

- DO NOT USE GUARDRAIL REFLECTORS WHERE THE ROADWAY IS LIGHTED.
- GUARDRAIL REFLECTORS ARE TO BE SPACED AT THE FOLLOWING INTERVALS:
 - 15.24 m ON TANGENT SECTIONS AND CURVES WITH RADIUS OF 350.0 m OR MORE.
 - 7.62 m ON CURVES WITH RADIUS LESS THAN 350.0 m.
- FOR GUARDRAIL REFLECTOR PLACEMENT ON APPROACH TERMINALS, SEE THE APPROPRIATE GUARDRAIL APPROACH TERMINAL STANDARD PLAN.
- A GUARDRAIL REFLECTOR IS TO BE PLACED ON THE SECOND POST FROM THE GUARDRAIL DEPARTING TERMINAL.
- ON GUARDRAIL, TYPE T AND TYPE TD GUARDRAIL REFLECTORS ARE TO BE PLACED ON THE UPPER POST BOLT.
- GUARDRAIL REFLECTORS SHALL MATCH COLOR OF EDGE LINE.

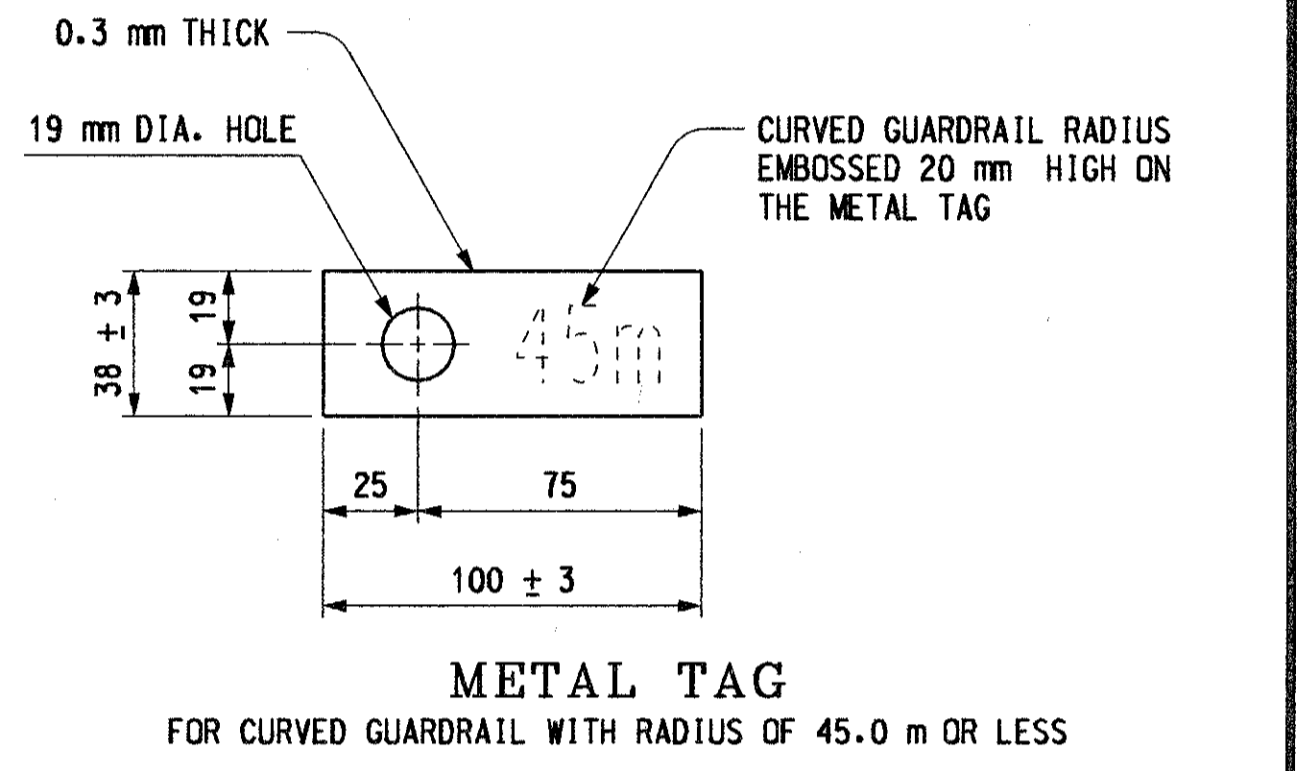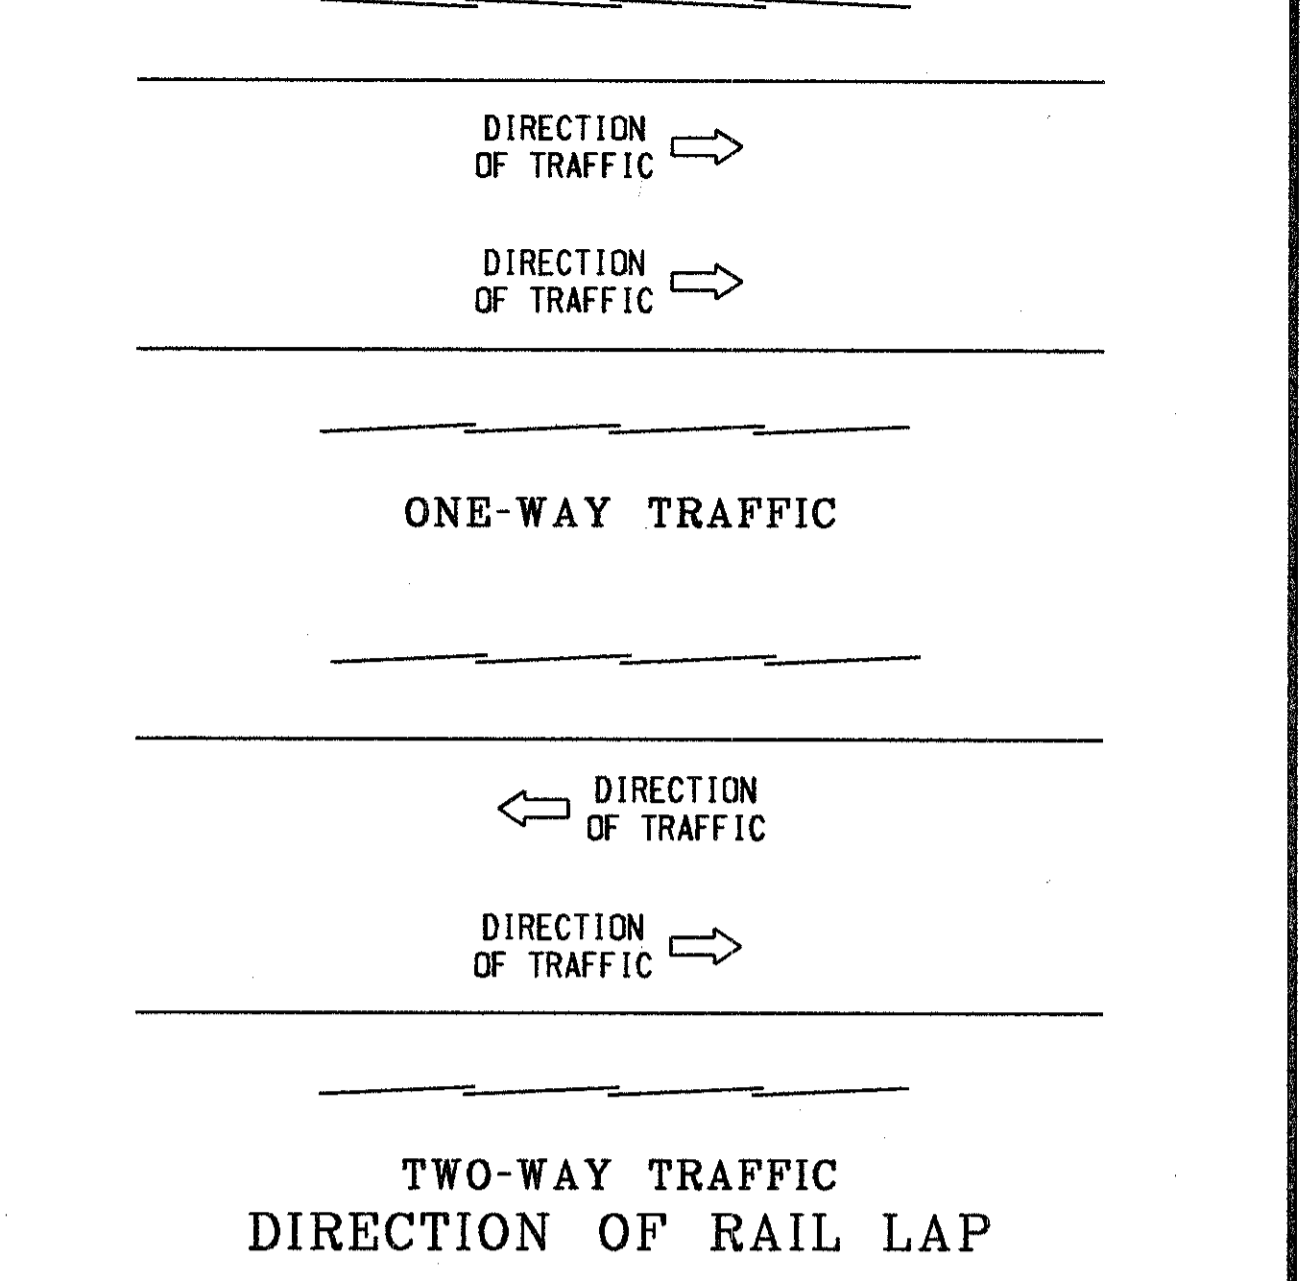

METAL TAG FOR CURVED GUARDRAIL WITH RADIUS OF 45.0 m OR LESS

NOTES:

DETAILS SPECIFIED ON THIS STANDARD ARE ACCORDING TO THE JOINT AASHTO - ARBA TECHNICAL BULLETIN NO. 268. "A GUIDE TO STANDARDIZED HIGHWAY BARRIER RAIL HARDWARE".

BEAM ELEMENTS SHALL BE SHOP BENT TO PLAN RADIUS FOR CURVE RADIUS 45.0 m OR LESS. A TAG IDENTIFYING THE CURVATURE OF THE SHOP BENT SECTION WILL BE REQUIRED FOR EACH CURVED ELEMENT.

POST BOLT SLOTS AT 1.905 m INTERVALS WILL BE ALLOWED IN BEAM ELEMENTS USED TO CONSTRUCT GUARDRAIL, TYPE A.

SEE STANDARD PLAN R-61-SERIES FOR GUARDRAIL APPROACH TERMINALS, STANDARD PLAN R-66-SERIES FOR GUARDRAIL DEPARTING TERMINALS AND STANDARD PLAN R-67-SERIES FOR GUARDRAIL ANCHORAGE, BRIDGE.

BEAM ELEMENTS SHALL BE FORMED FROM SHEETS HAVING A NOMINAL THICKNESS OF NOT LESS THAN 2.5 mm.

WHEN THE PLANS SPECIFY GUARDRAIL IS TO BE PLACED ON THE SHOULDER HINGE POINT, RATHER THAN AS SPECIFIED ON THIS PLAN, 2440 mm POSTS SHALL BE PROVIDED, WITH THE ADDITIONAL LENGTH EMBEDDED FOR ADDED STABILITY. (NOT NECESSARY WHEN THE SLOPE IS REASONABLY LEVEL BEYOND THE SHOULDER HINGE POINT, AS DETERMINED BY THE ENGINEER.)

WOOD POSTS WITH 10 mm BEVELS AT THE TOP MAY BE USED IN LIEU OF WOOD POSTS WITHOUT BEVELS SPECIFIED. THE LENGTH, WIDTH AND DEPTH OF THE POST SHALL BE AS SPECIFIED ON THIS STANDARD AND THE POST BOLT HOLES SHALL BE LOCATED TO ENSURE PROPER RAIL HEIGHT.


WOOD OFFSET BLOCKS WITH 10 mm BEVELS AT THE TOP AND BOTTOM OR A 20 mm BEVELED TOP MAY BE USED IN LIEU OF WOOD BLOCKS WITHOUT BEVELS SPECIFIED. THE LENGTH (FRONT AND BACK FACE), WIDTH AND DEPTH OF THE BLOCK SHALL BE AS SPECIFIED ON THIS STANDARD AND THE POST BOLT HOLES SHALL BE LOCATED TO ENSURE PROPER RAIL HEIGHT AND COMPATIBILITY WITH POST HOLES.

ALL DIMENSIONS ARE IN MILLIMETERS (mm) UNLESS OTHERWISE NOTED.


MICHIGAN DEPARTMENT OF TRANSPORTATION
BUREAU OF HIGHWAY TECHNICAL SERVICES STANDARD PLAN FOR

**GUARDRAIL,
TYPES A, B, BD, T, & TD**


F.H.W.A. APPROVAL _____ 4-16-99 PLAN DATE _____ R-60-E SHEET 10 OF 10

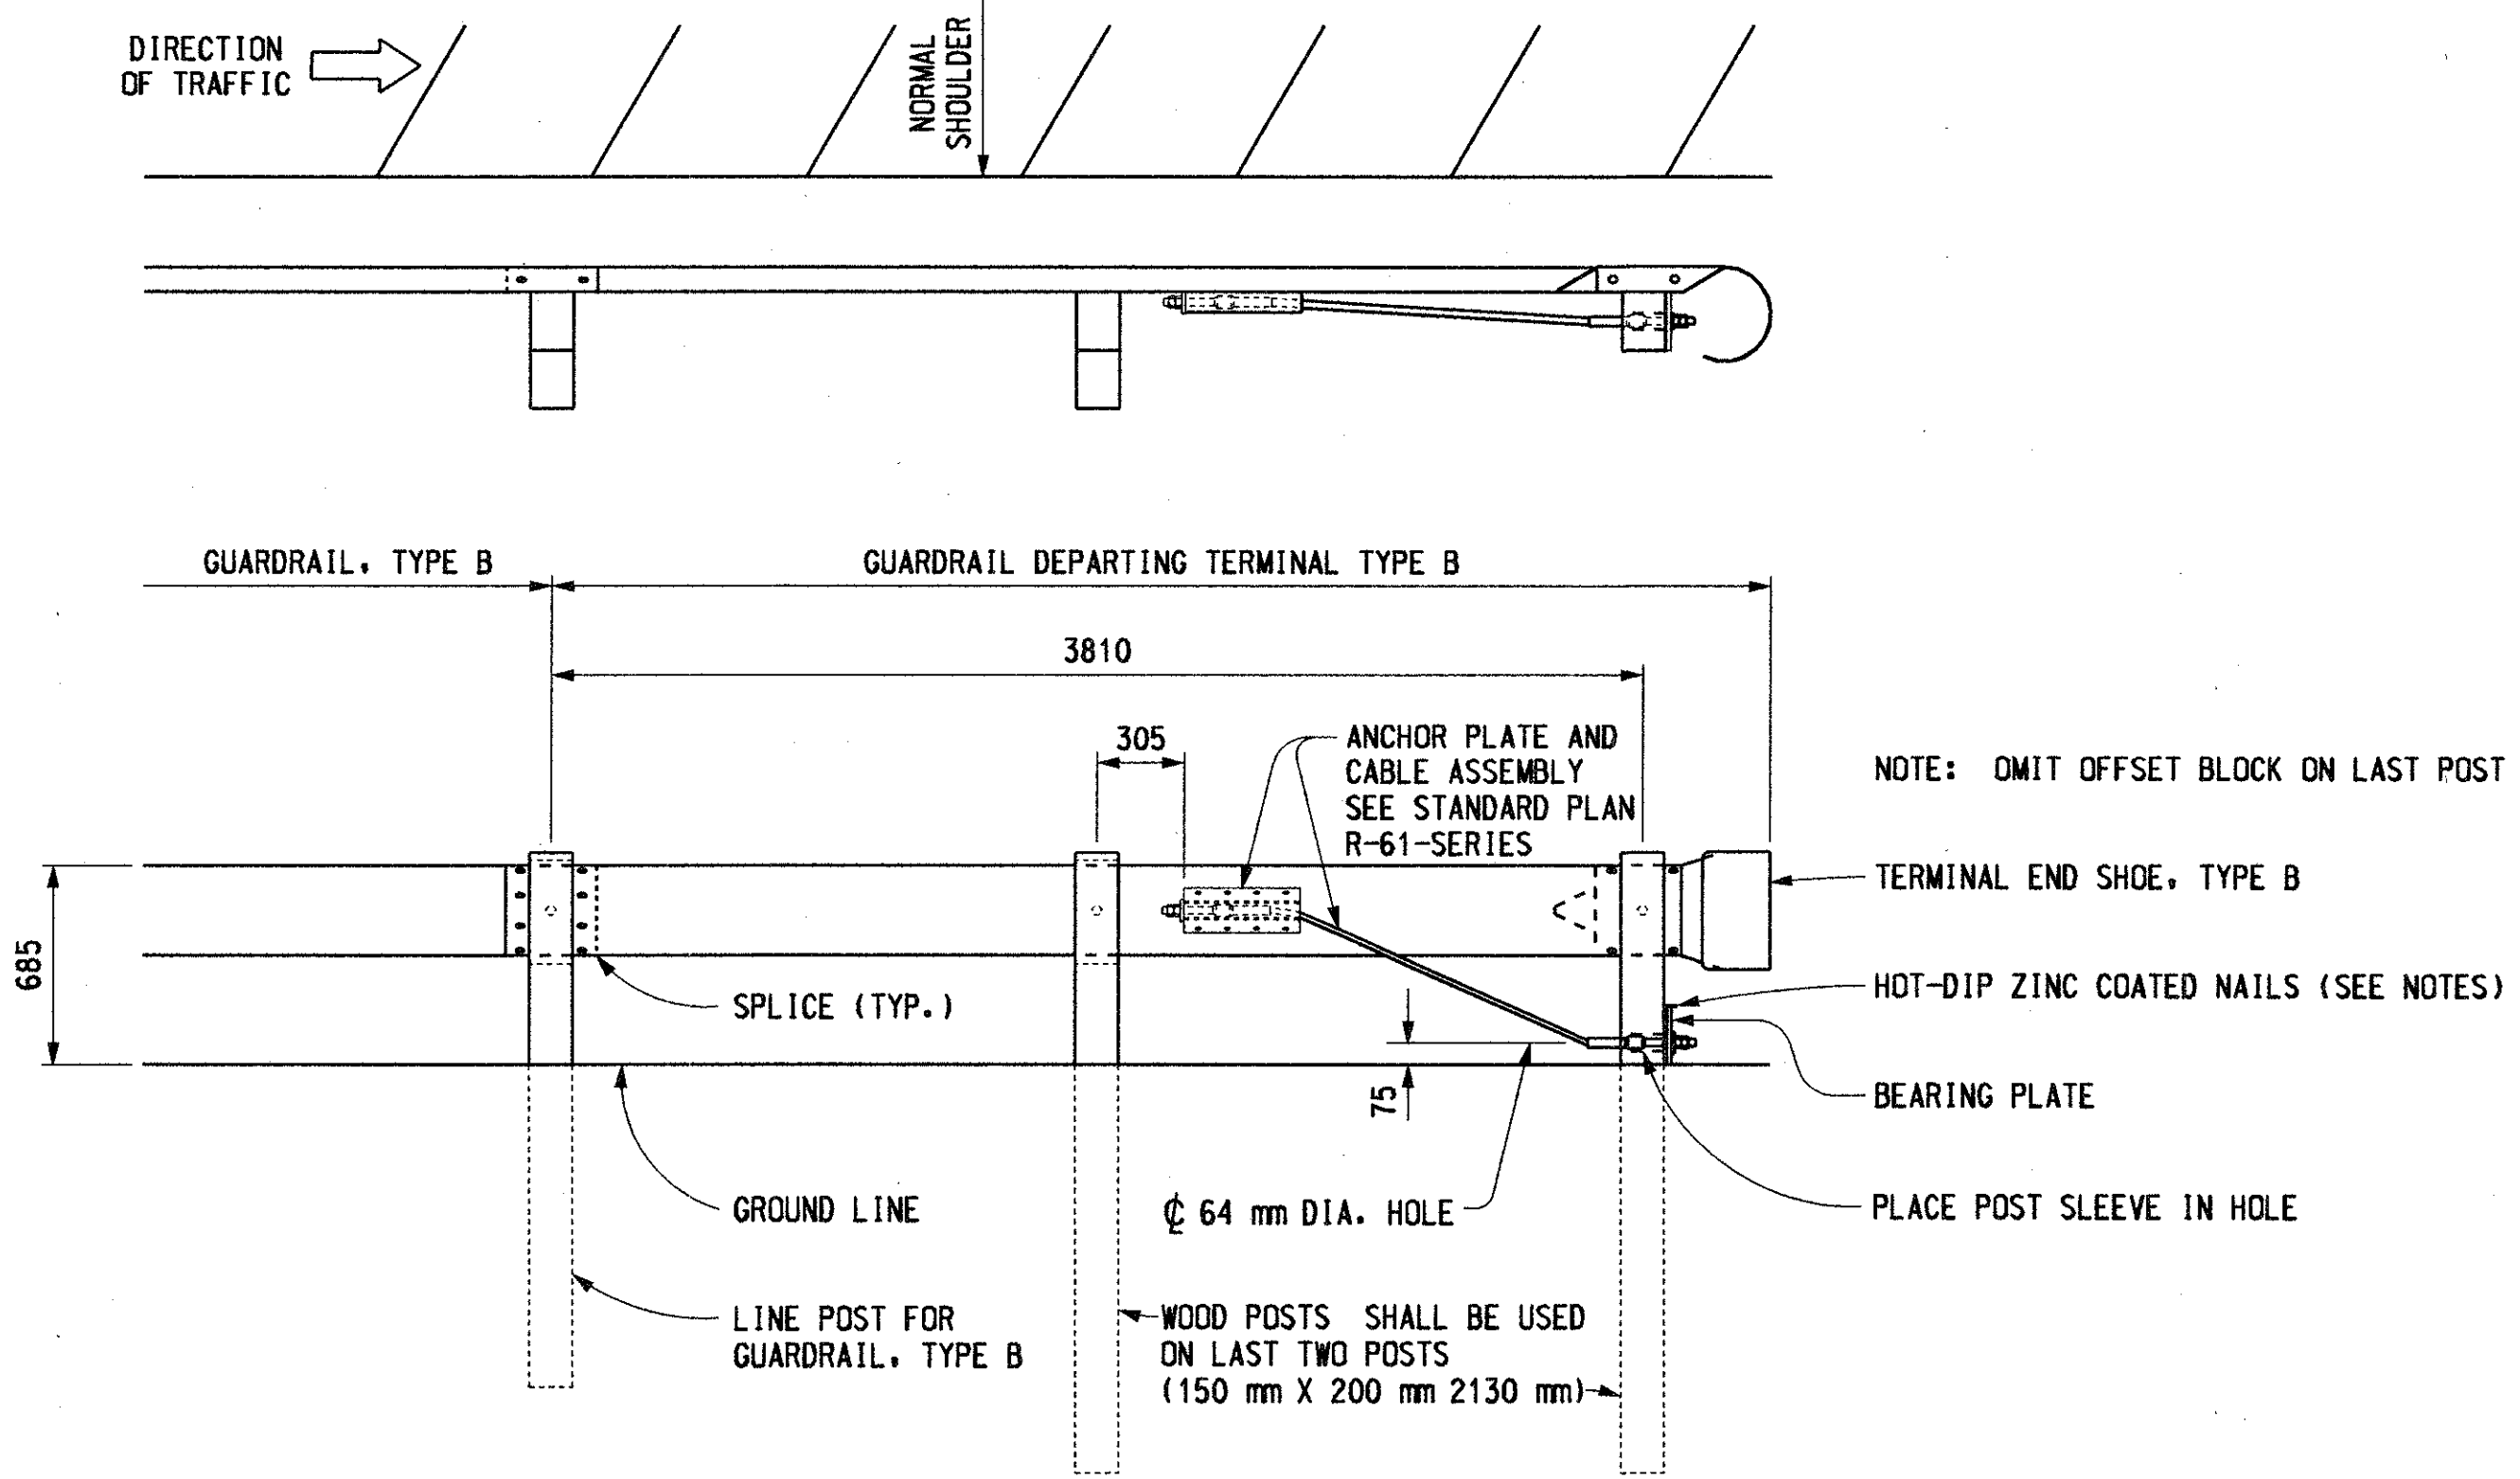


GUARDRAIL DEPARTING TERMINAL TYPE B

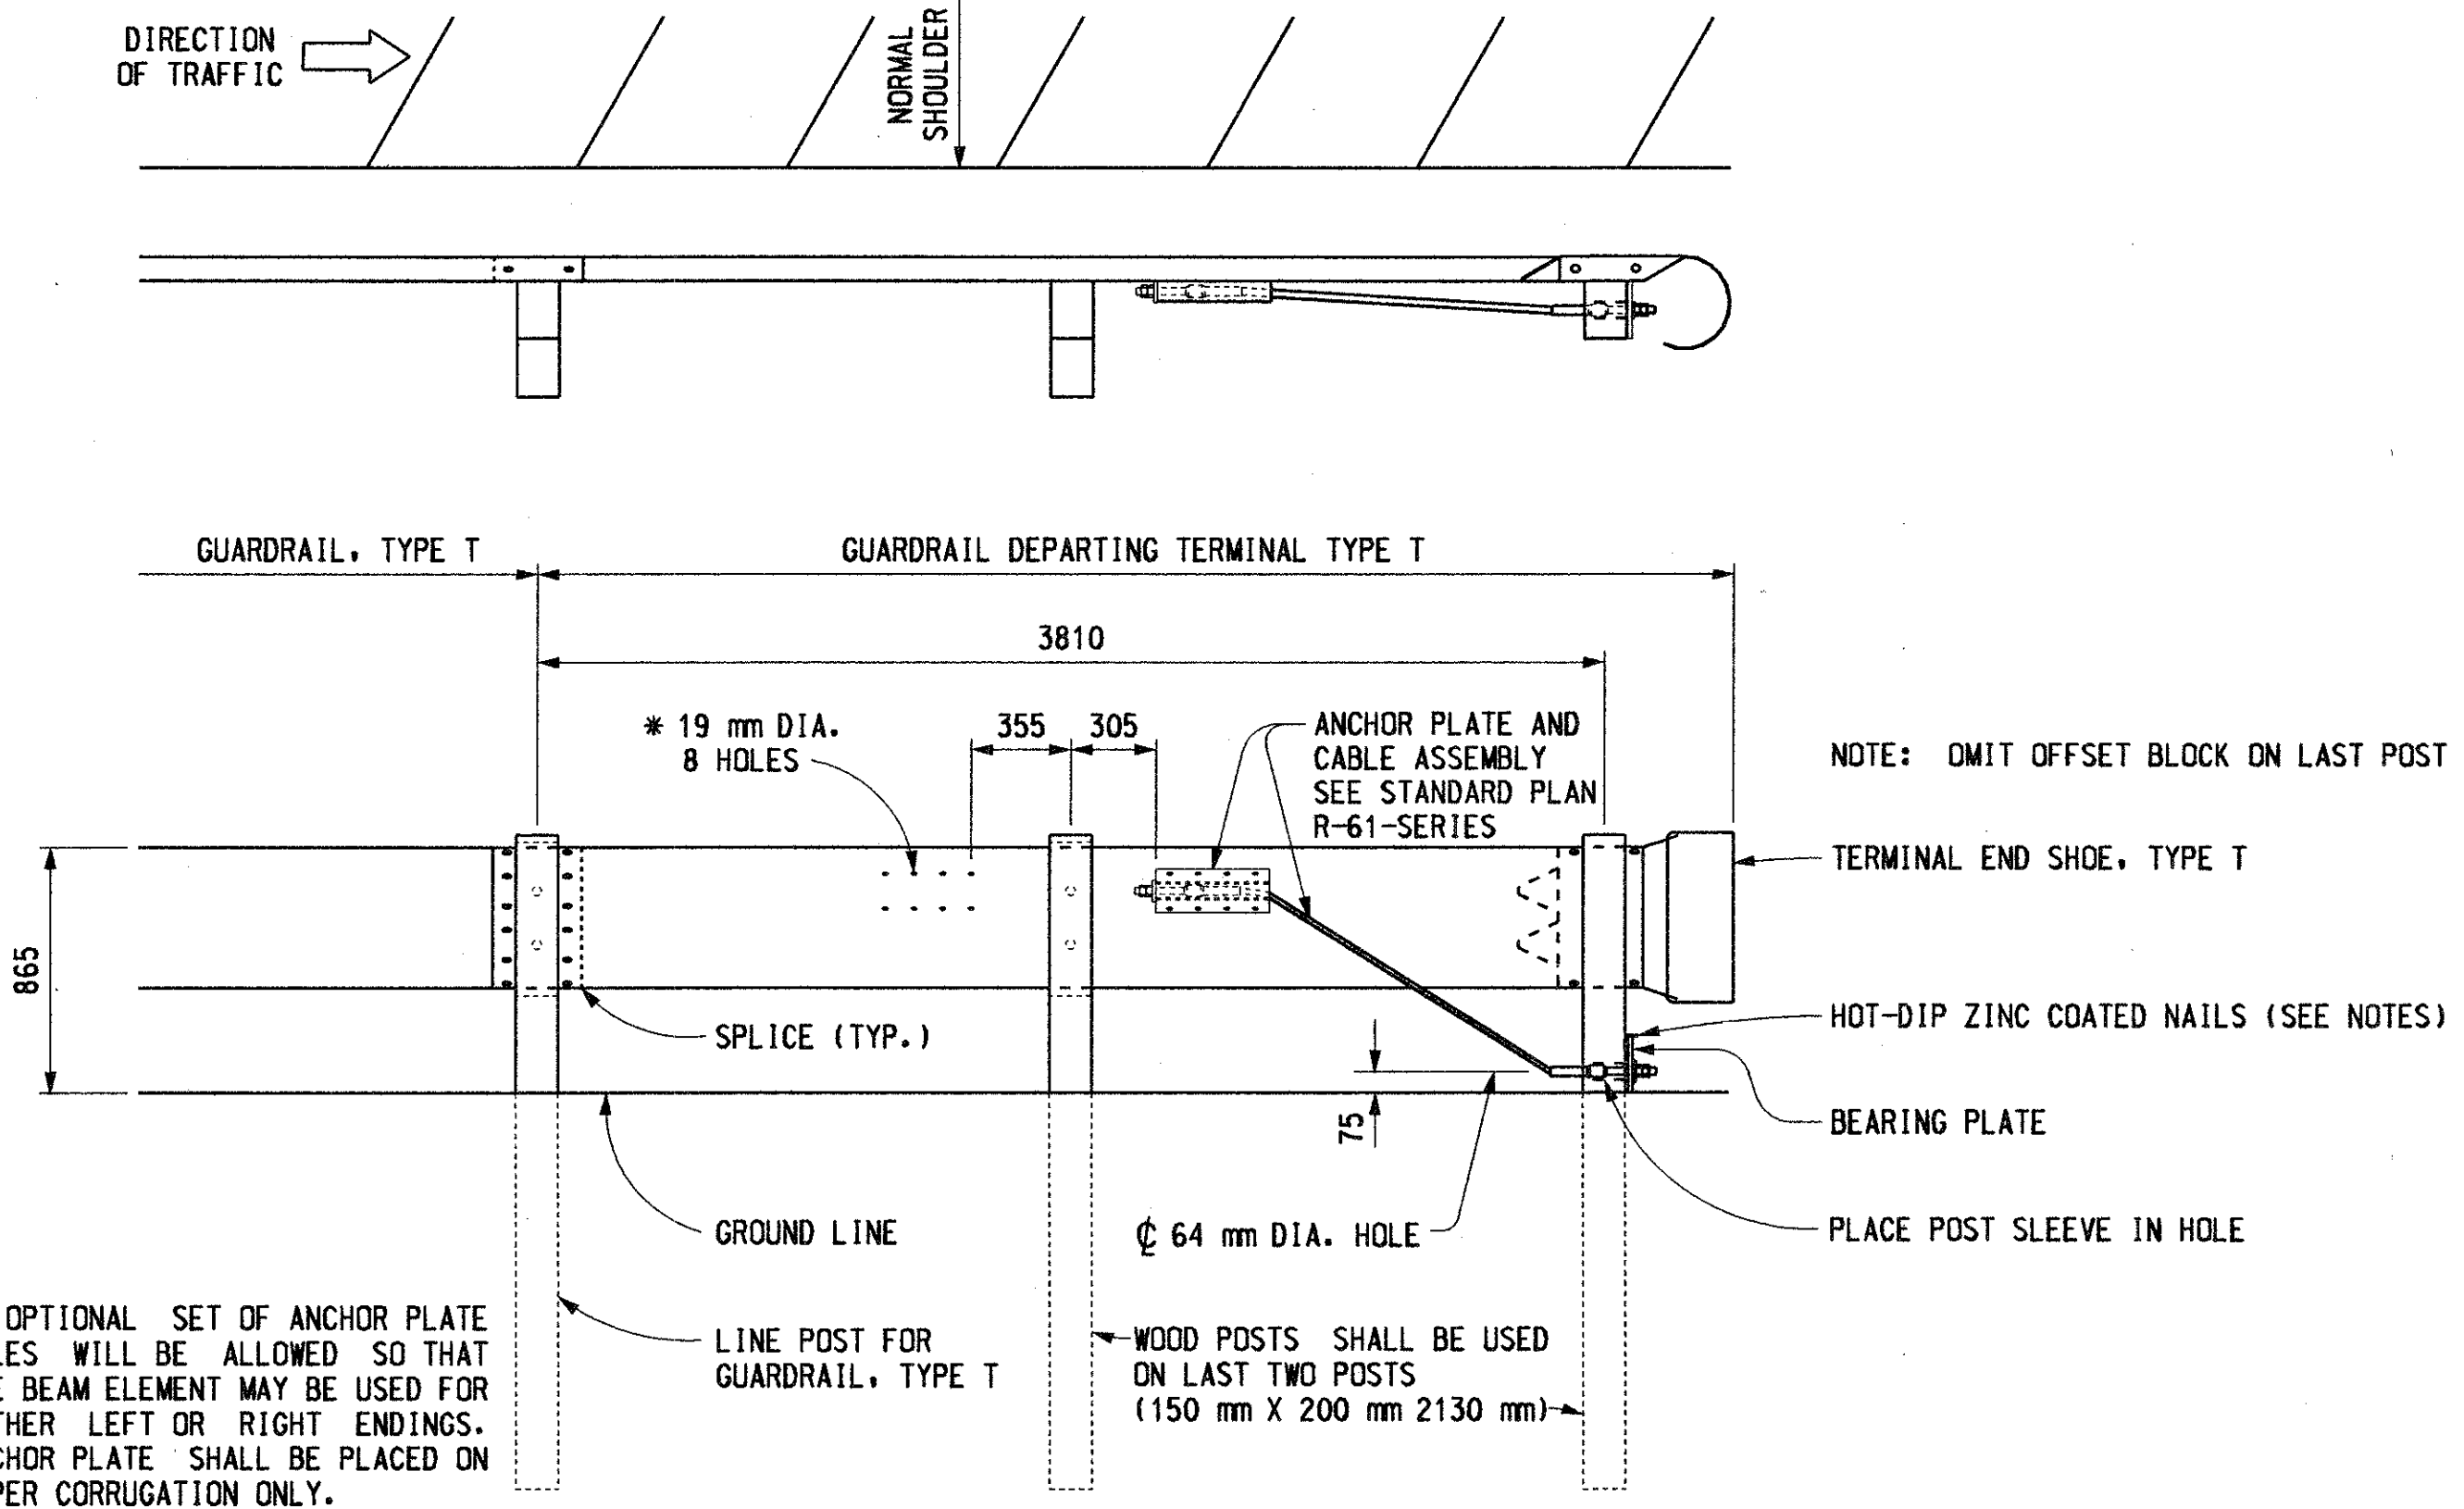



GUARDRAIL DEPARTING TERMINAL TYPE T

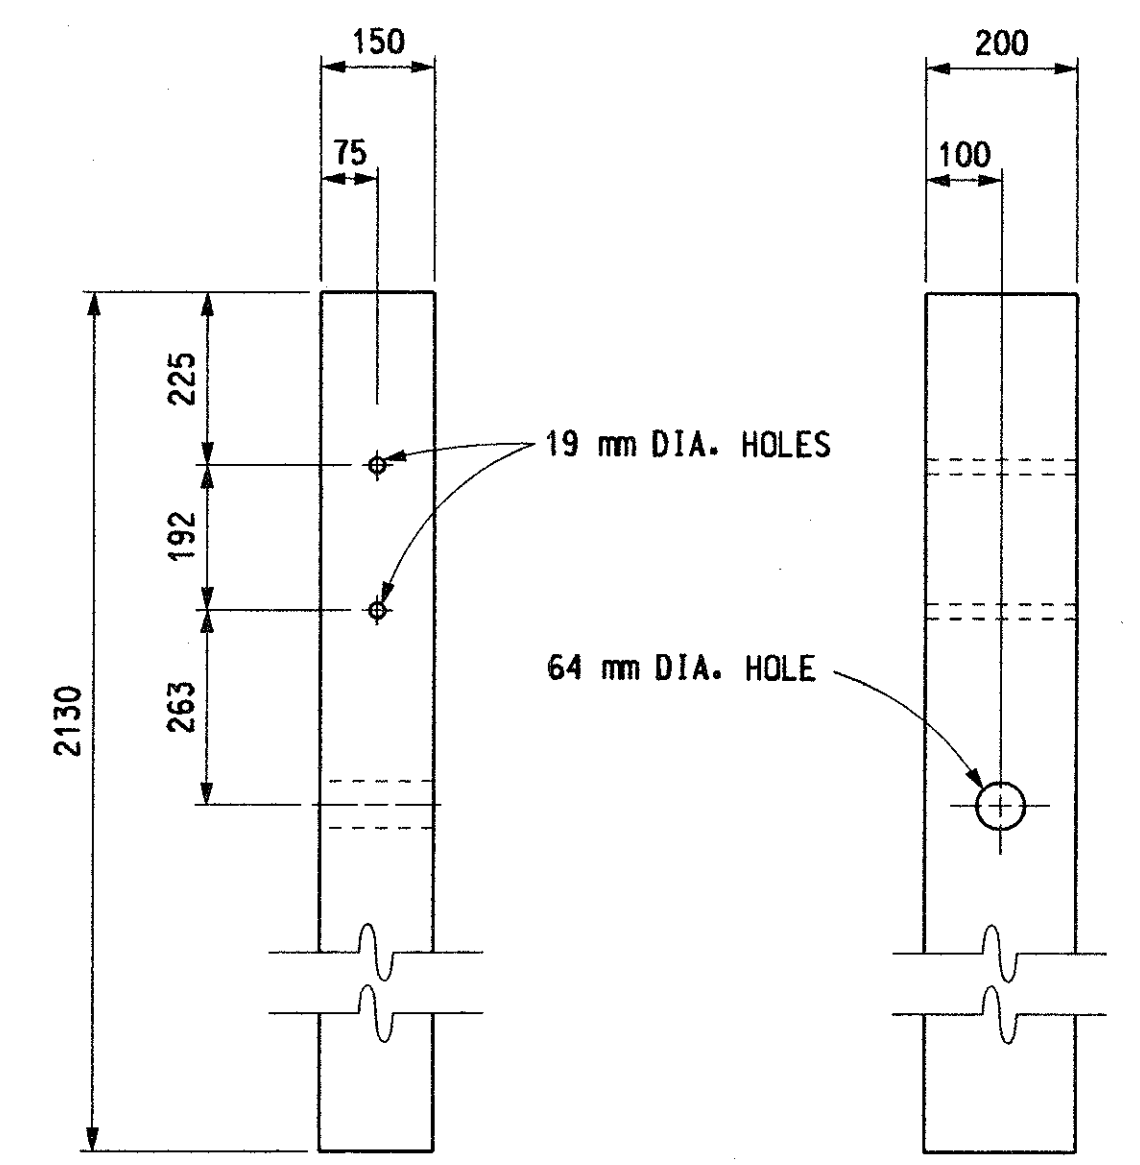



WOOD POST DETAIL
(FOR LAST POST, GUARDRAIL DEPARTING TERMINAL TYPE T)

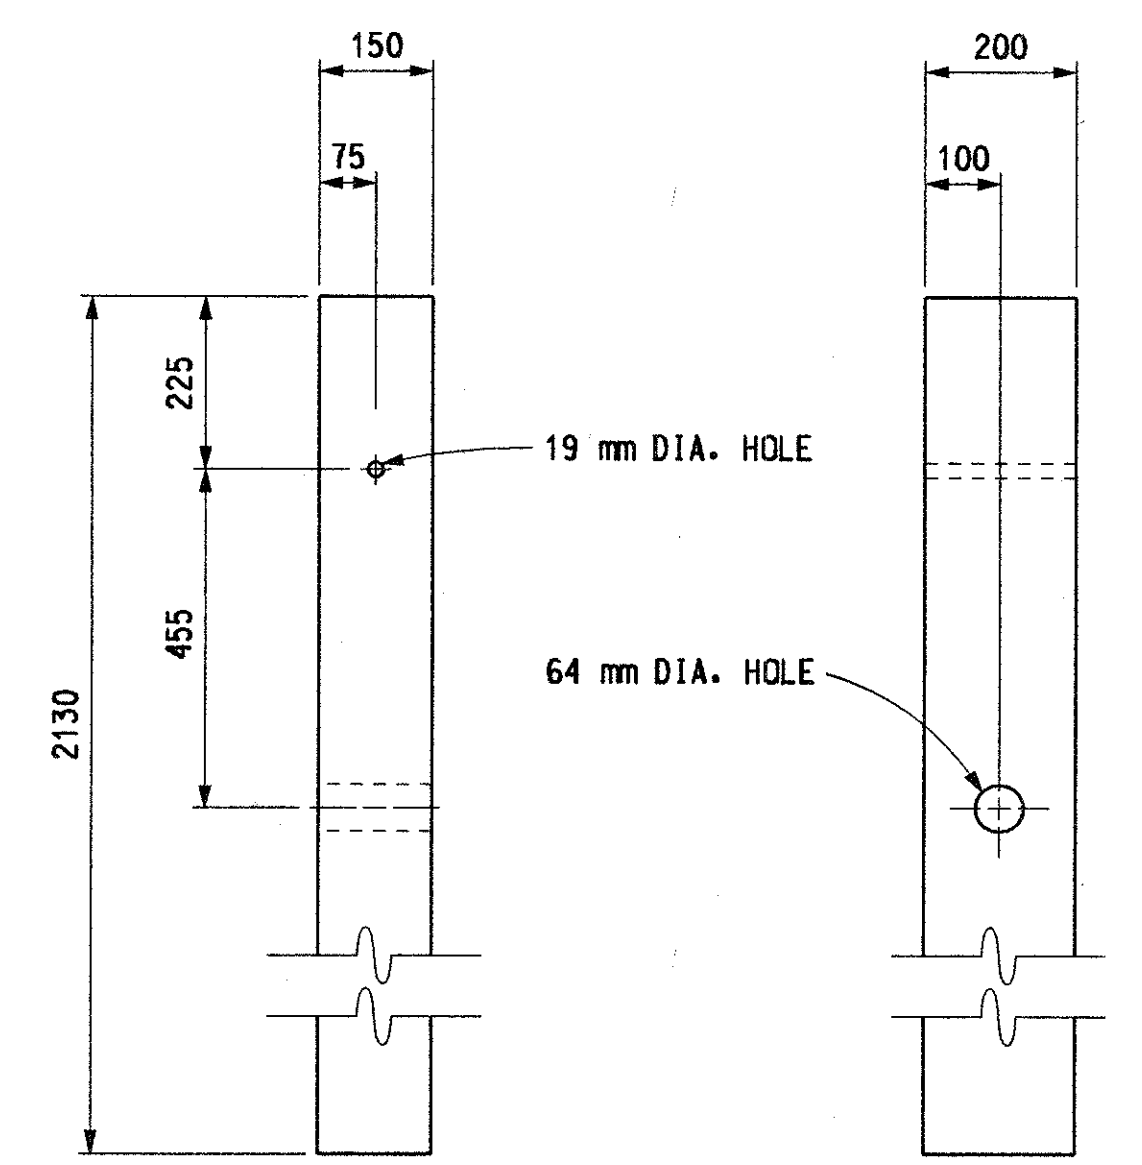

WOOD POST DETAIL
(FOR LAST POST, GUARDRAIL DEPARTING TERMINAL TYPE B)

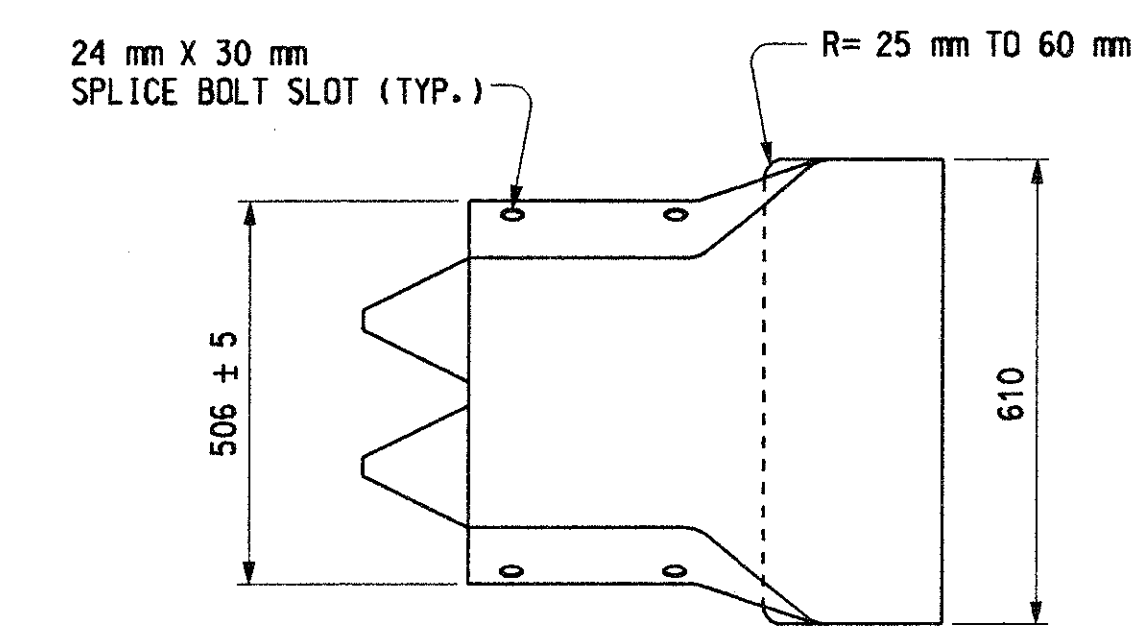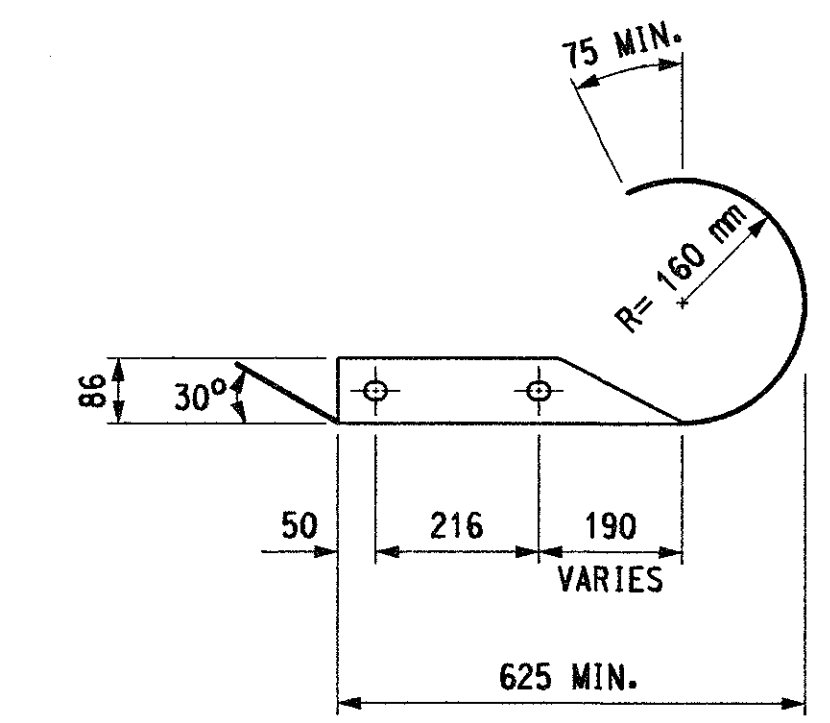


TERMINAL END SHOE, TYPE T

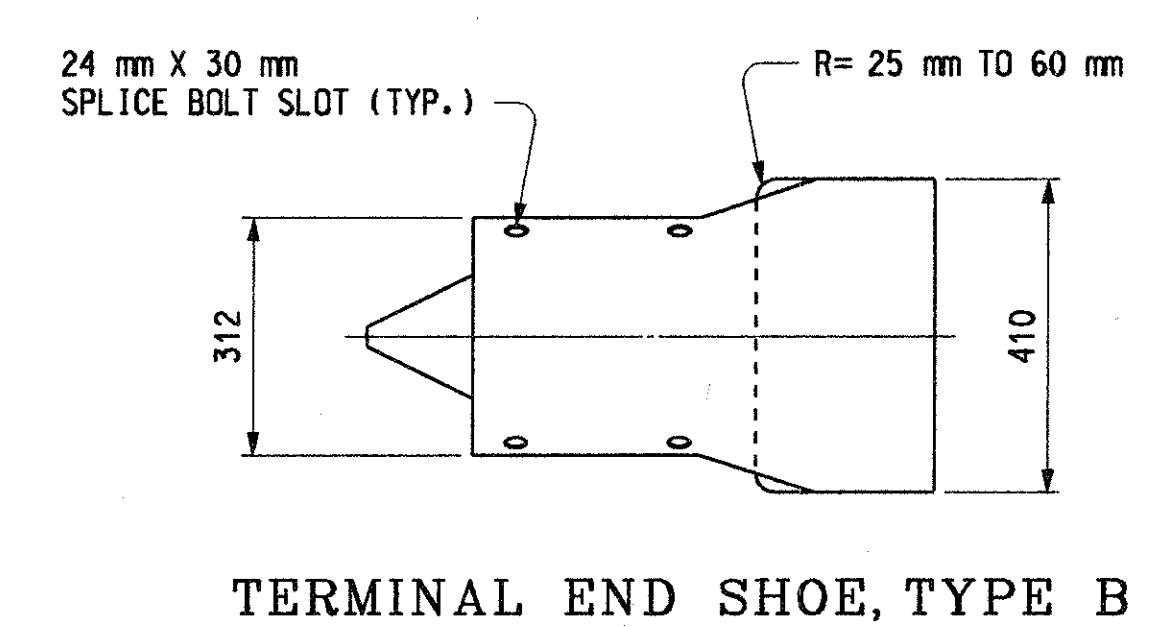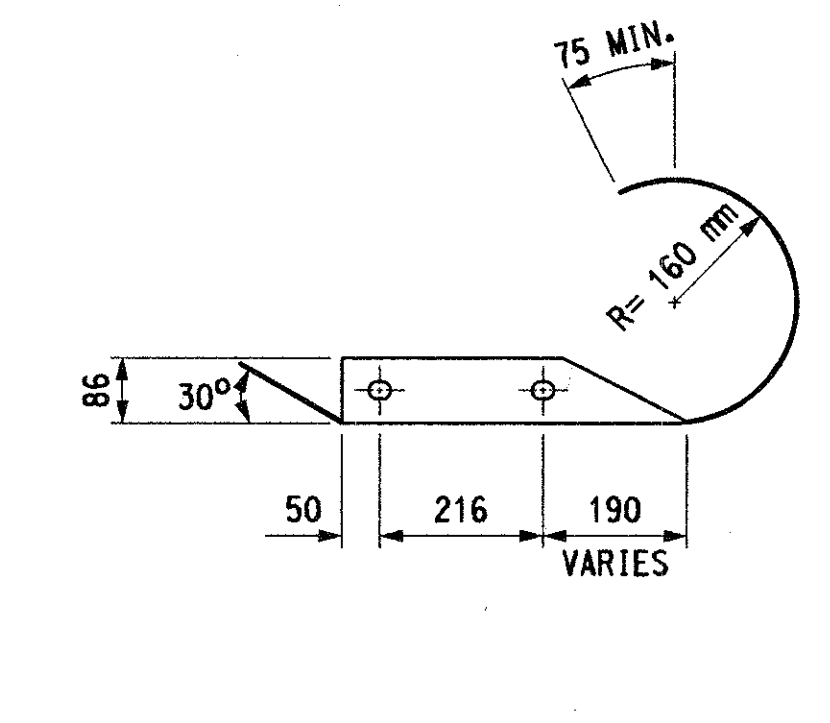


TERMINAL END SHOE, TYPE B

NOTES:
 ALL POSTS, OFFSET BLOCKS, BEAM ELEMENTS, AND HARDWARE (INCLUDING BOLTS, NUTS, AND WASHERS) SHALL CONFORM TO THE CURRENT STANDARD SPECIFICATIONS AND TO THE CURRENT STANDARD PLAN R-60-SERIES, WHERE APPLICABLE, EXCEPT AS SPECIFIED ON THIS STANDARD.
 ALL 1:10 SLOPES SHALL BE GRADED TO CLASS A SLOPE TOLERANCES.
 FOR DETAILS OF GUARDRAIL PLACEMENT, SEE STANDARD PLAN R-59-SERIES.
 AFTER THE CABLE ASSEMBLY HAS BEEN TIGHTENED, A SECOND NUT SHALL BE INSTALLED ON EACH END OF THE CABLE SO THAT THE CABLE WILL NOT LOOSEN.
 TWO HOT-DIP ZINC COATED NAILS SHALL BE DRIVEN INTO THE WOOD POST AT THE TOP OF THE BEARING PLATE TO KEEP THE BEARING PLATE FROM ROTATING.
 ALL DIMENSIONS ARE IN MILLIMETERS (mm) UNLESS OTHERWISE NOTED.

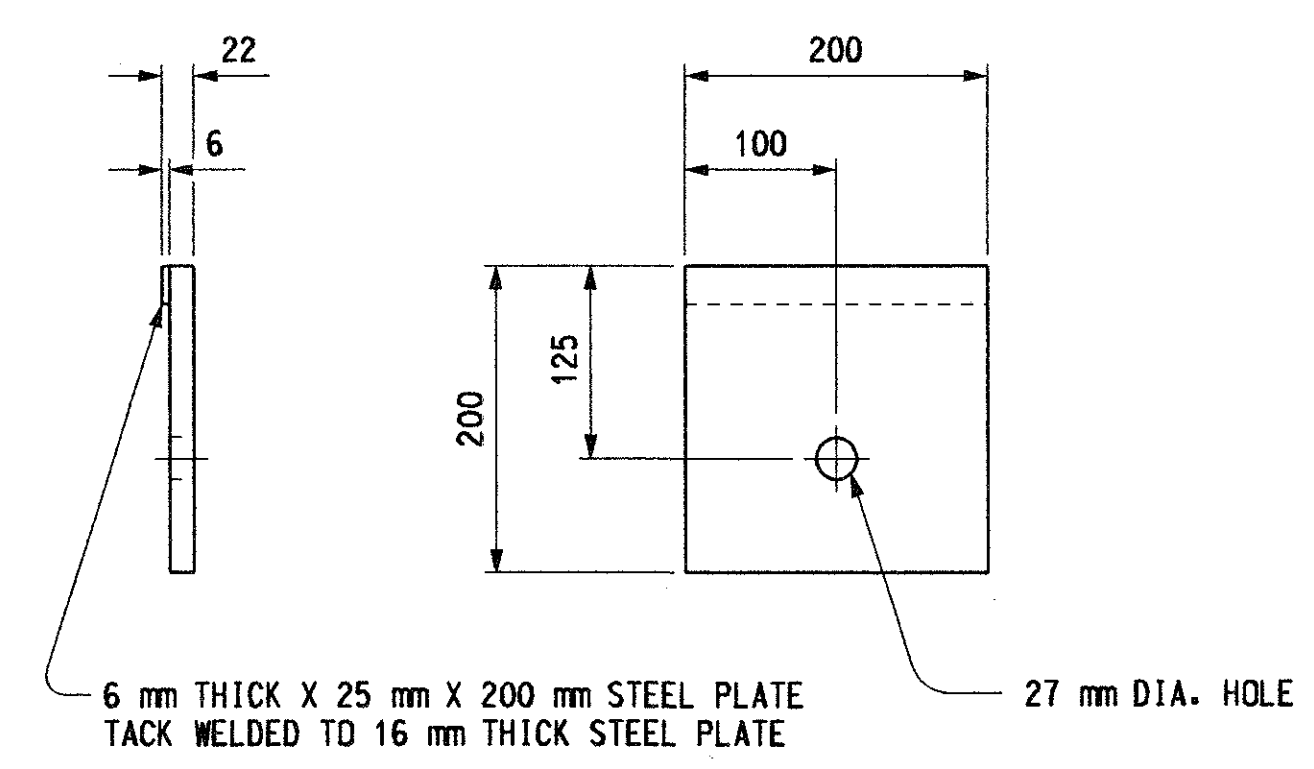

BEARING PLATE

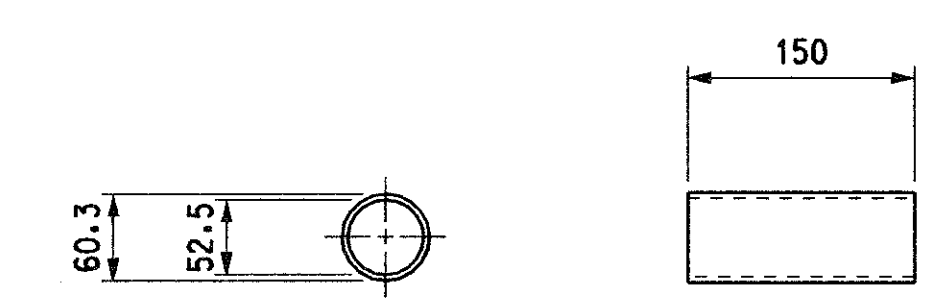

POST SLEEVE

	ENGINEER OF CONSTRUCTION & TECHNOLOGY	ENGINEER - ROAD DESIGN	MICHIGAN DEPARTMENT OF TRANSPORTATION BUREAU OF HIGHWAY TECHNICAL SERVICES STANDARD PLAN FOR GUARDRAIL DEPARTING TERMINAL TYPES B & T
	ENGINEER OF MAINTENANCE	ENGINEER OF DESIGN DEPARTMENT DIRECTOR James R. DeSana	
PREPARED BY DESIGN DIVISION	ENGINEER OF TRAFFIC AND SAFETY	BY: CHIEF ENGINEER/DEPUTY DIRECTOR BUREAU OF HIGHWAY TECHNICAL SERVICES	F.H.W.A. APPROVAL
DRAWN BY: B.L.T.			
CHECKED BY: W.K.P.			
		7-15-99 PLAN DATE	R-66-C
			SHEET 1 OF 2

MICHIGAN DEPARTMENT OF TRANSPORTATION BUREAU OF HIGHWAY TECHNICAL SERVICES STANDARD PLAN FOR GUARDRAIL DEPARTING TERMINAL TYPES B & T			
F.H.W.A. APPROVAL	7-15-99 PLAN DATE	R-66-C	SHEET 2 OF 2

LEGEND SHEET

UNDERGROUND

- M.H. 1234 EXISTING MANHOLE
- EXISTING HANDHOLE
- EXISTING DUCT RUN
- ABANDON EXISTING DUCT RUN
- BUILD ENCASED CONDUIT (E.C.) OR DIRECT BURIAL CONDUIT (D.B.) (4-100 mm E.C. SHOWN)
- M.H. 5678 BUILD NEW MANHOLE (2-WAY)
- M.H. 9012 BUILD NEW MANHOLE (3-WAY)
- M.H. 3456 BUILD NEW MANHOLE (4-WAY)
- M.H. 7890 BUILD NEW MANHOLE (CORNER)
- BUILD HANDHOLE (ROUND OR SQUARE AS INDICATED ON THE PLANS)
- BUILD POLYMER CONCRETE HANDHOLE
- BUILD TYPE "D" HANDHOLE
- EXISTING DIRECT BURIAL OR PARKWAY CABLE
- ABANDON DIRECT BURIAL OR PARKWAY CABLE
- INSTALL DIRECT BURIAL CABLE (NO. & SIZE AS INDICATED)
- INSTALL DIRECT BURIAL CONDUIT (1-75 mm SHOWN)
- EXISTING U.G.-FED ST. LTG. UNIT
- REMOVE U.G.-FED ST. LTG. UNIT & FDN. (EXCEPT AS OTHERWISE INDICATED)
- INSTALL COMB. T.S. & ST. LTG. STD. 1.8 m CLAMP-ON BRACKET ARM WITH 915 mm RISE ON NEW FDN. INSTALL 400W. TYPE LUMINAIRE.

OVERHEAD


- EXISTING WOOD POLE (M.B.T. POLE SHOWN)
- REMOVE WOOD POLE (D.E. CO. POLE SHOWN)
- REPLACE WOOD POLE (HEIGHT & CLASS AS INDICATED)
- INSTALL WOOD POLE (HEIGHT & CLASS AS INDICATED) (USE SALVAGED POLE WHERE INDICATED)
- EXISTING OVERHEAD ST. LTG. UNIT
- REMOVE OVERHEAD ST. LTG. UNIT
- INSTALL OVERHEAD ST. LTG. UNIT
- EXISTING OVERHEAD LINE
- REMOVE OVERHEAD LINE
- INSTALL OVERHEAD LINE
- INSTALL & LATER REMOVE OVERHEAD LINE
- INSTALL GUY & ANCHOR (12.7 mm GUY SHOWN)
- REMOVE GUY & ANCHOR ROD
- INSTALL POLE GUY (12.7 mm GUY SHOWN)
- INSTALL ARM GUY (9.5 mm GUY SHOWN)
- REMOVE GUY (TYPE AS SHOWN)
- MATERIAL TO BE INSTALLED
- MATERIAL TO BE REMOVED
- MAKE WOOD POLE SELF-SUPPORTING IN CONCRETE
- CABLE POLE

TRAFFIC SIGNAL

- INSTALL 3-SECTION TRAFFIC SIGNAL (1-WAY SHOWN)
- INSTALL 3-SECTION TRAFFIC SIGNAL WITH SALVAGED HEADS (2-WAY SHOWN)
- REMOVE 3-SECTION TRAFFIC SIGNAL (3-WAY SHOWN)
- EXISTING 3-SECTION TRAFFIC SIGNAL (4-WAY SHOWN)
- INSTALL 3-SECTION, 300 mm TRAFFIC SIGNAL (1-WAY SHOWN)
- INSTALL 2-WAY ILLUMINATED CASE SIGN
- INSTALL 2-WAY ILLUMINATED CASE SIGN (SALVAGED)
- REMOVE 2-WAY ILLUMINATED CASE SIGN
- EXISTING 2-WAY ILLUMINATED CASE SIGN
- INSTALL 4-WAY ILLUMINATED CASE SIGN
- INSTALL 4-WAY ILLUMINATED CASE SIGN (SALVAGED)
- REMOVE 4-WAY ILLUMINATED CASE SIGN
- EXISTING 4-WAY ILLUMINATED CASE SIGN
- INSTALL 2-SECTION, 300 mm PEDESTRIAN (WALK-DON'T WALK) TRAFFIC SIGNAL (2-WAY SHOWN)
- INSTALL 2-SECTION PEDESTRIAN (WALK-DON'T WALK) TRAFFIC SIGNAL WITH SALVAGED HEAD (2-WAY SHOWN)
- REMOVE 2-SECTION PEDESTRIAN (WALK-DON'T WALK) TRAFFIC SIGNAL (1-WAY SHOWN)
- EXISTING 2-SECTION PEDESTRIAN (WALK-DON'T WALK) TRAFFIC SIGNAL (1-WAY SHOWN)
- INSTALL TRAFFIC SIGNAL CONTROLLER (NEW OR SALVAGED AS INDICATED) ON NEW FDN. (EXCEPT AS OTHERWISE INDICATED)
- INSTALL TRUSS TYPE MAST ARM STD. & MAST ARM ON NEW FOUNDATION (EXCEPT AS OTHERWISE INDICATED)
- INSTALL 2.4 m TRAFFIC SIGNAL PEDESTAL ON NEW FOUNDATION (EXCEPT AS OTHERWISE INDICATED)
- INSTALL STEEL STRAIN POLE ON NEW FOUNDATION (POLE HEIGHT AS INDICATED ON PLANS)
- EXISTING TRAFFIC SIGNAL CONTROLLER
- EXISTING MAST ARM STANDARD
- EXISTING PEDESTAL
- EXISTING STEEL STRAIN POLE
- INSTALL OVERHEAD PLASTIC JACKETED CABLE
- EXISTING OVERHEAD PLASTIC JACKETED CABLE
- REMOVE OVERHEAD PLASTIC JACKETED CABLE

SH. 1 OF 2

FILENAME: D:\DGN-TSE-STD-METRIC-LEGSHT.TME

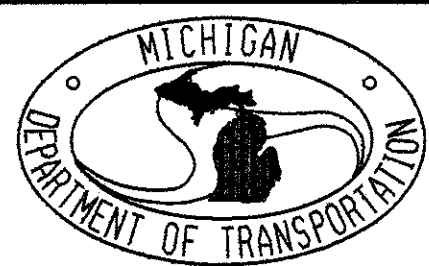

LEGEND SHEET

DATE	SCALE	CONT. SEC.	JOB NO.	T & S	CONST.
------	-------	------------	---------	-------	--------

LEGEND SHEET

TRAFFIC SIGNAL

- INSTALL JUNCTION BOX
- INSTALL SALVAGED JUNCTION BOX
- REMOVE JUNCTION BOX
- EXISTING JUNCTION BOX
- BACK-OUT LAMPS & HOOD SIGNALS (INCIDENTAL TO INSTALLATION OF T.S. ON THIS CONTRACT)
- REMOVE HOOD & INSTALL LAMPS (INCIDENTAL TO INSTALLATION OF T.S. ON THIS CONTRACT)
- POLE CONTACT HEIGHT OF T.S. SPAN WIRE
- LOW CONTACT HEIGHT OF SPAN WIRE T.S. TO SPAN WIRE
- INSTALL WARNING SIGN (TYPE AS INDICATED ON PLANS)
- INSTALL LOOP DETECTOR & CABINET (EXCEPT AS OTHERWISE INDICATED)

DIAGRAMS


- (U.G.-FED ST. LTG. STD. SYMBOLS SAME AS UNDERGROUND LEGEND OF THIS SHEET)
- M.H. 1234 PROPOSED MANHOLE
 - M.H. 5678 EXISTING MANHOLE
 - H.H. PROPOSED HANDHOLE
 - H.H. EXISTING HANDHOLE
 - M.H. 9012 PROPOSED MANHOLE IN SAME LOCATION AS EX. HOLE
 - INSTALL U.G. CABLE (NO. & SIZE AS INDICATED)
 - EXISTING U.G. CABLE
 - U.G. CABLE TO BE ABANDONED
 - U.G. CABLE TO BE REMOVED
 - DISCONNECT, INSULATE & CAP CABLE END
 - SPLICE STRAIGHT THRU
 - SPLICES
 - PROPERTY (ROW) LINE
 - FACE OF CURB & BACK OF CURB
 - FUTURE PAVEMENT
 - SEWER LINE, MANHOLE & CATCH BASIN
 - POWER CO. U.G. LINE & MANHOLE
 - TELEPHONE TEL. CO. U.G. LINE & M.H.
 - WATERMAIN & GATEWELL (OTHER UTILITIES SIMILAR)

GENERAL

PLAN INDEX

DRWG. NO.	SUB-TITLE
1	LEGEND
2-3	GENERAL INFORMATION
4-7	GENERAL PLANS
8-31	DETAIL SHEETS

SH. 2 OF 2

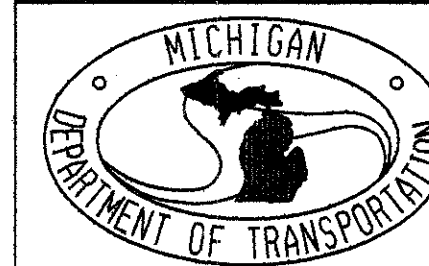

LEGEND SHEET

DATE	SCALE	CONT. SEC.	JOB NO.	T & S	CONST.
------	-------	------------	---------	-------	--------

9-21-99		63174	48404A	1 of 31	ID
---------	--	-------	--------	---------	----


GENERAL INFORMATION SHEET

GENERAL NOTES

1. CALL MISS DIG (800)482-7171 OR (313)647-7344 3 WORKING DAYS PRIOR TO ANY EXCAVATION FOR THE LOCATION OF UNDERGROUND UTILITIES.
2. WHERE ABANDONING OF U.G. CABLES IS CALLED FOR ON PLANS OR DIAGRAMS, CONTRACTOR SHALL CUT & REMOVE CABLES WITHIN MANHOLES & HANDHOLES.
3. WHERE INSTALLATION OF NEW MANHOLES OVER EXISTING CONDUITS (TO ACCOMMODATE NEW & EXISTING CONDUITS) IS CALLED FOR ON PLANS, CONTRACTOR SHALL CAREFULLY & SO AS NOT TO DAMAGE EXIST. CABLES, REMOVE THE EXISTING CONDUITS & ENCASEMENT WITHIN MANHOLES. EXIST. CABLES SHALL BE EXTENDED & PROPERLY TRAINED, RACKED & SUPPORTED.
4. ALL EXISTING STREET LIGHTING, TRAFFIC SIGNAL, PRIMARY, TRANSMISSION ETC. CIRCUITS SHALL ALWAYS BE MAINTAINED IN AN OPERATIONAL CONDITION (EXCEPT WHERE OTHERWISE NOTED).
5. ALL CONDUITS NOT TERMINATING IN STRUCTURES SUCH AS MANHOLES, HANDHOLES OR FOUNDATIONS SHALL EXTEND 600 mm BEYOND PAVEMENT LIMIT (EXCEPT AS OTHERWISE INDICATED). ALL UNOCCUPIED CONDUITS SHALL BE PLUGGED.
6. ALL TREE TRIMMING REQUIRED TO CLEAR NEW OR SALVAGED ST. LTG. & TRAFFIC SIGNAL STD.'S AND O.H. ST. LTG. & TRAFFIC SIGNAL UNITS SHALL BE INCLUDED TO THE PAY-ITEM & NO EXTRA PAYMENT SHALL BE MADE.
7. EXISTING O.H. & T.S. FACILITIES ARE NOT NECESSARILY SHOWN ON PLANS.
8. ALL OVERHEAD WIRES & UNDERGROUND CABLES SHALL CONSIST OF COPPER CONDUCTORS AS PER SPECIFICATIONS.
9. NEW CONDUITS BROKEN INTO EXISTING MANHOLES OR HANDHOLES SHALL NOT INTERFERE WITH RACKING AND/OR TRAINING OF CABLES.
10. ALL NEW ANCHOR GUYS SHALL BE INSTALLED ON A 1:1 RATIO OR AS NEARLY AS POSSIBLE (EXCEPT WHERE OTHERWISE NOTED). (STRUT GUYS ARE EXCEPTED).
11. ALL WIRES & CABLES SHALL BE TAGGED IN A PERMANENT MANNER INDICATING THE SOURCE & USE OF EACH. THIS SHALL BE DONE IN ALL MANHOLES, HANDHOLES & CABINETS WHERE THESE CABLES OR WIRES ENTER, EXIT, ARE SPLICED AND ARE TERMINATED.
12. INSTALL WOOD POLES SO AS NOT TO INTERFERE WITH TRAFFIC OR FUTURE CONSTRUCTION STAGES.
13. ALL SALVAGED WOOD POLES SHALL BE POLES PREVIOUSLY INSTALLED NEW ON THIS CONTRACT.
14. ALL TRAFFIC STREET SIGNS SUCH AS "NO PARKING", "NO STANDING" ETC. SHALL BE TRANSFERRED FROM OLD STD. OR POLE TO NEW STD. OR POLE AT SAME LOCATION OR IN CLOSE PROXIMITY BY DEPT. OF TRANSPORTATION.
15. ALL TRAFFIC SIGNALS SHALL BE MOUNTED WITH NEW STANDARD TRAFFIC SIGNAL BRACKETS & FITTINGS.
16. ALL TRAFFIC SIGNAL ITEMS, AS CALLED FOR ON PLANS, SHALL HAVE INCLUDED IN THE TRAFFIC SIGNAL ITEM ALL CABLES FROM THE CONTROLLER TO THE TRAFFIC SIGNALS & FOUNDATIONS AS INDICATED.
17. WHEN ENTERING PROPOSED CONDUIT INTO EXISTING MANHOLES & HANDHOLES, EXERCISE CAUTION NOT TO DISTURB EXISTING CABLES.
18. ALL SALVAGED TRAFFIC SIGNALS SHALL BE TRAFFIC SIGNALS PREVIOUSLY INSTALLED NEW ON THIS CONTRACT. (EXCEPT AS OTHERWISE INDICATED).
19. FOR TRAFFIC SIGNAL SPAN WIRE USE EXTRA HIGH STRENGTH GRADE AS PER SPECIFICATIONS.
20. CROSSARMS SHALL BE REMOVED AFTER ALL CONTACTS ARE REMOVED. (INCLUDED IN THE REMOVAL OF OVERHEAD LINES).

SH. 1 OF 3

LAST CORRECTION DATE:
FILENAME:

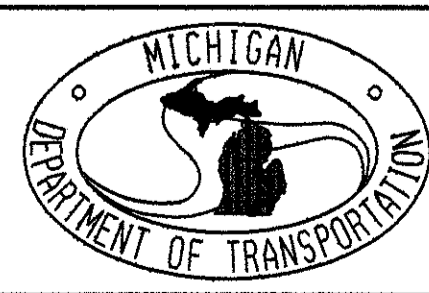

GENERAL INFORMATION SHEET


DATE	SCALE	CONT. SEC.	JOB NO.	T & S	CONST.

GENERAL INFORMATION SHEET

GENERAL NOTES

21. SEAL END OF CABLE WHERE COILING OF CABLE IS CALLED FOR ON PLANS. (CONTRACTOR SHALL RECEIVE PAYMENT FOR COILED-UP CABLES).
22. CONTRACTOR SHALL DELIVER WHERE REQUIRED TO THE ROAD COMMISSION OF OAKLAND COUNTY T.S. CONTROLLER FOR TIMING. CONTRACTOR SHALL PICK-UP CONTROLLER FROM R.C.O.C. WHEN READY FOR INSTALLATION.
23. PROPOSED T.S. SHALL BE PUT INTO OPERATION AT TIME OF REMOVAL OF EXISTING T.S. FACILITIES, CONTRACTOR SHALL NOTIFY R.C.O.C. IF UNABLE TO MAINTAIN T.S. IN AN OPERABLE CONDITION AT ALL TIMES.
24. A MINIMUM CLEARANCE OF 1050 mm HORIZONTAL & 300 mm VERTICAL MUST BE MAINTAINED BETWEEN PROPOSED FACILITIES & EXISTING U.G. WATER FACILITIES.
25. CONTACT LOCAL TELEPHONE COMPANY AND R.C.O.C. FOR INSTALLATION OF LOCAL TELEPHONE COMPANY SERVICE (INTERCONNECT).
26. UTILITY CO. SERVICE INSTALLATION FEES, METERED SERVICE CHARGES AND OTHER CHARGES AS DETAILED ON THE PLANS (FOR LENGTH OF CONTRACT) ARE TO BE ORDERED & PAID BY THE CONTRACTOR. (INCLUDED IN THE INSTALLATION OF T.S. ON THIS CONTRACT).
27. CONTACT MR. JOHN HORNING (R.C.O.C.) (248-858-7250) 2 WORKING DAYS PRIOR TO INSTALLATION AND INSPECTION OF TRAFFIC SIGNALS.
28. ALL MATERIAL REMOVED ON THE CONTRACT SHALL BECOME THE PROPERTY OF M.D.O.T., STORED ON SITE AND PICKED-UP BY R.C.O.C.
29. BAGGING OF TEMP. OR FINAL T.S. REQUIRED BY THE ENGINEER SHALL BE INCLUDED IN THE INSTALLATION OF T.S. ON THIS CONTRACT.
30. ALL O.H. TRAFFIC SIGNAL CABLE SHALL BE SUPPORTED BY 6.35 mm E.H.S. SPAN WIRE AS PER SPECIFICATIONS (INCLUDED IN THE INSTALLATION OF T.S. ON THIS CONTRACT.)
31. SEE DETAILS FOR TYPICAL PEDESTRIAN T.S. WIRING ON POLES; (M.D.O.T. STEEL POLES, WOOD POLES OR STEEL POLES OWNED BY OTHERS). ALL STEEL POLES SHALL BE ASSUMED TO BE OWNED BY MDOT UNLESS OTHERWISE NOTED ON PLANS.
32. ALL TRAFFIC SIGNAL INSTALLATIONS WITH SOLID STATE CONTROLLERS SHALL BE GROUNDED AT EACH SPAN CONTACT POLE. THE GROUNDING SHALL HAVE A MEASURED RESISTANCE NO GREATER THAN 10 OHMS WHEN INSTALLED.
33. CONCRETE PAVEMENT REPAIRS SHALL BE CONSTRUCTED IN ACCORDANCE WITH M.D.O.T. STANDARD PLAN R-44 SERIES, UP-1 & "STANDARD SPECIFICATIONS FOR CONSTRUCTION" SEC. 603.
34. ALL CONDUIT BENDS SHALL HAVE MINIMUM RADII IN ACCORDANCE WITH THE CURRENT N.E.C.
35. ALL TRAFFIC SIGNAL FITTINGS (SCREWS, NUTS, BOLTS, PINNACLES, ETC.) SHALL BE GREASED WITH A NON-OXIDE TYPE GREASE.
36. INSTALL STEEL POLE HANDHOLE, AS DESCRIBED ON DETAIL SHEET, IN ALL EXIST. STEEL POLES AS DIRECTED BY ENGINEER. (INCLUDED IN THE INSTALLATION OF T.S. ON THIS CONTRACT.)
37. FOR ELECTRICAL SERVICE INSPECTION CONTACT THE MICHIGAN DEPARTMENT OF LABOR.
38. NO CHANGES FROM PLANS IN LOCATION OF SUPPORTING STRUCTURES, SIGNAL HEAD PLACEMENT OR TRAFFIC SIGNAL EQUIPMENT WILL BE ALLOWED WITHOUT PRIOR APPROVAL OF THE MICHIGAN DEPARTMENT OF TRANSPORTATION, TRAFFIC AND SAFETY DIVISION, TRAFFIC SIGNALS UNIT IN LANSING, MI. ; PHONE: 1-517-373-2323.
39. INSTALLATION OF ENCASED CONDUIT CALLED FOR ON PLANS SHALL BE CONCRETE ENCASED UNLESS OTHERWISE DIRECTED BY THE ENGINEER.
40. STEMMING OF SIGNAL HEADS TO MAINTAIN EQUAL UNDERCLEARANCE FOR EACH SPAN WIRE MOUNTED SIGNAL HEAD (AT ALL INTERSECTIONS IN THIS CONTRACT) IS INCLUDED IN THIS CONTRACT.

SH. 2 OF 3

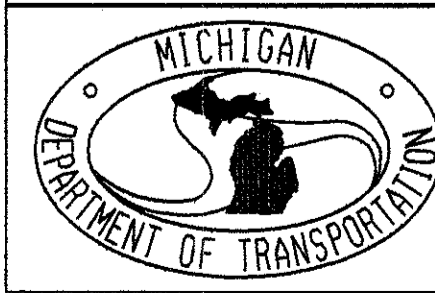

GENERAL INFORMATION SHEET

DATE	SCALE	CONT. SEC.	JOB NO.	T & S	CONST.
9-21-99		63174	48404A	2 of 31	2 D

CS 63174 JN 48404A No 2D

GENERAL INFORMATION SHEET


GENERAL NOTES

41. ALL PEDESTRIAN TRAFFIC SIGNAL HEADS SHALL BE 300 mm SYMBOLIC INDICATIONS CONSTRUCTED OF POLYCARBONATE MATERIAL UNLESS OTHERWISE INDICATED.
42. ALL JACKED-BORED, OPEN CUT OR DIRECT BURIAL CONDUIT CALLED FOR ON PLANS IS THE PREFERRED METHOD OF INSTALLATION. IF THE METHOD OF CONDUIT INSTALLATION IS IMPOSSIBLE TO CONSTRUCT OR IF THE CONTRACTOR PREFERS TO USE ANY OTHER METHOD, THE CHANGE OF METHOD MAY BE MADE UPON APPROVAL BY THE PROJECT ENGINEER.

THE CONTRACTOR IS RESPONSIBLE FOR DETERMINING OR ANTICIPATING HIS NEED OR DESIRE TO INSTALL THE CONDUIT BY ANY OTHER METHOD AND INCLUDE THE COST IN HIS CONTRACT BID.

NO EXTRA PAYMENT WILL BE ALLOWED FOR ANY CHANGE IN THE METHOD OF CONDUIT INSTALLATION.


SH. 3 OF 3

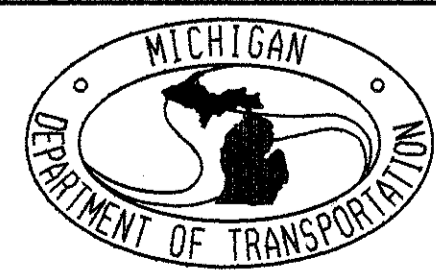

GENERAL INFORMATION SHEET

DATE	SCALE	CONT. SEC.	JOB NO.	T & S	CONST.

SH. OF


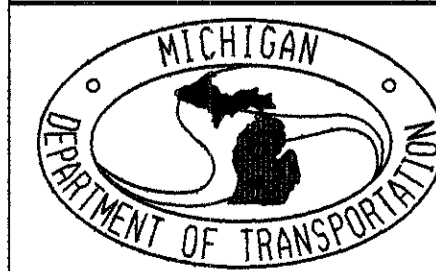


GENERAL INFORMATION SHEET


DATE	SCALE	CONT. SEC.	JOB NO.	T & S	CONST.
9-21-99		63174	48404A	3 of 31	3D

CS 63174 JN 48404A SH 3D


CONTROL SECTION 63174 JOB NO. 48404A SH. NO. 4D

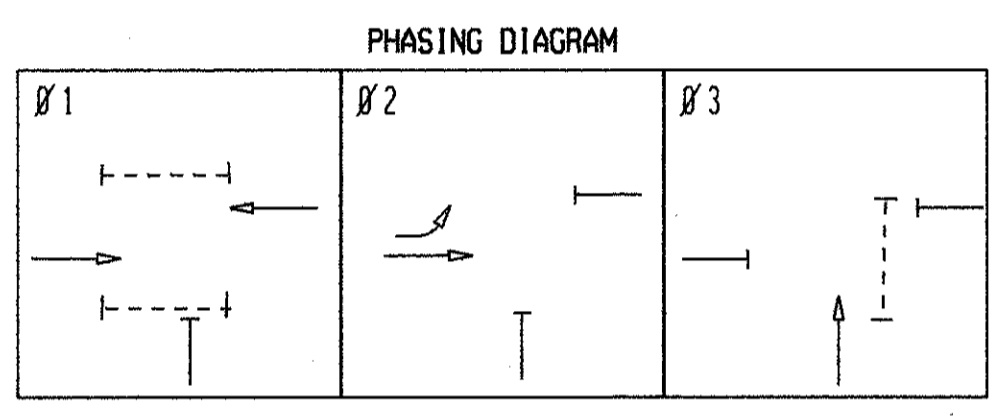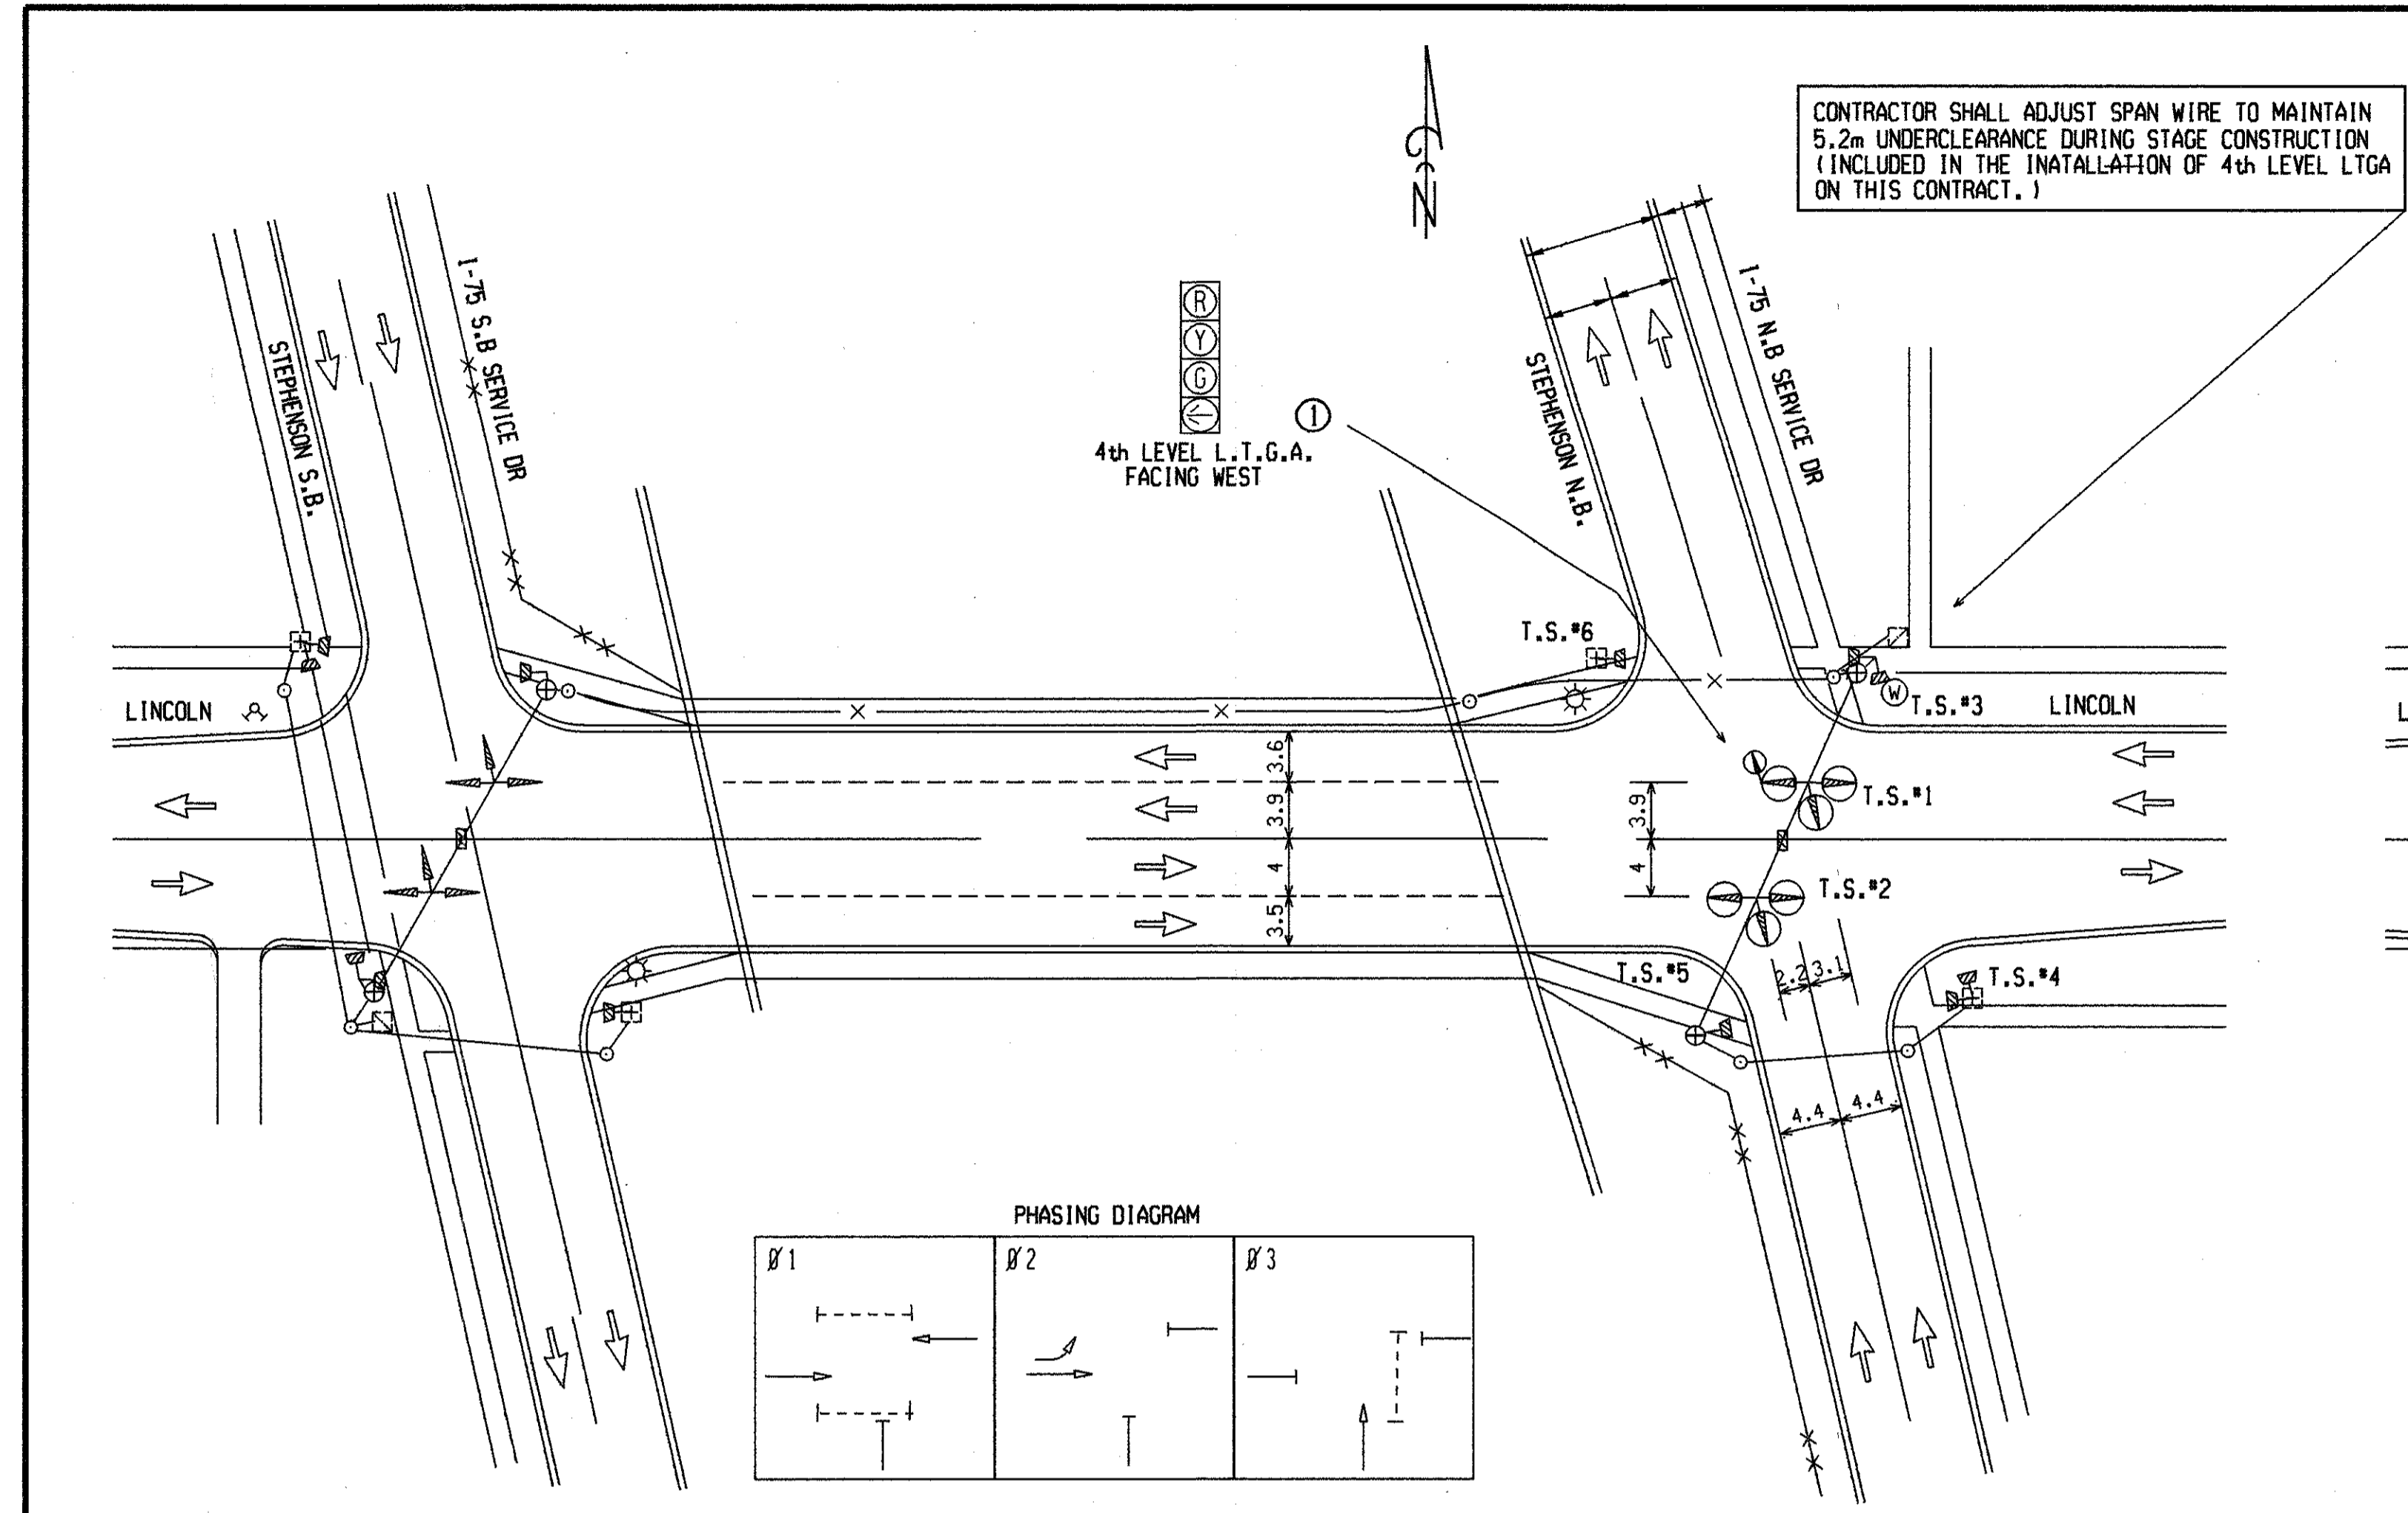

STAGE PLAN
1:400

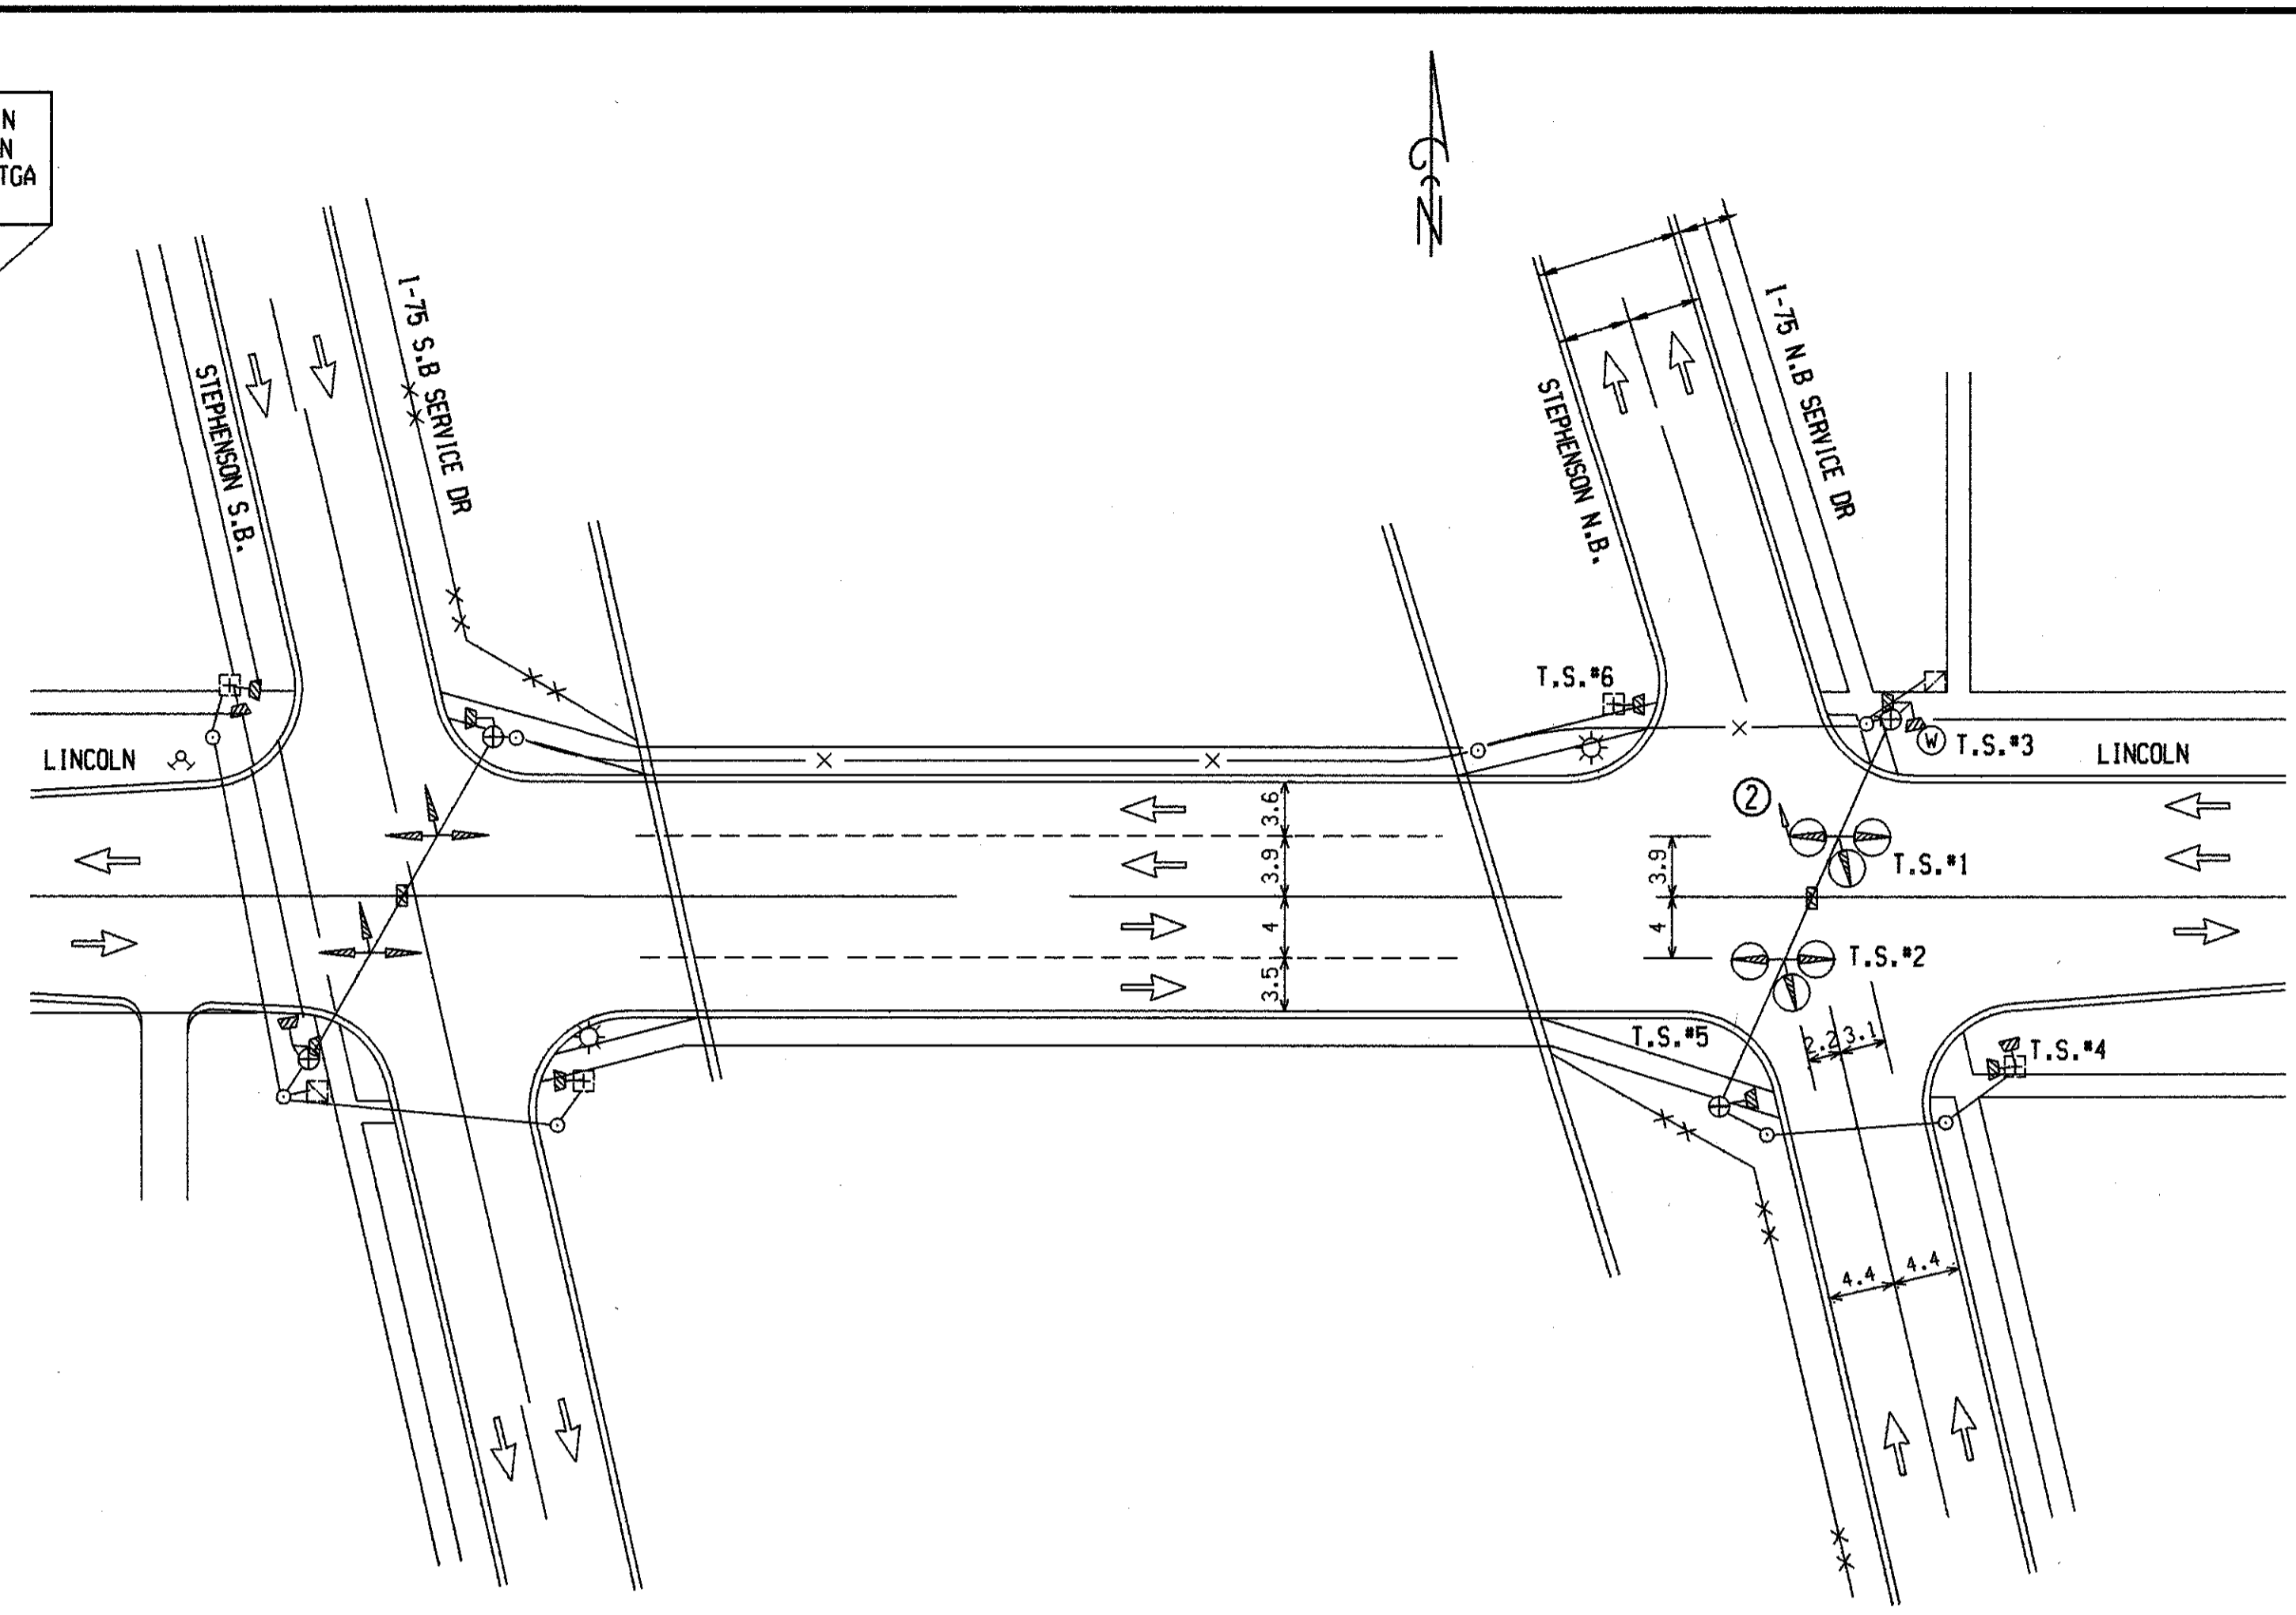

STAGE REMOVAL
1:400

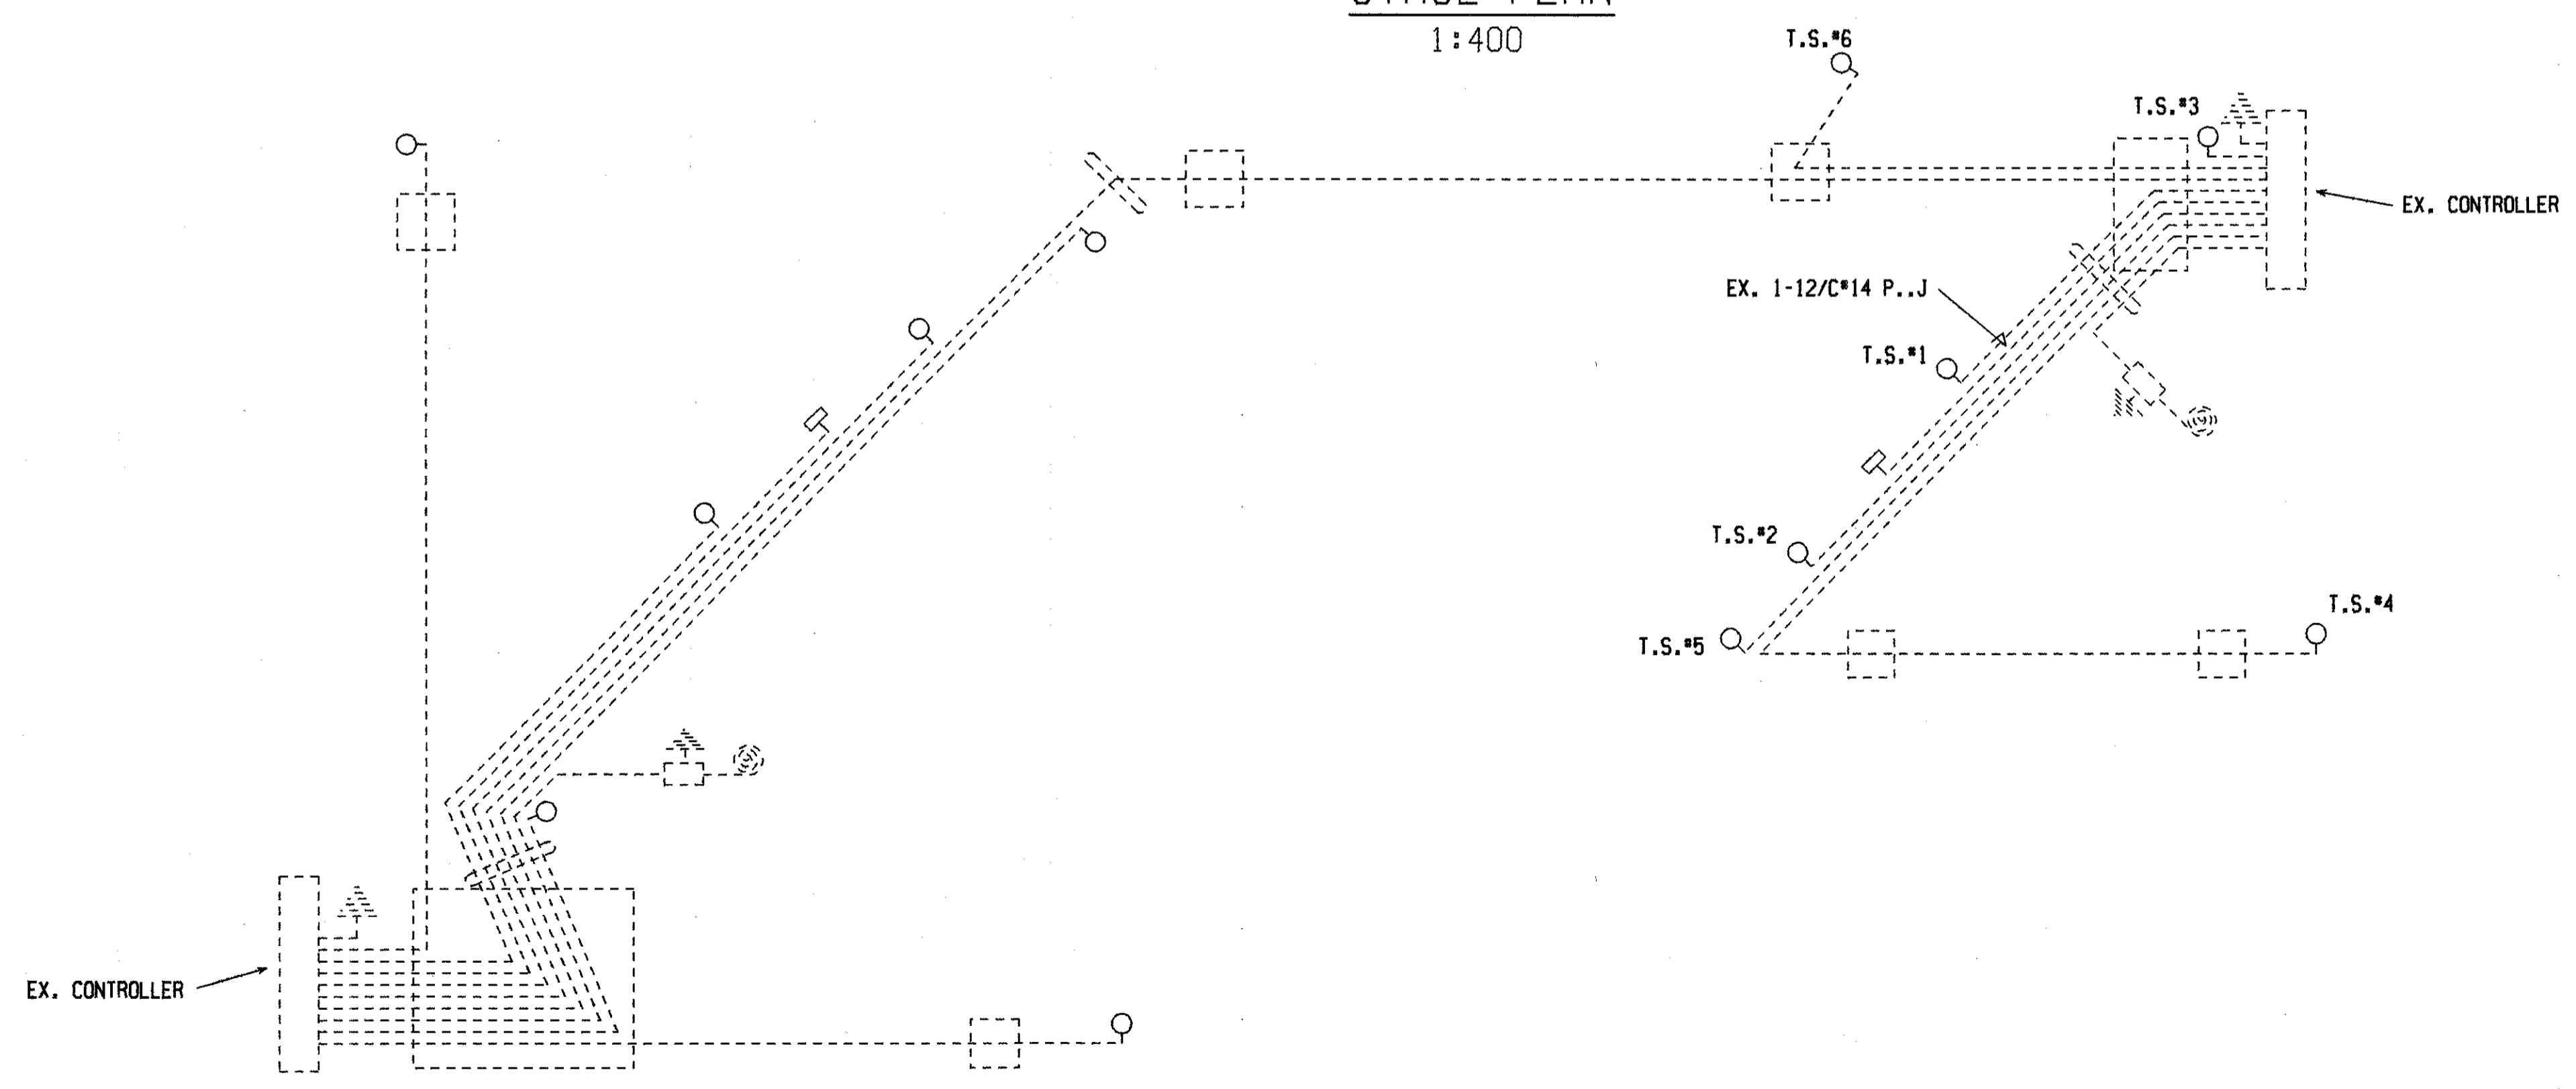


WIRING DIAGRAM
NOT TO SCALE

LIST OF MATERIAL			
NO.	ITEM	QUANTITIES	ITEM CODE
①	TS, 4th Level, LTGA	1 Each	8200250
②	TS, 4th Level Arrow, Rem	1 Each	8200066


All dimensions are in meters unless otherwise noted.

CONTROL SECTION 63174	JOB NUMBER 48404A	FEDERAL NUMBERS			AUTH. NO.	DRAWN FH	I-75 NB. SERVICE DR AT LINCOLN (10 1/2 MI) CITY OF ROYAL OAK OAKLAND COUNTY	CONST SHEET NO. 4D
		PROJECT	ITEM		CONT. SEC. 63174	DATE 9-11-99		
				ENGR/TECH F. HUNT	SCALE 1:400			
				SHEET 04 OF 31	PLAN 63174-01-023			

CONTROL SECTION 63174 JOB NO. 48404A SH. NO. 5D

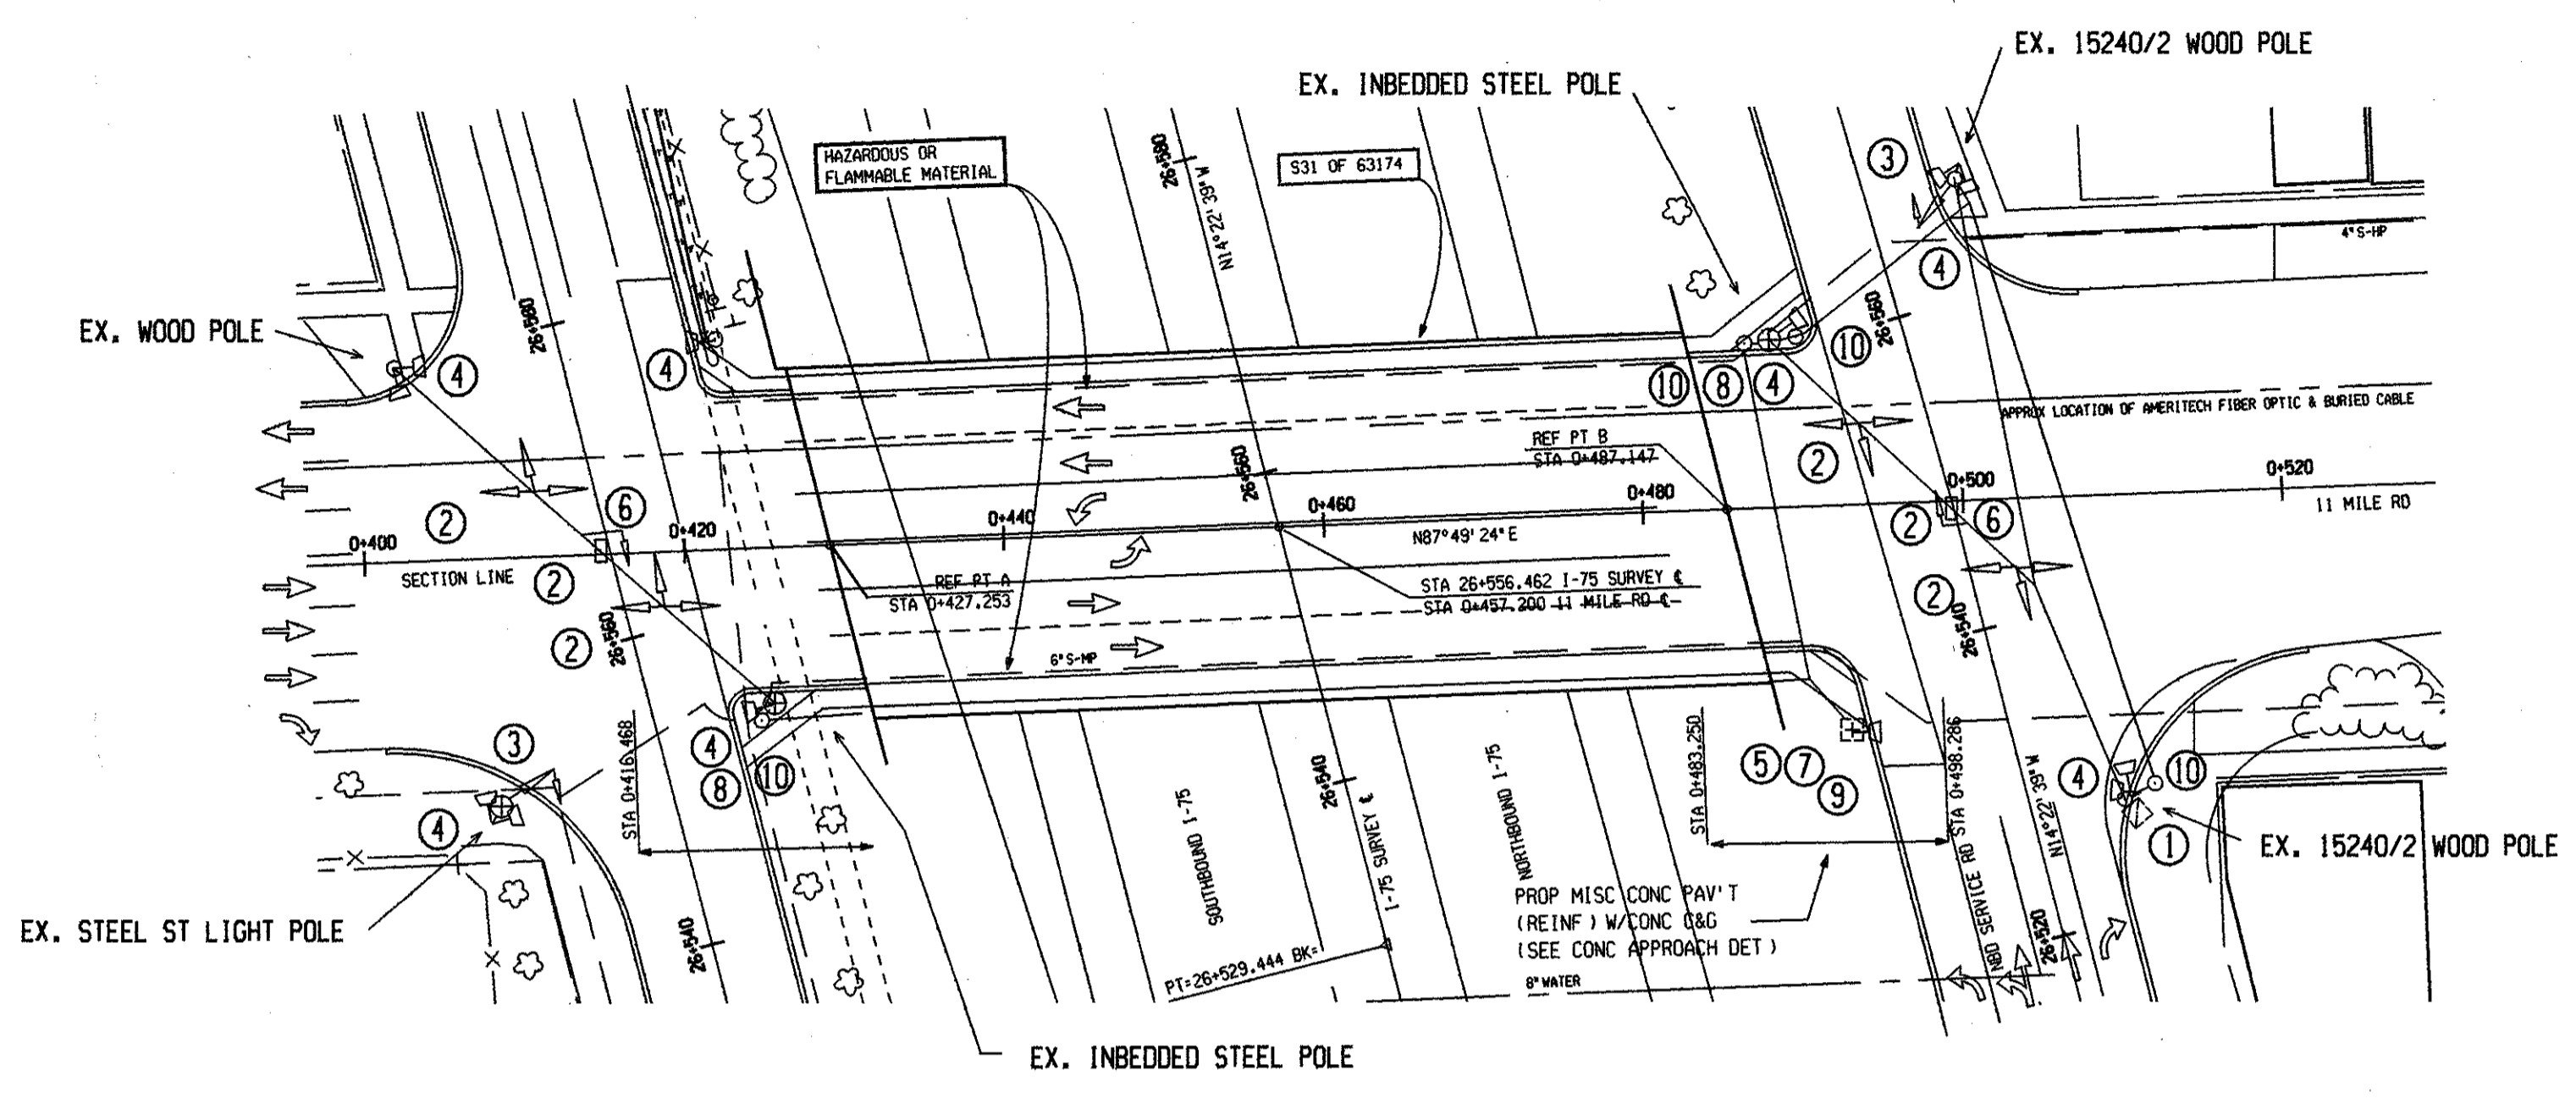

REMOVAL DIAGRAM
NOT TO SCALE

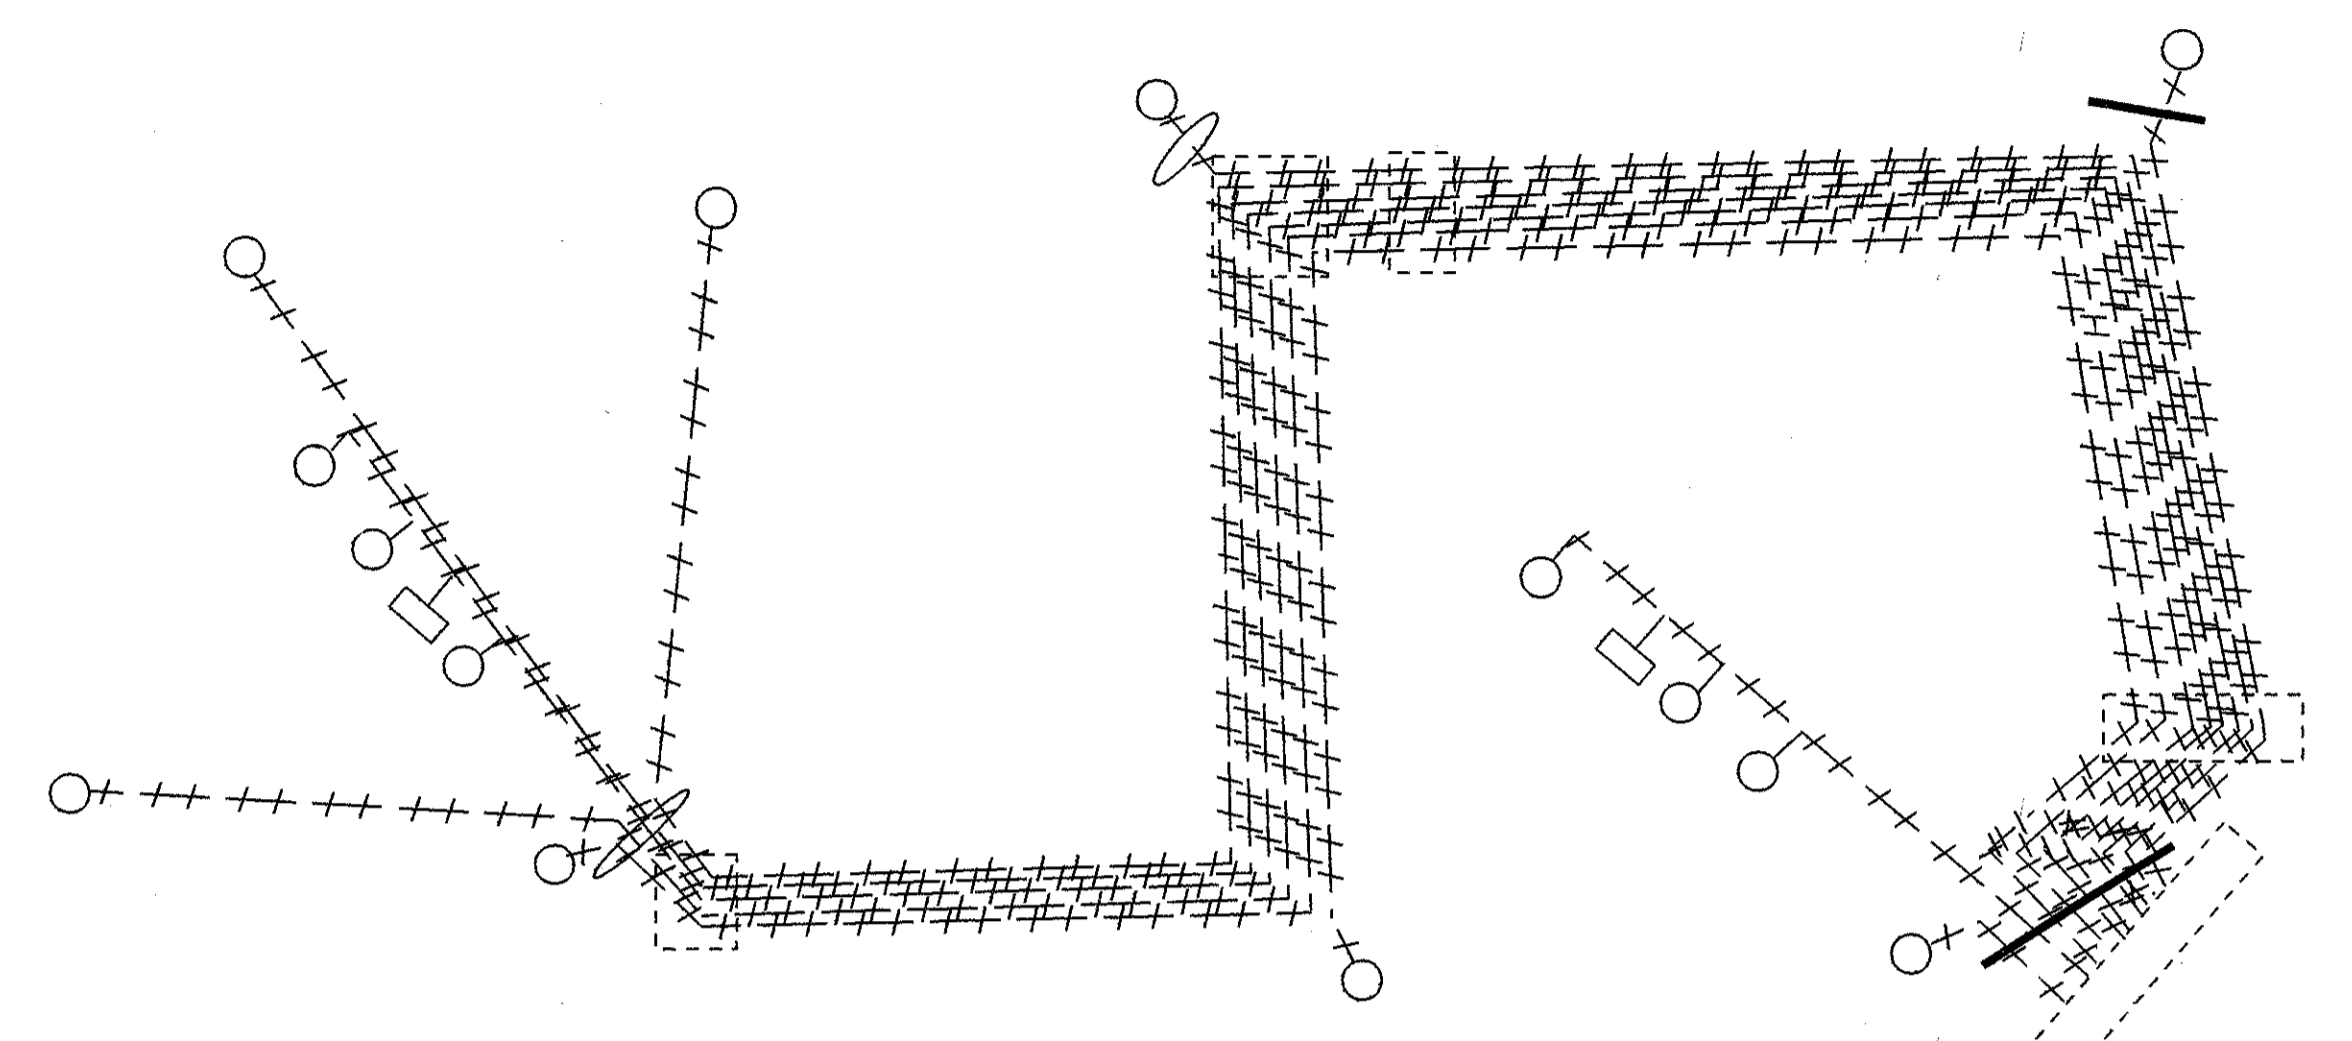

REMOVAL WIRING DIAGRAM
NOT TO SCALE



CONTACT: BOB JONES (D.E.CO.)
248-594-7132 FOR REMOVAL OF 2 SPAN
WIRES.

LIST OF MATERIAL			
NO.	ITEM	QUANTITIES	ITEM CODE
①	Controller and Cabinet, Rem	1 Each	8200017
②	TS, Span Wire Mtd, Rem	6 Each	8200071
③	TS, Bracket Arm Mtd, Rem	2 Each	8200065
④	TS, Pedestrian, Bracket Arm Mtd, Rem	7 Each	8200069
⑤	TS, Pedestrian, Pedestal Mtd, Rem	1 Each	8200070
⑥	Case Sign, Rem	2 Each	8200014
⑦	Pedestal, Rem	1 Each	8200039
⑧	Steel Pole, Rem	2 Each	8200053
⑨	Fdn, Rem	1 Each	8200022
⑩	Hh, Rem	4 Each	8190344

All dimensions are in meters
unless otherwise noted.

CONTROL SECTION 63174	JOB NUMBER 48404A	FEDERAL NUMBERS			AUTH. NO. CONT. SEC. 63174	DRAWN FH	I-75 N.B. SERVICE DRS AT 11 MILE RD CITY OF ROYAL OAK OAKLAND COUNTY	CONST SHEET NO. 5D
		PROJECT	ITEM		ENGR/TECH F. HUNT	DATE 9-12-99		






SH. NO. 48404A
JOB NO. 63174
CONTROL SECTION

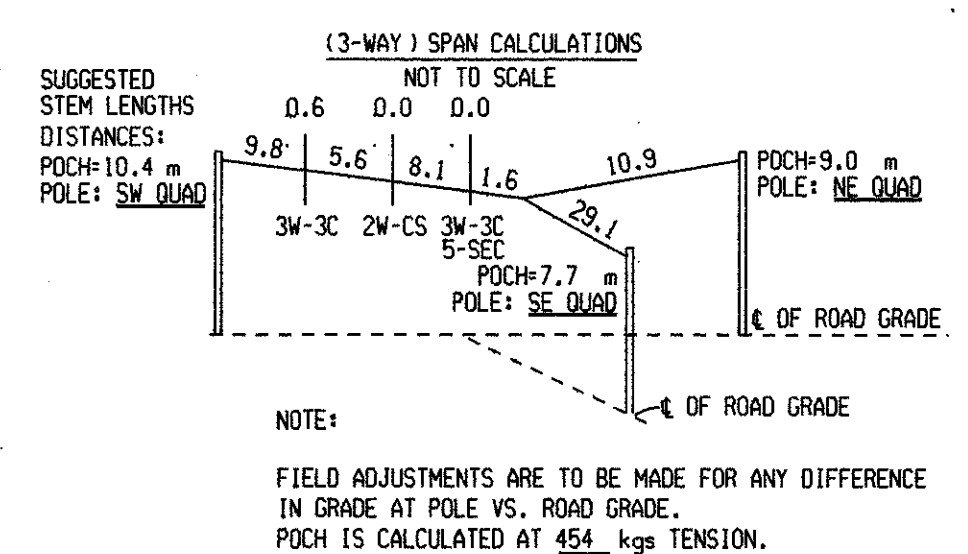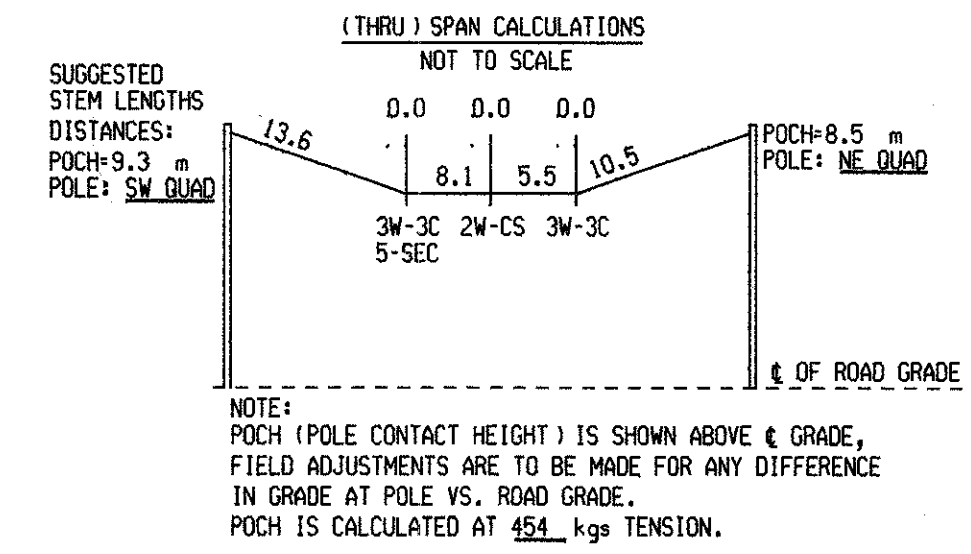

CONTACT: MDOT METRO REGION OFFICE SOILS ENGINEER (248-569-3993) FOR INSPECTION OF DRILLED SHAFT PRIOR TO INSTALLATION OF STEEL POLE FOUNDATION.

CONTACT: BOB JONES (D.E.CO.) 248-594-7132 FOR INSTALLATION OF 1 SPAN WIRE AND SECONDARY SERVICE AT 2 LOCATIONS. ESTIMATED COST TO CONTRACTOR \$2,000.00.

FOR ELECTRICAL SERVICE INSPECTION CONTACT THE MICHIGAN DEPARTMENT OF LABOR AT 517-241-9320 COST TO CONTRACTOR WILL BE \$40.00.

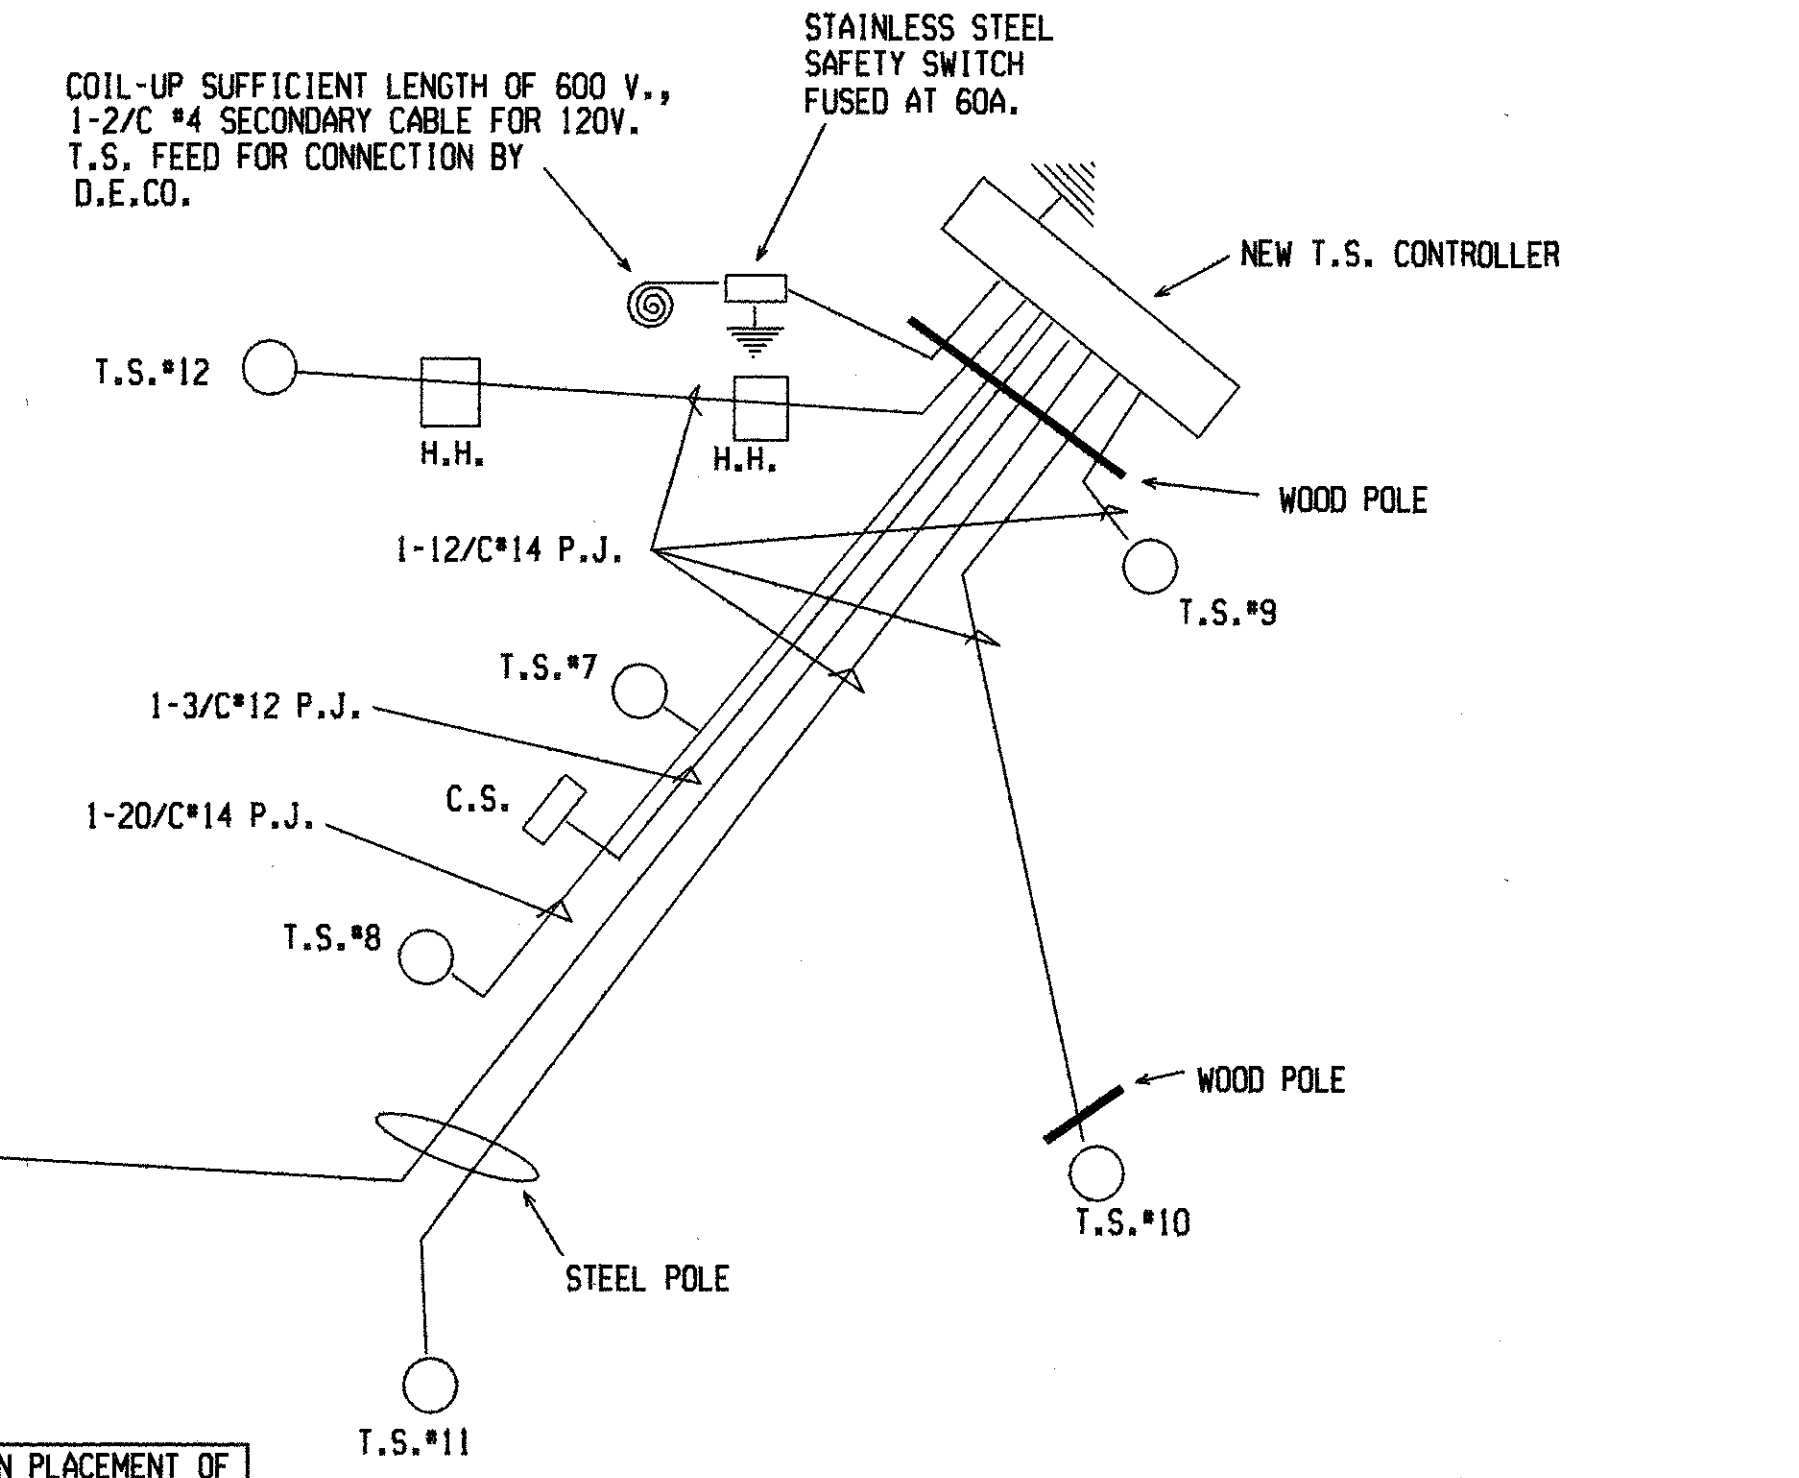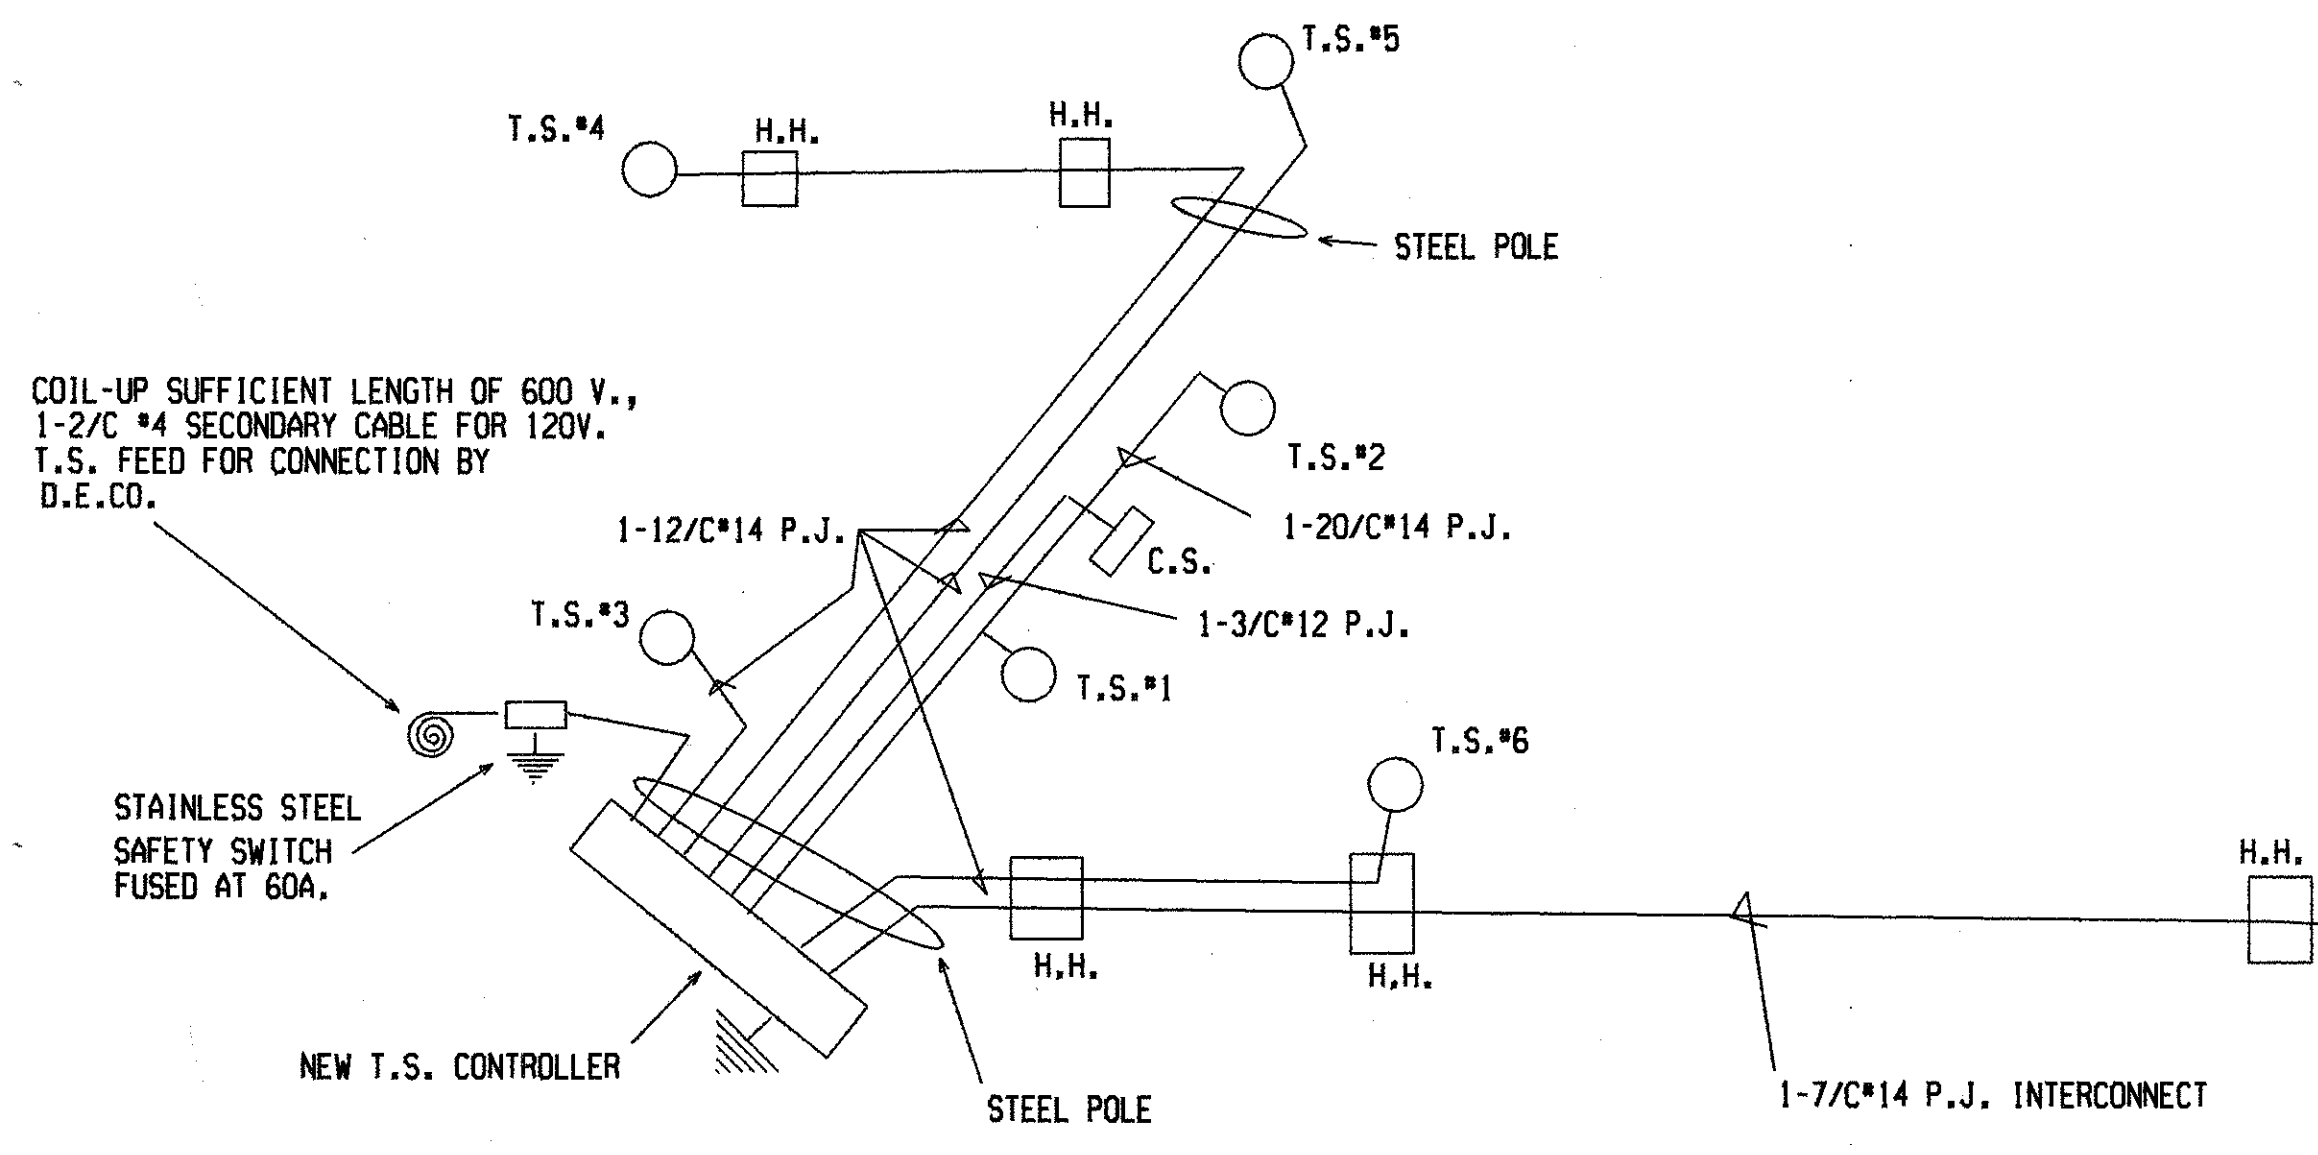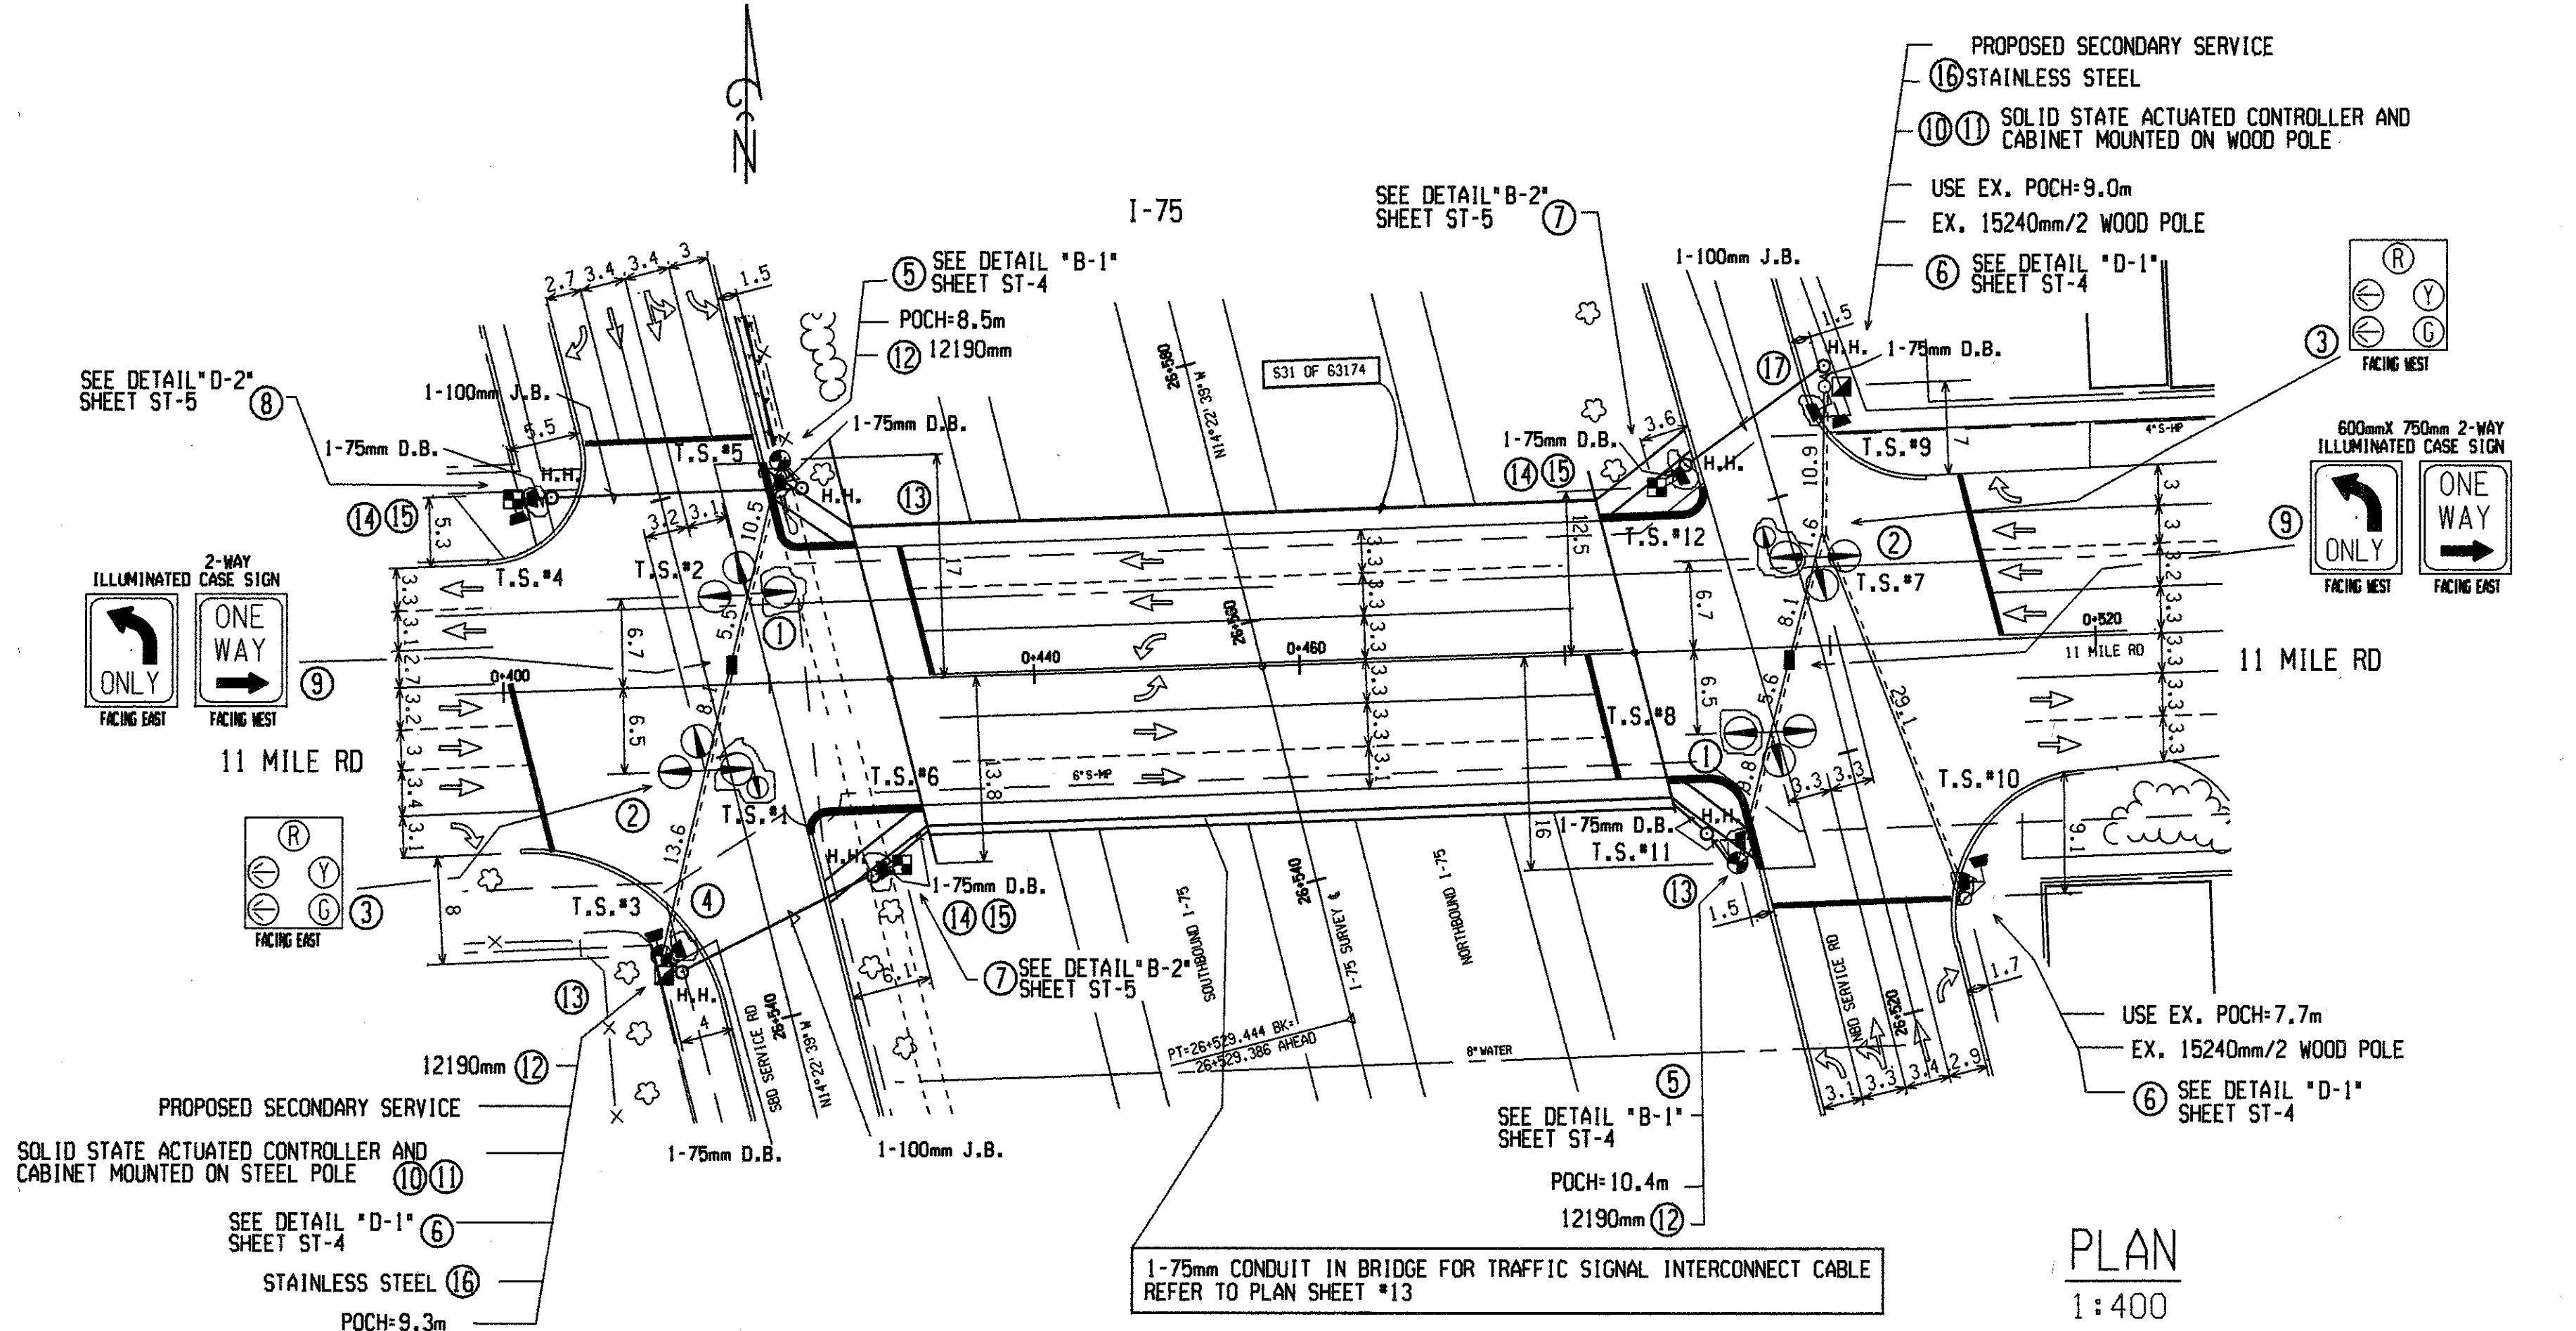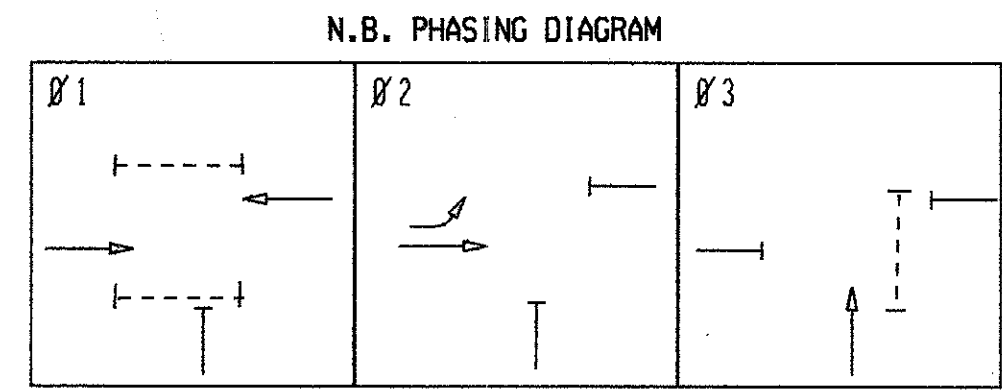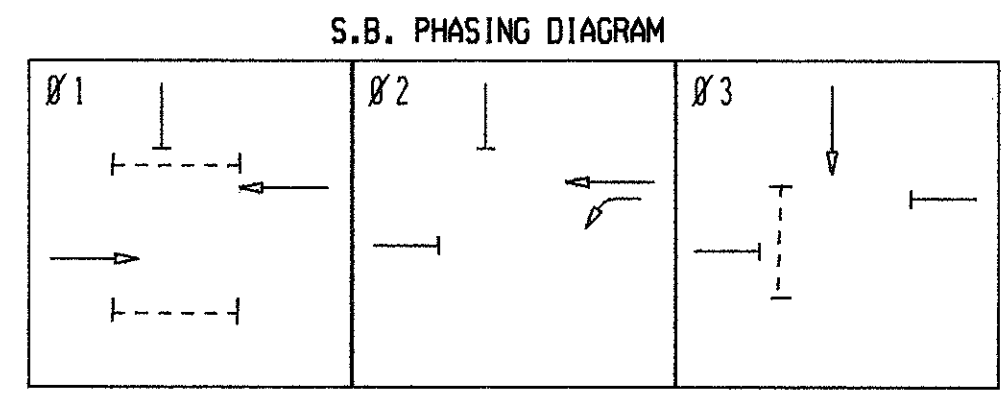


LIST OF MATERIAL			
NO.	ITEM	QUANTITIES	ITEM CODE
1	TS, 3 Way Span Wire Mtd	2 Each	8200243
2	TS, 2 Way Span Wire Mtd	2 Each	8200230
3	TS, One Way Span Wire Mtd, Five Sect	2 Each	8200222
4	Span Wire	1 Each	8200201
5	TS, Pedestrian, 1 Way Bracket Arm Mtd	2 Each	8200258
6	TS, Pedestrian, 2 Way Bracket Arm Mtd	3 Each	8200260
7	TS, Pedestrian, 1 Way Pedestal Mtd	2 Each	8200266
8	TS, Pedestrian, 2 Way Pedestal Mtd	1 Each	8200268
9	Case Sign, Two Way, 600 mm by 750 mm	2 Each	8200302
10	Controller and Cabinet, Solid State Actuated	2 Each	8200334
11	Controller and Cabinet, Solid State Actuated, Delivered	2 Each	8200330
12	Strain Pole, Steel, Anchor Base, 12190 mm	3 Each	8200417
13	Strain Pole Fdn, Uncased	12m	8200420
14	Pedestal, Alum, Uncased	3 Each	8200428
15	Pedestal, Fdn	3 Each	8200430
16	Safety Switch	2 Each	8200458
17	Wood Pole, Fit Up, TS Cable Pole	1 Each	8190942
	Hh, Round	7 Each	8190347
	Conduit, DB, 1, 75 mm	20m	8190064
	Conduit, Jacked Bored	30m	8190100
	P.J. Cable, 600V, 1, 7/C*14, Intercon	125m	8190403

INSTALLATION OF CABLE TO BE COMPLETED UPON PLACEMENT OF CONDUIT IN NEW BRIDGE STRUCTURE AS DIRECTED BY ENGINEER.


All dimensions are in meters unless otherwise noted.

CONTROL SECTION	JOB NUMBER	FEDERAL NUMBERS		MDOT Michigan Department of Transportation	AUTH. NO.	DRAWN FH	I-75 SERVICE DRS AT 11 MILE RD CITY OF ROYAL OAK OAKLAND COUNTY	CONST SHEET NO. 6D
63174	48404A	PROJECT	ITEM		CONTRACT SEC. 63174	DATE 9-12-99		



CONTROL SECTION 63174 JOB NO. 48404A SH. NO.

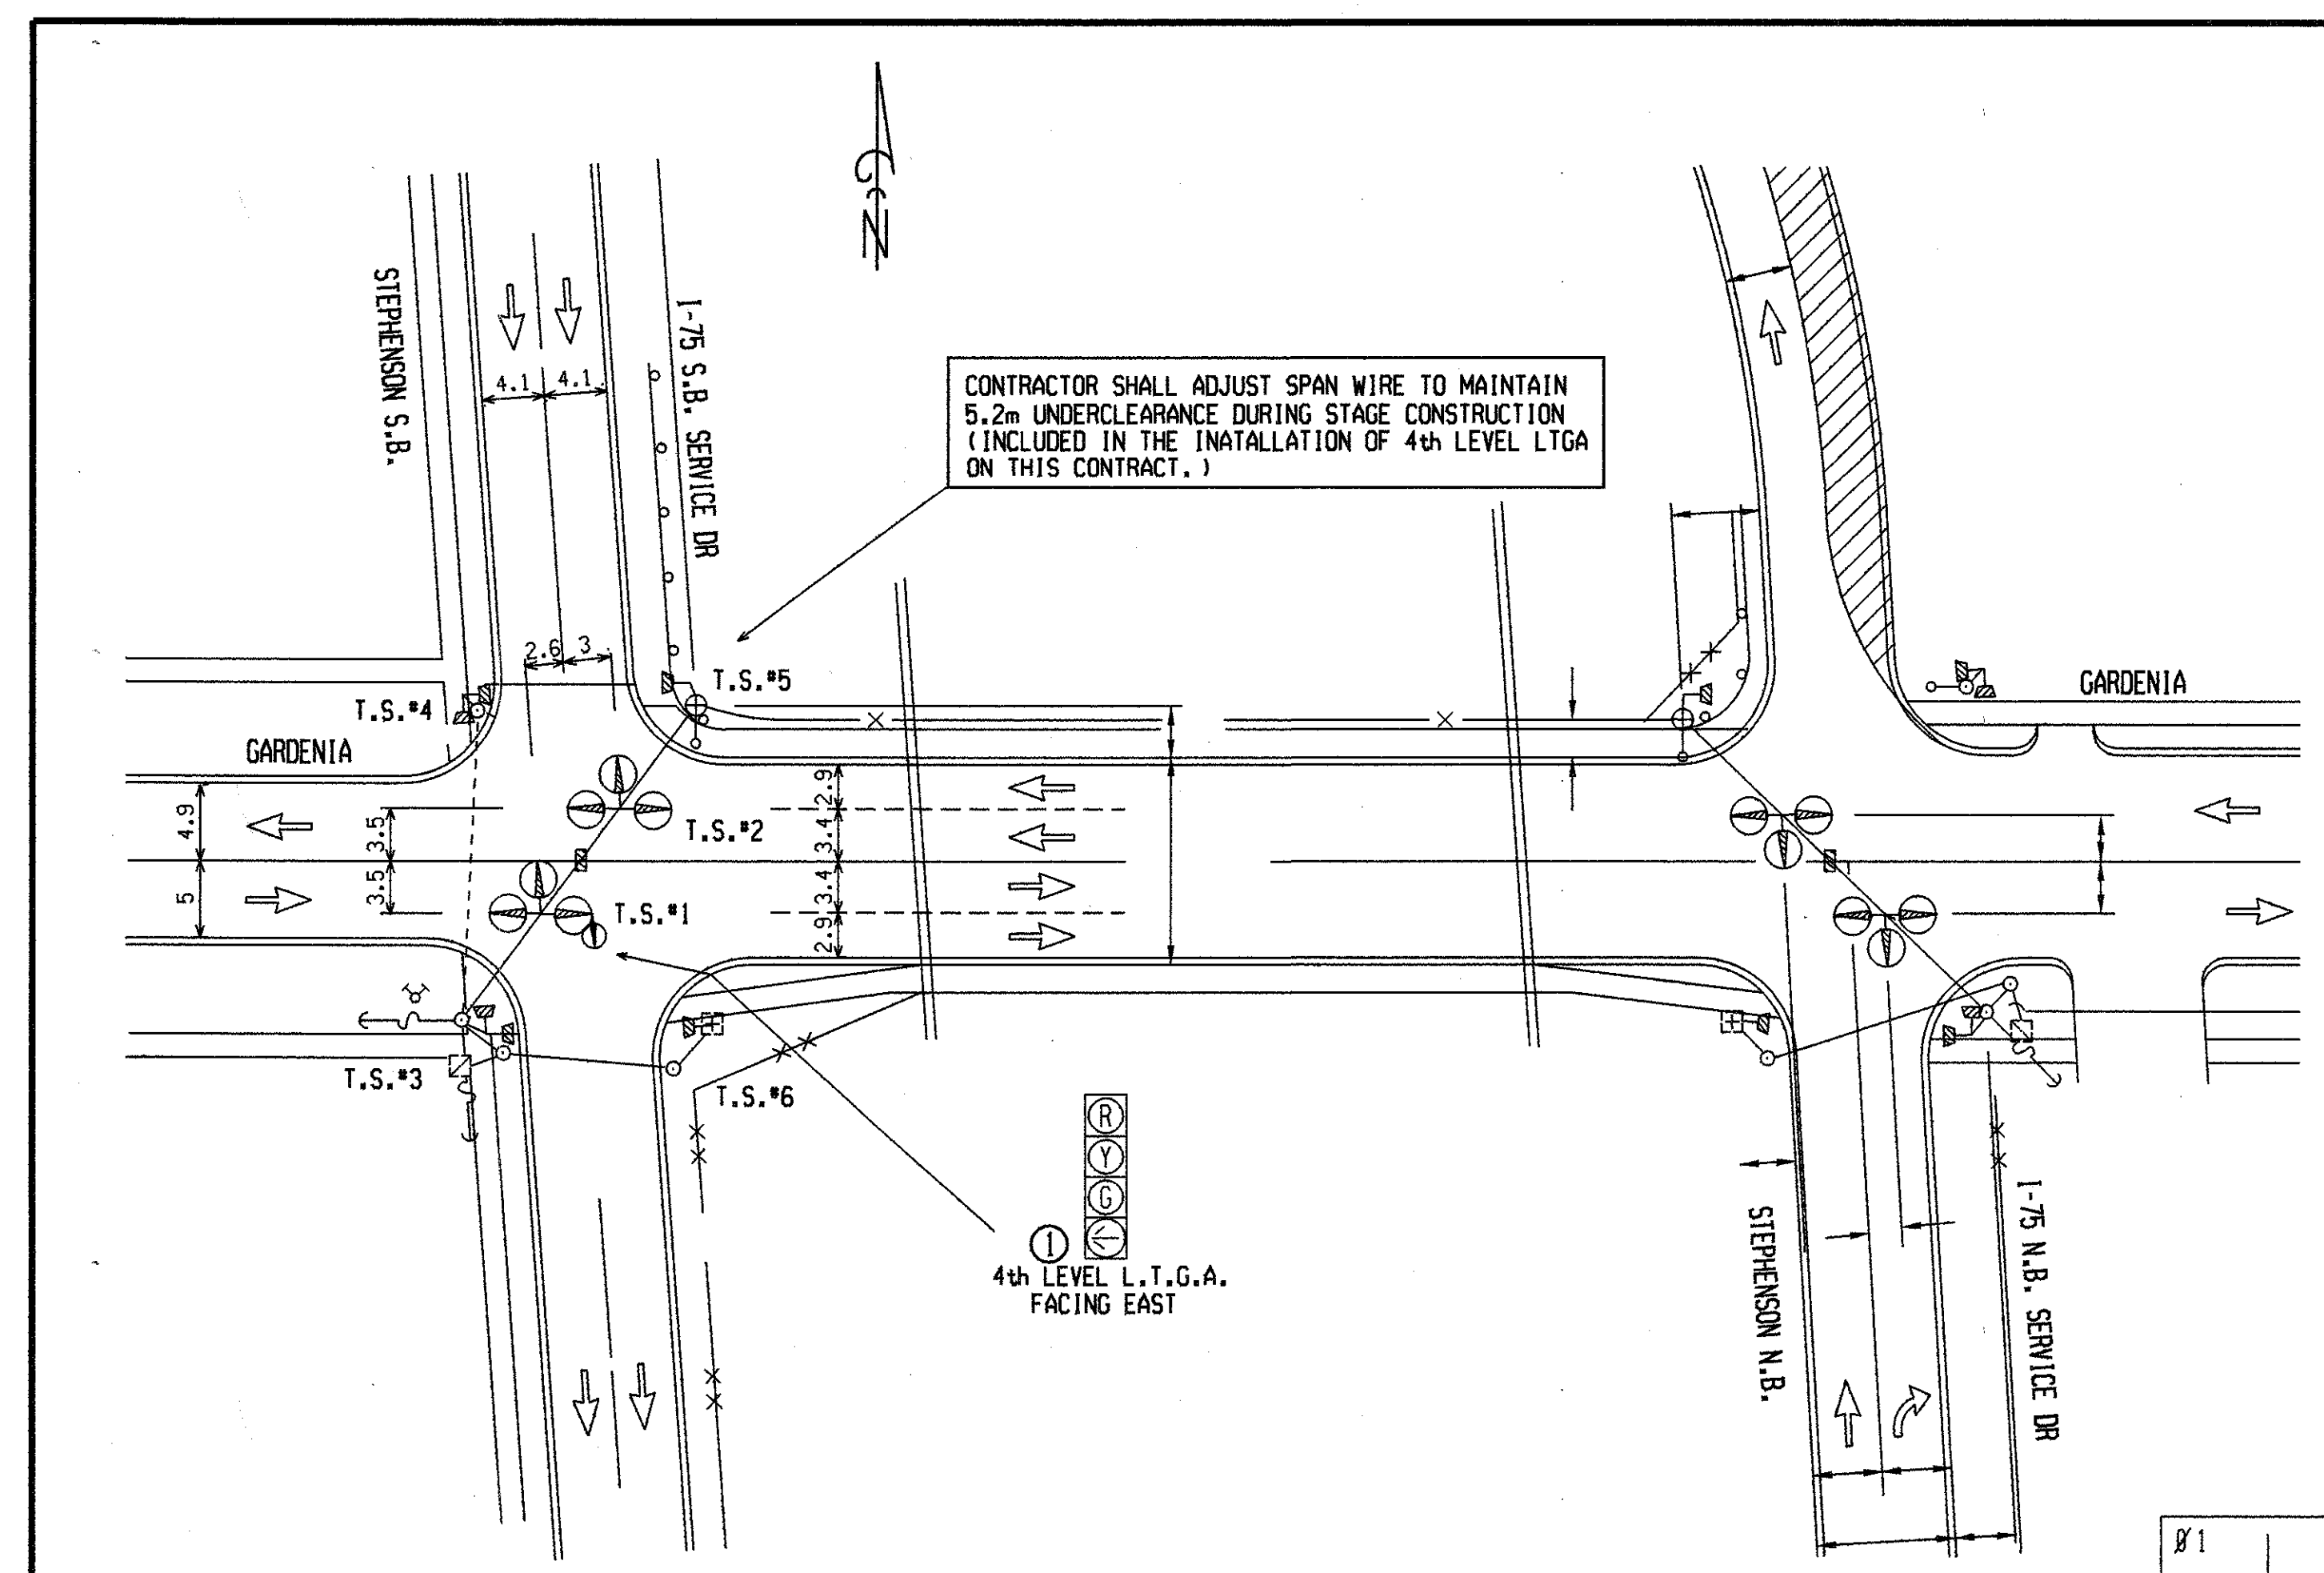

STAGE PLAN
1:400

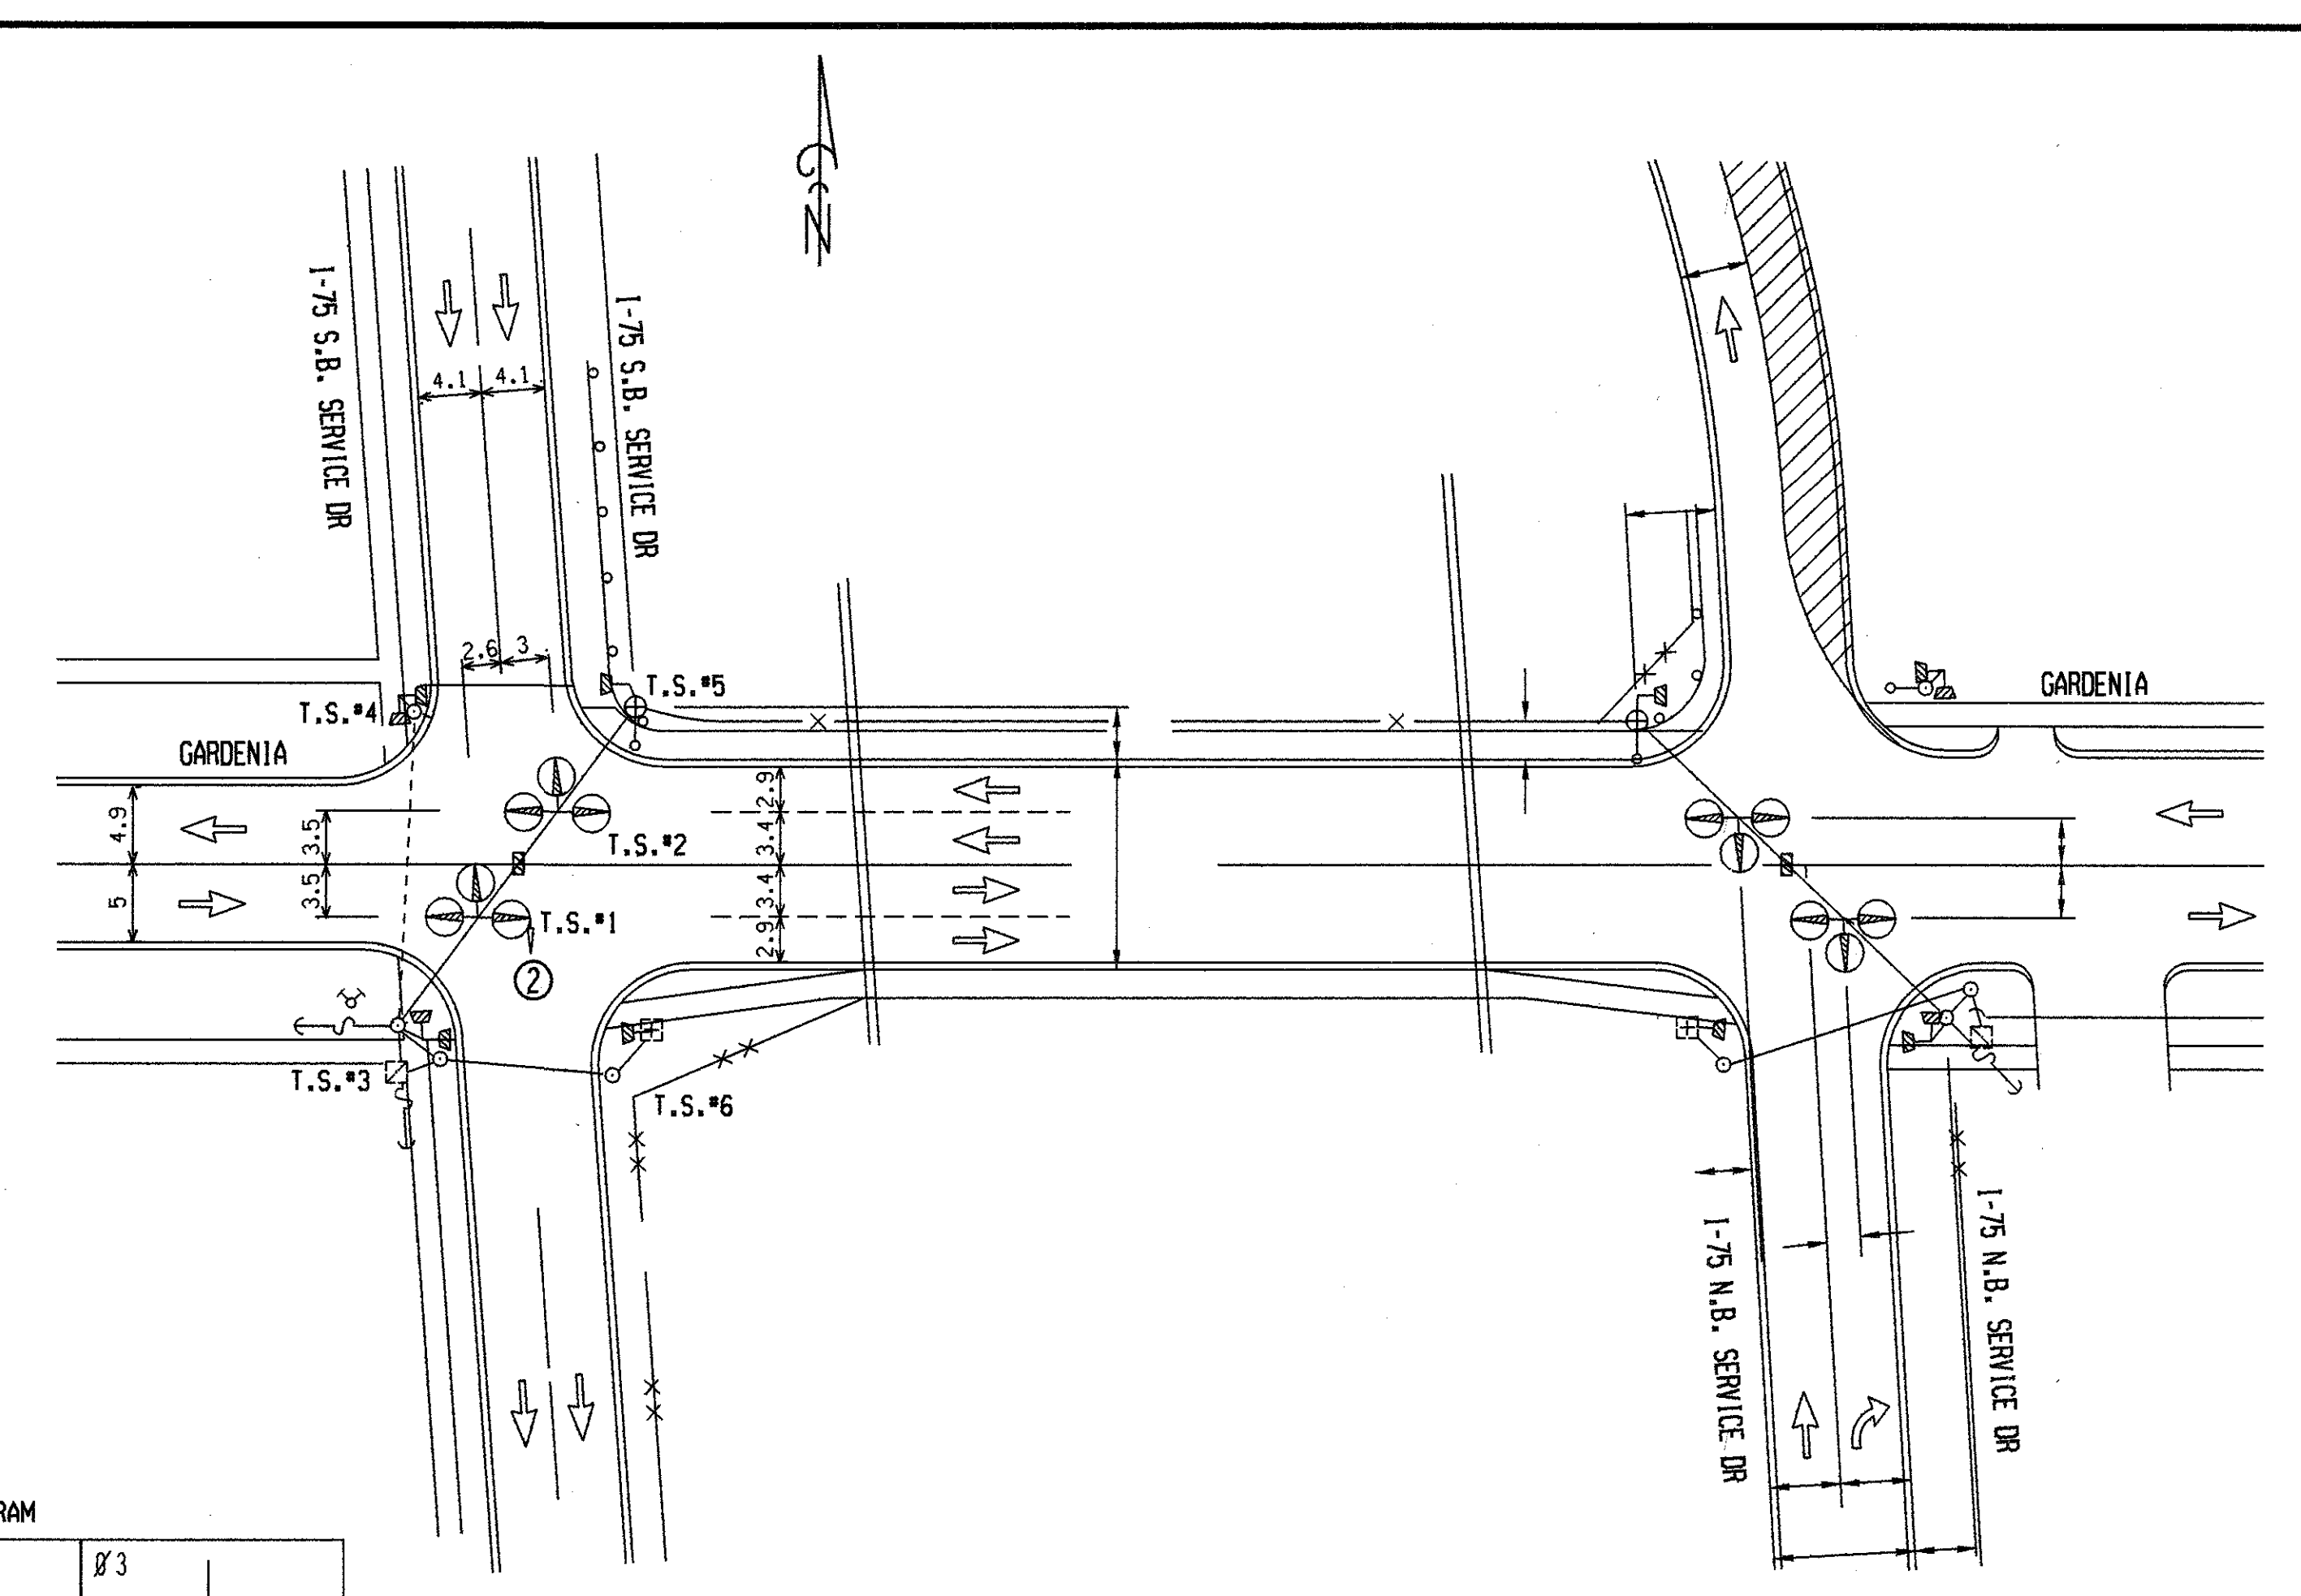

STAGE REMOVAL
1:400

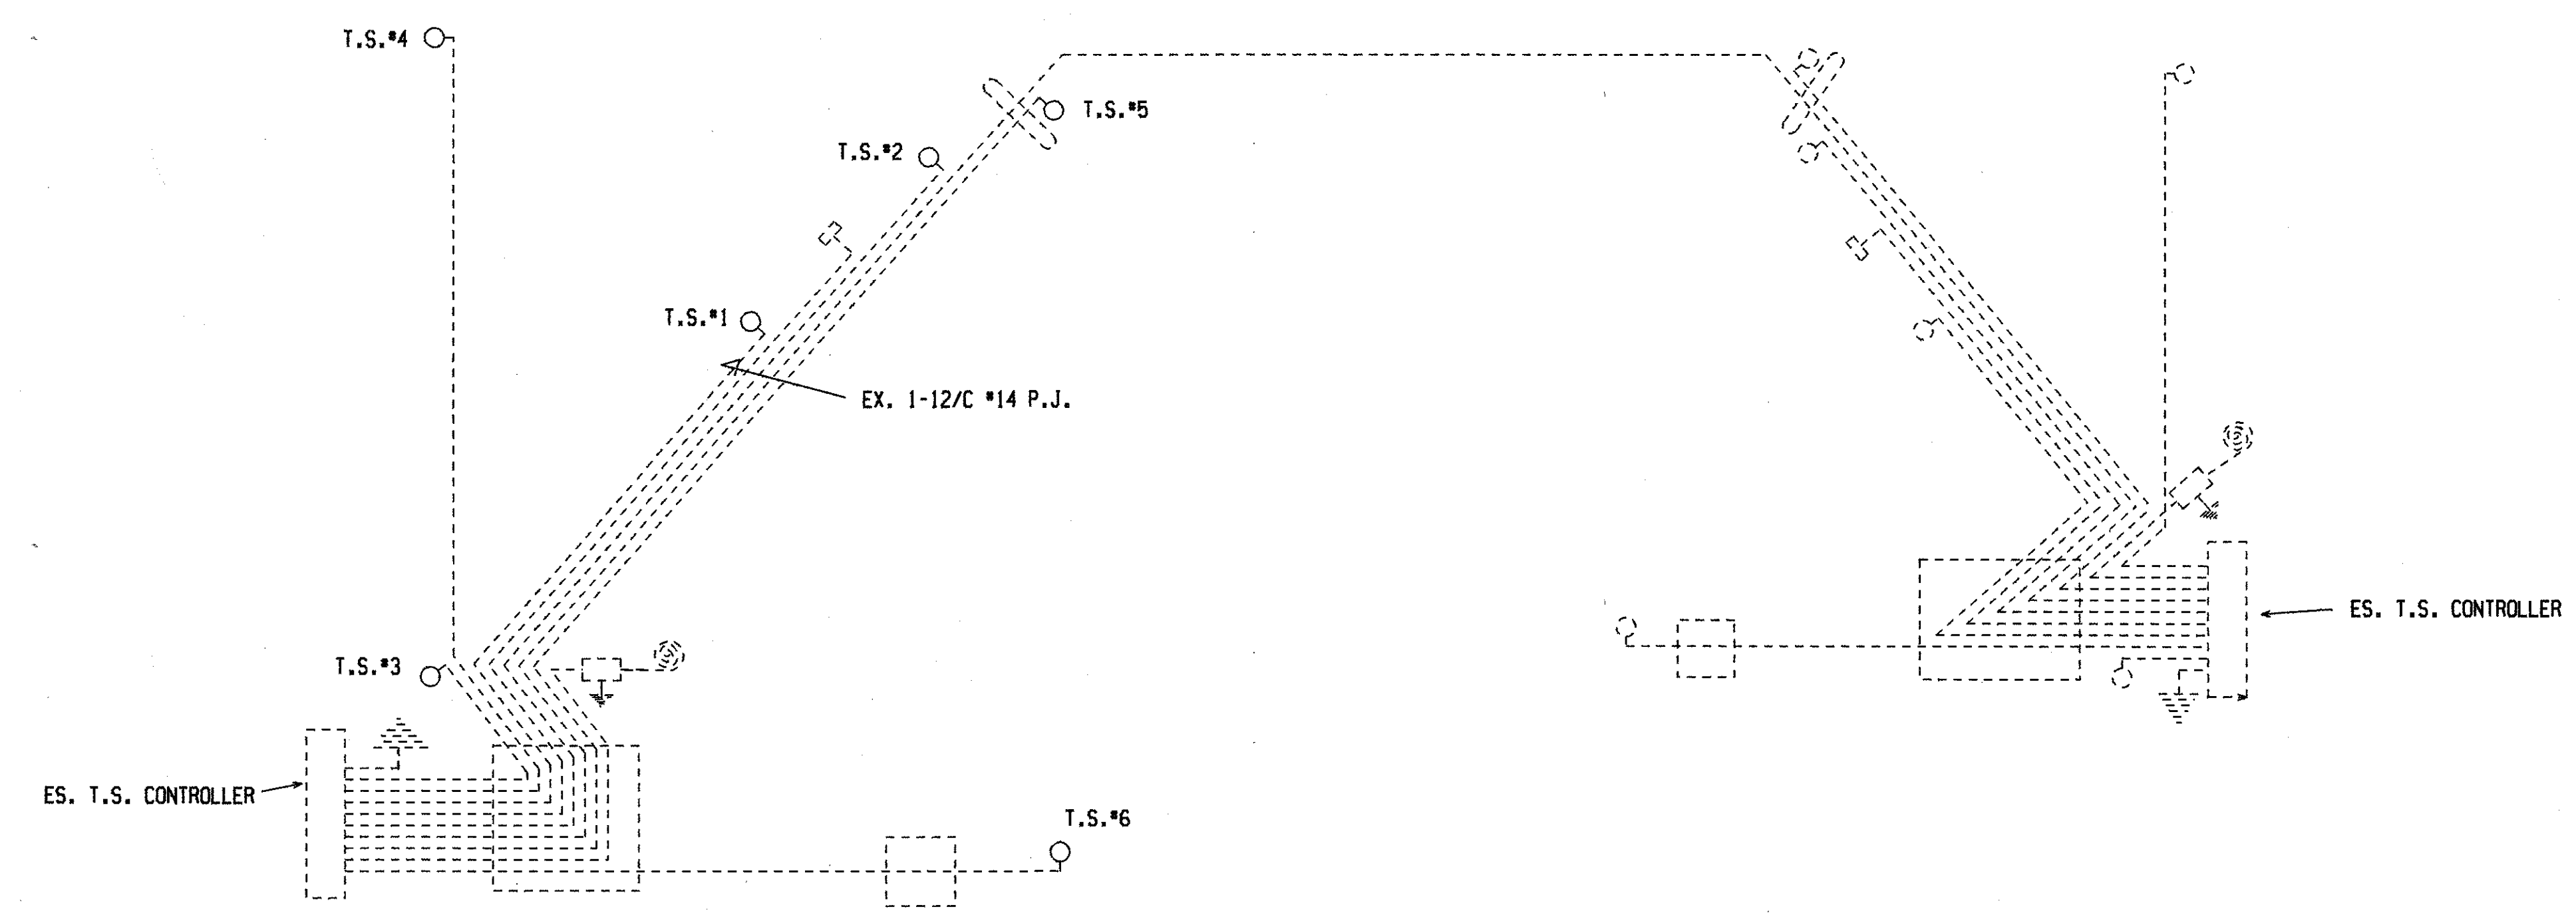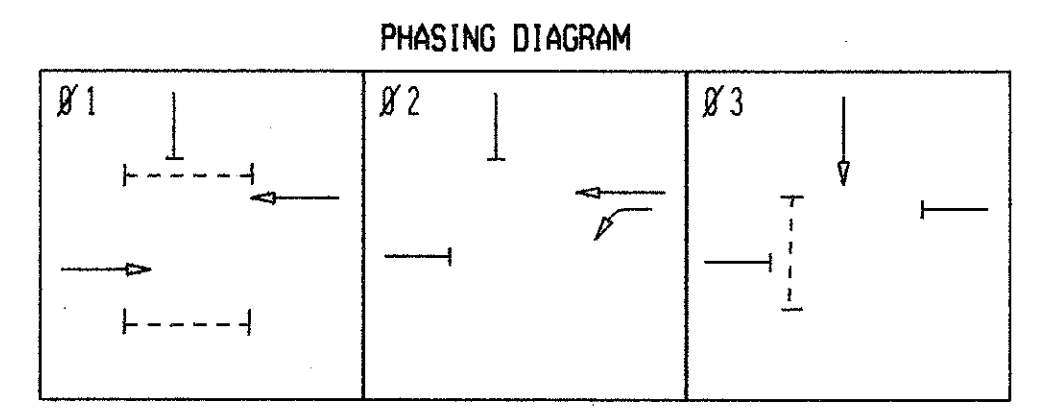


WIRING DIAGRAM
NOT TO SCALE

LIST OF MATERIAL			
NO.	ITEM	QUANTITIES	ITEM CODE
①	TS, 4th Level, LTGA	1 Each	8200250
②	TS, 4th Level Arrow, Rem	1 Each	8200066

All dimensions are in meters unless otherwise noted.

CONTROL SECTION 63174	JOB NUMBER 48404A	FEDERAL NUMBERS		AUTH. NO. CONT. SEC. 63174	DRAWN FH	DATE 0-11-99	SCALE 1:400	SHEET 7 OF 31	PLAN 63174-01-010	CYCLIC WATTS STEADY WATTS I-75 SB SERVICE DR AT GARDENIA (1 1/2 MI) CITY OF ROYAL OAK OAKLAND COUNTY	CONST SHEET NO. 7D
		PROJECT	ITEM								

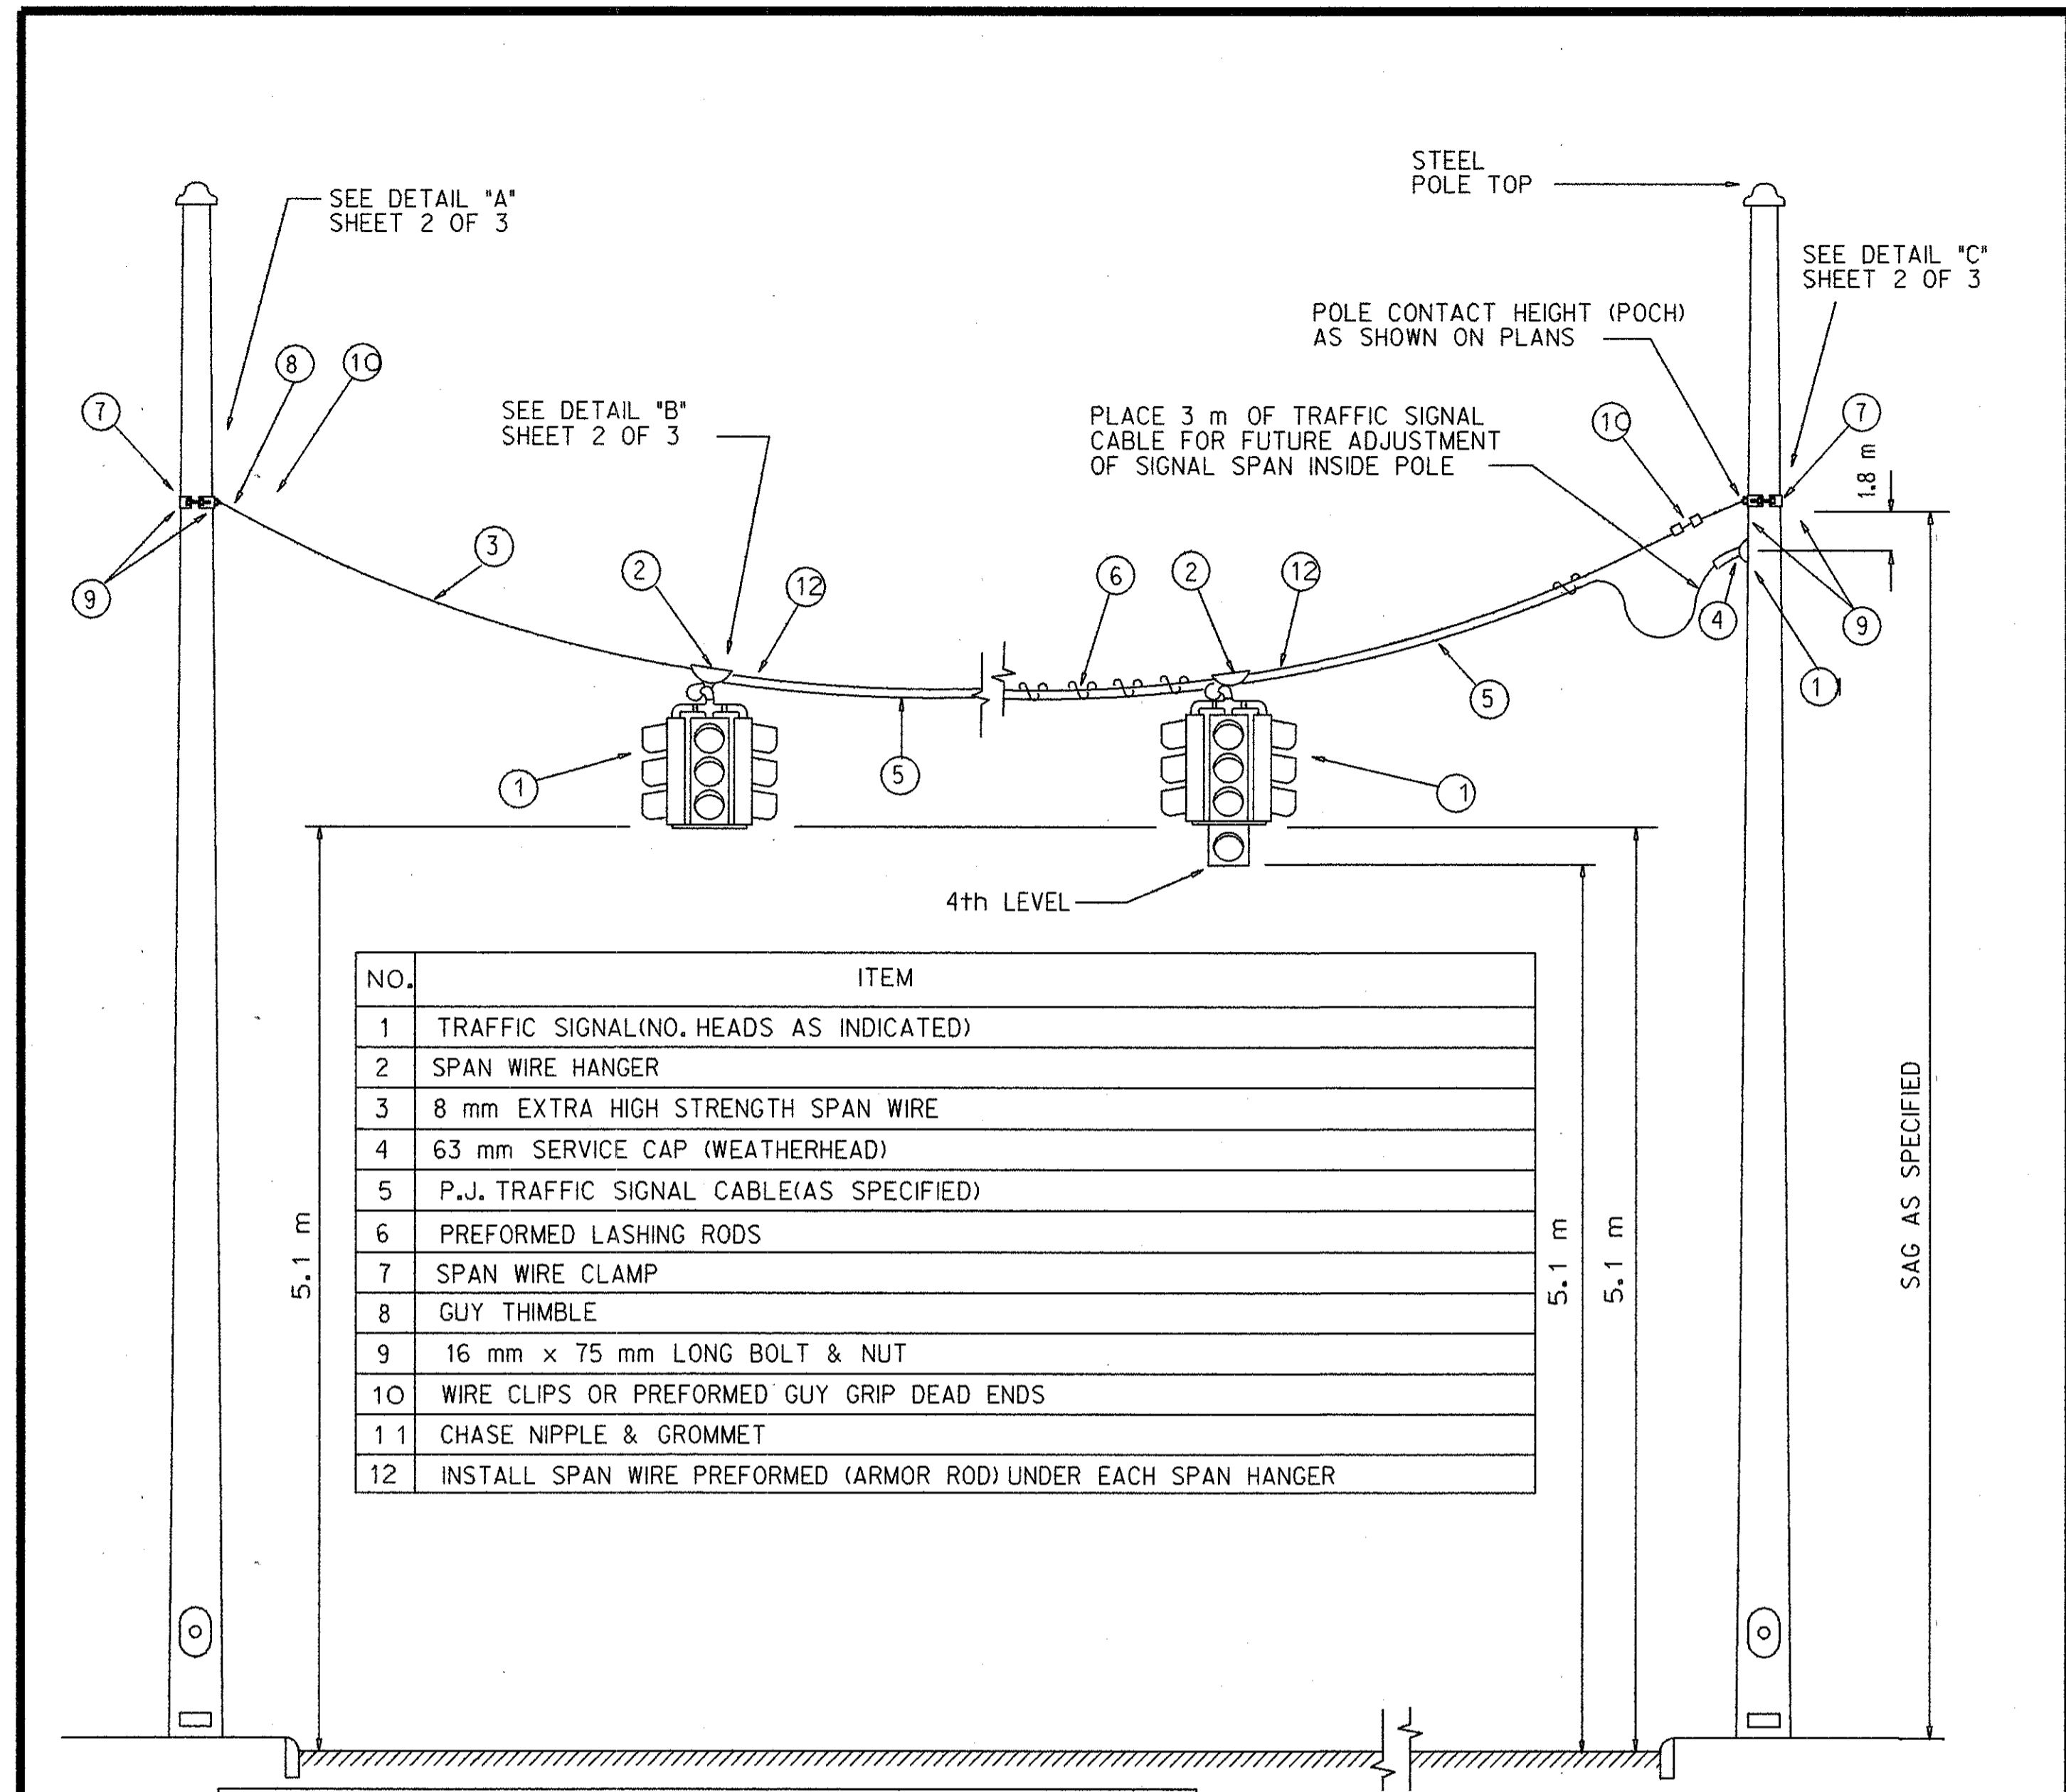

NO.	ITEM
1	TRAFFIC SIGNAL (NO. HEADS AS INDICATED)
2	SPAN WIRE HANGER
3	8 mm EXTRA HIGH STRENGTH SPAN WIRE
4	63 mm SERVICE CAP (WEATHERHEAD)
5	P.J. TRAFFIC SIGNAL CABLE (AS SPECIFIED)
6	PREFORMED LASHING RODS
7	SPAN WIRE CLAMP
8	GUY THIMBLE
9	16 mm x 75 mm LONG BOLT & NUT
10	WIRE CLIPS OR PREFORMED GUY GRIP DEAD ENDS
11	CHASE NIPPLE & GROMMET
12	INSTALL SPAN WIRE PREFORMED (ARMOR ROD) UNDER EACH SPAN HANGER

NOTE:
USE NUMBER & TYPE OF T.S. AS CALLED FOR ON PLAN

DETAIL : INSTALLATION OF SPAN WIRE T.S. ON STEEL POLES


NOTE:
INSTALL 19 mm x 3 m COPPER CLAD GROUND ROD(S) AS REQUIRED TO PROVIDE LESS THAN 10 OHM RESISTANCE TO GROUND. INSTALL #6 MIN. COPPER GROUND WIRES FROM GROUND ROD(S) TO SPAN WIRE AT EACH SUPPORTING POLE USING NON-SOLDER TYPE CONNECTIONS FOR SPAN WIRE GROUNDING.

NOTE: DETAILS NOT TO SCALE (N.T.S.)


SH 1 OF 3
OC-1

SPAN WIRE T.S. ON STEEL POLES


DATE	SCALE	CONT. SEC.	JOB NO.	T & S	CONST.

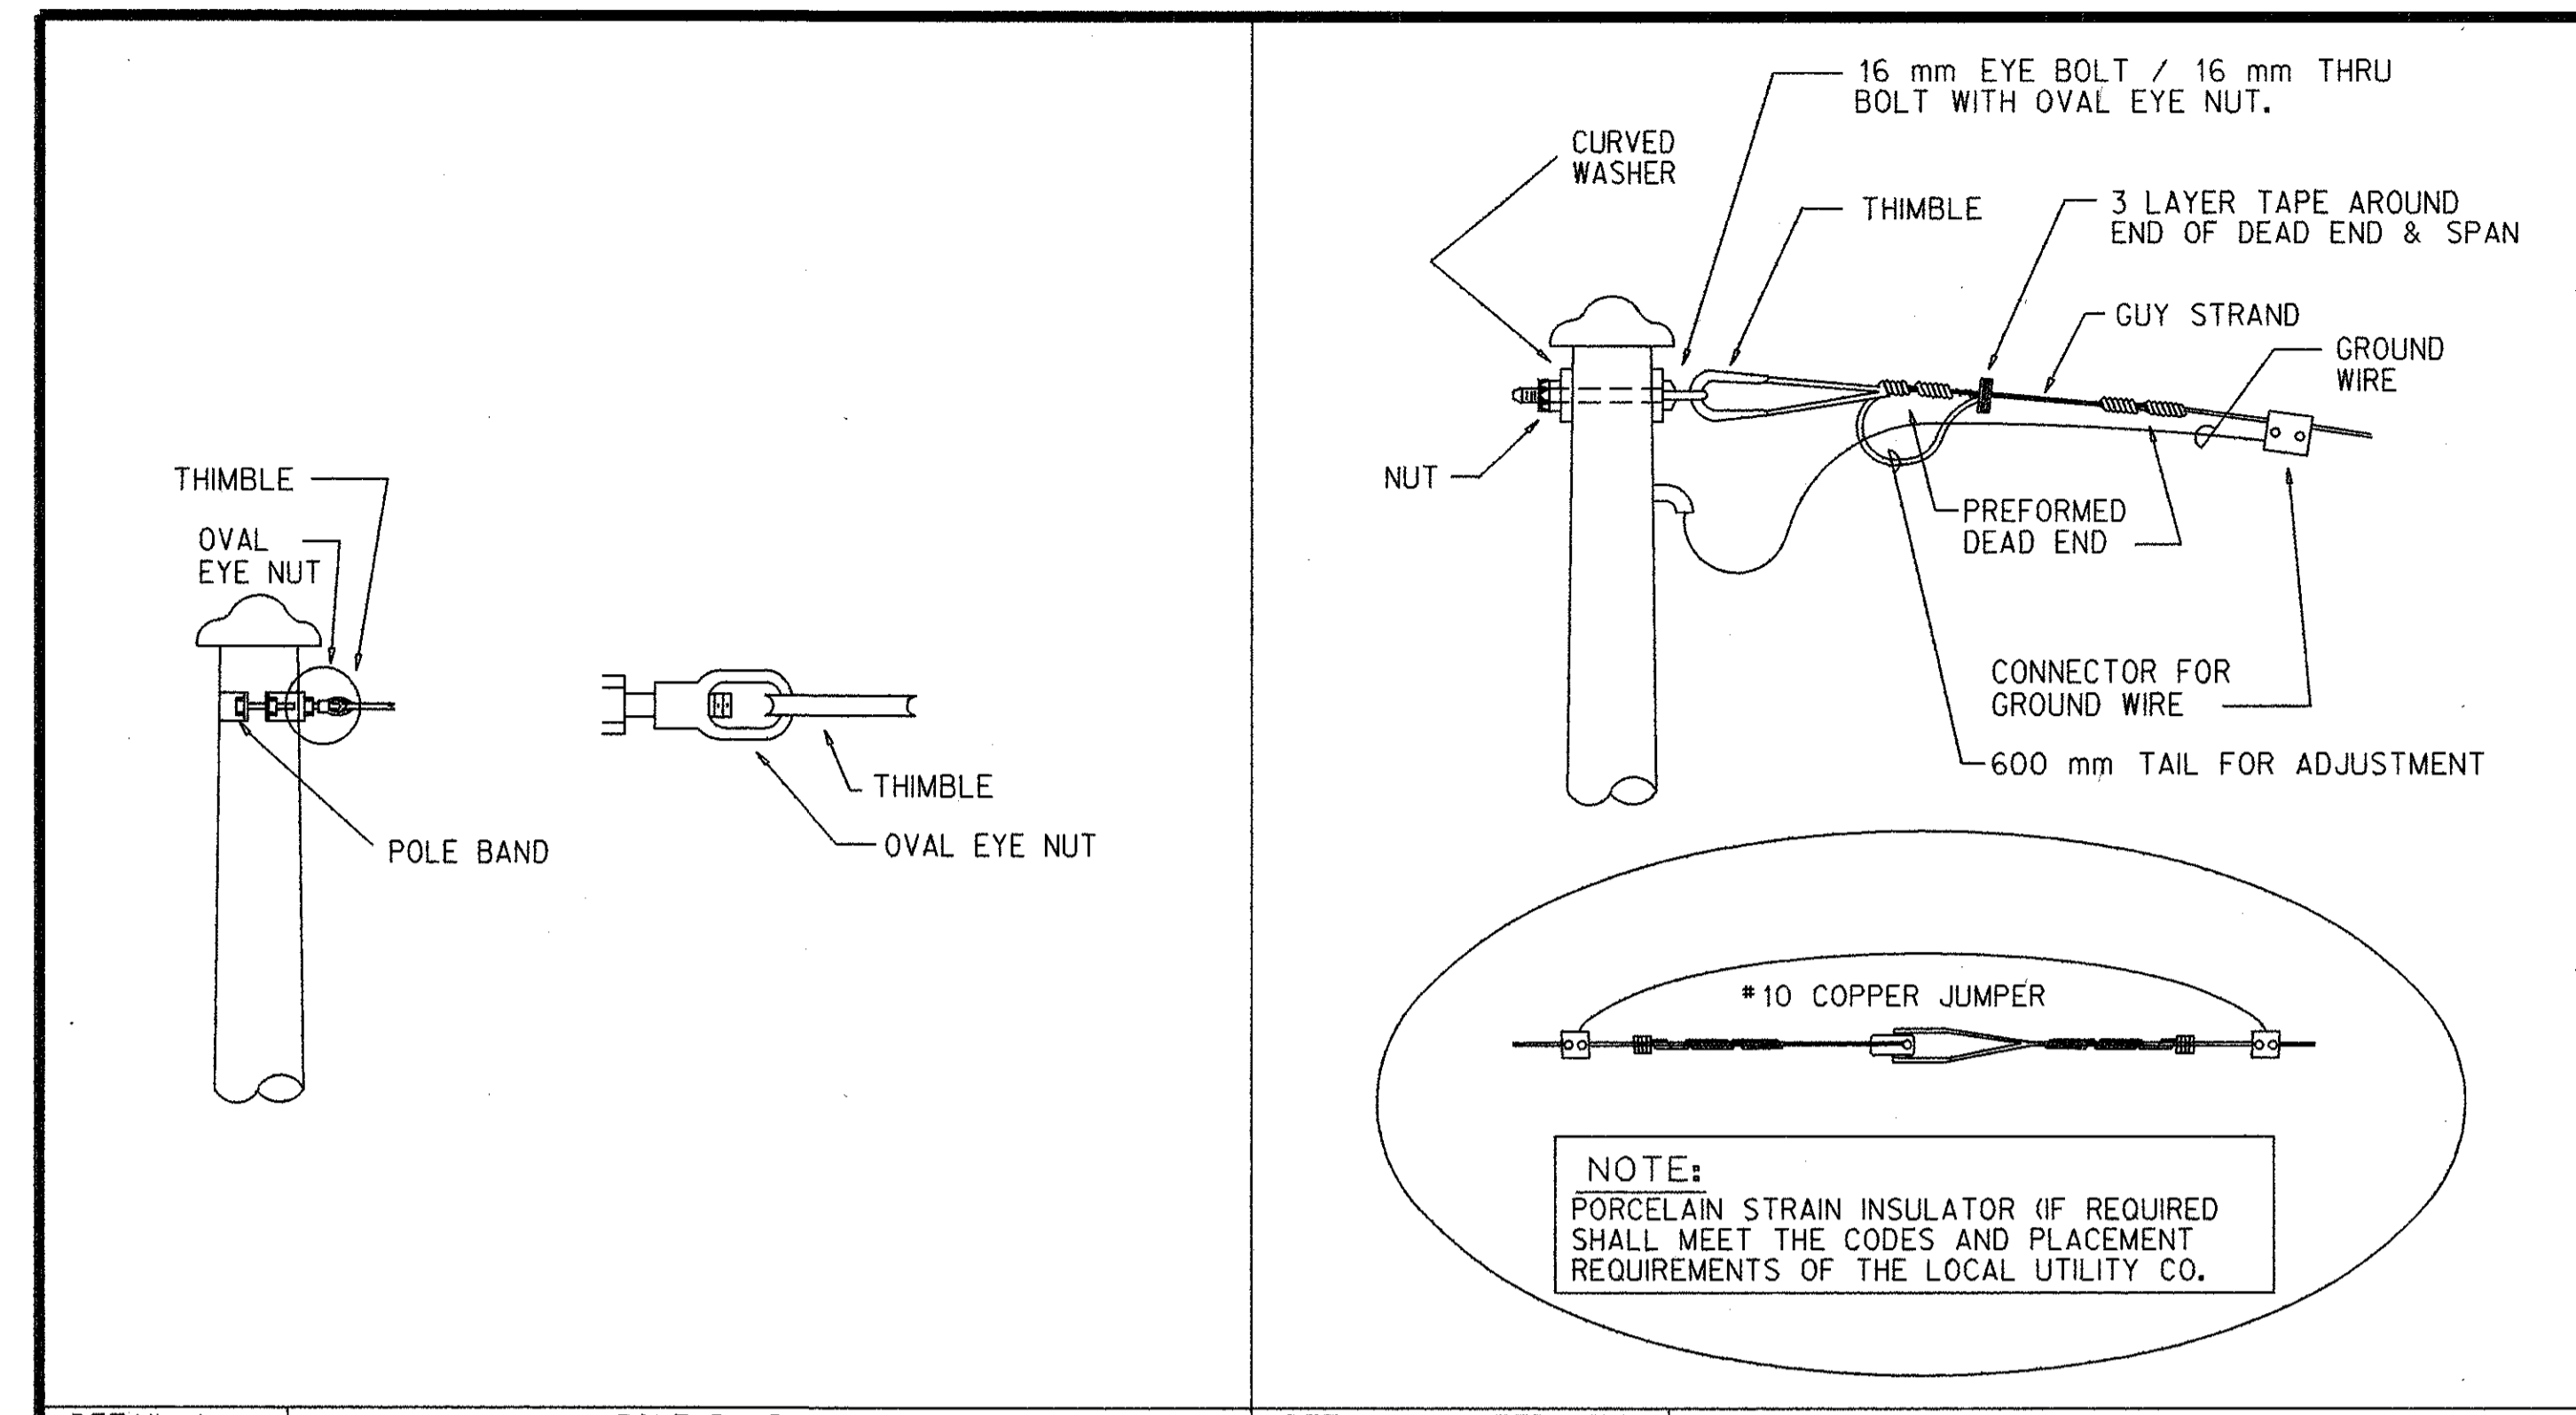

DETAIL A POLE BAND DETAIL A (ALTERNATE) EYE BOLT

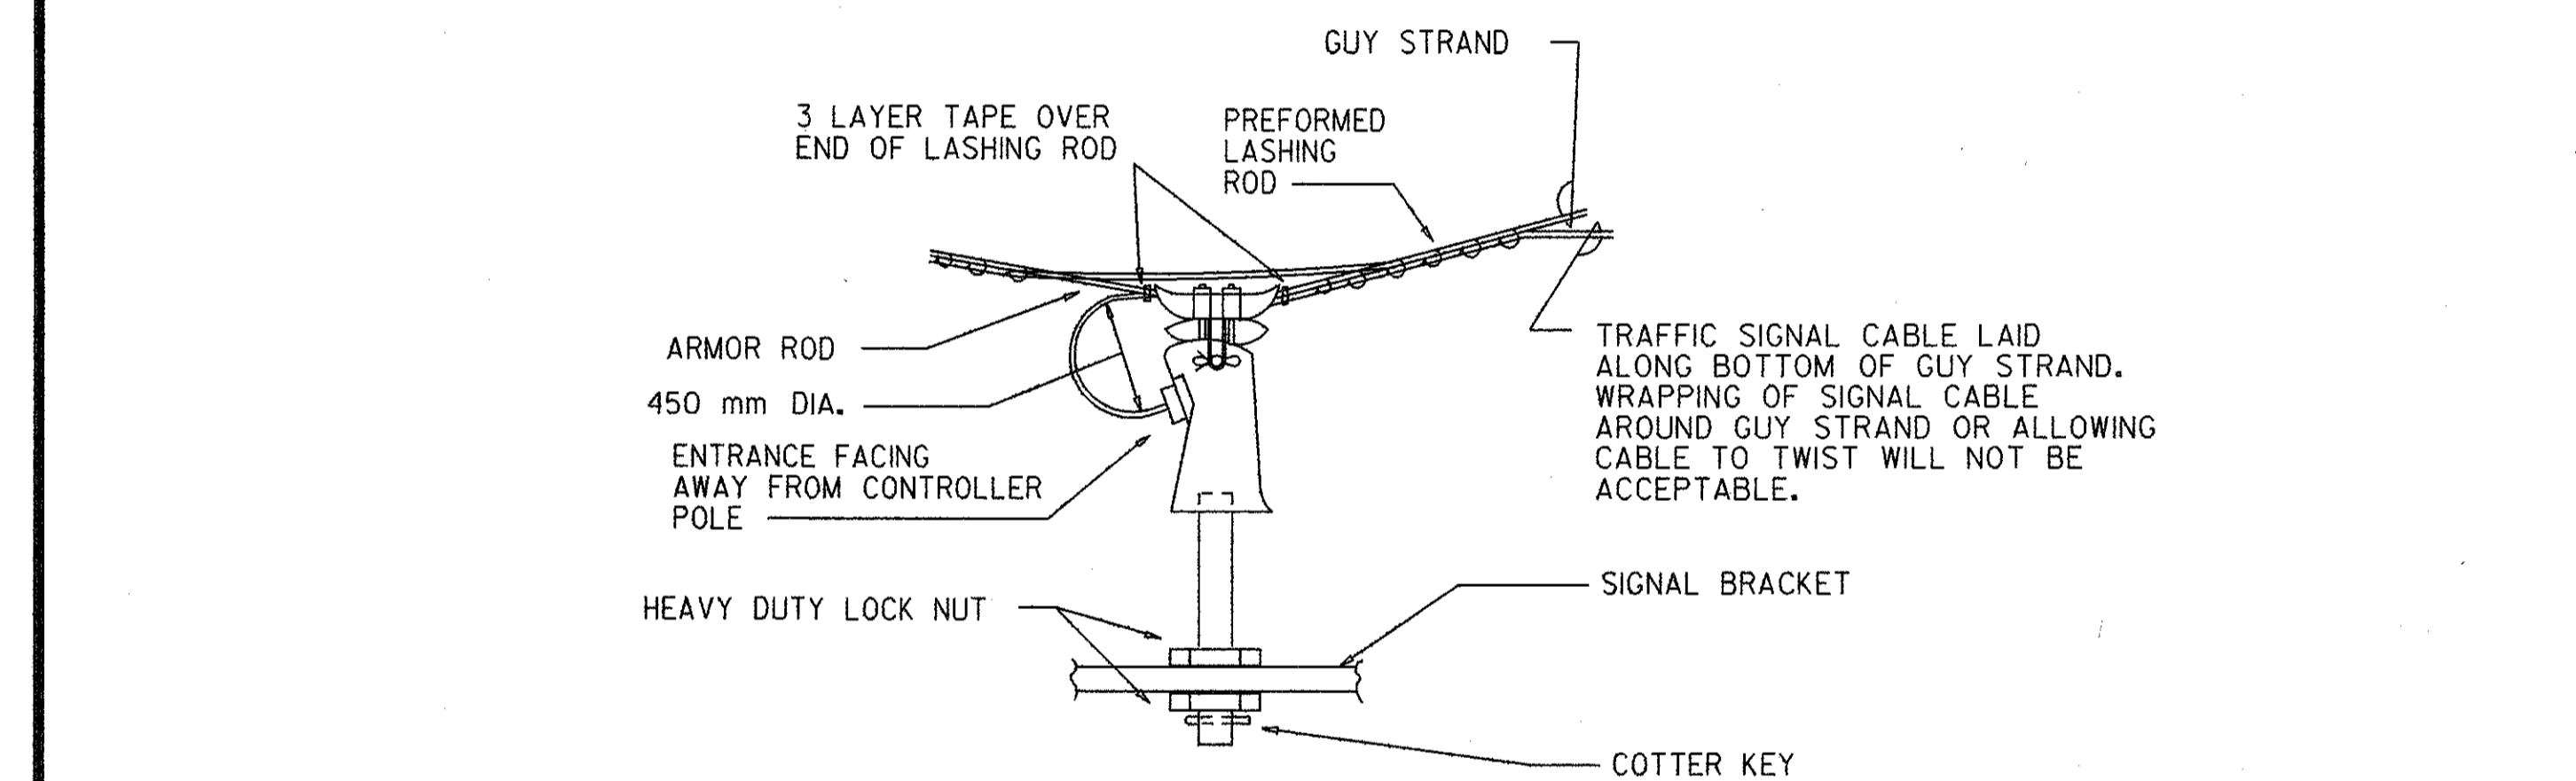

DETAIL B HANGER ATTACHMENT

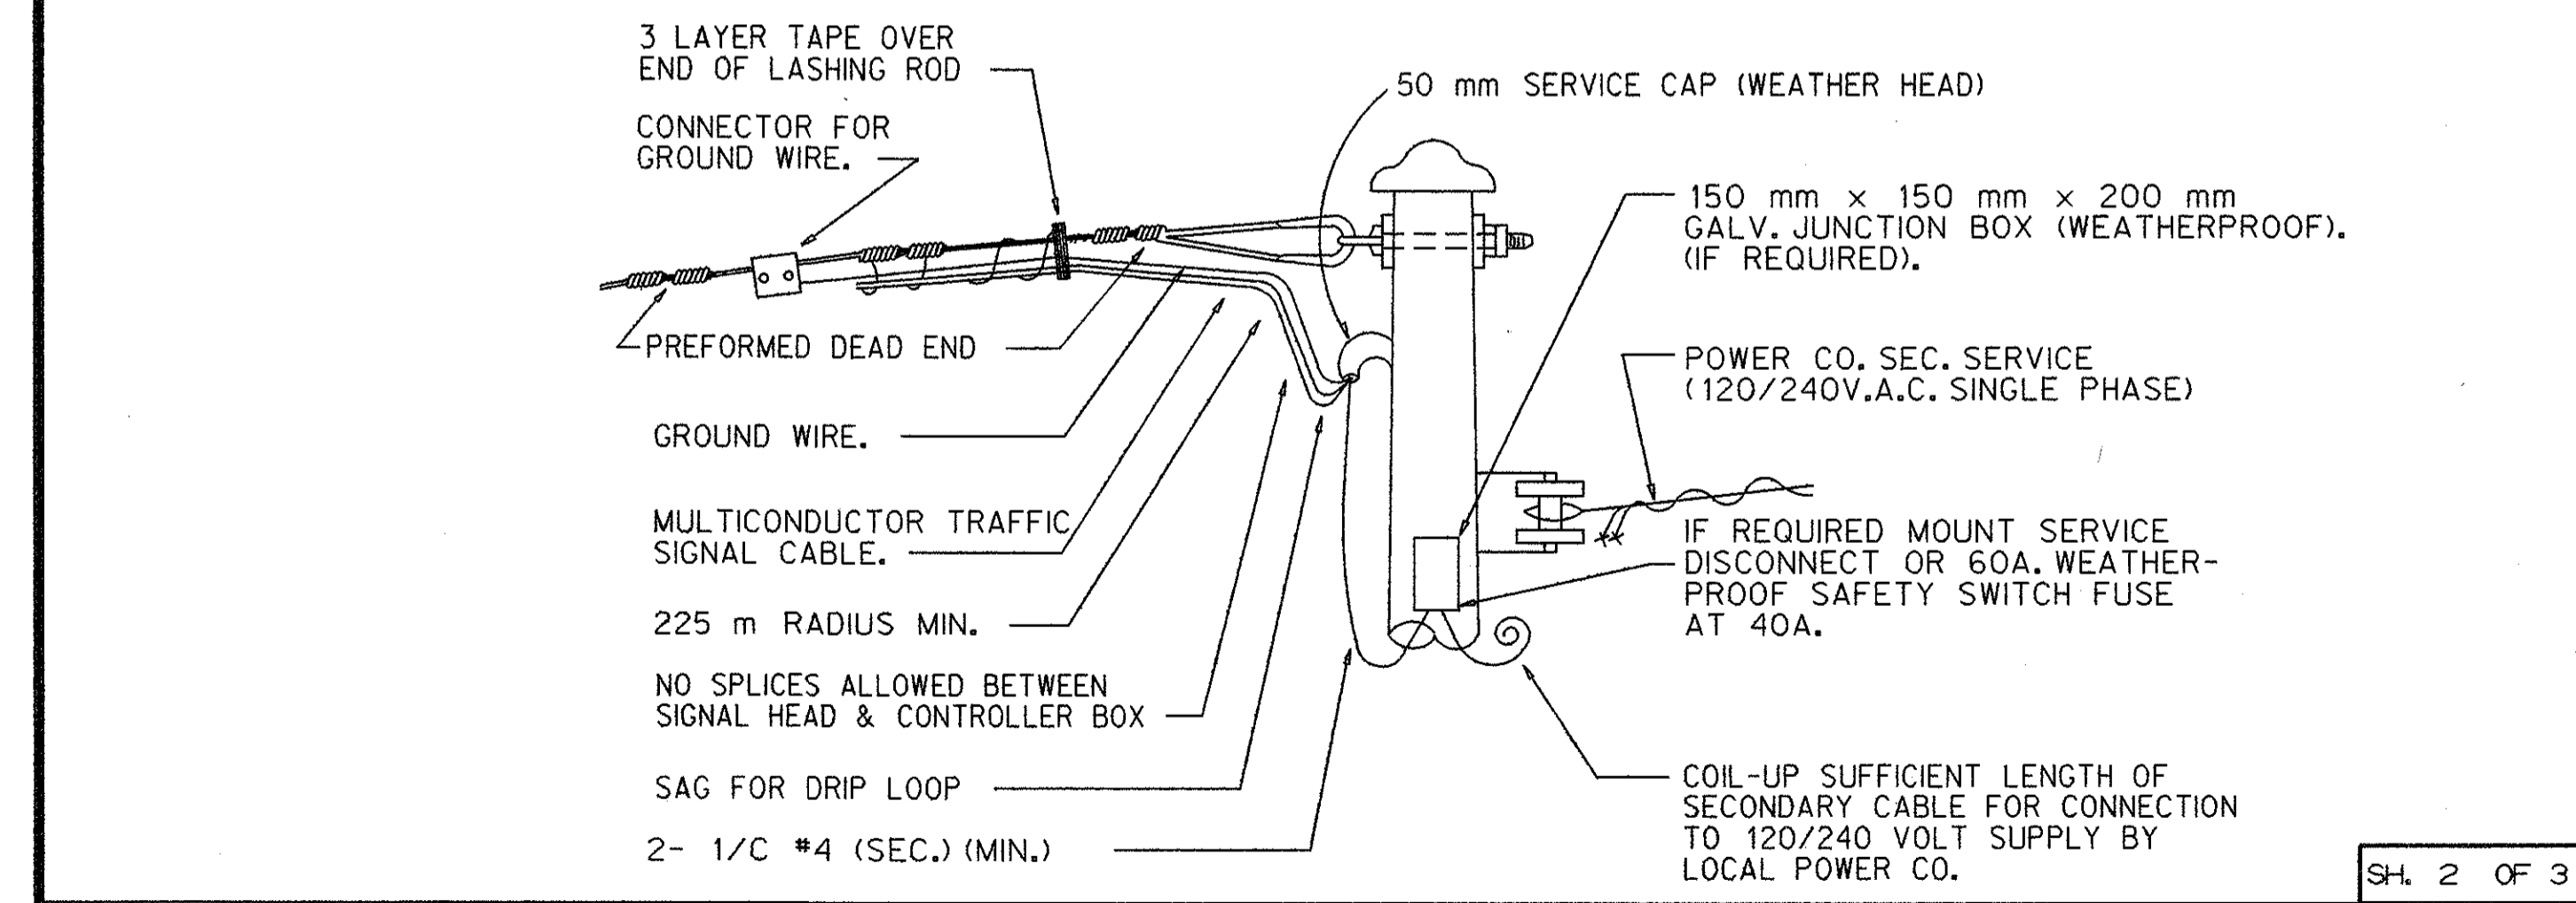


DETAIL C CABLING


SPAN WIRE T.S. ON STEEL POLES

DATE	SCALE	CONT. SEC.	JOB NO.	T & S	CONST.
9-21-99		63174	48404A	8 of 31	8D

LAST CORRECTION DATE: 12/27/95
FILENAME: OC1.DGN

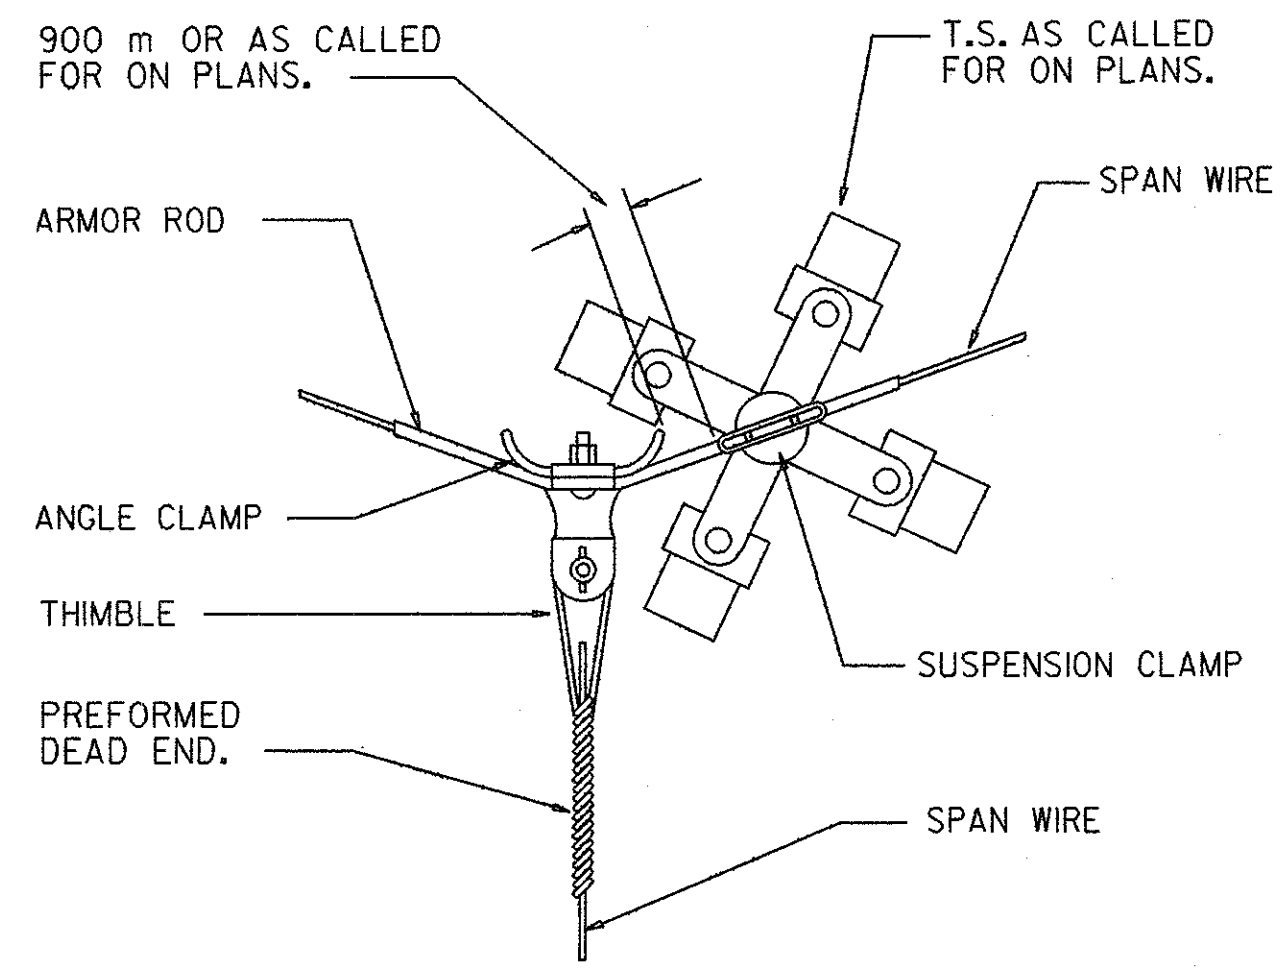

DETAIL : PULL-OFF CONNECTION FOR 3-WAY SUSPENSION

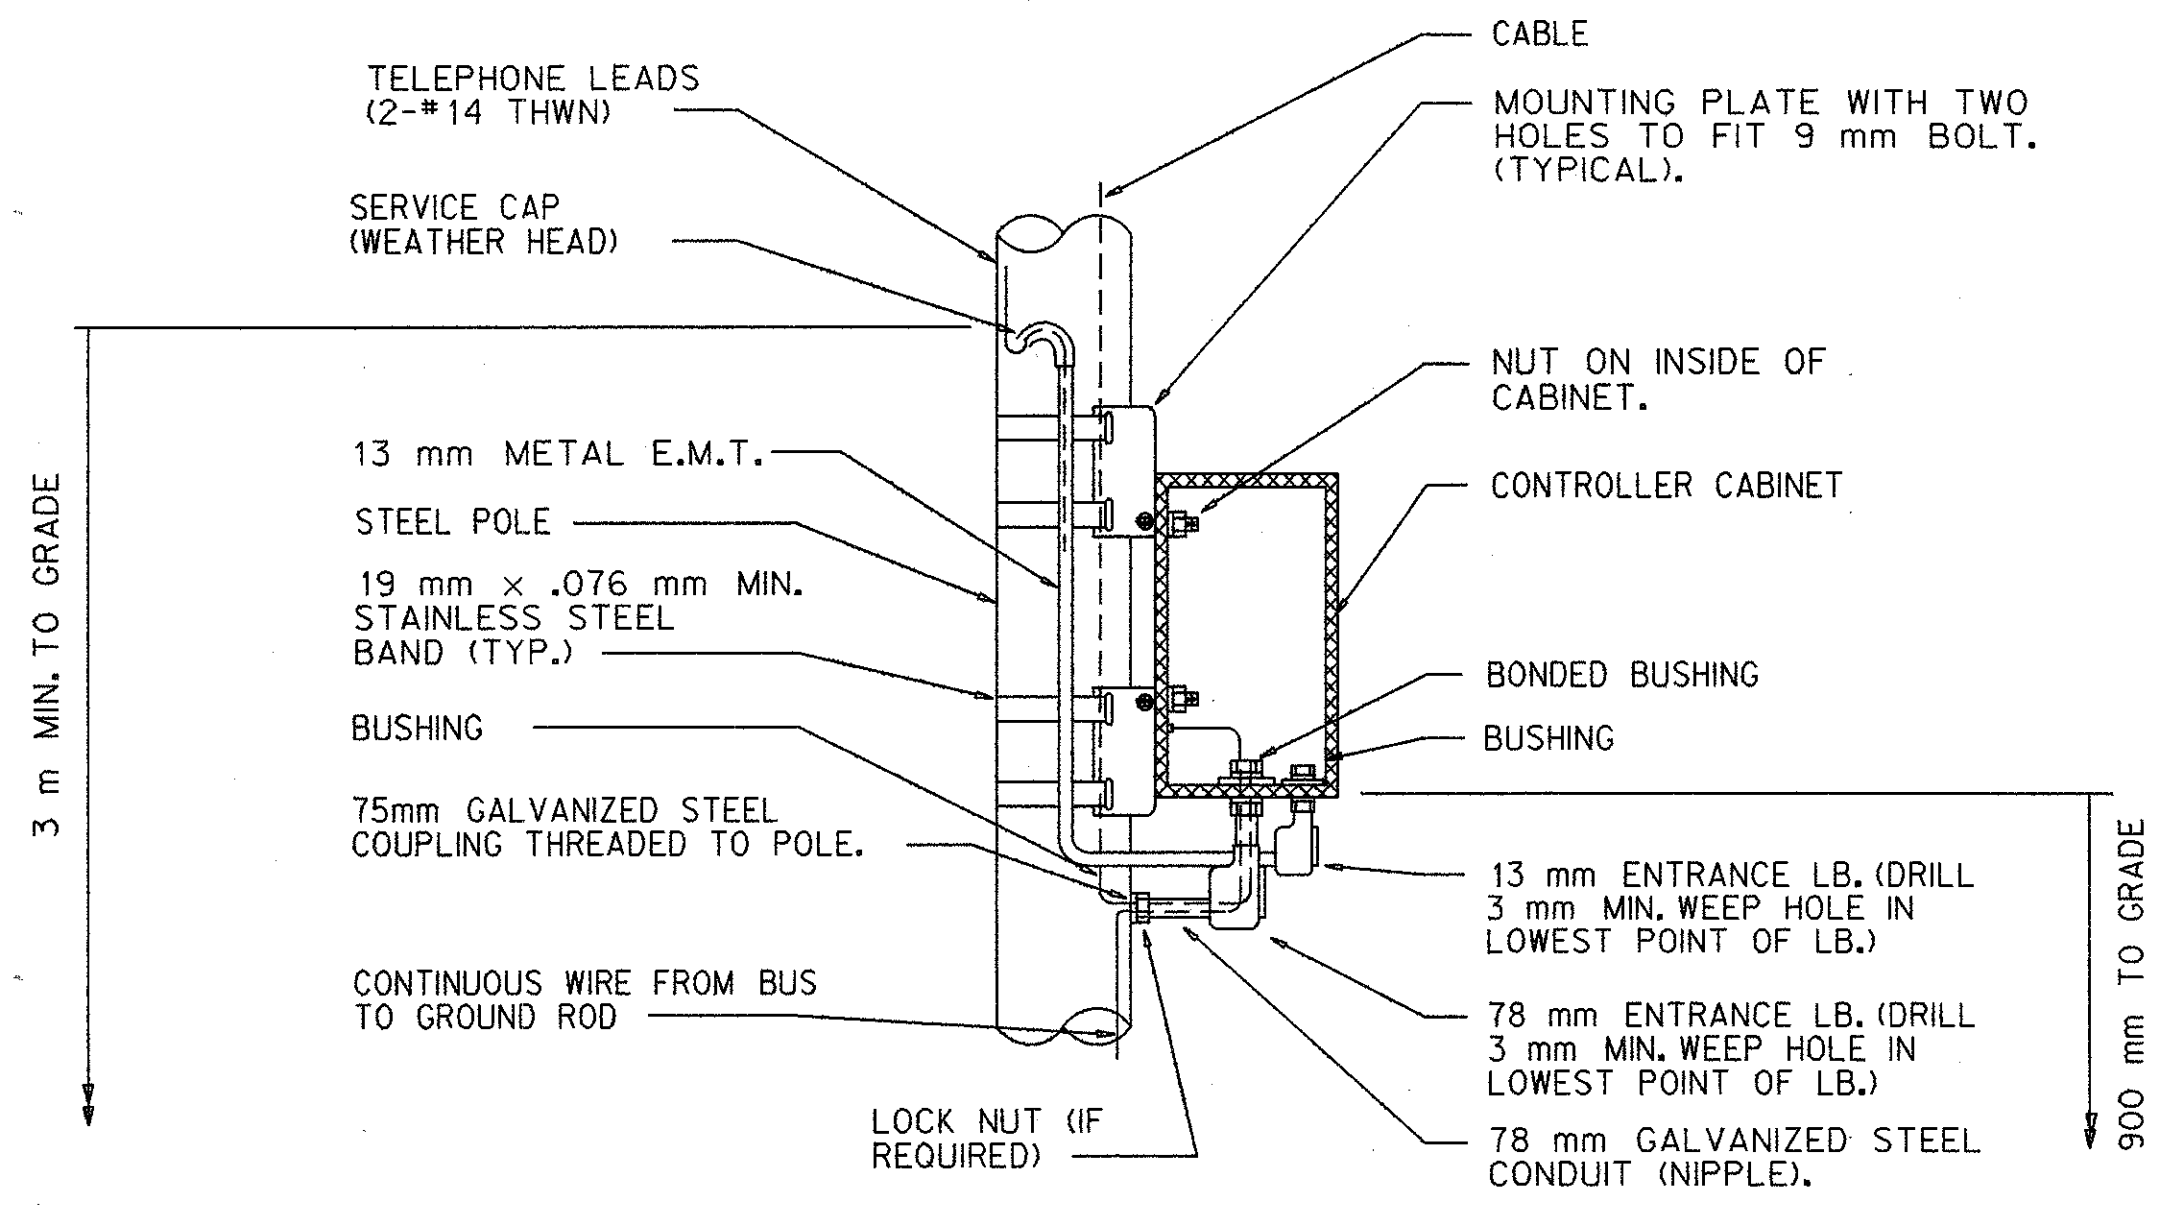

DETAIL : CONTROLLER MOUNTING

SH. 3 OF 3
OC-1


SPAN WIRE T.S. ON STEEL POLES

DATE	SCALE	CONT. SEC.	JOB NO.	T & S	CONST.

SH. OF

DATE	SCALE	CONT. SEC.	JOB NO.	T & S	CONST.
9-21-99		63174	48404A	9 of 31	9D

CS 63174 JN 48404A SH No 9D

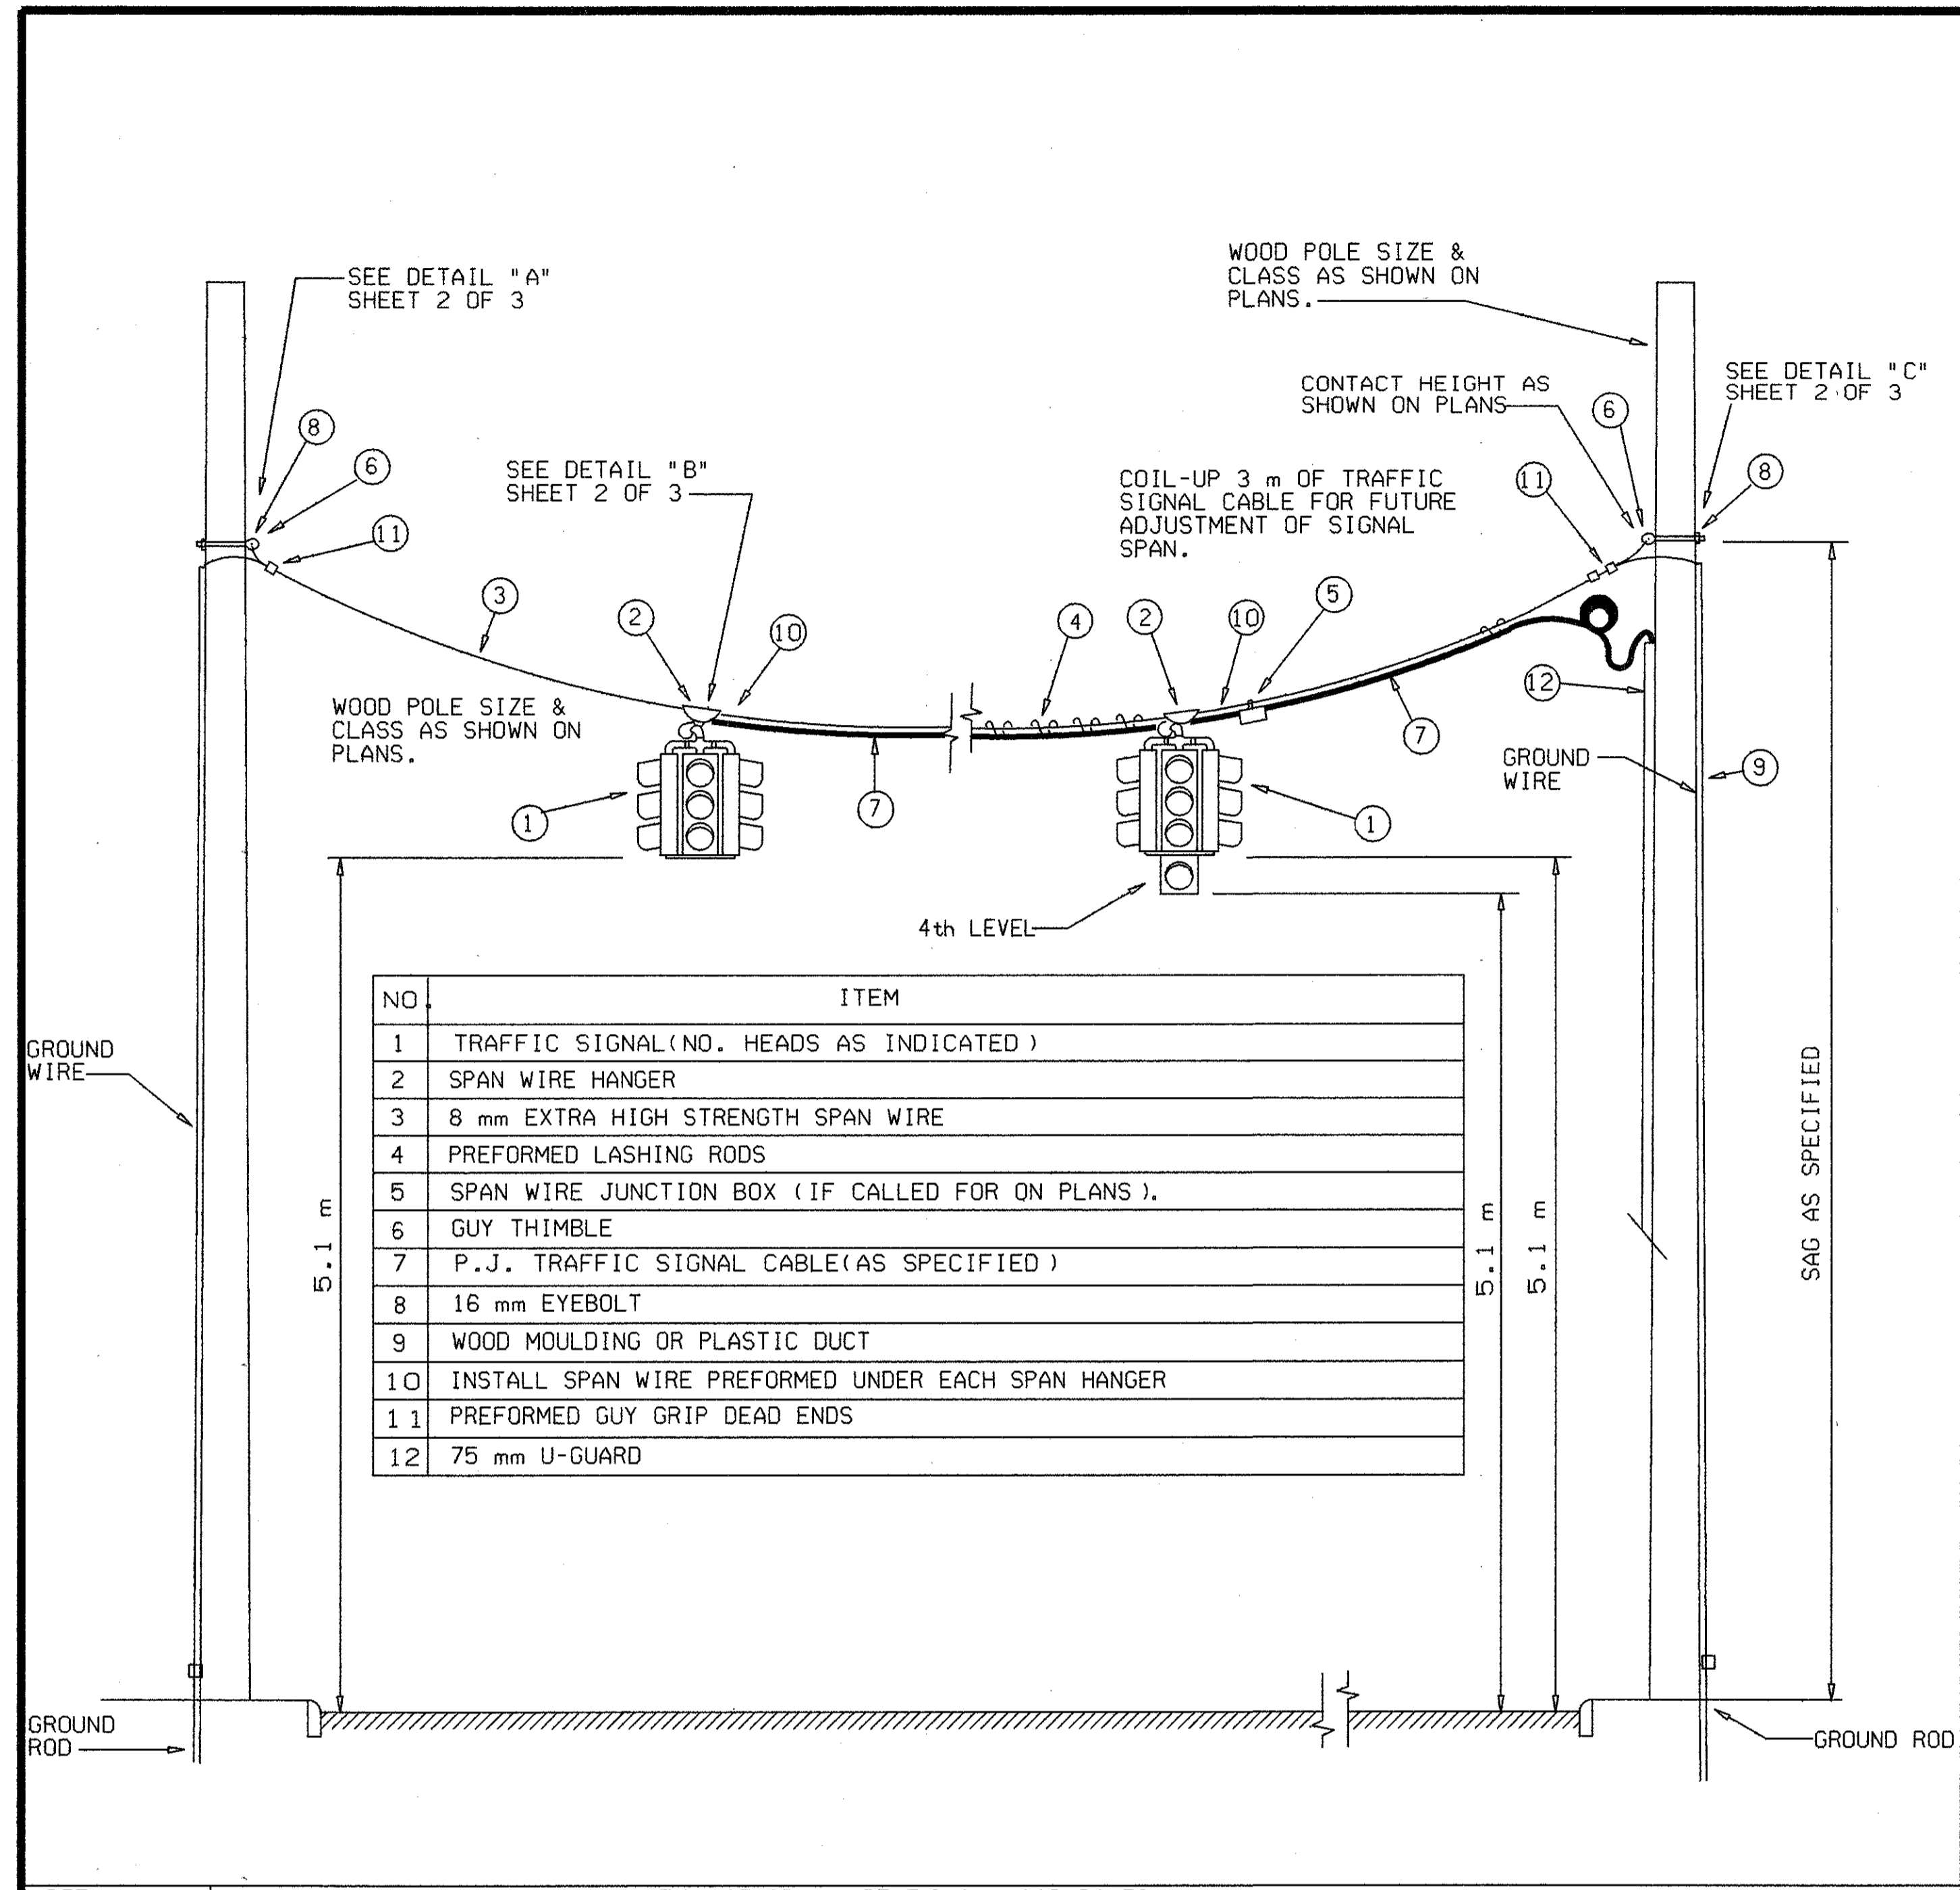

DETAIL : INSTALLATION OF SPAN WIRE T.S. ON WOOD POLES


NOTE:
INSTALL 19 mm x 3 m COPPER CLAD GROUND ROD(S) AS REQUIRED TO PROVIDE LESS THAN 10 OHM RESISTANCE TO GROUND. INSTALL #6 MIN. COPPER GROUND WIRES FROM GROUND ROD(S) TO SPAN WIRE AT EACH SUPPORTING POLE USING NON-SOLDER TYPE CONNECTIONS FOR SPAN WIRE GROUNDING.

NOTE: DETAILS NOT TO SCALE (N.T.S.)


SH. 1 OF 3
OC-1A

SPAN WIRE T.S. ON WOOD POLES


DATE	SCALE	CONT. SEC.	JOB NO.	T & S	CONST.
------	-------	------------	---------	-------	--------

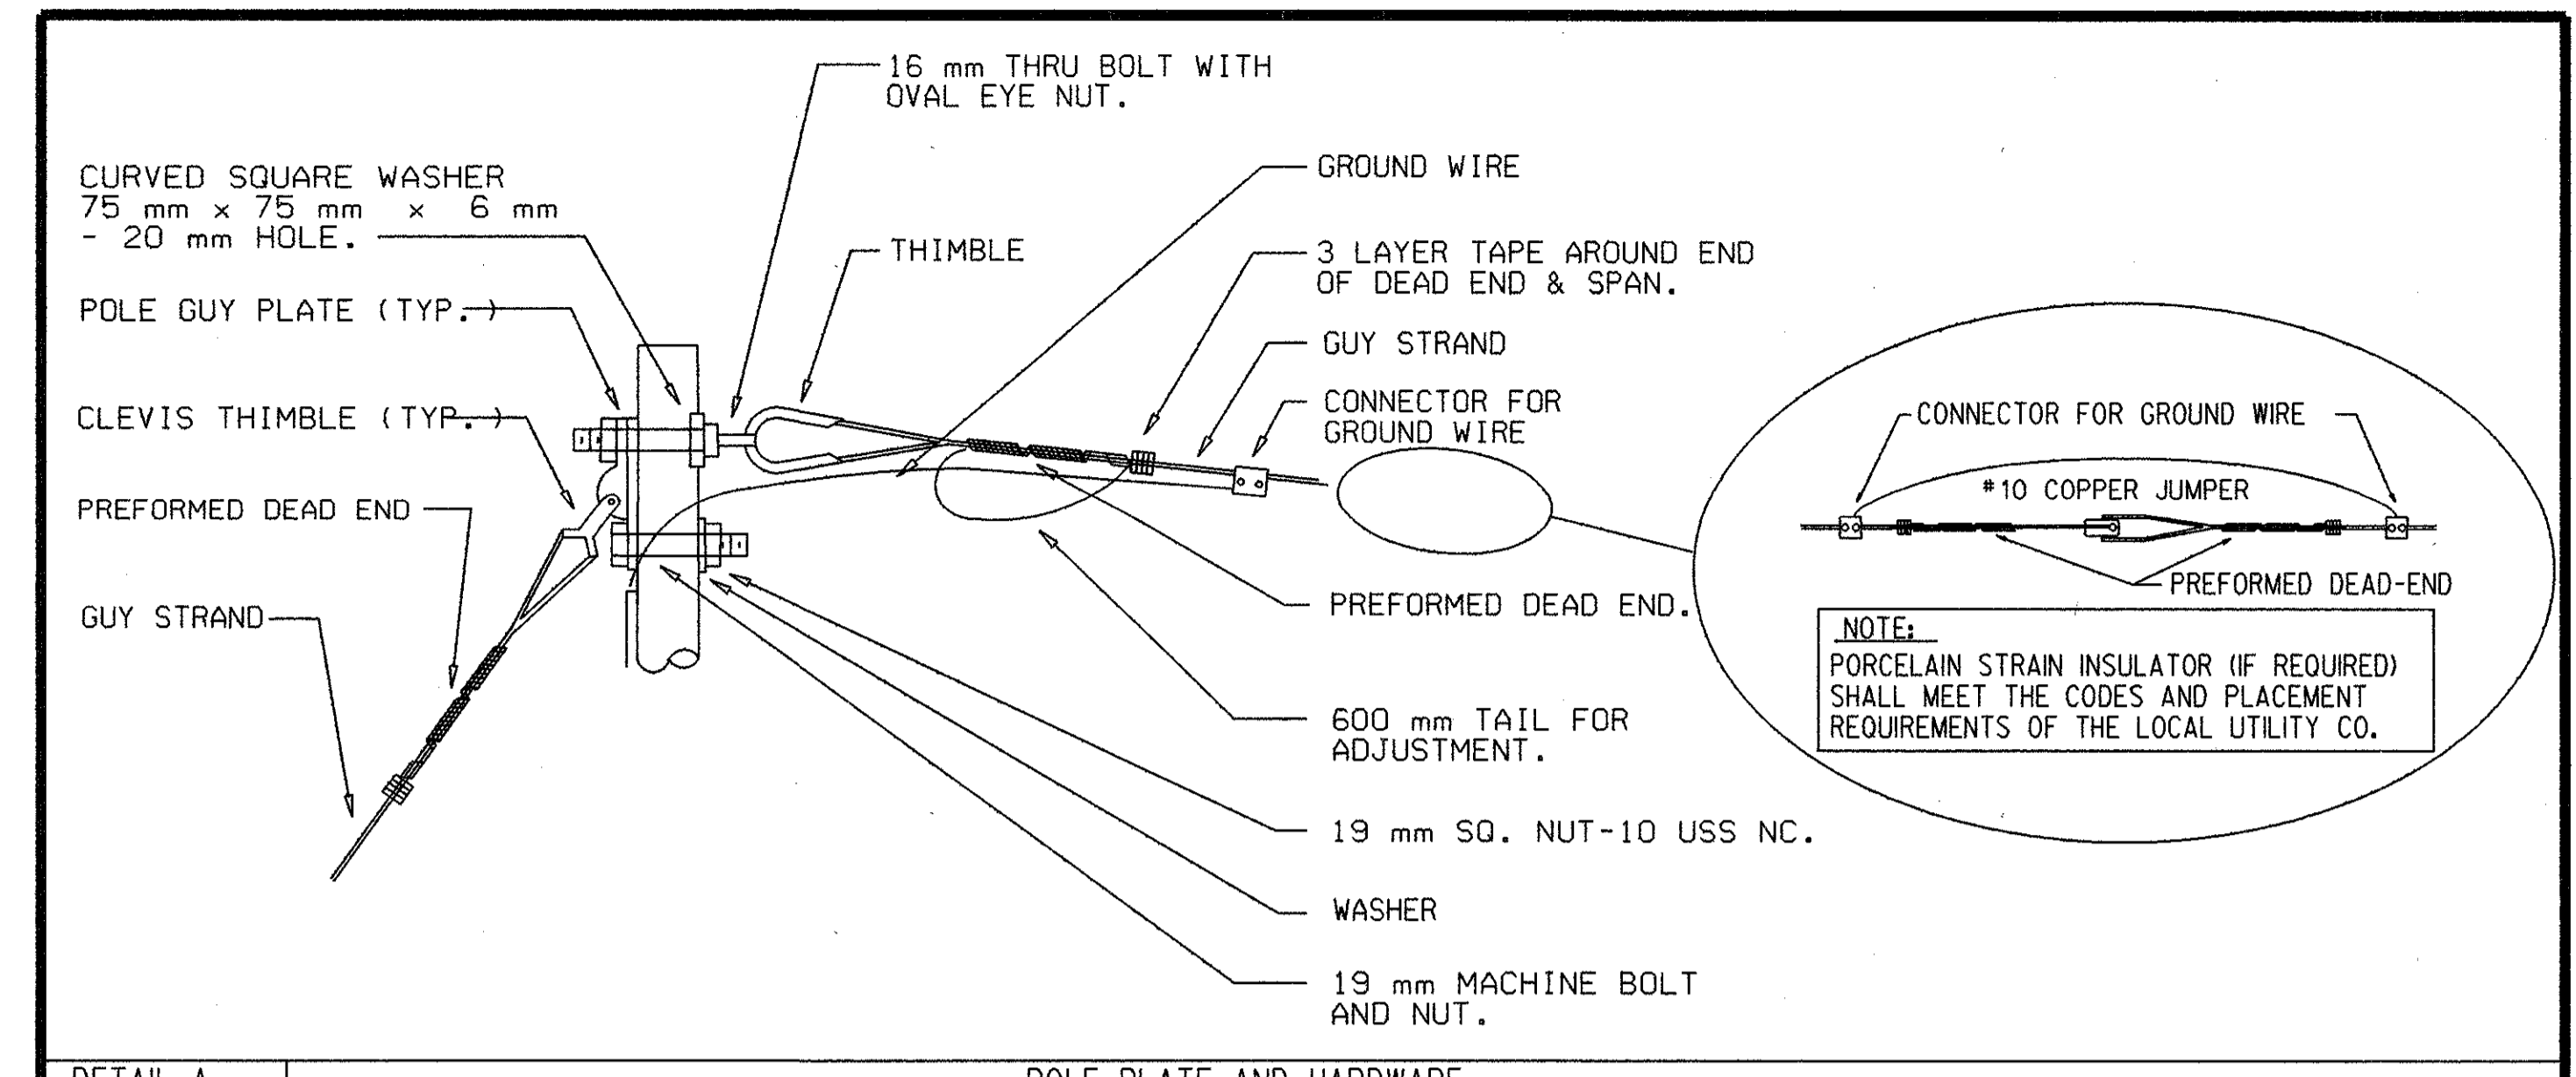

DETAIL A POLE PLATE AND HARDWARE

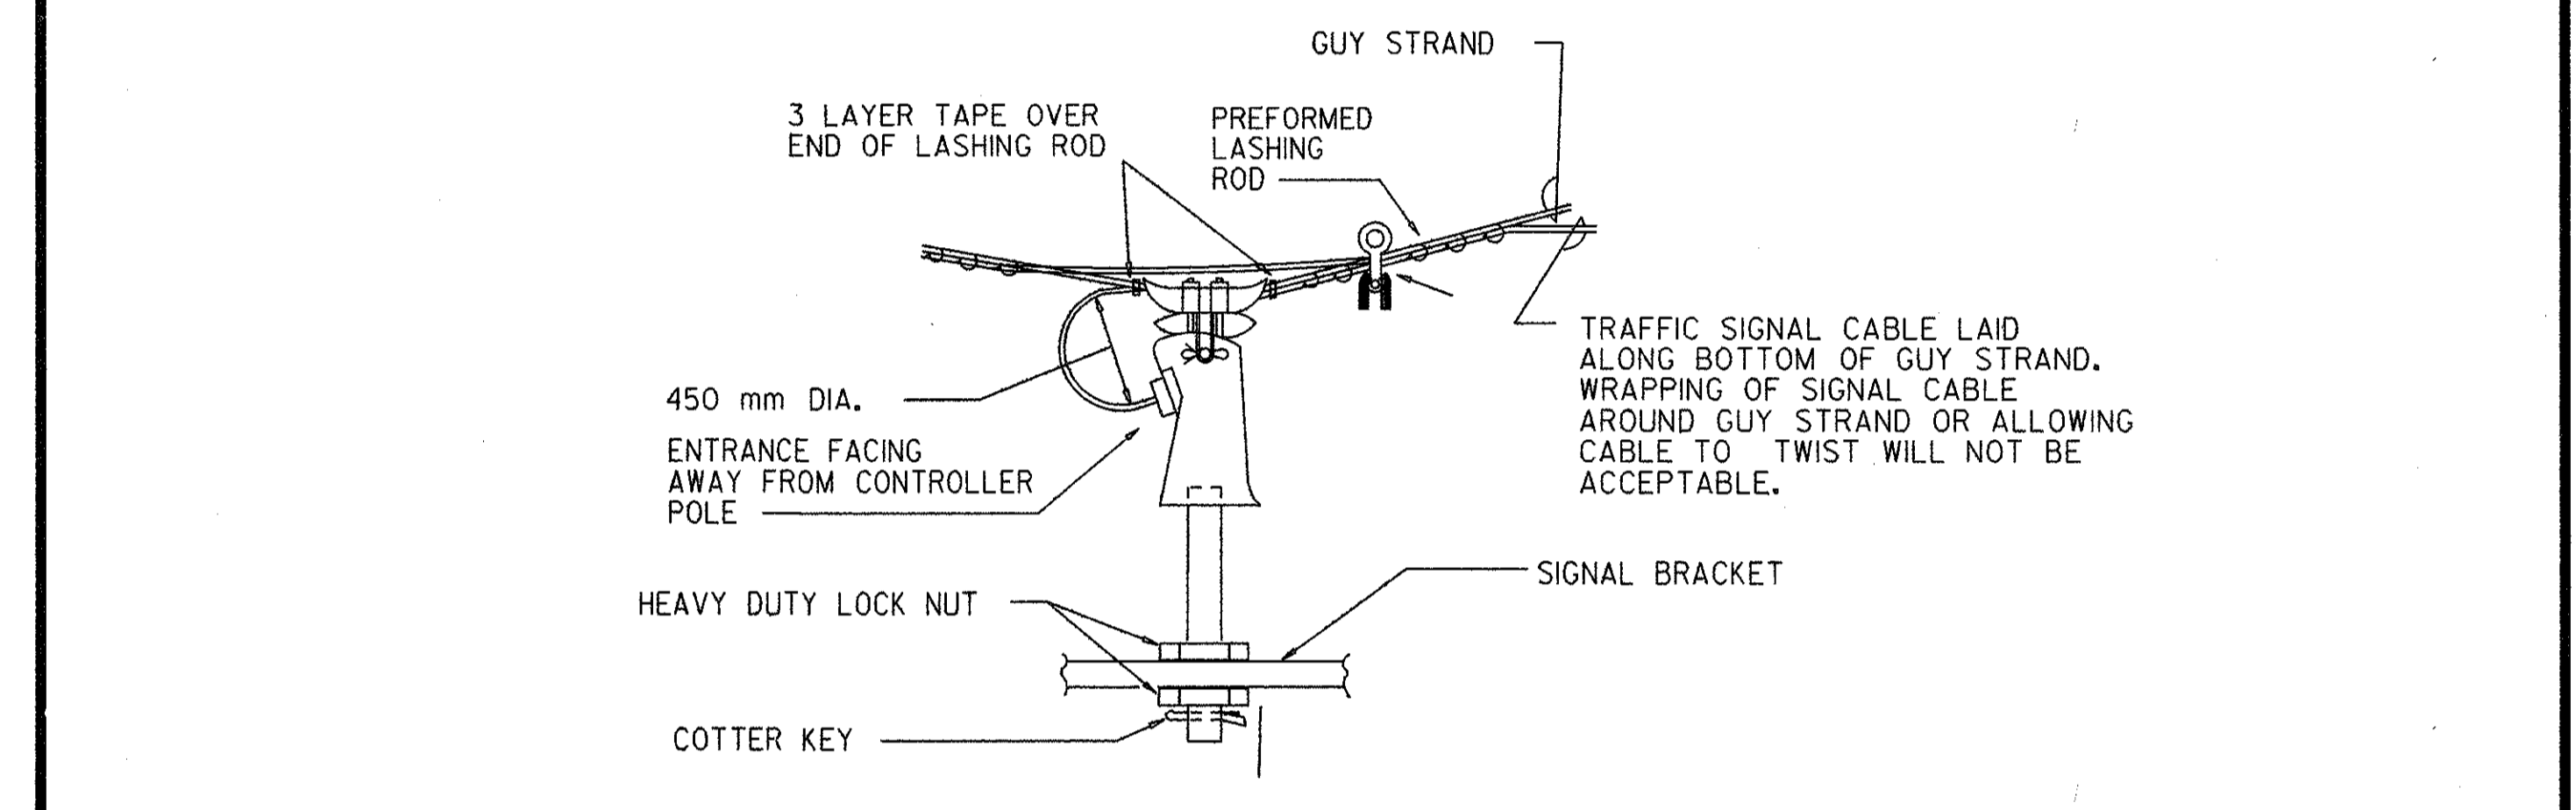

DETAIL B HANGER ATTACHMENT

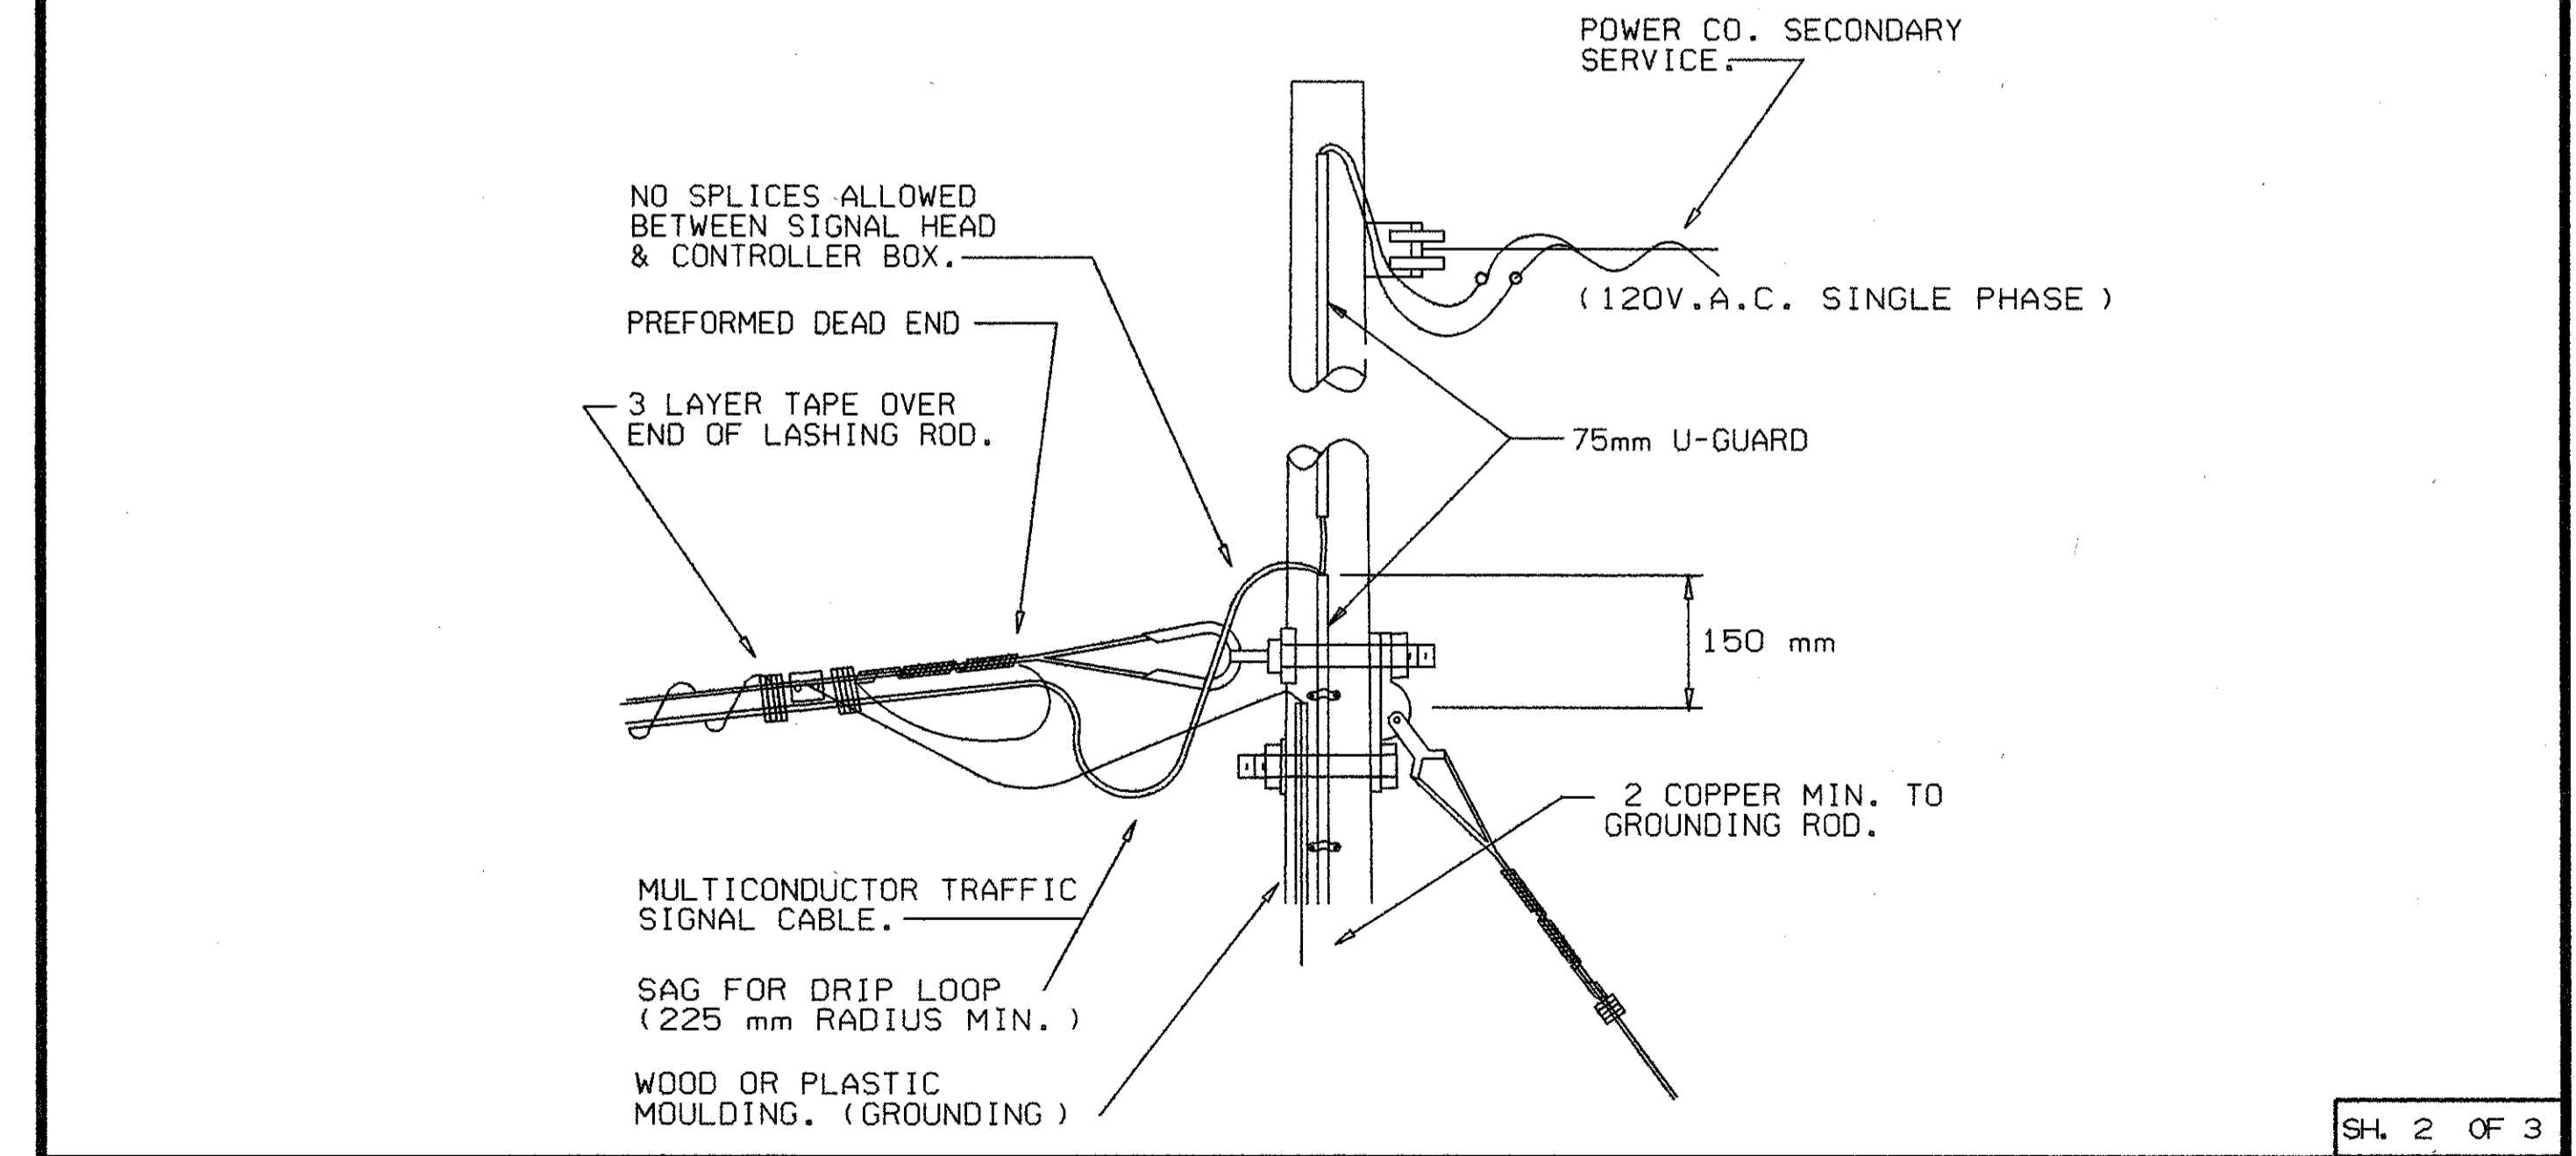


DETAIL C CABLING

SPAN WIRE T.S. ON WOOD POLES


DATE	SCALE	CONT. SEC.	JOB NO.	T & S	CONST.
9-21-99		63174	48404A	10 of 31	10 D

LAST CORRECTION DATE: 12/27/95
FILENAME: OC-1A.DGN

CS 63174 JN 48404A SH No 11D

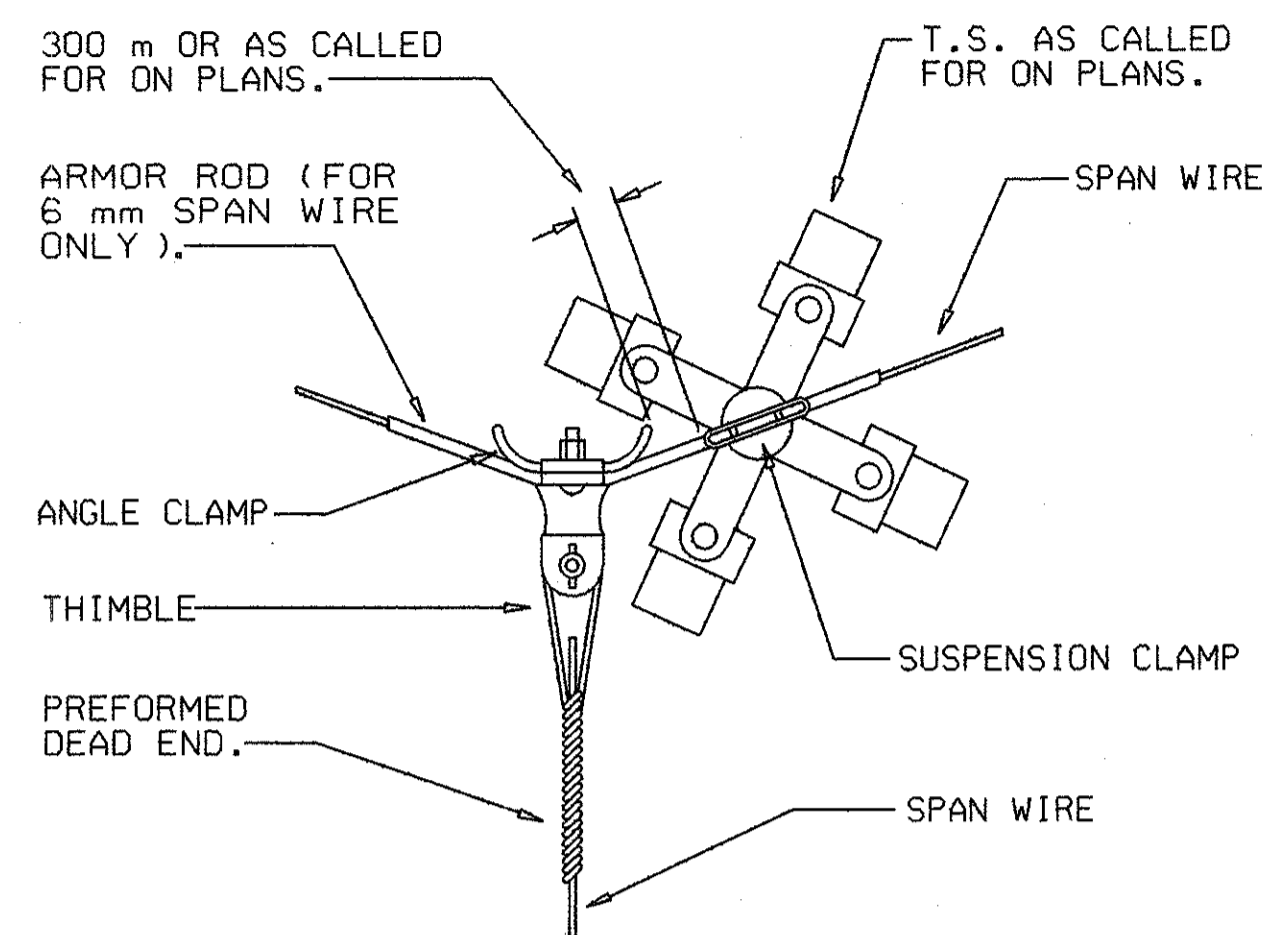

DETAIL : PULL-OFF CONNECTION FOR 3-WAY SUSPENSION

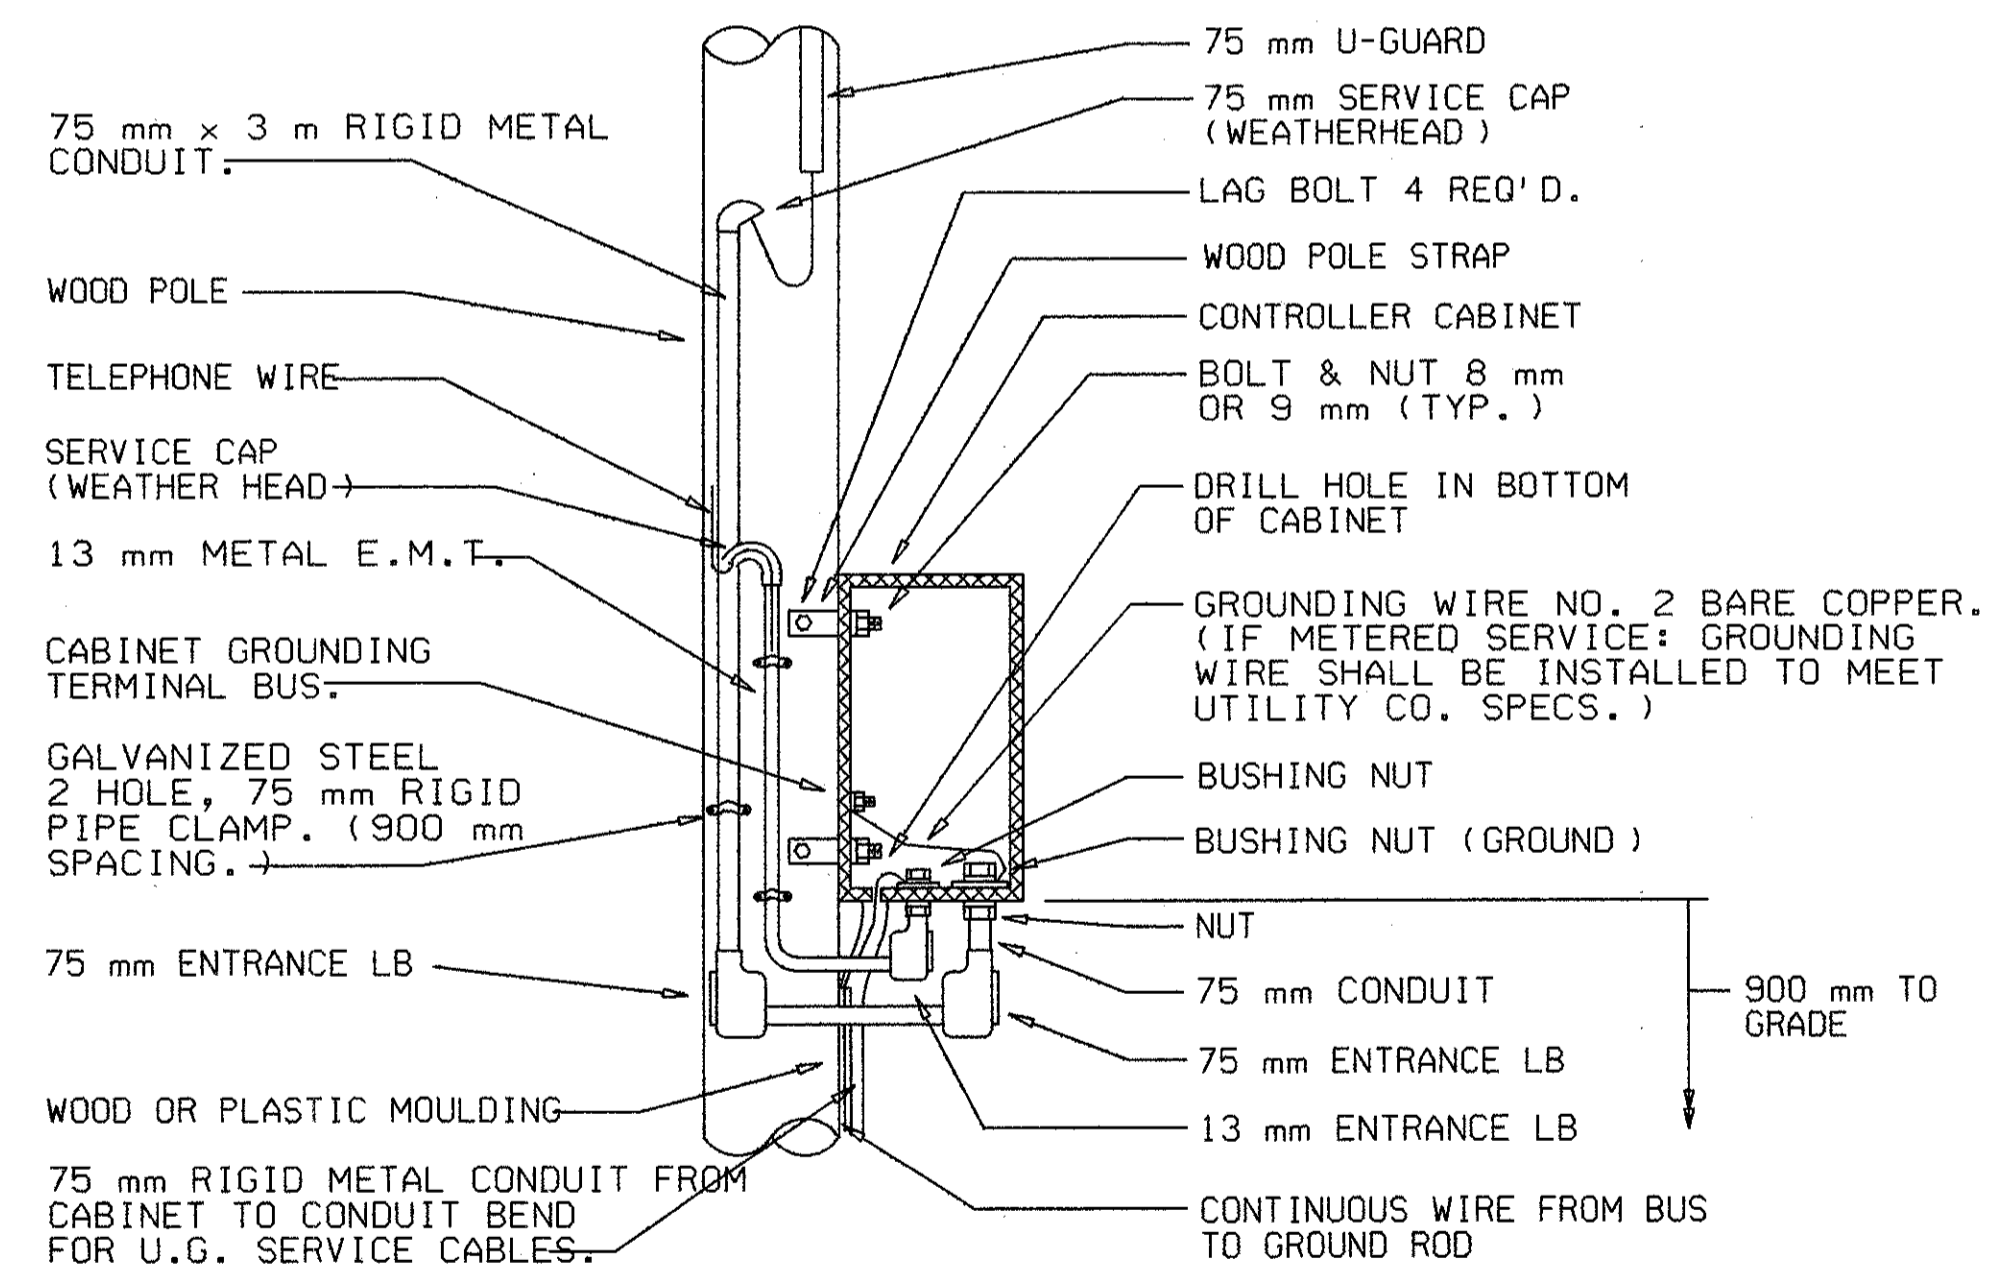

DETAIL : CONTROLLER MOUNTING


SH. 3 OF 3
OC-1A

SPAN WIRE T.S. ON WOOD POLES

DATE	SCALE	CONT. SEC.	JOB NO.	T & S	CONST.

SH. OF

DATE	SCALE	CONT. SEC.	JOB NO.	T & S	CONST.
9-21-99		63174	48404A	11 of 31	11D

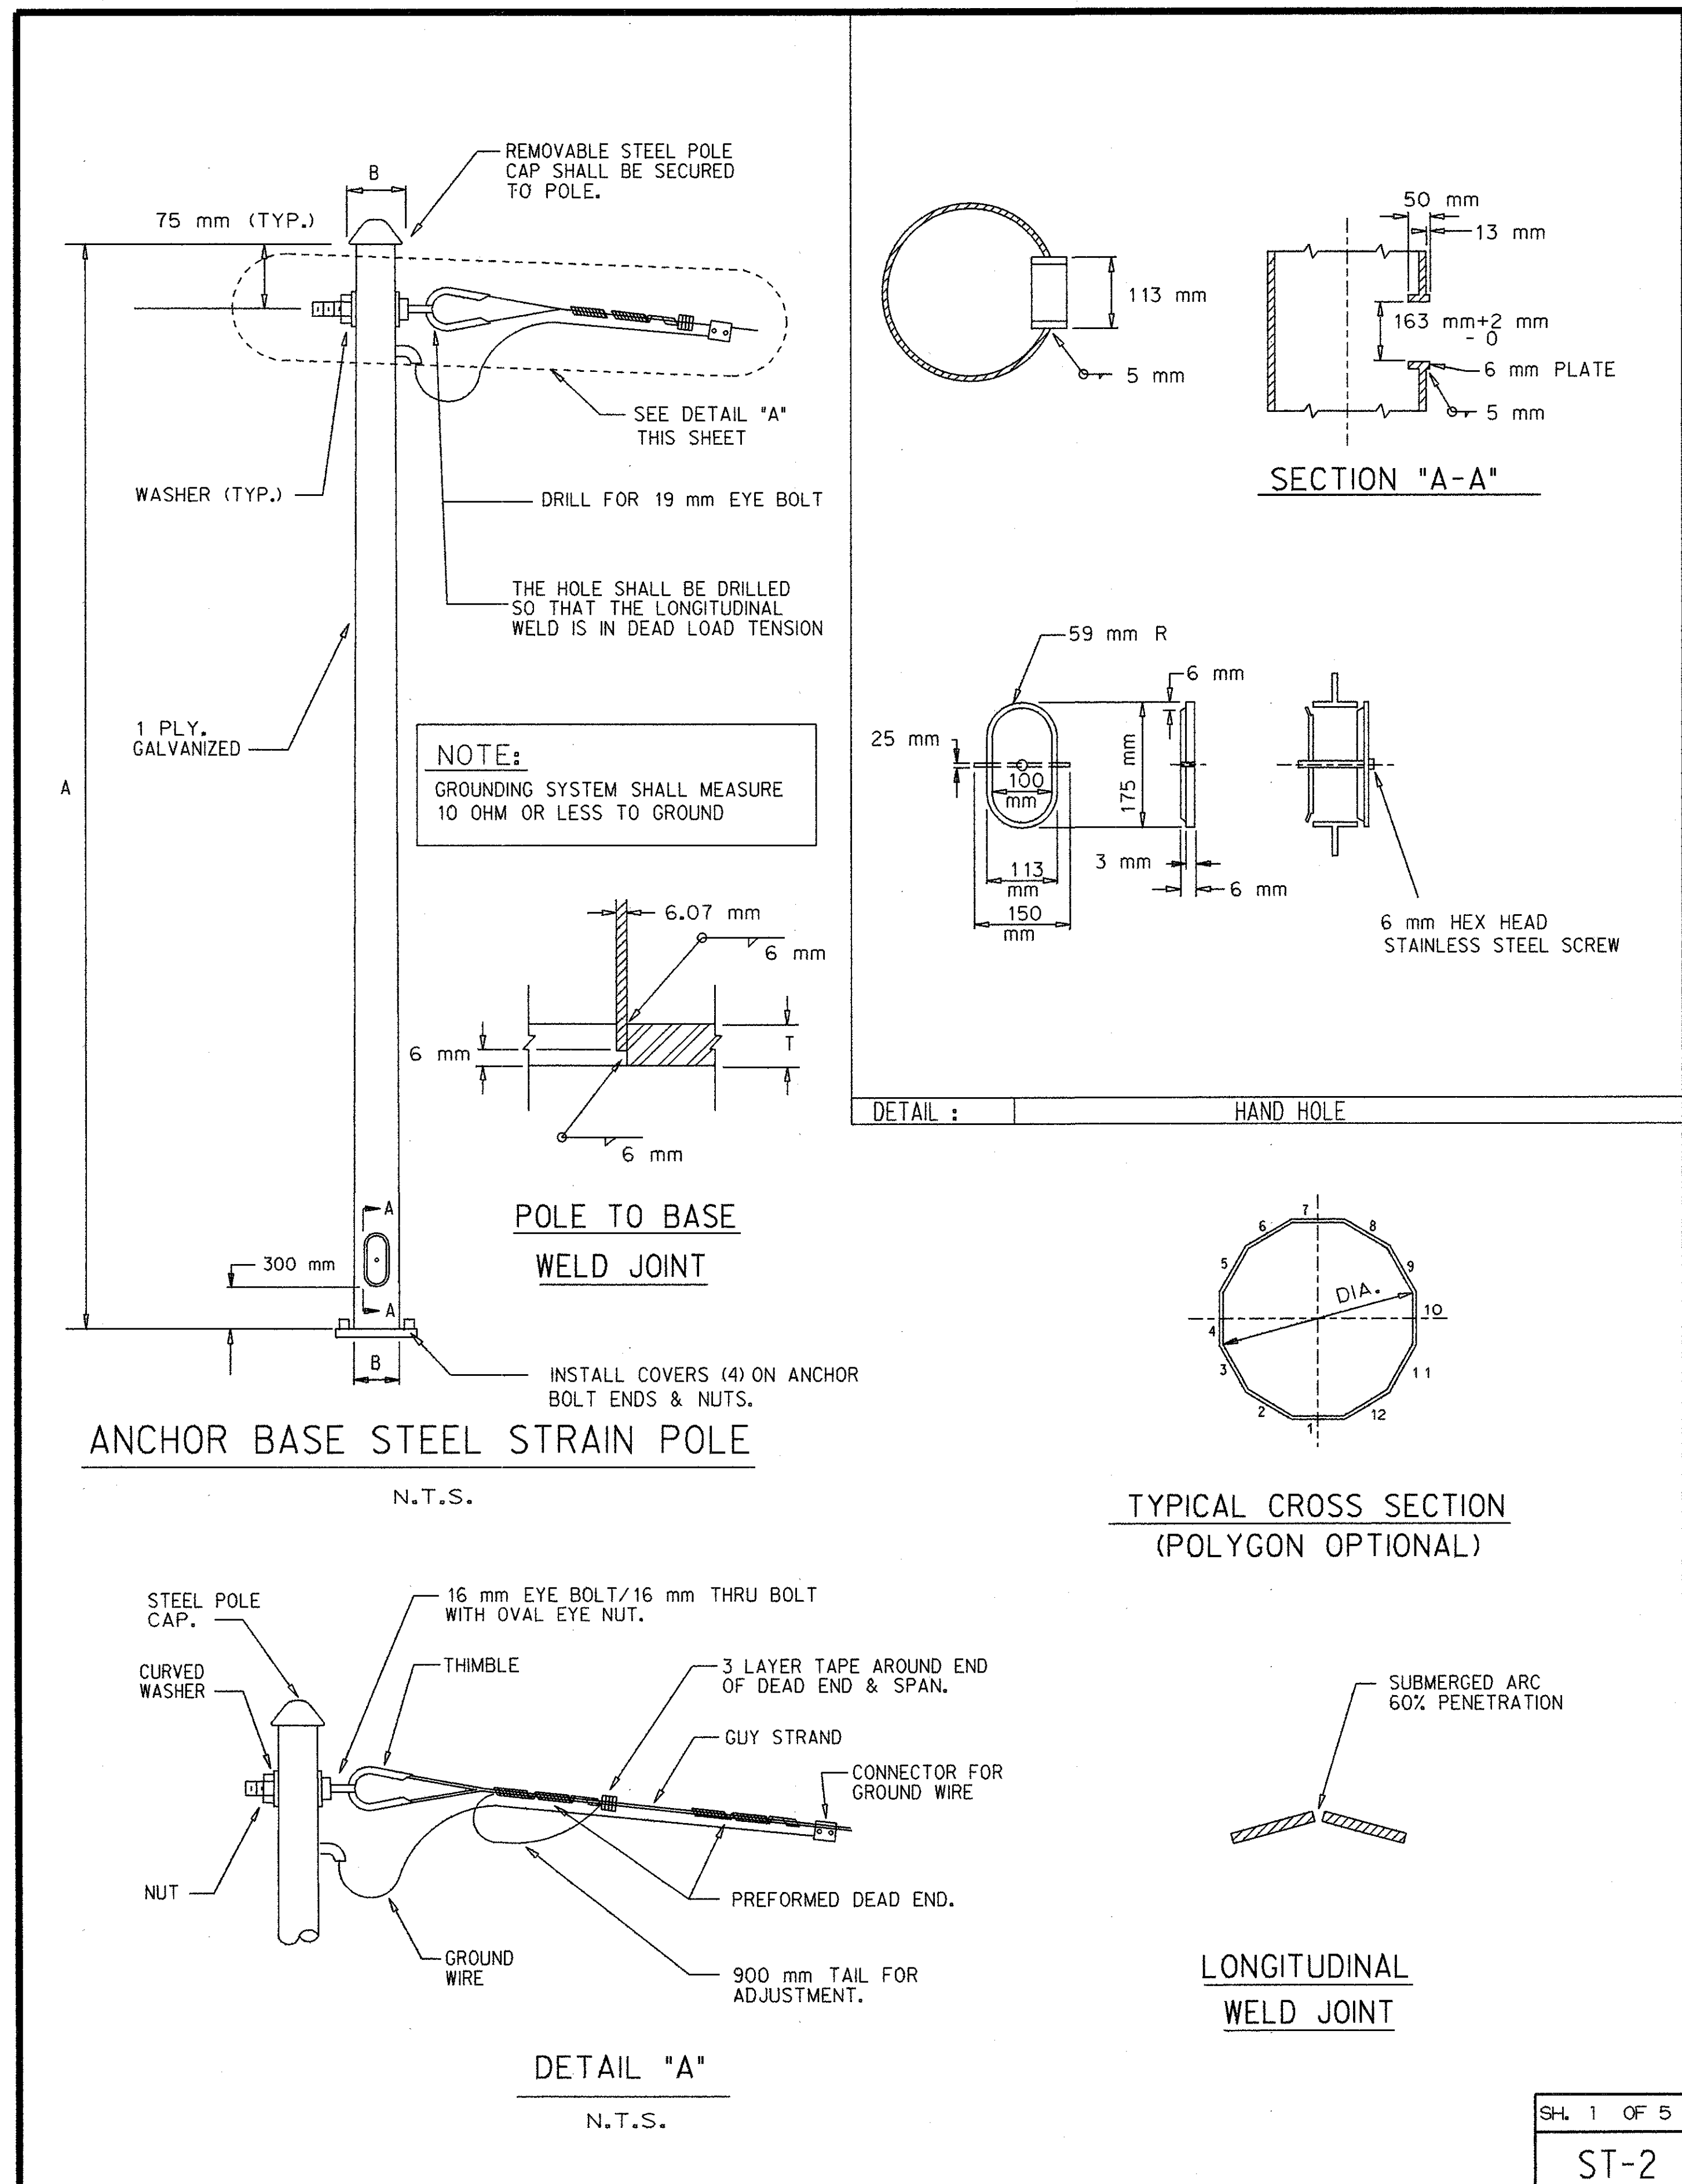

LAST CORRECTION DATE: 12/22/95
FILENAME: ST2.DGN

ANCHOR BASE STEEL STRAIN POLE AND FOUNDATION

DATE	SCALE	CONT. SEC.	JOB NO.	T & S	CONST.
------	-------	------------	---------	-------	--------

SH 1 OF 5
ST-2




ANCHOR BASE STEEL STRAIN POLE AND FOUNDATION

DATE	SCALE	CONT. SEC.	JOB NO.	T & S	CONST.
9-21-99		63174	48404A	12 of 31	12 D


SH 2 OF 5
ST-2

NOTES:

- ACCEPTABLE MILL TOLERANCES TO APPLY TO ALL NOMINAL DIMENSIONS.
- HANDHOLE SHALL BE PROVIDED & BE PERPENDICULAR TO EYE BOLT HOLE.
- MATERIAL () GALVANIZED FINISH.
 - SHAFT STEEL SHALL BE ASTM A572, Fy = 344.7 MPa.
 - BASE PLATE ASTM A36.
 - ALL GALVANIZING SHALL MEET ASTM A123.
 - ANCHOR BOLTS SHALL BE IN ACCORDANCE WITH SPECIAL PROVISIONS FOR TRAFFIC SIGNAL STRAIN POLE.
- WELDING
 - WELDING SHALL CONFORM TO AWS D1.1
 - ULTRASONIC INSPECTION FOR ALL 100% WELDS AND VISUAL AND/OR MAGNETIC PARTICLE FOR ALL OTHERS.
- TOLERANCES OVERALL HEIGHT +_1%.
 - SWEEP AND CHAMBER 3 mm PER METER.
 - TWIST 10 ° MAX. OVERALL.
- DESIGN CONFORMING TO CURRENT AASHTO
 - SPECIFICATIONS FOR DESIGN OF STRUCTURAL SUPPORTS FOR TRAFFIC SIGNALS ASSUMING A SAG OF 10% OF SPAN WITH MAXIMUM OF 5 SIGNALS WITH PLASTIC HEADS NOT TETHERED.

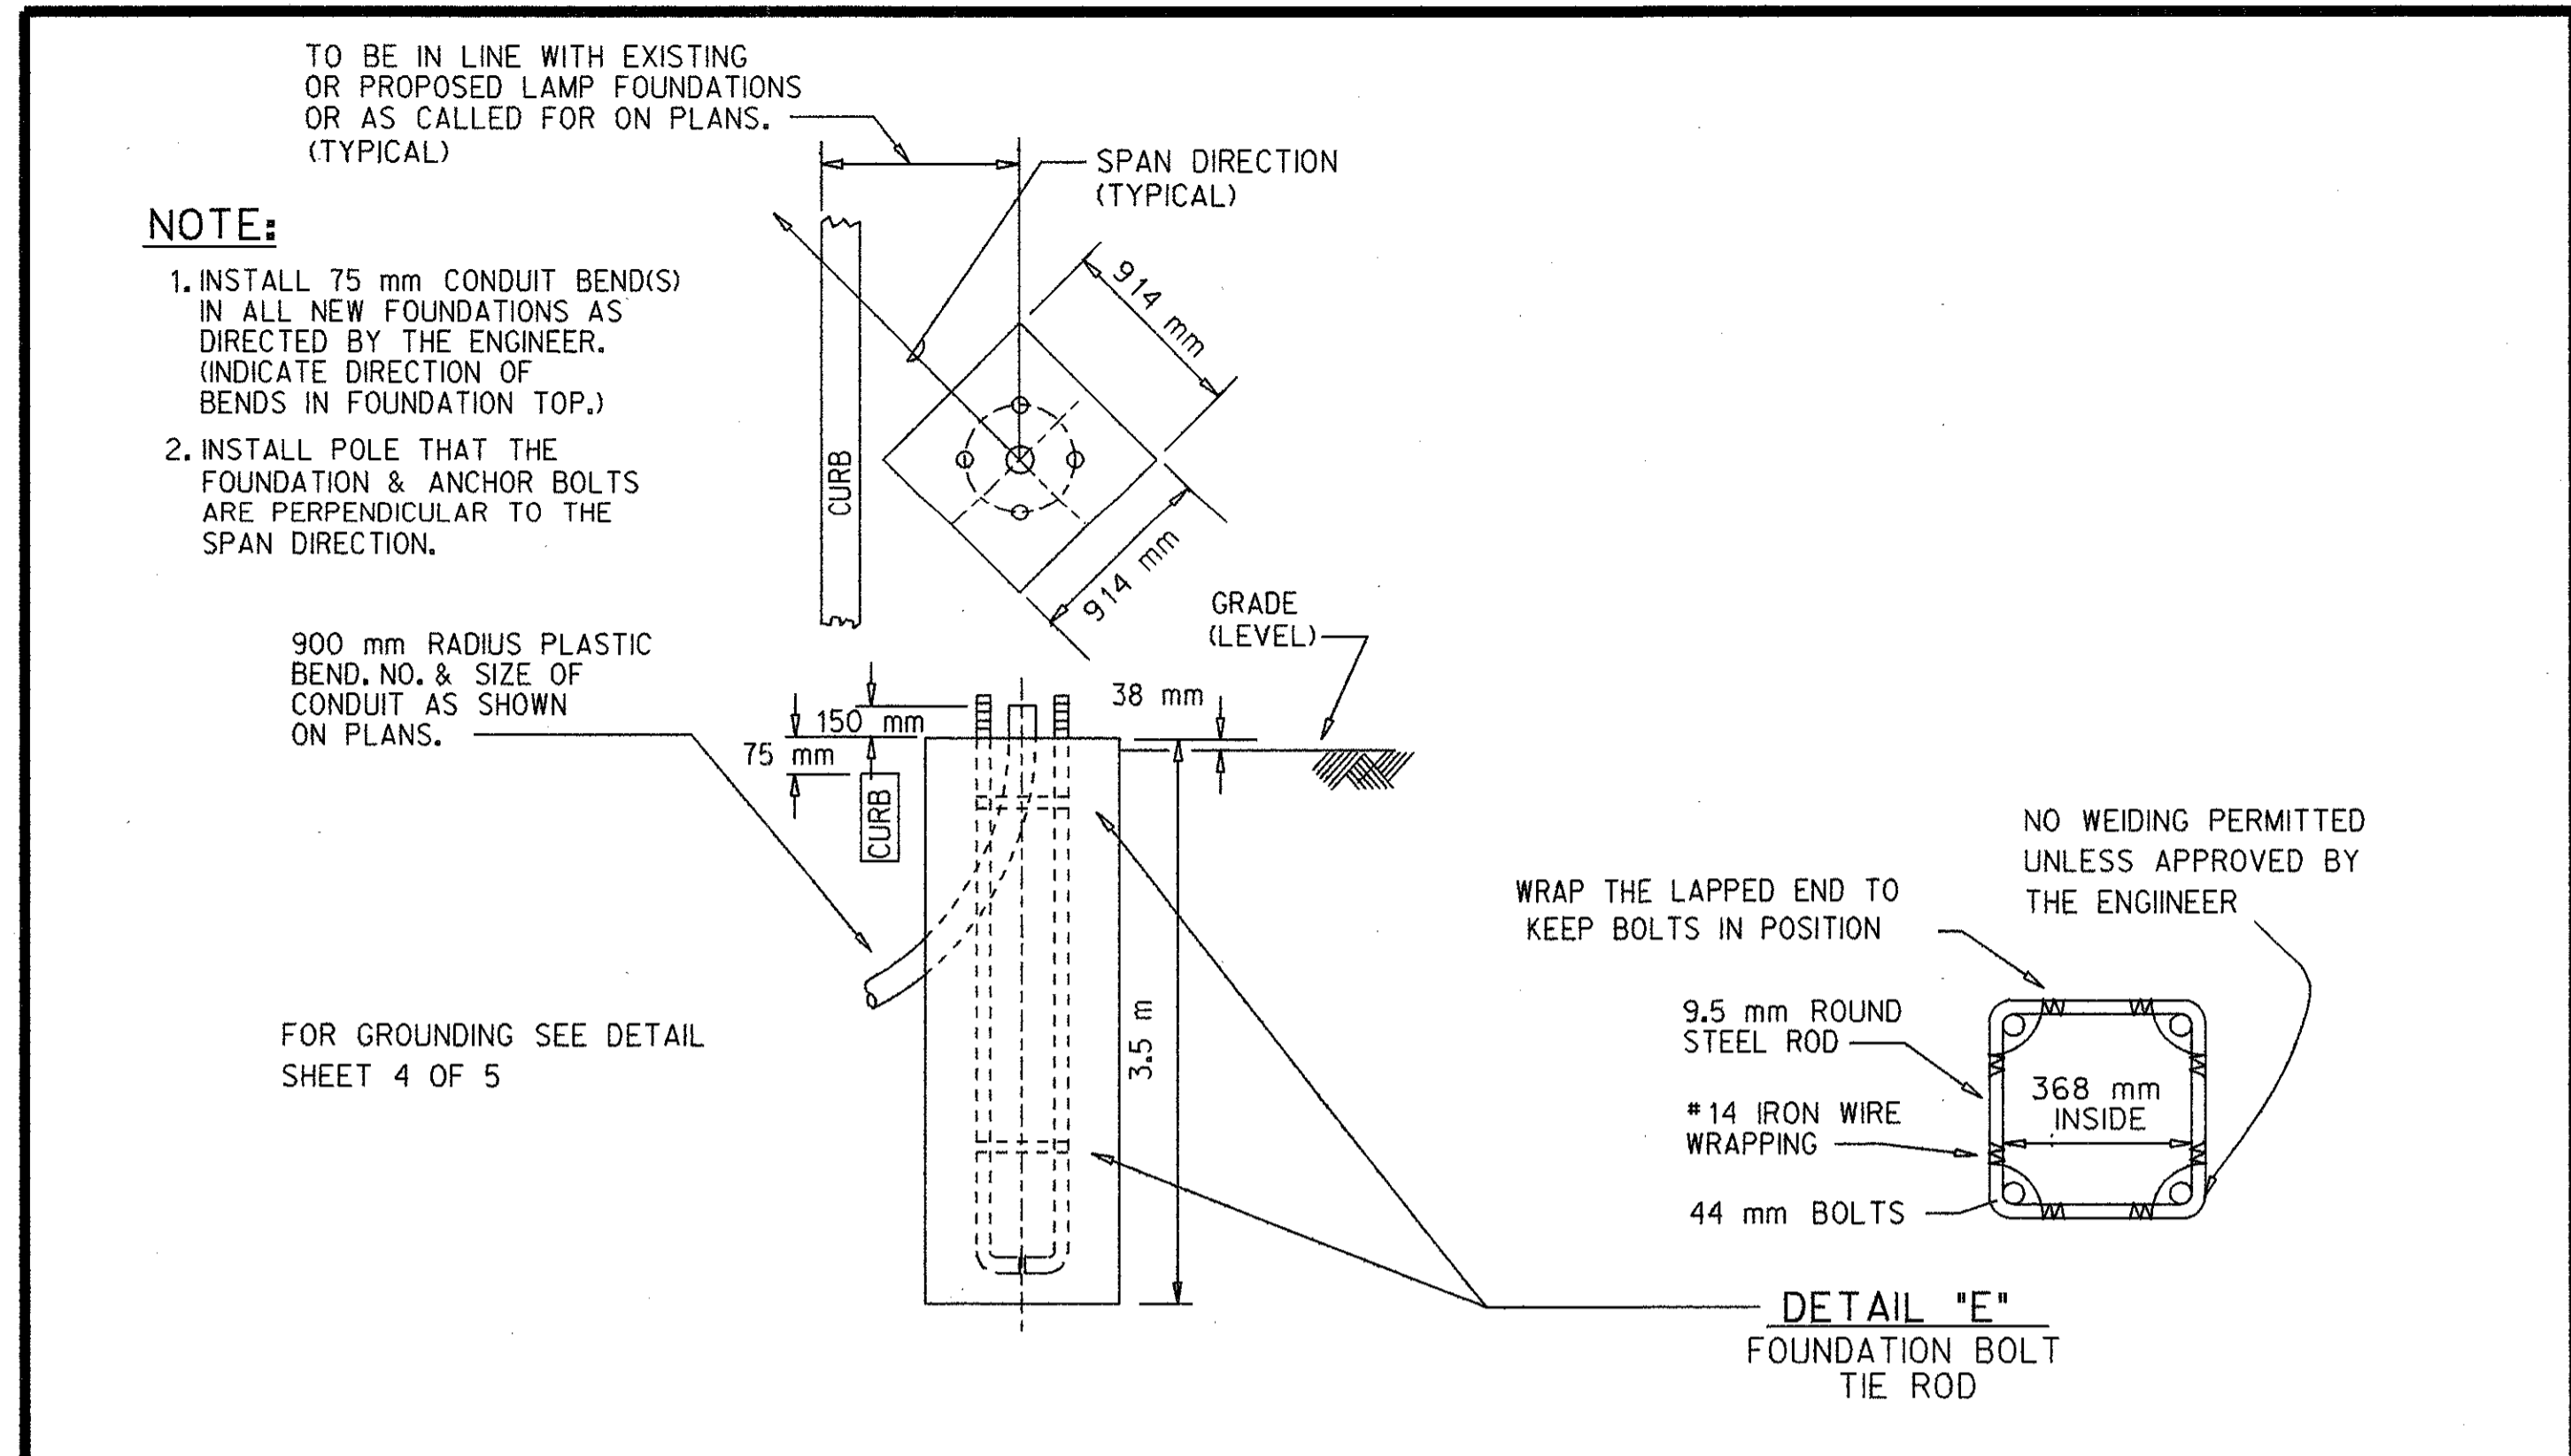


DETAIL : ANCHOR BASE STEEL STRAIN POLE FOUNDATION

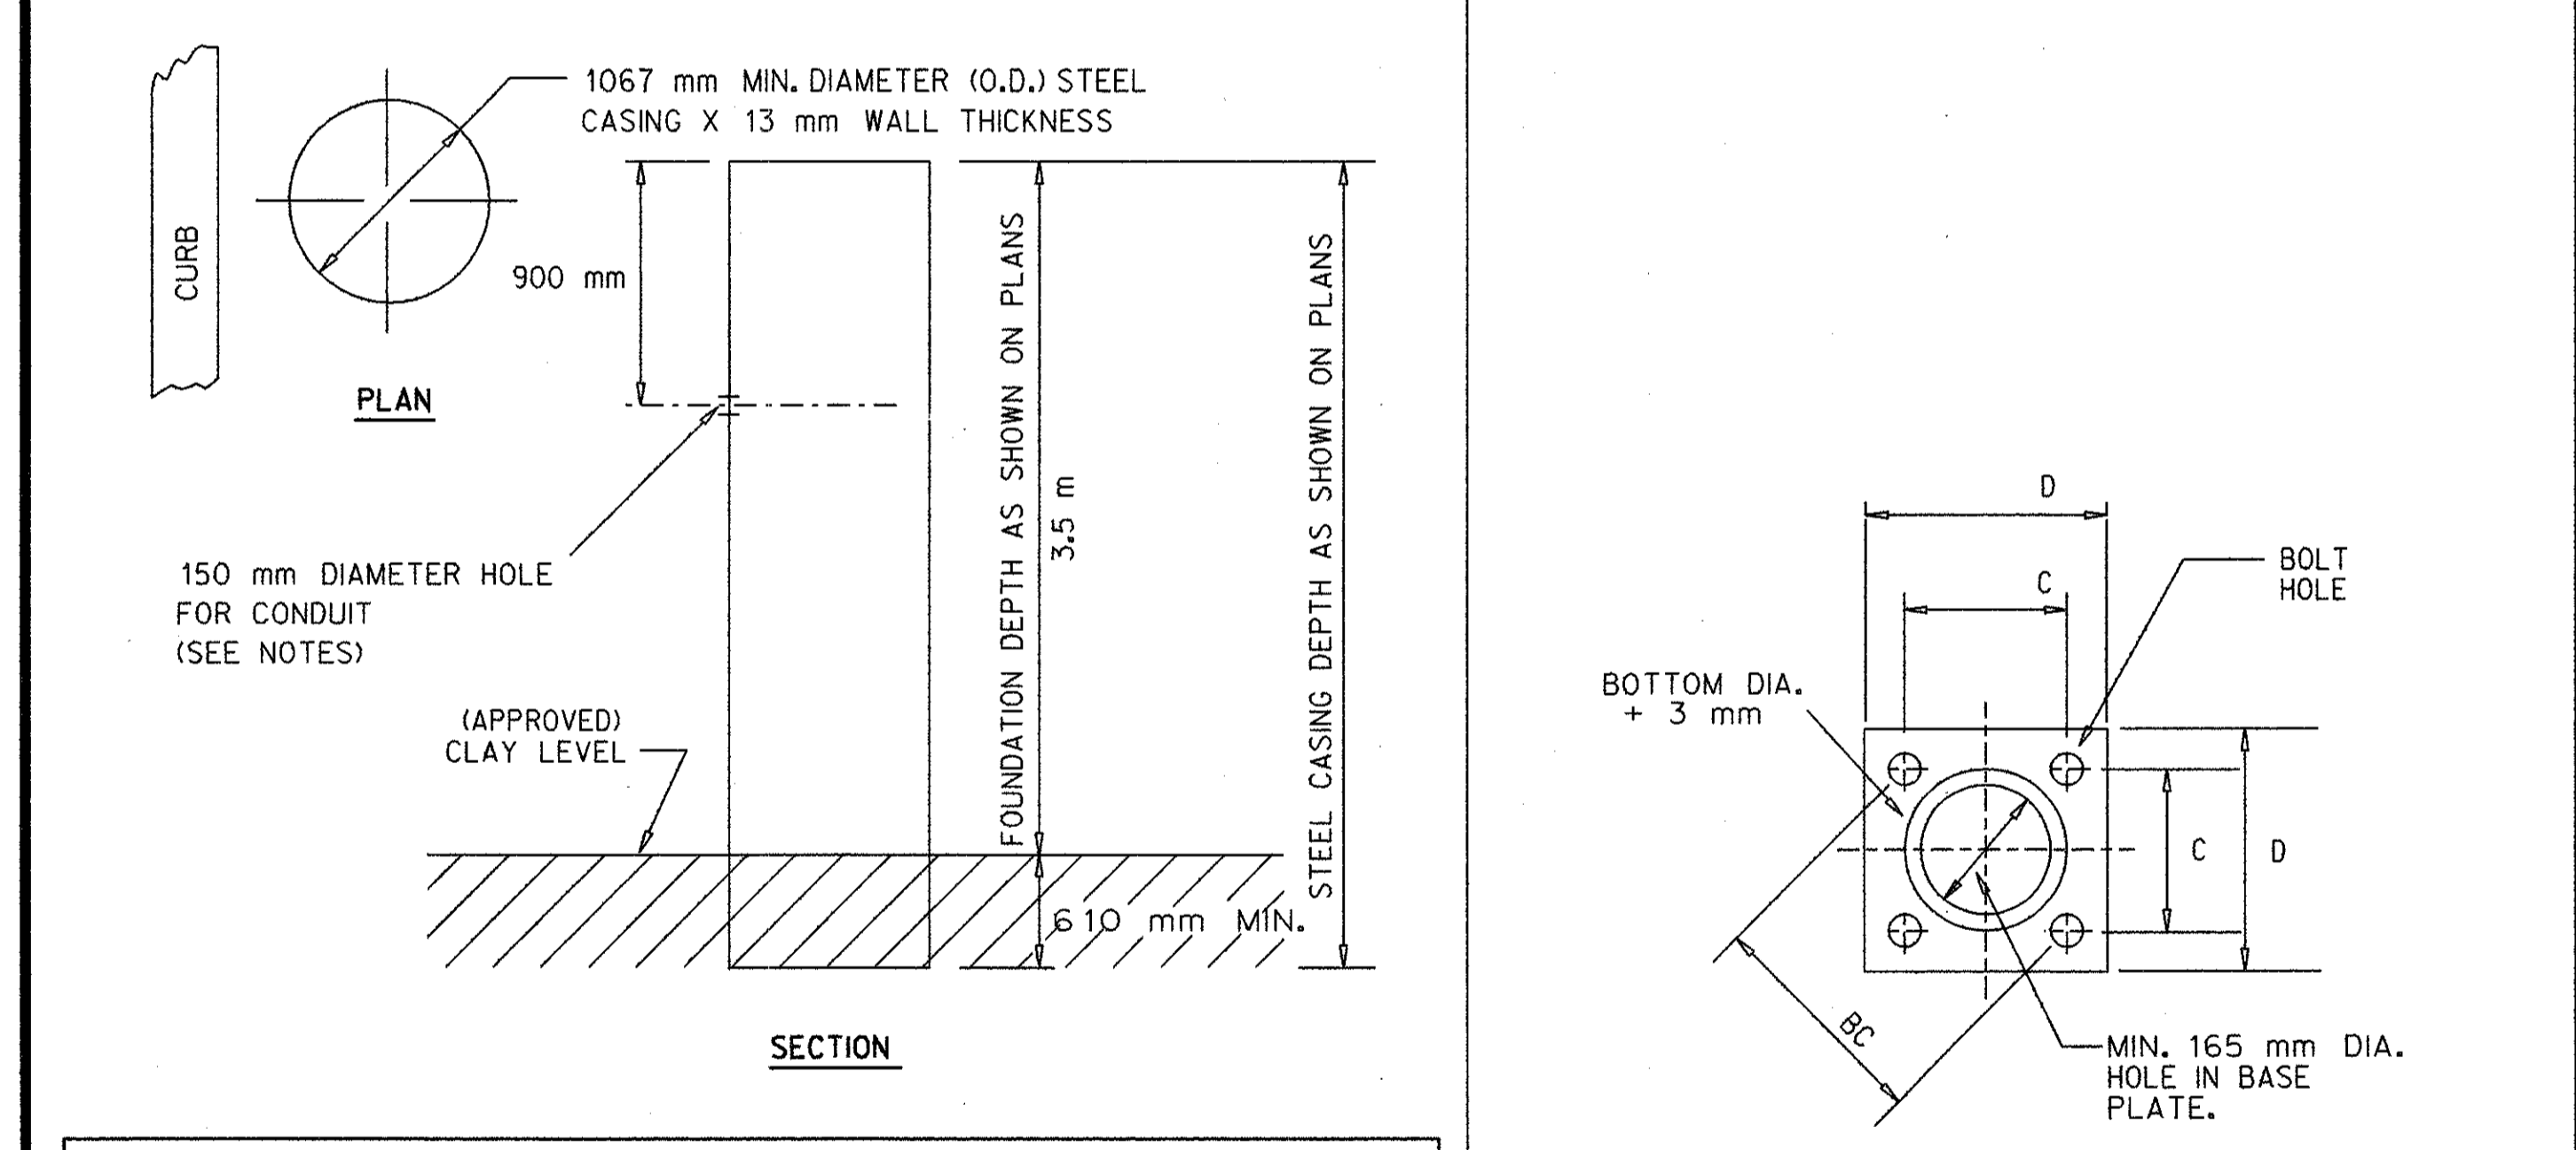


- NOTES:**
1. CUT 150 mm DIAMETER HOLE IN STEEL CASING AT 900 mm FROM TOP OF FOUNDATION FOR CONDUIT.
 2. TRENCH FOR PLACEMENT OF CONDUIT AFTER CASING IS IN PLACE AND BEFORE DEWATERING.
 3. SEE SPECIAL PROVISION FOR CONSTRUCTION OF DRILLED SHAFT FOUNDATIONS (TRAFFIC SIGNAL STRAIN POLES) AND LIGHT TOWERS.
 4. ALL DRILLED SHAFT FOUNDATIONS, CASED OR UNCASSED, SHALL HAVE A MINIMUM DIAMETER OF 1050 mm (OR LARGER AS DIRECTED BY THE ENGINEER).

DETAIL : DRILLED SHAFT FOUNDATION FOR STRAIN POLE (CASED AND UNCASSED) DETAIL : BASE PLATE SH 3 OF 5 ST-2

ANCHOR BASE STEEL STRAIN POLE AND FOUNDATION					
DATE	SCALE	CONT. SEC.	JOB NO.	T & S	CONST.

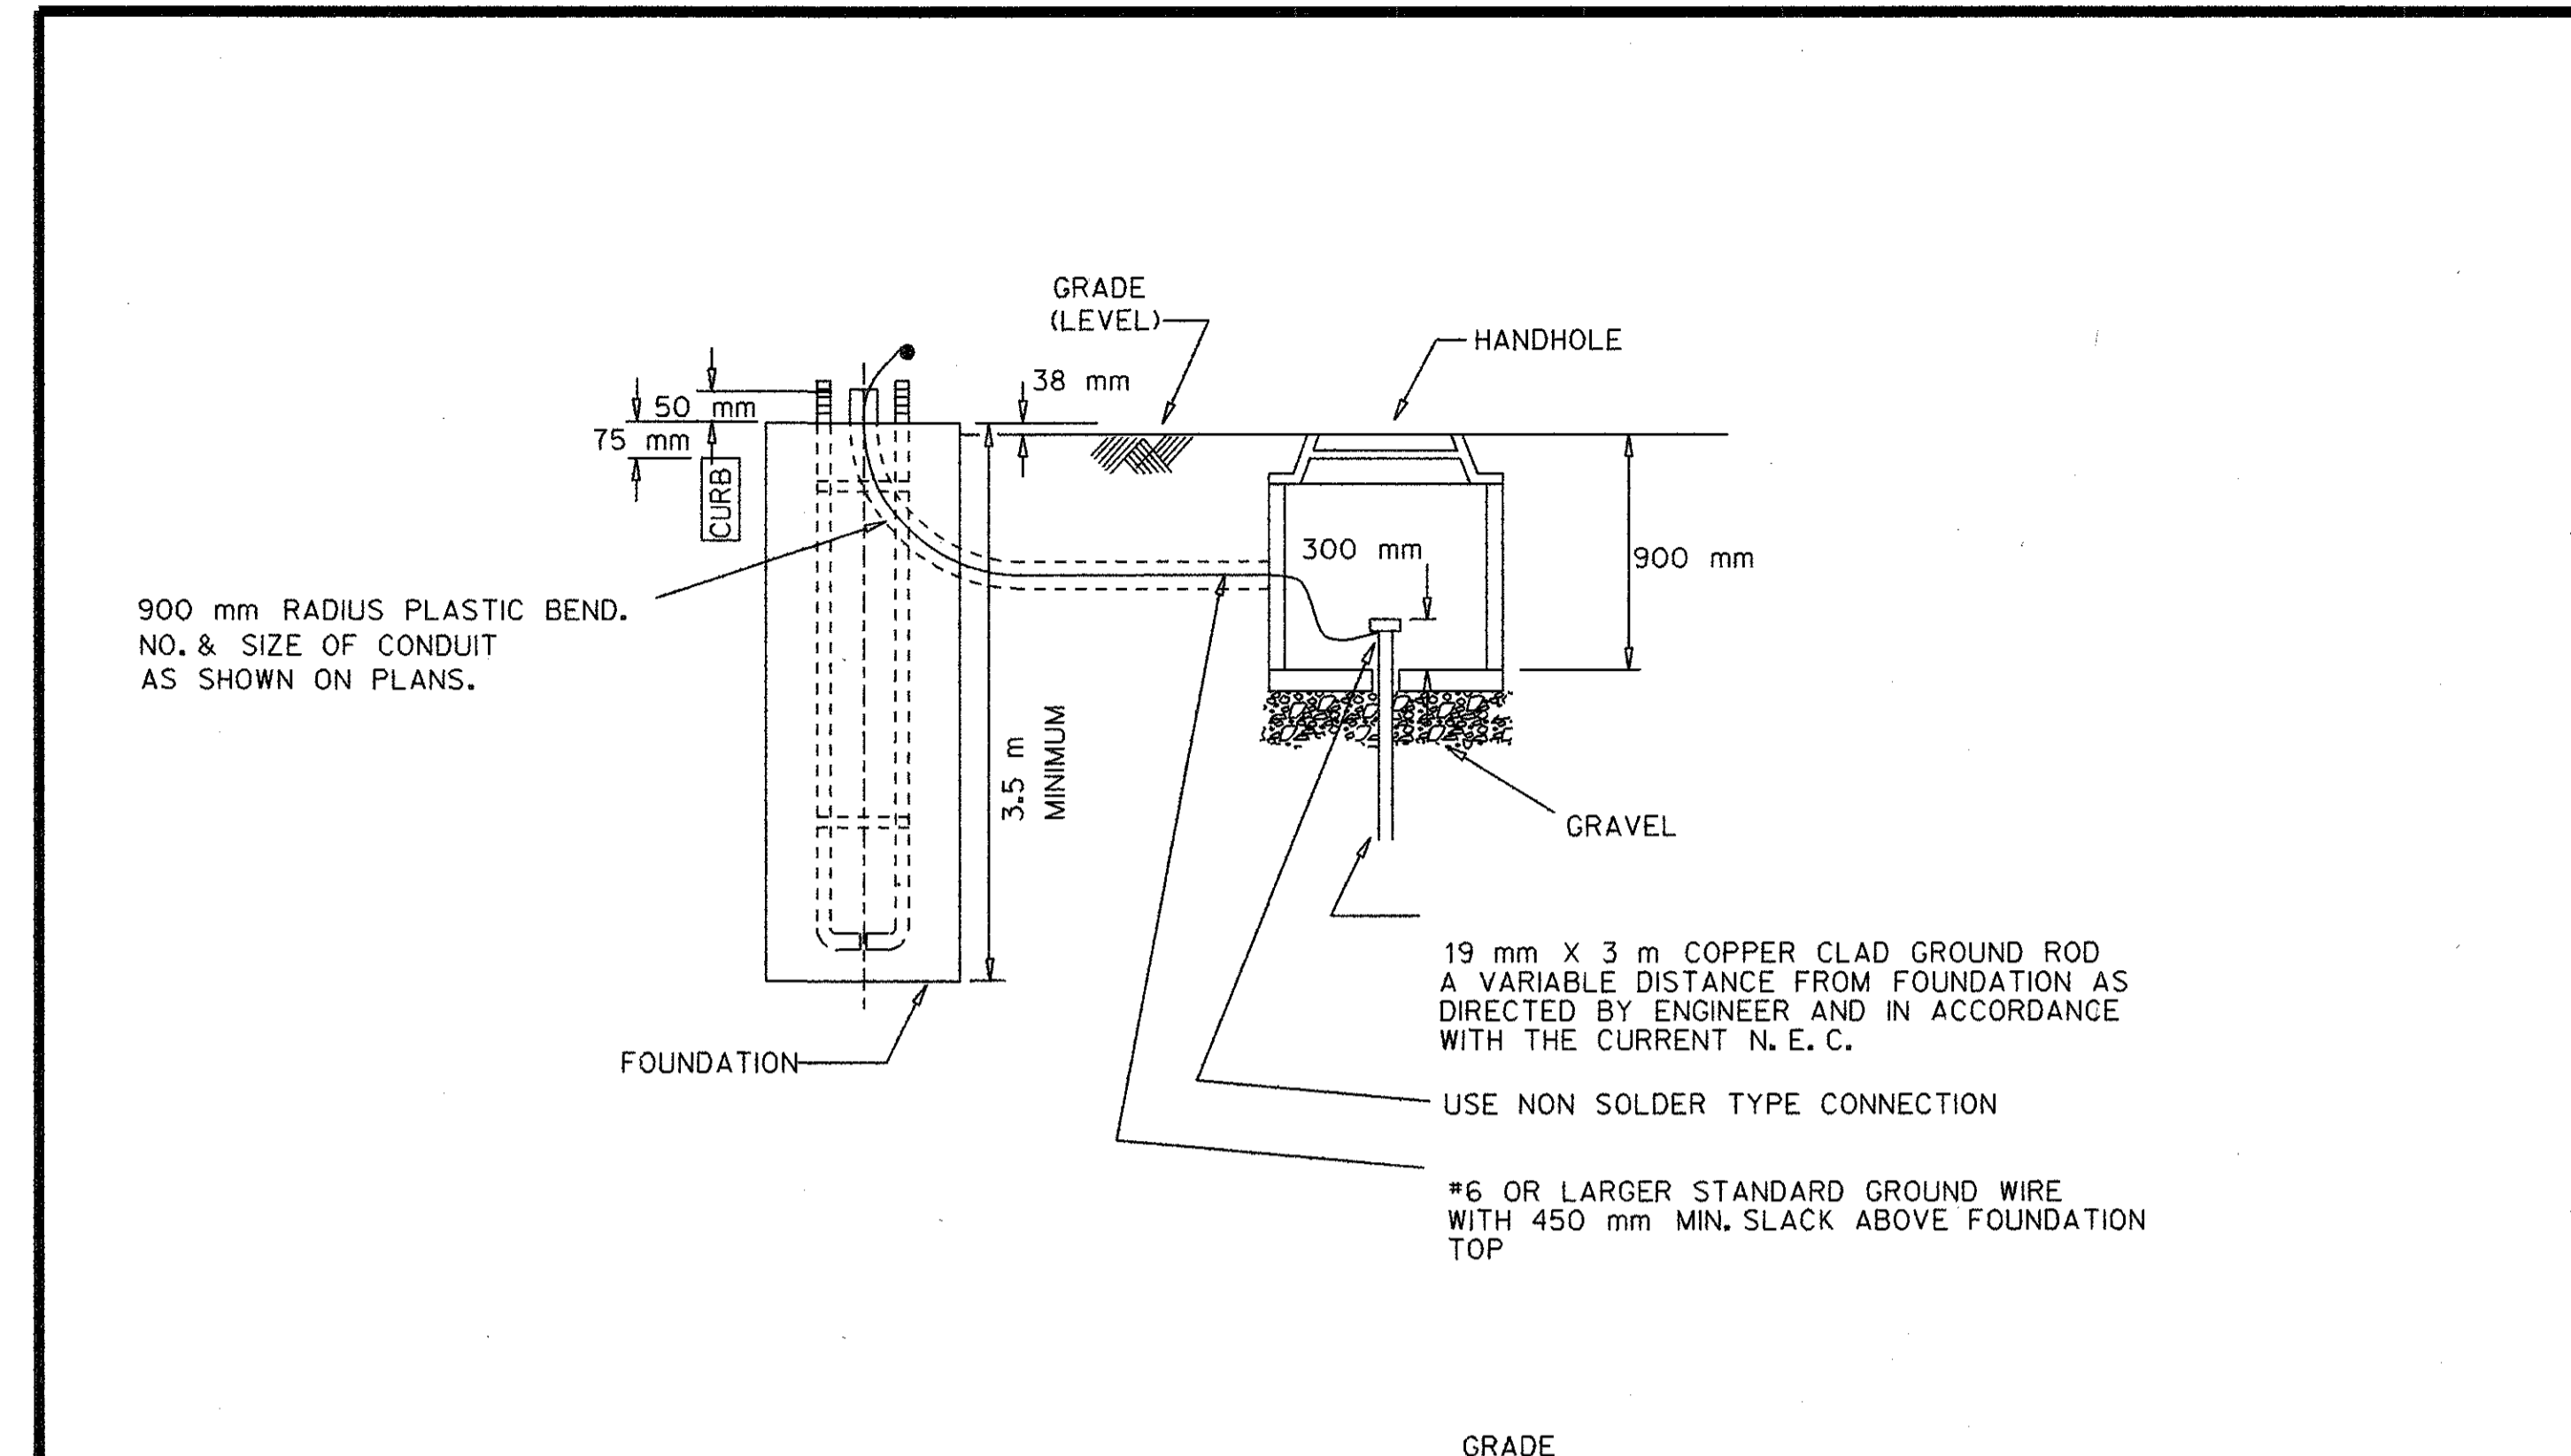

DETAIL : ANCHOR BASE STEEL STRAIN POLE FOUNDATION

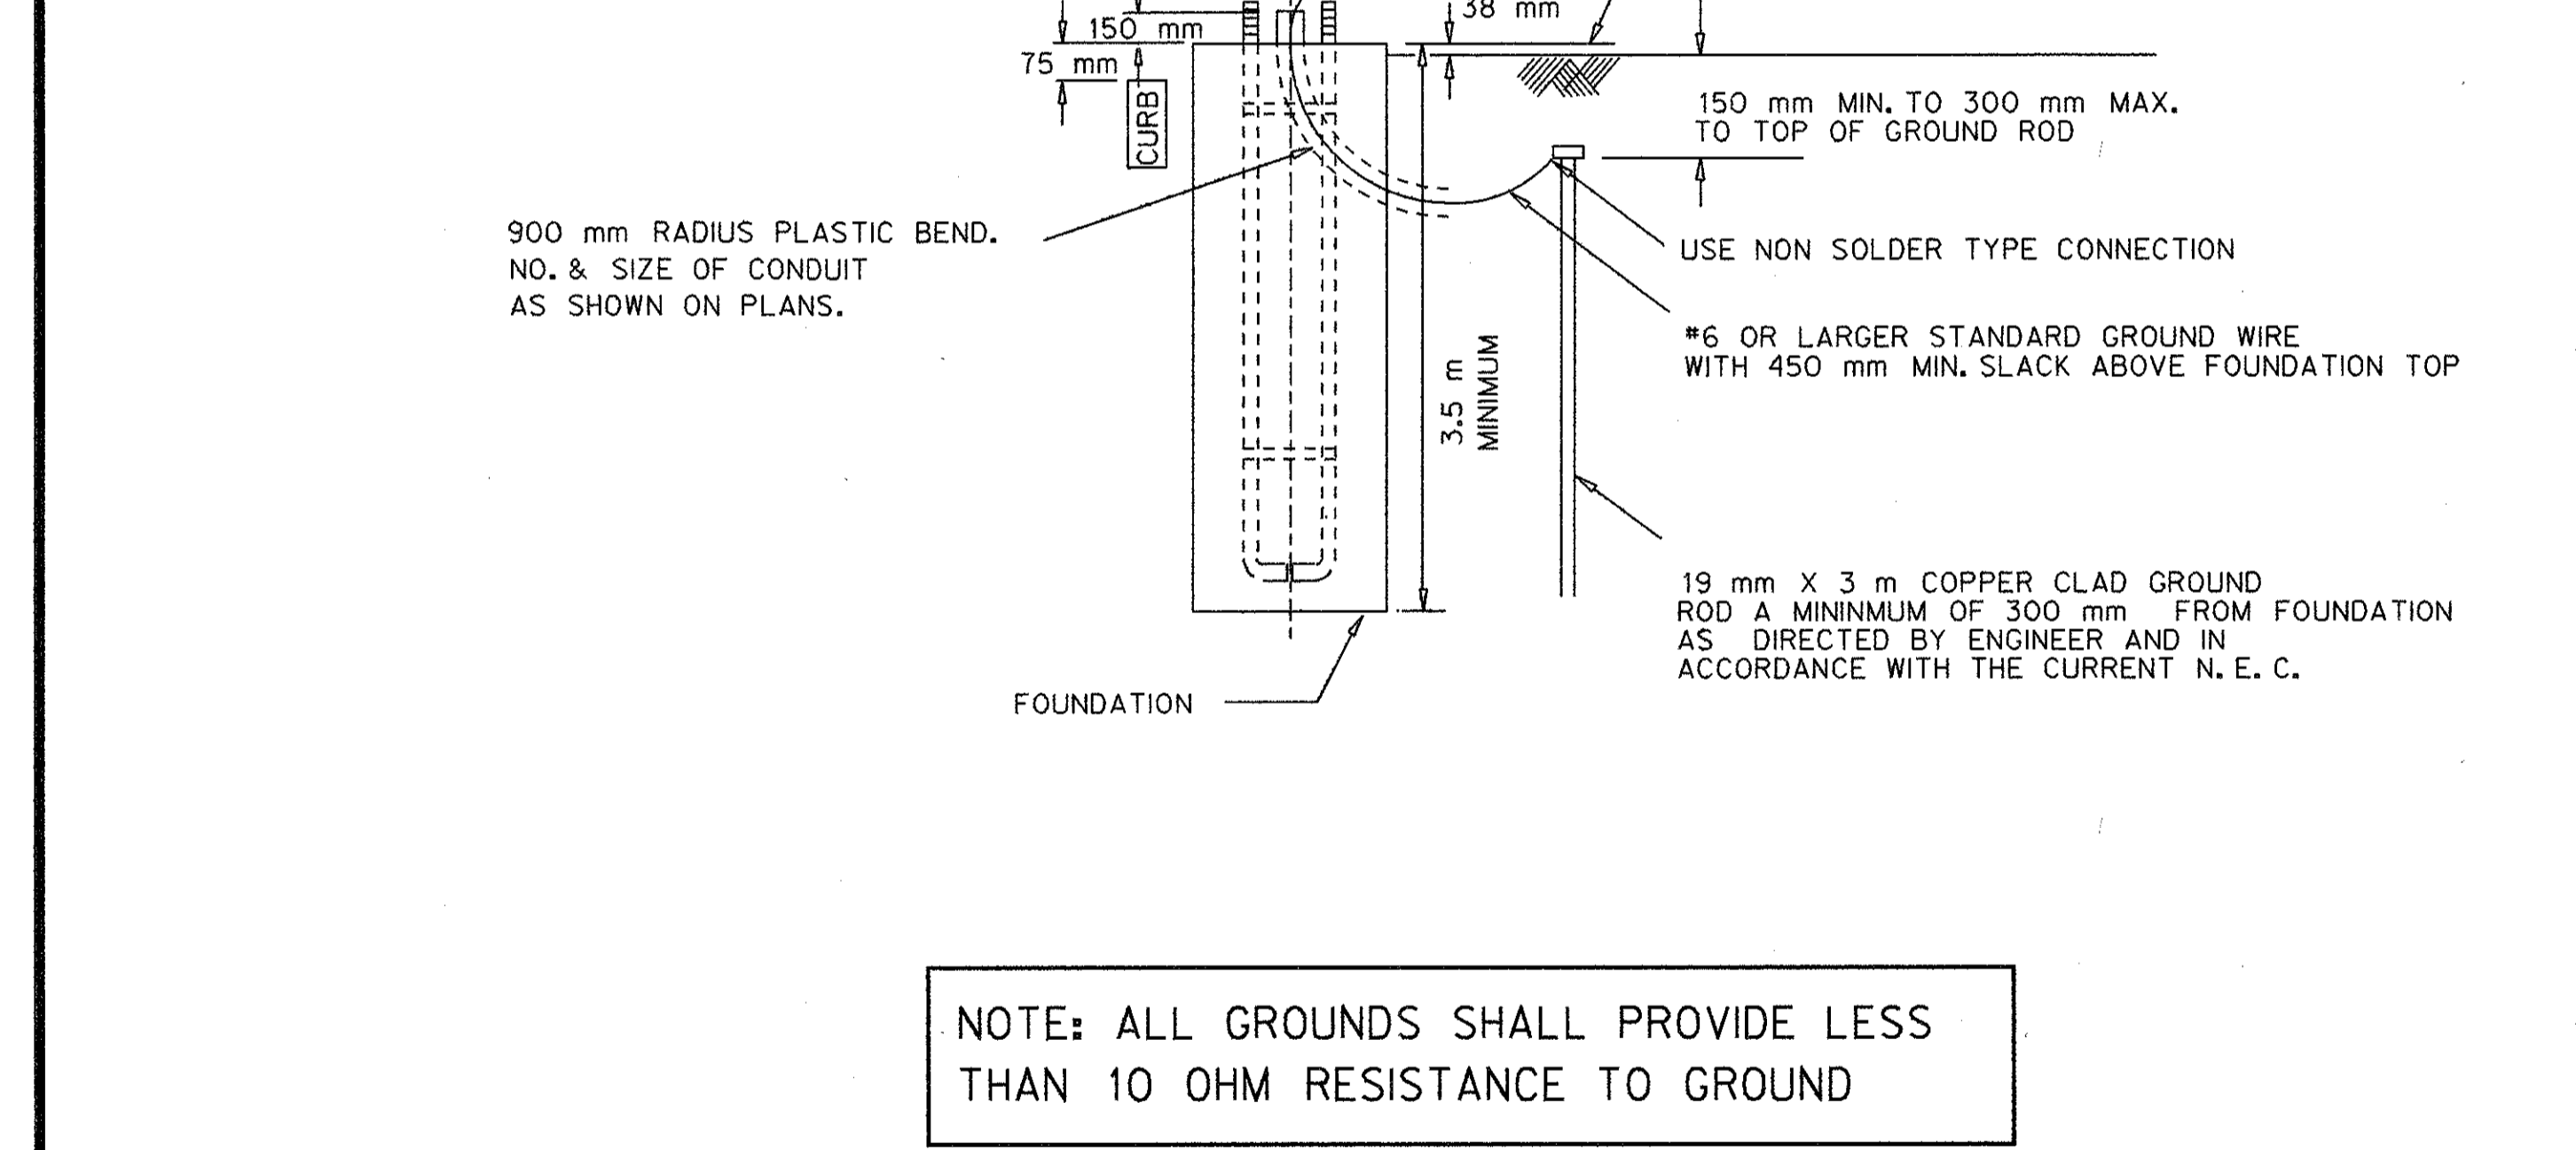


DETAIL : ANCHOR BASE STEEL STRAIN POLE GROUNDING


SH 4 OF 5 ST-2

ANCHOR BASE STEEL STRAIN POLE AND FOUNDATION					
DATE	SCALE	CONT. SEC.	JOB NO.	T & S	CONST.
9-21-99		63174	48404A	13 of 31	13D

LAST CORRECTION DATE: FILENAME:

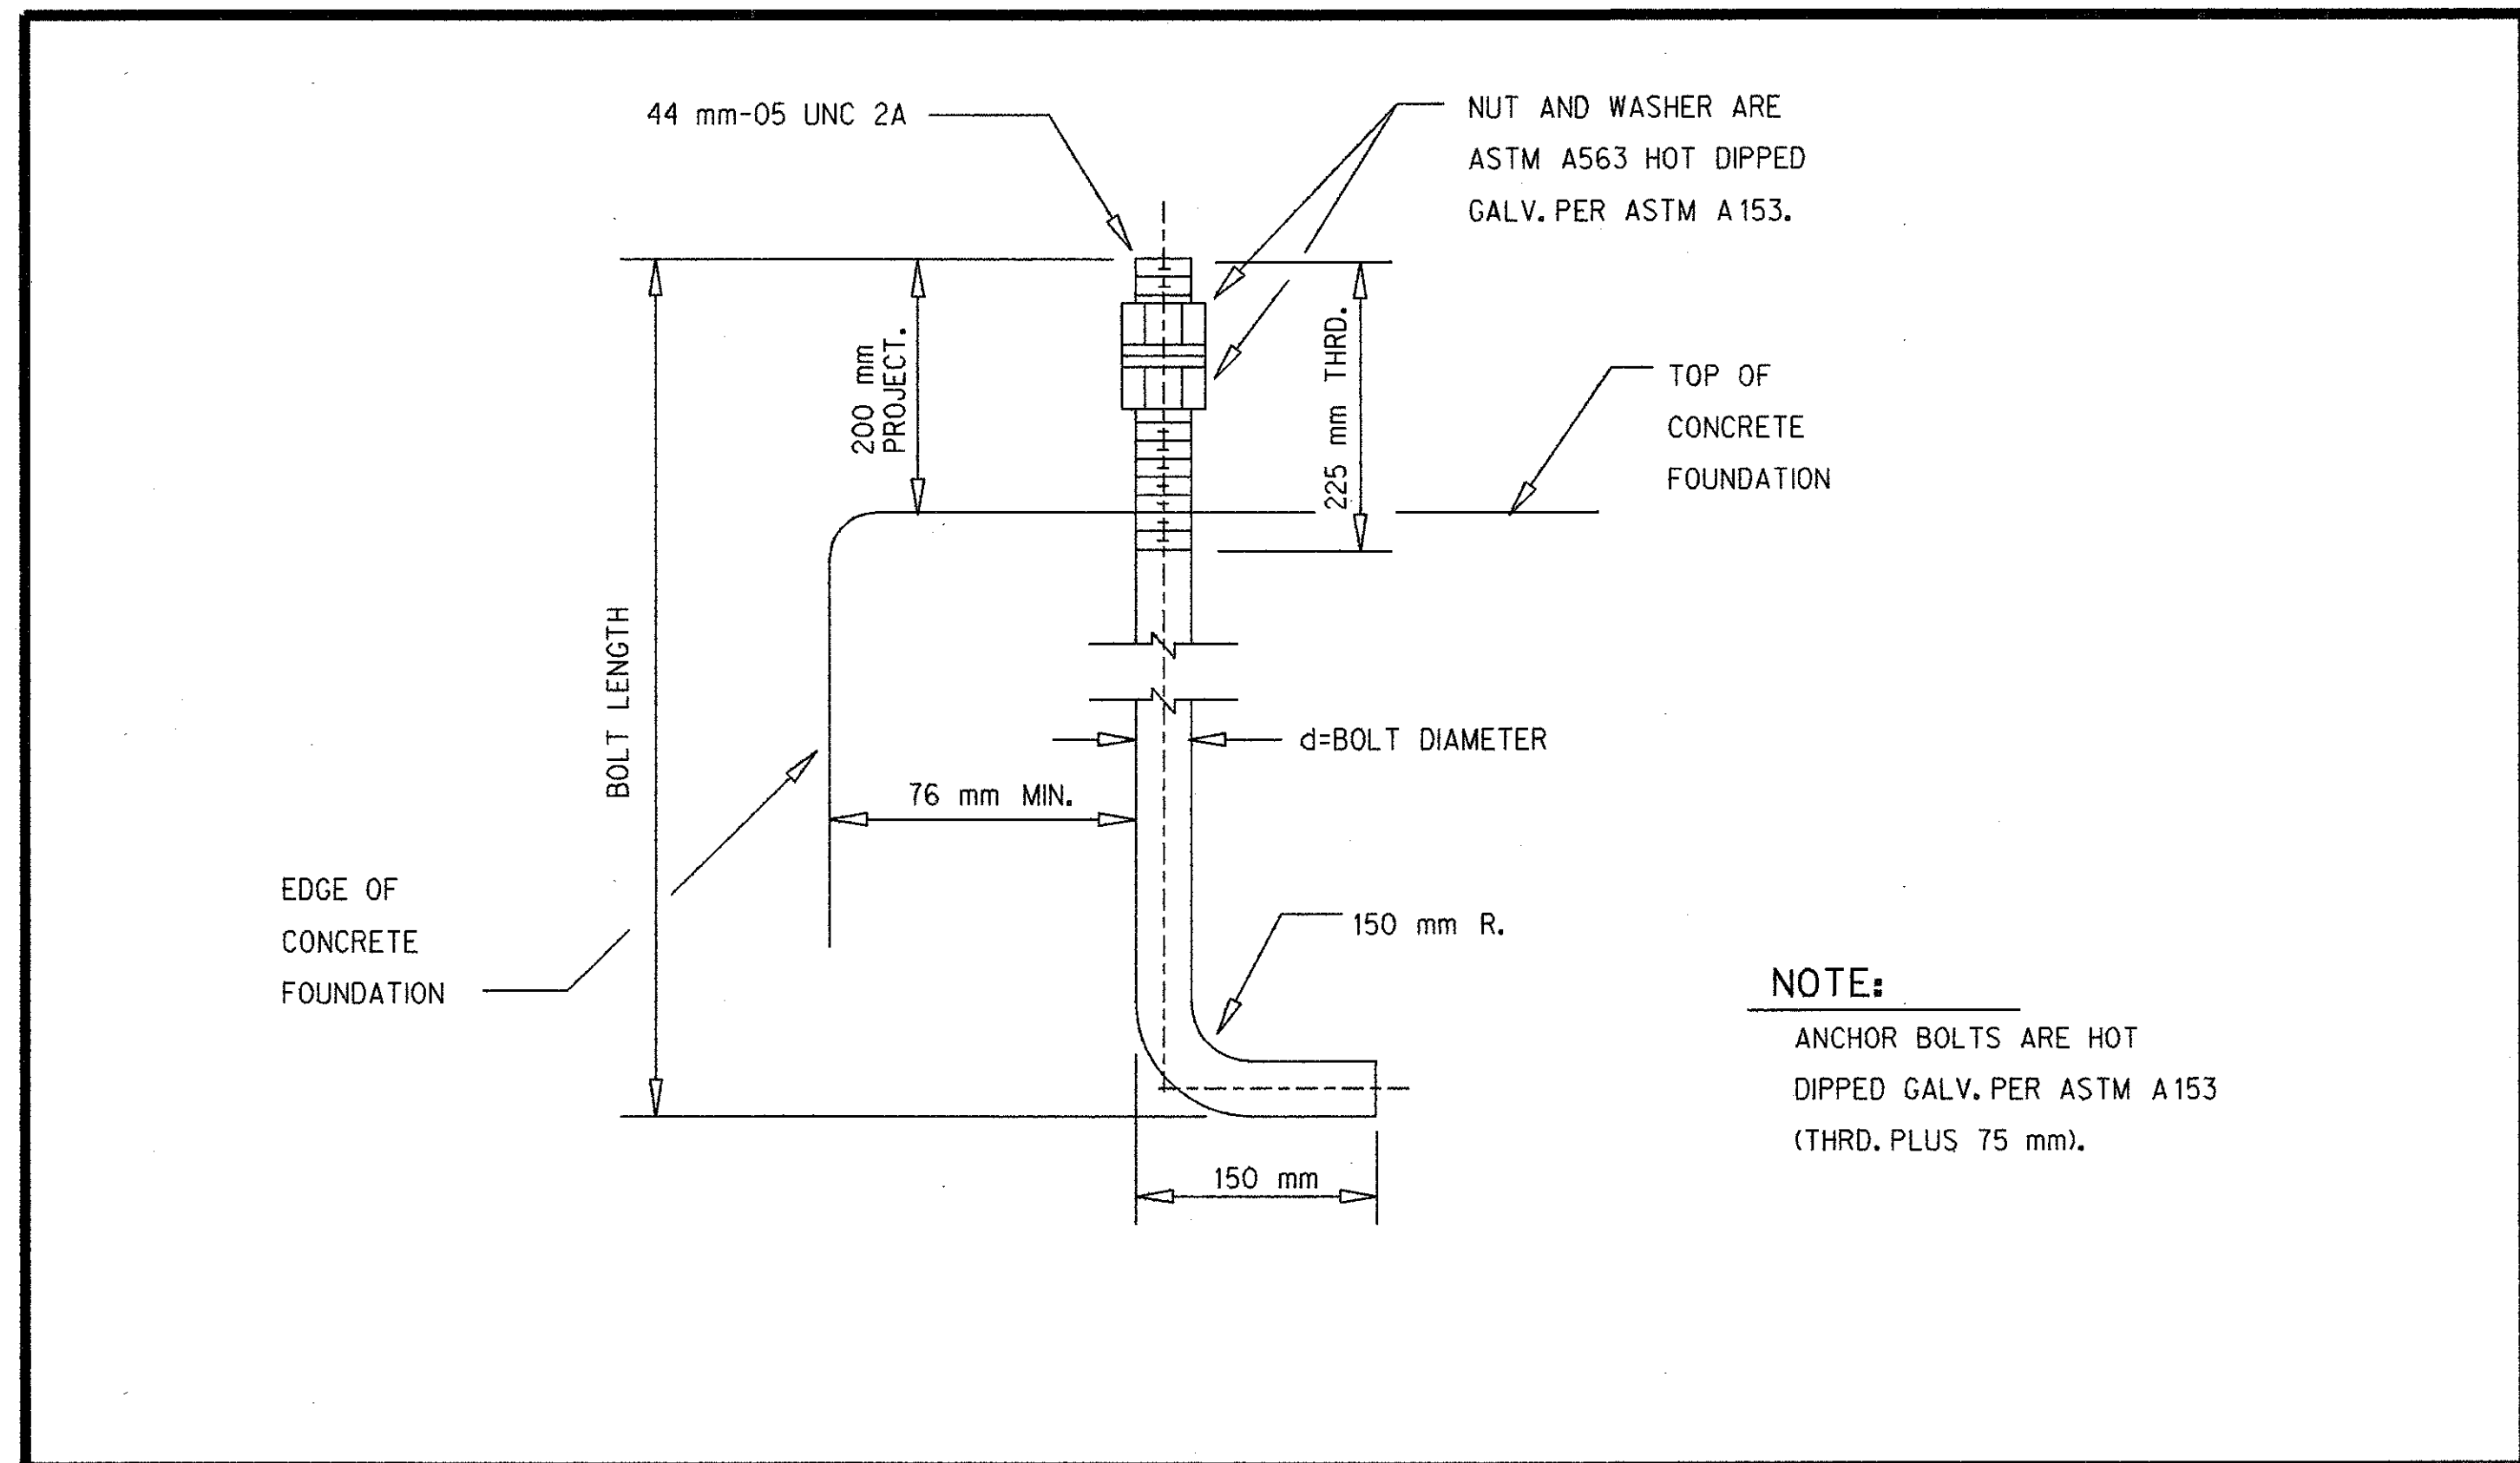

DETAIL : ANCHOR BASE STEEL STRAIN POLE FOUNDATION

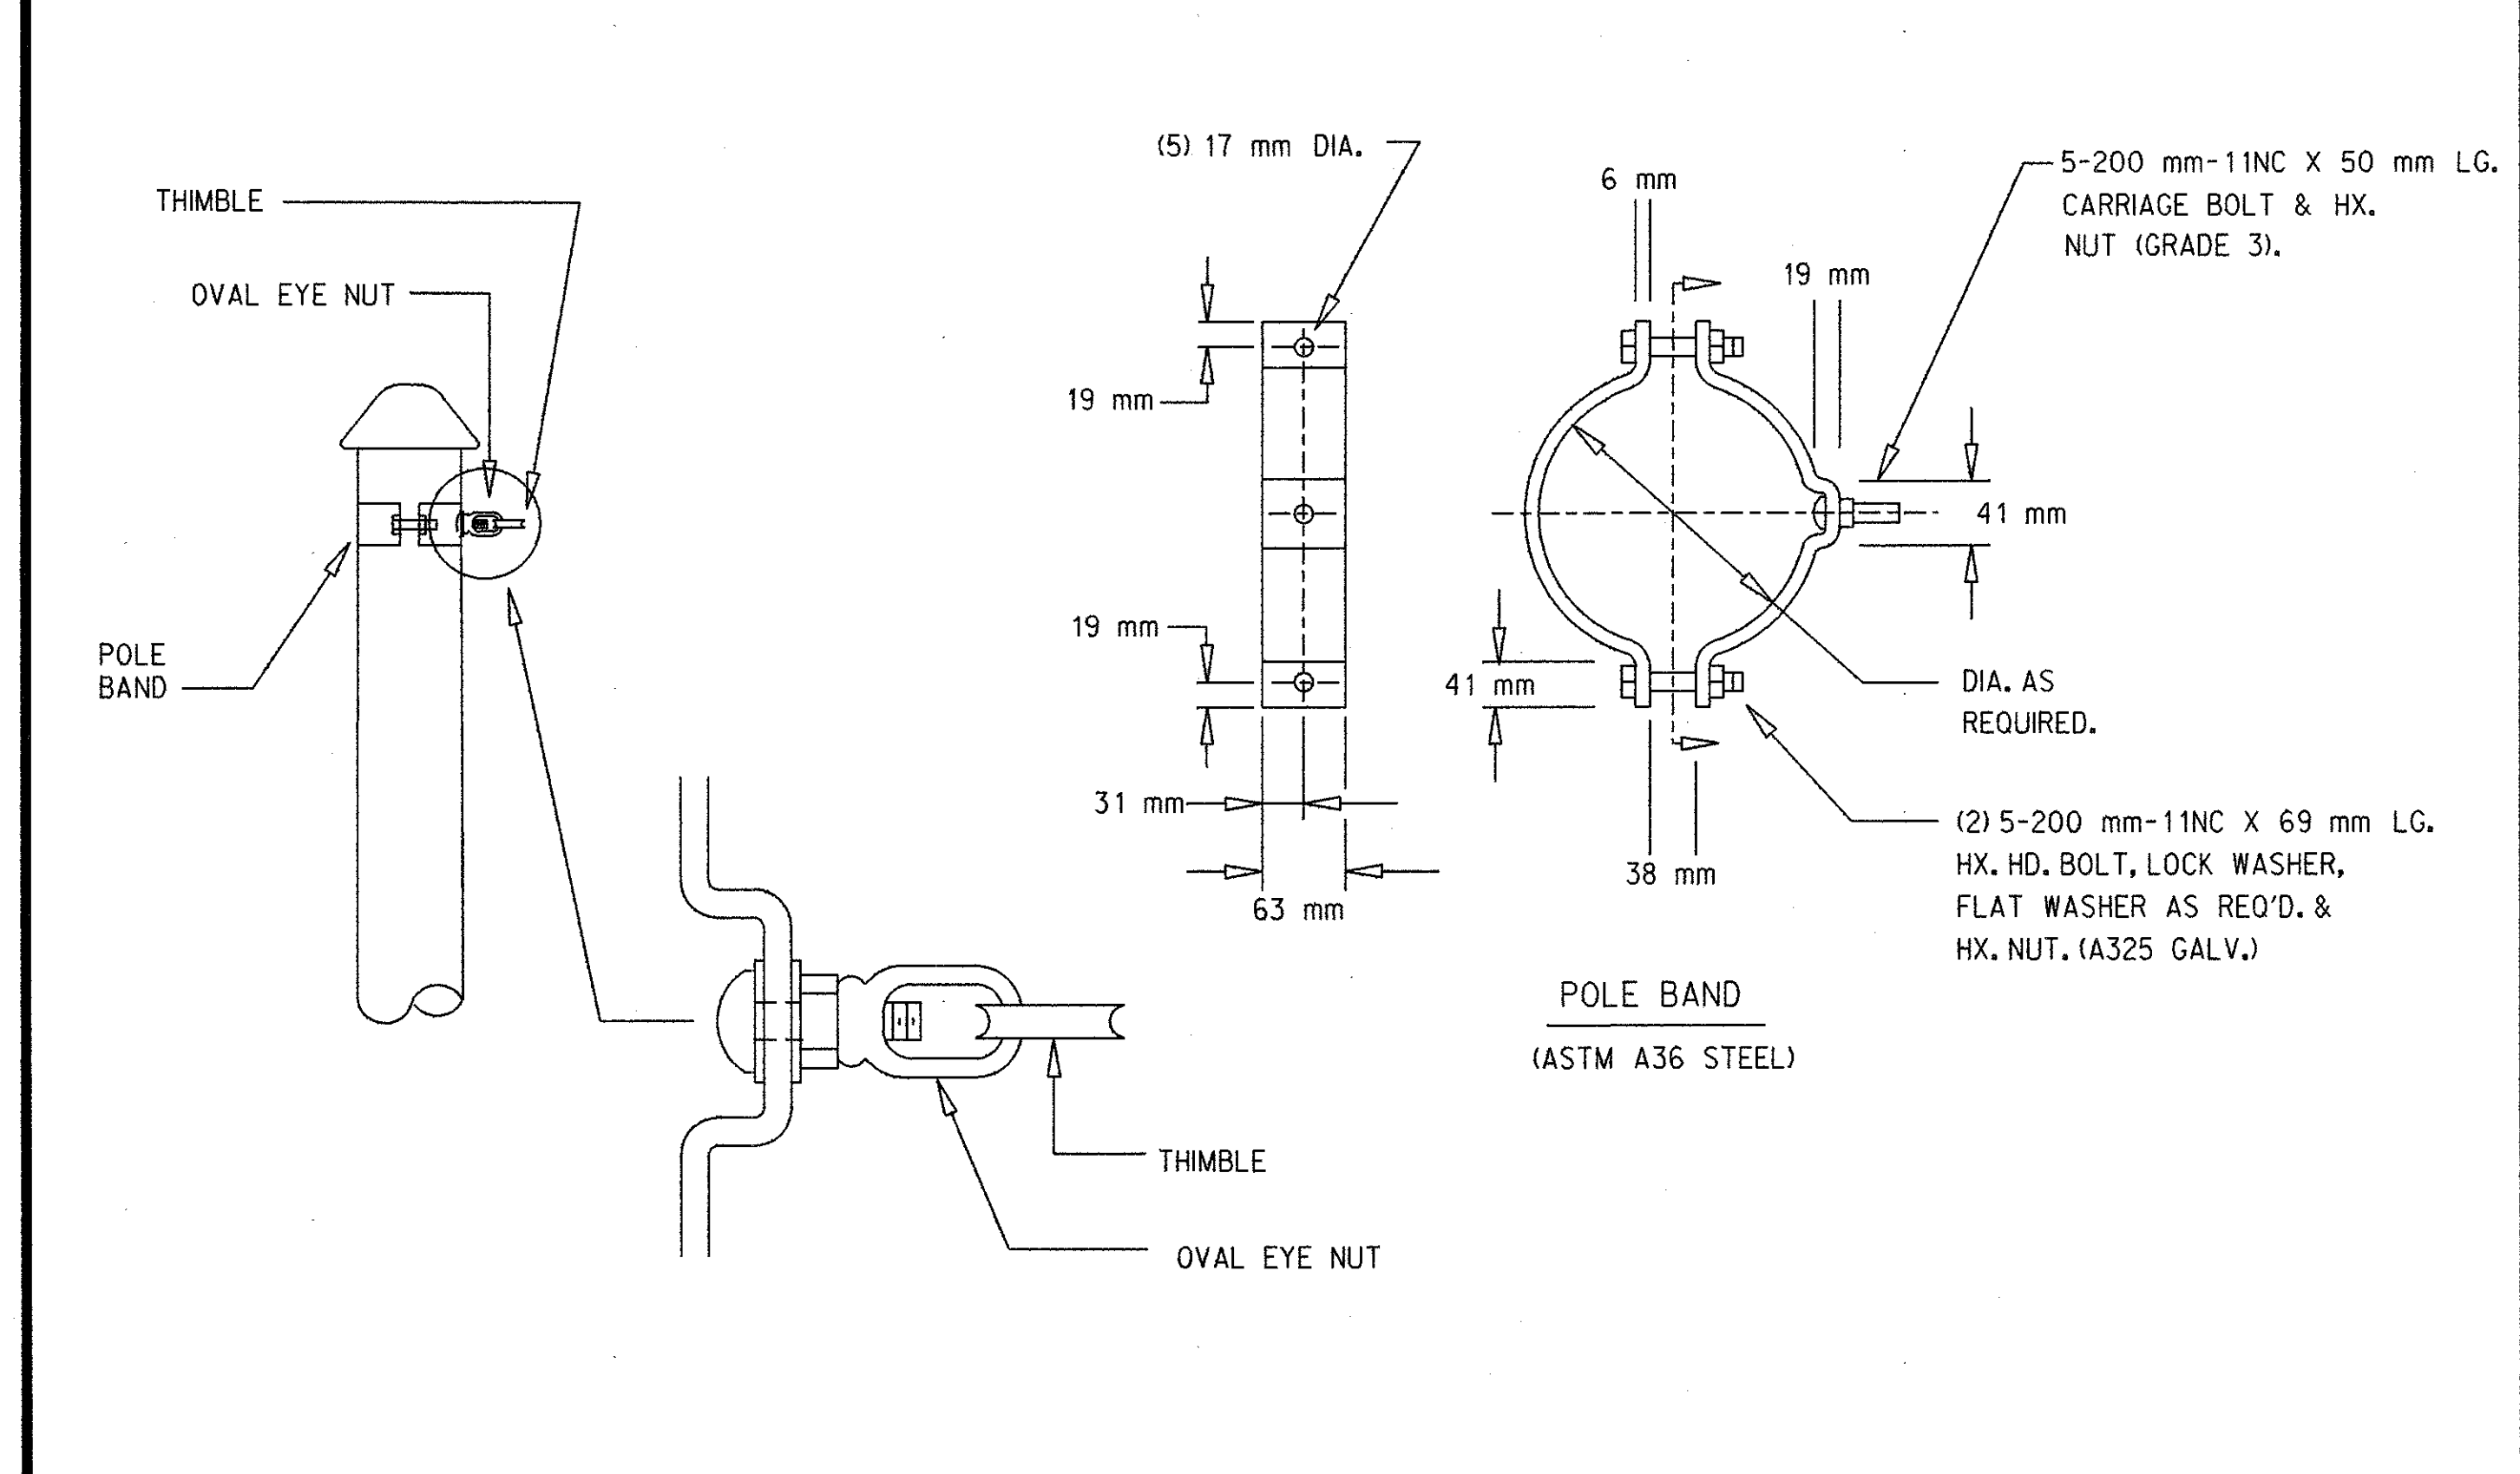

DETAIL A (ALTERNATE) POLE BAND


SH. 5 OF 5
ST-2

LAST CORRECTION DATE:
FILENAME:

ANCHOR BASE STEEL STRAIN POLE AND FOUNDATION					
DATE	SCALE	CONT. SEC.	JOB NO.	T & S	CONST.

SH. OF


DATE	SCALE	CONT. SEC.	JOB NO.	T & S	CONST.
9-21-99		63174	48404A	14 of 31	14D

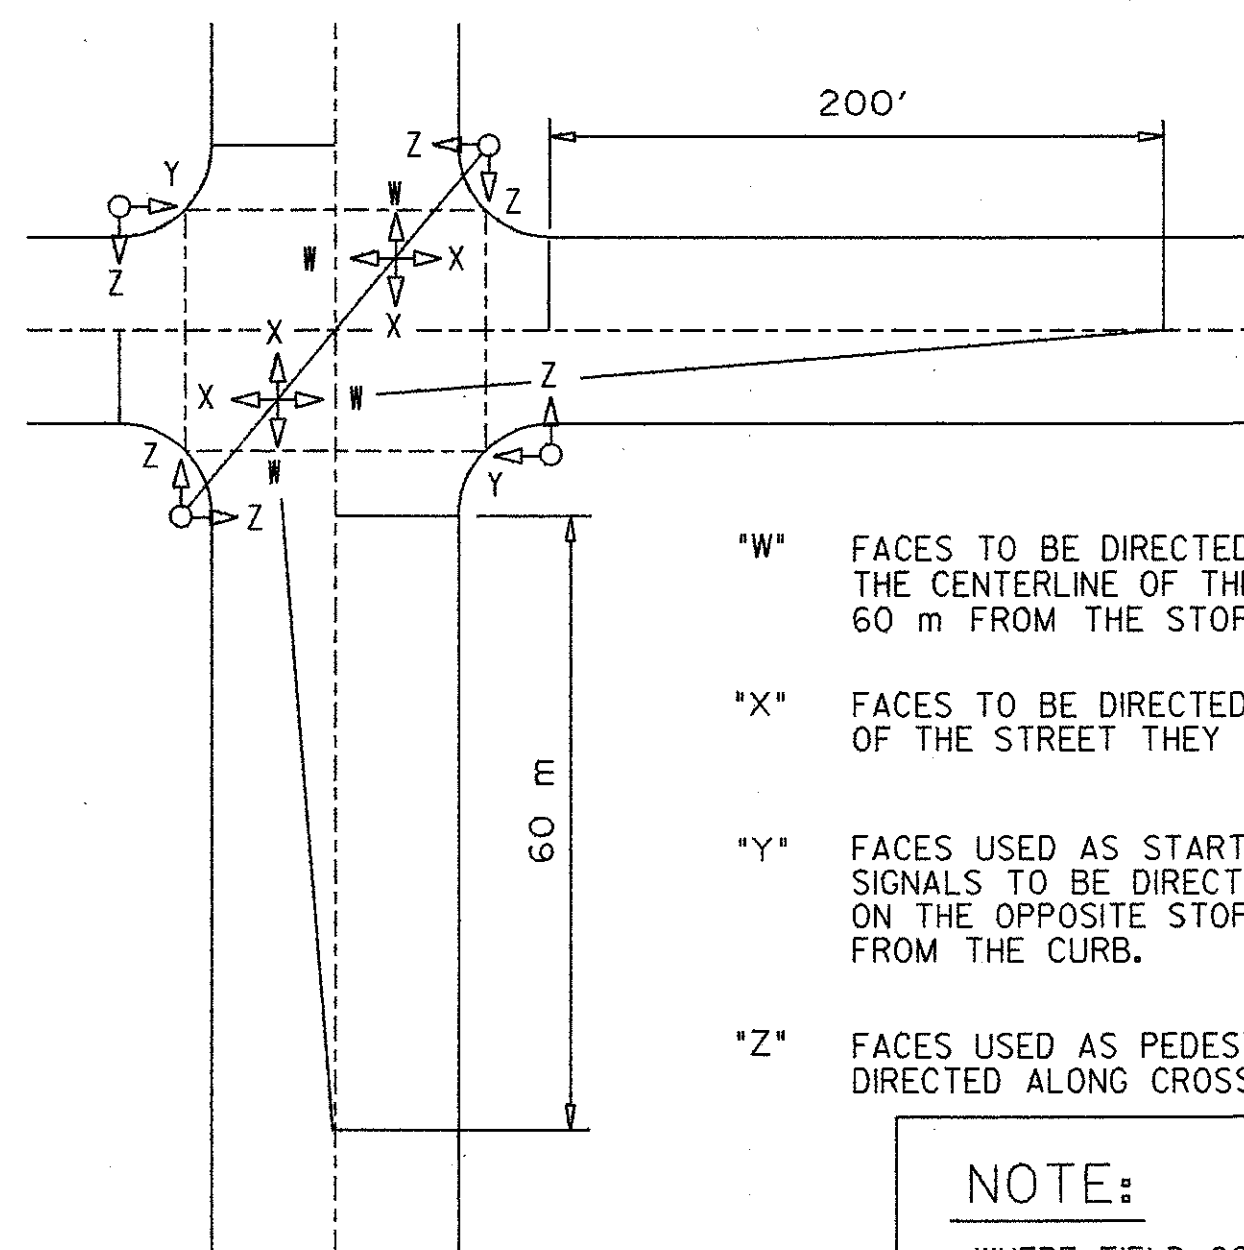

- "W" FACES TO BE DIRECTED TO INTERSECT A POINT ON THE CENTERLINE OF THE STREET THEY CONTROL 60 m FROM THE STOP BAR.
- "X" FACES TO BE DIRECTED PARALLEL TO THE CENTERLINE OF THE STREET THEY CONTROL.
- "Y" FACES USED AS STARTING SIGNALS WITH NEAR SIDE SIGNALS TO BE DIRECTED TO INTERSECT A POINT ON THE OPPOSITE STOP BAR APPROXIMATELY 1.2 m. FROM THE CURB.
- "Z" FACES USED AS PEDESTRIAN SIGNALS TO BE DIRECTED ALONG CROSSWALKS.

NOTE:
 WHERE FIELD CONDITIONS REQUIRE DEVIATION FROM THESE STANDARDS, ENGINEER WILL FURNISH SPECIFIC DIRECTIONAL SETTING FOR SIGNALS AT TIME OF INSTALLATION.

DETAIL : STANDARD FOR DIRECTIONAL SETTINGS OF TRAFFIC SIGNALS (N.T.S.)

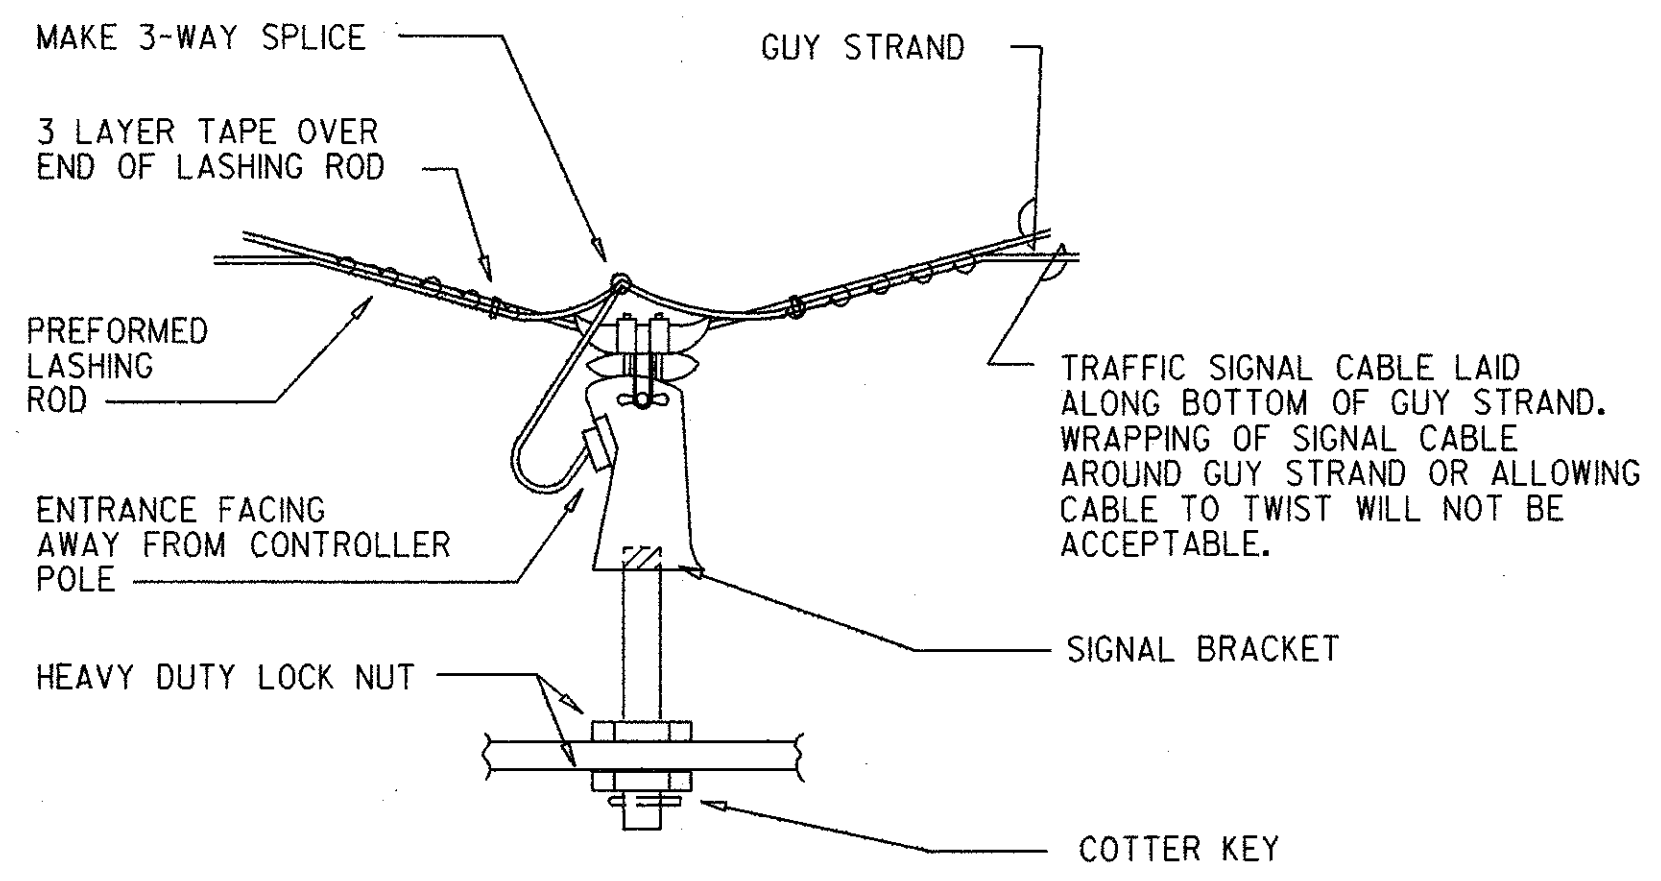

DETAIL : O.H. T.S. CABLE SPLICE

LAST CORRECTION DATE: 12/27/95
 FILENAME: OC3.DGN


SH. 1 OF 1
 OC-3

DIRECTIONAL SETTINGS/CABLE SPLICE

DATE	SCALE	CONT. SEC.	JOB NO.	T & S	CONST.


SH. OF

DATE	SCALE	CONT. SEC.	JOB NO.	T & S	CONST.
9-21-99		63174	48404A	15 of 31	15D

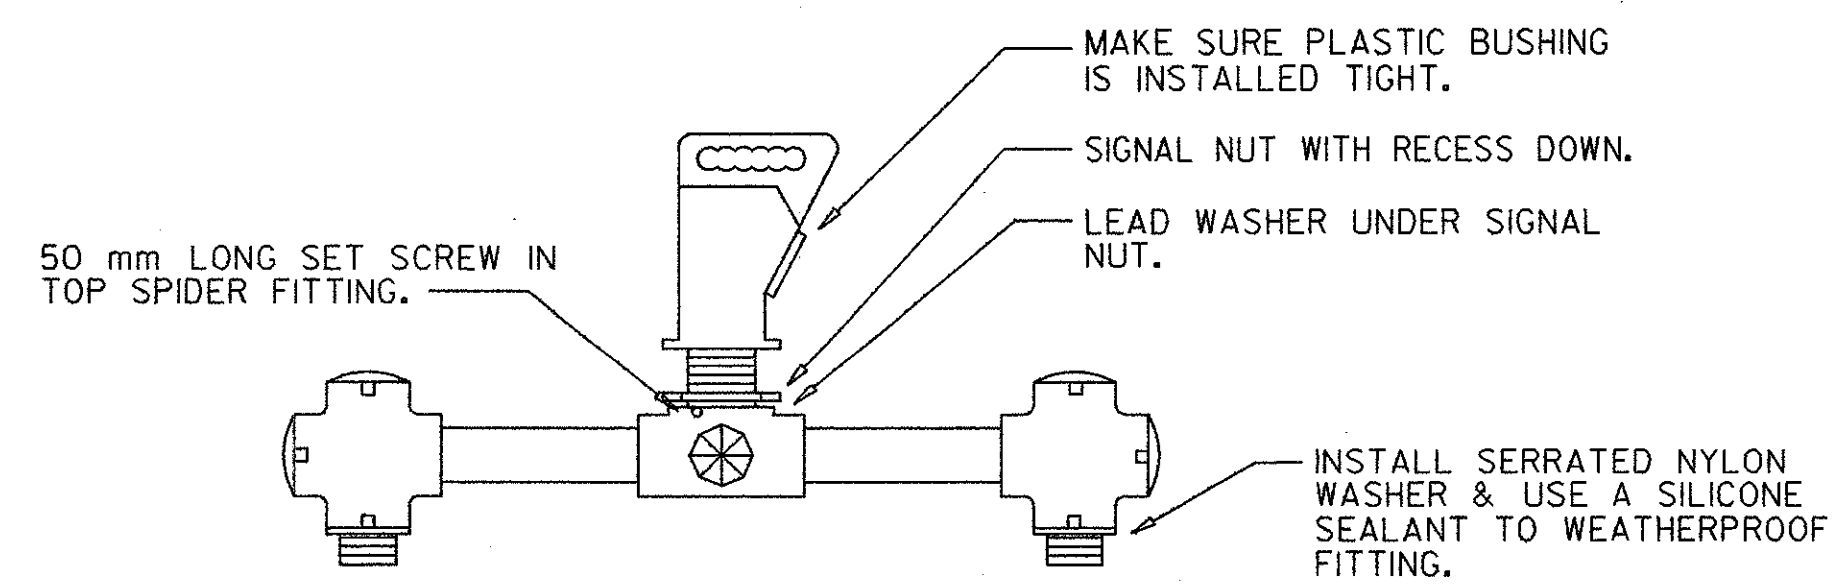


(2-WAY T.S. SHOWN 3-WAY & 4-WAY SIMILAR)

DETAIL : SPAN WIRE MOUNTED T.S. BRACKET ASSEMBLY (N.T.S.)

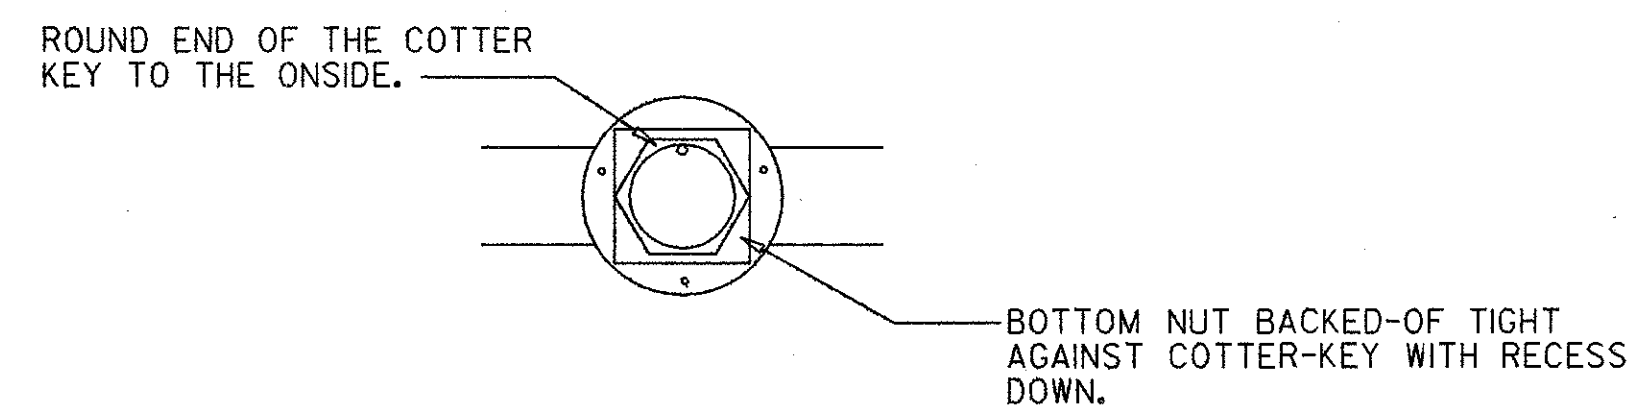

DETAIL : HUB WITH BOTTOM PLATE OFF (N.T.S.)

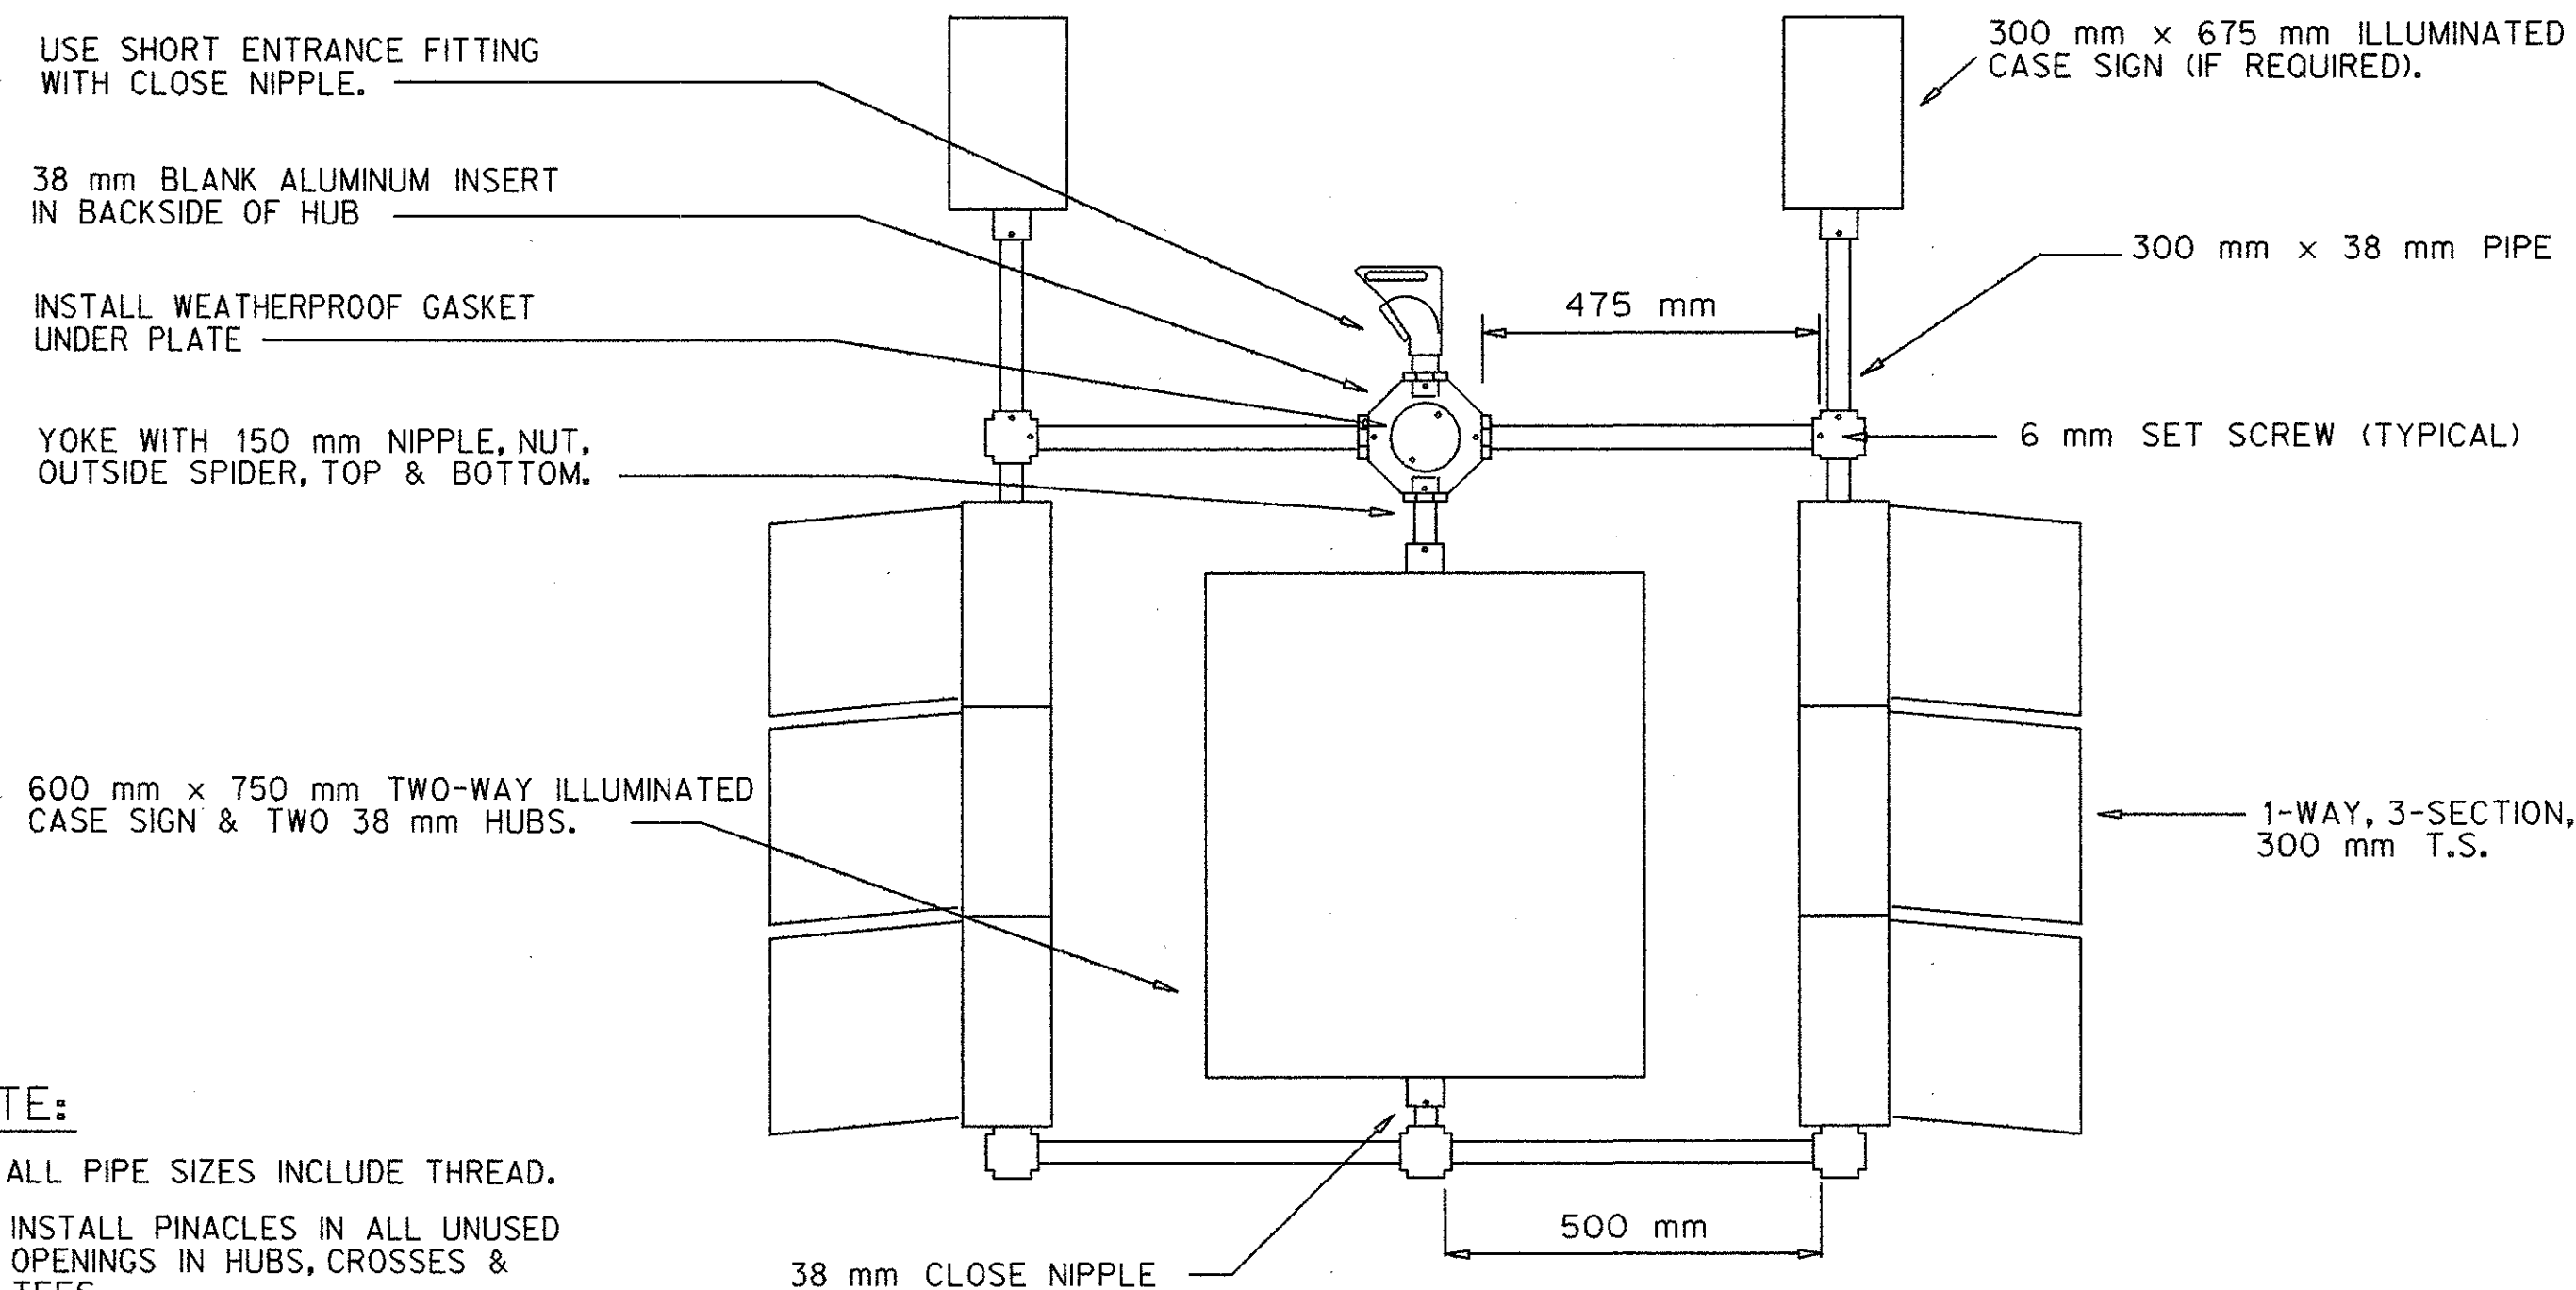

- NOTE:
1. ALL PIPE SIZES INCLUDE THREAD.
 2. INSTALL PINACLES IN ALL UNUSED OPENINGS IN HUBS, CROSSES & TEES.
 3. 2-WAY CASE SIGN LEGEND TO BE AS SHOWN ON PLANS.

DETAIL : 2-WAY T.S./CASE SIGN COMBINATION ABOVE HUB

SHL 1 OF 1
 OC-3A

TRAFFIC SIGNAL BRACKET ASSEMBLY/CASE SIGN COMBINATION

DATE	SCALE	CONT. SEC.	JOB NO.	T & S	CONST.

LAST CORRECTION DATE: 12/27/95
 FILENAME: CCSA.DGN

SHL OF

DATE	SCALE	CONT. SEC.	JOB NO.	T & S	CONST.
9-21-99		63174	48404A	16 of 31	16D

	COLOR	VEHICLE	PEDESTRIAN	PUSHBUTTON
		20/C	12/C	7/C
1	WHITE	COMMON (CASE SIGN)	COMMON	COMMON
2	BLACK	CASE SIGN	CASE SIGN	DW 2
3	RED	A Ø/RED	A Ø/RED	DW 1
4	GREEN	A Ø-GREEN	A Ø-GREEN	W 1
5	ORANGE	A Ø-AMBER	A Ø-AMBER	W 3
6	BLUE	L.T.G.A.	L.T.G.A.	W 2
7	WHITE W/BLACK TRACER	C Ø-AMBER	C Ø-AMBER	DW 3
8	GREEN W/BLACK TRACER	B Ø-GREEN	B Ø-GREEN	
9	ORANGE W/BLACK TRACER	B Ø-AMBER	B Ø-AMBER	
10	RED W/BLACK TRACER	B Ø/RED	B Ø/RED	
11	BLUE W/BLACK TRACER	C Ø-GREEN	C Ø-GREEN	
12	BLACK W/WHITE TRACER	C Ø/RED	C Ø/RED	
13	GREEN W/WHITE TRACER	D Ø-GREEN		
14	ORANGE W/RED TRACER	D Ø-AMBER		
15	RED W/WHITE TRACER	D Ø/RED		
16	BLACK W/RED TRACER	SPARE		
17	BLUE W/WHITE TRACER	SPARE		
18	BLUE W/RED TRACER	300 mm COMMON		
19	WHITE W/RED TRACER	300 mm COMMON		
20	RED W/GREEN TRACER	SPARE		

- #10/2-CONDUCTOR AND #12/2 CONDUCTOR-COLORS 1 & 2
- #12/3-CONDUCTOR-COLORS 1 THROUGH 3
- #14/7-CONDUCTOR-COLORS 1 THROUGH 7
- #14/12-CONDUCTOR-COLORS 1 THROUGH 12
- #14/20-CONDUCTOR-COLORS 1 THROUGH 20


SH 1 OF 1
OC-3B

COLOR CODE FOR WIRING CONNECTIUNG SIGNAL LAMPS


DATE	SCALE	CONT. SEC.	JOB NO.	T & S	CONST.
------	-------	------------	---------	-------	--------

SH OF


DATE	SCALE	CONT. SEC.	JOB NO.	T & S	CONST.
9-21-99		63174	48404A	17 of 31	17D

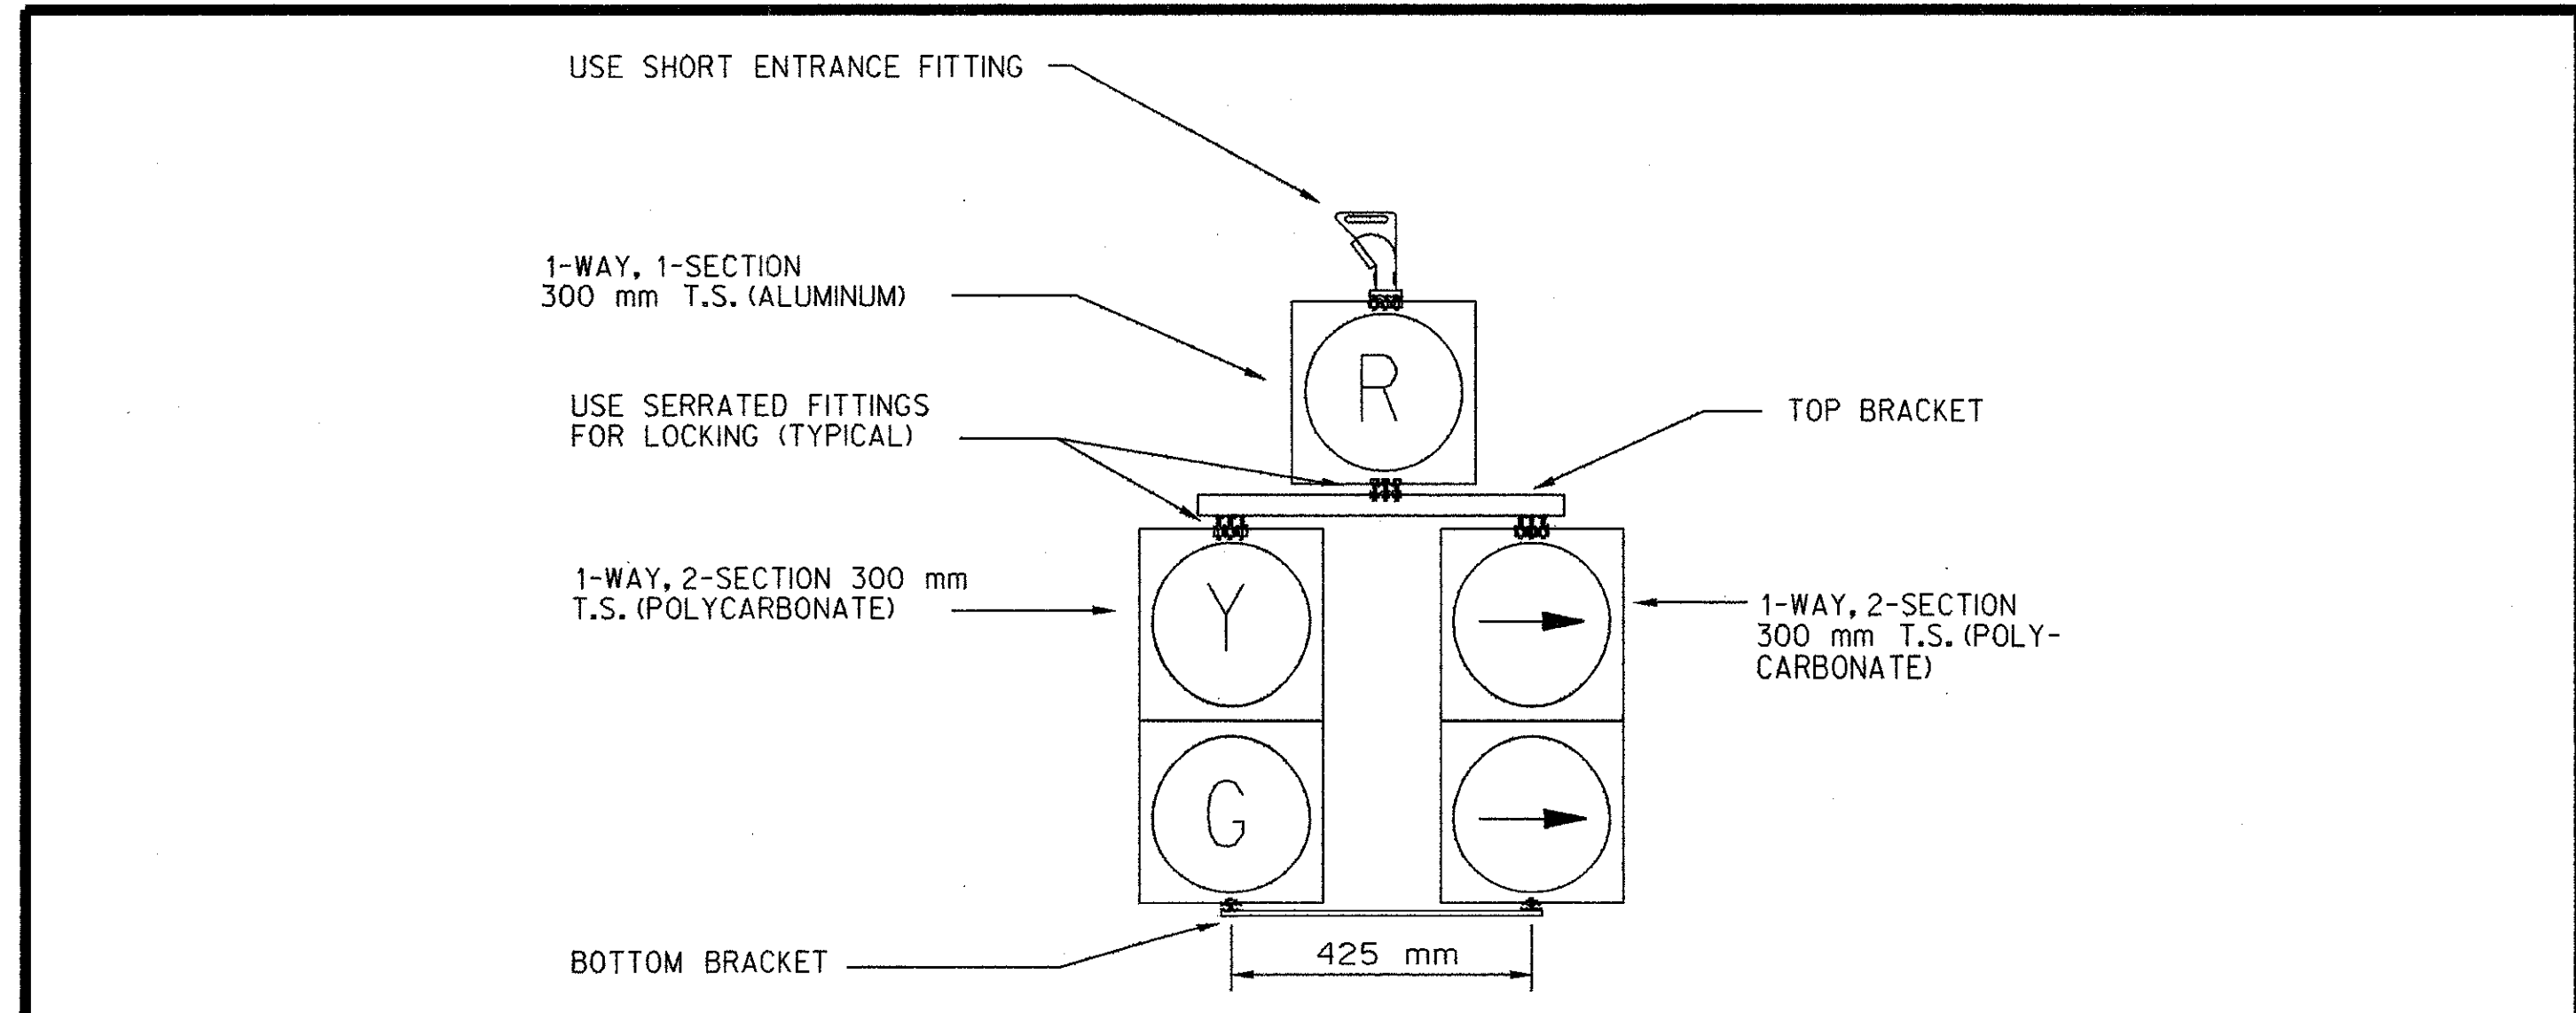

DETAIL : 5-SECTION CLUSTER TRAFFIC SIGNAL

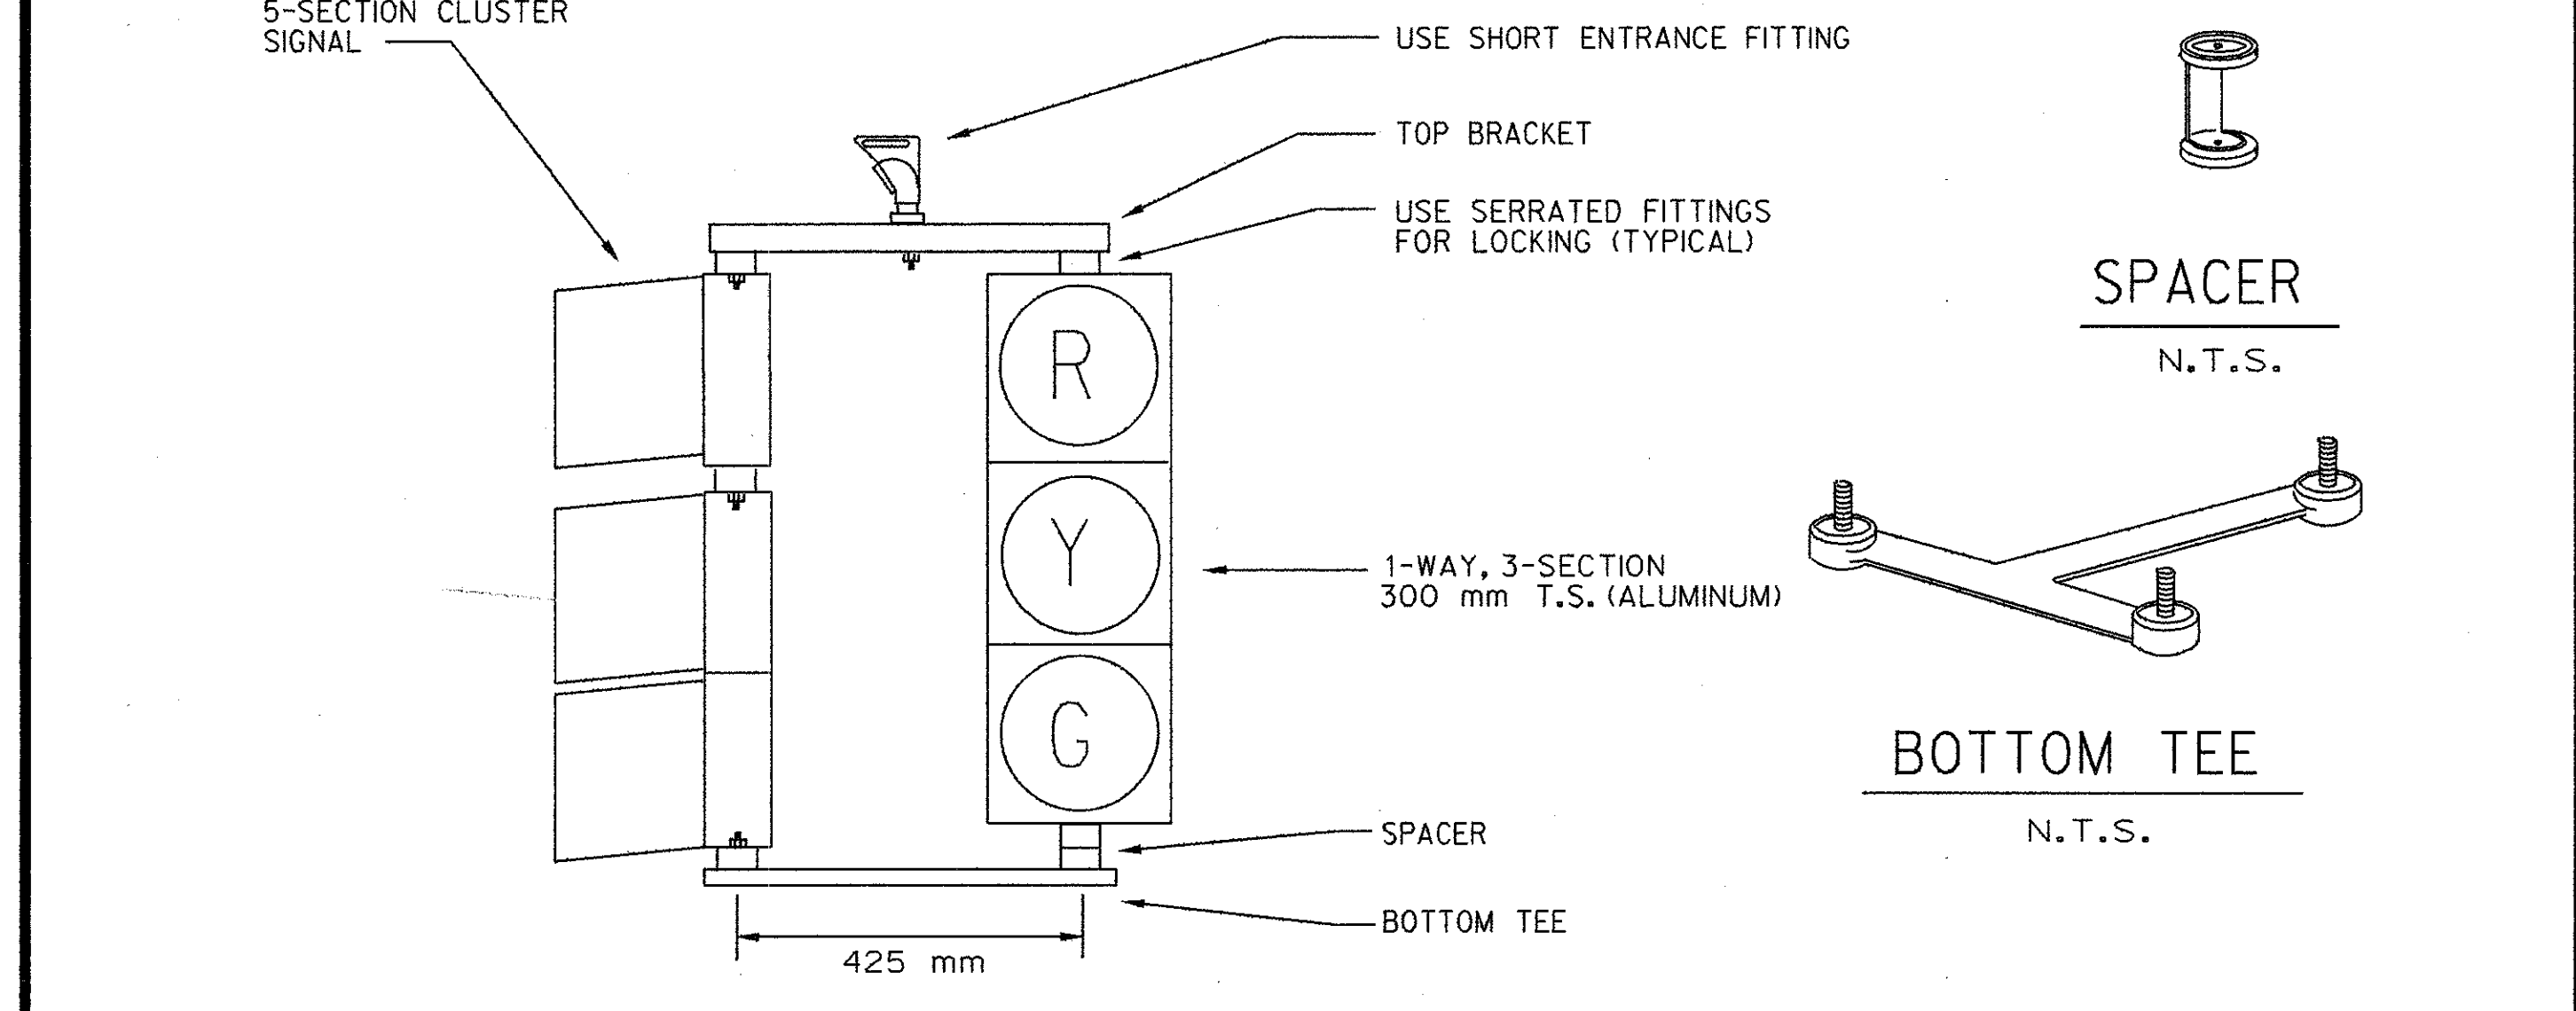

DETAIL : COMBINATION CLUSTER TRAFFIC SIGNAL

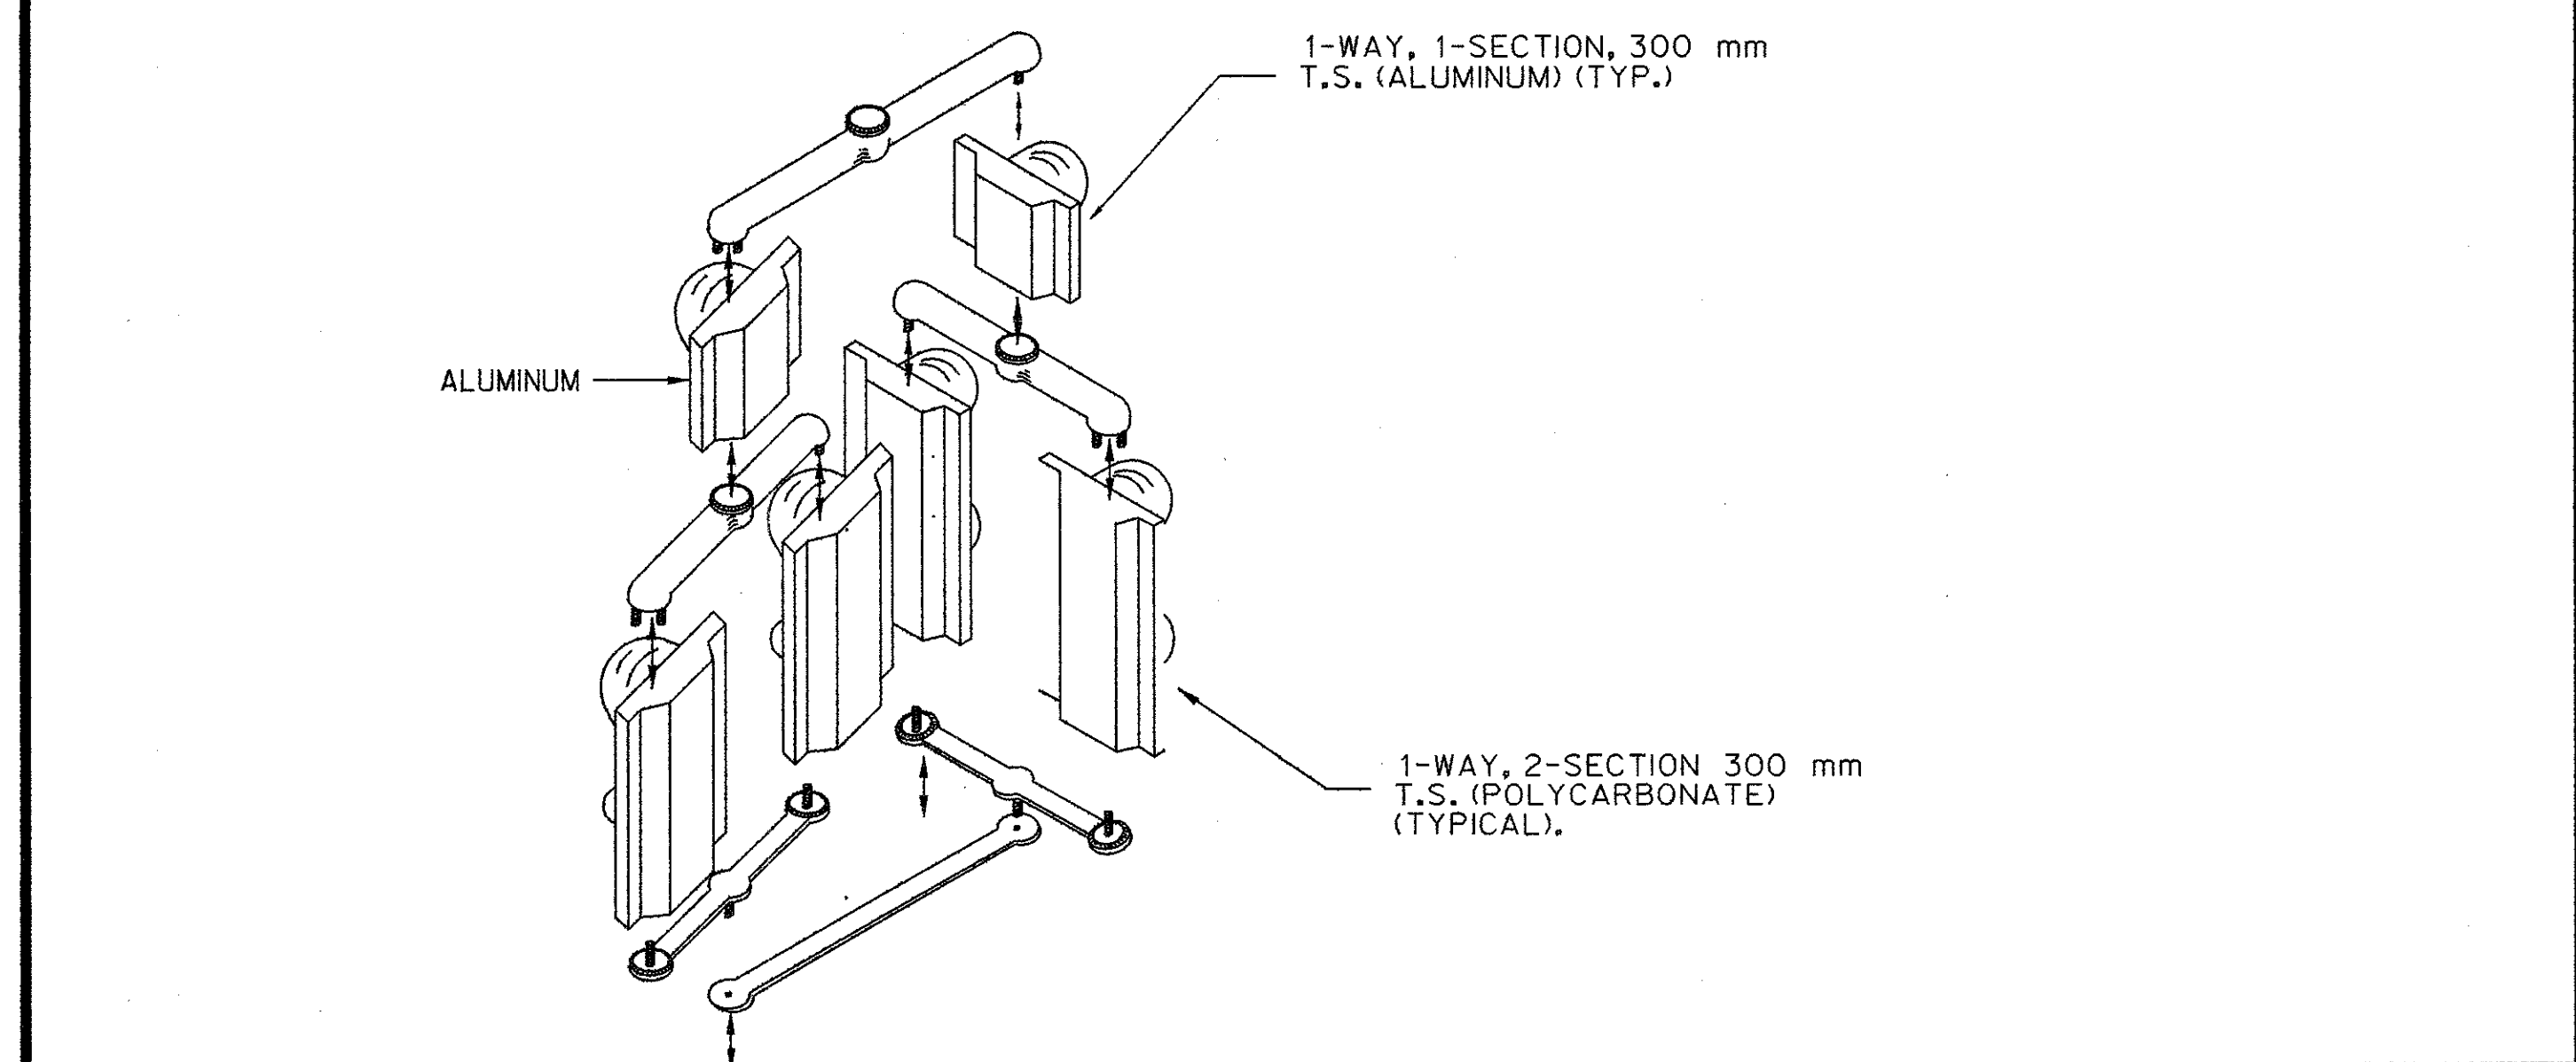


DETAIL : TWIN CLUSTER TRAFFIC SIGNAL

SH. 1 OF 1

ST-3D

T.S. SPECIAL BRACKETS 5-SECTION HEADS

DATE	SCALE	CONT. SEC.	JOB NO.	T & S	CONST.

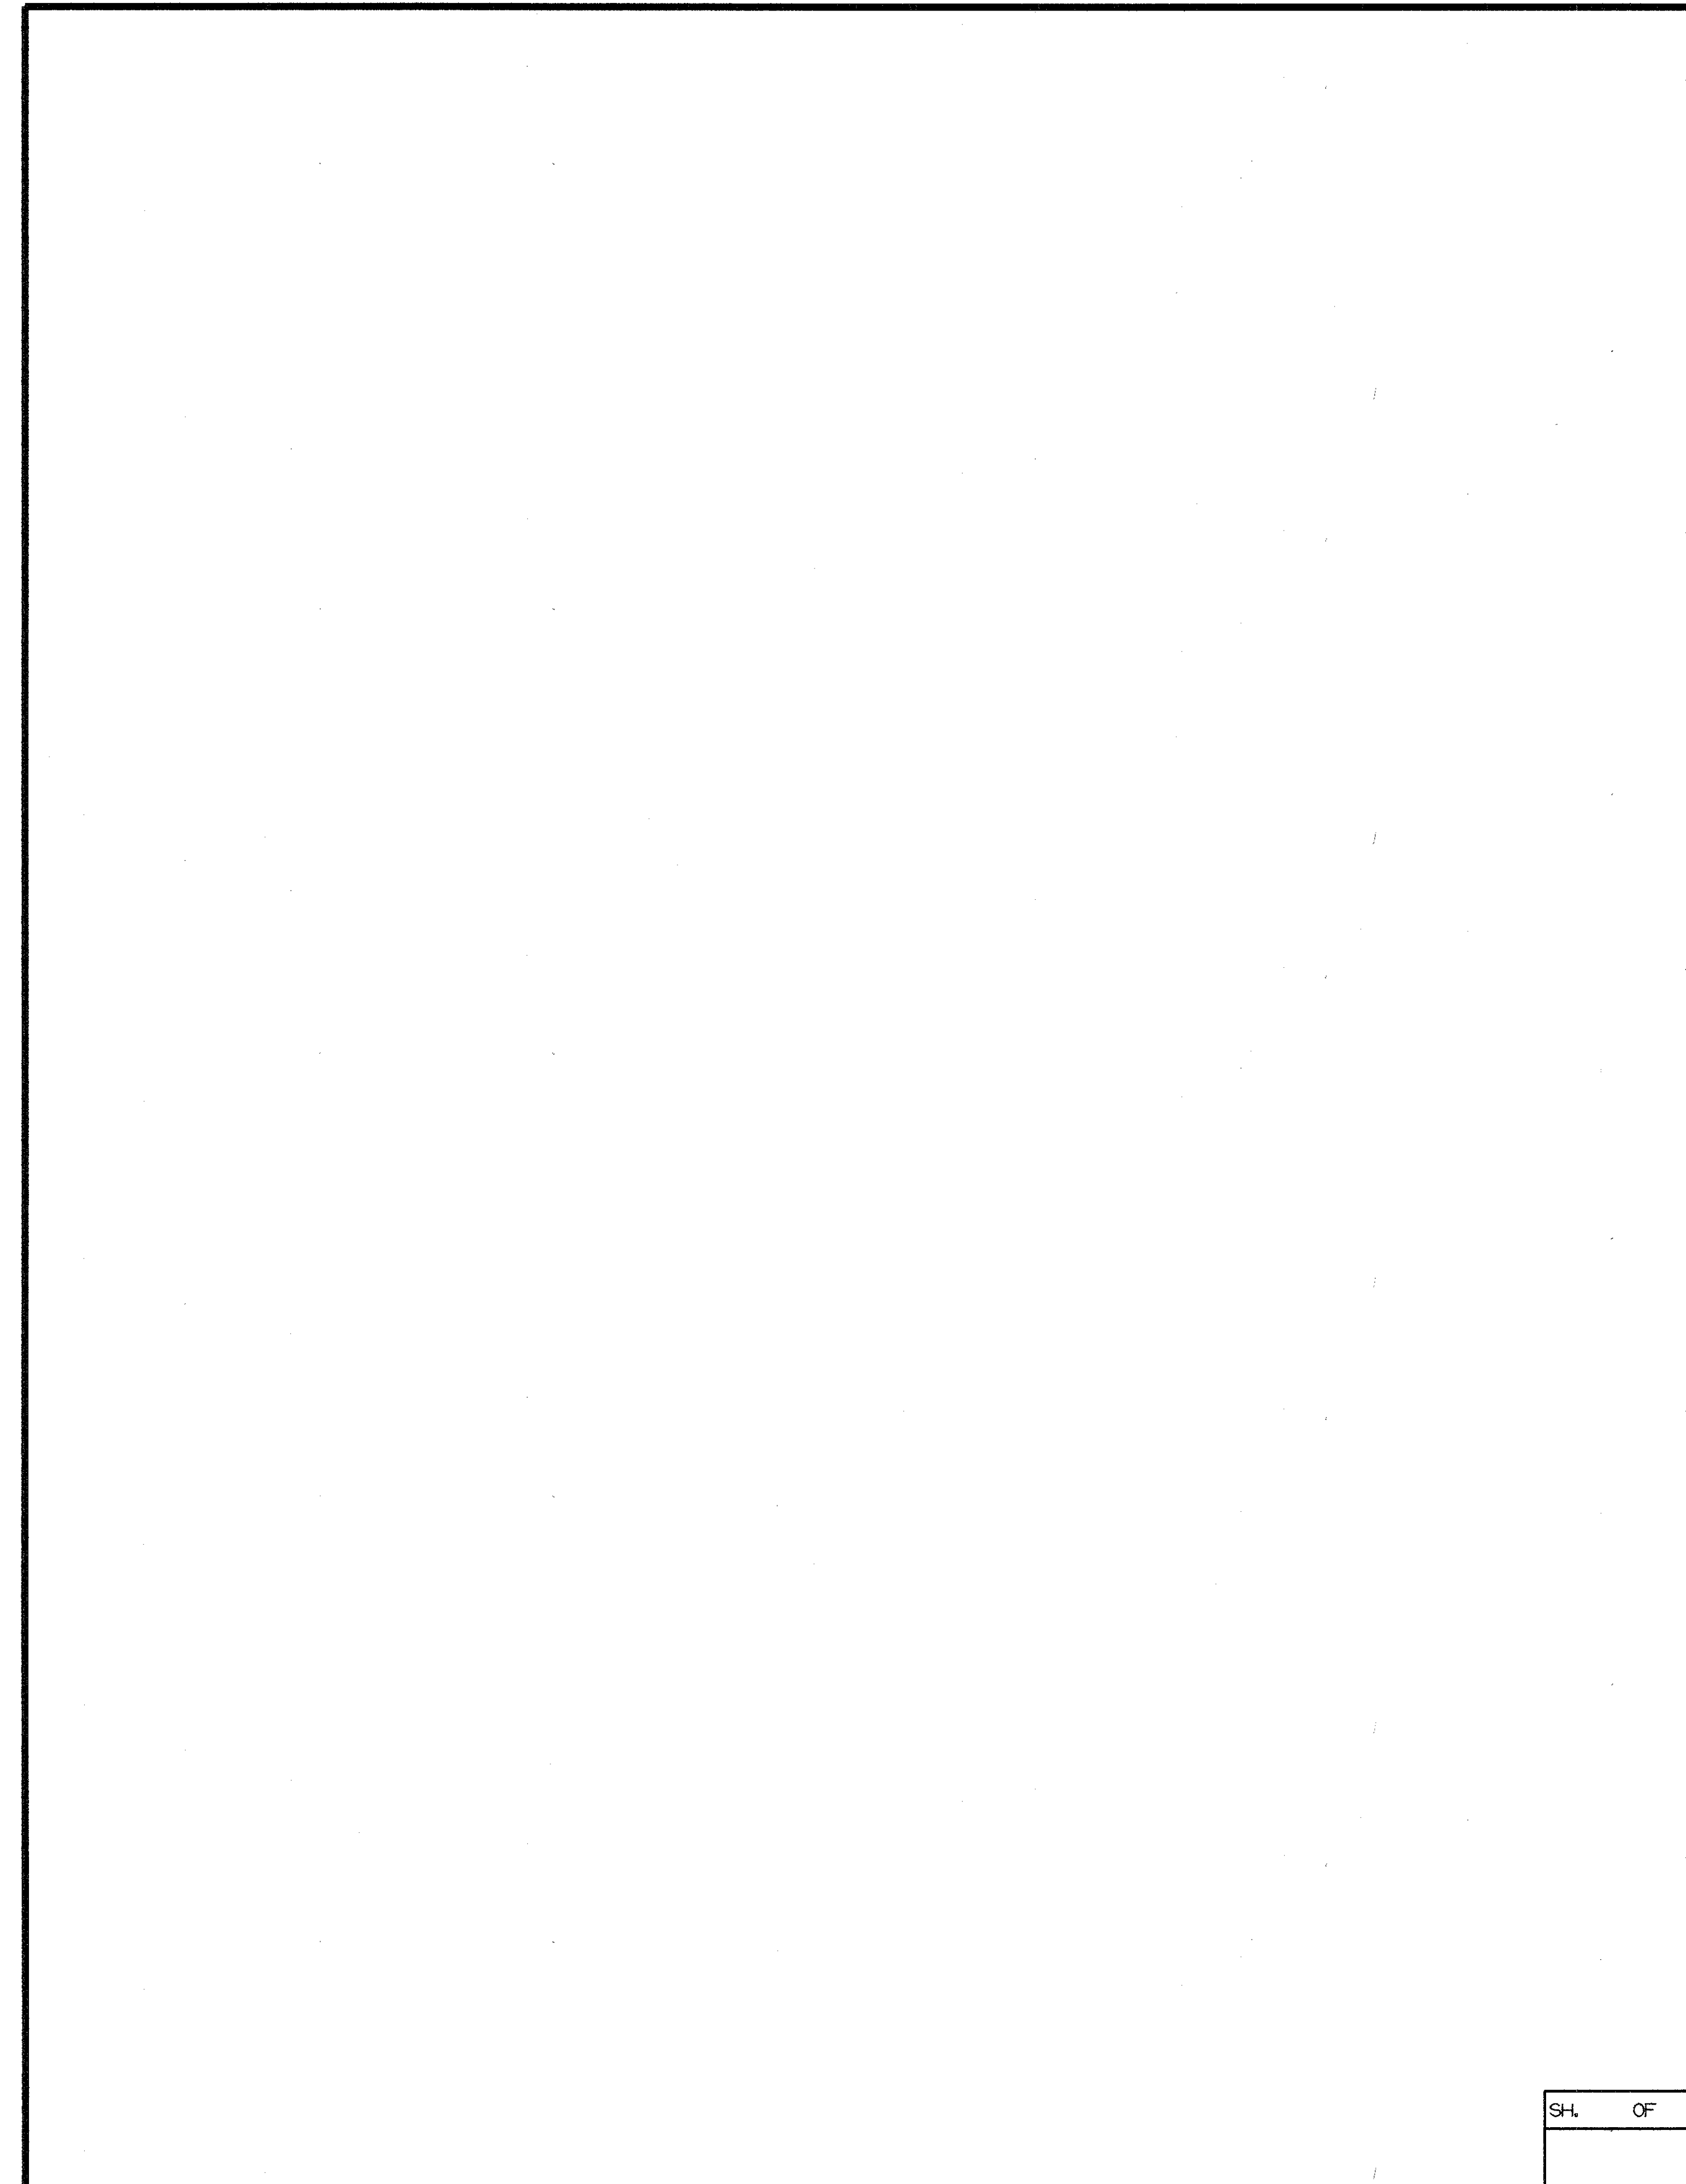


SH. OF


MDOT Michigan Department of Transportation

DATE	SCALE	CONT. SEC.	JOB NO.	T & S	CONST.
9-21-99		63174	48404A	18 of 31	18D

LAST CORRECTION DATE: 12/22/95
FILENAME: ST3D.DGN

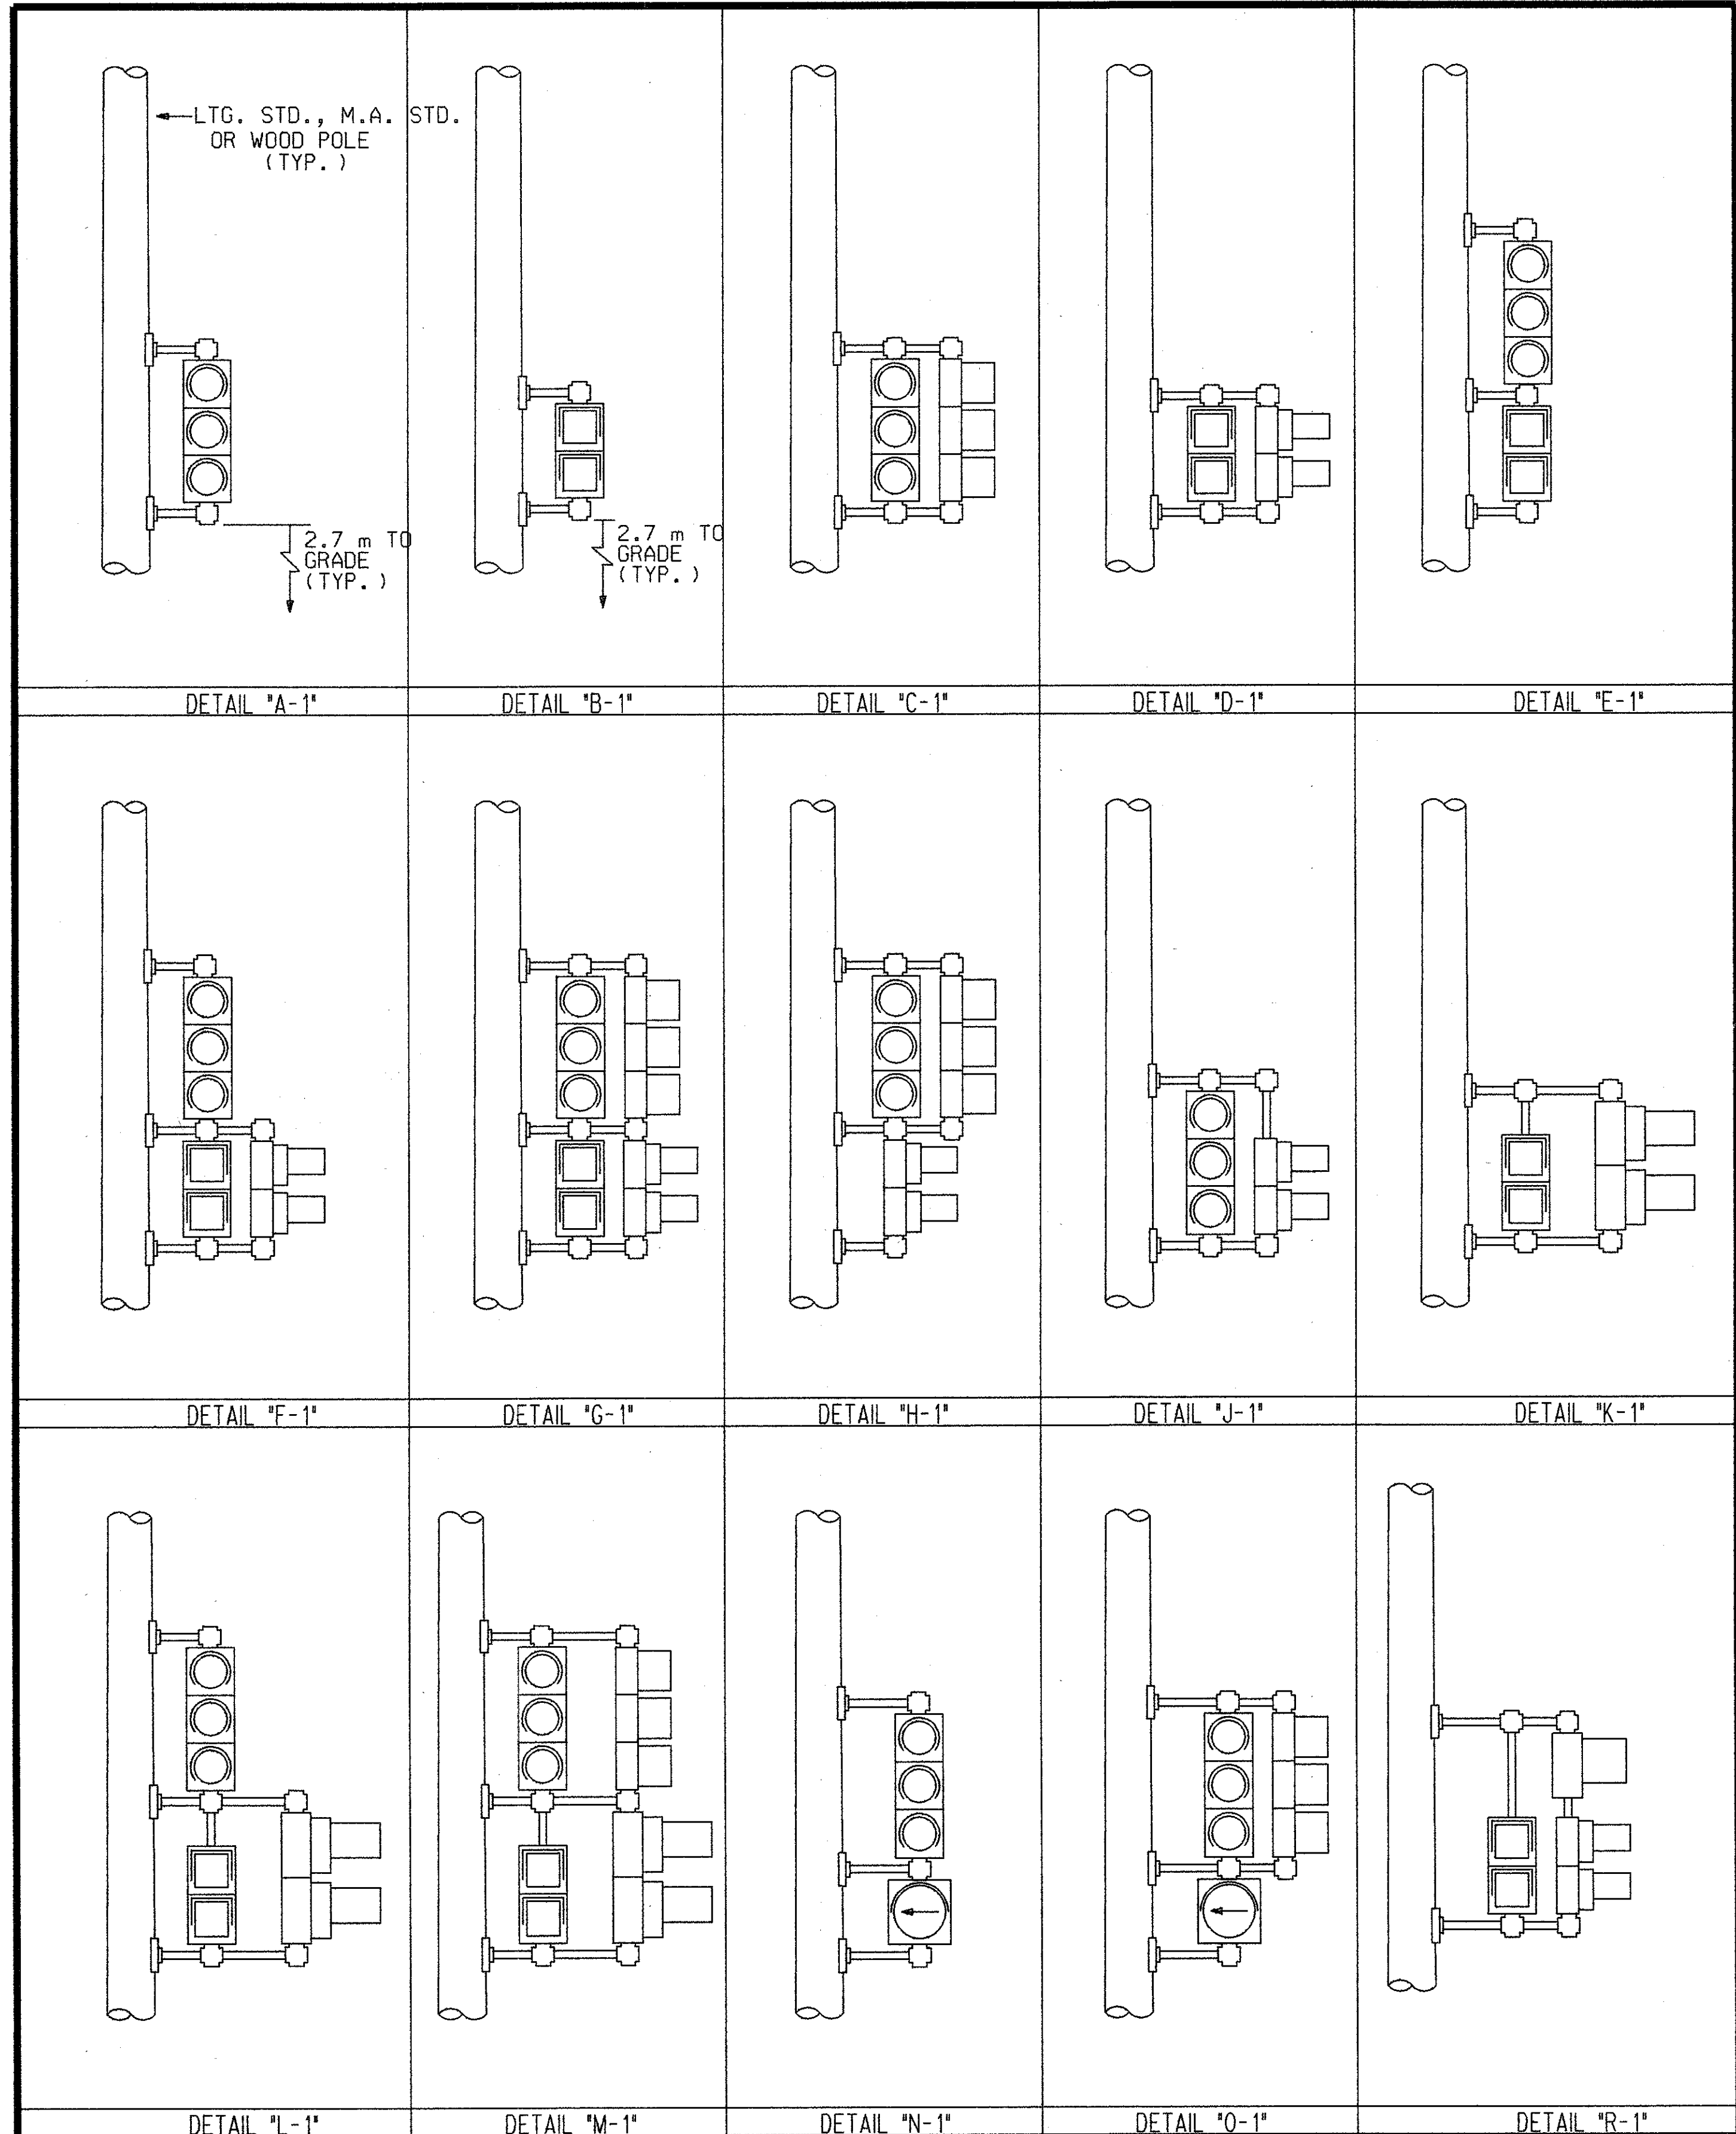

SH. 1 OF 2
ST-4

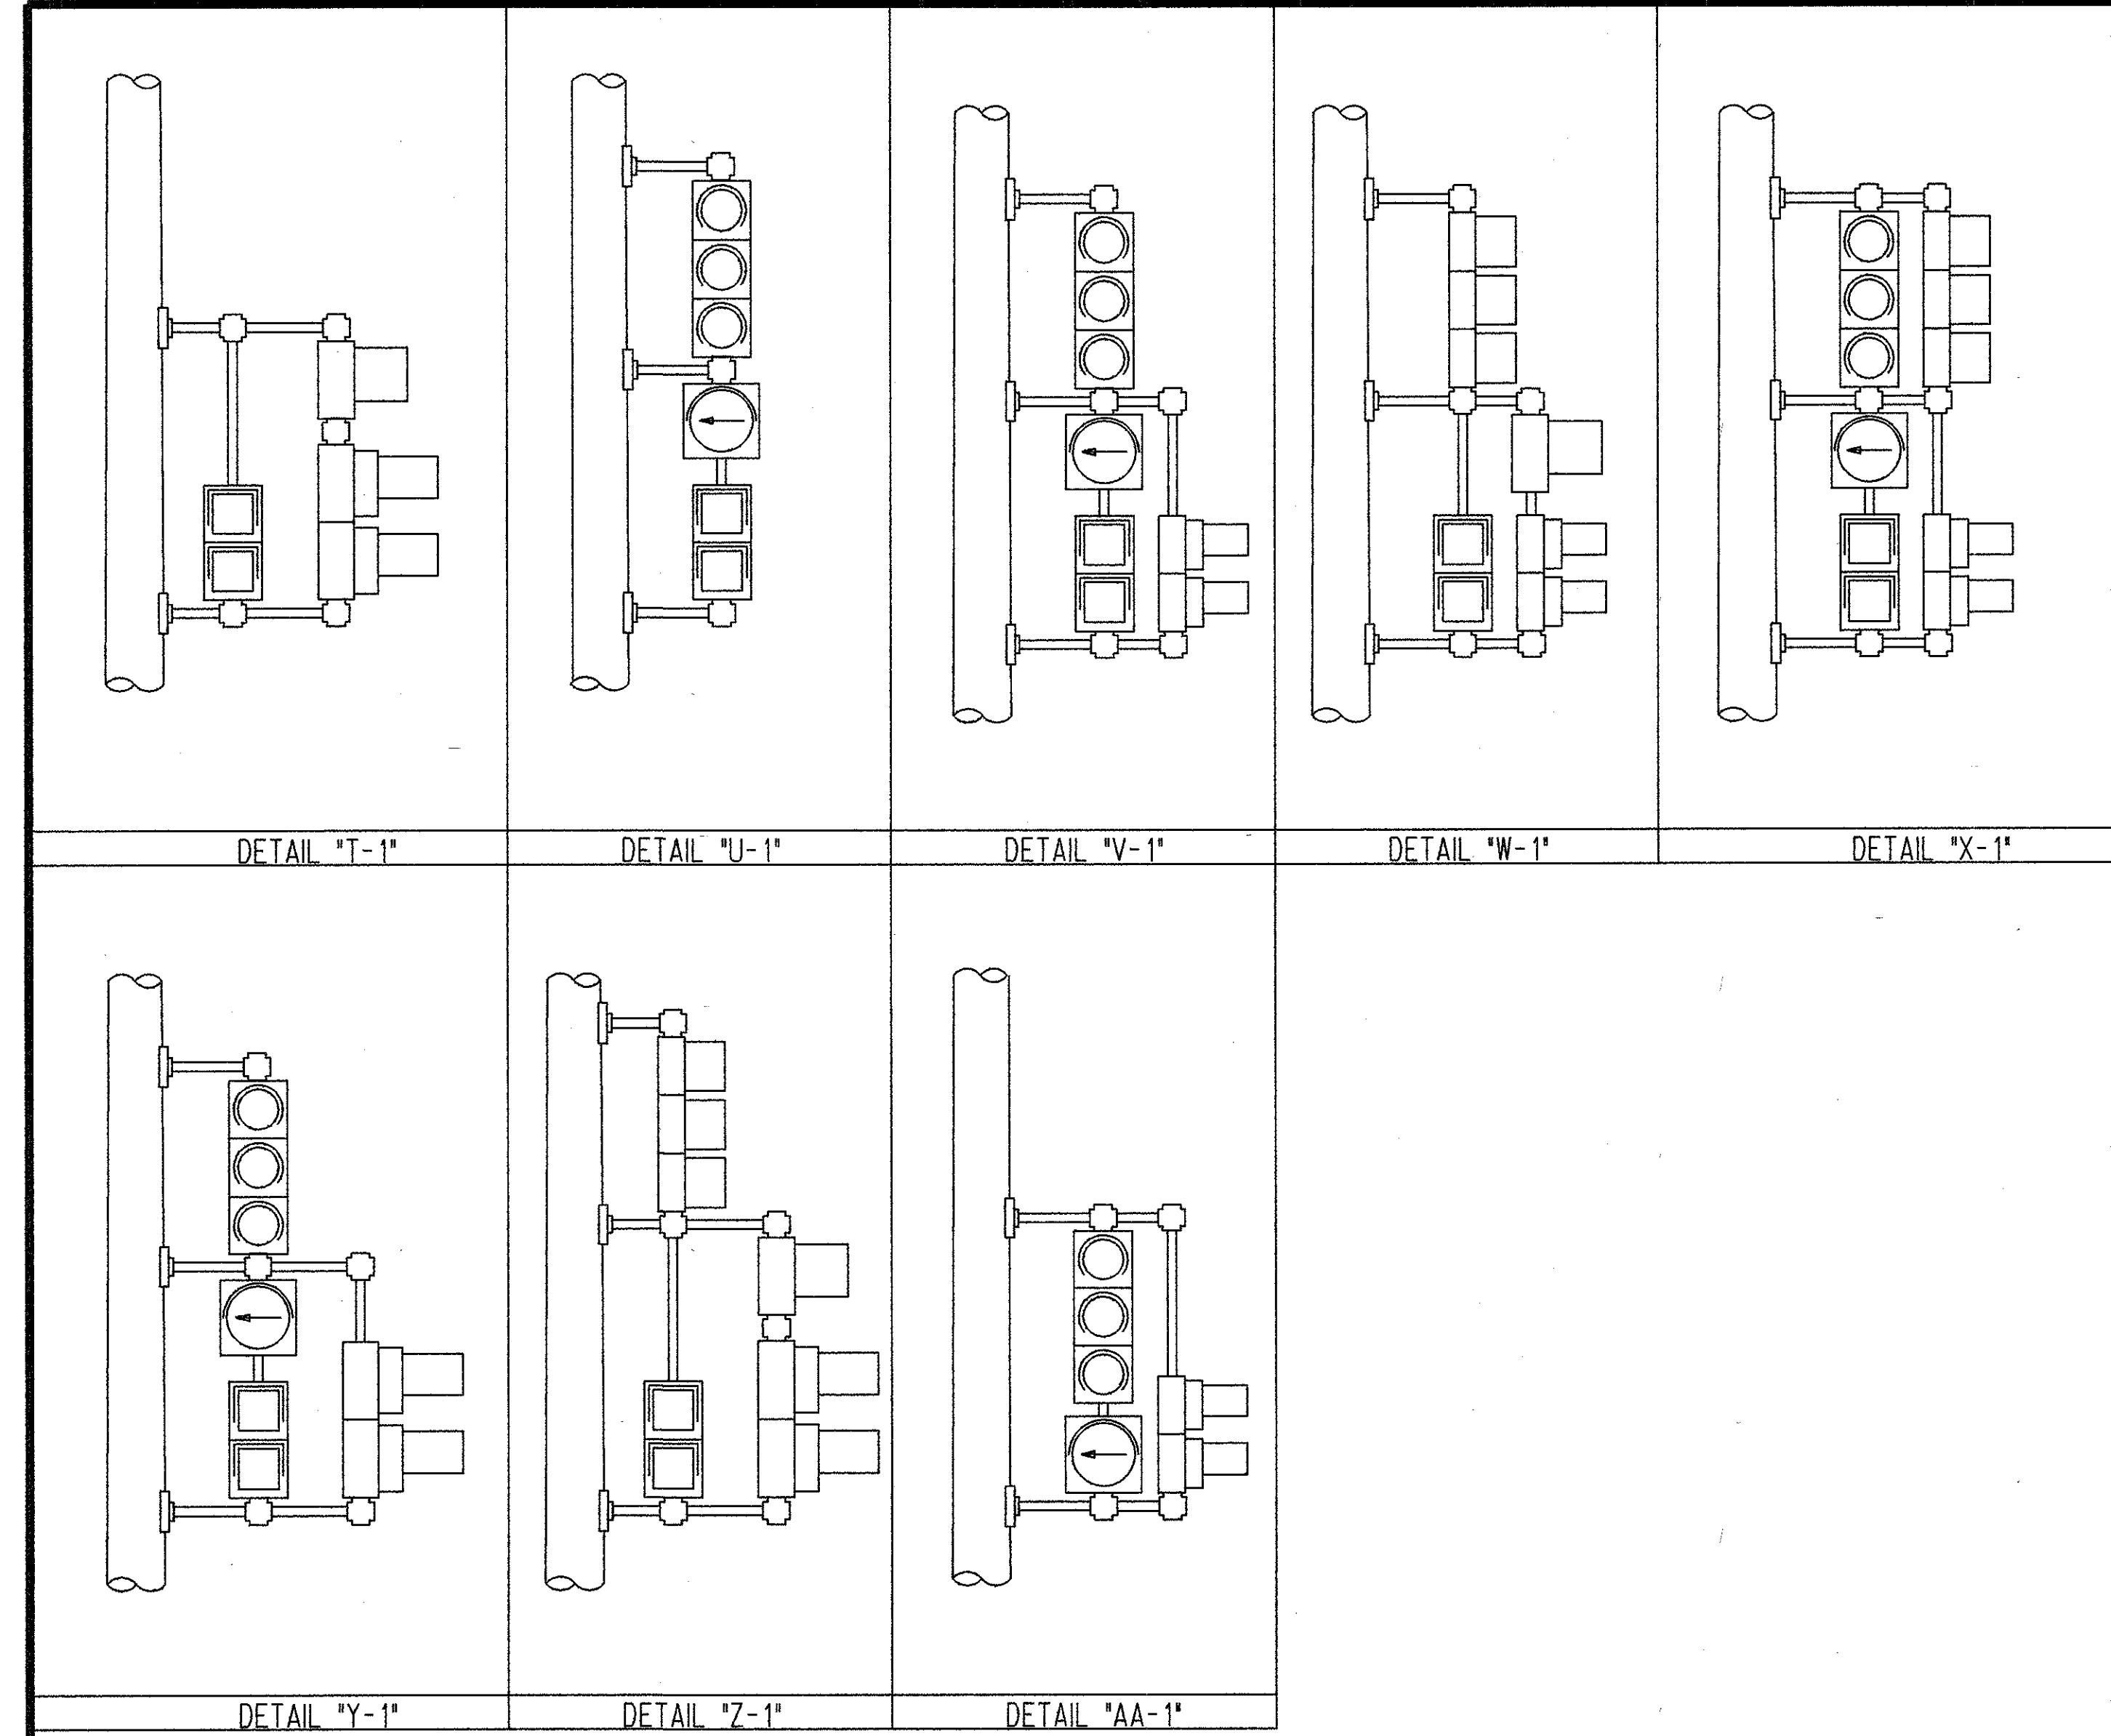

NOTE:


1. THE RELATIVE POSITION OF 2-WAY T.S. & PEDESTRIAN BRACKET ARM SIGNALS WITHIN THE BRACKET ASSEMBLY SHALL BE REVERSED (I.E. THE SIGNAL NEAREST THE POLE GOES TO THE OUTSIDE OF THE BRACKET ASSEMBLY & THE OUTSIDE SIGNAL GOES INBOARD OR NEAREST TO POLE) ACCORDING TO THE PLAN VIEW TO PROVIDE CLEAR VEHICULAR AND PEDESTRIAN VIEWING.
2. PIPE ASSEMBLY SHALL BE OF SUCH LENGTH AND HEIGHT AS TO ACCOMMODATE TRAFFIC SIGNALS AND PEDESTRIAN SIGNALS FOR PROPER MAINTENANCE AND CLEAR VEHICULAR AND PEDESTRIAN VIEWING.

SH. 2 OF 2
ST-4

LAST CORRECTION DATE: 12/22/95
FILENAME: ST4.DGN

TYPICAL POLE MOUNTED - T.S./PEDESTRIAN COMBINATIONS					
DATE	SCALE	CONT. SEC.	JOB NO.	T & S	CONST.

TYPICAL POLE MOUNTED - T.S./PEDESTRIAN COMBINATIONS					
DATE	SCALE	CONT. SEC.	JOB NO.	T & S	CONST.
9-21-99		63174	48404A	19 of 31	19D

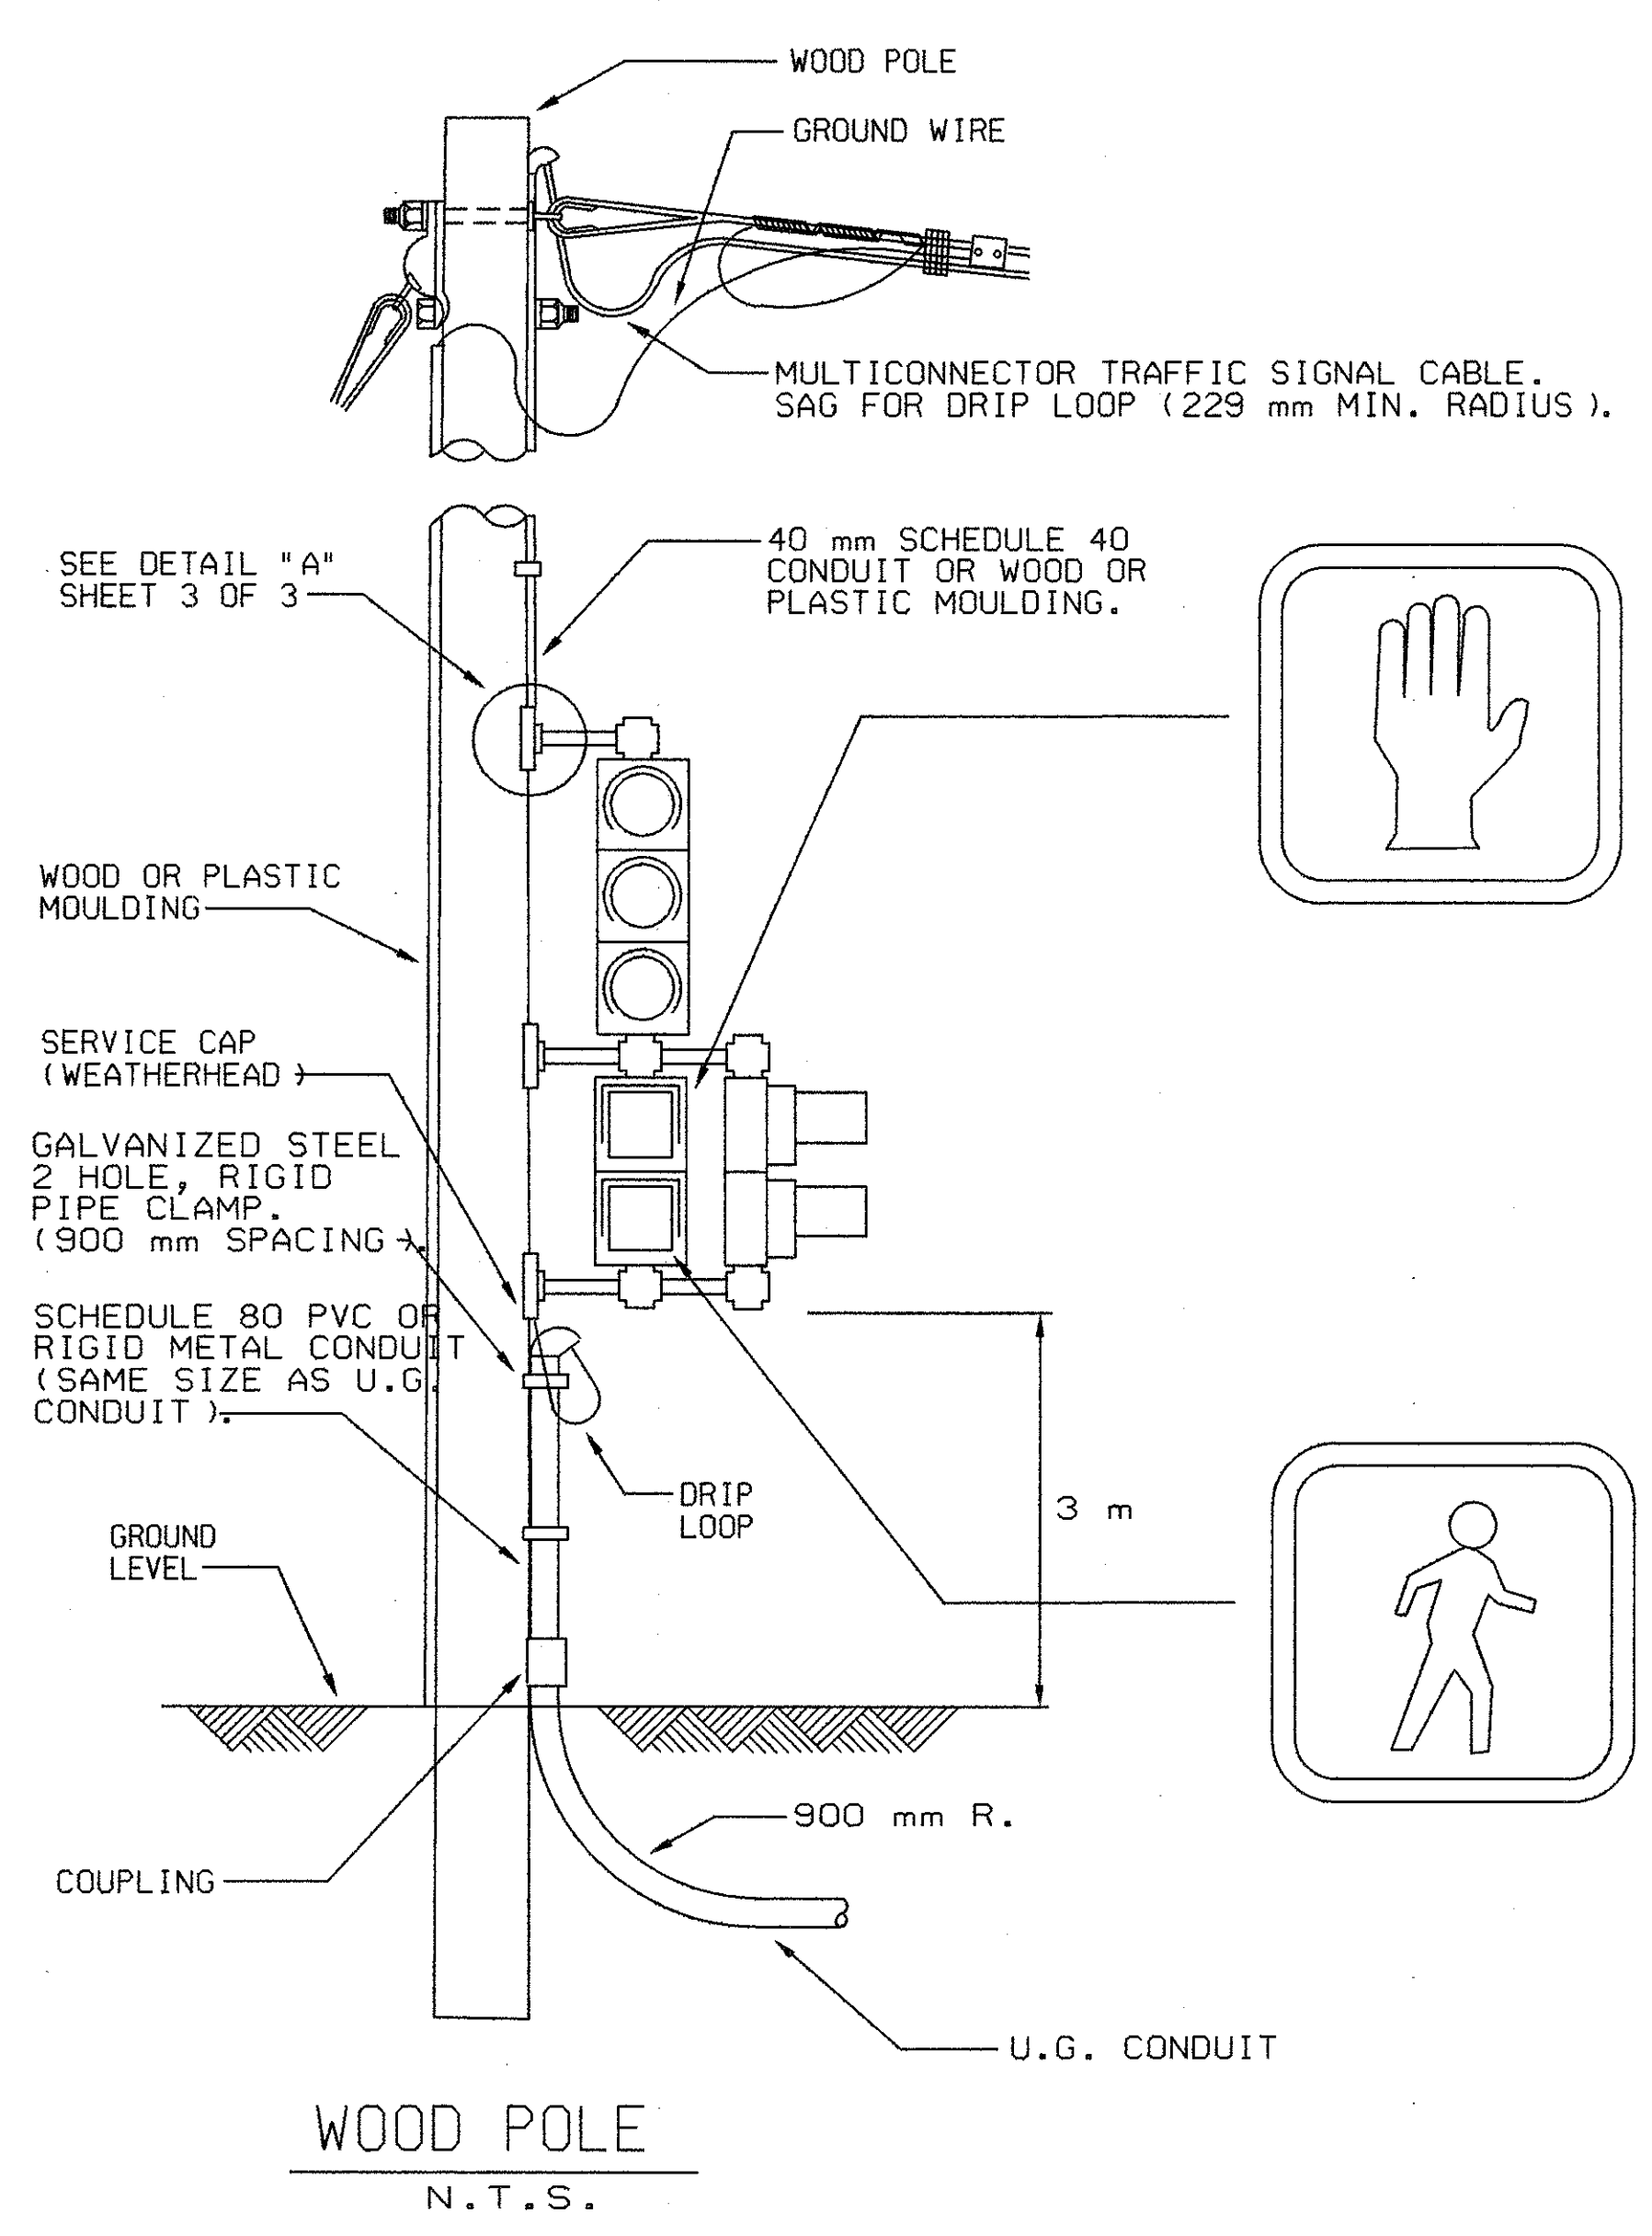


WOOD POLE
N.T.S.

SH. 1 OF 3
OC-4A

TYPICAL POLE MOUNTED - T.S./PEDESTRIAN COMBINATIONS

DATE	SCALE	CONT. SEC.	JOB NO.	T & S	CONST.
------	-------	------------	---------	-------	--------

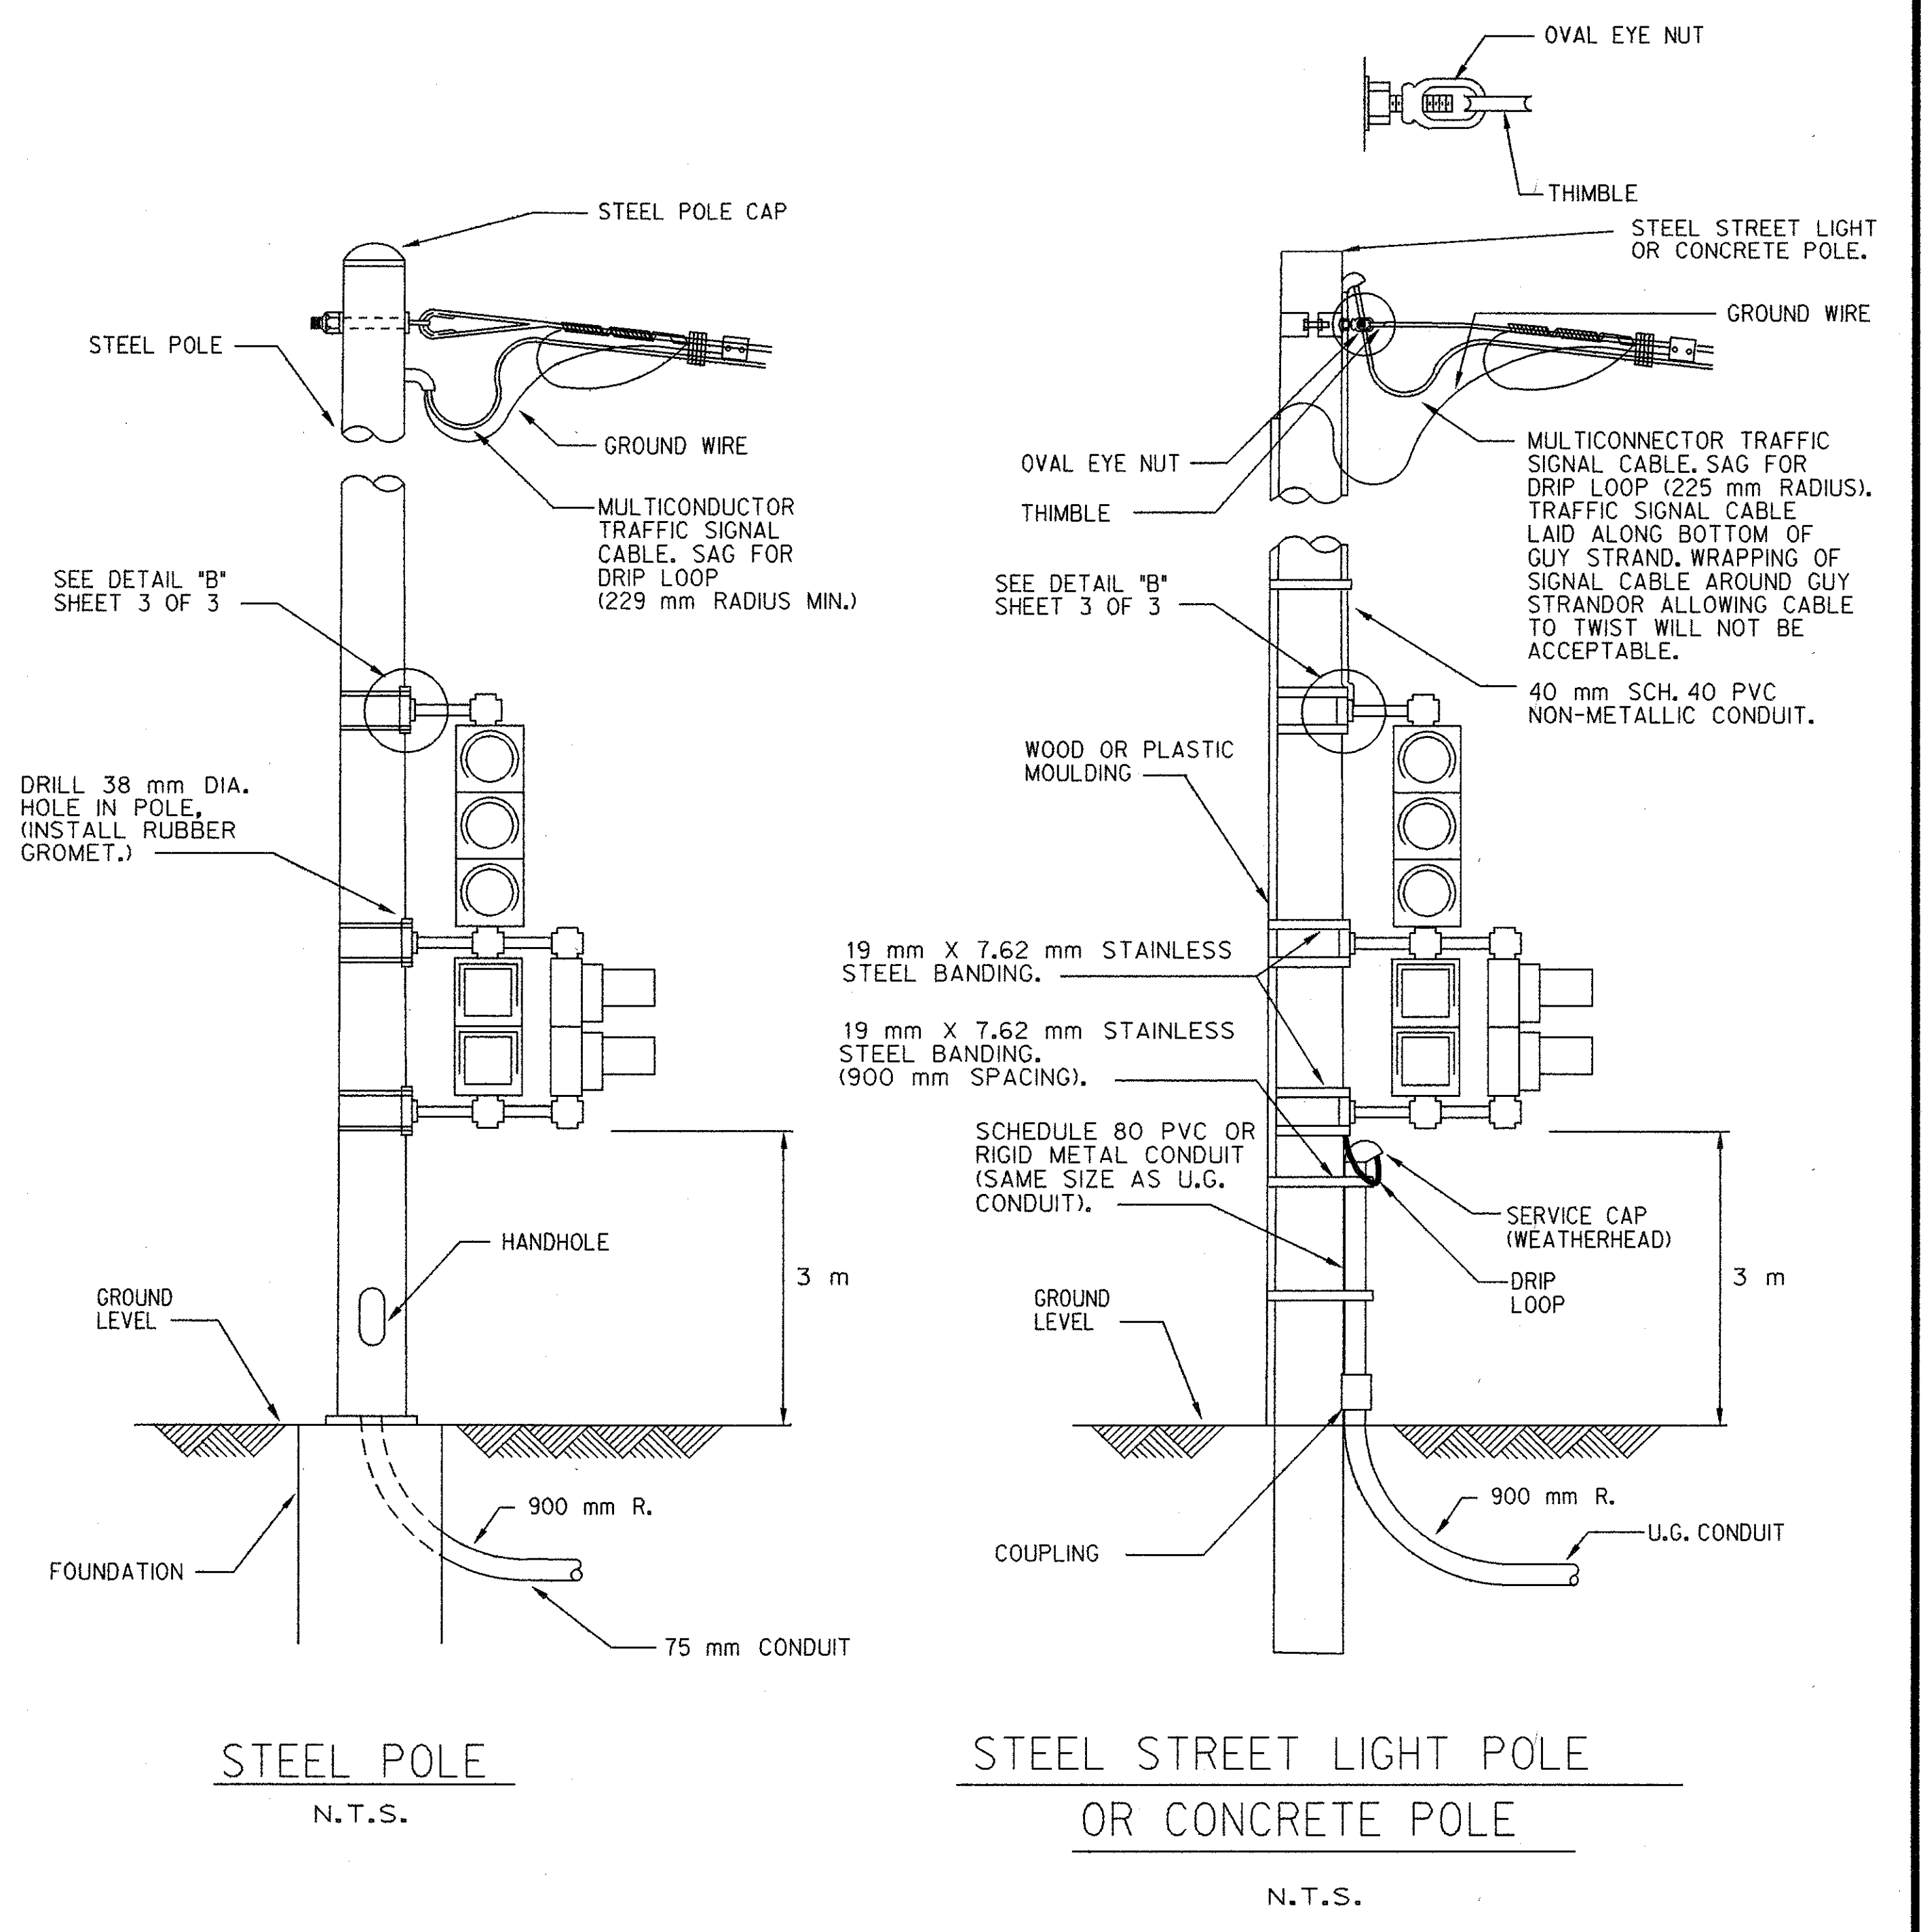

STEEL POLE
N.T.S.


STEEL STREET LIGHT POLE
OR CONCRETE POLE
N.T.S.

SH. 2 OF 3
OC-4A


TYPICAL POLE MOUNTED - T.S./PEDESTRIAN COMBINATIONS

DATE	SCALE	CONT. SEC.	JOB NO.	T & S	CONST.
9-21-99		63174	48404A	20 of 31	20D

LAST CORRECTION DATE: 12/27/95
 FILENAME: 0C4ADGN

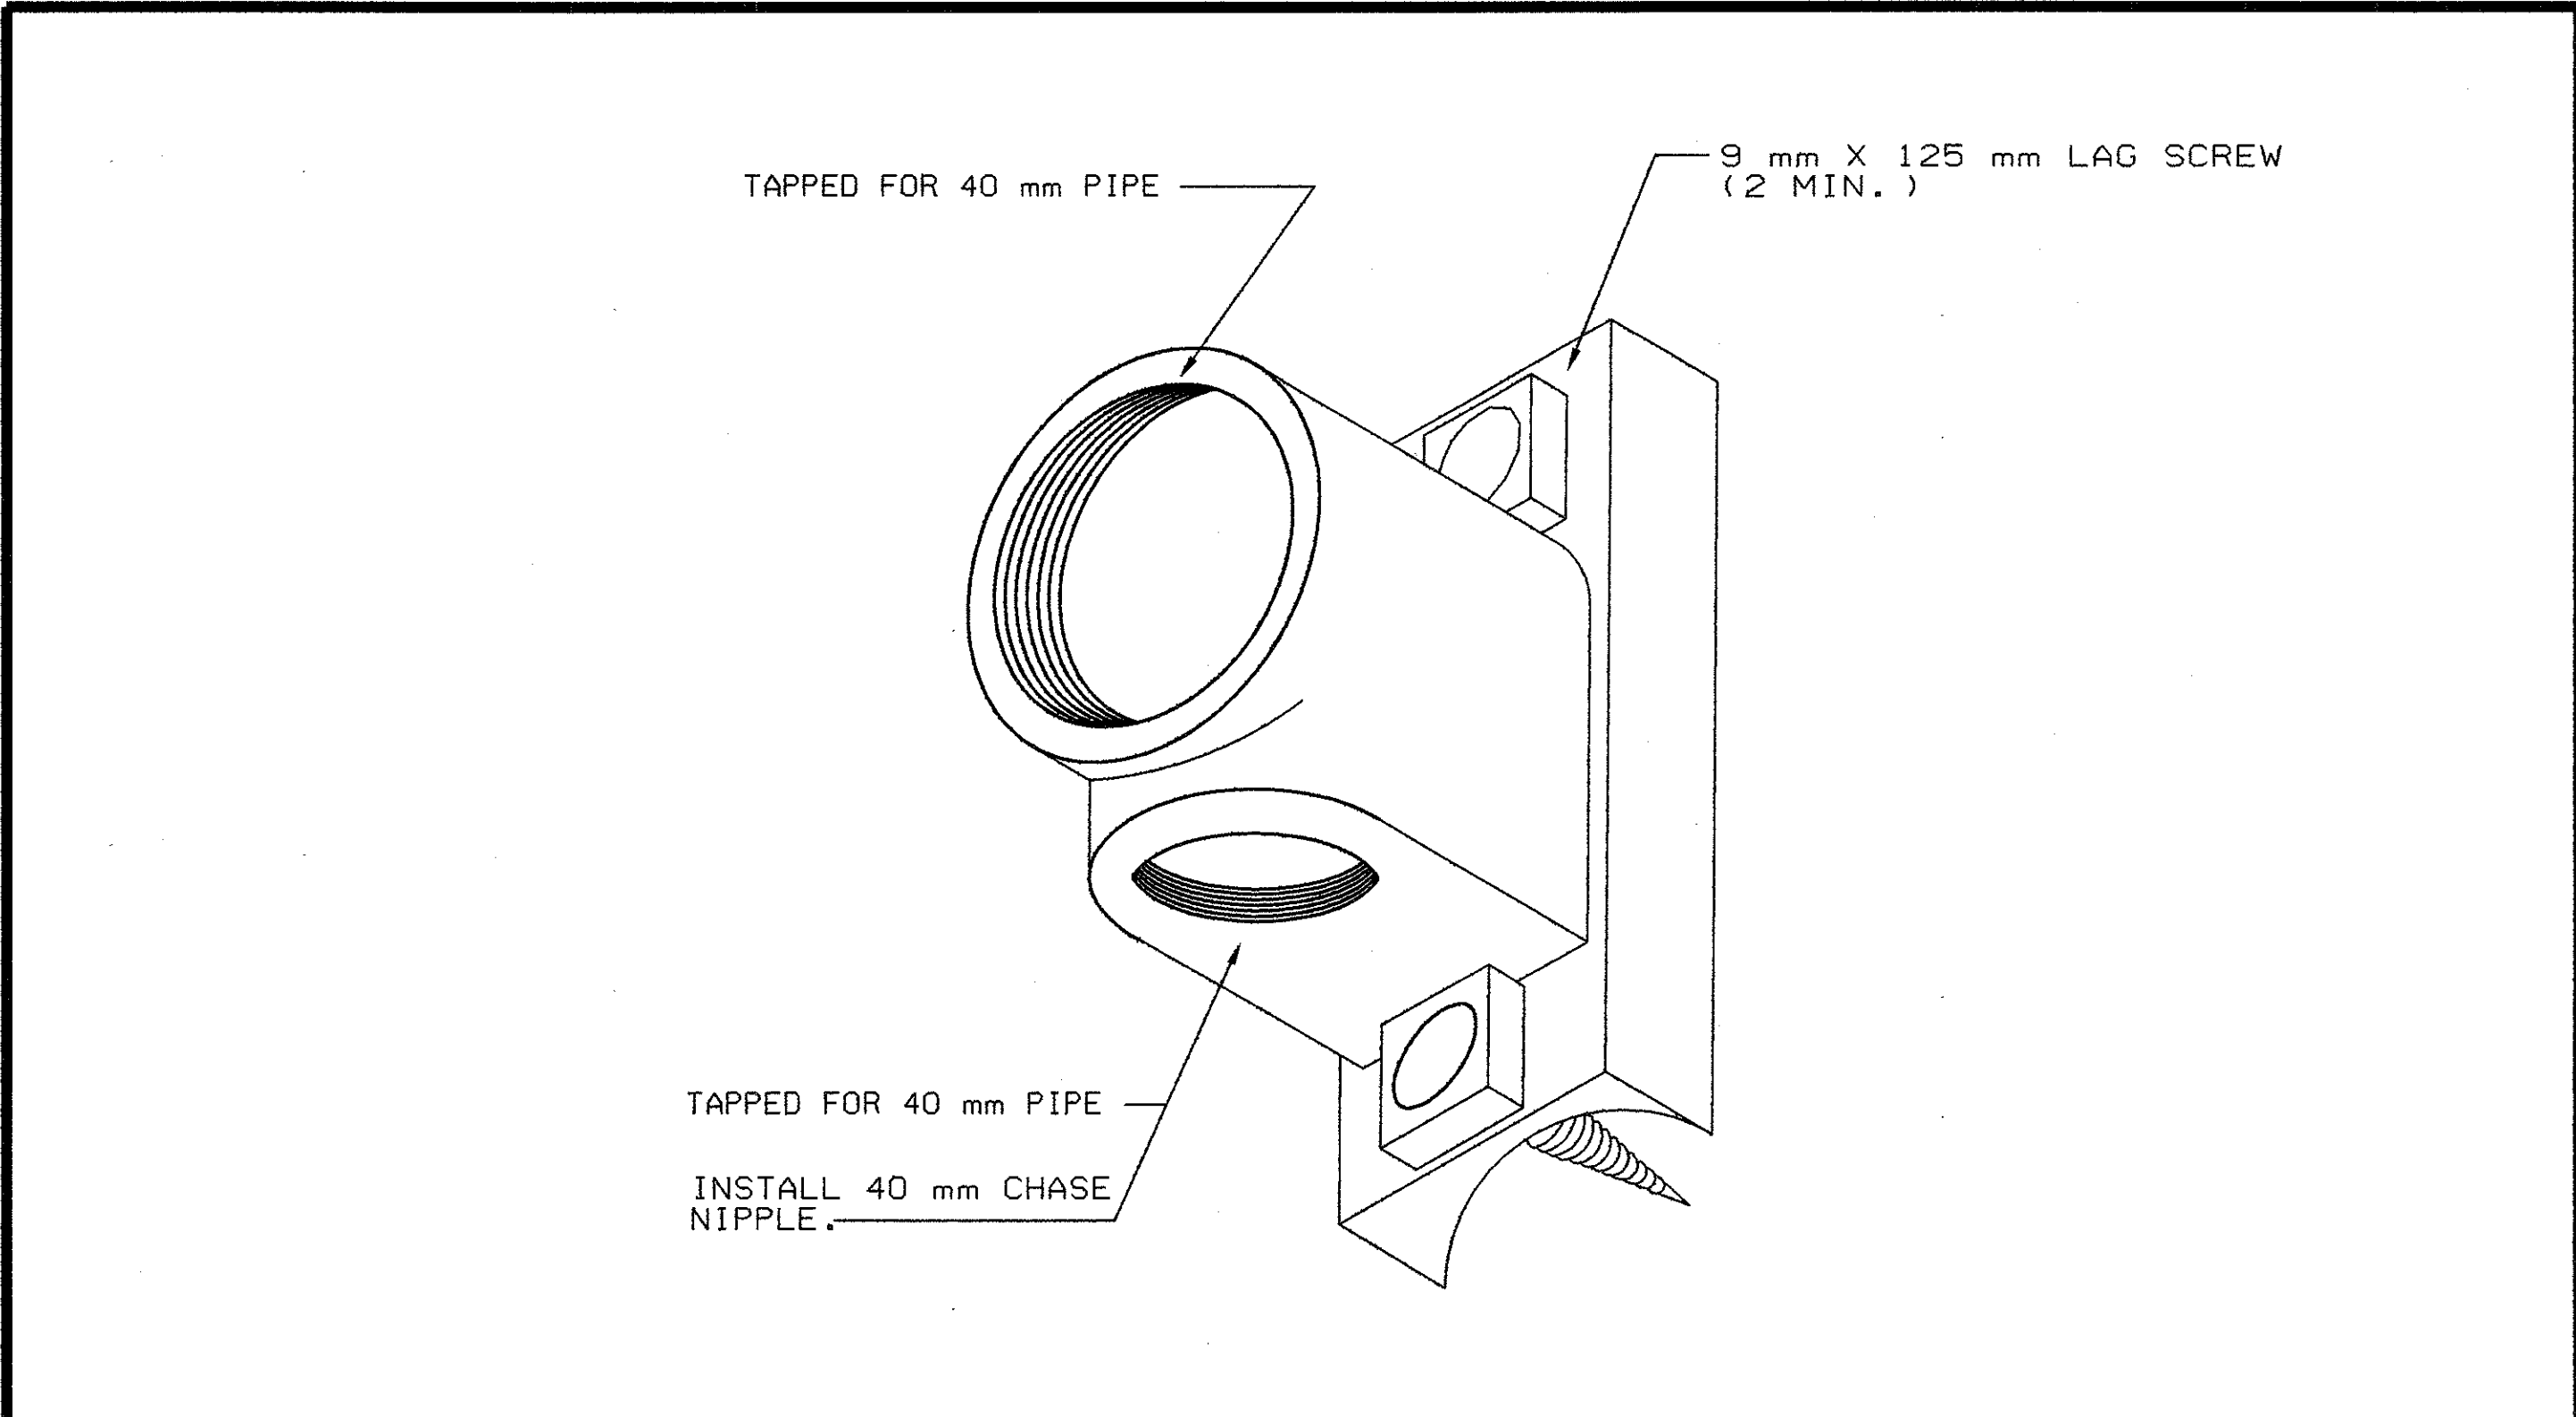


DETAIL A HUB MOUNTING DETAIL FOR WOOD POLE

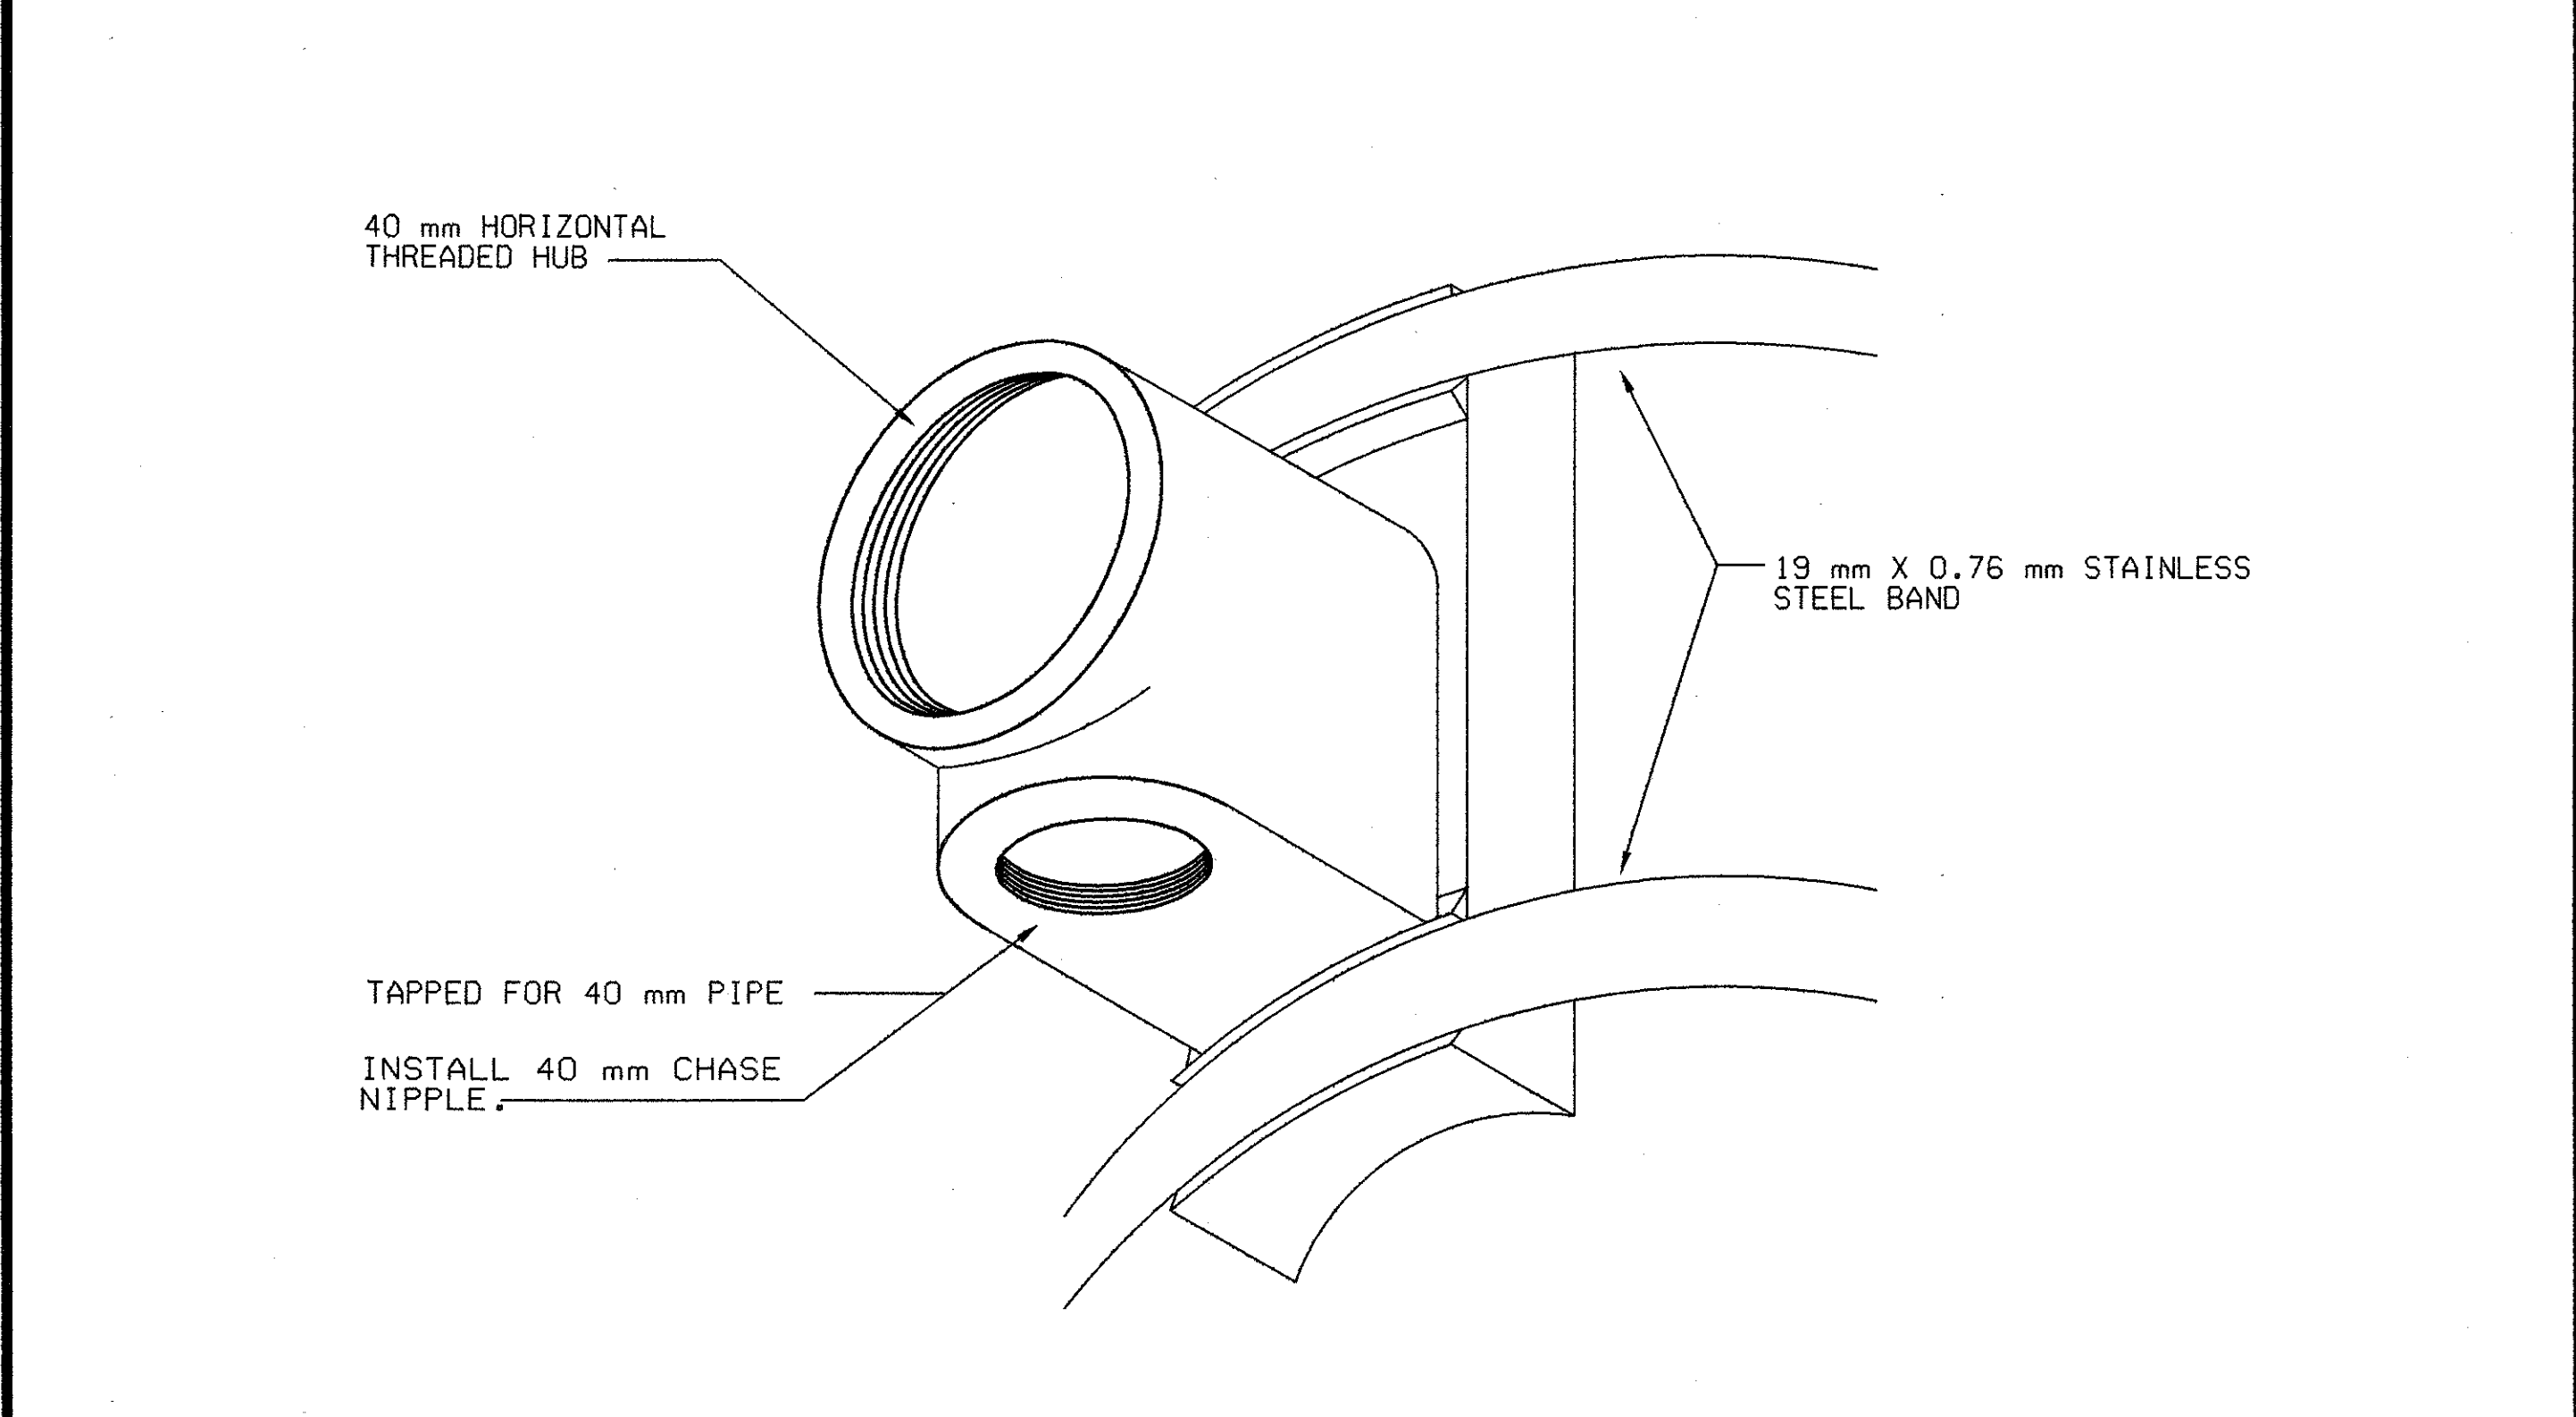

DETAIL B HUB MOUNTING DETAIL FOR STEEL OR CONCRETE POLE


SH 3 OF 3
OC-4A

TYPICAL POLE MOUNTED - T.S./PEDESTRIAN COMBINATIONS					
DATE	SCALE	CONT. SEC.	JOB NO.	T & S	CONST.

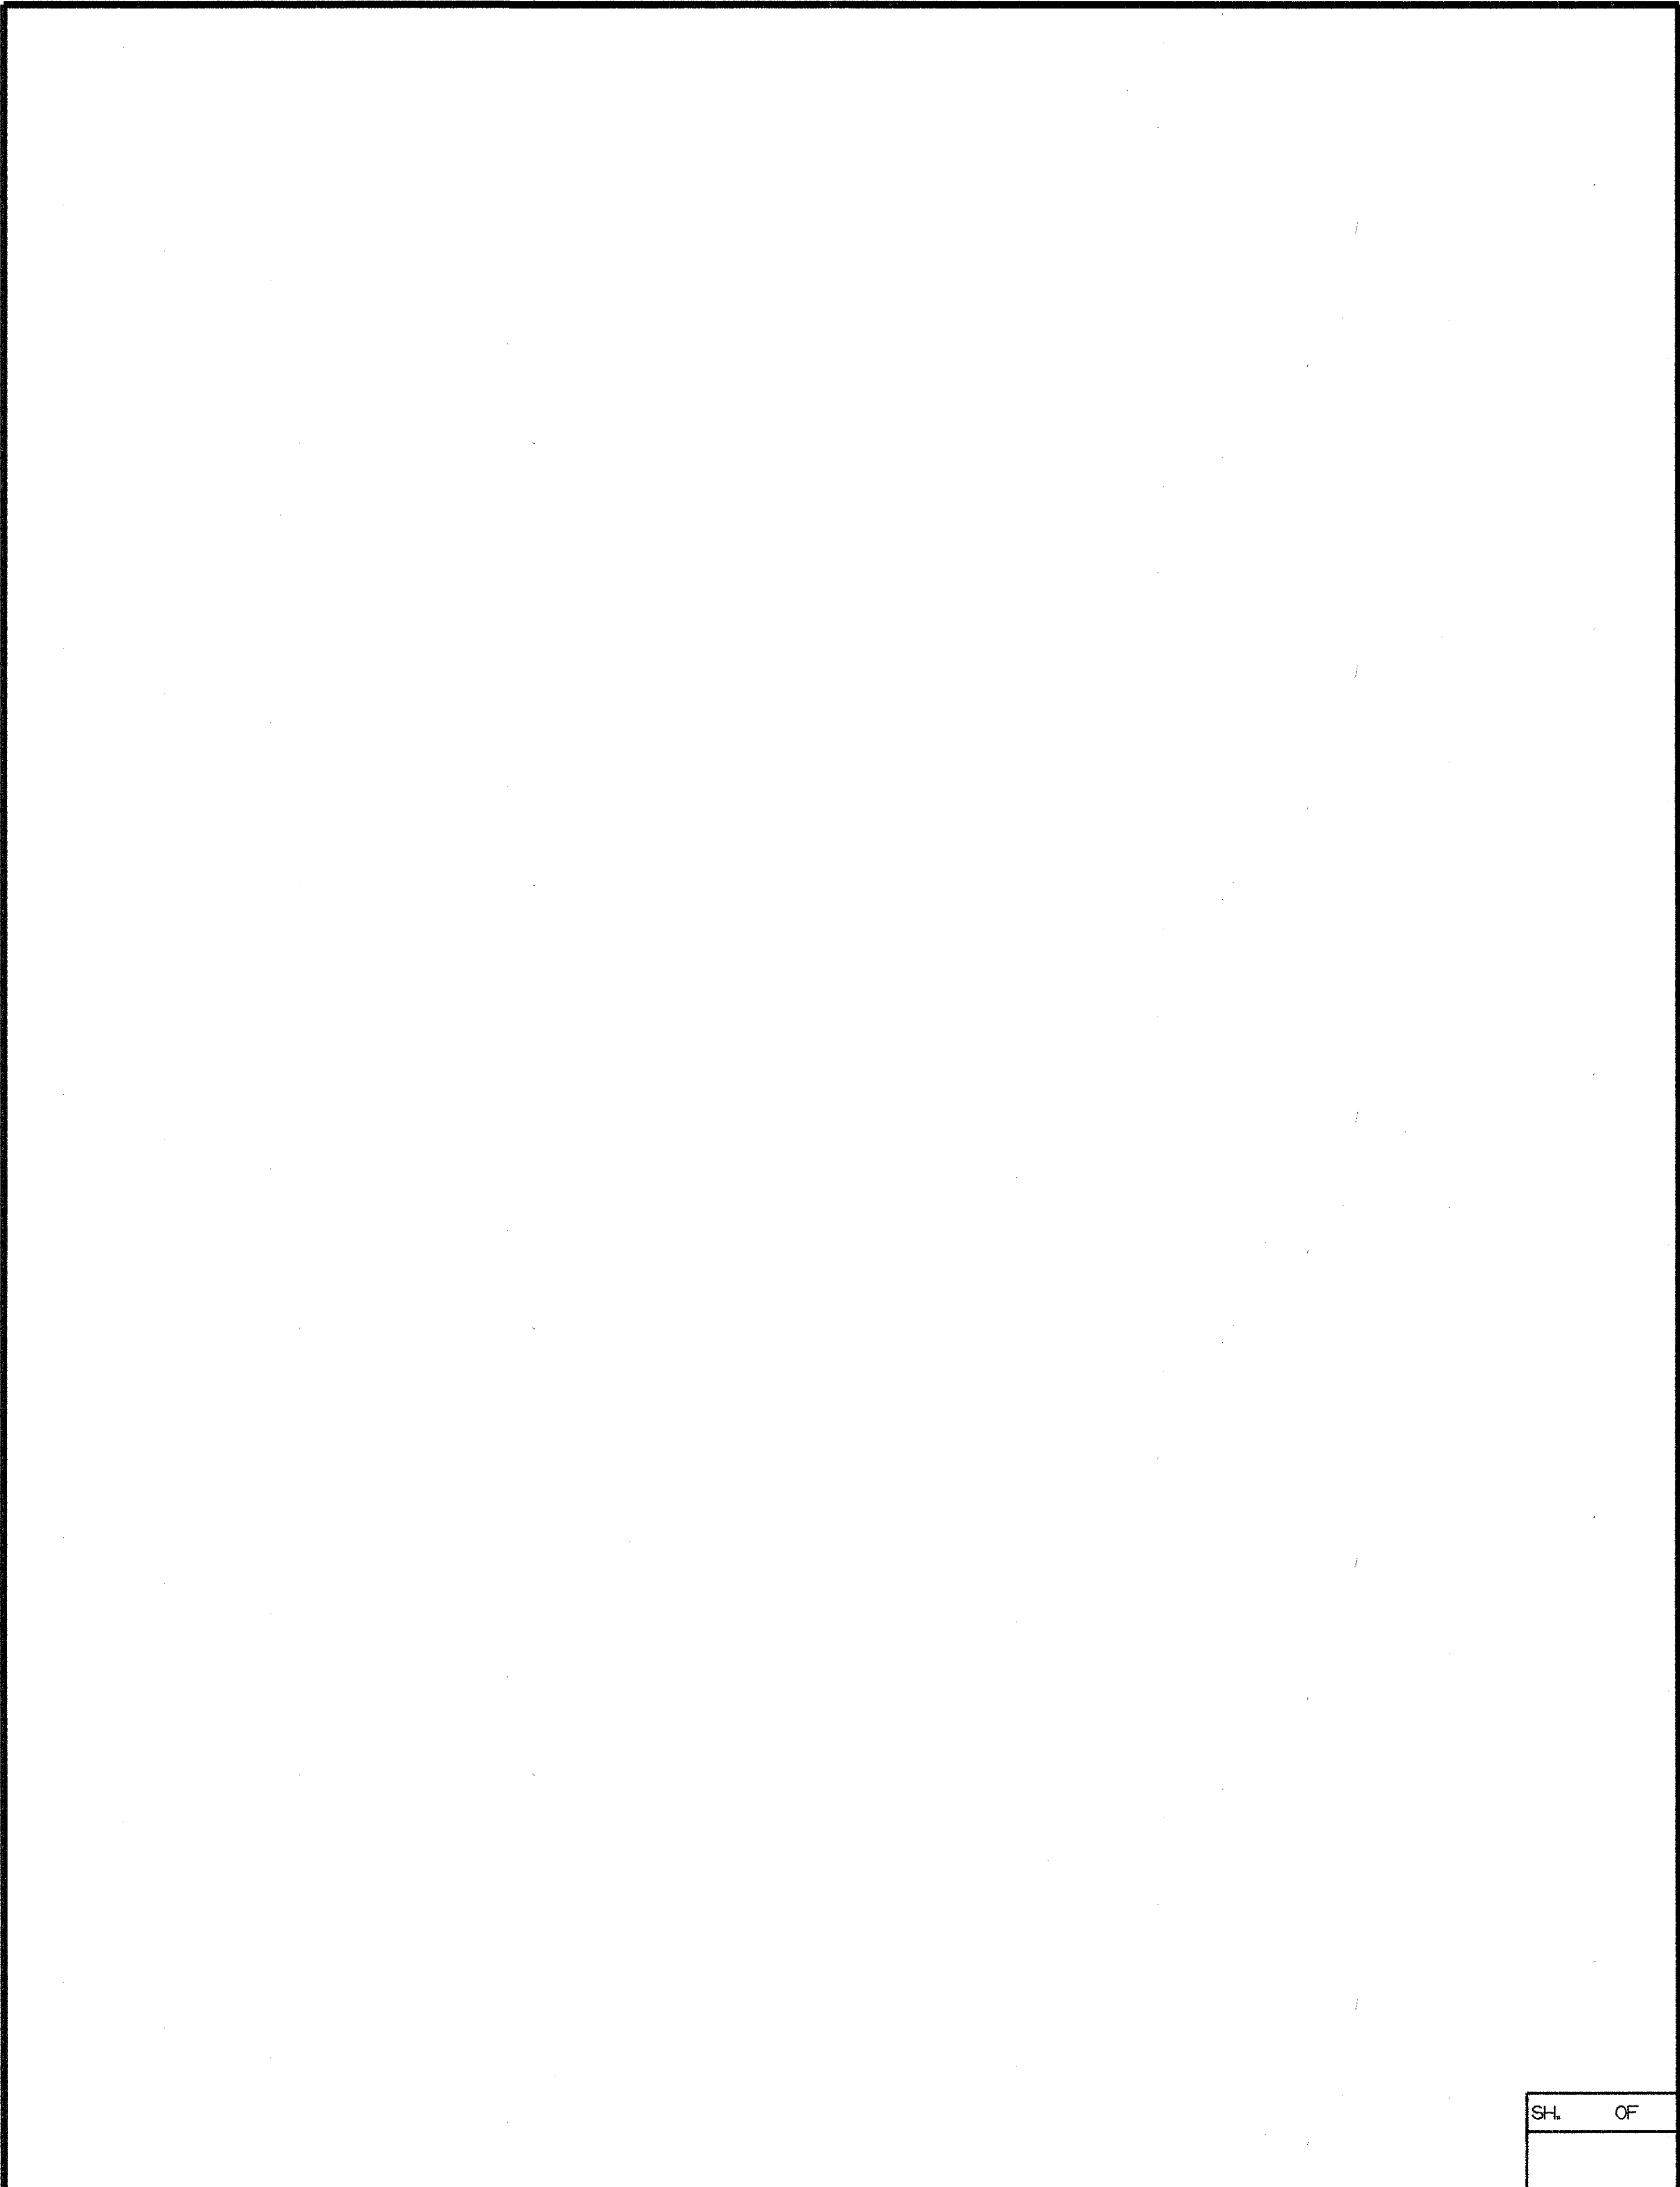

SH OF


DATE	SCALE	CONT. SEC.	JOB NO.	T & S	CONST.
9-21-99		63174	48404A	21 of 31	21D

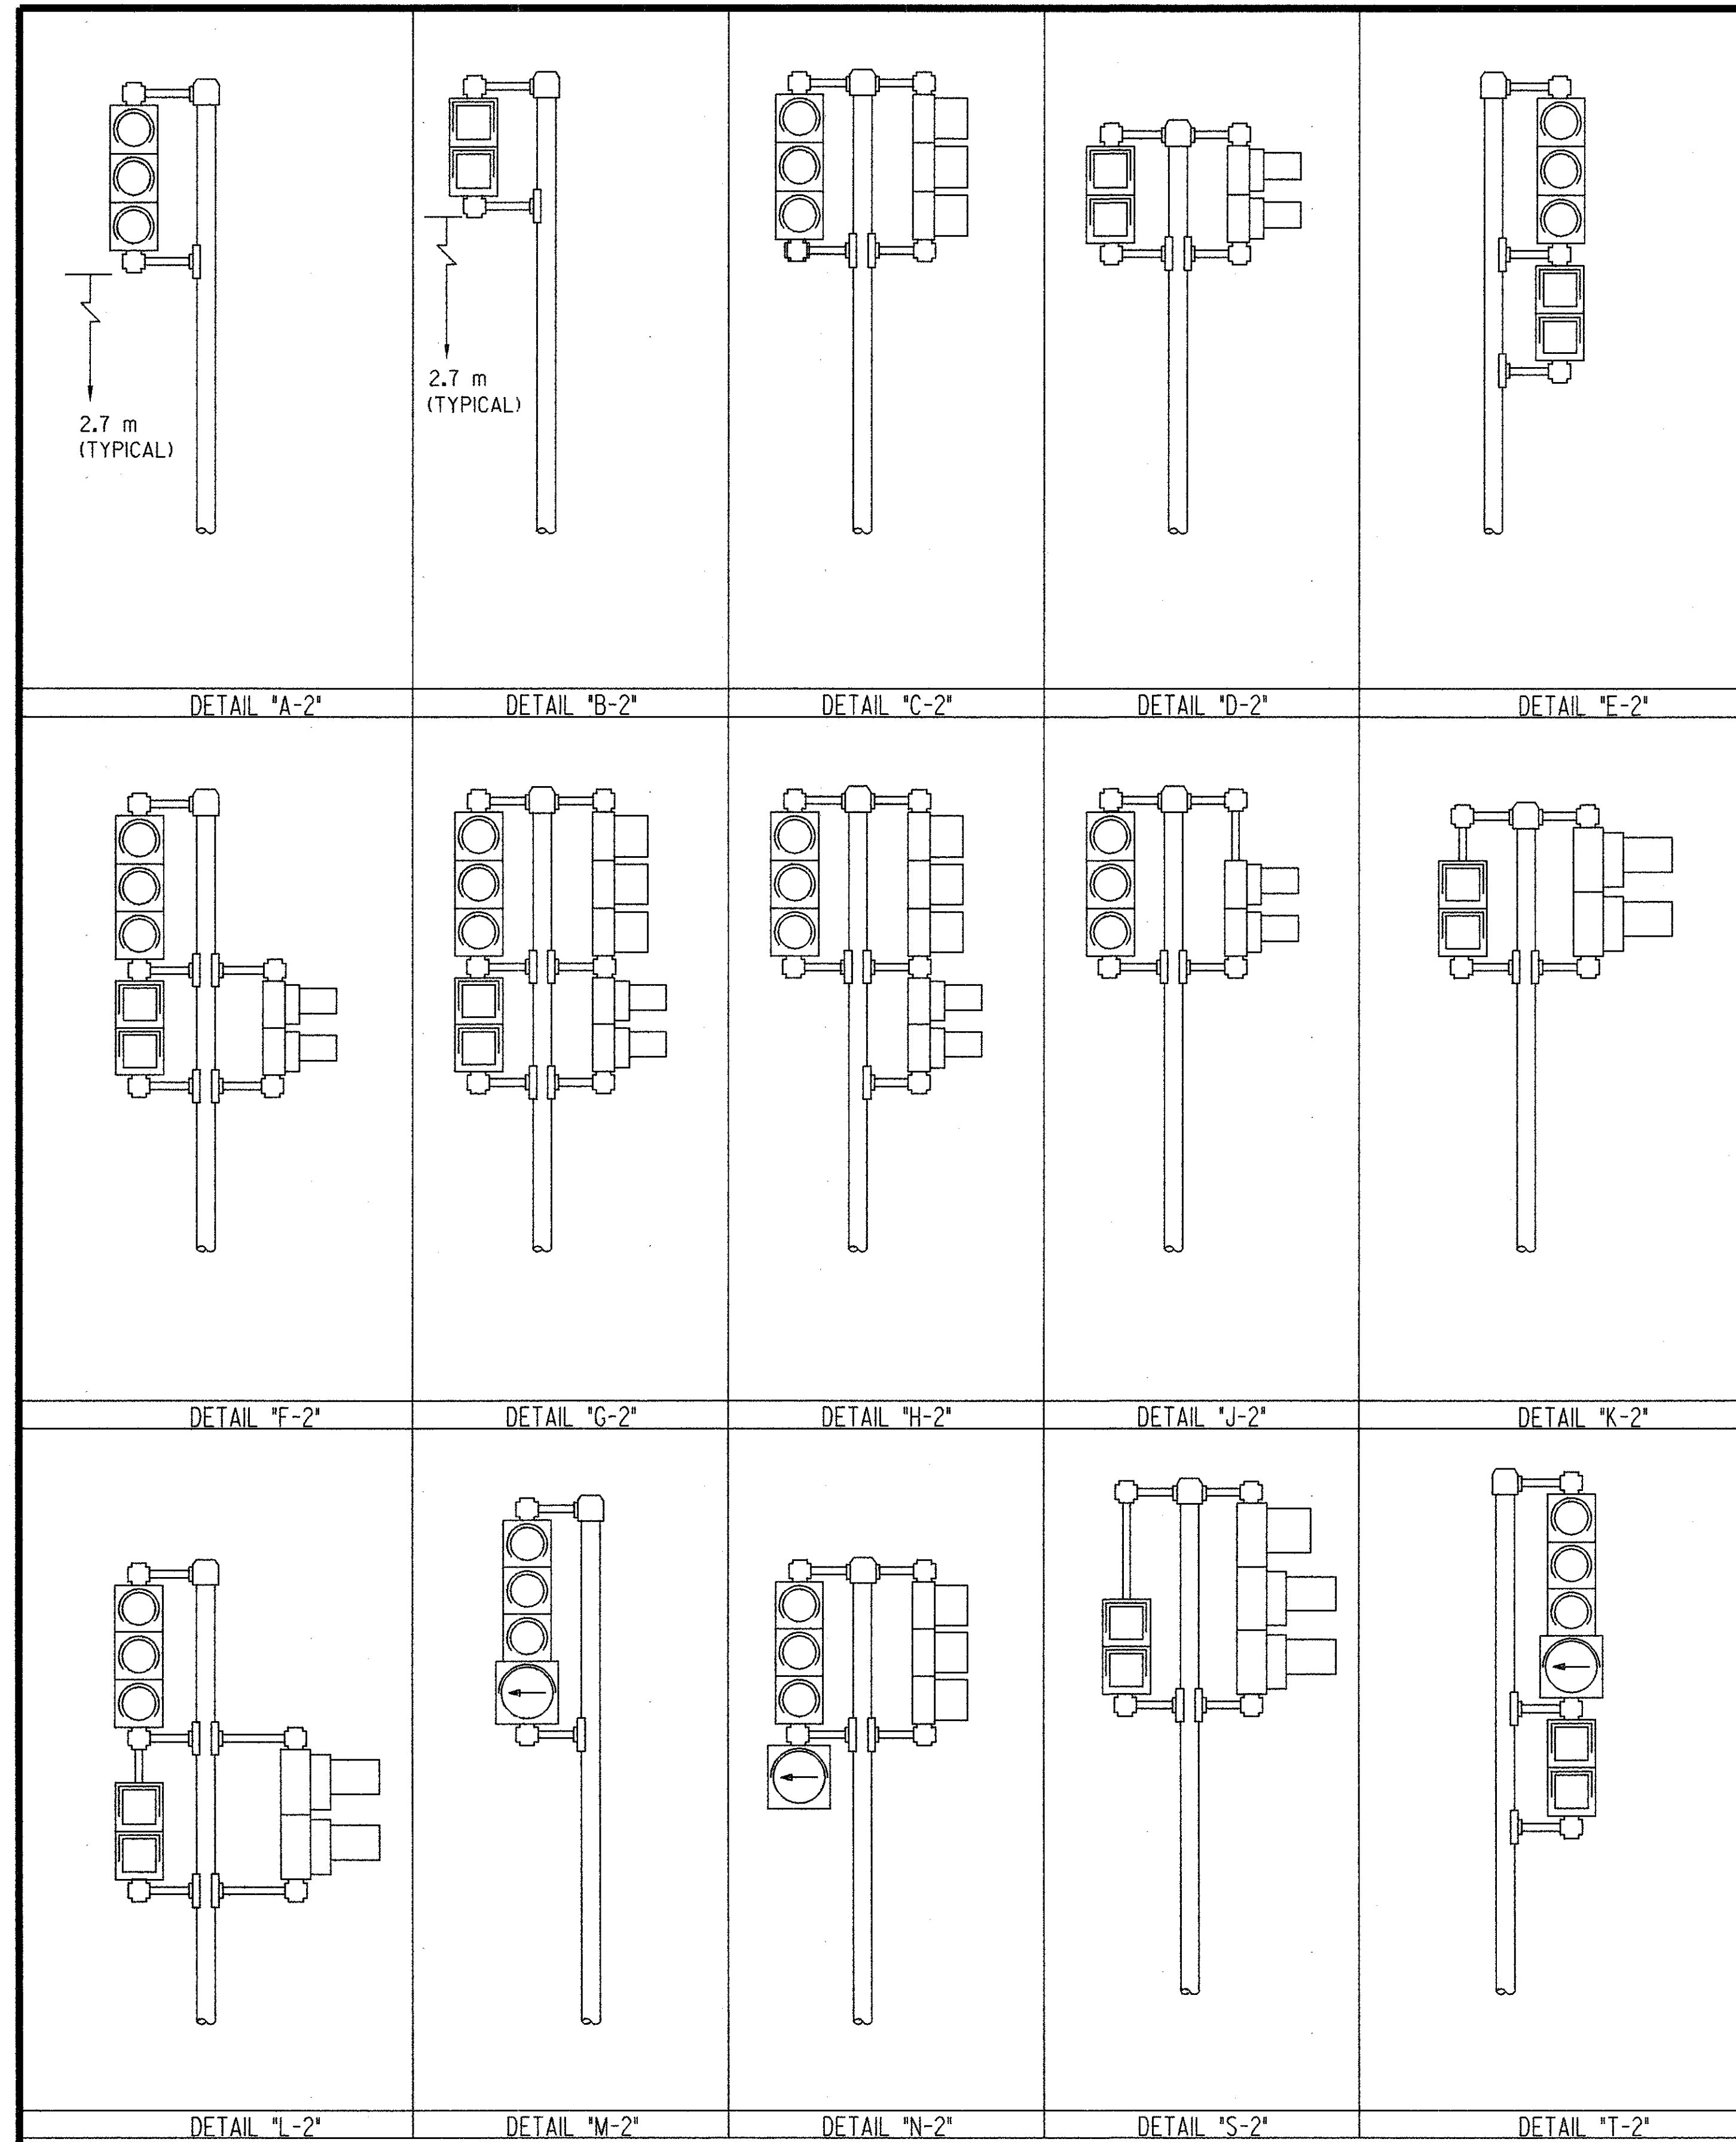

SH. 1 OF 2
ST-5

TYPICAL PEDESTAL MOUNTED-T.S. SIGNAL/PEDESTRIAN COMBINATIONS

DATE	SCALE	CONT. SEC.	JOB NO.	T & S	CONST.

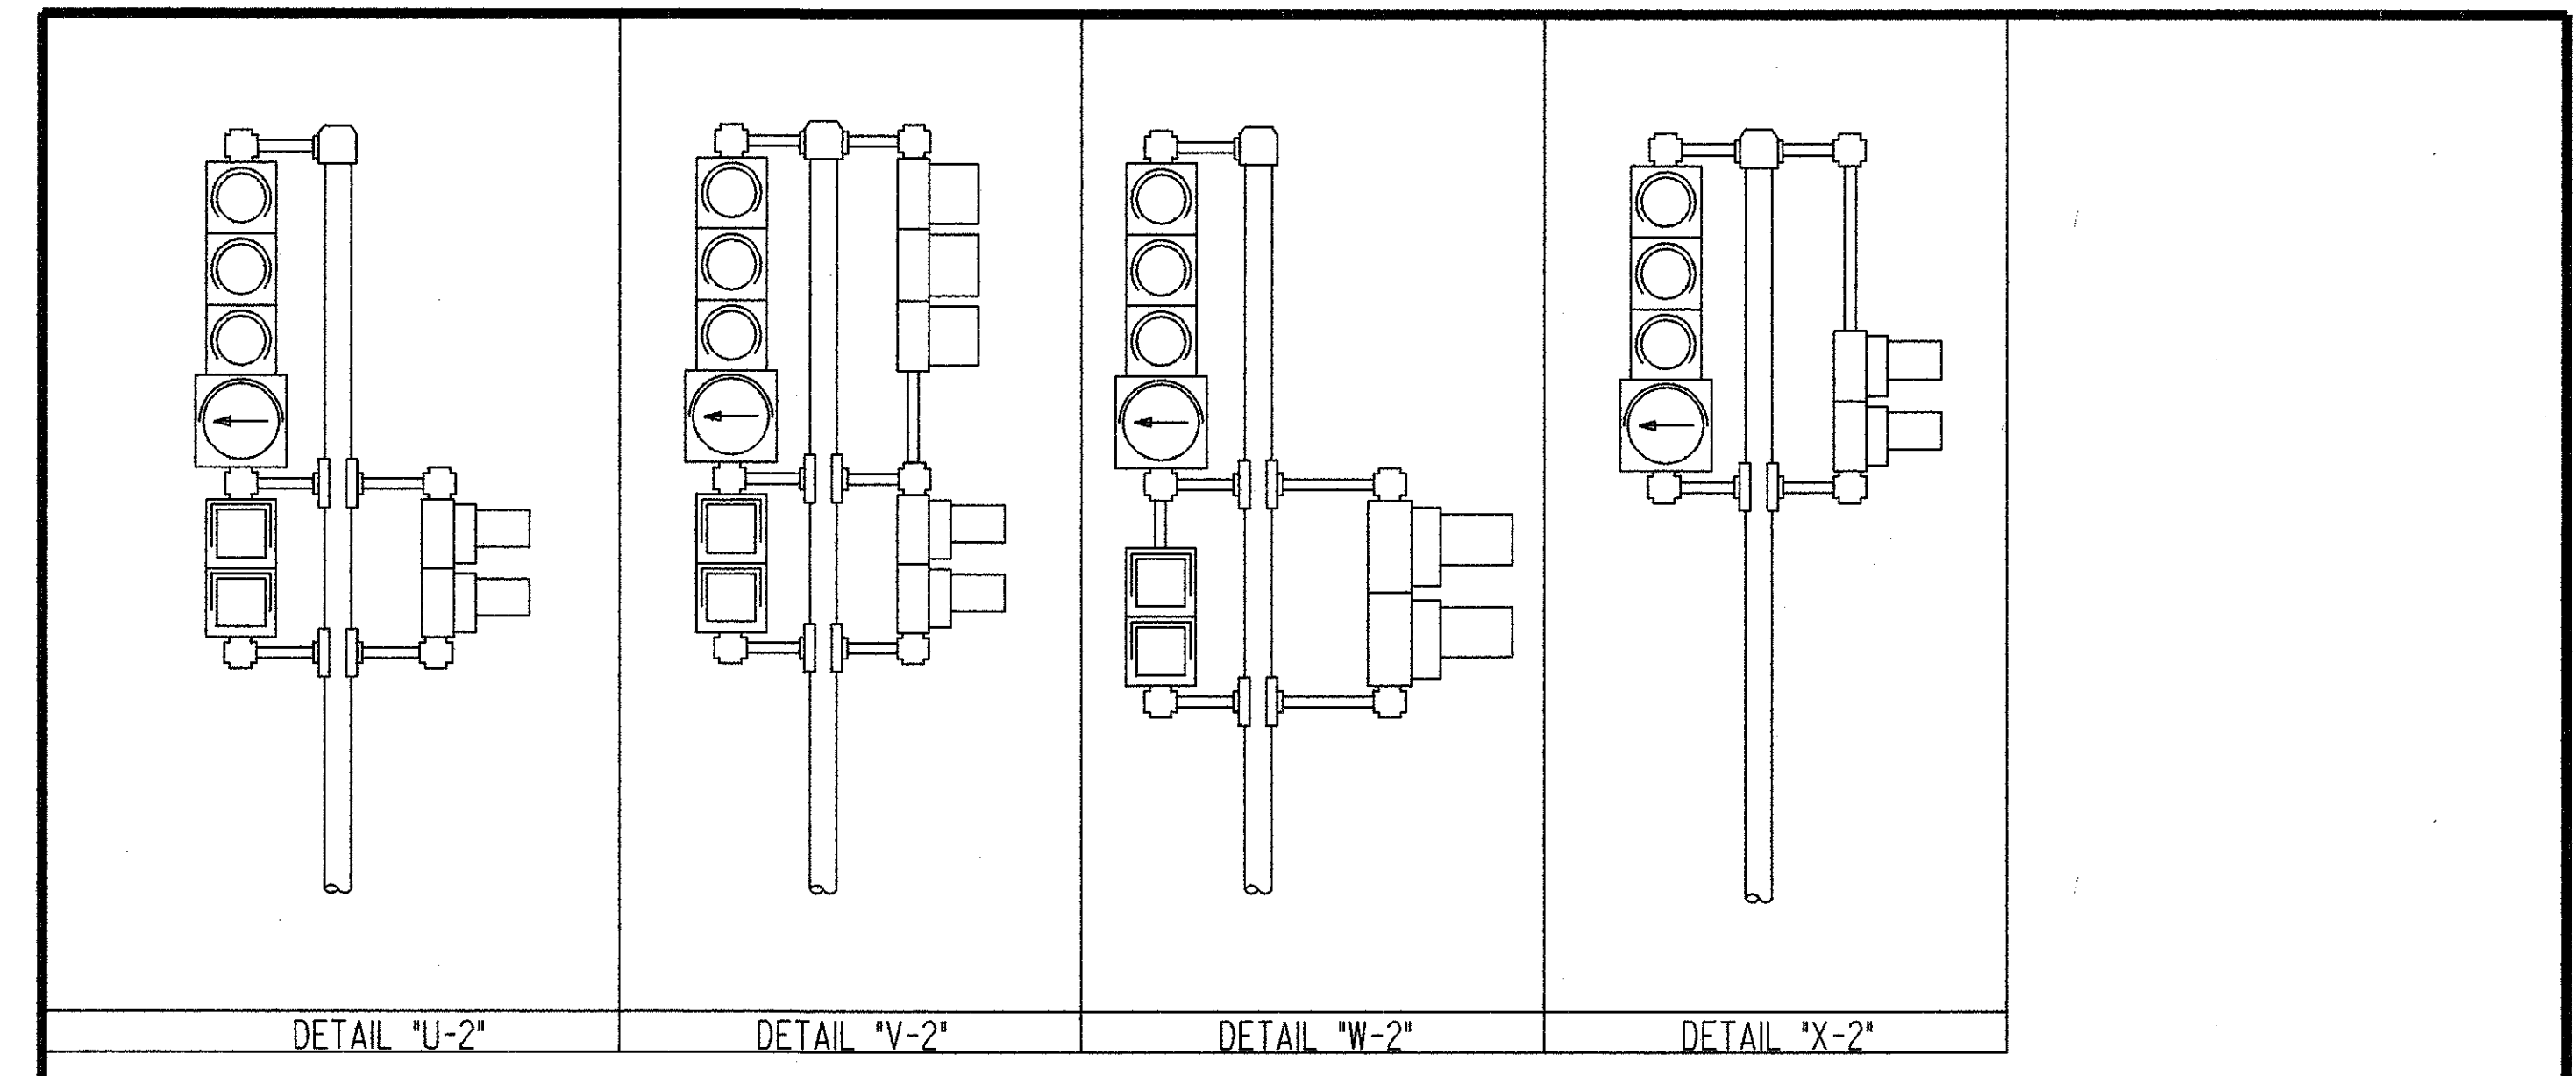


NOTE:
 PIPE ASSEMBLY SHALL BE SUCH LENGTH AND HEIGHT AS TO ACCOMMODATE TRAFFIC SIGNALS AND PEDESTRIAN SIGNALS FOR PROPER MAINTENANCE AND CLEAR VEHICULAR AND PEDESTRIAN VIEWING.

SH. 2 OF 2
ST-5


TYPICAL PEDESTAL MOUNTED-T.S. SIGNAL/PEDESTRIAN COMBINATIONS

DATE	SCALE	CONT. SEC.	JOB NO.	T & S	CONST.
9-21-99		63174	48404A	22 of 31	22D

LAST CORRECTION DATE: 2/22/95
FILENAME: ST5.DGN

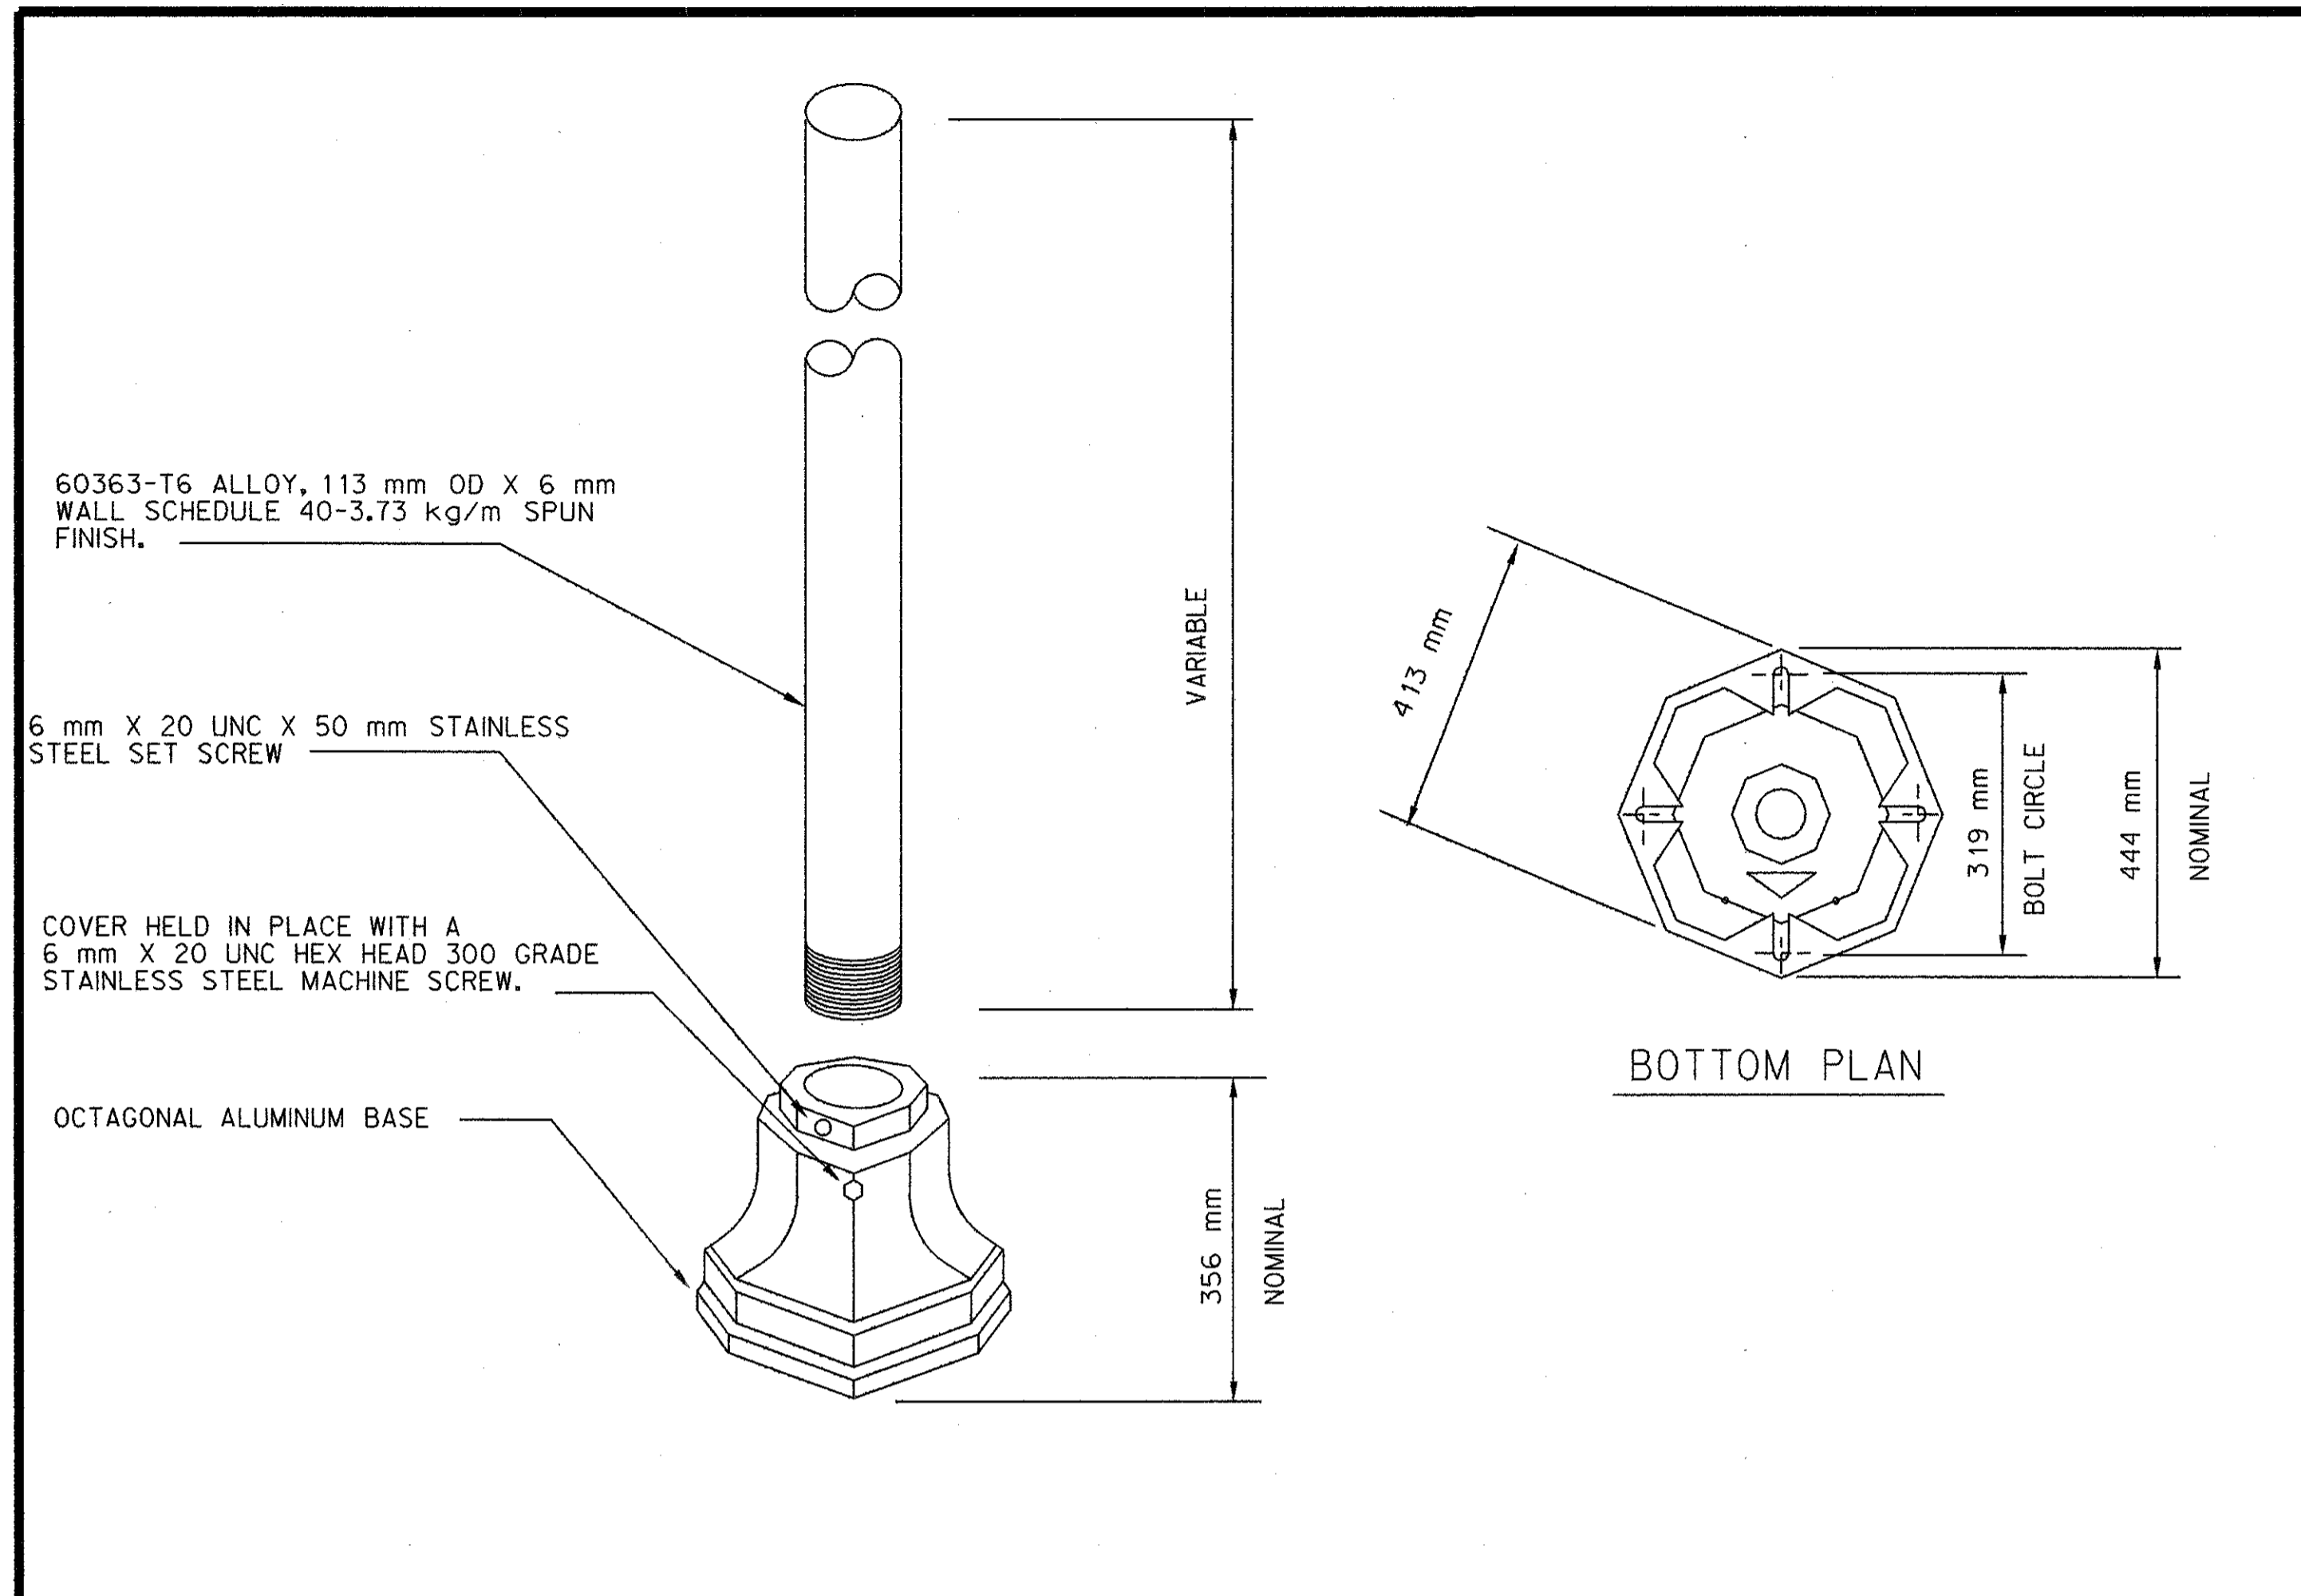

DETAIL : PEDESTAL

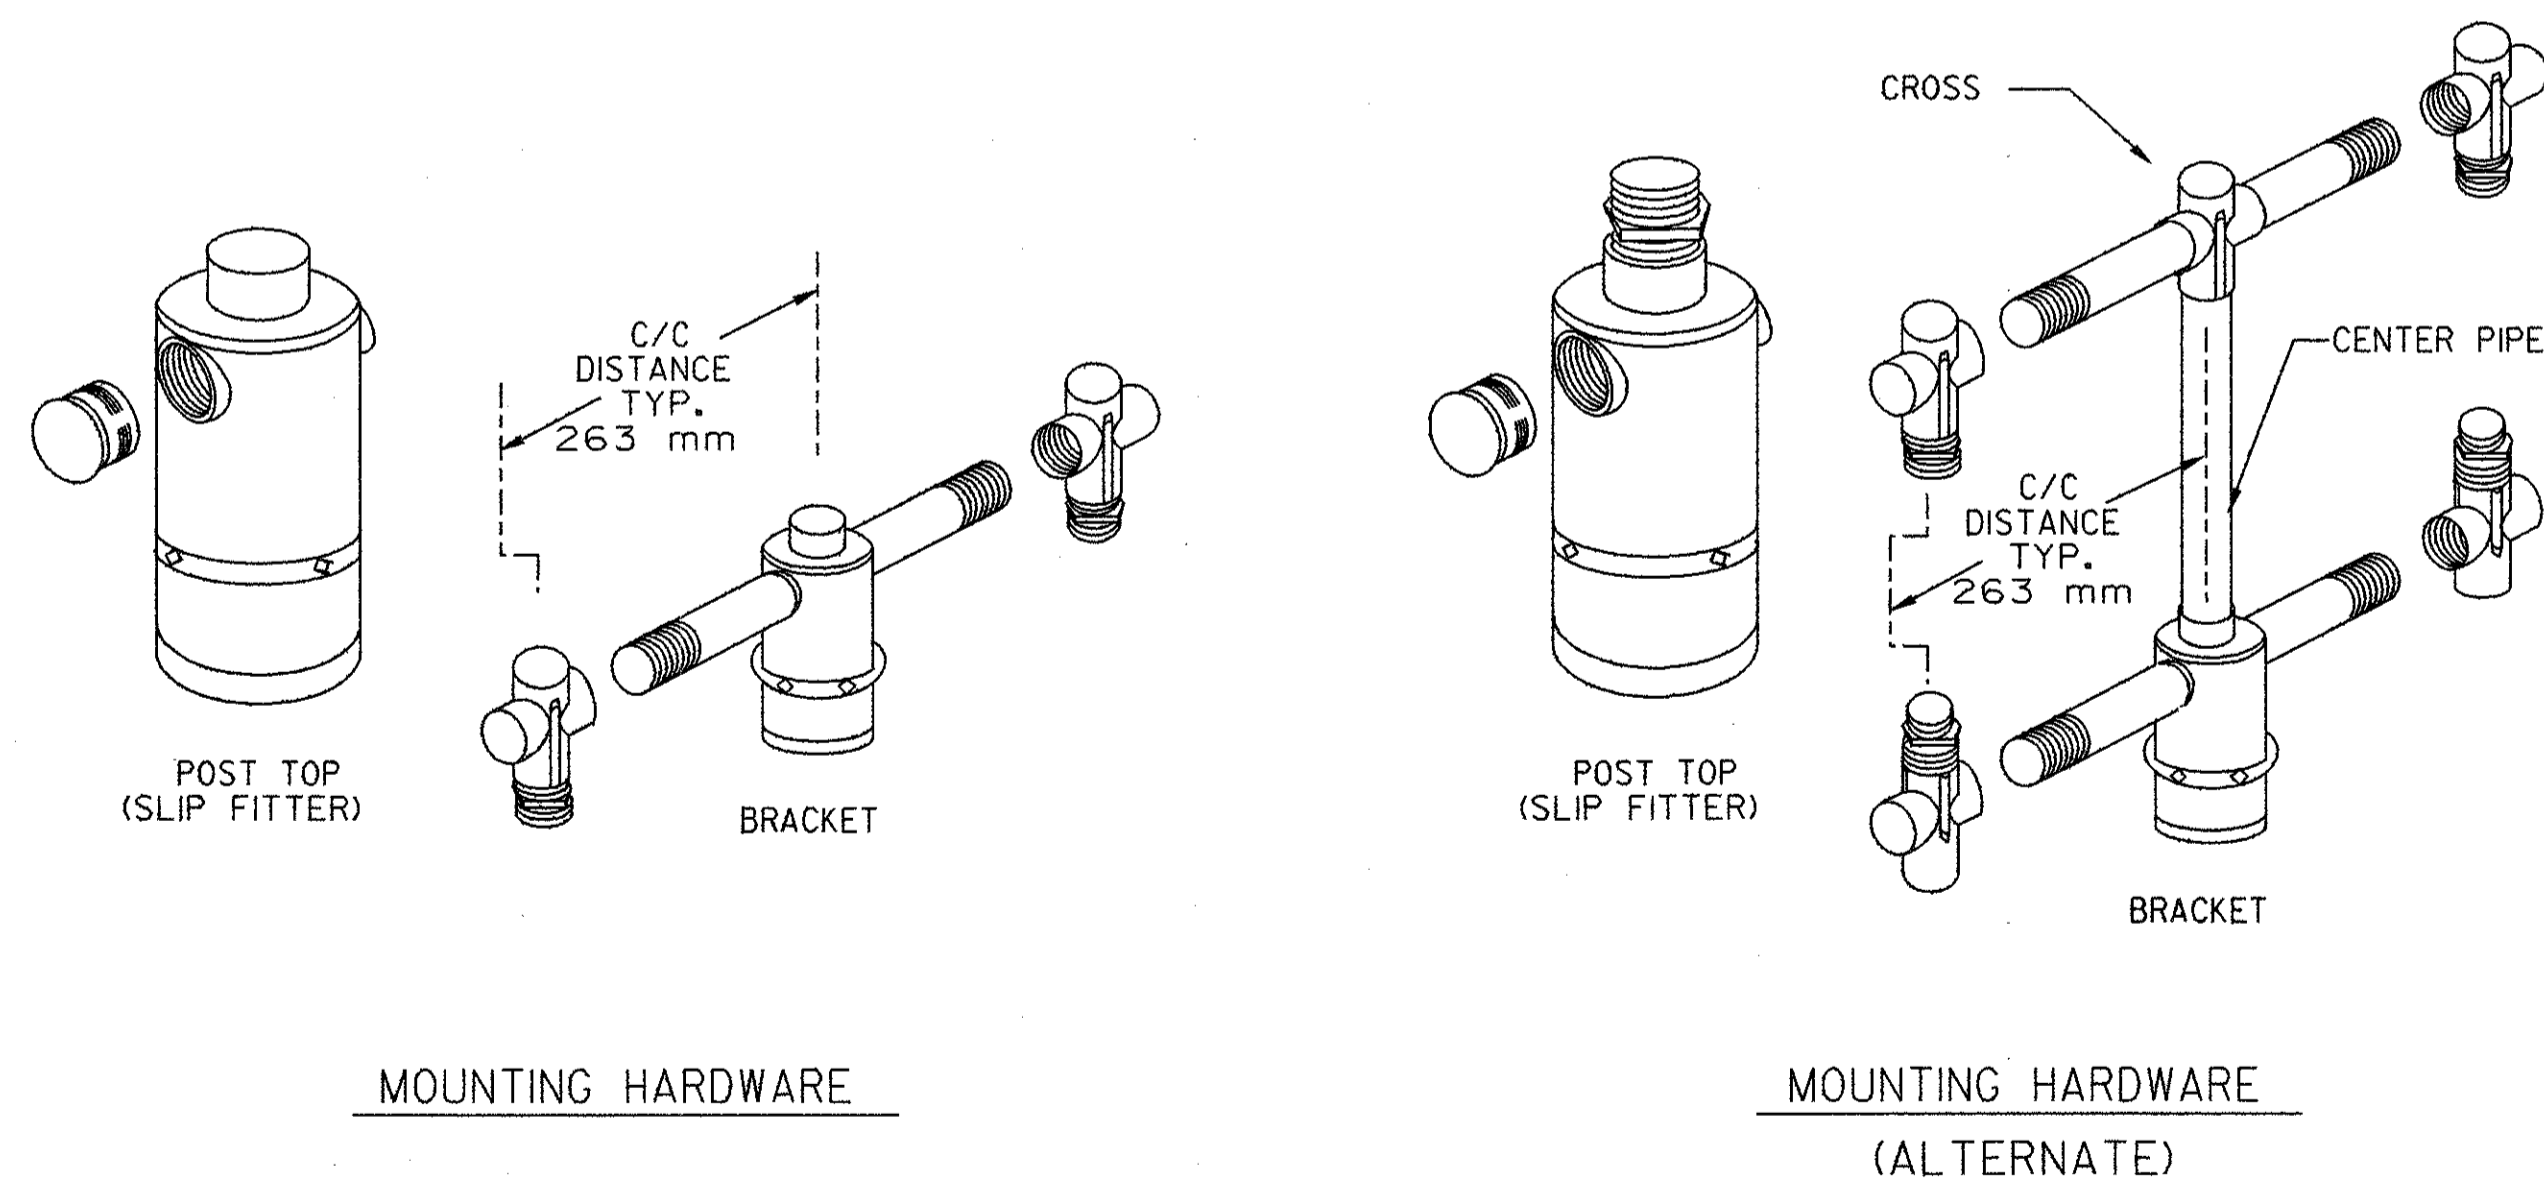

DETAIL : MOUNTING HARDWARE


SH. 1 OF 2
ST-5A

LAST CORRECTION DATE: 12/22/95
 FILENAME: 63174.DGN


MDOT Michigan Department of Transportation					
TYPICAL PEDESTAL/FOUNDATION & BRACKETING DETAILS					
DATE	SCALE	CONT. SEC.	JOB NO.	T & S	CONST.

NOTE:
GROUNDING SYSTEM SHALL MEASURE 10 OHM OR LESS TO GROUND.

NOTE:
ALTERNATE FOUNDATION MAY BE CONSTRUCTED 600 mm ROUND - 1200 mm DEEP.

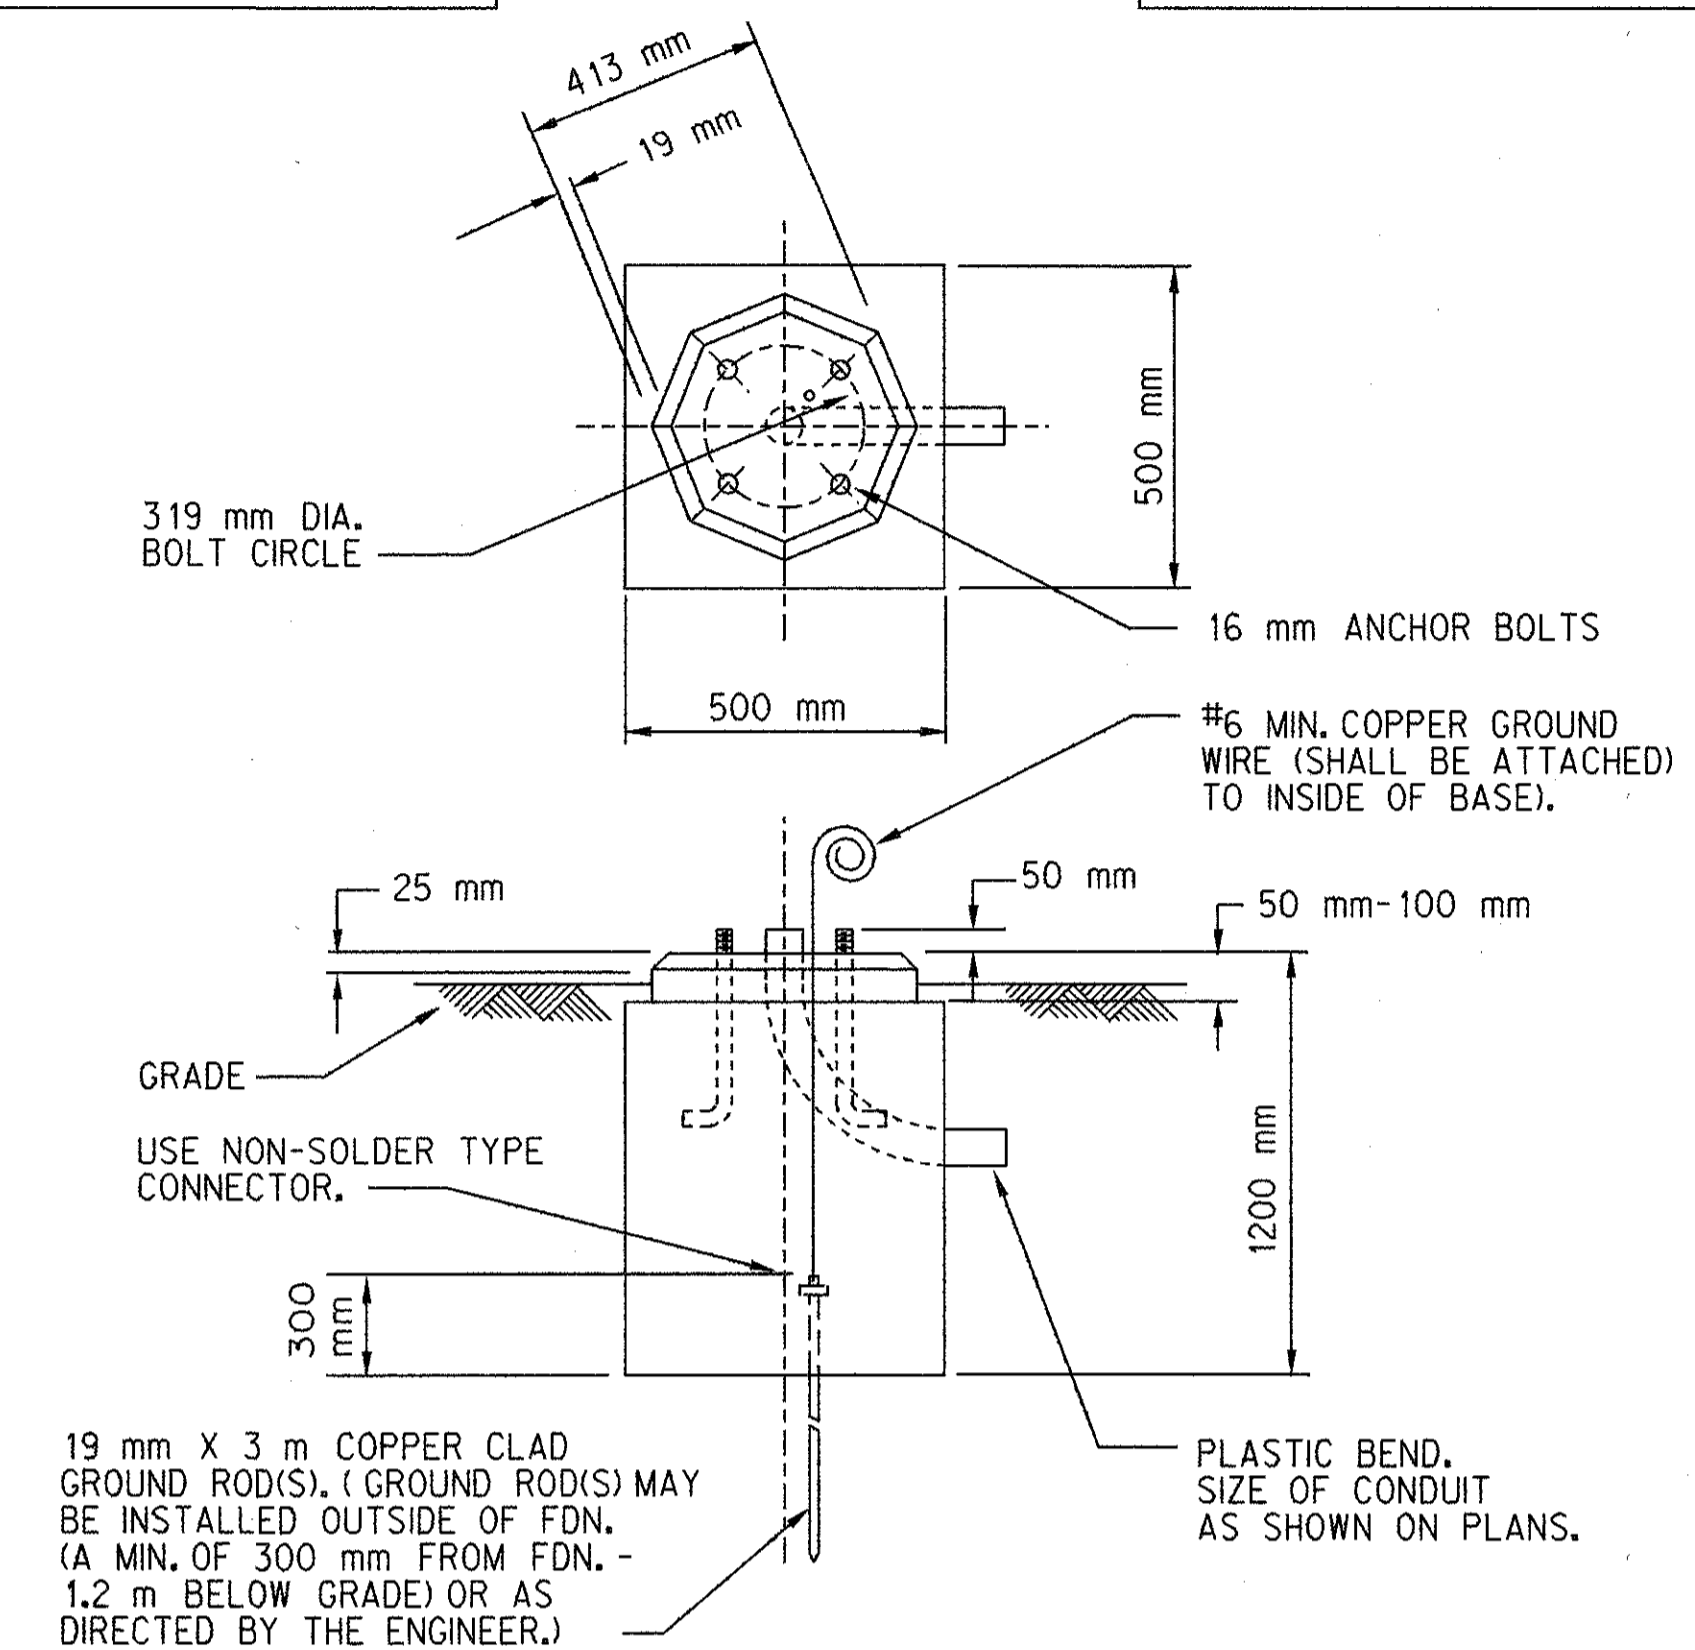

DETAIL : PEDESTAL FOUNDATION

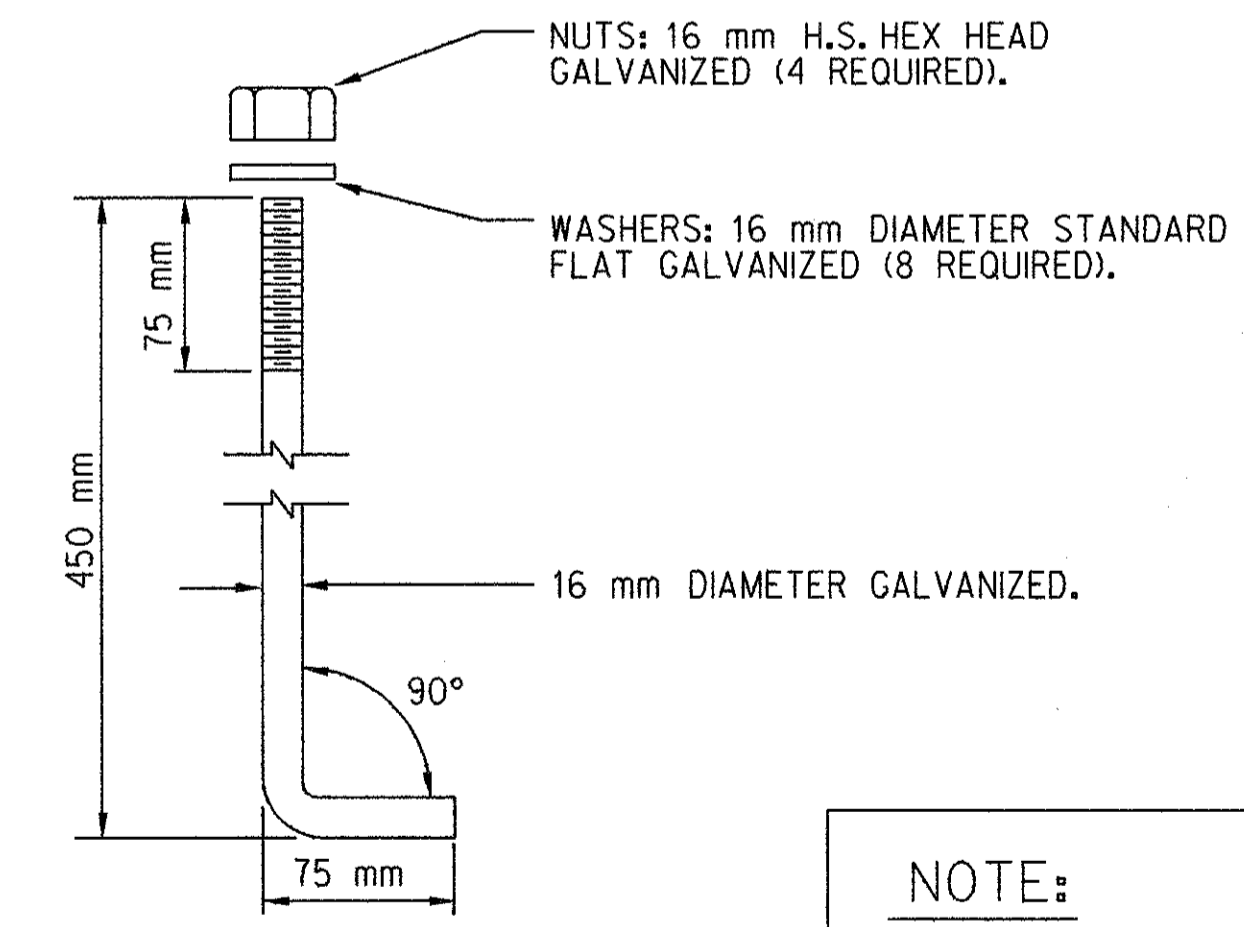


NOTE:
ANCHOR BOLTS ARE TO BE 307 STEEL (4-REQUIRED)

DETAIL : ANCHOR BOLT

SH. 2 OF 2
ST-5A

MDOT Michigan Department of Transportation					
TYPICAL PEDESTAL/FOUNDATION & BRACKETING DETAILS					
DATE	SCALE	CONT. SEC.	JOB NO.	T & S	CONST.
9-21-99		63174	48404A	23 of 31	23D

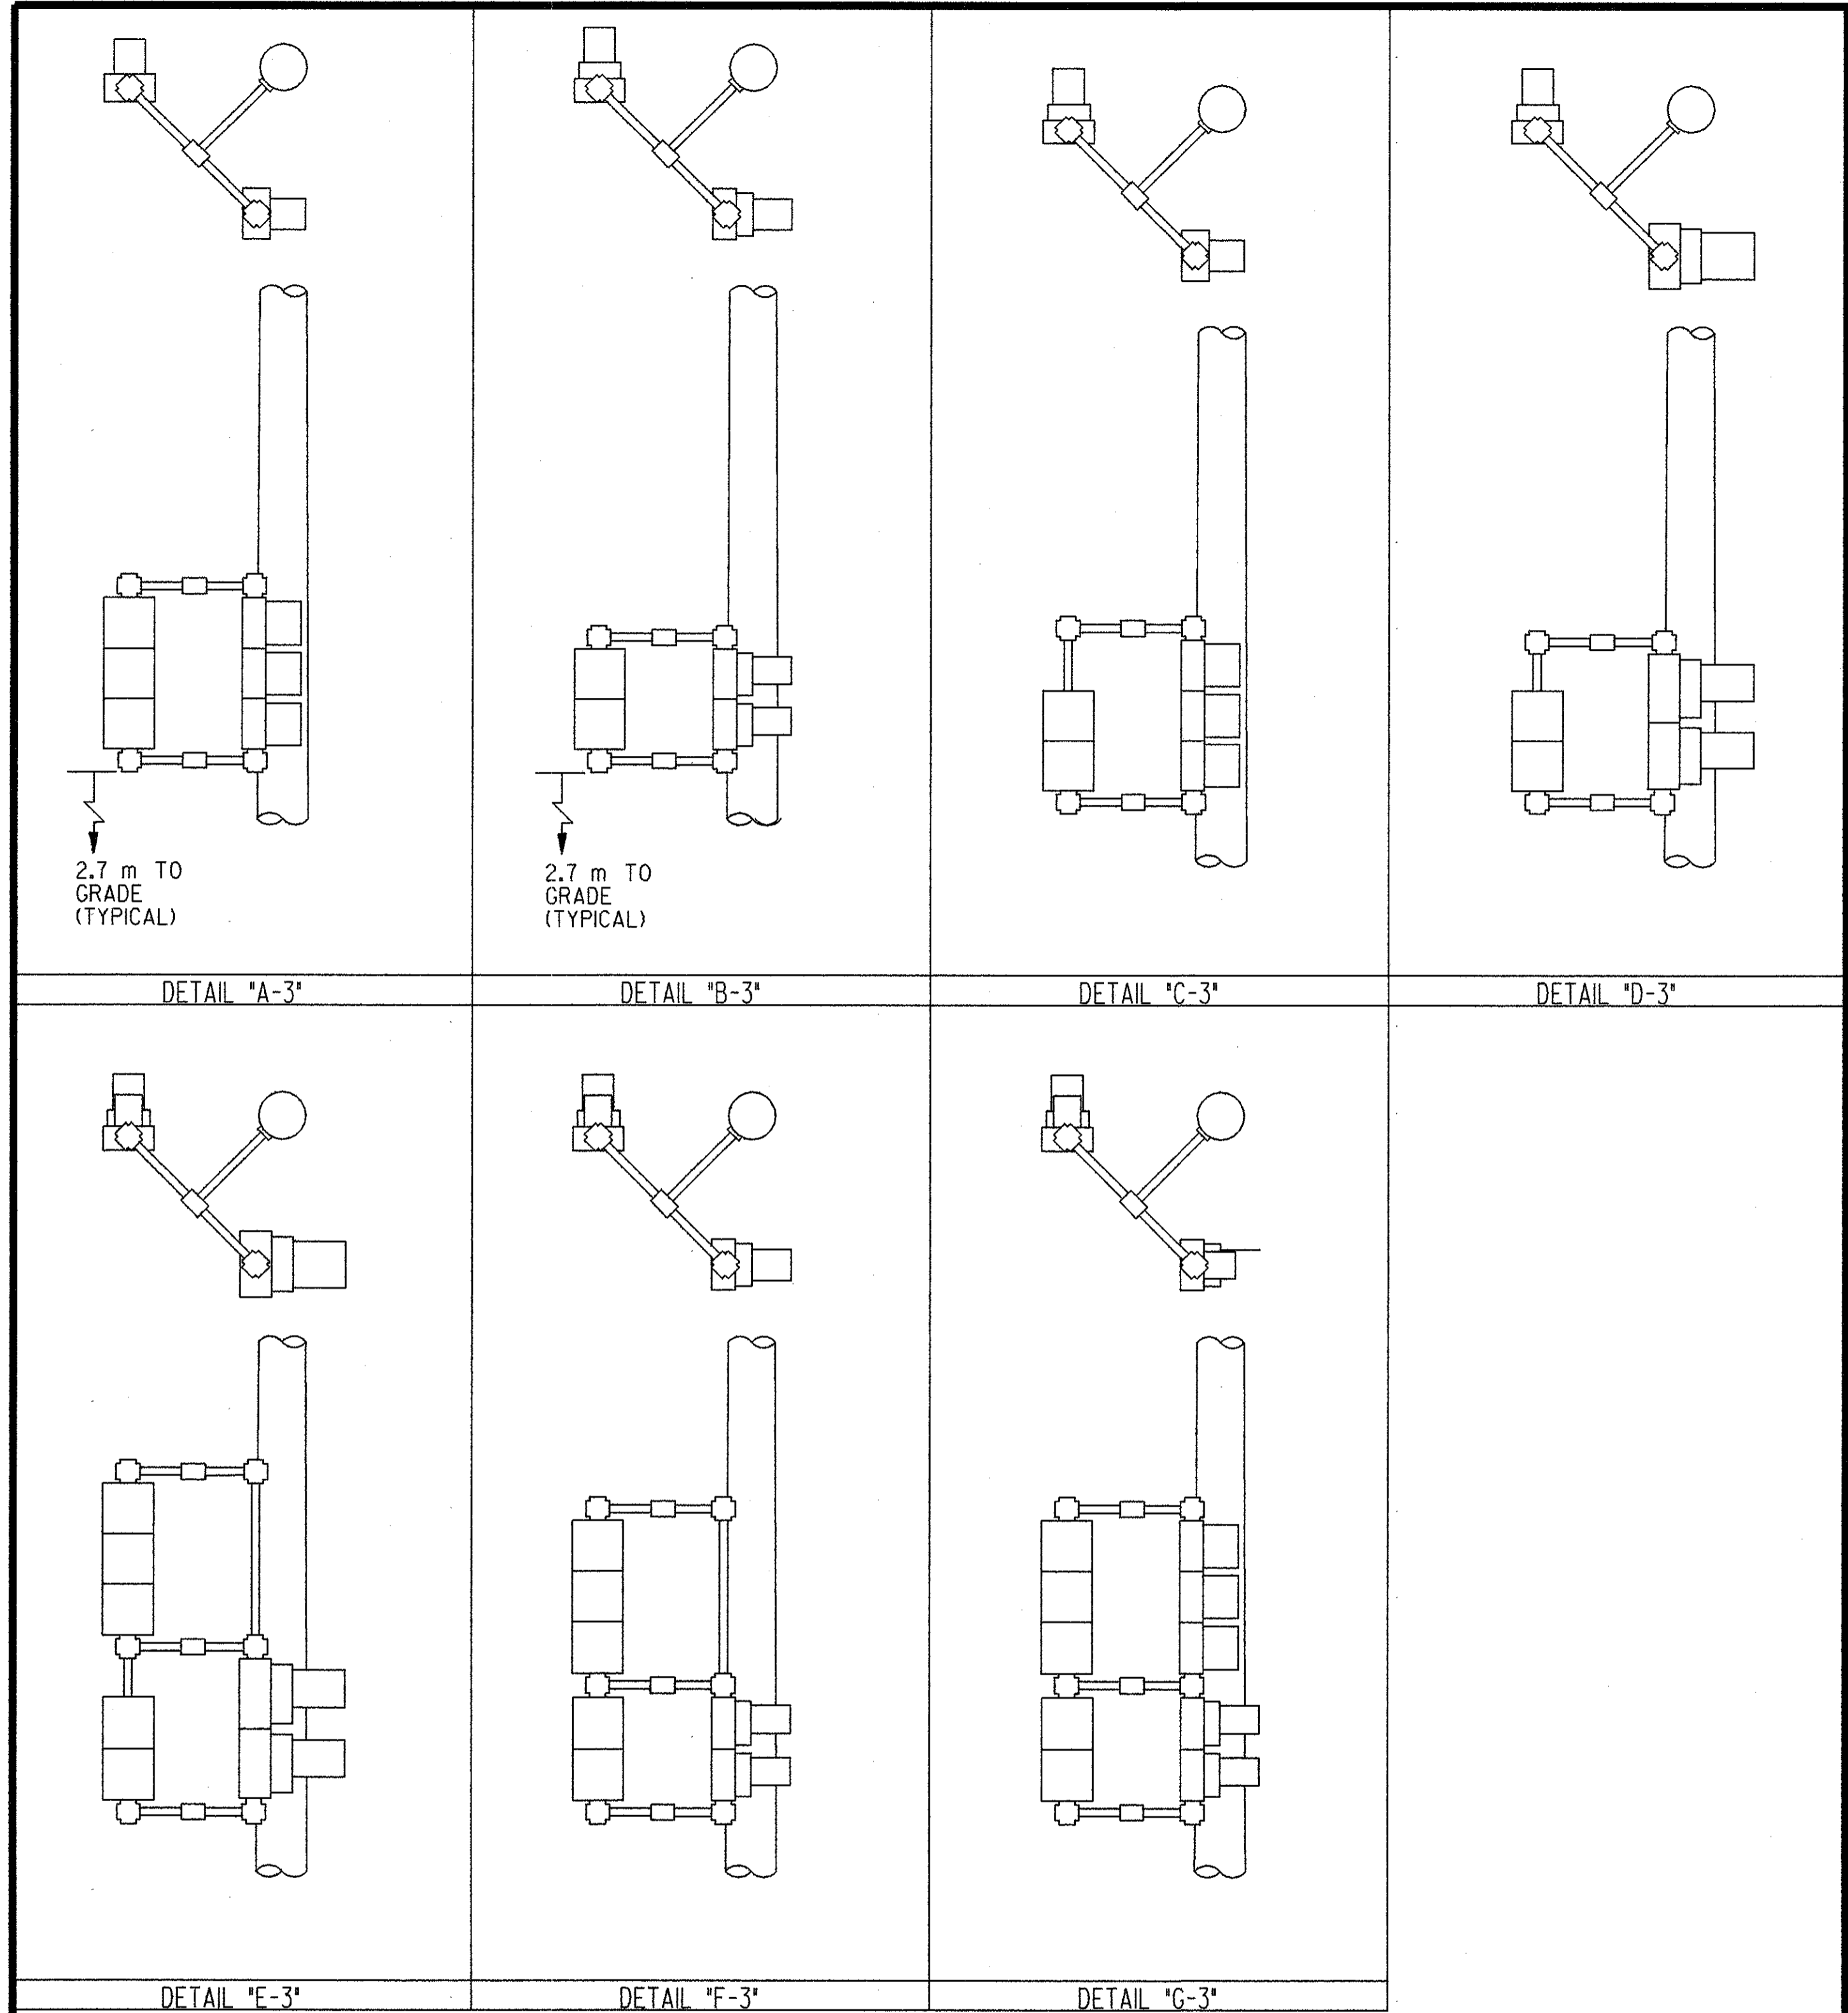


NOTE:
 PIPE ASSEMBLY SHALL BE OF SUCH LENGTH AND HEIGHT AS TO ACCOMMODATE TRAFFIC SIGNALS AND PEDESTRIAN SIGNALS FOR PROPER MAINTENANCE AND CLEAR VEHICULAR AND PEDESTRIAN VIEWING.

SH. 1 OF 1
 ST-6

LAST CORRECTION DATE: 12/22/95
 FILENAME: ST6.DGN


MDOT Michigan Department of Transportation					
TYPICAL POLE MOUNTED (BACK BRACKET) COMBINATIONS					
DATE	SCALE	CONT. SEC.	JOB NO.	T & S	CONST.

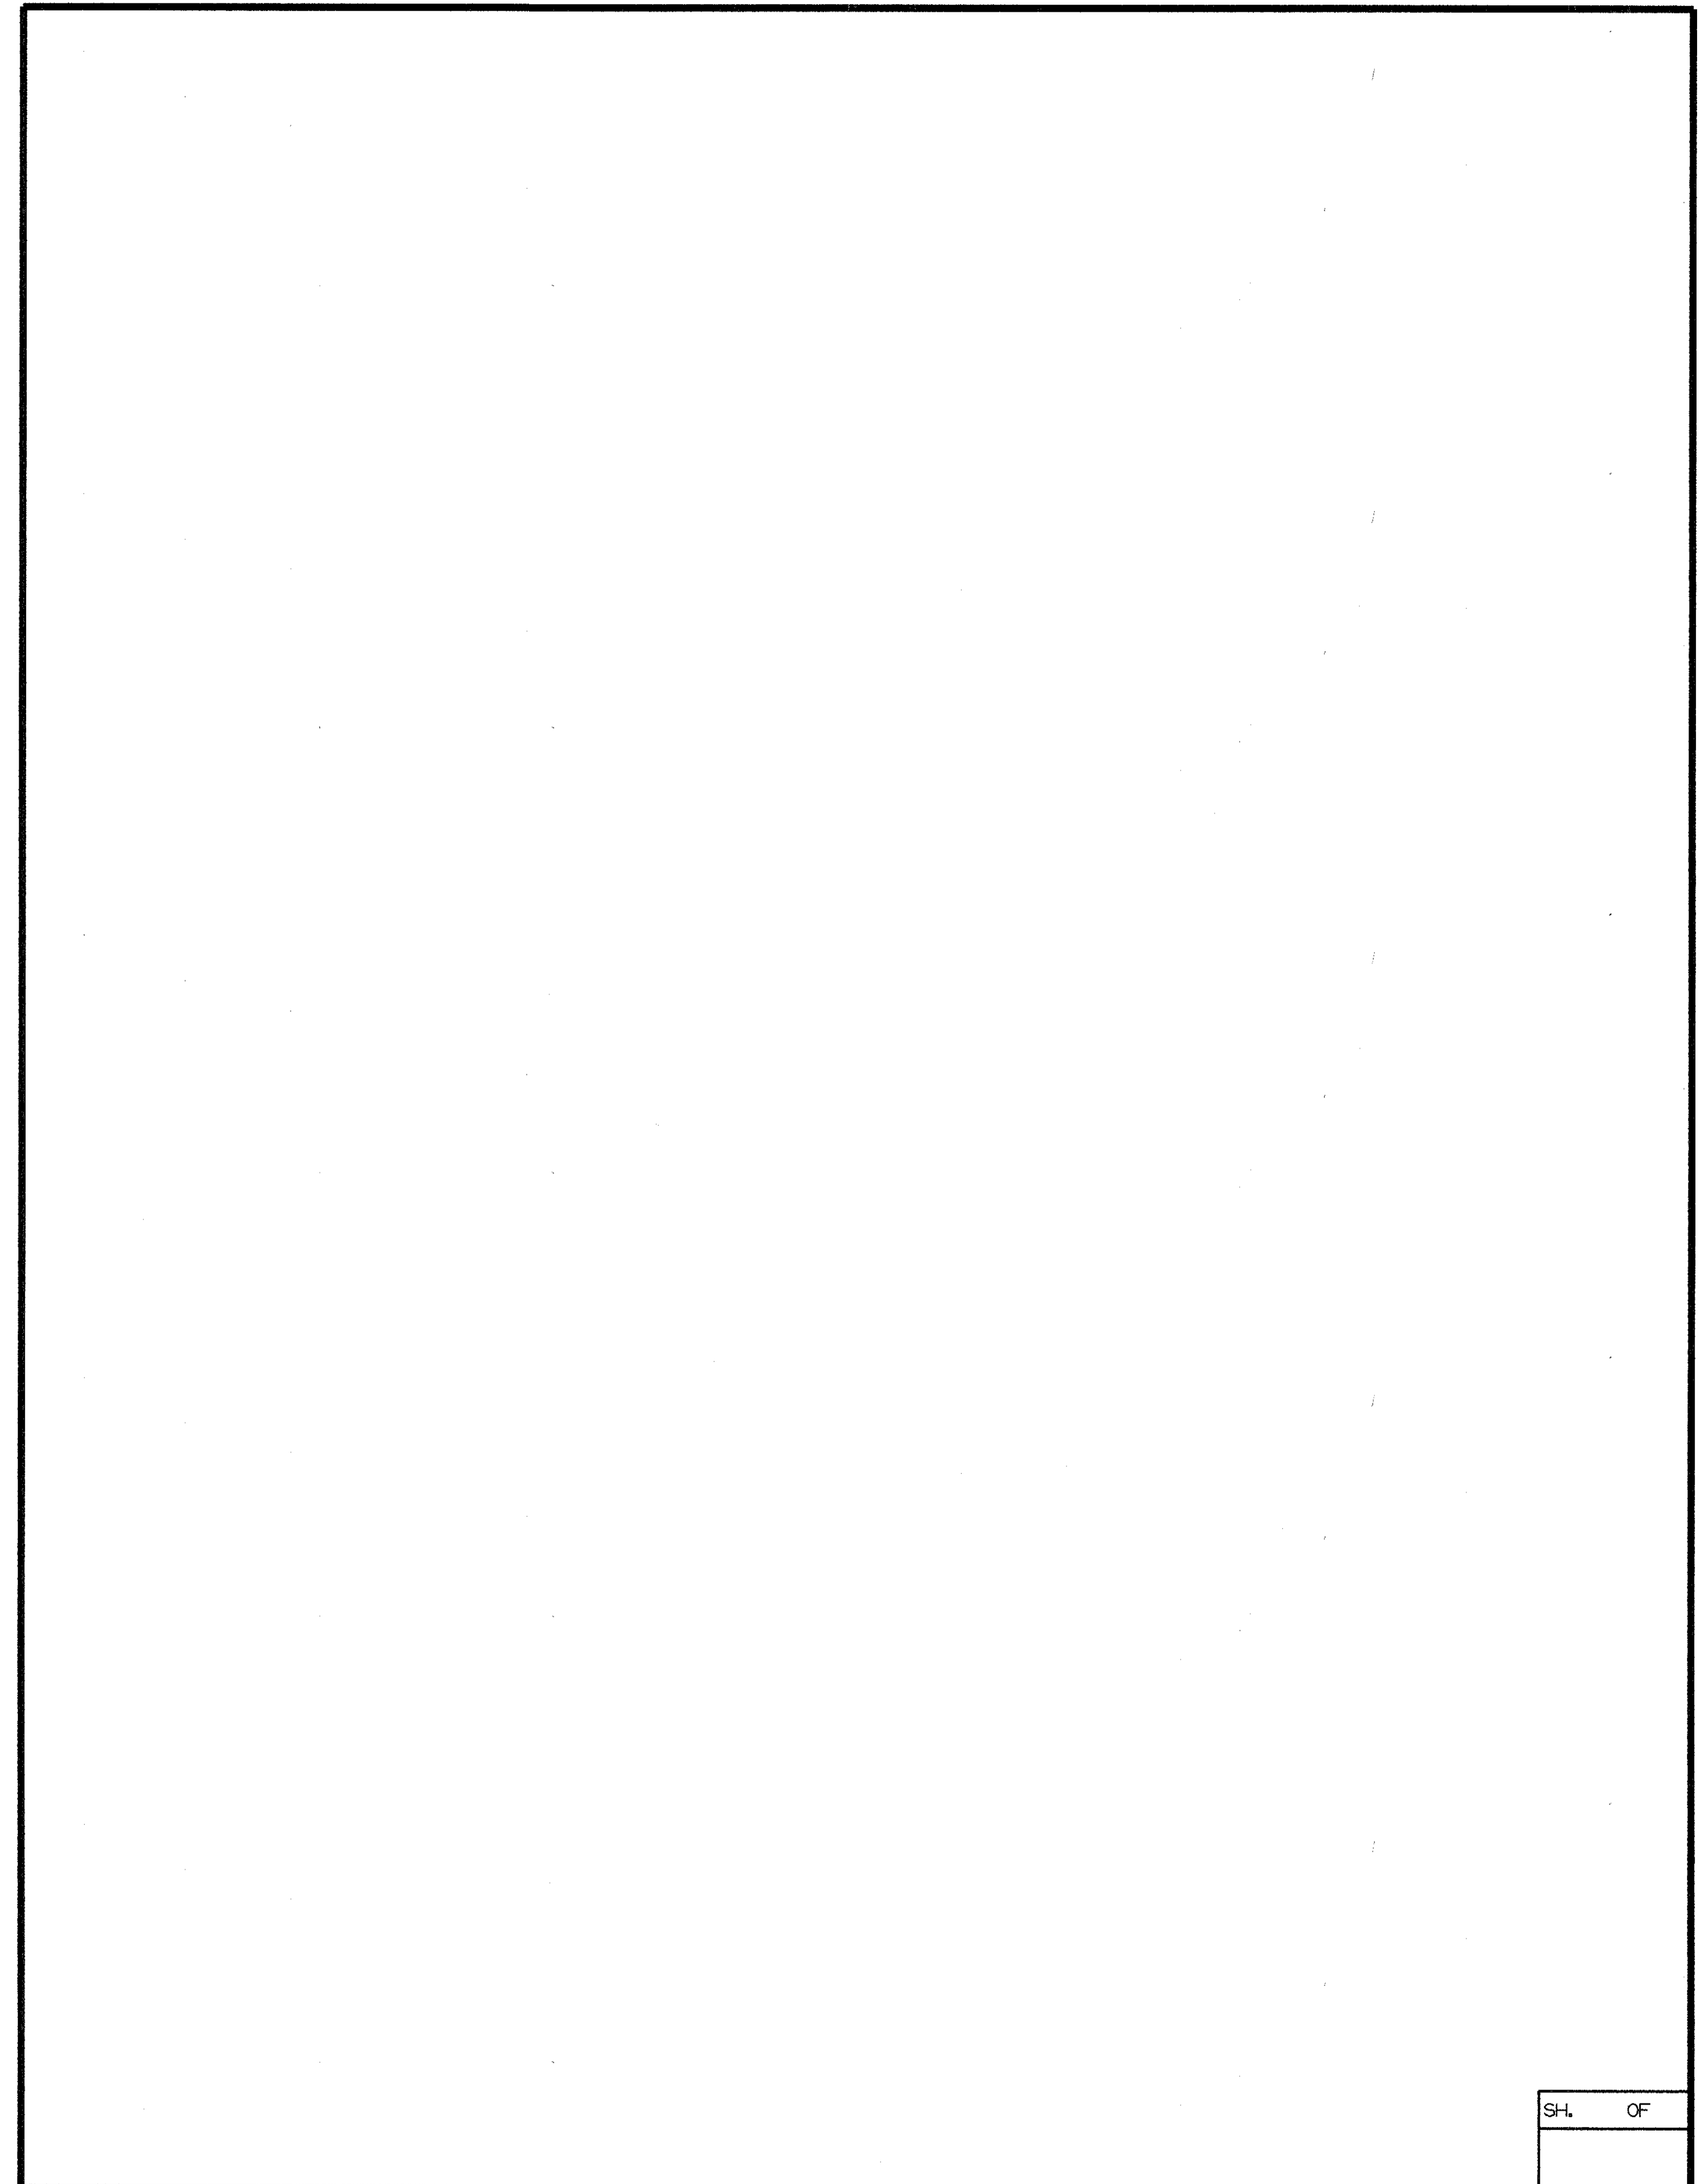


MDOT Michigan Department of Transportation					
DATE	SCALE	CONT. SEC.	JOB NO.	T & S	CONST.
9-21-99		63174	48404A	24 of 31	24D

SH. OF


SH No 25D
 JN 48404A
 C.S. 63174

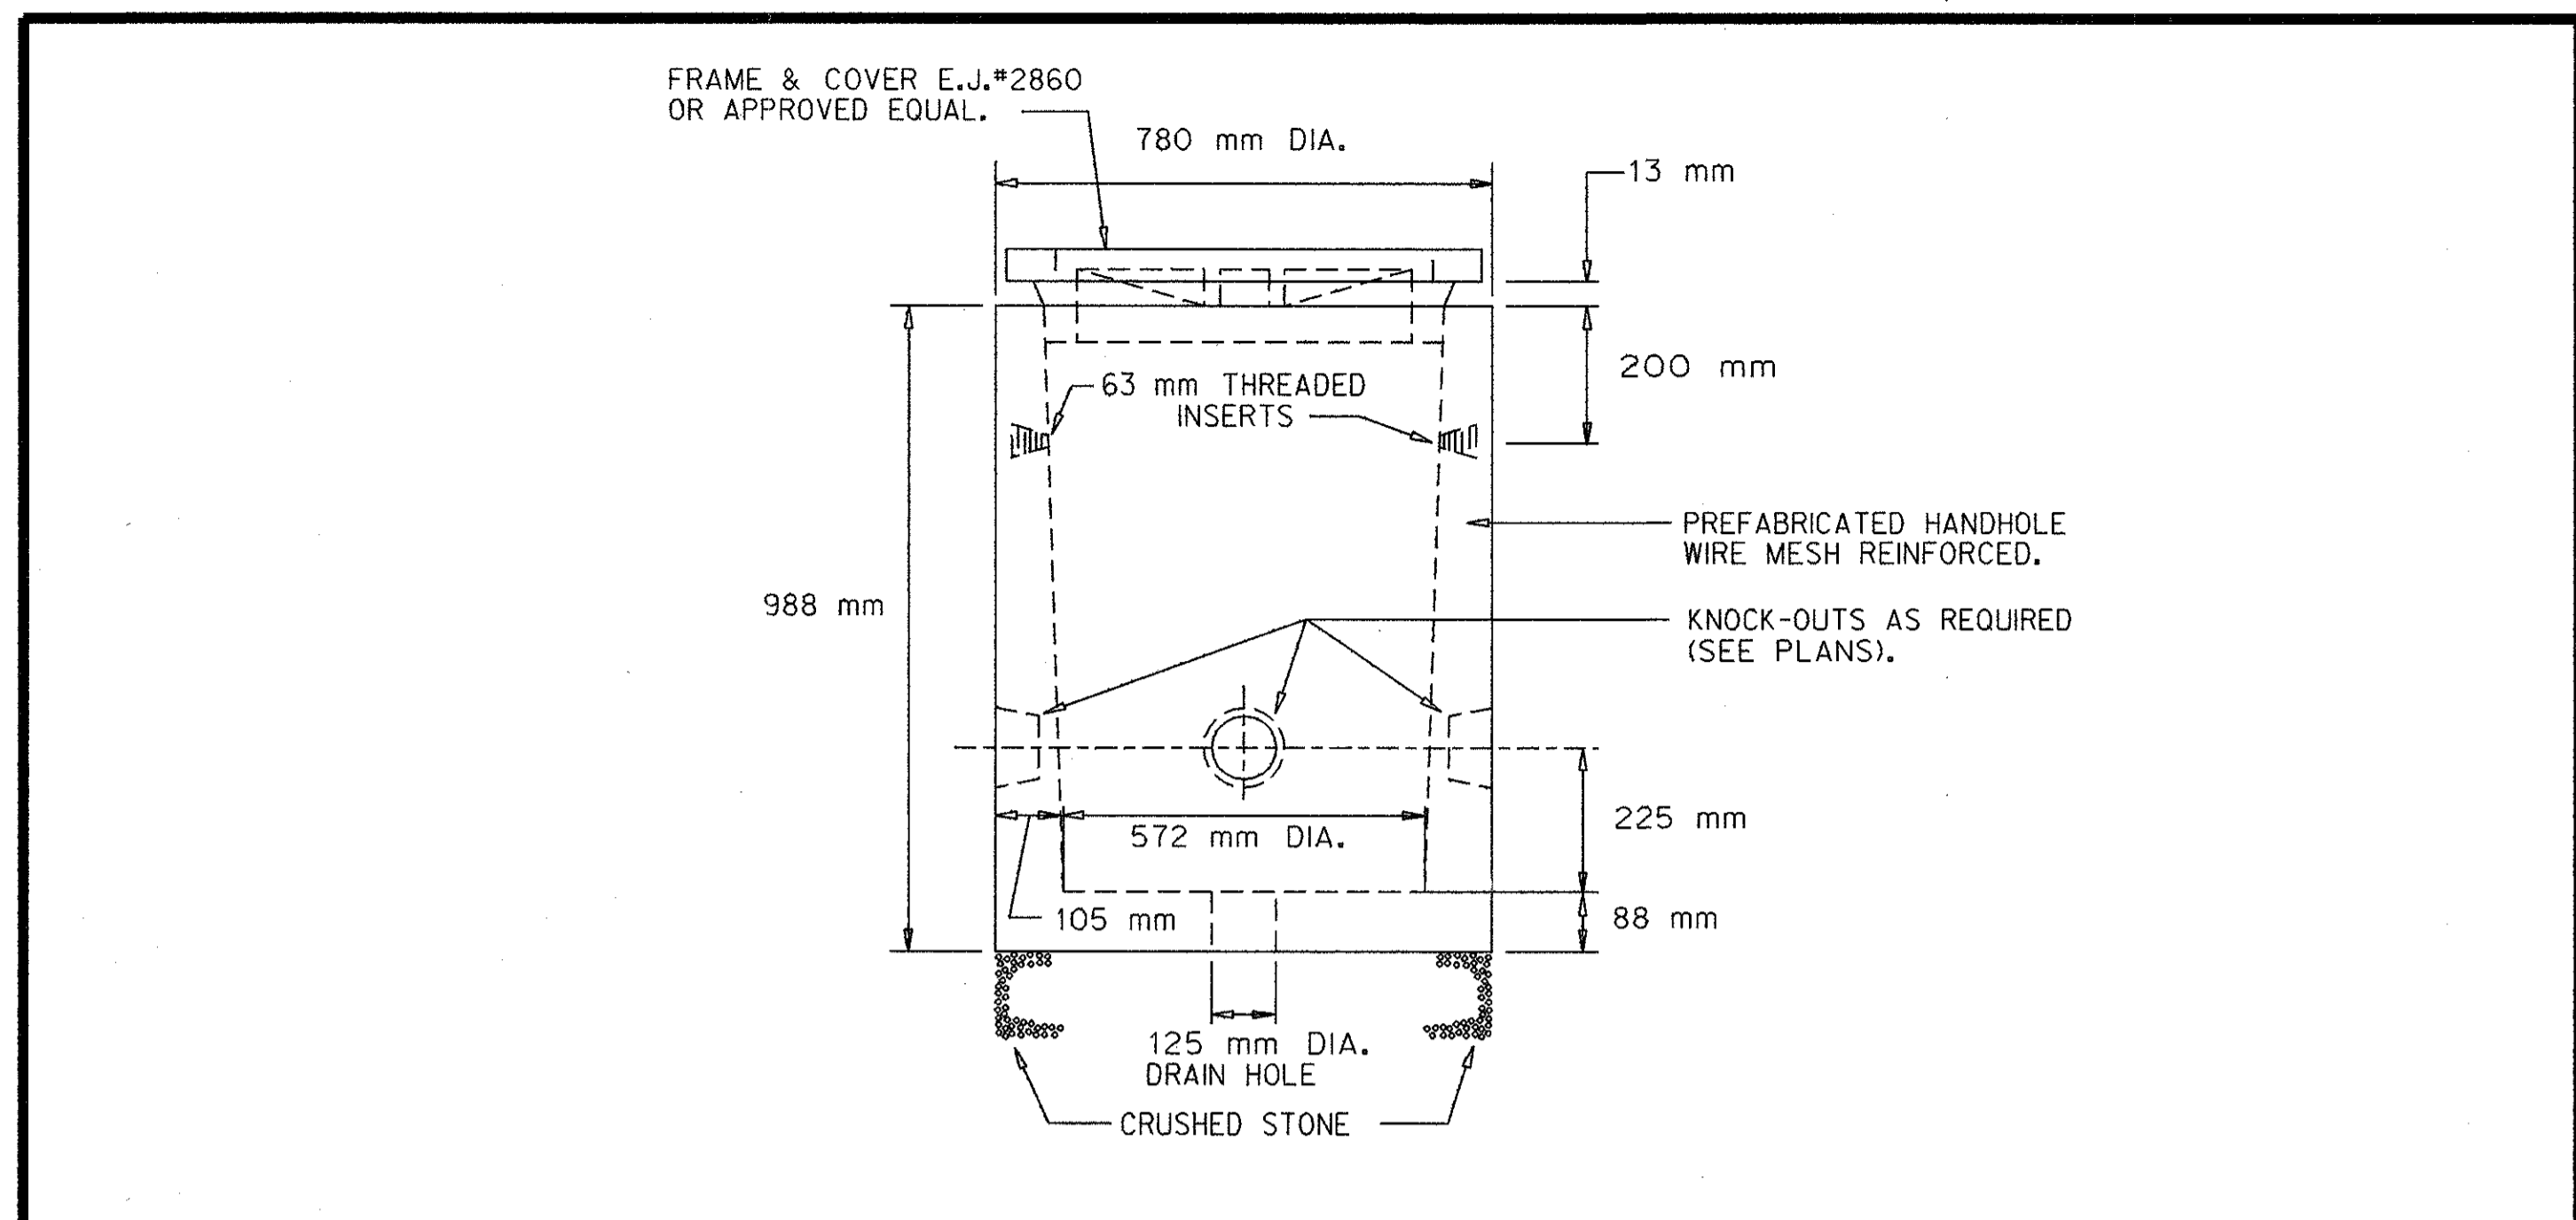


DETAIL : PRECAST ROUND HANDHOLE WITH FLOOR

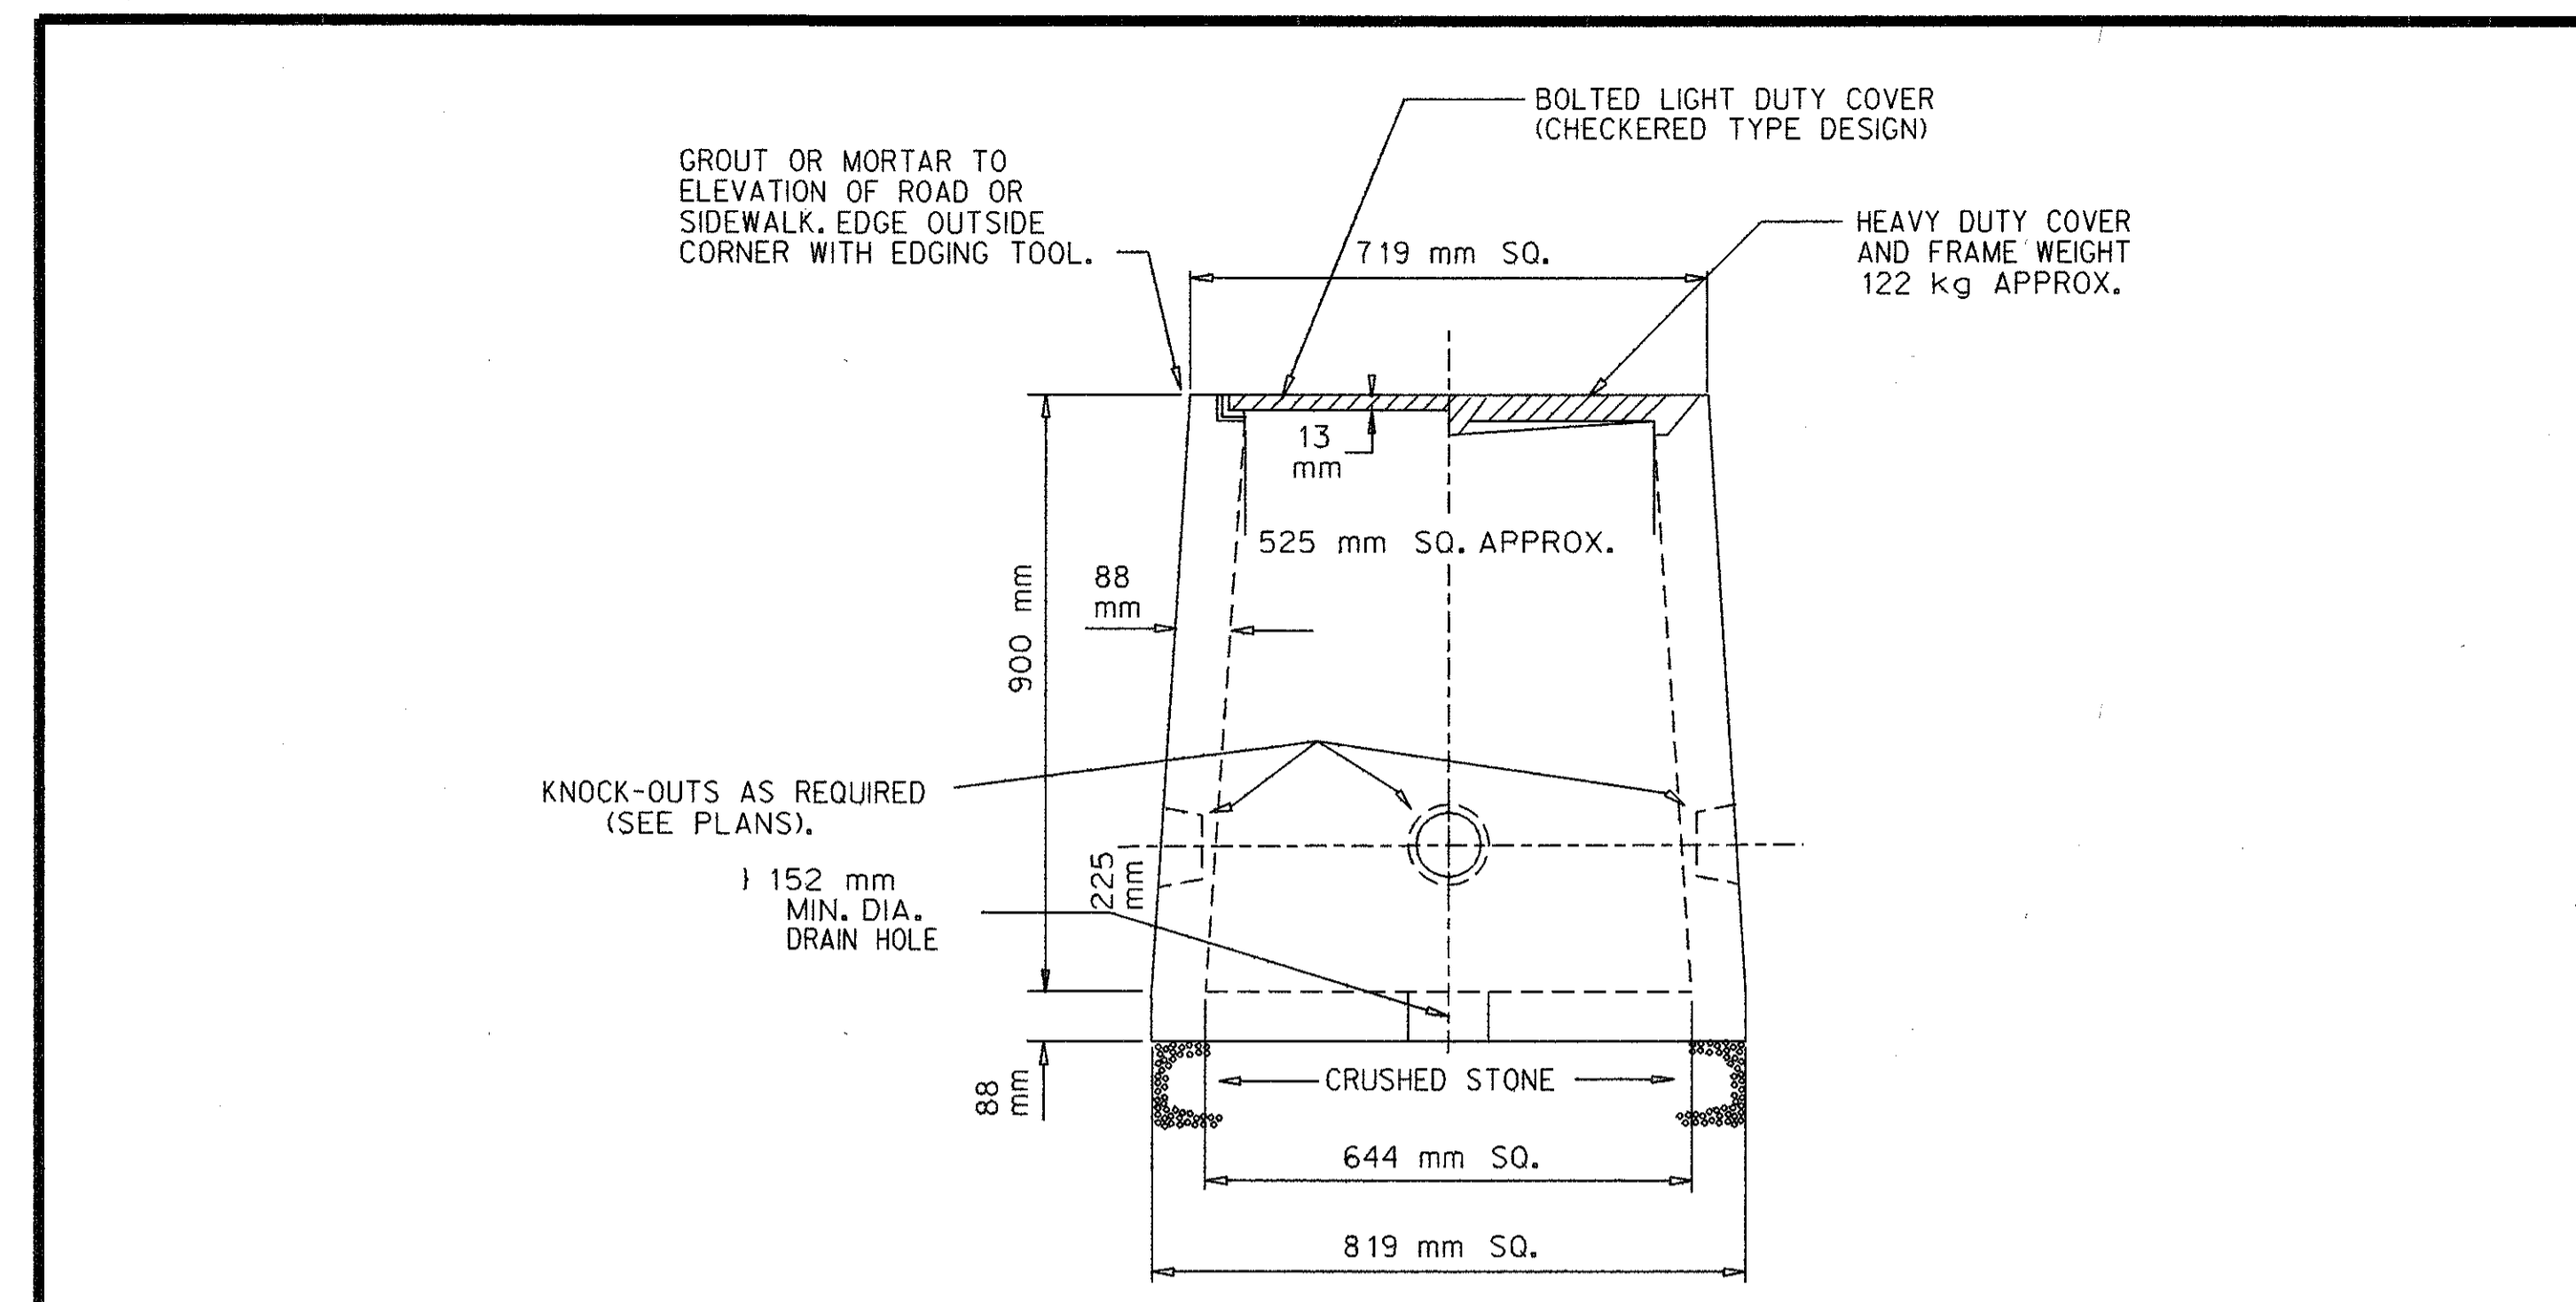


DETAIL : PRECAST SQUARE HANDHOLE WITH FLOOR

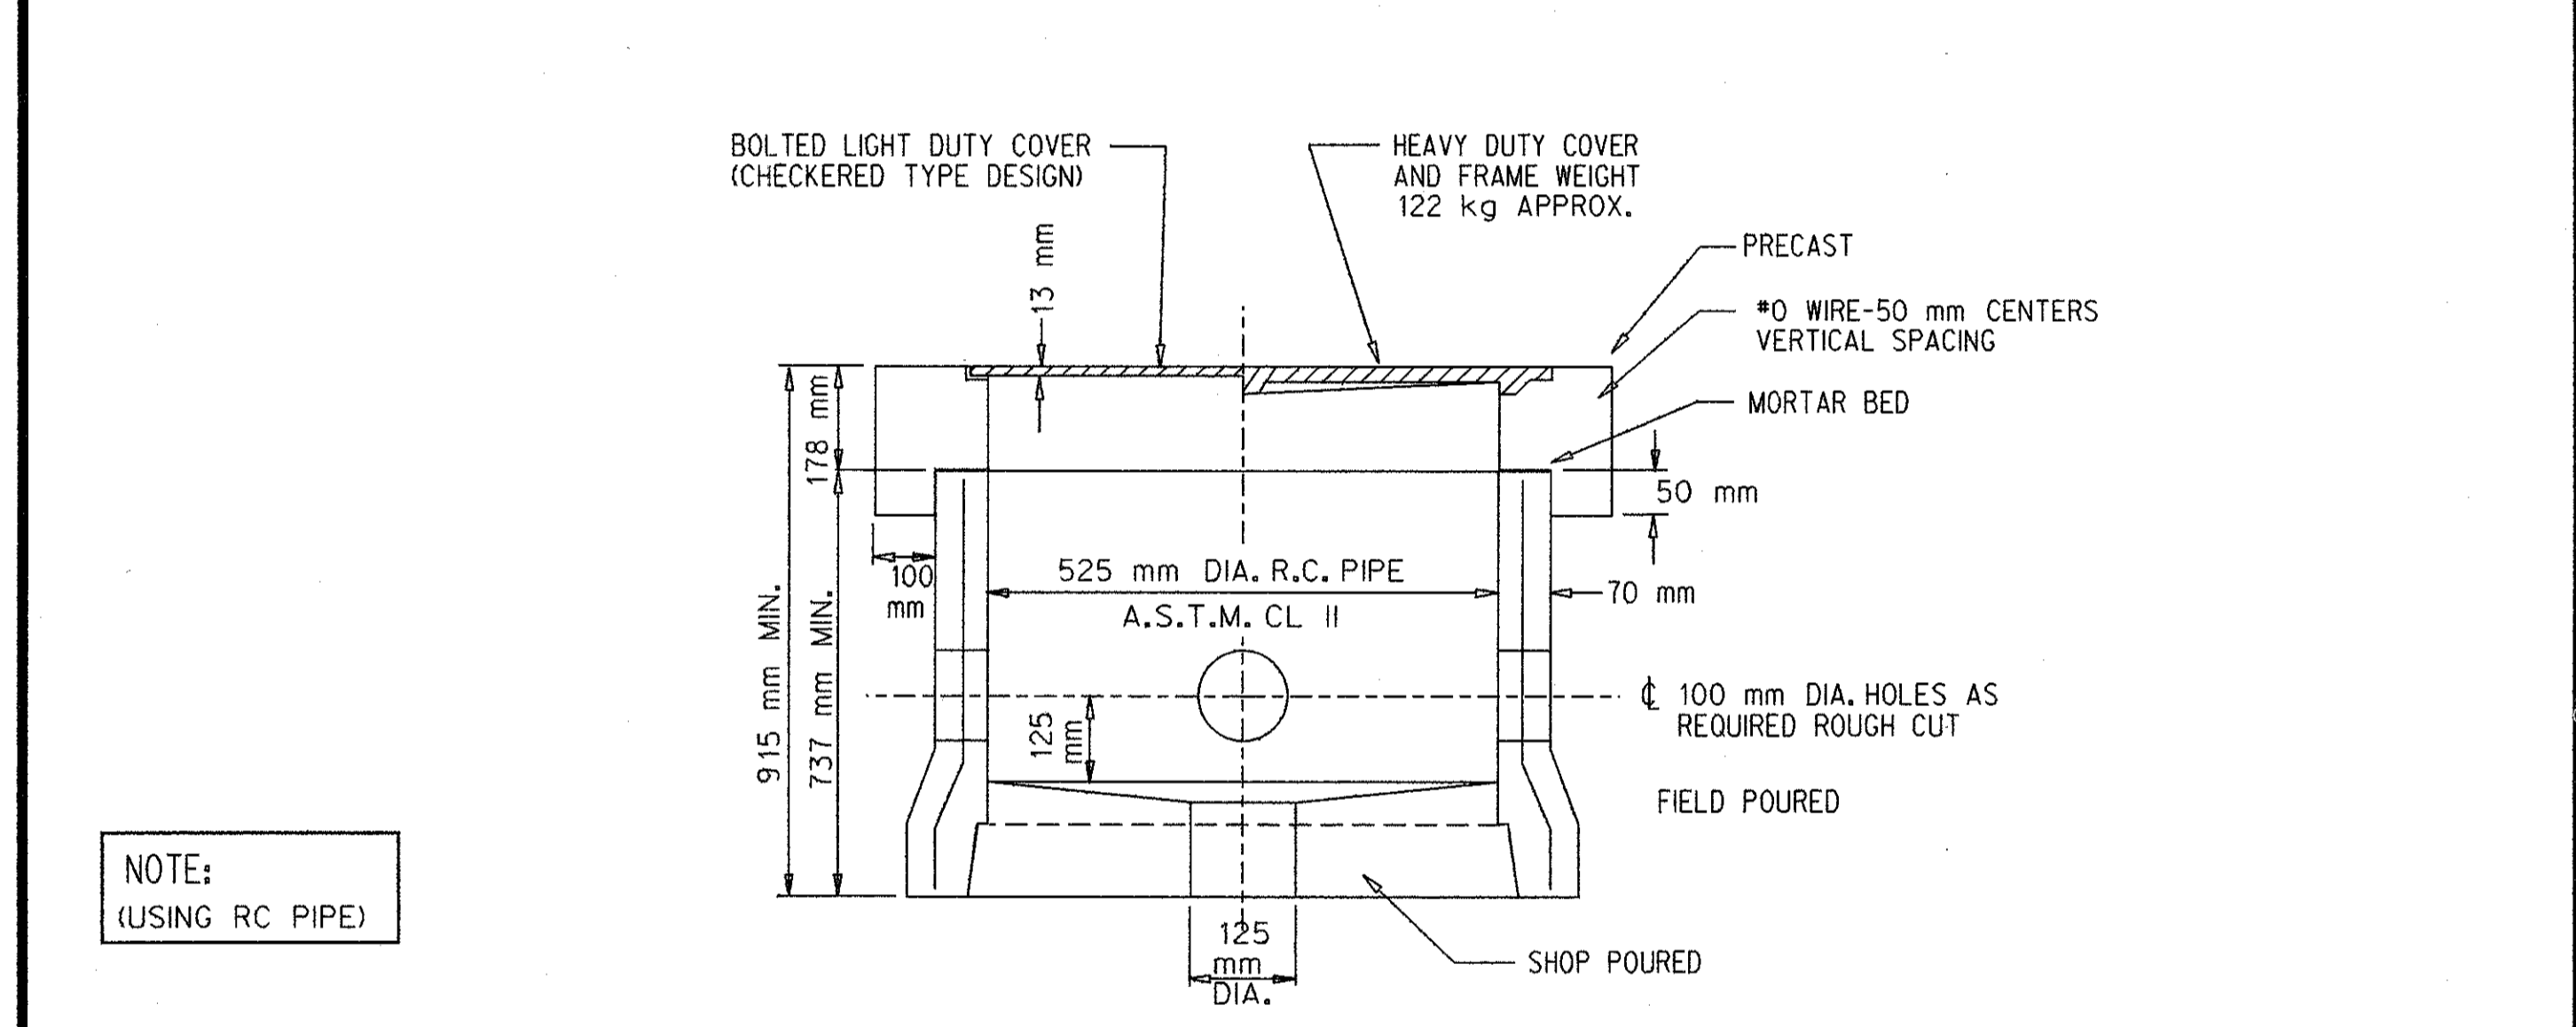


DETAIL (ALTERNATE): PRECAST CONCRETE HANDHOLE

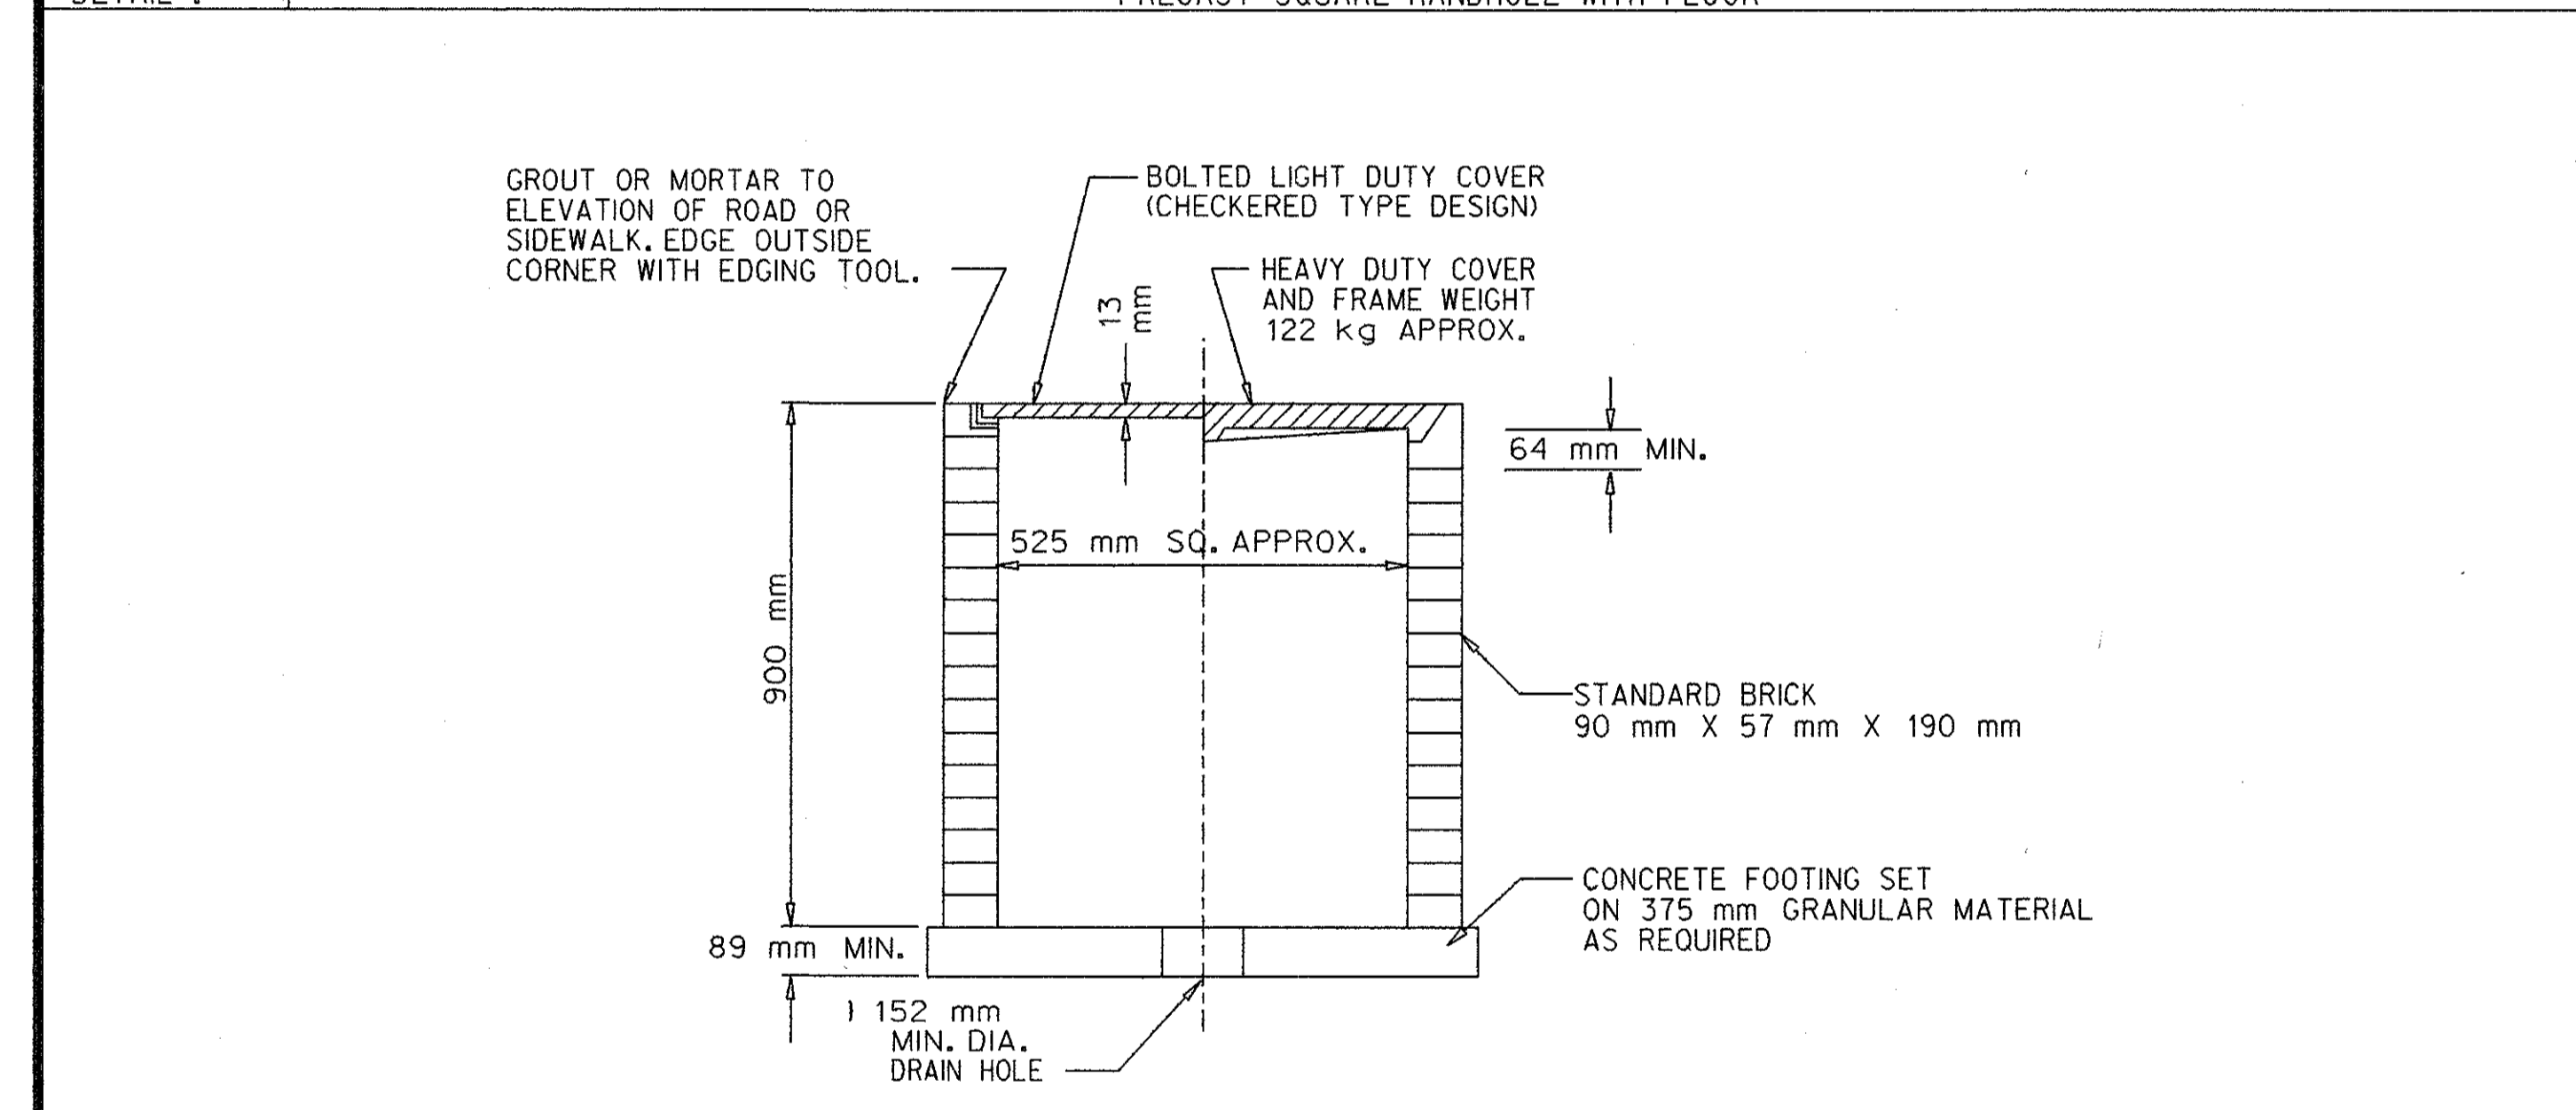

DETAIL : BRICK HANDHOLE

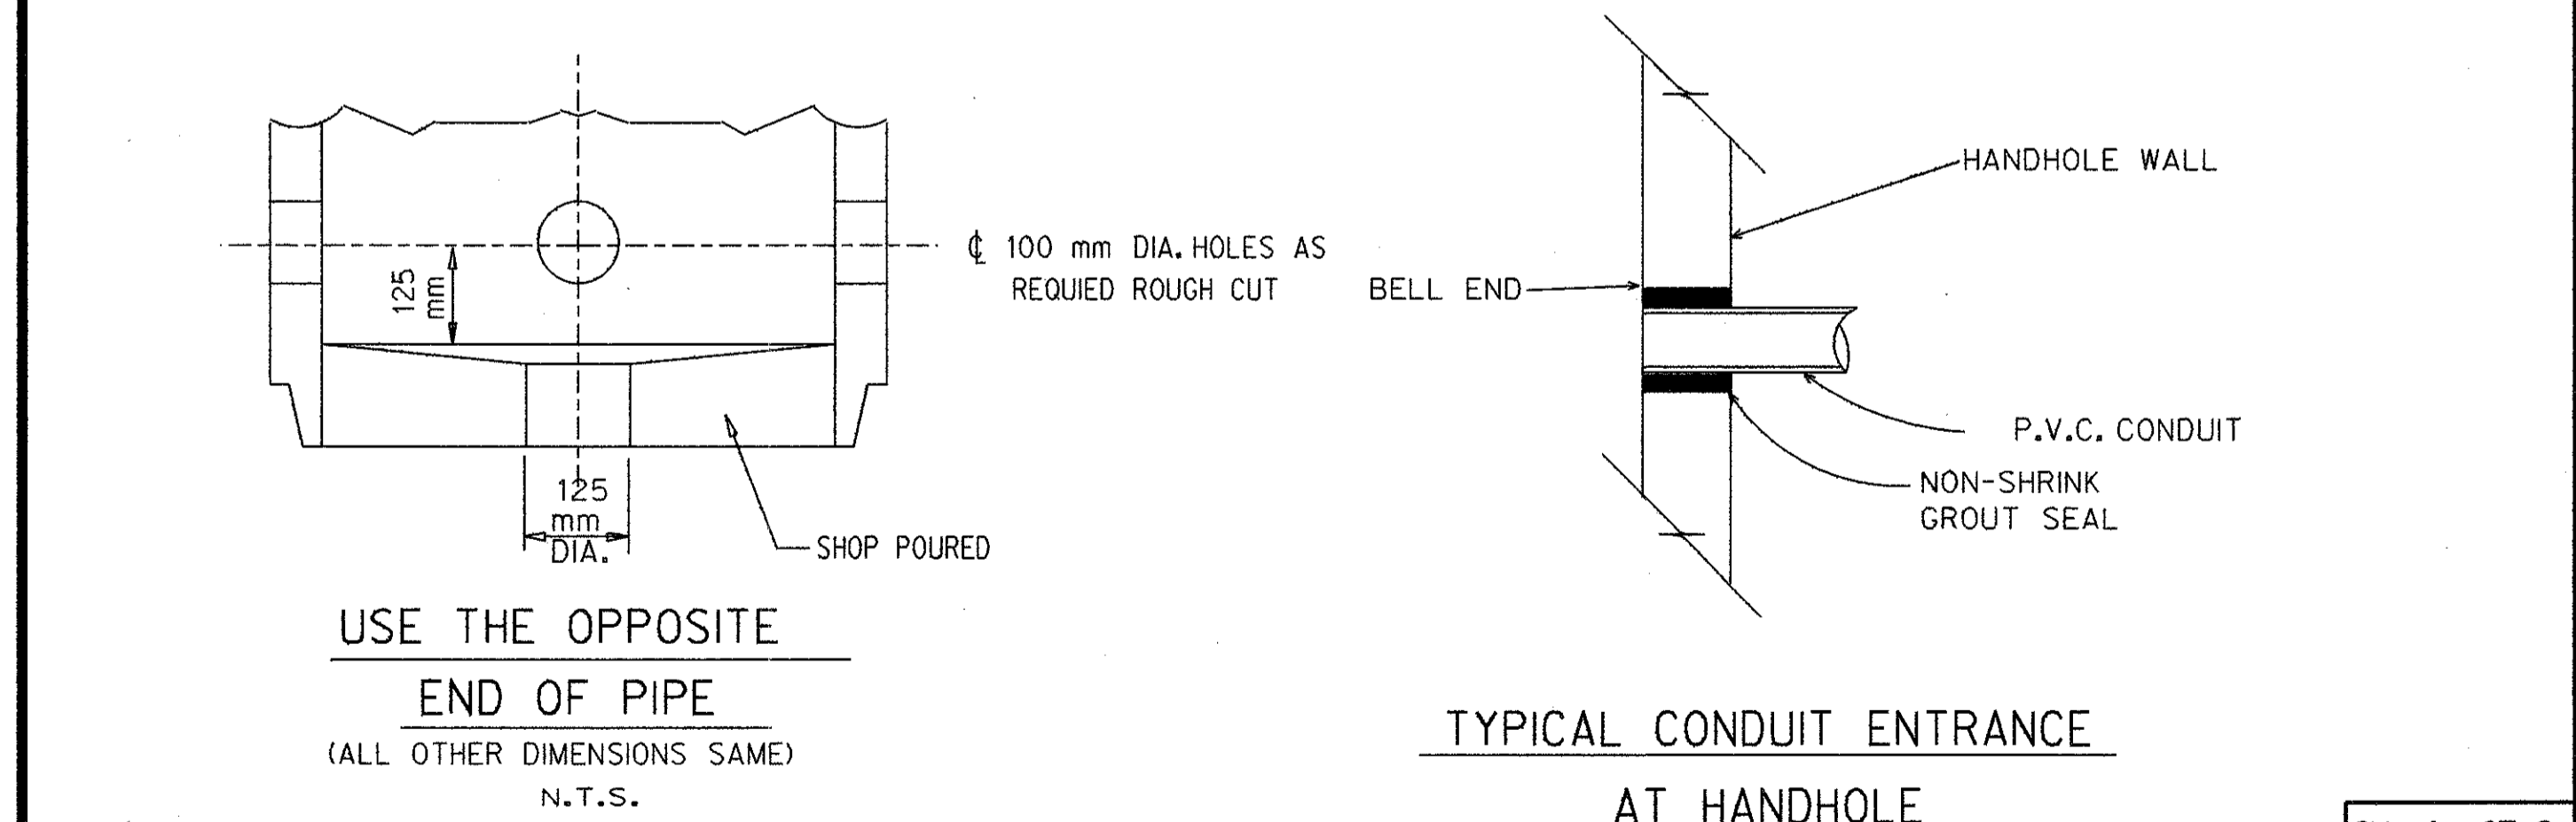

TYPICAL CONDUIT ENTRANCE AT HANDHOLE N.T.S.

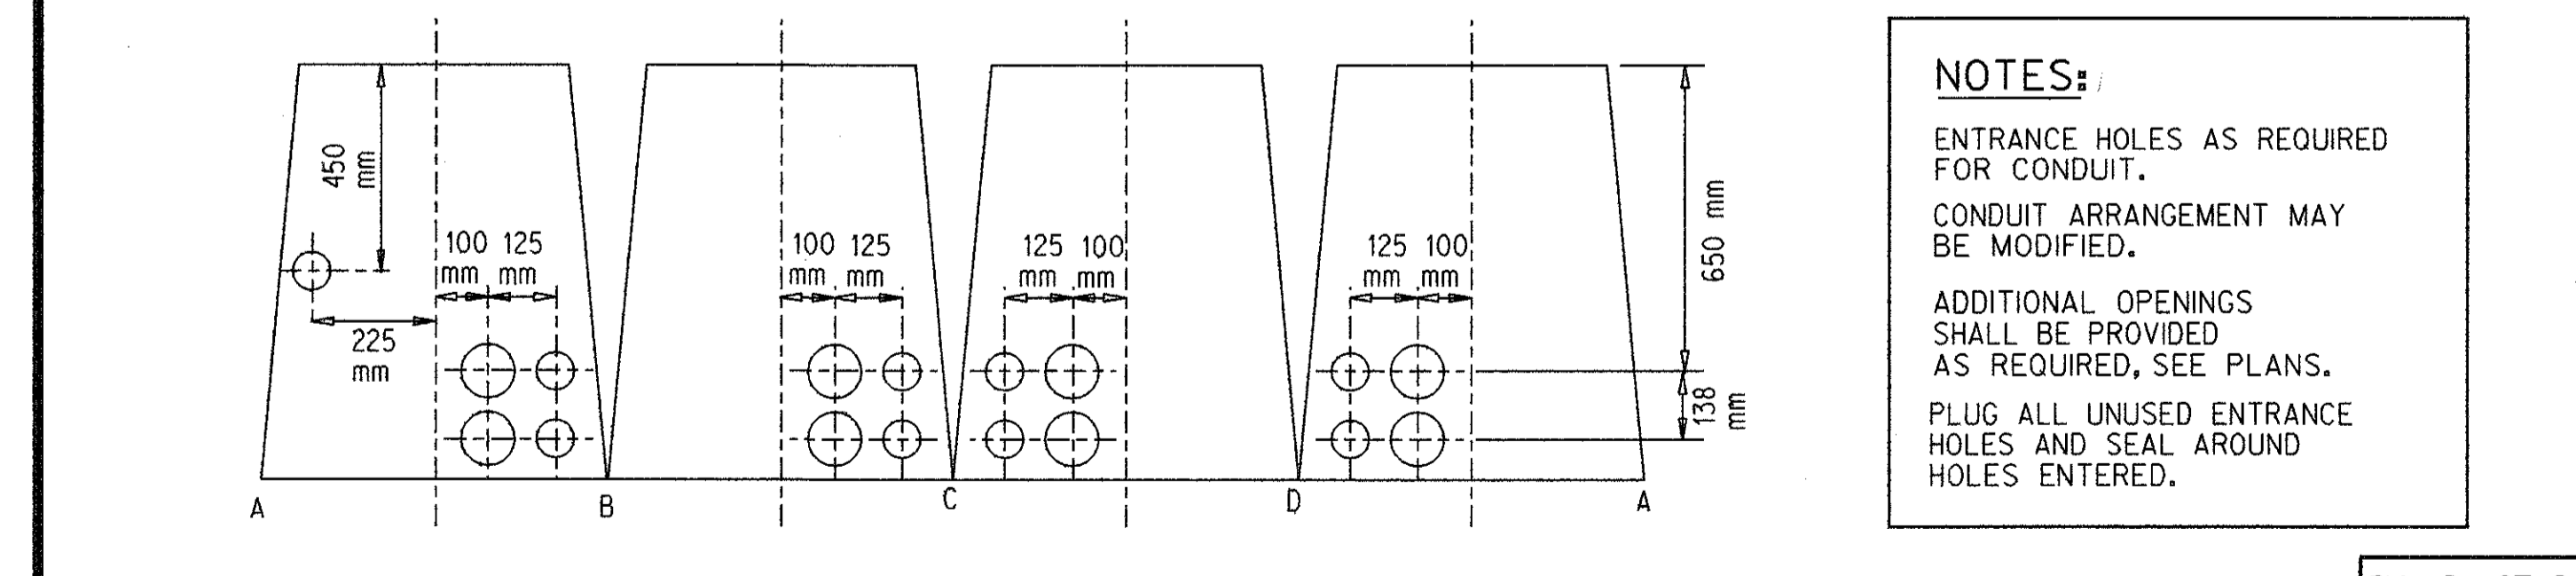

DETAIL : INTERIOR WALL ELEVATIONS-LIGHT AND HEAVY DUTY COVER TYPES

NOTES:
 ENTRANCE HOLES AS REQUIRED FOR CONDUIT.
 CONDUIT ARRANGEMENT MAY BE MODIFIED.
 ADDITIONAL OPENINGS SHALL BE PROVIDED AS REQUIRED, SEE PLANS.
 PLUG ALL UNUSED ENTRANCE HOLES AND SEAL AROUND HOLES ENTERED.

LAST CORRECTION DATE:12/22/95
 FILENAME:ST21.DGN



HANDHOLE - PRECAST, BRICK, POLYMER CONCRETE					
DATE	SCALE	CONT. SEC.	JOB NO.	T & S	CONST.

HANDHOLE - PRECAST, BRICK, POLYMER CONCRETE					
DATE	SCALE	CONT. SEC.	JOB NO.	T & S	CONST.
9-21-99		63174	48404A	25 of 31	25 D

SH. 1 OF 3
ST-21

SH. 2 OF 3
ST-21

NOTE:
LOGO IMPRINT MAY READ
"TRAFFIC CONTROL"

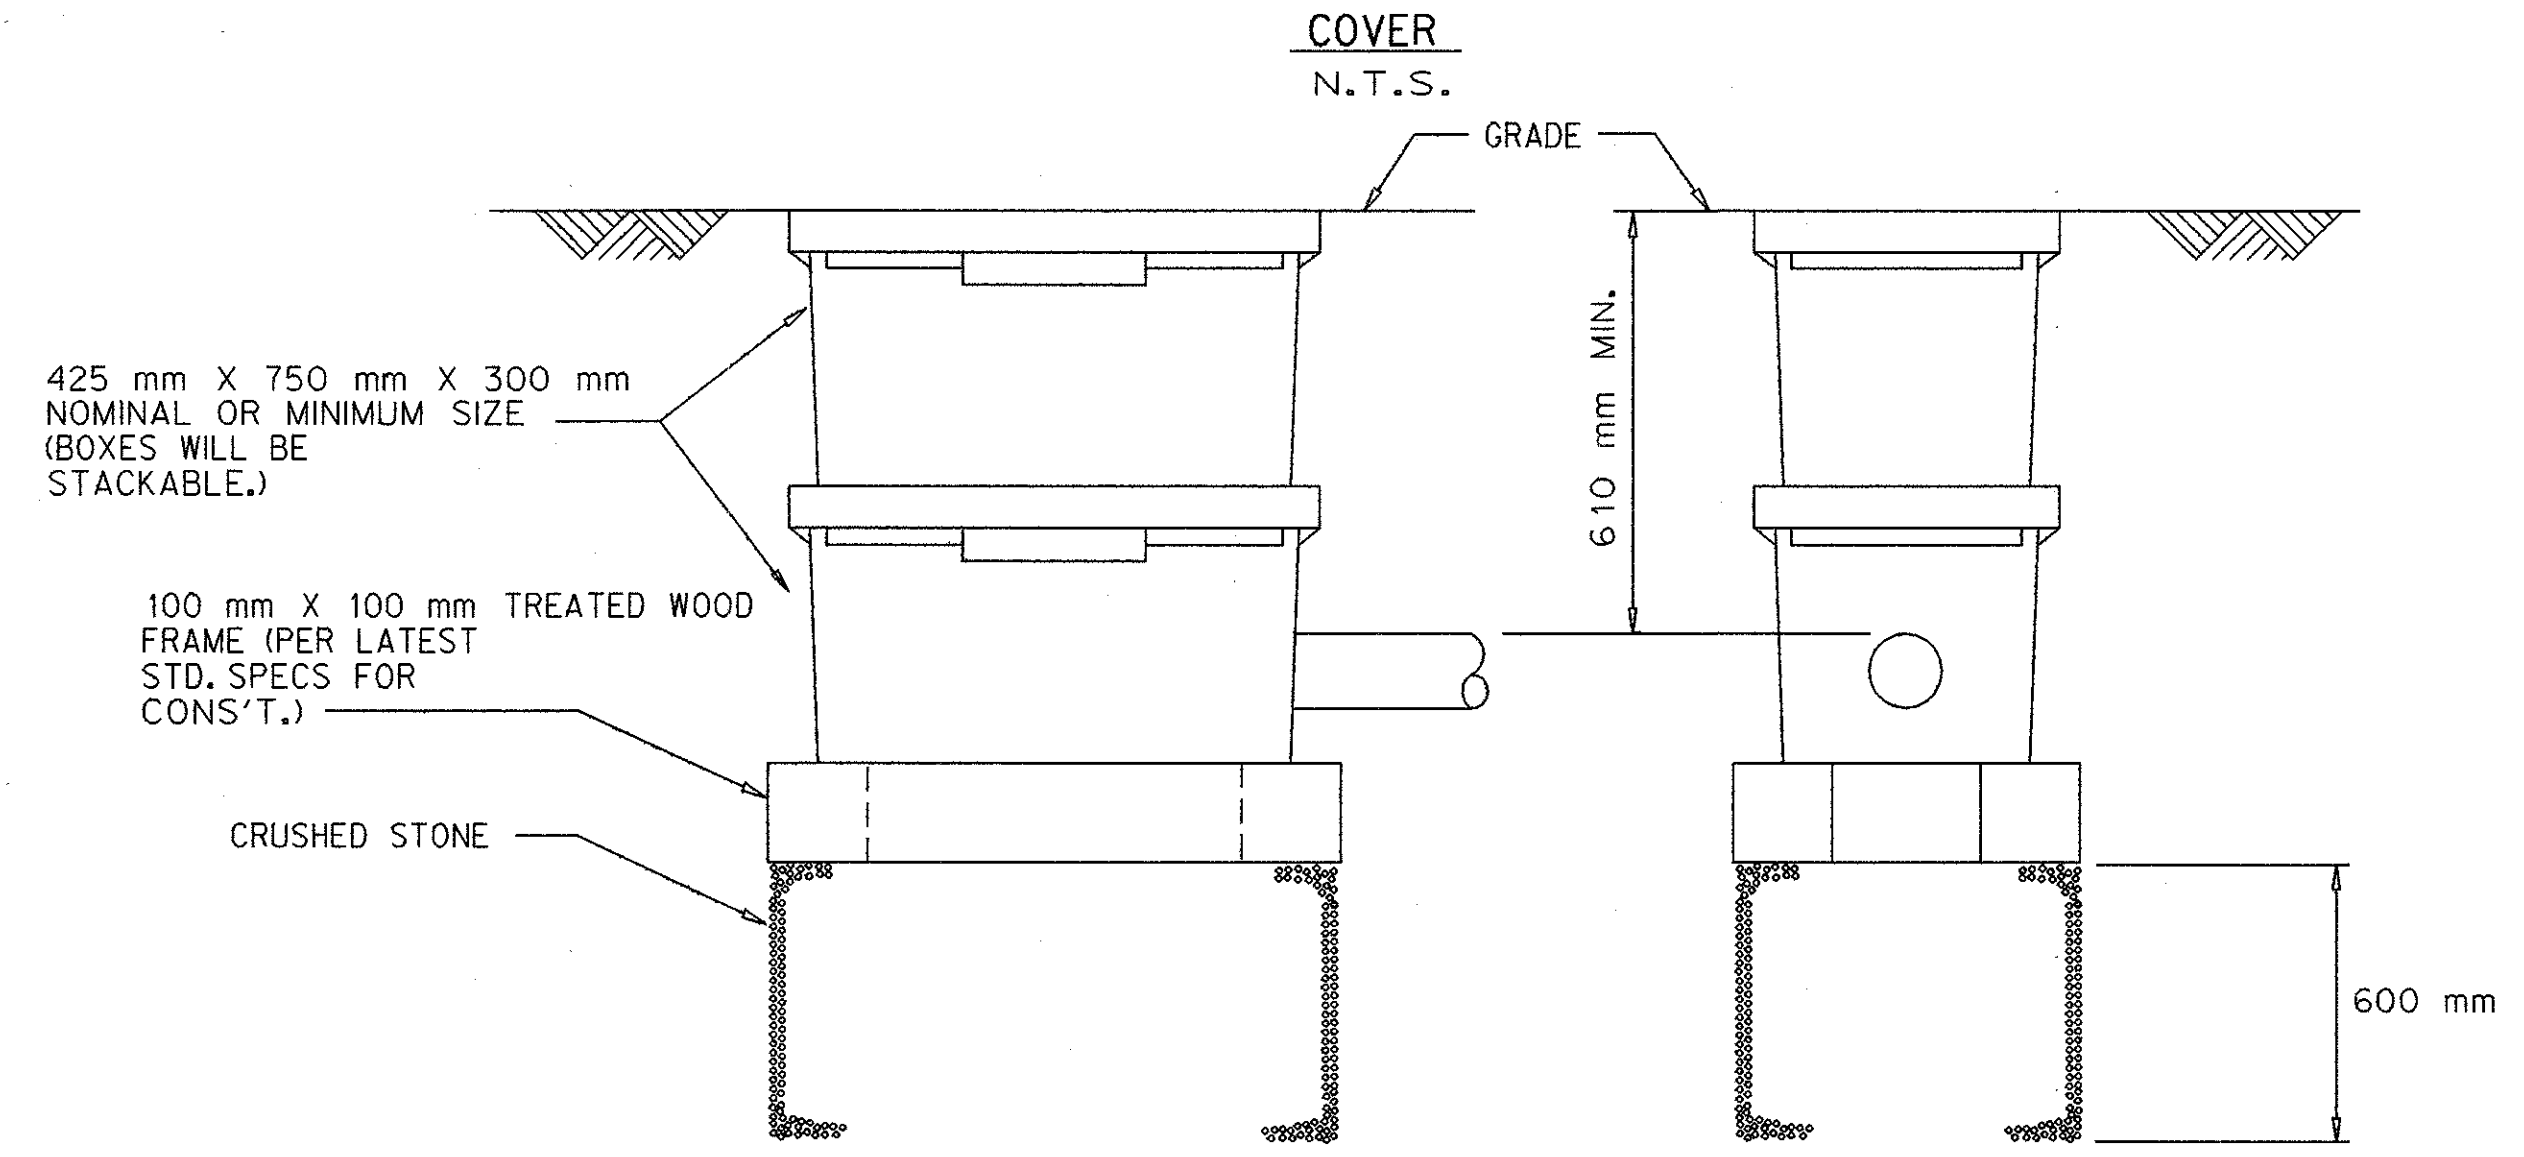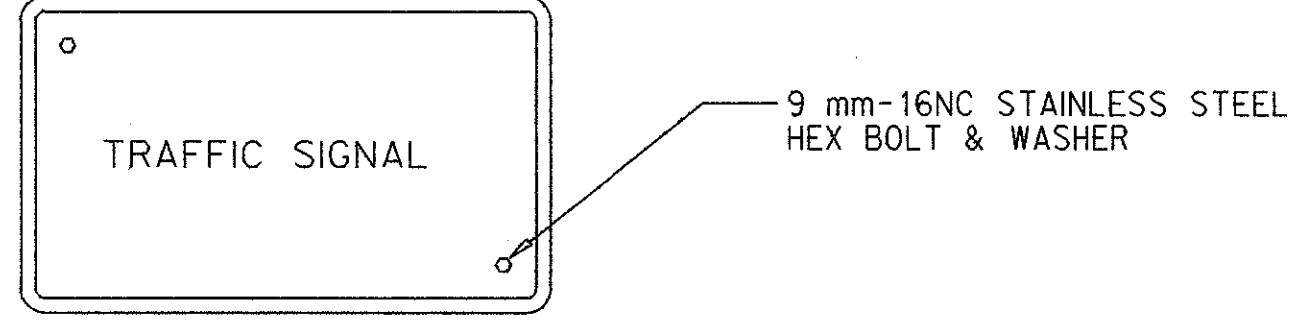

DETAIL : POLYMER CONCRETE HANDHOLE

NOTES:

THE MATERIAL AND WORKMANSHIP SHALL BE IN ACCORDANCE WITH THE CURRENT M.D.O.T. STANDARD SPECIFICATIONS.

THE CONTRACTOR MAY CONSTRUCT THE HANDHOLE STRUCTURE OF BRICK, CEMENT, CONCRETE, MASONARY, OR OF PRECAST REINFORCED CONCRETE.

ALL CONCRETE MASONARY SHALL BE GRADE 30M.

THE INNER SURFACE OF THE HANDHOLE SHALL BE SMOOTH.

HEAVY DUTY COVERS SHALL BE CASTINGS WHICH MEET THE REQUIREMENTS OF THE CURRENT SPECIFICATIONS FOR GRAY IRON CASTINGS ASTM DESIGNATION A48 AND SHALL HAVE A MINIMUM STRENGTH AS PROVIDED FOR CLASS NO. 30 GRAY IRON CASTINGS.

ALL CASTINGS SHALL BE CLEANED BY SAND BLASTING.

THE SEATING FACE OF THE COVER AND THE SEAT FOR THE SAME ON THE FRAME IF REQUIRED, SHALL BE GROUND OR MACHINED SO THAT THE COVER SHALL HAVE AN EVEN BEARING ON ITS SEAT TO PREVENT ROCKING OR TILTING.

THE CASTINGS SHALL BE FREE OF POURING FAULTS, BLOW HOLES, CRACKS, AND OTHER IMPERFECTIONS. THEY SHALL BE SOUND, TRUE TO FORM AND THICKNESS, CLEAN AND NEATLY FINISHED AND SHALL BE COATED WITH TAR PITCH VARNISH.

LIGHT DUTY COVER SHALL BE BOLTED TO FRAME WITH NOT LESS THAN 2 COUNTERSUNK HEX HEAD BRONZE BOLTS.

PRECAST HANDHOLE WITH HEAVY DUTY COVER SHALL BE SET ON A CONCRETE SLAB SIMILAR TO DETAIL FOR BRICK HANDHOLE.

THE HEAVY DUTY COVER & FRAME SHALL BE EAST JORDAN IRON WORKS #8206 NEENAH FOUNDRY, #R-6662-HP FOR SQUARE COVER OR EAST JORDAN IRON WORKS #2860 TYPE 'A', NEENAH FOUNDRY #R-6052 D FOR CIRCULAR COVER OR AN APPROVED EQUAL.

HANDHOLE SHALL BE EQUIPPED WITH CABLE RACK AND HOOKS TO TRAIN CABLE.

NOTES : PERTAIN TO PRECAST, BRICK HANDHOLES

SH. 3 OF 3
ST-21


HANDHOLE - PRECAST, BRICK, POLYMER CONCRETE

DATE	SCALE	CONT. SEC.	JOB NO.	T & S	CONST.
------	-------	------------	---------	-------	--------

SH. OF

DATE	SCALE	CONT. SEC.	JOB NO.	T & S	CONST.
9-21-99		63174	48404A	26 of 31	26 D

CS. 63174 JN 48404A SH No 26D

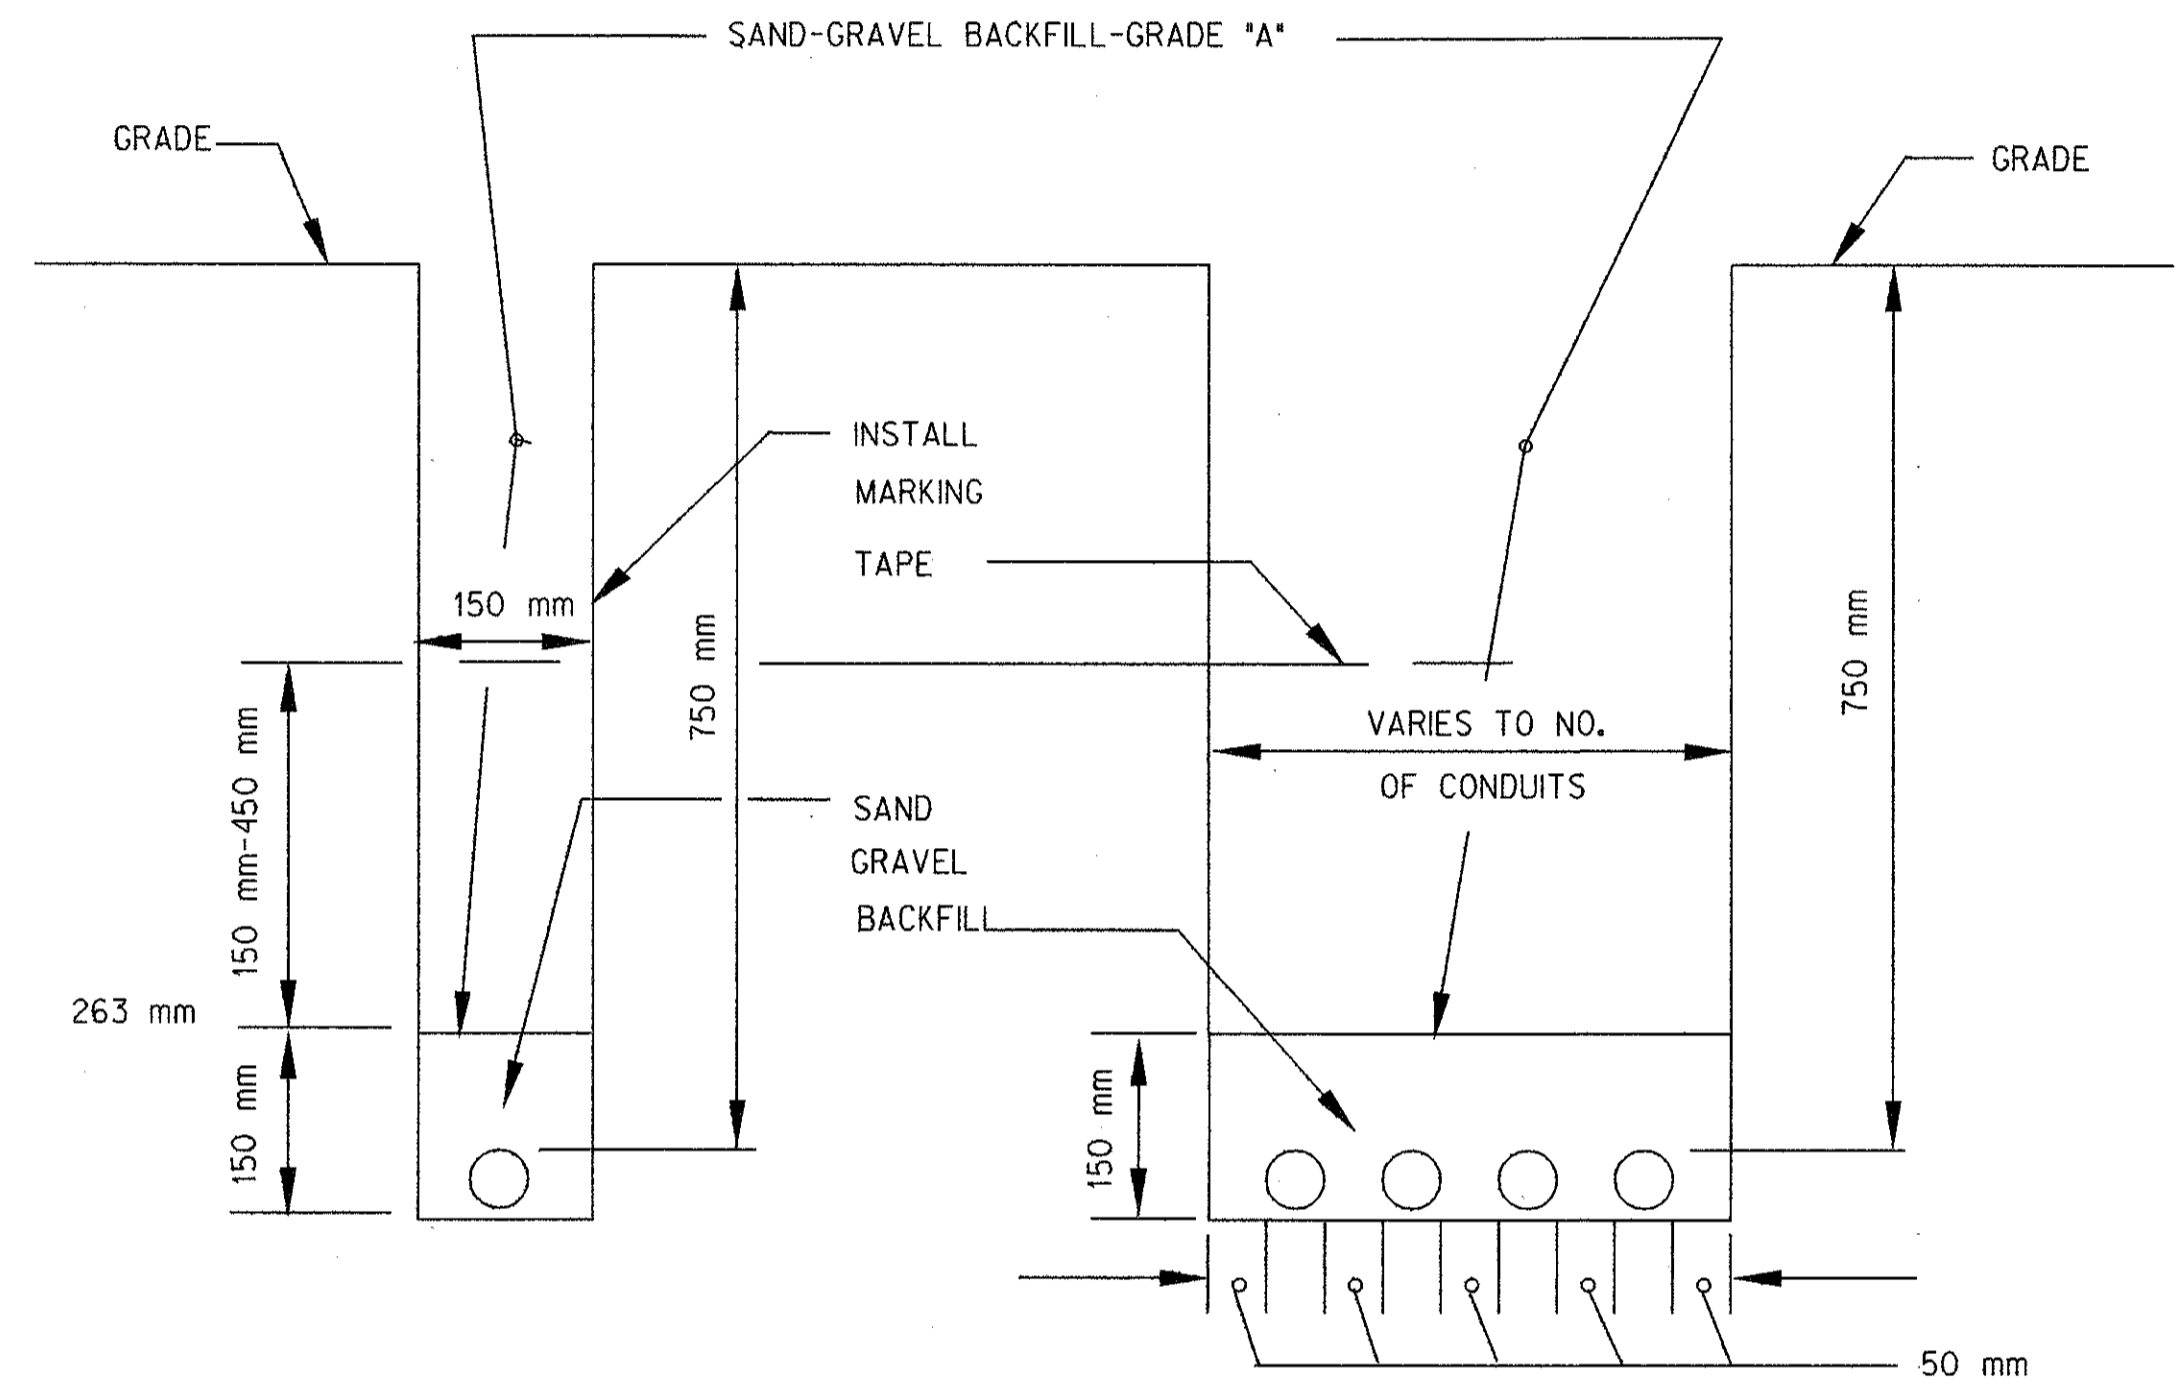

DIRECT BURIAL CONDUIT(S)/CABLE(S)
N.T.S.

SH. 1 OF 1
ST-22A


LAST CORRECTION DATE: 12/22/95
FILENAME: ST22A.DGN

DIRECT BURIAL CONDUIT


DATE	SCALE	CONT. SEC.	JOB NO.	T & S	CONST.
------	-------	------------	---------	-------	--------

SH. OF

DATE	SCALE	CONT. SEC.	JOB NO.	T & S	CONST.
9-21-99		63174	48404A	27 of 31	27D

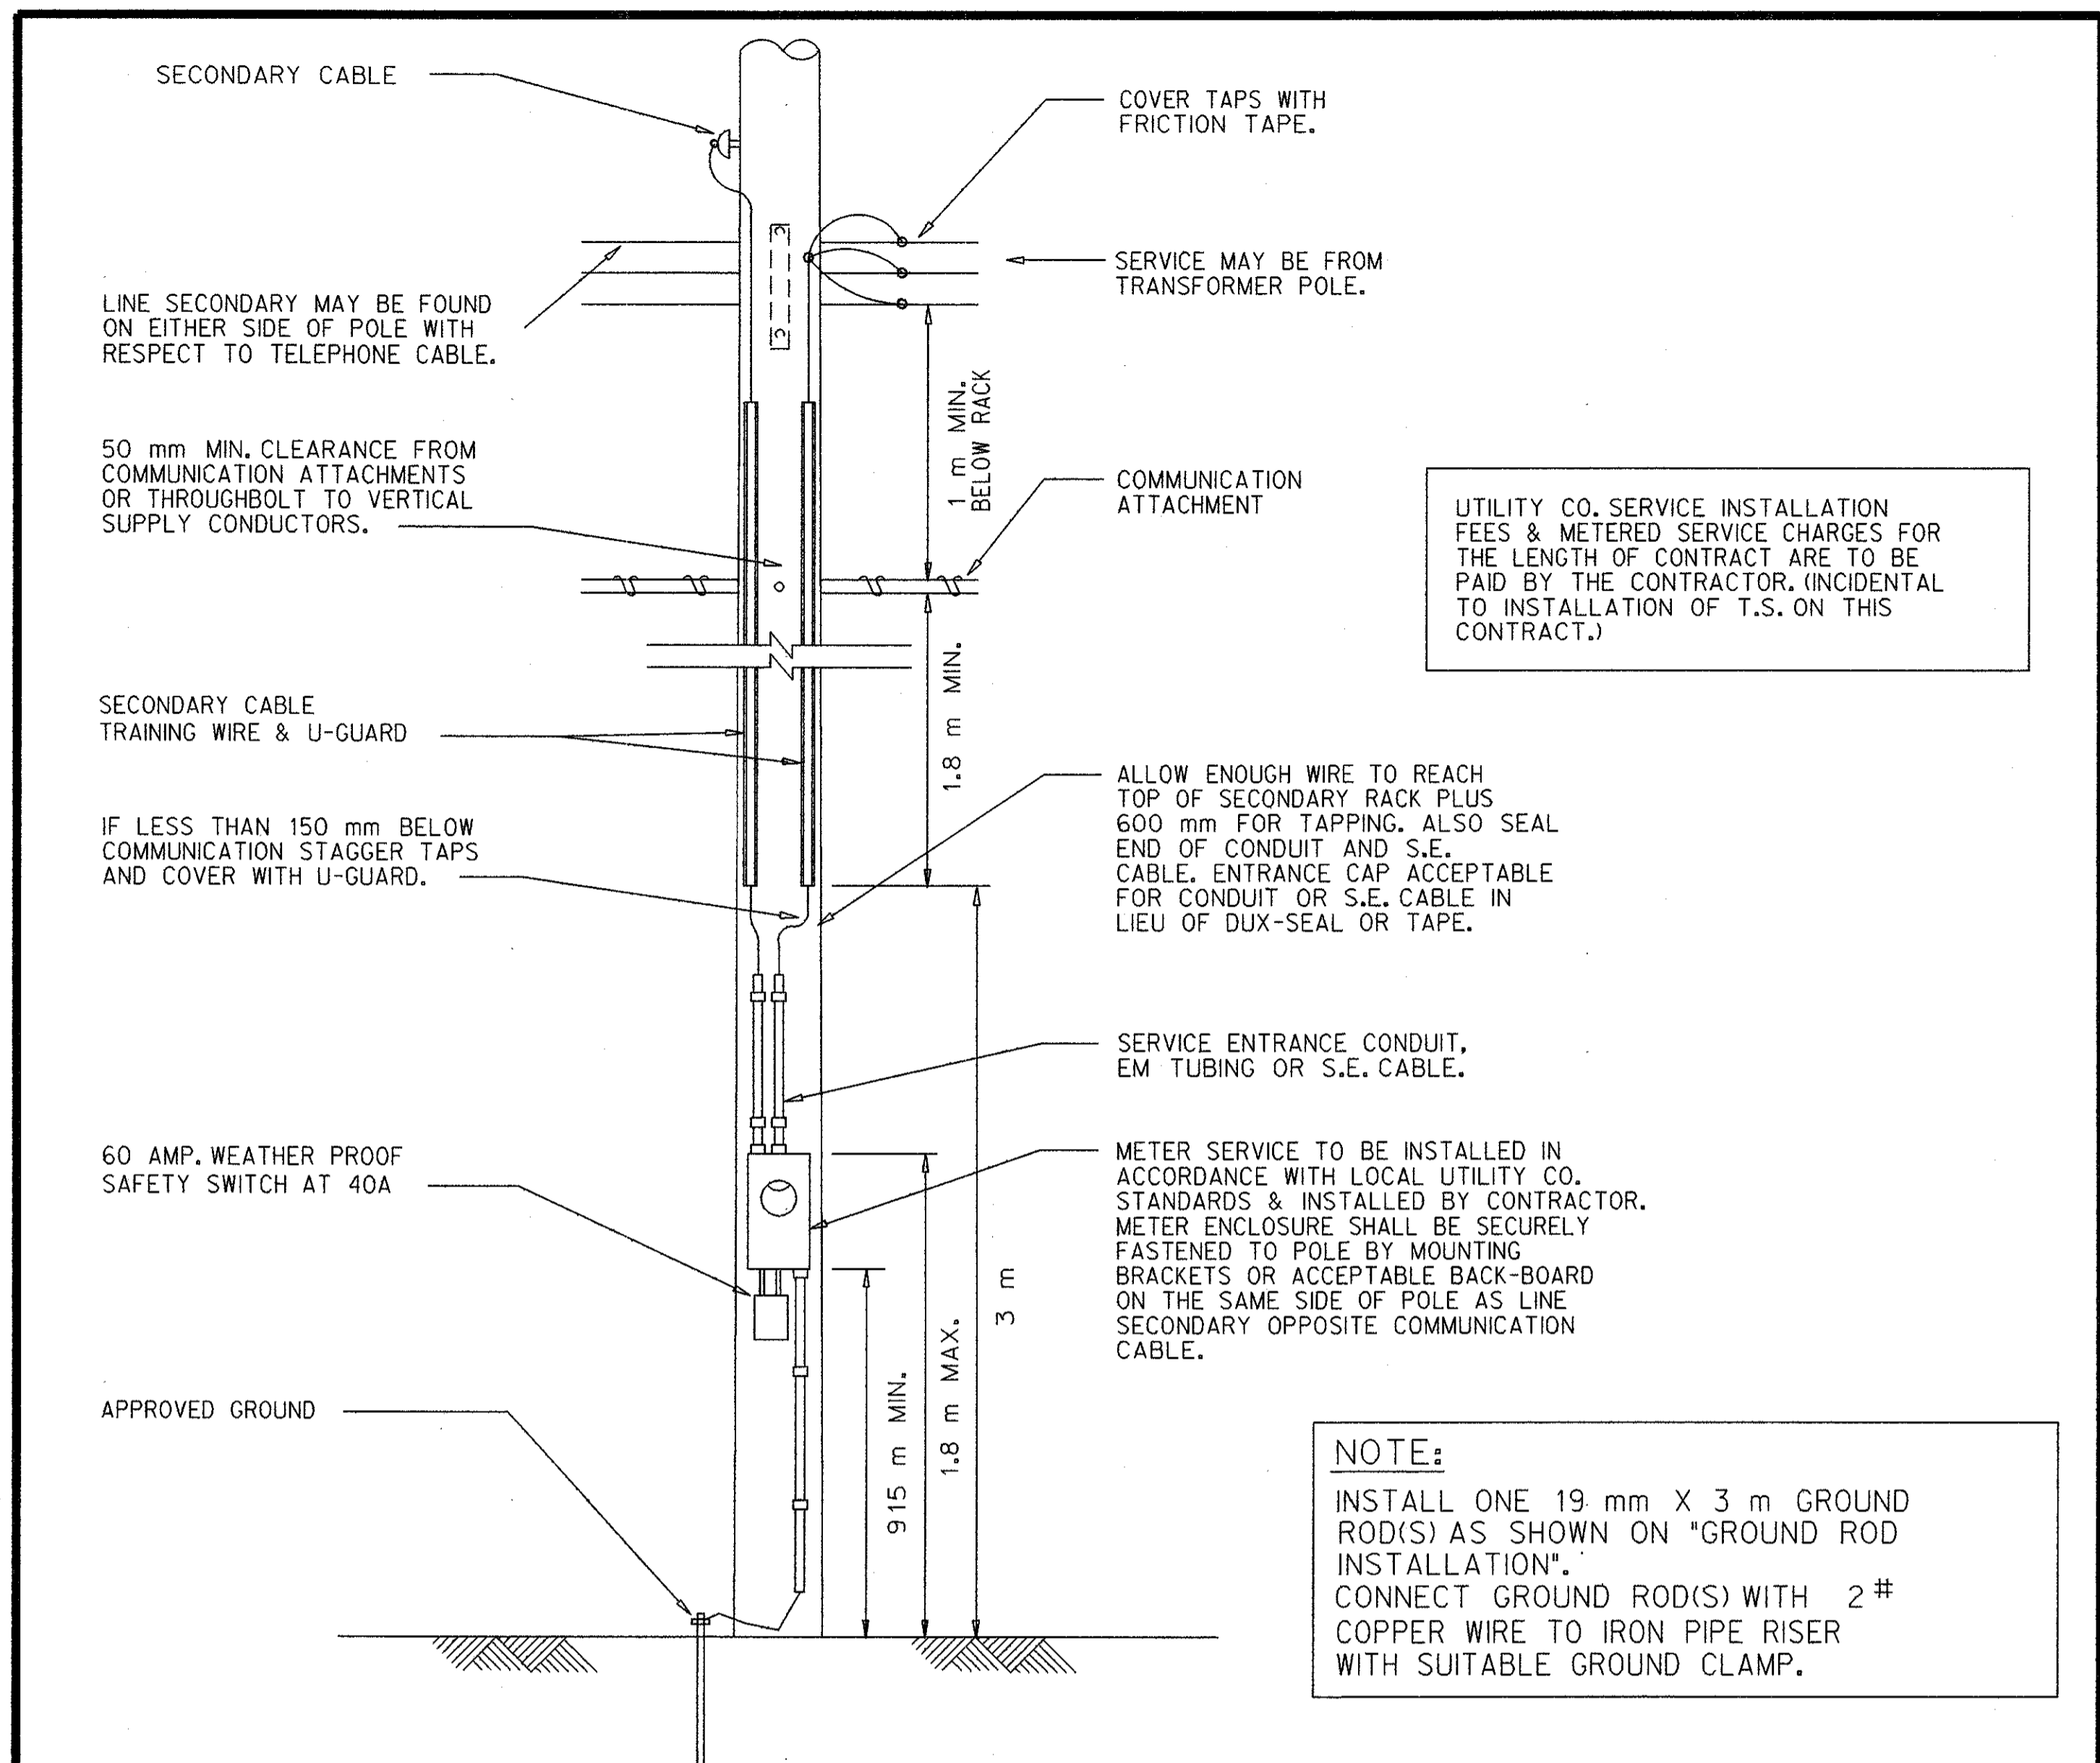

DETAIL : SERVICE POLE

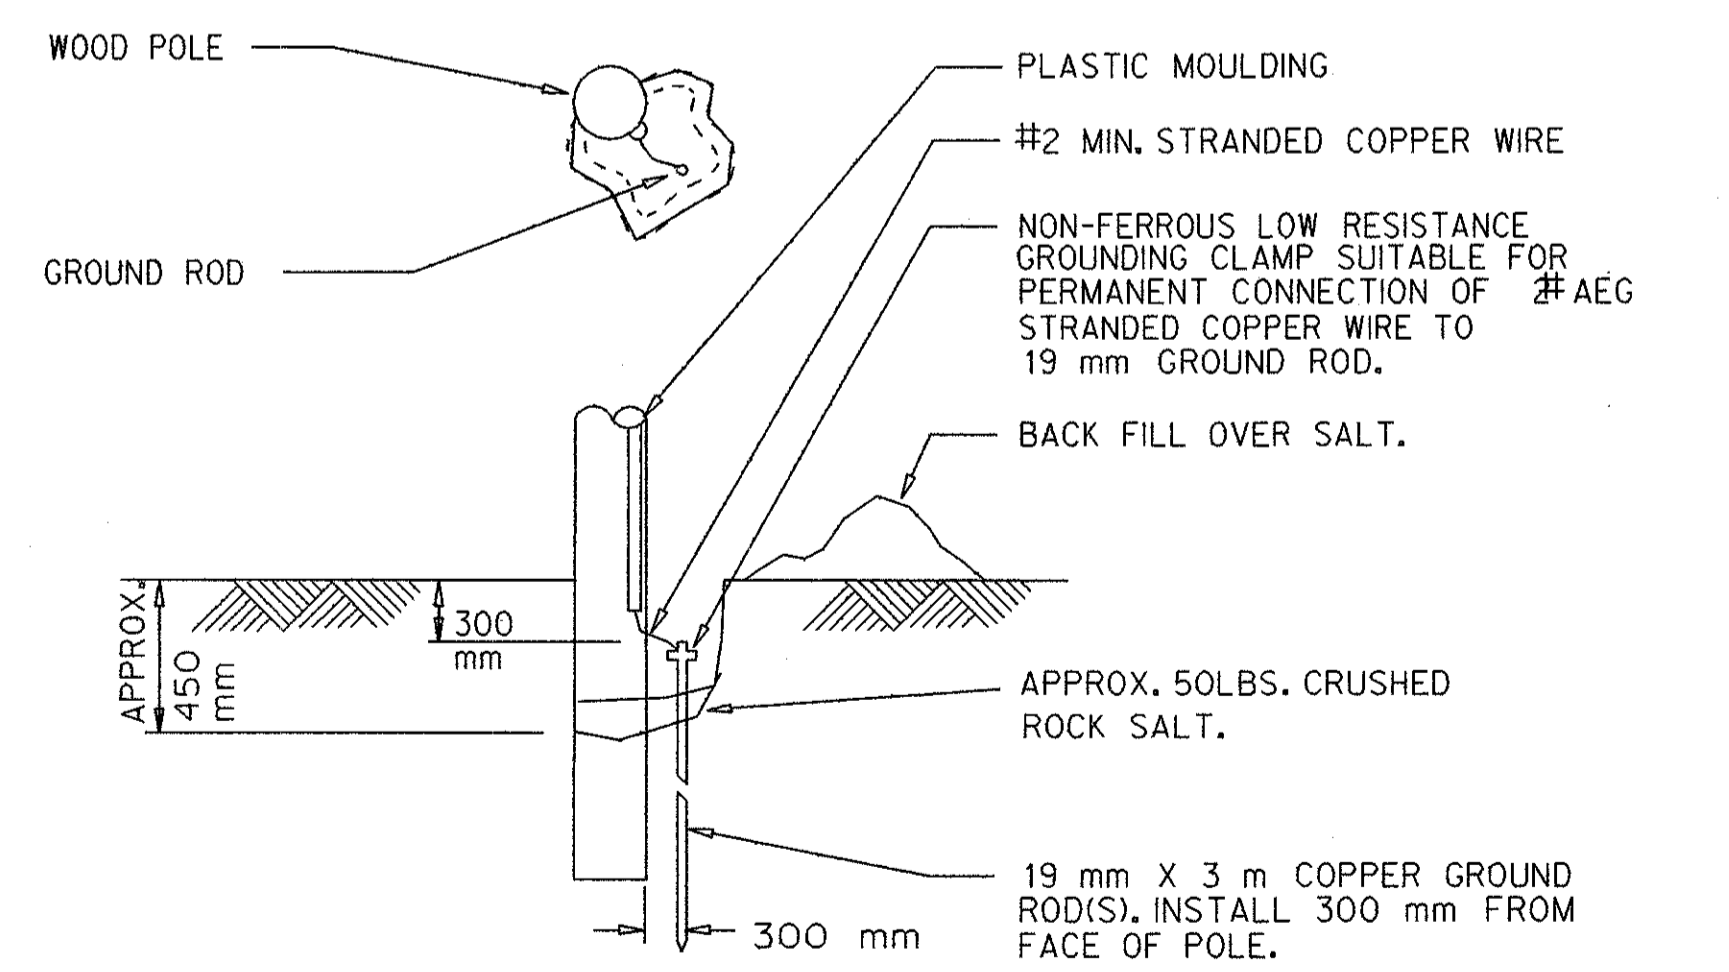


DETAIL : GROUND ROD INSTALLATION


SH 1 OF 4

OC-24

TEMPORARY SERVICE POLE					
DATE	SCALE	CONT. SEC.	JOB NO.	T & S	CONST.

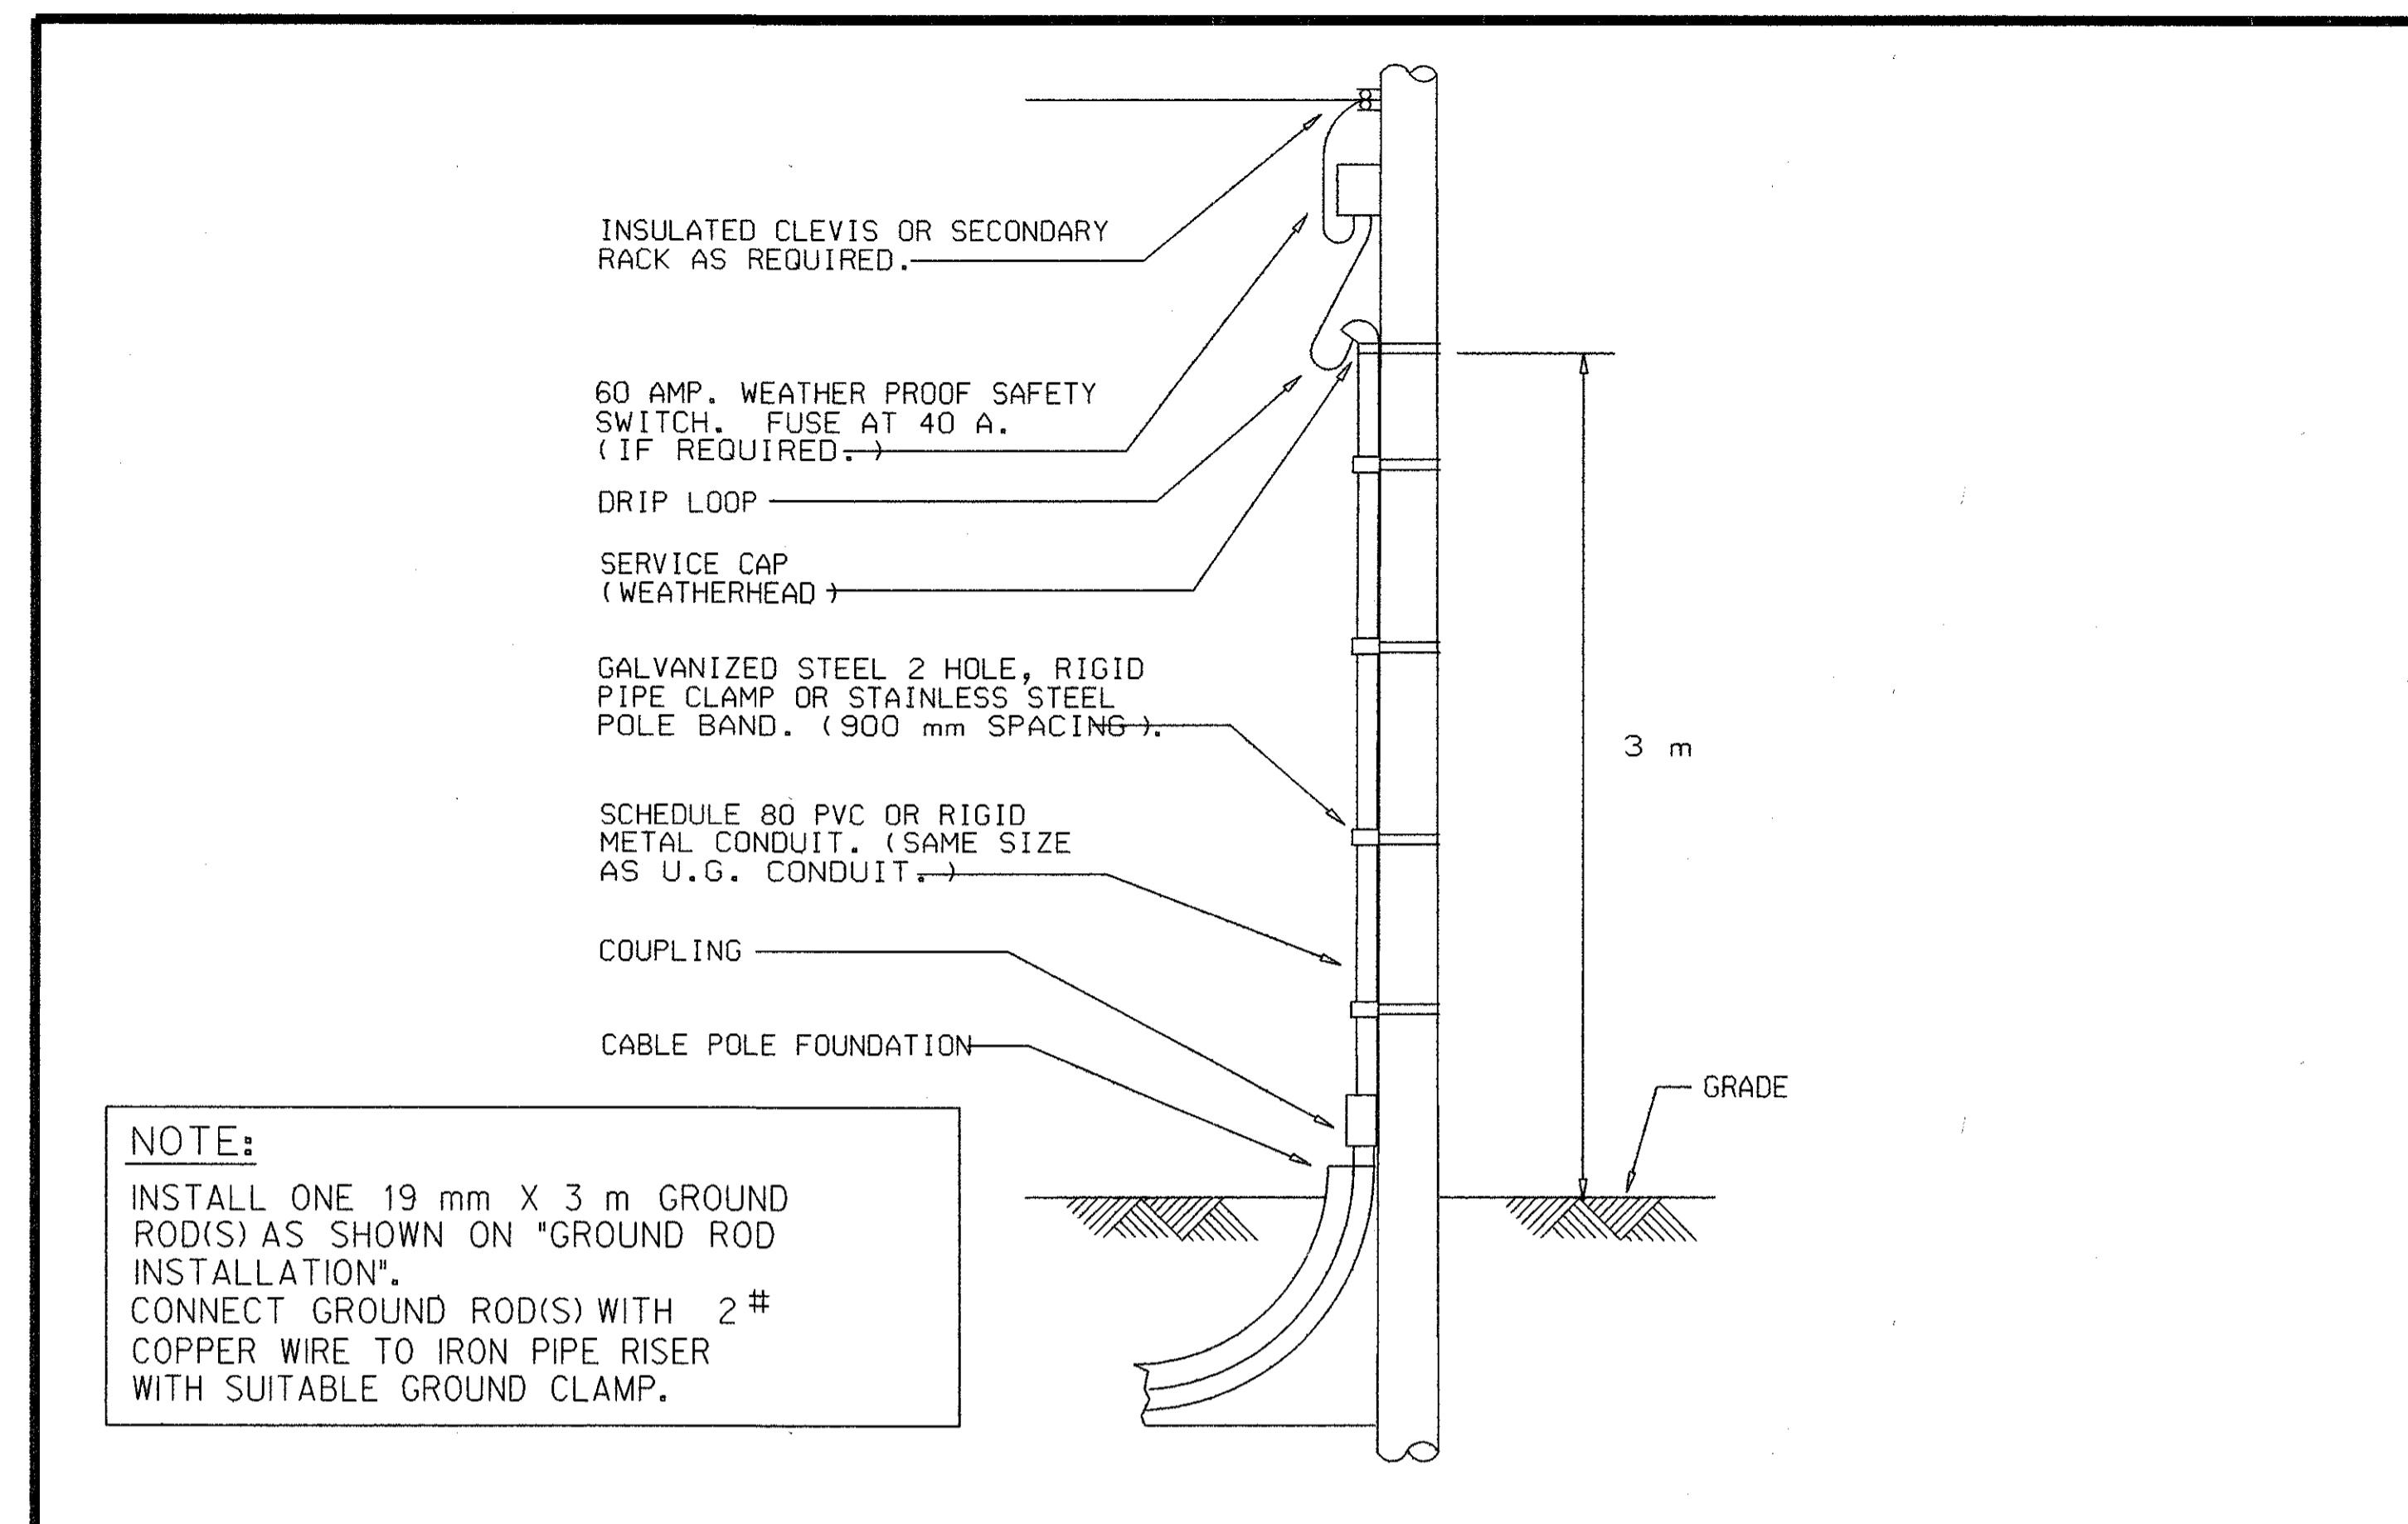

DETAIL : TYPICAL INTERCONNECT, SECONDARY & TRAFFIC SIGNAL CABLE POLE (N.T.S.)

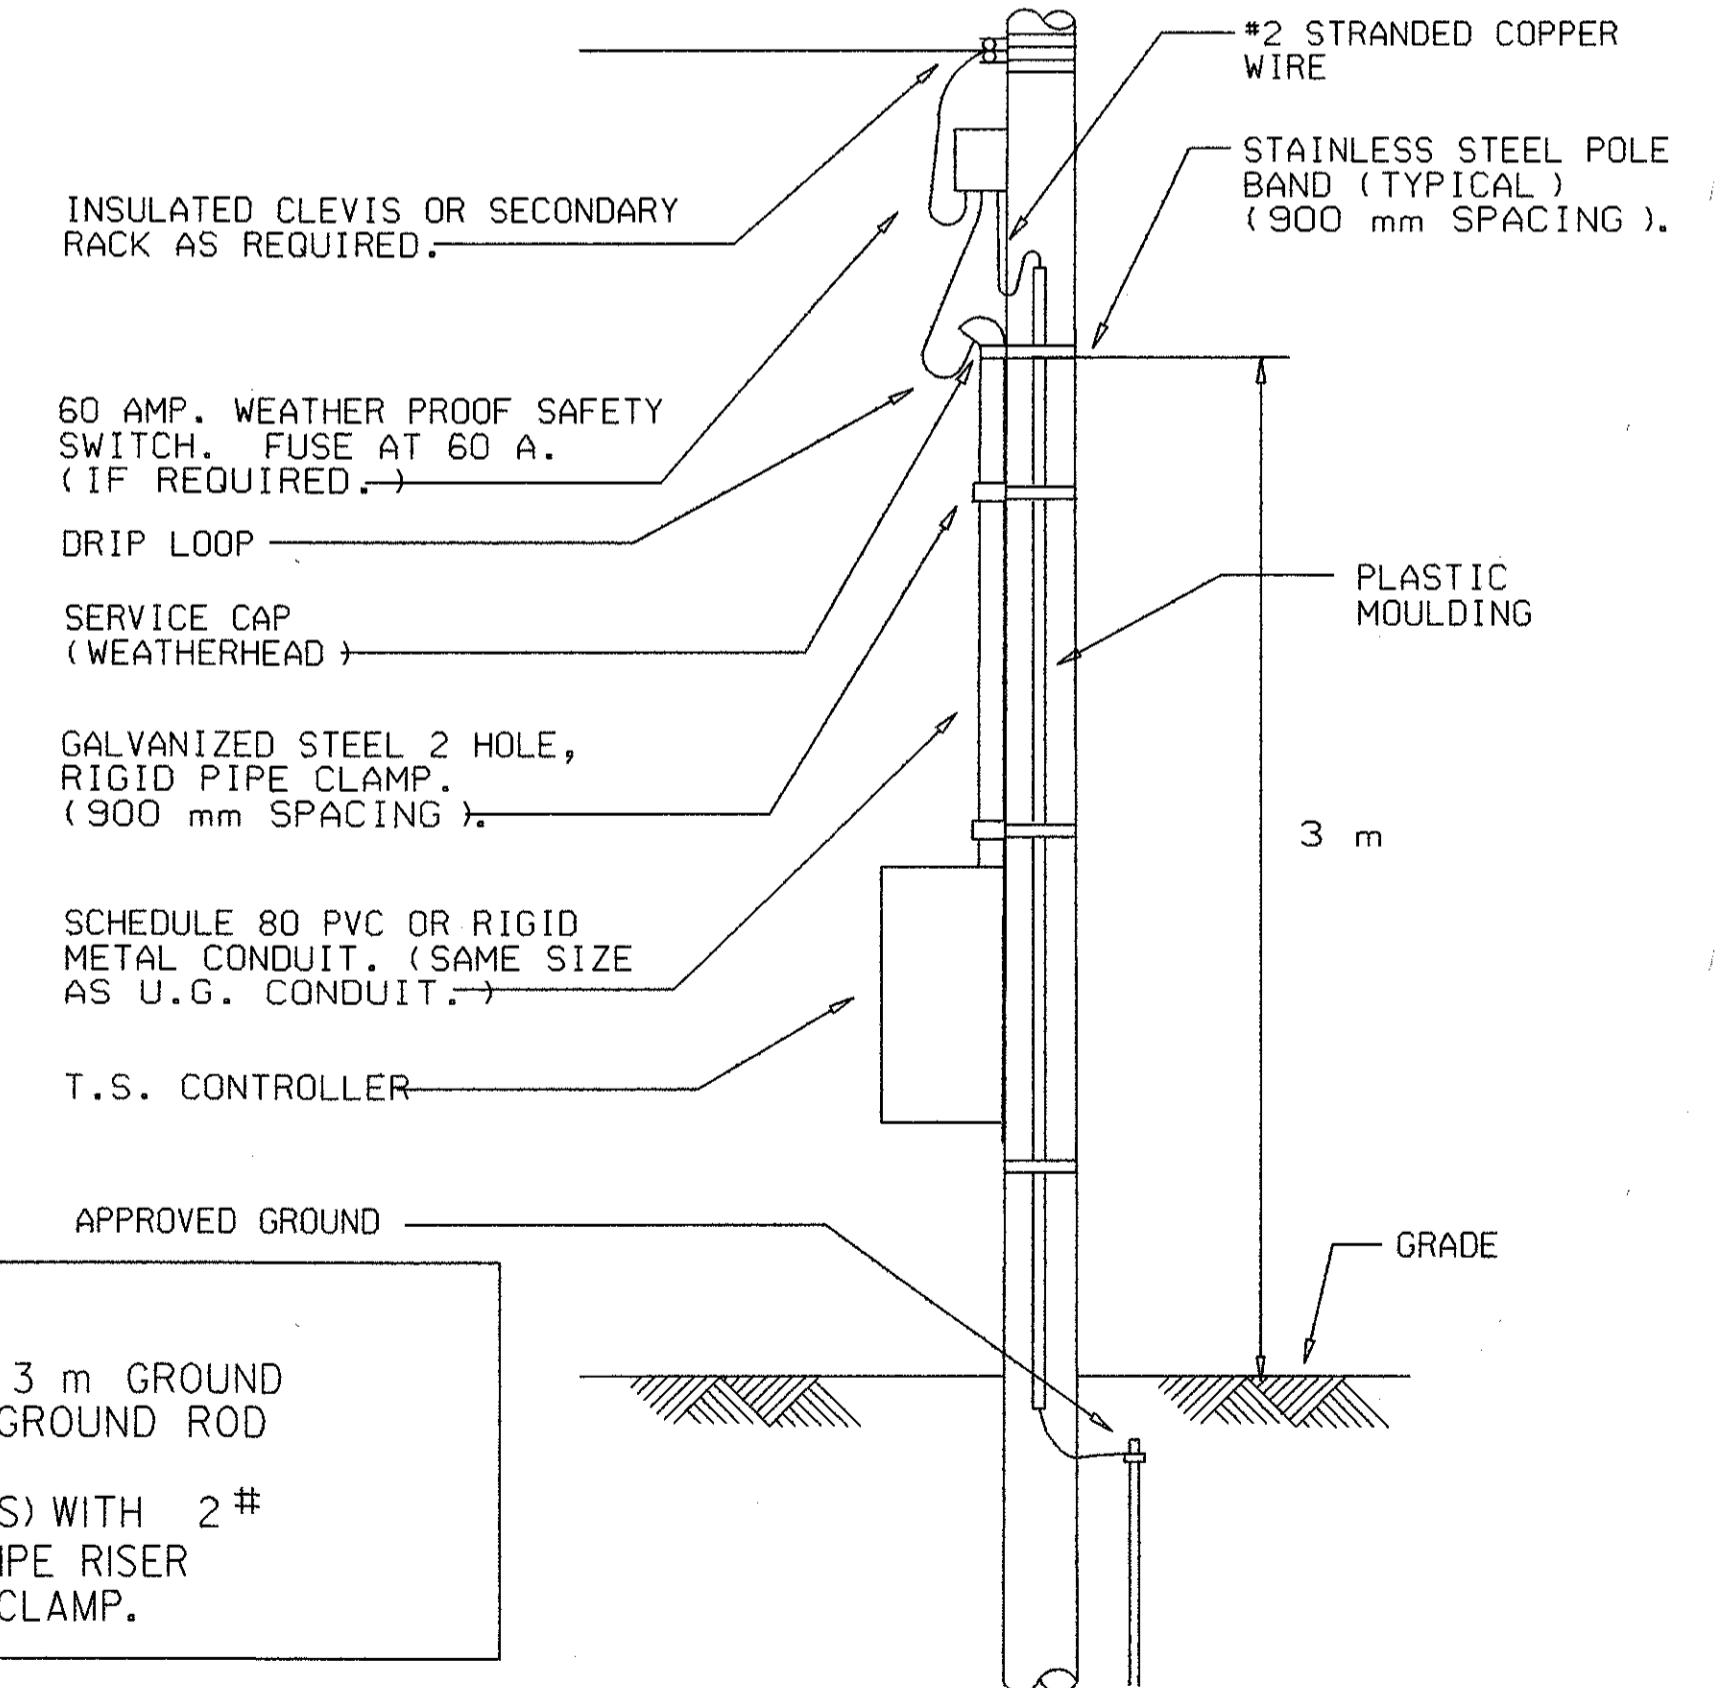


DETAIL : TYPICAL SERVICE POLE DETAIL


SH 2 OF 4

OC-24


TEMPORARY SERVICE POLE					
DATE	SCALE	CONT. SEC.	JOB NO.	T & S	CONST.
9-21-99		63174	48404A	28 of 31	28D

LAST CORRECTION DATE: 12/21/95
FILENAME: OC24.DGN

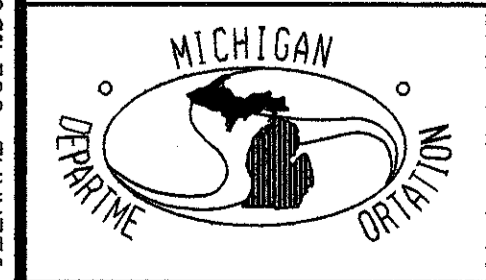


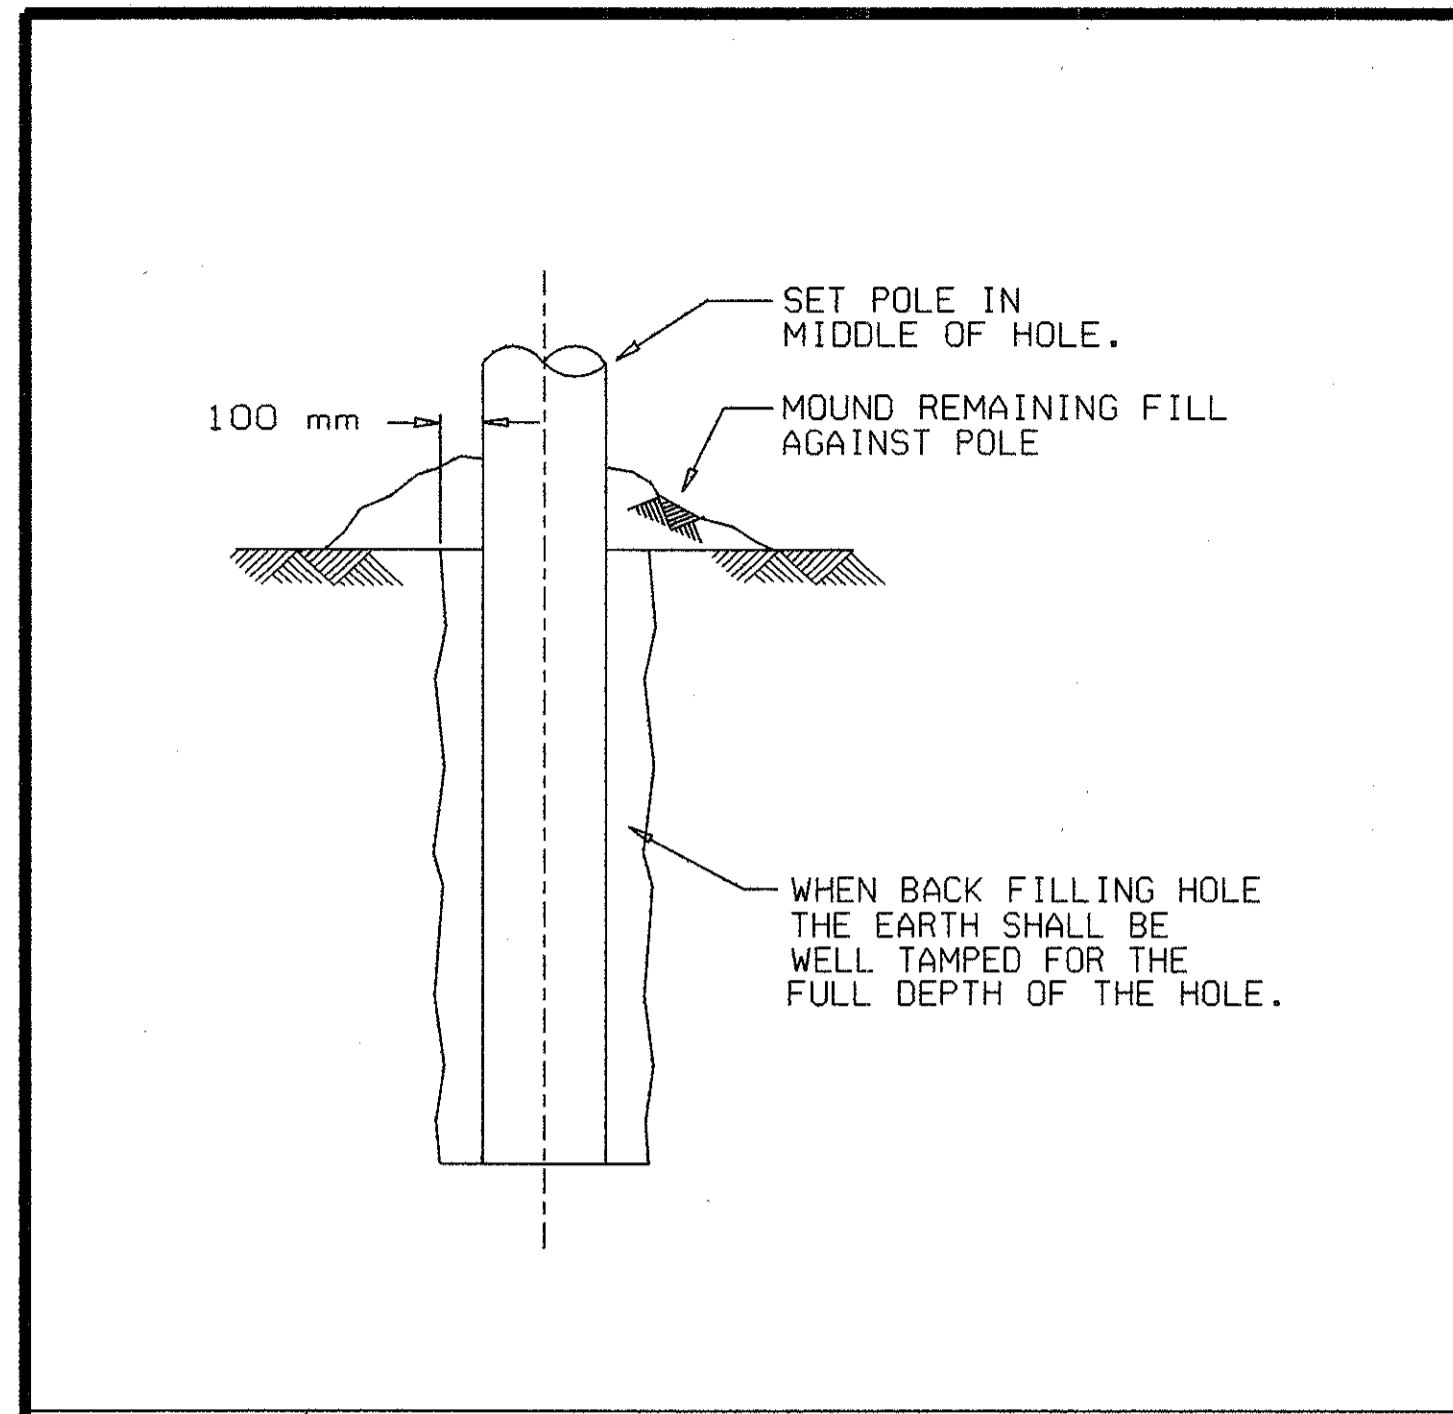


DETAIL : WOOD POLE INSTALLATION (N.T.S.)

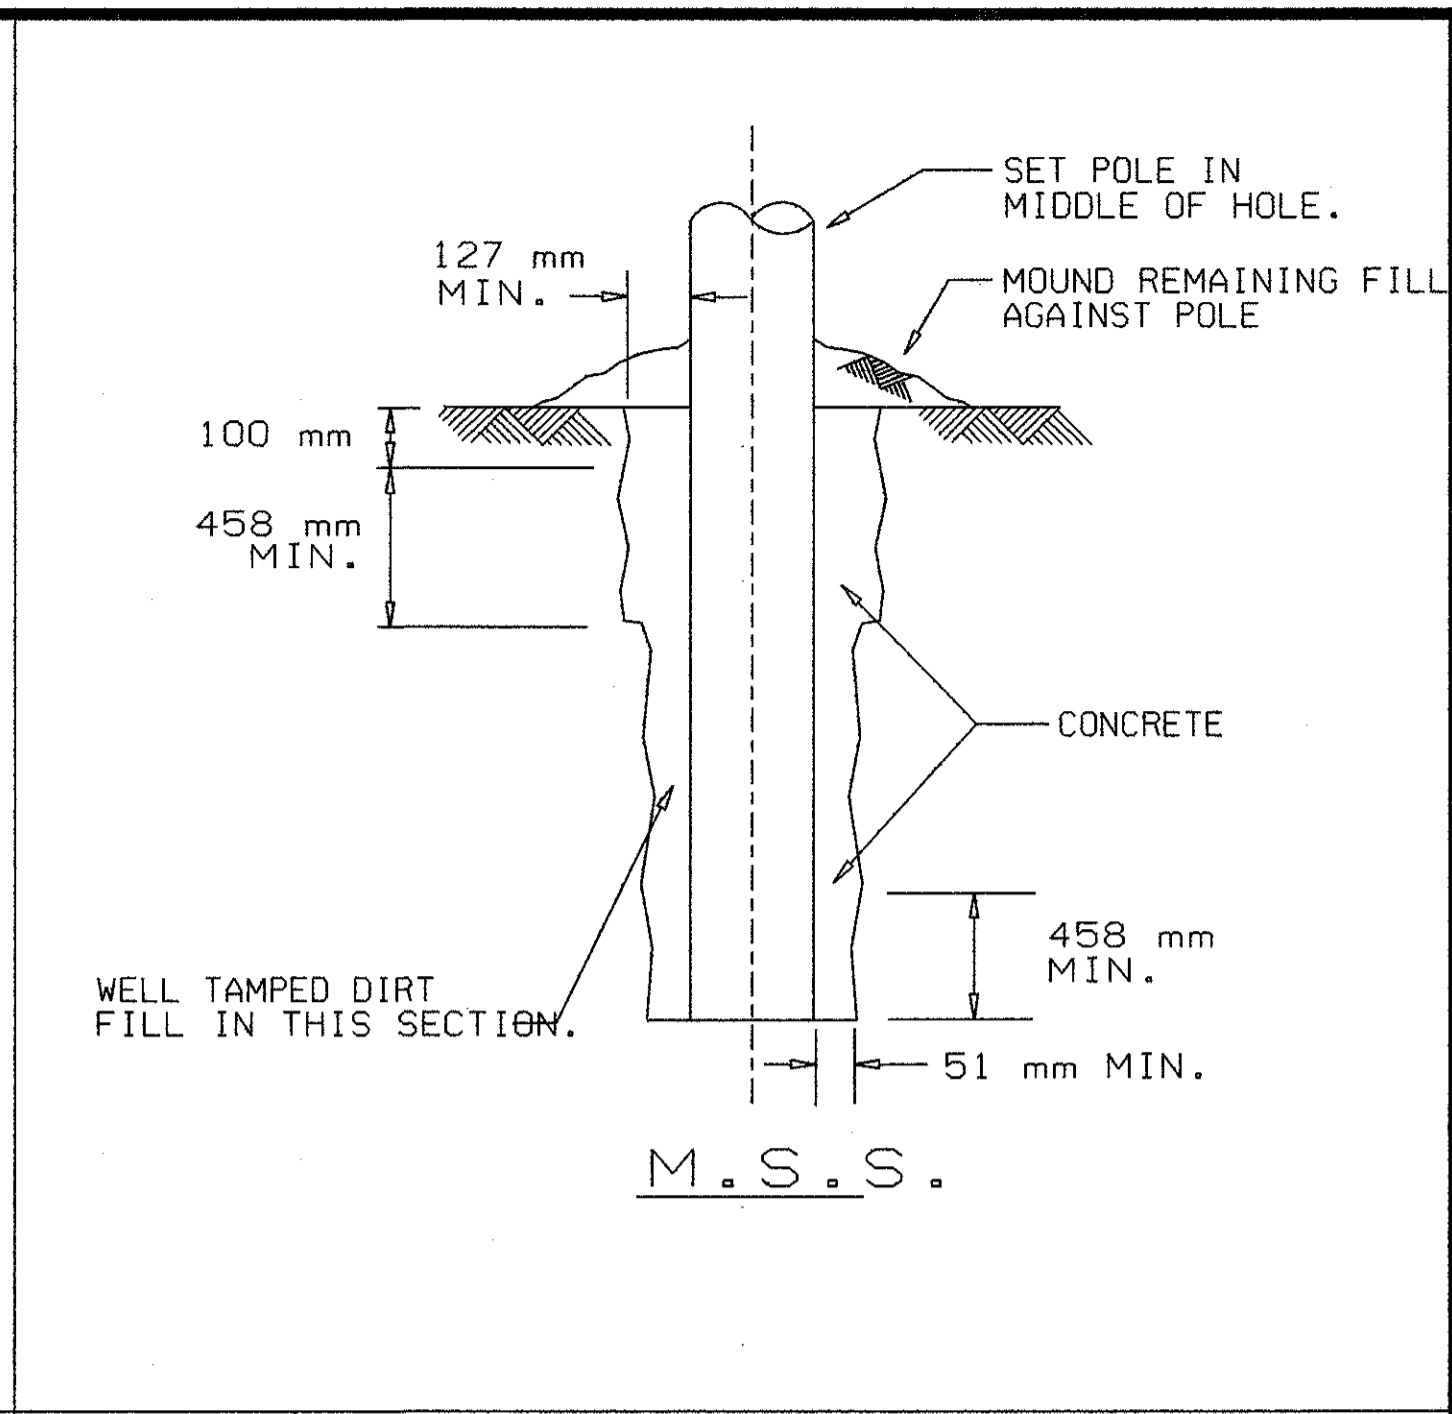

DETAIL : SELF-SUPPORTING WOOD POLE IN CONCRETE (N.T.S.)

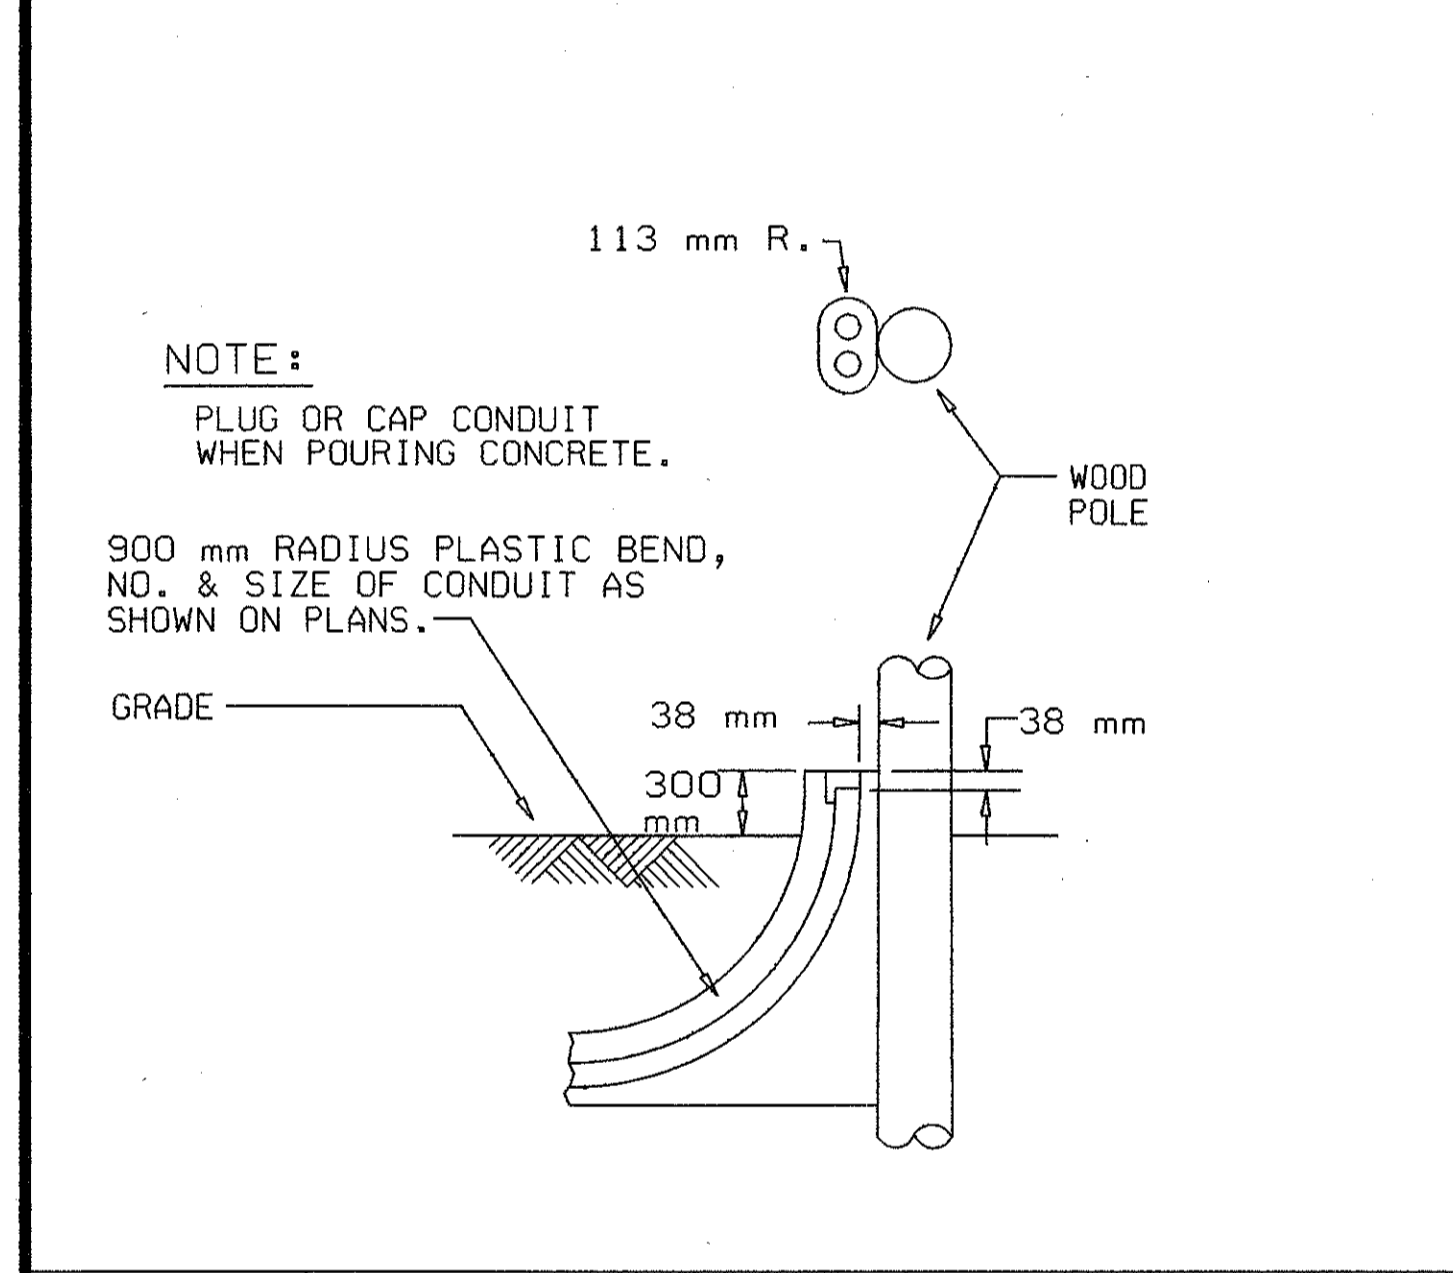

DETAIL : INSTALLATION OF CONDUIT AT CABLE POLE (N.T.S.)

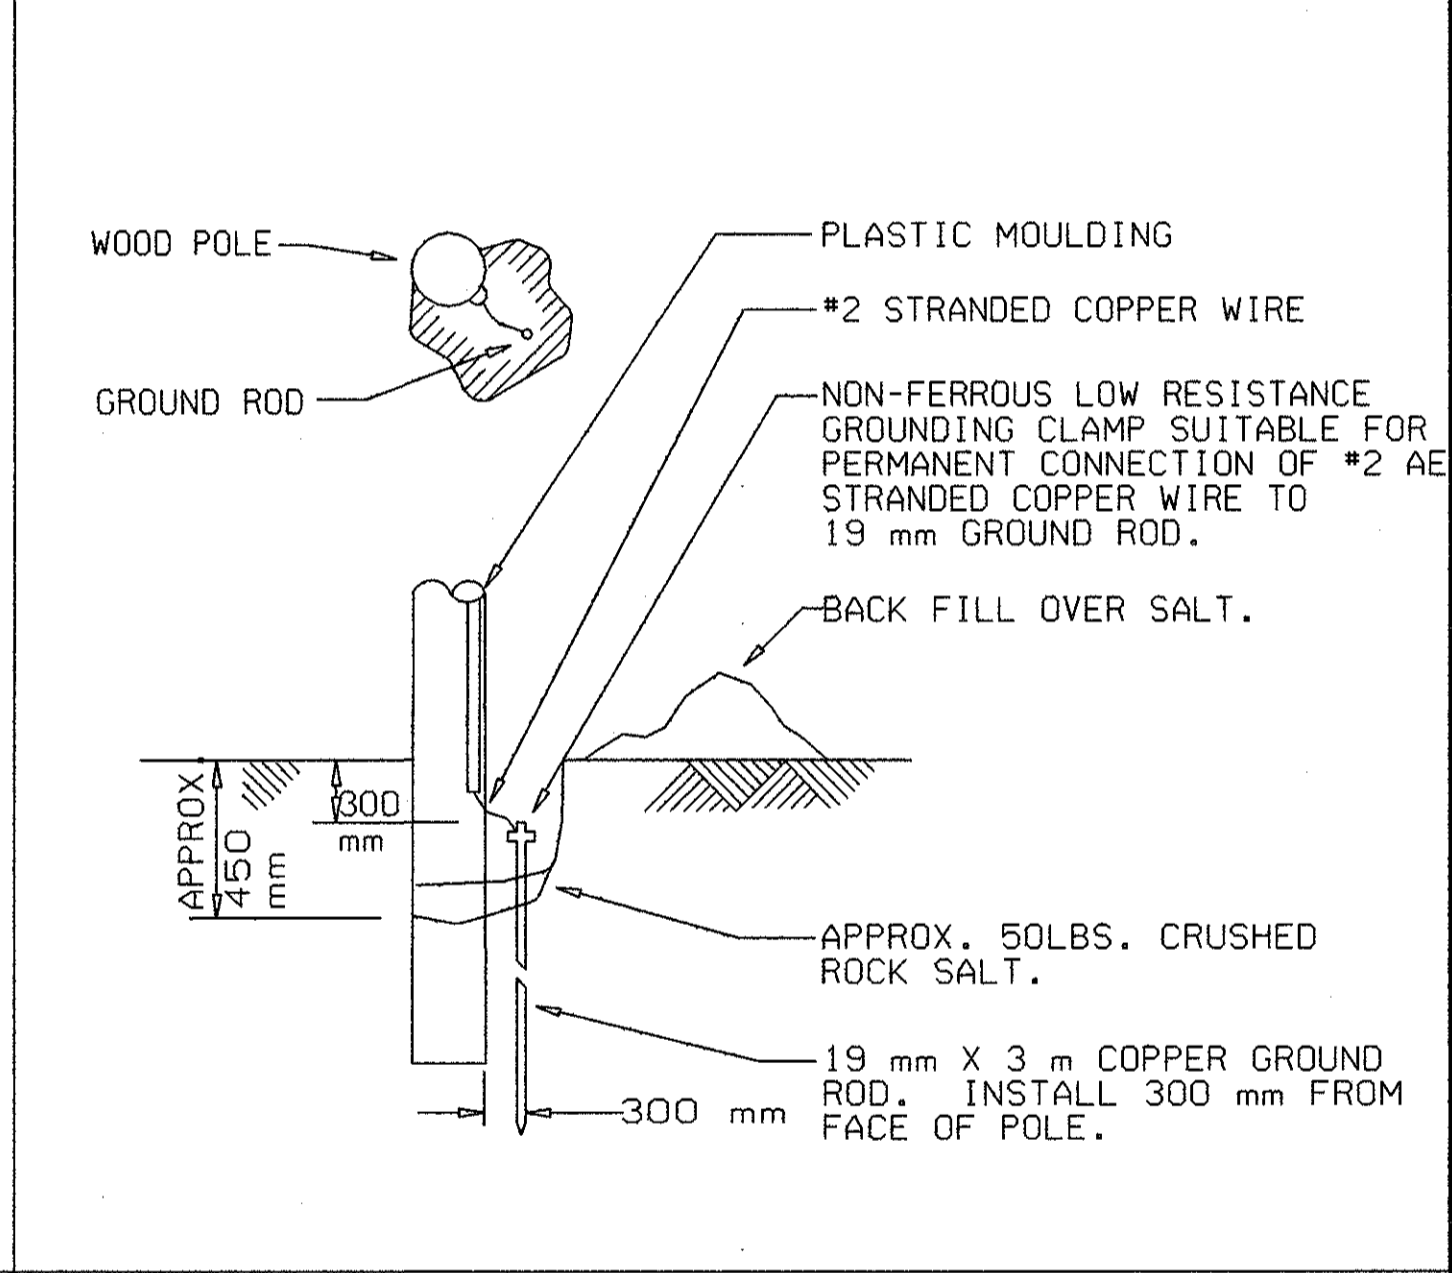


DETAIL : GROUND ROD INSTALLATION (N.T.S.)

POLE HEIGHT	SETTING DEPTH
9.1 m	1.8 m
10.7 m	1.8 m
12.2 m	1.8 m
13.7 m	2.0 m
15.2 m	2.1 m
16.8 m	2.3 m
18.3 m	2.4 m

NOTE:
FOR ALL CABLE POLES, INSTALL ONE 19 mm X 3 m GROUND ROD AS SHOWN ON "GROUND ROD INSTALLATION". CONNECT GROUND ROD WITH #2 COPPER WIRE TO IRON PIPE RISER WITH SUITABLE GROUND CLAMP.

SH. 3 OF 4
OC-24



TEMPORARY SERVICE POLE					
DATE	SCALE	CONT. SEC.	JOB NO.	T & S	CONST.

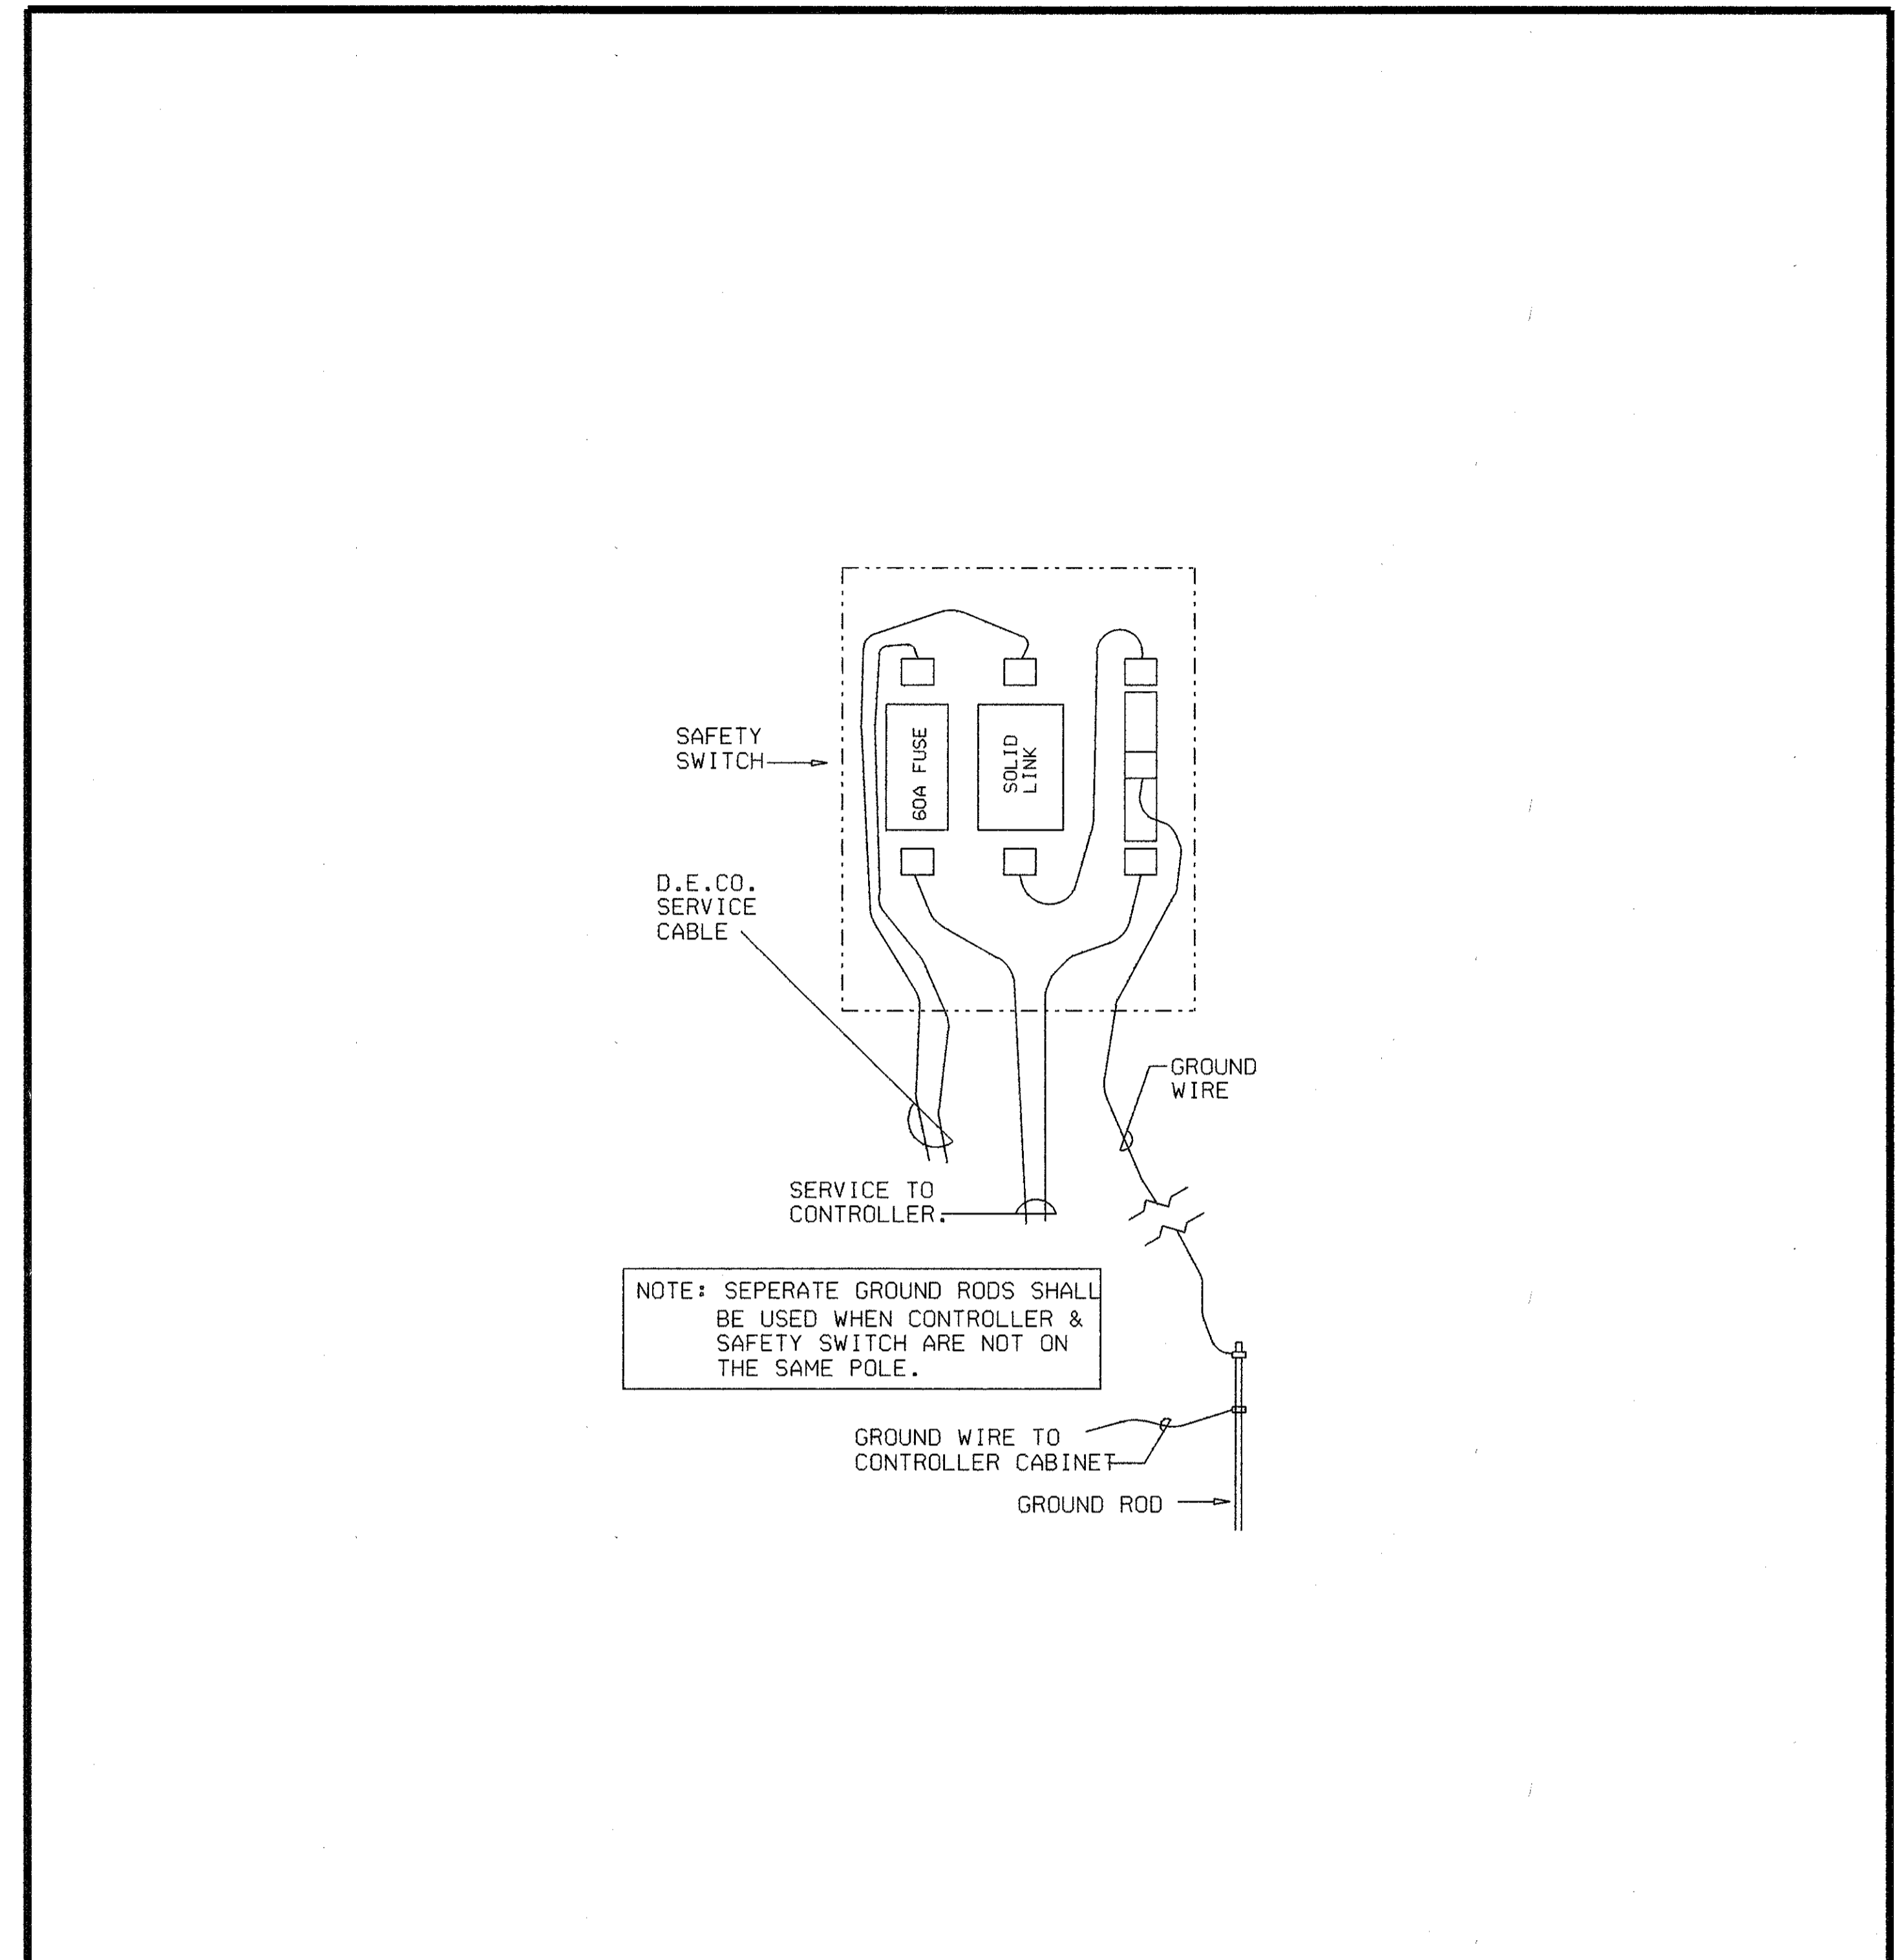

DETAIL : 60 AMP. SAFETY SWITCH (N.T.S.)

SH. 4 OF 4
OC-24

TEMPORARY SERVICE POLE					
DATE	SCALE	CONT. SEC.	JOB NO.	T & S	CONST.
9-21-99		63174	48404A	29 of 31	29D

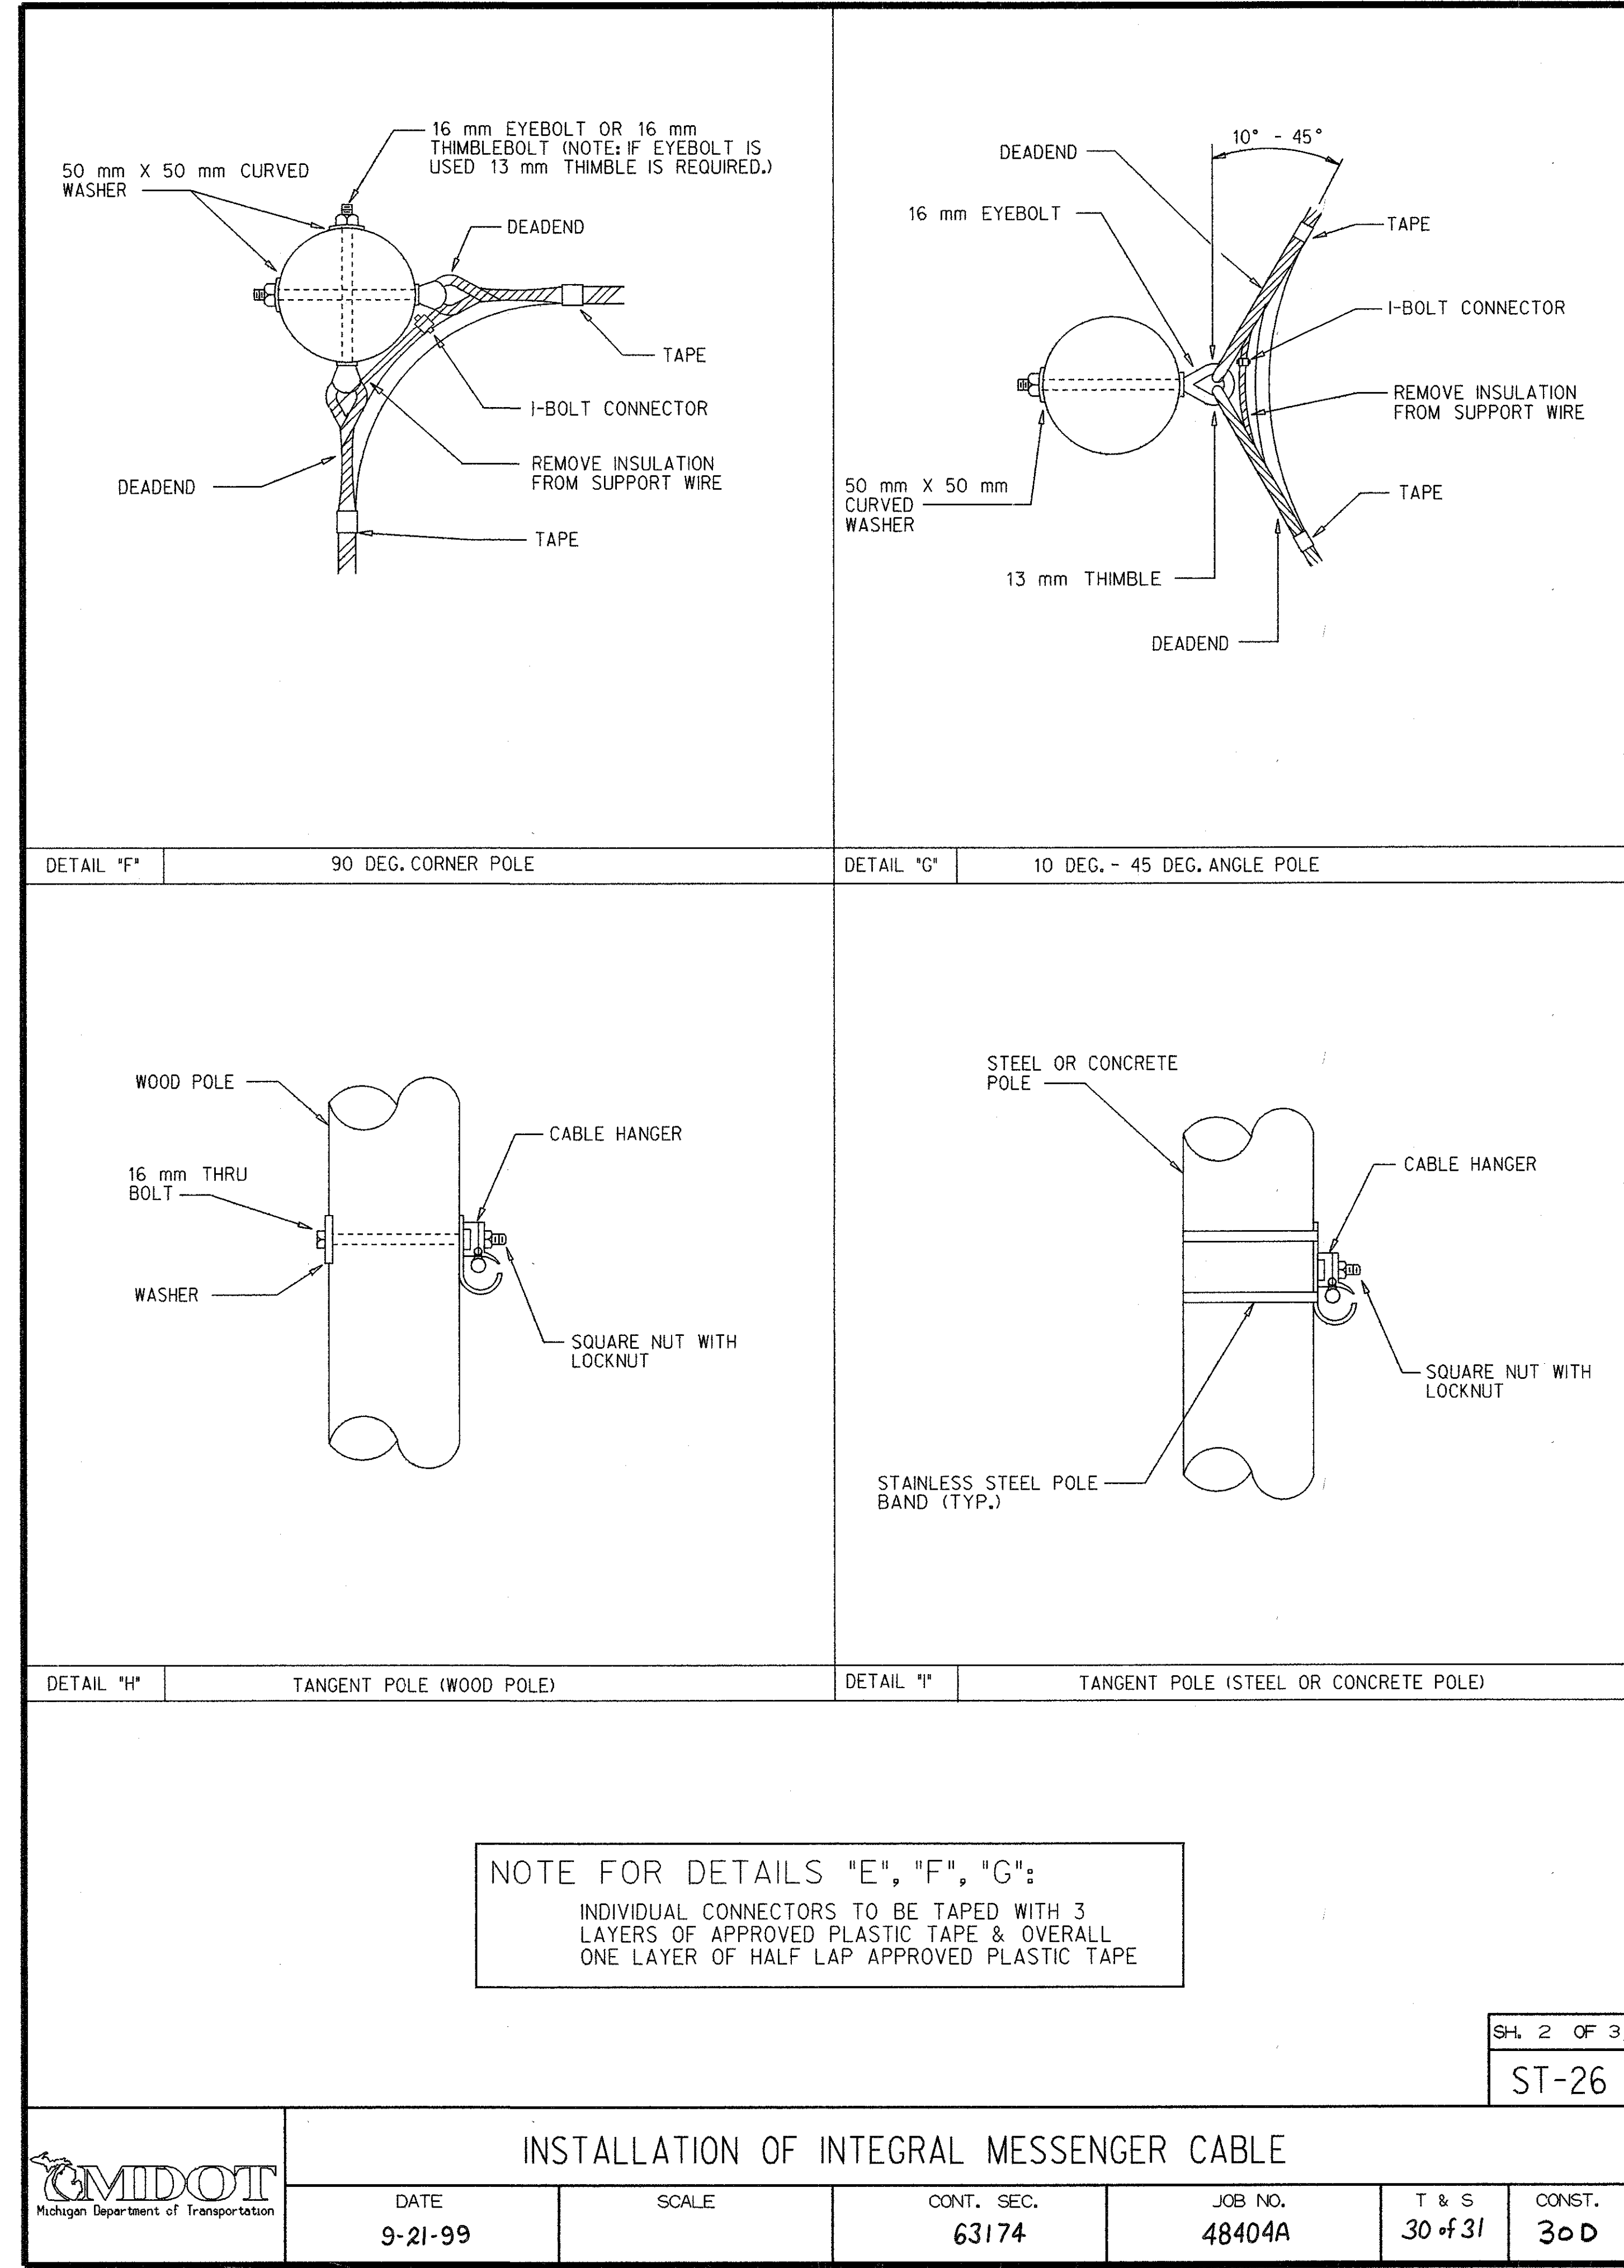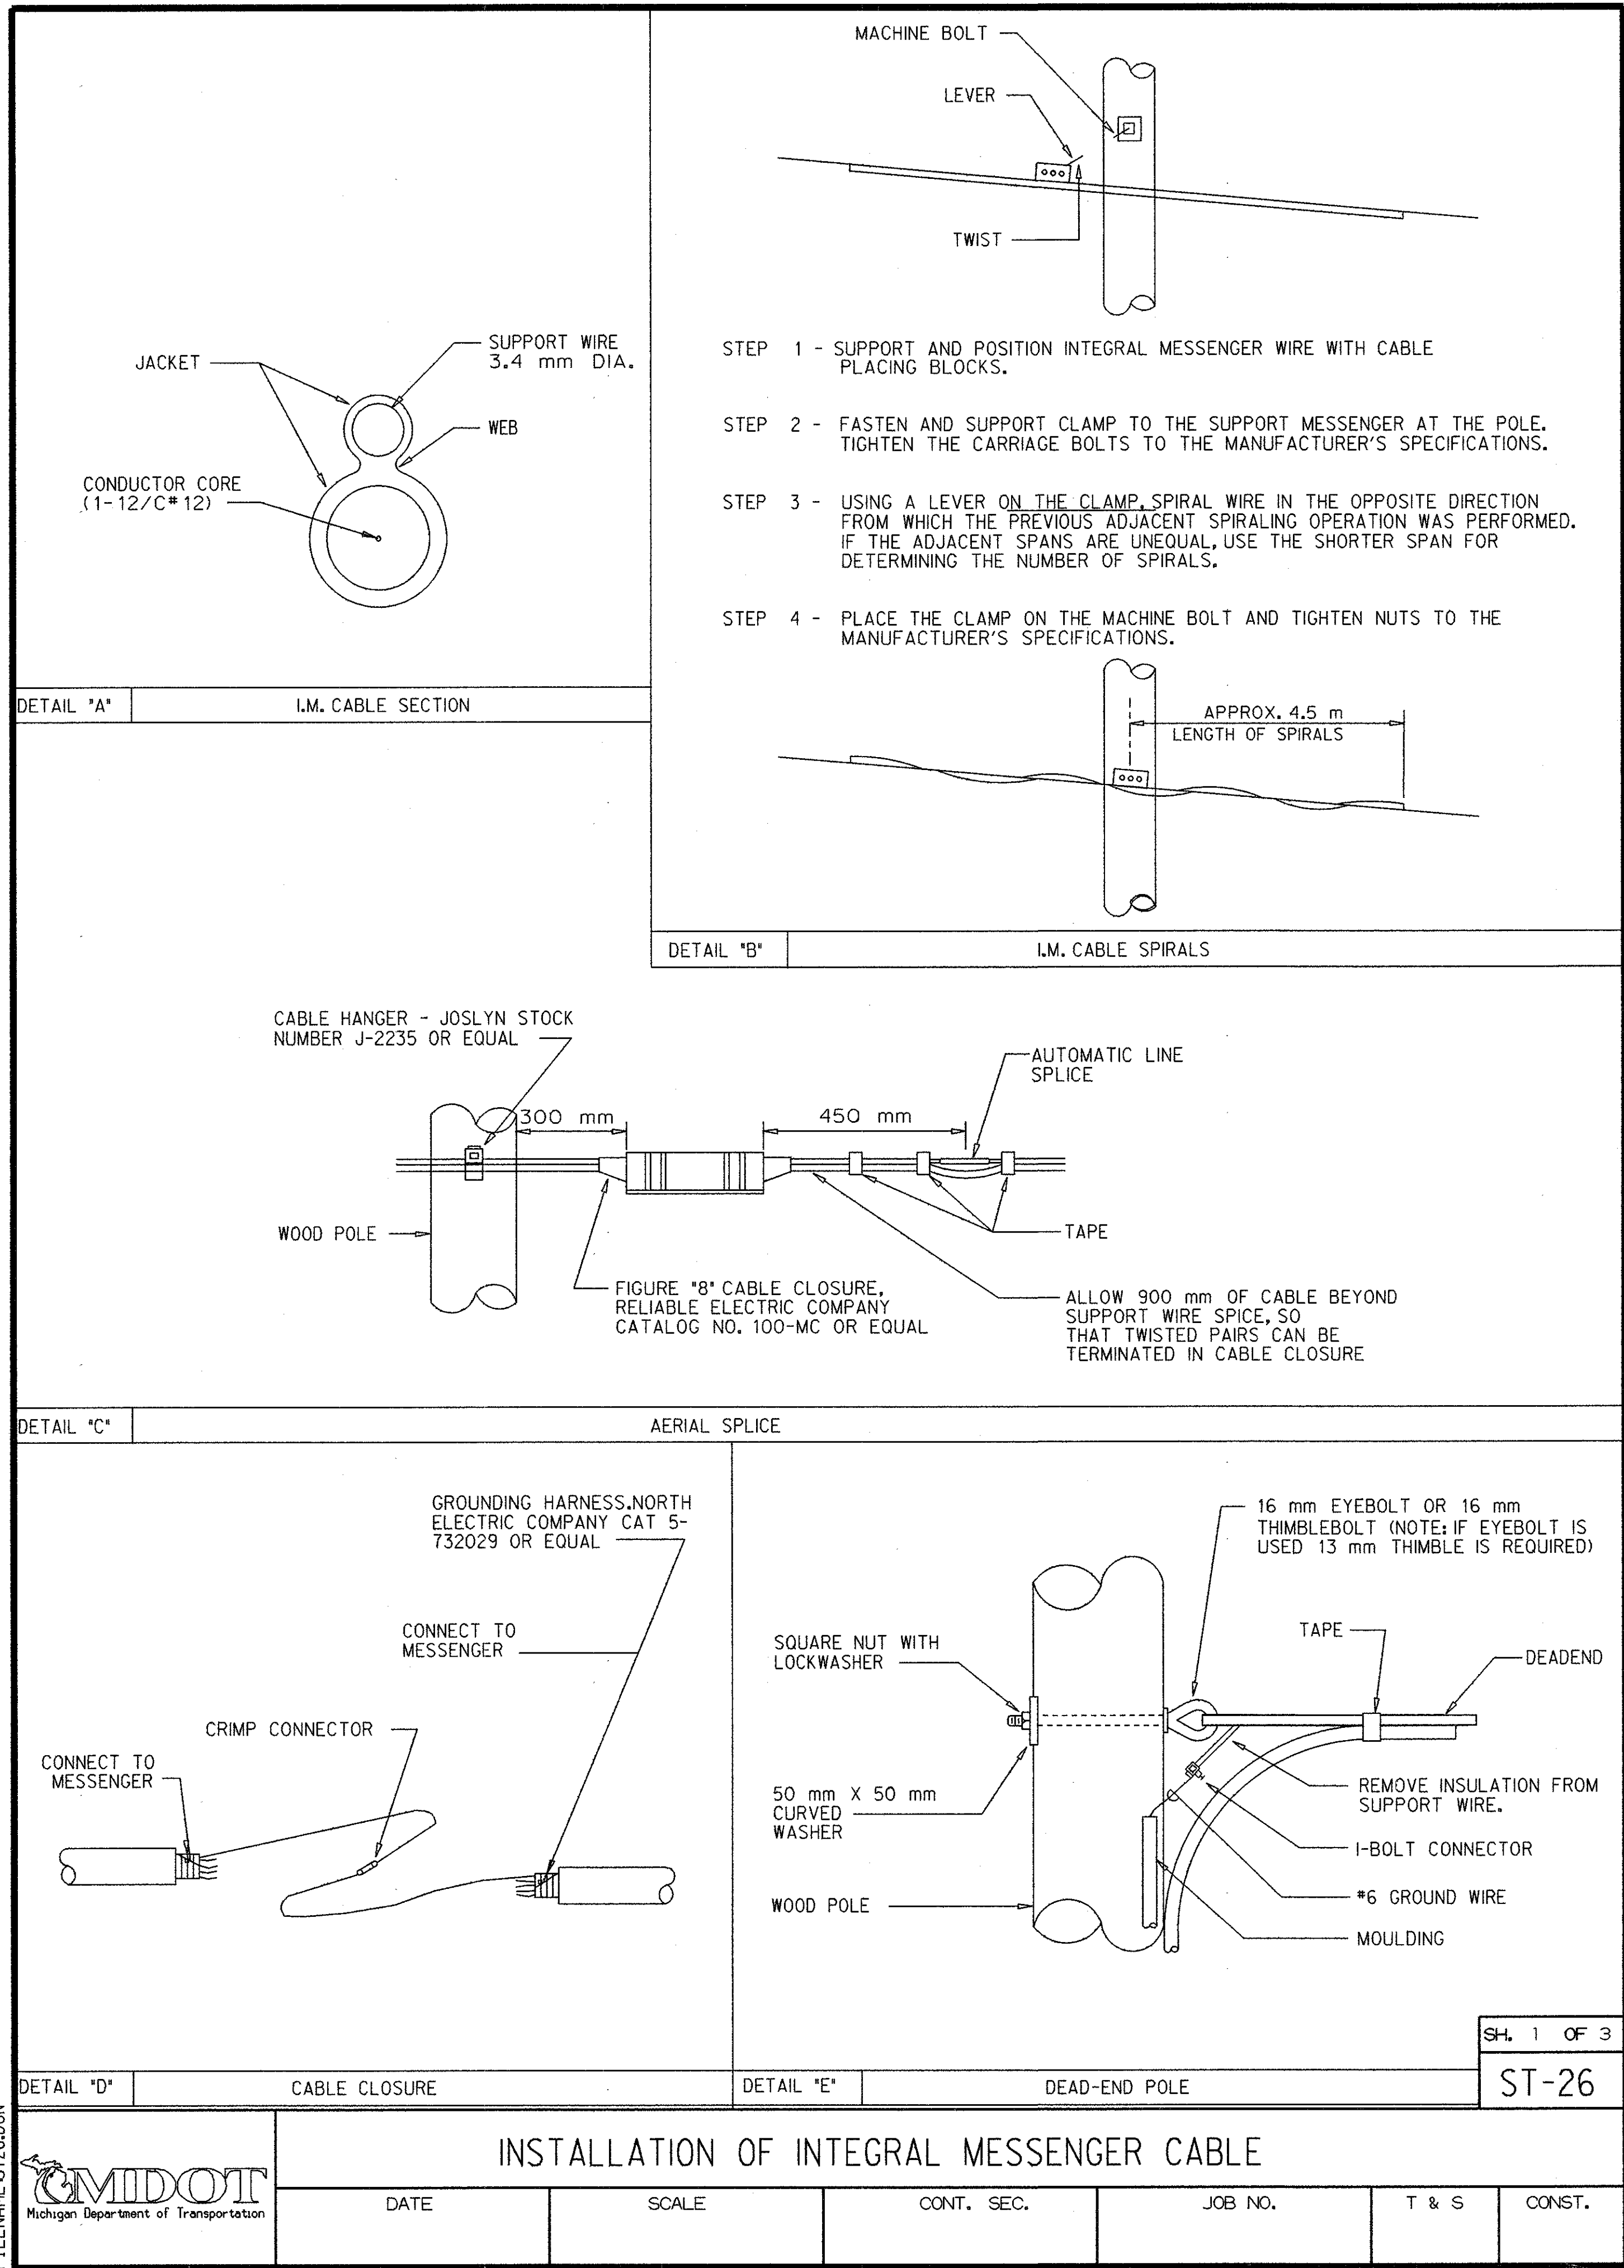

LAST CORRECTION DATE: 12/22/95
FILENAME: S126.DGN



DESCRIPTION:

INTEGRAL MESSENGER WIRE CONSISTS OF A SUPPORT WIRE AND A CONDUCTOR CORE LAID PARALLEL AND COVERED WITH A SINGLE EXTRUSION OF BLACK, LOW DENSITY POLYETHYLENE. THE SINGLE EXTRUSION PROVIDES A JACKET OVER THE SUPPORT WIRE AND CORE, AND FORMS A WEB JOINING THE TWO. SEE DETAIL "A" THIS SHEET. THE SUPPORT WIRE IS 3.4 mm IN DIAMETER, GRADE 190 STEEL, CLASS A GALVANIZED, EXTRA HIGH STRENGTH STEEL HAVING A RATED BREAKING STRENGTH OF 1216 kg.

INSTALLATION:

EVERY EFFORT SHALL BE MADE TO LIMIT THE LENGTH OF SPANS TO A MAXIMUM OF 76.2 m. INTEGRAL MESSENGER WIRE IS PRONE TO LOW FREQUENCY WIND VIBRATION COMMONLY REFERRED TO AS "DANCING" WHILE "DANCING" MAY NOT BE SO VIOLENT IN LOW WIND AREAS AS TO ATTRACT ATTENTION, PROLONGED LOW AMPLITUDE VIBRATION WILL EVENTUALLY CAUSE OPEN CIRCUITS AND/OR SUPPORT WIRE FAILURE. THEREFORE, REA RECOMMENDS THAT ALL INTEGRAL MESSENGER DISTRIBUTION WIRE BE SPIRALLED APPROXIMATELY ONE SPIRAL FOR EACH 5 m OF SPAN.


SPIRALLING OF THE WIRE SHOULD BE DONE FROM EVERY OTHER POLE BY APPLYING THE SPIRALLING TORQUE TO THE SUPPORT CLAMP AFTER THE TWO OUTSIDE BOLTS HAVE BEEN PROPERLY TIGHTENED, THUS KEEPING THE SPIRALLING TORQUE ON THE SUPPORT WIRE AND NOT ON THE CORE. AS SPIRALLING OPERATIONS PROCEED ALONG A LEAD, SPIRALLING AT ALTERNATE POLES SHOULD BE IN OPPOSITE DIRECTIONS, THEREBY REDUCING THE TORSION OTHERWISE IMPOSED ON THOSE CLAMPS WHICH ARE AT THE INTERMEDIATE POLES THE PROCEDURE TO BE FOLLOWED IN SPIRALLING DISTRIBUTION WIRE IS SHOWN IN DETAIL "B" OF THIS SHEET.

IF CLAMPS ARE NOT ADEQUATELY TIGHTENED THE TORSION DEVELOPED IN SPIRALLING WILL CAUSE THE SUPPORT WIRE TO TURN IN THE CLAMP RESULTING IN THE MIGRATION OF THE SPIRALS FROM THE SPANS TOWARD THE POLE. "DANCING" OF THE WIRE AND DAMAGE TO IT AT THE POLES WILL BE THE FINAL RESULTS OF INADEQUATE CLAMPING. THE PROPER TYPE OF SUPPORT CLAMPS MUST BE USED ON ALL CORNERS AS SHOWN IN DETAILS THIS SHEET.


WHEN PULLING THE WIRE UP TO CORRECT SAG, A SUITABLE WIRE GRIP SHOULD BE USED DIRECTLY ON THE INSULATED SUPPORT WIRE. THE GRIP SHOULD BE OF SUCH DESIGN AS TO GIVE PROPER HOLDING POWER AND YET NOT DAMAGE THE SUPPORT WIRE JACKET. THE CRESCENT TOOL COMPANY #800 OR AN EQUIVALENT GRIP IS SUGGESTED. A STANDARD LINE WIRE GRIP SHOULD NOT BE USED BECAUSE IT WILL DAMAGE THE INSULATION. IF THE INSULATION IS DAMAGED IN ANY WAY, IT MUST BE REPAIRED WITH SEALING COMPOUND OR BY CUTTING OUT THE DAMAGED PORTION. AT DEADENDS IT IS NECESSARY TO REMOVE THE SUPPORT WIRE COVERING BEFORE APPLYING THE DEADEND GRIPS. IT MUST BE DONE CAREFULLY TO AVOID DAMAGING THE SUPPORT WIRE OR CORE THE ELECTRICAL CONTINUITY OF THE SUPPORT WIRE MUST BE MAINTAINED THROUGHOUT THE LEAD.

SH. 3 OF 3
ST-26

LAST CORRECTION DATE:
 FILENAME:

	INSTALLATION OF INTEGRAL MESSENGER CABLE				
	DATE	SCALE	CONT. SEC.	JOB NO.	T & S

SH. OF

	DATE	SCALE	CONT. SEC.	JOB NO.	T & S	CONST.
	9-21-99		63174	48404A	31 of 31	31D

UNDERGROUND

- EXISTING MANHOLE
- MANHOLE (2-WAY)
- MANHOLE (3-WAY)
- MANHOLE (4-WAY)
- EXISTING HANDHOLE
- HANDHOLE
- EXISTING CONDUIT (- mm SHOWN)
- ABANDON EXISTING CONDUIT
- ENCASED CONDUIT (- mm SHOWN)
- GALVANIZED STEEL CONDUIT (- mm SHOWN)
- GALVANIZED STEEL CONDUIT, JACKING-BORING (1- 75 mm SHOWN)
- DIRECT BURIAL CABLE (NO. & SIZE AS INDICATED)
- EXISTING DIRECT BURIAL CABLE
- ABANDON CABLE
- BUILD mm SEWER
- DIRECT BURIAL CONDUIT (1- 75mm SHOWN)
- CONCRETE FOUNDATION FOR PAD MOUNT TRANSFORMER
- CONCRETE FOUNDATION FOR FIRE OR POLICE CALL BOX
- EXISTING UG. FED. ST. LTG. UNIT
- REMOVE UG. FED. ST. LTG. UNIT
- UG. FED, 250W, TYPE II HIGH PRESSURE SODIUM ST. LTG. UNIT WITH mm BRACKET ARM ON NEW FOUNDATION WITH mm MOUNTING HEIGHT. (EXCEPT WHERE OTHERWISE NOTED)
- UG. FED, 400W, TYPE III HIGH PRESSURE SODIUM ST. LTG. UNIT WITH mm BRACKET ARM ON NEW FOUNDATION WITH mm MOUNTING HEIGHT. (EXCEPT WHERE OTHERWISE NOTED)
- UG. FED, 250W, TYPE II HIGH PRESSURE SODIUM ST. LTG. UNIT WITH mm BRACKET ARM ON BRIDGE OR RETAINING WALL WITH mm MOUNTING HEIGHT. (EXCEPT WHERE OTHERWISE NOTED)
- UG. FED, 400W, TYPE III HIGH PRESSURE SODIUM ST. LTG. UNIT WITH DBL. BRACKET ARM (mm) ON MEDIAN WALL WITH mm MOUNTING HEIGHT. (EXCEPT WHERE OTHERWISE NOTED)
- TOWER LIGHTING UNIT WITH 8-1000W METAL HALIDE LUMINAIRES, TYPE V, 30500mm MOUNTING HEIGHT.
- EXISTING UG. FED. ST. LTG. UNIT WITH INTERSTATE LUMINAIRE.
- EXISTING TOWER LIGHTING UNIT
- TOWER LIGHTING UNIT WITH 4-1000W METAL HALIDE LUMINAIRES, TYPE V, 24384mm MOUNTING HEIGHT
- EXISTING U.G. FED ST. LTG. UNIT. 400WATT HIGH PRESSURE SODIUM LUMINAIRE, 13710mm MOUNTING HEIGHT, NO ARM.

OVERHEAD

- EXISTING WOOD POLE
- WOOD POLE (HEIGHT & CLASS AS INDICATED)
- O.H.-FED. 400W, TYPE II, HIGH PRESSURE SODIUM ST. LTG. UNIT WITH mm BRACKET ARM ON WOOD POLE AND mm MOUNTING HEIGHT.
- EXISTING O.H. FED. ST. LTG. UNIT WITH WOOD POLE
- EXISTING O.H. LINE (-# SHOWN)
- OVERHEAD LINE (-# SHOWN)
- REMOVE O.H. LINE
- 400W TYPE I HIGH PRESSURE SODIUM ST. LTG. UNIT ON SPAN WIRE AND MINIMUM mm MOUNTING HEIGHT.

GENERAL


- RIGHT OF WAY LINE
- LIMITED ACCESS RIGHT OF WAY LINE
- PROPOSED PAVEMENT JOINT LINE
- P.L.D. INDICATES THE PUBLIC LIGHTING DEPARTMENT
- D.E. CO. INDICATES THE DETROIT EDISON COMPANY
- C.P. CO. INDICATES THE CONSUMER POWER COMPANY

PUBLIC UTILITIES

THE EXISTING UTILITIES LISTED BELOW AND SHOWN ON THE PLANS REPRESENT THE INFORMATION AVAILABLE TO US. THIS INFORMATION DOES NOT RELIEVE THE CONTRACTOR OF THE RESPONSIBILITY IN CASE UTILITIES HAVE BEEN CONSTRUCTED OR REMOVED SINCE THEN.

TYPE OF UTILITY	OWNER
GAS	
TELEPHONE	
WATER	
ELECTRIC	

FOR THE PROTECTION OF UNDERGROUND UTILITIES, THE CONTRACTOR SHALL DIAL 1-800-482-7171 A MINIMUM OF 48 HOURS PRIOR TO EXCAVATING IN THE VICINITY OF THE UTILITIES LINES. ALL MISS DIG PARTICIPATING MEMBERS WILL THUS BE ROUTINELY NOTIFIED. THIS DOES NOT RELIEVE THE CONTRACTOR OF THE RESPONSIBILITY OF NOTIFYING UTILITY OWNERS WHO MAY NOT BE A PART OF THE "MISS DIG" ALERT SYSTEM.

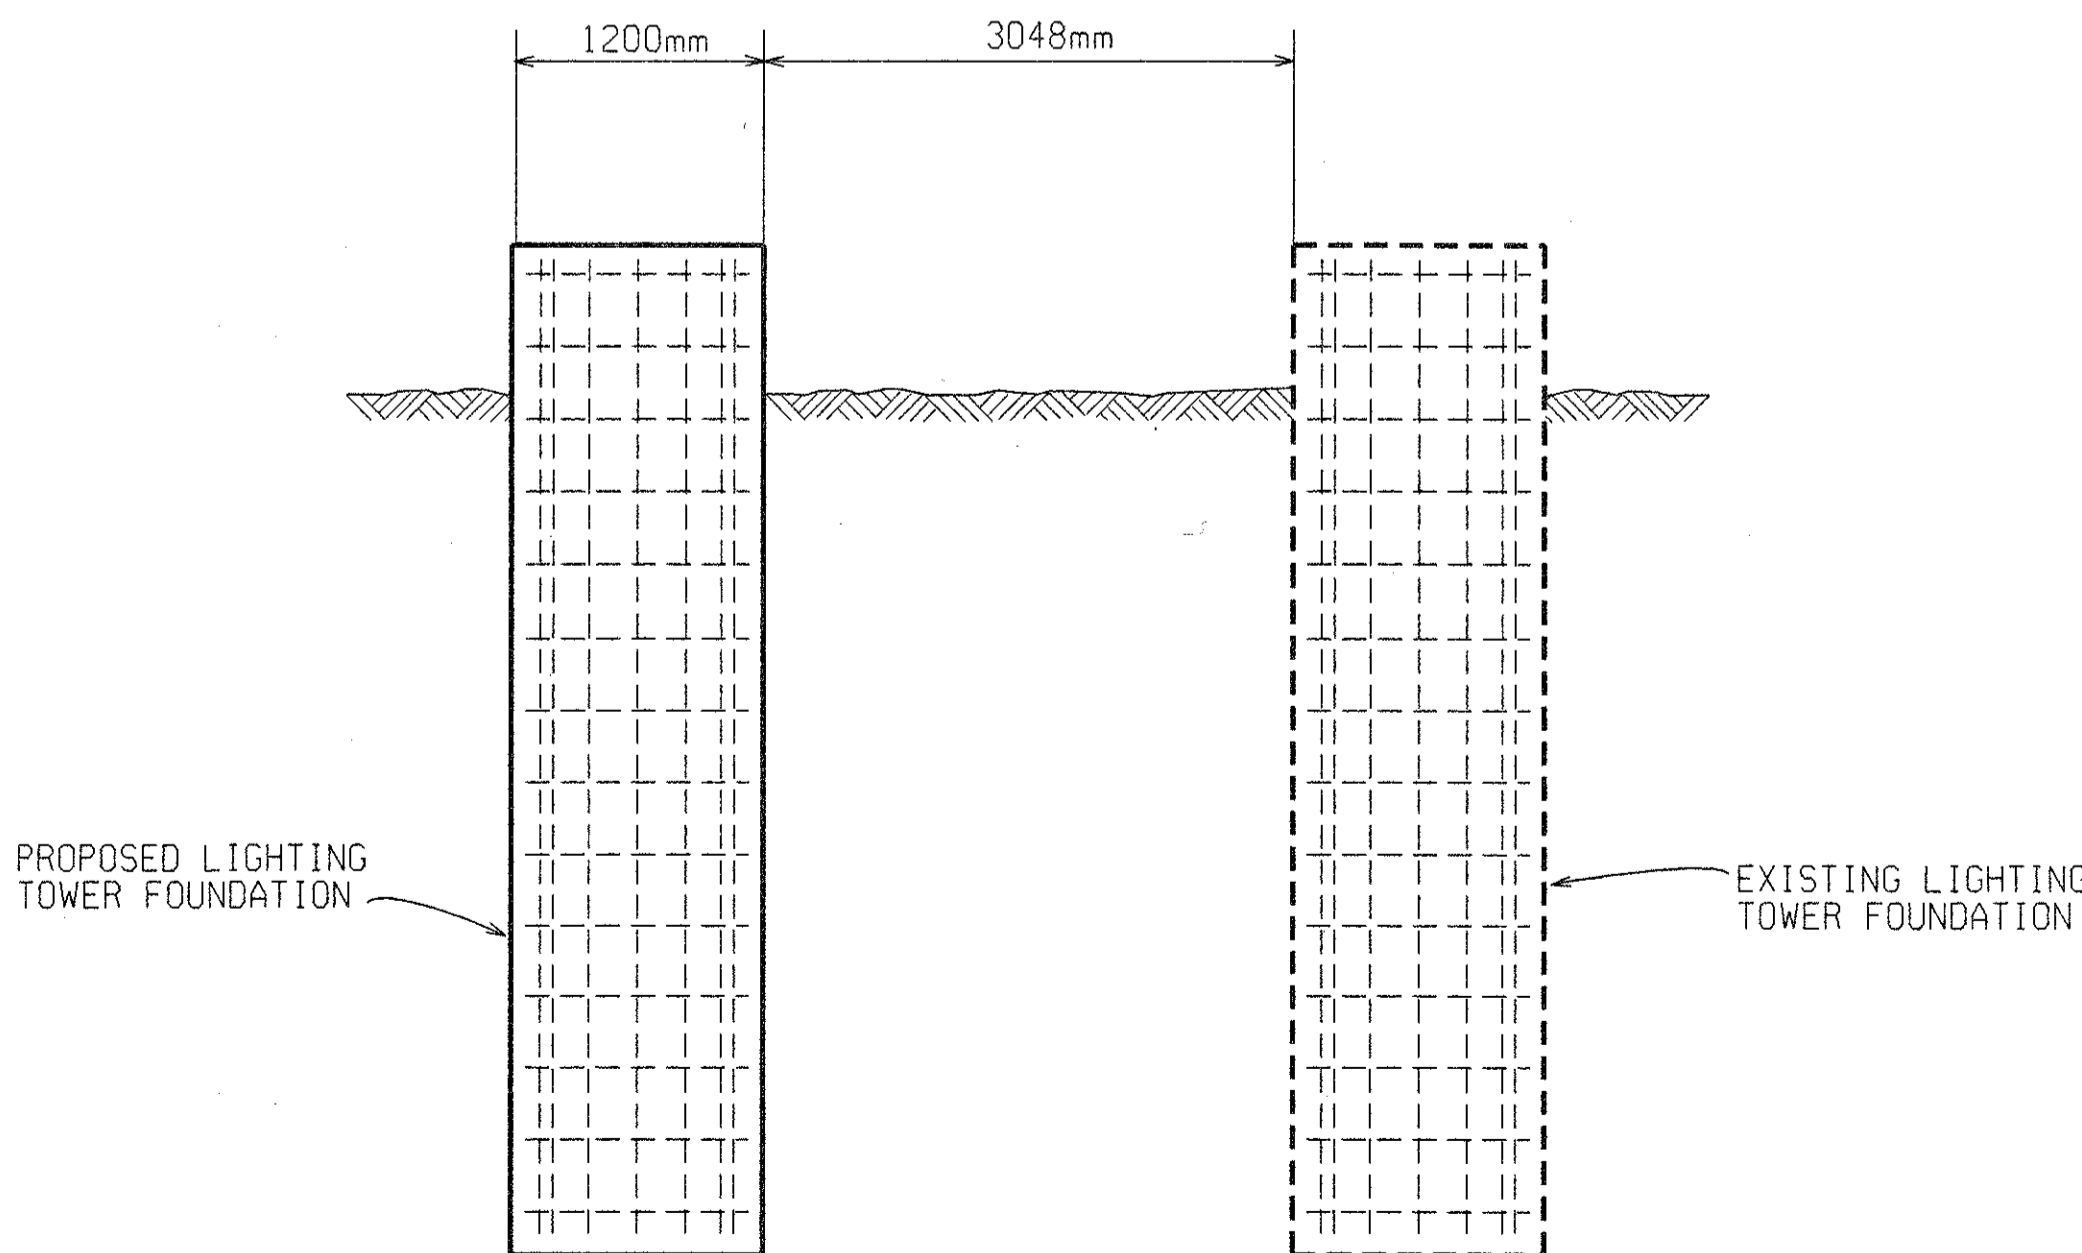

LOCATION OF PROPOSED LIGHTING TOWER FOUNDATION


NOTES

1. NOTIFY THE SYSTEM OPERATING ENGINEER, DETROIT EDISON CO. AND DAVID JOHNS (PH # 248-483-5125), MDOT MAINTENANCE, 72 HOURS PRIOR TO WORKING ON LIGHTING CIRCUITS.
2. ELECTRICAL SERVICE SHALL BE 240/480 VOLT, 1Ø, 3 WIRE.
3. ALL CONDUIT CROSSING PAVEMENT SHALL EXTEND 1220 mm BEYOND CURB, EDGE OF PAVEMENT, OR PAVED SHOULDER AND SHALL HAVE 762mm MINIMUM COVER.
4. SMOOTH SURFACE CONDUIT ONLY IS ALLOWED ON THIS JOB.
5. THE 152mm EDGE DRAIN REQUIRED TO REPLACE DAMAGED EDGE DRAIN DUE TO LIGHTING CONSTRUCTION SHALL BE INCLUDED IN THE PROJECT AND WILL NOT BE PAID FOR SEPARATELY.
6. ALL CABLE SHALL BE INSTALLED IN CONTINUOUS UNCU LENGTH BETWEEN HANDHOLES OR LIGHT STANDARDS.
7. THE EXISTING FREEWAY LIGHTING SYSTEM SHALL BE IN OPERATION DURING CONSTRUCTION. ANY DAMAGES TO THE SYSTEM CAUSED BY THE CONTRACTOR SHALL BE REPAIRED AT THE CONTRACTOR'S OWN EXPENSE WITHIN A REASONABLE TIME AS DIRECTED BY THE ENGINEER.
8. LUMINAIRES FOR TOWER LIGHTING SHALL BE PROVIDED WITH 240 VOLT BALLASTS FOR METAL HALIDE.
9. ALL TOWERS SHALL BE MADE BY THE SAME MANUFACTURER.
10. THE POLES FOR THE 30500 mm TOWER LIGHTING UNITS MAY BE ONE SECTION OR NOT MORE THAN 4 SECTIONS.
11. JACKING PITS SHALL BE LOCATED AS DIRECTED BY THE ENGINEER.
12. WHERE THERE IS TOWER LIGHTING OR LIGHTING IN THE SHOULDER, THE RESTORATION OF THE AREAS INVOLVED SHALL BE INCLUDED IN THE PAY ITEM "CONDUIT, SCHEDULE 40, 75mm".
13. TREES AND SHRUBS DAMAGED BY THE CONTRACTOR'S OPERATION SHALL BE REPLACED (IN KIND) AT THE CONTRACTORS EXPENSE, AS DIRECTED BY THE ENGINEER.
14. LOCATION OF MITS UNDERGROUND AS SHOWN ON THE PLANS IS ONLY APPROXIMATE. CONTRACTOR WILL NEED TO LOCATE EXACT LOCATION OF MITS UNDERGROUND TO AVOID CONFLICT WITH PROPOSED UNDERGROUND TO TOWER LIGHTING.
15. DIRECTIONAL BORE IS AN OPTIONAL ALTERNATIVE AS APPROVED BY THE ENGINEER. WHERE UTILIZED, DIRECTIONAL BORE SHALL BE PAID FOR AS "CONDUIT JACKED IN PLACE".
16. BREAKAWAY CONNECTOR SHALL BE LITTLE FUSE LEBASS, BUSSMAN TYPE HEP WITH INSULATING BOOTS, HOMAC MFG. CO. FLOOD SEAL DYU OR APPROVED EQUAL.
17. CONTRACTOR SHALL INSTALL NEW NO. 8 CABLE IN EXISTING LIGHT STANDARDS AND PAYMENT SHALL BE INCLUDED IN THE PAY ITEM "DB CABLE IN CONDUIT, 600V, 1/C#6" AND WILL NOT BE PAID FOR SEPARATELY.

ENTIRE PROJECT

THE FOLLOWING ITEMS OF WORK SHALL BE DONE AS THEY APPLY THROUGHOUT THE PROJECT. THESE ITEMS ARE NOT DETAILED OR INCLUDED ON THE PLANS.

LOCATING UNDERGROUND CABLE 500m

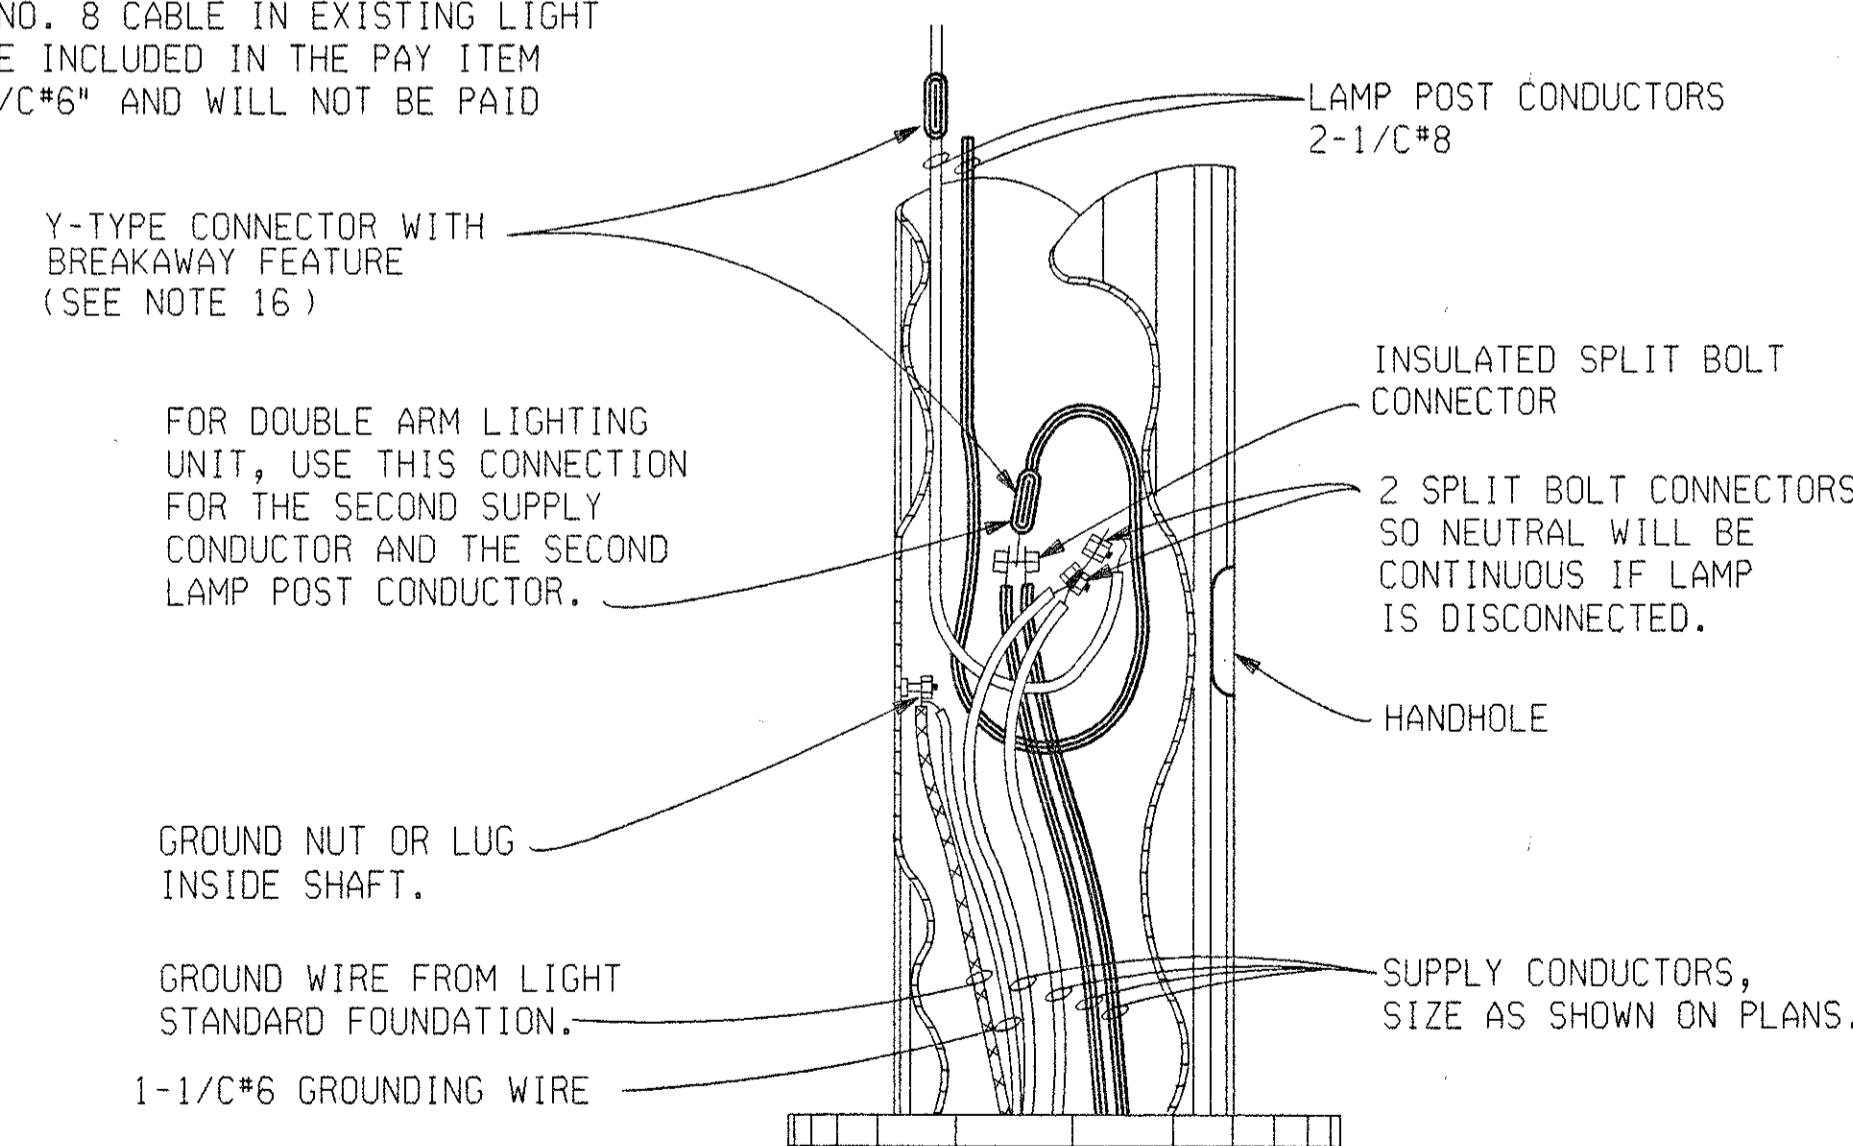


TYPICAL MULTIPLE STREET LIGHTING CONNECTION

NOT TO SCALE

MDOT Michigan Department of Transportation		NOTES AND LEGEND					
DATE	SCALE	CONT. SEC.	JOB NO.	DESIGN UNIT	SHEET NO.		
06/02/99	NONE	63174	48404A	ZIELINSKI	R.O.W	1E	

EXISTING BY: DATE: 10/08/99
 PROPOSED BY: DATE:
 LAST CORRECTION BY: CLARK/BENSON DATE:
 FILE NAME: 48404696.dgn
 1 2 3 4 5 6 7 8 9 10 11 12 13 14 15 16 17 18 19 20 21 22 23 24 25 26 27 28 29 30 31 32 33 34 35 36 37 38 39 40 41 42 43 44 45 46 47 48 49 50 51 52 53 54 55 56 57 58 59 60 61 62 63

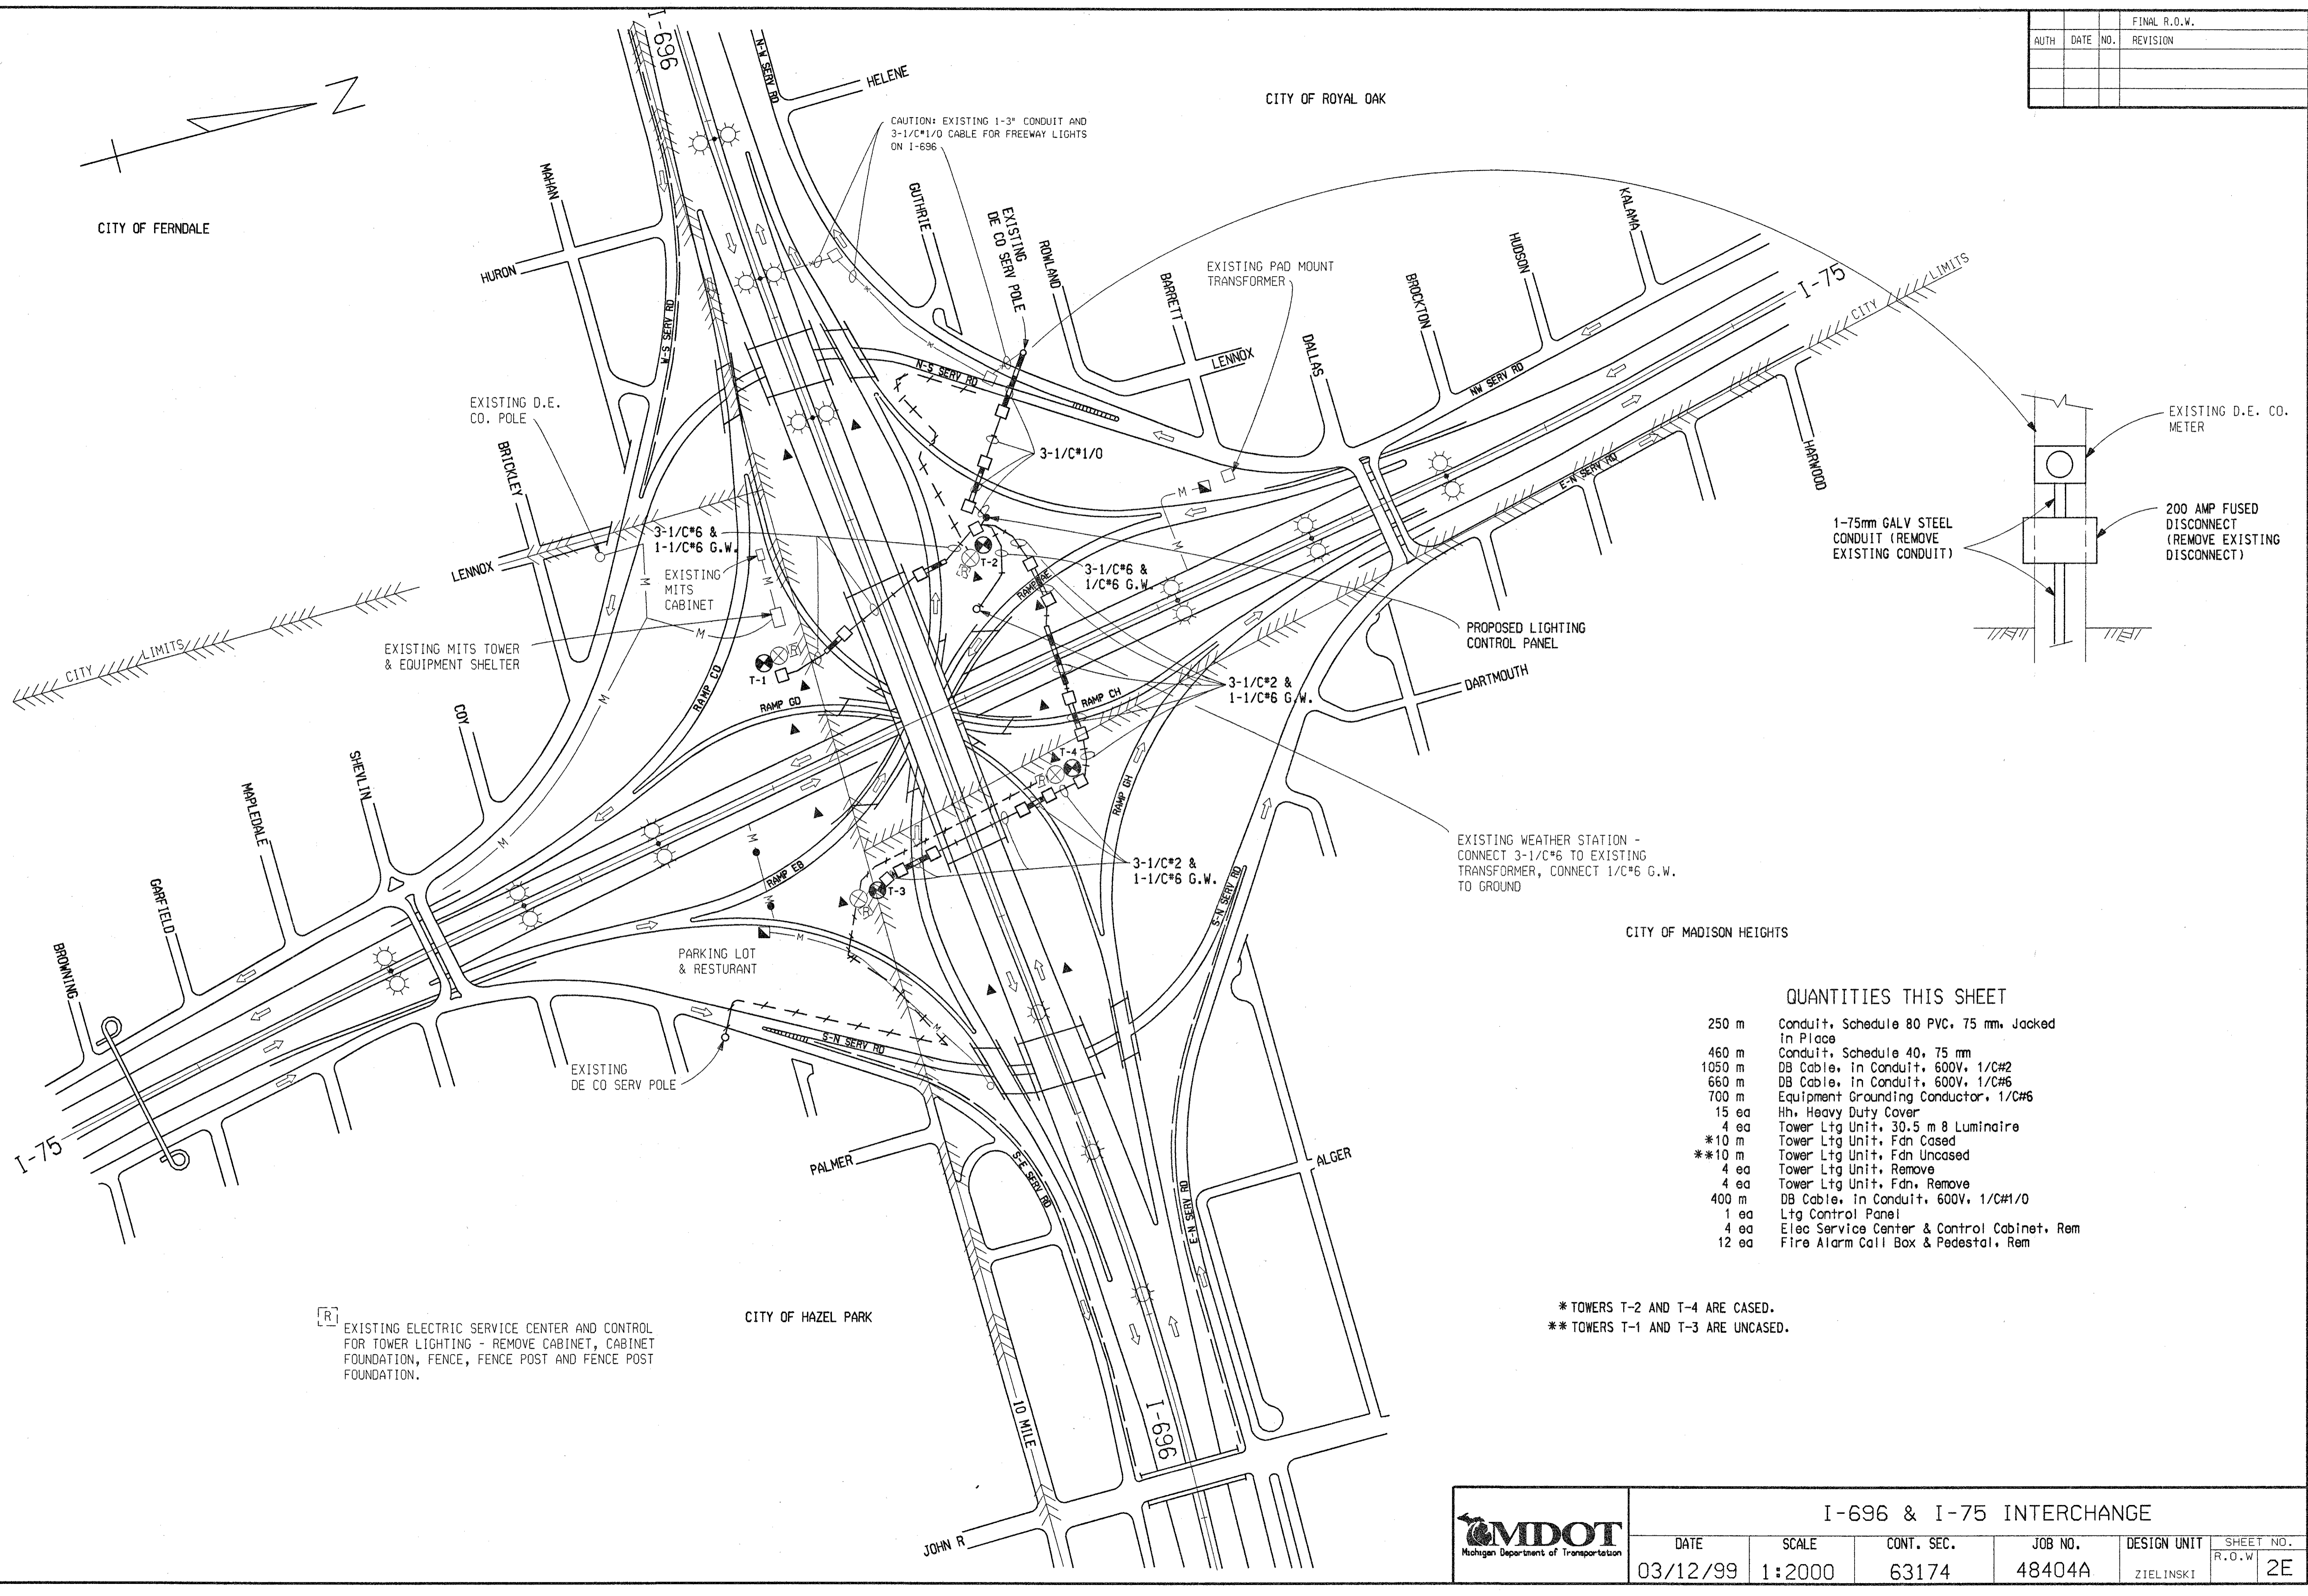


FINAL R.O.W.		
AUTH	DATE	NO. REVISION

QUANTITIES THIS SHEET

250 m	Conduit, Schedule 80 PVC, 75 mm. Jacked in Place
460 m	Conduit, Schedule 40, 75 mm
1050 m	DB Cable, in Conduit, 600V, 1/C#2
660 m	DB Cable, in Conduit, 600V, 1/C#6
700 m	Equipment Grounding Conductor, 1/C#6
15 ea	Hh, Heavy Duty Cover
4 ea	Tower Ltg Unit, 30.5 m 8 Luminaire
*10 m	Tower Ltg Unit, Fdn Cased
*10 m	Tower Ltg Unit, Fdn Uncased
4 ea	Tower Ltg Unit, Remove
4 ea	Tower Ltg Unit, Fdn, Remove
400 m	DB Cable, in Conduit, 600V, 1/C#1/0
1 ea	Ltg Control Panel
4 ea	Elec Service Center & Control Cabinet, Rem
12 ea	Fire Alarm Call Box & Pedestal, Rem

	I-696 & I-75 INTERCHANGE					
	DATE	SCALE	CONT. SEC.	JOB NO.	DESIGN UNIT	SHEET NO. R.O.W.
	03/12/99	1:2000	63174	48404A	ZIELINSKI	2E

FINAL R.O.W.		
AUTH	DATE	NO.

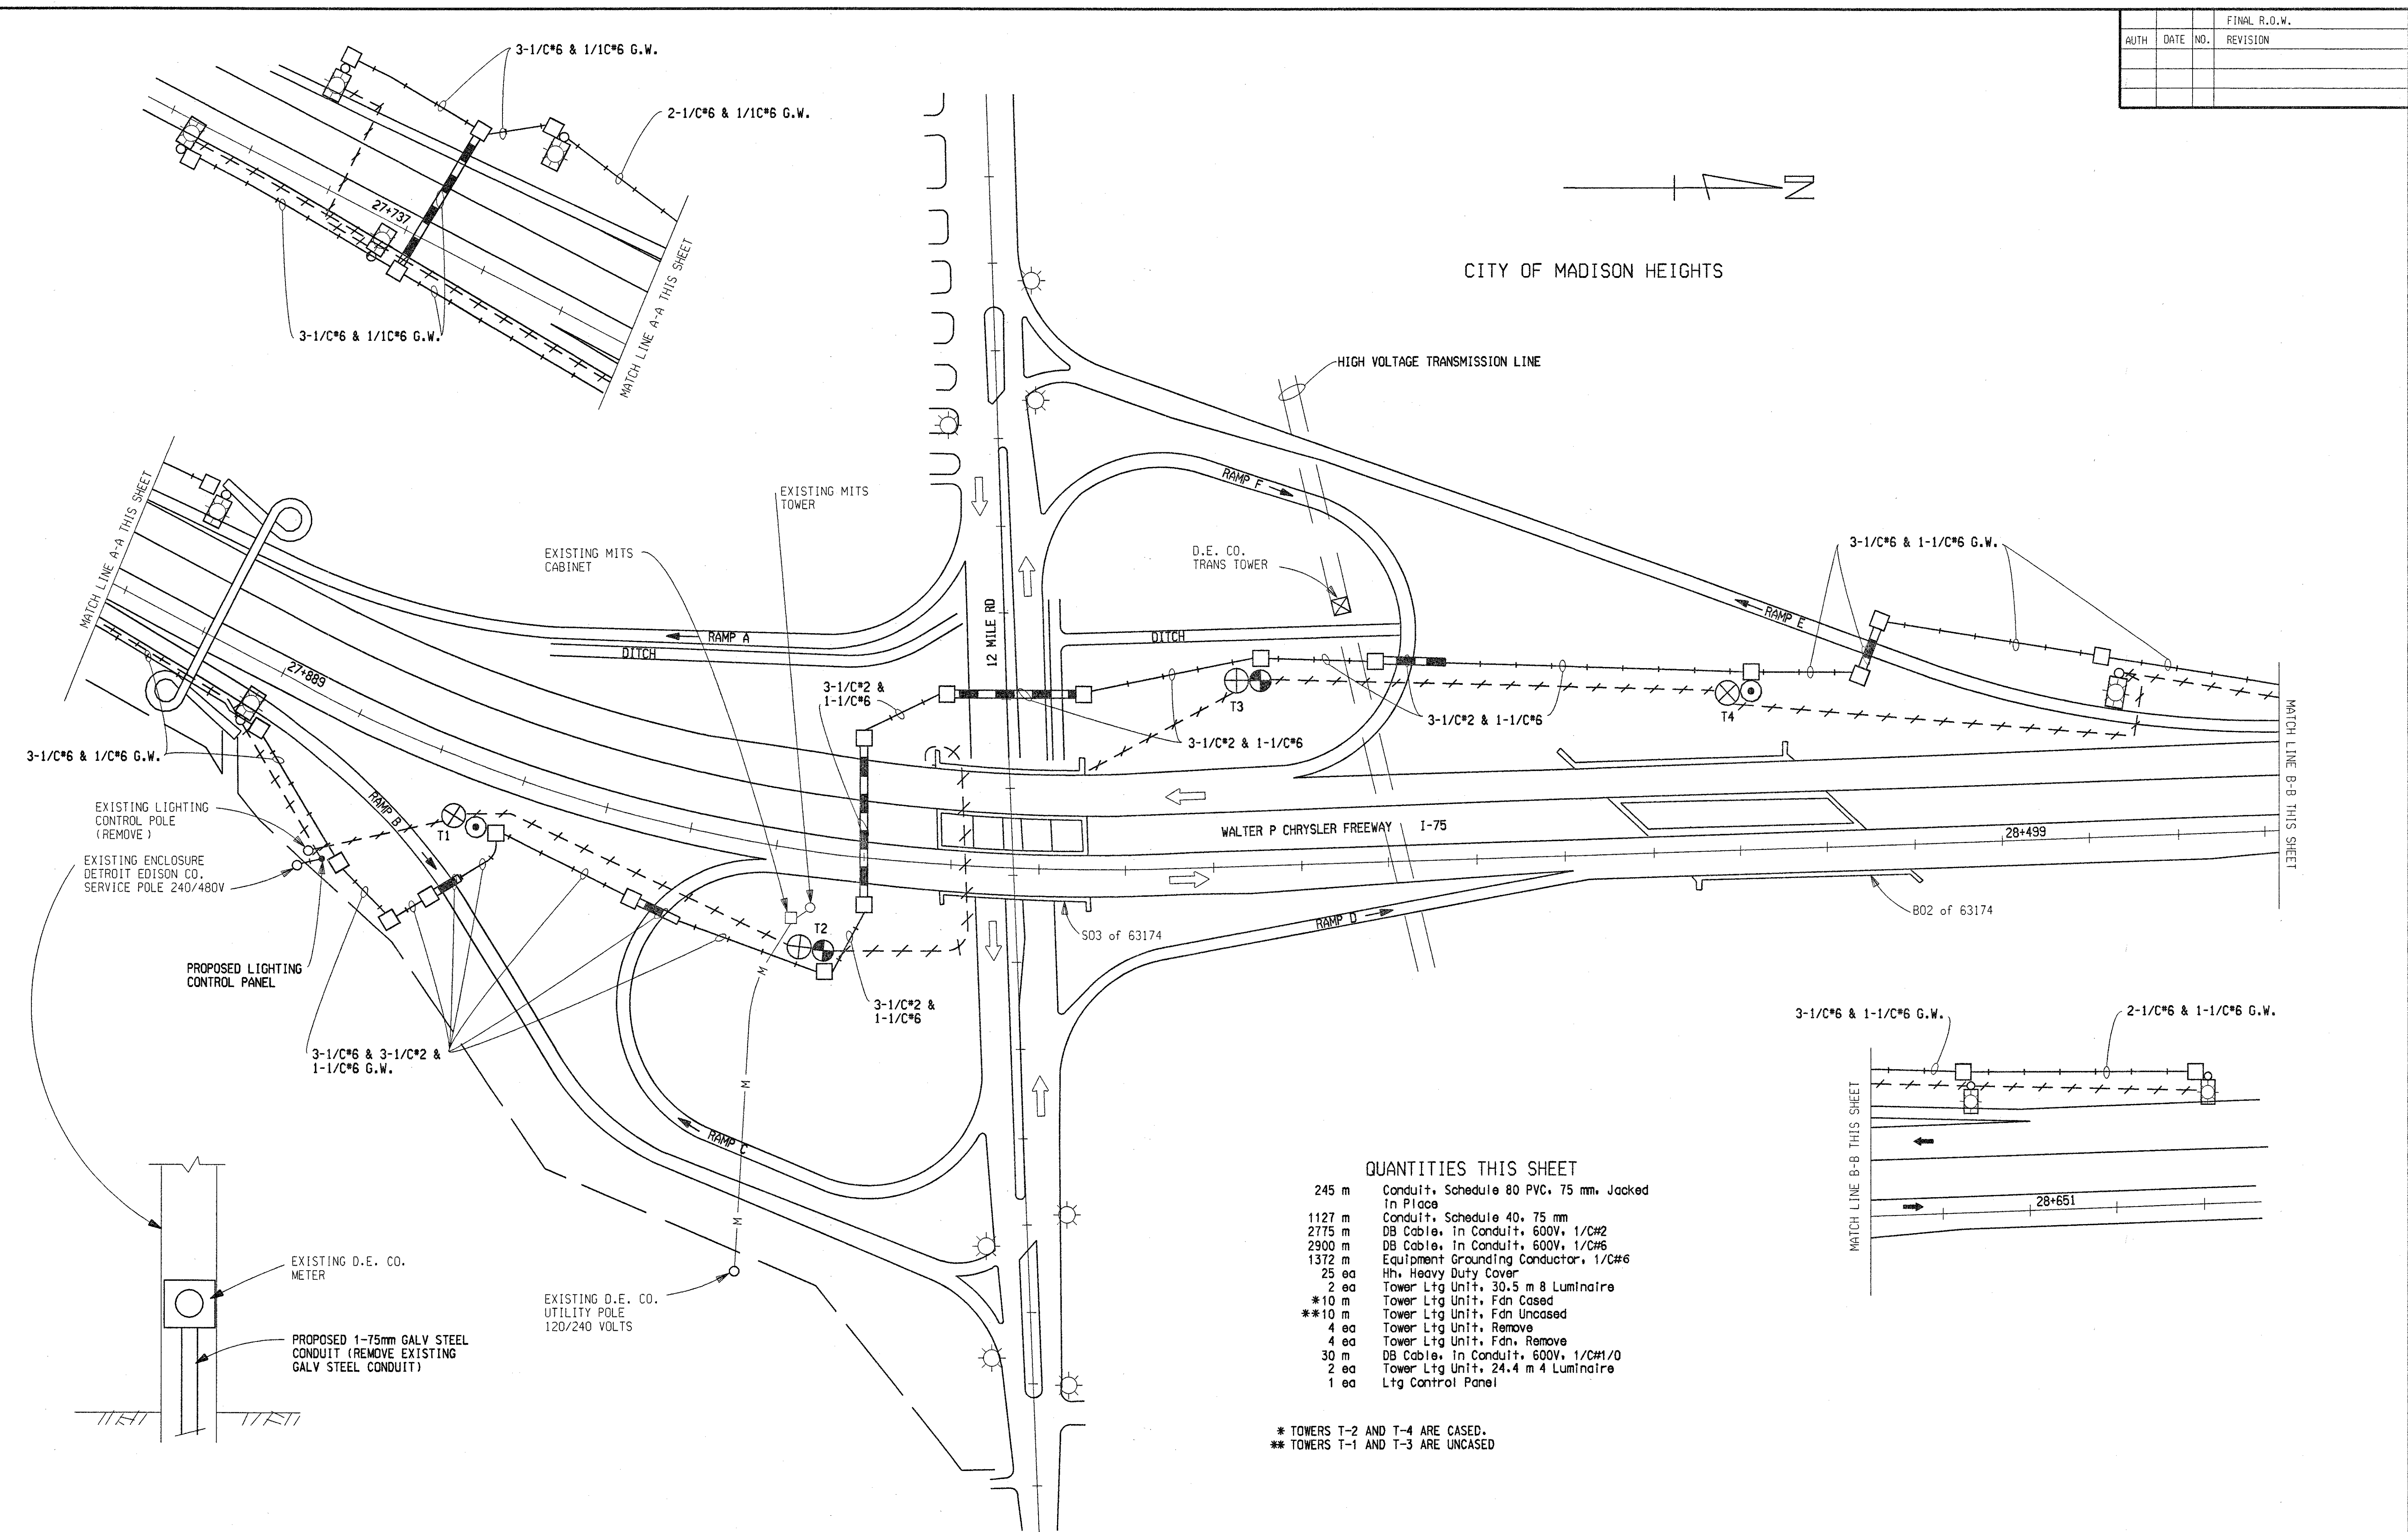



QUANTITIES THIS SHEET

245 m	Conduit, Schedule 80 PVC, 75 mm, Jacked in Place
1127 m	Conduit, Schedule 40, 75 mm
2775 m	DB Cable, in Conduit, 600V, 1/C#2
2900 m	DB Cable, in Conduit, 600V, 1/C#6
1372 m	Equipment Grounding Conductor, 1/C#6
25 ea	Hh, Heavy Duty Cover
2 ea	Tower Ltg Unit, 30.5 m 8 Luminaire
*10 m	Tower Ltg Unit, Fdm Casad
**10 m	Tower Ltg Unit, Fdm Uncasad
4 ea	Tower Ltg Unit, Remove
4 ea	Tower Ltg Unit, Fdm, Remove
30 m	DB Cable, in Conduit, 600V, 1/C#1/0
2 ea	Tower Ltg Unit, 24.4 m 4 Luminaire
1 ea	Ltg Control Panel


* TOWERS T-2 AND T-4 ARE CASED.
 ** TOWERS T-1 AND T-3 ARE UNCASED

	I-75 @ 12 MILE RD				SHEET NO. 3E
	DATE	SCALE	CONT. SEC.	JOB NO.	
	04/06/99	1:1000	63174	48404A	DESIGN UNIT ZIELINSKI

FINAL R.O.W.		
AUTH	DATE	NO.

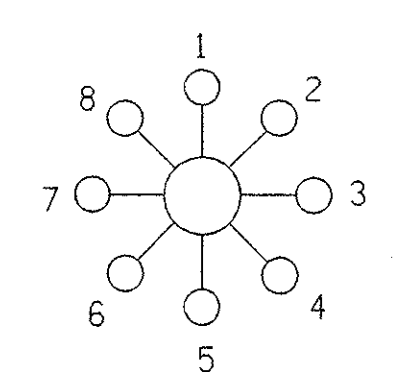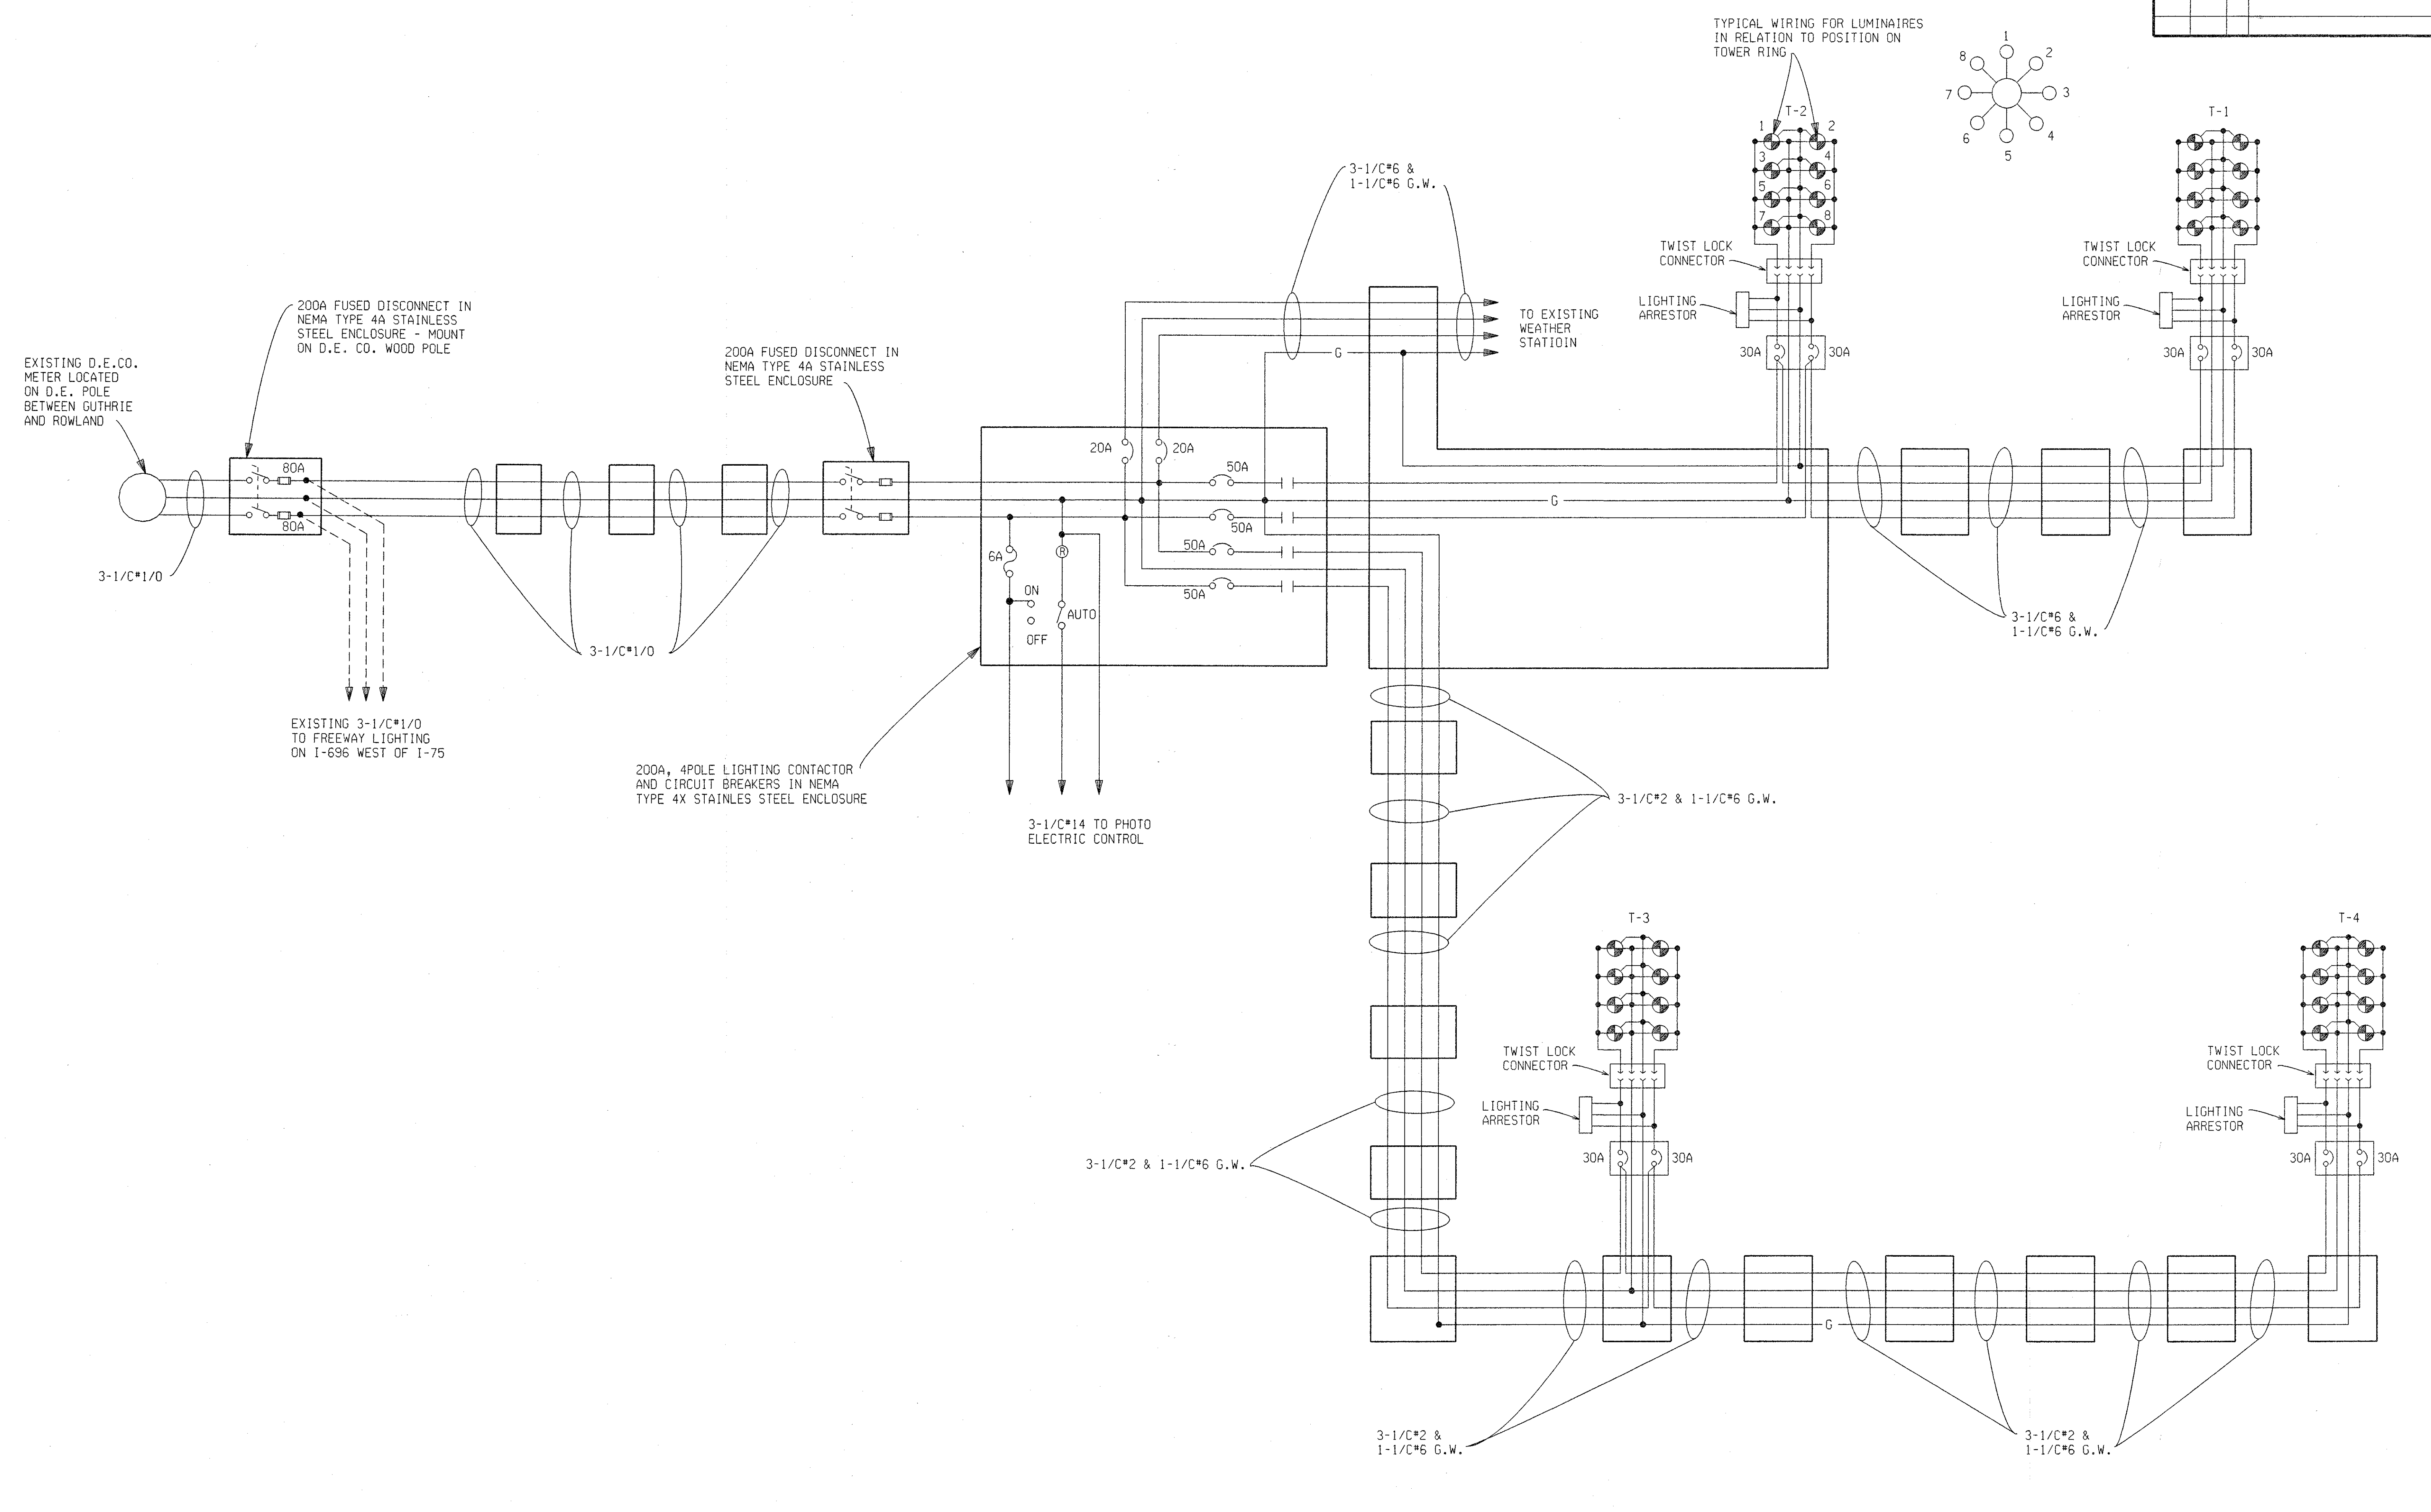


FINAL R.O.W.		
AUTH	DATE	NO.

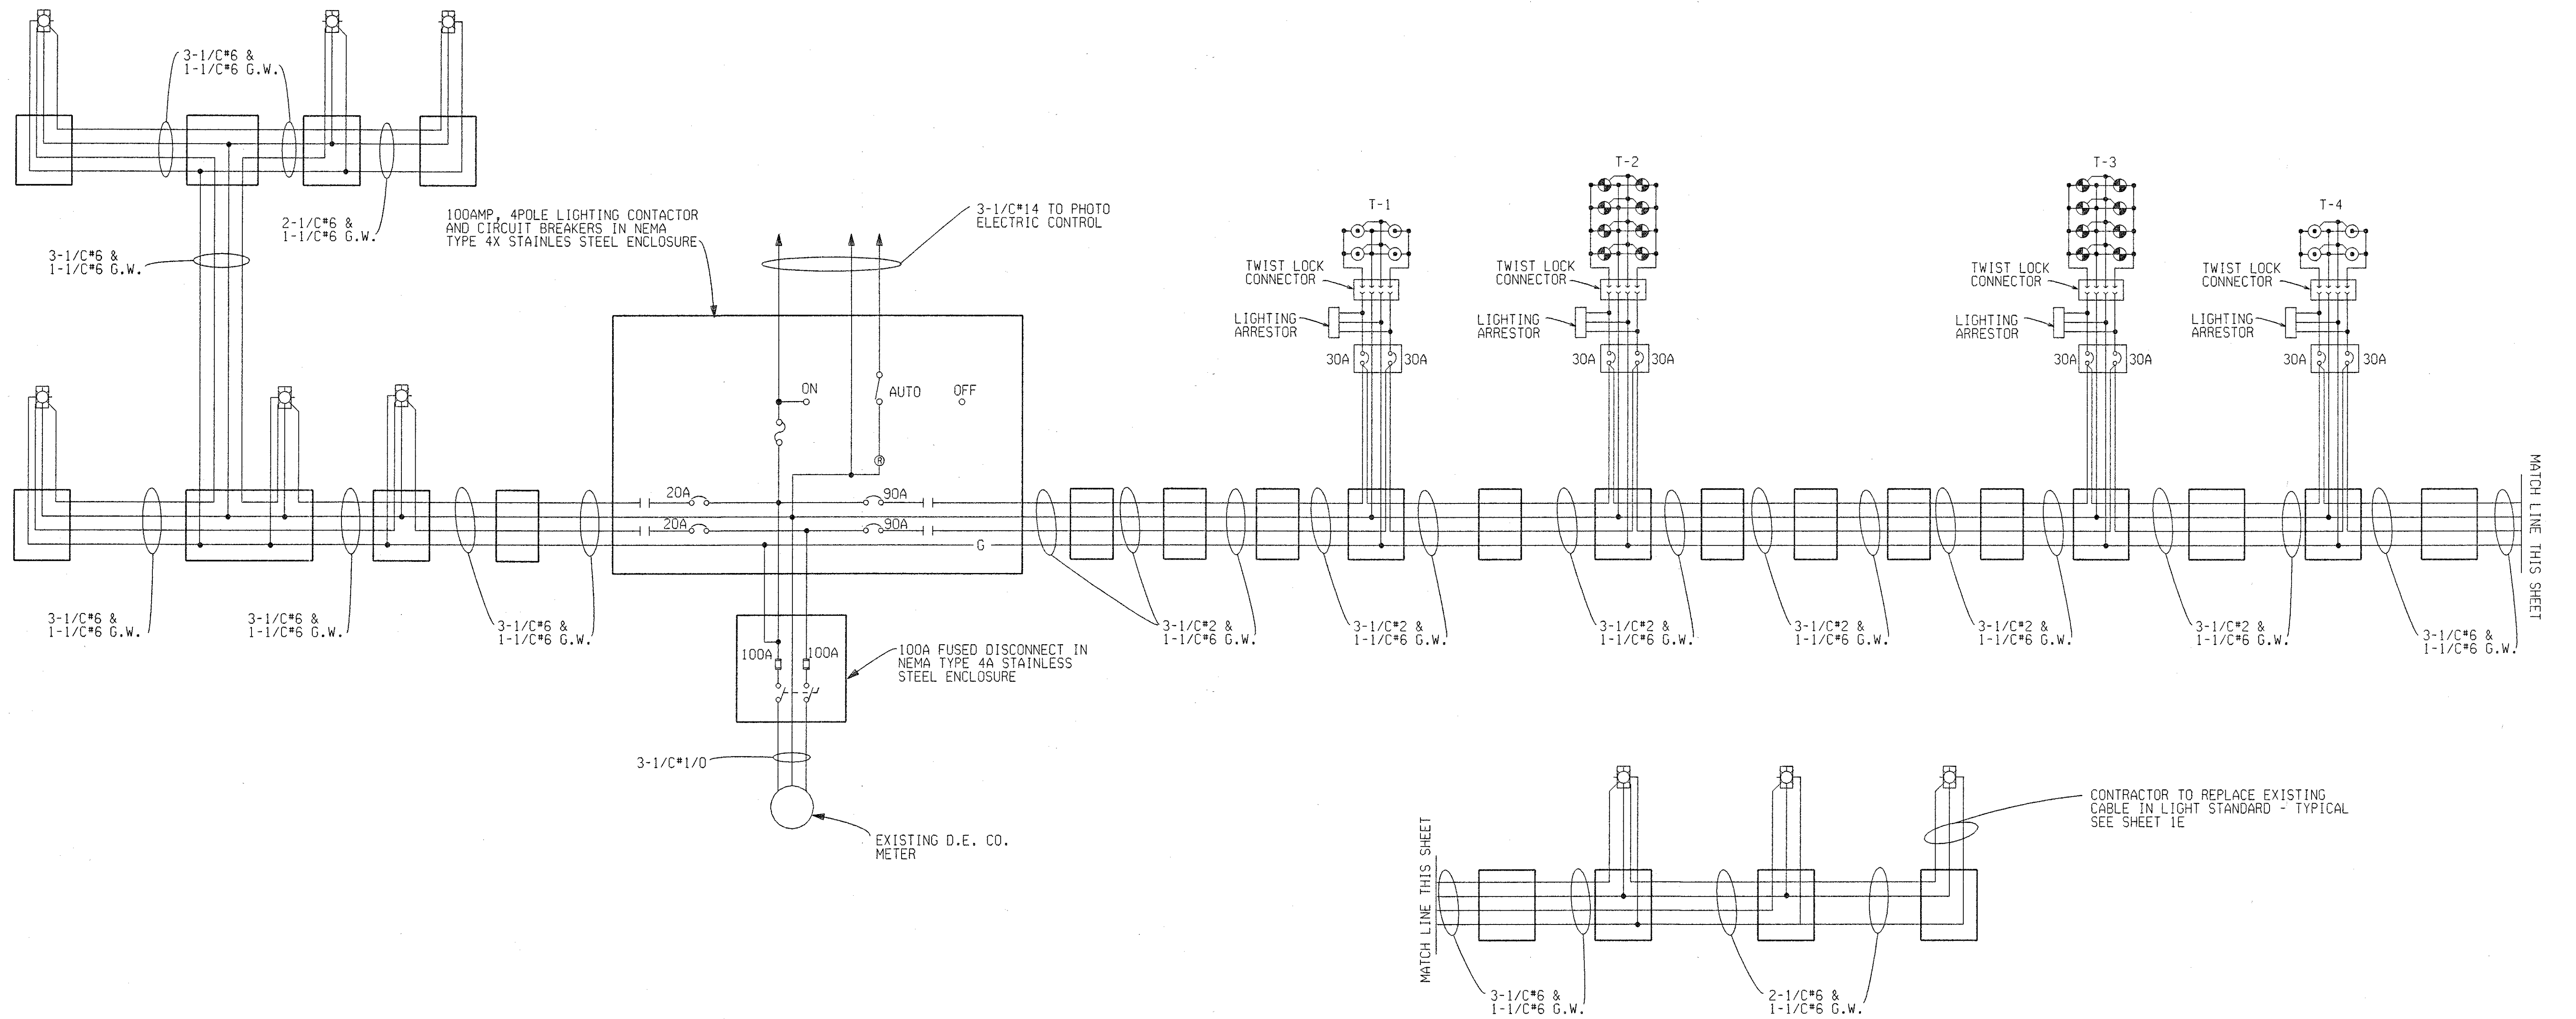


	WIRING DIAGRAM - I-75 & 12 MILE RD					
	DATE	SCALE	CONT. SEC.	JOB NO.	DESIGN UNIT	SHEET NO.
09/01/99	NONE	63174	48404 A	ZIELINSKI	CONST.	5E

FINAL R.O.W.			
AUTH	DATE	NO.	REVISION

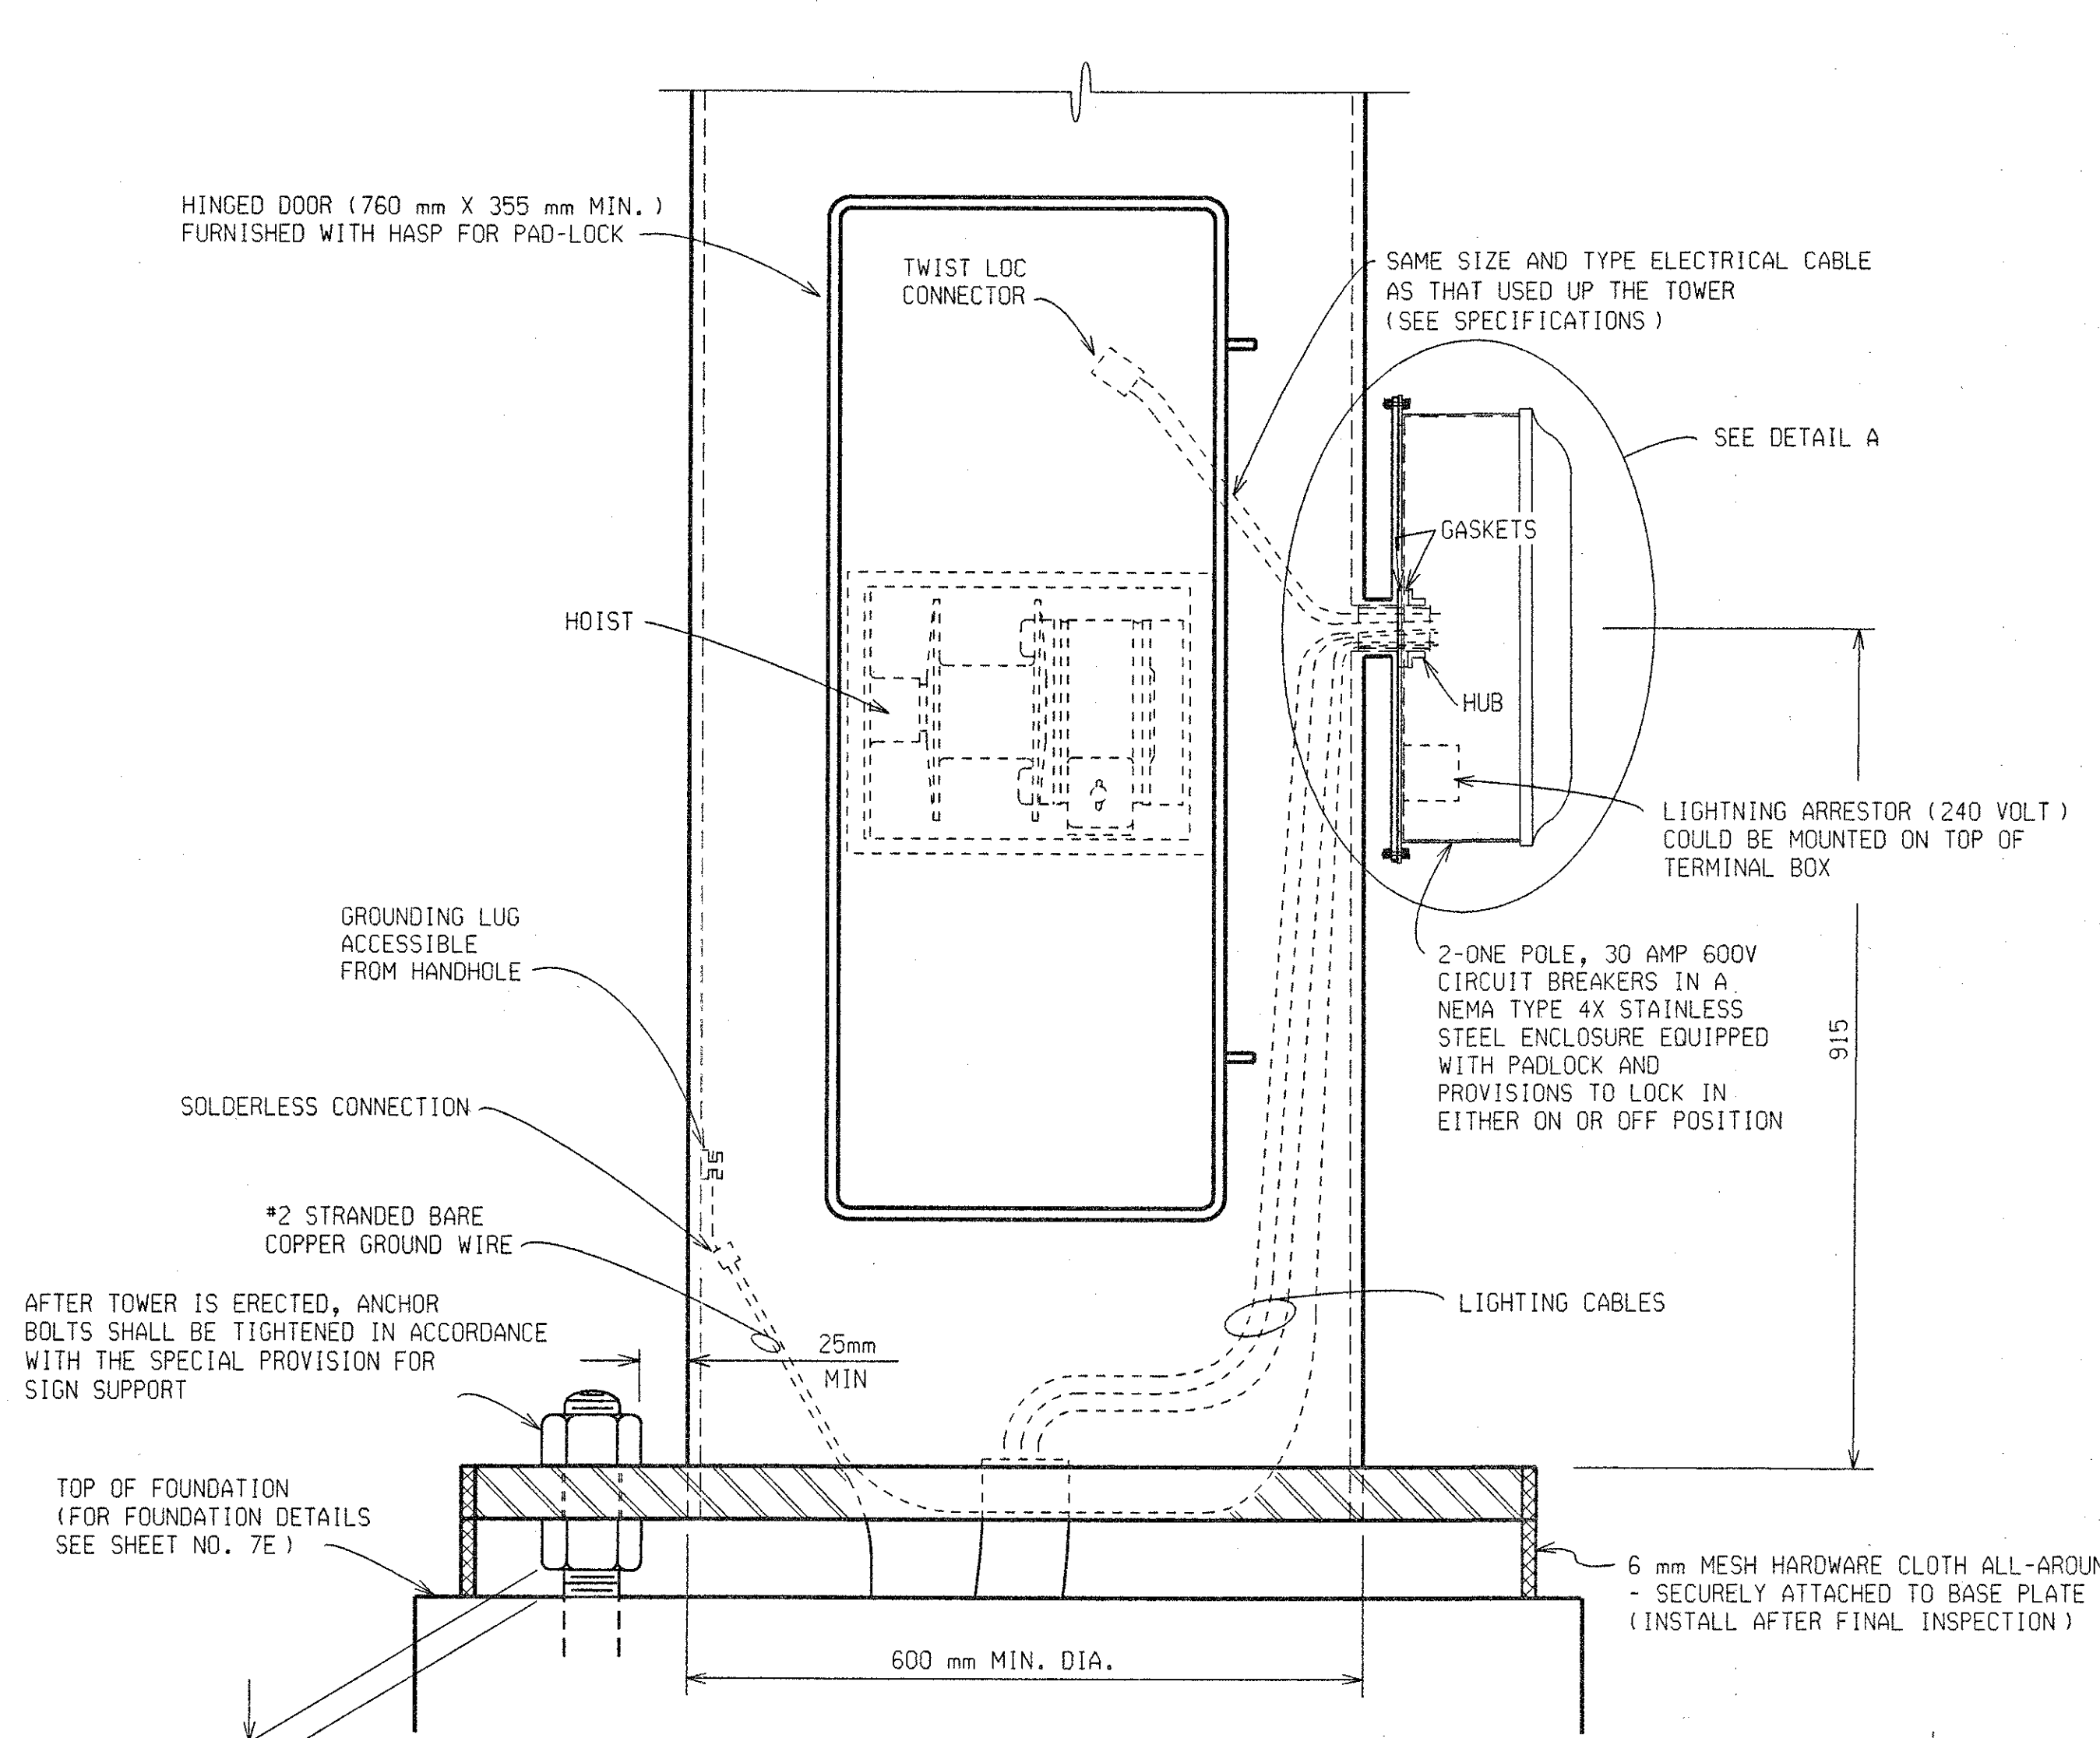


DETAIL OF CONNECTIONS INSIDE OF TOWER

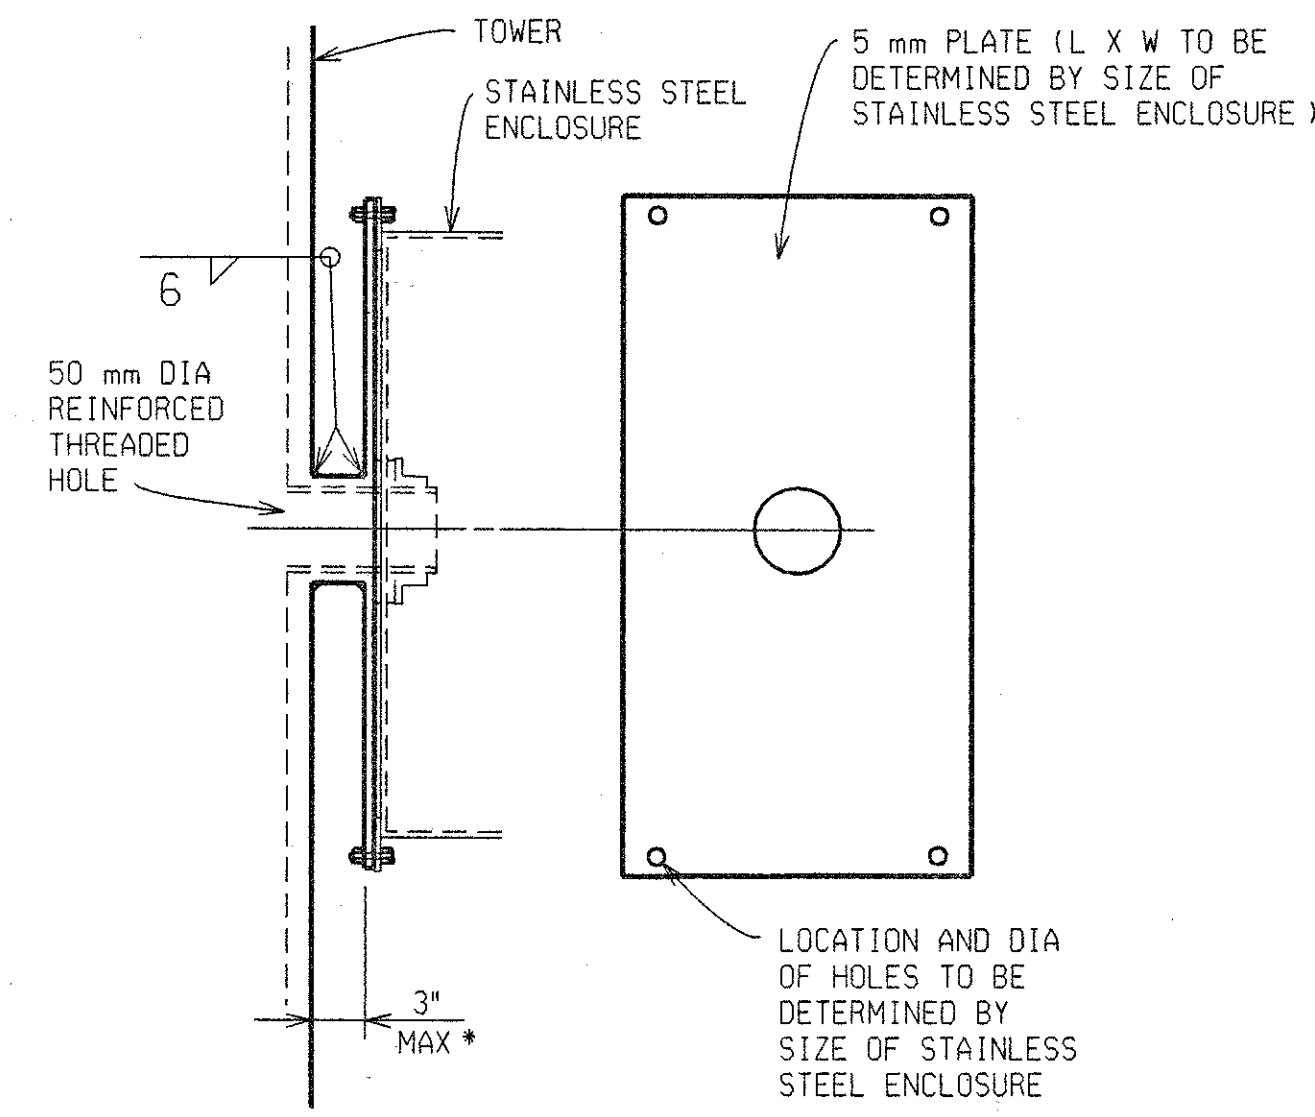


DETAIL A


* DISTANCE SHALL ONLY BE LARGE ENOUGH TO ALLOW ACCESS FOR WELDING.
 INSTALL 50 mm THREADED PIPE, INTERIOR AND EXTERIOR GASKETS, ENCLOSURE AND TIGHTEN WITH HUB.

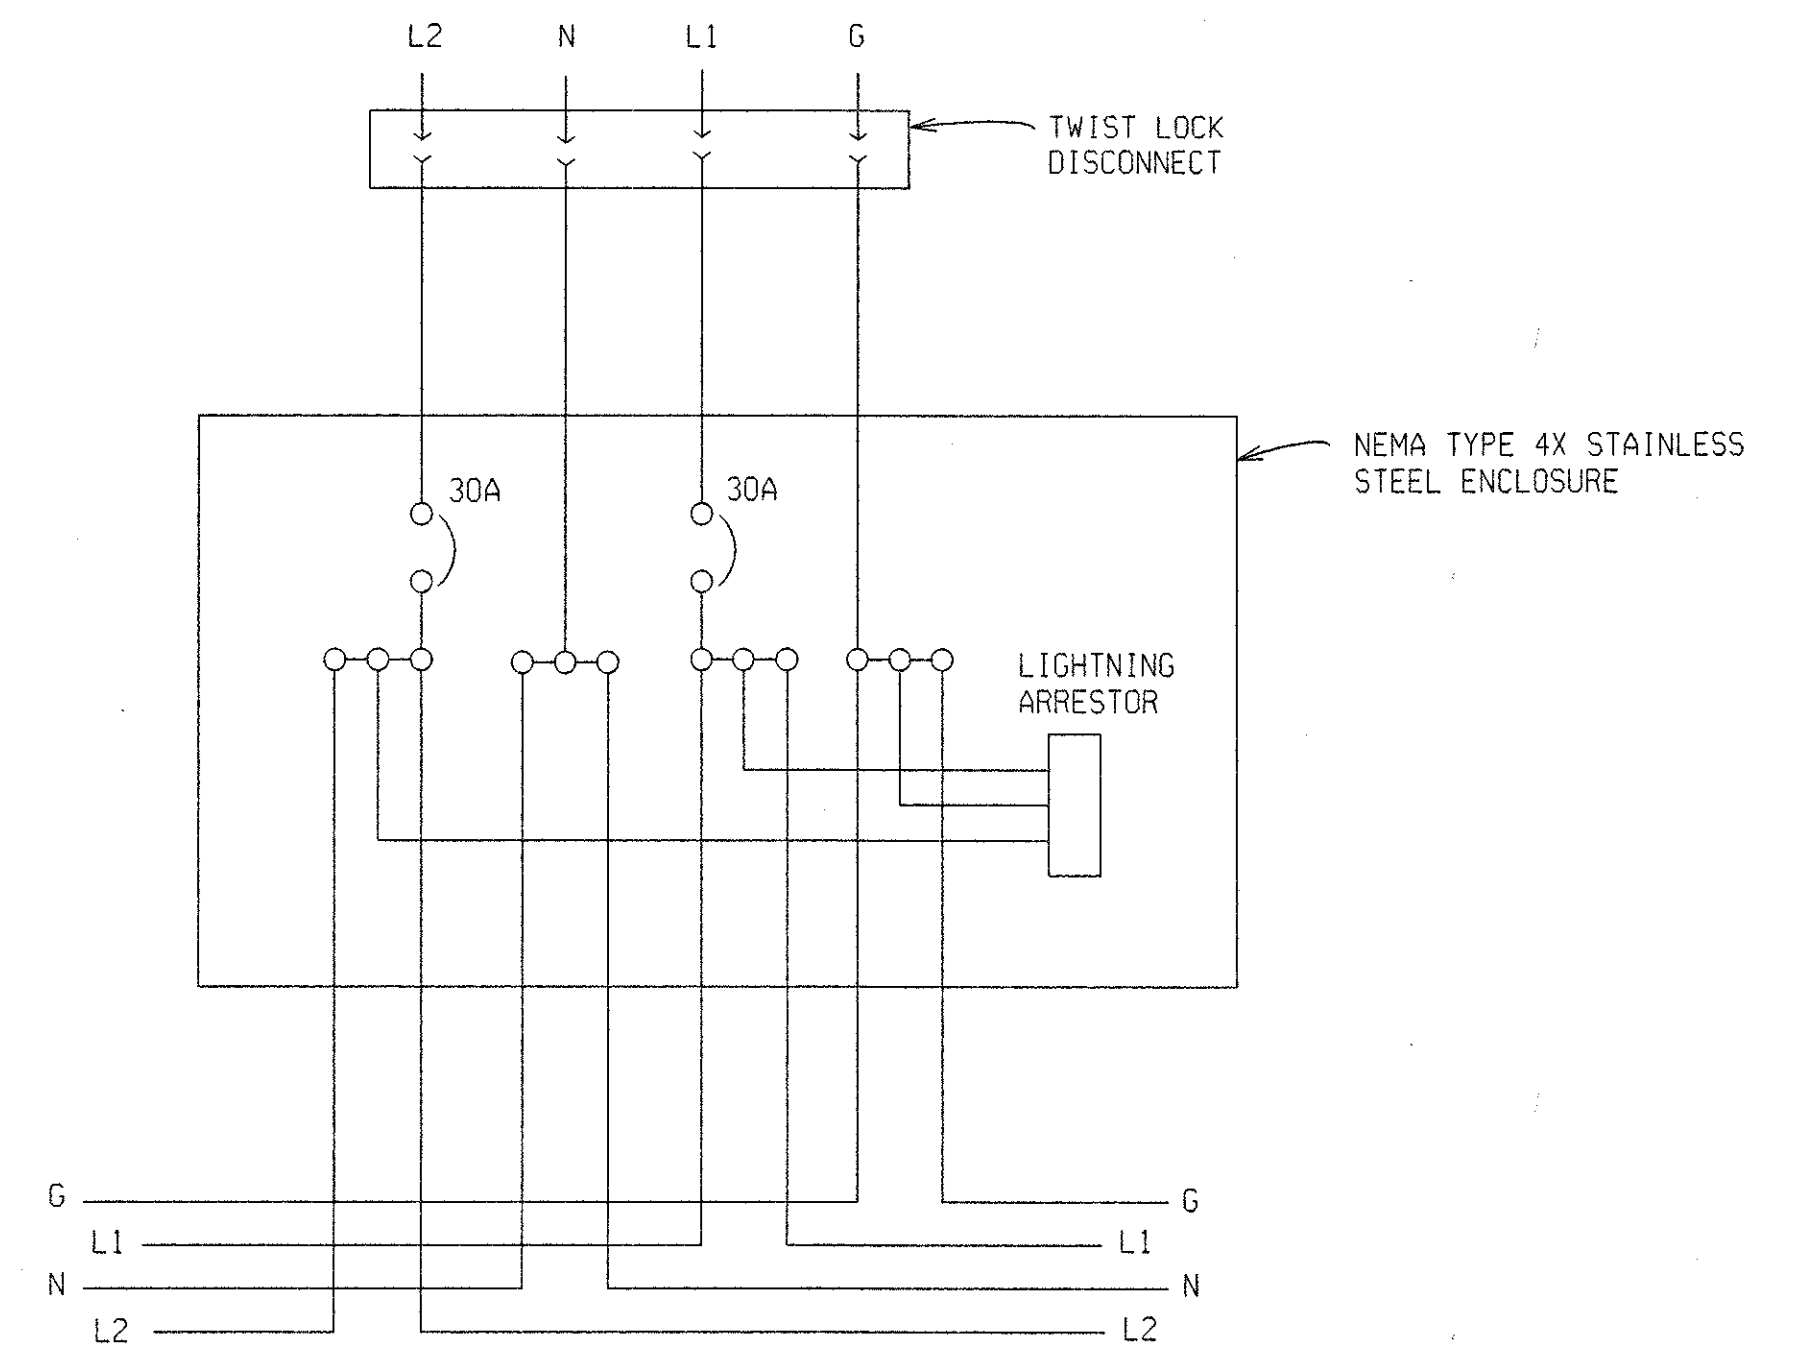

WIRING DIAGRAM IN TOWER

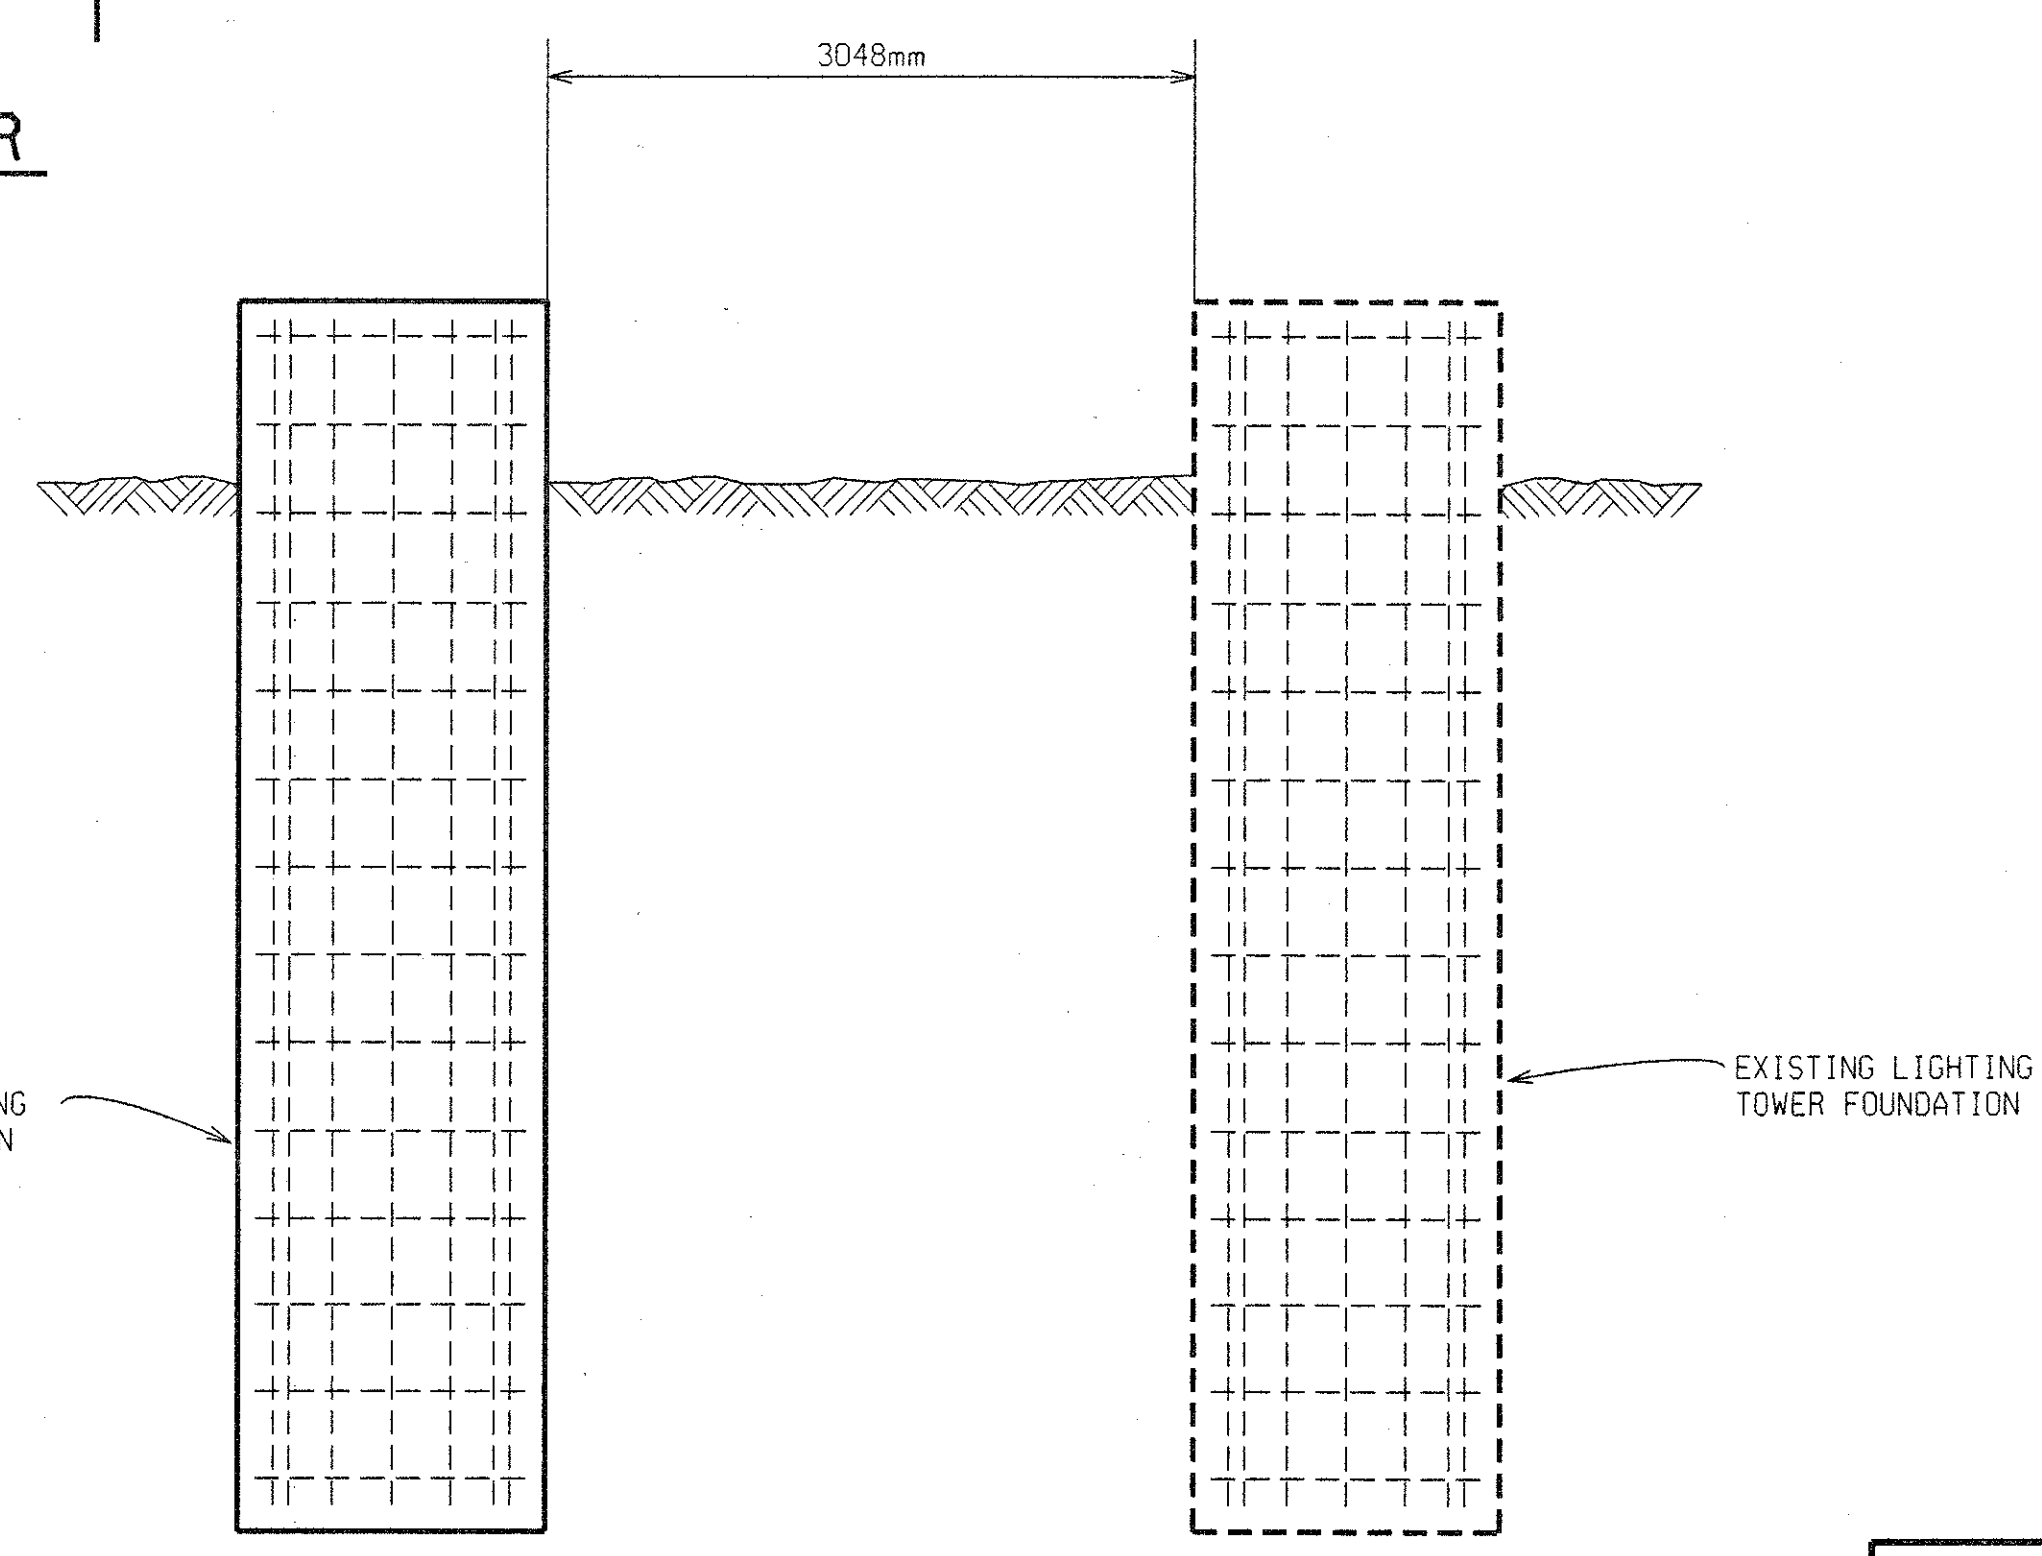

LOCATION OF PROPOSED LIGHTING TOWER FOUNDATION

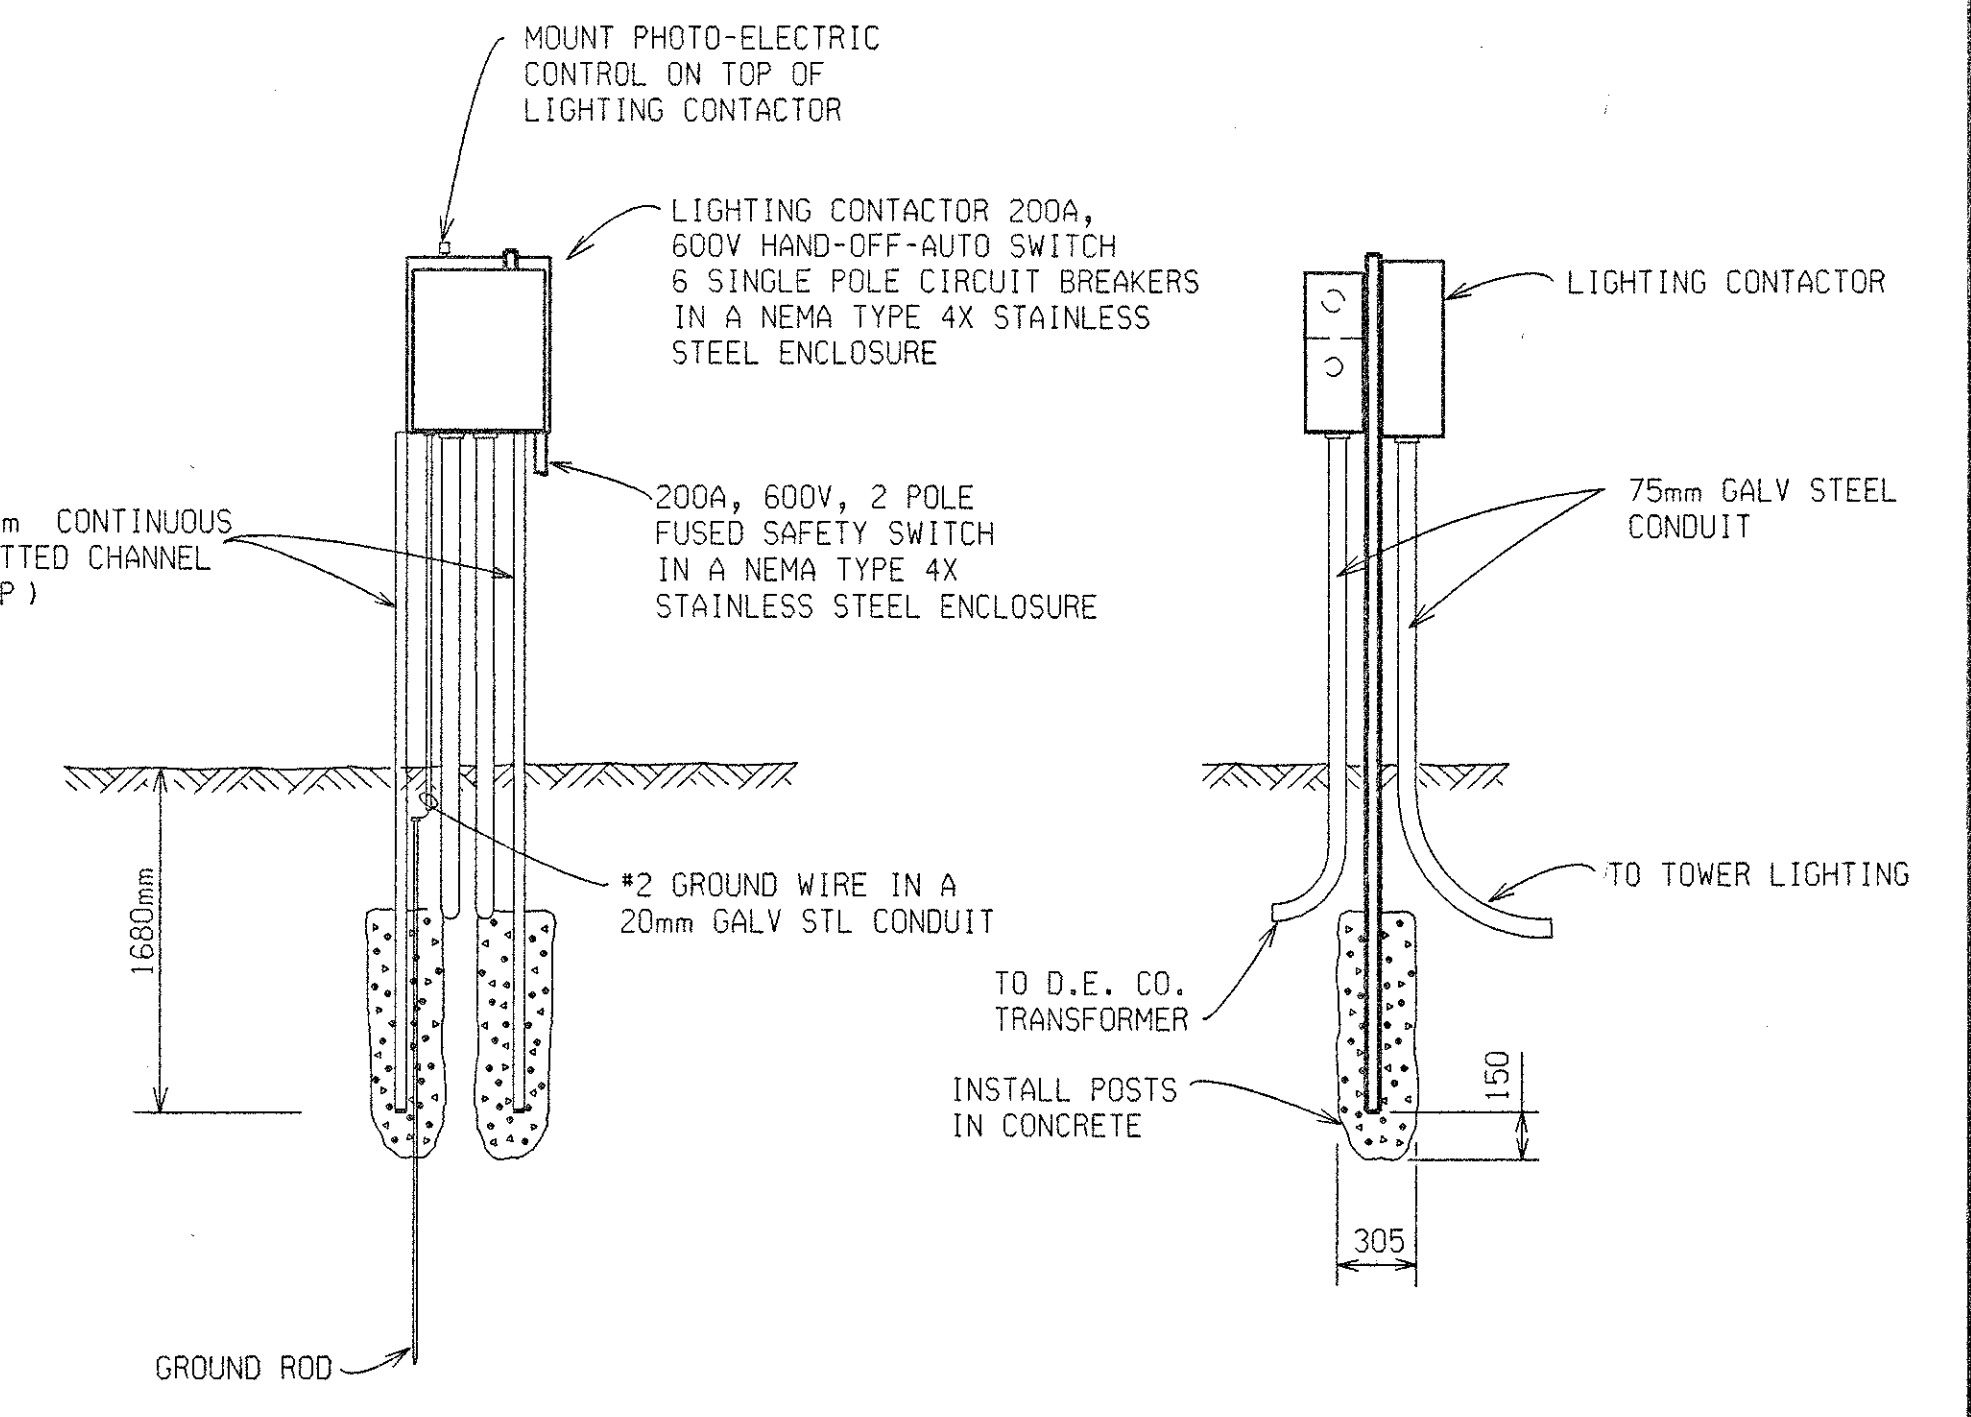


LIGHTING CONTROL PANEL



TOWER LIGHTING DETAILS					
DATE	SCALE	CONT. SEC.	JOB NO.	DESIGN UNIT	SHEET NO.
07/21/99	NONE	63174	48404	ZIELINSKI	R.O.W. 6E



			FINAL R.O.W.
AUTH	DATE	NO.	REVISION

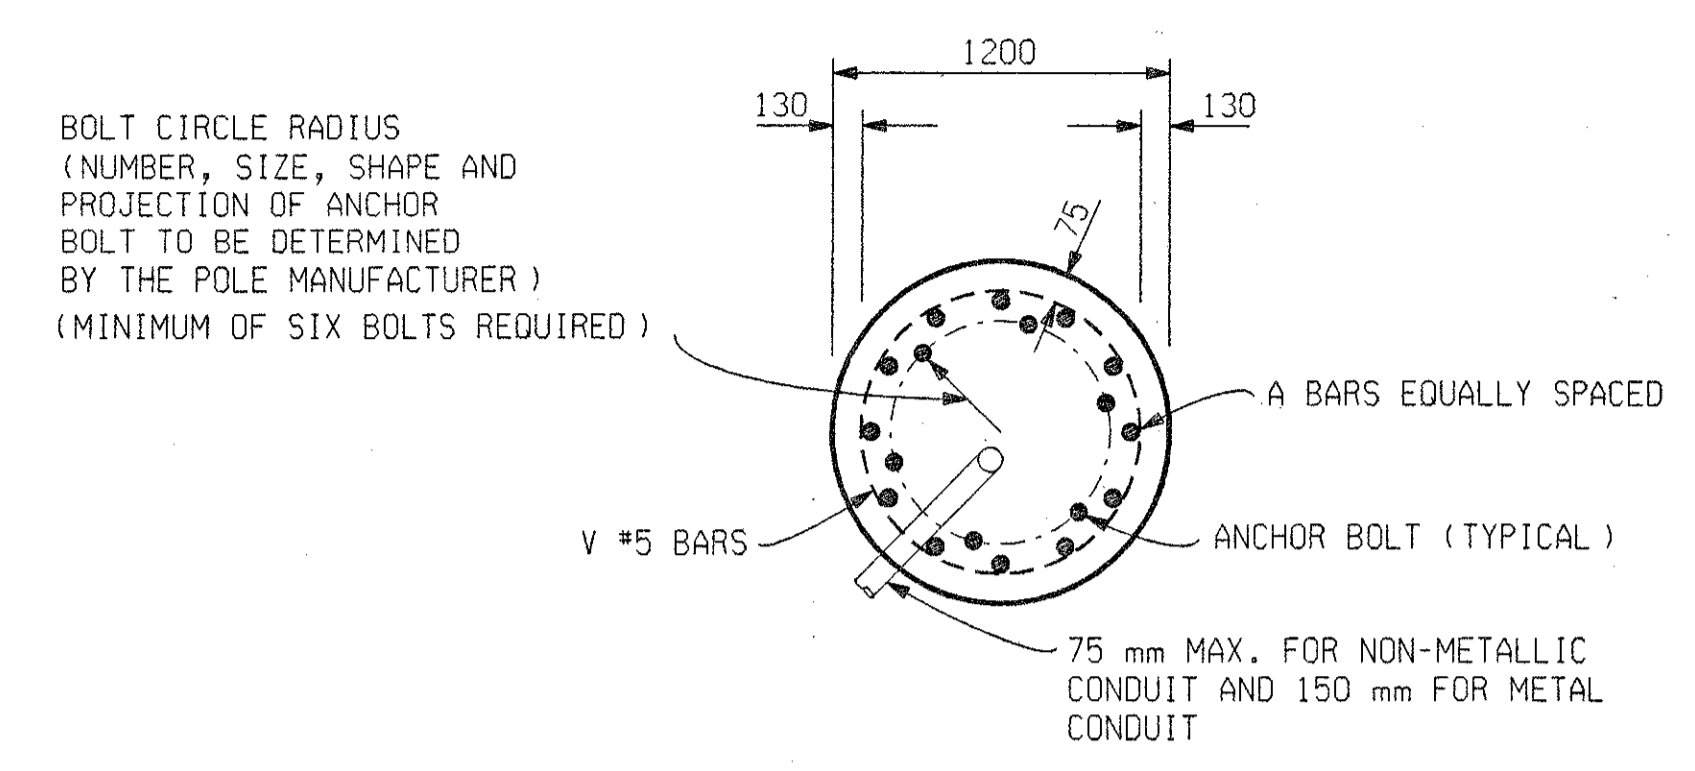

PLAN OF CYLINDRICAL FOOTING

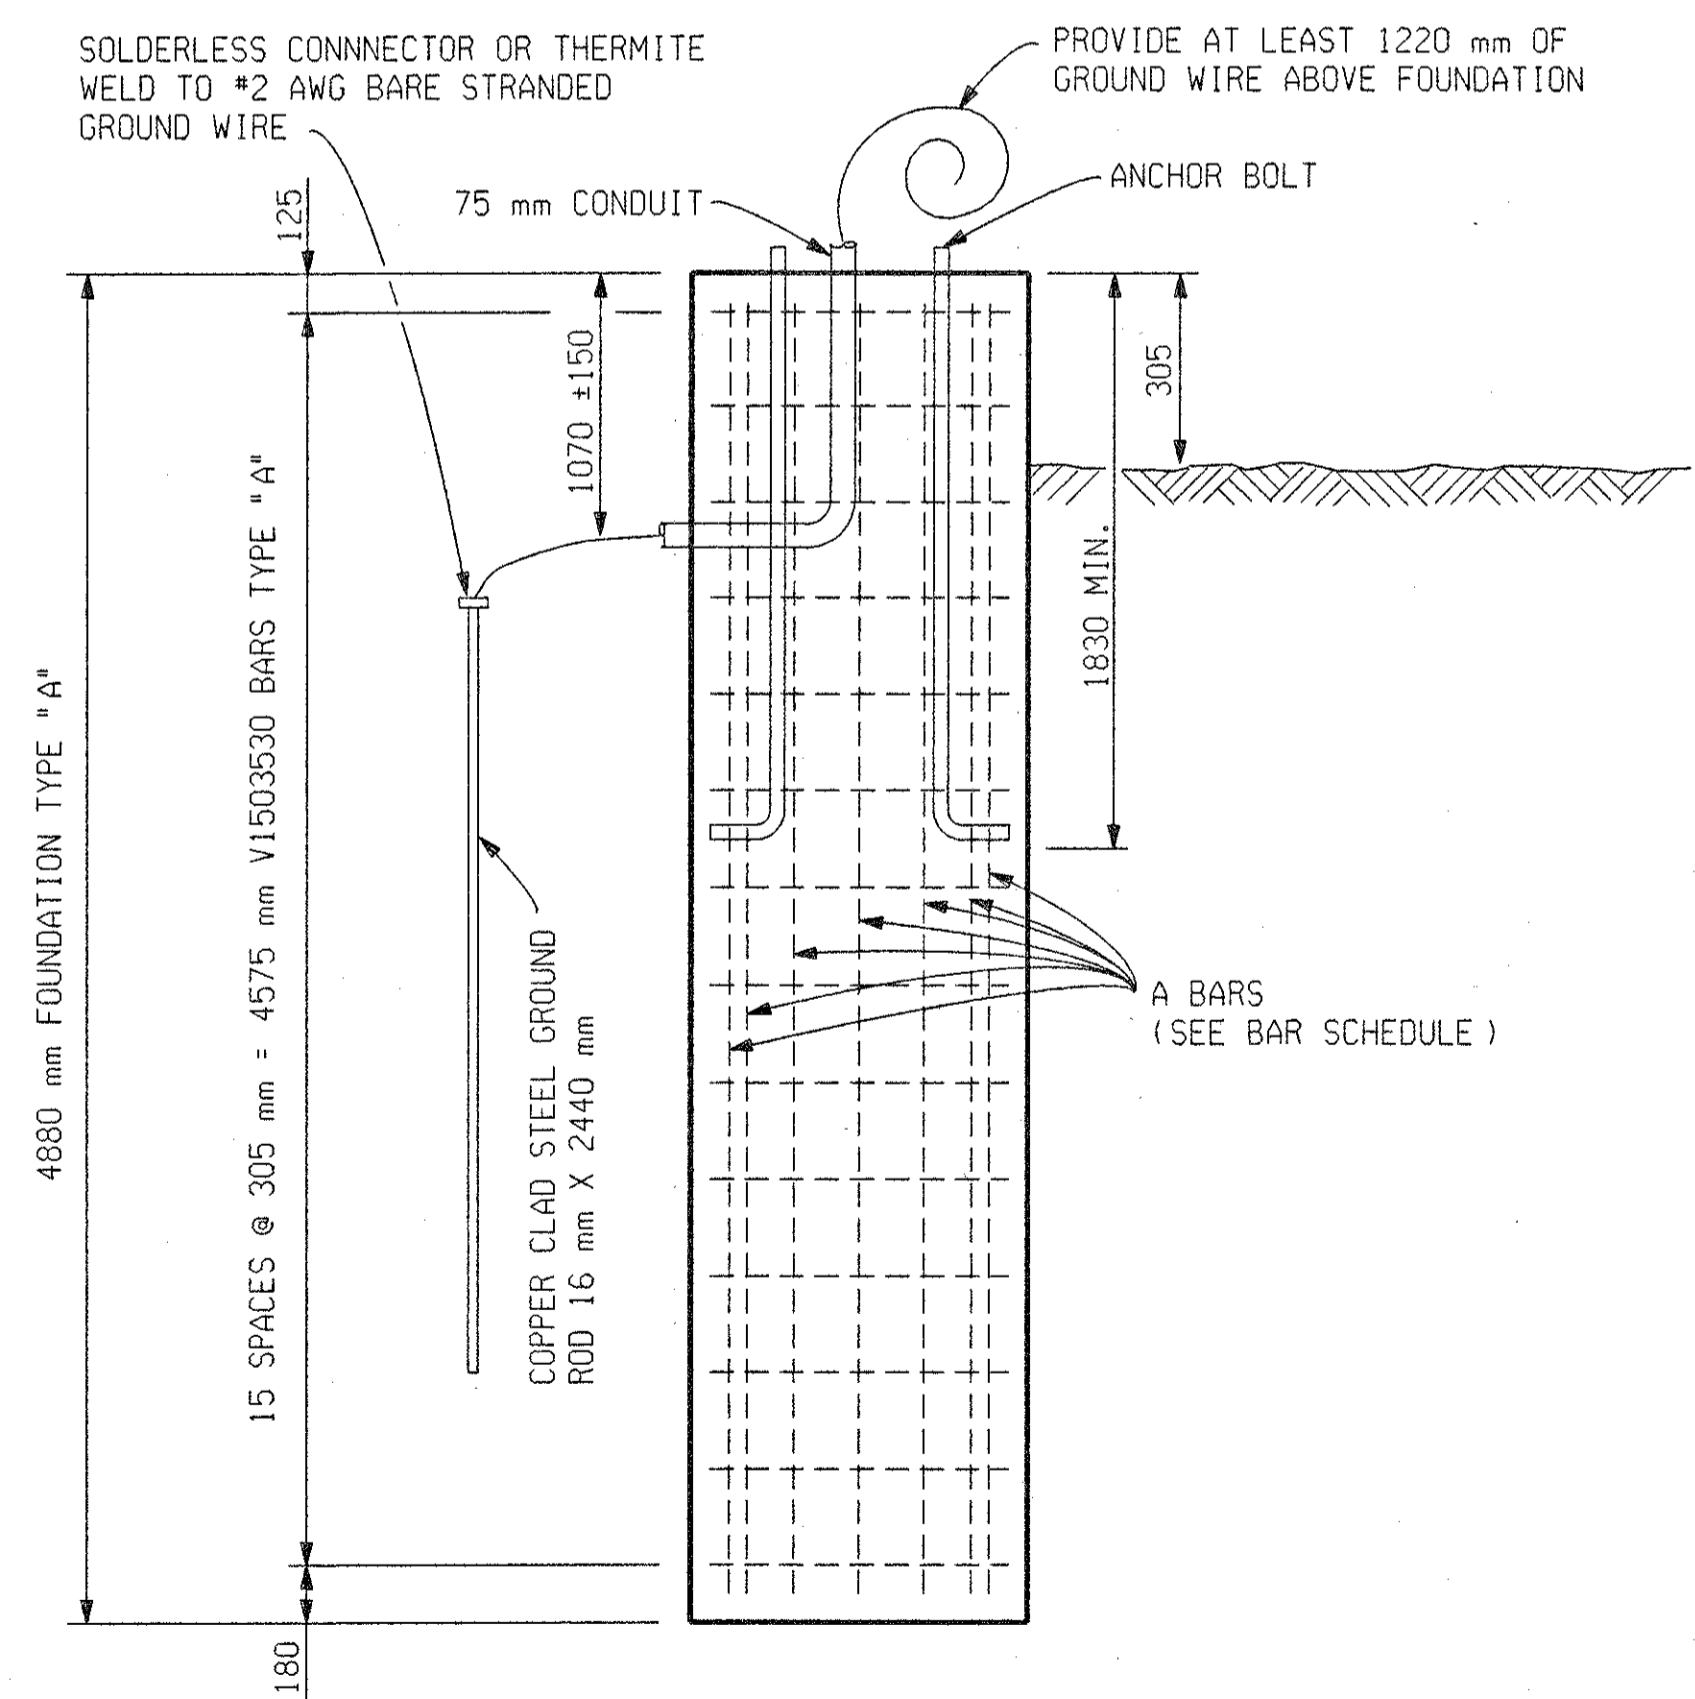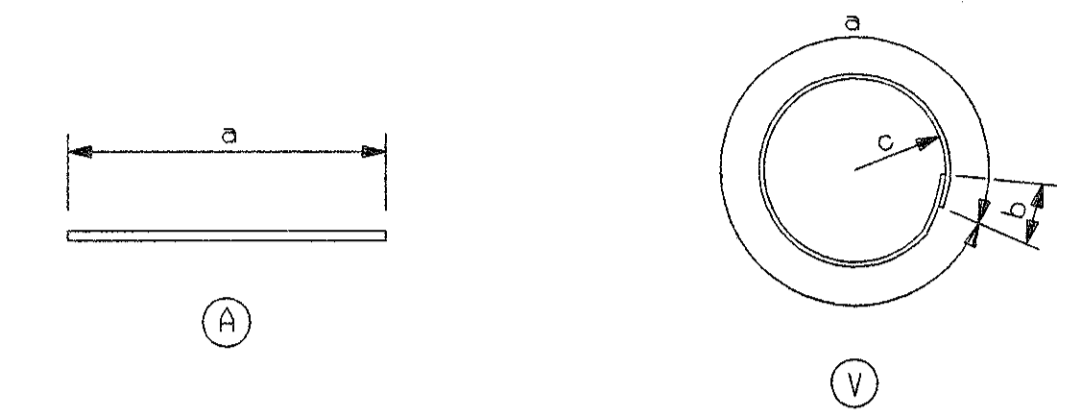

SECTION THRU FOOTING

FOUNDATION TYPE "A"


STEEL REINFORCEMENT BAR SCHEDULE								
A3604725	4725				36	4725	12	448.0
V1603530	2980	550	475		16	3530	16	88.0
FOUNDATION TYPE "A" TOTAL WT. 536 kg.								

QUANTITIES			
FOUNDATION TYPE "A"	ITEM	UNIT	AMOUNT
	CONCRETE GRADE S2	m ³	5.50


NOTES:

- ALL DIMENSIONS ARE IN MILLIMETERS.
- ALL CONCRETE TO BE GRADE S2
- THE GRADES AND WORKING STRESSES OF THE STRUCTURAL MATERIALS USED IN THESE FOUNDATIONS ARE AS FOLLOWS:
 STEEL REINFORCEMENT $f_y = 400 \text{ MPa}$
 CONCRETE GRADE S2 $f'_c = 21 \text{ MPa}$
- THESE LIGHT STANDARD FOUNDATIONS ARE TO BE POURED AGAINST UNDISTURBED SOIL IN AS MUCH AS POSSIBLE.
- ALL EXCESS EXCAVATED MATERIAL SHALL BE REMOVED AND DISPOSED OF BY THE CONTRACTOR. THIS REMOVAL SHALL BE PART OF THE ITEM "LIGHT TOWER FOUNDATION" OF THE TYPE SPECIFIED AND WILL NOT BE PAID FOR SEPARATELY.


	TOWER LIGHTING FOUNDATION AND BAR DETAIL					
	DATE	SCALE	CONT. SEC.	JOB NO.	DESIGN UNIT	SHEET NO.
07/21/9	NONE	63174	48404A	ZIELINSKI	R.O.W/CONST.	7E

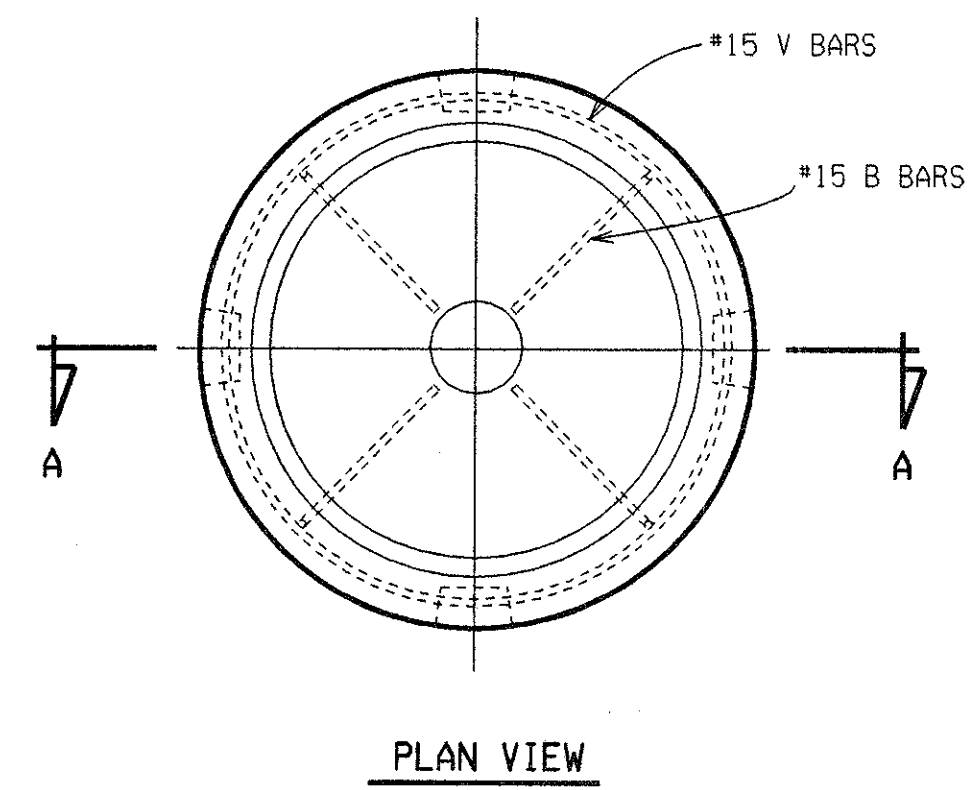


PLAN VIEW

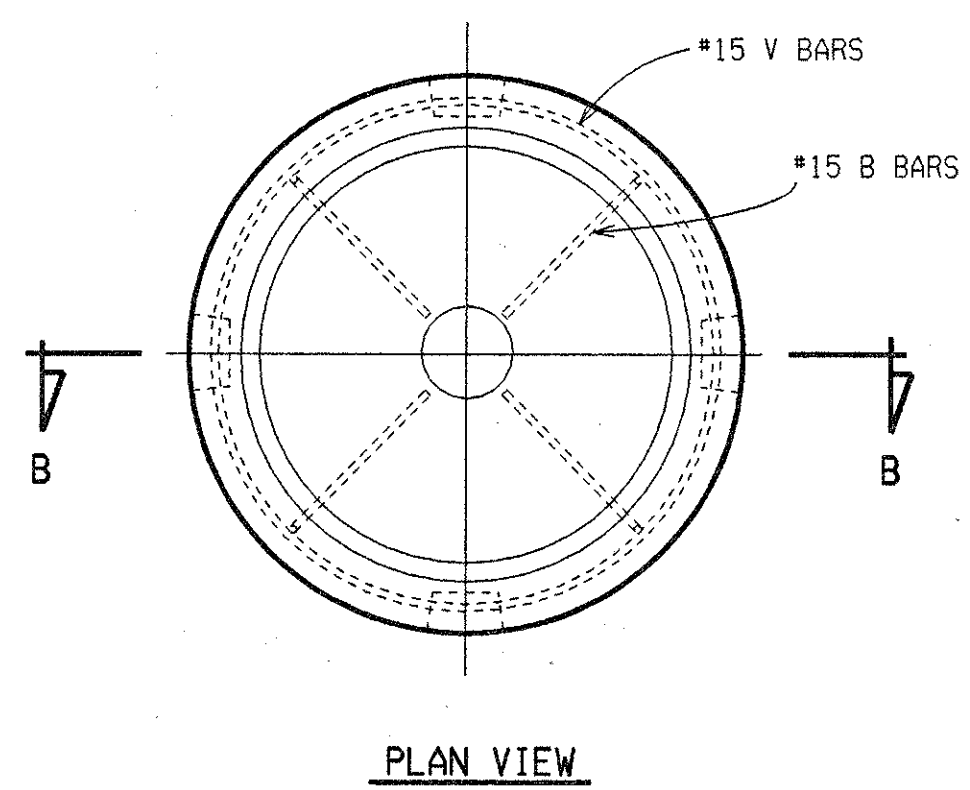


PLAN VIEW

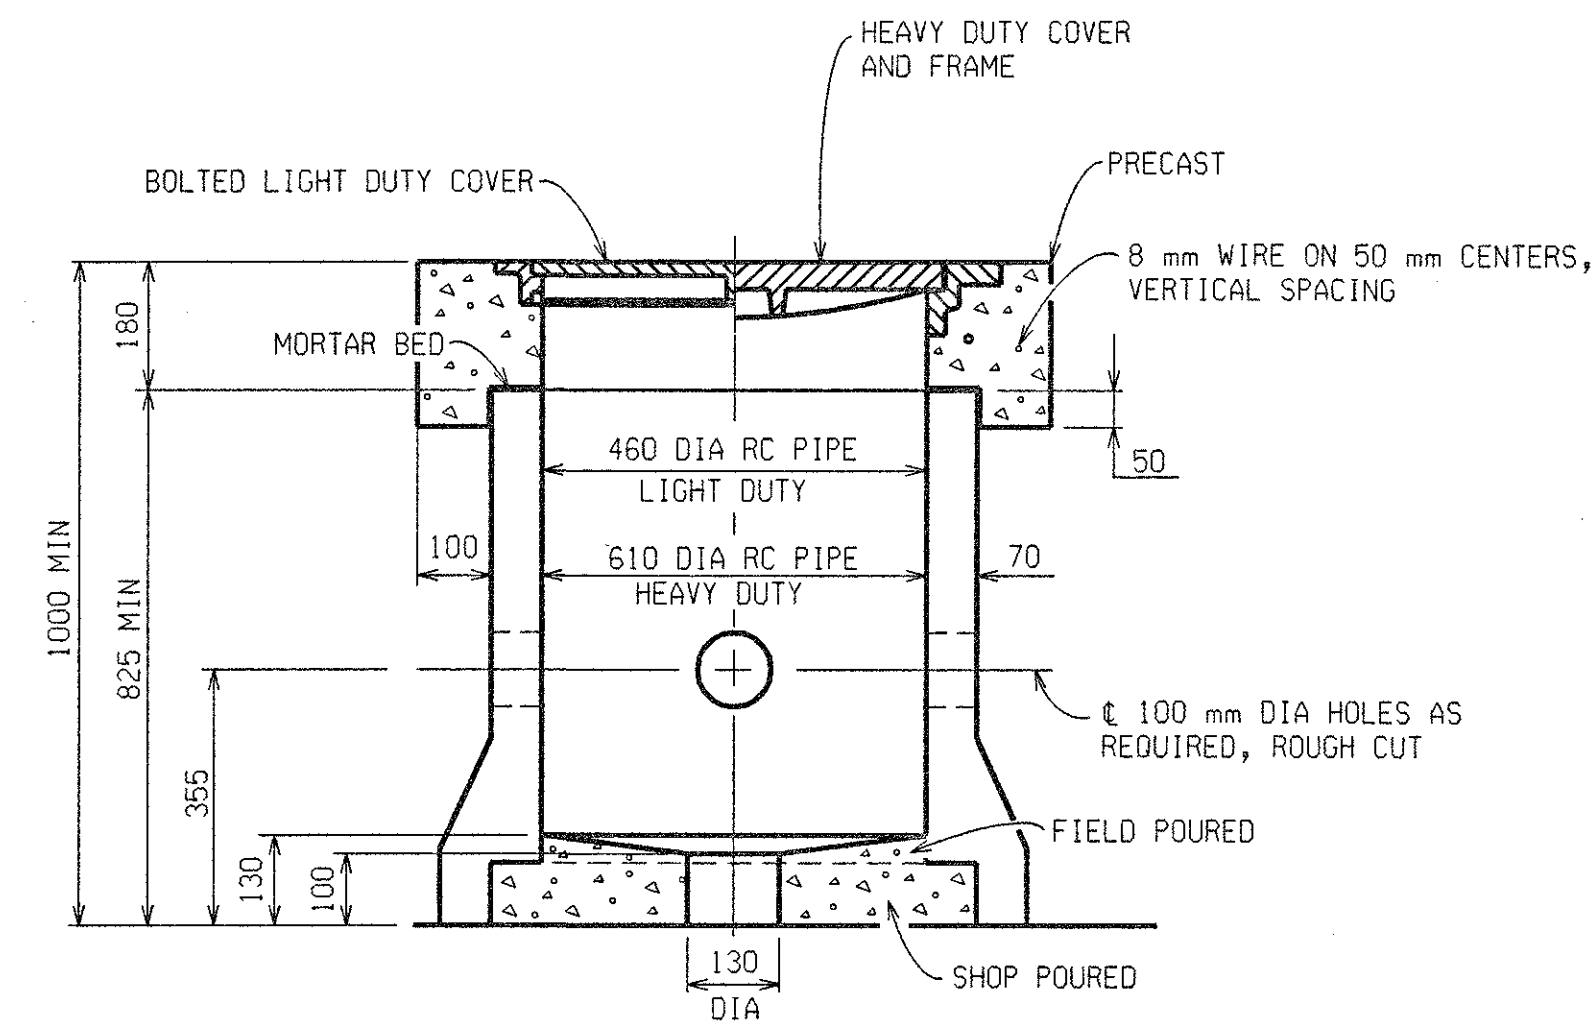

ALTERNATE PRECAST CONCRETE HANDHOLE USING REINFORCED CONCRETE PIPE

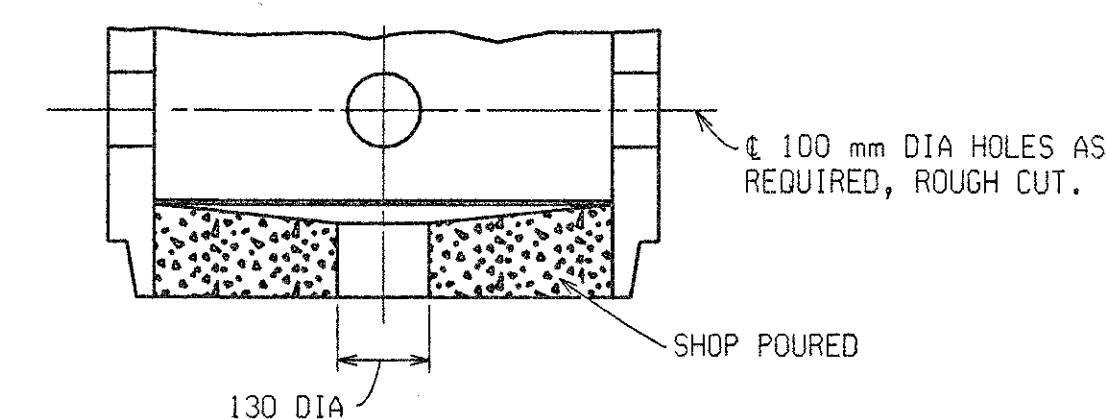

ALTERNATE PRECAST CONCRETE HANDHOLE USE OF OPPOSITE END OF R.C. PIPE (ALL OTHER DIMENSIONS SAME)

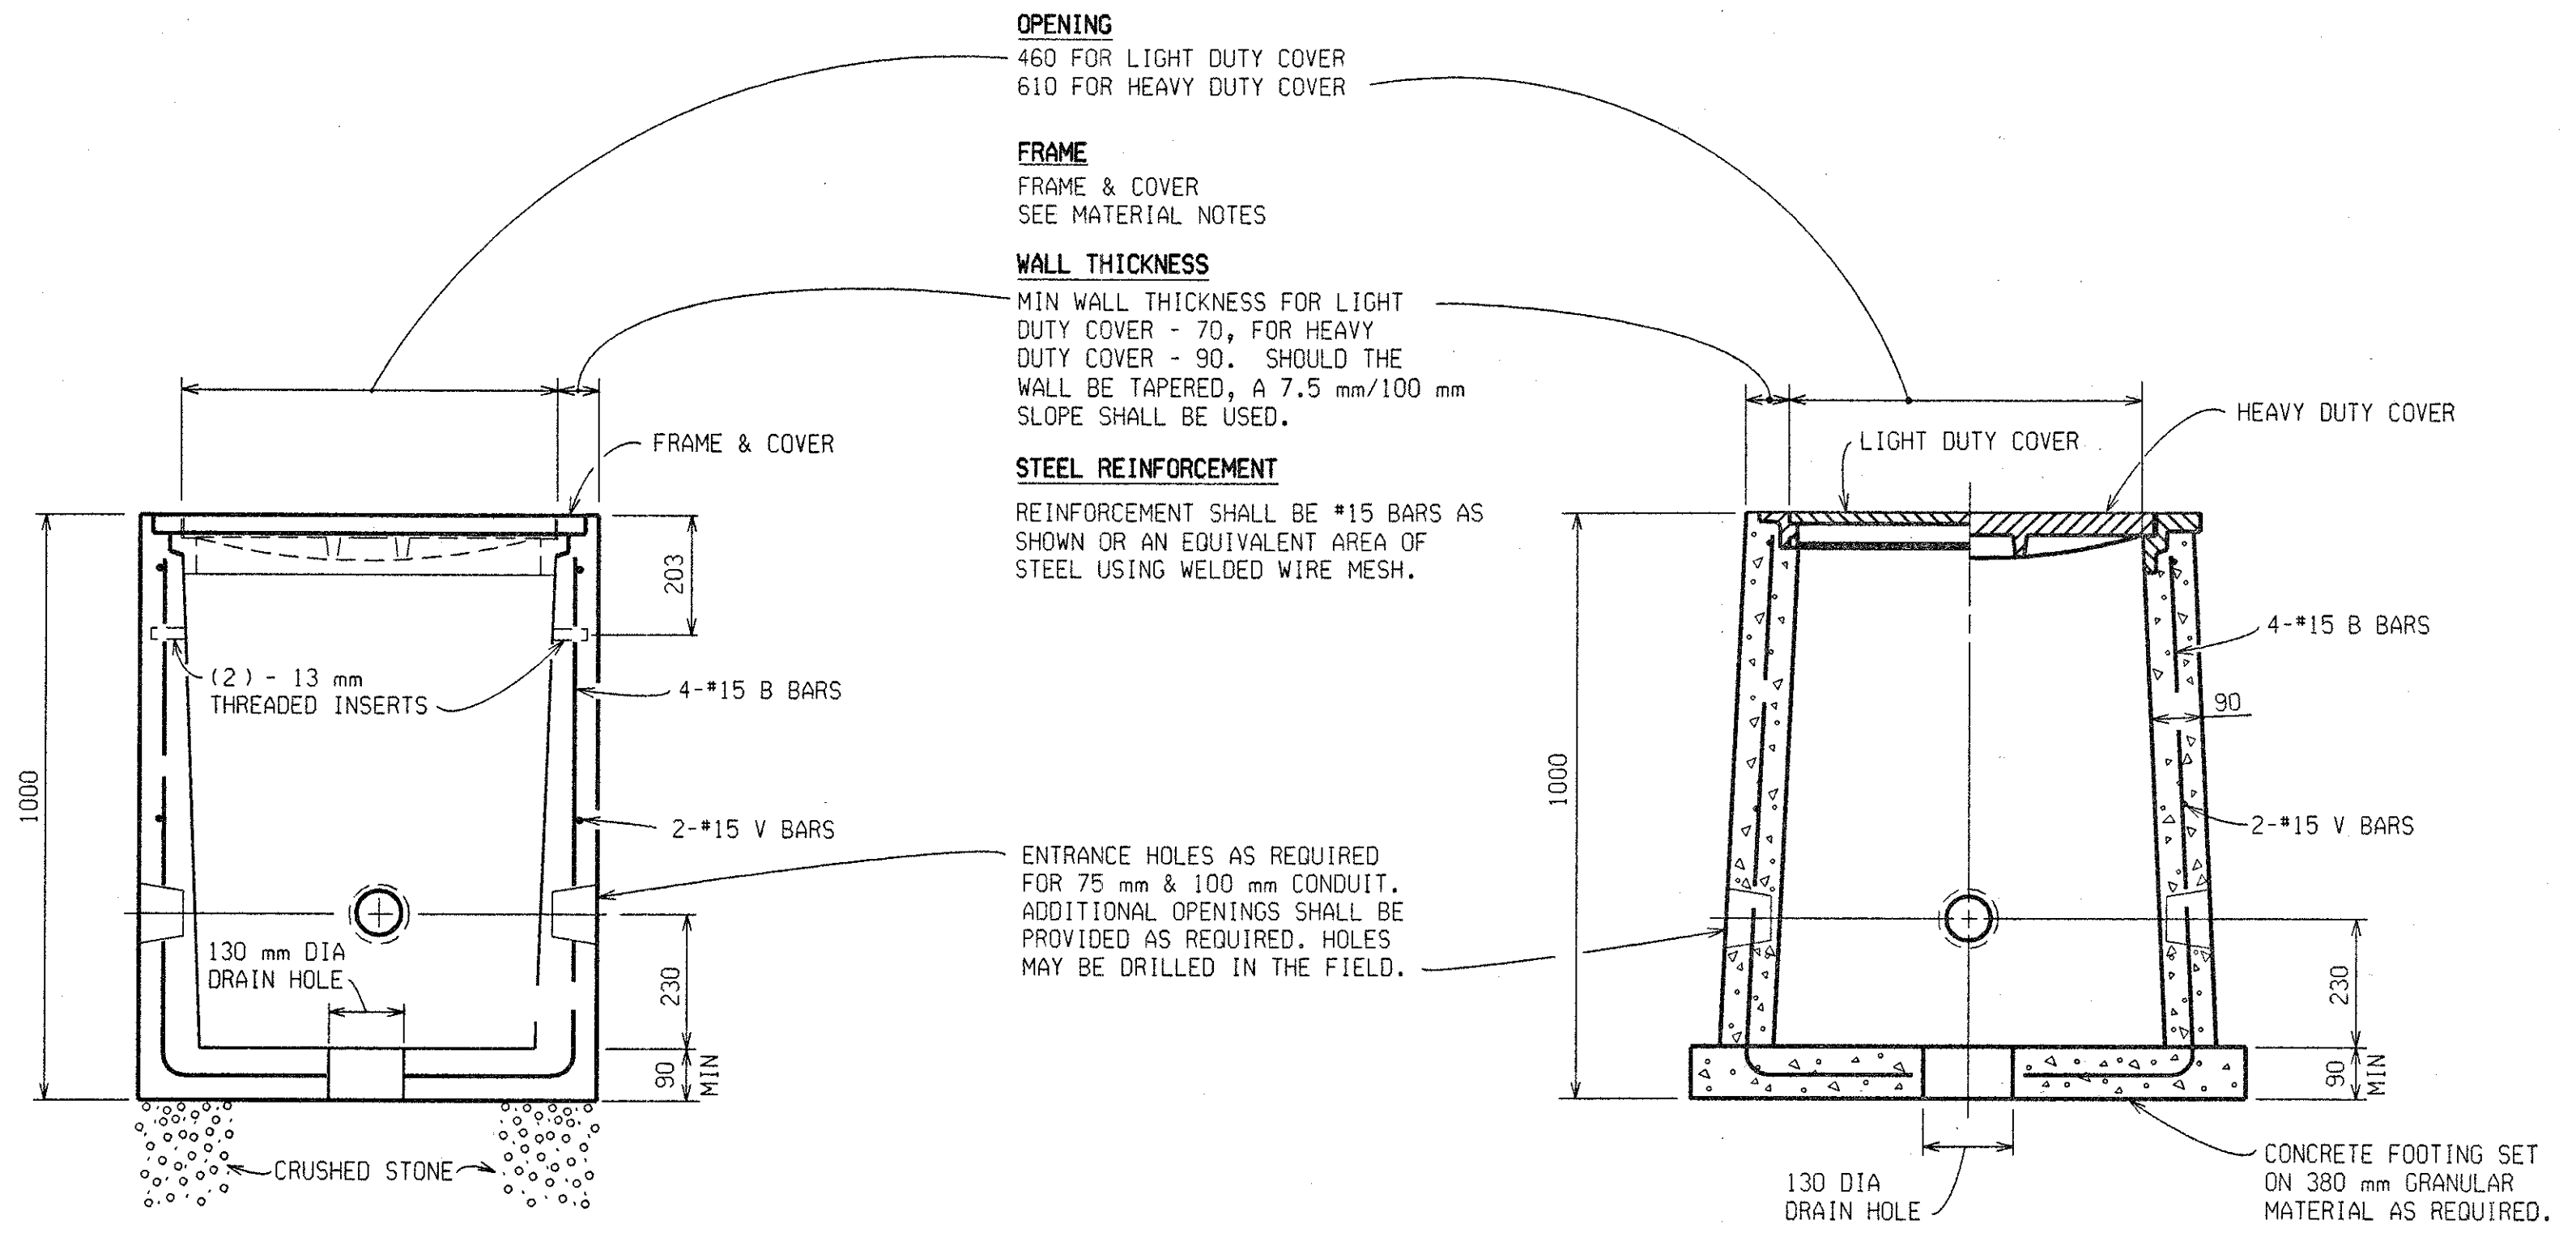

SECTION A-A PRECAST CONCRETE HANDHOLE

SECTION B-B PRECAST CONCRETE HANDHOLE

OPENING
 460 FOR LIGHT DUTY COVER
 610 FOR HEAVY DUTY COVER

FRAME
 FRAME & COVER
 SEE MATERIAL NOTES

WALL THICKNESS
 MIN WALL THICKNESS FOR LIGHT DUTY COVER - 70, FOR HEAVY DUTY COVER - 90. SHOULD THE WALL BE TAPERED, A 7.5 mm/100 mm SLOPE SHALL BE USED.

STEEL REINFORCEMENT
 REINFORCEMENT SHALL BE #15 BARS AS SHOWN OR AN EQUIVALENT AREA OF STEEL USING WELDED WIRE MESH.


ENTRANCE HOLES AS REQUIRED FOR 75 mm & 100 mm CONDUIT. ADDITIONAL OPENINGS SHALL BE PROVIDED AS REQUIRED. HOLES MAY BE DRILLED IN THE FIELD.

GENERAL NOTES:


- ALL DIMENSIONS ARE IN MILLIMETERS.
- THE MATERIAL AND WORKMANSHIP SHALL BE IN ACCORDANCE WITH THE CURRENT M.D.O.T. STANDARD SPECIFICATIONS.
- THE CONTRACTOR MAY CONSTRUCT THE HANDHOLE STRUCTURE OF CONCRETE MASONRY, OR OF PRECAST REINFORCED CONCRETE.
- THE INNER SURFACE OF THE HANDHOLE SHALL BE SMOOTH.
- ALL CASTINGS SHALL BE CLEANED BY SAND BLASTING.
- THE SEATING FACE OF THE COVER AND THE SEAT FOR THE COVER ON THE FRAME IF REQUIRED, SHALL BE GROUND OR MACHINED SO THAT THE COVER SHALL HAVE AN EVEN BEARING ON ITS SEAT TO PREVENT ROCKING OR TILTING.
- THE CASTINGS SHALL BE FREE OF POURING FAULTS, BLOW HOLES, CRACKS, AND OTHER IMPERFECTIONS. THEY SHALL BE SOUND, TRUE TO FORM AND THICKNESS, CLEAN AND NEATLY FINISHED AND SHALL BE COATED WITH COAL TAR PITCH VARNISH.
- HANDHOLE SHALL BE EQUIPPED WITH CABLE RACK AND HOOKS TO TRAIN CABLE.
- LIGHT DUTY COVER SHALL BE BOLTED TO FRAME WITH NOT LESS THAN 2 COUNTERSUNK HEX HEAD BRONZE BOLTS.
- PRECAST HANDHOLE WITH HEAVY DUTY COVER SHALL BE SET ON A CONCRETE SLAB.

MATERIAL NOTES:

- HEAVY DUTY COVERS SHALL BE CASTINGS WHICH MEET THE REQUIREMENTS OF THE CURRENT SPECIFICATIONS FOR GRAY IRON CASTINGS ASTM DESIGNATION A48 AND SHALL HAVE A MINIMUM STRENGTH AS PROVIDED FOR CLASS NO. 30B GRAY IRON CASTINGS.
- ALL CONCRETE MASONRY SHALL BE GRADE 30M.
- THE HEAVY DUTY COVER & FRAME SHALL BE EAST JORDAN IRON WORKS #2860 TYPE "A" OR NEENAH FOUNDRY #R-6052 D FOR CIRCULAR COVER OR AN APPROVED EQUAL.
- LIGHT DUTY COVER AND FRAME SHALL BE EAST JORDAN IRON WORKS #2982A-18 OR NEENAH FOUNDRY #R-6012 D FOR CIRCULAR COVER OR AN APPROVED EQUAL.

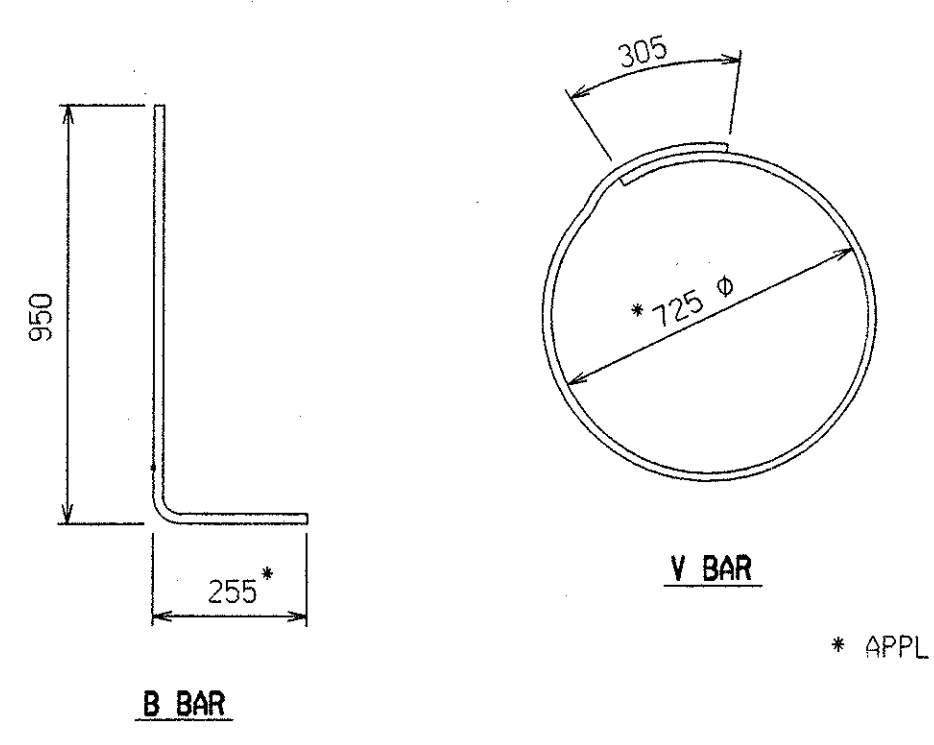

* APPLIES TO 610 mm HANDHOLE

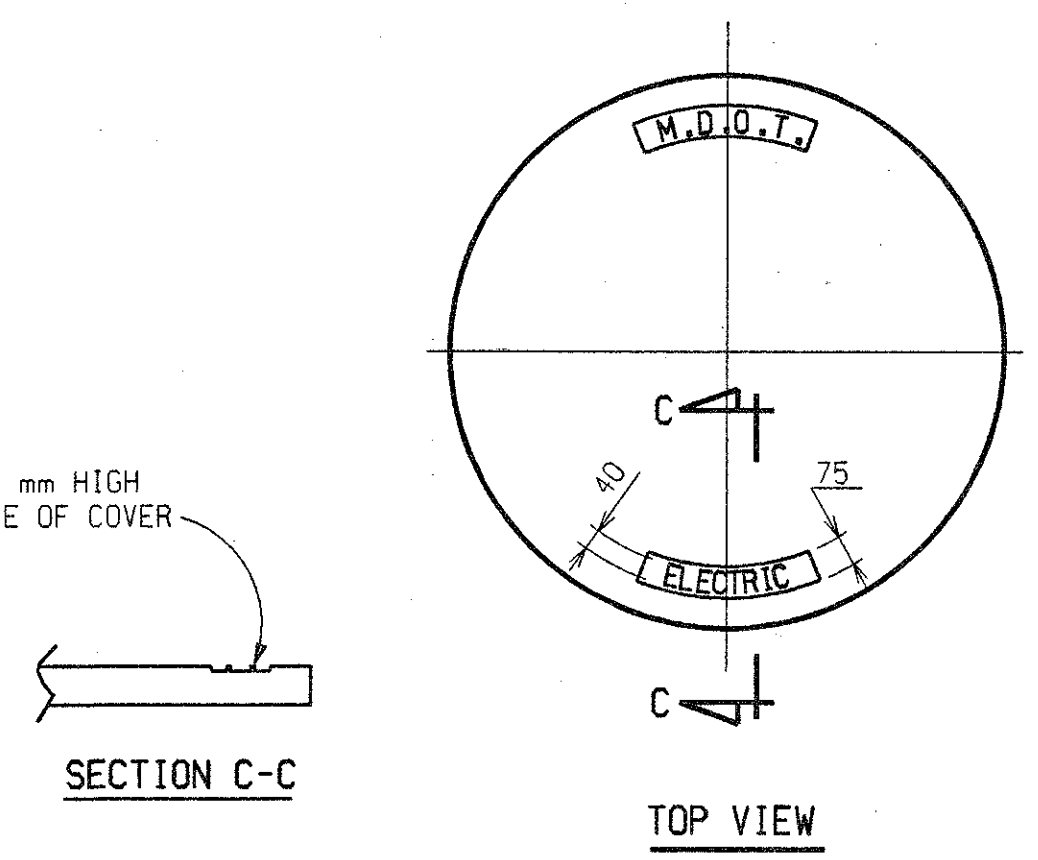

ALL LETTERING TO BE 6 mm HIGH AND FLUSH WITH SURFACE OF COVER


SECTION C-C

TOP VIEW

	ELECTRIC HANDHOLE DETAILS					6900242-3
	DATE 07/21/99	SCALE NONE	CONT. SEC. 63174	JOB NO. 48404A	DESIGN UNIT ZIELINSKI	SHEET NO. R.O.W 8E


1 2 3 4 5 6 7 8 9 10 11 12 13 14 15 16 17 18 19 20 21 22 23 24 25 26 27 28 29 30 31 32 33 34 35 36 37 38 39 40 41 42 43 44 45 46 47 48 49 50 51 52 53 54 55 56 57 58 59 60 61 62 63

TESTHOLE NO. 01
Sta. SEE PLANS N.W. QUADRANT
I-75 & 696 INTERCHANGE
TIN R11E SEC. 23, DAKLAND CO.
Date Drilled 08-17-99
Elevation:

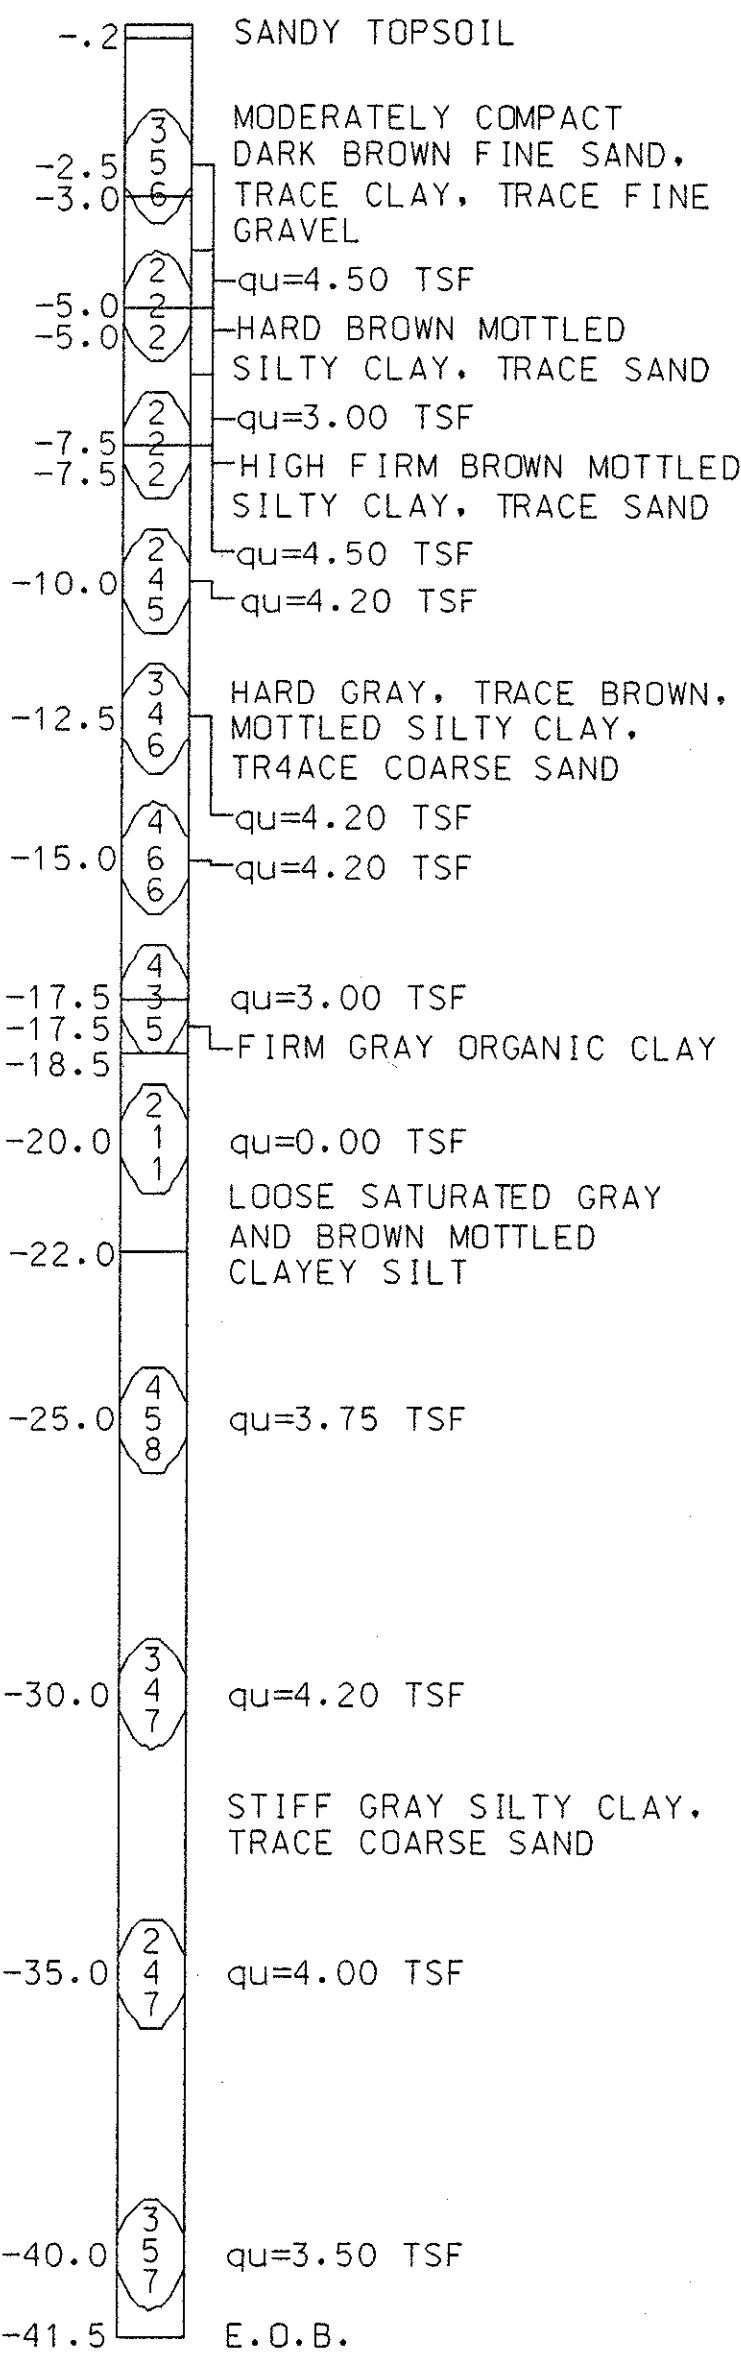


qu= UNCONFINED COMP. STR. POCKET PEN. IN TSF DRY HOLE

TESTHOLE NO. 02
Sta. SEE PLANS N.W. QUADRANT
I-75 & 696 INTERCHANGE
TIN R11E SEC. 23, DAKLAND CO.
Date Drilled 08-18-99
Elevation:

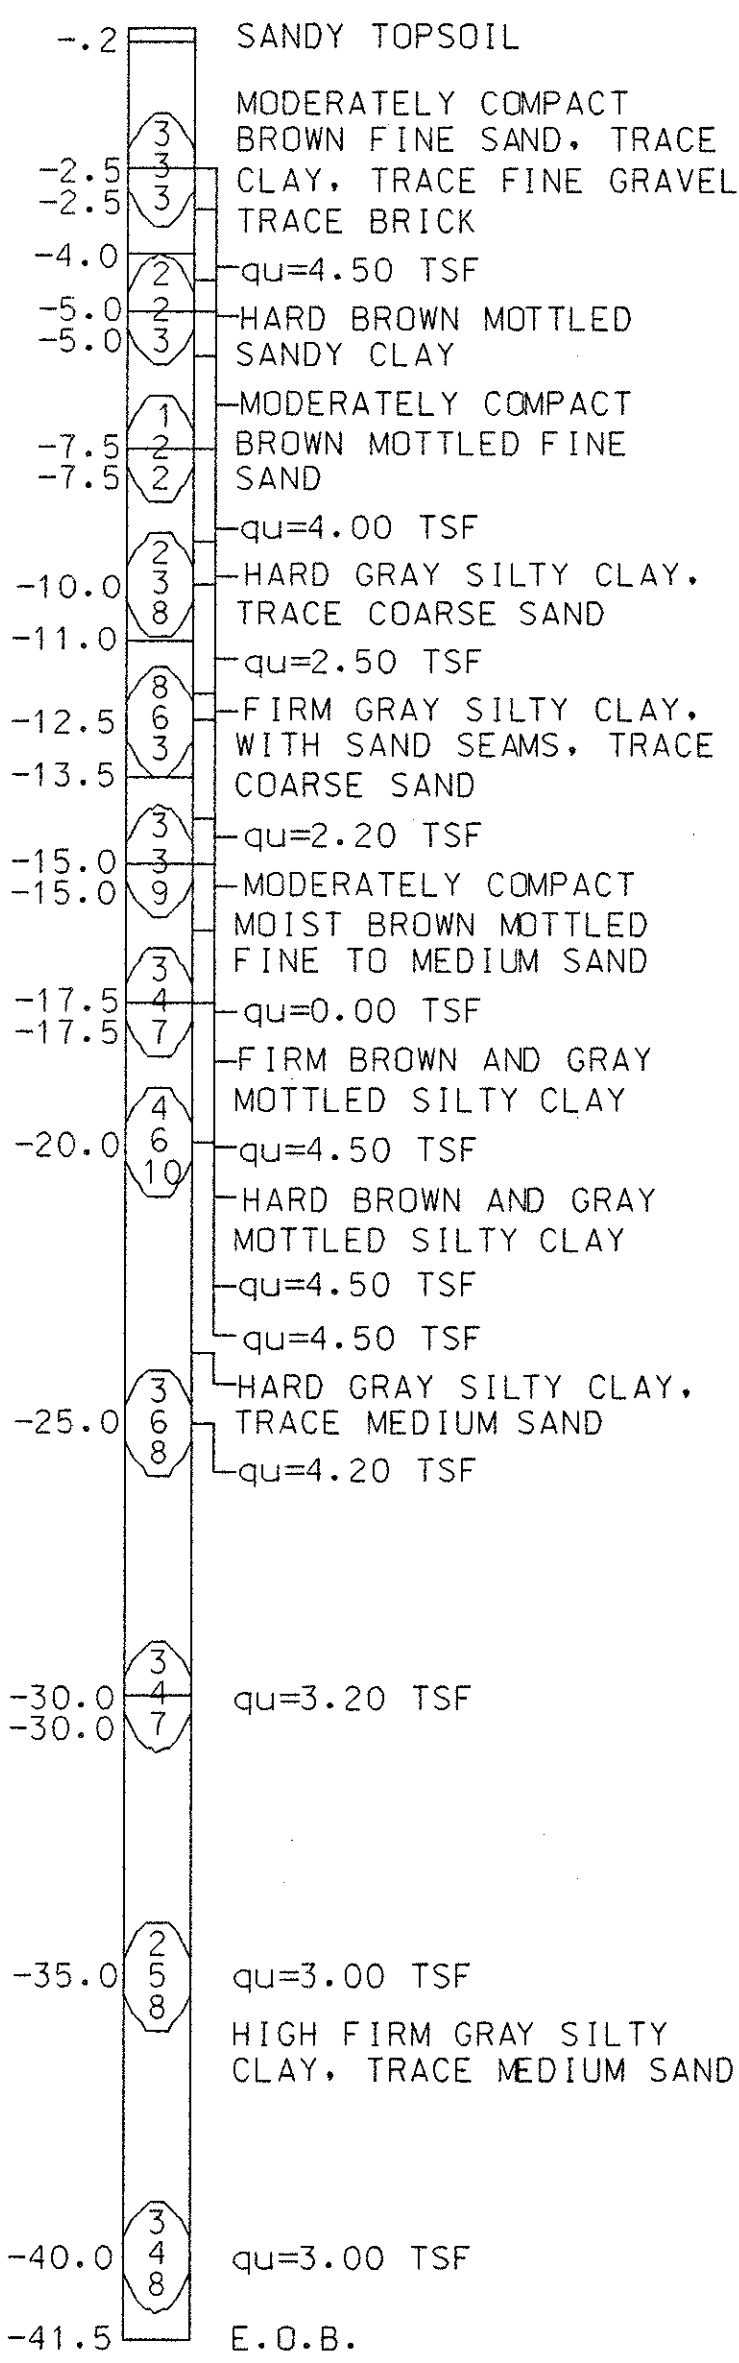


qu= UNCONFINED COMP. STR. POCKET PEN. IN TSF DRY HOLE

TESTHOLE NO. 03
Sta. SEE PLANS N.W. QUADRANT
I-75 & 696 INTERCHANGE
TIN R11E SEC. 26, DAKLAND CO.
Date Drilled 08-18-99
Elevation:

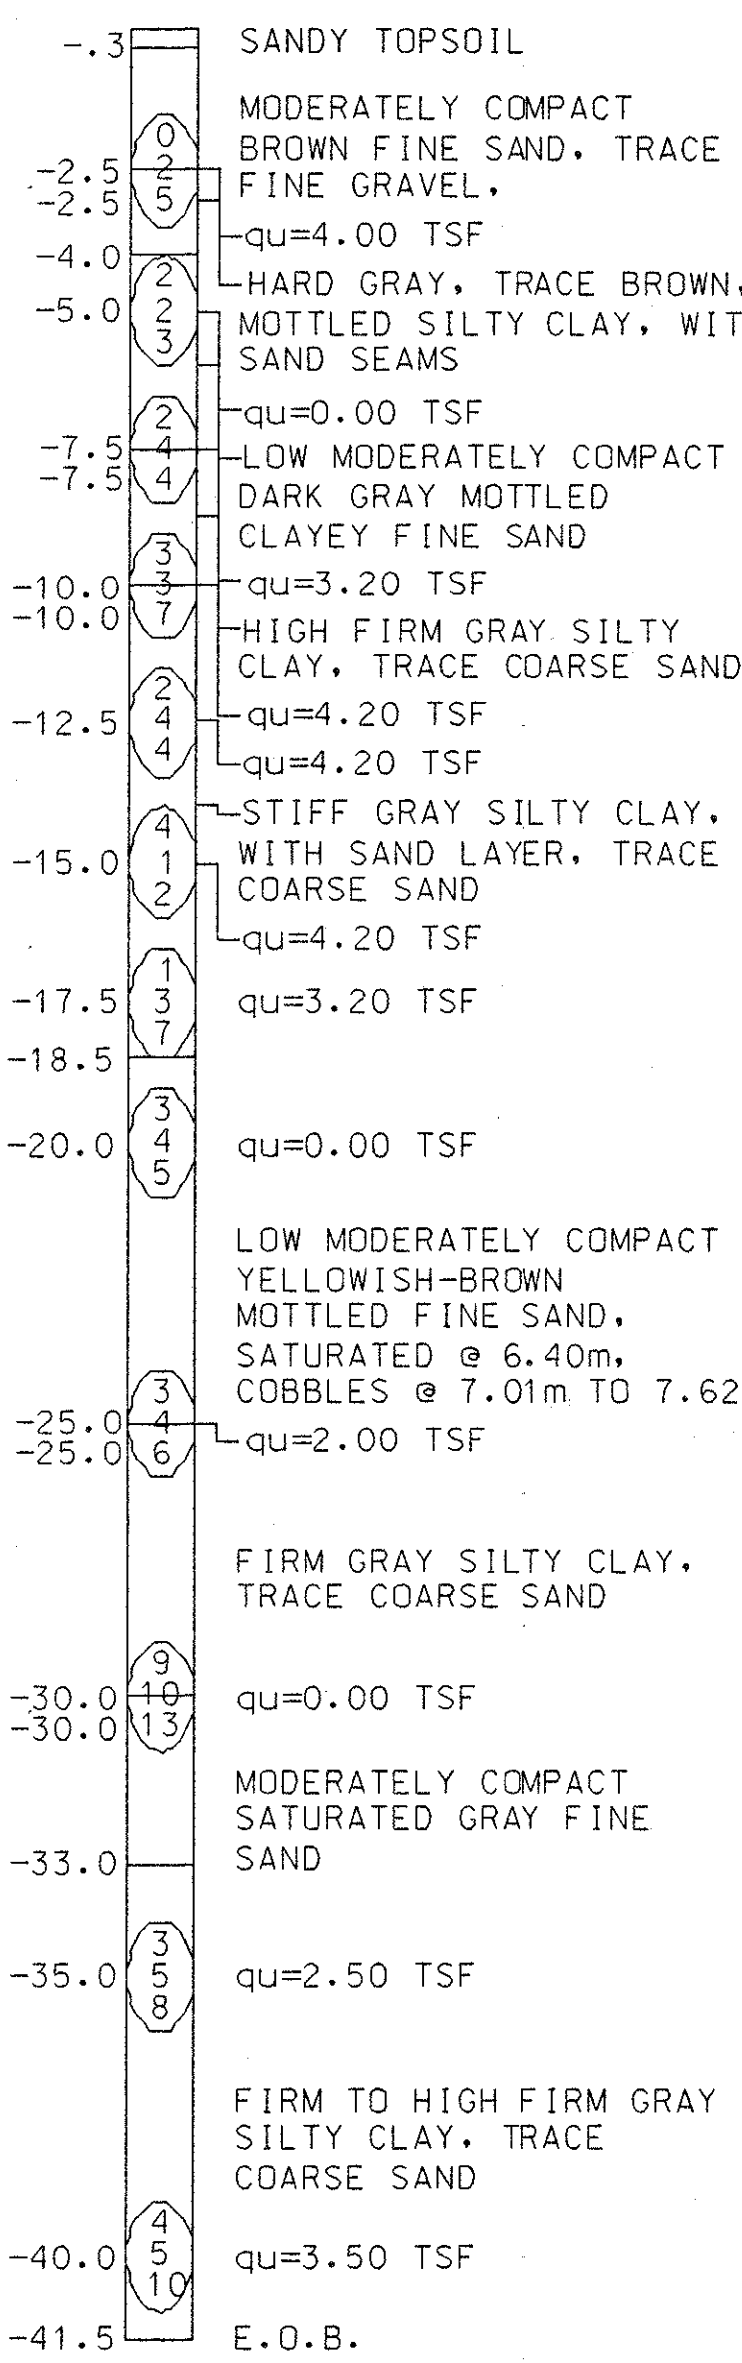

qu= UNCONFINED COMP. STR. POCKET PEN. IN TSF WATER LEVEL @ 6.86m WATER LEVEL @ 6.71m (AFTER 20 MIN.)

TESTHOLE NO. 04
Sta. SEE PLANS N.W. QUADRANT
I-75 & 696 INTERCHANGE
TIN R11E SEC. 23, DAKLAND CO.
Date Drilled 08-19-99
Elevation:

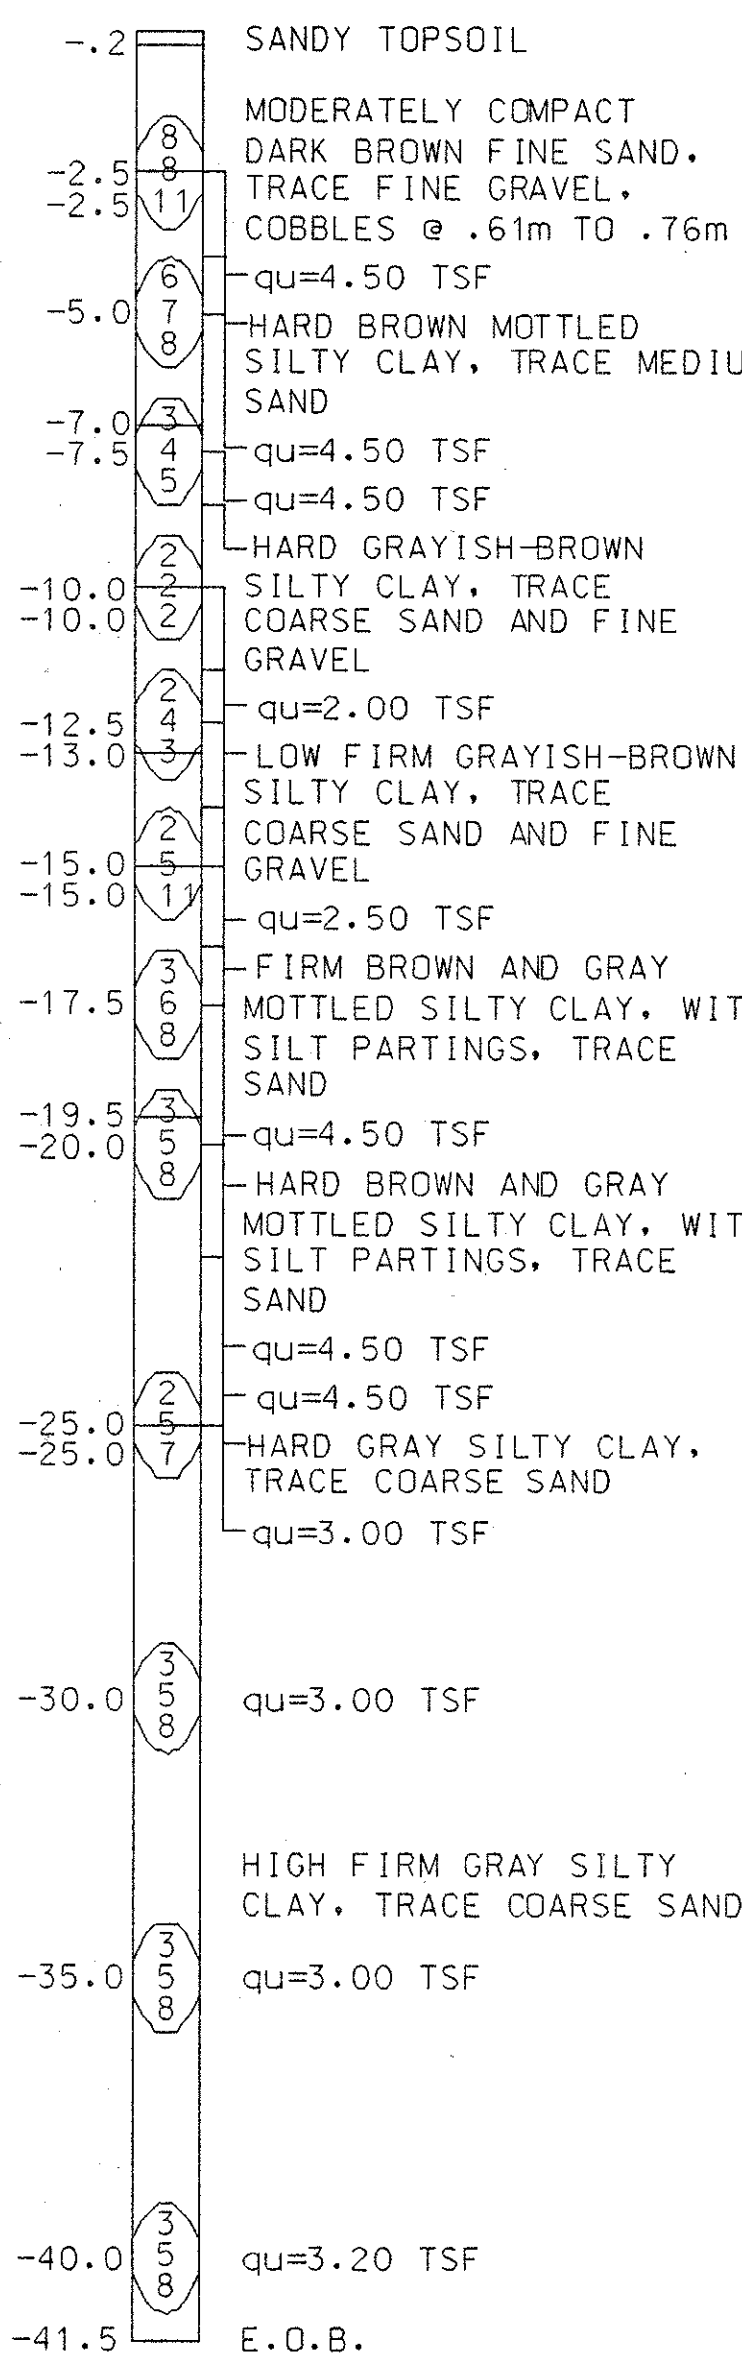

qu= UNCONFINED COMP. STR. POCKET PEN. IN TSF DRY HOLE

REVISIONS		
NO.	DESCRIPTION	DATE BY

NOTES:

- 1st 0.15 m
- 2nd 0.15 m
- 3rd 0.15 m

NUMBERS IN CIRCLES DENOTE NUMBER OF BLOWS REQUIRED TO DRIVE A 51 mm O.D. (38 mm I.D.) SPLIT SPOON SAMPLER 3 SUCCESSIVE 0.15 m INCREMENTS USING A 63.5 kg HAMMER FALLING 0.76 m.

CONSISTENCY WAS DETERMINED BY INSPECTION OF SAMPLES AND SUBSTANTIATED BY SOILS RESISTANCE TO DRILLING TOOLS.

THE SOIL BORING LOGS REPRESENT POINT INFORMATION. PRESENTATION OF THIS INFORMATION IN NO WAY IMPLIES THAT SUBSURFACE CONDITIONS ARE THE SAME AT LOCATIONS OTHER THAN THE EXACT LOCATION OF THE BORING.

SOIL BORING DATA




DATE	CONT. SEC.	JOB NO.	DESIGN UNIT	SHEET
09-09-99	63174	48404A	ZIELINSKI	9E

FILE NAME: 48404bor2.dgn
DRAWN BY:
CHECKED BY:
DATE:
CORRECTED BY: CLARK
DATE: 10-08-99


1 2 3 4 5 6 7 8 9 10 11 12 13 14 15 16 17 18 19 20 21 22 23 24 25 26 27 28 29 30 31 32 33 34 35 36 37 38 39 40 41 42 43 44 45 46 47 48 49 50 51 52 53 54 55 56 57 58 59 60 61 62 63

TESTHOLE NO. 03
Sta. SEE PLANS
I-75 & 12 MILE RD. INTERCHANGE
TIN R11E SEC. 11, OAKLAND CO.
Date Drilled 08-11-99
Elevation:

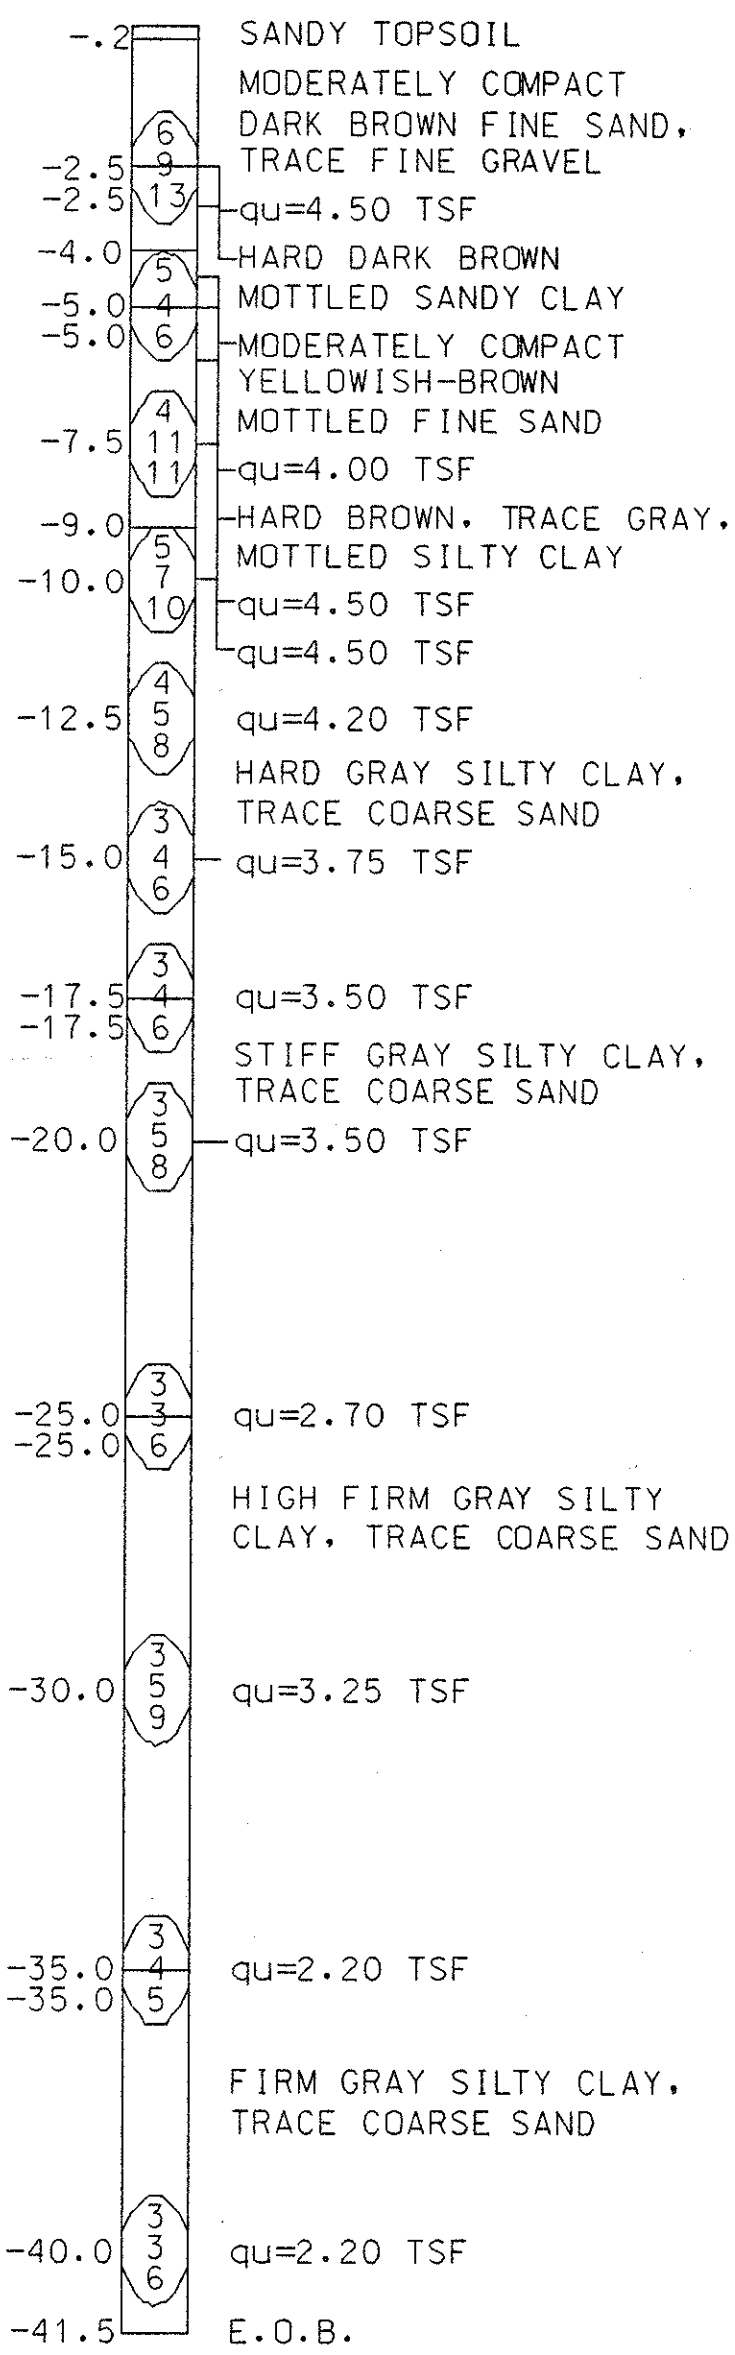


qu= UNCONFINED COMP. STR. POCKET PEN. IN TSF
TEST HOLE DRY

TESTHOLE NO. 04
Sta. SEE PLANS
I-75 & 12 MILE RD. INTERCHANGE
TIN R11E SEC. 11, OAKLAND CO.
Date Drilled 08-12-99
Elevation:

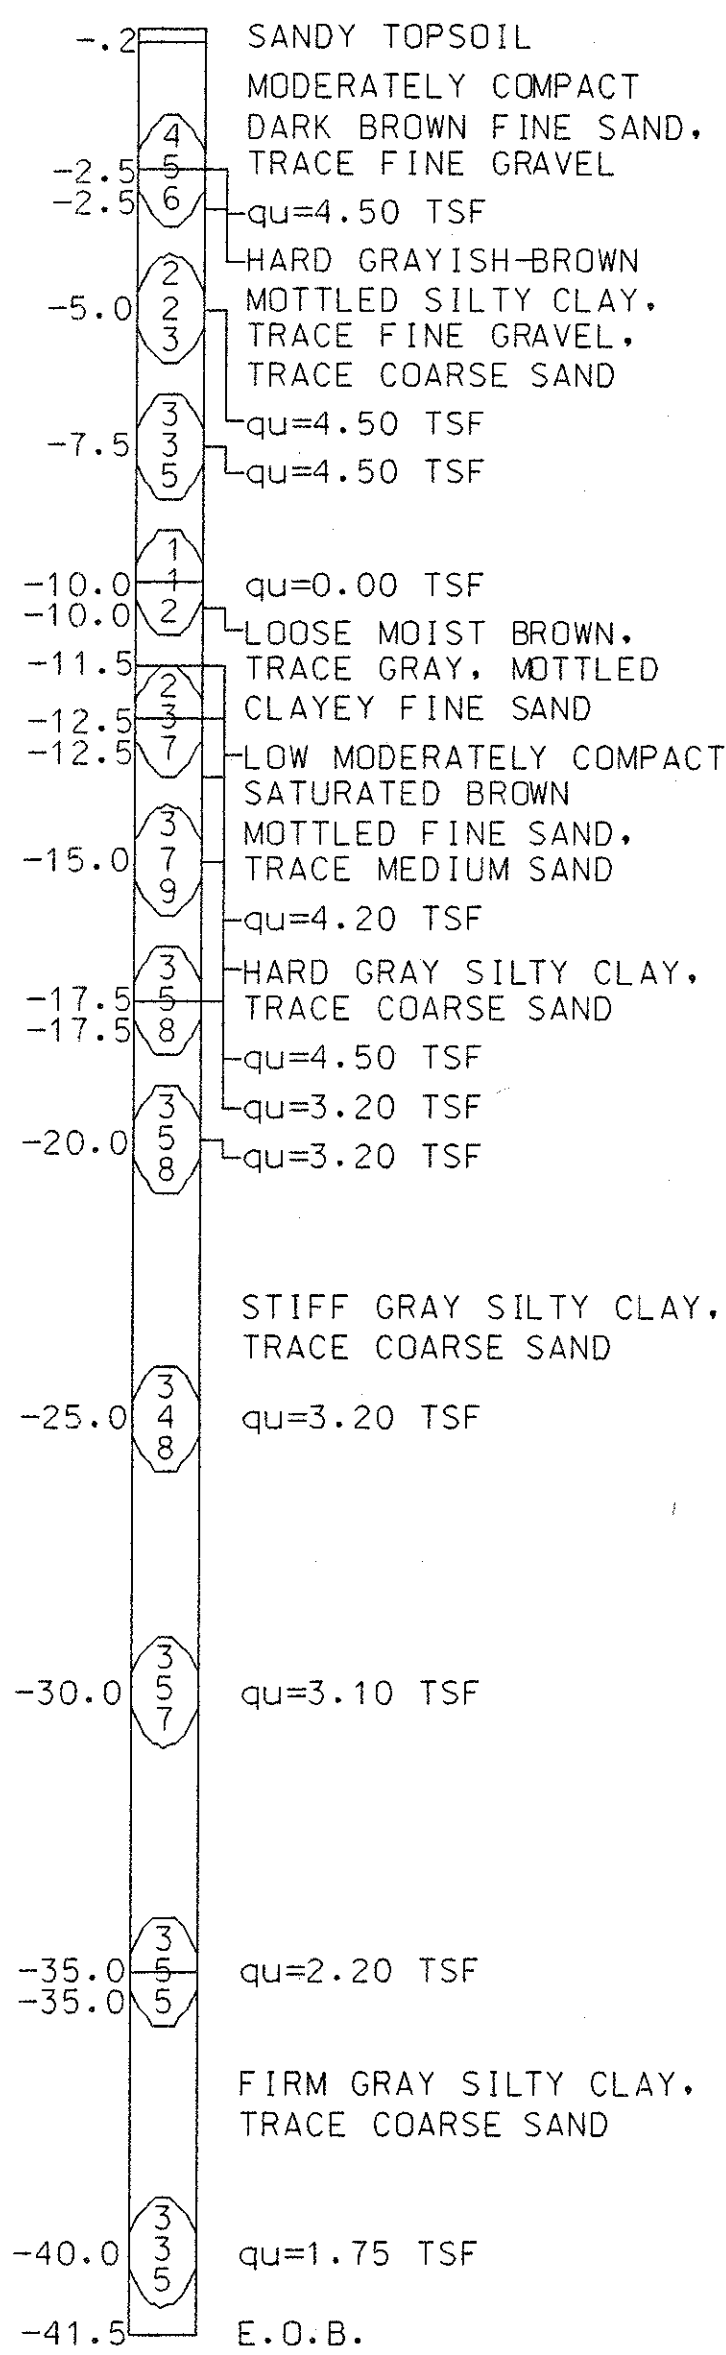


qu= UNCONFINED COMP. STR. POCKET PEN. IN TSF
WATER LEVEL @ 6.54m
WATER LEVEL @ 5.30m (AFTER 90 MIN.)

TESTHOLE NO. 01
Sta. SEE PLANS
I-75 & 12 MILE RD. INTERCHANGE
TIN R11E SEC. 14, OAKLAND CO.
Date Drilled 08-16-99
Elevation:

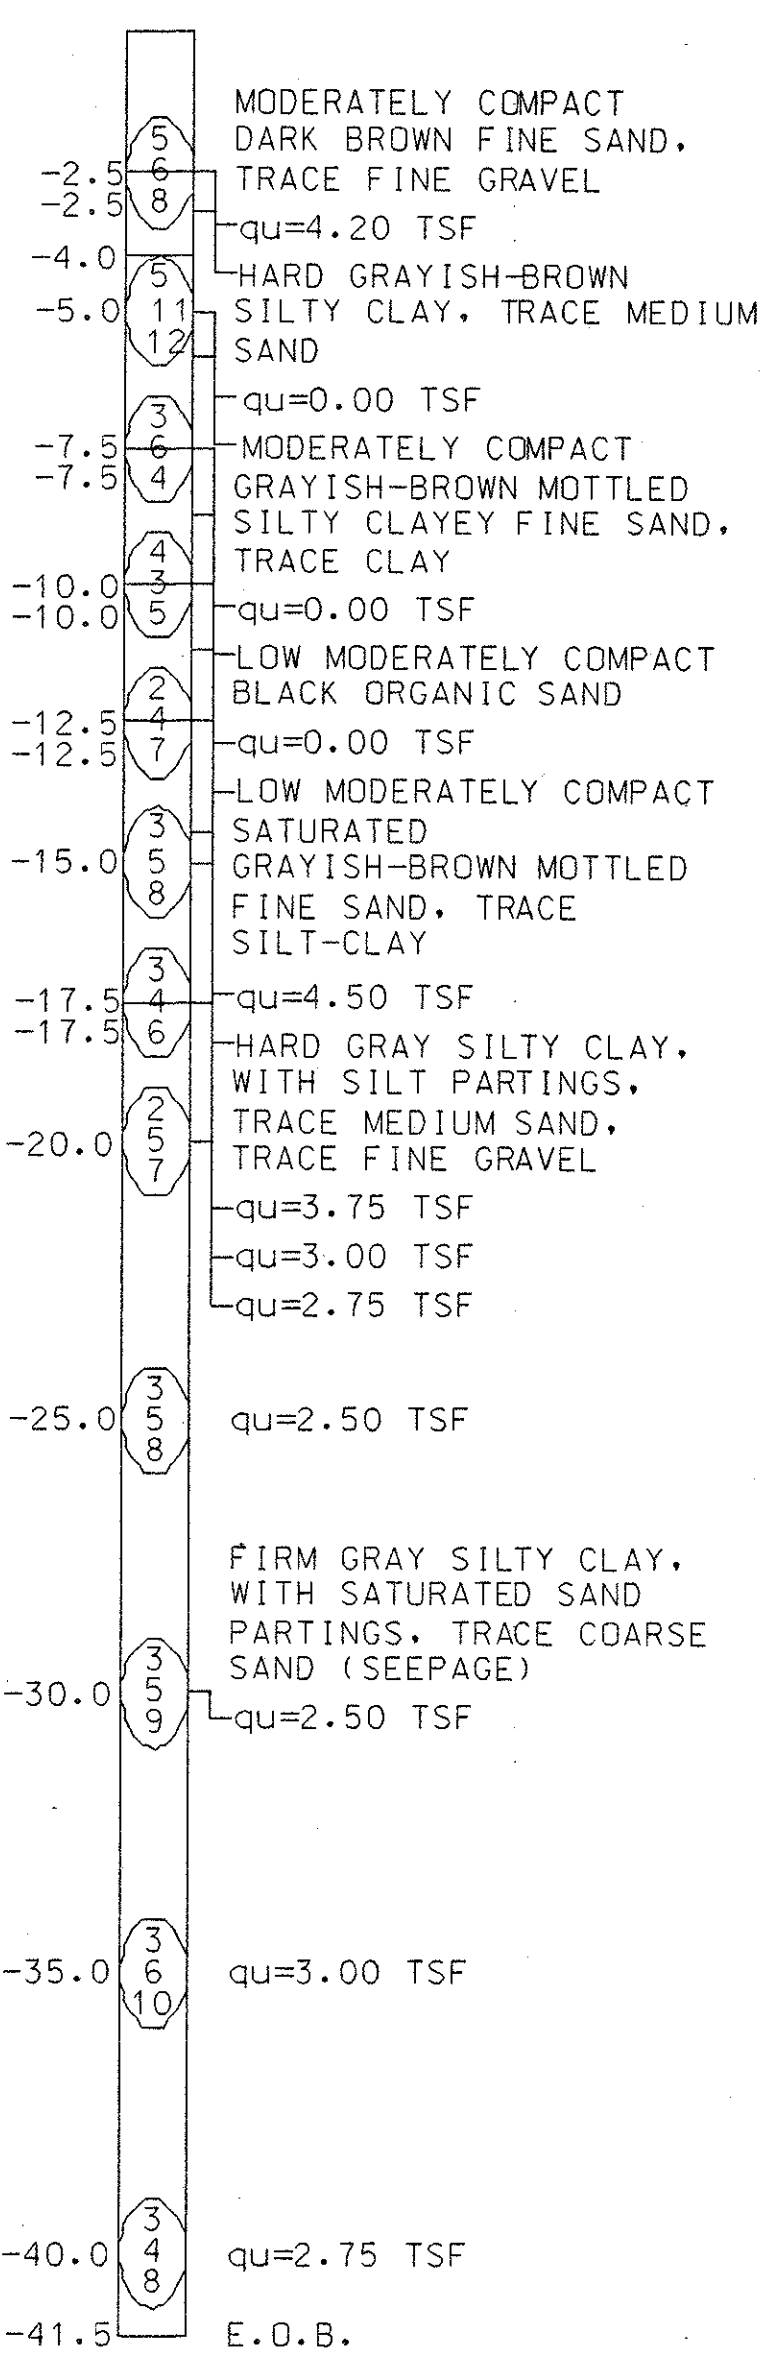

qu= UNCONFINED COMP. STR. POCKET PEN. IN TSF
WATER LEVEL @ 9.66m
WATER LEVEL @ 8.41m (AFTER 30 MIN.)

TESTHOLE NO. 02
Sta. SEE PLANS
I-75 & 12 MILE RD. INTERCHANGE
TIN R11E SEC. 14, OAKLAND CO.
Date Drilled 08-17-99
Elevation:

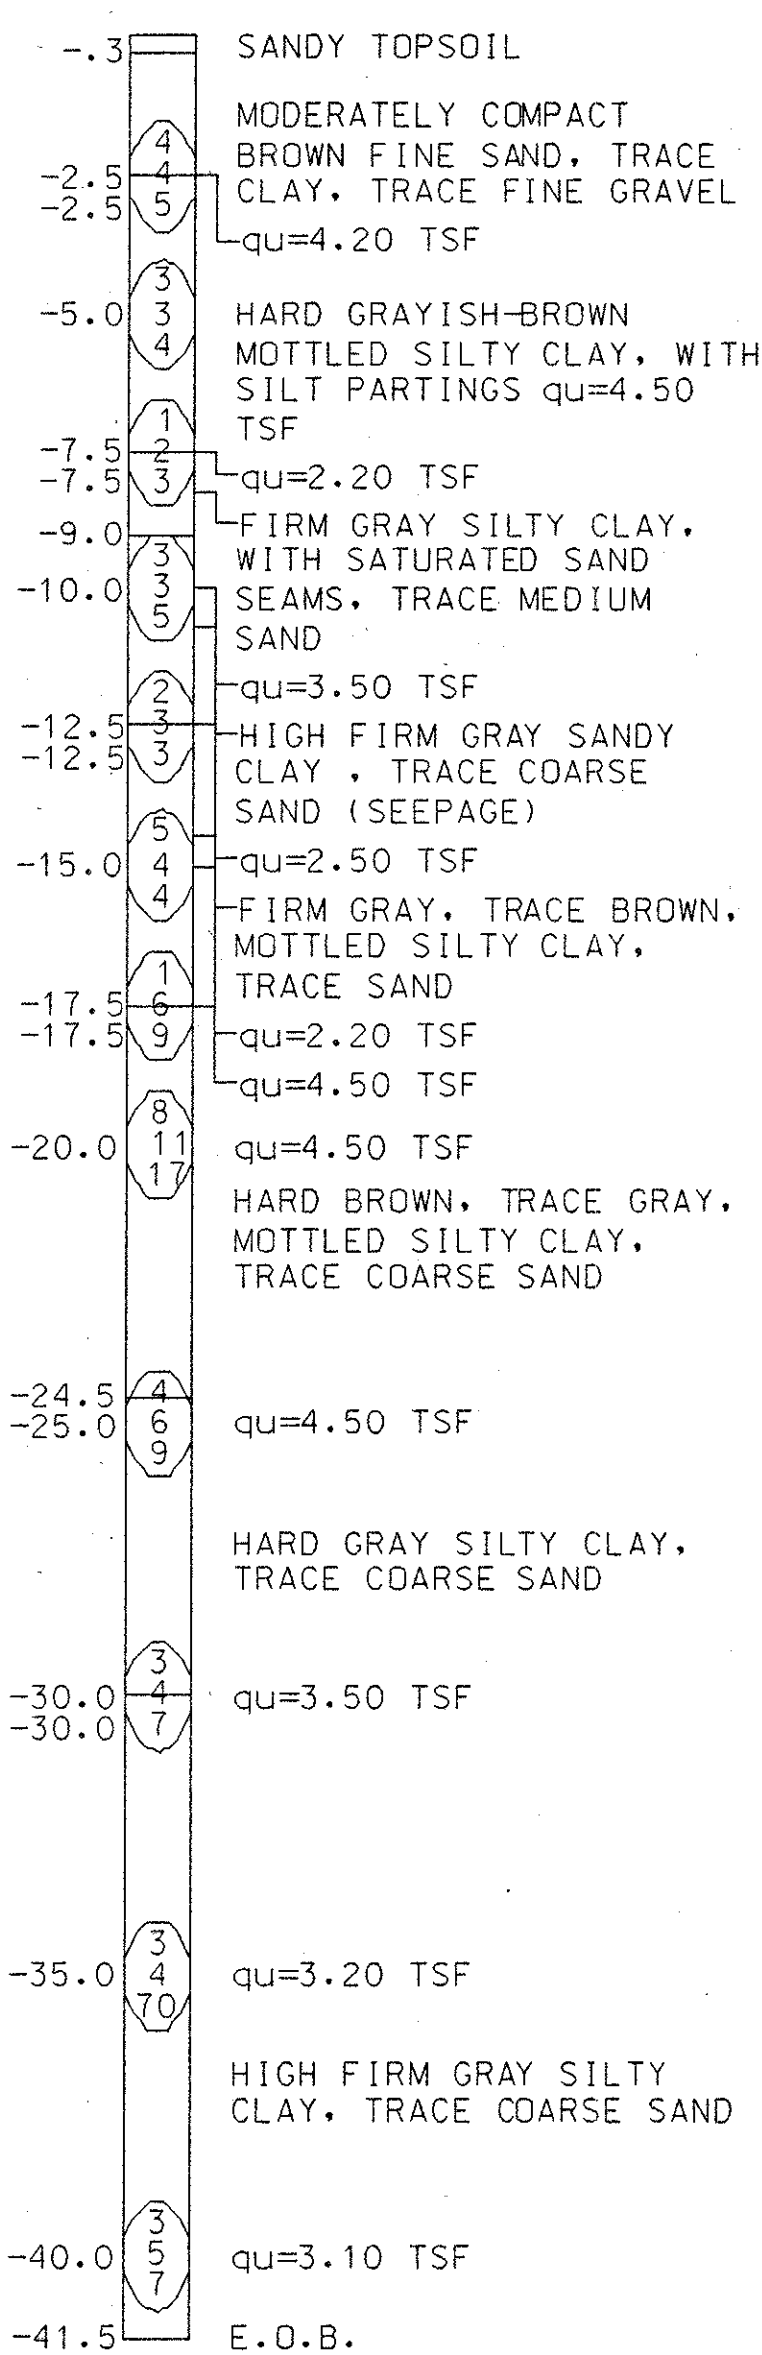

qu= UNCONFINED COMP. STR. POCKET PEN. IN TSF
DRY HOLE (AFTER 25 MIN.)

REVISIONS			
NO.	DESCRIPTION	DATE	BY

NOTES:

- 0 1st 0.15 m
- 0 2nd 0.15 m
- 0 3rd 0.15 m

NUMBERS IN CIRCLES DENOTE NUMBER OF BLOWS REQUIRED TO DRIVE A 51 mm O.D. (38 mm I.D.) SPLIT SPOON SAMPLER 3 SUCCESSIVE 0.15 m INCREMENTS USING A 63.5 kg HAMMER FALLING 0.76 m.

CONSISTENCY WAS DETERMINED BY INSPECTION OF SAMPLES AND SUBSTANTIATED BY SOIL'S RESISTANCE TO DRILLING TOOLS.

THE SOIL BORING LOGS REPRESENT POINT INFORMATION. PRESENTATION OF THIS INFORMATION IN NO WAY IMPLIES THAT SUBSURFACE CONDITIONS ARE THE SAME AT LOCATIONS OTHER THAN THE EXACT LOCATION OF THE BORING.




SOIL BORING DATA



DATE	CONT. SEC.	JOB NO.	DESIGN UNIT	SHEET
09-09-99	63174	48404A	ZIELINSKI	10E

DATE: 10-08-99
CORRECTED BY: CLARK
DATE:
CHECKED BY:
DATE:
DRAWN BY:
FILE NAME: 48404bor.dgn

1 2 3 4 5 6 7 8 9 10 11 12 13 14 15 16 17 18 19 20 21 22 23 24 25 26 27 28 29 30 31 32 33 34 35 36 37 38 39 40 41 42 43 44 45 46 47 48 49 50 51 52 53 54 55 56 57 58 59 60 61 62 63

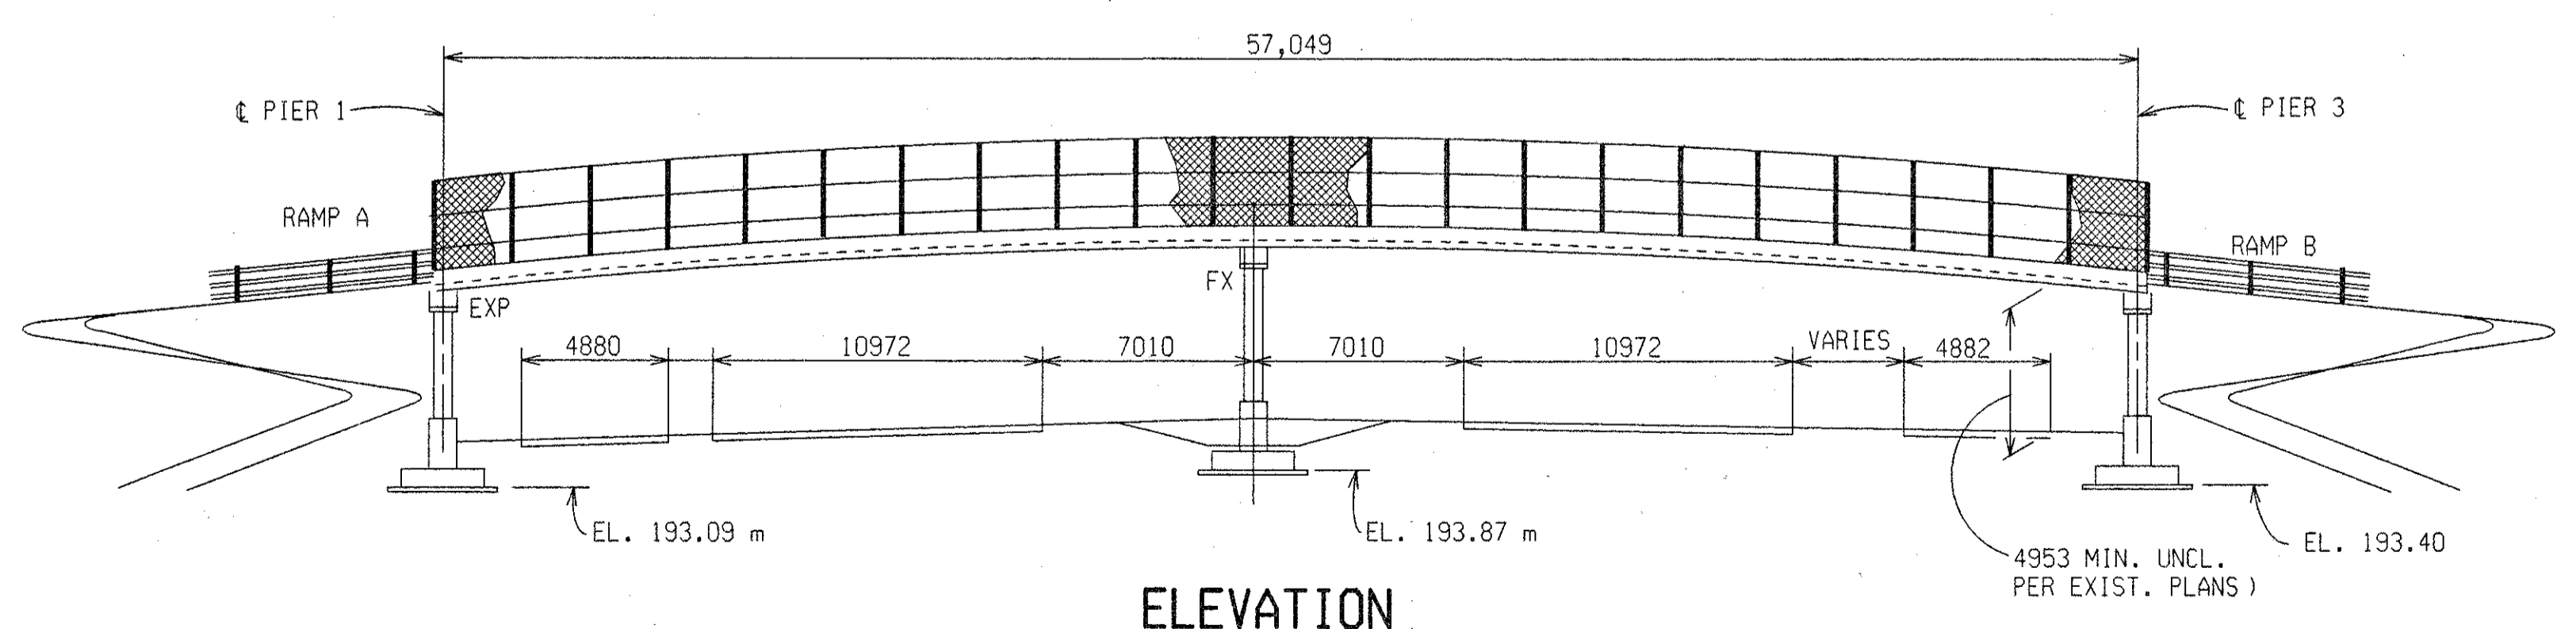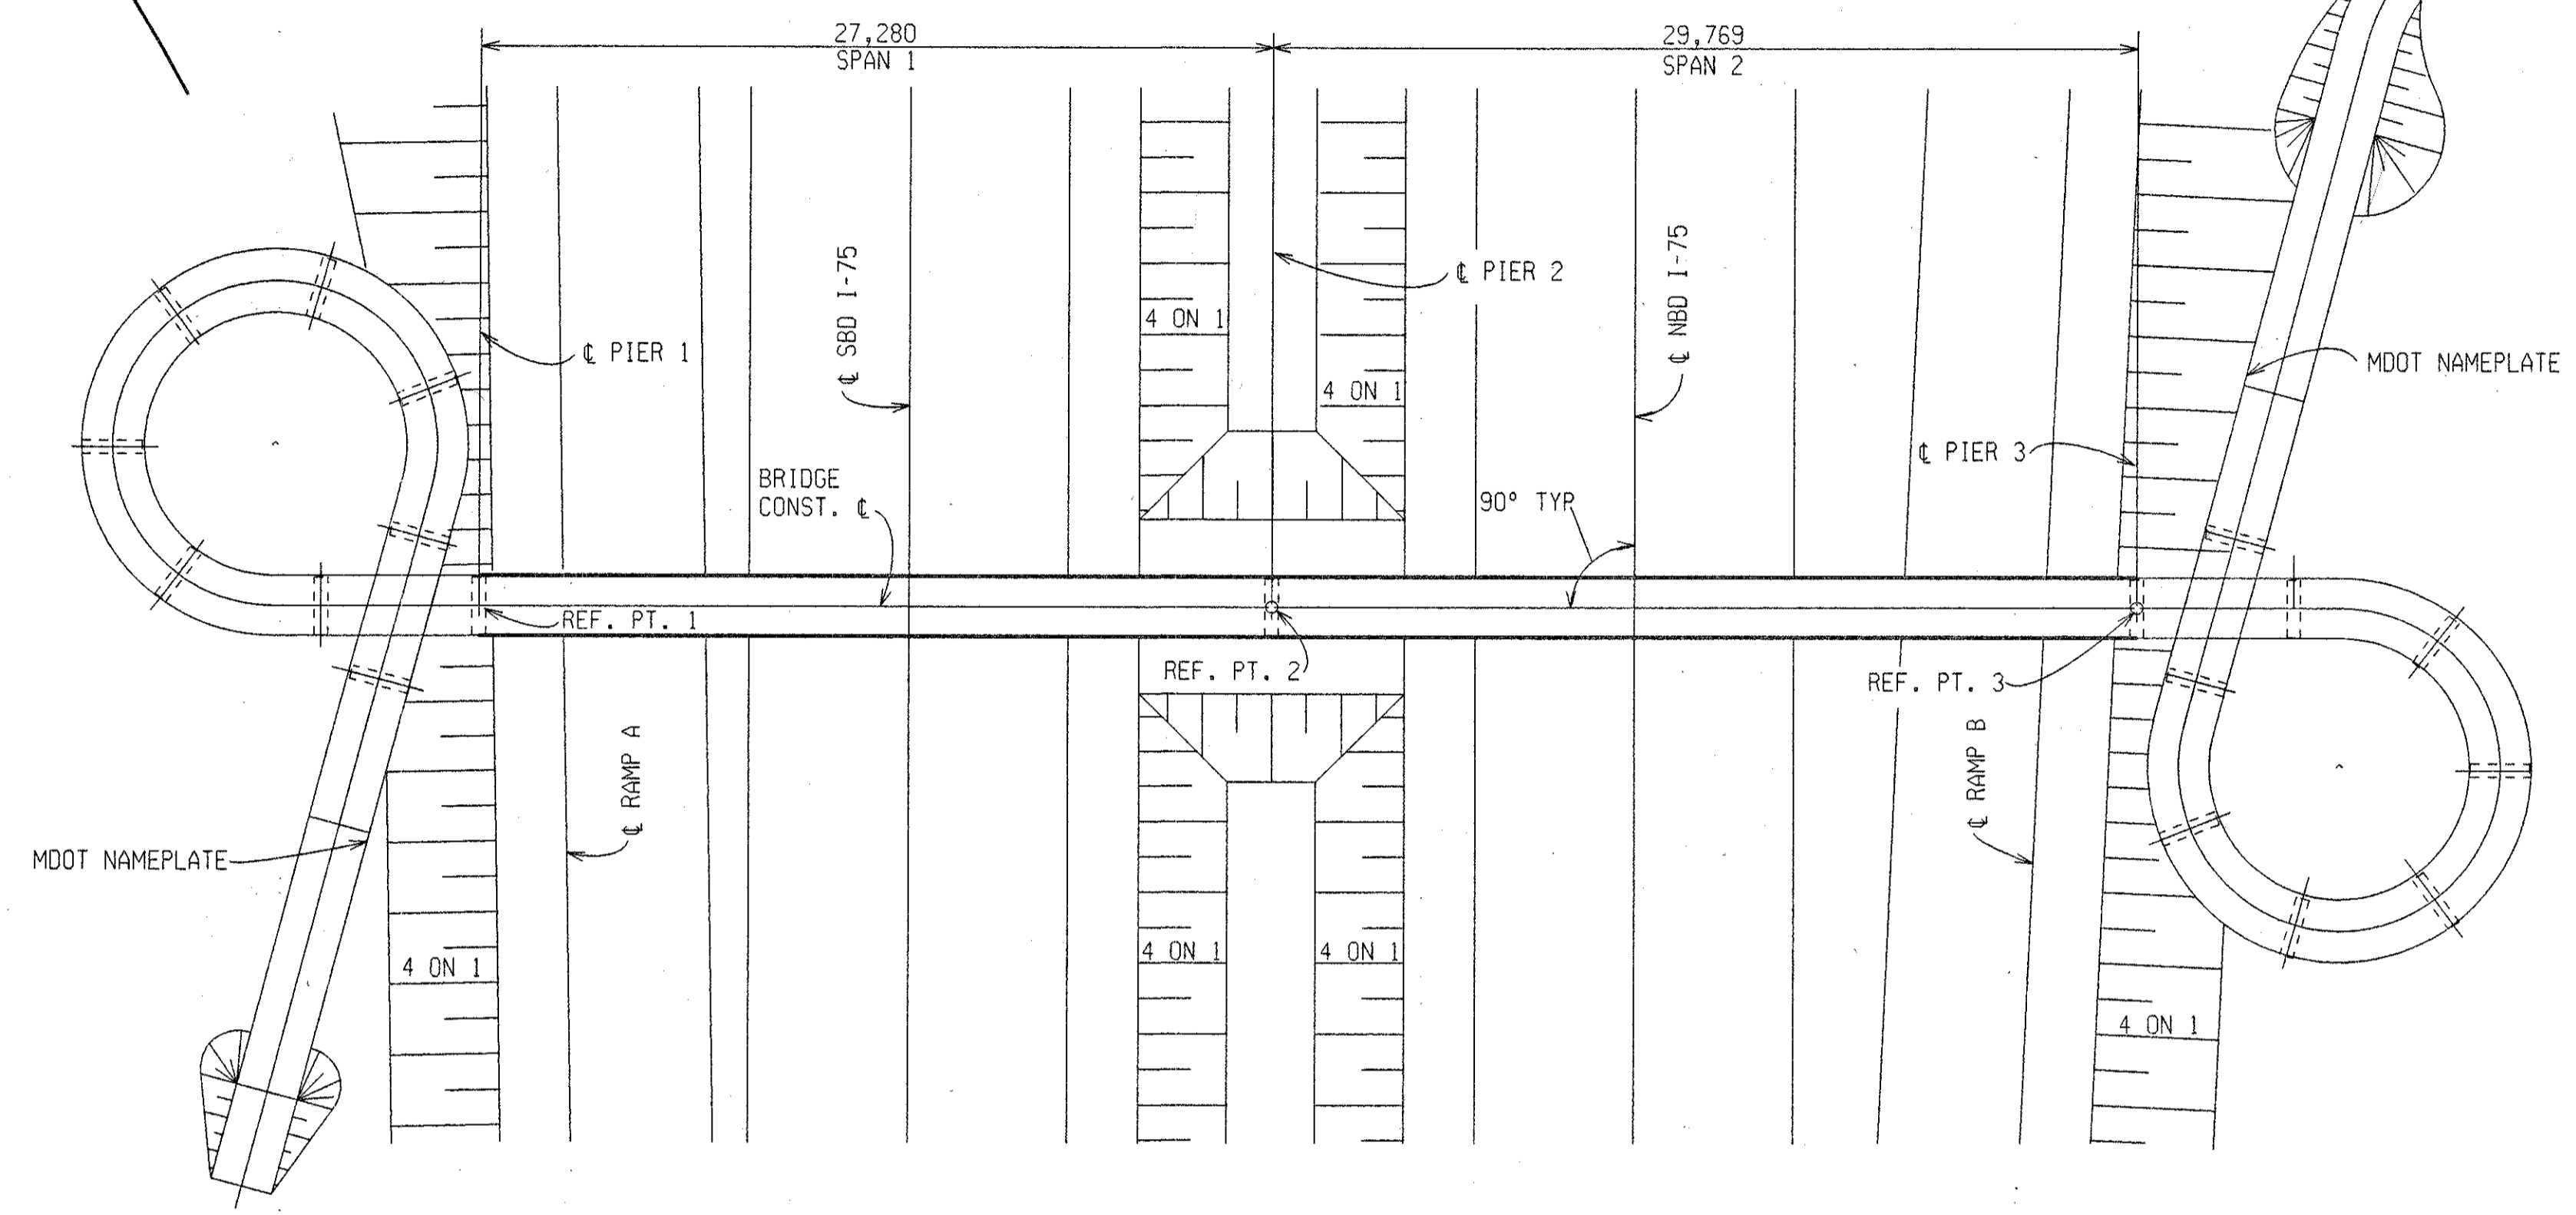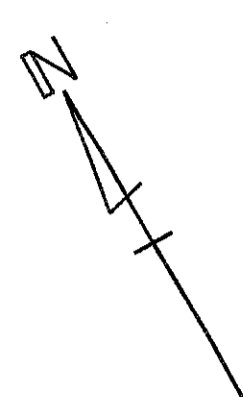


MISCELLANEOUS QUANTITIES	
1 ea	Elec Grounding System
123 m ²	False Decking
1 LS	Structures, Rehabilitation, Rem Portions (P01)
1 LS	Steel Structure, Cleaning, Type 4 (P01)
1 LS	Steel Structure, Coating, Type 4 (P01)
5 m ²	Water Repellent Treatment

APPROVED *Steven P. Beck* 10/19/99
DESIGN SUPERVISING ENGINEER



GENERAL PLAN OF STRUCTURE				
I-75 UNDER 12 MILE WALKOVER				
DATE	CONT. SEC.	JOB NO.	DESIGN UNIT	SHEET
9-21-99	P01 OF 63174	48404A	MAHDAVI	2 OF 16

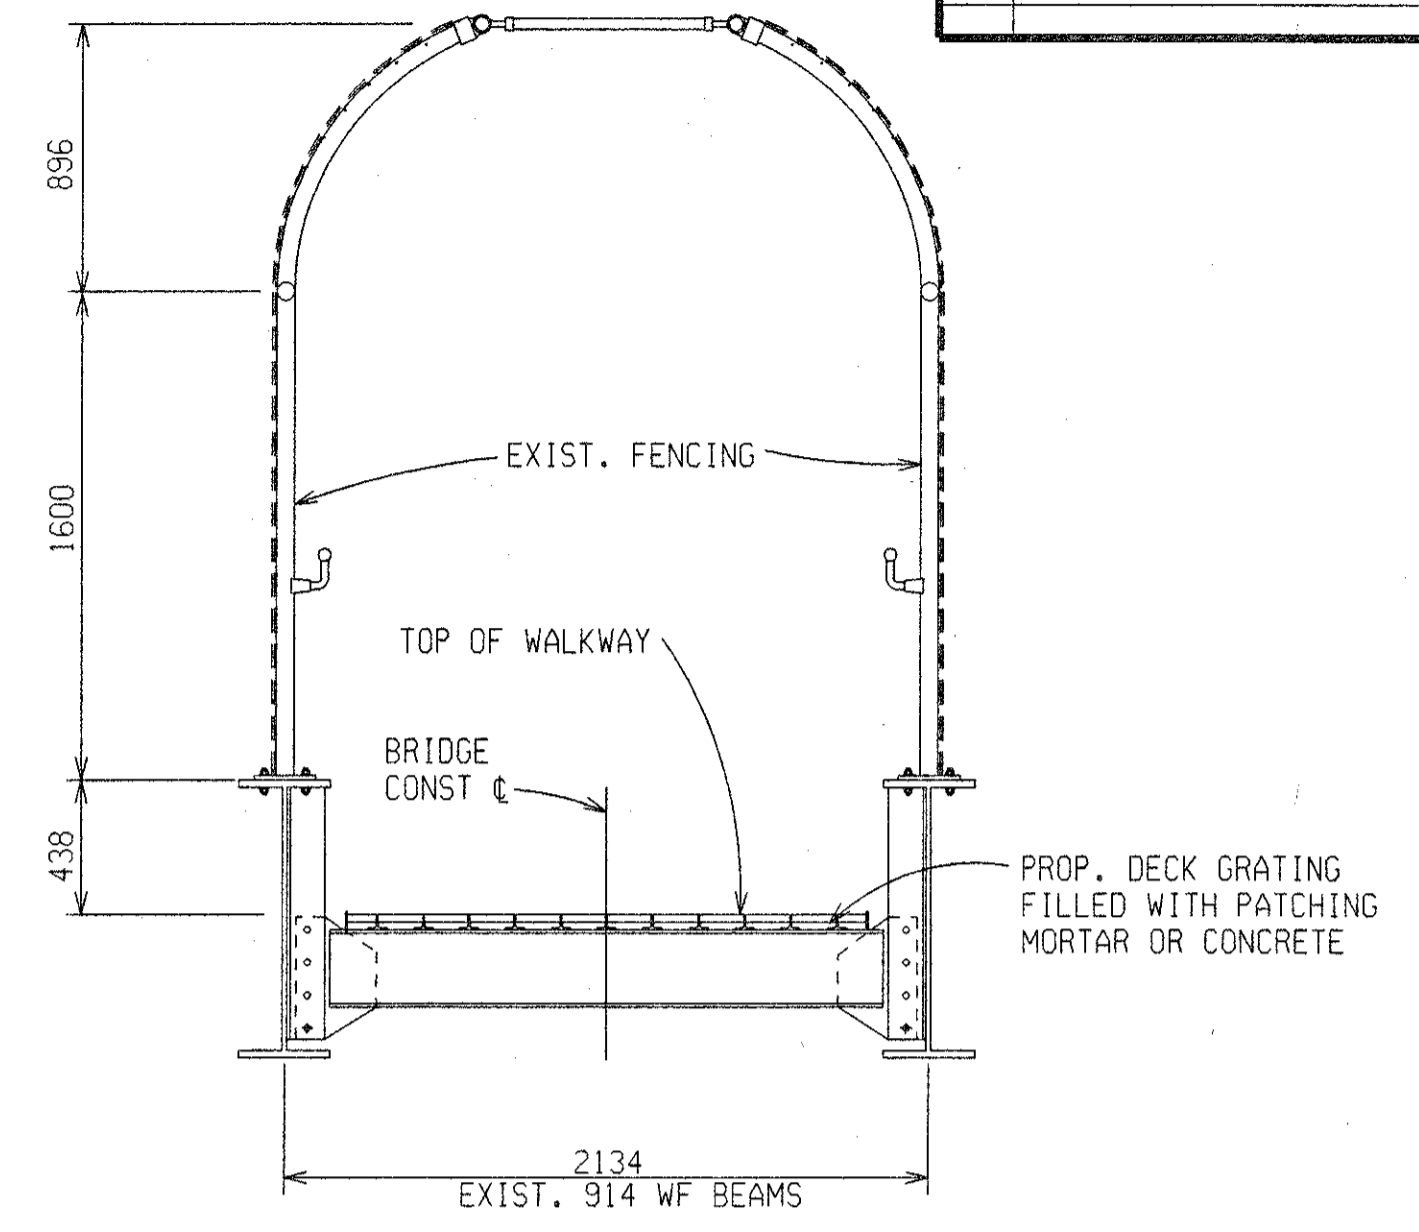

NOTES:

- THE WORK COVERED BY THESE PLANS INCLUDES DECK REPLACEMENT, STRUCTURAL STEEL REPAIR AND RETROFIT AND MAINTAINING TRAFFIC.
- THE DESIGN OF THIS STRUCTURE IS BASED ON CURRENT AASHTO STANDARDS SPECIFICATIONS FOR HIGHWAY BRIDGES. THE LOAD FACTOR METHOD WAS USED FOR THIS DESIGN.
- FALSE DECKING SHALL INCLUDE THE AREA FROM PIER 1 TO PIER 3 AND BETWEEN THE BEAM WEBS.
- I-75 TRAFFIC IS TO BE MAINTAINED BY PART WIDTH CONSTRUCTION. THE BRIDGE SHALL BE CLOSED TO PEDESTRIAN TRAFFIC DURING CONSTRUCTION.
- THE ENGINEER SHALL INSPECT THE STRUCTURAL STEEL PARTS THAT HAVE BEEN BLAST CLEANED FOR EVIDENCE OF CRACKS OR LOSS OF SECTION DUE TO CORROSION OF MORE THAN 25 PERCENT. SUCH DETERIORATION SHALL BE REPORTED IN WRITING TO THE ENGINEER, STRUCTURES AND ROAD MAINTENANCE OF THE MAINTENANCE DIVISION IN LANSING.
- THE ESTIMATED AREA OF STRUCTURAL STEEL TO BE COATED IS 366 SQUARE METERS. THE PAINTING AREAS ARE FOR ALL STRUCTURAL STEEL MEMBERS INCLUDING THE DOWNSPOUTS AT PIERS 1 AND 3, ALL FENCE POSTS AND HORIZONTAL FENCE RAILS, THE TOP OF BEAMS AND BEAM ENDS.
- PENETRATING WATER REPELLENT TREATMENT SHALL BE APPLIED TO THE TOP OF PIERS 1 & 3.
- SEALANT SHALL BE APPLIED AROUND THE PERIMETER OF BEARING PLATES TO CONCRETE CONTACT SURFACES AFTER CUTTING AWAY ANY PROTRUDING PORTION OF LEAD PLATE.
- THIS BRIDGE IS COATED WITH LEAD BASED PAINT.
- THE COLOR OF THE URETHANE PROTECTIVE COAT SHALL MATCH COLOR NUMBER 1, LIGHT GRAY OF FEDERAL STANDARD NUMBER 595a.
- THE CONTRACTOR SHALL TAKE NECESSARY MEASURES TO AVOID OVERSPRAY ON ADJACENT SUBSTRUCTURE AND SUPERSTRUCTURE CONCRETE SURFACES. (INCLUDED IN THE BID ITEM "STEEL STRUCTURE, COATING, TYPE 4 (P01)".
- MEASURES SHALL BE TAKEN TO PREVENT DEBRIS FROM FALLING FROM THE STRUCTURE.
- SEE SUBSECTION 715 OF THE STANDARD SPECIFICATIONS FOR PROTECTION OF WORK AND ENVIRONMENT DURING THE BLAST CLEANING OF STRUCTURES.

FILE NAME: p0163174.st DRAWN BY: SHAFFER CHECKED BY: MICKUKI DATE: 2-19-99 CORRECTED BY: R. PRATT DATE: 10-18-99




CONTROL POINT OF 63174 JOB NO. 48404A SHEET NO. 3

BENCH MARKS
 B.M. No. 71 - Elev. 638.34 M.S.H.D. Tag in roof of 24' Elm 167' Rt. Sta. 912+60 N.B. Rdwy.
 B.M. No. 73 - Elev. 638.77 M.S.H.D. Tag in base of 20' Oak 248' Lt. of Sta. 903+87 N.B. Rdwy.

UTILITIES
 None



CURVE DATA
RAMP "A"
 Δ = 24°22'18"
 D = 7°00'00"
 R = 918.51'
 T = 176.76'
 L = 348.17'
 E = 18.81'
 P.C. = 8+95.73
 P.L. = 8+97.85
 P.T. = 8+69.26
 Se. = 0.077/FT.

CURVE DATA
RAMP "B"
 Δ = 28°42'35"
 D = 7°00'00"
 R = 818.51'
 T = 209.47'
 L = 410.14'
 E = 26.38'
 P.C. = 8+85.73
 P.L. = 8+95.20
 P.T. = 10+95.87
 Se. = 0.077/FT.

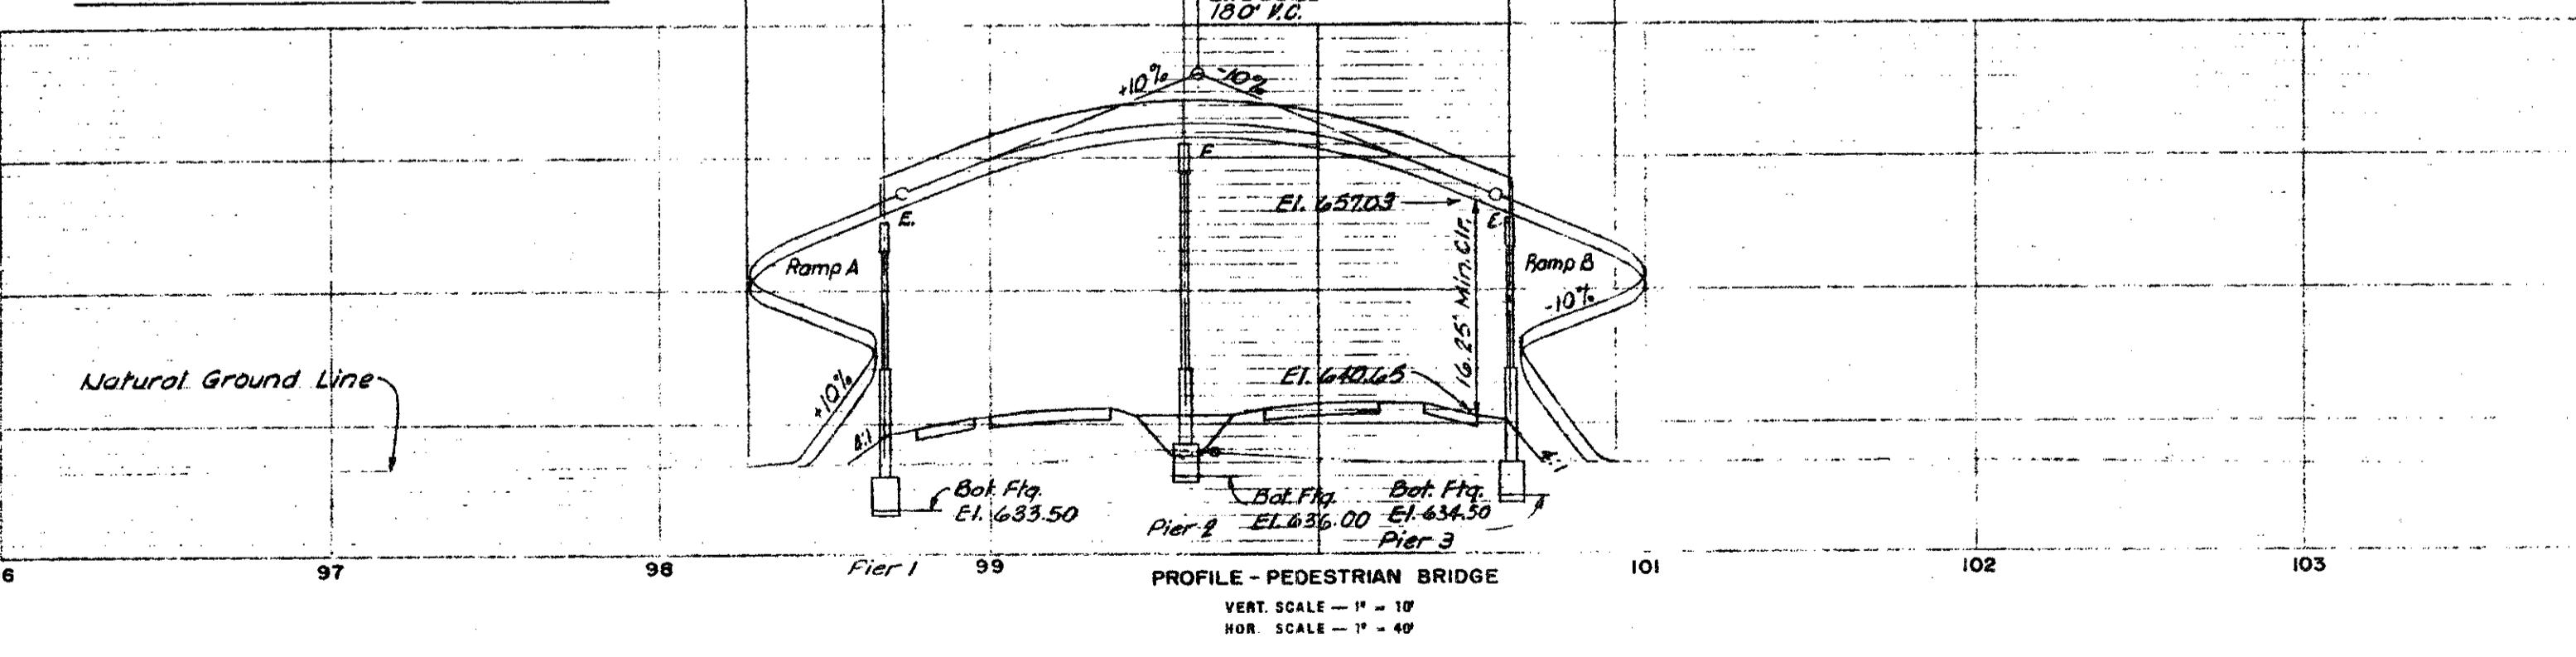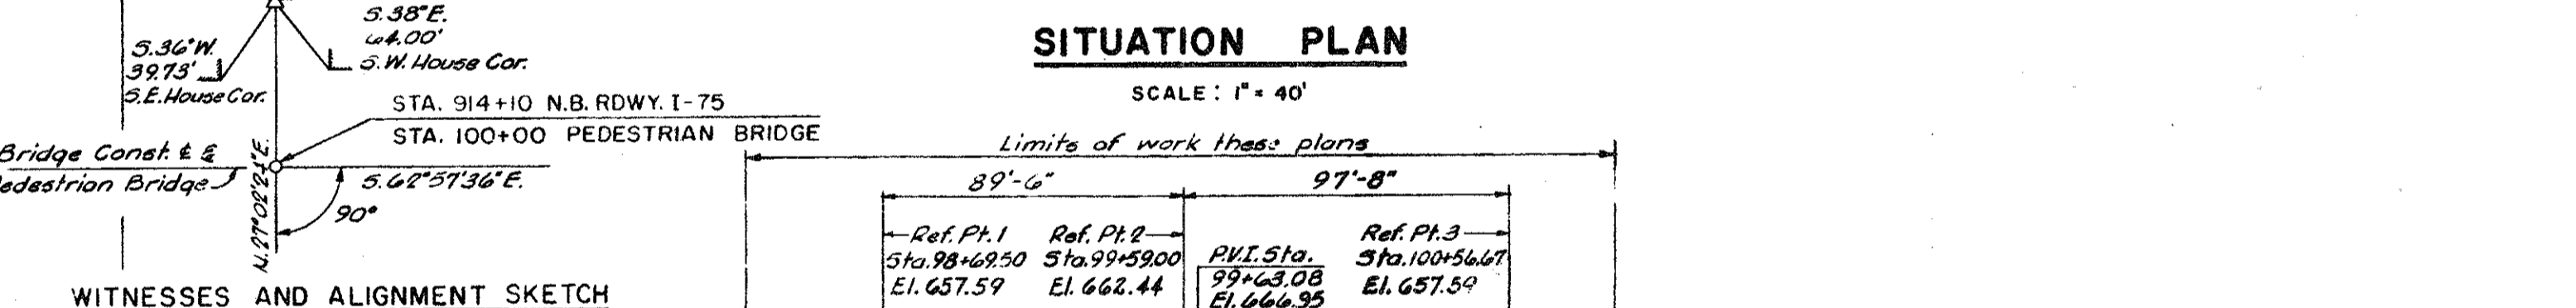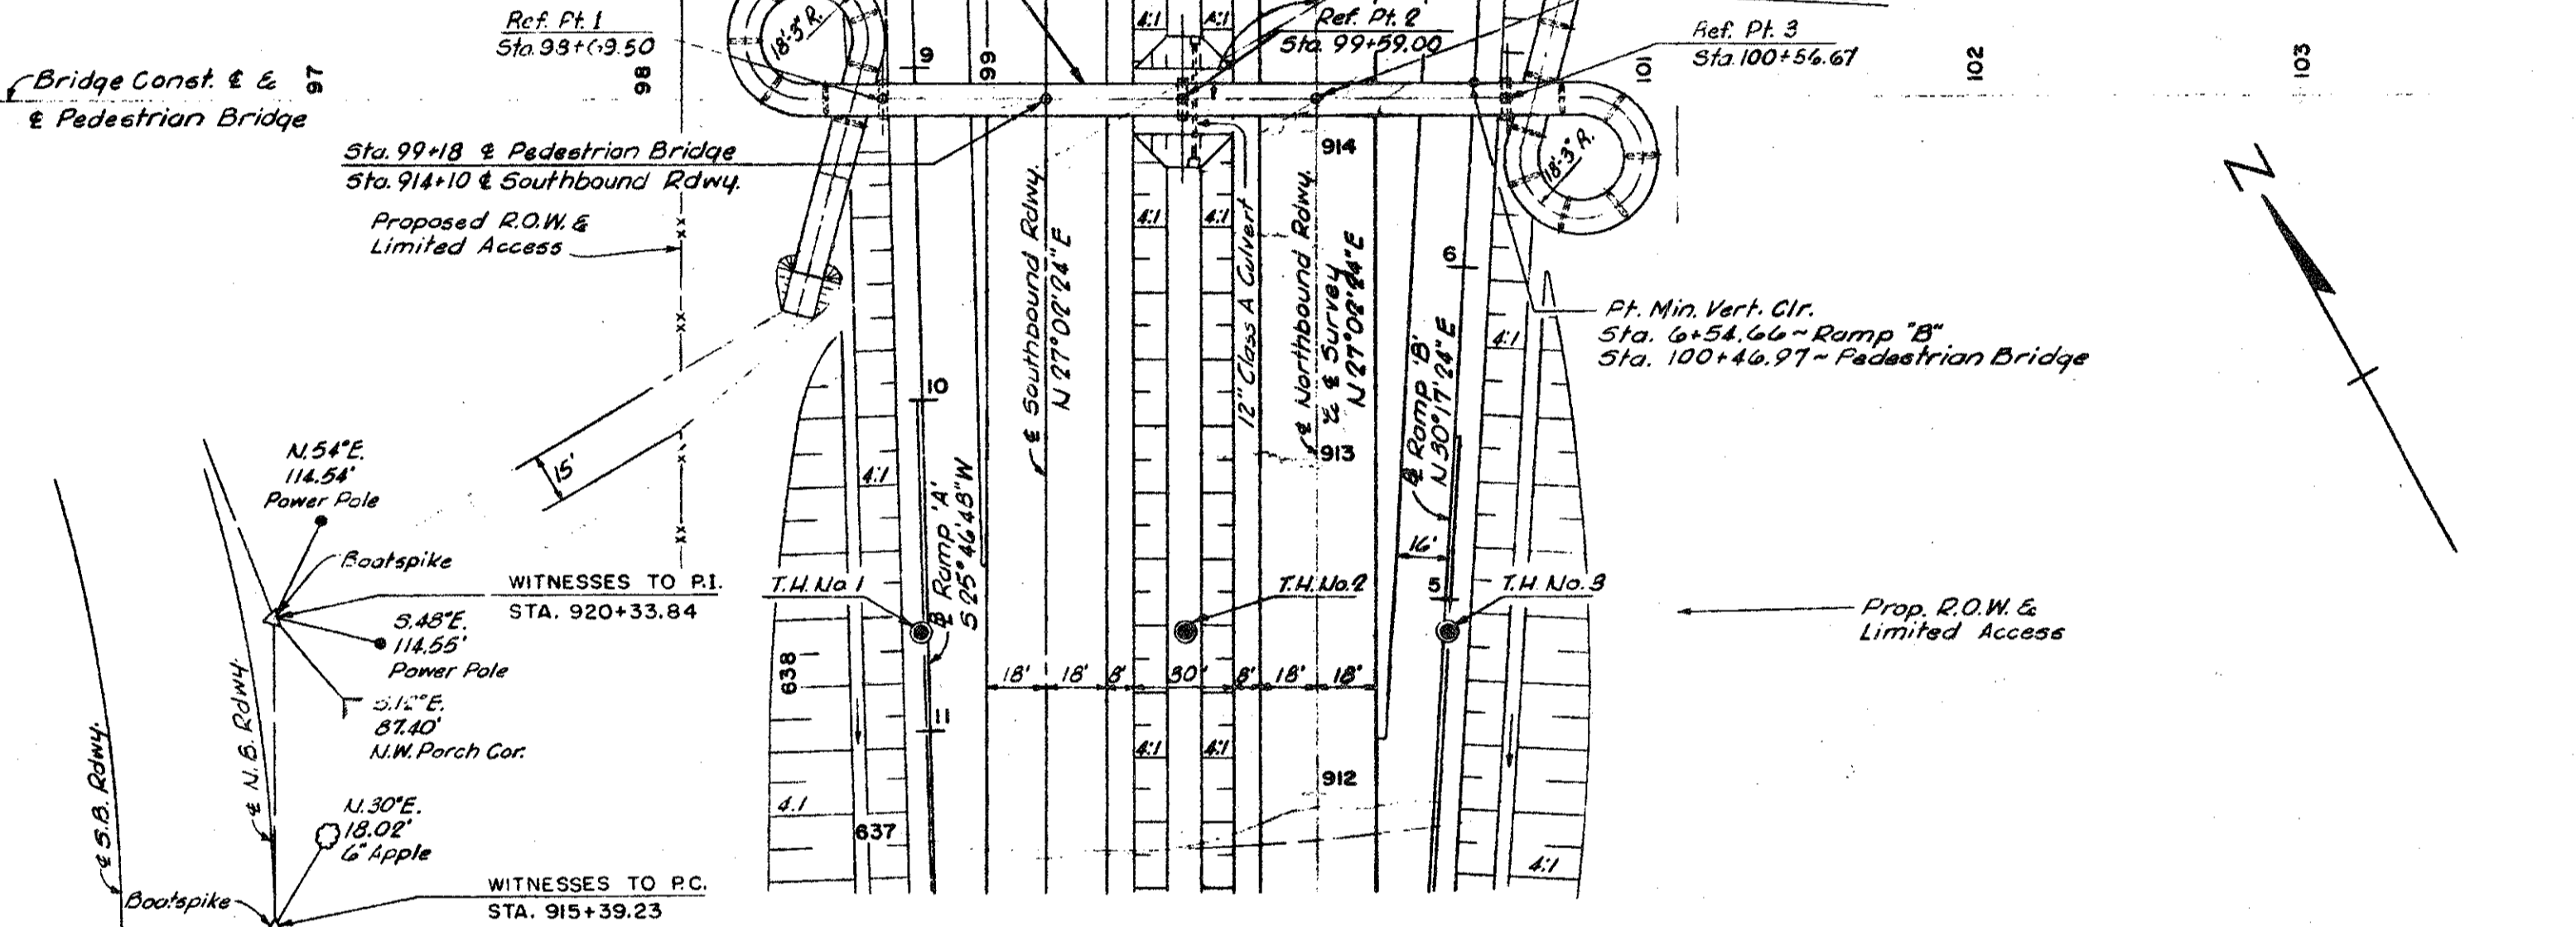

CURVE DATA
N.B. CONST.
 Δ = 29°08'20"
 D = 3°00'00"
 R = 1,909.86'
 T = 494.61'
 L = 967.96'
 E = 63.01'
 P.C. = 915+39.23
 P.L. = 920+33.84
 P.T. = 925+07.19
 Se. = 0.0577/FT.

SECTION 14
 T IN R IIE
 ROYAL OAK TWP
 CITY OF MADISON HEIGHTS

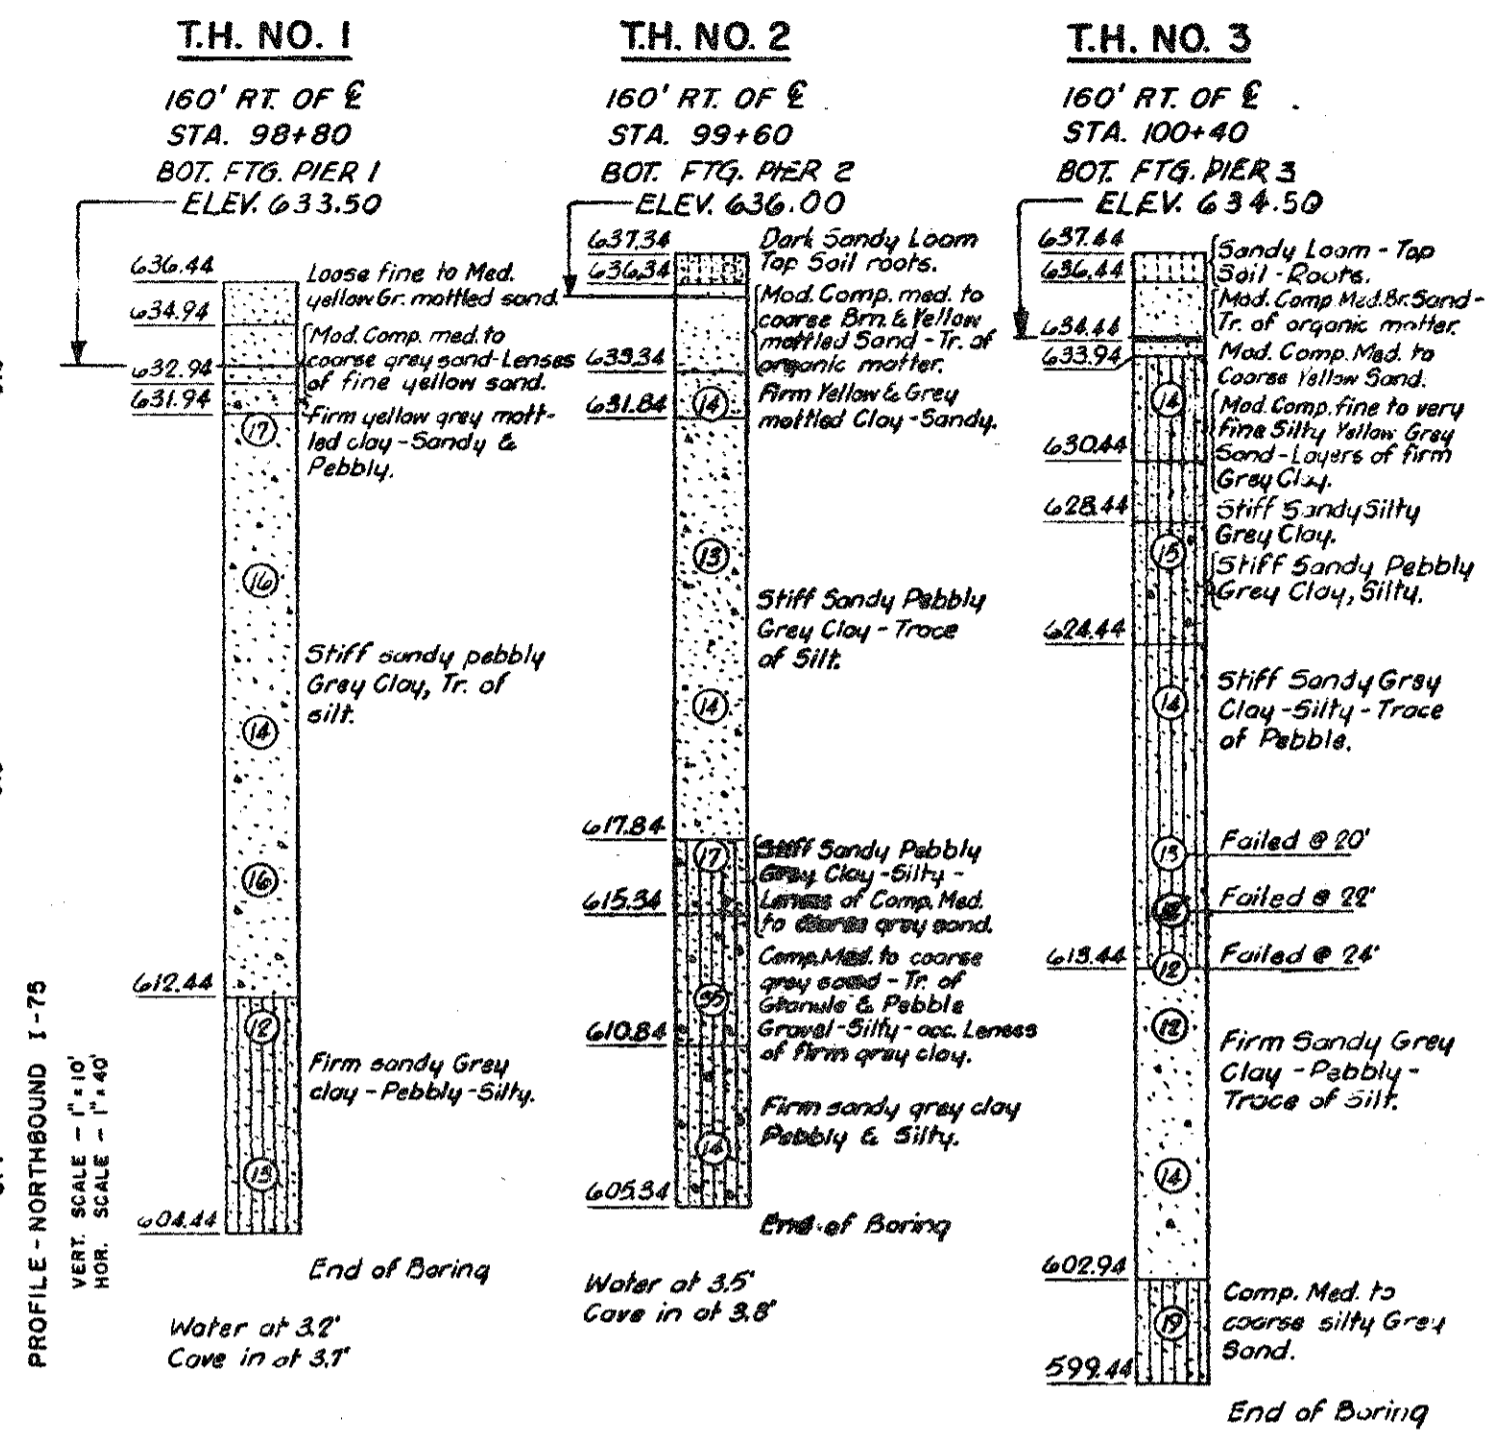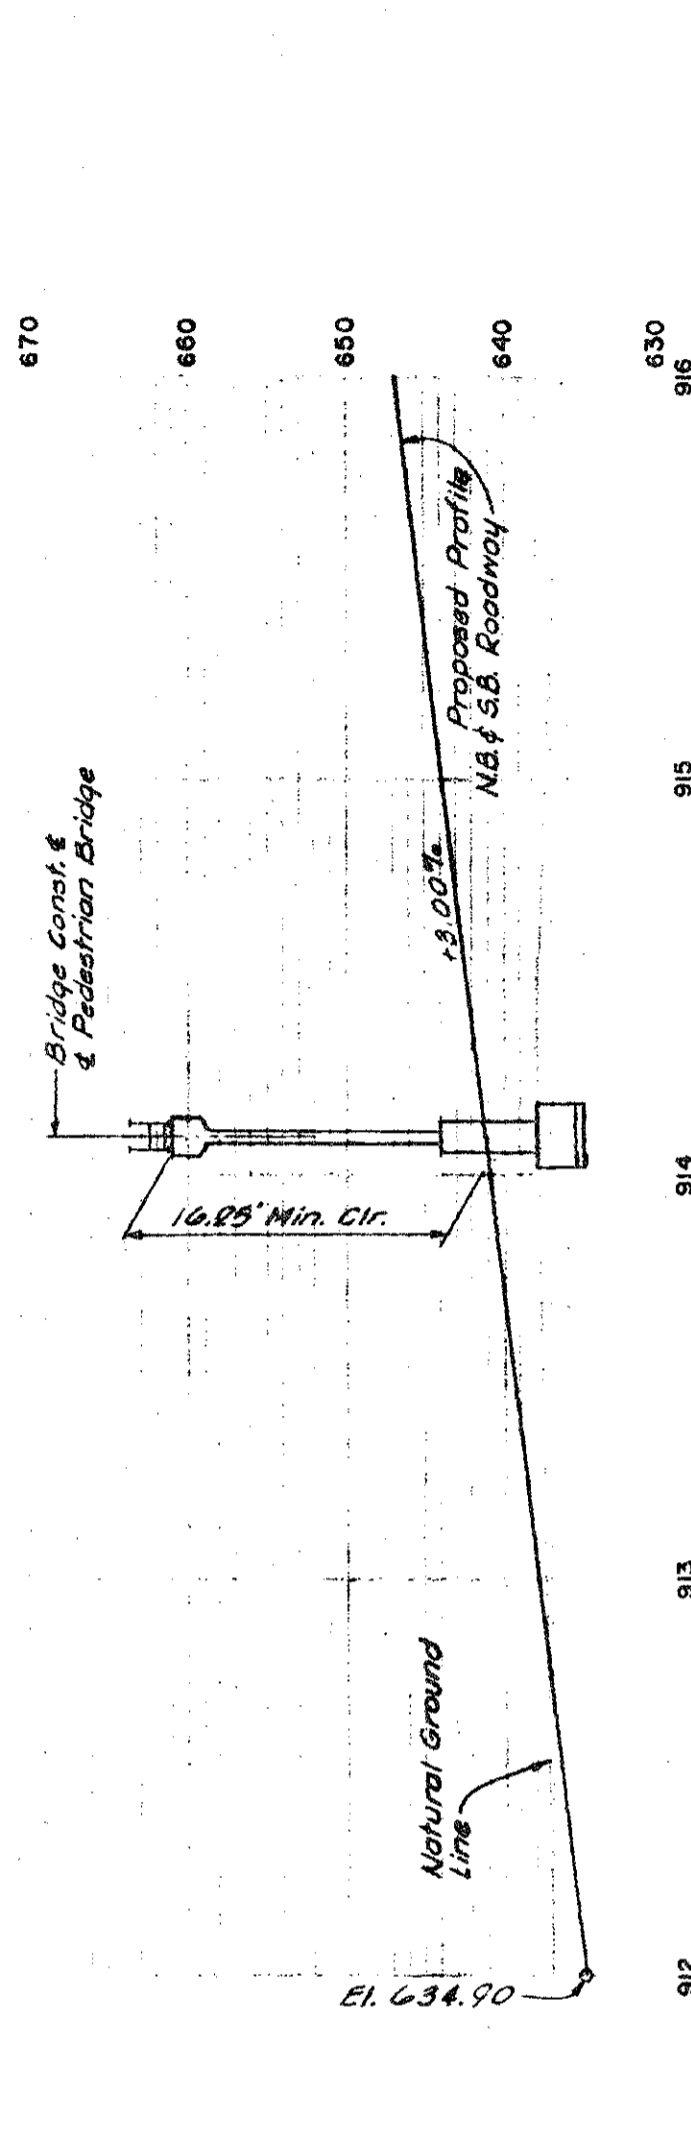

NOTES:
 Consistency determined by inspection of samples and substantiated by soils relationship to casing and jet rod (All T.H.s).
 Excavation samples taken with O.D. 1 1/4", I.D. 1 1/8" sampler driven 12" with 140# hammer with a free fall of 30".
 Method of sampling - Undisturbed.
 No water table as water used in Boring Operations does not seep into the clay soils below first 3' to 4' of Sand (All T.H.s).

GENERAL NOTES:
 Fences, and utilities are to be moved by others.
 Buildings are to be removed by others.
 Datum refers to U.S.G.S. Datum.
 The work covered by these plans includes construction of the proposed bridge, ramps, sidewalks and fill under sidewalks.
 All work not listed above is included in the Road Plans.

CONTROL SECTION 631741

MICHIGAN STATE HIGHWAY DEPARTMENT
 PEDESTRIAN BRIDGE CROSSING I-75 SOUTH OF 12 MILE ROAD
 IN THE CITY OF MADISON HEIGHTS
 GENERAL PLAN OF SITE

TECON ENGINEERS, INC.
 J. V. Murray
 COORDINATING ENGINEER
 6-5-62


DATE: 6-5-62
 SHEET: 135 OF 312
 POI OF 631741

NOTE:
 DO NOT WORK FROM THIS SHEET. THE INFORMATION SHOWN HERE IS FOR REFERENCE ONLY. NO PAY ITEMS ARE SHOWN.


FOR INFORMATION ONLY				
DATE	CONT. SEC.	JOB NO.	DESIGN UNIT	SHEET
02-05-99	P01 OF 63174	48404A	MADHAVI	3 OF 16

DATE: _____ CHECKED BY: _____ CORRECTED BY: _____ DATE: _____ DRAWN BY: mdr FILE NAME: p0163174n


1 2 3 4 5 6 7 8 9 10 11 12 13 14 15 16 17 18 19 20 21 22 23 24 25 26 27 28 29 30 31 32 33 34 35 36 37 38 39 40 41 42 43 44 45 46 47 48 49 50 51 52 53 54 55 56 57 58 59 60 61 62 63

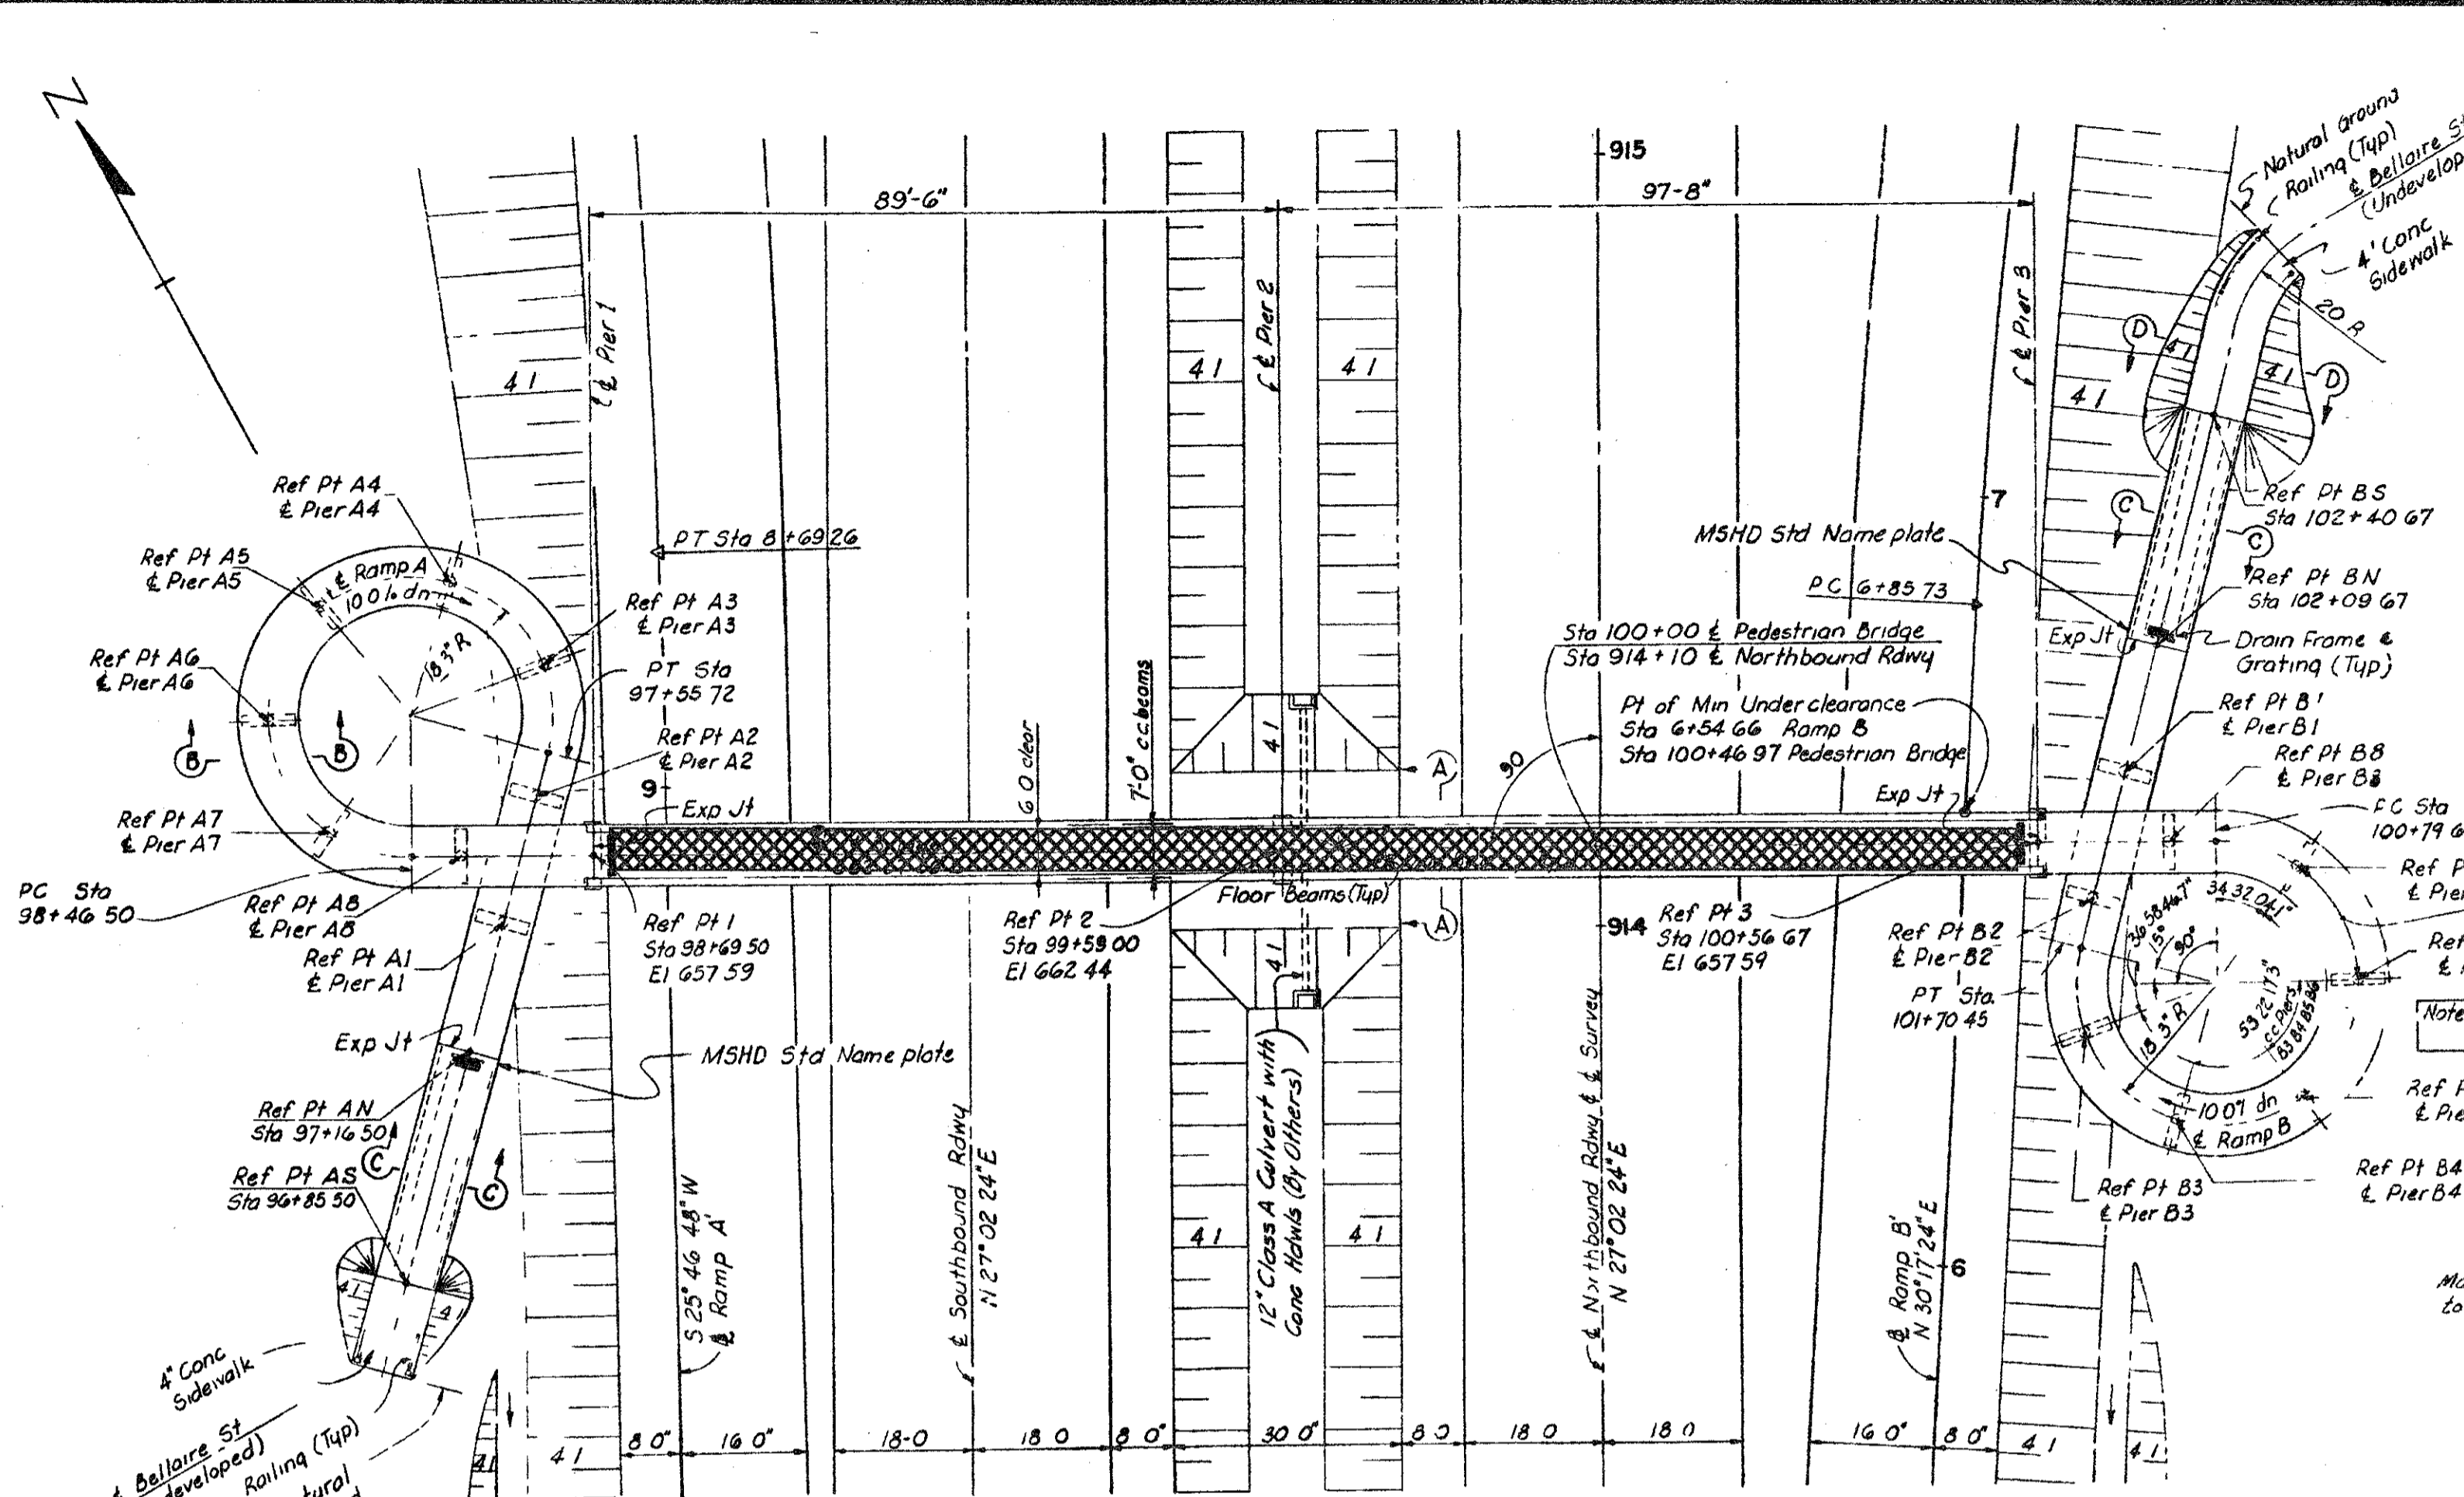

PLAN
Scale 1/8" = 1'-0"

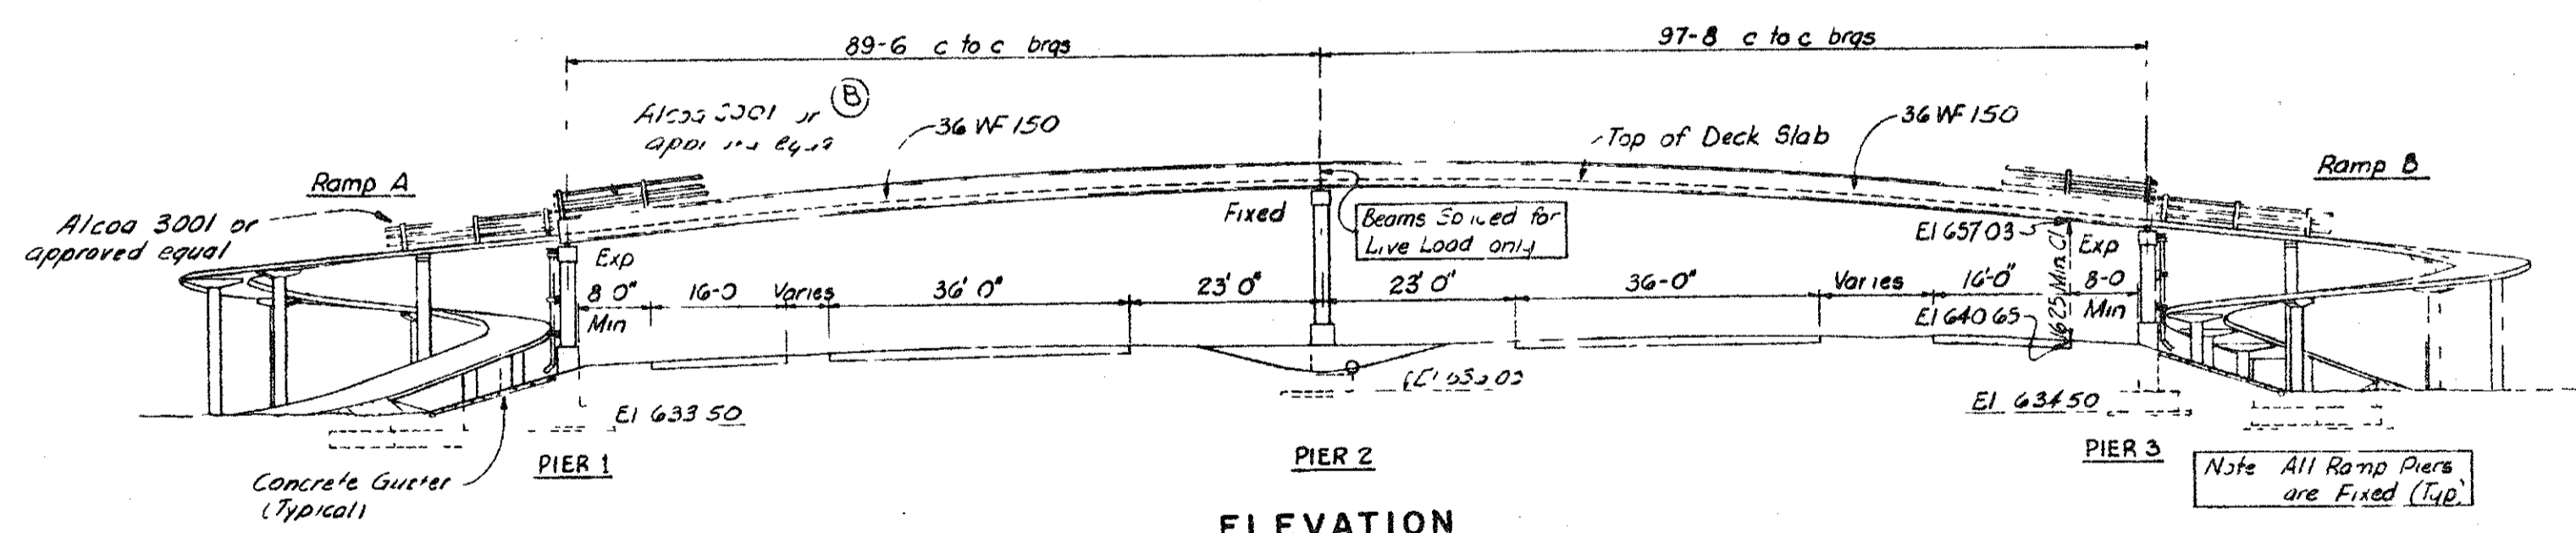


ELEVATION
Scale 1/8" = 1'-0"

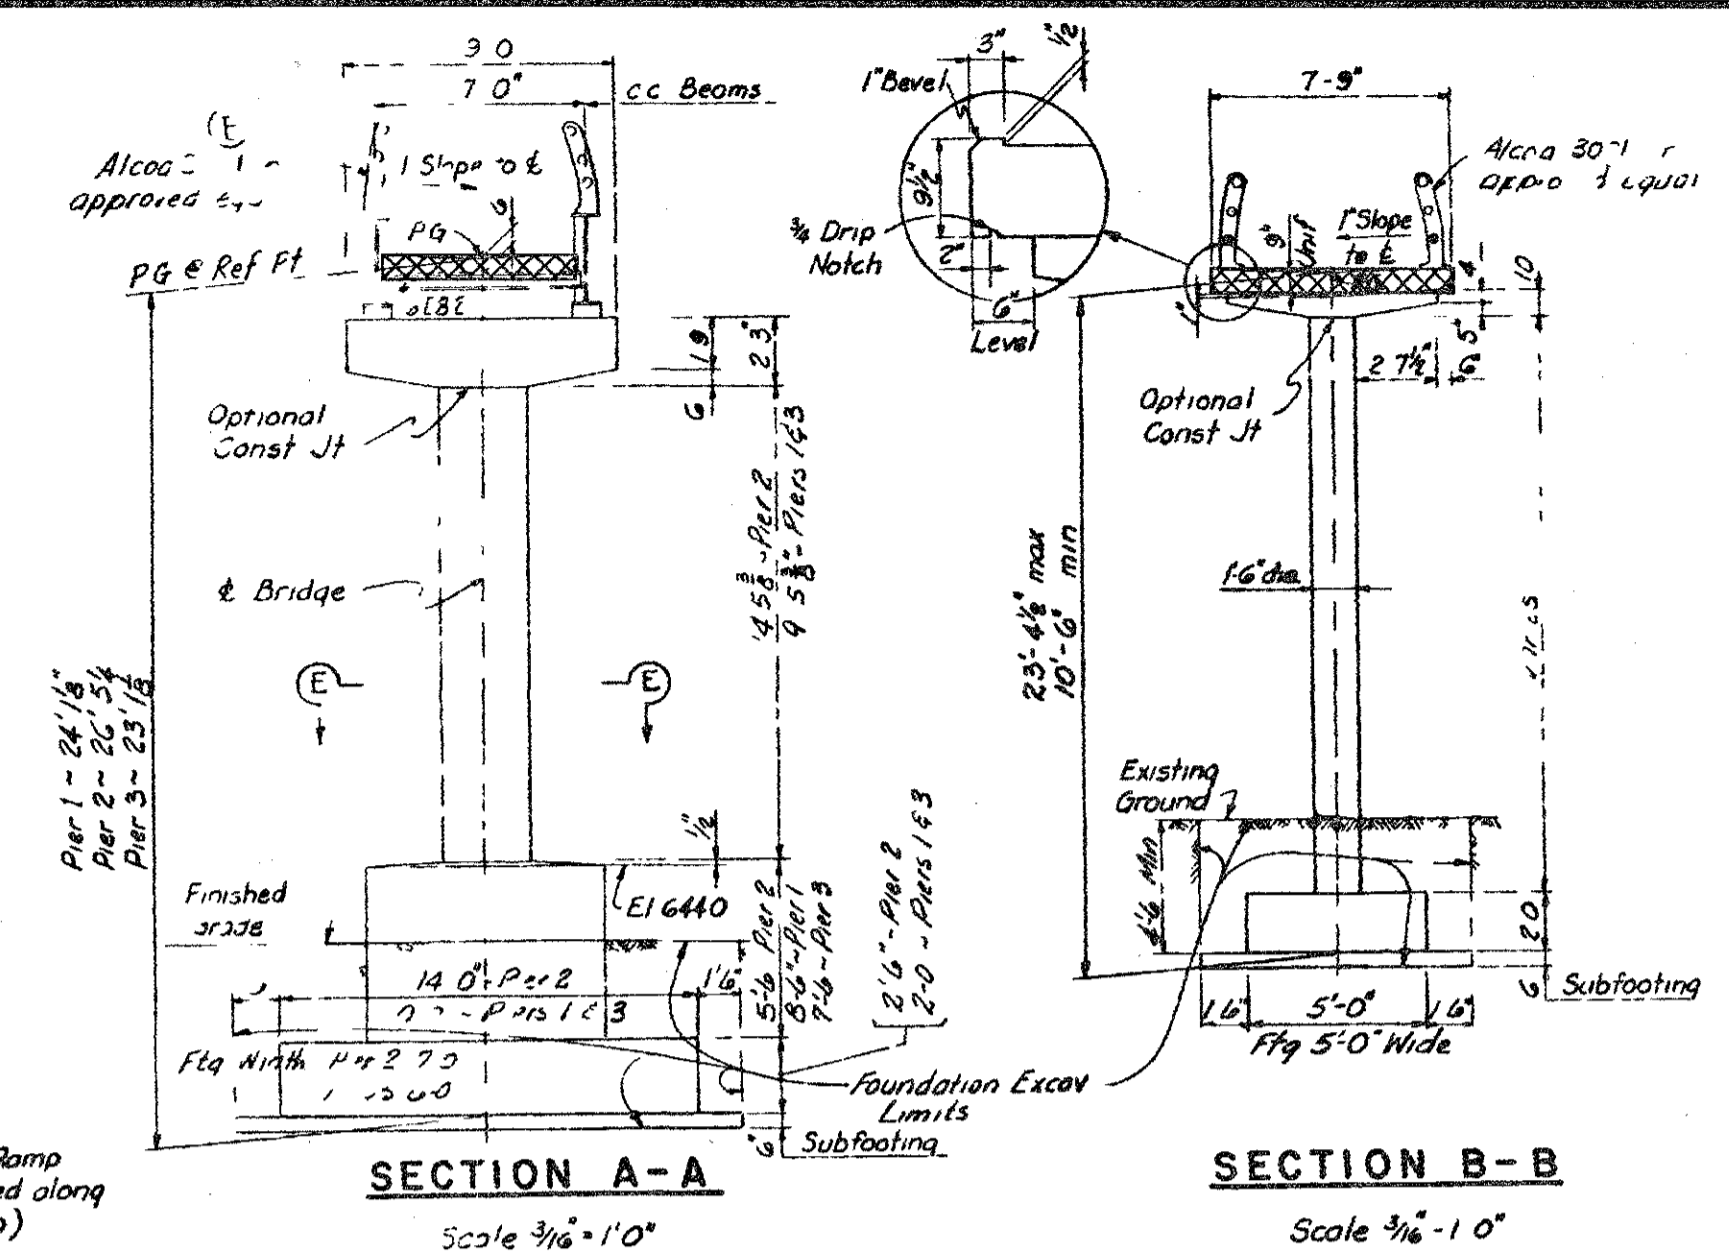


SECTION A-A
Scale 3/16" = 1'-0"

SECTION B-B
Scale 3/16" = 1'-0"

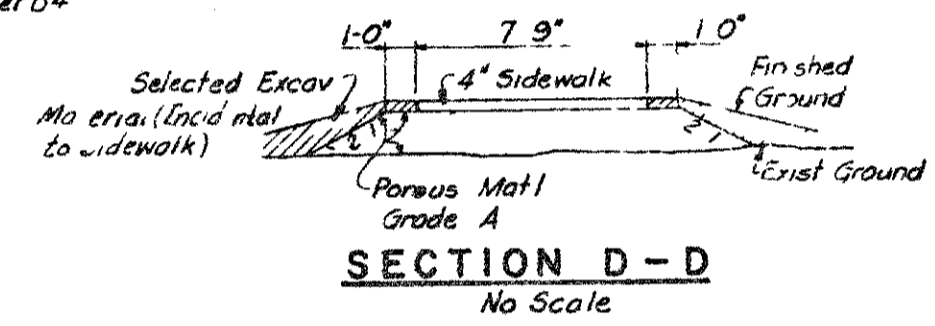


SECTION D-D
Scale 3/16" = 1'-0"

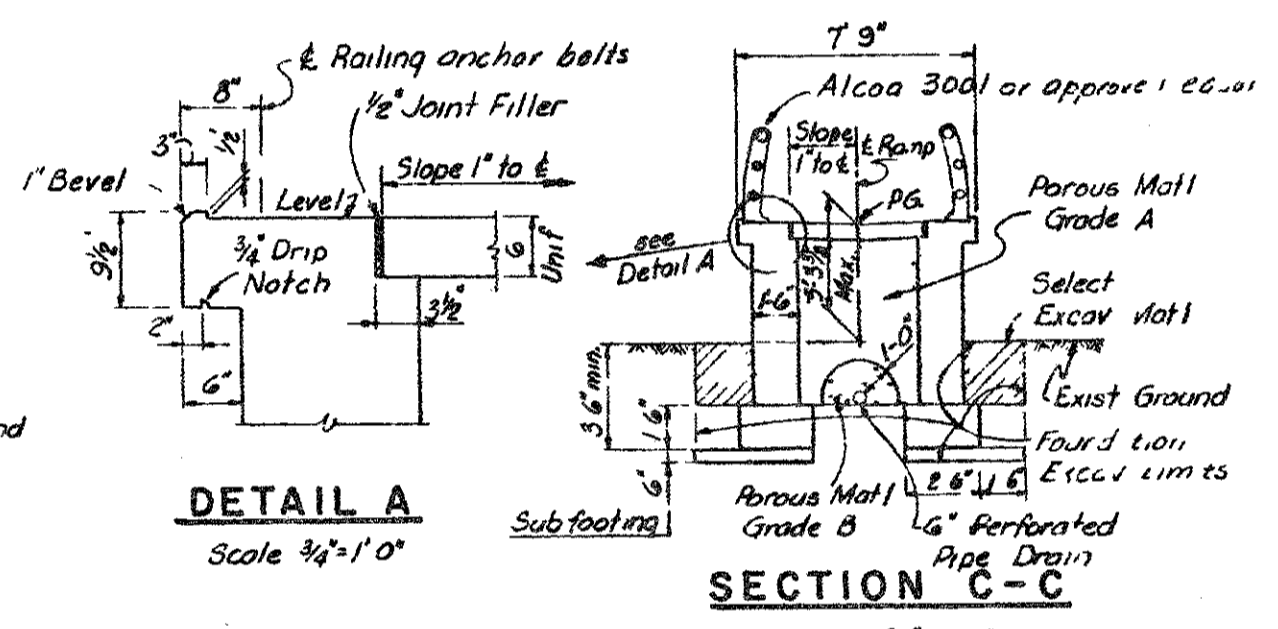


DETAIL A
Scale 3/16" = 1'-0"

SECTION C-C
Scale 3/16" = 1'-0"

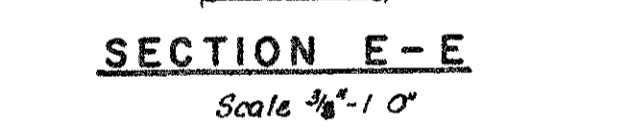

SECTION E-E
Scale 3/16" = 1'-0"

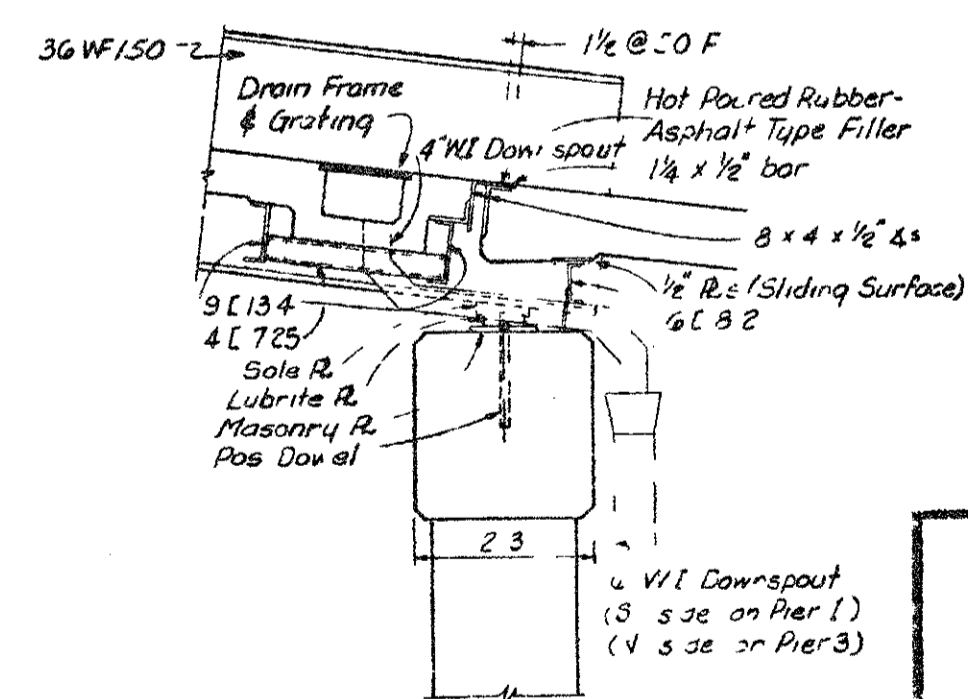

SECTION AT EXP JT
AT PIER #1 & #3
Scale 1/2" = 1'-0"

CONTROL SECTION 63174 I

MICHIGAN STATE HIGHWAY DEPARTMENT
PEDESTRIAN BRIDGE CROSSING I-75 SOUTH OF 12 MILE ROAD
IN THE CITY OF MADISON HEIGHTS

GENERAL PLAN OF STRUCTURE

TECON ENGINEERS, INC.
J. V. Murray
COORDINATING ENGINEER
6-15-62

DATE: 1-1-62
CDB: 2-27-61
J.V.: 1-4-62
139: 312

ENGINEER OF DESIGN - CONSULTANTS
POI OF 63174 I

NOTE:
THE ONLY ITEMS OF WORK TO BE DONE FROM THIS SHEET ARE IDENTIFIED BY THE LEGEND BOX BELOW, LABELED WITH THIS PROJECT'S JOB NUMBER.

JOB NO. 44073A

DENOTES REMOVAL PORTIONS




DATE	CONT. SEC.	JOB NO.	DESIGN UNIT	SHEET
02-05-99	P01 OF 63174	48404A	MADHAVI	4 OF 16


REMOVAL PORTIONS

DATE: _____ CORRECTED BY: _____ CHECKED BY: _____ DATE: _____ DRAWN BY: rmdr FILE NAME: p0163174sn


2 3 4 5 6 7 8 9 10 11 12 13 14 15 16 17 18 19 20 21 22 23 24 25 26 27 28 29 30 31 32 33 34 35 36 37 38 39 40 41 42 43 44 45 46 47 48 49 50 51 52 53 54 55 56 57 58 59 60 61 62 63

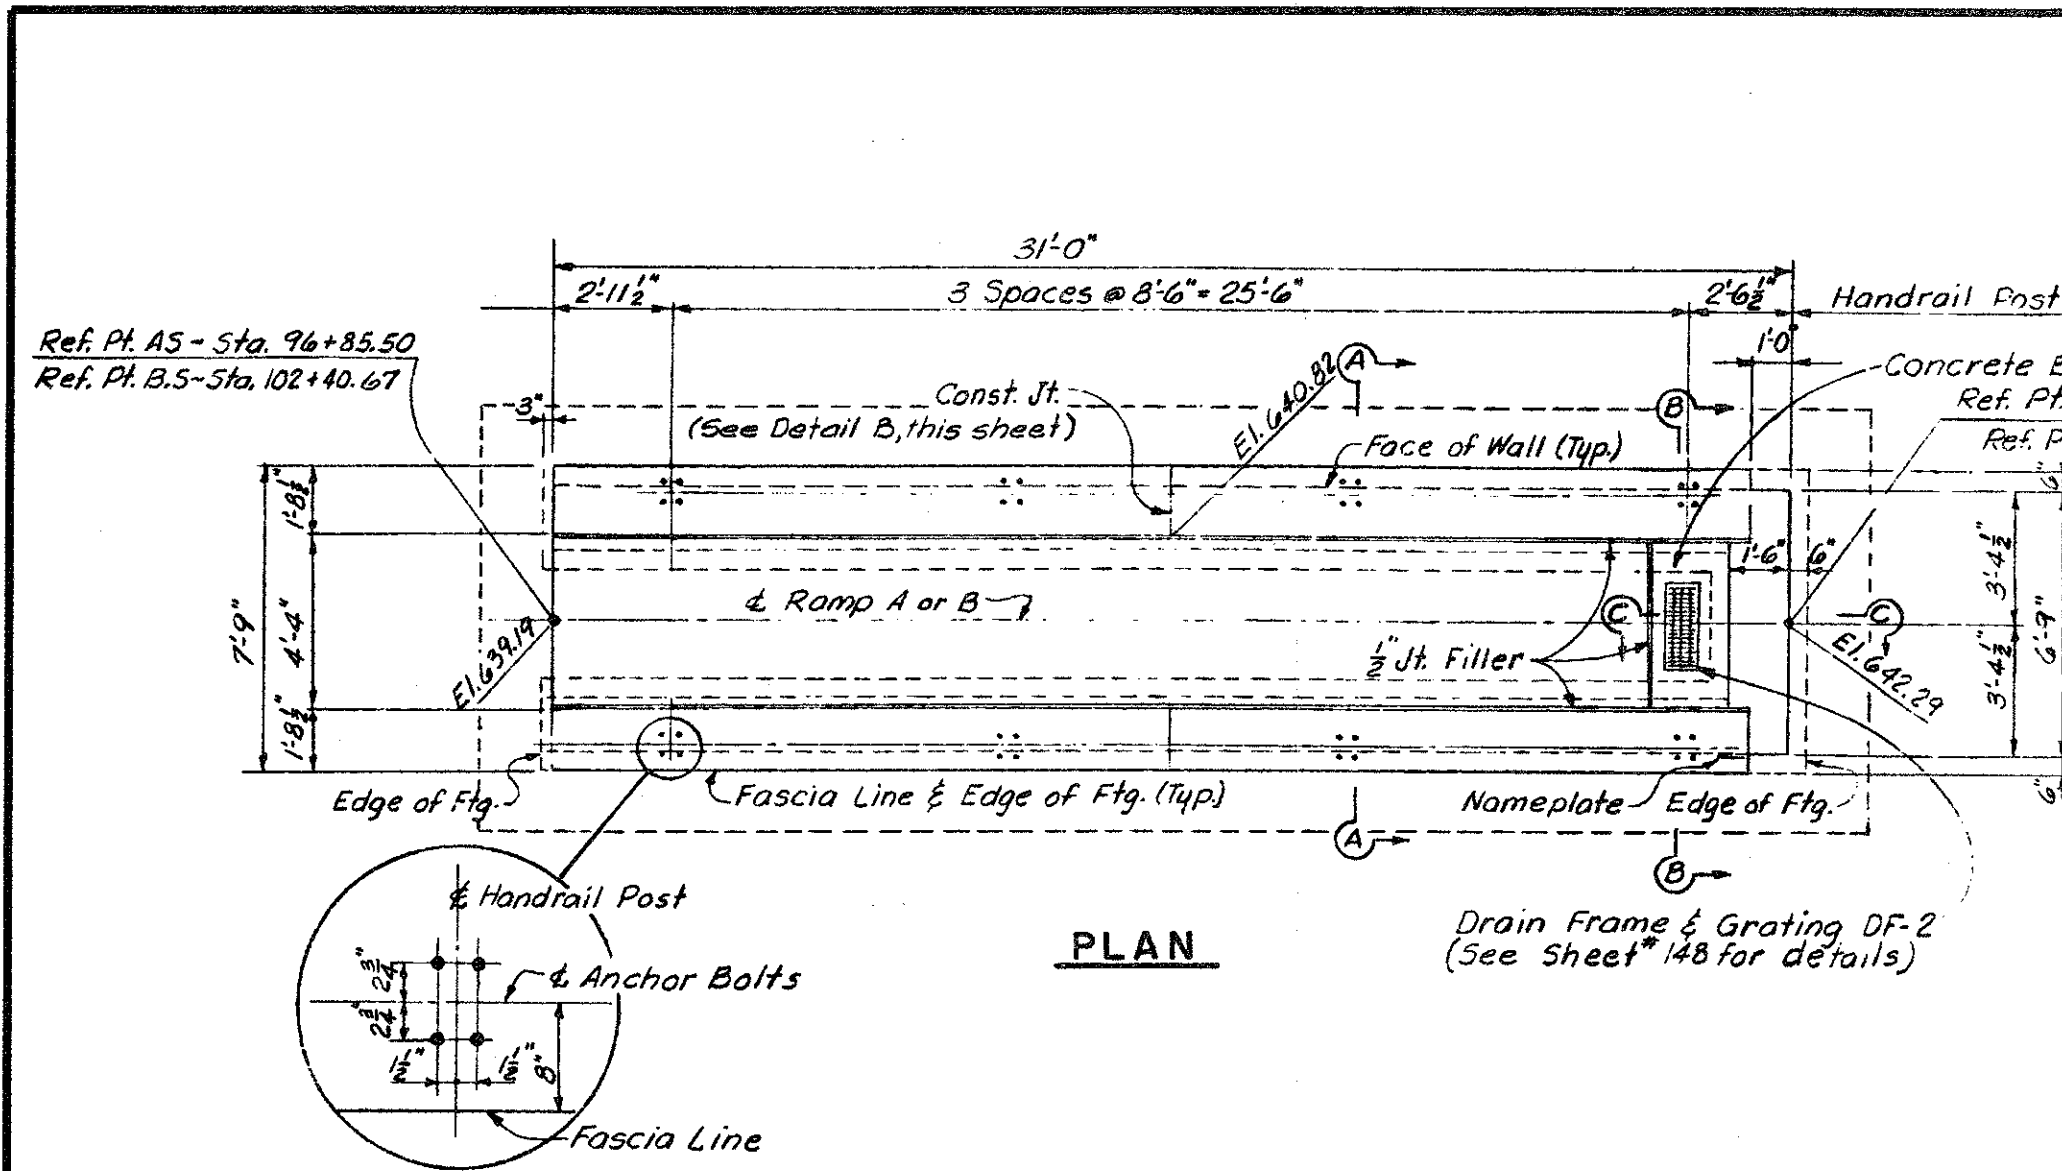

PLAN

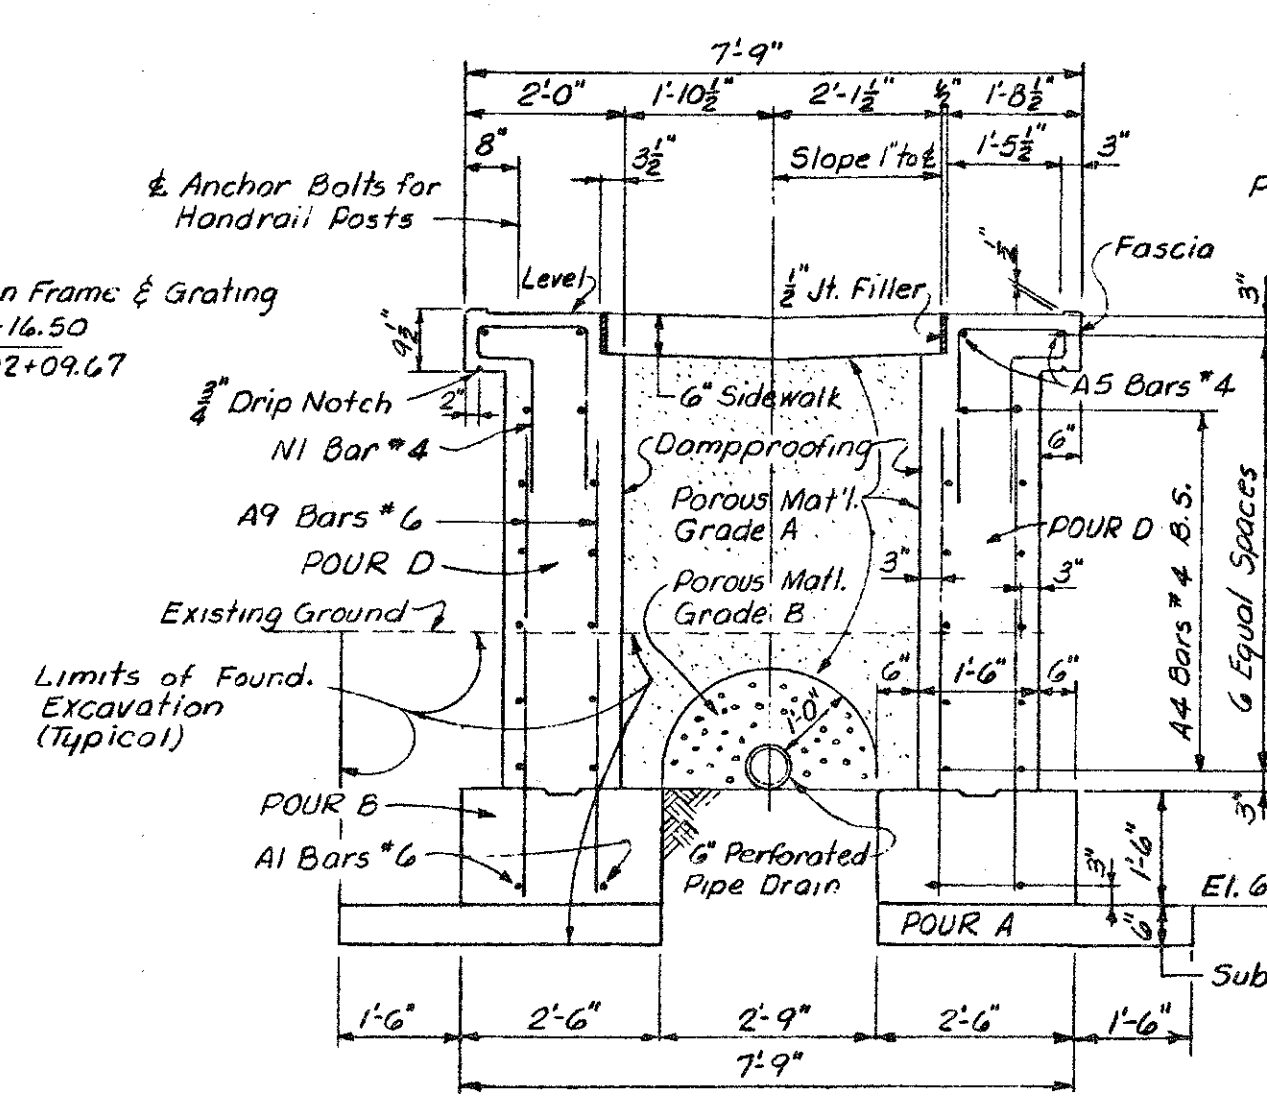

SECTION A-A

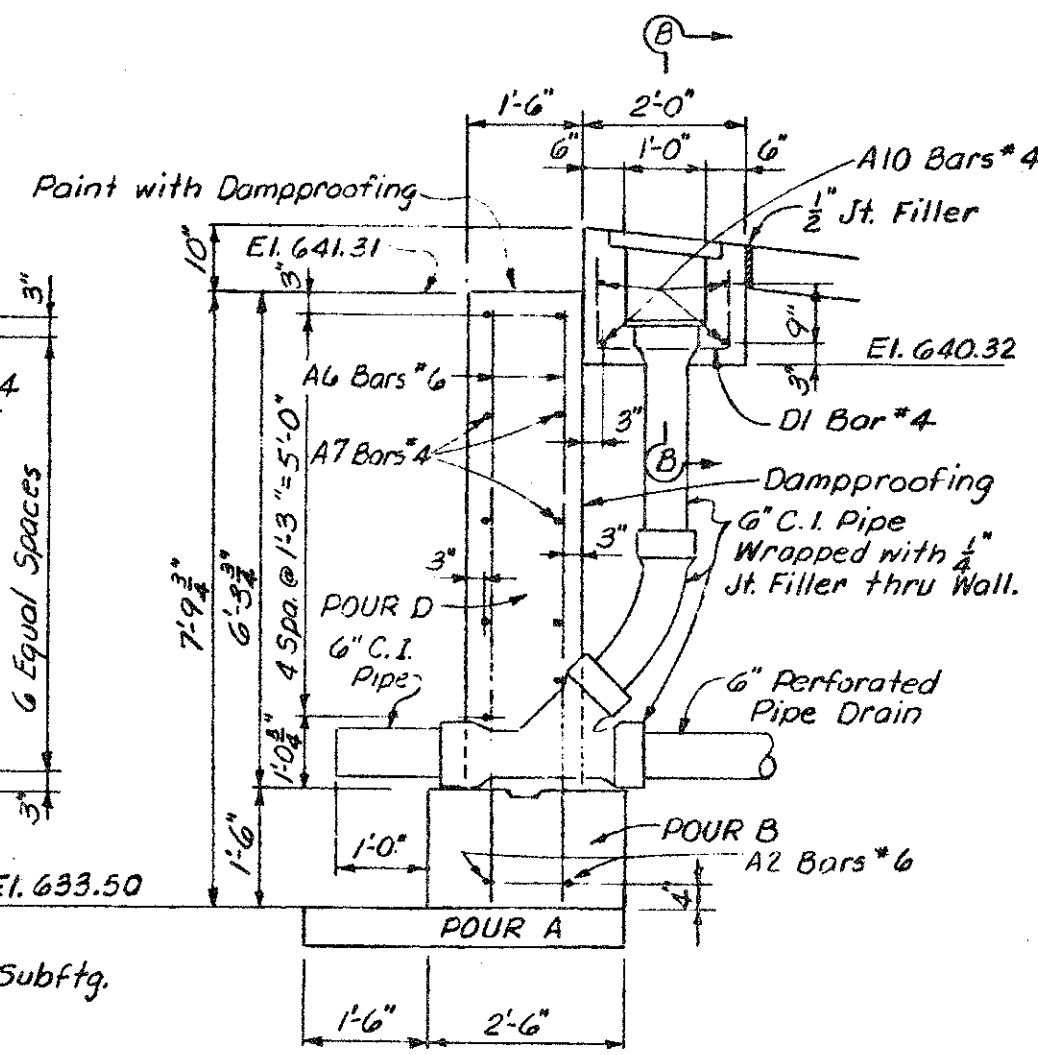


SECTION C-C

CONCRETE QUANTITIES - CU. YDS.


POUR	RAMP A		RAMP B	
	GR. A(6A)	GR. A(6AA)	GR. A(6B)	GR. A(6BA)
A	5.0		5.0	
B	9.2		9.2	
C		9.1		9.1
D		12.8		12.8
E		0.4		0.4
F	1.2		1.8	
Totals	17.4	22.3	18.0	22.3

MISCELLANEOUS QUANTITIES


ITEM	UNIT	QUANTITY	
		RAMP A	RAMP B
Foundation Excavation	Cu. Yds.	65	50
1/2" Joint Filler	Sq. Ft.	38	40
Porous Material Gr. A	Cu. Yds.	20	25
Porous Material Gr. B	Cu. Yds.	4	4
Dampproofing	Sq. Ft.	335	335
4" Conc. Sidewalk	Sq. Ft.	85	161
6" Conc. Sidewalk	Sq. Ft.	117	117
1/2" Joint Filler	Sq. Ft.	100	100
6" C.I. Pipe	Lin. Ft.	11	11
6" Perforated Pipe	Lin. Ft.	31	31

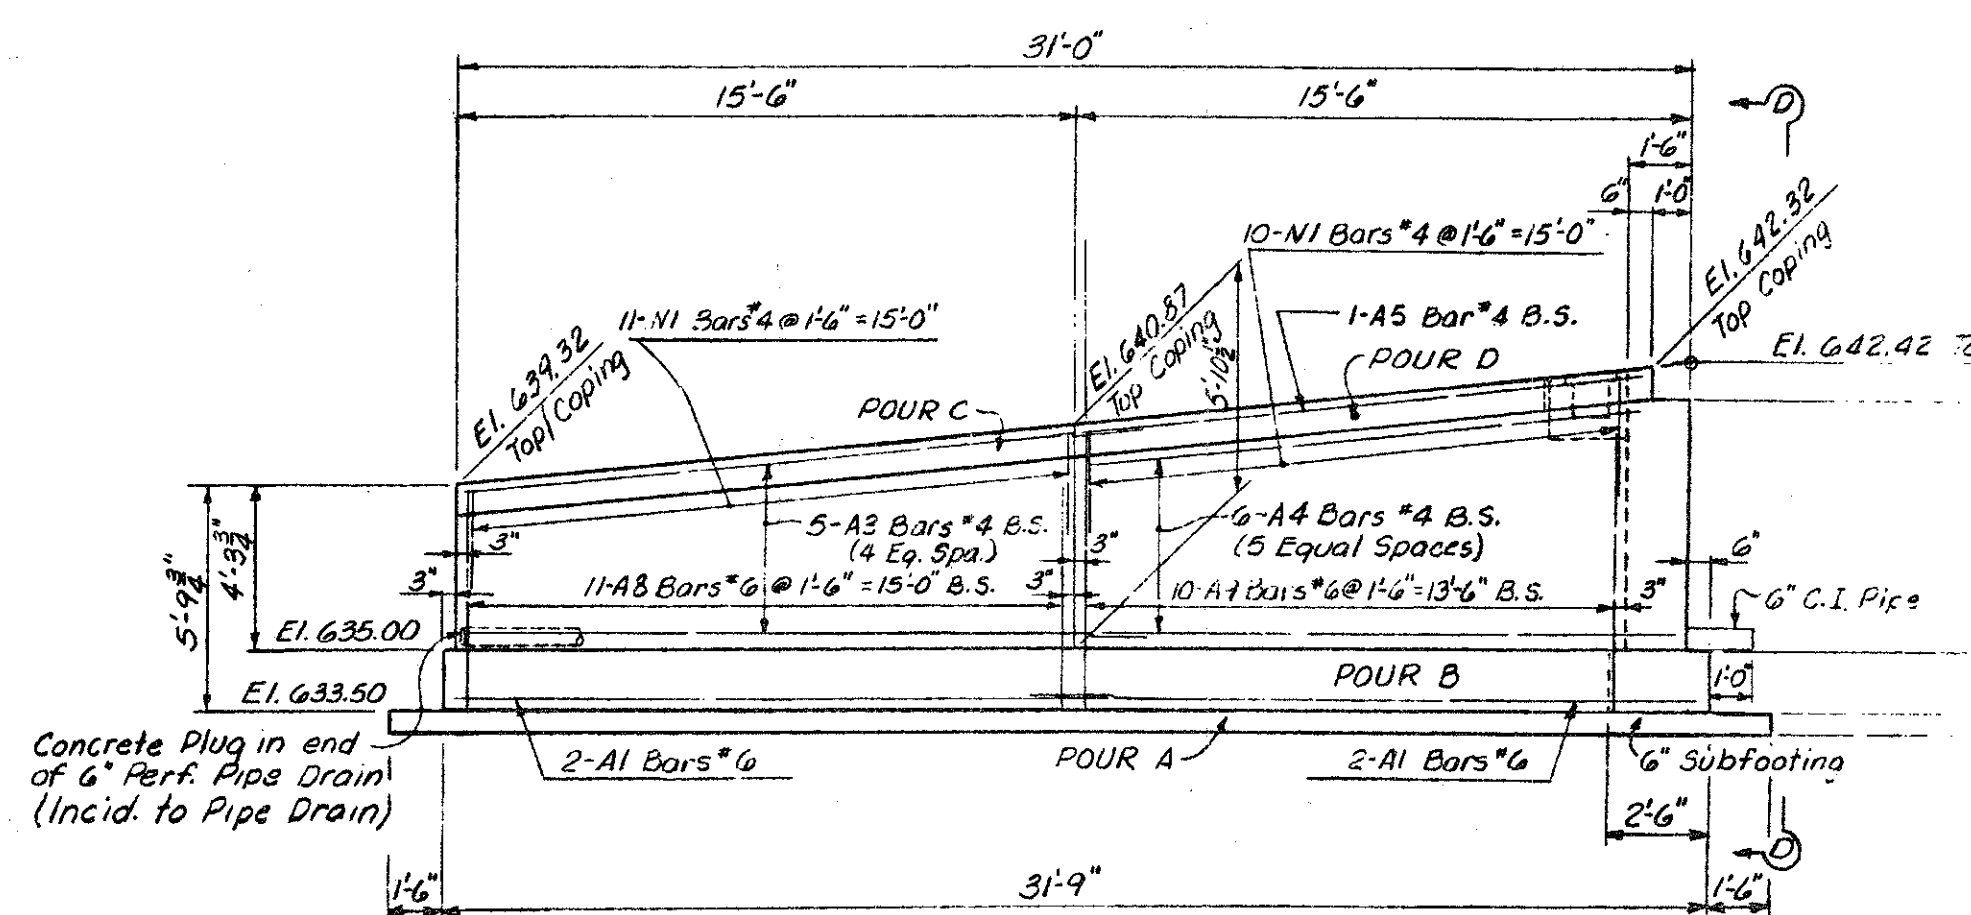

TYPICAL WALL ELEVATION

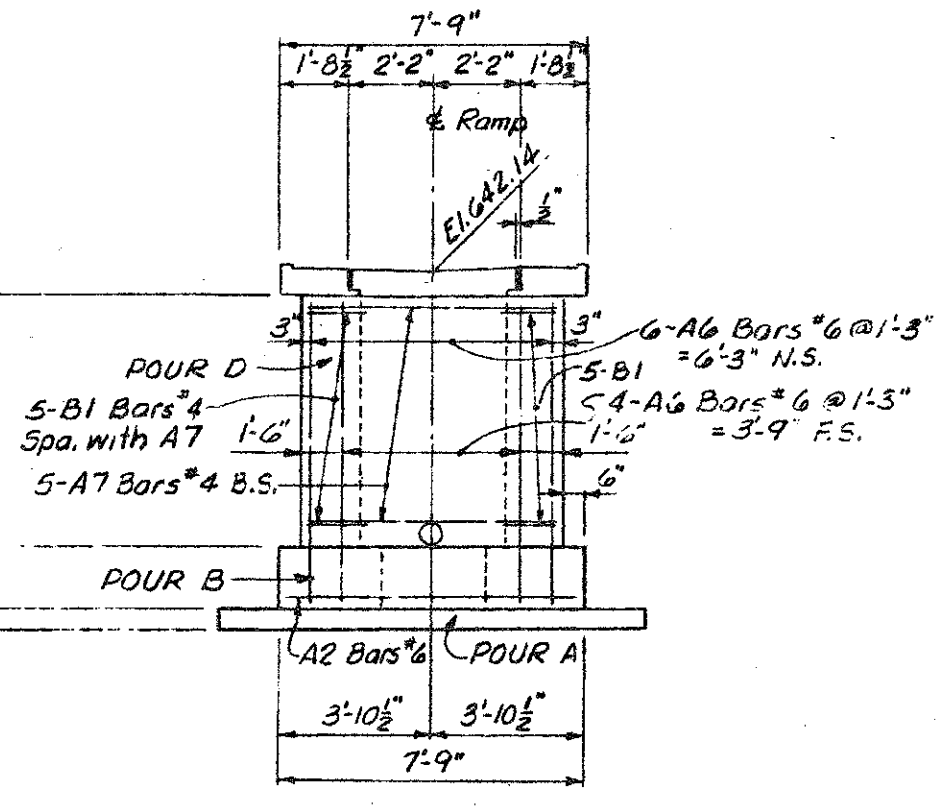


ELEVATION D-D

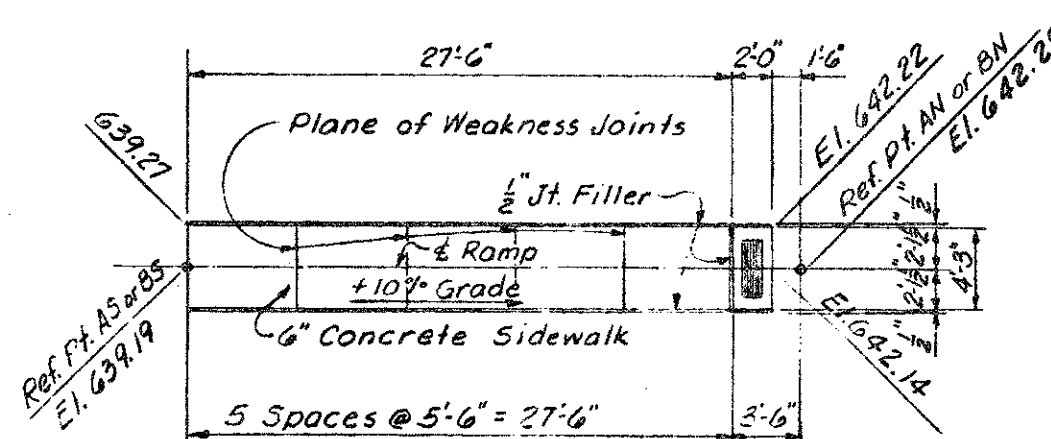


PLAN OF SIDEWALK

GENERAL NOTES

N.S. denotes near side.
 F.S. denotes far side.
 B.S. denotes both sides.
 For Bevel & Molding details see Standard Sheet R11.
 For location of name plates see General Plan of Structure.
 Top of end wall (at Ref. Pt. AN or BN) shall be finished to a true plane at the elevation shown and shall not vary more than 1/8" under a ten foot straight edge.

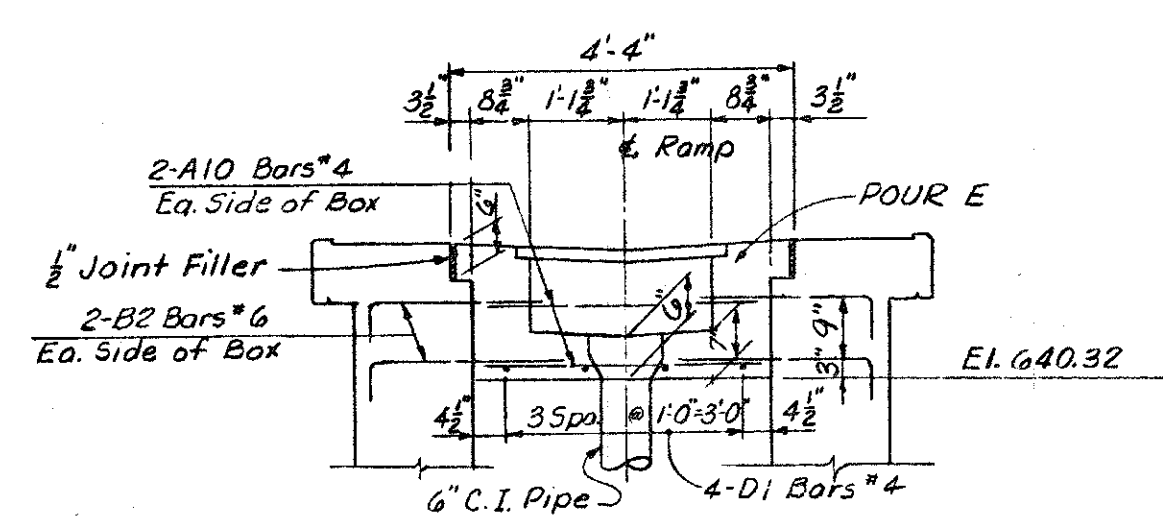

SECTION B-B

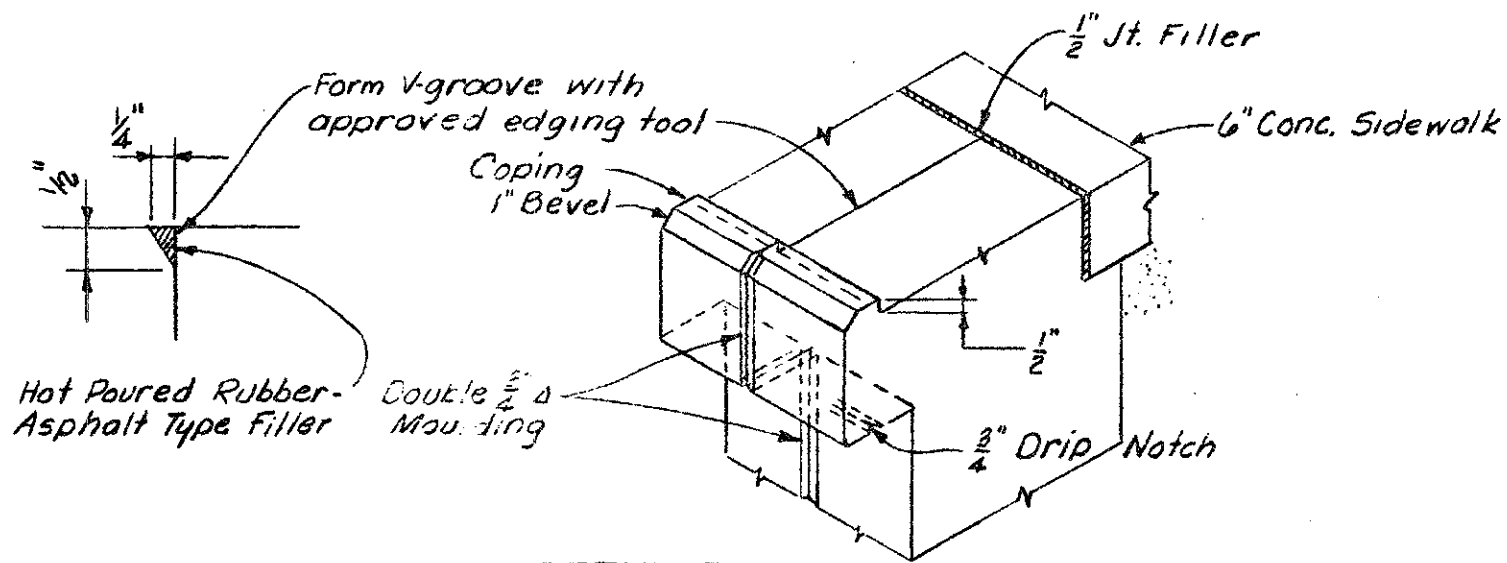

DETAIL B

Work this sheet with sheets 142, 149 & 150

MICHIGAN STATE HIGHWAY DEPARTMENT

RAMP APPROACH DETAILS

TECON ENGINEERS, INC.

JDC 5-7-62
 RFC
 M.A.C. 8-25-62
 141 312
P01 OF 631741

NOTE:
 DO NOT WORK FROM THIS SHEET. THE INFORMATION SHOWN HERE IS FOR REFERENCE ONLY. NO PAY ITEMS ARE SHOWN.

FOR INFORMATION ONLY




DATE	CONT. SEC.	JOB NO.	DESIGN UNIT	SHEET
02-05-99	P01 OF 63174	48404A	MADHAVI	5 OF 16

DATE: _____ CORRECTED BY: _____ CHECKED BY: _____ DATE: _____ DRAWN BY: rander FILE NAME: p0163174sn

CONTROL POINT NO. 63174 SECTION NO. 48404A SHEET NO. 6


1 2 3 4 5 6 7 8 9 10 11 12 13 14 15 16 17 18 19 20 21 22 23 24 25 26 27 28 29 30 31 32 33 34 35 36 37 38 39 40 41 42 43 44 45 46 47 48 49 50 51 52 53 54 55 56 57 58 59 60 61 62 63

REVISIONS			
NO.	DESCRIPTION	DATE	BY

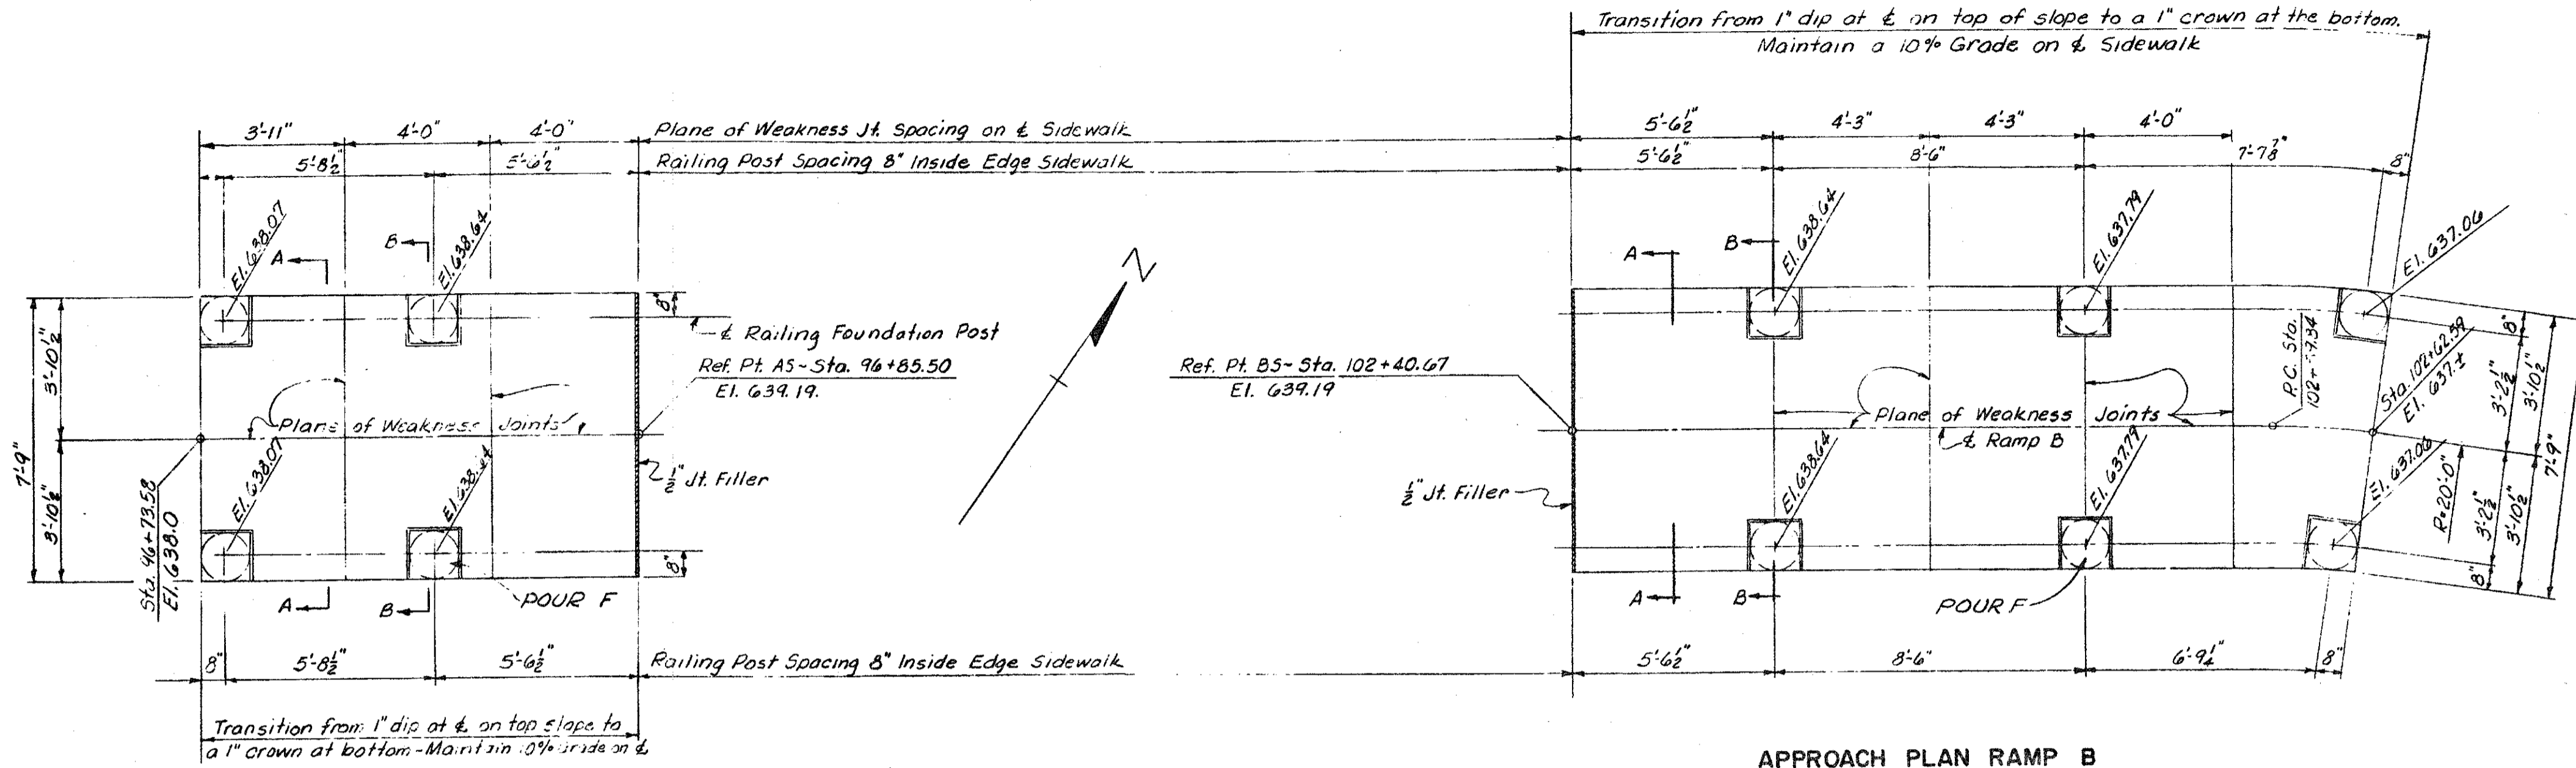


APPROACH PLAN RAMP A


APPROACH PLAN RAMP B

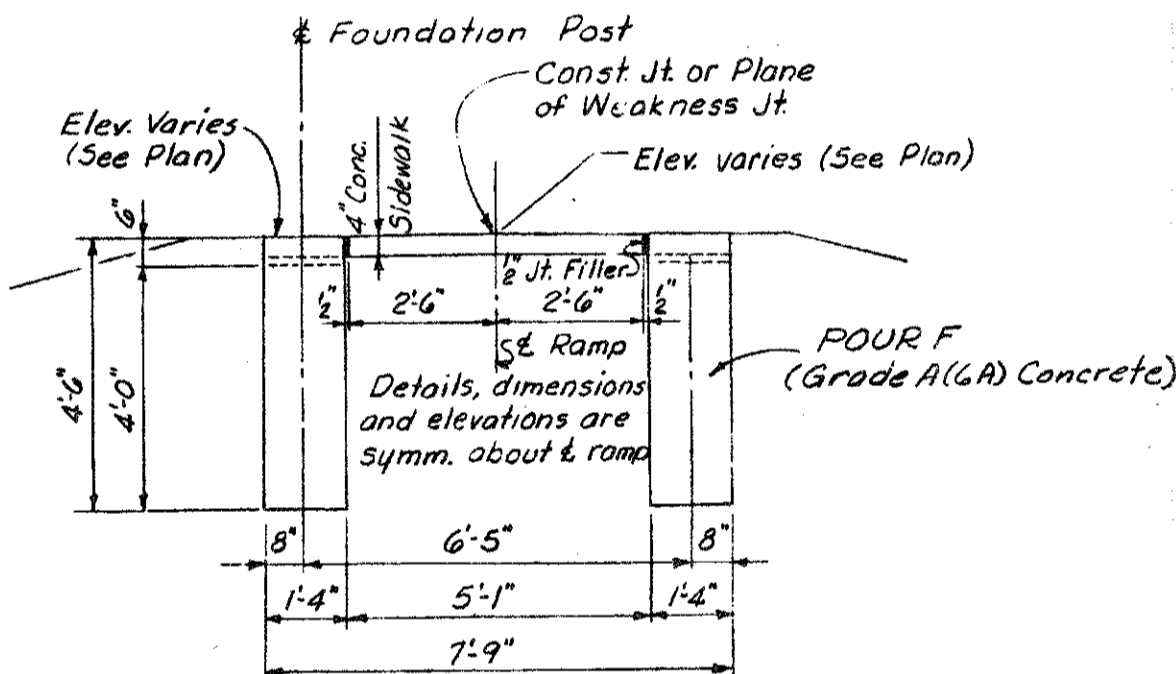

SECTION B-B

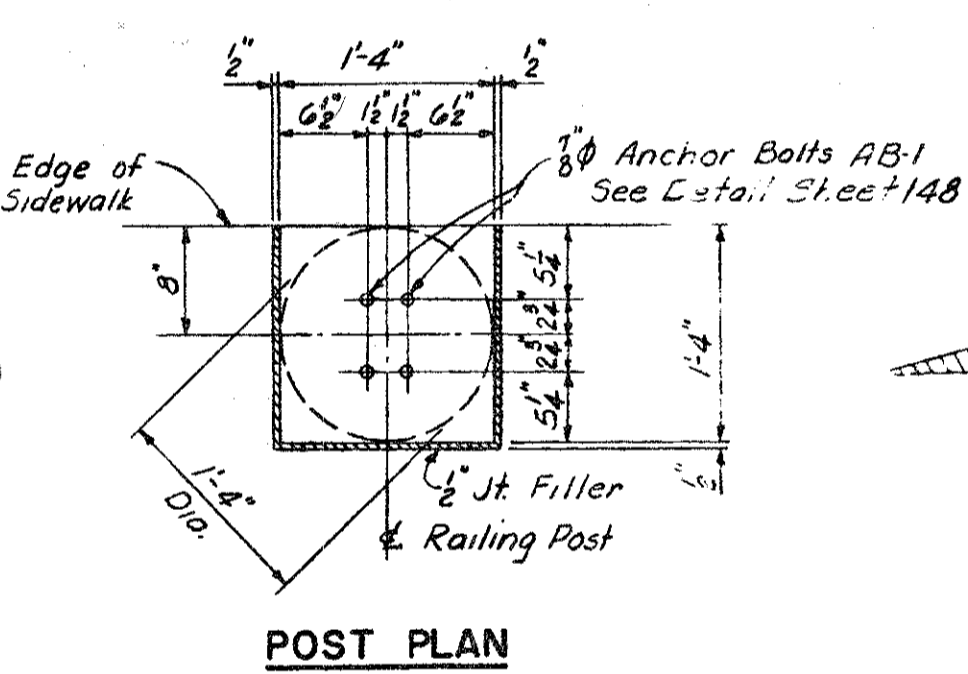

POST PLAN

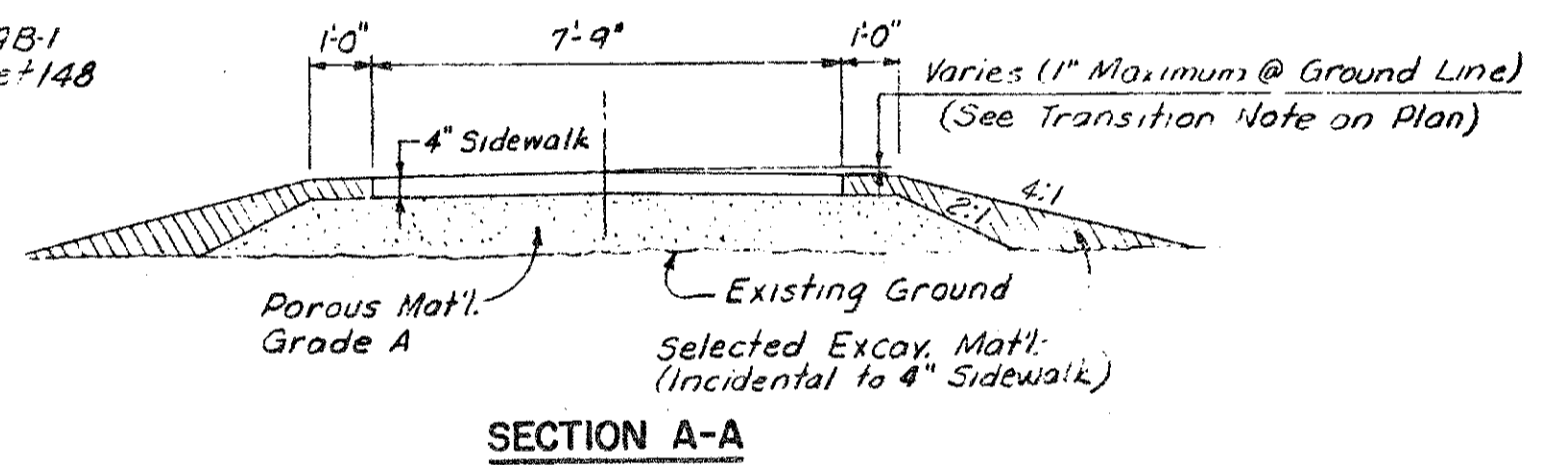

SECTION A-A

Work this sheet with sheets 141 & 149

MICHIGAN STATE HIGHWAY DEPARTMENT

RAMP APPROACH DETAILS

TECON ENGINEERS, INC.

DATE	BY

JDC 5762
RFC
MAC 82662
142 312
POI of 63174 1

NOTE:
DO NOT WORK FROM THIS SHEET. THE INFORMATION SHOWN
HERE IS FOR REFERENCE ONLY. NO PAY ITEMS ARE SHOWN.


FOR INFORMATION ONLY










DATE	CONT. SEC.	JOB NO.	DESIGN UNIT	SHEET
02-05-99	P01 OF 63174	48404A	MADHAVI	6 OF 16

DATE: _____ CHECKED BY: _____ CORRECTED BY: _____ DATE: _____ DRAWN BY: inder FILE NAME: p0163174sn

REVISIONS			
NO.	DESCRIPTION	DATE	BY

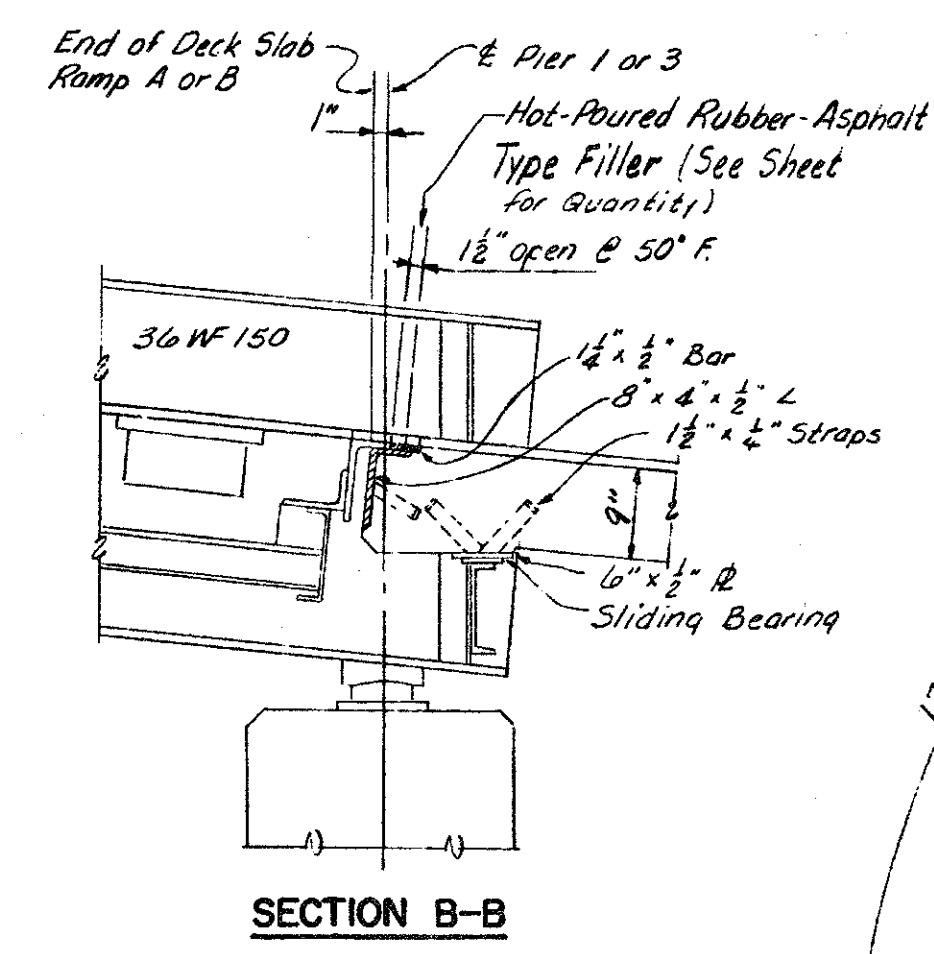

Pier No.	Col. Ht. h'	Col. Vert. Bars	No. Ancl. Bars	Col. Tie Bars	No. Reqd. Bars	No. Reqd. Bars
A1 or B1	8'-0"	B101	8	T101	8	8
A2 or B2	9'-9"	B102	8	T101	10	10
A3 or B3	11'-6"	B103	8	T101	11	11
A4 or B4	13'-3"	B104	8	T101	13	13
A5 or B5	15'-0"	B105	8	T101	15	15
A6 or B6	16'-6"	B106	8	T101	16	16
A7 or B7	18'-3"	B107	8	T101	18	18
A8 or B8	20'-0"	B108	8	T101	20	20

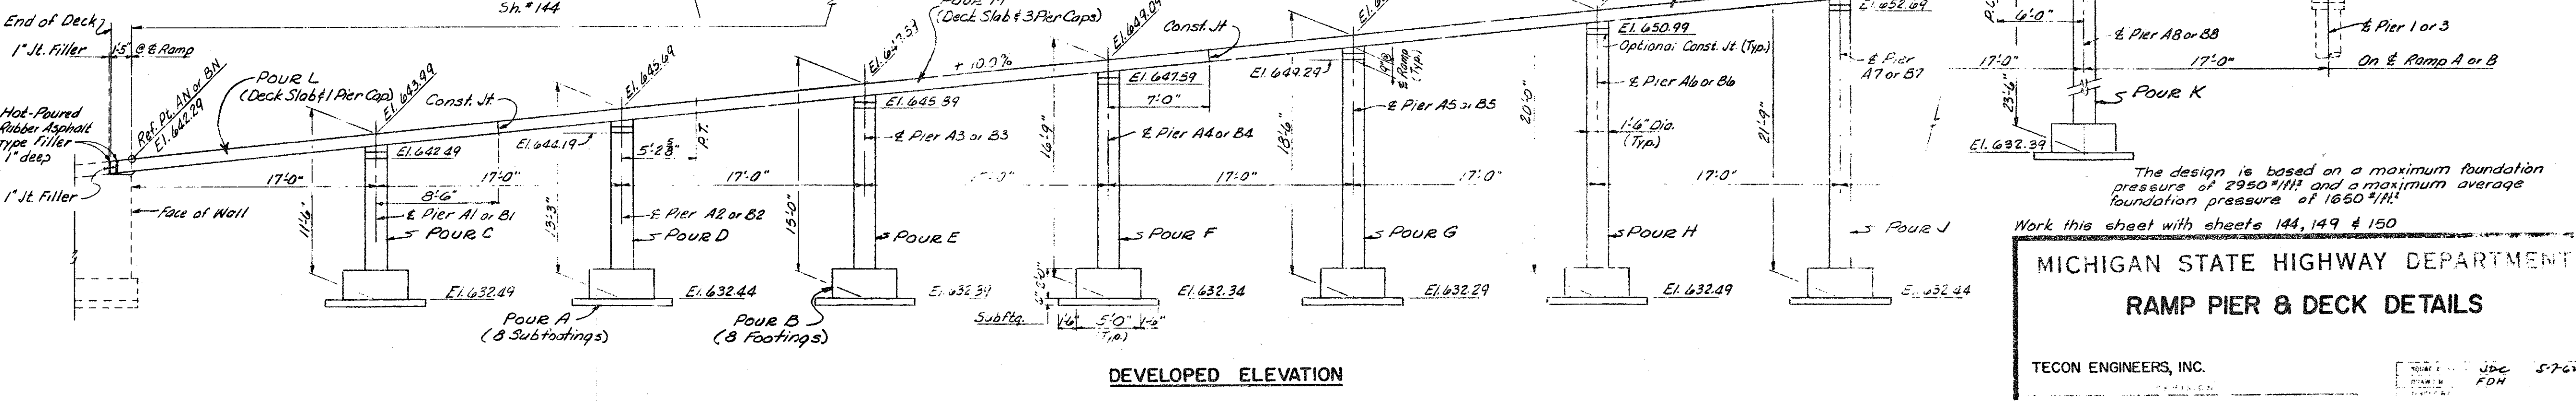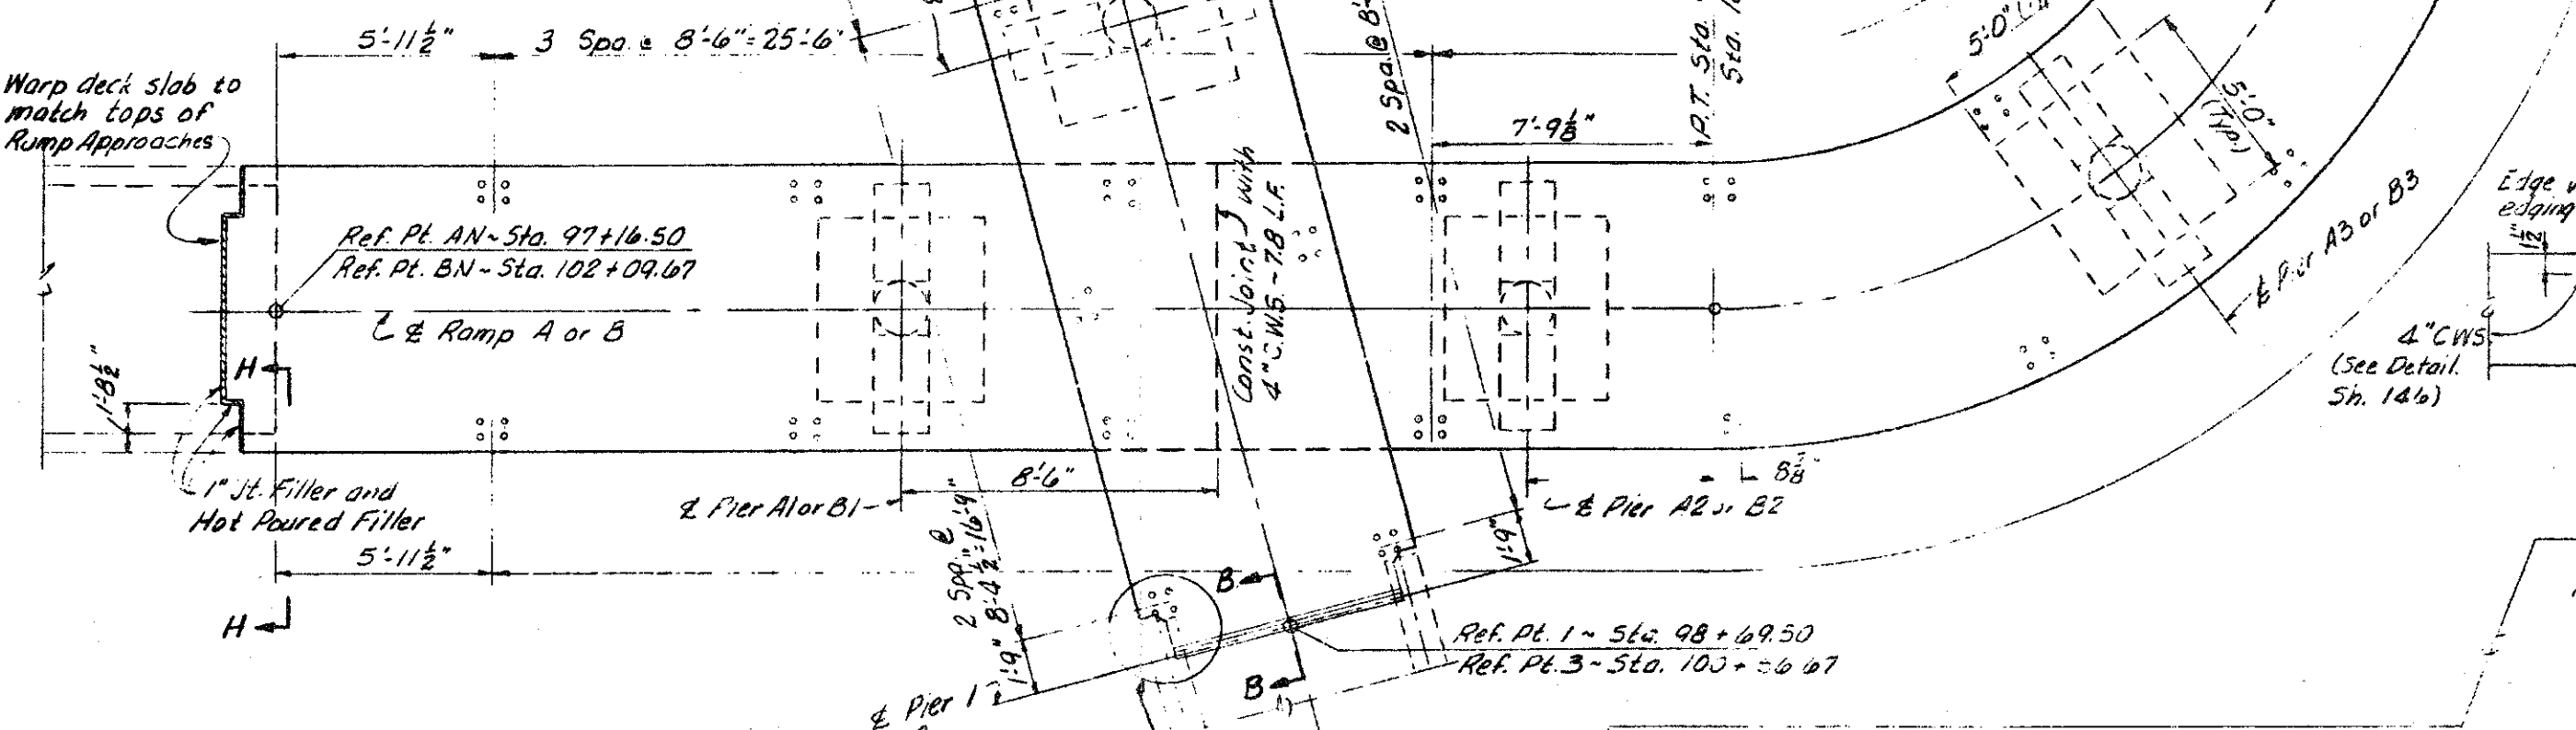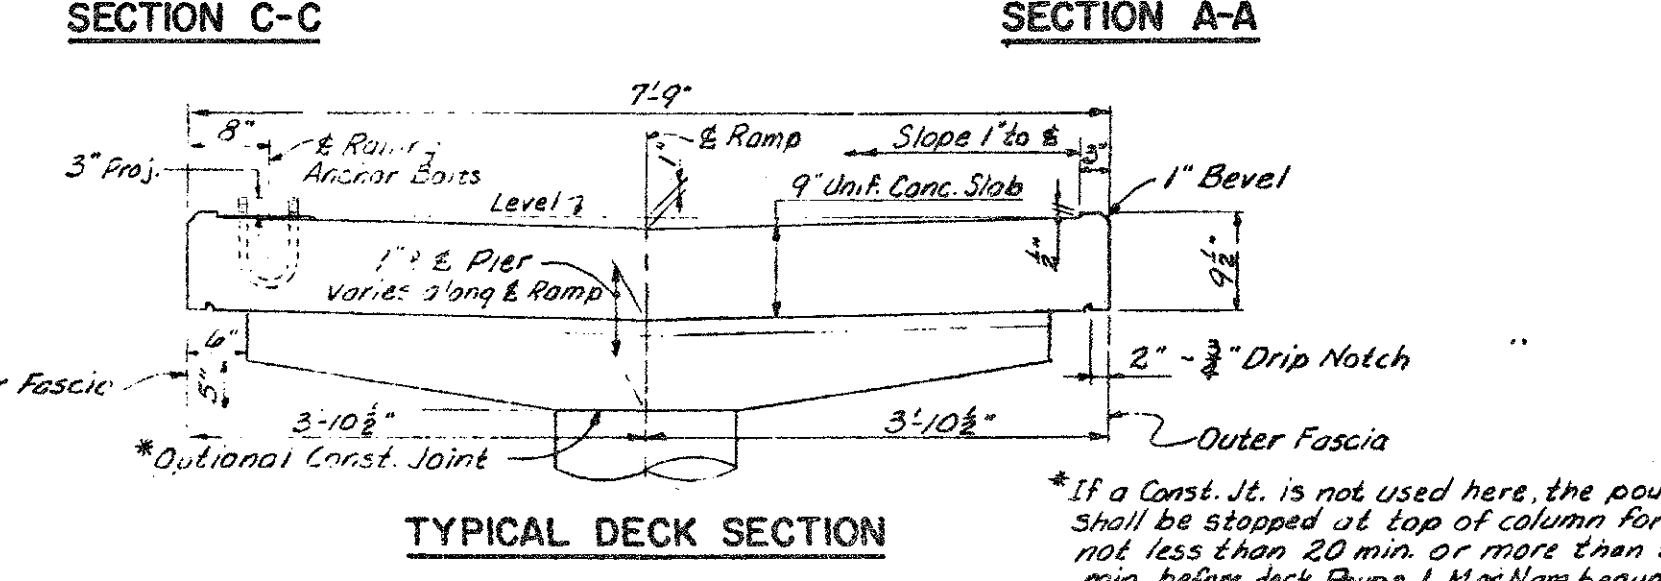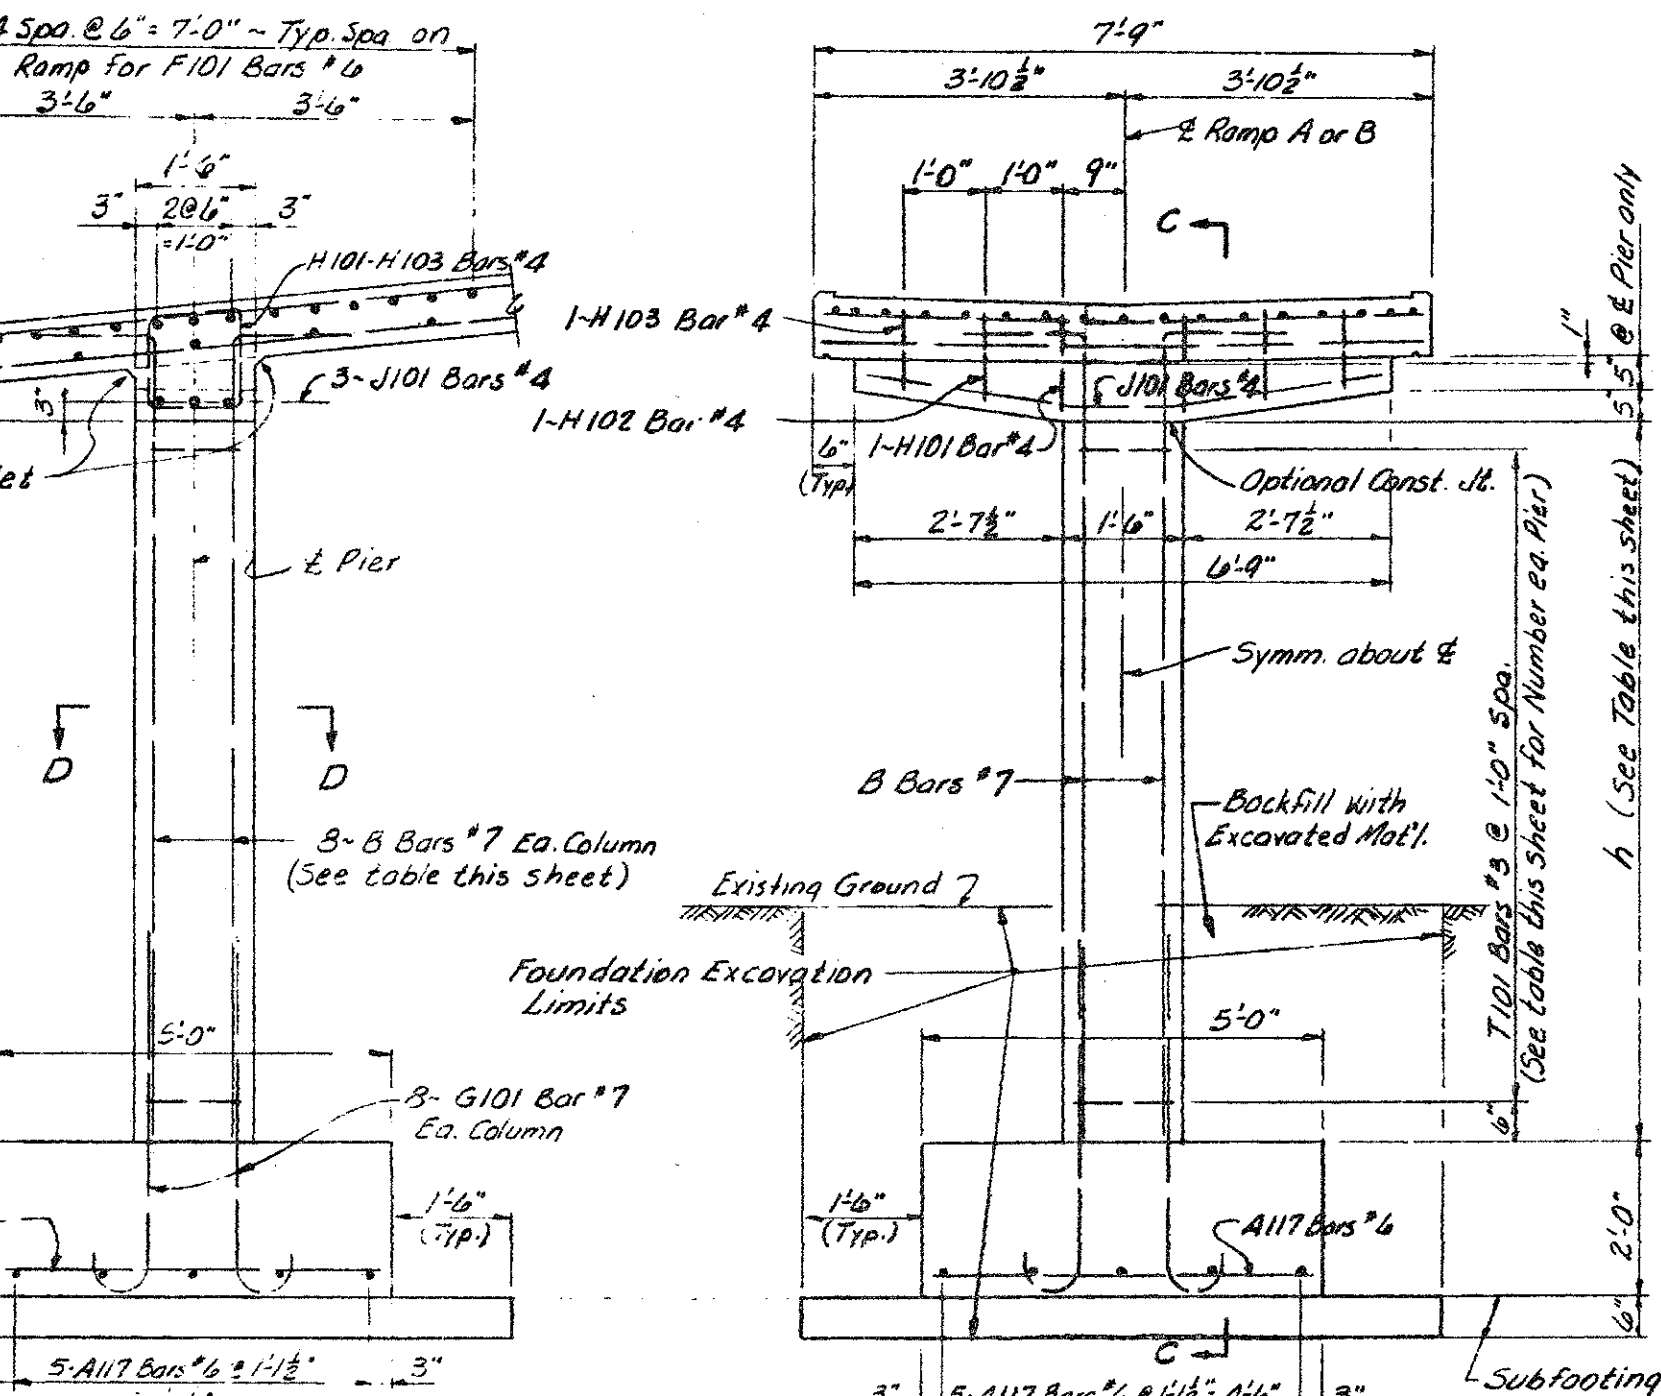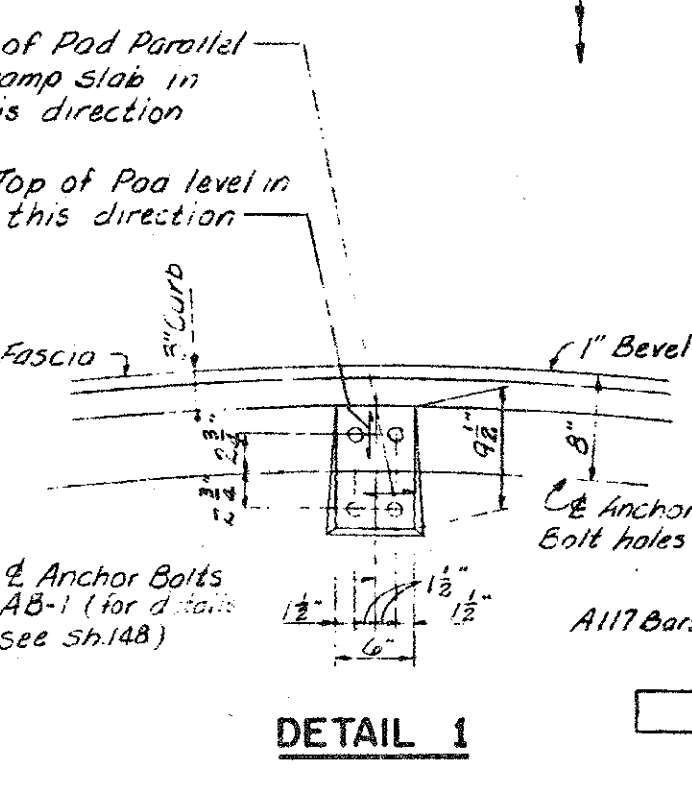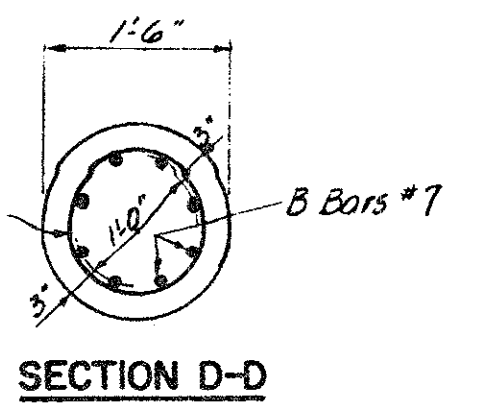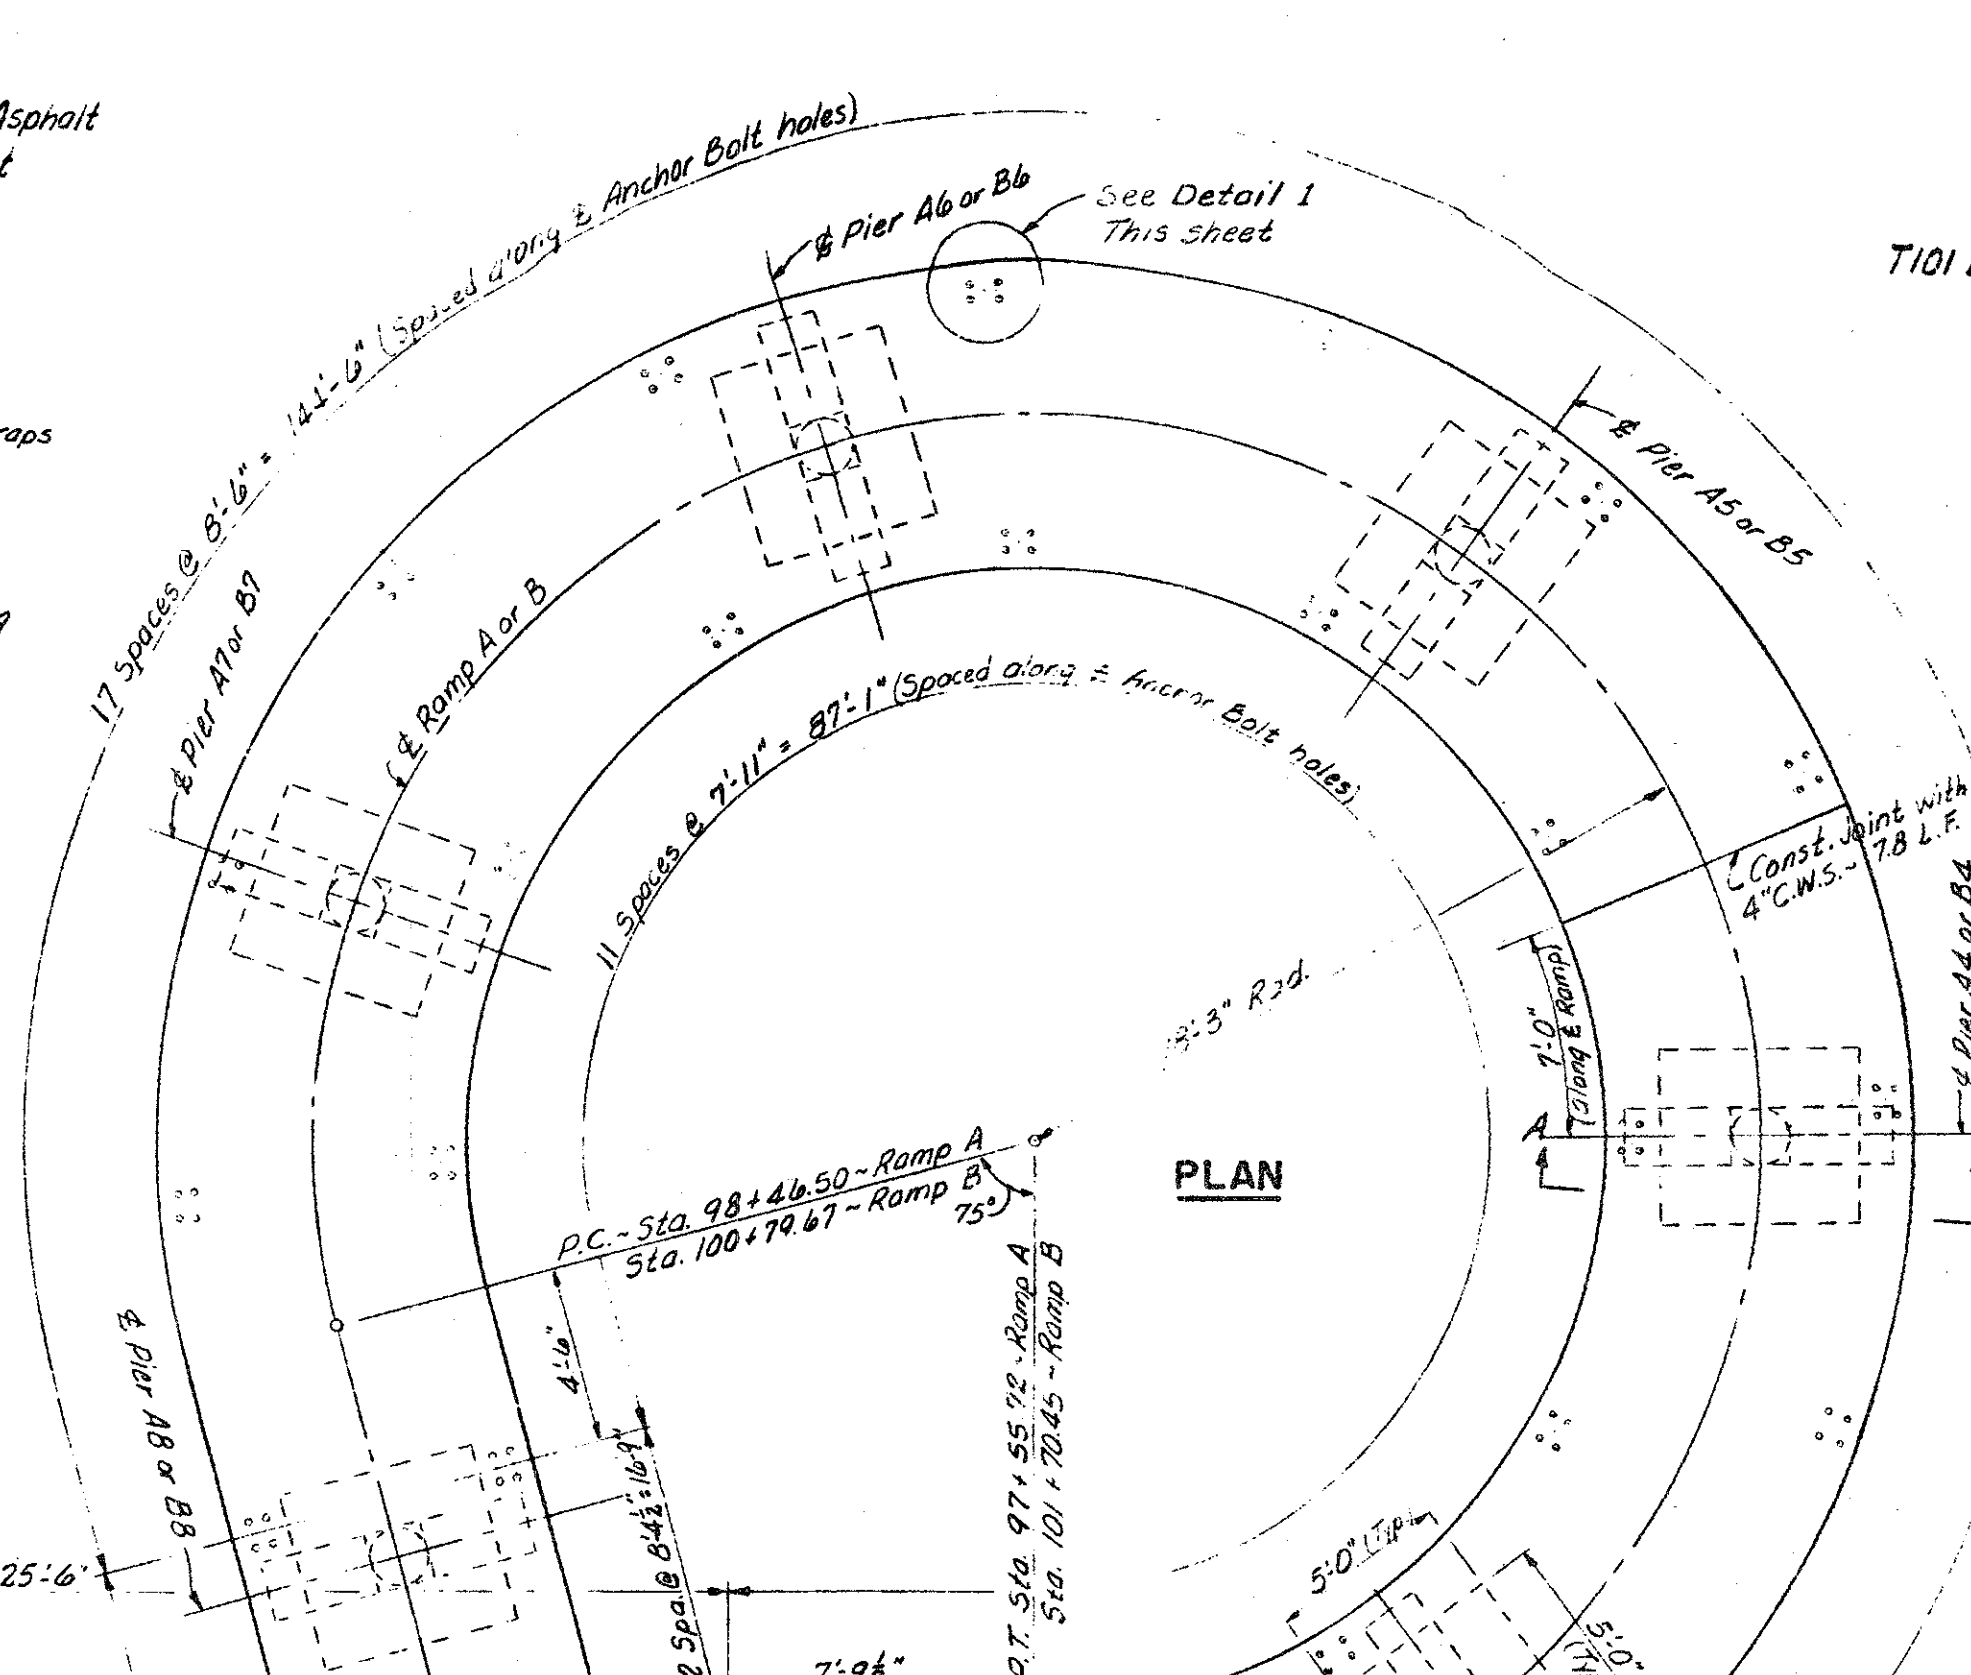



MICHIGAN STATE HIGHWAY DEPARTMENT
RAMP PIER & DECK DETAILS
 TECON ENGINEERS, INC.
 JDE
 EDH
 5-7-99

NOTE:
 DO NOT WORK FROM THIS SHEET. THE INFORMATION SHOWN
 HERE IS FOR REFERENCE ONLY. NO PAY ITEMS ARE SHOWN.

FOR INFORMATION ONLY				
DATE	CONT. SEC.	JOB NO.	DESIGN UNIT	SHEET
02-05-99	P01 OF 63174	48404A	MADHAVI	7 OF 16

DRAWN BY: inder CHECKED BY: DATE: CORRECTED BY: DATE: FILE NAME: p0163174.d

1 2 3 4 5 6 7 8 9 10 11 12 13 14 15 16 17 18 19 20 21 22 23 24 25 26 27 28 29 30 31 32 33 34 35 36 37 38 39 40 41 42 43 44 45 46 47 48 49 50 51 52 53 54 55 56 57 58 59 60 61 62 63

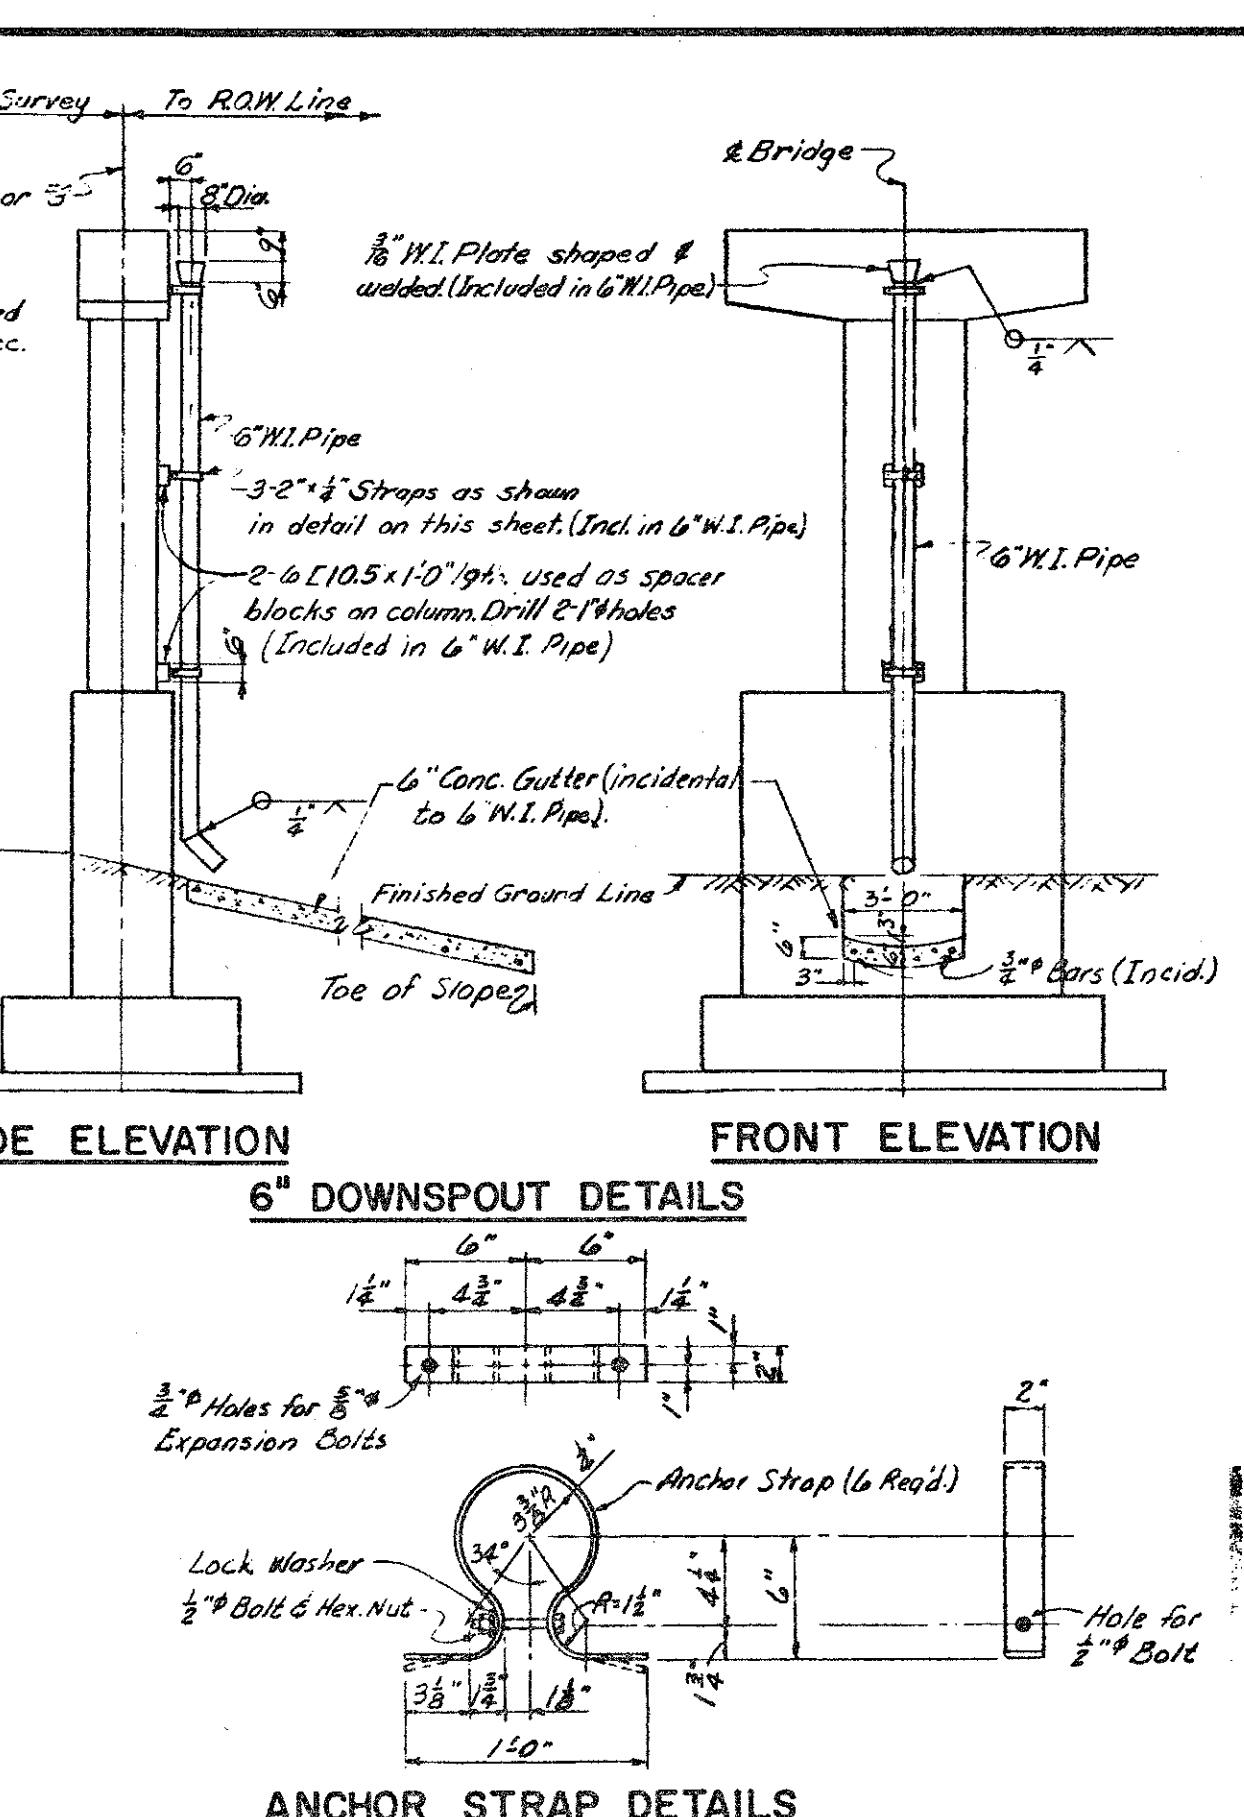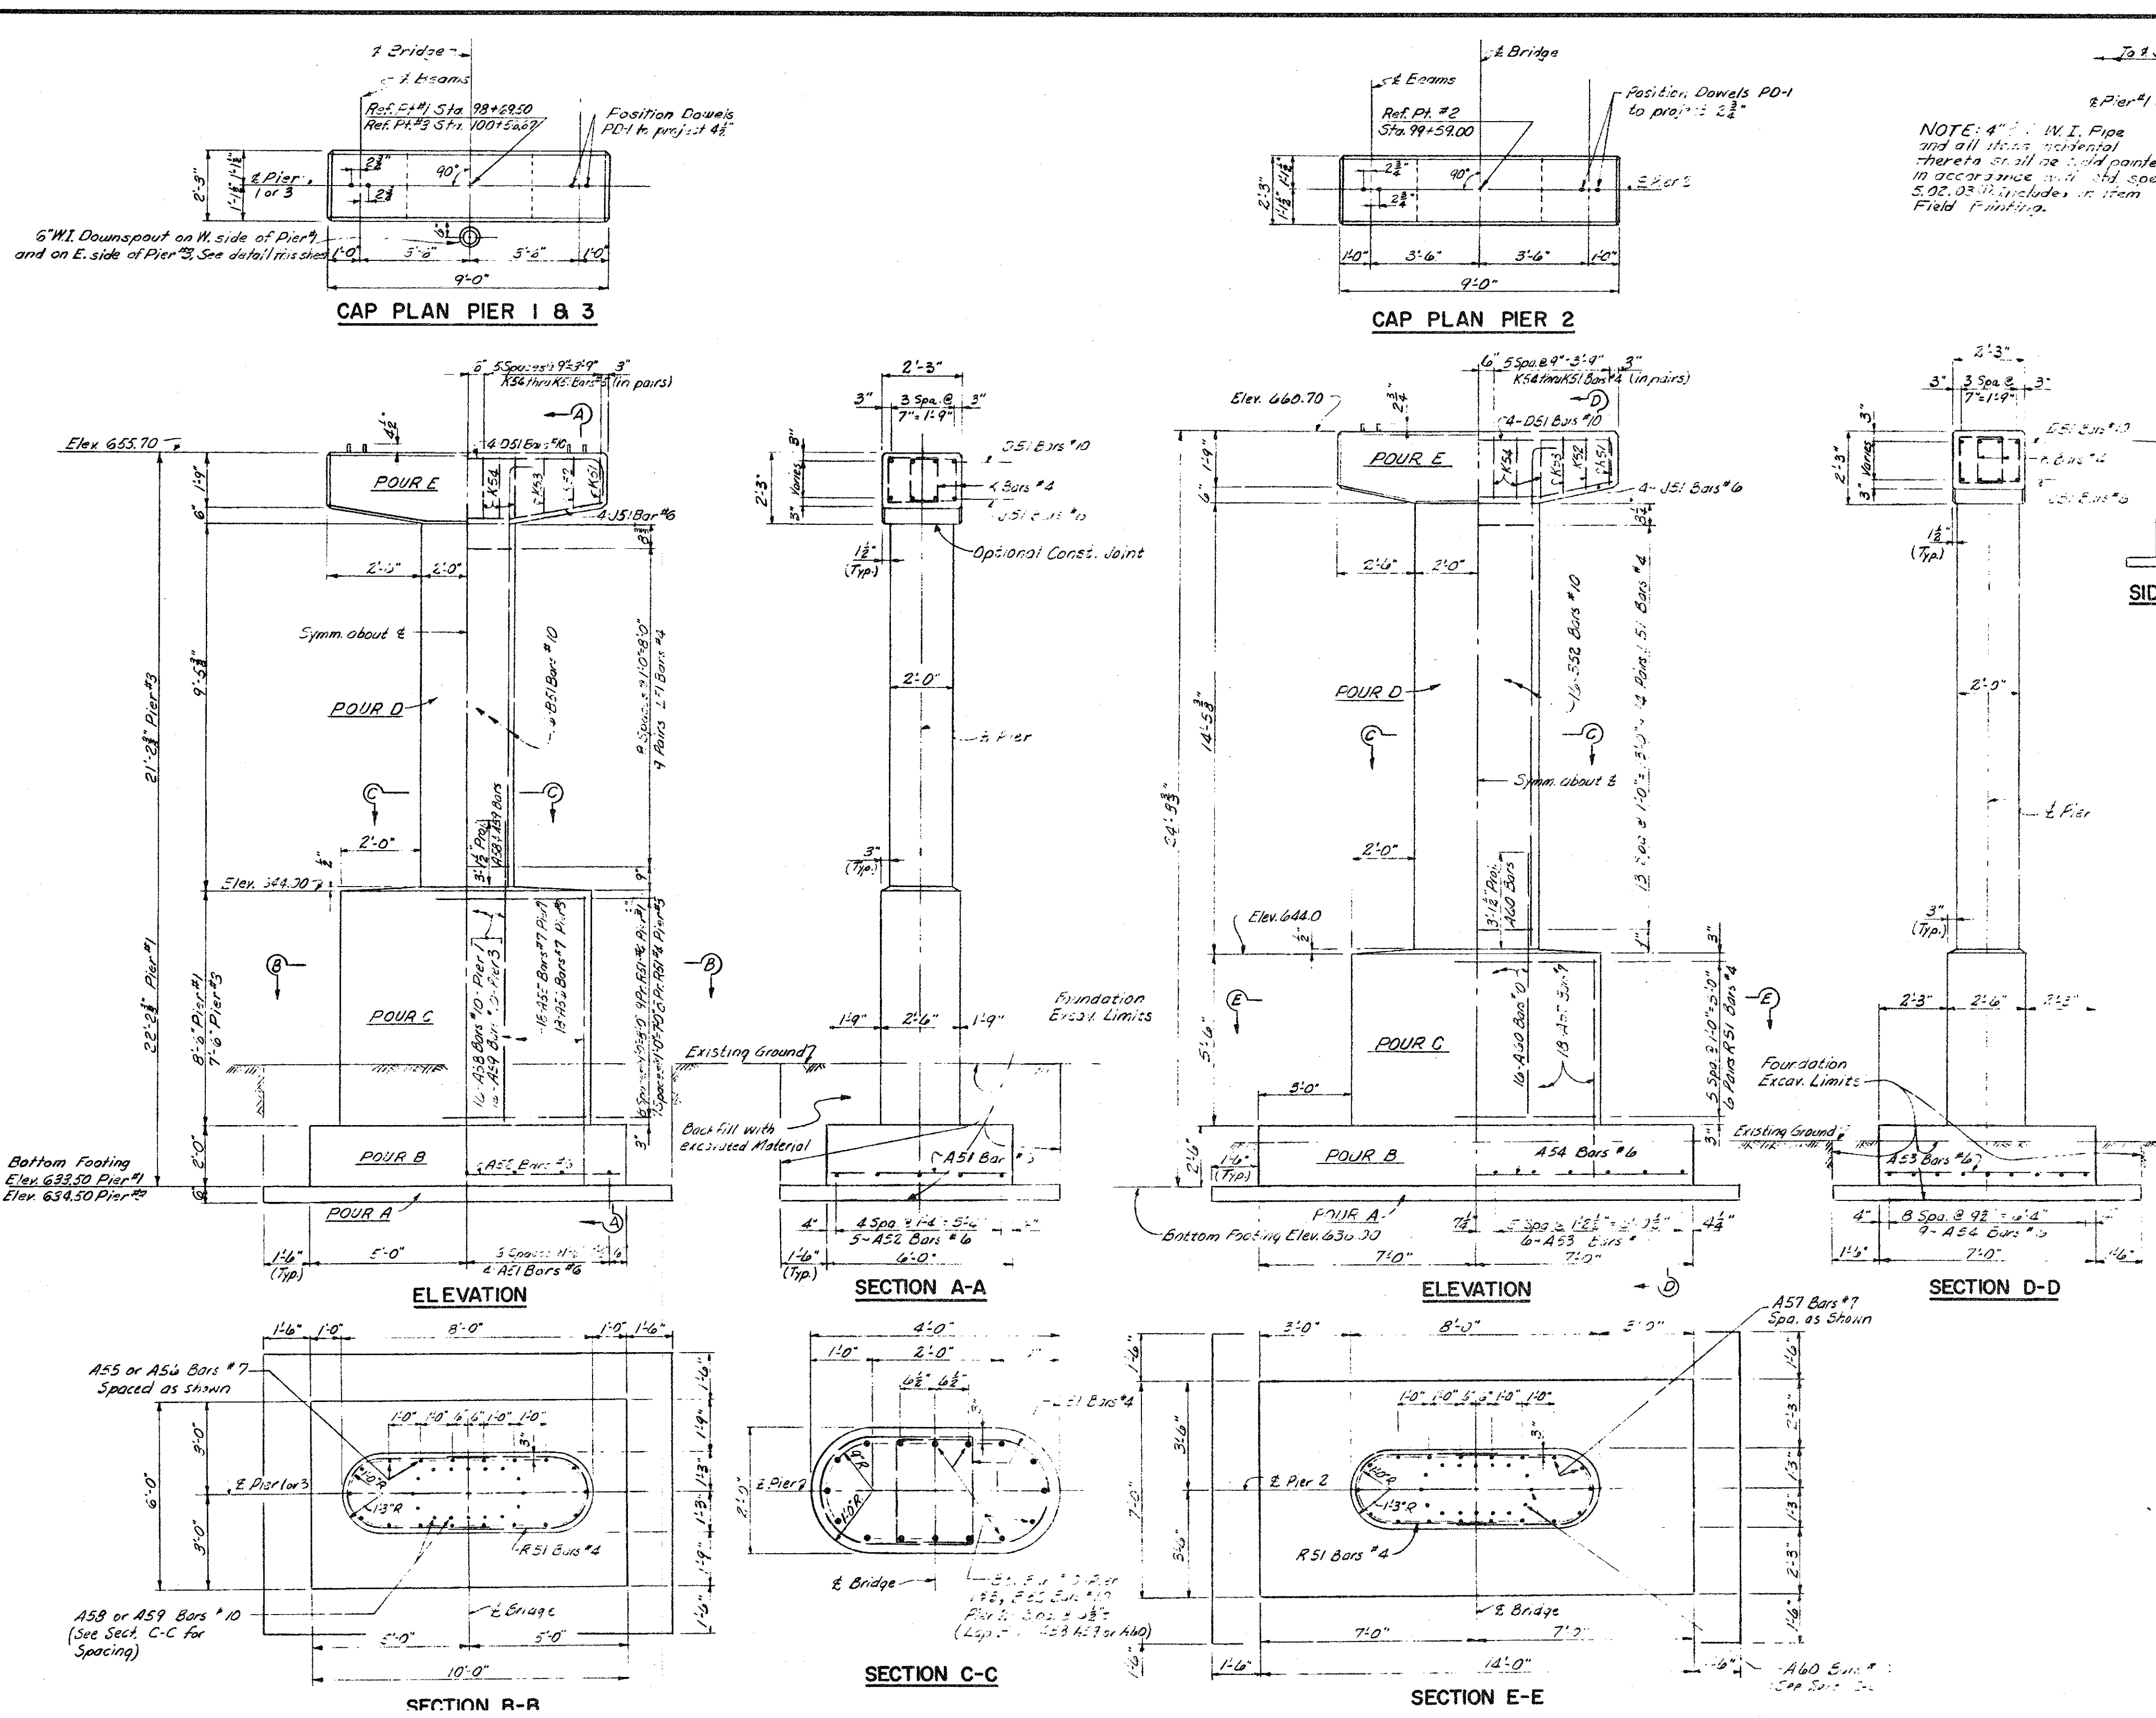

GENERAL NOTES

Top of Pier shall be finished to a true plane of elevation shown and shall not vary more than 1/8" under a 10' straight edge or more than 1/16" under any bearing.

If the contractor elects to pour column and beam monolithically, the concrete pour in the column shall be stopped at the bottom of the beam for not less than 20 minutes, and not more than 30 minutes before completing the pour.

The design is based on a maximum foundation pressure of 4750 pcf and a maximum average foundation pressure of 2450 pcf.

CONCRETE QUANTITIES - CU.YDS.						
POUR	LOCATION	GRADE	PIER 1	PIER 2	PIER 3	TOTAL
A	Sub Footing	A(6A)	2.2	3.2	2.2	7.6
B	Footing	"	4.5	9.2	4.5	18.2
C	Pedestal	A(6A)	4.0	3.8	5.2	15.0
D	Column	"	2.2	3.8	2.5	8.8
E	Pier Beam	"	1.6	1.6	4.8	28.6
			TOTAL	TOTAL	TOTAL	TOTAL
			17.0	13.0	17.0	47.0

MISCELLANEOUS QUANTITIES				
ITEM	UNIT	PIER 1	PIER 2	TOTAL
Foundation Excavation	Cu.Yds.	17.0	13.0	47.0
6" Wrought Iron Pipe	Lin. Ft.	15.0	-	15.0

Work this sheet with sheet 100.

MICHIGAN STATE HIGHWAY DEPARTMENT

BRIDGE PIER DETAILS

TECON ENGINEERS, INC.









REVISIONS			
NO.	DESCRIPTION	DATE	BY

NOTE:
DO NOT WORK FROM THIS SHEET. THE INFORMATION SHOWN HERE IS FOR REFERENCE ONLY. NO PAY ITEMS ARE SHOWN.

FOR INFORMATION ONLY				
DATE	CONT. SEC.	JOB NO.	DESIGN UNIT	SHEET
02-05-99	P01 OF 63174	48404A	MADHAVI	9 OF 16


DATE: _____ CORRECTED BY: _____ CHECKED BY: _____ DATE: _____ DRAWN BY: mander FILE NAME: p0163174sn

1 2 3 4 5 6 7 8 9 10 11 12 13 14 15 16 17 18 19 20 21 22 23 24 25 26 27 28 29 30 31 32 33 34 35 36 37 38 39 40 41 42 43 44 45 46 47 48 49 50 51 52 53 54 55 56 57 58 59 60 61 62 63

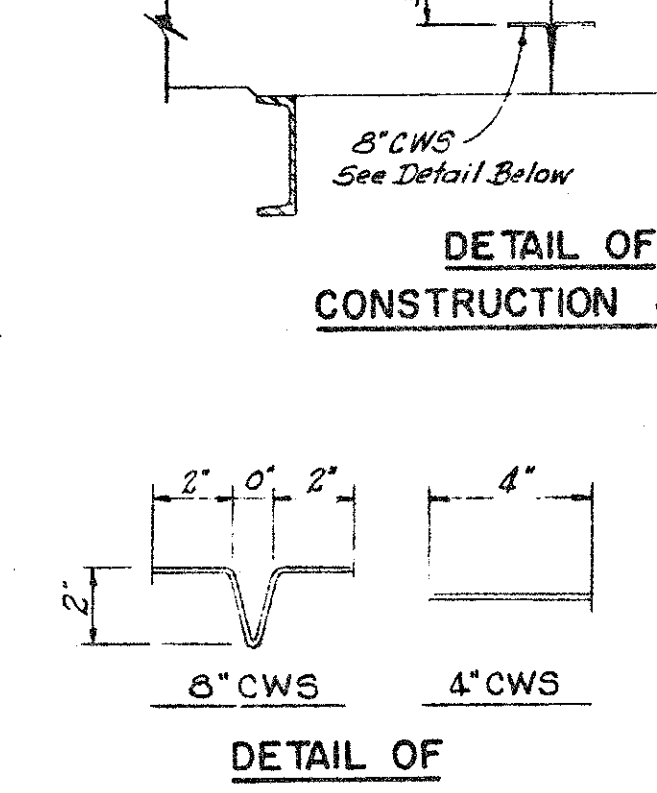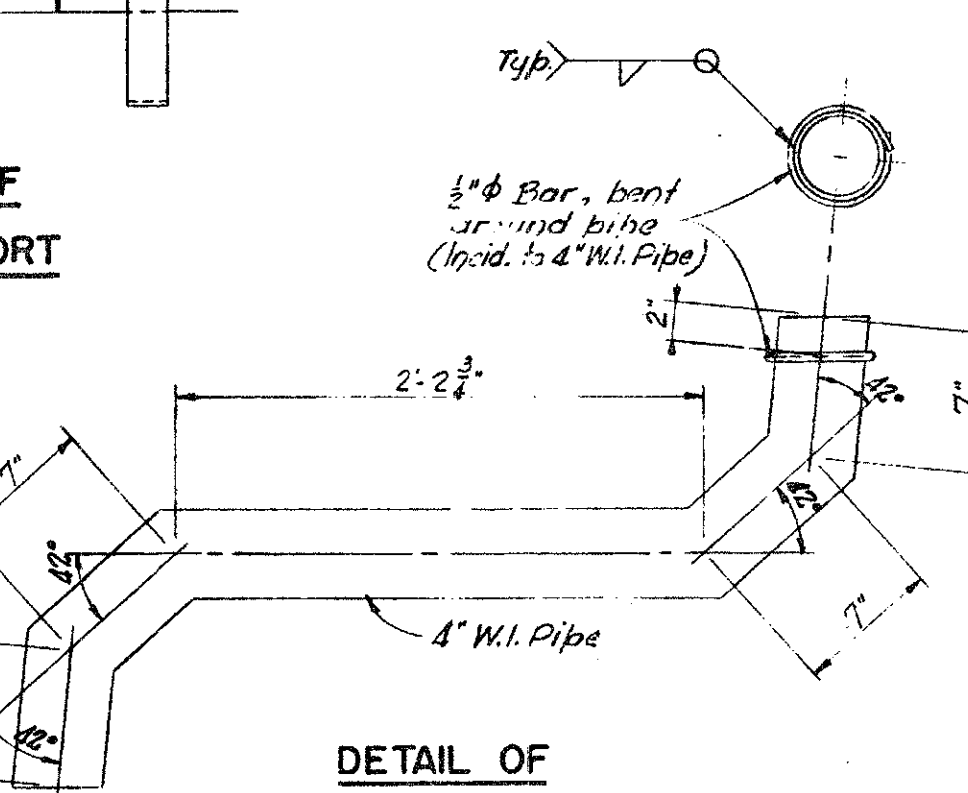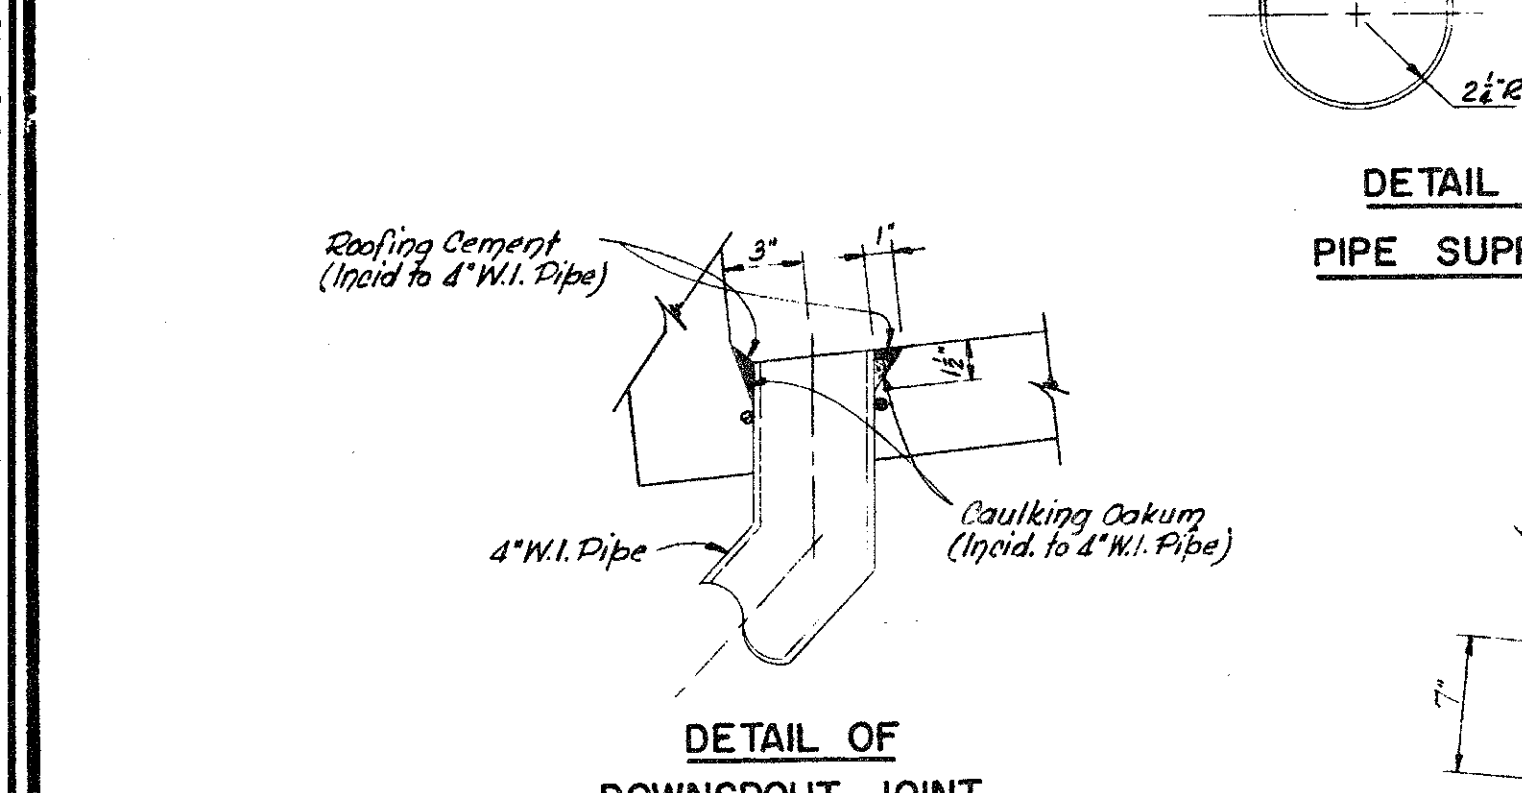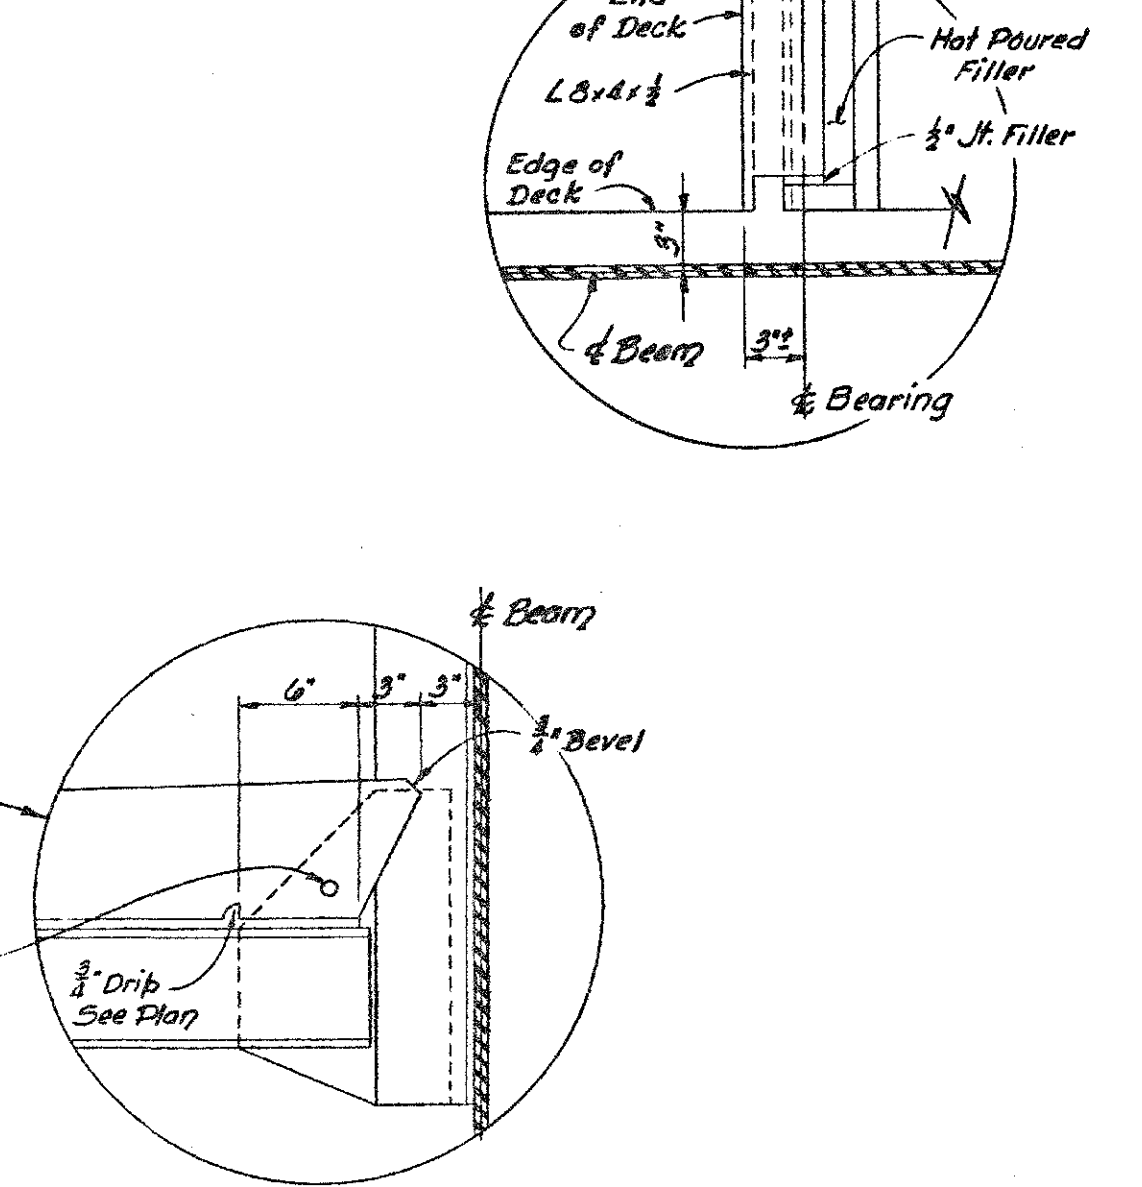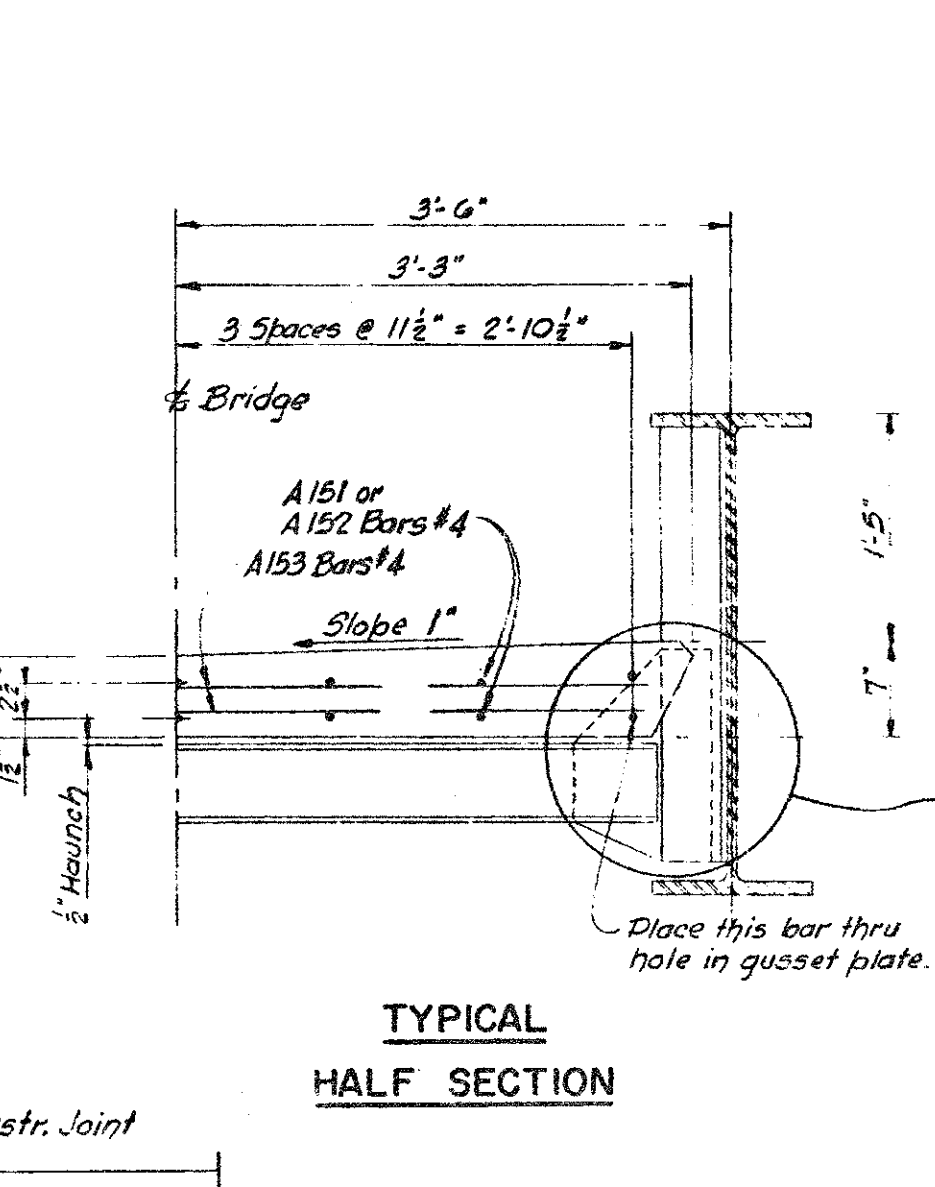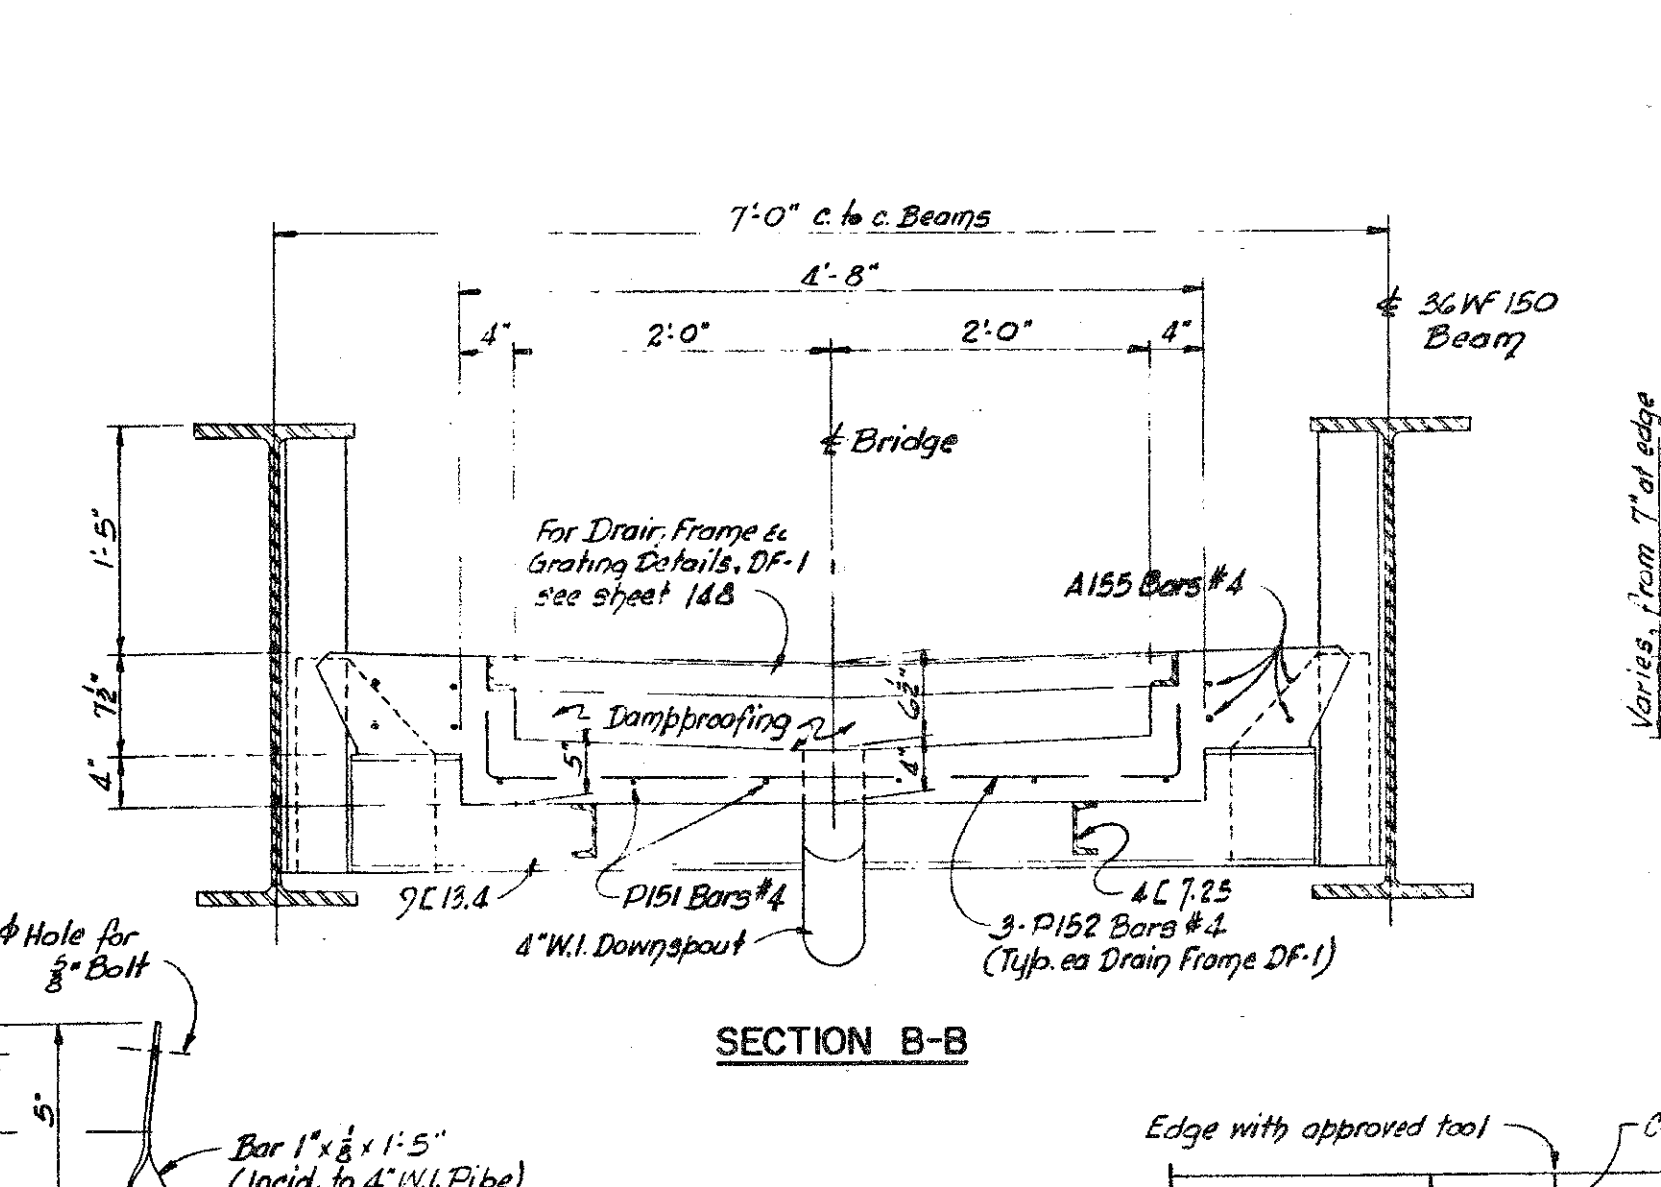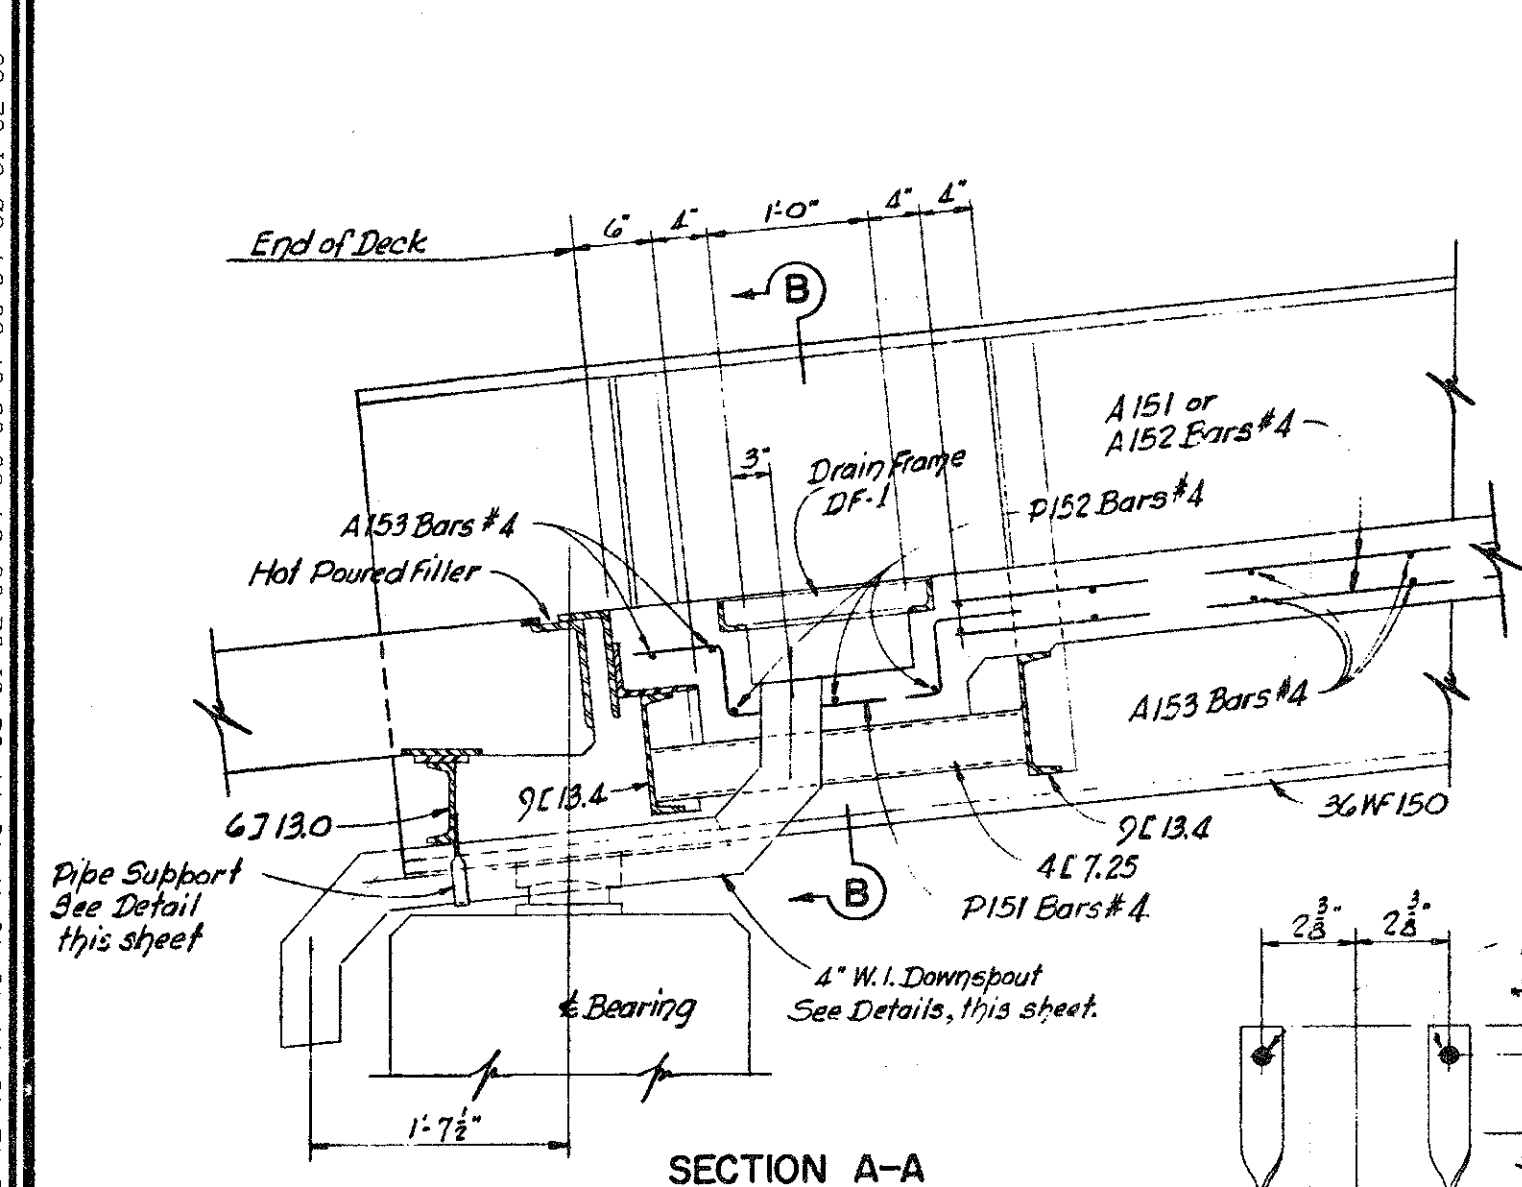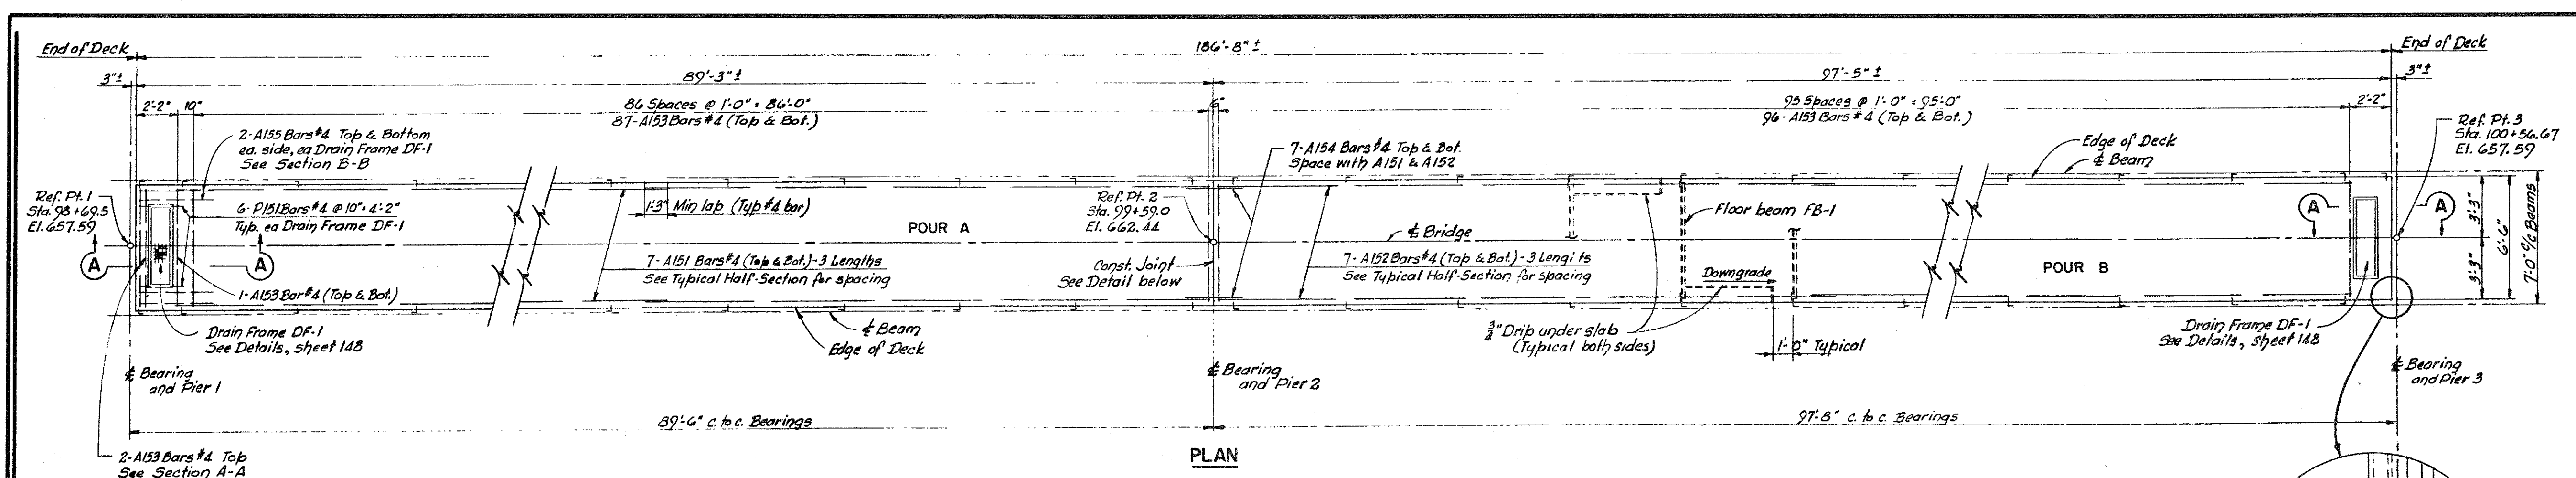

CONCRETE GRAVITY		
POUR	CU. YDS.	
A	11.5	
B	12.2	

MISCELLANEOUS QUANTITIES		
ITEM	UNIT	AMT.
4" Wrought Iron Pipe	FT.	11
Dampproofing	Sq. Ft.	15
Copper	Lbs.	2
H.R.R.A.T. Filler	Cu. Ft.	15

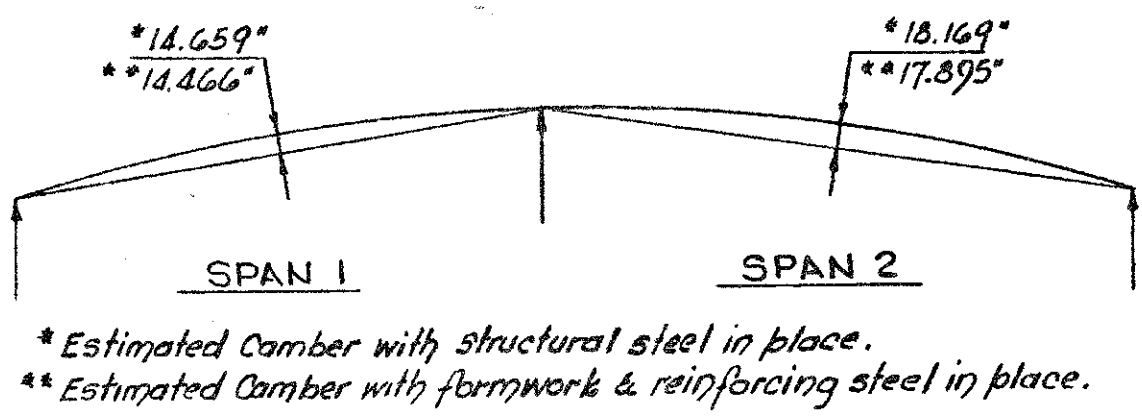

Work this sheet with sheets 149 & 150

MICHIGAN STATE HIGHWAY DEPARTMENT
BRIDGE DECK DETAILS

TECON ENGINEERS, INC.

JDC 5-76
MAC
FDN
146 5/2
POI of 63174 I

NOTE: DO NOT WORK FROM THIS SHEET. THE INFORMATION SHOWN HERE IS FOR REFERENCE ONLY. NO PAY ITEMS ARE SHOWN.


FOR INFORMATION ONLY				
DATE	CONT. SEC.	JOB NO.	DESIGN UNIT	SHEET
02-05-99	P01 OF 63174	48404A	MADHAVI	10 OF 16



REVISIONS			
NO.	DESCRIPTION	DATE	BY

FILE NAME: p0163174gn DRAWN BY: mader CHECKED BY: DATE: CORRECTED BY: DATE:

1 2 3 4 5 6 7 8 9 10 11 12 13 14 15 16 17 18 19 20 21 22 23 24 25 26 27 28 29 30 31 32 33 34 35 36 37 38 39 40 41 42 43 44 45 46 47 48 49 50 51 52 53 54 55 56 57 58 59 60 61 62 63

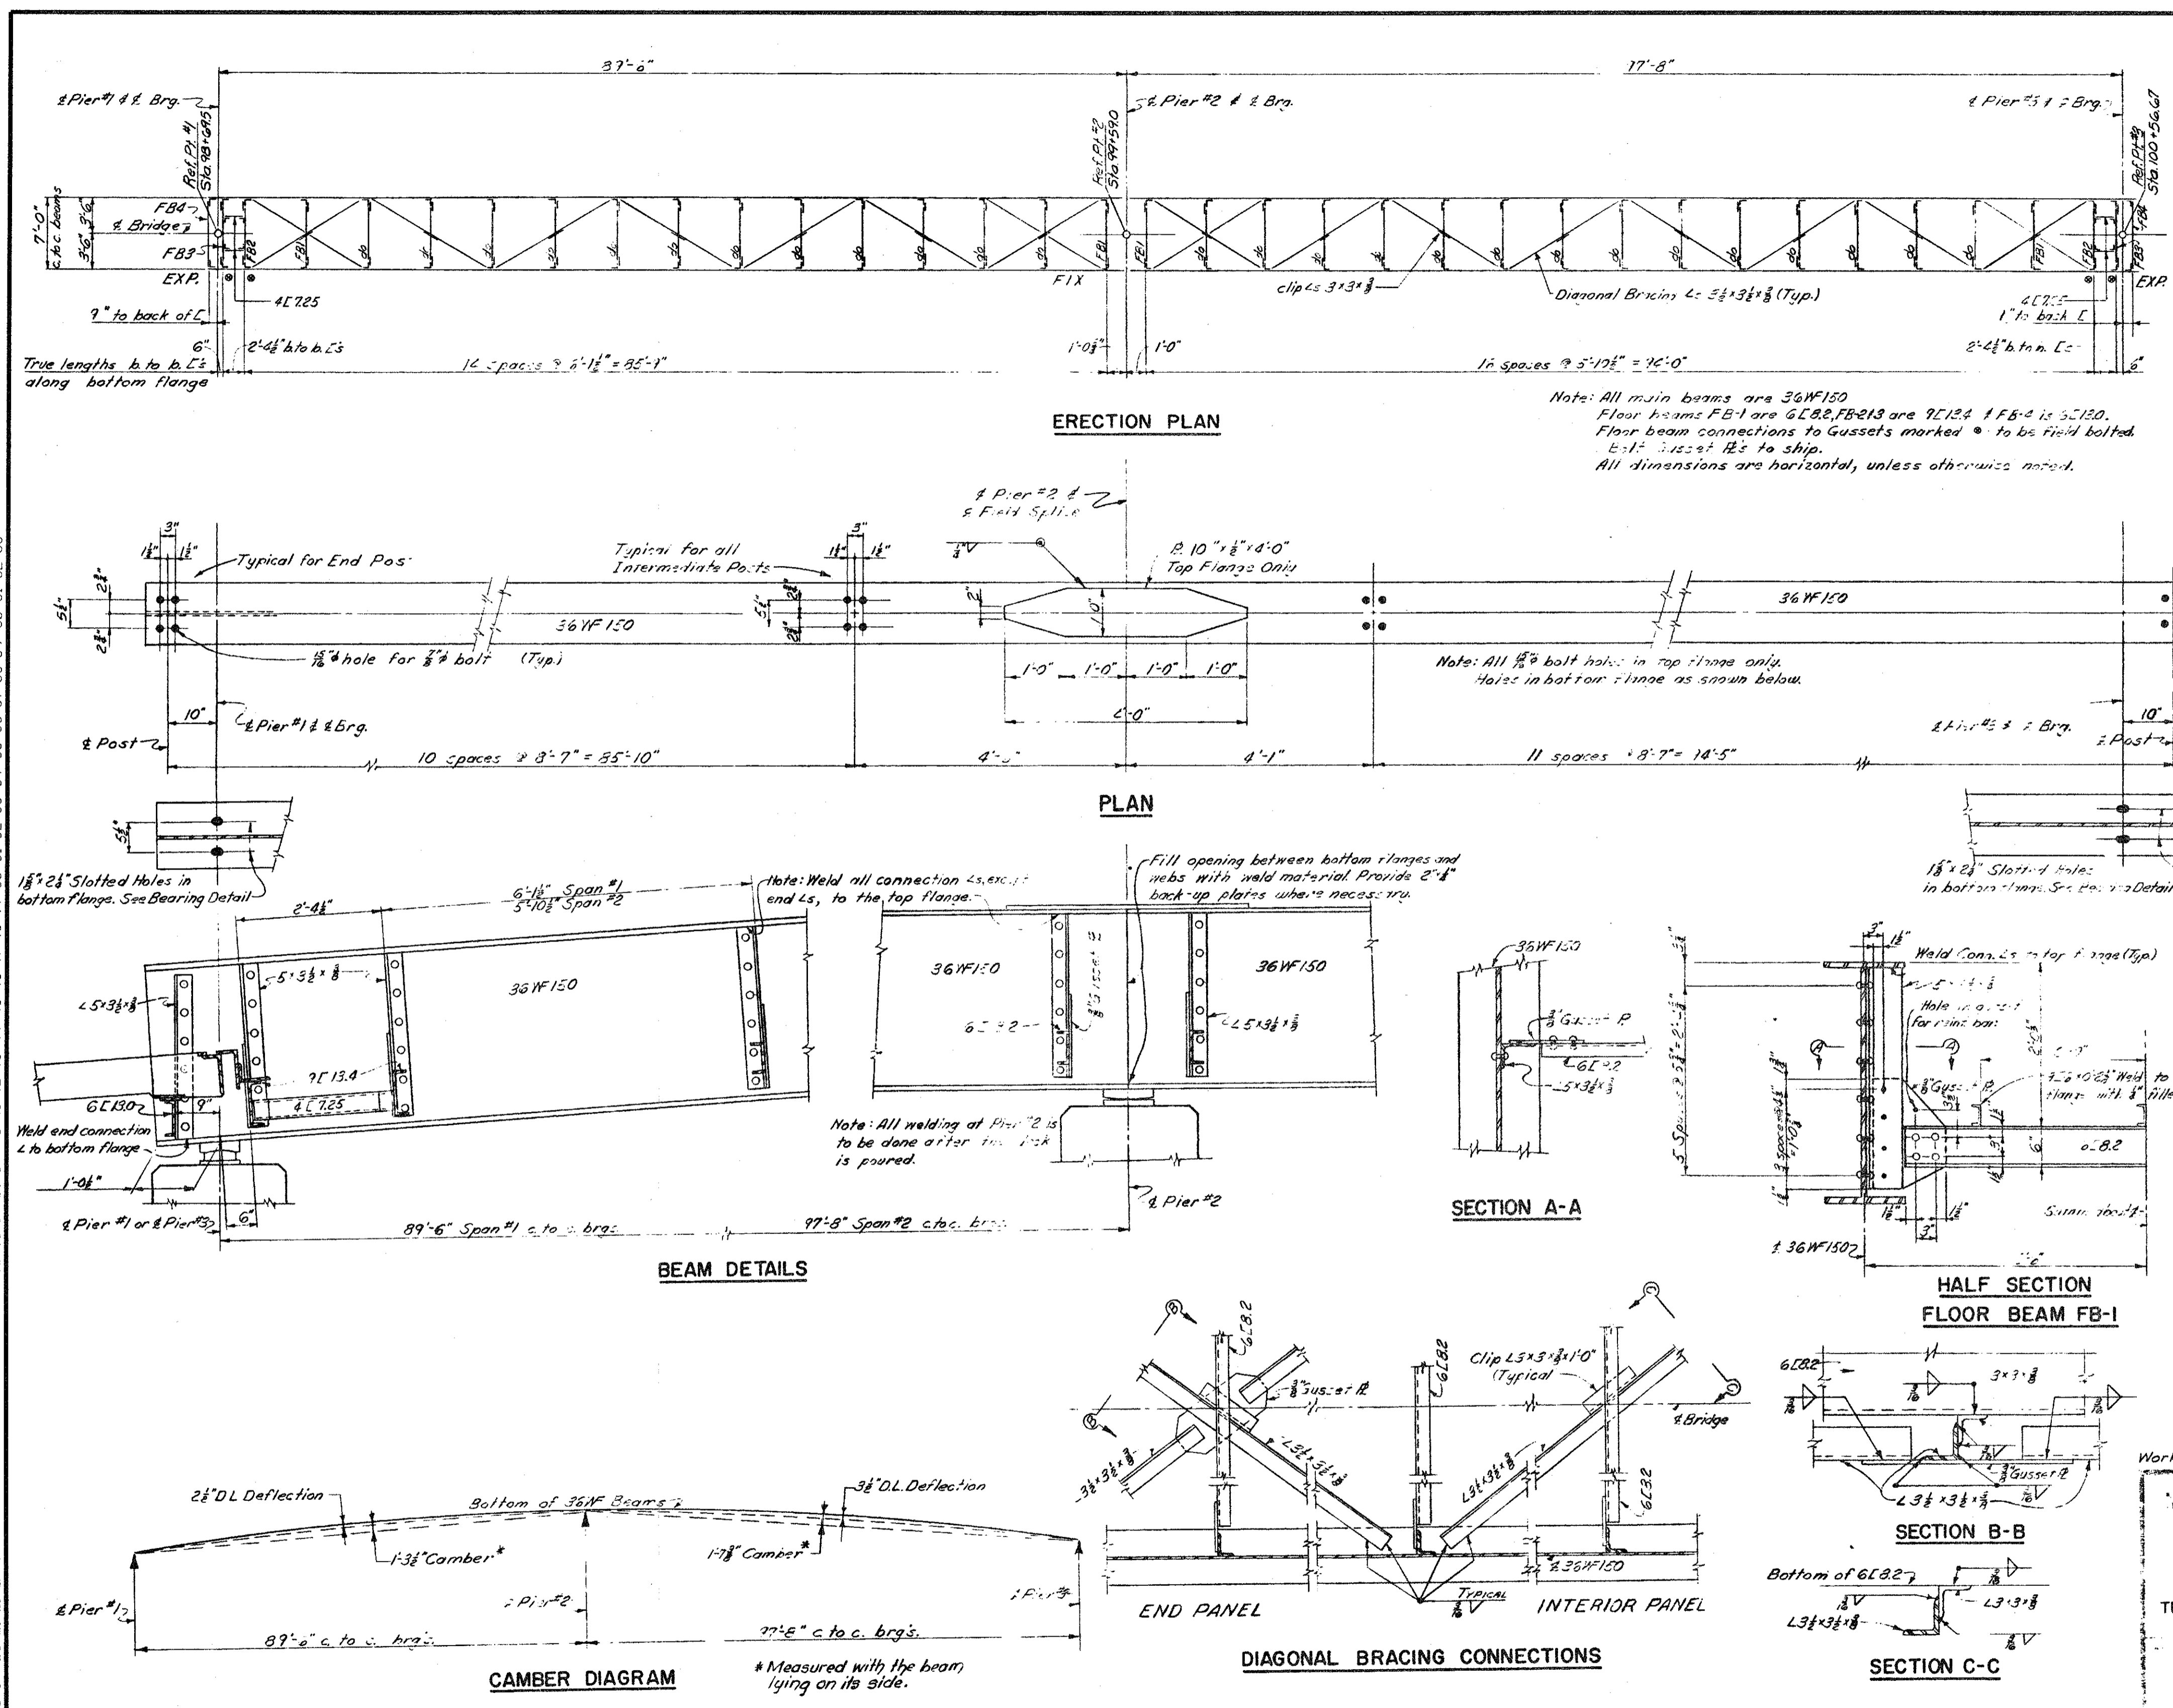

STRUCTURAL STEEL NOTES

FABRICATION: Michigan State Highway Department's Standard Specifications for Road and Bridge Construction - 1960 Edition.

DESIGN: Michigan State Highway Department's Specifications for Design of Highway Bridges - 1958 Edition. Live Load for main steel beams - 60 k/ft and for floor beams - 85 k/ft.

SHOP CONNECTIONS: All shop connections to be welded or riveted as shown on the plans.

FIELD CONNECTIONS: Field connections shall be bolted with high strength bolts except the sole plates, splices and diagonal bracing shall be welded. Where high strength bolts are used for field connections, contact surfaces shall be thoroughly cleaned immediately prior to assembly of the joint.

RIVETS OR HIGH STRENGTH BOLTS: 3/4"

OPEN HOLES: Open holes for rivets or high strength bolts shall be 1/8" unless otherwise noted.

SHOP PAINT: In addition to the shop paint provisions of the Standard Specifications, the finished surfaces of the sole plates and masonry plates shall be coated in accordance with the requirements for machine finished surfaces. The top surfaces of all floor beams and surfaces to be field welded shall receive one coat of boiled linseed oil only. Metal expansion joints shall be painted as noted on the plans.

CAMBER: The WF beams shall be cambered 1-3/8" in Span 1 and cambered 1-7/8" in Span 2 as shown on the Camber Diagram, this sheet. The camber is to be measured with the beam lying on its side. The allowable tolerance is $\pm 1/8"$. Where necessary, heat is to be applied to assure permanency of camber and camber within the required tolerances.

GALVANIZING: Floor Drain Frames shall be galvanized in accordance with current A.S.T.M. Specification Designation A123.

MATERIAL: The main beams and splices shall conform to the requirements for weldable steel (A.S.T.M.-A313). All other steel shall be A.S.T.M.-A7. Self lubricating plates shall be "Lubrite" or equal. Where wrought iron materials are called for on the plans, corrosion resistant, low alloy steels such as "Austenitic", "Mayari-12", "Yaloy" and "Hi-steel" may be substituted.

QUANTITIES: The quantity Structural Steel - Furnishing & Fabricating includes:
 9920 # (Includes drains & Exp. devices)
 A7 Steel 57055
 Lubrite 125 (or equal) 125
 Total 67100 # Structural Steel - Furnish & Fab.
 Total 67100 # Structural Steel - Erection
 Field Painting - Lump Sum

Mark	No.	Description
BI	92	6" x 2" Angle - SOUTH H.H.N.L.E
AB-1	168	Lock Washers - all Galv.
DB-1	12	1/4" Plain End x 1'-4" long.

FIELD PAINTING: Includes painting of 4" and 6" W.I. pipe. See sheets 145 & 146.

Work this sheet with sheet 148.

MICHIGAN STATE HIGHWAY DEPARTMENT
STRUCTURAL STEEL DETAILS

TECON ENGINEERS, INC.
 JDC 5-7-62
 MMW
 M.A.C. 4-28-62
 147 312
POI OF 63174 I


NOTE:
 DO NOT WORK FROM THIS SHEET. THE INFORMATION SHOWN
 HERE IS FOR REFERENCE ONLY. NO PAY ITEMS ARE SHOWN.

DATE	CONT. SEC.	JOB NO.	DESIGN UNIT	SHEET
02-05-99	P01 OF 63174	48404A	MADHAVI	11 OF 16




DATE: _____ CORRECTED BY: _____ DATE: _____ CHECKED BY: _____ DATE: _____ DRAWN BY: indr FILE NAME: p0163174.snr


REVISIONS			
NO.	DESCRIPTION	DATE	BY

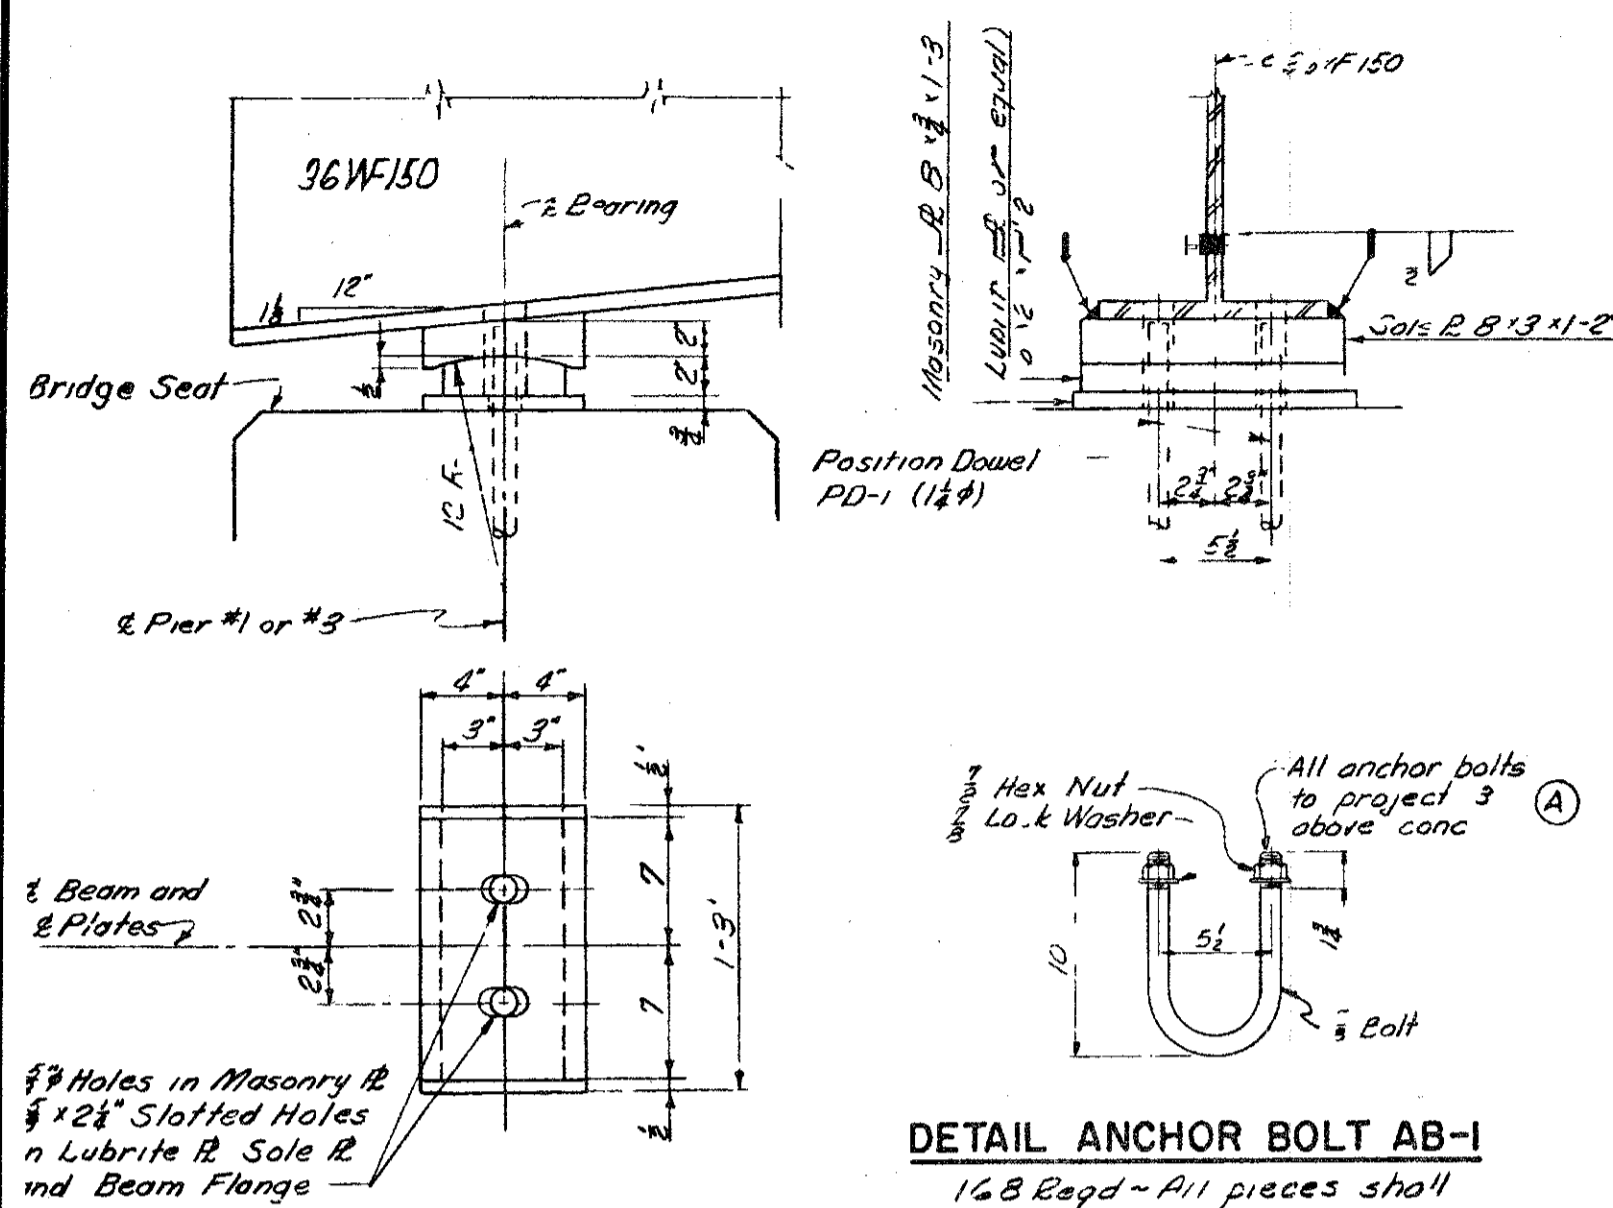


PIER 1 & 3 BEARING DETAILS

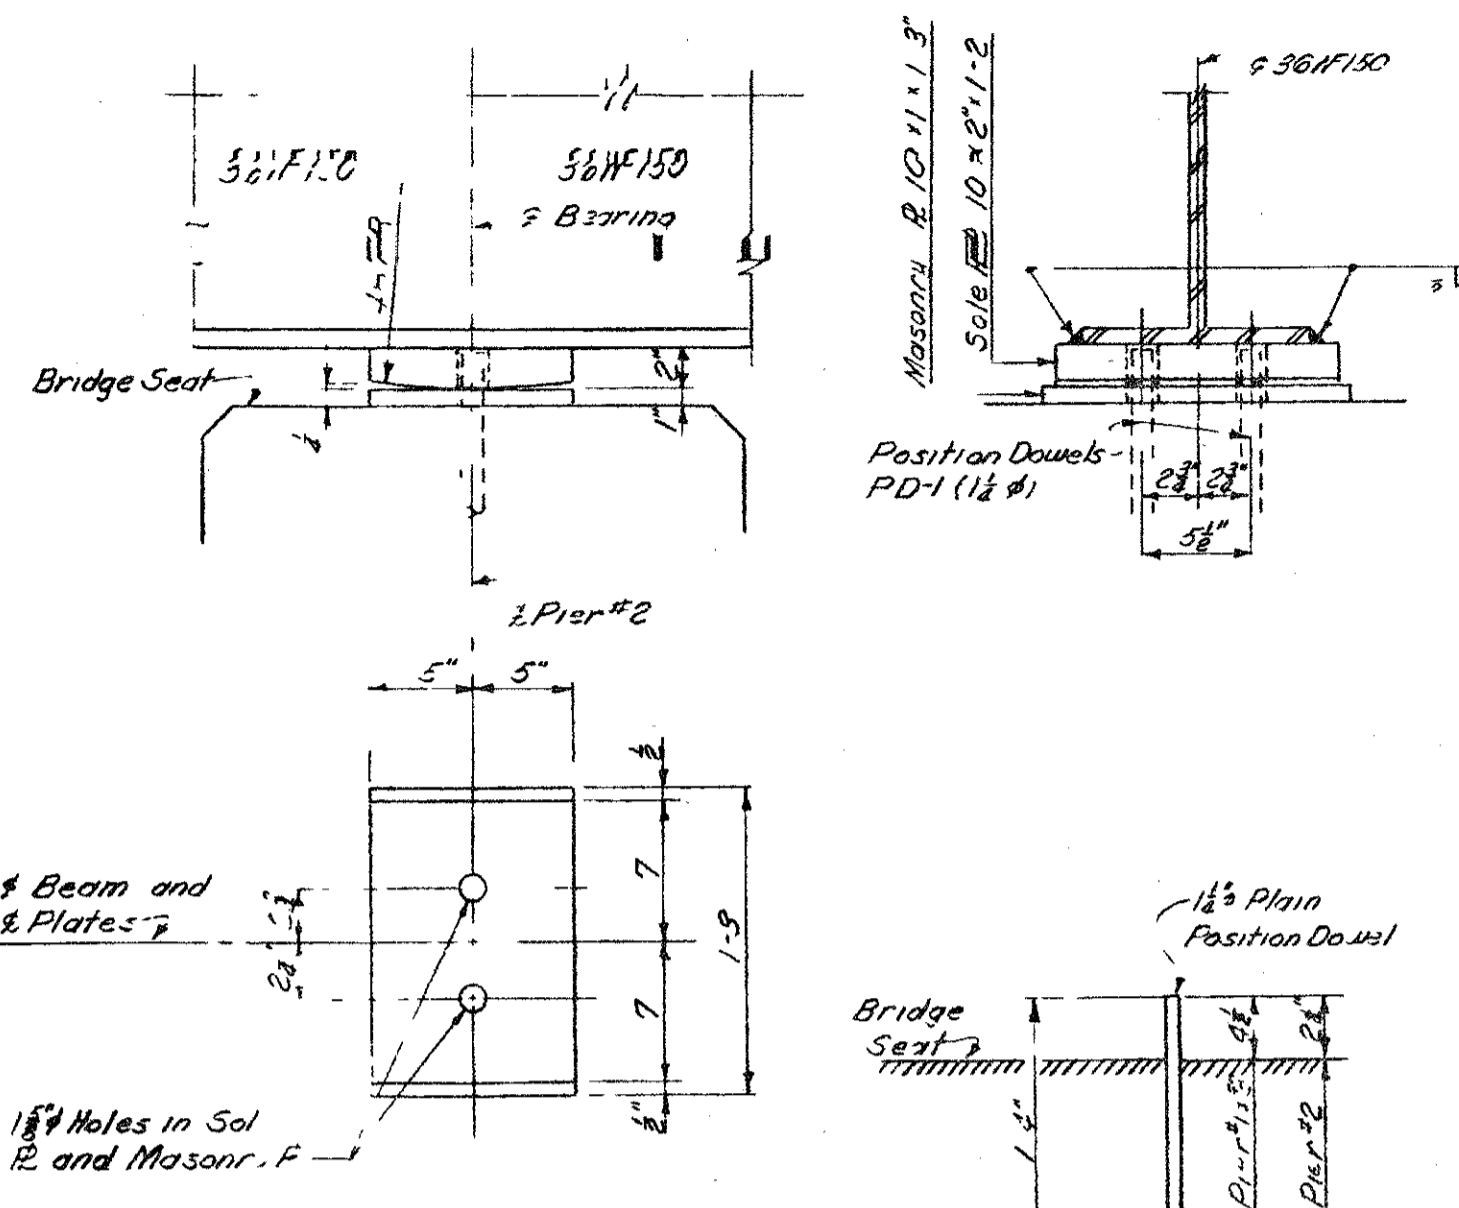


PIER 2 BEARING DETAILS

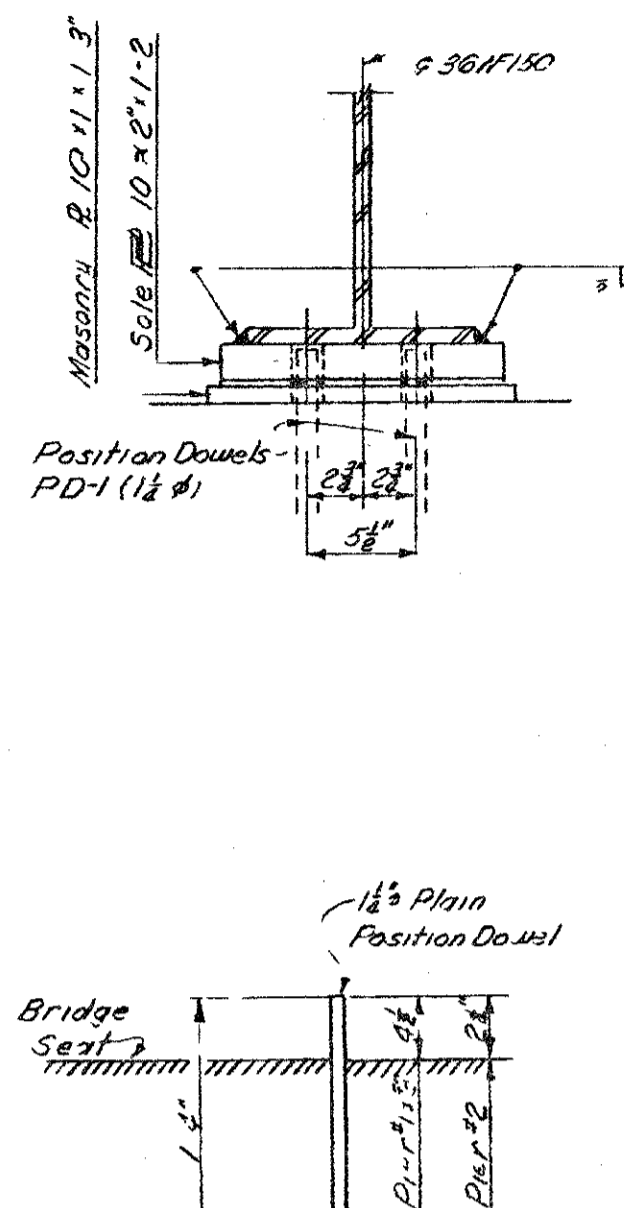


DETAIL POSITION DOWEL PD-1

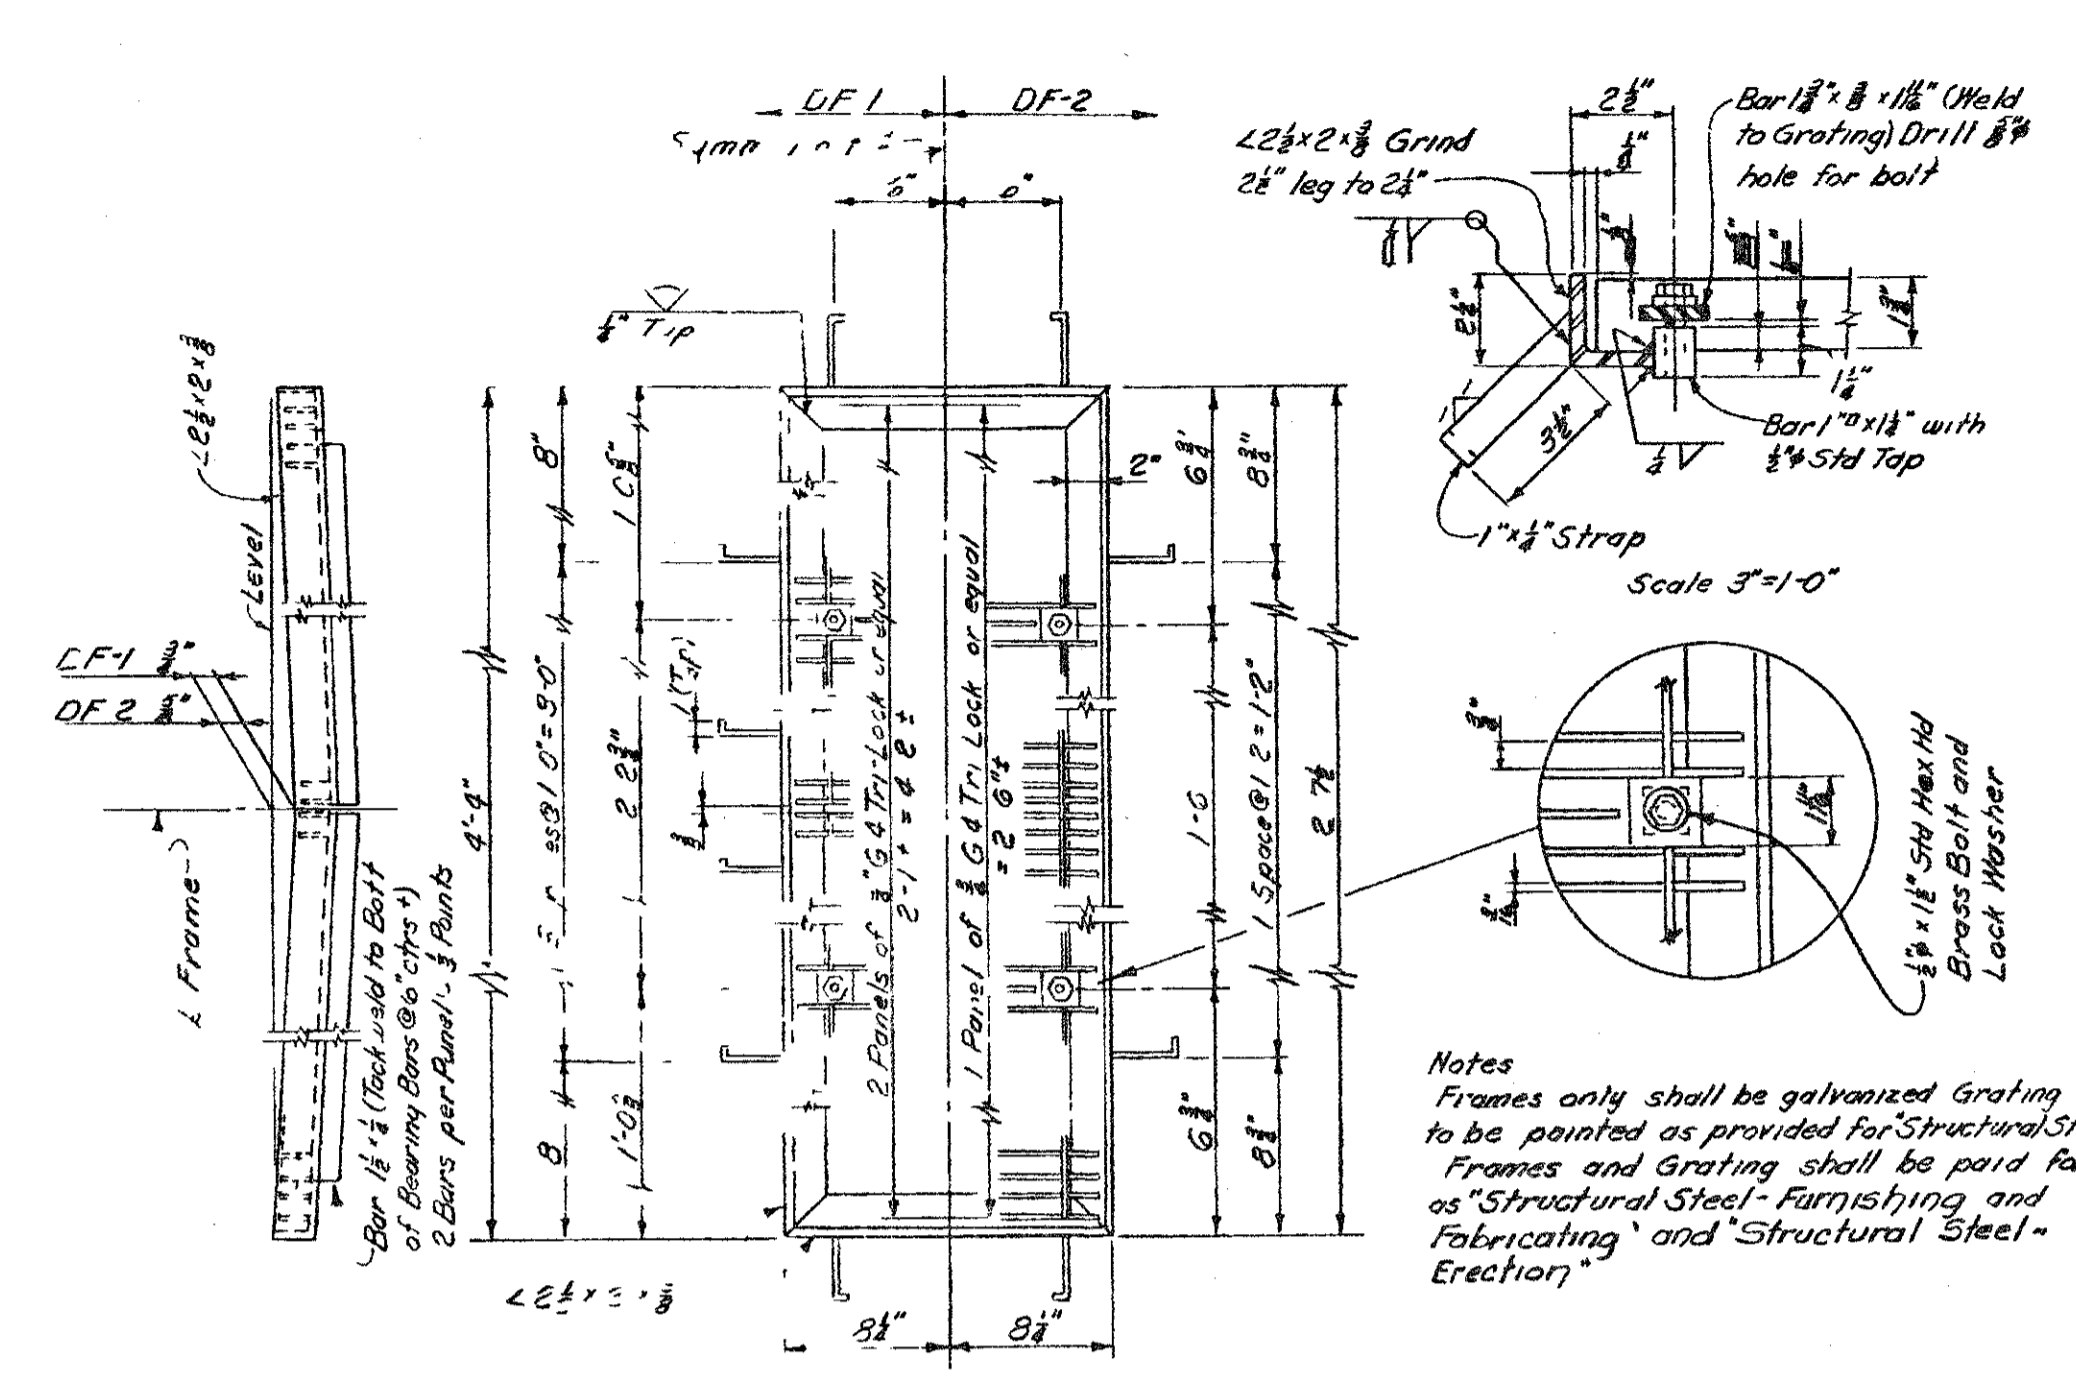


DRAIN FRAME & GRATING DETAILS

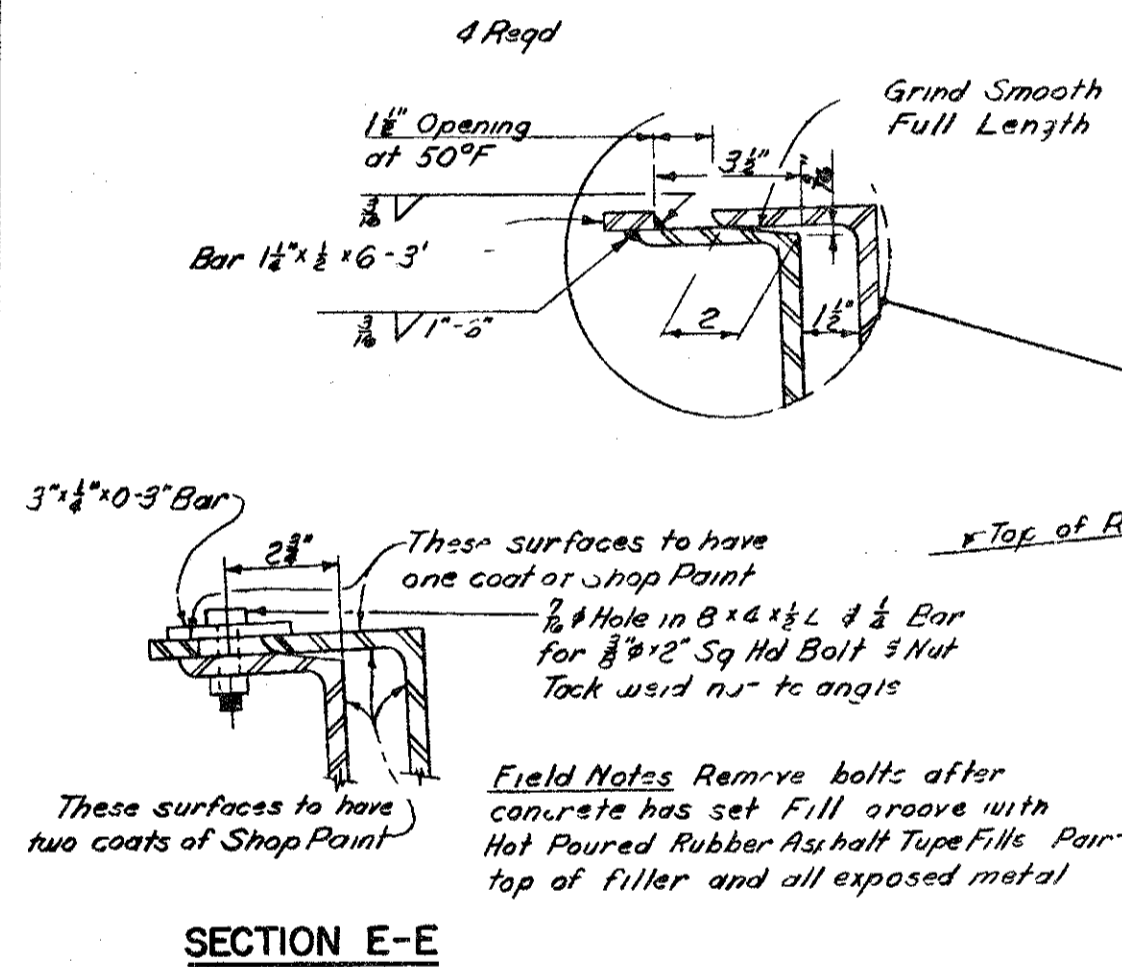


SECTION E-E

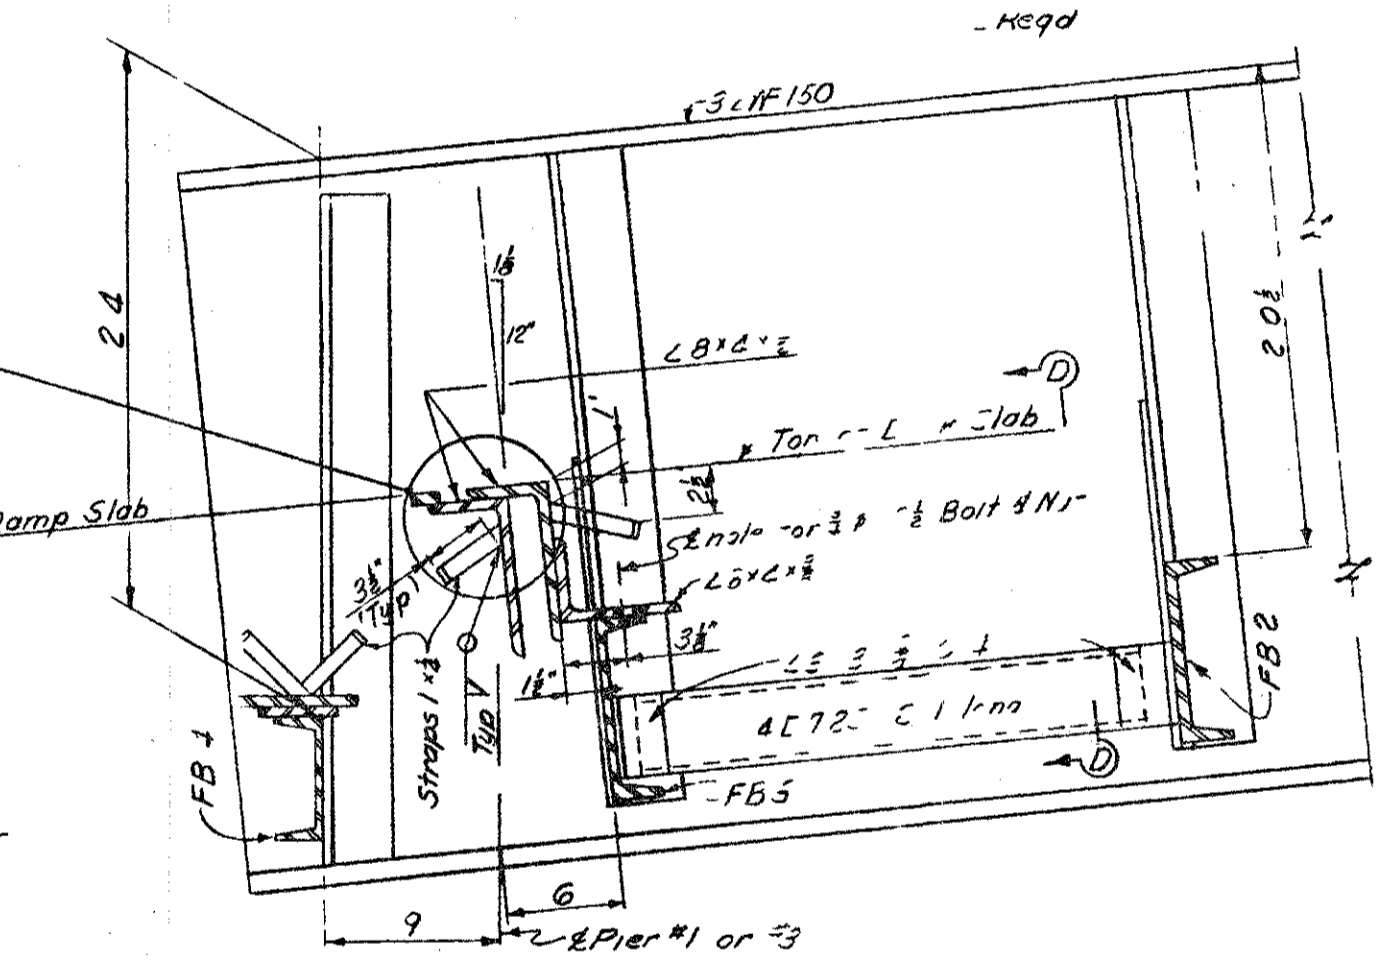


DETAILS AT EXPANSION JOINTS

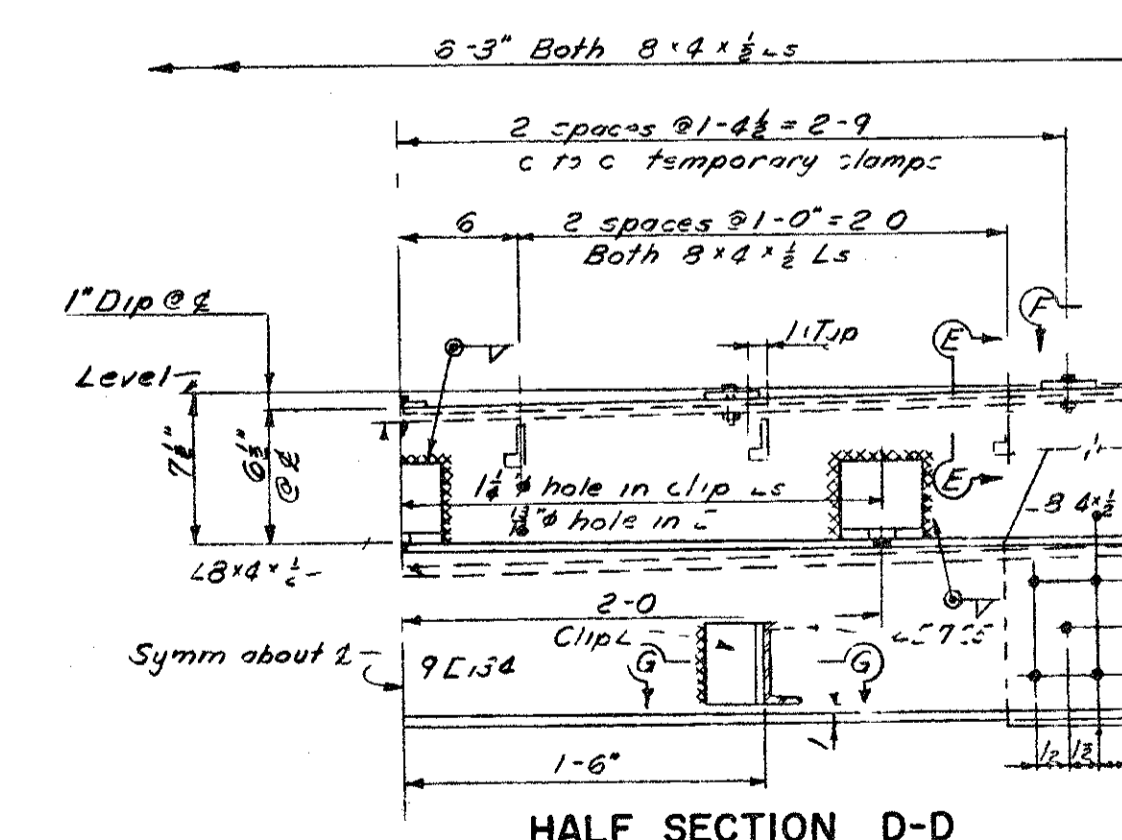


HALF SECTION D-D

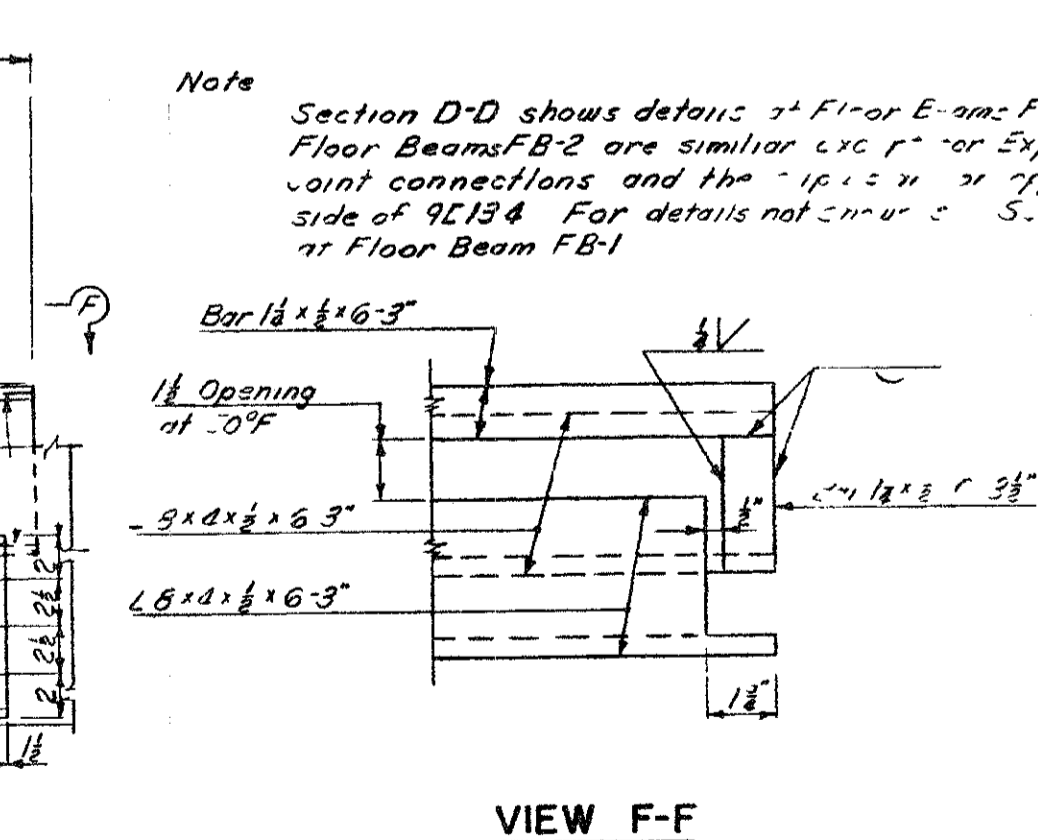


VIEW F-F

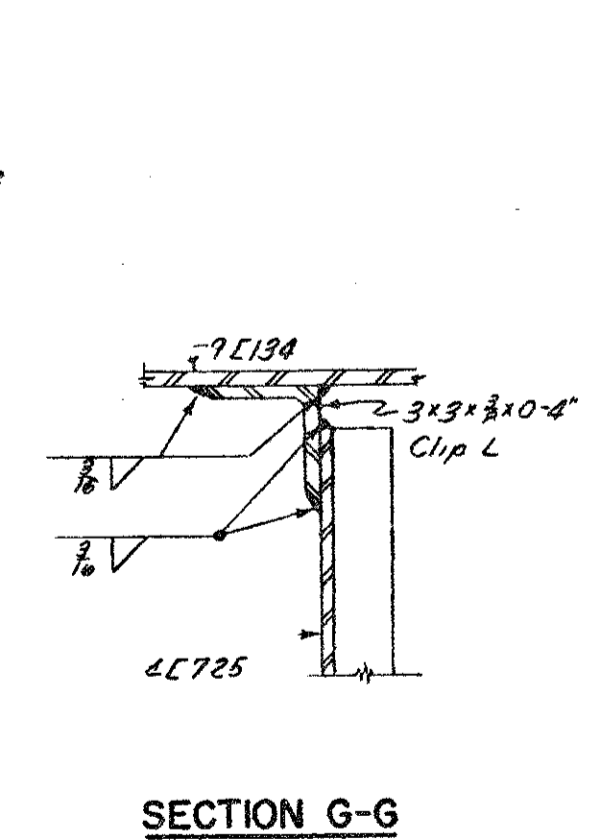


SECTION G-G

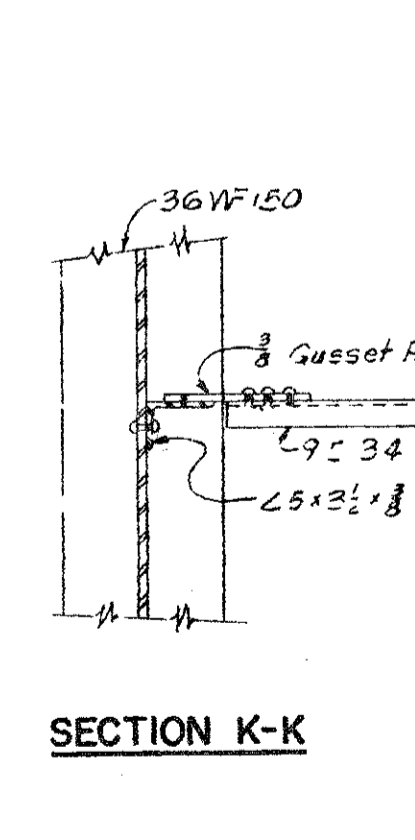


SECTION K-K

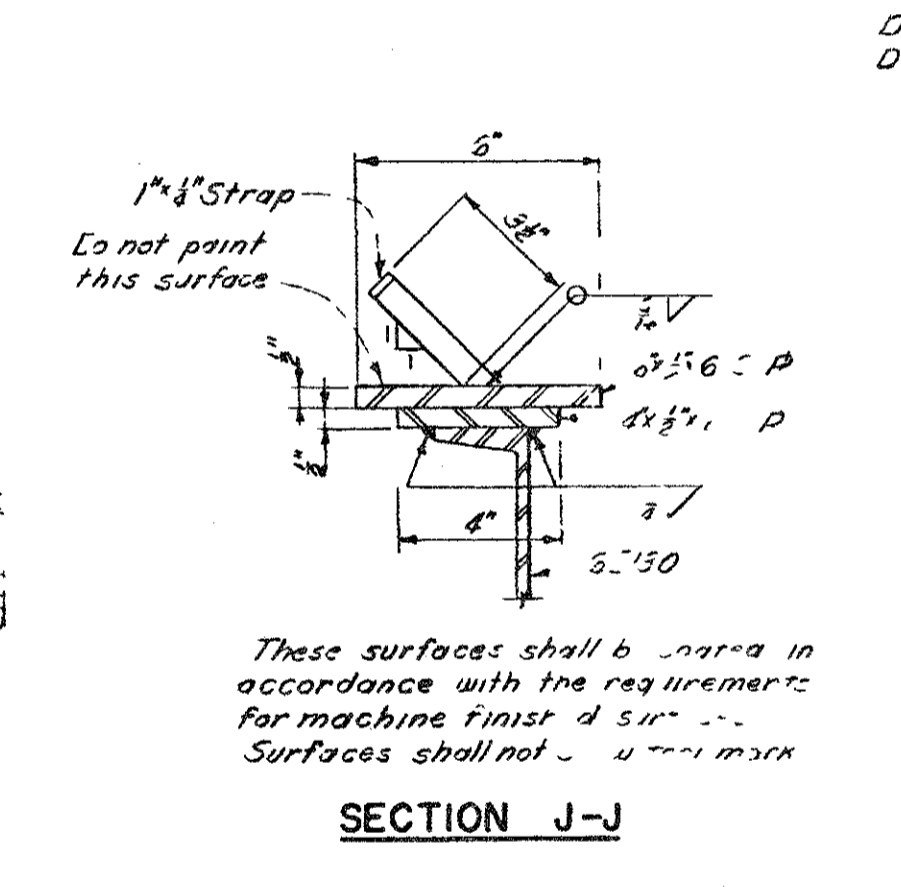

SECTION J-J

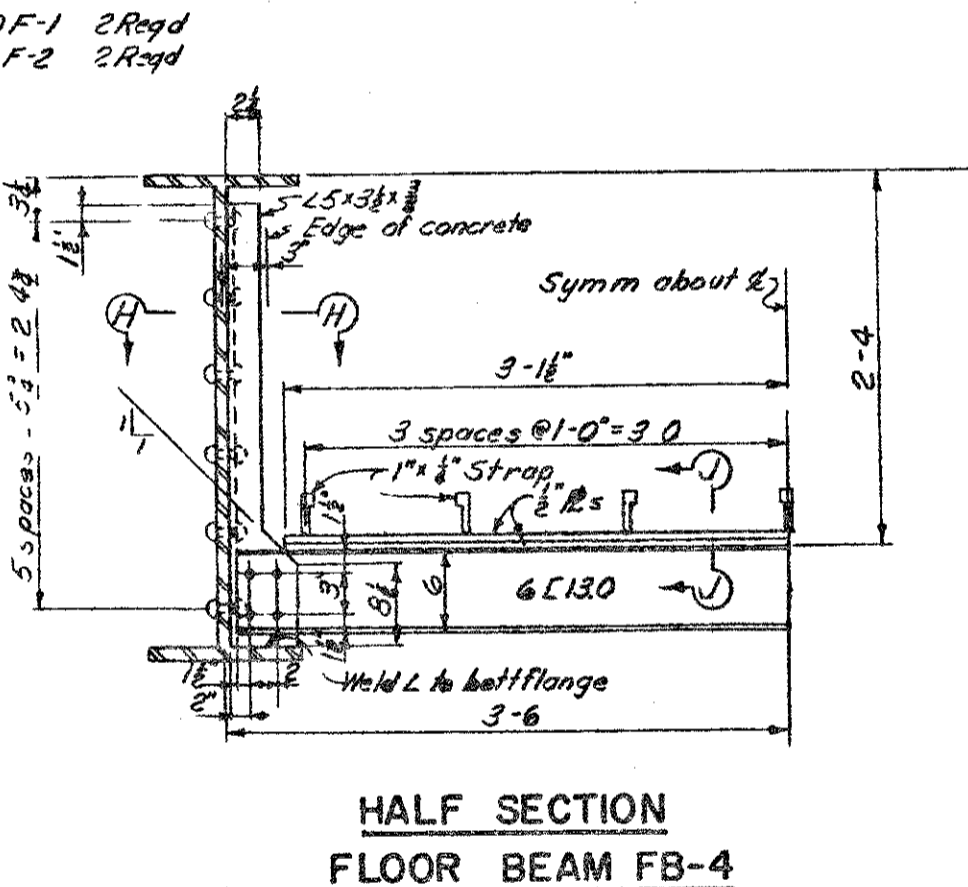

HALF SECTION FLOOR BEAM FB-4

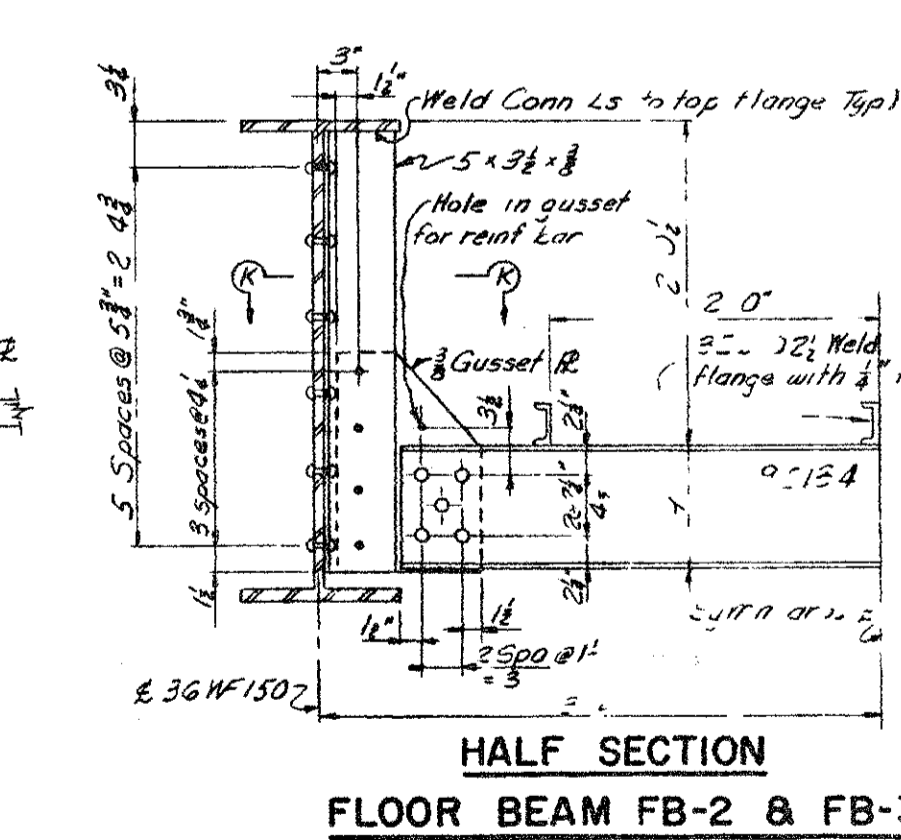

HALF SECTION FLOOR BEAM FB-2 & FB-3

MICHIGAN STATE HIGHWAY
STRUCTURAL STEEL DETAILS

TECON ENGINEERS, INC
JDC 57-6V
MMW
MAC 47462
148-312
POI OF 63174 I

Work this sheet with sheet 147

A Revised anchor bolt projection of 30 to 40

NOTE:
DO NOT WORK FROM THIS SHEET. THE INFORMATION SHOWN
HERE IS FOR REFERENCE ONLY. NO PAY ITEMS ARE SHOWN.

FOR INFORMATION ONLY







DATE	CONT. SEC.	JOB NO.	DESIGN UNIT	SHEET
02-05-99	P01 OF 63174	48404A	MADHAVI	12 OF 16

DRAWN BY: inder CHECKED BY: DATE: CORRECTED BY: DATE:

1 2 3 4 5 6 7 8 9 10 11 12 13 14 15 16 17 18 19 20 21 22 23 24 25 26 27 28 29 30 31 32 33 34 35 36 37 38 39 40 41 42 43 44 45 46 47 48 49 50 51 52 53 54 55 56 57 58 59 60 61 62 63

REVISIONS			
NO.	DESCRIPTION	DATE	BY

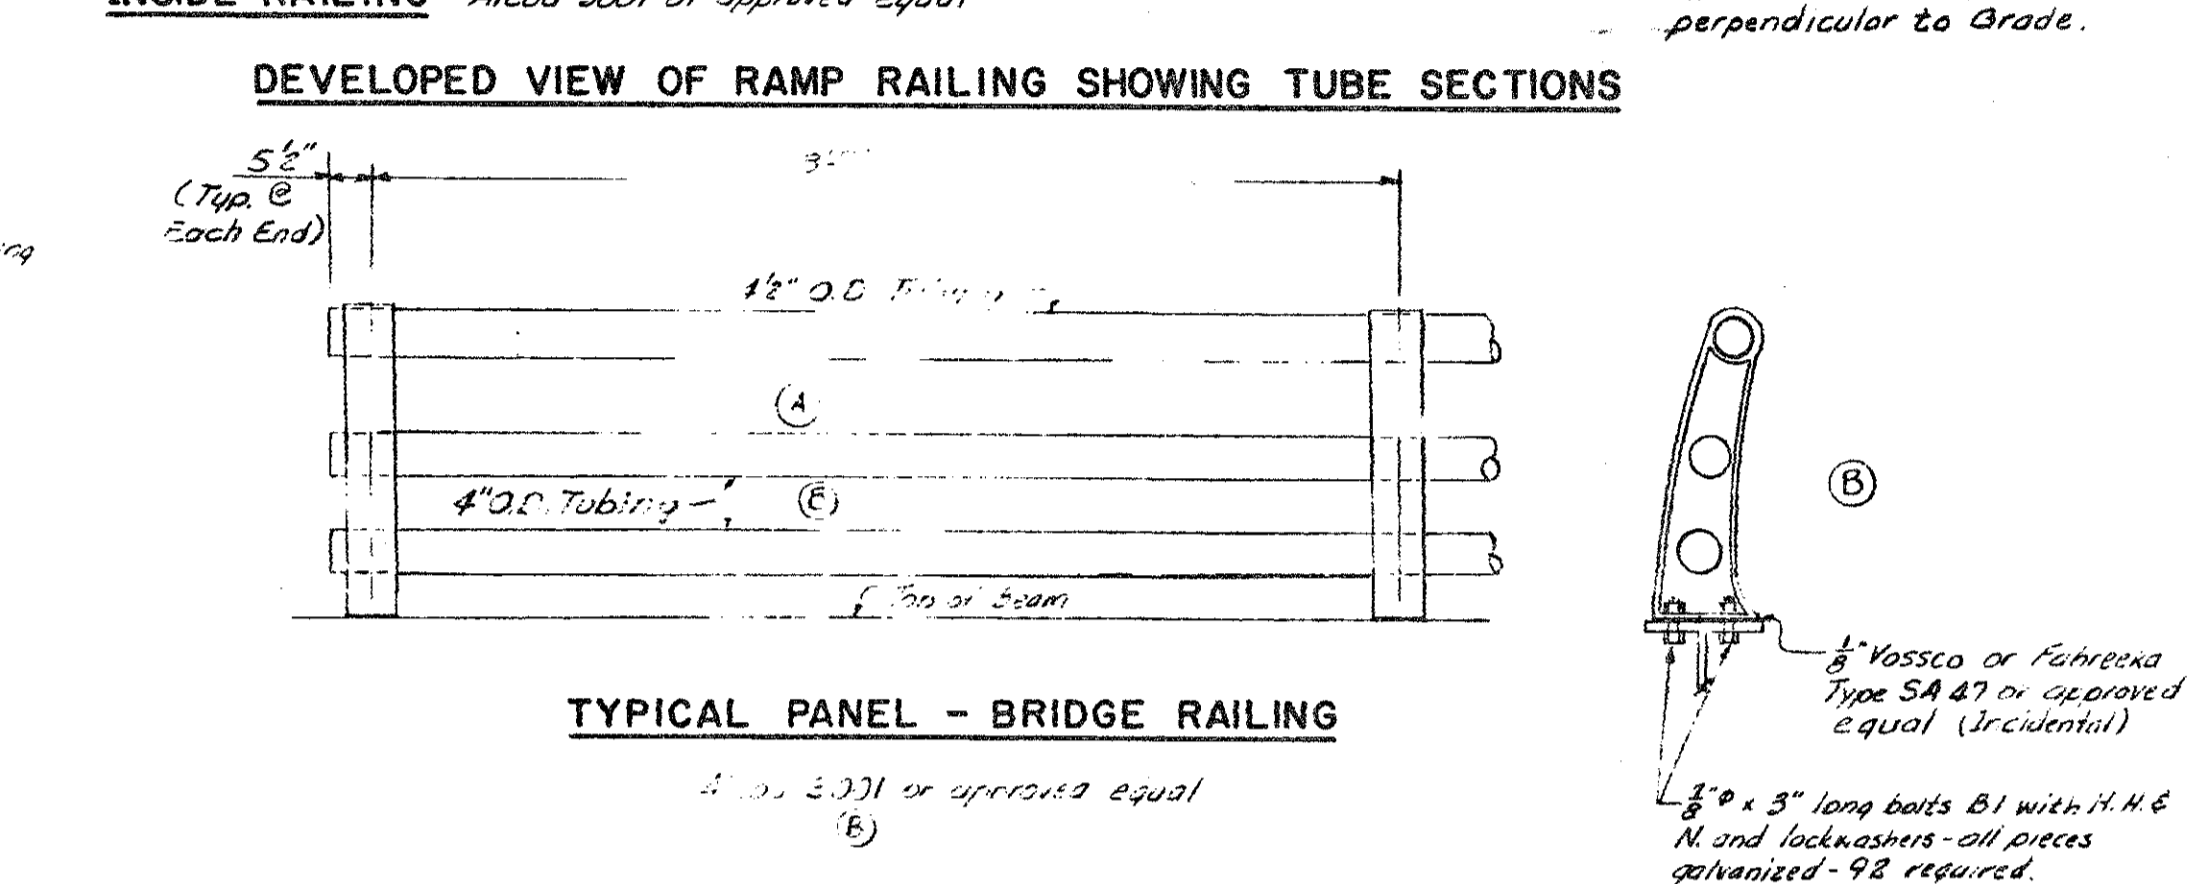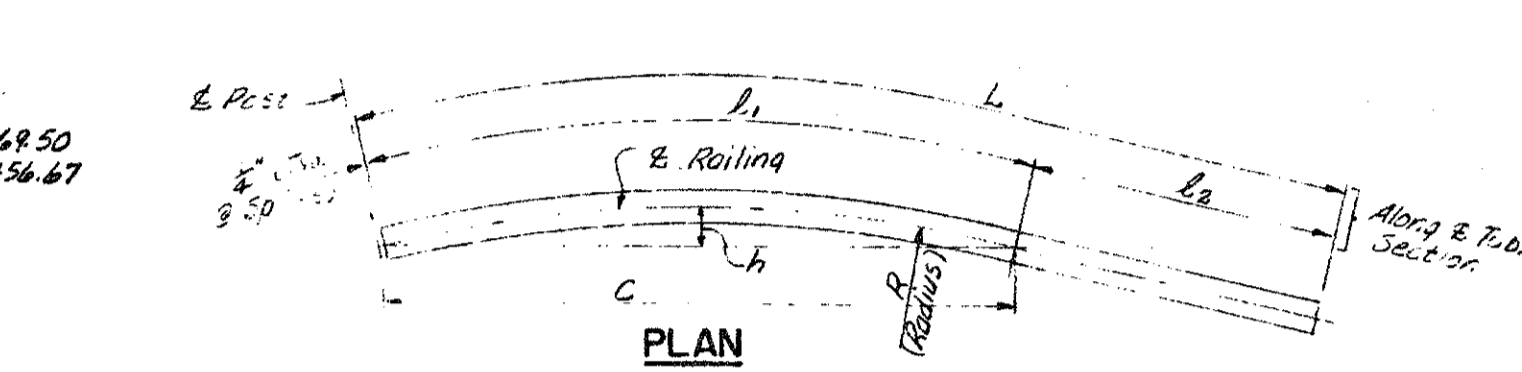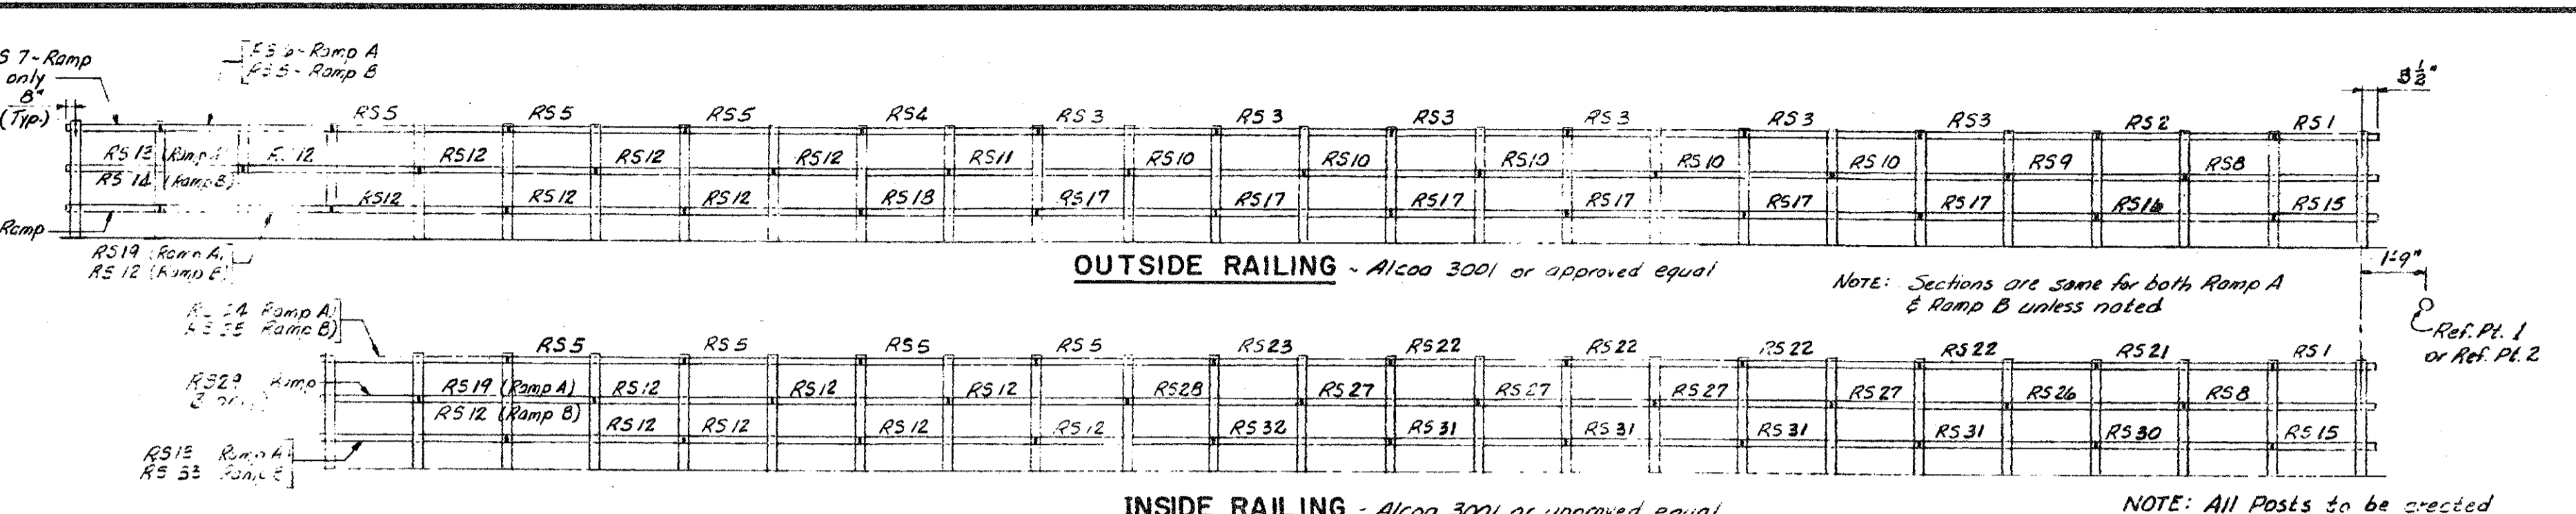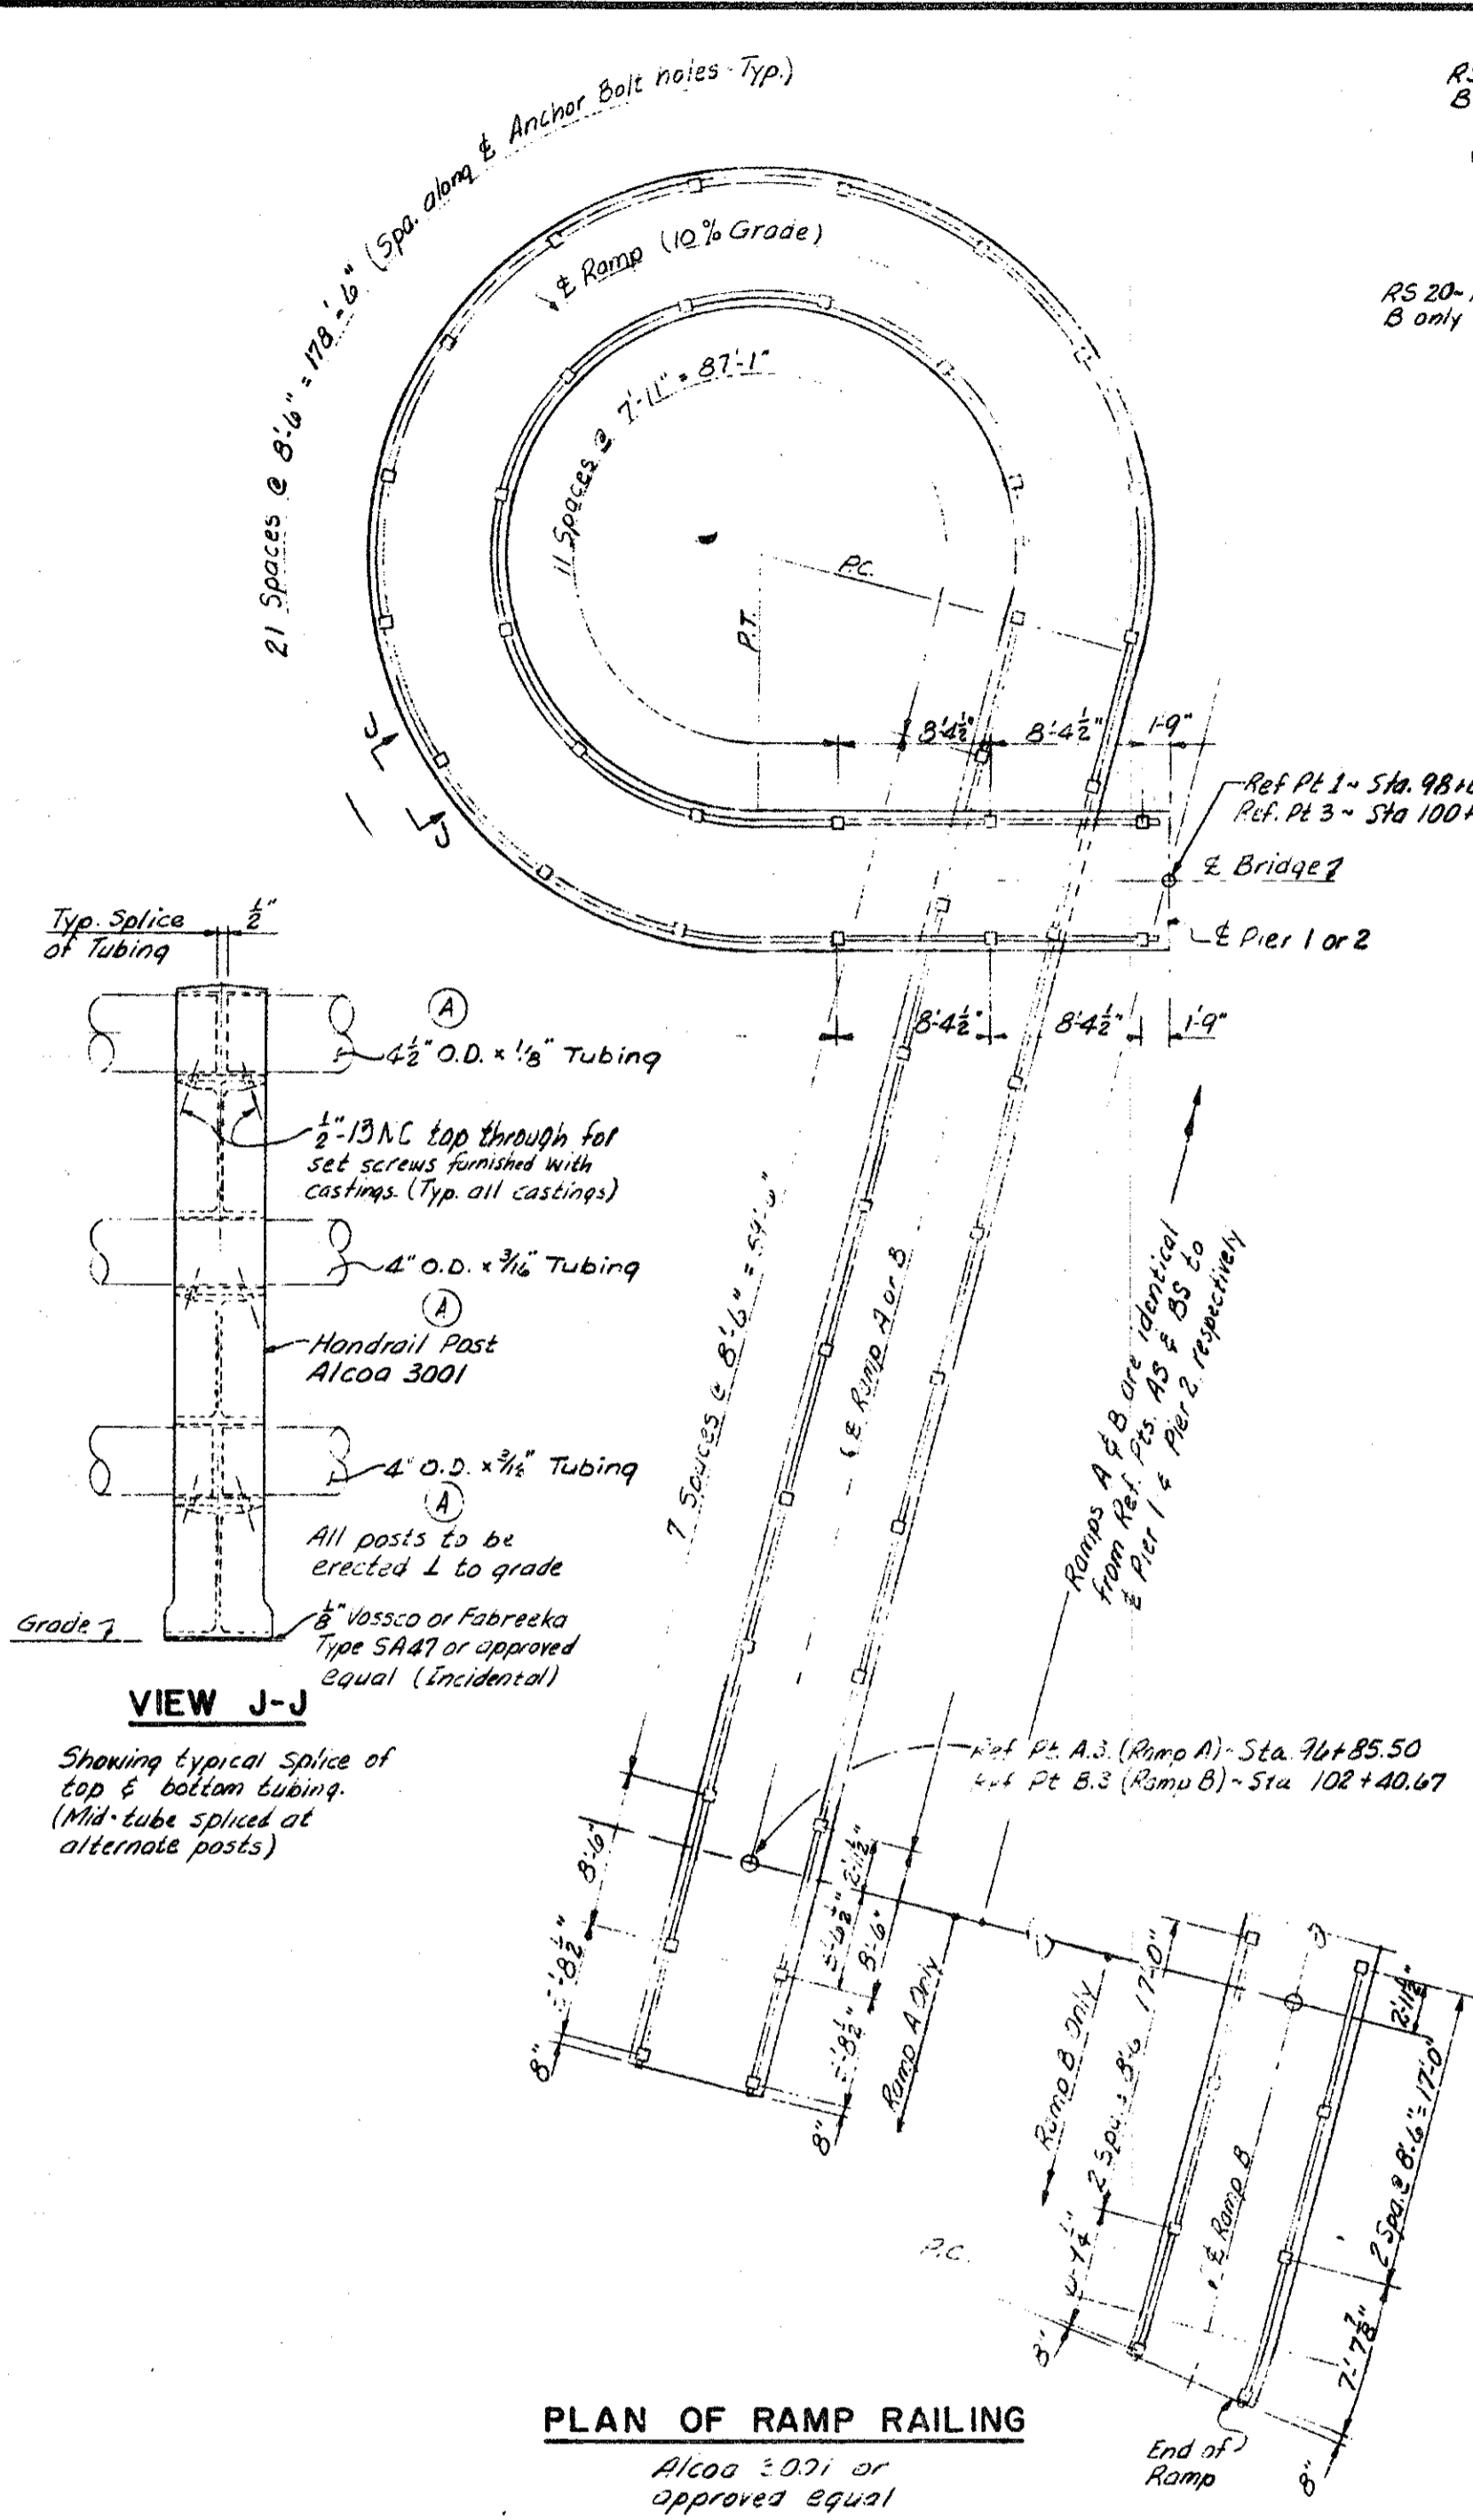

* RAMP TUBE SECTIONS (ALCOA 3001)							
MARK	TYPE	NO.	L	R	C	h	l ₁ l ₂
RS 7	15°	4	8'-8"				
RS 8	15°	2	16'-10 3/8"	21'-3 3/8"	3'-11 1/8"	18"	3'-1 3/8" 12'-11"
RS 9	15°	12	16'-10 3/8"	"	16'-5 3/8"	1'-7 1/8"	
RS 10	15°	5	17'-0 1/2"	"	16'-5 3/8"	1'-7 1/8"	8 3/8" 16'-3 3/8"
RS 11	15°	15	17'-0 1/2"	"	16'-5 3/8"	1'-7 1/8"	
RS 12	15°	1	14'-11 1/8"				
RS 13	15°	1	3'-5 3/8"	23'-0 1/8"	3'-2 3/8"	1/2"	3'-2 3/8" 5'-1 1/8"
RS 14	15°	1	17'-1"				
RS 15	15°	1	17'-0 3/8"	21'-6"	12'-4 1/8"	10 3/8"	12'-4 1/8" 4'-16"
RS 16	15°	1	17'-0 3/8"	"	16'-7 3/8"	1'-8"	
RS 17	15°	1	17'-0 3/8"	"	9'-2 3/8"	6"	7'-3 3/8" 7'-9 3/8"
RS 18	15°	20	17'-0 3/8"				
RS 19	15°	1	3'-4 3/8"				
RS 20	15°	1	15'-10 3/8"	23'-3"	3'-2 3/8"	1/2"	3'-2 3/8" 15'-5 3/8"
RS 21	15°	1	3'-5 3/8"				
RS 22	15°	1	16'-11 1/8"	21'-7 3/8"	2'-0 3/8"	18"	4'-0 3/8" 1'-11"
RS 23	15°	1	17'-0 3/8"	"	16'-8 3/8"	1'-8"	
RS 24	15°	1	17'-0 3/8"	"	9"	1/2"	4'-8" 16'-3 3/8"
RS 25	15°	1	13'-11 1/8"				
RS 26	15°	1	3'-1 1/8"	23'-4 3/8"	3'-2 3/8"	1/2"	3'-2 3/8" 5'-1 1/8"
RS 27	15°	1	16'-4 3/8"	15'-2 3/8"	3'-5 3/8"	1/2"	3'-5 3/8" 1'-11"
RS 28	15°	1	16'-0 3/8"	"	15'-5 3/8"	1'-8"	
RS 29	15°	1	15'-11 1/8"	"	5'-1 1/8"	18"	8'-0 3/8" 7'-9 3/8"
RS 30	15°	1	15'-0 3/8"	16'-11 1/8"	3'-2 3/8"	1/2"	3'-4 1/8" 15'-9 3/8"
RS 31	15°	1	15'-12 3/8"	15'-0"	11'-1 3/8"	1'-0 3/8"	17'-4 3/8" 4'-5"
RS 32	15°	1	15'-12 3/8"	"	5'-1 3/8"	5'-0 3/8"	
RS 33	15°	1	15'-12 3/8"	"	5'-1 3/8"	0	18" 16'-8 3/8"
RS 34	15°	1	7'-5 3/8"	16'-9"	2'-3 3/8"	1/2"	2'-5 3/8" 5'-1 1/8"
RS 35	15°	1	9'-3 3/8"	14'-10 3/8"	3'-4 3/8"	1/2"	3'-4 3/8" 15'-11"
RS 36	15°	1	14'-11 1/8"	"	15'-0 3/8"	5'-0 3/8"	
RS 37	15°	1	15'-11 1/8"	"	7'-11 1/8"	4 1/2"	8'-0 3/8" 7'-1 1/8"
RS 38	15°	1	13'-11 1/8"	16'-7 3/8"	2'-5 3/8"	1/2"	2'-5 3/8" 13'-5 3/8"

* NOTE: Posts are to be bent in the shop to conform to the required radius for the curved portions of the ramp.

QUANTITIES

Ramp Railing - Alcoa 3001 or approved equal - 802.2 Lin. Ft.

Bridge Railing - Alcoa 3001 or approved equal - 379.5 Lin. Ft.

NOTE: All railing tube shall be spliced within posts. All posts are to have approved test coupon cast integrally with the base. The anchor bolts for both the two-tube and the three-tube railing are included in the bid items Structural Steel-Furnishing and Fabricating and Structural Steel-Erection.

MICHIGAN STATE HIGHWAY DEPARTMENT
HANDRAIL DETAILS

TECON ENGINEERS, INC.

DATE: 5-1-62
BY: R.E.
CHECKED BY: M.H.C. 5-9-62
DATE: 1-9-62

A Added Tube Thickness 7-30-62 R.E.
B Changed from 2001 to 3001 Tube railing on Bridge 5-26-64 A.F.B.

POI of 63174 I

NOTE: DO NOT WORK FROM THIS SHEET. THE INFORMATION SHOWN HERE IS FOR REFERENCE ONLY. NO PAY ITEMS ARE SHOWN.

FOR INFORMATION ONLY


DATE	CONT. SEC.	JOB NO.	DESIGN UNIT	SHEET
02-05-99	P01 OF 63174	48404A	MADHAVI	13 OF 16




DRAWN BY: mder DATE: CORRECTED BY: DATE: FILE NAME: p0163174sn

1 2 3 4 5 6 7 8 9 10 11 12 13 14 15 16 17 18 19 20 21 22 23 24 25 26 27 28 29 30 31 32 33 34 35 36 37 38 39 40 41 42 43 44 45 46 47 48 49 50 51 52 53 54 55 56 57 58 59 60 61 62 63


REVISIONS			
NO.	DESCRIPTION	DATE	BY

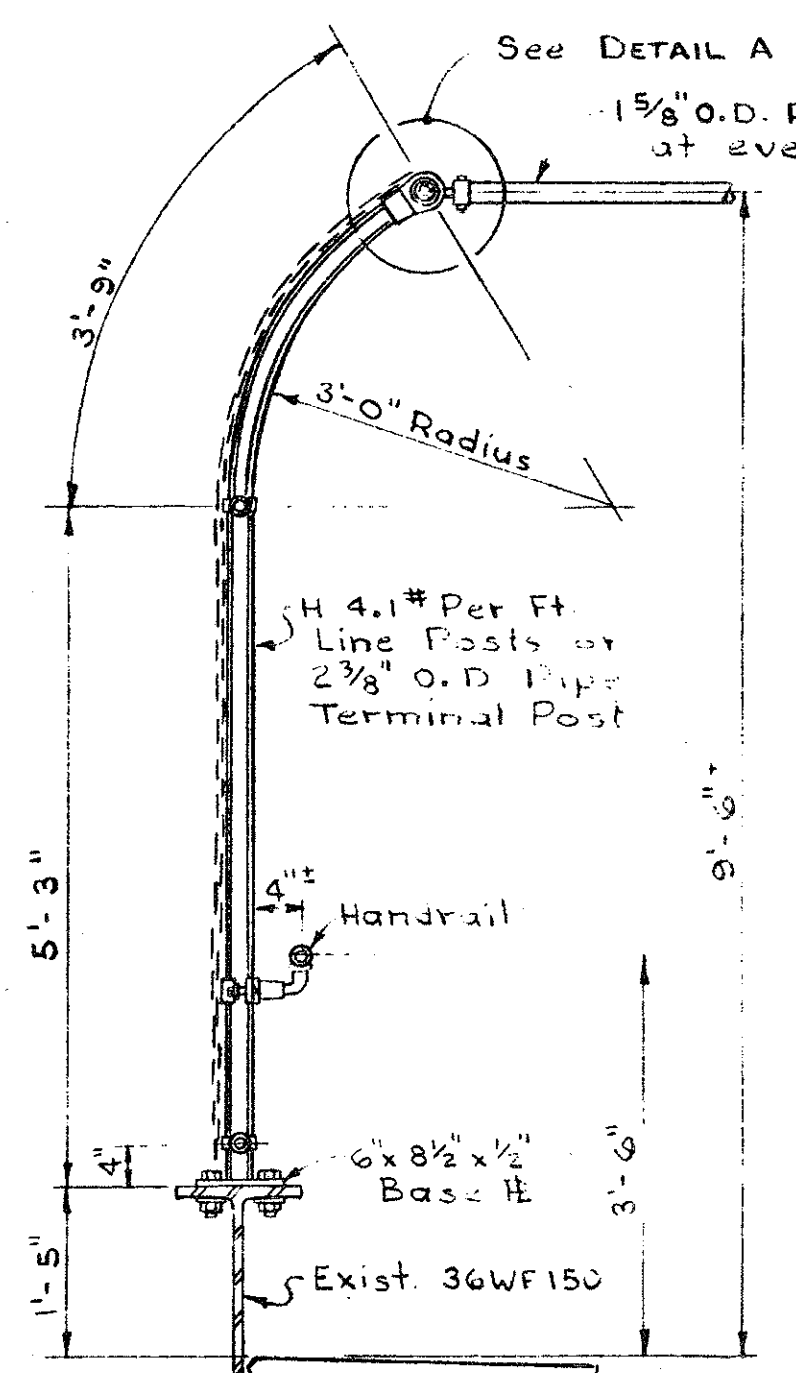


SECTION A-A

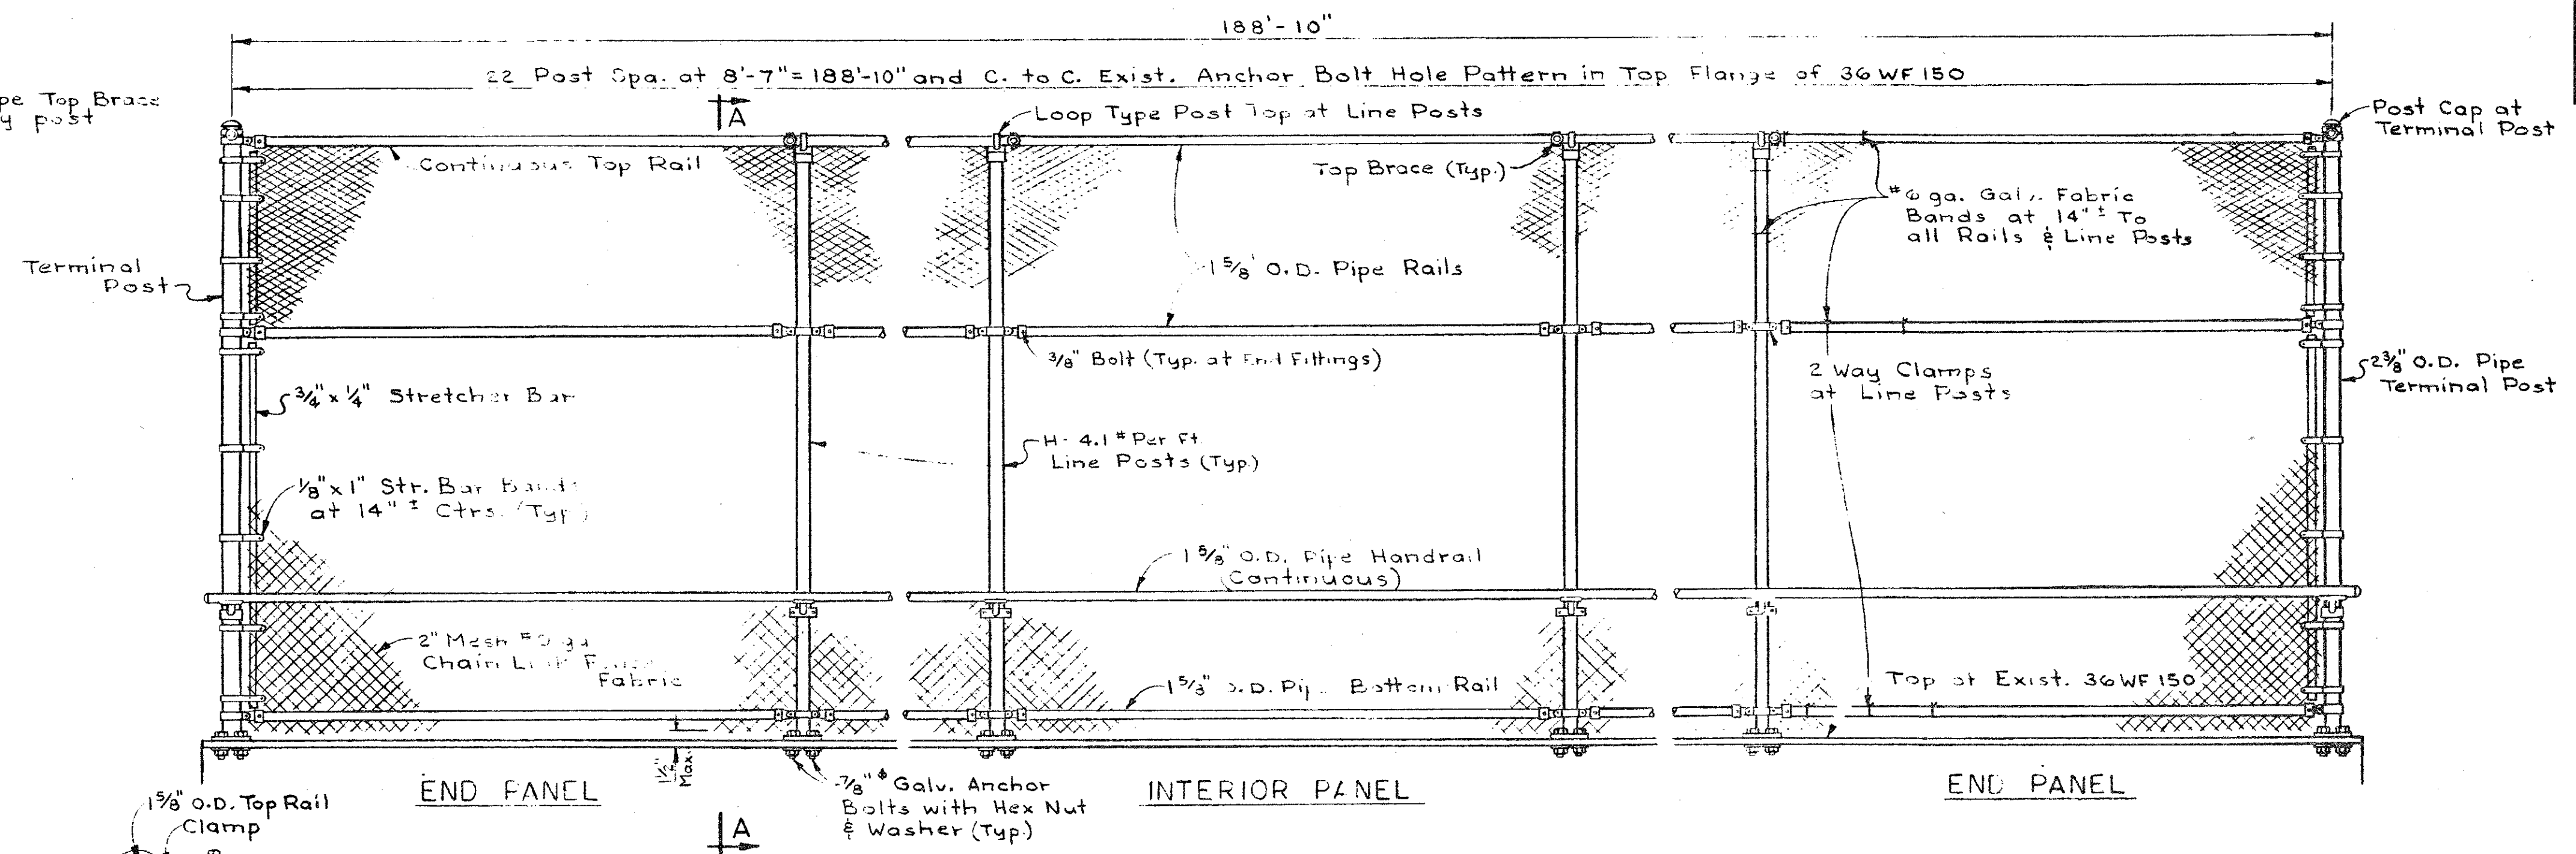


INSIDE ELEVATION

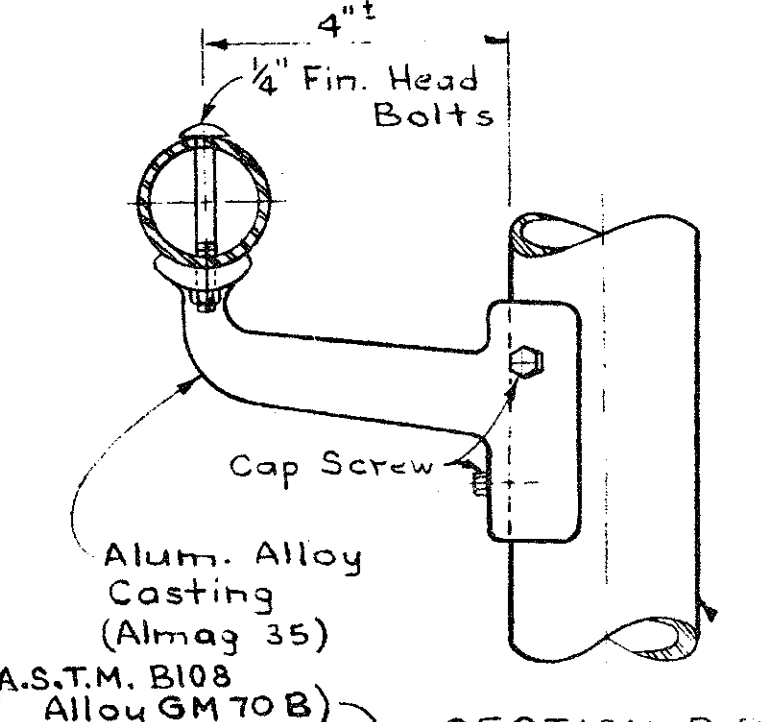


SECTION B-B

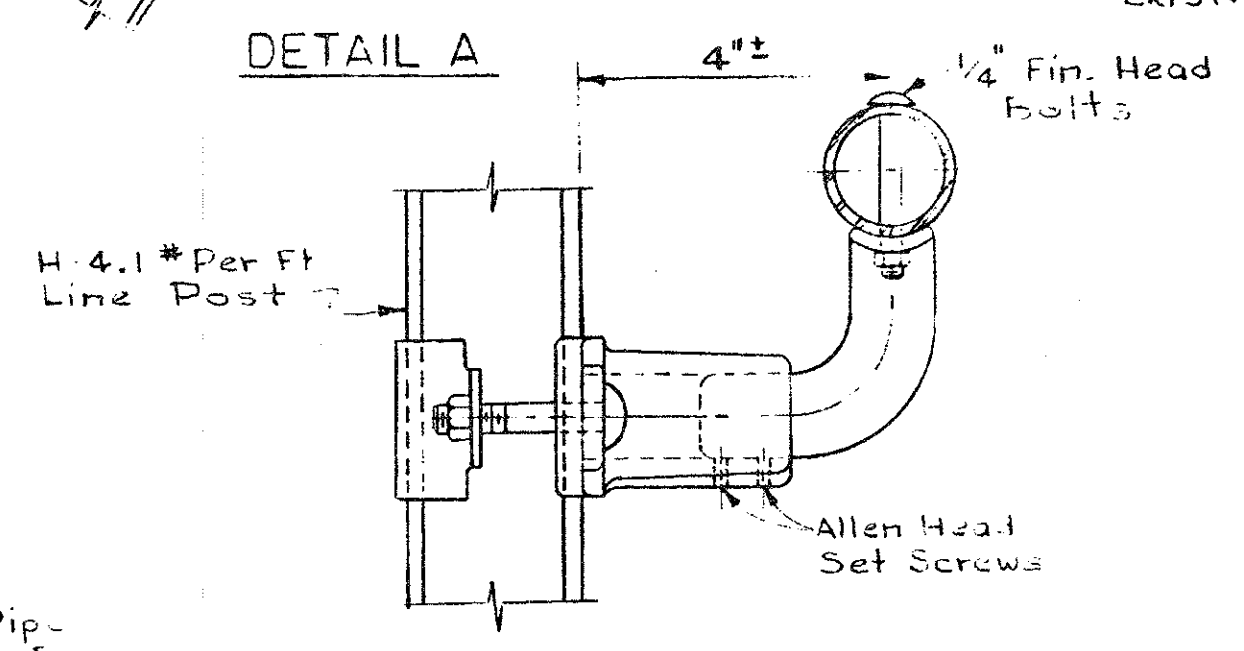

DETAIL A

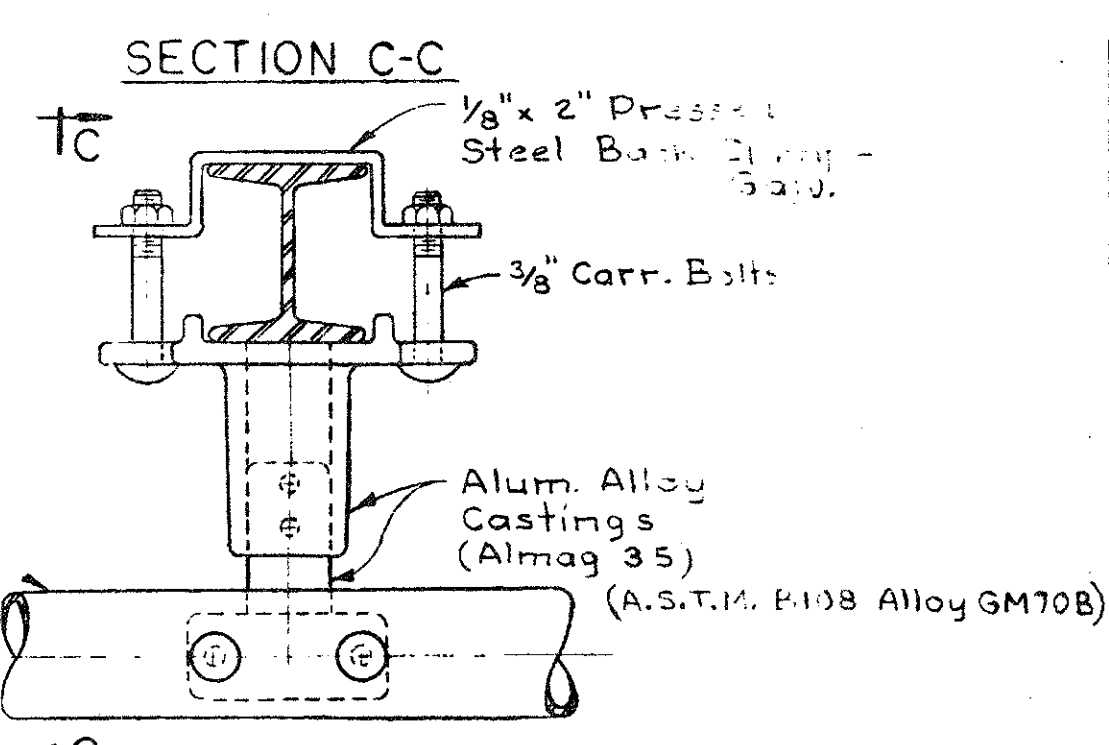

SECTION C-C

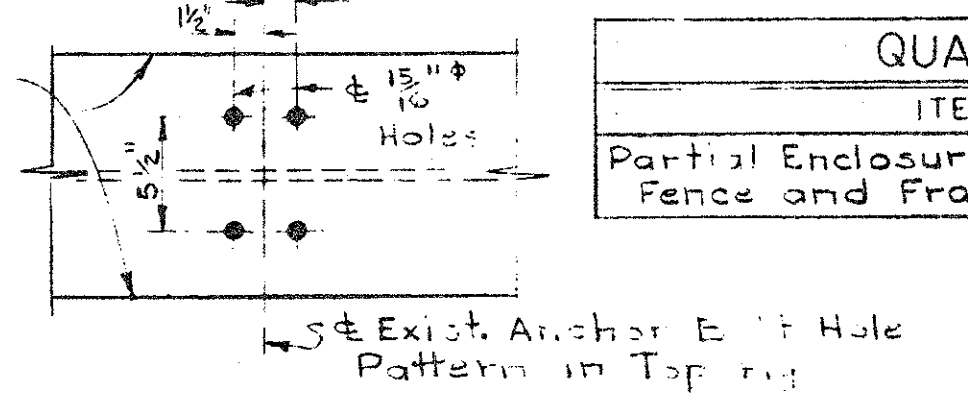

EXISTING ANCHOR BOLT HOLES

QUANTITIES		
ITEM	UNIT	AMT.
Partial Enclosure Chain Link Fence and Framing	Lin.Ft.	377.7

NOTES

The Chain Link Fence Enclosure shall conform to the M.D.S.H. Standard Specifications except as shown on these plans.

2 3/8" O.D. pipe shall be 2.375" outside diameter steel pipe or tubing weighing 3.65 lbs. per ft., galvanized. 1 1/2" O.D. pipe shall be 1.660" outside diameter steel pipe or tubing weighing 2.27 lbs. per ft., galvanized. The H-posts shall be 2 1/2" x 2" H Beam weighing 4.1 lbs. per ft., galvanized. The Chain Link Fence Fabric shall be #9 gage - 2" Mesh Aluminum or Zinc coated steel wire.

All tubing and H-posts shall be furnished with suitable connections and its minimum weight shall be within 5% of that specified.

The post base plates, anchor bolts, hand rail supports, end caps and other fittings are incidental to the Chain Link fence enclosure.

All components are to be galvanized after fabrication. Bolts, nuts and washers to be galvanized in accordance with A.S.T.M. designation A-153.


The enclosure posts are to be placed vertically.

All fabric for chain link fence shall be furnished with knuckling at both selvages.


Steel in anchor bolts may be A.S.T.M. A-307.

Touch up the top flange of the existing WF beams, in the vicinity of the post base plates, with a commercial grade aluminum paint. (incidental)

Peen all 3/8" bolts.

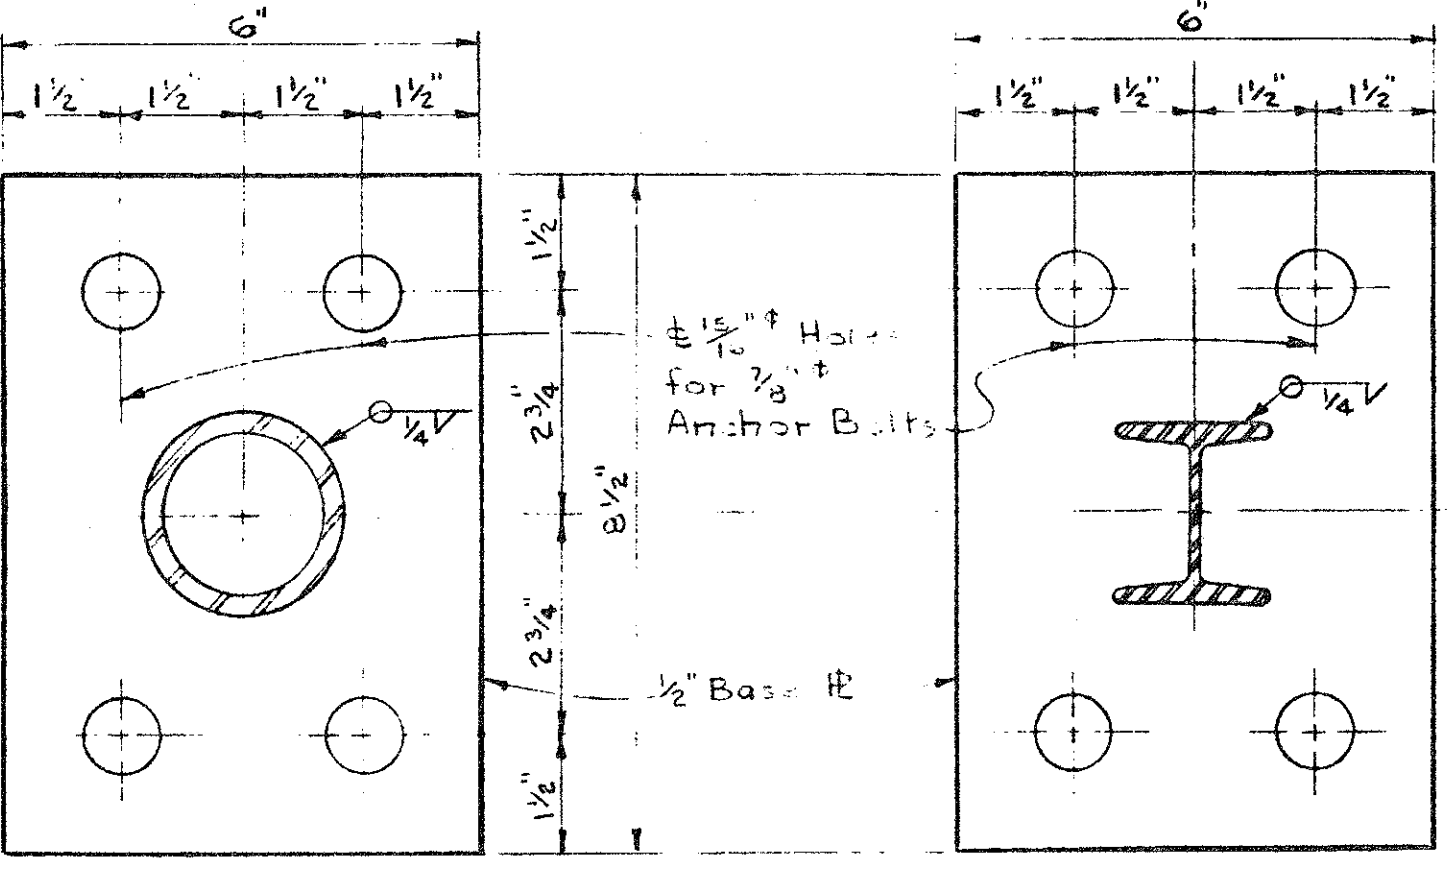

TERMINAL POST LINE POST

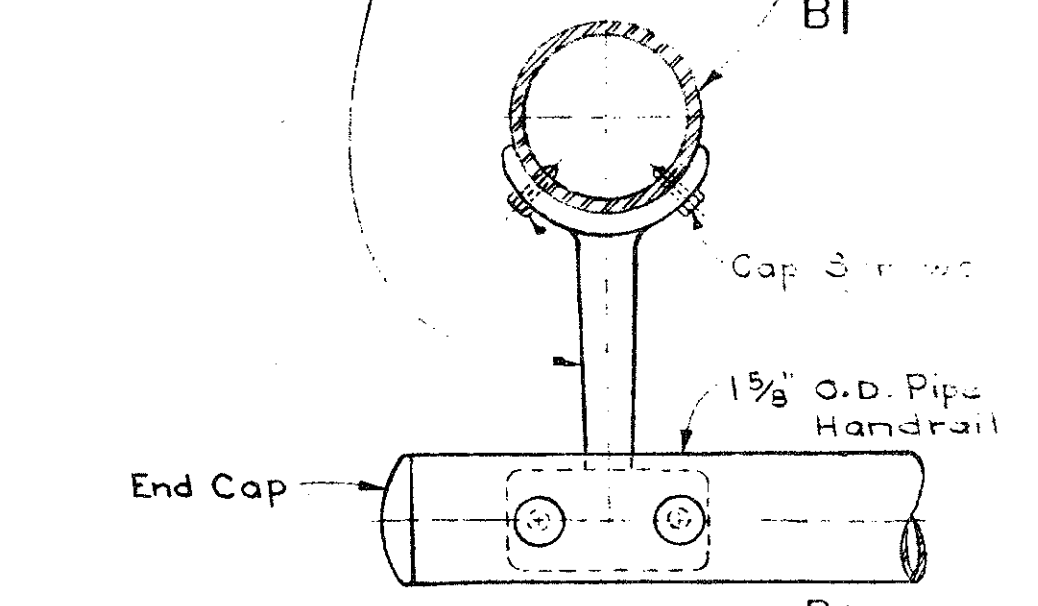

AT TERMINAL POST



AT LINE POST

HANDRAIL DETAILS

MICHIGAN DEPARTMENT OF STATE HIGHWAYS

SCREENING DETAILS

REVISIONS

NO.	DESCRIPTION	DATE	BY

DRAWN BY: Rieger 7-26-79
 CHECKED BY: W.L. 2-13-70
 DATE: 2-16-70
 SHEET: 4 OF 4
P01 of 63174 C



NOTE:
DO NOT WORK FROM THIS SHEET. THE INFORMATION SHOWN HERE IS FOR REFERENCE ONLY. NO PAY ITEMS ARE SHOWN.

FOR INFORMATION ONLY				
DATE	CONT. SEC.	JOB NO.	DESIGN UNIT	SHEET
02-05-99	P01 OF 63174	48404A	MADHAVI	14 OF 16




DRAWN BY: mdr DATE: CHECKED BY: DATE: CORRECTED BY: DATE: FILE NAME: p0163174sn

1 2 3 4 5 6 7 8 9 10 11 12 13 14 15 16 17 18 19 20 21 22 23 24 25 26 27 28 29 30 31 32 33 34 35 36 37 38 39 40 41 42 43 44 45 46 47 48 49 50 51 52 53 54 55 56 57 58 59 60 61 62 63


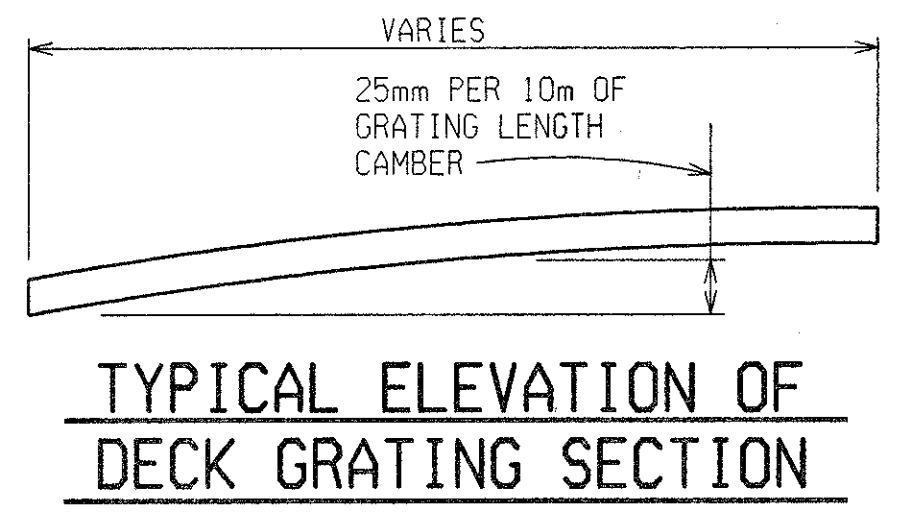
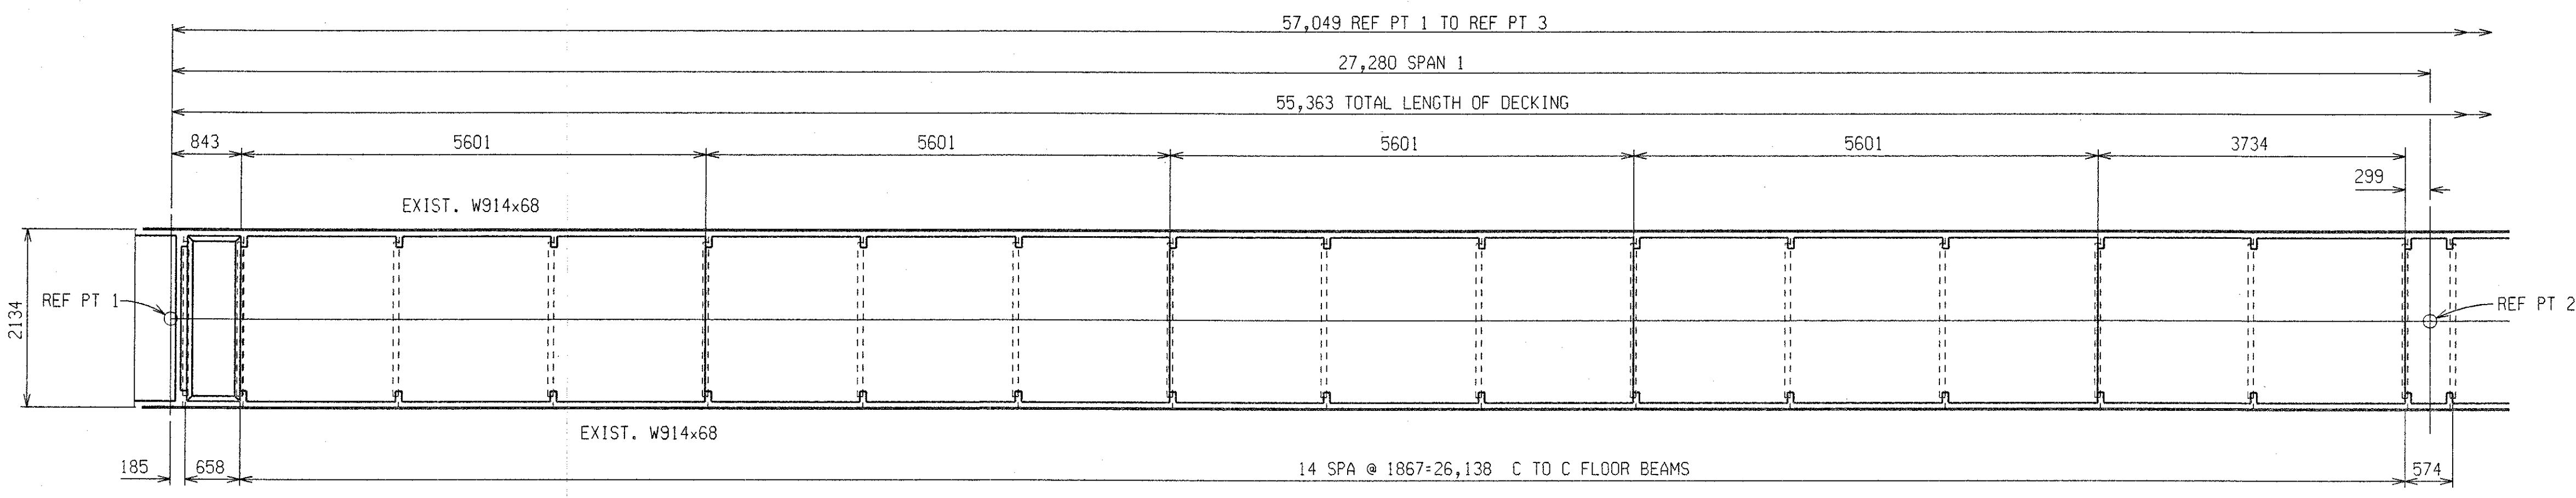


MISCELLANEOUS QUANTITIES


122	m2	Deck Grating, Furnishing
122	m2	Deck grating, Erecting
7	m3	Patching Mortar or Conc
1800	kg	Structural Steel, Retrofit, Furn, Fab, and Erect
1	LS	Field Repair of Damaged Coating (P01)
5	m	Expansion Joint Device

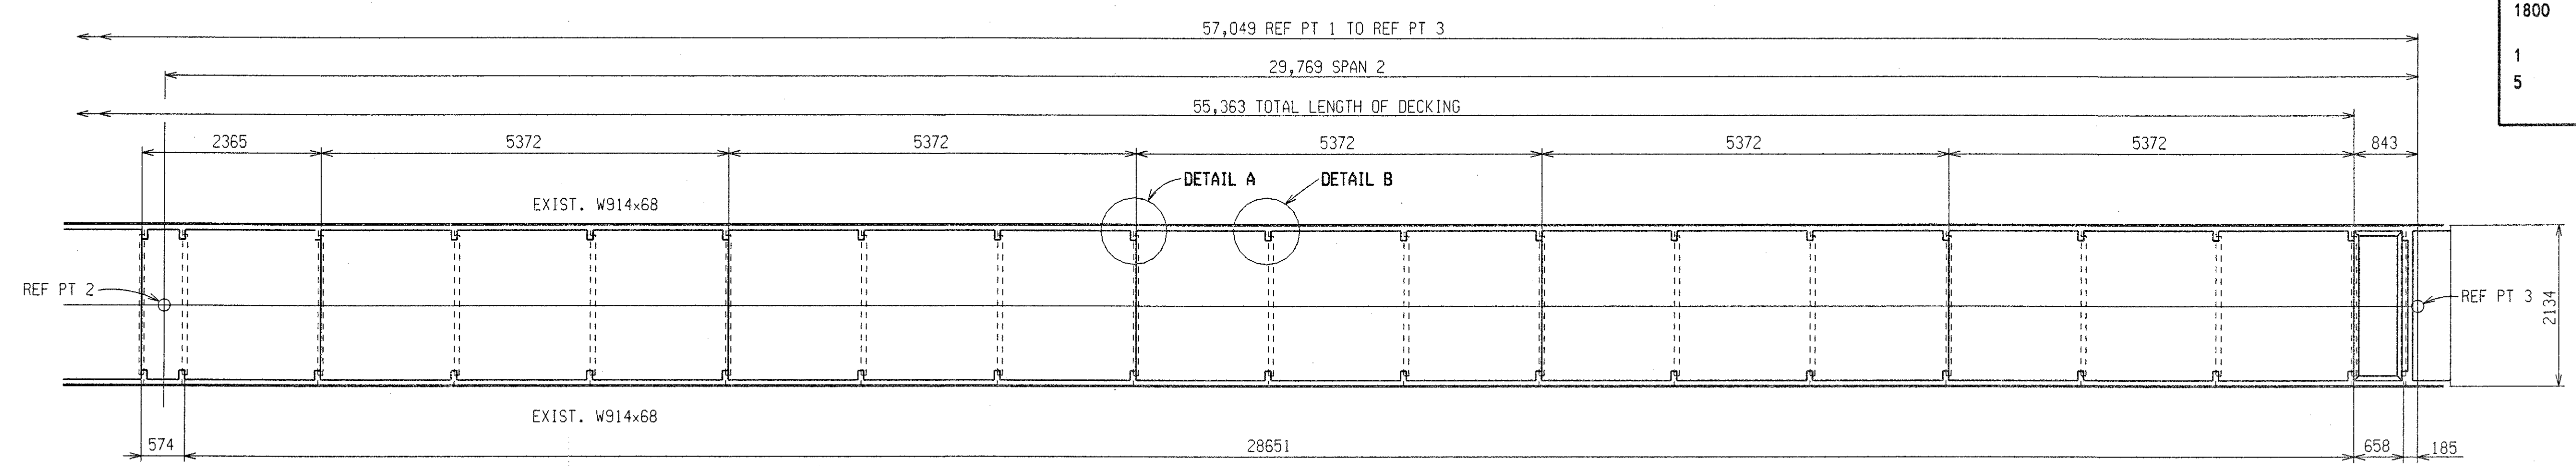

PLAN OF DECK

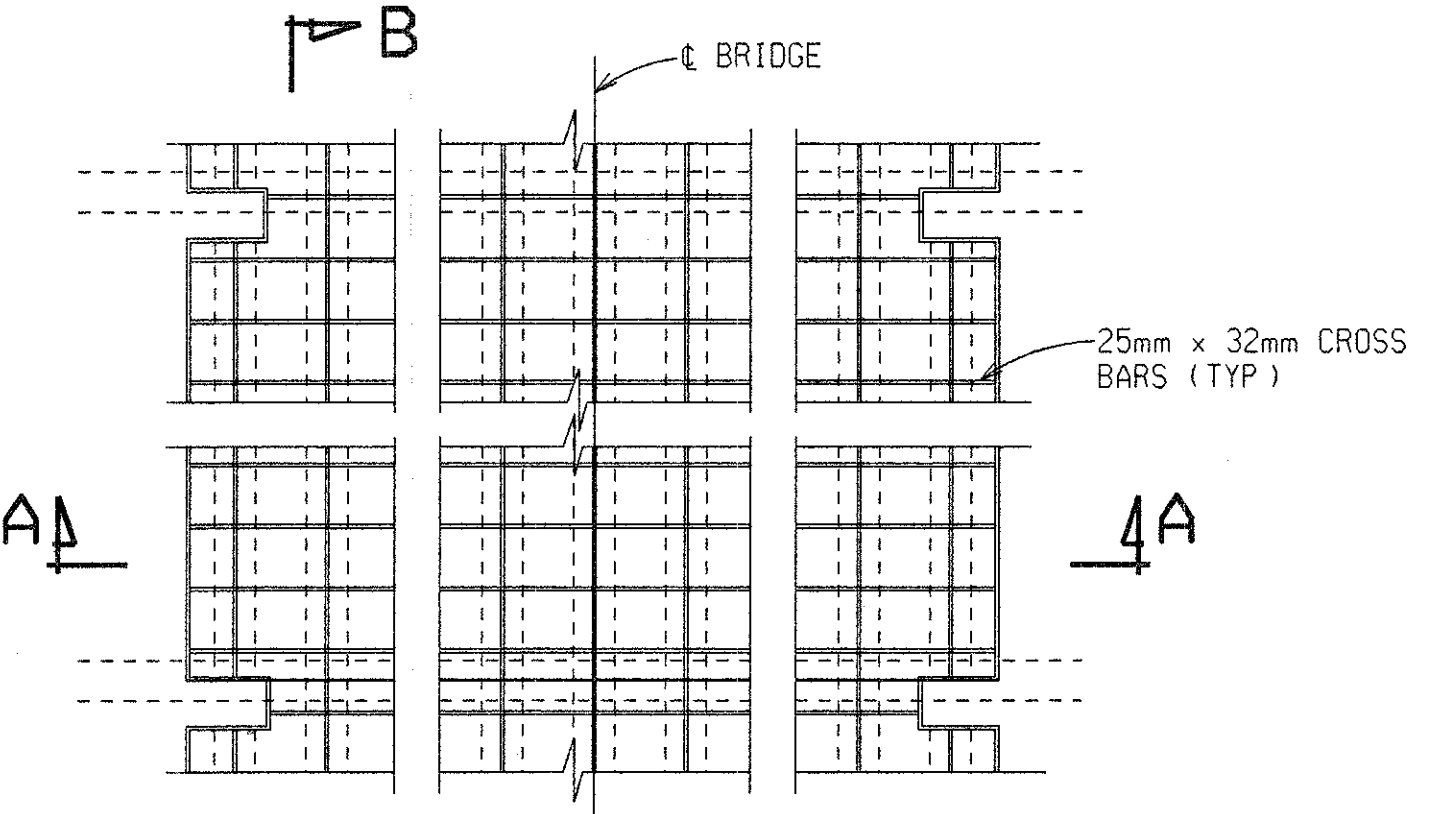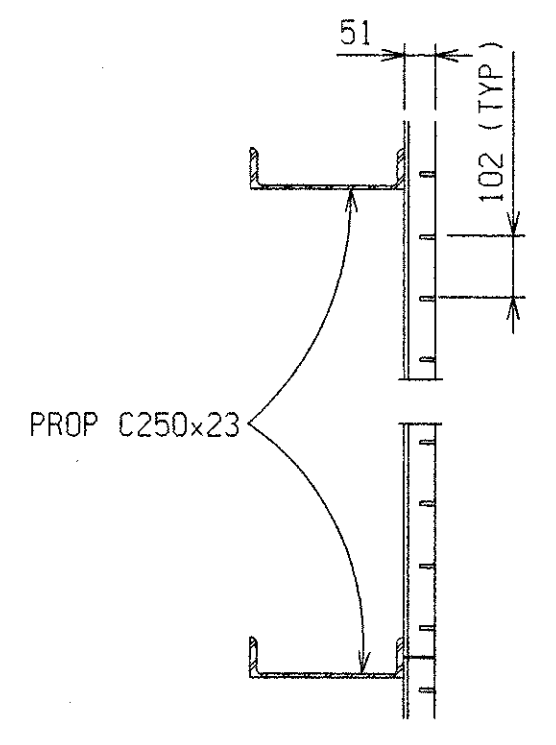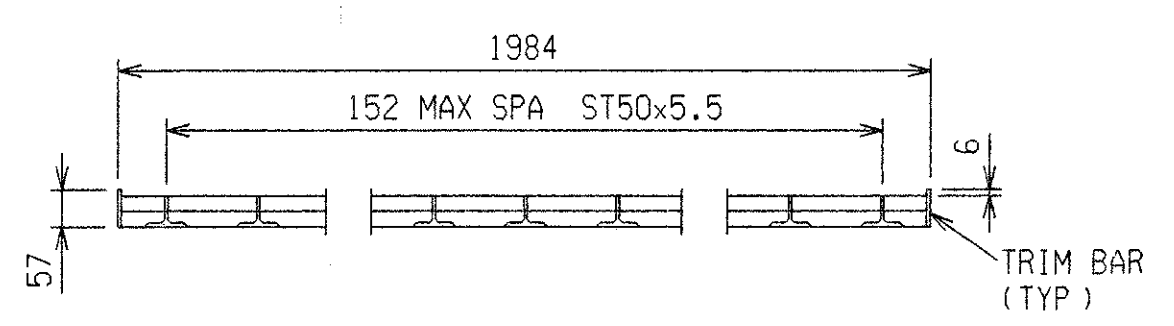

PROP DECK GRATING DETAILS

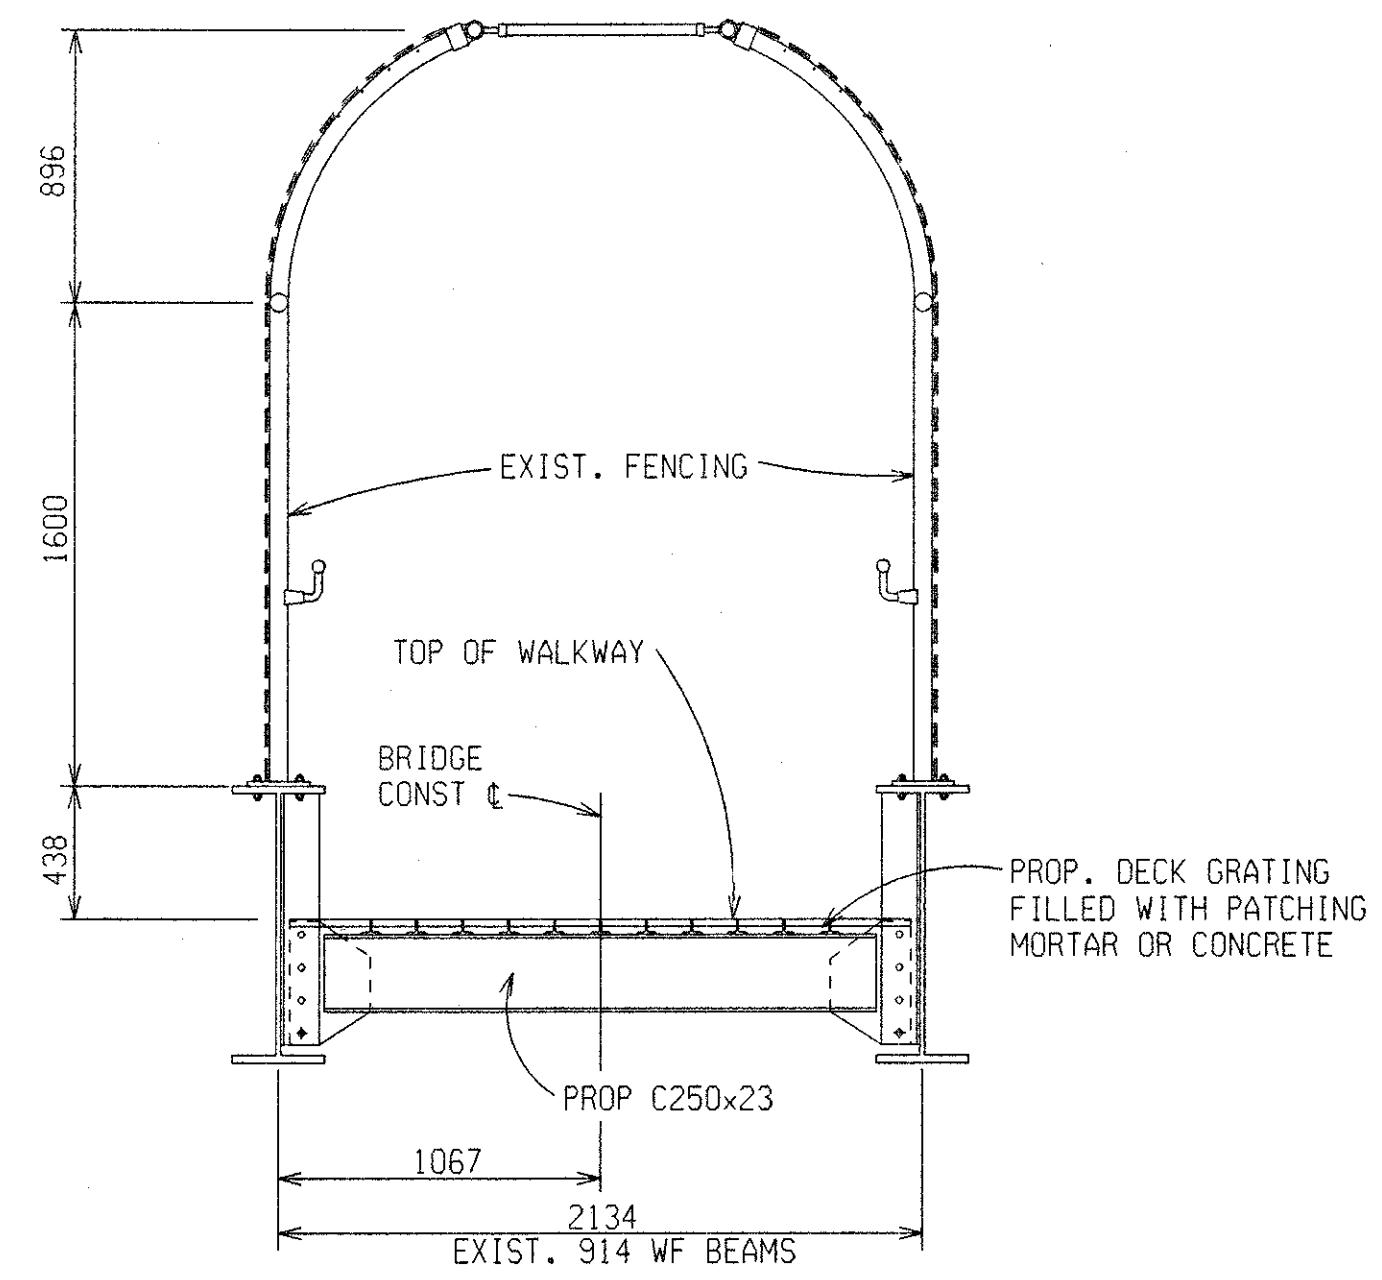

DECK SECTION

NOTES:


- THE PROPOSED DECK SHALL BE MORTAR FILLED STEEL GRATINGS AS DETAILED ON THESE PLANS.
- DECK GRATING AND ALL APPURTANCES ARE TO BE HOT-DIPPED GALVANIZED AS PER STANDARD SPECIFICATIONS, SECTION 707.03C.
- DECK GRATING IS TO BE FILLED WITH PATCHING MORTAR OR CONCRETE FLUSH WITH THE TOP OF GRATING SECTION AND CROSS BARS.
- DIMENSIONS ASSOCIATED WITH EXISTING STRUCTURAL STEEL ARE FROM THE EXISTING DETAIL SHEETS. THE CONTRACTOR SHALL VERIFY THESE DIMENSIONS ON THE ACTUAL STRUCTURE PRIOR TO FABRICATING ANY PROPOSED STRUCTURAL ELEMENTS.
- DECK GRATING AND ALL APPURTANCES SHALL BE CONSTRUCTED FROM ASTM A36 STEEL, SHALL BE AS MANUFACTURED BY IKG GREULICH, LB FOSTER, UNITED INTERLOCK, OR APPROVED EQUAL, AND SHALL BE ABLE TO SPAN A MINIMUM OF 2134mm, WITHSTANDING A LIVE LOAD OF 488 Kg/m² WITH A MAXIMUM ALLOWABLE DEFLECTION OF 1/800.
- EXPANSION JOINT SHALL BE PROVIDED AT PIERS 1 AND 3 AND SHALL BE DESIGNED FOR THE SPECIFIC DECK GRATING SYSTEM USED, AS APPROVED BY THE ENGINEER. NO OPENING SHALL BE ALLOWED AND A SMOOTH RIDING SURFACE SHALL BE MAINTAINED. PAID FOR AS "EXPANSION JOINT DEVICE".
- THE EXPANSION JOINT DEVICE SHALL PROVIDE A MINIMUM TOTAL TRAVEL OF 32mm.
- ALL EXISTING EXPOSED REINFORCEMENT SHALL BE EMBEDDED INTO THE NEW CONCRETE, AS DIRECTED BY THE ENGINEER.
- BLAST CLEAN AND PRIME FAYING SURFACES PRIOR TO ERECTING DIAPHRAGMS AND BENT PLATES. THIS WORK IS INCLUDED IN THE PAY ITEMS FOR CLEANING AND COATING EXISTING STRUCTURAL STEEL.

SUPERSTRUCTURE DETAILS


DATE	CONT. SEC.	JOB NO.	DESIGN UNIT	SHEET
9-21-99	P01 OF 63174	48404A	MAHDAVI	15 OF 16

FILE NAME: p0163174.dwg DRAWN BY: R.K.OLIN CHECKED BY: DATE: 9/99 CORRECTED BY: R. PRATT DATE: 10-18-99


REVISIONS			
NO.	DESCRIPTION	DATE	BY

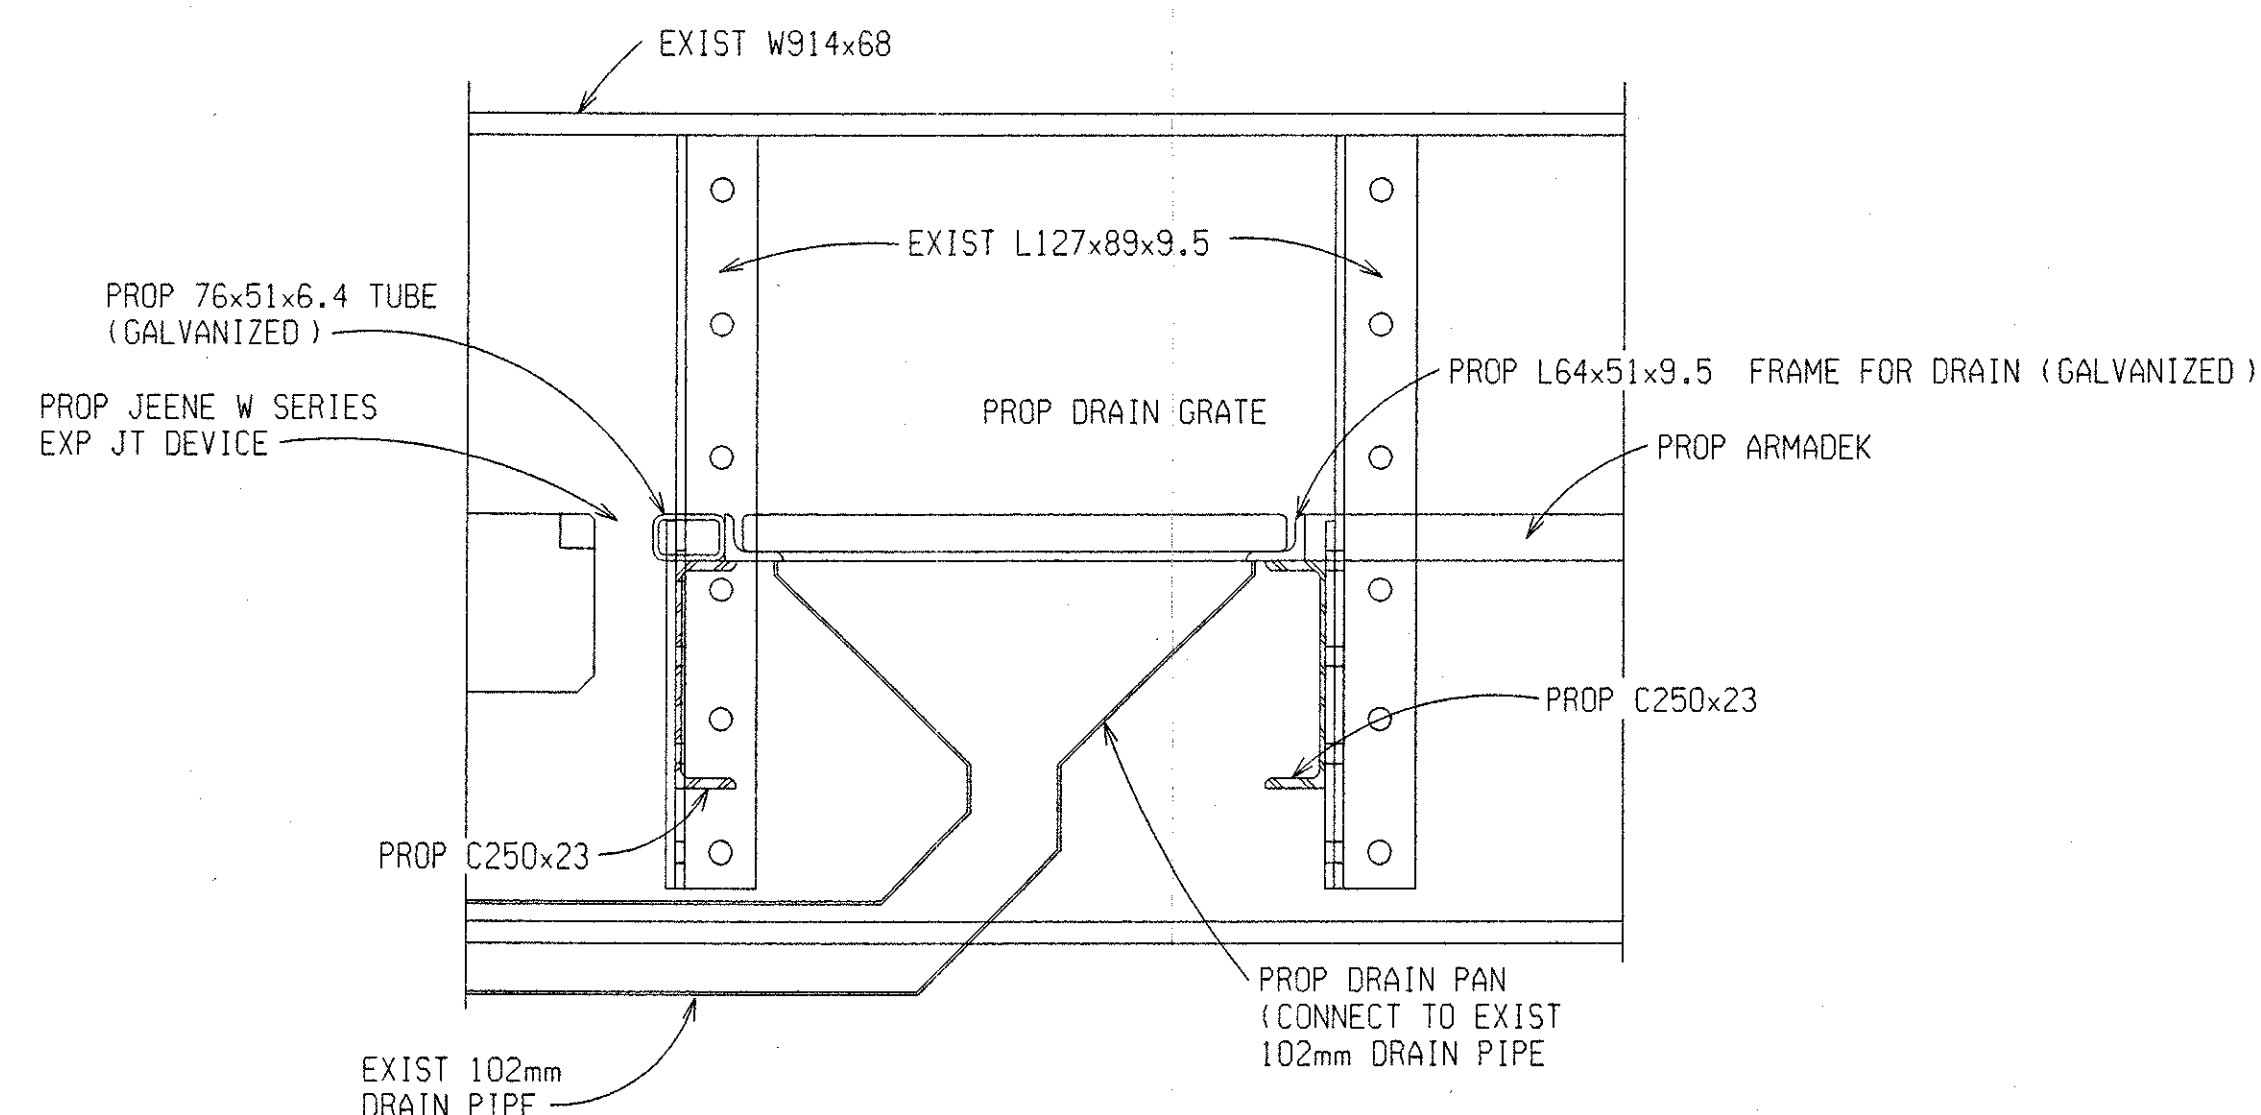


SECTION AT DRAIN

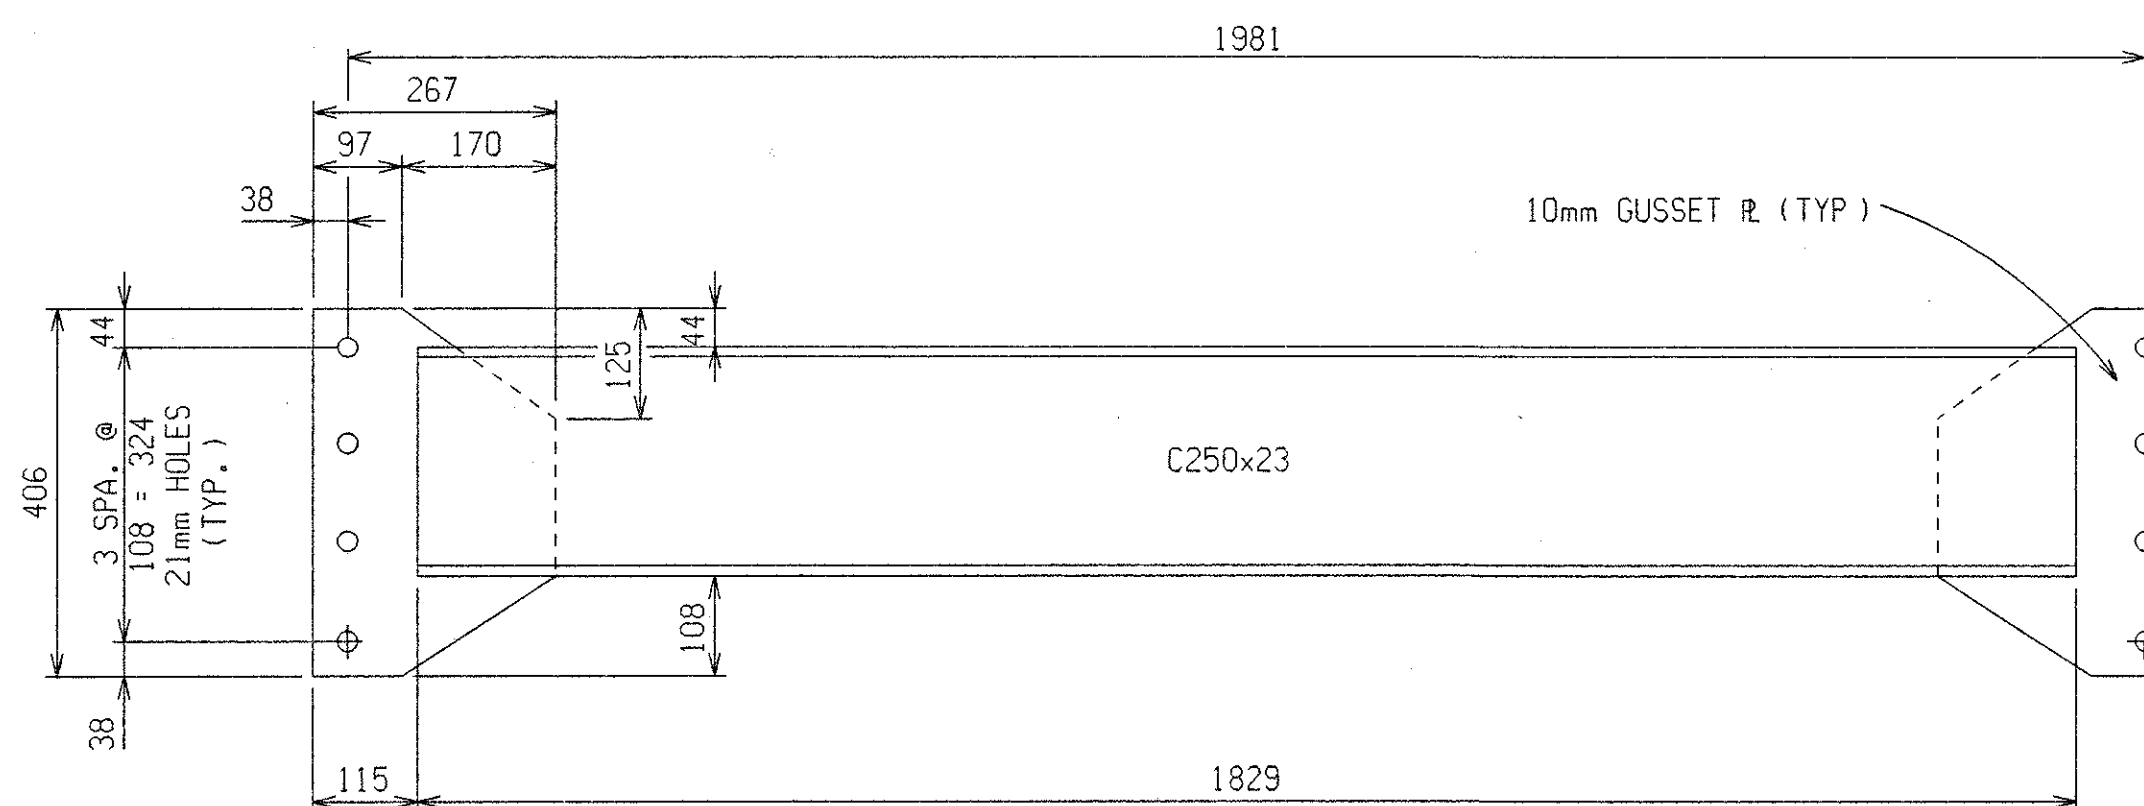


FLOOR BEAM DETAILS

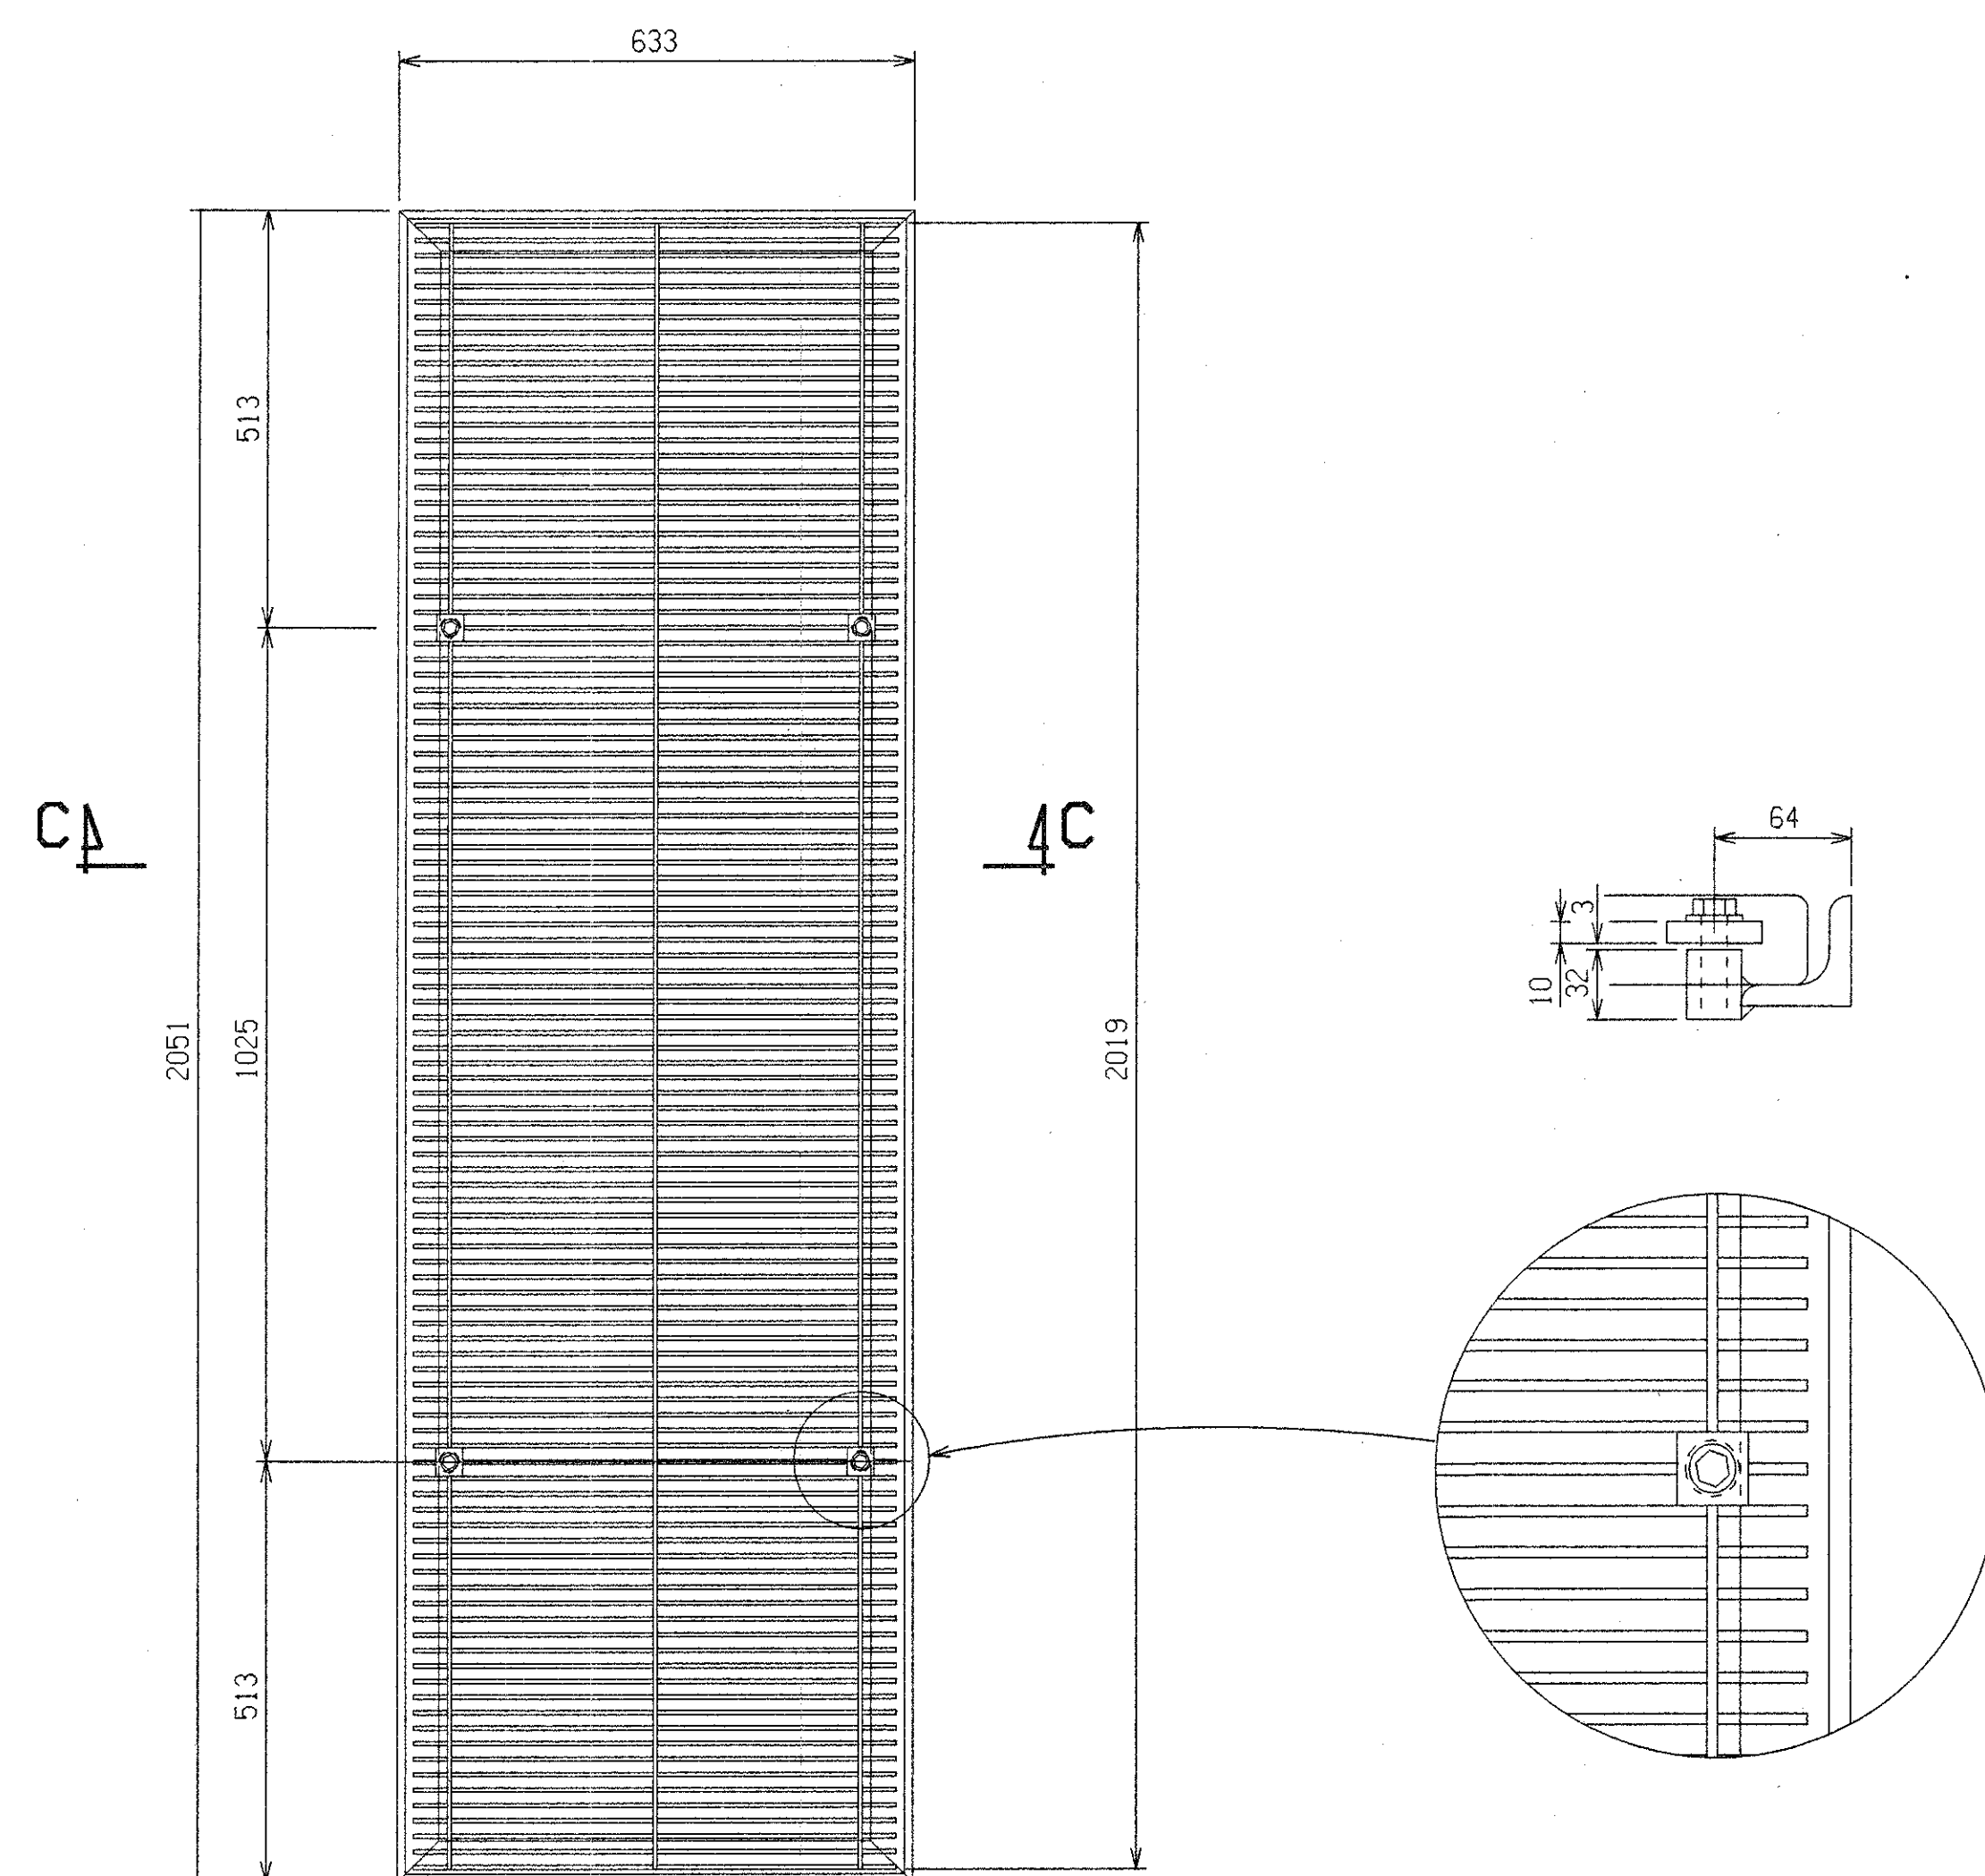


DRAIN DETAILS

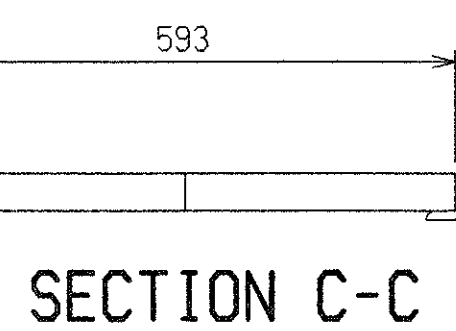

SECTION C-C

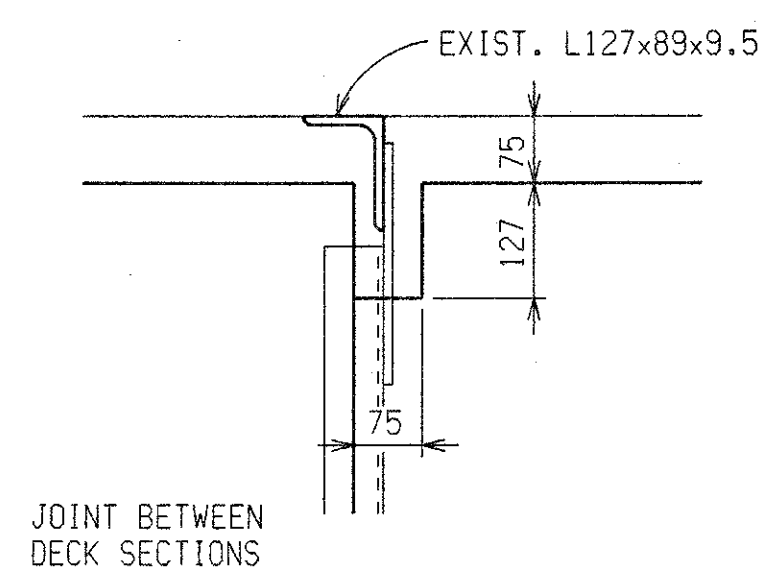

DETAIL A

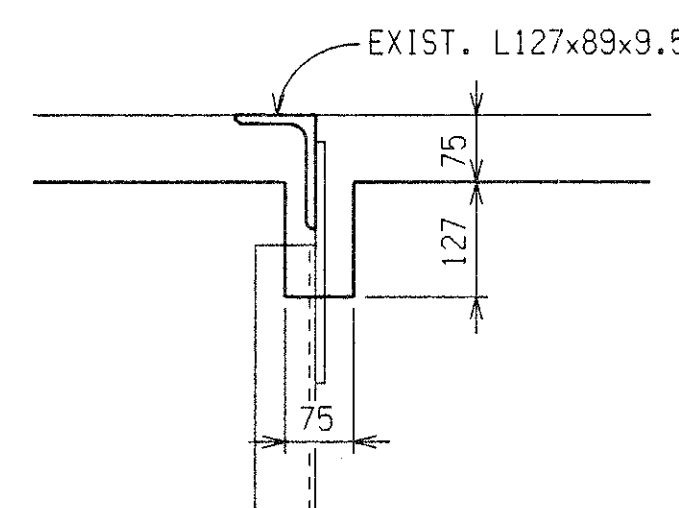

DETAIL B

NOTES:

- DRAIN CASTINGS SHALL BE GRAY IRON CASTINGS IN ACCORDANCE WITH ASTM A48, CLASS 35B.
- STEEL FOR BRACKETS AND CONNECTION FRAME SHALL BE ASTM A36, GALVANIZED.
- FASTENERS SHALL MEET THE REQUIREMENTS OF ASTM A307, GALVANIZED.
- WASHERS SHALL MEET THE REQUIREMENTS OF ASTM F844, GALVANIZED.
- GALVANIZING SHALL BE BY THE HOT DIP PROCESS IN ACCORDANCE WITH SECTION 7.07 OF THE 1996 STANDARD SPECIFICATIONS. ALL FABRICATION SHALL BE COMPLETED BEFORE GALVANIZING.
- ALL WORK FOR DRAIN CASTINGS SHALL BE INCLUDED IN THE PAY ITEM "STRUCTURAL STEEL, RETROFIT FURN, FAB AND ERECT".



SUPERSTRUCTURE DETAILS				
DATE	CONT. SEC.	JOB NO.	DESIGN UNIT	SHEET
9-21-99	P01 OF 63174	48404A	MAHDAVI	16 OF 16

CONTROL SECTION S04 OF 63103 JOB NO. 48404A SH. NO. 2
 1 2 3 4 5 6 7 8 9 10 11 12 13 14 15 16 17 18 19 20 21 22 23 24 25 26 27 28 29 30 31 32 33 34 35 36 37 38 39 40 41 42 43 44 45 46 47 48 49 50 51 52 53 54 55 56 57 58 59 60 61 62 63

REVISIONS			
NO.	DESCRIPTION	DATE	BY

WITNESSES TO TRANSIT PTS.

Sta. 801+00 H.C.P. #34
 N30°W 193.3' Light Pole
 N22°E 216.4' Light Pole
 S27°W 109.5' Light Pole

Sta. 805+00 H.C.P. #35
 N31°W 117.9' Light Pole
 N71°E 106.2' Light Pole
 N06°E 93.3' 25" Conc.

Sta. 809+00 H.C.P. #36
 S57°W 93.3' Light Pole
 S04°W 52.9' P. Pole
 S63°E 120.8' Light Pole

Curve Data

Const. & I-75 Δ = 46° 08' 43" Rt. D = 0° 00' 15" 25" R = 22,298.90' T = 1606.66' L = 3207.78' E = 57.81' PC = 782+20.01 PT = 798+26.67 RT = 814+27.79	Service Rd. W-5 Δ = 46° 08' 43" Rt. D = 6° 00' 00" R = 954.93' T = 406.77' L = 769.09' E = 83.03' PC = 546+75.40 PT = 550+82.17 RT = 554+44.49	Service Rd. SE Δ = 4° 45' 51" Lt. D = 6° 00' 00" R = 954.93' T = 393.45' L = 746.43' E = 77.88' PC = 546+75.40 PT = 548+21.02 RT = 551+74.00	Ramp CD Δ = 0° 45' 51" Lt. D = 0° 00' 15" 25" R = 22,298.90' T = 343.32' L = 686.59' E = 2.64' PC = 556+80.09 PT = 560+23.41 RT = 562+82.90	Ramp EB Δ = 0° 07' 57" Lt. D = 0° 34' 45" 00" R = 1527.89' T = 108.62' L = 216.87' E = 3.86' PC = 560+66.03 PT = 561+74.65 RT = 562+82.90
--	---	---	--	--

BENCH MARKS


BM #83 El. 636.83
 Top of Arrow on fire hydrant.
 S.E. Cor. Stephenson & Kenneth
 86' Rt. Sta. 819+09

BM #84 El. 636.93
 Top of Arrow on fire hydrant.
 S.E. Cor. Coy & Stephenson
 118' Rt. Sta. 807+80

BM #85 El. 637.17
 Top of Arrow on fire hydrant.
 S.E. Cor. Morehouse & Stephenson
 137' Rt. Sta. 793+92


UTILITIES

Telephone - Michigan Bell Telephone
 Gas - Consumers Power Co.
 Power - Detroit Edison Co.
 66" Sewer - Oakland County
 Water & Sewer - City of Hazel Park

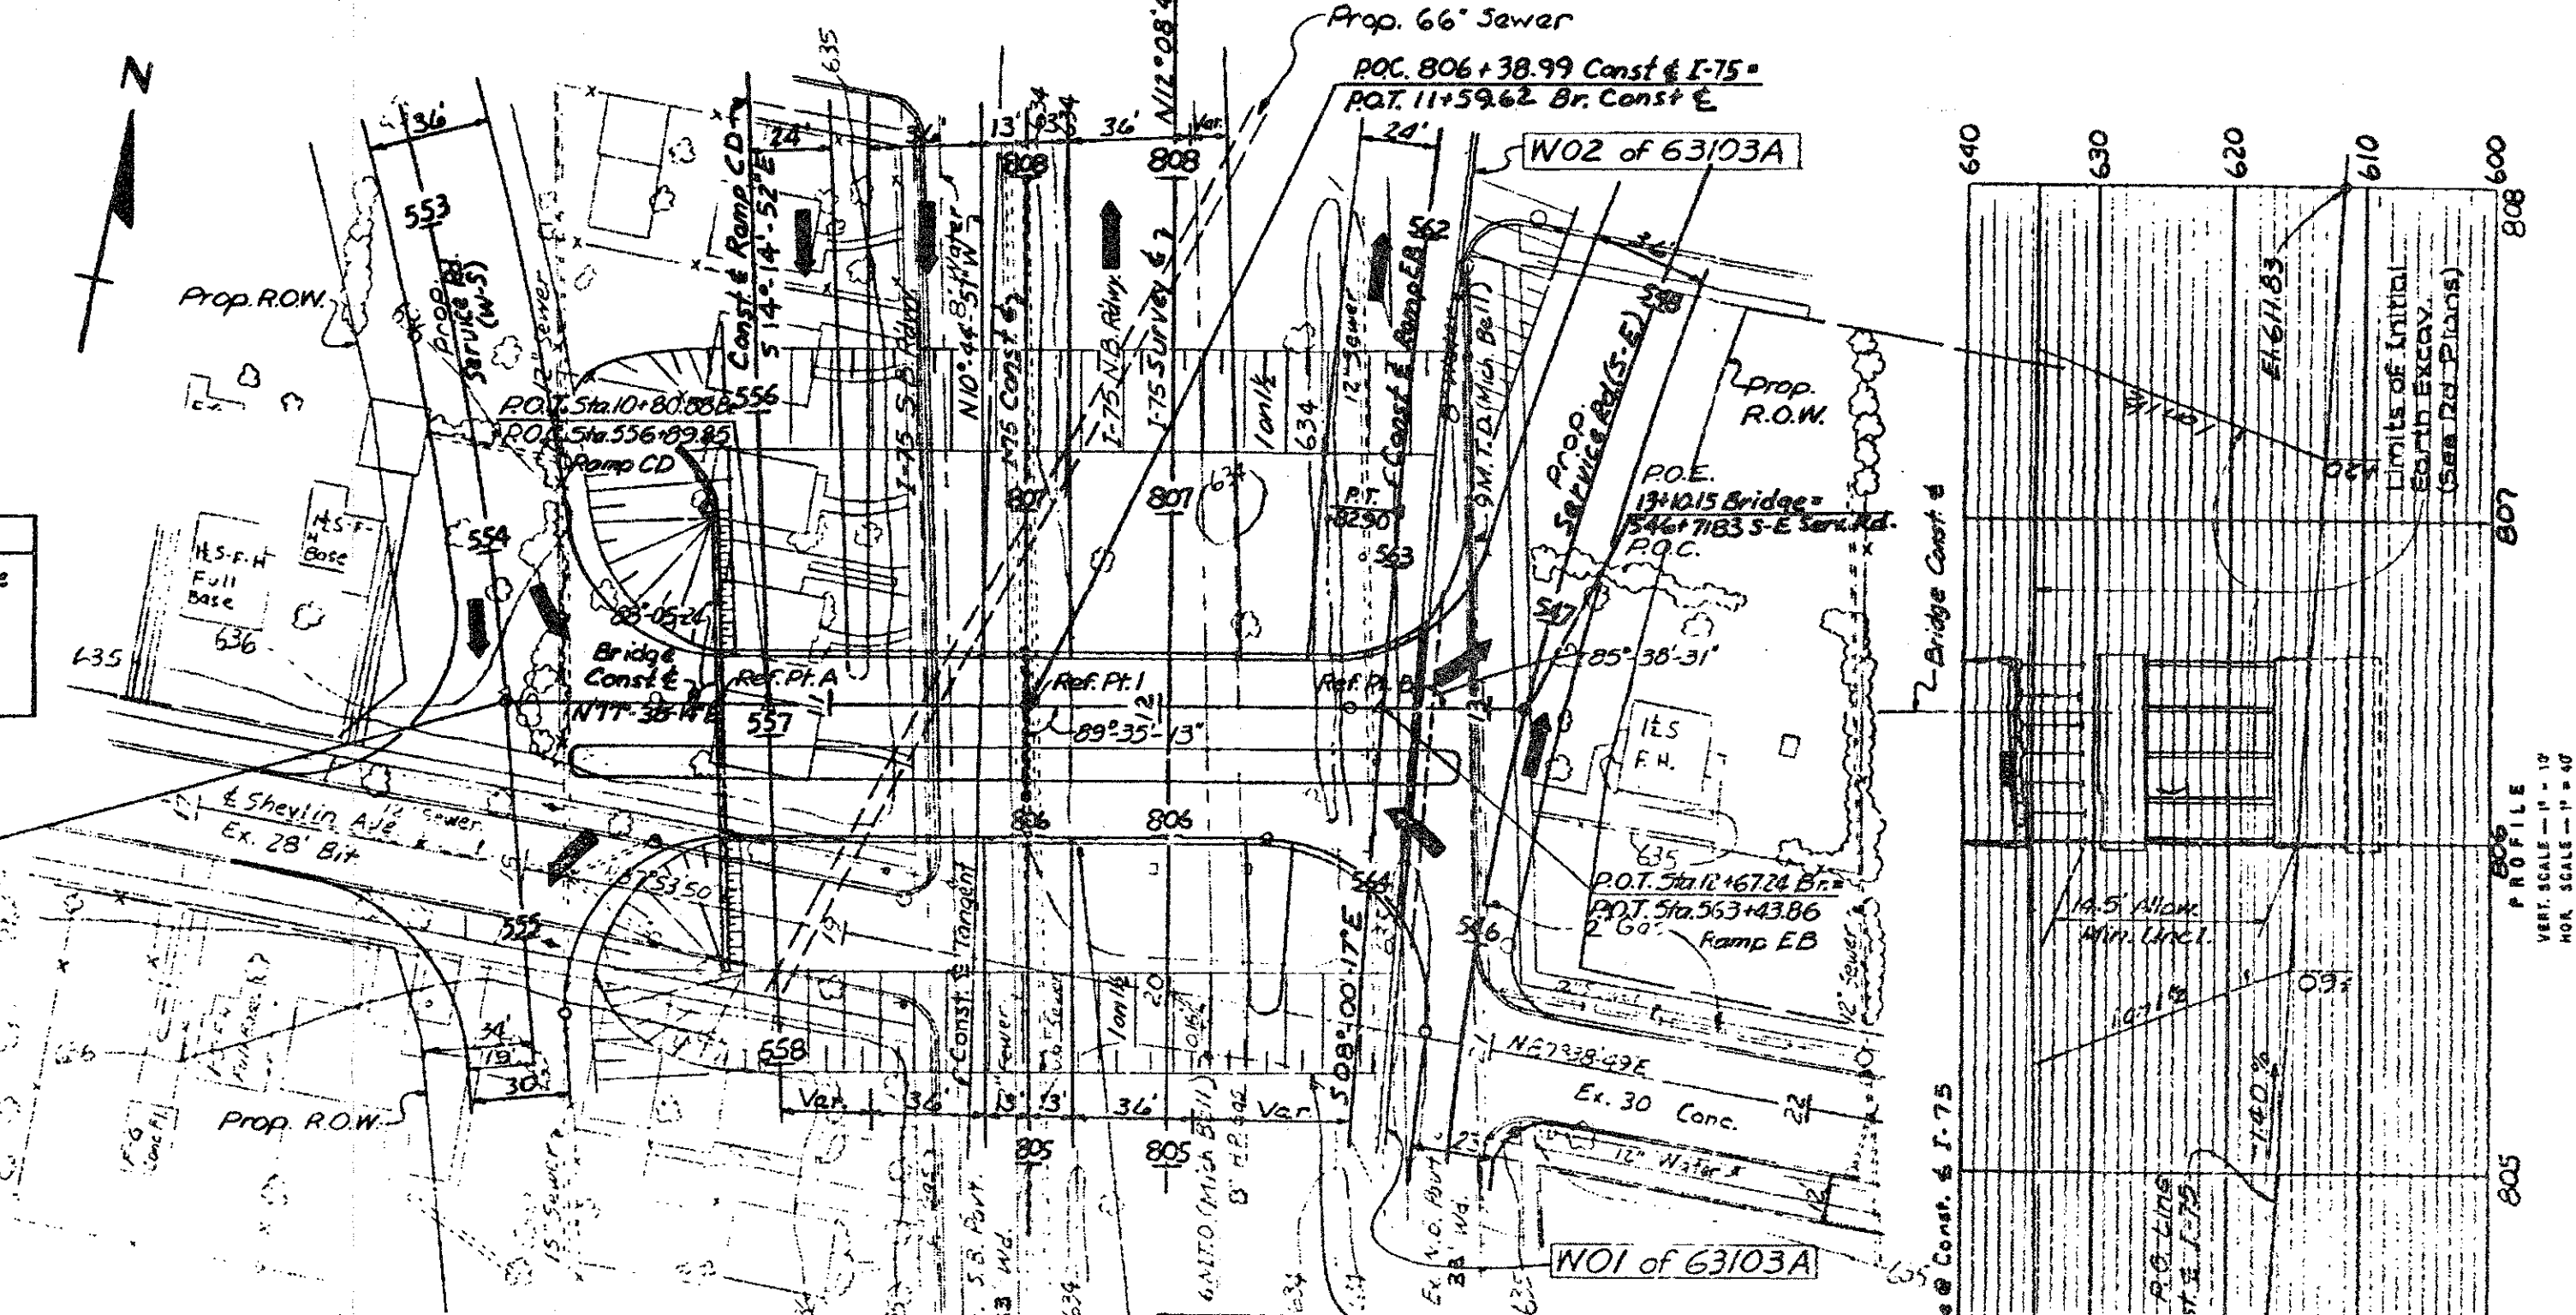


WITNESSES TO ALIGNMENT

PK Nail
 N55°E 74.78' N.W. Cor. Bldg. #1409
 N77°E 43.10' S.W. Cor. Bldg. #1409
 S60°E 85.04' S.W. Cor. Bldg. #1415
 P.O.C. Sta. 816+41.50
 PK Nail
 N2°W 62.08' N4C-GP
 N34°E 87.57' N4C-GP
 S63°E 89.22' N4C-GP
 P.I. Sta. 795+12.06
 Boat Spike
 N78°W 55.25' N.E. Corner Bldg. #4207
 S53°W 56.58' N4C-LP
 S18°W 113.25' N4C-Tk12' Elm.

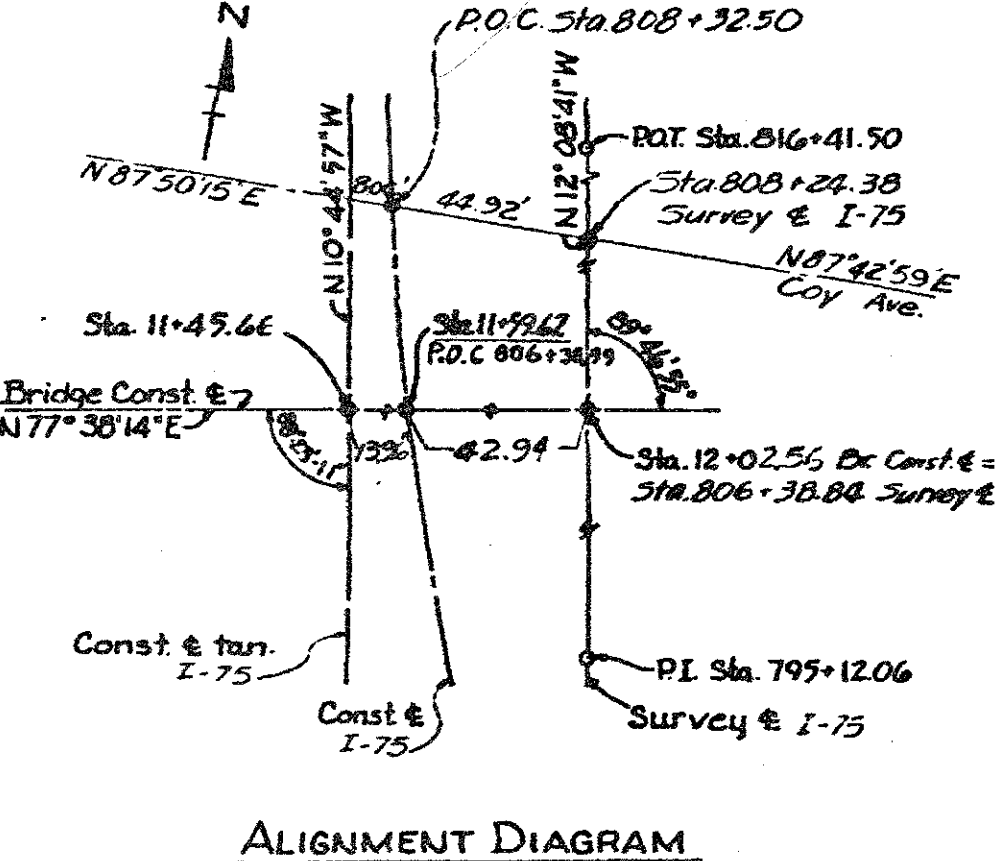

Construction Sequence

Construct Abut. A.
 Remove Old N.B. Pavement.
 Construct Abut. B.
 Construct Ret. Wall, WO1 & WO2 of 63103A.
 Complete Construction of Bridge.

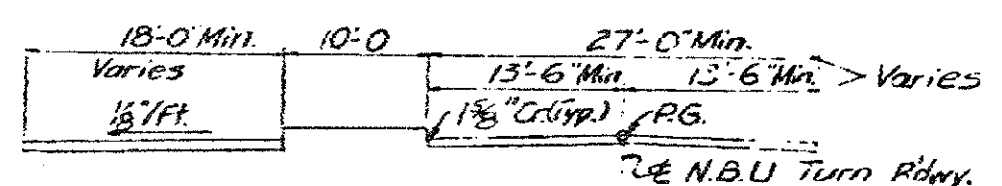



NOTES:

This bridge is part of an interchange and all area shown is within M.D.S.H. R.O.W.

The work shown on these plans includes construction of the proposed bridge, placing slope protection to the limits shown and filling abandoned basins to the grade shown. All other items which are a part of this contract.

The contractor shall locate all active underground utilities prior to starting work, and shall conduct his operations in such a manner as to insure that these utilities not requiring relocation will not be disturbed.

Removal of buildings is not a part of this contract. Shevlin Ave. traffic is to be detoured over the Exist Streets. The Detroit Edison Co. power lines in the vicinity of the proposed structure will be relocated or removed.

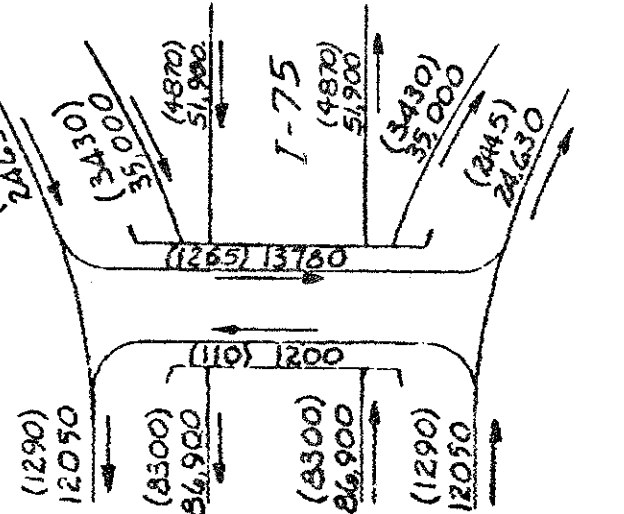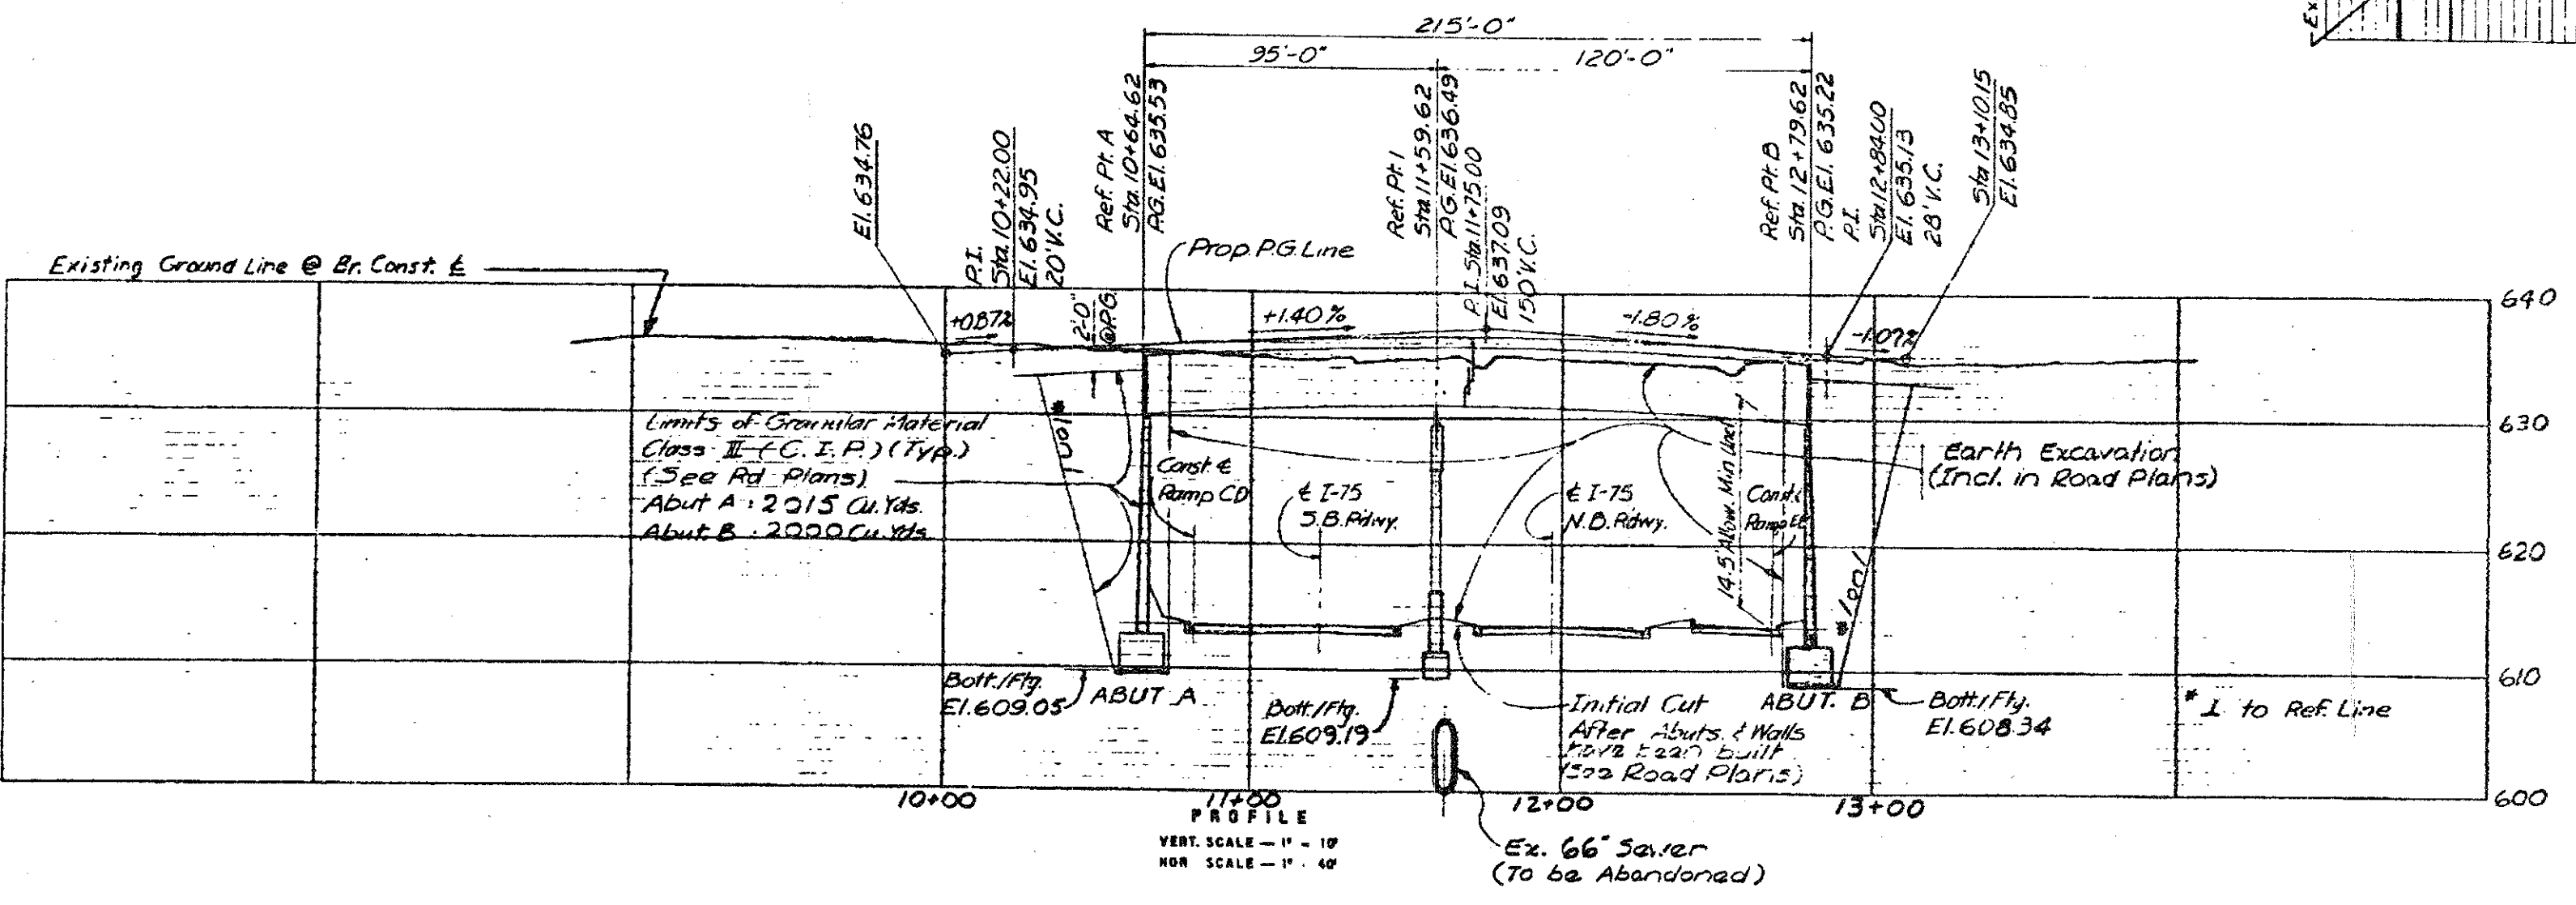

MICHIGAN STATE HIGHWAY DEPARTMENT
 SHEVLIN DOUBLE U TURN OVER I-75 IN THE CITY OF HAZEL PARK
 GENERAL PLAN OF SITE

APPROVED: *Laurence O. Check* 6-5-69
 ASST. SUPERVISOR-DESIGN

APPROVED: *John C. Feltus* 6-5-69
 SUPERVISOR-DESIGN

DATE: 6-5-69
 SHEET: 2 OF 22
 S04 OF 63103A






NOTE:
 DO NOT WORK FROM THIS SHEET. THE INFORMATION SHOWN HERE IS FOR REFERENCE ONLY. NO PAY ITEMS ARE SHOWN.

FOR INFORMATION ONLY

DATE	CONT. SEC.	JOB NO.	DESIGN UNIT	SHEET
10-18-99	S04 OF 63103	48404A	MAHDAVI	2 OF 24

DATE: DATE: DATE: DATE: 02-10-99 CHECKED BY: INDOR DRAWN BY: INDOR FILE NAME: s0463103a

REVISIONS			
NO.	DESCRIPTION	DATE	BY

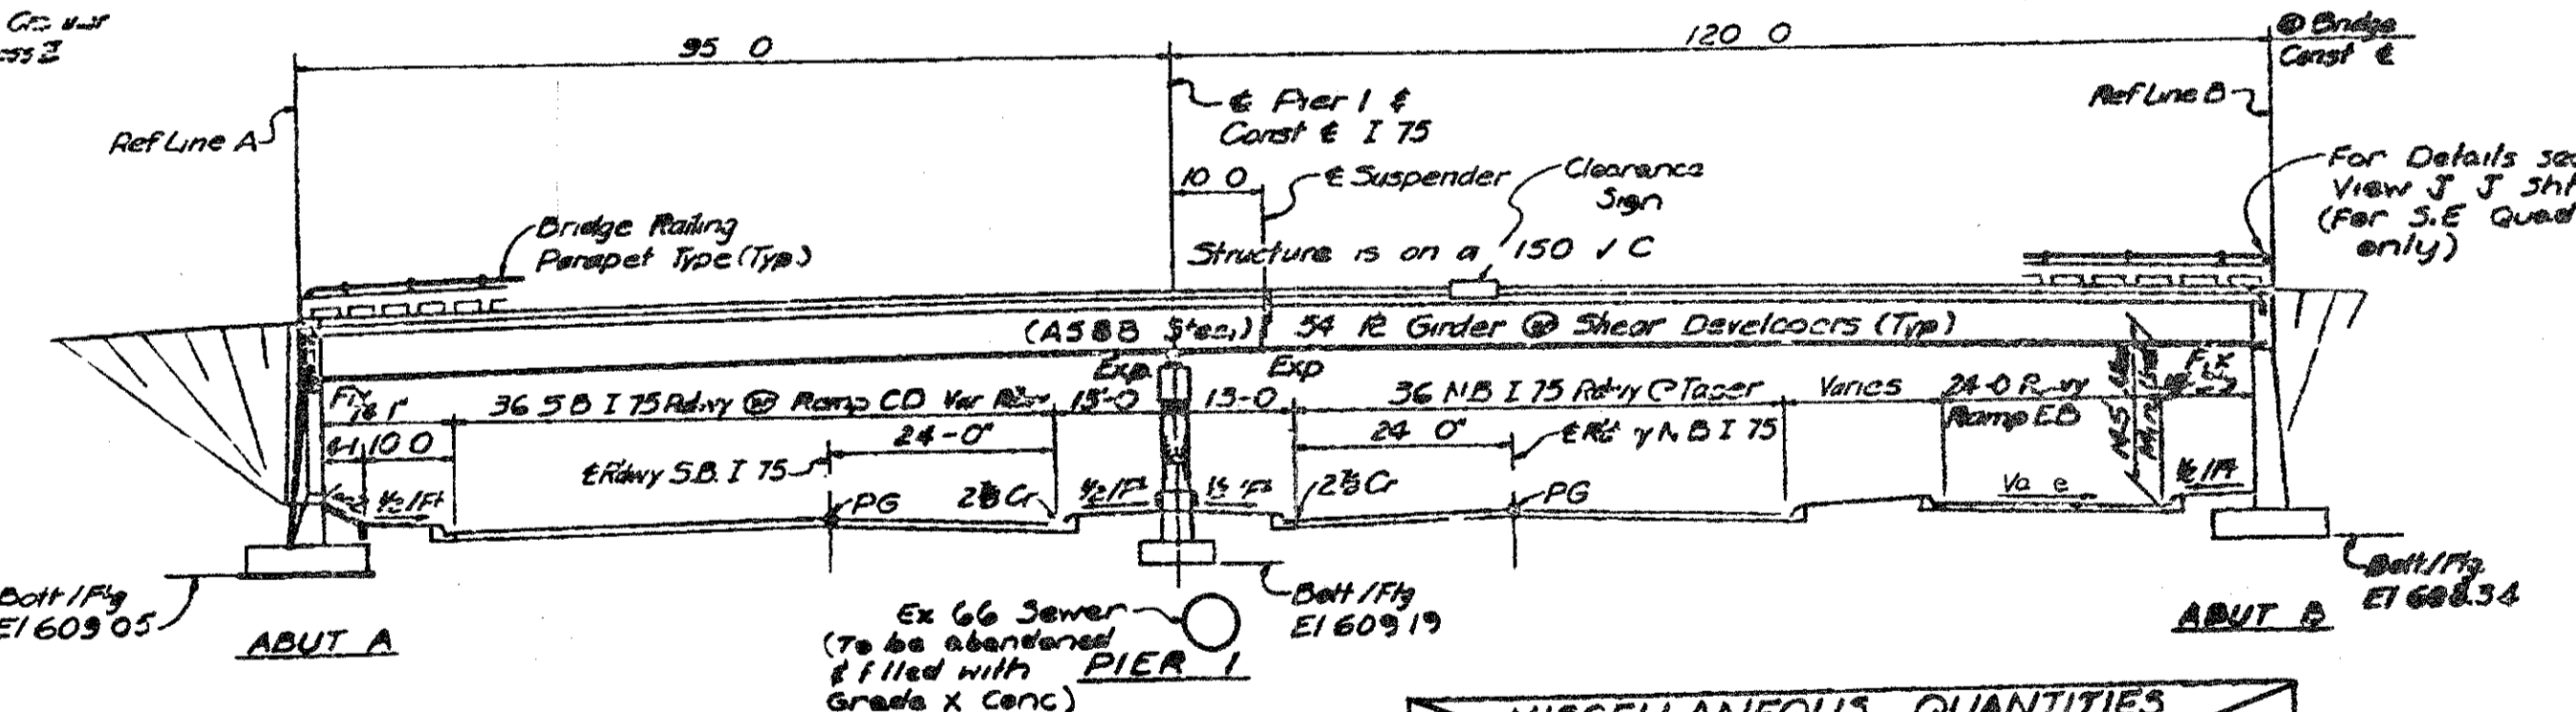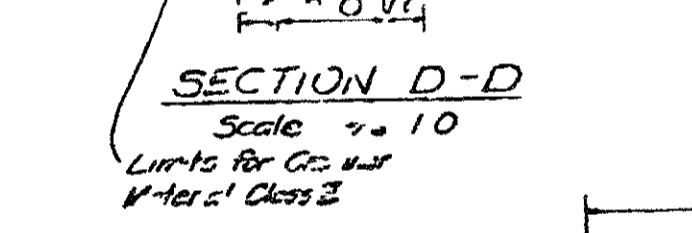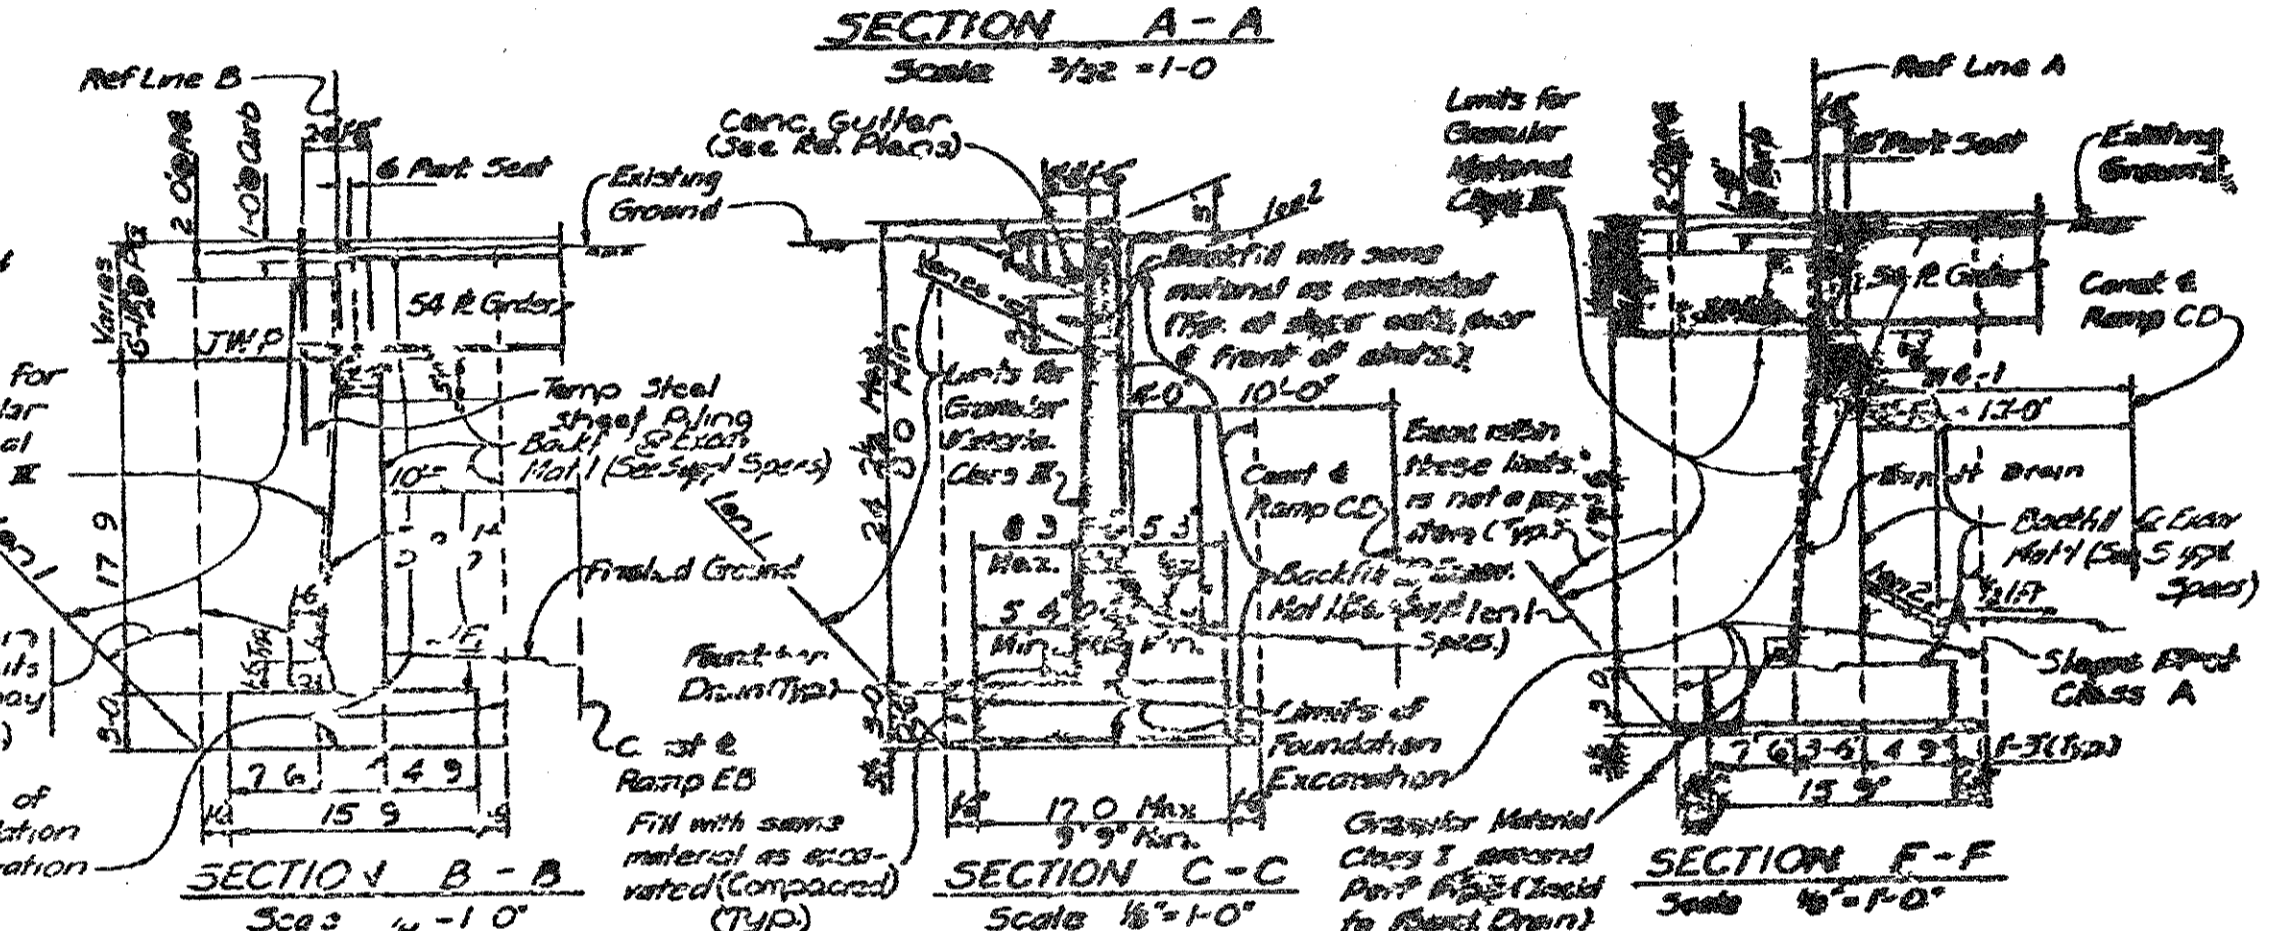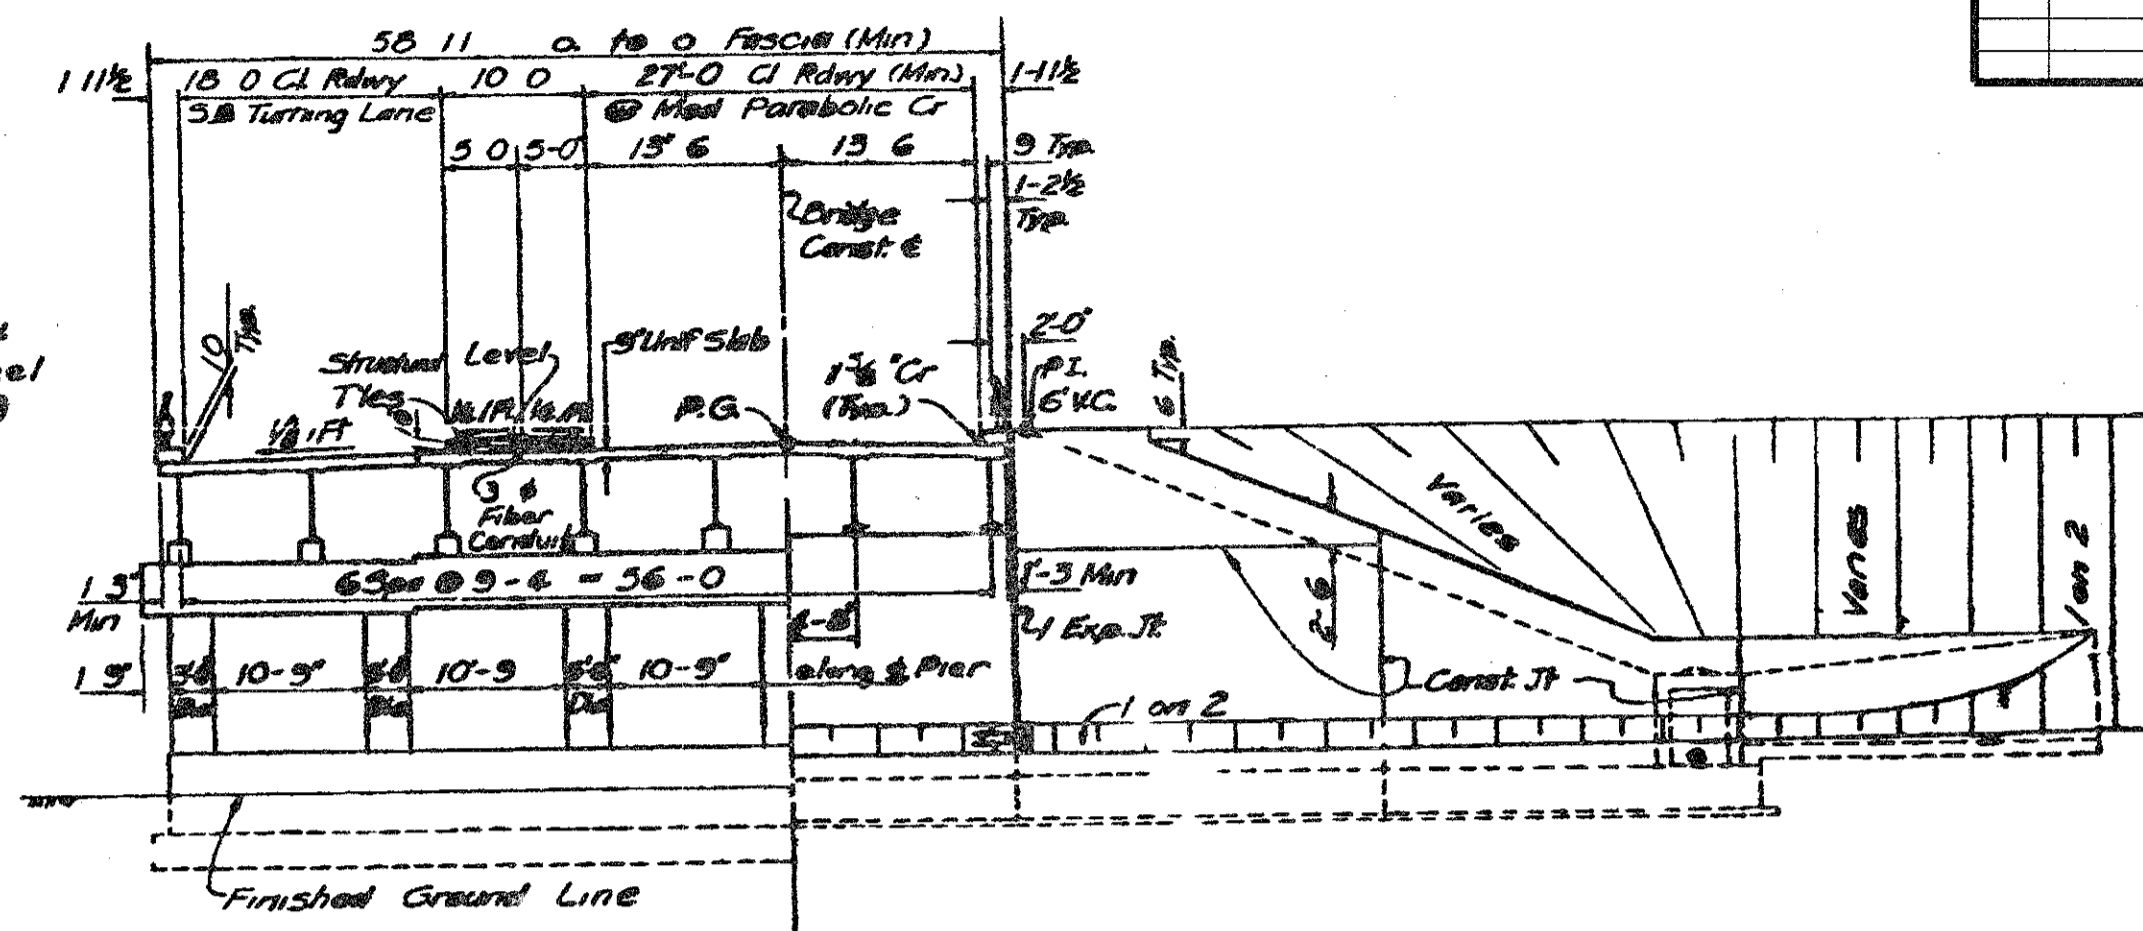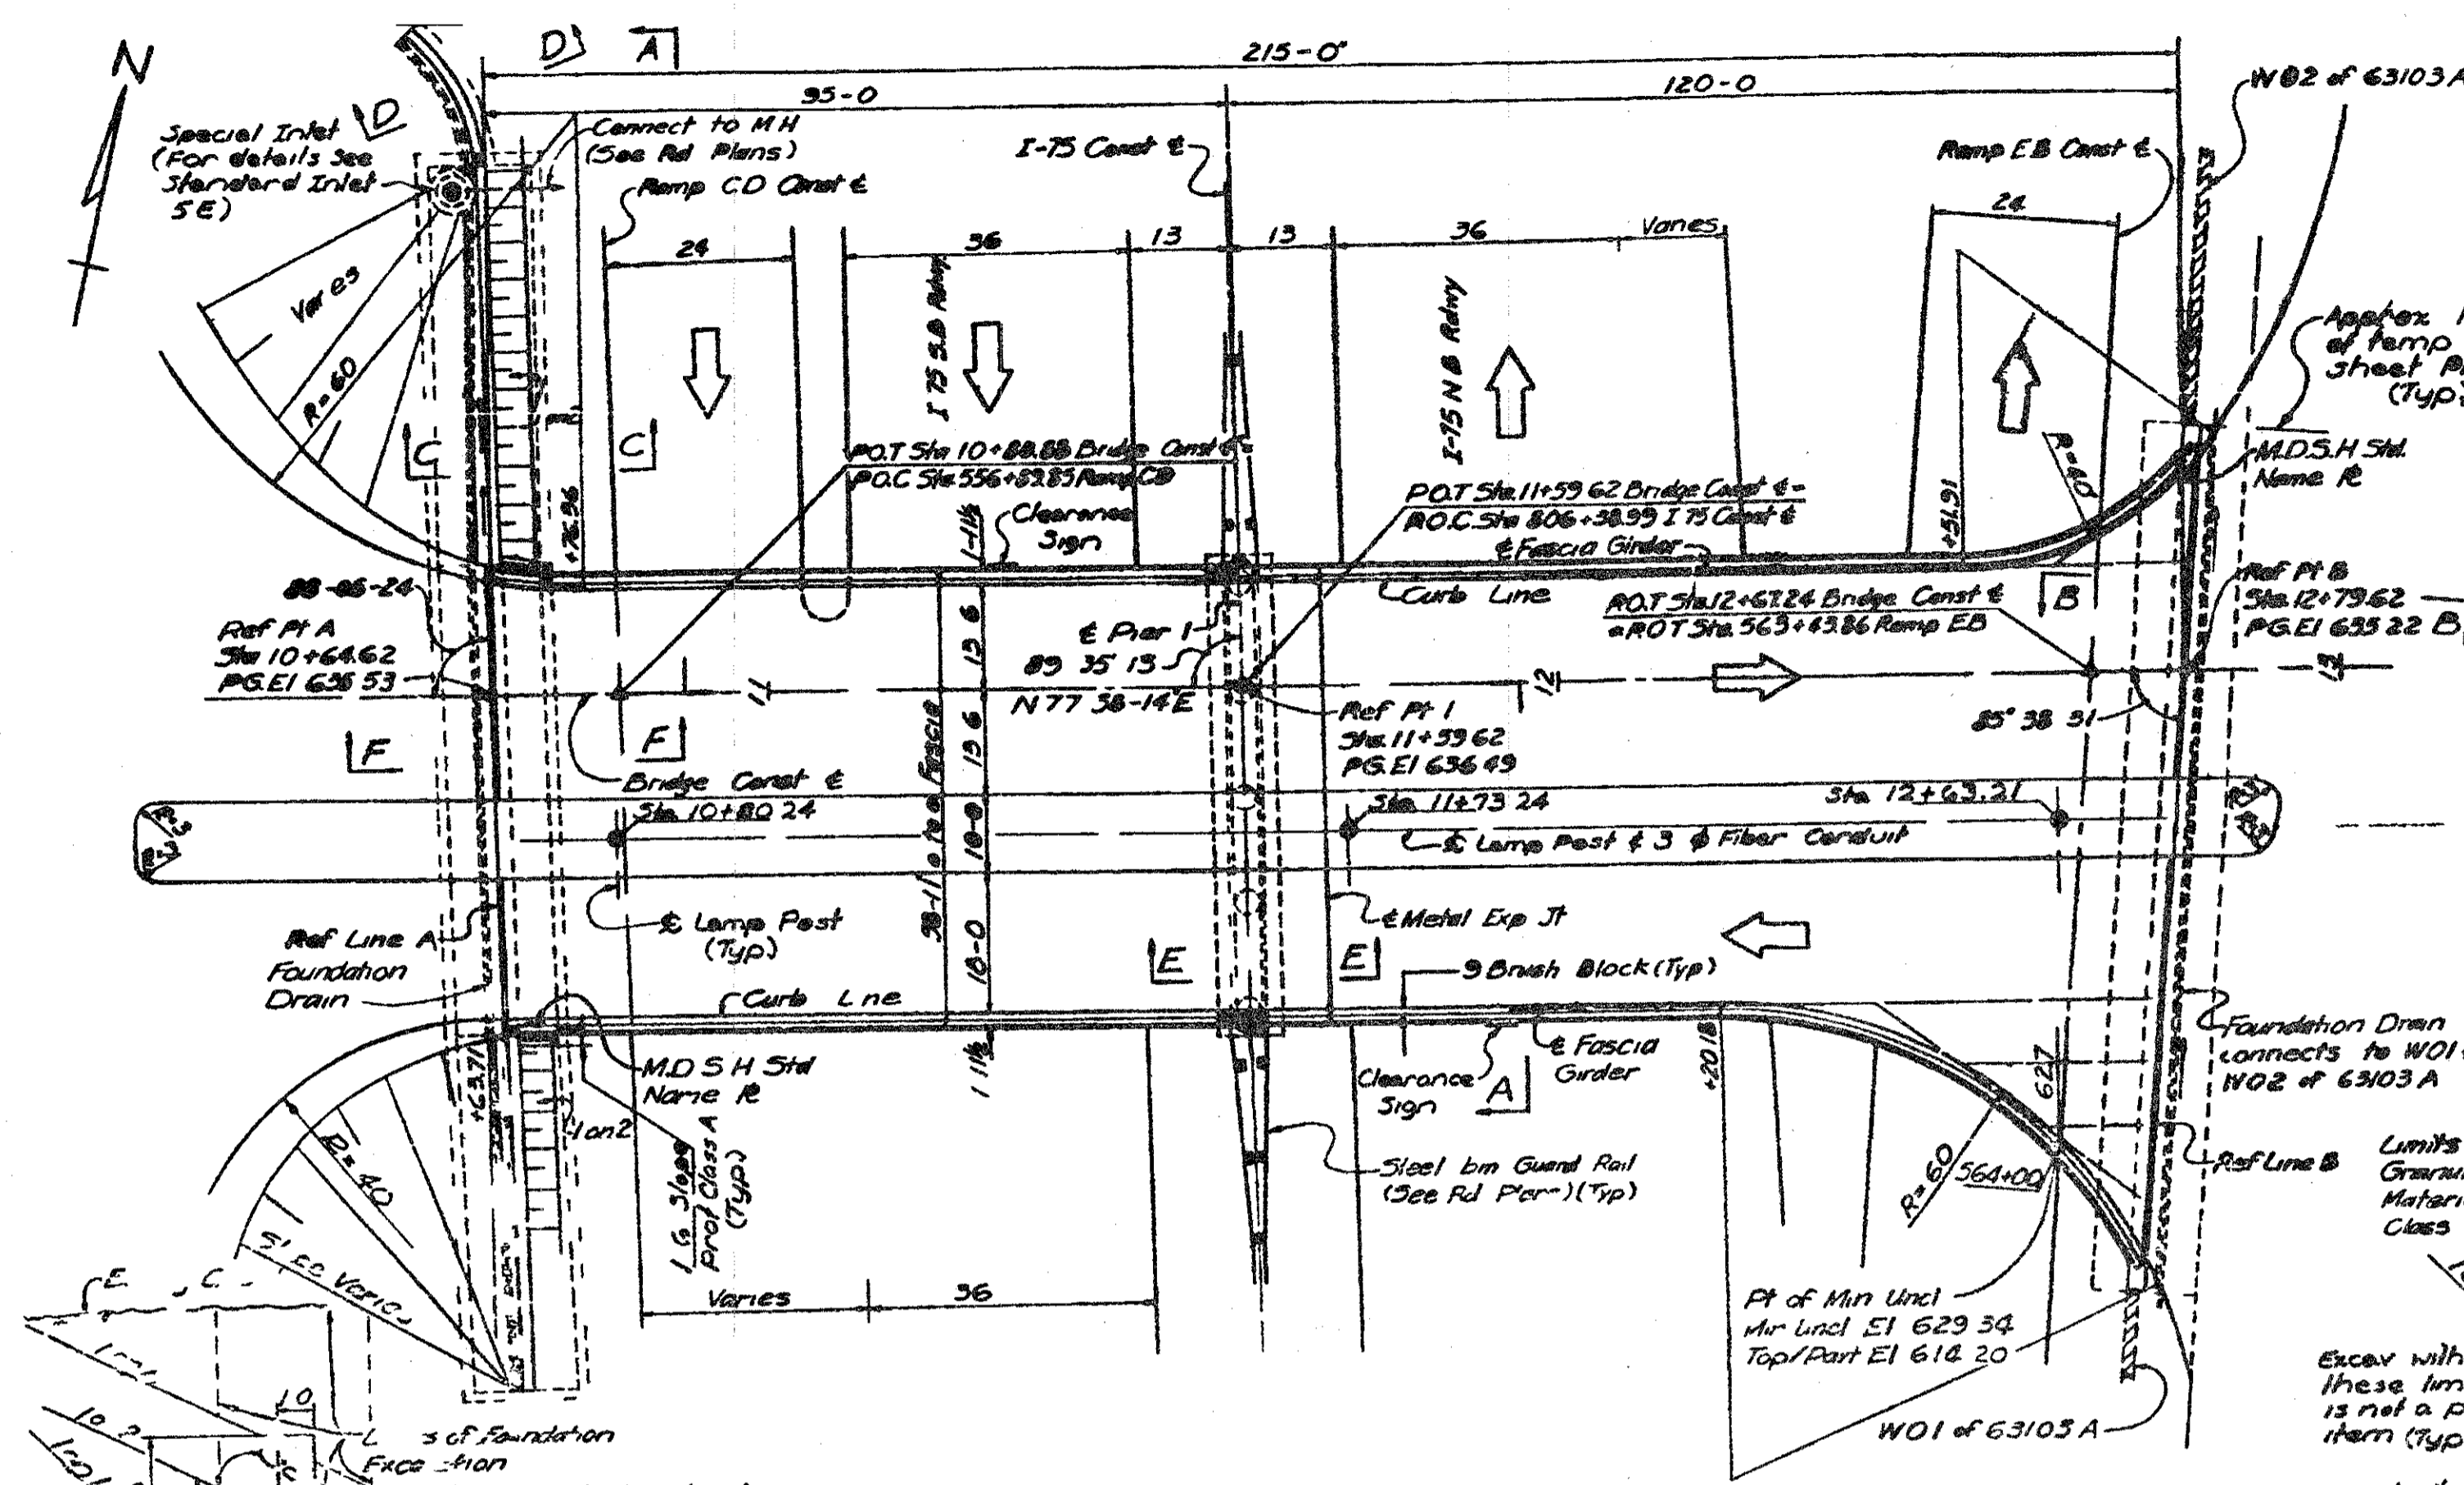

MISCELLANEOUS QUANTITIES		
Item	Unit	Amount
Slope Protection Class A	Sq Yds	31
Slope Protection Headers	Ln Ft	73
Temporary Steel Sheet Piling	Sq Ft	990
Foundation drain	Ln Ft	296
Special Inlet	Each	1
Parade X Concrete	Cu Yds	75

NOTES:
 The design of this structure is based on the M.D.S.H. Specifications for the Design of Highway Bridges, 1958 edition and current AASHTO Standard Specifications for Highway Bridges (HSB) loading. Live load plus impact deflection equals $V/1000$ of span length and $1/350$ of cantilever arm.
 The top of roadway slabs and tops of curbs are parallel to the vertical curve and tangents except as modified by super-elevation transition.
 The lateral pay limits of temporary steel sheet piling are as required & determined by the engineer.
 The contractor shall be responsible for providing adequate protection of bottoms and sides of the footing excavations against damage by personnel equipment and water.
 The abandoned '66 sewer shall be filled with grade X concrete between sfa 805'-85' and sfa 806'+70'.
 For details of Slope Protect on see Standard Sheet SP 2.
 Where walling against faces of walls that are exposed, the concrete will be protected by a soil polymer type film or other suitable material included in unclassified Elevation.

MICHIGAN DEPARTMENT OF STATE HIGHWAYS
 I 69 EB SERVICE RD & I 75 SERVICE RD U TURNS OVER I 75 IN HAZEL PARK
GENERAL PLAN OF STRUCTURE

APPROVED: *Lawrence J. Chisholm* 6-2-99 SUPERVISOR-DESIGN
 APPROVED: *J. C. Tinkler* 6-5-99 SUPERVISOR-DESIGN

DATE: 6-2-99
 SHEET: S04 of 63103A

NOTE:
 DO NOT WORK FROM THIS SHEET. THE INFORMATION SHOWN HERE IS FOR REFERENCE ONLY. NO PAY ITEMS ARE SHOWN.

FOR INFORMATION ONLY




DATE	CONT. SEC.	JOB NO.	DESIGN UNIT	SHEET
10-18-99	S04 OF 63103	48404A	MAHDAVI	3 OF 24



DATE: 02-18-99 CHECKED BY: INDEX DRAWN BY: INDEX CORRECTED BY: INDEX

CONTROL S04 OF 63103 SECTION NO. 48404A

REVISIONS			
NO.	DESCRIPTION	DATE	BY

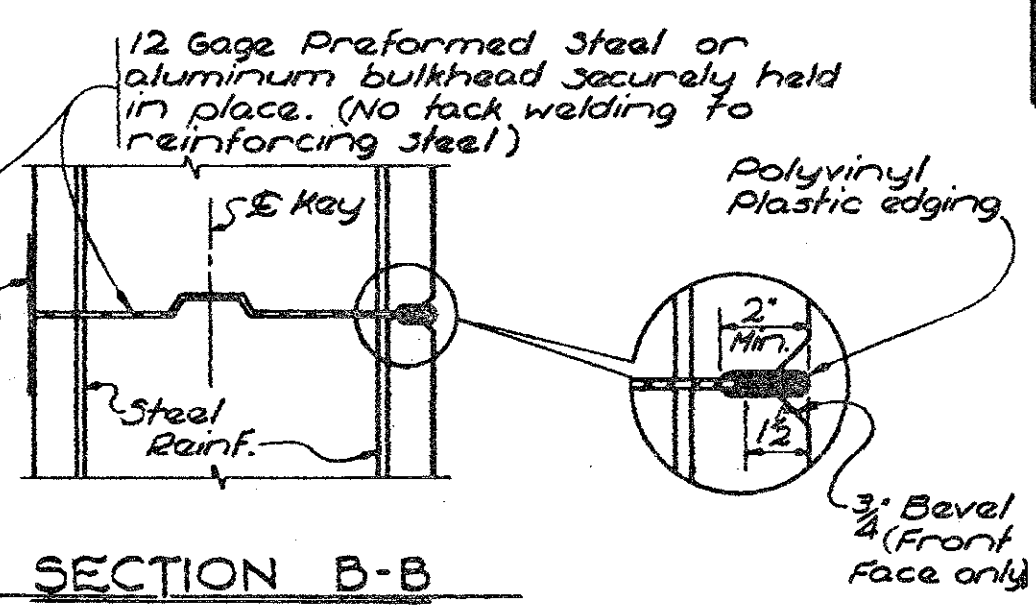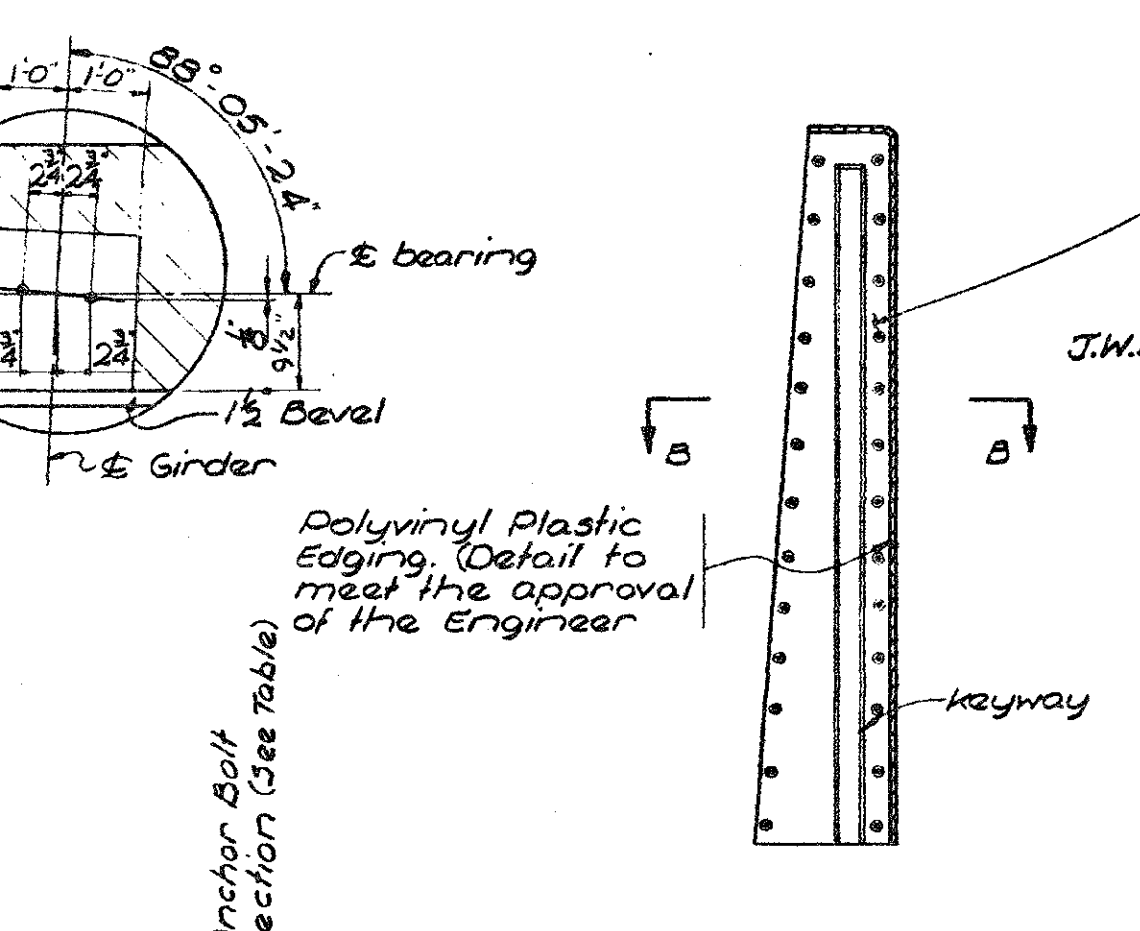
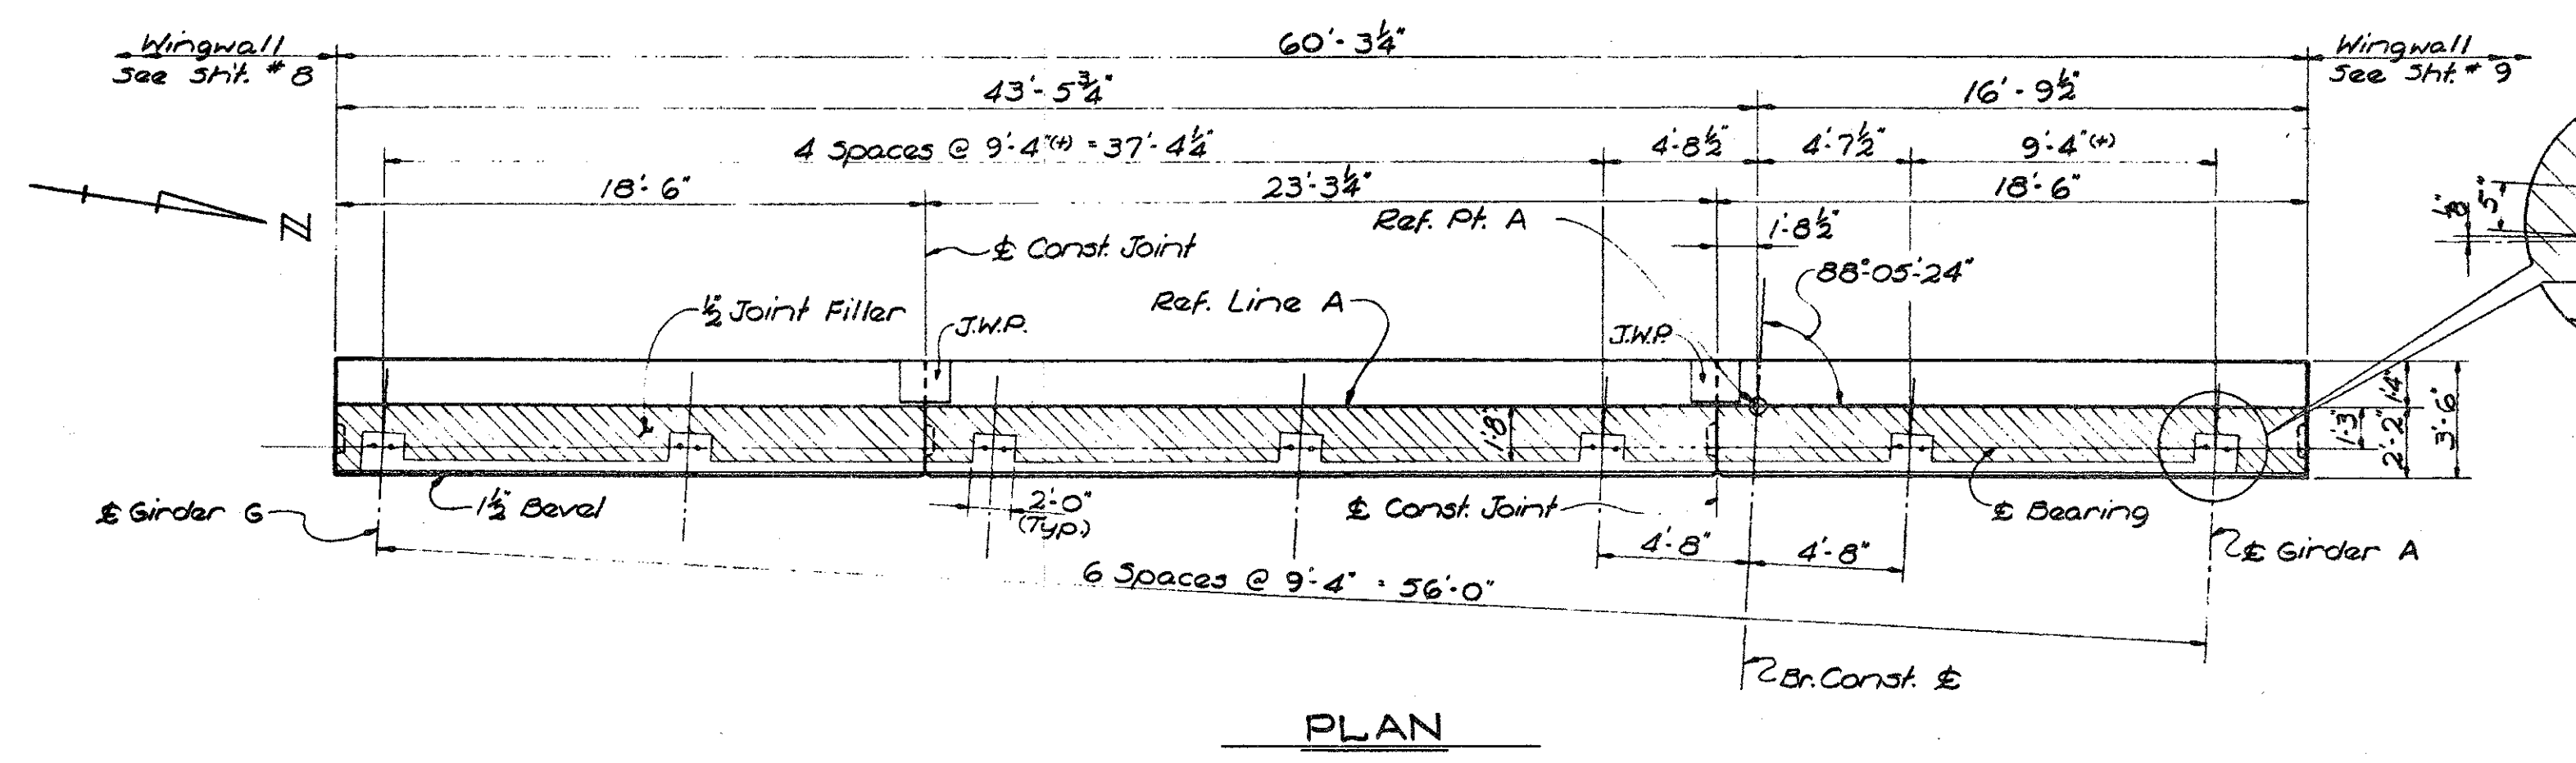


NOTES:

The metal bulkhead may be used as alternate construction joint at contractor's expense.

Care is to be used in casting concrete around bulkhead to prevent displacement or misalignment of the bulkhead.

Cut holes in metal bulkhead for reinforcing steel.

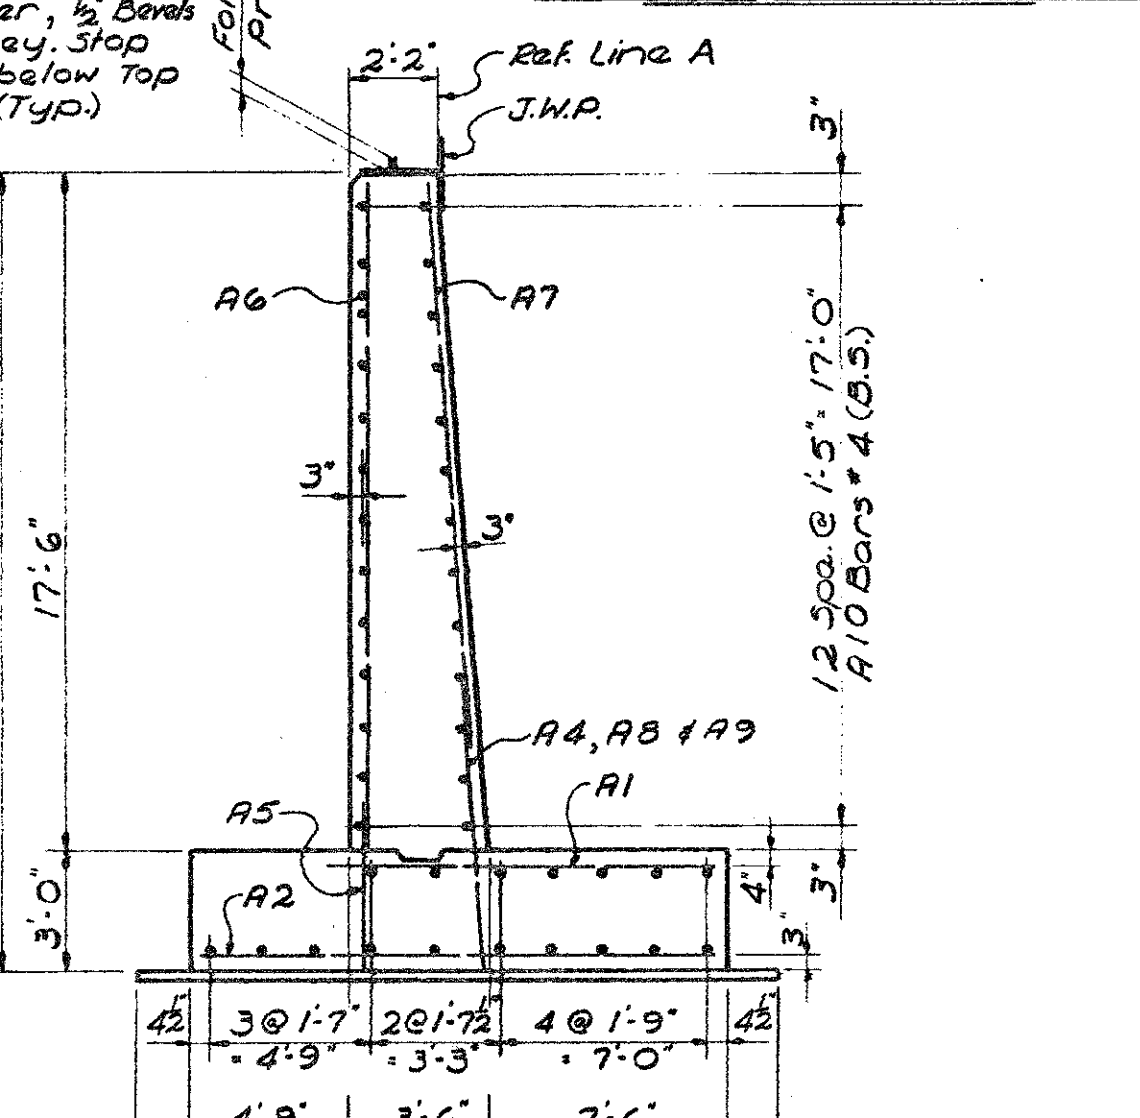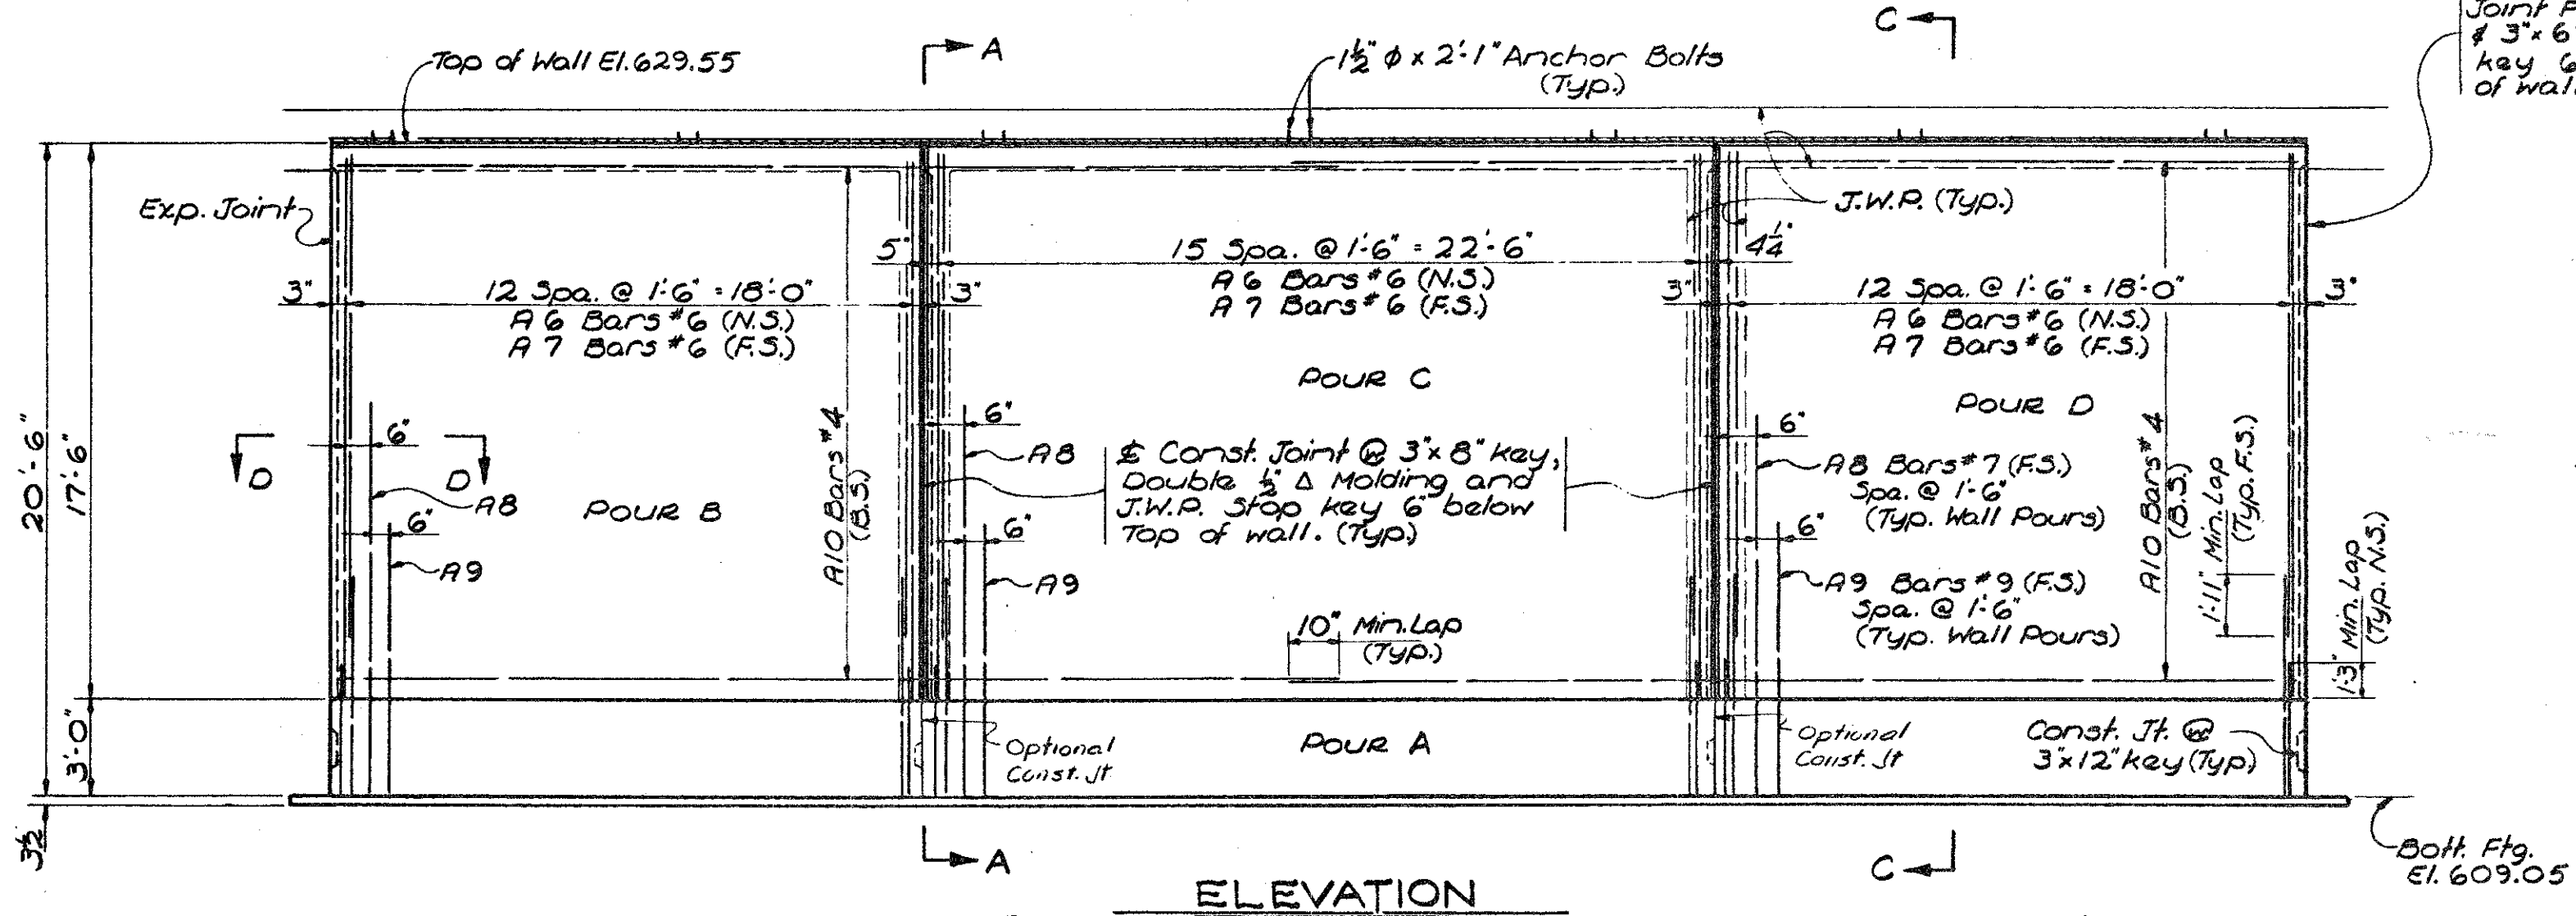

CONCRETE QUANTITIES

Pour	Grade A (GA) Cu. Yds.		Grade A (GAA) Cu. Yds.	
	Abut. 'A'	Abut. 'B'	Abut. 'A'	Abut. 'B'
A	105.5	72.3		
B		123.1	33.9	
C			42.7	37.5
D			33.9	37.3
E				37.3
F				48.0
G				46.4
SUBTOTAL	105.5	195.4	110.5	206.5
TOTAL	300.9 Cu. Yds.		317.0 Cu. Yds.	

MISCELLANEOUS QUANTITIES

Item	UNIT	Abut. 'A'	Abut. 'B'	Total
1/2" Joint Filler	Sq. Ft.	23	34	57
3/4" Joint Filler	Sq. Ft.	89	175	264
1" Joint Filler	Sq. Ft.	121	174	295
Joint Waterproofing	Sq. Ft.	141	245	386
Expansion Joint Drain	Each	2	3	5
Clear Prot. Coating for Subst. C	Sq. Yds.	121	226	347
Concrete Subfooting	Cu. Yds.	12.3		12.3
Unclassified Excavation	Cu. Yds.	1080	1970	3050
Low Temp. Protection	Cu. Yds.			
Substructure Concrete	Cu. Yds.		401.9	401.9

NOTES:

J.W.P. denotes joint waterproofing.

N.S. denotes near side.

F.S. denotes far side.

B.S. denotes both sides.

For bevel and molding details, see standard sheet R11 or R12.

Anchor bolts shall be accurately set to a template.

Maximum average foundation pressure D.L. only equals 3050 pounds per sq. ft.

Maximum foundation pressure D.L. and L.L. equals 1

NOTE:
DO NOT WORK FROM THIS SHEET. THE INFORMATION SHOWN HERE IS FOR REFERENCE ONLY. NO PAY ITEMS ARE SHOWN.


FOR INFORMATION ONLY

DATE	CONT. SEC.	JOB NO.	DESIGN UNIT	SHEET
10-18-99	S04 OF 63103	48404A	MAHDAVI	4 OF 24




1 2 3 4 5 6 7 8 9 10 11 12 13 14 15 16 17 18 19 20 21 22 23 24 25 26 27 28 29 30 31 32 33 34 35 36 37 38 39 40 41 42 43 44 45 46 47 48 49 50 51 52 53 54 55 56 57 58 59 60 61 62 63


REVISIONS			
NO.	DESCRIPTION	DATE	BY

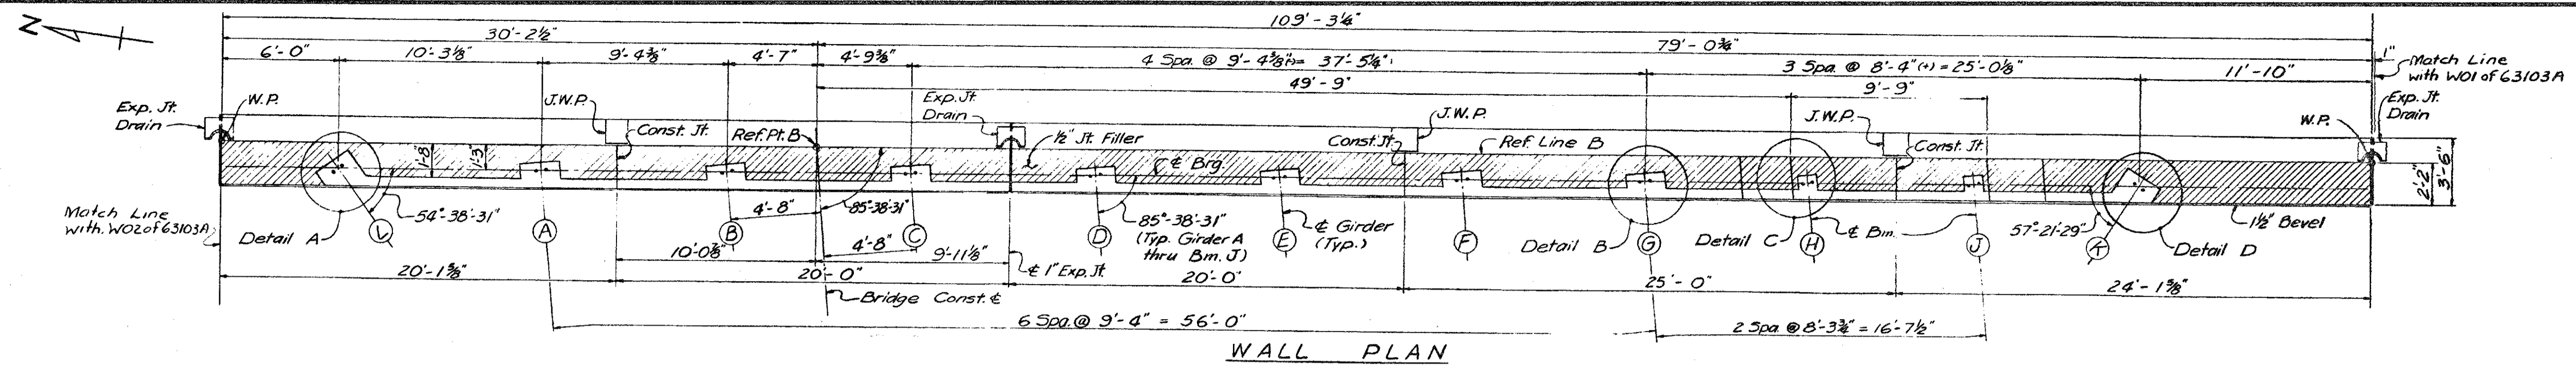

WALL PLAN

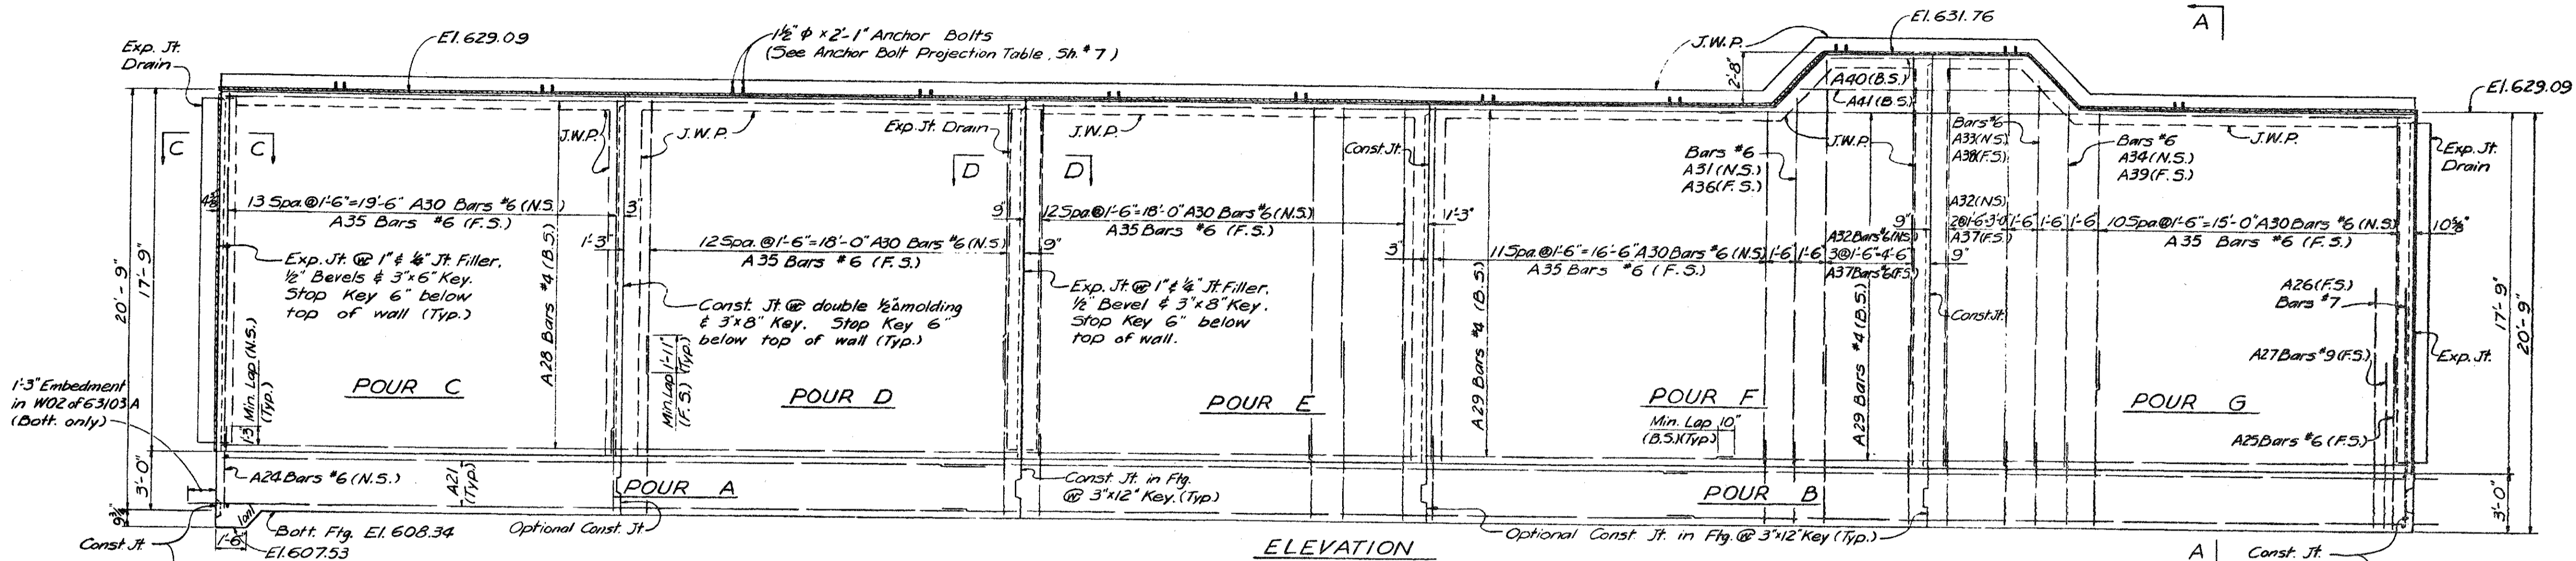

ELEVATION

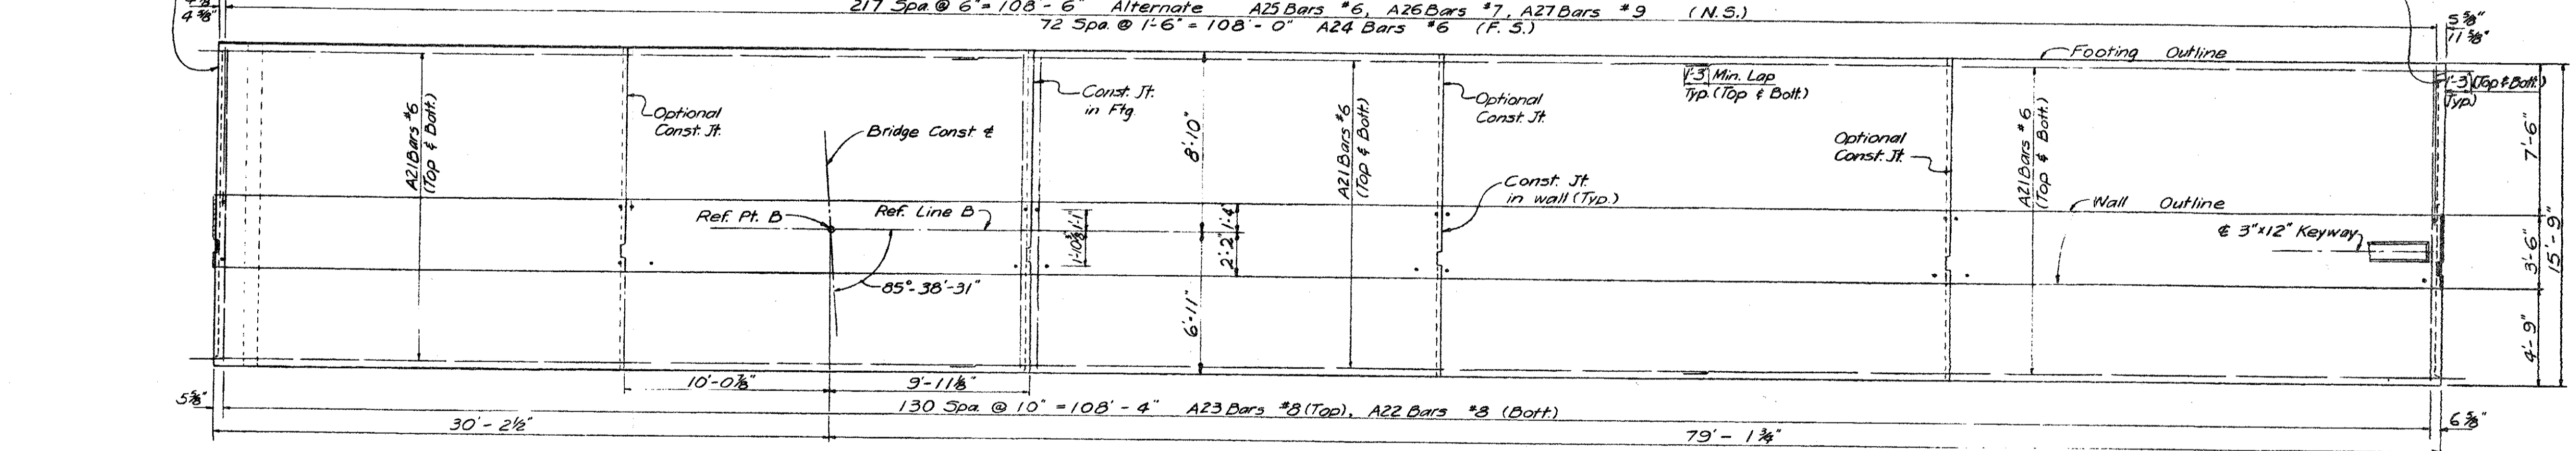

FOOTING PLAN

Work this sheet with sheets # 5 & 7

MICHIGAN DEPARTMENT OF STATE HIGHWAYS

ABUTMENT B DETAILS

REVISIONS			
NO.	DESCRIPTION	DATE	BY

DRAWN BY: Fisher 6-4-69
 CHECKED BY: CHUANG 3-17-69
 SHEET 6 OF 22
S04 of 63103A

NOTE:
DO NOT WORK FROM THIS SHEET. THE INFORMATION SHOWN
HERE IS FOR REFERENCE ONLY. NO PAY ITEMS ARE SHOWN.

FOR INFORMATION ONLY





DATE	CONT. SEC.	JOB NO.	DESIGN UNIT	SHEET
10-18-99	S04 OF 63103	48404A	MAHDAVI	5 OF 24



DATE: DATE: DATE: DATE: 02-10-99 CHECKED BY: CORRECTED BY: DRAWN BY: INDCR FILE NAME: s0463103a

1 2 3 4 5 6 7 8 9 10 11 12 13 14 15 16 17 18 19 20 21 22 23 24 25 26 27 28 29 30 31 32 33 34 35 36 37 38 39 40 41 42 43 44 45 46 47 48 49 50 51 52 53 54 55 56 57 58 59 60 61 62 63


REVISIONS			
NO.	DESCRIPTION	DATE	BY

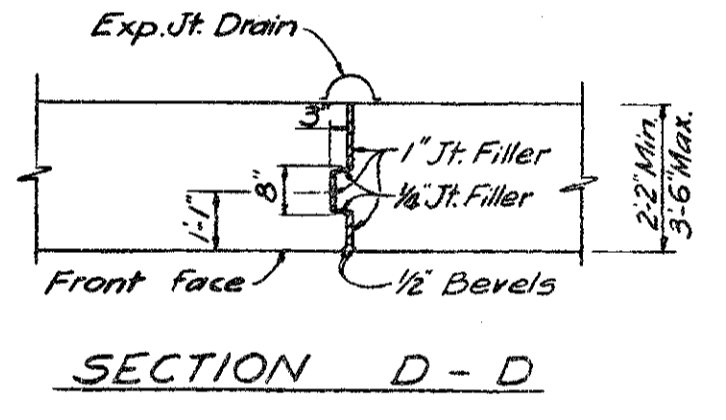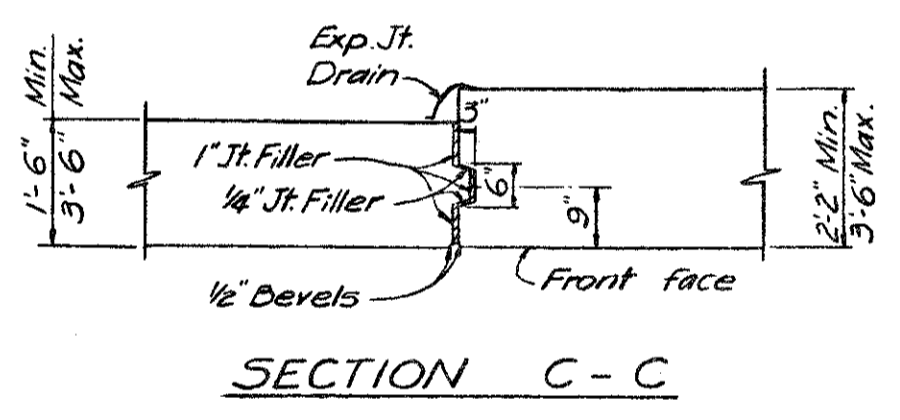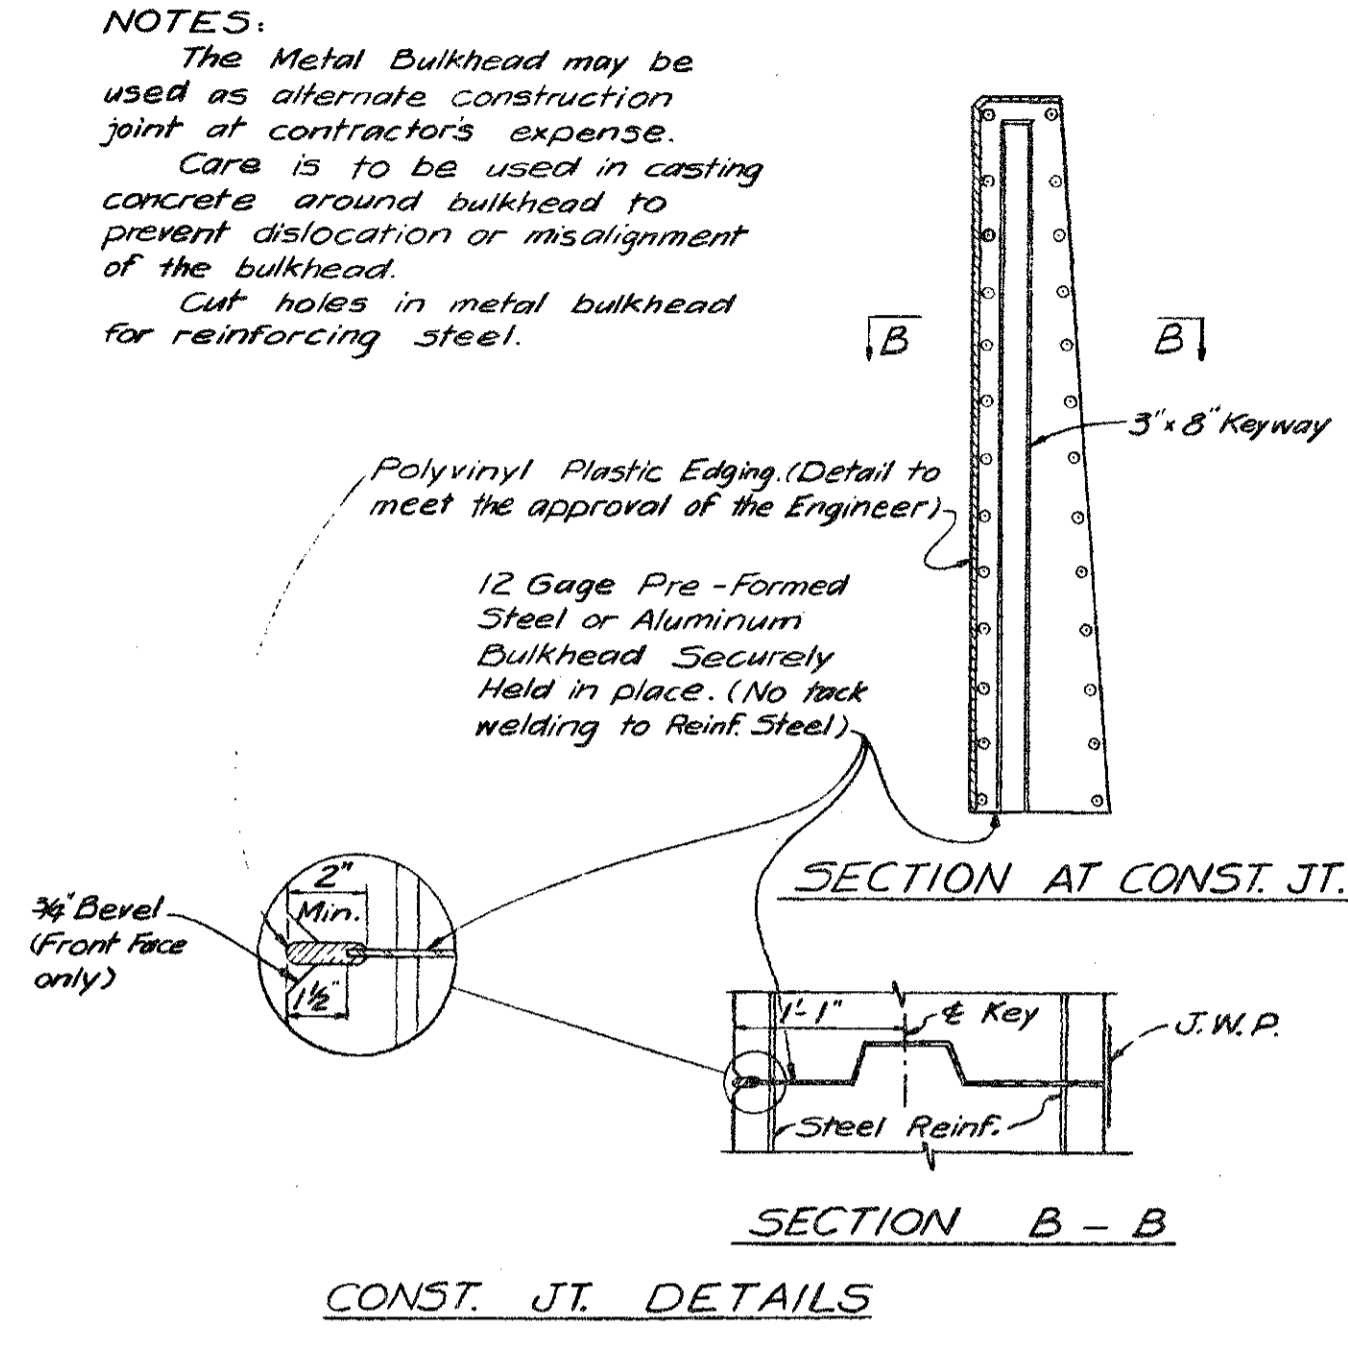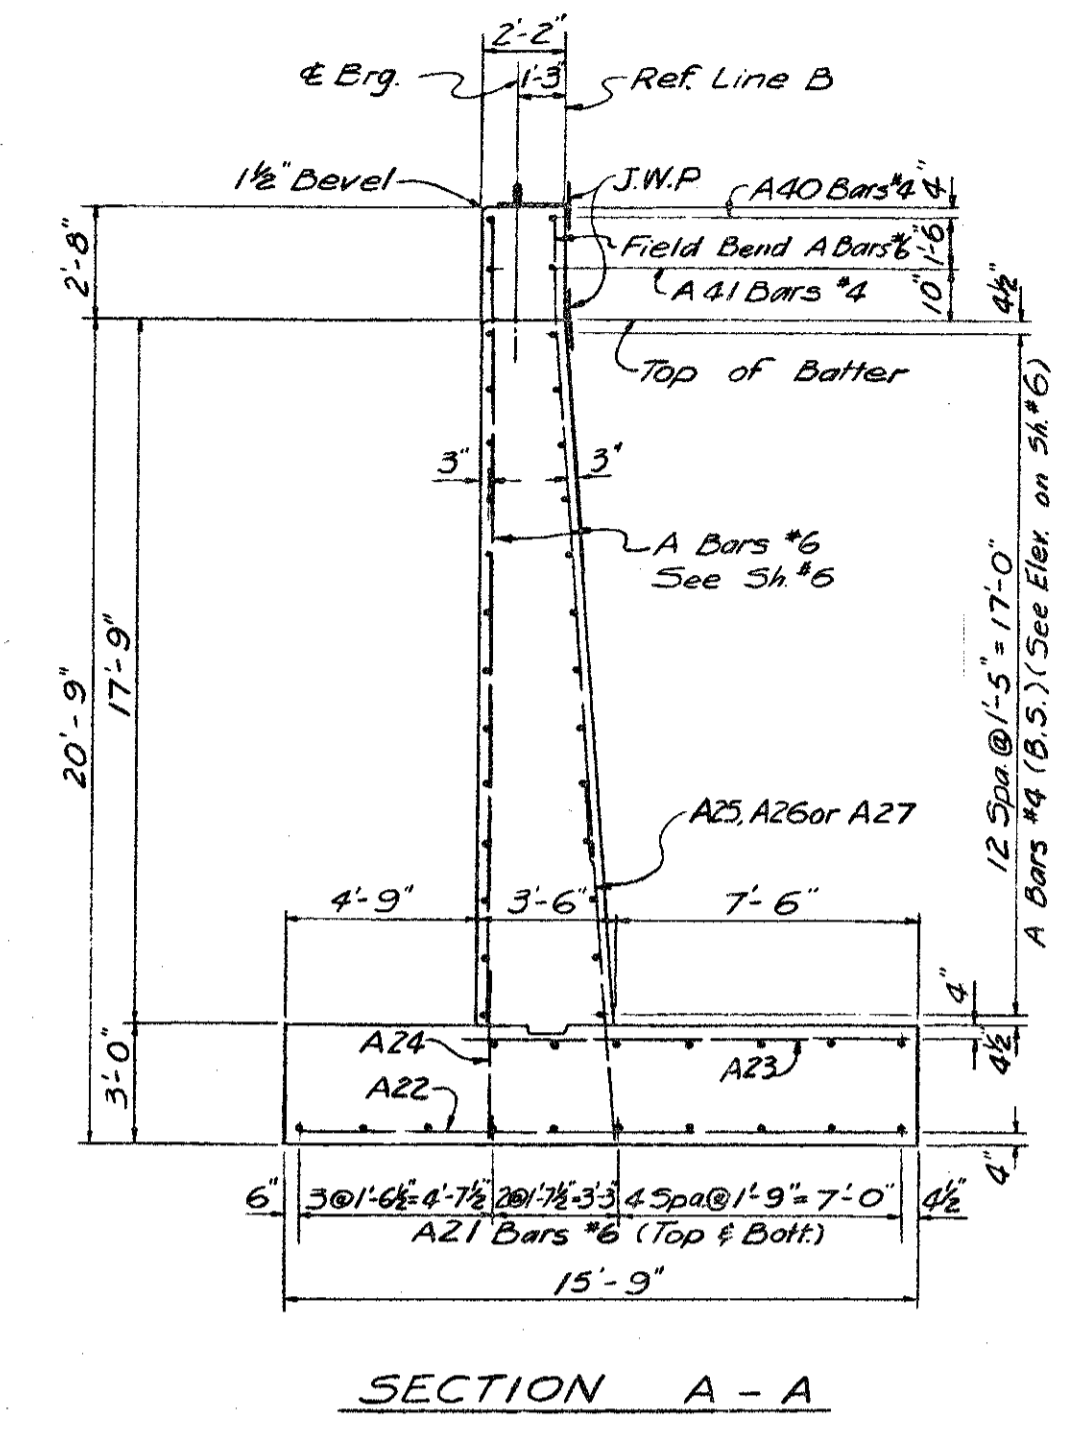

ANCHOR BOLT PROJECTION TABLE

Beam	Abut. B
L	7 1/2"
A	8 3/4"
B	10"
C	10 1/2"
D	9 1/2"
E	9 1/4"
F	8 1/4"
G	7 1/4"
H	7"
J	6 1/4"
K	5 3/4"

NOTES:
 Steel Sheet Piling left in place & Temporary Steel sheet piling shall be of the continuous interlock type, either new or used, in good condition, weighing not less than 22 pounds per square foot of wall and shall be furnished with suitable connecting and corner pieces. Ladle analysis and mill reports are not required for steel used in sheet piling.
 Steel sheet piling left in place shall be driven to its final penetration before adjacent concrete is poured. If it is necessary to lower the top of sheeting after the concrete has been poured, the excess shall be removed by cutting.
 For Expansion Joint Drain Details, see sheet #3.
 For general notes, concrete quantities & miscellaneous quantities, see sh. #5.
 Footing concrete quantities are computed on the basis of an outline 3/4 inch outside of the footing outline, back of the Abutment B, where the concrete is poured against steel sheet piling left in place. No additional allowance will be made in concrete or excavation quantities regardless of the steel sheet piling used.

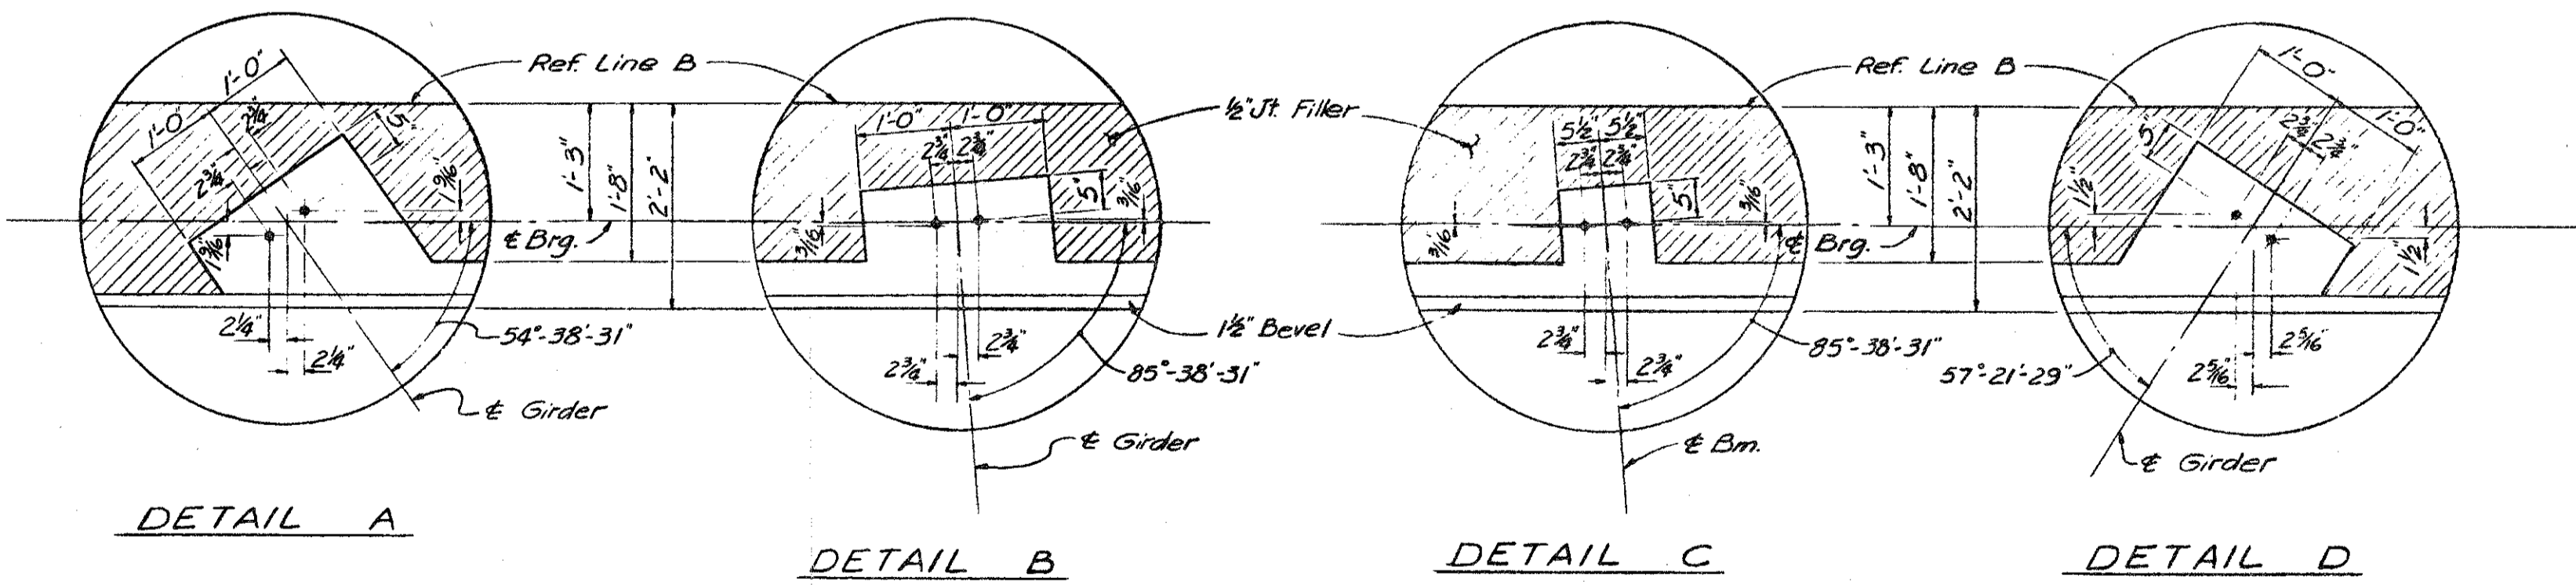

Work this sheet with sh. #5 & 6

MICHIGAN DEPARTMENT OF STATE HIGHWAYS

ABUTMENT B DETAILS

REVISIONS			
NO.	DESCRIPTION	DATE	BY

DRAWN BY: Fisher 1-1-69
 CHECKED BY: CHUNG 3-9-69
 SHEET 7 OF 22
S04 of 63103A

NOTE:
 DO NOT WORK FROM THIS SHEET. THE INFORMATION SHOWN HERE IS FOR REFERENCE ONLY. NO PAY ITEMS ARE SHOWN.

FOR INFORMATION ONLY


DATE	CONT. SEC.	JOB NO.	DESIGN UNIT	SHEET
10-18-99	S04 OF 63103	48404A	MAHDAVI	6 OF 24




DRAWN BY: INDER CHECKED BY: DATE: 02-10-99 CORRECTED BY: DATE: FILE NAME: s0463103a

SH. NO. 7
JOB NO. 48404A
SECTION NO. S04 OF 63103
CONTROL SECTION

1
2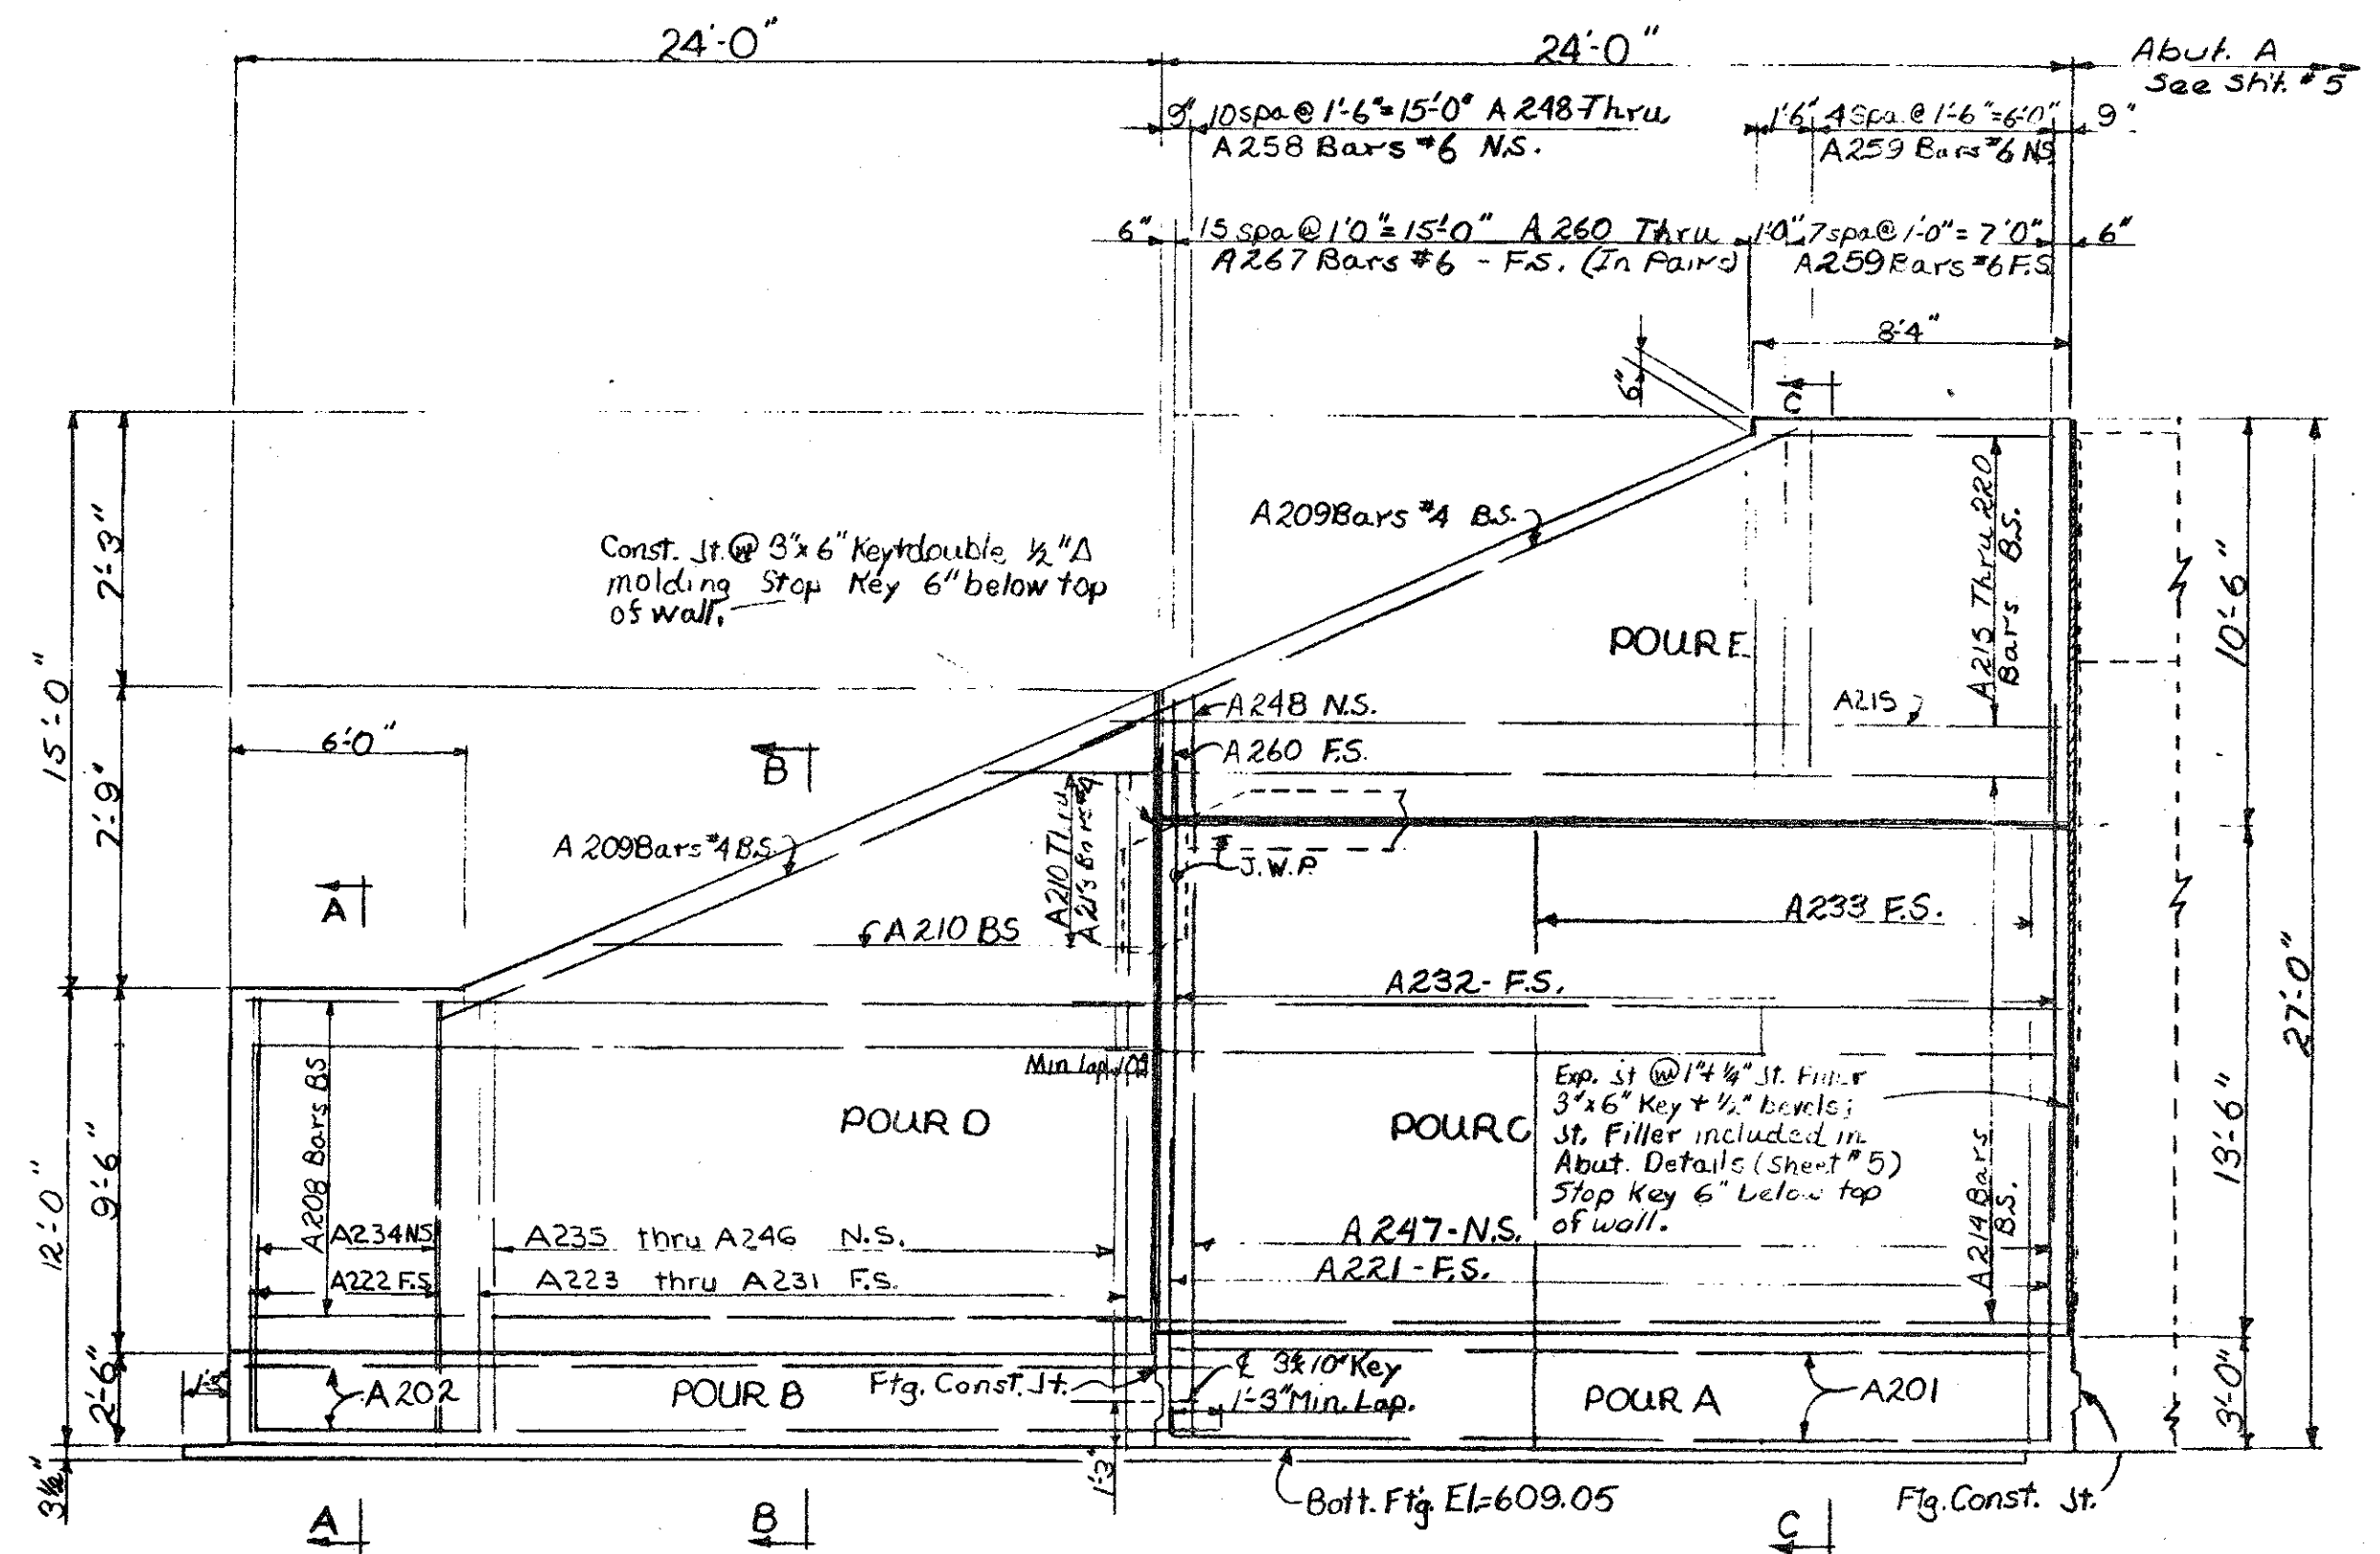
ELEVATION

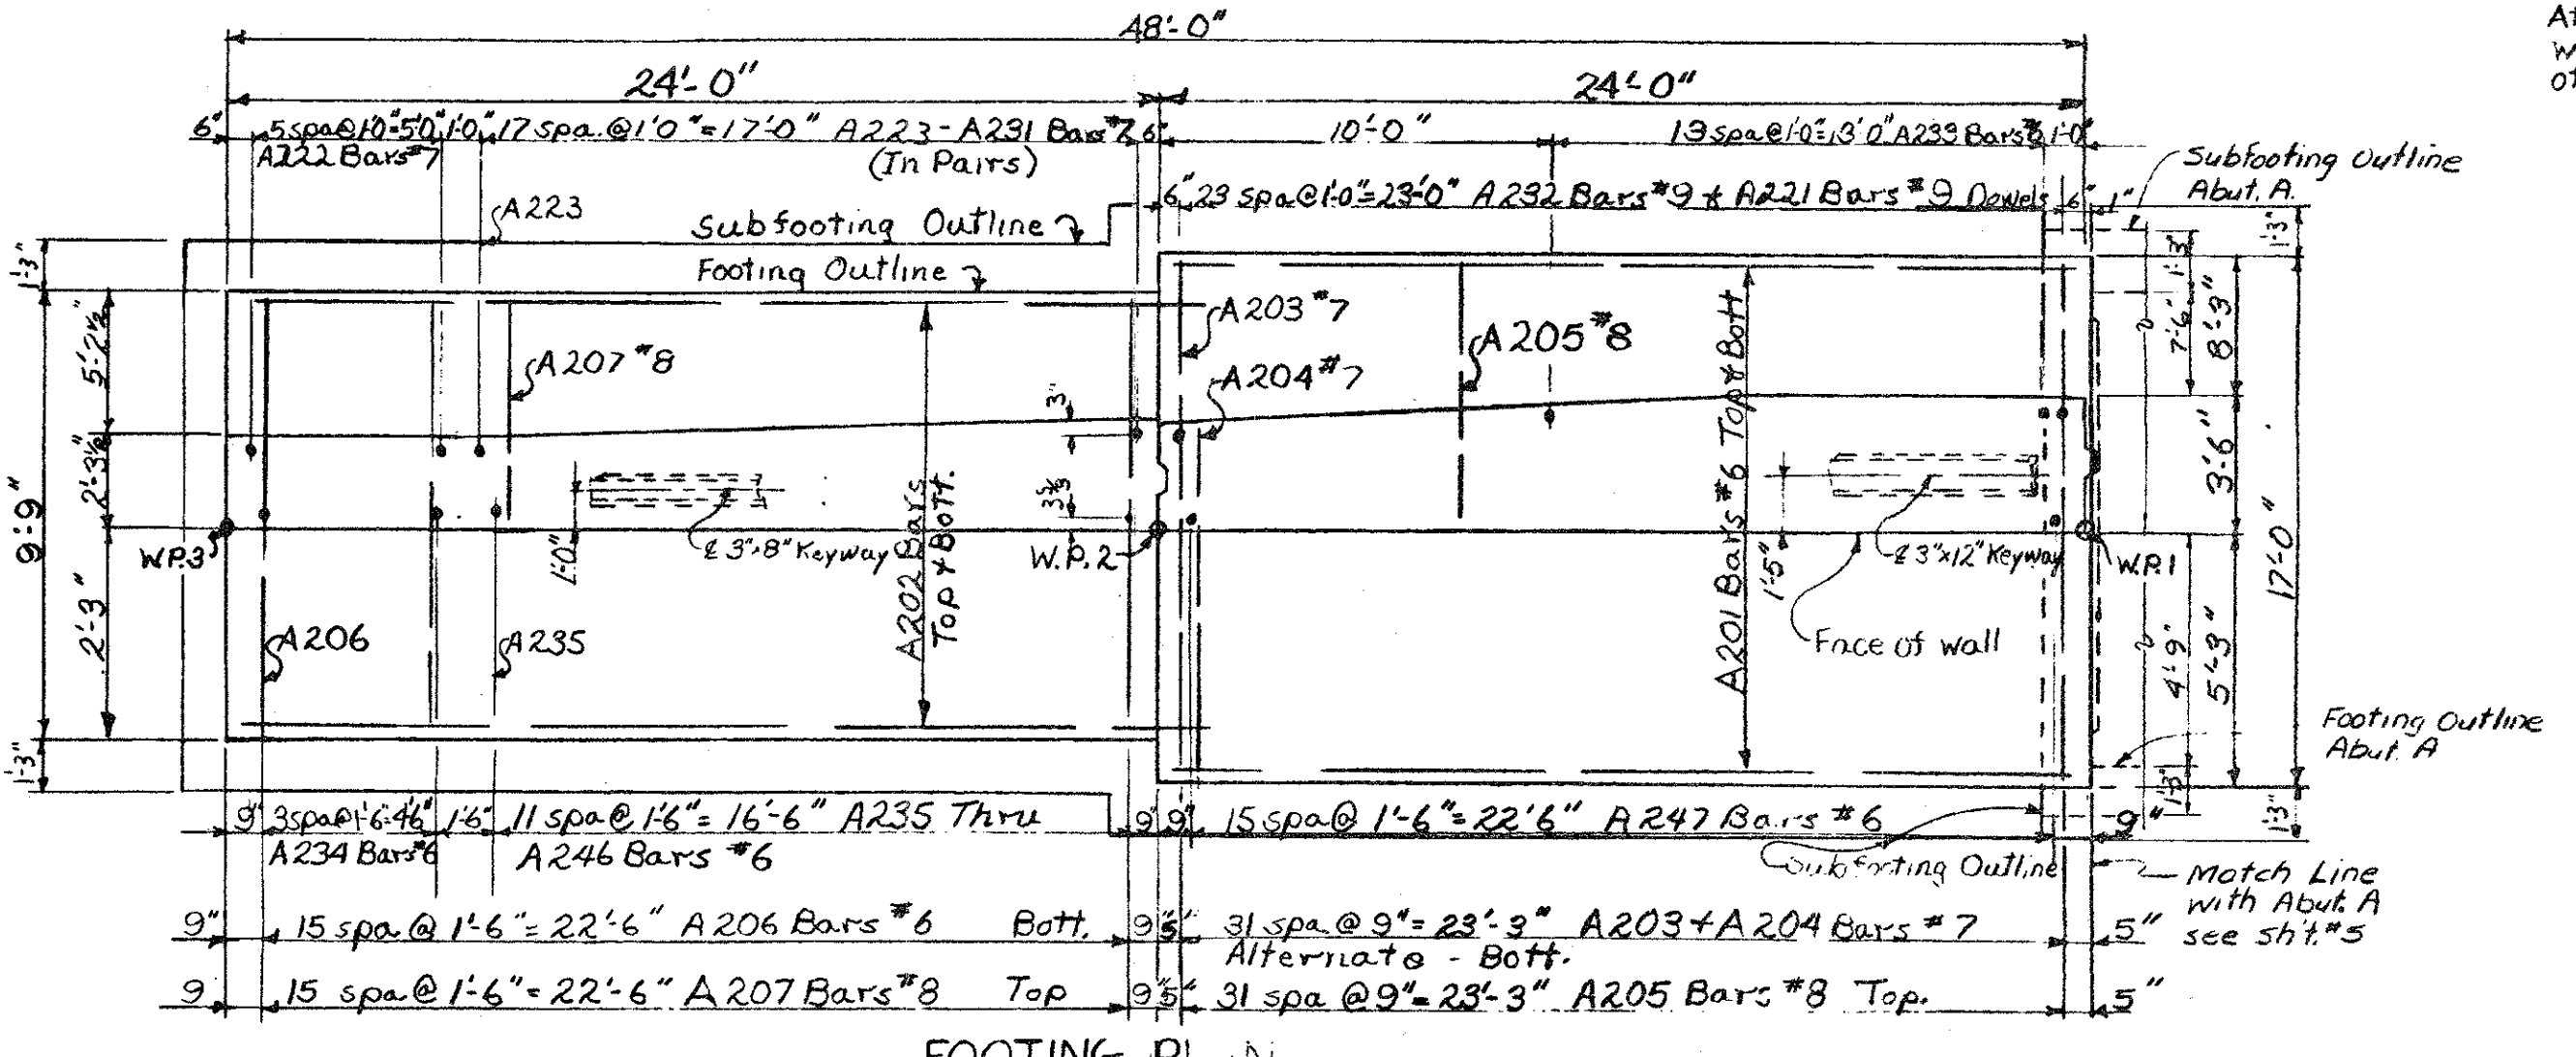


FOOTING PLAN

CONCRETE QUANTITIES		
Pour	Gv. AC(6A)	Gv. K(6AA)
A	45.5	
B	21.7	
C		33.0
D		22.8
E	13.5	
Total	67.2 Cu. Yds.	69.3 Cu. Yds.


MISCELLANEOUS QUANTITIES		
Item	Unit	Amount
Joint Waterproofing	Sq. Ft.	57
Unclassified Exc.	Cu. Yd.	760
Concrete Subfooting	Cu. Yd.	8.0

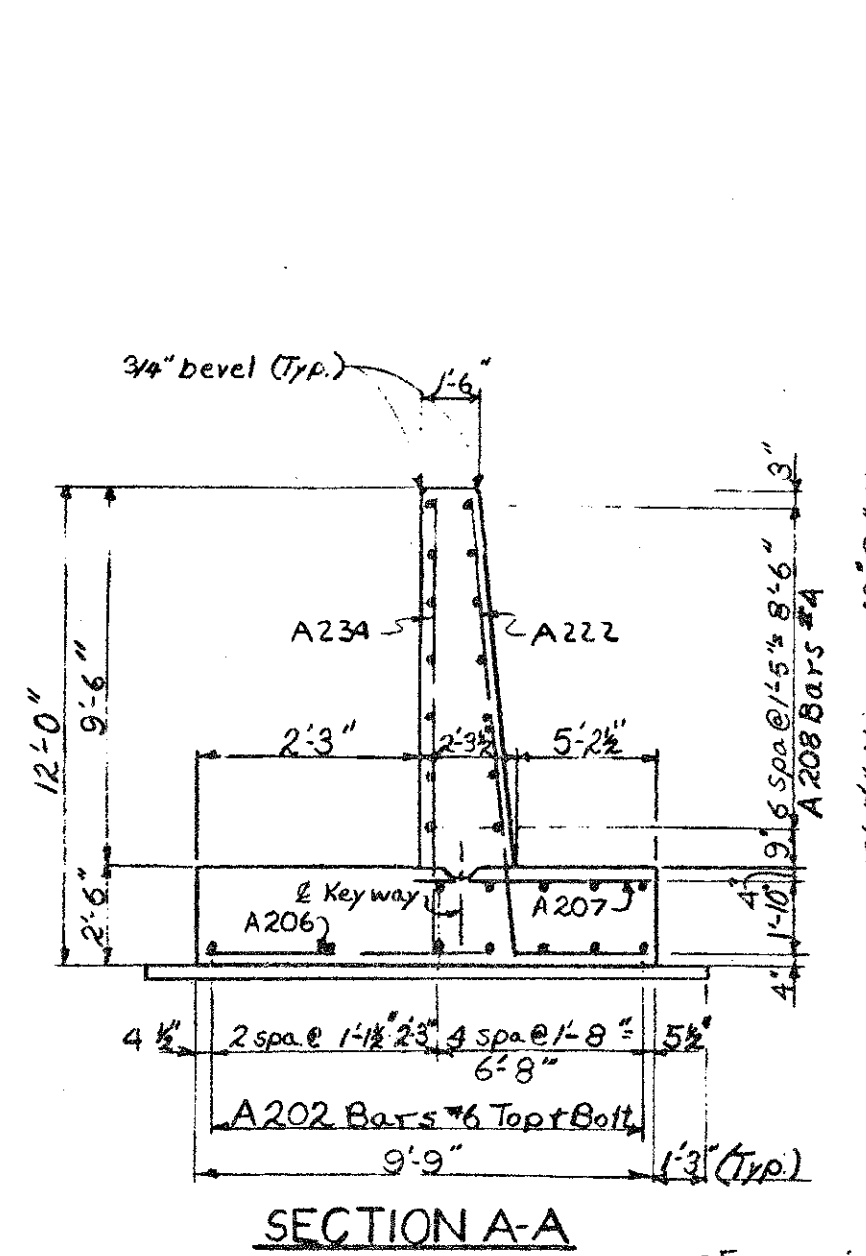


SECTION A-A

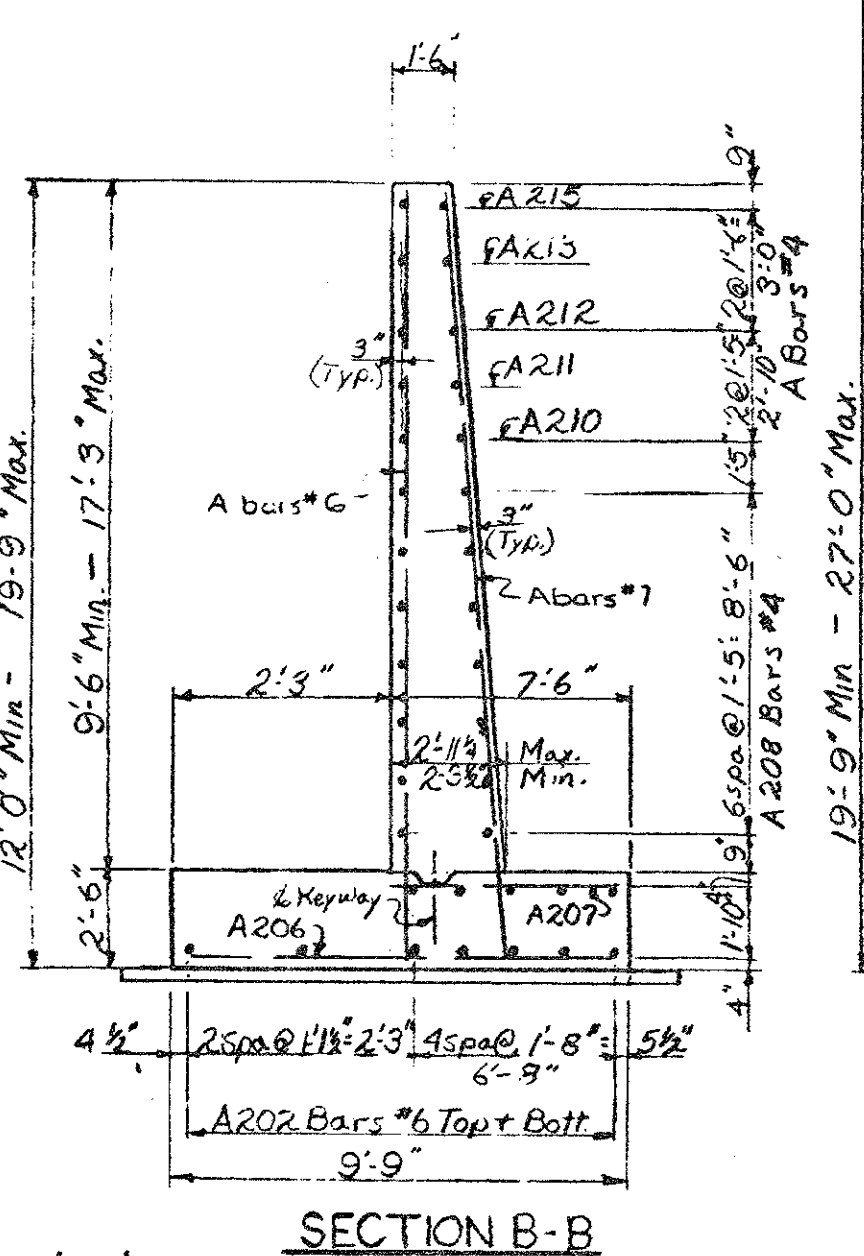

SECTION B-B

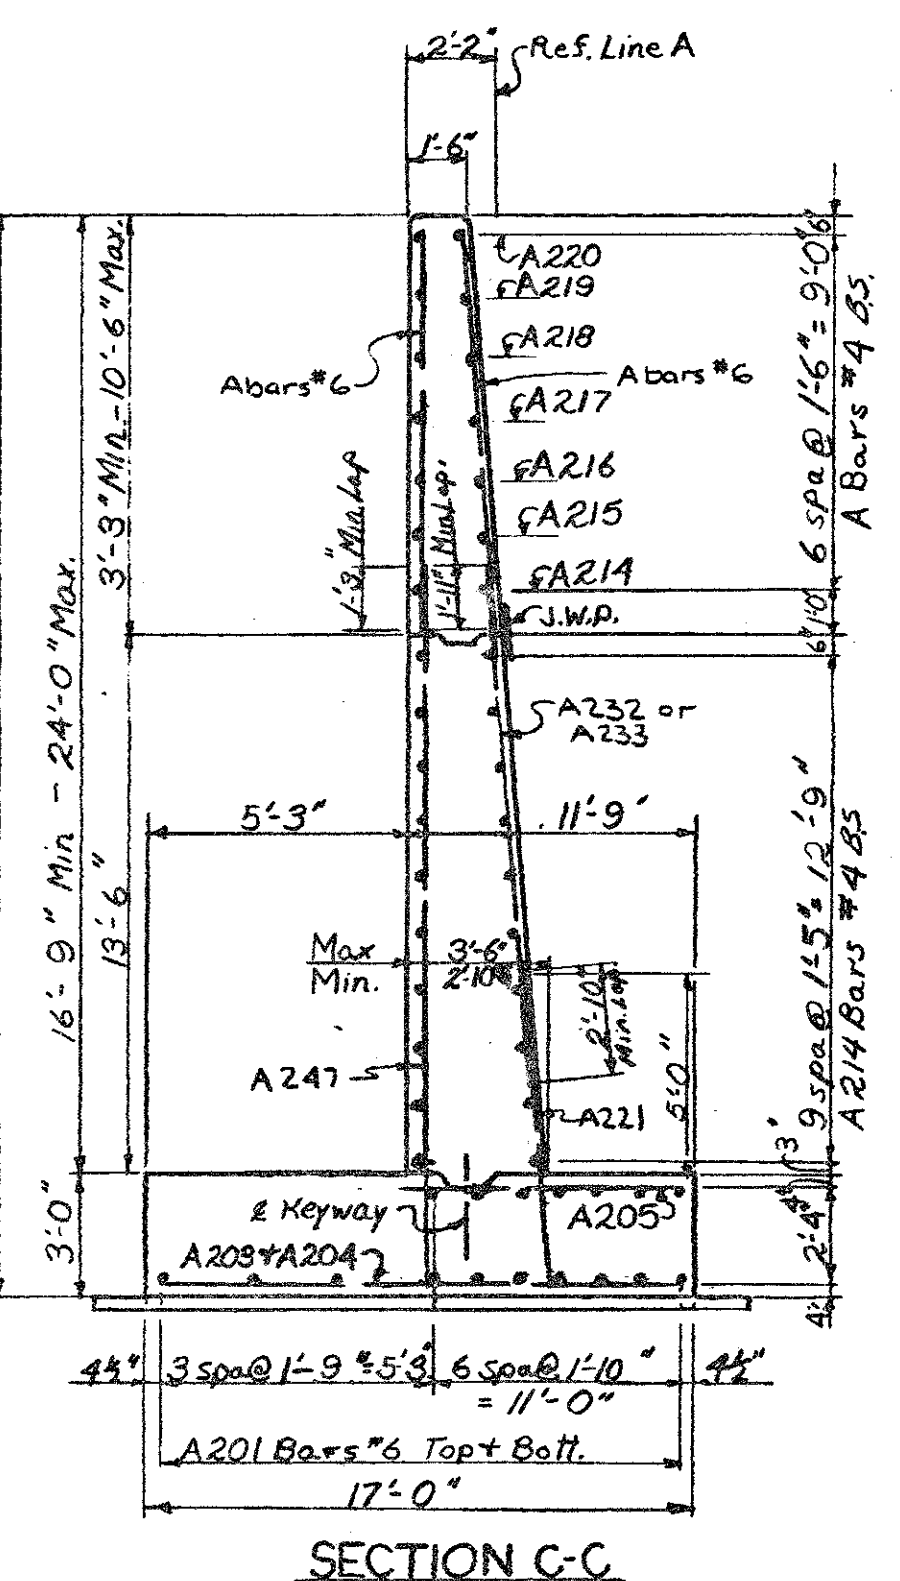

SECTION C-C

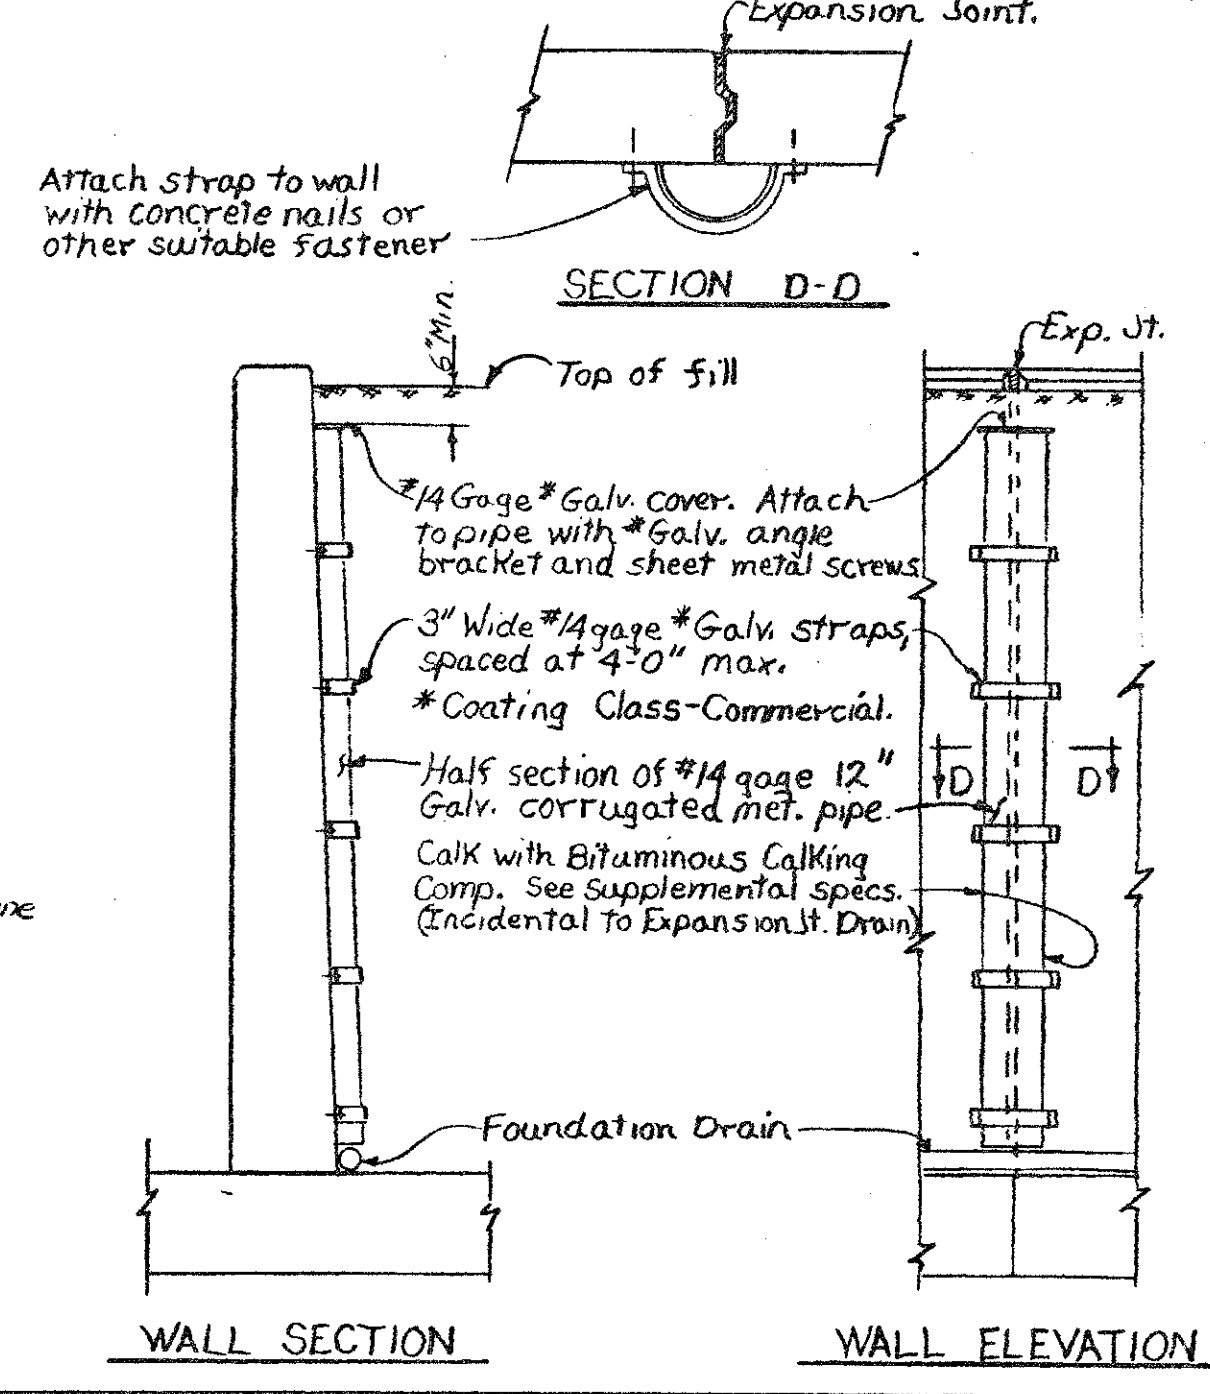

WALL SECTION

WALL ELEVATION

NOTES:
 For level and molding details see standard sheet R11 or R12.
 B.S. denotes both sides.
 F.S. denotes far side.
 N.S. denotes near side.
 W.P. denotes working point.
 J.W.P. denotes joint waterproofing.
 For expansion joint details (See sheet #5)
 A metal bulkhead may be used as an alternate construction joint at the contractors expense, for details. (See sheet #5)
 Maximum average foundation pressure D.L. only = 2570 $\frac{lb}{sq. ft}$
 Winwall shall not be poured until superstructure is completed to tops of sidewalls.

Work this sheet with sheet #5.

MICHIGAN DEPARTMENT OF STATE HIGHWAYS

ABUTMENT A

WINGWALL DETAILS

REVISIONS			
NO.	DESCRIPTION	DATE	BY

DRAWN BY: Fisher, A. A. 4-19-03
 CHECKED BY: Hicks, A. D. 4-29-03
 SHEET # 22

S04 OF 63103A


NOTE:
 DO NOT WORK FROM THIS SHEET. THE INFORMATION SHOWN
 HERE IS FOR REFERENCE ONLY. NO PAY ITEMS ARE SHOWN.

FOR INFORMATION ONLY				
DATE	CONT. SEC.	JOB NO.	DESIGN UNIT	SHEET
10-18-99	S04 OF 63103	48404A	MAHDAVI	7 OF 24



DRAWN BY: INDER
 CHECKED BY:
 CORRECTED BY:
 DATE: 02-10-99





2 3 4 5 6 7 8 9 10 11 12 13 14 15 16 17 18 19 20 21 22 23 24 25 26 27 28 29 30 31 32 33 34 35 36 37 38 39 40 41 42 43 44 45 46 47 48 49 50 51 52 53 54 55 56 57 58 59 60 61 62 63

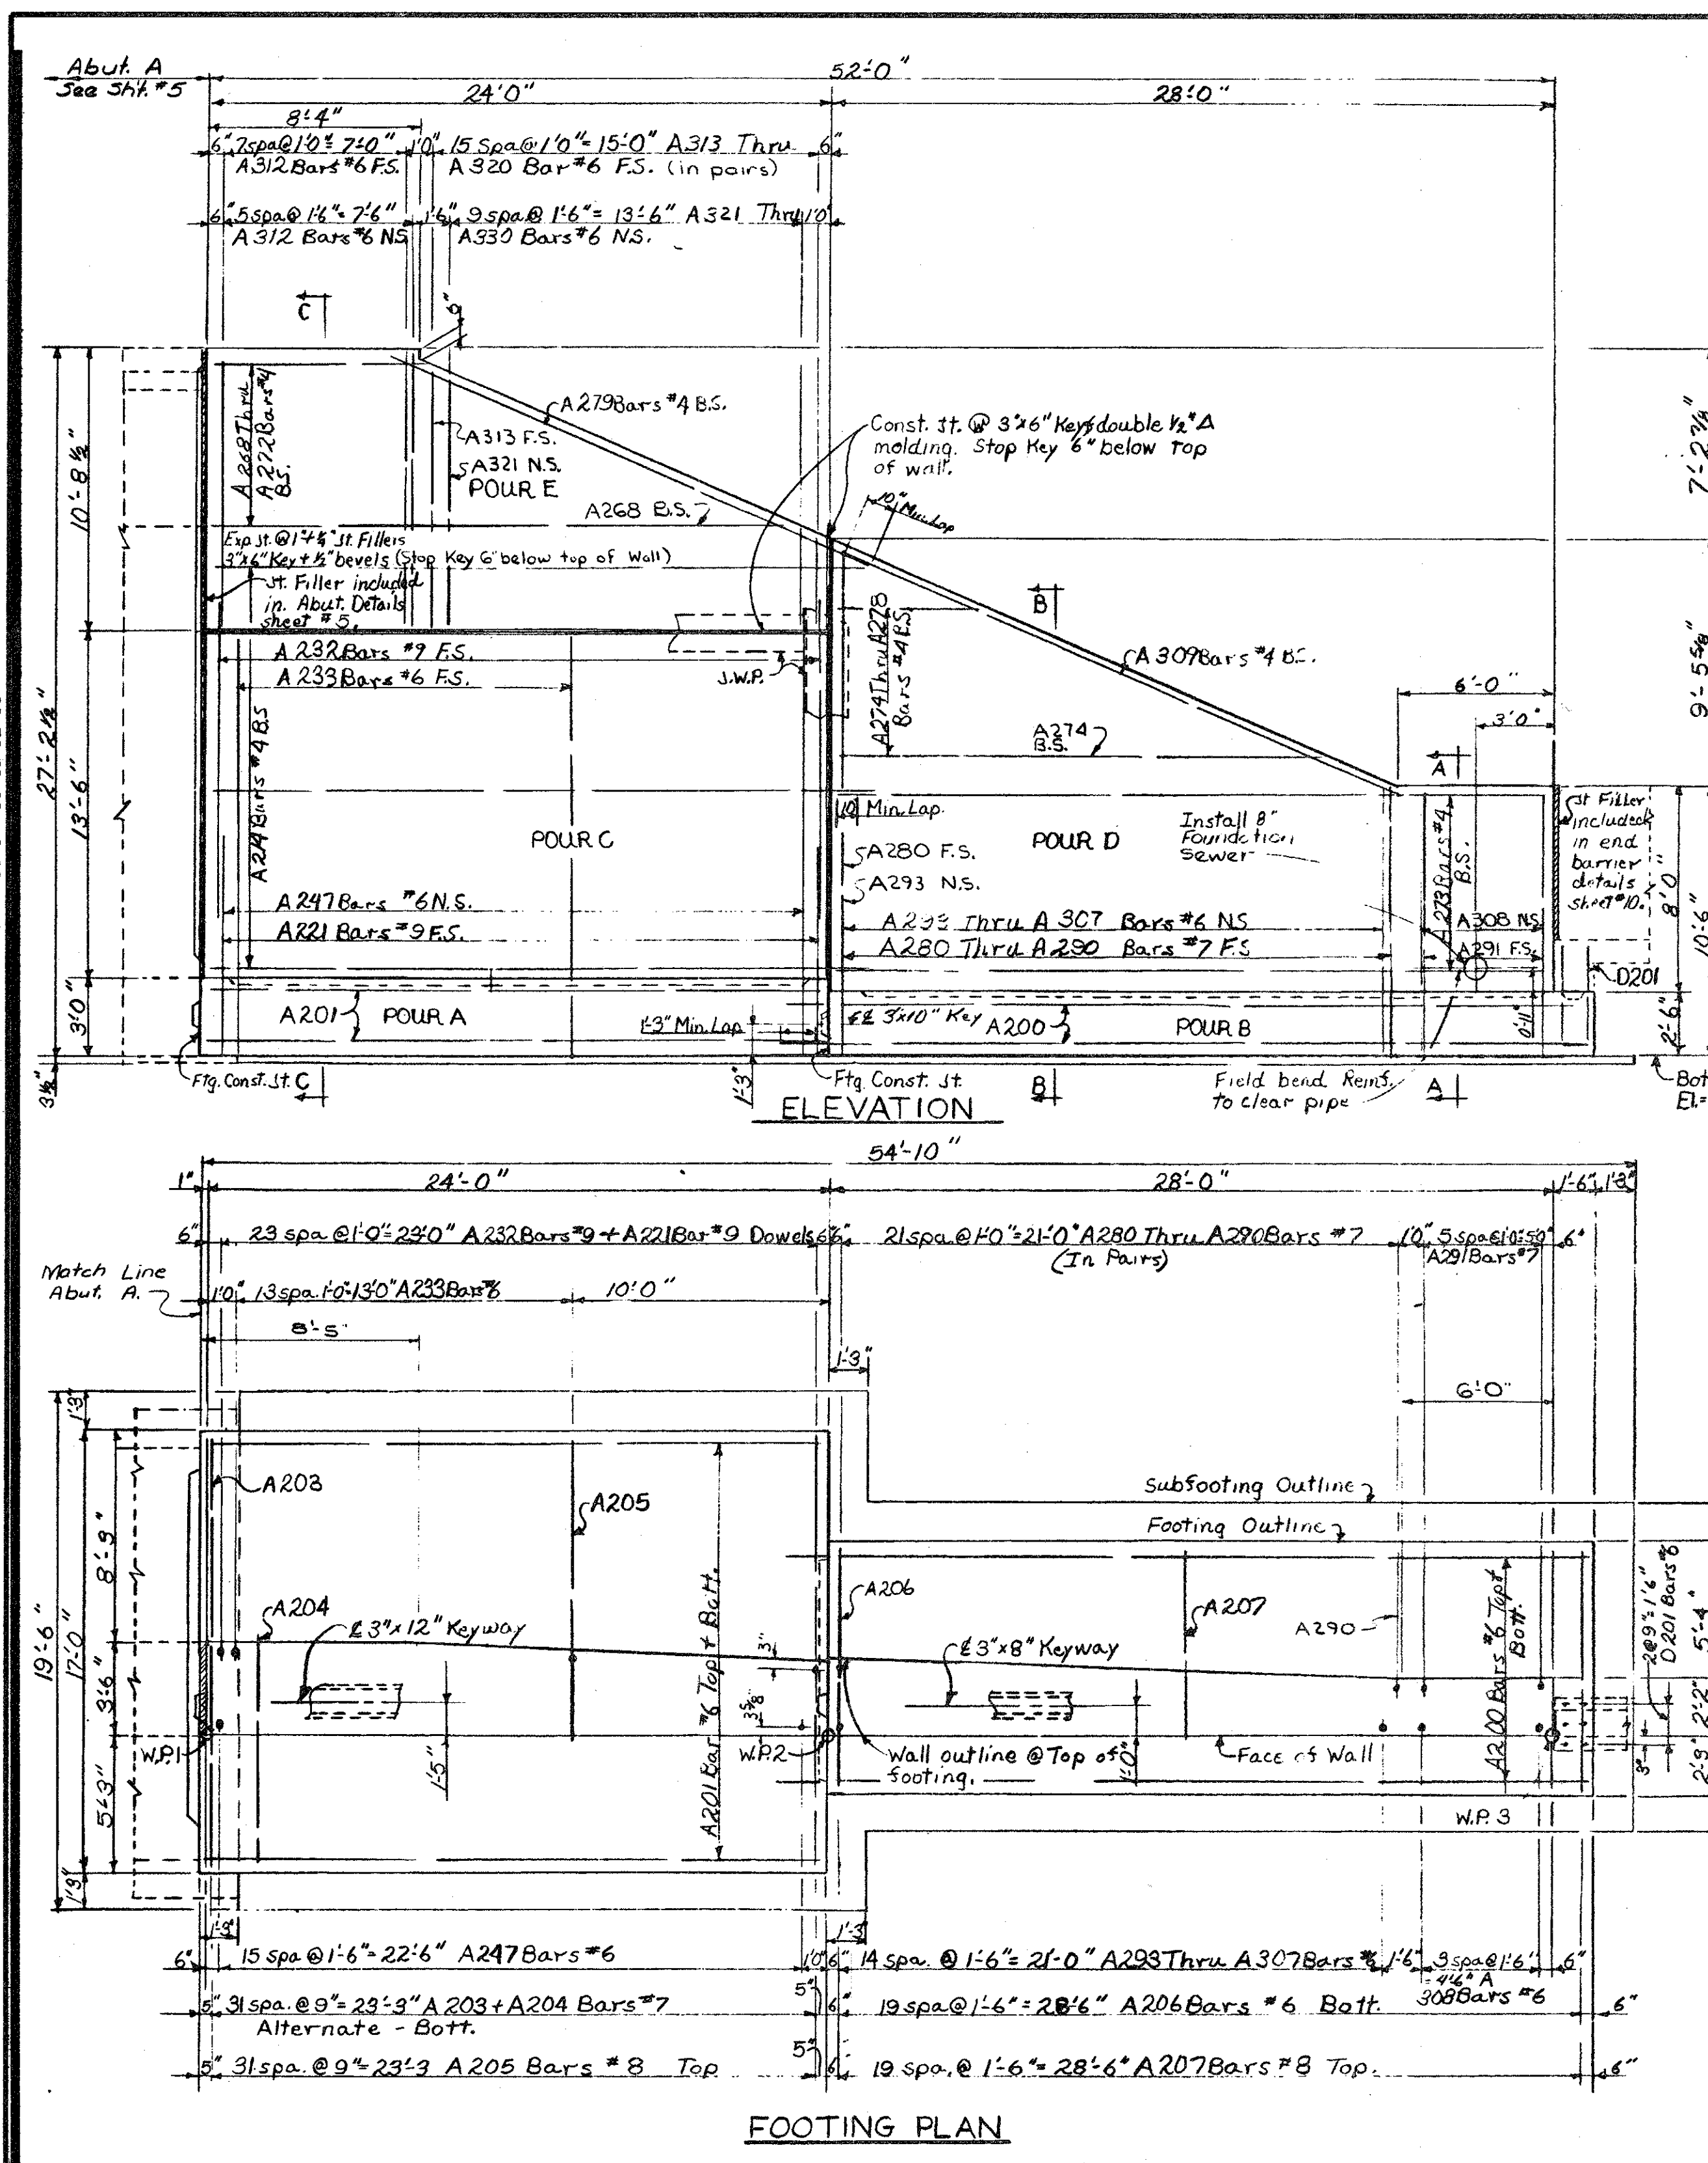

POUR	Gr. A(5A)	Gr. A(6A)
A	45.5	
B	26.6	
C		33.2
D		25.2
E		13.8
Total	72.1 Cu Yds	72.2 Cu Yds

Item	Unit	Amount
Joint Waterproofing	Sq. Ft.	57
Concrete Subfooting	Cu. Yd.	8.8
8" Foundation sewer	Lin. Ft.	4.0
Unclassified Exc.	Cu. Yd.	85.0
Special Inlet	Each	1

REVISIONS			
NO.	DESCRIPTION	DATE	BY

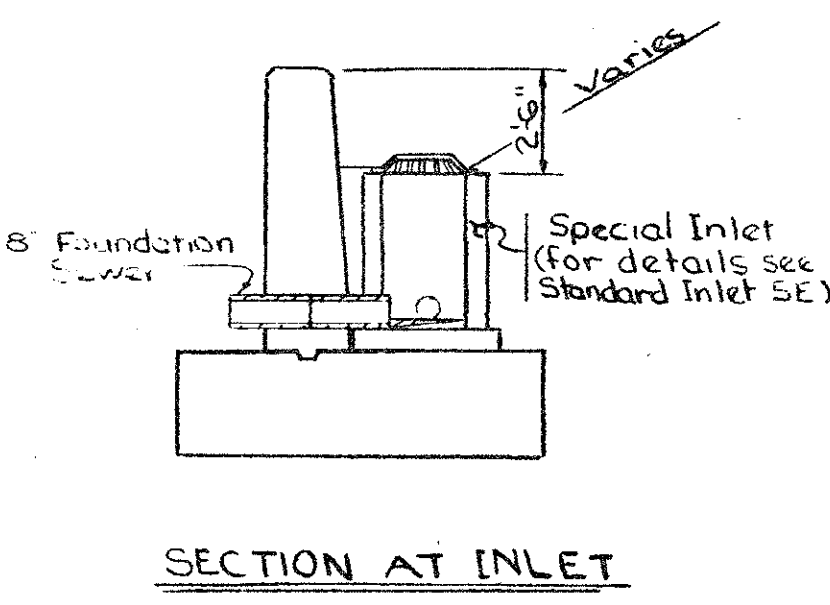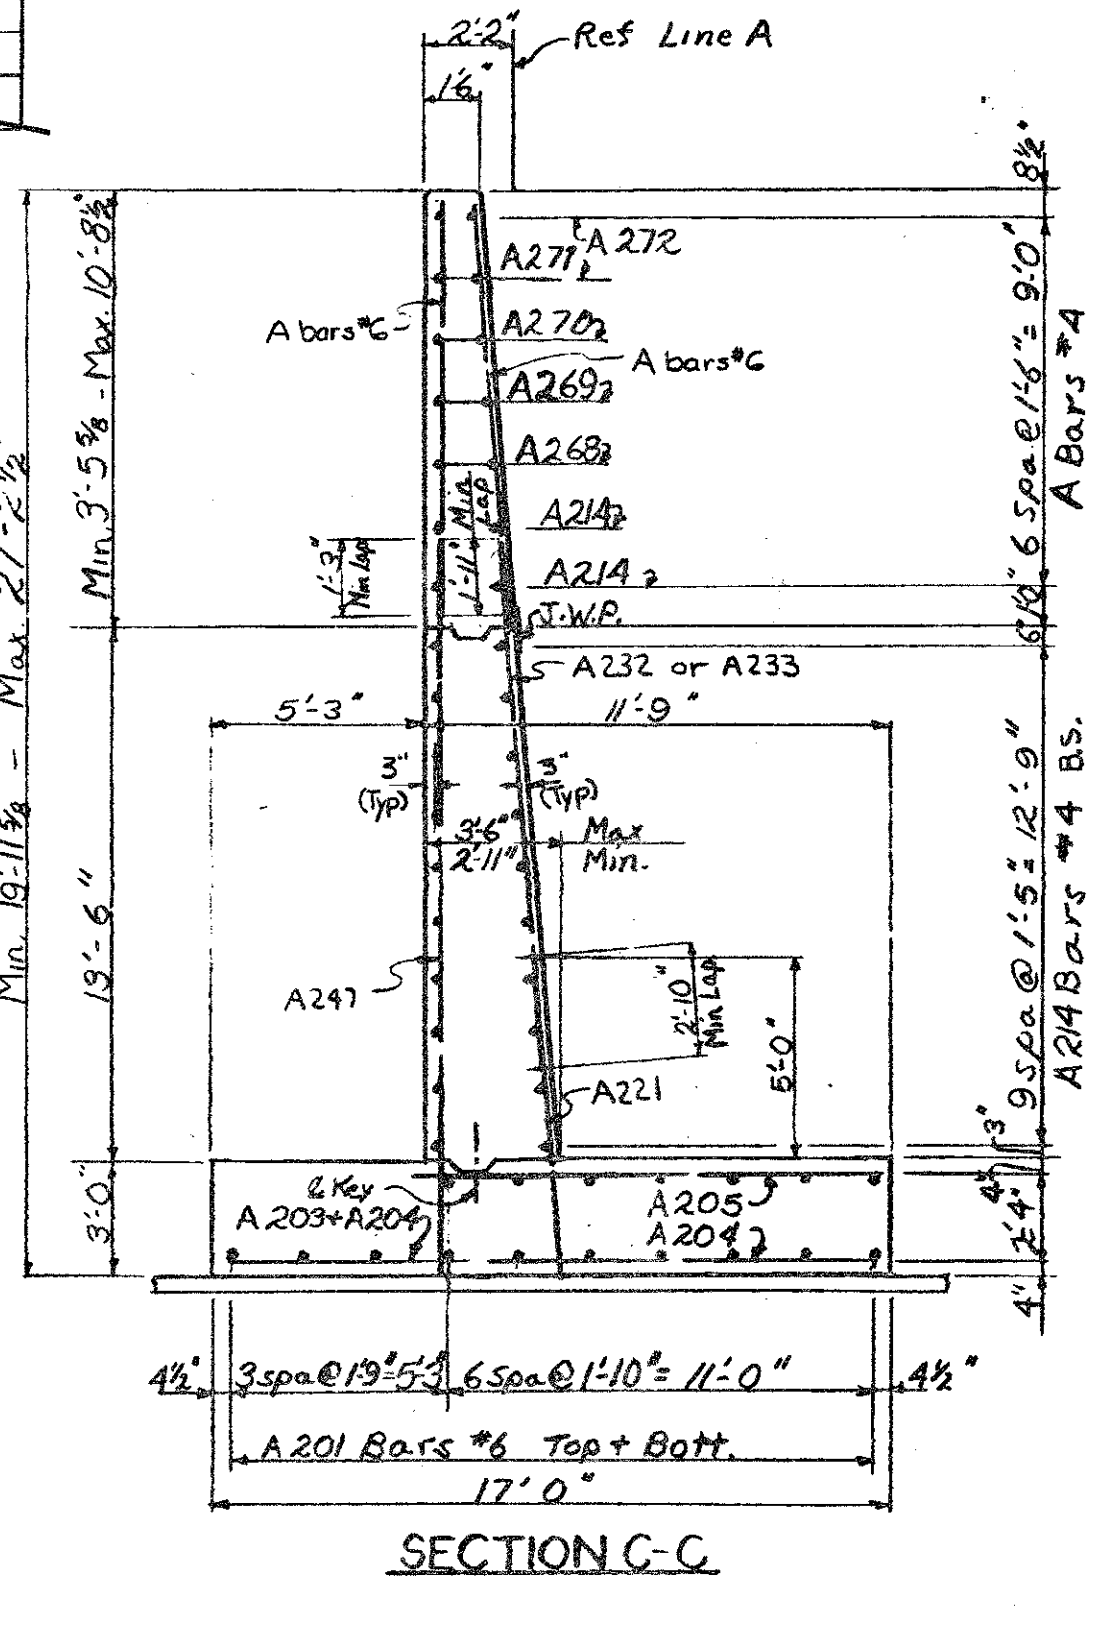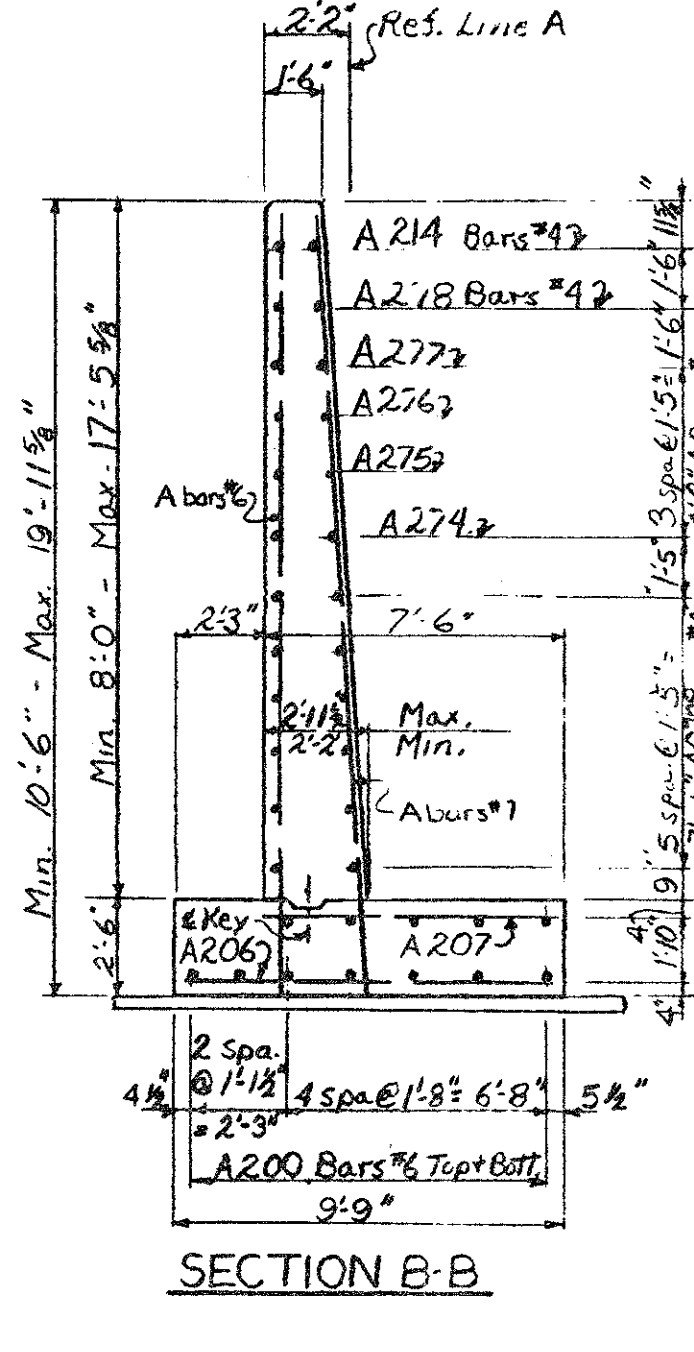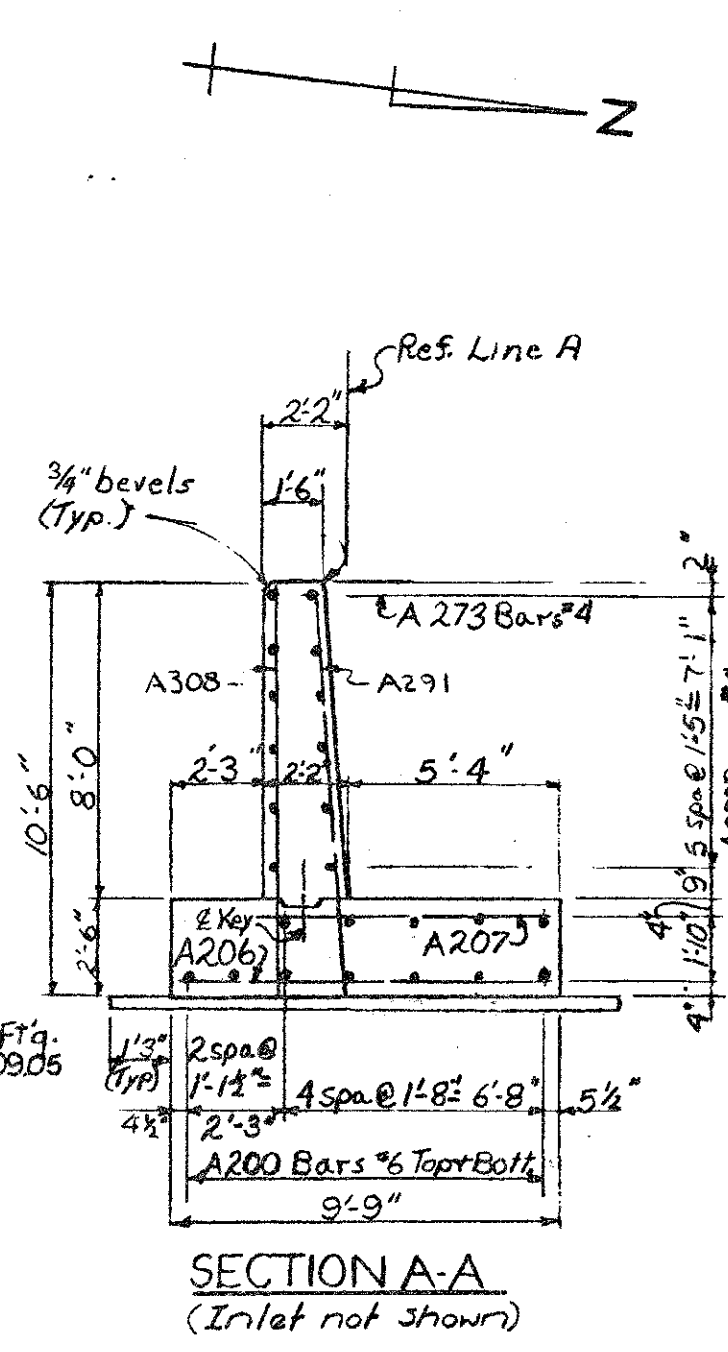

NOTES:
 For notes see sheet # 8
 For expansion joint drain details see sheet # 8

Work this sheet with sheets No. 5+8+10

MICHIGAN DEPARTMENT OF STATE HIGHWAYS
ABUTMENT A
WINGWALL DETAILS

REVISIONS			
NO.	DESCRIPTION	DATE	BY

DESIGNED BY	Fisher 6-4-69
DRAWN BY	Hicke 4-30-69
CHECKED BY	Redman 5-21-69
SHEET	9 of 22

S04 of 63103A

NOTE:
 DO NOT WORK FROM THIS SHEET. THE INFORMATION SHOWN
 HERE IS FOR REFERENCE ONLY. NO PAY ITEMS ARE SHOWN.






FOR INFORMATION ONLY				
DATE	CONT. SEC.	JOB NO.	DESIGN UNIT	SHEET
10-18-99	S04 OF 63103	48404A	MAHDAVI	8 OF 24



DATE: DATE: DATE: DATE: CHECKED BY: CORRECTED BY: DRAWN BY: INDER FILE NAME: s0463103a


1 2 3 4 5 6 7 8 9 10 11 12 13 14 15 16 17 18 19 20 21 22 23 24 25 26 27 28 29 30 31 32 33 34 35 36 37 38 39 40 41 42 43 44 45 46 47 48 49 50 51 52 53 54 55 56 57 58 59 60 61 62 63

REVISIONS			
NO.	DESCRIPTION	DATE	BY

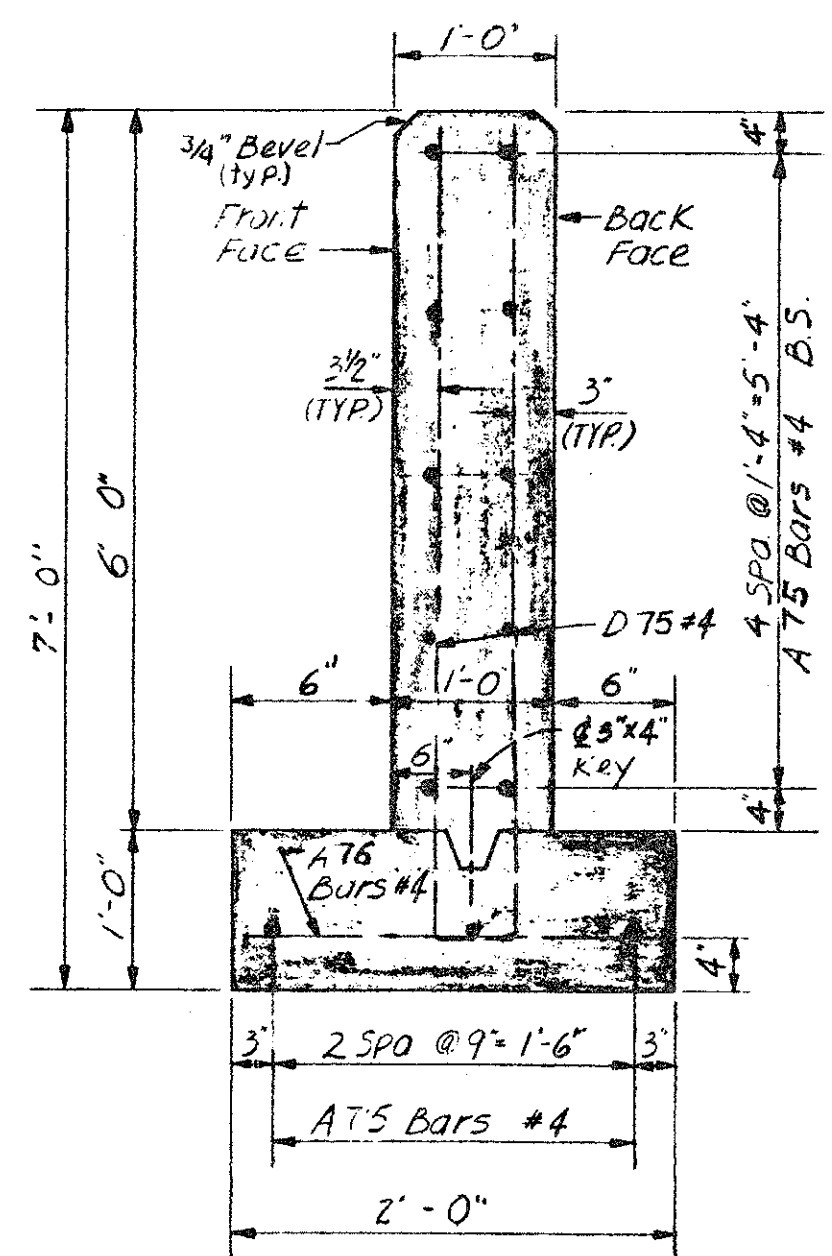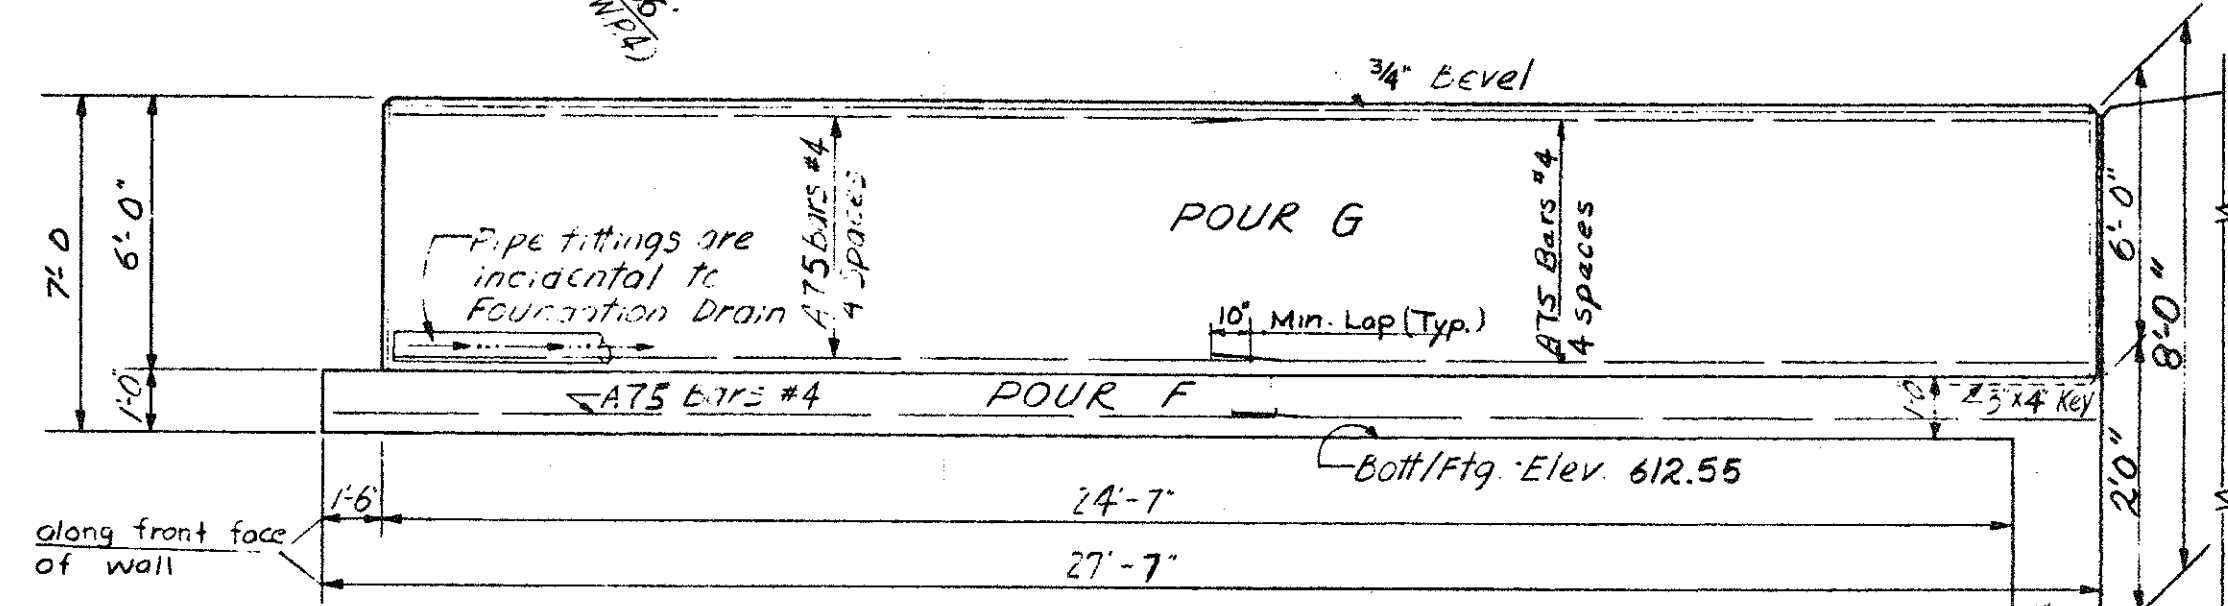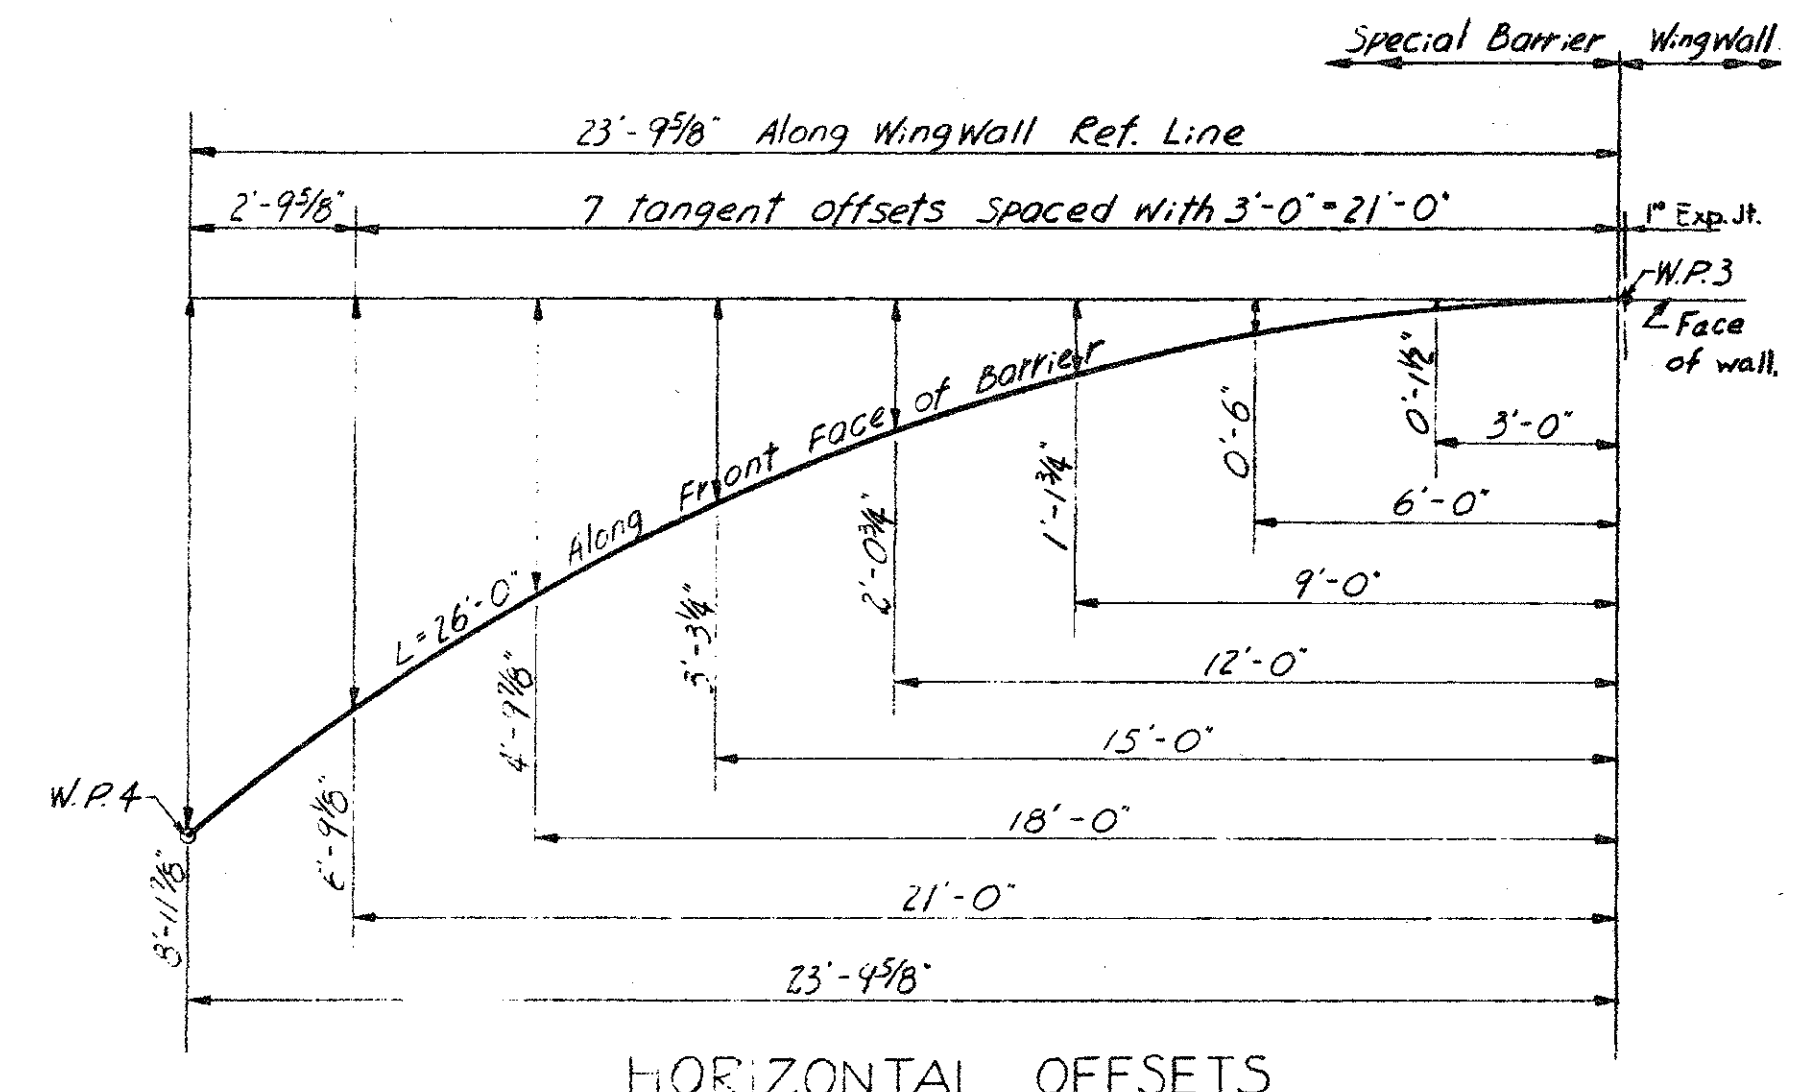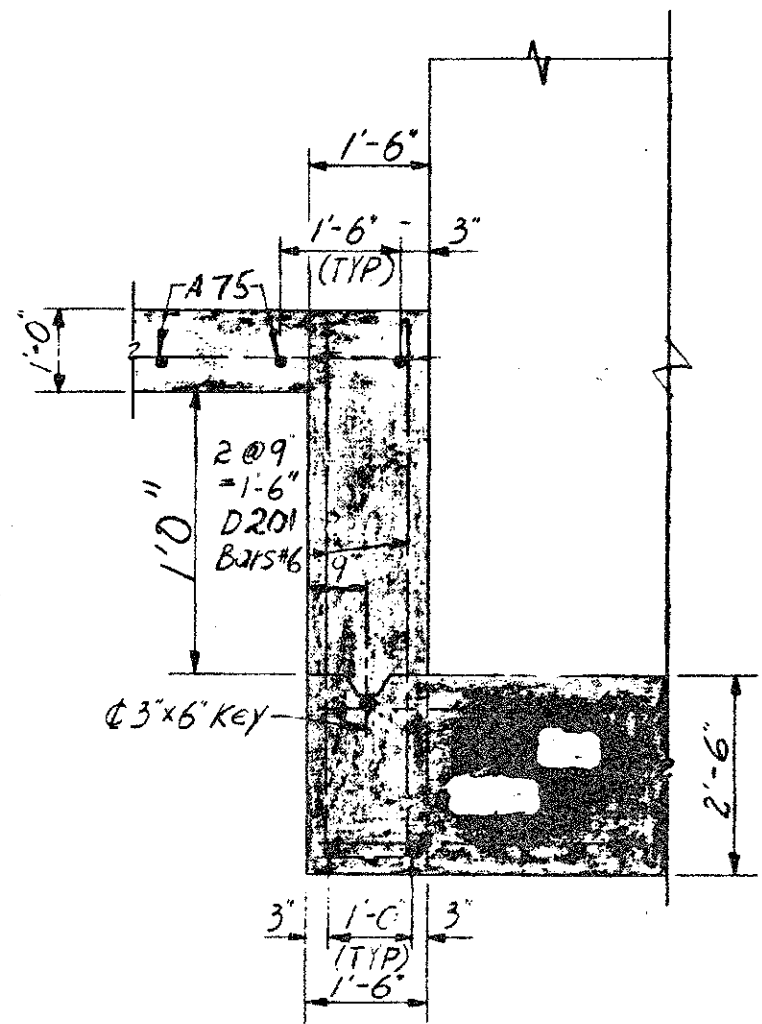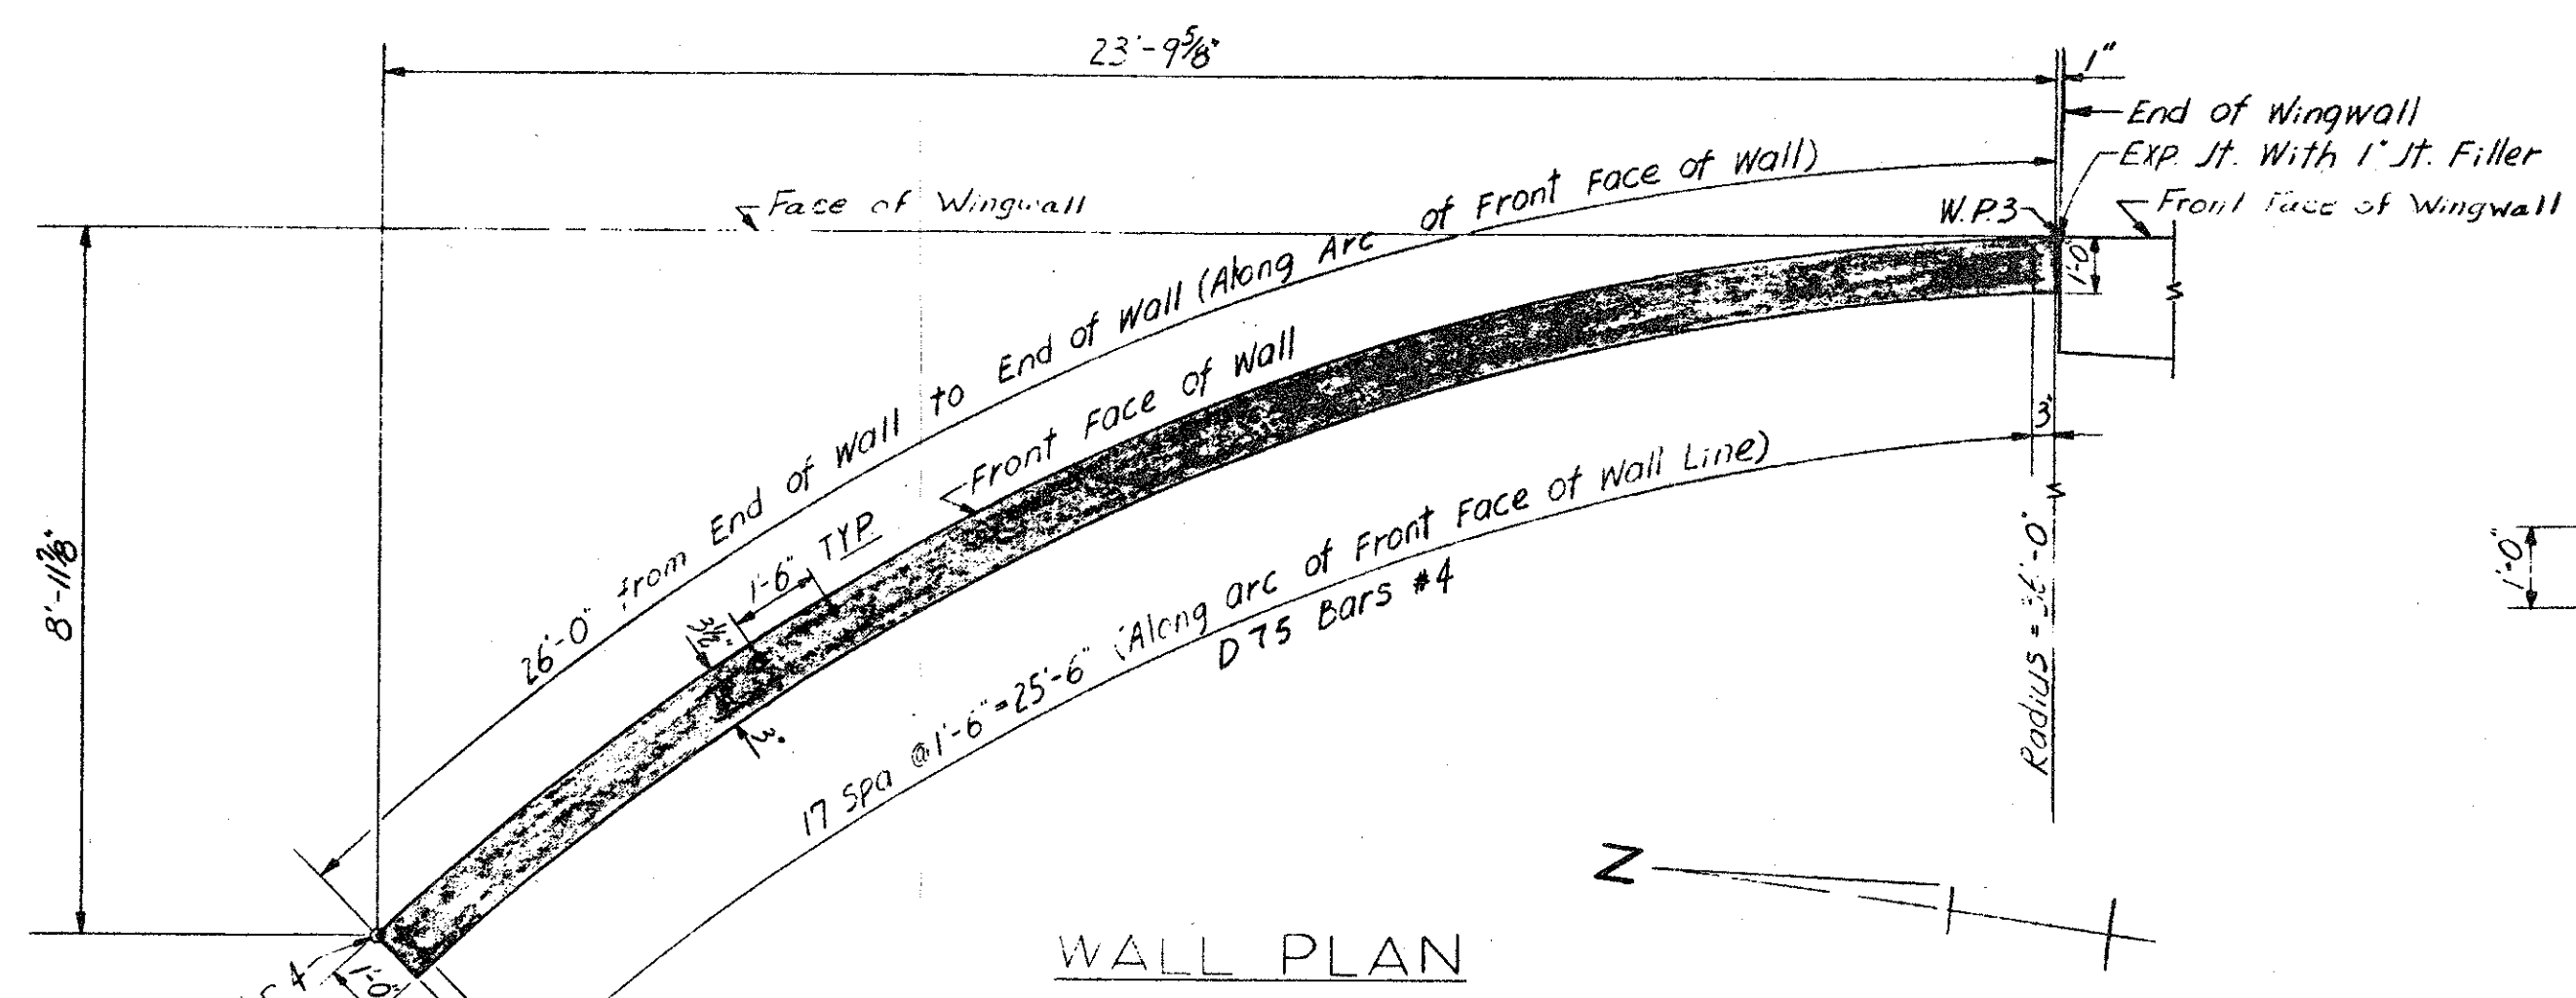

MISCELLANEOUS QUANTITIES		
Item	Unit	Amount
1" Joint Filler	Sq. Ft.	6
Joint Waterproofing	Sq. Ft.	9
Unclassified Exc.	Cu. Yds.	120

CONC. QUANTITIES CURB		
POUR	A(6.2)	A(6.A)
F	2.2	5.8

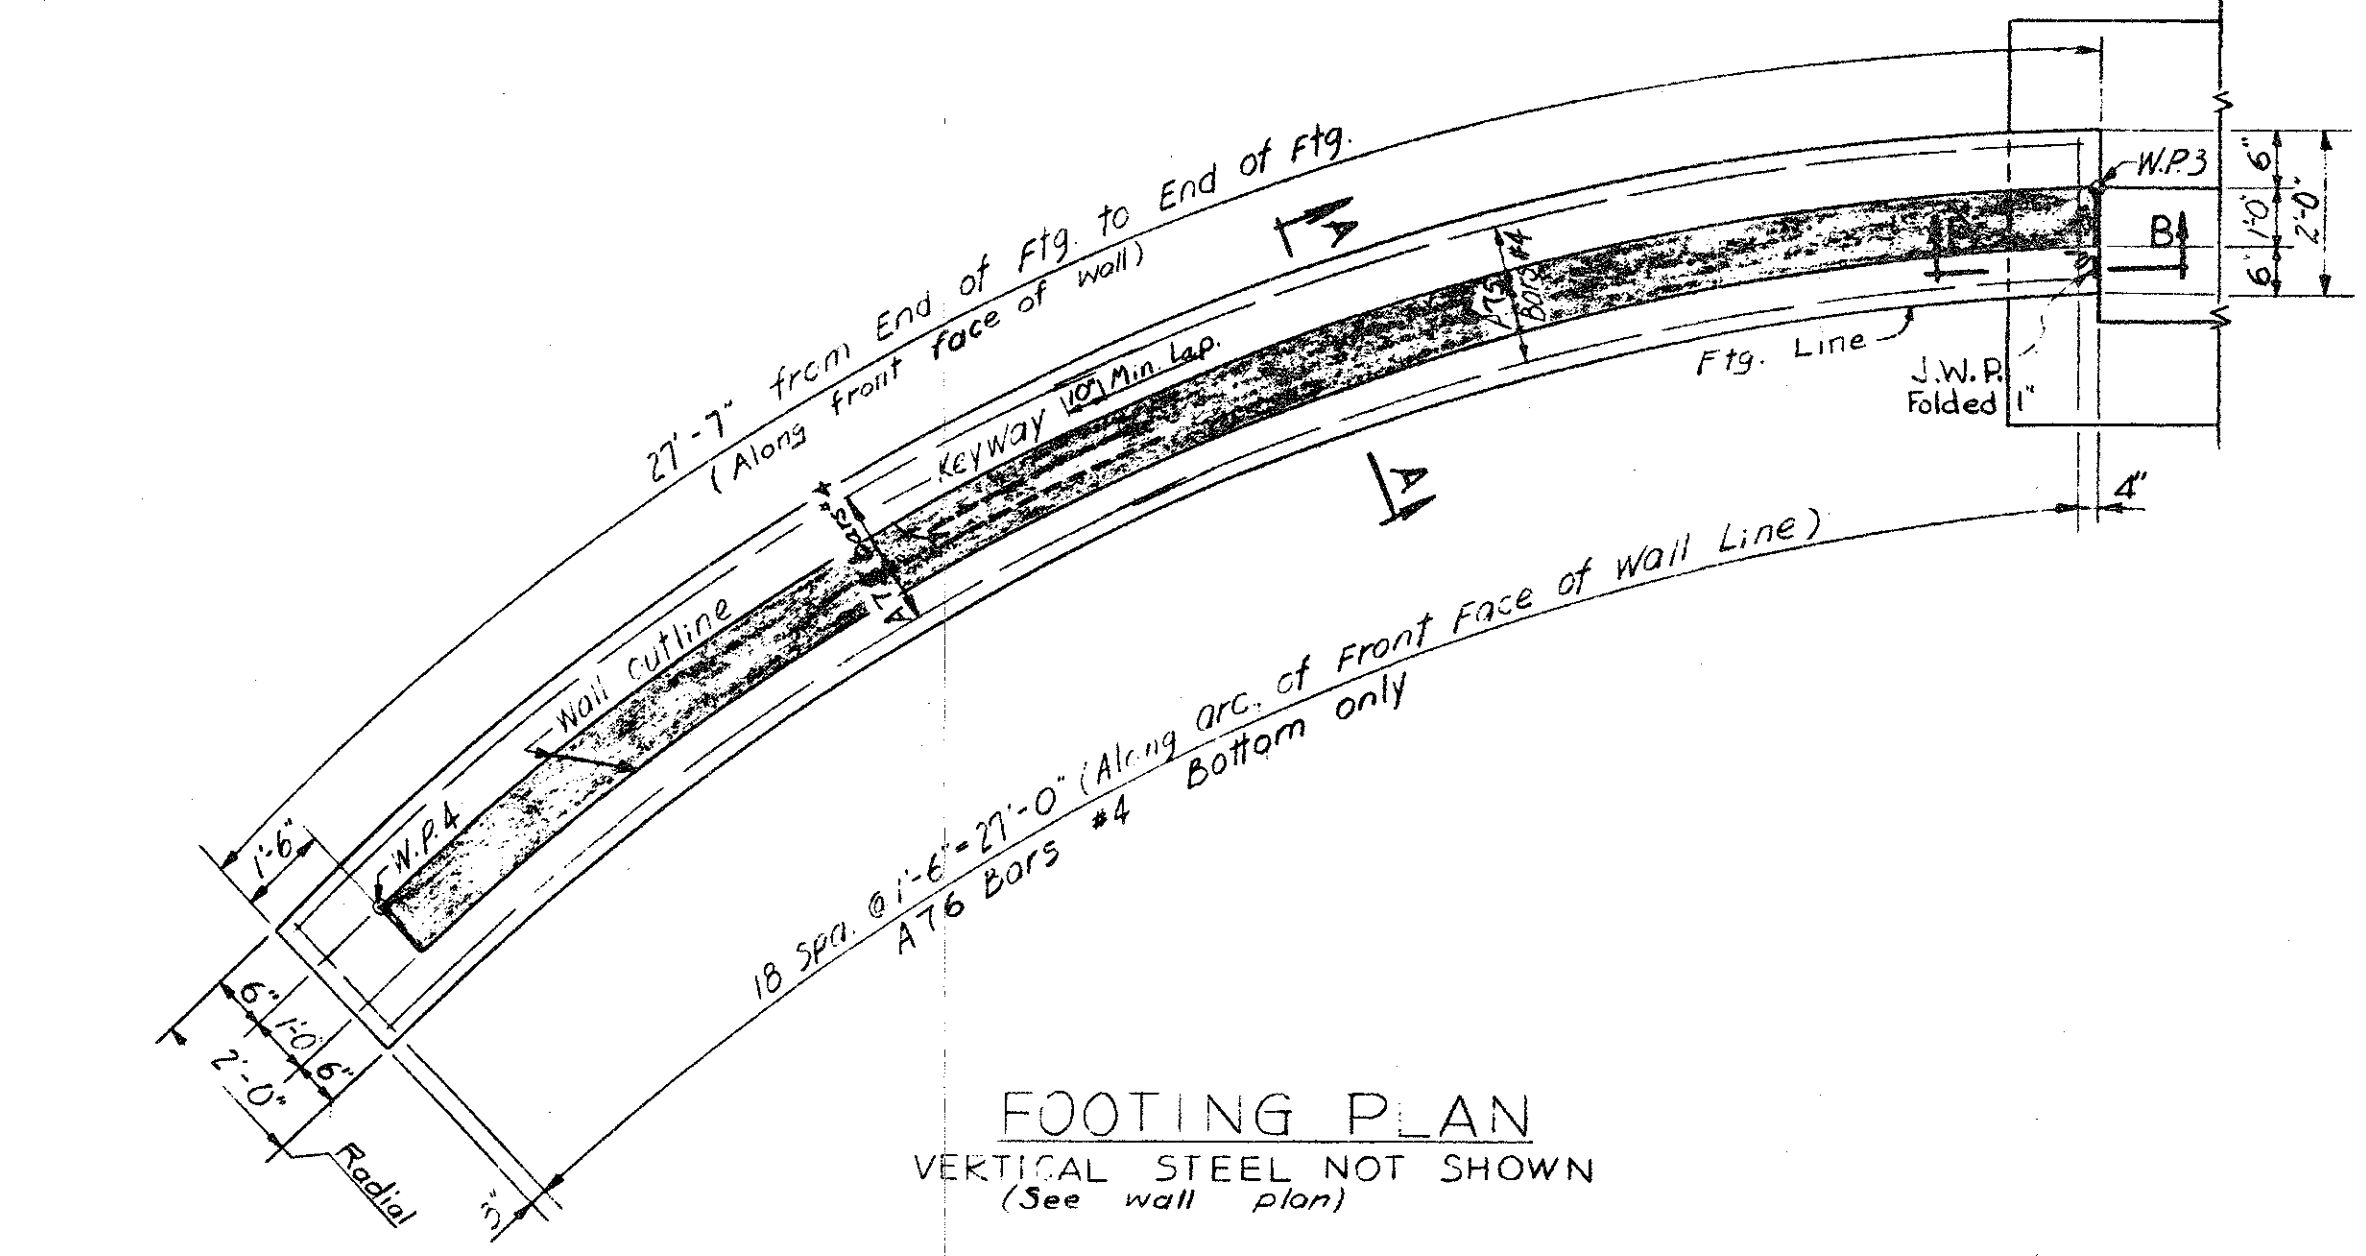

- NOTES:
 B.S. denotes Both Sides.
 WP denotes Working Point.
 For bevel & molding, See Std Sheet RH+RL.
 J.W.P. denotes Joint Waterproofing.

Work this sheet with sheet # 9.

MICHIGAN DEPARTMENT OF STATE HIGHWAYS

WALL ENDING DETAILS

NO.	REVISIONS	DATE	BY

DESIGNED BY	Fisher 6-4-78
DRAWN BY	C. Dubose 3-17-83
CHECKED BY	Calman 5-9-88
SHEET	10 of 22

S04 of 63103A

NOTE:
 DO NOT WORK FROM THIS SHEET. THE INFORMATION SHOWN
 HERE IS FOR REFERENCE ONLY. NO PAY ITEMS ARE SHOWN.

FOR INFORMATION ONLY








DATE	CONT. SEC.	JOB NO.	DESIGN UNIT	SHEET
10-18-99	S04 OF 63103	48404A	MAHDAVI	9 OF 24



DATE: _____ CORRECTED BY: _____ CHECKED BY: _____ DATE: 02-10-99 DRAWN BY: INDER FILE NAME: s0463103a.

1 2 3 4 5 6 7 8 9 10 11 12 13 14 15 16 17 18 19 20 21 22 23 24 25 26 27 28 29 30 31 32 33 34 35 36 37 38 39 40 41 42 43 44 45 46 47 48 49 50 51 52 53 54 55 56 57 58 59 60 61 62 63

REVISIONS			
NO.	DESCRIPTION	DATE	BY

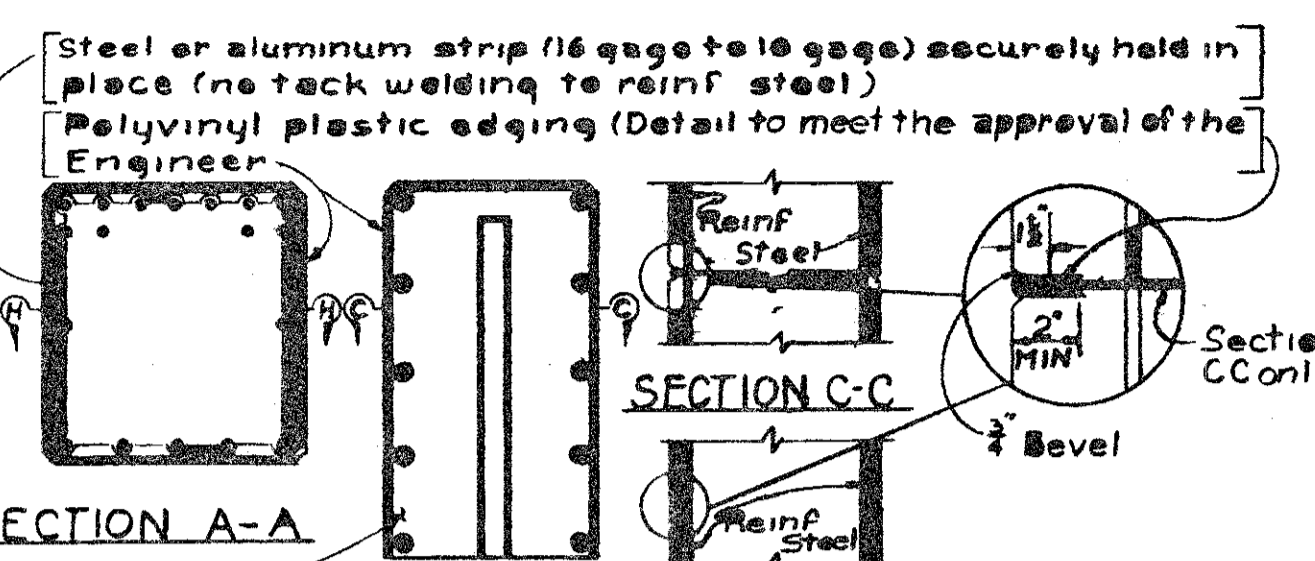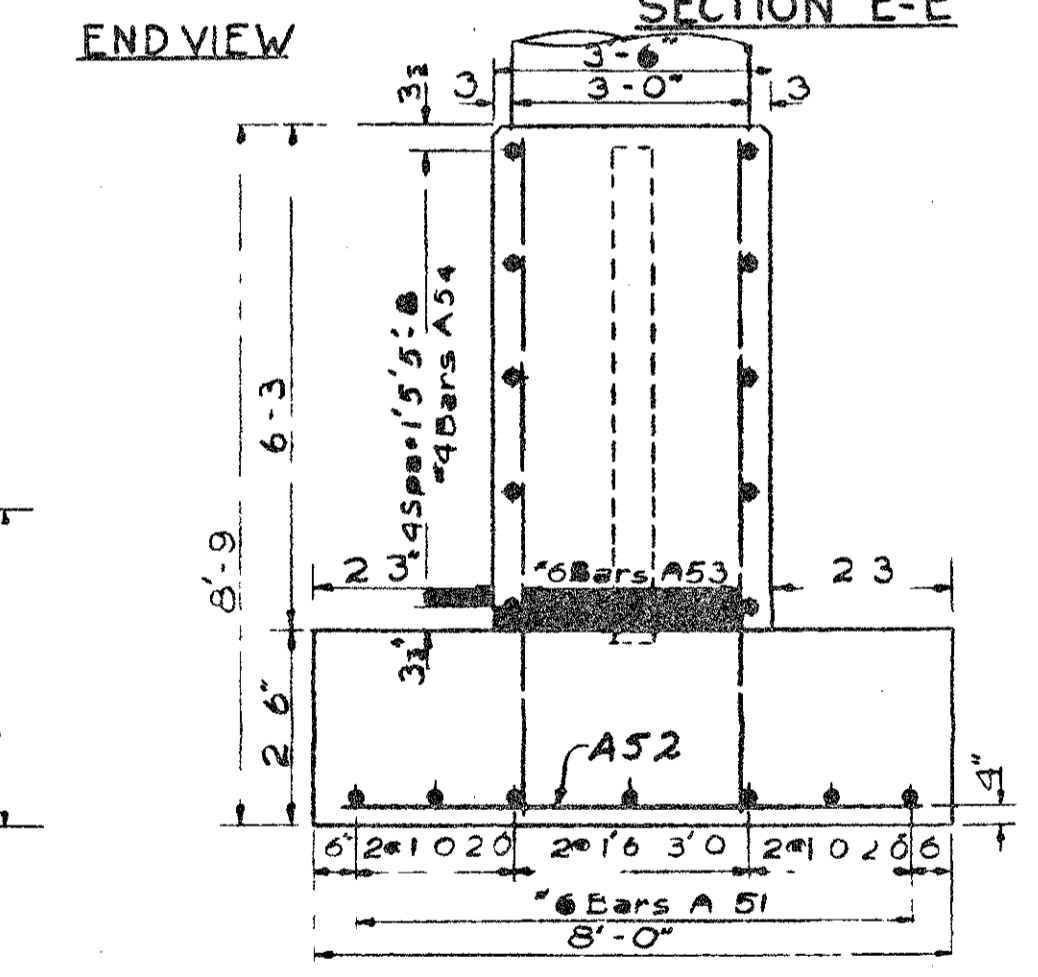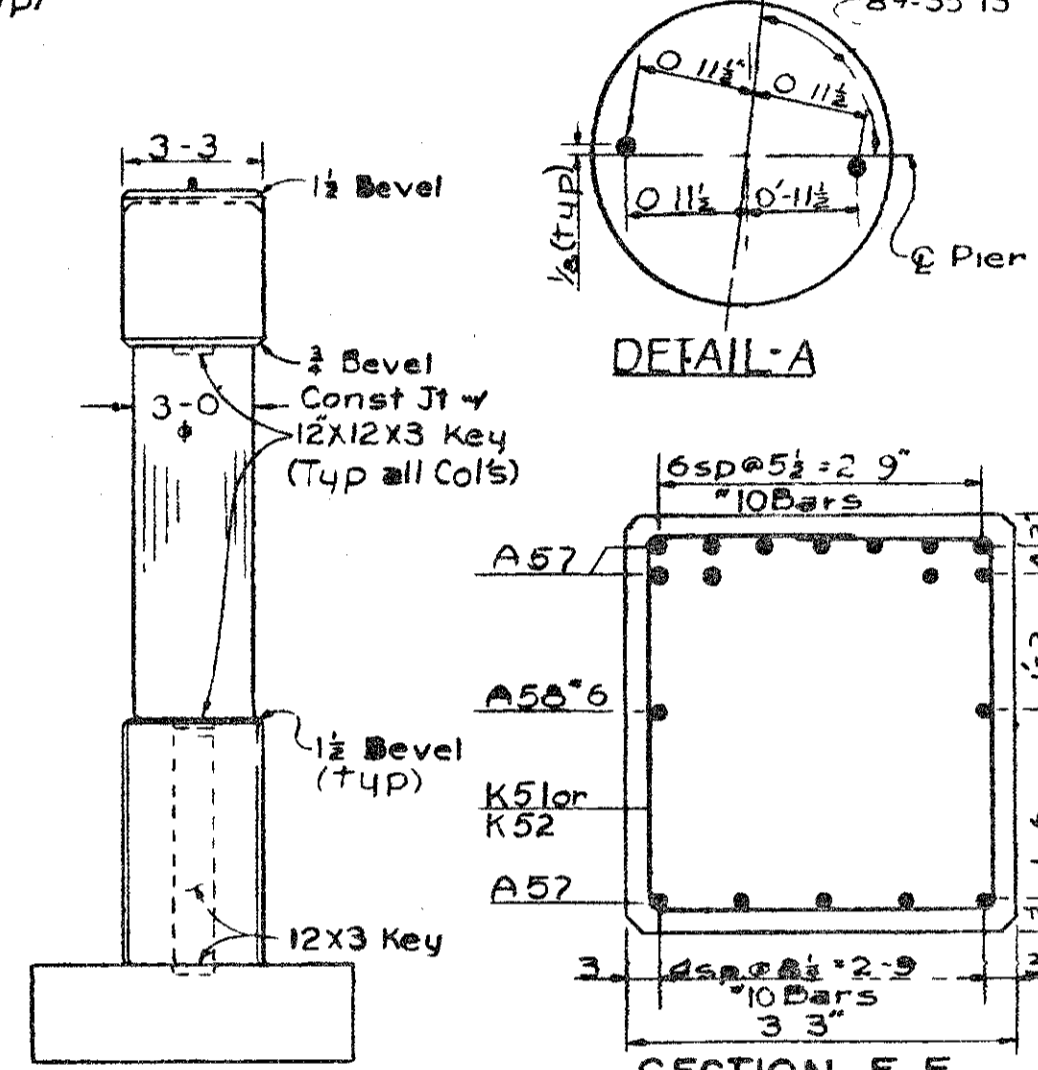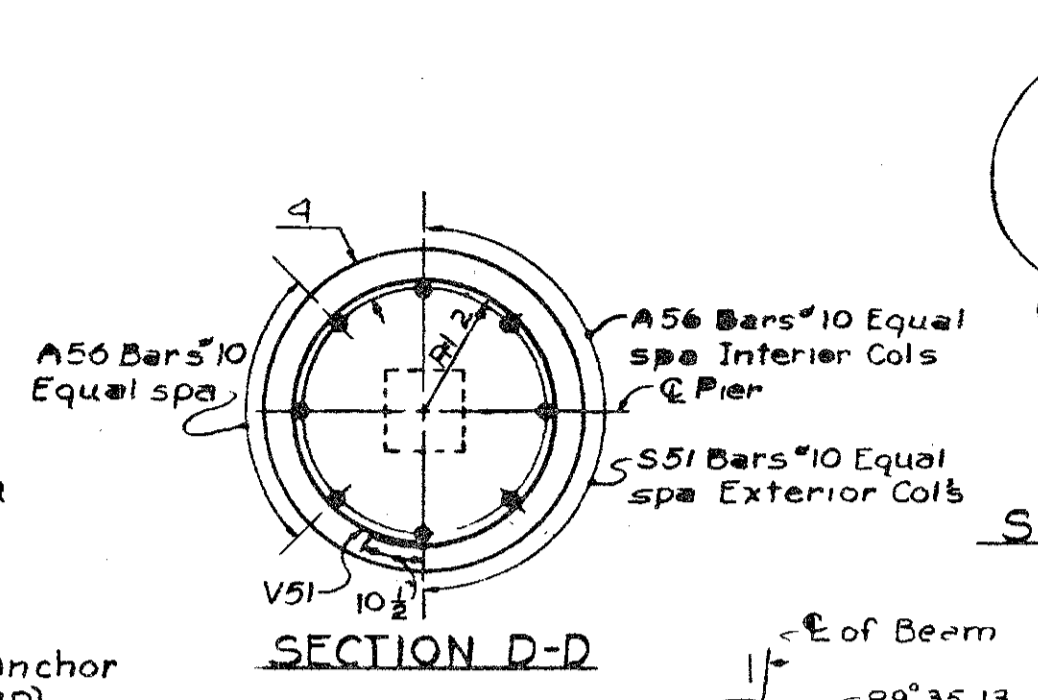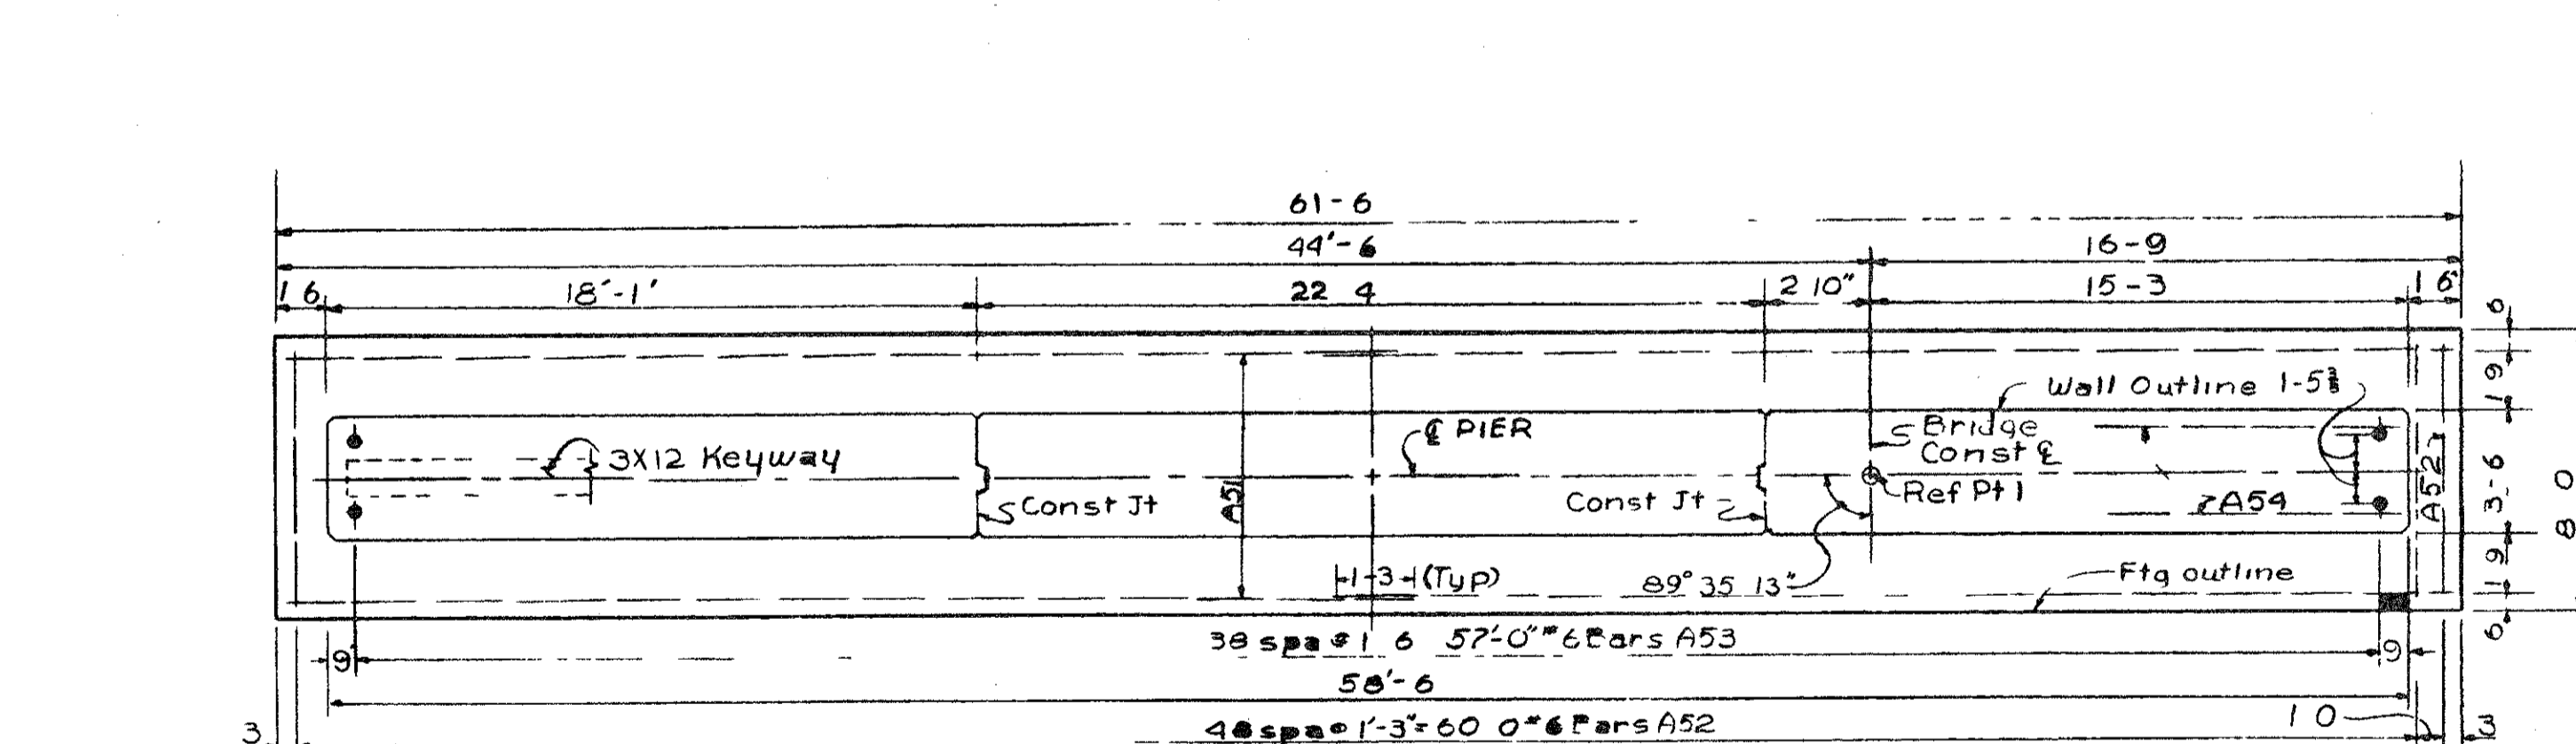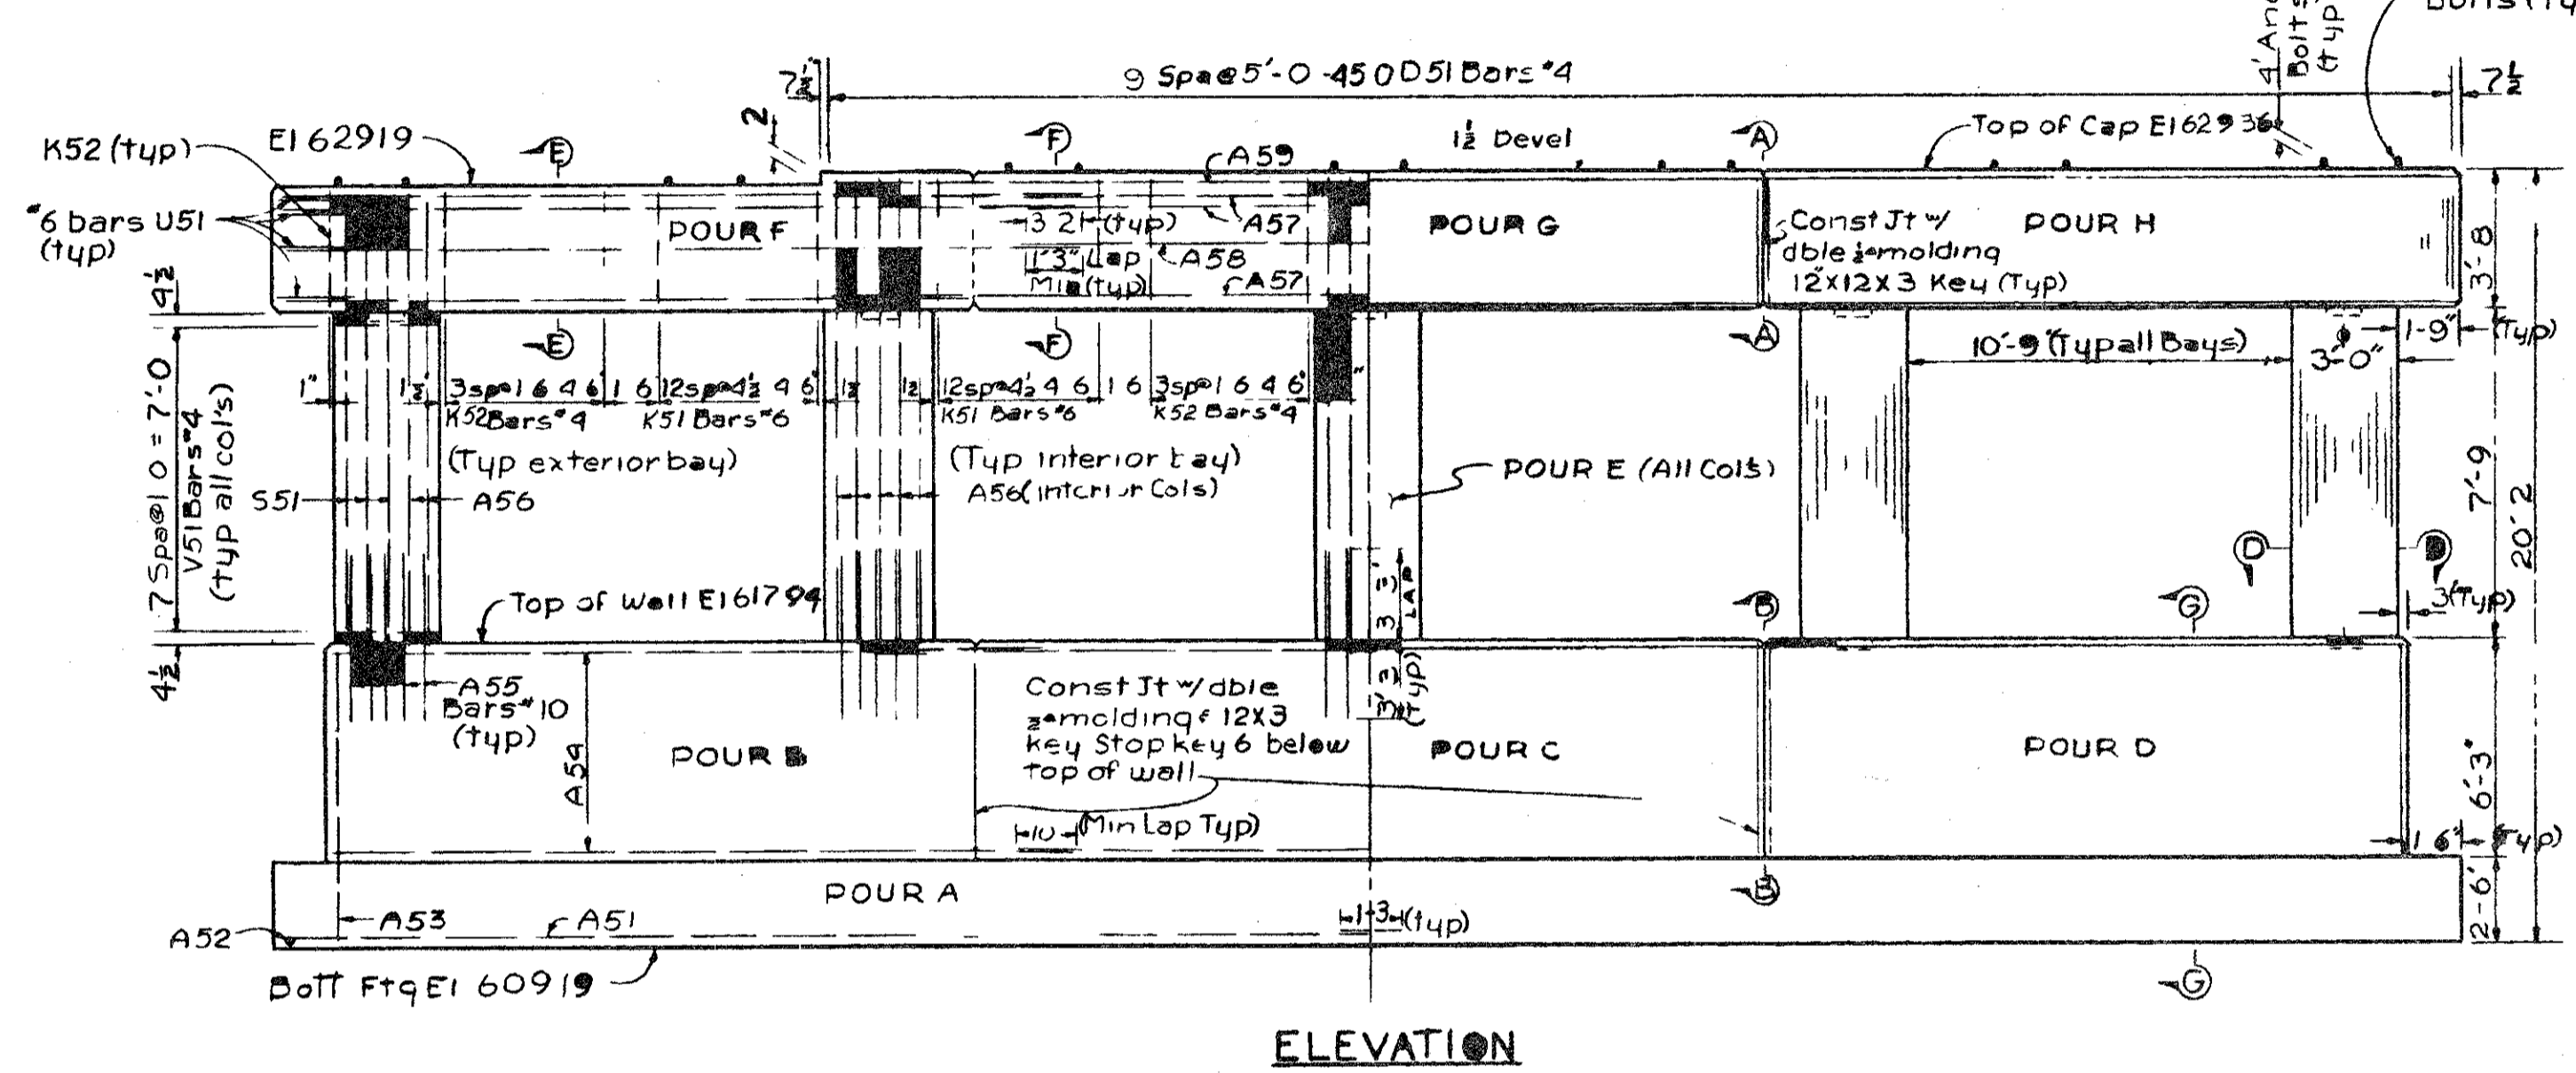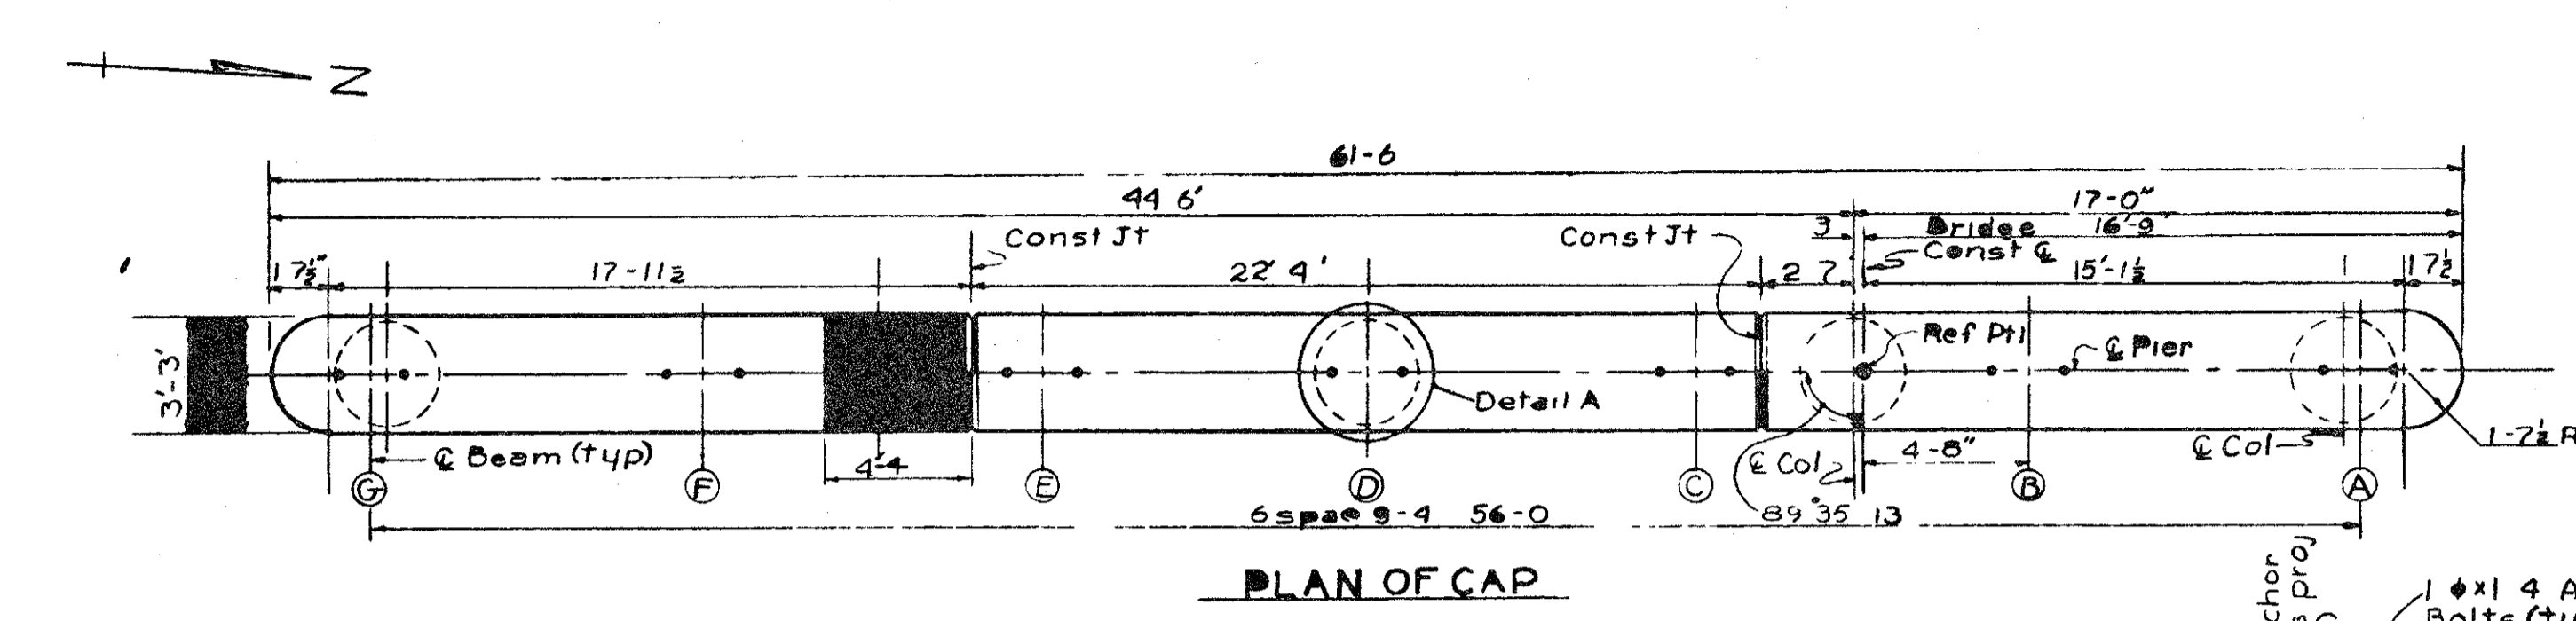

NOTE:
 1/2 gage preformed Alum steel bulkhead securely held in place (No tack welding to reinf steel)
 Partial metal bulkhead may be used as alternate const jt in cap at contractor's expense. Netch metal strip around reinf steel. The metal bulkhead in base wall may be used as alternate const jt at contractor's expense. Cut holes in metal bulkhead for reinf steel.
 Care is to be used in casting concrete around bulkhead to prevent misalignment or dislocation of the bulkhead.

NOTES:
 For bevel molding details, see standard sheet R11 or R12
 Anchor bolts shall be accurately set to a template
 Adjust the spacing of the reinforcing steel as required to permit placing of anchor bolts
 Maximum average foundation pressure DL only = 3800 #/sq ft
 Maximum foundation pressure DL + LL = 5950 #/sq ft
 All exposed surfaces above the top of footing of the pier shall be given an application of Clear Protective Coating for Substructure Concrete (See Supplemental Specifications)
 Anchorage for guard rail is to be provided in pier base wall. For details see Re Plans

MISCELLANEOUS QUANTITIES	
ITEM	QUANTITY
Unclassified Excavation	
Clear Protective Coating for Substructure Concrete	237

CONCRETE QUANTITIES		
Pour	Grade (GA)	Grade (MAA)
A	45.6 cu yds	
B		146 cu yds
C		101
D		146
E		101
F		82
G		90
H		85
Total	45.6 cu yds	890 cu yds

MICHIGAN DEPARTMENT OF STATE HIGHWAYS
PIER DETAILS

REVISIONS
 DESCRIPTION
 SHEET 11 OF 22
S04 OF 63103A



NOTE:
 DO NOT WORK FROM THIS SHEET. THE INFORMATION SHOWN HERE IS FOR REFERENCE ONLY. NO PAY ITEMS ARE SHOWN.

FOR INFORMATION ONLY

DATE	CONT. SEC.	JOB NO.	DESIGN UNIT	SHEET
10-18-99	S04 OF 63103	48404A	MAHDAVI	10 OF 24


DATE: _____ CORRECTED BY: _____ CHECKED BY: _____ DATE: 02-10-99 DRAWN BY: INDER FILE NAME: s0463103a

1 2 3 4 5 6 7 8 9 10 11 12 13 14 15 16 17 18 19 20 21 22 23 24 25 26 27 28 29 30 31 32 33 34 35 36 37 38 39 40 41 42 43 44 45 46 47 48 49 50 51 52 53 54 55 56 57 58 59 60 61 62 63

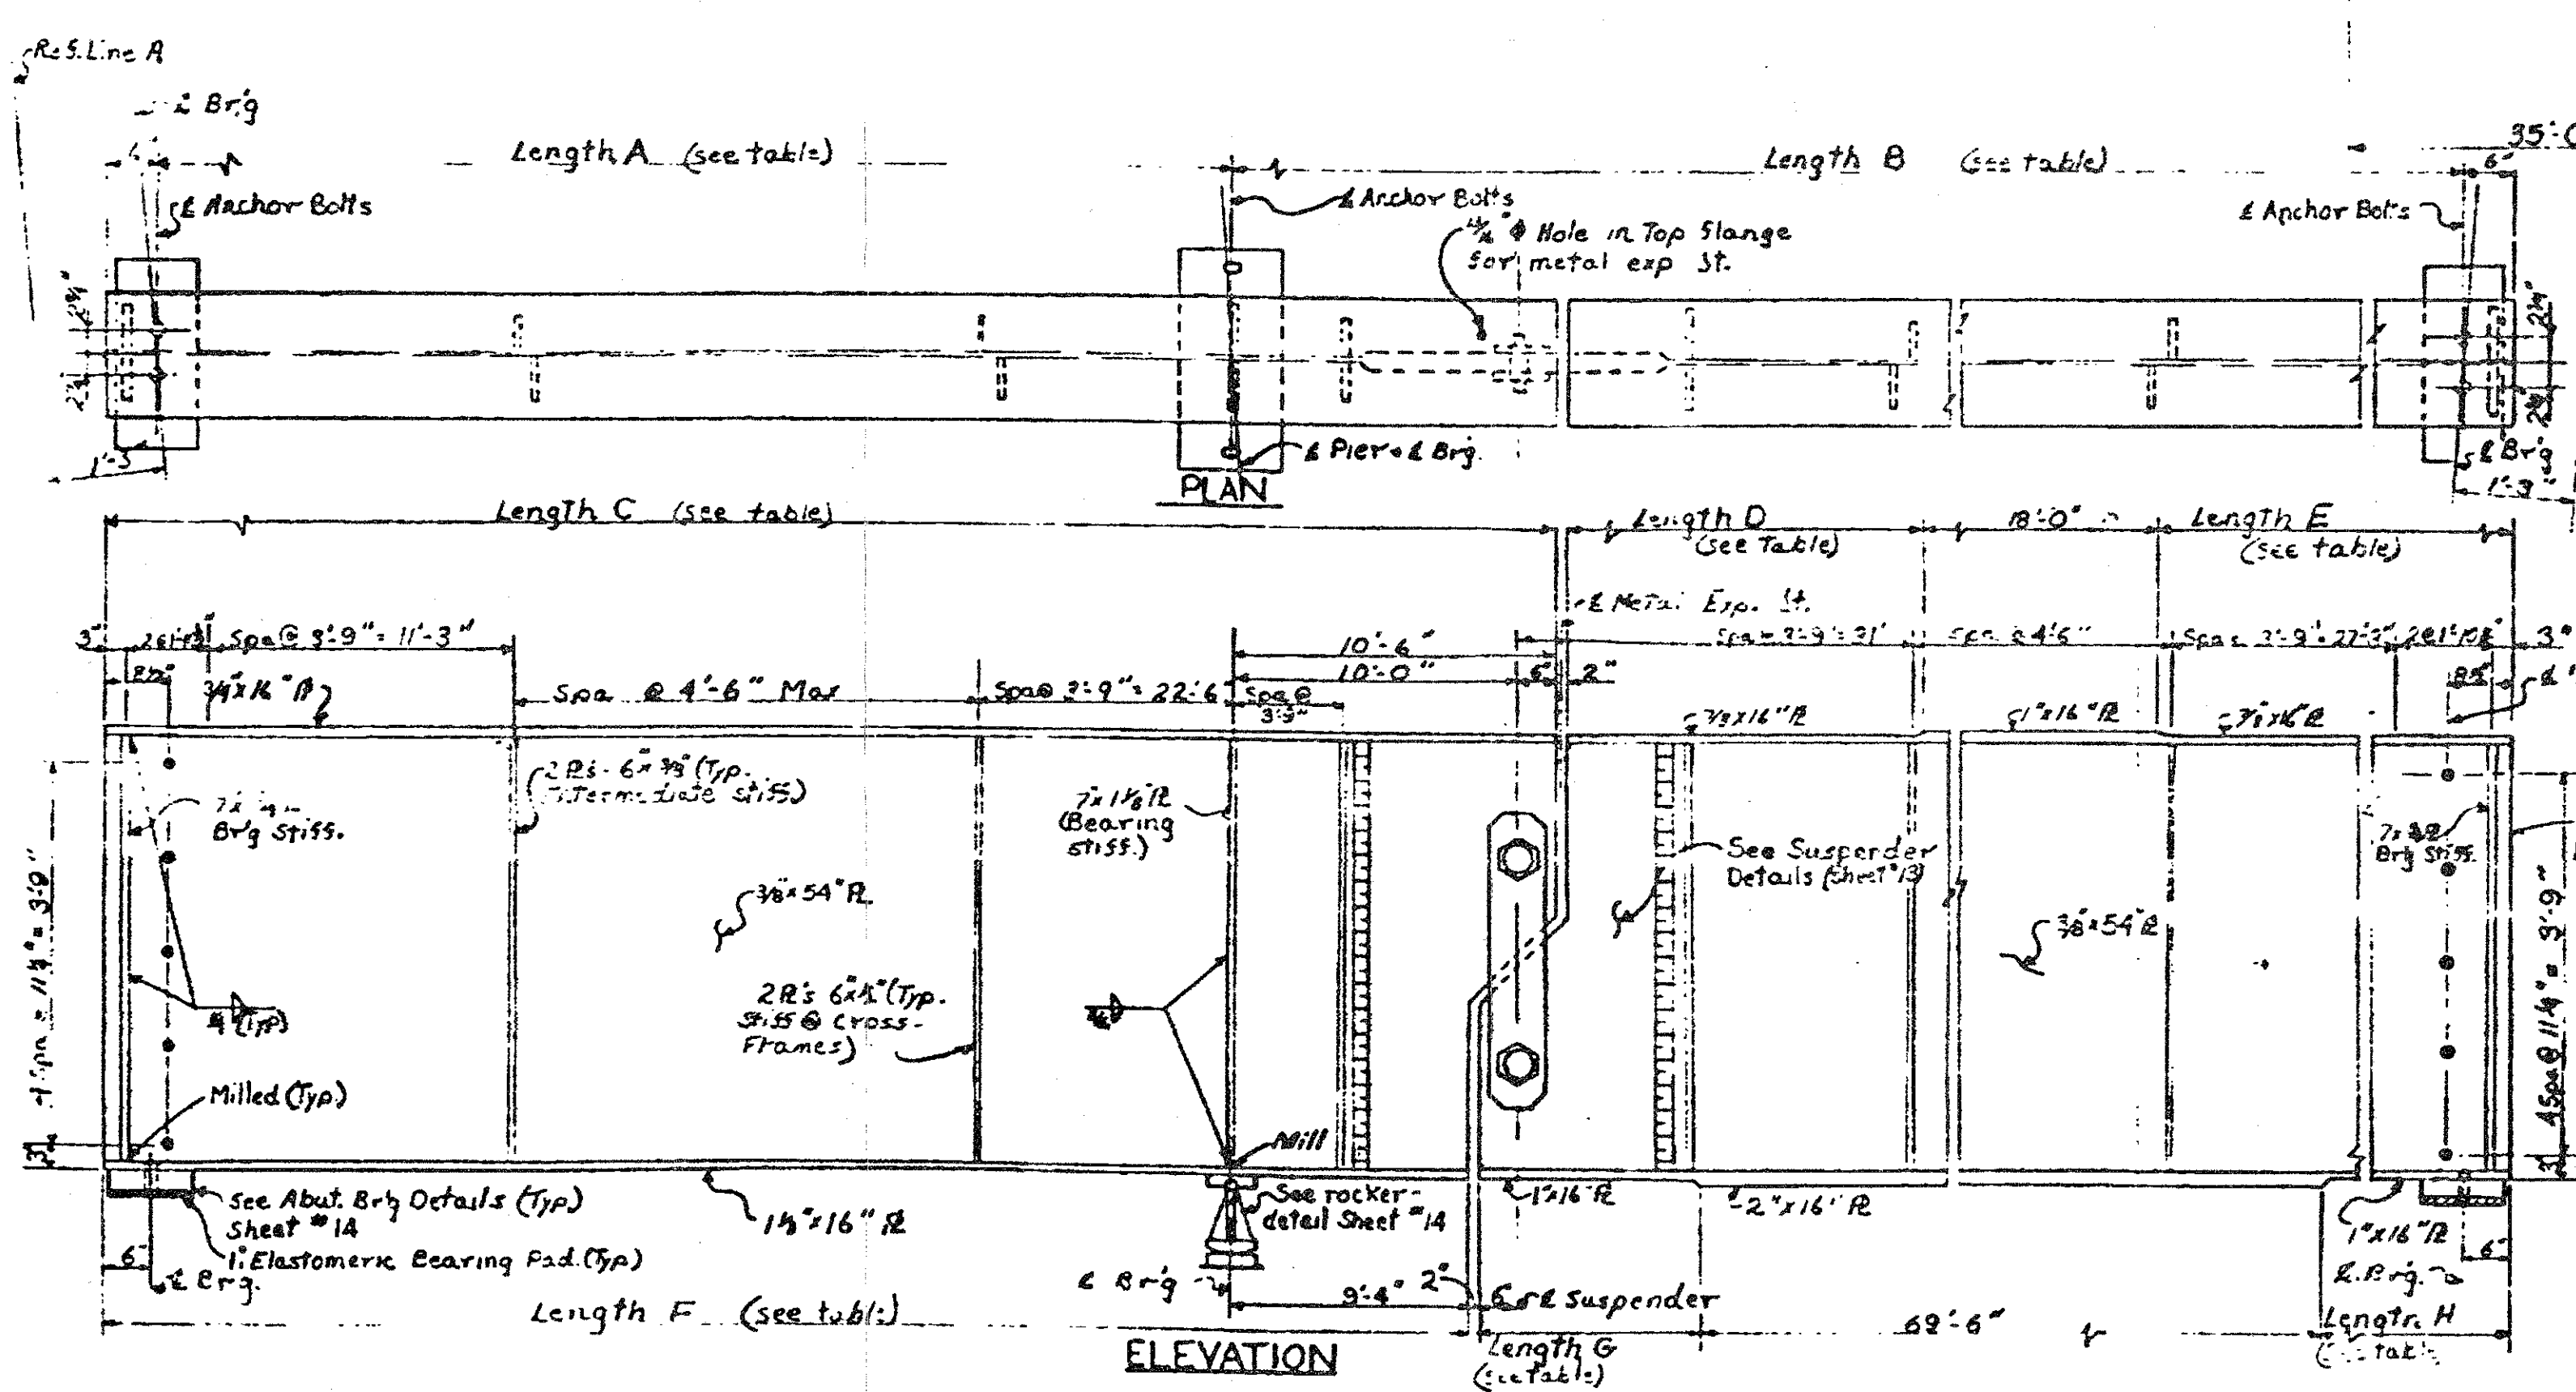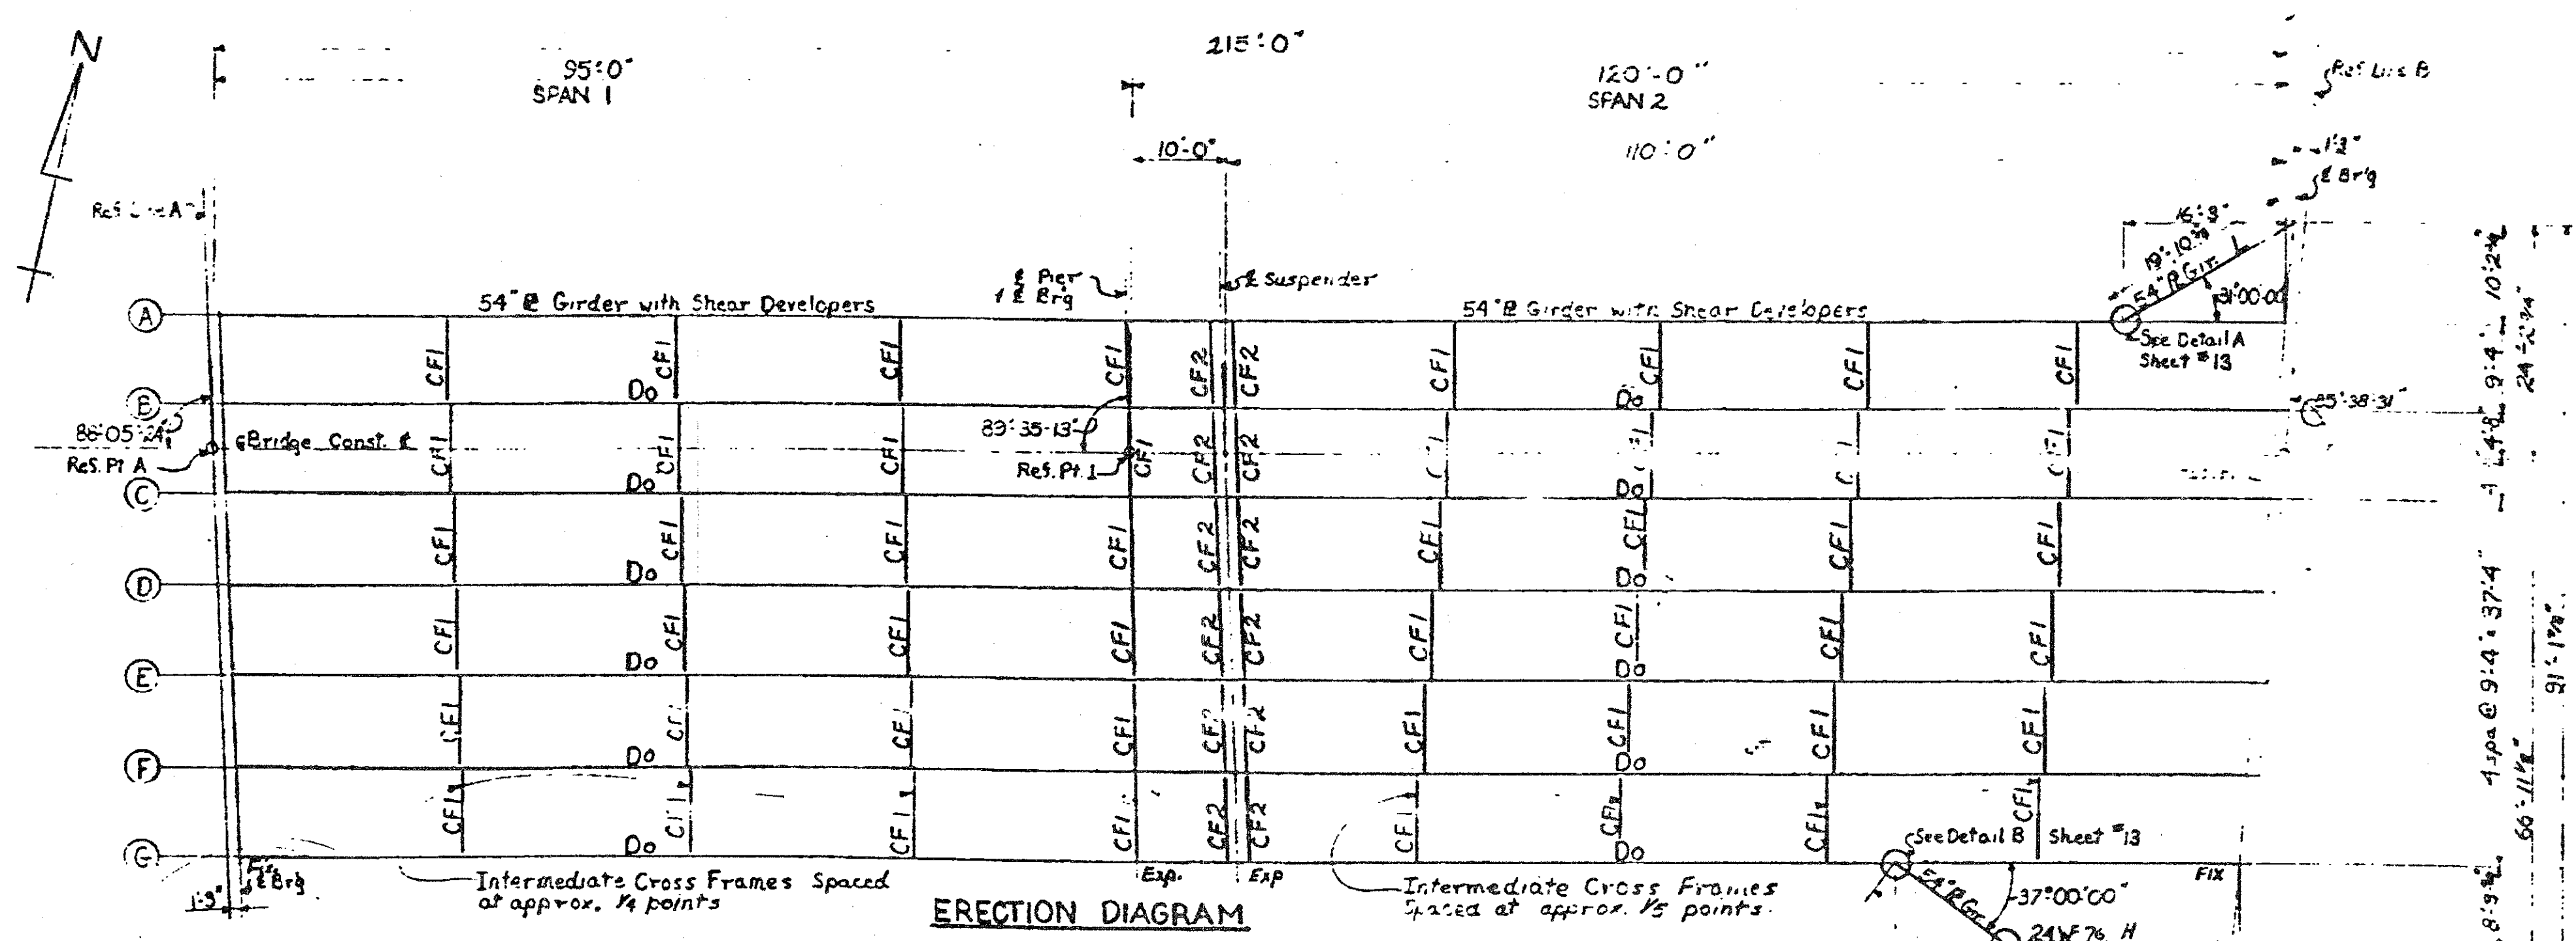

INTERMEDIATE TRANSVERSE STIFFENERS
 Note: When fabricating intermediate stiffeners:
 A - Use a stiffener if it does not fit too tightly.
 B - Push it tight against the tension flange or web.
 C - Weld it to the web.
 D - Weld it to the compression flange. For location of compression region see Sheet #12.

Girder	LENGTH							
	A	B	C	D	E	F	G	H
A	94'-11"	119'-11"	105'-11"	145'-3"	146'-5"	103'-8"	120'-8"	20'-8"
B	93'-10"	118'-10"	104'-10"	144'-4"	145'-6"	102'-8"	119'-8"	20'-5"
C	95'-7"	118'-11"	104'-7"	144'-4"	145'-3"	103'-5"	119'-11"	19'-11"
D	93'-4"	117'-7"	104'-0"	143'-11"	145'-3"	103'-2"	119'-6"	19'-6"
E	93'-11"	118'-9"	104'-11"	144'-8"	144'-10"	102'-11"	119'-11"	19'-11"
F	92'-10"	116'-0"	103'-10"	143'-4"	144'-5"	102'-6"	118'-9"	18'-9"
G	92'-7"	115'-3"	103'-7"	142'-11"	144'-11"	102'-5"	118'-4"	18'-4"

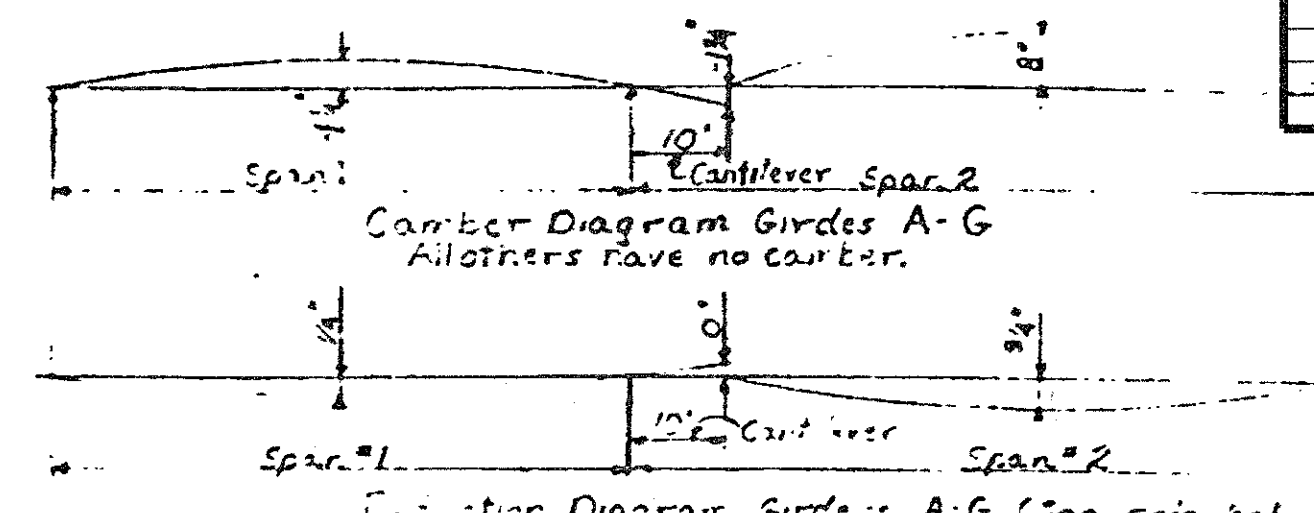

MISCELLANEOUS QUANTITIES

Item	Unit	Amount
Structural Steel - Erection	Lbs.	374,000
Structural Steel - Erection	Lbs.	374,000
Cast-in-place Concrete Pad	Sq. Ft.	161

NOTES:
 Design: Michigan Department of State Highways Specifications for Design of Highway Bridges - 1955 edition and current AASHTO Standard Specifications for Highway Bridges (MS 20-44) loading.
 Fabrication: Michigan Department of State Highways Specifications for Road and Bridge Construction - 1967 edition.
 Shop connections shall be welded as shown on plans.
 Field connections shall be bolted with 1/2" high strength bolts.
 The top and bottom edges of the web plates shall be cut simultaneously to a parabolic camber to minimize distortion.
 The girders are to be cambered as shown on the camber diagram. The camber is to be measured with the girder lying on its side. Heating is to be used, if necessary, to attain camber permanency within the tolerance specified in AWS Specifications. The dead load deflection of the girders alone is as shown on the deflection diagram.
 Steel in anchor bolts may be ASTM A307.
 A shop spike will be permitted in single plates over 50 feet in length. This spike must be located at a minimum distance of 10 feet from the center of the plate.
 Sole plates 3" or more in thickness may be built up by welding together plates not less than 1/2" in thickness. Edges must be beveled 1/4" and welded with a continuous weld for the full perimeter. Welds shall be ground flush with faces of plates.
 Magnetic particle inspection of welds is required and shall consist of 100% inspection of not less than one fabricated section selected at random for each ten sections or fractions thereof.
 Anchor bolts (including nuts and washers) shall be galvanized in accordance with ASTM Designation A153.
 All steel material used for bearings, with exception of part welded to girders, shall be galvanized in accordance with ASTM Designation A123. Galvanizing shall be applied after fabrication of bearing. Mill scale and foreign material shall be removed prior to galvanizing.
 Bronze for washers shall be ASTM B100, Alloy No. 510 or No. 635.
 All steel shall be unpainted A.S.T.M. A550 except as noted.
 The quantity Structural Steel includes:
 A588 Steel - 372,000
 Bronze - 199
 Lead - 49
 Total - 374,000
 The web plate may be spliced at the option of the fabricator.

Work this sheet with sheets No. 13 & 14

MICHIGAN DEPARTMENT OF STATE HIGHWAY

STRUCTURAL STEEL DETAILS

S04 of 63103

NOTE:
 DO NOT WORK FROM THIS SHEET. THE INFORMATION SHOWN HERE IS FOR REFERENCE ONLY. NO PAY ITEMS ARE SHOWN.

FOR INFORMATION ONLY

DATE	CONT. SEC.	JOB NO.	DESIGN UNIT	SHEET
10-18-99	S04 OF 63103	48404A	MAHDAVI	11 OF 24







REVISIONS: NO., DESCRIPTION, DATE, BY

DATE: 02-10-99



CHECKED BY: INDER

FILE NAME: s0463103a

REVISIONS			
NO.	DESCRIPTION	DATE	BY

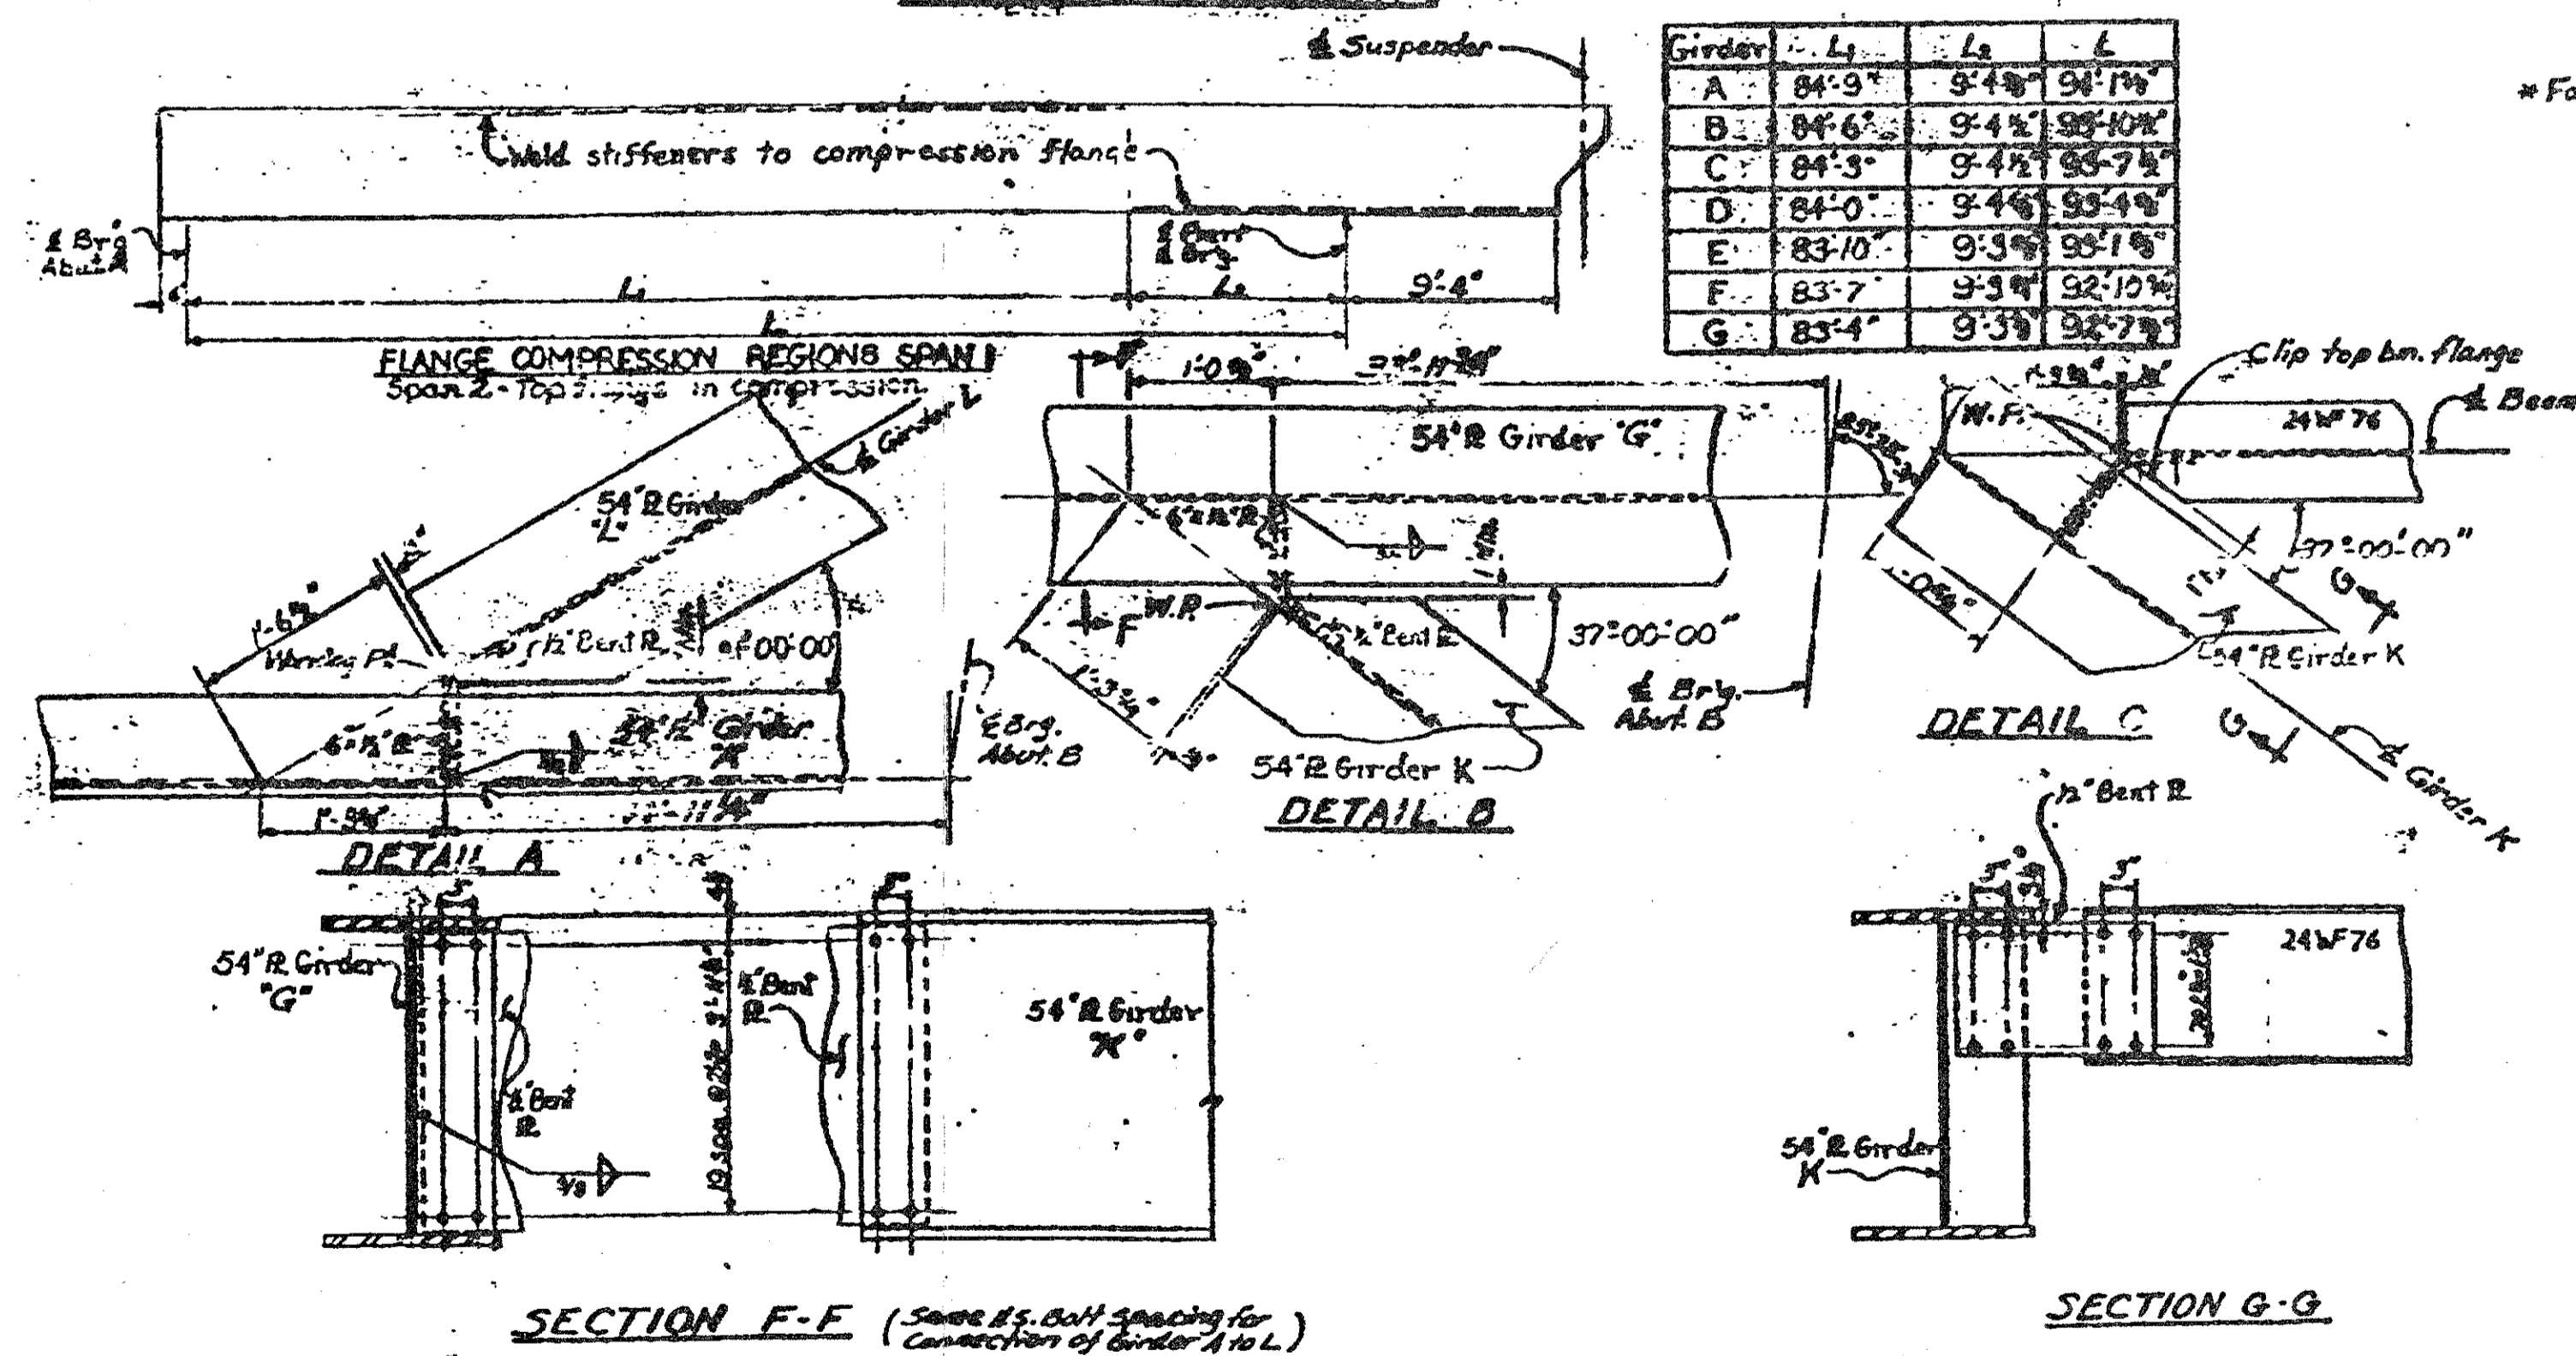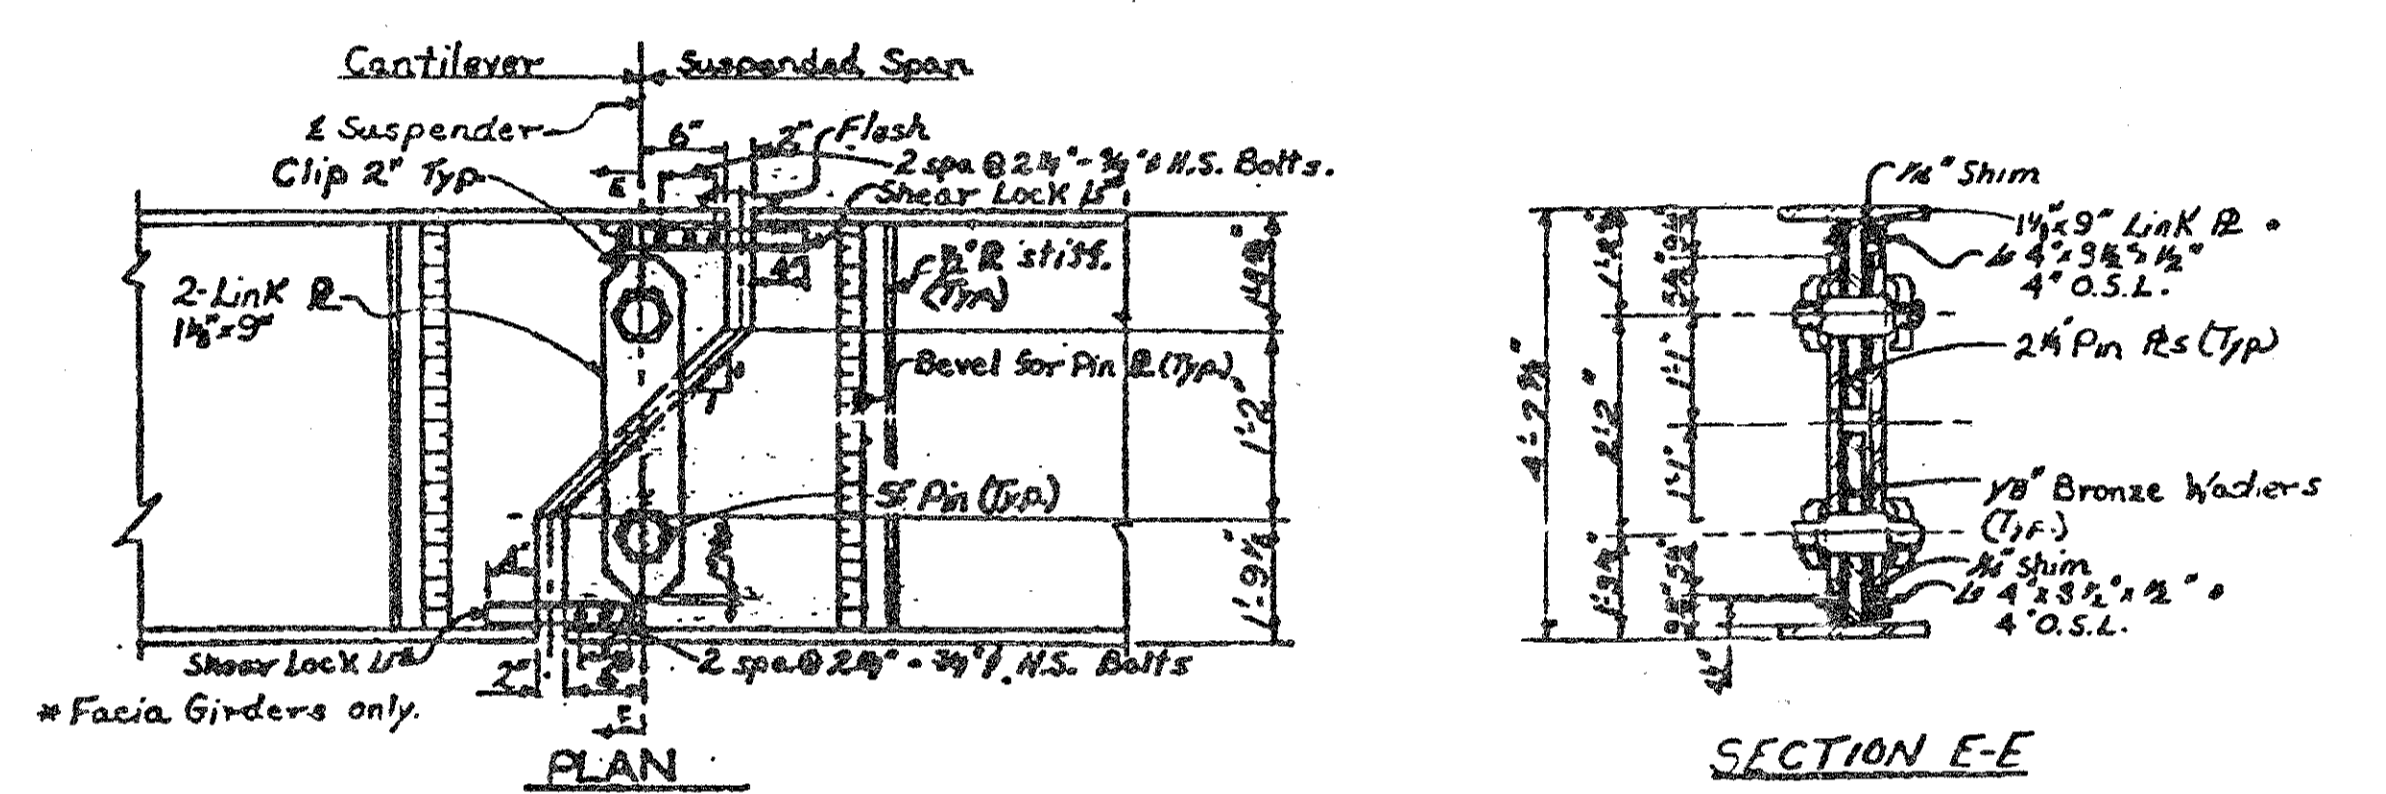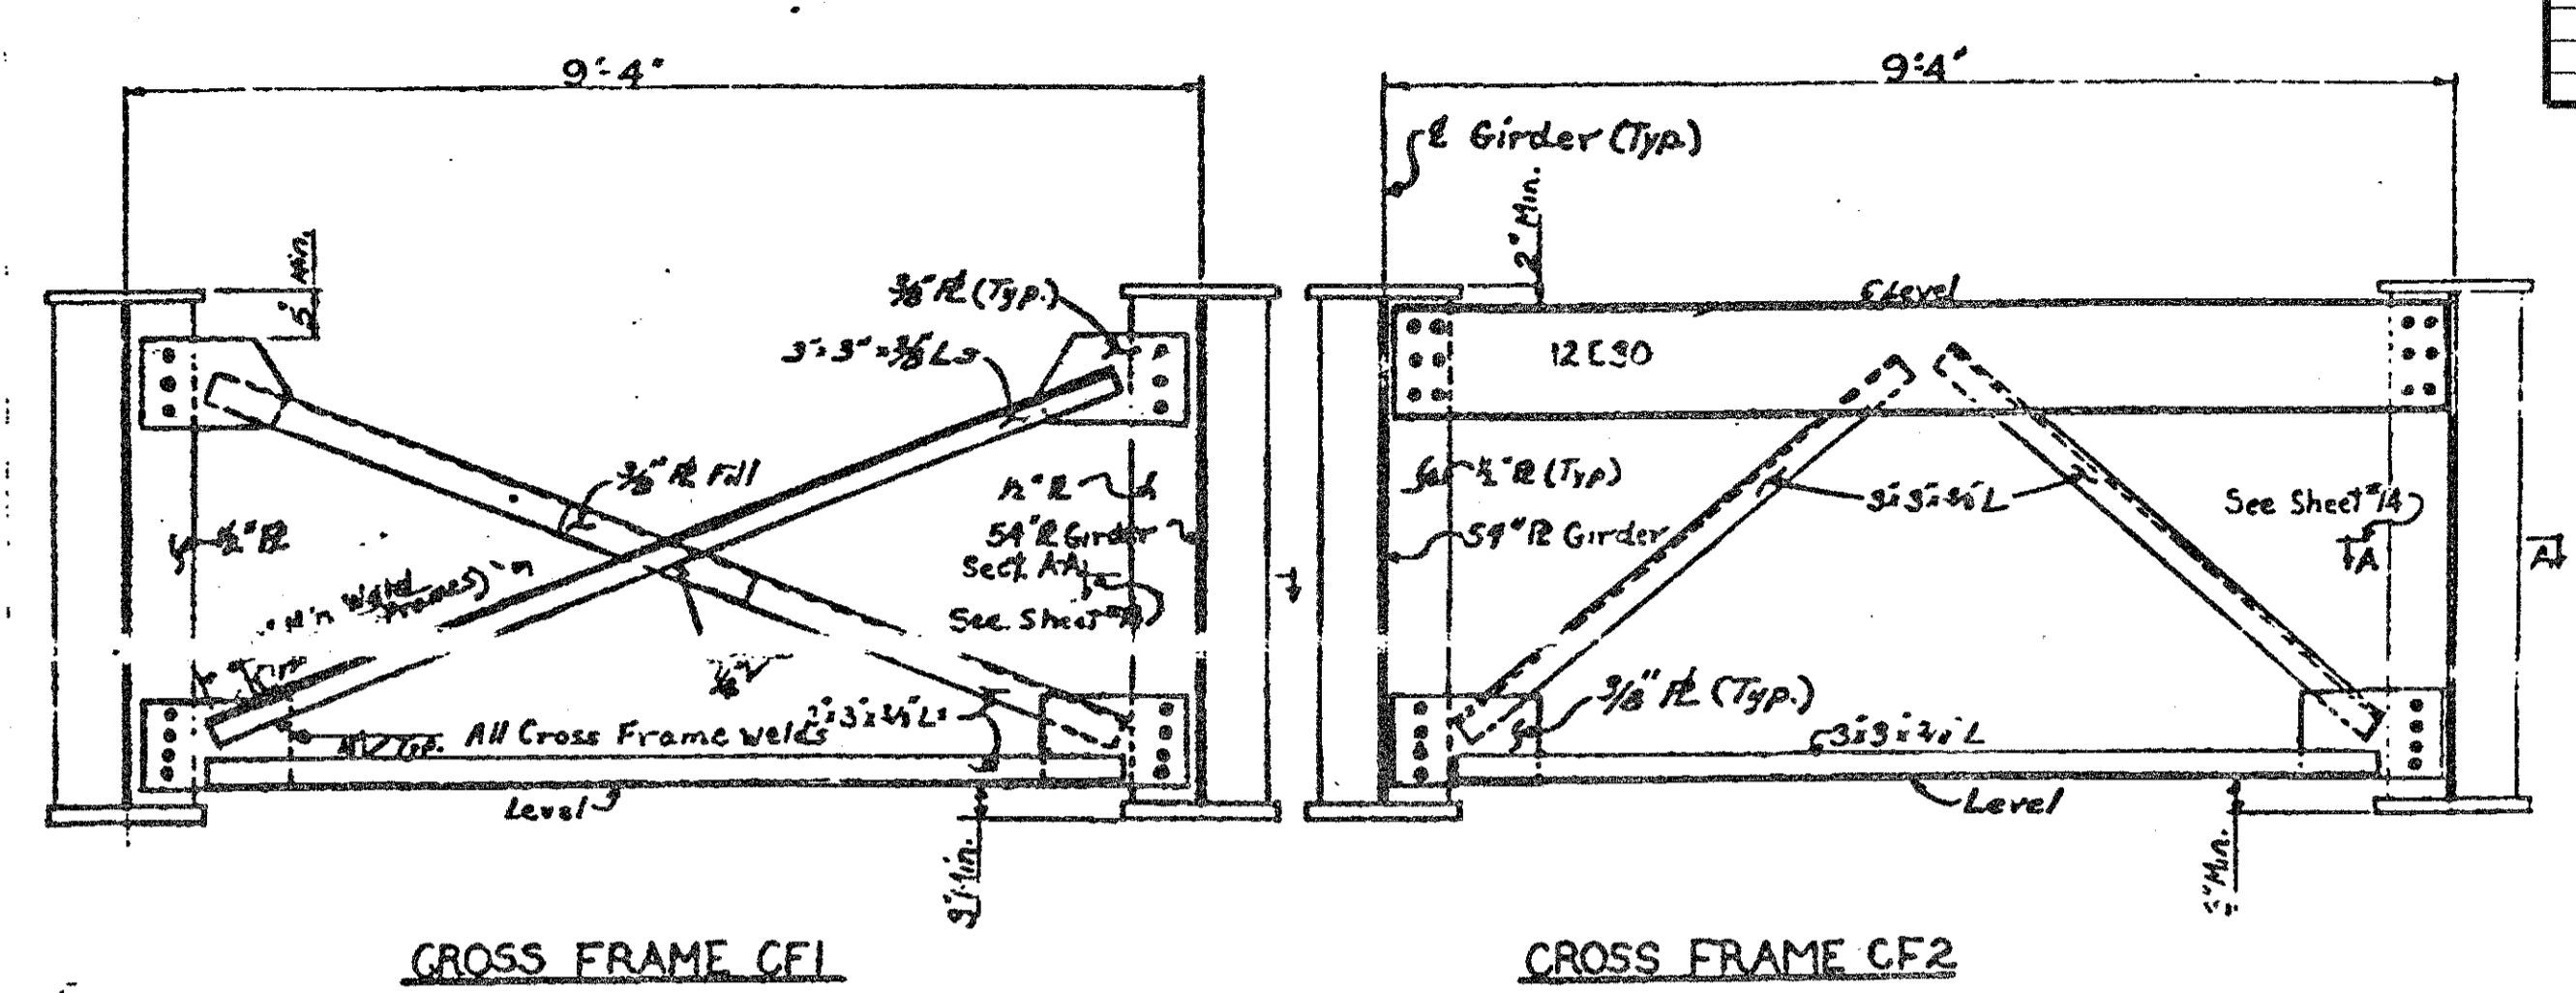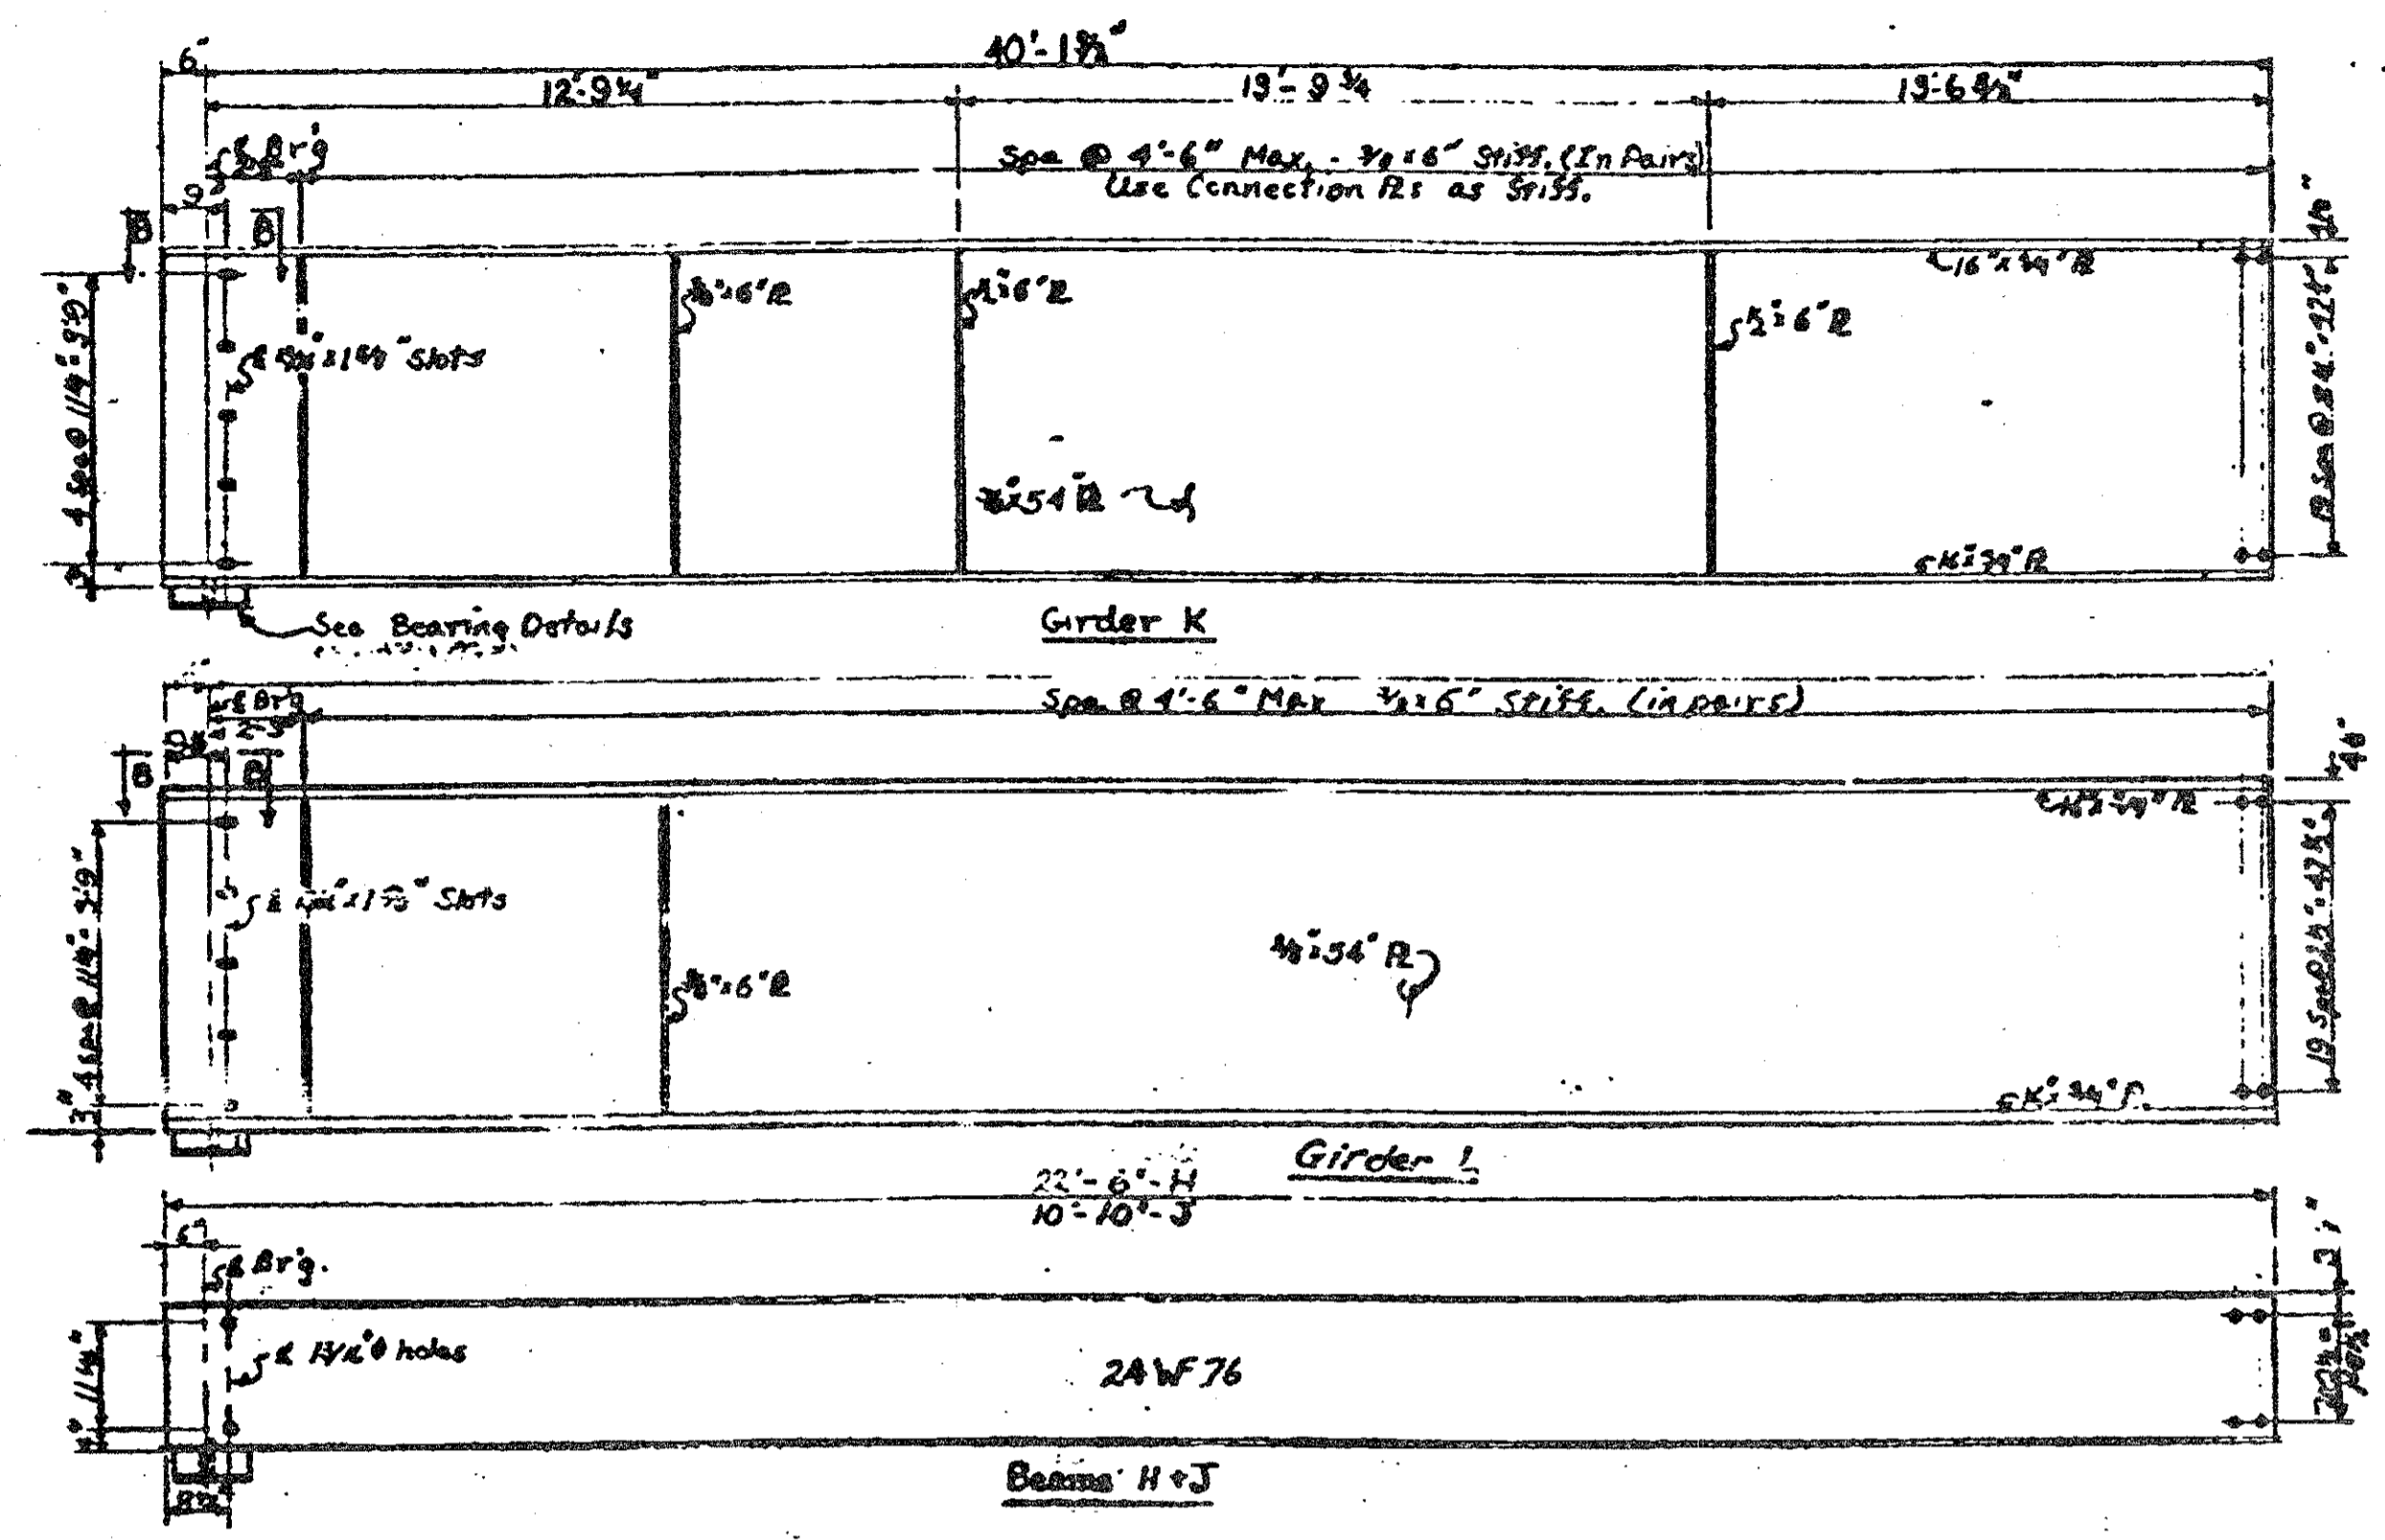

Girder	L1	L2	L
A	84'-9"	9'-4 1/2"	94'-1 1/2"
B	84'-6"	9'-4 1/2"	98'-10"
C	84'-3"	9'-4 1/2"	93'-7 1/2"
D	84'-0"	9'-4 1/2"	93'-4 1/2"
E	83'-10"	9'-3 1/2"	93'-1 1/2"
F	83'-7"	9'-3 1/2"	92'-10"
G	83'-4"	9'-3 1/2"	92'-7 1/2"

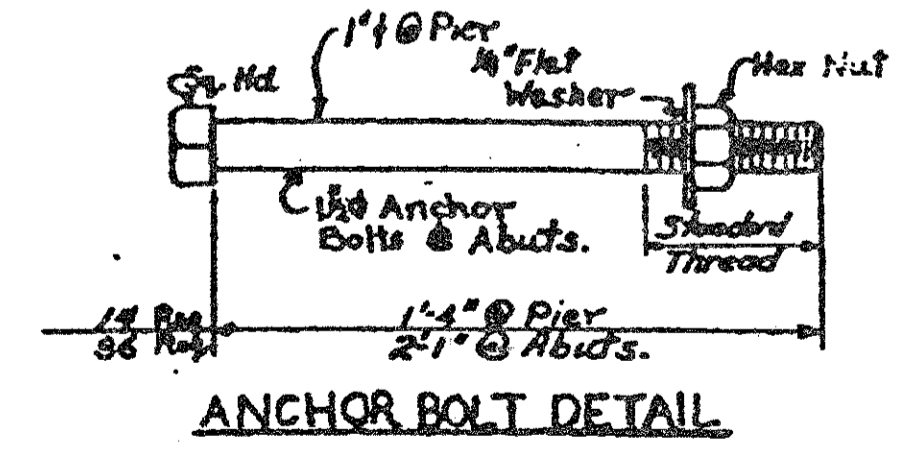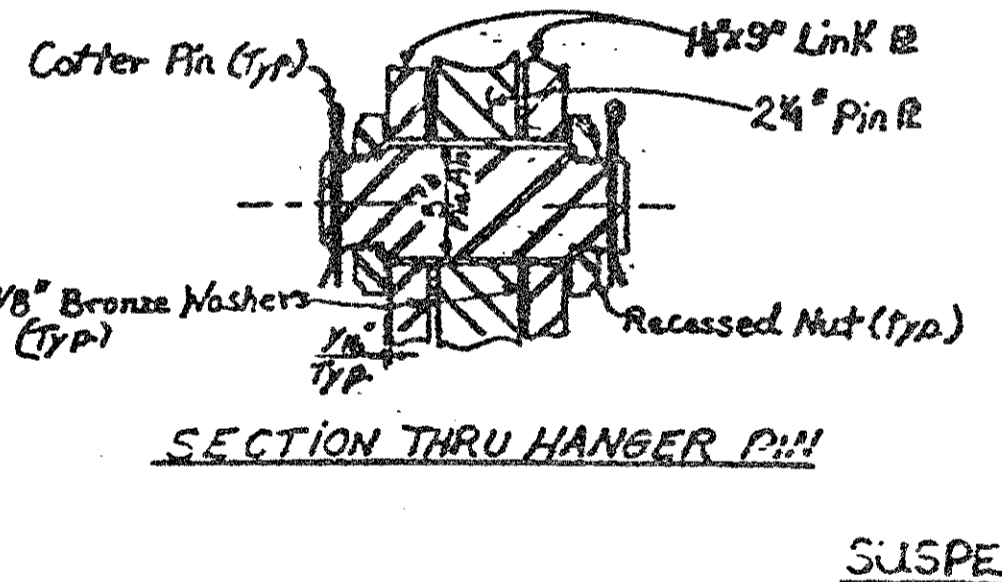

Work this sheet with sheets No 12+14.

MICHIGAN DEPARTMENT OF STATE HIGHWAYS

STRUCTURAL STEEL DETAILS

REVISIONS		
NO.	DESCRIPTION	DATE

Drawn by: Fisher (6-4-99)
Checked by: C. Makris (7-8-99)
Scale: As Shown
Date: 12-9-99

S04 of 63103A











NOTE:
DO NOT WORK FROM THIS SHEET. THE INFORMATION SHOWN HERE IS FOR REFERENCE ONLY. NO PAY ITEMS ARE SHOWN.

FOR INFORMATION ONLY				
DATE	CONT. SEC.	JOB NO.	DESIGN UNIT	SHEET
10-18-99	S04 OF 63103	48404A	MAHDAVI	12 OF 24





DRAWN BY: INDR DATE: 02-10-99 CHECKED BY: DATE: CORRECTED BY: DATE: FILE NAME: s0463103a


REVISIONS			
NO.	DESCRIPTION	DATE	BY

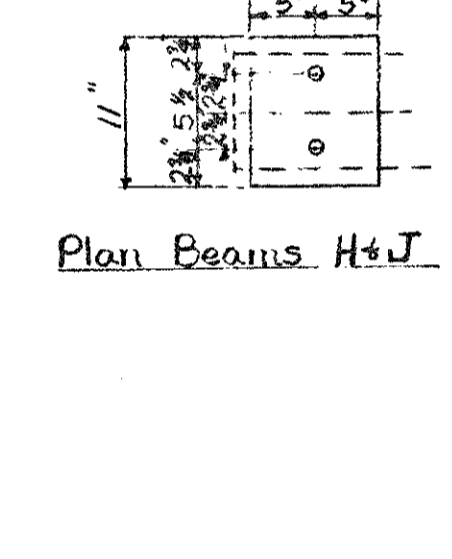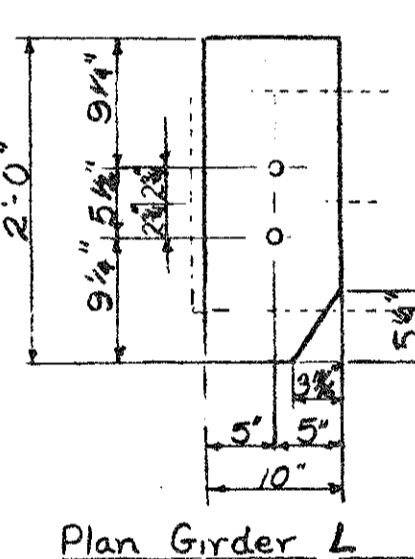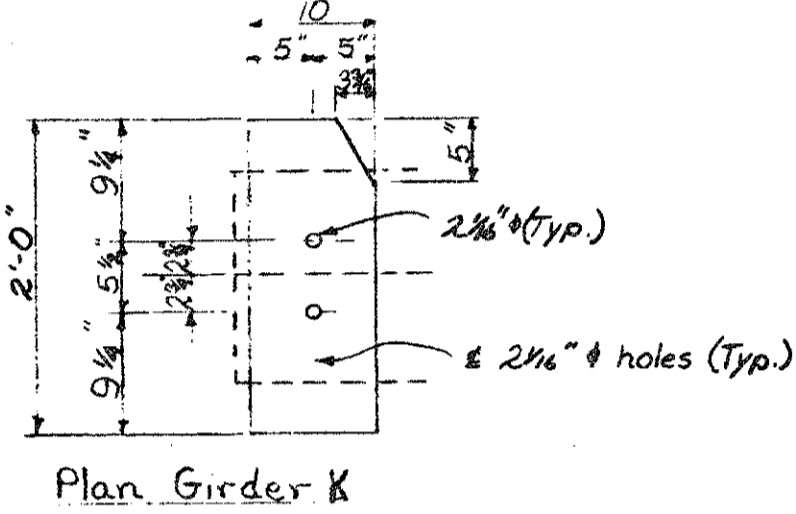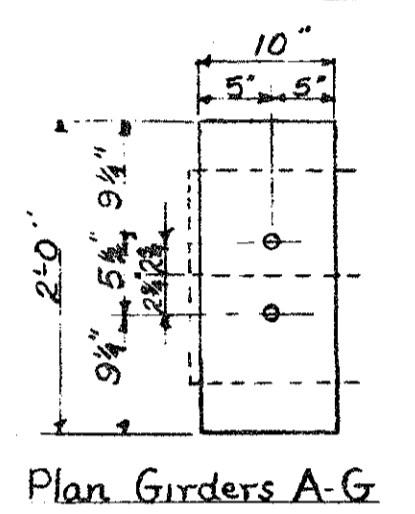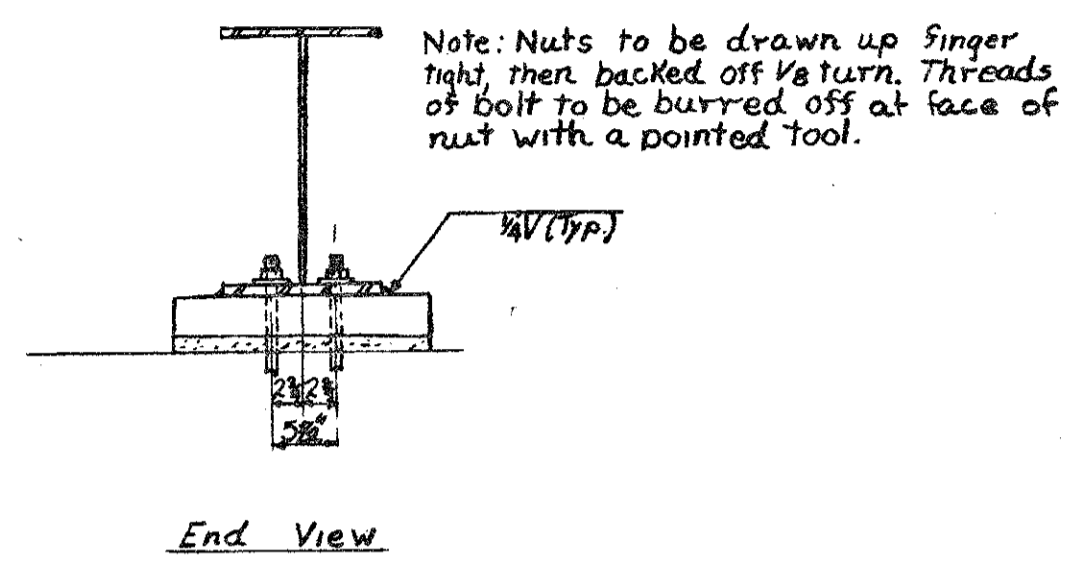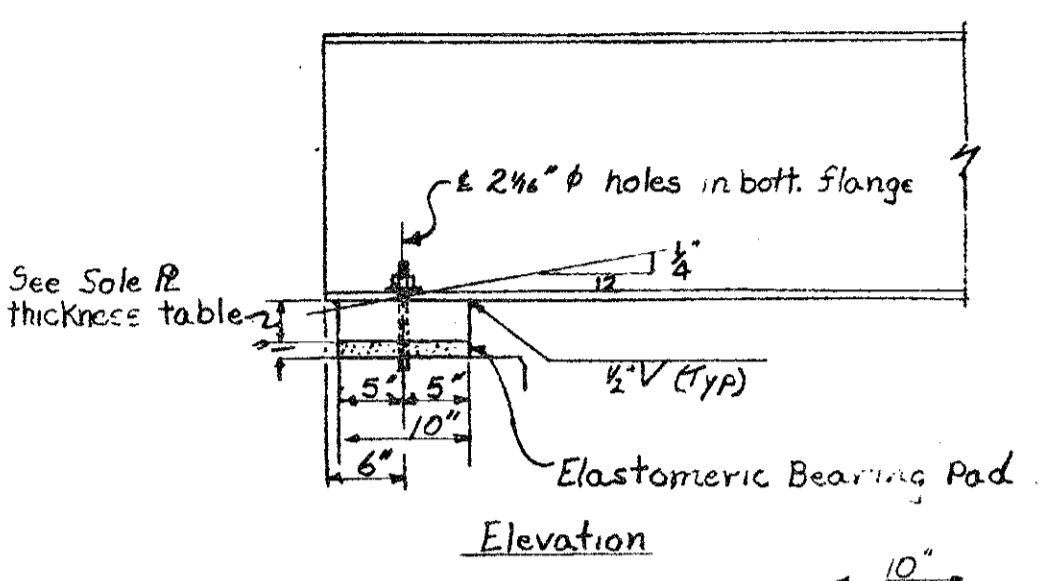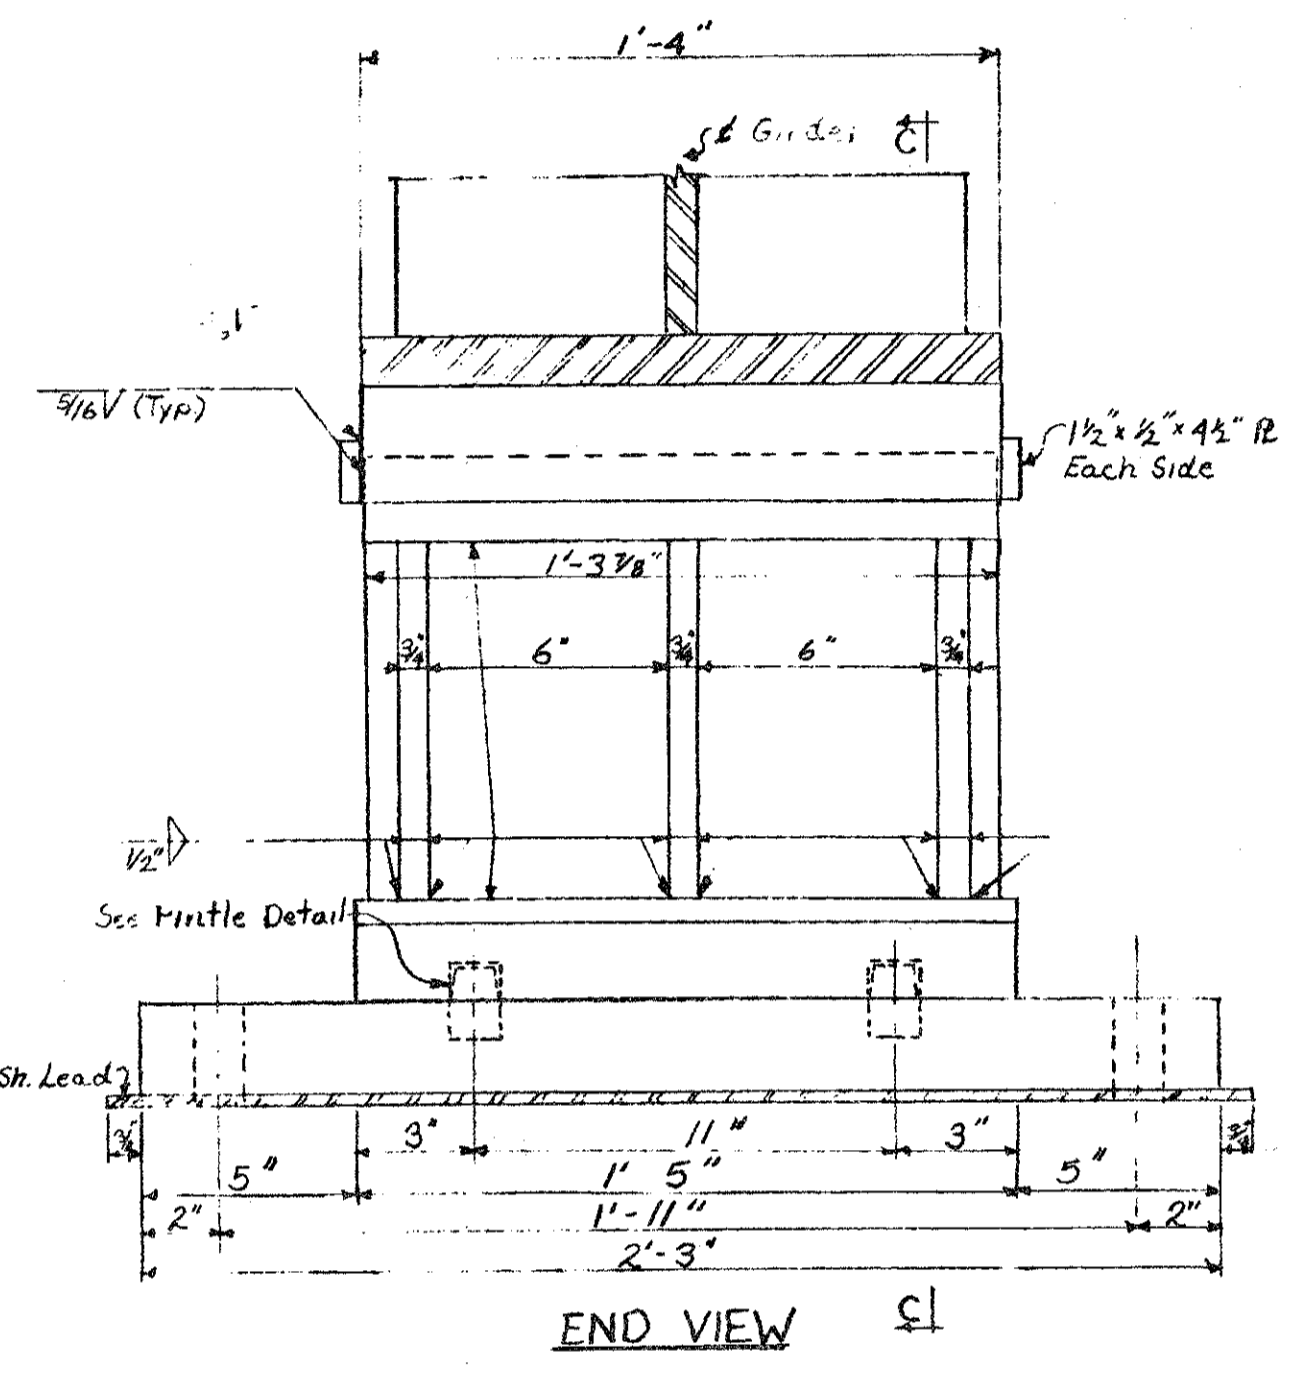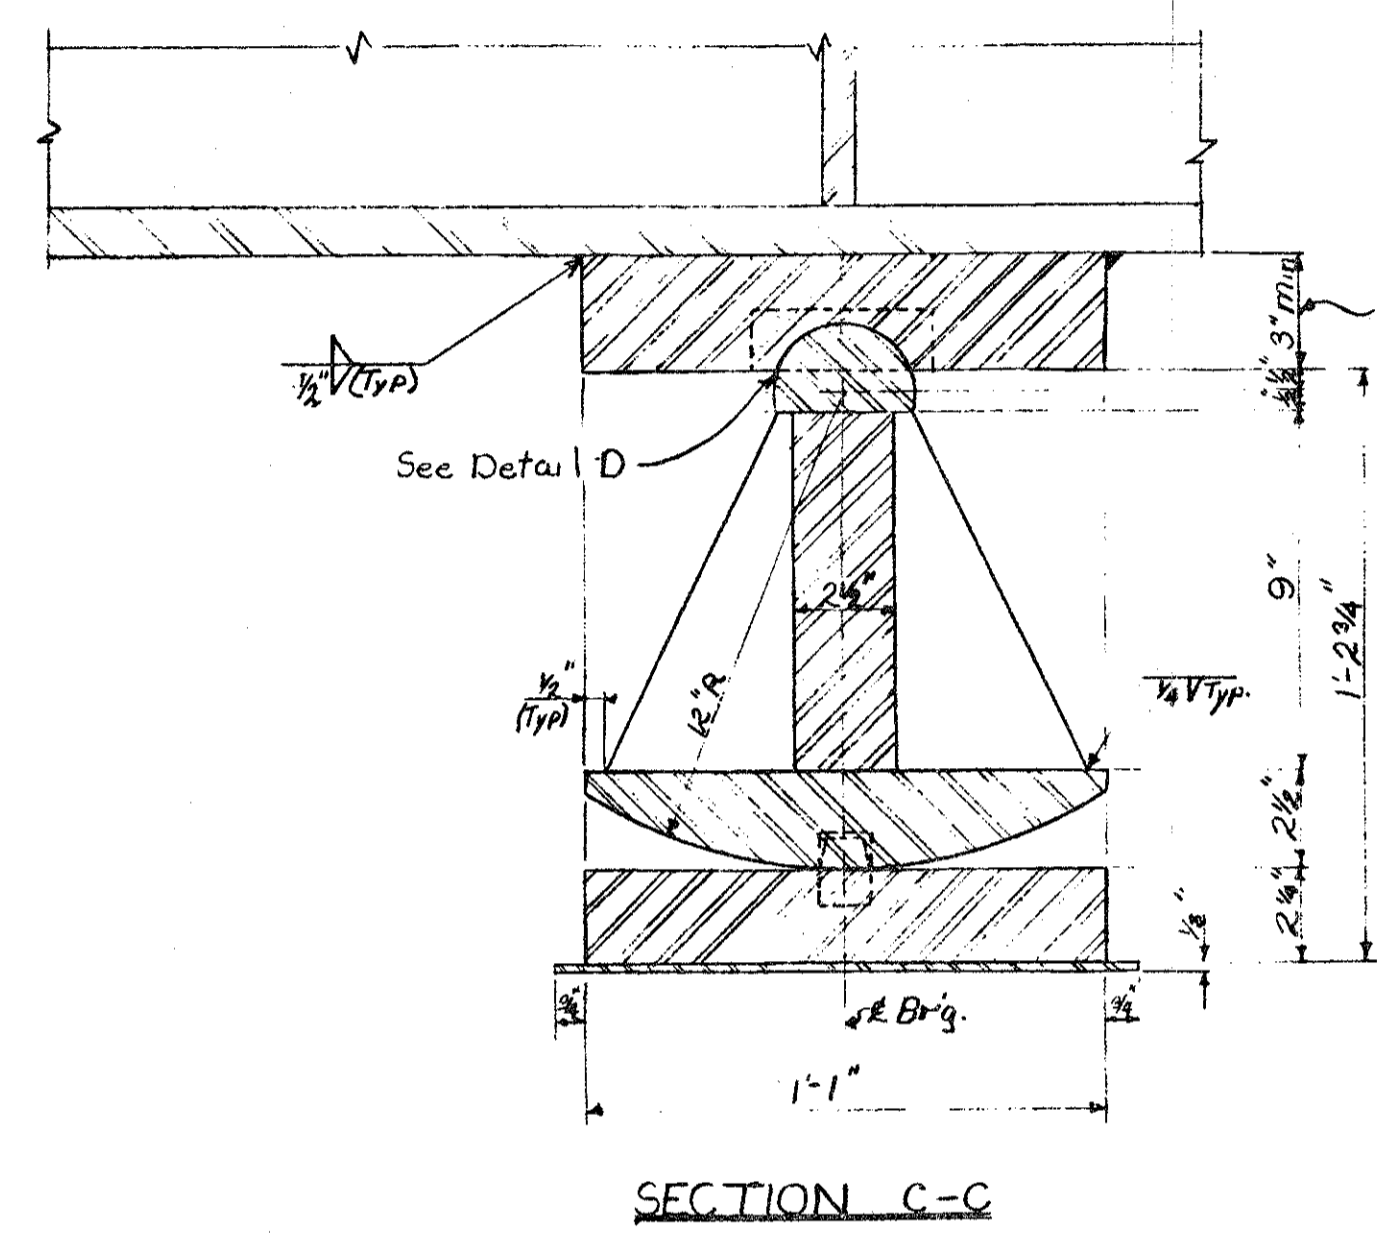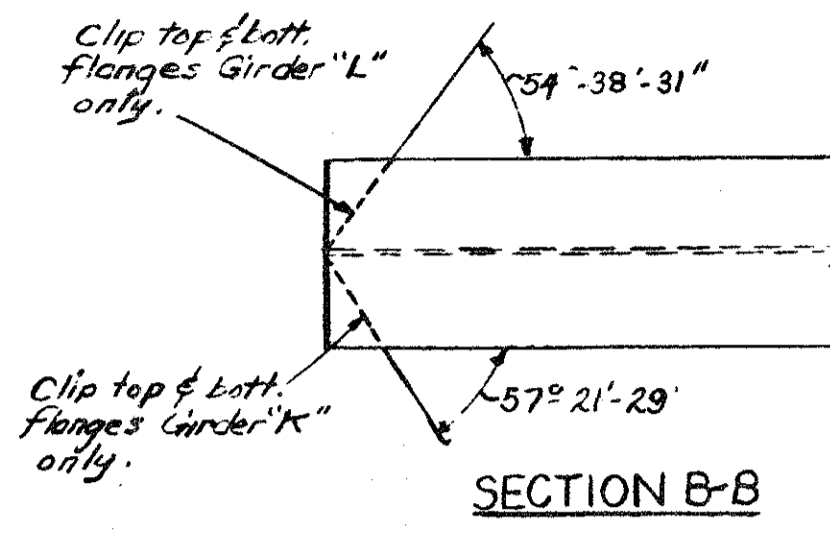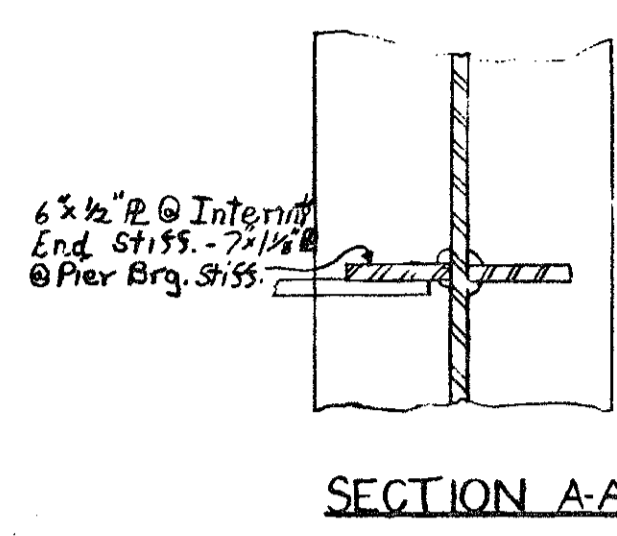

BEARING DETAILS-PIER

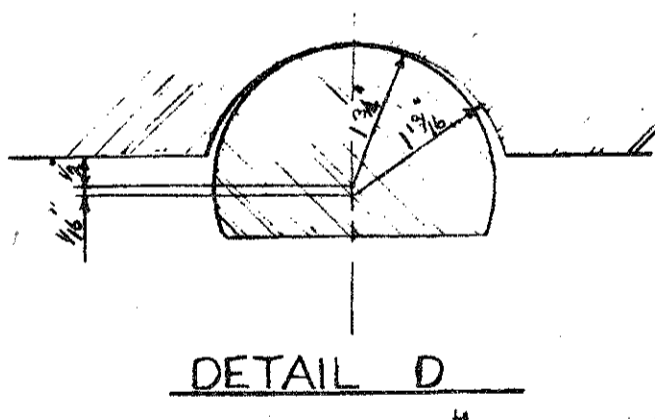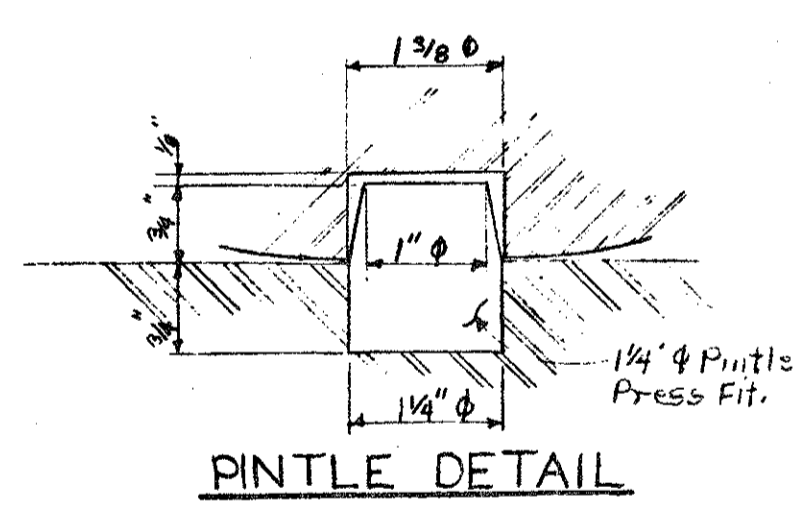

BEARING DETAILS ABUT. A+B

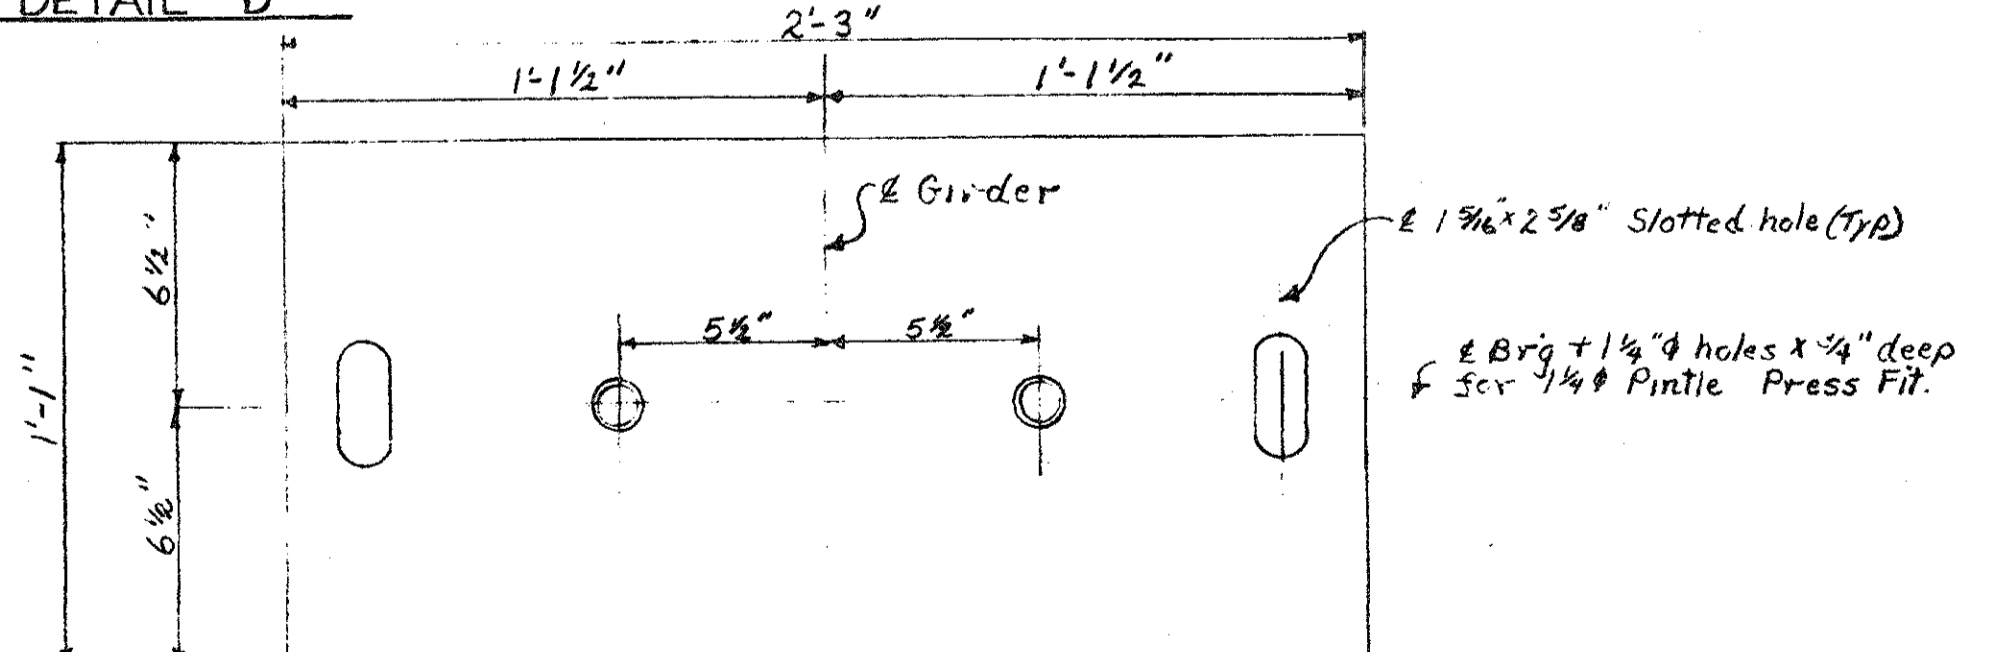

Girder	Abut. A		Pier		Abut. B	
	Thickness	Bevel	Thickness	Bevel	Thickness	Bevel
A	3 1/2"	+ 1/4"	3 1/4"	0 1/4"	4 1/2"	+ 1/4"
B	4 3/8"	+ 1/4"	4 1/2"	0 1/4"	5 3/8"	+ 1/4"
C	4 3/8"	+ 1/4"	4 1/2"	0 1/4"	6"	+ 1/4"
D	3 1/2"	+ 1/4"	3 1/4"	0 1/4"	5"	+ 1/4"
E	3 3/4"	+ 1/4"	3 1/4"	0 1/4"	5"	+ 1/4"
F	2 1/2"	+ 1/4"	4"	0 1/4"	4"	+ 1/4"
G	1 1/2"	+ 1/4"	3"	0 1/4"	3"	+ 1/4"

NOTE: DO NOT WORK FROM THIS SHEET. THE INFORMATION SHOWN HERE IS FOR REFERENCE ONLY. NO PAY ITEMS ARE SHOWN.

Work this sheet with sheets No. 12+13.

MICHIGAN DEPARTMENT OF STATE HIGHWAYS

STRUCTURAL STEEL DETAILS

DESIGNED BY: Fisher 6-4-61
DRAWN BY: T. H. Kirk 7-19-61



504 of 13 03A

DATE: DATE: DATE: DATE: DATE: DATE: DATE: DATE: DATE: DATE: DRAWN BY: INDR CORRECTED BY: CHECKED BY: FILE NAME: s0463103sn.




DATE	CONT. SEC.	JOB NO.	DESIGN UNIT	SHEET
10-18-99	S04 OF 63103	48404A	MAHDAVI	13 OF 24

FOR INFORMATION ONLY

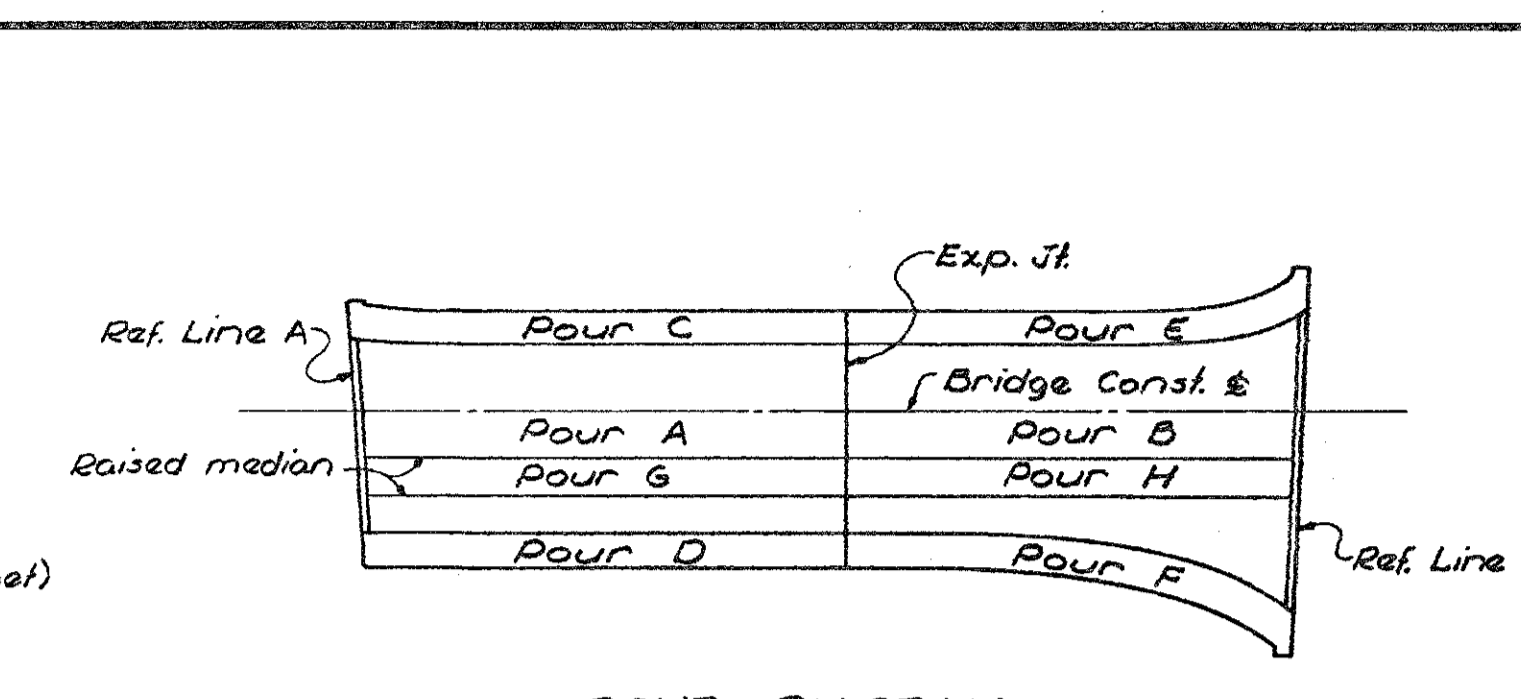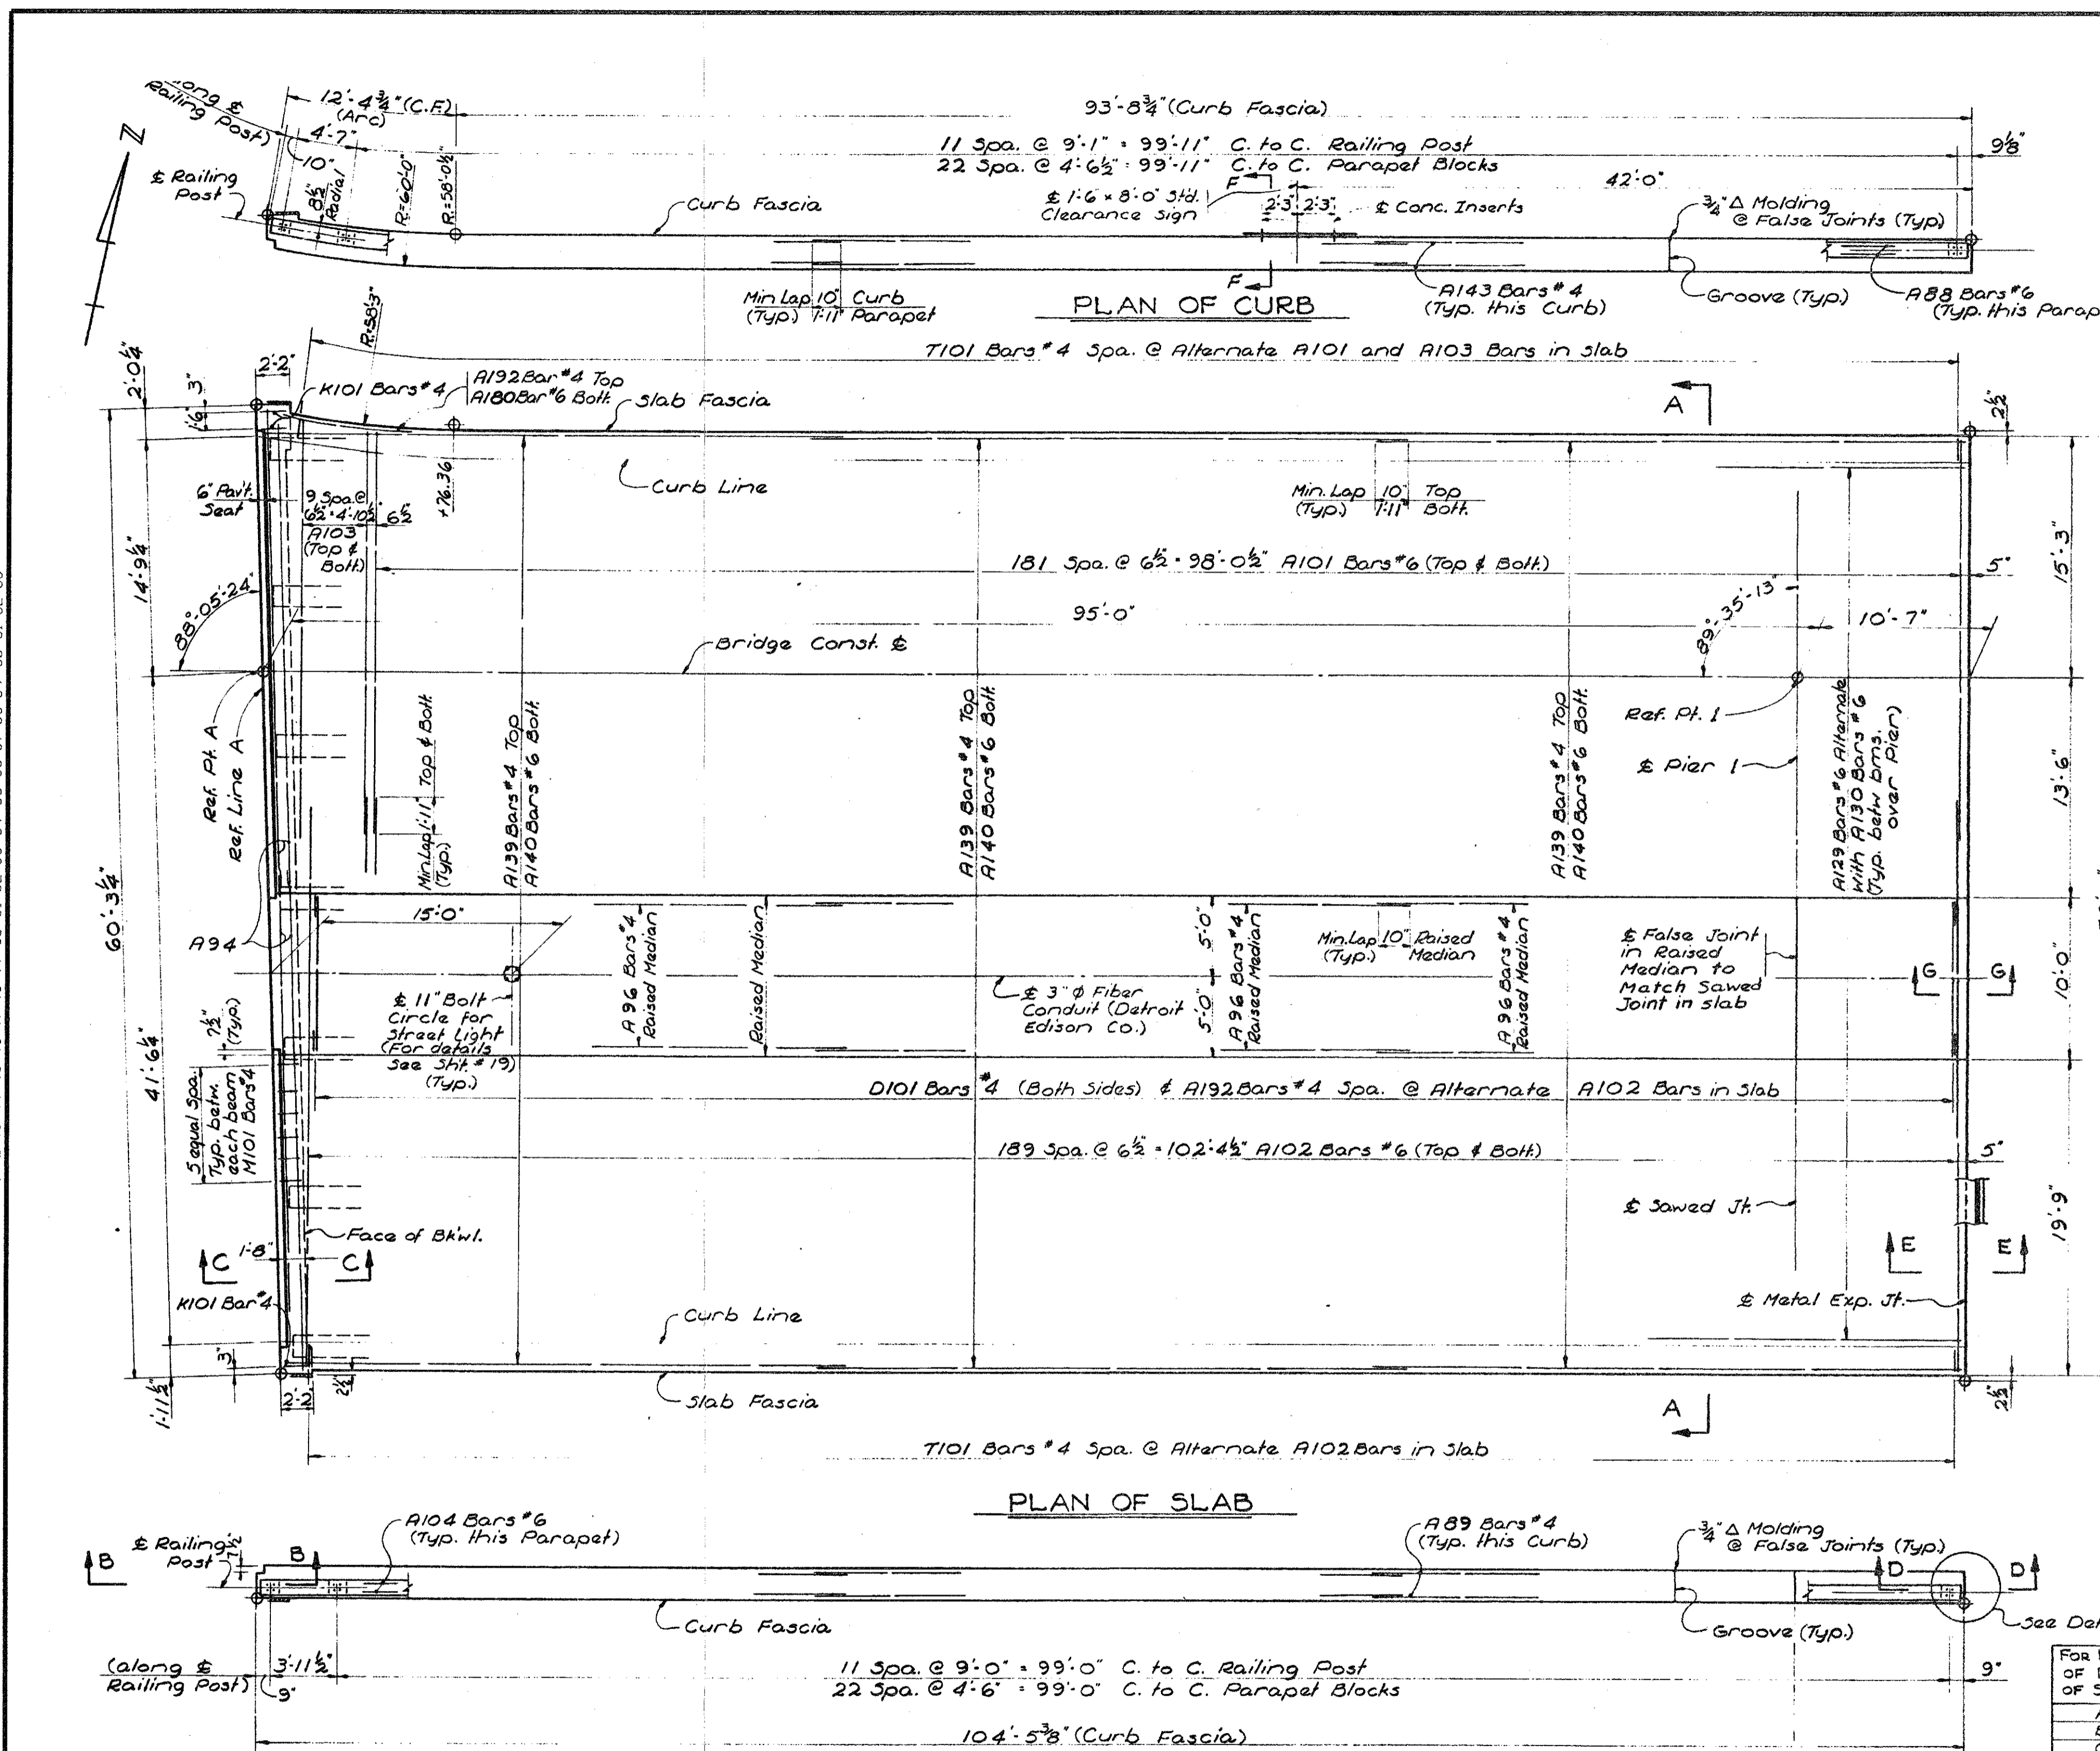

MISCELLANEOUS QUANTITIES

ITEM	UNIT	AMOUNT
Bridge Railing - Parapet Type	Lin. Ft.	440.6
Hot-Poured Rubber Asphalt Type Filler	Lin. Ft.	59
Water Reducing Retarding Admixture	Gals.	61
Structural Tile 6"x12"x12"	Each	1254
Protective Treatment for Bridge Decks	Sq. Ft.	13250

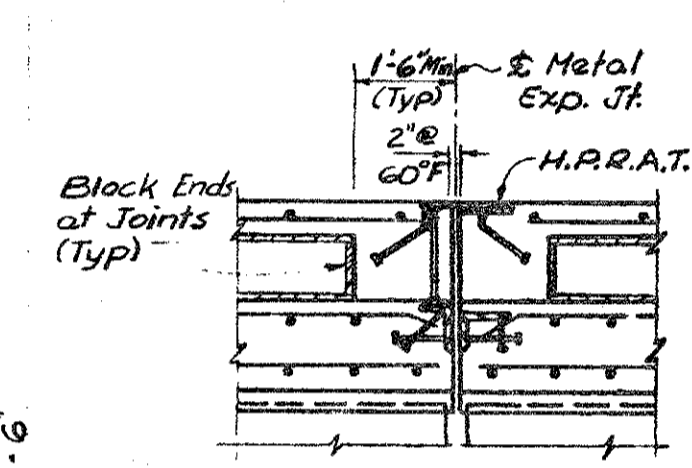

CONCRETE QUANT.

Pour	Grade	AMOUNT
A	Grade A (6A)(C)(1/4)	175.9
B		200.8
C		6.4
D		6.3
E		7.0
F		7.1
G		22.9
H		23.6
Blk. A		18.2
Blk. B		32.4
Total		500.8 Cu Yds.

NOTES:

J.W.P. denotes Joint Waterproofing.
 H.P.R.A.T.F. denotes Hot-Poured Rubber Asphalt Type Filler.
 For details of bevels, moldings and bridge railing, see Standard Sheet R11 or R12.
 Edge or Groove denote edging or grooving with an approved tool.
 The contractor is to provide a sawed joint 1/2" deep by 1/4" wide (min) in the top of slab over and parallel to the centerline of pier. The joint is to be sawed before casting of curbs and raised median and is to be filled with hot-poured rubber asphalt type filler (incidental).
 Bridge railing is to be either aluminum or steel tubular railing on concrete parapet. See railing standard R11 or R12.
 Protective treatment for bridge decks is to be applied to all superstructure concrete surfaces between fascia lines. (See supplemental specifications)
 For name plate mounting details see standard sheet R11 or R12.
 For location of name plate see sheet # 4.
 Curb and raised median pours shall not be cast until slab concrete has attained at least 50% of its design strength as determined by section 5.01.05 of the standard specifications.
 False joints in curbs & raised medians shall be placed midway between parapet blocks at approx. every fourth panel.
 Alphabetical designation of pours is not to be construed as a pour sequence.

Work this sheet with sheet # 18 & 19

MICHIGAN DEPARTMENT OF STATE HIGHWAYS

SUPERSTRUCTURE DETAILS


DATE: 10-18-99
 CONT. SEC.: S04 OF 63103
 JOB NO.: 48404A
 DESIGN UNIT: MAHDAVI
 SHEET: 14 OF 24

NOTE:
 DO NOT WORK FROM THIS SHEET. THE INFORMATION SHOWN HERE IS FOR REFERENCE ONLY. NO PAY ITEMS ARE SHOWN.

MIDOT
 Michigan Department of Transportation

DATE: 10-18-99
 CONT. SEC.: S04 OF 63103
 JOB NO.: 48404A
 DESIGN UNIT: MAHDAVI
 SHEET: 14 OF 24

1 2 3 4 5 6 7 8 9 10 11 12 13 14 15 16 17 18 19 20 21 22 23 24 25 26 27 28 29 30 31 32 33 34 35 36 37 38 39 40 41 42 43 44 45 46 47 48 49 50 51 52 53 54 55 56 57 58 59 60 61 62 63

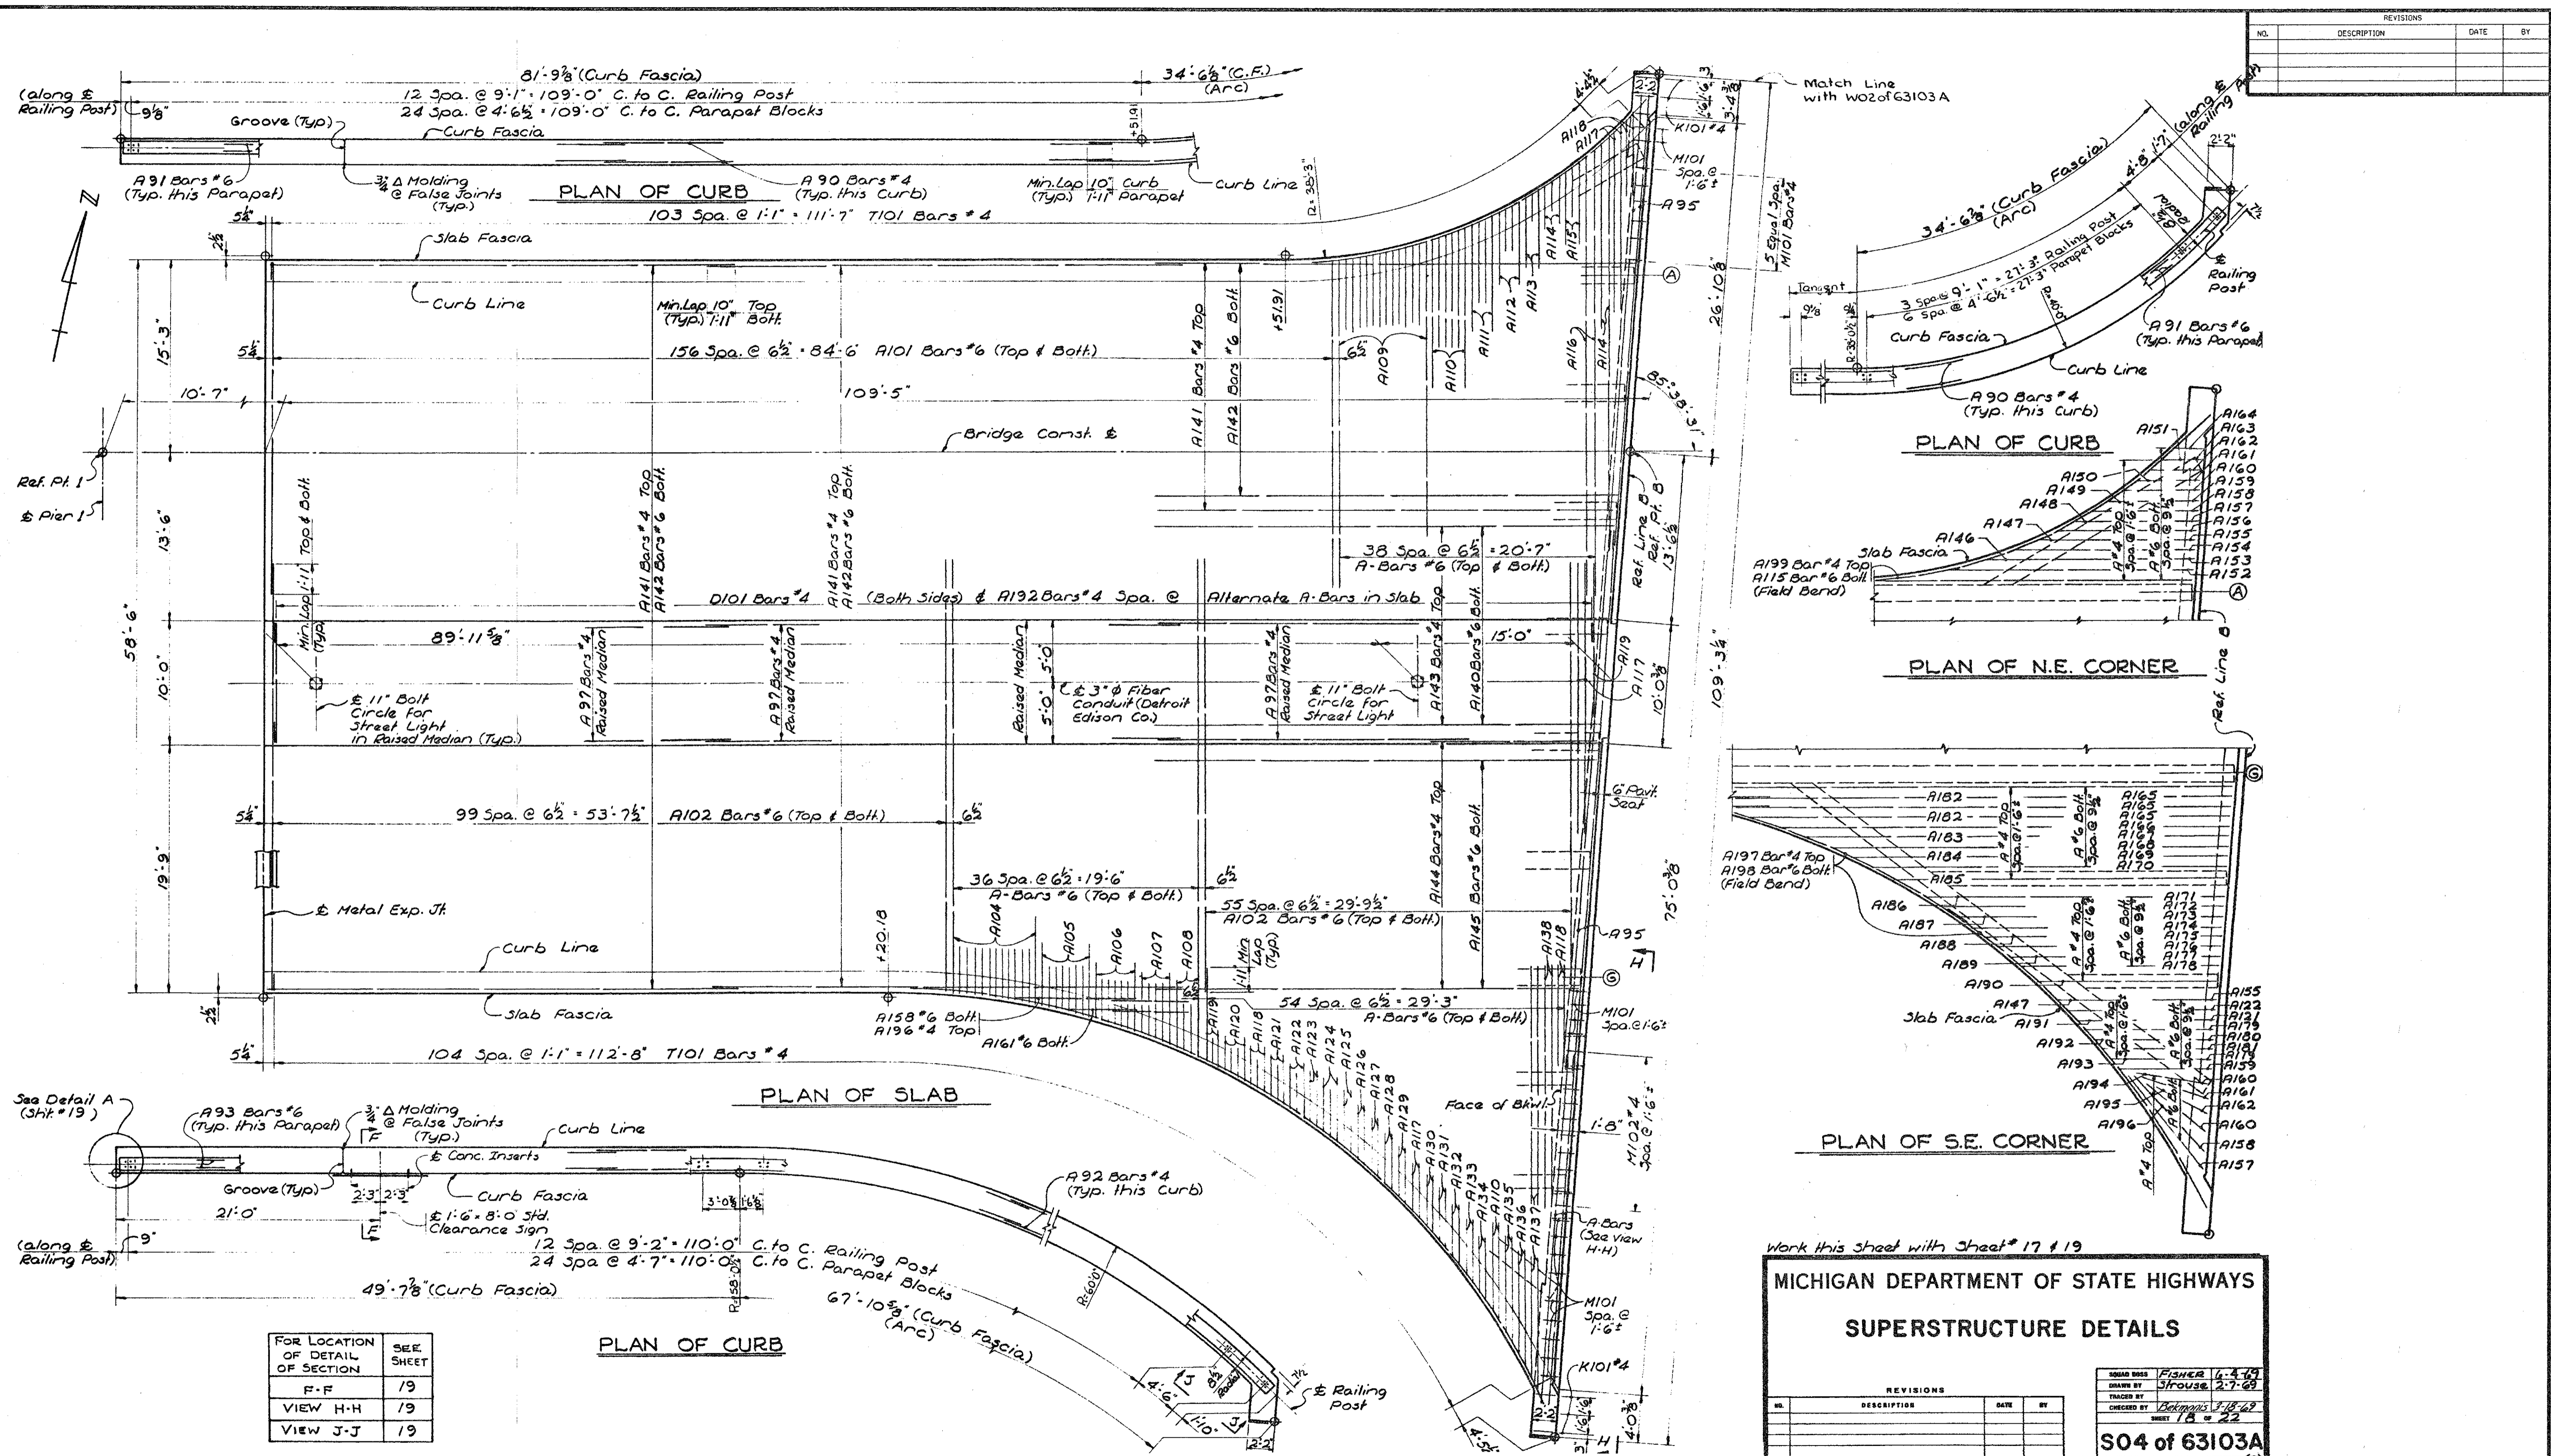

REVISIONS			
NO.	DESCRIPTION	DATE	BY

FOR LOCATION OF DETAIL OF SECTION	SEE SHEET
F-F	19
VIEW H-H	19
VIEW J-J	19

Work this sheet with sheet # 17 & 19

MICHIGAN DEPARTMENT OF STATE HIGHWAYS

SUPERSTRUCTURE DETAILS

REVISIONS			
NO.	DESCRIPTION	DATE	BY

DRAWN BY: FISHER 6-4-69
 CHECKED BY: SHROUSE 2-7-69
 SHEET 18 OF 22
S04 OF 63103A

NOTE:
DO NOT WORK FROM THIS SHEET. THE INFORMATION SHOWN HERE IS FOR REFERENCE ONLY. NO PAY ITEMS ARE SHOWN.

FOR INFORMATION ONLY







DATE	CONT. SEC.	JOB NO.	DESIGN UNIT	SHEET
10-18-99	S04 OF 63103	48404A	MAHDAVI	15 OF 24



DATE: _____ CORRECTED BY: _____ DATE: _____ CHECKED BY: _____ DATE: 02-10-99 DRAWN BY: INDER FILE NAME: s0463103a




1 2 3 4 5 6 7 8 9 10 11 12 13 14 15 16 17 18 19 20 21 22 23 24 25 26 27 28 29 30 31 32 33 34 35 36 37 38 39 40 41 42 43 44 45 46 47 48 49 50 51 52 53 54 55 56 57 58 59 60 61 62 63

REVISIONS			
NO.	DESCRIPTION	DATE	BY

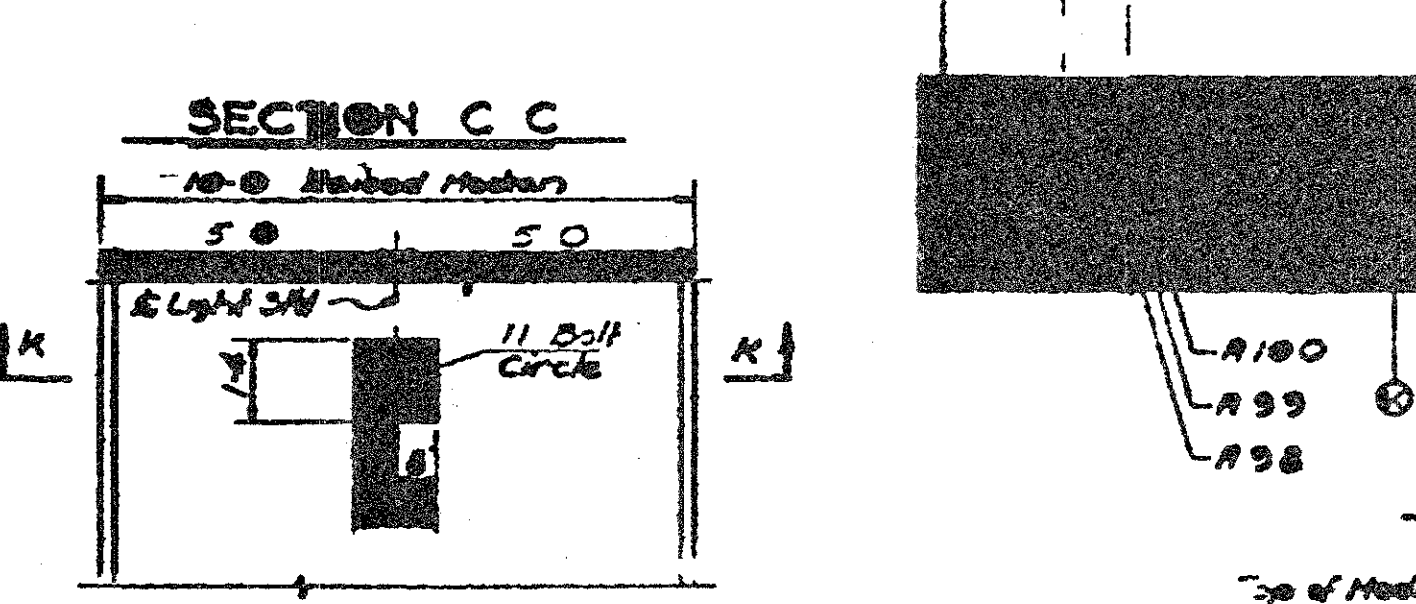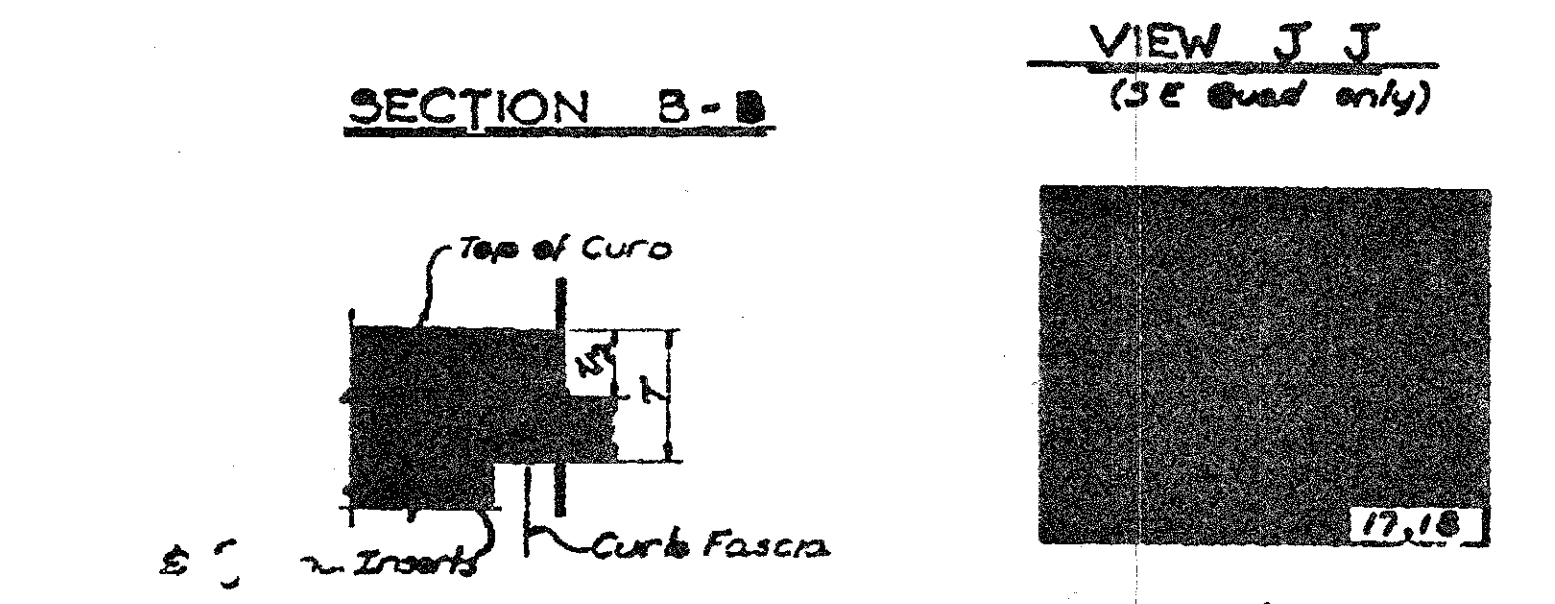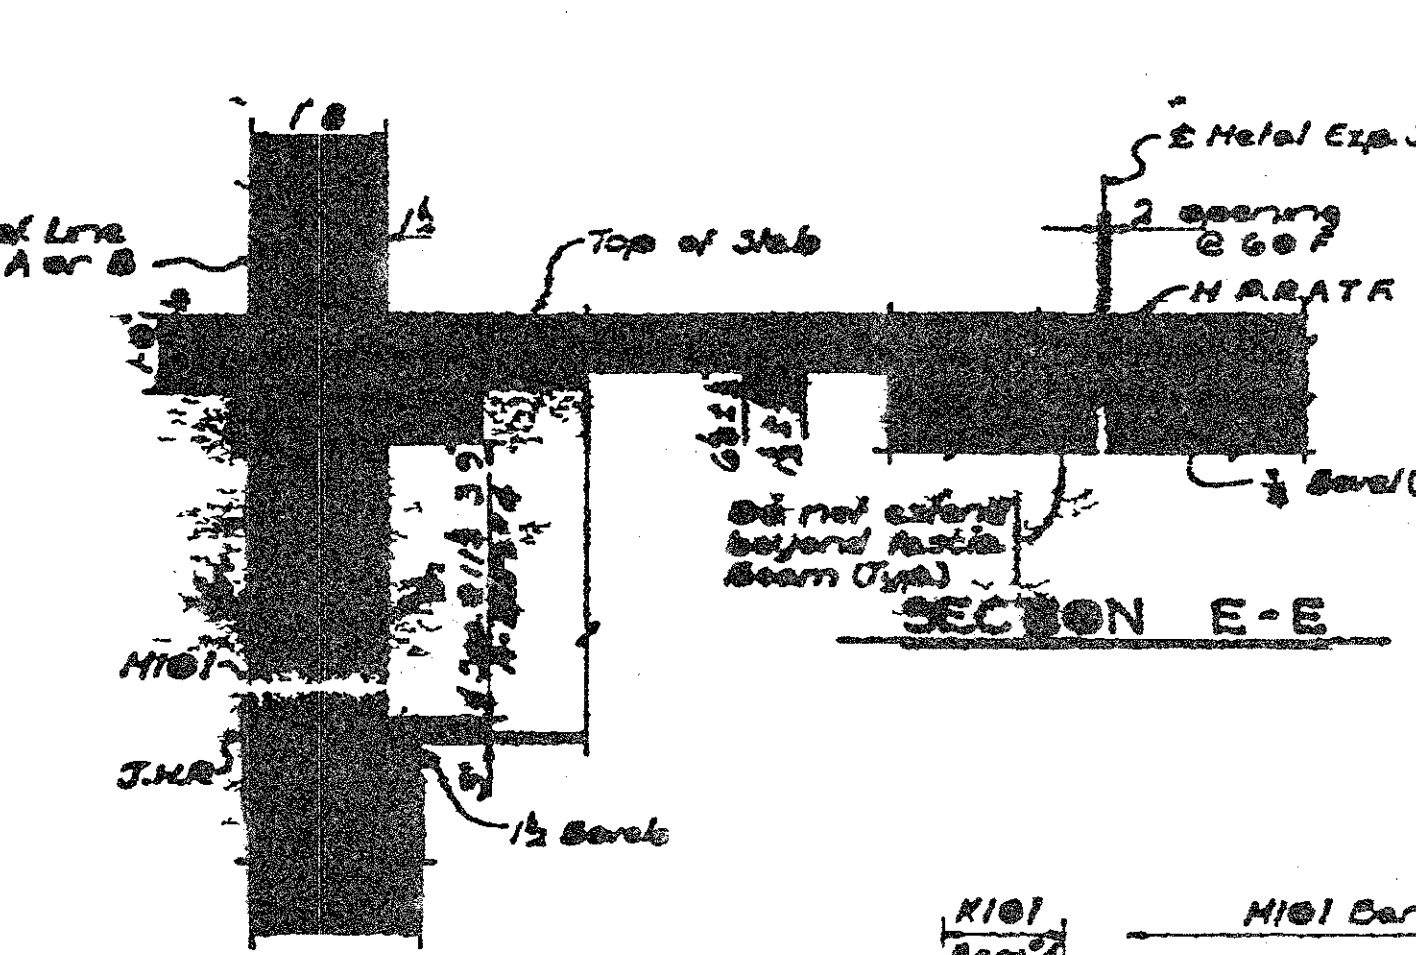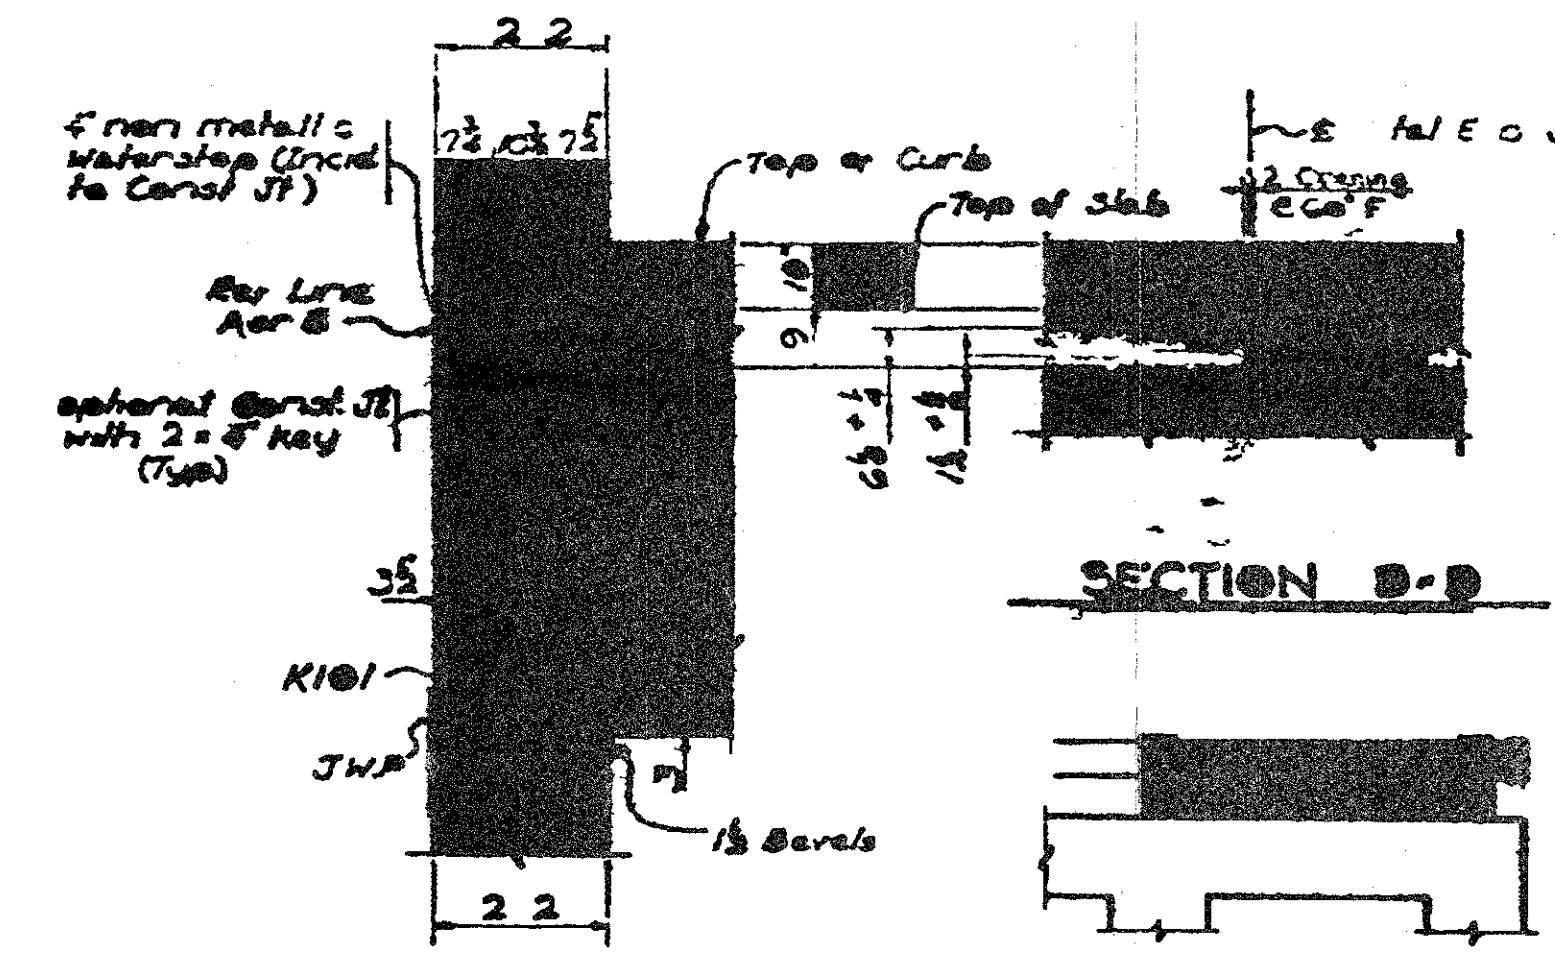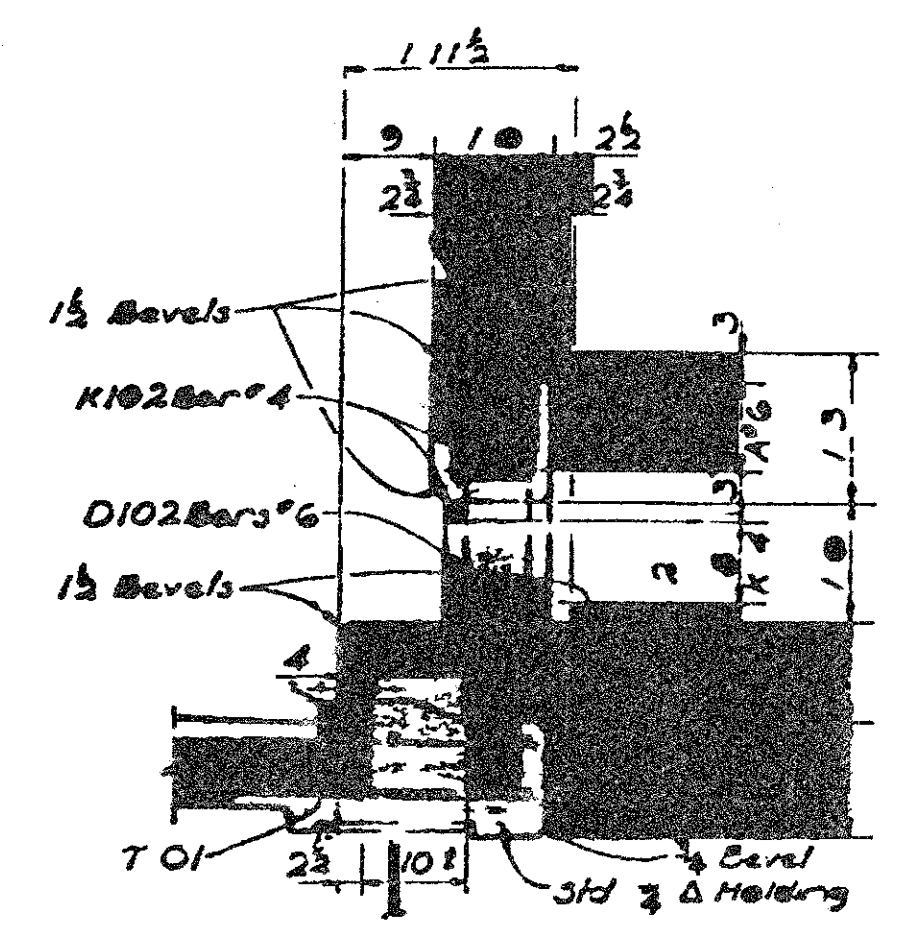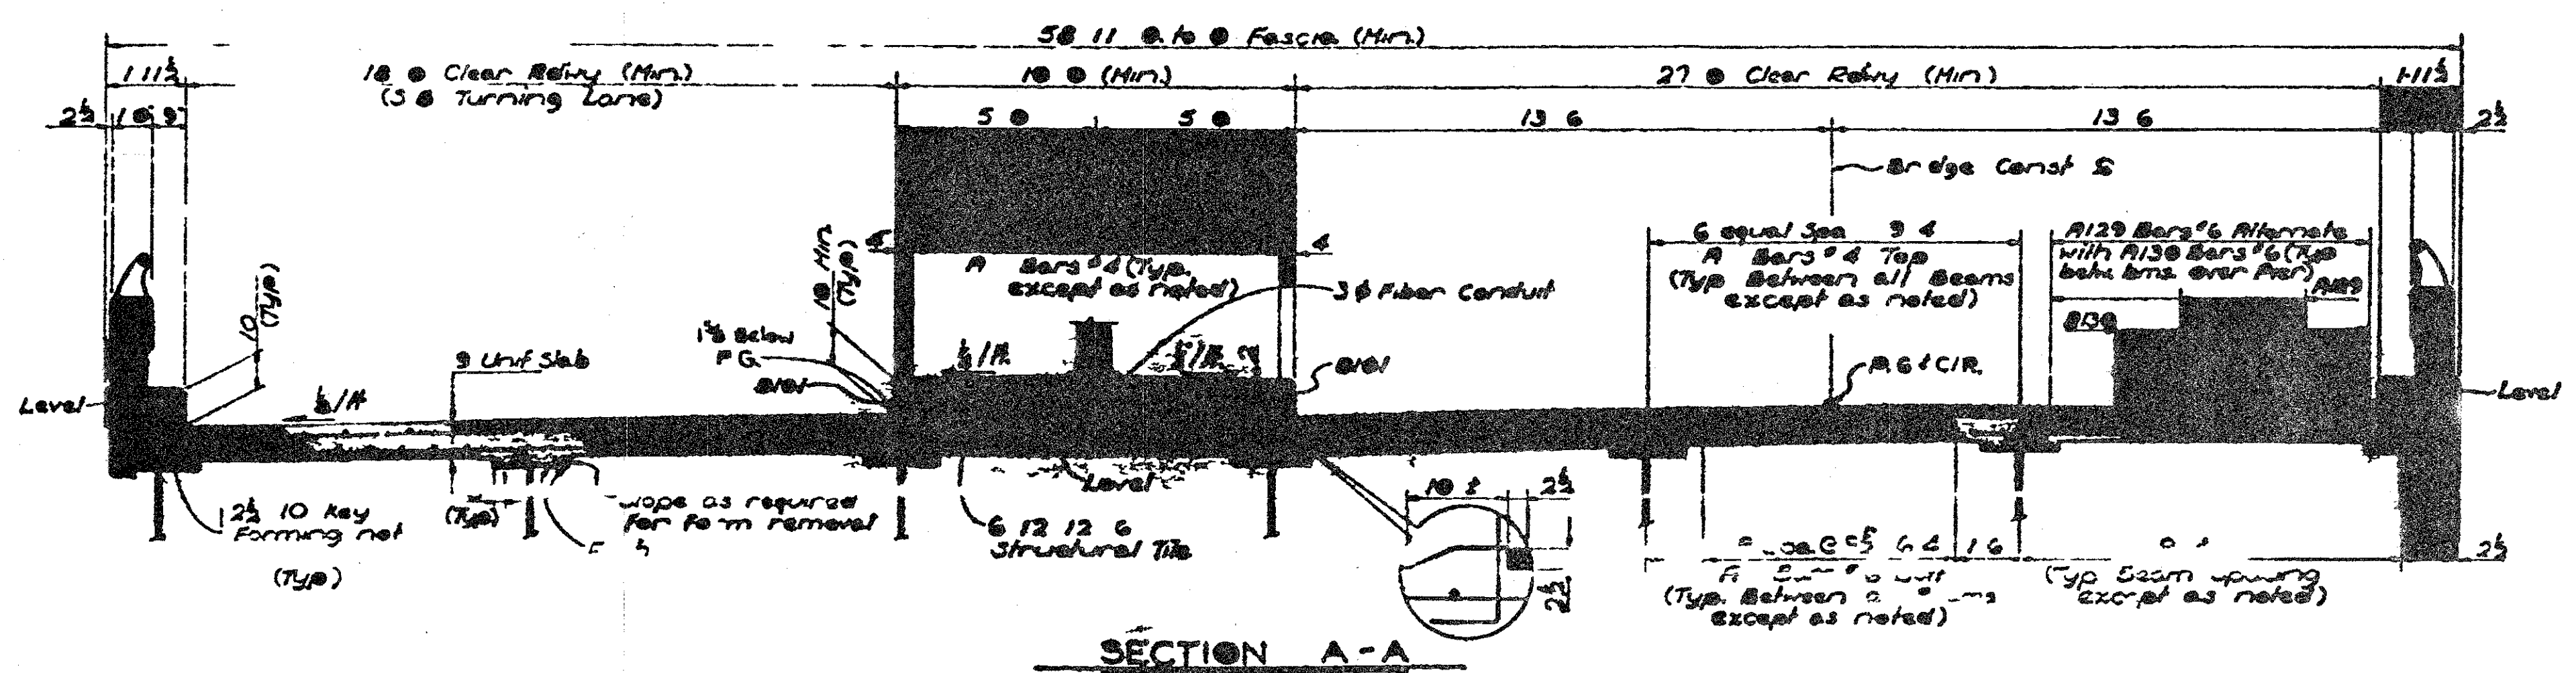

SECTION F-F
 Inserts are to be 5/8" Truscon Threaded inserts or approved equal and are to be provided with a suitable setting plug.
 Furnishing and placing concrete inserts is incidental to superstructure work.
 Clearance signs and mounting brackets are to be furnished and installed by others.

SECTION K-K
 Note: Post Foundation (1 bolt circle) will be furnished by the Detroit Edison Co. and installed by the contractor.
 Level Pad for Light Std.
 3 @ Galv. Stud Slaves - 4 1/2 Long (Typ)
 3 @ Galv. Stud Slaves - 4 1/2 Long (Typ)
 3 @ Galv. Stud Slaves - 4 1/2 Long (Typ)
 3 @ Galv. Stud Slaves - 4 1/2 Long (Typ)
 1 1/2 12 Anchor Bolts (Typ)

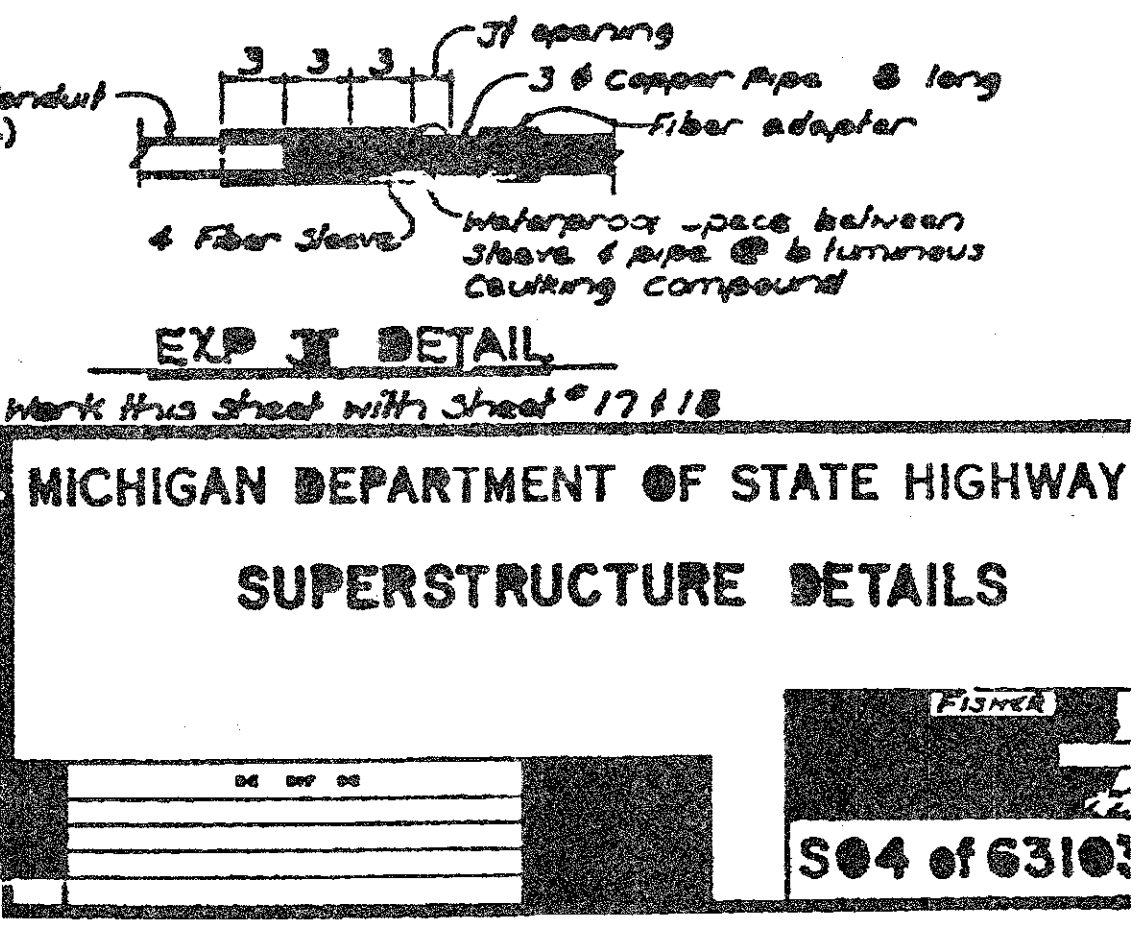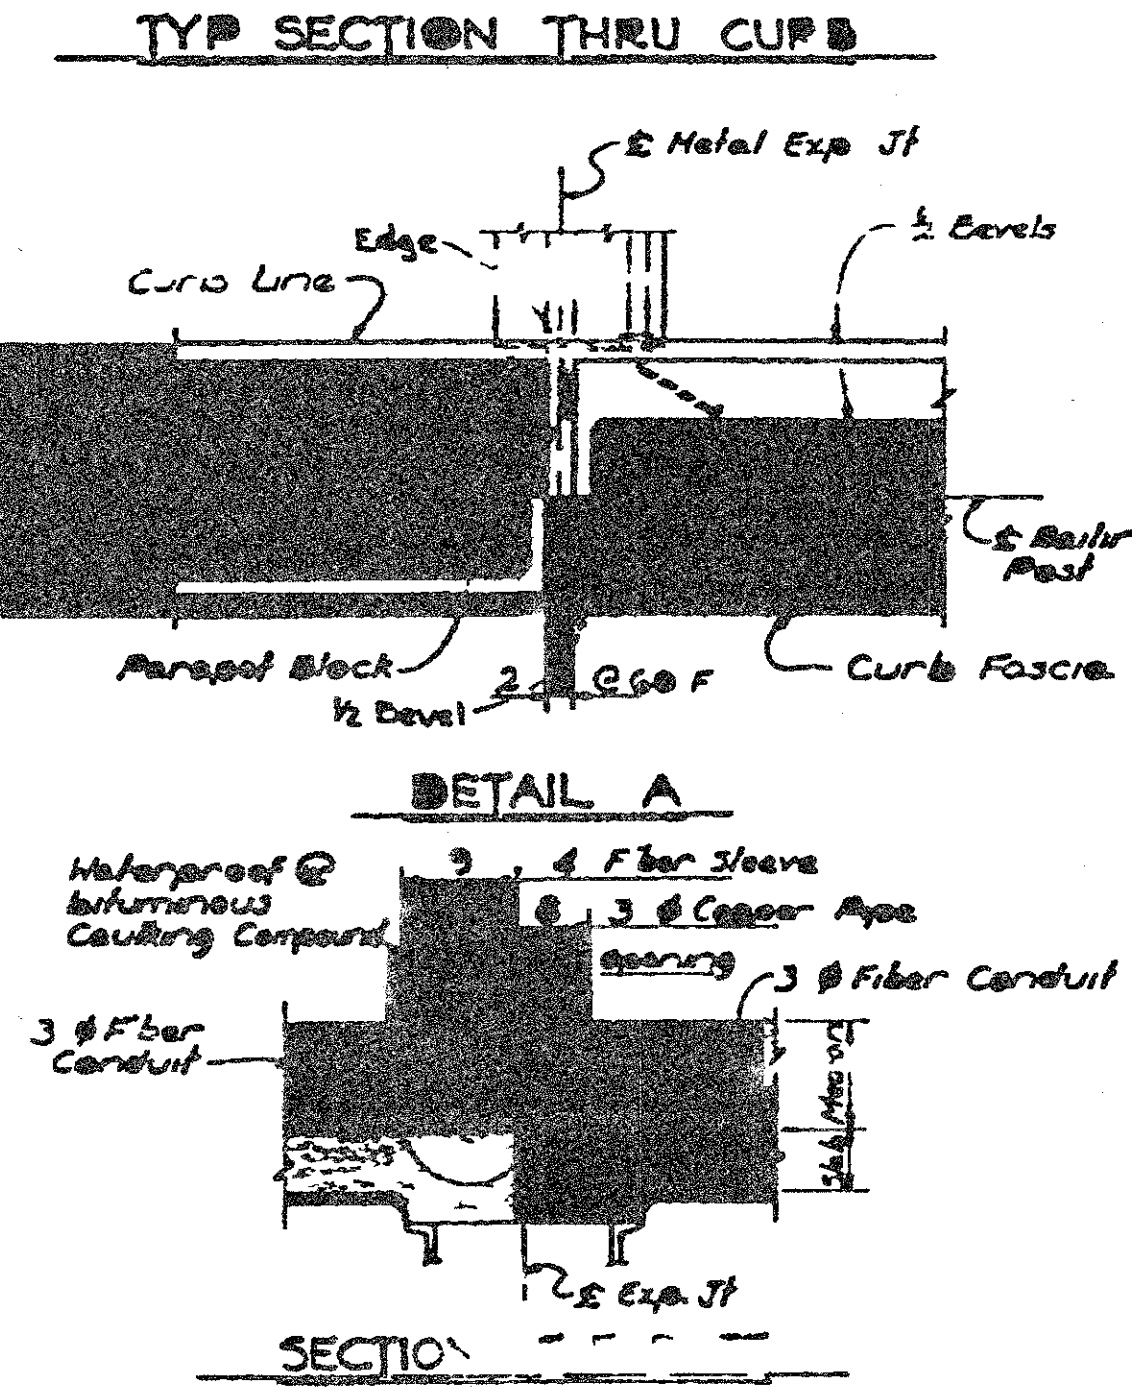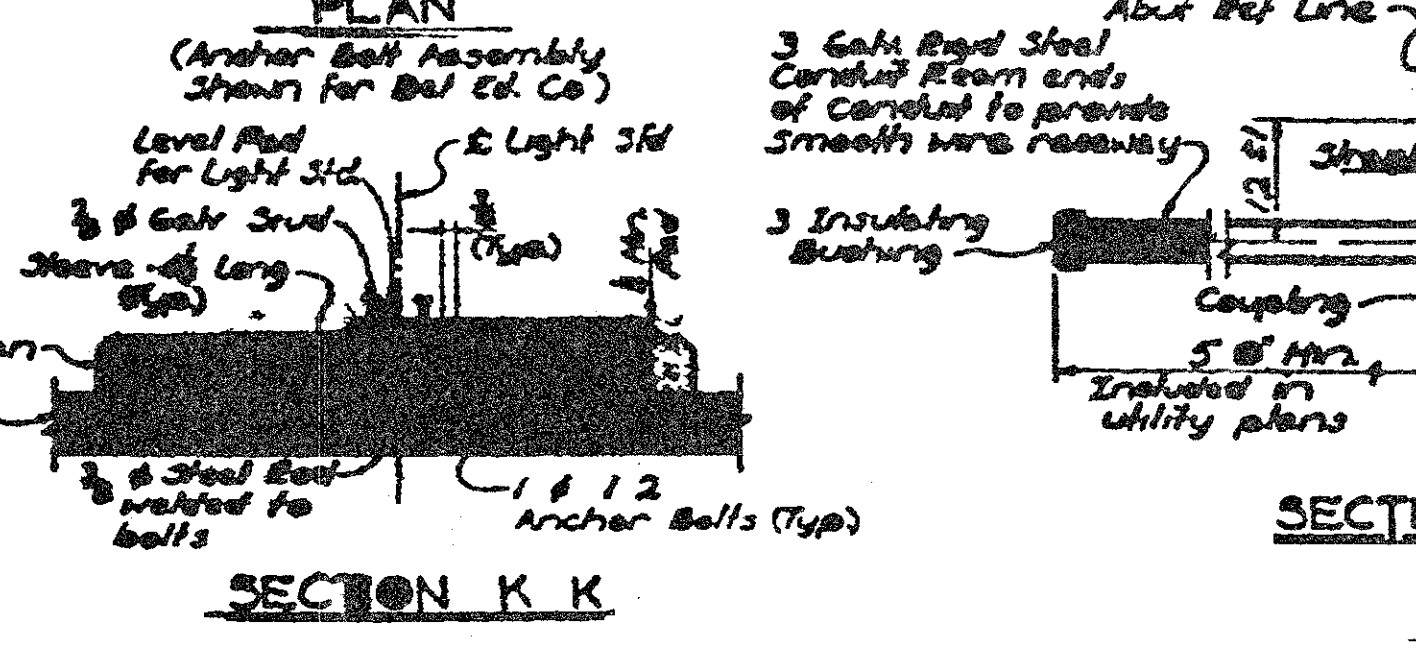

NOTE:
 DO NOT WORK FROM THIS SHEET. THE INFORMATION SHOWN HERE IS FOR REFERENCE ONLY. NO PAY ITEMS ARE SHOWN.

FOR INFORMATION ONLY




DATE 10-18-99	CONT. SEC. S04 OF 63103	JOB NO. 48404A	DESIGN UNIT MAHDAVI	SHEET 16 OF 24
------------------	----------------------------	-------------------	------------------------	-------------------





DATE: 02-10-99
 CHECKED BY:
 CORRECTED BY:
 DRAWN BY: INDER
 FILE NAME: s0463103sn.

1 2 3 4 5 6 7 8 9 10 11 12 13 14 15 16 17 18 19 20 21 22 23 24 25 26 27 28 29 30 31 32 33 34 35 36 37 38 39 40 41 42 43 44 45 46 47 48 49 50 51 52 53 54 55 56 57 58 59 60 61 62 63

REVISIONS			
NO.	DESCRIPTION	DATE	BY

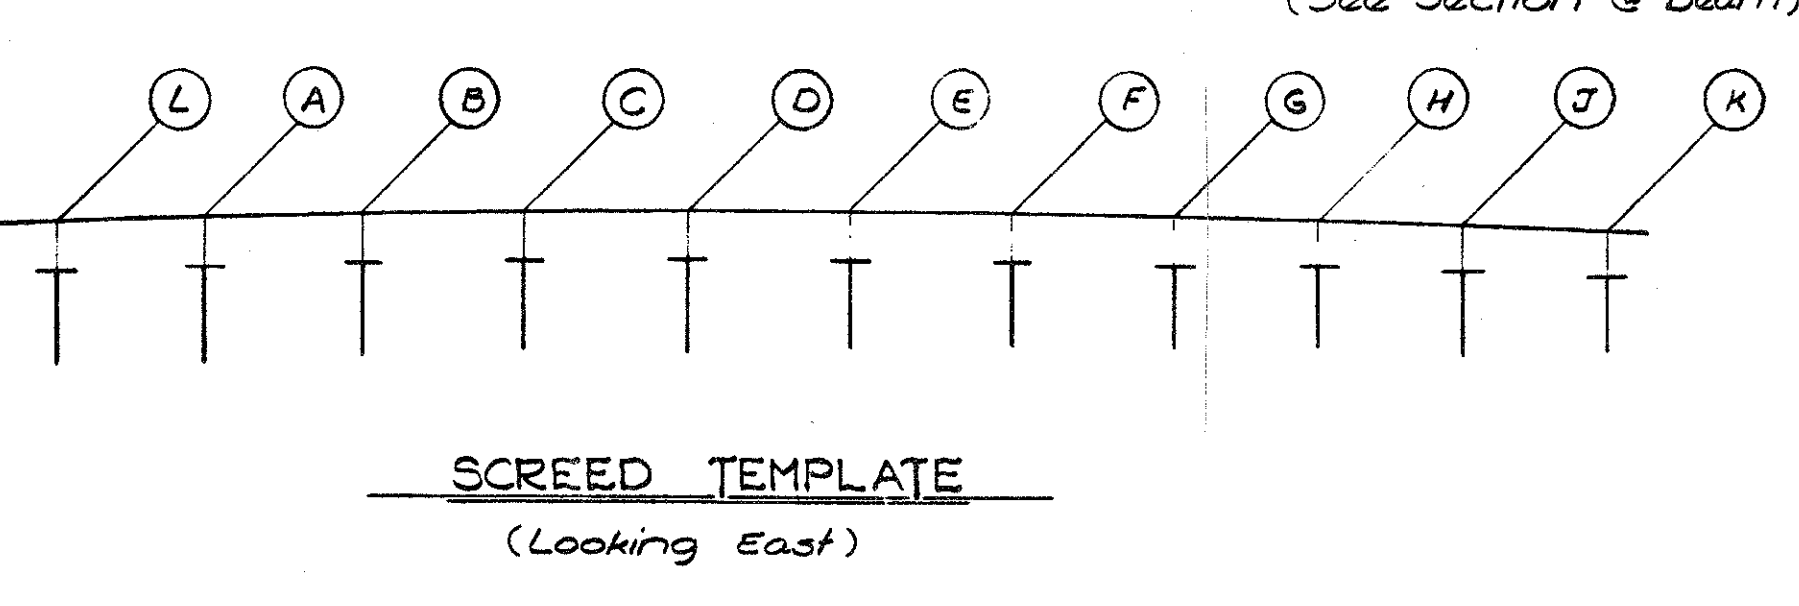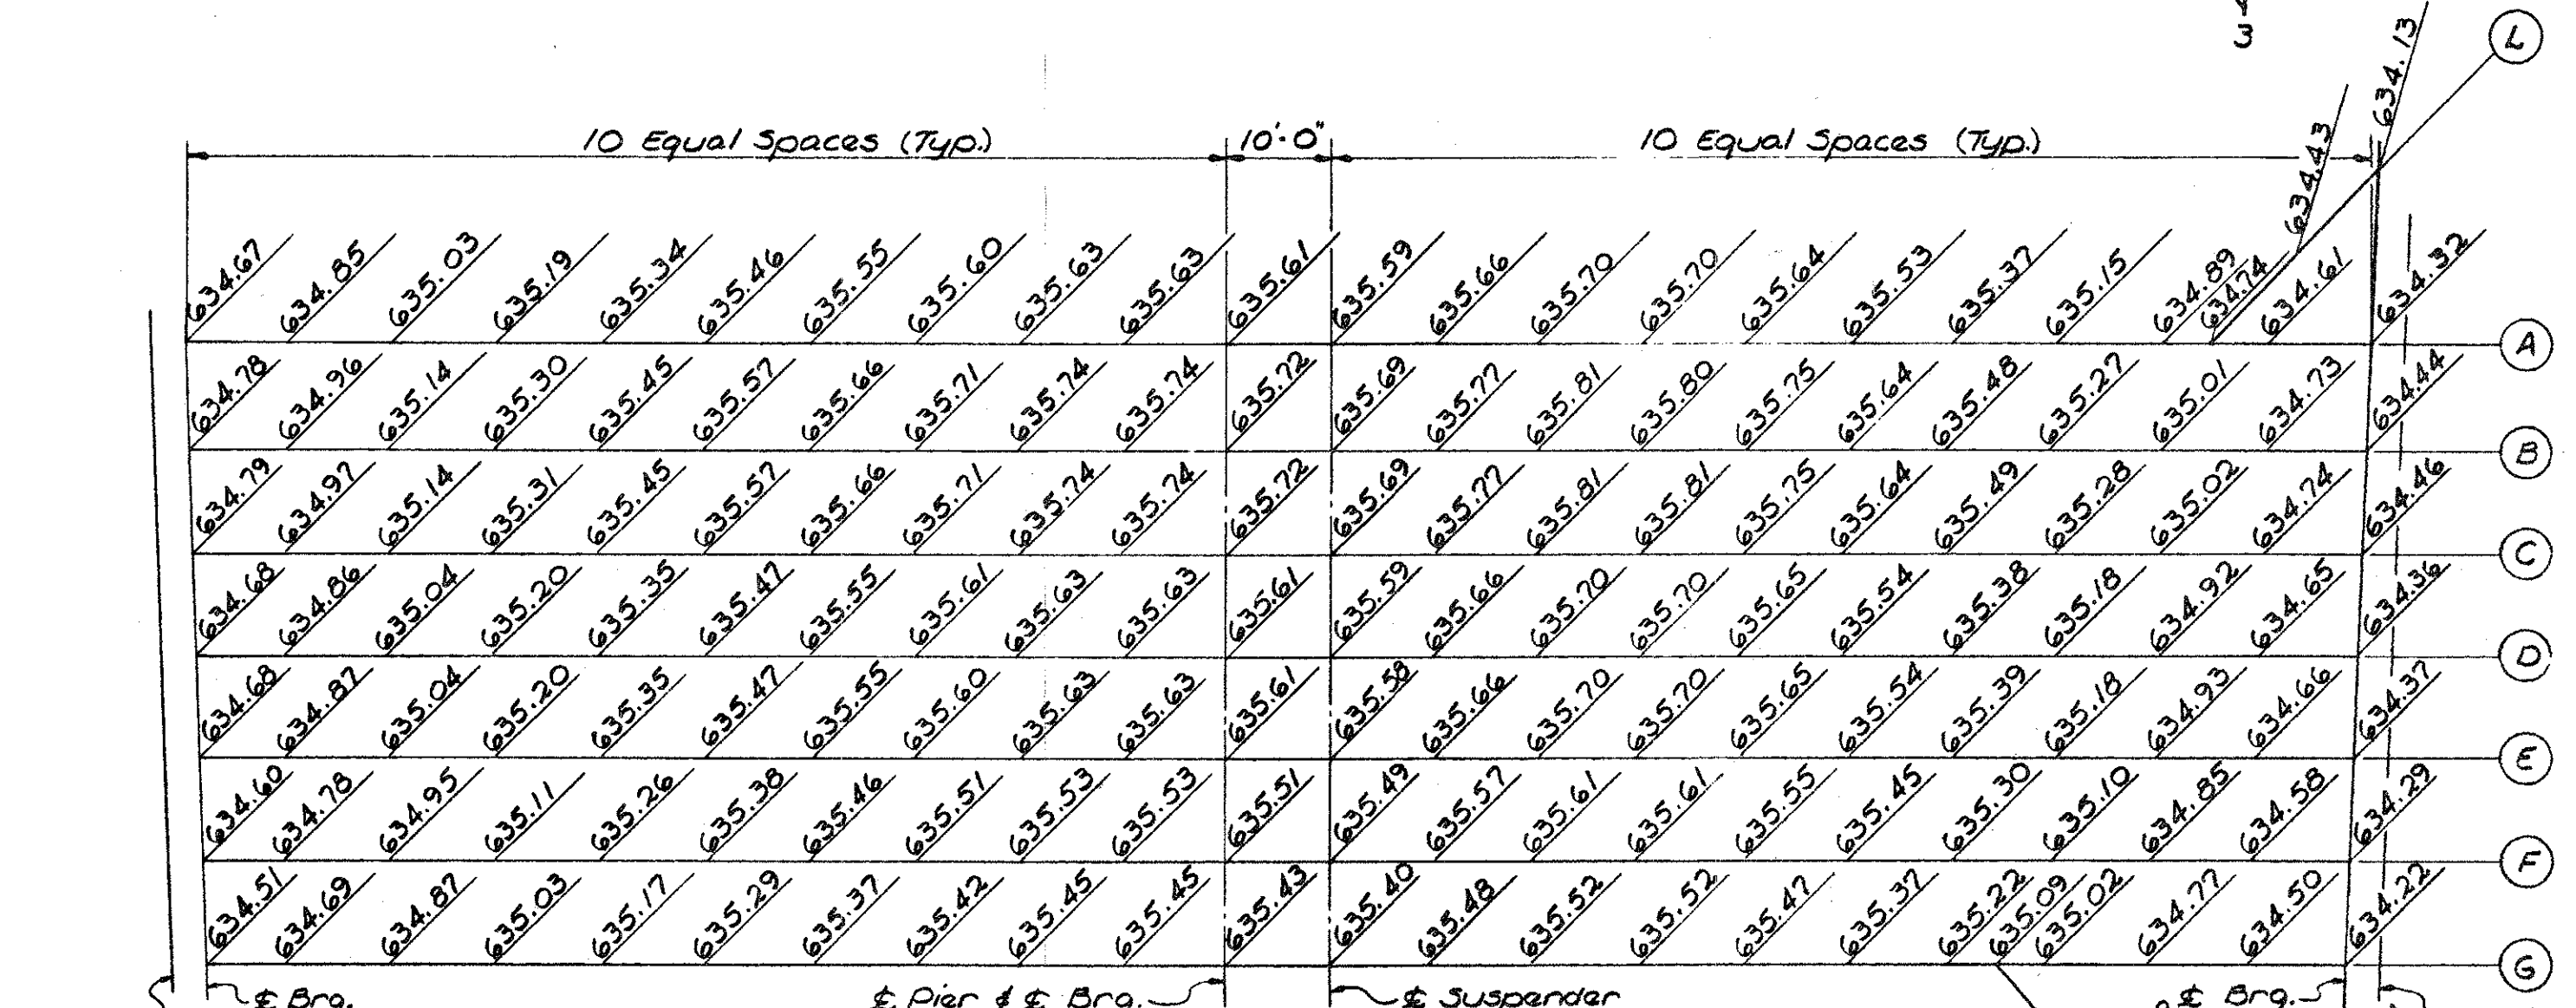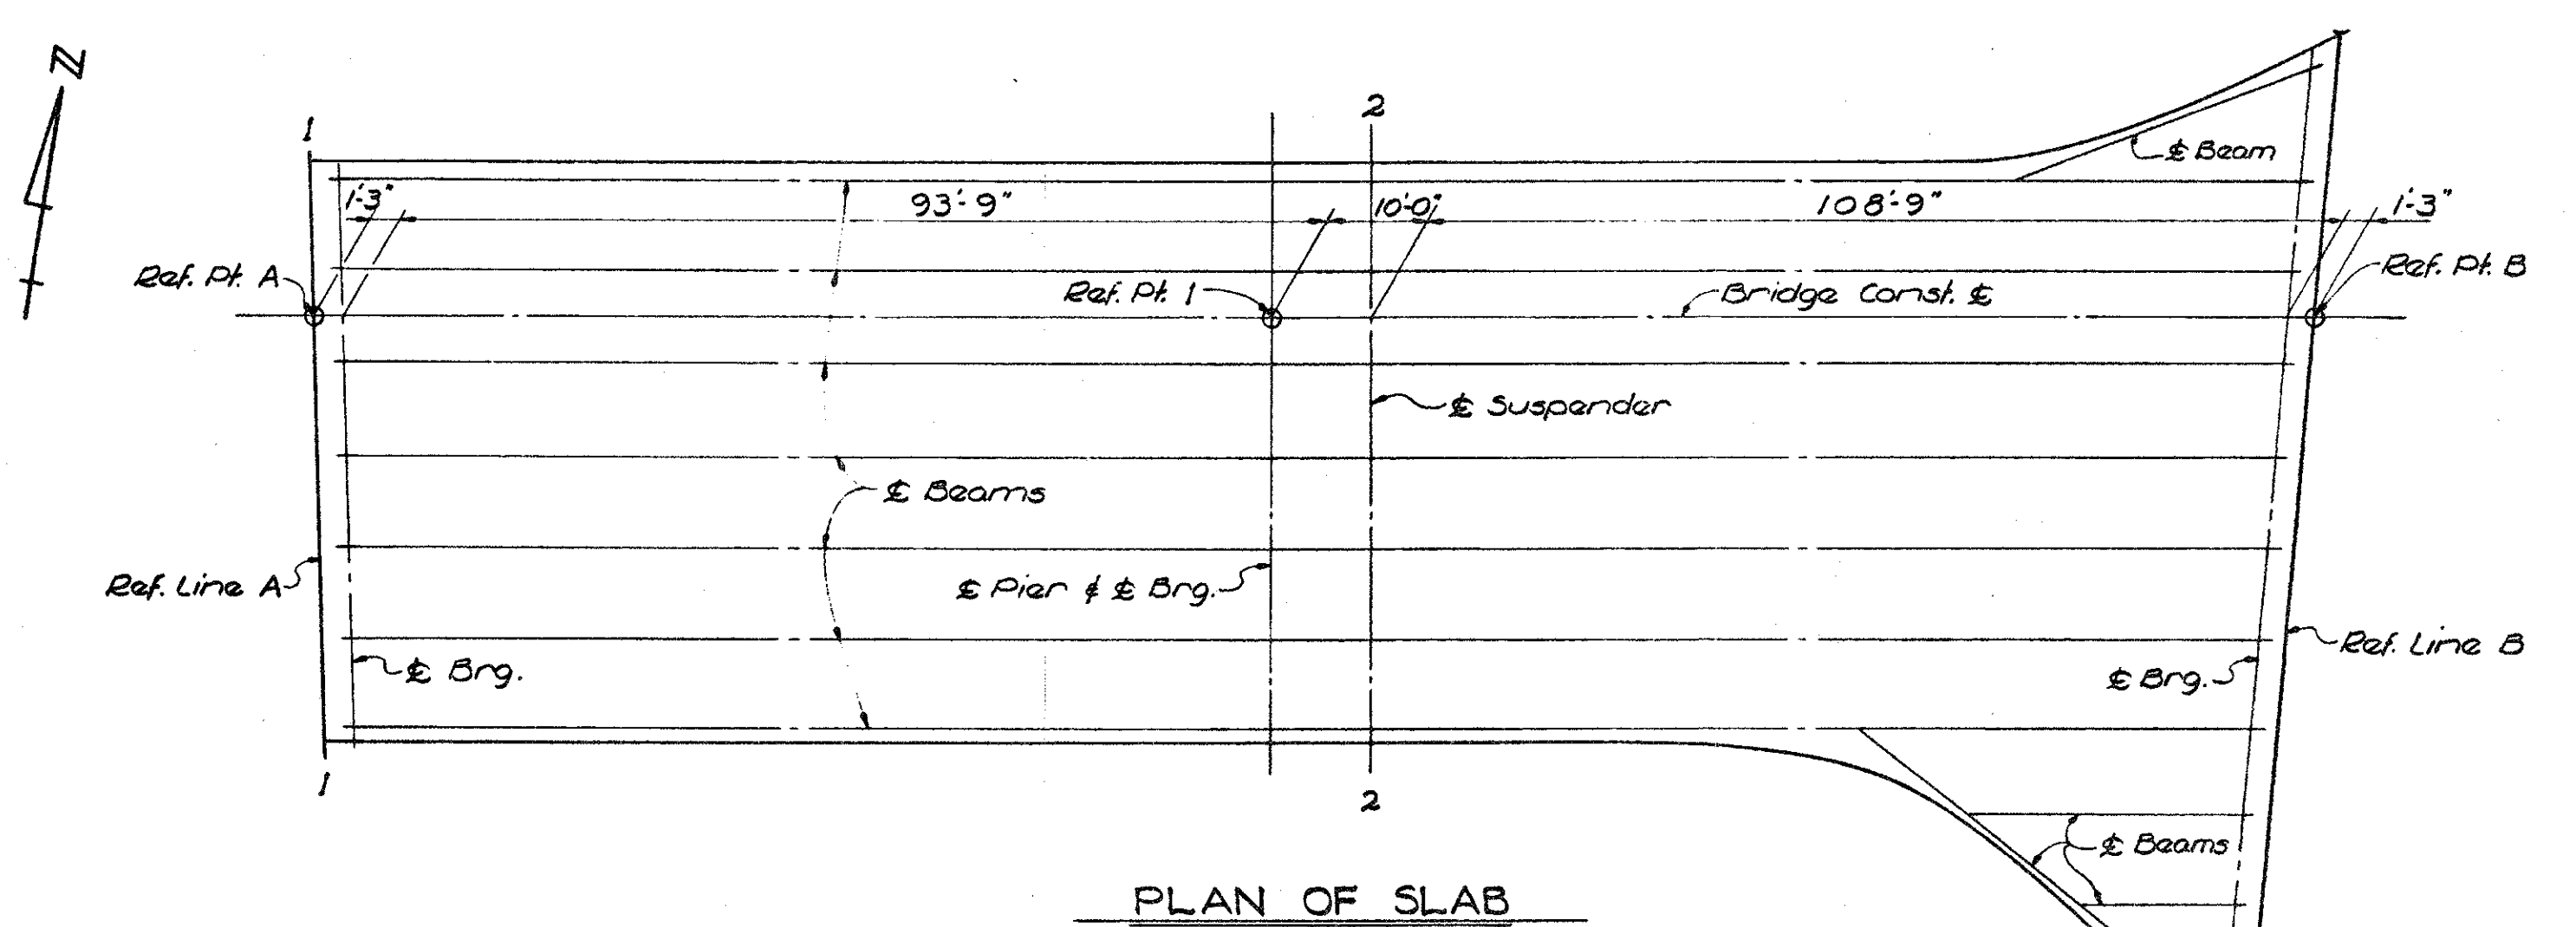

SCREED TEMPLATE ELEVATION											
LINE	L	A	B	C	D	E	F	G	H	J	K
1-1	635.40	635.57	635.52	635.41	635.42	635.33	635.24				
2-2	636.33	636.44	636.44	636.33	636.33	636.24	636.15				
3-3	634.84	635.05	635.17	635.19	635.09	635.10	635.02	634.94	634.87	634.80	634.72

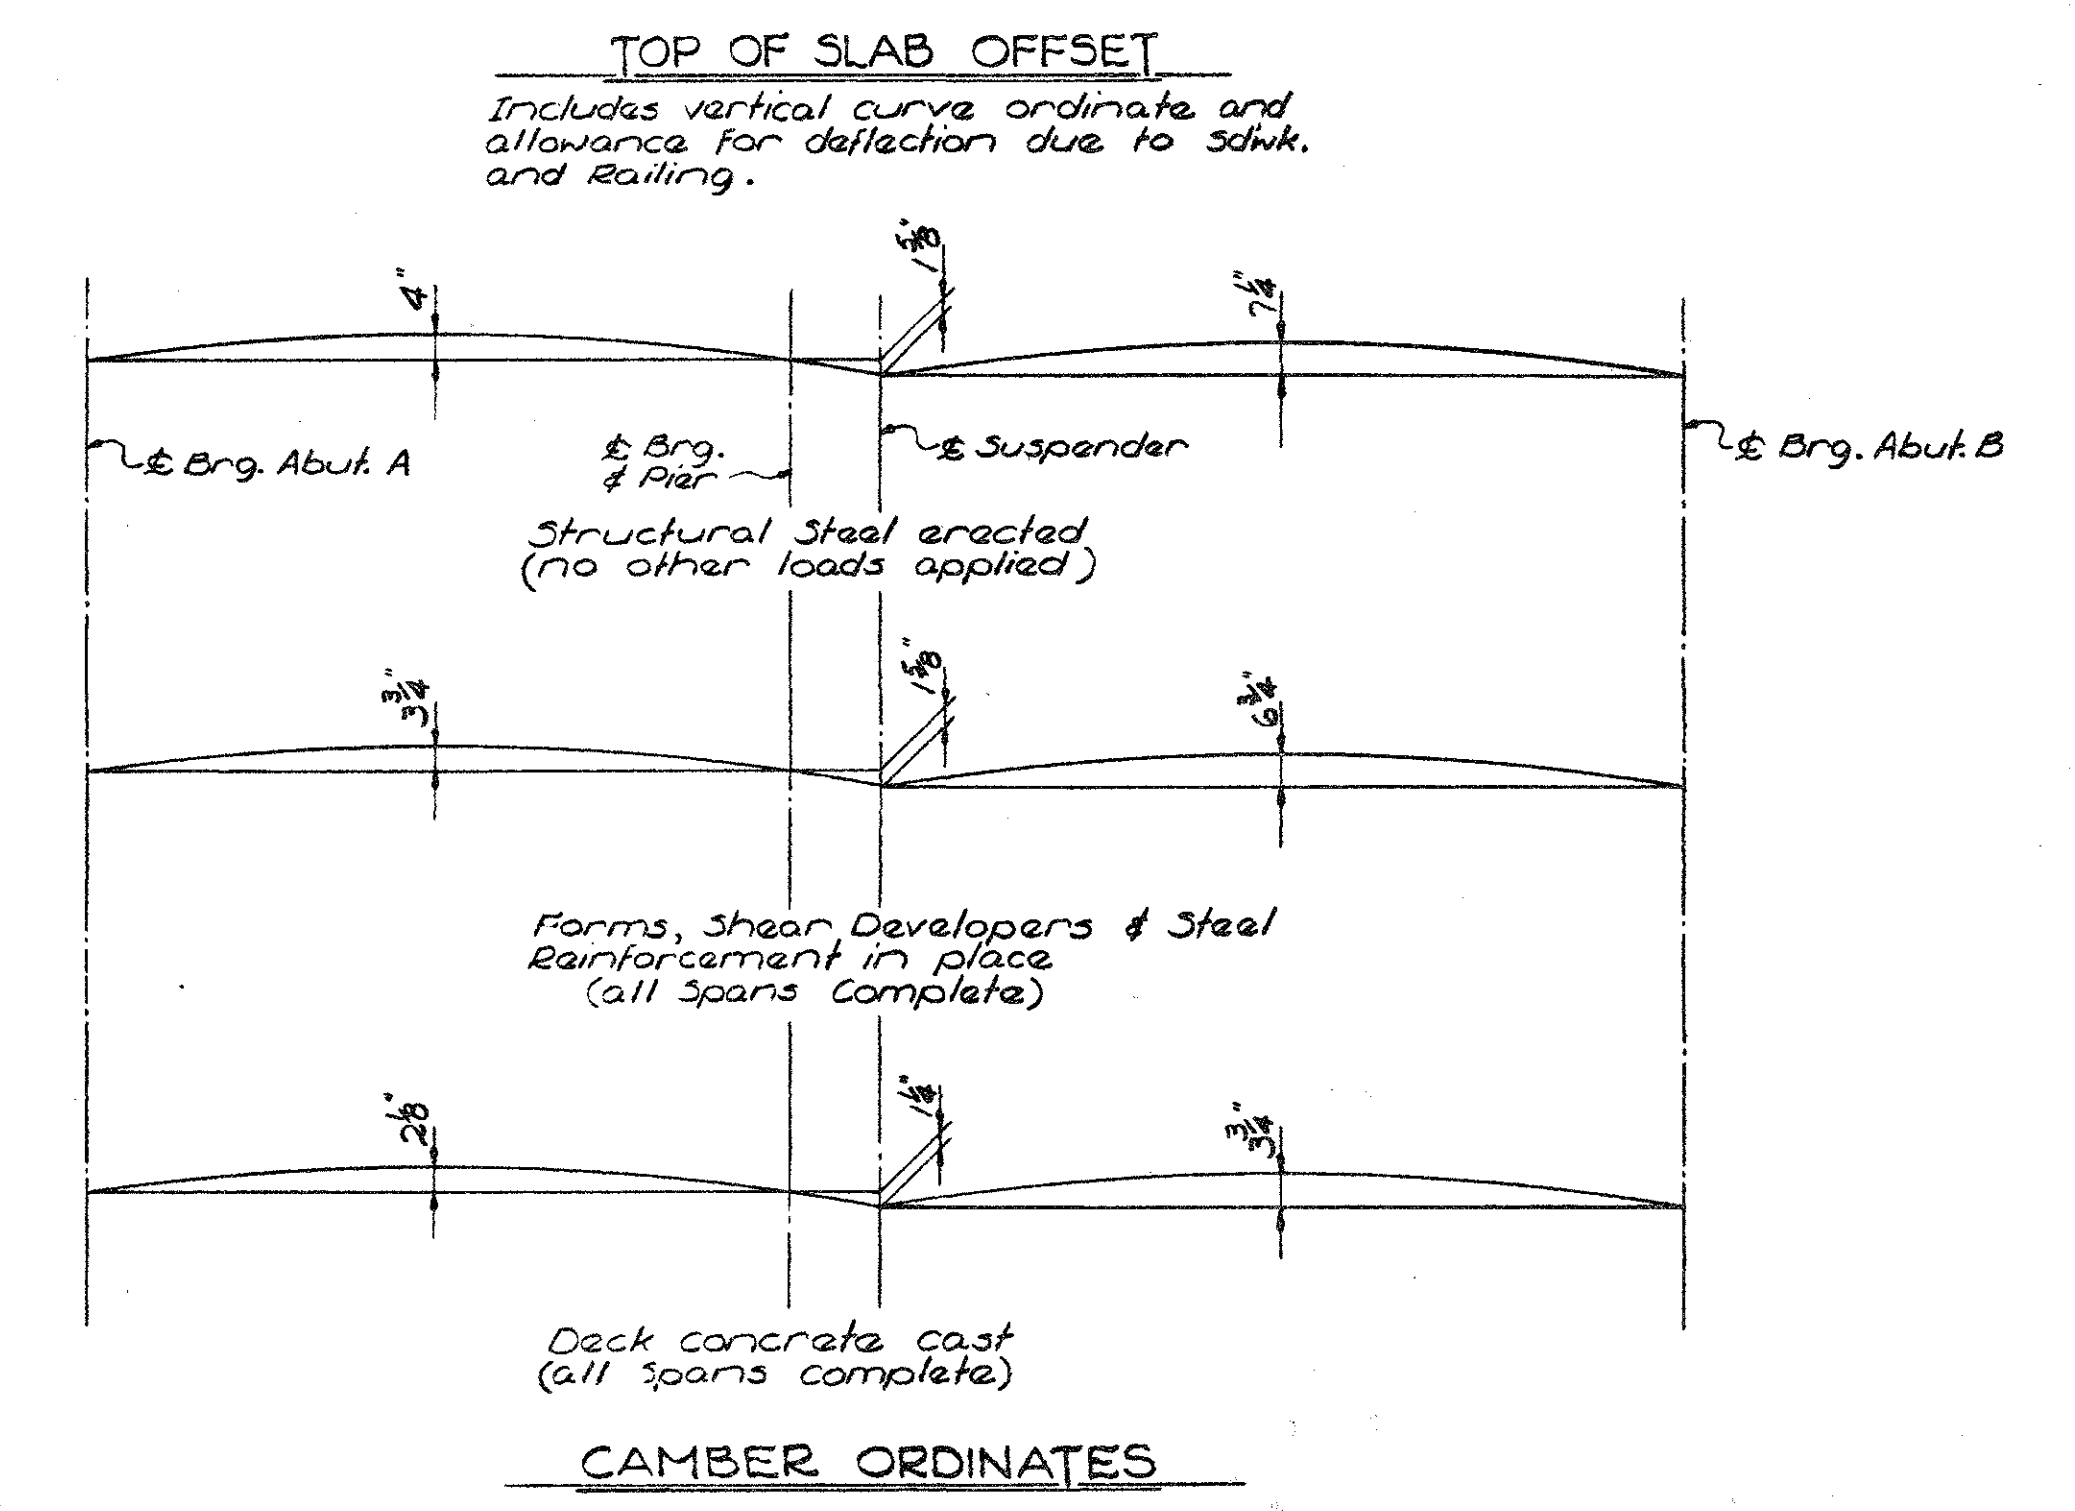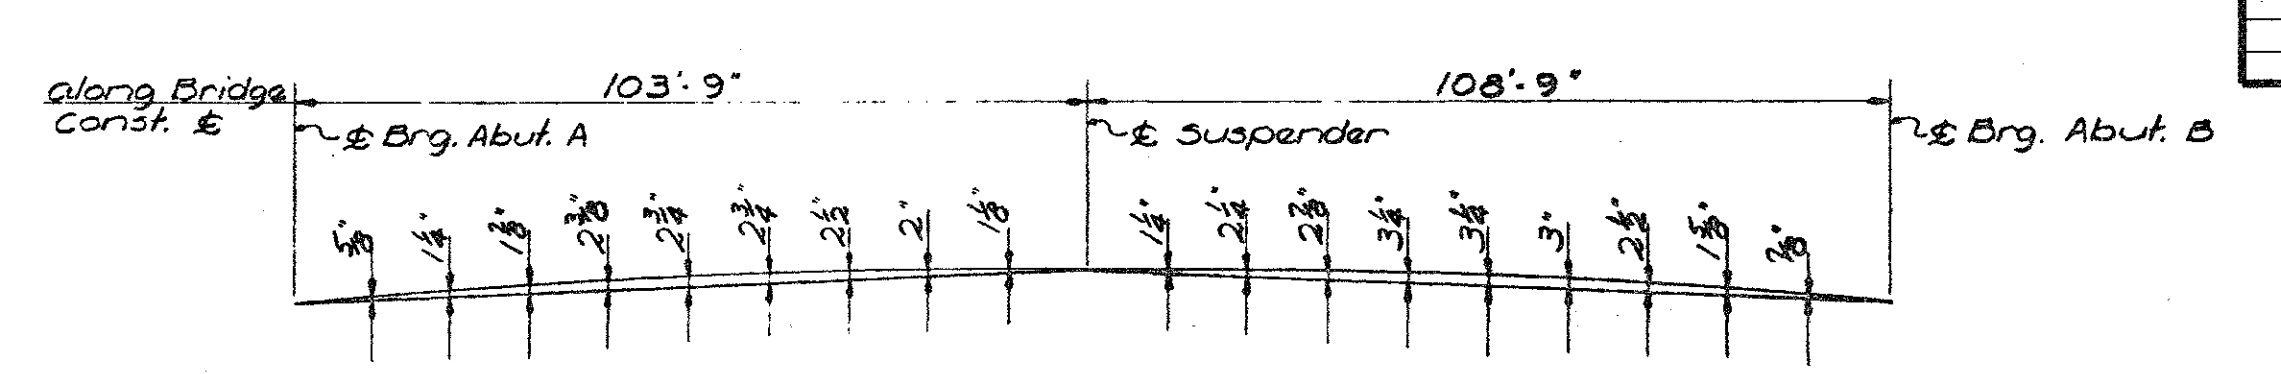

NOTES:
 Scared elevations are based on the condition that no slab concrete has been cast and that formwork, steel reinforcement and shear developers are in place.
 Bottom of slab elevations are based on the condition that all structural steel has been erected, but no other loads applied. These elevations include allowances for deflections due to forms, steel reinforcement, shear developers in place, deck concrete and railing.
 Screeds affected by loads in other spans are to be set to the elevations shown before casting any concrete. Concrete in the suspended span is to be cast before the concrete in the anchor span.
 Longitudinal strike-off finishing machine is to be used in placing deck concrete and the flared quadrants shall be hand screeded.

Work this sheet with sheet # 17, 18 & 19

MICHIGAN DEPARTMENT OF STATE HIGHWAYS

SUPERSTRUCTURE DETAILS

NO.	DESCRIPTION	DATE	BY

DRAWN BY: FISHER 11-4-69
 CHECKED BY: Strouse 4-17-69
 SHEET 20 OF 22
S04 OF 63103A


NOTE:
 DO NOT WORK FROM THIS SHEET. THE INFORMATION SHOWN HERE IS FOR REFERENCE ONLY. NO PAY ITEMS ARE SHOWN.

FOR INFORMATION ONLY				
DATE	CONT. SEC.	JOB NO.	DESIGN UNIT	SHEET
10-18-99	S04 OF 63103	48404A	MAHDAVI	17 OF 24



DATE: 02-10-99
 CORRECTED BY:
 CHECKED BY:
 DRAWN BY: INDER
 FILE NAME: s0463103a


1 2 3 4 5 6 7 8 9 10 11 12 13 14 15 16 17 18 19 20 21 22 23 24 25 26 27 28 29 30 31 32 33 34 35 36 37 38 39 40 41 42 43 44 45 46 47 48 49 50 51 52 53 54 55 56 57 58 59 60 61 62 63

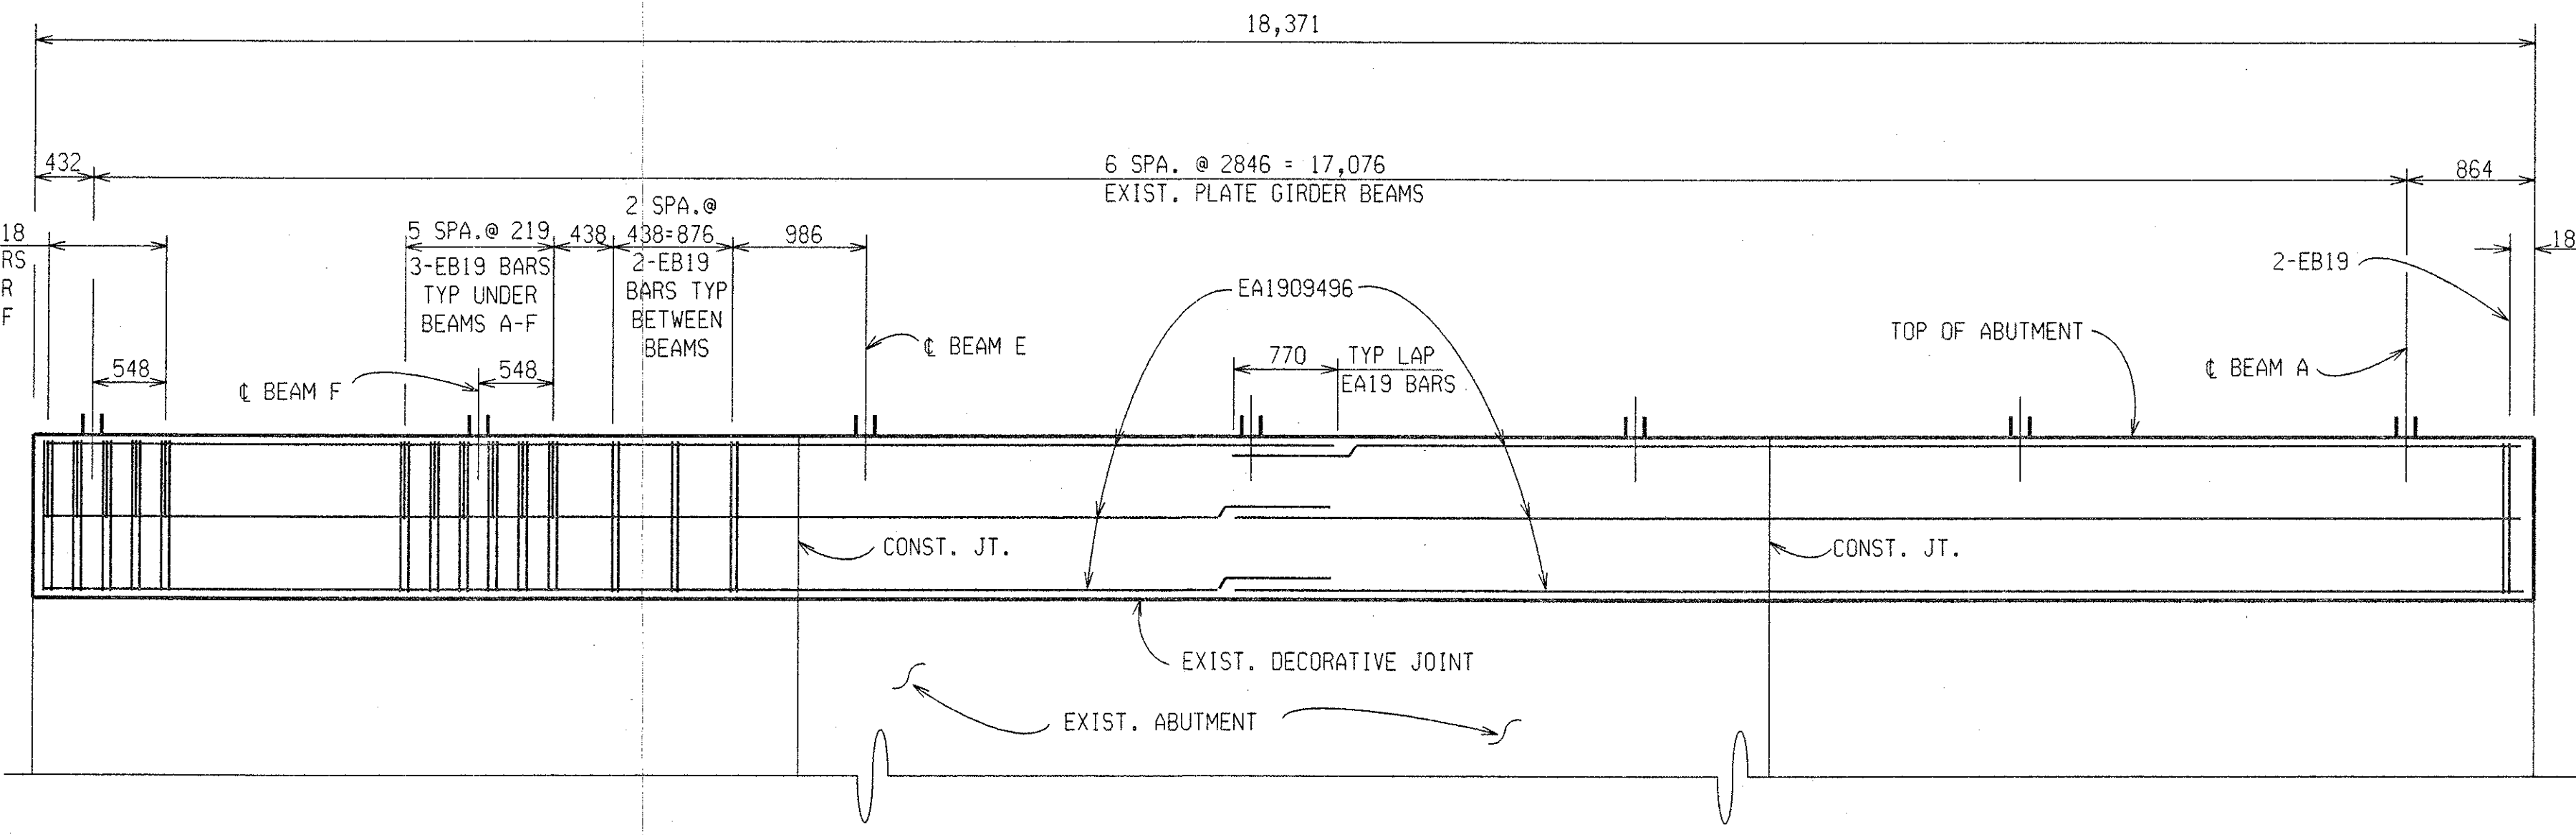


ABUTMENT A ELEVATION

REVISIONS			
NO.	DESCRIPTION	DATE	BY

MISCELLANEOUS QUANTITIES	
7 ea	Support, Column, Temp
565 kg	Reinforcement, Steel, Epoxy Coated
156 ea	Adhesive Anchoring of Horizontal Bar, 19
5 m3	Hand Chipping, Other Than Deck
8 m3	Patching Conc. LM
26 m2	Patch, Forming
105 m2	Water Repellent Treatment

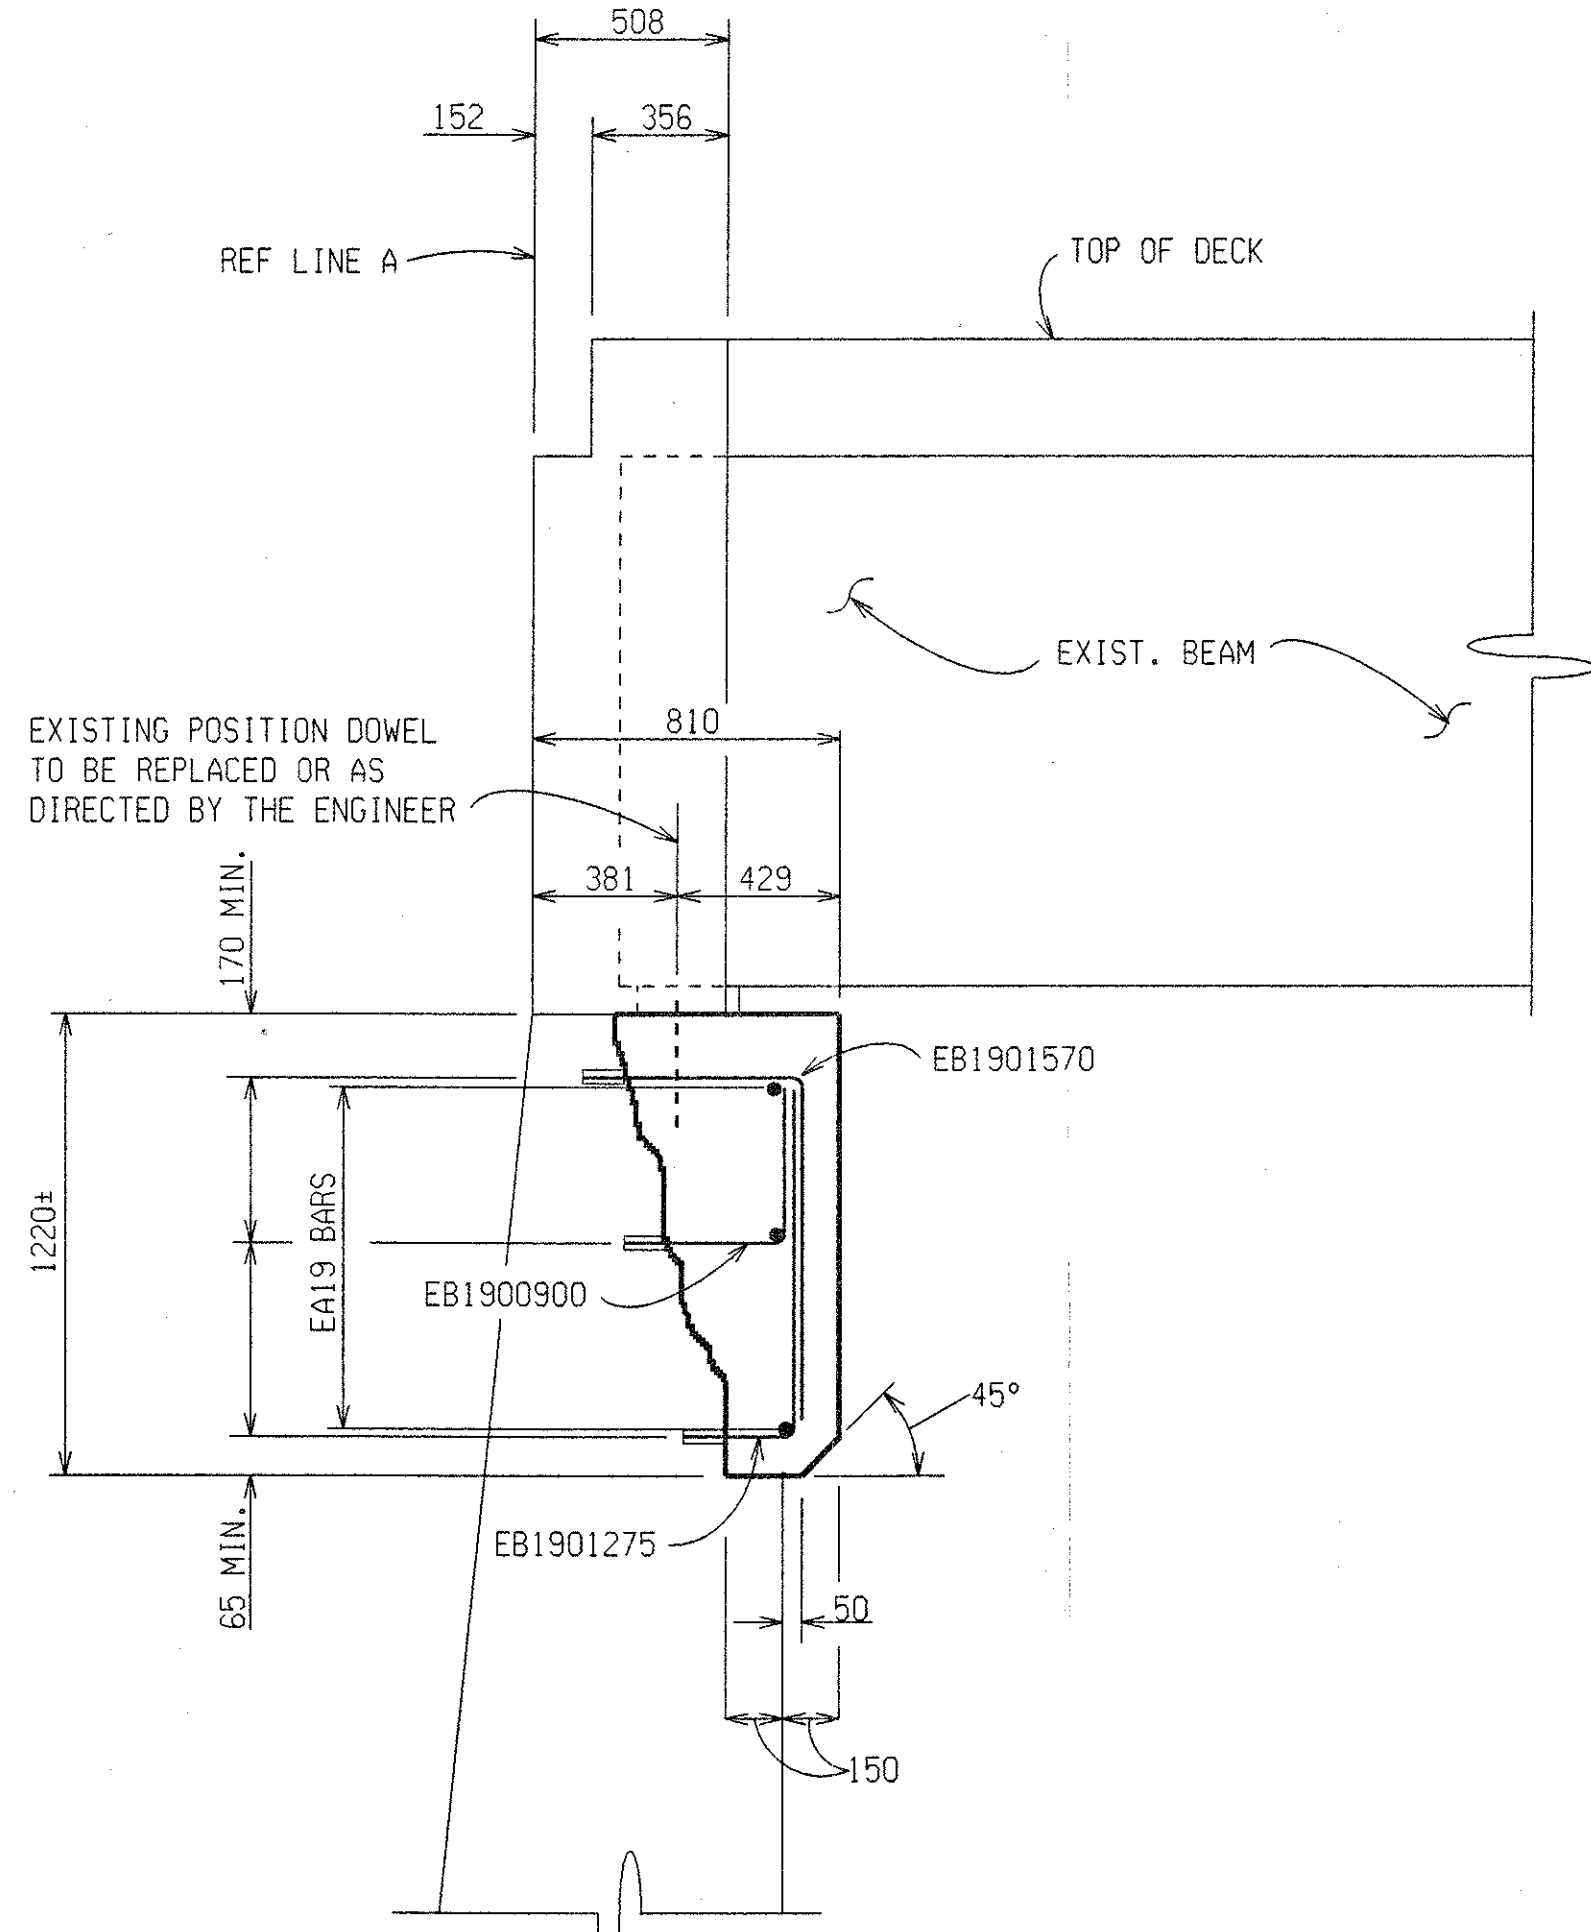

SECTION THRU ABUTMENT
PROPOSED REPAIRS UNDER BEAMS
SALVAGE ALL REINFORCEMENT EXCEPT LONGITUDINAL

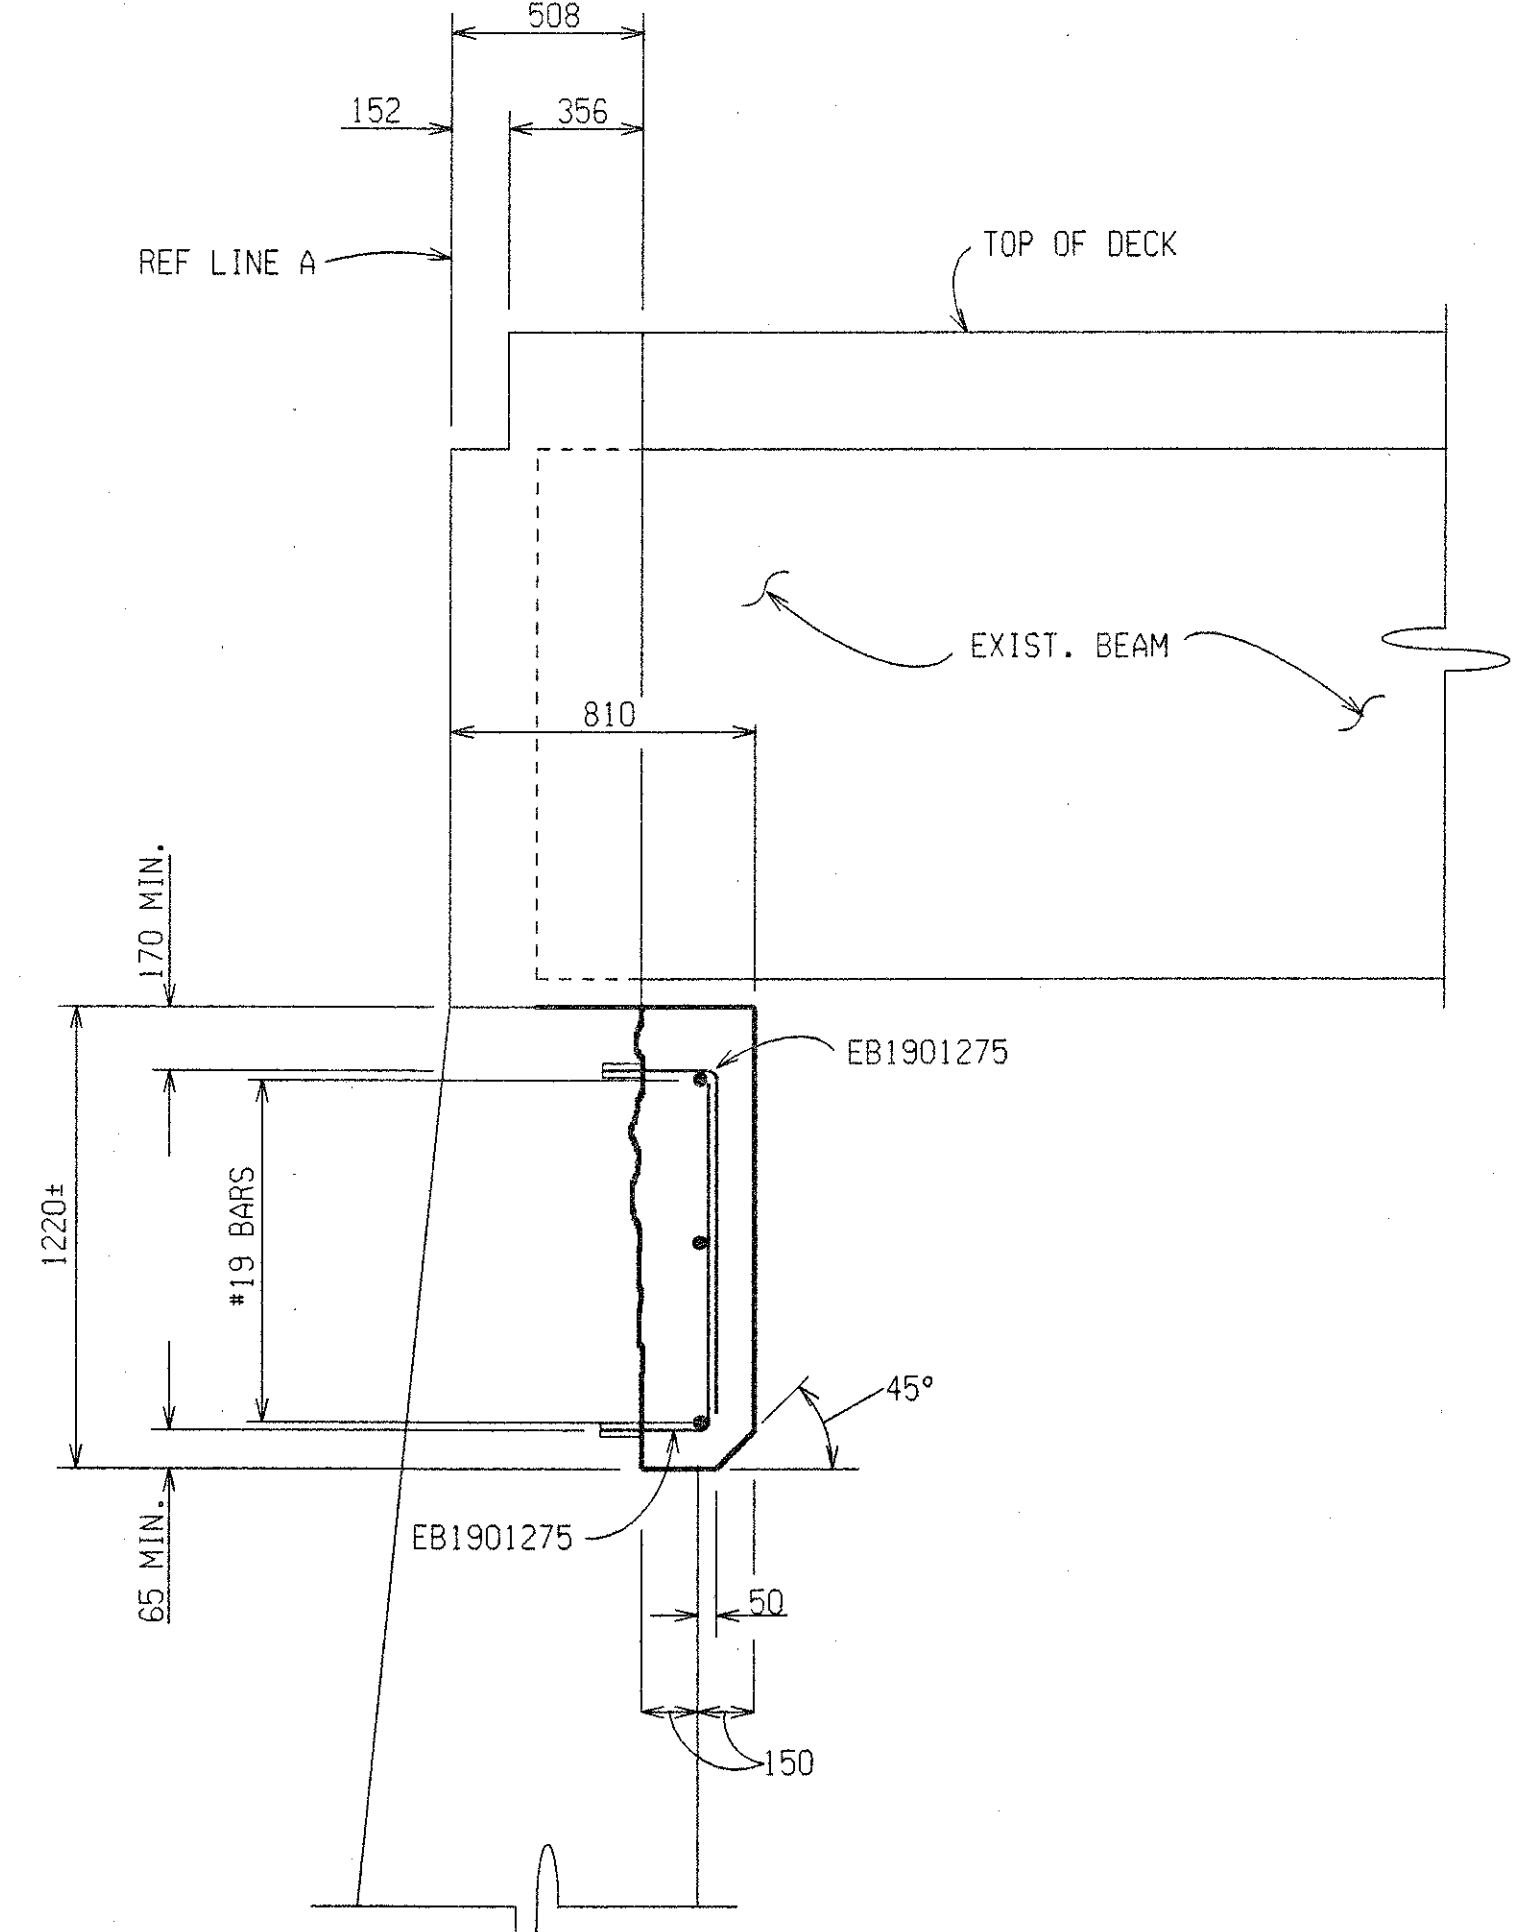

SECTION THRU ABUTMENT
PROPOSED REPAIRS BETWEEN BEAMS

NOTES:


- EXISTING TEMPORARY SUPPORTS LOCATED UNDER THE BEAMS AT ABUTMENT A SHALL BE REMOVED AND REPLACED WITH THE NEW TEMPORARY SUPPORTS DESIGNED FOR THE ABUTMENT REPAIR WORK. PLACE PROPOSED TEMPORARY SUPPORTS PRIOR TO REMOVAL OF ANY OF THE EXISTING SUPPORTS.
- EXISTING TEMPORARY SUPPORTS SHALL BE STOCK PILED ON THE JOB SITE AND DELIVERED TO AUBURN HILLS MAINTENANCE FACILITY AS DIRECTED BY THE ENGINEER (INCLUDED IN PAYMENT FOR TEMPORARY SUPPORTS.)
- REMOVAL OF THE EXISTING TEMPORARY SUPPORTS SHALL BE INCLUDED IN THE PAY ITEM "SUPPORT, COLUMN, TEMP".
- ALTERNATE DESIGNS FOR THE TEMPORARY SUPPORT SHALL BE BASED ON LOADS AS FOLLOWS:
800 kN VERTICAL GIRDER LOAD
120 kPa ALLOWABLE SOIL PRESSURE
- FORMS FOR LARGE PATCHES SHALL BE INSTALLED IN 600 mm TO 1200 mm HIGH SECTIONS WITH THE TOP OF FORM NO MORE THAN 1200 mm ABOVE THE LEVEL OF CONCRETE AS THE POUR PROGRESSES.
- TEMPORARY SUPPORTS SHALL NOT REMAIN LOADED FOR A PERIOD GREATER THAN FOUR WEEKS.
- WATER REPELLENT TREATMENT SHALL BE APPLIED TO THE ENTIRE REPAIRED AND EXPOSED EXISTING SURFACES OF ABUTMENT A.
- ALL CONCRETE ANCHORS SHALL BE INSTALLED ACCORDING TO MANUFACTURERS RECOMMENDATIONS
- SYSTEMS FOR ANCHORING HORIZONTAL OR VERTICAL REINFORCEMENT IN EXISTING CONCRETE SHALL BE CHOSEN FROM THE QUALIFIED PRODUCTS LIST IN THE CURRENT MOOT MATERIALS SAMPLING GUIDE.
- TEMPORARY CONCRETE BARRIER SHALL BE USED TO PROTECT THE TEMPORARY SUPPORT AS SHOWN ON THE PLANS OR AS DIRECTED BY THE ENGINEER.
- THE CONTRACTOR WILL BE FURNISHED WITH PLANS OF THE EXISTING STRUCTURE IF REQUESTED.
- WELDING ON EXISTING BEAMS WILL NOT BE PERMITTED (EXCEPT AS NOTED).

ABUTMENT A REPAIR DETAILS				
DATE	CONT. SEC.	JOB NO.	DESIGN UNIT	SHEET
10-18-99	S04 OF 63103	48404A	MAHDAVI	18 OF 24




DATE: 10-19-99
CORRECTED BY: R. PRATT/ JINDER
DATE:
CHECKED BY:
DATE: 3-15-99
DRAWN BY: SHAFFER
FILE NAME: S0463103.ABR

1 2 3 4 5 6 7 8 9 10 11 12 13 14 15 16 17 18 19 20 21 22 23 24 25 26 27 28 29 30 31 32 33 34 35 36 37 38 39 40 41 42 43 44 45 46 47 48 49 50 51 52 53 54 55 56 57 58 59 60 61 62 63

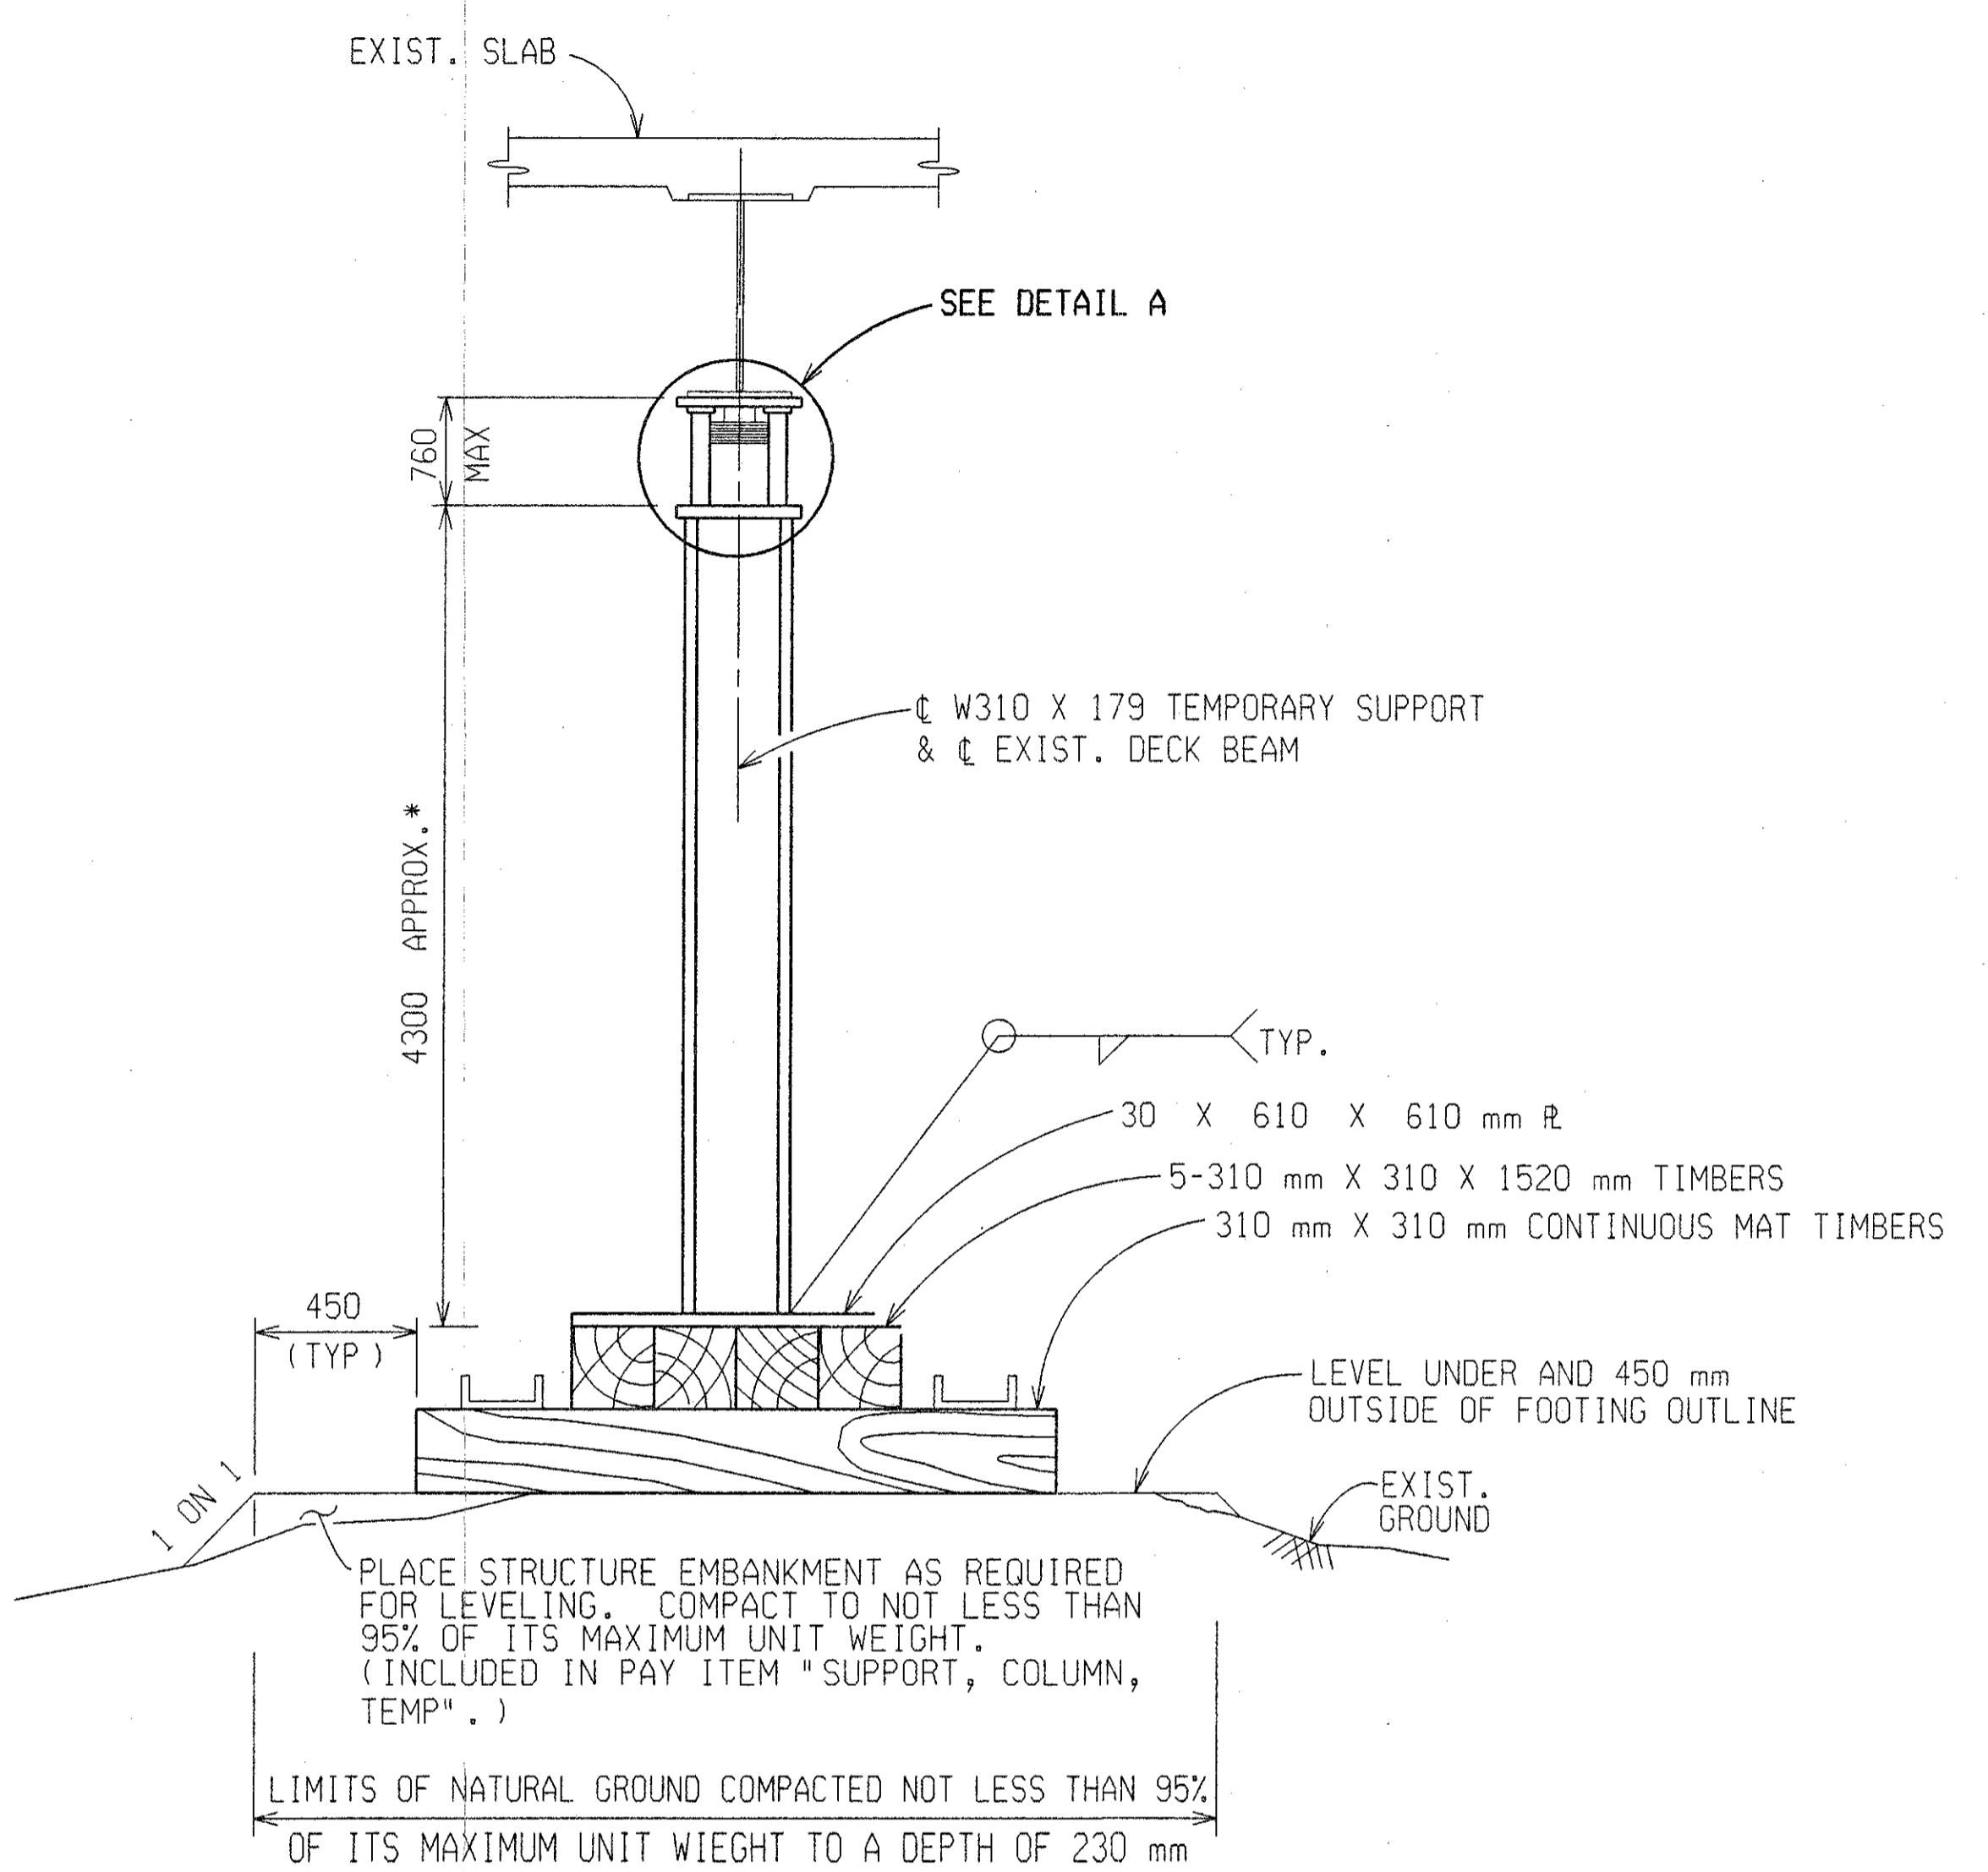


TIMBER FOOTING ON NATURAL GROUND


* EXACT HEIGHT TO BE DETERMINED BY CONTRACTOR. HEIGHT NOT TO EXCEED

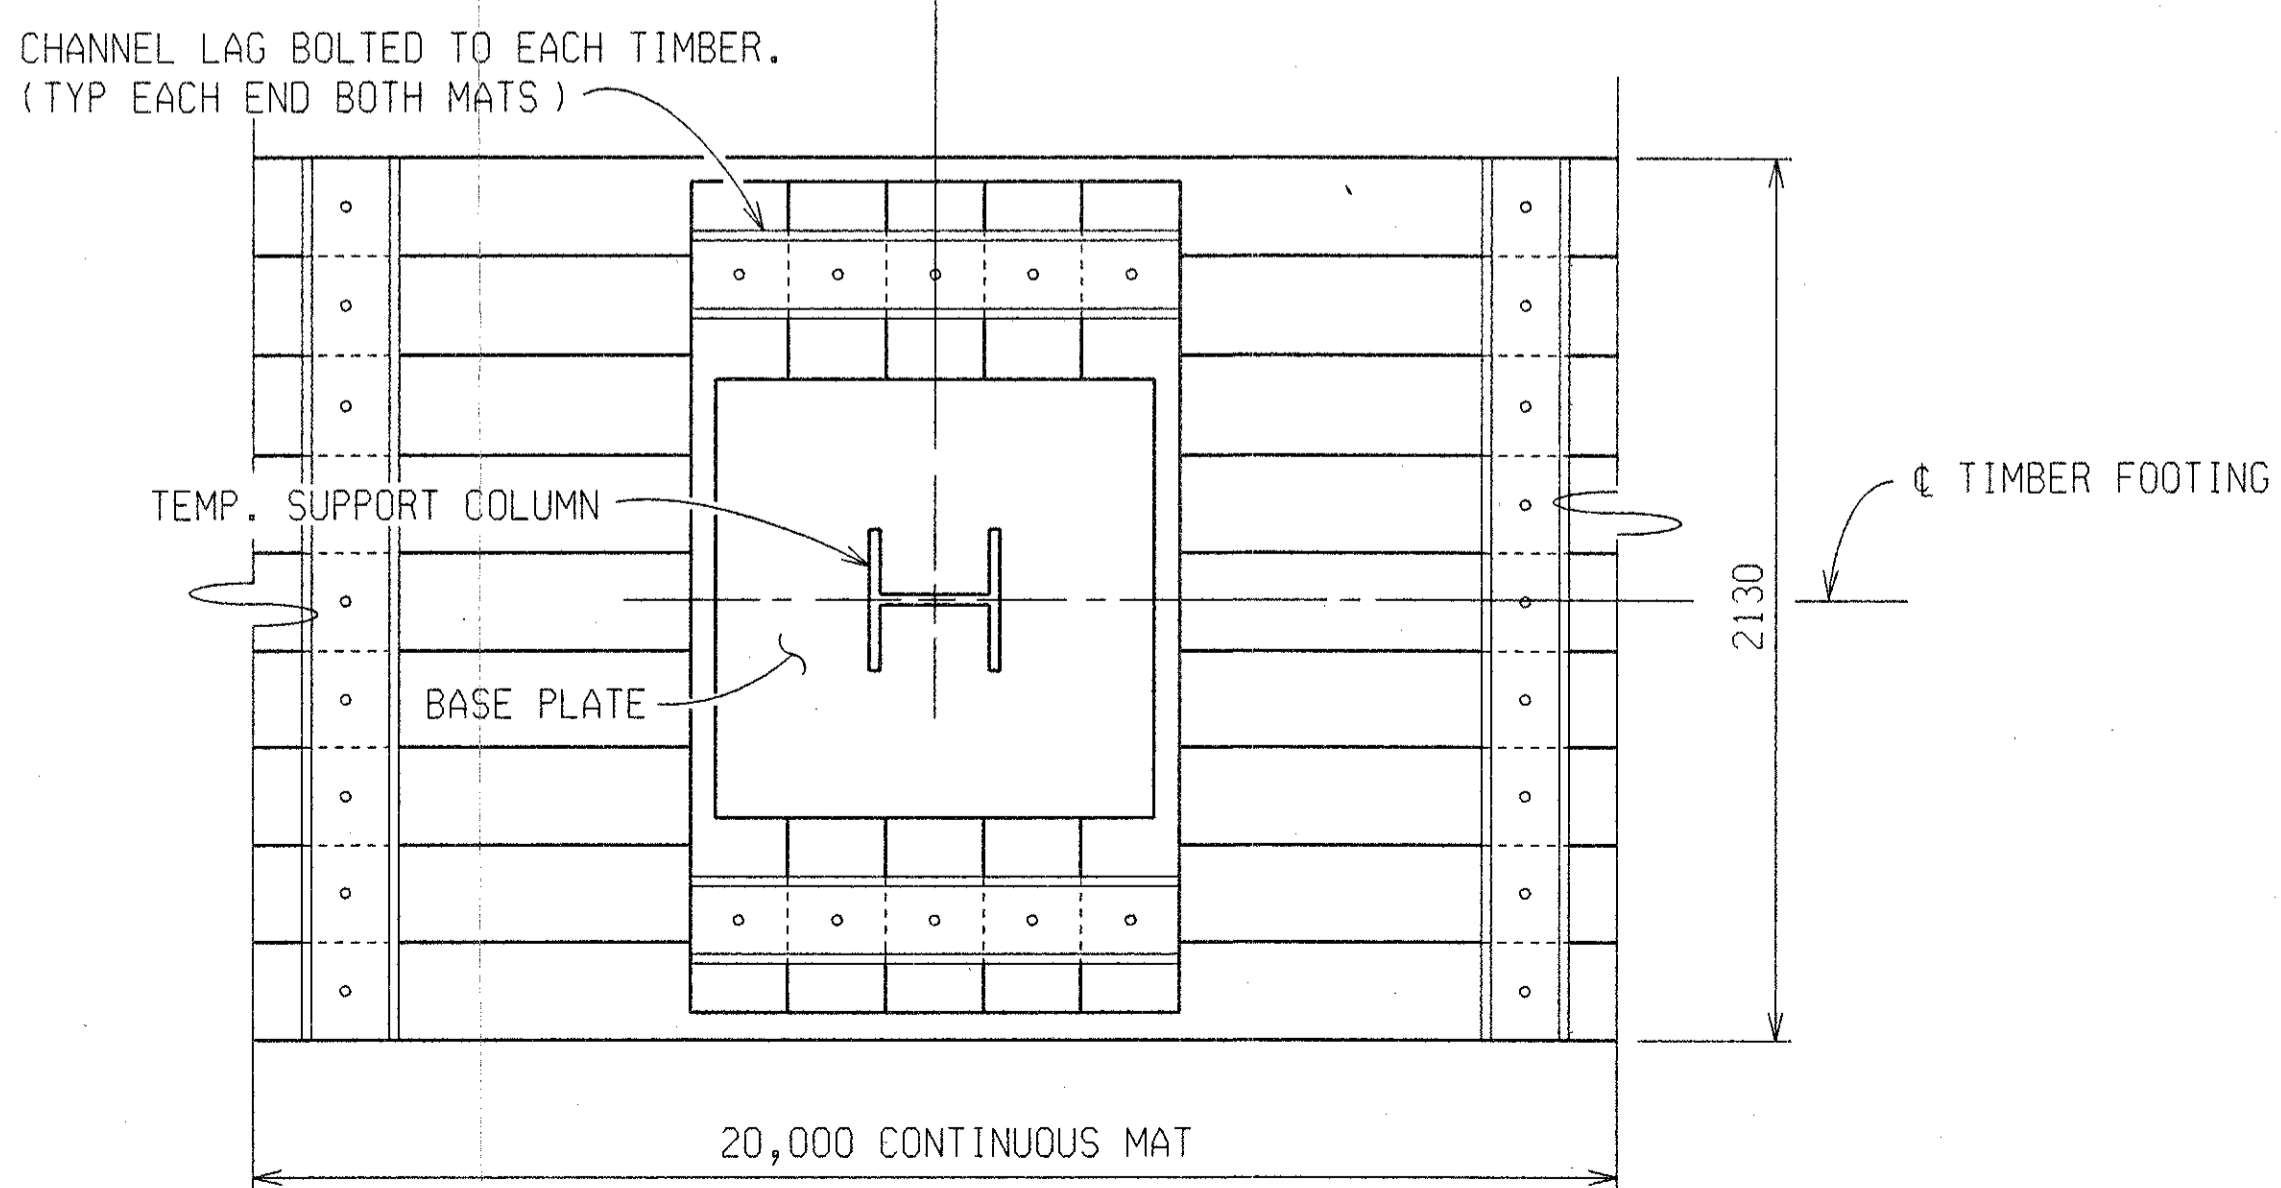

TIMBER FOOTING PLAN

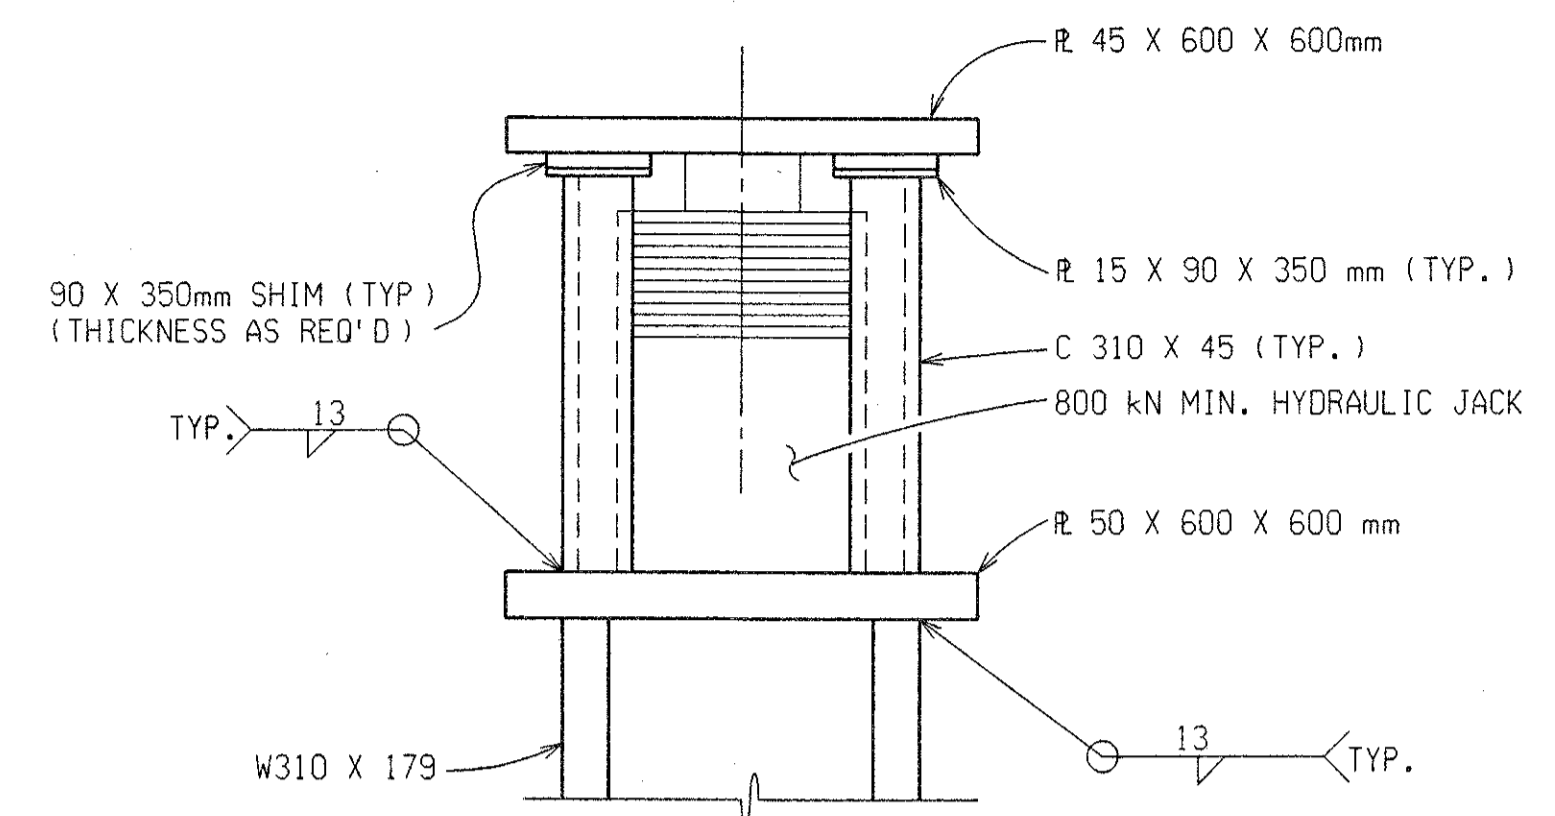


DETAIL A

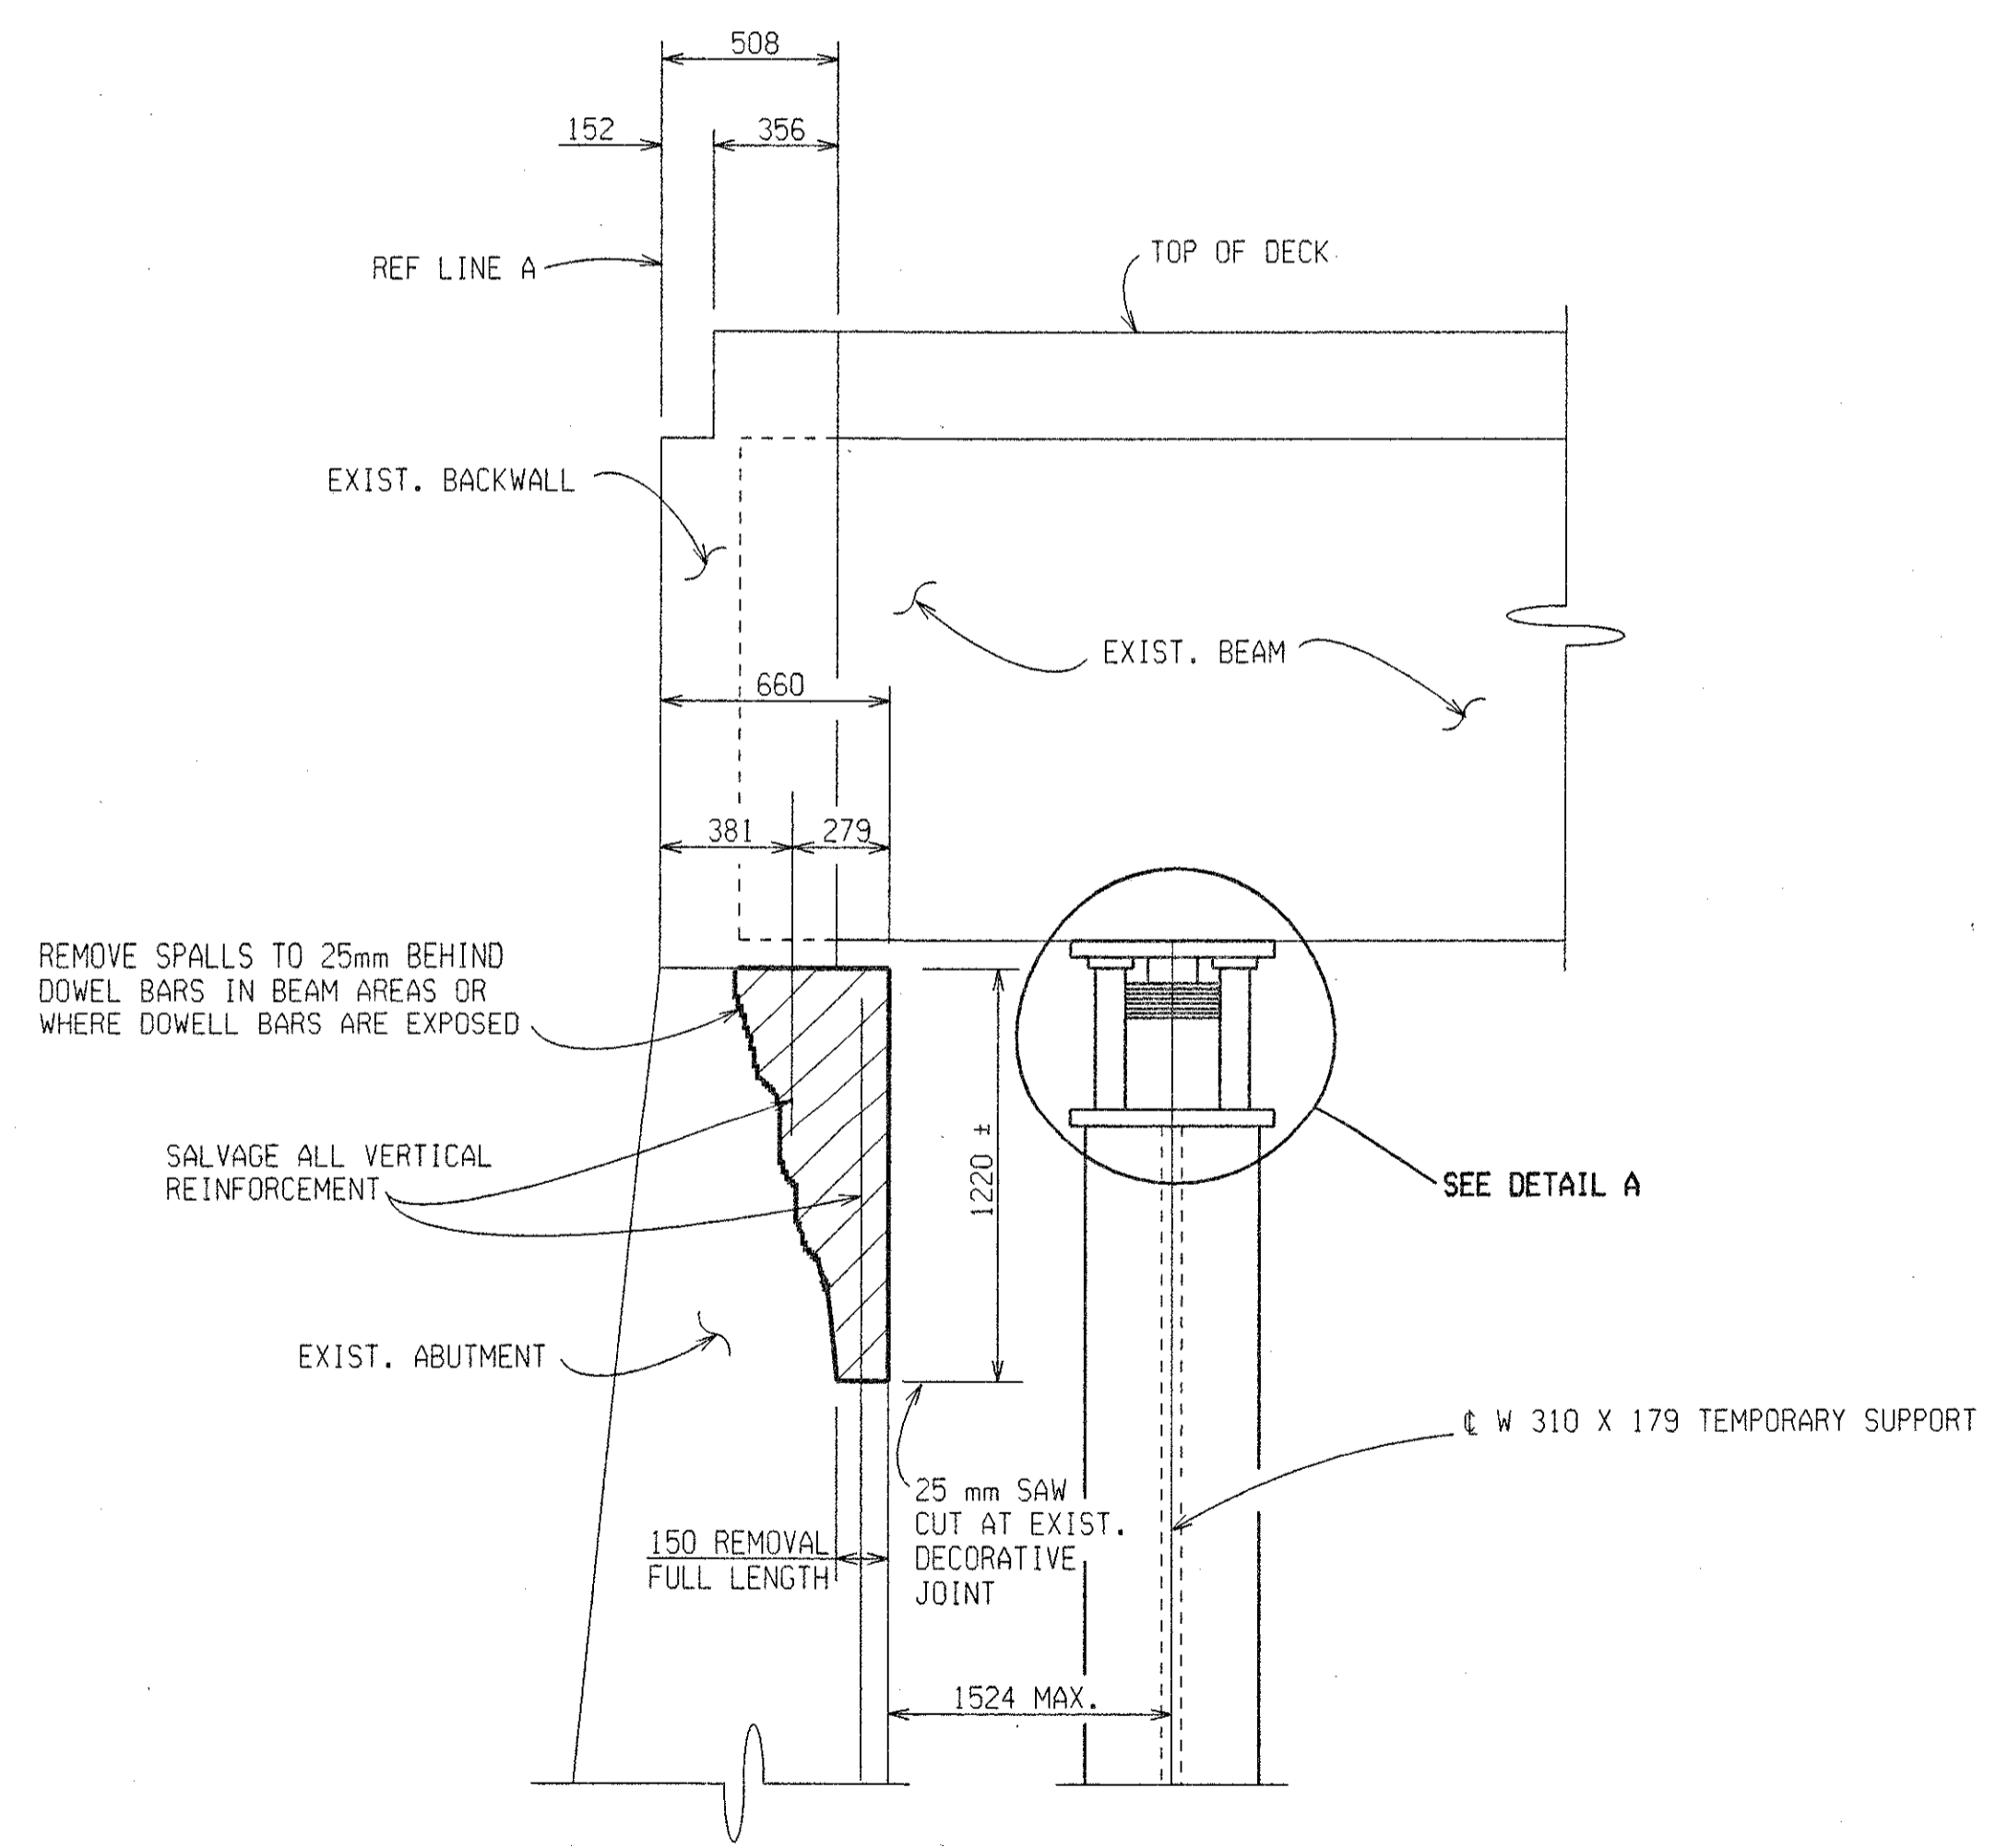

SECTION THRU ABUTMENT SHOWING REMOVAL

REVISIONS			
NO.	DESCRIPTION	DATE	BY

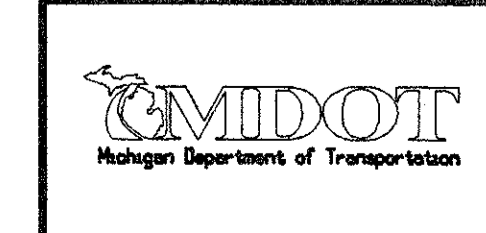


ABUTMENT A REPAIR DETAILS				
DATE	CONT. SEC.	JOB NO.	DESIGN UNIT	SHEET
10-18-99	S04 OF 63103	48404A	MAHDAVI	19 OF 24

FILE NAME: S0463103.ABR DRAWN BY: SHAEFFER CHECKED BY: DATE: 3-15-99 CORRECTED BY: R. PRATT / INDER DATE: 10-18-99


CONTROL SECTION S04 OF 63103 JOB NO. 48404D SHEET NO. 20

1 2 3 4 5 6 7 8 9 10 11 12 13 14 15 16 17 18 19 20 21 22 23 24 25 26 27 28 29 30 31 32 33 34 35 36 37 38 39 40 41 42 43 44 45 46 47 48 49 50 51 52 53 54 55 56 57 58 59 60 61 62 63


REVISIONS			
NO.	DESCRIPTION	DATE	BY

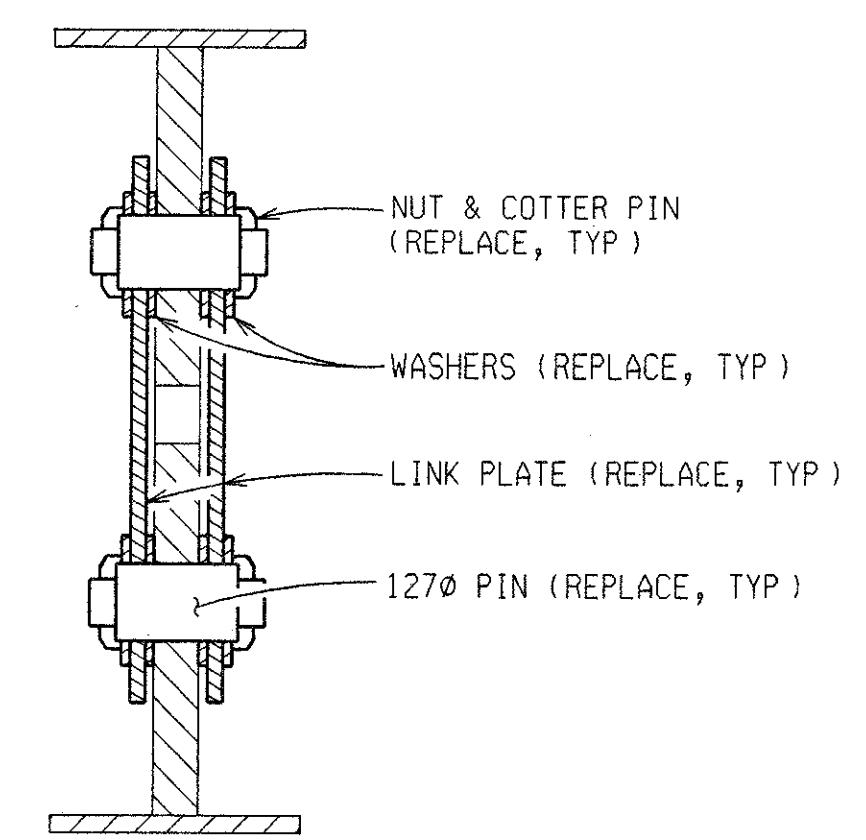


SECTION B-B
(EXISTING)

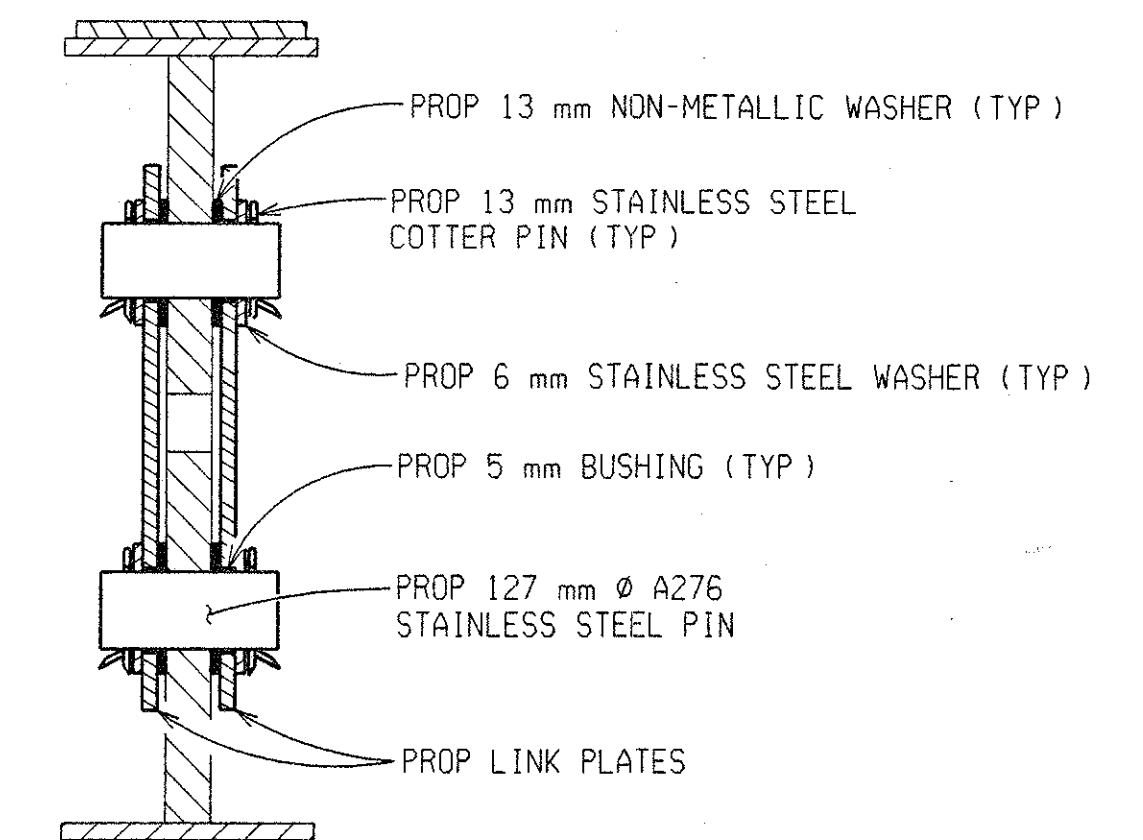


SECTION B-B
(PROPOSED)

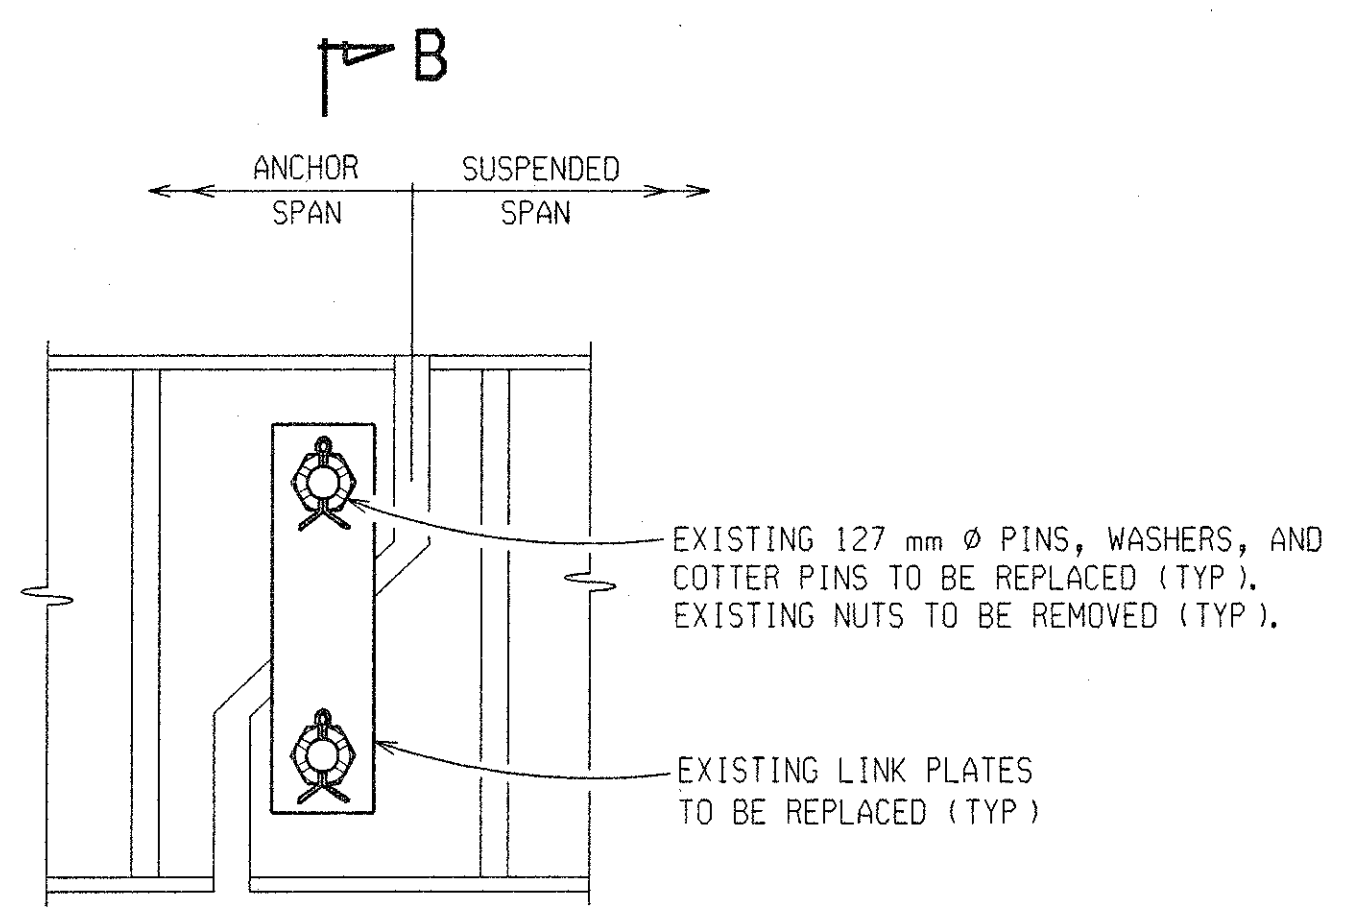

ELEVATION AT PIN

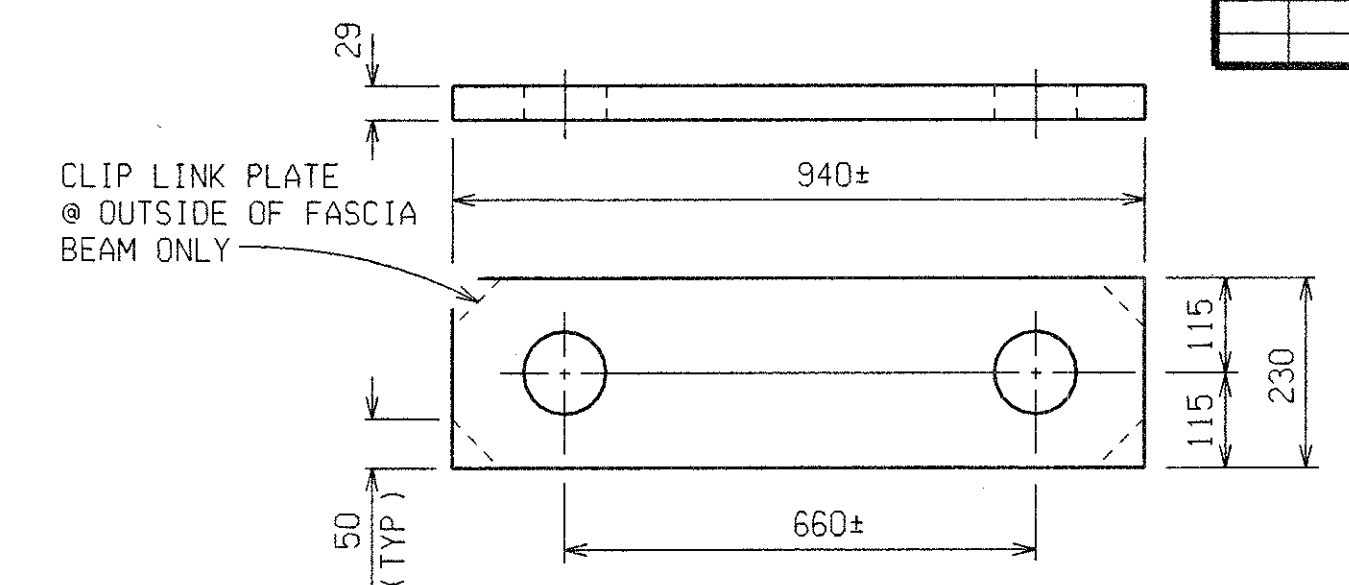


LINK PLATE
(14 REQ'D.)

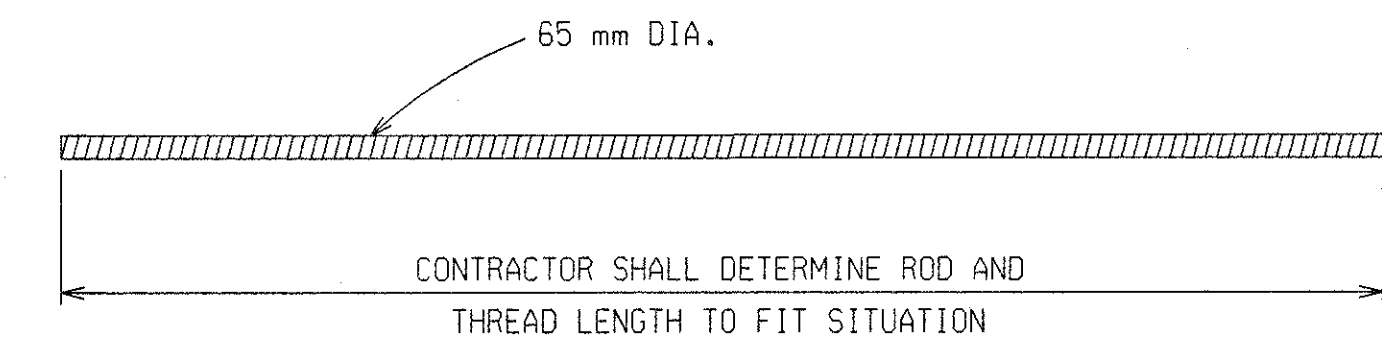


SUSPENDER ROD DETAIL

4 REQUIRED PER ASSEMBLY W/7 HEAVY HEX NUTS
& 4 HARDENED WASHER PER ROD


MISCELLANEOUS QUANTITIES	
7 ea	Support, Suspension, Temp
28 ea	Bushing
1000 kg	Structural Steel, Furn and Fab, Pin and Hanger
7 ea	Hanger Assembly, Rem and Erect
7 ea	Hanger Assembly, Field Measurement
1 LS	Field Repr of Damged Coating (S04)
1 LS	Steel Structure, Cleaning, Type 4 (S04)
1 LS	Steel Structure, Coating, Type 4 (S04)

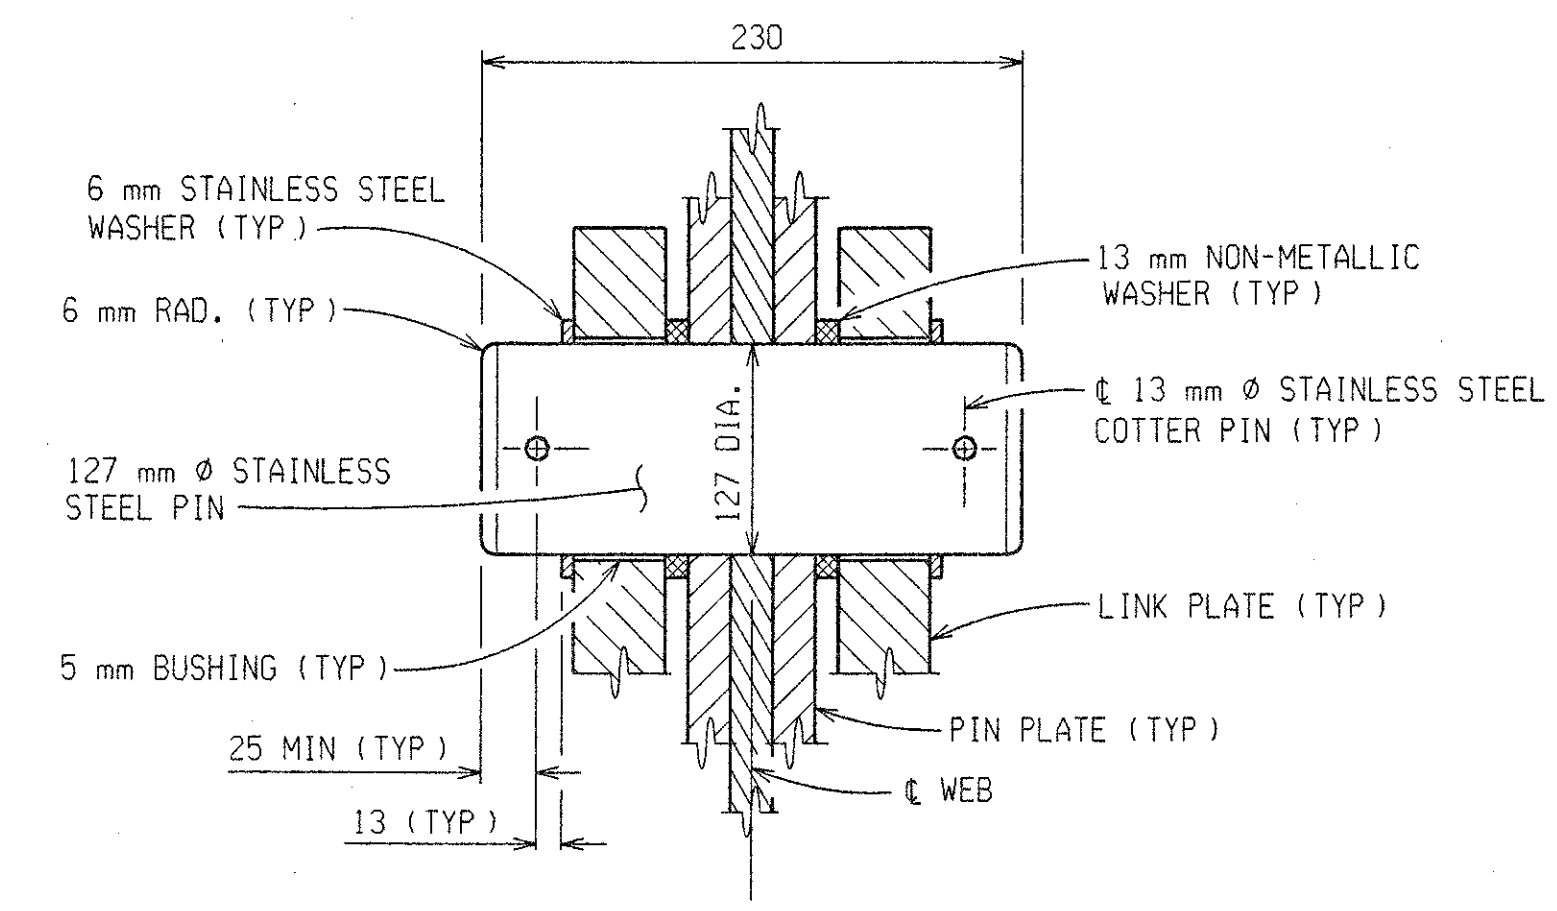


PROPOSED PIN DETAIL
(14 REQ'D.)

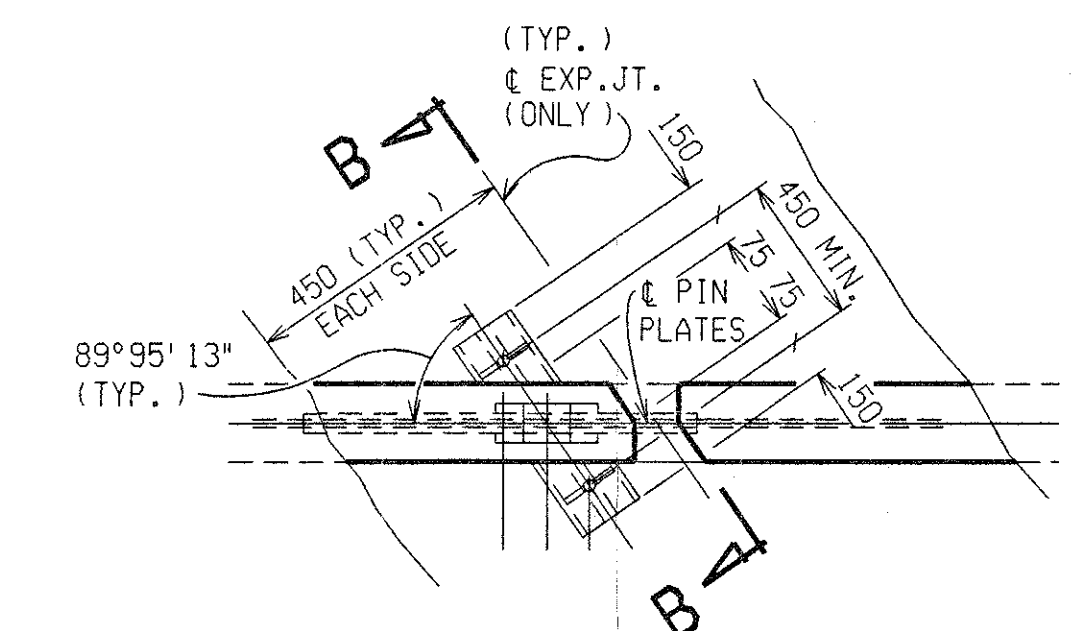

SECTION A-A

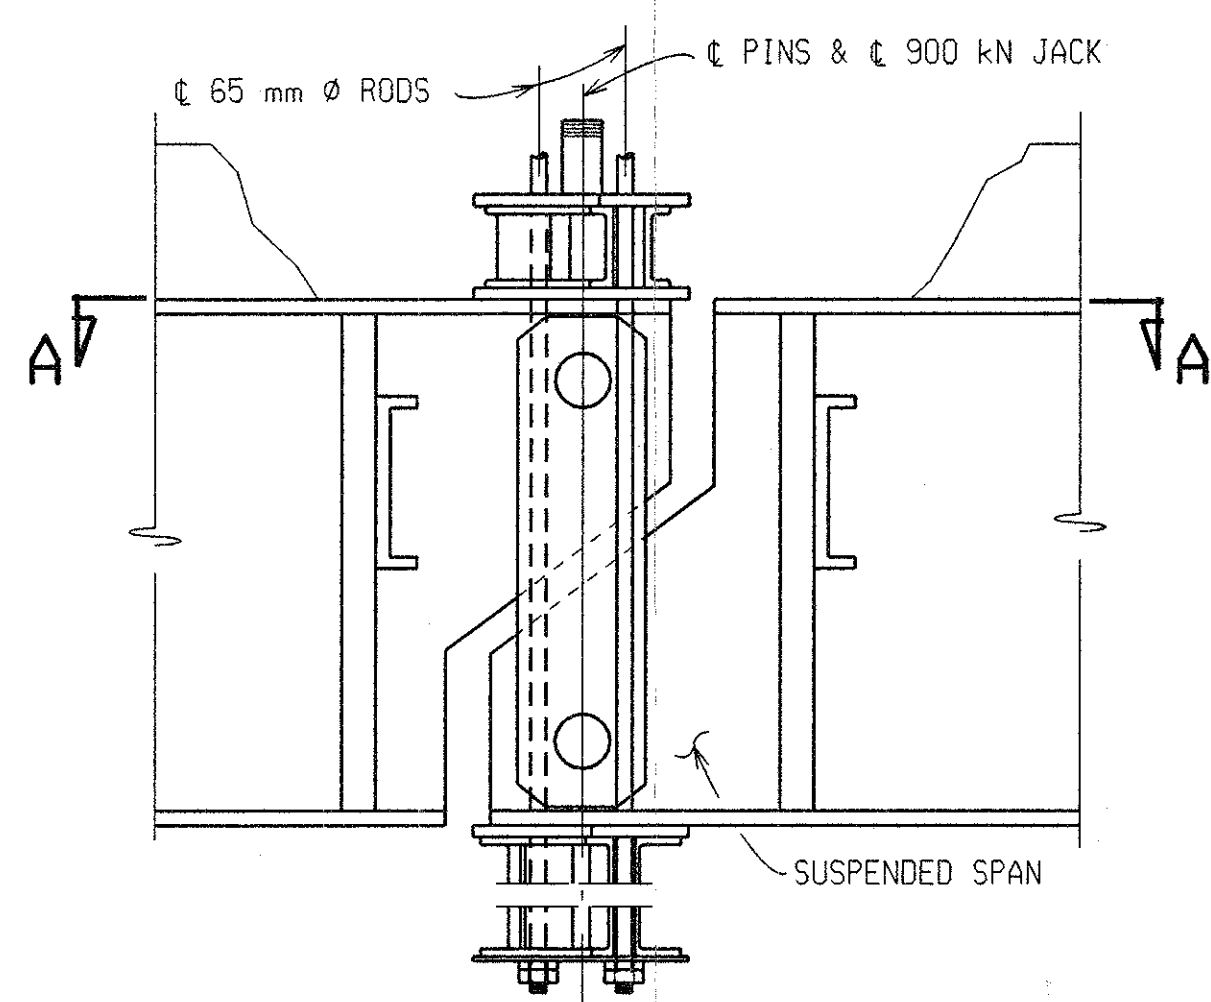

TEMPORARY SUPPORT

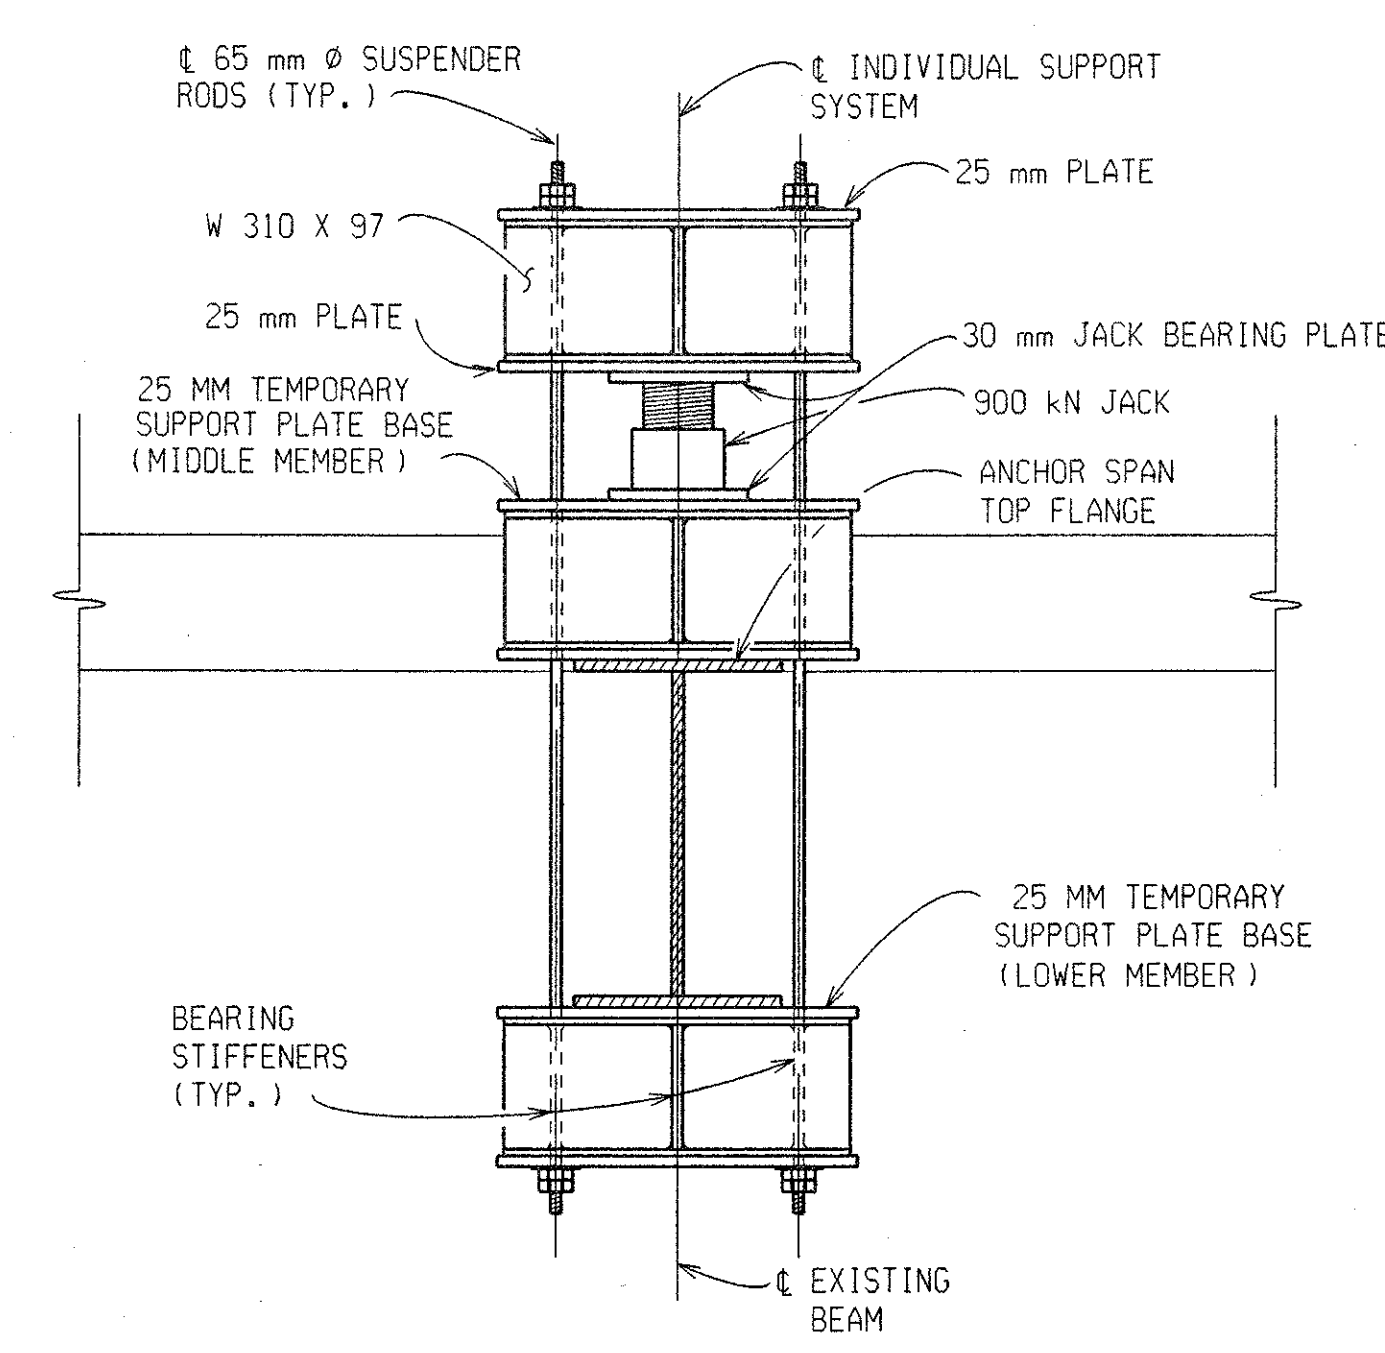

DECK SECTION A-A
(TYPICAL ALL BEAMS)

13 mm NON-METALLIC WASHER
(INCIDENTAL TO STRUCTURAL STEEL)
(28 REQ'D.)

6 mm STAINLESS STEEL WASHER
(28 REQ'D.)

NOTES:

THE AREA BEHIND AND AROUND THE HANGER ASSEMBLY SHALL BE COATED PRIOR TO INSTALLING THE NEW LINK PLATES AND PINS. PROPOSED LINK PLATES SHALL BE SHOP COATED.

THE PROTECTION OF WORK AND ENVIRONMENT DURING BLAST CLEANING OF WEBS BEHIND AND AROUND HANGER ASSEMBLIES SHALL BE ACCORDING TO SUBSECTION 715 OF THE STANDARD SPECIFICATIONS. (INCLUDED IN THE BID ITEM "HANGER ASSEMBLY, REMOVE AND ERECT".)

THE CONTRACTOR SHALL TAKE FIELD MEASUREMENTS OF THE EXISTING HANGER ASSEMBLIES INDICATED ON THE PLANS PRIOR TO THE PREPARATION OF LINK PLATE AND PIN SHOP DRAWINGS.

WELDING ON EXISTING GIRDERS WILL NOT BE PERMITTED.

THE CONTRACTOR WILL BE FURNISHED WITH PLANS OF THE EXISTING STRUCTURE IF REQUESTED.

ALTERNATE DESIGNS OF THE TEMPORARY SUPPORT SHALL BE BASED ON LOADS AS FOLLOWS:
900 kN VERTICAL GIRDER LOAD.

THIS BRIDGE IS COATED WITH LEAD BASED PAINT.

SEE SUBSECTION 715 OF THE STANDARD SPECIFICATIONS FOR PROTECTION OF WORK AND ENVIRONMENT DURING THE BLAST CLEANING OF STRUCTURES.


THE ENGINEER SHALL INSPECT THE STRUCTURAL STEEL PARTS THAT HAVE BEEN BLAST CLEANED FOR EVIDENCE OF CRACKS OR LOSS OF SECTION DUE TO CORROSION OF MORE THAN 25 PERCENT. SUCH DETERIORATION SHALL BE REPORTED IN WRITING TO THE ENGINEER, STRUCTURES AND ROAD MAINTENANCE OF THE MAINTENANCE DIVISION IN LANSING.

THE ESTIMATED AREA OF STRUCTURAL STEEL TO BE COATED IS 2090 SQUARE METERS.

THE SIGNS OVER I-75, NB AND SB, SHALL BE REMOVED FOR CLEANING AND COATING OF THE FASCIA BEAMS. SIGNS SHALL BE REINSTALLED USING NEW CONNECTION HARDWARE ACCORDING TO SUBSECTION 919.02 OF THE STANDARD SPECIFICATIONS. (INCLUDED IN THE BID ITEMS FOR CLEANING AND COATING EXISTING STEEL STRUCTURES.)

THE COLOR OF THE URETHANE PROTECTIVE COAT SHALL MATCH COLOR NUMBER 15488 LIGHT BLUE OF FEDERAL STANDARD NUMBER 595a.

THE CONTRACTOR SHALL TAKE NECESSARY MEASURES TO AVOID OVERSPRAY ON ADJACENT SUBSTRUCTURE AND SUPERSTRUCTURE CONCRETE SURFACES. (INCLUDED IN THE BID ITEM "STEEL STRUCTURE, COATING, TYPE 4", (S04)).

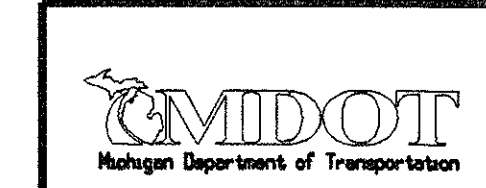


SUSPENDER REPLACEMENT DETAILS				
DATE	CONT. SEC.	JOB NO.	DESIGN UNIT	SHEET
10-18-99	S04 OF 63103	48404D	MAHDAVI	20 OF 24

DATE: 9-20-99 CORRECTED BY: SHAEFFER CHECKED BY: DATE: DRAWN BY: SHAEFFER FILE NAME: S0463103.PR

CONTROL SECTION S04 OF 63103 JOB NO. 48404D SH. 21


1 2 3 4 5 6 7 8 9 10 11 12 13 14 15 16 17 18 19 20 21 22 23 24 25 26 27 28 29 30 31 32 33 34 35 36 37 38 39 40 41 42 43 44 45 46 47 48 49 50 51 52 53 54 55 56 57 58 59 60 61 62 63

REVISIONS			
NO.	DESCRIPTION	DATE	BY

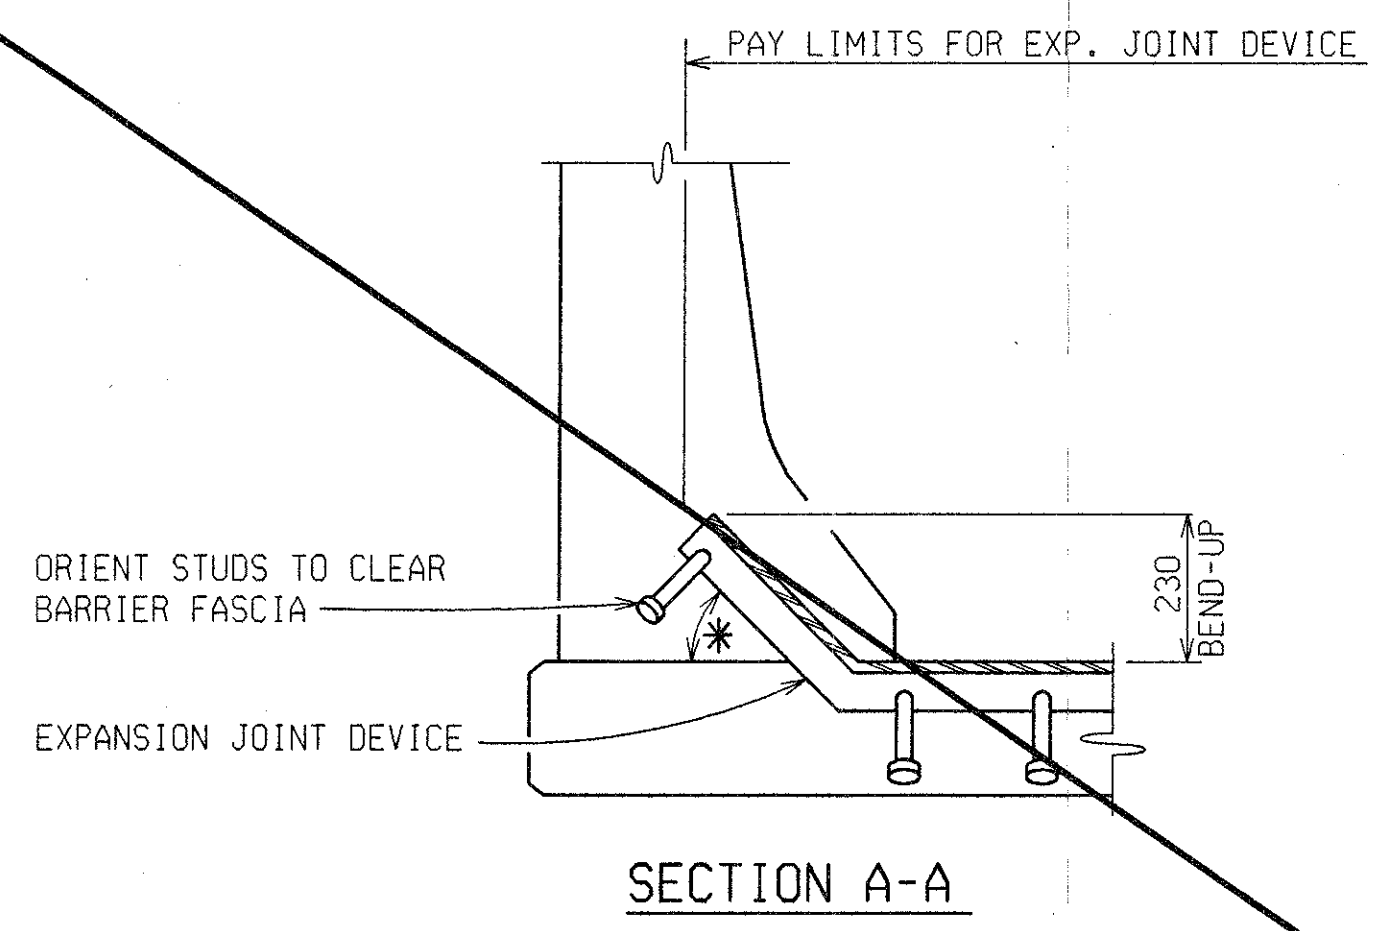


SECTION A-A


* - FOR ANGLES OF CROSSING FROM 90° TO 45° INCLUSIVE, BEND ANCHORAGE UP 45° ALONG EXPANSION JT. FOR ANGLES OF CROSSING LESS THAN 45°, A SPECIAL ENDING MAY BE REQUIRED.

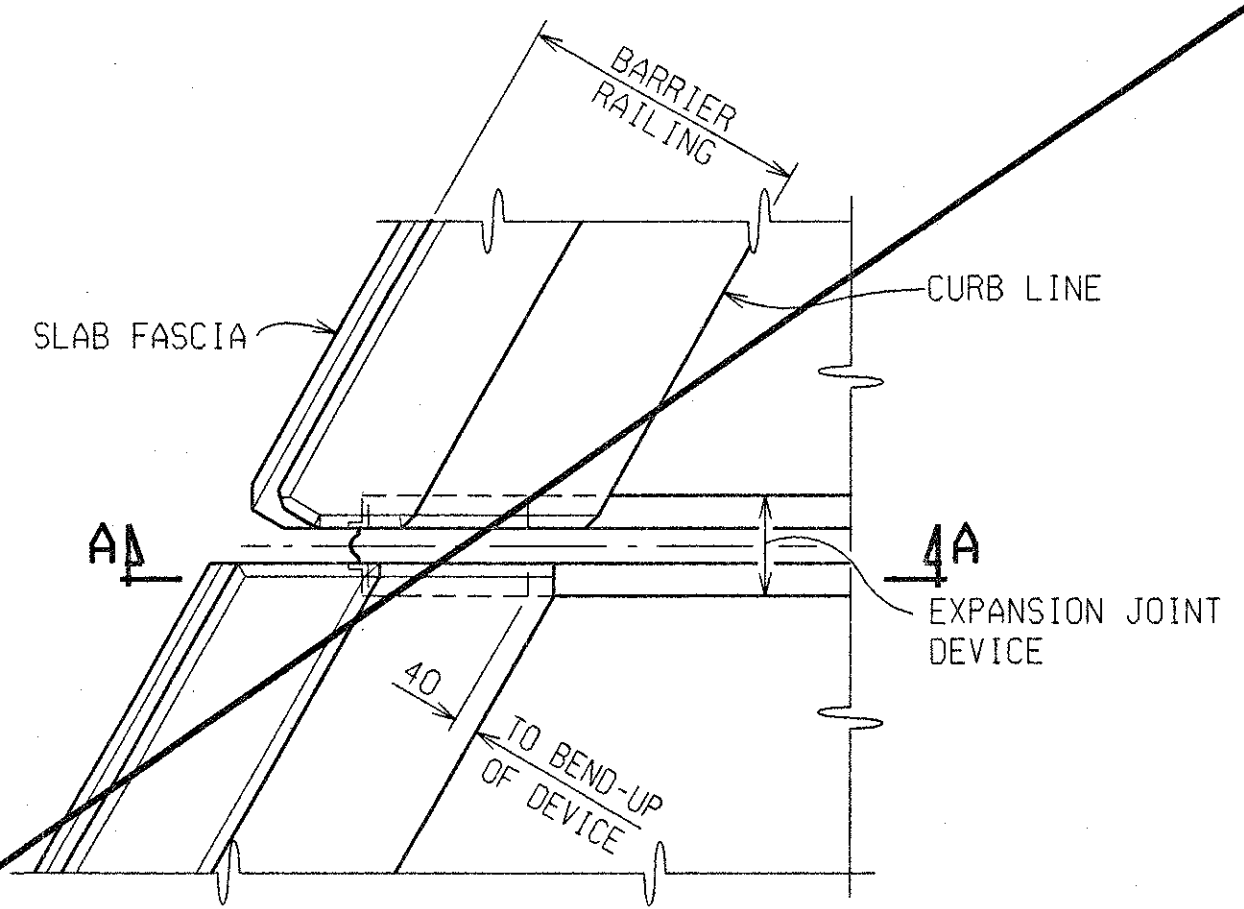


PLAN AT BARRIER RAILING

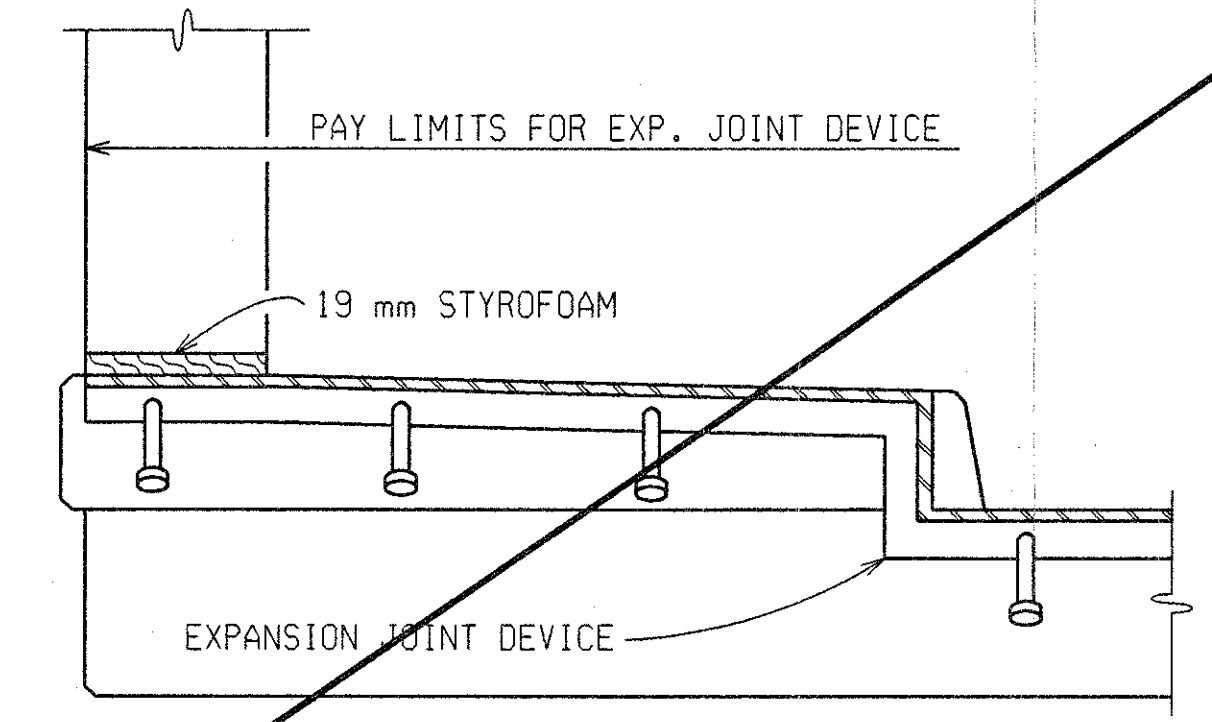


SECTION B-B

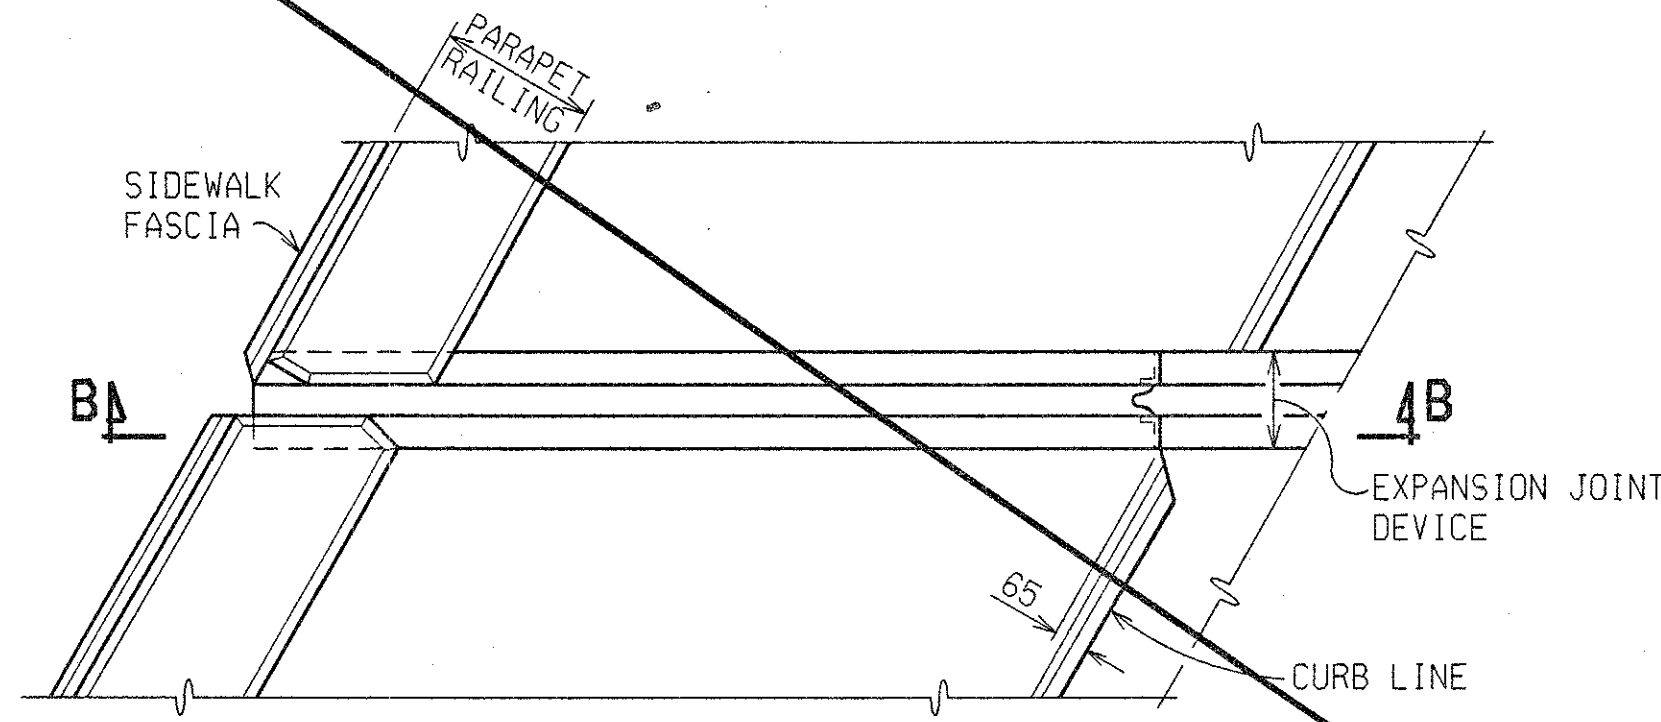

PLAN AT PARAPET RAILING
(DETAILS ARE SIMILAR FOR BRIDGE RAILING, 5 TUBE)

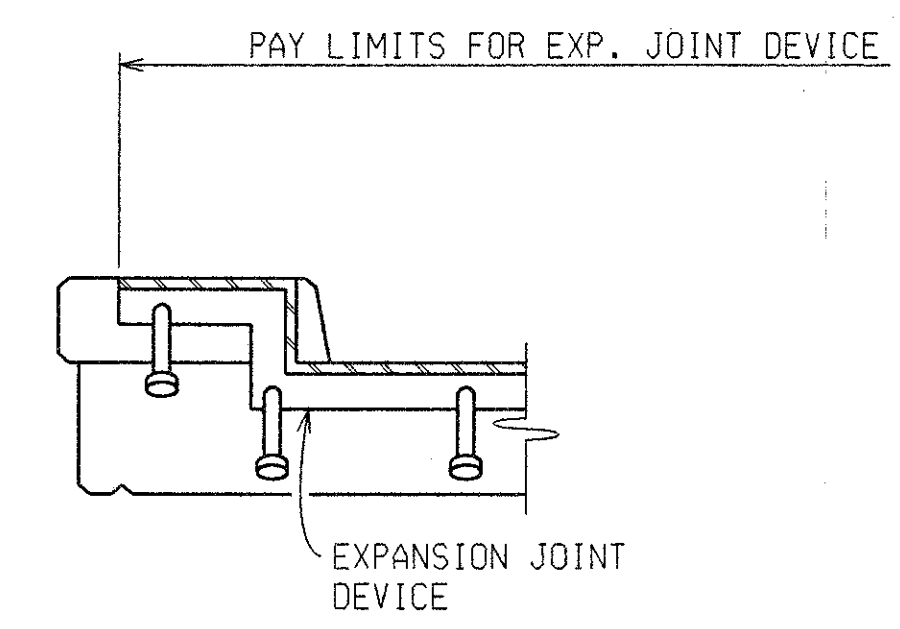

SECTION C-C

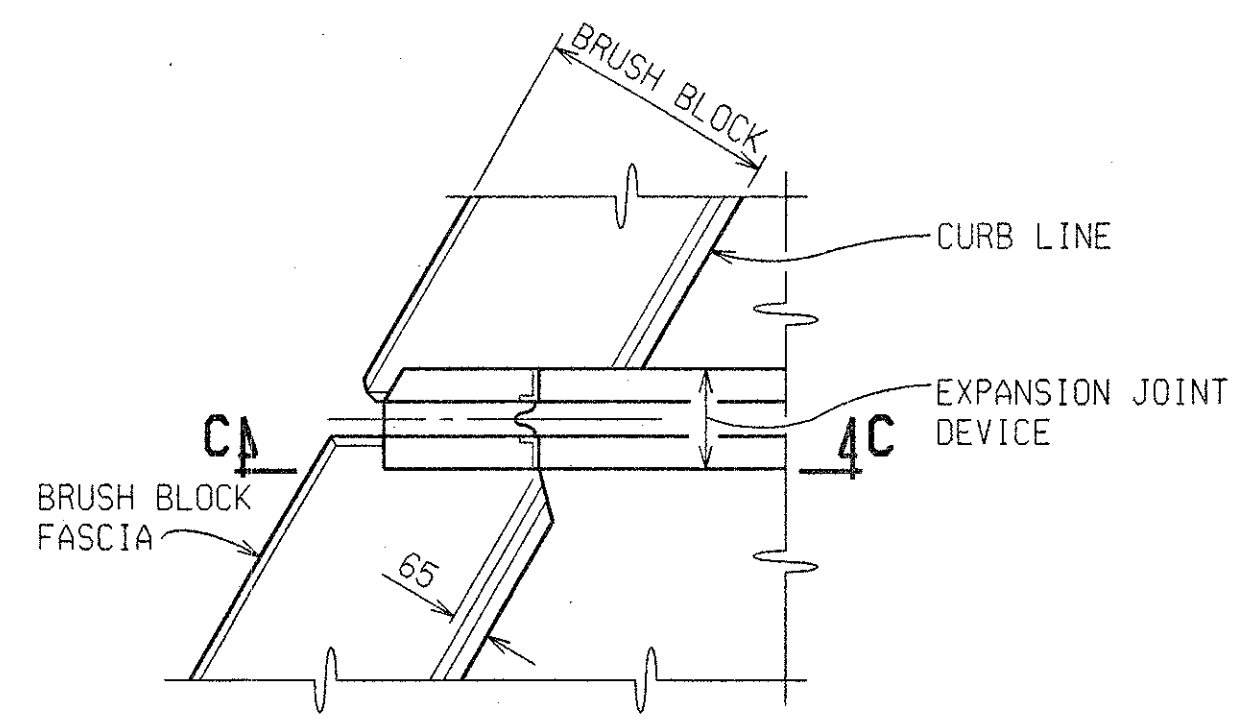

PLAN AT BRIDGE RAILING, 2 TUBE

BARRIER TREATMENT

SIDEWALK TREATMENT

BRUSH BLOCK TREATMENT

NOTES:

JOINT TYPES:

THE EXPANSION JOINT DEVICE SHALL BE OF A TYPE THAT INCLUDES A CONTINUOUS NEOPRENE (OR EQUIVALENT) SEAL ACROSS THE DECK. UNLESS OTHERWISE NOTED ON THE PLANS, THE CONTRACTOR HAS THE OPTION OF USING ANY OF THE DEVICES LISTED BELOW:

DEVICE	MANUFACTURER
WABO STRIP SEAL	WATSON-BOWMAN & ACME, INC.
PRO-SPAN	FEL-PRO, INC.
STEELFLEX-SSA2	D.S. BROWN
STEELFLEX-SSCM	D.S. BROWN
STEELFLEX-RS	D.S. BROWN
DNFLEX 40 SS	STRUCTURAL RUBBER PRODUCTS CO.
STRUPCO 400L	STRUCTURAL RUBBER PRODUCTS CO.

THE MODEL OF THE JOINT TYPE SELECTED SHALL BE SUITABLE TO ACCOMMODATE THE TOTAL MOVEMENT NOTED ON THE PLANS.

COMPLETE WORKING DRAWINGS OF ALL DETAILS OF FABRICATION OF THE EXPANSION JOINT DEVICE SHALL BE SUBMITTED FOR REVIEW IN ACCORDANCE WITH STANDARD SPECIFICATION 104.02. THIS REQUIREMENT IS WAIVED FOR EXPANSION JOINT DEVICES FOR WHICH A SET OF STANDARD INSTALLATION DETAILS HAS BEEN APPROVED. STANDARD INSTALLATION DETAILS CAN BE OBTAINED FROM THE DESIGN DIVISION.

FABRICATION AND INSTALLATION:

THE EXPANSION JOINT SHALL BE SHOP FABRICATED TO CONFORM TO THE CONTOUR OF THE BRIDGE DECK, BARRIERS, ETC. IT SHALL BE INSTALLED IN ACCORDANCE WITH MANUFACTURER'S RECOMMENDATIONS SUBJECT TO NOTES HEREIN AND THE APPROVAL OF THE ENGINEER.

THE TOP OF THE ELASTOMERIC JOINT DEVICE SHALL BE SET 3 - 6 mm BELOW THE CONCRETE SLAB (PAVEMENT) WITH A TOLERANCE OF ± 3 mm.

THE STEEL ANCHORAGE FOR STRIP SEAL GLANDS SHALL BE HOT DIP GALVANIZED IN ACCORDANCE WITH SUBSECTION 707.16 OF THE STANDARD SPECIFICATIONS.

THE PRO-SPAN DEVICE MUST INCORPORATE A CAST-IN-PLACE STEEL SEAT.

THE AREA OF THE STEEL ANCHORAGE AND SEALING GLAND WHICH WILL BE IN CONTACT WITH A SEALANT, OR LUBRICANT-ADHESIVE SHALL BE CLEANED WITH TOLUENE OR OTHER APPROVED SOLVENT.

WHERE THE SEALING GLAND IS LOCKED INTO A STEEL ANCHORAGE, A LUBRICANT-ADHESIVE CONFORMING TO STANDARD SPECIFICATION 914.4-E SHALL BE REQUIRED BETWEEN THE SEAL AND STEEL ANCHORAGE.

ALL BOLT WELL CAVITIES SHALL BE FILLED WITH AN APPROVED FLEXIBLE EPOXY OR A SEALANT CONFORMING TO FEDERAL SPECIFICATION TT-S-00230C.

IN THE EVENT THAT THE CONSTRUCTION SEQUENCE REQUIRES SPLICING THE SEALING GLAND, IT SHALL BE SPLICED BY AN APPROVED METHOD (SUCH AS COLD VULCANIZATION) BY A TRAINED REPRESENTATIVE OF THE MANUFACTURER.

DETAILS AT CURBS OR BARRIERS:


THE DETAILS ON THIS SHEET SHOW AN APPROVED MEANS OF TERMINATING THE EXPANSION JOINT DEVICE AT CURBS OR BARRIERS. VARIATIONS OR ALTERNATIVE SCHEMES WILL BE CONSIDERED AND MAY BE USED IF APPROVED BY THE ENGINEER.

MATERIALS:

THE COST OF ALL MATERIALS AND LABOR REQUIRED FOR PROPER INSTALLATION OF THE EXPANSION JOINT AND THE TERMINAL ASSEMBLIES AT THE CURBS, SIDEWALKS, OR BARRIERS IS INCLUDED IN THE PAYMENT FOR THE EXPANSION JOINT DEVICE.

ITEM	QUANTITY	UNIT	AMOUNT
EXPANSION JOINT DEVICE		m	18

STRUCTURE NUMBER	ANGLE OF CROSSING TO NEAREST 10°	LOCATION OF JOINT	MIN. TOT. TRAVEL ALONG CENTERLINE OF BRIDGE	REQUIRED LENGTH OF EXPANSION JOINT DEVICE
S04	90°	PIER 1	35	18 m

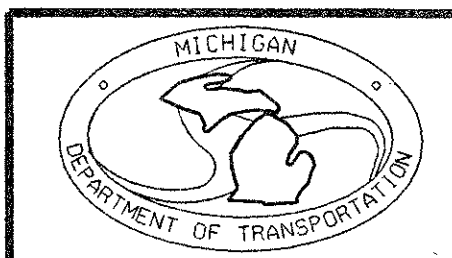

EXPANSION JOINT DETAILS

DATE	CONT. SEC.	JOB NO.	DESIGN UNIT	SHEET
10-18-99	S04 OF 63103	48404D	MAHDAVI	21 OF 24


EJ3T (11-17-97)

DATE: 5-10-99 CORRECTED BY: SHAFFER DATE: 07-16-96 CHECKED BY: VZ/SPB DATE: STANDARDS DRAWN BY: FILE NAME: S0463103-JT

CONTROL SECTION S04 OF 63103 JOB NO. 48404A SH: 23


1 2 3 4 5 6 7 8 9 10 11 12 13 14 15 16 17 18 19 20 21 22 23 24 25 26 27 28 29 30 31 32 33 34 35 36 37 38 39 40 41 42 43 44 45 46 47 48 49 50 51 52 53 54 55 56 57 58 59 60 61 62 63

REVISIONS			
NO.	DESCRIPTION	DATE	BY

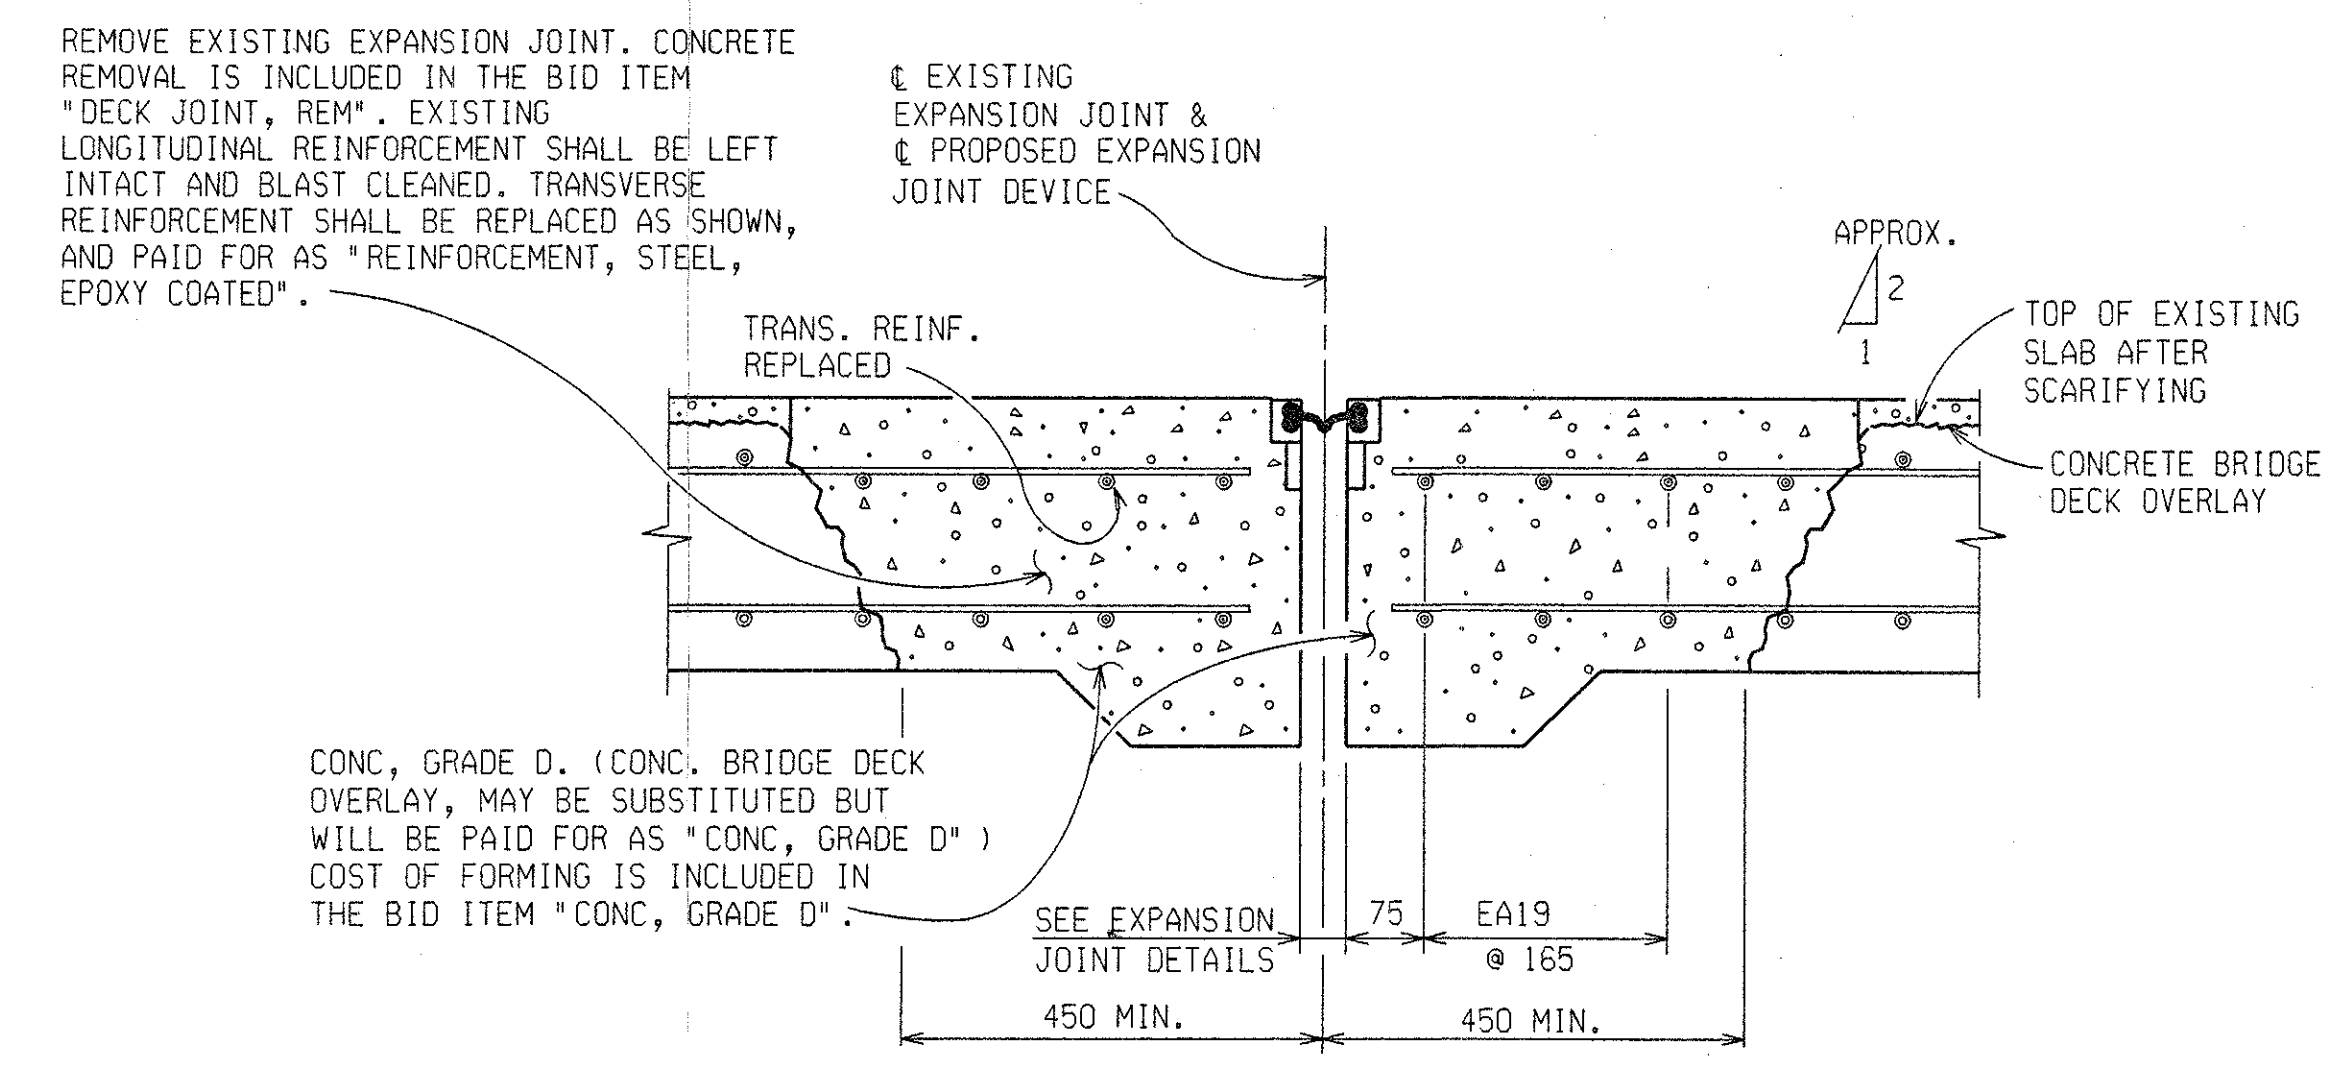


SECTION AT PROPOSED EXPANSION JOINT DEVICE


BEFORE FORMING, SOUND CONCRETE TO SEE IF ADDITIONAL REMOVAL WILL BE REQUIRED.

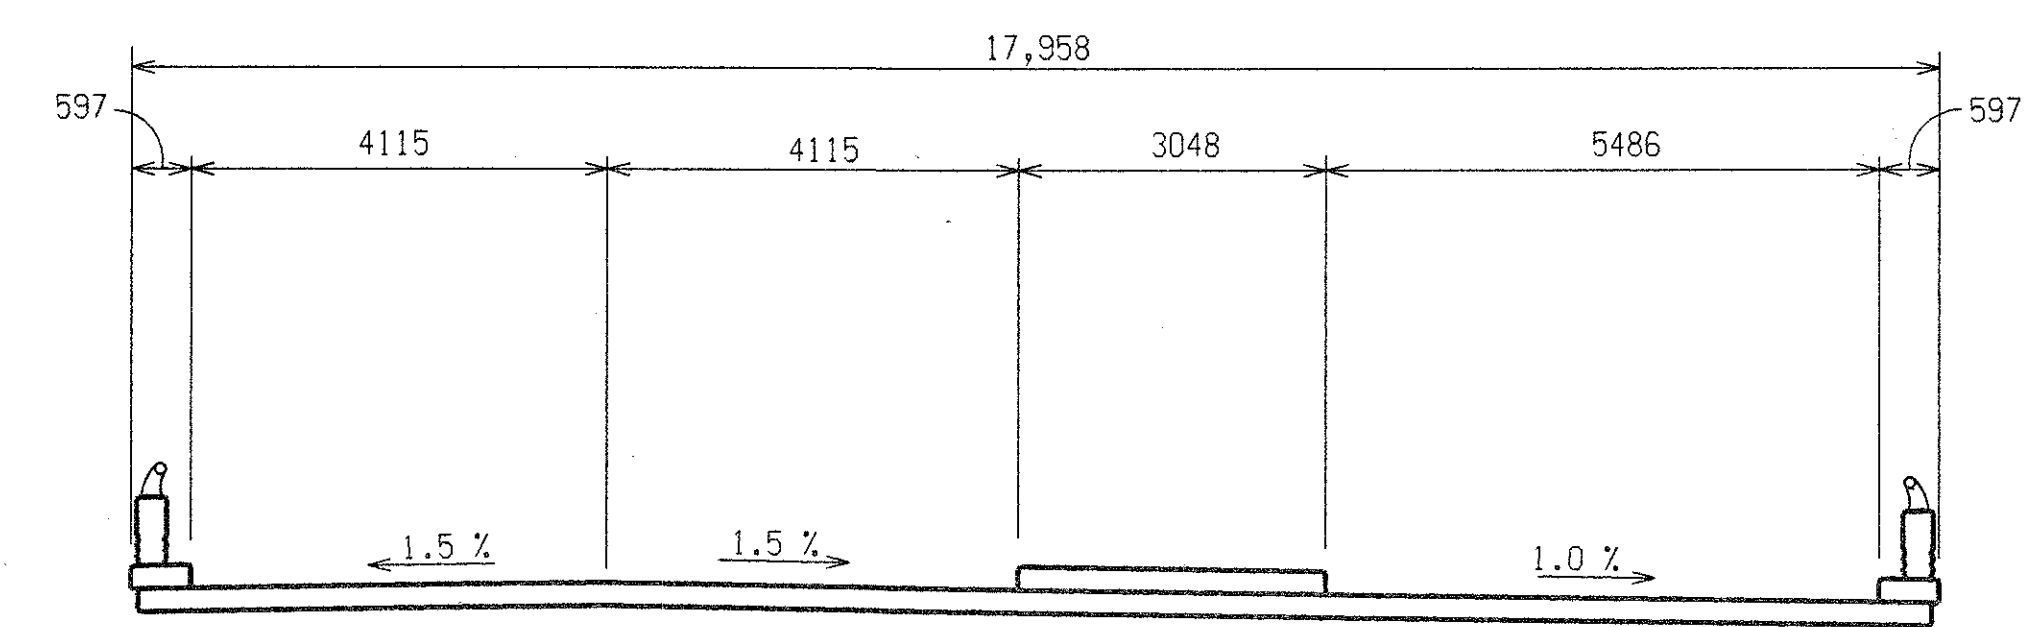

SECTION A-A

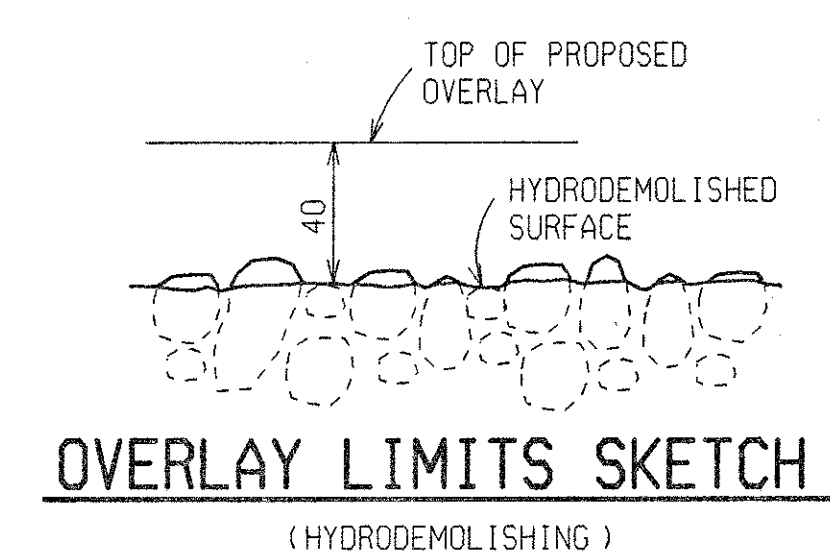


OVERLAY LIMITS SKETCH
(HYDRODEMOLISHING)

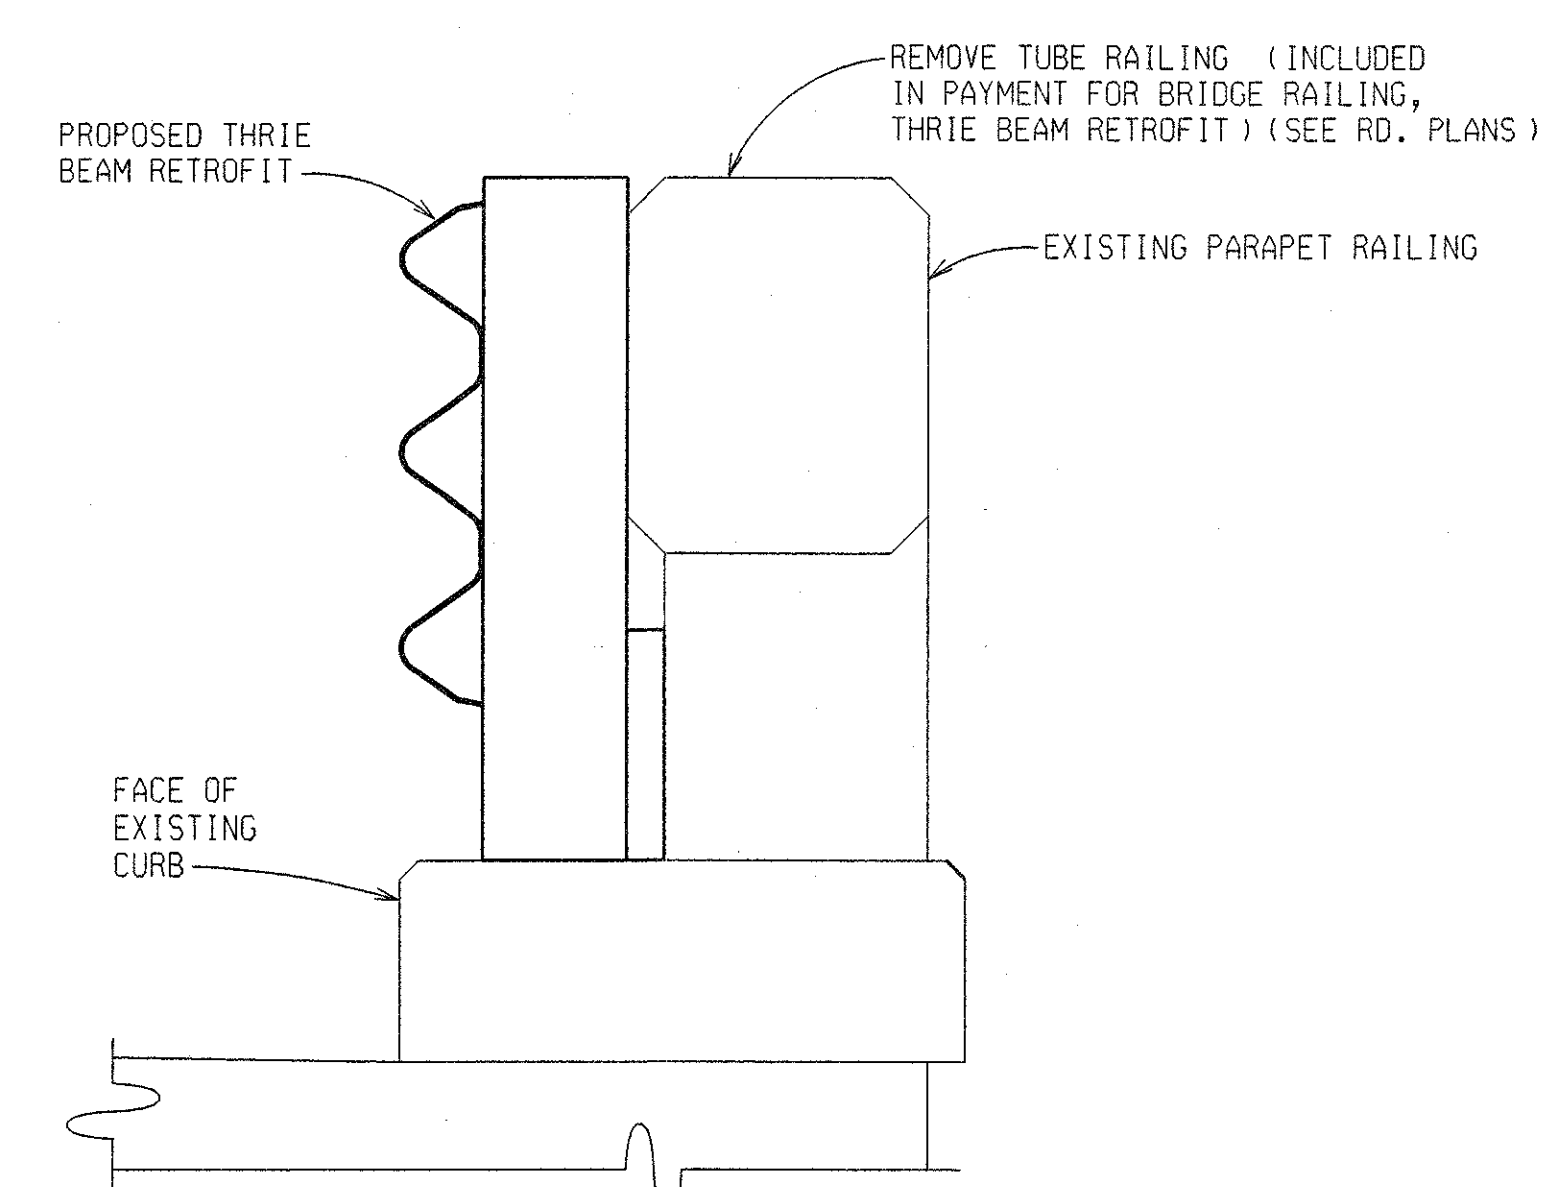

SECTION THRU PARAPET RAILING THRIE BEAM RETROFIT

(SEE ROAD PLANS AND STANDARD PLAN B-23 FOR THRIE BEAM RETROFIT DETAILS AND QUANTITIES)

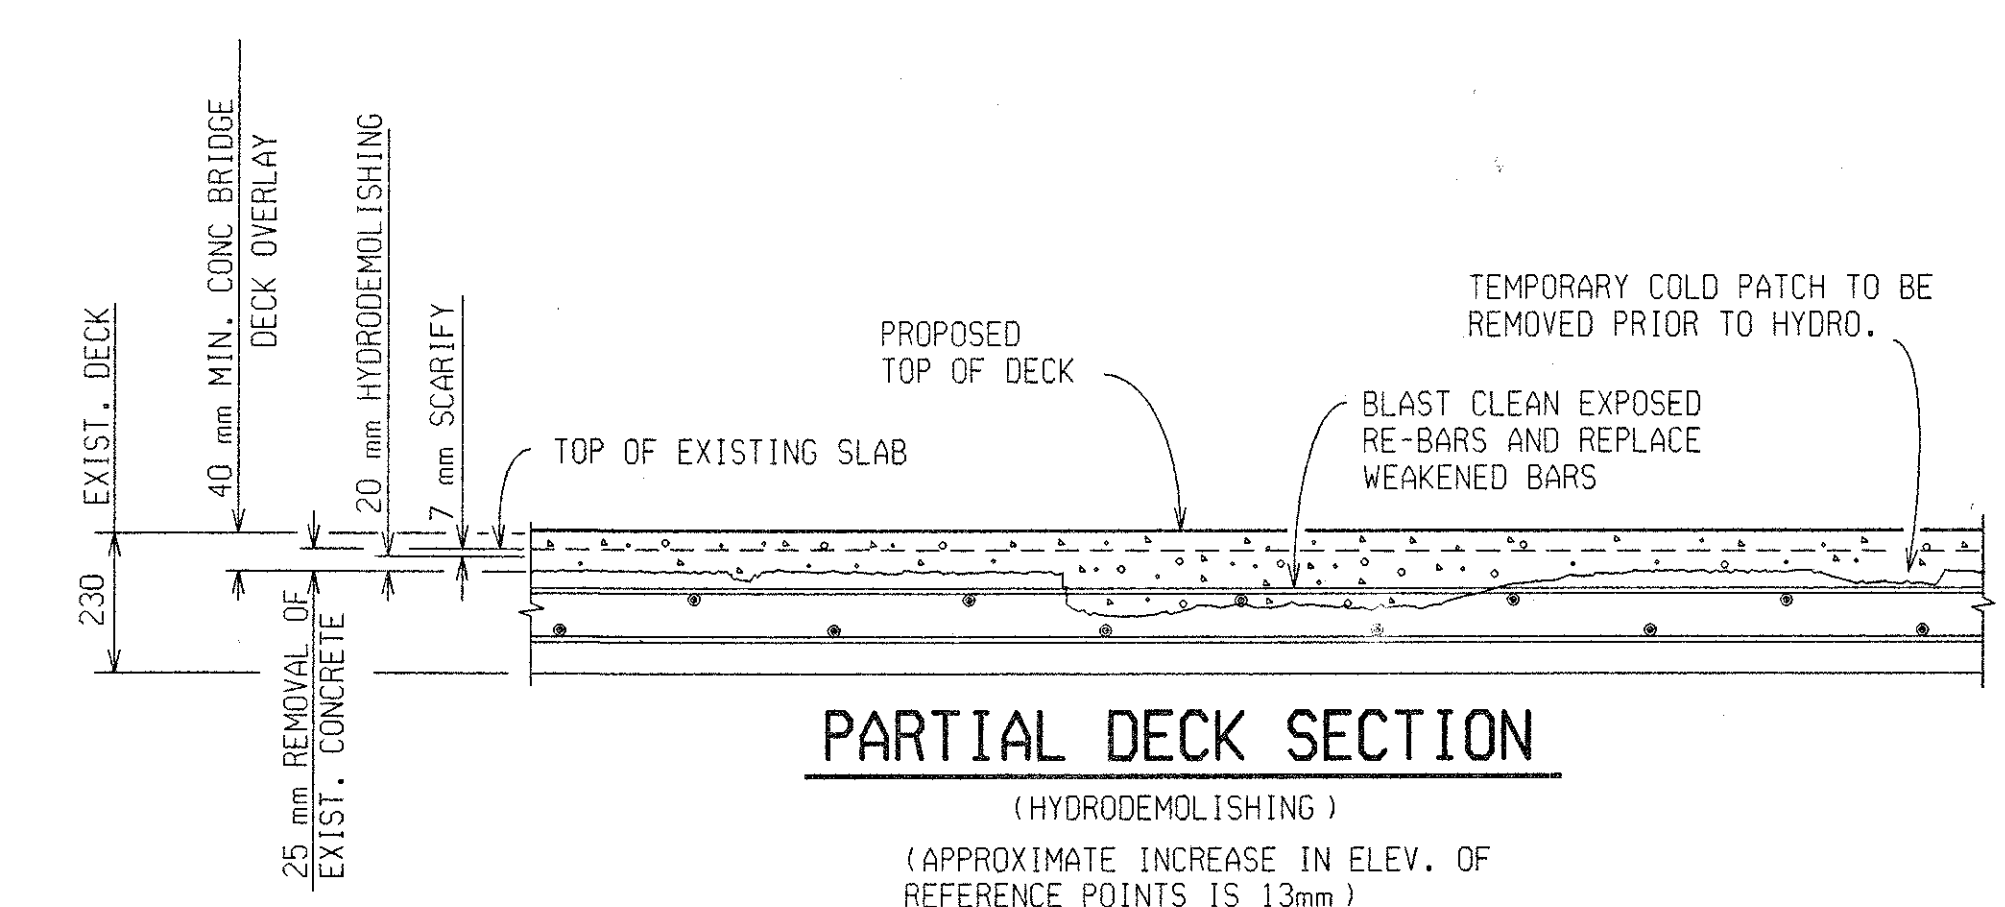

PARTIAL DECK SECTION

(HYDRODEMOLISHING)
(APPROXIMATE INCREASE IN ELEV. OF REFERENCE POINTS IS 13mm)




DECK OVERLAY DETAILS				
DATE	CONT. SEC.	JOB NO.	DESIGN UNIT	SHEET
10-18-99	S04 OF 63103	48404A	MAHDAVI	23 OF 24

DRAWN BY: SHAFFER CHECKED BY: MIKUCKI DATE: 2-25-99 CORRECTED BY: SHAFFER DATE: 9-20-99 FILE NAME: S0463103.0V


1 2 3 4 5 6 7 8 9 10 11 12 13 14 15 16 17 18 19 20 21 22 23 24 25 26 27 28 29 30 31 32 33 34 35 36 37 38 39 40 41 42 43 44 45 46 47 48 49 50 51 52 53 54 55 56 57 58 59 60 61 62 63

REVISIONS			
NO.	DESCRIPTION	DATE	BY

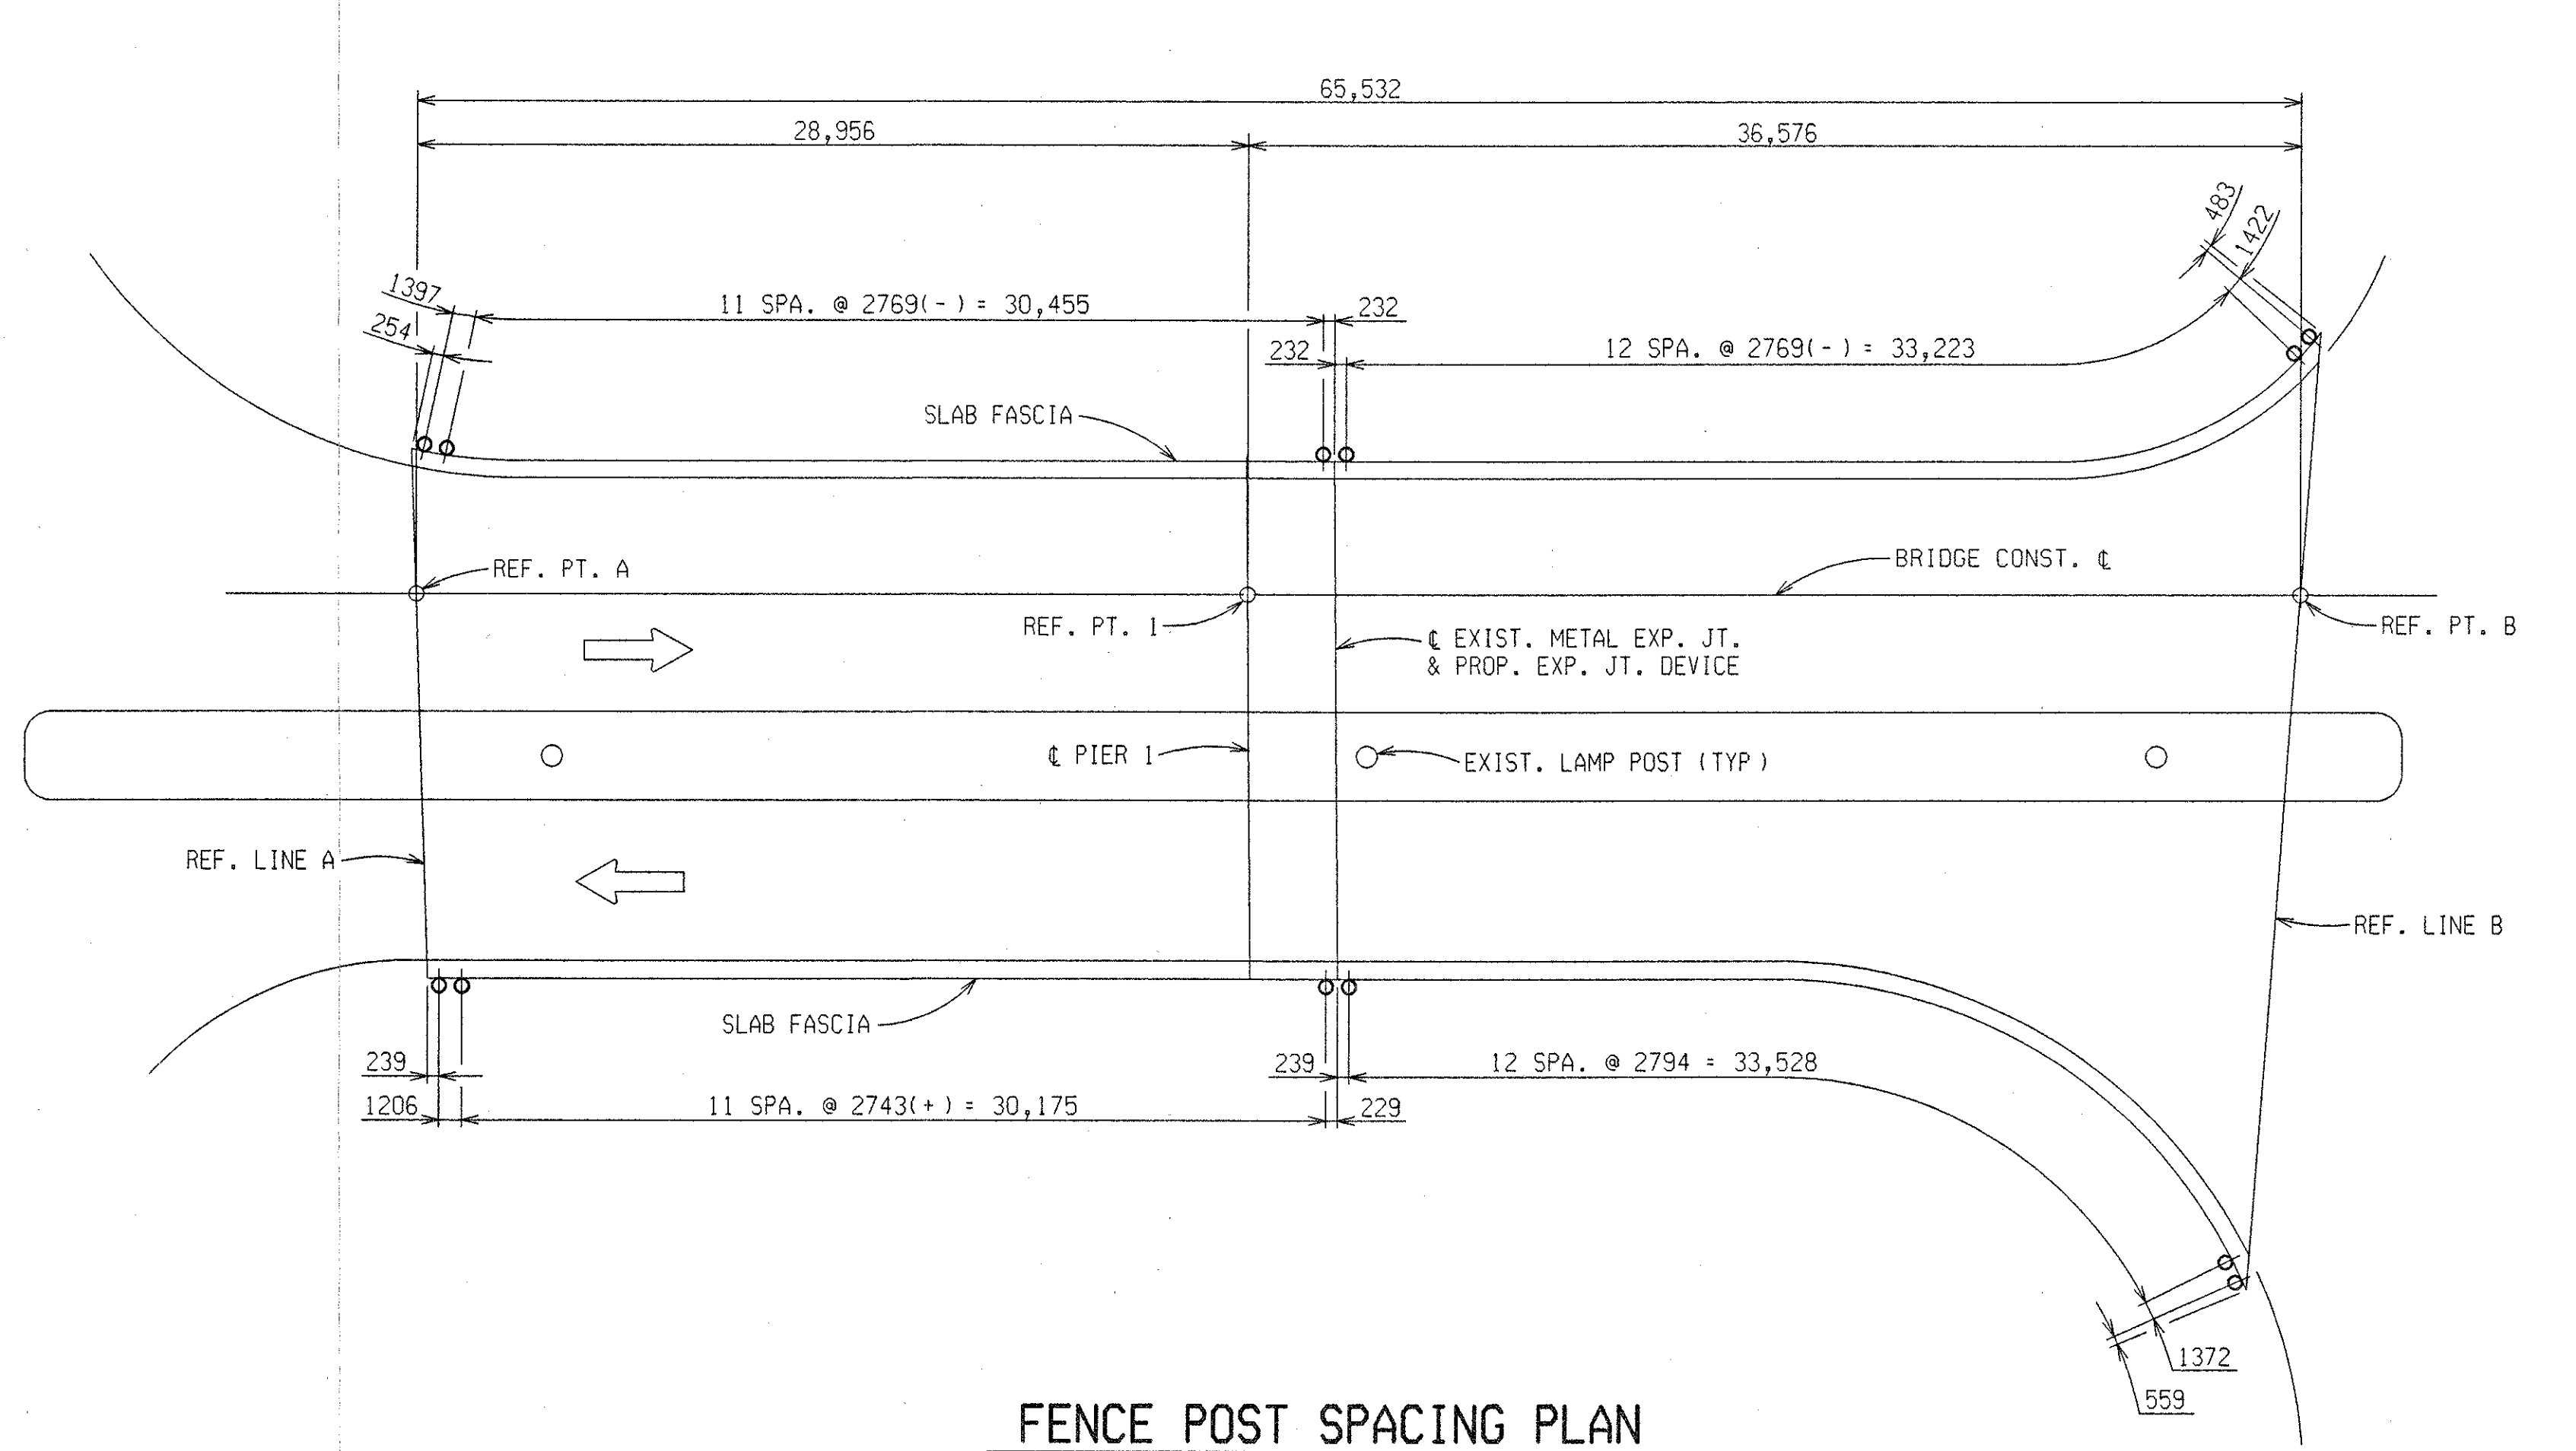

FENCE POST SPACING PLAN


THE EXISTING BRIDGE RAILING ON THIS STRUCTURE IS OPEN PARAPET TYPE.

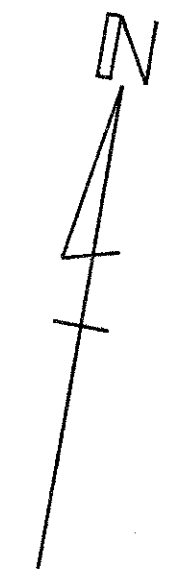

MISCELLANEOUS QUANTITIES		
322	m ²	Fencing, Structures
1	ea	Elec Grounding System

NOTES:


- ANY BRUSH OR OTHER VEGETATION WHICH MAY INTERFERE WITH THE INSTALLATION OF THE PROPOSED PEDESTRIAN FENCING SHALL BE REMOVED AS DIRECTED BY THE ENGINEER AND IS INCLUDED IN THE BID ITEM "FENCING, STRUCTURES".
- SIGNING MOUNTED ON BRIDGE FASCIAS SHALL BE LEFT IN PLACE DURING INSTALLATION OF PEDESTRIAN FENCING UNLESS OTHERWISE DIRECTED BY THE ENGINEER. FENCE POST SPACING MAY BE ADJUSTED (3050 MAX.) WITH THE APPROVAL OF THE ENGINEER TO FACILITATE INSTALLATION AND IS INCLUDED IN THE BID ITEM "FENCING, STRUCTURES".
- THE CONTRACTOR WILL BE FURNISHED WITH PLANS OF THE EXISTING STRUCTURE IF REQUESTED.
- THE CONTRACTOR SHALL VERIFY FIELD CONDITIONS BEFORE FABRICATING FENCE DETAILS.
- A STRAIGHT FENCE AS SHOWN IN THE STANDARD PLAN B-32A SHALL BE USED ON THIS STRUCTURE.
- GROUNDING CABLES AND TOPS OF GROUNDING RODS SHALL BE PLACED 300 mm MINIMUM BELOW FINISHED GROUND.
- CHAIN LINK FENCE FABRIC SHALL BE 50mm MESH.

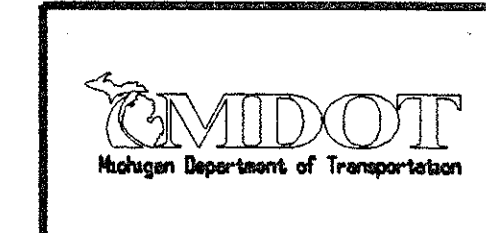

FENCING DEATILS				
DATE	CONT. SEC.	JOB NO.	DESIGN UNIT	SHEET
10-18-99	S04 OF 63103	48404A	MAHDAVI	24 OF 24

FILE NAME: s0463103.fe DRAWN BY: R. PRATT CHECKED BY: DATE: 9-22-99 CORRECTED BY: DATE:

1 2 3 4 5 6 7 8 9 10 11 12 13 14 15 16 17 18 19 20 21 22 23 24 25 26 27 28 29 30 31 32 33 34 35 36 37 38 39 40 41 42 43 44 45 46 47 48 49 50 51 52 53 54 55 56 57 58 59 60 61 62 63

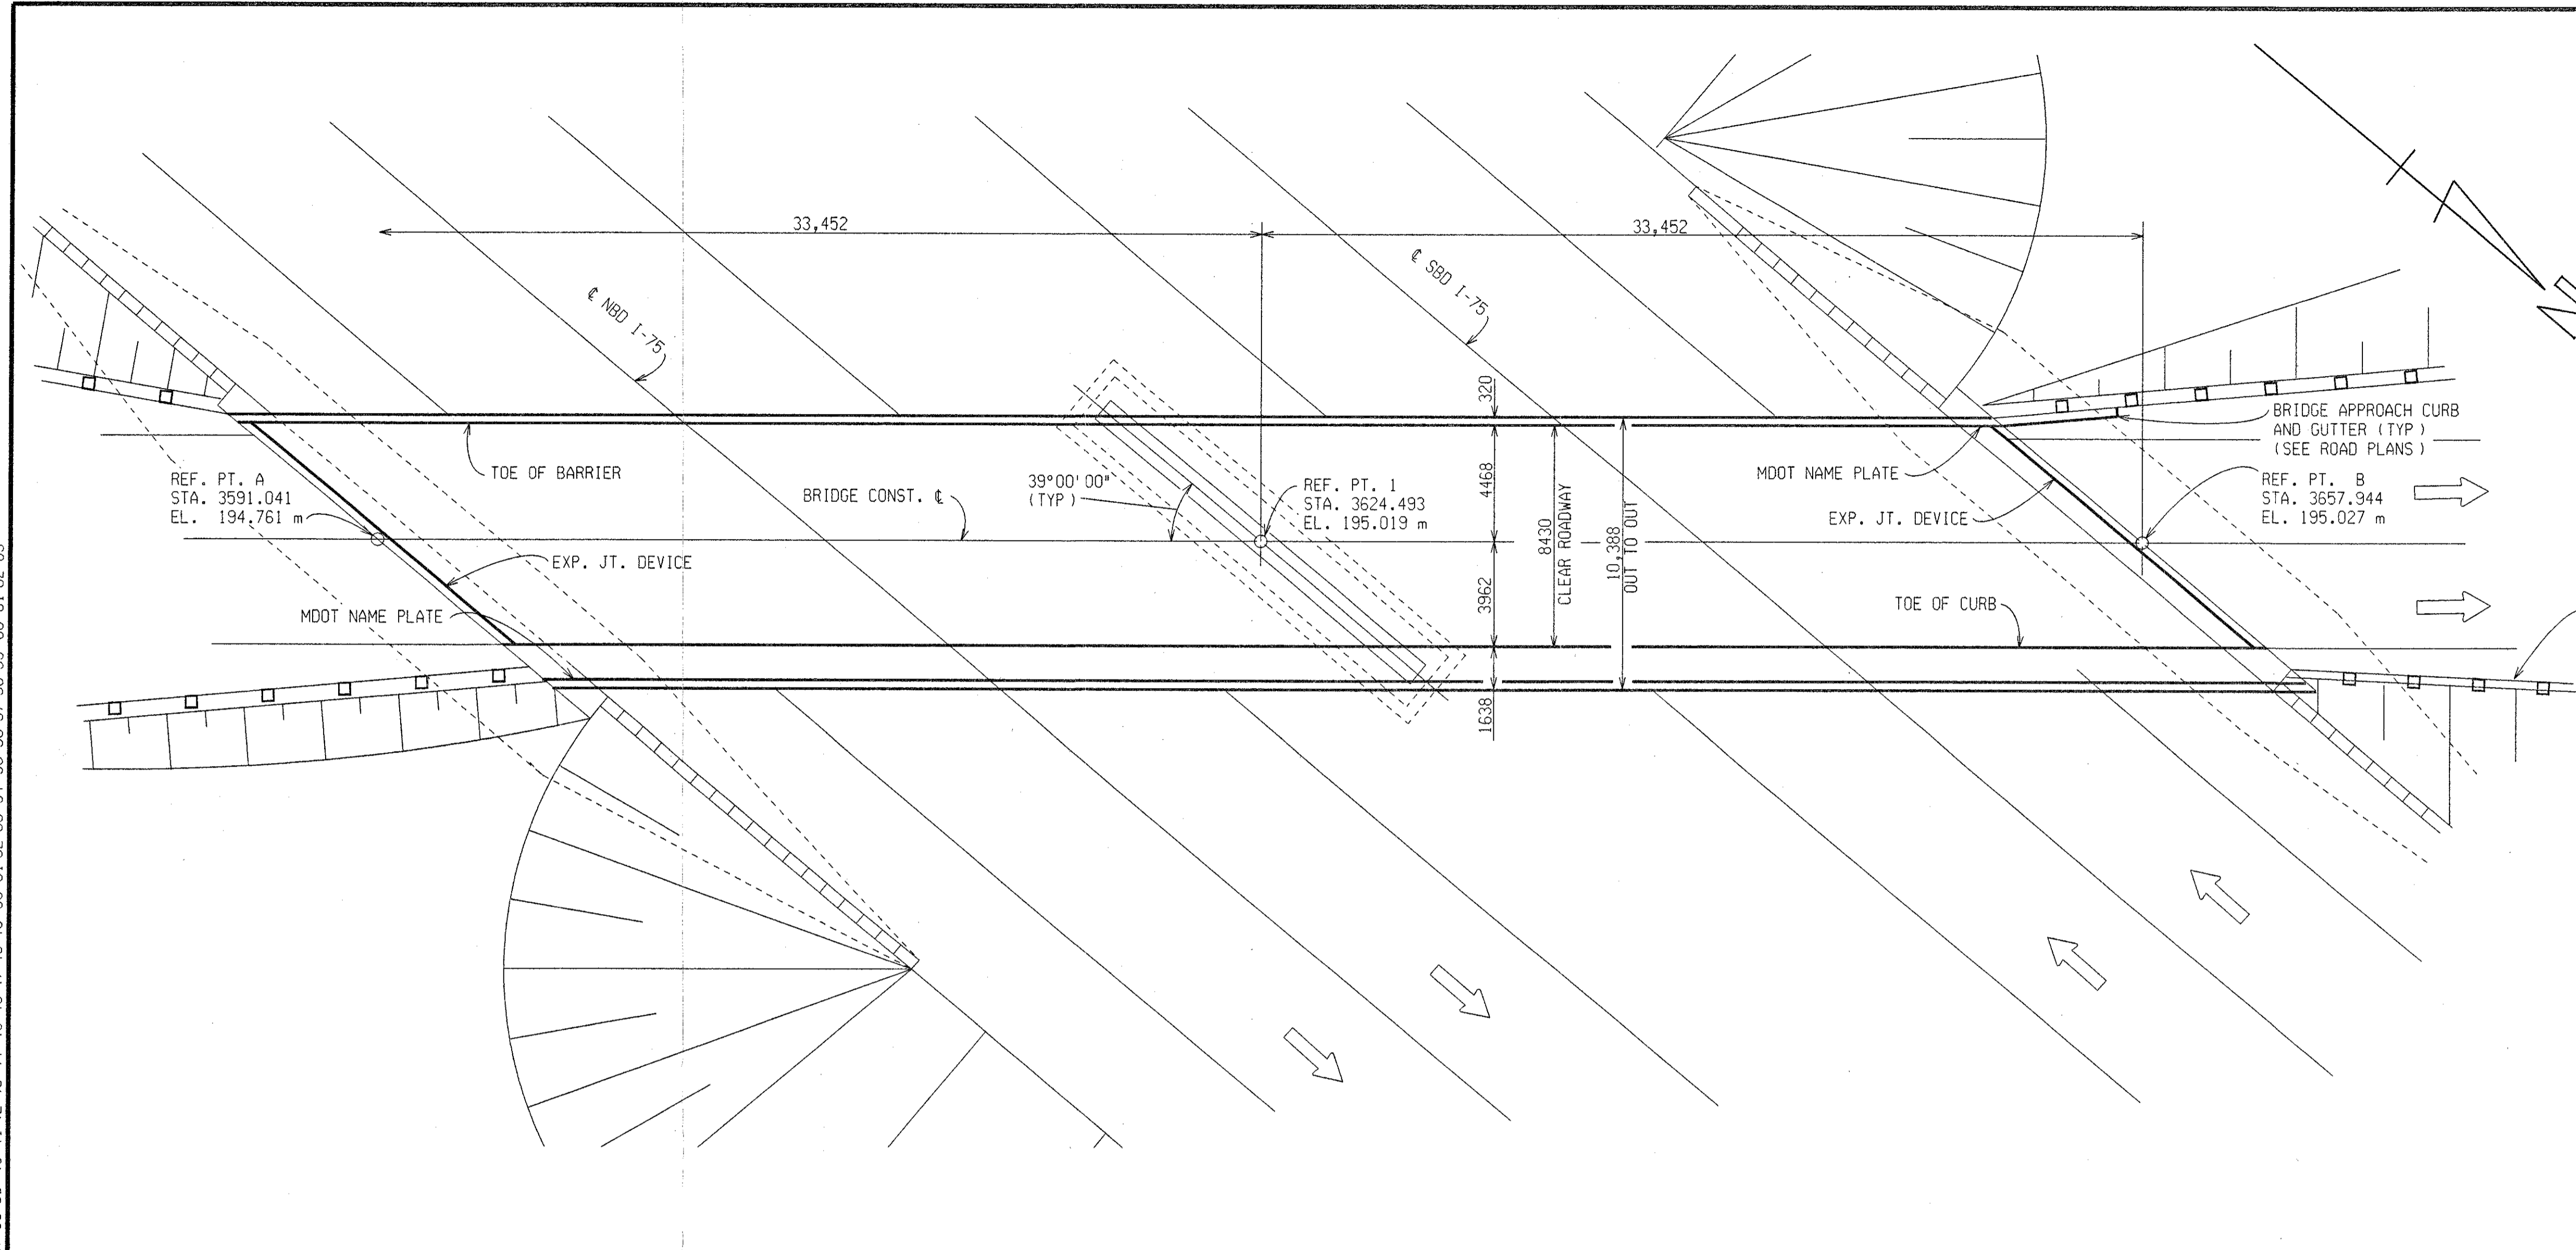

REVISIONS			
NO.	DESCRIPTION	DATE	BY

MISCELLANEOUS QUANTITIES	
1 LS	Structures, Rehabilitation, Rem Portions (S02)
* 5 m3	Hand Chipping, Other Than Deck
* 5 m3	Patching Conc. LM
* 50 m2	Patch, Forming
685 m2	False Decking
412 m2	Water Repellent Treatment

* TO BE USED FOR ABUTMENT REPAIRS AS DIRECTED BY THE ENGINEER

PLAN

THE LIMITS OF FALSE DECKING ARE BETWEEN THE FACES OF THE ABUTMENTS AND SLAB FASCIAS.

NOTES:

THE WORK COVERED BY THESE PLANS INCLUDES DECK REPLACEMENT, ABUTMENT REPAIR, PEDESTRIAN FENCING, AND MAINTAINING TRAFFIC. ALL OTHER WORK IS COVERED BY ROAD PLANS THAT ARE PART OF THIS CONTRACT.

THE REHABILITATION DESIGN IS BASED ON CURRENT AASHTO STANDARD SPECIFICATIONS FOR HIGHWAY BRIDGES MS18 LOADING. LIVE LOAD PLUS IMPACT DEFLECTION DOES NOT EXCEED 1/1000 OF SPAN LENGTH. THE WORKING STRESS METHOD WAS USED FOR THIS DESIGN. THE ORIGINAL STRUCTURE WAS DESIGNED FOR H20 LOADING.


N.B. SERVICE ROAD TRAFFIC IS TO BE DETOURED. I-75 TRAFFIC IS TO BE MAINTAINED BY PART-WIDTH CONSTRUCTION.

THE EXISTING TUBE RAILINGS SHALL BE SALVAGED AND STOCKPILED ON THE JOB SITE AS DIRECTED BY THE ENGINEER. INCLUDED IN THE PAY ITEM "STRUCTURES, REHABILITATION, REMOVE PORTIONS (S02)."

MEASURES SHALL BE TAKEN TO PREVENT DEBRIS FROM FALLING FROM THE STRUCTURE.

THE CONTRACTOR SHALL LOCATE ALL ACTIVE UNDERGROUND UTILITIES PRIOR TO STARTING WORK AND SHALL CONDUCT HIS OPERATIONS IN SUCH A MANNER AS TO ENSURE THAT THOSE UTILITIES NOT REQUIRING RELOCATION WILL NOT BE DISTURBED.

PENETRATING WATER REPELLENT TREATMENT SHALL BE APPLIED TO THE TOP OF ABUTMENTS AND FRONT FACE OF THE INDEPENDENT BACKWALL.

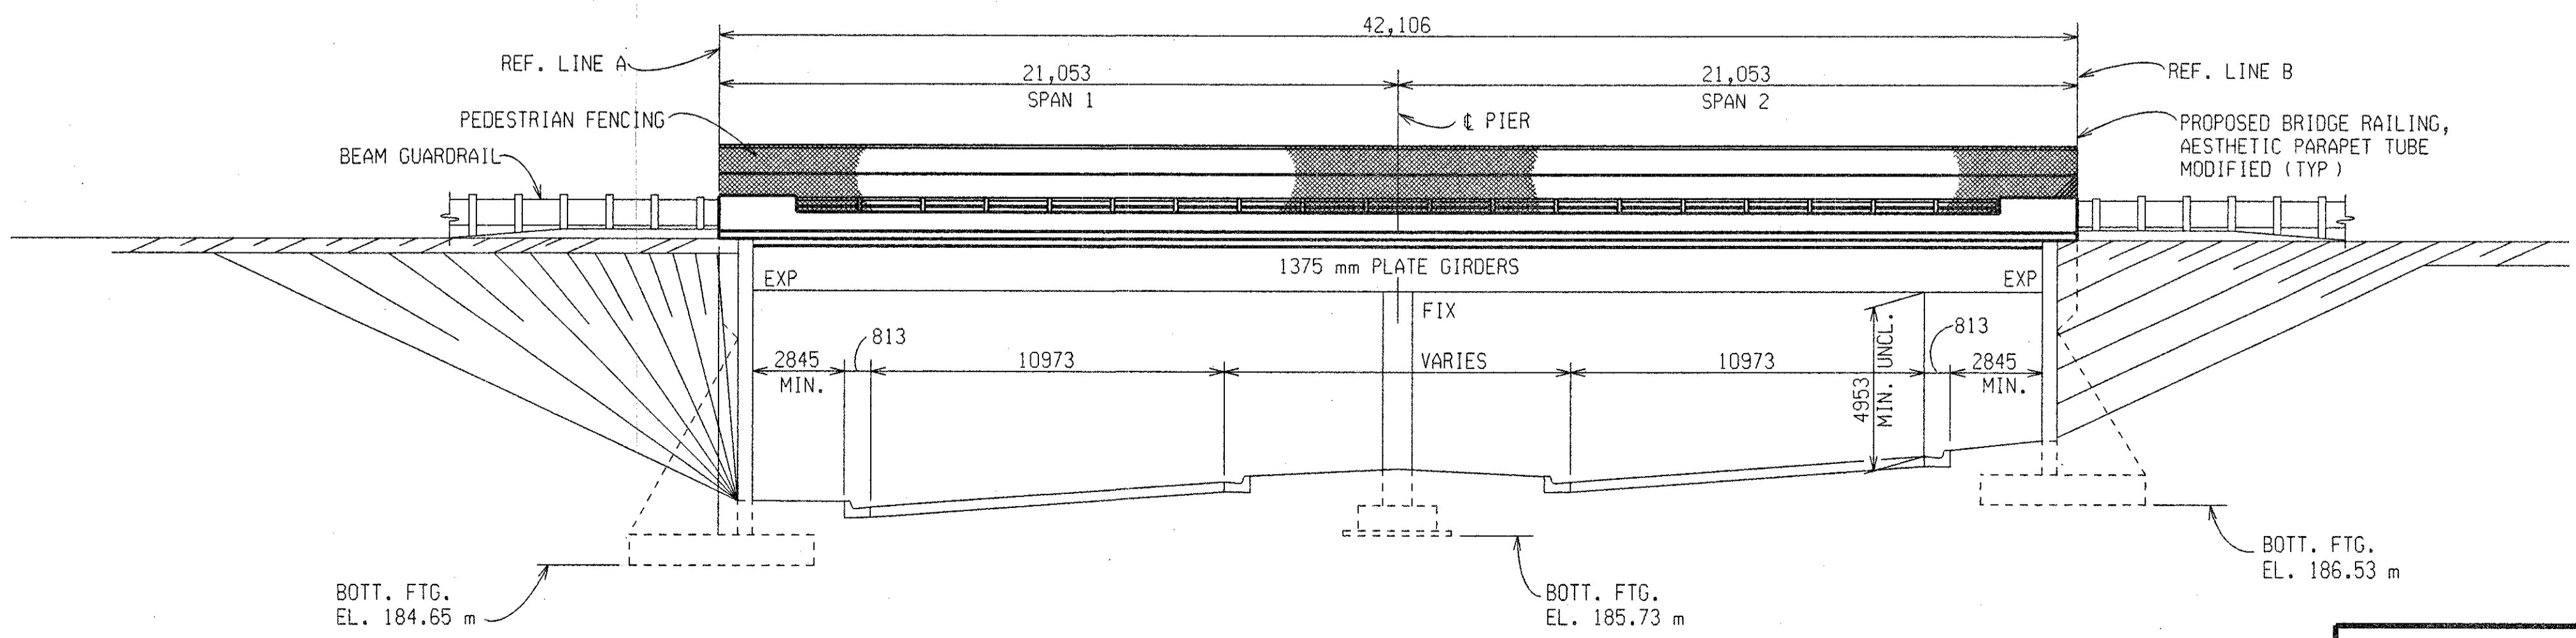

ELEVATION

SHOWN 1 TO SUBSTRUCTURE UNITS

APPROVED *Steven P. Beck* 10/19/99
DESIGN SUPERVISING ENGINEER




GENERAL PLAN OF STRUCTURE				
I-75 UNDER NB SERVICE RD.				
DATE	CONT. SEC.	JOB NO.	DESIGN UNIT	SHEET
10-13-99	S02 OF 63174	48404	MAHDAVI	2 OF 29


DATE: 10-13-99
CORRECTED BY: SHAFER
DATE:
CHECKED BY: MIKUCKI
DATE: 2-8-99
DRAWN BY: SHAFER
FILE NAME: S0263174.S11

1 2 3 4 5 6 7 8 9 10 11 12 13 14 15 16 17 18 19 20 21 22 23 24 25 26 27 28 29 30 31 32 33 34 35 36 37 38 39 40 41 42 43 44 45 46 47 48 49 50 51 52 53 54 55 56 57 58 59 60 61 62 63

REVISIONS			
NO.	DESCRIPTION	DATE	BY

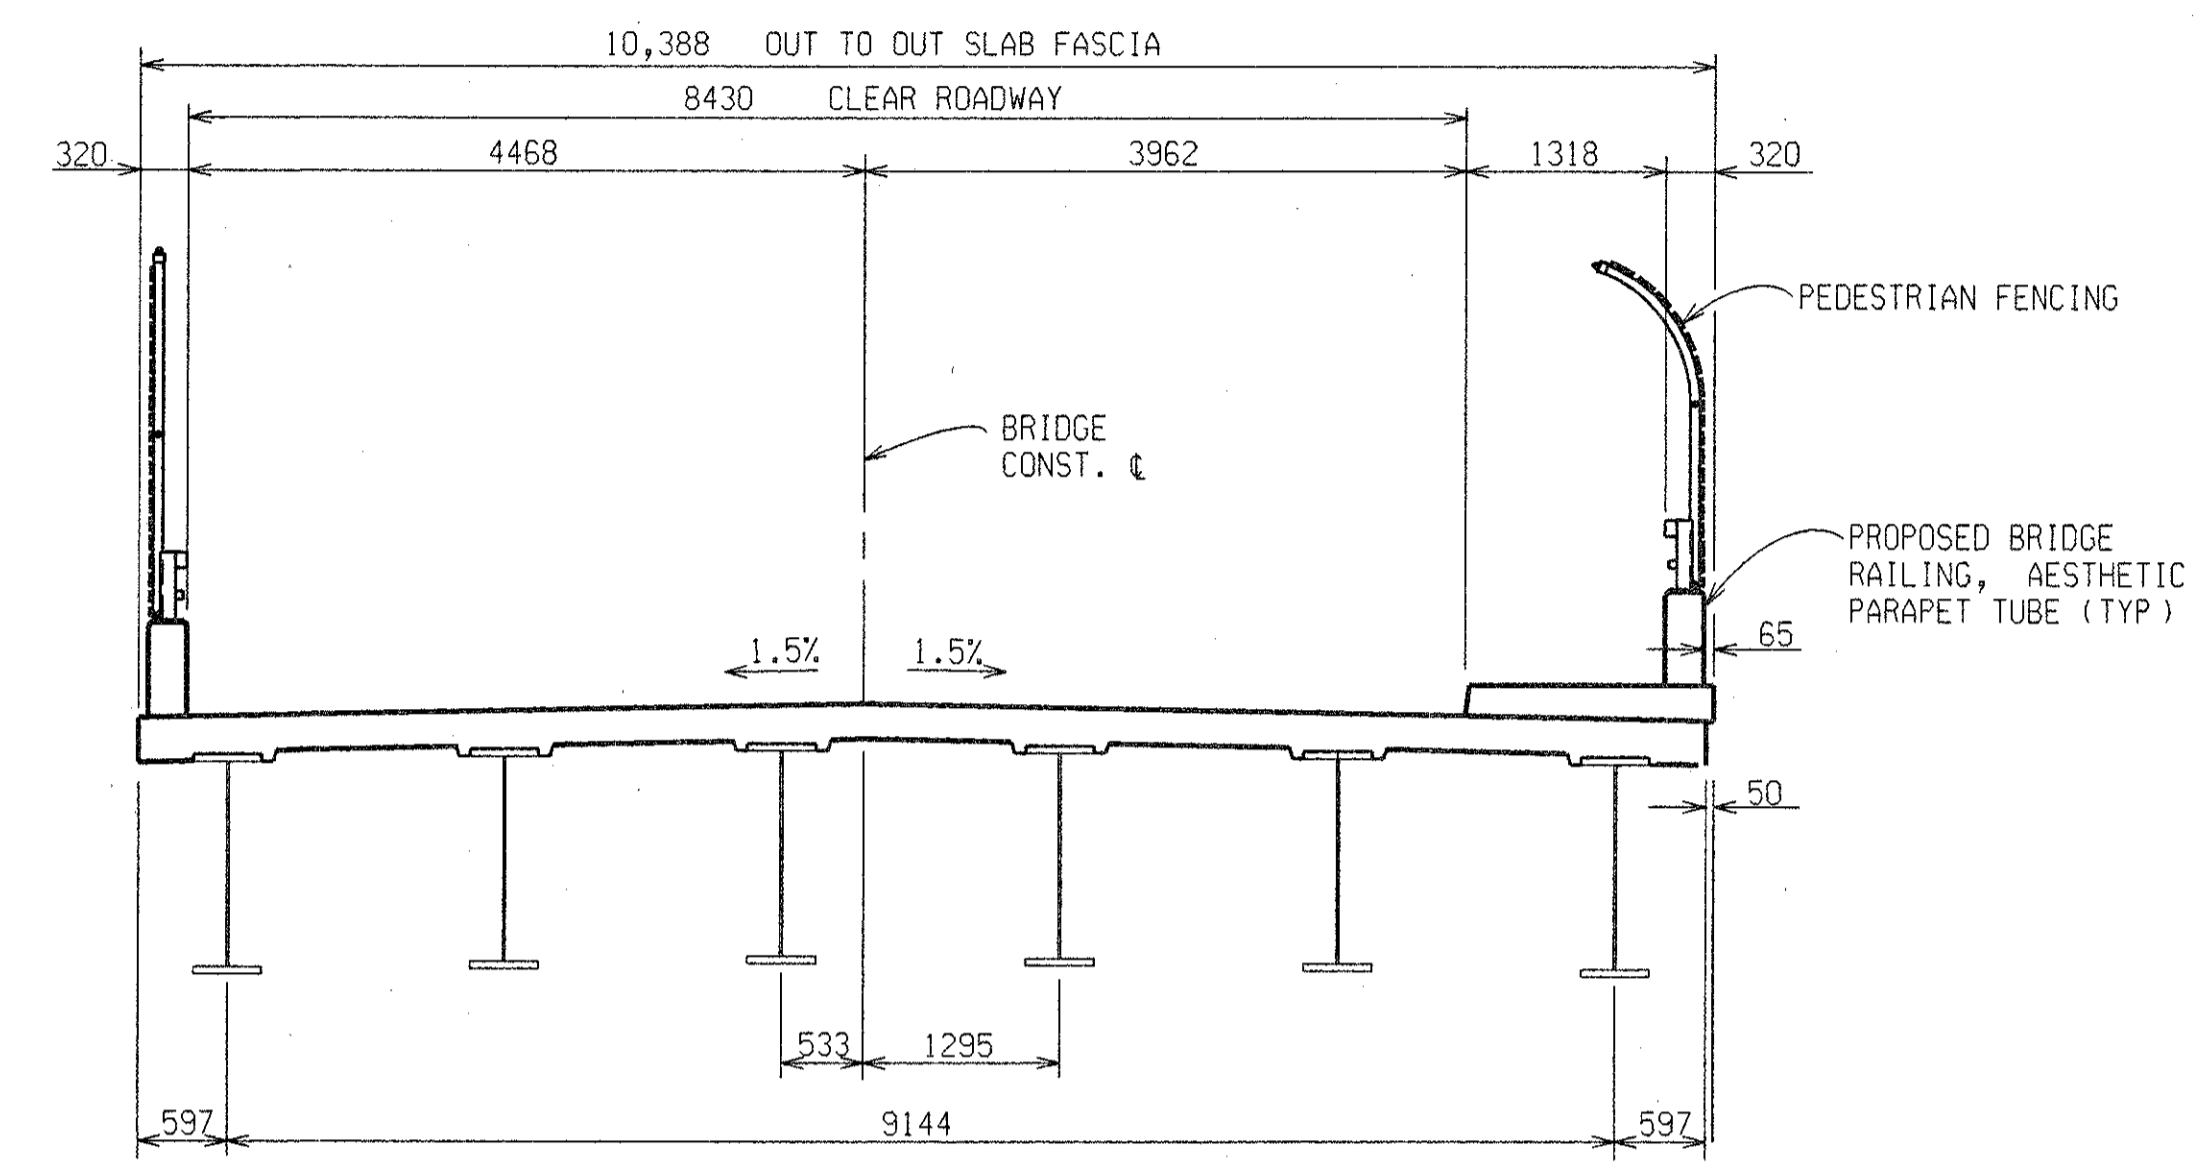

TYPICAL DECK SECTION

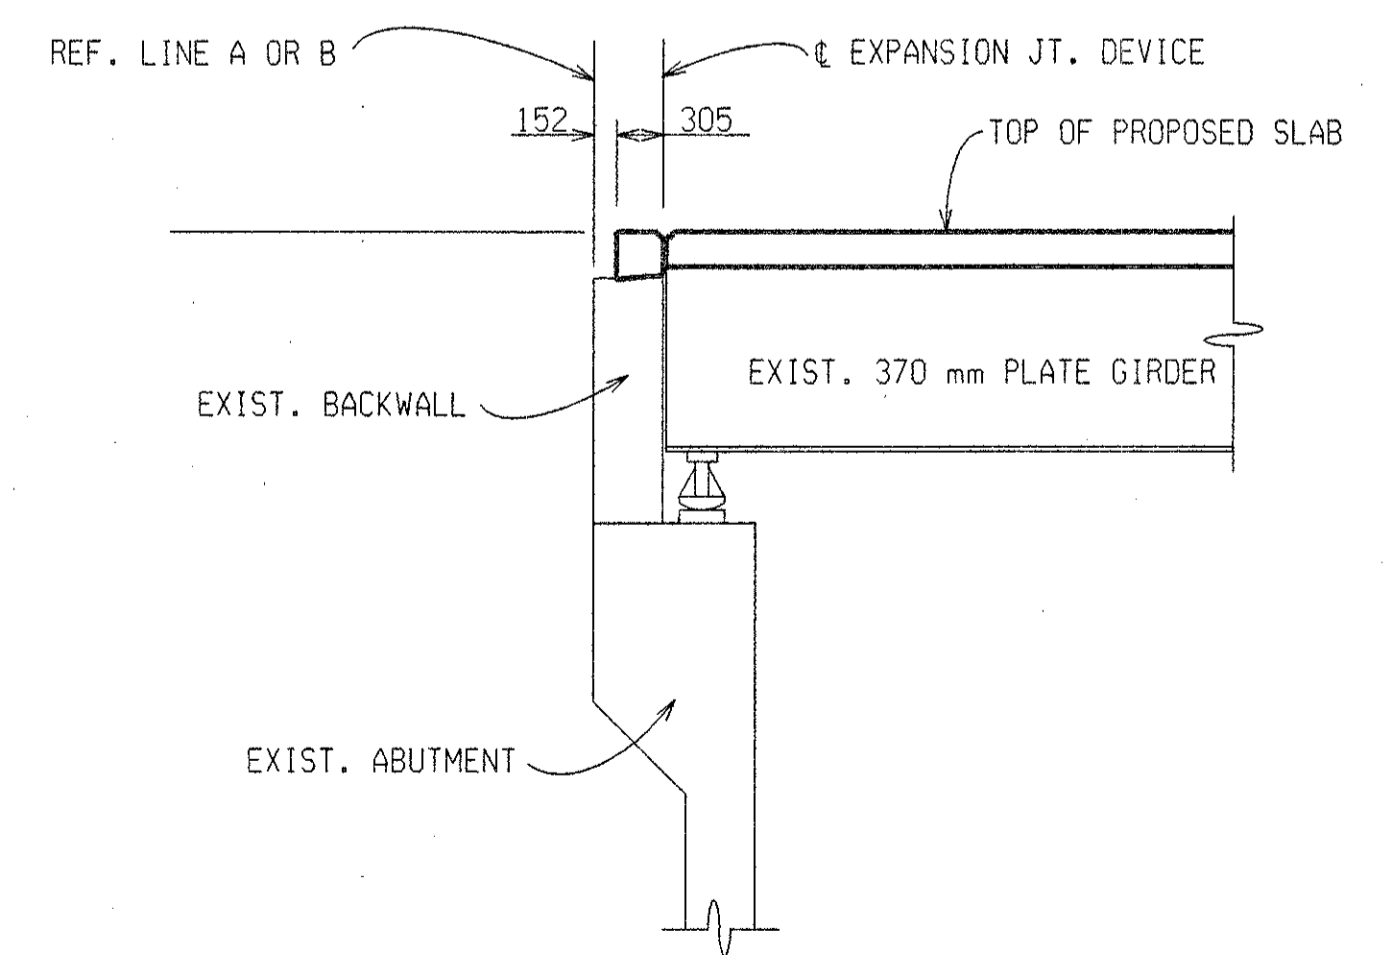

SECTION THRU ABUTMENT

APPROVED _____
DESIGN SUPERVISING ENGINEER



GENERAL PLAN OF STRUCTURE				
I-75 UNDER NB SERVICE RD.				
DATE	CONT. SEC.	JOB NO.	DESIGN UNIT	SHEET
7-23-99	S02 OF 63174	48404	MAHDAVI	3 OF 29

FILE NAME: S0263174.ST1 DRAWN BY: SHAFFER CHECKED BY: MIKUCKI DATE: 2-8-99 CORRECTED BY: SHAFFER DATE: 7-23-99

BENCH MARKS

B.M. #76 El. 637.52 M.S.H.D. B.M. Top in base of 12" x 12" x 179" L.A. of 892' + 80 N.B. Edwy.
B.M. #73 El. 638.77 M.S.H.D. B.M. Top in base of 23" x 23" x 248" L.A. of 902' + 37 N.B. Rdwy.


UTILITIES

City of Royal Oak Combined Sewer 30" dia. crosses E. approach of Sta. 900+10.
City of Royal Oak Combined Sewer 12"-15" dia. 120' RT of E. N.B. between Forest and Gardenia Aves.
Detroit Edison Co. Power Line 3 Wires crosses E. 36' South of E. of Gardenia Ave.
Detroit Edison Co. Power Line 3 Wires crosses E. 36' North of E. of Gardenia Ave.
Mich. Bell Telephone Co. Telephone Cable crosses E. 36' North of E. of Gardenia Ave.
Detroit Edison Co. Power Line, N. & S. along East edge of Stephenson R.O.W.


CURVE DATA

S.B. CONST.	N.B. CONST.	E.N.B. SERVICE RD. & N.B. SERVICE RD.
A = 29°59'53"	29°59'53"	26°23'18" Lt
D = 2°52'35"	3°00'00"	26°20'46" Rt
R = 1991.86'	1909.86'	180.00'
T = 333.68'	311.71'	42.20'
L = 1042.87'	999.94'	82.90'
E = 70.26'	67.36'	4.81'
P.C. = 899+80.93	899+46.29	116+87.51
P.T. = 903+14.49	904+159.00	117+23.77
RT. = 910+23.80	903+46.23	117+72.41
S.E. = 0.06 VFT	0.06 VFT	121+47.51
		122+46.84
		123+42.57


SECTION 14
TIN RIE
ROYAL OAK TWP.

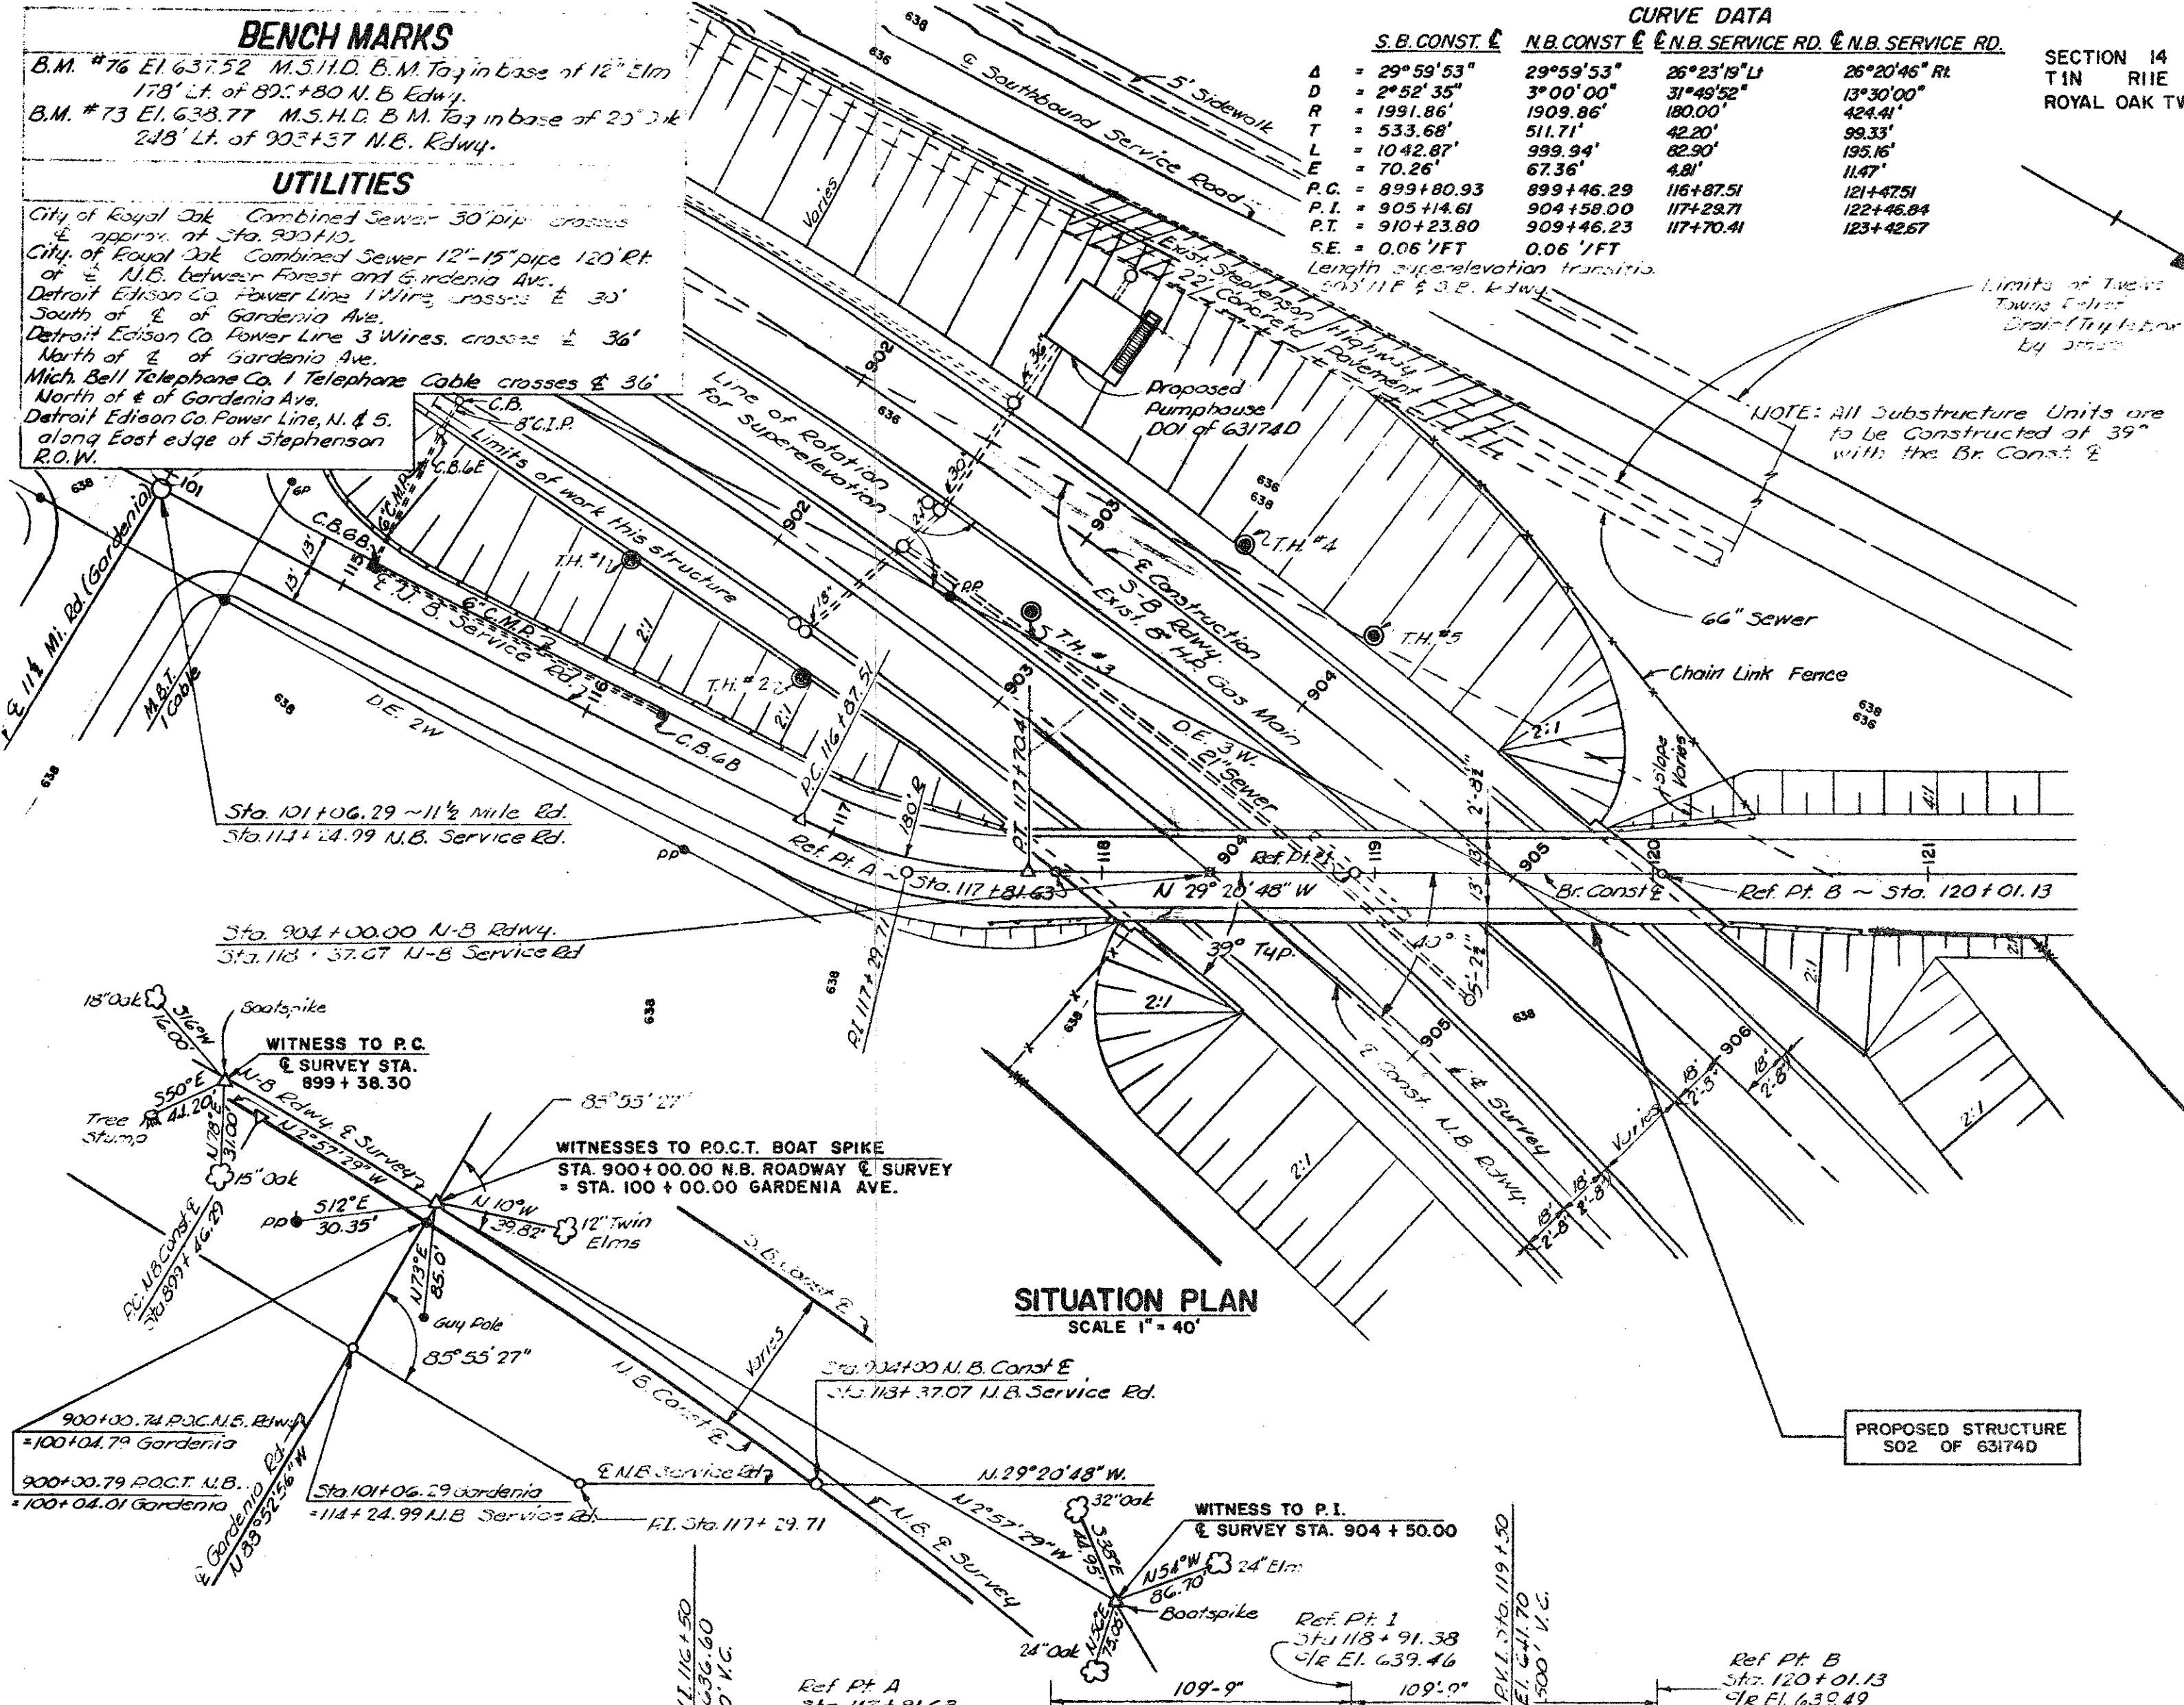

SITUATION PLAN
SCALE 1" = 40'



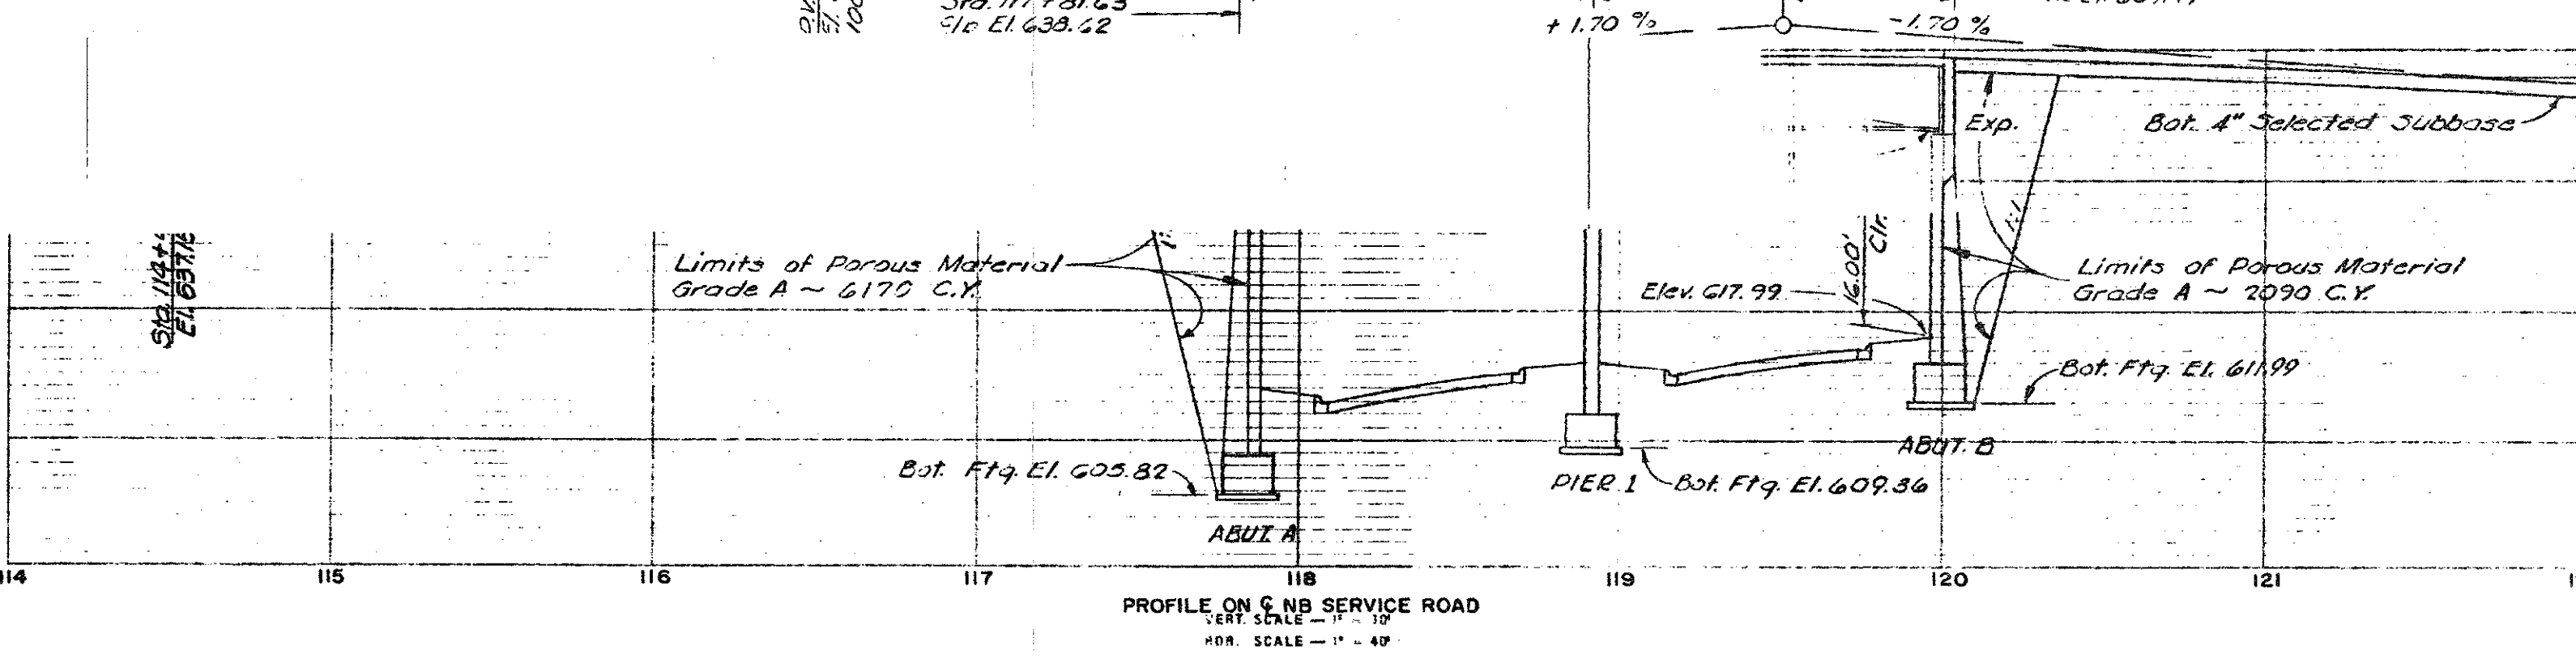


PROFILE ON E.N.B. SERVICE ROAD
VERT. SCALE - 1" = 10'
HOR. SCALE - 1" = 40'

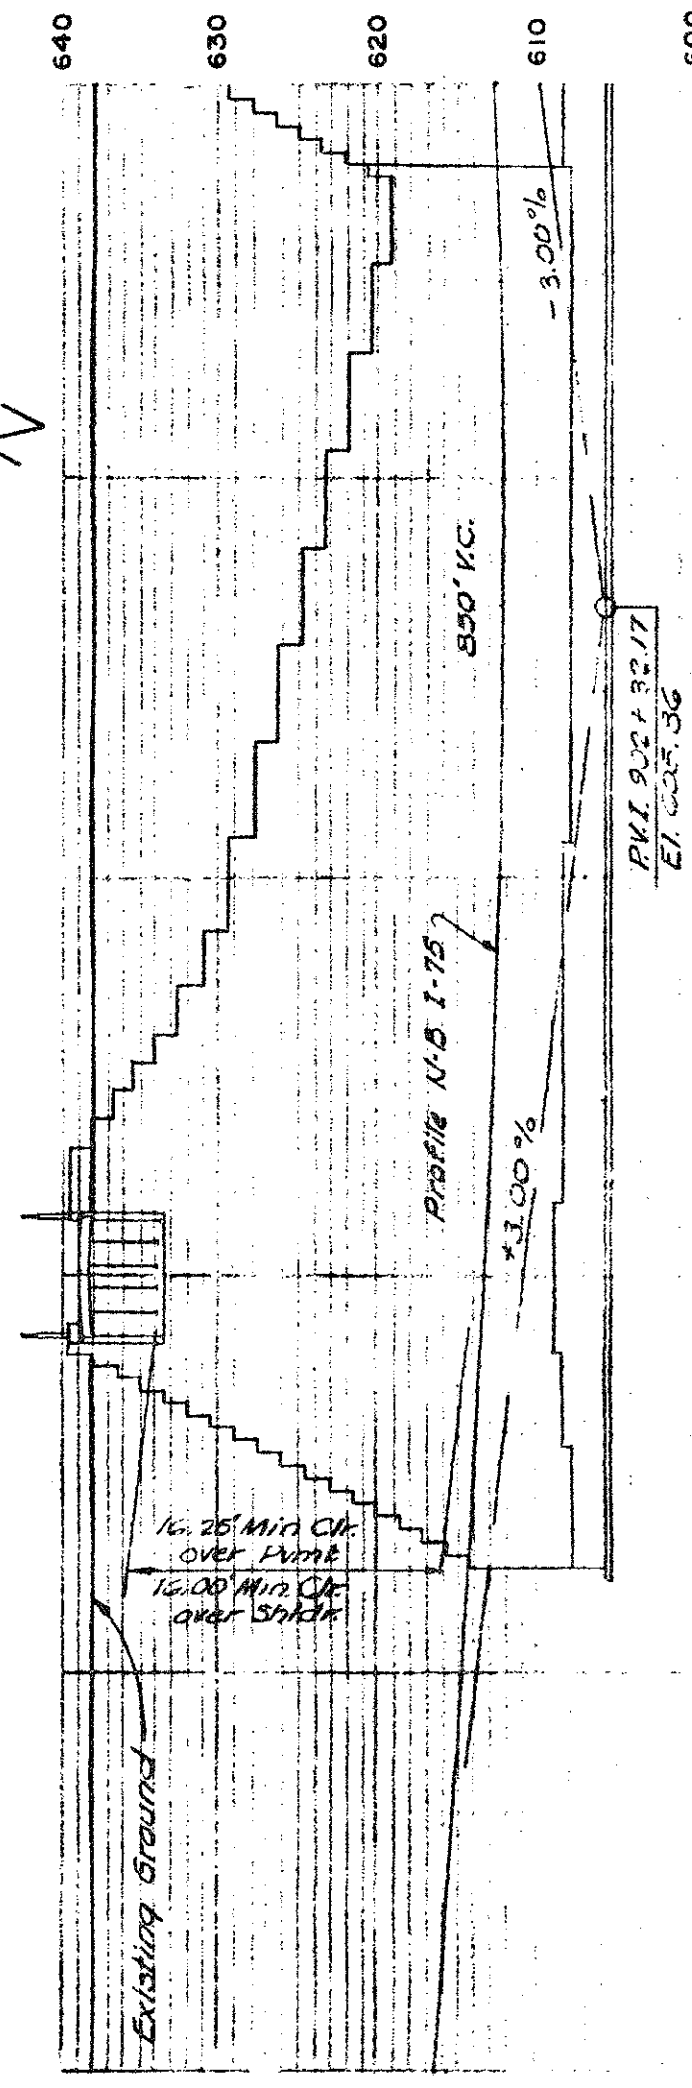

GENERAL NOTES

Fences & utilities are to be removed by others. Buildings are to be removed by others. Datum refers to U.S.C.S. Datum. See Sketch above for Details. The contractor shall locate underground utilities prior to starting work and shall protect them in such a manner as to insure that they will not be disturbed. The work covered by these plans includes construction of the proposed bridge & placing porous material to the limits shown. All work not listed above is included in the Road Plans.

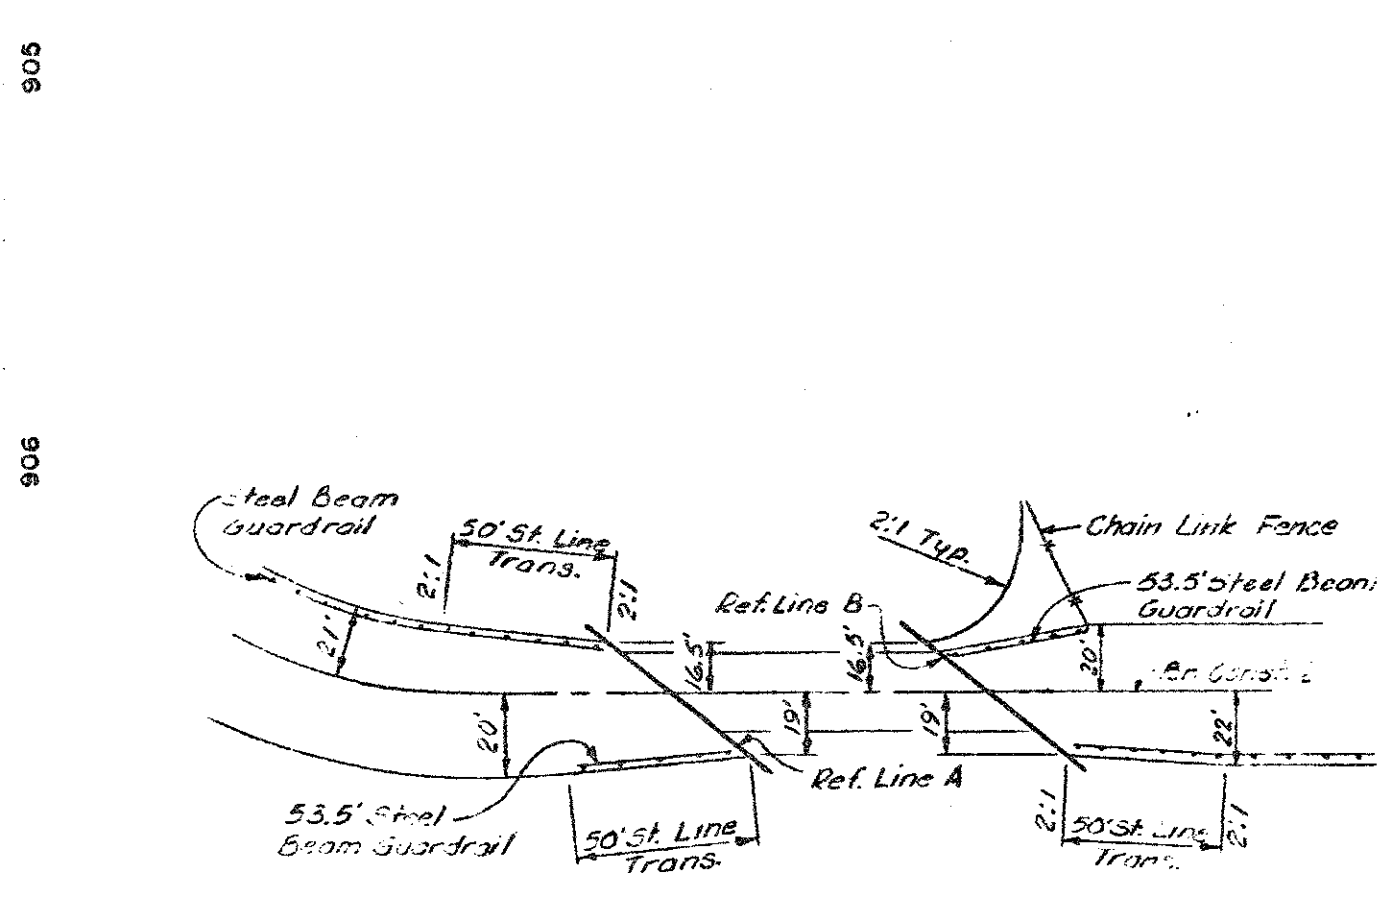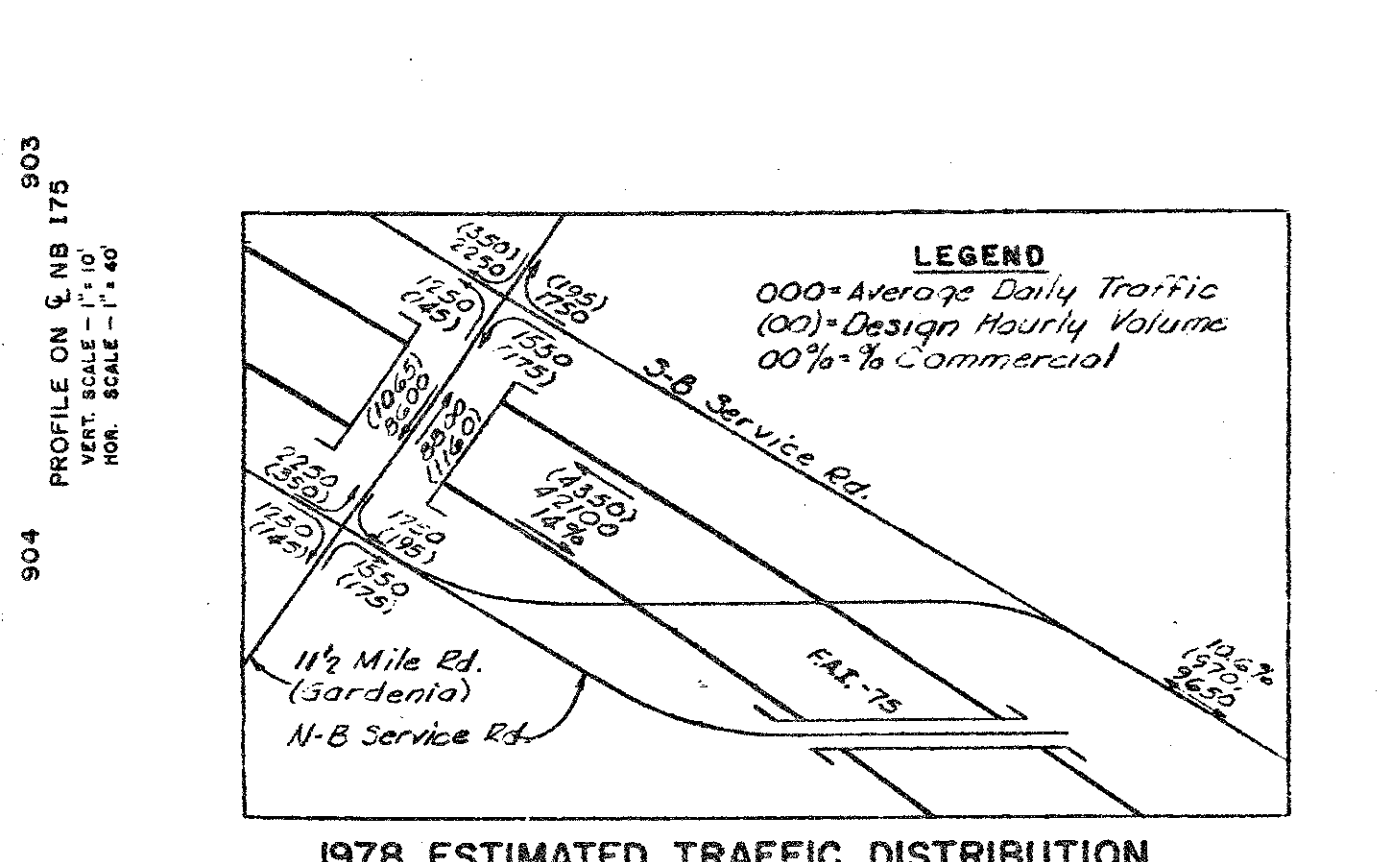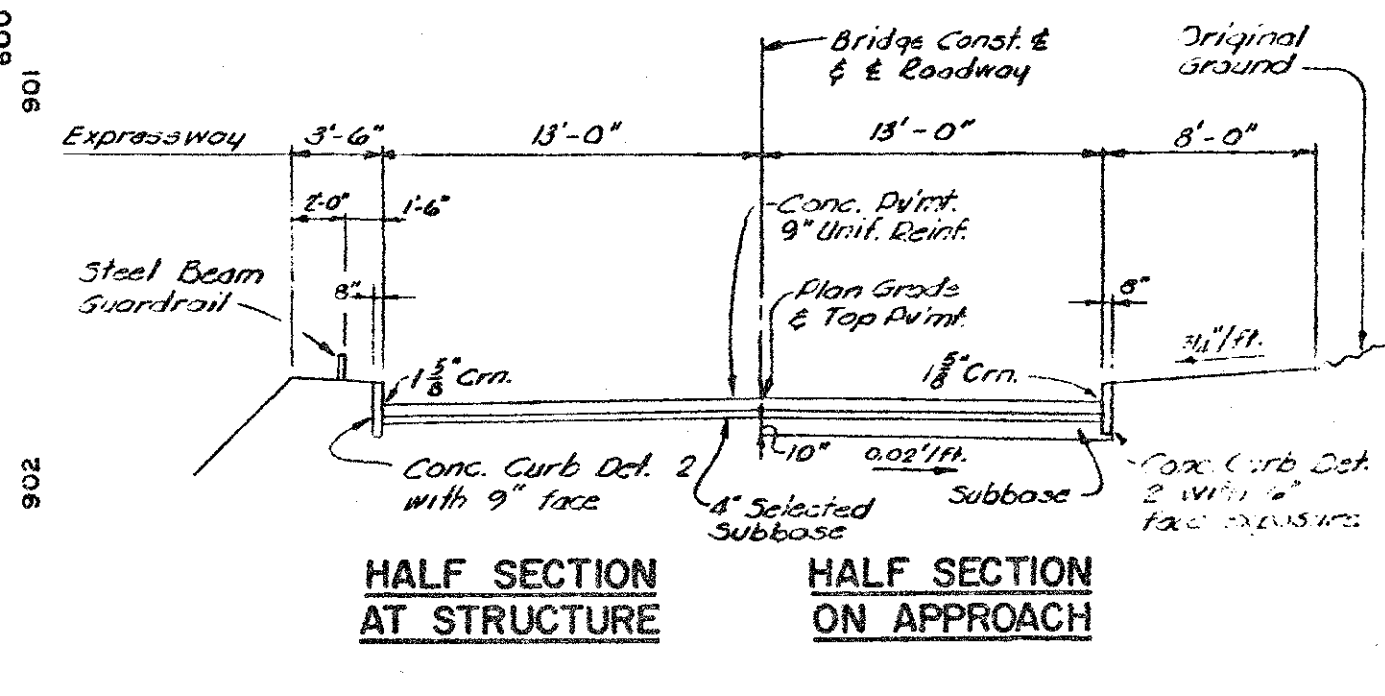

CONTROL SECTION 63174D

MICHIGAN STATE HIGHWAY DEPARTMENT

NORTHBOUND SERVICE ROAD OVER 175 IN THE CITY OF ROYAL OAK

GENERAL PLAN OF SITE

TECON ENGINEERS, INC.

APPROVED: [Signature] G.R.O.
COORDINATING ENGINEER
APPROVED: [Signature] R.A.D. 9-1-62
ENGINEER OF DESIGN-CONSULTANTS 119 312

S02 OF 63174D

REVISIONS			
NO.	DESCRIPTION	DATE	BY


NOTE:
DO NOT WORK FROM THIS SHEET. THE INFORMATION SHOWN HERE IS FOR REFERENCE ONLY. NO PAY ITEMS ARE SHOWN.



FOR INFORMATION ONLY				
DATE	CONT. SEC.	JOB NO.	DESIGN UNIT	SHEET
10-13-99	S02 OF 63174	48404A	MADHAVI	4 OF 29



DATE: _____ CHECKED BY: _____ DATE: _____ CORRECTED BY: _____ DATE: _____ DRAWN BY: inder FILE NAME: s0263174.dwg

2 3 4 5 6 7 8 9 10 11 12 13 14 15 16 17 18 19 20 21 22 23 24 25 26 27 28 29 30 31 32 33 34 35 36 37 38 39 40 41 42 43 44 45 46 47 48 49 50 51 52 53 54 55 56 57 58 59 60 61 62 63

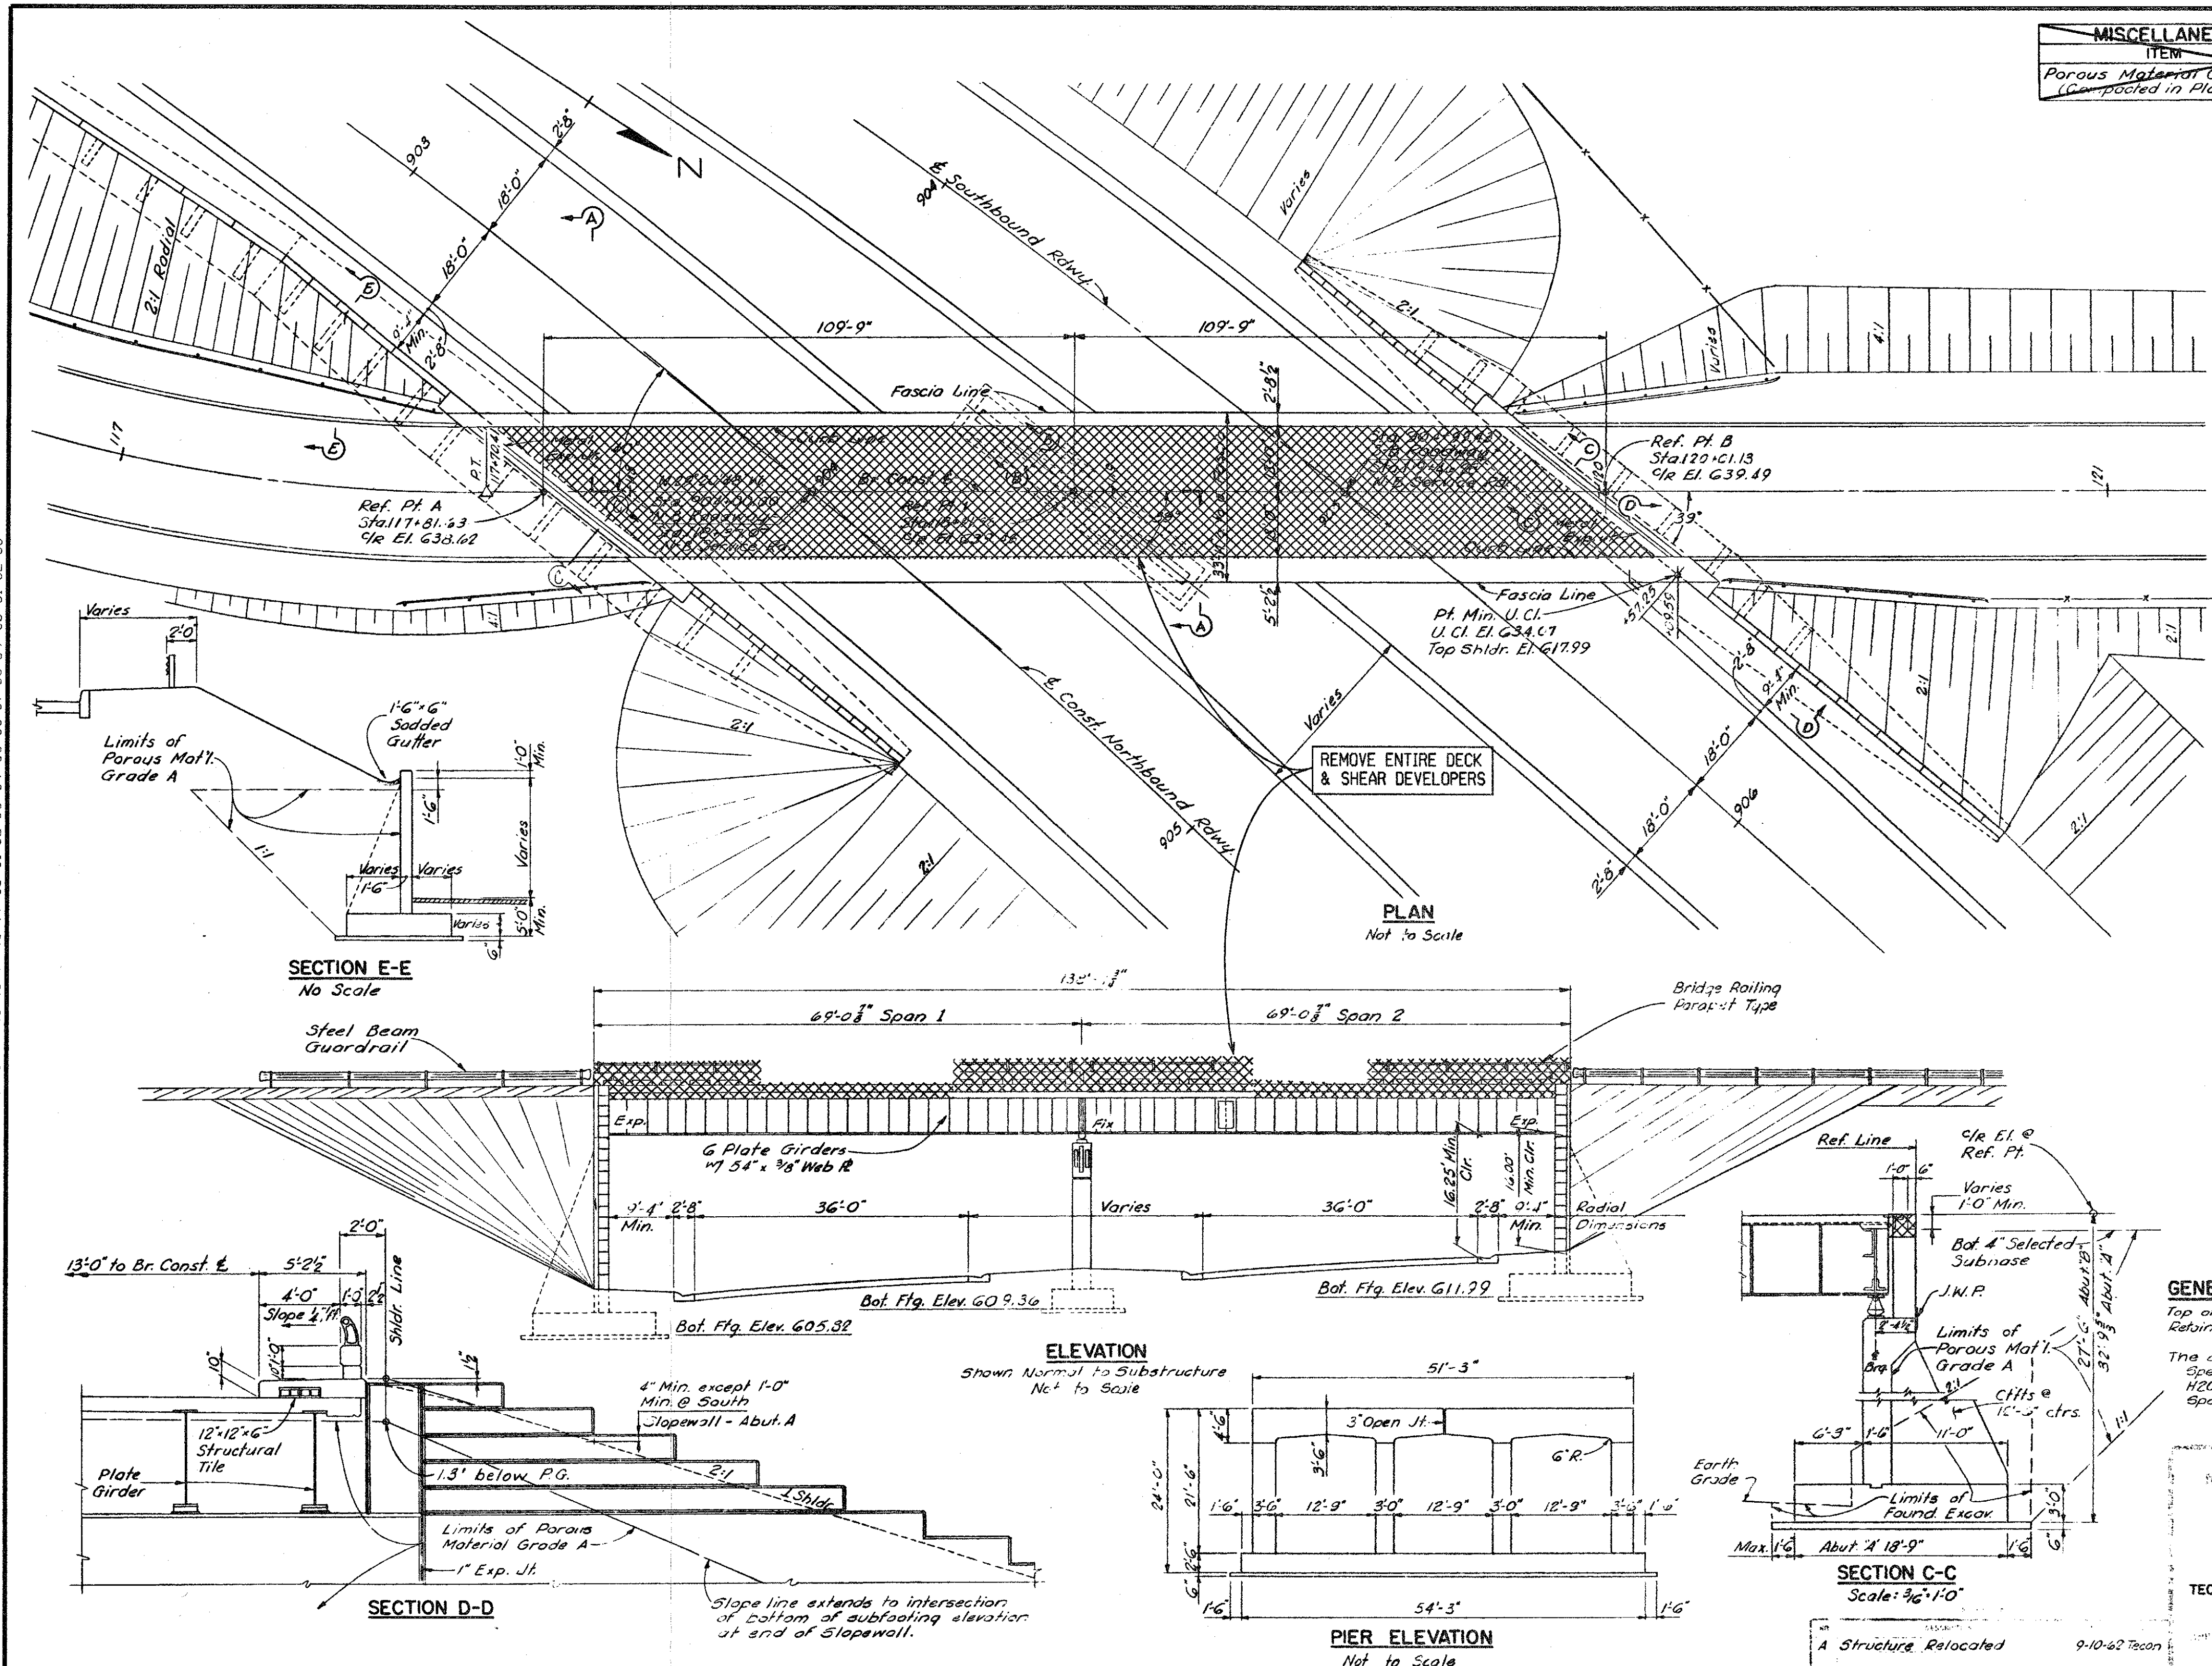

MISCELLANEOUS QUANTITIES		
ITEM	UNITS	AMOUNT
Porous Material Grade A (Compacted in Place)	Cu. Yds.	2260

REVISIONS			
NO.	DESCRIPTION	DATE	BY

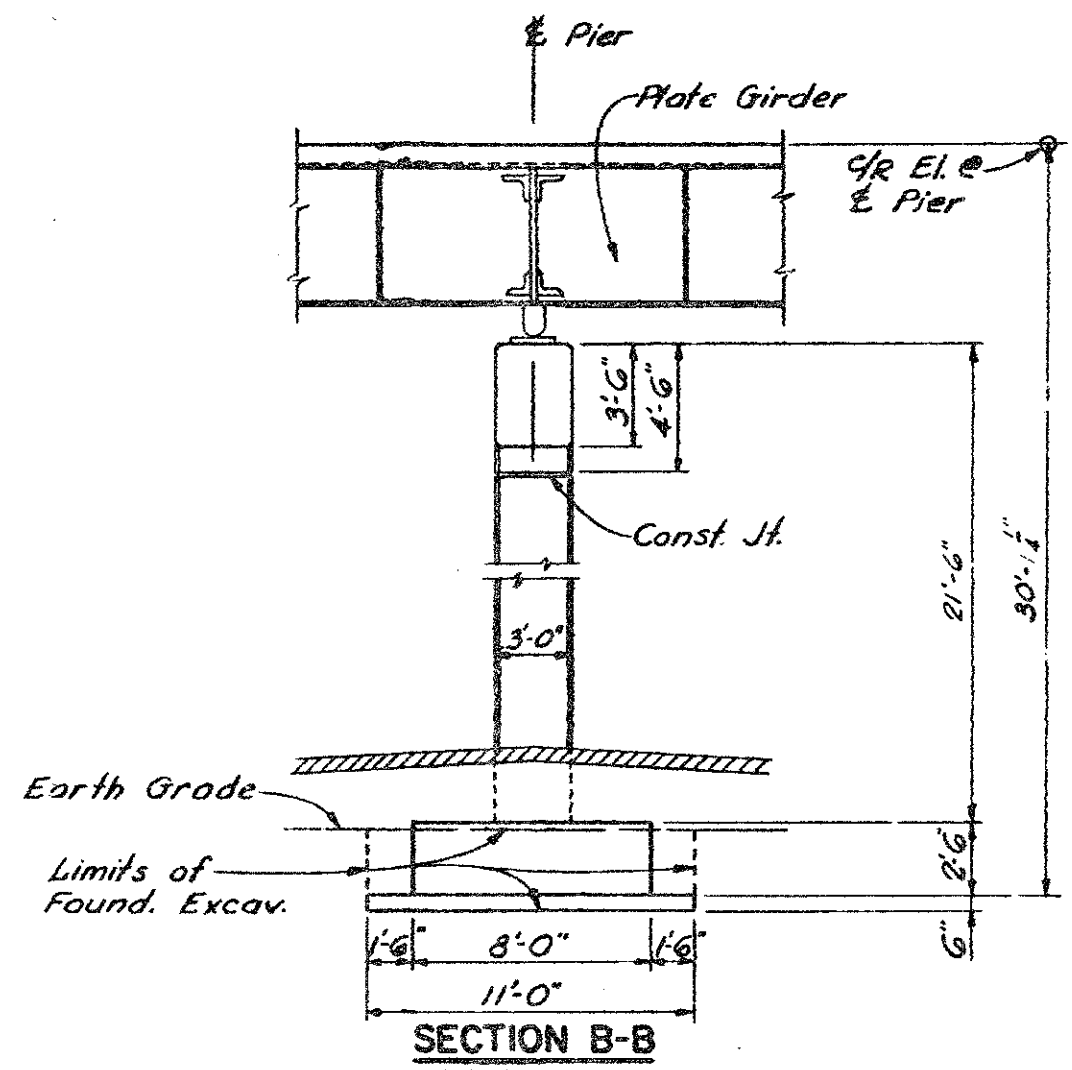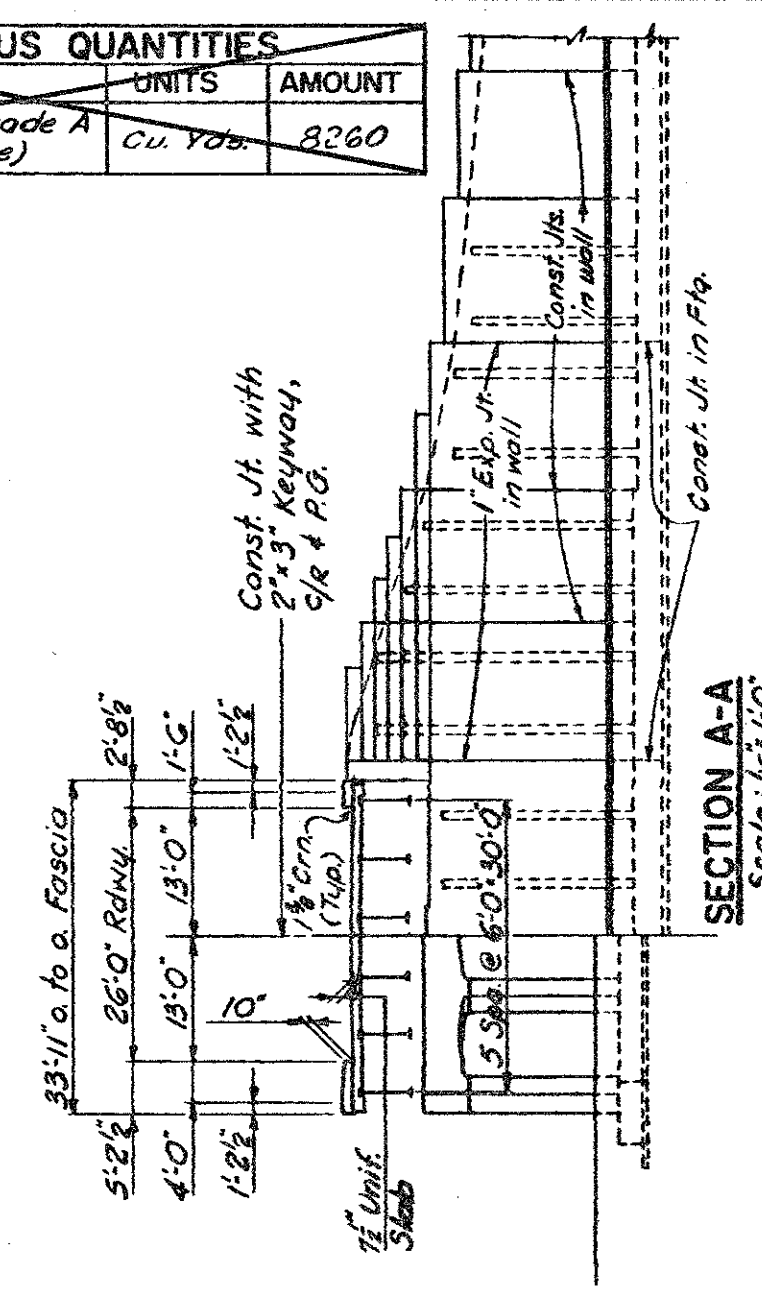

GENERAL NOTES
 Top of roadway slab and tops of curbs are parallel to the vertical curve. Retaining wall and integral catch basin are a part of this contract.
 The design of this structure is based on the M.S.H.D. Standard Specifications for the Design of Highway Bridges - 1958 Edition H20-44 Loading. Live Load plus impact deflection = 1/800 of span length.

CONTROL SECTION 63174D

MICHIGAN STATE HIGHWAY DEPARTMENT
 NORTHBOUND SERVICE ROAD OVER I-75 IN CITY OF ROYAL OAK

GENERAL PLAN OF STRUCTURE

TECON ENGINEERS, INC.
 J.V. Murray 6-5-22
 COORDINATING ENGINEER

DATE: 9-10-62
 PROJECT: A Structure Relocated

DATE: 6-5-22
 PROJECT: S02 OF 63174D

THE ONLY ITEMS OF WORK TO BE DONE FROM THIS SHEET ARE IDENTIFIED BY THE LEGEND BOX BELOW, LABELED WITH THIS PROJECT'S JOB NUMBER.


JOB NO. 48404A

DENOTES REMOVAL PORTIONS
 PROPOSED WORK




REMOVAL PORTIONS				
DATE	CONT. SEC.	JOB NO.	DESIGN UNIT	SHEET
10-13-99	S02 OF 63174	48404A	MADHAVI	5 OF 29


DRAWN BY: mder DATE: 9-10-62 CHECKED BY: DATE: 10-13-99 CORRECTED BY: DATE: 10-13-99

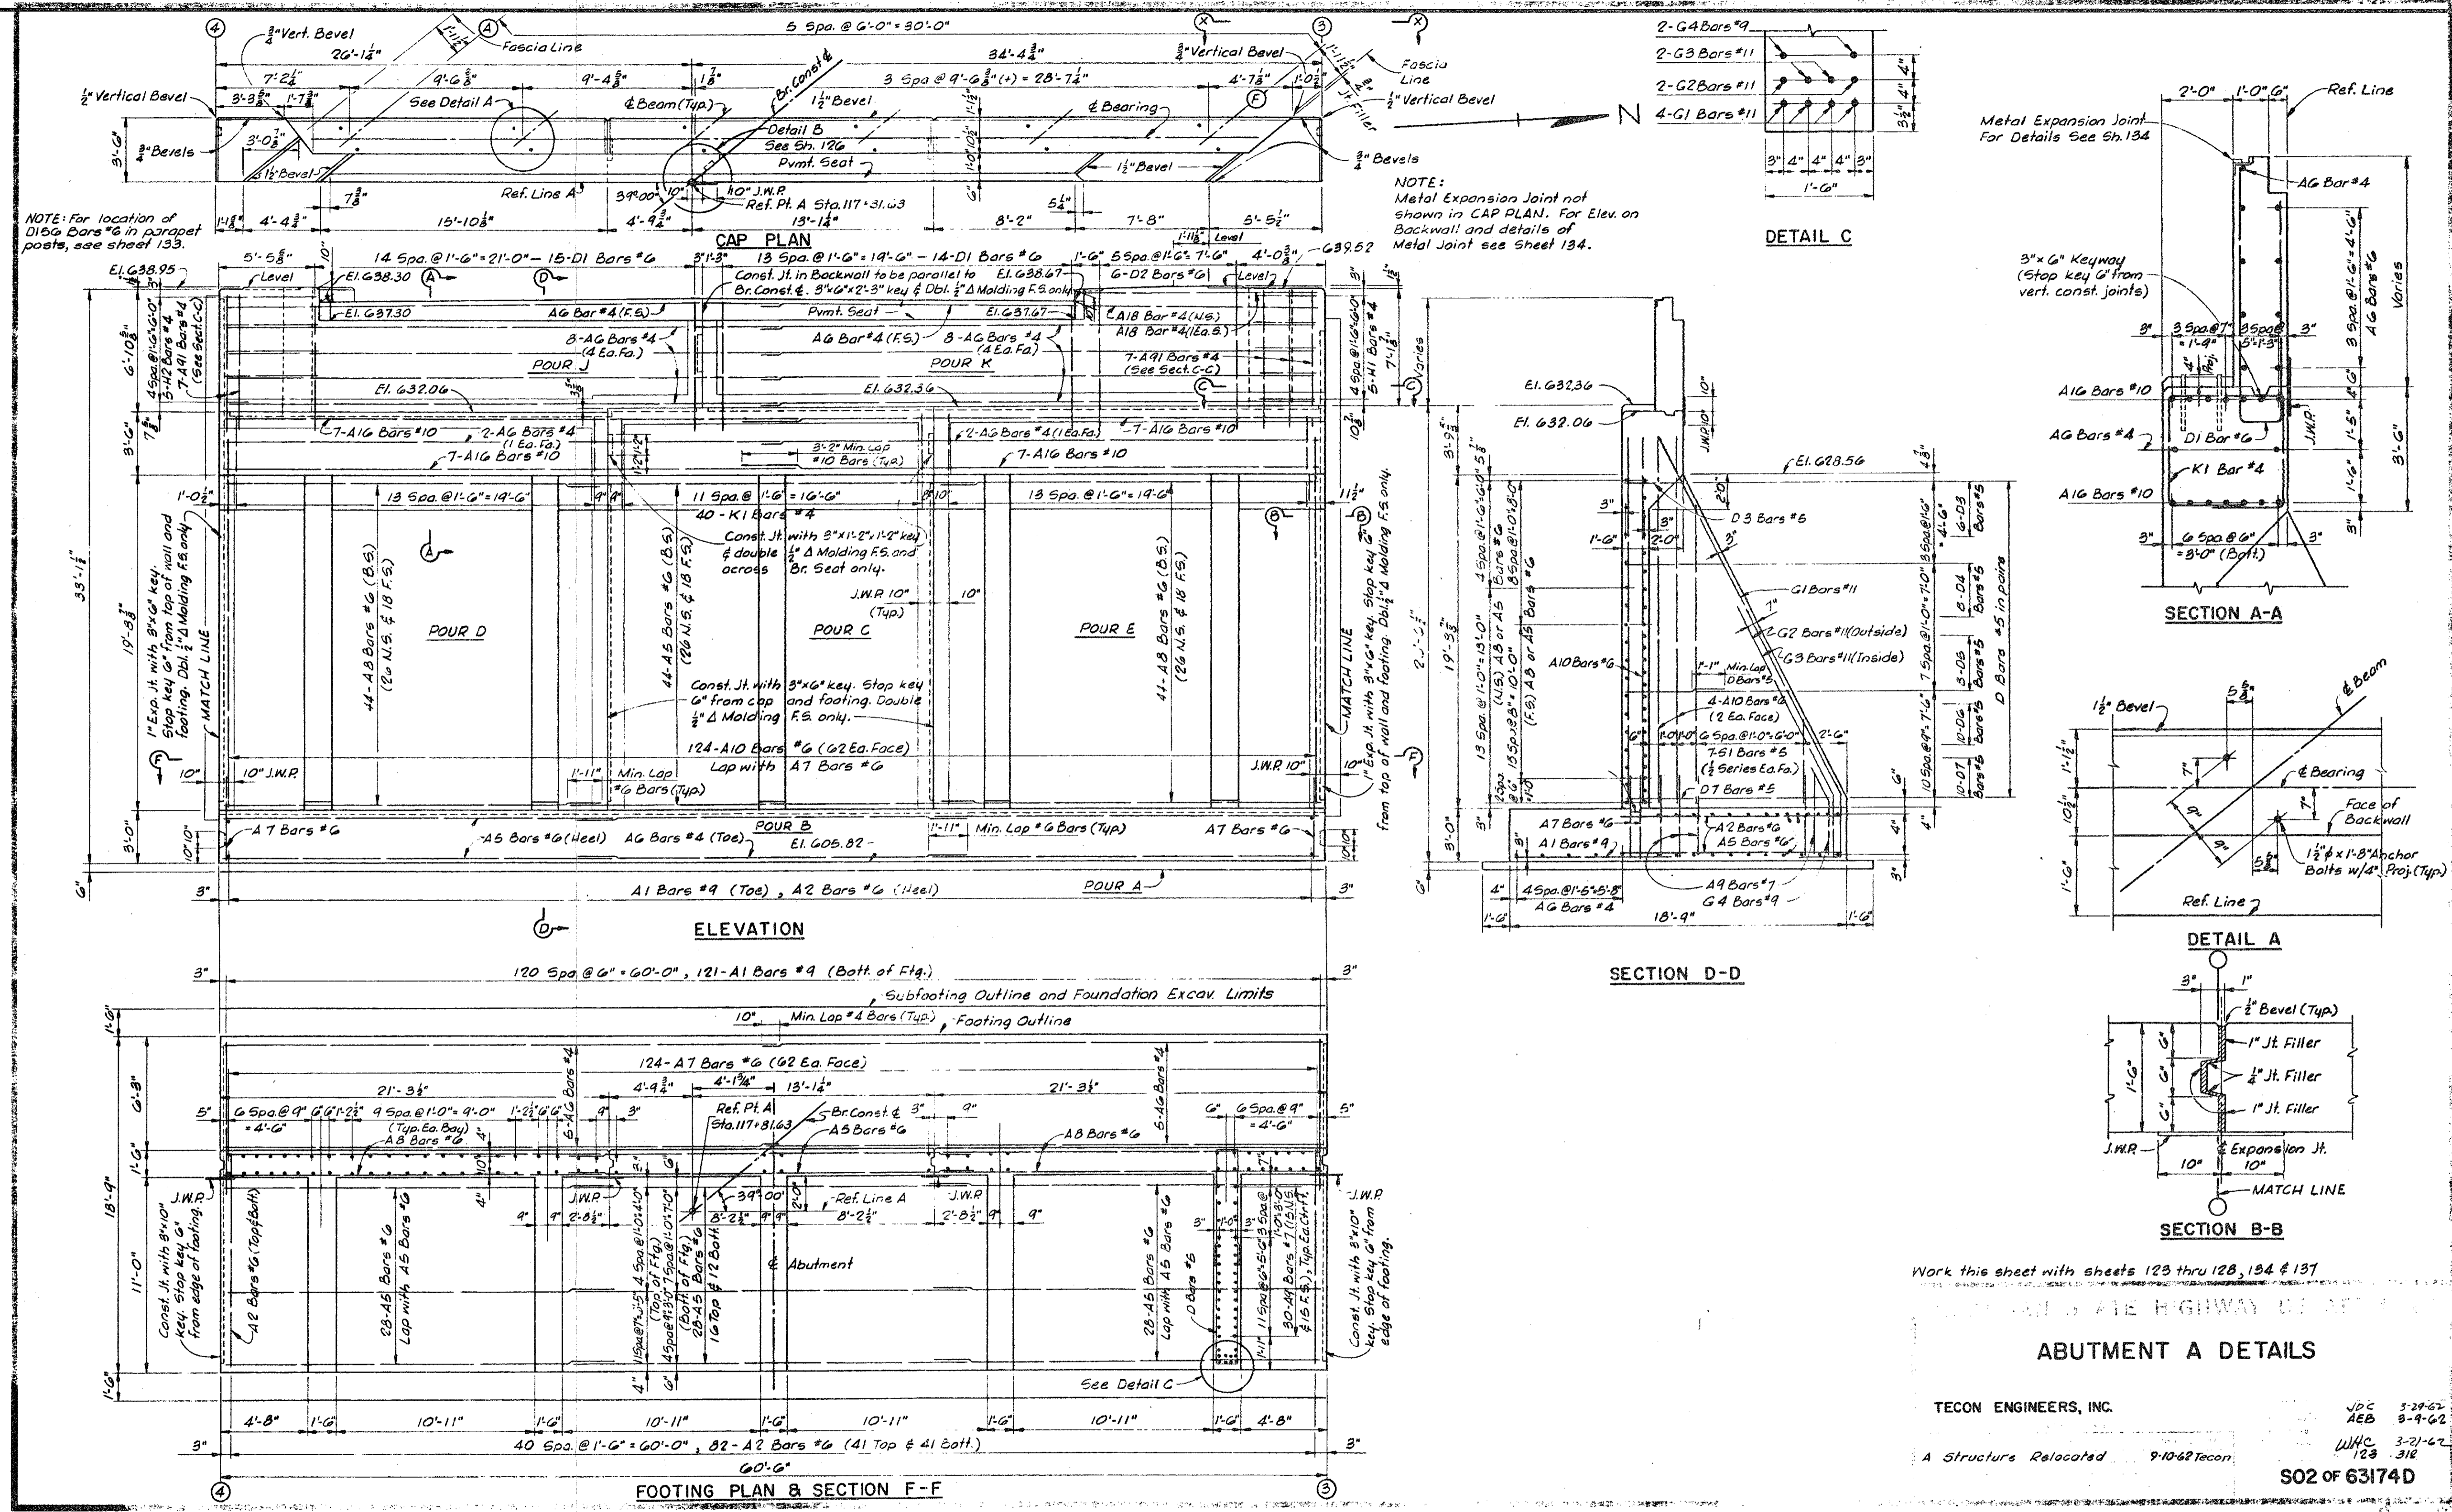


REVISIONS			
NO.	DESCRIPTION	DATE	BY

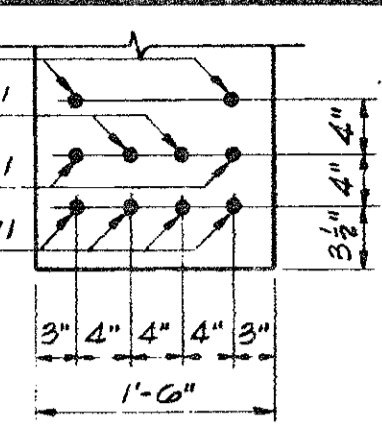


DETAIL C

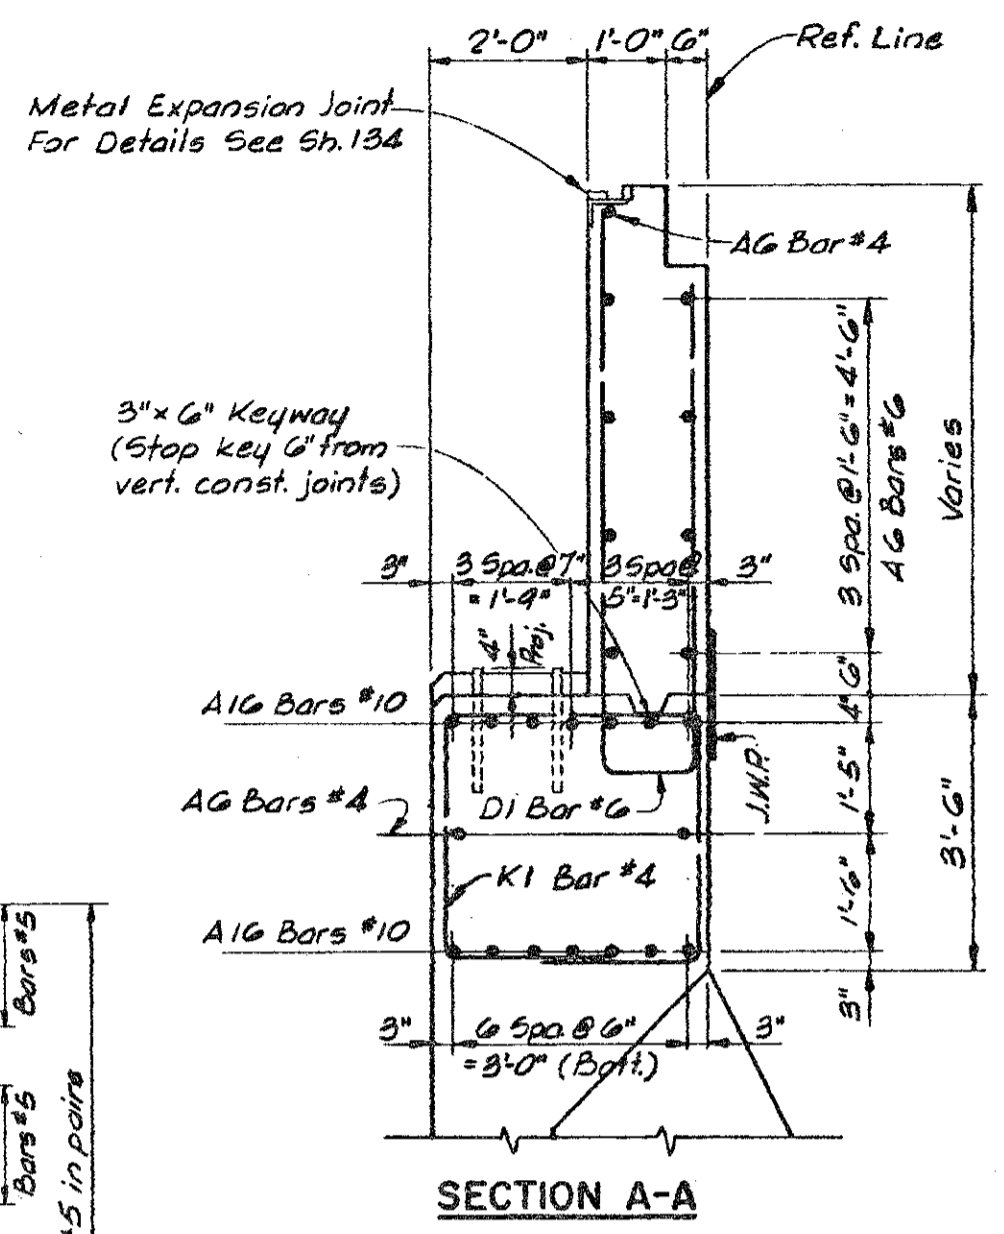

SECTION A-A

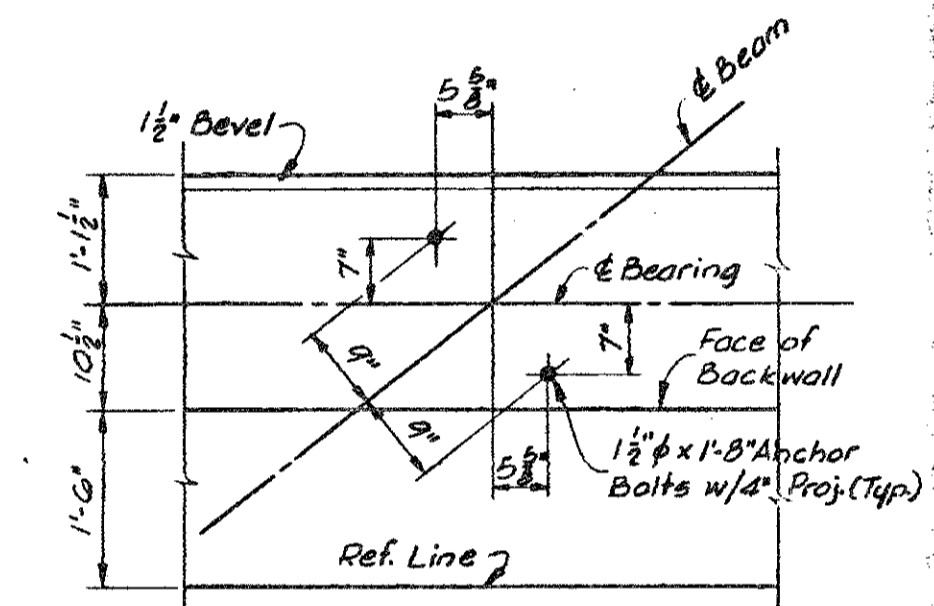

DETAIL A

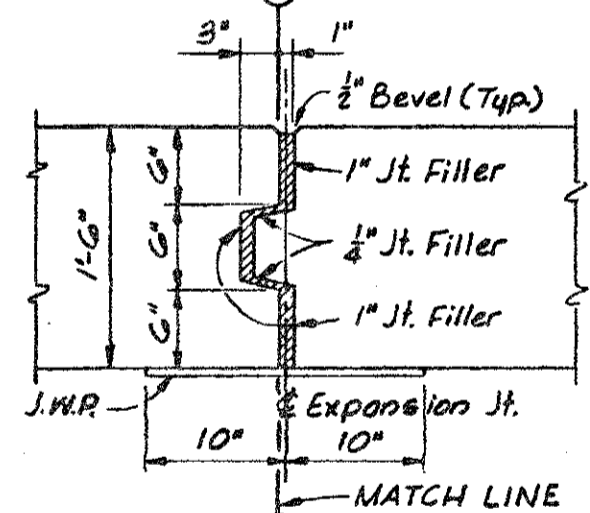

SECTION B-B

Work this sheet with sheets 123 thru 128, 134 & 137

ABUTMENT A DETAILS

TECON ENGINEERS, INC.

A Structure Relocated 9-10-62 Teccon

JDC 5-29-62
AEB 8-9-62
WNC 3-21-62
JLR 3-18-62


S02 OF 63174D

NOTE:
DO NOT WORK FROM THIS SHEET. THE INFORMATION SHOWN
HERE IS FOR REFERENCE ONLY. NO PAY ITEMS ARE SHOWN.




FOR INFORMATION ONLY				
DATE	CONT. SEC.	JOB NO.	DESIGN UNIT	SHEET
10-13-99	S02 OF 63174	48404A	MADHAVI	6 OF 29


DRAWN BY: inder DATE: CHECKED BY: DATE: CORRECTED BY: DATE: FILE NAME: s0263174.s

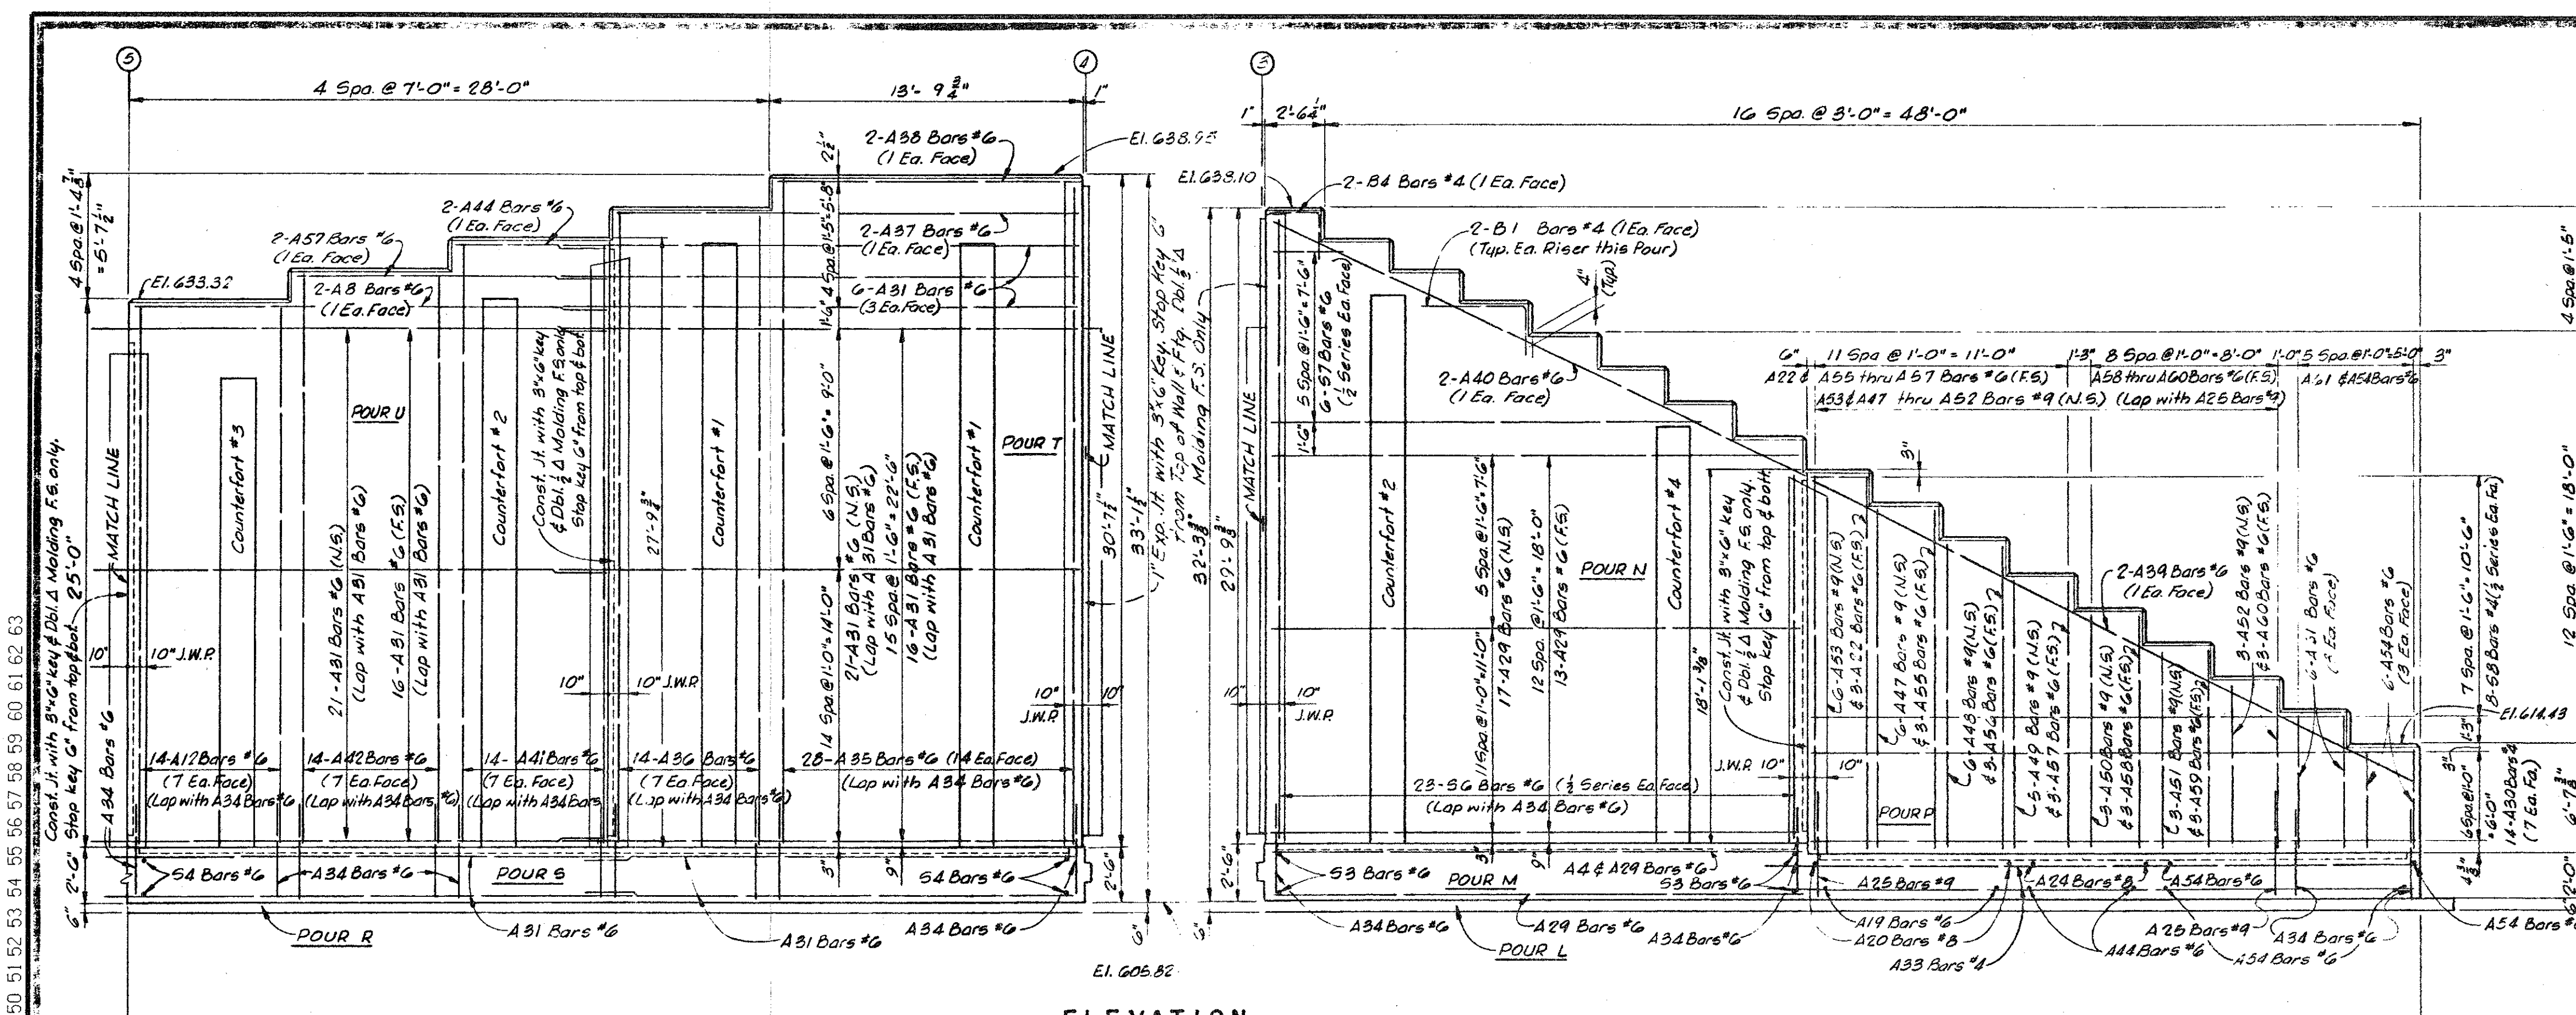

ELEVATION

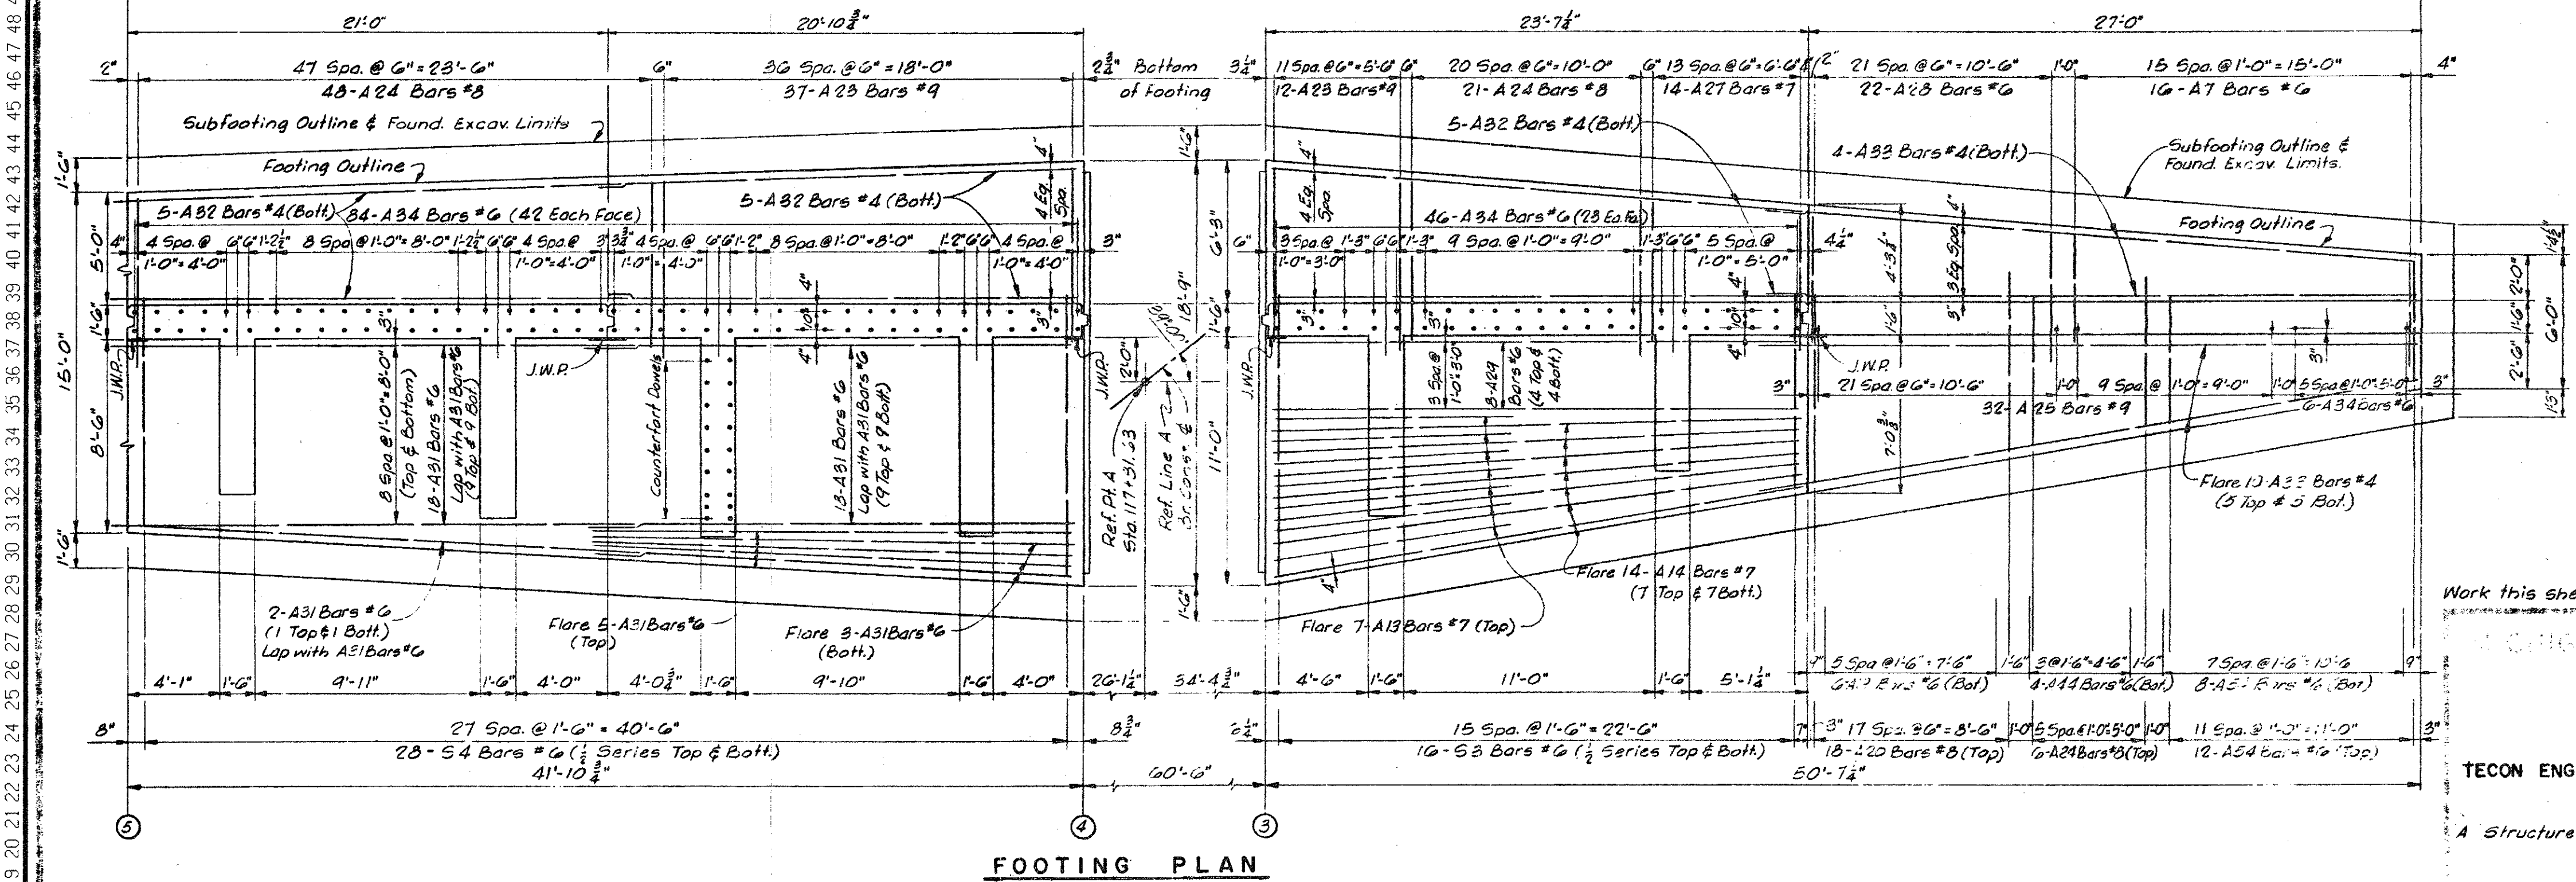

FOOTING PLAN

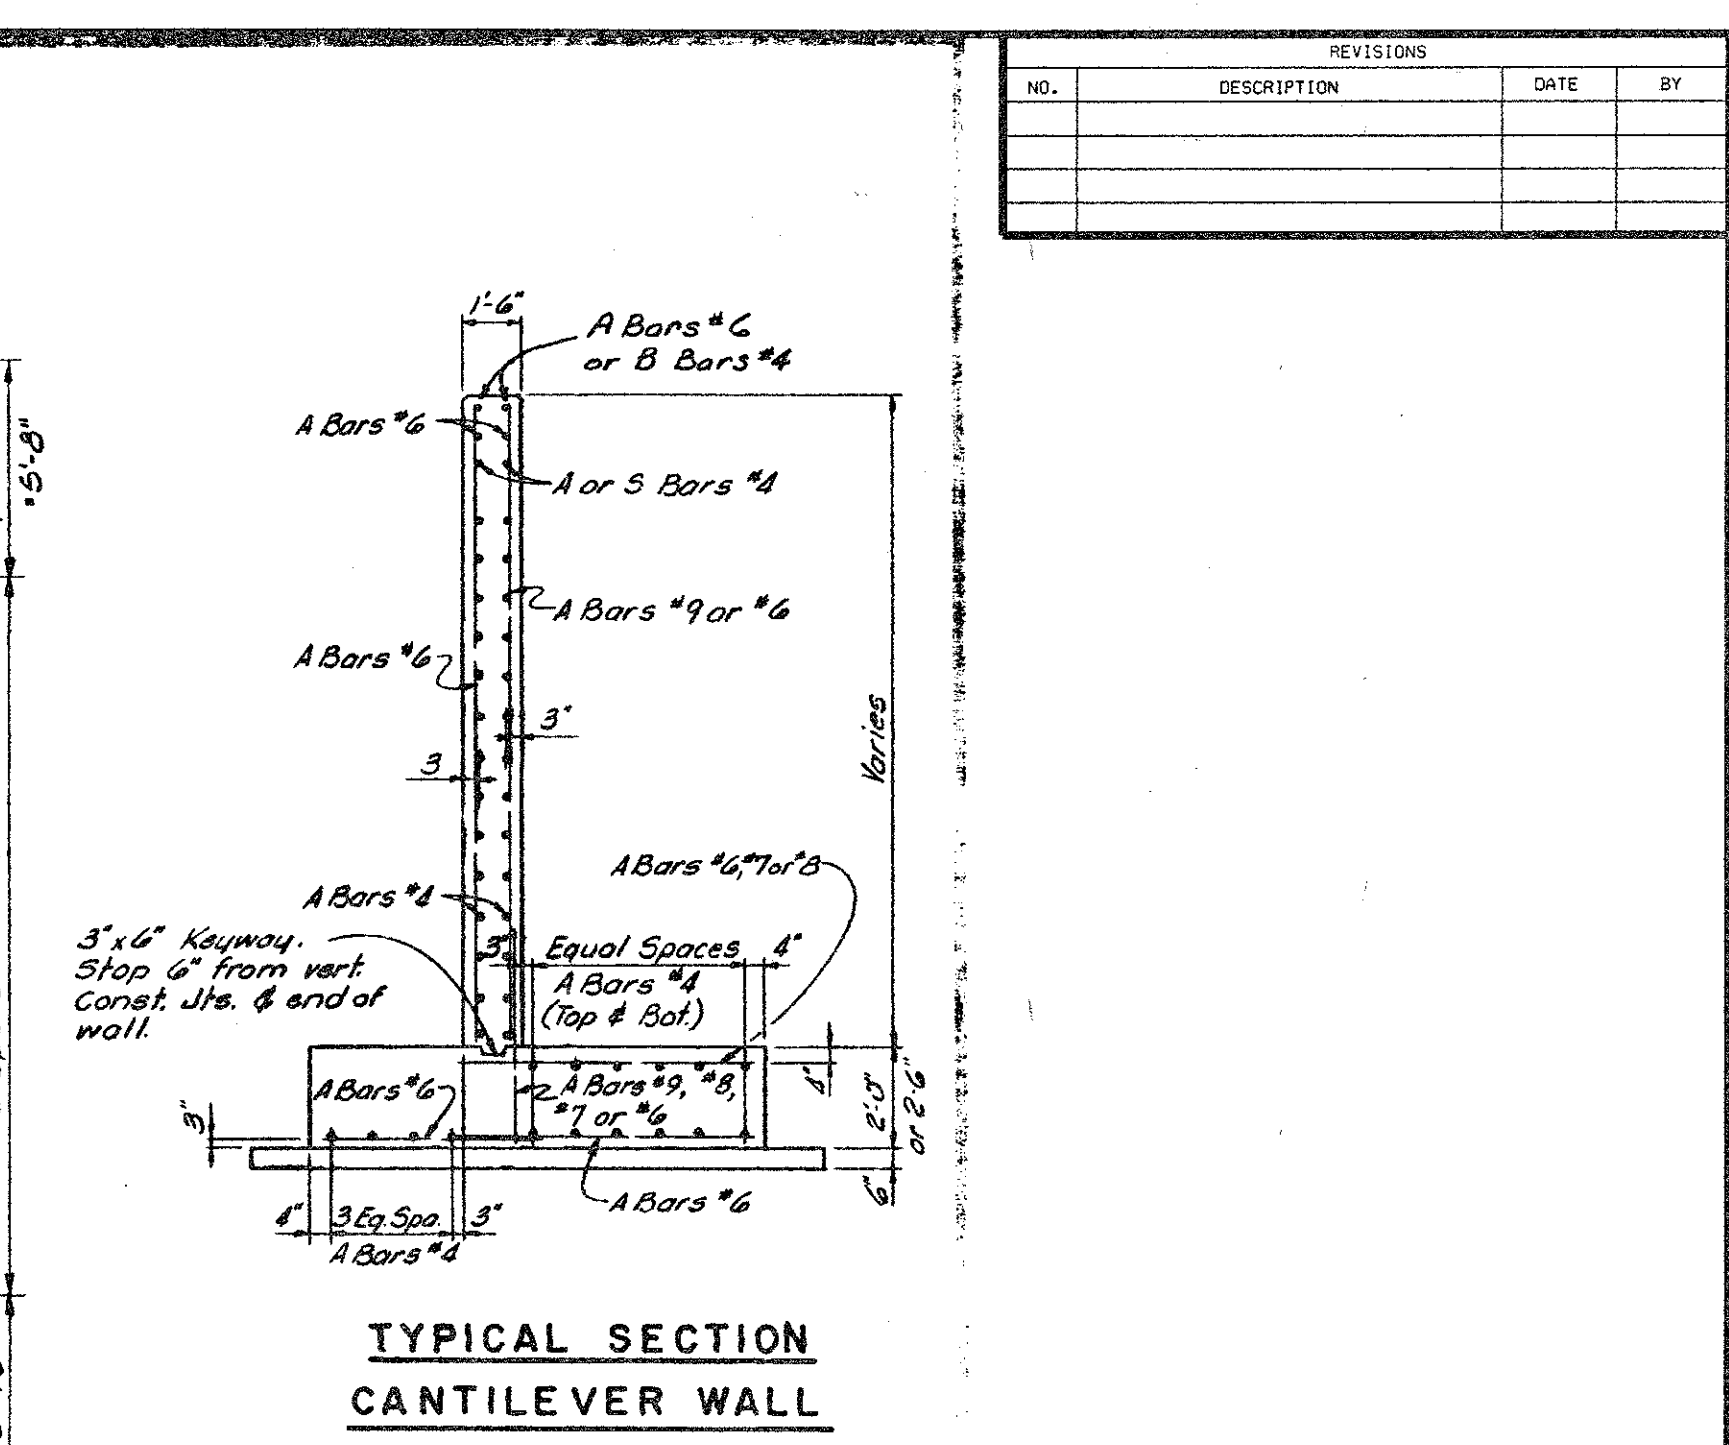

TYPICAL SECTION CANTILEVER WALL

NOTE: See Sheet #128 for Typical Counterforted Wall Section.


Work this sheet with sheets 123 thru 128, 134 & 137
MICHIGAN STATE HIGHWAY...
ABUTMENT A DETAILS
TECON ENGINEERS, INC.
A Structure Relocated 9-10-62 Tecon
JDC 3-24-62
AEB 3-16-62
CWC 3-24-62
TCS 3-18-62
S02 OF 63174D

NOTE:
DO NOT WORK FROM THIS SHEET. THE INFORMATION SHOWN
HERE IS FOR REFERENCE ONLY. NO PAY ITEMS ARE SHOWN.




FOR INFORMATION ONLY				
DATE	CONT. SEC.	JOB NO.	DESIGN UNIT	SHEET
10/13/99	S02 OF 63174	48404A	MAHDAVI	7 OF 29

FILE NAME: s0263714.sn
DRAWN BY: R.K.O.LIN
CHECKED BY:
DATE: 10/99
CORRECTED BY:
DATE:

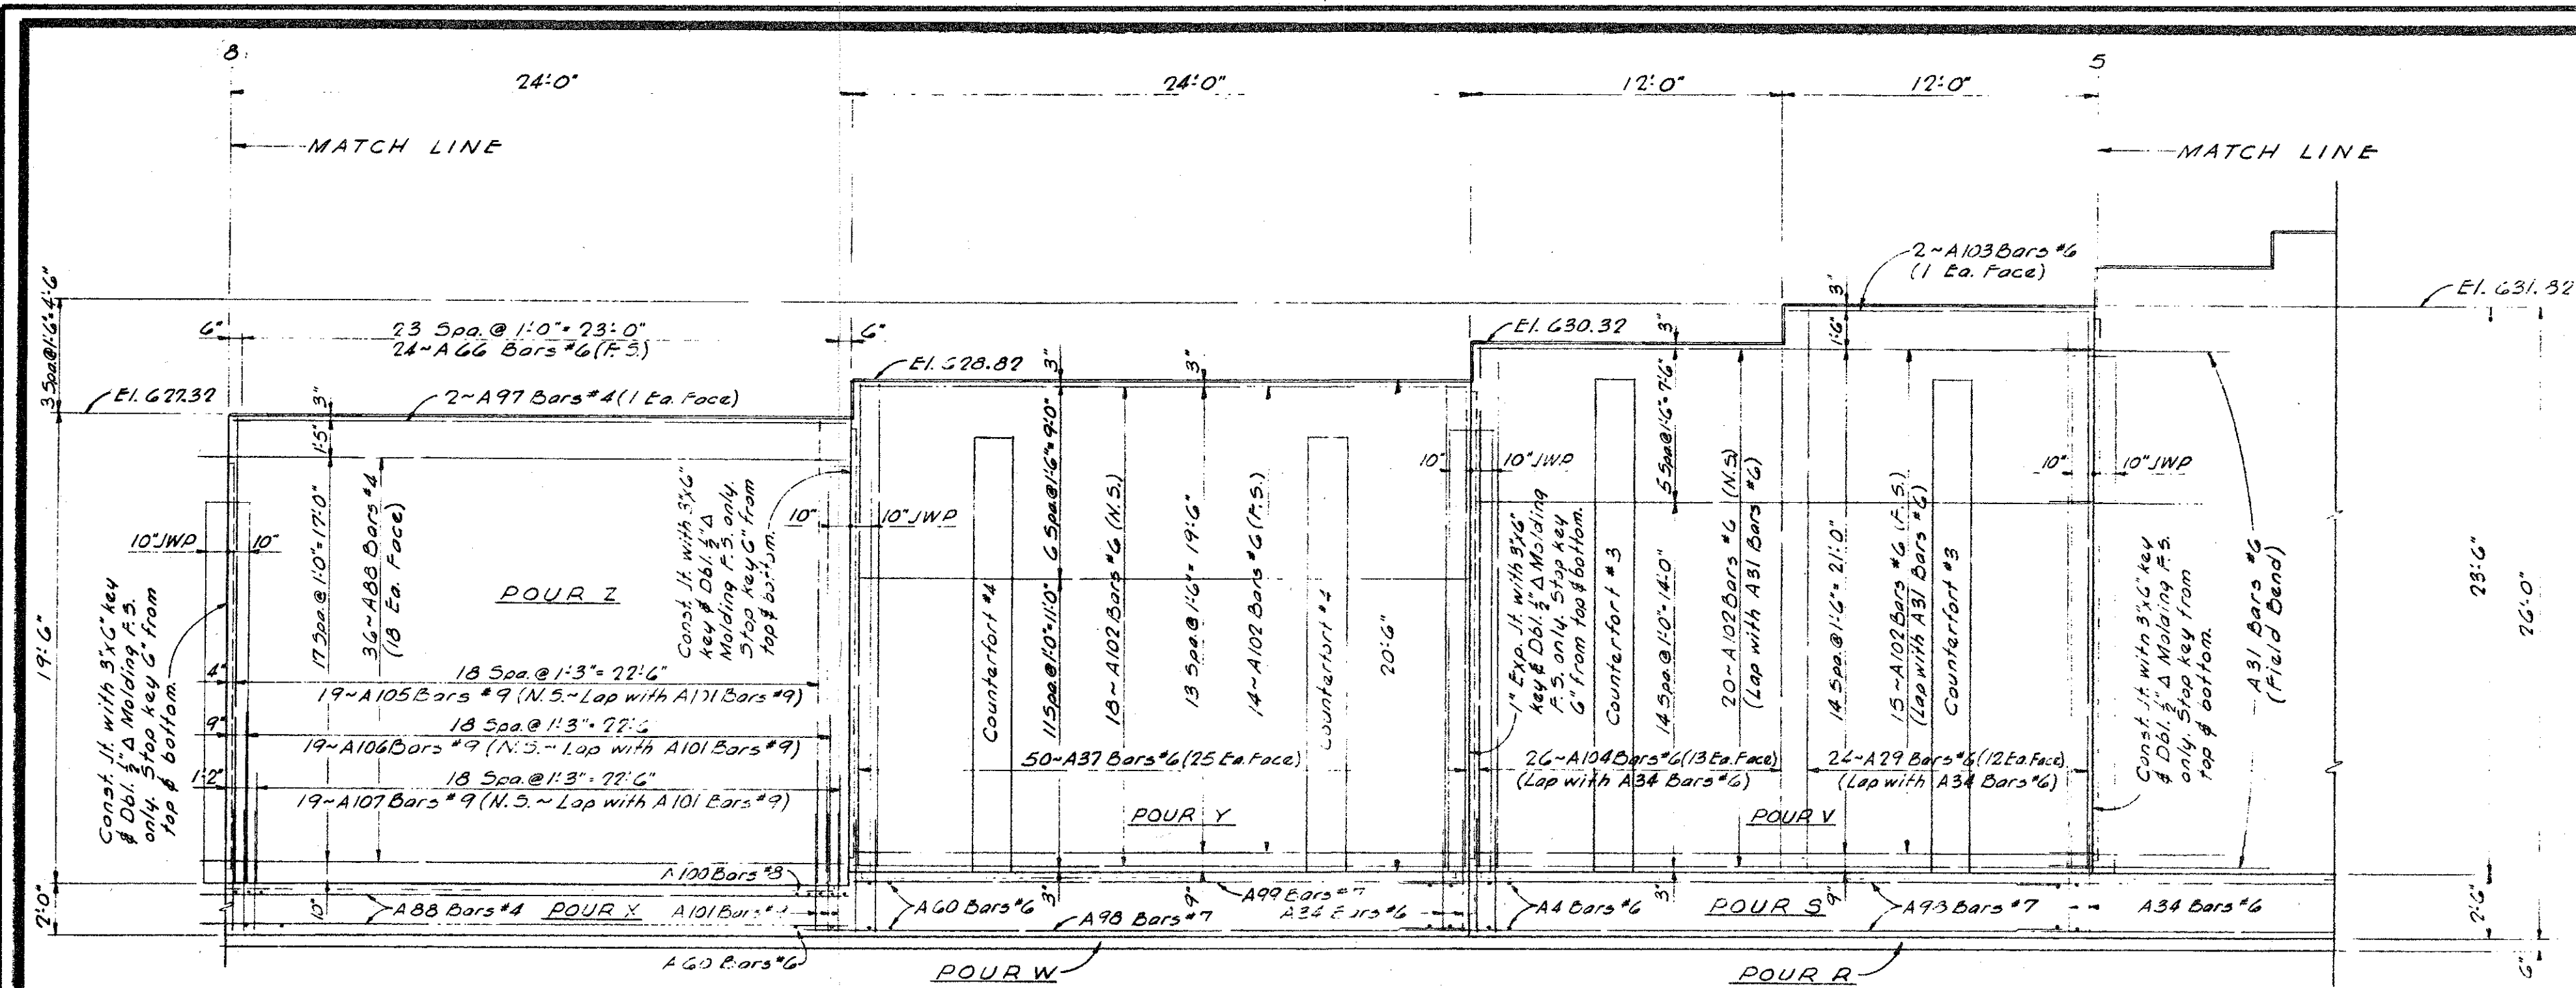

ELEVATION

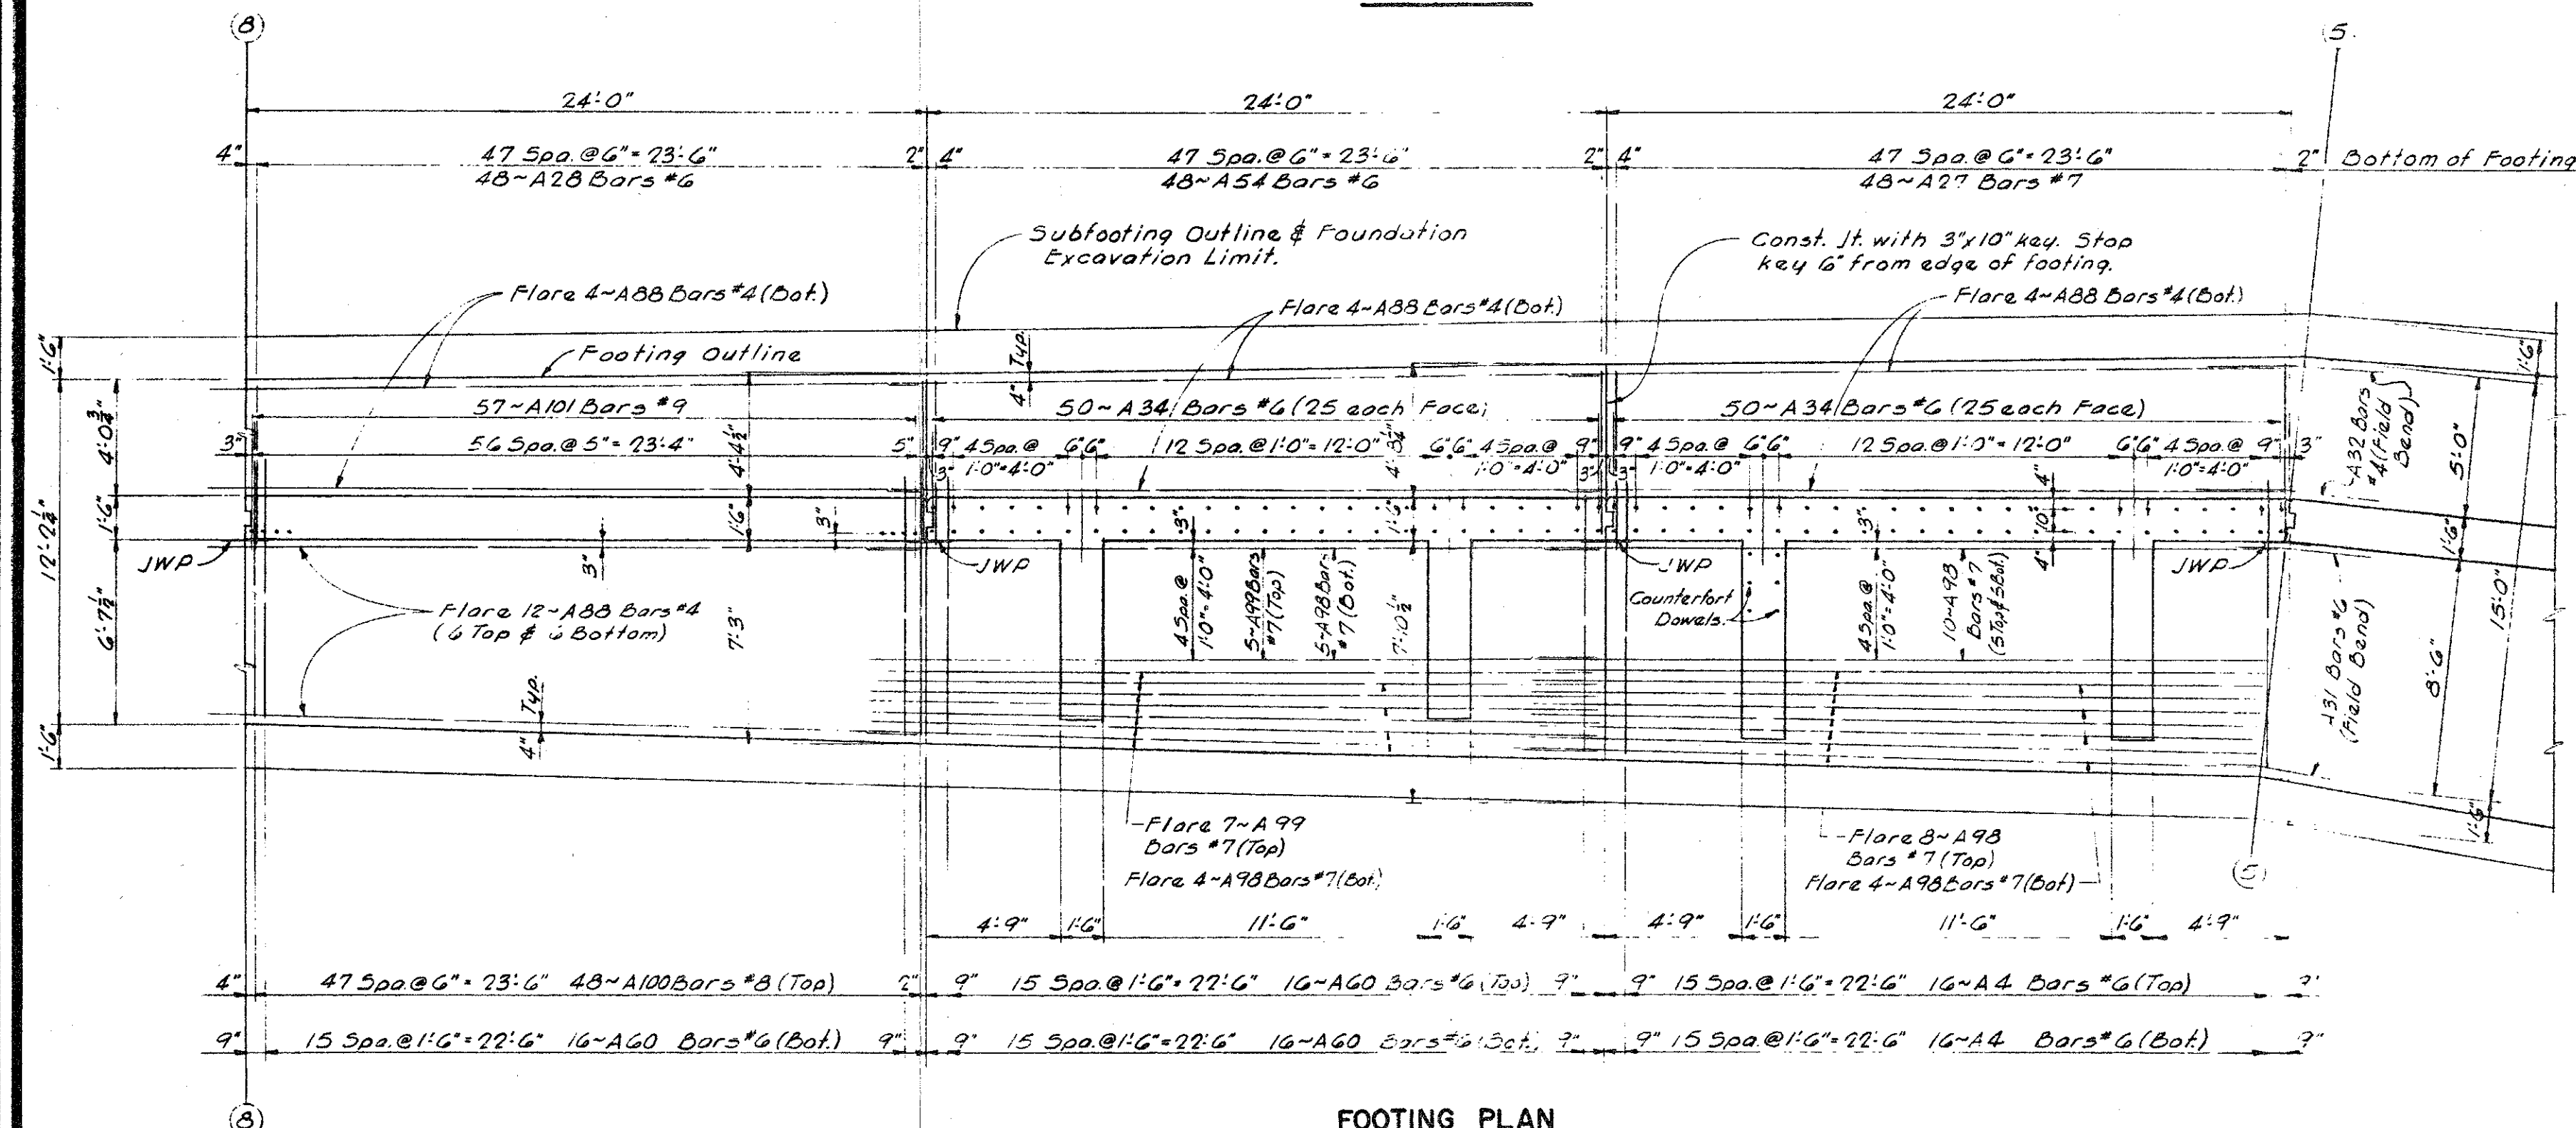

FOOTING PLAN

Note: See Sheet #124 for Typical Counterfort Wall Sections. See Sheet #128 for Typical Counterforted Wall Section.

Work this sheet with sheets 123 thru 126, 134 & 137.

ABUTMENT A DETAILS

TECON ENGINEERS, INC.

A Structure Relocated 9-10-62 Tecon

JDC 9-5-62
RLN 8-30-62
HMN 9-5-62
LMA 3/2

S02 OF 63174D

NOTE:
DO NOT WORK FROM THIS SHEET. THE INFORMATION SHOWN
HERE IS FOR REFERENCE ONLY. NO PAY ITEMS ARE SHOWN.





FOR INFORMATION ONLY				
DATE	CONT. SEC.	JOB NO.	DESIGN UNIT	SHEET
10/13/99	S02 OF 63174	48404A	MAHDAVI	8 OF 29

REVISIONS: NO. DESCRIPTION DATE BY

DATE: 10/99 CHECKED BY: R.K. OLIN DRAWN BY: R.K. OLIN FILE NAME: s0263174.sn1

1 2 3 4 5 6 7 8 9 10 11 12 13 14 15 16 17 18 19 20 21 22 23 24 25 26 27 28 29 30 31 32 33 34 35 36 37 38 39 40 41 42 43 44 45 46 47 48 49 50 51 52 53 54 55 56 57 58 59 60 61 62 63

REVISIONS			
NO.	DESCRIPTION	DATE	BY

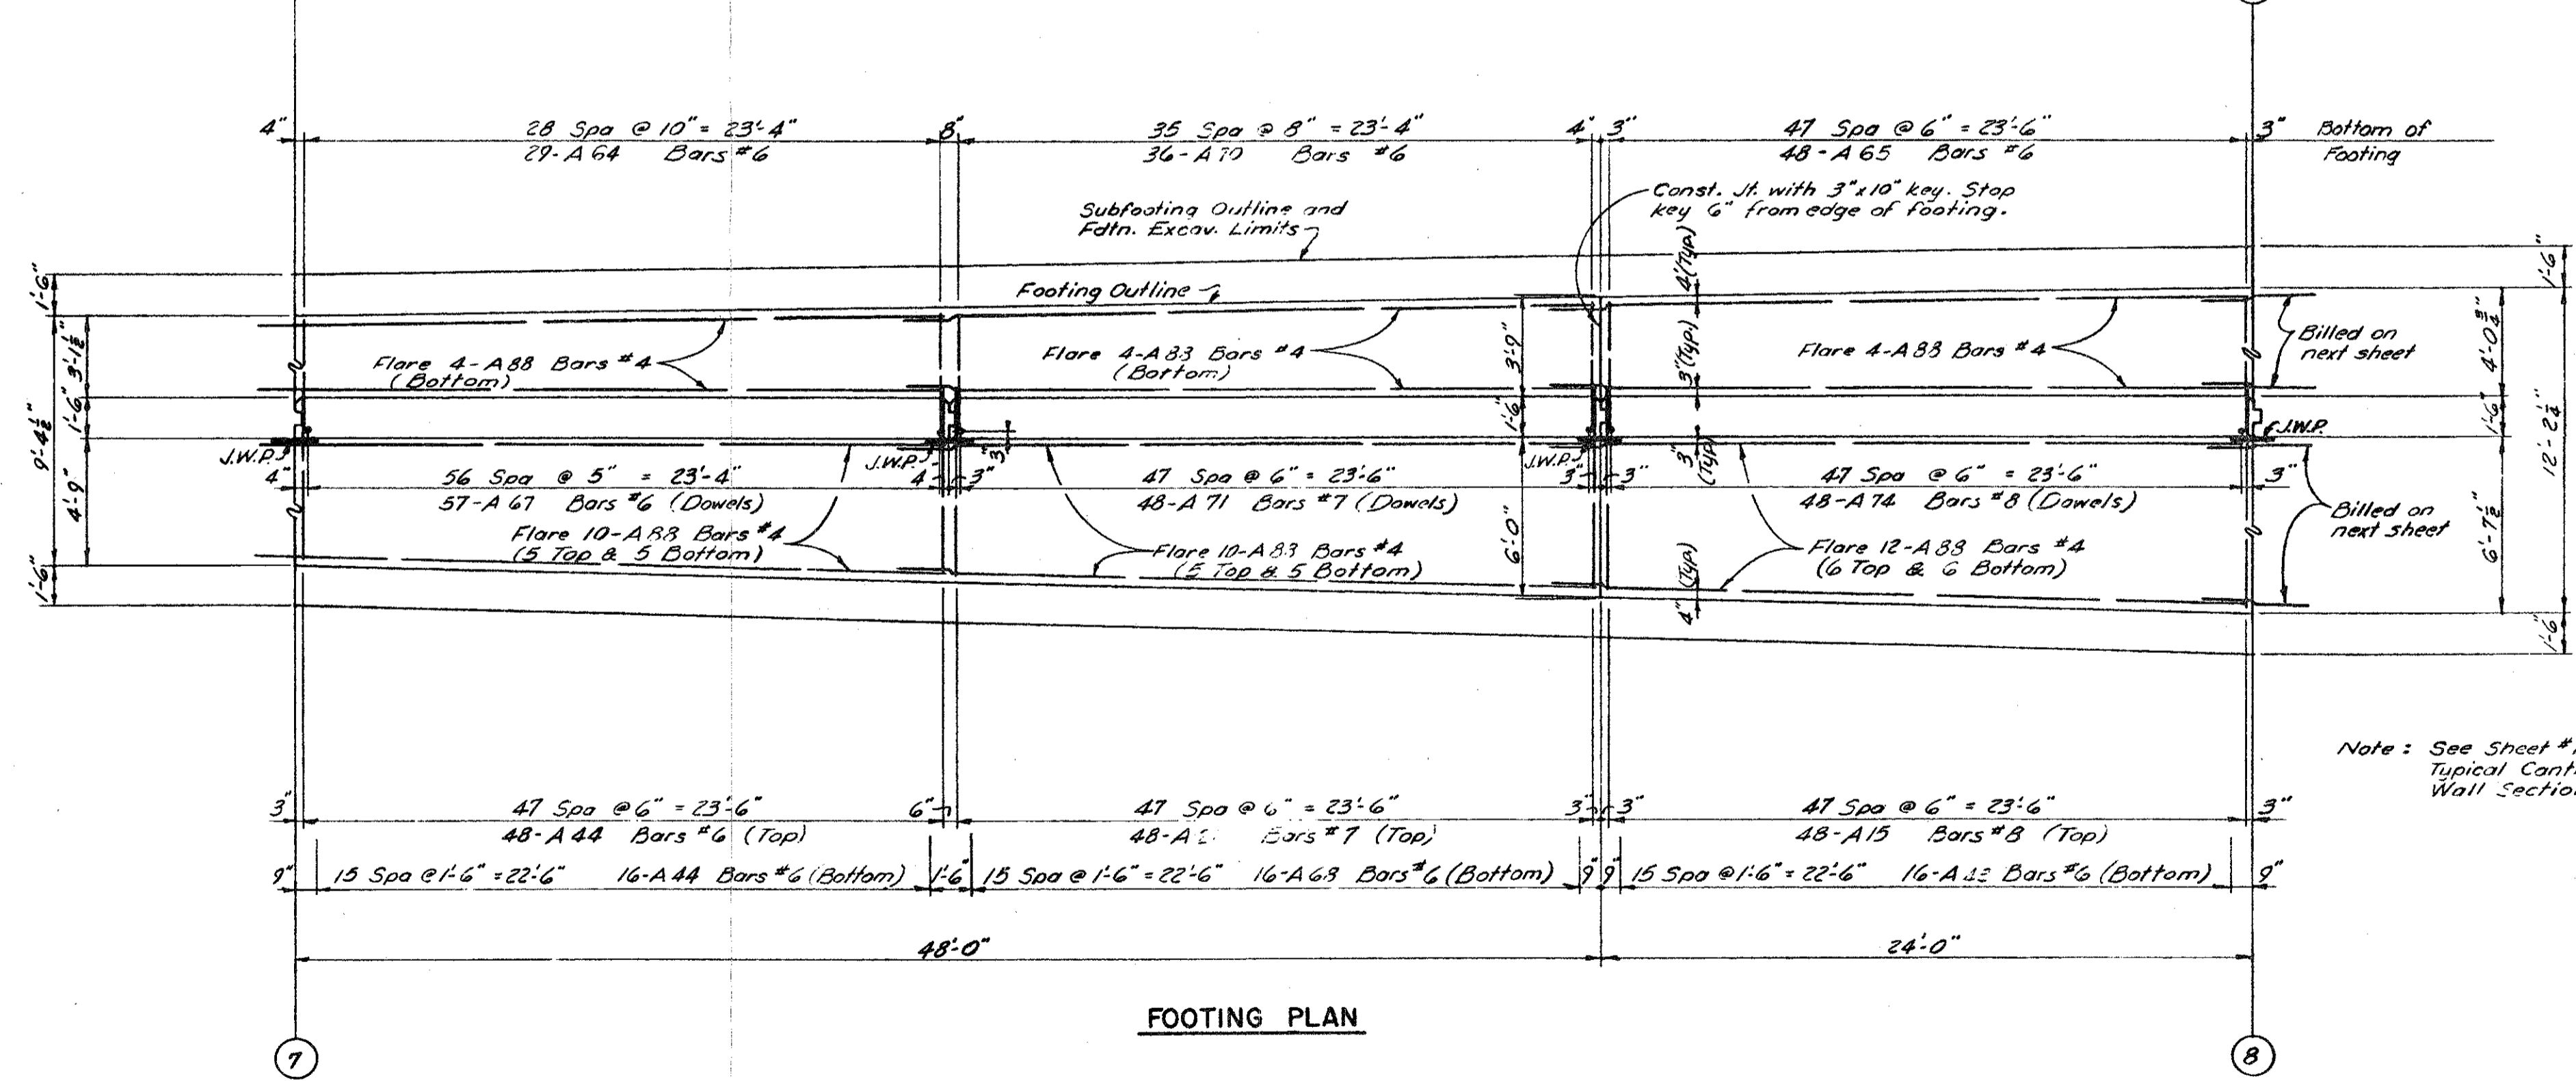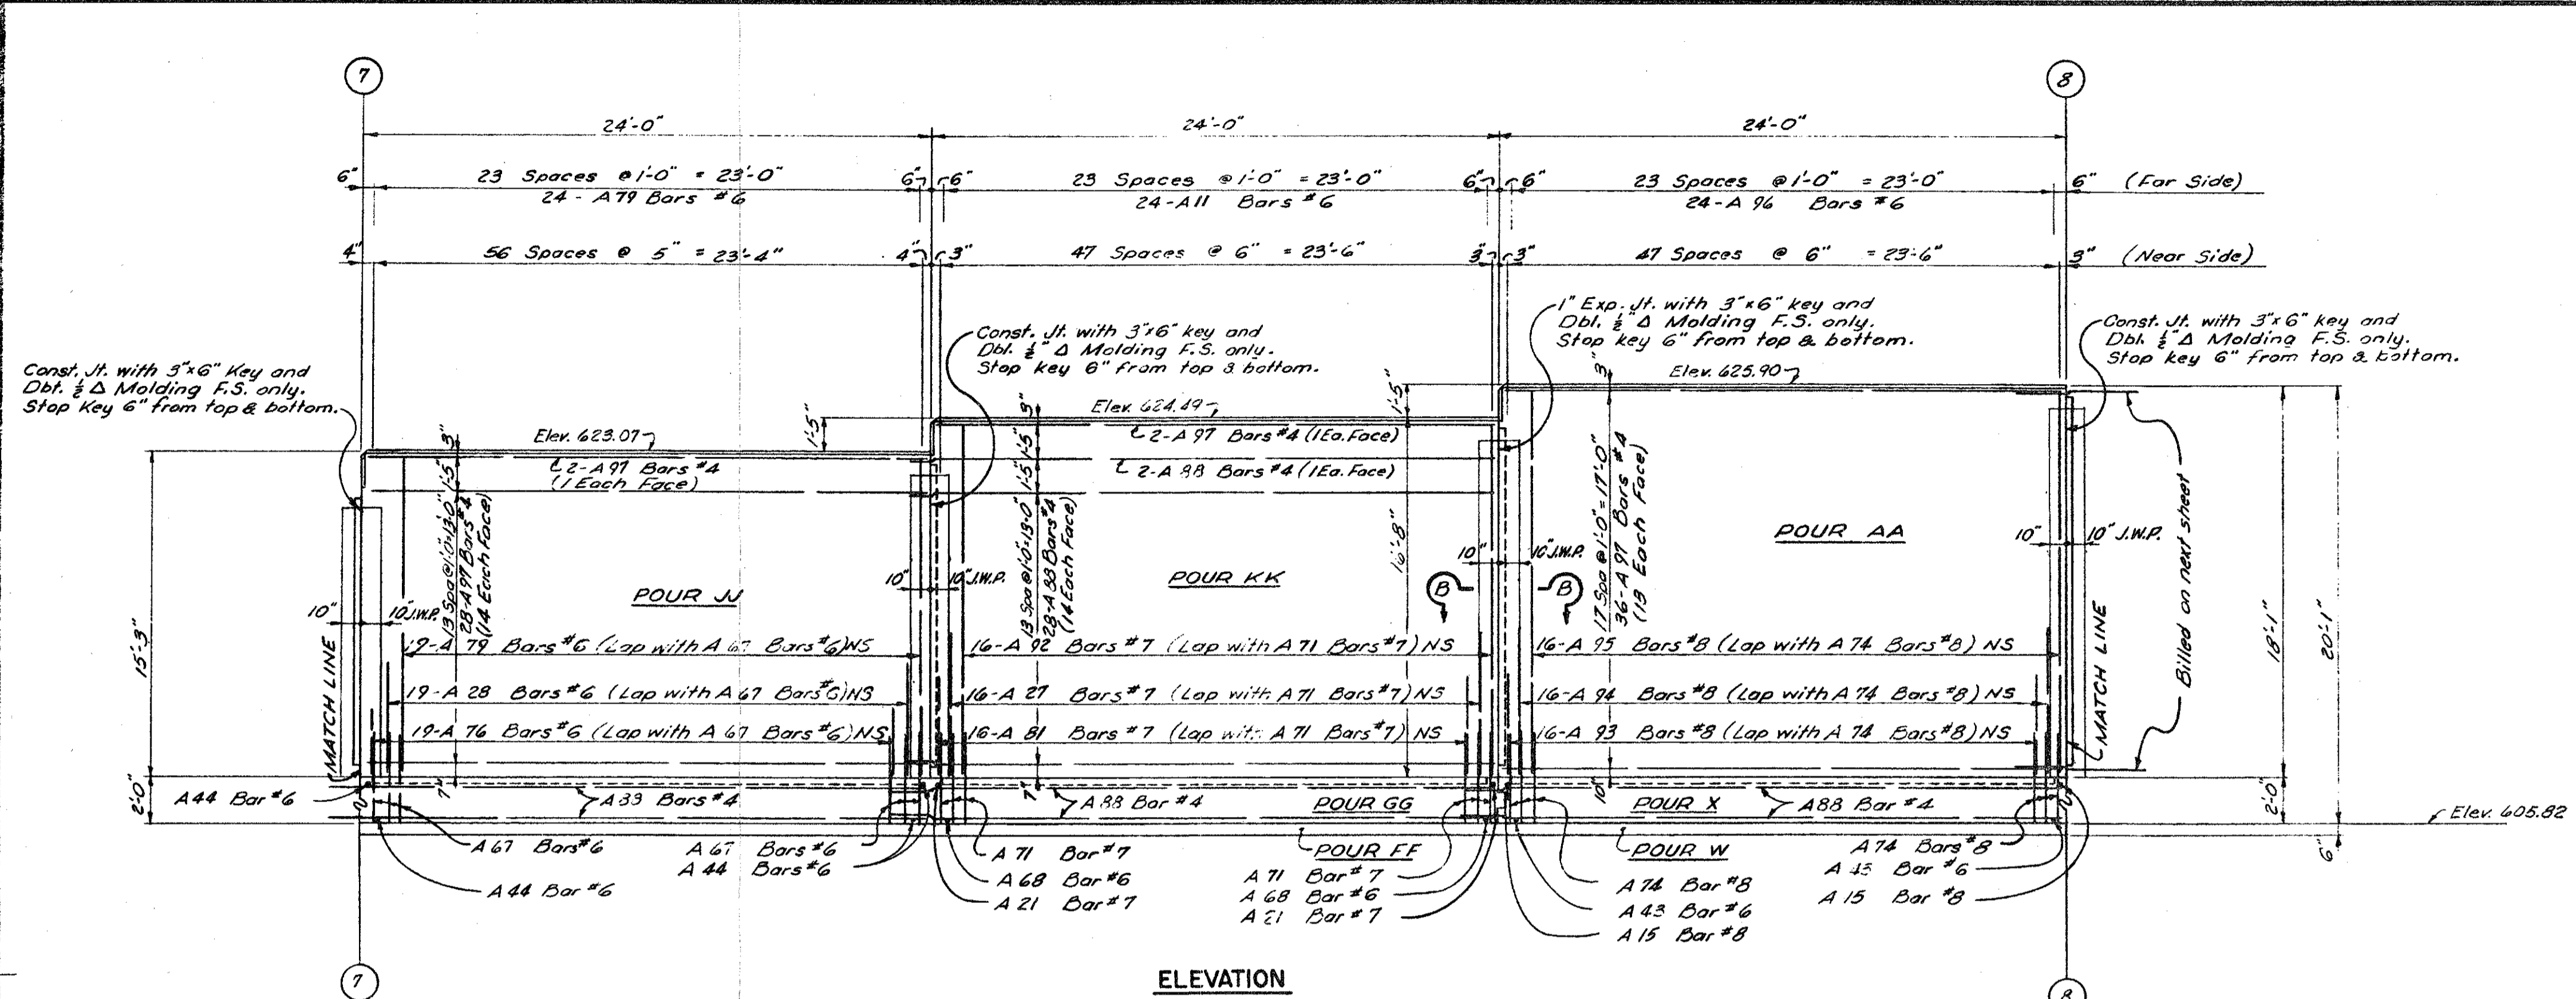

Note: See Sheet #124 for typical Cantilever Wall Section.

Work this sheet with sheets 123 thru 128, 134, 137

ABUTMENT A DETAILS

TECON ENGINEERS, INC.

A Structure Relocated 9-10-62 Tecon

JDC 9-5-62
CEV 9-5-62
HMM 9-5-62
123 B 312

S02 OF 63174 D

NOTE:
DO NOT WORK FROM THIS SHEET. THE INFORMATION SHOWN HERE IS FOR REFERENCE ONLY. NO PAY ITEMS ARE SHOWN.





FOR INFORMATION ONLY				
DATE	CONT. SEC.	JOB NO.	DESIGN UNIT	SHEET
10-13-99	S02 OF 63174	48404A	MADHAVI	9 OF 29

FILE NAME: s0263174.sn DRAWN BY: mader CHECKED BY: DATE: CORRECTED BY: DATE:

1 2 3 4 5 6 7 8 9 10 11 12 13 14 15 16 17 18 19 20 21 22 23 24 25 26 27 28 29 30 31 32 33 34 35 36 37 38 39 40 41 42 43 44 45 46 47 48 49 50 51 52 53 54 55 56 57 58 59 60 61 62 63

REVISIONS			
NO.	DESCRIPTION	DATE	BY

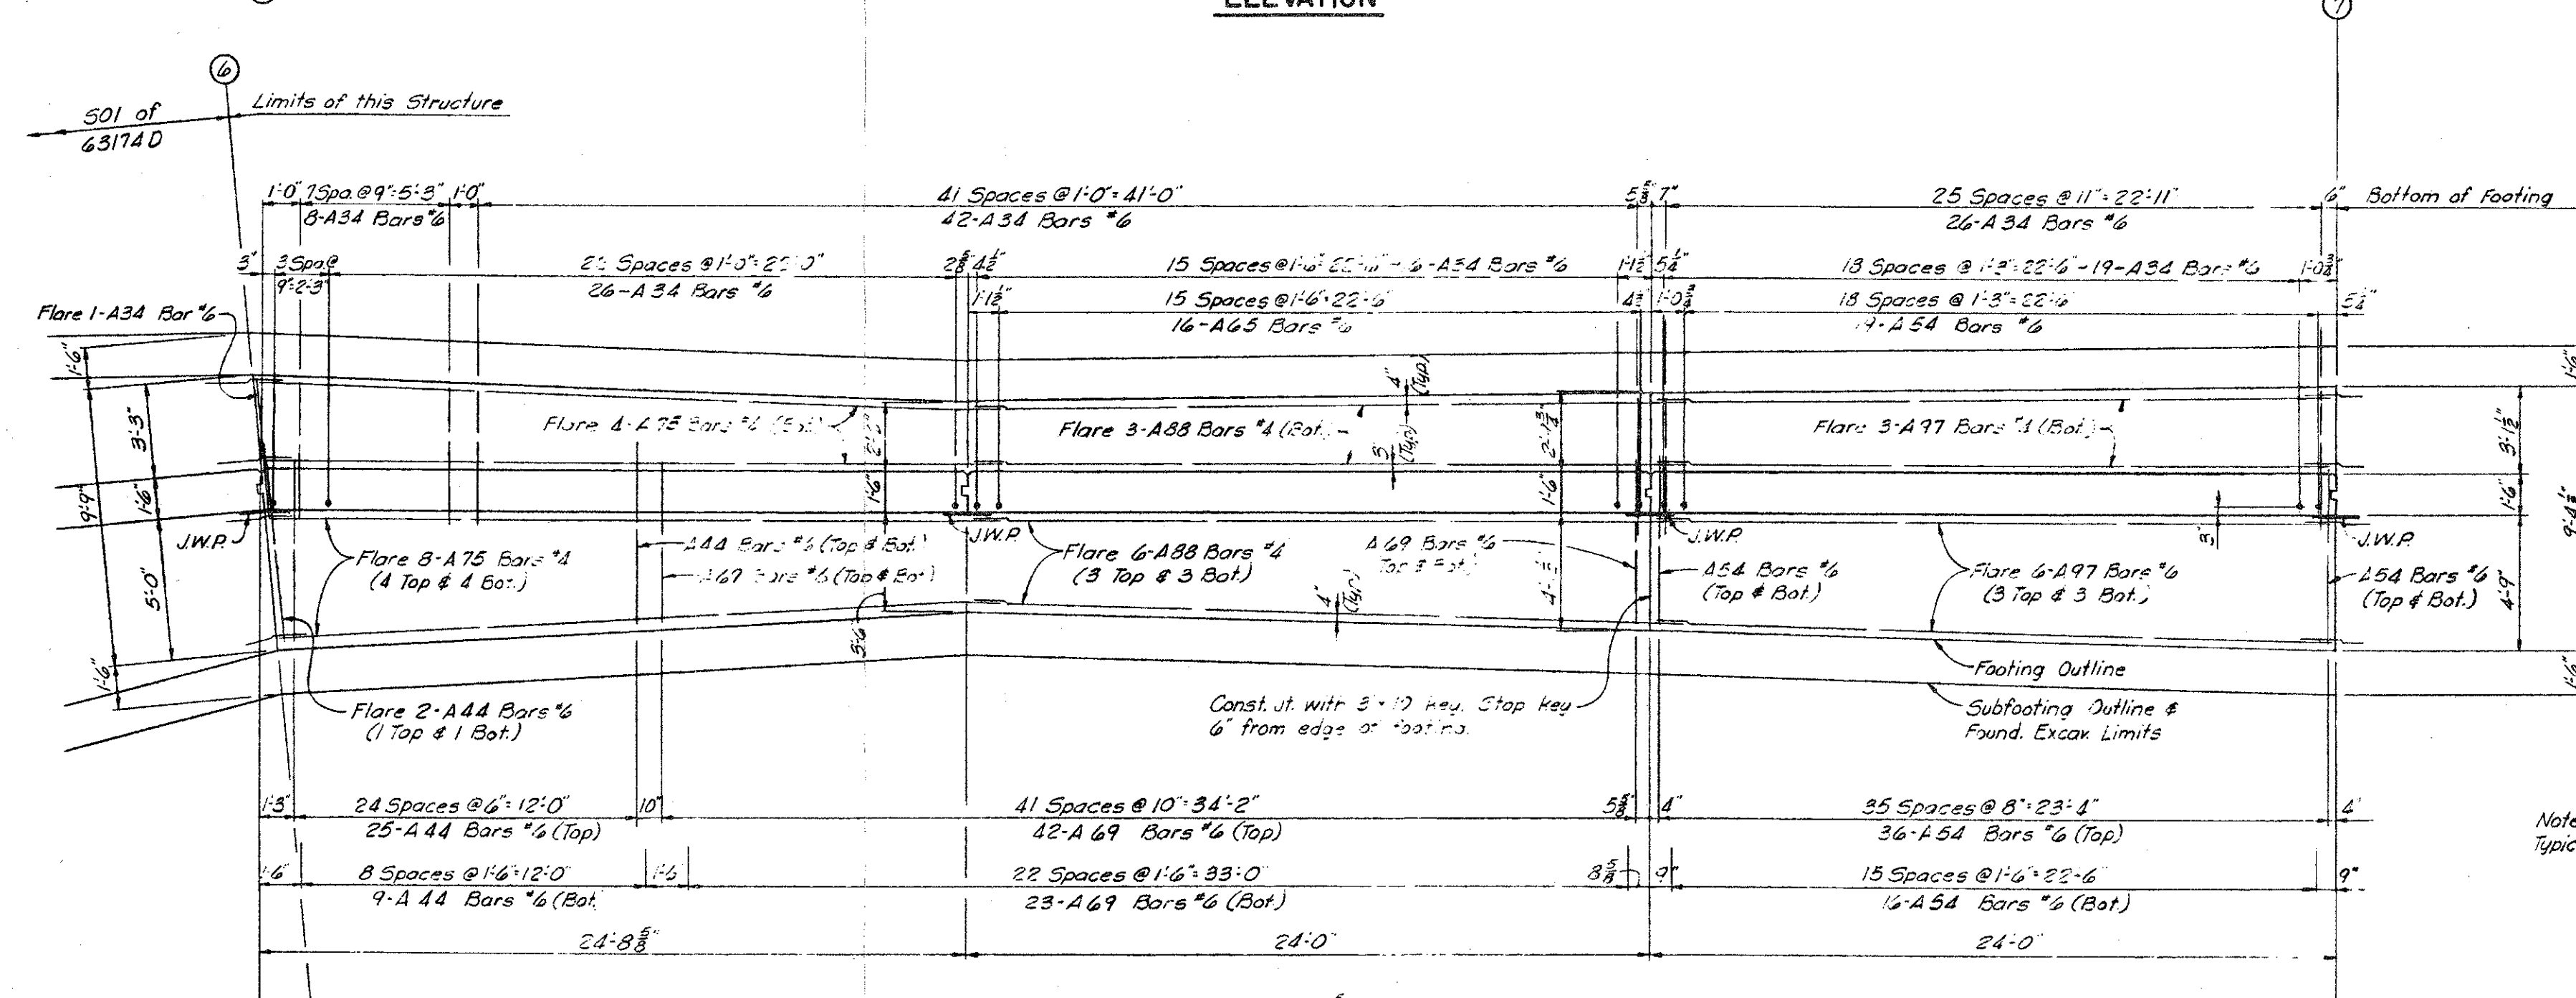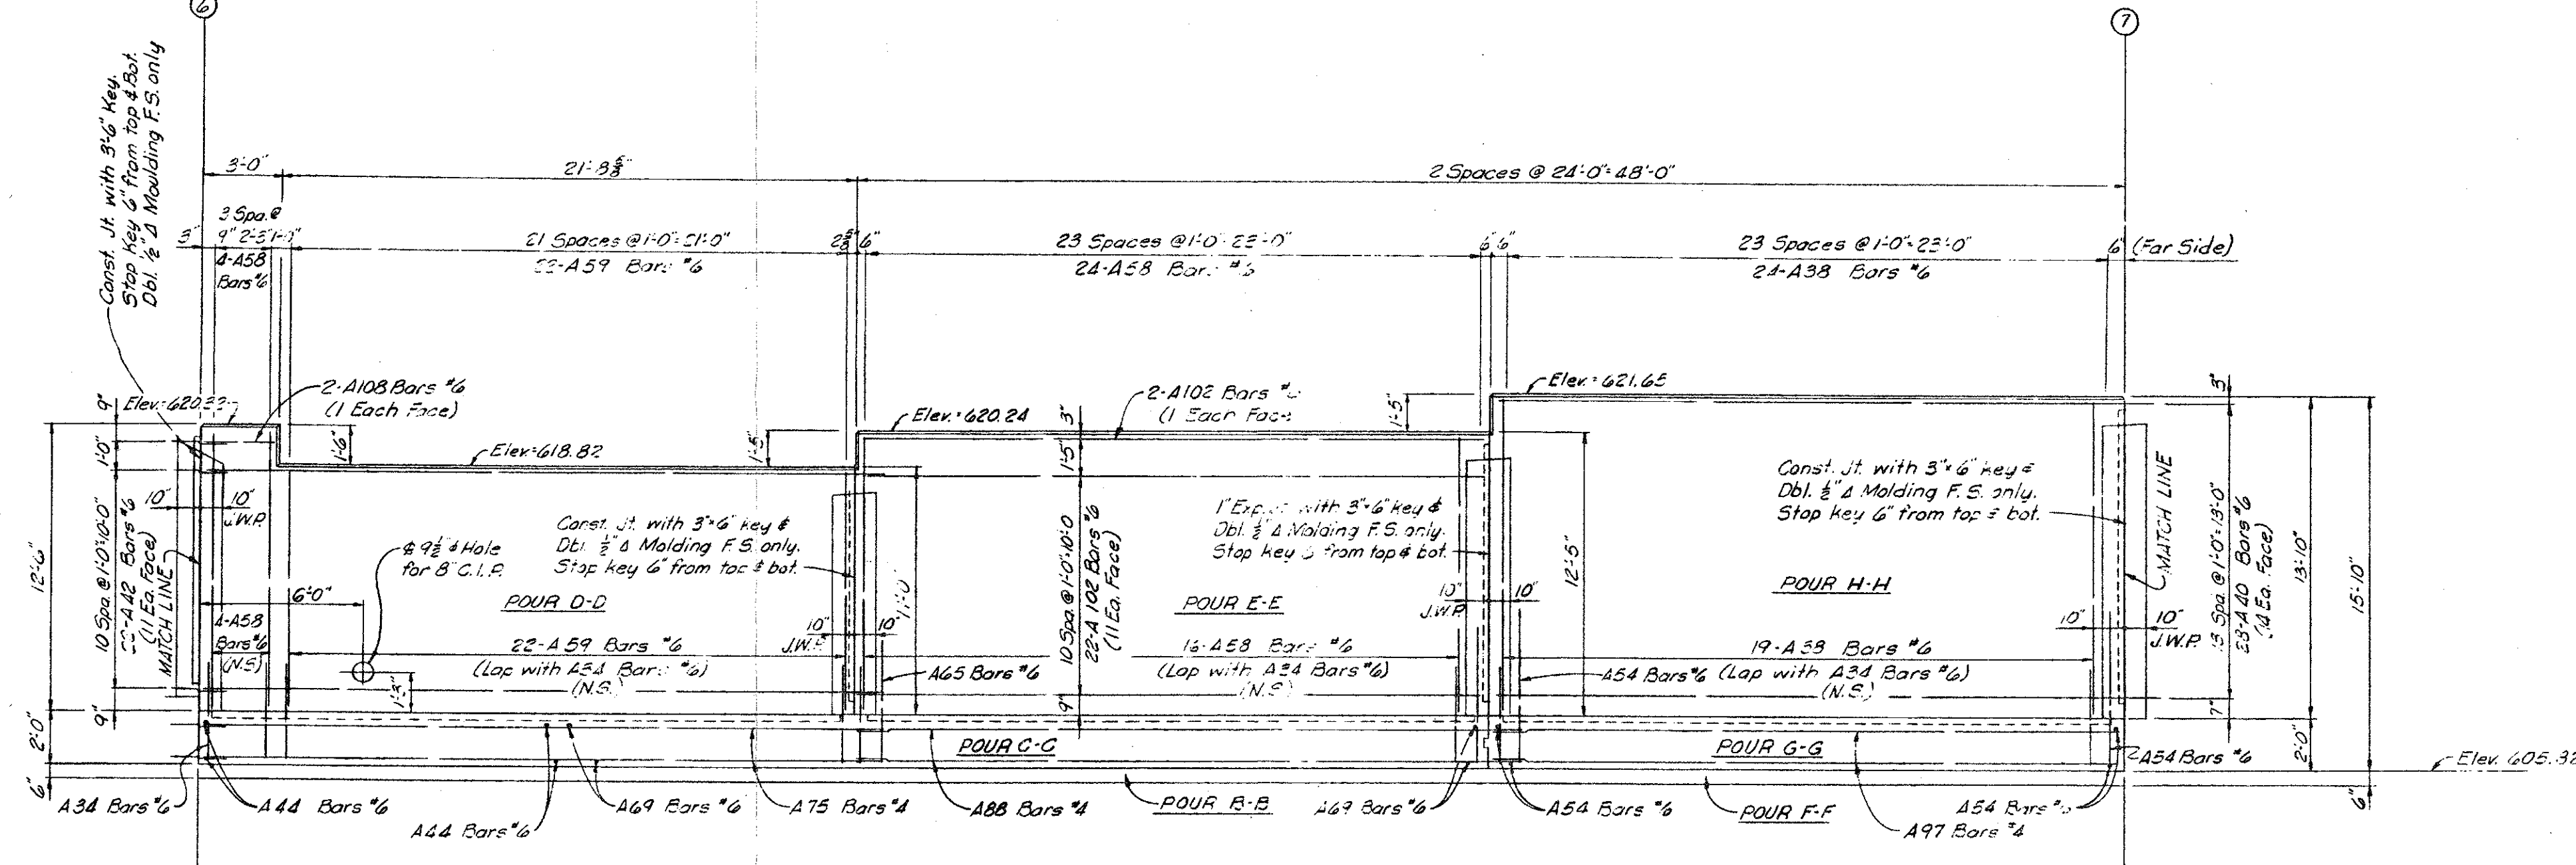

Note: See Sheet 104 for Typical Cantilever wall section.

Work this sheet with sheets 123 thru 128, 134 & 137

ABUTMENT A DETAILS

TECON ENGINEERS, INC.

A Structure Relocated 9-10-92 Tecon

JDC	9-5-92
DRS	8-30-92
HMW	9-5-92
RESO	3/8


S02 OF 63174 D

NOTE:
DO NOT WORK FROM THIS SHEET. THE INFORMATION SHOWN
HERE IS FOR REFERENCE ONLY. NO PAY ITEMS ARE SHOWN.



FOR INFORMATION ONLY				
DATE	CONT. SEC.	JOB NO.	DESIGN UNIT	SHEET
10-13-99	S02 OF 63174	48404A	MADHAVI	10 OF 29

DRAWN BY: inder DATE: CORRECTED BY: DATE: FILE NAME: s0263174.dwg

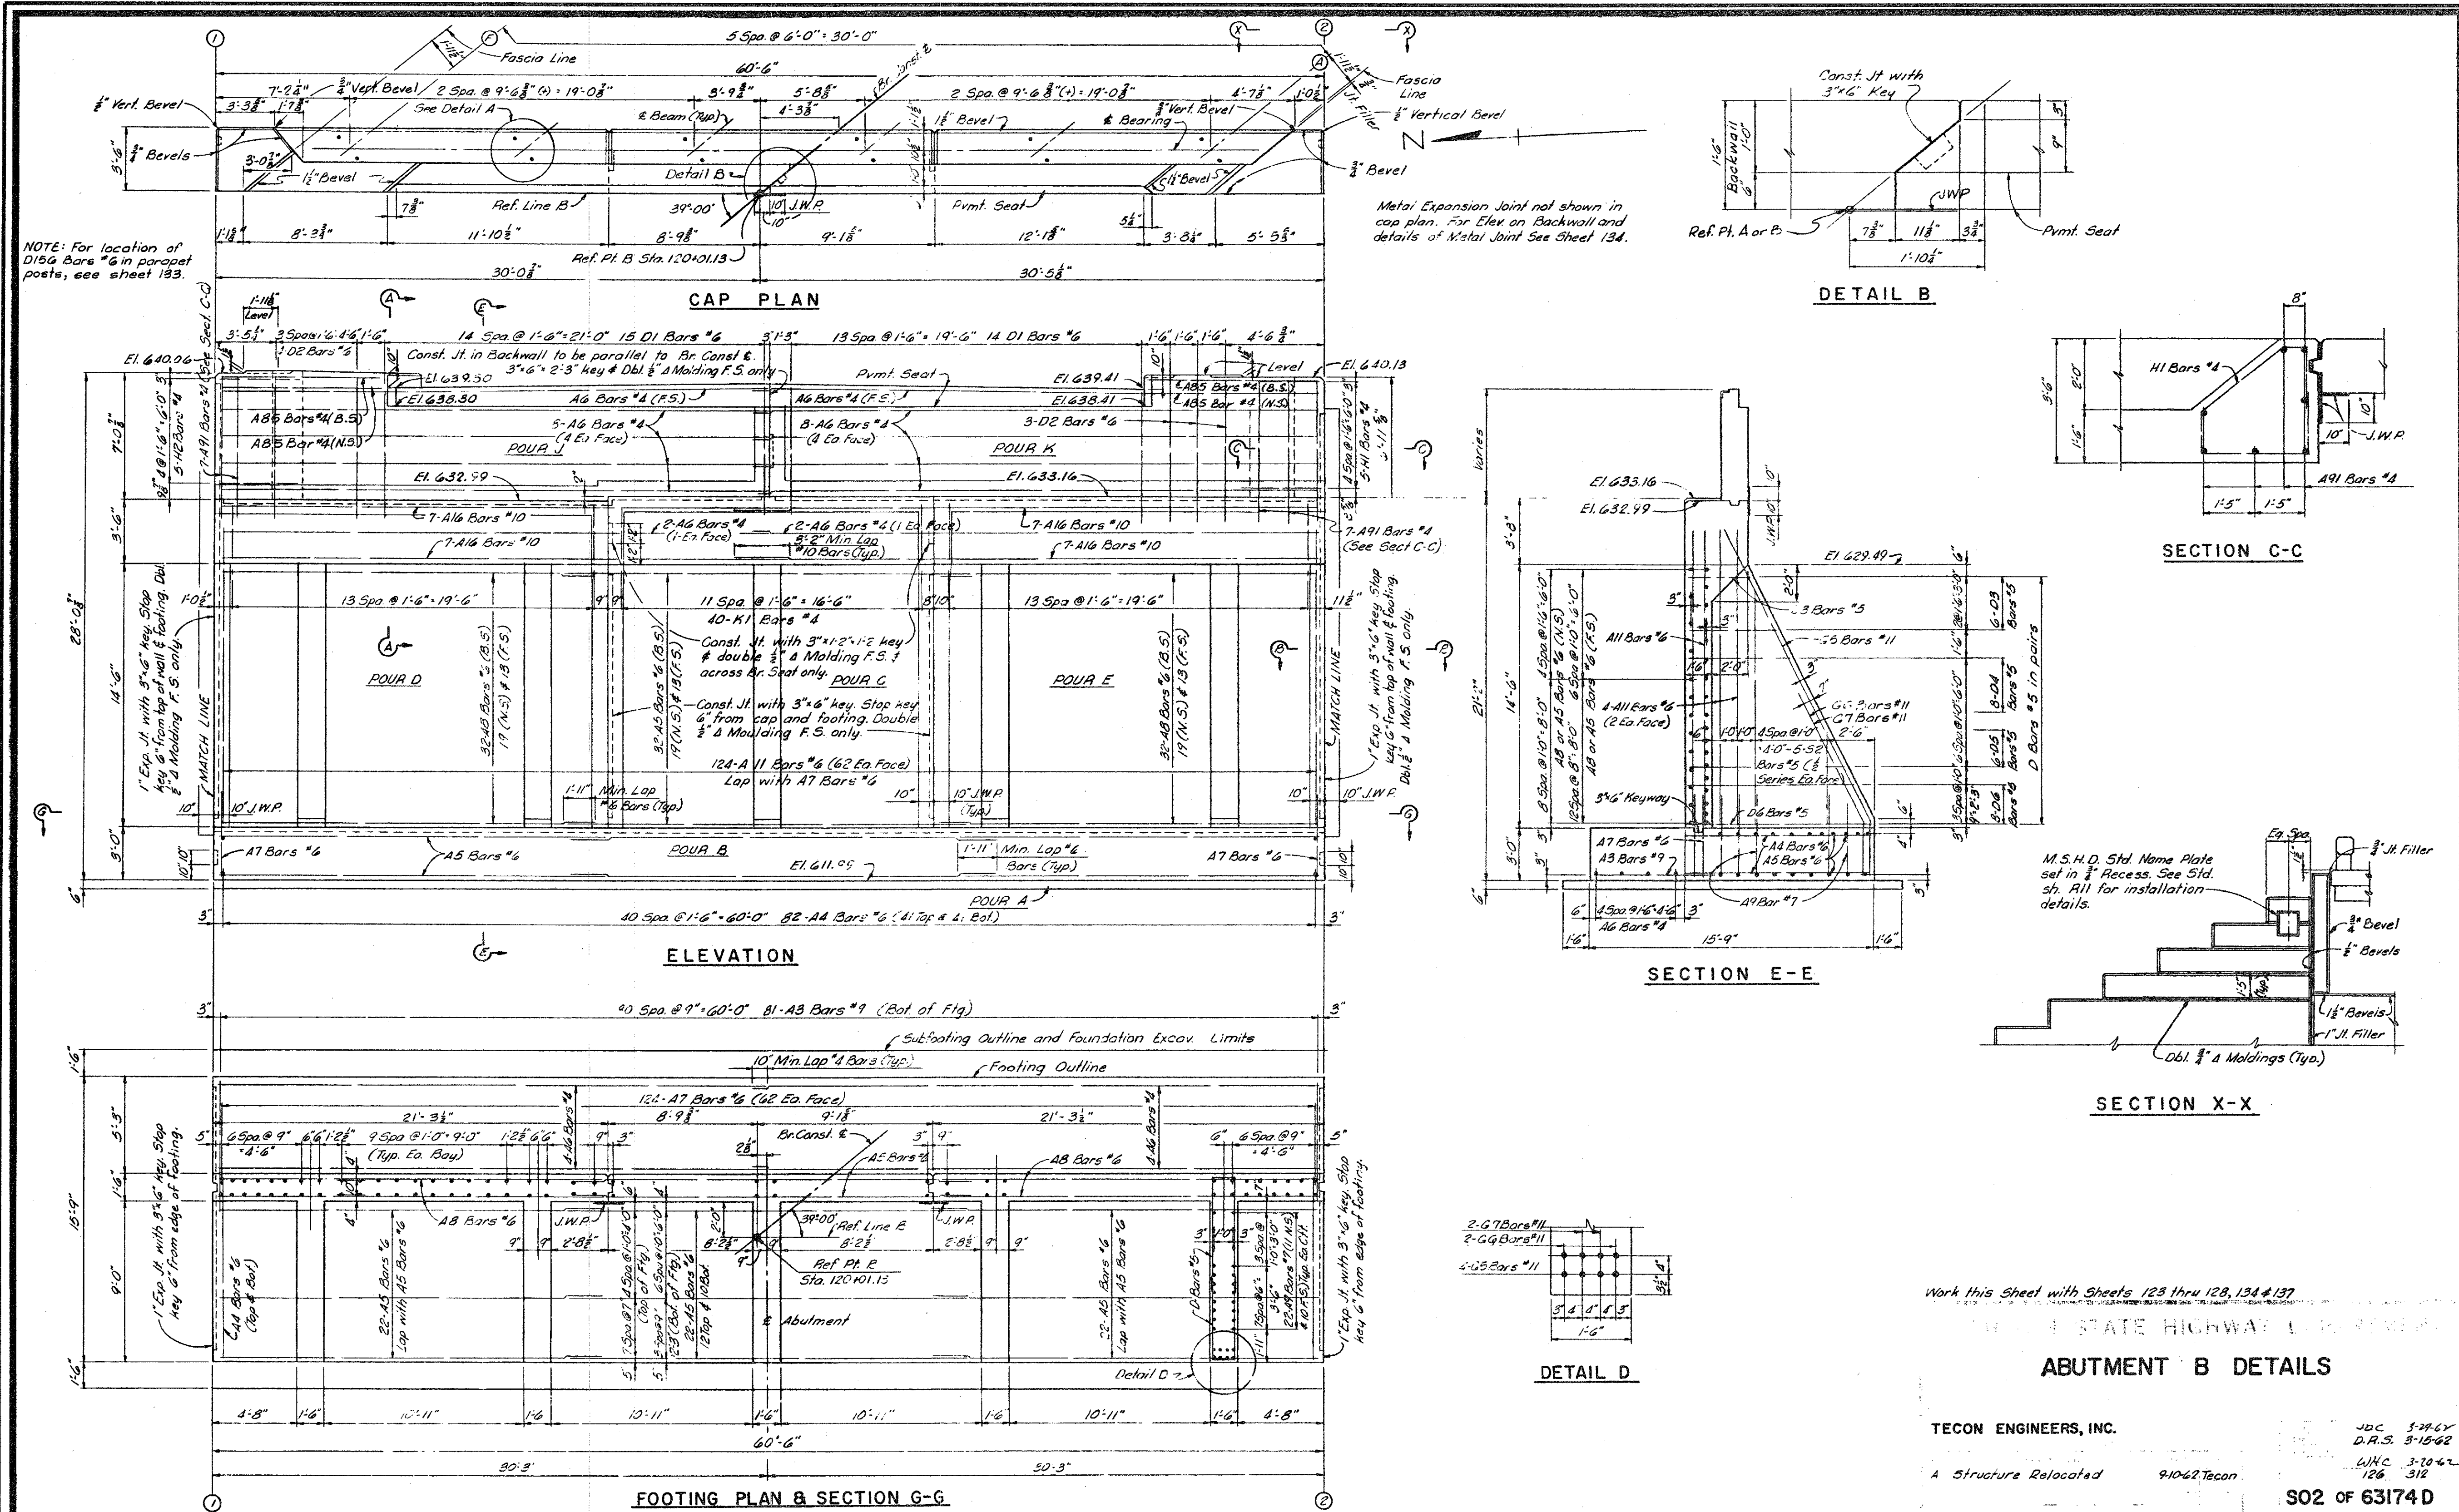


REVISIONS			
NO.	DESCRIPTION	DATE	BY

NOTE:
DO NOT WORK FROM THIS SHEET. THE INFORMATION SHOWN
HERE IS FOR REFERENCE ONLY. NO PAY ITEMS ARE SHOWN.

Work this Sheet with Sheets 123 thru 128, 134 & 137.
 STATE HIGHWAY DEPARTMENT
ABUTMENT B DETAILS
 TECON ENGINEERS, INC.
 JDC 5-26-67
 D.A.S. 5-15-68
 W.H.C. 3-20-62
 126 312
S02 of 63174 D

FOR INFORMATION ONLY				
DATE	CONT. SEC.	JOB NO.	DESIGN UNIT	SHEET
10/13/99	S02 OF 63174	484044	MAHDAVI	11 OF 29

1 2 3 4 5 6 7 8 9 10 11 12 13 14 15 16 17 18 19 20 21 22 23 24 25 26 27 28 29 30 31 32 33 34 35 36 37 38 39 40 41 42 43 44 45 46 47 48 49 50 51 52 53 54 55 56 57 58 59 60 61 62 63

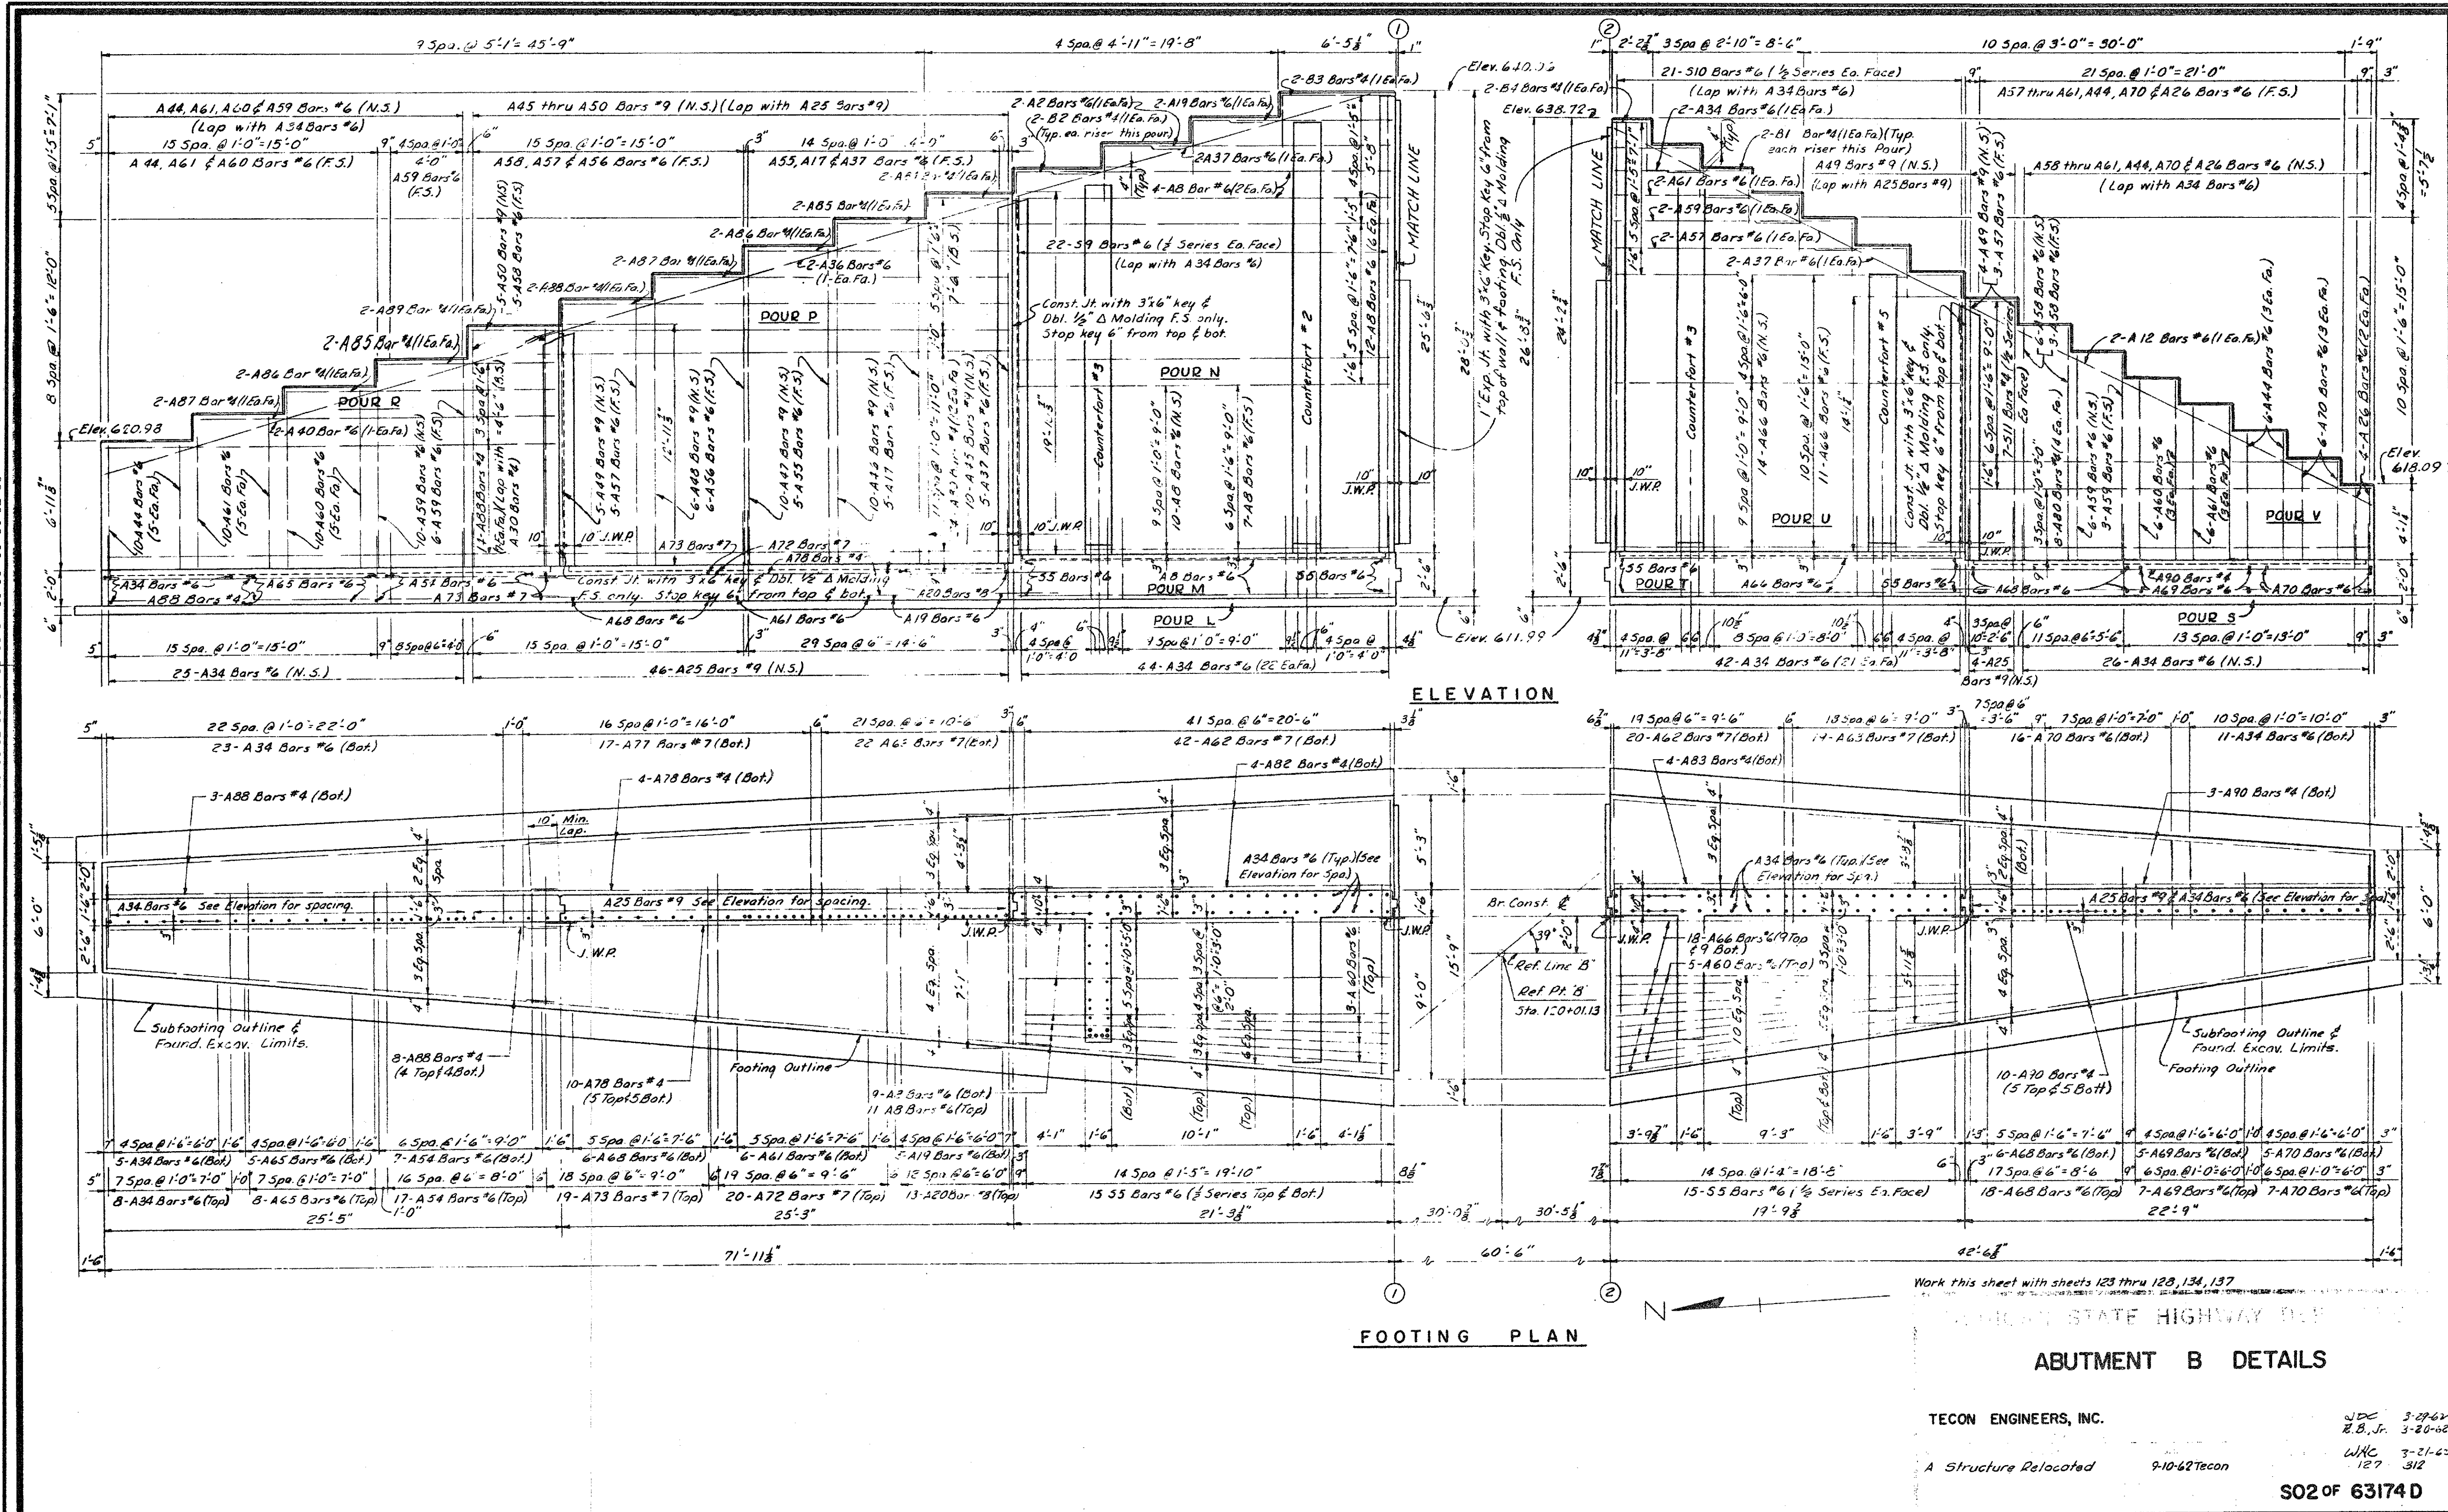

REVISIONS			
NO.	DESCRIPTION	DATE	BY

ELEVATION

FOOTING PLAN

ABUTMENT B DETAILS

TECON ENGINEERS, INC.
 A Structure Relocated 9-10-62 Tecon
 JDC 3-29-62
 R.B.Jr. 3-20-62
 WJC 3-21-62
 127 312
S02 OF 63174 D


NOTE:
 DO NOT WORK FROM THIS SHEET. THE INFORMATION SHOWN
 HERE IS FOR REFERENCE ONLY. NO PAY ITEMS ARE SHOWN.

FOR INFORMATION ONLY				
DATE	CONT. SEC.	JOB NO.	DESIGN UNIT	SHEET
10/13/99	S02 OF 63174	48404A	MAHDAVI	12 OF 29




DRAWN BY: R.K.O.LIN CHECKED BY: DATE: 10/99 CORRECTED BY: DATE:


1 2 3 4 5 6 7 8 9 10 11 12 13 14 15 16 17 18 19 20 21 22 23 24 25 26 27 28 29 30 31 32 33 34 35 36 37 38 39 40 41 42 43 44 45 46 47 48 49 50 51 52 53 54 55 56 57 58 59 60 61 62 63

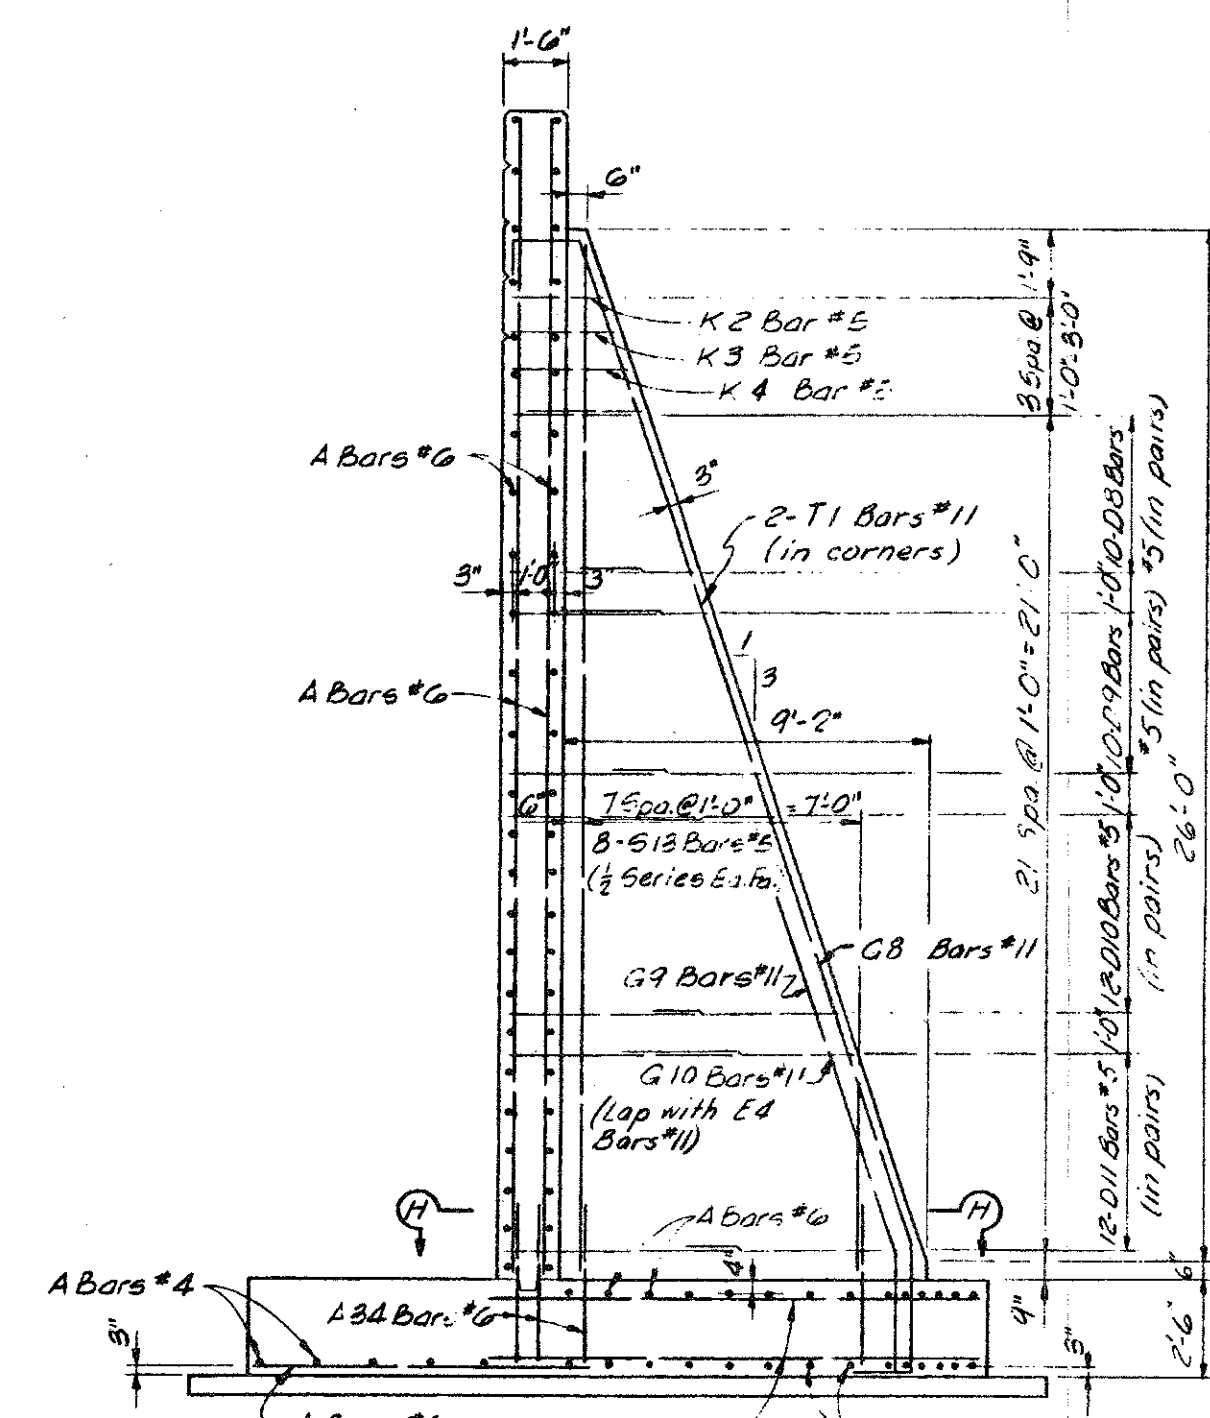


TYPICAL COUNTERFORT SECTION B COUNTERFORT #1

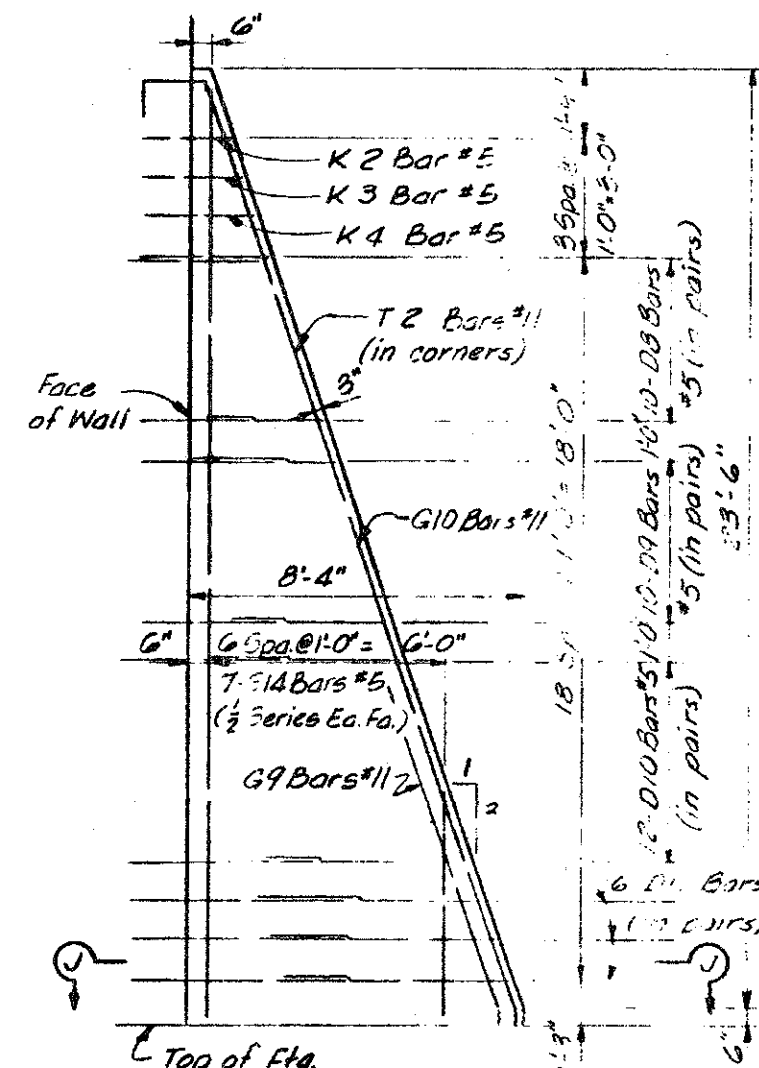


COUNTERFORT #2

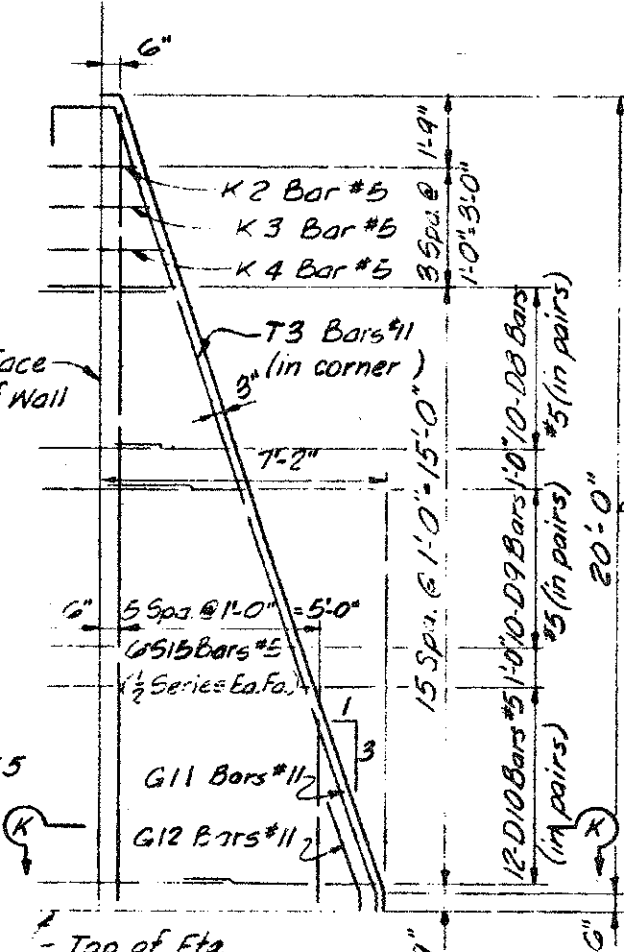

COUNTERFORT #3

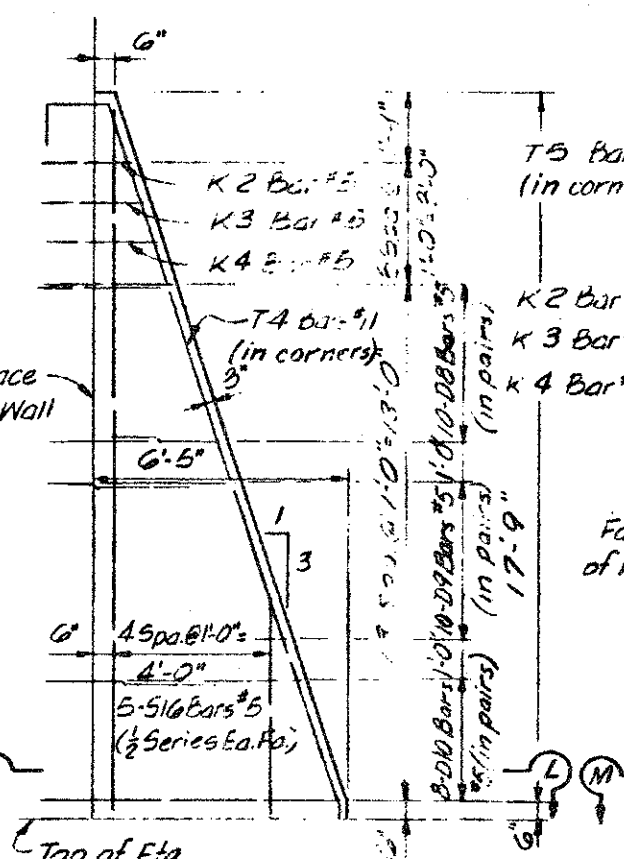

COUNTERFORT #4

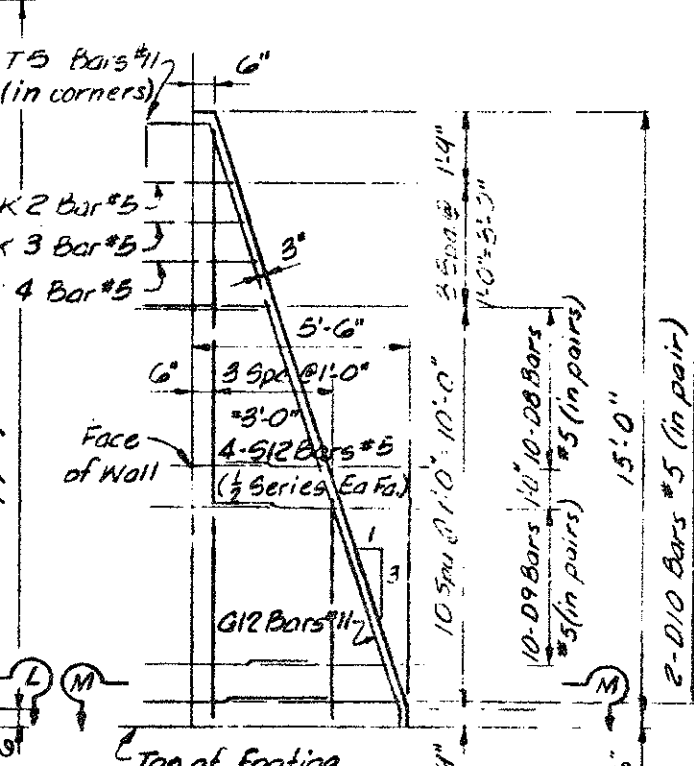

COUNTERFORT #5




MISCELLANEOUS QUANTITIES				
ITEM	UNIT	ABUT. A	ABUT. B	TOTAL
1/4" Joint Filler	Sq. Ft.	34	16	50
3/4" Joint Filler	Sq. Ft.	2	2	4
1" Joint Filler	Sq. Ft.	16.4	7.3	23.7
Jt. Waterpro'g	Sq. Ft.	620	527	947
Unclass. Excon.	Cu Yds.	132.9	68.4	200.7

POUR	ABUTMENT A		ABUTMENT B	
	A(6A)	A(6AA)	A(6A)	A(6AA)
A	24.4		21.0	
B	126.0		106.1	
C		38.9		28.3
D		48.9		37.4
E		49.7		37.4
F		Not Used		Used
G		Not Used		Used
H		Not Used		Used
J	11.5		13.2	
K	13.0		11.5	
L	14.6		18.7	
M	53.2		63.7	
N		41.7		38.9
P		18.9		24.4
R	23.7			14.1
S	100.1		11.2	
T		49.3		39.5
U		41.1		28.8
V		39.2		12.1
W	20.8			
X	73.5			
Y		34.5		
Z		26.0		
A-A		24.1		
B-B	10.2			
C-C	29.9			
D-D		15.3		
E-E		16.5		
F-F	17.1			
G-G	52.5			
H-H		18.4		
J-J		20.3		
K-K		22.2		
Total	544.0	527.5	2600	245.5

Pours need not be made in alphabetical order, except pours H-H, J-J & K-K are to be made last.

NOTES:

- J.W.P. denotes joint waterproofing.
- N.S. denotes nearside.
- F.S. denotes forside.
- B.S. denotes botmsides.
- For Bevel and Molding Details, see Standard Sheet R11.
- For location of Name Plates, see Sheet 107 and Standard Sheet R11; for mounting Details, see Standard Sheet R11.
- Anchor bolts shall be set accurately to a template.
- The Project Engineer shall adjust the spacing of the reinforcing steel to permit placing of anchor bolts.
- Field bend steel reinforcing to clear drain holes.
- The top of abutment shall be finished to a true plane at the elevation shown and shall not vary more than 1/8" under a ten foot straight edge nor more than 1/4" under any bearing.
- Design is based on a maximum foundation pressure of 5350 pounds per square foot and a maximum average foundation pressure of 3100 pounds per square foot.

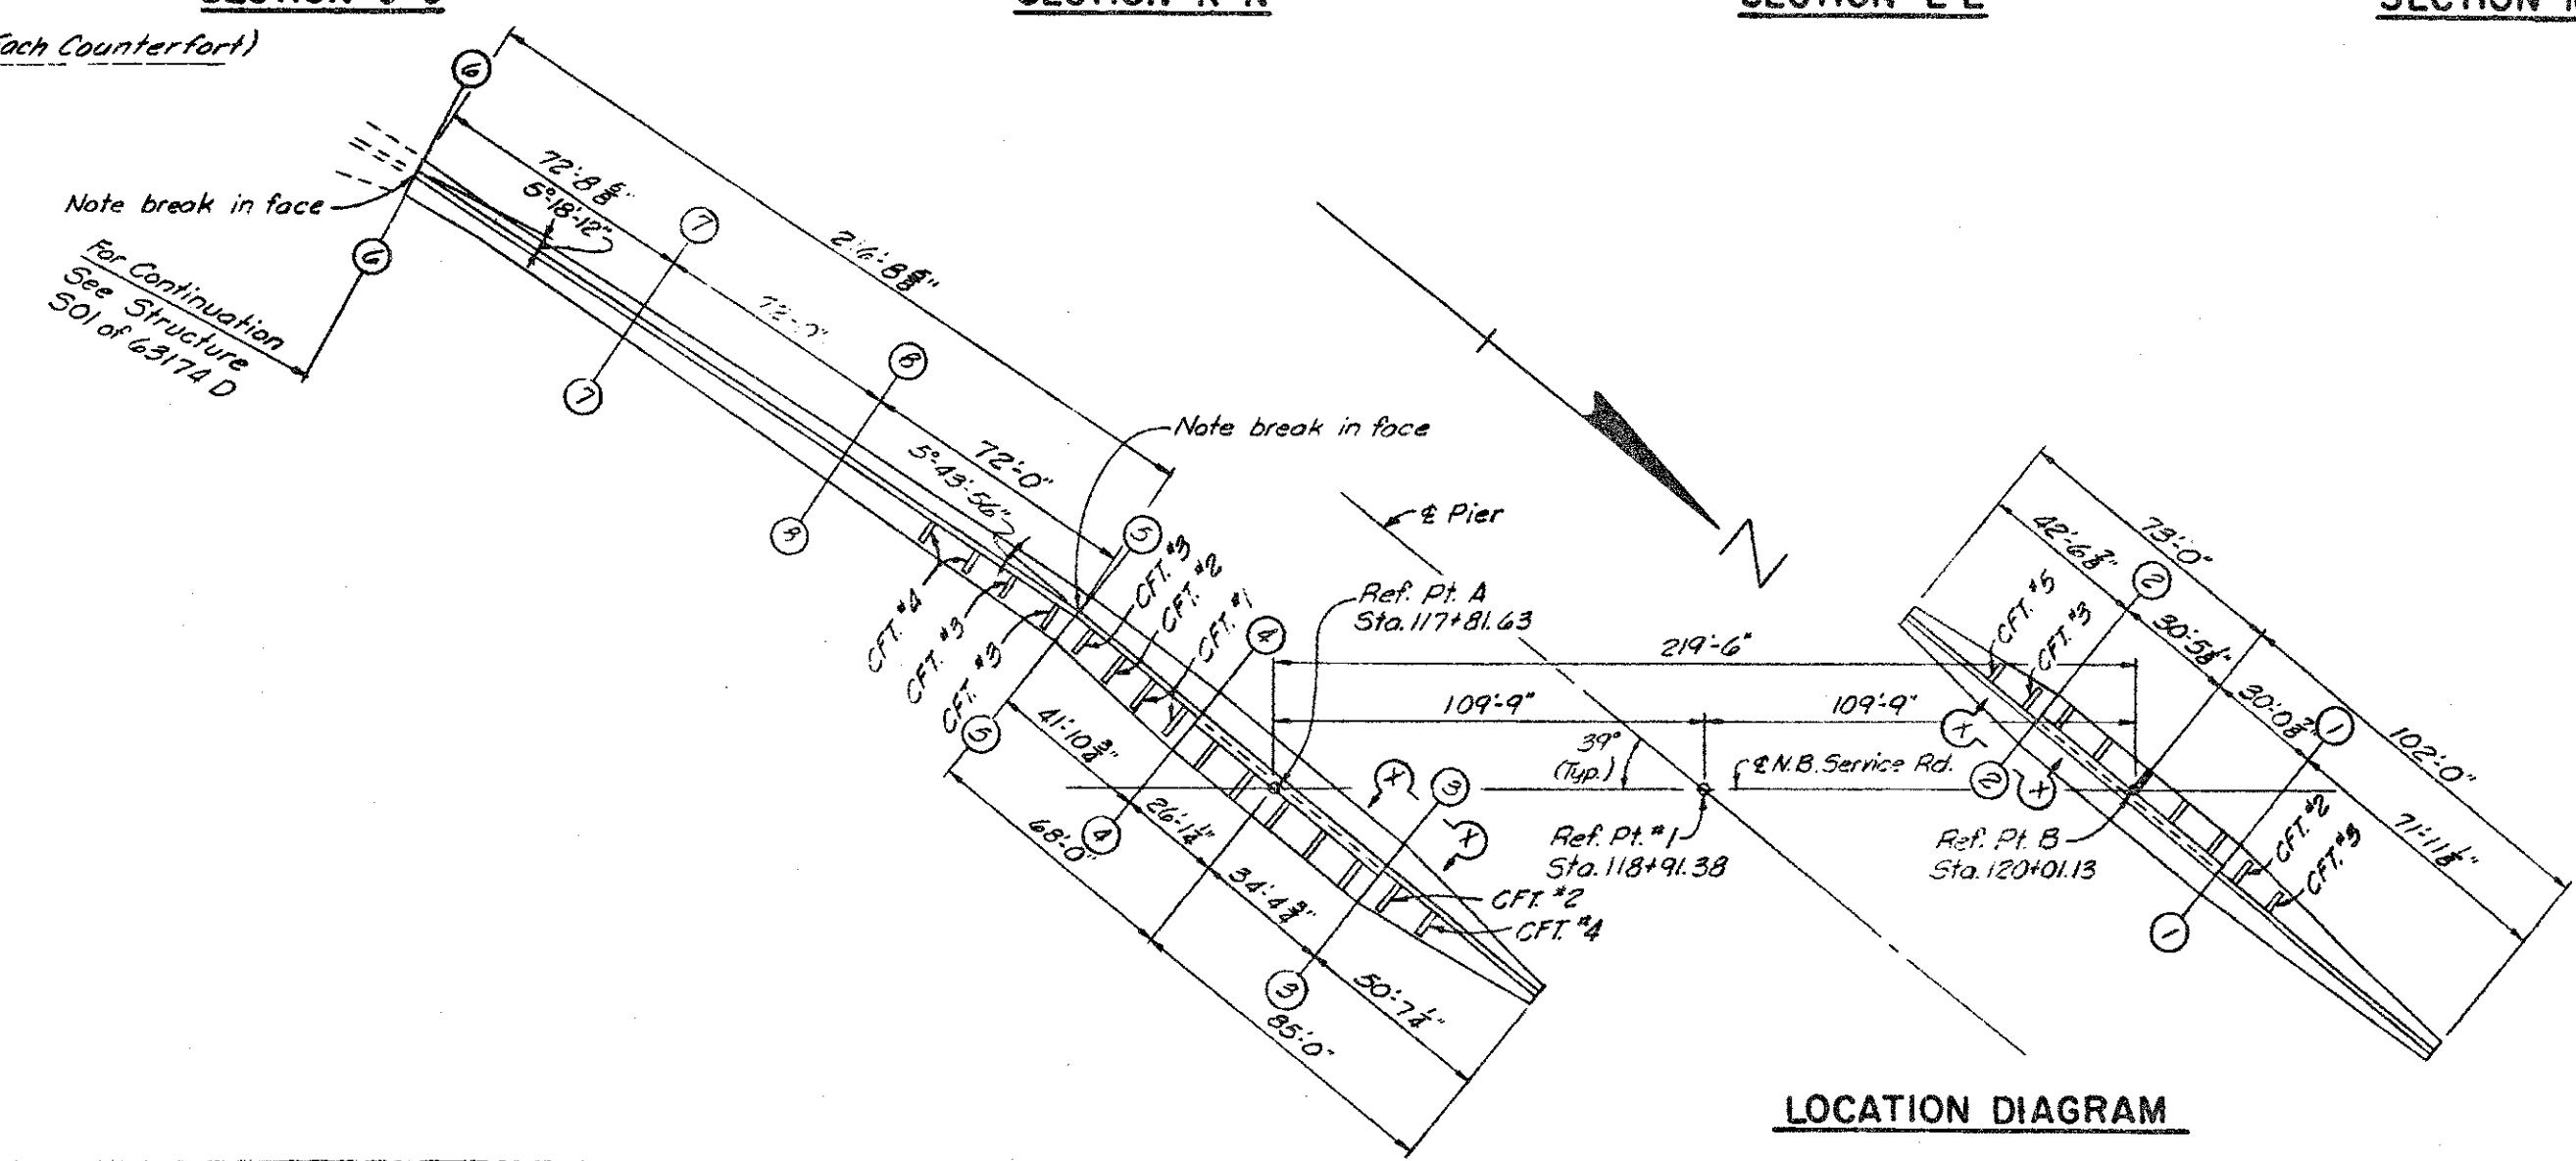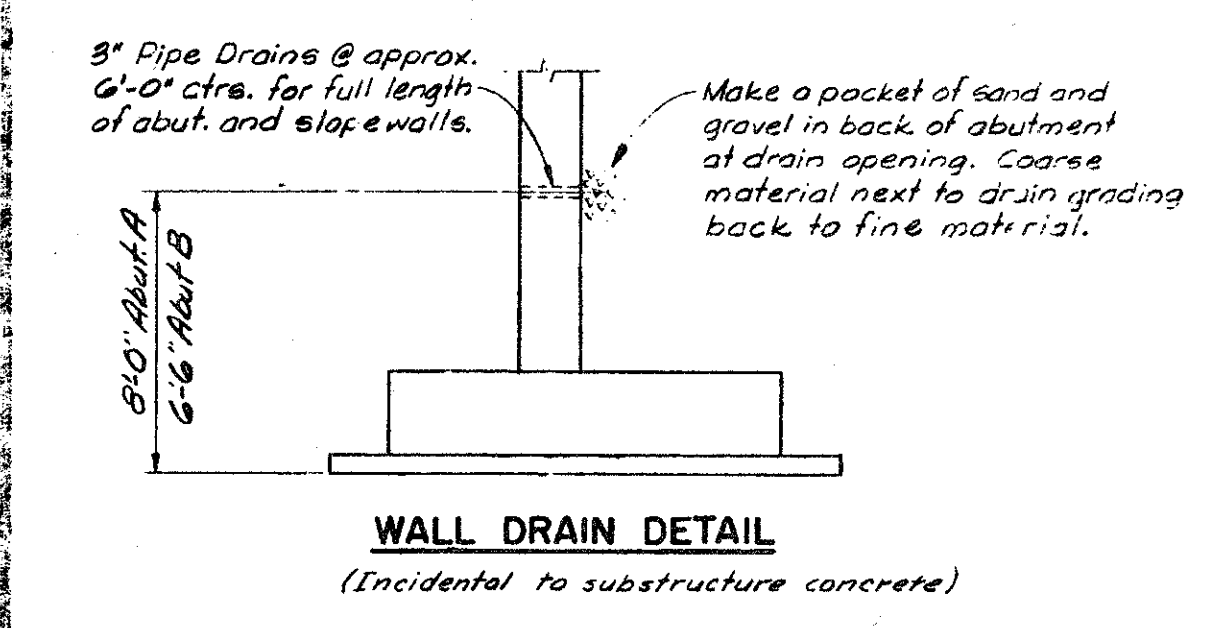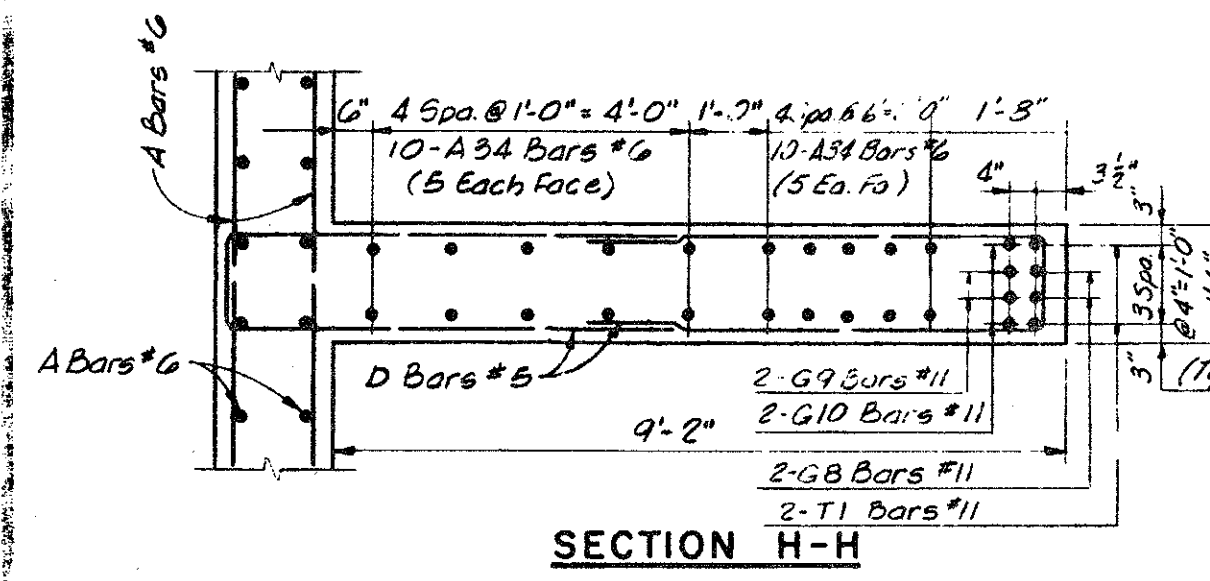

Work this sheet with sheets 123 thru 128, 134 and 137

INDIAN STATE HIGHWAY DEPARTMENT

ABUTMENT DETAILS

TECON ENGINEERS, INC.

A Structure Relocated 9-10-62 Tecon

JDC 3-24-62
AEB 3-22-62
WAC 3-24-62
128 312

502 OF 63174 D








NOTE:
DO NOT WORK FROM THIS SHEET. THE INFORMATION SHOWN HERE IS FOR REFERENCE ONLY. NO PAY ITEMS ARE SHOWN.



FOR INFORMATION ONLY				
DATE	CONT. SEC.	JOB NO.	DESIGN UNIT	SHEET
10-14-99	S02 OF 63174	48404A	MADHAVI	13 OF 29

DRAWN BY: rander DATE: CHECKED BY: DATE: CORRECTED BY: DATE: REVISIONS: NO. DESCRIPTION DATE BY

REVISIONS			
NO.	DESCRIPTION	DATE	BY

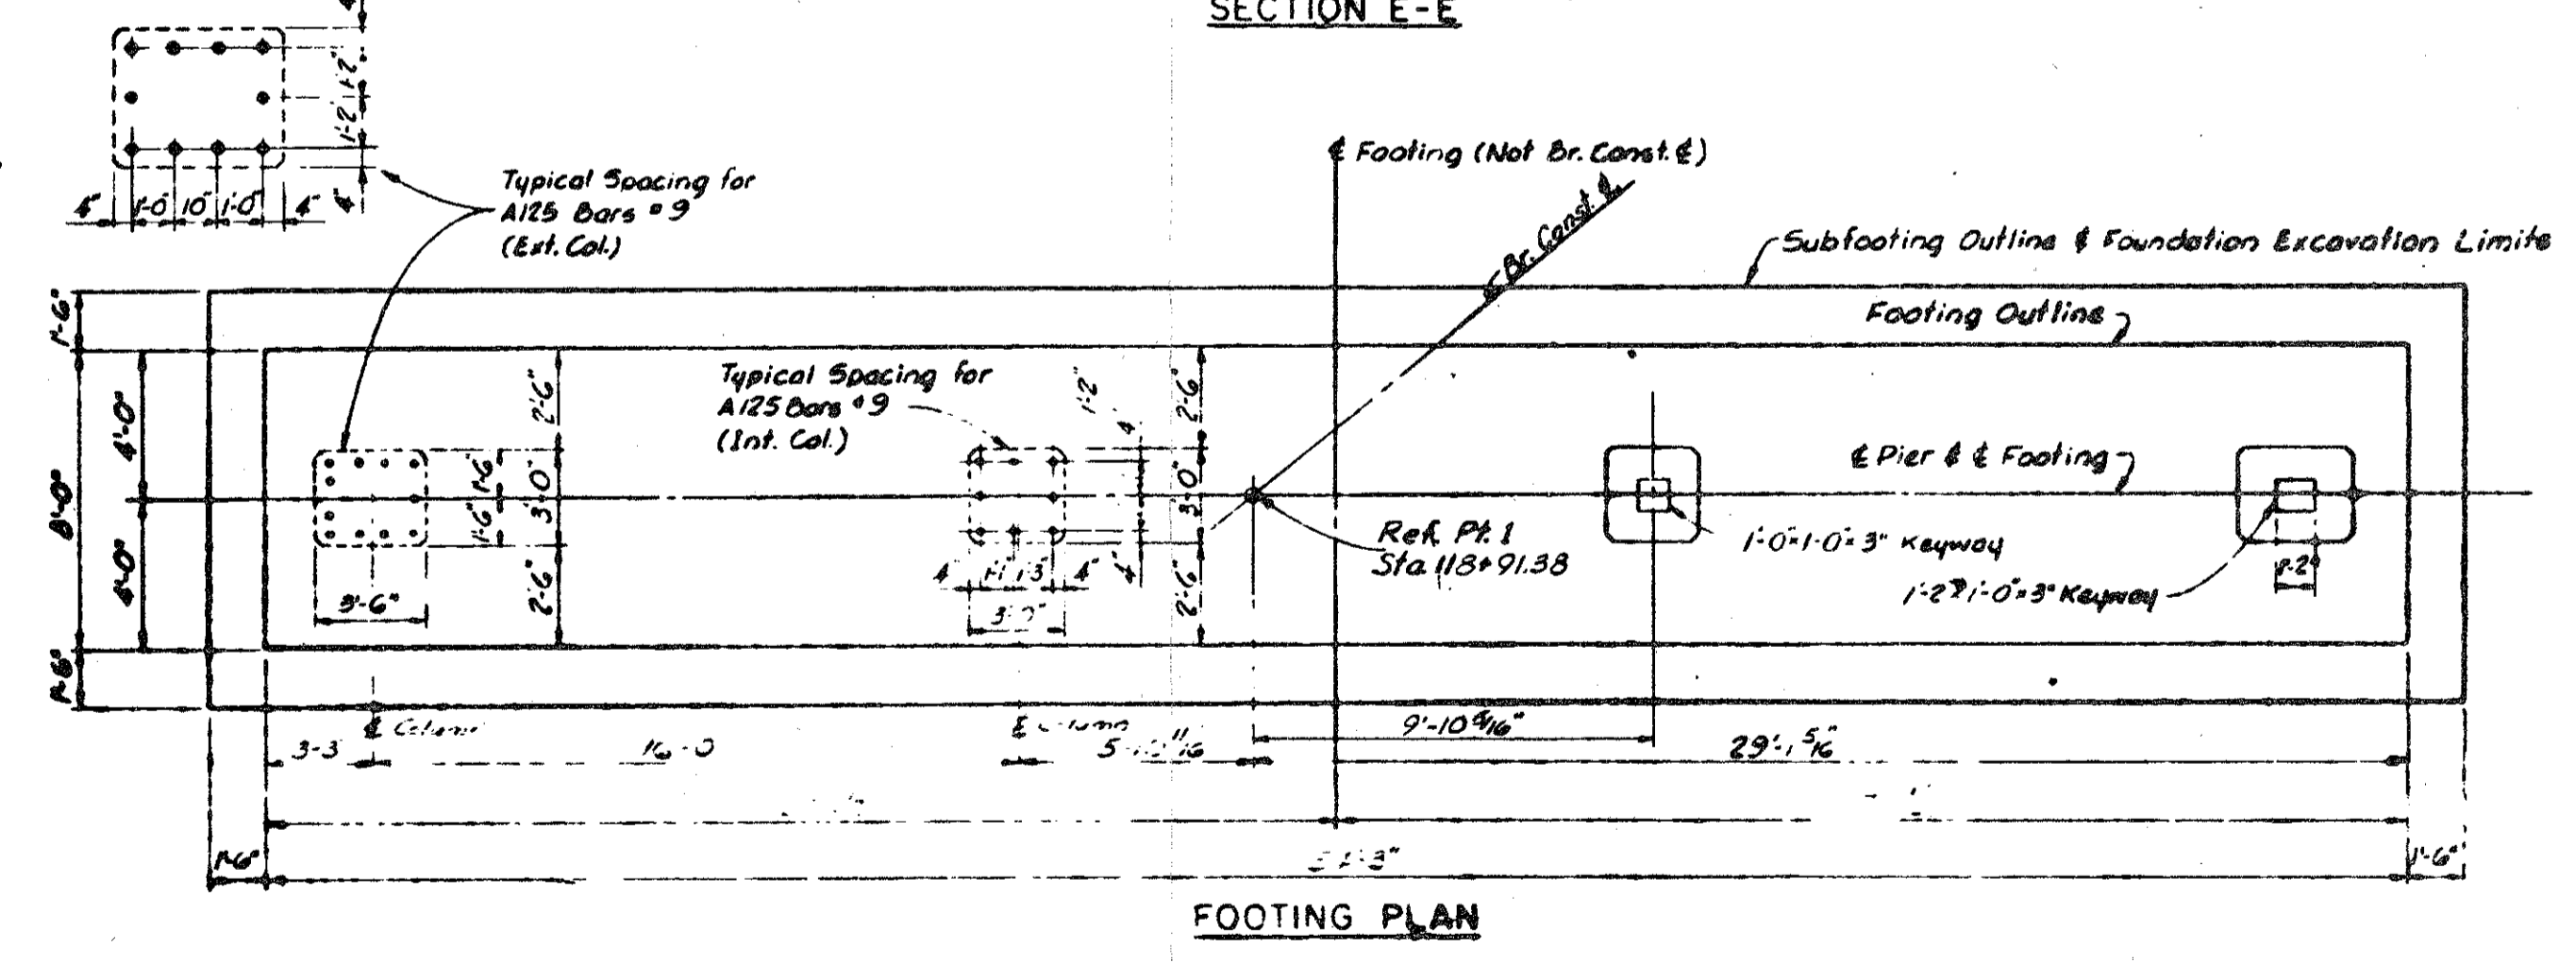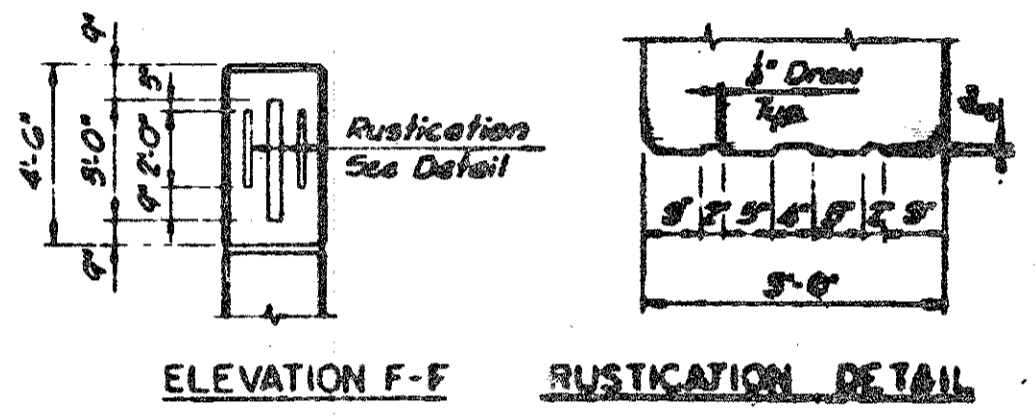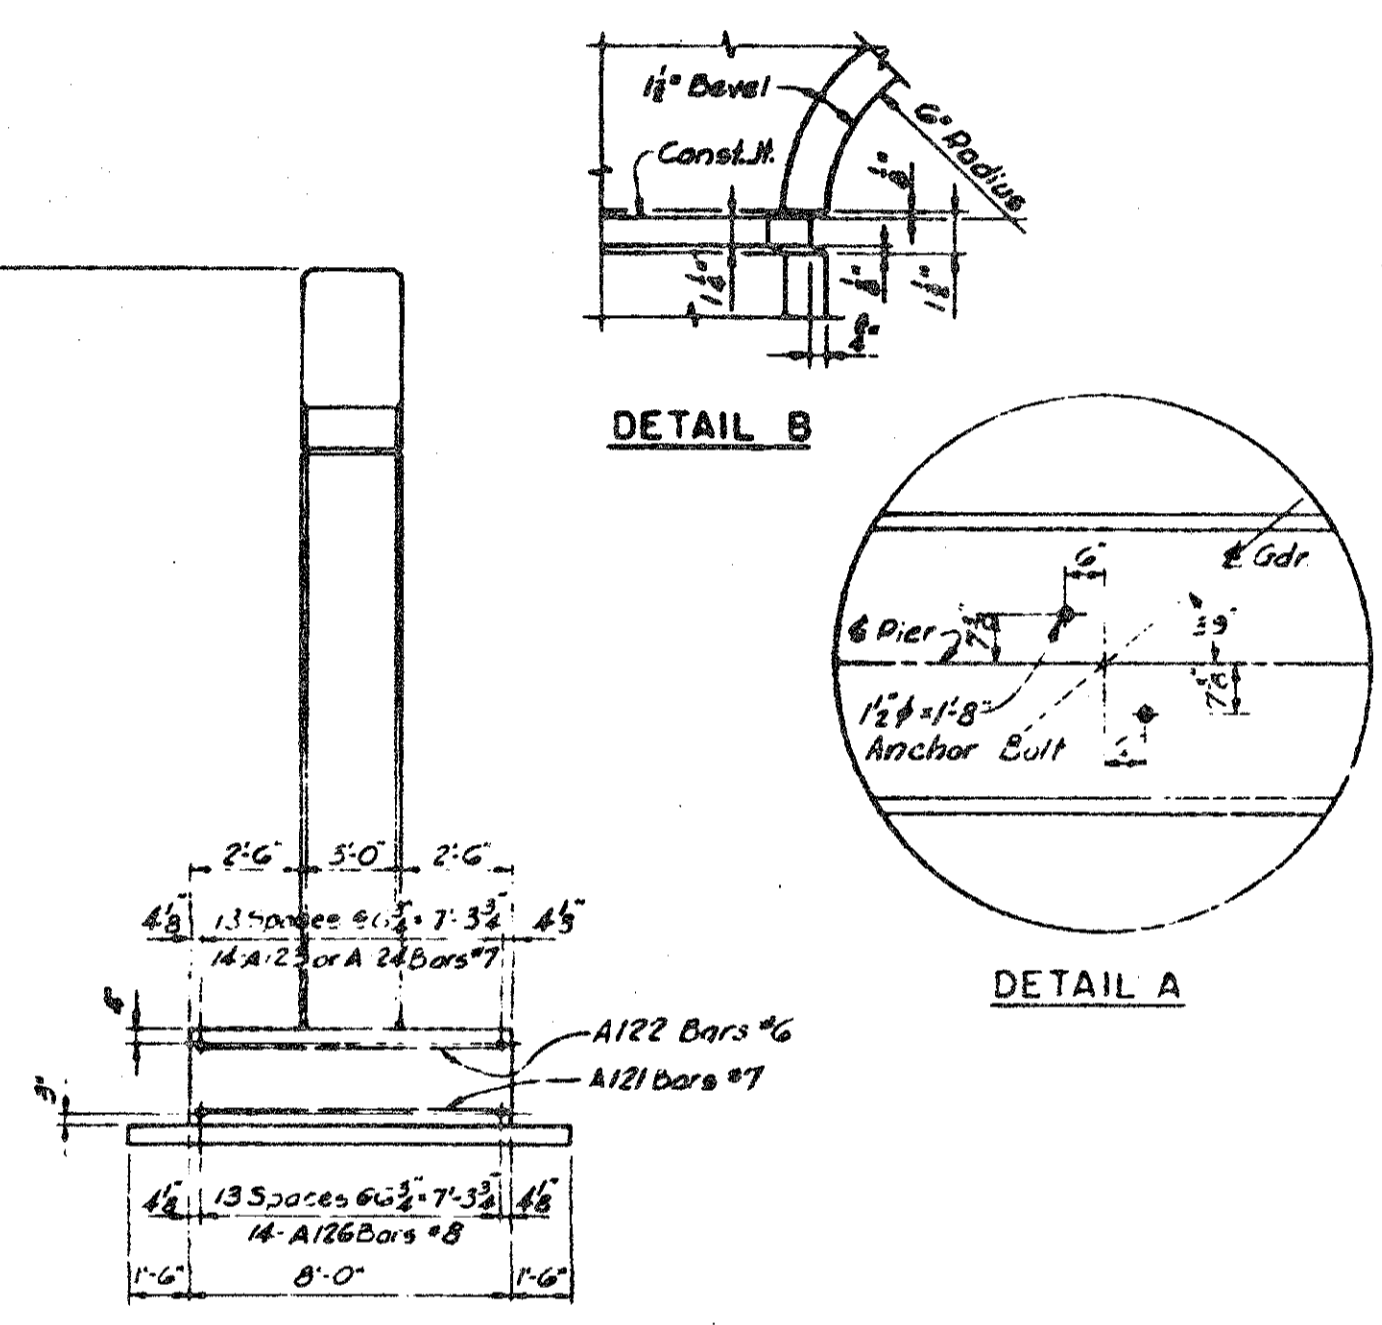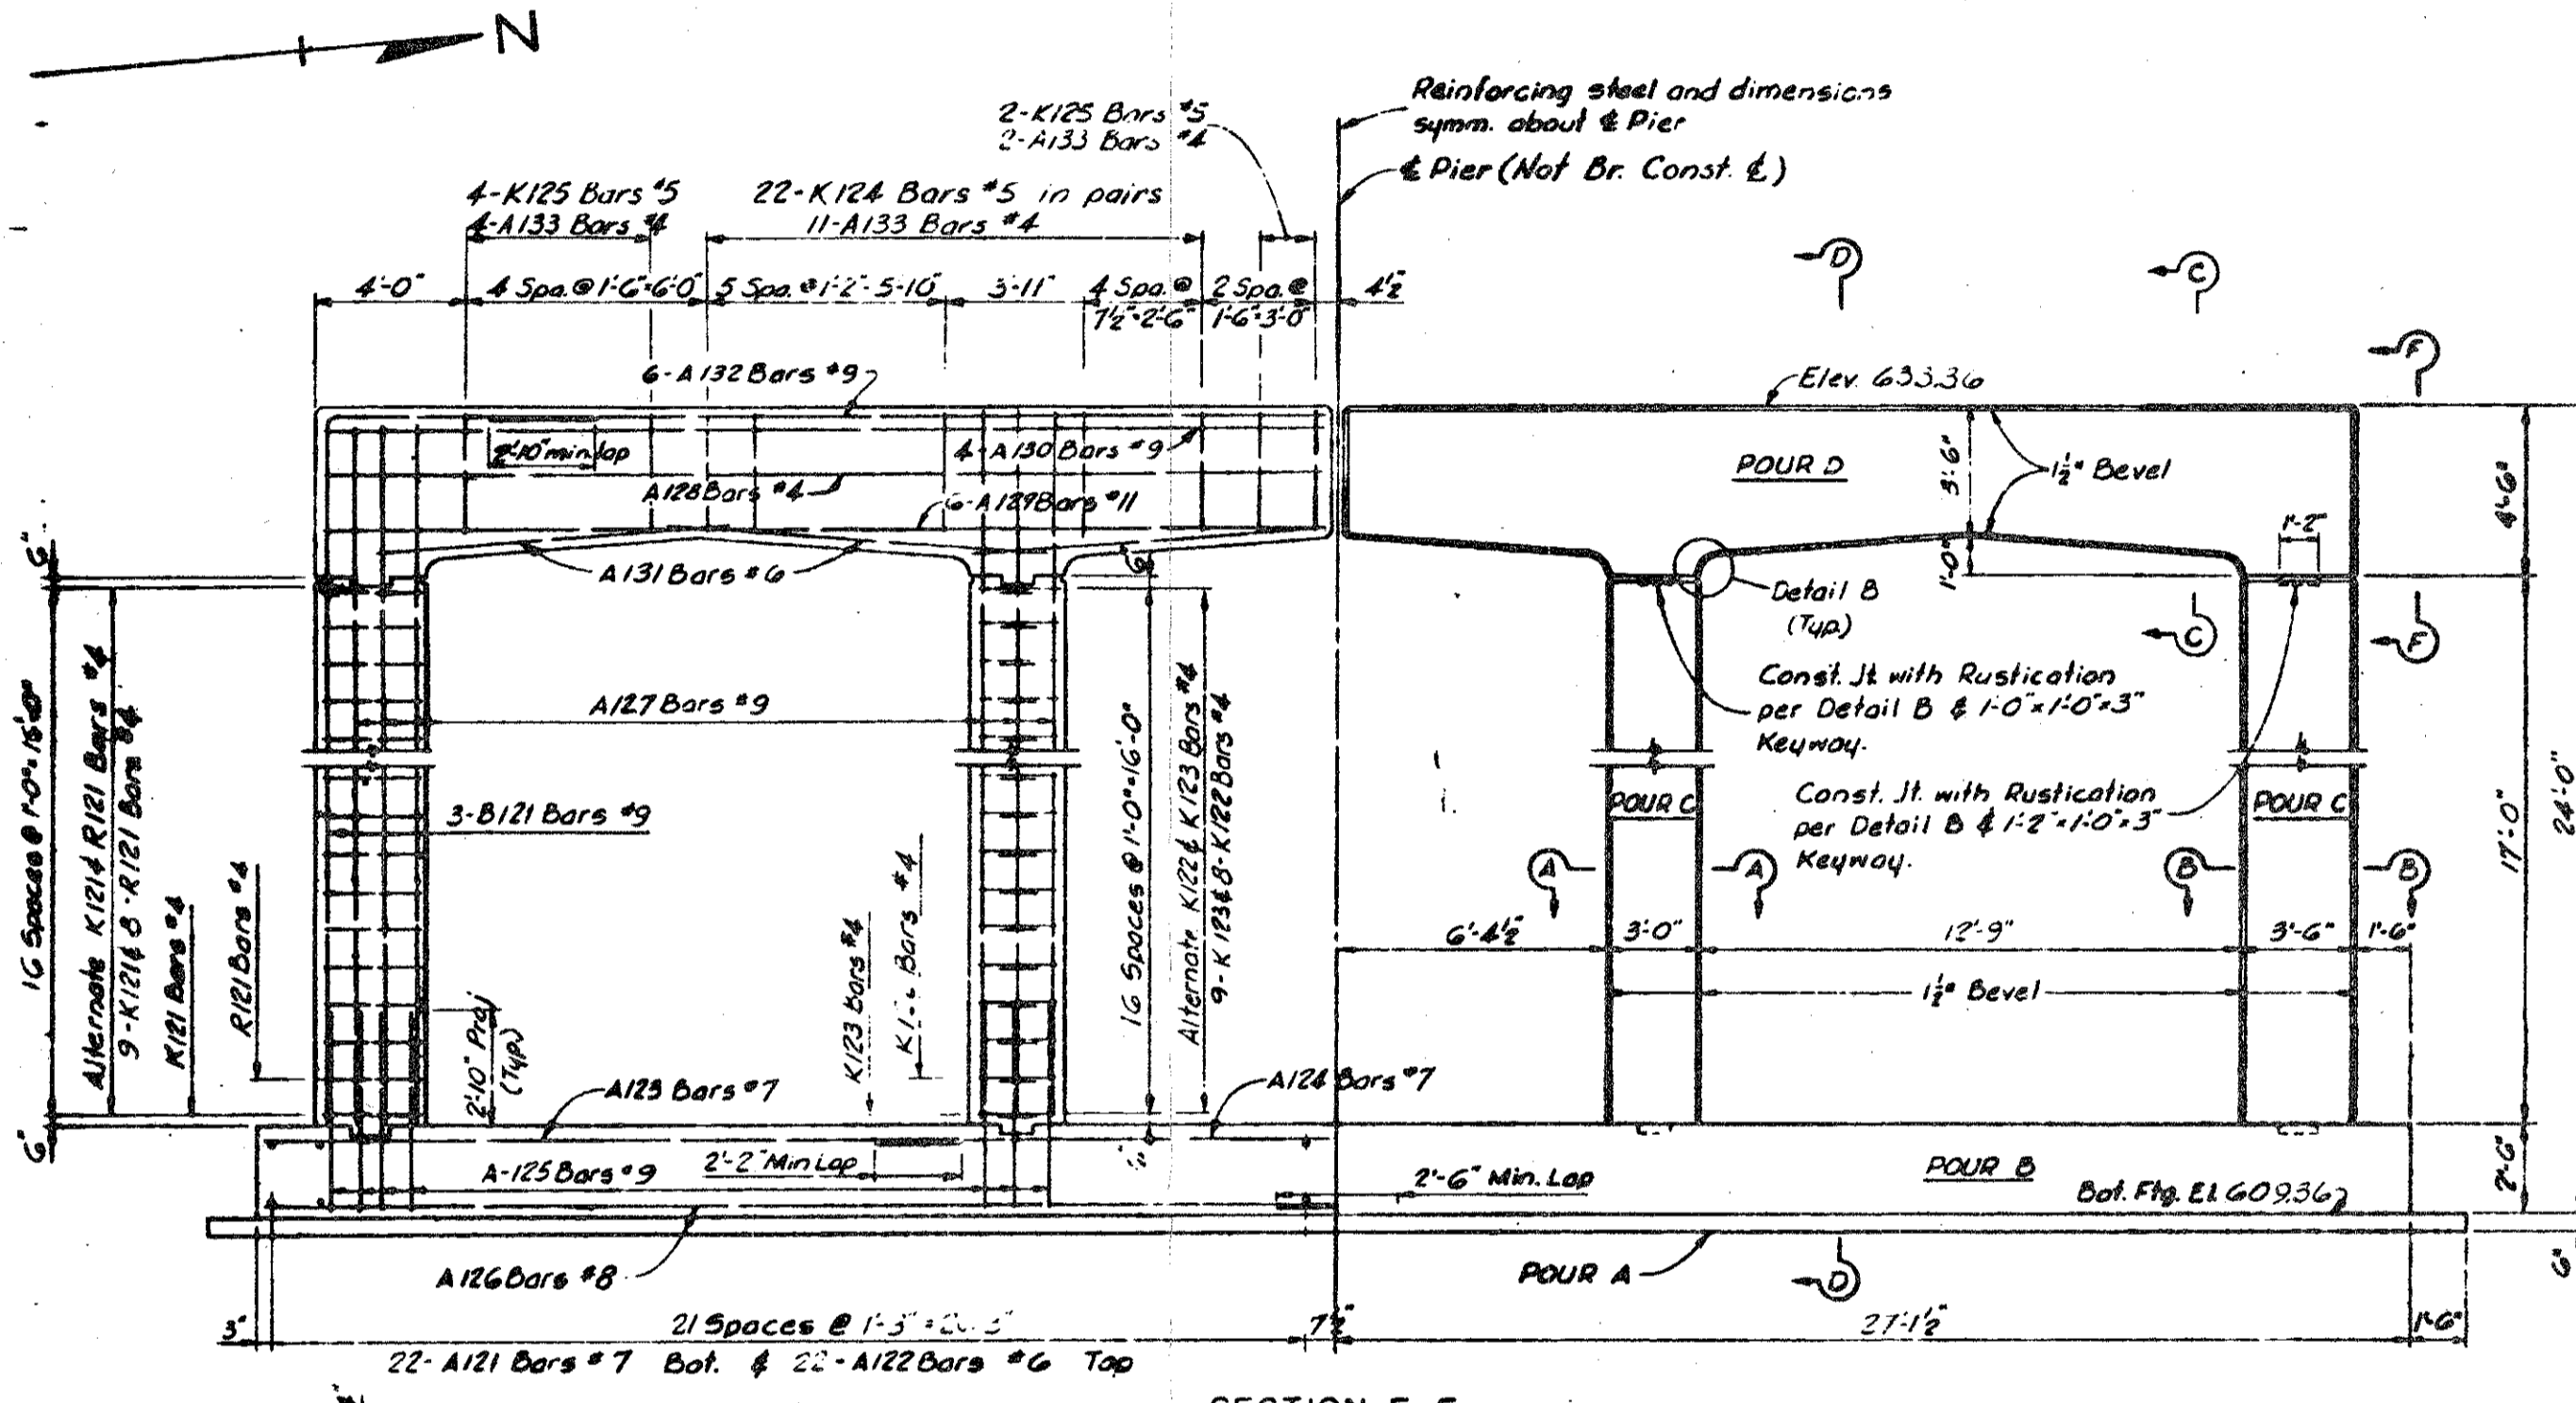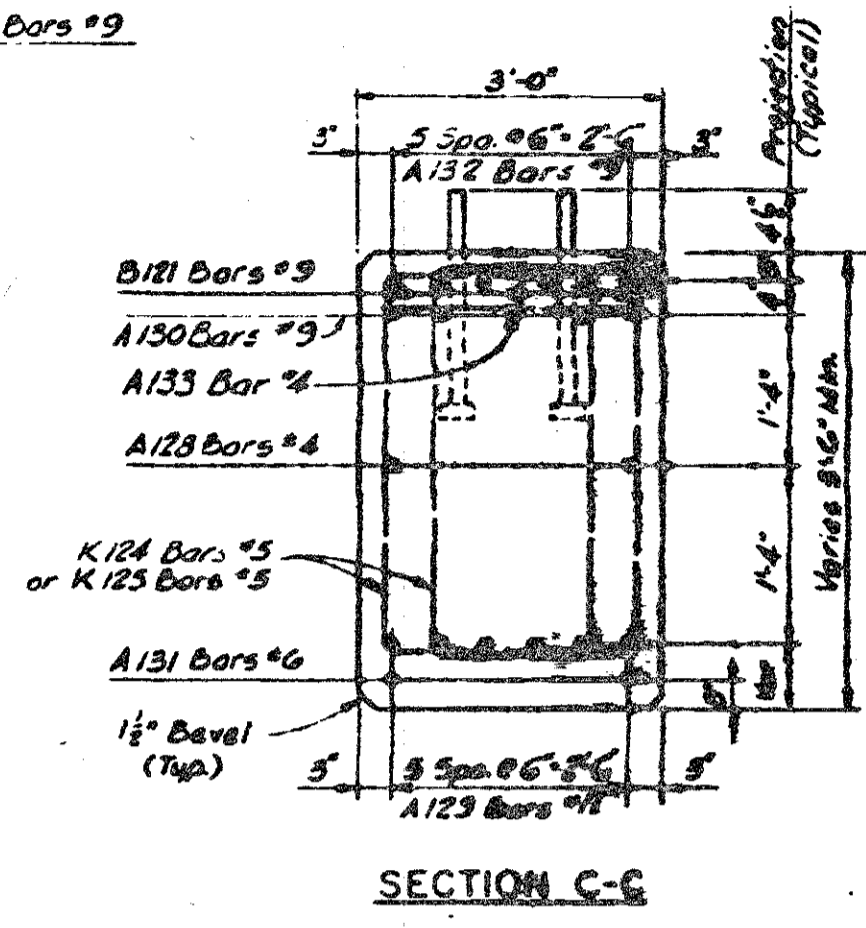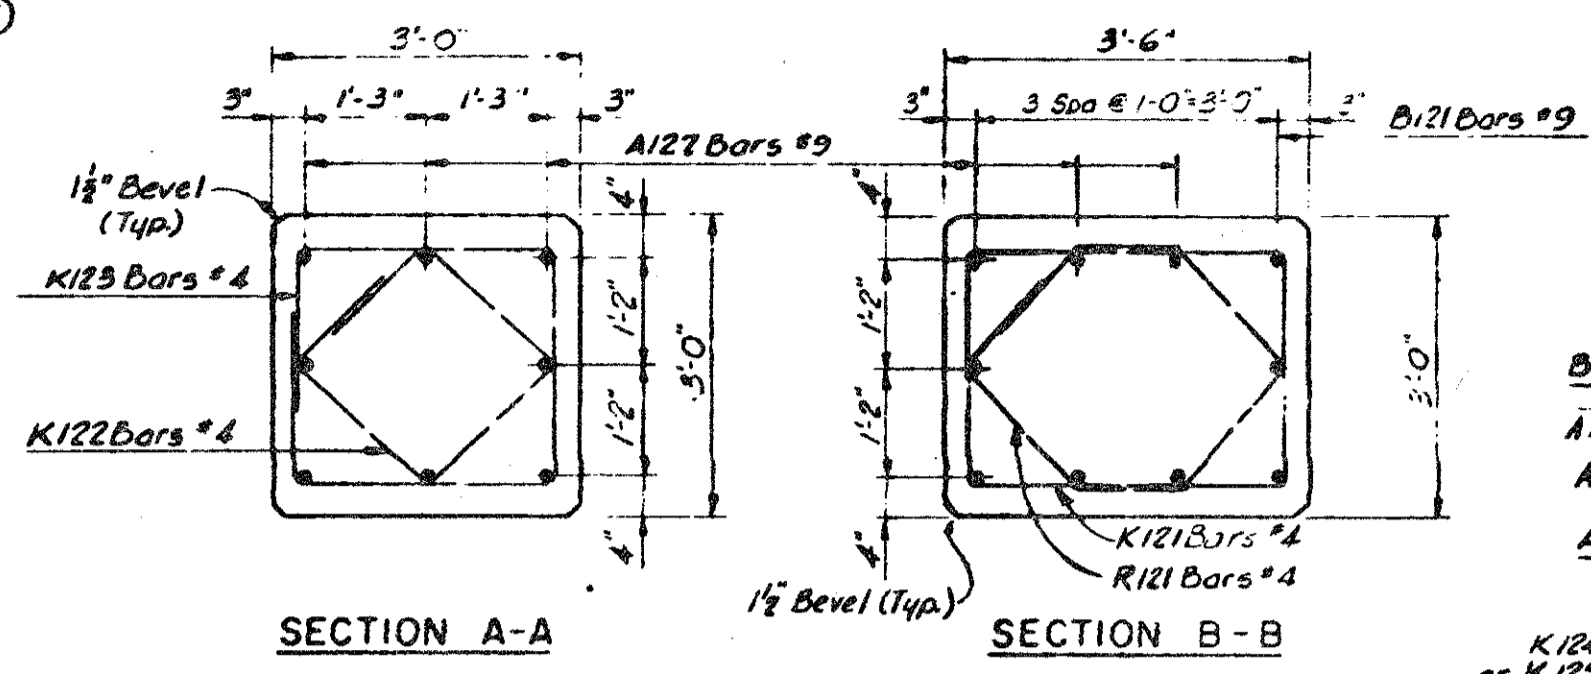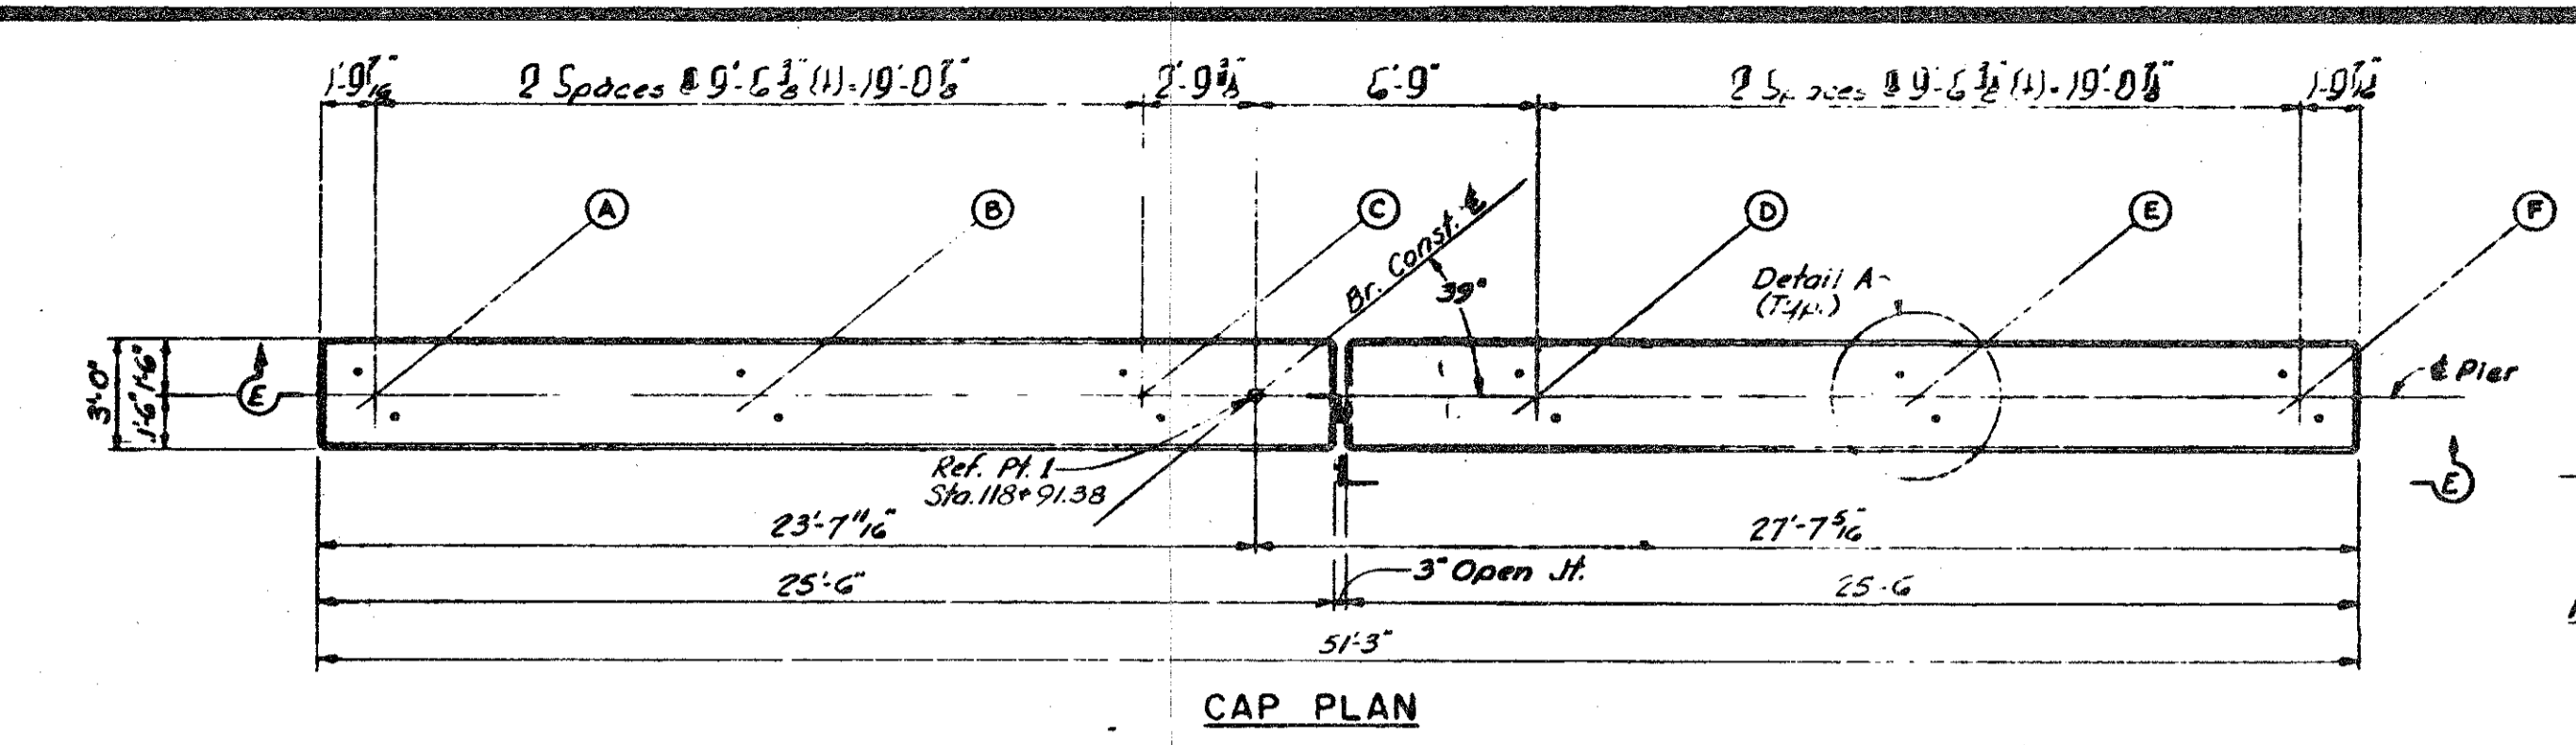

CONCRETE QUANTITIES - CU YDS			
POUR	LOCATION	OR (A) (B) (C) (D)	QUANTITY
A	Footings	1/1	40.3
B	Footings		
C	Column		28.6
D	Cap		22.4
MISCELLANEOUS QUANTITIES			
ITEM	UNITS	QUANTITY	
Class 1-1 Excav	Cu. Yds	63	

NOTES

- *For Bevels and Molding Details, see Standard Sheet R11.
- *Anchor Bolts shall be set accurately to a template.
- *The Project Engineer shall adjust the spacing of the reinforcing steel as required to permit placing of the anchor bolts.
- *The top of pier shall be finished to a true plane at the elevations shown and shall not vary more than 1/8" under a 10m flat straight edge, nor more than 1/16" under any bearing.
- *This design is based on a maximum foundation pressure of 4,050 lb/ft² and a maximum average foundation pressure of 3,850 lb/ft².

**MICHIGAN STATE HIGHWAY DEPARTMENT
PIER DETAILS**

TECON ENGINEERS, INC.	
DESIGNED BY	JPC 3-2-99
CHECKED BY	WLS 3-2-99
DATE	3-2-99
PROJECT	Structure Relocated
DATE	9-10-98
BY	WLS

S02 of 63174D

NOTE:
DO NOT WORK FROM THIS SHEET. THE INFORMATION SHOWN
HERE IS FOR REFERENCE ONLY. NO PAY ITEMS ARE SHOWN.










FOR INFORMATION ONLY				
DATE	CONT. SEC.	JOB NO.	DESIGN UNIT	SHEET
10-14-99	S02 OF 63174	48404A	MADHAVI	14 OF 29

DRAWN BY: inder CHECKED BY: DATE: CORRECTED BY: DATE: FILE NAME: s0263174.snr

1 2 3 4 5 6 7 8 9 10 11 12 13 14 15 16 17 18 19 20 21 22 23 24 25 26 27 28 29 30 31 32 33 34 35 36 37 38 39 40 41 42 43 44 45 46 47 48 49 50 51 52 53 54 55 56 57 58 59 60 61 62 63

REVISIONS			
NO.	DESCRIPTION	DATE	BY

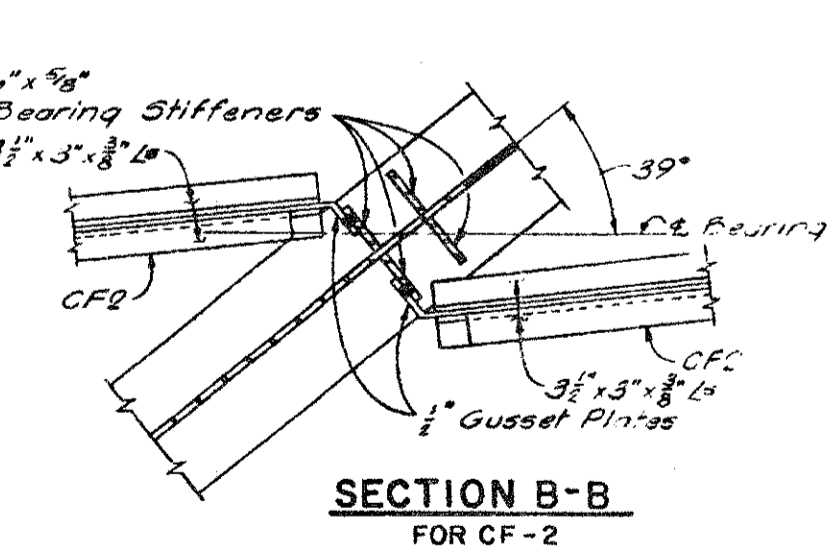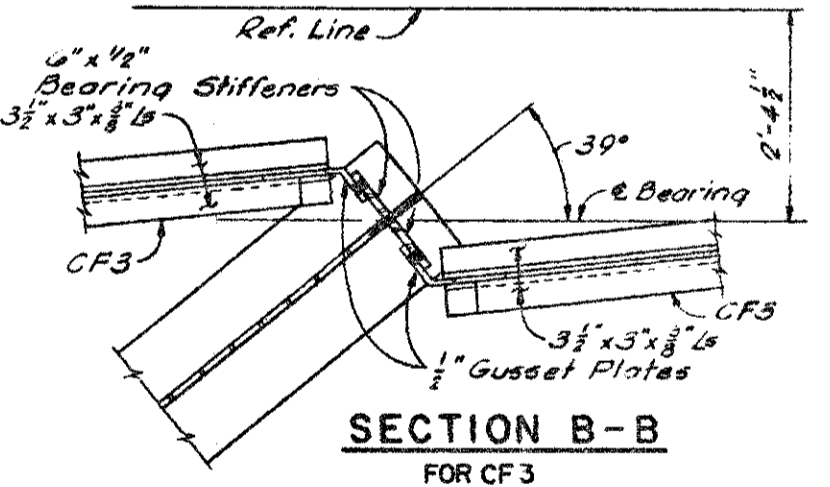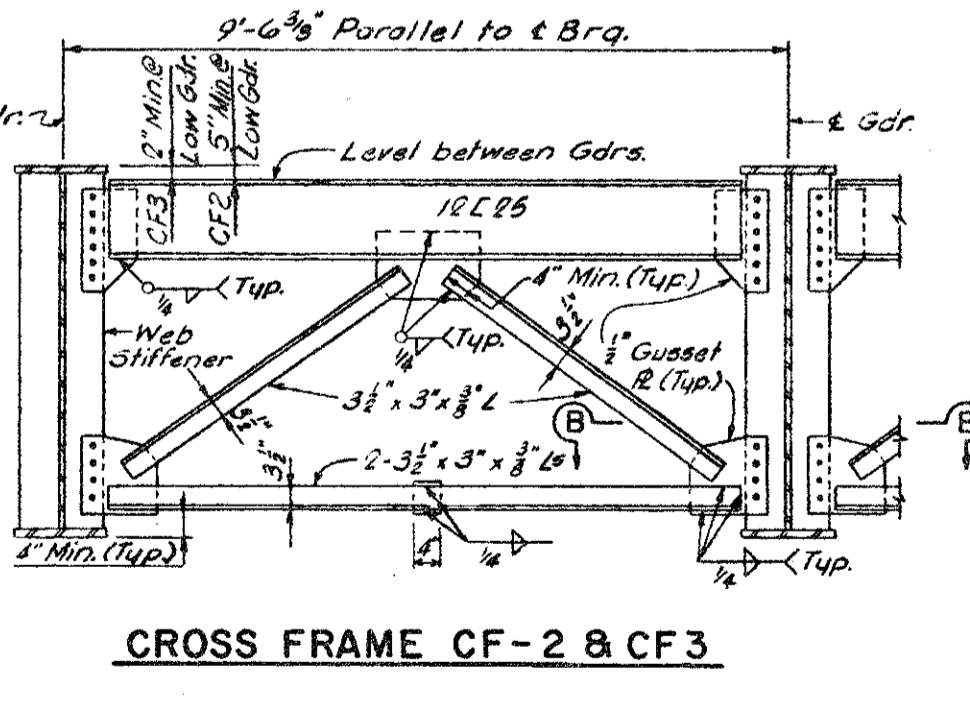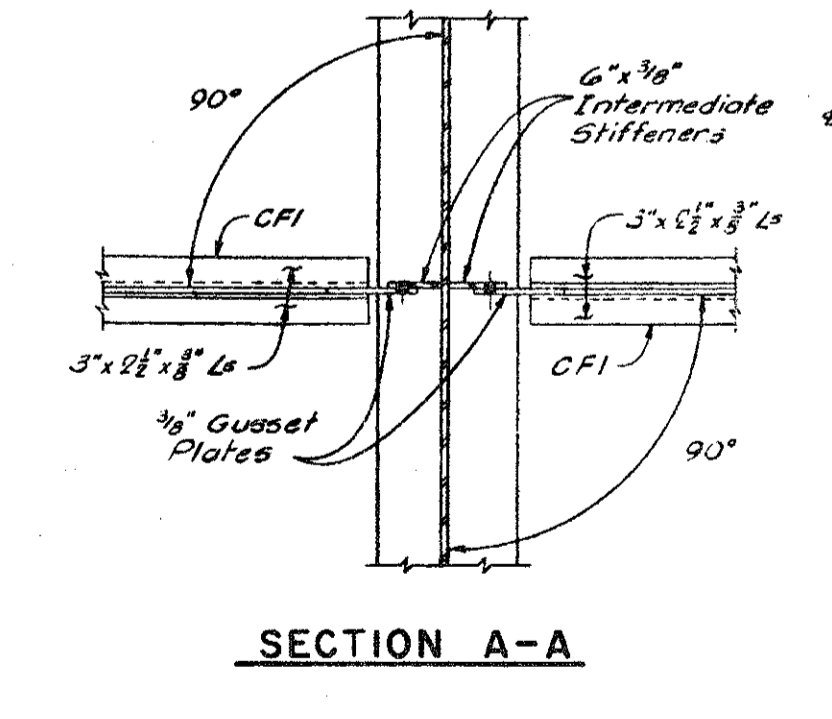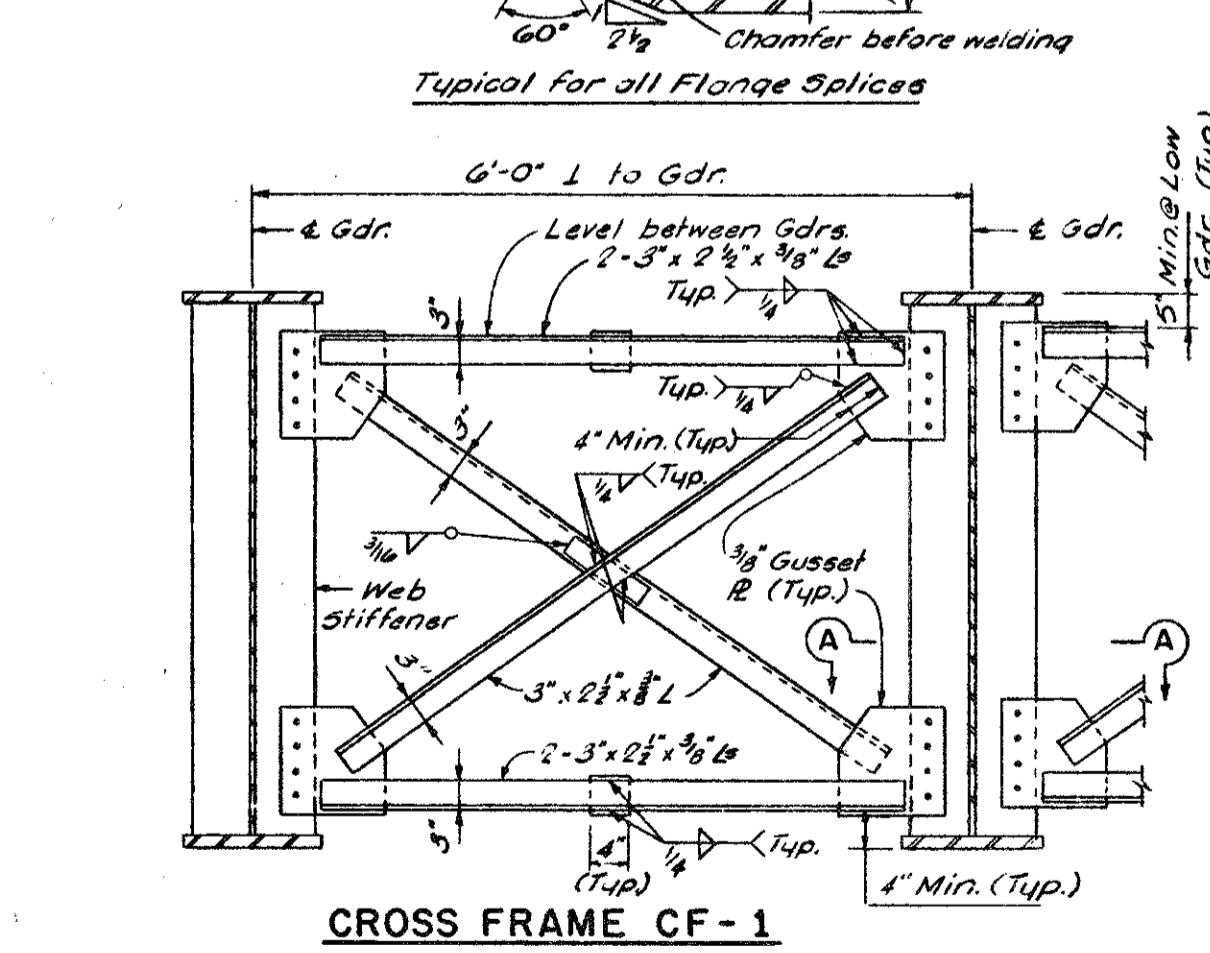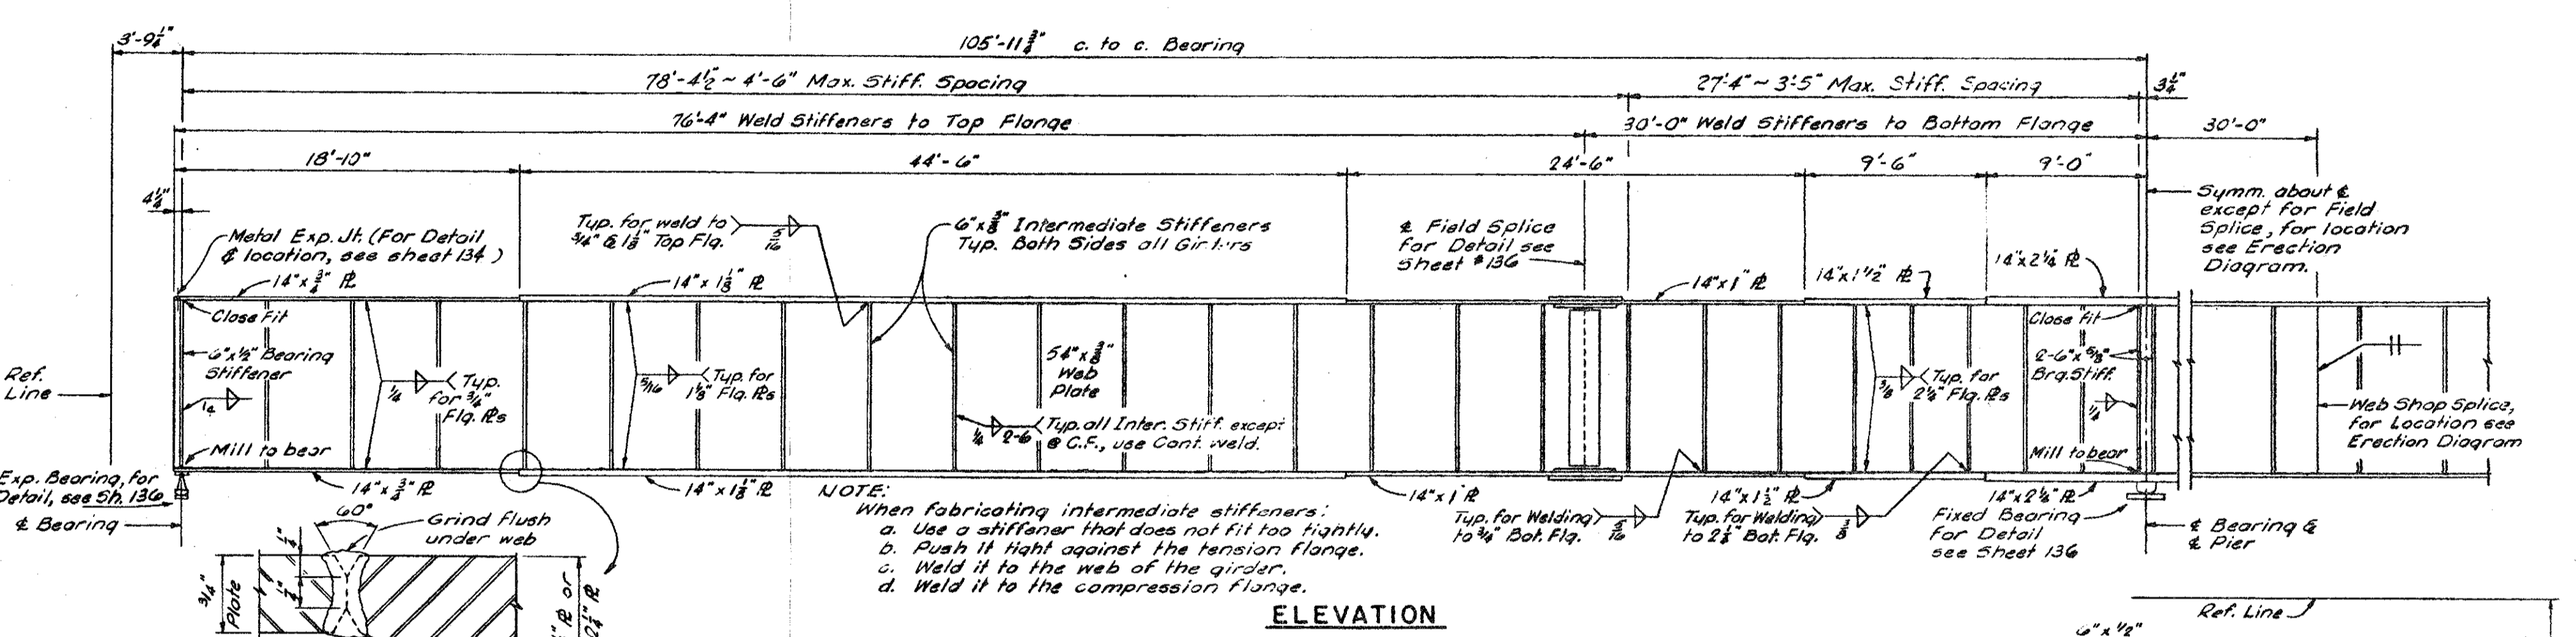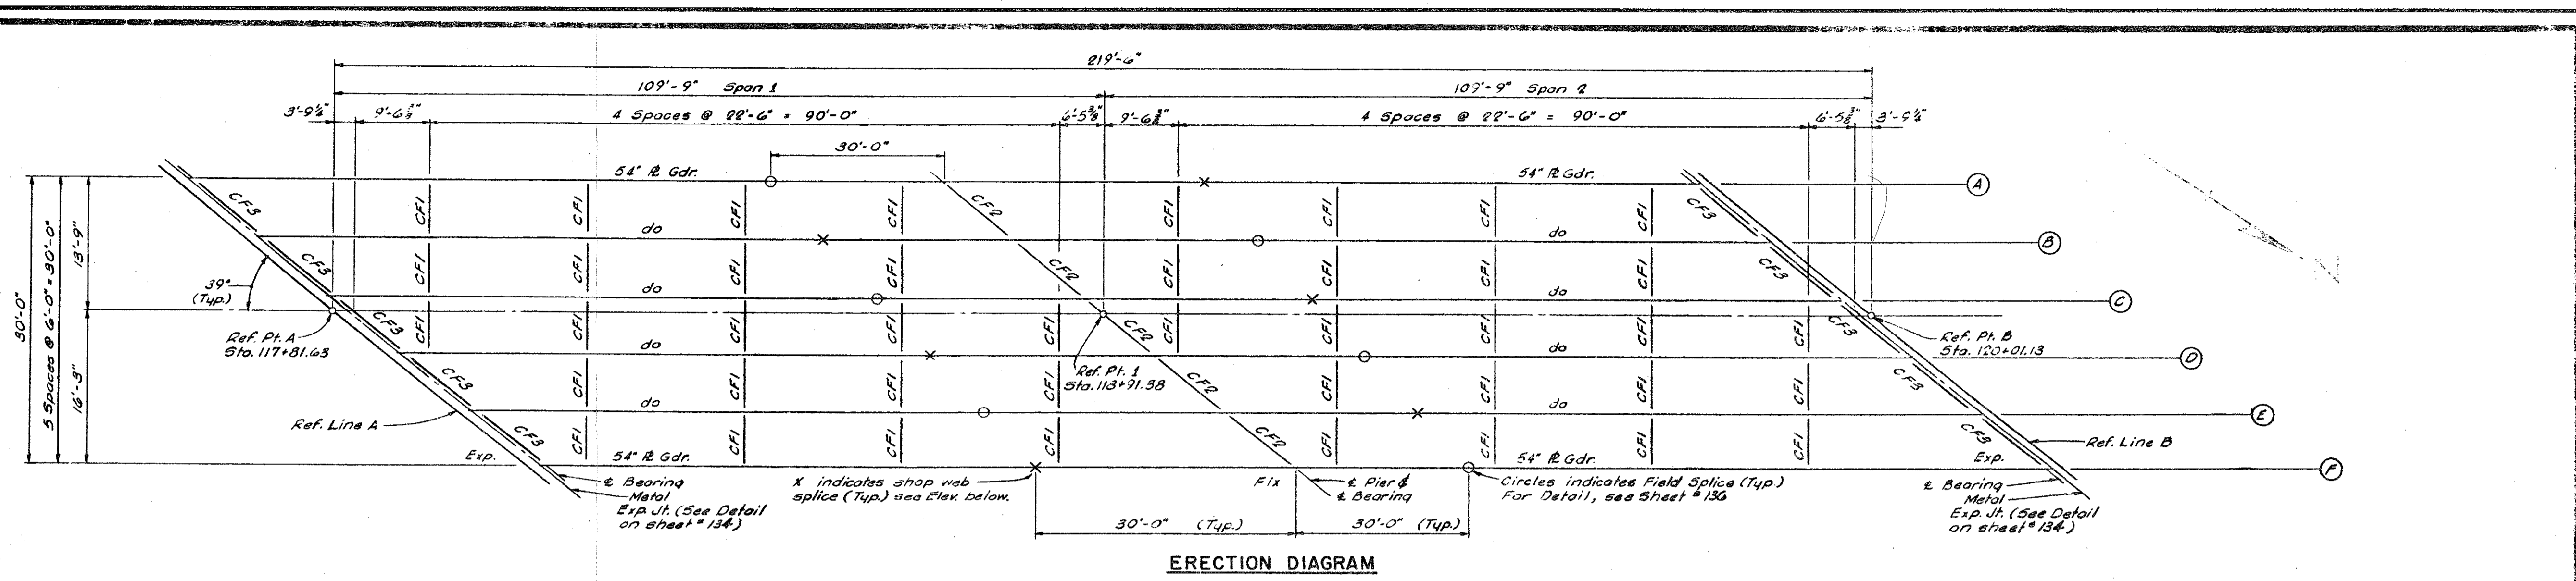

STRUCTURAL STEEL NOTES:
 Fabrication: Michigan State Highway Department's Standard Specifications for Road & Bridge Construction - 1960 Edition.
 Design: Michigan State Highway Department's Specifications for Design of Highway Bridges - 1958 Edition, 190-44 Loading. Allowable Live Load + Impact Deflection = Span + 800.
 Shop Connections: All shop connections shall be welded or riveted as shown on the plans.
 Field Connections: Field connections, unless otherwise noted, shall be bolted with high-strength bolts. Contact surfaces shall be thoroughly cleaned immediately prior to assembly of joints.
 High-Strength Bolts: 3/4" dia. high-strength bolts shall be used.
 Open Holes: Open holes for high-strength bolts shall be 1/16" in excess of hole diameter.
 Shop Paint: In addition to the shop paint provisions of the Standard Specifications the top surfaces of masonry plates shall be coated in accordance with the requirements for machine finished surfaces.
 Metal floor joints shall not be painted in shop except as noted on the plans.
 Camber: The girders shall be cambered as shown on the plans.
 Sole Plates: Sole plates 3" or more in thickness may be built up by welding together plates not less than 1/4" in thickness. Edges must be beveled 1/4" and welded with a continuous weld, for the full perimeter. Welds shall be ground flush with faces of plates.
 All web plates, flange plates and stiffeners shall conform to the requirements for welding A.S.T.M. A-375. All other steel shall be A-37.
 The quantity "Structural Steel - Furnishing and Fabricating" includes:
 A-37 Steel 34900 (Includes Wt. Metal Exp. Jt.)
 A-375 Steel 233,300
 Lead Plates 200
 Total 268,400 Structural Steel - Furnishing & Fabricating
 Total 268,400 Structural Steel - Erection
 Field Jointing: Lump Sum
 Camber and other dimensional tolerances are to be in accordance with American Welding Society Specifications.

Work this sheet with sheets 134 & 136

MICHIGAN STATE HIGHWAY DEPARTMENT
STRUCTURAL STEEL DETAILS

TECON ENGINEERS, INC.

JDC 5-27-62
 M.S.A.
 RAD 3-10-62
 155-312


S02 OF 63174D

NOTE:
 DO NOT WORK FROM THIS SHEET. THE INFORMATION SHOWN HERE IS FOR REFERENCE ONLY. NO PAY ITEMS ARE SHOWN.




FOR INFORMATION ONLY				
DATE	CONT. SEC.	JOB NO.	DESIGN UNIT	SHEET
10/13/99	S02 OF 63174	48404A	MAHDAVI	15 OF 29

DRAWN BY: R.K. OLIN CHECKED BY: DATE: 10/99 CORRECTED BY: DATE: FILE NAME: s0263174.sn

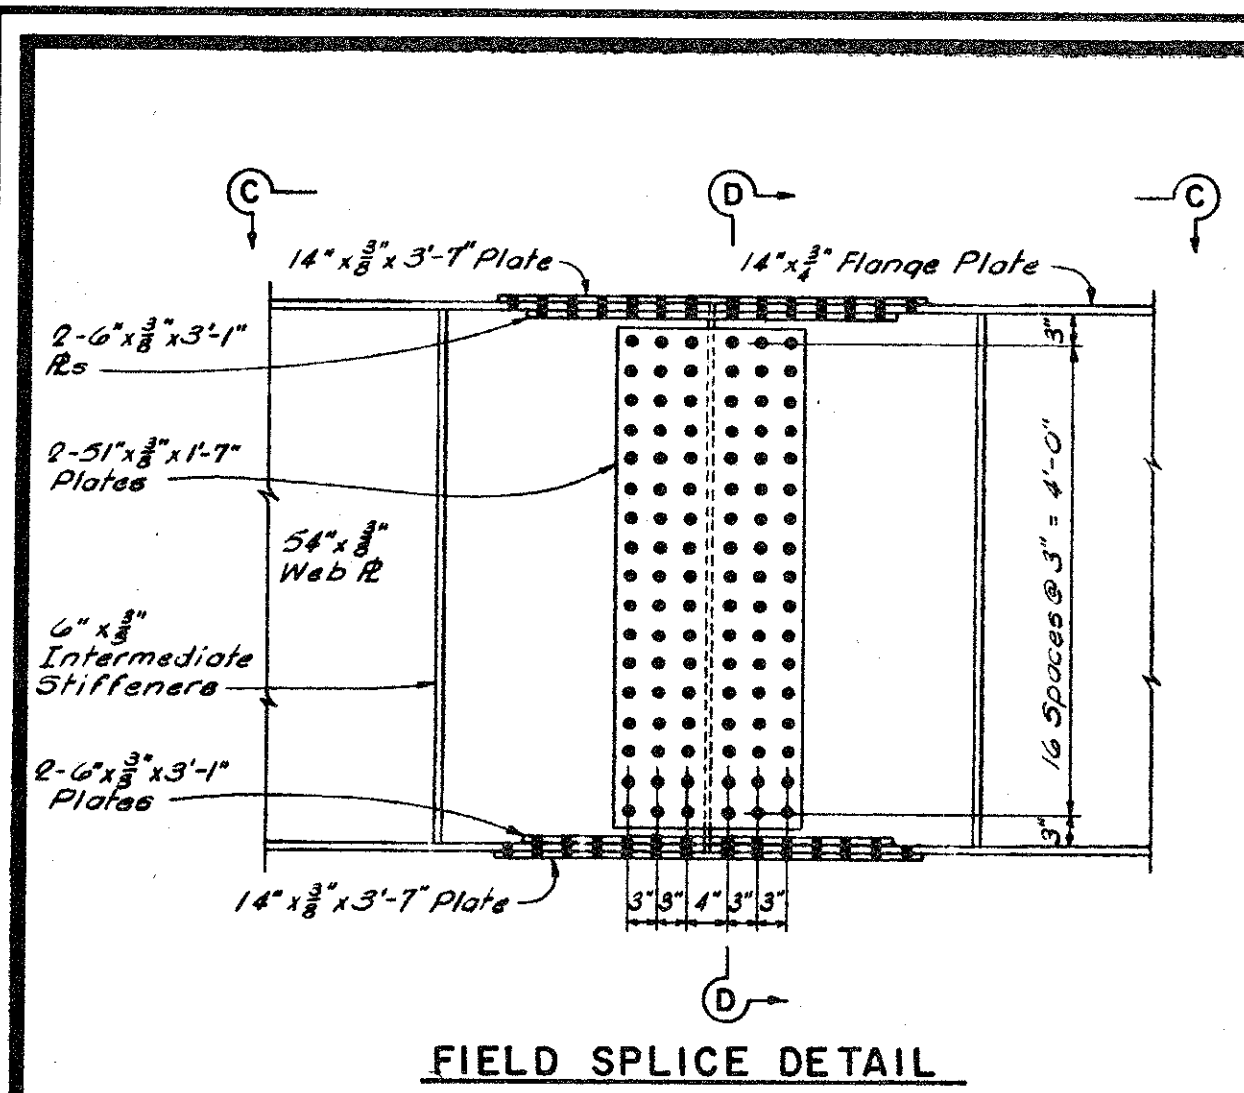

FIELD SPLICE DETAIL

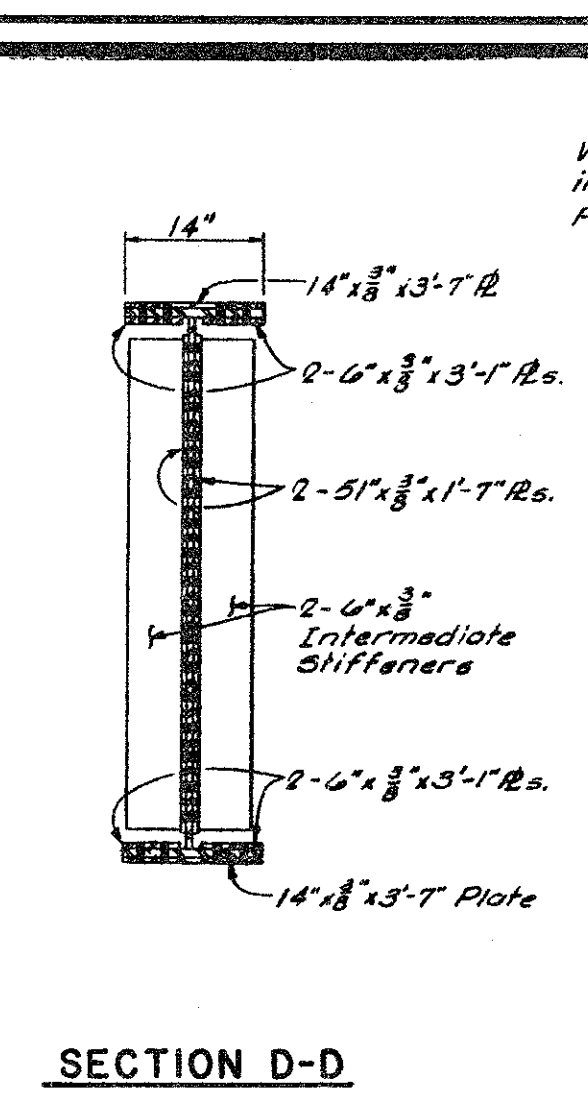

SECTION D-D


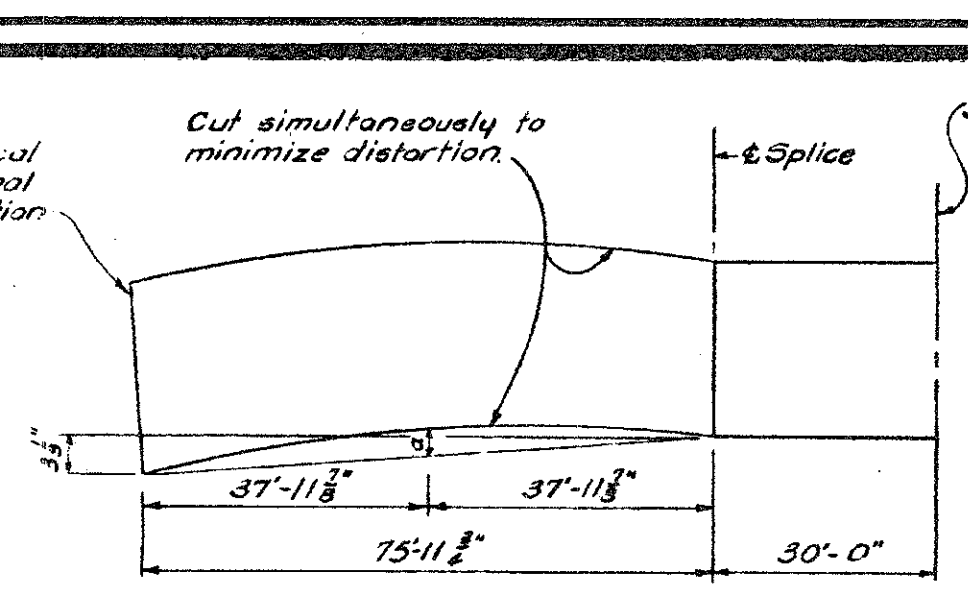


TABLE OF THEORETICAL CAMBER (INCHES)

CONSTRUCTION STAGE	BEAM POSITION	
	FLAT	UPRIGHT
After cutting web and assembling	1 3/4"	1 1/2"
After welding flanges & stiffeners*	1 3/4"	1 1/2"

Cut web plates to parabolic camber indicated by diagram.
 * At this stage camber should be corrected within ± 1/32" x 1/10" tolerance by heating in the shop.

CAMBER & BLOCKING DIAGRAM FOR FABRICATION OF SPLICES
 (Interior & Fascia Girders)

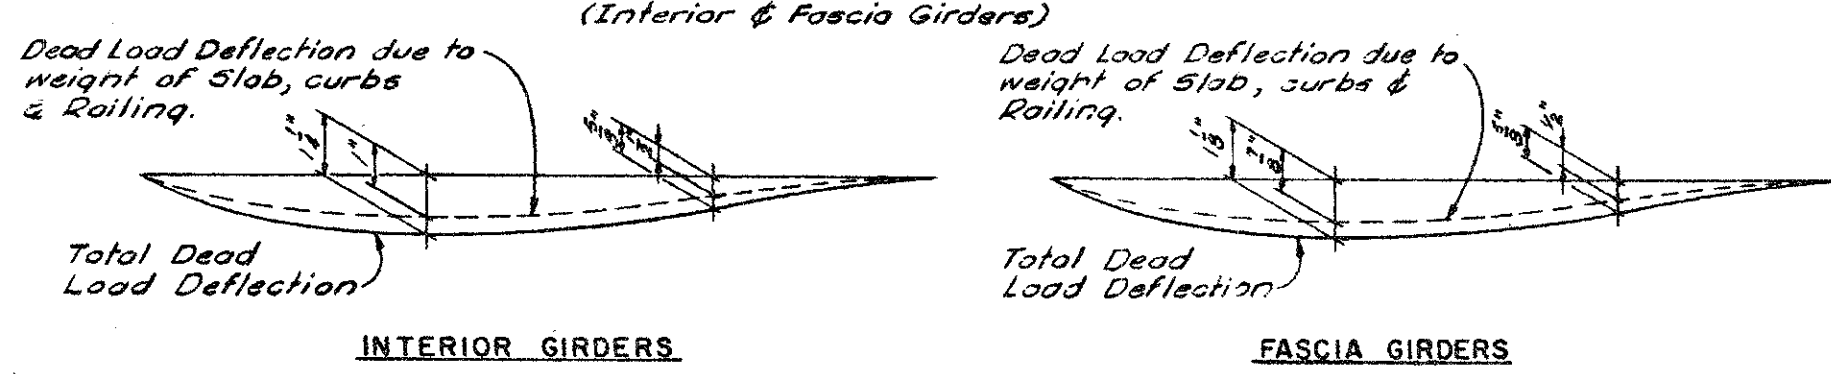


DEFLECTION DIAGRAMS

SOLE PLATE THICKNESS TABLE


BEAM LINE	ABUT. A	PIER 1	ABUT. B
A	2"	2"	2"
B	3 1/8"	3 1/2"	2 1/2"
C	2"	4 3/8"	3"
D	2 1/2"	4 1/2"	2 3/4"
E	3"	4"	3 1/2"
F	3"	3 3/8"	2"

REVISIONS


NO.	DESCRIPTION	DATE	BY

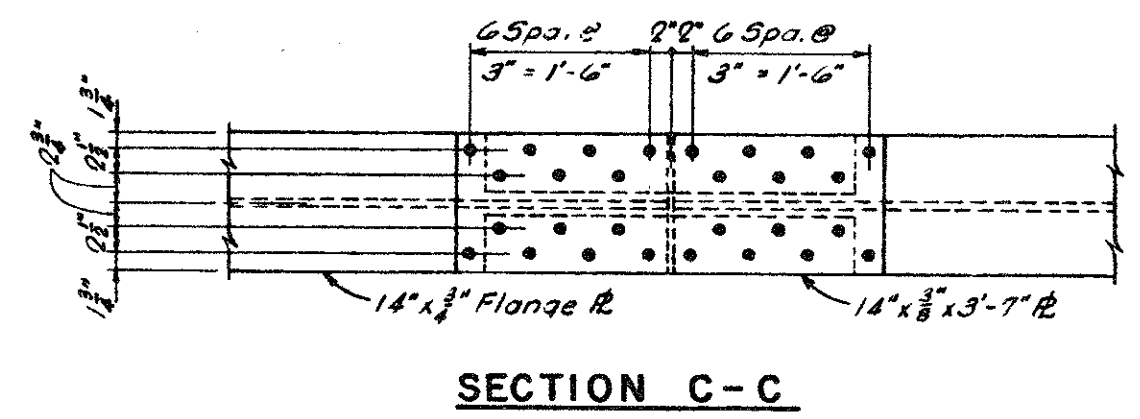


SECTION C-C

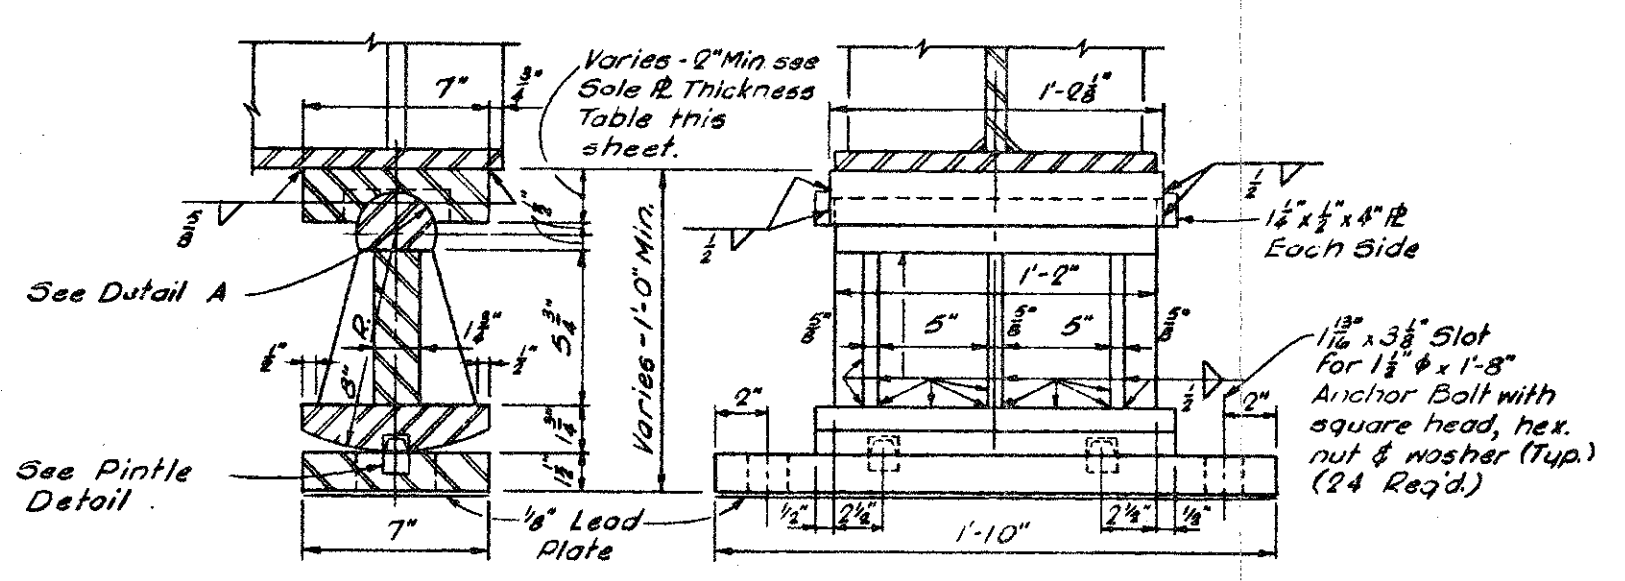


EXPANSION BEARING DETAIL - ABUT. A & B

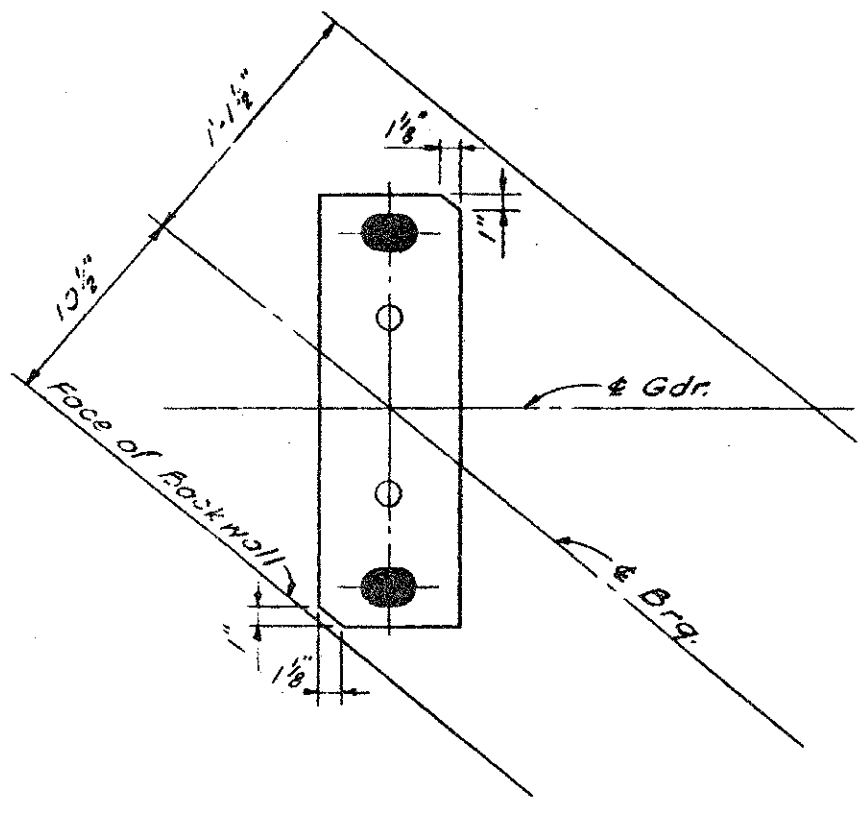


DETAIL OF ABUTMENT BEARING PLATE SHOWING CLIP

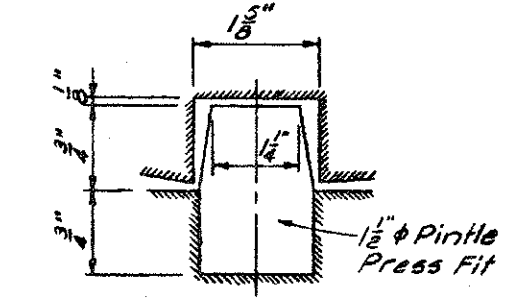

PINTLE DETAIL

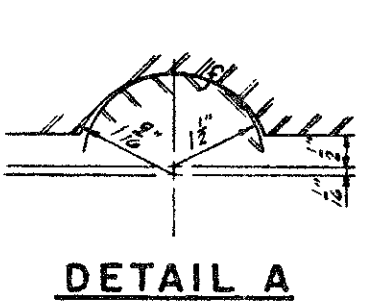

DETAIL A

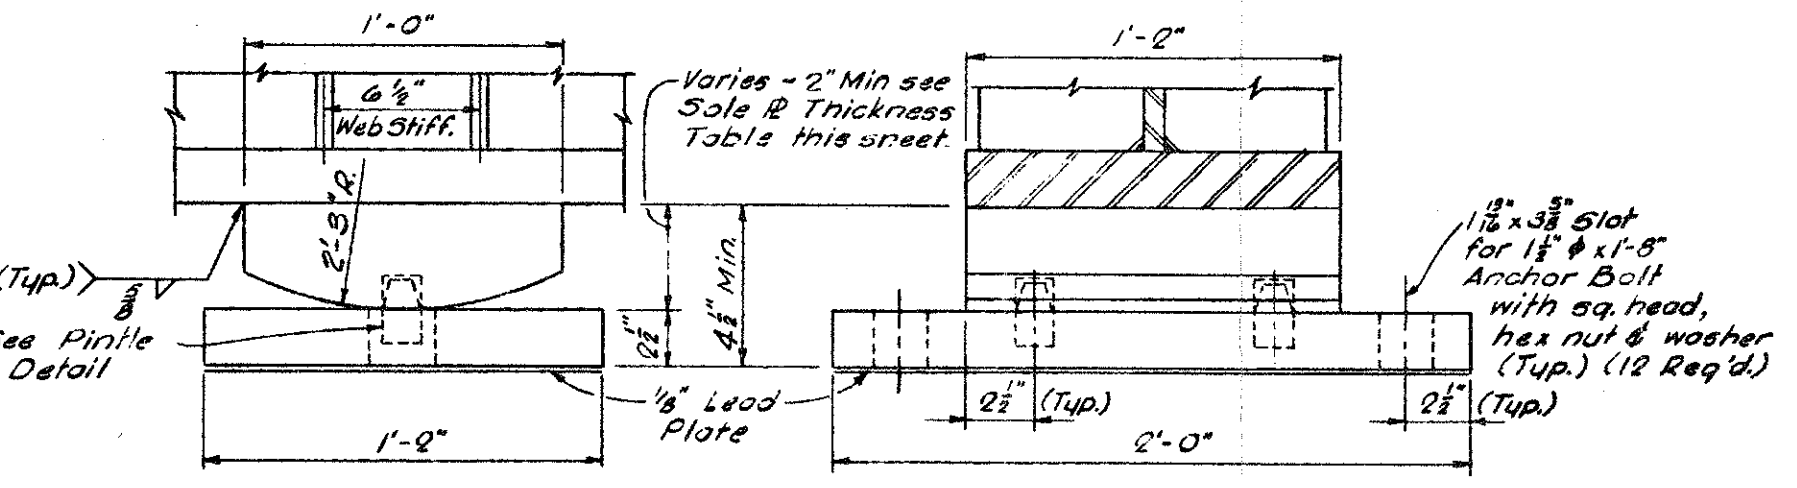

FIXED BEARING DETAIL - PIER 1

Work this sheet with sheets 134 & 135

MICHIGAN STATE HIGHWAY DEPARTMENT

STRUCTURAL STEEL DETAILS

TECON ENGINEERS, INC.

A Structure Relocated 9/10/62 Tecon

JDC 5-29-62
 M.B.A.
 RAD 3-10-62
 136 312

S02 OF 63174D

NOTE:
 DO NOT WORK FROM THIS SHEET. THE INFORMATION SHOWN
 HERE IS FOR REFERENCE ONLY. NO PAY ITEMS ARE SHOWN.








FOR INFORMATION ONLY

DATE	CONT. SEC.	JOB NO.	DESIGN UNIT	SHEET
10/13/99	S02 OF 63174	48404A	MAHDAVI	16 OF 29

CONTROL SECTION S02 OF 63174 JOB NO. 48404A SH. NO. 17

1 2 3 4 5 6 7 8 9 10 11 12 13 14 15 16 17 18 19 20 21 22 23 24 25 26 27 28 29 30 31 32 33 34 35 36 37 38 39 40 41 42 43 44 45 46 47 48 49 50 51 52 53 54 55 56 57 58 59 60 61 62 63

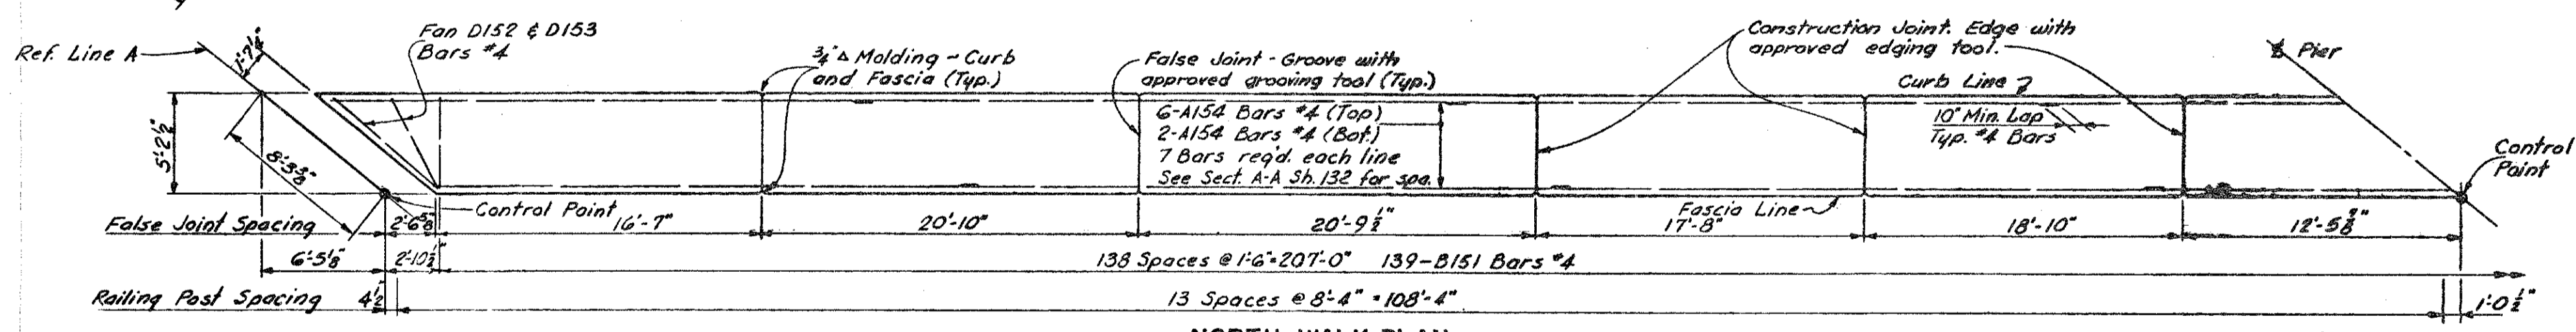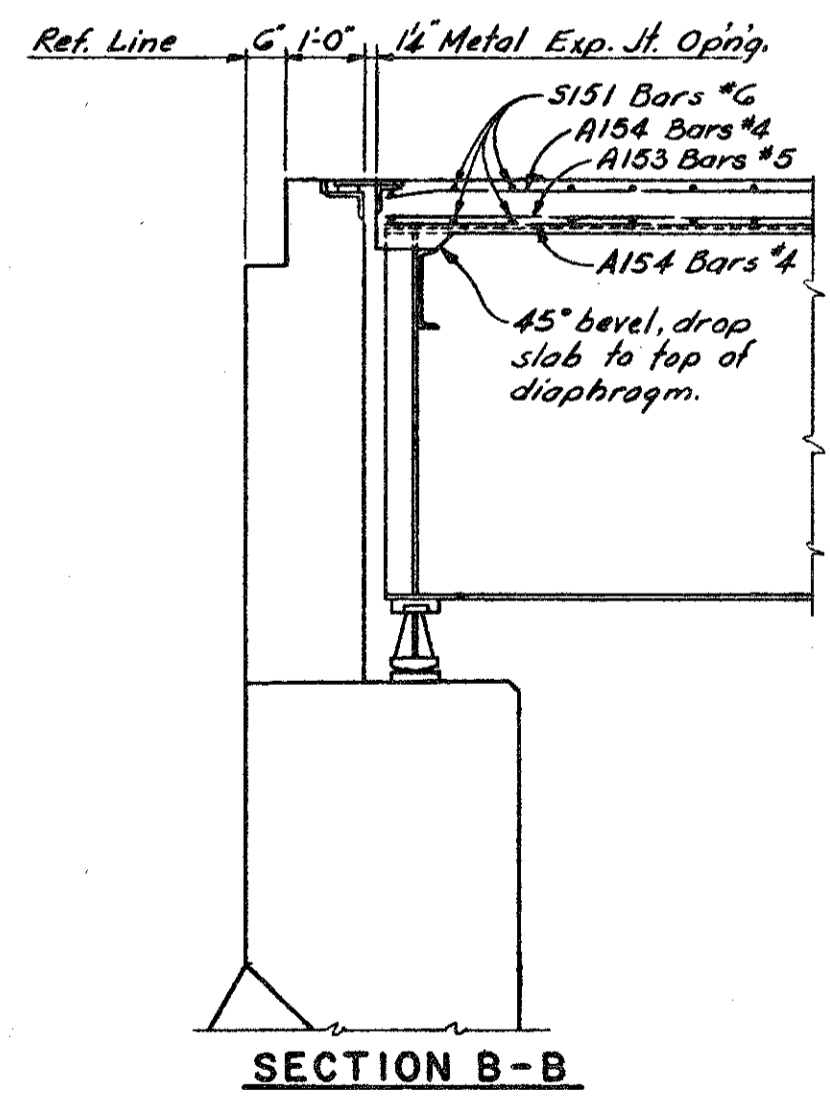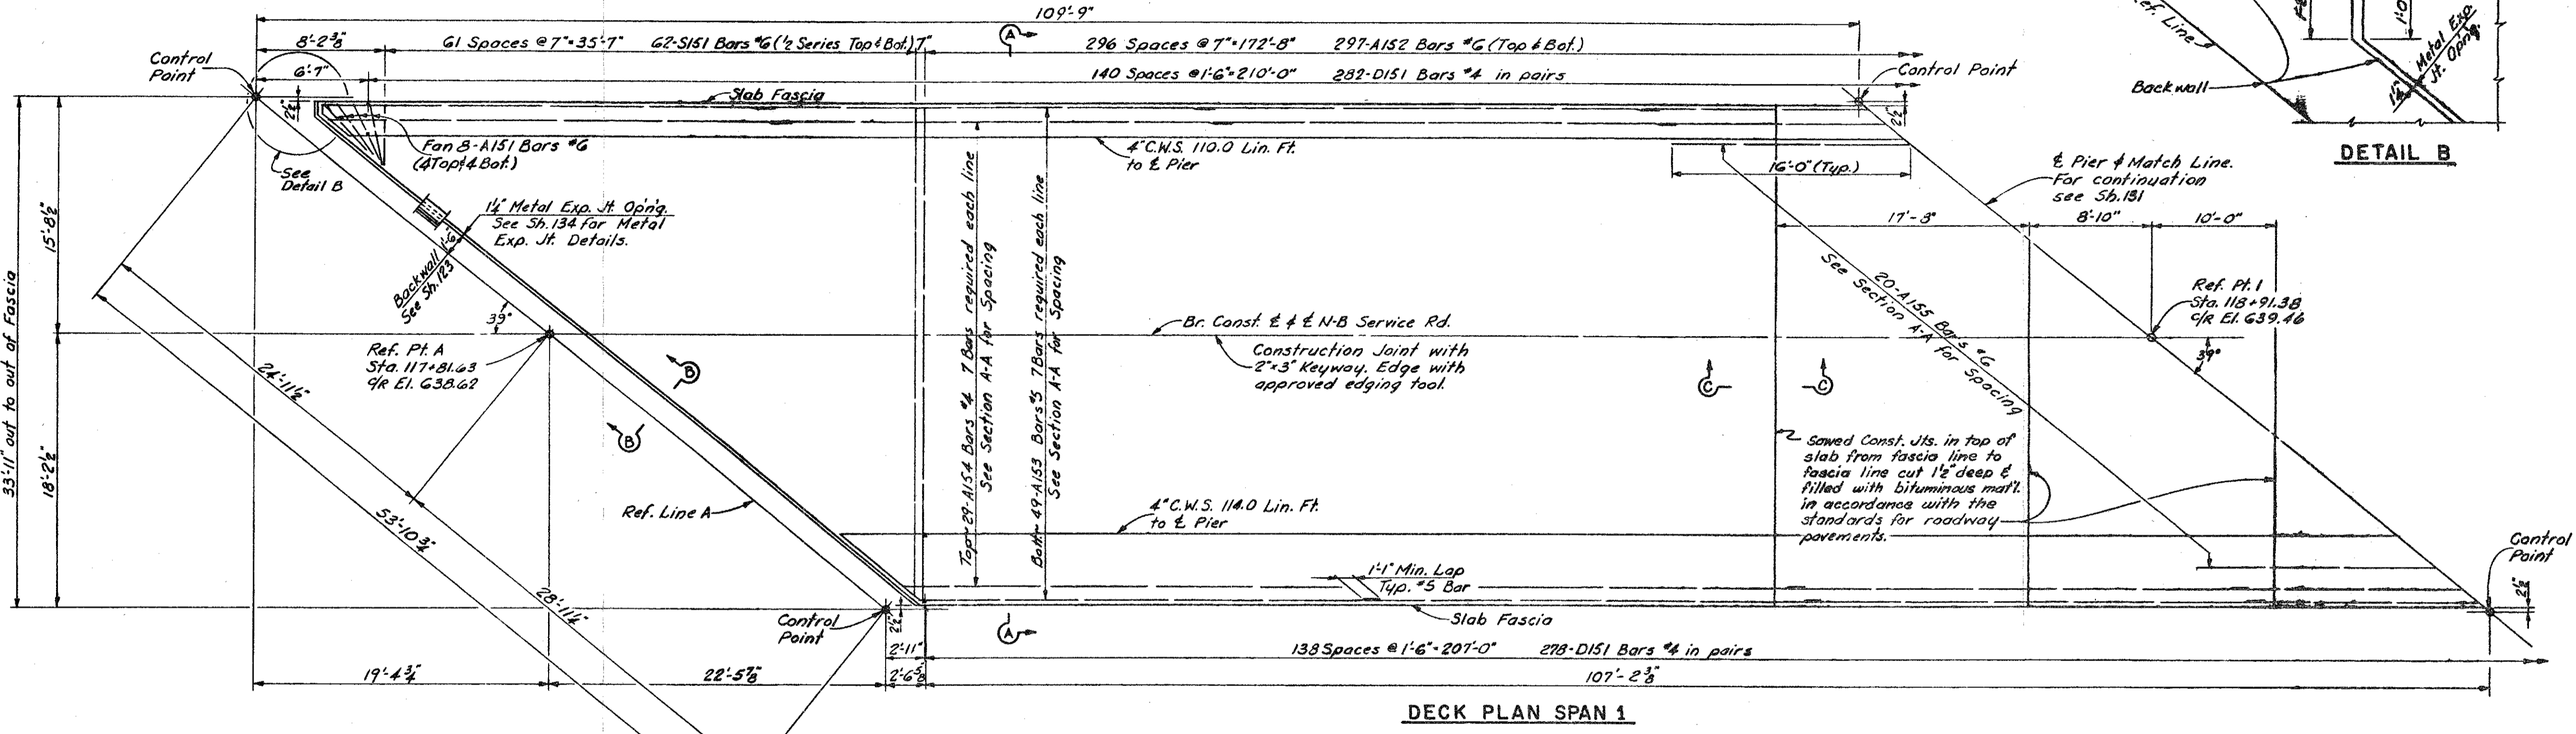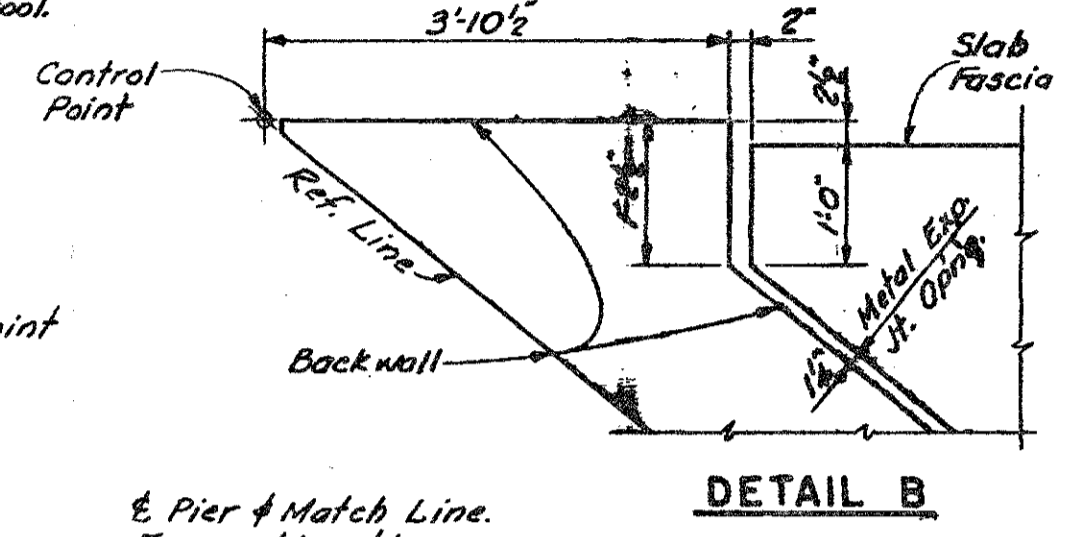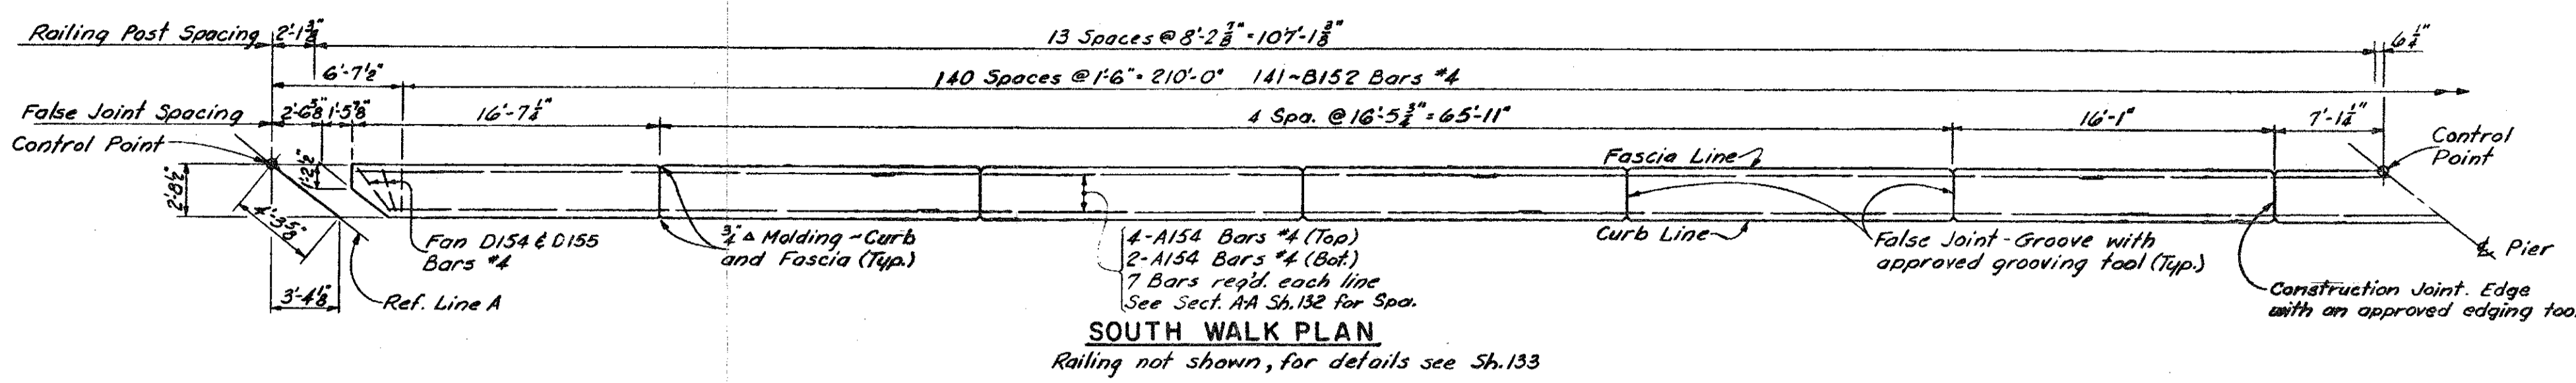

REVISIONS			
NO.	DESCRIPTION	DATE	BY

Work this sheet with sheets 131, 132 & 133

MICHIGAN STATE HIGHWAY DEPARTMENT
SUPERSTRUCTURE DETAILS


TECON ENGINEERS, INC.

REVISIONS		
NO.	DESCRIPTION	DATE
1	Structure Relocated	9-10-99

DESIGNED BY	JDC	3-29-02
DRAWN BY	JDC	2-5-02
CHECKED BY	RAO	3-5-02
DATE	9-10-99	TECON

S02 OF 63174D


NOTE:
DO NOT WORK FROM THIS SHEET. THE INFORMATION SHOWN
HERE IS FOR REFERENCE ONLY. NO PAY ITEMS ARE SHOWN.

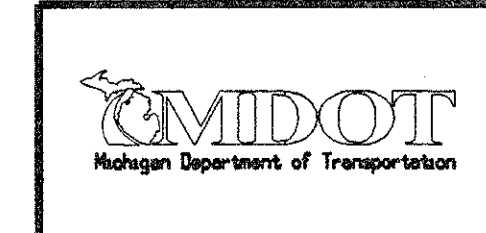

FOR INFORMATION ONLY				
DATE	CONT. SEC.	JOB NO.	DESIGN UNIT	SHEET
10/13/99	S02 OF 63174	48404A	MAHDAVI	17 OF 29

FILE NAME: s0263174.spl
DRAWN BY: R.K. OLIN
DATE: 10/99
CHECKED BY:
DATE:
CORRECTED BY:
DATE:

1 2 3 4 5 6 7 8 9 10 11 12 13 14 15 16 17 18 19 20 21 22 23 24 25 26 27 28 29 30 31 32 33 34 35 36 37 38 39 40 41 42 43 44 45 46 47 48 49 50 51 52 53 54 55 56 57 58 59 60 61 62 63

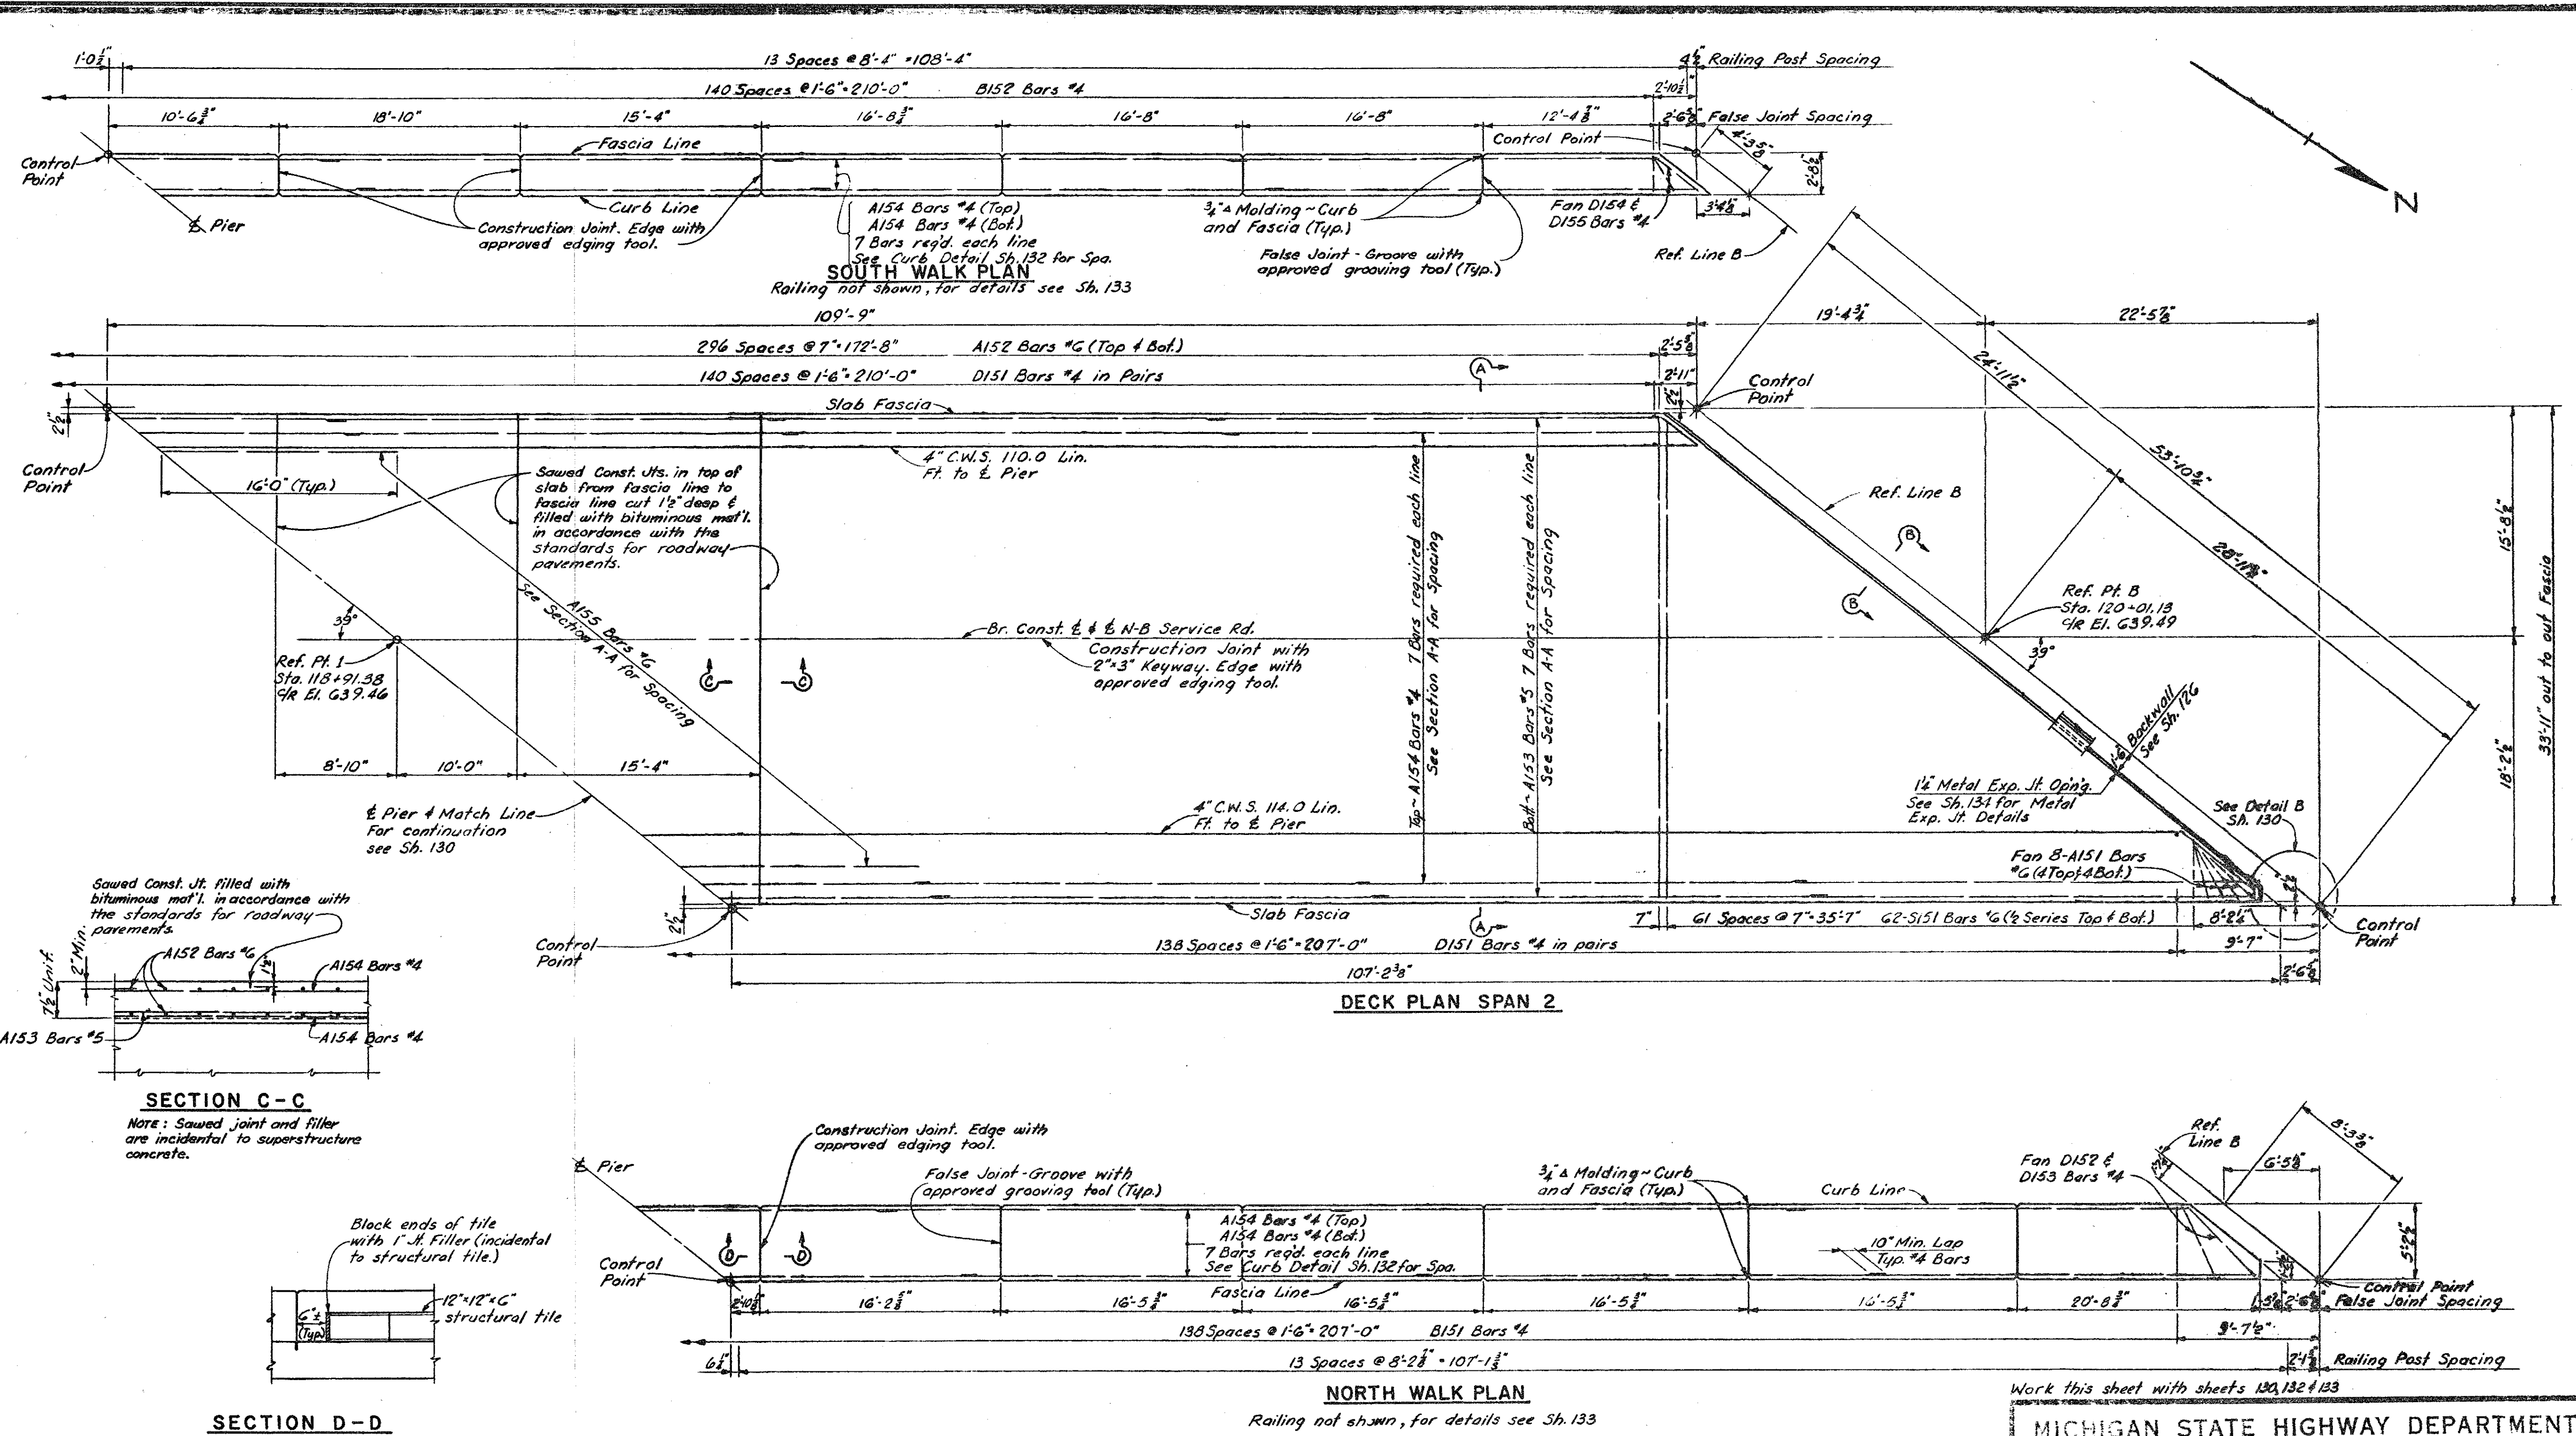

REVISIONS			
NO.	DESCRIPTION	DATE	BY

Work this sheet with sheets 130, 132 & 133

**MICHIGAN STATE HIGHWAY DEPARTMENT
SUPERSTRUCTURE DETAILS**

TECON ENGINEERS, INC.

DESIGNED BY	JDC	3-29-92
DRAWN BY	JDC	2-2-92
CHECKED BY	RAD	3-9-92
DATE	9-10-92	TECON

S02 OF 63174D


NOTE:
DO NOT WORK FROM THIS SHEET. THE INFORMATION SHOWN HERE IS FOR REFERENCE ONLY. NO PAY ITEMS ARE SHOWN.




FOR INFORMATION ONLY				
DATE	CONT. SEC.	JOB NO.	DESIGN UNIT	SHEET
10/13/99	S02 OF 63174	48404A	MAHDAVI	18 OF 29

FILE NAME: 40263174.sr1 DRAWN BY: R.K. OLIN CHECKED BY: DATE: 10/99 CORRECTED BY: DATE:


REVISIONS			
NO.	DESCRIPTION	DATE	BY

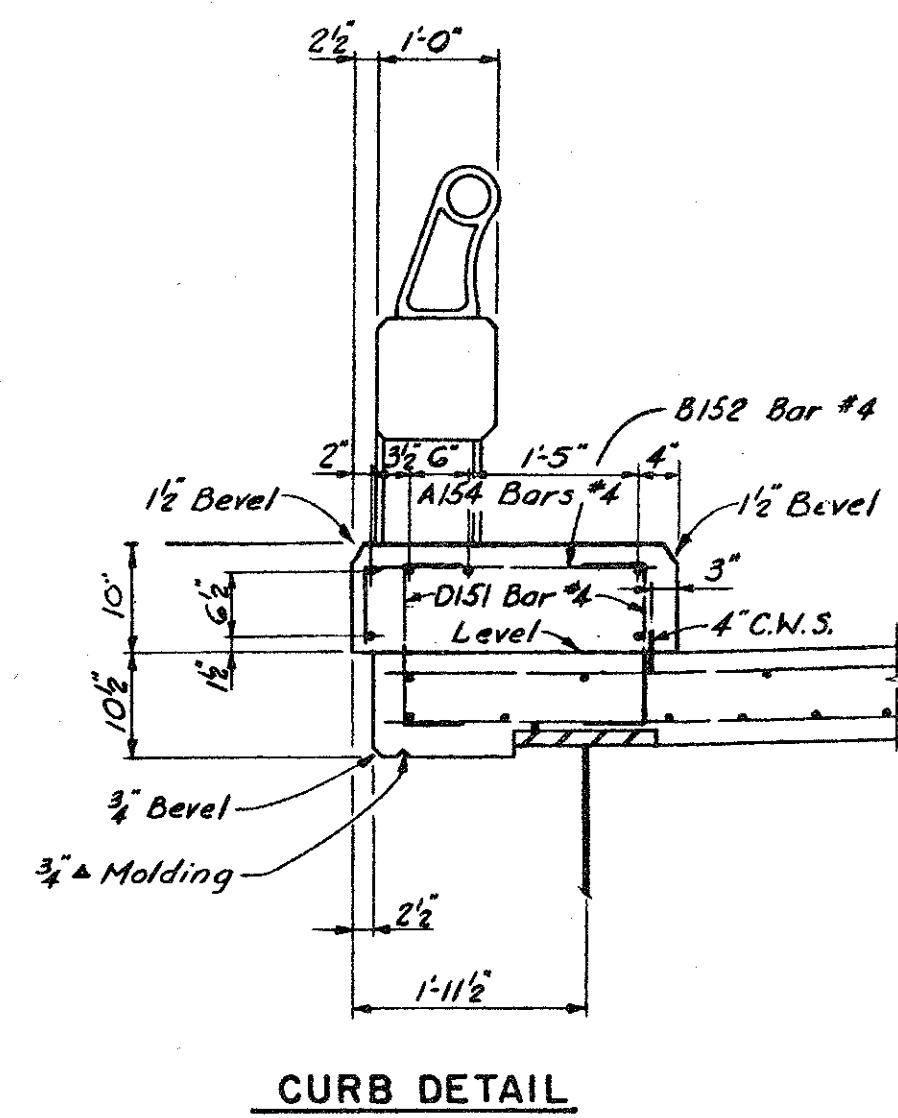


CURB DETAIL

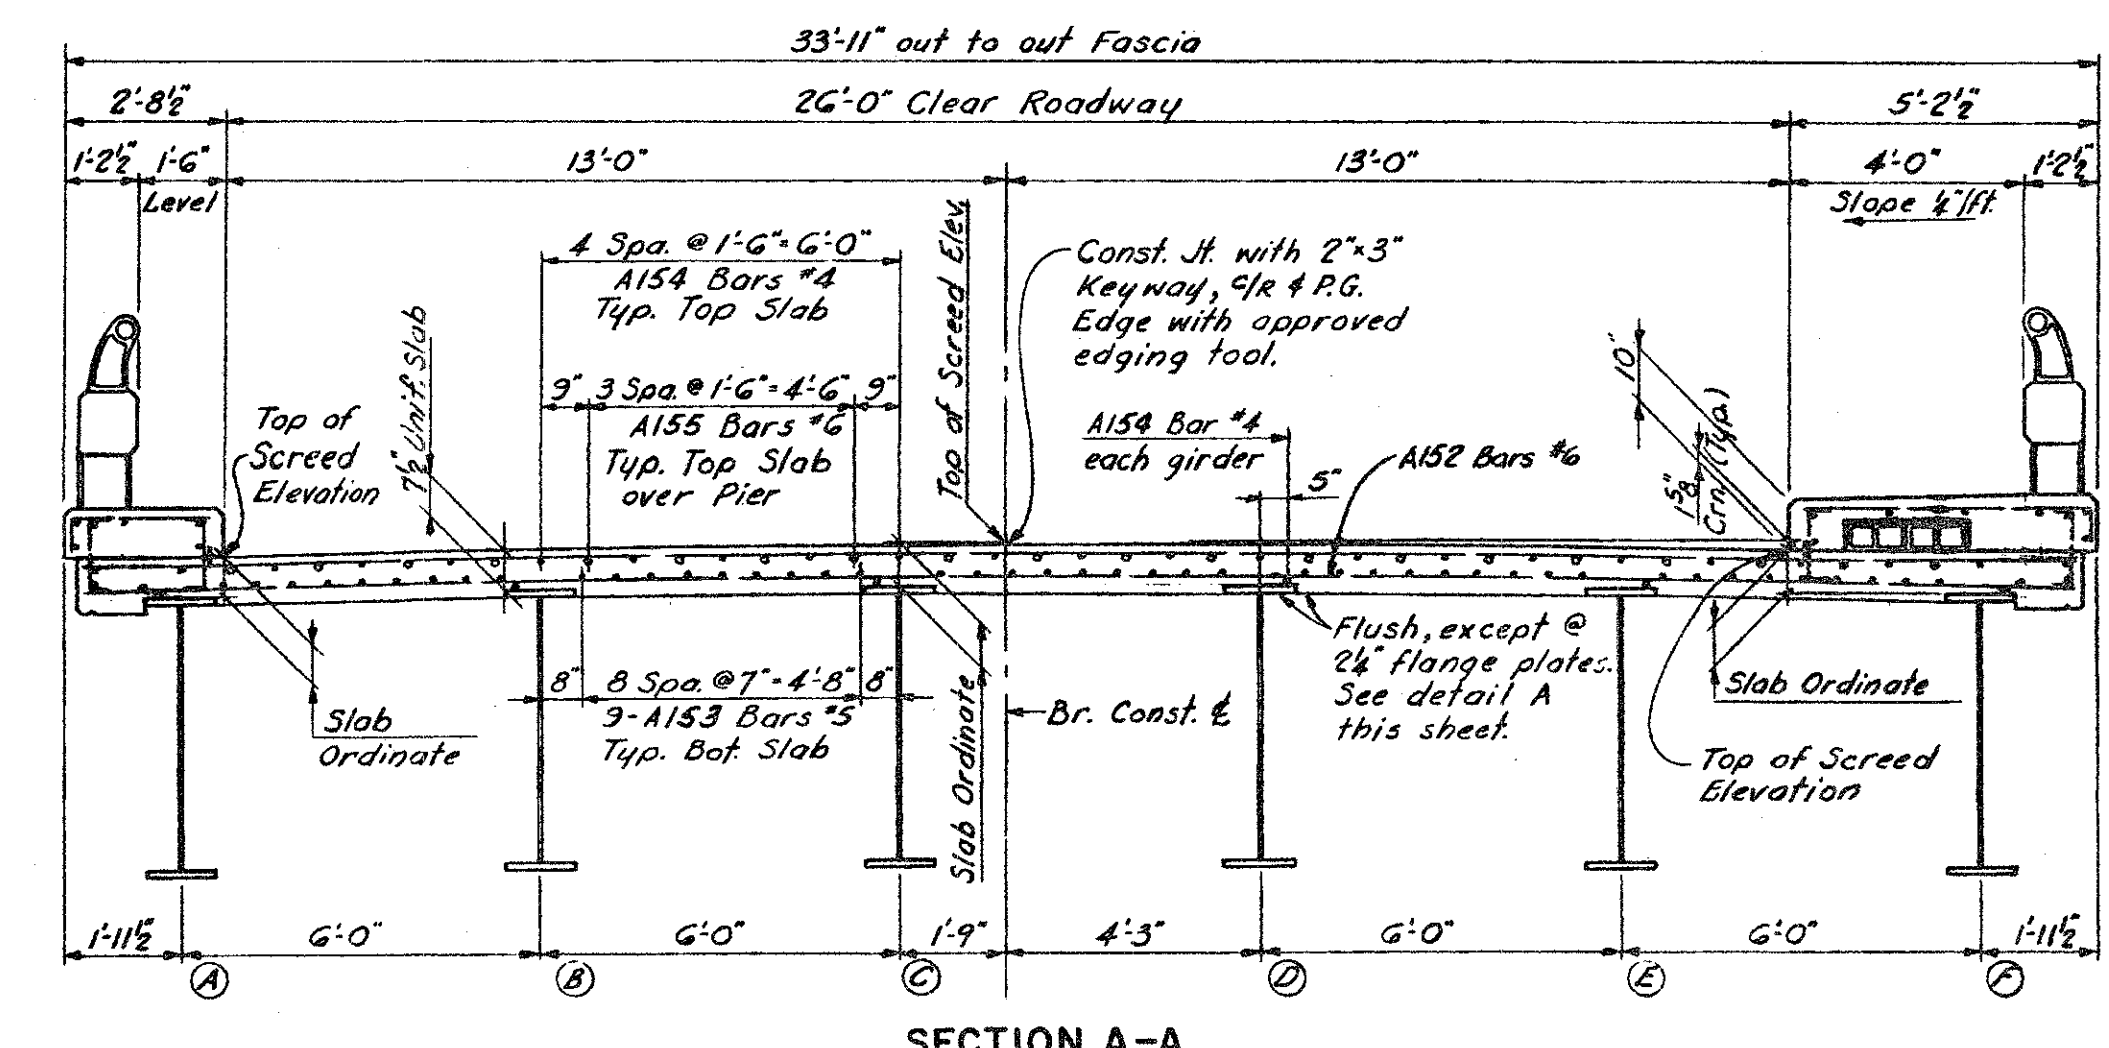


SECTION A-A

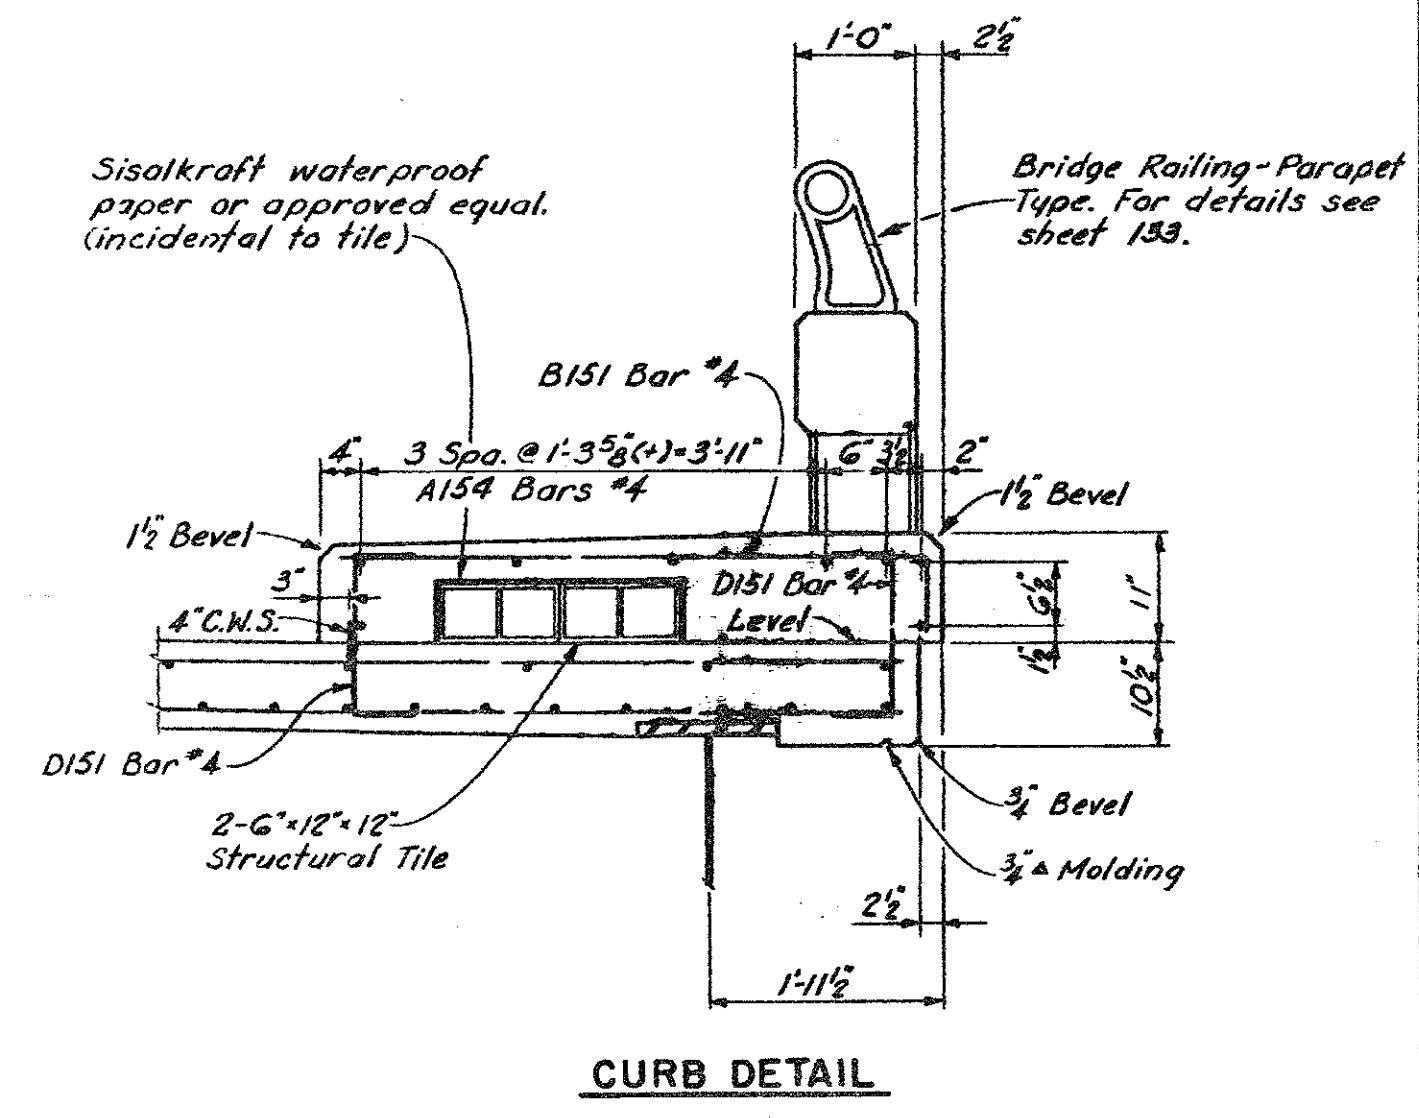

CURB DETAIL

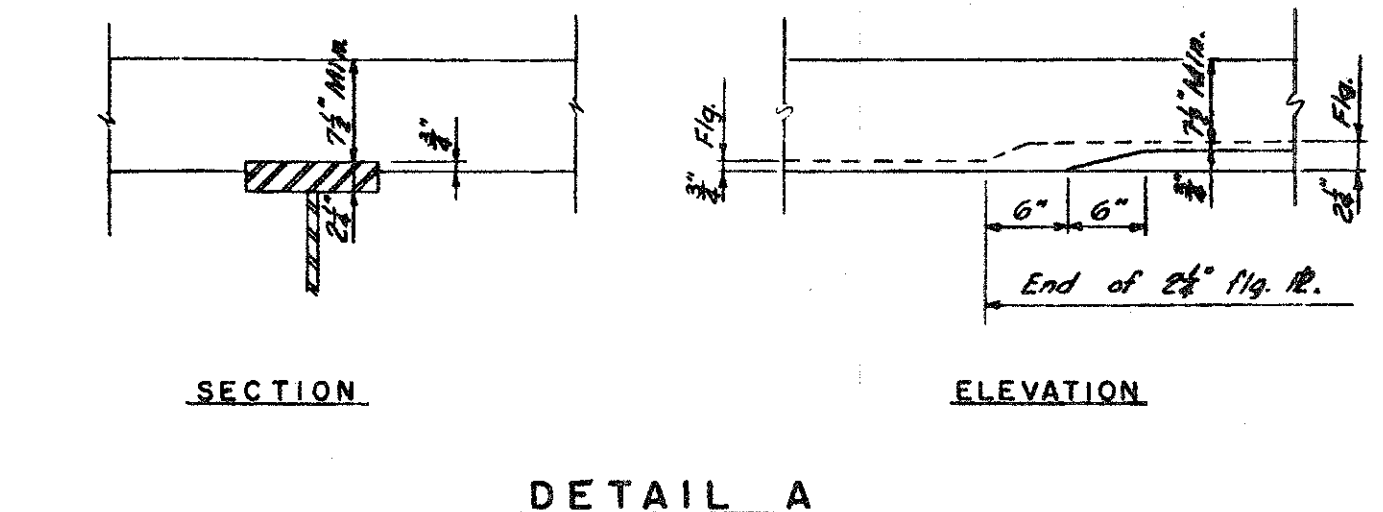

DETAIL A

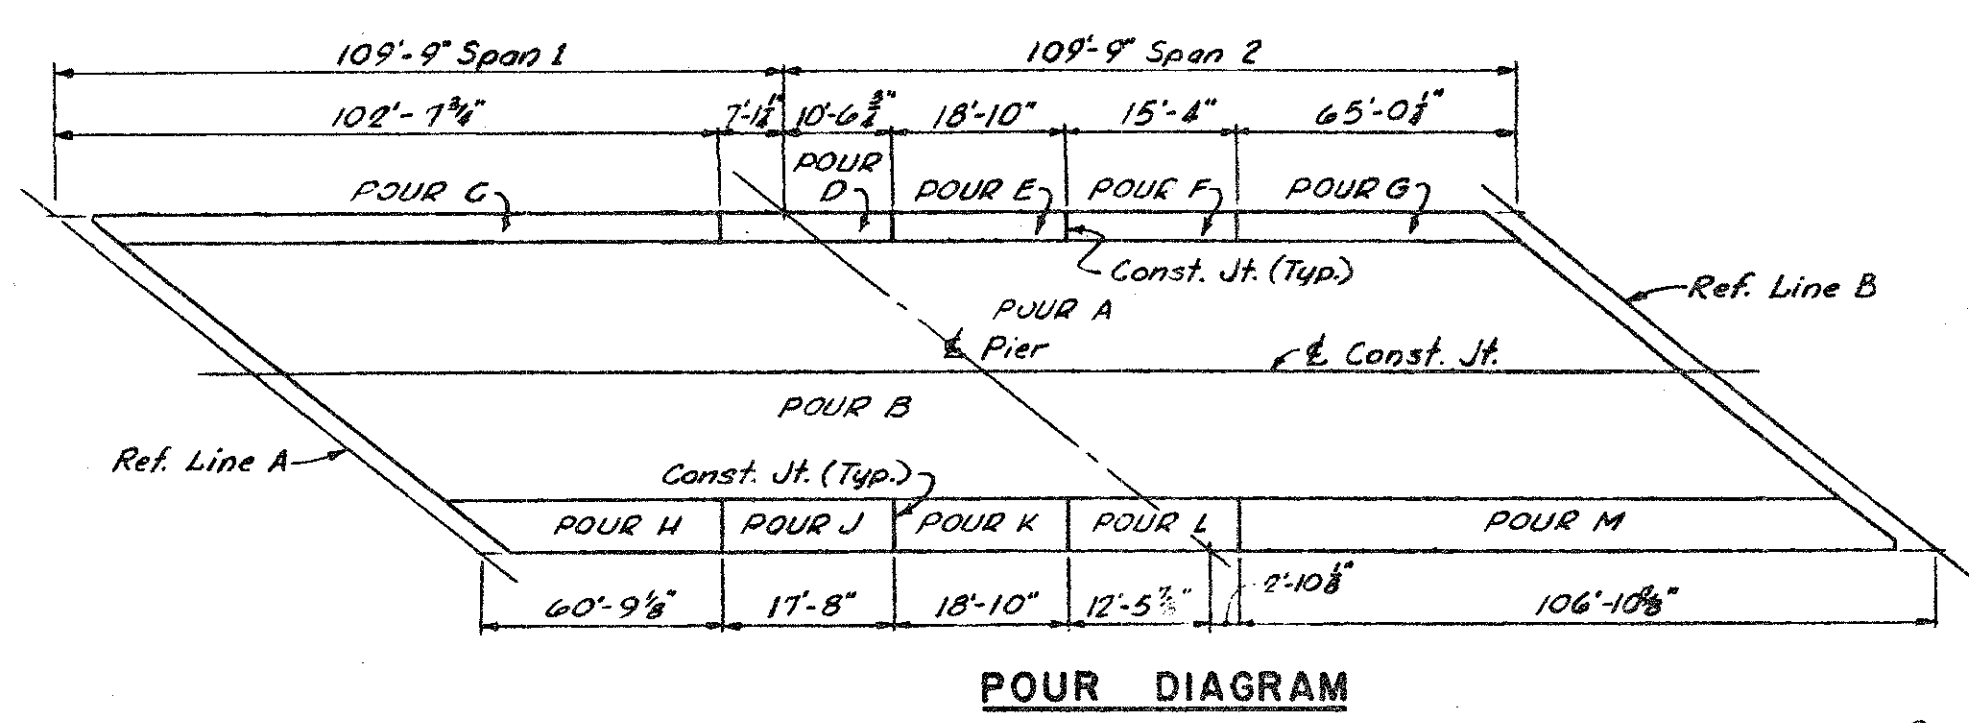

POUR DIAGRAM

CONCRETE QUANTITIES GRADE A (GAA)-CU YDS.													
POUR	A	B	C	D	E	F	G	H	J	K	L	M	Total
AMOUNT	24.1	102.2	8.1	1.5	1.6	1.2	5.4	8.5	2.3	2.5	2.1	12.5	250.0


Concrete Pours need not be placed in alphabetical order.

MISCELLANEOUS QUANTITIES		
ITEM	UNITS	AMOUNT
12"x12"x6" Structural File	Ea.	414
Copper	Lbs.	149
Hot Poured Rubber-Asphalt Type Filler	Lin. Ft.	108
Bridge Railing-Parapet Type	Lin. Ft.	435.3


NOTES

For Railing Details, See Sheet No. 133.
 C.N.S. indicates copper material.
 For Bevel and Molding Details, See Std. Sheet R11.
 Edge and Groove denote Edging or Grooving with an approved tool.

Elevations shown are for top of screed before pouring any concrete and are based on a minimum slab thickness of 7 1/2". After screeds are set, if check indicates that less than the minimum thickness will be obtained, adjust screeds and expansion dams accordingly. The slab ordinates shown provide for dead load deflection, crown girder camber, and will to be measured from the top of the girder indicators (on a line parallel to the reference lines) to the top of the screed. Screeds affected by loads in other spans are to be set to the elevations shown and checked for minimum slab thickness before pouring any concrete.

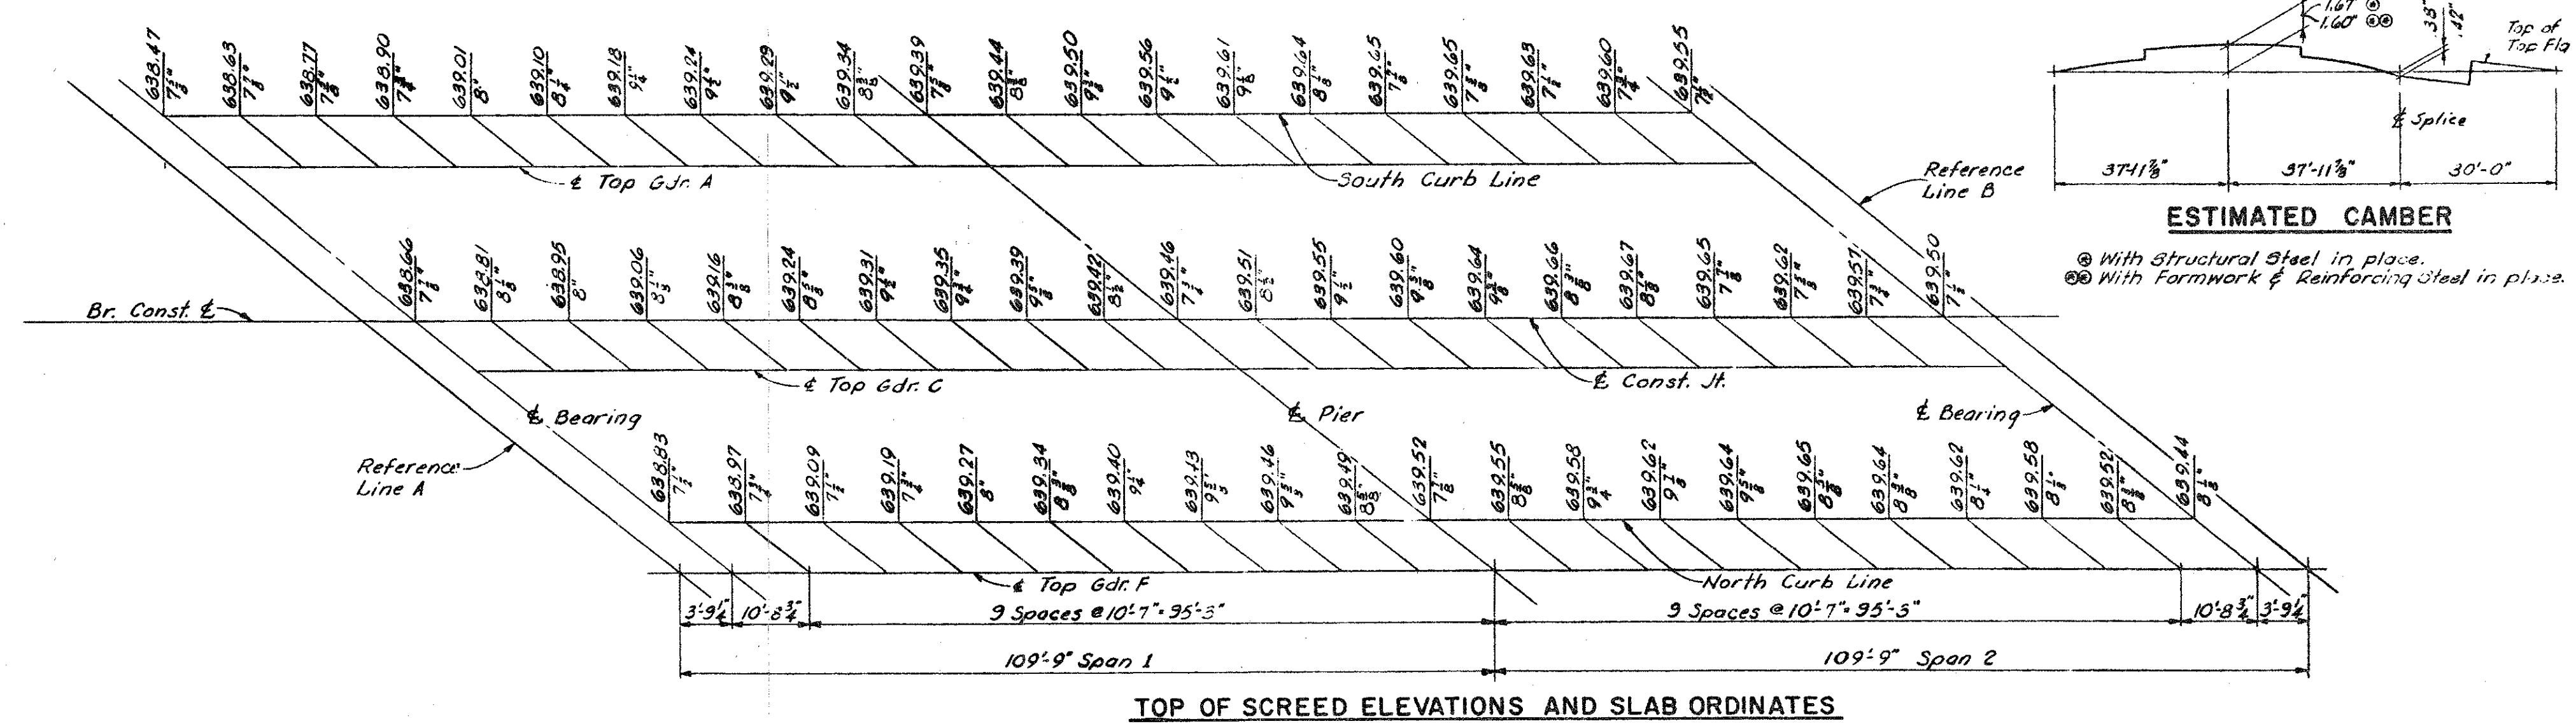

TOP OF SCREED ELEVATIONS AND SLAB ORDINATES

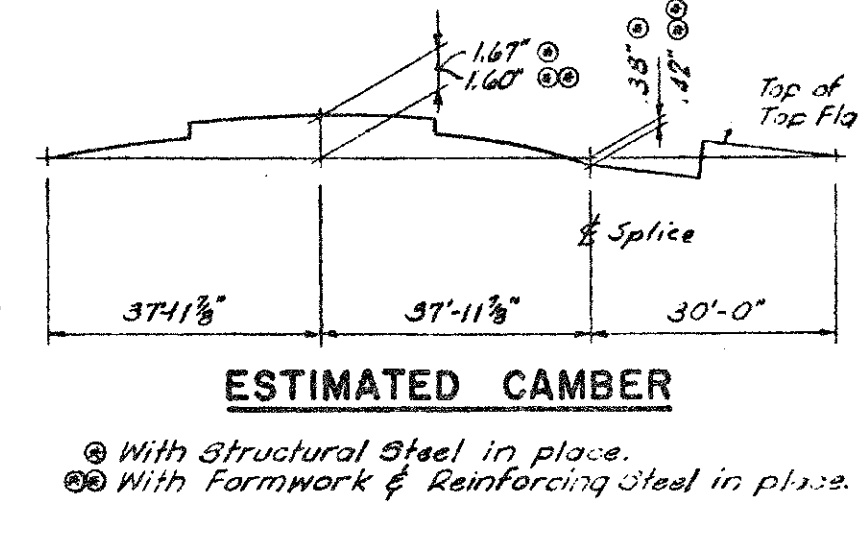

ESTIMATED CAMBER

Work this Sheet with Sheets 130, 131, 133

MICHIGAN STATE HIGHWAY DEPARTMENT
SUPERSTRUCTURE DETAILS

TECON ENGINEERS, INC.

REVISIONS: DATE BY
 1 Structure Relocated 9-10-88 Tecon


DATE: 10-13-99
 CONT. SEC.: S02 OF 63174
 JOB NO.: 48404A
 DESIGN UNIT: MAHDAVI
 SHEET: 19 OF 29

NO. 3042 8783
 CHECKED BY: JDC 3-28-82
 DRAWN BY: JDC 2-6-82
 CHECKED BY: RAD 3-9-88
 SHEET: 132 OF 312
S02 OF 63174D




NOTE:
 DO NOT WORK FROM THIS SHEET. THE INFORMATION SHOWN HERE IS FOR REFERENCE ONLY. NO PAY ITEMS ARE SHOWN.



FOR INFORMATION ONLY				
DATE	CONT. SEC.	JOB NO.	DESIGN UNIT	SHEET
10/13/99	S02 OF 63174	48404A	MAHDAVI	19 OF 29

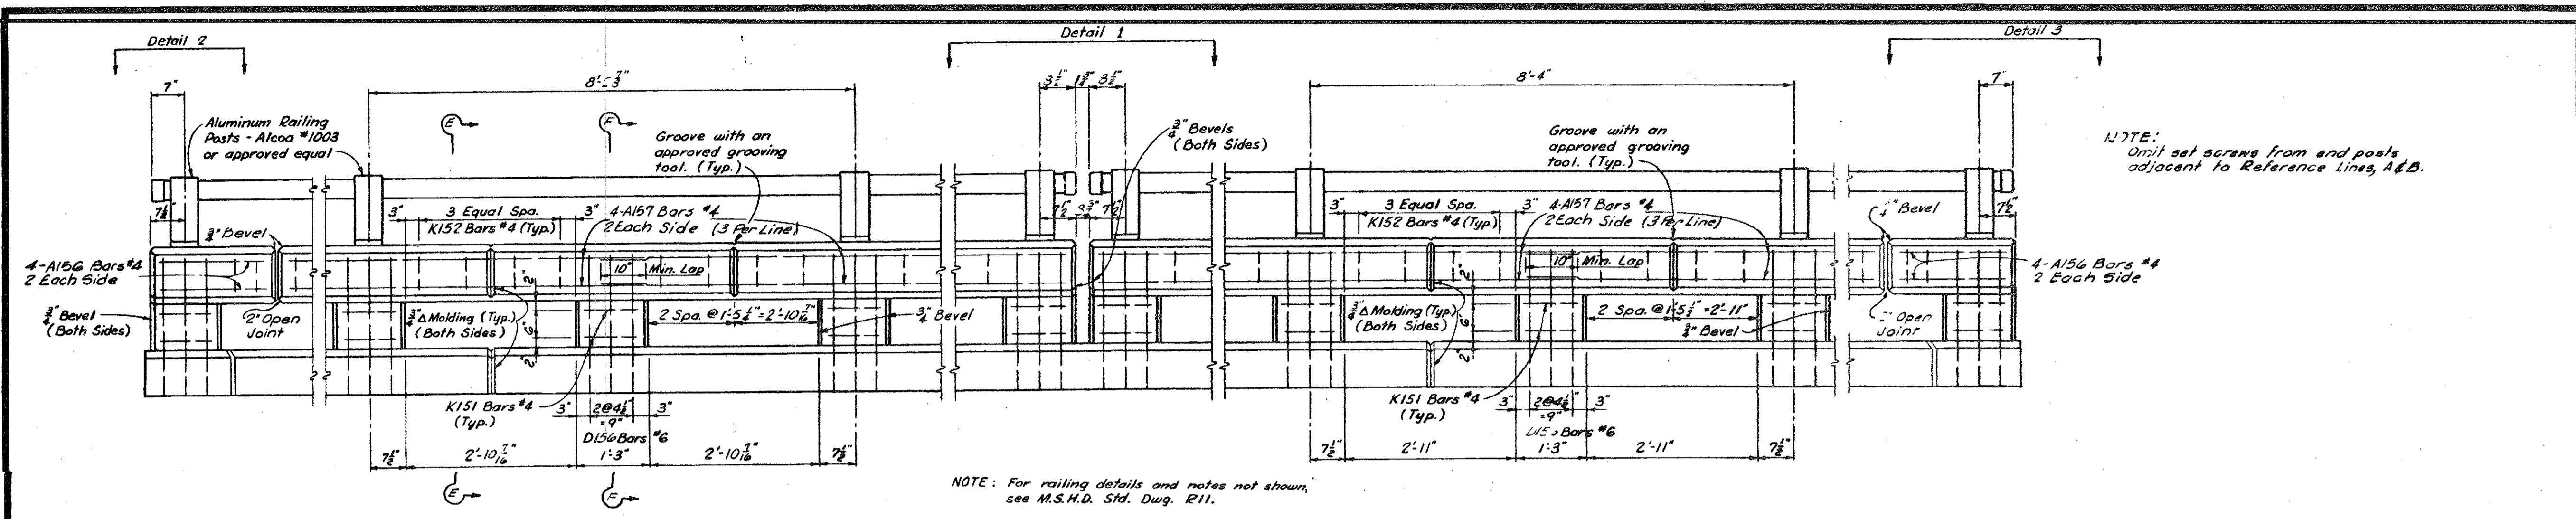

INSIDE ELEVATION - BRIDGE RAILING - PARAPET TYPE

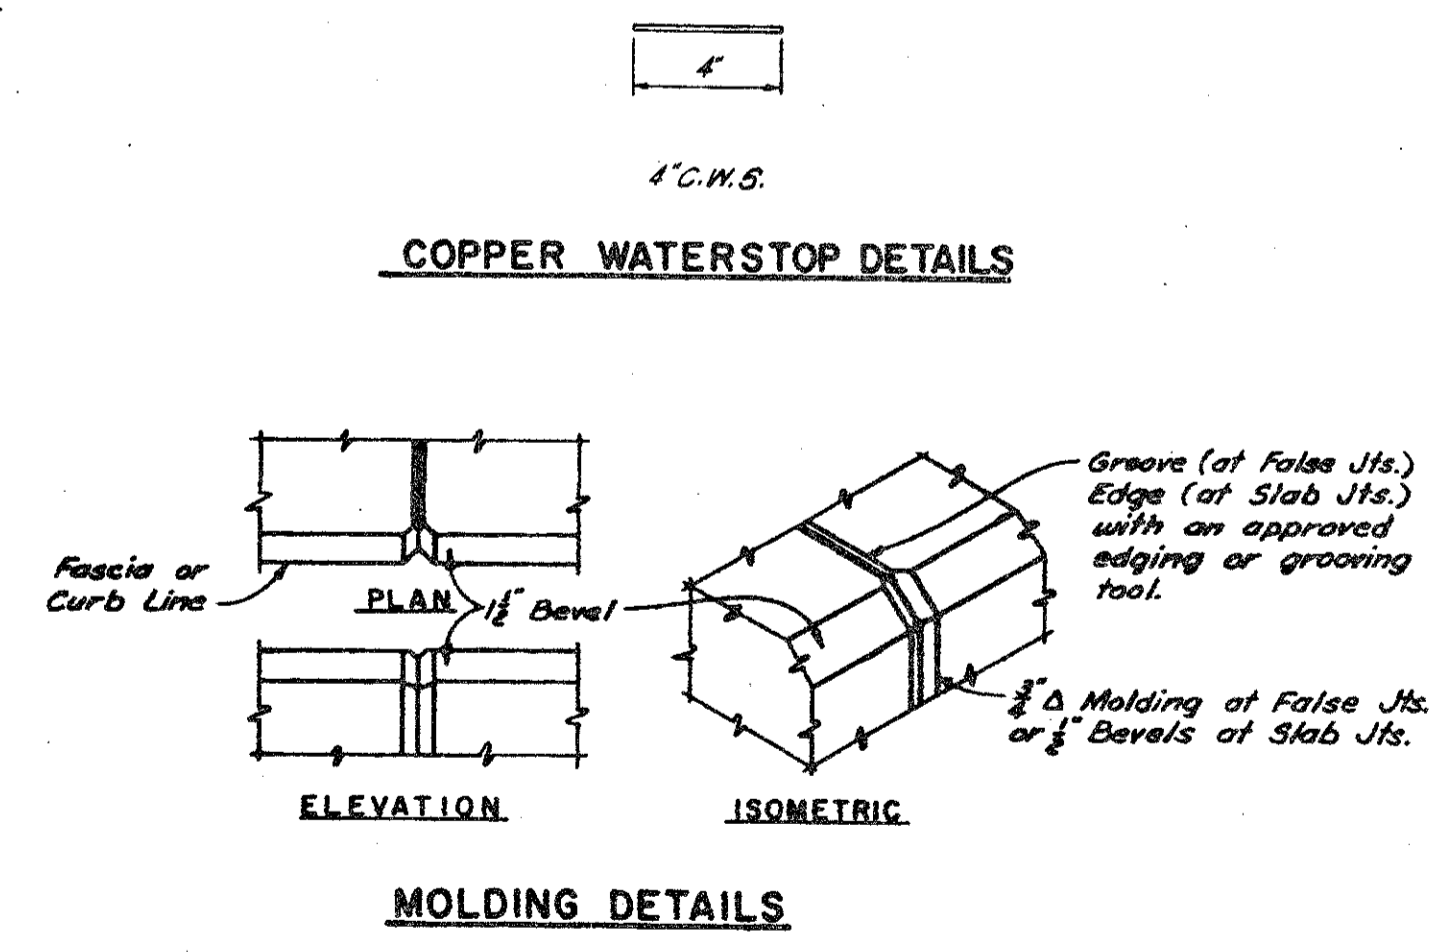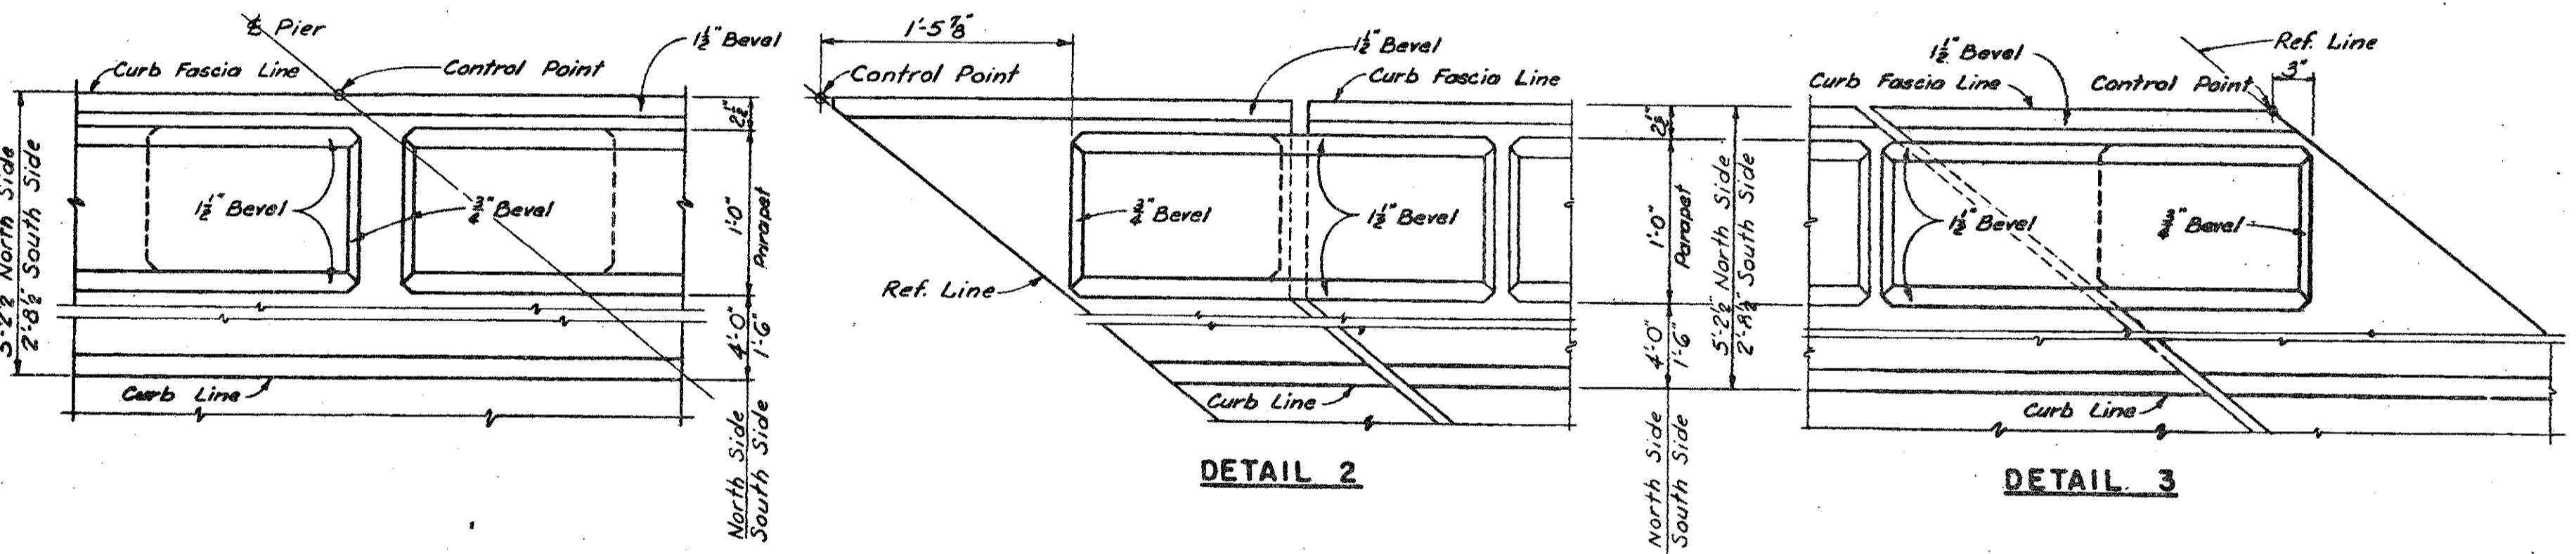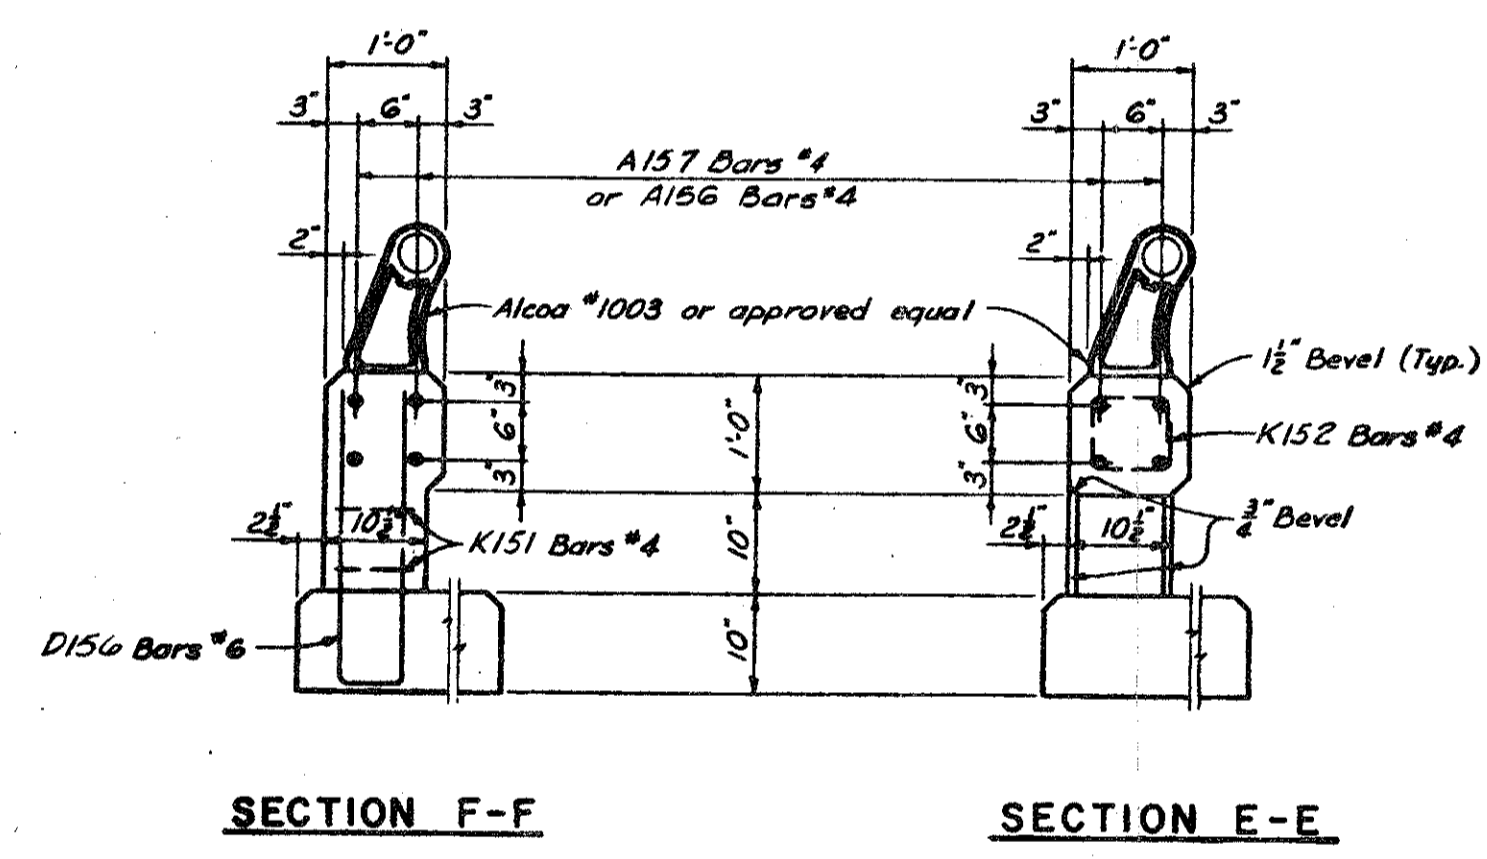

Work this sheet with sheets 130, 131 & 132

MICHIGAN STATE HIGHWAY DEPARTMENT
SUPERSTRUCTURE DETAILS

TECON ENGINEERS, INC.
REVISIONS

NO.	DESCRIPTION	DATE	BY
A	Structure Relocated	9-10-88	Tecon

DATE: 10-14-99 DRAWN BY: rander

NOTE:
DO NOT WORK FROM THIS SHEET. THE INFORMATION SHOWN
HERE IS FOR REFERENCE ONLY. NO PAY ITEMS ARE SHOWN.




FOR INFORMATION ONLY				
DATE	CONT. SEC.	JOB NO.	DESIGN UNIT	SHEET
10-14-99	S02 OF 63174	48404A	MADHAVI	20 OF 29

DATE: CORRECTED BY: CHECKED BY: DATE: DATE: DRAWN BY: rander FILE NAME: s0263174.spc


CONTROL S02 OF 63174 JOB NO. 48404E SH. NO. 21

1 2 3 4 5 6 7 8 9 10 11 12 13 14 15 16 17 18 19 20 21 22 23 24 25 26 27 28 29 30 31 32 33 34 35 36 37 38 39 40 41 42 43 44 45 46 47 48 49 50 51 52 53 54 55 56 57 58 59 60 61 62 63

REVISIONS			
NO.	DESCRIPTION	DATE	BY

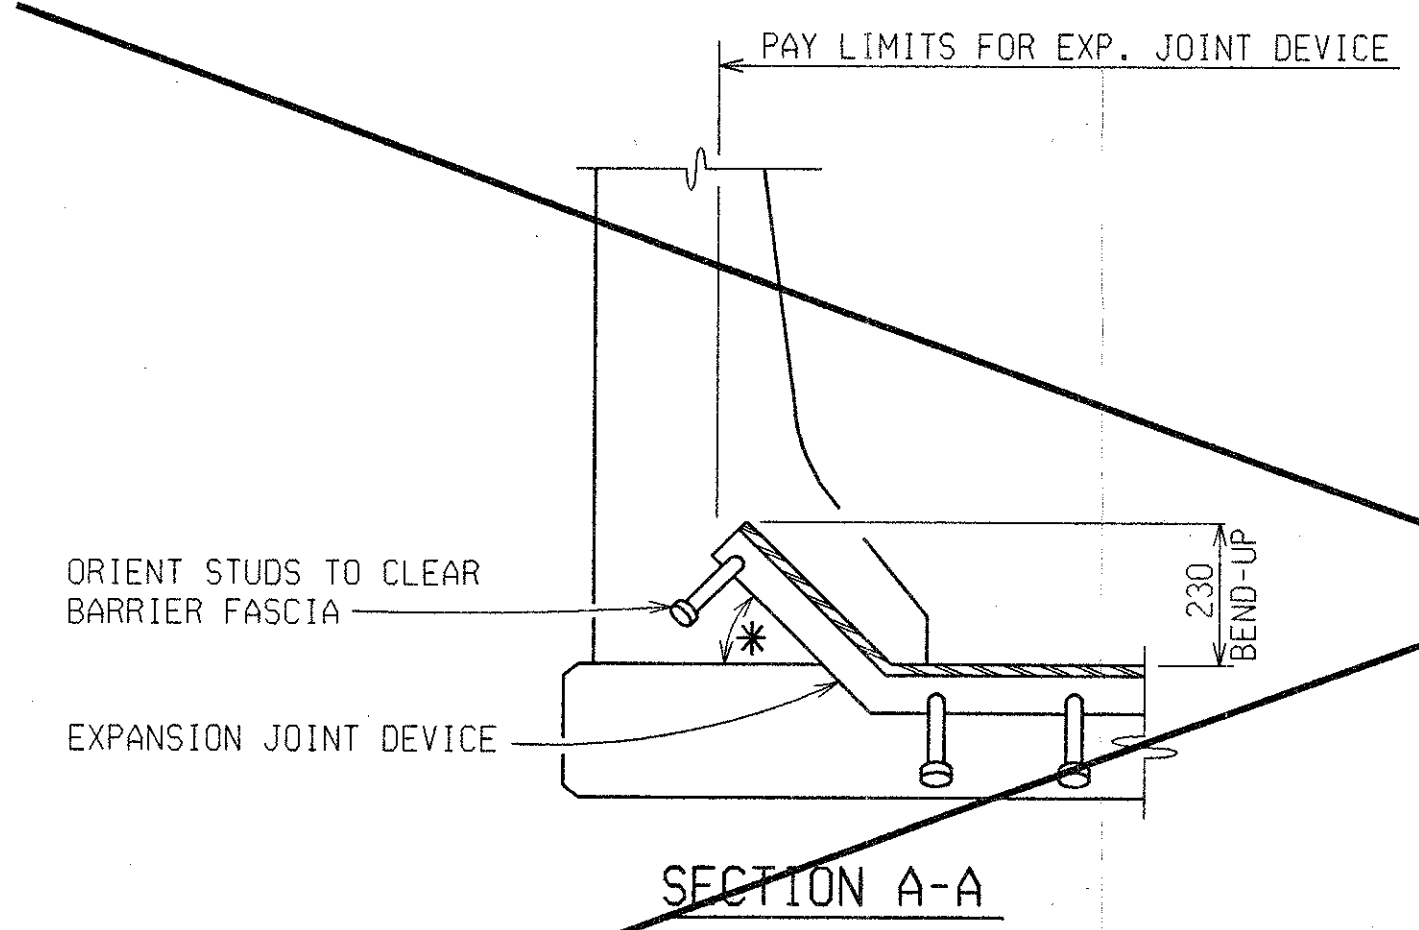

* FOR ANGLES OF CROSSING FROM 90° TO 45° INCLUSIVE, BEND ANCHORAGE UP 45° ALONG EXPANSION JT. FOR ANGLES OF CROSSING LESS THAN 45°, A SPECIAL ENDING MAY BE REQUIRED.

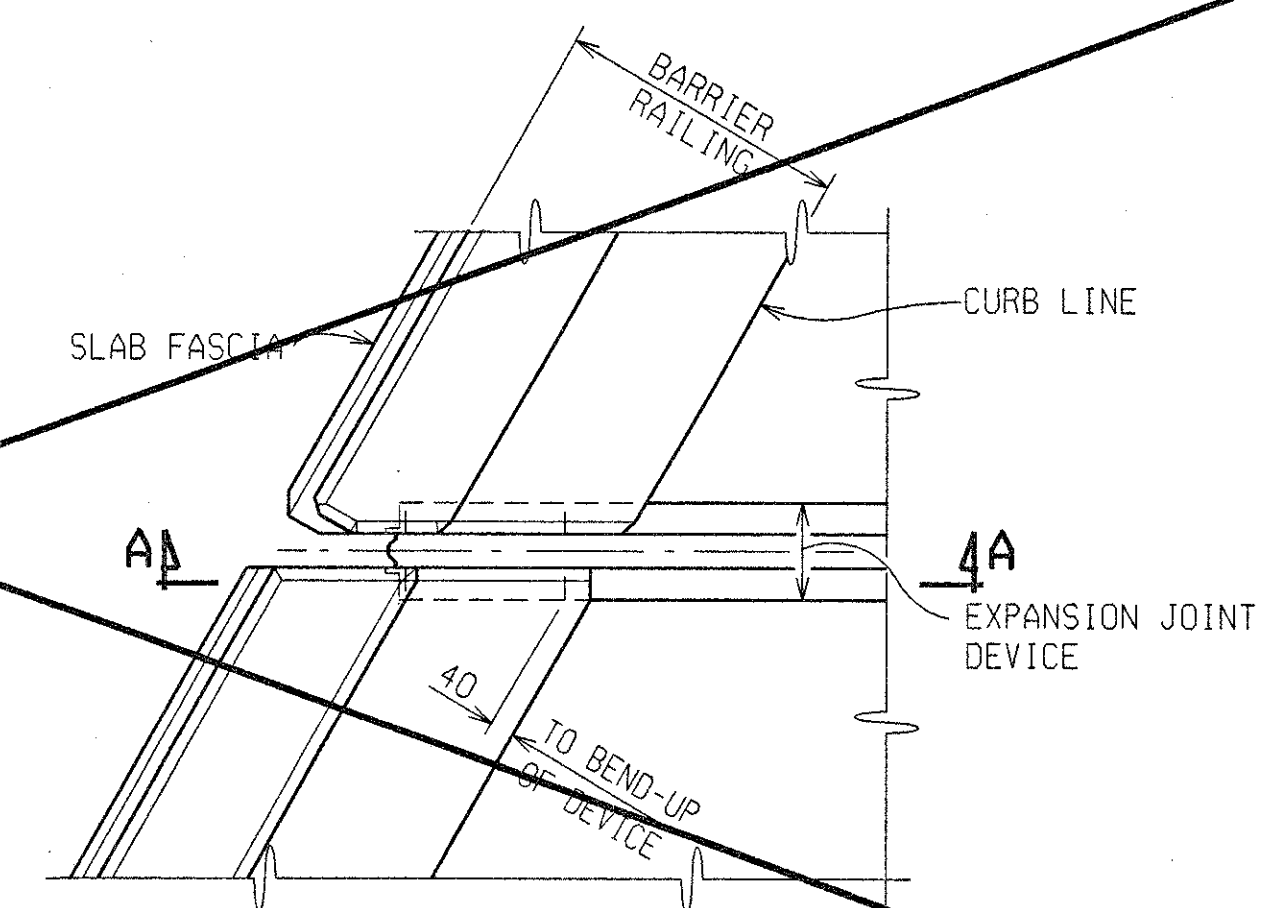

BARRIER TREATMENT

NOTES:

JOINT TYPES:

DEVICE	MANUFACTURER
WABO STRIP SEAL	WATSON-BOWMAN & ACME, INC.
PRO-SPAN	FEL-PRO, INC.
STEELFLEX-SSA2	D.S. BROWN
STEELFLEX-SSCM	D.S. BROWN
STEELFLEX-RS	D.S. BROWN
ONFLEX 40 SS	STRUCTURAL RUBBER PRODUCTS CO.
STRUPCO 400L	STRUCTURAL RUBBER PRODUCTS CO.

THE EXPANSION JOINT DEVICE SHALL BE OF A TYPE THAT INCLUDES A CONTINUOUS NEOPRENE (OR EQUIVALENT) SEAL ACROSS THE DECK. UNLESS OTHERWISE NOTED ON THE PLANS, THE CONTRACTOR HAS THE OPTION OF USING ANY OF THE DEVICES LISTED BELOW:

THE MODEL OF THE JOINT TYPE SELECTED SHALL BE SUITABLE TO ACCOMMODATE THE TOTAL MOVEMENT NOTED ON THE PLANS.

COMPLETE WORKING DRAWINGS OF ALL DETAILS OF FABRICATION OF THE EXPANSION JOINT DEVICE SHALL BE SUBMITTED FOR REVIEW IN ACCORDANCE WITH STANDARD SPECIFICATION 104.02. THIS REQUIREMENT IS WAIVED FOR EXPANSION JOINT DEVICES FOR WHICH A SET OF STANDARD INSTALLATION DETAILS HAS BEEN APPROVED. STANDARD INSTALLATION DETAILS CAN BE OBTAINED FROM THE DESIGN DIVISION.

FABRICATION AND INSTALLATION:

THE EXPANSION JOINT SHALL BE SHOP FABRICATED TO CONFORM TO THE CONTOUR OF THE BRIDGE DECK, BARRIERS, ETC. IT SHALL BE INSTALLED IN ACCORDANCE WITH MANUFACTURER'S RECOMMENDATIONS SUBJECT TO NOTES HEREIN AND THE APPROVAL OF THE ENGINEER.

THE TOP OF THE ELASTOMERIC JOINT DEVICE SHALL BE SET 3 - 6 mm BELOW THE CONCRETE SLAB (PAVEMENT) WITH A TOLERANCE OF ± 3 mm.

THE STEEL ANCHORAGE FOR STRIP SEAL GLANDS SHALL BE HOT DIP GALVANIZED IN ACCORDANCE WITH SUBSECTION 707.16 OF THE STANDARD SPECIFICATIONS.

THE PRO-SPAN DEVICE MUST INCORPORATE A CAST-IN-PLACE STEEL SEAT.

THE AREA OF THE STEEL ANCHORAGE AND SEALING GLAND WHICH WILL BE IN CONTACT WITH A SEALANT, OR LUBRICANT-ADHESIVE SHALL BE CLEANED WITH TOLUENE OR OTHER APPROVED SOLVENT.

WHERE THE SEALING GLAND IS LOCKED INTO A STEEL ANCHORAGE, A LUBRICANT-ADHESIVE CONFORMING TO STANDARD SPECIFICATION 914.4-E SHALL BE REQUIRED BETWEEN THE SEAL AND STEEL ANCHORAGE.

ALL BOLT WELL CAVITIES SHALL BE FILLED WITH AN APPROVED FLEXIBLE EPOXY OR A SEALANT CONFORMING TO FEDERAL SPECIFICATION TT-S-00230C.

IN THE EVENT THAT THE CONSTRUCTION SEQUENCE REQUIRES SPLICING THE SEALING GLAND, IT SHALL BE SPLICED BY AN APPROVED METHOD (SUCH AS COLD VULCANIZATION) BY A TRAINED REPRESENTATIVE OF THE MANUFACTURER.


DETAILS AT CURBS OR BARRIERS:

THE DETAILS ON THIS SHEET SHOW AN APPROVED MEANS OF TERMINATING THE EXPANSION JOINT DEVICE AT CURBS OR BARRIERS. VARIATIONS OR ALTERNATIVE SCHEMES WILL BE CONSIDERED AND MAY BE USED IF APPROVED BY THE ENGINEER.


MATERIALS:

THE COST OF ALL MATERIALS AND LABOR REQUIRED FOR PROPER INSTALLATION OF THE EXPANSION JOINT AND THE TERMINAL ASSEMBLIES AT THE CURBS, SIDEWALKS, OR BARRIERS IS INCLUDED IN THE PAYMENT FOR THE EXPANSION JOINT DEVICE.

ITEM	QUANTITY	UNIT	AMOUNT
EXPANSION JOINT DEVICE		m	33

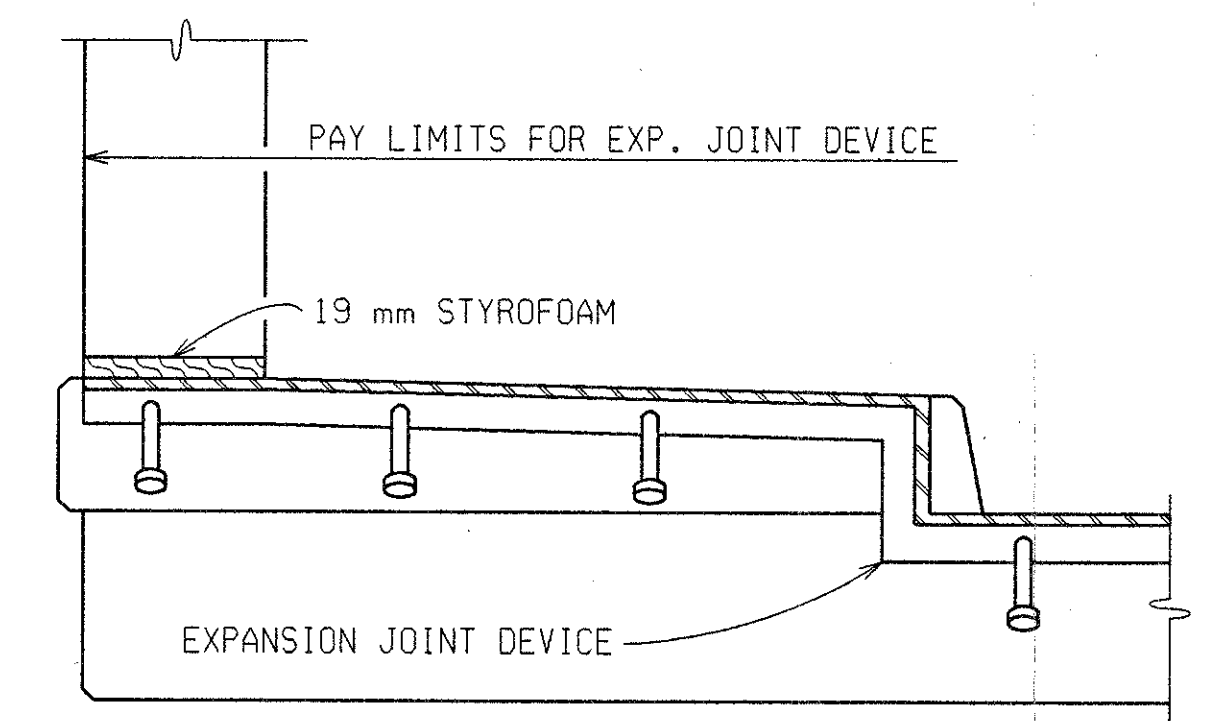


SECTION B-B

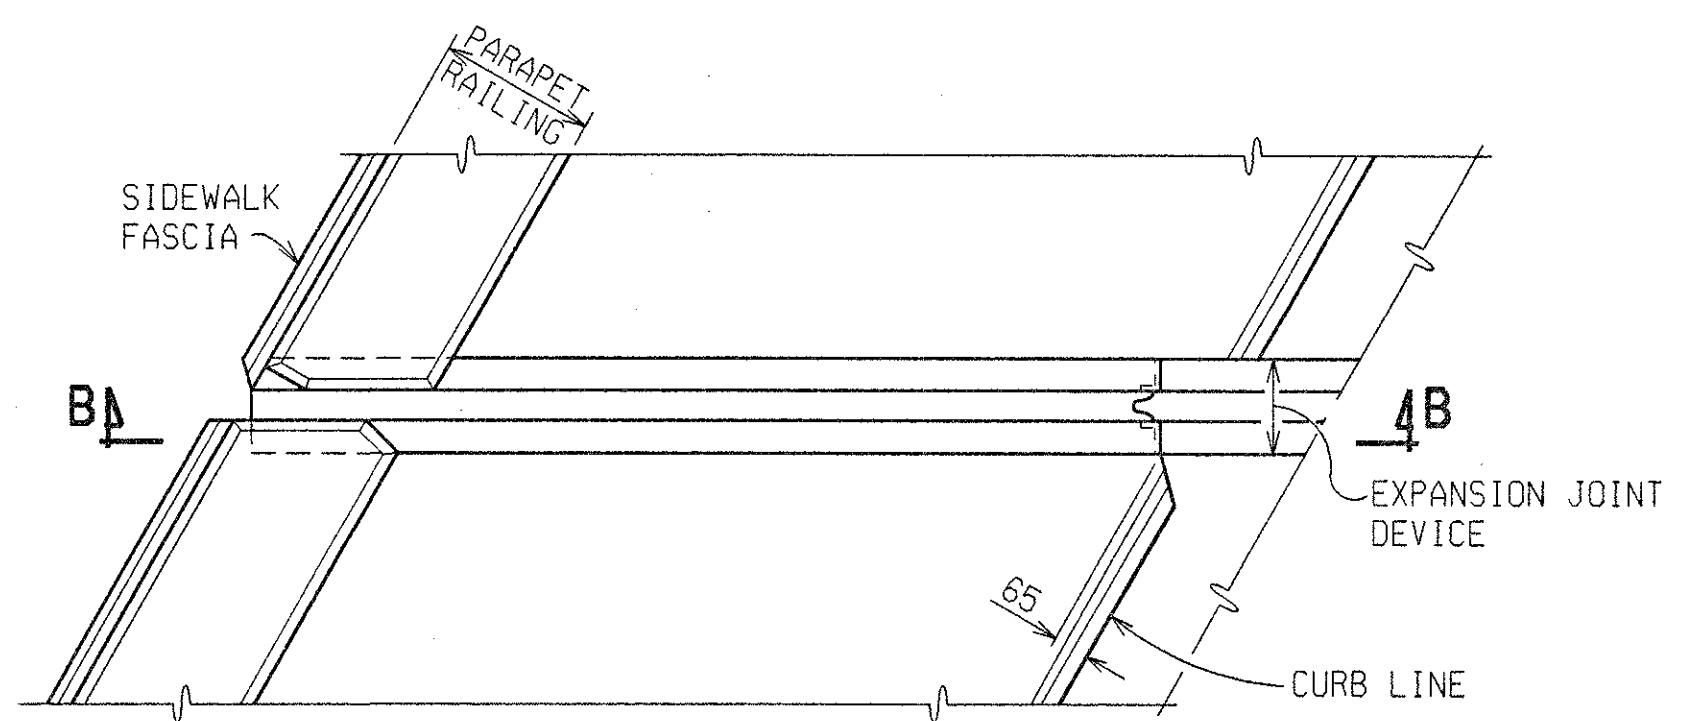


PLAN AT PARAPET RAILING
(DETAILS ARE SIMILAR FOR BRIDGE RAILING, 5 TUBE)

SIDEWALK TREATMENT

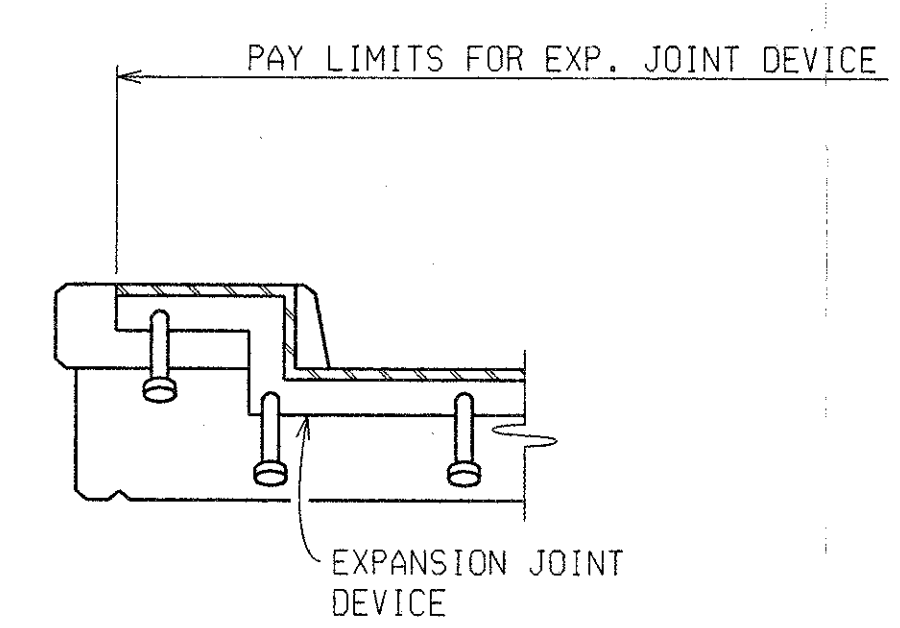


SECTION C-C

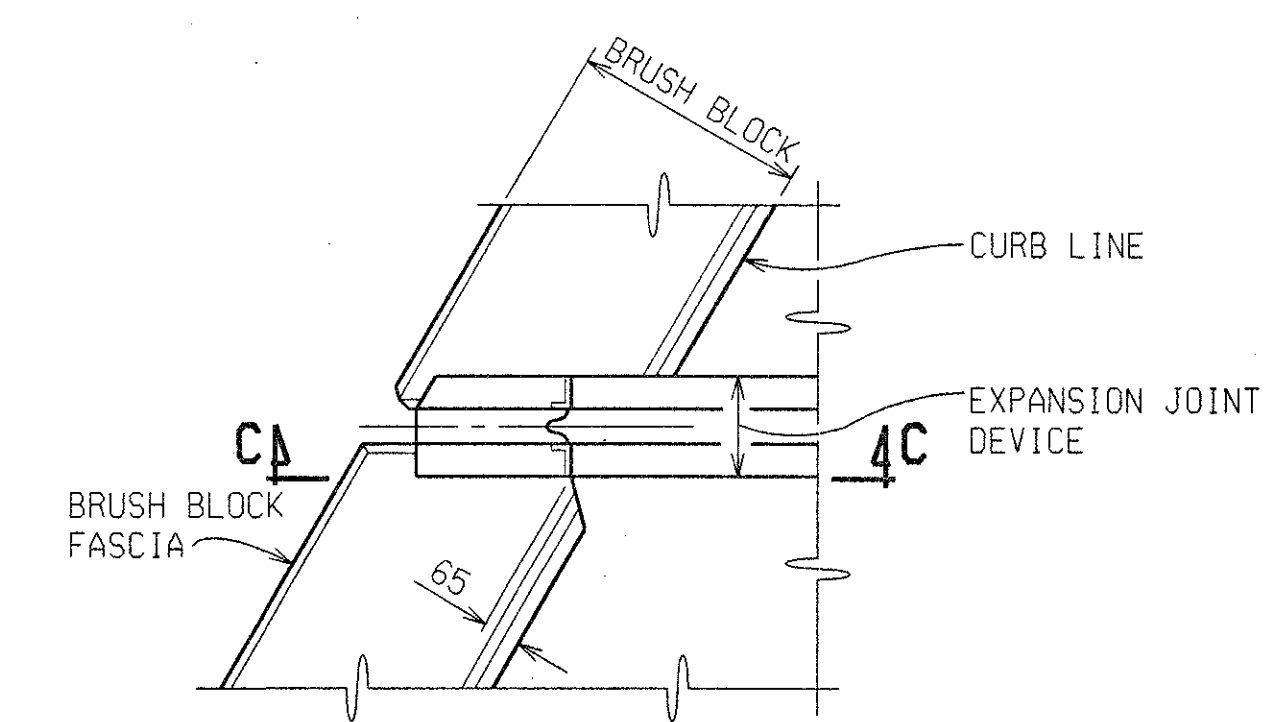

PLAN AT BRIDGE RAILING, 2 TUBE

BRUSH BLOCK TREATMENT

STRUCTURE NUMBER	ANGLE OF CROSSING TO NEAREST 10°	LOCATION OF JOINT	MIN. TOT. TRAVEL ALONG CENTERLINE OF BRIDGE	REQUIRED LENGTH OF EXPANSION JOINT DEVICE
S02	40°	ABUT A	25 mm	16.2 m
S02	40°	ABUT B	25 mm	16.2 m

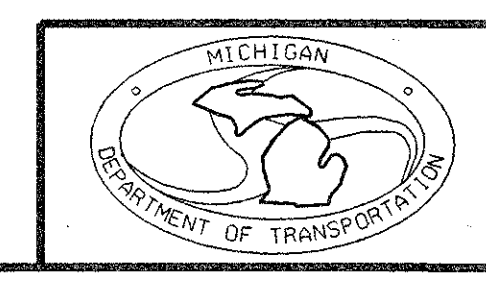


EXPANSION JOINT DETAILS

DATE	CONT. SEC.	JOB NO.	DESIGN UNIT	SHEET
10-13-99	S02 OF 63174	48404E	MAHDAVI	21 OF 29

EJ3T (11-17-97)


DATE: 5-11-99 CORRECTED BY: SHAFER DATE: 07-16-96 CHECKED BY: VZ/SPB DATE: STANDARDS DRAWN BY: FILE NAME: S0263174.EJ

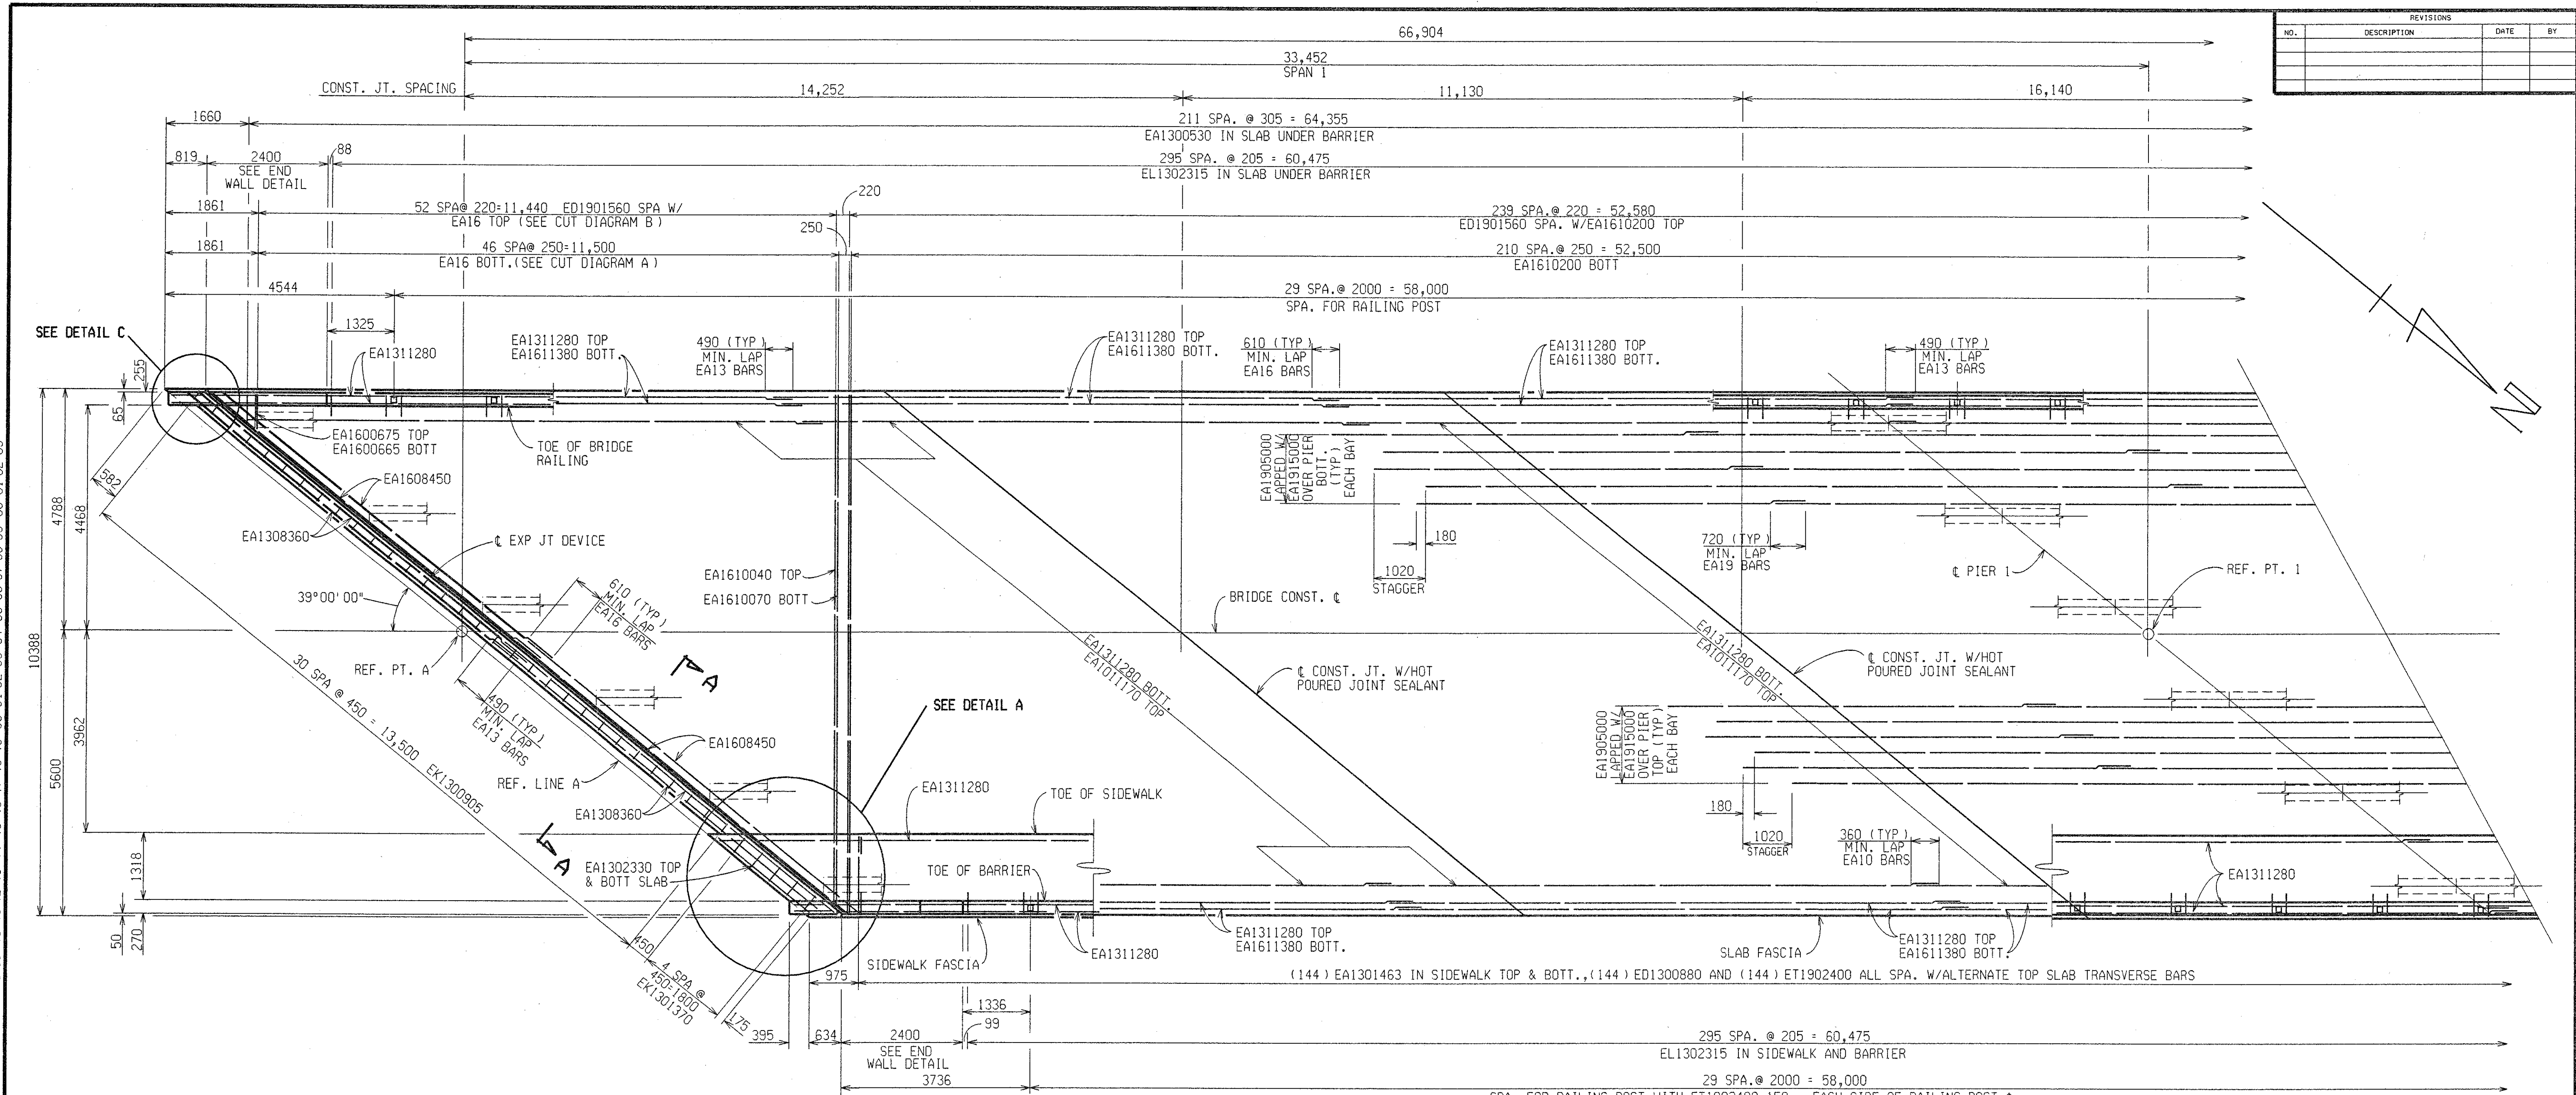

REVISIONS			
NO.	DESCRIPTION	DATE	BY

PLAN OF SLAB

NOTES:
 FOR BRIDGE RAILING, ANCHORAGE FOR GUARDRAIL AND NAME PLATE MOUNTING DETAILS, SEE STANDARD B-25 SERIES. FOR DETAILS OF NAME PLATES, MOLDINGS AND BEVELS, SEE STANDARD PLAN B-103-SERIES.
 FOR NAME PLATE LOCATION, SEE GENERAL PLAN OF STRUCTURE SHEET.
 PERMANENT METAL STAY-IN-PLACE DECK FORMS ARE OPTIONAL.
 HPJS DENOTES HOT-POURED JOINT SEALANT.
 THE CONTRACTOR IS TO PROVIDE A SAWED JOINT 12 mm DEEP BY 3 mm WIDE (MINIMUM) IN THE TOP OF SLAB AT TRANSVERSE CONSTRUCTION JOINTS. THE JOINT IS TO BE SAWED BEFORE CASTING OF BARRIERS OR SIDEWALKS AND IS TO BE FILLED WITH HOT-POURED JOINT SEALANT OR COLD-APPLIED JOINT SEALANT, SINGLE COMPONENT TYPE IN ACCORDANCE WITH STANDARD SPECIFICATION SUBSECTION 9.14.04. INCLUDED IN THE BID ITEM "SUPERSTRUCTURE CONC., FORM, FINISH AND CURE (NIGHT CASTING) (S02)".
 NO PORTION OF THE DECK FORMWORK SHALL ENCRoACH ON THE EXISTING UNDERCLEARANCE.
 THIS DECK POUR IS DESIGNATED A NIGHT POUR, AND THEREFORE SUBJECT TO THE RESTRICTIONS OF SECTION 706.03 J OF THE STANDARD SPECIFICATIONS.
 DECK POURS ARE TO BE MADE IN THE FOLLOWING SEQUENCE A, B, C, D, AND E.

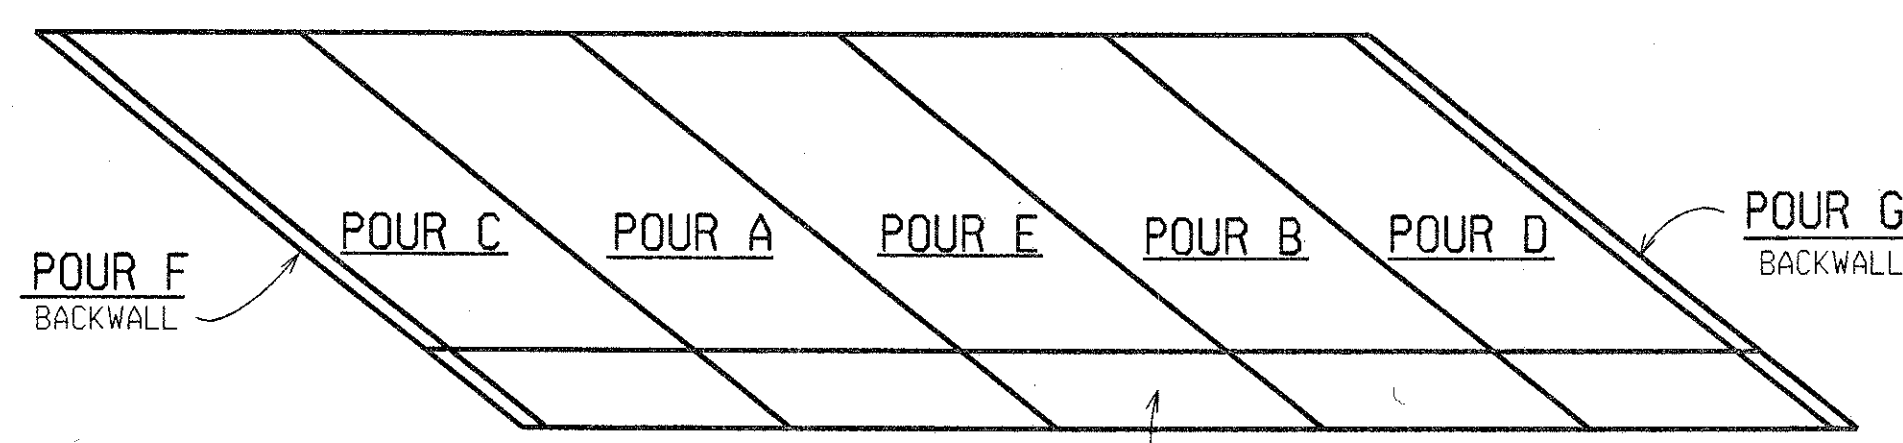

POUR DIAGRAM

DECK POURS

POUR	CUBIC METERS
A	28.1
B	28.1
C	33.9
D	33.9
E	41.0
TOTAL CONC: 165 CUBIC METERS	

SIDEWALK AND BARRIERS

POUR	CUBIC METERS
F	3
G	3
H	20
TOTAL CONC: 26 CUBIC METERS	

MISCELLANEOUS QUANTITIES	
1 LS	Shear Developers (S02)
1 LS	Superstructure Conc. Form, Finish, and Cure, Night Casting (S02)
134 m	Bridge Railing, Aesthetic Parapet Tube, Modified
1 LS	Bridge Lighting, Furnish and Remove (S02)
165 m3	Bridge Lighting, Operate and Maintain
140 m2	Top Flanges and Beam Ends, Clean and Prime
85 m2	Joint Waterproofing
1 LS	Superstructure Conc. Form, Finish, and Cure (S02)
320 m2	Conc Surface Sealer

DECK REPLACEMENT DETAILS






DATE	CONT. SEC.	JOB NO.	DESIGN UNIT	SHEET
10-13-99	S02 OF 63174	48404A	MAHDAVI	22 OF 29



DATE: 10-13-99 CORRECTED BY: SHAFFER DATE: DATE: 8-24-99 CHECKED BY: DATE: 8-24-99 DRAWN BY: SHAFFER FILE NAME: S0263174.DK

1 2 3 4 5 6 7 8 9 10 11 12 13 14 15 16 17 18 19 20 21 22 23 24 25 26 27 28 29 30 31 32 33 34 35 36 37 38 39 40 41 42 43 44 45 46 47 48 49 50 51 52 53 54 55 56 57 58 59 60 61 62 63

REVISIONS			
NO.	DESCRIPTION	DATE	BY

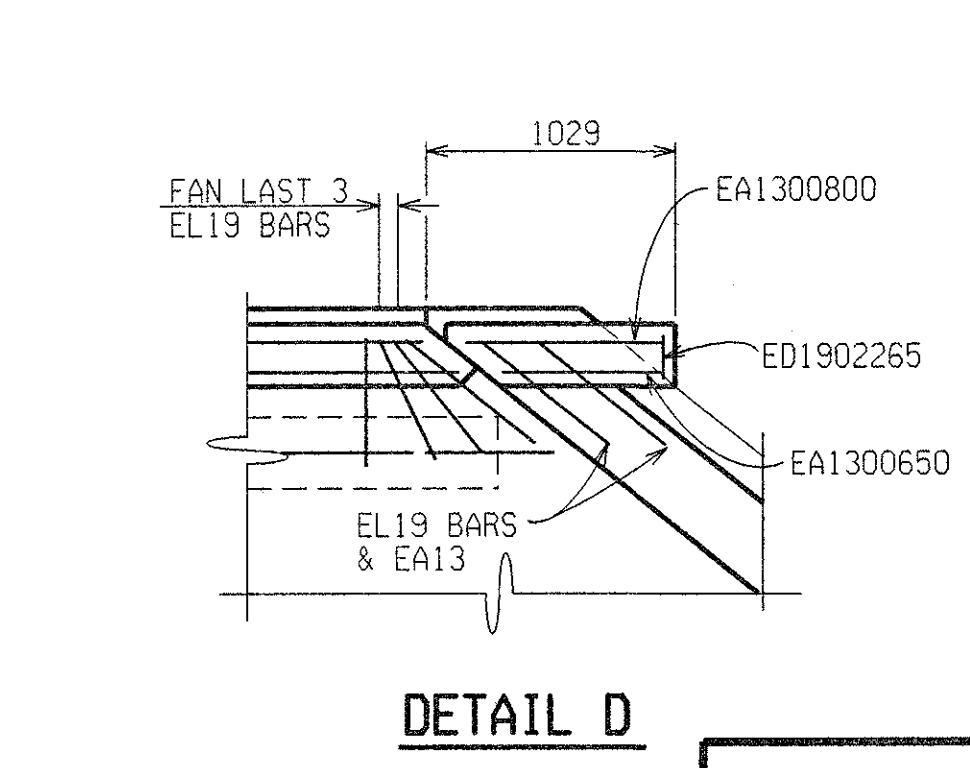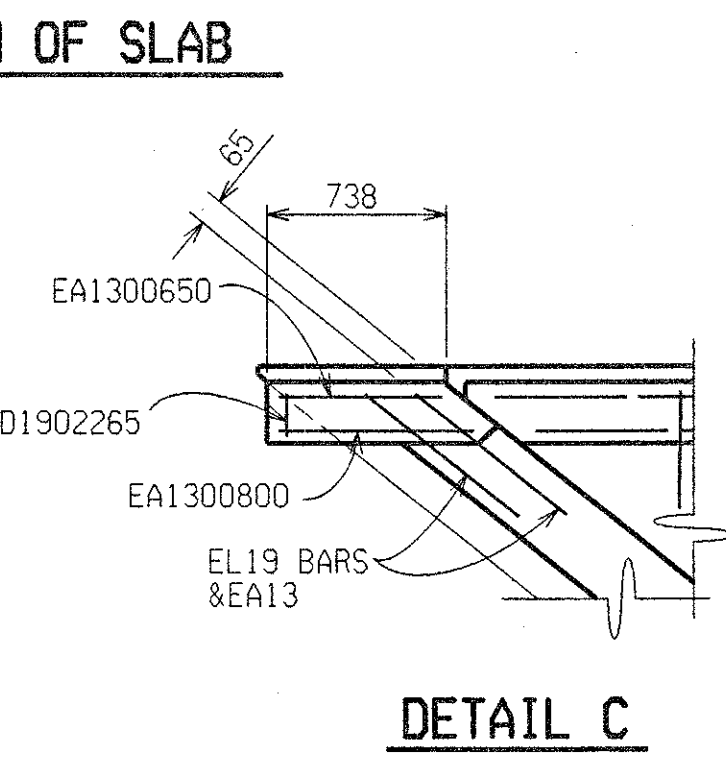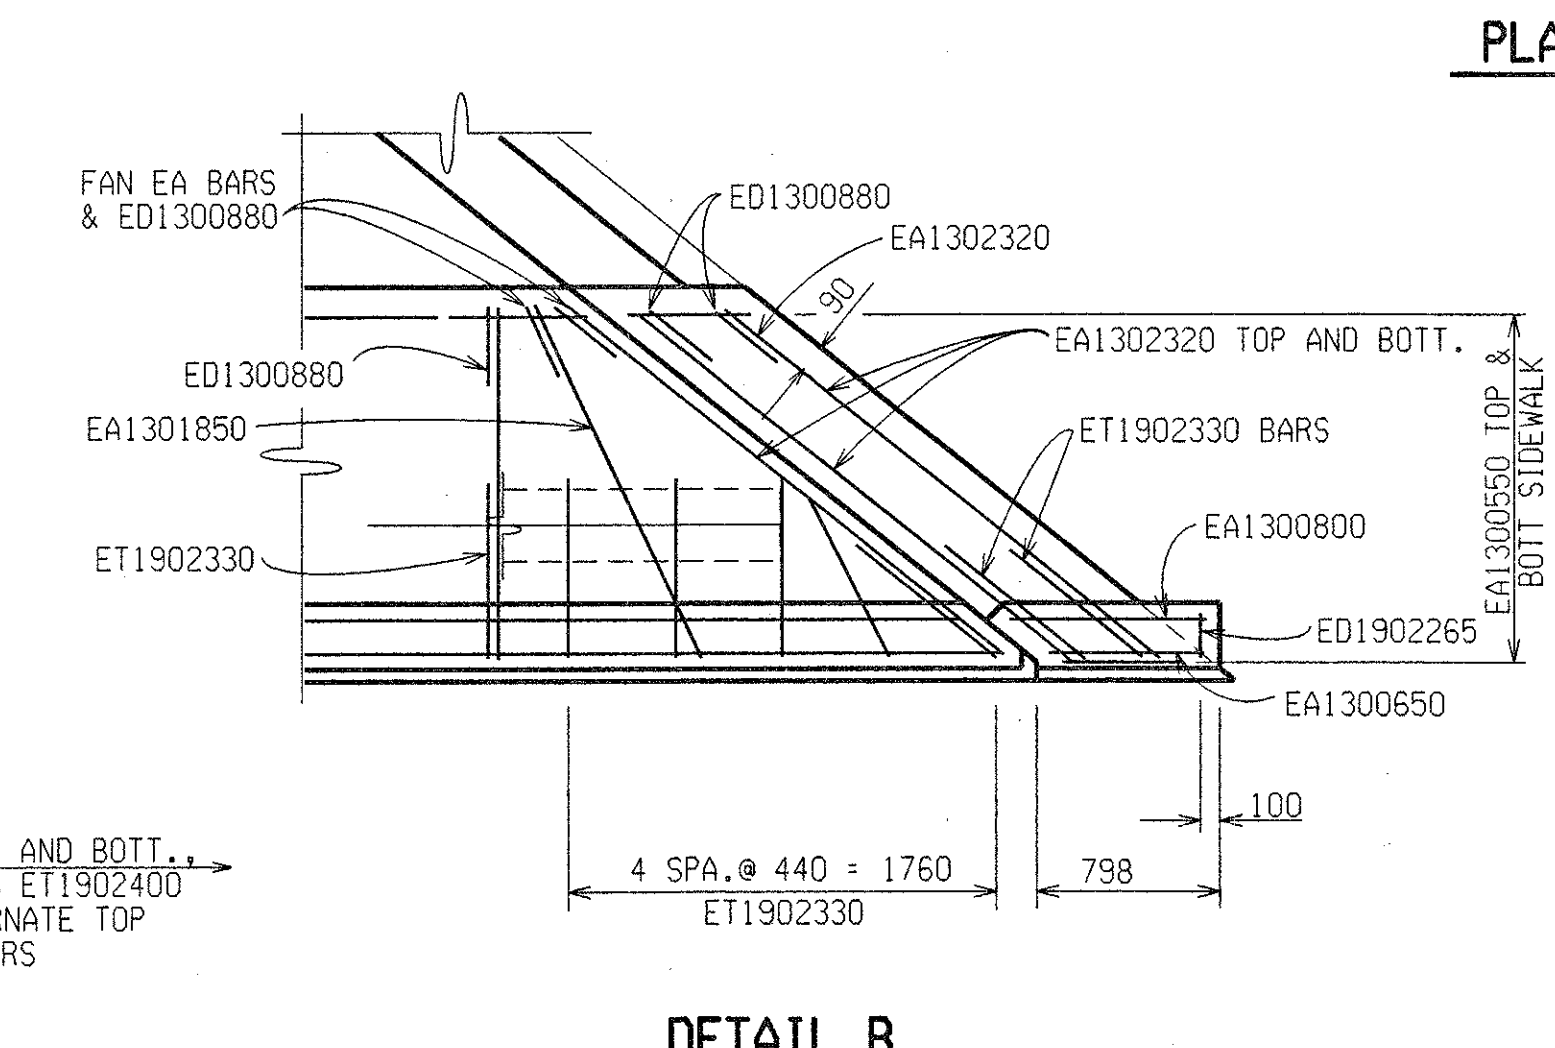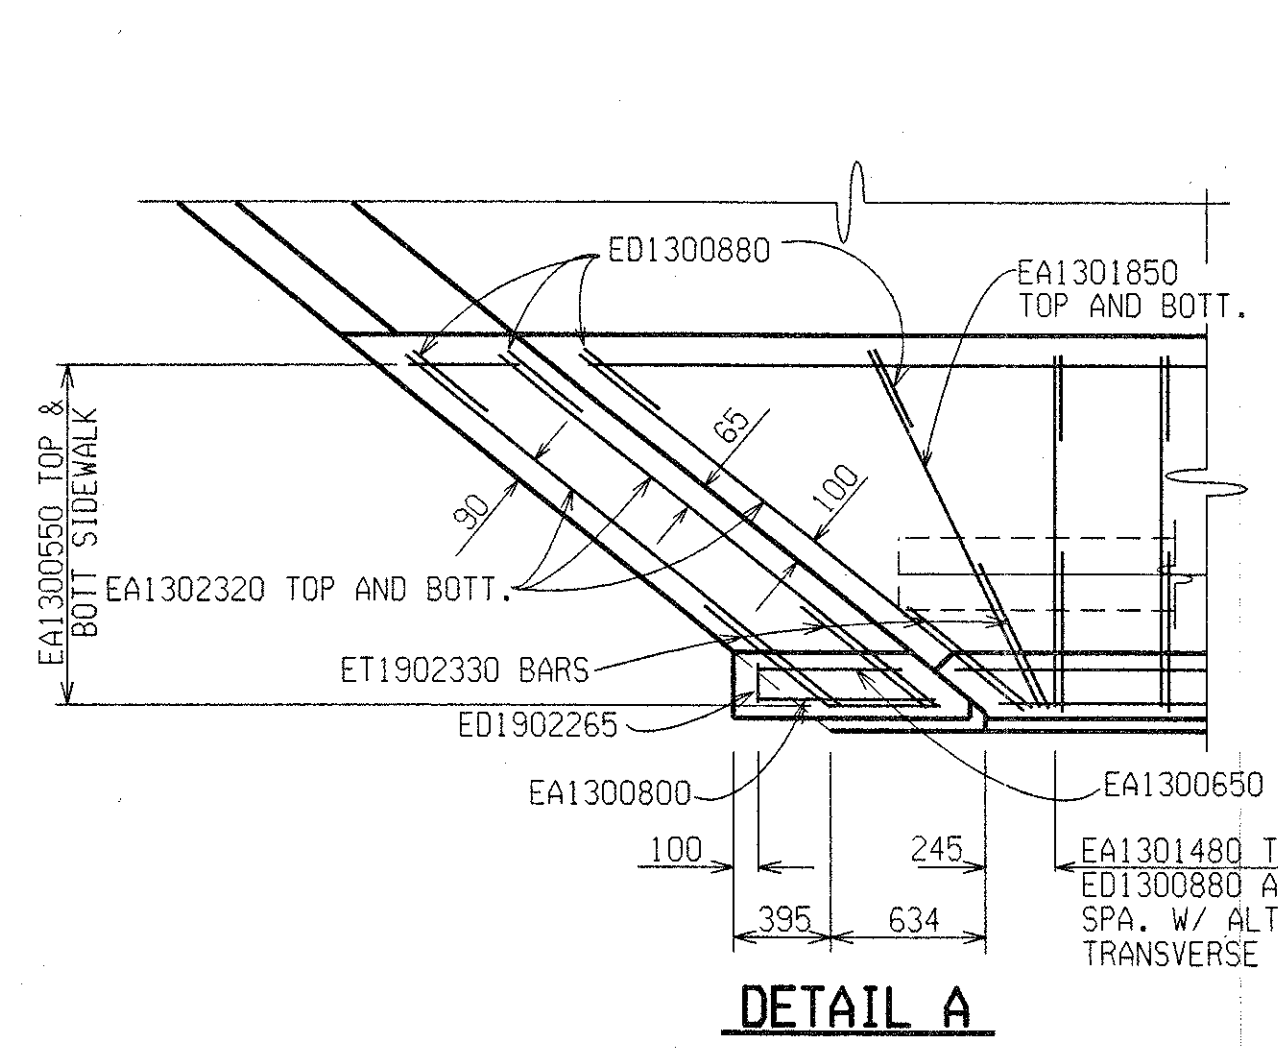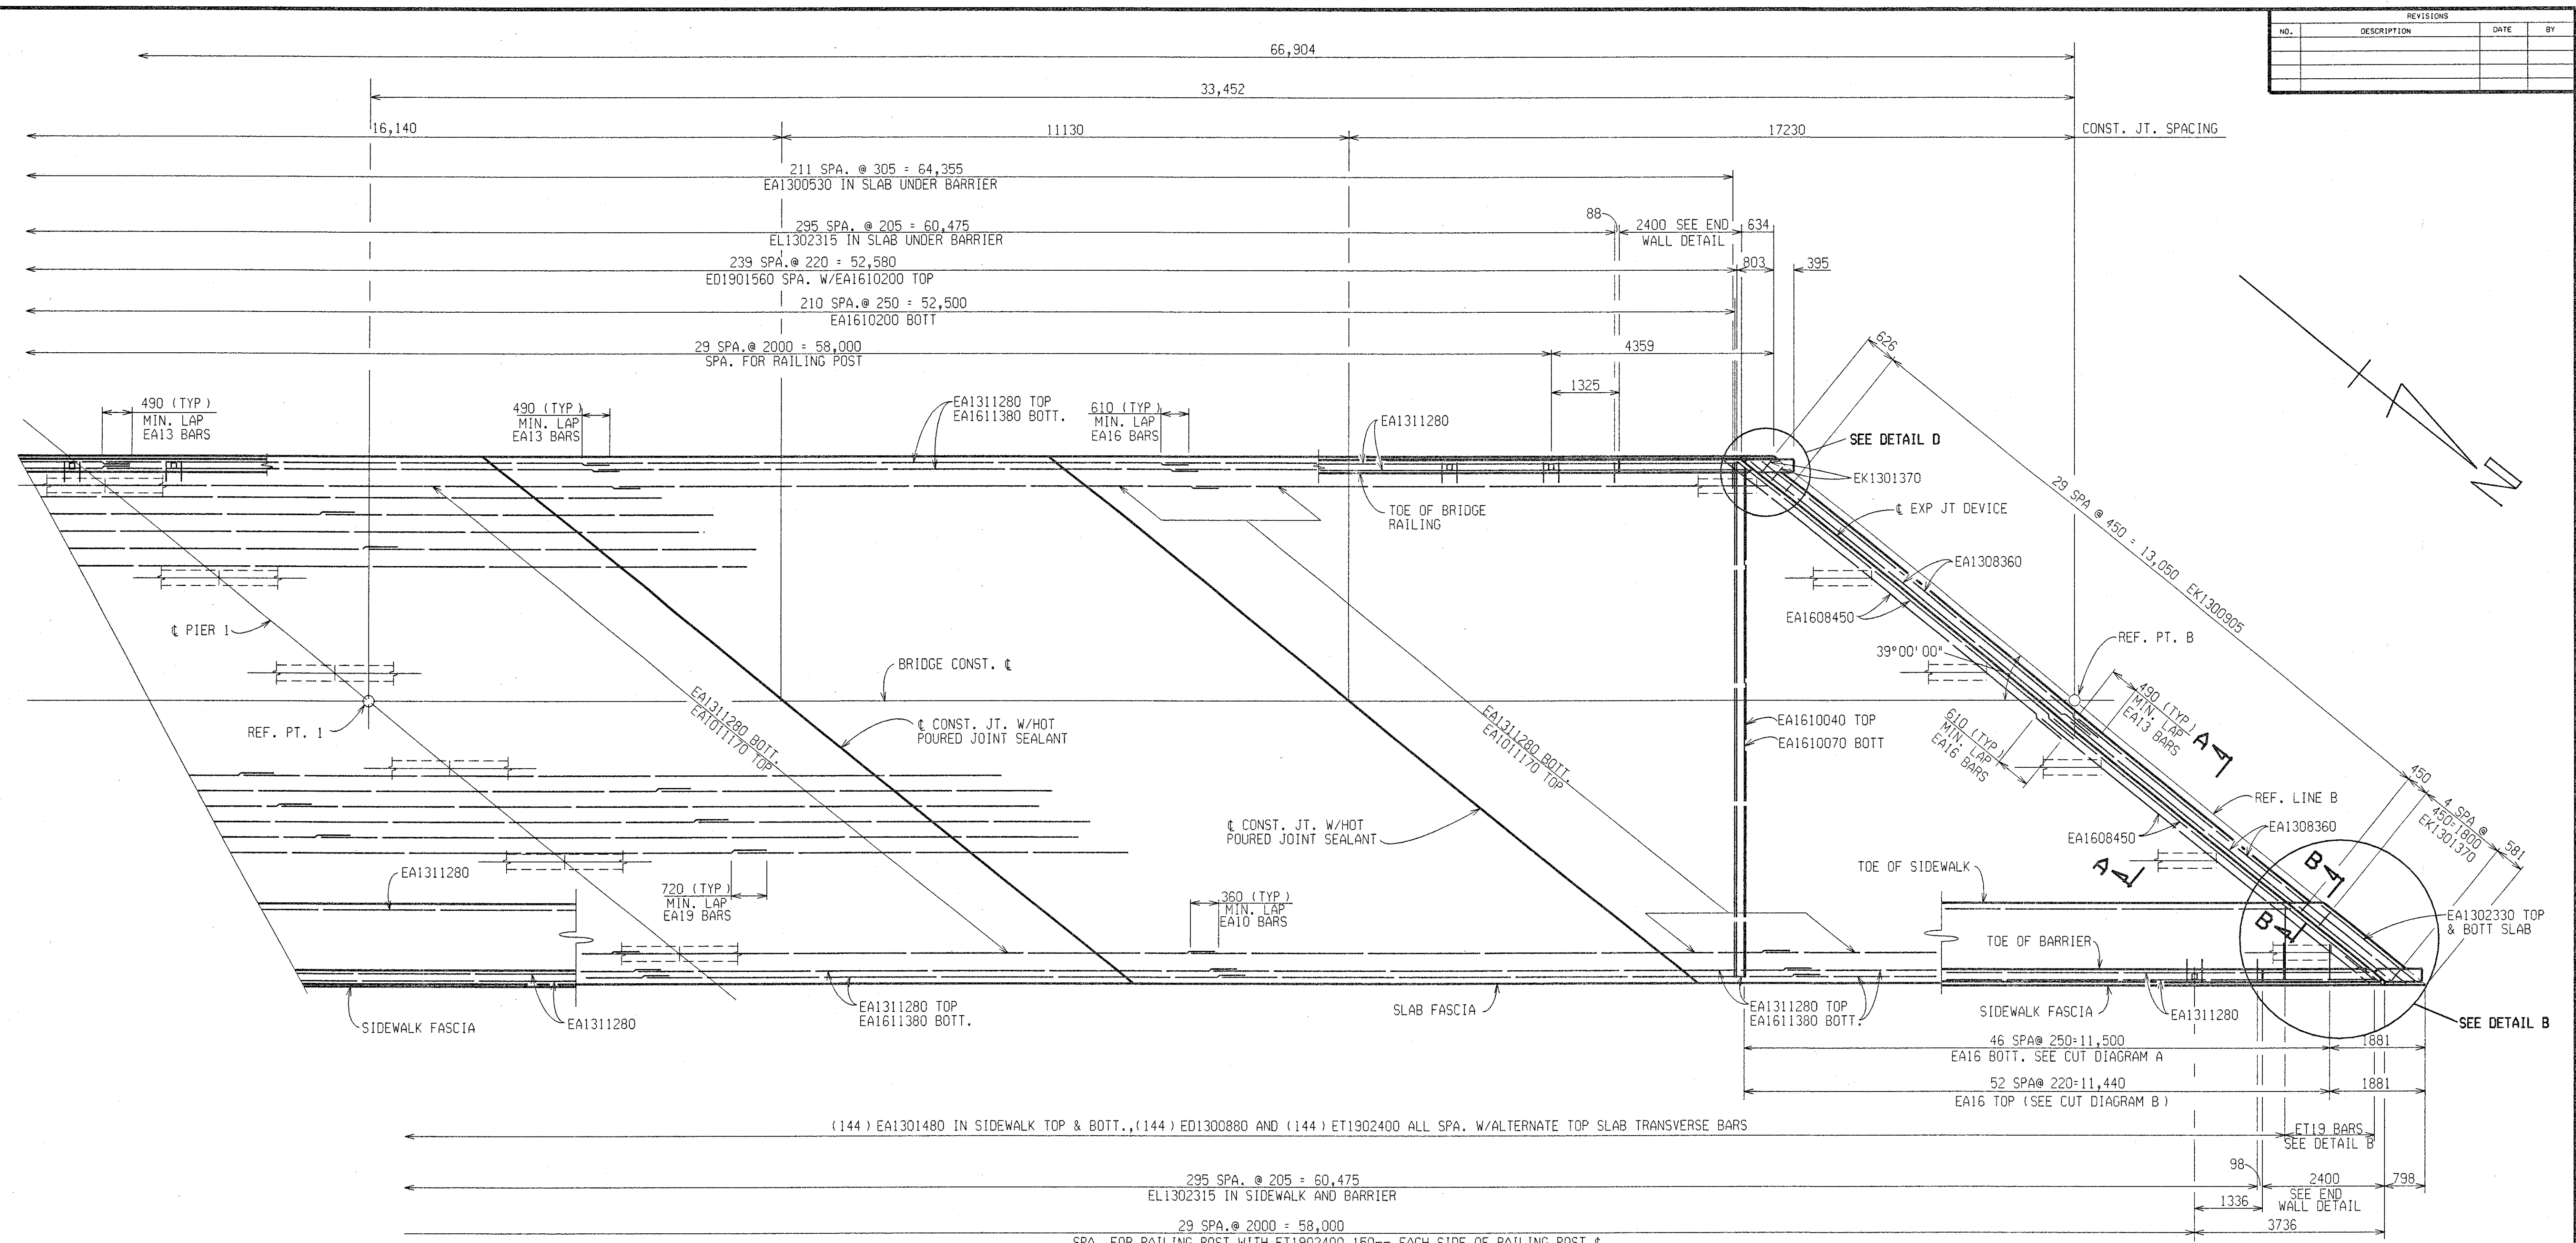

NOTES:

BRIDGE RAILING, AESTHETIC PARAPET TUBE, MODIFIED SHALL BE IN ACCORDANCE WITH THE STANDARD PLAN B-25 EXCEPT FOR THE ADDITION OF FRACTURED FIN RUSTIFICATION ON THE BACK SIDE OF THE RAILING AS DETAILED ON THE PLANS.

THE ENTIRE CONCRETESURFACES OF THE BRIDGE RAILING, AESTHETIC PARAPET TUBE, MODIFIED SHALL BE COATED WITH CONCRETE SURFACE SEALER (SEE SPECIAL PROVISIONS).

WHERE CAST-IN-ANCHORAGE IS USED FOR EXPANSION JOINT DEVICES, IT IS RECOMMENDED THAT THE PLACING OF DECK CONCRETE PROGRESS TOWARD THE JOINT SO THAT THE EFFECTS OF DEAD LOAD DEFLECTION WILL OCCUR BEFORE CONCRETE IS PLACED AT THE ANCHORAGE.

THIS DECK POUR IS DESIGNATED A NIGHT POUR, AND THEREFORE SUBJECT TO THE RESTRICTIONS OF SECTION 706.03 J OF THE STANDARD SPECIFICATIONS.


*EDGE OR "GROOVE" DENOTES EDGING OR GROOVING WITH AN APPROVED TOOL.

DECK REPLACEMENT DETAILS				
DATE	CONT. SEC.	JOB NO.	DESIGN UNIT	SHEET
10-12-99	S02 OF 63174	48404A	MAHDAVI	23 OF 29


DATE: 10-12-99 CORRECTED BY: SHAFFER DATE: 8-24-99 CHECKED BY: SHAFFER DRAWN BY: SHAFFER FILE NAME: 63174

1 2 3 4 5 6 7 8 9 10 11 12 13 14 15 16 17 18 19 20 21 22 23 24 25 26 27 28 29 30 31 32 33 34 35 36 37 38 39 40 41 42 43 44 45 46 47 48 49 50 51 52 53 54 55 56 57 58 59 60 61 62 63


REVISIONS			
NO.	DESCRIPTION	DATE	BY

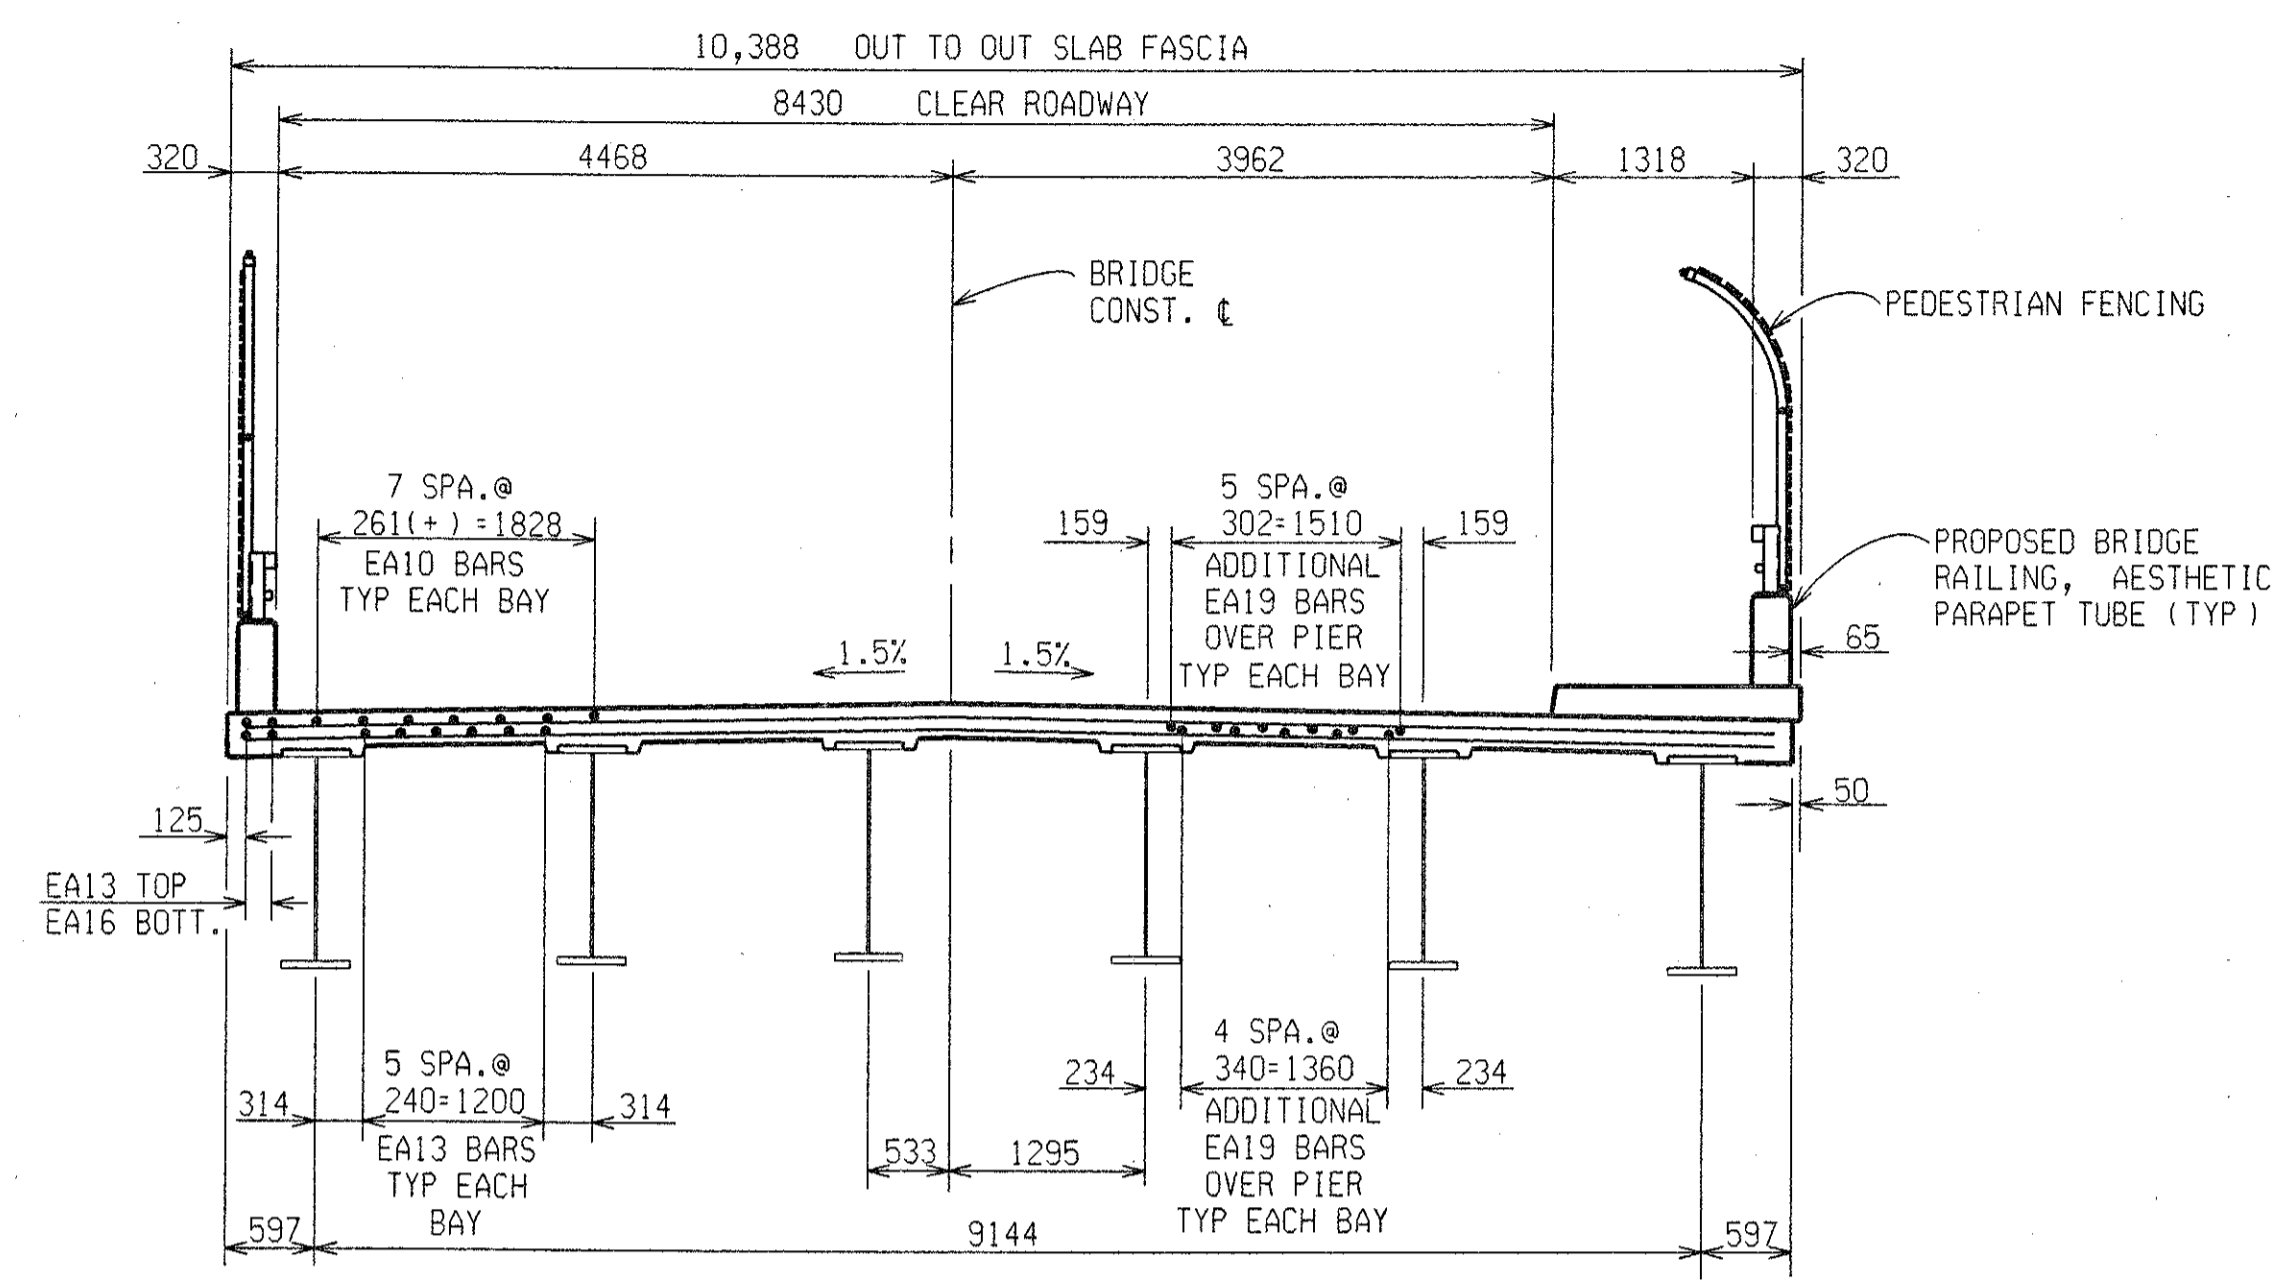


TYPICAL DECK SECTION

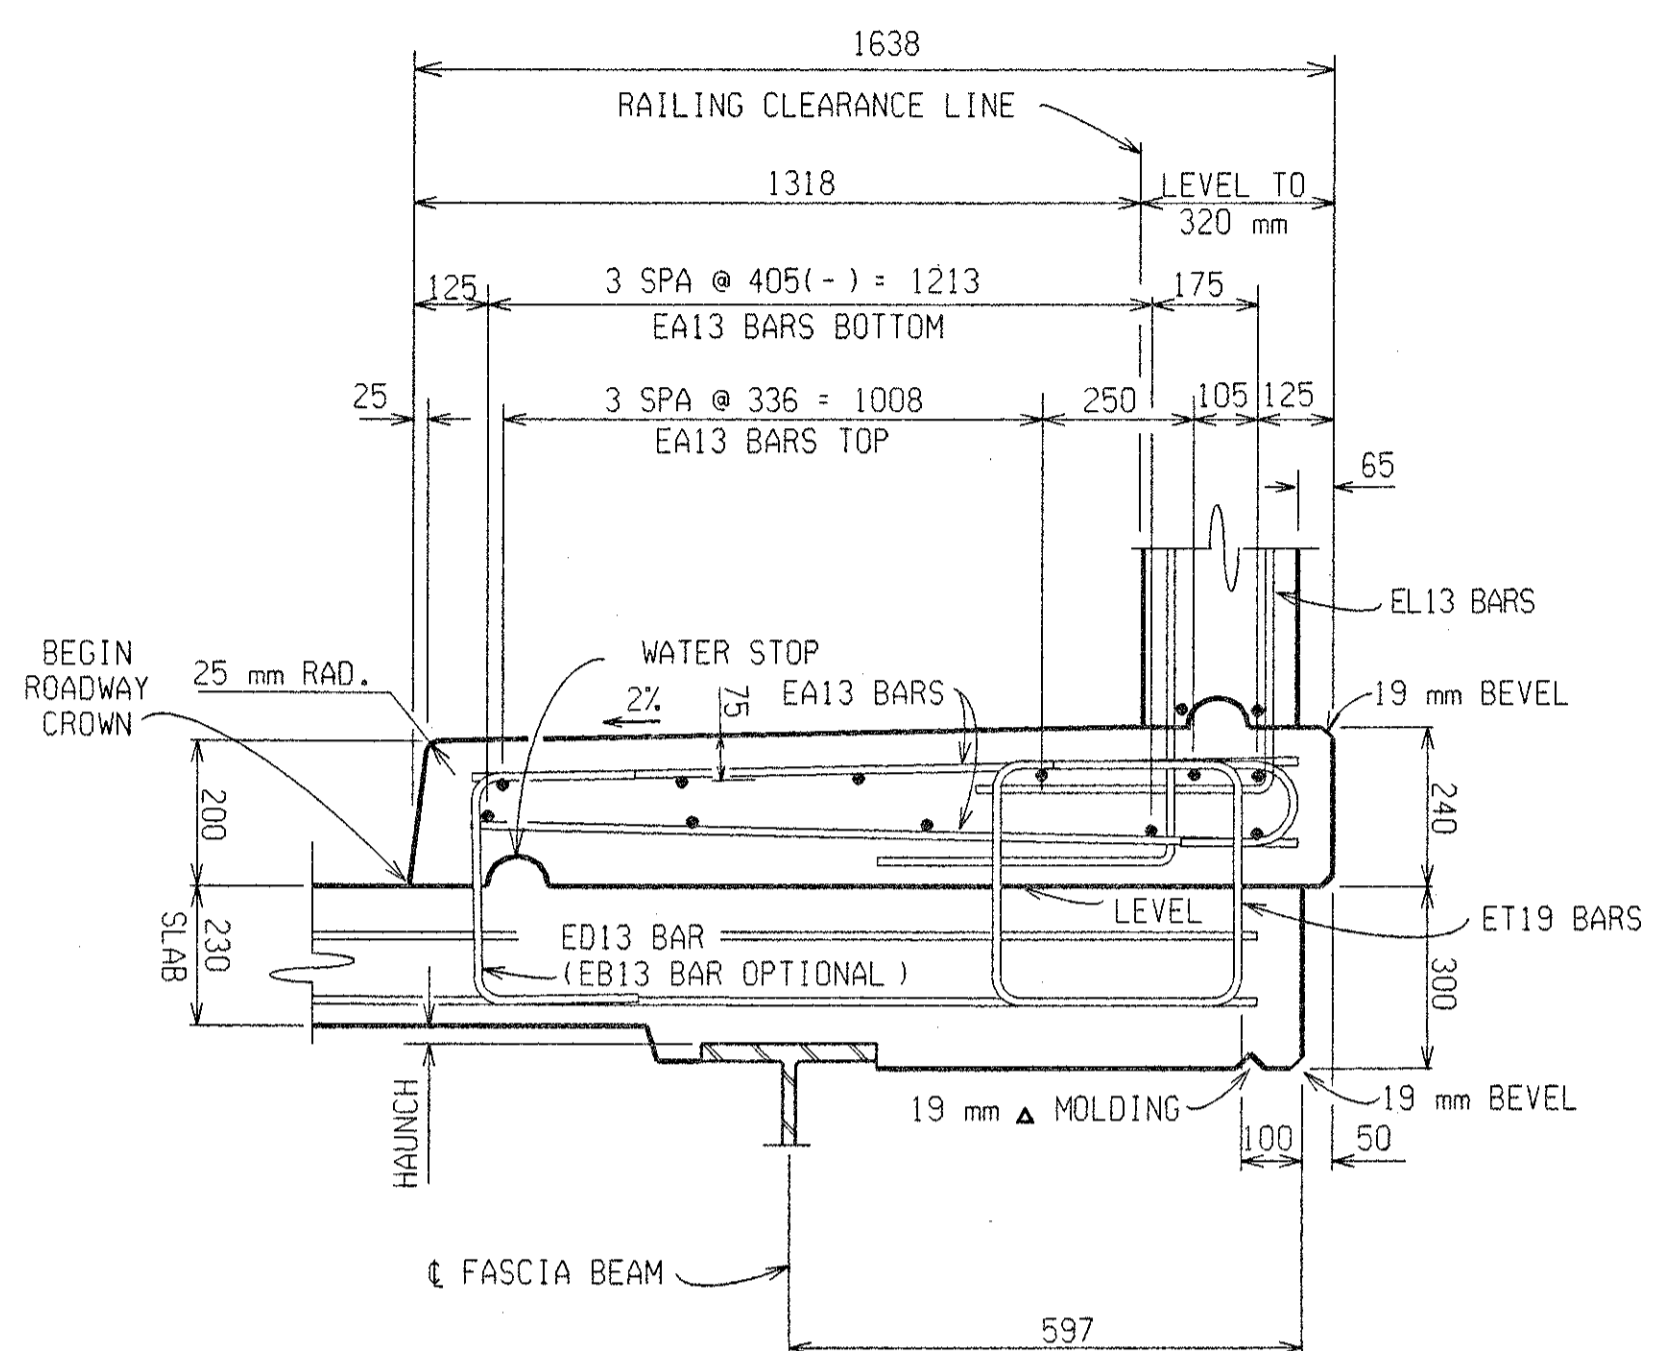


SIDEWALK SECTION

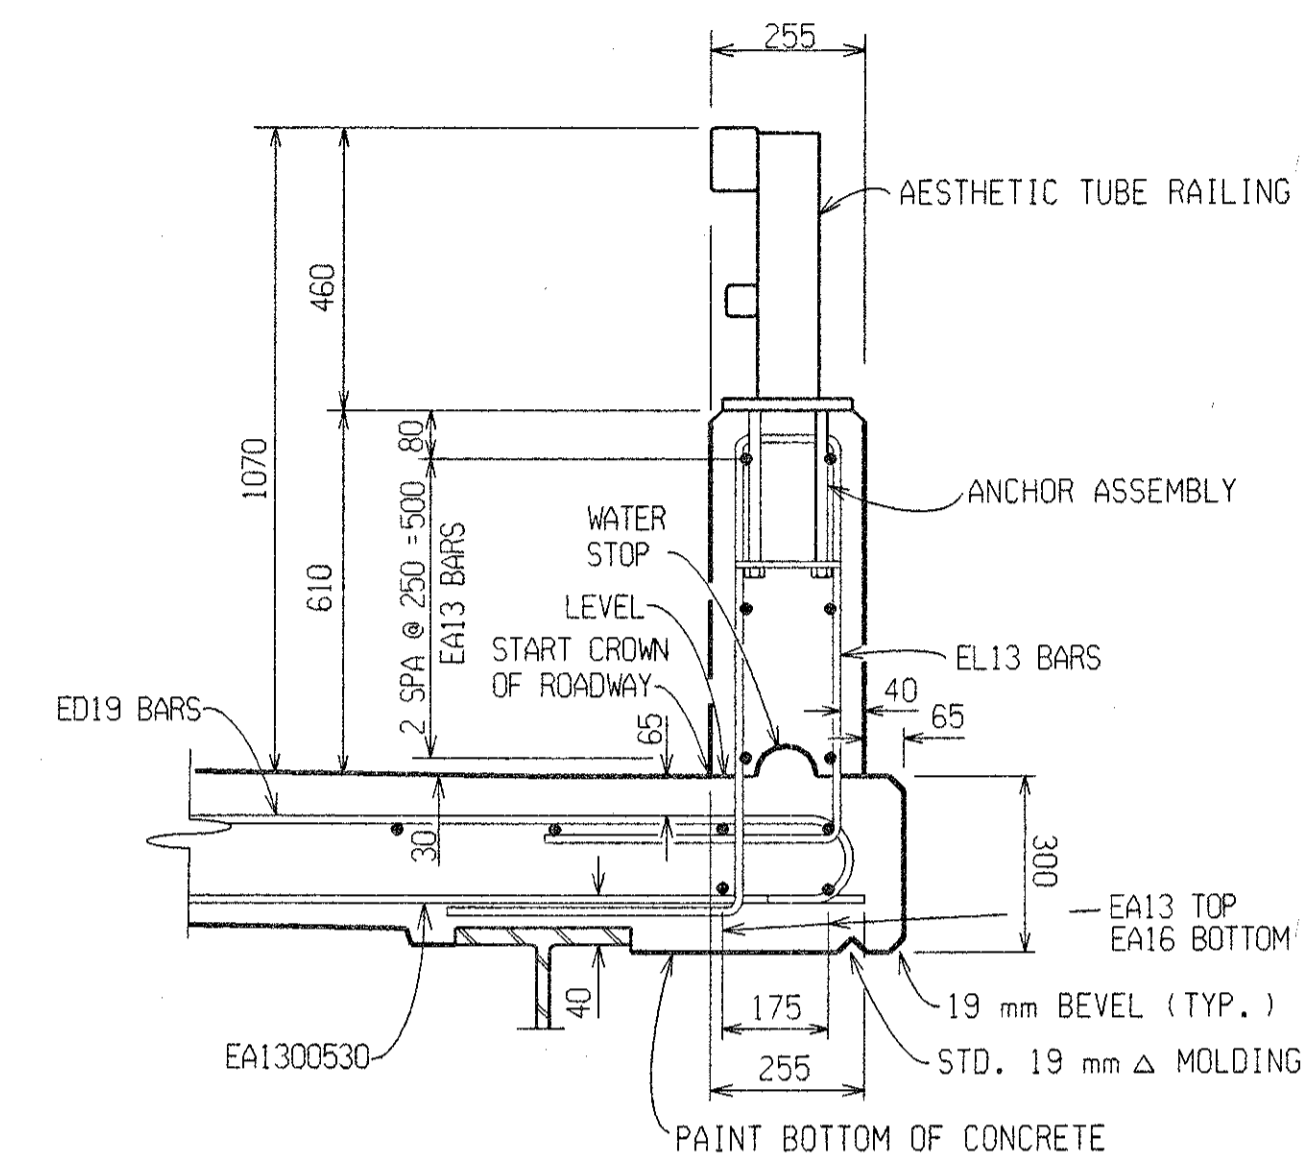


SECTION THRU RAILING

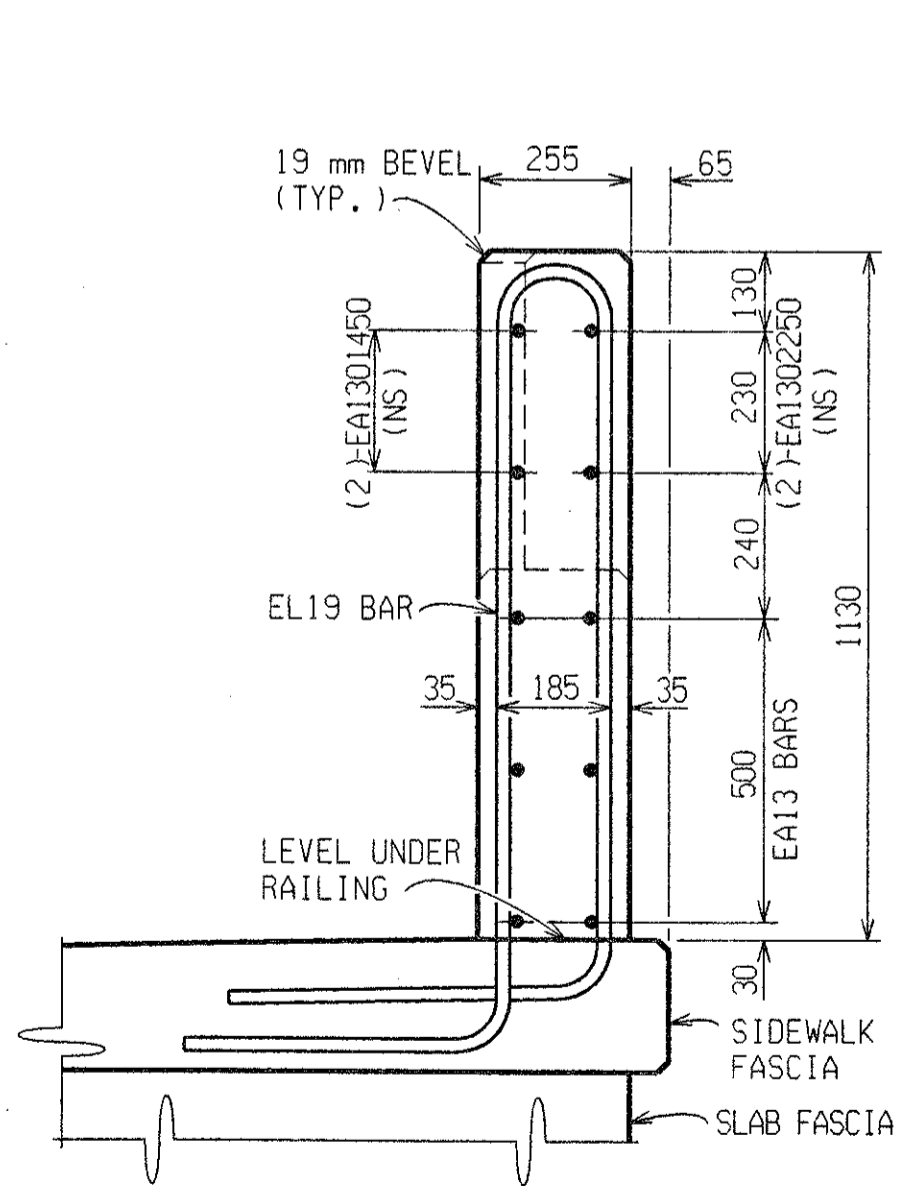


SECTION AT END WALL (FULL CONCRETE AREA)

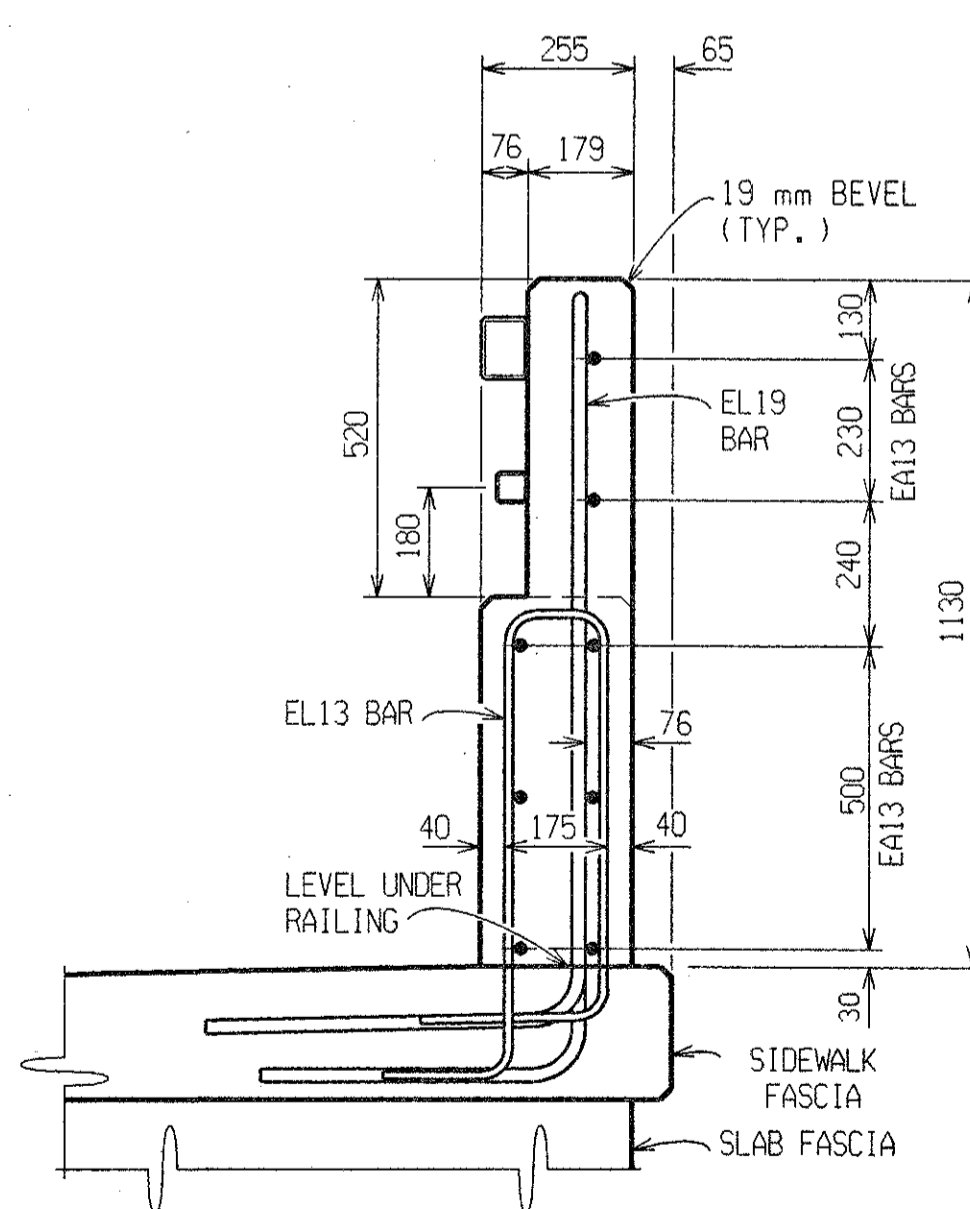

SECTION AT END WALL (TUBE CONNECTION AREA)

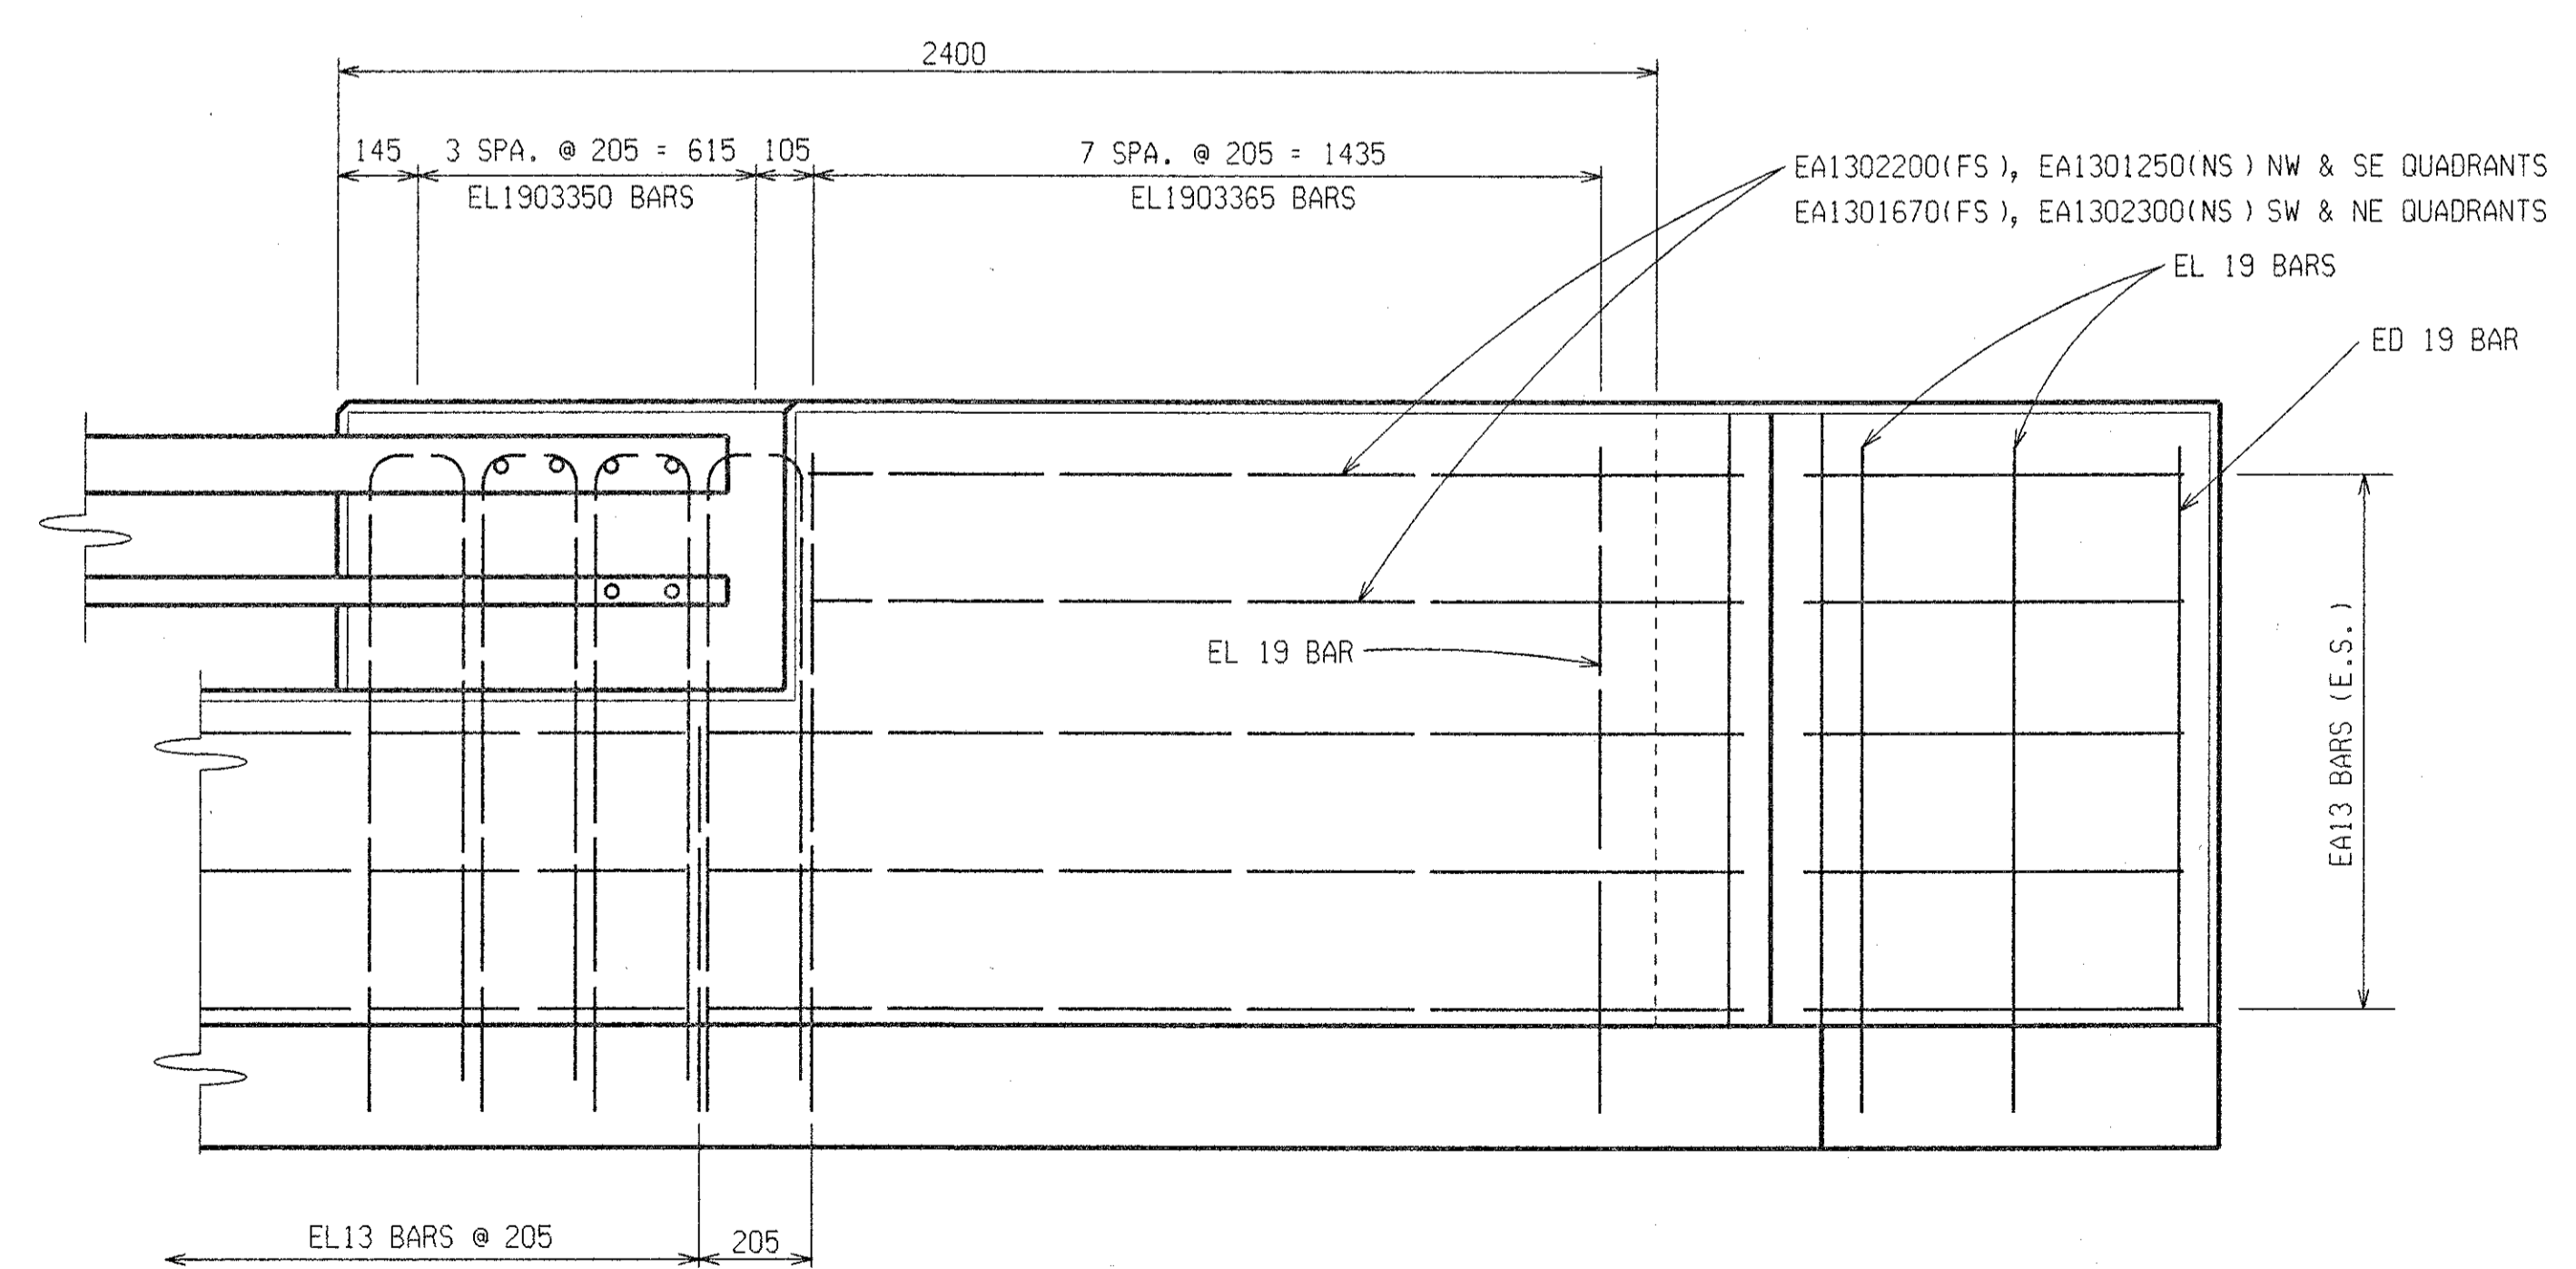





END WALL DETAIL

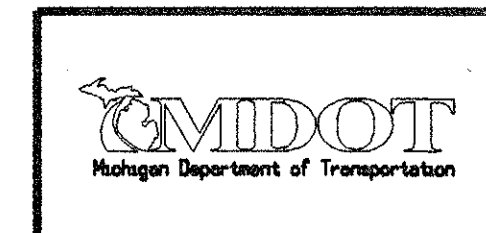

DECK REPLACEMENT DETAILS				
DATE	CONT. SEC.	JOB NO.	DESIGN UNIT	SHEET
10-8-99	S02 OF 63174	48404A	MAHDAVI	24 OF 29


DATE: 10-8-99 CORRECTED BY: SHAFFER DATE: CHECKED BY: DATE: 8-24-99 DRAWN BY: SHAFFER FILE NAME: S0263174.DK

REVISIONS			
NO.	DESCRIPTION	DATE	BY

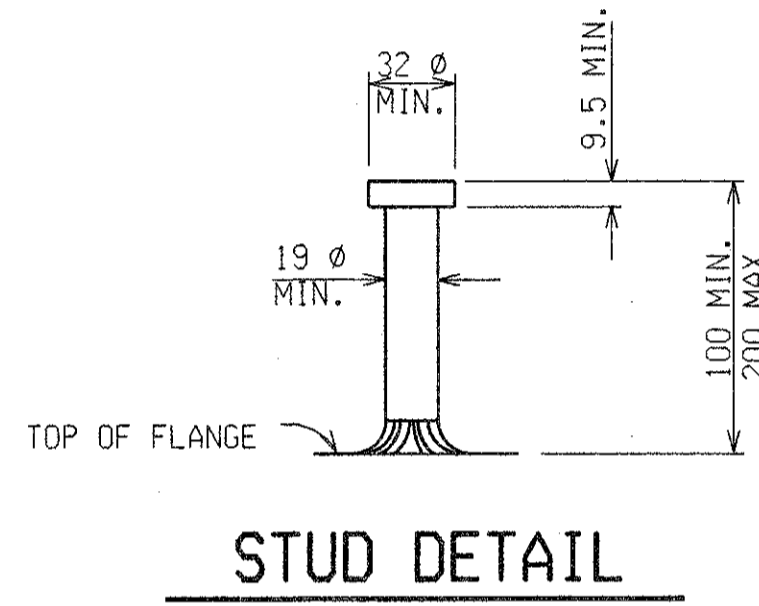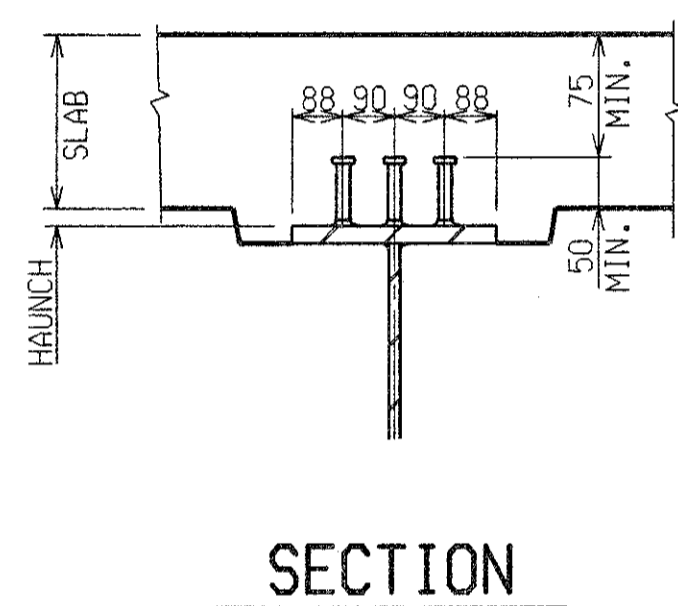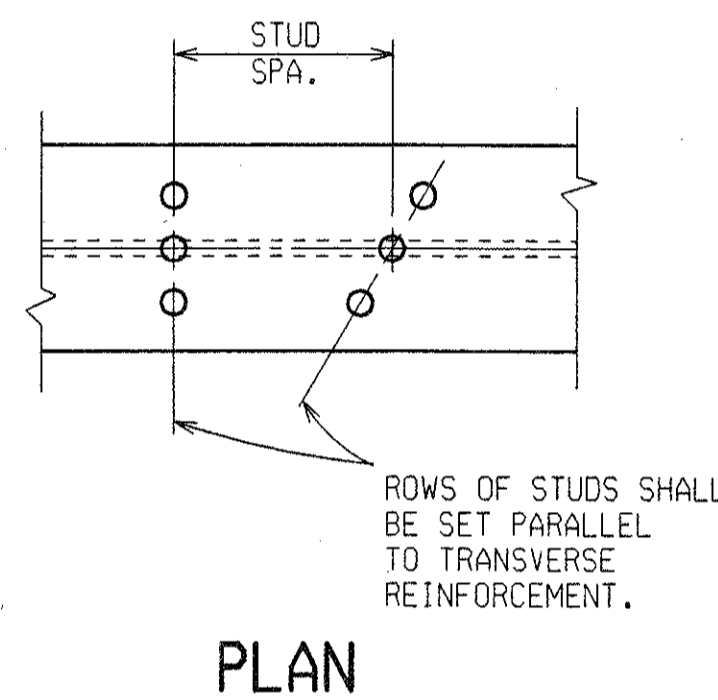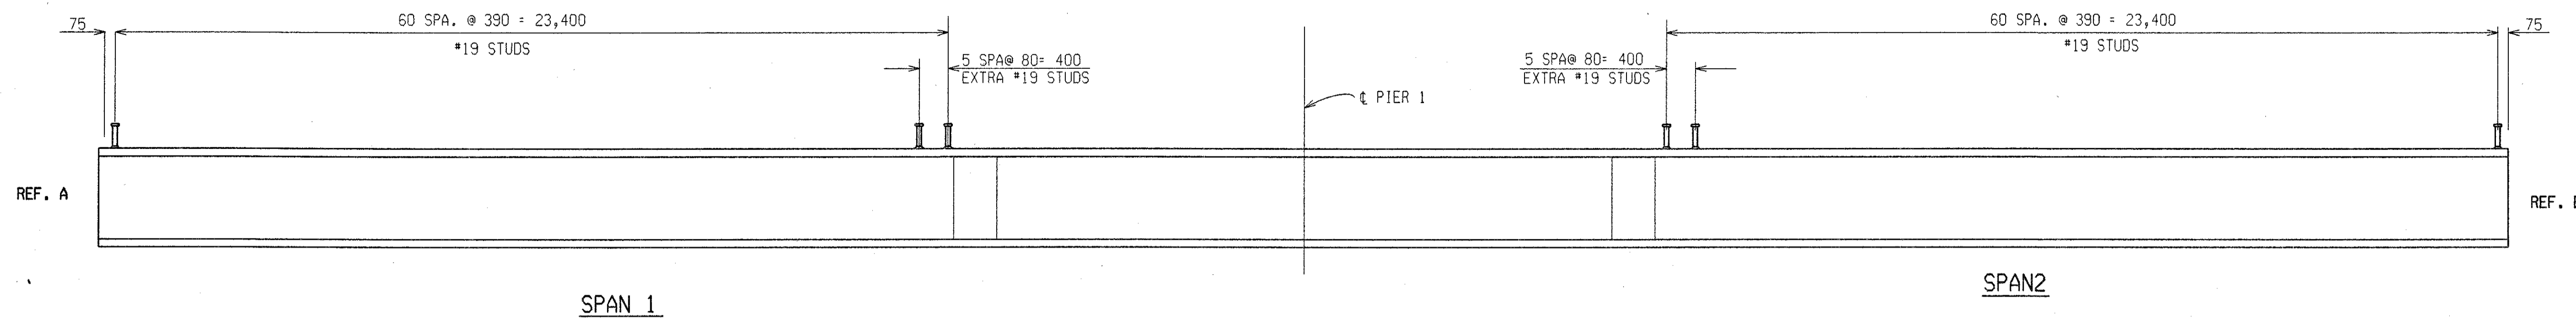


STUD SHEAR DEVELOPER DETAILS


SHEAR DEVELOPER DETAIL

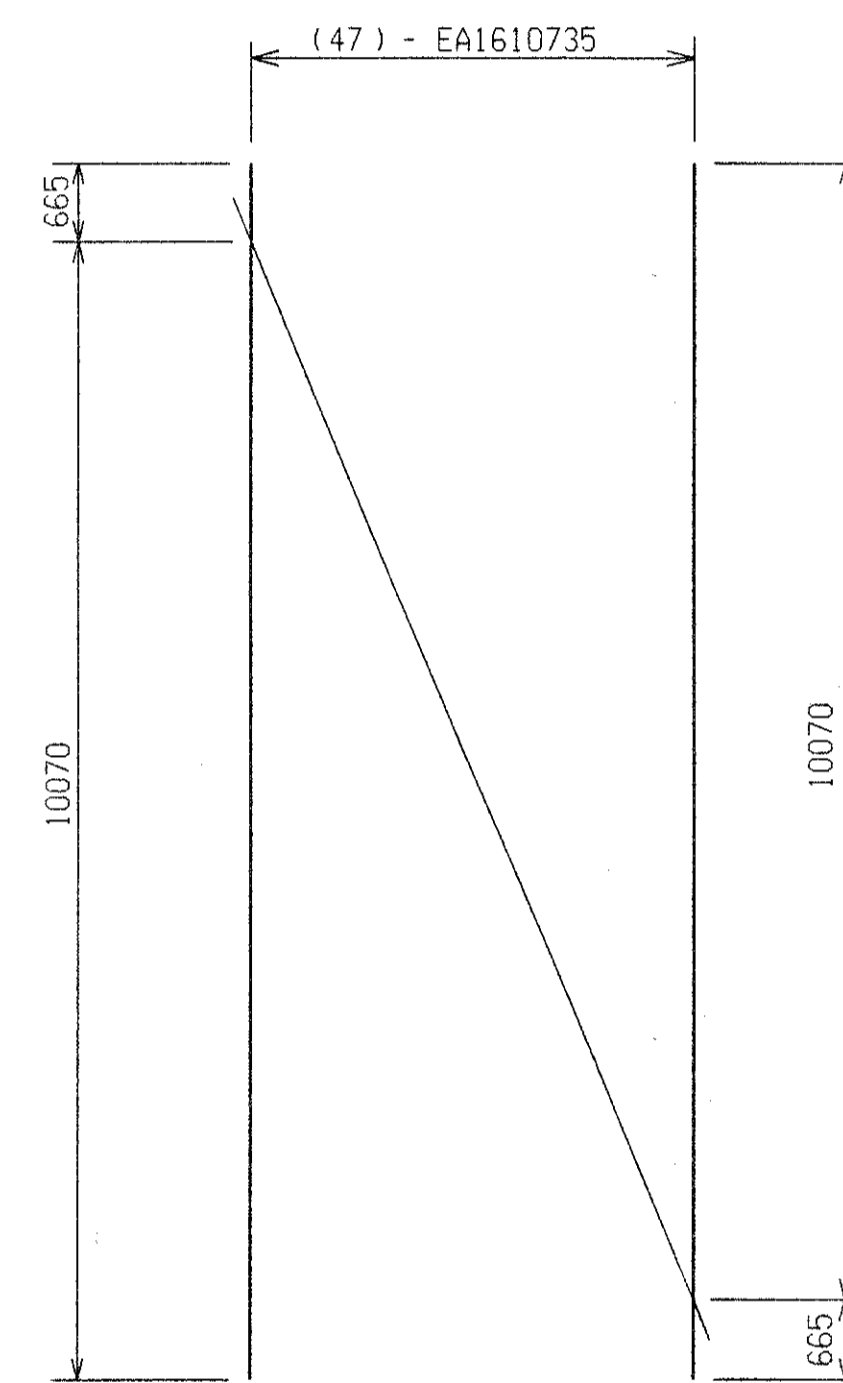


CUT DIAGRAM A
FOR BOTTOM BARS

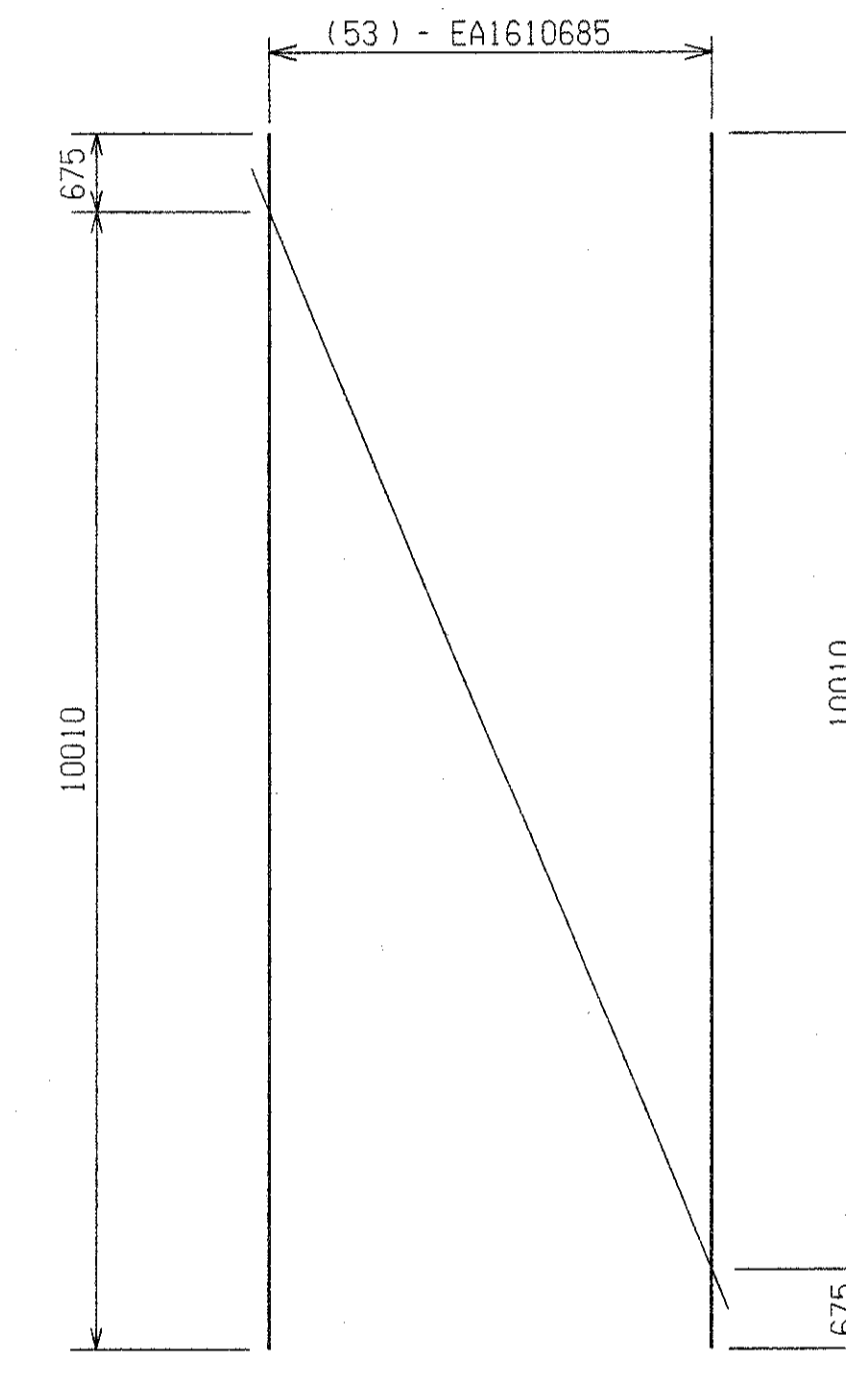


CUT DIAGRAM B
FOR TOP BARS

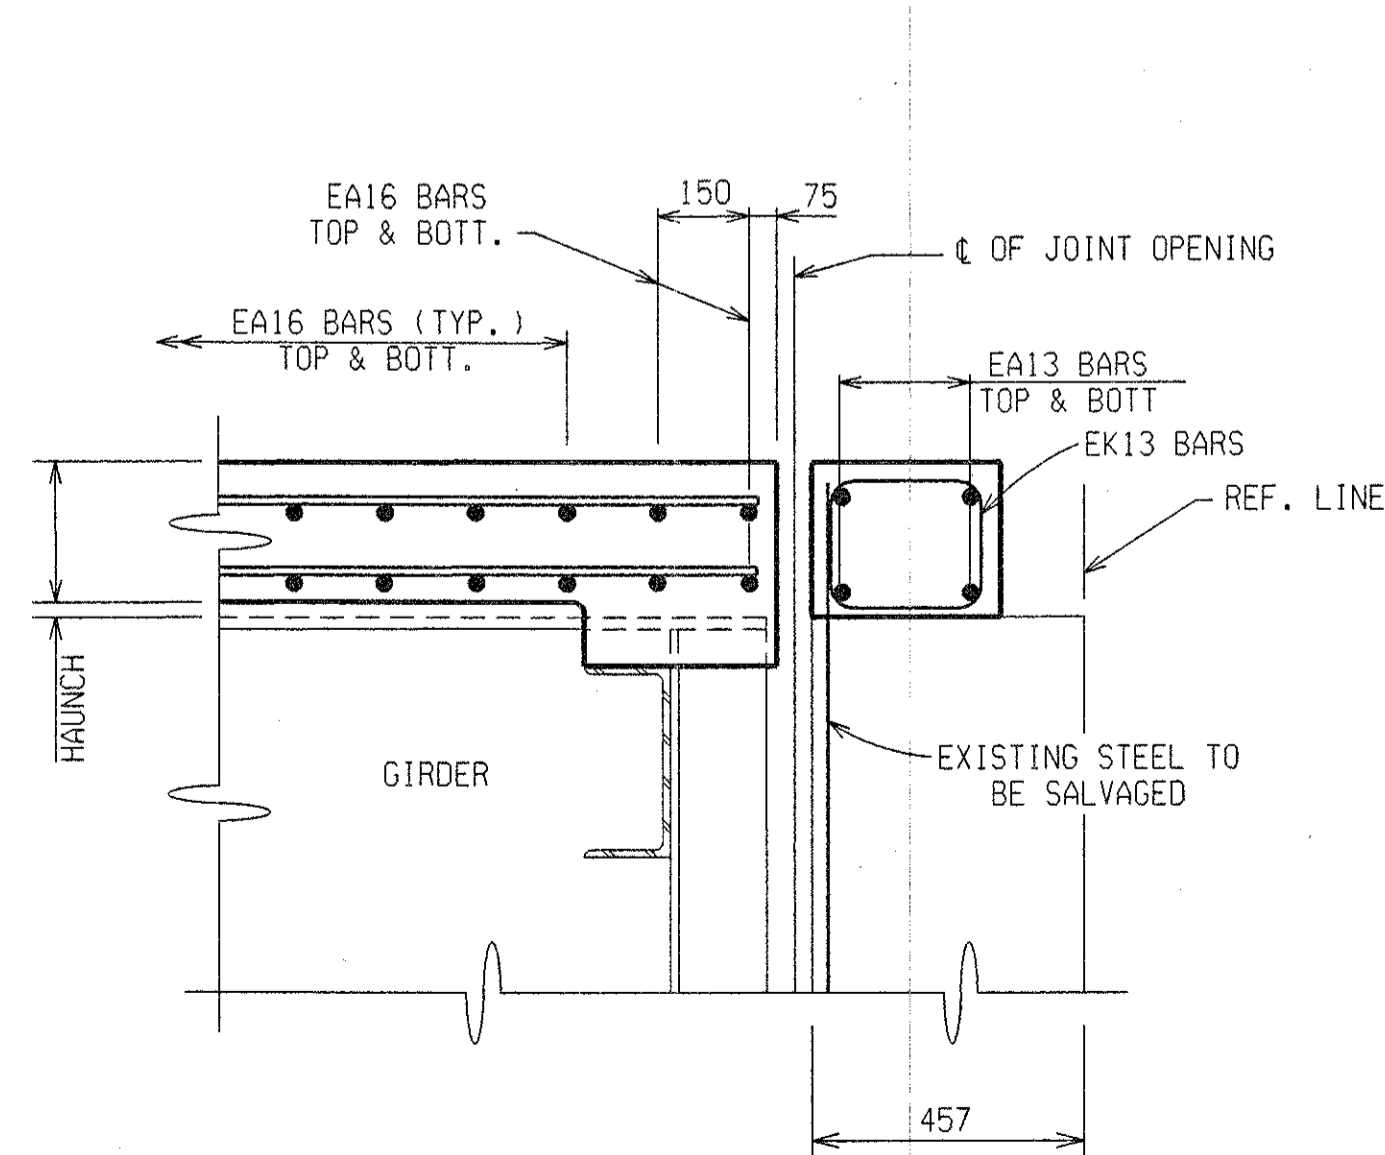

SECTION A-A

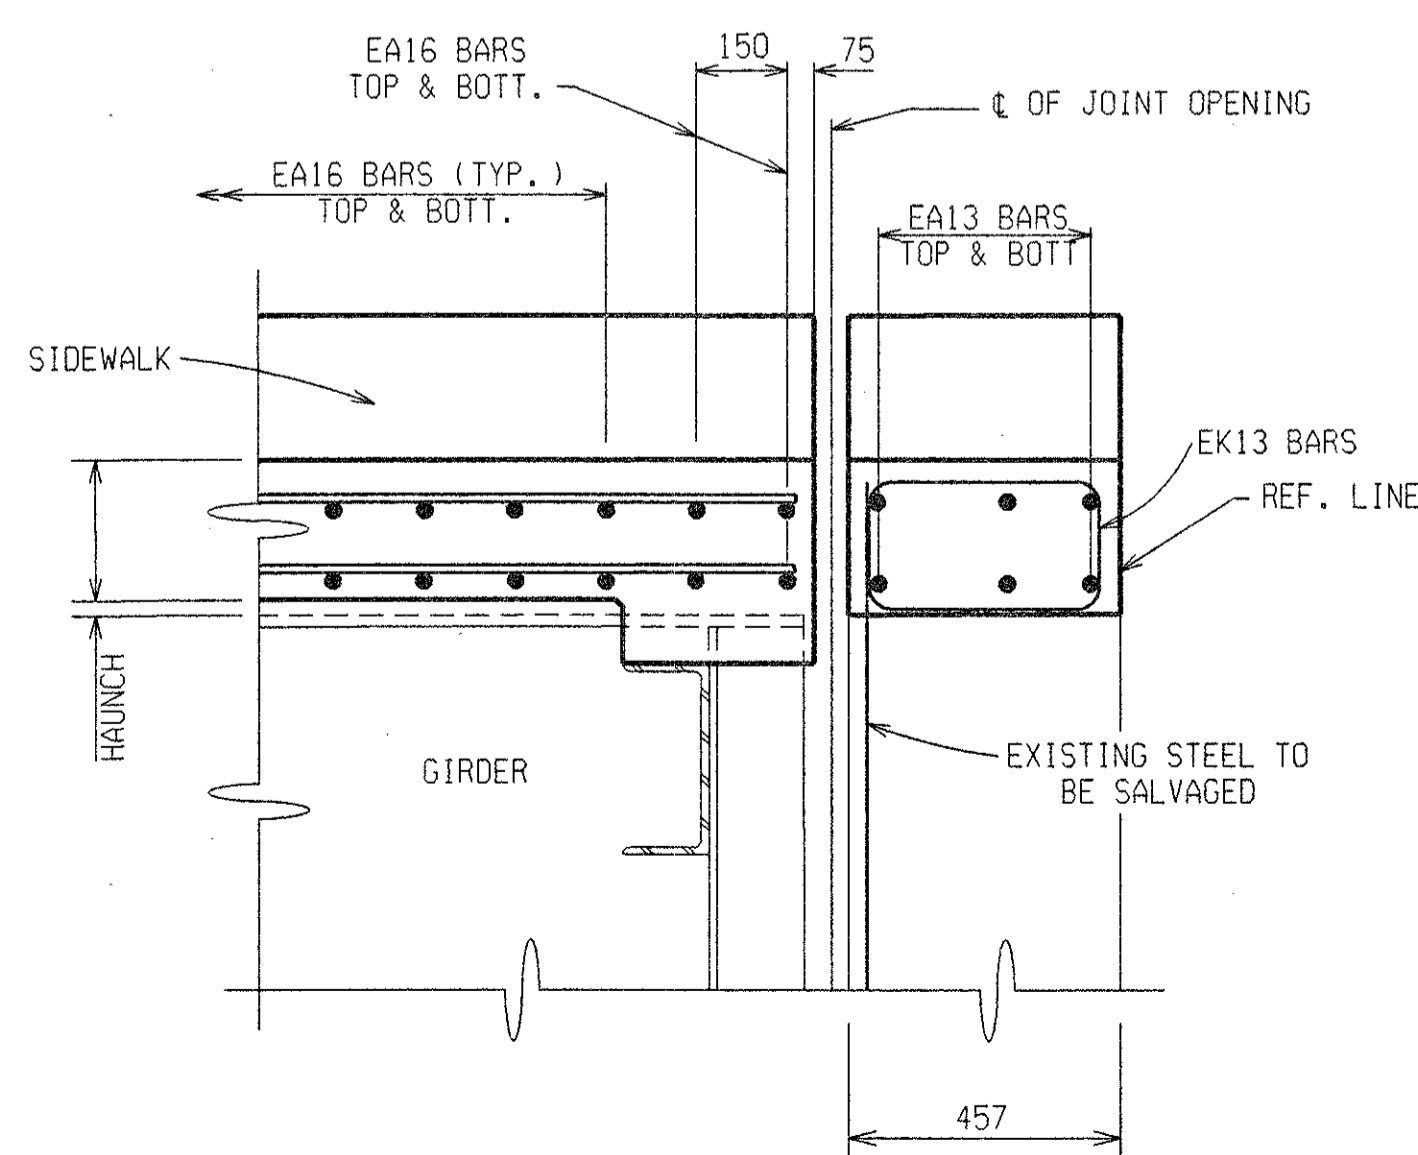

SECTION B-B

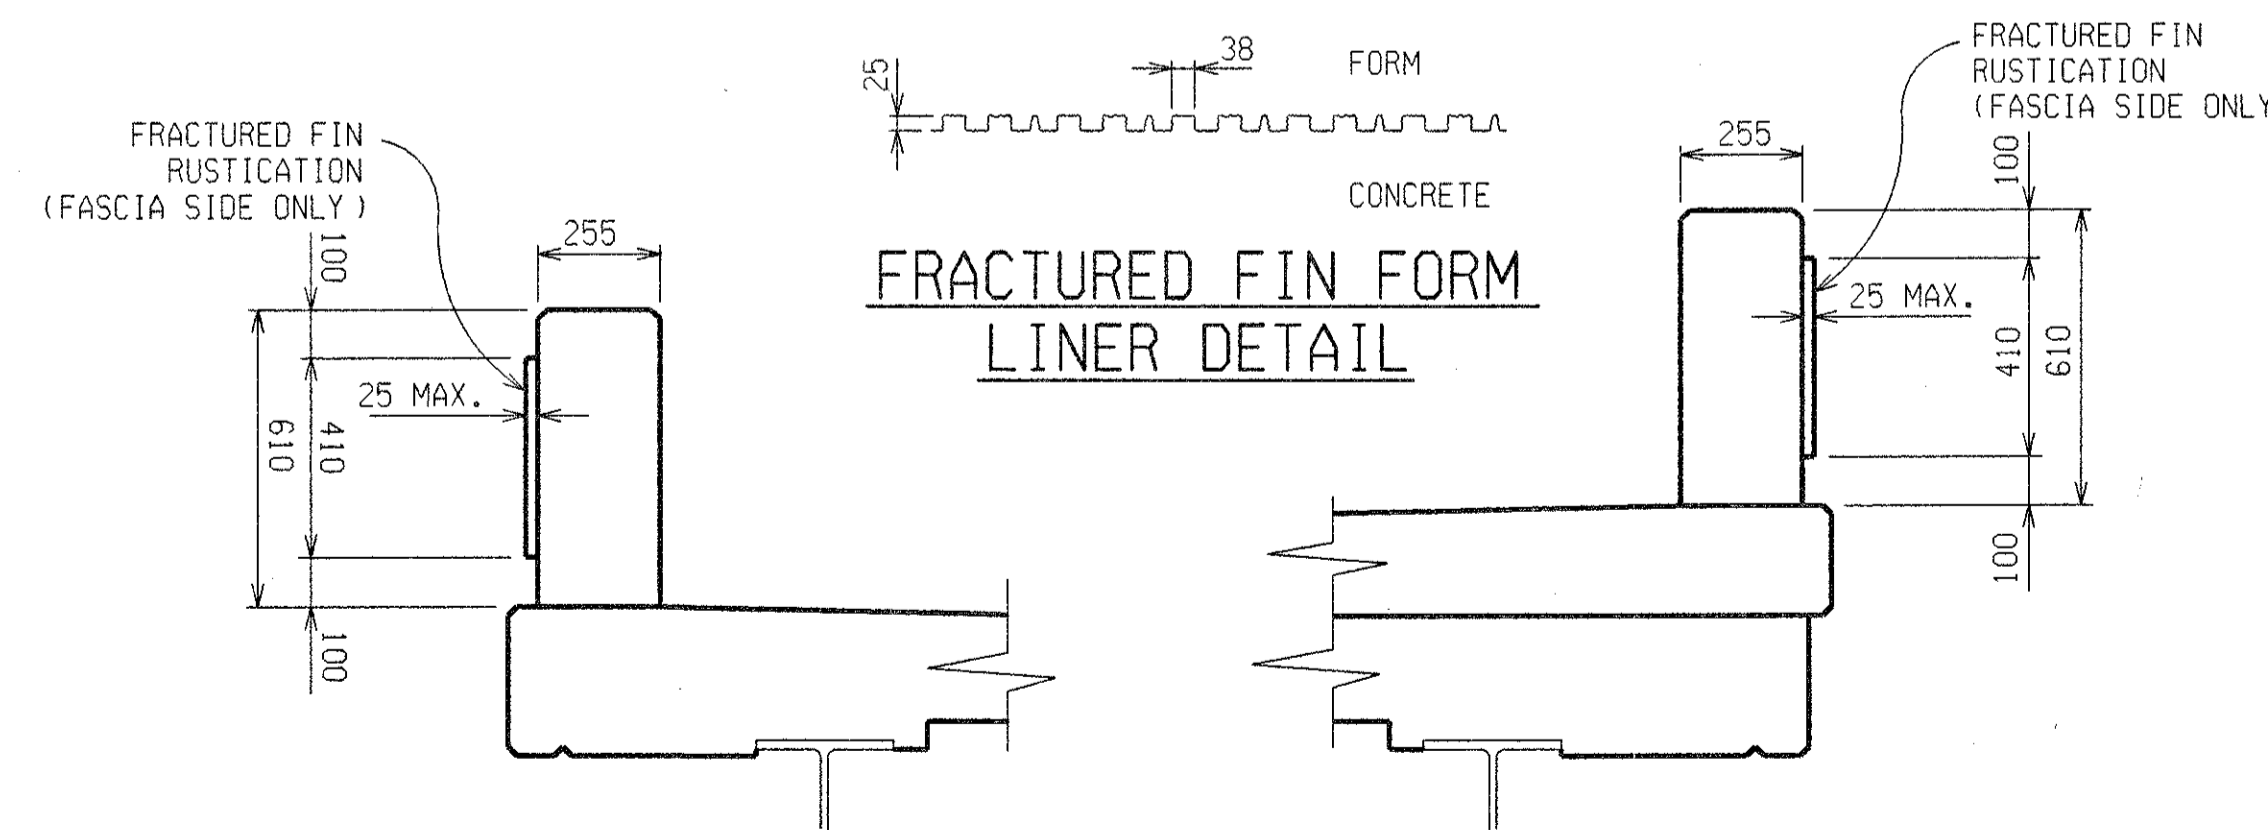


TYPICAL RAILING SECTION
SHOWING RUSTICATION



DECK REPLACEMENT DETAILS				
DATE	CONT. SEC.	JOB NO.	DESIGN UNIT	SHEET
10-11-99	S02 OF 63174	48404A	MAHDAVI	25 OF 19

1 2 3 4 5 6 7 8 9 10 11 12 13 14 15 16 17 18 19 20 21 22 23 24 25 26 27 28 29 30 31 32 33 34 35 36 37 38 39 40 41 42 43 44 45 46 47 48 49 50 51 52 53 54 55 56 57 58 59 60 61 62 63



REVISIONS			
NO.	DESCRIPTION	DATE	BY

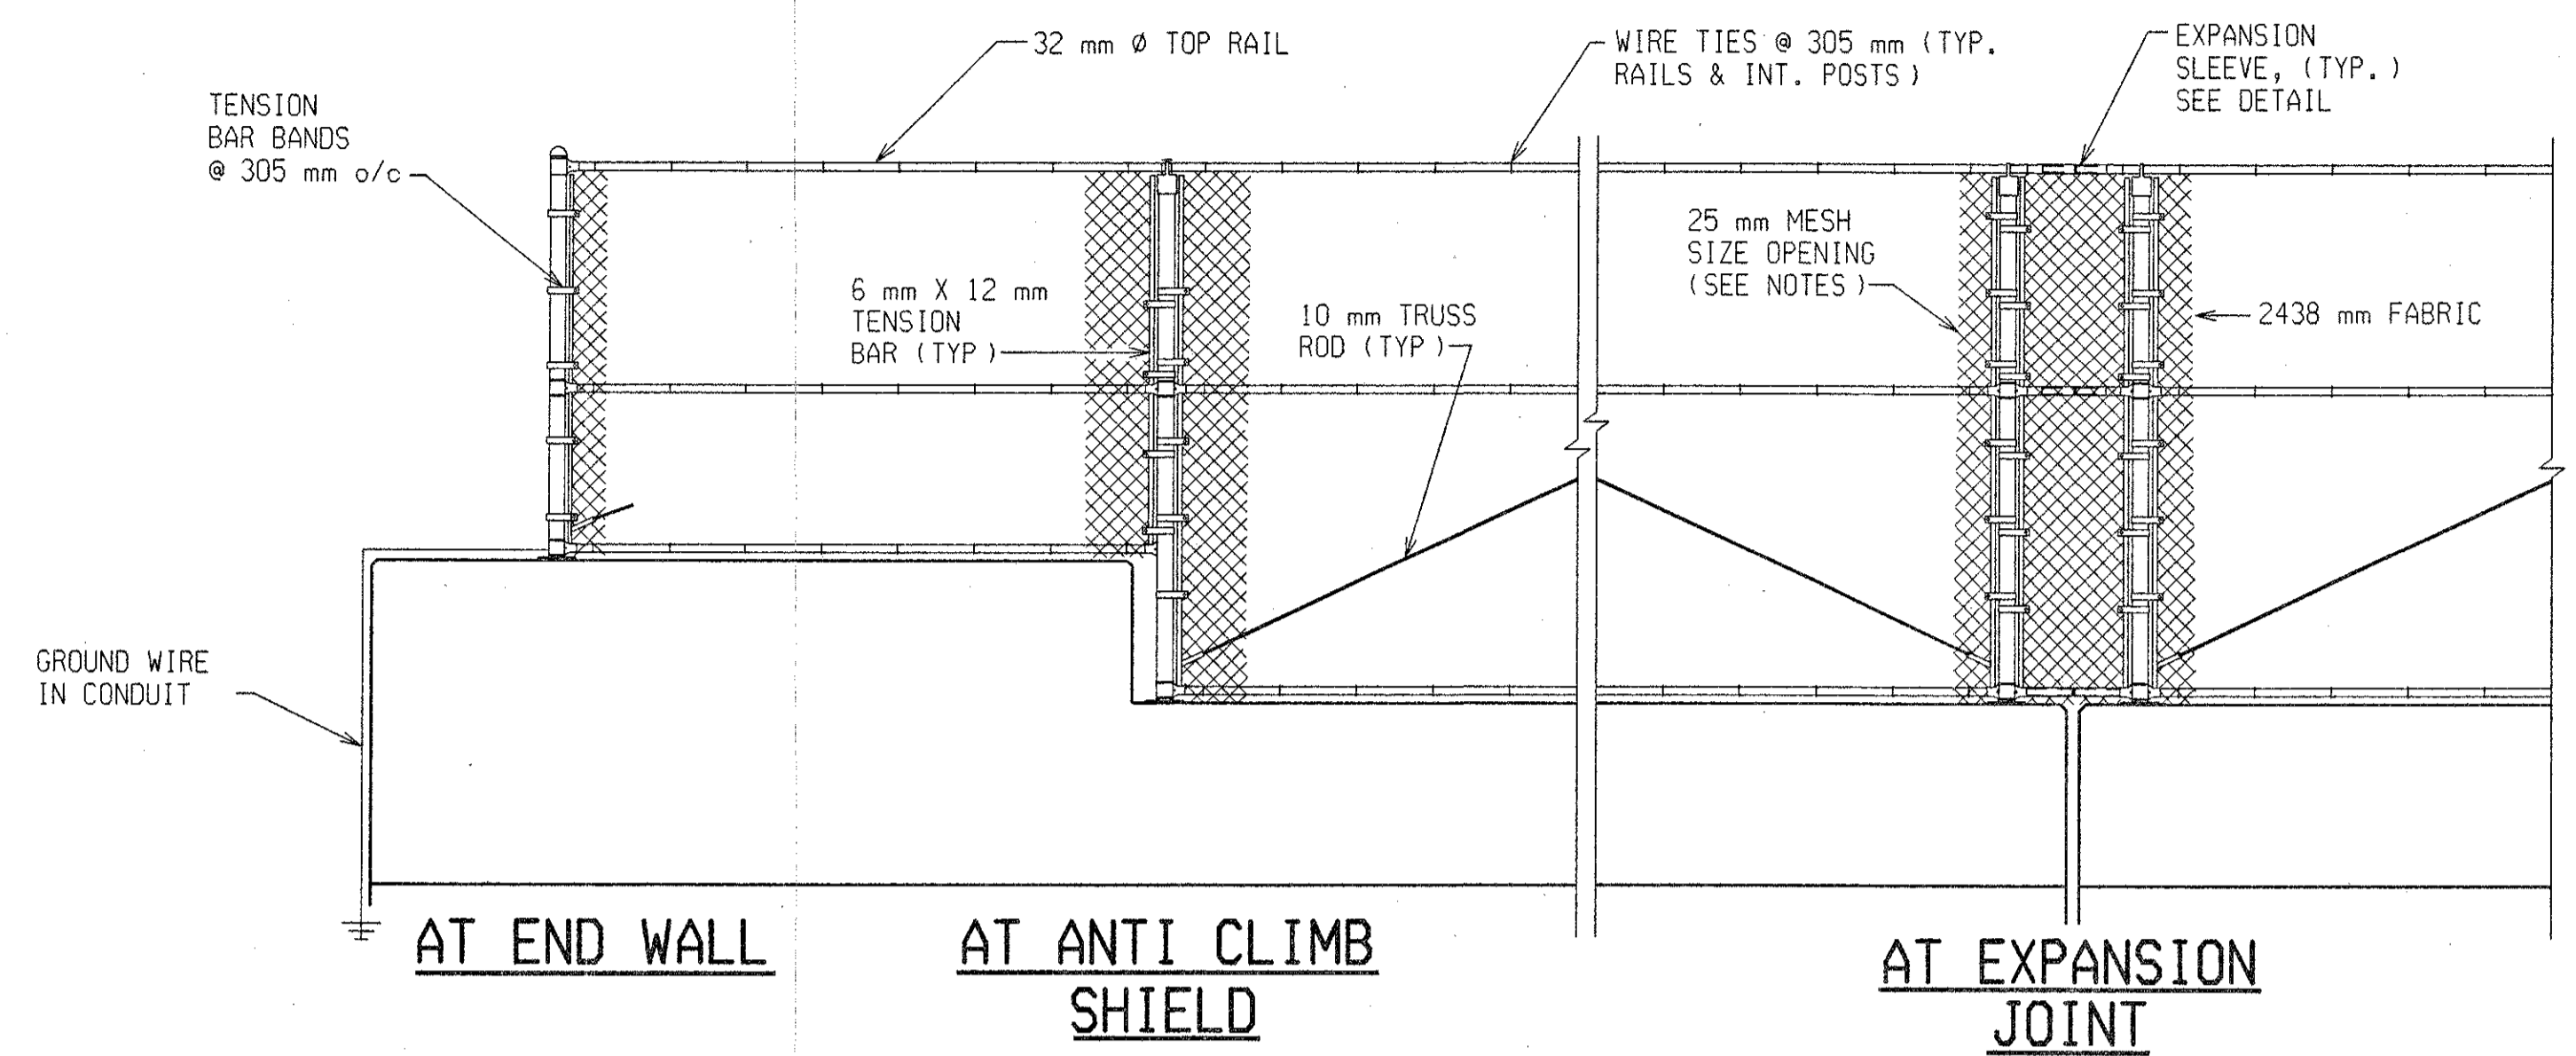


MISCELLANEOUS QUANTITIES	
327 m ²	Fencing, Structures
1 ea	Elec Grounding System

NOTES:


- ALL FENCE POSTS SHALL BE 64 NOMINAL, (73 O.D.) PIPE AND ANTI-CLIMB SHIELD PIPE FRAMES SHALL BE 32 NOMINAL, (42 O.D.) PIPE, IN CONFORMANCE WITH ASTM F669, CLASS 1C.
- HORIZONTAL RAILS SHALL BE 32 NOMINAL (42 O.D.) PIPE IN CONFORMANCE WITH ASTM F669, CLASS 1C OR ASTM F1083.
- ALL FENCE COMPONENTS, UNLESS OTHERWISE INDICATED, SHALL BE GALVANIZED IN ACCORDANCE WITH MDOT'S CURRENT STANDARD SPECIFICATIONS FOR CONSTRUCTION.
- ALL POSTS, ANTI-CLIMB SHIELDS OR OTHER COMPONENTS TO BE FABRICATED SHALL BE FURNISHED "BLACK" AND THEN GALVANIZED AFTER FABRICATION.
- DAMAGED GALVANIZED SURFACES SHALL BE REPAIRED IN CONFORMANCE WITH MDOT'S CURRENT STANDARD SPECIFICATIONS FOR CONSTRUCTION.
- FENCE FABRIC SHALL BE #9 GAGE MESH AND BE GALVANIZED OR ALUMINUM COATED IN CONFORMANCE WITH MDOT'S CURRENT STANDARD SPECIFICATIONS FOR CONSTRUCTION. MESH SIZE OPENING SHALL BE 25 mm.
- GALVANIZED 10 mm Ø TRUSS RODS SHALL EXTEND DIAGONALLY FROM THE TOP CONNECTION CLIP AT EACH TENSION BAR TO THE ADJACENT POST, EXCEPT ACROSS EXPANSION JOINTS AND AT LIGHT STANDARDS WITH A CURVED FENCE DETAIL, WHEN THERE ARE TWO OR MORE CONTINUOUS PANELS OF FABRIC.
- ALL POSTS SHALL BE INSTALLED PLUMB AND MAY BE SHIMMED WITH NON-METALLIC SHIMS, APPROVED BY THE ENGINEER. COSTS FOR SHIMMING SHALL BE INCLUDED IN THE PAY ITEM "FENCING, STRUCTURES".
- BOTTOM STRAP ON THE VERTICAL POST SHALL BE CONNECTED WITH RAIL ENDS (BRACE BANDS) RATHER THAN A TWO WAY CLAMP TO ALLOW A MINIMUM OF 7 mm OFFSET.
- FIELD WELDING SHALL BE ALLOWED ONLY FOR THE HANDRAIL SPLICES AND FOR ATTACHMENT OF THE HANDRAIL TO THE POST. ALL FIELD WELDS SHALL BE GROUND SMOOTH PRIOR TO COATING WITH ZINC-RICH PAINT OR SPRAYED ZINC IN ACCORDANCE WITH MDOT'S CURRENT STANDARD SPECIFICATIONS.
- THE GROUND WIRE SHALL BE PLACED IN A NON-METALLIC CONDUIT, FROM THE END POST CONNECTION TO THE GROUND ROD CONNECTION. THE CONDUIT SHALL BE SECURED TO THE STRUCTURE USING EITHER EXPANSION BOLTS OR ADHESIVE ANCHORED BOLTS WITH GALVANIZED METAL STRIPS, AS APPROVED BY THE ENGINEER.
- IN THE EVENT THAT INSTALLATION OF A GROUND ROD IS IMPRACTICAL, THE GROUND WIRE SHALL BE CONNECTED TO THE NEAREST LIGHT STANDARD, USING A MECHANICAL CLIP, ONLY AFTER OBTAINING PERMISSION FROM THE LOCAL PUBLIC LIGHTING AUTHORITY.
- EXPANSION JOINT SLEEVES, FOR HORIZONTAL RAILS, SHALL BE THE MANUFACTURER'S STANDARD OVERSIZED SLEEVES, CRIMPED IN THE MIDDLE.
- ALL DIMENSIONS ARE IN MILLIMETERS.
- GROUNDING CABLES AND TOPS OF GROUNDING RODS SHALL BE PLACED 300 mm MINIMUM BELOW FINISHED GROUND.

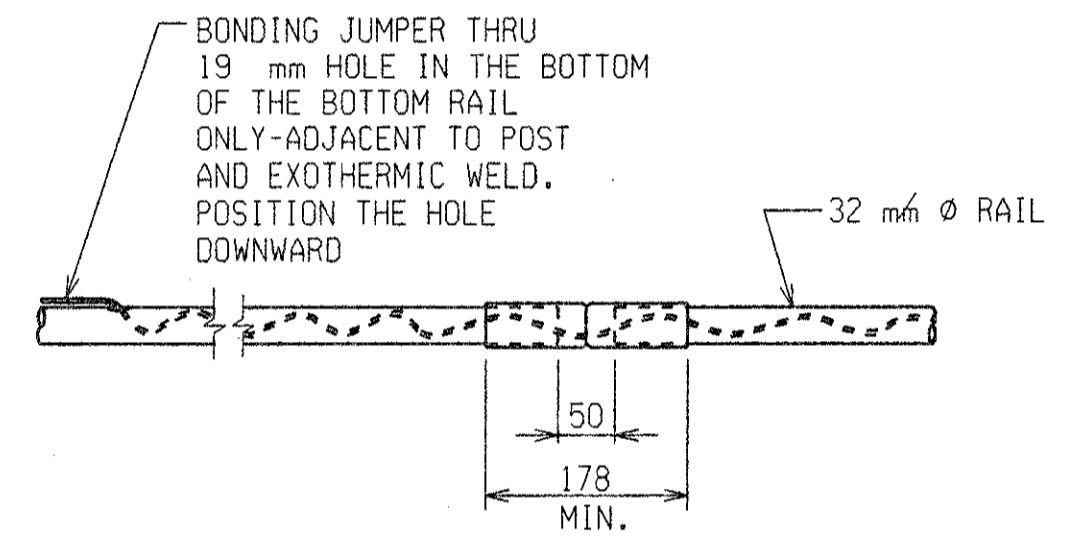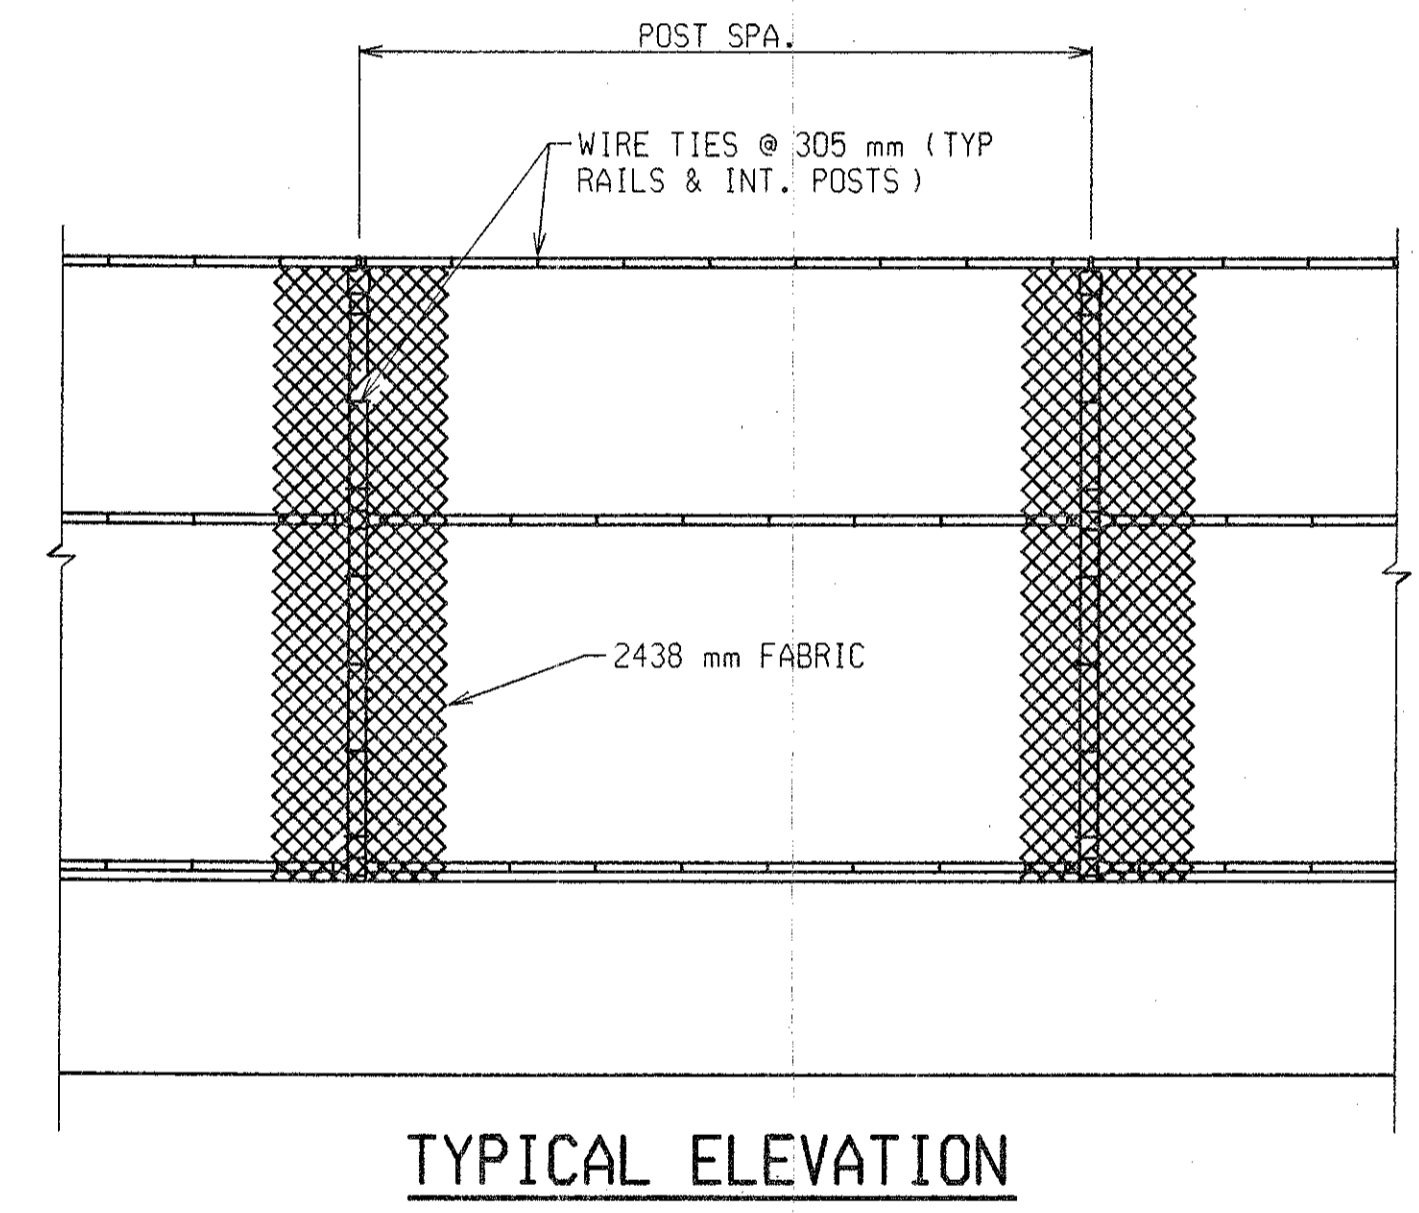

EXPANSION SLEEVE DETAIL

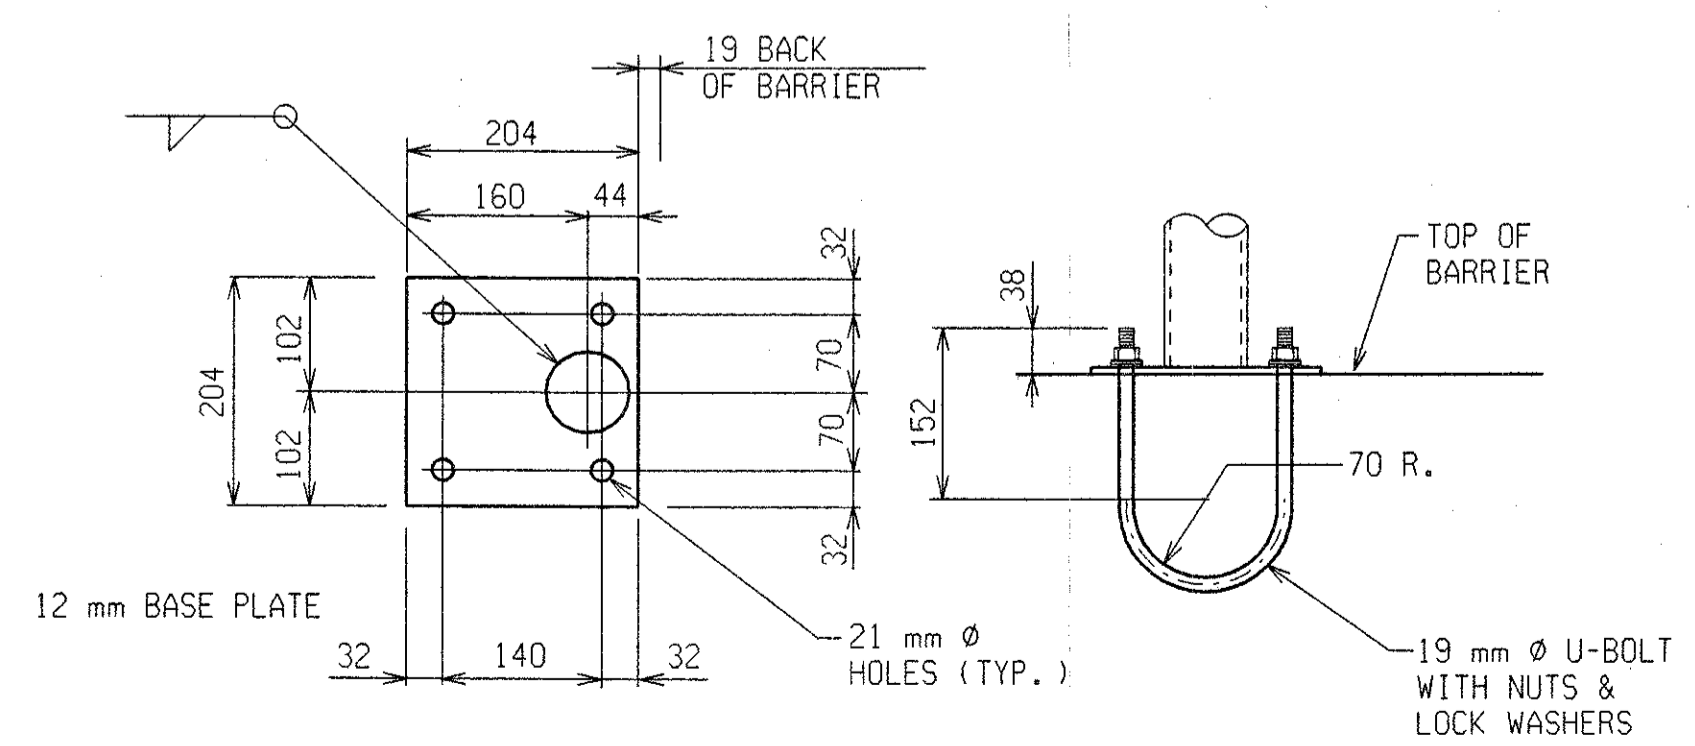

BASE PLATE DETAILS

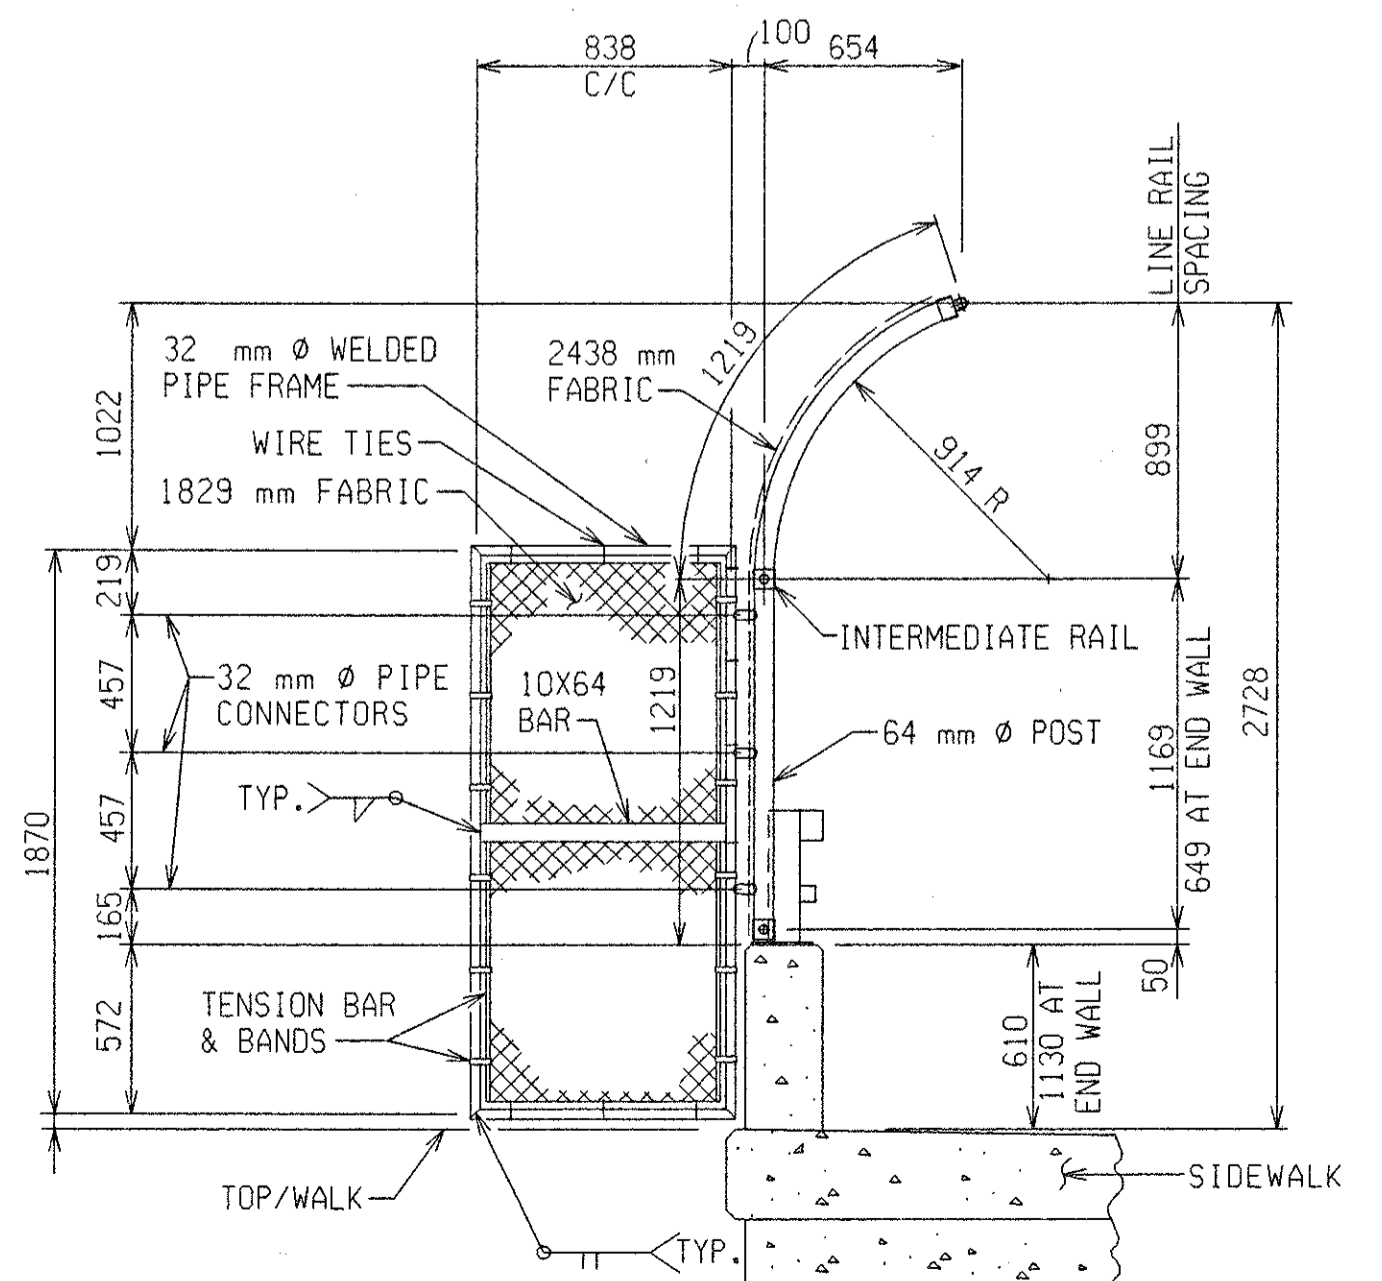


TYPICAL SECTION (SHOWING ANTI-CLIMB SHIELD)

FENCING DETAILS				
DATE	CONT. SEC.	JOB NO.	DESIGN UNIT	SHEET
10-12-99	S02 OF 63174	48404A	MAHDAVI	26 OF 29




DATE: 10-12-99 CORRECTED BY: SHAFFER DATE: DATE: 9-23-99 CHECKED BY: SHAFFER DRAWN BY: SHAFFER FILE NAME: S0263174.FE

1 2 3 4 5 6 7 8 9 10 11 12 13 14 15 16 17 18 19 20 21 22 23 24 25 26 27 28 29 30 31 32 33 34 35 36 37 38 39 40 41 42 43 44 45 46 47 48 49 50 51 52 53 54 55 56 57 58 59 60 61 62 63

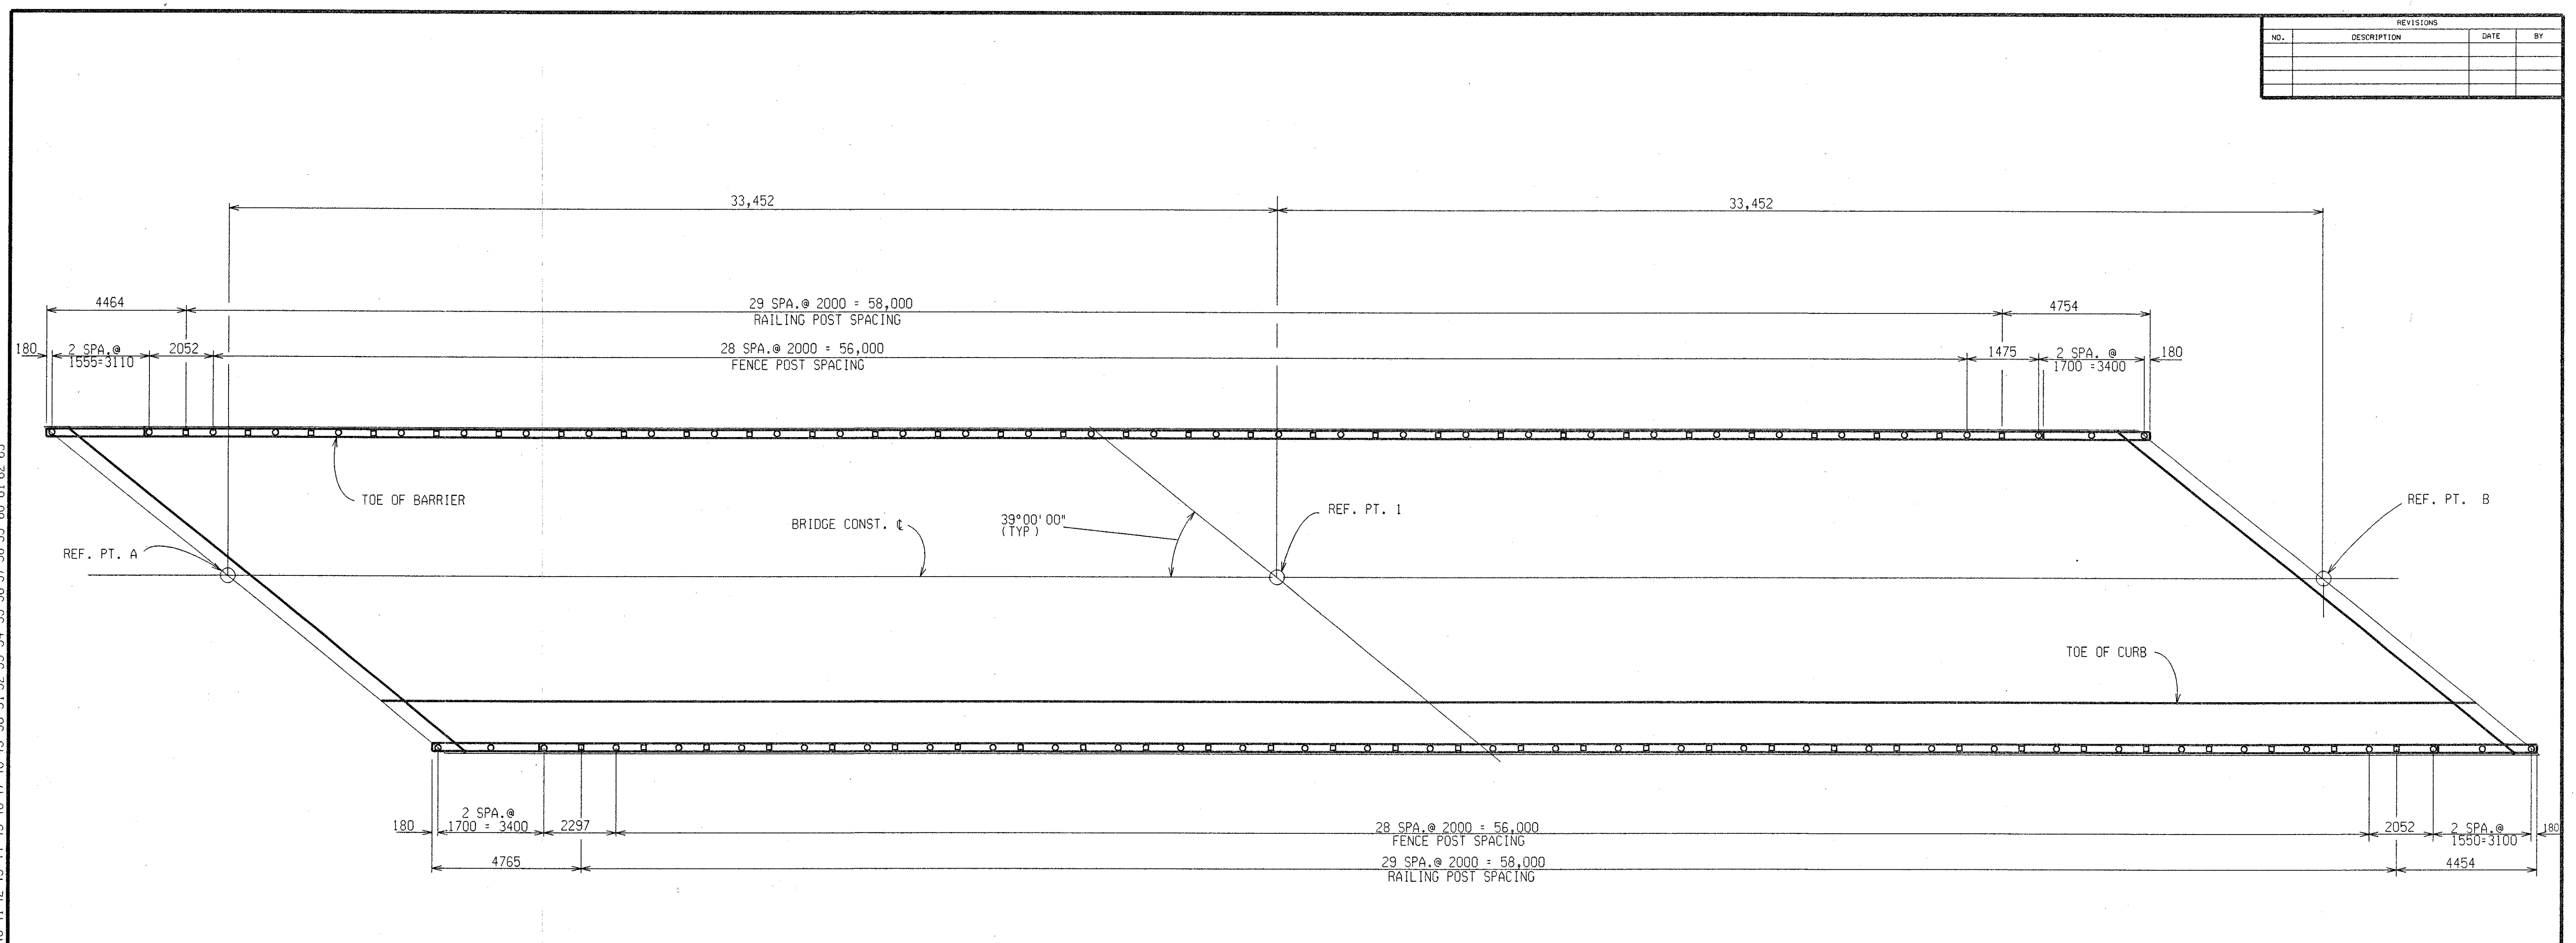

PLAN VIEW

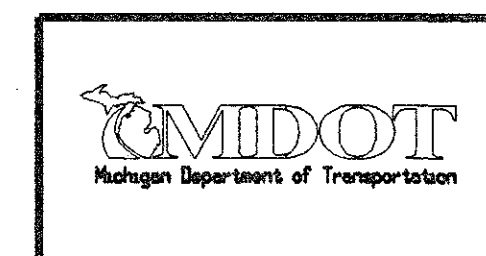

FENCING DETAILS				
DATE	CONT. SEC.	JOB NO.	DESIGN UNIT	SHEET
10-12-99	S02 OF 63174	48404A	MAHDAVI	27 OF 29

FILE NAME: S0263174.FE DRAWN BY: SHAFER DATE: 9-22-99 CHECKED BY: DATE: 10-12-99 CORRECTED BY: DATE:

1 2 3 4 5 6 7 8 9 10 11 12 13 14 15 16 17 18 19 20 21 22 23 24 25 26 27 28 29 30 31 32 33 34 35 36 37 38 39 40 41 42 43 44 45 46 47 48 49 50 51 52 53 54 55 56 57 58 59 60 61 62 63



REVISIONS			
NO.	DESCRIPTION	DATE	BY

BOTTOM OF SLAB ELEVATIONS

REF.		SPAN 1												SPAN 2													
		0	1	2	3	4	5	6	7	8	9	10	11	12	0	1	2	3	4	5	6	7	8	9	10	11	12
A	FASCIA	194.350	194.393	194.433	194.470	194.501	194.529	194.551	194.570	194.585	194.598	194.609	194.620	194.632	194.632	194.648	194.664	194.680	194.695	194.708	194.717	194.722	194.723	194.719	194.710	194.697	194.682
	RIGHT	194.424	194.467	194.506	194.543	194.575	194.602	194.625	194.643	194.658	194.671	194.682	194.693	194.706	194.706	194.721	194.737	194.754	194.769	194.781	194.790	194.795	194.796	194.792	194.783	194.771	194.755
B	LEFT	194.471	194.513	194.552	194.587	194.617	194.643	194.664	194.682	194.695	194.707	194.716	194.726	194.737	194.737	194.751	194.766	194.781	194.795	194.806	194.814	194.818	194.817	194.811	194.801	194.787	194.771
	RIGHT	194.478	194.520	194.559	194.594	194.624	194.650	194.671	194.688	194.702	194.713	194.723	194.733	194.744	194.744	194.758	194.773	194.788	194.802	194.813	194.821	194.824	194.823	194.818	194.808	194.794	194.778
C	LEFT	194.525	194.565	194.603	194.636	194.665	194.690	194.710	194.726	194.738	194.748	194.756	194.765	194.775	194.775	194.787	194.801	194.814	194.827	194.837	194.843	194.845	194.843	194.836	194.825	194.810	194.792
	RIGHT	194.532	194.572	194.609	194.643	194.672	194.697	194.717	194.732	194.745	194.755	194.763	194.772	194.781	194.781	194.794	194.808	194.821	194.834	194.844	194.850	194.852	194.850	194.843	194.832	194.817	194.799
D	LEFT	194.545	194.584	194.620	194.653	194.680	194.703	194.722	194.737	194.748	194.756	194.763	194.770	194.779	194.779	194.790	194.802	194.815	194.826	194.834	194.839	194.840	194.836	194.828	194.816	194.799	194.780
	RIGHT	194.539	194.578	194.613	194.646	194.673	194.697	194.715	194.730	194.741	194.749	194.757	194.764	194.772	194.772	194.783	194.795	194.808	194.819	194.827	194.832	194.833	194.830	194.822	194.809	194.792	194.773
E	LEFT	194.542	194.579	194.614	194.645	194.671	194.693	194.710	194.723	194.733	194.740	194.746	194.752	194.759	194.759	194.769	194.780	194.791	194.800	194.808	194.811	194.811	194.806	194.796	194.782	194.764	194.744
	RIGHT	194.535	194.573	194.607	194.638	194.664	194.686	194.704	194.717	194.726	194.734	194.739	194.745	194.752	194.752	194.762	194.773	194.784	194.794	194.801	194.805	194.804	194.799	194.790	194.775	194.758	194.737
F	LEFT	194.549	194.585	194.618	194.648	194.673	194.693	194.709	194.721	194.723	194.735	194.739	194.744	194.749	194.749	194.758	194.767	194.777	194.785	194.791	194.794	194.792	194.785	194.775	194.759	194.740	194.718
	FASCIA	194.481	194.517	194.551	194.580	194.605	194.625	194.641	194.653	194.662	194.667	194.672	194.676	194.682	194.682	194.690	194.700	194.710	194.718	194.724	194.726	194.724	194.718	194.707	194.692	194.672	194.650

SCREED ELEVATIONS

LEFT	194.642	194.683	194.722	194.758	194.789	194.816	194.839	194.859	194.875	194.889	194.901	194.913	194.926	194.926	194.941	194.957	194.973	194.987	194.999	195.008	195.012	195.013	195.010	195.003	194.992	194.979
RIGHT	194.766	194.802	194.834	194.864	194.889	194.910	194.926	194.940	194.950	194.957	194.963	194.969	194.976	194.976	194.985	194.994	195.004	195.012	195.017	195.020	195.018	195.013	195.004	194.990	194.973	194.953

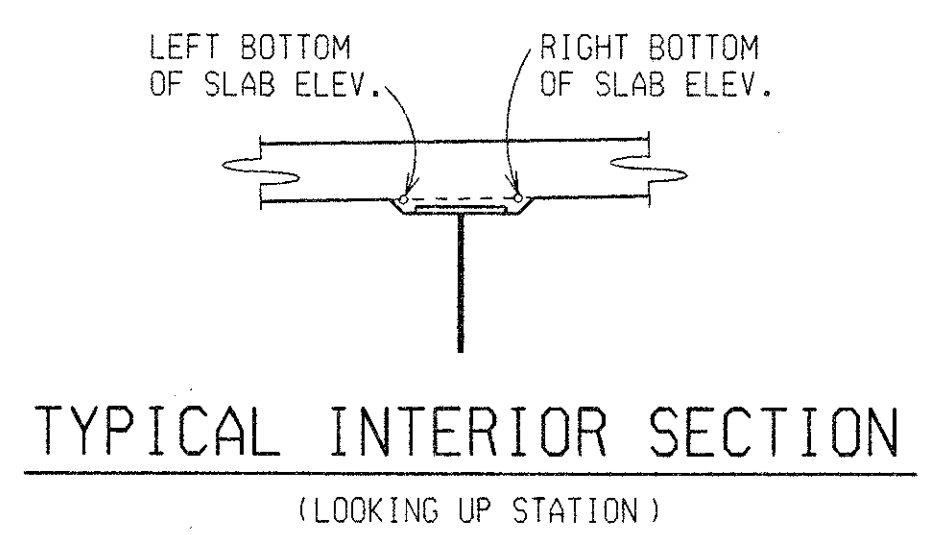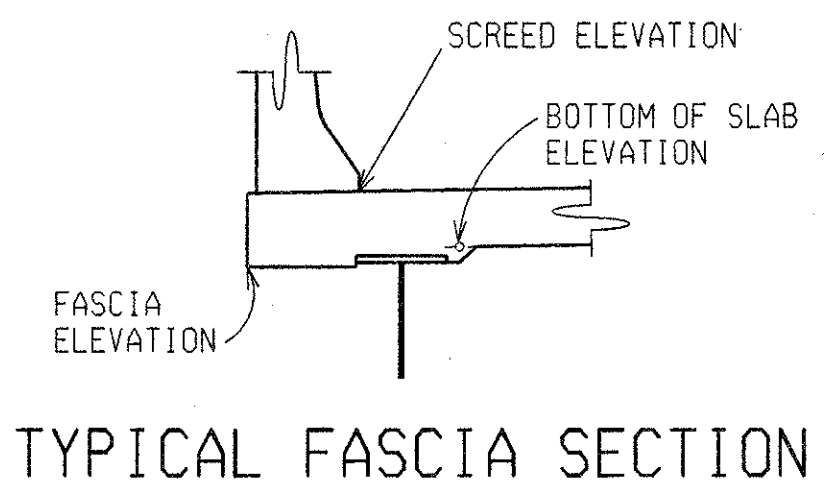


BULKHEAD ELEVATIONS

	ABUT. A						ABUT. B
A	194.649	194.823	194.895	194.978	195.017	194.982	
B	194.703	194.871	194.938	195.012	195.046	195.004	
C	194.757	194.918	194.979	195.046	195.074	195.025	
D	194.771	194.925	194.981	195.039	195.062	195.006	
E	194.767	194.915	194.965	195.015	195.032	194.970	
F	194.777	194.918	194.963	195.005	195.017	194.947	

SECTIONS FOR BOTTOM OF SLAB AND/OR SCREED ELEVATIONS ARE GIVEN ALONG BEAM CENTERLINES FROM CENTERLINE OF BEARING OR PIN & HANGER TO CENTERLINE OF BEARING OR PIN & HANGER AS APPLICABLE AT EQUAL SPACINGS.

SLAB AND SCREED DATA				
DATE	CONT. SEC.	JOB NO.	DESIGN UNIT	SHEET
9-22-1999	S02 OF 63174	48404D	MAHDAVI	28 OF 29

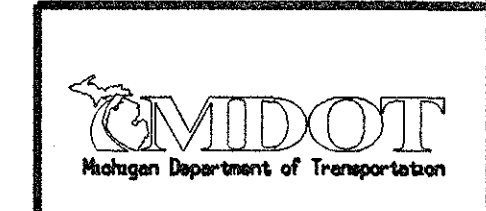


DATE: _____ CORRECTED BY: _____ DATE: _____ CHECKED BY: _____ DATE: _____ DRAWN BY: _____ FILE NAME: s0263174.ss

UPERSTRUCTURE

BAR	DIMENSIONS										NO. REQ'D	TOTAL WT.
	a	b	c	d	e	f	g	h	j			
EA1011170	11170										216	1351
EA1311280	11280										24	269
EA1311280	11280										180	2018
EA1611380	11380										24	424
EA1905000	5000										55	615
EA1915000	15000										55	1844
EA1610200	10200										451	7140
EA1610685	10685										53	879
EA1610735	10735										47	783
EA1300530	530										216	114
EA1608450	8450										16	210
EA1308360	8360										16	133
EA1302330	2330										4	9
EA1311280	11280										138	1547
EA1301480	1480										288	424
EA1301850	1850										4	7
EA1302320	2320										12	28
EA1300550	550										22	12
EA1302200	2200										4	9
EA1301250	1250										4	5
EA1302300	2300										4	9
EA1301670	1670										4	7
EA1300800	800										20	16
EA1300650	650										20	13
ED1901560	1260	150	150								297	1036
ED1300880	270	340	270								155	136
ED1902185	1000	185	1000								4	20
EK1301370	175	340	340	340							12	16
EK1300905	175	185	185	185							61	55
EL1302315	660	175	760	360	360	175					592	1362
EL1903350	1180	170	1280	360	360		170				16	120
EL1903365	1180	185	1280	360	360	185					40	301
ET1902400	310	410	380	510	160	200					154	826

BAR	DIMENSIONS										NO. REQ'D	TOTAL WT.
	a	b	c	d	e	f	g	h	j			

BAR	DIMENSIONS										NO. REQ'D	TOTAL WT.
	a	b	c	d	e	f	g	h	j			

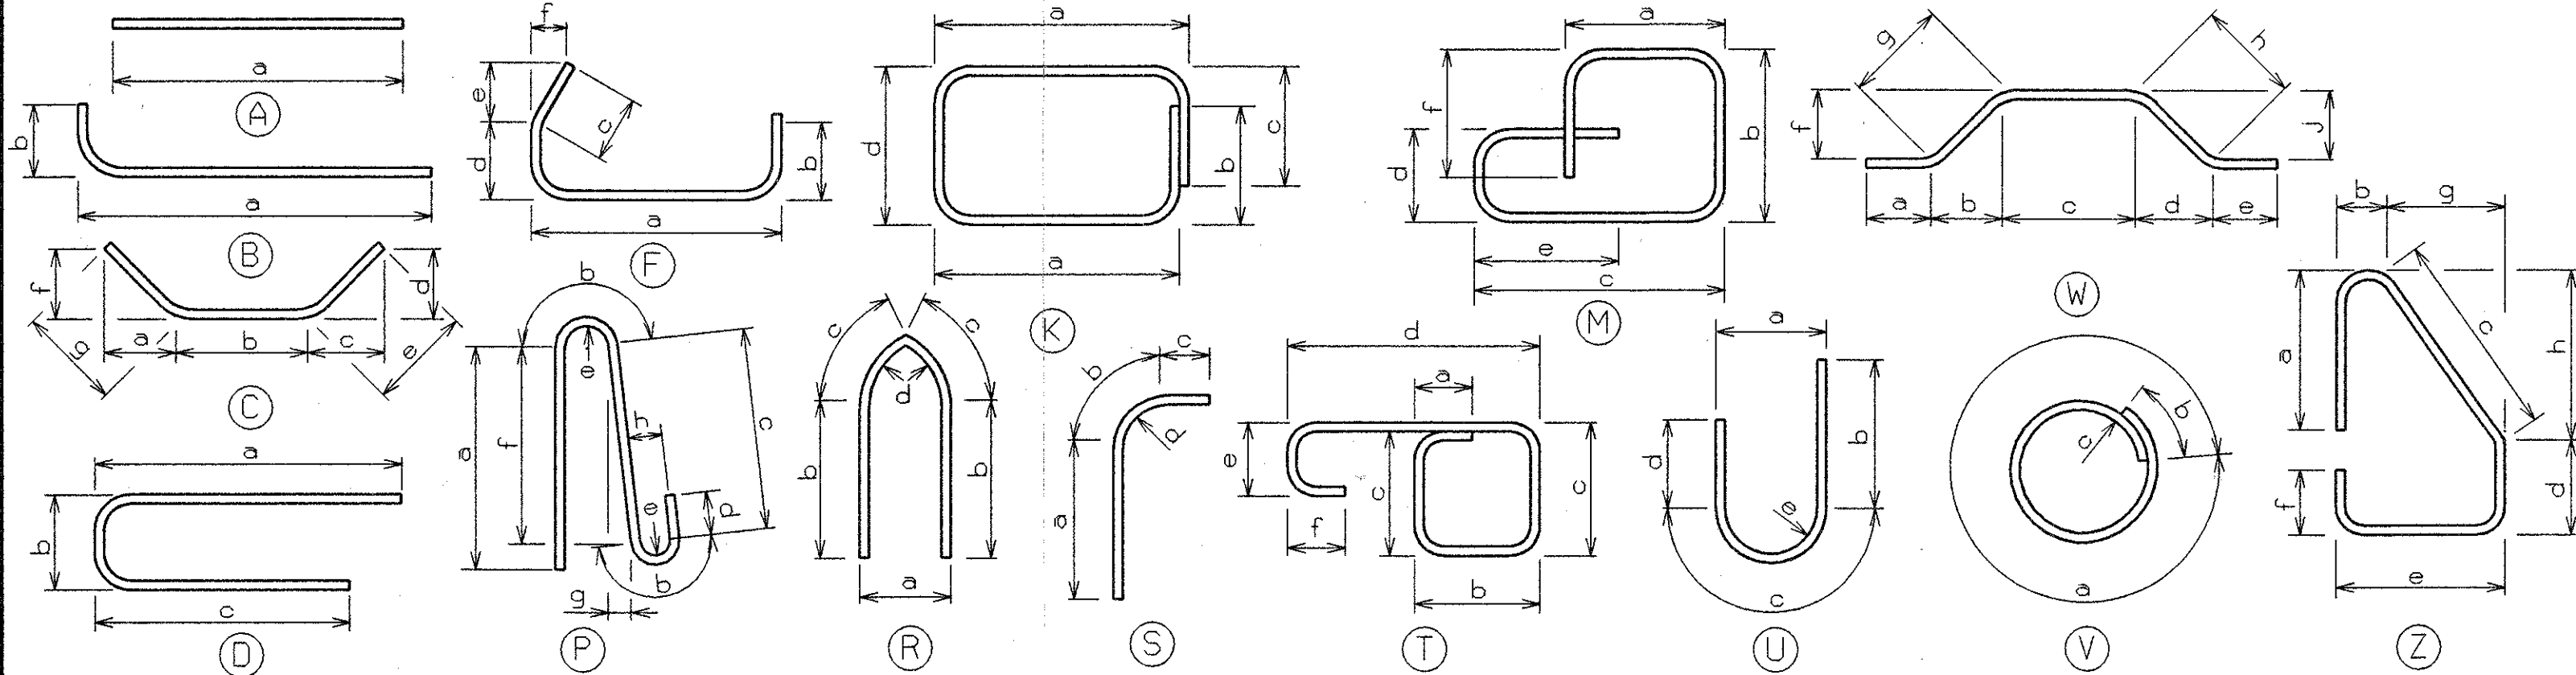

EPOXY COATED BAR SIZE
EA2013000
BAR SHAPE
BAR LENGTH (mm.)
BAR LEGEND

0	kg	REINFORCEMENT, STEEL
21738	kg	REINFORCEMENT, STEEL, EPOXY COATED

REINFORCEMENT SHALL BE BUNDLED AND TAGGED AS TO THE LOCATION AS SHOWN ON THIS SHEET.


DATE	CONT. SEC.	JOB NO.	DESIGN UNIT	SHEET
10/13/99	S02 OF 63174	48404A	MAHDAVI	29 OF 29

REVISIONS			
NO.	DESCRIPTION	DATE	BY





CONTROL SECTION S30 OF 63174 JOB NO. 48404A SH. NO. 2

1 2 3 4 5 6 7 8 9 10 11 12 13 14 15 16 17 18 19 20 21 22 23 24 25 26 27 28 29 30 31 32 33 34 35 36 37 38 39 40 41 42 43 44 45 46 47 48 49 50 51 52 53 54 55 56 57 58 59 60 61 62 63

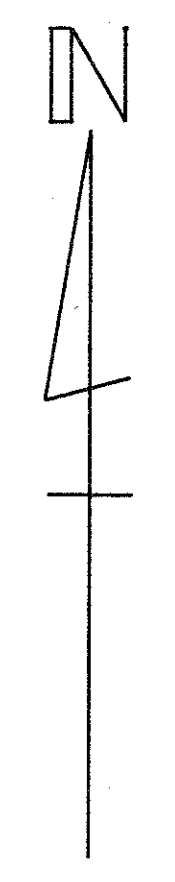

REVISIONS			
NO.	DESCRIPTION	DATE	BY

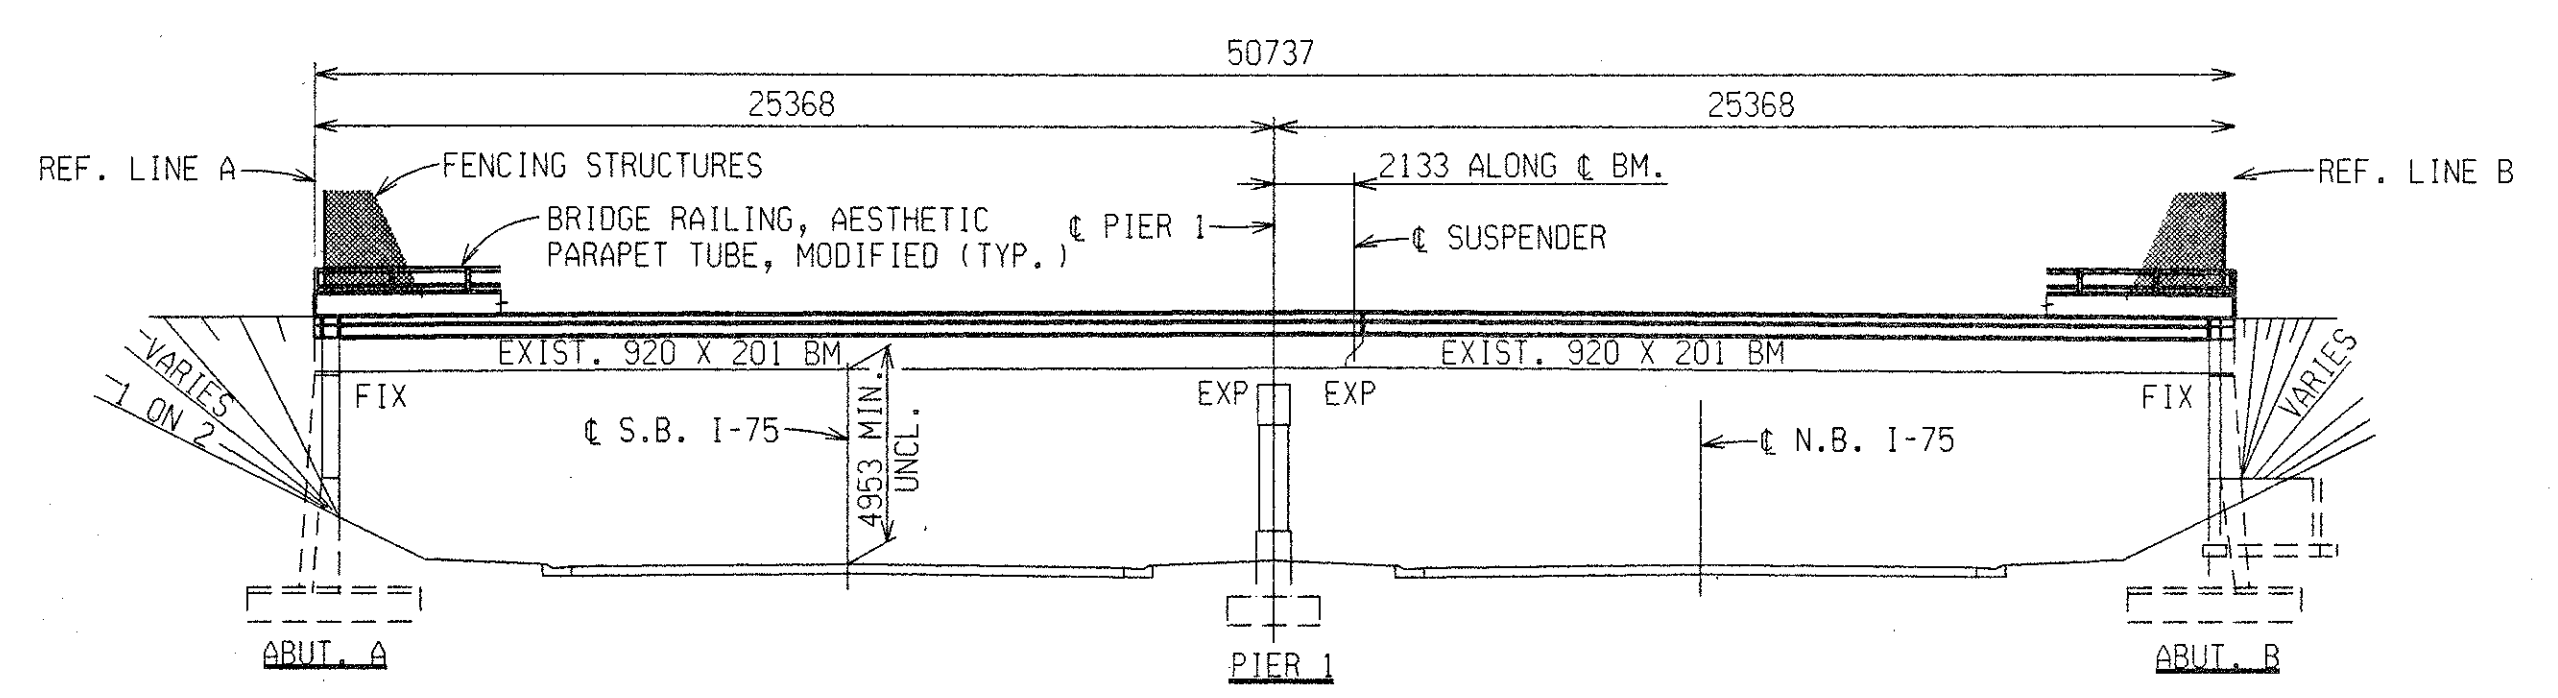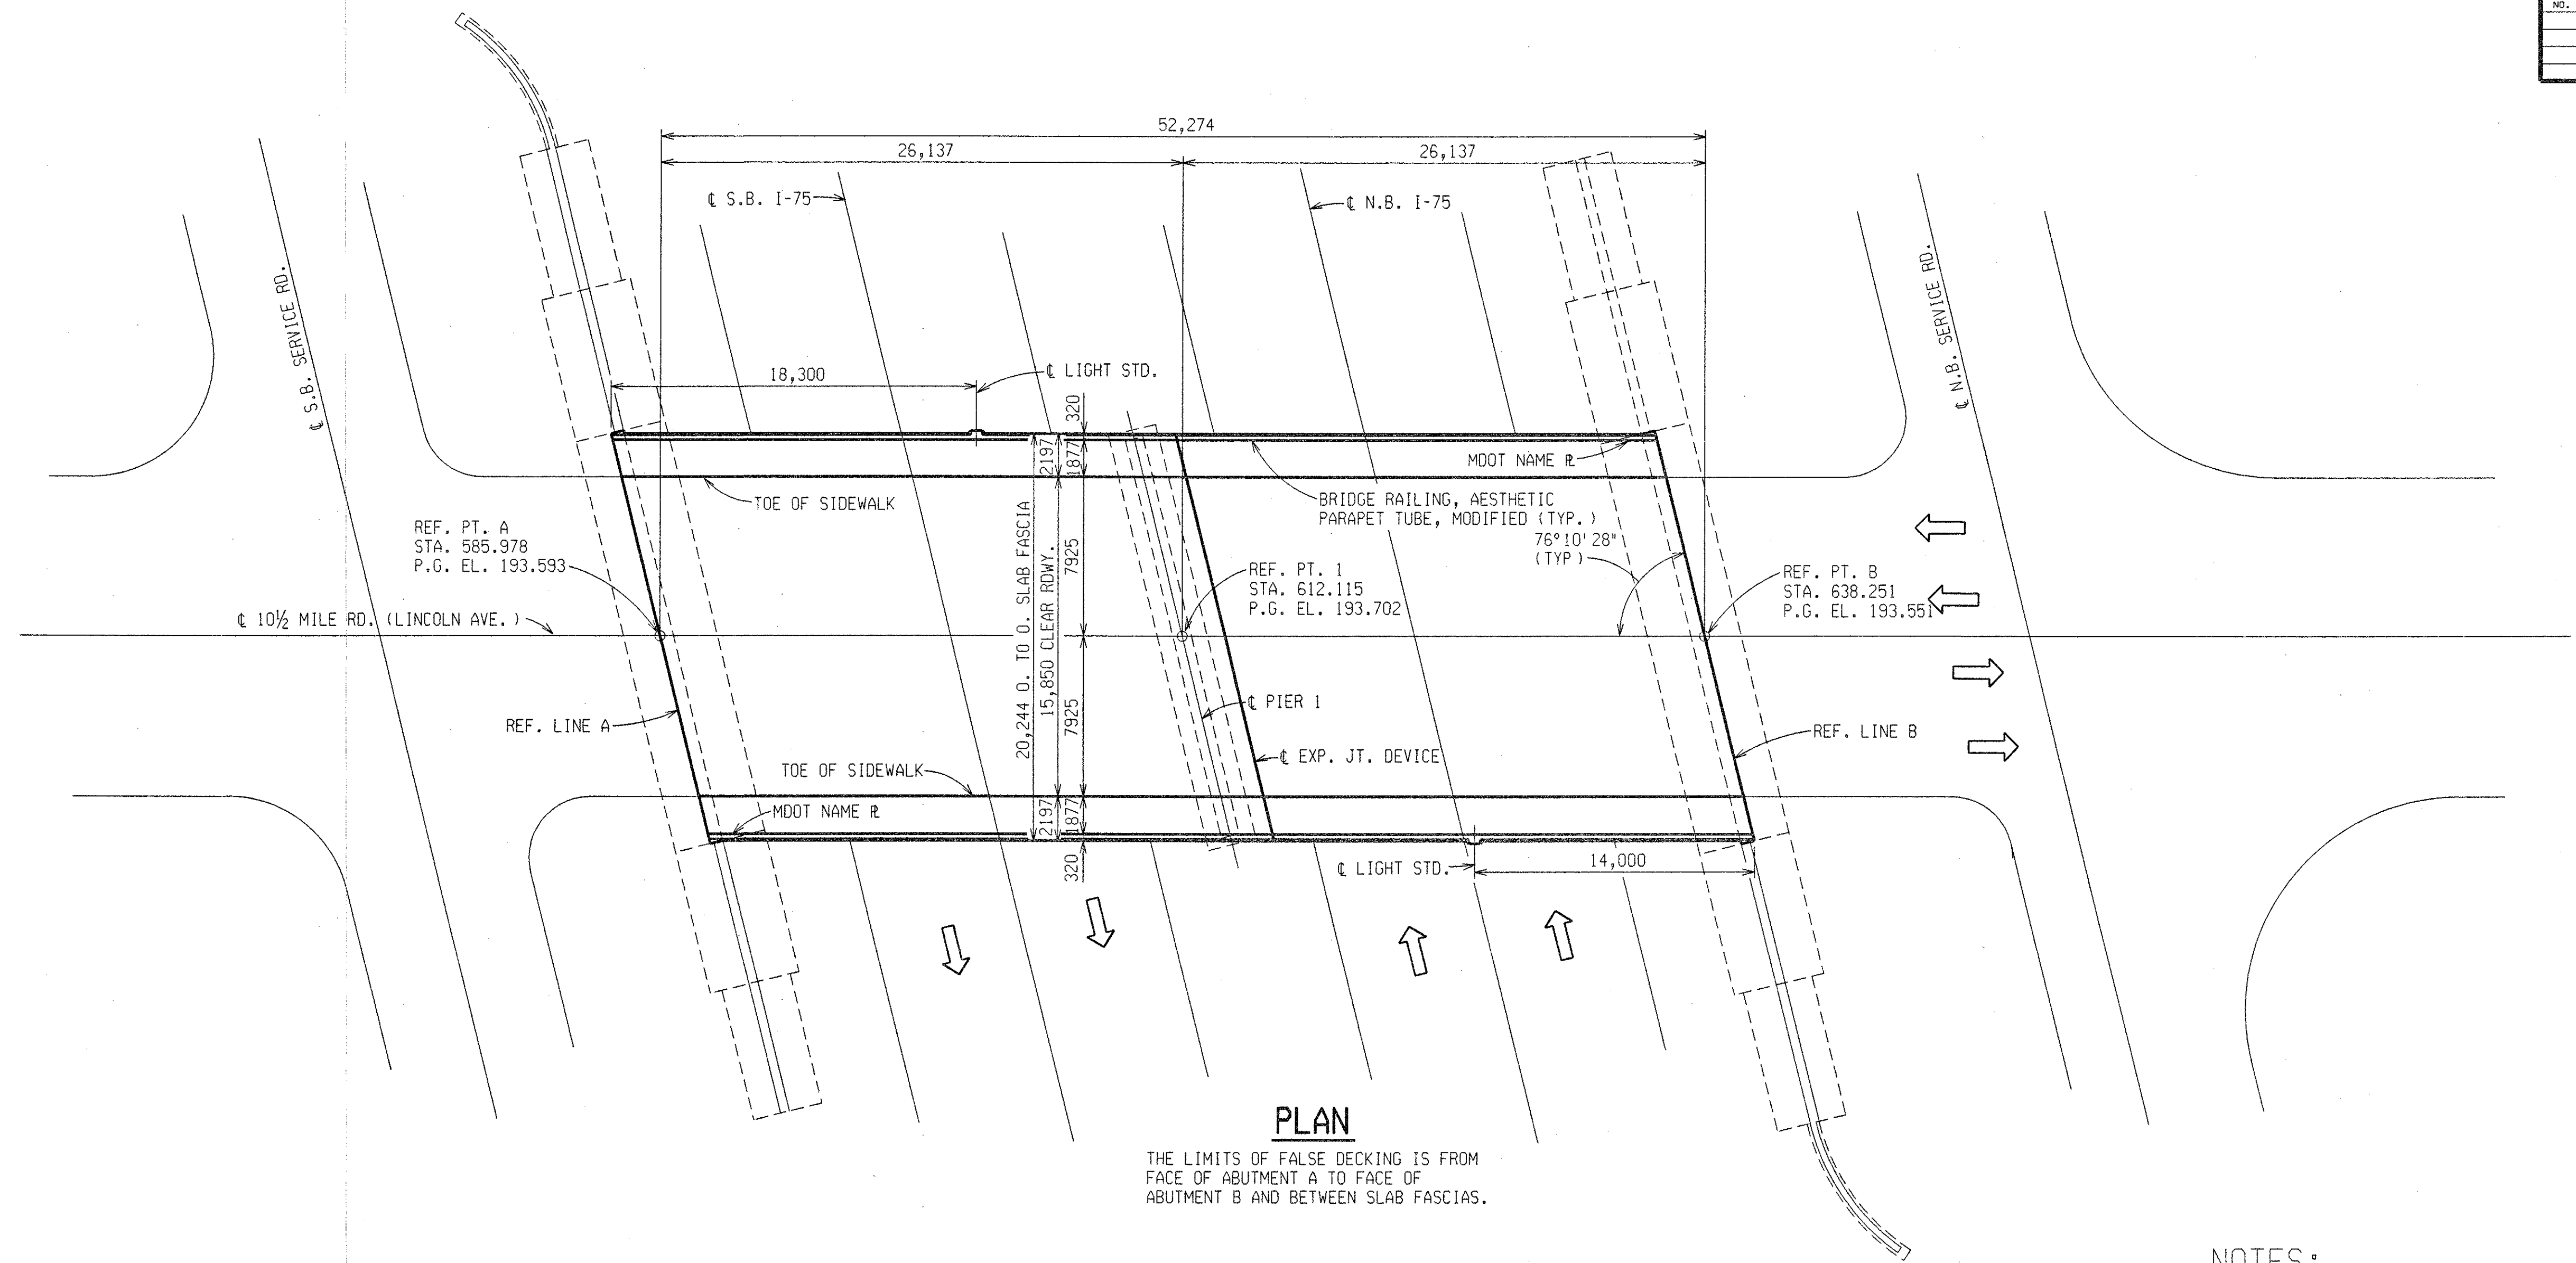

MISCELLANEOUS QUANTITIES	
1031 m ²	False Decking
1 LS	Structures, Rehabilitation, Rem Portions (S30)

NOTES:

THE WORK COVERED BY THESE PLANS INCLUDES DECK REPLACEMENT, PEDESTRIAN SCREENING, PIN AND HANGER REPLACEMENT, PAINTING OF THE EXISTING STRUCTURAL STEEL, AND MAINTAINING TRAFFIC. ALL OTHER WORK IS INCLUDED IN THE ROAD PLANS THAT ARE A PART OF THIS CONTRACT.

THE REHABILITATION DESIGN IS BASED ON CURRENT AASHTO STANDARD SPECIFICATIONS FOR HIGHWAY BRIDGES MS18 LOADING. LIVE LOAD PLUS IMPACT DEFLECTION DOES NOT EXCEED 1/1000 OF SPAN LENGTH AND 1/375 OF CANTILEVER ARM. THE (LOAD FACTOR) METHOD WAS USED FOR THIS DESIGN. THE ORIGINAL STRUCTURE WAS DESIGNED FOR MS18 LOADING.

THE CONTRACTOR SHALL LOCATE ALL ACTIVE UNDERGROUND UTILITIES PRIOR TO STARTING WORK AND SHALL CONDUCT HIS OPERATIONS IN SUCH A MANNER AS TO ENSURE THAT THOSE UTILITIES NOT REQUIRING RELOCATION WILL NOT BE DISTURBED.

THE CONTRACTOR SHALL NOTIFY DETROIT EDISON FOR DEACTIVATION OF STREET LIGHTS AND TRAFFIC SIGNAL CIRCUITS PRIOR TO DECK REMOVAL AND FOR REINSTALLATION OF THE STREET LIGHTING AND SIGNALS FOLLOWING COMPLETION OF BRIDGE DECK CONSTRUCTION.

ALL WORK FOR TEMPORARY SUPPORT AND PROTECTION OF THE AMERITECH DUCTS AND THE CONSUMER ENERGY GAS MAIN SHALL BE INCLUDED IN THE PAY ITEM "STRUCTURES, REHABILITATION, REMOVE PORTIONS (S30)".


LINCOLN AVE. TRAFFIC IS TO BE DETOURED OVER OTHER EXISTING ROADS.

MEASURES SHALL BE TAKEN TO PREVENT DEBRIS FROM FALLING FROM THE STRUCTURE.

THE EXISTING GAS MAIN AND AMERITECH DUCTS WILL REQUIRE TEMPORARY SUPPORTS PRIOR TO REMOVAL OF THE DECK.

GENERAL PLAN OF STRUCTURE				
I-75 UNDER 10.5 MI., LINCOLN AVE. IN ROYAL OAK				
DATE	CONT. SEC.	JOB NO.	DESIGN UNIT	SHEET
10-13-99	S30 OF 63174	48404A	MAHDAVI	2 OF 22

APPROVED *Steven A. Beck* 10/19/99
DESIGN SUPERVISING ENGINEER



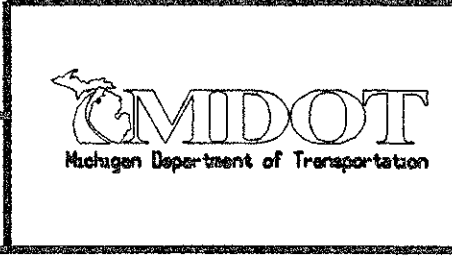


FILE NAME: s3063174.st DRAWN BY: CASLER CHECKED BY: DATE: 1-15-99 CORRECTED BY: CASLER DATE: 10-13-99

CONTROL SECTION S30 OF 63174 JOB NO. 48404A SH. 3

1 2 3 4 5 6 7 8 9 10 11 12 13 14 15 16 17 18 19 20 21 22 23 24 25 26 27 28 29 30 31 32 33 34 35 36 37 38 39 40 41 42 43 44 45 46 47 48 49 50 51 52 53 54 55 56 57 58 59 60 61 62 63

REVISIONS			
NO.	DESCRIPTION	DATE	BY

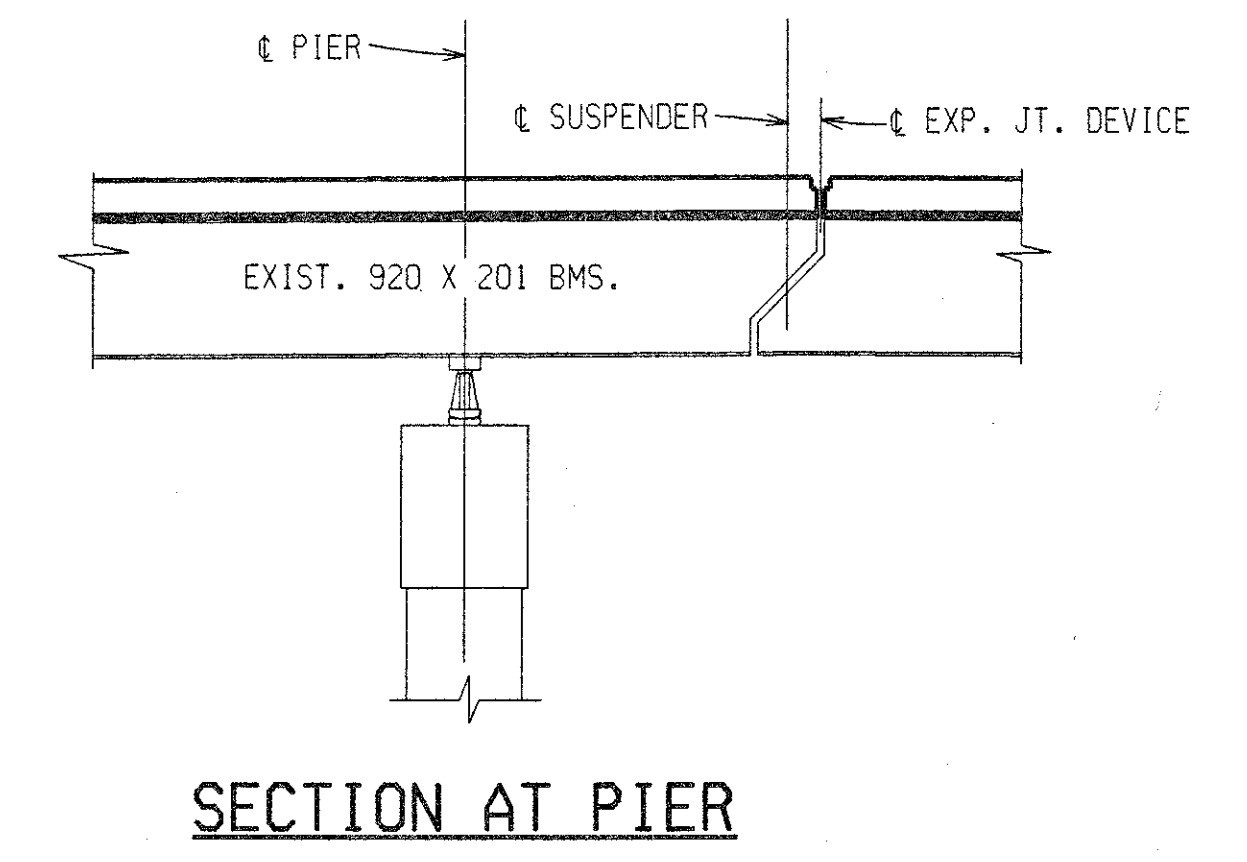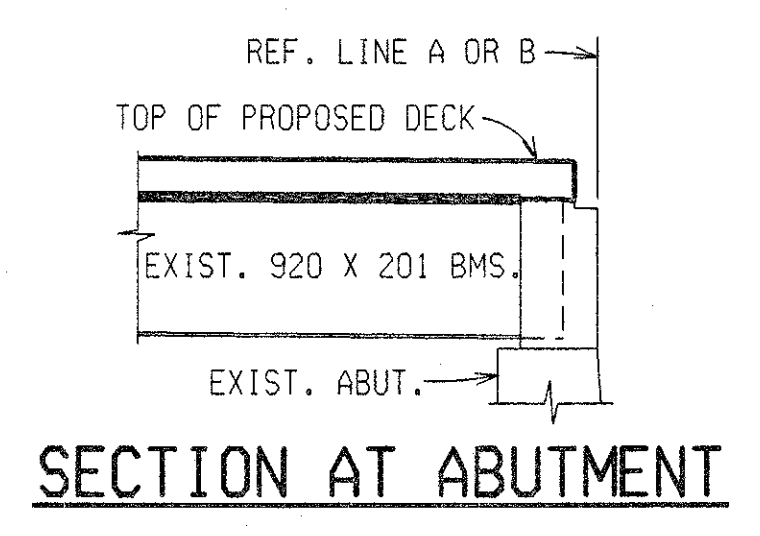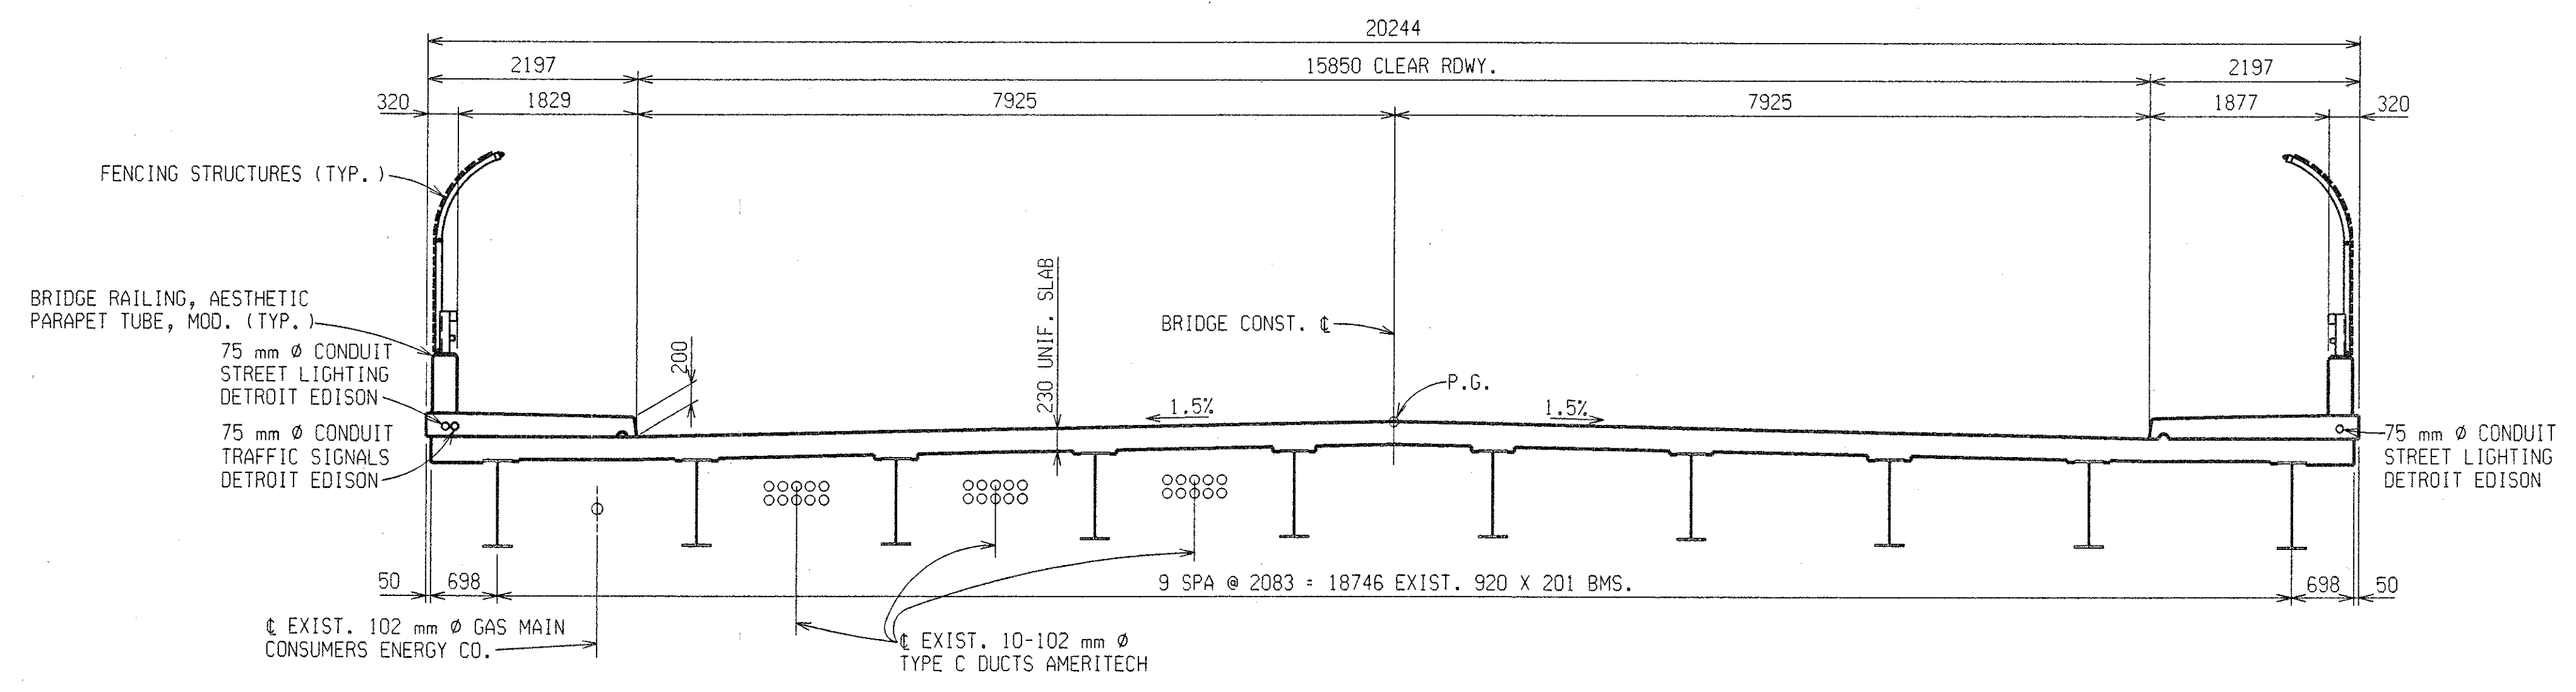





APPROVED *Steven A. Beck* 10/19/99
DESIGN SUPERVISING ENGINEER



GENERAL PLAN OF STRUCTURE				
I-75 UNDER 10.5 MI., LINCOLN AVE. IN ROYAL OAK				
DATE	CONT. SEC.	JOB NO.	DESIGN UNIT	SHEET
10-13-99	S30 OF 63174	48404A	MAHDAVI	3 OF 22


FILE NAME: s3063174.st
DRAWN BY: CASLER
CHECKED BY:
DATE: 1-25-99
CORRECTED BY: SHAFER
DATE: 7-24-99

JOB NO. 48404A
 SECTION 30 OF 63174
 SHEET NO. 4
 DATE: 10-13-99
 CHECKED BY: [Name]
 CORRECTED BY: [Name]
 DRAWN BY: [Name]

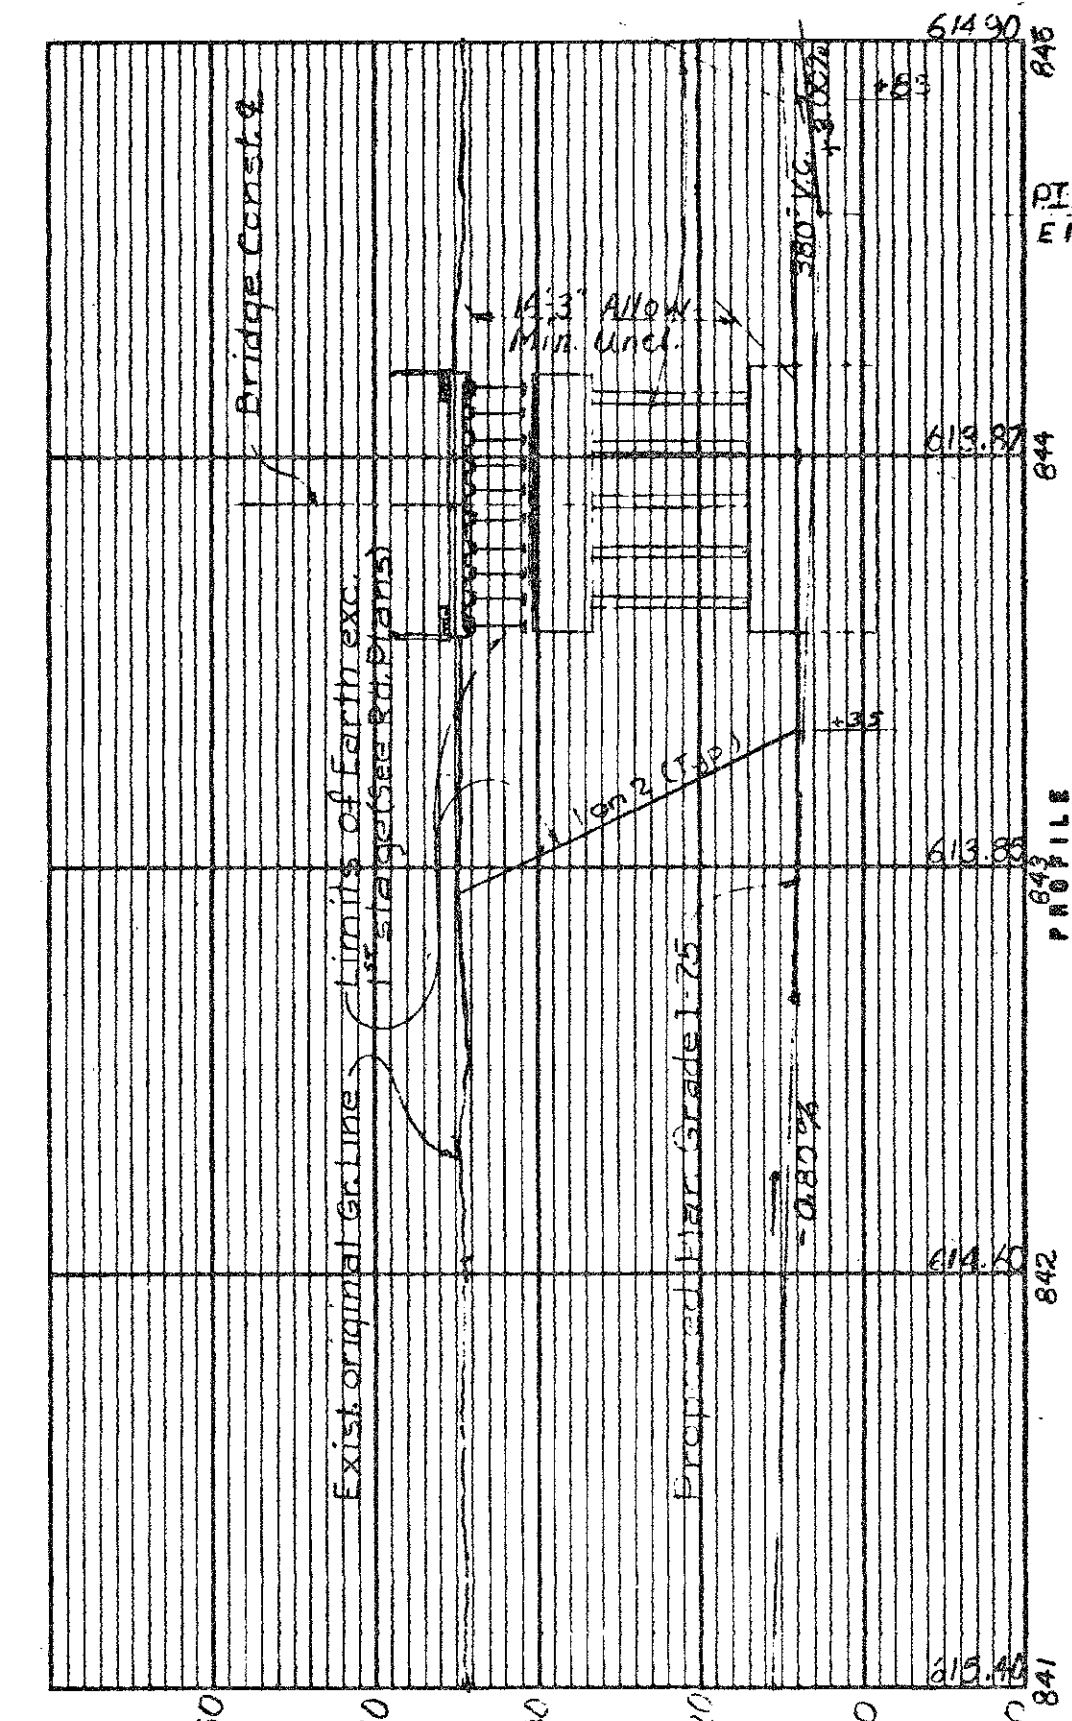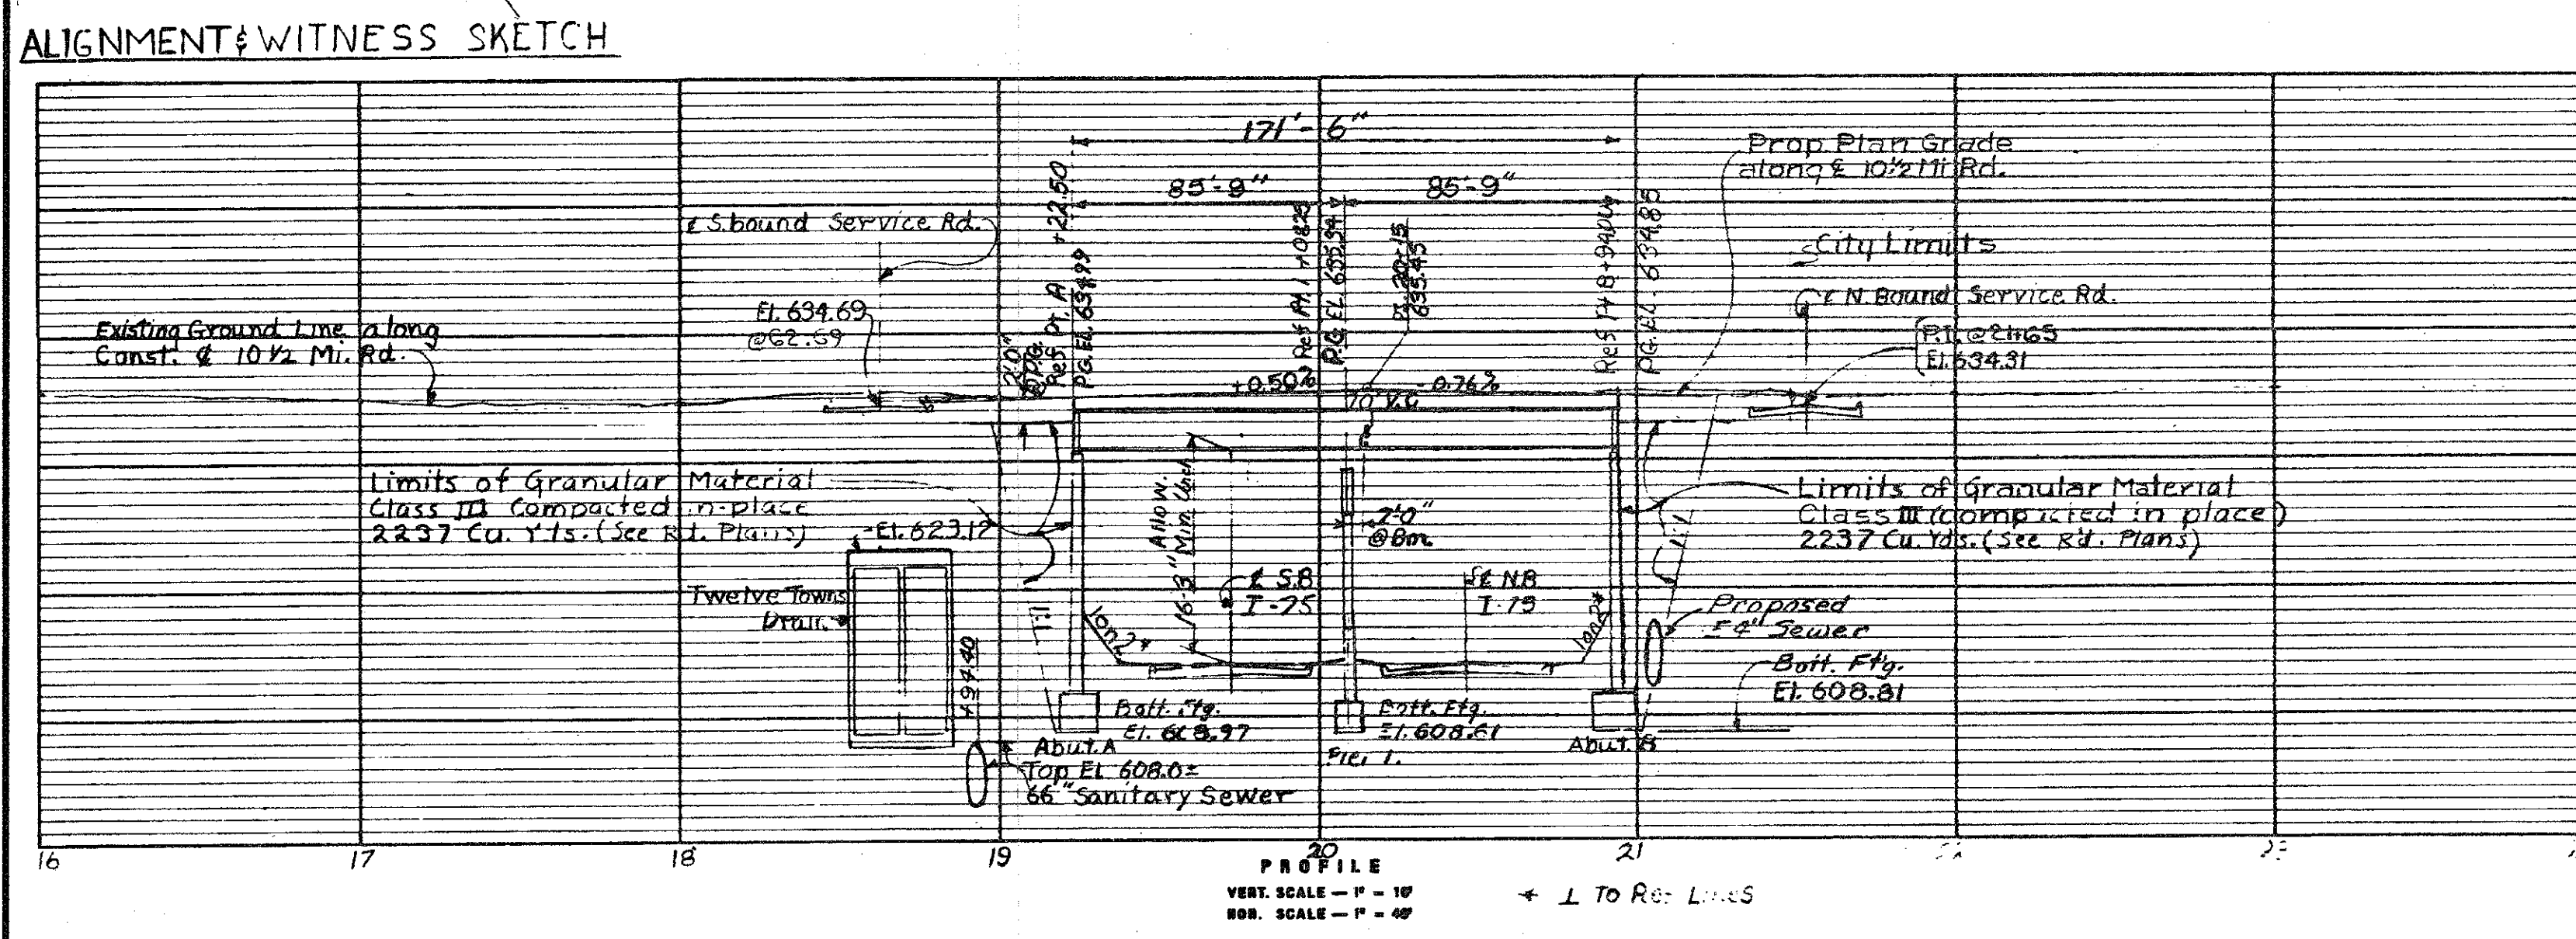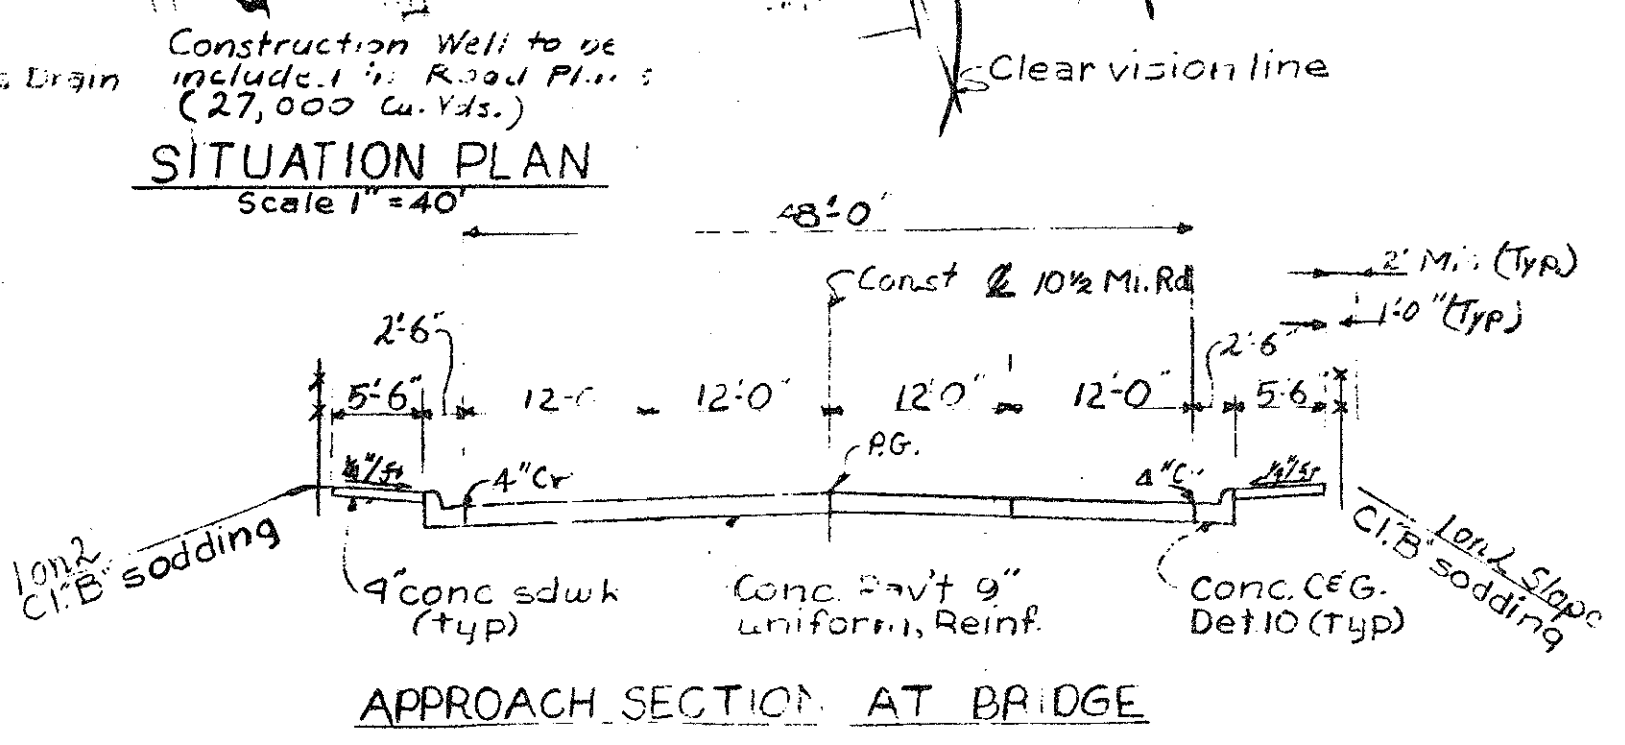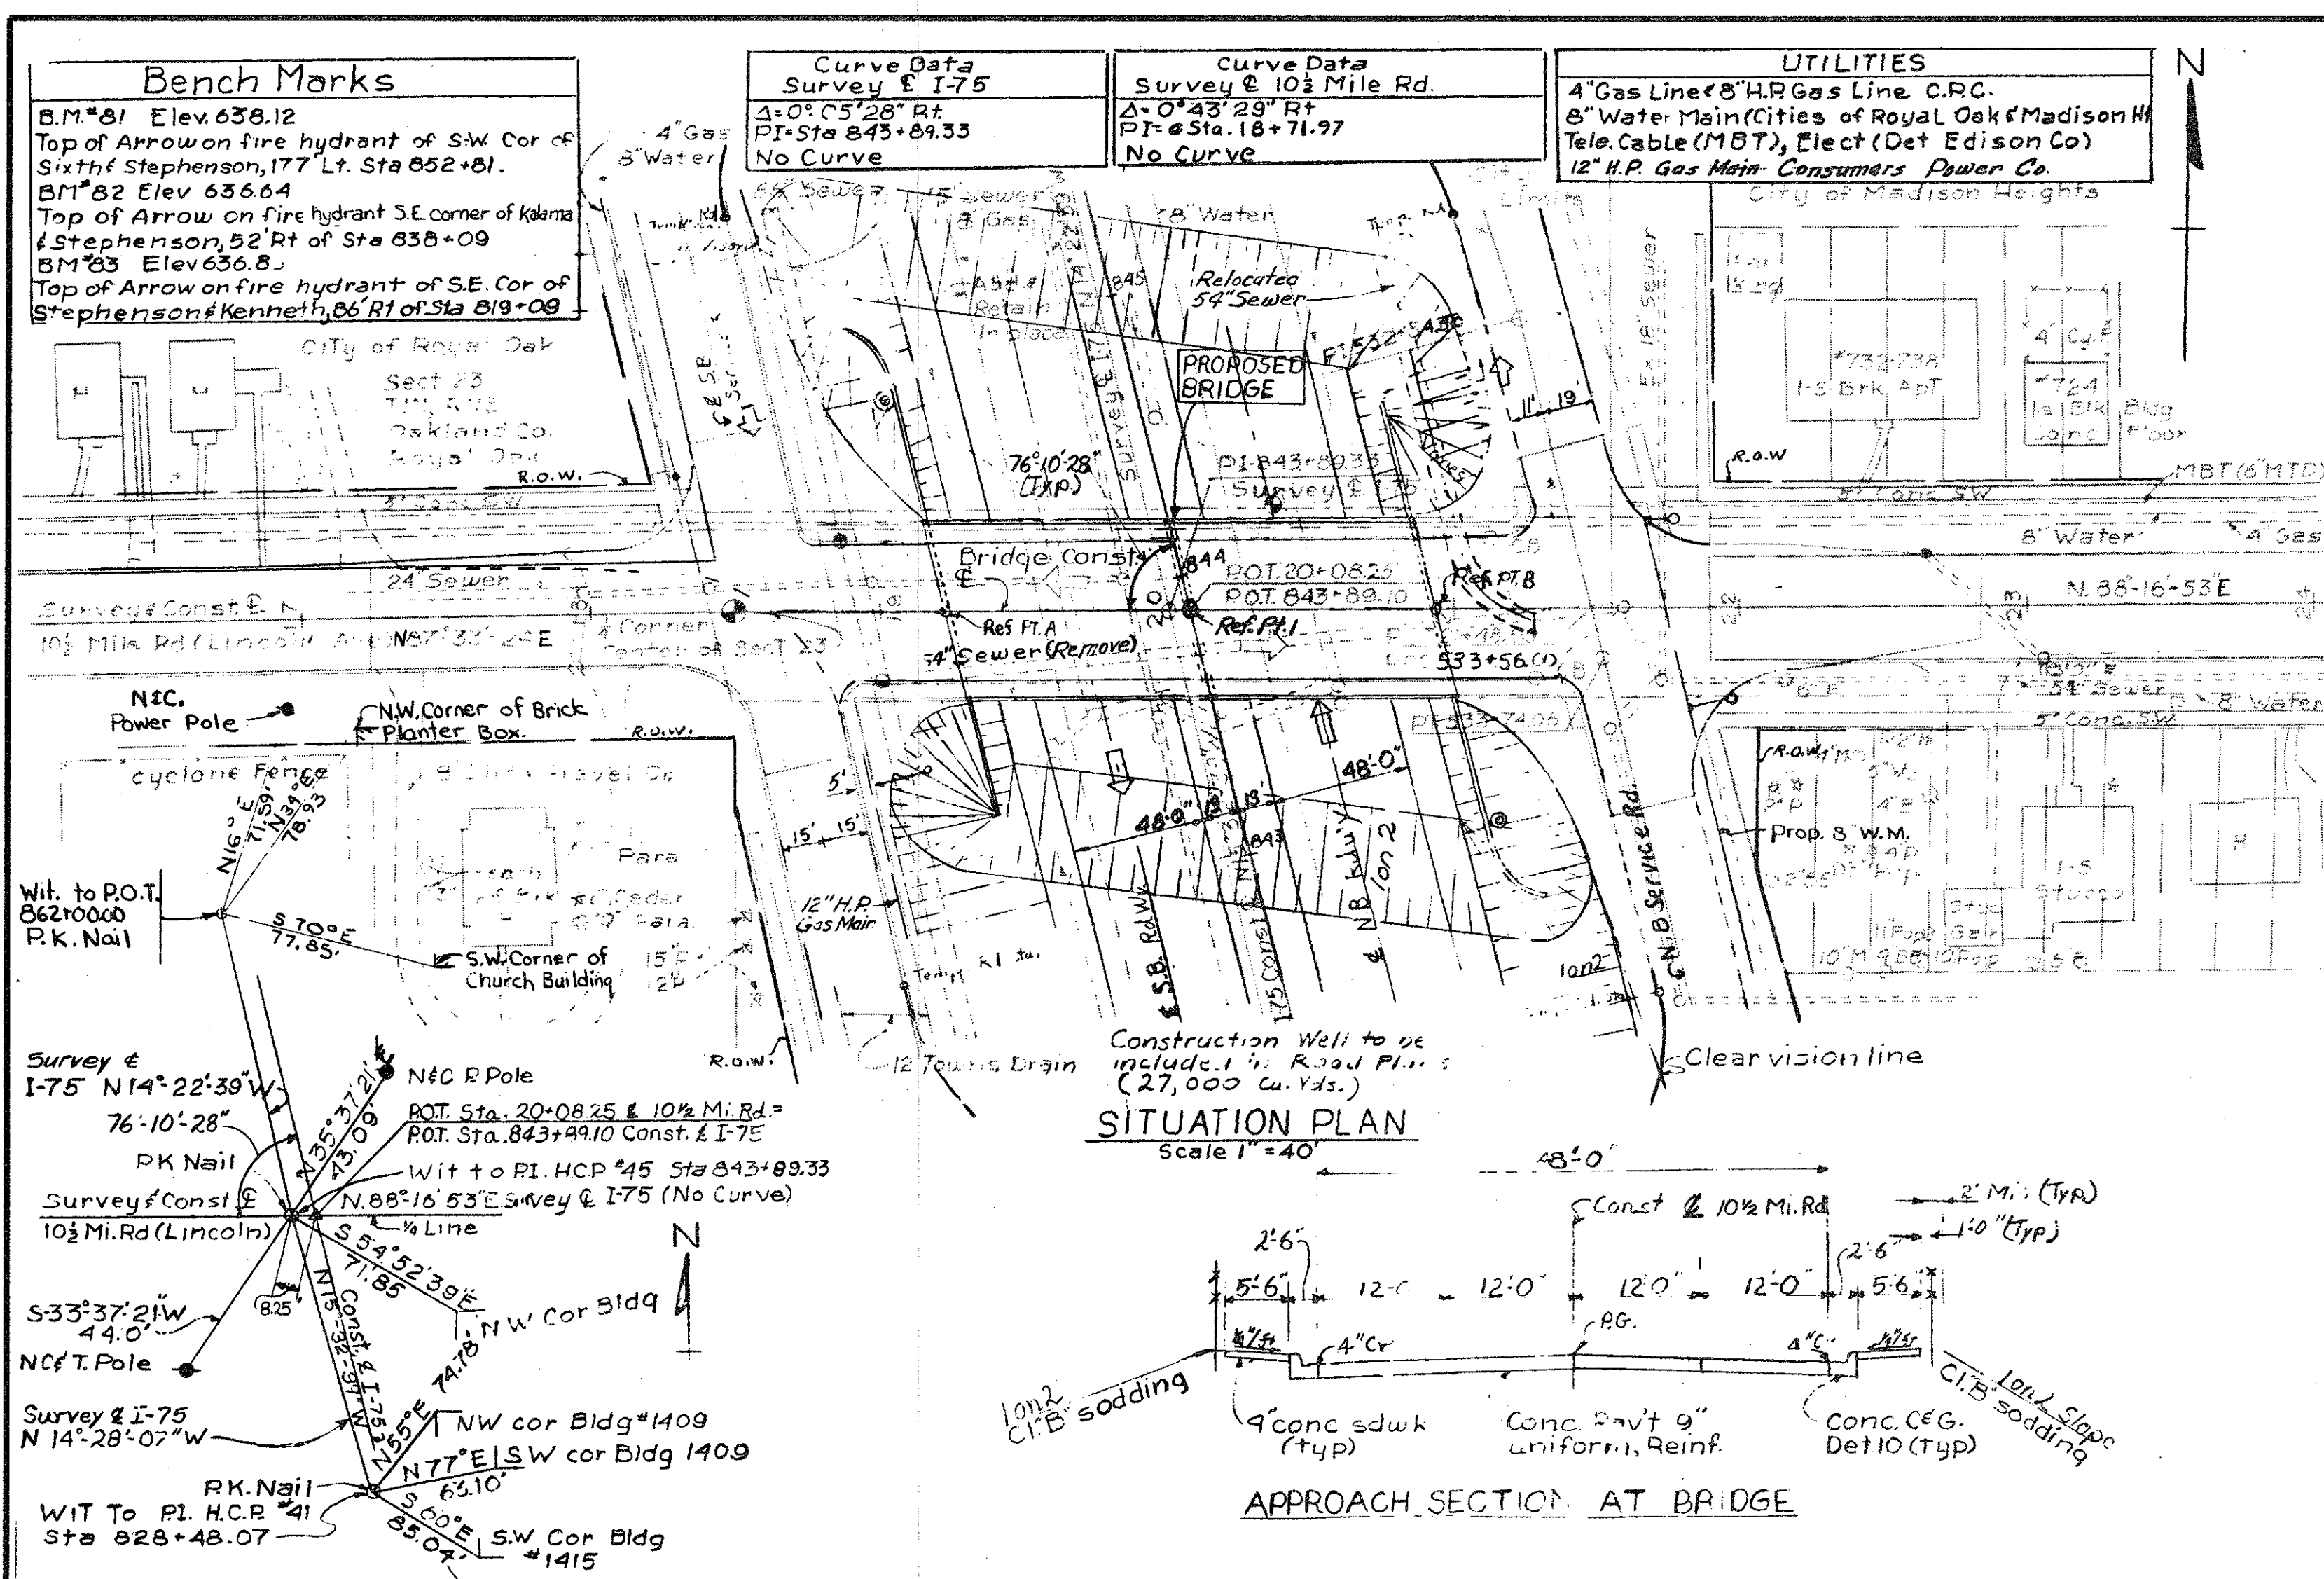

Construction Sequence
 Construct E.N. & E.S. Service Rd.
 Construct Temporary Run Around.
 Excavate & Construct Bridge.

NOTES:
 Traffic maintained for:
 I-75 on new & existing Service Roads
 10 1/2 Mi. Rd. by two one-way temp.
 run-arounds will be used to maintain traffic
 on Lincoln, one to the north and one to the
 south. They will be placed so that
 all slope walls can be built during one
 stage.
 Grading of construction well only in the vicinity of
 the structure to be done prior to starting
 work on the structure.
 The work covered by these plans
 includes construction of the proposed
 bridge, placing foundation drains including
 the special inlets and placing slope protection
 to the limits shown.
 Utilities requiring moving are to
 be moved by their respective owners.
 Removal of fences and buildings
 is not a part of this contract.
 The contractor shall locate all
 active underground utilities prior to
 starting work & shall conduct his
 operation in such a manner as to
 insure that those utilities not requiring
 relocation will not be disturbed.

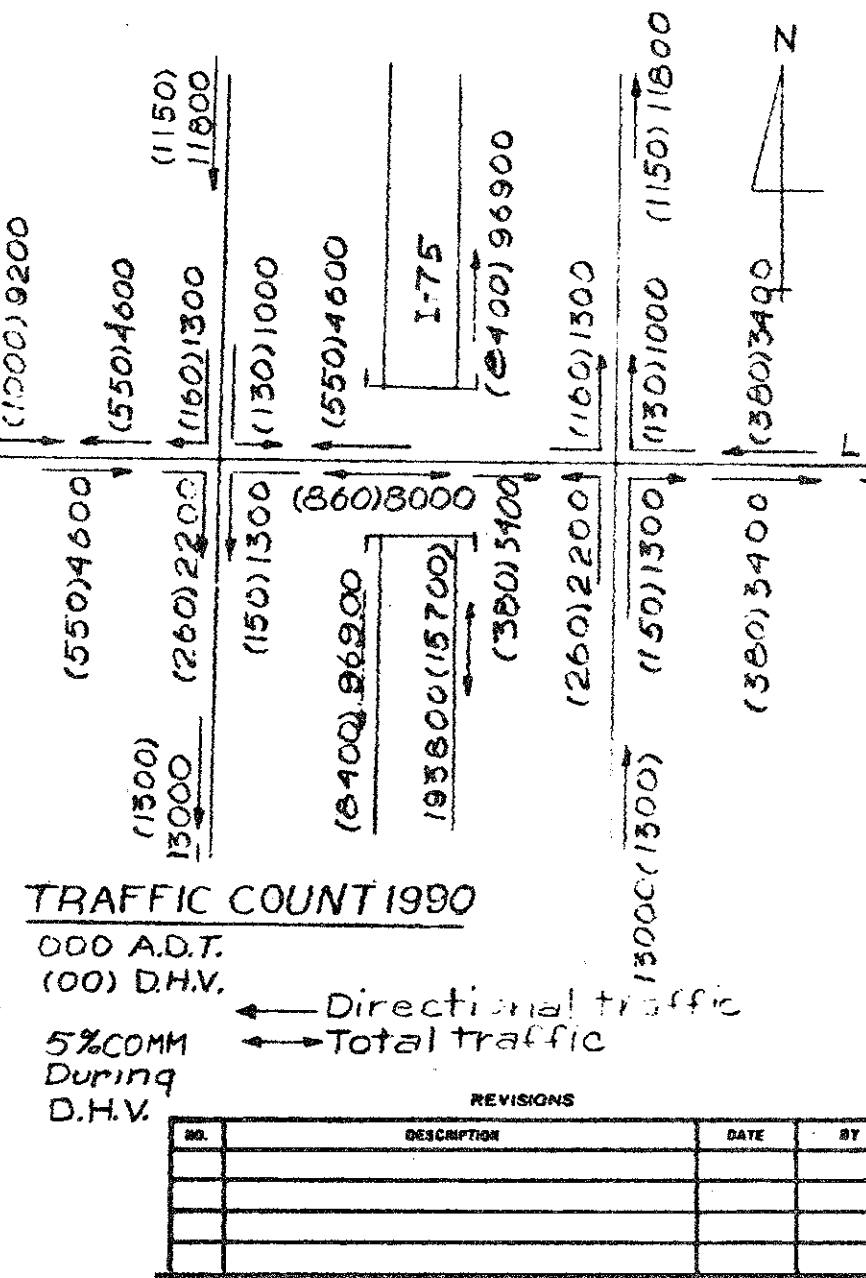

MICHIGAN DEPARTMENT OF STATE HIGHWAYS
 10 1/2 MILE ROAD (LINCOLN AVE.) OVER I-75 - CITY OF ROYAL OAK
GENERAL PLAN OF SITE

DESIGNED BY	FISHER	DATE	10-13-99
DRAWN BY	HARTMAN	DATE	9-19-98
CHECKED BY	R. MARSH	DATE	9-24-98
PROJECT NO.	S30 OF 63174B		

APPROVED: [Signature] ASST. SUPERVISOR - DESIGN
 APPROVED: [Signature] SUPERVISOR - DESIGN

NOTE:
 DO NOT WORK FROM THIS SHEET. THE INFORMATION SHOWN
 HERE IS FOR REFERENCE ONLY. NO PAY ITEMS ARE SHOWN.

FOR INFORMATION ONLY.

DATE	CONT. SEC.	JOB NO.	DESIGN UNIT	SHEET
10-13-99	S30 OF 63174	48404A	MADHAVI	4 OF 22







FILE NAME: s3073174.sn
 DATE: 10-13-99
 CHECKED BY: [Name]
 CORRECTED BY: [Name]

1 2 3 4 5 6 7 8 9 10 11 12 13 14 15 16 17 18 19 20 21 22 23 24 25 26 27 28 29 30 31 32 33 34 35 36 37 38 39 40 41 42 43 44 45 46 47 48 49 50 51 52 53 54 55 56 57 58 59 60 61 62 63

REVISIONS			
NO.	DESCRIPTION	DATE	BY

MISCELLANEOUS QUANTITIES			
Item	Class	Quantity	Amount
Slope Protection	Class A	134	
Slope Protection Head		174	
Foundation Drain		24	
Special Inlet		2	

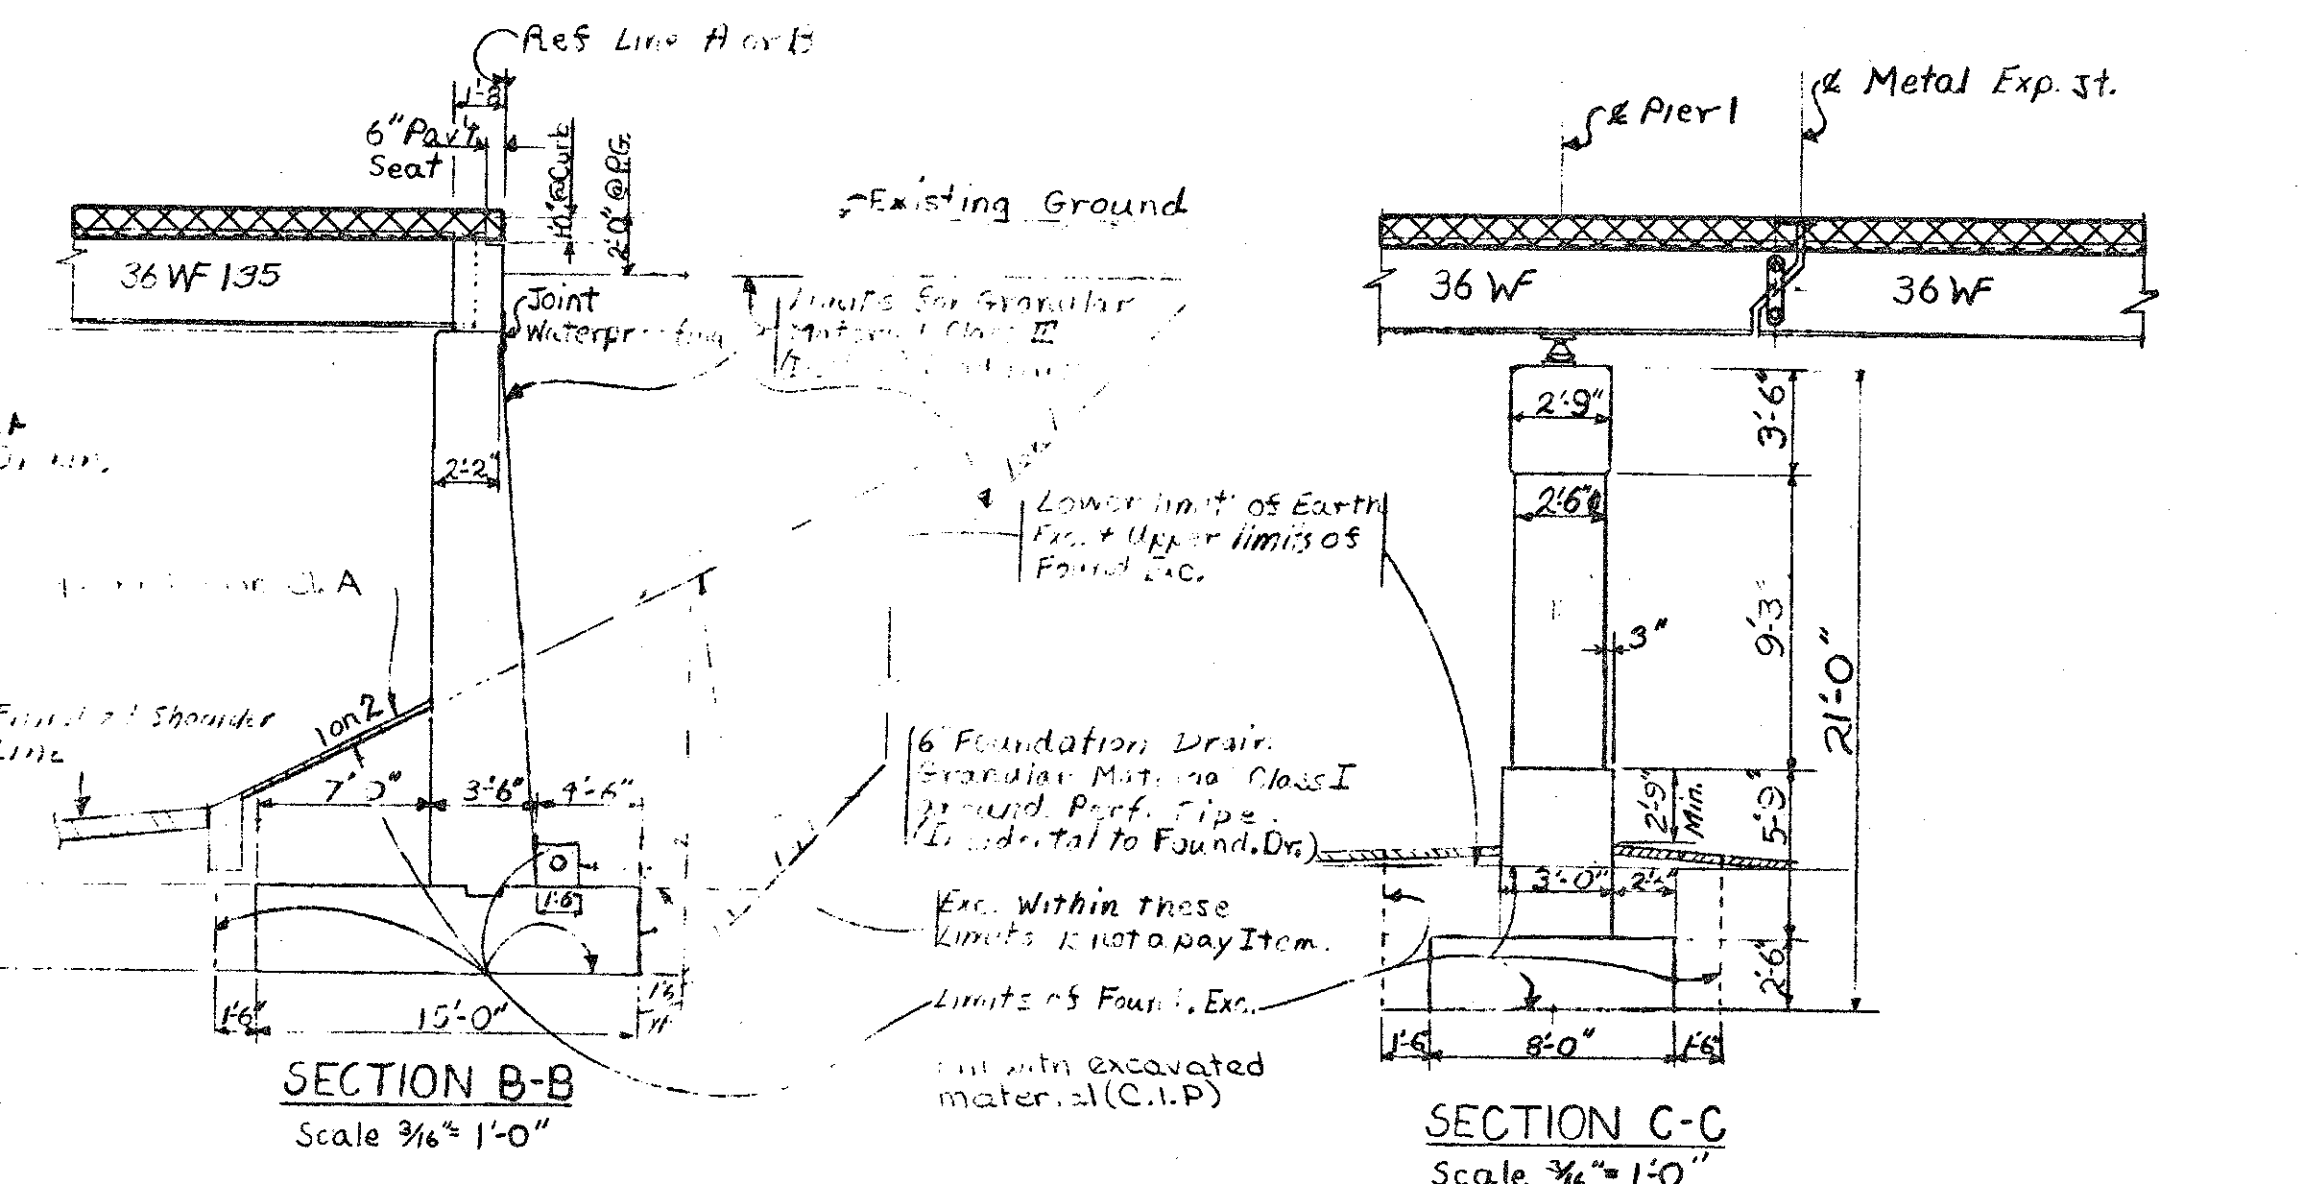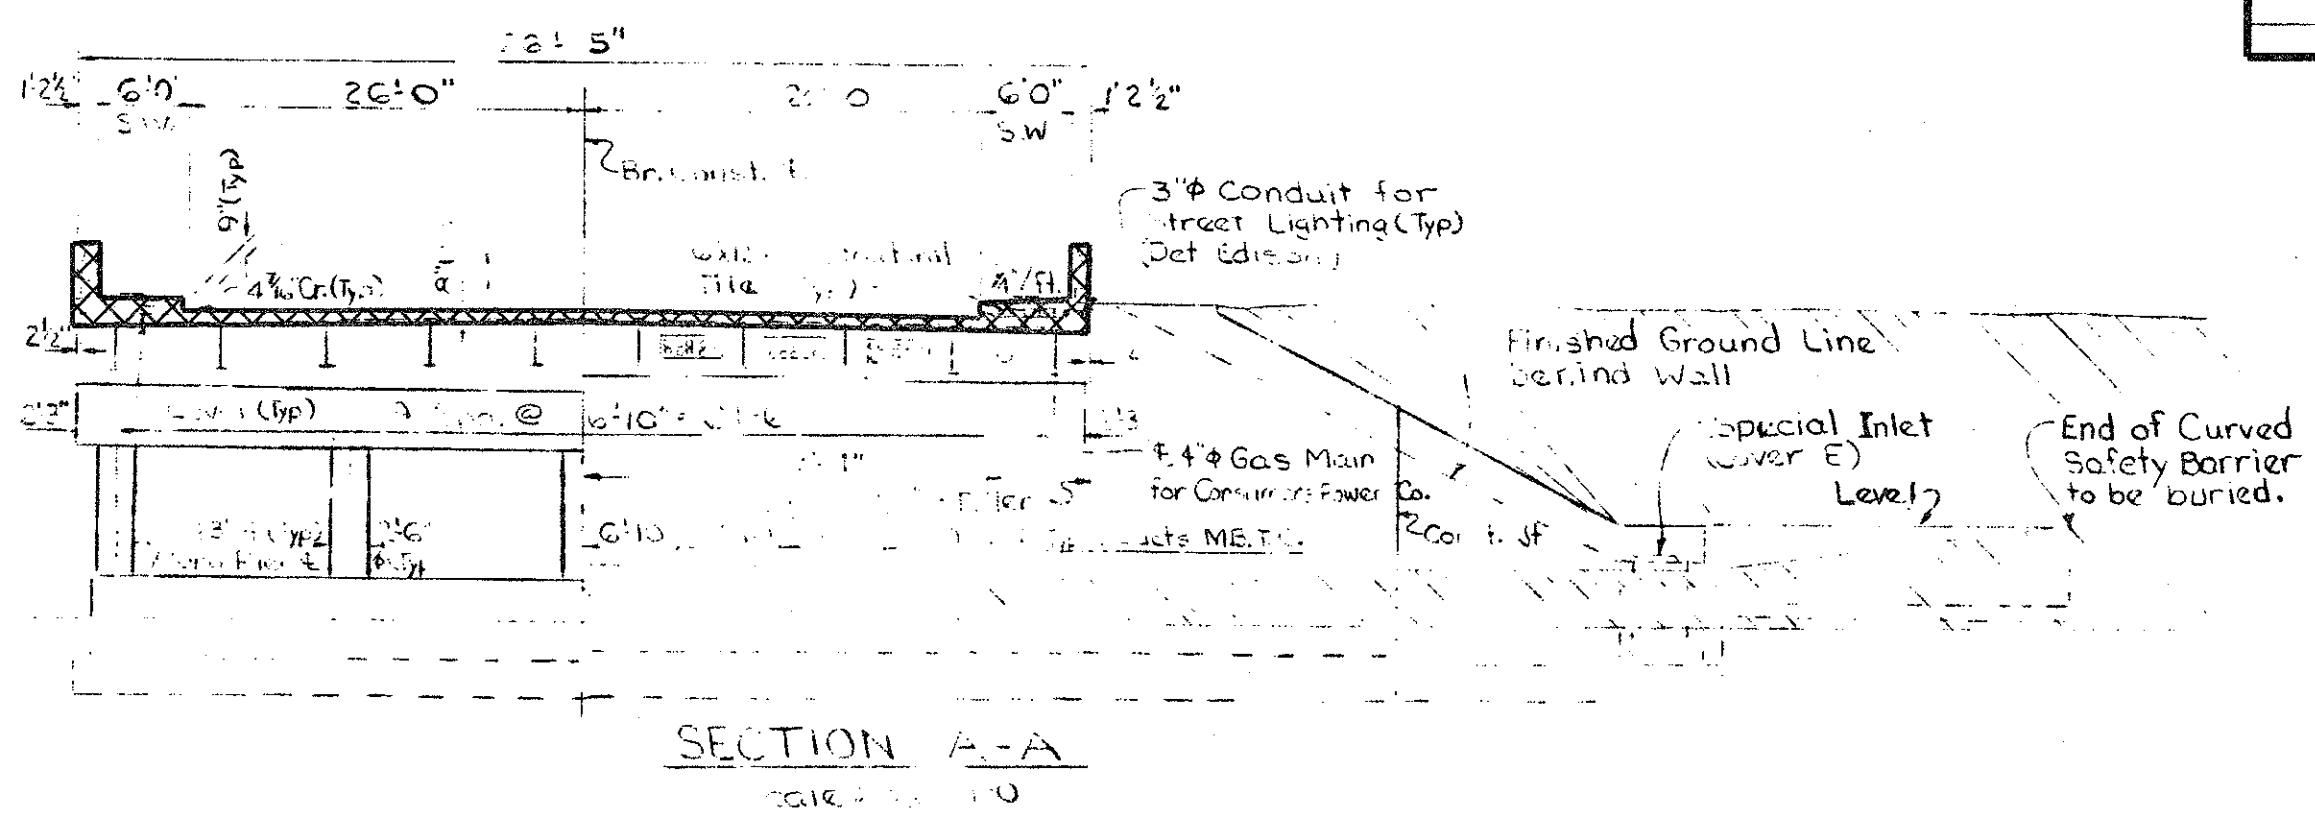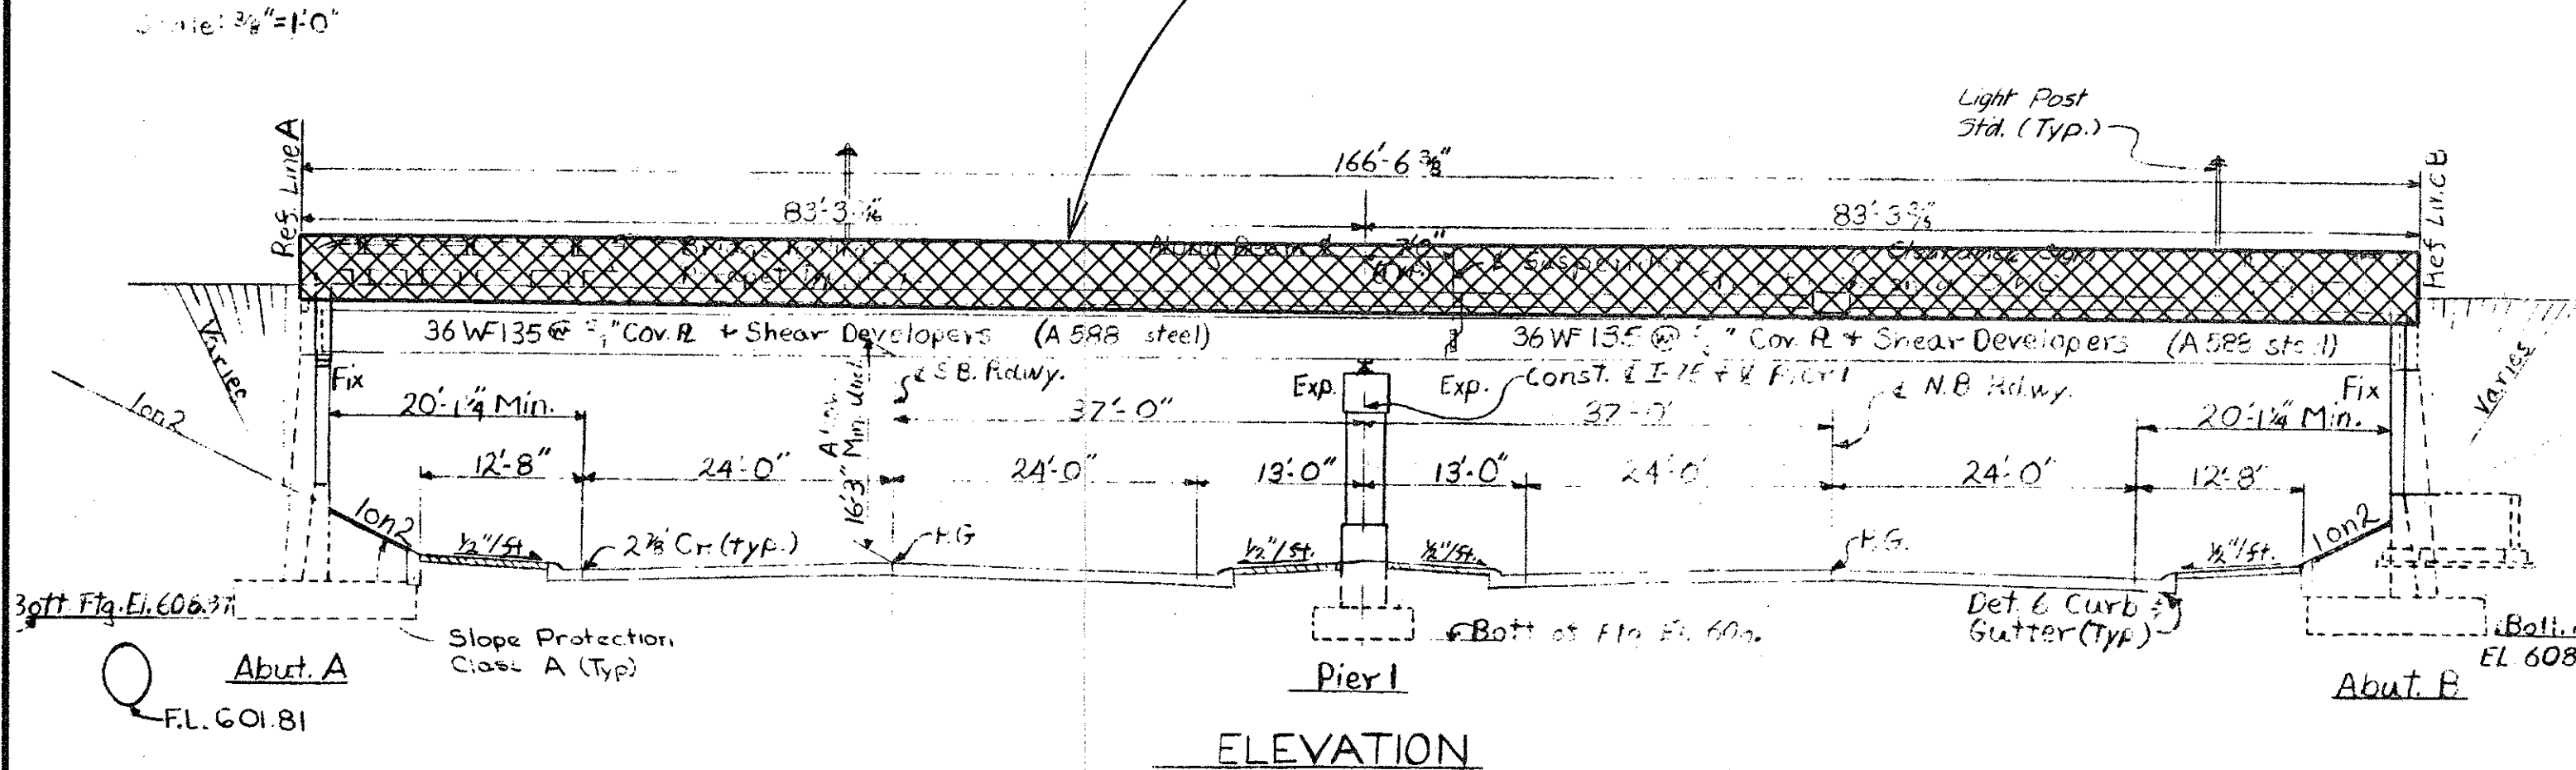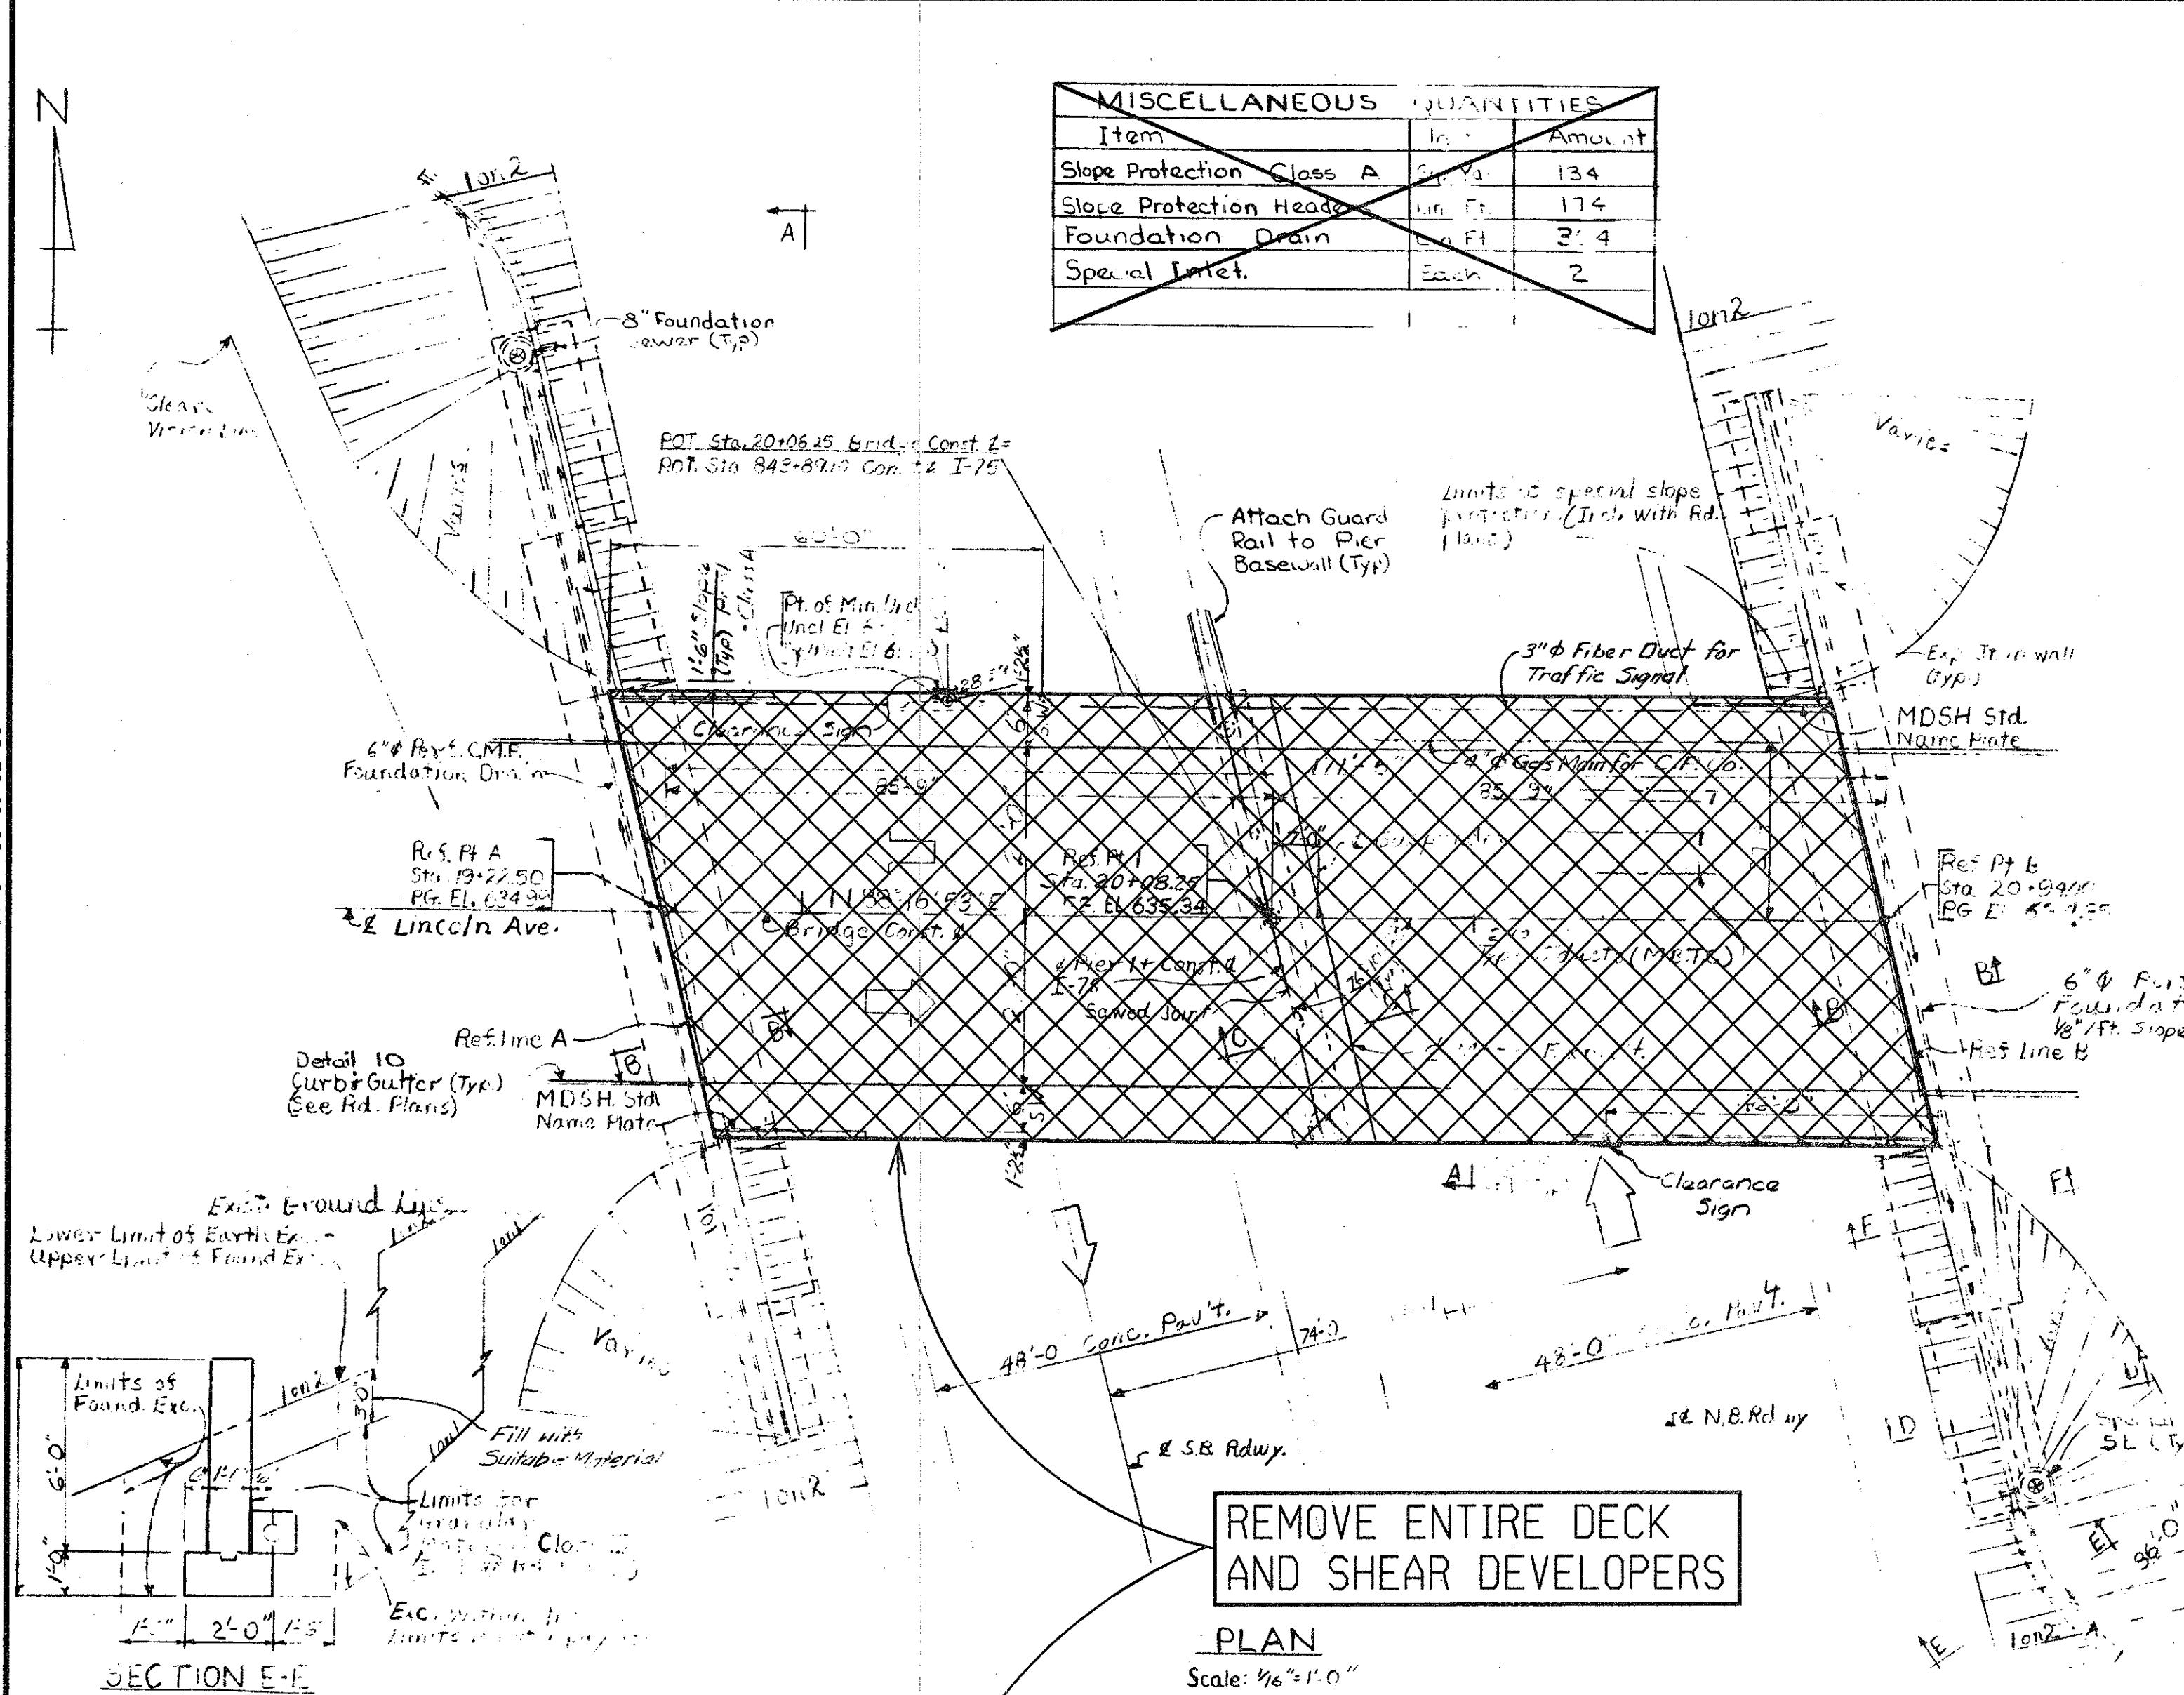

NOTES:
The design of this structure is based on the AASHTO Specifications for the Design of Highway Bridges, 1988 Edition, and current AASHTO Standard Specifications for Highway Bridges - H20-44 Loading. Live load plus impact deflection = 1/800 of the span length and = 1/300 of cantilever arm.
The top of roadway slab and tops of sidewalks are parallel to the vertical curve and tangents.
For details of Slope Protection, see Standard Sheet SP2.

10 1/2 MILE ROAD (LINCOLN AVE) OVER I-75-CITY OF ROYAL OAK

THE ONLY ITEMS OF WORK TO BE DONE FROM THIS SHEET ARE IDENTIFIED BY THE LEGEND BOX BELOW, LABELED WITH THIS PROJECT'S JOB NUMBER.

	DENOTES REMOVAL PORTIONS
	PROPOSED WORK



Lawrence O. Chick 6-5-69
ASS'T SUPERVISOR - DESIGN
J.C. Trickett 6-5-69
SUPERVISOR - DESIGN
Fischer 1-2-69
Hicks
Taylor 5-7-69
4 20
S30 of 63174 B



REMOVAL PORTIONS				
DATE	CONT. SEC.	JOB NO.	DESIGN UNIT	SHEET
10-13-99	S30 OF 63174	48404A	MADHAVI	5 OF 22

DATE: 5-11-99
CORRECTED BY: GASLER
DATE:
CHECKED BY:
DATE: 01-12-99
DRAWN BY: INDER
FILE NAME: s3073174.sn

1 2 3 4 5 6 7 8 9 10 11 12 13 14 15 16 17 18 19 20 21 22 23 24 25 26 27 28 29 30 31 32 33 34 35 36 37 38 39 40 41 42 43 44 45 46 47 48 49 50 51 52 53 54 55 56 57 58 59 60 61 62 63

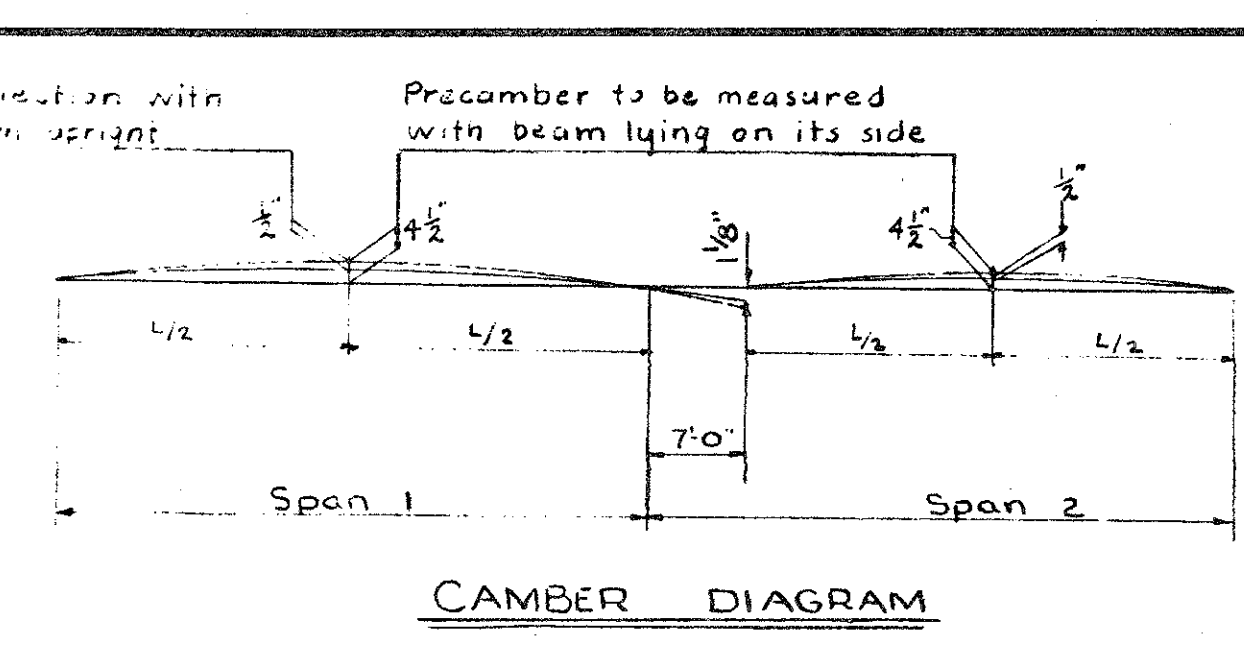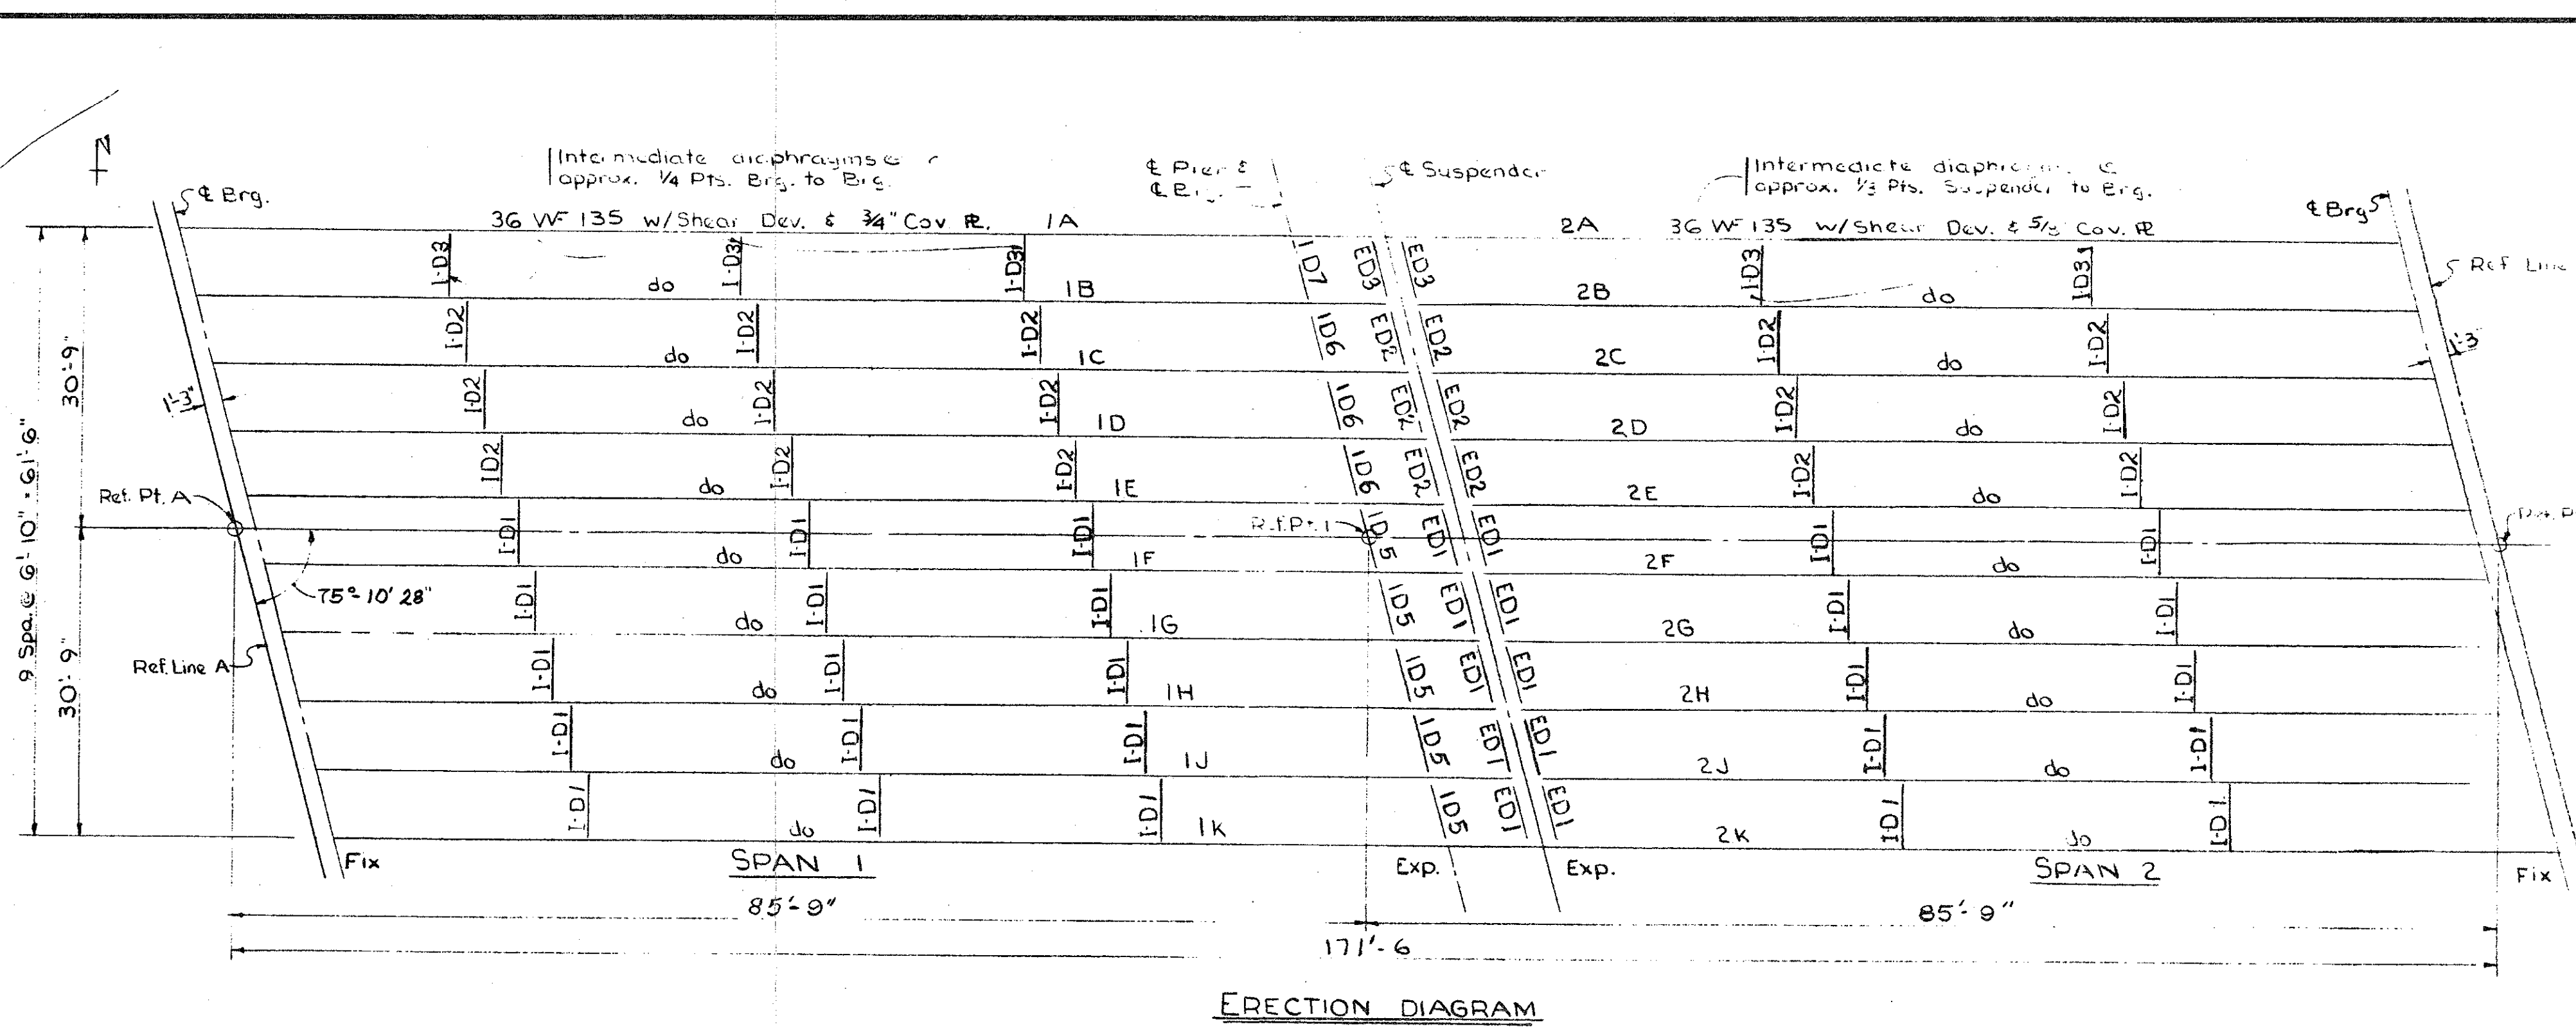

Item	Unit	Total
Structural Steel-Fabrication	lbs.	295,500
Structural Steel-Erection	lbs.	295,500
Elastomeric Bearing Pdds	Sq. Ft.	29

NOTES:

Design: Michigan Department of State Highways Specifications for Design of Highway Bridges - 1958 edition and current AASHTO Standard Specifications for Highway Bridges. (H 20 Loading).

Fabrication: Michigan Department of State Highways Standard Specifications for Road and Bridge Construction 1967 edition.

Shop connections shall be welded as shown on the plans.
 Field connections shall be bolted with 3/4" high-strength bolts, except as noted.

The beams are to be cambered as shown in the camber diagram. This camber is to be measured with the beam lying on its side. Allowable camber tolerance for rolled beams is ±1/4". Heating is to be used if necessary, to assure camber permanency within the above tolerance. The dead load deflection of the beams alone is calculated to be 1/2" in spans 1 & 2.

Sole plates 3" or more in thickness may be built up by welding together plates not less than 1/2" in thickness. Edges must be beveled 1/4" and welded with a continuous weld for the full perimeter. Welds shall be ground flush with faces of plate.

Magnetic particle inspection of welds is required and shall consist of 100% inspection of not less than one fabricated section selected at random for each ten sections or fabrications thereof.

Anchor Bolts (including nuts and washers) shall be galvanized in accordance with ASTM Designation A 153.



All steel material used for bearings, with exception of portion welded to beams, shall be galvanized in accordance with ASTM Designation A 123. Galvanizing shall be applied after fabrication of bearing. Mill scale and foreign material shall be removed prior to galvanizing.

Bronze for washers shall be ASTM B100, Alloy No. S10 or No. G35.

The quantity Structural Steel includes:

A 588 Steel	295,321 #
Bronze	55 #
Lead	124 #
Total	295,500 #

All steel shall be unpainted A.S.T.M. A 588.
 For Details see sheet No. 11

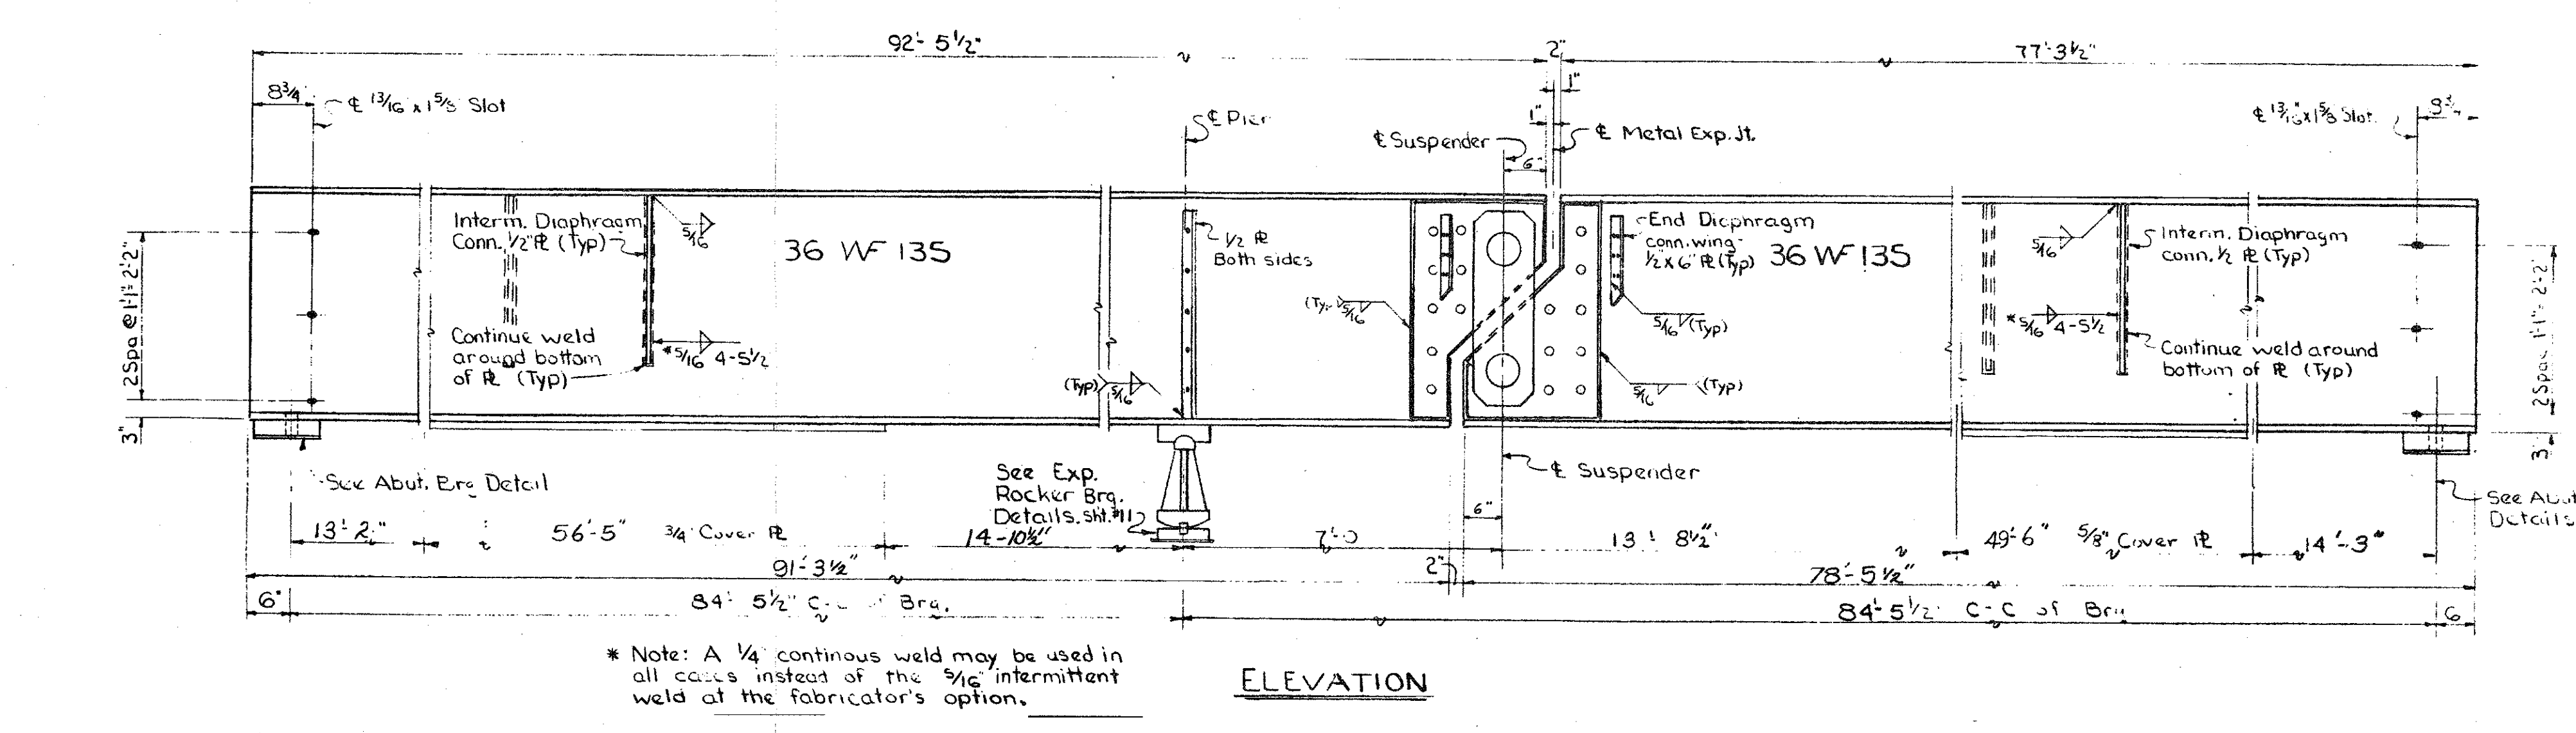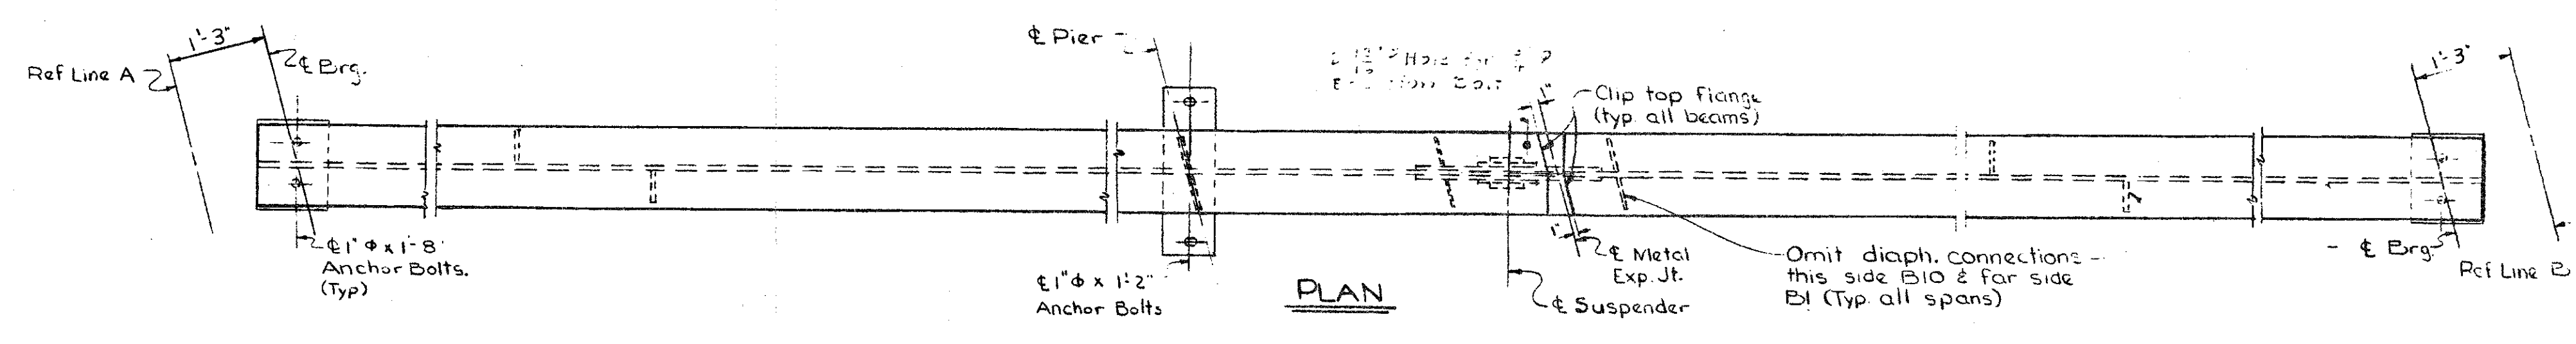

* Note: A 1/4" continuous weld may be used in all cases instead of the 3/16" intermittent weld at the fabricator's option.

NOTE:
 DO NOT WORK FROM THIS SHEET. THE INFORMATION SHOWN HERE IS FOR REFERENCE ONLY. NO PAY ITEMS ARE SHOWN.

MICHIGAN DEPARTMENT OF STATE HIGHWAYS

STRUCTURAL STEEL DETAILS

NO.	DESCRIPTION	DATE	BY

DESIGNED BY: Fisher 6/4/69
 DRAWN BY: R. MARSH 3/10/69
 CHECKED BY: T. Taylor 3-26-69
 SHEET 10 OF 20



S30 of 63174 B



FOR INFORMATION ONLY				
DATE	CONT. SEC.	JOB NO.	DESIGN UNIT	SHEET
10-13-99	S30 OF 63174	48404A	MADHAVI	6 OF 22






DATE: _____ CORRECTED BY: _____ CHECKED BY: _____ DATE: 01-12-99 DRAWN BY: under FILE NAME: s3073174.ssn

REVISIONS			
NO.	DESCRIPTION	DATE	BY





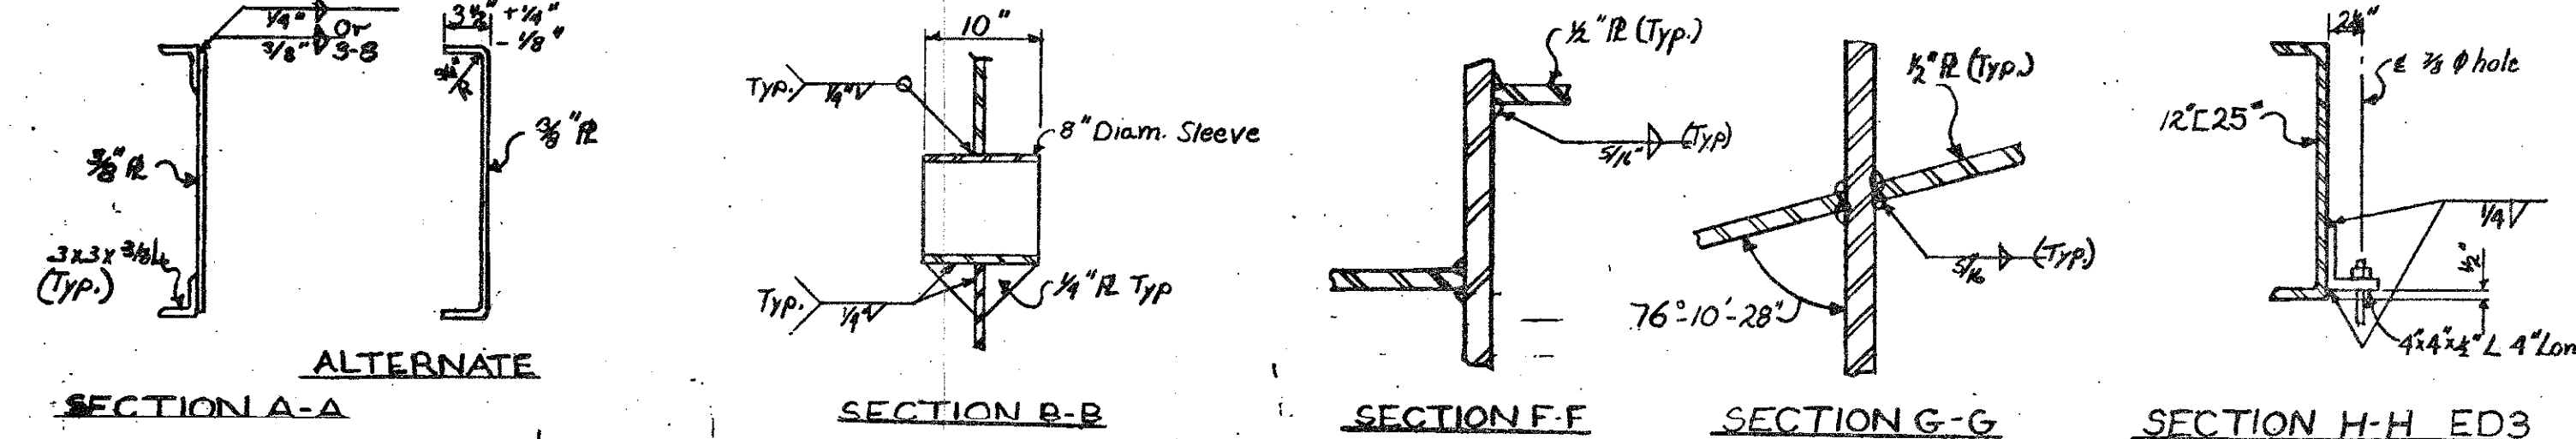
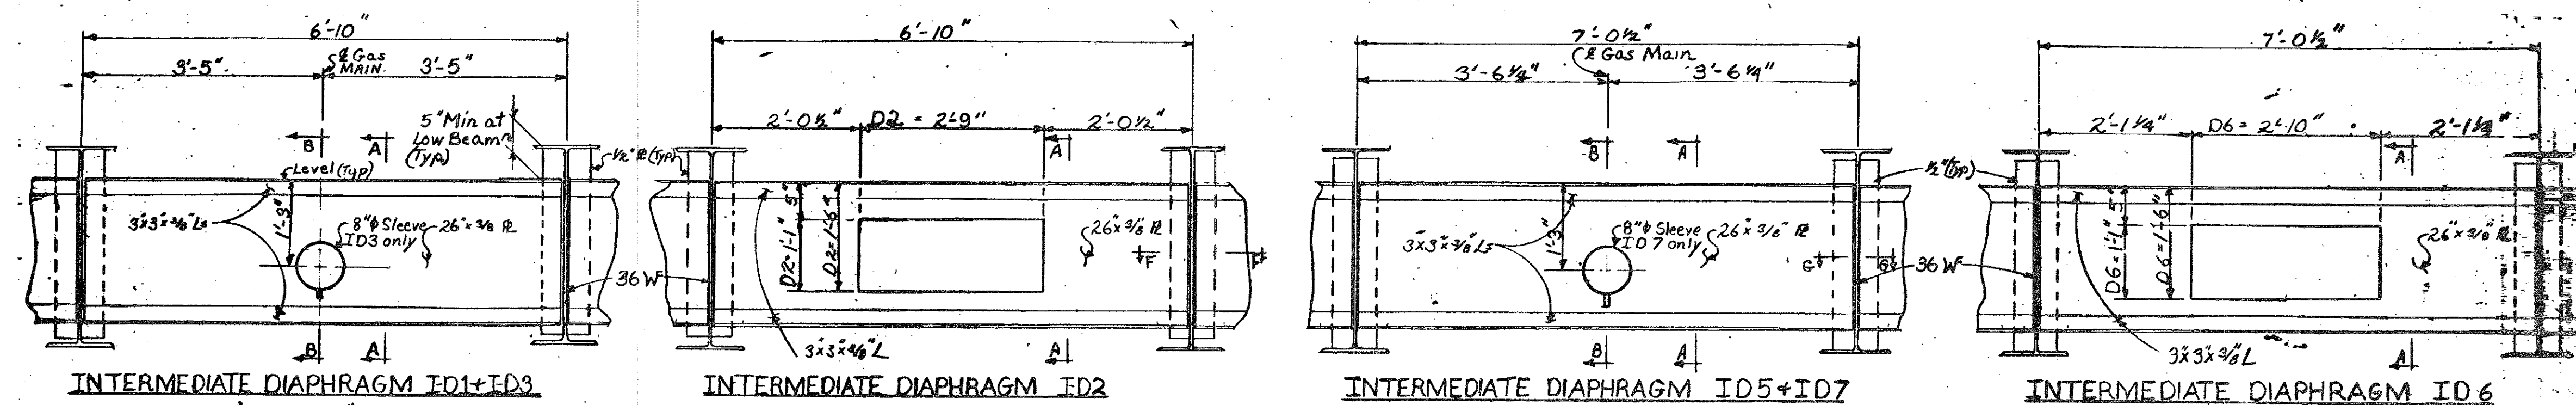


SOLE PLATE THICKNESS TABLE

Beam	Abut. A	Pier	Abut. B
A	1 1/2"	3"	3 1/2"
B	3 1/4"	4 3/4"	5"
C	2"	8 1/4"	3 1/4"
D	3 1/2"	4 3/4"	4 1/4"
E	4 1/2"	5 3/4"	5"
F	4 3/4"	5 3/4"	4 3/4"
G	4"	4 3/4"	3 1/2"
H	2 3/4"	3 1/2"	2 1/4"
J	4 1/4"	5"	3 1/4"
K	9"	9 1/2"	1 1/2"

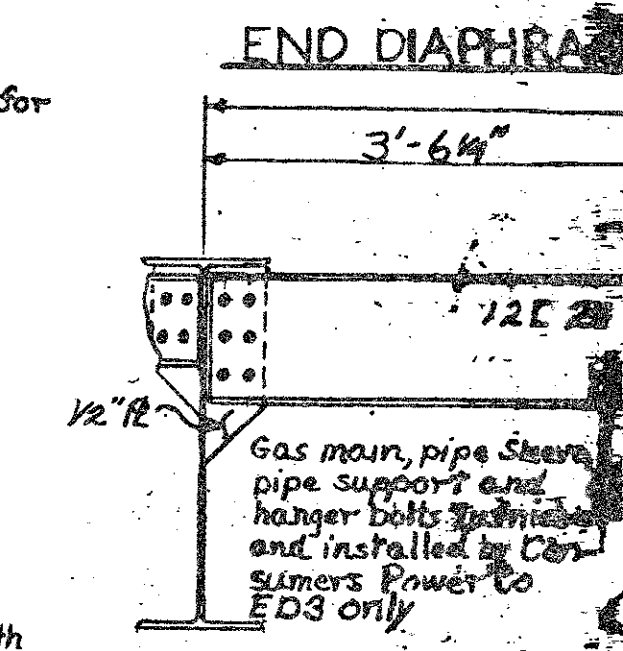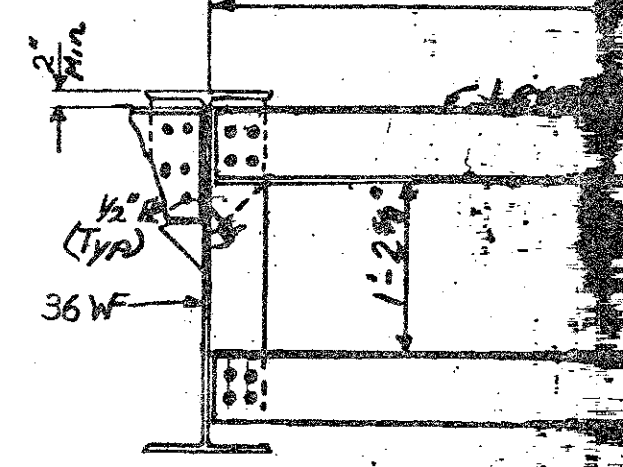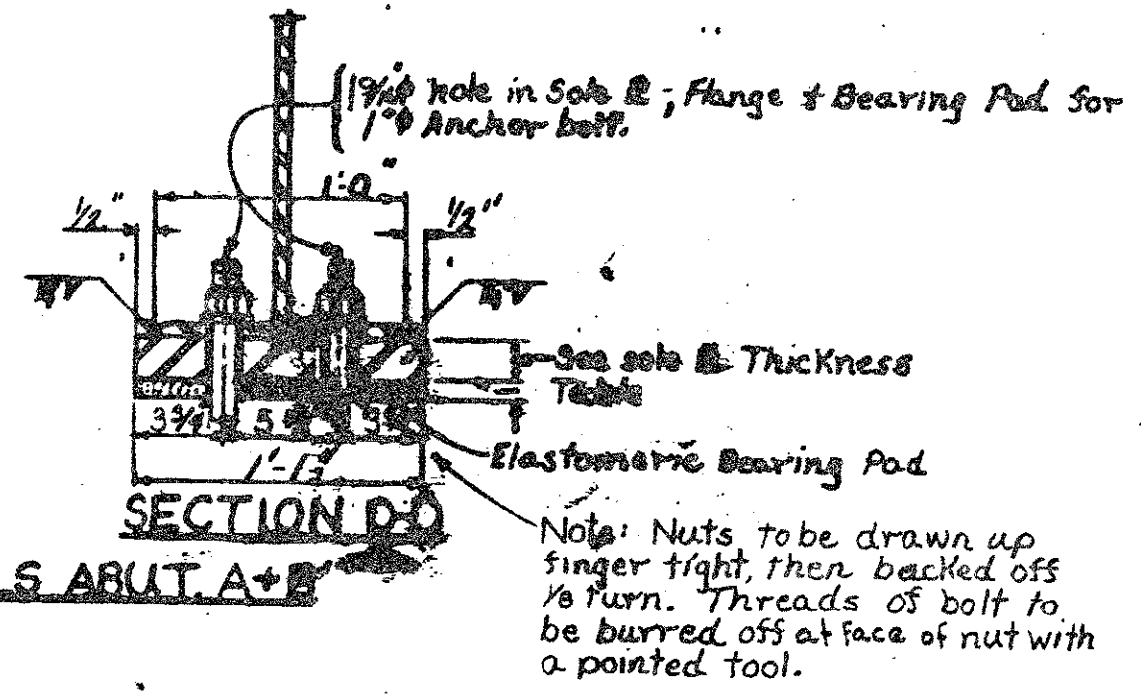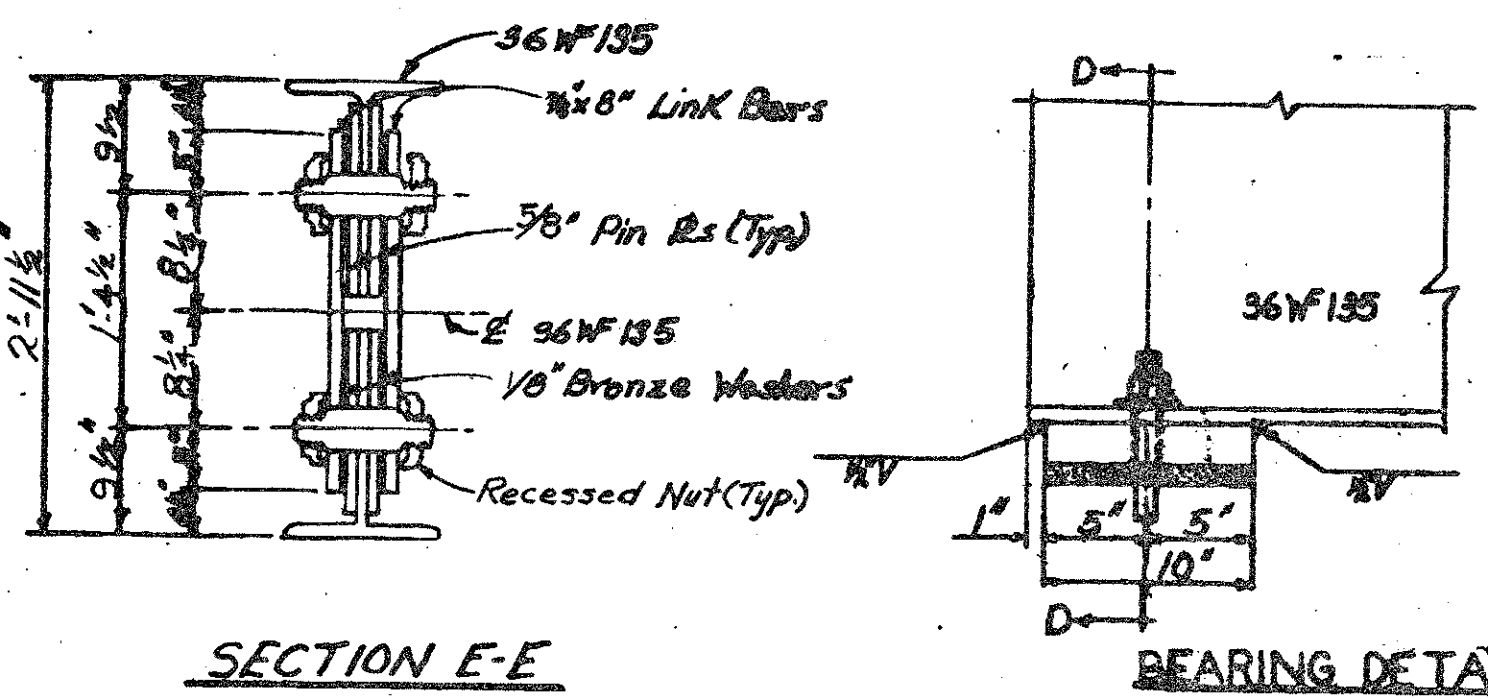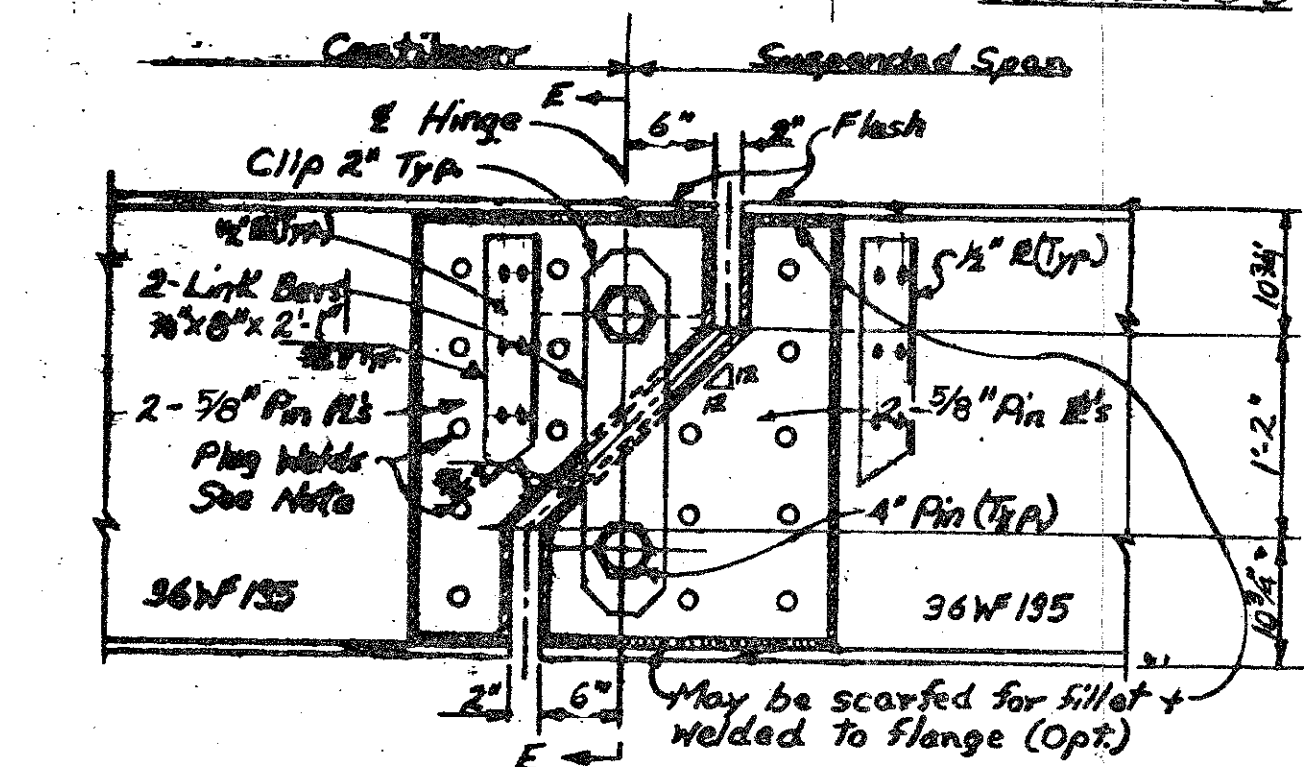

Note: Size and spacing of plug welds shall be according to the A.W.S. Current specifications.

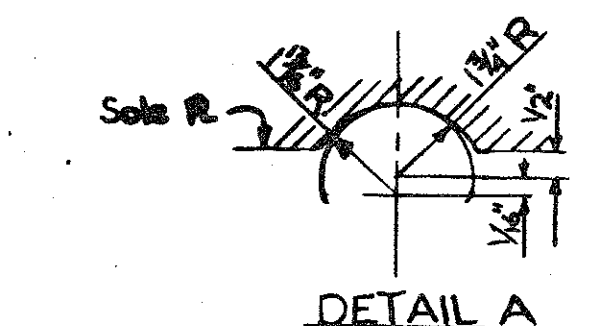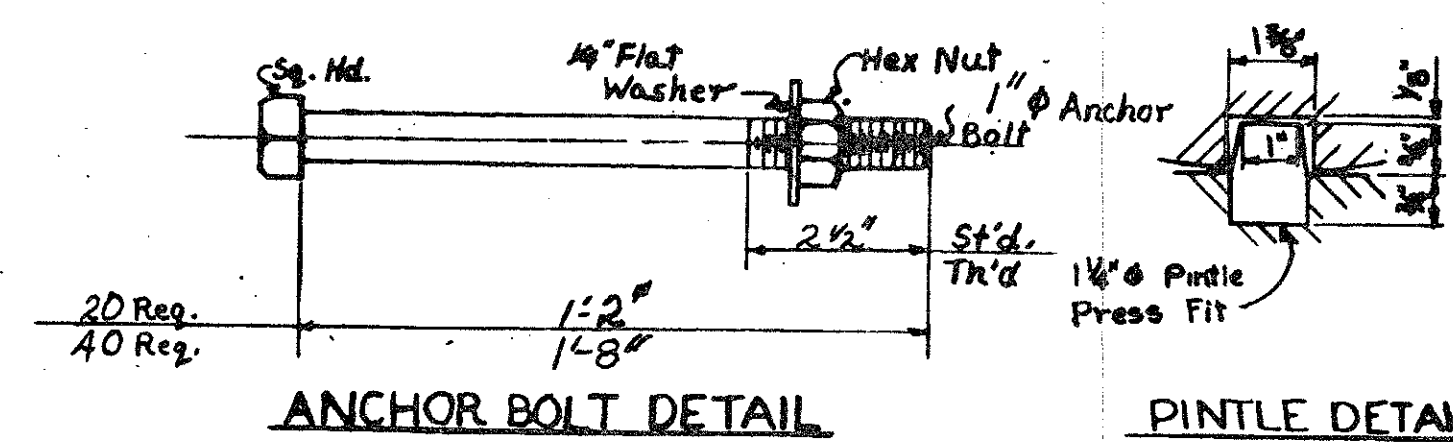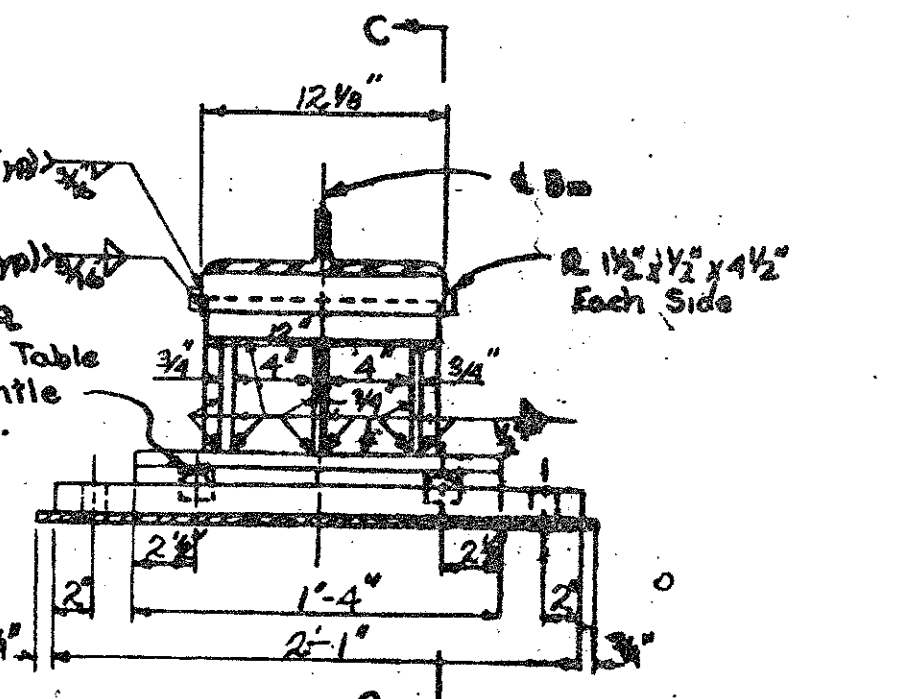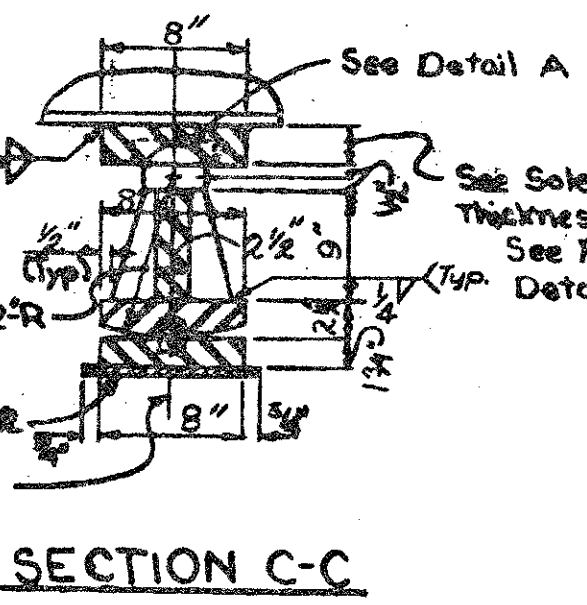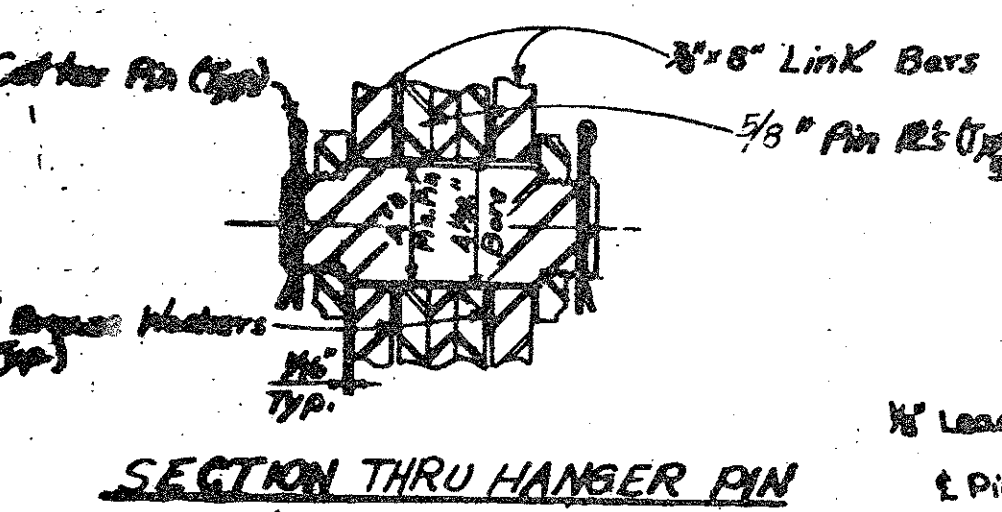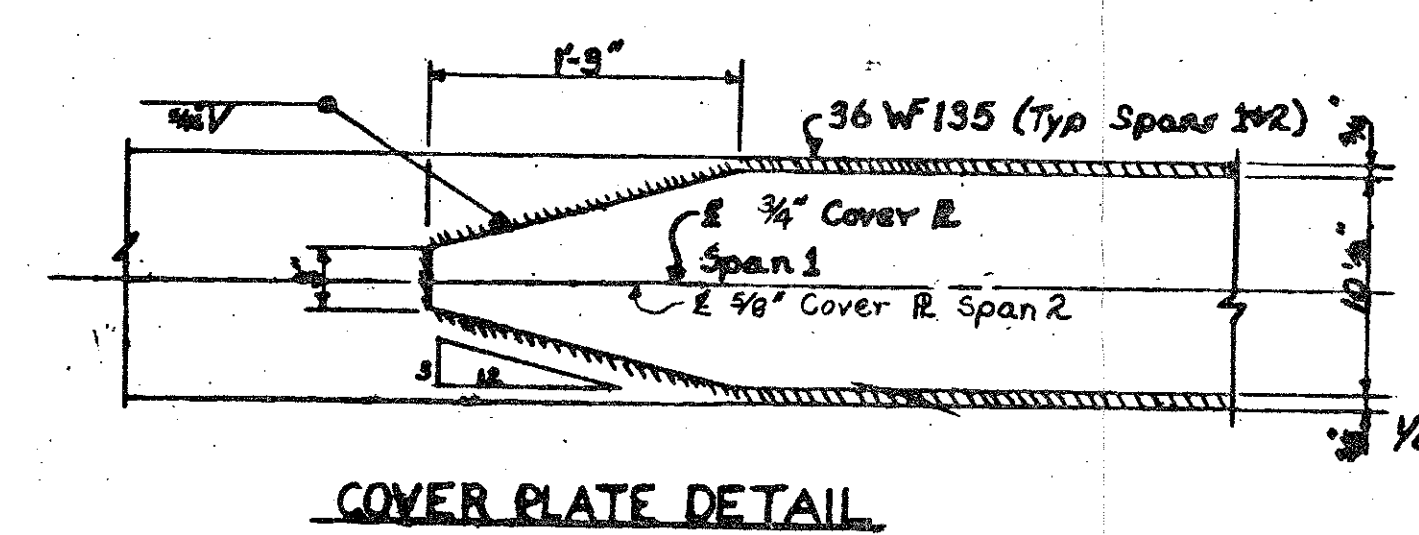

WORK THIS SHEET WITH SHOP NO. 10

MICHIGAN DEPARTMENT OF TRANSPORTATION

STRUCTURAL STEEL - DETAILS

REVISIONS

NO.	DESCRIPTION	DATE	BY

S30 OF 63174 B

NOTE: DO NOT WORK FROM THIS SHEET. THE INFORMATION SHOWN HERE IS FOR REFERENCE ONLY. NO PAY ITEMS ARE SHOWN.


FOR INFORMATION ONLY

DATE	CONT. SEC.	JOB NO.	DESIGN UNIT	SHEET
10-13-99	S30 OF 63174	48404A	MADHAVI	7 OF 22



DATE: DATE: DATE: CHECKED BY: CORRECTED BY: DRAWN BY: UNDER FILE NAME: s3073174.sn

1 2 3 4 5 6 7 8 9 10 11 12 13 14 15 16 17 18 19 20 21 22 23 24 25 26 27 28 29 30 31 32 33 34 35 36 37 38 39 40 41 42 43 44 45 46 47 48 49 50 51 52 53 54 55 56 57 58 59 60 61 62 63

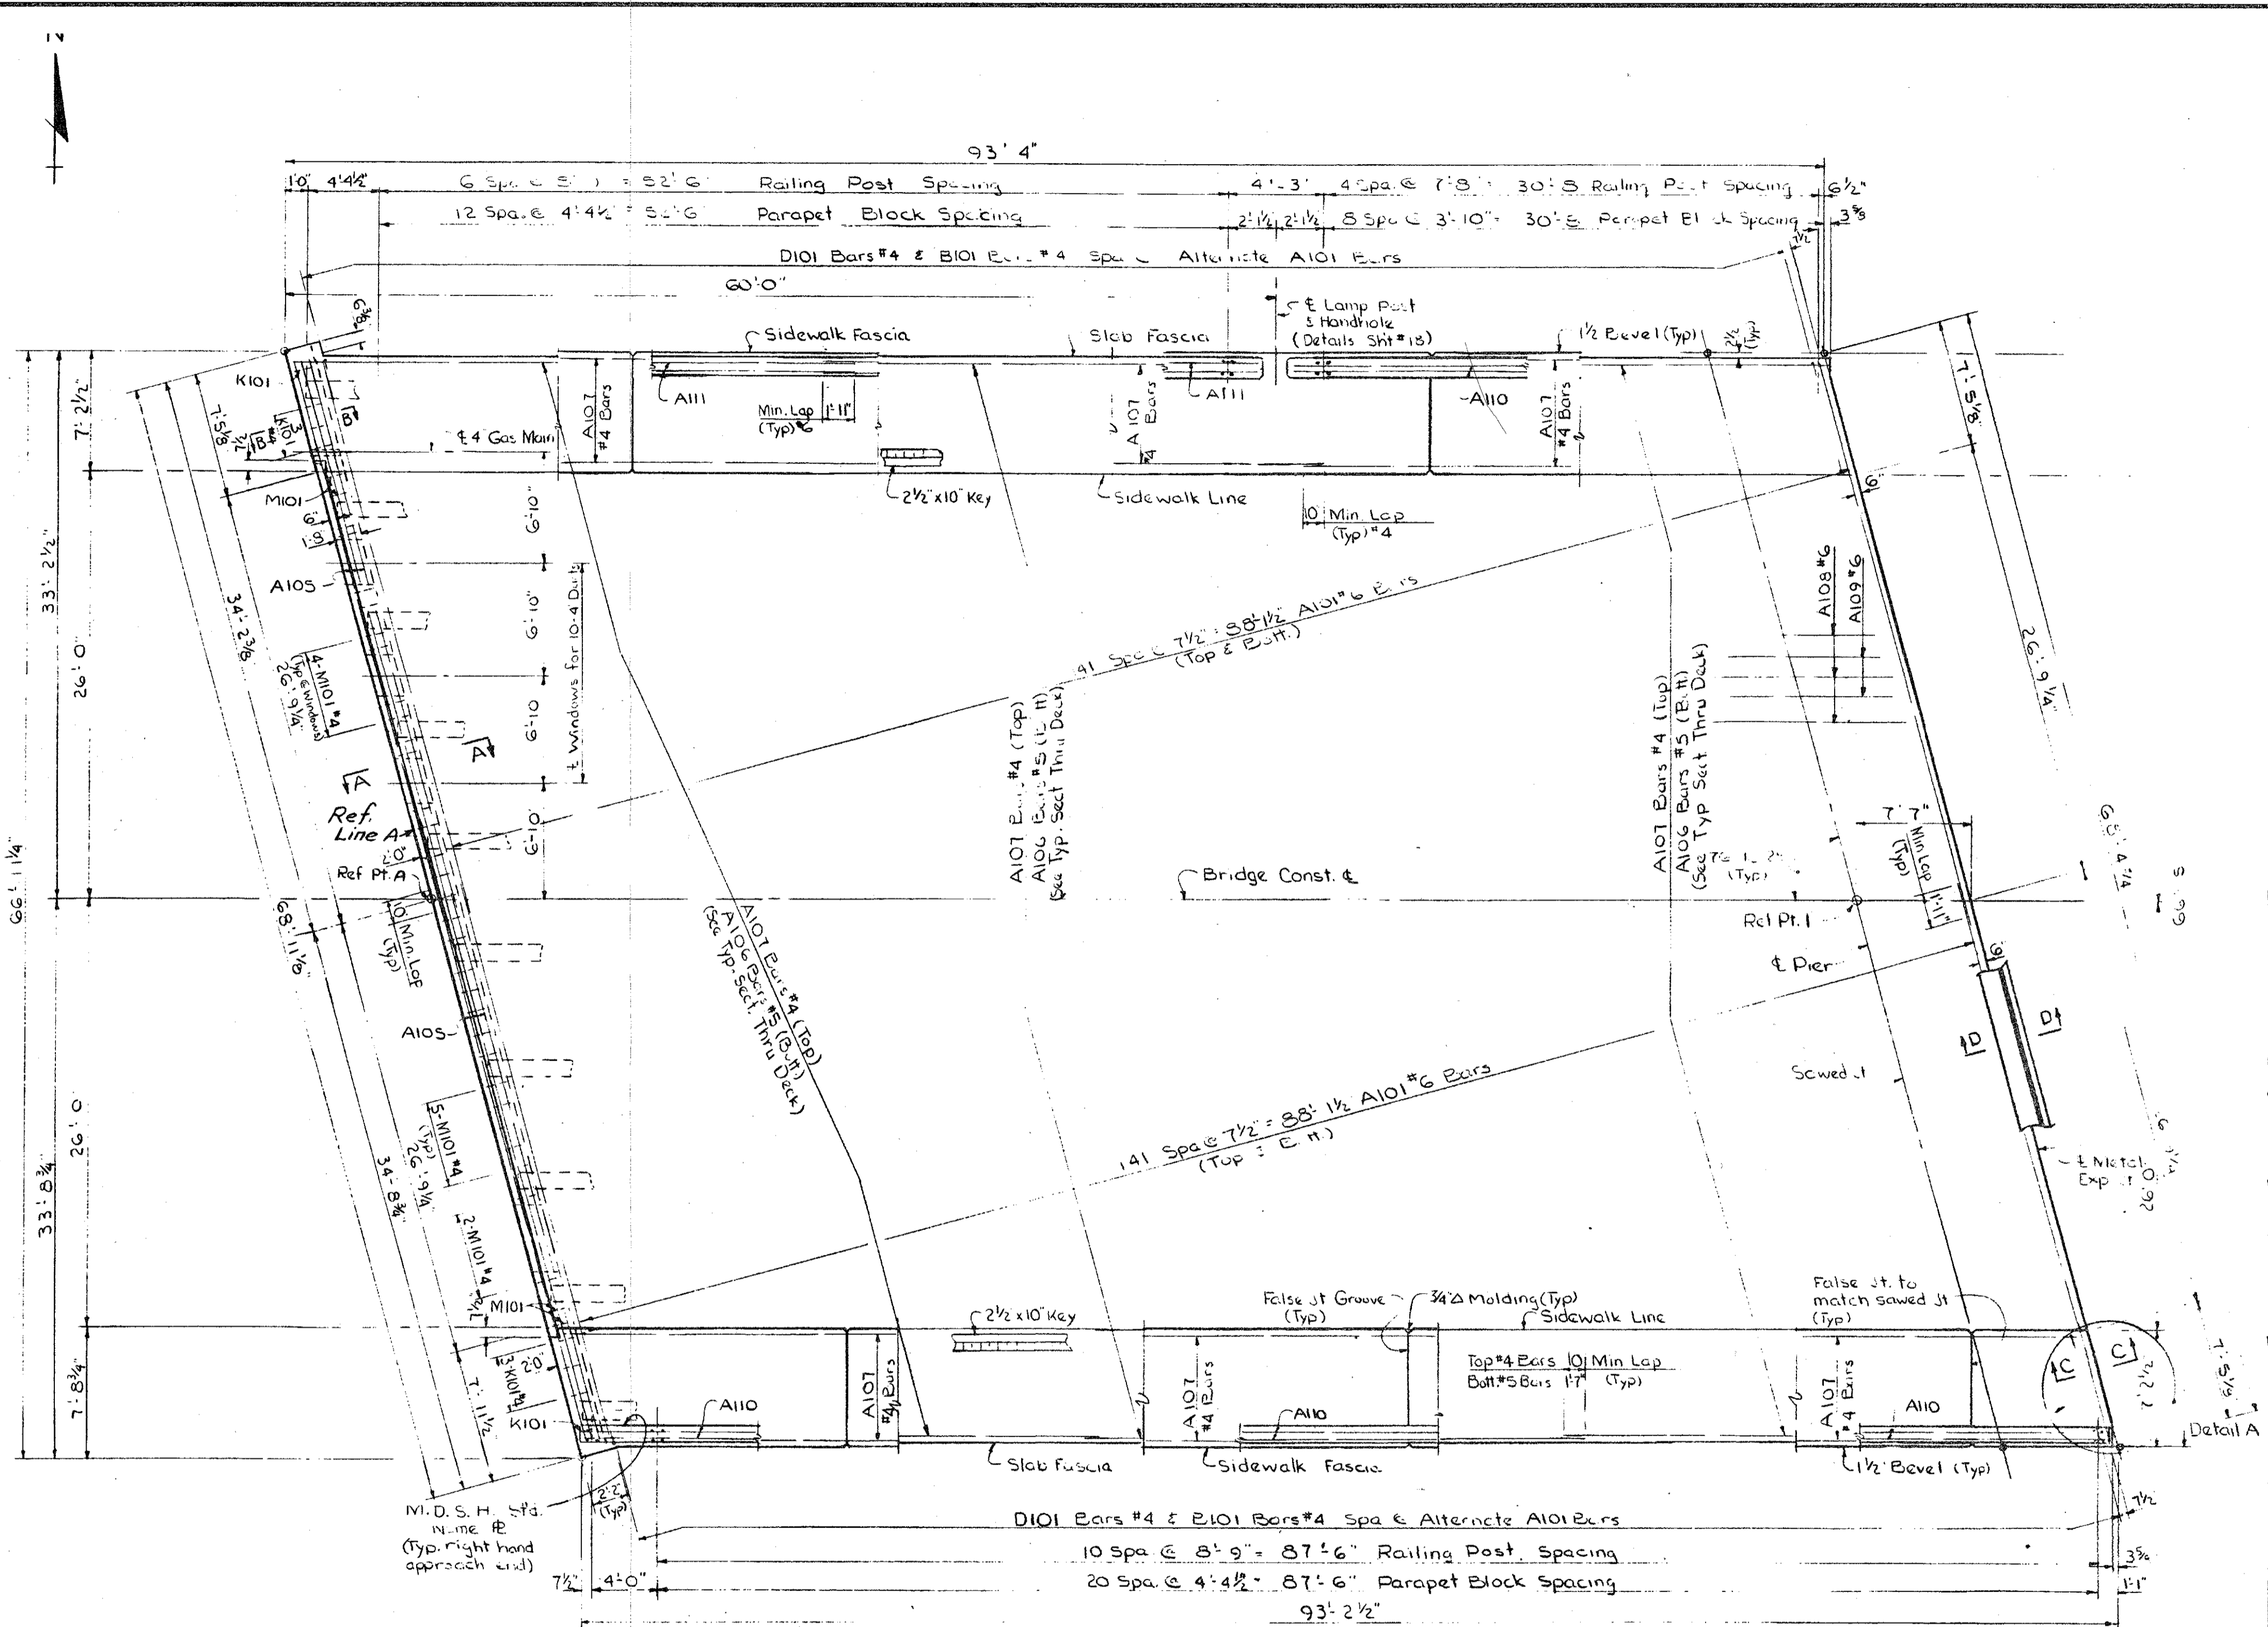

PLAN OF SLAB SPAN 1

For Details of Section	See Sheet
A-A	16
B-B	16
C-C	16
D-D	16
Detail A	16

NOTE: DO NOT WORK FROM THIS SHEET. THE INFORMATION SHOWN HERE IS FOR REFERENCE ONLY. NO PAY ITEMS ARE SHOWN.

NOTES:

J.V.P. denotes Joint Waterproofing.
 H.P.R.A.T.F. denotes Hot-Poured Rubber Asphalt Type Filler. For details of bevels, moldings and Bridge Railing, see Standard Sheet R11 or R12.
 Edge or groove denote edging or grooving with an approved tool.
 Sidewalk pours shall not be cast until slab concrete has attained at least 50% of its design strength as determined by Section 5.01.05 of the Standard Specifications.
 The District Utility Engineer is to be notified five days in advance of the time of installation of the ducts in the sidewalk.
 The contractor is to provide a sawed joint 1/2" deep by 1/2" wide (min) in the top of slab over and parallel to the centerline of the pier. The joint is to be sawed before casting of sidewalks and is to be filled with Hot-Poured Rubber Asphalt Type Filler (Incidental).
 Bridge Railing is to be either aluminum or Steel Tubular railing on concrete parapet. See Railing Standard R11 or R12.
 Protective Treatment for Bridge Decks is to be applied to all superstructure concrete surfaces between fascia lines. (See Supplemental Specifications).
 False joints in sidewalks shall be placed midway between concrete posts at approx. every fourth panel.
 Screeds affected by loads in other spans are to be set to the elevations shown before casting any concrete. Concrete in the suspended span is to be cast before the concrete in the anchor span.
 For name plate mounting details see standard sheet R11 or R12. For location of name plate see this sheet.

work this sheet with sheets No. 15, 16, 17

MICHIGAN DEPARTMENT OF STATE HIGHWAYS

SUPERSTRUCTURE DETAILS

NO.	DESCRIPTION	DATE	BY

DRAWN BY: **Flaher** 6-4-69
 CHECKED BY: **R. MARSH** 3/13/69
 SHEET 14 OF 20
S30 of 63174 B


FOR INFORMATION ONLY

DATE	CONT. SEC.	JOB NO.	DESIGN UNIT	SHEET
10-13-99	S30 OF 63174	48404A	MADHAVI	8 OF 22



DATE: CORRECTED BY: CHECKED BY: DATE: 01-12-99 DRAWN BY: inder FILE NAME: s3073174.sn

1 2 3 4 5 6 7 8 9 10 11 12 13 14 15 16 17 18 19 20 21 22 23 24 25 26 27 28 29 30 31 32 33 34 35 36 37 38 39 40 41 42 43 44 45 46 47 48 49 50 51 52 53 54 55 56 57 58 59 60 61 62 63

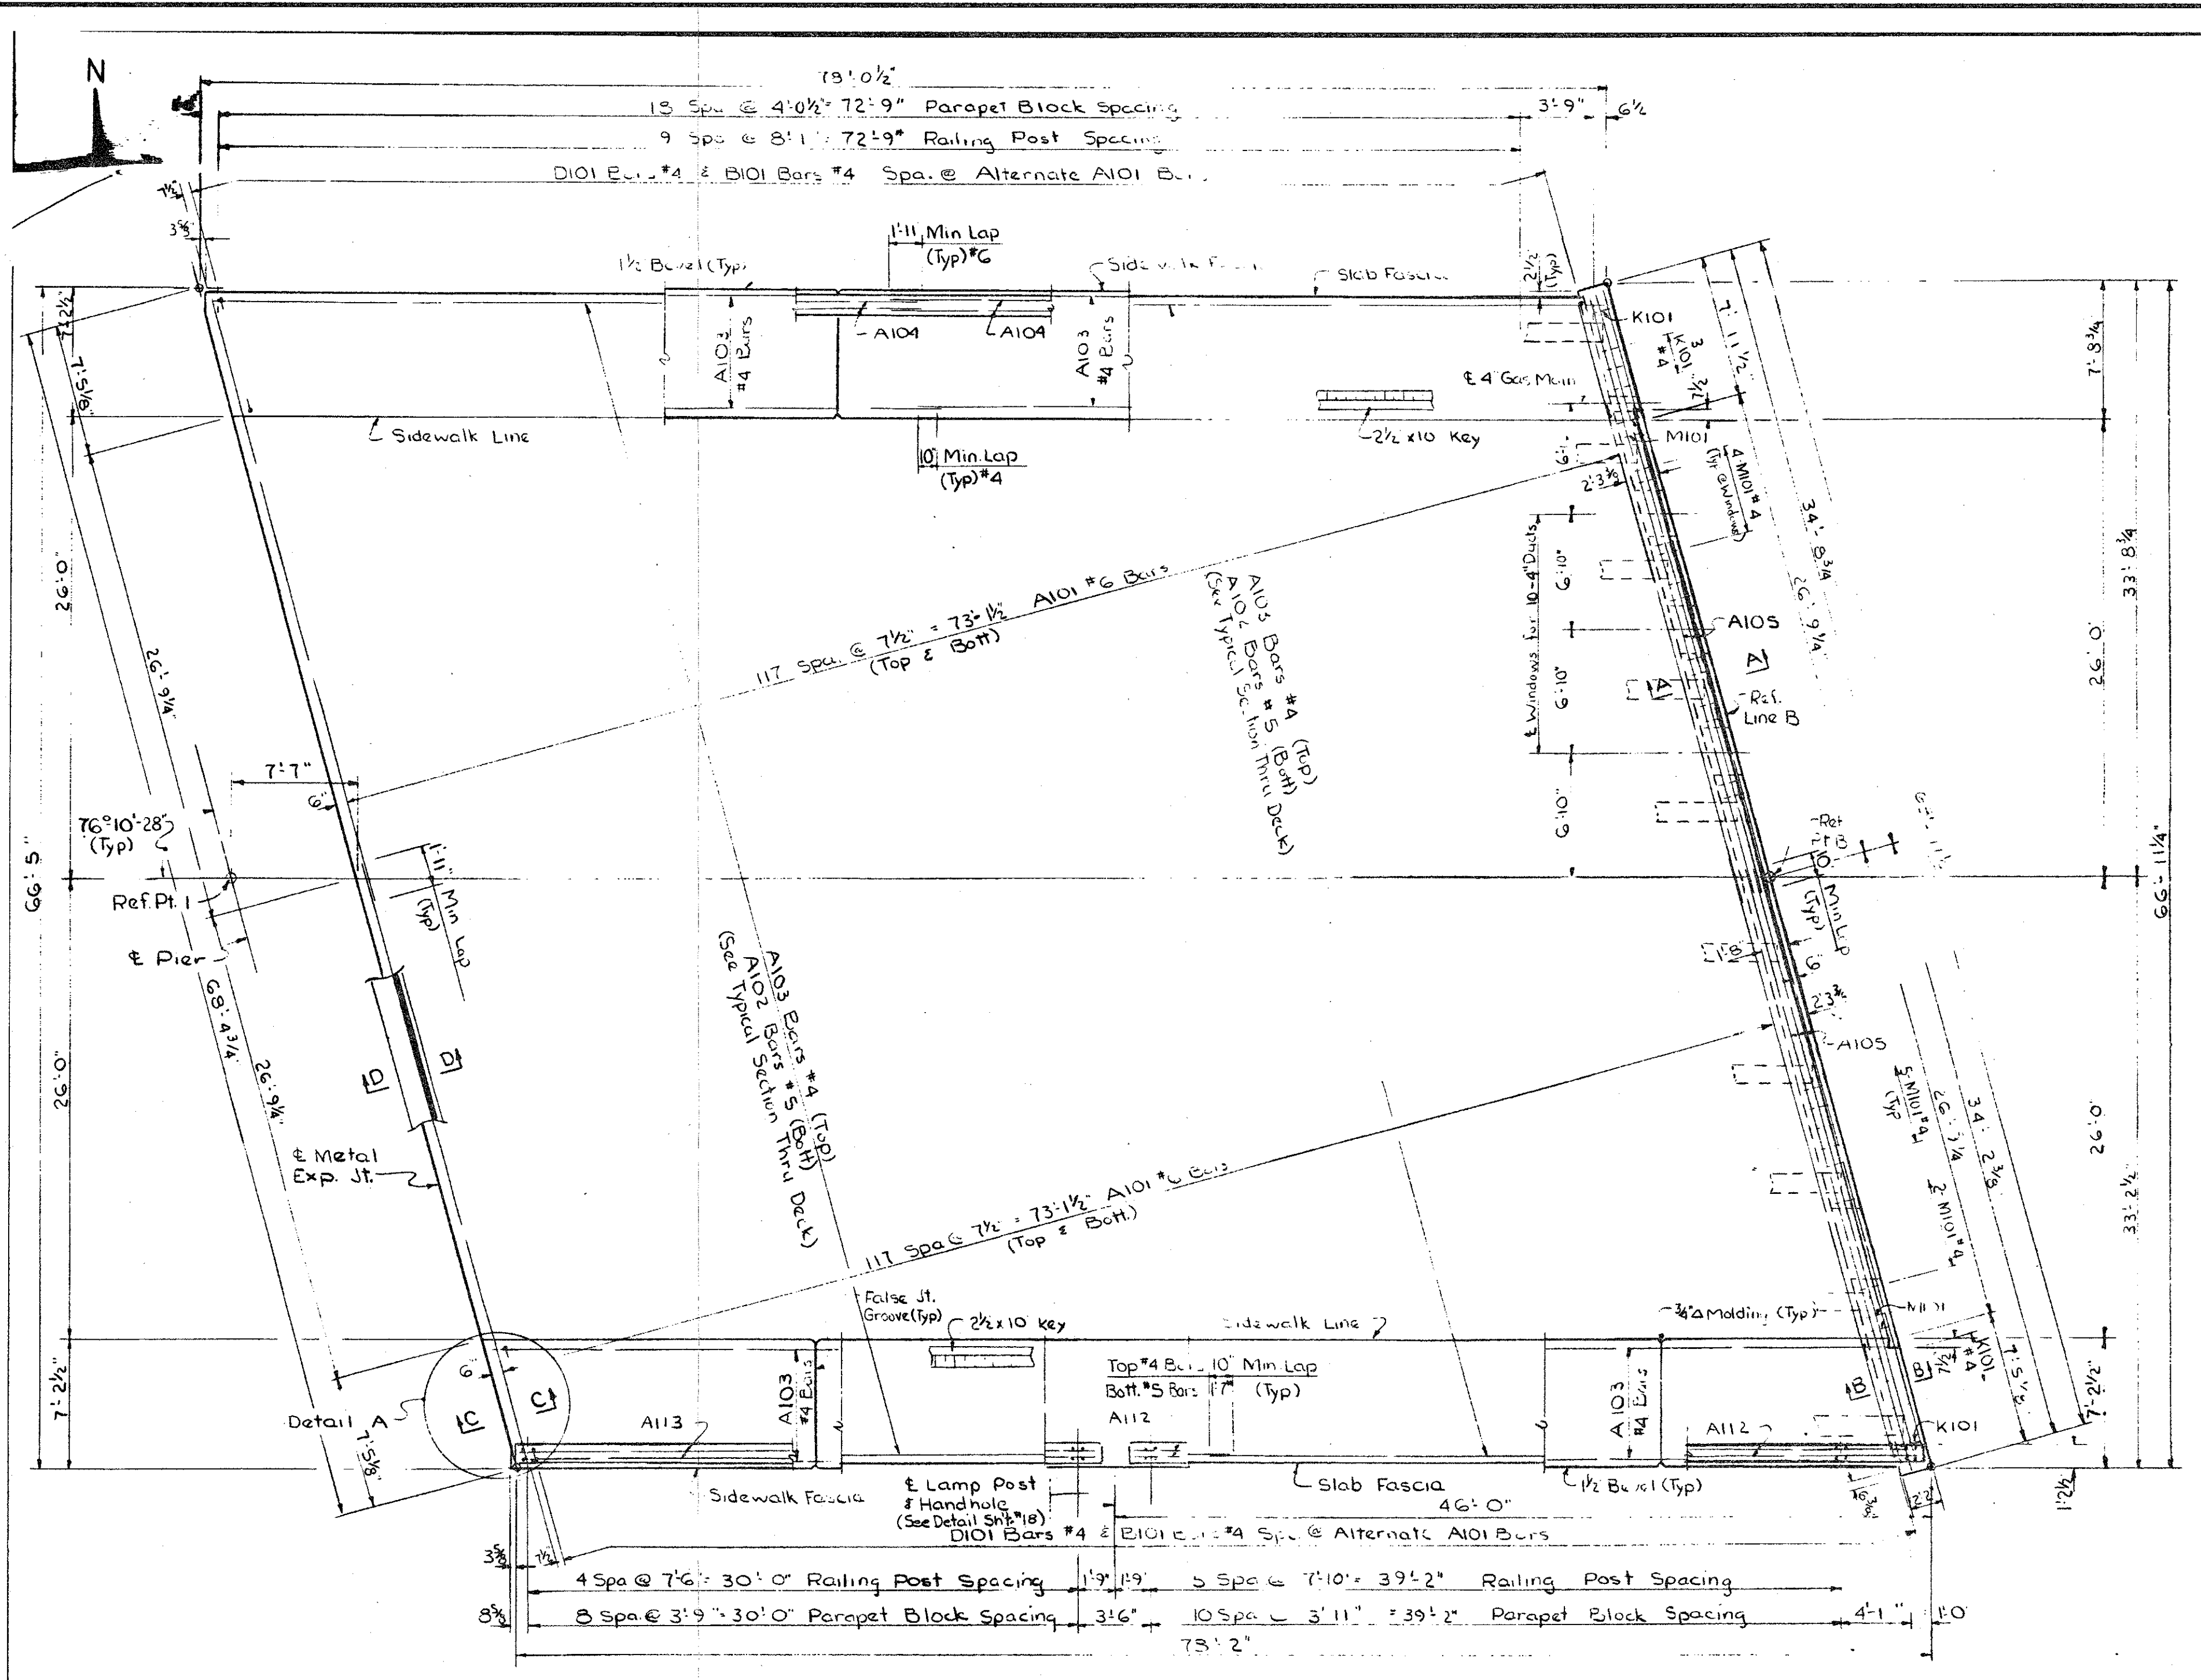

PLAN OF SLAB SPAN 2

For Details of Section	See Sheet
A-A	16
B-B	16
C-C	16
D-D	16
Detail A	16

Work this sheet with sheets No. 14, 16 & 17

**MICHIGAN DEPARTMENT OF STATE HIGHWAYS
SUPERSTRUCTURE DETAILS**

REVISIONS			
NO.	DESCRIPTION	DATE	BY

DESIGNER	Fisher	6-4-62
DRAWN BY	R. MARSH	3/13/62
CHECKED BY	T. Taylor	4-4-61
SHEET 15 OF 20		


S30 of 63174 B

NOTE:
DO NOT WORK FROM THIS SHEET. THE INFORMATION SHOWN
HERE IS FOR REFERENCE ONLY. NO PAY ITEMS ARE SHOWN.

FOR INFORMATION ONLY

MDOT Michigan Department of Transportation	DATE 10-13-99	CONT. SEC. S30 OF 63174	JOB NO. 48404A	DESIGN UNIT MADHAVI	SHEET 9 OF 22
--	------------------	----------------------------	-------------------	------------------------	------------------

REVISIONS			
NO.	DESCRIPTION	DATE	BY

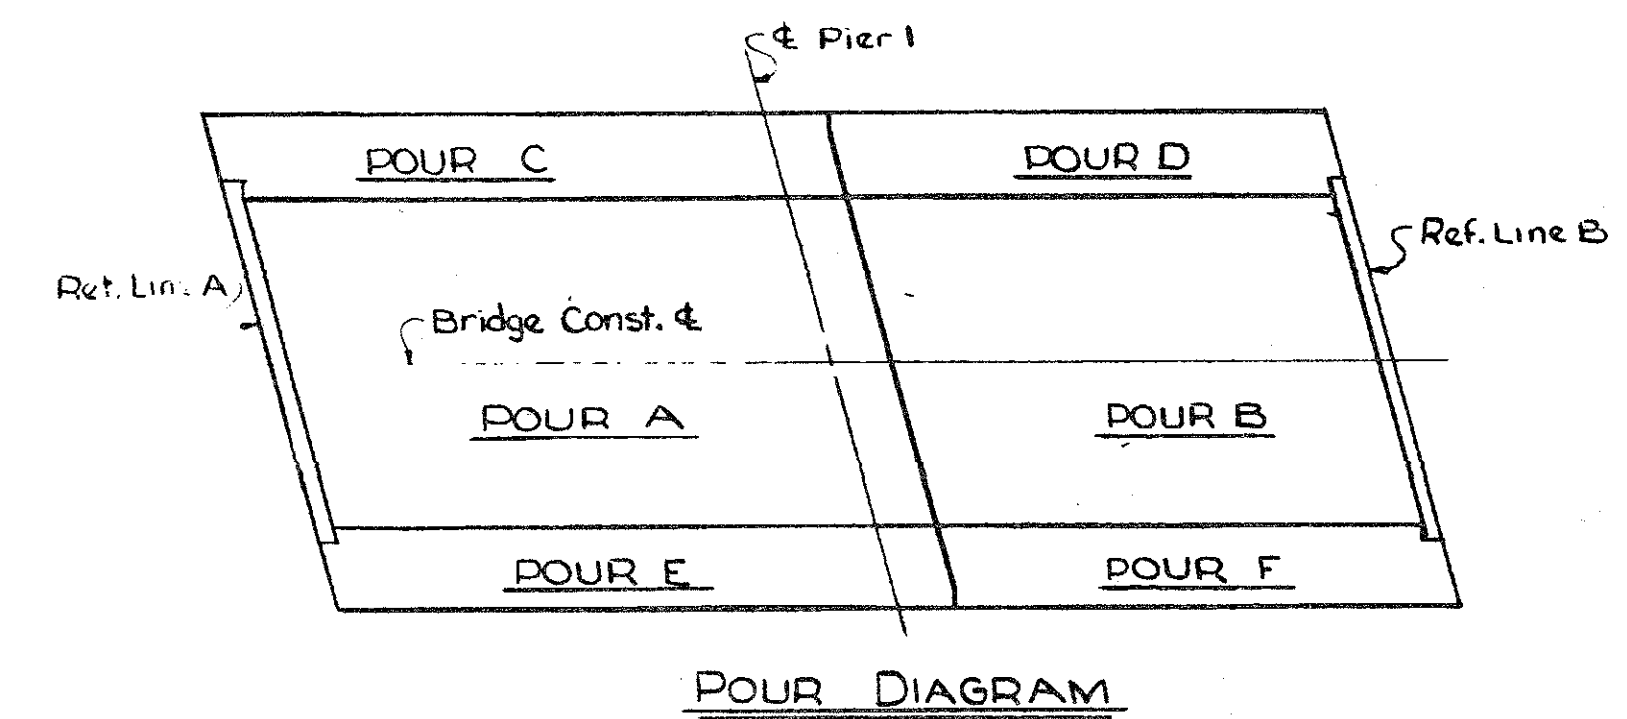


MISCELLANEOUS QUANTITIES		
Item	Unit	Amount
Hot-Poured Rubber Asphalt Type Filler	Lin. Ft.	66
Water Reducing Retarding Admixture	Gals.	42
Bridge Railing Parapet Type	Lin. Ft.	342.1
Structural Tile 6" x 12" x 12"	Each	1510
Protective Treatment for Bridge Decks	Sq. Ft.	11,300
Fiber Conduit	Lin. Ft.	792


CONCRETE QUANTITIES		
SLAB	Pour	Grade A (GA) Cu. Yds.
CURB	A	15.0
	B	134.2
	C	13.0
	D	12.6
	E	11.5
	F	4.3
Backwall - Abut. A		14.1
Backwall - Abut. B		14.1
Total		369.8 Cu. Yds.

DRAWN BY: inder DATE: 01-12-99 CHECKED BY: DATE: CORRECTED BY: DATE: FILE NAME: s3073174.sn


REVISIONS			
NO.	DESCRIPTION	DATE	BY

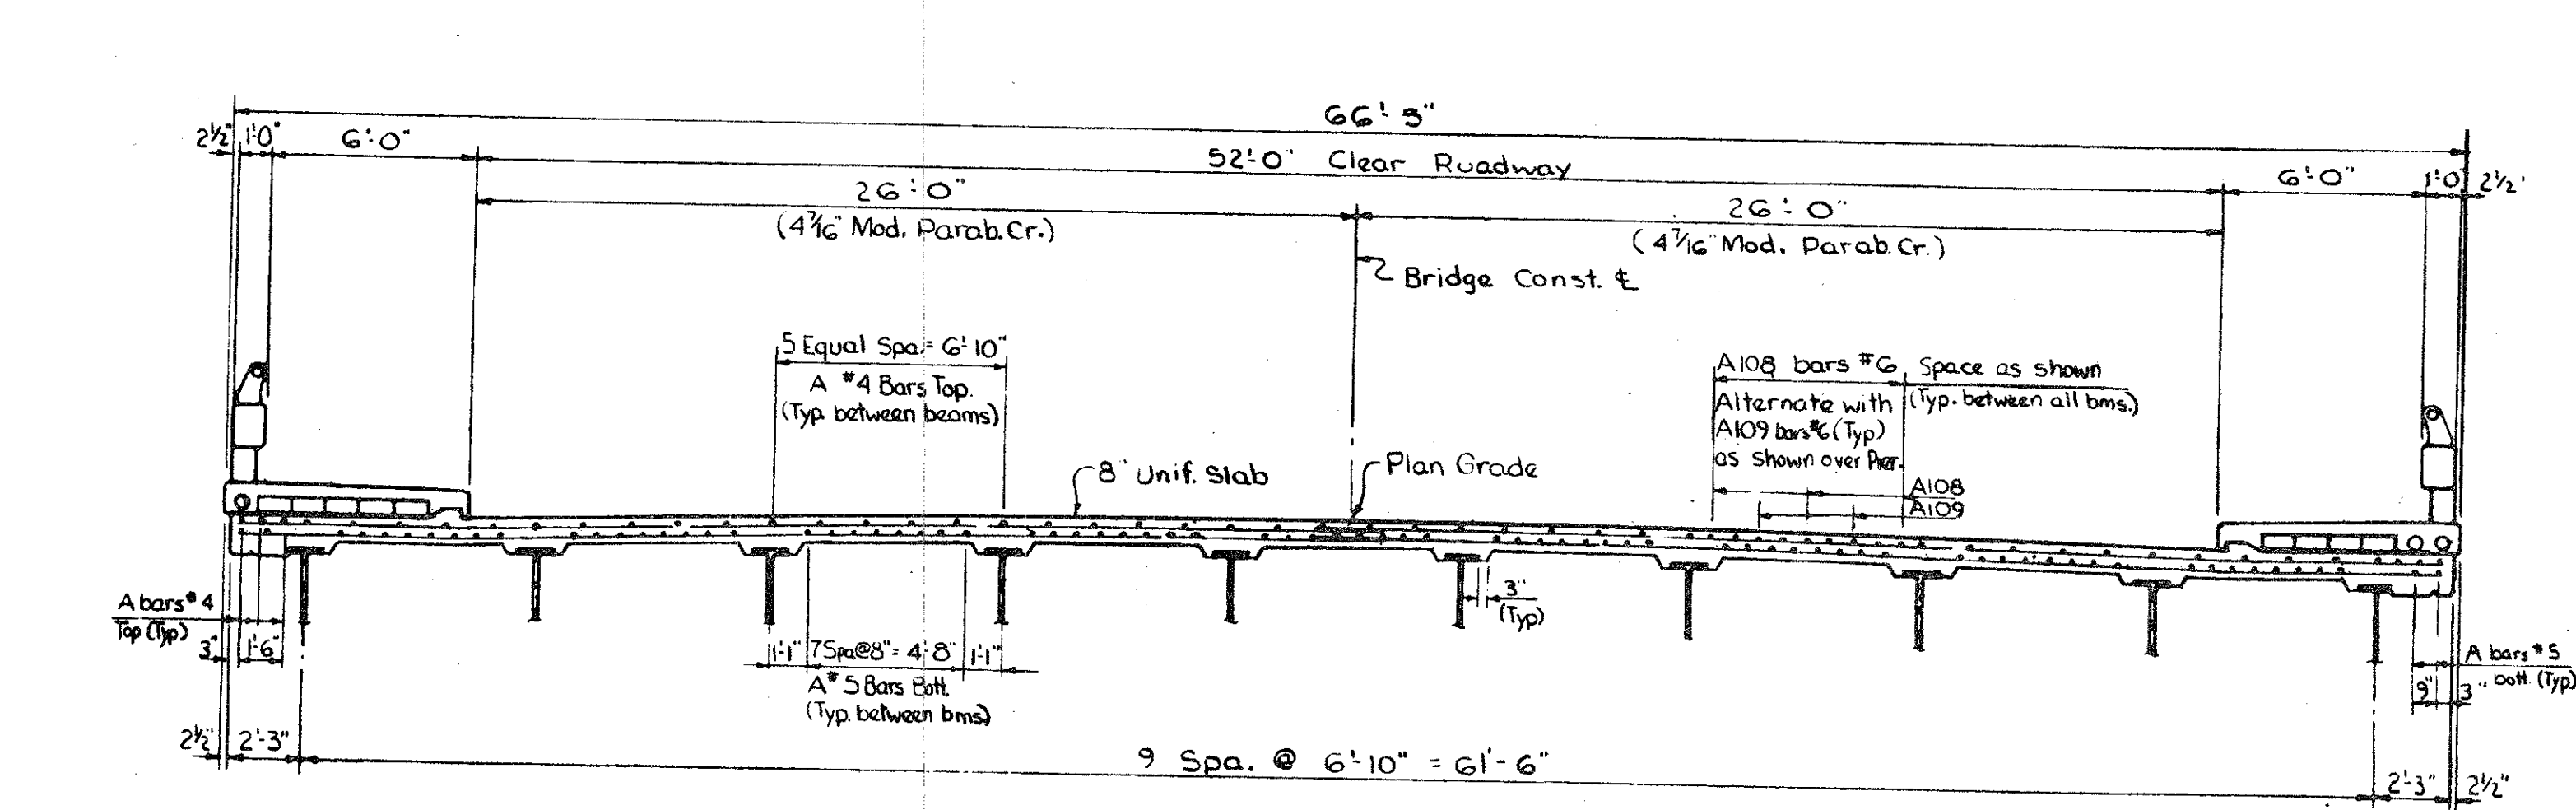

TYPICAL SECTION THRU DECK

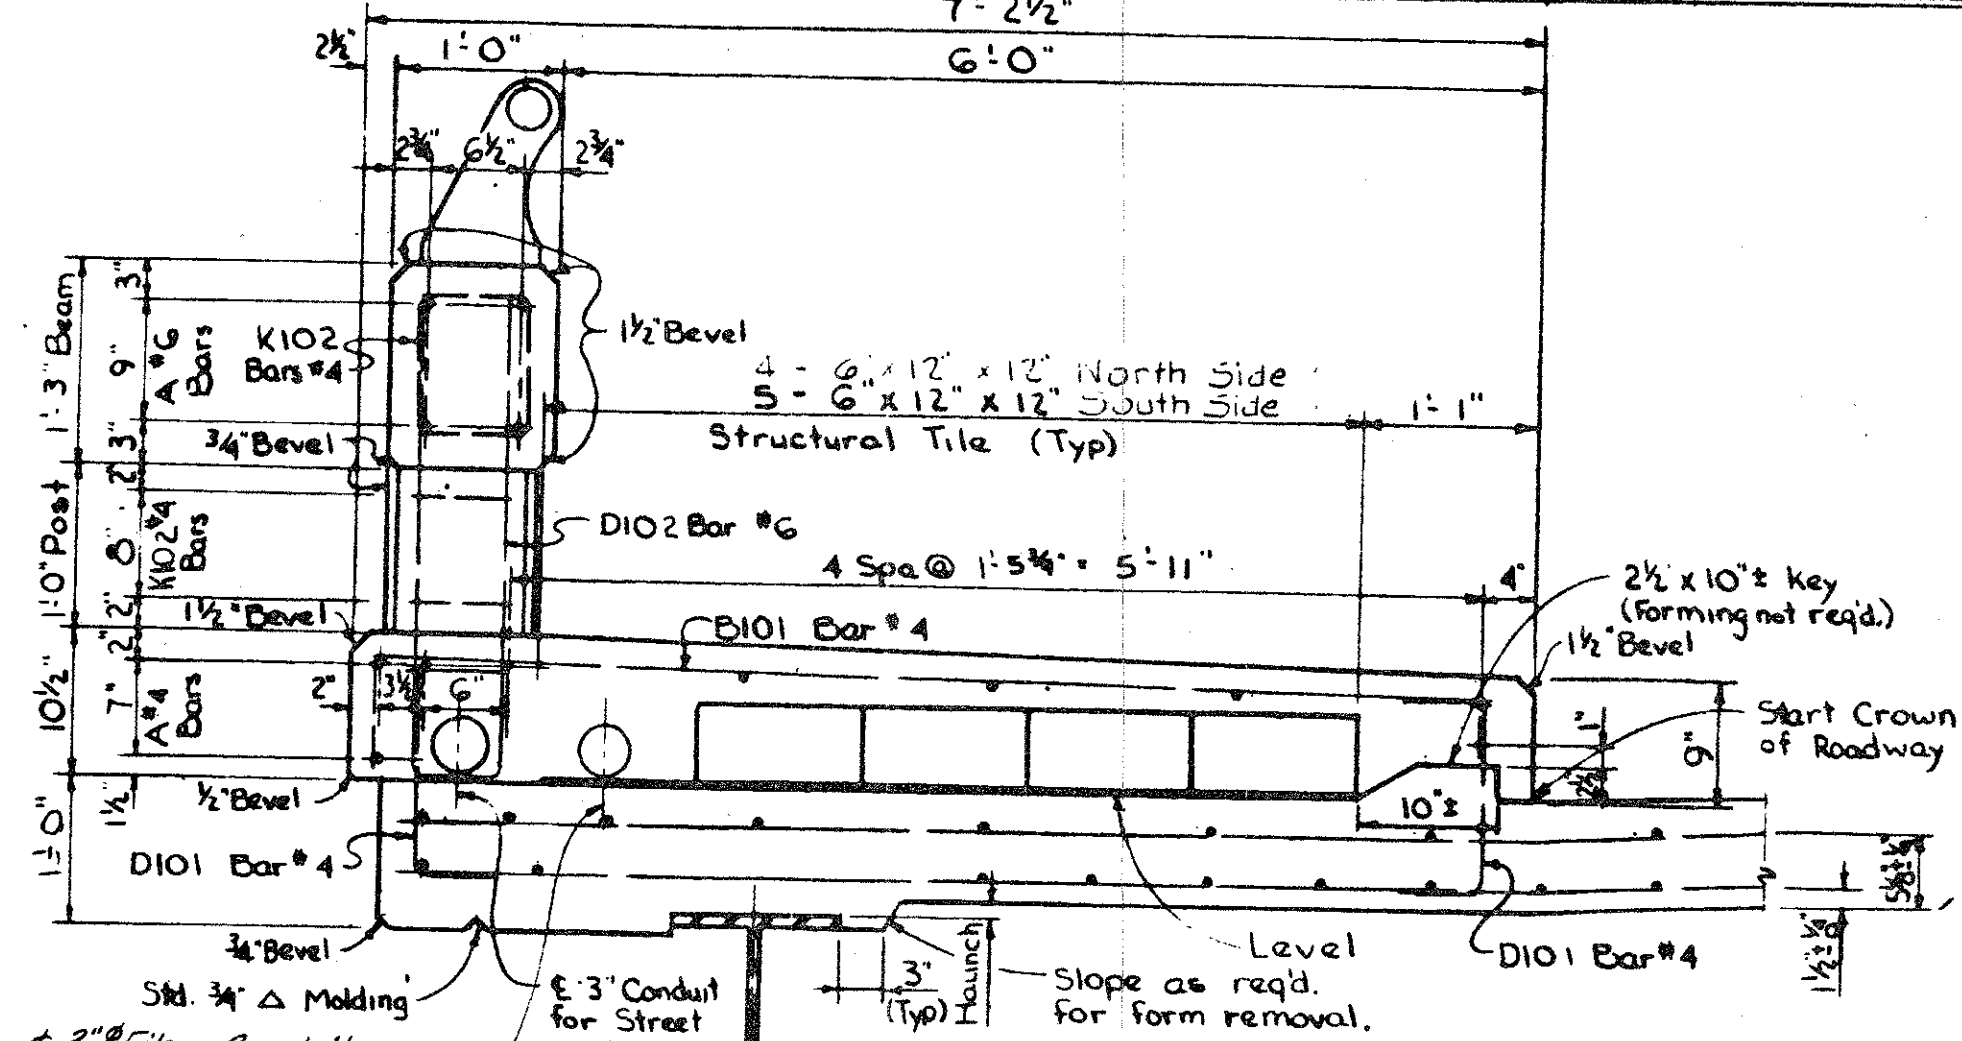


TYPICAL SECTION THRU SIDEWALK

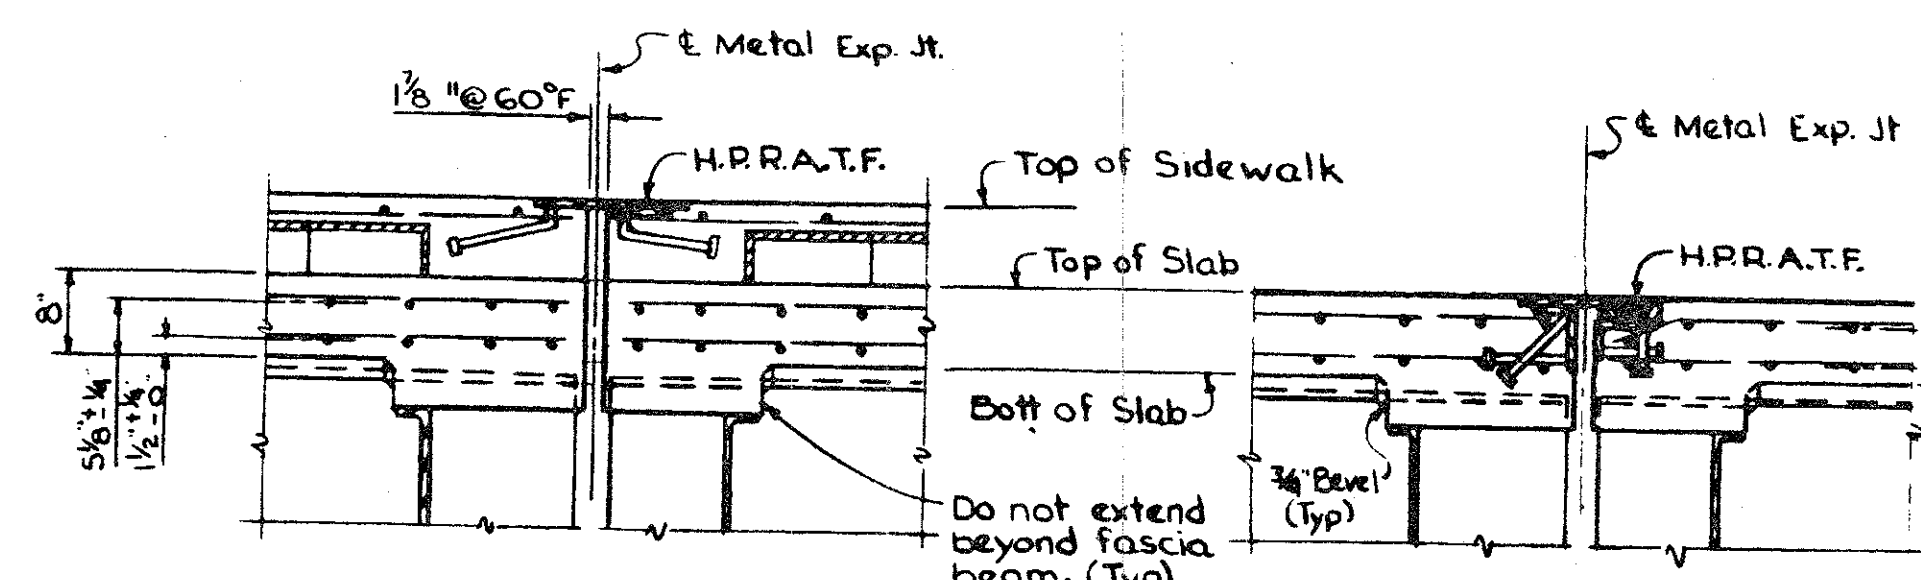


SECTION C-C

SECTION D-D

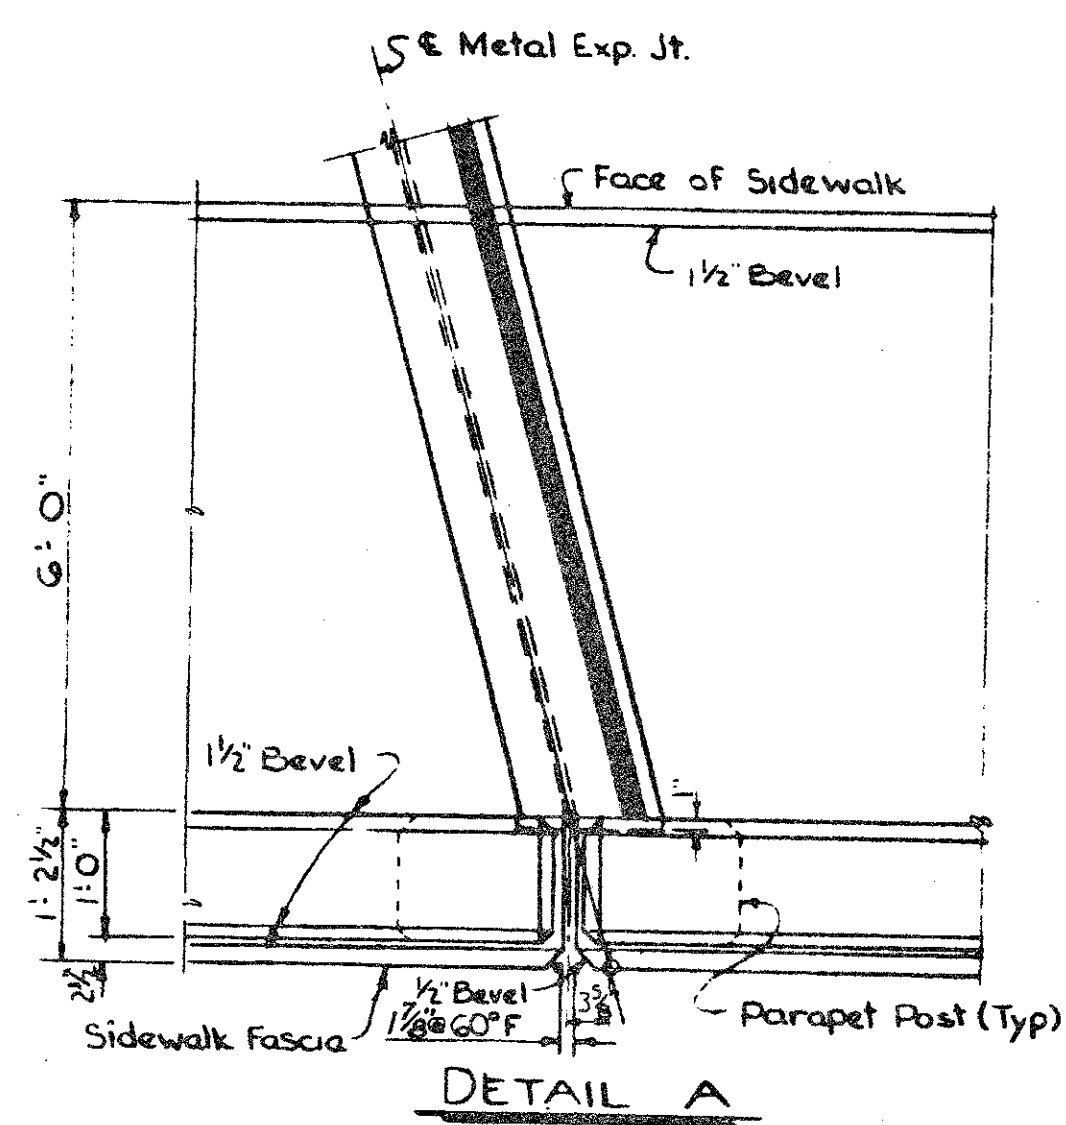


DETAIL A

For Location of Sections	See Sheet
A-A	14 & 15
B-B	14 & 15
C-C	14 & 15
D-D	14 & 15
Detail A	14 & 15

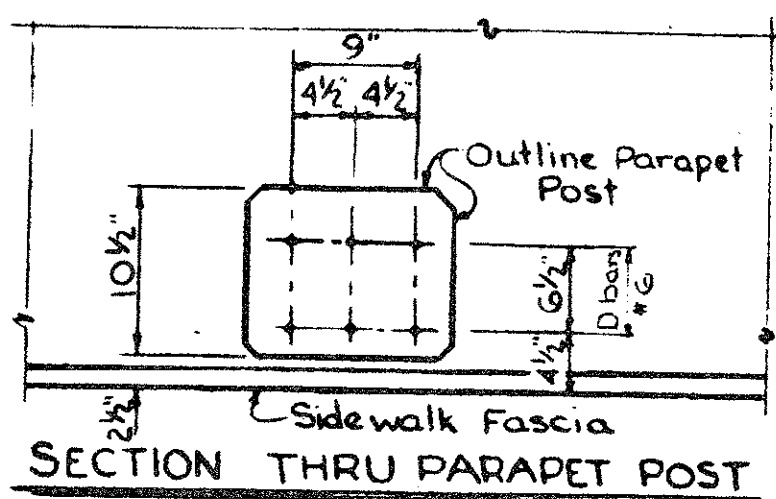


SECTION THRU PARAPET POST

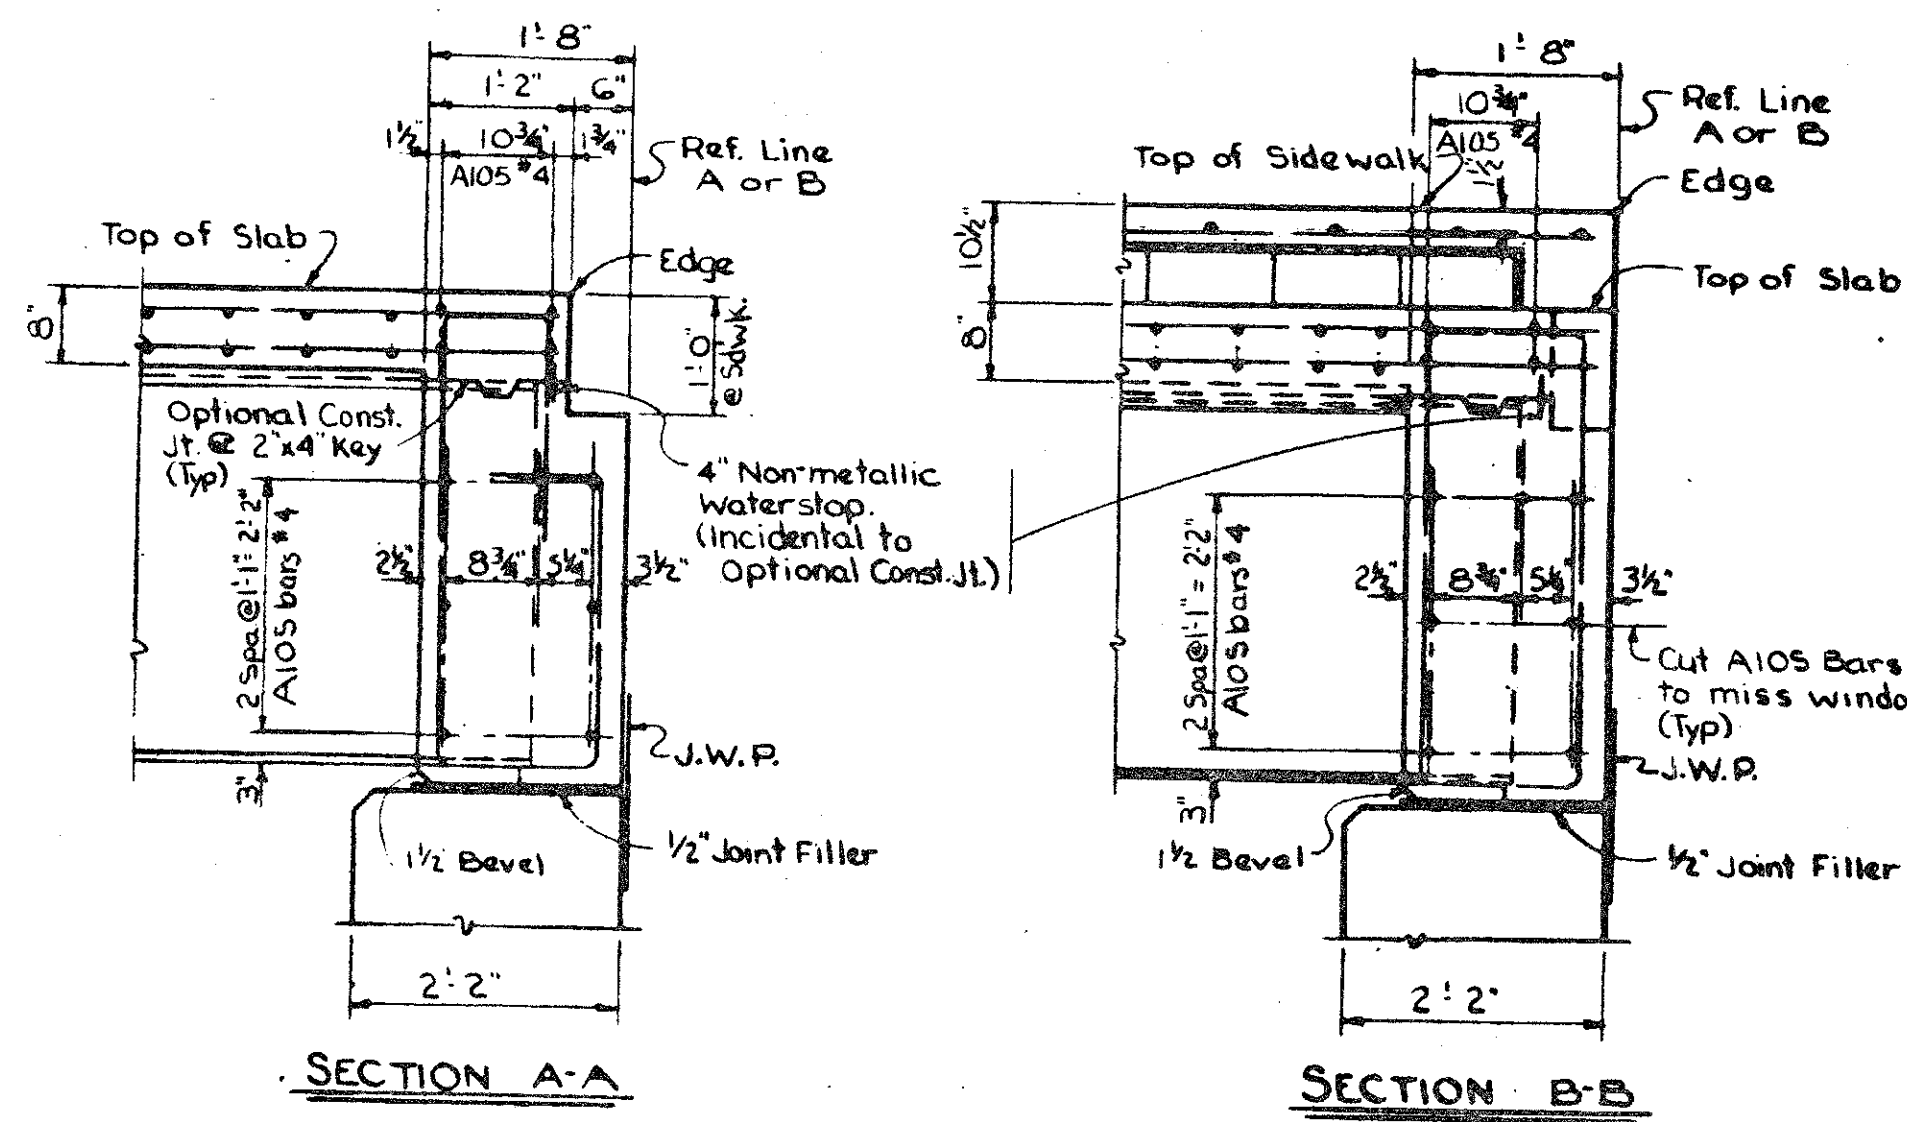

SECTION A-A

SECTION B-B

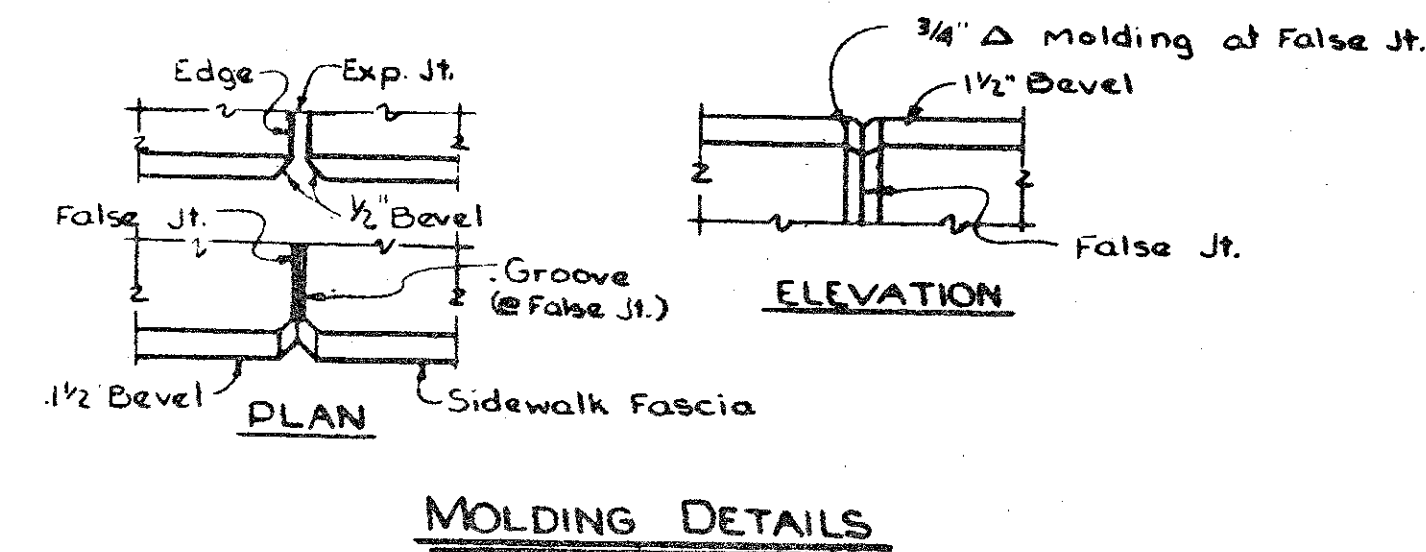

MOLDING DETAILS

Work this sheet with sheets No. 14, 15 & 17

MICHIGAN DEPARTMENT OF STATE HIGHWAYS
SUPERSTRUCTURE DETAILS

REVISIONS			
NO.	DESCRIPTION	DATE	BY

DESIGNED BY: Fisher 4-4-69
 CHECKED BY: R. MARSH 1-25-69
 DRAWN BY: Taylor 3-18-69
 SHEET NO. 16 OF 20

S30 of 63174B

NOTE: DO NOT WORK FROM THIS SHEET. THE INFORMATION SHOWN HERE IS FOR REFERENCE ONLY. NO PAY ITEMS ARE SHOWN.

FOR INFORMATION ONLY				
DATE	CONT. SEC.	JOB NO.	DESIGN UNIT	SHEET
10-13-99	S30 OF 63174	48404A	MADHAVI	10 OF 22





DRAWN BY: inder DATE: 01-12-99 CHECKED BY: DATE: CORRECTED BY: DATE:



FILE NAME: s307374.sn

1 2 3 4 5 6 7 8 9 10 11 12 13 14 15 16 17 18 19 20 21 22 23 24 25 26 27 28 29 30 31 32 33 34 35 36 37 38 39 40 41 42 43 44 45 46 47 48 49 50 51 52 53 54 55 56 57 58 59 60 61 62 63

REVISIONS			
NO.	DESCRIPTION	DATE	BY

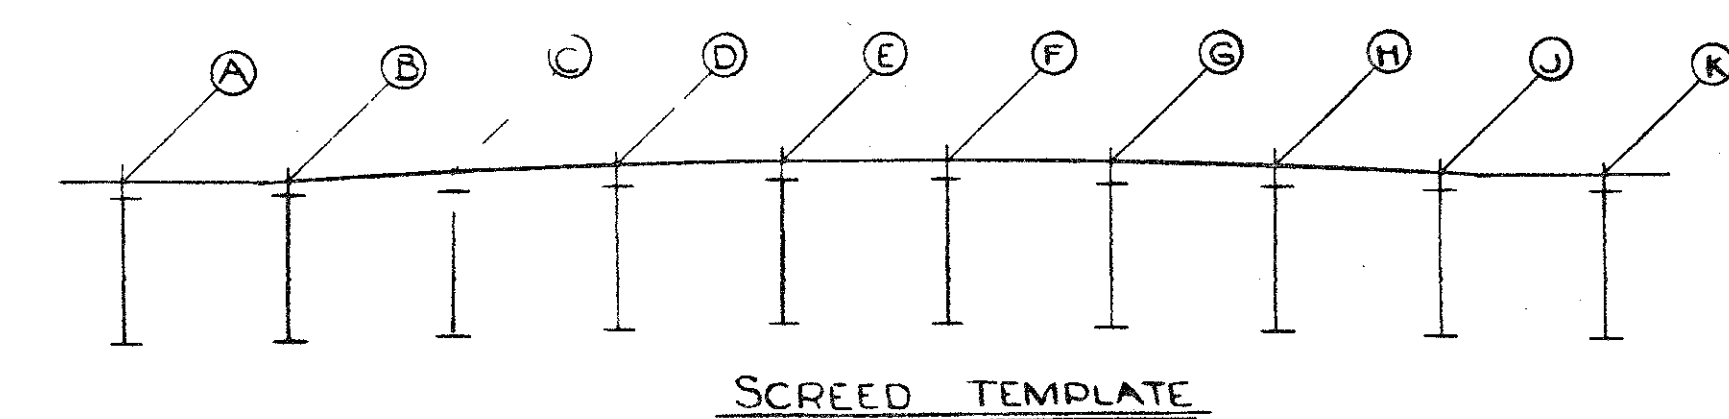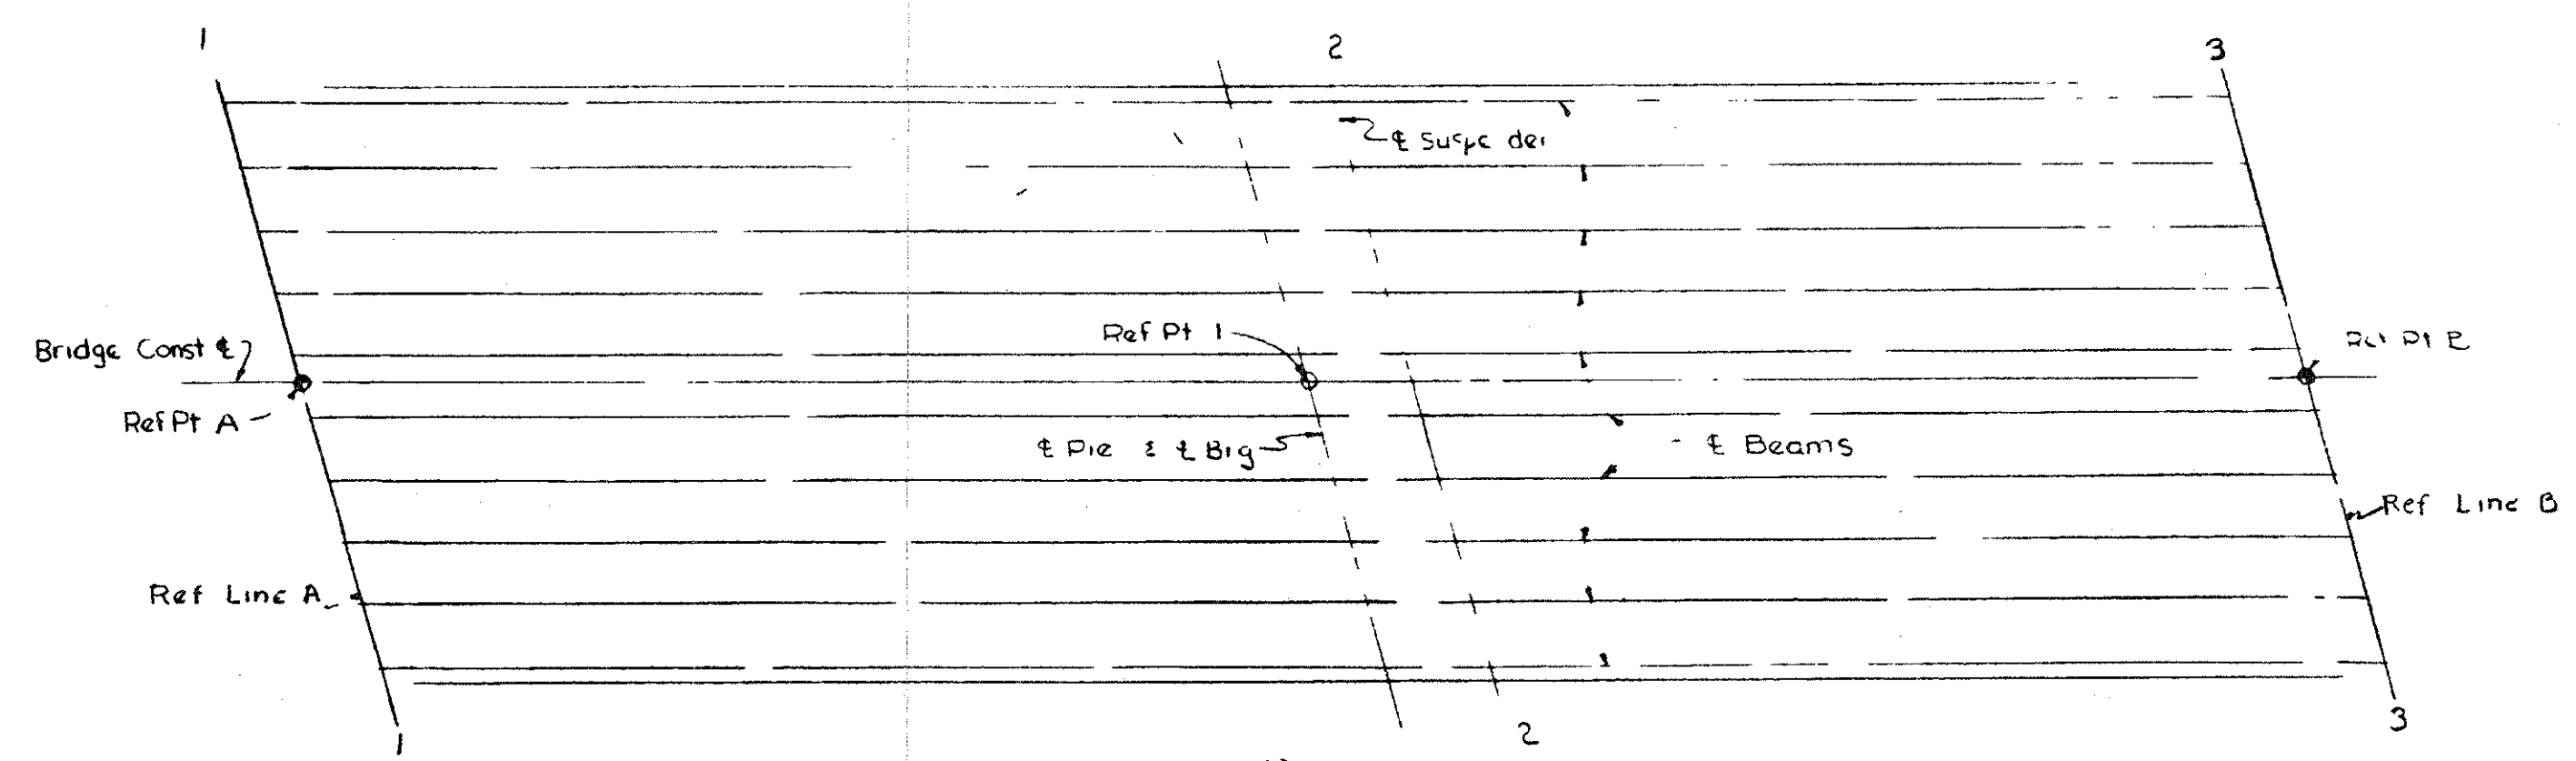



SCREED TEMPLATE ELEVATION										
Line	A	B	C	D	E	F	G	H	J	K
1-1	G3458	G3463	G3477	G3488	G3497	G3497	G3491	G3481	G3469	G3465
2-2	G3494	G3498	G3511	G3521	G3529	G3528	G3521	G3510	G3496	G3492
3-3	G3454	G3451	G3469	G3478	G3484	G3483	G3474	G3462	G3448	G3442

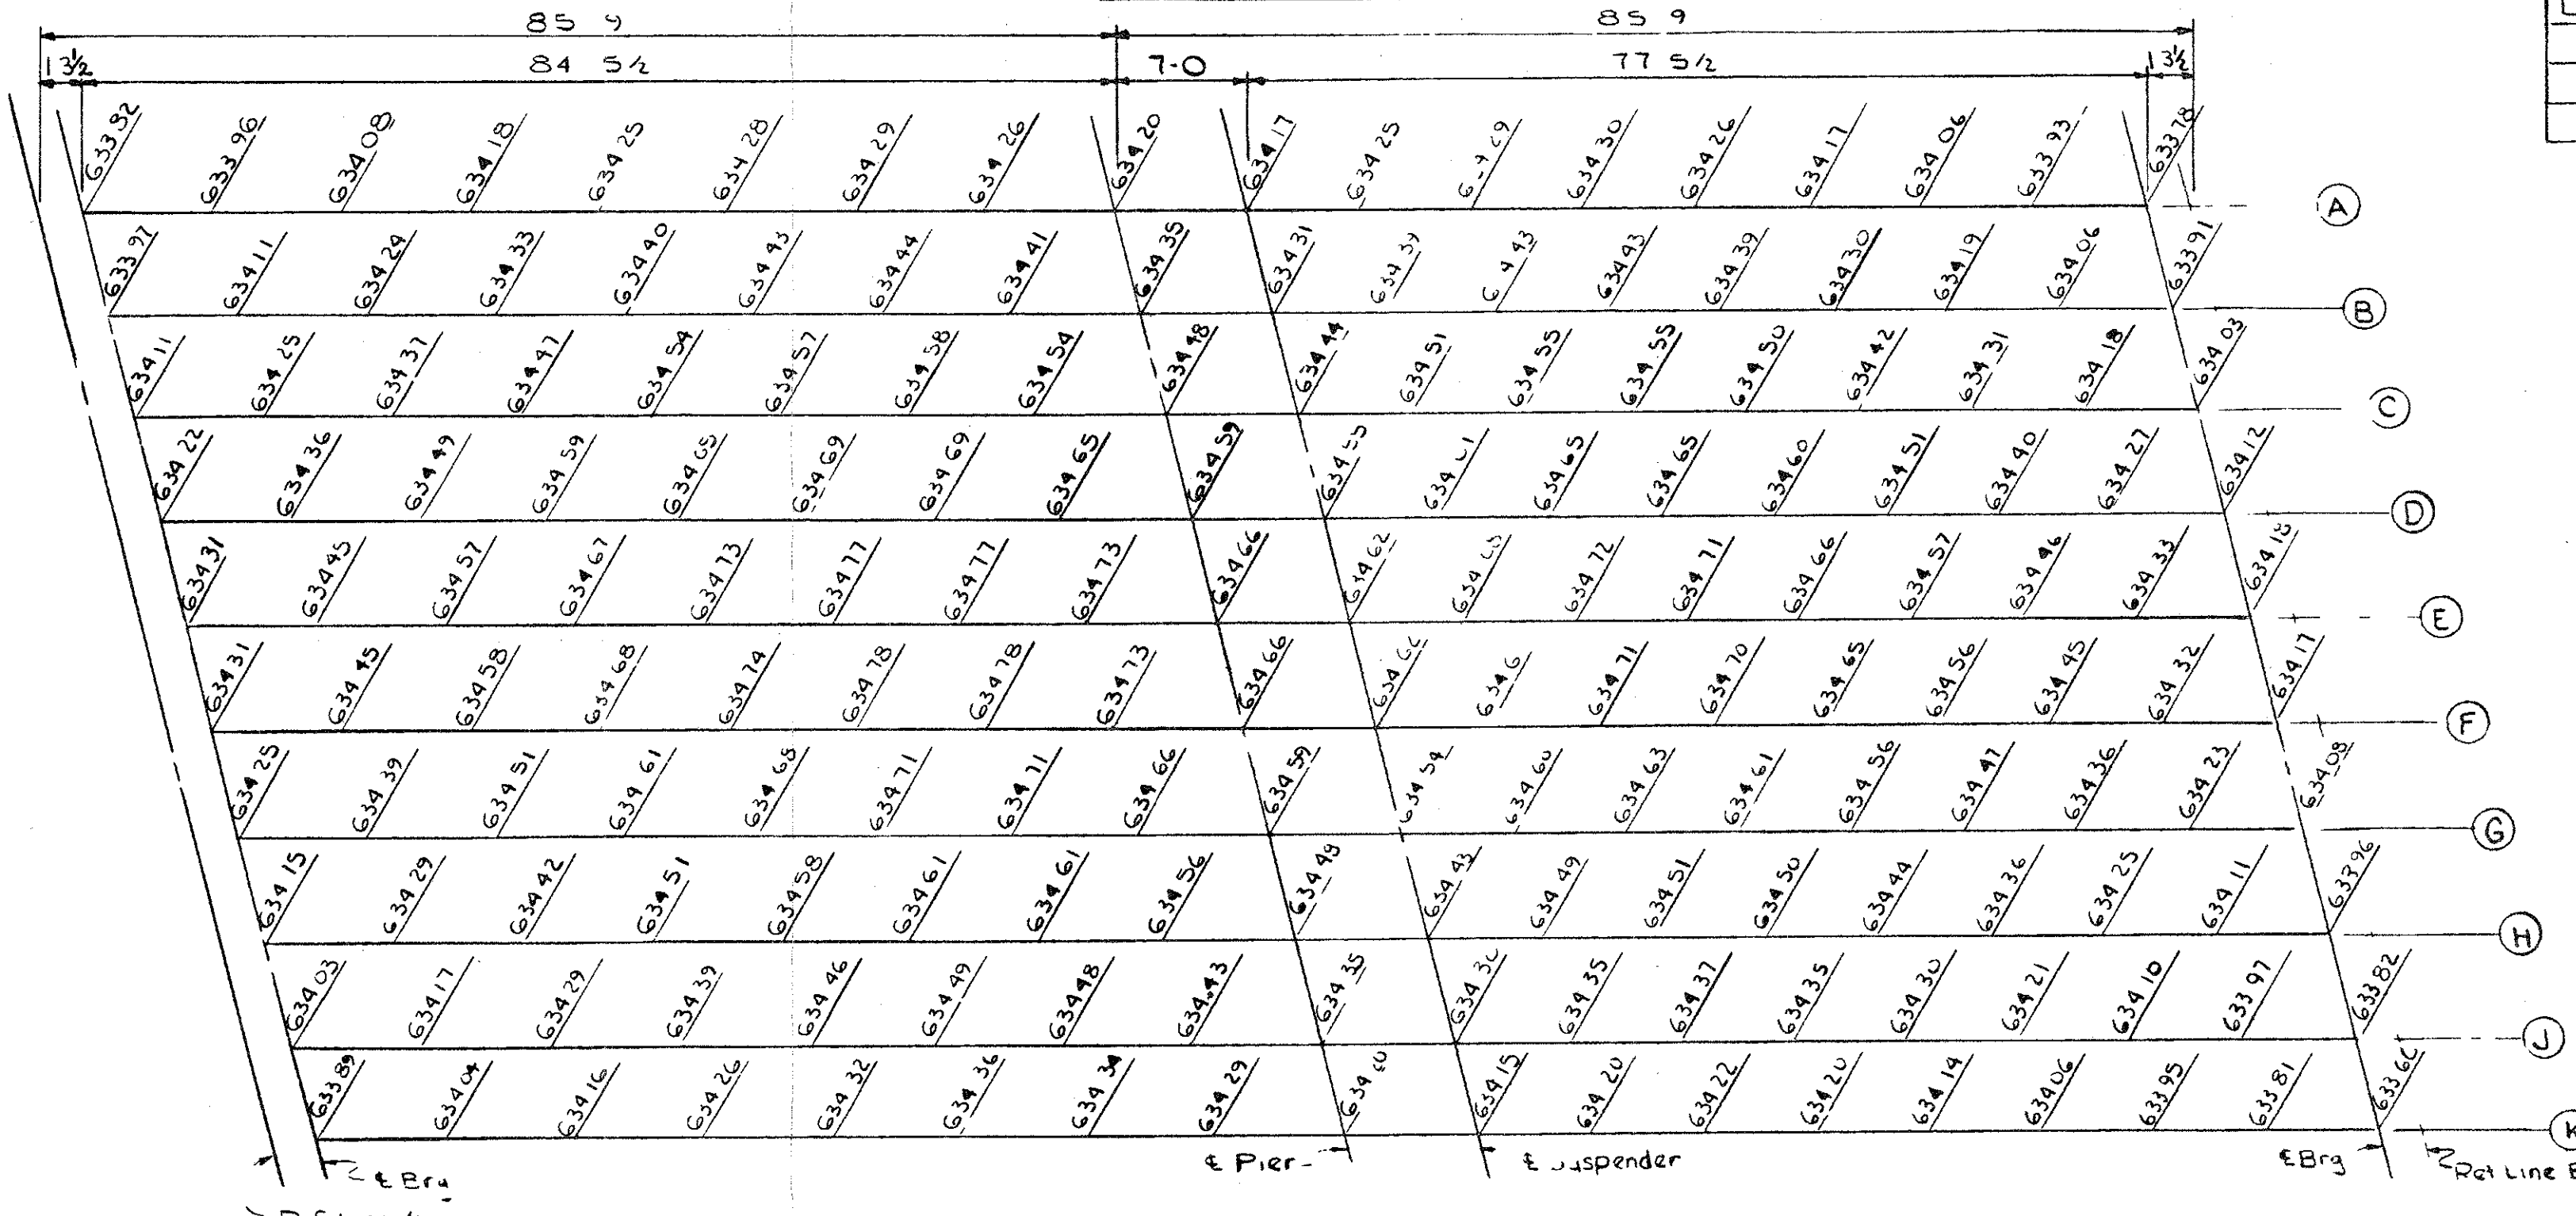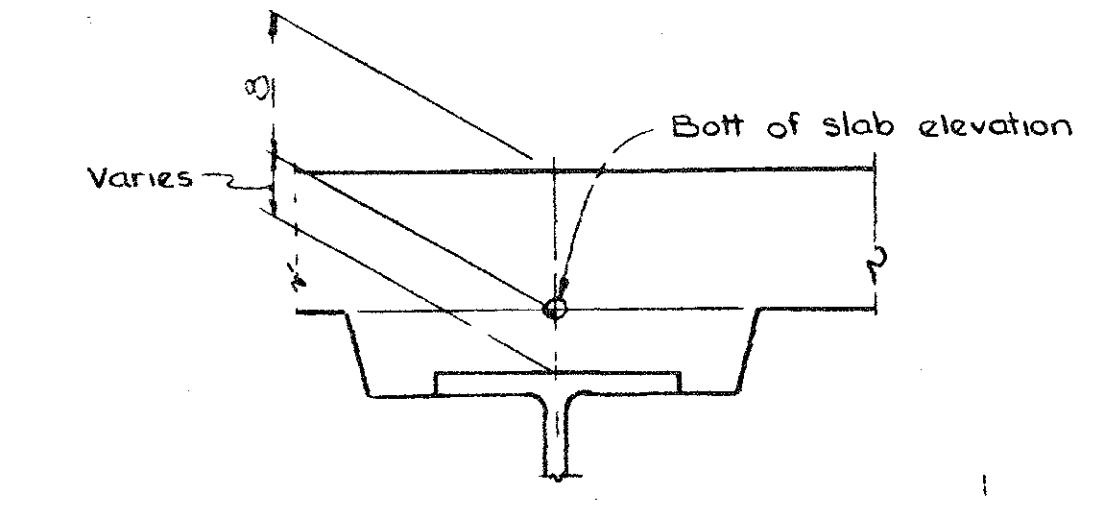

NOTES

Screed elevations are based on the condition that no slab concrete has been cast and that formwork, steel reinforcement and shear developers are in place.

Bottom of slab elevations are based on the condition that all structural steel has been erected, but no other loads applied. These elevations include allowances for deflections due to forms, steel reinforcement, shear developers in place, deck concrete and railing.

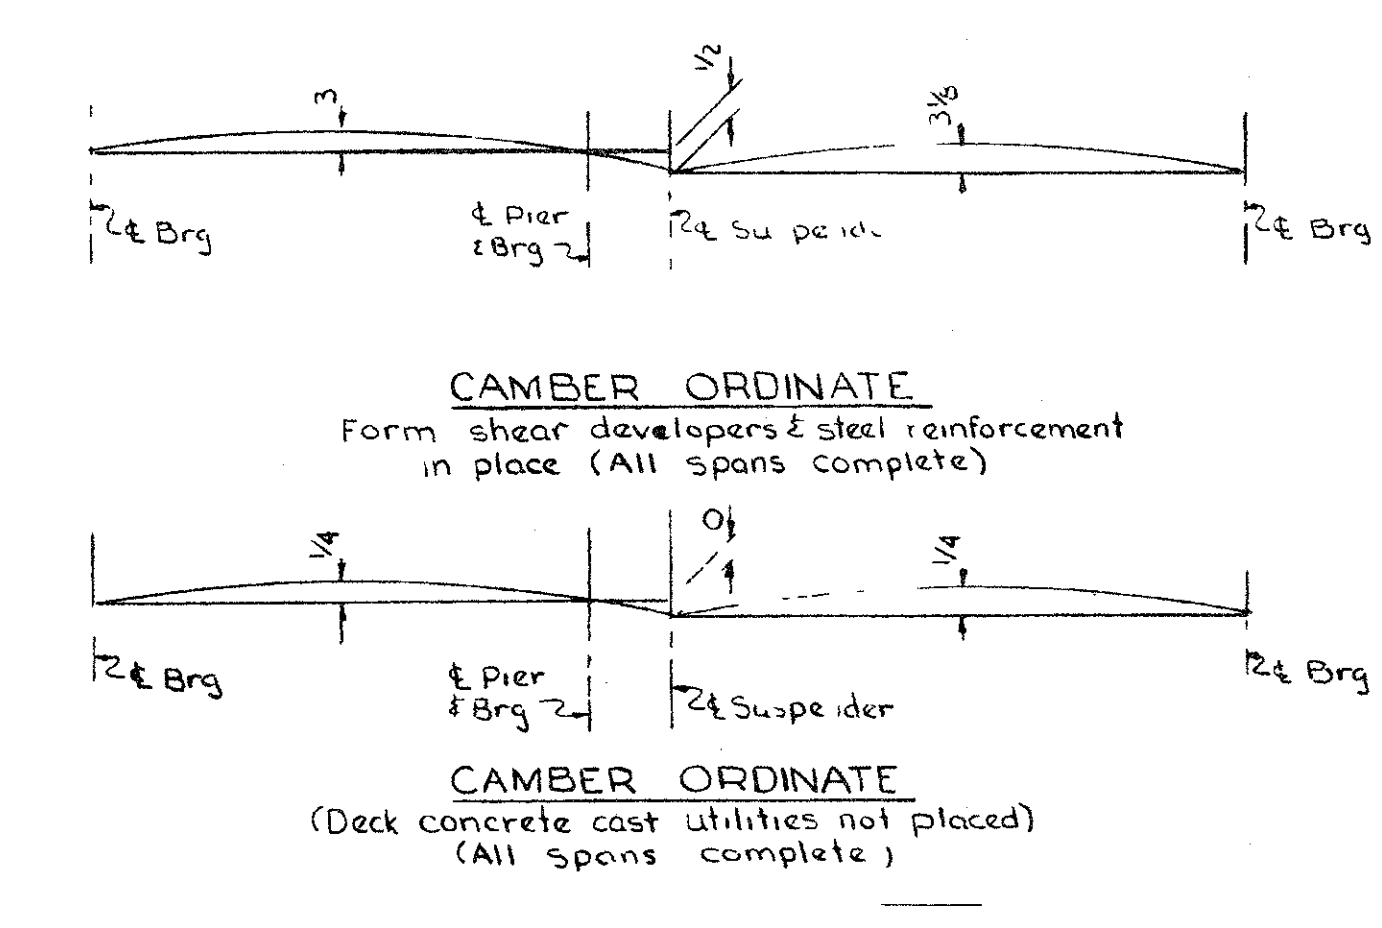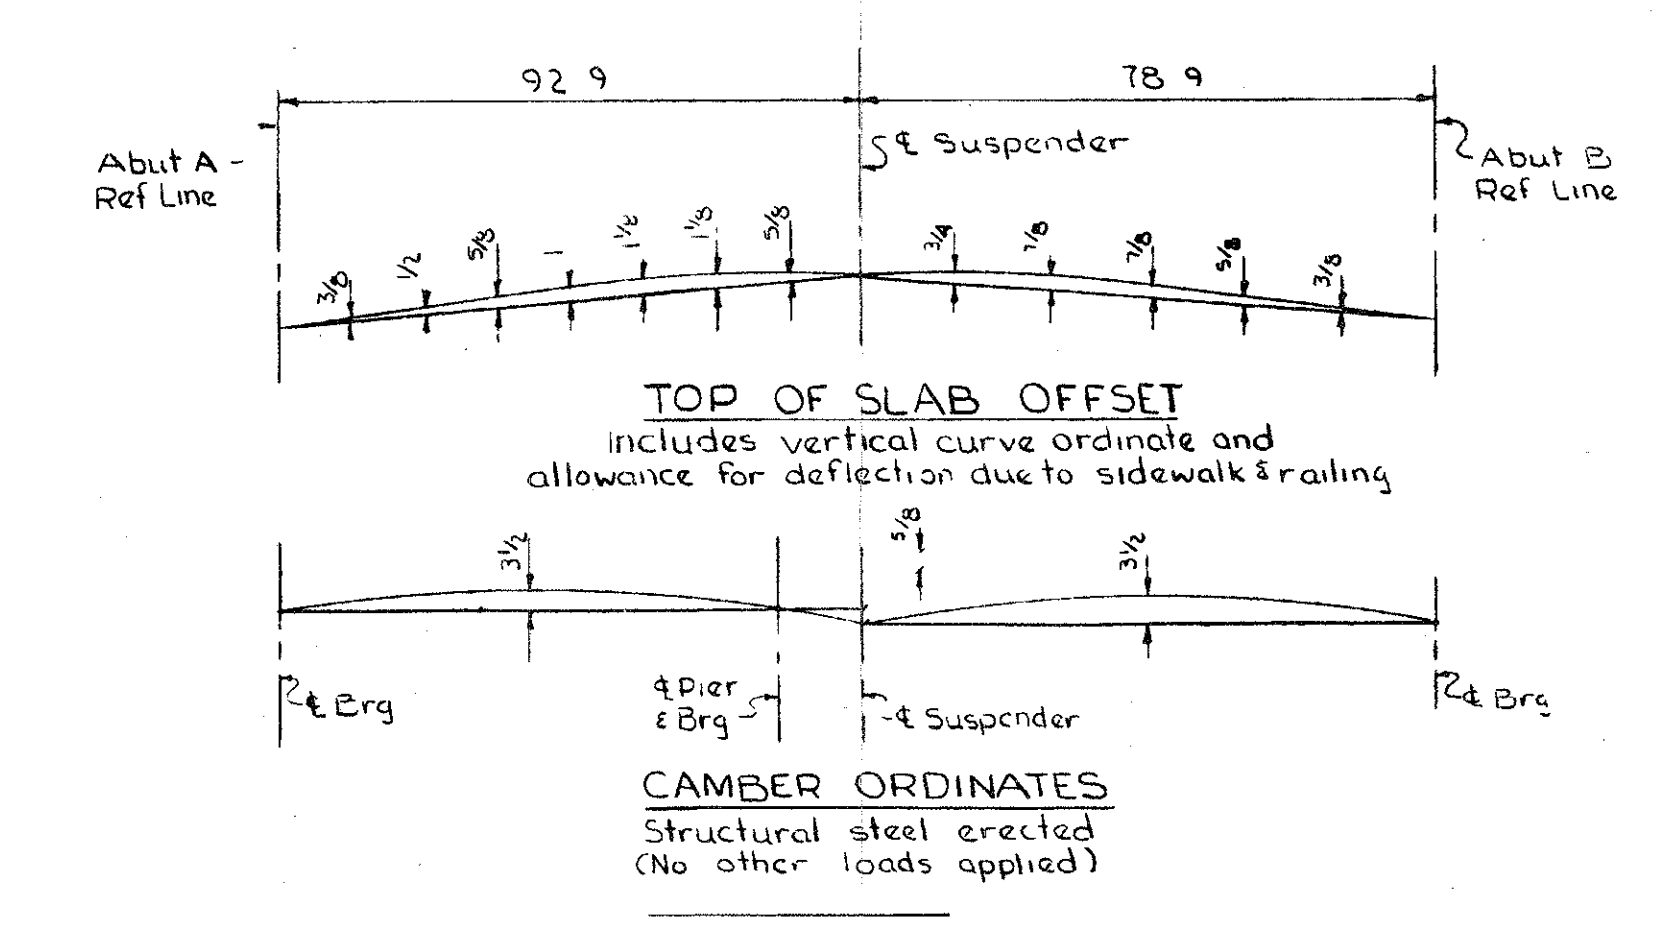

Work this sheet with sheets No 14, 15 & 16

MICHIGAN DEPARTMENT OF STATE HIGHWAYS

SUPERSTRUCTURE DETAILS

NO.	DESCRIPTION	DATE	BY

DRAWN BY: Fisher 6/4/69
 CHECKED BY: R. MARSH 3/21/67
 SHEET 17 OF 20

S30 OF 63174 B

NOTE:
DO NOT WORK FROM THIS SHEET. THE INFORMATION SHOWN HERE IS FOR REFERENCE ONLY. NO PAY ITEMS ARE SHOWN.

FOR INFORMATION ONLY





DATE	CONT. SEC.	JOB NO.	DESIGN UNIT	SHEET
10-13-99	S30 OF 63174	48404A	MADHAVI	11 OF 22



DATE: _____ CORRECTED BY: _____ DATE: _____ CHECKED BY: _____ DATE: 01-12-99 DRAWN BY: inder FILE NAME: s3073174.sn

1 2 3 4 5 6 7 8 9 10 11 12 13 14 15 16 17 18 19 20 21 22 23 24 25 26 27 28 29 30 31 32 33 34 35 36 37 38 39 40 41 42 43 44 45 46 47 48 49 50 51 52 53 54 55 56 57 58 59 60 61 62 63

REVISIONS			
NO.	DESCRIPTION	DATE	BY

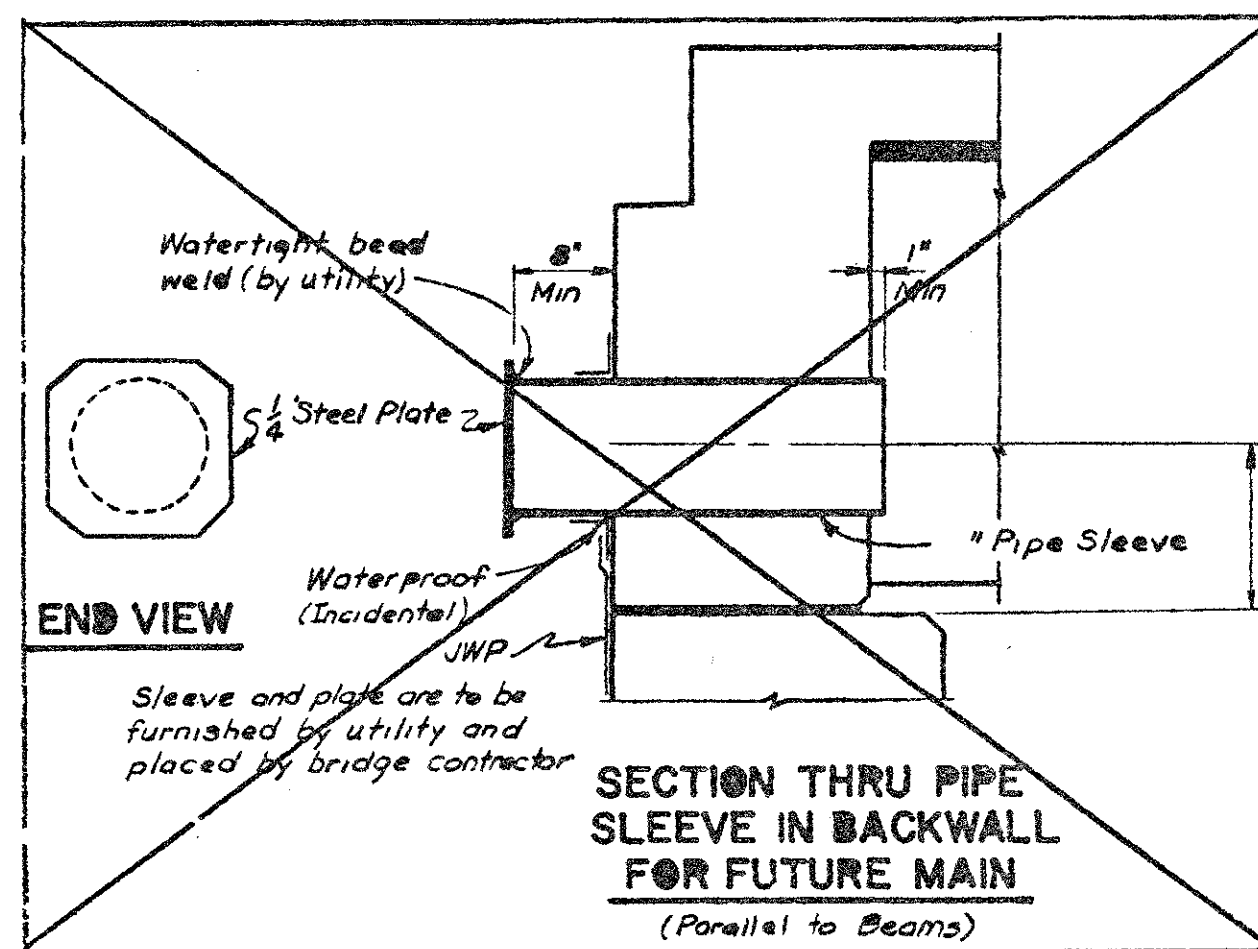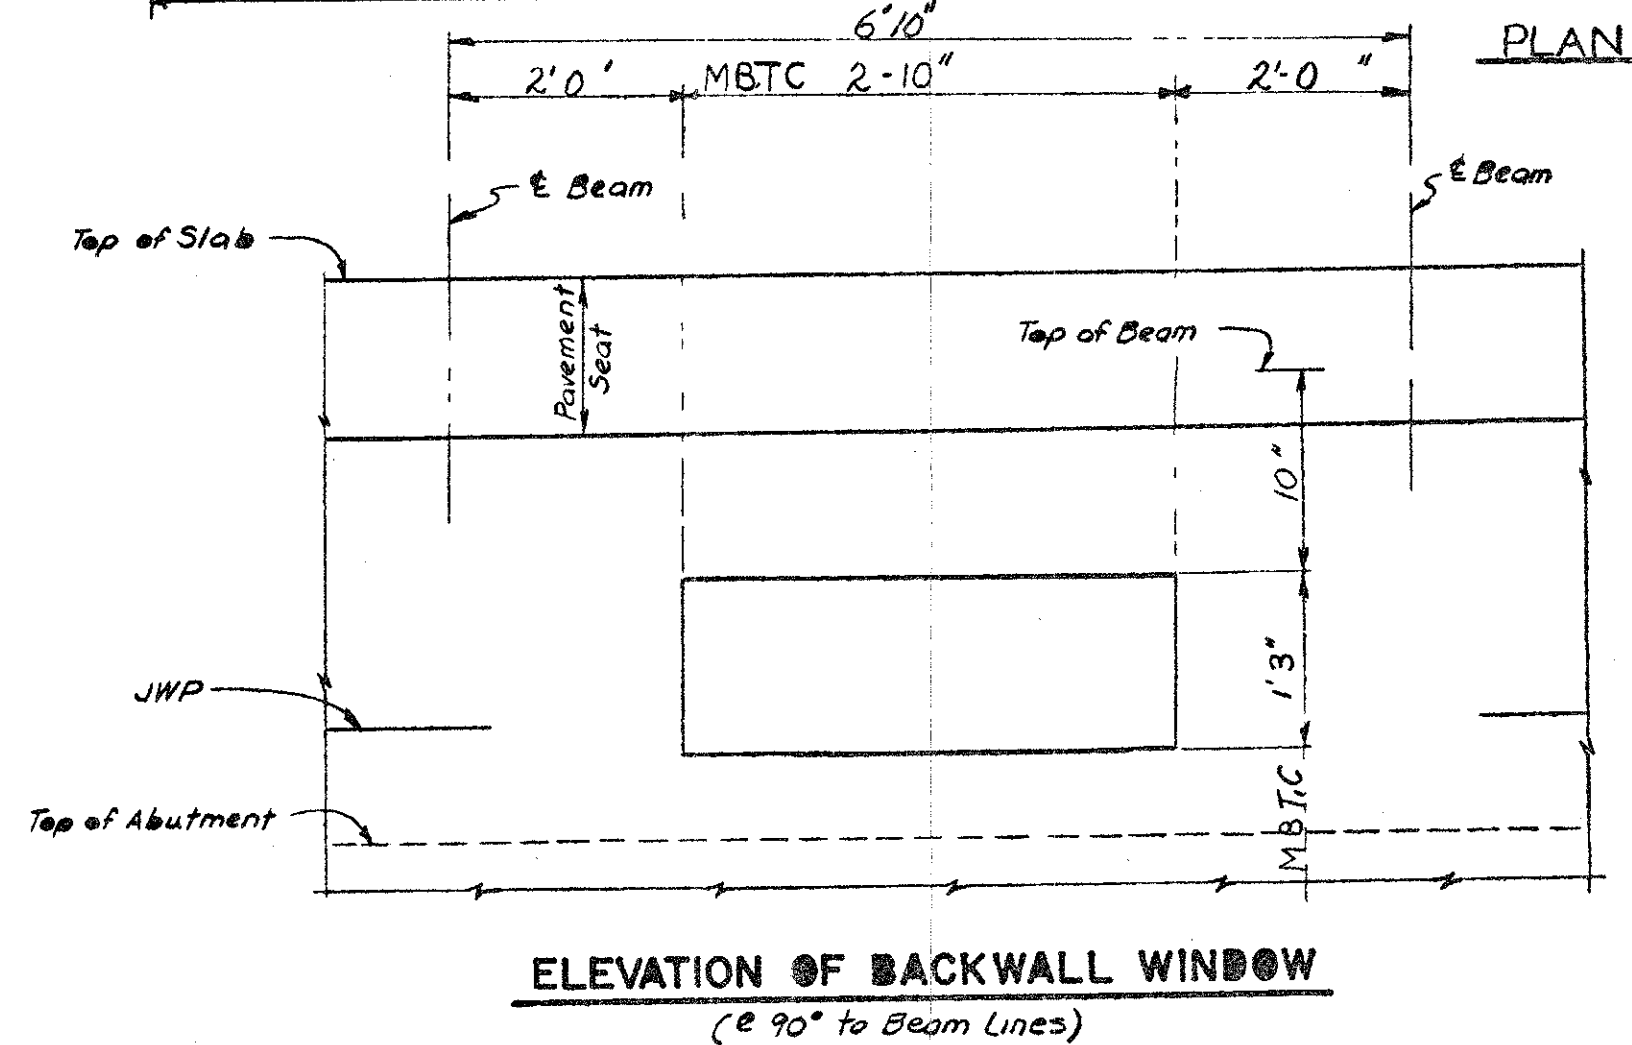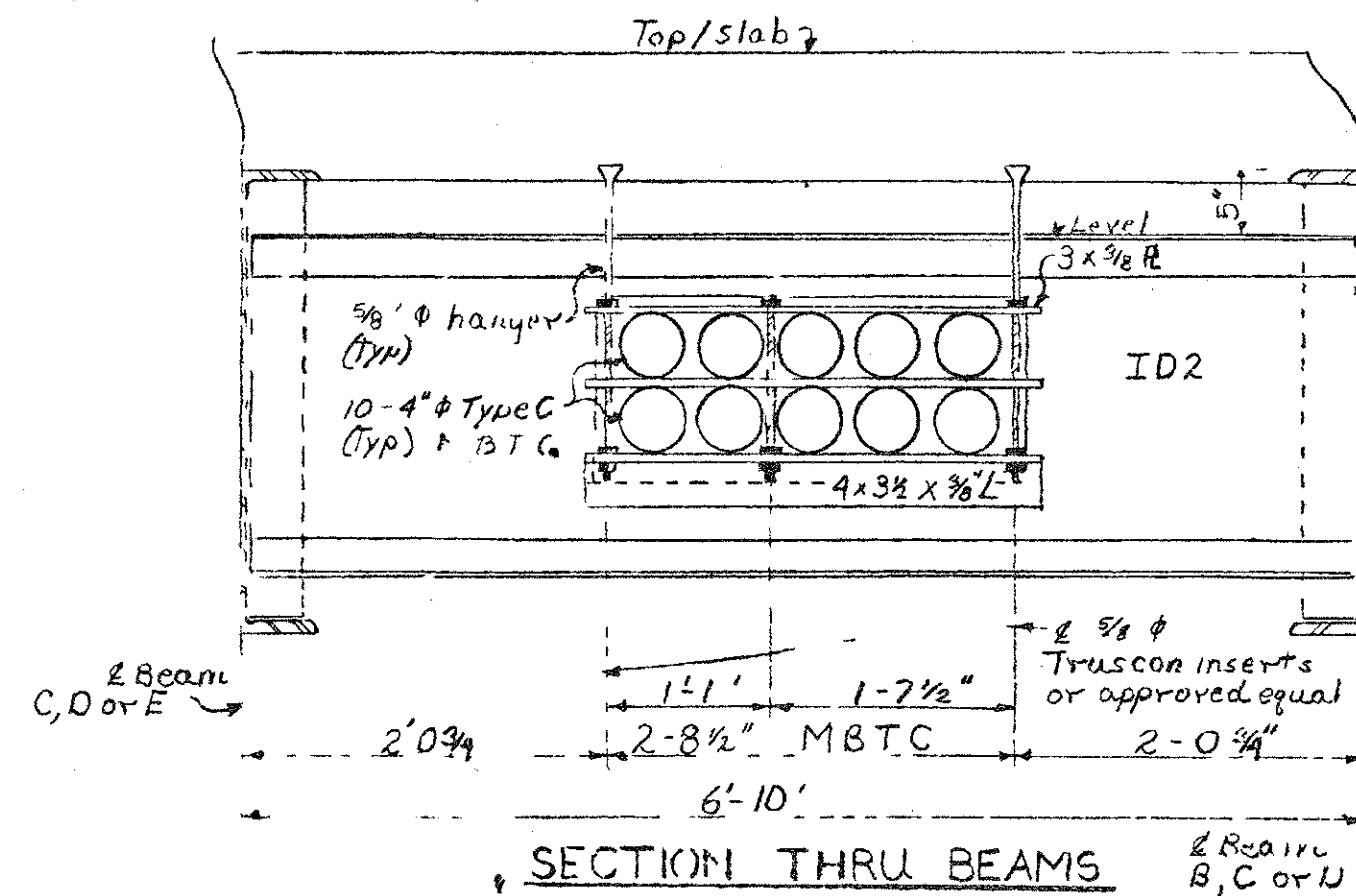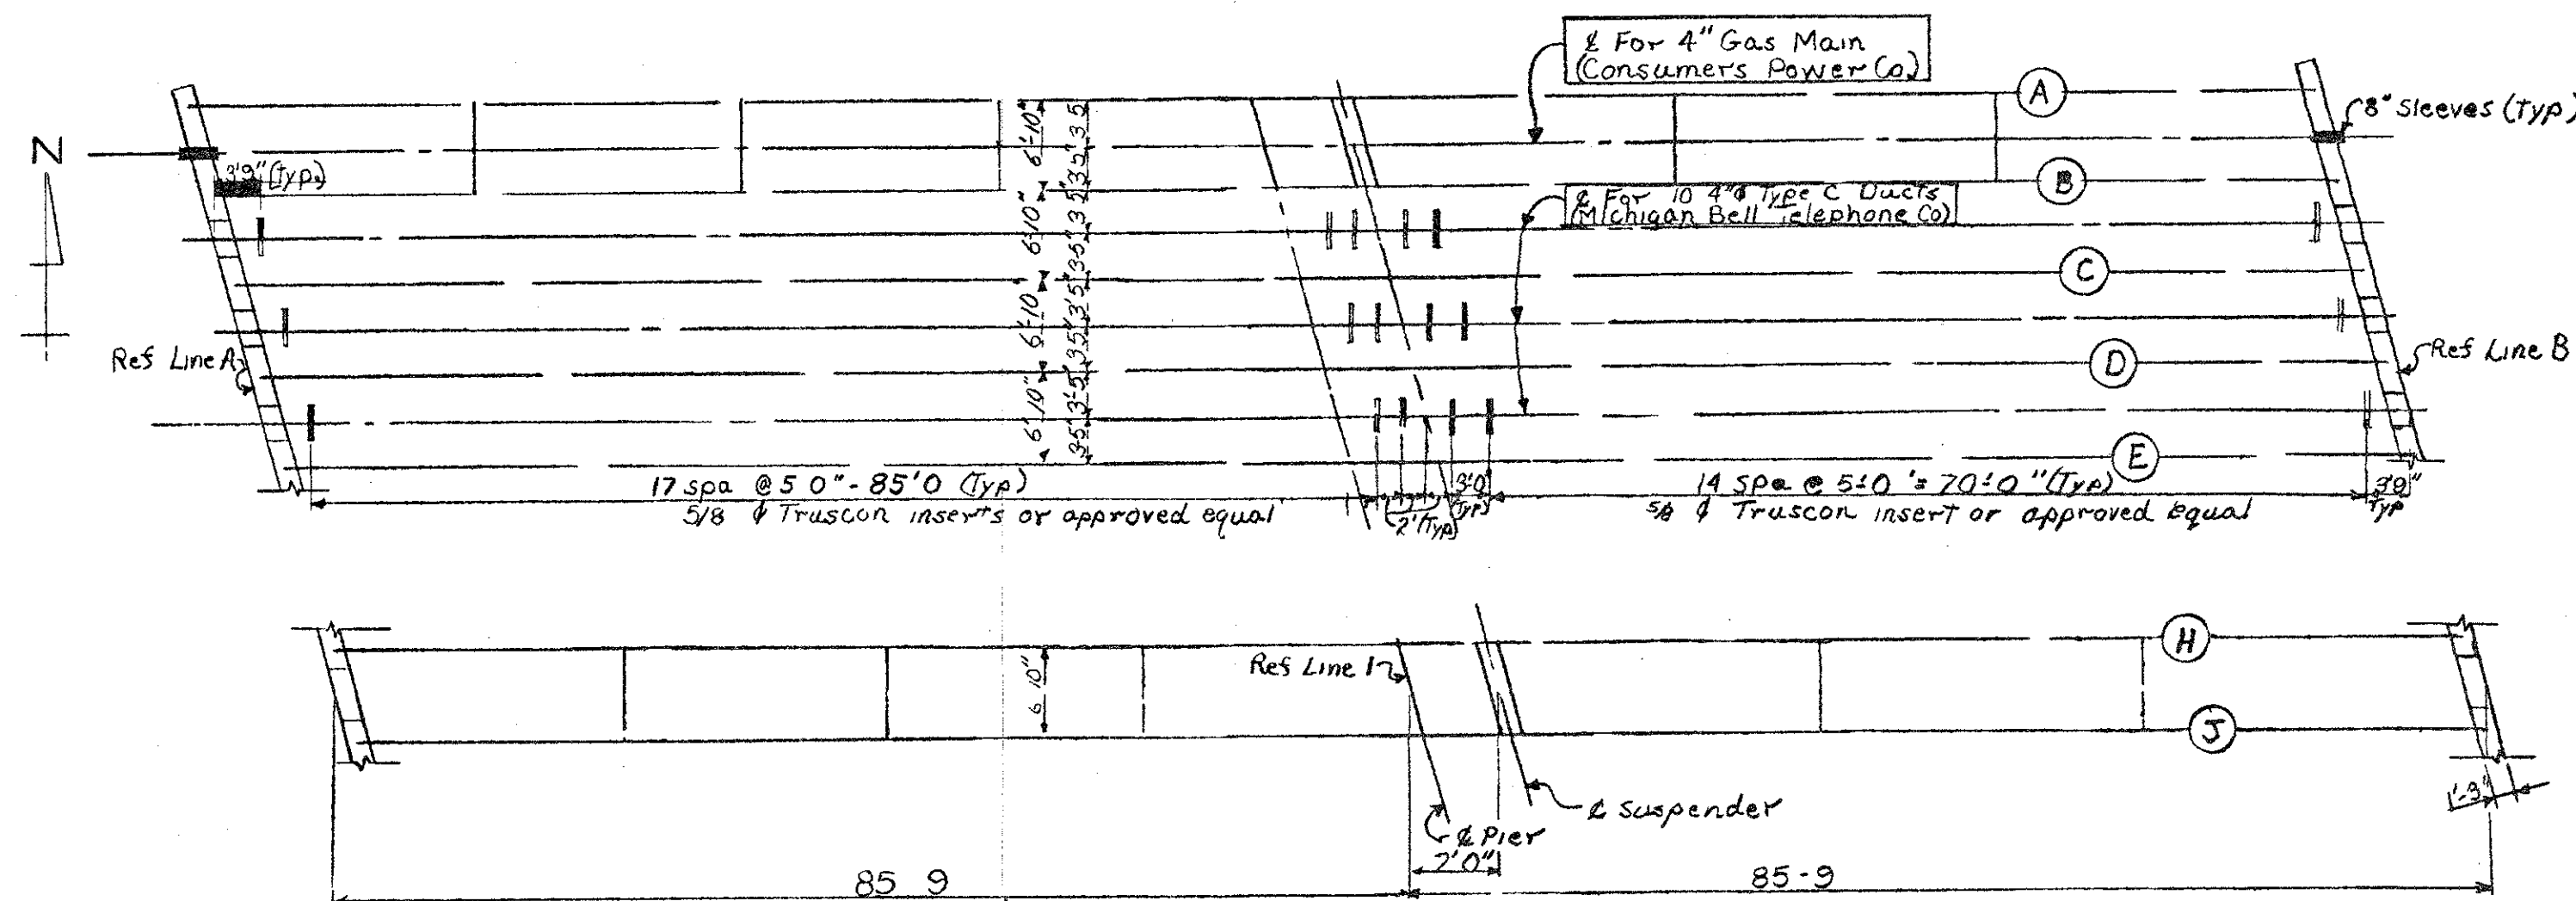

MISCELLANEOUS QUANTITIES	
UTILITY	ITEM
Mich Bell Tel Co	5/8" #4 Pipe Sleeve - Placed
Consumer Power Co	4" Gas Main

NOTES:

Furnishing and installing telephone conduits including all incidental work necessary for installation are not a part of this contract. Installation of ducts shall be in accordance with the manufacturer's and telephone company's recommendations.

Installation of inserts, pipe sleeves and forming of windows through backwalls and diaphragms is included in this contract. All other work shown is not a part of this contract.

Furnishing and installing Gas Main including all incidental work necessary for installation are not a part of this contract.

Adjust the spacing of concrete inserts to clear intermediate and end diaphragms

The item JWP (Joint Waterproofing) is a pay item and is included as such elsewhere in these plans

Waterproof denotes waterproofing with four mappings of asphaltic roofing cement containing not more than 2.5% by weight of short fiber asbestos

The contractor shall advise the District Utility Engineer as soon as the structure is ready for installation of conduits or main in bridge




Items shown to be galvanized are to be galvanized steel (ASTM A 153)

Work this sheet with sheets No 4+11

**MICHIGAN STATE HIGHWAY DEPARTMENT
UTILITY DETAILS**

REVISIONS			
NO.	DESCRIPTION	DATE	BY

Traced by: E. Fisher 4/79
 Checked by: J. T. 1/13
 Sheet 12 of 22
S30 of 63174S

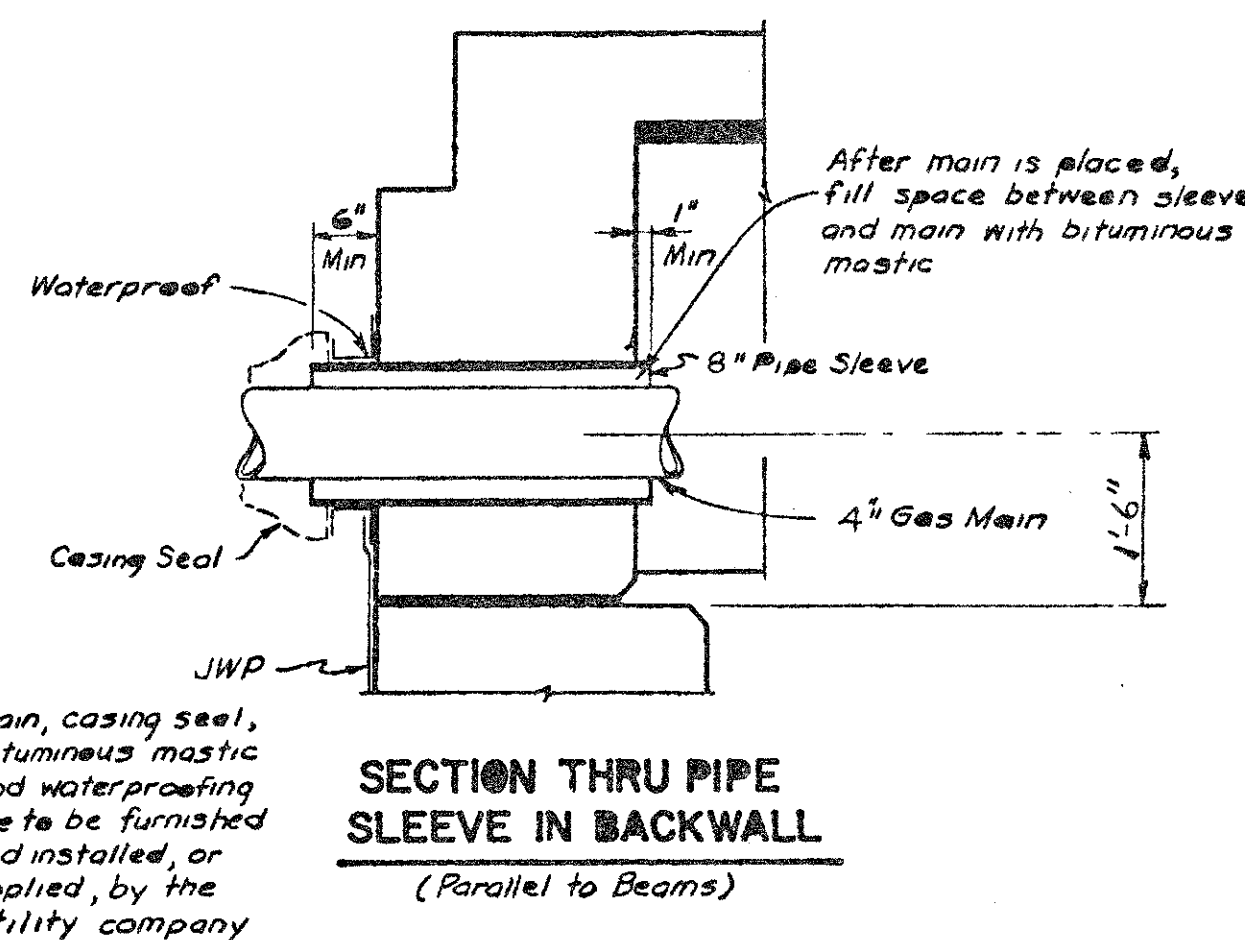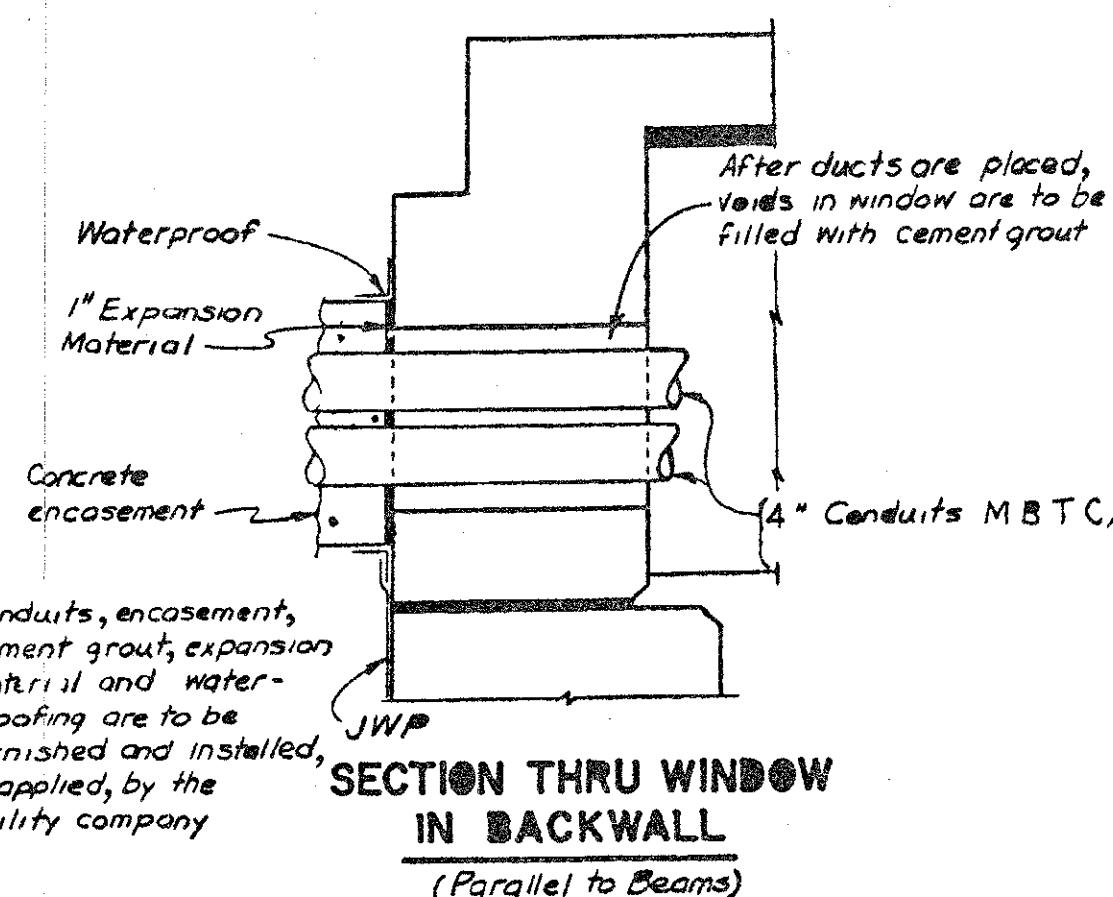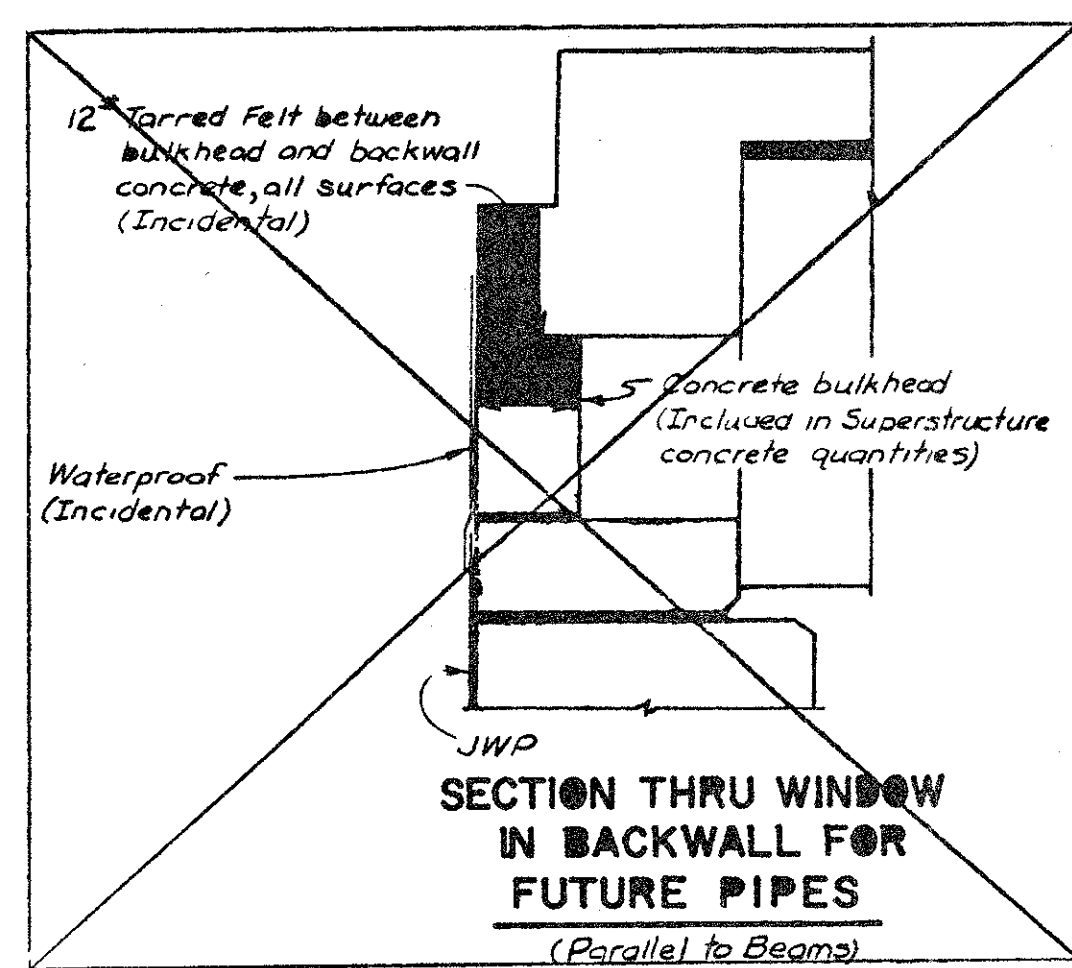

NOTE:
DO NOT WORK FROM THIS SHEET. THE INFORMATION SHOWN HERE IS FOR REFERENCE ONLY. NO PAY ITEMS ARE SHOWN.




FOR INFORMATION ONLY				
DATE	CONT. SEC.	JOB NO.	DESIGN UNIT	SHEET
10-13-99	S30 OF 63174	48404A	MADHAVI	12 OF 22

DATE: DATE: DATE: DATE: DATE: FILE NAME: s3073174.sn


CONTROL SECTION S30 OF 63174 JOB NO. 48404A SHEET NO. 13

1 2 3 4 5 6 7 8 9 10 11 12 13 14 15 16 17 18 19 20 21 22 23 24 25 26 27 28 29 30 31 32 33 34 35 36 37 38 39 40 41 42 43 44 45 46 47 48 49 50 51 52 53 54 55 56 57 58 59 60 61 62 63


REVISIONS			
NO.	DESCRIPTION	DATE	BY

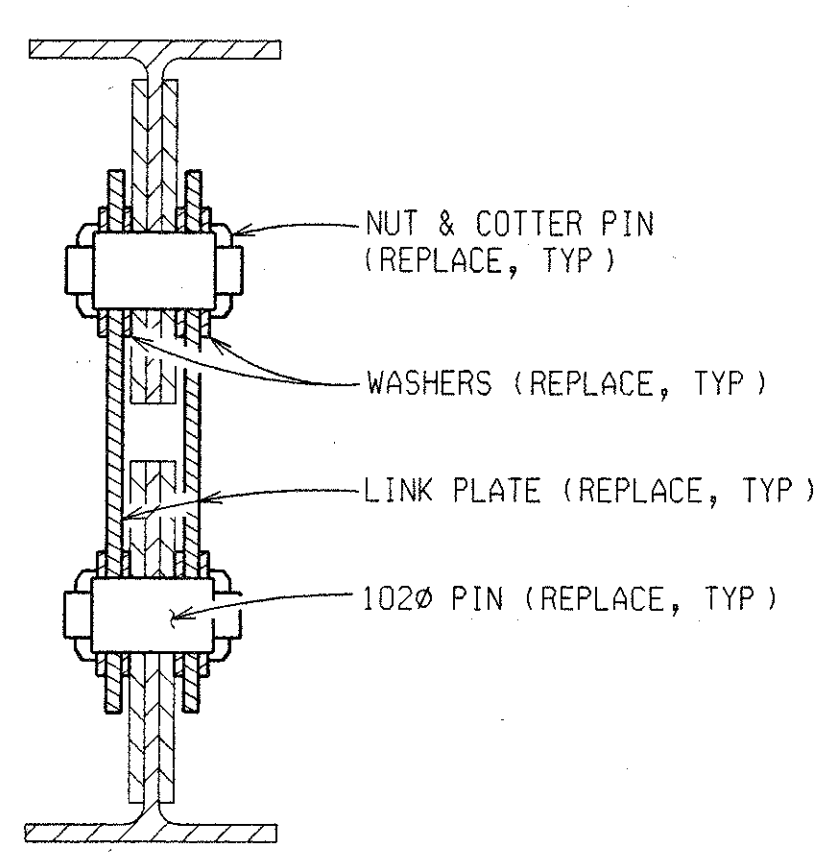


**SECTION A-A
(EXISTING)**

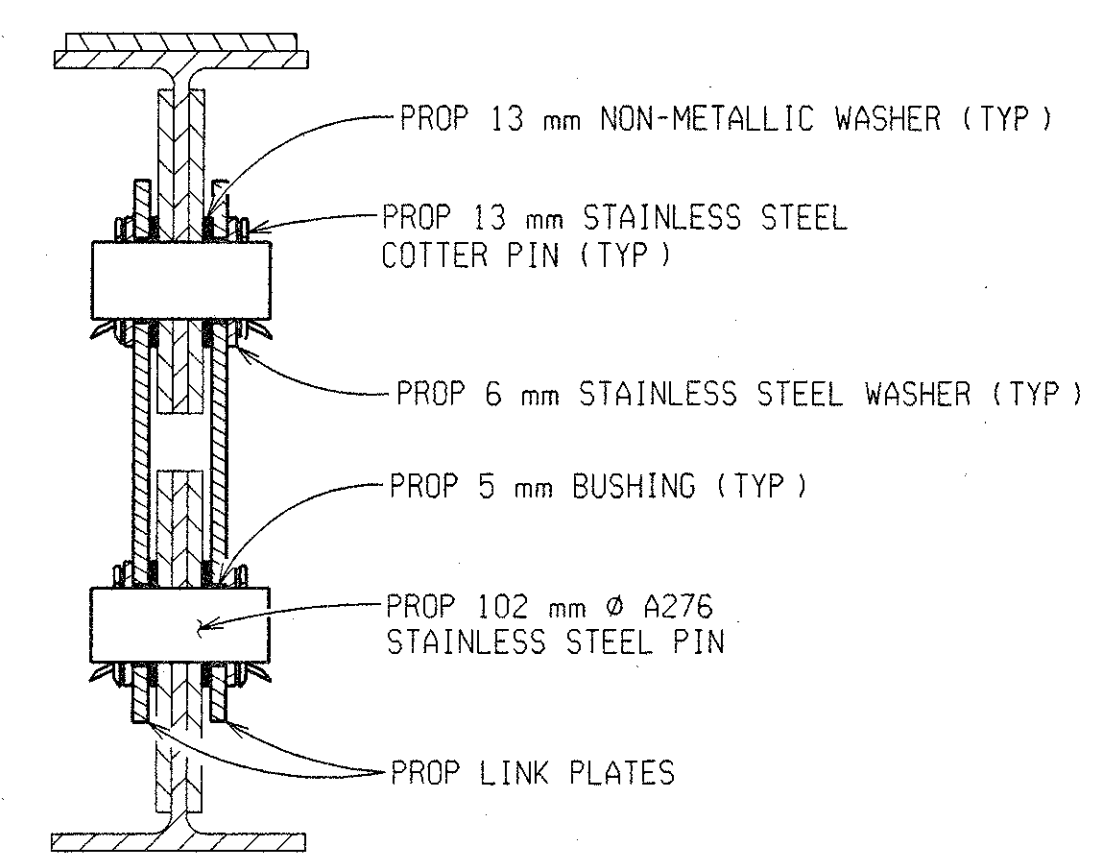


**SECTION A-A
(PROPOSED)**

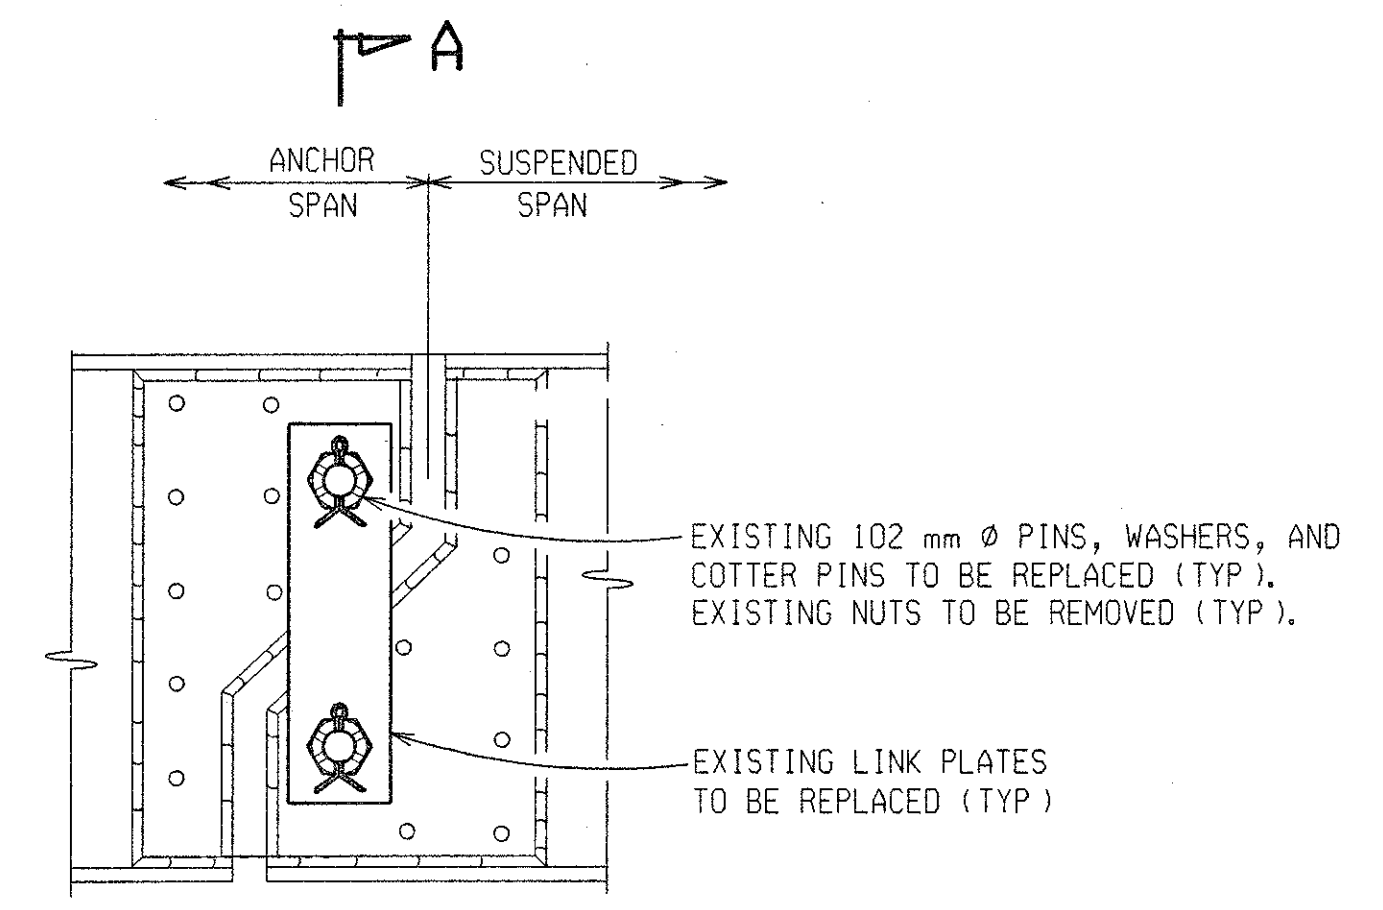

ELEVATION AT PIN

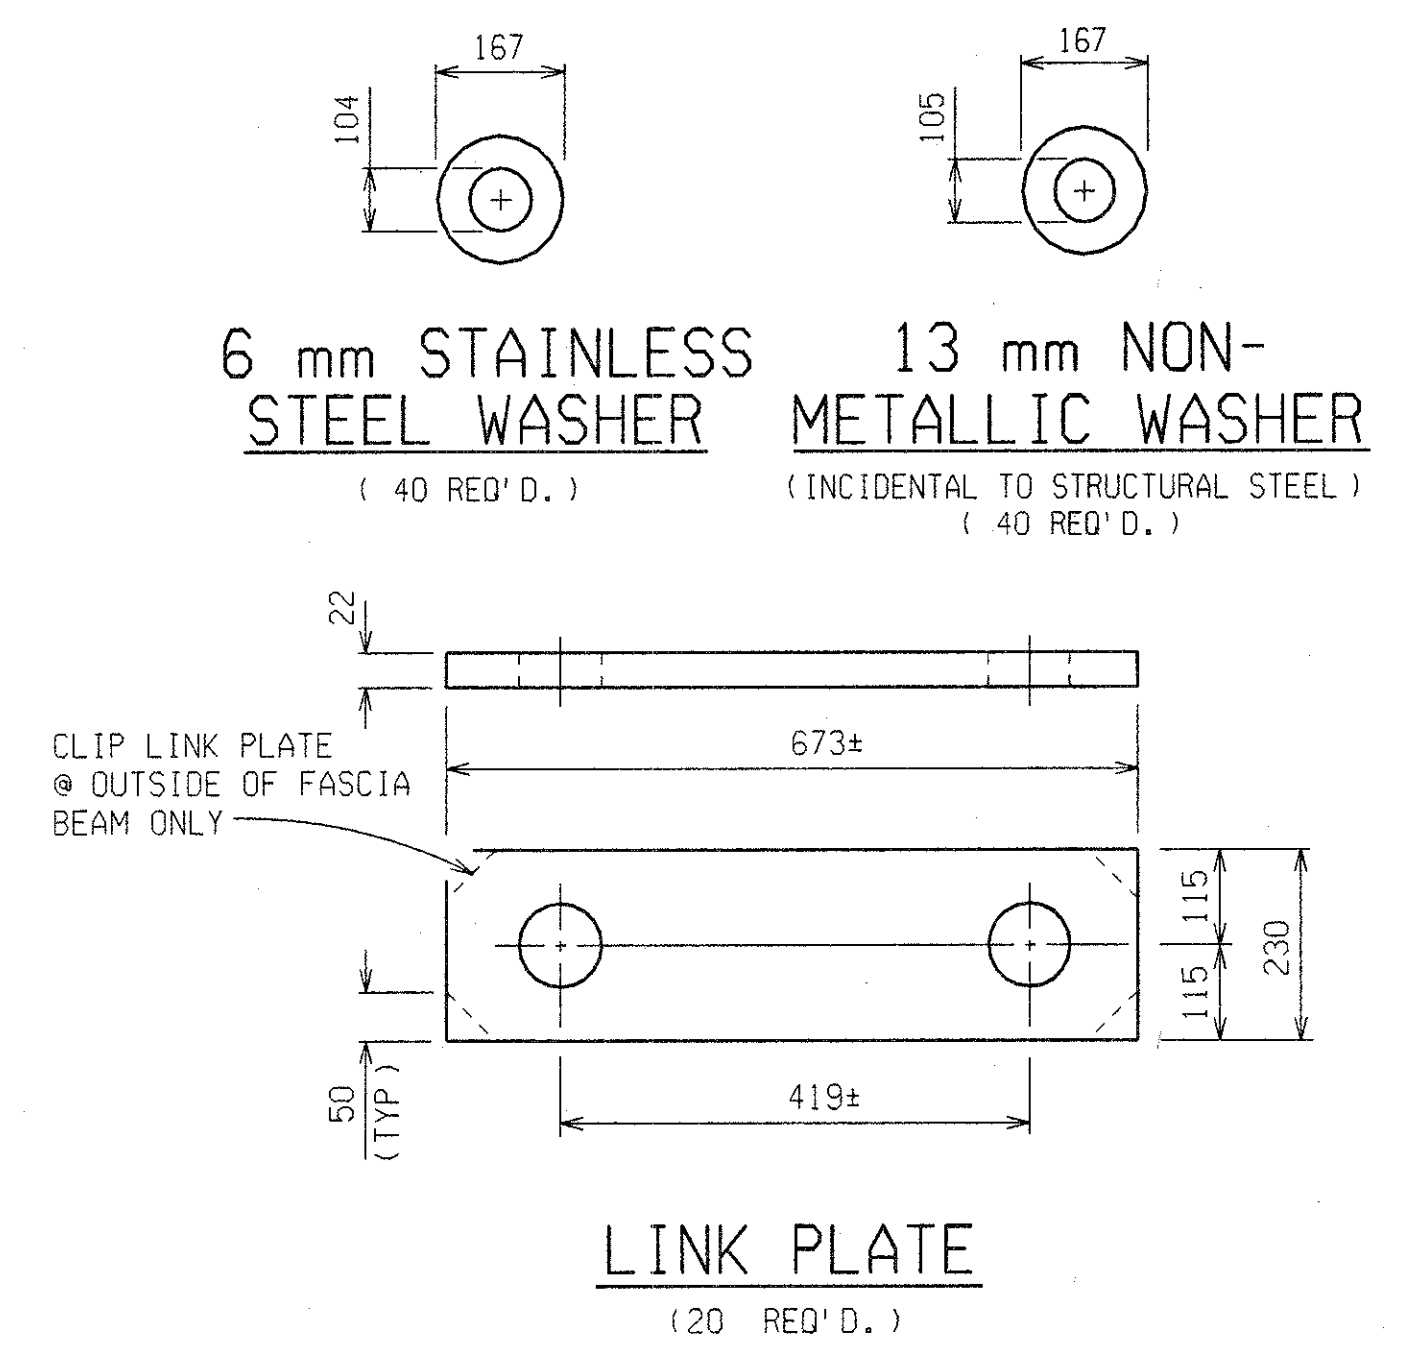


**LINK PLATE
(20 REQ'D.)**

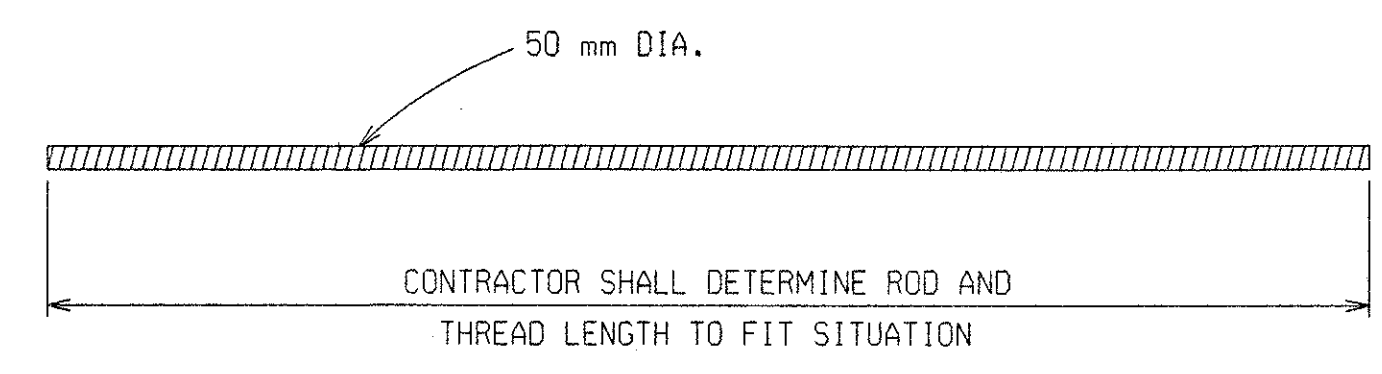


SUSPENSER ROD DETAIL

4 REQUIRED PER ASSEMBLY W/7 HEAVY HEX NUTS & 4 HARDENED WASHER PER ROD

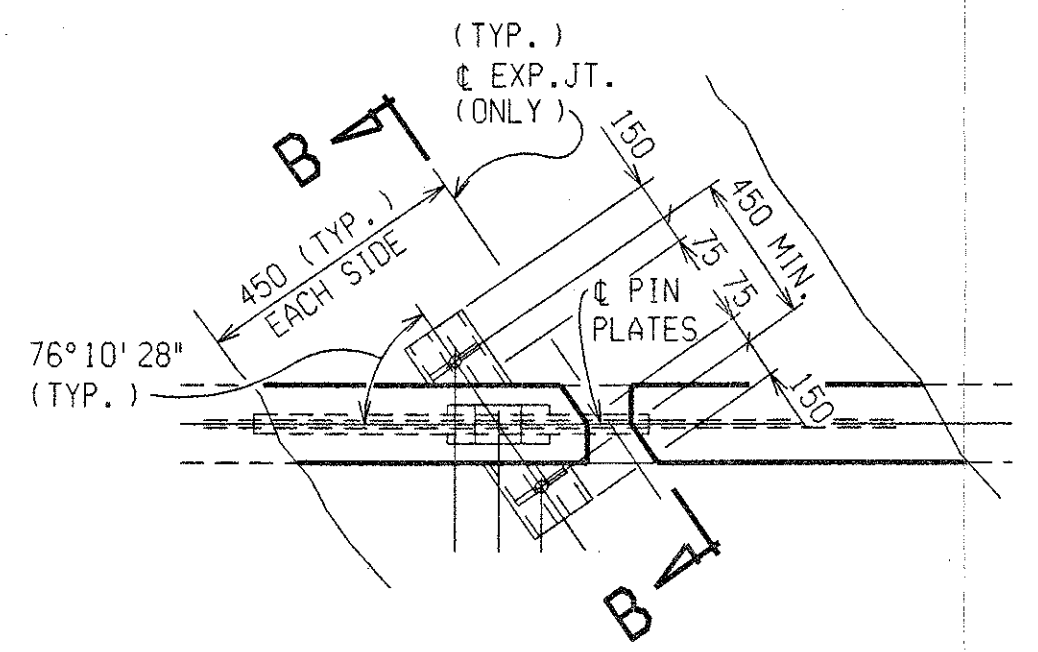

PLAN OF TEMPORARY SUPPORT

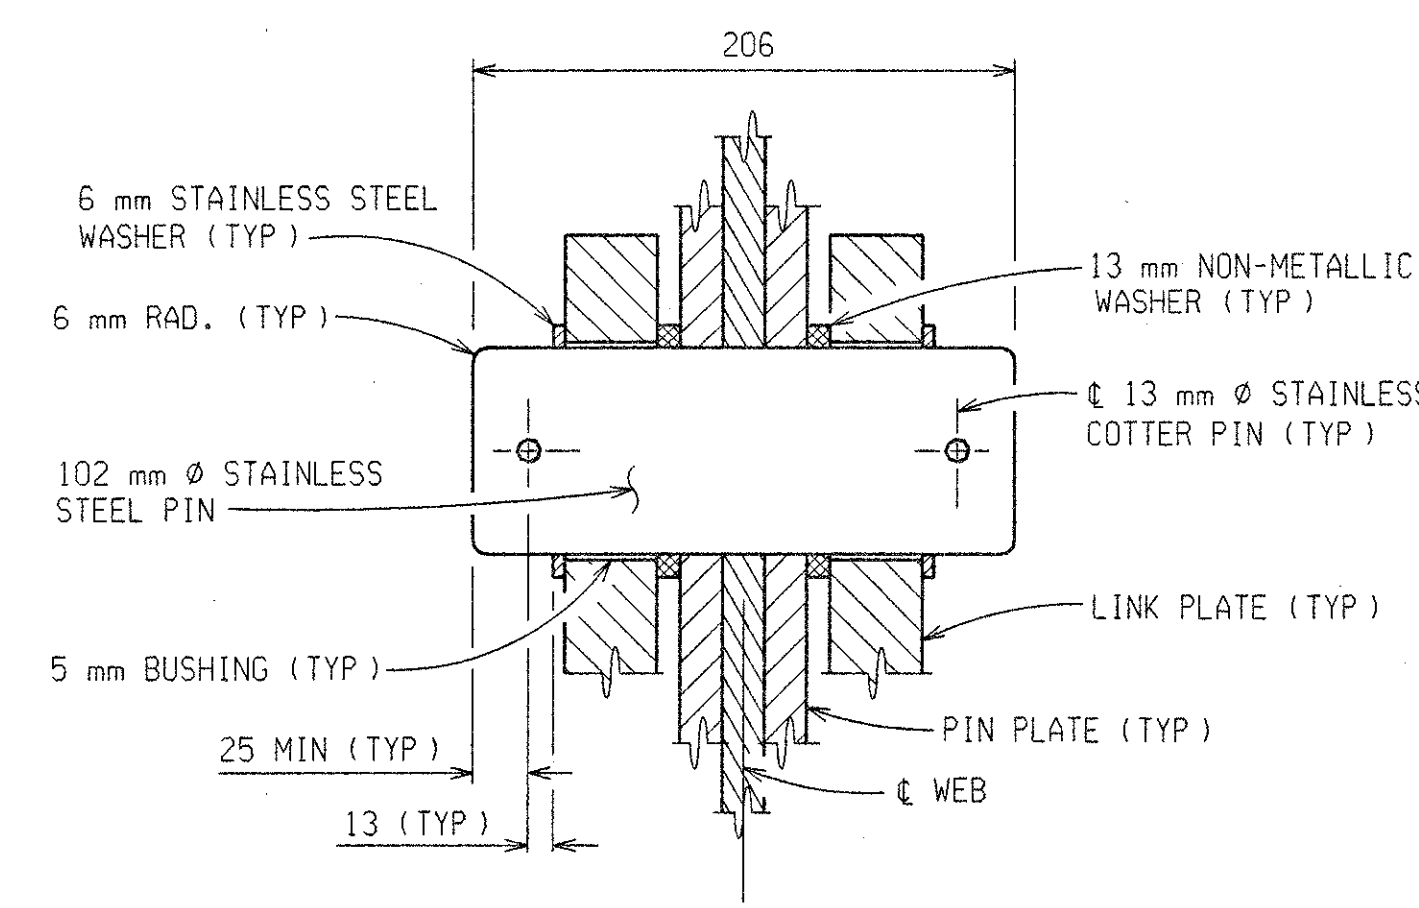


**PROPOSED PIN DETAIL
(20 REQ'D.)**

NOTES:


- THE AREA BEHIND AND AROUND THE HANGER ASSEMBLY SHALL BE PAINTED PRIOR TO INSTALLING THE NEW LINK PLATES AND PINS. PROPOSED LINK PLATES SHALL BE SHOP PAINTED.
- THE PROTECTION OF WORK AND ENVIRONMENT DURING BLAST CLEANING OF WEBS BEHIND AND AROUND HANGER ASSEMBLIES SHALL BE ACCORDING TO SUBSECTION 715 OF THE STANDARD SPECIFICATIONS. (INCLUDED IN THE BID ITEM "HANGER ASSEMBLY, REMOVE AND ERECT".)
- THE CONTRACTOR SHALL TAKE FIELD MEASUREMENTS OF THE EXISTING HANGER ASSEMBLIES INDICATED ON THE PLANS PRIOR TO THE PREPARATION OF LINK PLATE AND PIN SHOP DRAWINGS.
- WELDING ON EXISTING BEAMS WILL NOT BE PERMITTED.
- THE CONTRACTOR WILL BE FURNISHED WITH PLANS OF THE EXISTING STRUCTURE IF REQUESTED.
- ALTERNATE DESIGNS OF THE TEMPORARY SUPPORT SHALL BE BASED ON LOADS AS FOLLOWS:
514 kN VERTICAL GIRDER LOAD.
- THIS BRIDGE IS COATED WITH LEAD BASED PAINT.
- SEE SUBSECTION 715 OF THE STANDARD SPECIFICATIONS FOR PROTECTION OF WORK AND ENVIRONMENT DURING THE BLAST CLEANING OF STRUCTURES.
- THE COLOR FOR THE URETHANE PROTECTIVE COAT SHALL MATCH COLOR NUMBER 16440 (LIGHT GRAY) OF FEDERAL STANDARD NUMBER 595A.
- THE ENGINEER SHALL INSPECT THE STRUCTURAL STEEL PARTS THAT HAVE BEEN BLAST CLEANED FOR EVIDENCE OF CRACKS OR LOSS OF SECTION DUE TO CORROSION OF MORE THAN 25 PERCENT. SUCH DETERIORATION SHALL BE REPORTED IN WRITING TO THE ENGINEER, STRUCTURES AND ROAD MAINTENANCE OF THE MAINTENANCE DIVISION IN LANSING.
- THE ESTIMATED AREA OF STRUCTURAL STEEL TO BE PAINTED IS 1600 SQUARE METERS.
- SEALANT SHALL BE APPLIED AROUND THE PERIMETER OF BEARING PLATES TO CONCRETE CONTACT SURFACES OVER PIER 2 AFTER CUTTING AWAY ANY PROTRUDING PORTION OF LEAD PLATE.
- THE CONTRACTOR SHALL TAKE NECESSARY MEASURES TO AVOID OVERSPRAY ON ADJACENT SUBSTRUCTURE AND SUPERSTRUCTURE CONCRETE SURFACES. (INCLUDED IN THE BID ITEM "STEEL STRUCTURE, COATING, TYPE 4 (S30)".)

MISCELLANEOUS QUANTITIES	
10 ea	Support, Suspension, Temp
40 ea	Bushing
610 kg	Structural Steel, Furn and Fab, Pin and Hanger
10 ea	Hanger Assembly, Rem and Erect
10 ea	Hanger Assembly, Field Measurement
1 LS	Field Repr of Damaged Coating (S30)
1 LS	Steel Structure, Cleaning, Type 4 (S30)
1 LS	Steel Structure, Coating, Type 4 (S30)
16 m	Beam Plate, Seal Perimeter
*208 m	Protective Shield, Utility Pipe


* PAY ITEM IS FOR PROTECTIVE SHIELD OF THE AMERITECH DUCTS AND THE CONSUMER ENERGY GAS MAIN.

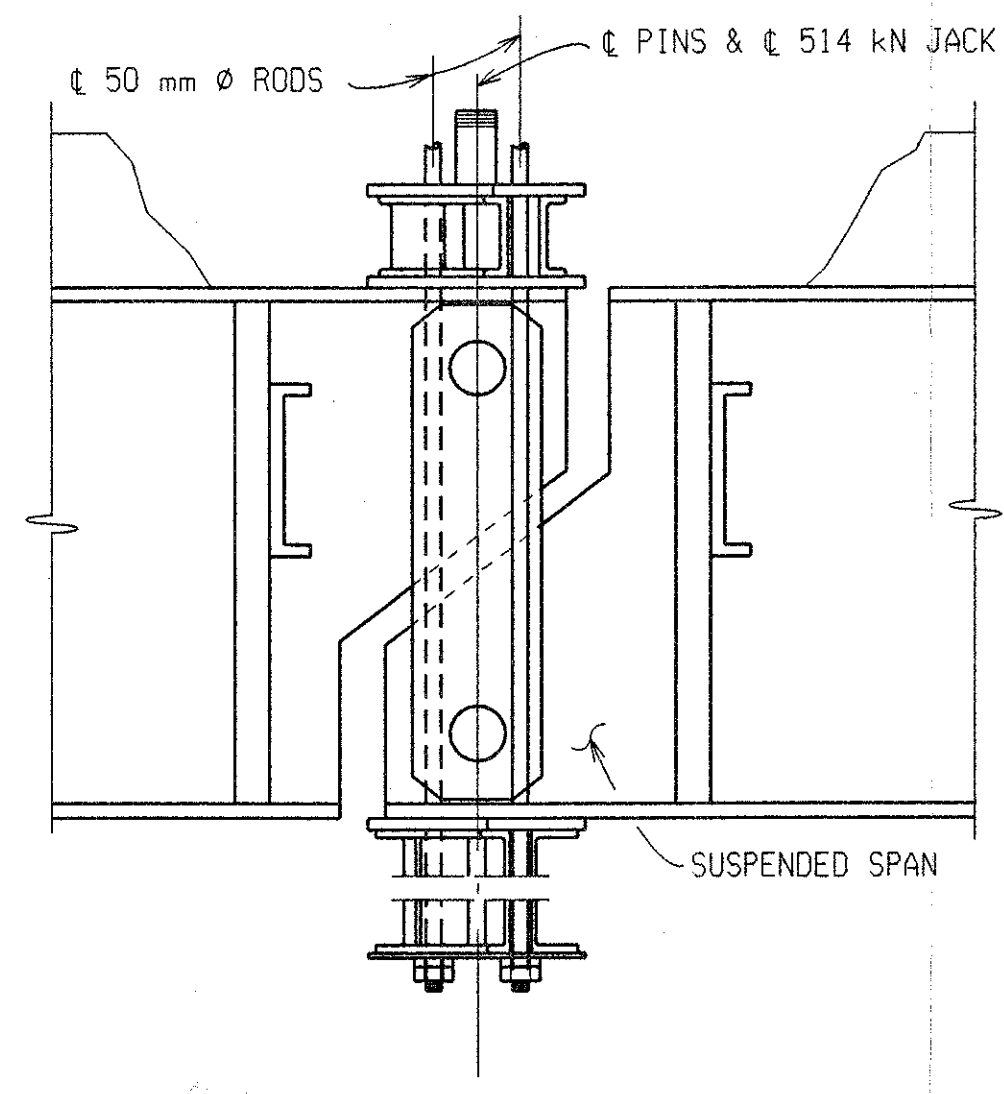

TEMPORARY SUPPORT

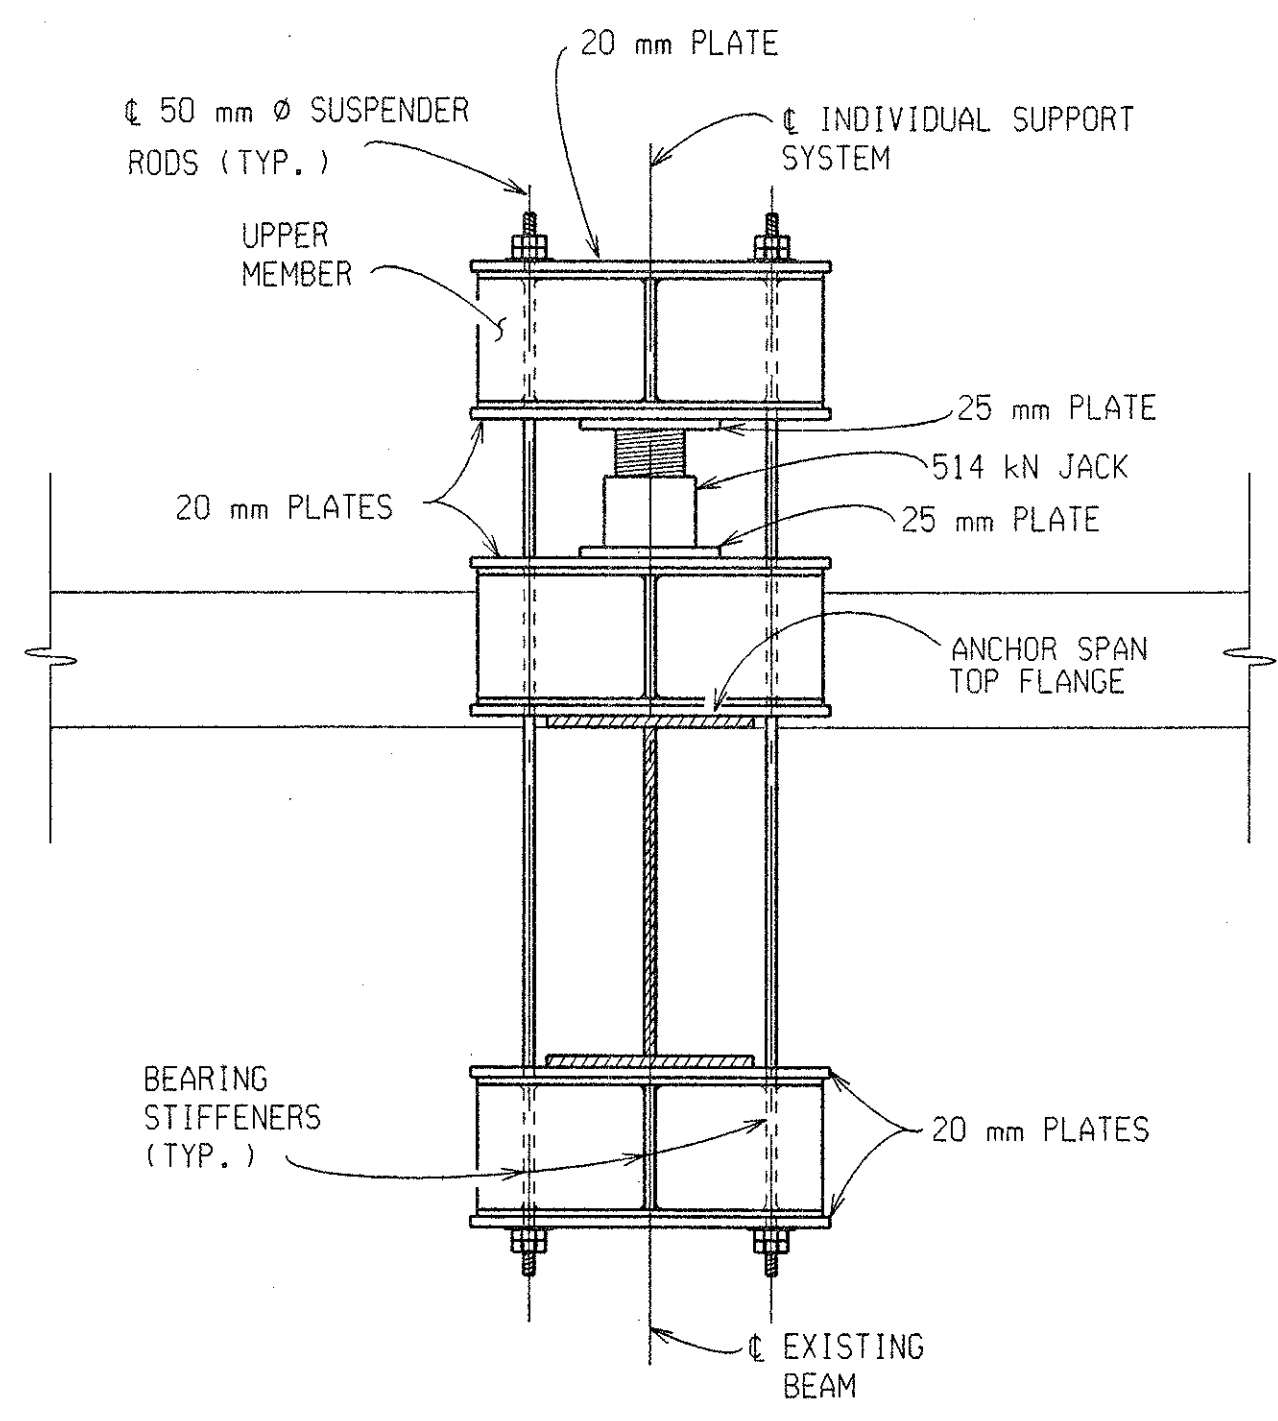

**DECK SECTION B-B
(TYPICAL ALL BEAMS)**

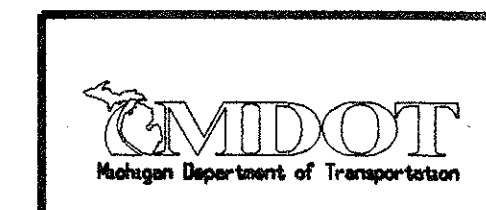


SUSPENSER REPLACEMENT DETAILS				
DATE	CONT. SEC.	JOB NO.	DESIGN UNIT	SHEET
10-13-99	S30 OF 63174	48404A	MAHDAVI	13 OF 22


DATE: 9-21-99 CORRECTED BY: CASLER CHECKED BY: DATE: 4-30-99 DRAWN BY: CASLER FILE NAME: s3063174.pr

CONTROL SECTION S30 OF 63174 JOB NO. 48404A SH. NO. 14


1 2 3 4 5 6 7 8 9 10 11 12 13 14 15 16 17 18 19 20 21 22 23 24 25 26 27 28 29 30 31 32 33 34 35 36 37 38 39 40 41 42 43 44 45 46 47 48 49 50 51 52 53 54 55 56 57 58 59 60 61 62 63

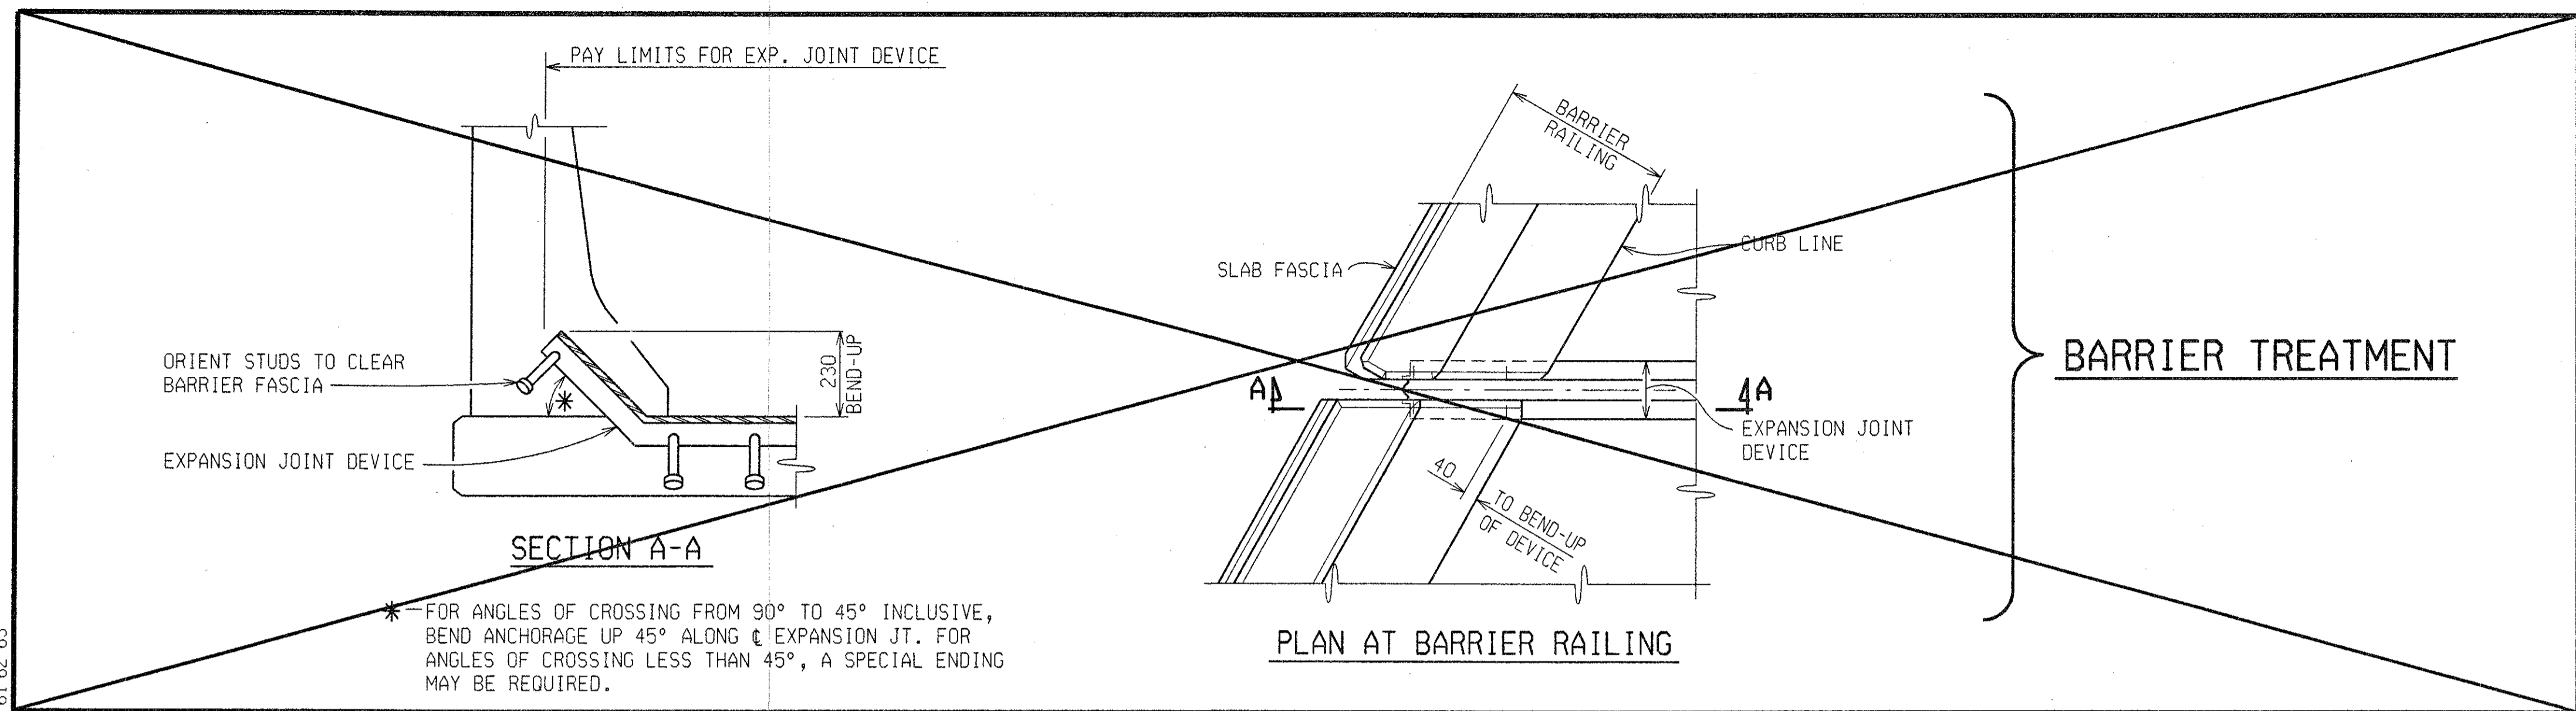

BARRIER TREATMENT

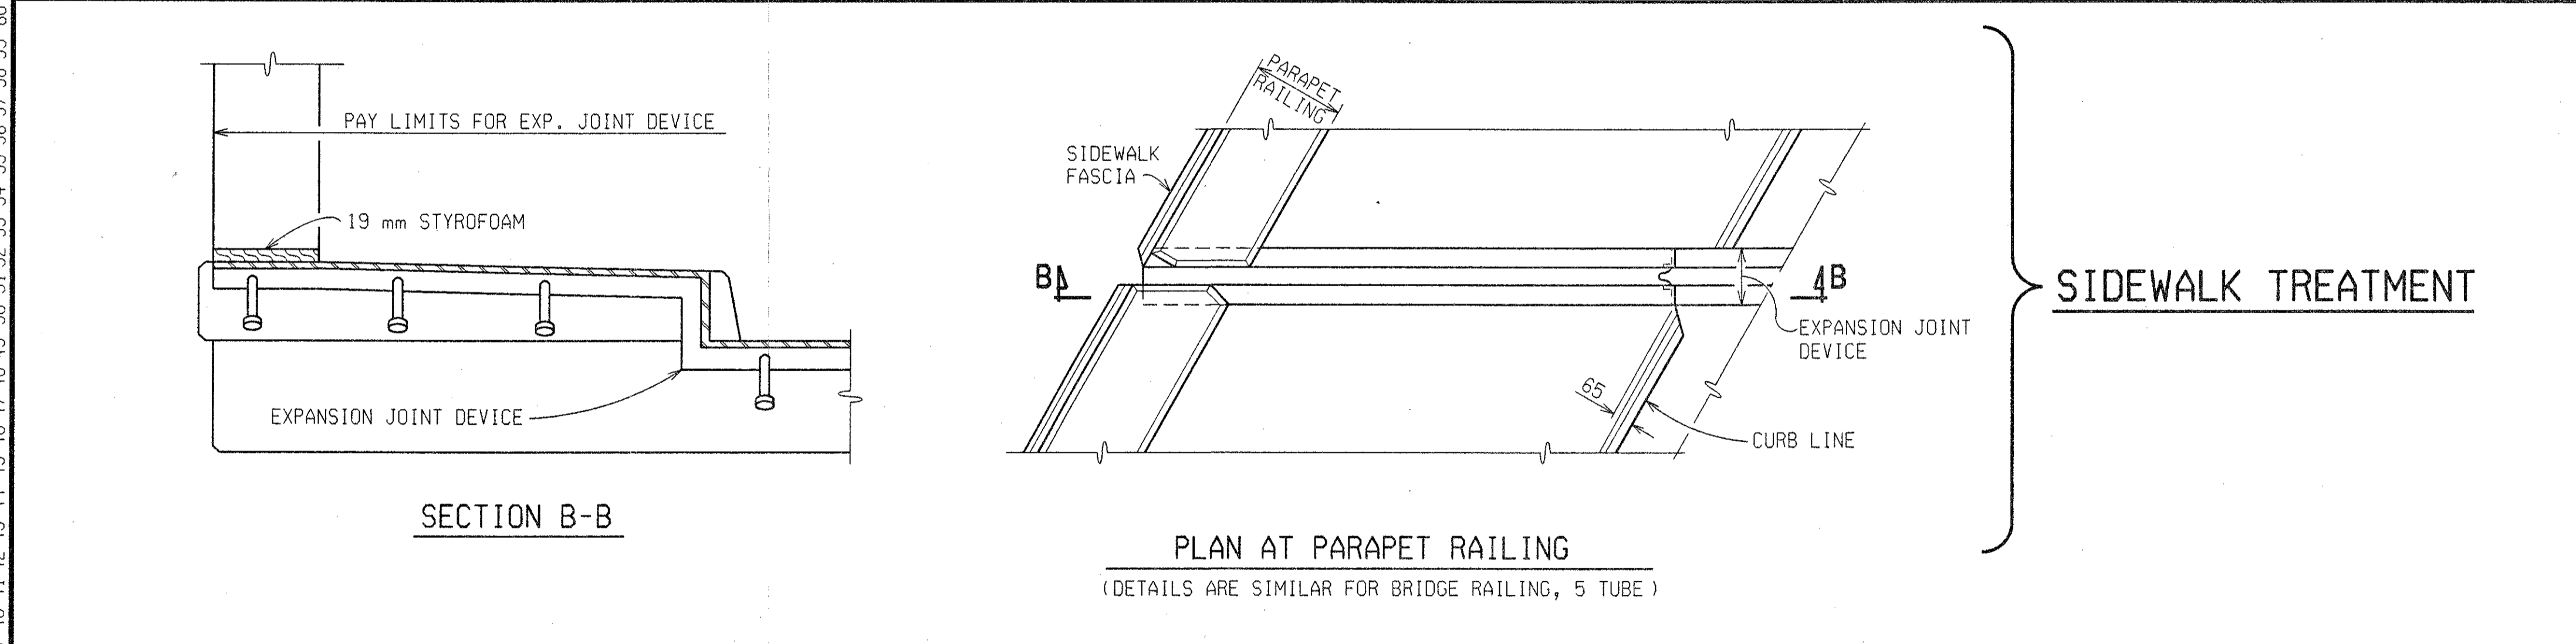

SIDEWALK TREATMENT

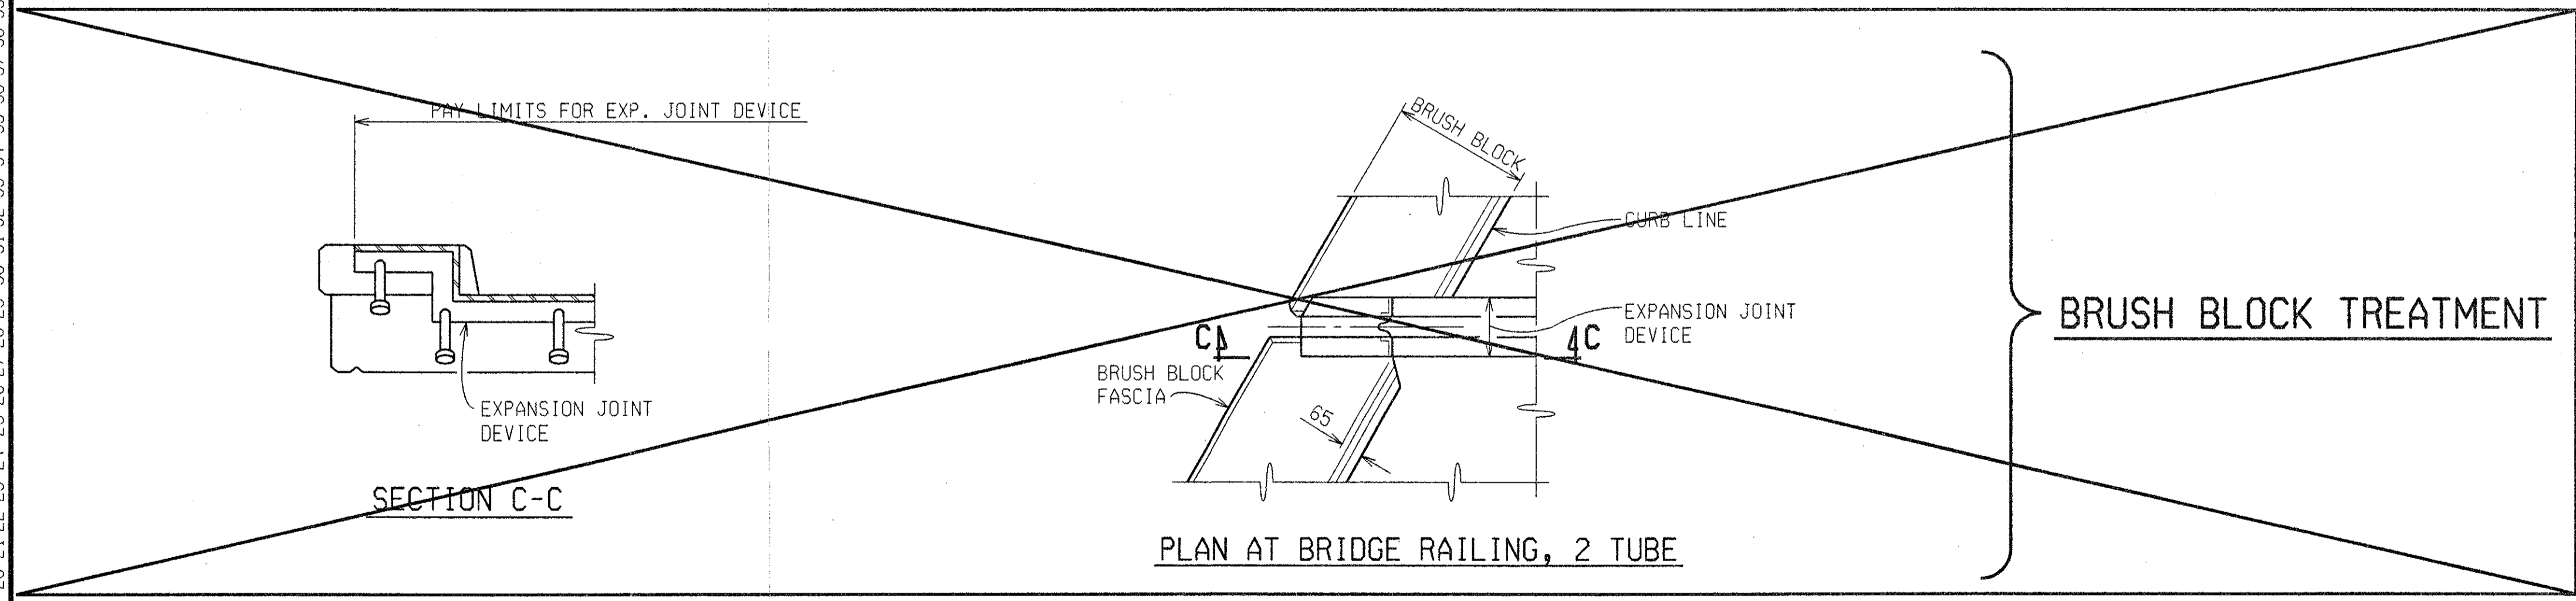

BRUSH BLOCK TREATMENT

REVISIONS			
NO.	DESCRIPTION	DATE	BY

NOTES:

JOINT TYPES:

THE EXPANSION JOINT DEVICE SHALL BE OF A TYPE THAT INCLUDES A CONTINUOUS NEOPRENE (OR EQUIVALENT) SEAL ACROSS THE DECK. UNLESS OTHERWISE NOTED ON THE PLANS, THE CONTRACTOR HAS THE OPTION OF USING ANY OF THE DEVICES LISTED BELOW:

DEVICE	MANUFACTURER
WABO STRIP SEAL	WATSON-BOWMAN & ACME, INC.
PRO-SPAN	FEL-PRO, INC.
STEELFLEX-SSA2	D.S. BROWN
STEELFLEX-SSCM	D.S. BROWN
STEELFLEX-RS	D.S. BROWN
DNFLEX 40 SS	STRUCTURAL RUBBER PRODUCTS CO.
STRUPCO 40DL	STRUCTURAL RUBBER PRODUCTS CO.

THE MODEL OF THE JOINT TYPE SELECTED SHALL BE SUITABLE TO ACCOMMODATE THE TOTAL MOVEMENT NOTED ON THE PLANS.

COMPLETE WORKING DRAWINGS OF ALL DETAILS OF FABRICATION OF THE EXPANSION JOINT DEVICE SHALL BE SUBMITTED FOR REVIEW IN ACCORDANCE WITH STANDARD SPECIFICATION 104.02. THIS REQUIREMENT IS WAIVED FOR EXPANSION JOINT DEVICES FOR WHICH A SET OF STANDARD INSTALLATION DETAILS HAS BEEN APPROVED. STANDARD INSTALLATION DETAILS CAN BE OBTAINED FROM THE DESIGN DIVISION.

FABRICATION AND INSTALLATION:

THE EXPANSION JOINT SHALL BE SHOP FABRICATED TO CONFORM TO THE CONTOUR OF THE BRIDGE DECK, BARRIERS, ETC. IT SHALL BE INSTALLED IN ACCORDANCE WITH MANUFACTURER'S RECOMMENDATIONS SUBJECT TO NOTES HEREIN AND THE APPROVAL OF THE ENGINEER.

THE TOP OF THE ELASTOMERIC JOINT DEVICE SHALL BE SET 3 - 6 mm BELOW THE CONCRETE SLAB (PAVEMENT) WITH A TOLERANCE OF ± 3 mm.

THE STEEL ANCHORAGE FOR STRIP SEAL GLANDS SHALL BE HOT DIP GALVANIZED IN ACCORDANCE WITH SUBSECTION 707.16 OF THE STANDARD SPECIFICATIONS.

THE PRO-SPAN DEVICE MUST INCORPORATE A CAST-IN-PLACE STEEL SEAT.

THE AREA OF THE STEEL ANCHORAGE AND SEALING GLAND WHICH WILL BE IN CONTACT WITH A SEALANT, OR LUBRICANT-ADHESIVE SHALL BE CLEANED WITH TOLUENE OR OTHER APPROVED SOLVENT.

WHERE THE SEALING GLAND IS LOCKED INTO A STEEL ANCHORAGE, A LUBRICANT-ADHESIVE CONFORMING TO STANDARD SPECIFICATION 914.4-E SHALL BE REQUIRED BETWEEN THE SEAL AND STEEL ANCHORAGE.

ALL BOLT WELL CAVITIES SHALL BE FILLED WITH AN APPROVED FLEXIBLE EPOXY OR A SEALANT CONFORMING TO FEDERAL SPECIFICATION TT-S-00230C.

IN THE EVENT THAT THE CONSTRUCTION SEQUENCE REQUIRES SPLICING THE SEALING GLAND, IT SHALL BE SPLICED BY AN APPROVED METHOD (SUCH AS COLD VULCANIZATION) BY A TRAINED REPRESENTATIVE OF THE MANUFACTURER.

DETAILS AT CURBS OR BARRIERS:


THE DETAILS ON THIS SHEET SHOW AN APPROVED MEANS OF TERMINATING THE EXPANSION JOINT DEVICE AT CURBS OR BARRIERS. VARIATIONS OR ALTERNATIVE SCHEMES WILL BE CONSIDERED AND MAY BE USED IF APPROVED BY THE ENGINEER.

MATERIALS:

THE COST OF ALL MATERIALS AND LABOR REQUIRED FOR PROPER INSTALLATION OF THE EXPANSION JOINT AND THE TERMINAL ASSEMBLIES AT THE CURBS, SIDEWALKS, OR BARRIERS IS INCLUDED IN THE PAYMENT FOR THE EXPANSION JOINT DEVICE.

ITEM	QUANTITY	UNIT	AMOUNT
EXPANSION JOINT DEVICE	22	m	22

STRUCTURE NUMBER	ANGLE OF CROSSING TO NEAREST 10°	LOCATION OF JOINT	MIN. TOT. TRAVEL ALONG CENTERLINE OF BRIDGE	REQUIRED LENGTH OF EXPANSION JOINT DEVICE
S30	80	PIER 1	51 mm	21.2 m

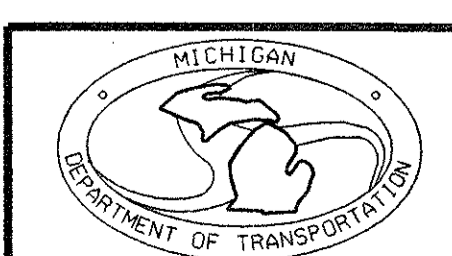

EXPANSION JOINT DETAILS

DATE	CONT. SEC.	JOB NO.	DESIGN UNIT	SHEET
10-13-99	S30 OF 63174	48404A	MAHDAVI	14 OF 22

EJ3T (11-17-97)

DATE: 07-16-96 CORRECTED BY: VZ/SPB CHECKED BY: CASLER DRAWN BY: CASLER FILE NAME: s3063174.ej

1 2 3 4 5 6 7 8 9 10 11 12 13 14 15 16 17 18 19 20 21 22 23 24 25 26 27 28 29 30 31 32 33 34 35 36 37 38 39 40 41 42 43 44 45 46 47 48 49 50 51 52 53 54 55 56 57 58 59 60 61 62 63

REVISIONS			
NO.	DESCRIPTION	DATE	BY

SUPERSTRUCTURE CONCRETE NIGHT CASTING QUANTITIES		SUPERSTRUCTURE CONCRETE QUANTITIES	
POUR	CUBIC METERS	POUR	CUBIC METERS
A	147.5	C	13.7
B	118.5	D	11.3
E	13.7	E	13.7
F	11.3	F	11.3
TOTAL CONC: 266 CUBIC METERS		TOTAL CONC: 50 CUBIC METERS	

MISCELLANEOUS QUANTITIES	
105 m	Bridge Railing, Aesthetic Parapet Tube, Modified
30 m ²	Joint Waterproofing
152 m ²	Top Flanges and Beam Ends, Clean and Prime
50 m ³	Superstructure Conc
1 LS	Superstructure Conc. Form, Finish, and Cure (S30)
266 m ³	Superstructure Conc. Night Casting
1 LS	Superstructure Conc. Form, Finish, and Cure, Night Casting (S30)
1 LS	Shear Developers (S30)
1 LS	Bridge Lighting, Furnish and Remove (S30)
266 m ³	Bridge Lighting, Operate and Maintain
157 m	Conduit, 75 mm
270 m ²	Conc Surface Sealer
210 ea	Conc insert, Placed

NOTES:

N.S. DENOTES NEAR SIDE.

FOR BRIDGE RAILING, ANCHORAGE FOR GUARDRAIL AND NAME PLATE MOUNTING DETAILS, SEE STANDARD PLAN B-25-SERIES. FOR DETAILS OF NAME PLATES, MOLDINGS AND BEVELS, SEE STANDARD PLAN B-103-SERIES.

BRIDGE RAILING, AESTHETIC PARAPET TUBE, MODIFIED SHALL BE IN ACCORDANCE WITH THE STANDARD PLAN B-25 EXCEPT FOR THE ADDITION OF FRACTURE FIN RUSTIFICATION ON THE BACK SIDE OF THE RAILING AS DETAILED ON THE PLANS.

FOR NAME PLATE LOCATION, SEE GENERAL PLAN OF STRUCTURE SHEET.

FOR DETAILS OF LIGHT STANDARD ANCHOR BOLT ASSEMBLIES, SEE STANDARD PLAN B-103-SERIES.

EDGE OR *GROOVE* DENOTES EDGING OR GROOVING WITH AN APPROVED TOOL.

ALPHABETICAL DESIGNATION OF DECK POURS IS NOT TO BE CONSTRUED AS A POUR SEQUENCE.

NO PORTION OF THE DECK FORMWORK SHALL ENCRDACH ON THE EXISTING UNDERCLEARANCE.

THE UTILITY COMPANY SHALL BE NOTIFIED ONE WEEK IN ADVANCE OF THE TIME OF INSTALLATION OF THE DUCTS IN THE SIDEWALK.

WHERE CAST-IN-ANCHORAGE IS USED FOR EXPANSION JOINT DEVICES, IT IS RECOMMENDED THAT THE PLACING OF DECK CONCRETE PROGRESS TOWARD THE JOINT SO THAT THE EFFECTS OF DEAD LOAD DEFLECTION WILL OCCUR BEFORE CONCRETE IS PLACED AT THE ANCHORAGE.

THE LIGHT STANDARD ANCHOR BOLT ASSEMBLIES ARE INCLUDED IN THE PAYMENT FOR "BRIDGE RAILING, AESTHETIC PARAPET TUBE, MODIFIED".

THIS DECK POUR IS DESIGNATED A NIGHT POUR, AND THEREFORE SUBJECT TO THE RESTRICTIONS OF SECTION 706.03 J OF THE STANDARD SPECIFICATIONS.


METAL STAY IN PLACE FORMS ARE OPTIONAL.

IF STAY IN PLACE METAL FORMS ARE TO BE USED, THE CONTRACTOR MAY OMIT THE STYROFOAM FROM THE CORRUGATIONS AND FILL THE FORMS FULL DEPTH. THE EXTRA CONCRETE REQUIRED TO FILL THE CORRUGATIONS WILL NOT BE PAID FOR.

ALL CONCRETE SURFACES OF THE BRIDGE RAILING, THE DECK FASCIAS, AND THE OUTSIDE BOTTOM OF DECK TO FASCIA BEAMS SHALL BE COATED WITH CONCRETE SURFACE SEALER (SEE SPECIAL PROVISION).


CONCRETE INSERTS SHALL BE FURNISHED BY AMERITECH AND INSTALLED BY THE CONTRACTOR. ALL MATERIAL NECESSARY FOR REINSTALLATION OF THE DUCTS SHALL BE PROVIDED BY THE UTILITY COMPANY.

THE CONTRACTOR SHALL VERIFY THE LOCATION OF THE INSERTS PRIOR TO INSTALLING THE INSERTS IN THE DECK (SEE SHEET # 12 FOR INFORMATION).

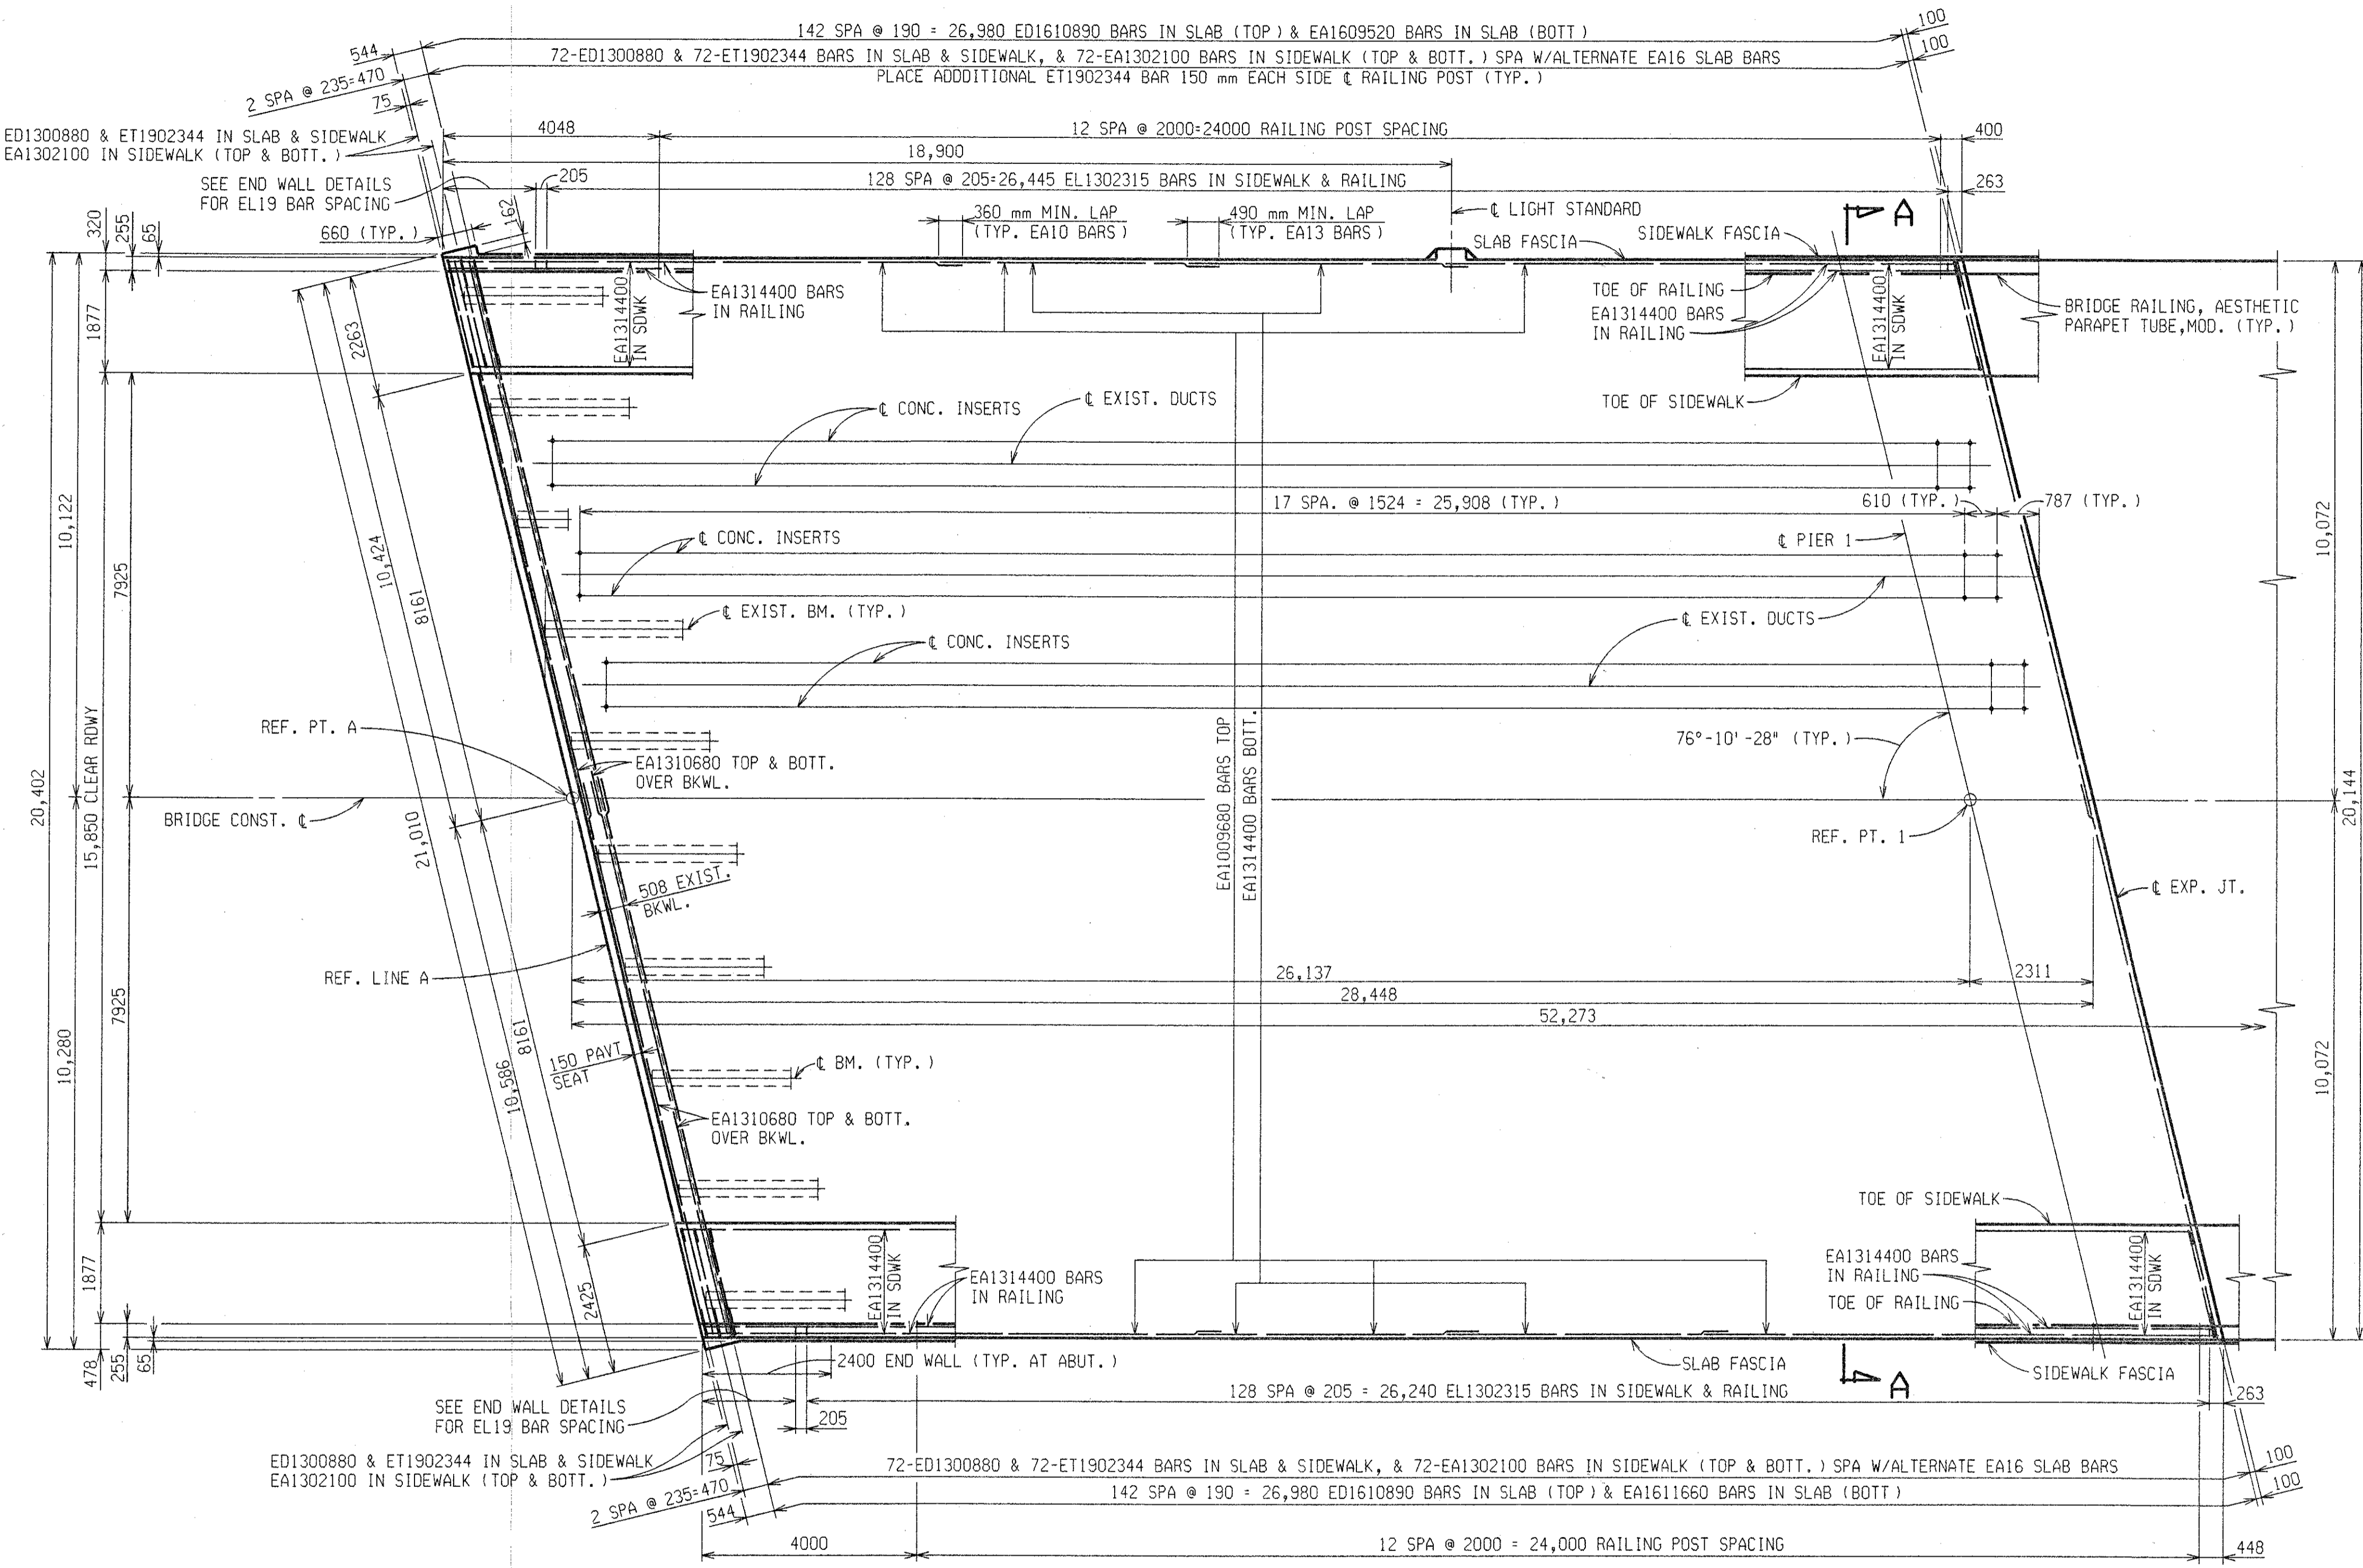


PLAN-SPAN 1

ADJUST REINFORCEMENT TO PERMIT PLACEMENT OF RAILING & FENCE POST ANCHORAGES & LIGHT STANDARDS.

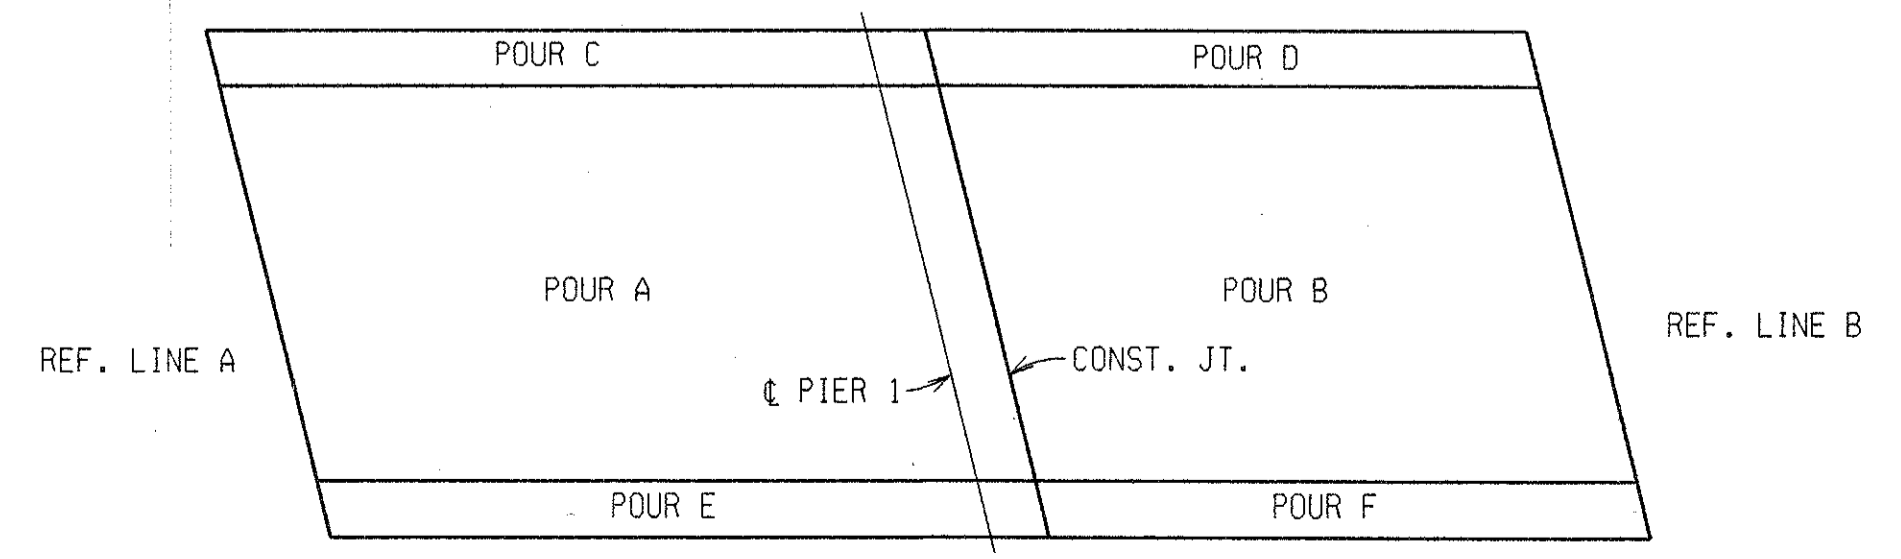


POUR DIAGRAM

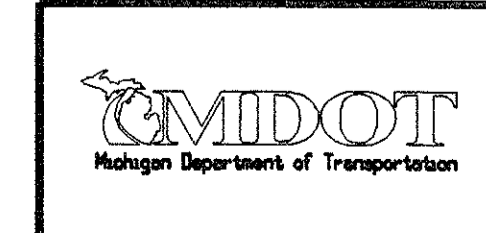


SUPERSTRUCTURE DETAILS				
DATE	CONT. SEC.	JOB NO.	DESIGN UNIT	SHEET
10-13-99	S30 OF 63174	48404A	MAHDAVI	15 OF 22

DATE: _____ CORRECTED BY: _____ CHECKED BY: _____ DATE: 9-3-99 DRAWN BY: CASLER FILE NAME: s3063174.dk

1 2 3 4 5 6 7 8 9 10 11 12 13 14 15 16 17 18 19 20 21 22 23 24 25 26 27 28 29 30 31 32 33 34 35 36 37 38 39 40 41 42 43 44 45 46 47 48 49 50 51 52 53 54 55 56 57 58 59 60 61 62 63

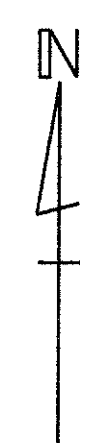

REVISIONS			
NO.	DESCRIPTION	DATE	BY

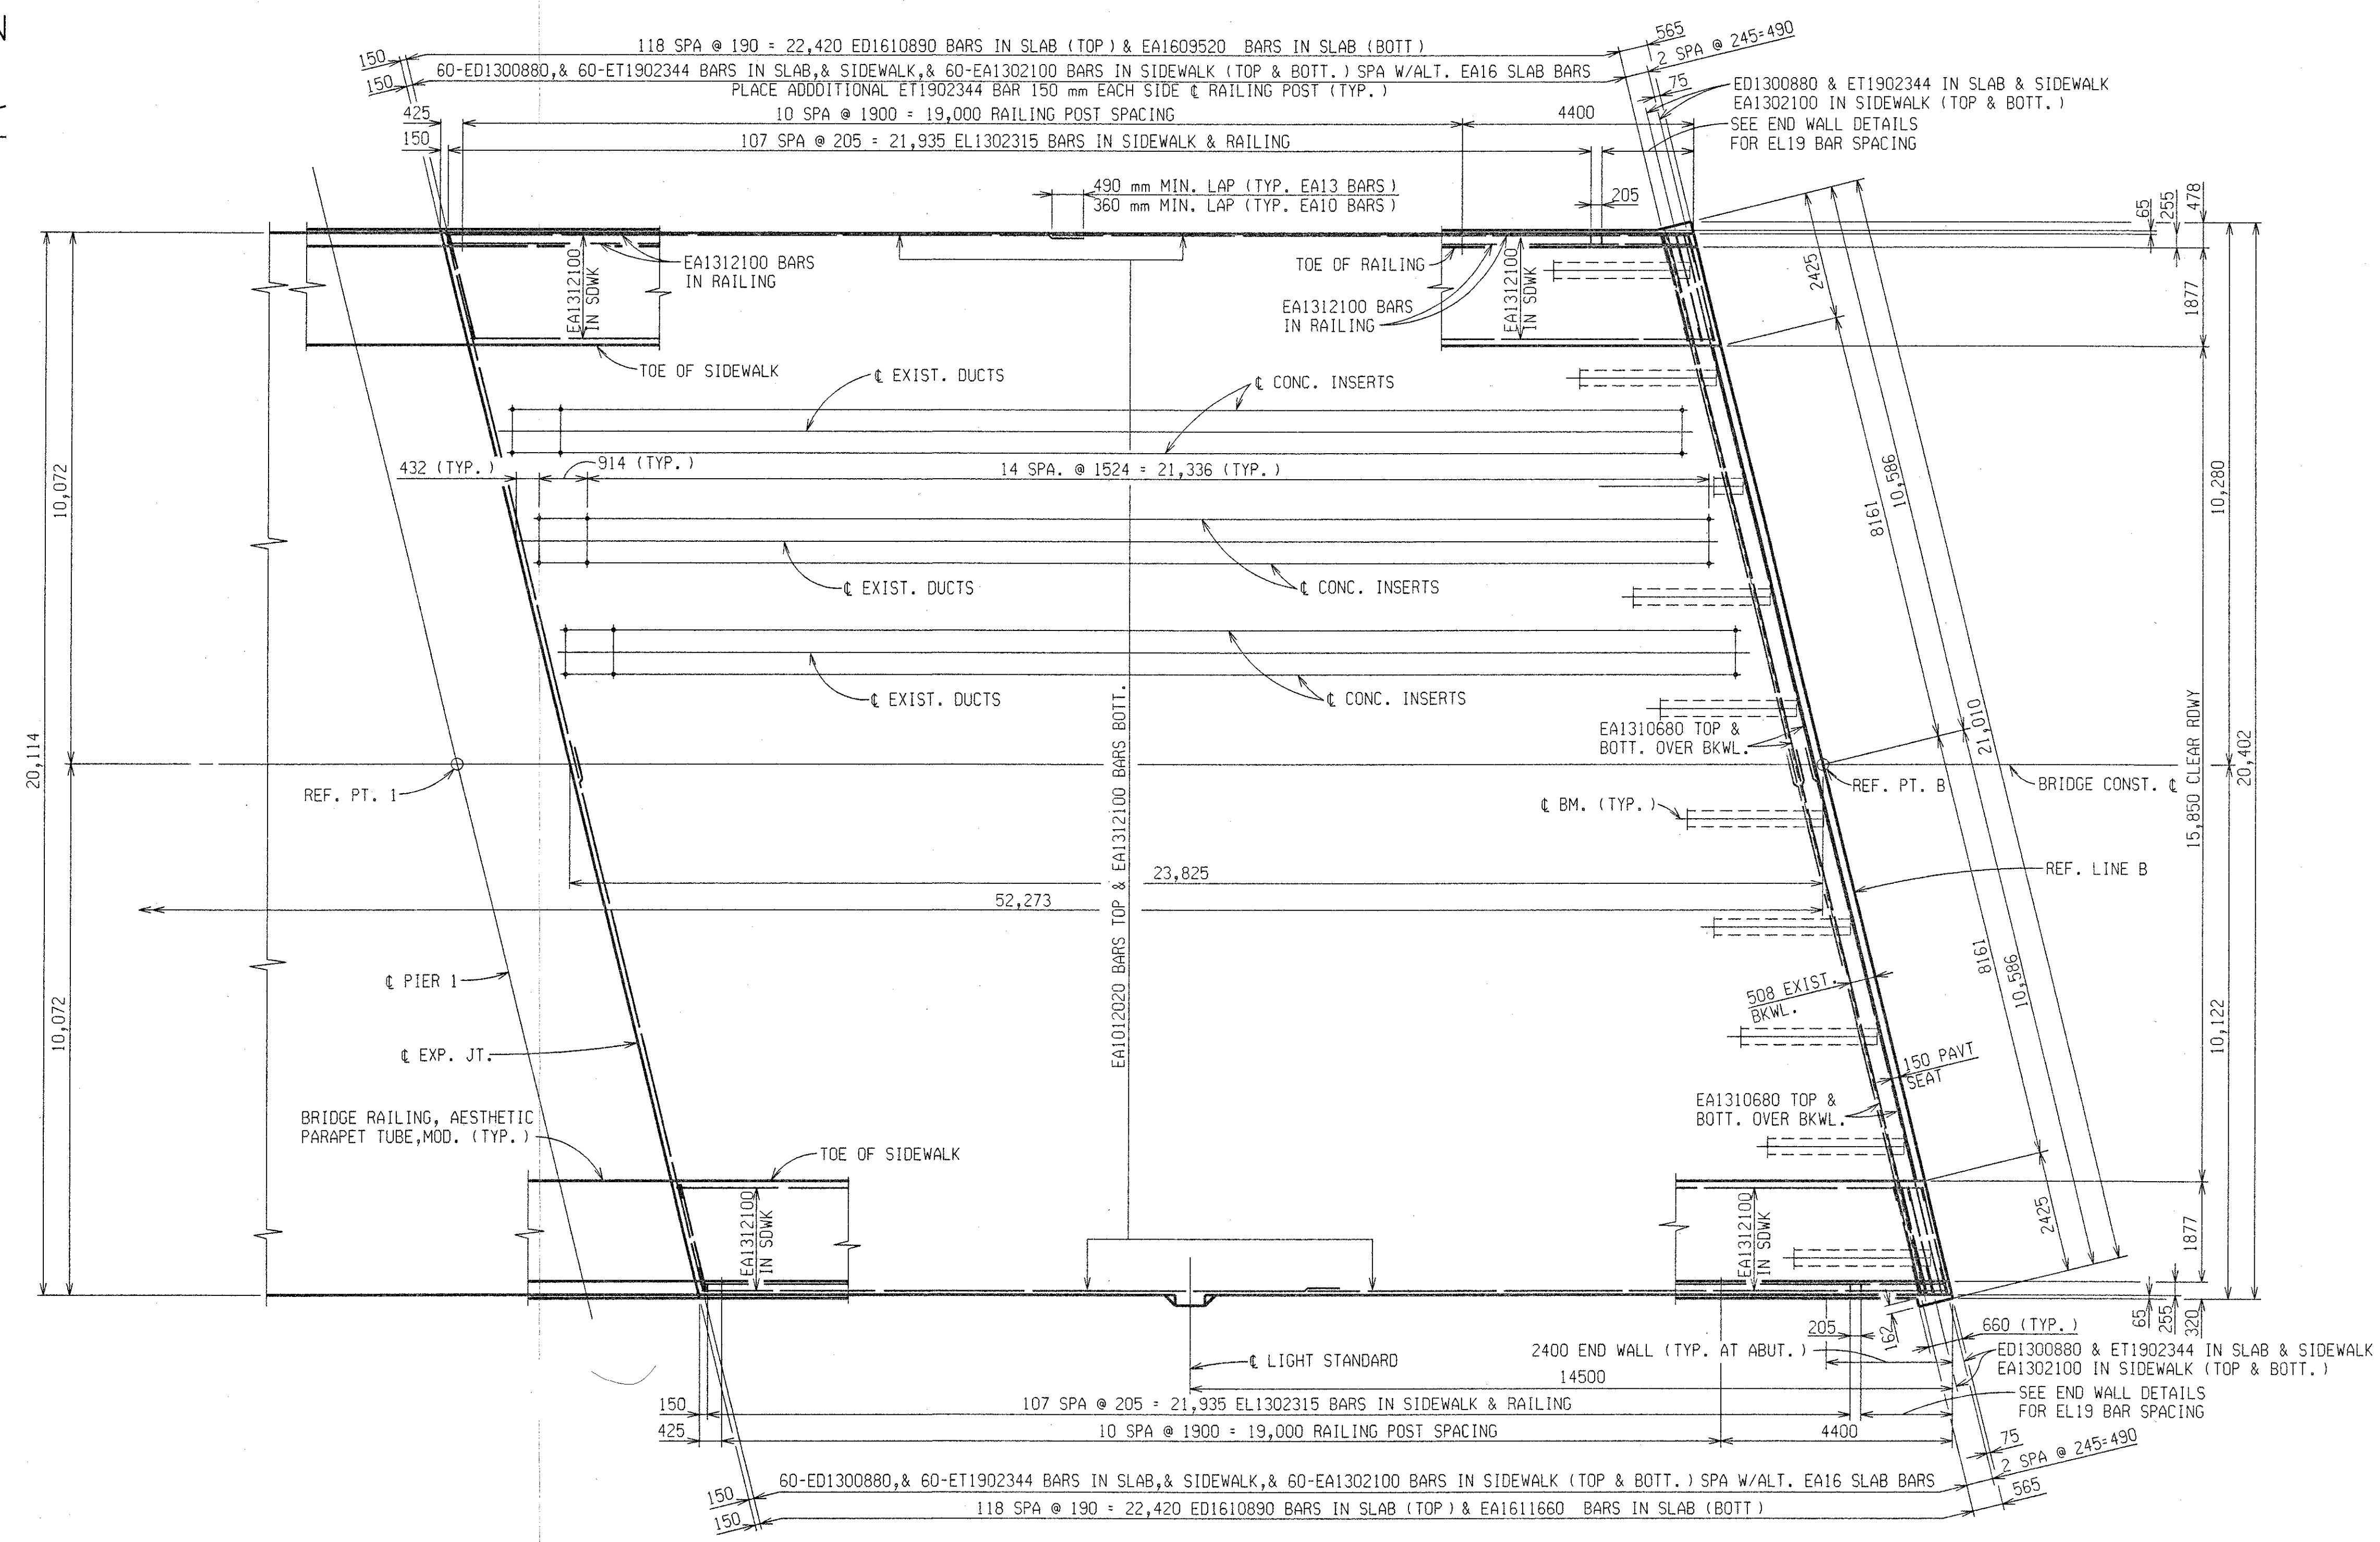


PLAN-SPAN 2

ADJUST REINFORCEMENT TO PERMIT PLACEMENT OF RAILING & FENCE POST ANCHORAGES & LIGHT STANDARDS.


DATE: _____ CORRECTED BY: _____ DATE: _____ CHECKED BY: _____ DATE: _____ DRAWN BY: CASLER

SUPERSTRUCTURE DETAILS				
DATE	CONT. SEC.	JOB NO.	DESIGN UNIT	SHEET
10-13-99	S30 OF 63174	48404A	MAHDAVI	16 OF 22

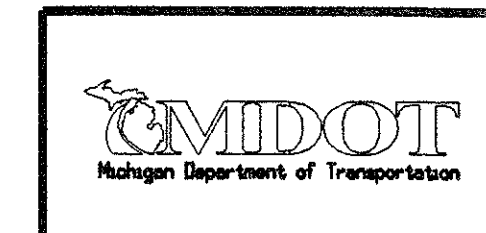


CONTROL SECTION S30 OF 63174 JOB NO. 48404A SHEET NO. 17


REVISIONS			
NO.	DESCRIPTION	DATE	BY

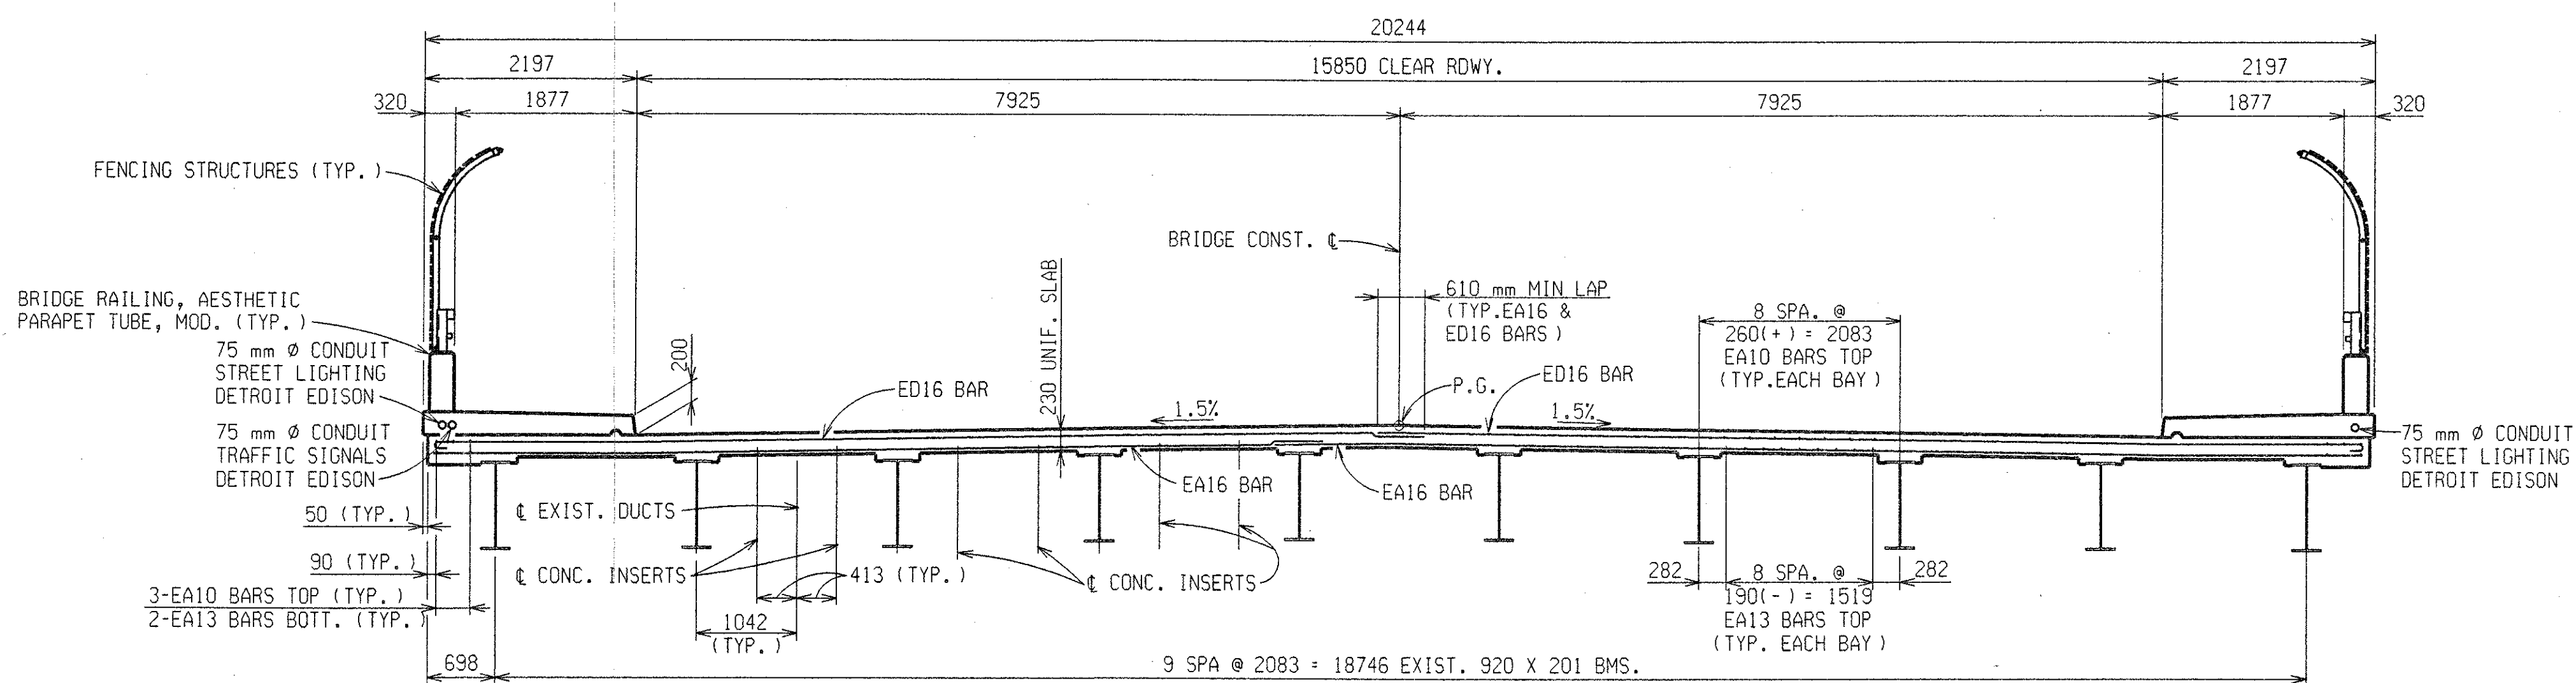


SECTION A-A

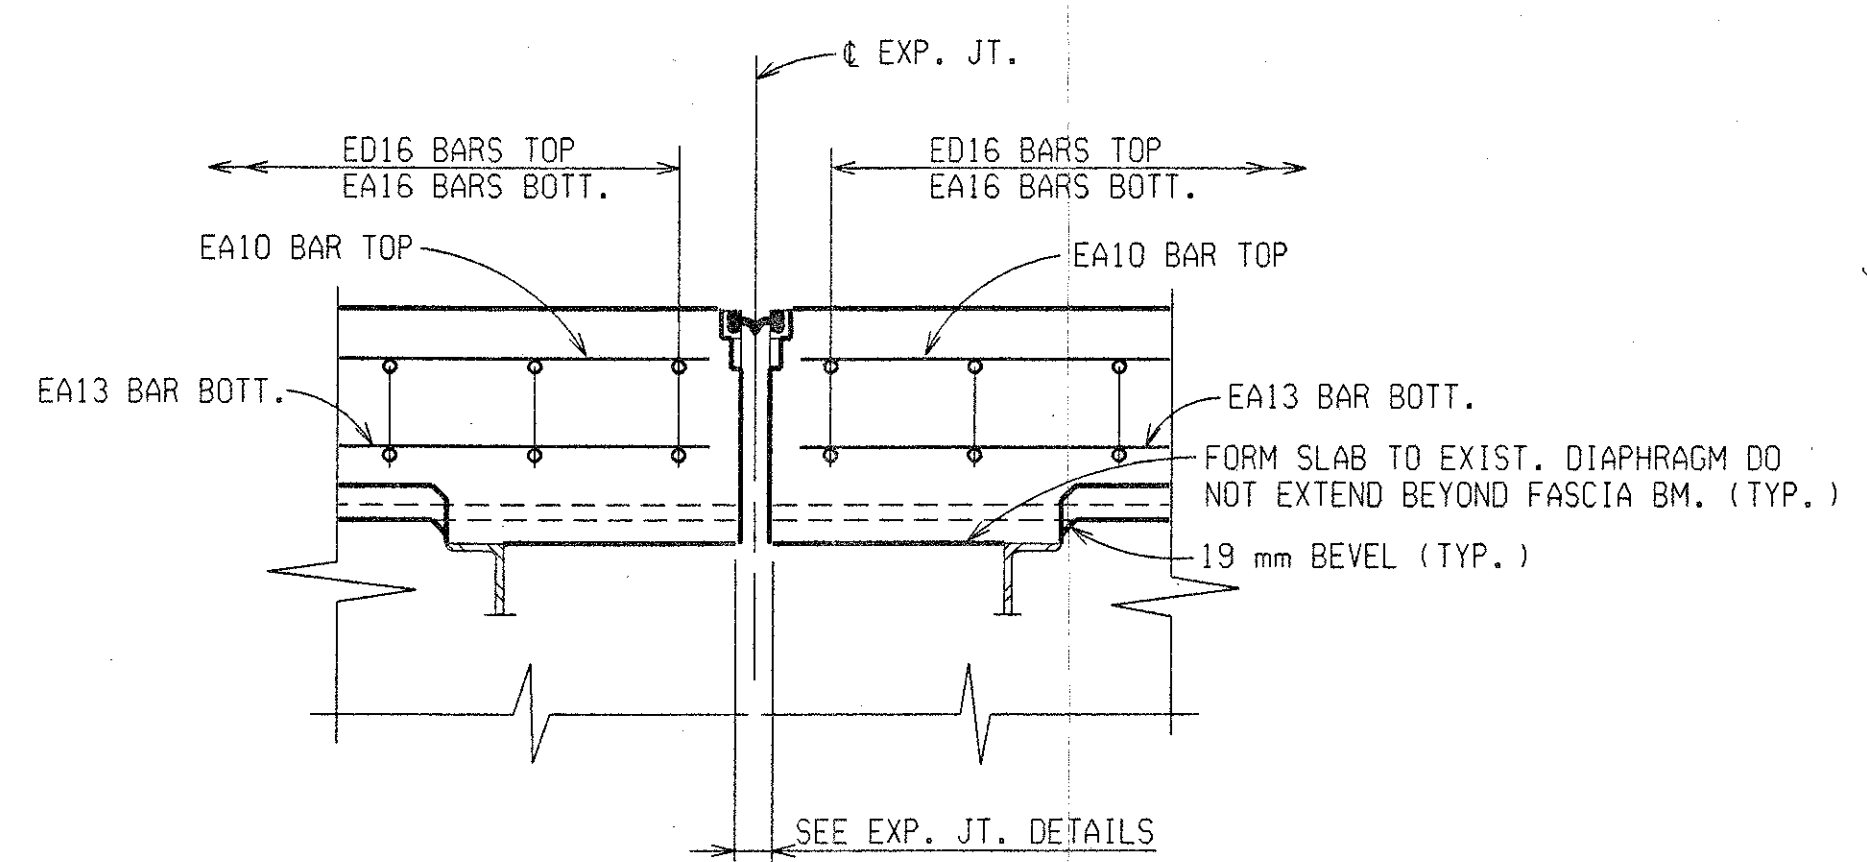


SECTION THRU EXPANSION JOINT

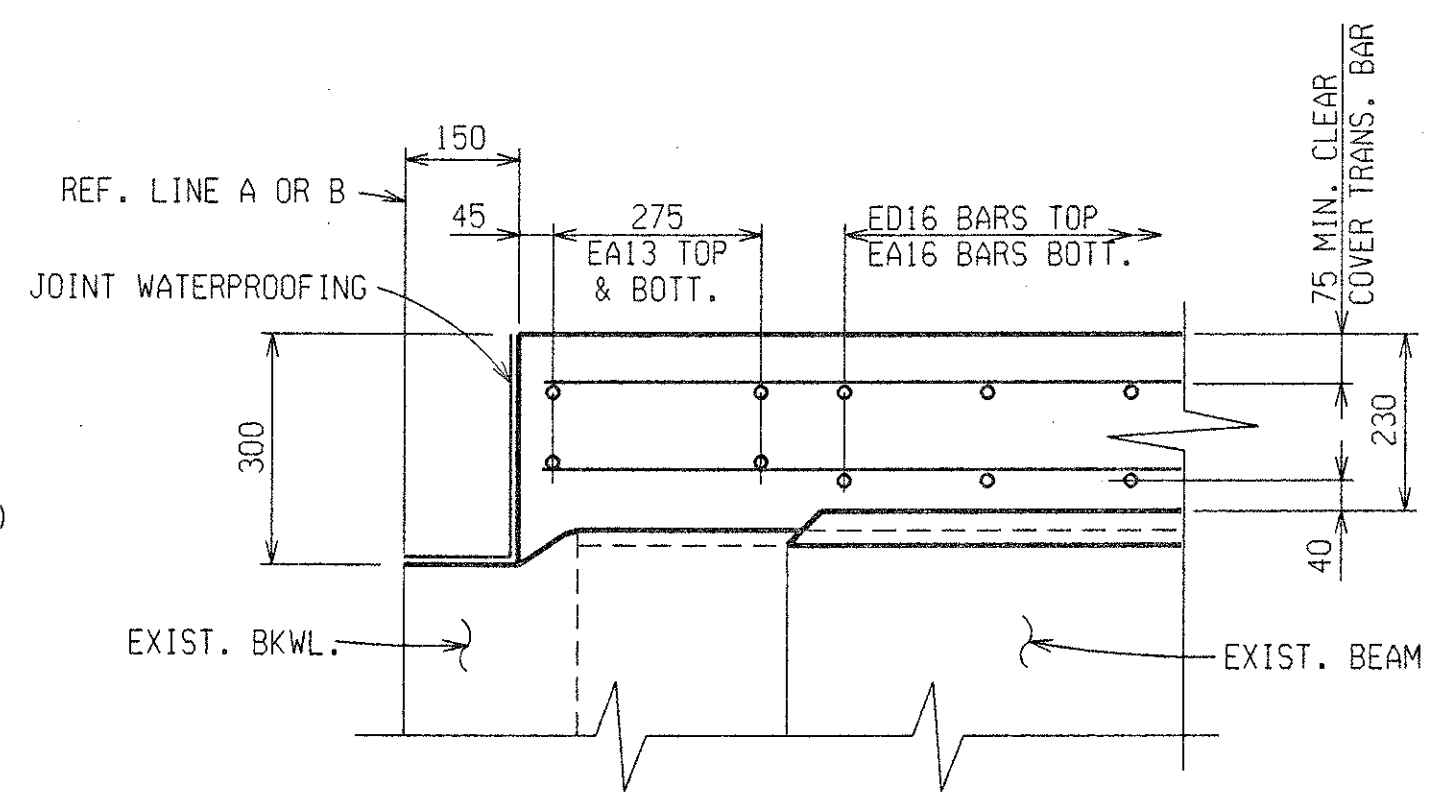


SECTION THRU BACKWALL

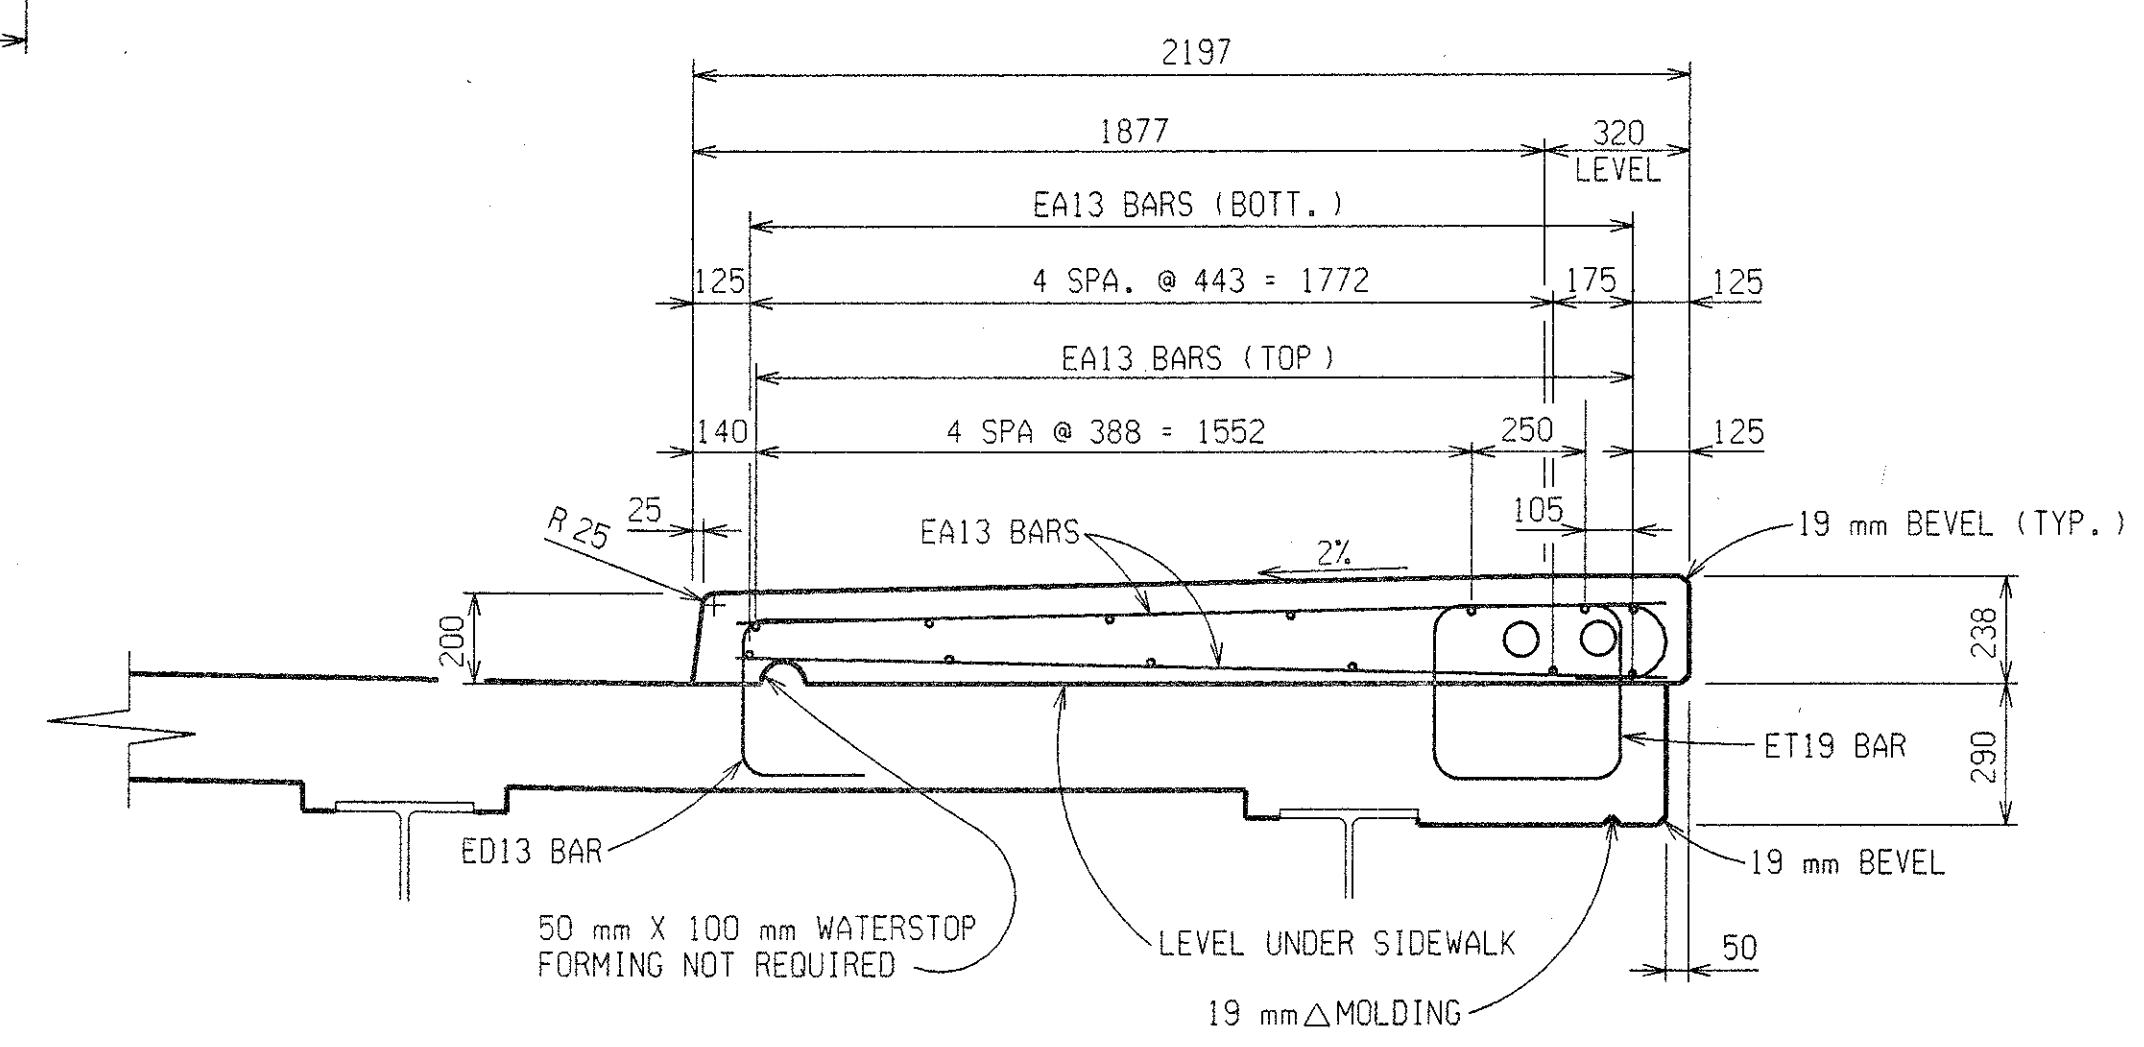


SECTION THRU SIDEWALK

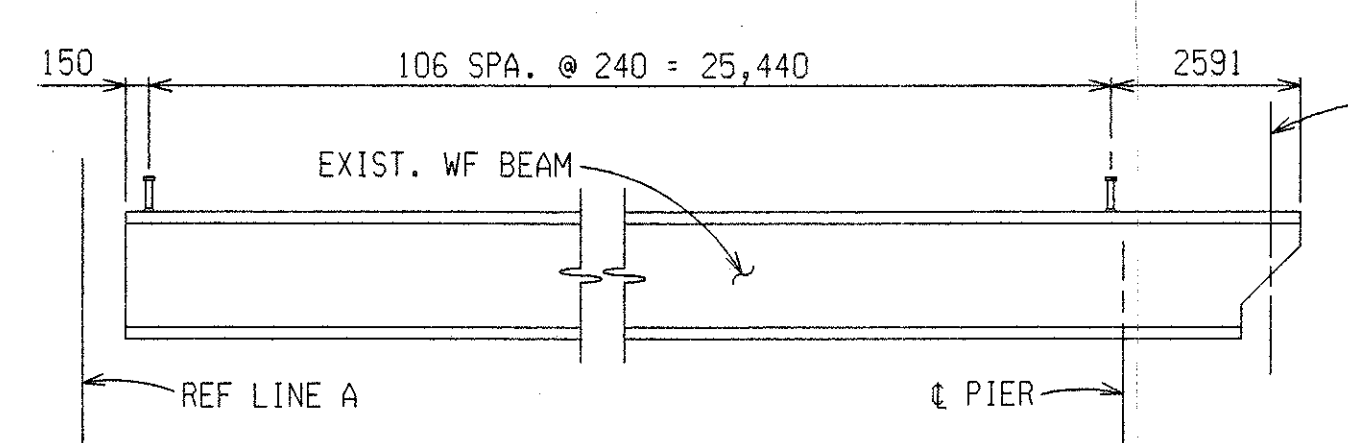


BEAM ELEVATION SPAN 1
SHOWING STUD SPACING

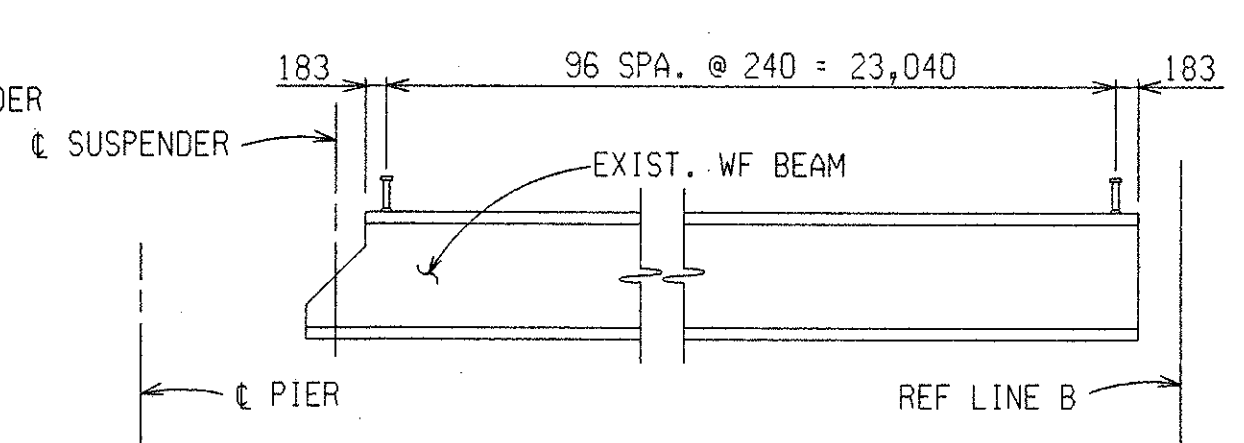


BEAM ELEVATION SPAN 2
SHOWING STUD SPACING

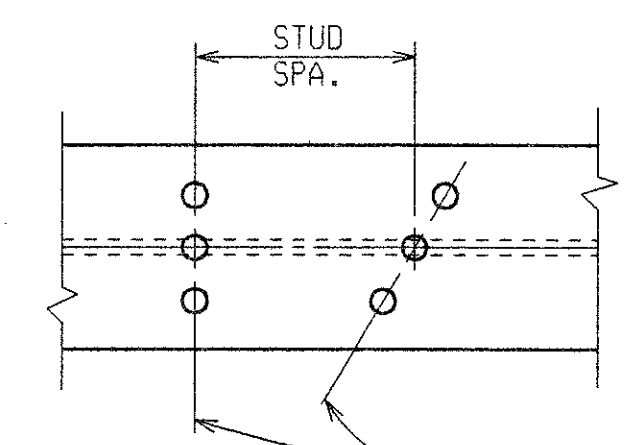

PLAN

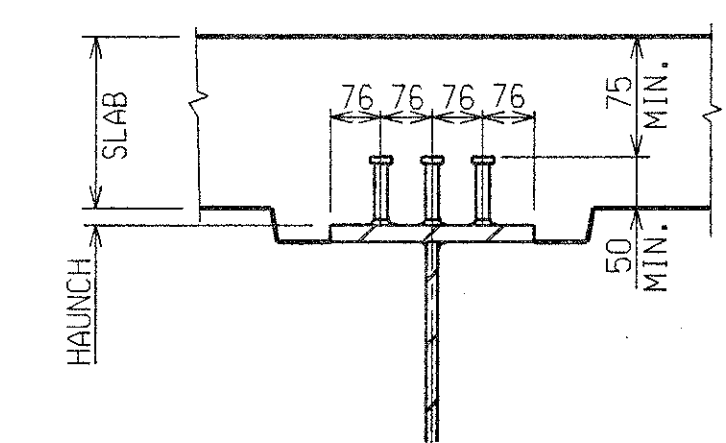

SECTION

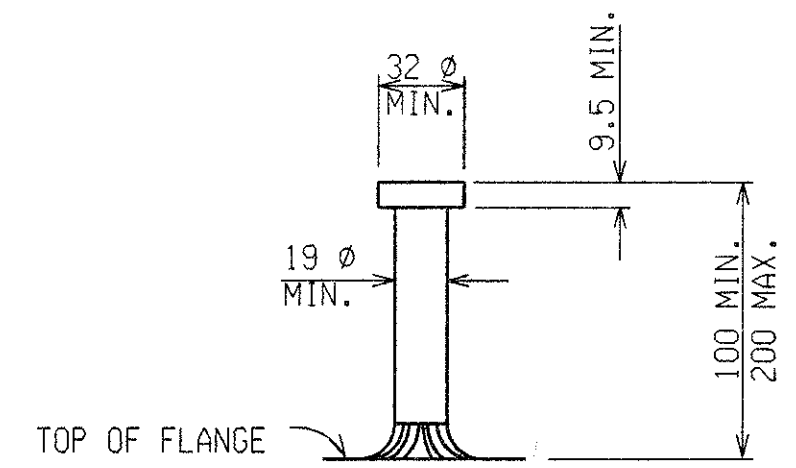

STUD DETAIL

ROWS OF STUDS SHALL BE SET PARALLEL TO TRANSVERSE REINFORCEMENT.

STUD SHEAR DEVELOPER DETAILS











SUPERSTRUCTURE DETAILS				
DATE	CONT. SEC.	JOB NO.	DESIGN UNIT	SHEET
10-13-99	S30 OF 63174	48404A	MAHDAVI	17 OF 22

1 2 3 4 5 6 7 8 9 10 11 12 13 14 15 16 17 18 19 20 21 22 23 24 25 26 27 28 29 30 31 32 33 34 35 36 37 38 39 40 41 42 43 44 45 46 47 48 49 50 51 52 53 54 55 56 57 58 59 60 61 62 63

DRAWN BY: CASLER CHECKED BY: DATE: 9-3-99 CORRECTED BY: DATE: FILE NAME: s3063174.dwg

1 2 3 4 5 6 7 8 9 10 11 12 13 14 15 16 17 18 19 20 21 22 23 24 25 26 27 28 29 30 31 32 33 34 35 36 37 38 39 40 41 42 43 44 45 46 47 48 49 50 51 52 53 54 55 56 57 58 59 60 61 62 63

REVISIONS			
NO.	DESCRIPTION	DATE	BY

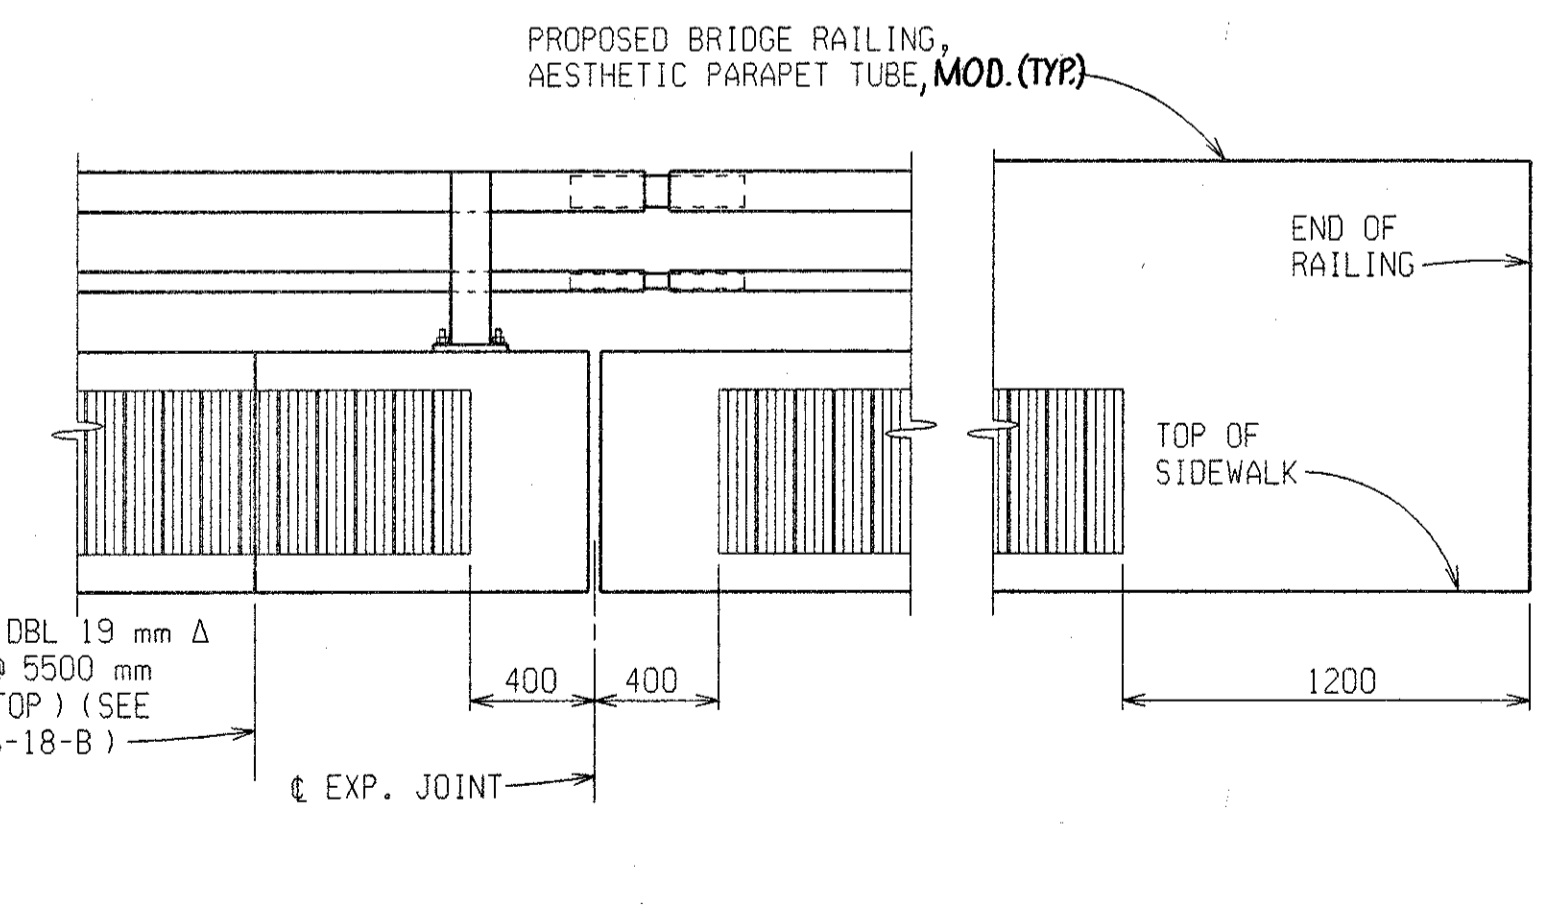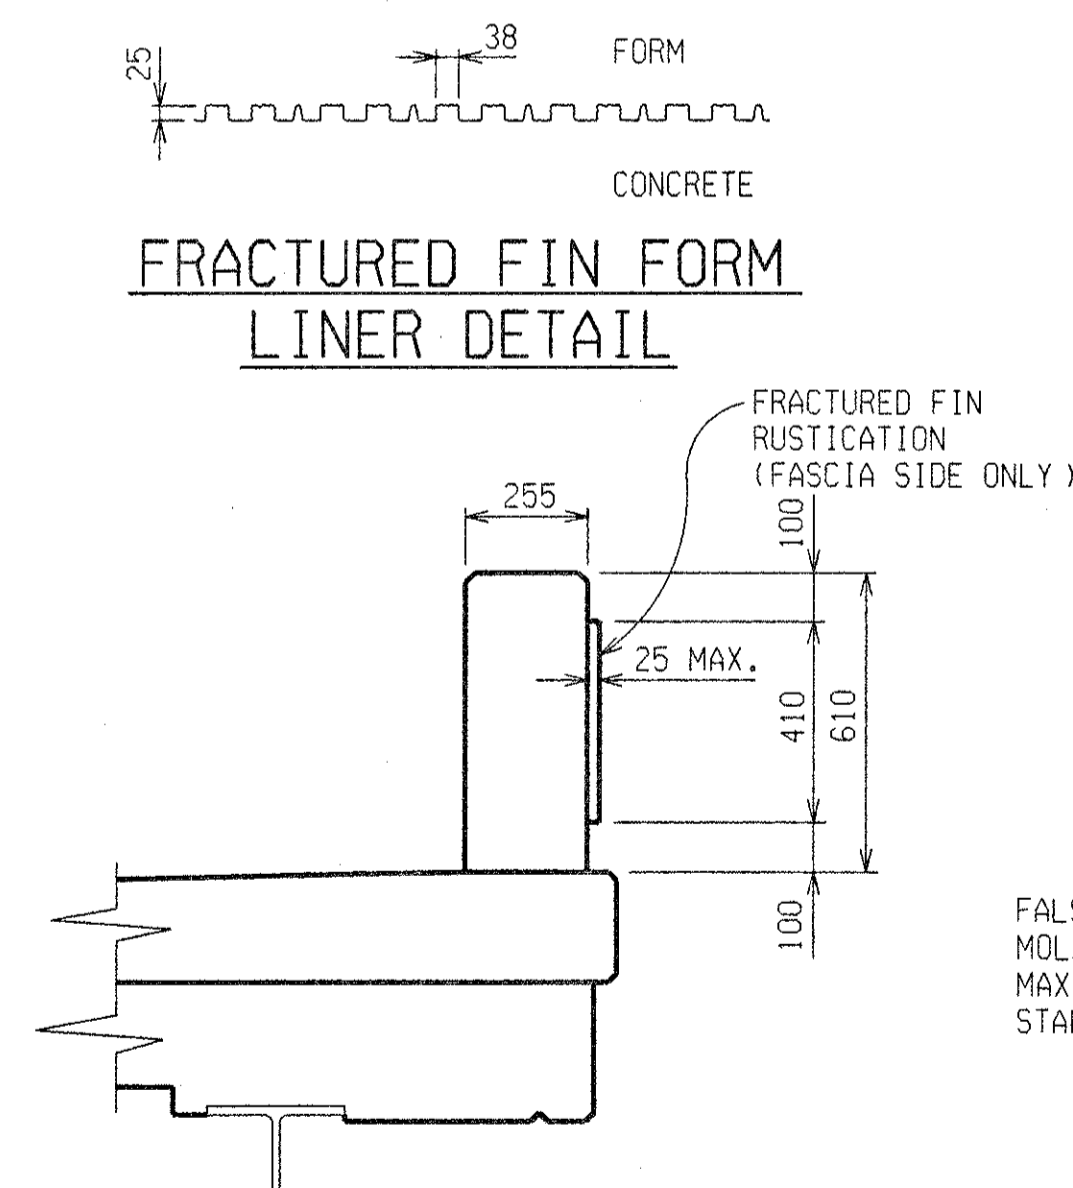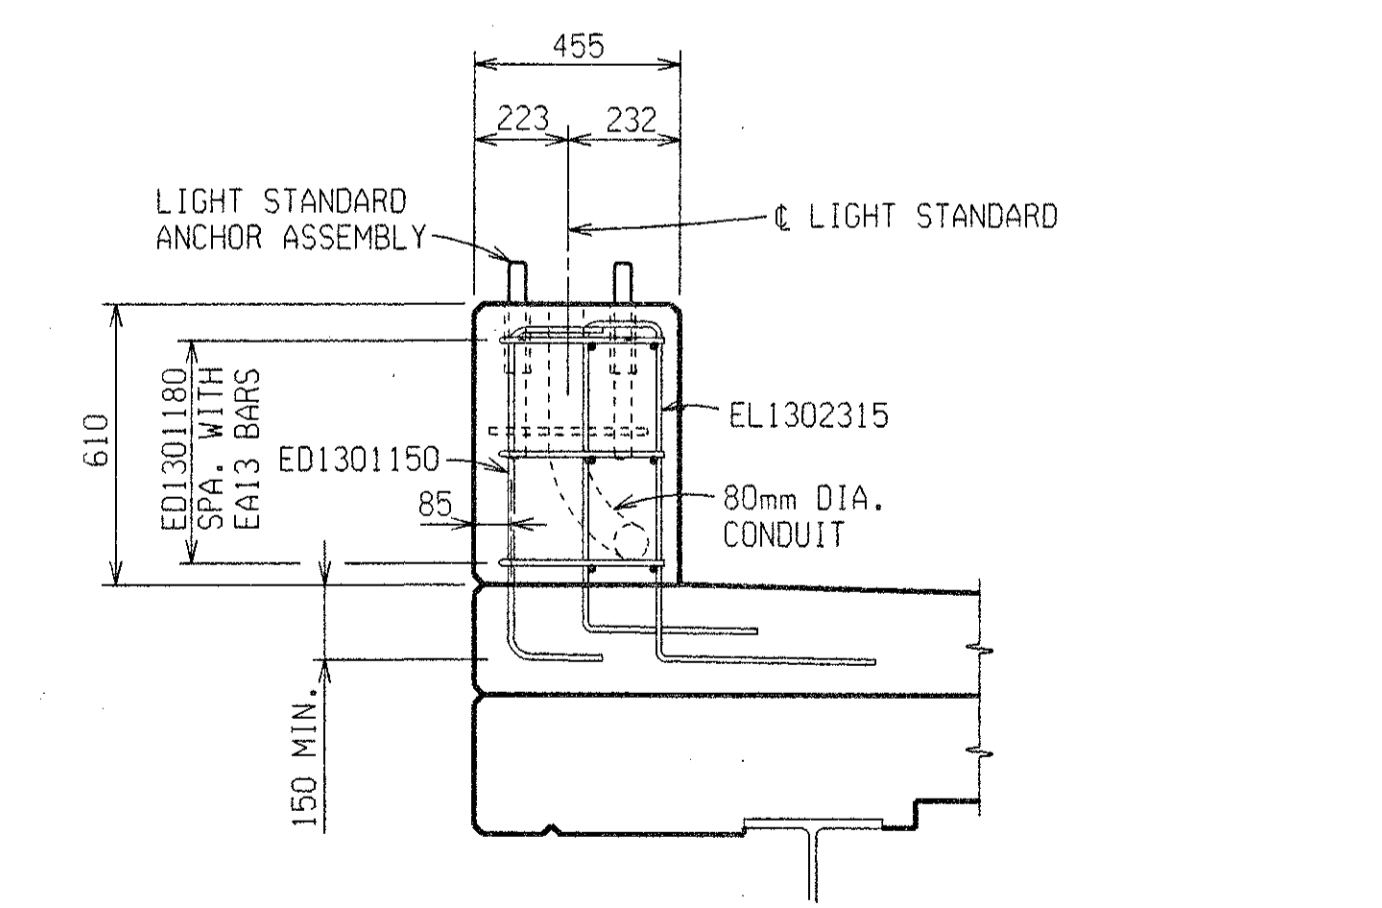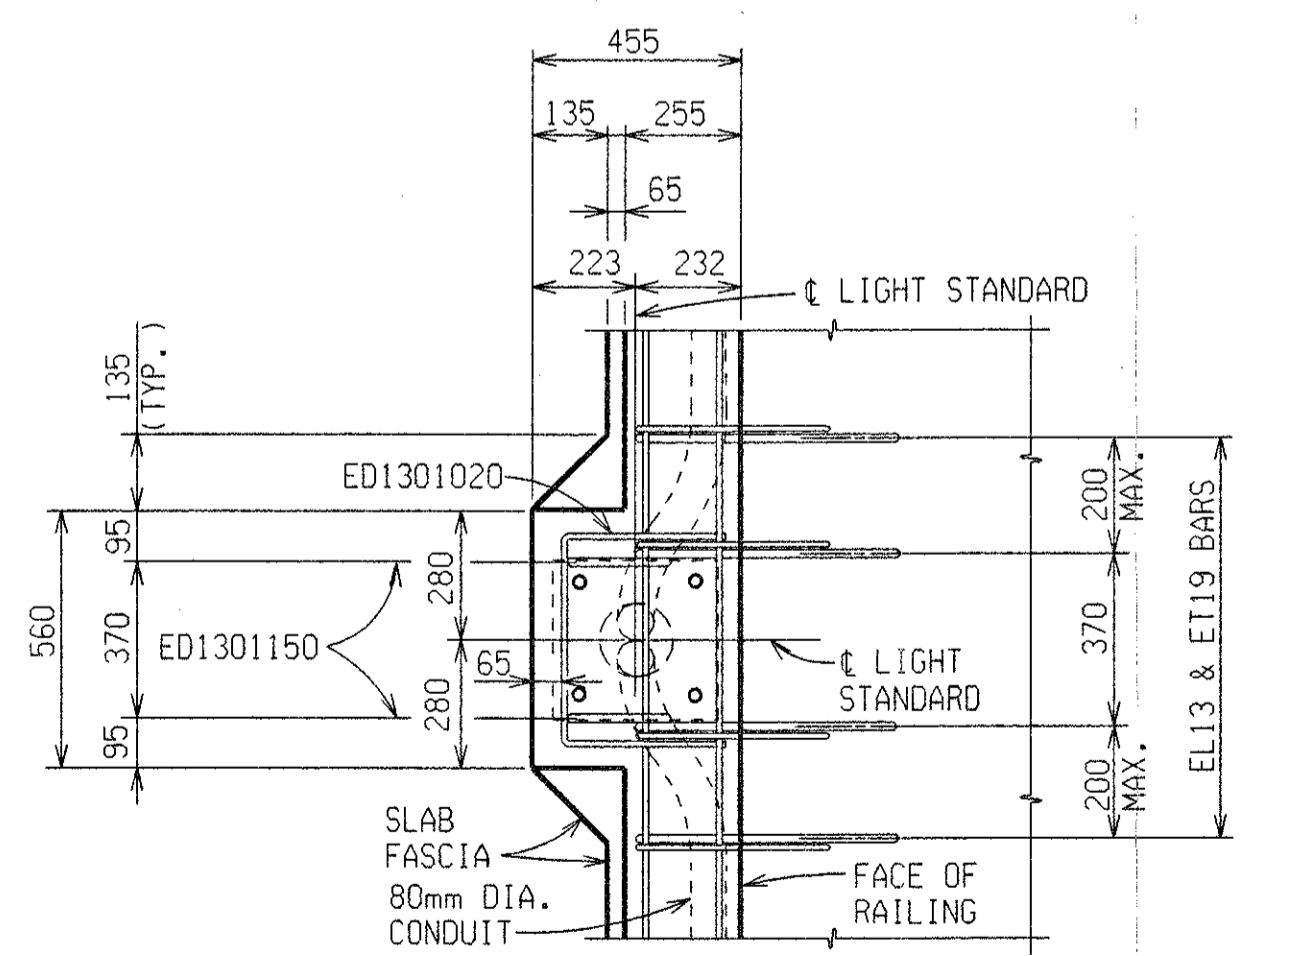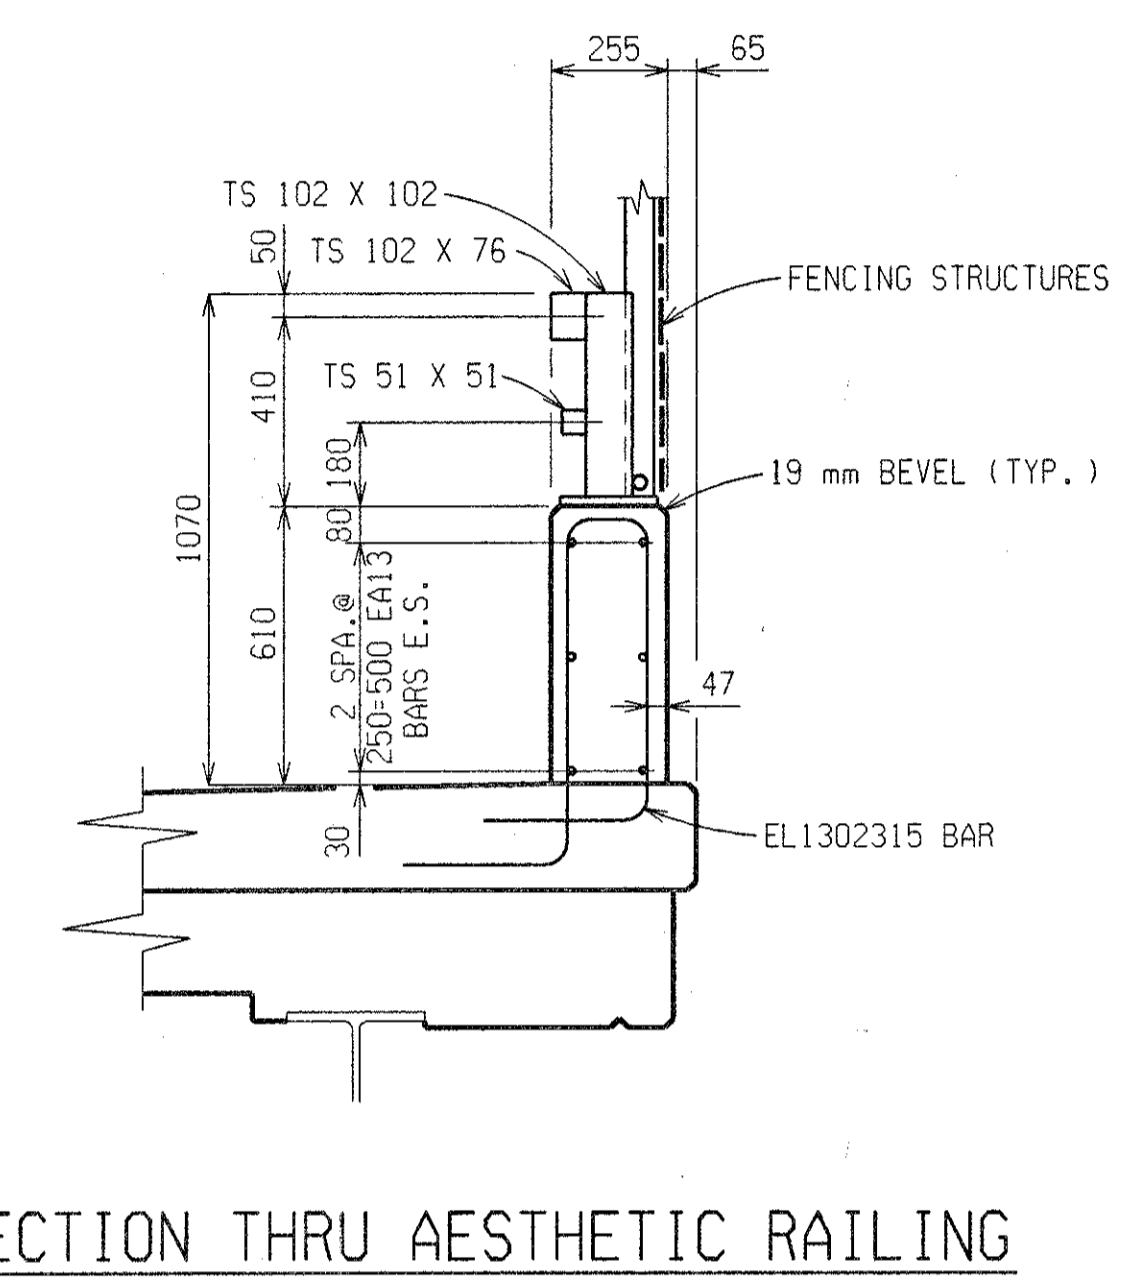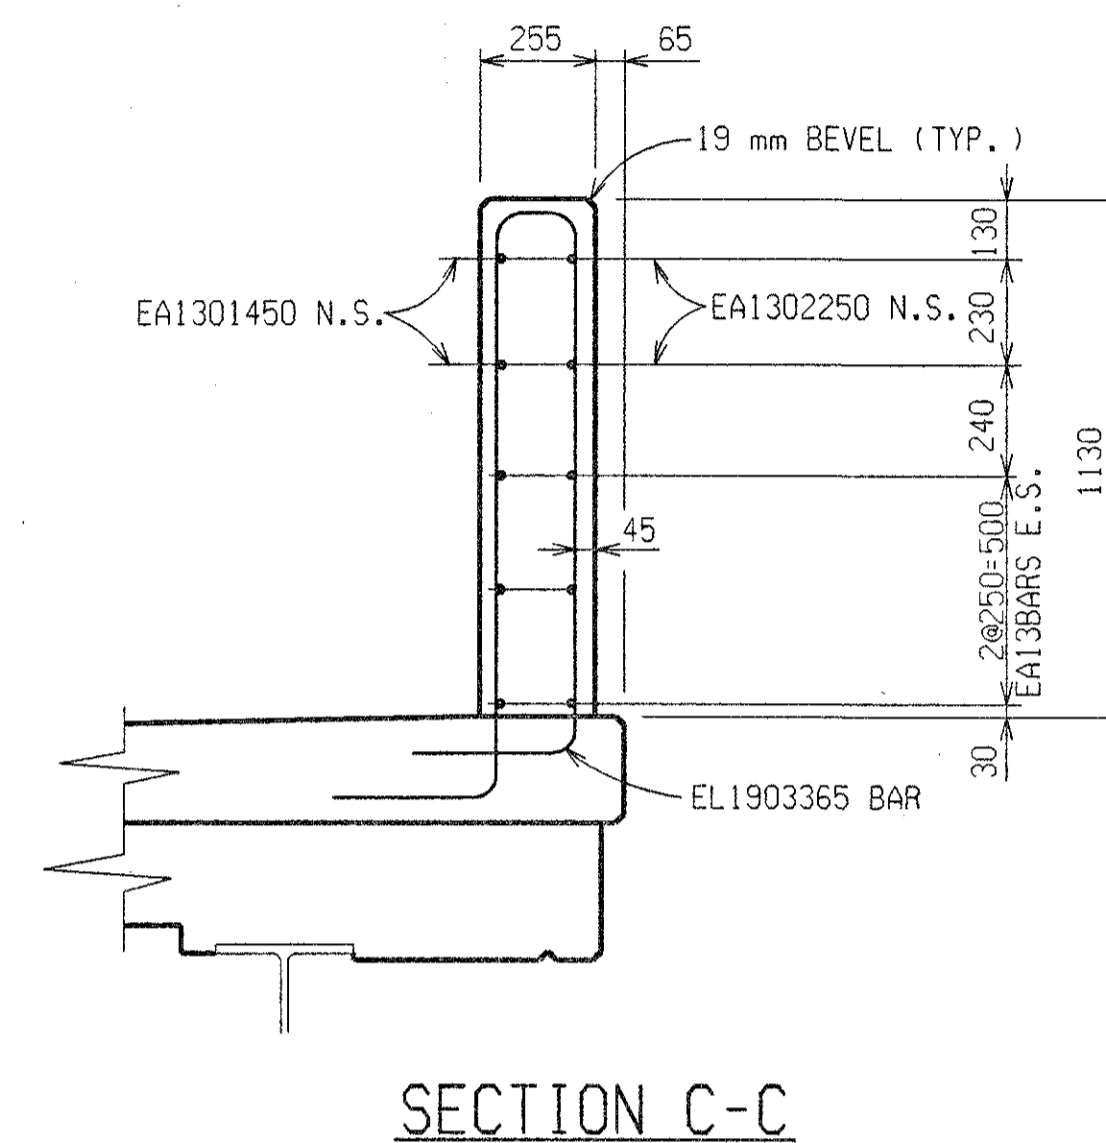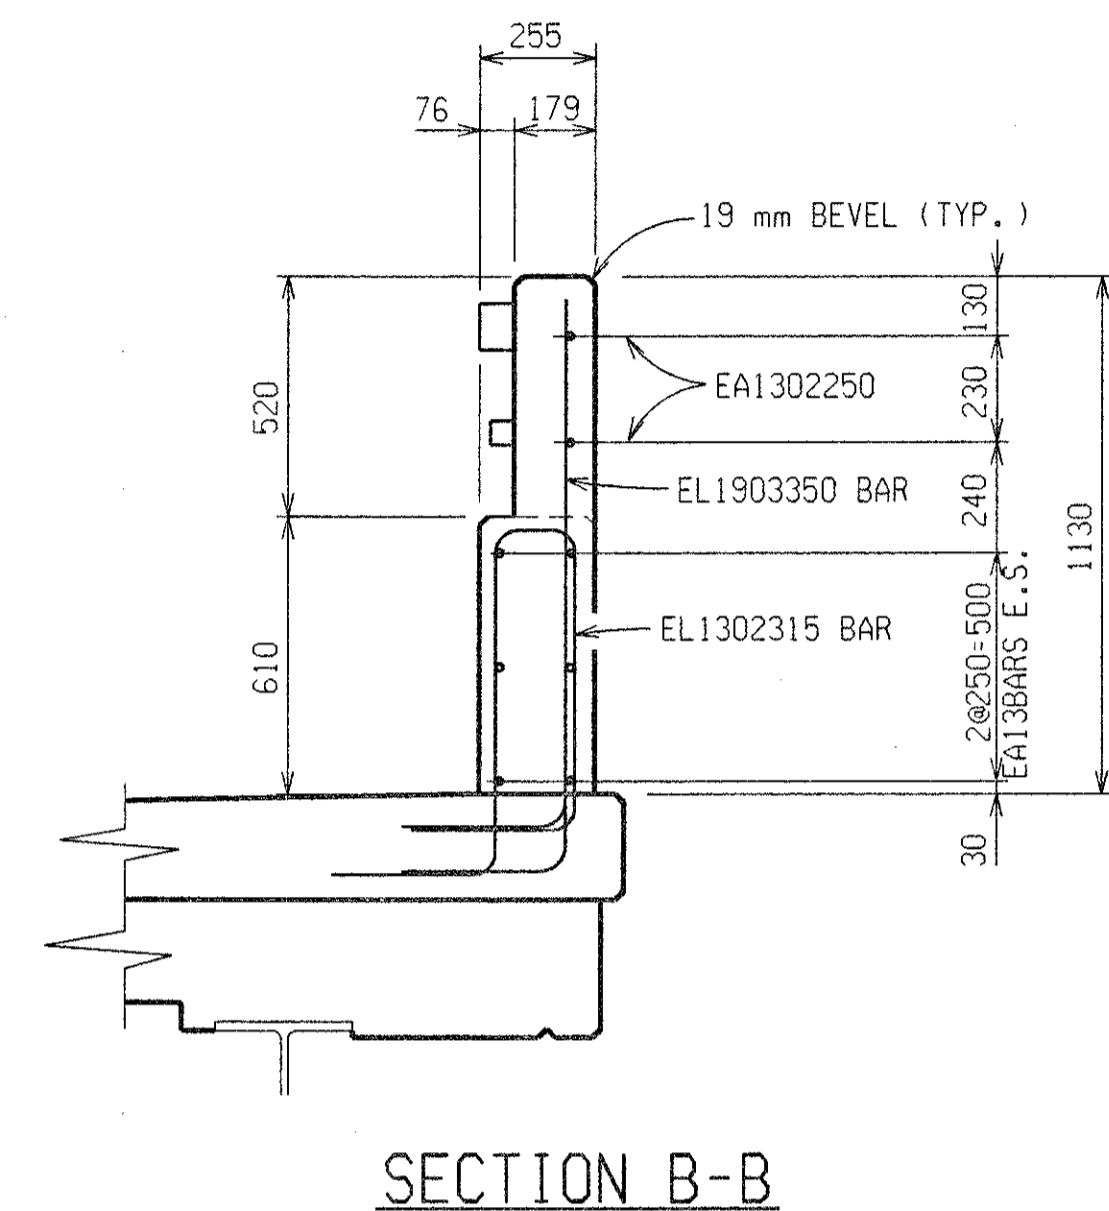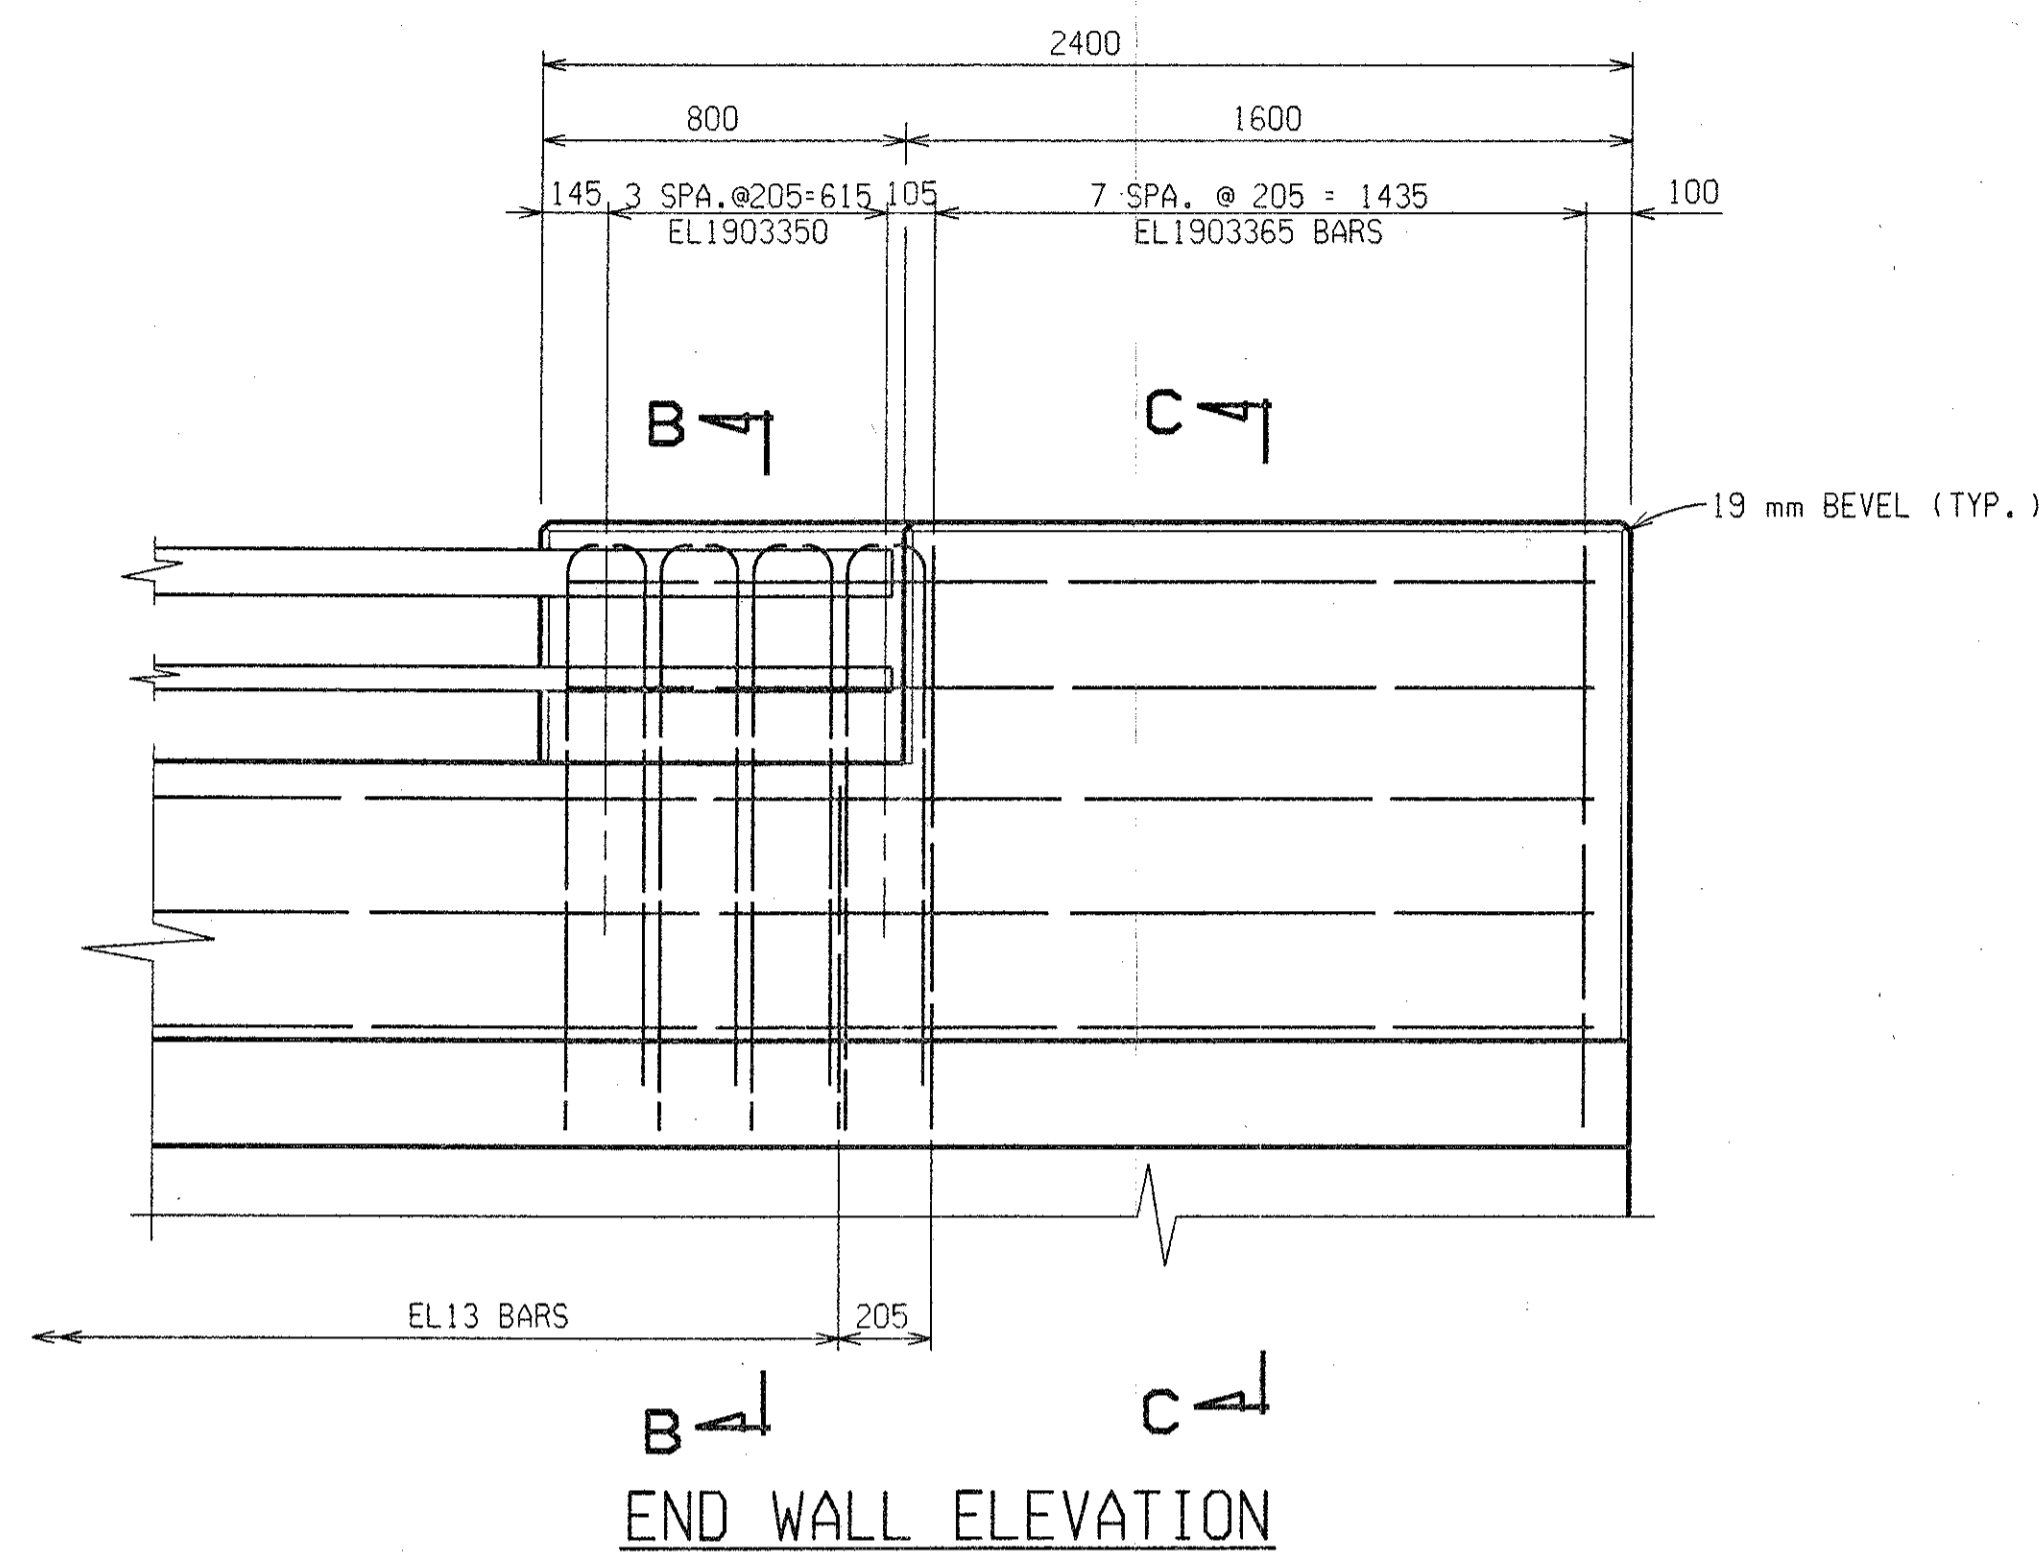


PLAN OF RAILING AT LIGHT STANDARD

SECTION THRU RAILING AT LIGHT STANDARD

TYPICAL RAILING SECTION SHOWING RUSTICATION

RAILING ELEVATION LATERAL LIMITS OF RUSTICATION

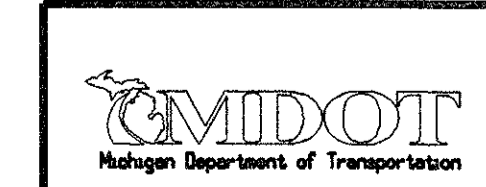





SUPERSTRUCTURE DETAILS				
DATE	CONT. SEC.	JOB NO.	DESIGN UNIT	SHEET
10-13-99	S30 OF 63174	48404A	MAHDAVI	18 OF 22

DATE: _____ CORRECTED BY: _____ CHECKED BY: _____ DRAWN BY: CASLER FILE NAME: s3063174.dwg

1 2 3 4 5 6 7 8 9 10 11 12 13 14 15 16 17 18 19 20 21 22 23 24 25 26 27 28 29 30 31 32 33 34 35 36 37 38 39 40 41 42 43 44 45 46 47 48 49 50 51 52 53 54 55 56 57 58 59 60 61 62 63

REVISIONS			
NO.	DESCRIPTION	DATE	BY


MISCELLANEOUS QUANTITIES	
265 m ²	Fencing, Structures
1 ea	Elec Grounding System

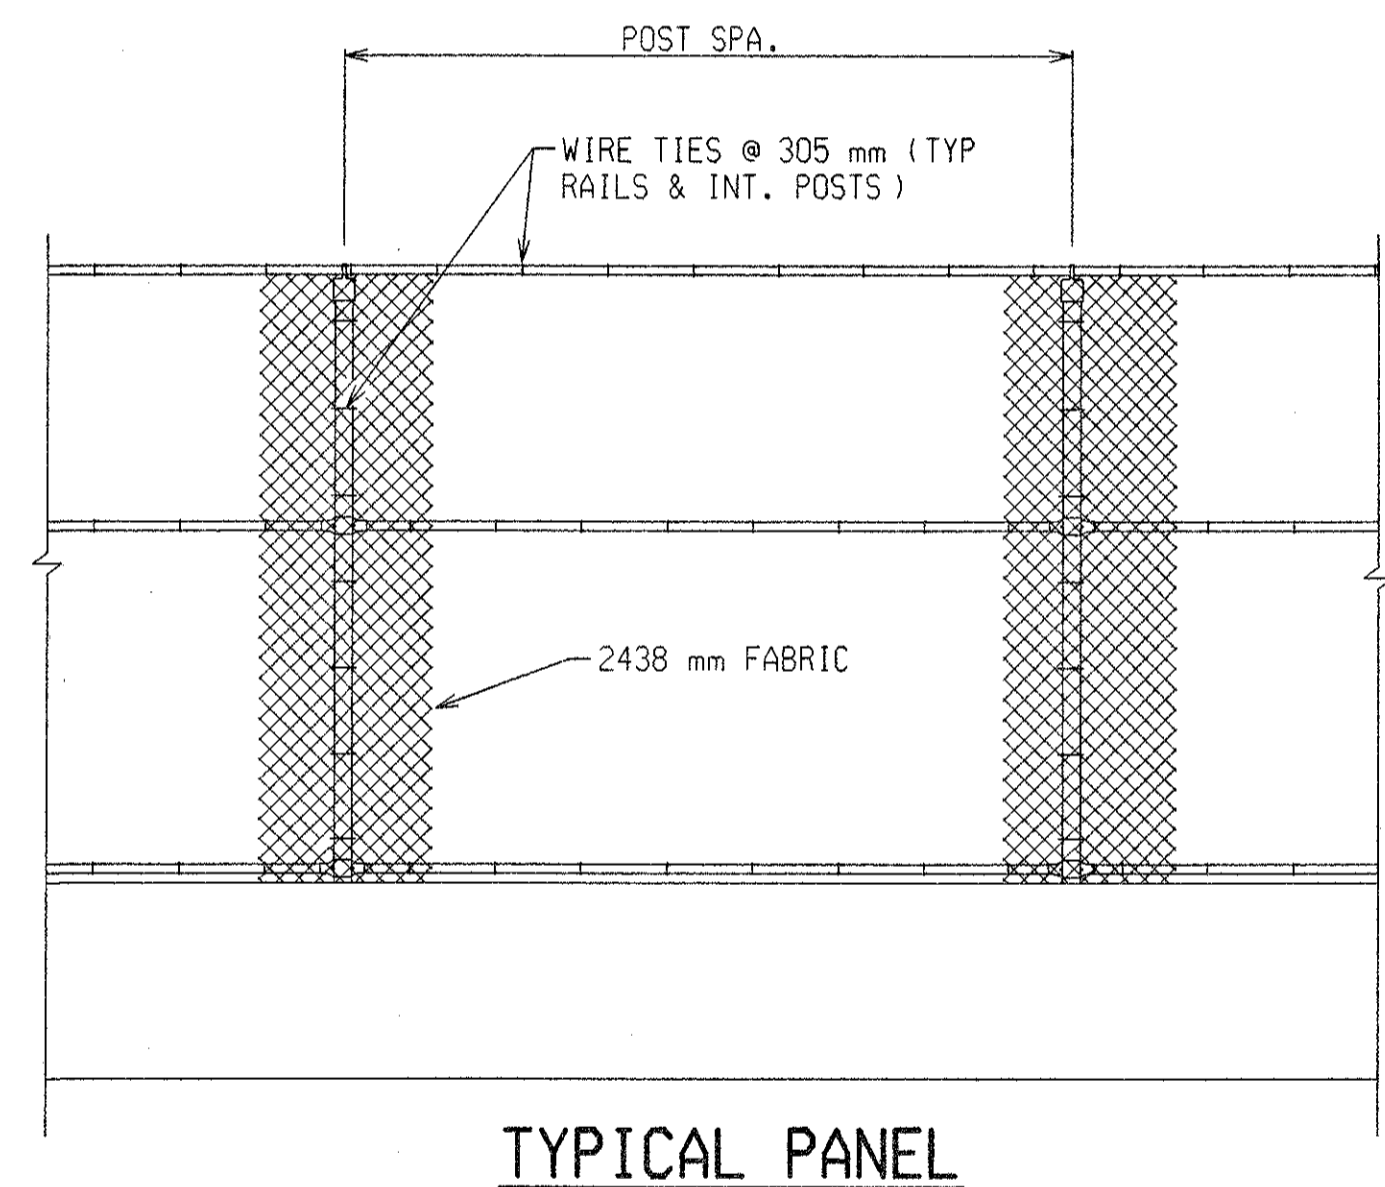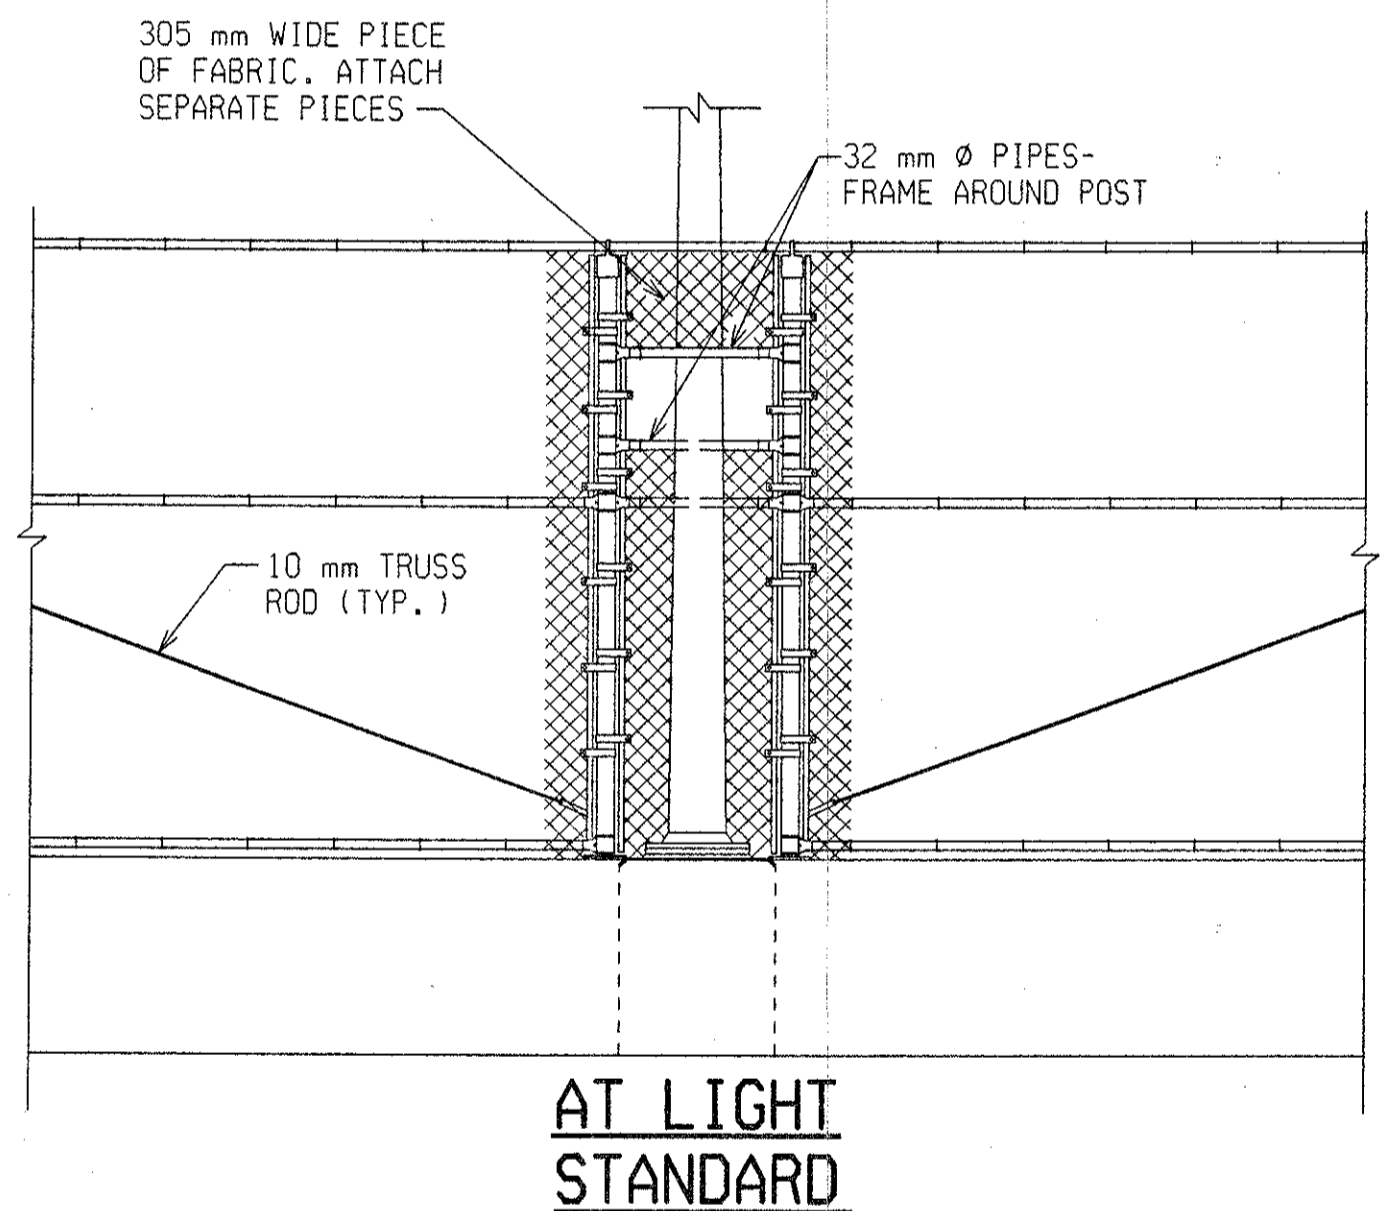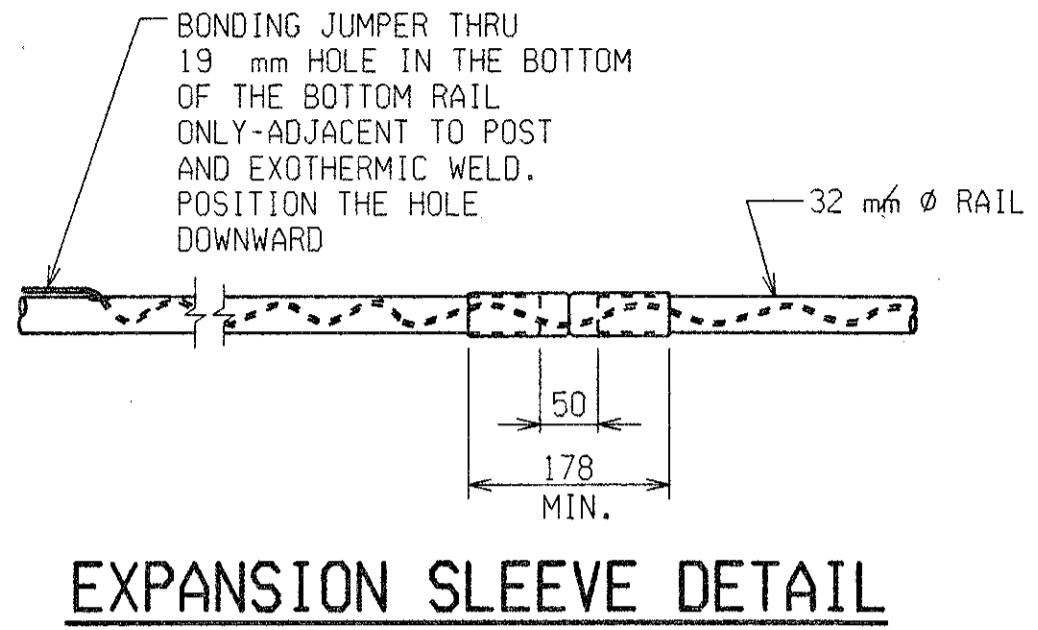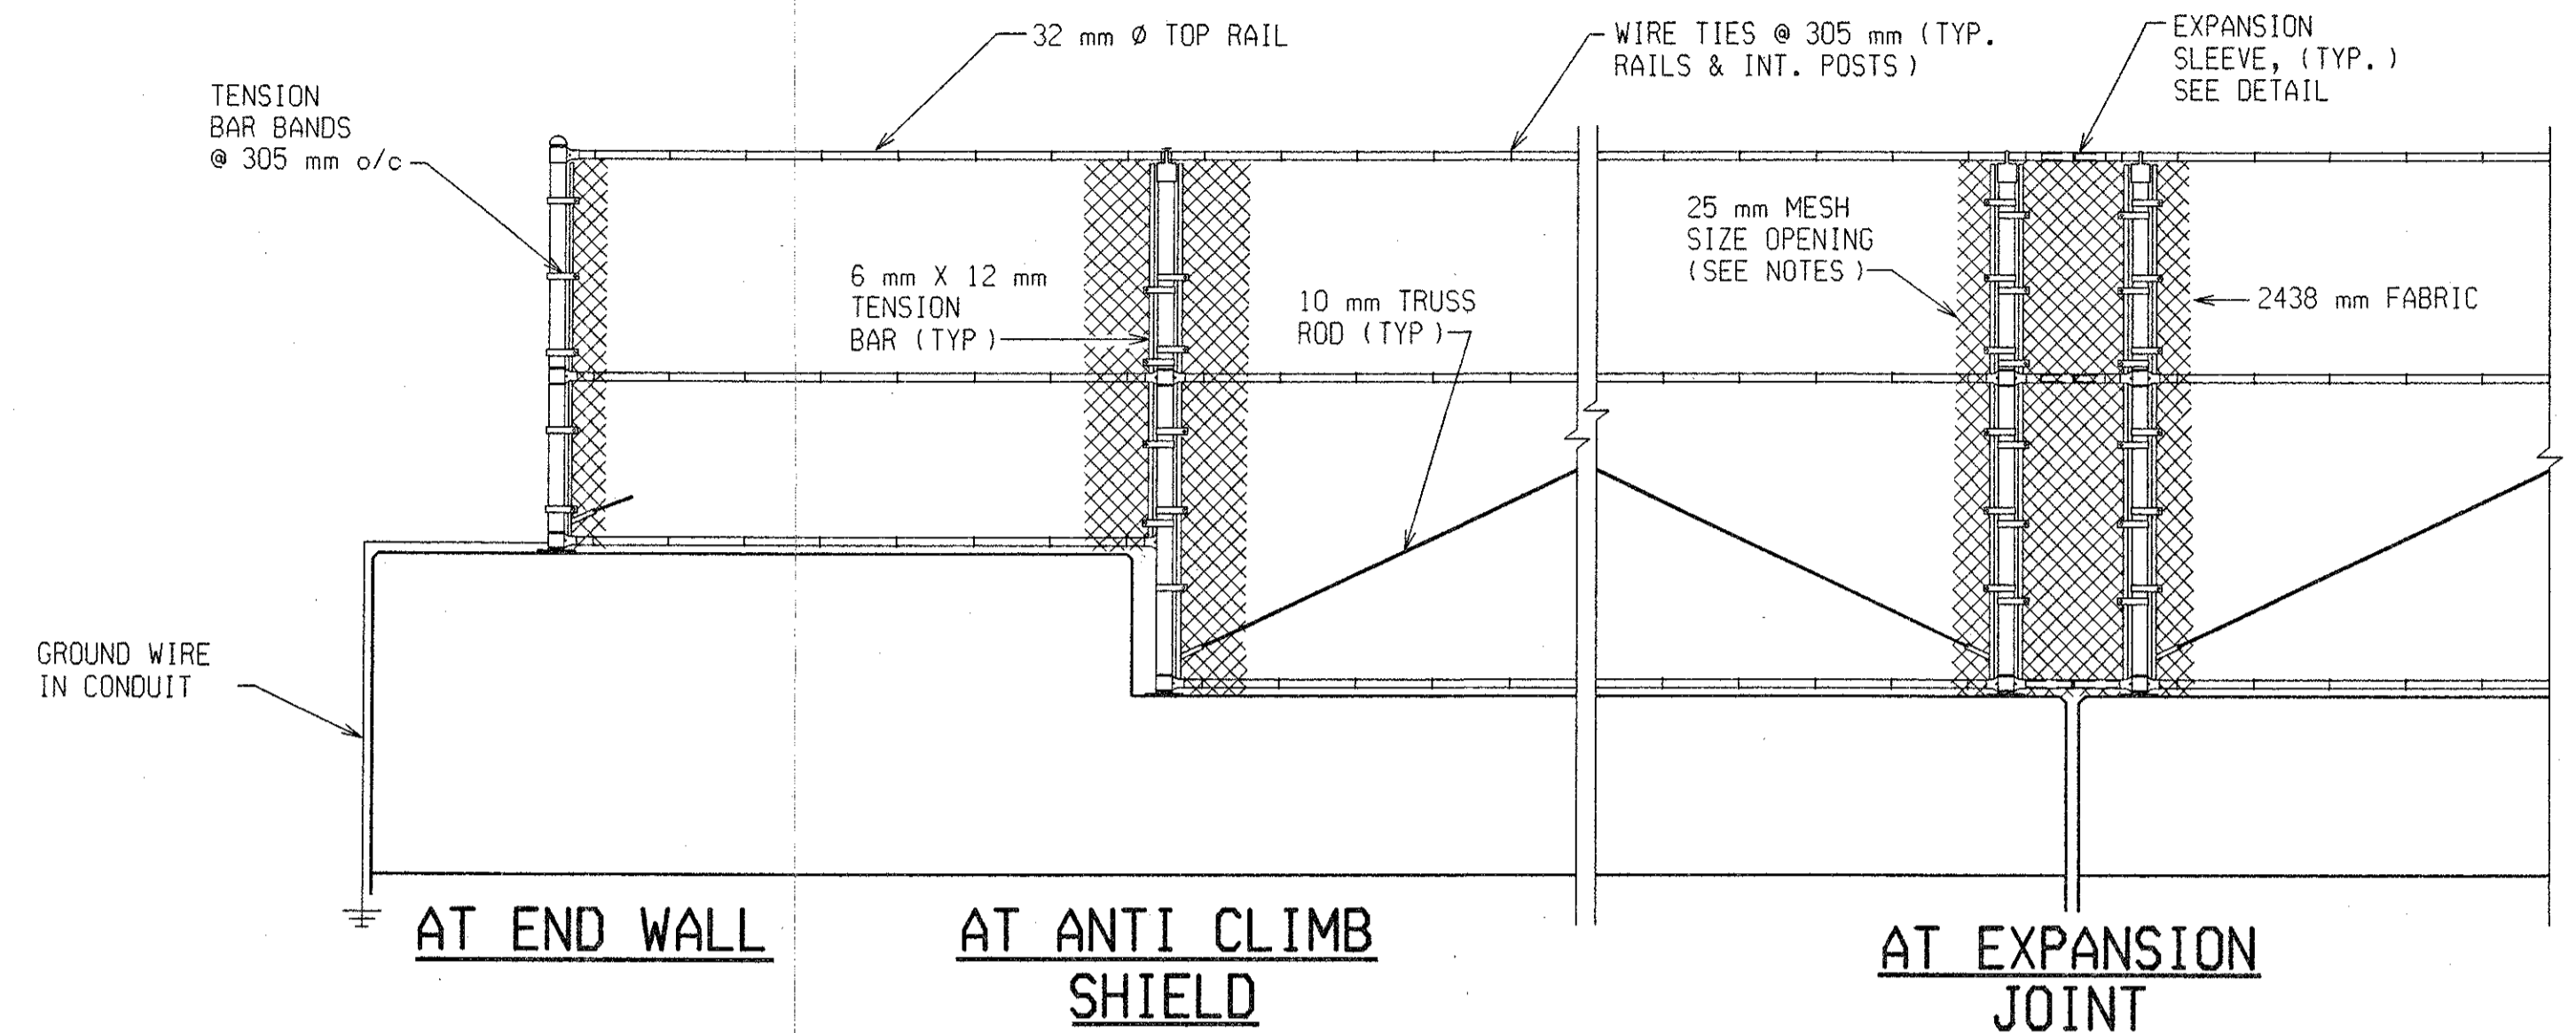


TYPICAL ELEVATIONS

NOTES:

- ALL FENCE POSTS SHALL BE 64 NOMINAL, (73 O.D.) PIPE AND ANTI-CLIMB SHIELD PIPE FRAMES SHALL BE 32 NOMINAL, (42 O.D.) PIPE, IN CONFORMANCE WITH ASTM F669, CLASS 1C.
- HORIZONTAL RAILS SHALL BE 32 NOMINAL (42 O.D.) PIPE IN CONFORMANCE WITH ASTM F669, CLASS 1C OR ASTM F1083.
- ALL FENCE COMPONENTS, UNLESS OTHERWISE INDICATED, SHALL BE GALVANIZED IN ACCORDANCE WITH MDOT'S CURRENT STANDARD SPECIFICATIONS FOR CONSTRUCTION.
- ALL POSTS, ANTI-CLIMB SHIELDS OR OTHER COMPONENTS TO BE FABRICATED SHALL BE FURNISHED "BLACK" AND THEN GALVANIZED AFTER FABRICATION.
- DAMAGED GALVANIZED SURFACES SHALL BE REPAIRED IN CONFORMANCE WITH MDOT'S CURRENT STANDARD SPECIFICATIONS FOR CONSTRUCTION.
- FENCE FABRIC SHALL BE #9 GAGE MESH AND BE GALVANIZED OR ALUMINUM COATED IN CONFORMANCE WITH MDOT'S CURRENT STANDARD SPECIFICATIONS FOR CONSTRUCTION. MESH SIZE OPENING SHALL BE 25 mm.
- GALVANIZED 10 mm Ø TRUSS RODS SHALL EXTEND DIAGONALLY FROM THE TOP CONNECTION CLIP AT EACH TENSION BAR TO THE ADJACENT POST, EXCEPT ACROSS EXPANSION JOINTS AND AT LIGHT STANDARDS WITH A CURVED FENCE DETAIL, WHEN THERE ARE TWO OR MORE CONTINUOUS PANELS OF FABRIC.
- ALL POSTS SHALL BE INSTALLED PLUMB AND MAY BE SHIMMED WITH NON-METALLIC SHIMS, APPROVED BY THE ENGINEER. COSTS FOR SHIMMING SHALL BE INCLUDED IN THE PAY ITEM "FENCING, STRUCTURES".
- BOTTOM STRAP ON THE VERTICAL POST SHALL BE CONNECTED WITH RAIL ENDS (BRACE BANDS) RATHER THAN A TWO WAY CLAMP TO ALLOW A MINIMUM OF 7 mm OFFSET.
- FIELD WELDING SHALL BE ALLOWED ONLY FOR THE HANDRAIL SPLICES AND FOR ATTACHMENT OF THE HANDRAIL TO THE POST. ALL FIELD WELDS SHALL BE GROUND SMOOTH PRIOR TO COATING WITH ZINC-RICH PAINT OR SPRAYED ZINC IN ACCORDANCE WITH MDOT'S CURRENT STANDARD SPECIFICATIONS.
- THE GROUND WIRE SHALL BE PLACED IN A NON-METALLIC CONDUIT, FROM THE END POST CONNECTION TO THE GROUND ROD CONNECTION. THE CONDUIT SHALL BE SECURED TO THE STRUCTURE USING EITHER EXPANSION BOLTS OR ADHESIVE ANCHORED BOLTS WITH GALVANIZED METAL STRIPS, AS APPROVED BY THE ENGINEER.
- IN THE EVENT THAT INSTALLATION OF A GROUND ROD IS IMPRACTICAL, THE GROUND WIRE SHALL BE CONNECTED TO THE NEAREST LIGHT STANDARD, USING A MECHANICAL CLIP, ONLY AFTER OBTAINING PERMISSION FROM THE LOCAL PUBLIC LIGHTING AUTHORITY.
- EXPANSION JOINT SLEEVES, FOR HORIZONTAL RAILS, SHALL BE THE MANUFACTURER'S STANDARD OVERSIZED SLEEVES, CRIMPED IN THE MIDDLE.
- ALL DIMENSIONS ARE IN MILLIMETERS.
- FENCE FABRIC SHALL BE CONTINUOUS AT LIGHT POLE, BUT MAY BE CUT AND SPLICED. REINFORCE OPENING IN THE FABRIC AT POSTS WITH #6 GAUGE WIRE.
- GROUNDING CABLES AND TOPS OF GROUNDING RODS SHALL BE PLACED 300 mm MINIMUM BELOW FINISHED GROUND.

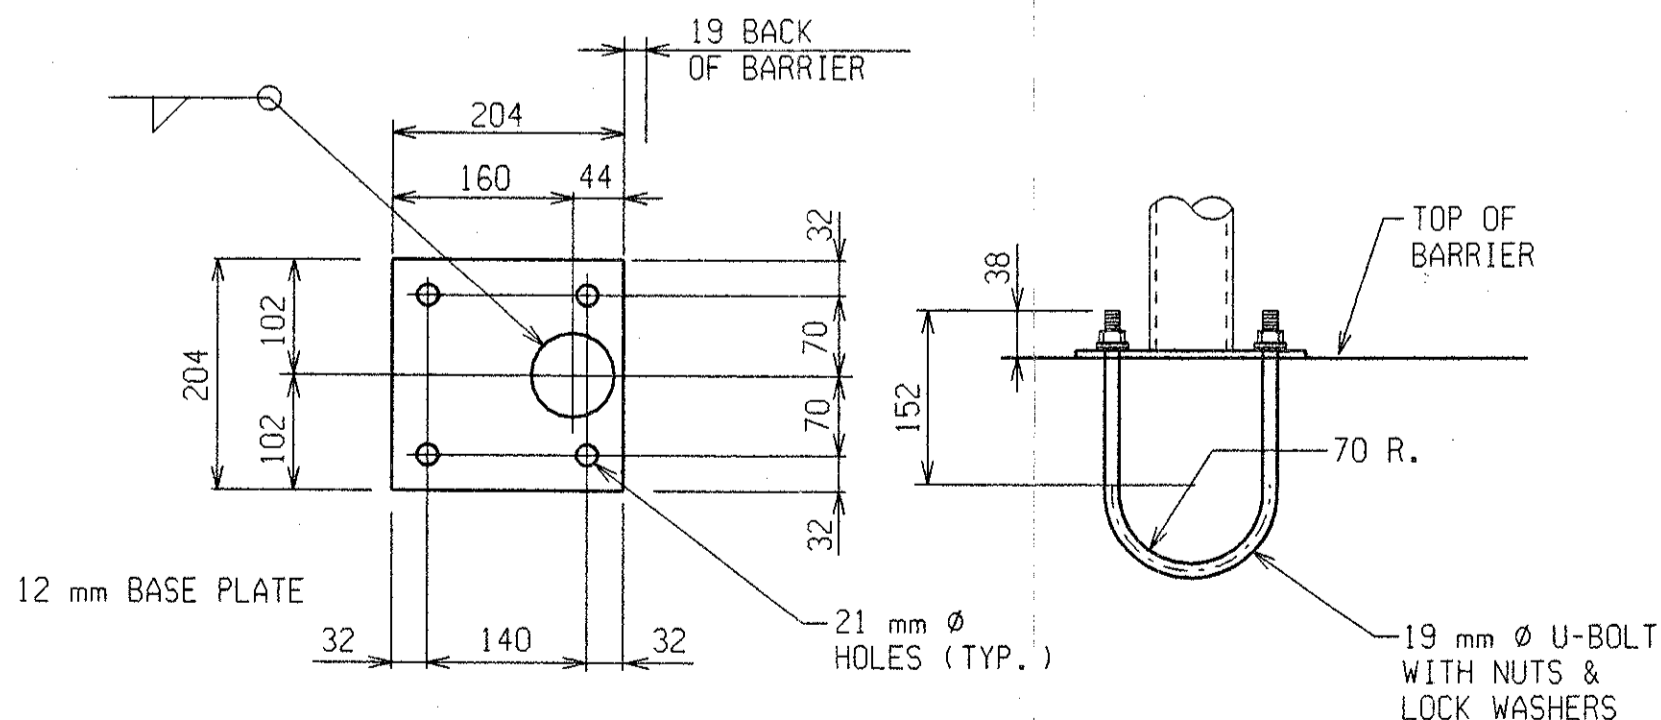

BASE PLATE DETAILS

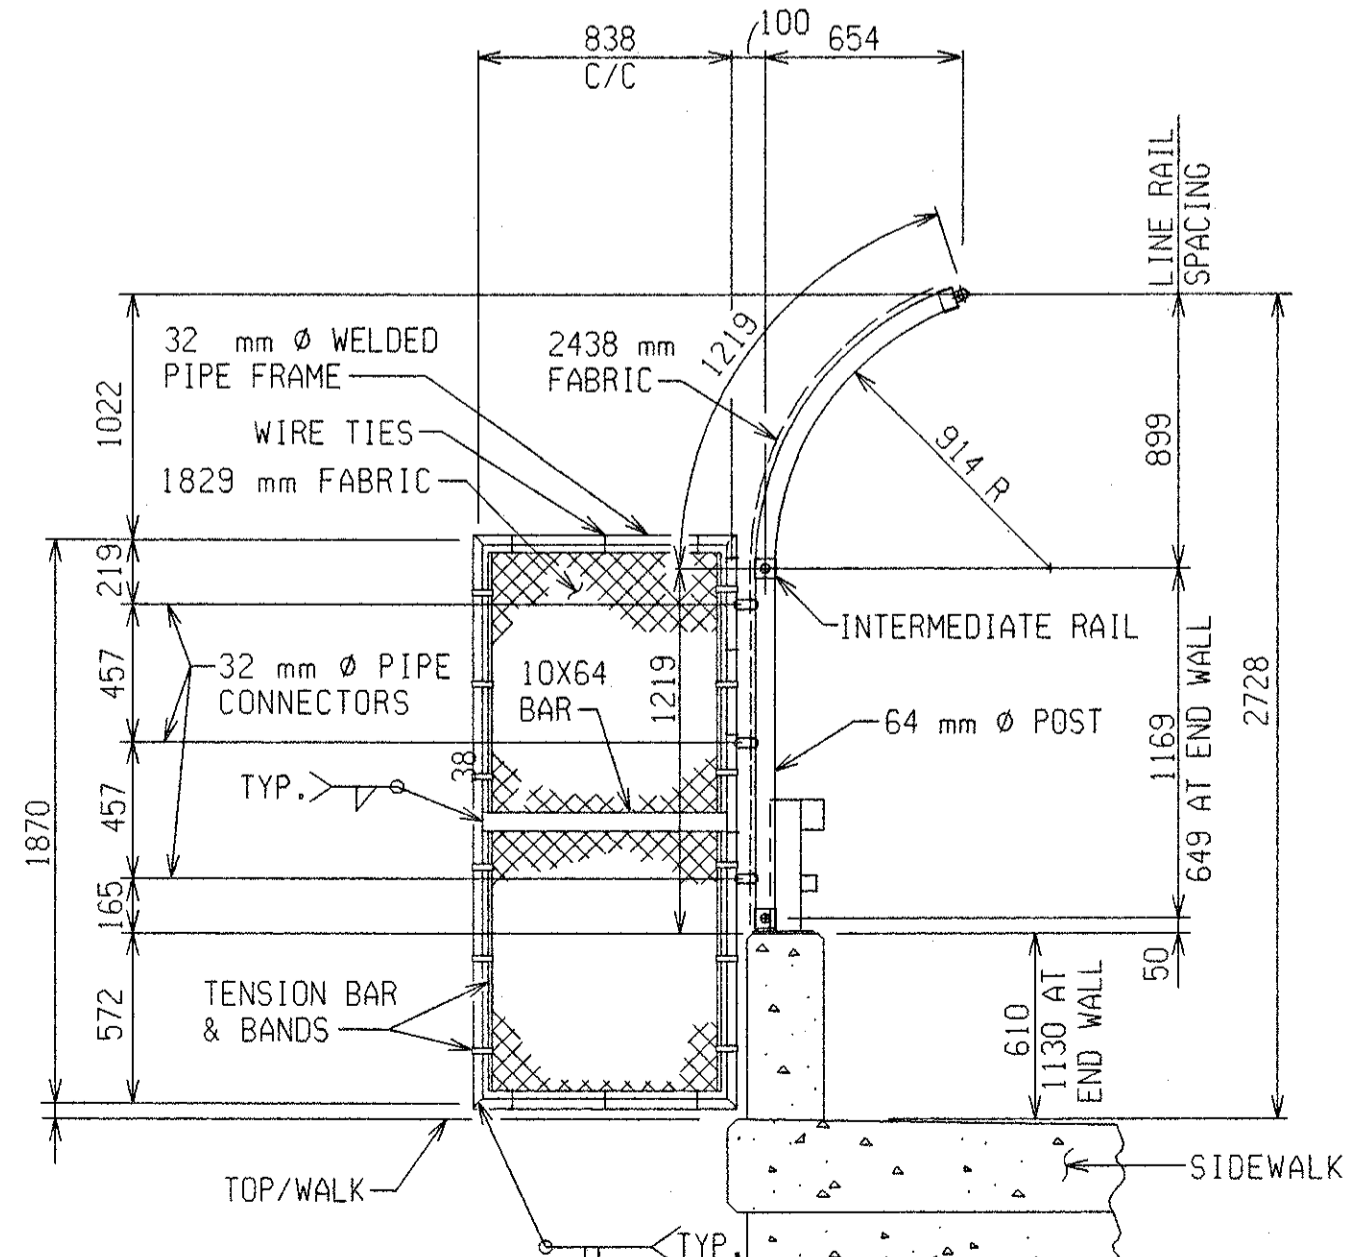

TYPICAL SECTION (SHOWING ANTI-CLIMB SHIELD)

FENCING DETAILS				
DATE	CONT. SEC.	JOB NO.	DESIGN UNIT	SHEET
10-13-99	S30 OF 63174	48404A	MAHDAVI	19 OF 22




DATE: 9-20-99 CORRECTED BY: CASLER DATE: CHECKED BY: DATE: 8-10-99 DRAWN BY: CASLER FILE NAME: s3063174.fe


1 2 3 4 5 6 7 8 9 10 11 12 13 14 15 16 17 18 19 20 21 22 23 24 25 26 27 28 29 30 31 32 33 34 35 36 37 38 39 40 41 42 43 44 45 46 47 48 49 50 51 52 53 54 55 56 57 58 59 60 61 62 63



REVISIONS			
NO.	DESCRIPTION	DATE	BY

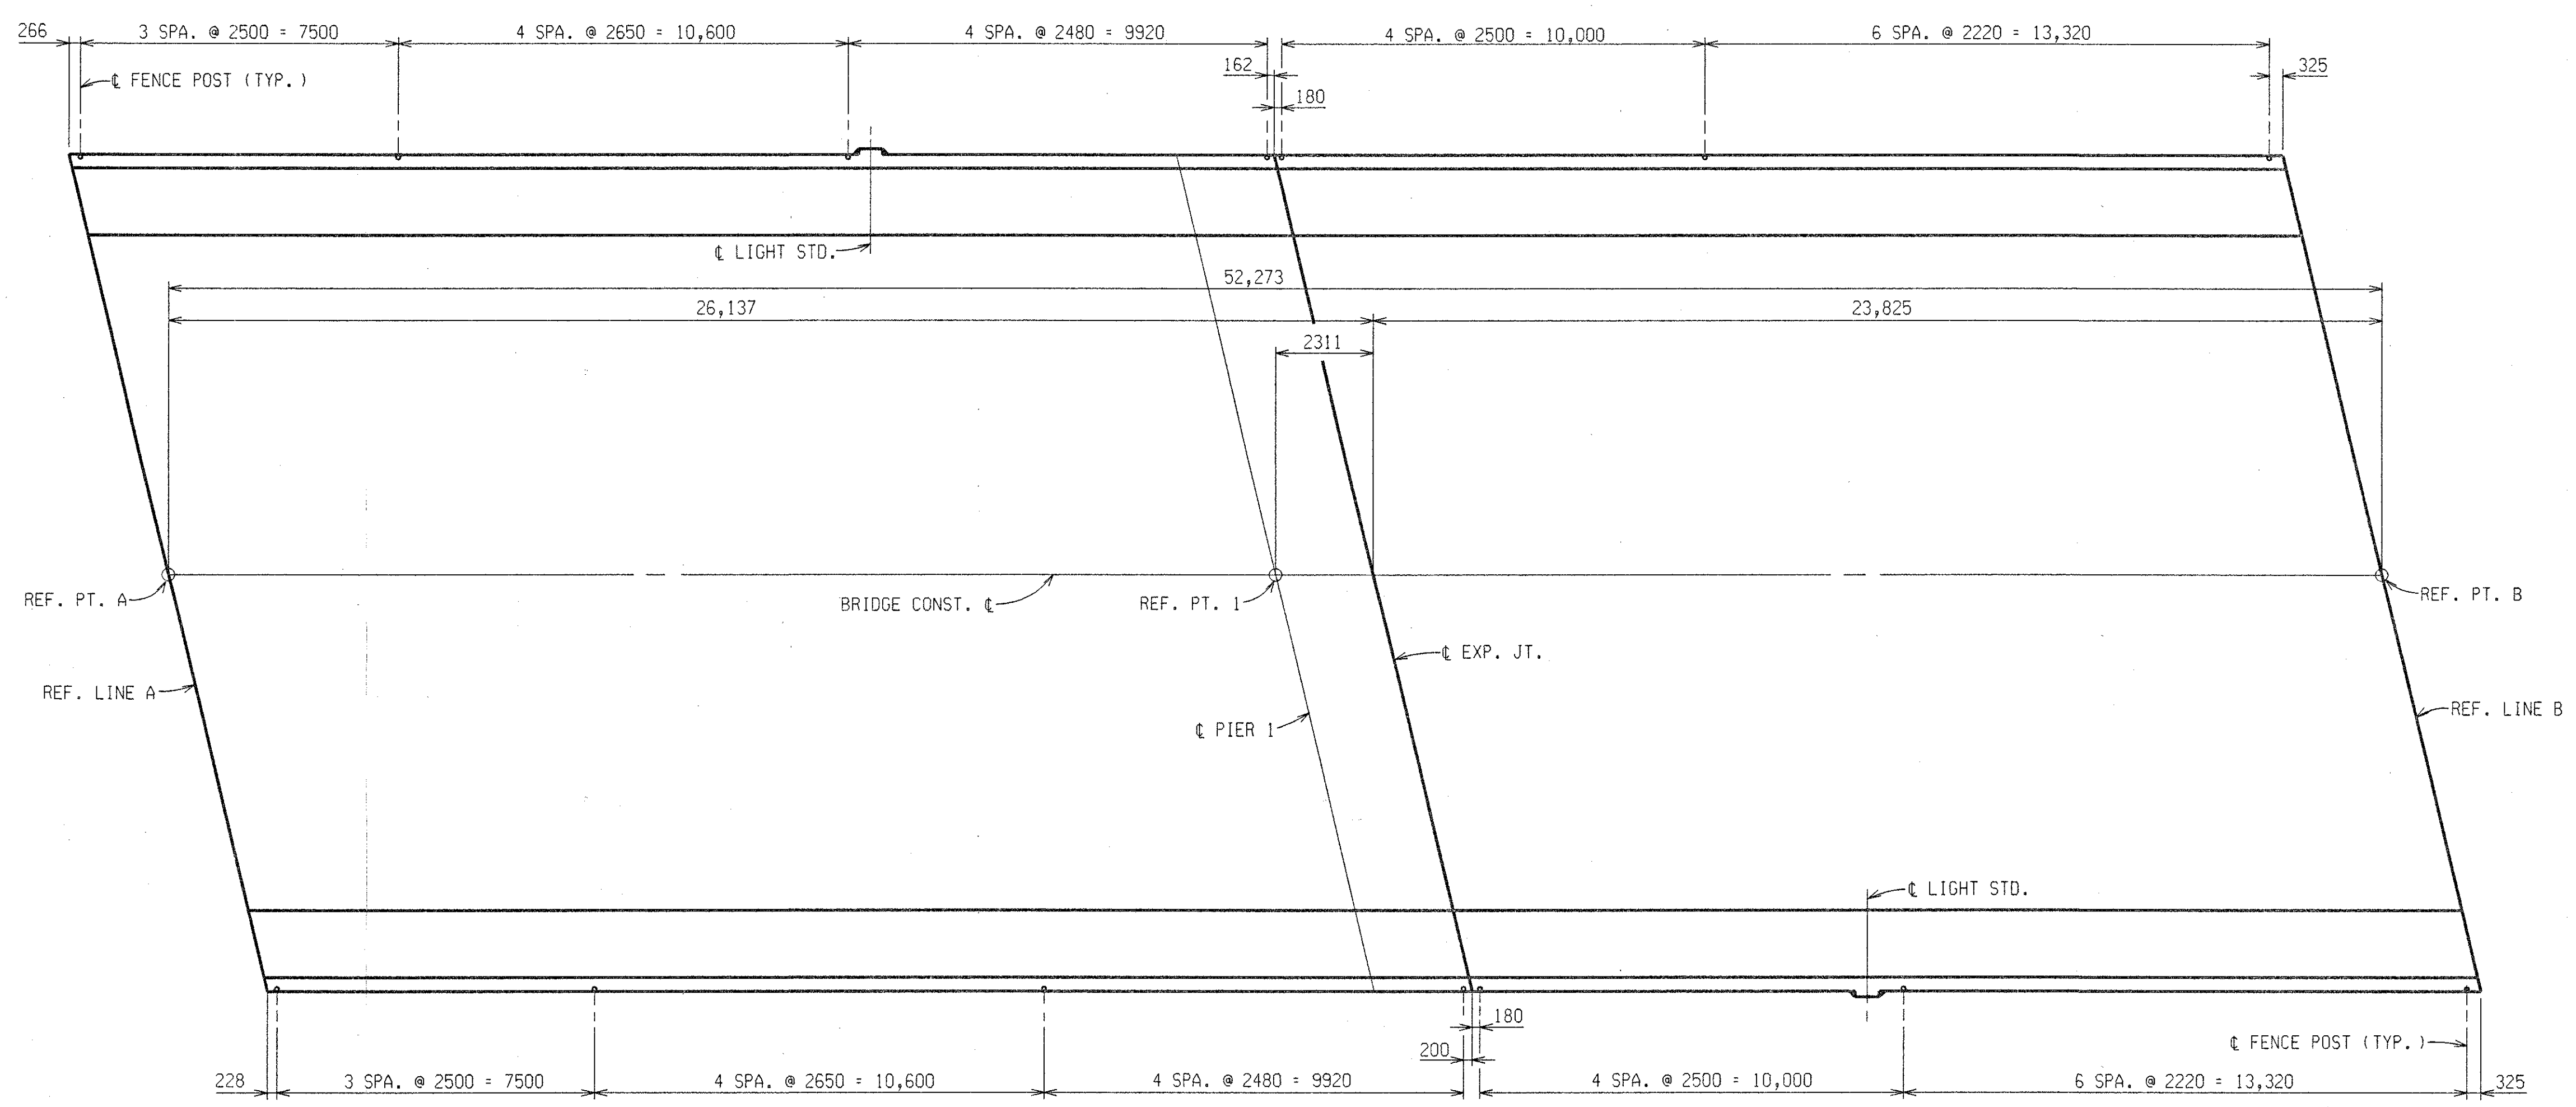

PLAN
(SHOWING FENCE POST SPACING)

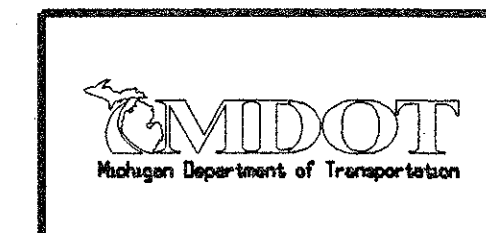

FENCING DETAILS				
DATE	CONT. SEC.	JOB NO.	DESIGN UNIT	SHEET
10-13-99	S30 OF 63174	48404A	MAHDAVI	20 OF 22



FILE NAME: s3063174.fe DRAWN BY: CASLER CHECKED BY: DATE: 9-7-99 CORRECTED BY: DATE:

BOTTOM OF SLAB ELEVATIONS

		SPAN 1								REF. 1		SPAN 2								REF. B	
		0	1	2	3	4	5	6	7	BRG 8	P&H 0	1	2	3	4	5	6	7	8		
A	FASCIA RIGHT	193.172	193.218	193.259	193.292	193.314	193.324	193.323	193.311	193.289	193.291	193.312	193.324	193.324	193.311	193.284	193.249	193.207	193.161		
	RIGHT	193.236	193.282	193.323	193.355	193.377	193.387	193.387	193.375	193.352	193.354	193.375	193.387	193.387	193.374	193.347	193.312	193.270	193.224		
B	LEFT	193.244	193.290	193.331	193.364	193.386	193.396	193.395	193.383	193.359	193.360	193.380	193.391	193.390	193.376	193.349	193.314	193.272	193.226		
	RIGHT	193.251	193.297	193.338	193.371	193.392	193.403	193.402	193.389	193.366	193.367	193.387	193.398	193.397	193.383	193.356	193.321	193.279	193.233		
C	LEFT	193.278	193.324	193.365	193.398	193.419	193.430	193.429	193.415	193.391	193.391	193.410	193.420	193.419	193.404	193.377	193.341	193.299	193.253		
	RIGHT	193.285	193.331	193.372	193.405	193.426	193.436	193.436	193.422	193.398	193.398	193.417	193.427	193.426	193.410	193.384	193.348	193.306	193.260		
D	LEFT	193.312	193.358	193.399	193.432	193.453	193.463	193.462	193.448	193.422	193.422	193.440	193.449	193.447	193.431	193.404	193.369	193.327	193.281		
	RIGHT	193.319	193.365	193.406	193.438	193.460	193.470	193.469	193.455	193.429	193.428	193.447	193.456	193.454	193.438	193.411	193.376	193.334	193.287		
E	LEFT	193.346	193.392	193.433	193.465	193.487	193.497	193.496	193.480	193.454	193.452	193.470	193.478	193.475	193.458	193.431	193.396	193.354	193.308		
	RIGHT	193.353	193.399	193.440	193.472	193.494	193.504	193.503	193.487	193.461	193.459	193.477	193.485	193.482	193.465	193.438	193.403	193.361	193.315		
F	LEFT	193.355	193.401	193.442	193.475	193.496	193.507	193.505	193.488	193.461	193.458	193.475	193.483	193.478	193.461	193.434	193.399	193.357	193.311		
	RIGHT	193.348	193.394	193.435	193.468	193.490	193.500	193.498	193.481	193.454	193.452	193.468	193.476	193.471	193.454	193.428	193.392	193.350	193.304		
G	LEFT	193.326	193.372	193.414	193.446	193.468	193.478	193.475	193.458	193.429	193.426	193.442	193.449	193.444	193.426	193.399	193.364	193.322	193.276		
	RIGHT	193.320	193.366	193.407	193.439	193.461	193.471	193.468	193.451	193.422	193.419	193.435	193.442	193.437	193.419	193.392	193.357	193.315	193.269		
H	LEFT	193.298	193.344	193.385	193.417	193.439	193.449	193.446	193.427	193.398	193.394	193.409	193.415	193.409	193.391	193.364	193.329	193.287	193.241		
	RIGHT	193.291	193.337	193.378	193.411	193.432	193.442	193.439	193.420	193.391	193.387	193.402	193.408	193.402	193.384	193.357	193.322	193.280	193.234		
J	LEFT	193.269	193.315	193.356	193.389	193.410	193.421	193.416	193.396	193.366	193.361	193.375	193.380	193.373	193.356	193.329	193.294	193.252	193.205		
	RIGHT	193.262	193.308	193.349	193.382	193.404	193.414	193.409	193.390	193.359	193.355	193.369	193.374	193.367	193.349	193.322	193.287	193.245	193.199		
K	LEFT	193.259	193.305	193.346	193.378	193.400	193.410	193.404	193.384	193.352	193.347	193.360	193.364	193.357	193.339	193.312	193.277	193.235	193.189		
	FASCIA	193.194	193.240	193.281	193.314	193.335	193.345	193.340	193.319	193.288	193.283	193.296	193.300	193.293	193.275	193.248	193.213	193.171	193.125		

SCREED ELEVATIONS

LEFT	193.467	193.509	193.547	193.577	193.598	193.609	193.610	193.602	193.583	193.584	193.601	193.609	193.607	193.592	193.566	193.533	193.494	193.451
CENTER	193.596	193.638	193.675	193.705	193.726	193.737	193.738	193.725	193.703	193.701	193.715	193.720	193.714	193.697	193.670	193.637	193.598	193.555
RIGHT	193.487	193.529	193.566	193.596	193.617	193.628	193.625	193.609	193.583	193.578	193.588	193.590	193.581	193.563	193.537	193.503	193.464	193.421

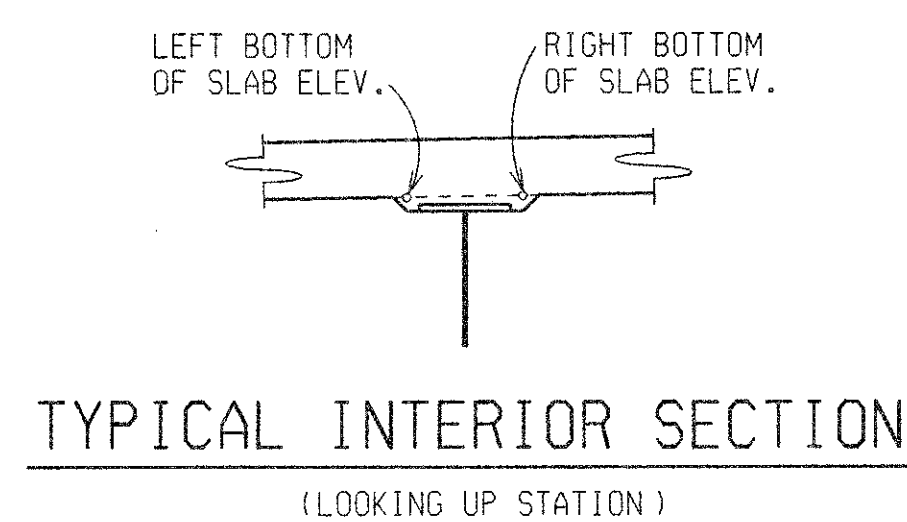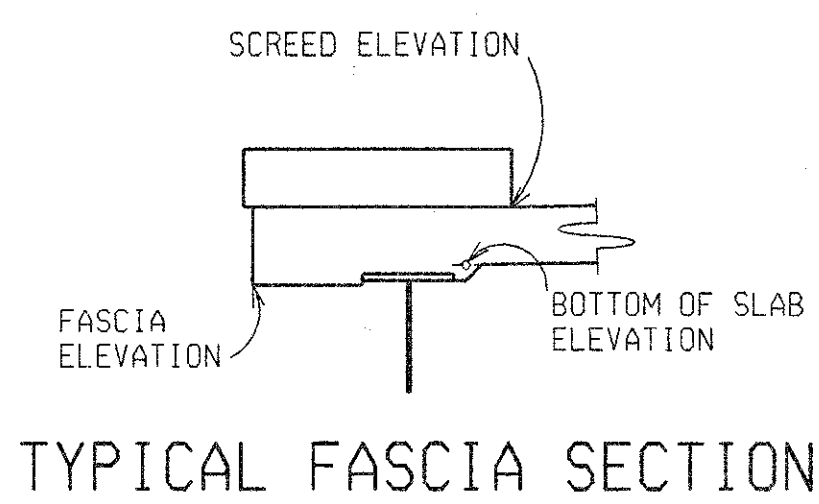

BULKHEAD ELEVATIONS

	ABUT. A	± JT.	ABUT. B
A	193.465	193.584	193.453
B	193.477	193.593	193.458
C	193.511	193.624	193.486
D	193.545	193.655	193.513
E	193.578	193.686	193.540
F	193.581	193.685	193.536
G	193.552	193.653	193.501
H	193.524	193.621	193.466
J	193.495	193.589	193.431
K	193.488	193.578	193.418


NOTES:

SCREED ELEVATIONS ARE BASED ON THE CONDITION THAT NO SLAB CONCRETE HAS BEEN CAST AND THAT FORMWORK, SHEAR DEVELOPERS AND STEEL REINFORCEMENT ARE IN PLACE.

BOTTOM OF SLAB ELEVATIONS (ARE AT RIGHT ANGLES TO THE BEAM CENTERLINE AND ARE BASED ON THE CONDITION THAT THE BEAMS AND DIAPHRAGMS ARE COMPLETELY ERECTED WITH NO OTHER LOADS APPLIED. NO TEMPORARY SUPPORTS ARE ALLOWED AT THIS TIME. THESE ELEVATIONS INCLUDE ALLOWANCE FOR VERTICAL CURVE AND DEFLECTION DUE TO FORMS, STEEL REINFORCEMENT, CONCRETE SLAB, SIDEWALKS, RAILING, AND UTILITIES.

SECTIONS FOR BOTTOM OF SLAB AND/OR SCREED ELEVATIONS ARE GIVEN ALONG BEAM CENTERLINES FROM CENTERLINE OF BEARING OR PIN & HANGER TO CENTERLINE OF BEARING OR PIN & HANGER AS APPLICABLE AT EQUAL SPACINGS.

SLAB AND SCREED DATA				
DATE	CONT. SEC.	JOB NO.	DESIGN UNIT	SHEET
10-13-99	S30 OF 63174	48404A	MAHDAVI	21 OF 22

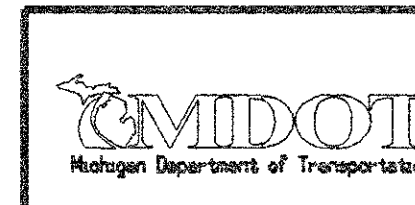



SUPERSTRUCTURE SPAN 1

BAR	DIMENSIONS										NO. REQ'D	TOTAL WT.
	a	b	c	d	e	f	g	h	j			
EA1009680	9680										237	1285
EA1314400	14400										246	3521
EA1310680	10680										8	85
EA1609520	9520										143	2113
EA1611660	11660										143	2588
EA1302100	2100										296	618
EA1302250	2250										4	9
EA1301450	1450										4	6
ED1610890	10660	97	133								286	4834
ED1300880	270	340	270								148	129
ED1301150	225	700	225								2	2
ED1301020	305	410	305								3	3
EL1302315	760	175	660	360	360	162					258	594
EL1903365	1280	185	1180	360	360	172					16	120
EL1903350	1180	170	1280	360	360		170				8	60
ET1902344	310	410	378	510	158	200					200	1048

SUPERSTRUCTURE SPAN 2

BAR	DIMENSIONS										NO. REQ'D	TOTAL WT.
	a	b	c	d	e	f	g	h	j			
EA1012020	12020										237	1595
EA1312100	12100										246	2959
EA1310680	10680										8	85
EA1609520	9520										119	1758
EA1611660	11660										119	2153
EA1302100	2100										248	518
EA1302250	2250										4	9
EA1301450	1450										4	6
ED1610890	10660	97	133								238	4023
ED1300880	270	340	270								124	108
ED1301150	225	700	225								2	2
ED1301020	305	410	305								3	3
EL1302315	760	175	660	360	360	162					216	497
EL1903365	1280	185	1180	360	360	172					16	120
EL1903350	1180	170	1280	360	360		170				8	60
ET1902344	310	410	378	510	158	200					168	880

BAR	DIMENSIONS										NO. REQ'D	TOTAL WT.
	a	b	c	d	e	f	g	h	j			

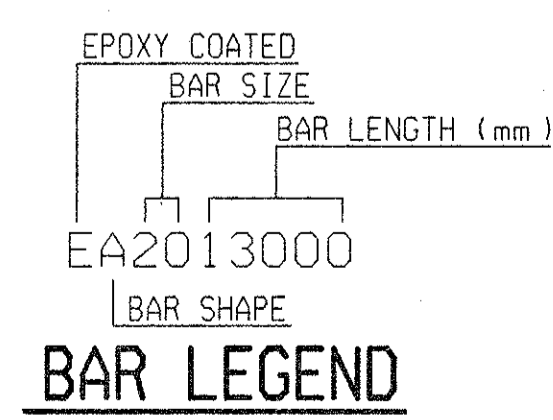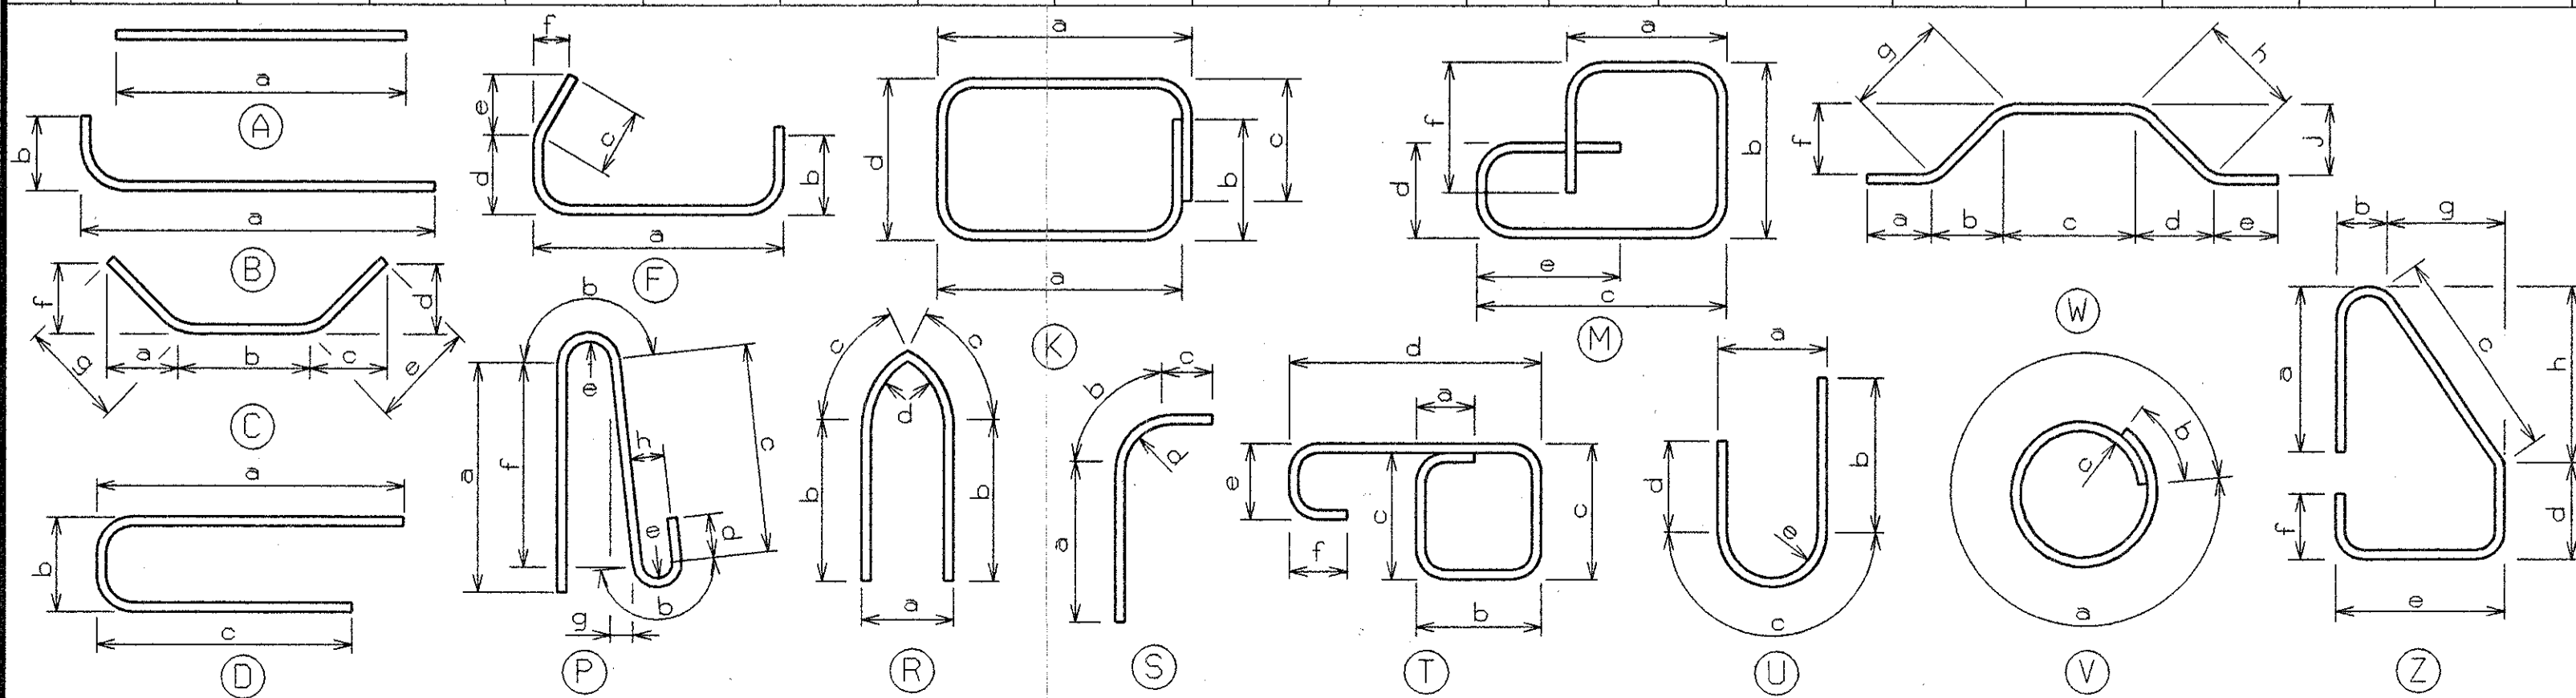

MISCELLANEOUS QUANTITIES

0	kg	REINFORCEMENT, STEEL
31791	kg	REINFORCEMENT, STEEL, EPOXY COATED

REINFORCEMENT SHALL BE BUNDLED AND TAGGED AS TO THE LOCATION AS SHOWN ON THIS SHEET.

STEEL REINFORCEMENT DETAILS

DATE	CONT. SEC.	JOB NO.	DESIGN UNIT	SHEET
10-13-99	S30 OF 63174	48404A	MAHDAVI	22 OF 22

NO.	DESCRIPTION	DATE	BY





DRAWN BY: inder DATE: 9-27-99 CHECKED BY: MM DATE: 10-12-99 CORRECTED BY: inder DATE: 10-13-99

FILE NAME: s3063174.rsv

CONTROL SECTION S31 OF 63174 JOB NO. 48404A SH. 2


1 2 3 4 5 6 7 8 9 10 11 12 13 14 15 16 17 18 19 20 21 22 23 24 25 26 27 28 29 30 31 32 33 34 35 36 37 38 39 40 41 42 43 44 45 46 47 48 49 50 51 52 53 54 55 56 57 58 59 60 61 62 63

REVISIONS			
NO.	DESCRIPTION	DATE	BY

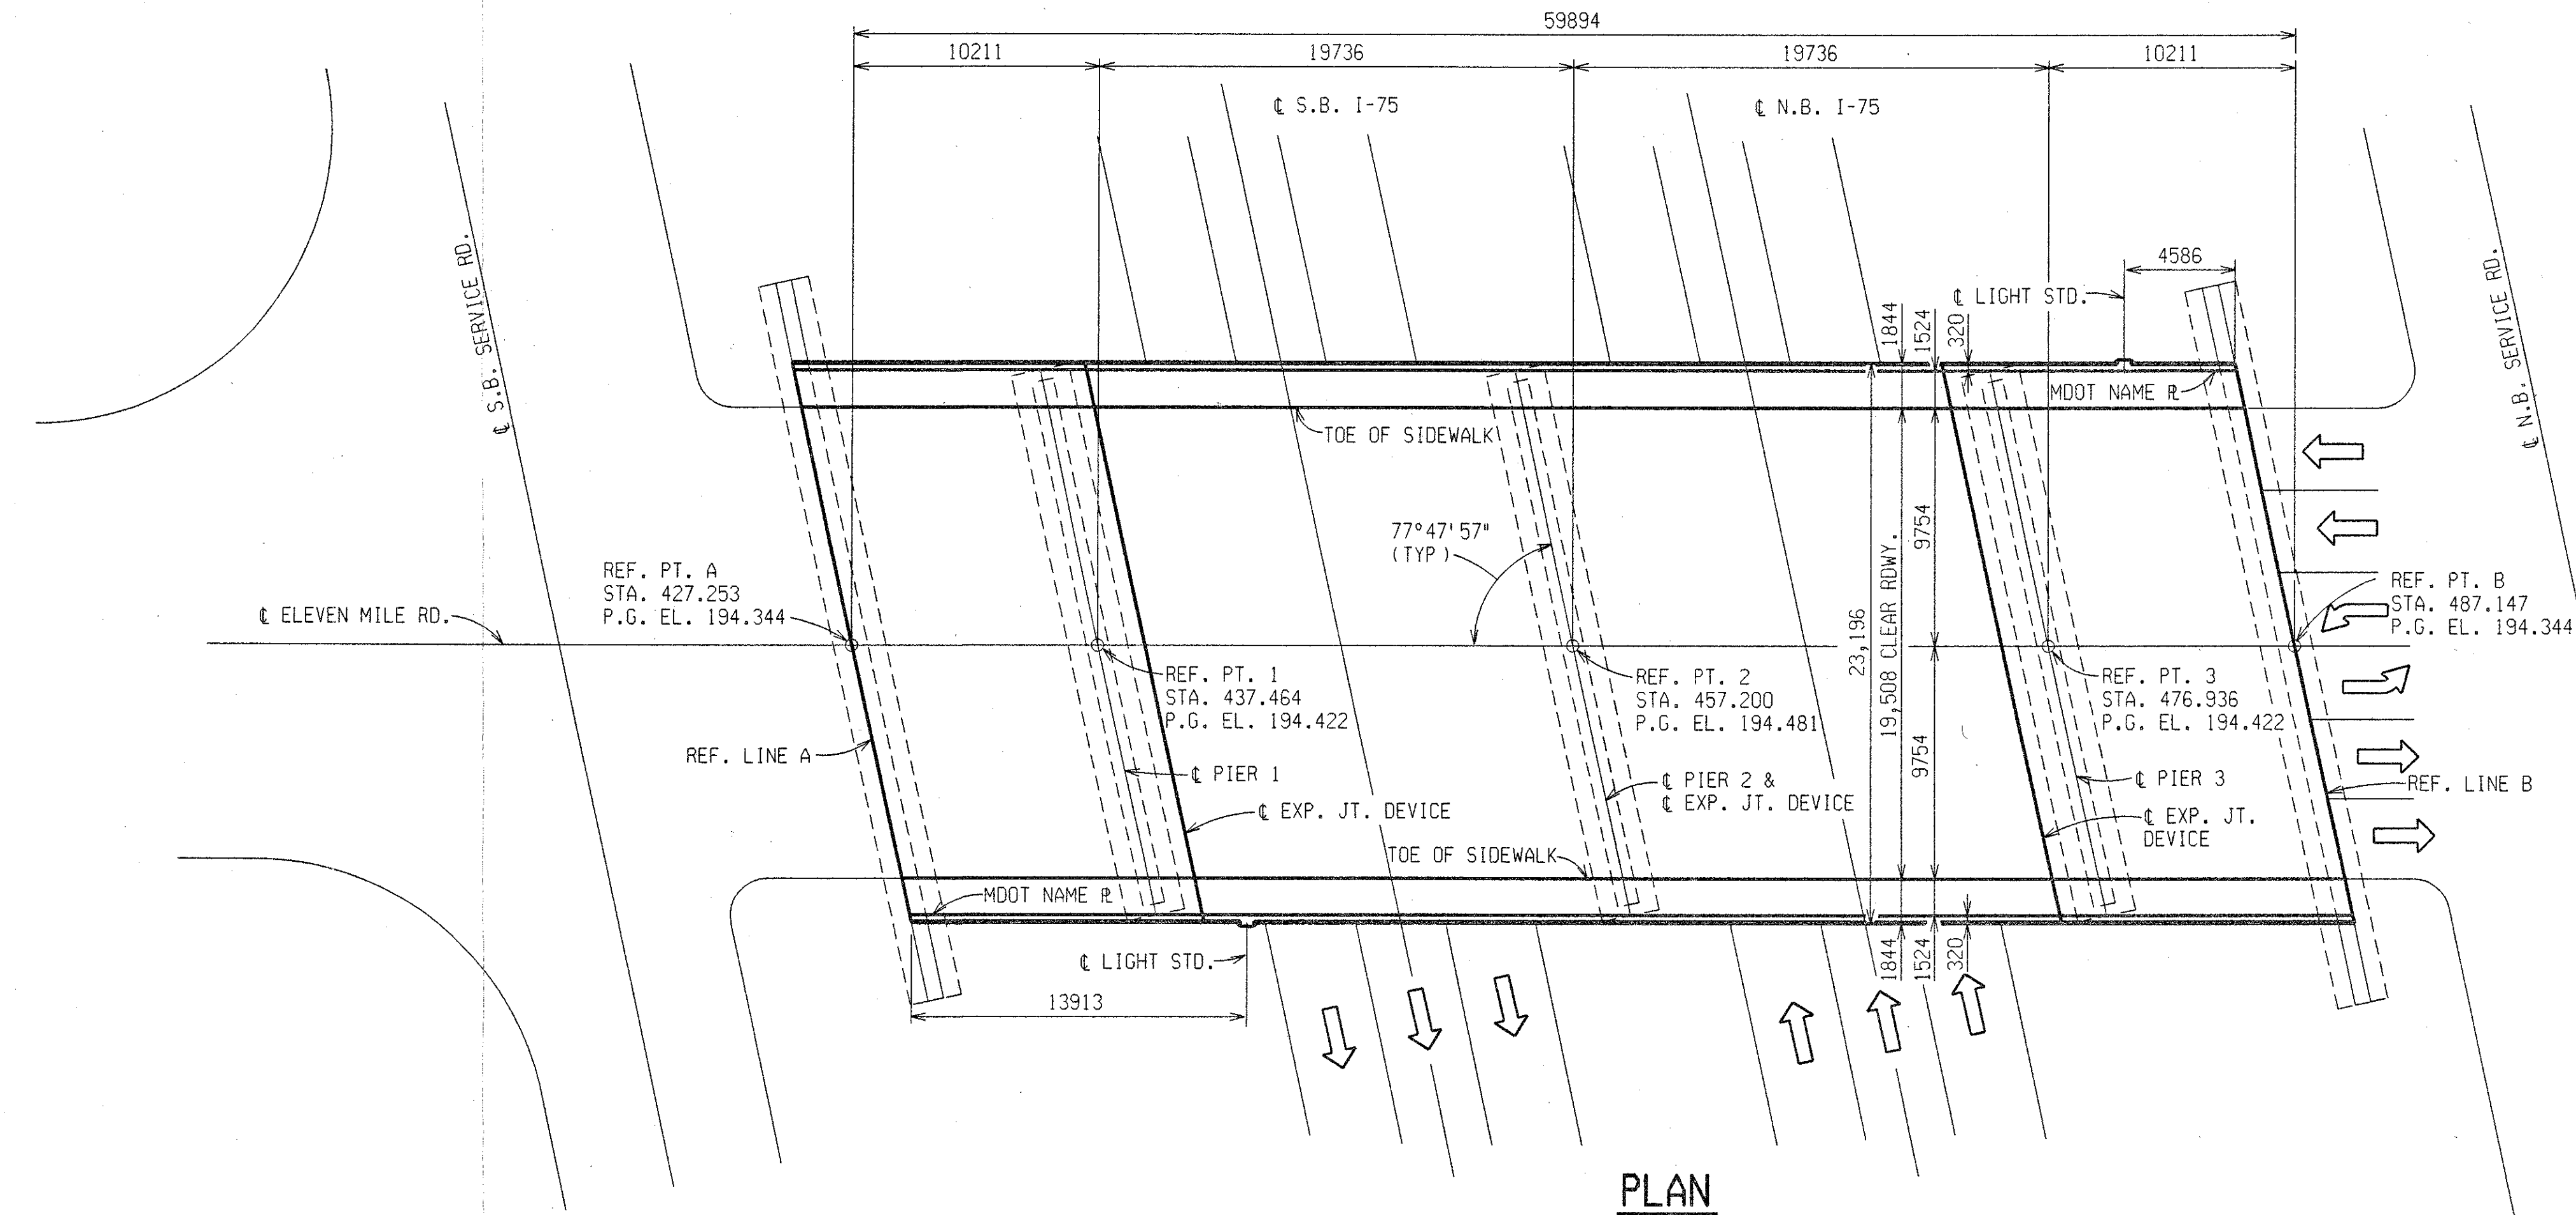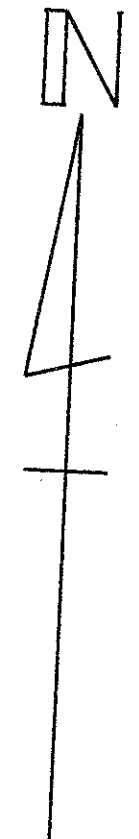

PLAN

THE LIMITS OF FALSE DECKING IS FROM INSIDE FACE OF PIER 1 TO INSIDE FACE OF PIER 3 AND BETWEEN SLAB FASCIAS.

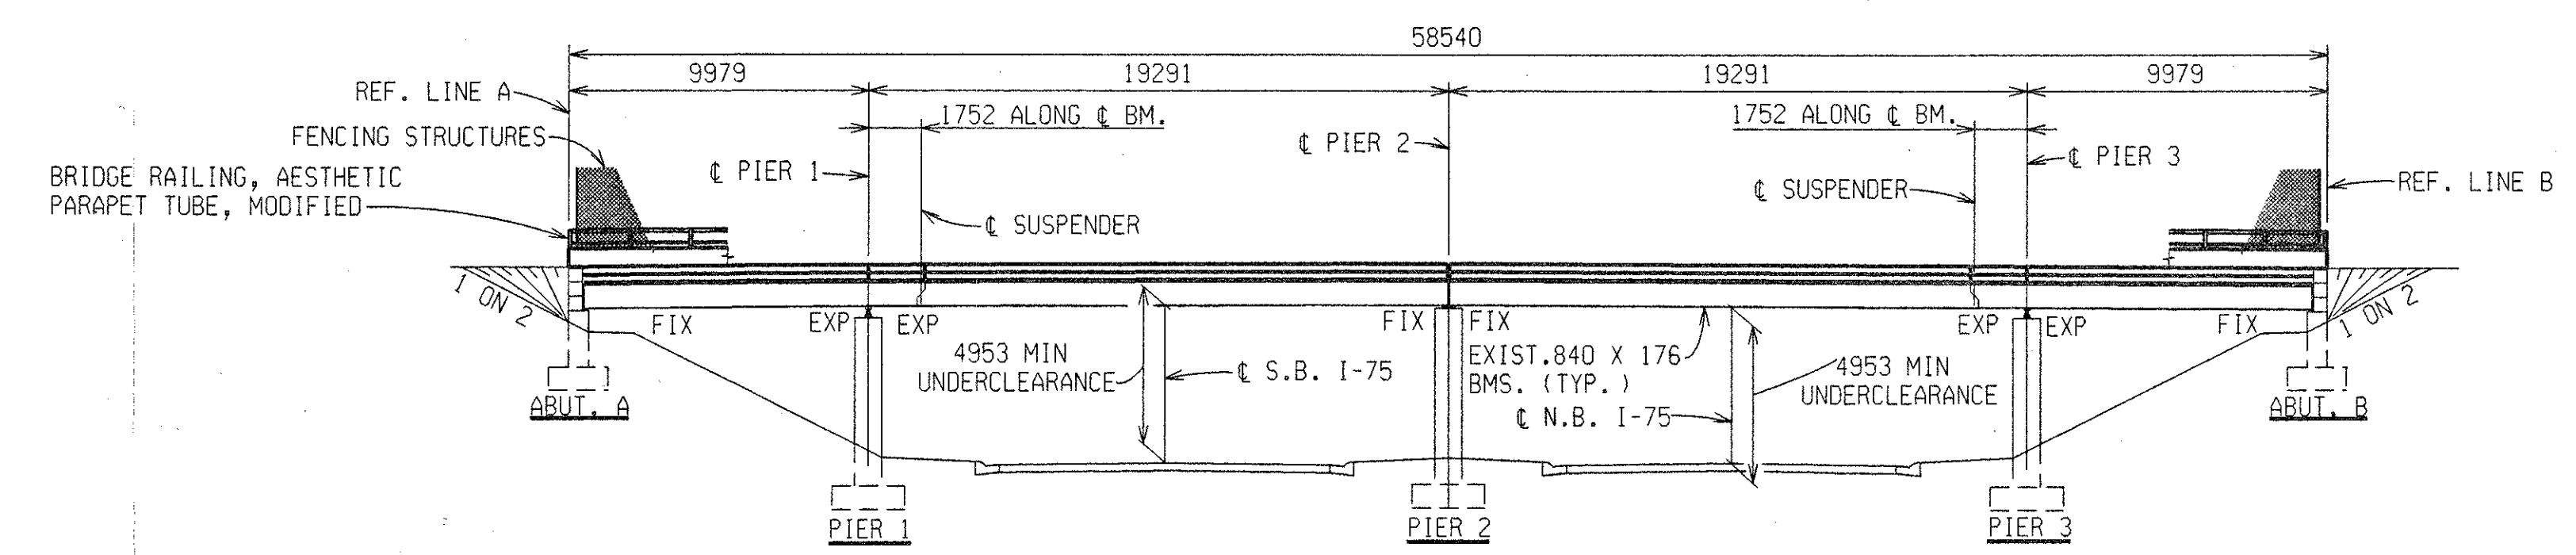

ELEVATION

SHOWN 1 TO I-75

MISCELLANEOUS QUANTITIES	
863 m ²	False Decking
1 LS	Structures, Rehabilitation, Rem Portions (S31)

NOTES:

THE WORK COVERED BY THESE PLANS INCLUDES DECK REPLACEMENT, PEDESTRIAN SCREENING, PIN AND HANGER REPLACEMENT, PAINTING OF THE EXISTING STRUCTURAL STEEL, AND MAINTAINING TRAFFIC. ALL OTHER WORK IS INCLUDED IN THE ROAD PLANS THAT ARE A PART OF THIS CONTRACT.

THE REHABILITATION DESIGN IS BASED ON CURRENT AASHTO STANDARD SPECIFICATIONS FOR HIGHWAY BRIDGES MS18 LOADING. LIVE LOAD PLUS IMPACT DEFLECTION DOES NOT EXCEED 1/1000 OF SPAN LENGTH AND 1/375 OF CANTILEVER ARM. THE LOAD FACTOR METHOD WAS USED FOR THIS DESIGN. THE ORIGINAL STRUCTURE WAS DESIGNED FOR MS18 LOADING.

THE CONTRACTOR SHALL LOCATE ALL ACTIVE UNDERGROUND UTILITIES PRIOR TO STARTING WORK AND SHALL CONDUCT HIS OPERATIONS IN SUCH A MANNER AS TO ENSURE THAT THOSE UTILITIES NOT REQUIRING RELOCATION WILL NOT BE DISTURBED.

THE CONTRACTOR SHALL NOTIFY DETROIT EDISON FOR DEACTIVATION OF STREET LIGHTS AND TRAFFIC SIGNAL CIRCUITS PRIOR TO DECK REMOVAL AND FOR REINSTALLATION OF THE STREET LIGHTING AND SIGNALS FOLLOWING COMPLETION OF BRIDGE DECK CONSTRUCTION.

ALL WORK FOR TEMPORARY SUPPORT AND PROTECTION OF THE AMERITECH DUCTS AND THE CONSUMER ENERGY GAS MAIN SHALL BE INCLUDED IN THE PAY ITEM "STRUCTURES, REHABILITATION, REMOVE PORTIONS (S31)"


ELEVEN MILE ROAD TRAFFIC IS TO BE DETOURED OVER OTHER EXISTING ROADS.

MEASURES SHALL BE TAKEN TO PREVENT DEBRIS FROM FALLING FROM THE STRUCTURE.

THE EXISTING GAS MAIN AND AMERITECH DUCTS WILL REQUIRE TEMPORARY SUPPORTS PRIOR TO REMOVAL OF THE DECK.

GENERAL PLAN OF STRUCTURE				
I-75 UNDER ELEVEN MI. IN ROYAL OAK				
DATE	CONT. SEC.	JOB NO.	DESIGN UNIT	SHEET
10-13-99	S31 OF 63174	48404A	MAHDAVI	2 OF 20

APPROVED *Steve P. Beck* 10/19/99
DESIGN SUPERVISING ENGINEER


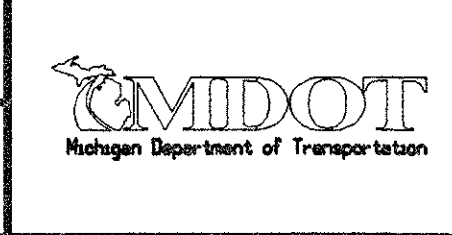


FILE NAME: s3163174.st DRAWN BY: CASLER CHECKED BY: DATE: 2-5-99 CORRECTED BY: CASLER DATE: 9-20-99


CONTROL SECTION S31 OF 63174 JOB NO. 48404A SH. NO. 3

1 2 3 4 5 6 7 8 9 10 11 12 13 14 15 16 17 18 19 20 21 22 23 24 25 26 27 28 29 30 31 32 33 34 35 36 37 38 39 40 41 42 43 44 45 46 47 48 49 50 51 52 53 54 55 56 57 58 59 60 61 62 63


REVISIONS			
NO.	DESCRIPTION	DATE	BY

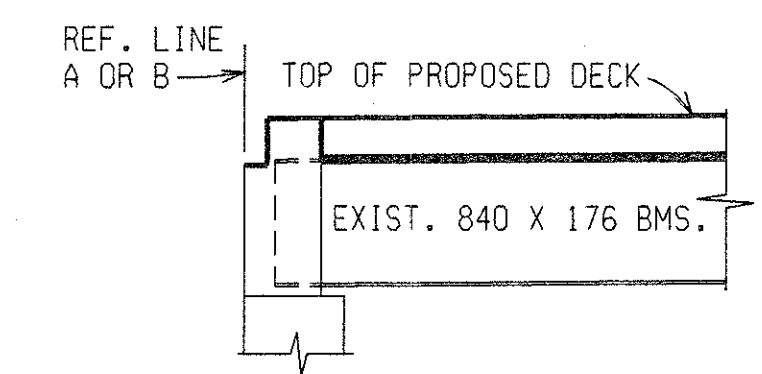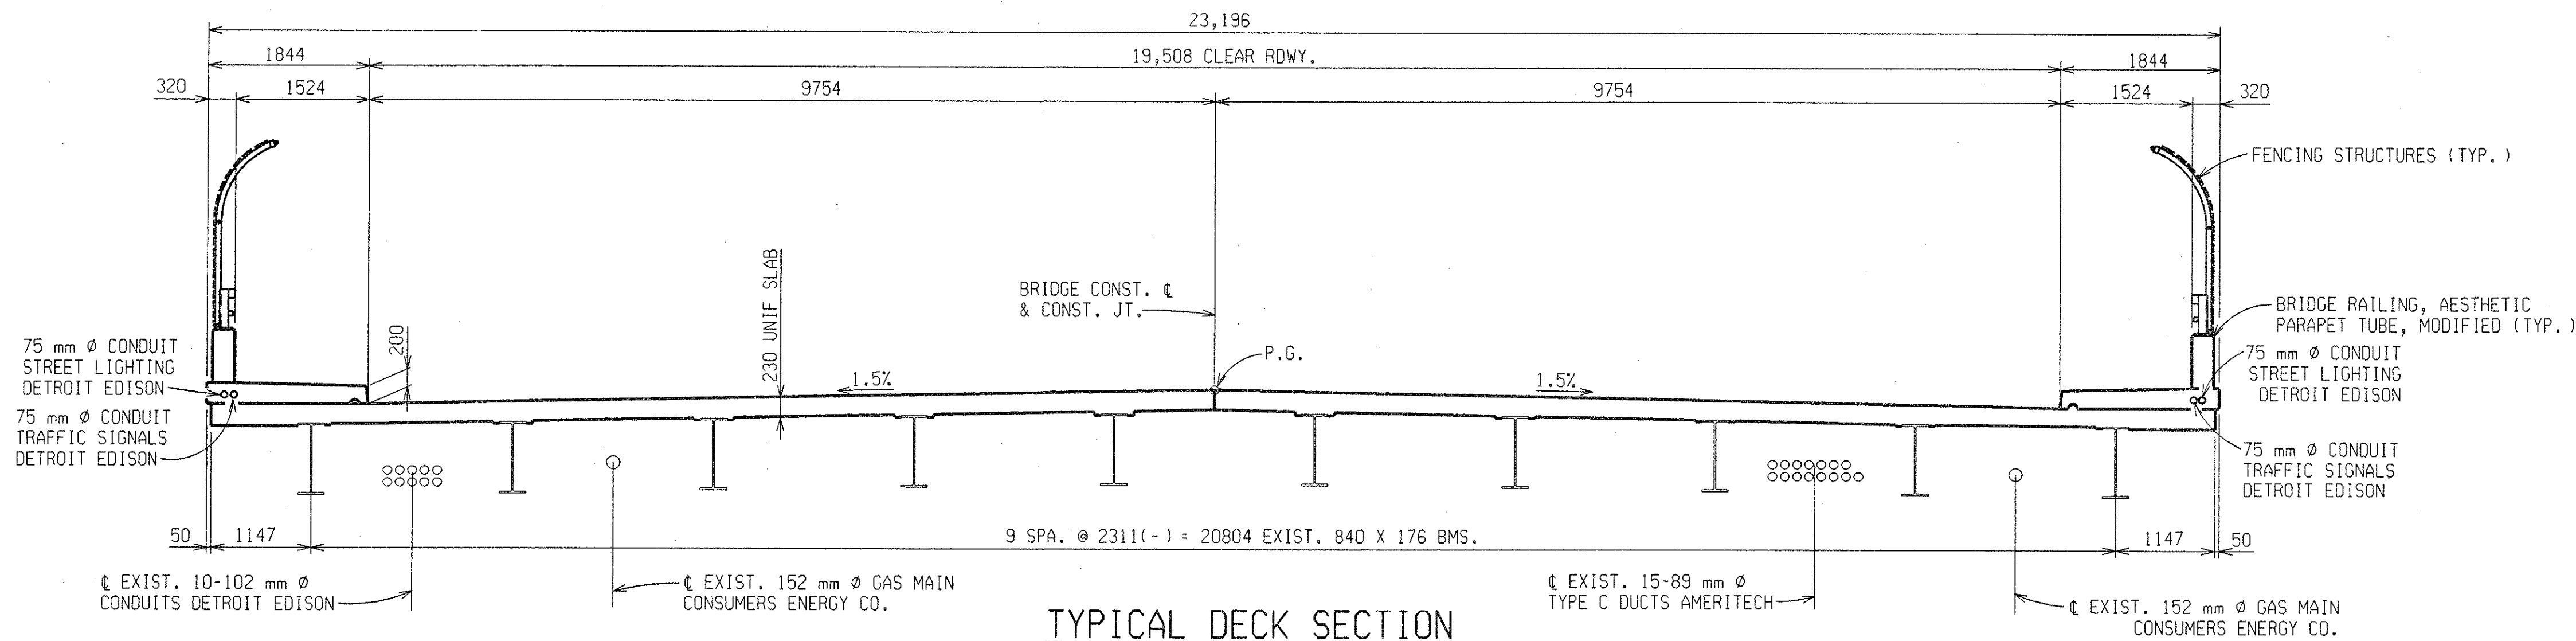

SECTION AT ABUTMENT

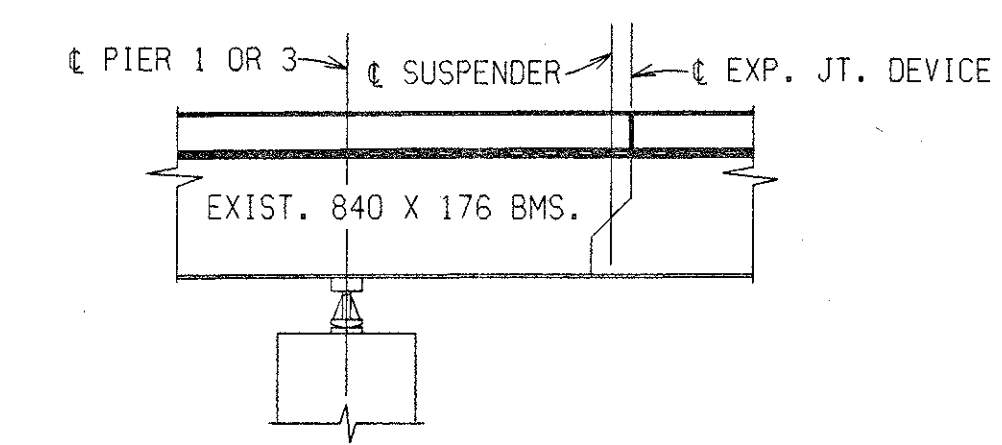

SECTION AT PIER 1 & 3

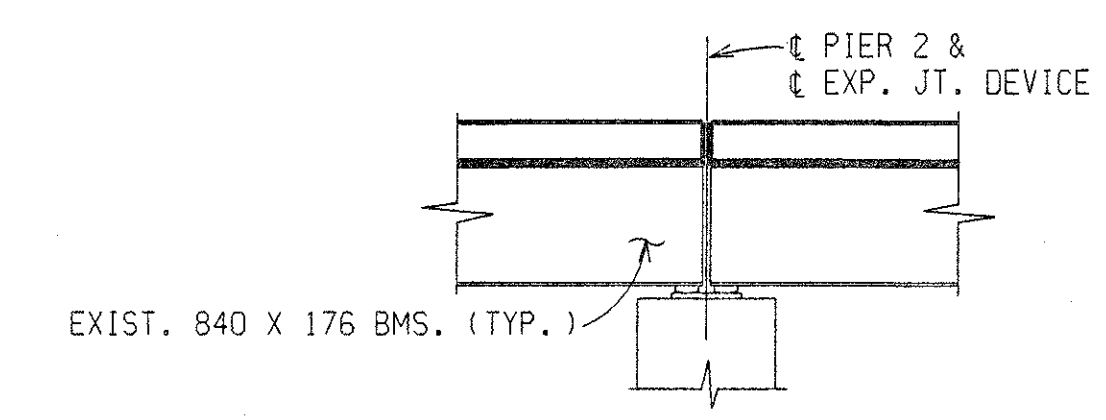

SECTION AT PIER 2



DATE: 9-20-99
CORRECTED BY: CASLER
DATE: 4-1-99
CHECKED BY: MIKUCKI
DATE: 3-29-99
DRAWN BY: CASLER
FILE NAME: s3163174.st

APPROVED *Steven P. Beck* 10/19/99
DESIGN SUPERVISING ENGINEER



GENERAL PLAN OF STRUCTURE				
I-75 UNDER ELEVEN MI., IN ROYAL OAK				
DATE	CONT. SEC.	JOB NO.	DESIGN UNIT	SHEET
10-13-99	S31 OF 63174	48404A	MAHDAVI	3 OF 20

2 3 4 5 6 7 8 9 10 11 12 13 14 15 16 17 18 19 20 21 22 23 24 25 26 27 28 29 30 31 32 33 34 35 36 37 38 39 40 41 42 43 44 45 46 47 48 49 50 51 52 53 54 55 56 57 58 59 60 61 62 63

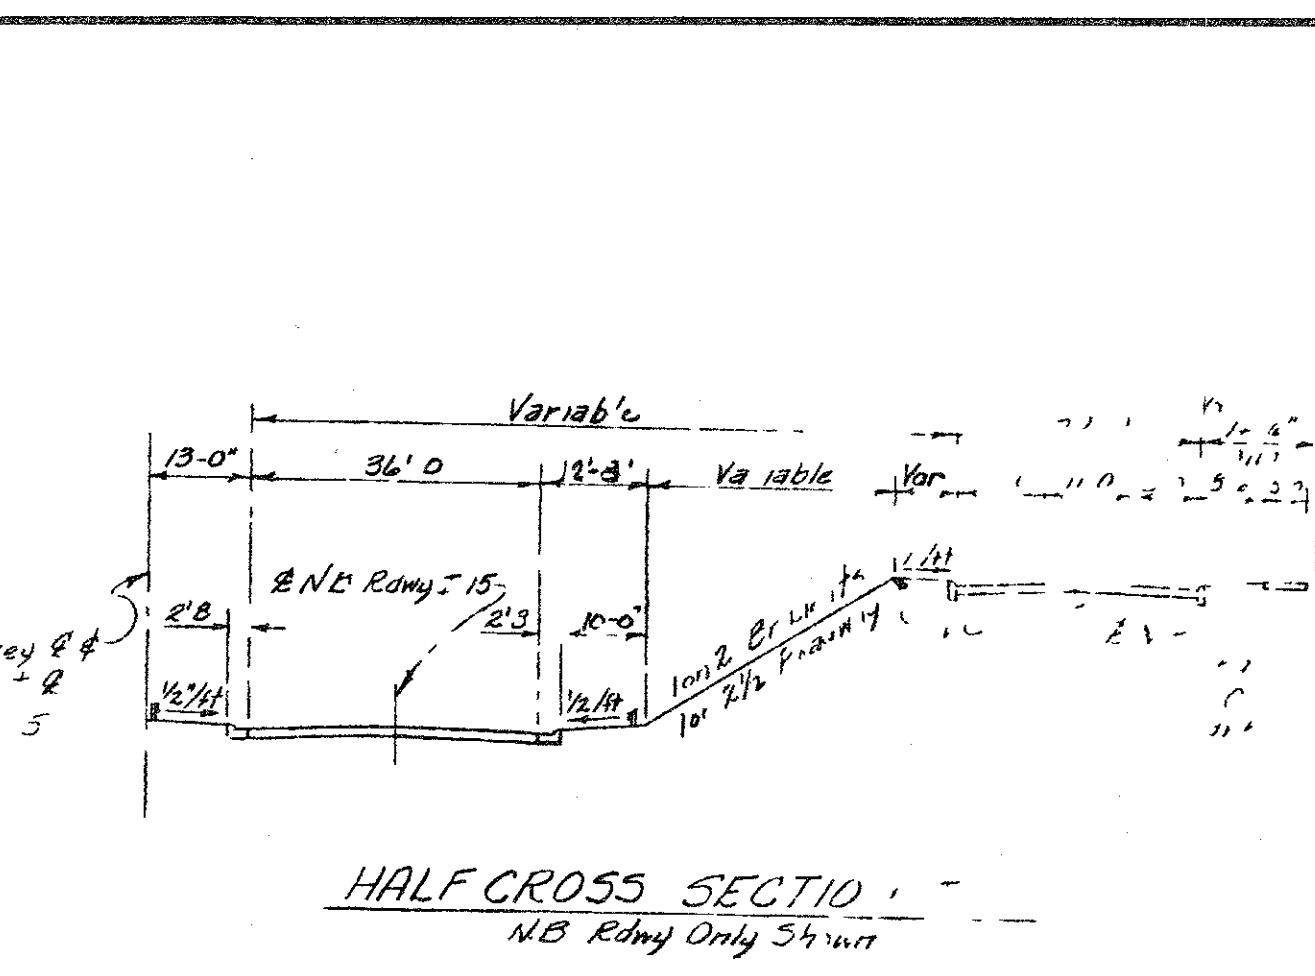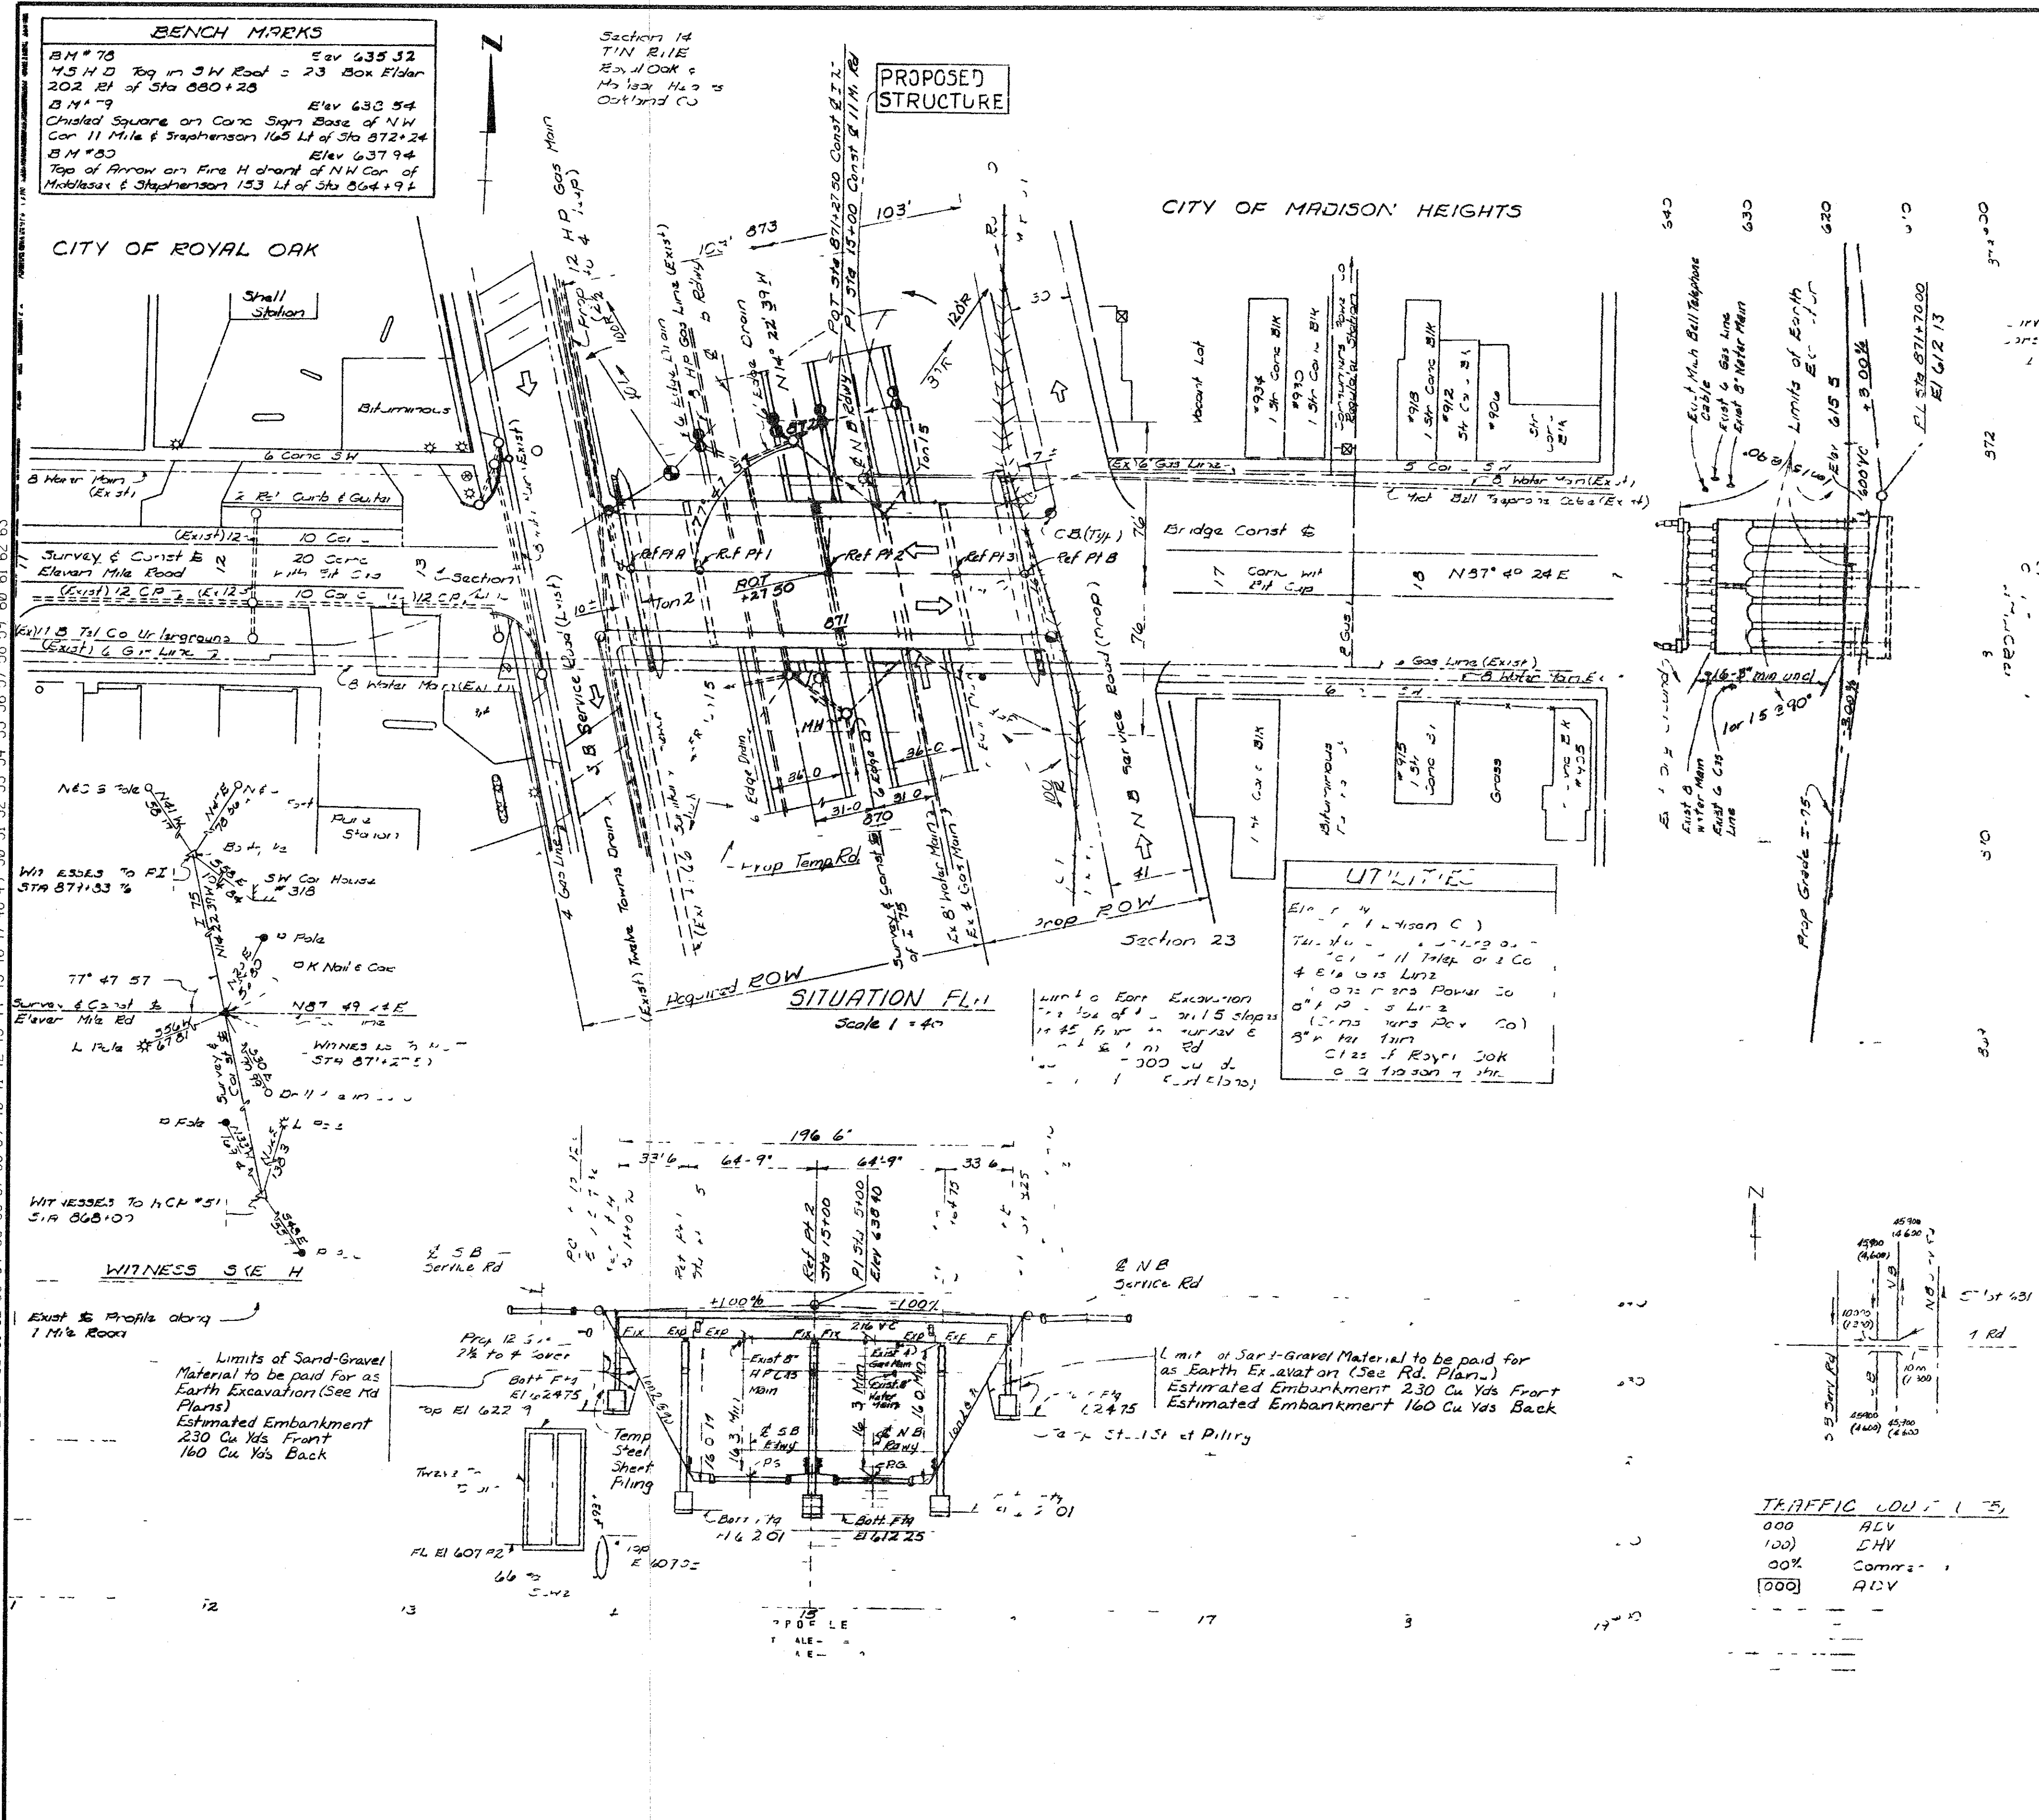

NOTES
 The work covered by these plans includes construction of the proposed bridge and placing Slope Protection to the 11 Mile Road.
 For 2013 by or these plans and not listed above are included in Road 11 Mile which are a part of this contract.
 Removal of fences and buildings is not a part of this contract.
 Contractor shall locate all active underground utilities prior to starting work, and shall conduct this in a manner such a manner as to insure that those utilities not requiring relocation will not be disturbed.
 Grading of I-75 in the vicinity of the structure to be prior to starting work on the structure.
 Traffic maintained for 1 mile on new & existing Service Roads 1/2 mile by temporary roads which are included in Road Plans.
 The backfill material placed around the substructure will be required to have a 95 percent density.

STATE HIGHWAY DEPARTMENT
 SB & NB I-75 Crossing 11 Mile Road
 GENERAL PLAN OF SITE
 DESIGN SUPERVISING ENGINEER
 Wang Wang
 77.65
 S31 of 63174B

NOTE:
 DO NOT WORK FROM THIS SHEET. THE INFORMATION SHOWN HERE IS FOR REFERENCE ONLY. NO PAY ITEMS ARE SHOWN.








FOR INFORMATION ONLY				
DATE	CONT. SEC.	JOB NO.	DESIGN UNIT	SHEET
10-13-99	S31 OF 63174.	48404A	MAHDAVI	4 OF 20



REVISIONS
 NO. DESCRIPTION DATE BY
 DATE: 01-13-99
 CHECKED BY:
 CORRECTED BY:
 DATE:
 DRAWN BY: INDER
 FILE NAME: s3163174.dgn

1 2 3 4 5 6 7 8 9 10 11 12 13 14 15 16 17 18 19 20 21 22 23 24 25 26 27 28 29 30 31 32 33 34 35 36 37 38 39 40 41 42 43 44 45 46 47 48 49 50 51 52 53 54 55 56 57 58 59 60 61 62 63

NO.	DESCRIPTION	DATE	BY

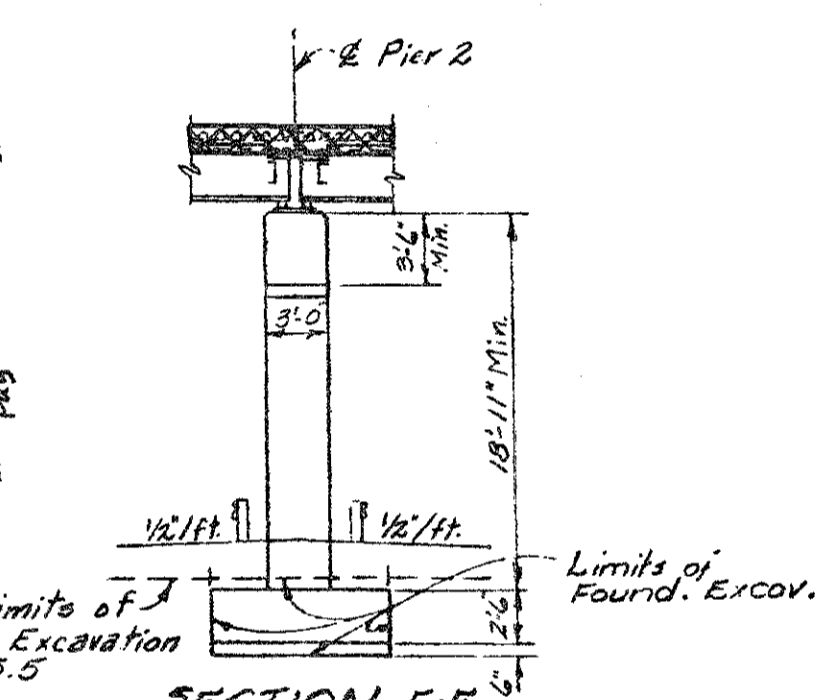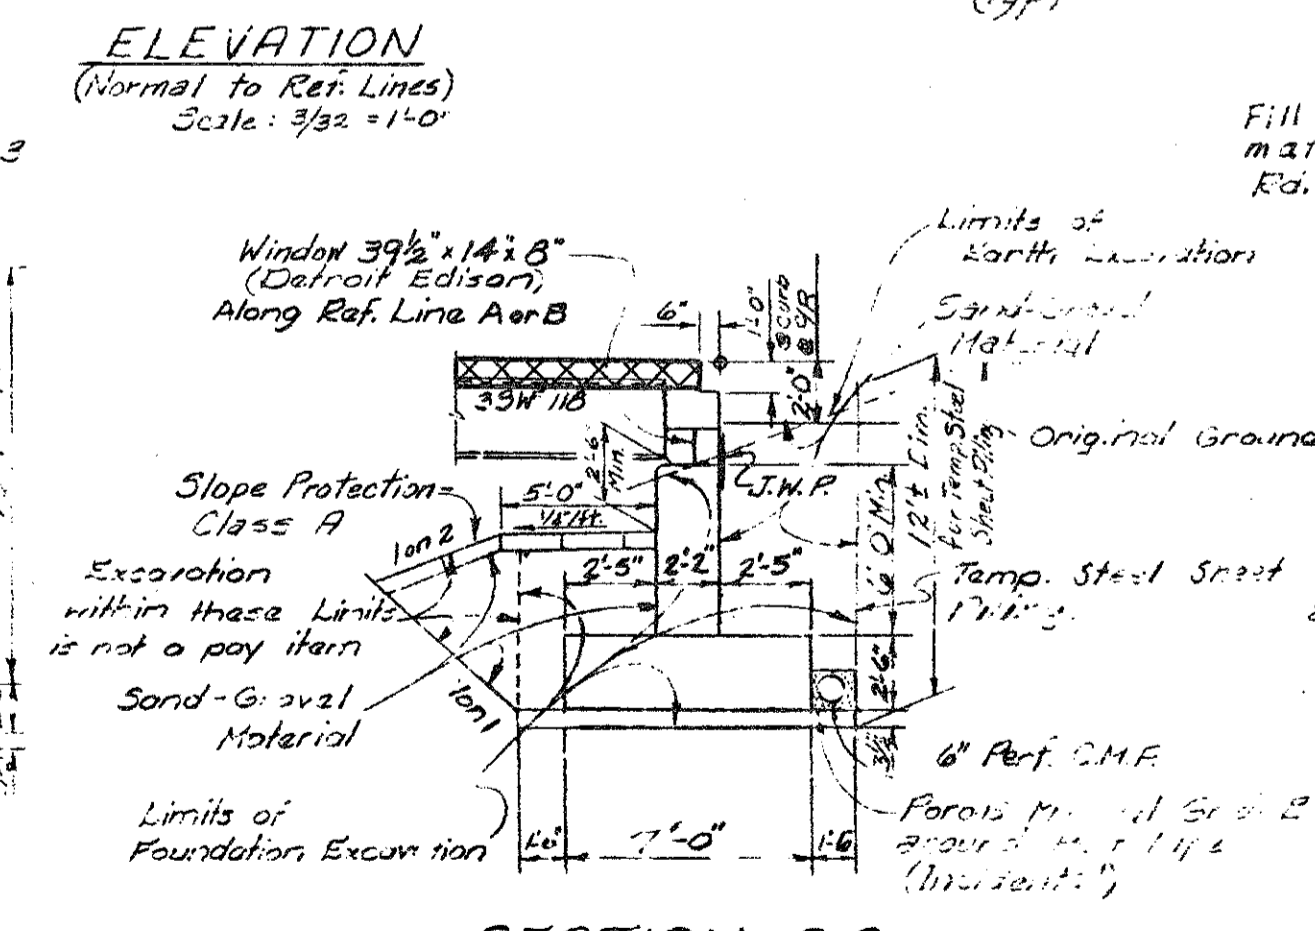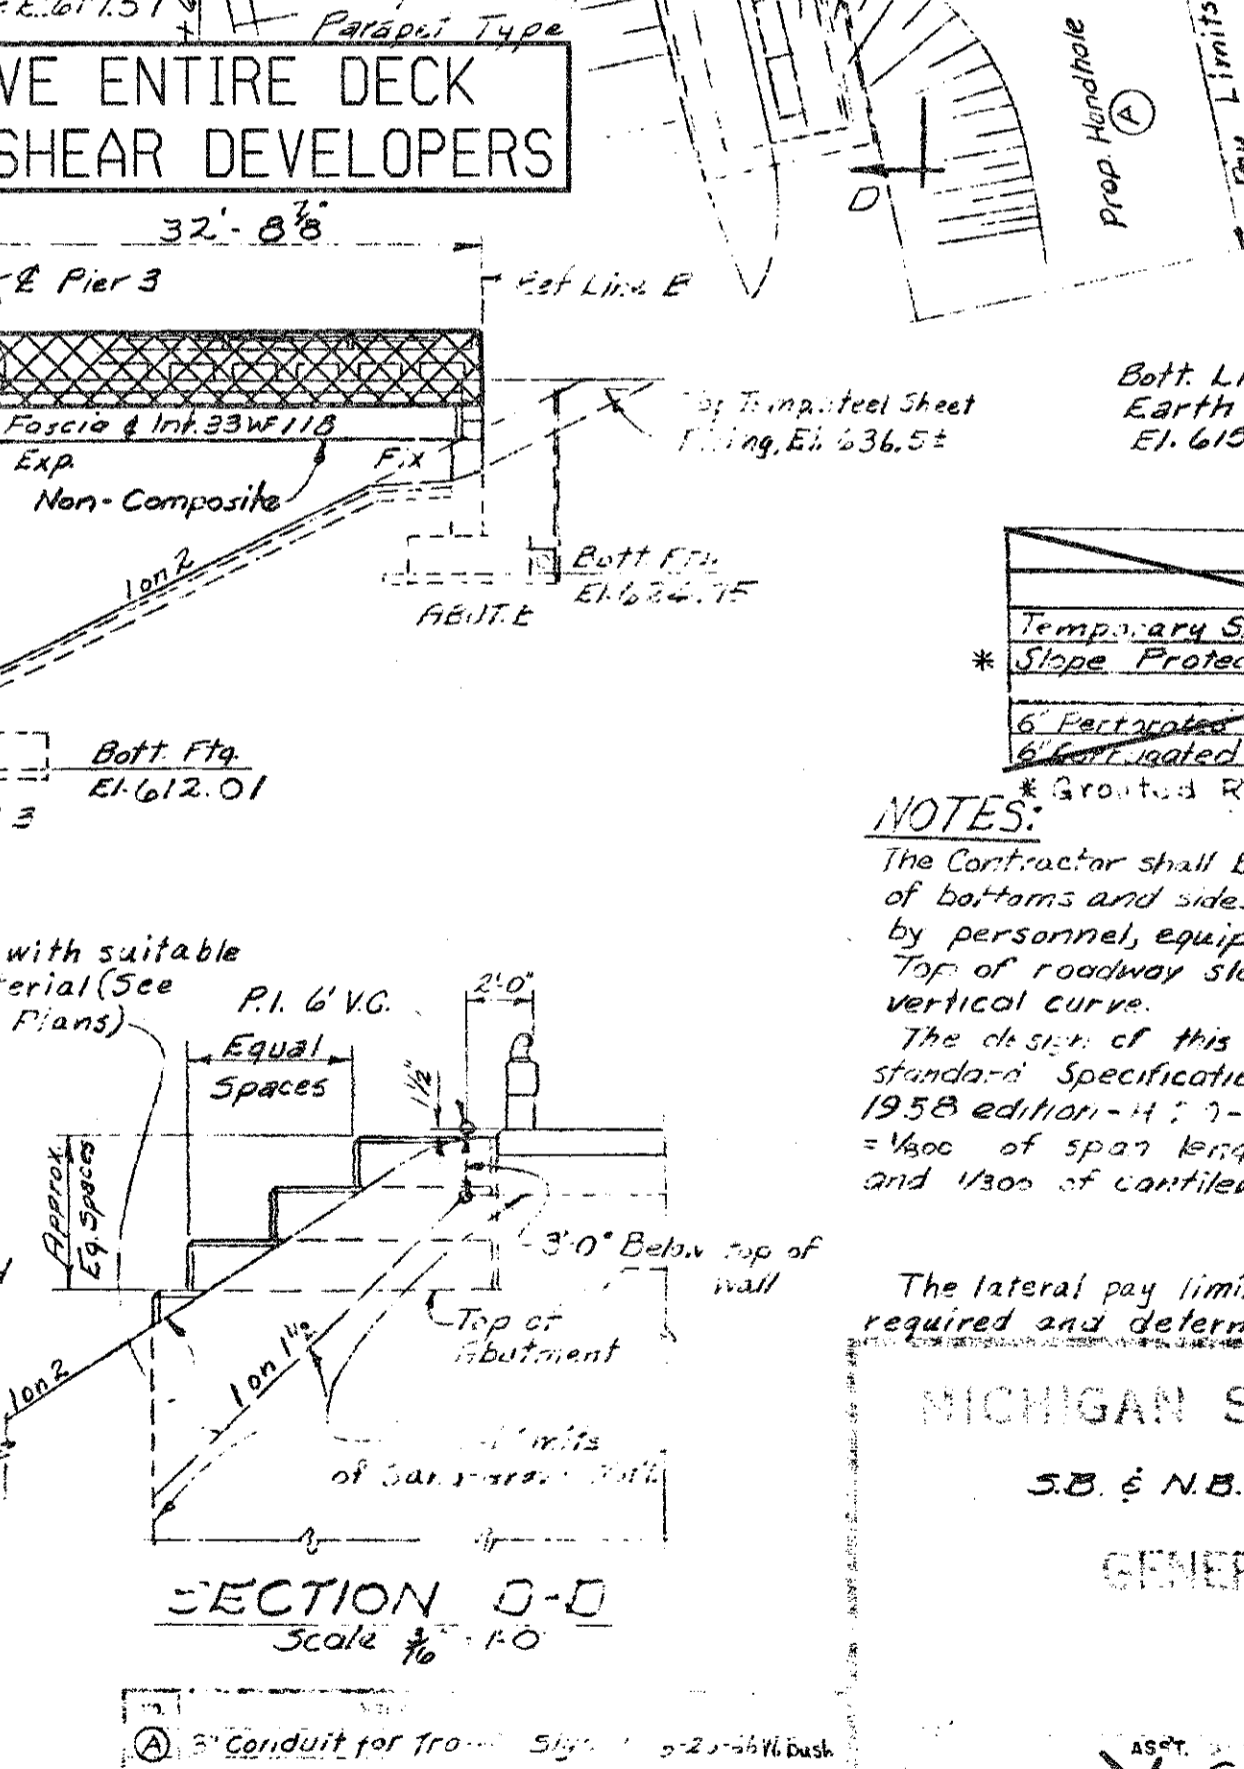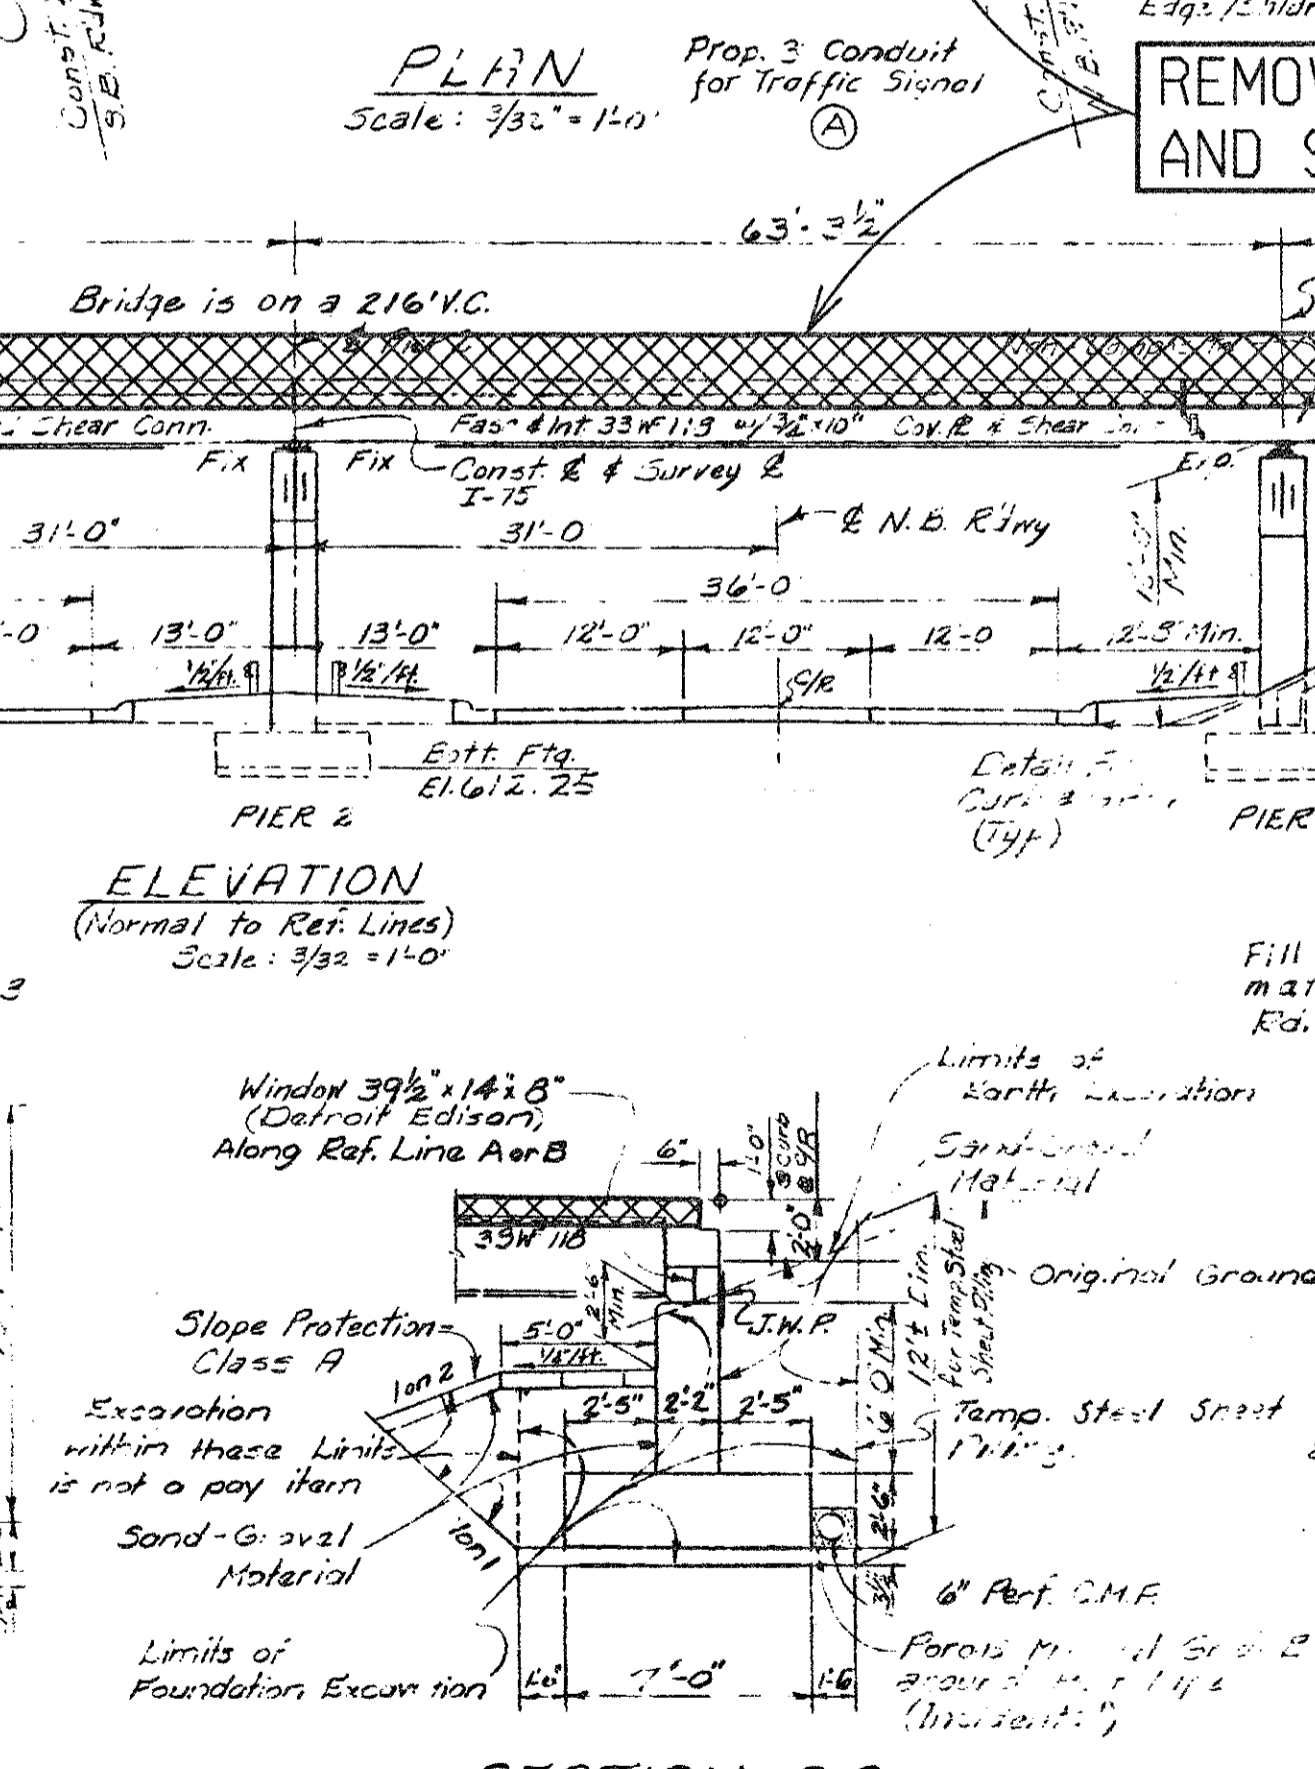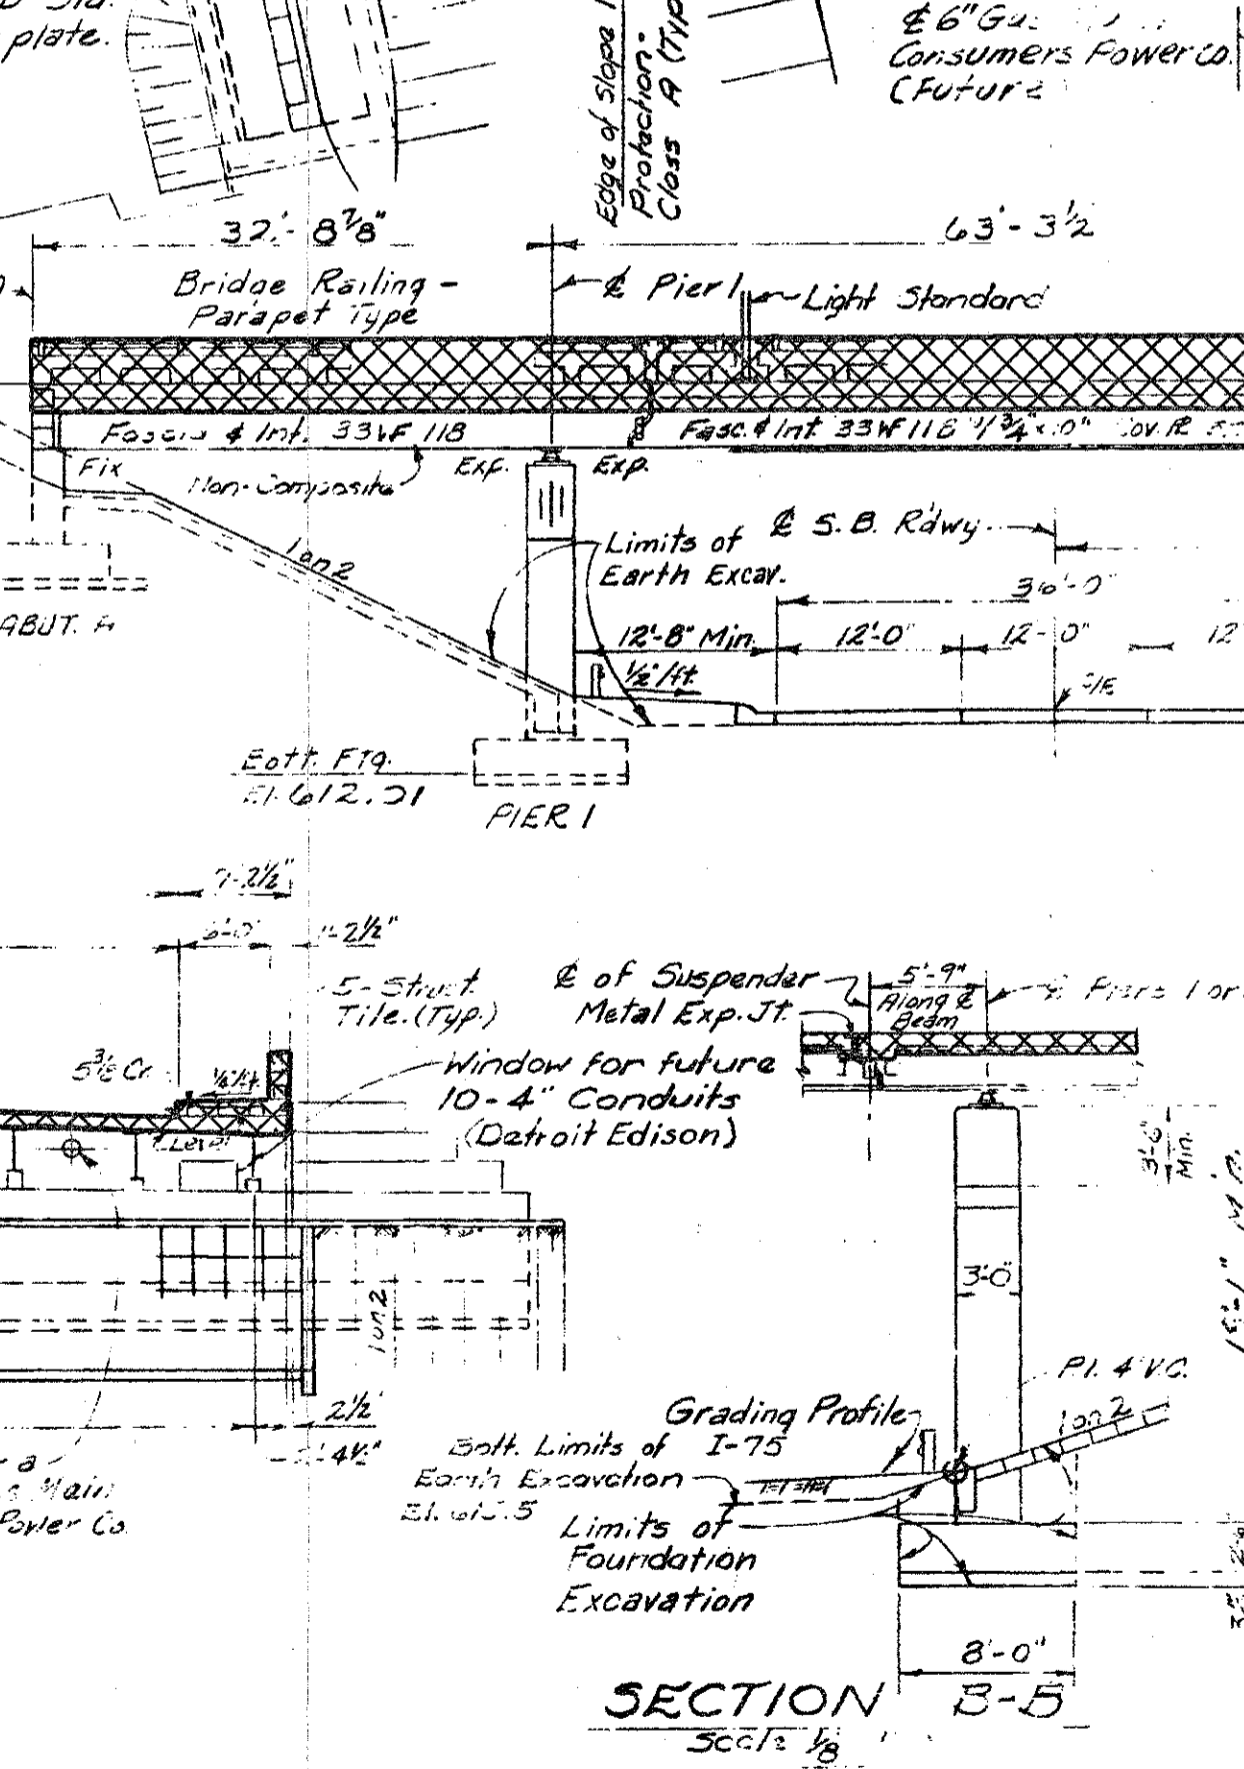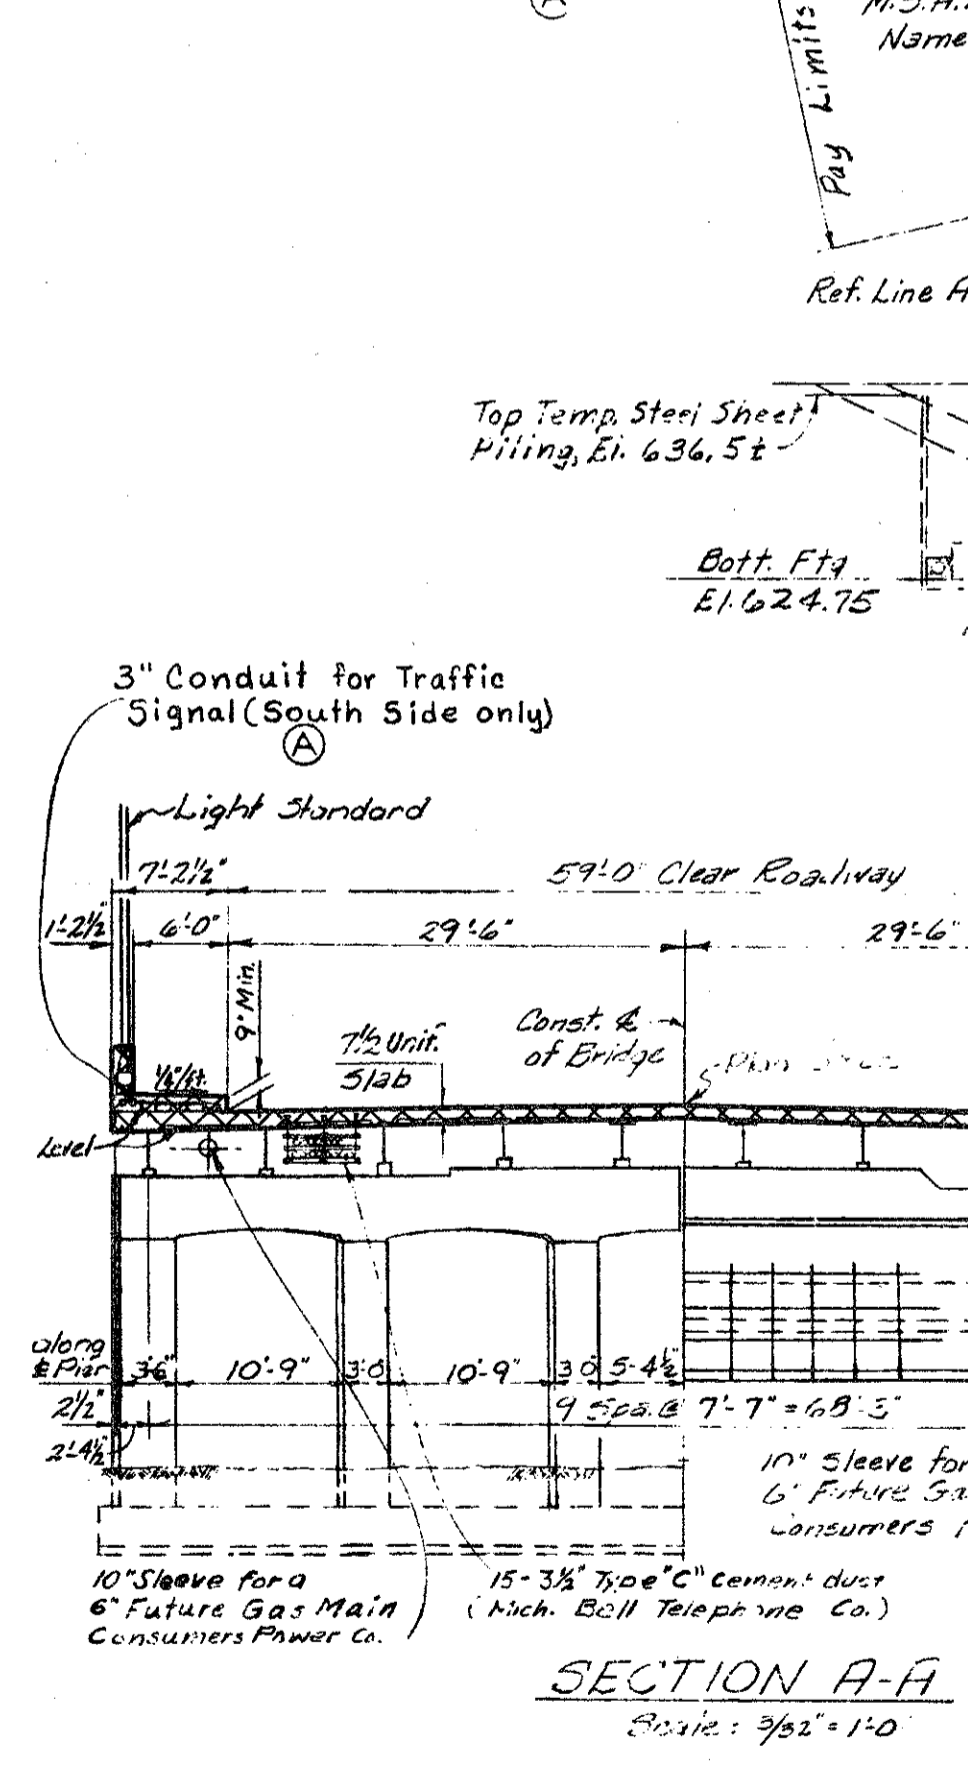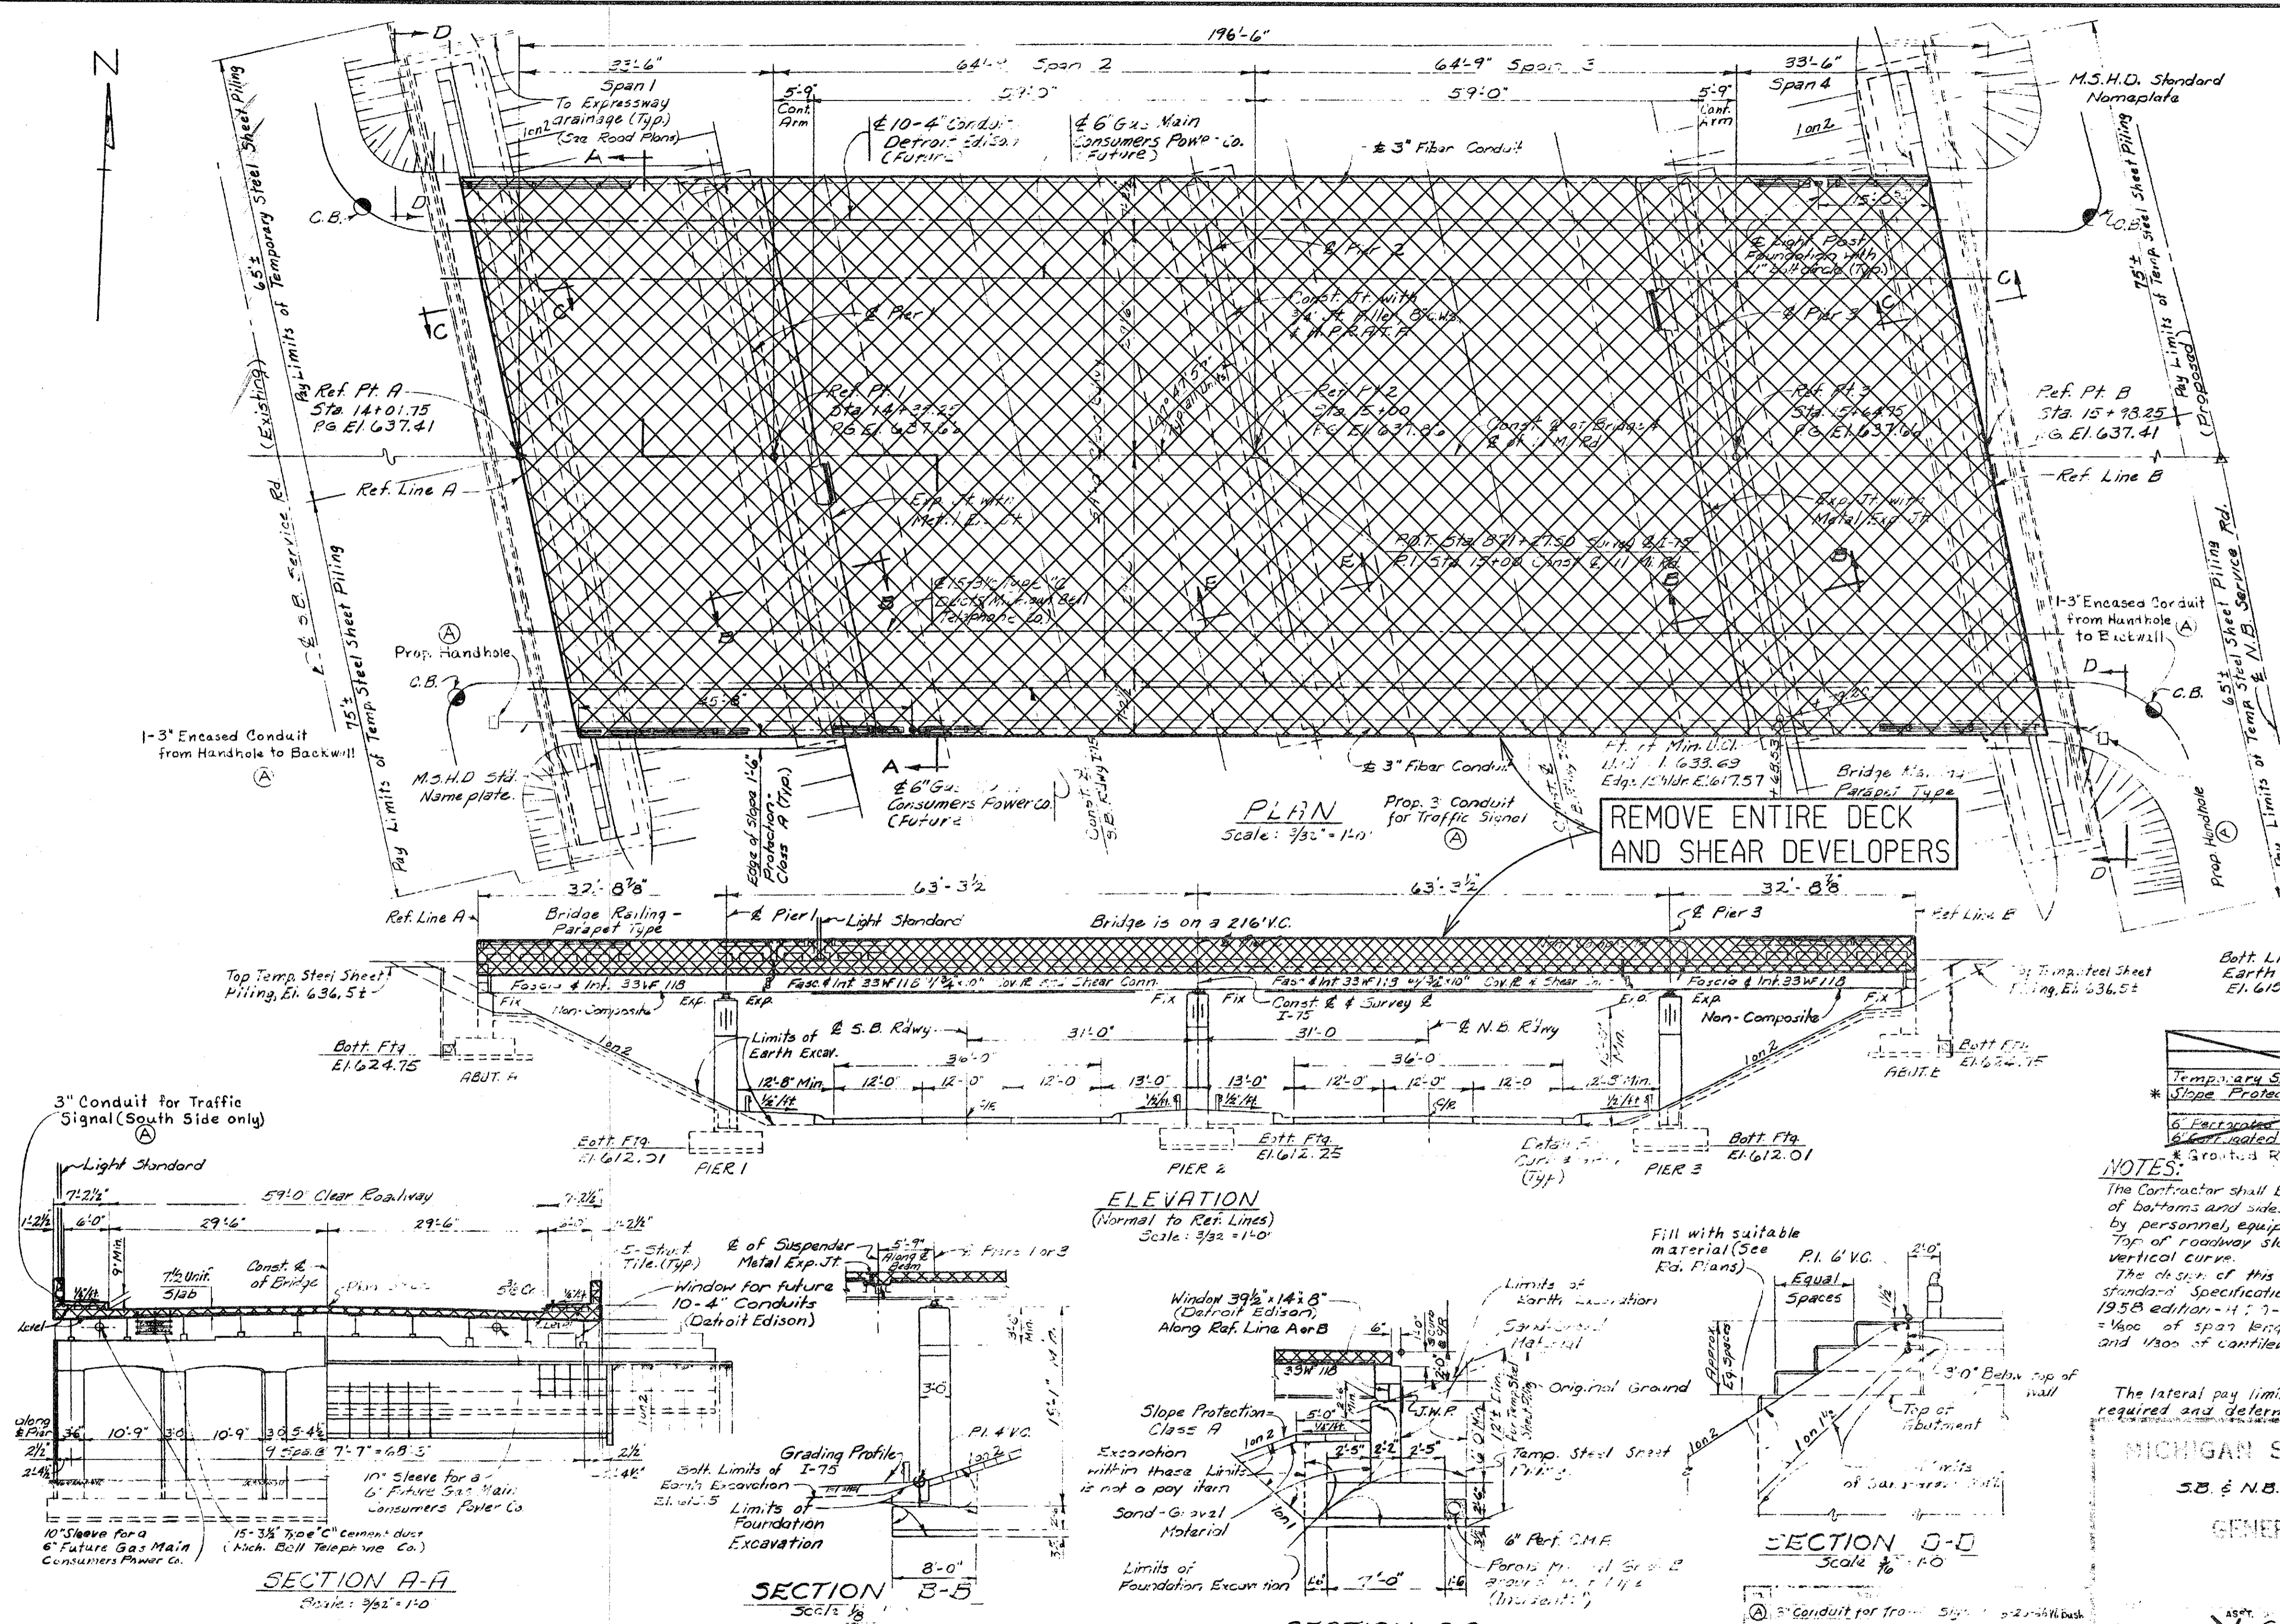

MISCELLANEOUS QUANTITIES		
Item	UNIT	Amount
Temporary Steel Sheet Piling	Sq. Ft.	3400
Slope Protection - Class A	Sq. Yds.	615
6" Encased Corrugated Metal Pipe	Lin. Ft.	200
6" Galvanized Metal Pipe	Lin. Ft.	240

NOTES:
 The Contractor shall be responsible for providing adequate protection of bottoms and sides of the footing excavation against damage by personnel, equipment and water.
 Top of roadway slab and tops of sidewalks are parallel to the vertical curve.
 The design of this structure is based on the the M.S.H.D. Standard Specifications for the Design of Highway Bridges - 1958 edition - 4: 7-44 Loading, Live load plus impact deflection = 1/800 of span length of suspended span and anchor span and 1/300 of cantilever arm.

MICHIGAN STATE HIGHWAY DEPARTMENT
 S.B. & N.B. I-75 crossing 11 Mile Rd.
 GENERAL PLAN OF STRUCTURE


DATE: 10-13-99
 DRAWN BY: INDER
 CHECKED BY: DATE: 01-13-99
 CORRECTED BY: CASLER
 DATE: 5-11-99

J.C. Tolson
 DESIGN SUPERVISING ENGINEER
 7.7.65
 S31 of 63174B

THE ONLY ITEMS OF WORK TO BE DONE FROM THIS SHEET ARE IDENTIFIED BY THE LEGEND BOX BELOW, LABELED WITH THIS PROJECT'S JOB NUMBER.

JOB NO. 48404A


DENOTES REMOVAL PORTIONS
 PROPOSED WORK

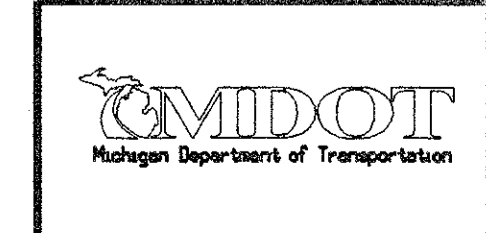

REMOVAL PORTIONS				
DATE	CONT. SEC.	JOB NO.	DESIGN UNIT	SHEET
10-13-99	S31 OF 63174	48404A	MAHDAVI	5 OF 20

FILE NAME: s3163174.sn

1 2 3 4 5 6 7 8 9 10 11 12 13 14 15 16 17 18 19 20 21 22 23 24 25 26 27 28 29 30 31 32 33 34 35 36 37 38 39 40 41 42 43 44 45 46 47 48 49 50 51 52 53 54 55 56 57 58 59 60 61 62 63

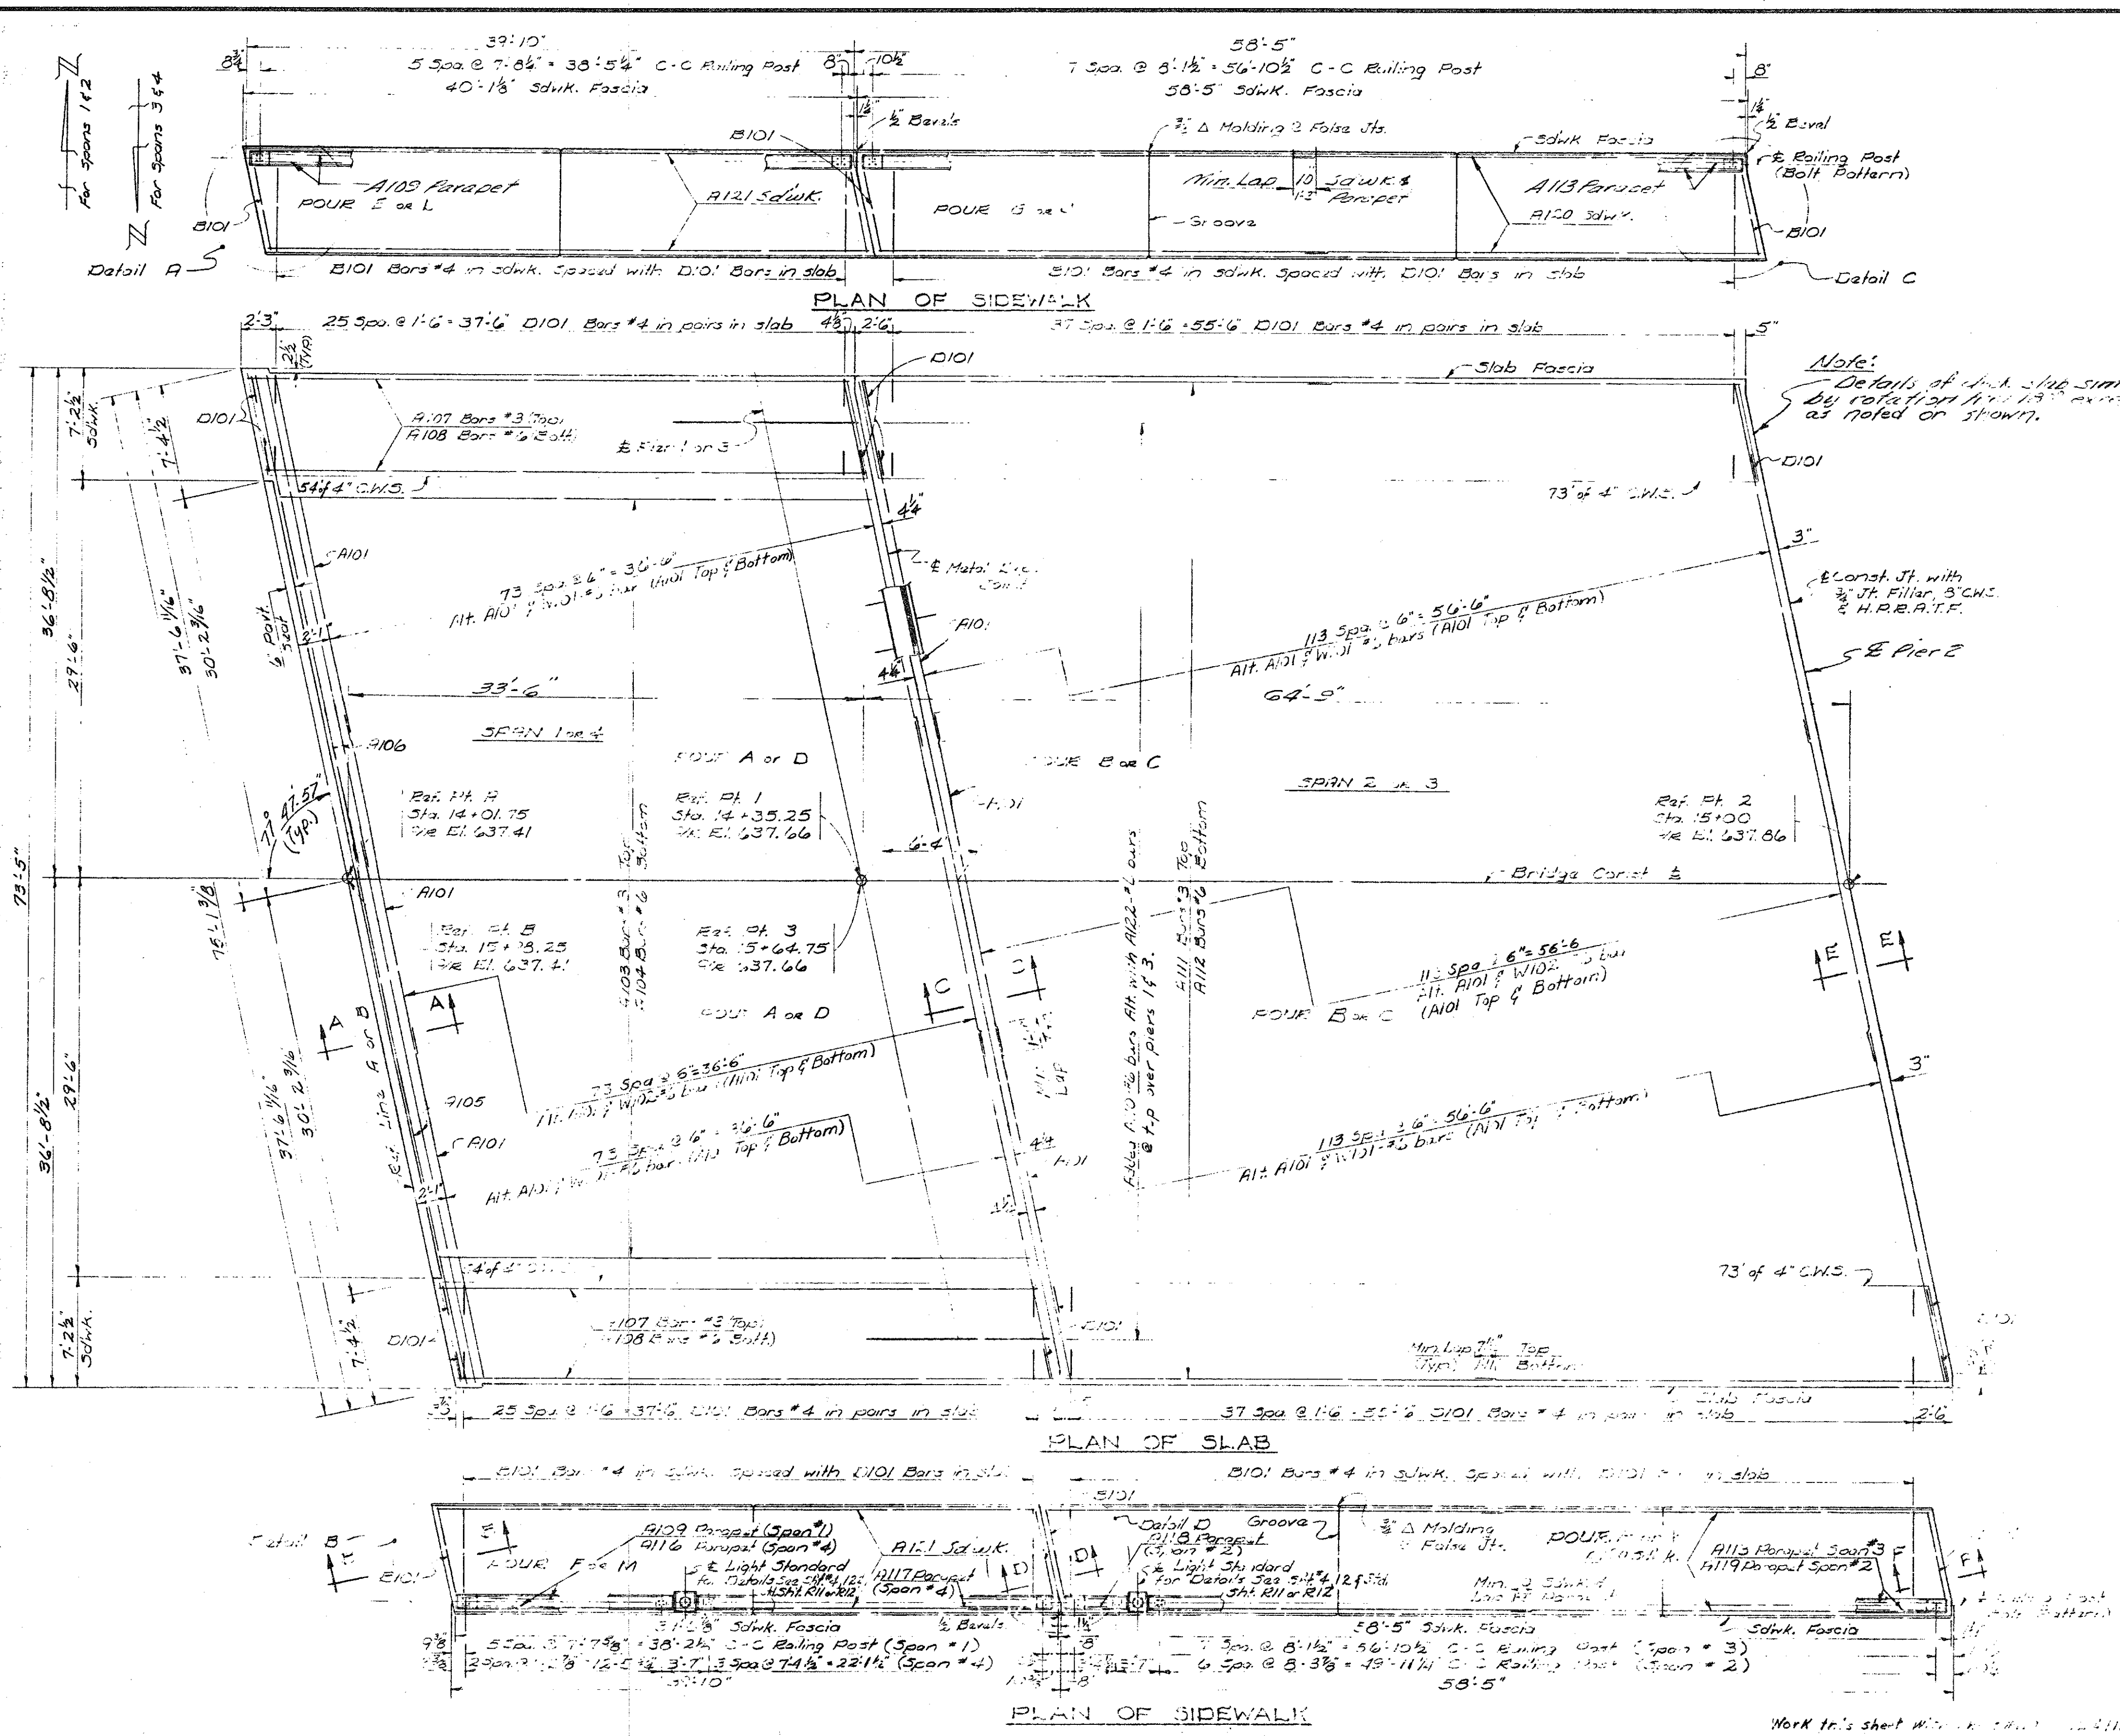


CONCRETE QUANTITIES - SUPERSTR.

FOUR	GRADE A (GAA)	Cu. Yds.
A		87.5
B		110.0
C		110.0
D		87.5
E		6.5
F		6.5
G		9.5
H		9.5
I		9.5
J		9.5
K		9.5
L		9.5
M		6.5
TOTAL		459.0

TRISCELLANEOUS QUANTITIES - SUPERSTR.

ITEM	UNIT	AMOUNT
1/2" Joint Filler	Sq. Ft.	65
Joint Waterproofing	Sq. Ft.	32
Copper	Lbs.	220
Bridge Railing - Parapet Type	Lin. Ft.	390.3
Water-Reducing Retarding Admixture	Gal.	57
Hot-Poured Rubber-Asphalt Type Filler	Lin. Ft.	235
Structural Tile 4'x12'x12"	Each	1360

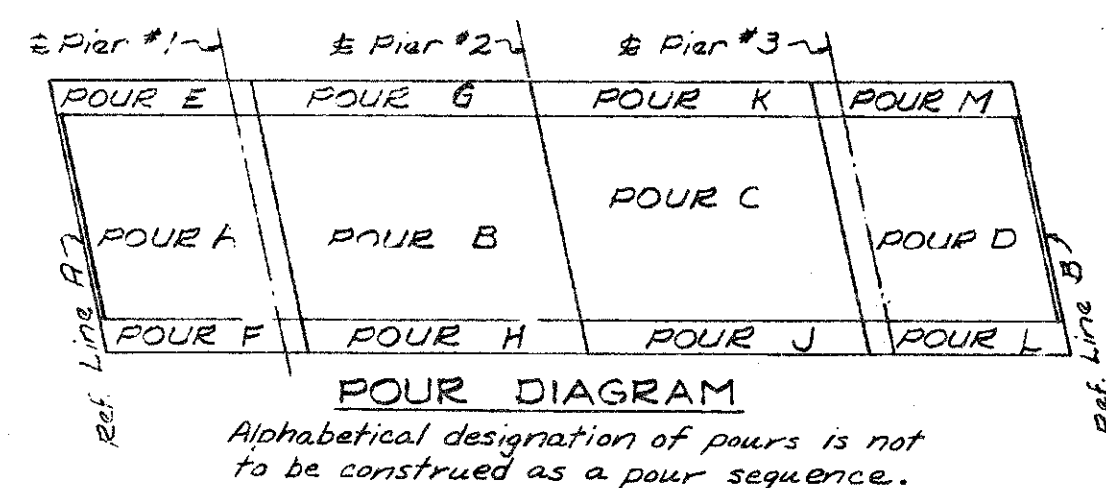

NOTES:
 For Railing Details, See Standard Sheet No. R11 or R12
 For Bents and Holding Details, see standard sheet No. R11 or R12
 H.P.R.A.T.F. indicates Hot-Poured Rubber-Asphalt Type Filler.
 C.W.F. indicates copper waterproofing.
 J.W.P. indicates joint waterproofing.
 Edge and Groove denote Edging or Grooving with an approved tool.
 Sidewalk pours shall not be cast until slab concrete has attained at least 50% of its design strength as determined by the table in section 5.01.03 of the Standard Specifications.
 False joints in sidewalk shall be placed midway between concrete blocks @ approx. every 4th panel.
 Bridge Railing is to be either aluminum or steel tubular railing on concrete parapet. See Std. Sh. R11 or R12.

SUPERSTRUCTURE DETAILS

Notes 11-25-64
 Show 12-5-63
 11/23 5-2-64
 109 113

S31 of 63174B

NOTE:
 DO NOT WORK FROM THIS SHEET. THE INFORMATION SHOWN
 HERE IS FOR REFERENCE ONLY. NO PAY ITEMS ARE SHOWN.











FOR INFORMATION ONLY

DATE	CONT. SEC.	JOB NO.	DESIGN UNIT	SHEET
10-13-99	S31 OF 63174.	48404A	MAHDAVI	6 OF 20

DATE: CORRECTED BY: CHECKED BY: DATE: DRAWN BY: INDR FILE NAME: s3163174.sst

1 2 3 4 5 6 7 8 9 10 11 12 13 14 15 16 17 18 19 20 21 22 23 24 25 26 27 28 29 30 31 32 33 34 35 36 37 38 39 40 41 42 43 44 45 46 47 48 49 50 51 52 53 54 55 56 57 58 59 60 61 62 63

REVISIONS			
NO.	DESCRIPTION	DATE	BY

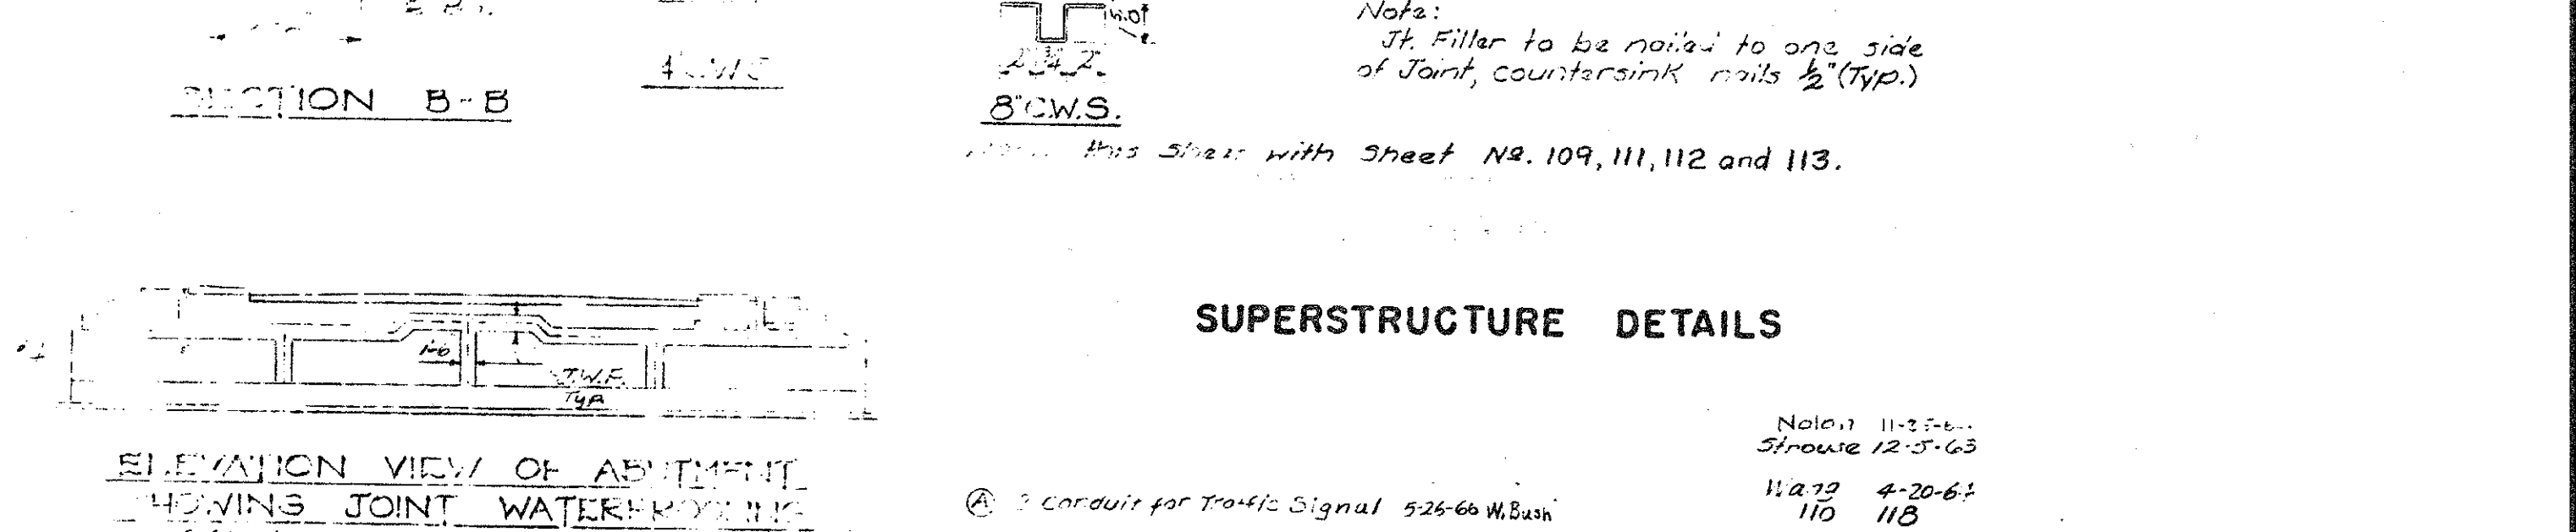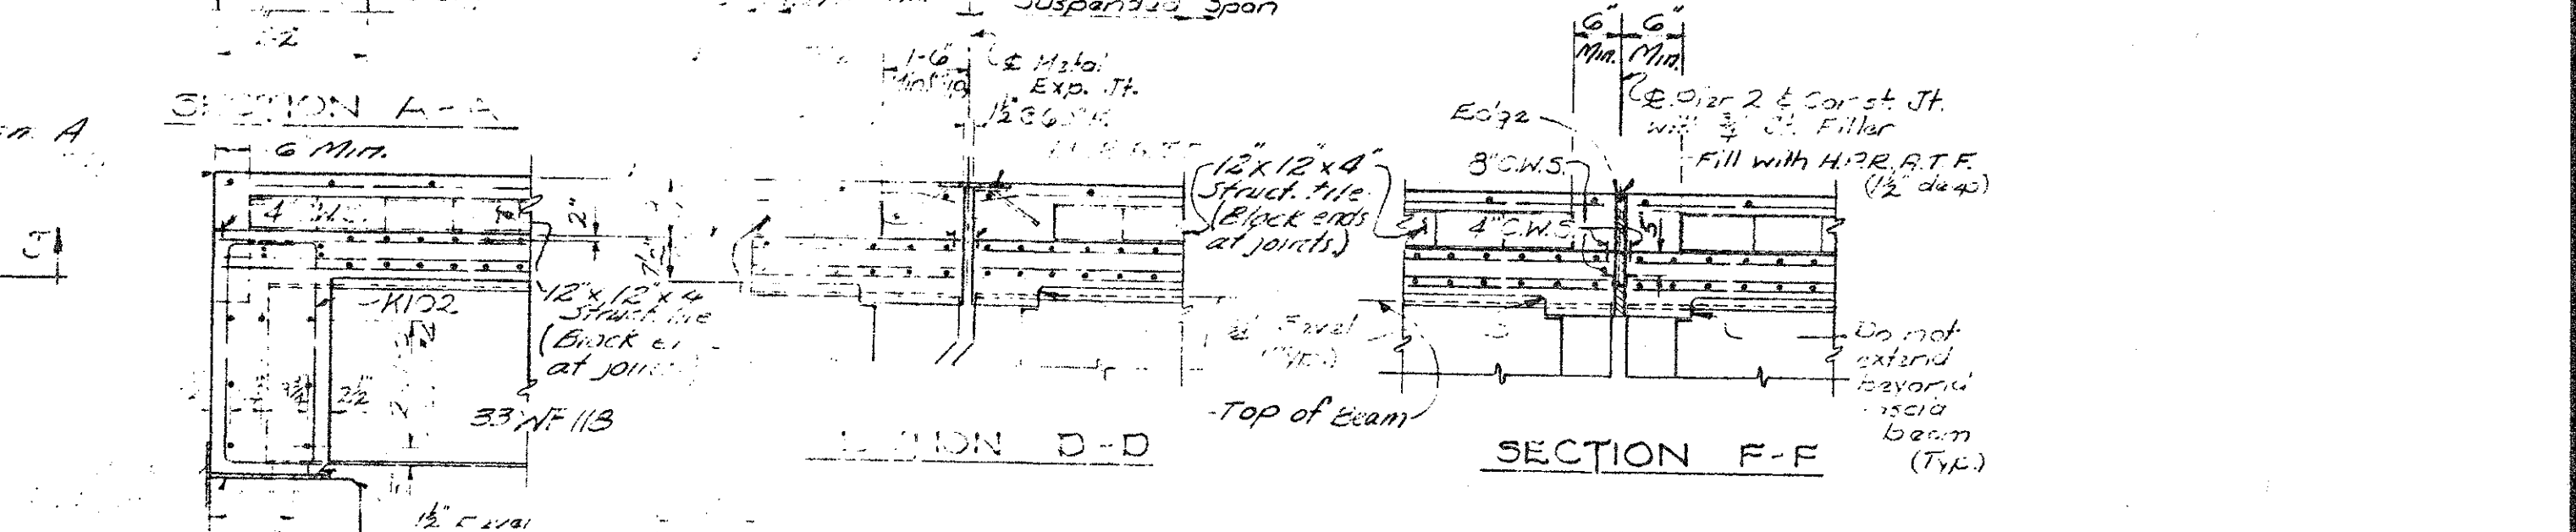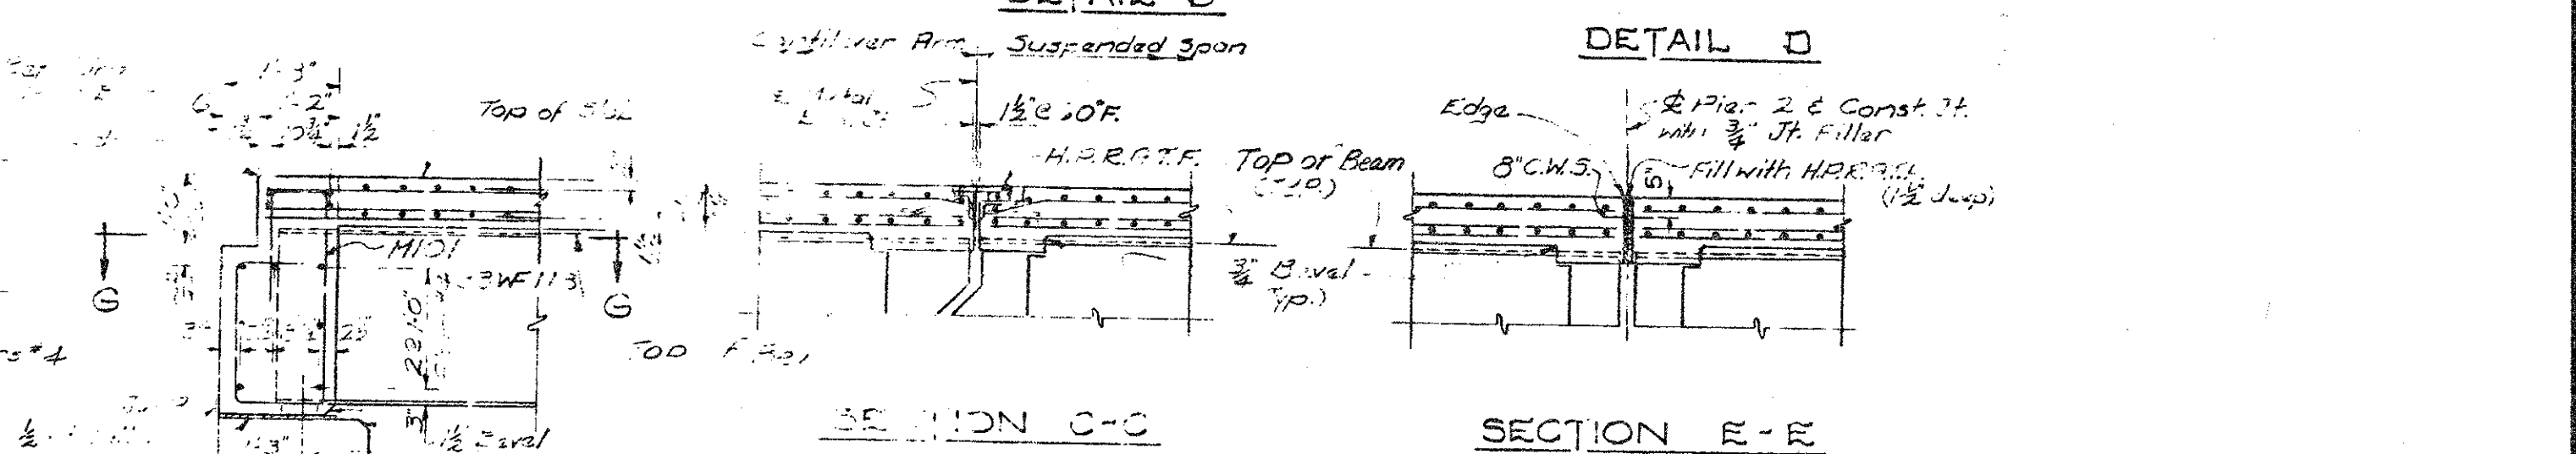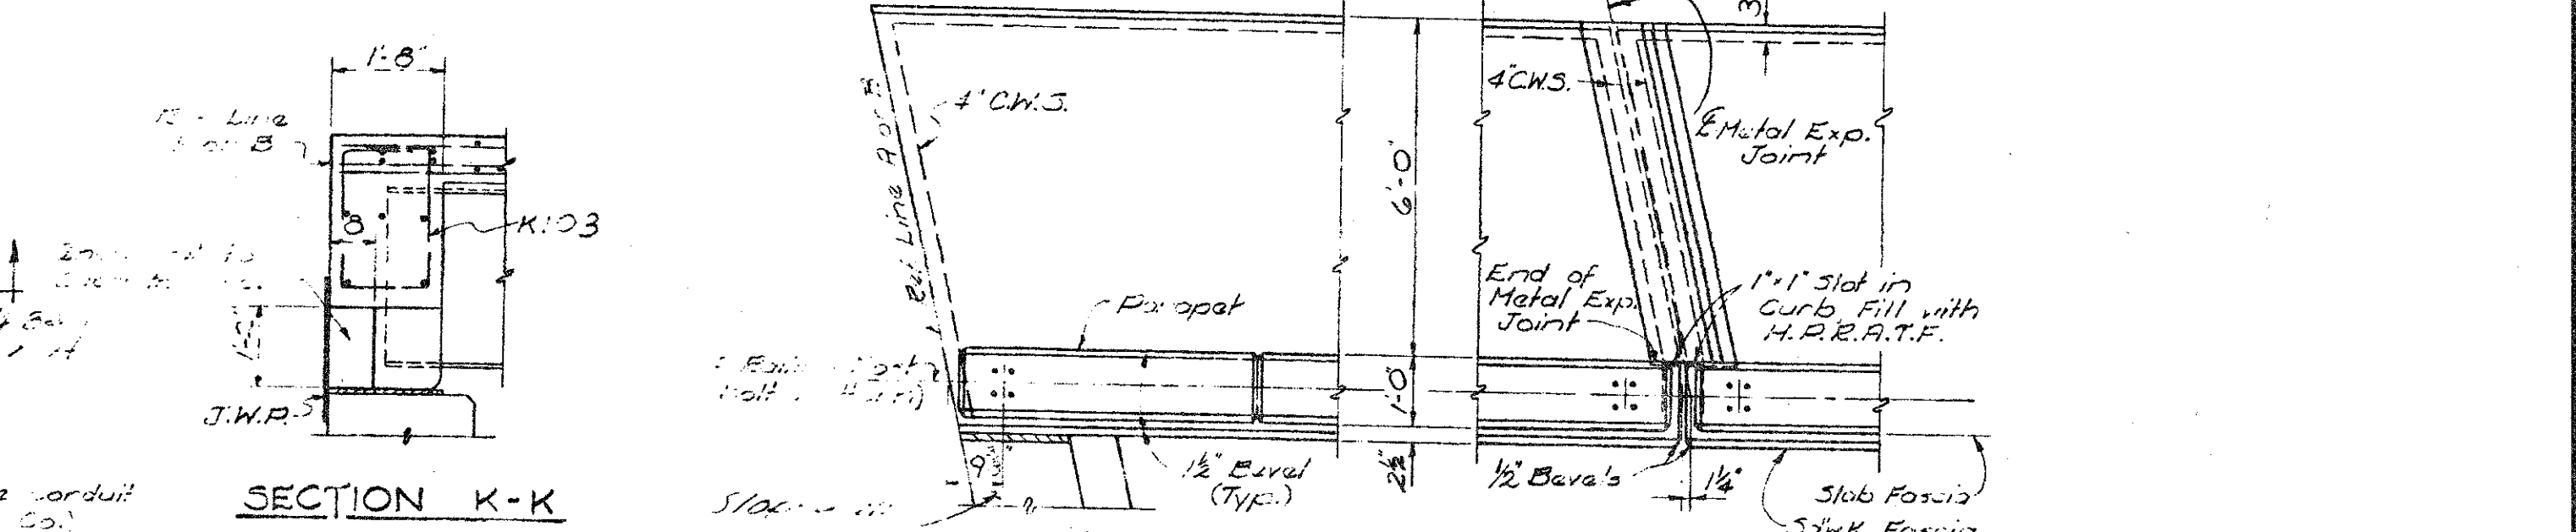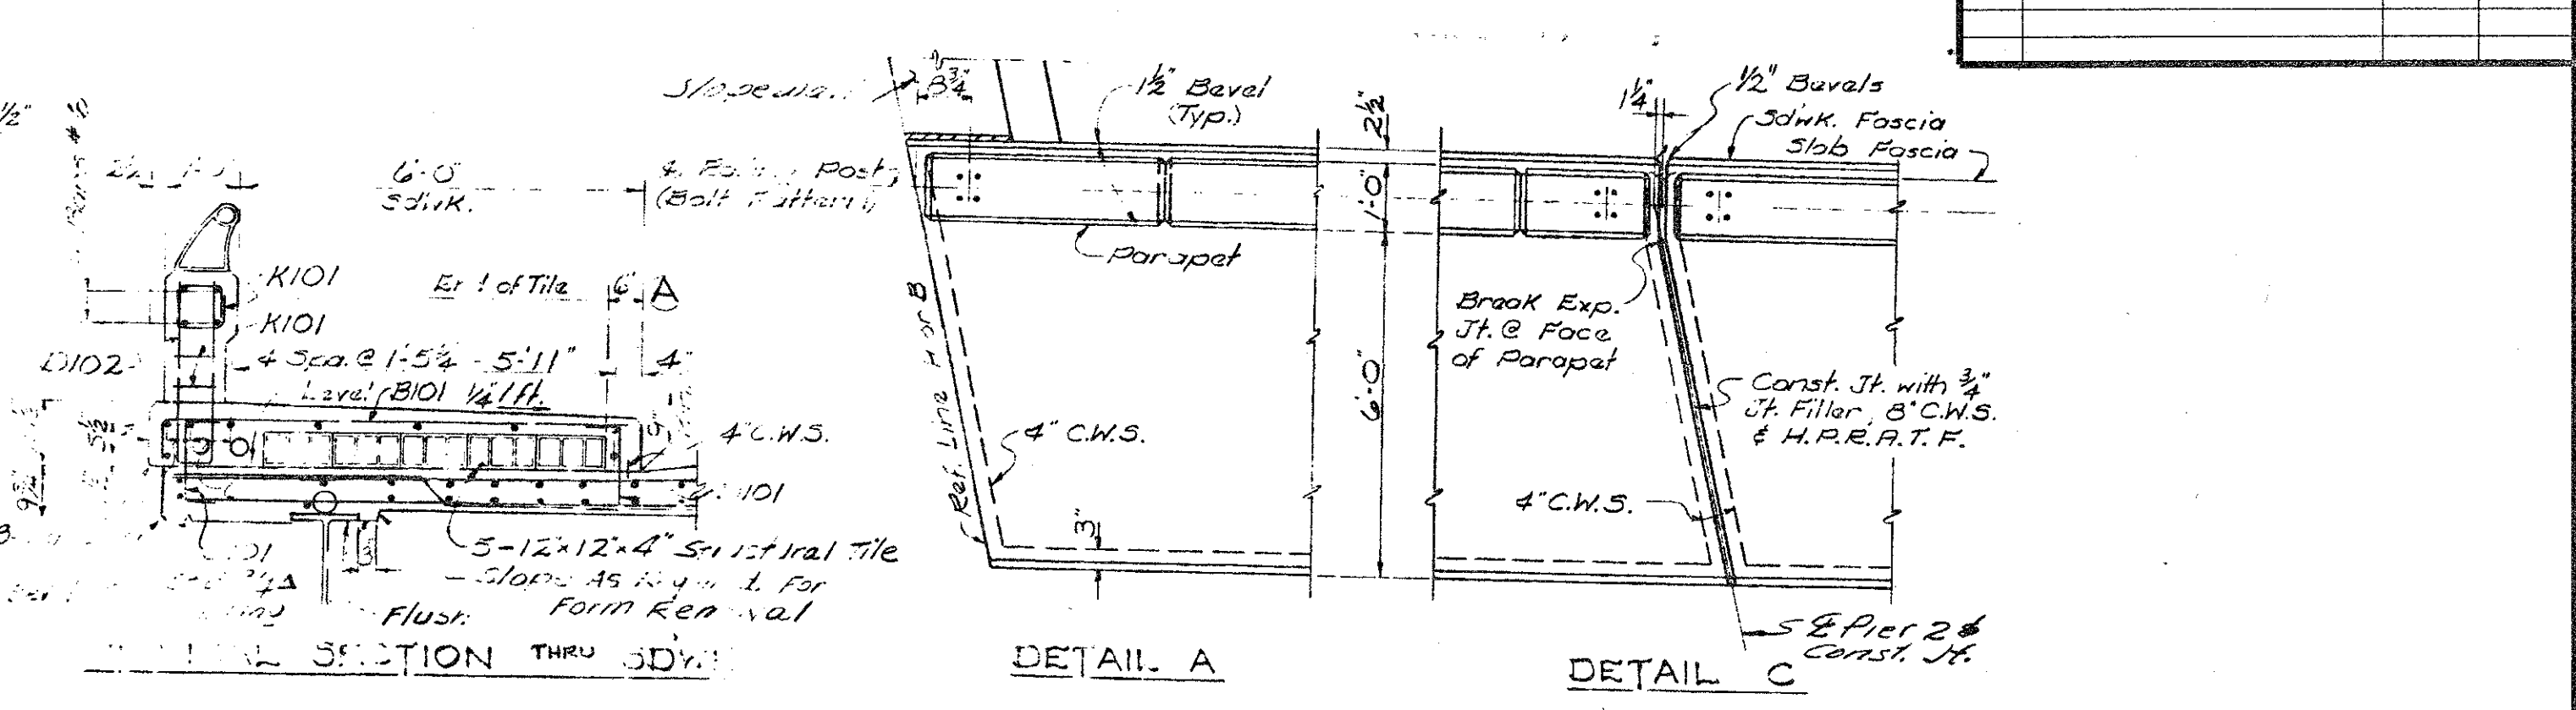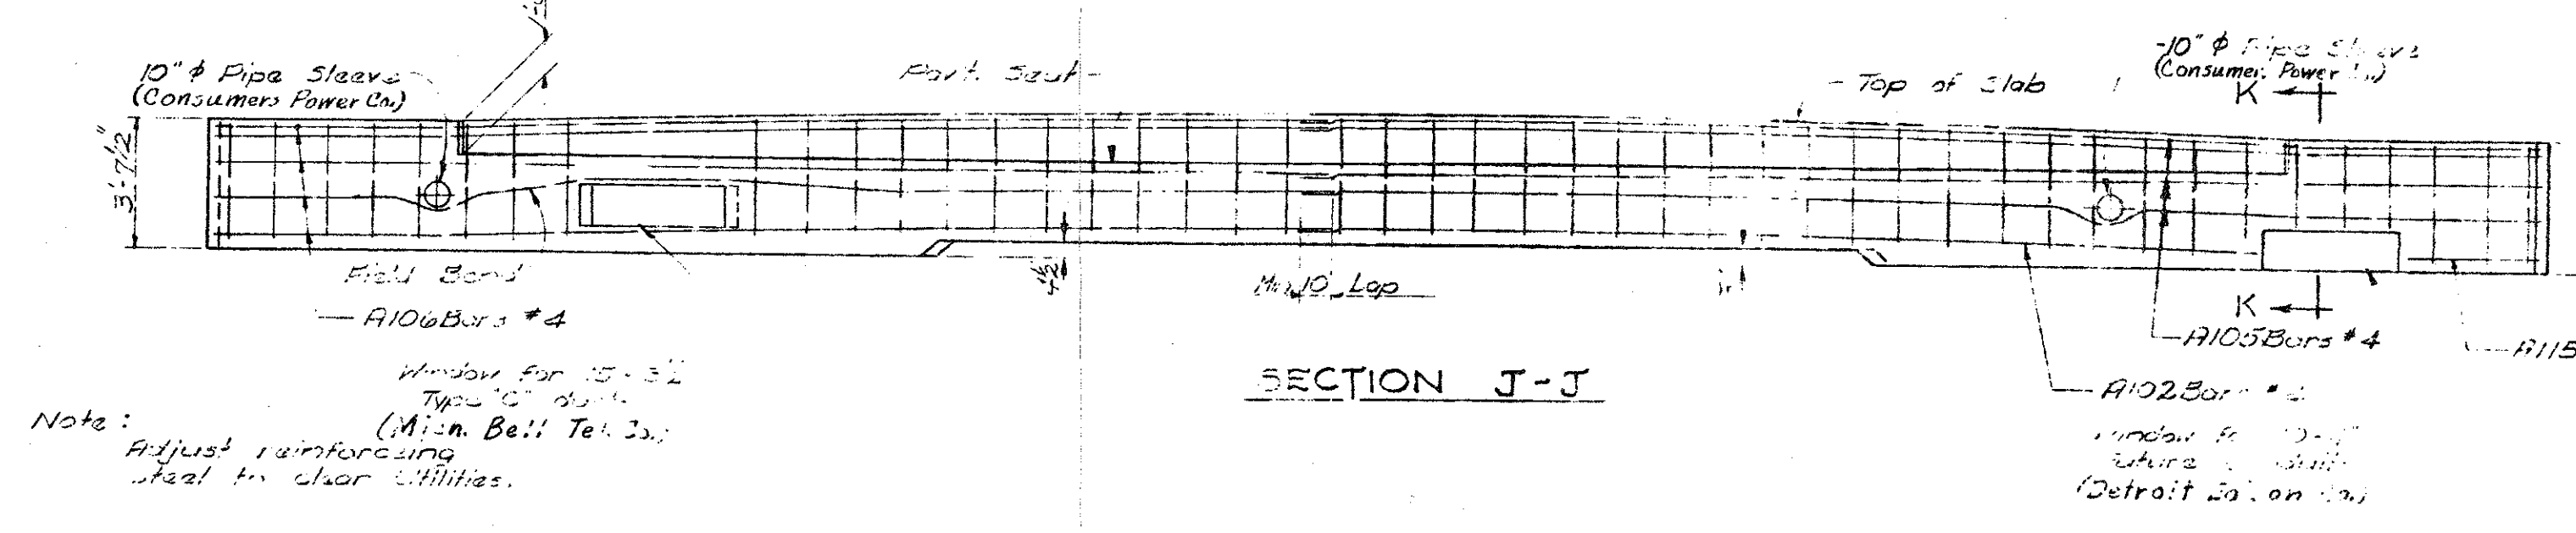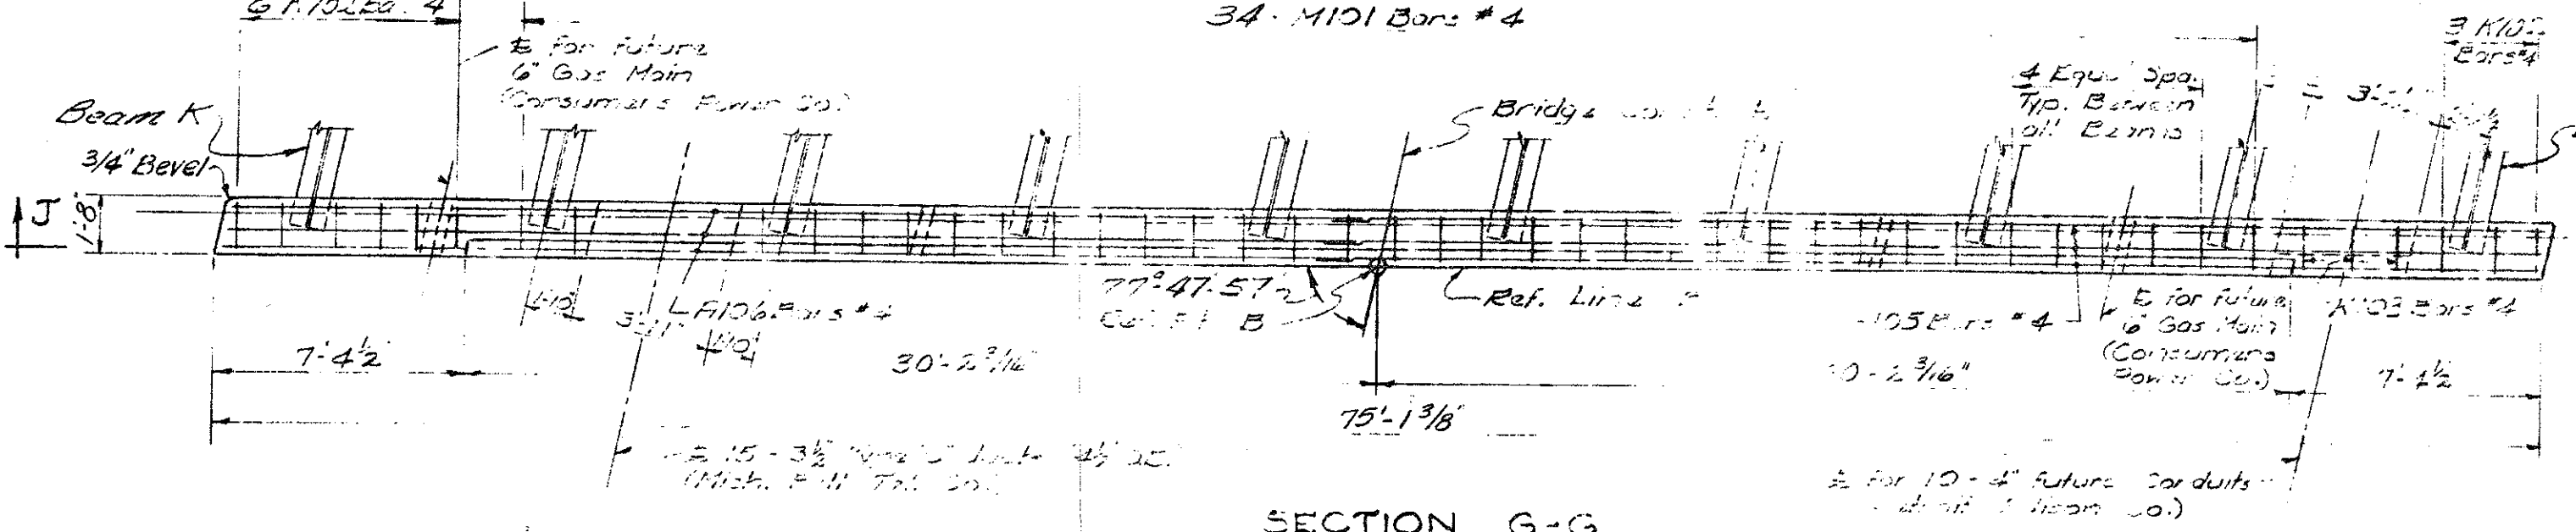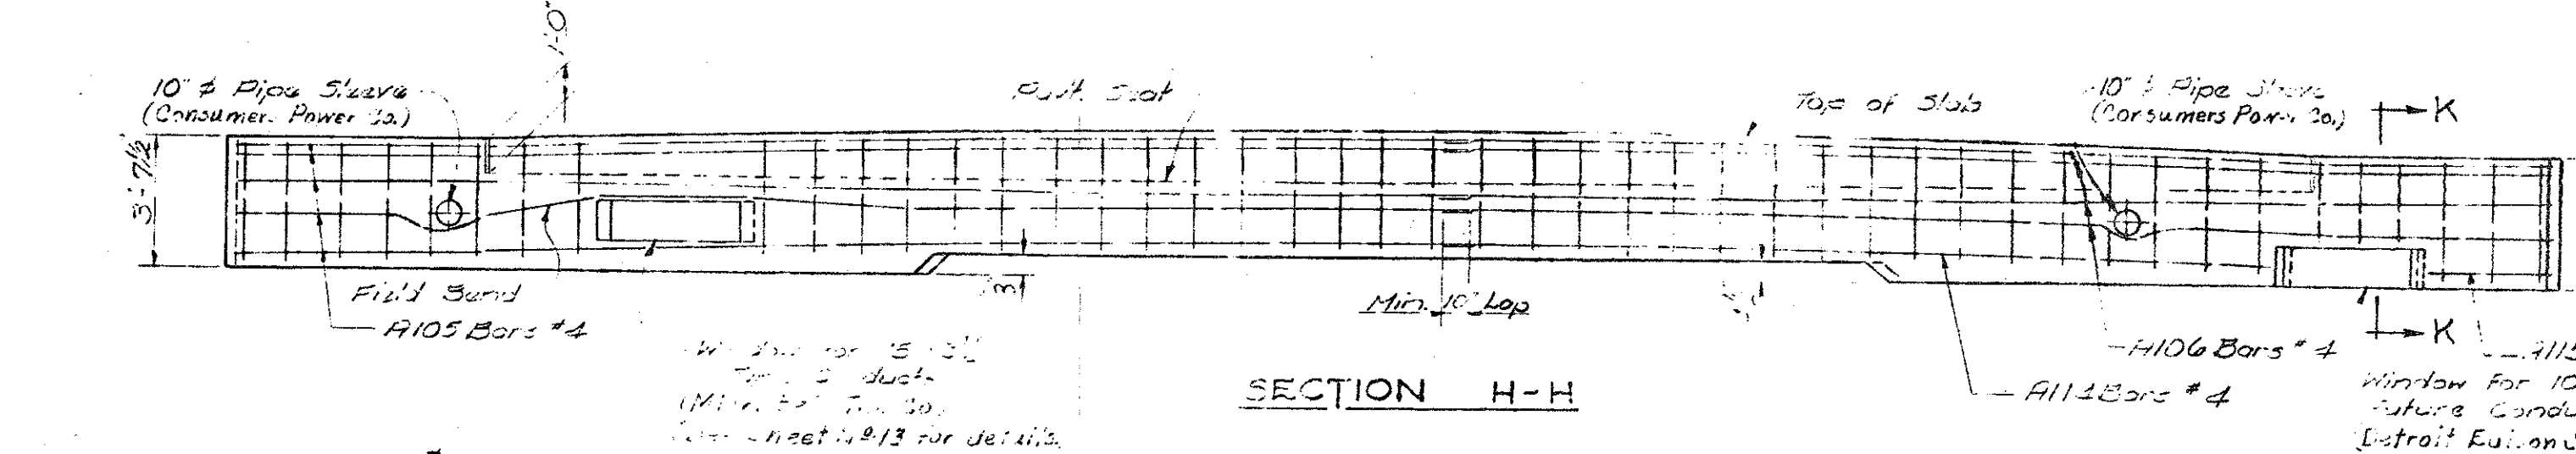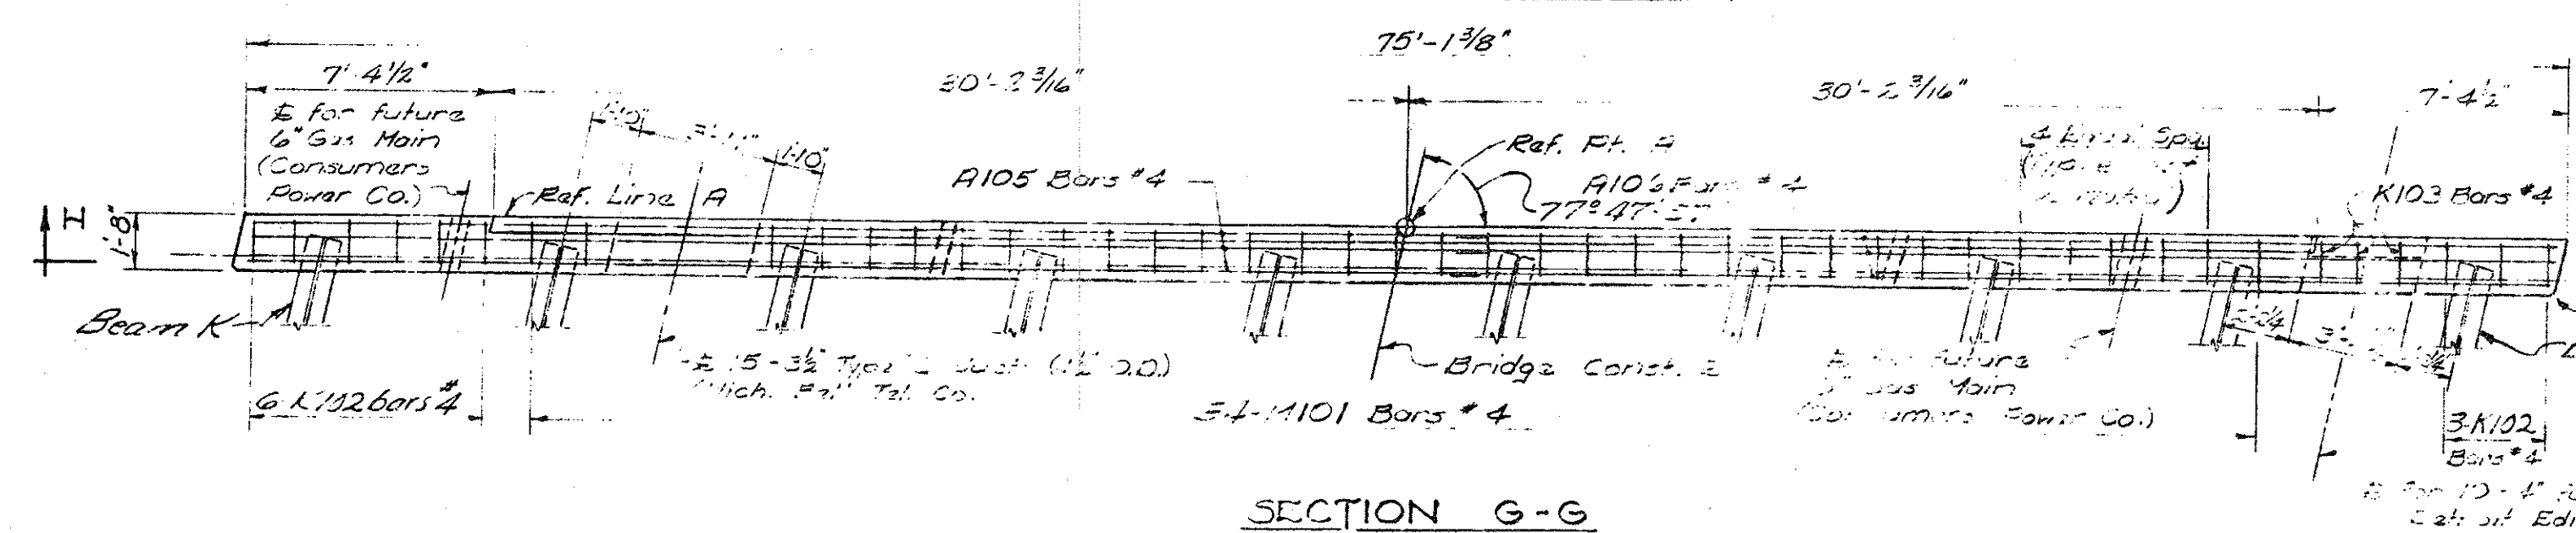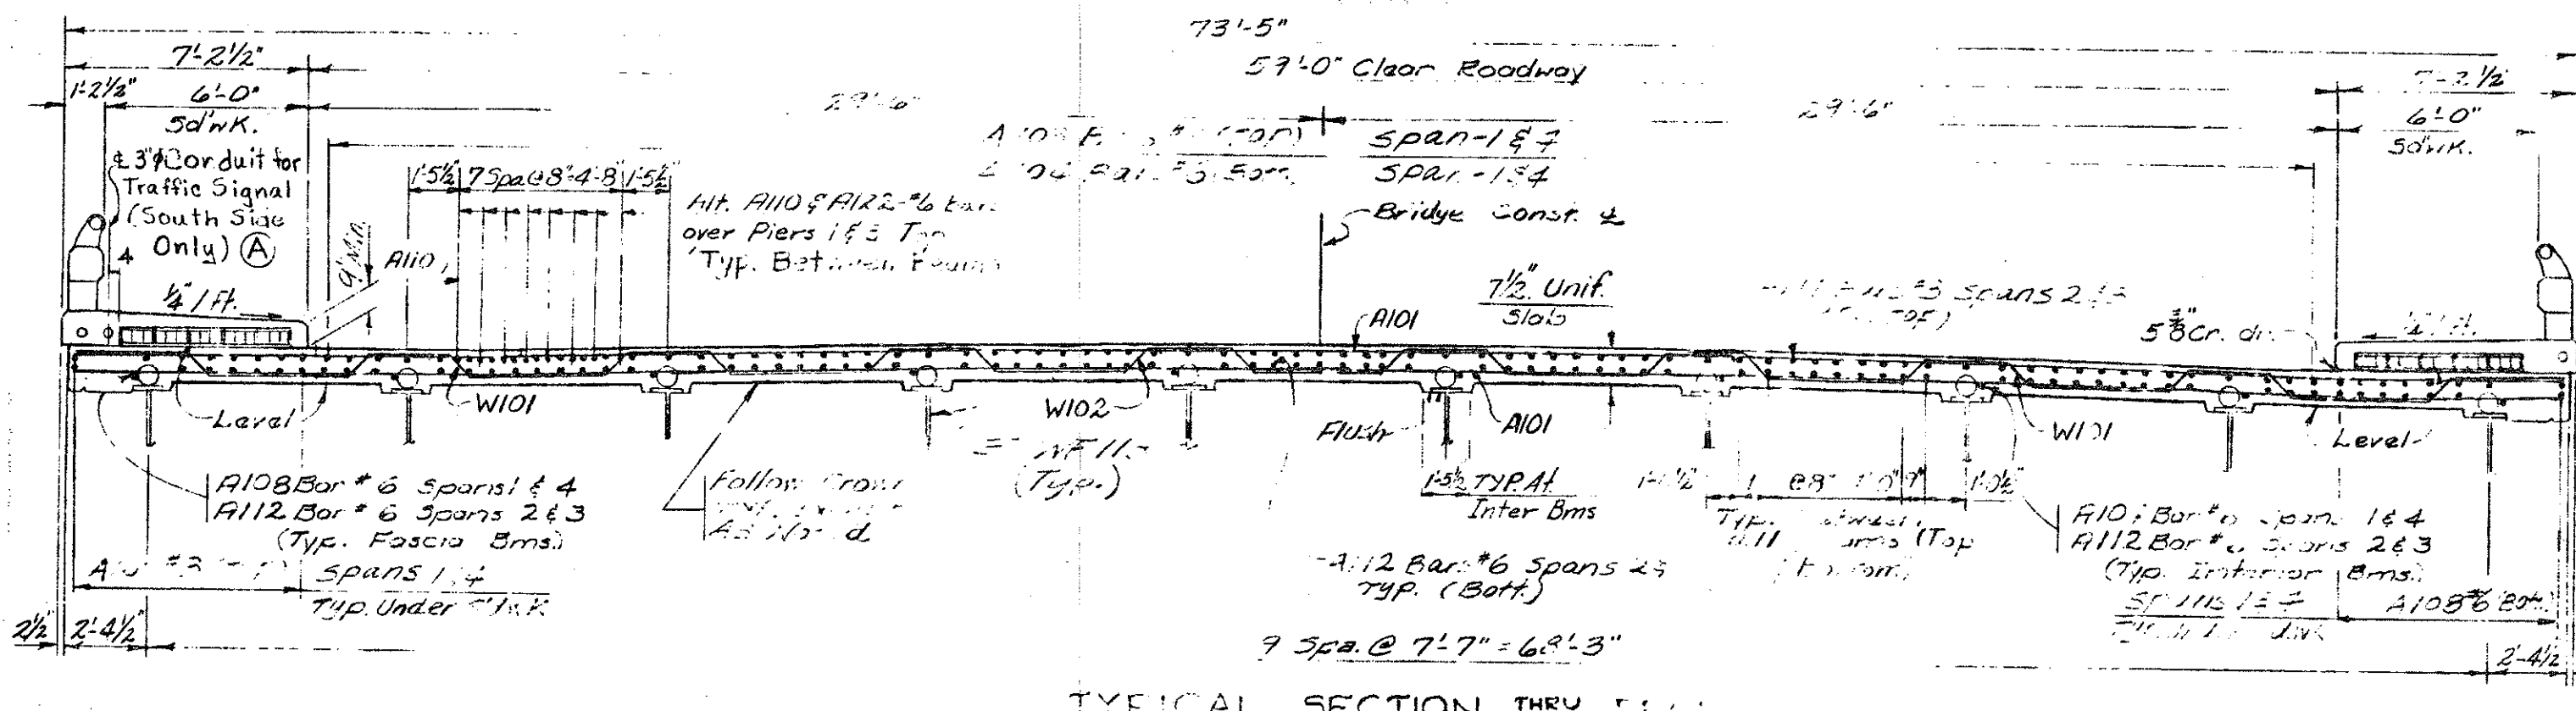

SUPERSTRUCTURE DETAILS

ELEVATION VIEW OF ADJUTMENT SHOWING JOINT WATERPROOFING (A.L.A.B. Section About A.C. Section)

Note: Jt. Filler to be nailed to one side of Joint, counter-sink nails 1/2" (Typ.)
 Show this Sheet with Sheet No. 109, 111, 112 and 113.

S31 of 63174B




NOTE:
 DO NOT WORK FROM THIS SHEET. THE INFORMATION SHOWN HERE IS FOR REFERENCE ONLY. NO PAY ITEMS ARE SHOWN.



FOR INFORMATION ONLY				
DATE	CONT. SEC.	JOB NO.	DESIGN UNIT	SHEET
10-13-99	S31 OF 63174.	48404A	MAHDAVI	7 OF 20

DRAWN BY: INDER CHECKED BY: DATE: 01-13-99 CORRECTED BY: DATE: FILE NAME: s3163174.sn

1 2 3 4 5 6 7 8 9 10 11 12 13 14 15 16 17 18 19 20 21 22 23 24 25 26 27 28 29 30 31 32 33 34 35 36 37 38 39 40 41 42 43 44 45 46 47 48 49 50 51 52 53 54 55 56 57 58 59 60 61 62 63

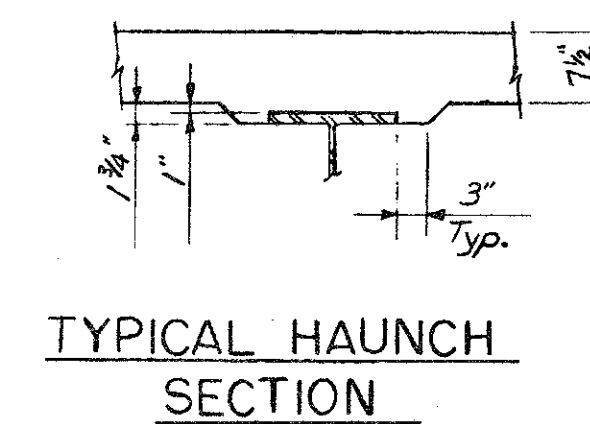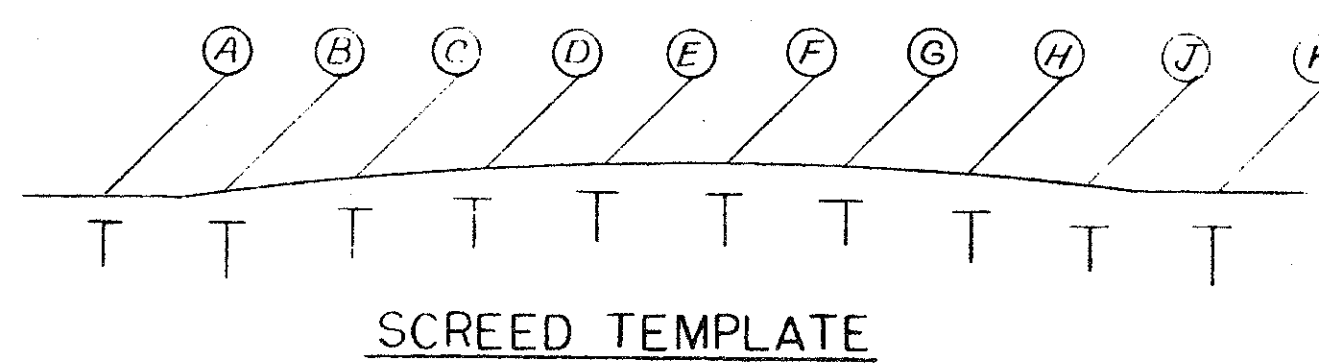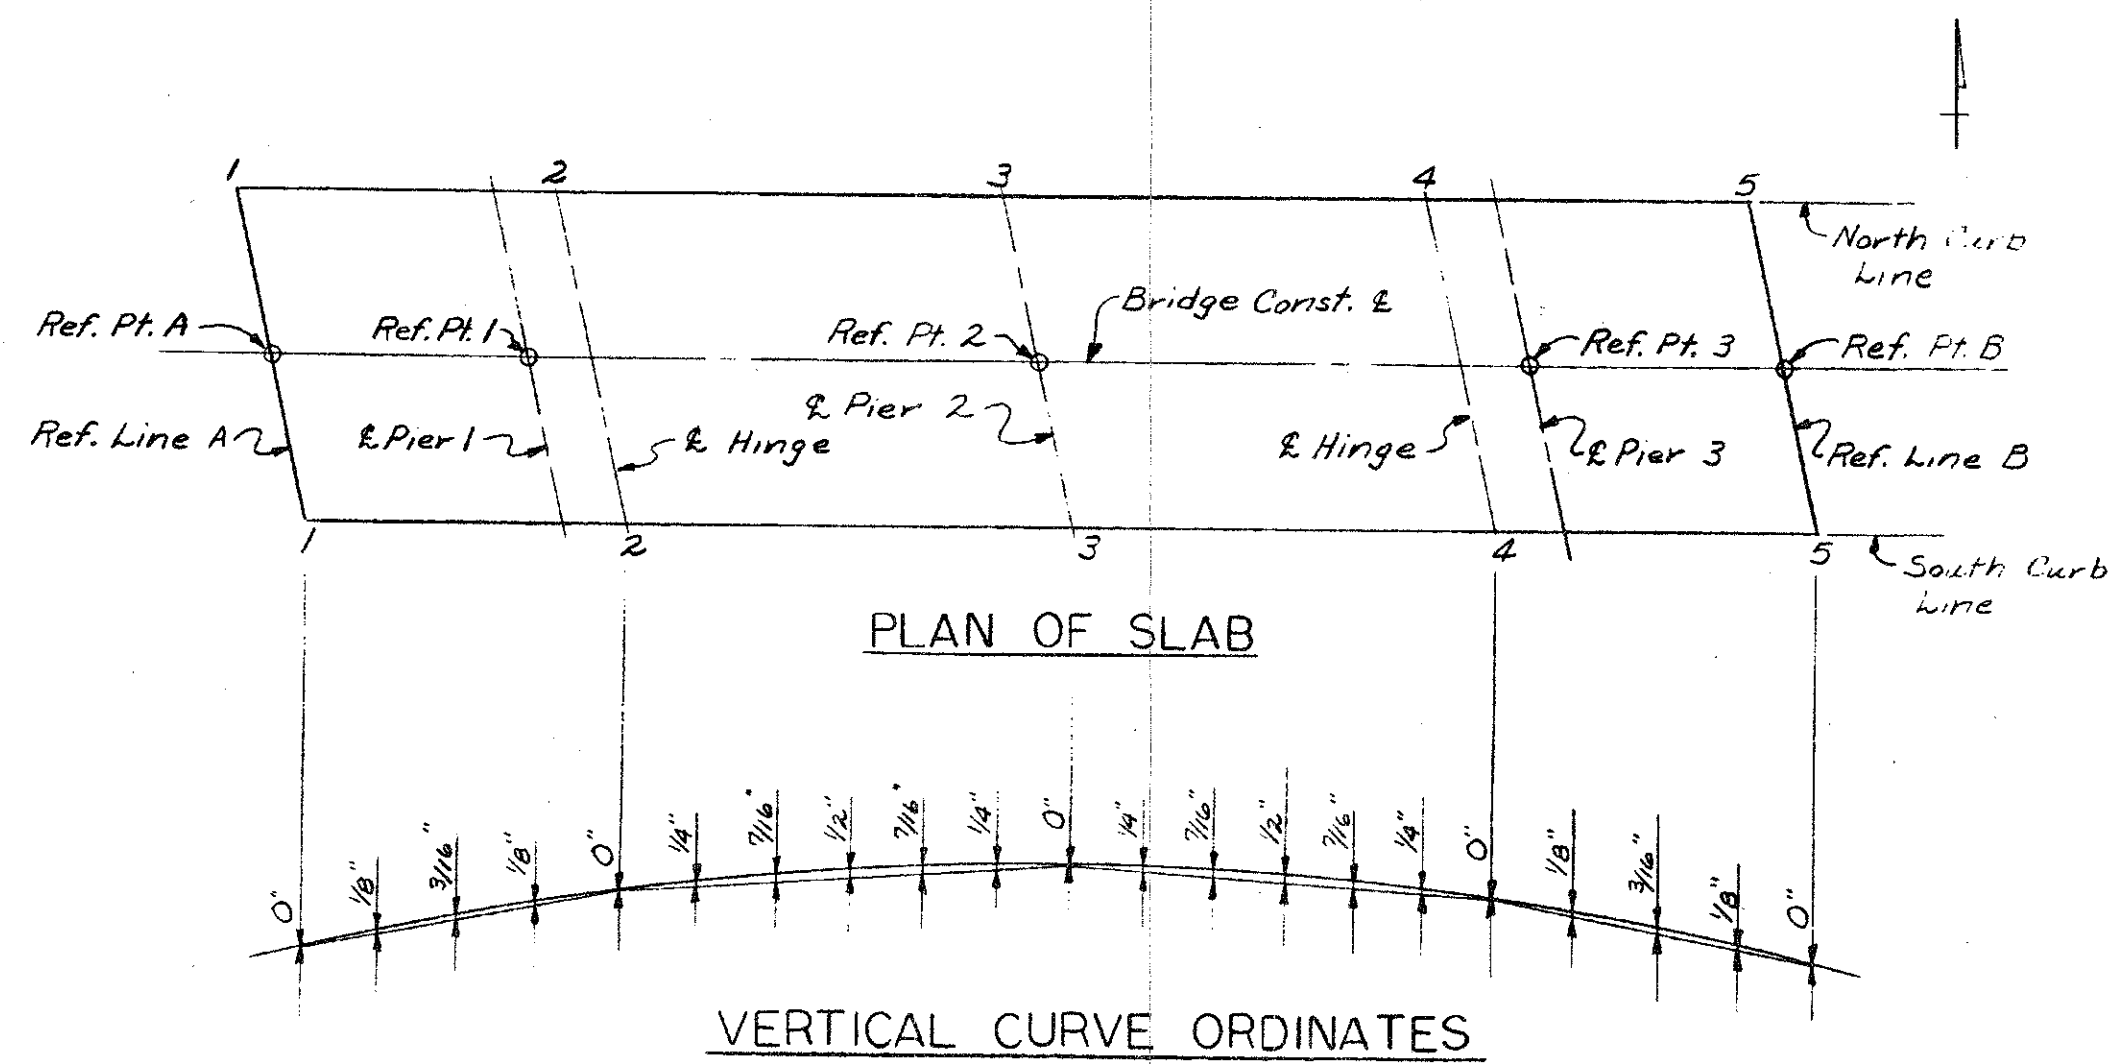


SCREED TEMPLATE ELEVATIONS

Line Sta. @ Const. E.	Bm. A	Bm. B	Bm. C	Bm. D	Bm. E	Bm. F	Bm. G	Bm. H	Bm. J	Bm. K	
1-1	14+01.75	636.89	636.98	637.14	637.28	637.38	637.40	637.33	637.22	637.08	637.03
2-2	14+41.00	637.21	637.28	637.44	637.58	637.67	637.68	637.60	637.49	637.35	637.29
3-3	15+00.00	637.41	637.48	637.63	637.75	637.84	637.84	637.75	637.63	637.48	637.41
4-4	15+59.00	637.29	637.35	637.49	637.60	637.68	637.67	637.58	637.44	637.28	637.21
5-5	15+98.25	637.03	637.08	637.22	637.33	637.40	637.38	637.28	637.14	636.98	636.89

THEORETICAL TOP OF BEAM ELEVATION

Beam	Abut. A	Pier 1	Hinge	Pier 2	Hinge	Pier 3	Abut. B
A	636.20	636.46	636.50	636.70	636.70	636.58	636.55
B	636.20	636.46	636.50	636.70	636.70	636.58	636.55
C	636.44	636.69	636.73	636.91	636.91	636.77	636.74
D	636.58	636.83	636.86	637.04	637.04	636.89	636.86
E	636.48	636.93	636.96	637.13	637.13	636.97	636.94
F	636.70	636.94	636.97	637.13	637.13	636.96	636.93
G	636.42	636.86	636.89	637.04	637.04	636.86	636.83
H	636.51	636.74	636.77	636.91	636.91	636.73	636.69
J	636.33	636.55	636.58	636.70	636.70	636.50	636.46
K	636.33	636.55	636.58	636.70	636.70	636.50	636.46

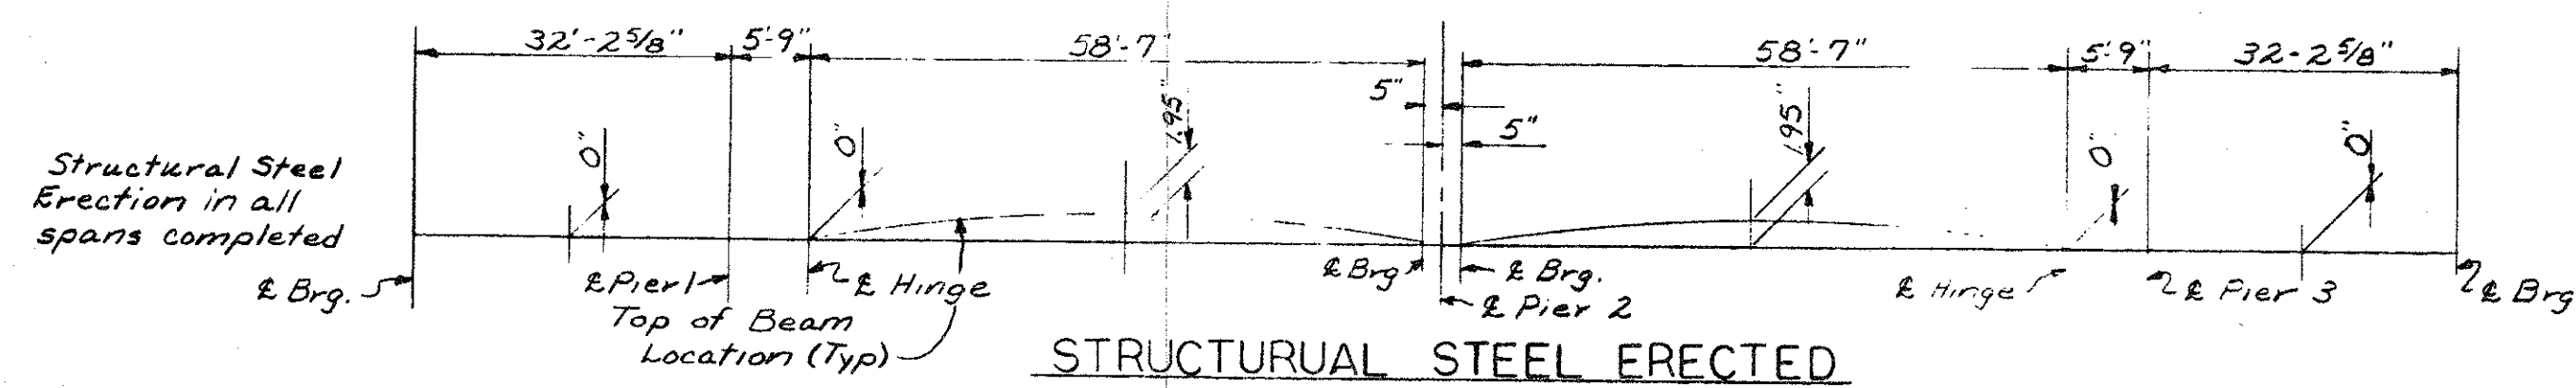

NOTES:
 Screed template elevations are based on the condition that no slab concrete has been poured and with formwork, steel reinforcement and shear developers in place.
 Screeds which will be affected by loads in other spans are to be set to the elevations shown before casting any concrete.
 Concrete in the suspended spans is to be cast before the concrete in the anchor spans.
 Haunch dimensions as shown are based on the theoretical elevation of the tops of beams with beams only fully erected. If actual tops of beams differ from theoretical tops of beams adjust haunch depths accordingly.
 Longitudinal strike-off finishing machine is to be used in placing deck concrete.

Work this sheet with sheets #109, 110, 113, 114 & 117

SUPERSTRUCTURE DETAILS

Noted 1-3-66
 J. Bullen 12-27-65
 Wang 12-29-65
 111 118

S31 of 63174B


NOTE:
 DO NOT WORK FROM THIS SHEET. THE INFORMATION SHOWN HERE IS FOR REFERENCE ONLY. NO PAY ITEMS ARE SHOWN.

FOR INFORMATION ONLY				
DATE	CONT. SEC.	JOB NO.	DESIGN UNIT	SHEET
10-13-99	S31 OF 63174.	48404A	MAHDAVI	8 OF 20




REVISIONS: NO., DESCRIPTION, DATE, BY
 DATE: 01-13-99
 CHECKED BY:
 CORRECTED BY:
 DATE:
 DRAWN BY: INDER
 FILE NAME: s3163174.s

1 2 3 4 5 6 7 8 9 10 11 12 13 14 15 16 17 18 19 20 21 22 23 24 25 26 27 28 29 30 31 32 33 34 35 36 37 38 39 40 41 42 43 44 45 46 47 48 49 50 51 52 53 54 55 56 57 58 59 60 61 62 63

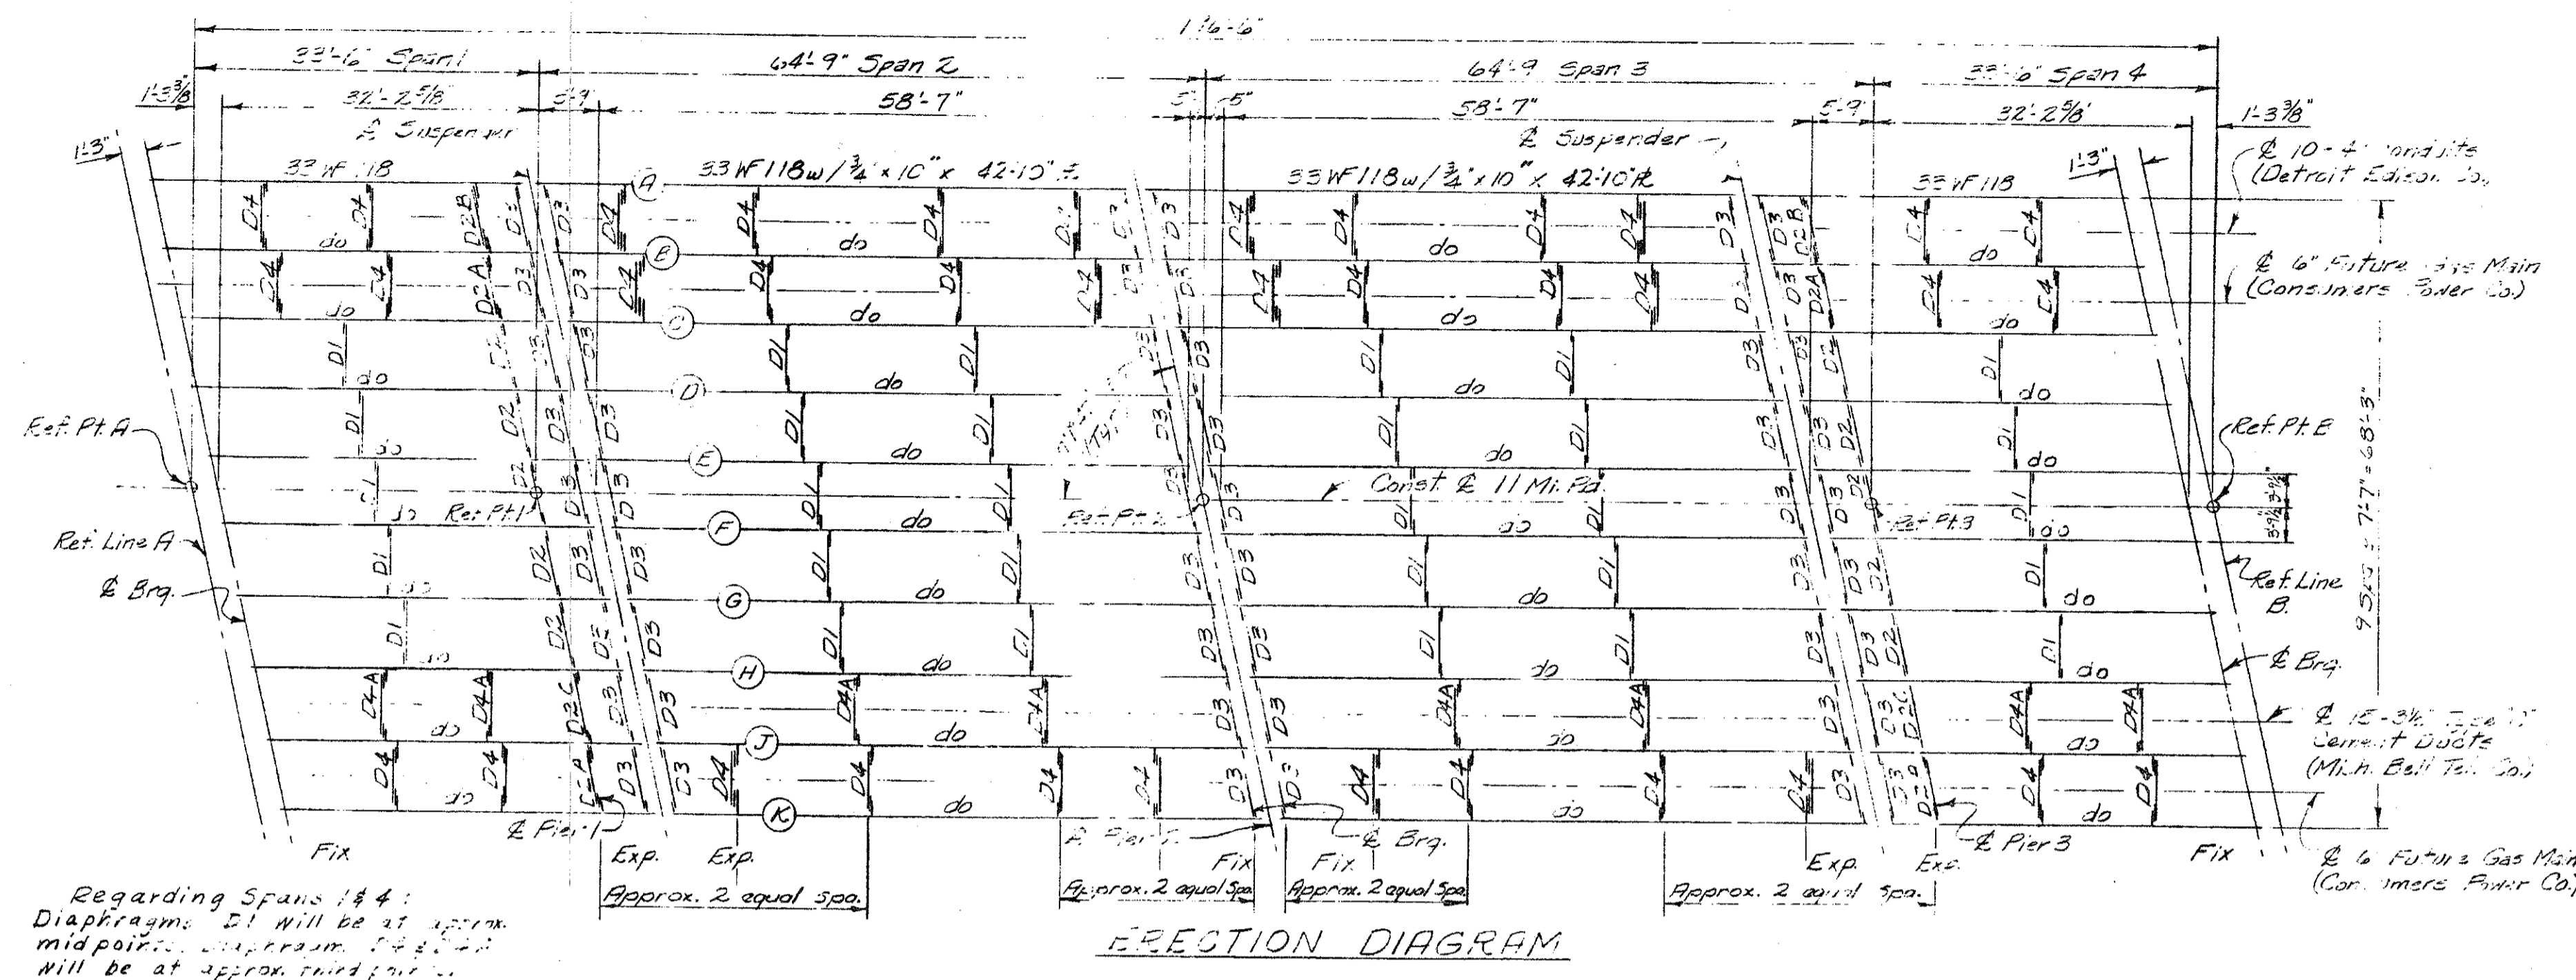


Regarding Spans 1 & 4:
Diaphragms D1 will be at approx. midpoints. Suspender E1 & E2 will be at approx. third points.

ERECTION DIAGRAM

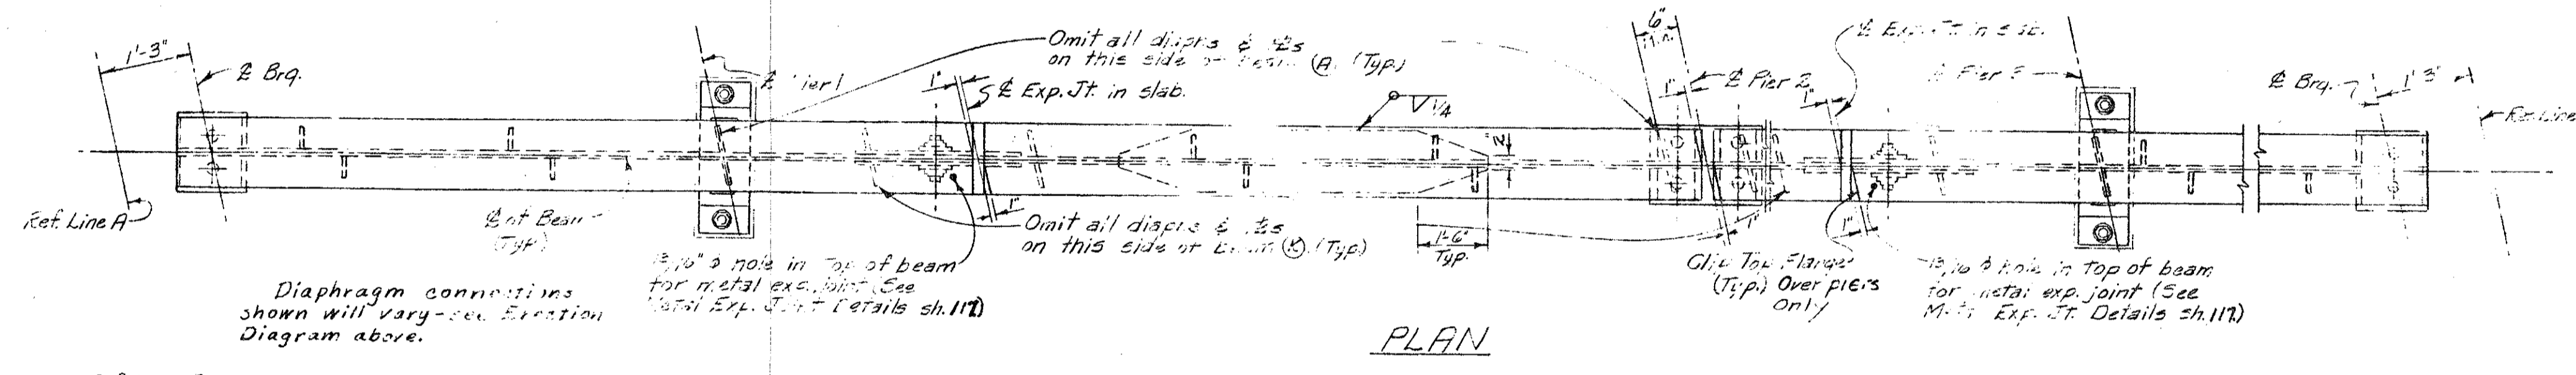


PLAN

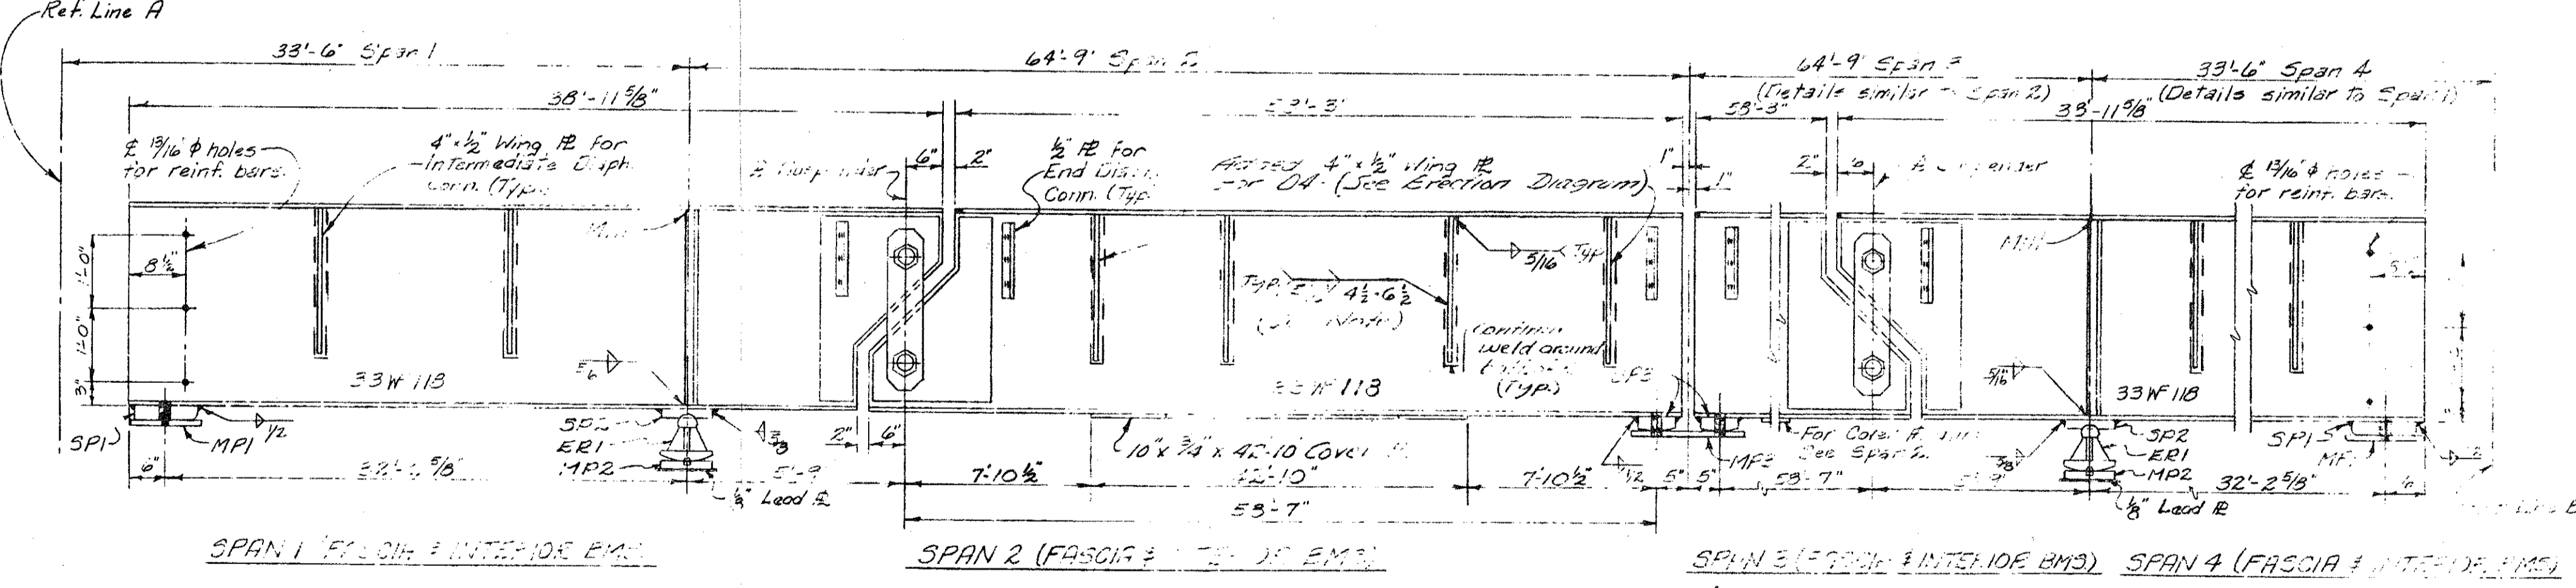

ELEVATION

Note: Regarding Intermediate Diaphragm Connections, a continuous weld may be used at the fabricator's option.

STRUCTURAL STEEL NOTES
 Fabrication: Michigan State Highway Department's Standard Specifications for Road and Bridge Construction - 1965 Edition
 Design: Michigan State Highway Department's Specifications for the Design of Highway Bridges - 1953 Edition (H20-44 Loading)
 Shop Connections: All shop connections shall be welded as shown on plans.
 Field Connections shall be bolted with 3/4" high strength bolts.
 Open Holes: Open holes for high-strength bolts shall be 1 3/16" or less otherwise noted.
 Shop Paint: In addition to the shop paint provisions of the Standard Specifications the top surfaces of masonry plates shall be coated in accordance with the requirements for machine finished surfaces.
 Sole Plates: Sole plates 3" or more in thickness may be built up by welding together plates not less than 1/2" in thickness. Edges must be beveled 1/4" and welded with a continuous weld for the full perimeter. Welds shall be ground flush with faces of plate.
 Camber: The beams in spans 1 & 4 are to have 0 inches of camber and the beams in spans 2 and 3 are to have 3/16" camber (max ordinates). Allowable camber tolerance is + 1/8", - 1/4". Heating is to be used, if necessary, to assure camber permanency within the above tolerance. The dead load deflection of the beams alone is calculated to be 0" for spans 1 & 4 and 3/16" for spans 2 & 3.
 Steel in anchor bolts may be ASTM A-307.
 Field Paint for Structural Steel is to be Gray-Blue. (See Supplemental Specifications)
 Utility Provisions: See sheet #103 for utility provisions (Consumers Power Co., Detroit Edison Co., Mich. Bell Telephone Co.). All casing and cover plates shall conform to the requirements for Welding (A.S.T.M. A36-62T).
 Quantity "Structural Steel-Furnishing and Fabricating" includes:
 A36 = 321,600 #
 Lead = 300 #
 Bronze = 100 #
 Total = 328,000 #
 Structural Steel-Furnishing & Fabricating 328,000 #
 Structural Steel-Erection 328,000 #
 Field Painting Lump Sum
 Wear Developpers Lump Sum

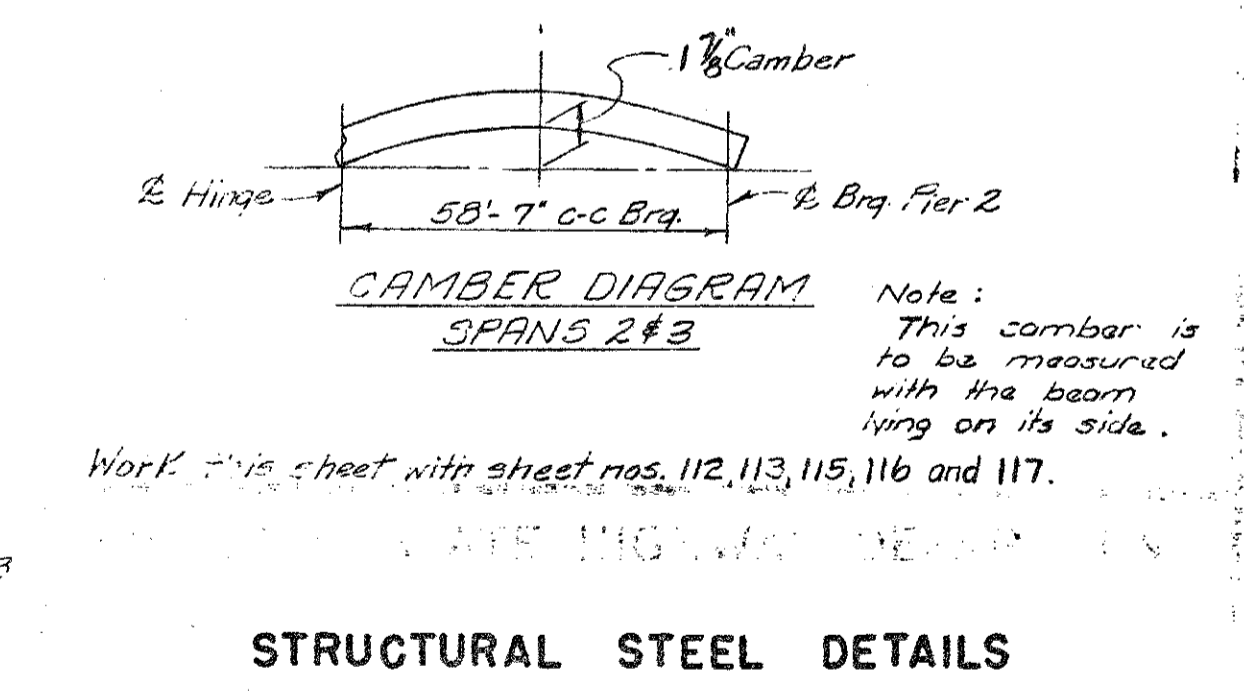

STRUCTURAL STEEL DETAILS


S31 of 63174B

NOTE:
DO NOT WORK FROM THIS SHEET. THE INFORMATION SHOWN HERE IS FOR REFERENCE ONLY. NO PAY ITEMS ARE SHOWN.

FOR INFORMATION ONLY				
DATE	CONT. SEC.	JOB NO.	DESIGN UNIT	SHEET
10-13-99	S31 OF 63174.	48404A	MAHDAVI	9 OF 20

DRAWN BY: INDER DATE: 01-13-99 CHECKED BY: DATE: CORRECTED BY: DATE: REVISIONS

1 2 3 4 5 6 7 8 9 10 11 12 13 14 15 16 17 18 19 20 21 22 23 24 25 26 27 28 29 30 31 32 33 34 35 36 37 38 39 40 41 42 43 44 45 46 47 48 49 50 51 52 53 54 55 56 57 58 59 60 61 62 63









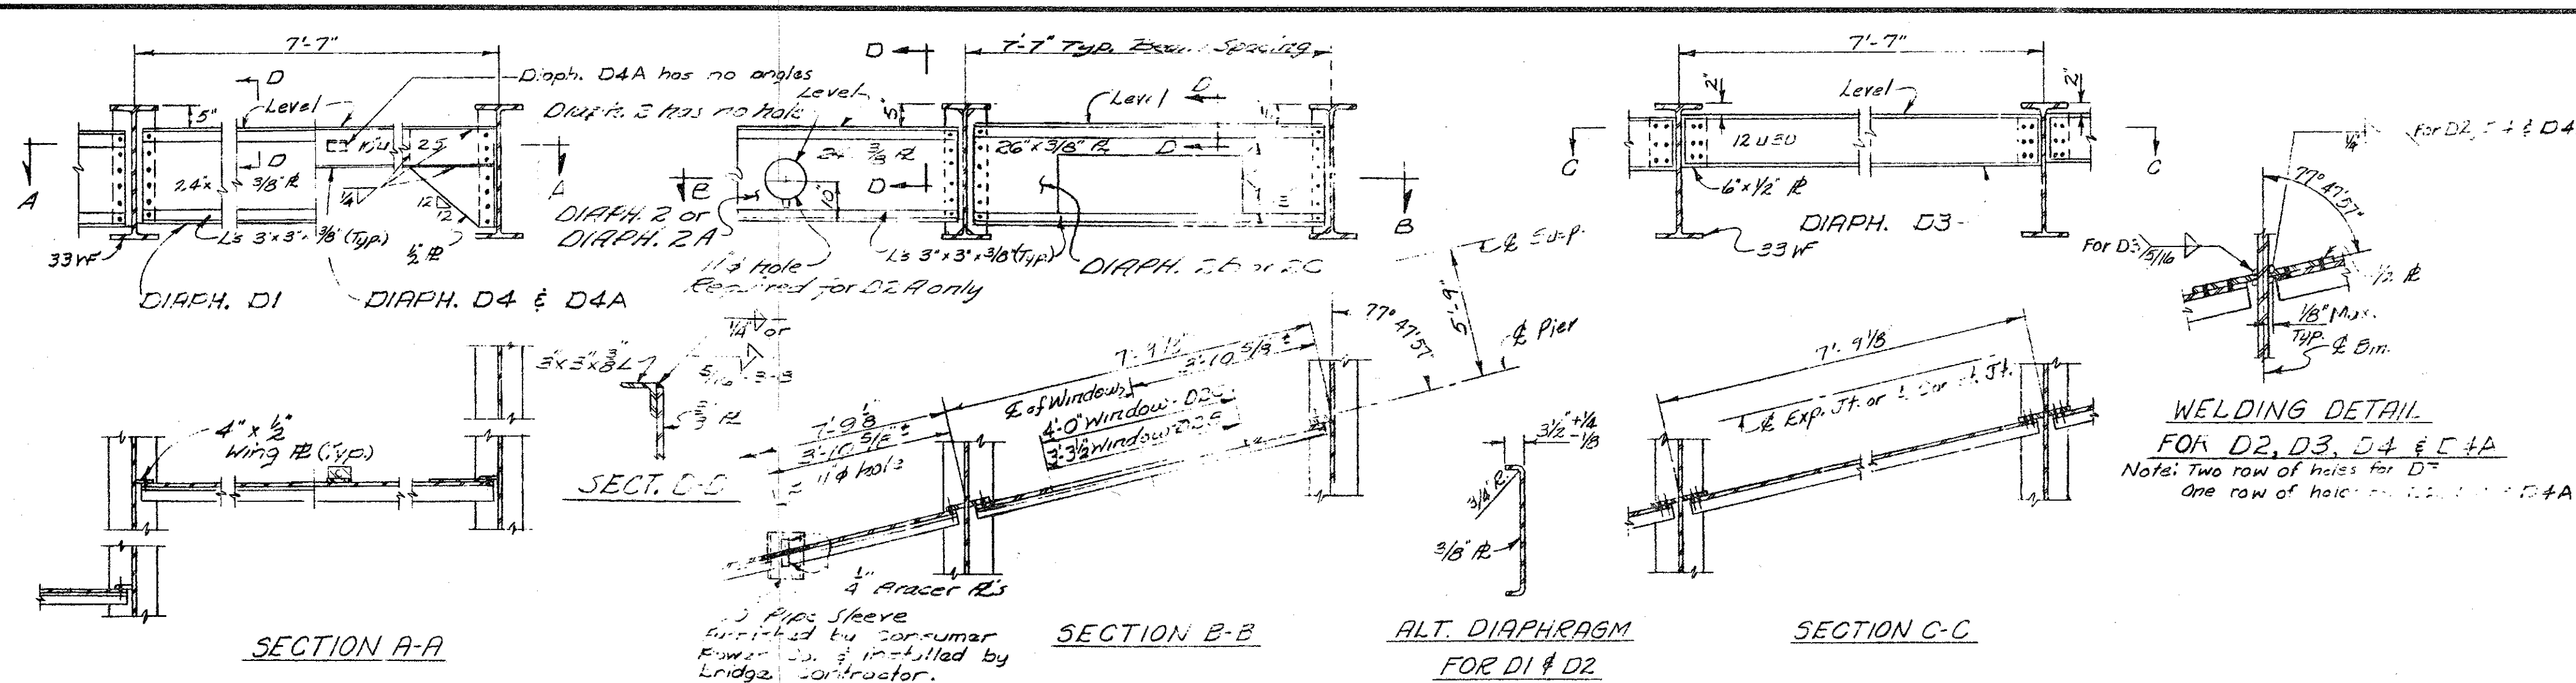


INTERM. DIAPHRAGM DI, D4 & D4A DETAILS INTERM. DIAPHRAGM D2, D2A, D2B & D2C DETAILS END DIAPHRAGM D3 DETAILS

SOLE PLATE THICKNESS TABLE

BEAM TYPE	t	BEAM TYPE	t		
Abutment A	A SP1	2"	Pier 2 - Span 3	A SP3	2"
	B	2"		B	2"
	C	4 1/2"		C	4 1/2"
	D	2"		D	2"
	E	3 1/2"		E	3"
	F	3 1/2"		F	3"
	G	2 1/2"		G	2"
	H	4"		H	4 1/2"
	J	2"		J	2"
	K	2"		K	2"
	Pier 1	A SP2		2 1/2"	Pier 3
B		2 1/2"	B	3 1/2"	
C		5 1/2"	C	5 1/2"	
D		2 1/2"	D	2 1/2"	
E		3 1/2"	E	3 1/2"	
F		3 1/2"	F	3 1/2"	
G		2 1/2"	G	2 1/2"	
H		5 1/2"	H	5 1/2"	
J		3 1/2"	J	2 1/2"	
K		3 1/2"	K	2 1/2"	
Pier 2 - Span 2		A SP3	2"	Abutment B	
	B	2"	B		2"
	C	4 1/2"	C		4"
	D	2"	D		2 1/2"
	E	3"	E		3 1/2"
	F	3"	F		3 1/2"
	G	2"	G		2"
	H	4 1/2"	H		4 1/2"
	J	2"	J		2"
	K	2"	K		2"

Note: Two rows of bolts for D²
One row of bolts for D¹ & D^{4A}

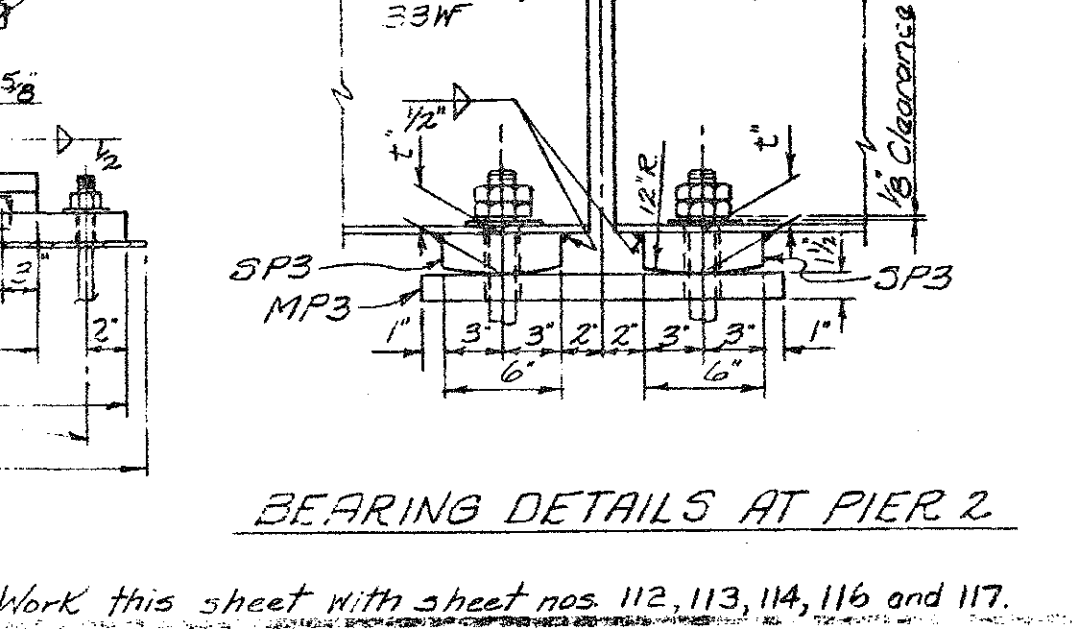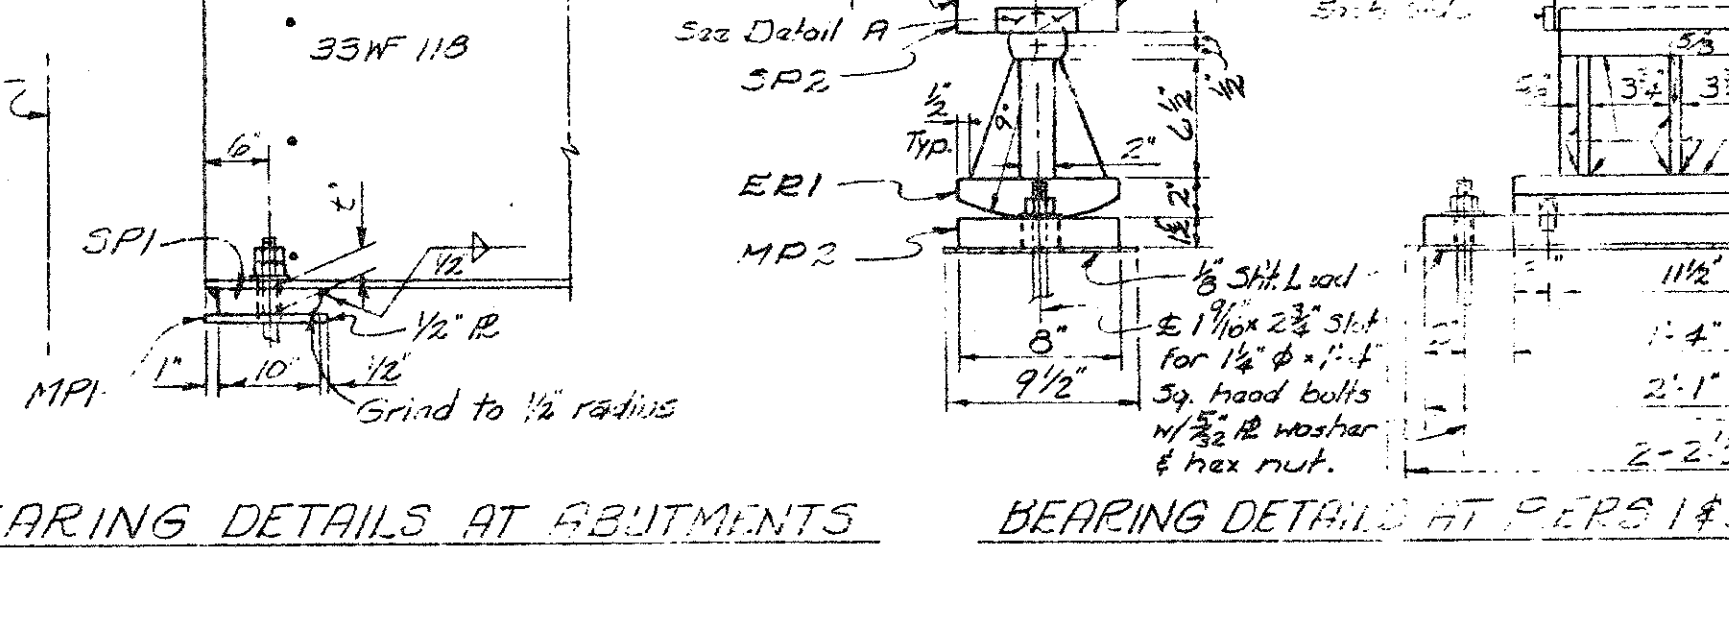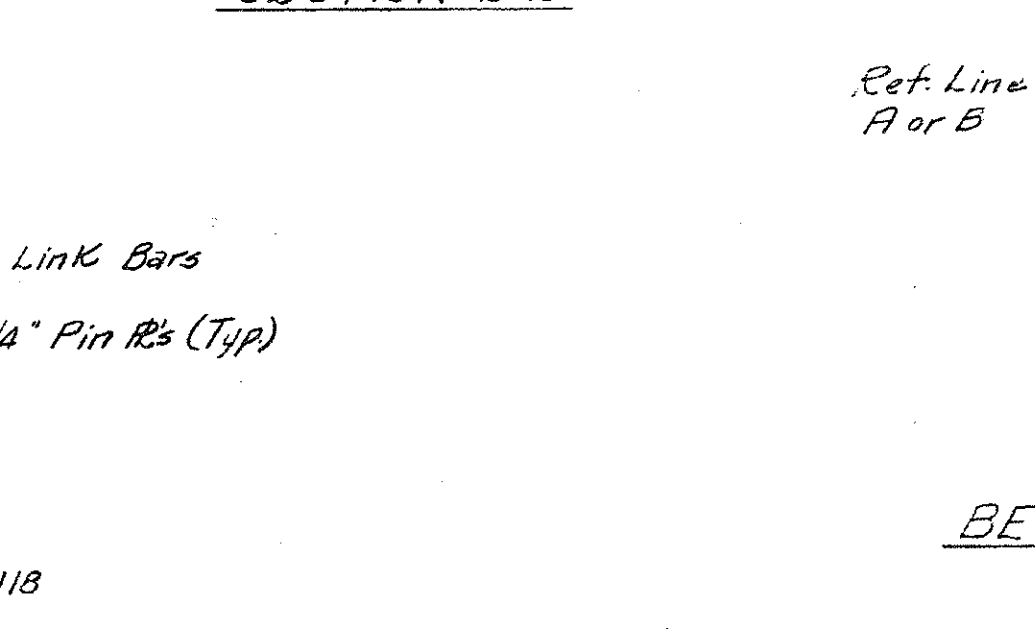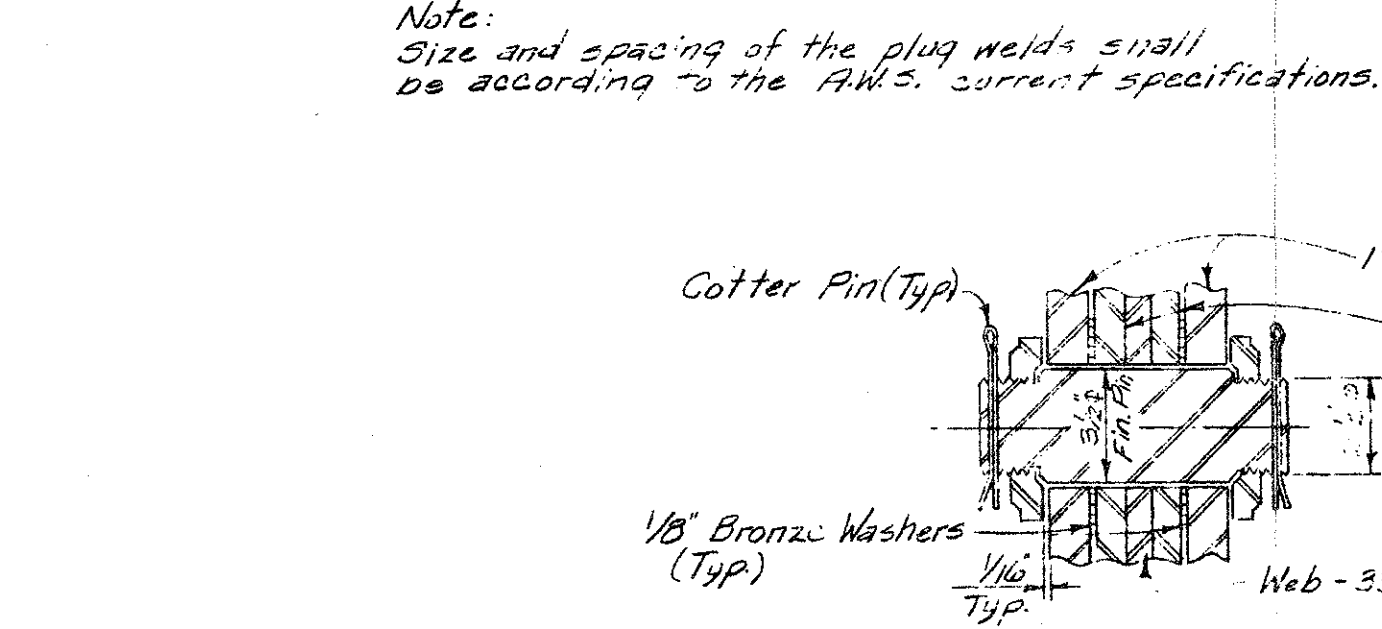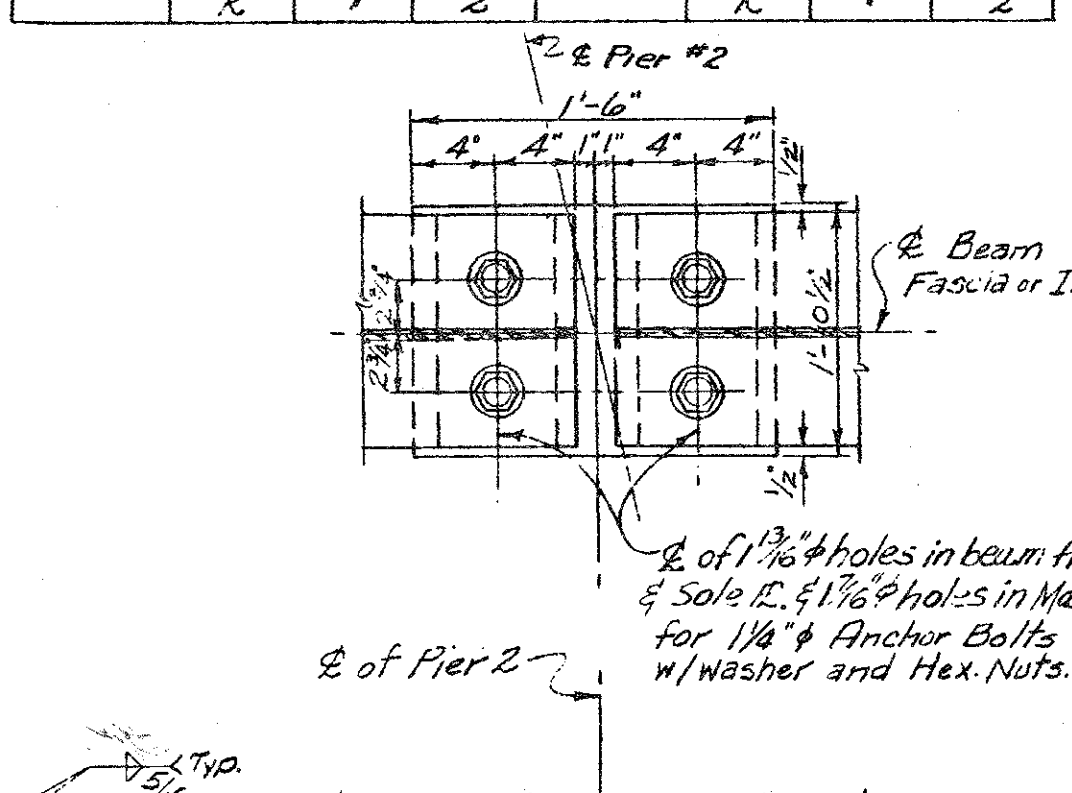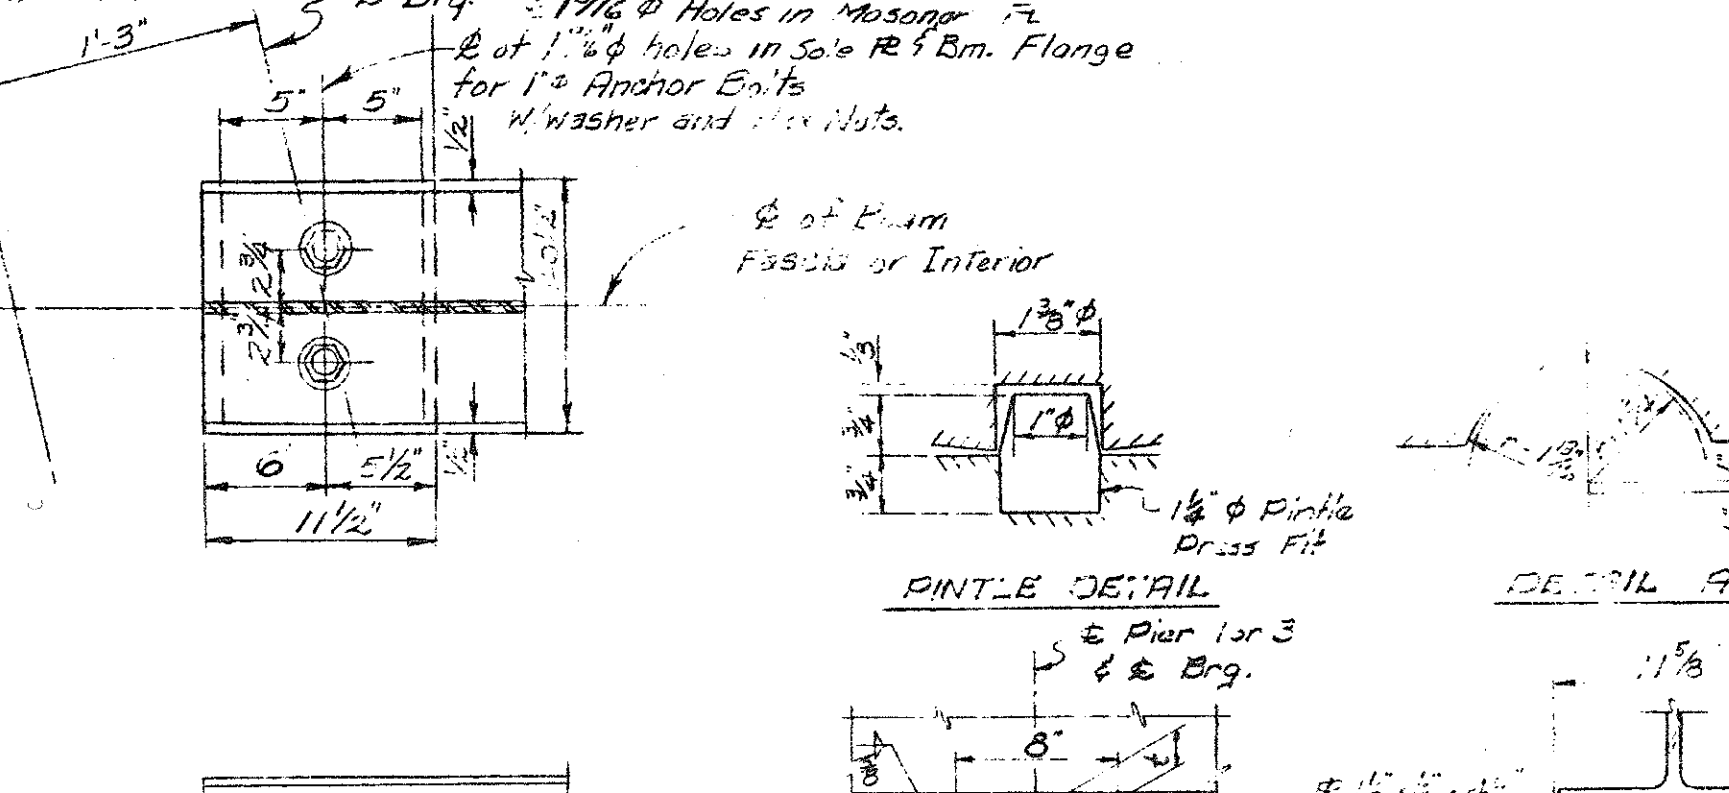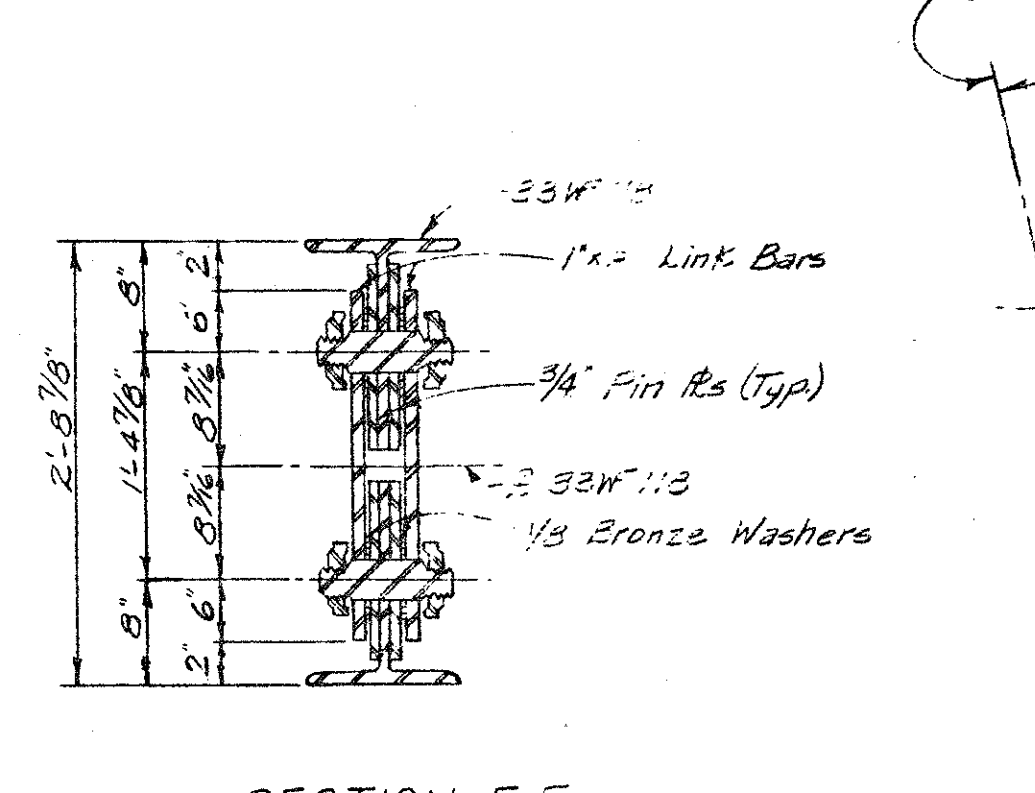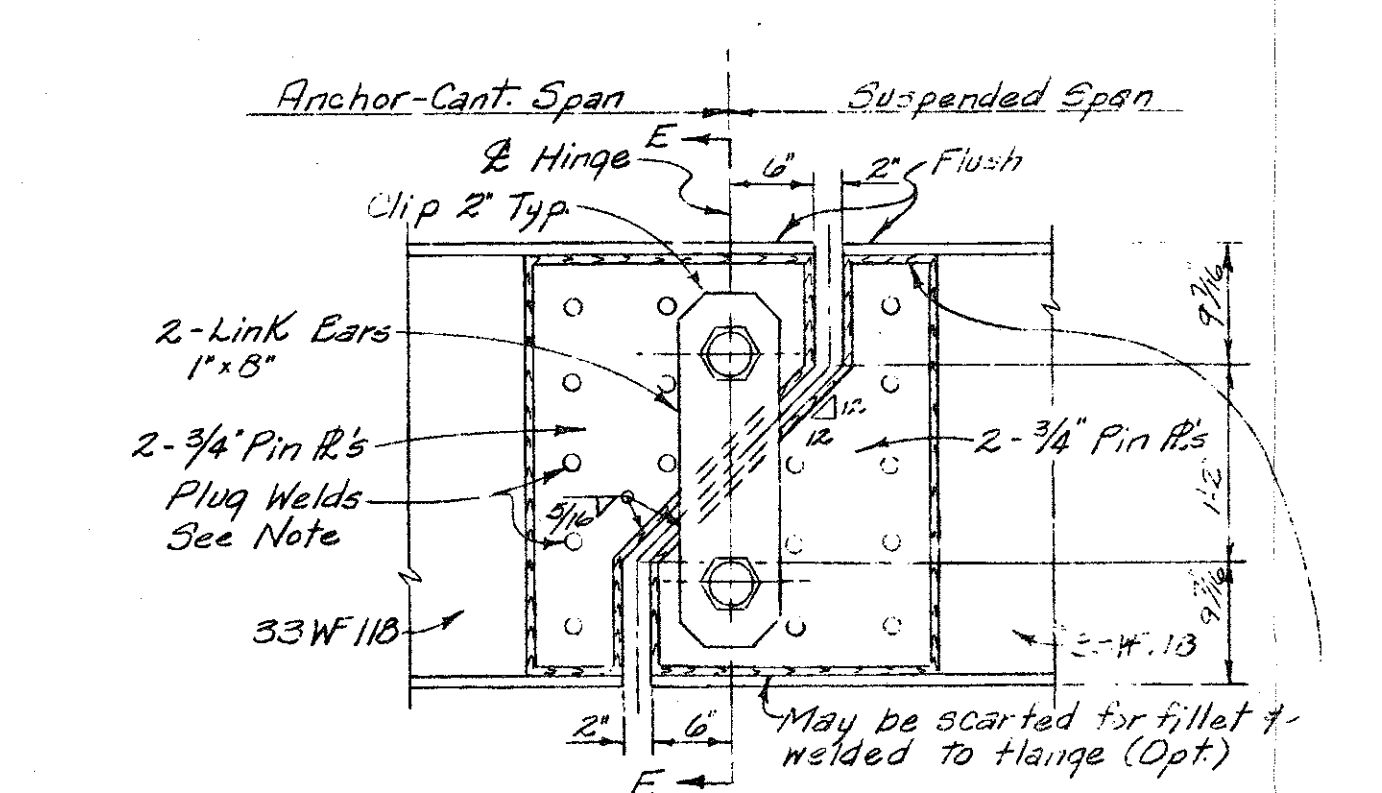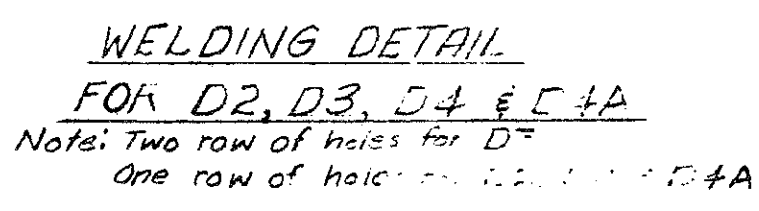

Note: Size and spacing of the plug welds shall be according to the AISC's current specifications.

Note: See Utility Details Sheet #115 for provisions for UH115. (Consumers Power Co. & Central Edison Co.)

Note: See Detail A for 1/2" Pin. Grind to 1/2" radius.

Work this sheet with sheet nos. 112, 113, 114, 116 and 117.

STRUCTURAL STEEL DETAILS

S31 of 63174B


NOTE: DO NOT WORK FROM THIS SHEET. THE INFORMATION SHOWN HERE IS FOR REFERENCE ONLY. NO PAY ITEMS ARE SHOWN.

FOR INFORMATION ONLY

DATE	CONT. SEC.	JOB NO.	DESIGN UNIT	SHEET
10-13-99	S31 OF 63174.	48404A	MAHDAVI	10 OF 20


REVISIONS: NO. DESCRIPTION DATE BY. CORRECTED BY: DATE: CHECKED BY: DATE: DRAWN BY: INDER FILE NAME: s3163174.sn

REVISIONS			
NO.	DESCRIPTION	DATE	BY

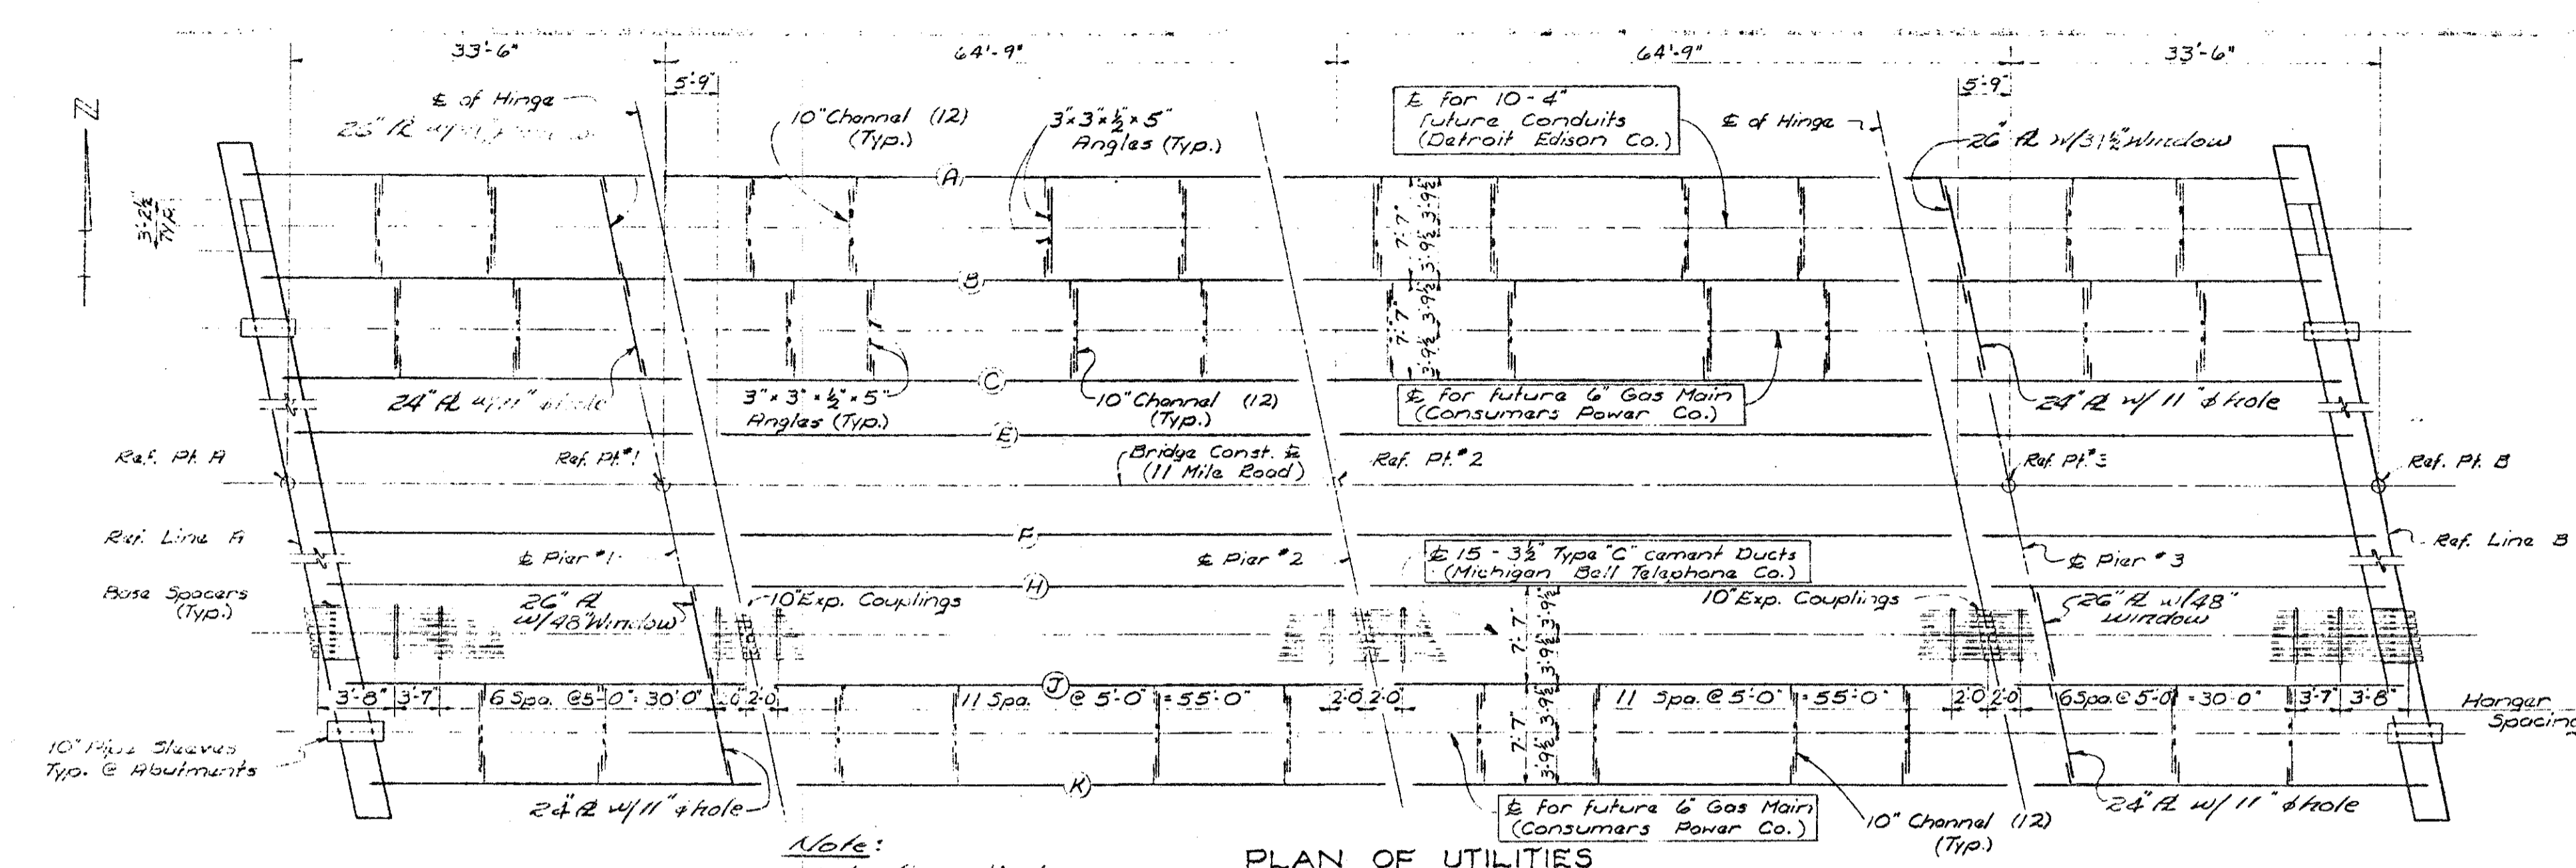


Note:
Only those dim. programs
superior to utilities
are shown.


PLAN OF UTILITIES
(Michigan Bell Telephone Co.)
(Consumers Power Co.)
(Detroit Edison Co.)

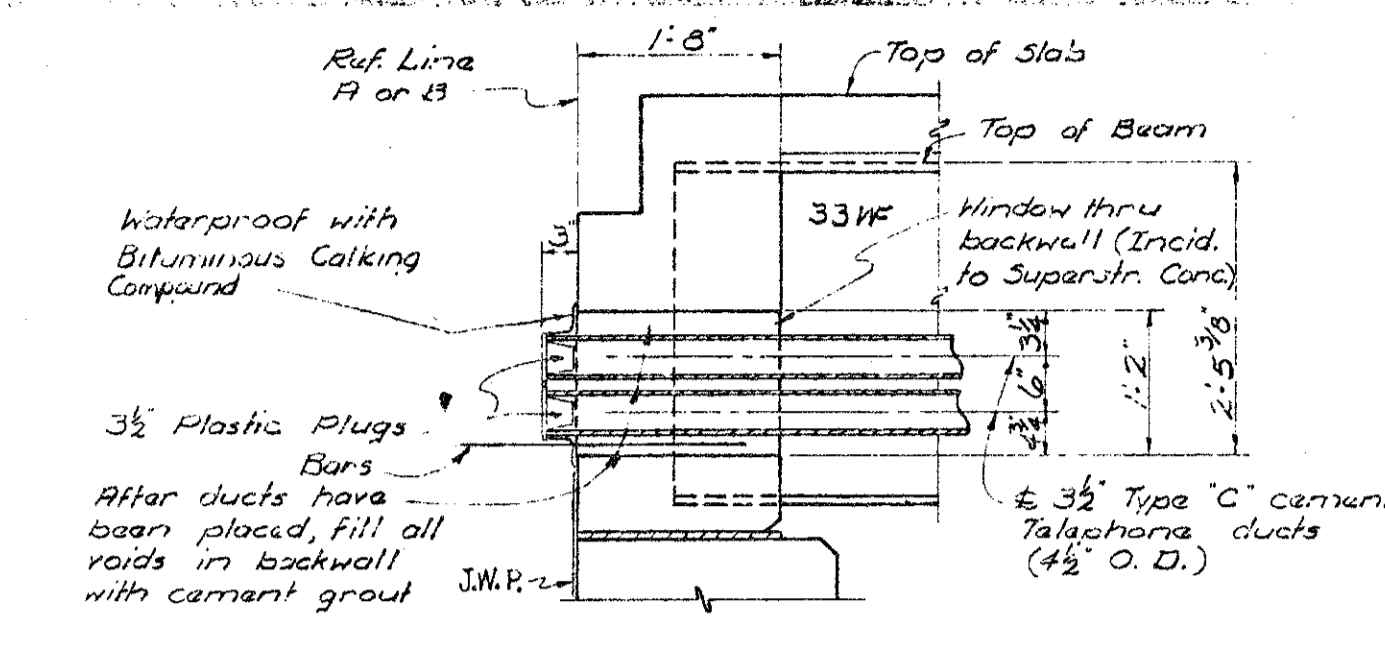


SECTION THRU BACKWALL

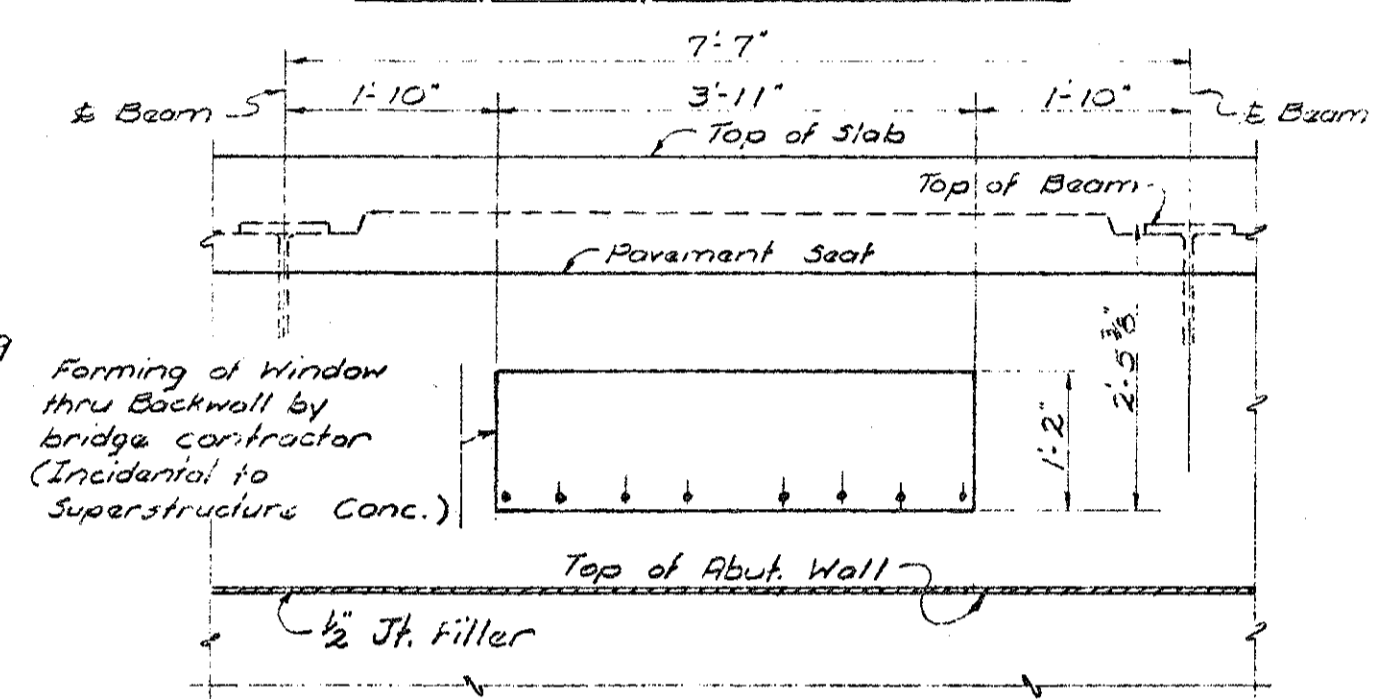


END VIEW OF BACKWALL @ 90° TO E BEAM

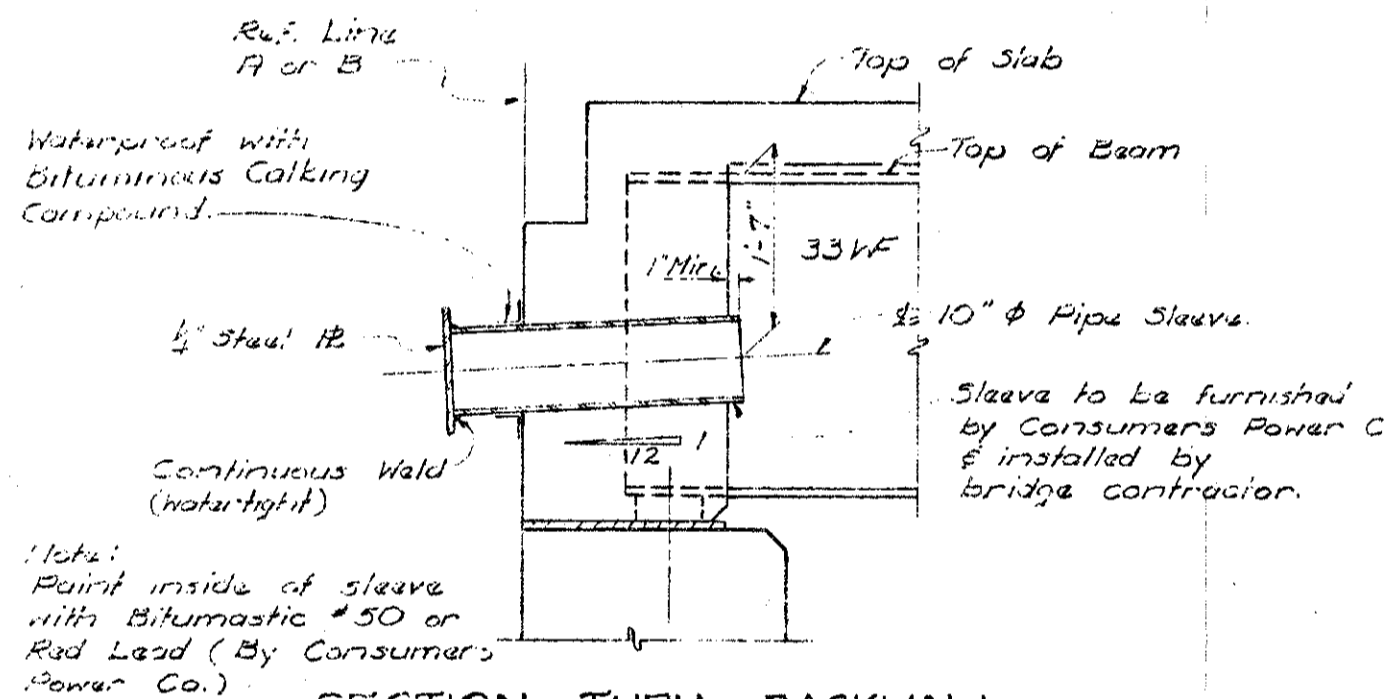


SECTION THRU BACKWALL

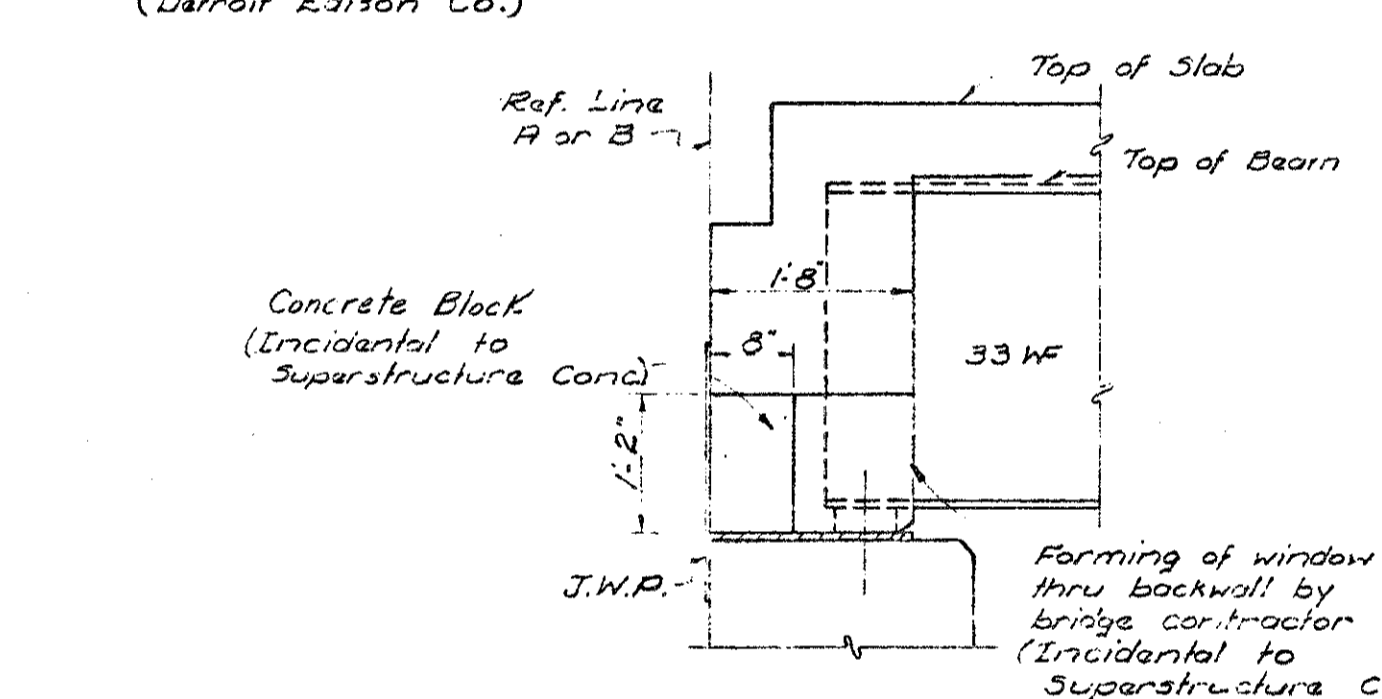

SECTION THRU BACKWALL

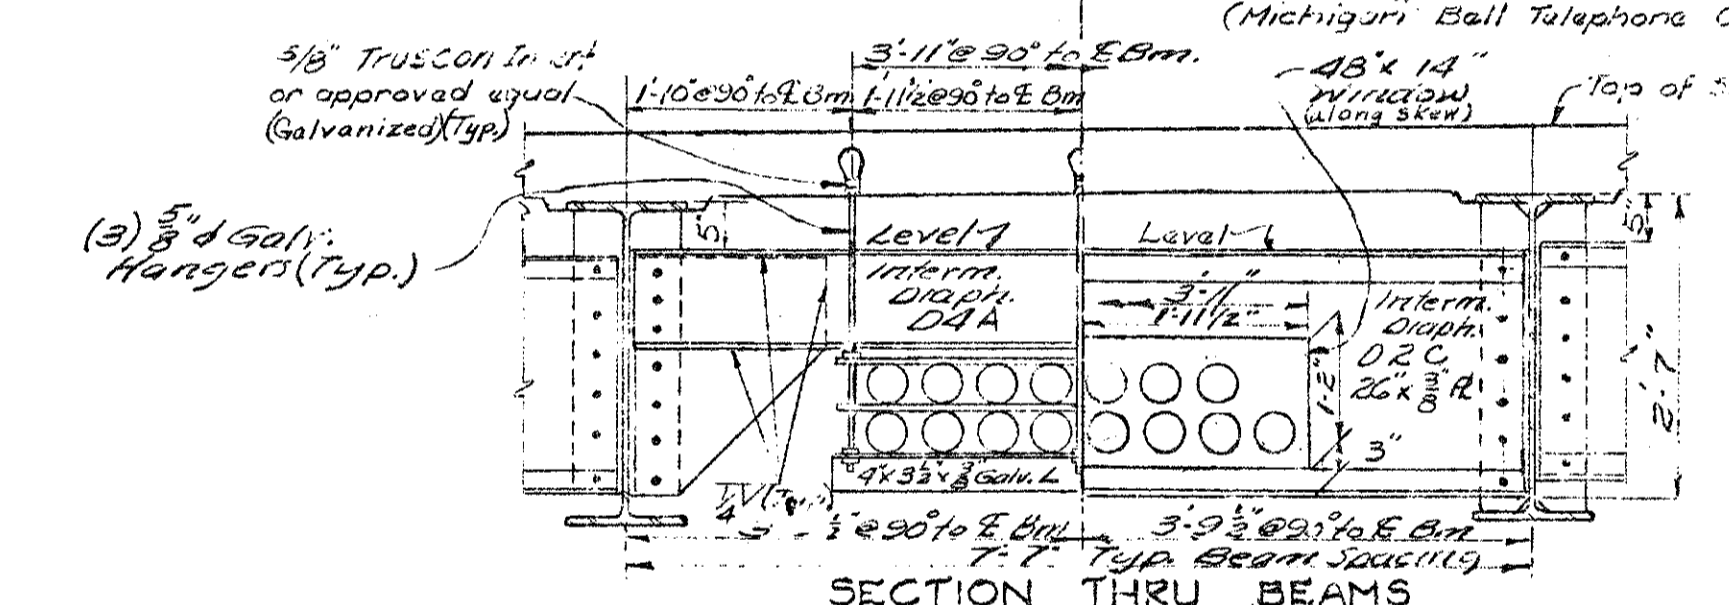


SECTION THRU BEAMS (FOR TELEPHONE DUCTS)
MICH. BELL TEL. CO.

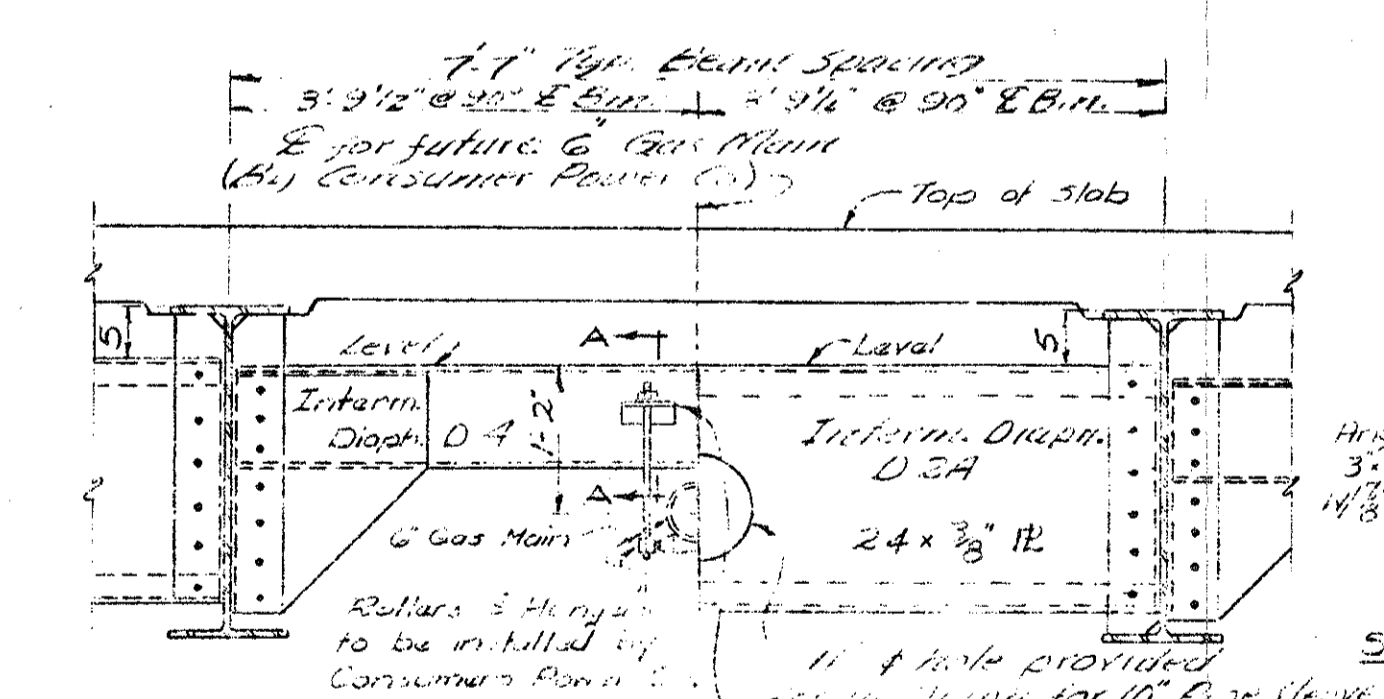

SECTION THRU BEAMS

CONSUMERS POWER CO.
(FOR FUTURE 6.375 LINE)

(For Quantities chargeable to Consumers Power Co. See Table)

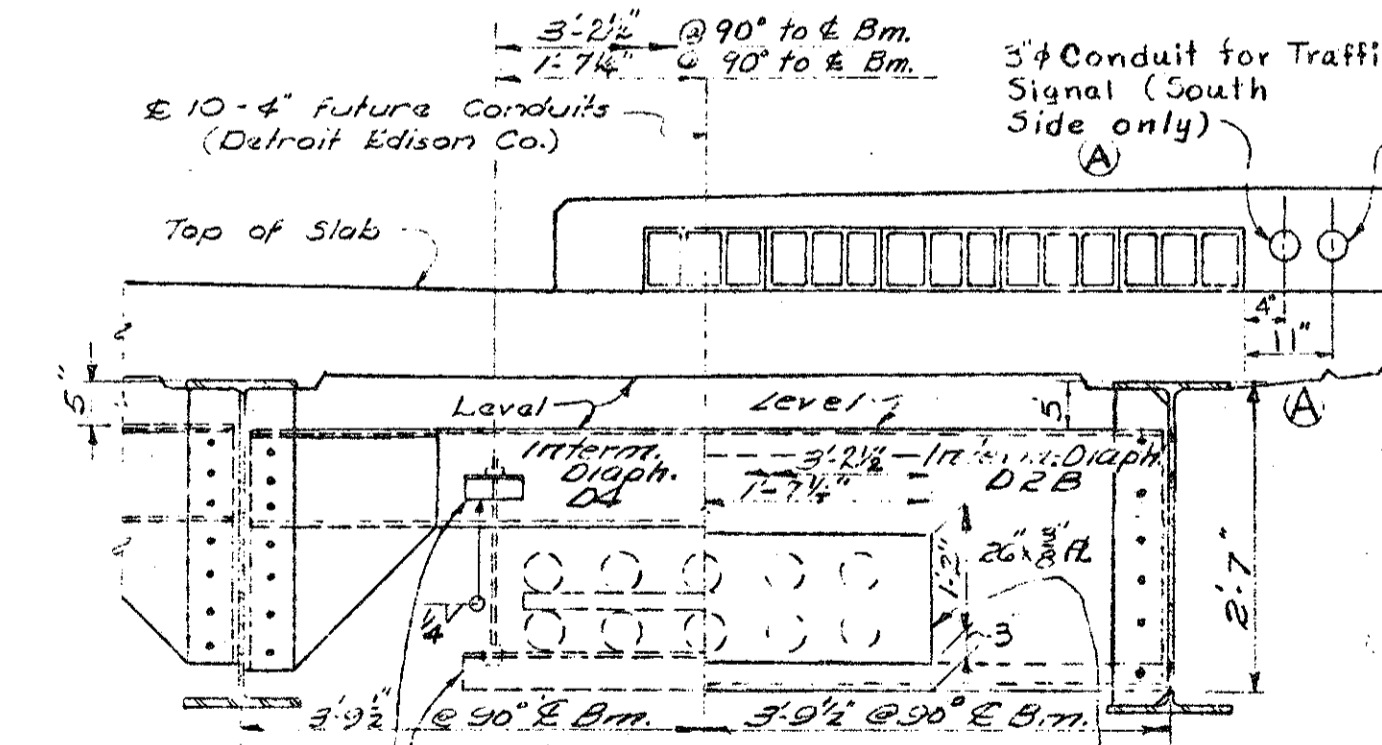

SECTION THRU BEAMS

DETROIT EDISON CO.
(FOR FUTURE 10-4 ELEC. CONDUITS)

(For Quantities chargeable to Detroit Edison Co. See Table)

NOTES:
MICHIGAN BELL TELEPHONE CO.
The inserts in the deck slab are included in this contract.
Forming of window in backwalls is incidental to superstructure concrete.
Furnishing & installing of telephone conduit is not a part of this contract, and the installer of the ducts shall be in accordance with the manufacturers & telephone company's recommendations.
DETROIT EDISON CO.
Angles for supporting the future hanger arrangement are included in this contract (Structural Steel).
Forming of window in backwalls is incidental to superstructure concrete.
All other work shown is not a part of this contract.
CONSUMERS POWER CO.
Angles for supporting the future hanger arrangement are included in this contract (Structural Steel).
All other work shown is not a part of this contract.

UTILITY QUANTITIES

CHARGE TO	ITEM	UNIT	AMOUNT
Mich. Bell Tel. Co.	5/8" φ Concrete Inserts	Each	150
	10" φ Pipe Sleeves - Placed	Each	-
Consumers Power	Structural Steel - Furnishing & Fabricating	Lbs.	190
	Structural Steel - Erection	Lbs.	190
Detroit Edison Co.	Structural Steel - Furnishing & Fabricating	Lbs.	190
	Structural Steel - Erection	Lbs.	190

* Included in Structural Steel Quantities S3114
The Contractor shall advise the District Utility Engineer as soon as the structure is ready for installation of conduits or mains in bridge.
Work this sheet with sheet nos 109, 110, 111, 114, & 115

UTILITY DETAILS

ITEM	QUANTITY
3" Conduit for Traffic Signal	526' 6" @ 10' B.M.

S31 of 63174B

NOTE:
DO NOT WORK FROM THIS SHEET. THE INFORMATION SHOWN HERE IS FOR REFERENCE ONLY. NO PAY ITEMS ARE SHOWN.

FOR INFORMATION ONLY

DATE	CONT. SEC.	JOB NO.	DESIGN UNIT	SHEET
10-13-99	S31 OF 63174.	48404A	MAHDAVI	11 OF 20




1 2 3 4 5 6 7 8 9 10 11 12 13 14 15 16 17 18 19 20 21 22 23 24 25 26 27 28 29 30 31 32 33 34 35 36 37 38 39 40 41 42 43 44 45 46 47 48 49 50 51 52 53 54 55 56 57 58 59 60 61 62 63


DATE: 01-13-99
CORRECTED BY:
CHECKED BY:
DRAWN BY: INDER
FILE NAME: s3163174.sn

1 2 3 4 5 6 7 8 9 10 11 12 13 14 15 16 17 18 19 20 21 22 23 24 25 26 27 28 29 30 31 32 33 34 35 36 37 38 39 40 41 42 43 44 45 46 47 48 49 50 51 52 53 54 55 56 57 58 59 60 61 62 63


REVISIONS			
NO.	DESCRIPTION	DATE	BY

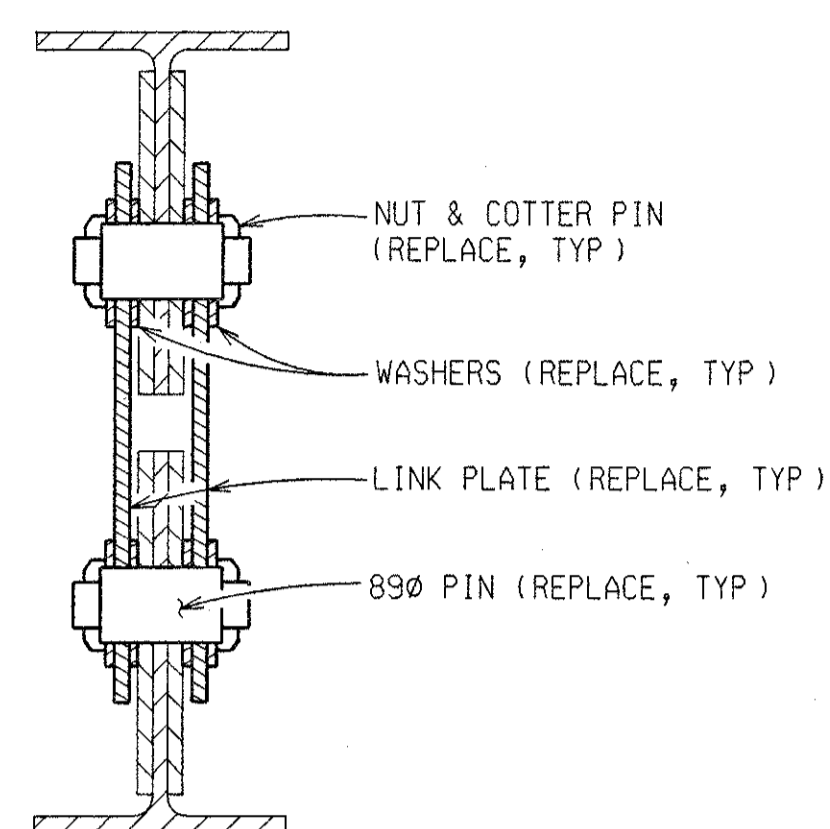


SECTION A-A
(EXISTING)

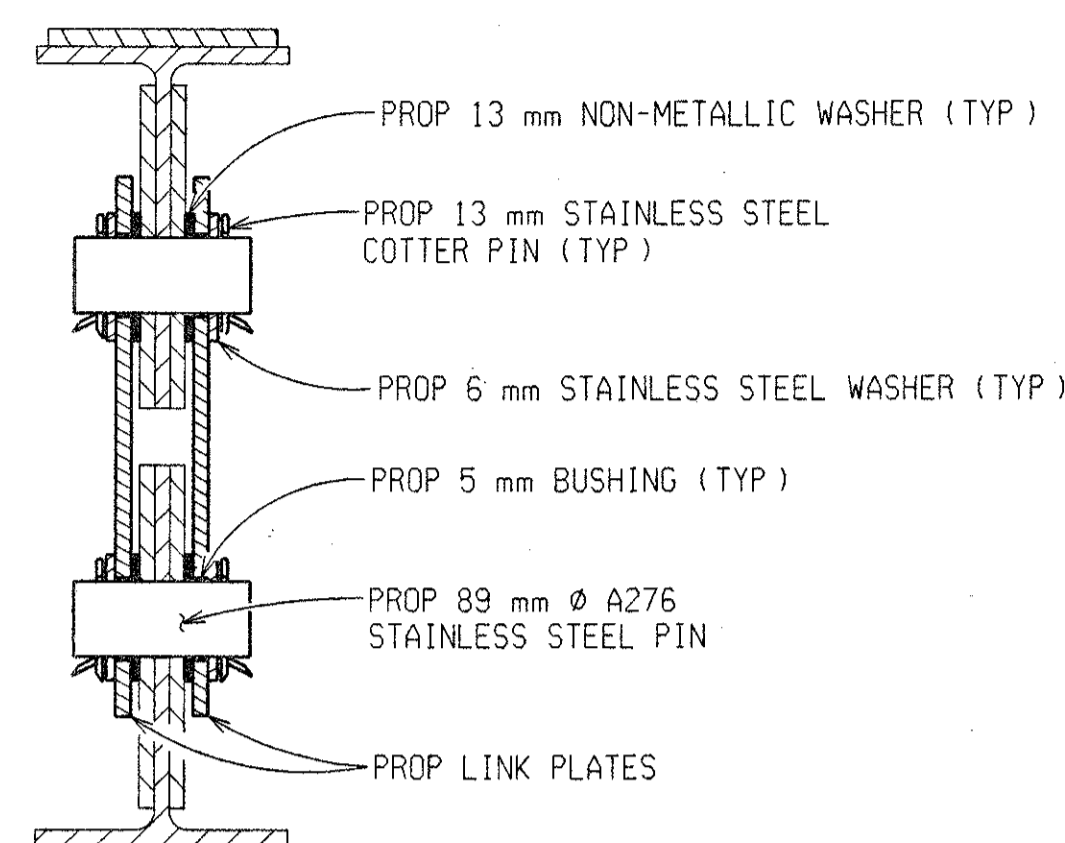


SECTION A-A
(PROPOSED)

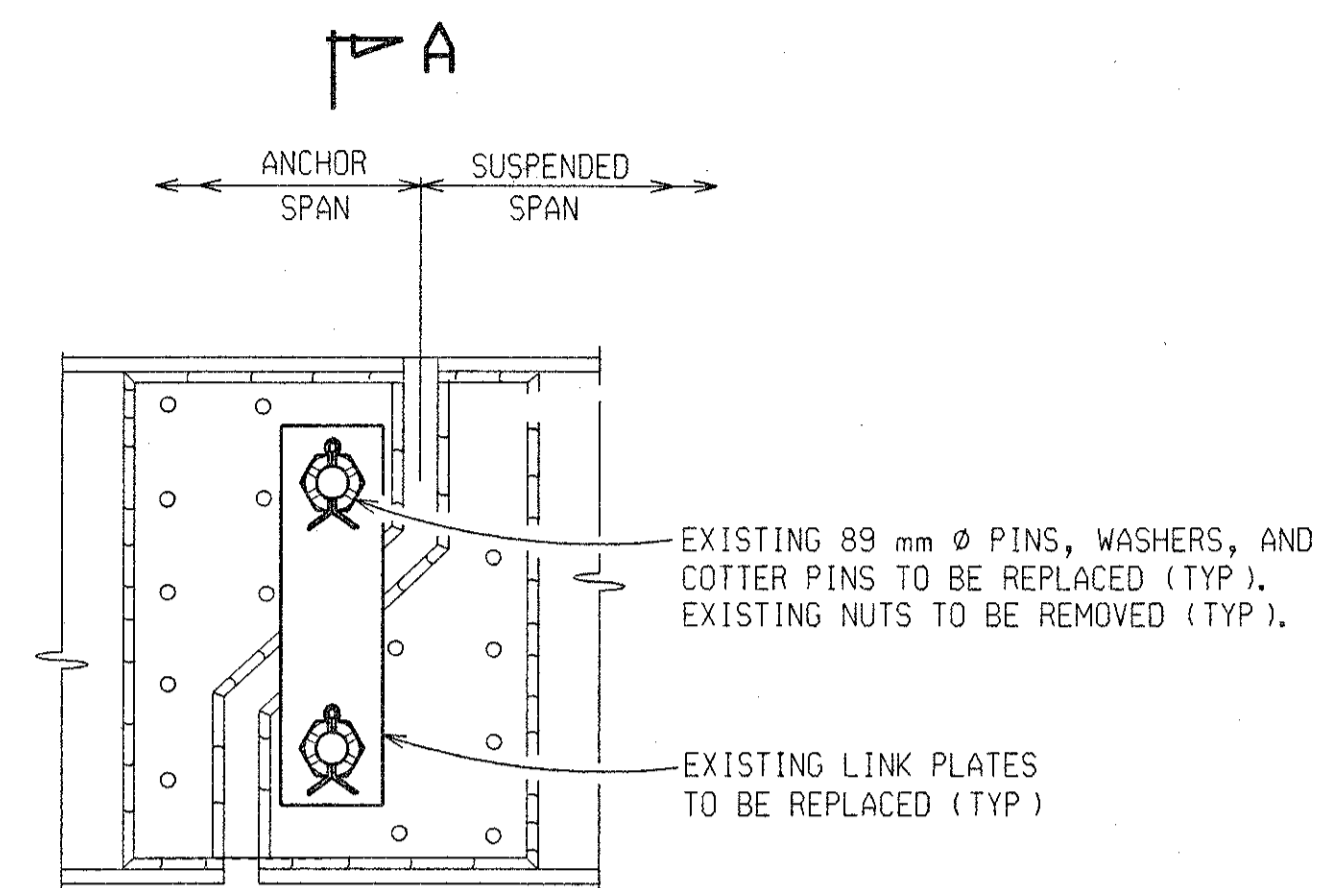


ELEVATION AT PIN

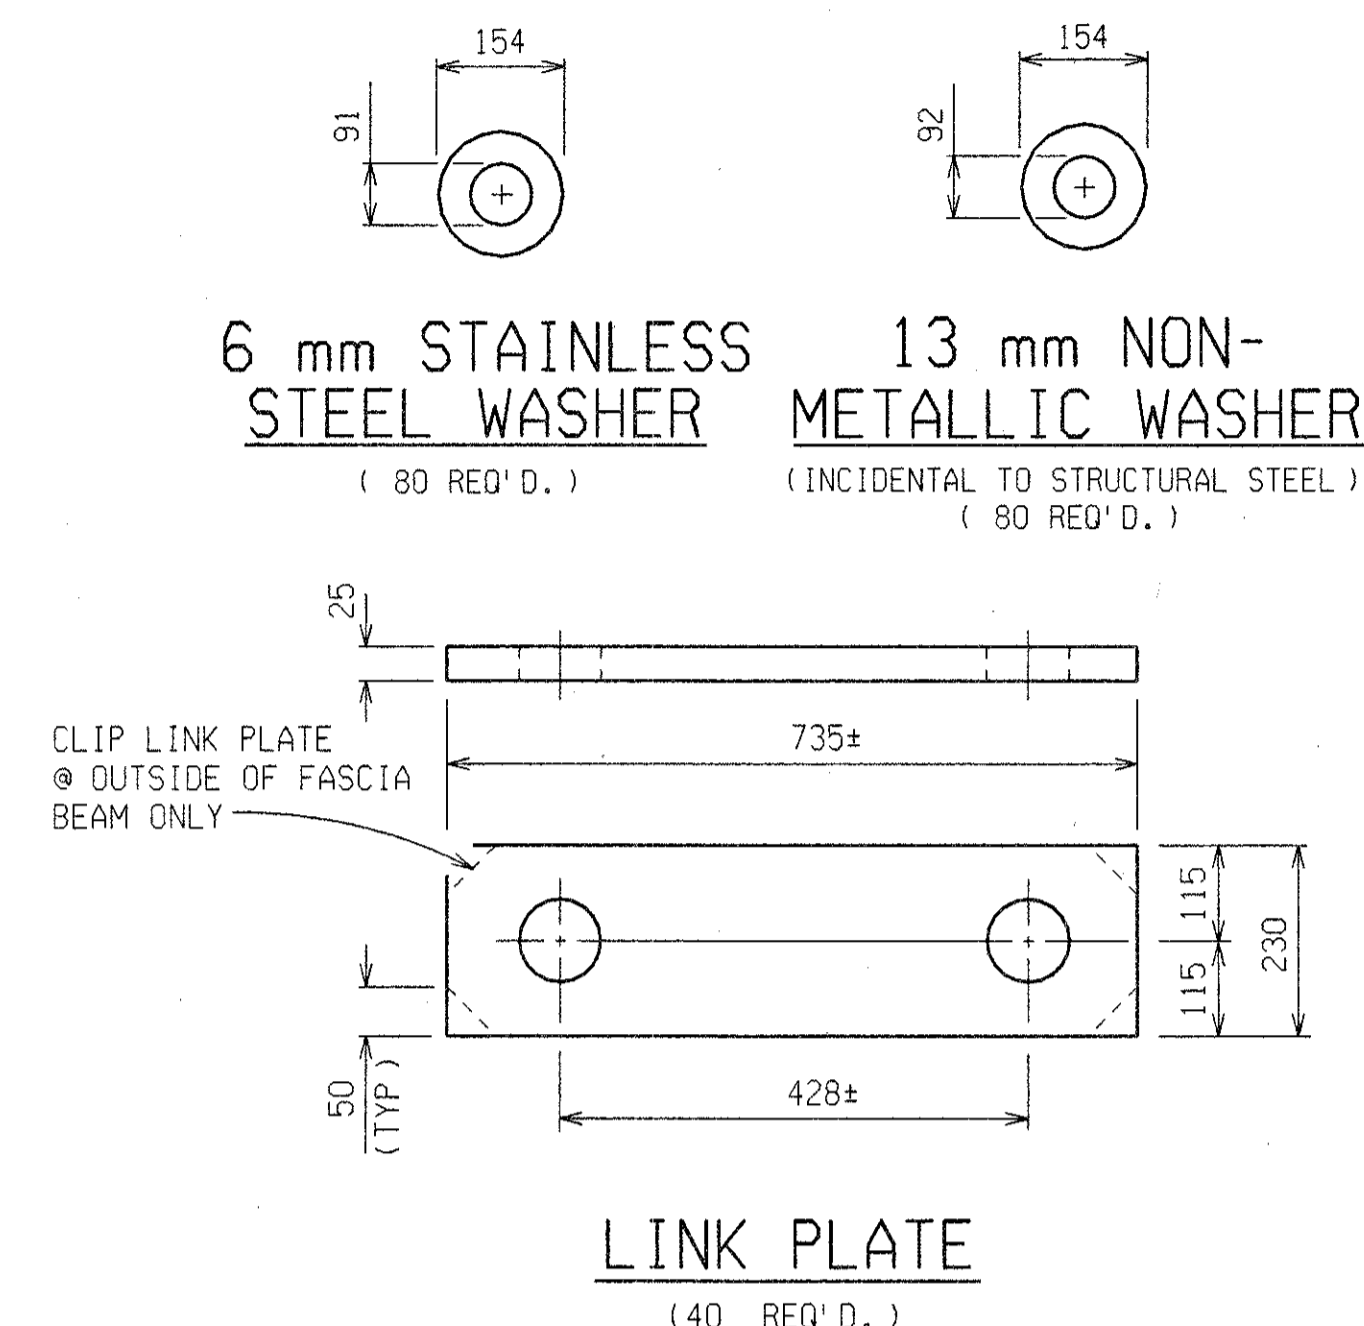

LINK PLATE
(40 REQ'D.)

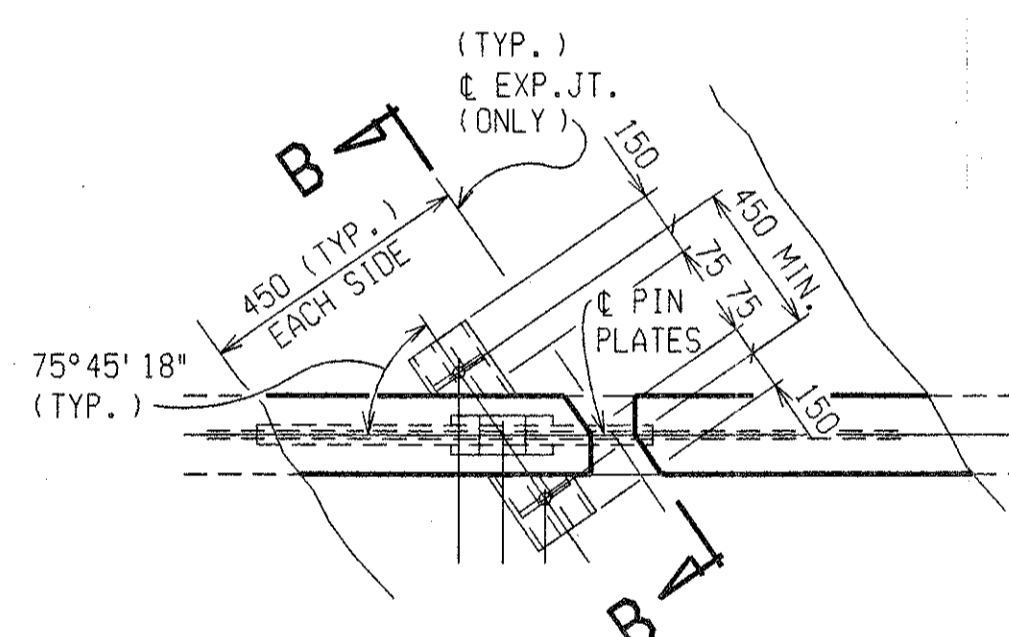


PLAN OF TEMPORARY SUPPORT

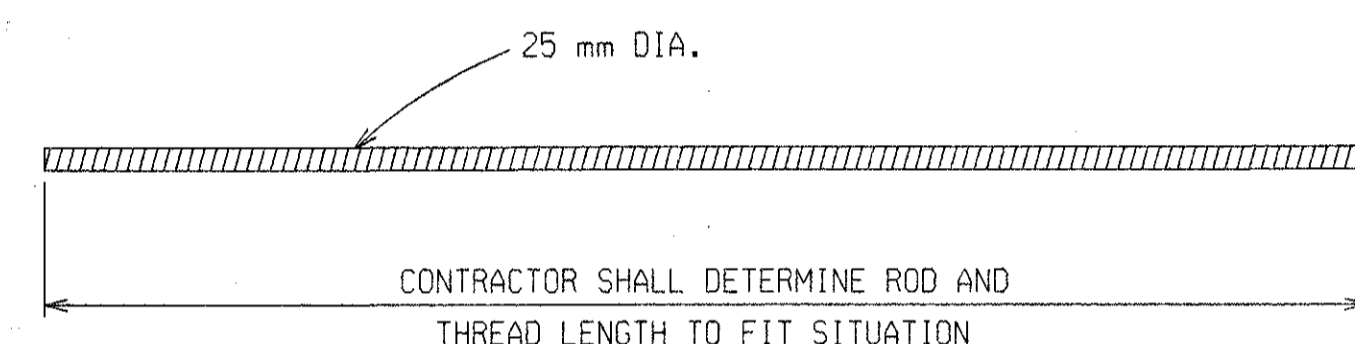

SUSPENSER ROD DETAIL

4 REQUIRED PER ASSEMBLY W/7 HEAVY HEX NUTS & 4 HARDENED WASHER PER ROD

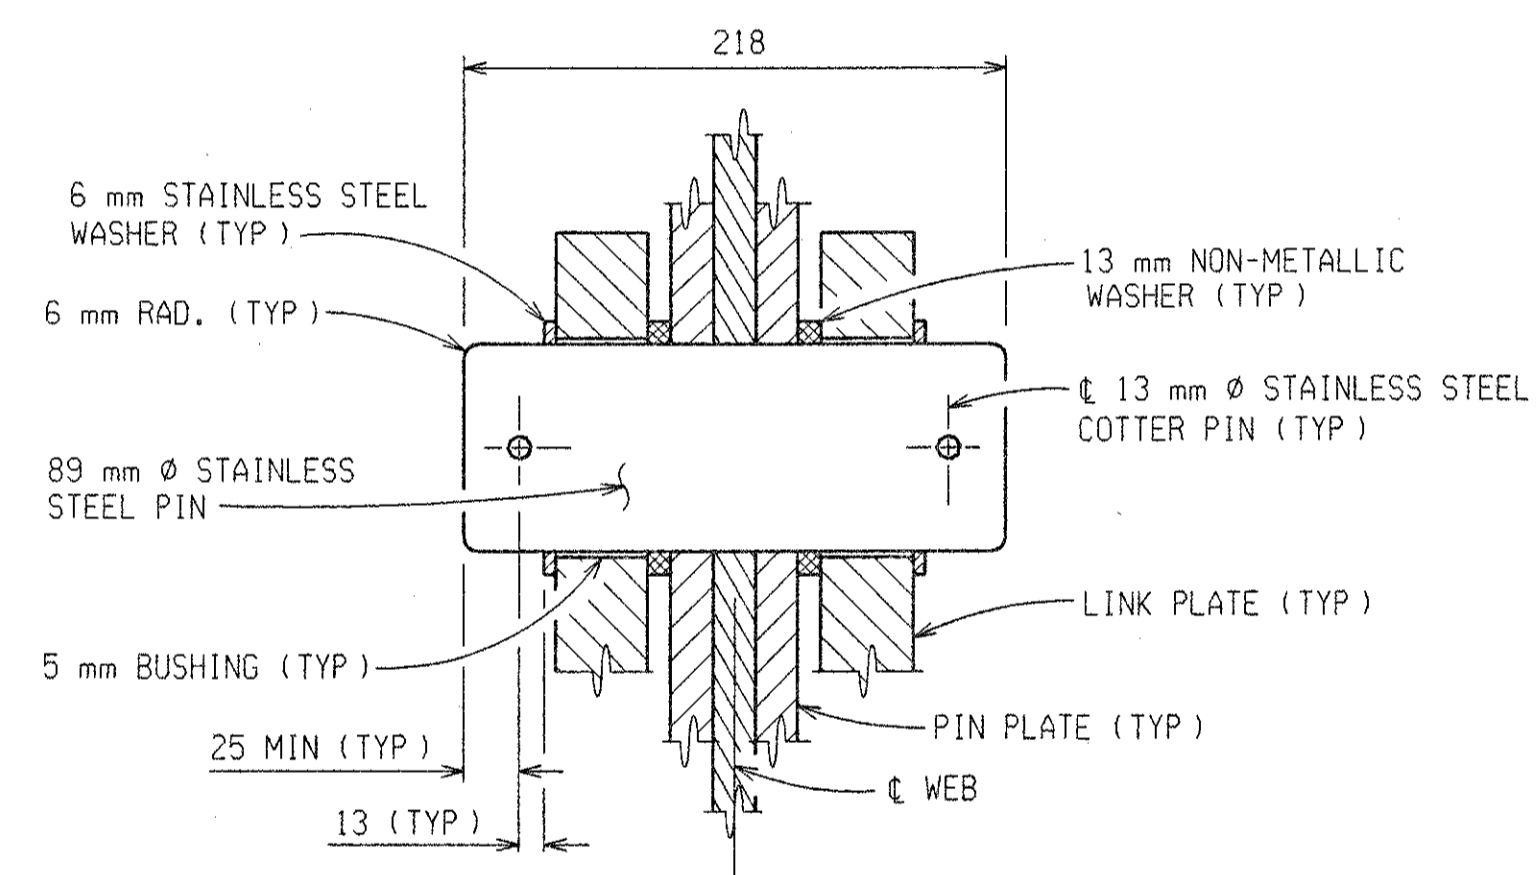

PROPOSED PIN DETAIL
(40 REQ'D.)

NOTES:

ALL STRUCTURAL STEEL SHALL BE FIELD PAINTED. THE AREA BEHIND AND AROUND THE HANGER ASSEMBLY SHALL BE PAINTED PRIOR TO INSTALLING THE NEW LINK PLATES AND PINS. PROPOSED LINK PLATES SHALL BE SHOP PAINTED.

WELDING ON EXISTING BEAMS WILL NOT BE PERMITTED.

THE PROTECTION OF WORK AND ENVIRONMENT DURING BLAST CLEANING OF WEBS BEHIND AND AROUND HANGER ASSEMBLIES SHALL BE ACCORDING TO SUBSECTION 715 OF THE STANDARD SPECIFICATIONS. (INCLUDED IN THE BID ITEM "HANGER ASSEMBLY, REMOVE AND ERECT".)

THE CONTRACTOR SHALL TAKE FIELD MEASUREMENTS OF THE EXISTING HANGER ASSEMBLIES INDICATED ON THE PLANS PRIOR TO THE PREPARATION OF LINK PLATE AND PIN SHOP DRAWINGS.

THE CONTRACTOR WILL BE FURNISHED WITH PLANS OF THE EXISTING STRUCTURE IF REQUESTED.

ALTERNATE DESIGNS OF THE TEMPORARY SUPPORT SHALL BE BASED ON LOADS AS FOLLOWS:

516 kN VERTICAL GIRDER LOAD.

THIS BRIDGE IS COATED WITH LEAD BASED PAINT.

SEE SUBSECTION 715 OF THE STANDARD SPECIFICATIONS FOR PROTECTION OF WORK AND ENVIRONMENT DURING THE BLAST CLEANING OF STRUCTURES.

THE COLOR FOR THE URETHANE PROTECTIVE COAT SHALL MATCH COLOR NUMBER 16440 (LIGHT GRAY) OF FEDERAL STANDARD NUMBER 595A.


THE ENGINEER SHALL INSPECT THE STRUCTURAL STEEL PARTS THAT HAVE BEEN BLAST CLEANED FOR EVIDENCE OF CRACKS OR LOSS OF SECTION DUE TO CORROSION OF MORE THAN 25 PERCENT. SUCH DETERIORATION SHALL BE REPORTED IN WRITING TO THE ENGINEER, STRUCTURES AND ROAD MAINTENANCE OF THE MAINTENANCE DIVISION IN LANSING.

THE ESTIMATED AREA OF STRUCTURAL STEEL TO BE PAINTED IS 1700 SQUARE METERS.


SEALANT SHALL BE APPLIED AROUND THE PERIMETER OF BEARING PLATE TO CONCRETE CONTACT SURFACES AFTER CUTTING AWAY ANY PROTRUDING PORTION OF THE LEAD PLATE AT PIER 2 ONLY.

THE TOP OF PIER 2 SHALL BE GIVEN AN APPLICATION OF PENETRATING WATER REPELLENT TREATMENT.

THE CONTRACTOR SHALL TAKE NECESSARY MEASURES TO AVOID OVERSPRAY ON ADJACENT SUBSTRUCTURE AND SUPERSTRUCTURE CONCRETE SURFACES. (INCLUDED IN THE BID ITEM "STEEL STRUCTURE, COATING, TYPE 4 (S31)".)

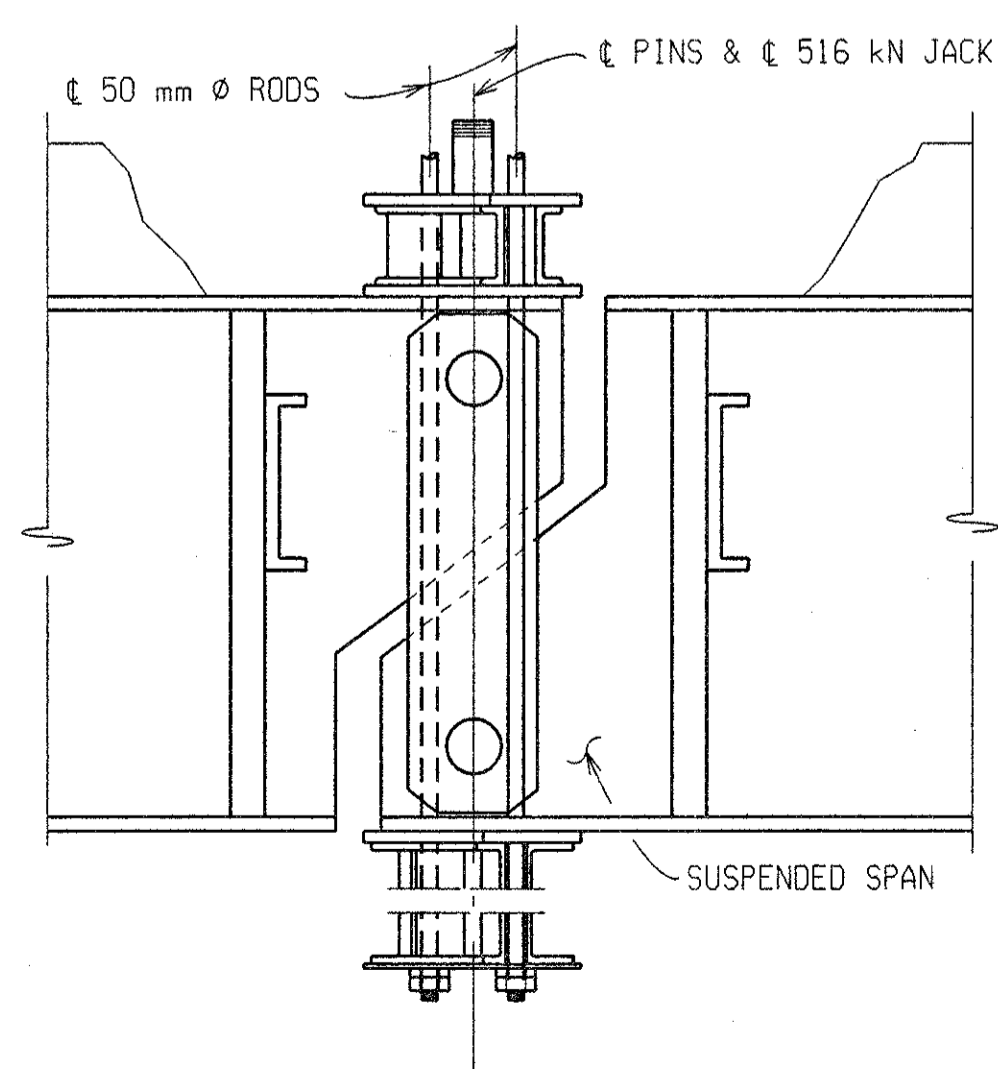

TEMPORARY SUPPORT

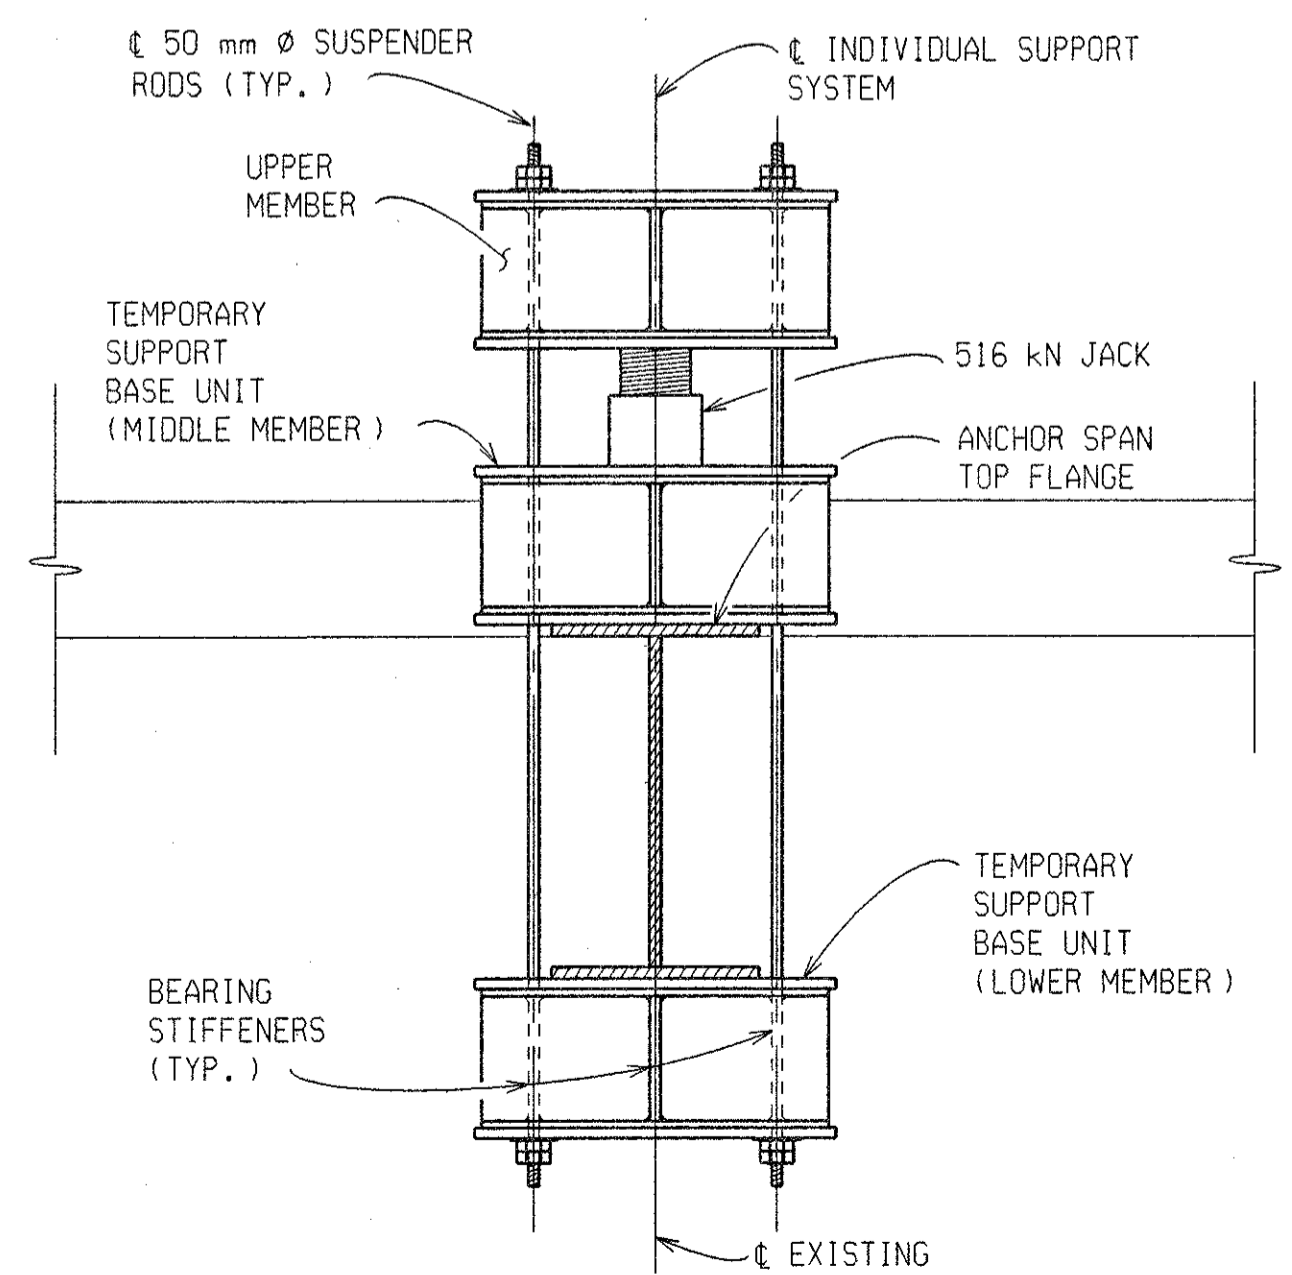

DECK SECTION B-B
(TYPICAL ALL BEAMS)

MISCELLANEOUS QUANTITIES

20 ea	Support, Suspension, Temp
80 ea	Bushing
1715 kg	Structural Steel, Furn and Fab, Pin and Hanger
20 ea	Hanger Assembly, Rem and Erect
20 ea	Hanger Assembly, Field Measurement
1 LS	Field Repr of Damaged Coating (S31)
1 LS	Steel Structure, Cleaning, Type 4 (S31)
1 LS	Steel Structure, Coating, Type 4 (S31)
20 m ²	Water Repellent Treatment
16 m	Beam Plate, Seal Perimeter
* 239 m	Protective Shield, Utility Pipe

* PAY ITEM IS FOR PROTECTIVE SHIELD OF THE AMERITECH DUCTS, DETROIT EDISON DUCTS, AND THE CONSUMER ENERGY GAS MAIN.



SUSPENSER REPLACEMENT DETAILS				
DATE	CONT. SEC.	JOB NO.	DESIGN UNIT	SHEET
10-13-99	S31 OF 63174	48404A	MAHDAVI	12 OF 20

DATE: 7-26-99

CORRECTED BY: CASLER

DATE:

CHECKED BY:


DATE: 4-30-99

DRAWN BY: CASLER


FILE NAME: s3163174.pr

CONTROL S31 OF 63174 JOB NO. 48404A SH. NO. 13


1 2 3 4 5 6 7 8 9 10 11 12 13 14 15 16 17 18 19 20 21 22 23 24 25 26 27 28 29 30 31 32 33 34 35 36 37 38 39 40 41 42 43 44 45 46 47 48 49 50 51 52 53 54 55 56 57 58 59 60 61 62 63

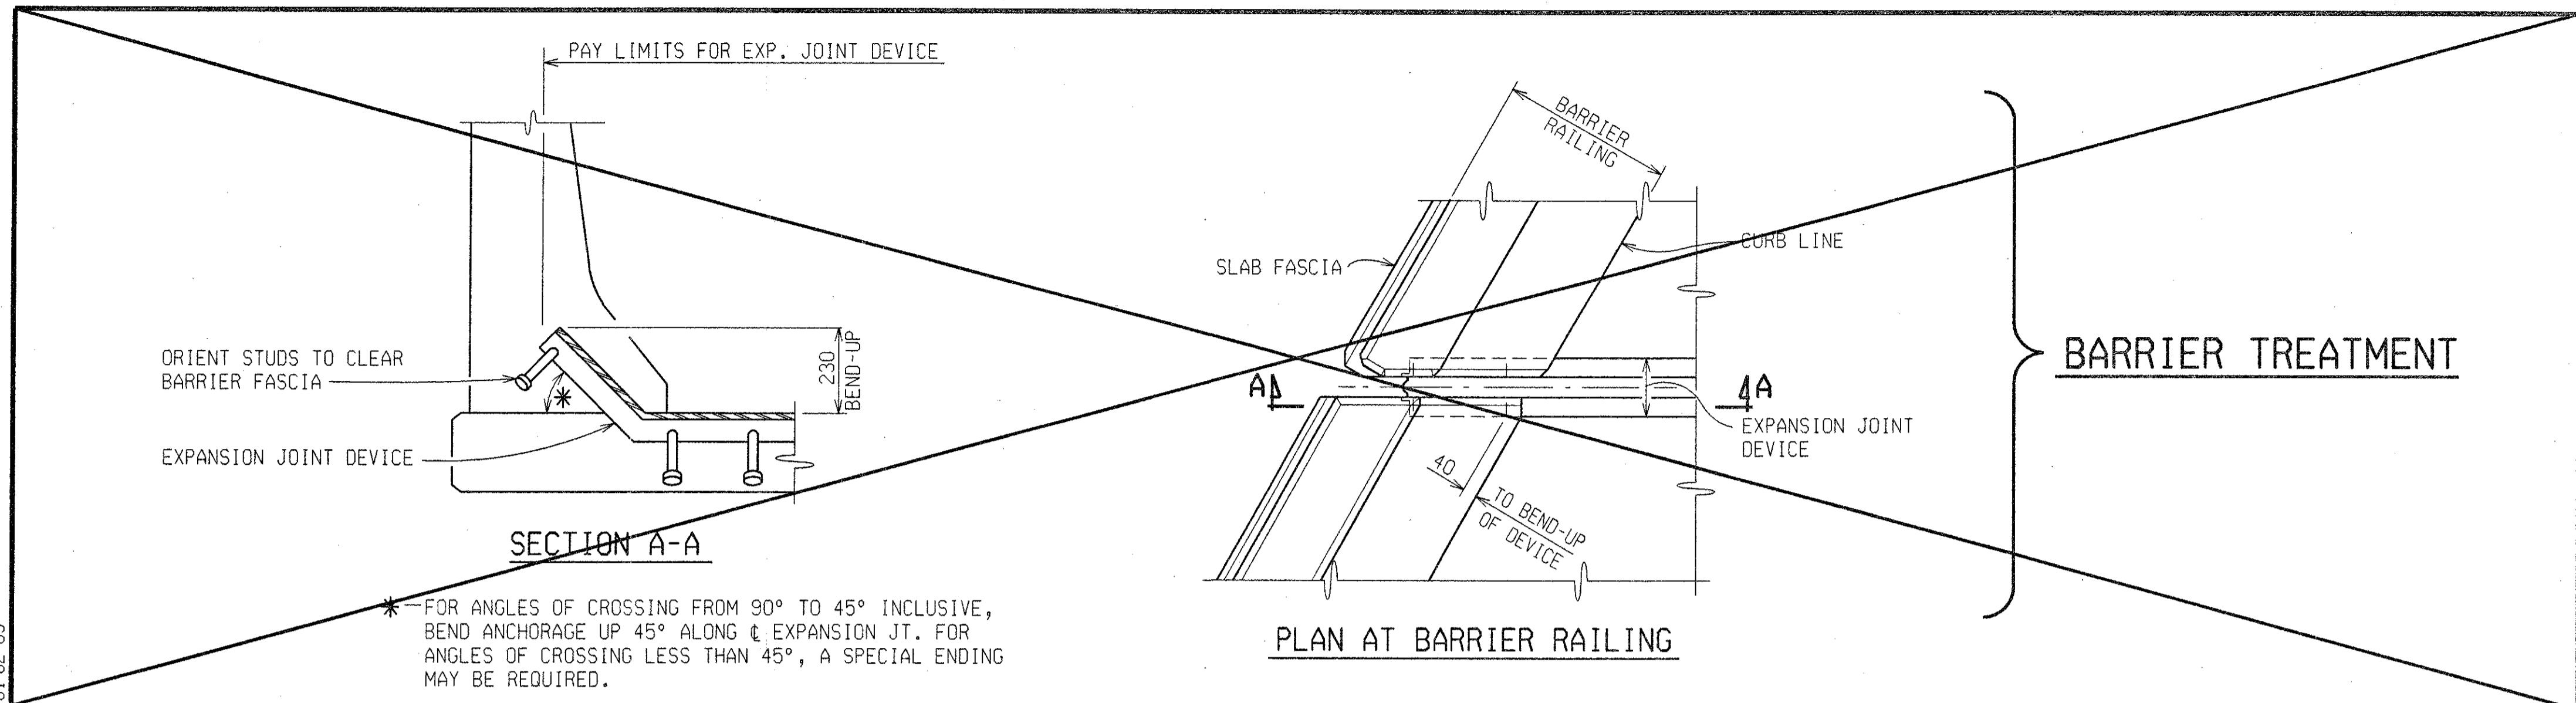

BARRIER TREATMENT

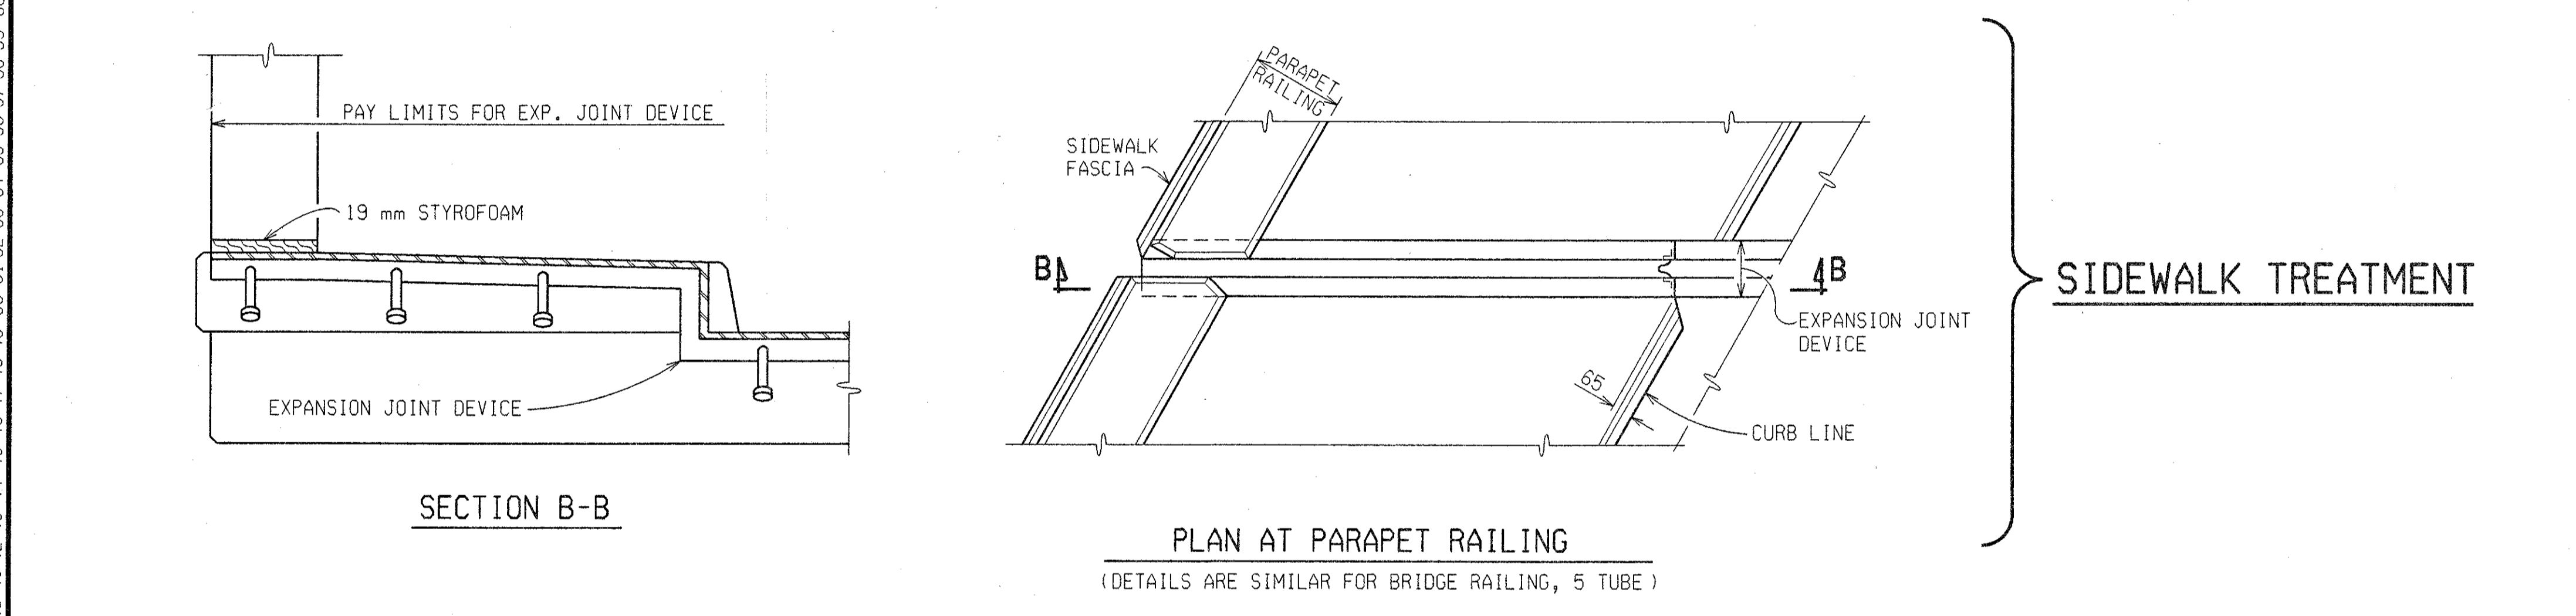

SIDEWALK TREATMENT

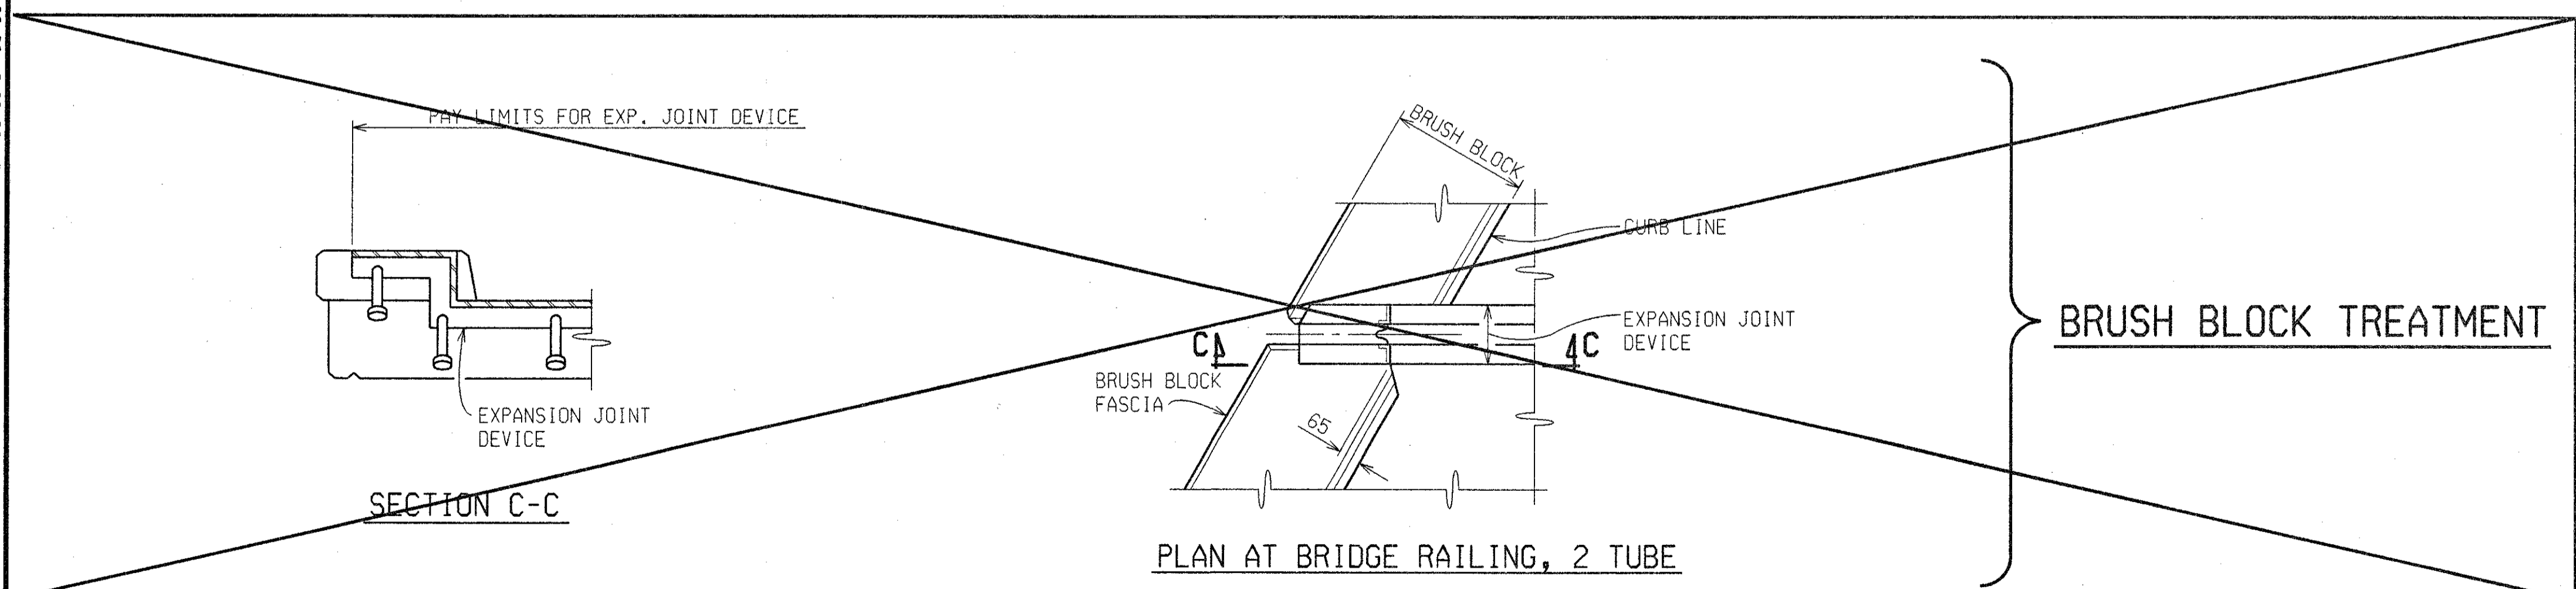

BRUSH BLOCK TREATMENT

REVISIONS			
NO.	DESCRIPTION	DATE	BY

NOTES:

JOINT TYPES:

THE EXPANSION JOINT DEVICE SHALL BE OF A TYPE THAT INCLUDES A CONTINUOUS NEOPRENE (OR EQUIVALENT) SEAL ACROSS THE DECK. UNLESS OTHERWISE NOTED ON THE PLANS, THE CONTRACTOR HAS THE OPTION OF USING ANY OF THE DEVICES LISTED BELOW:

DEVICE	MANUFACTURER
WABO STRIP SEAL	WATSON-BOWMAN & ACME, INC.
PRO-SPAN	FEL-PRO, INC.
STEELFLEX-SSA2	D.S. BROWN
STEELFLEX-SSCM	D.S. BROWN
STEELFLEX-RS	D.S. BROWN
ONFLEX 40 SS	STRUCTURAL RUBBER PRODUCTS CO.
STRUPCO 40DL	STRUCTURAL RUBBER PRODUCTS CO.

THE MODEL OF THE JOINT TYPE SELECTED SHALL BE SUITABLE TO ACCOMMODATE THE TOTAL MOVEMENT NOTED ON THE PLANS.

COMPLETE WORKING DRAWINGS OF ALL DETAILS OF FABRICATION OF THE EXPANSION JOINT DEVICE SHALL BE SUBMITTED FOR REVIEW IN ACCORDANCE WITH STANDARD SPECIFICATION 104.02. THIS REQUIREMENT IS WAIVED FOR EXPANSION JOINT DEVICES FOR WHICH A SET OF STANDARD INSTALLATION DETAILS HAS BEEN APPROVED. STANDARD INSTALLATION DETAILS CAN BE OBTAINED FROM THE DESIGN DIVISION.

FABRICATION AND INSTALLATION:

THE EXPANSION JOINT SHALL BE SHOP FABRICATED TO CONFORM TO THE CONTOUR OF THE BRIDGE DECK, BARRIERS, ETC. IT SHALL BE INSTALLED IN ACCORDANCE WITH MANUFACTURER'S RECOMMENDATIONS SUBJECT TO NOTES HEREIN AND THE APPROVAL OF THE ENGINEER.

THE TOP OF THE ELASTOMERIC JOINT DEVICE SHALL BE SET 3 - 6 mm BELOW THE CONCRETE SLAB (PAVEMENT) WITH A TOLERANCE OF ± 3 mm.

THE STEEL ANCHORAGE FOR STRIP SEAL GLANDS SHALL BE HOT DIP GALVANIZED IN ACCORDANCE WITH SUBSECTION 707.16 OF THE STANDARD SPECIFICATIONS.

THE PRO-SPAN DEVICE MUST INCORPORATE A CAST-IN-PLACE STEEL SEAT.

THE AREA OF THE STEEL ANCHORAGE AND SEALING GLAND WHICH WILL BE IN CONTACT WITH A SEALANT, OR LUBRICANT-ADHESIVE SHALL BE CLEANED WITH TOLUENE OR OTHER APPROVED SOLVENT.

WHERE THE SEALING GLAND IS LOCKED INTO A STEEL ANCHORAGE, A LUBRICANT-ADHESIVE CONFORMING TO STANDARD SPECIFICATION 914.4-E SHALL BE REQUIRED BETWEEN THE SEAL AND STEEL ANCHORAGE.

ALL BOLT WELL CAVITIES SHALL BE FILLED WITH AN APPROVED FLEXIBLE EPOXY OR A SEALANT CONFORMING TO FEDERAL SPECIFICATION TT-S-00230C.

IN THE EVENT THAT THE CONSTRUCTION SEQUENCE REQUIRES SPLICING THE SEALING GLAND, IT SHALL BE SPLICED BY AN APPROVED METHOD (SUCH AS COLD VULCANIZATION) BY A TRAINED REPRESENTATIVE OF THE MANUFACTURER.

DETAILS AT CURBS OR BARRIERS:


THE DETAILS ON THIS SHEET SHOW AN APPROVED MEANS OF TERMINATING THE EXPANSION JOINT DEVICE AT CURBS OR BARRIERS. VARIATIONS OR ALTERNATIVE SCHEMES WILL BE CONSIDERED AND MAY BE USED IF APPROVED BY THE ENGINEER.

MATERIALS:

THE COST OF ALL MATERIALS AND LABOR REQUIRED FOR PROPER INSTALLATION OF THE EXPANSION JOINT AND THE TERMINAL ASSEMBLIES AT THE CURBS, SIDEWALKS, OR BARRIERS IS INCLUDED IN THE PAYMENT FOR THE EXPANSION JOINT DEVICE.

ITEM	QUANTITY	UNIT	AMOUNT
EXPANSION JOINT DEVICE		m	70

STRUCTURE NUMBER	ANGLE OF CROSSING TO NEAREST 10°	LOCATION OF JOINT	MIN. TOT. TRAVEL ALONG CENTERLINE OF BRIDGE	REQUIRED LENGTH OF EXPANSION JOINT DEVICE
S31	80	PIER 1	28 mm	23.3 m
S31	80	PIER 2	15 mm	23.3 m
S31	80	PIER 3	28 mm	23.4 m

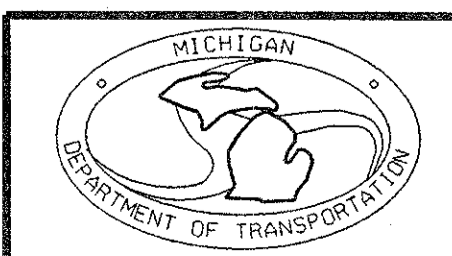



EXPANSION JOINT DETAILS

DATE	CONT. SEC.	JOB NO.	DESIGN UNIT	SHEET
10-13-99	S31 OF 63174	48404A	MAHDAVI	13 OF 20

EJ3T (11-17-97)

DATE: 07-16-96 CORRECTED BY: VZ/SFB CHECKED BY: CASLER DRAWN BY: CASLER FILE NAME: s3163174.ej

1 2 3 4 5 6 7 8 9 10 11 12 13 14 15 16 17 18 19 20 21 22 23 24 25 26 27 28 29 30 31 32 33 34 35 36 37 38 39 40 41 42 43 44 45 46 47 48 49 50 51 52 53 54 55 56 57 58 59 60 61 62 63

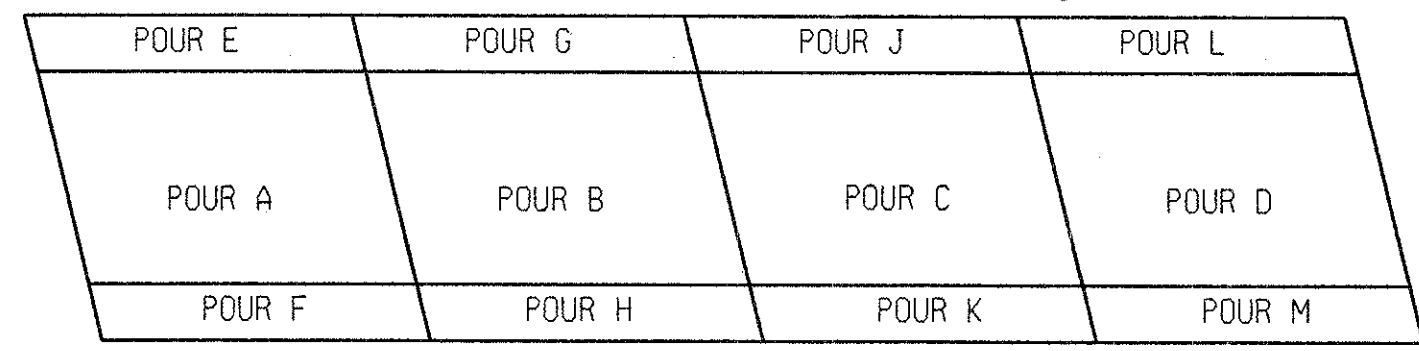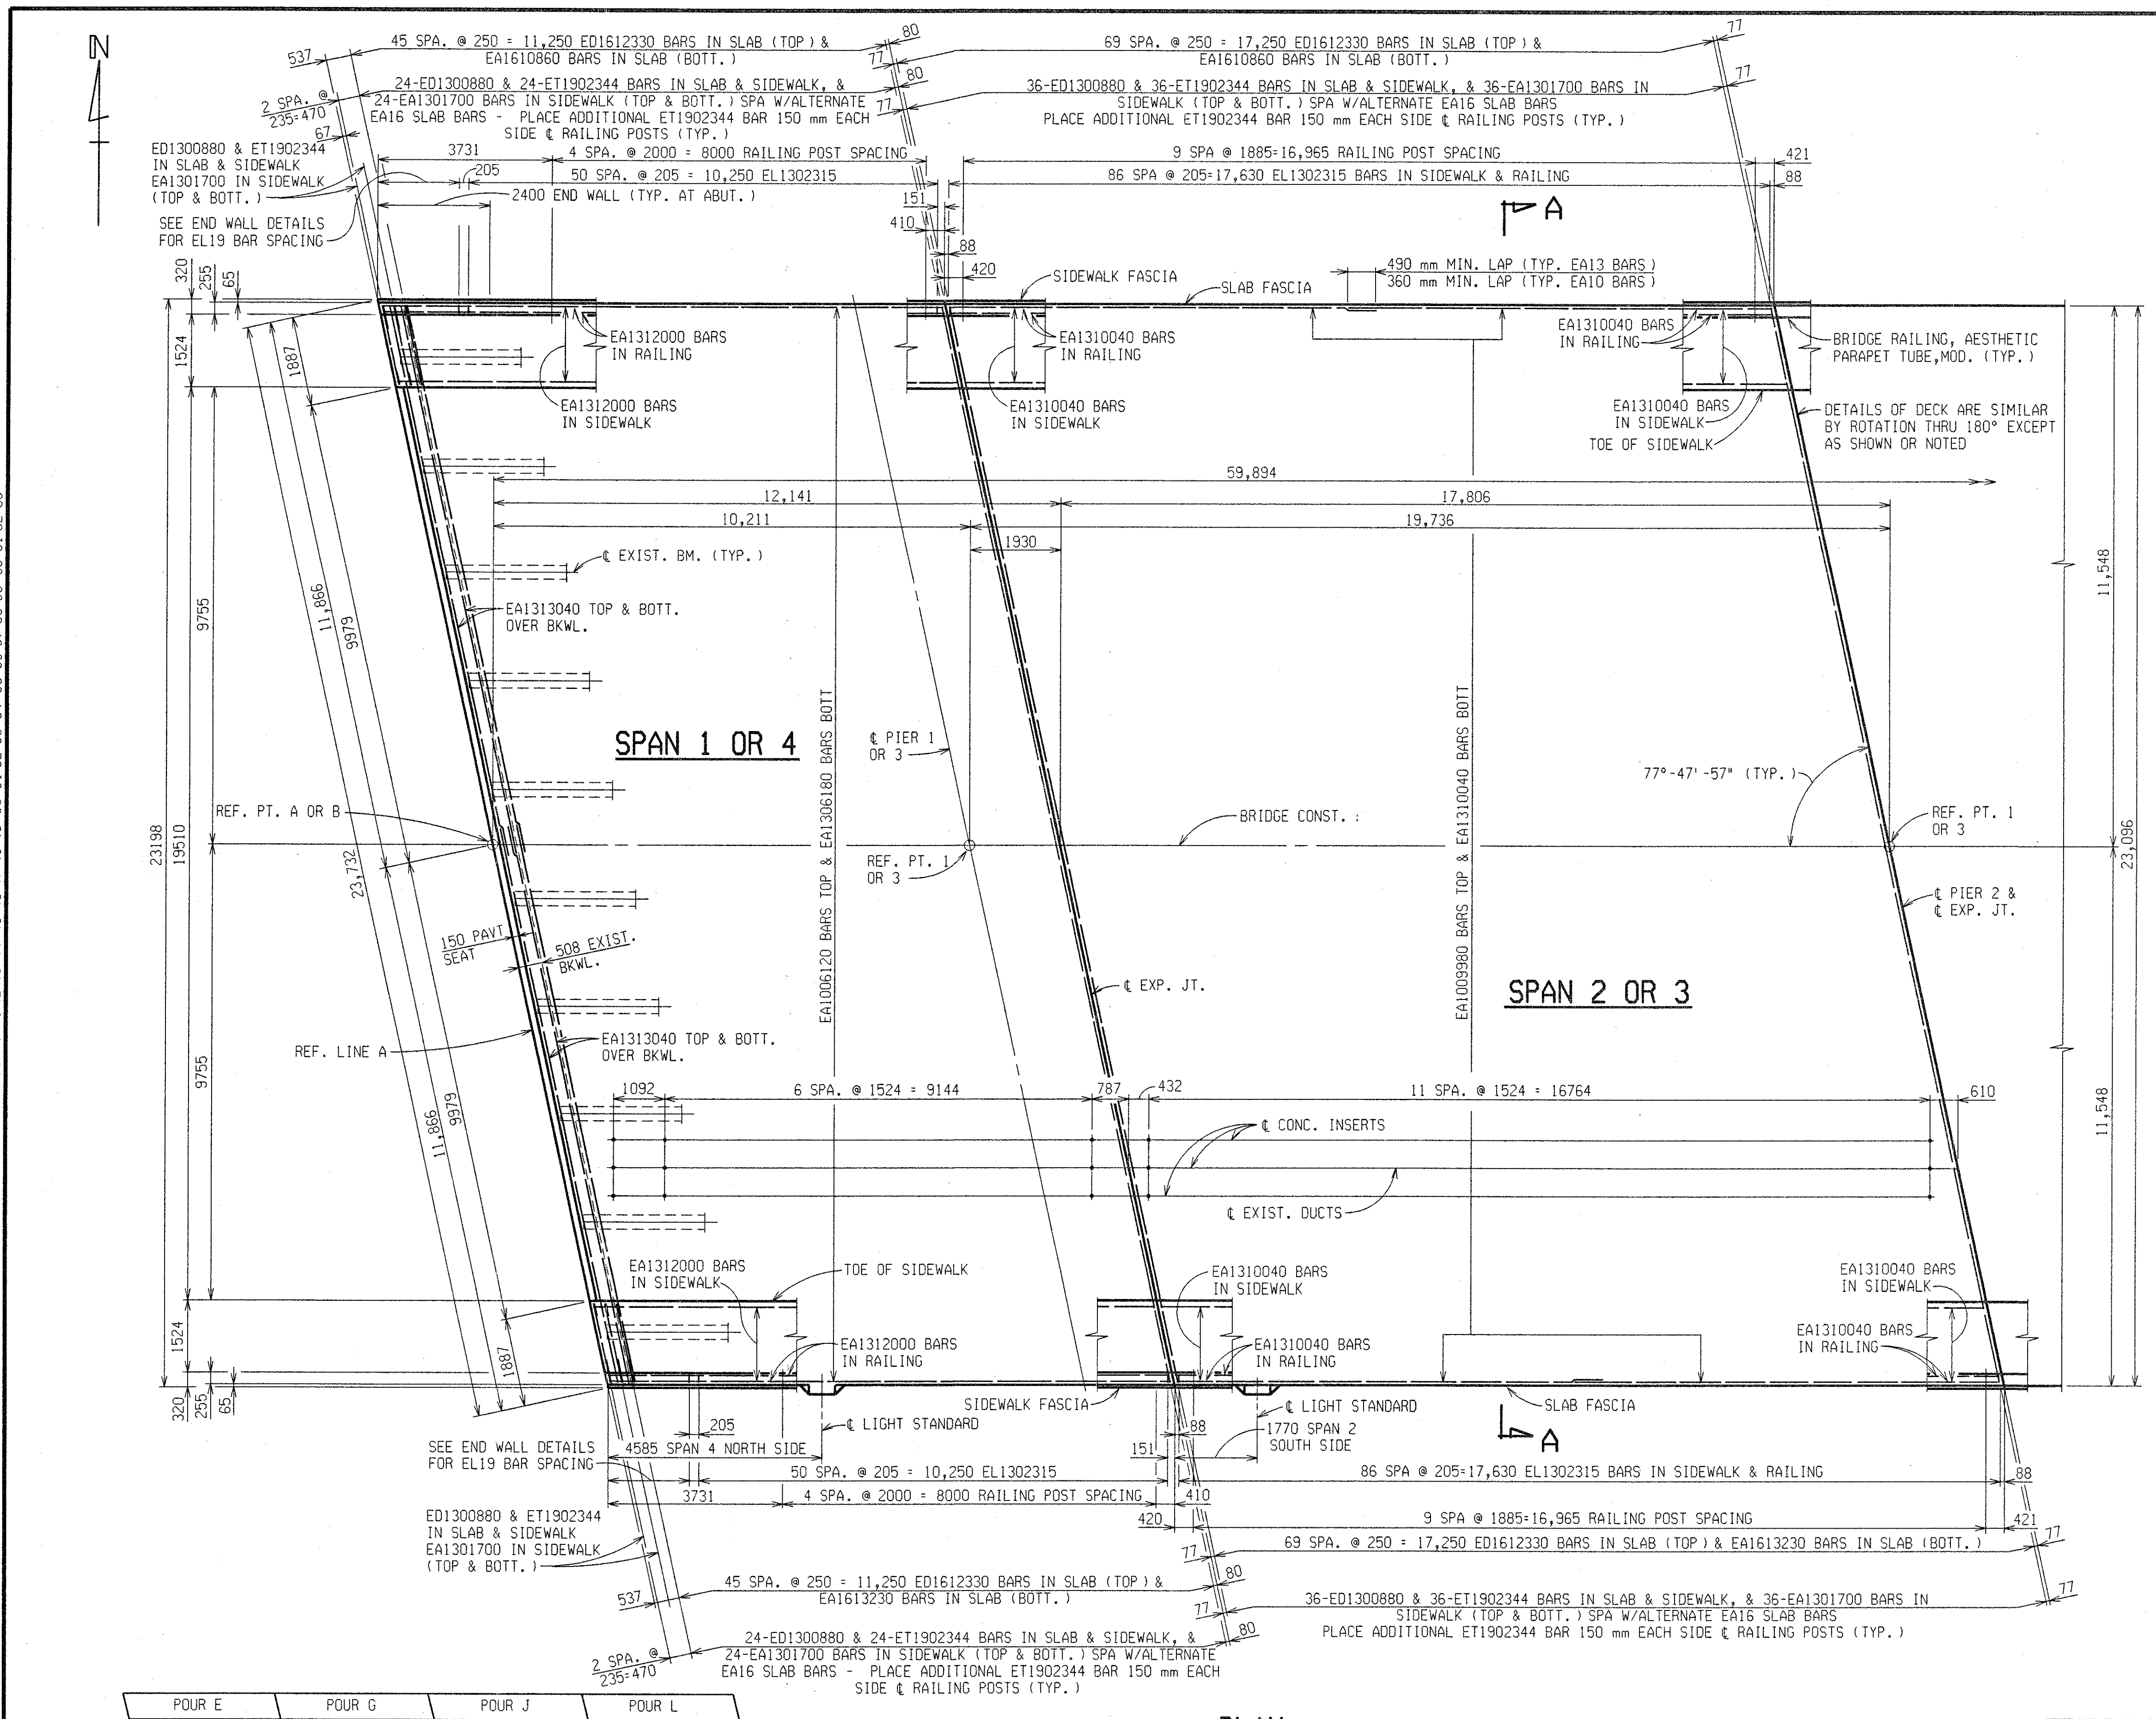

PLAN
ADJUST REINFORCEMENT TO PERMIT PLACEMENT OF RAILING & FENCE POST ANCHORAGES & LIGHT STANDARDS.

REVISIONS			
NO.	DESCRIPTION	DATE	BY

SUPERSTRUCTURE CONCRETE NIGHT CASTING QUANTITIES	
POUR	CUBIC METERS
A	65
B	105
C	105
D	65
TOTAL CONC: 340	CUBIC METERS

SUPERSTRUCTURE CONCRETE QUANTITIES	
POUR	CUBIC METERS
E	5
F	5
G	7
H	7
J	7
K	7
L	5
M	5
TOTAL CONC:	48 CUBIC METERS

MISCELLANEOUS QUANTITIES	
120 m	Bridge Railing, Aesthetic Parapet Tube, Modified
22 m ²	Joint Waterproofing
194 m ²	Top Flanges and Beam Ends, Clean and Prime
50 m ³	Superstructure Conc
1 LS	Superstructure Conc. Form, Finish, and Cure (S31)
340 m ³	Superstructure Conc. Night Casting
1 LS	Superstructure Conc. Form, Finish, and Cure, Night Casting (S31)
1 LS	Shear Developers (S31)
1 LS	Bridge Lighting, Furnish and Remove (S31)
340 m ³	Bridge Lighting, Operate and Maintain
240 m	Conduit, 75 mm
338 m ²	Conc Surface Sealer
120 ea	Conc Insert, Placed


NOTES:
N.S. DENOTES NEAR SIDE.
FOR BRIDGE RAILING, ANCHORAGE FOR GUARDRAIL AND NAME PLATE MOUNTING DETAILS, SEE STANDARD PLAN B-25-SERIES. FOR DETAILS OF NAME PLATES, MOLDINGS AND BEVELS, SEE STANDARD PLAN B-103-SERIES.
BRIDGE RAILING, AESTHETIC PARAPET TUBE, MODIFIED SHALL BE IN ACCORDANCE WITH THE STANDARD PLAN B-25 EXCEPT FOR THE ADDITION OF FRACTURE FIN RUSTIFICATION ON THE BACK SIDE OF THE RAILING AS DETAILED ON THE PLANS.
FOR NAME PLATE LOCATION, SEE GENERAL PLAN OF STRUCTURE SHEET.
FOR DETAILS OF LIGHT STANDARD ANCHOR BOLT ASSEMBLIES, SEE STANDARD PLAN B-103-SERIES.
"EDGE" OR "GROOVE" DENOTES EDGING OR GROOVING WITH AN APPROVED TOOL.
ALPHABETICAL DESIGNATION OF DECK POURS IS NOT TO BE CONSTRUED AS A POUR SEQUENCE.
NO PORTION OF THE DECK FORMWORK SHALL ENCR OACH ON THE EXISTING UNDERCLEARANCE.
THE UTILITY COMPANY SHALL BE NOTIFIED ONE WEEK IN ADVANCE OF THE TIME OF INSTALLATION OF THE DUCTS IN THE SIDEWALK.
WHERE CAST-IN-ANCHORAGE IS USED FOR EXPANSION JOINT DEVICES, IT IS RECOMMENDED THAT THE PLACING OF DECK CONCRETE PROGRESS TOWARD THE JOINT SO THAT THE EFFECTS OF DEAD LOAD DEFLECTION WILL OCCUR BEFORE CONCRETE IS PLACED AT THE ANCHORAGE.
THE LIGHT STANDARD ANCHOR BOLT ASSEMBLIES ARE INCLUDED IN THE PAYMENT FOR "BRIDGE RAILING, AESTHETIC PARAPET TUBE, MODIFIED".
THIS DECK POUR IS DESIGNATED A NIGHT POUR, AND THEREFORE SUBJECT TO THE RESTRICTIONS OF SECTION 706.03 J OF THE STANDARD SPECIFICATIONS.
METAL STAY IN PLACE FORMS ARE OPTIONAL.
IF STAY IN PLACE METAL FORMS ARE TO BE USED, THE CONTRACTOR MAY OMIT THE STYROFOAM FROM THE CORRUGATIONS AND FILL THE FORMS FULL DEPTH. THE EXTRA CONCRETE REQUIRED TO FILL THE CORRUGATIONS WILL NOT BE PAID FOR.
ALL CONCRETE SURFACES OF THE BRIDGE RAILING, THE DECK FASCIAS, AND THE OUTSIDE BOTTOM OF DECK TO FASCIA BEAMS SHALL BE COATED WITH CONCRETE SURFACE SEALER (SEE SPECIAL PROVISION).
CONCRETE INSERTS SHALL BE FURNISHED BY AMERITECH AND INSTALLED BY THE CONTRACTOR. ALL MATERIAL NECESSARY FOR REINSTALLATION OF THE DUCTS SHALL BE PROVIDED BY THE UTILITY COMPANY.
THE CONTRACTOR SHALL VERIFY THE LOCATION OF THE INSERTS PRIOR TO INSTALLING THE INSERTS IN THE DECK (SEE SHEET # 11 FOR INFORMATION).




SUPERSTRUCTURE DETAILS				
DATE	CONT. SEC.	JOB NO.	DESIGN UNIT	SHEET
10-13-99	S31 OF 63174	48404A	MAHDAVI	14 OF 20

DATE: _____ CORRECTED BY: _____ CHECKED BY: _____ DATE: 9-16-99 DRAWN BY: CASLER FILE NAME: s3163174.dk


REVISIONS			
NO.	DESCRIPTION	DATE	BY

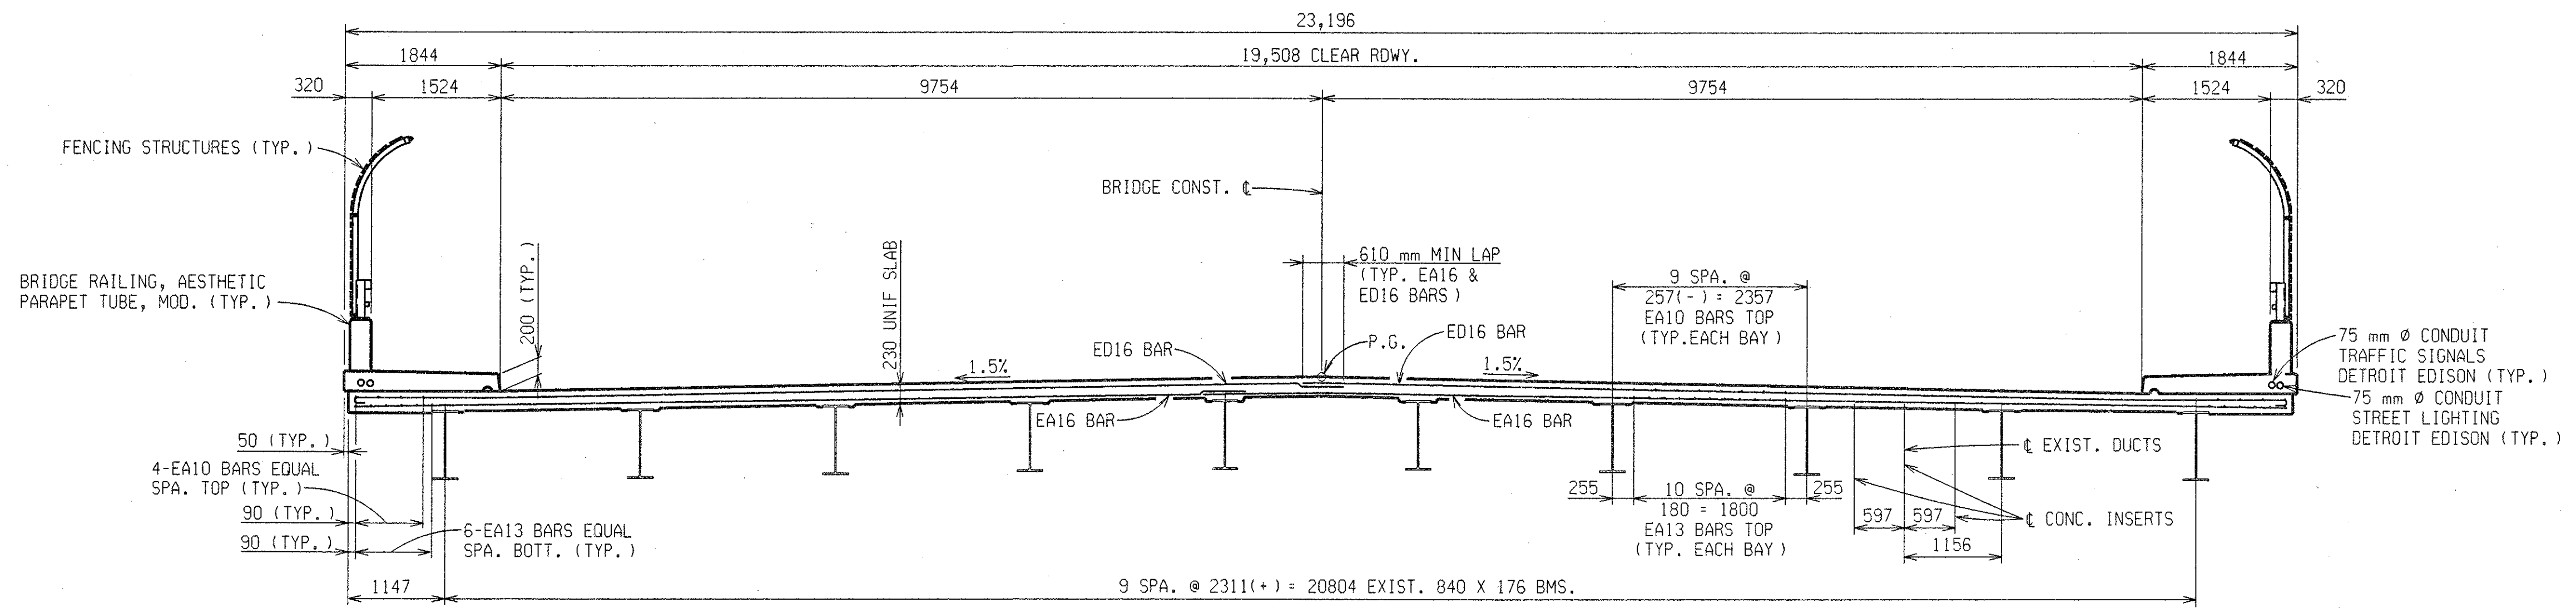


SECTION A-A

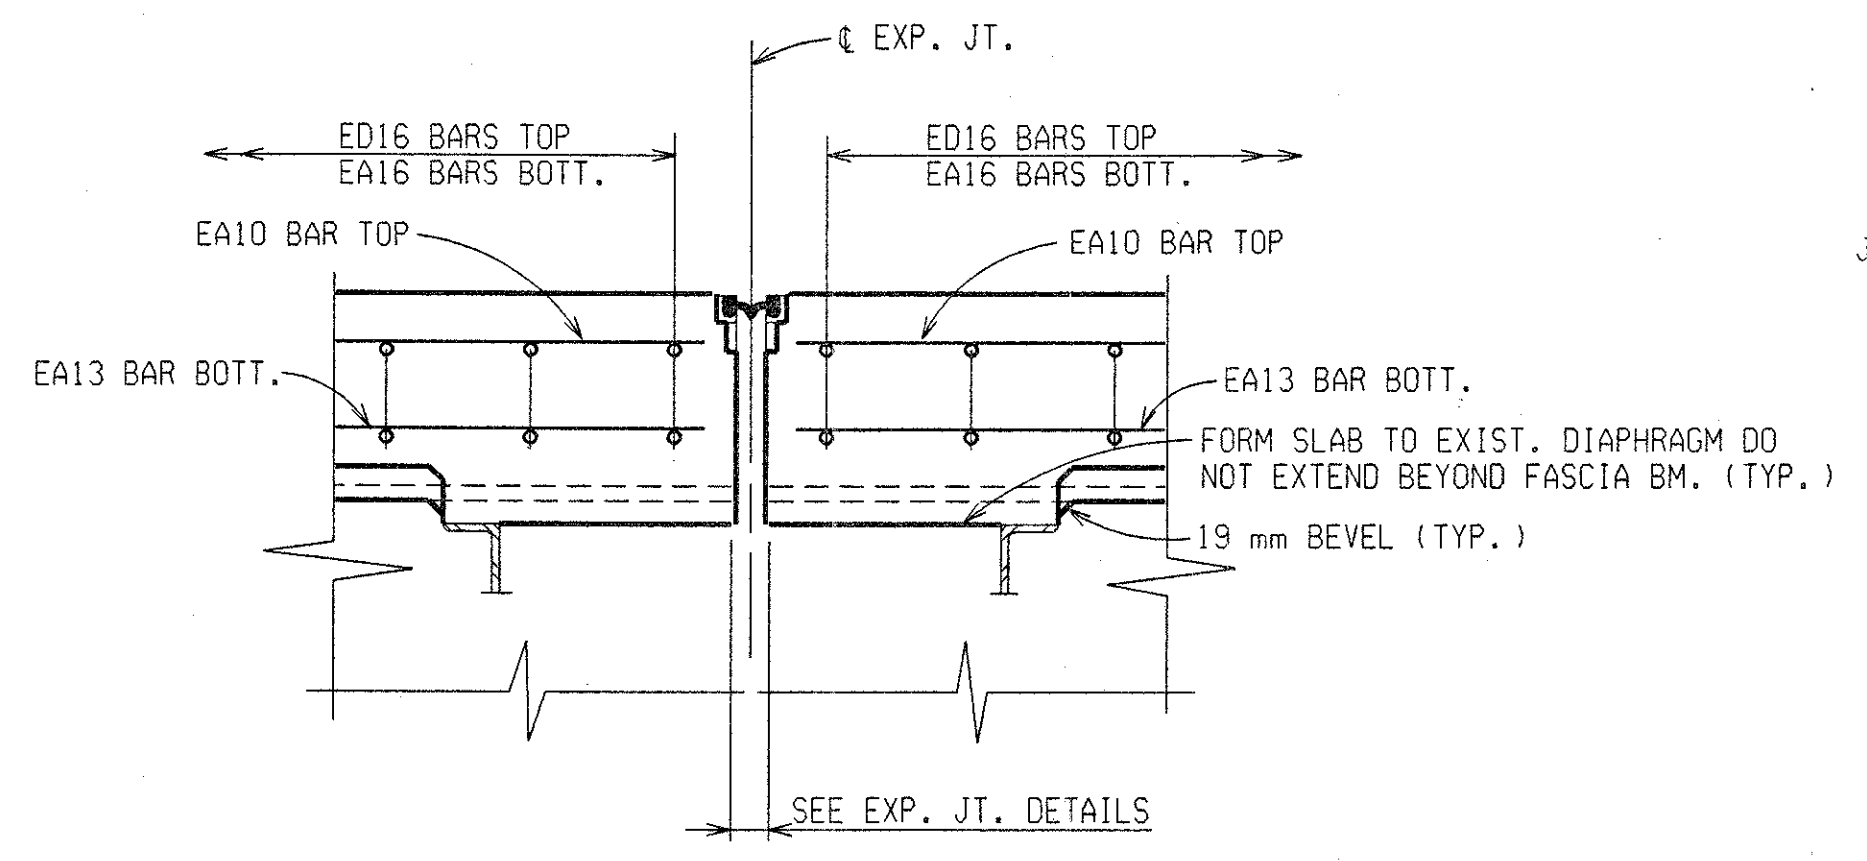


SECTION THRU EXPANSION JOINT

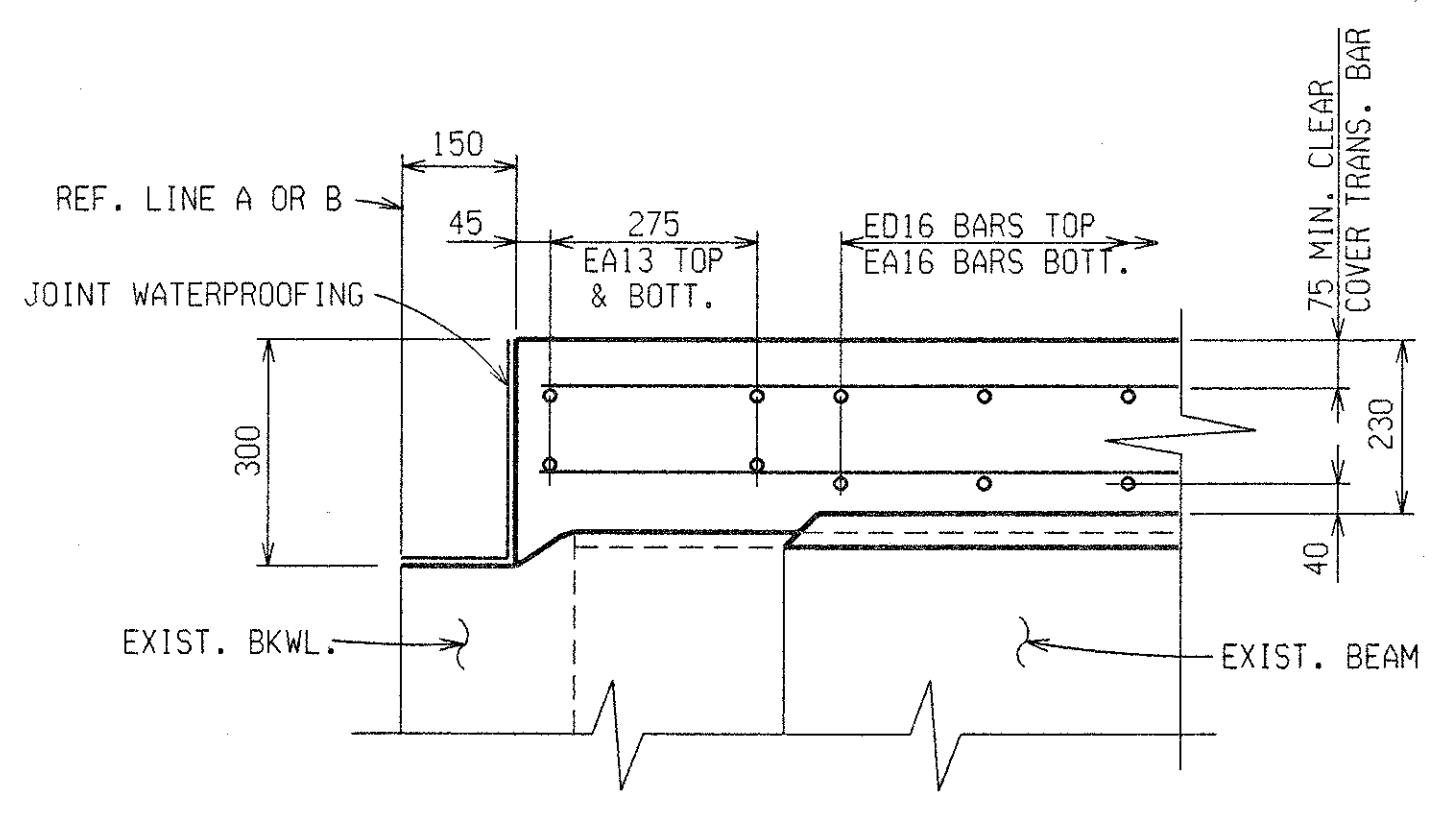


SECTION THRU BACKWALL

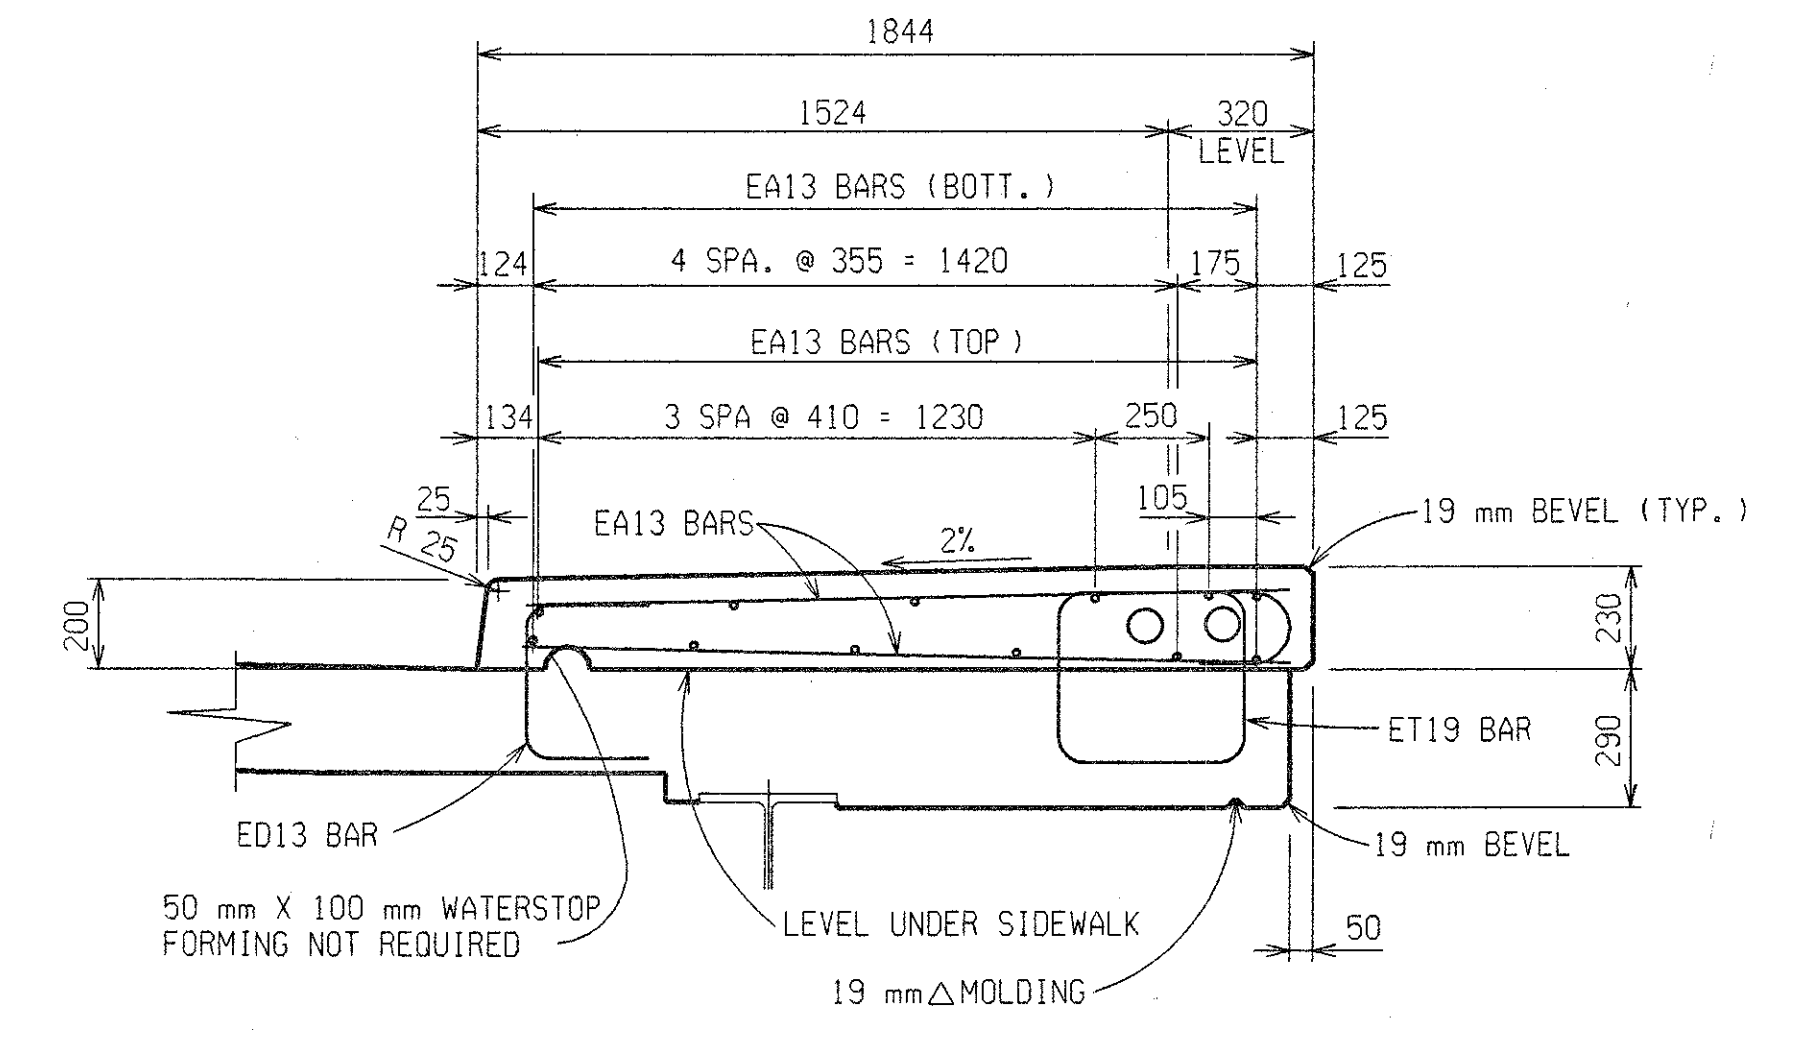


SECTION THRU SIDEWALK

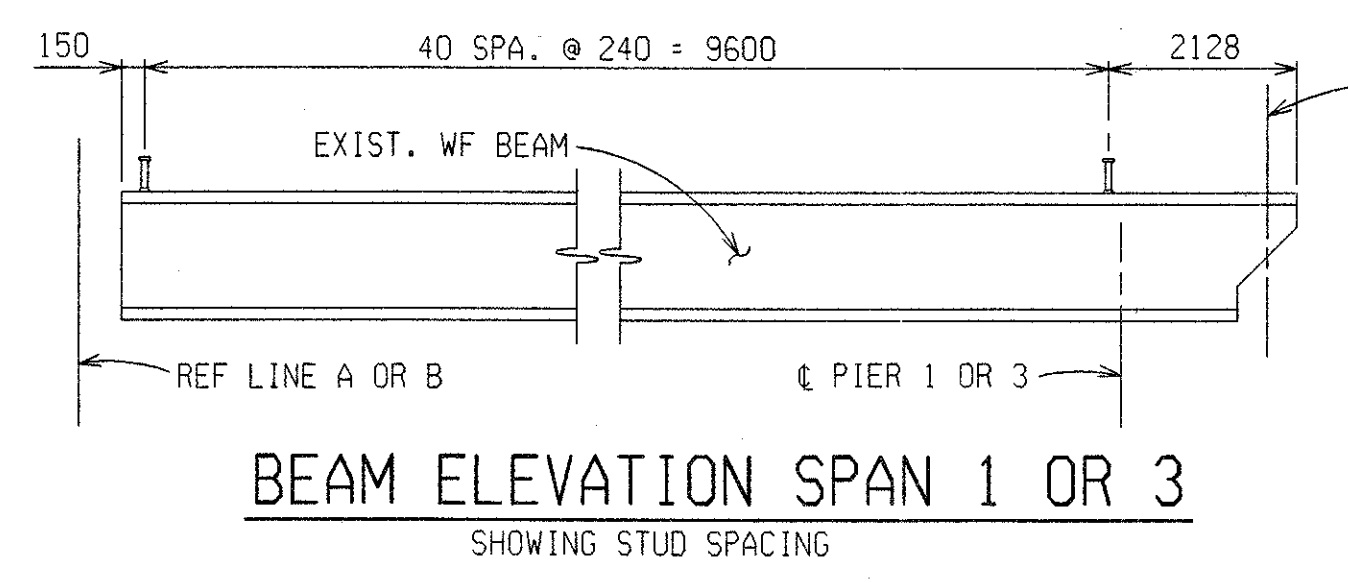


BEAM ELEVATION SPAN 1 OR 3
SHOWING STUD SPACING

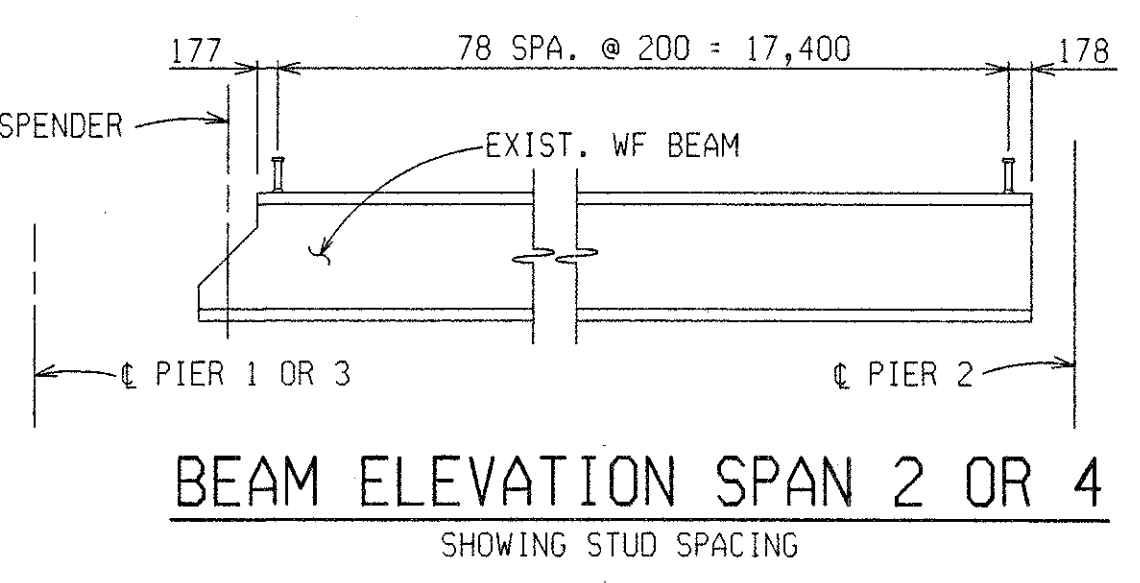


BEAM ELEVATION SPAN 2 OR 4
SHOWING STUD SPACING

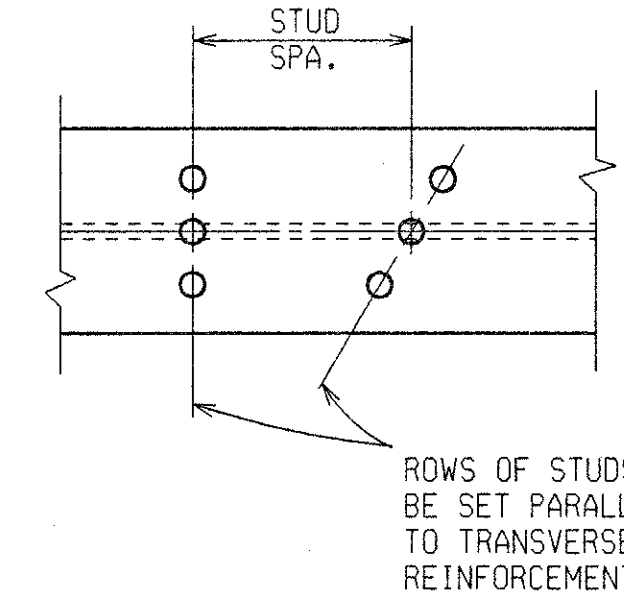

PLAN

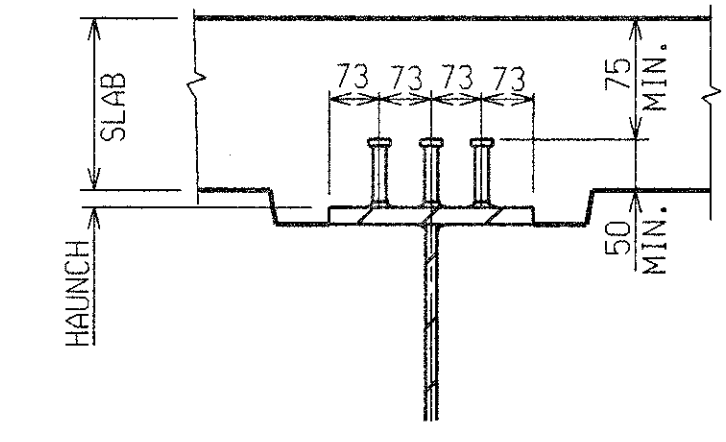

SECTION

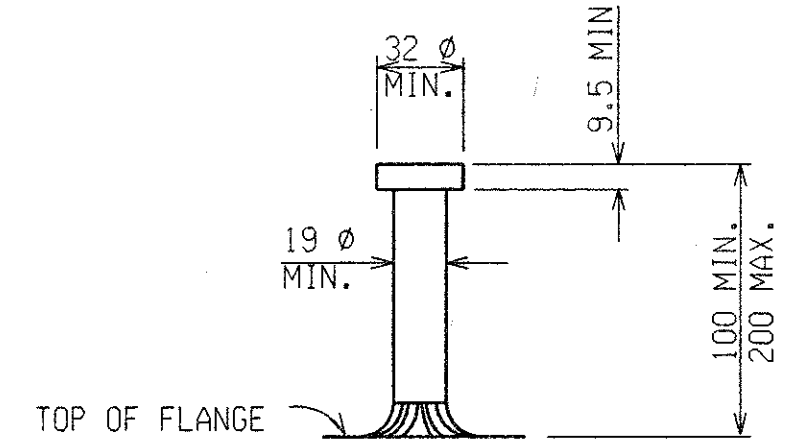

STUD DETAIL









STUD SHEAR DEVELOPER DETAILS



SUPERSTRUCTURE DETAILS				
DATE	CONT. SEC.	JOB NO.	DESIGN UNIT	SHEET
10-13-99	S31 OF 63174	48404A	MAHDAVI	15 OF 20

1 2 3 4 5 6 7 8 9 10 11 12 13 14 15 16 17 18 19 20 21 22 23 24 25 26 27 28 29 30 31 32 33 34 35 36 37 38 39 40 41 42 43 44 45 46 47 48 49 50 51 52 53 54 55 56 57 58 59 60 61 62 63

REVISIONS			
NO.	DESCRIPTION	DATE	BY

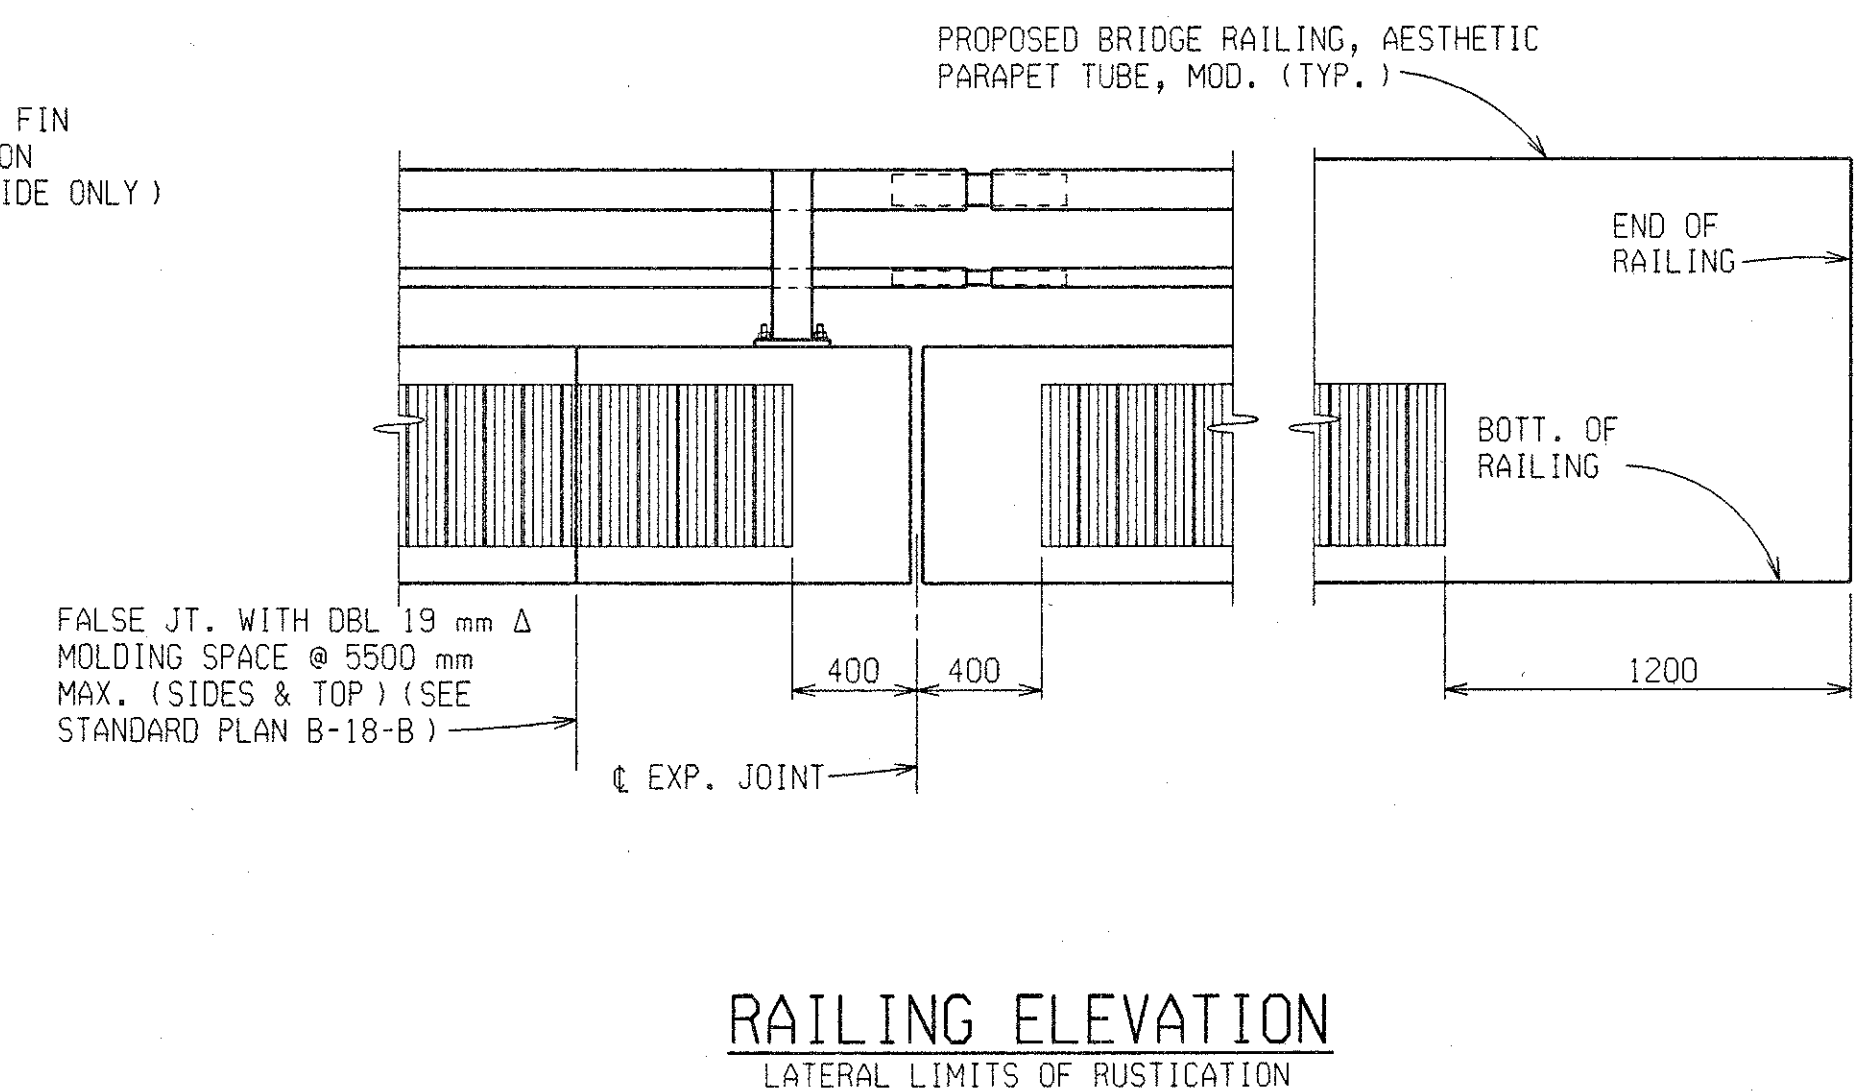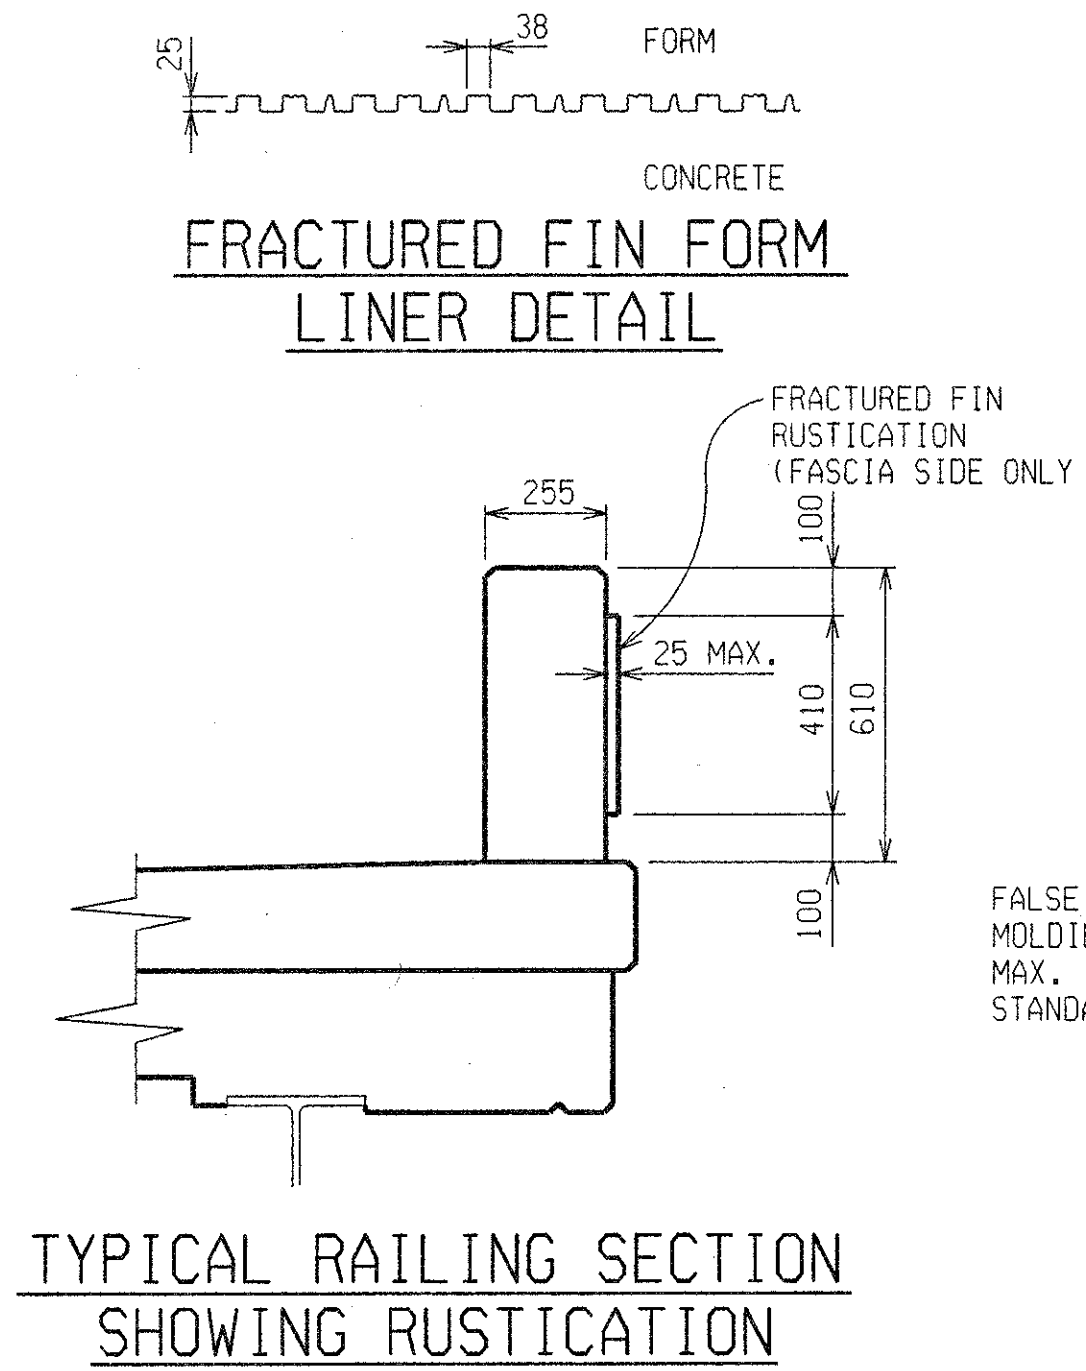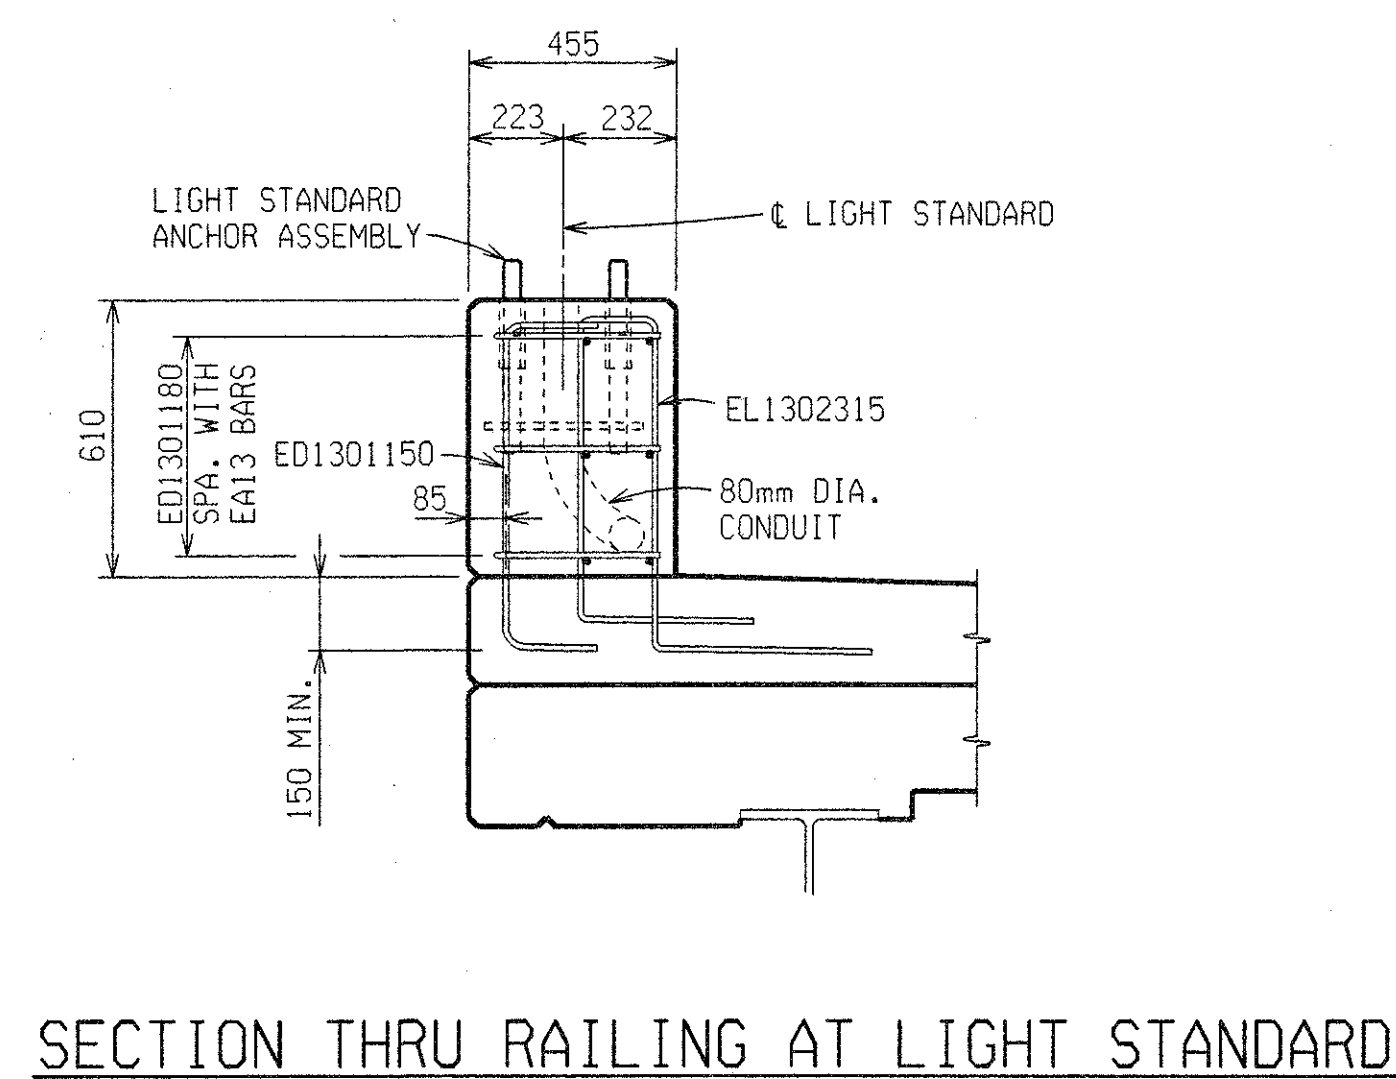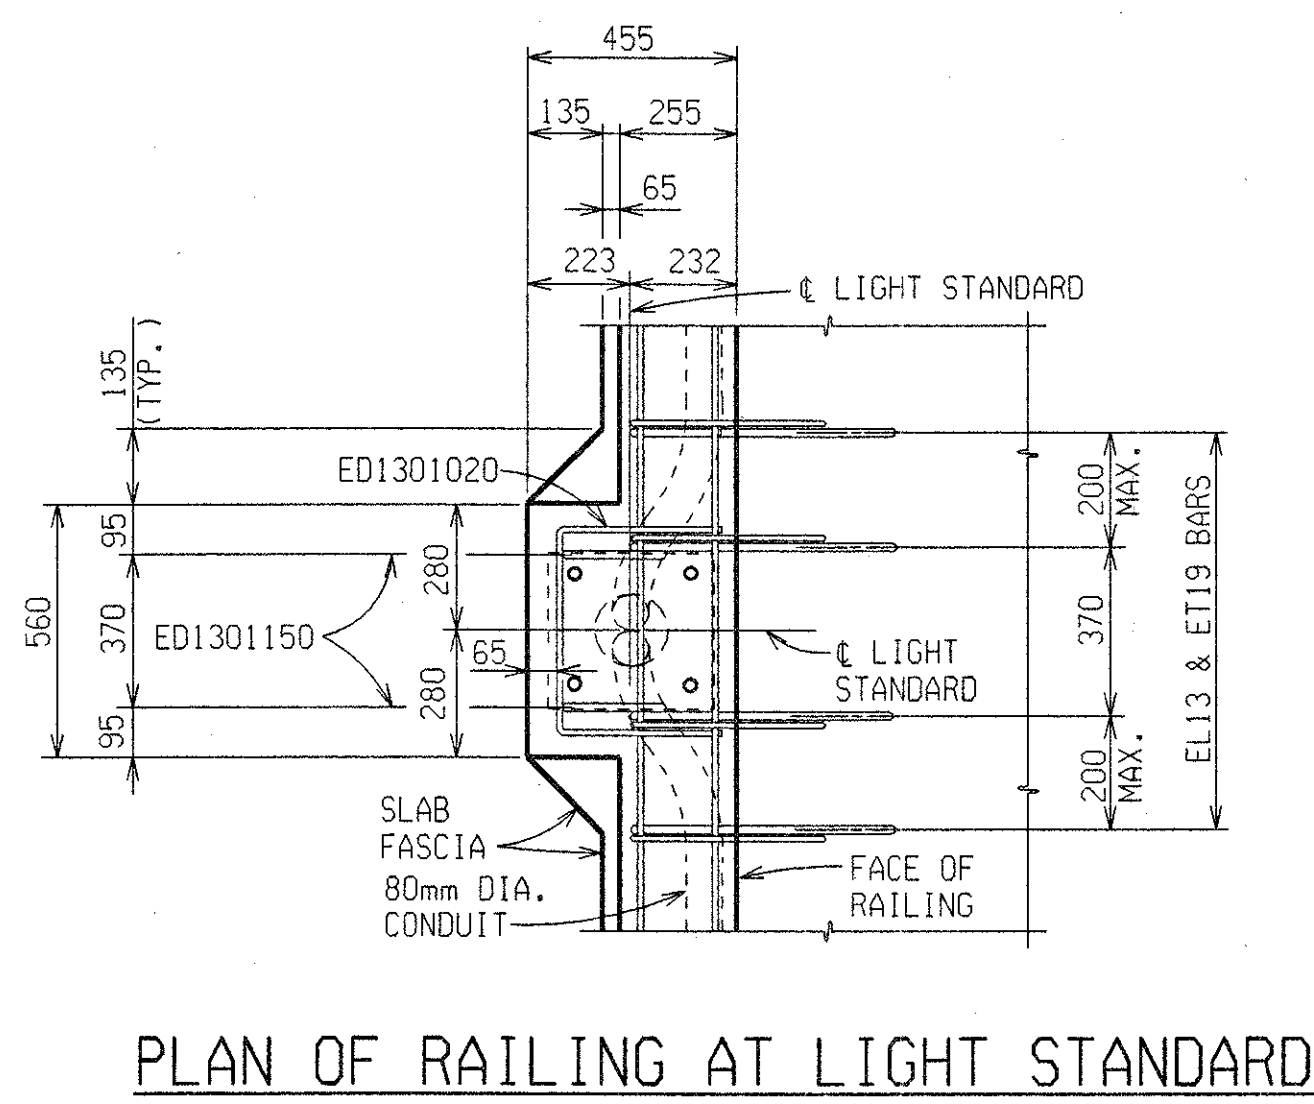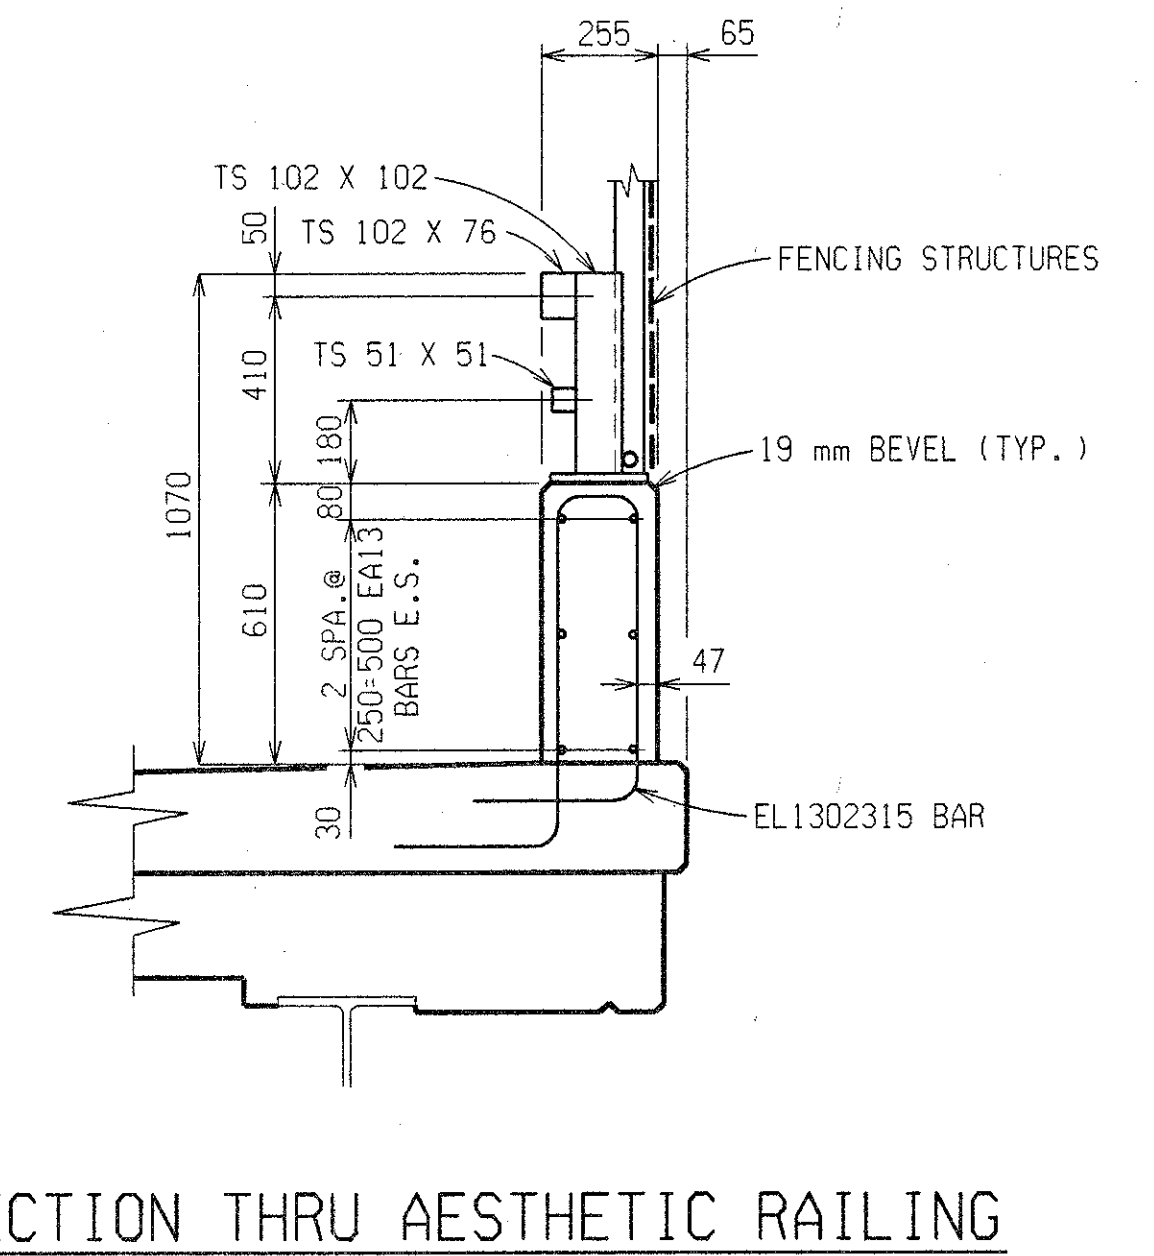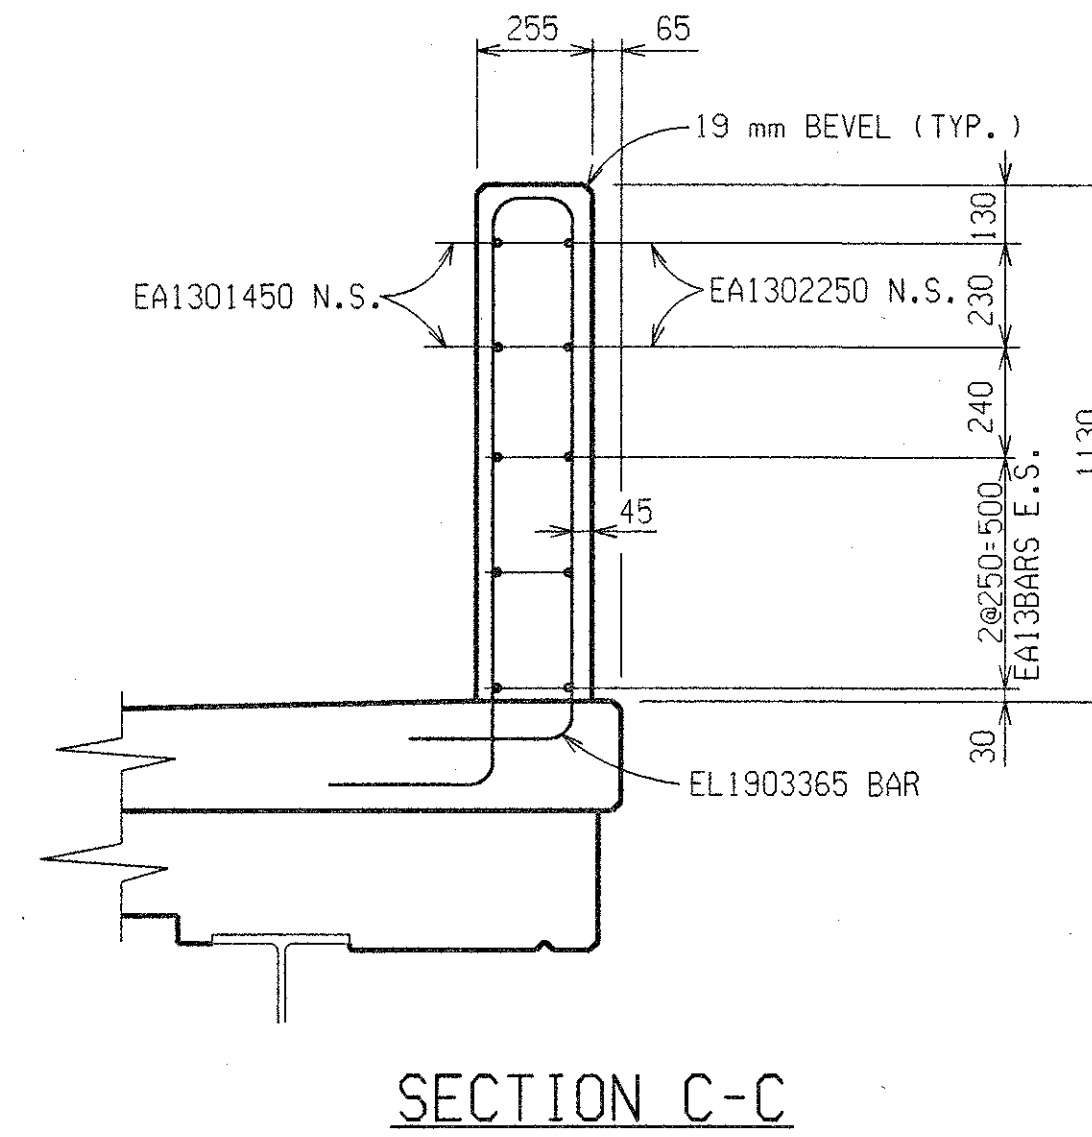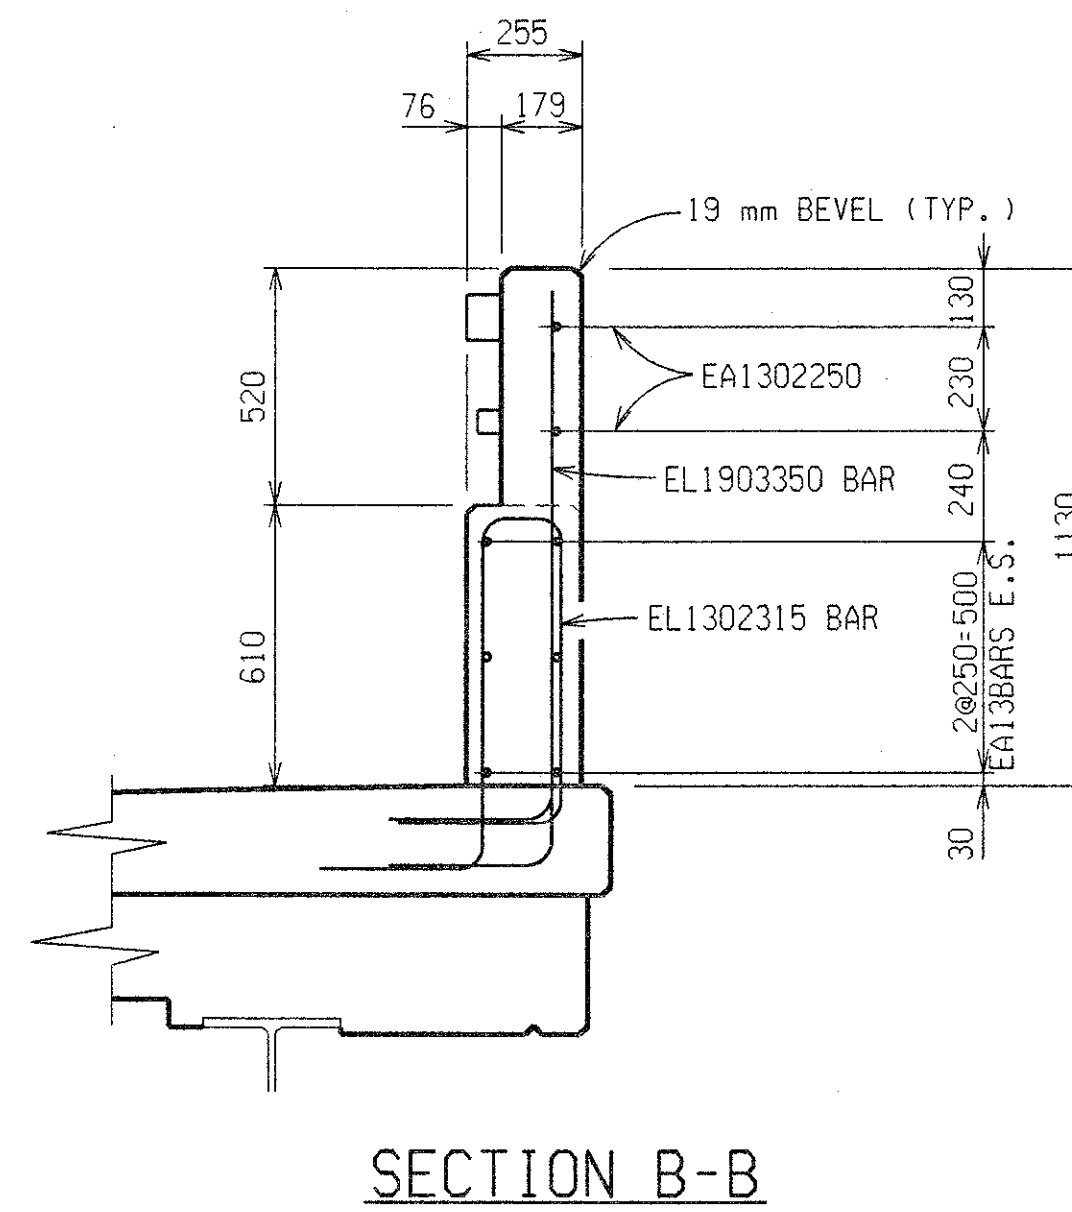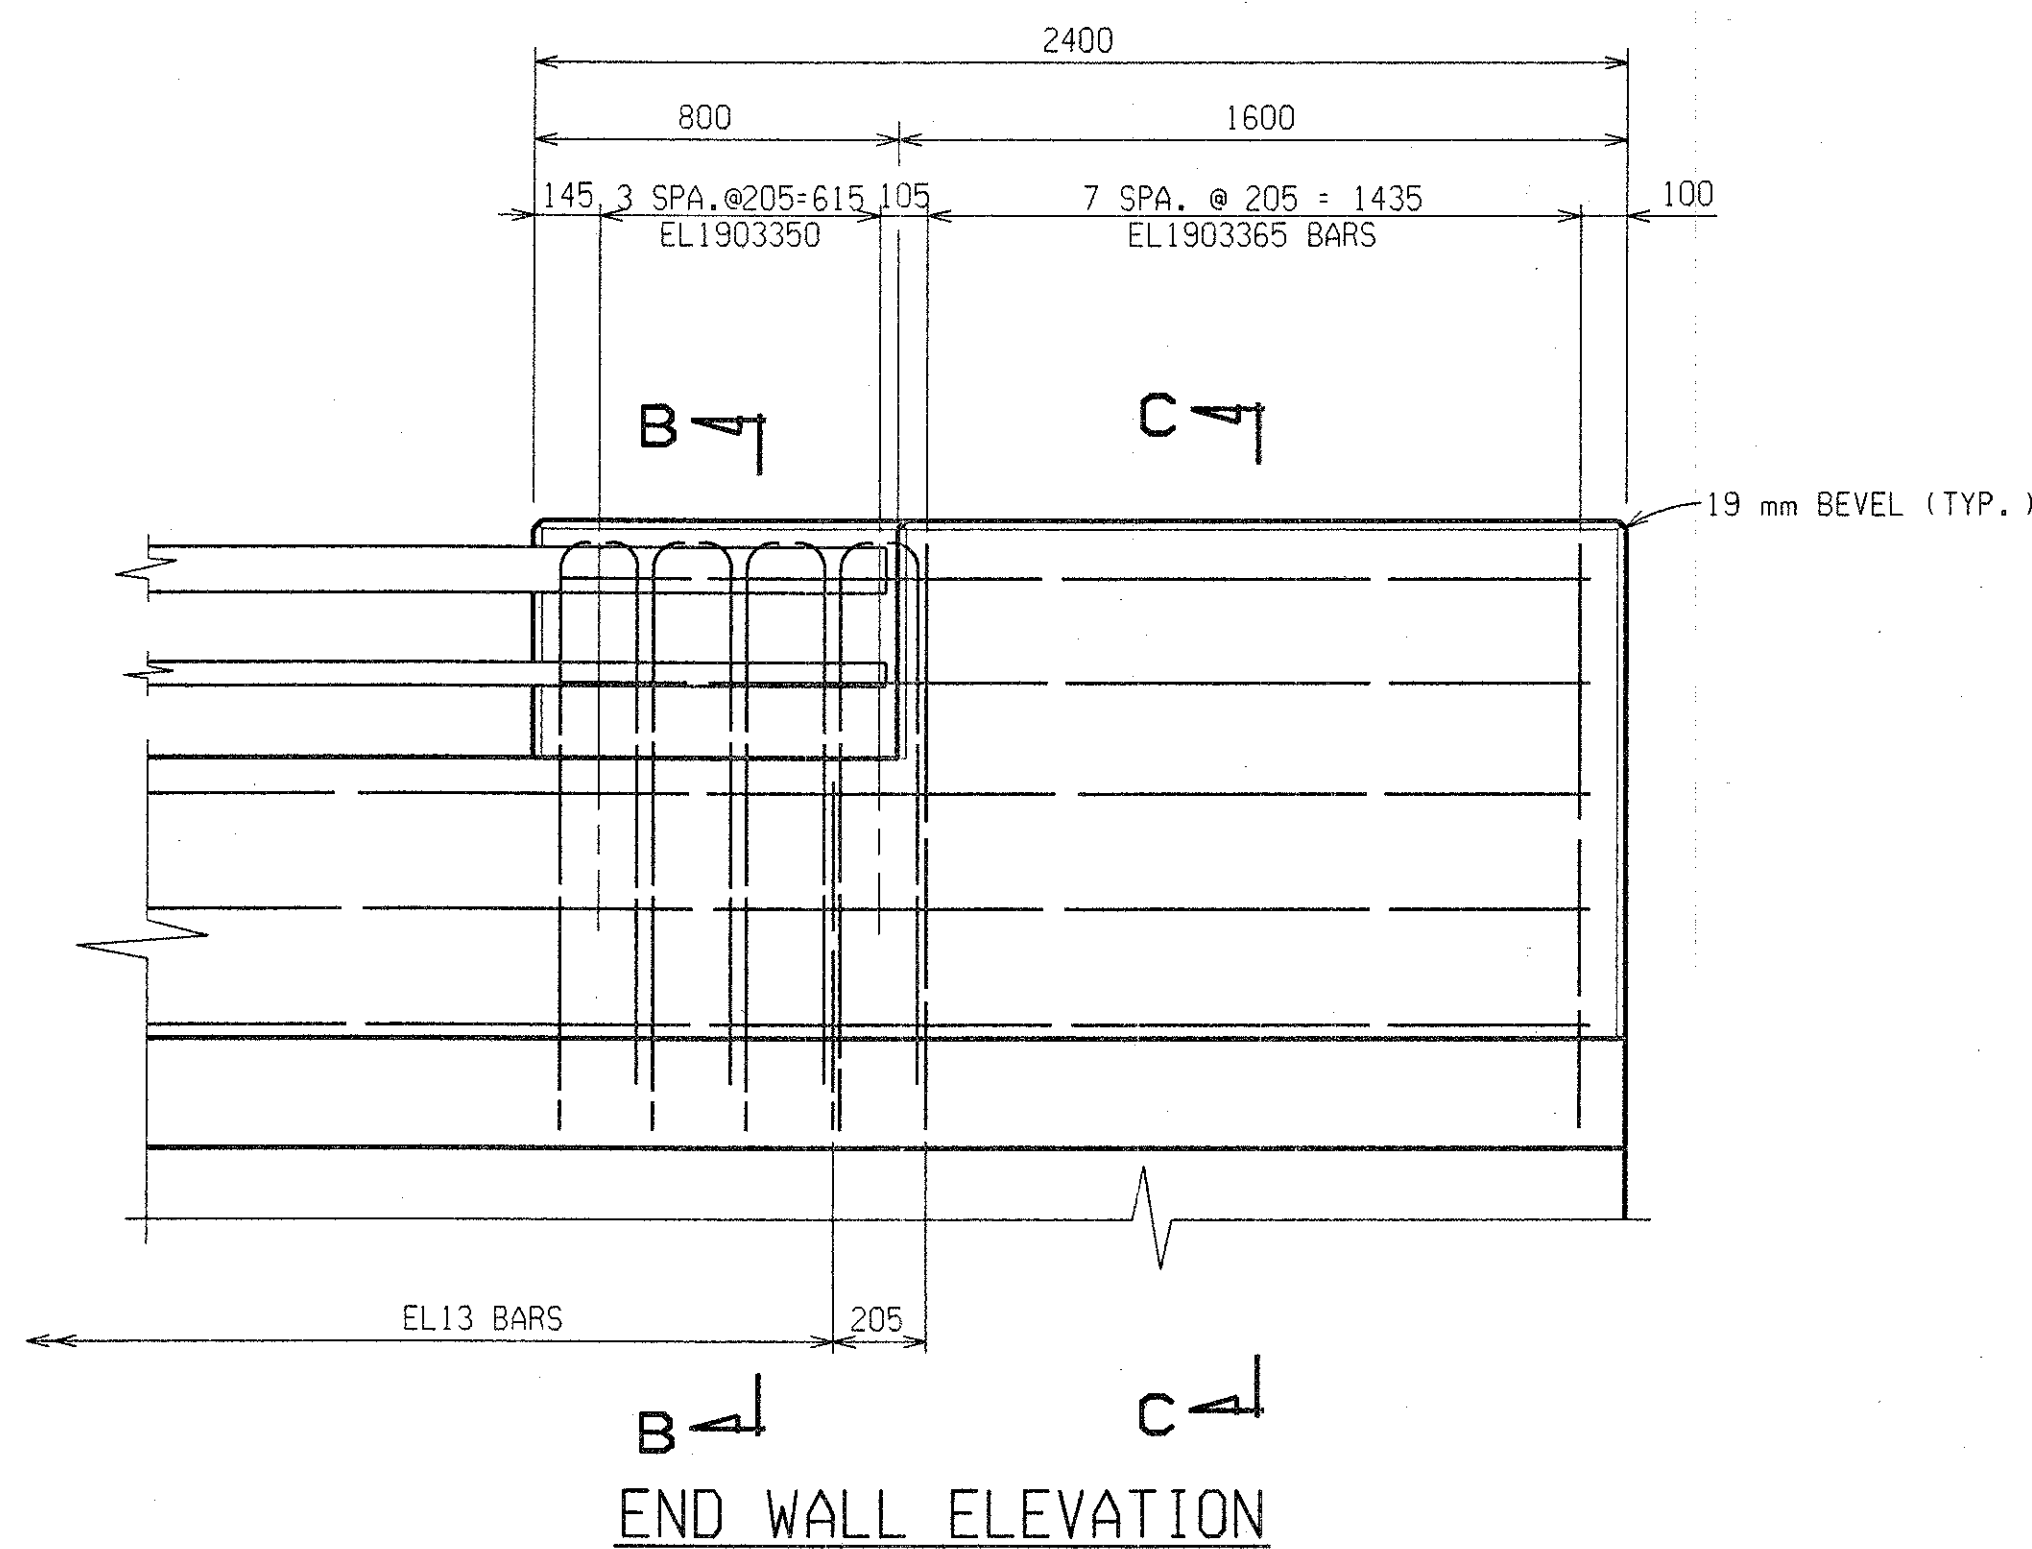



SUPERSTRUCTURE DETAILS



DATE	CONT. SEC.	JOB NO.	DESIGN UNIT	SHEET
10-13-99	S31 OF 63174	48404A	MAHDAVI	16 OF 20

DATE: CORRECTED BY: DATE: CHECKED BY: DATE: 9-16-99 CASLER DRAWN BY: FILE NAME: s3163174.dwg

1 2 3 4 5 6 7 8 9 10 11 12 13 14 15 16 17 18 19 20 21 22 23 24 25 26 27 28 29 30 31 32 33 34 35 36 37 38 39 40 41 42 43 44 45 46 47 48 49 50 51 52 53 54 55 56 57 58 59 60 61 62 63


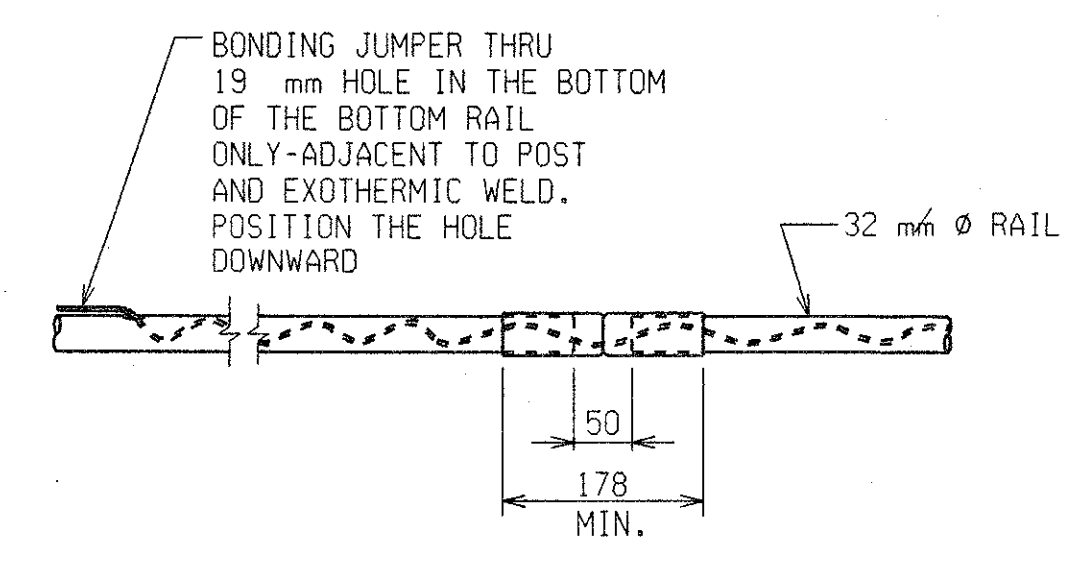
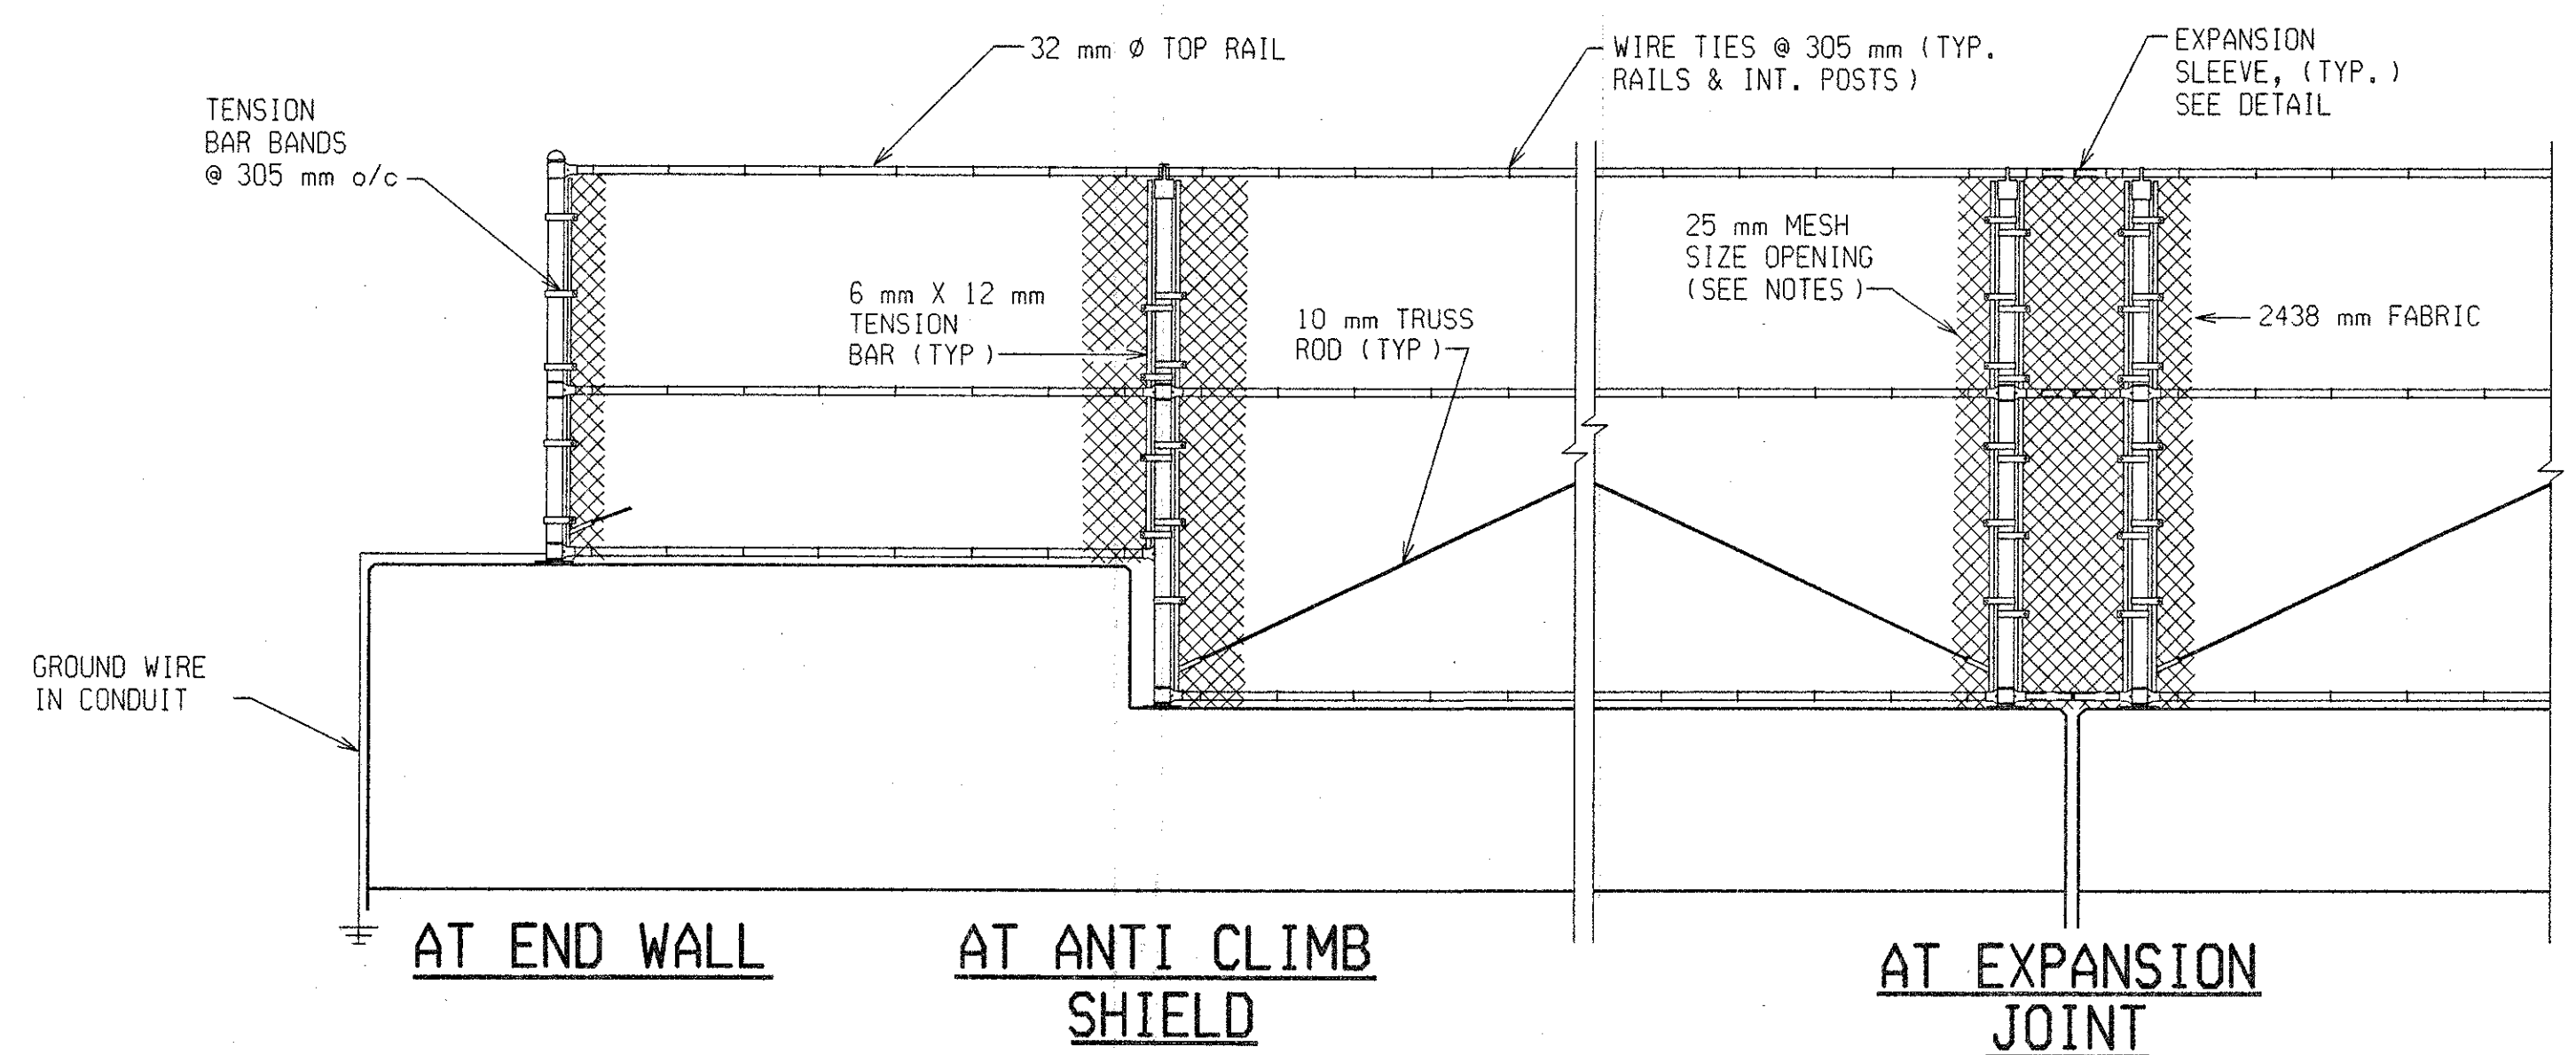


REVISIONS			
NO.	DESCRIPTION	DATE	BY

MISCELLANEOUS QUANTITIES	
292 m ²	Fencing, Structures
1 ea	Elec Grounding System

NOTES:

- ALL FENCE POSTS SHALL BE 64 NOMINAL, (73 O.D.) PIPE AND ANTI-CLIMB SHIELD PIPE FRAMES SHALL BE 32 NOMINAL, (42 O.D.) PIPE, IN CONFORMANCE WITH ASTM F669, CLASS 1C.
- HORIZONTAL RAILS SHALL BE 32 NOMINAL (42 O.D.) PIPE IN CONFORMANCE WITH ASTM F669, CLASS 1C OR ASTM F1083.
- ALL FENCE COMPONENTS, UNLESS OTHERWISE INDICATED, SHALL BE GALVANIZED IN ACCORDANCE WITH MDOT'S CURRENT STANDARD SPECIFICATIONS FOR CONSTRUCTION.
- ALL POSTS, ANTI-CLIMB SHIELDS OR OTHER COMPONENTS TO BE FABRICATED SHALL BE FURNISHED "BLACK" AND THEN GALVANIZED AFTER FABRICATION.
- DAMAGED GALVANIZED SURFACES SHALL BE REPAIRED IN CONFORMANCE WITH MDOT'S CURRENT STANDARD SPECIFICATIONS FOR CONSTRUCTION.
- FENCE FABRIC SHALL BE #9 GAGE MESH AND BE GALVANIZED OR ALUMINUM COATED IN CONFORMANCE WITH MDOT'S CURRENT STANDARD SPECIFICATIONS FOR CONSTRUCTION. MESH SIZE OPENING SHALL BE 25 mm.
- GALVANIZED 10 mm Ø TRUSS RODS SHALL EXTEND DIAGONALLY FROM THE TOP CONNECTION CLIP AT EACH TENSION BAR TO THE ADJACENT POST, EXCEPT ACROSS EXPANSION JOINTS AND AT LIGHT STANDARDS WITH A CURVED FENCE DETAIL, WHEN THERE ARE TWO OR MORE CONTINUOUS PANELS OF FABRIC.
- ALL POSTS SHALL BE INSTALLED PLUMB AND MAY BE SHIMMED WITH NON-METALLIC SHIMS, APPROVED BY THE ENGINEER. COSTS FOR SHIMMING SHALL BE INCLUDED IN THE PAY ITEM "FENCING, STRUCTURES".
- BOTTOM STRAP ON THE VERTICAL POST SHALL BE CONNECTED WITH RAIL ENDS (BRACE BANDS) RATHER THAN A TWO WAY CLAMP TO ALLOW A MINIMUM OF 7 mm OFFSET.
- FIELD WELDING SHALL BE ALLOWED ONLY FOR THE HANDRAIL SPLICES AND FOR ATTACHMENT OF THE HANDRAIL TO THE POST. ALL FIELD WELDS SHALL BE GROUND SMOOTH PRIOR TO COATING WITH ZINC-RICH PAINT OR SPRAYED ZINC IN ACCORDANCE WITH MDOT'S CURRENT STANDARD SPECIFICATIONS.
- THE GROUND WIRE SHALL BE PLACED IN A NON-METALLIC CONDUIT, FROM THE END POST CONNECTION TO THE GROUND ROD CONNECTION. THE CONDUIT SHALL BE SECURED TO THE STRUCTURE USING EITHER EXPANSION BOLTS OR ADHESIVE ANCHORED BOLTS WITH GALVANIZED METAL STRIPS, AS APPROVED BY THE ENGINEER.
- IN THE EVENT THAT INSTALLATION OF A GROUND ROD IS IMPRACTICAL, THE GROUND WIRE SHALL BE CONNECTED TO THE NEAREST LIGHT STANDARD, USING A MECHANICAL CLIP, ONLY AFTER OBTAINING PERMISSION FROM THE LOCAL PUBLIC LIGHTING AUTHORITY.
- EXPANSION JOINT SLEEVES, FOR HORIZONTAL RAILS, SHALL BE THE MANUFACTURER'S STANDARD OVERSIZED SLEEVES, CRIMPED IN THE MIDDLE.
- ALL DIMENSIONS ARE IN MILLIMETERS.
- FENCE FABRIC SHALL BE CONTINUOUS AT LIGHT POLE, BUT MAY BE CUT AND SPLICED. REINFORCE OPENING IN THE FABRIC AT POSTS WITH #6 GAUGE WIRE.
- GROUNDING CABLES AND TOPS OF GROUNDING RODS SHALL BE PLACED 300 mm MINIMUM BELOW FINISHED GROUND.

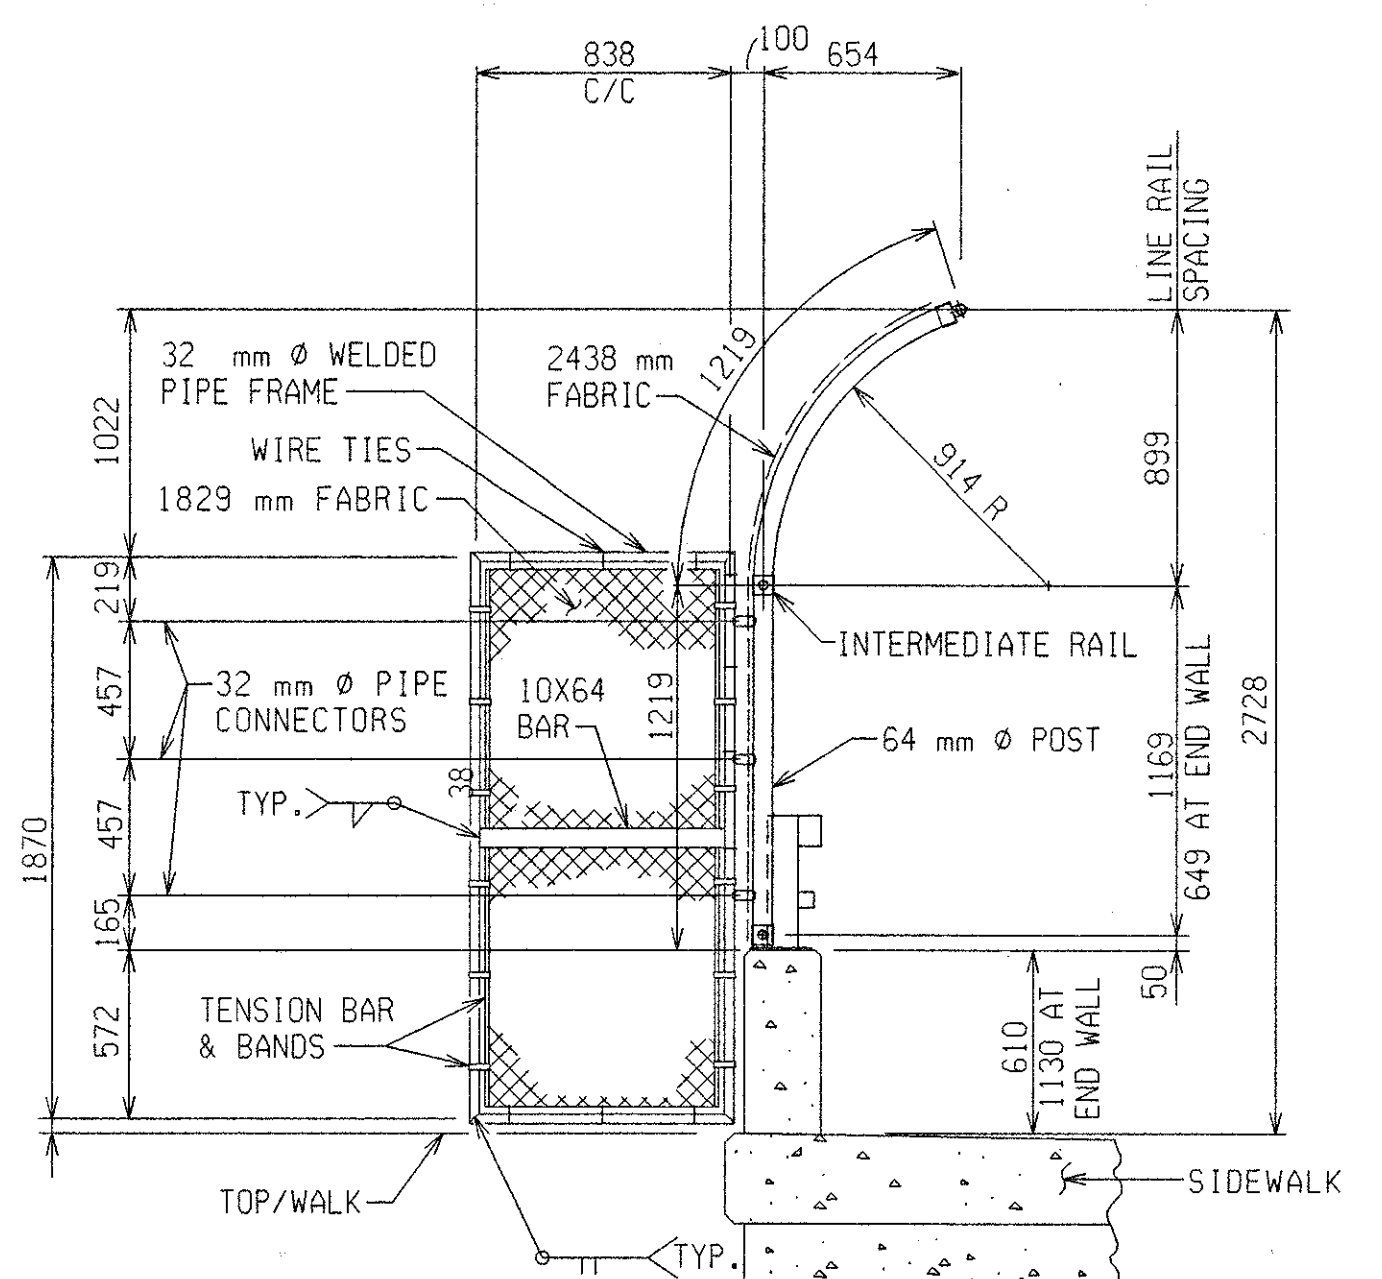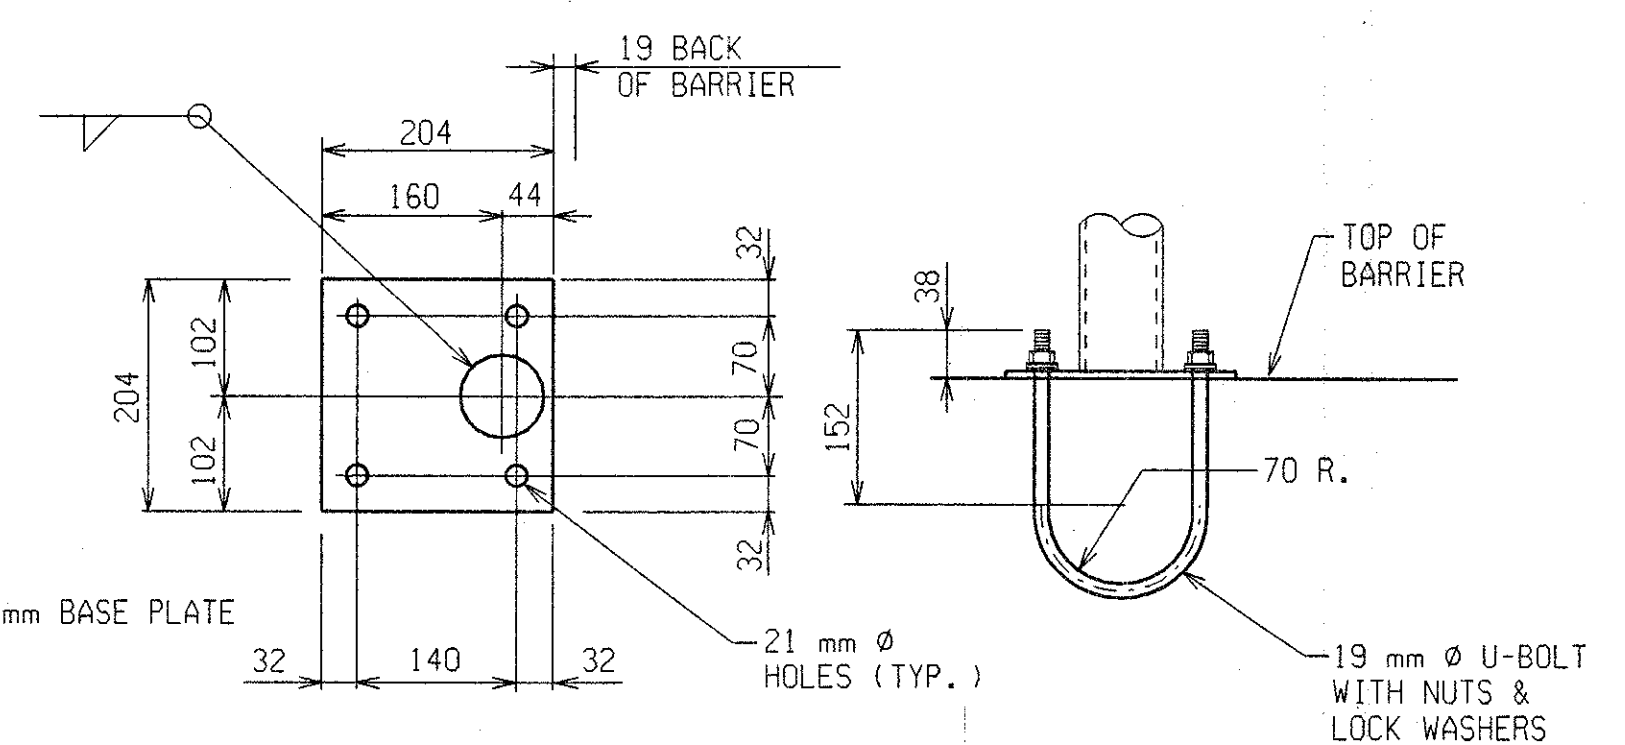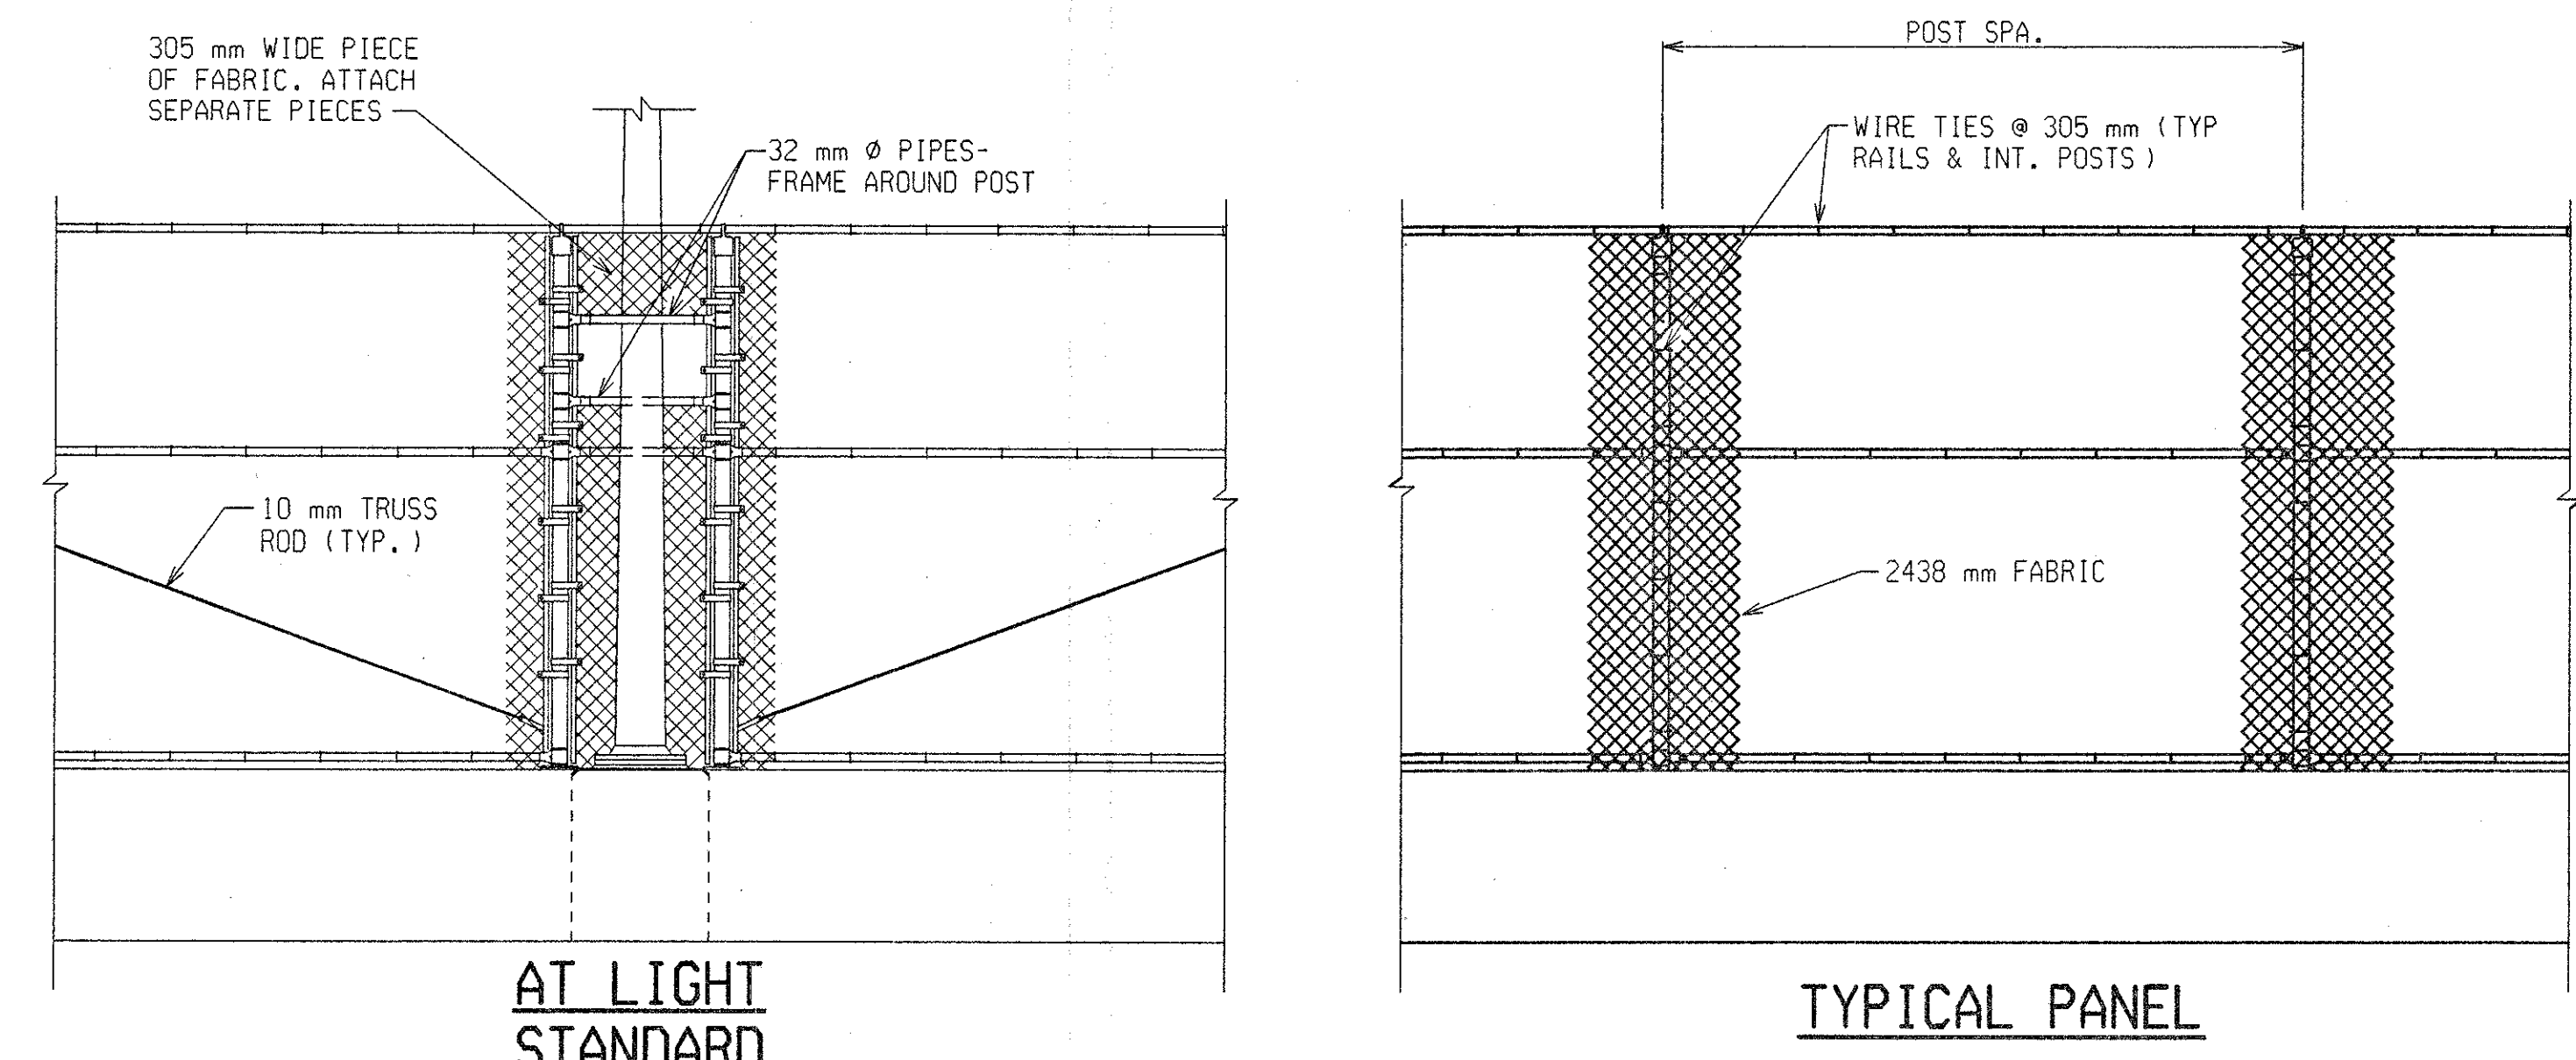


FENCING DETAILS				
DATE	CONT. SEC.	JOB NO.	DESIGN UNIT	SHEET
10-13-99	S31 OF 63174	48404A	MAHDAVI	17 OF 20



DATE: _____ CORRECTED BY: _____ DATE: _____ CHECKED BY: _____ DATE: 9-17-99 DRAWN BY: CASLER FILE NAME: s3063174.fe

REVISIONS			
NO.	DESCRIPTION	DATE	BY

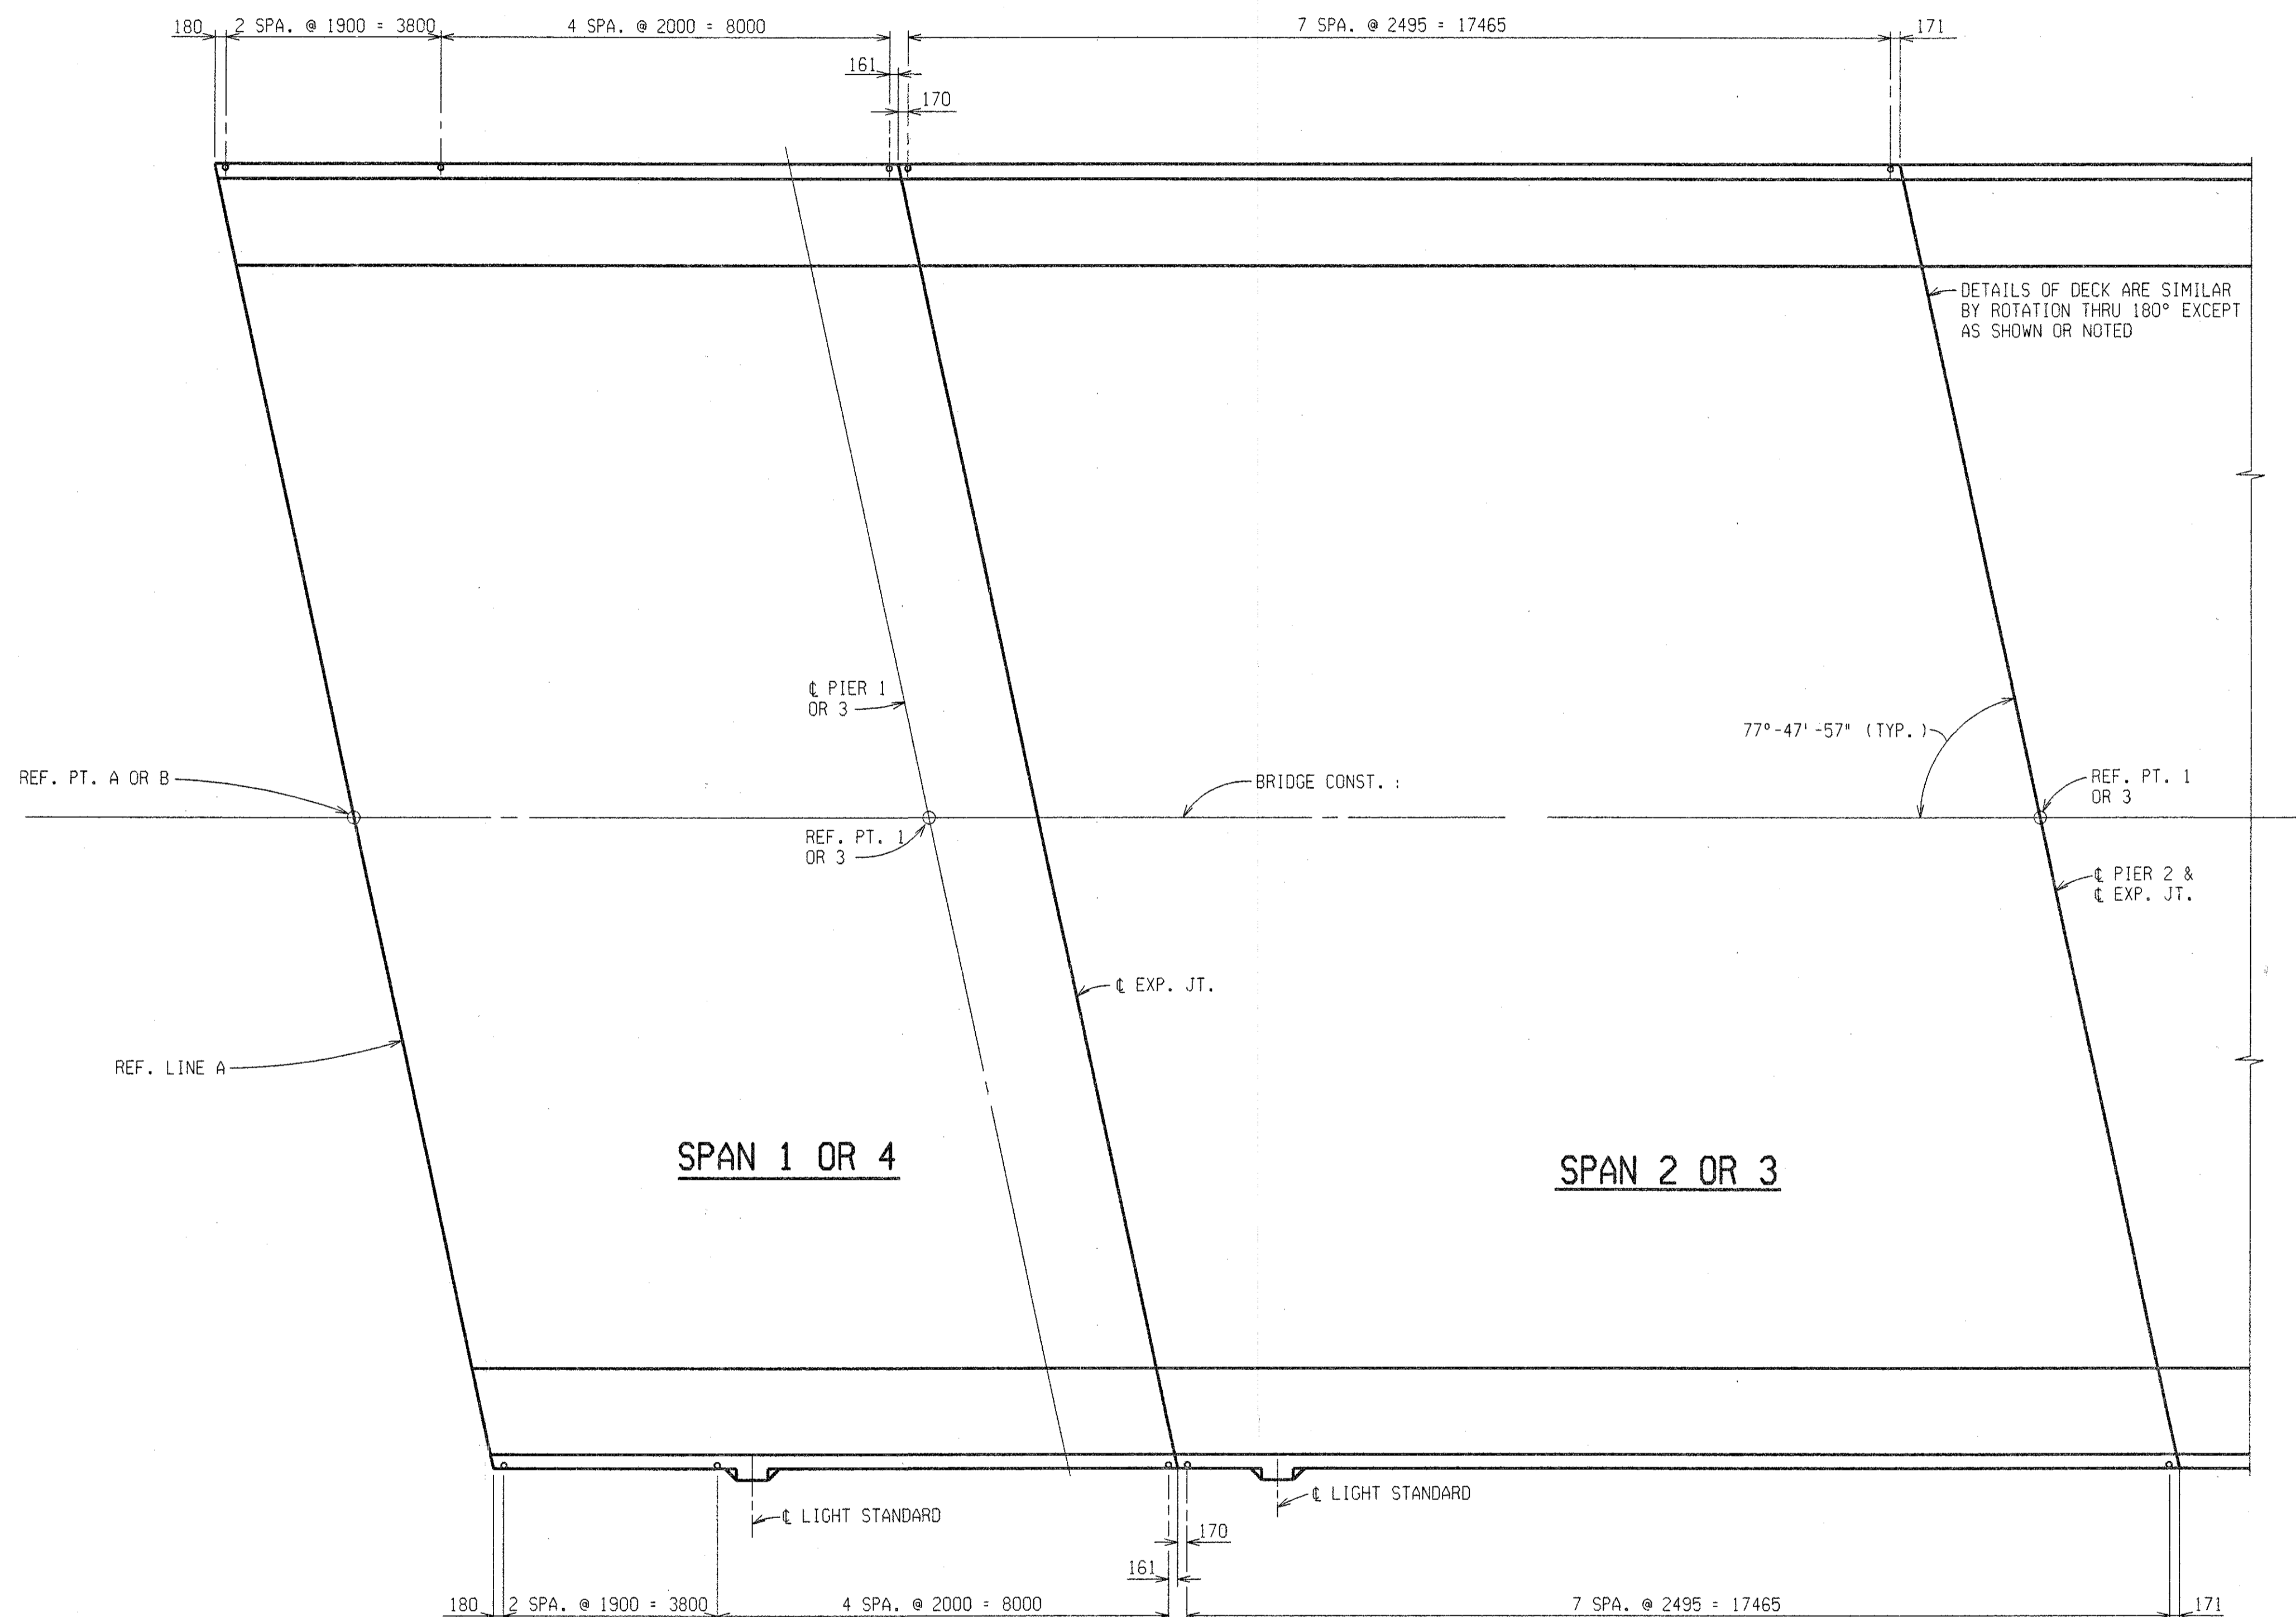

PLAN
(SHOWING FENCE POST SPACING)

FENCING DETAILS



DATE	CONT. SEC.	JOB NO.	DESIGN UNIT	SHEET
10-13-99	S31 OF 63174	48404A	MAHDAVI	18 OF 20

1 2 3 4 5 6 7 8 9 10 11 12 13 14 15 16 17 18 19 20 21 22 23 24 25 26 27 28 29 30 31 32 33 34 35 36 37 38 39 40 41 42 43 44 45 46 47 48 49 50 51 52 53 54 55 56 57 58 59 60 61 62 63

REVISIONS			
NO.	DESCRIPTION	DATE	BY

BOTTOM OF SLAB ELEVATIONS

	REF. A	SPAN 1						SPAN 2						SPAN 3						SPAN 4				REF. B	
		0	1	2	3	¢ BRG 4	¢ P&H 0	1	2	3	4	5	¢ BRG 6	¢ BRG 0	1	2	3	4	5	¢ P&H 6	¢ BRG 0	1	2		3
A	FASCIA RIGHT	193.887	193.912	193.933	193.951	193.966	193.986	194.017	194.042	194.057	194.062	194.057	194.046	194.046	194.061	194.070	194.069	194.058	194.038	194.010	193.993	193.982	193.967	193.949	193.927
B	LEFT RIGHT	193.951	193.976	193.997	194.015	194.030	194.043	194.075	194.100	194.115	194.120	194.115	194.104	194.104	194.119	194.128	194.127	194.116	194.095	194.068	194.057	194.045	194.031	194.013	193.991
C	LEFT RIGHT	193.977	194.002	194.023	194.040	194.055	194.068	194.099	194.123	194.138	194.142	194.137	194.125	194.126	194.141	194.149	194.147	194.136	194.115	194.087	194.076	194.064	194.049	194.030	194.009
D	LEFT RIGHT	193.984	194.008	194.029	194.047	194.061	194.075	194.106	194.130	194.145	194.149	194.144	194.132	194.132	194.147	194.155	194.154	194.143	194.122	194.094	194.082	194.071	194.056	194.037	194.015
E	LEFT RIGHT	194.017	194.041	194.061	194.079	194.092	194.106	194.136	194.160	194.174	194.178	194.173	194.160	194.160	194.175	194.183	194.181	194.169	194.148	194.119	194.108	194.096	194.080	194.061	194.039
F	LEFT RIGHT	194.023	194.047	194.068	194.085	194.099	194.112	194.143	194.167	194.181	194.185	194.179	194.167	194.167	194.182	194.189	194.188	194.176	194.154	194.126	194.114	194.102	194.087	194.068	194.046
G	LEFT RIGHT	194.056	194.080	194.100	194.117	194.130	194.143	194.173	194.197	194.210	194.214	194.208	194.195	194.195	194.209	194.217	194.214	194.202	194.180	194.151	194.139	194.127	194.111	194.092	194.069
H	LEFT RIGHT	194.062	194.086	194.107	194.123	194.137	194.150	194.180	194.203	194.217	194.221	194.215	194.202	194.202	194.216	194.223	194.221	194.209	194.187	194.158	194.146	194.134	194.118	194.099	194.076
I	LEFT RIGHT	194.095	194.118	194.139	194.155	194.168	194.181	194.210	194.233	194.247	194.250	194.243	194.230	194.230	194.244	194.250	194.248	194.235	194.213	194.183	194.171	194.158	194.142	194.123	194.100
J	LEFT RIGHT	194.102	194.125	194.145	194.162	194.175	194.187	194.217	194.240	194.253	194.256	194.250	194.237	194.237	194.250	194.256	194.255	194.242	194.219	194.190	194.178	194.165	194.149	194.129	194.106
K	LEFT RIGHT	194.106	194.129	194.149	194.165	194.178	194.190	194.219	194.242	194.255	194.257	194.250	194.237	194.237	194.250	194.256	194.253	194.240	194.217	194.187	194.175	194.162	194.145	194.125	194.102
L	LEFT RIGHT	194.100	194.123	194.142	194.158	194.171	194.183	194.213	194.235	194.248	194.250	194.244	194.230	194.230	194.243	194.250	194.247	194.233	194.210	194.181	194.168	194.155	194.139	194.118	194.095
M	LEFT RIGHT	194.076	194.099	194.118	194.134	194.146	194.158	194.187	194.209	194.221	194.223	194.216	194.202	194.202	194.215	194.221	194.217	194.203	194.180	194.150	194.137	194.123	194.107	194.086	194.062
N	LEFT RIGHT	194.069	194.092	194.111	194.127	194.139	194.151	194.180	194.202	194.214	194.217	194.209	194.195	194.195	194.208	194.214	194.210	194.197	194.173	194.143	194.130	194.117	194.100	194.080	194.056
O	LEFT RIGHT	194.046	194.068	194.087	194.102	194.114	194.126	194.154	194.176	194.188	194.189	194.182	194.167	194.167	194.179	194.185	194.181	194.167	194.143	194.112	194.099	194.085	194.068	194.047	194.023
P	LEFT RIGHT	194.039	194.061	194.080	194.096	194.108	194.119	194.148	194.169	194.181	194.183	194.175	194.160	194.160	194.173	194.178	194.174	194.160	194.136	194.106	194.092	194.079	194.061	194.041	194.017
Q	LEFT RIGHT	194.015	194.037	194.056	194.071	194.082	194.094	194.122	194.143	194.154	194.155	194.147	194.132	194.132	194.144	194.149	194.145	194.130	194.106	194.075	194.061	194.047	194.029	194.008	193.984
R	LEFT RIGHT	194.009	194.030	194.049	194.064	194.076	194.087	194.115	194.136	194.147	194.149	194.141	194.126	194.125	194.137	194.142	194.138	194.123	194.099	194.068	194.055	194.040	194.023	194.002	193.977
S	LEFT FASCIA	193.991	194.013	194.031	194.045	194.057	194.068	194.095	194.116	194.127	194.128	194.119	194.104	194.104	194.115	194.120	194.115	194.100	194.075	194.043	194.030	194.015	193.997	193.976	193.951
T	RIGHT	193.927	193.949	193.967	193.982	193.993	194.010	194.038	194.058	194.069	194.070	194.061	194.046	194.046	194.057	194.062	194.057	194.042	193.986	193.966	193.951	193.933	193.912	193.887	

SCREED ELEVATIONS

LEFT	194.182	194.206	194.228	194.246	194.260	194.274	194.303	194.326	194.341	194.346	194.343	194.334	194.334	194.347	194.354	194.352	194.342	194.323	194.297	194.286	194.274	194.259	194.241	194.220
CENTER	194.348	194.371	194.391	194.407	194.420	194.433	194.460	194.481	194.494	194.497	194.492	194.481	194.481	194.492	194.497	194.494	194.481	194.460	194.433	194.420	194.407	194.391	194.371	194.348
RIGHT	194.220	194.241	194.259	194.274	194.286	194.297	194.323	194.342	194.352	194.354	194.347	194.334	194.334	194.343	194.346	194.341	194.326	194.303	194.274	194.260	194.246	194.228	194.206	194.182

BULKHEAD ELEVATIONS


	ABUT. A	¢ JT.	PIER 2	¢ JT.	ABUT. B
A	194.179	194.272	194.334	194.297	194.220
B	194.209	194.300	194.359	194.319	194.241
C	194.249	194.338	194.394	194.351	194.271
D	194.288	194.375	194.429	194.384	194.302
E	194.327	194.413	194.463	194.416	194.332
F	194.332	194.416	194.463	194.413	194.327
G	194.302	194.384	194.429	194.375	194.288
H	194.271	194.351	194.394	194.338	194.249
J	194.241	194.319	194.359	194.300	194.209
K	194.220	194.297	194.334	194.272	194.179

NOTES:


SCREED ELEVATIONS ARE BASED ON THE CONDITION THAT NO SLAB CONCRETE HAS BEEN CAST AND THAT FORMWORK, SHEAR DEVELOPERS, AND STEEL REINFORCEMENT ARE IN PLACE.

BOTTOM OF SLAB ELEVATIONS ARE AT RIGHT ANGLES TO THE BEAM CENTERLINE AND ARE BASED ON THE CONDITION THAT THE BEAMS AND DIAPHRAGMS ARE COMPLETELY ERECTED WITH NO OTHER LOADS APPLIED. NO TEMPORARY SUPPORTS ARE ALLOWED AT THIS TIME. THESE ELEVATIONS INCLUDE ALLOWANCE FOR VERTICAL CURVE AND DEFLECTION DUE TO FORMS, STEEL REINFORCEMENT, CONCRETE SLAB, SIDEWALKS, RAILING AND UTILITIES.

SECTIONS FOR BOTTOM OF SLAB AND/OR SCREED ELEVATIONS ARE GIVEN ALONG BEAM CENTERLINES FROM CENTERLINE OF BEARING OR PIN & HANGER TO CENTERLINE OF BEARING OR PIN & HANGER AS APPLICABLE AT EQUAL SPACINGS.

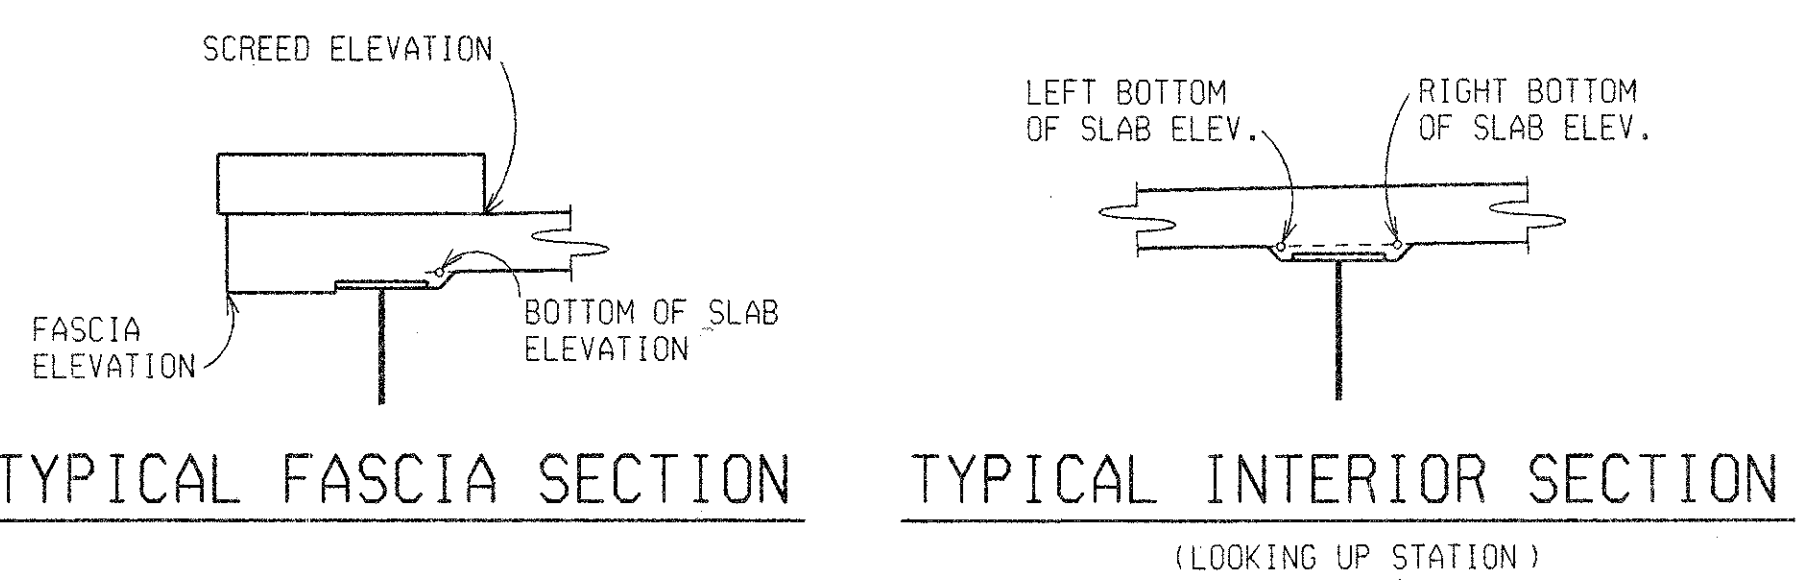

SLAB AND SCREED DATA				
DATE	CONT. SEC.	JOB NO.	DESIGN UNIT	SHEET
10-13-99	S31 OF 63174	48404A	MAHDAVI	19 OF 20


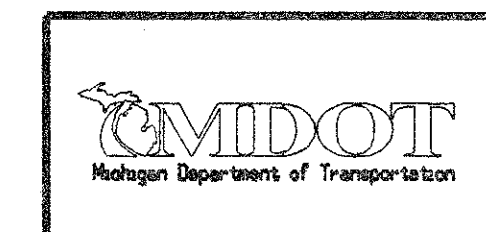


CHECKED BY: DATE: DRAWN BY: DATE: FILE NAME: s3163174.s5

BAR	DIMENSIONS										NO. REQ'D	TOTAL WT.
	a	b	c	d	e	f	g	h	J			
EA1006120	6120										180	617
EA1306180	6180										222	1364
EA1312000	12000										48	573
EA1312040	12040										8	96
EA1610860	10860										46	775
EA1613230	13230										46	945
EA1301700	1700										104	176
EA1302250	2250										4	9
EA1301450	1450										4	6
ED1612330	12100	97	133								92	1761
ED1300880	270	340	270								52	45
EL1302315	760	175	660	360	360	162					102	235
EL1903365	1280	185	1180	360	360	172					16	120
EL1903350	1180	170	1280	360	360		170				8	60
ET1902344	310	410	378	510	158	200					72	377

BAR	DIMENSIONS										NO. REQ'D	TOTAL WT.
	a	b	c	d	e	f	g	h	J			
EA1009980	9980										180	1006
EA1310040	10040										270	2695
EA1610860	10860										70	1180
EA1613230	13230										70	1437
EA1301700	1700										144	243
ED1612330	12100	97	133								140	2679
ED1300880	270	340	270								72	63
EL1302315	760	175	660	360	360	162					174	400
ET1902344	310	410	378	510	158	200					112	587

BAR	DIMENSIONS										NO. REQ'D	TOTAL WT.
	a	b	c	d	e	f	g	h	J			
EA1006120	6120										180	617
EA1306180	6180										222	1364
EA1312000	12000										48	573
EA1312040	12040										8	96
EA1610860	10860										46	775
EA1613230	13230										46	945
EA1301700	1700										104	176
EA1302250	2250										4	9
EA1301450	1450										4	6
ED1301150	255	700	255								2	2
ED1612330	12100	97	133								92	1761
ED1300880	270	340	270								52	45
ED1301020	305	410	305								3	3
EL1302315	760	175	660	360	360	162					102	235
EL1903365	1280	185	1180	360	360	172					16	120
EL1903350	1180	170	1280	360	360		170				8	60
ET1902344	310	410	378	510	158	200					72	377

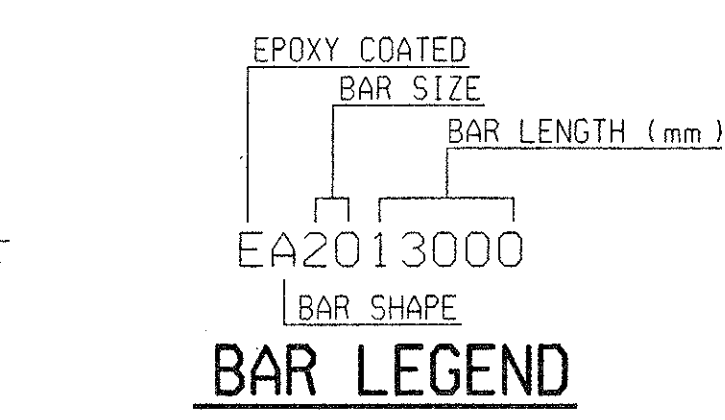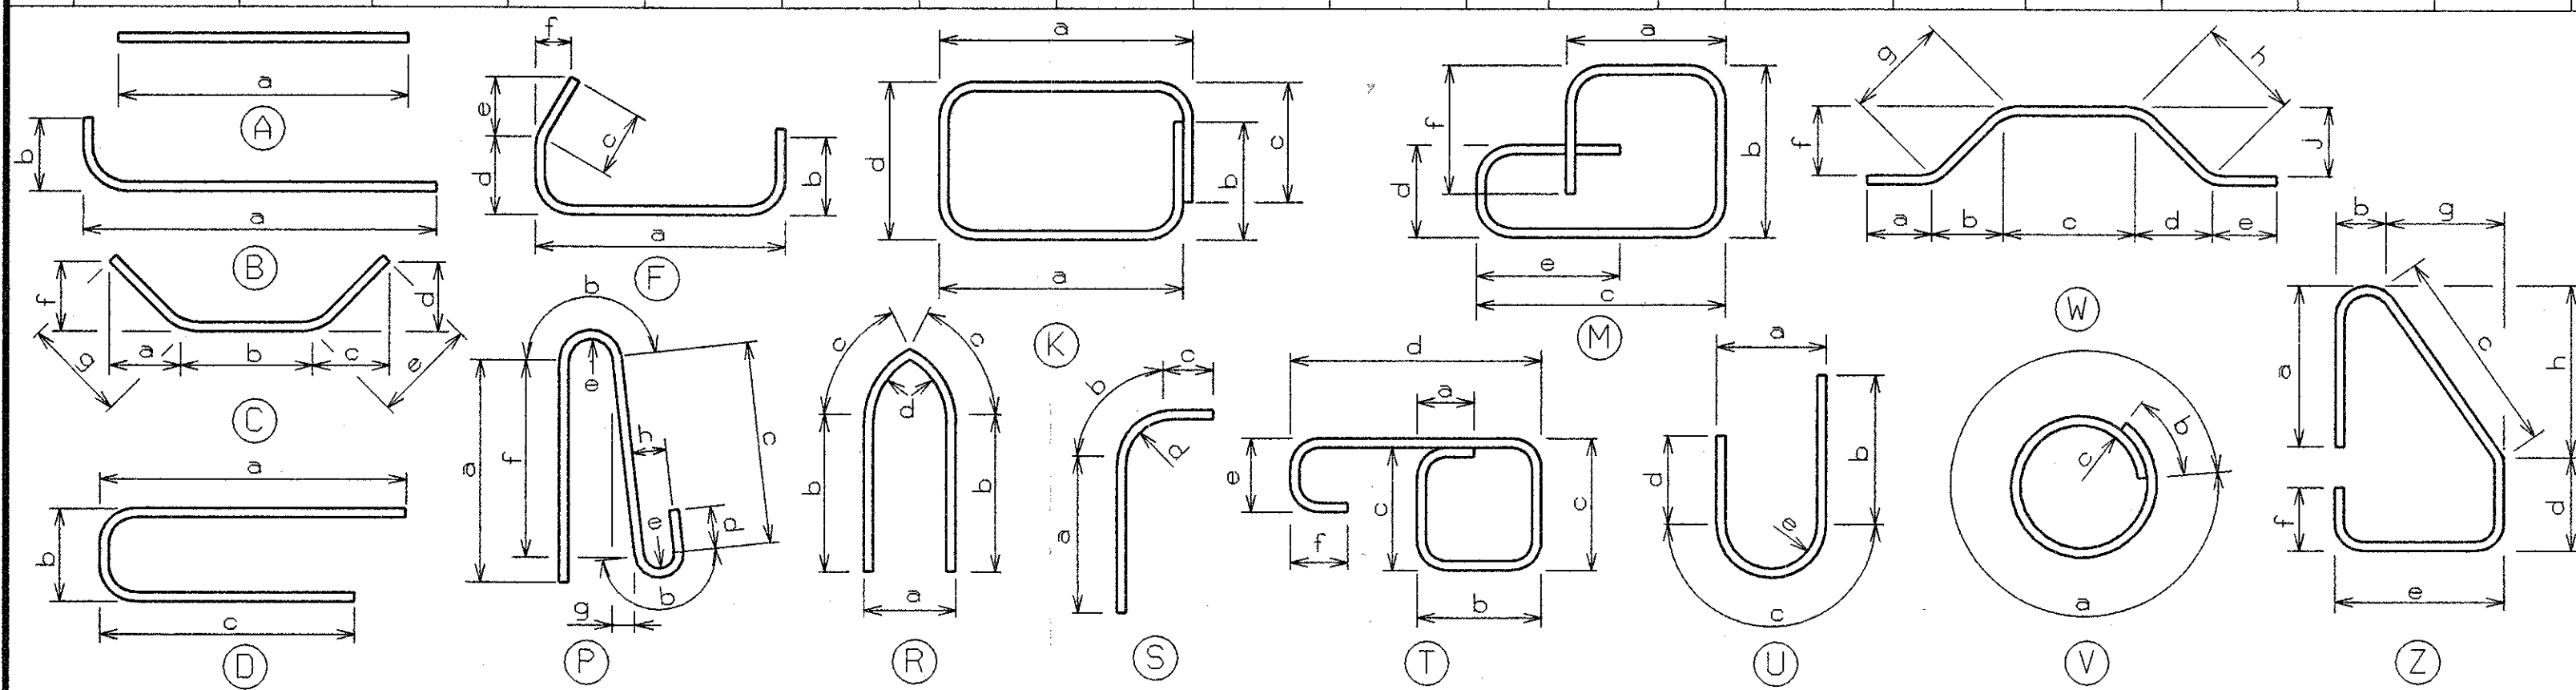

MISCELLANEOUS QUANTITIES	
0	kg REINFORCEMENT, STEEL
34908	kg REINFORCEMENT, STEEL, EPOXY COATED

REINFORCEMENT SHALL BE BUNDLED AND TAGGED AS TO THE LOCATION AS SHOWN ON THIS SHEET.

STEEL REINFORCEMENT DETAILS				
DATE	CONT. SEC.	JOB NO.	DESIGN UNIT	SHEET
10-13-99	S31 OF 63174	48404A	MAHDAVI	20 OF 20

REVISIONS			
NO.	DESCRIPTION	DATE	BY



MICROFILM CONTENT SHEET

BATCH # 08-3G

OUT TO MICROFILM 3/21/2008

Control Section	Structure	Job Number	Sheet Number	Let Date	Region	Total Sheets	Plan Set	Box
MAIN JOB 63174		48647		3/2/2001	METRO	210		1
SEE ME FILES	B02 49595 S03 49595 S04 49595	SEE 63174 48647 SEE 63174 48647 SEE 63174 48647						
63174-53697		SEE 63174 48647						
	63174-48647, 53697, 49595 MILLING AND RESURFACING, SHOULDER UPGRADES, MEDIAN GUARDRAIL, INSTALLATION, AND GUARDRAIL REPLACEMENT/ UPGRADES BRIDGE APPROACHES. 63174-49595-B02, S03, S04 DECK REPLACEMENT, OVERLAY, PAINTING, CONCRETE BEAM REPAIR, SUBSTRUCTURE REPAIR, THRIE BEAM RETROFIT AND APPROACH WORK.							

CONTROL SECTION 63174

JOB 53697, 49595 & 48647

SH. NO.

DATE: 12-07-00
DATE: 12-07-00
EXISTING BY: RICK'S TEAM
PROPOSED BY: RICK'S TEAM
LAST CORRECTION BY: RICK'S TEAM

PART 1
ROAD PLANS

	SHEET NUMBERS
TITLE	1
TYPICAL CROSS SECTIONS	2-7
NOTE SHEET	8
STANDARD SYMBOLS	9
PLAN	10-39
MAINTAINING TRAFFIC/CONSTRUCTION STAGING	40-75
LOG OF BORINGS	76-77
MITSU LOOP DETAILS	78-79
SPECIAL DETAILS	80-86

MICHIGAN
DEPARTMENT OF TRANSPORTATION

PLANS OF PROPOSED

MICHIGAN PROJECT **IM 0163(018), BHI 0163(017) & IMG 0163(016)**
CONTROL SECTION **63174**
JOB NUMBER **53697, 49595 & 48647**

THE IMPROVEMENTS COVERED BY THESE PLANS SHALL BE DONE IN ACCORDANCE WITH THE MICHIGAN DEPARTMENT OF TRANSPORTATION 1996 STANDARD SPECIFICATIONS AND SUPPLEMENTAL SPECIFICATIONS.

	YEAR 2000	YEAR 2001
A.D.T.	167,600	204,000
D.H.V.	13,400	16,300
COMM. %	7%	8%
DESIGN SPEED	120km/h	

OAKLAND COUNTY
MADISON HEIGHTS, TROY, AUBURN HILLS &
BLOOMFIELD TOWNSHIP

PART 2
BRIDGE PLANS

MICHIGAN PROJECT
CONTROL SECTION 63174
JOB NUMBER 53697 & 48647
POE : STA 22+620



MICHIGAN PROJECT
CONTROL SECTION 63174
JOB NUMBER 49595
POE : STA 30+000

MICHIGAN PROJECT
CONTROL SECTION 63174
JOB NUMBER 53697, 48647 & 49595
POB : STA 28+030

TITLE SHEET LEGEND

PROPOSED PROJECT	
EXISTING ROADS	
PAVED	
BITUMINOUS	
GRAVEL	
UNIMPROVED OR CITY STREET	
SECTION LINE	
TOWNSHIP LINE	
COUNTY LINE	
CITY OR VILLAGE LIMITS	
RAILROADS	

CONTRACT FOR: MILLING AND RESURFACING, SHOULDER UPGRADES, MEDIAN GUARDRAIL INSTALLATION, AND GUARDRAIL REPLACEMENT/UPGRADES BRIDGE APPROACHES

APPROVALS		
RECOMMENDED FOR APPROVAL	<i>Jack M. Rick</i> PROJECT MANAGER	1/10/00 DATE
RECOMMENDED FOR APPROVAL	<i>Mark Stue</i> RESIDENT ENGINEER	1-10-01 DATE

MICHIGAN
DEPARTMENT OF TRANSPORTATION
GREGORY J. ROSINE - DIRECTOR



APPROVED BY *Gary D. Taylor* 1/22/2001
DEPUTY DIRECTOR/HIGHWAYS DATE

M-DOT METRIC		M-DOT DESIGN COORDINATOR	
RICK		RICK	
DESIGN UNIT		DESIGN UNIT	
CONTROL SECTION	JOB NUMBER	FEDERAL NUMBERS	SHEET NO.
63174	49595 48647 53697	07 12 39 07 12 39 07 12 39	1

JOB NUMBER 63174 -- 53697, 49595 & 48647

AS LET PLANS

FINAL R.O.W.			
AUTH	DATE	NO.	REVISION

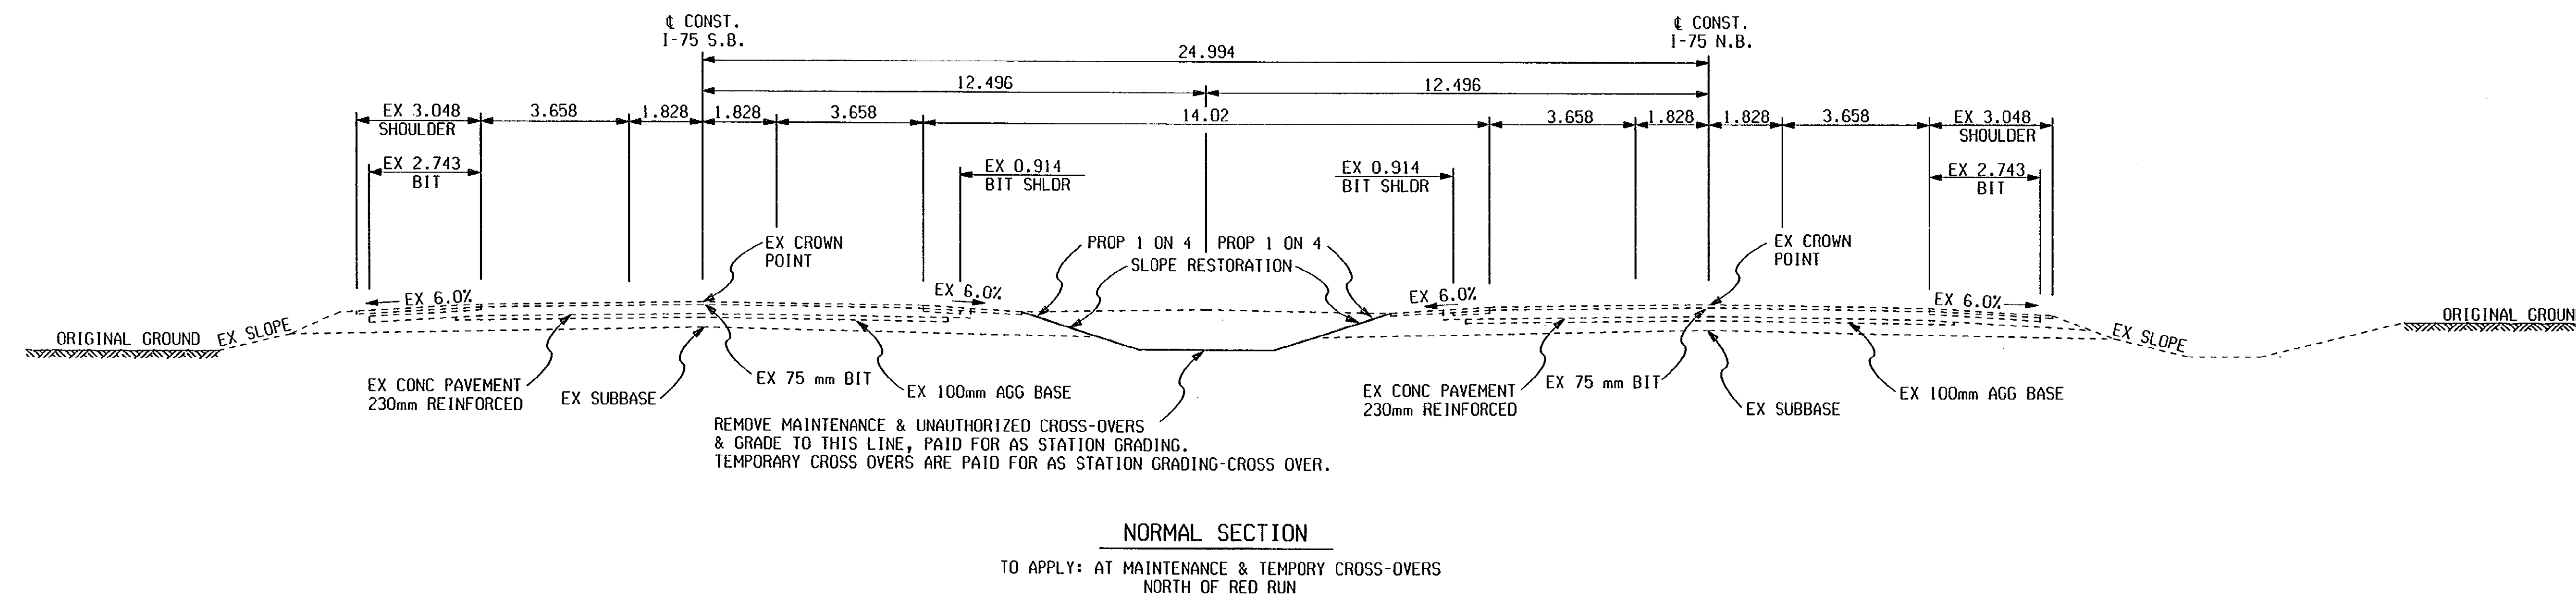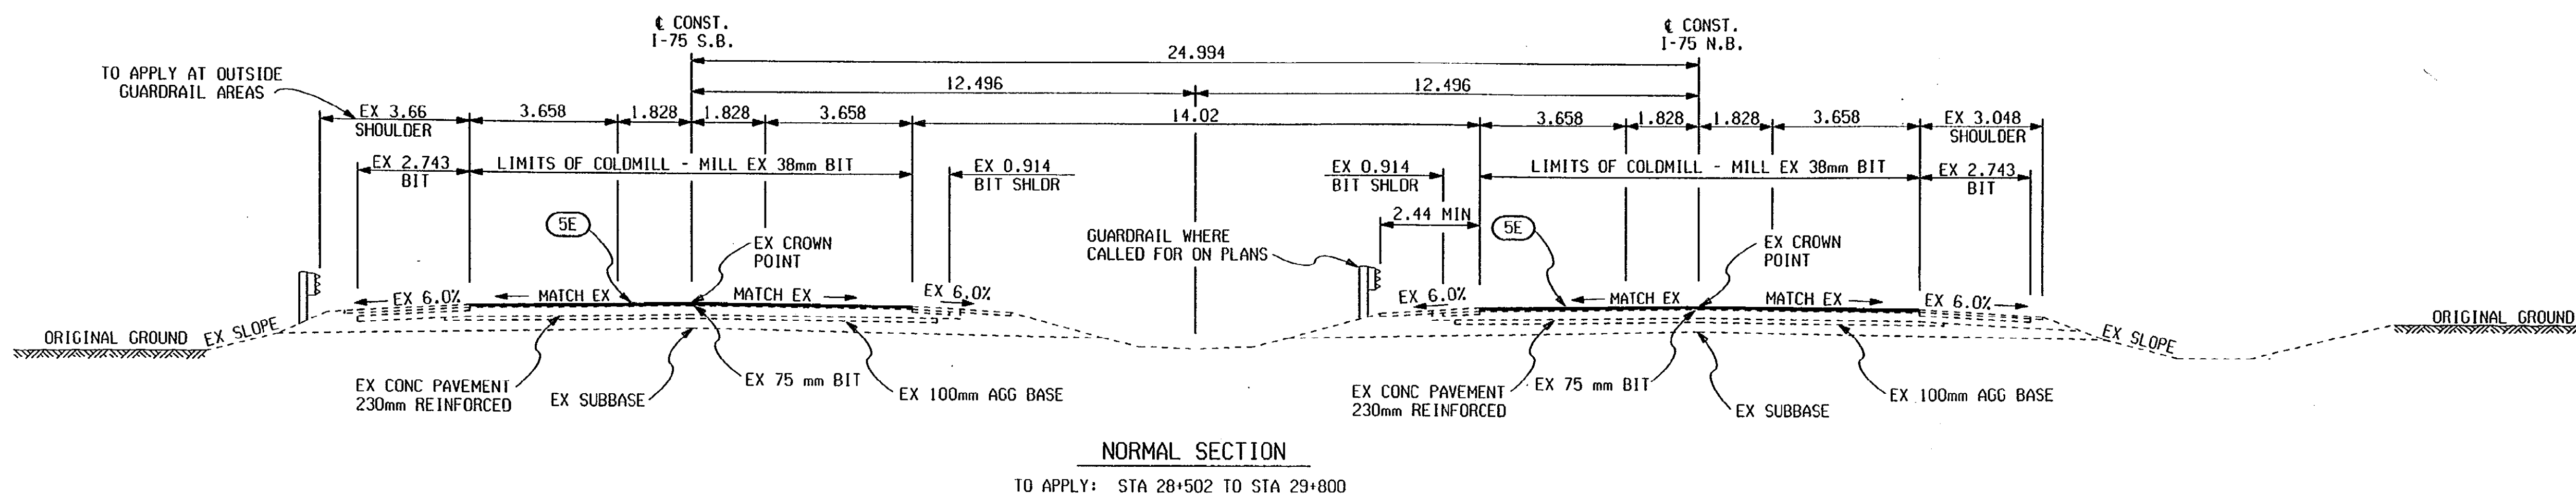

BITUMINOUS APPLICATION ESTIMATE

IDENT NO.	ITEM	RATE PER M ²	PERFORMANCE GRADE	REMARKS
5E	BITUMINOUS MIXTURE, 5E30	90 kg	70-22	
4C	HAND PATCHING		58-22	
	* BITUMINOUS BOND COAT	0-0.45 L		

*FOR INFORMATION ONLY



TYPICAL CROSS SECTIONS

DATE	SCALE	CONT. SEC.	JOB NO.	DESIGN UNIT	SHEET NO.
01/11/01	1:100	63174	53697	RICK	2

SH. NO. 2

JOB NO. 53697




CONTROL SECTION 63174

EXISTING BY: RICK'S TEAM
 PROPOSED BY: RICK'S TEAM
 LAST CORRECTION BY: RICK'S TEAM

FILE NAME: 53697typ.dgn
 1 2 3

EXISTING BY: DATE: PROPOSED BY: DATE: LAST CORRECTION BY: RICK'S TEAM DATE: 01-11-01

FINAL R.O.W.			
AUTH	DATE	NO.	REVISION

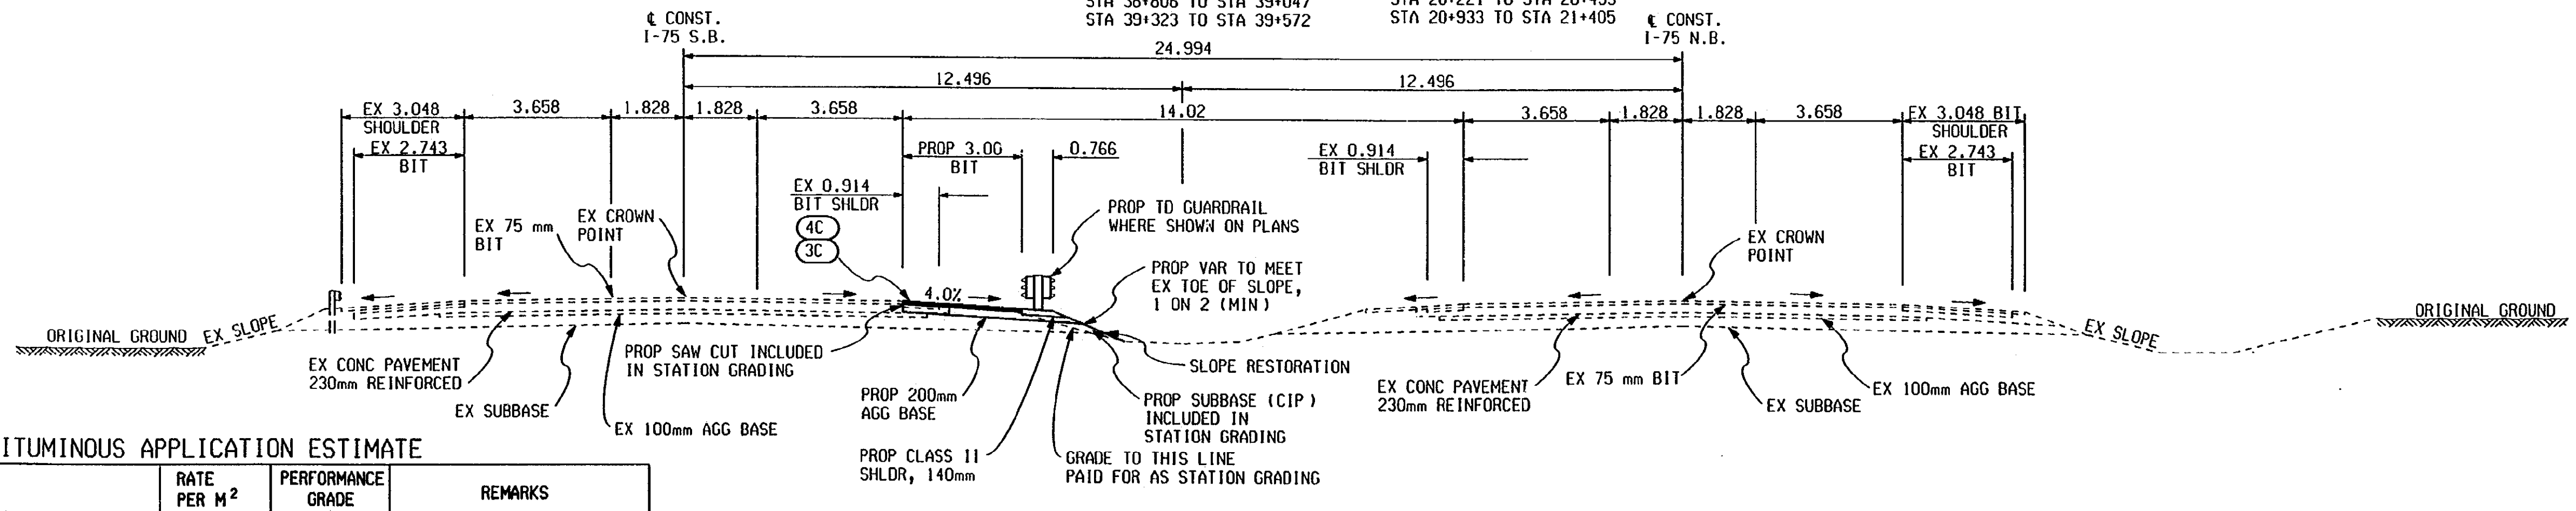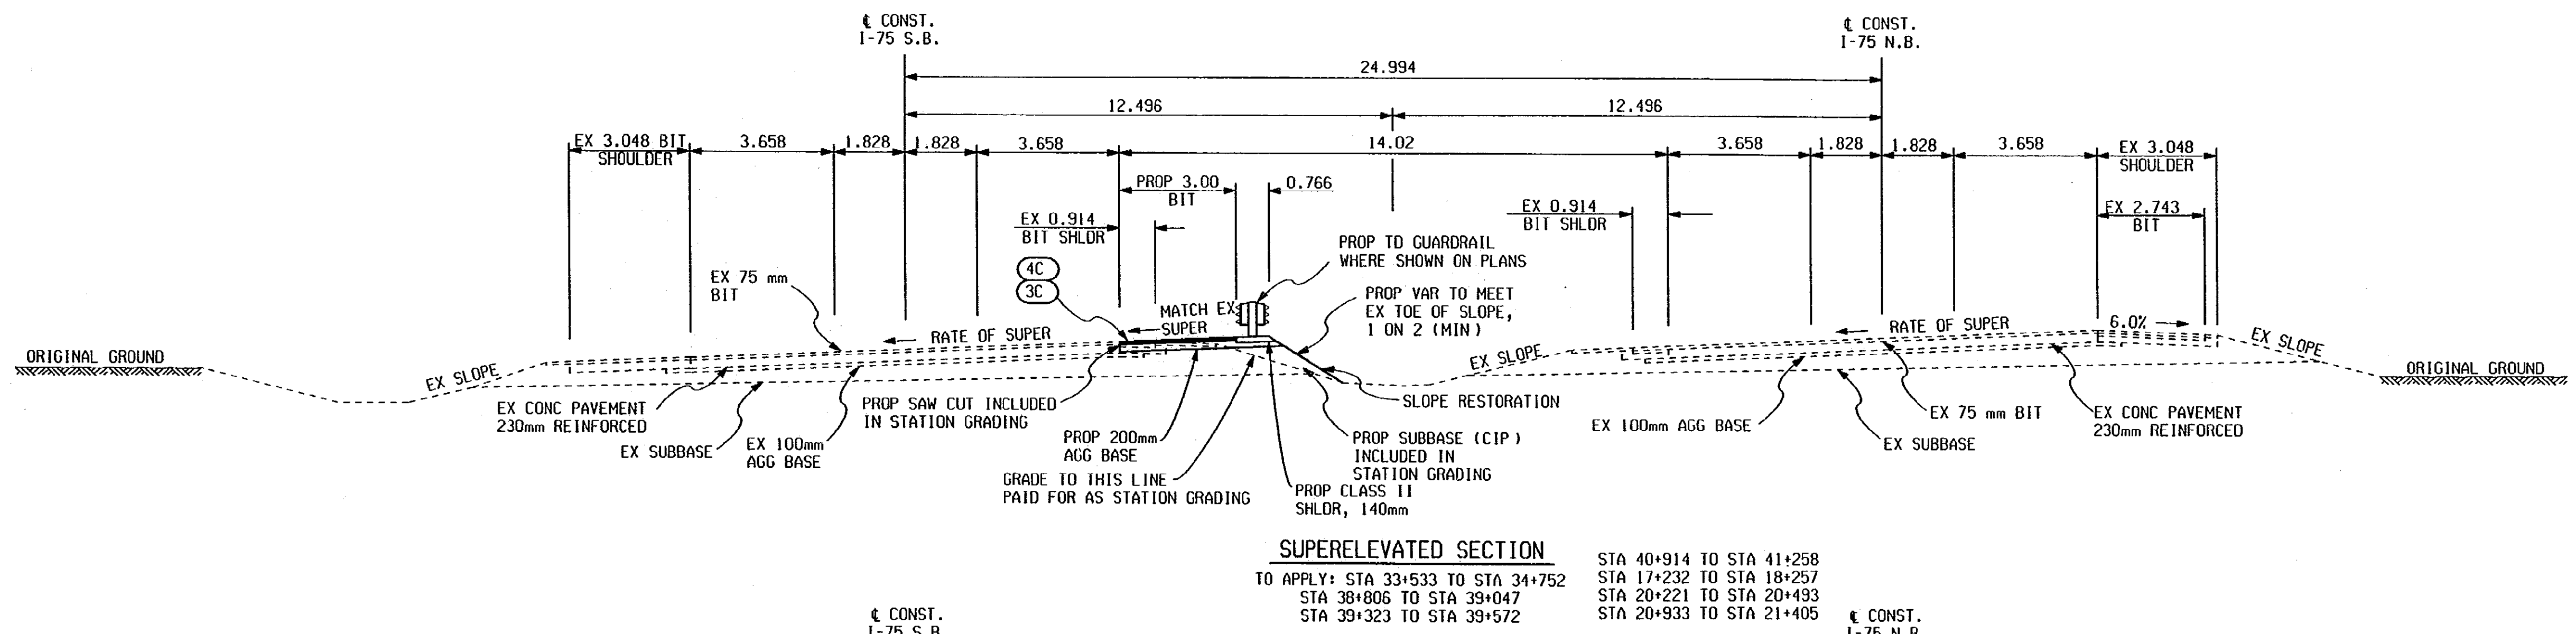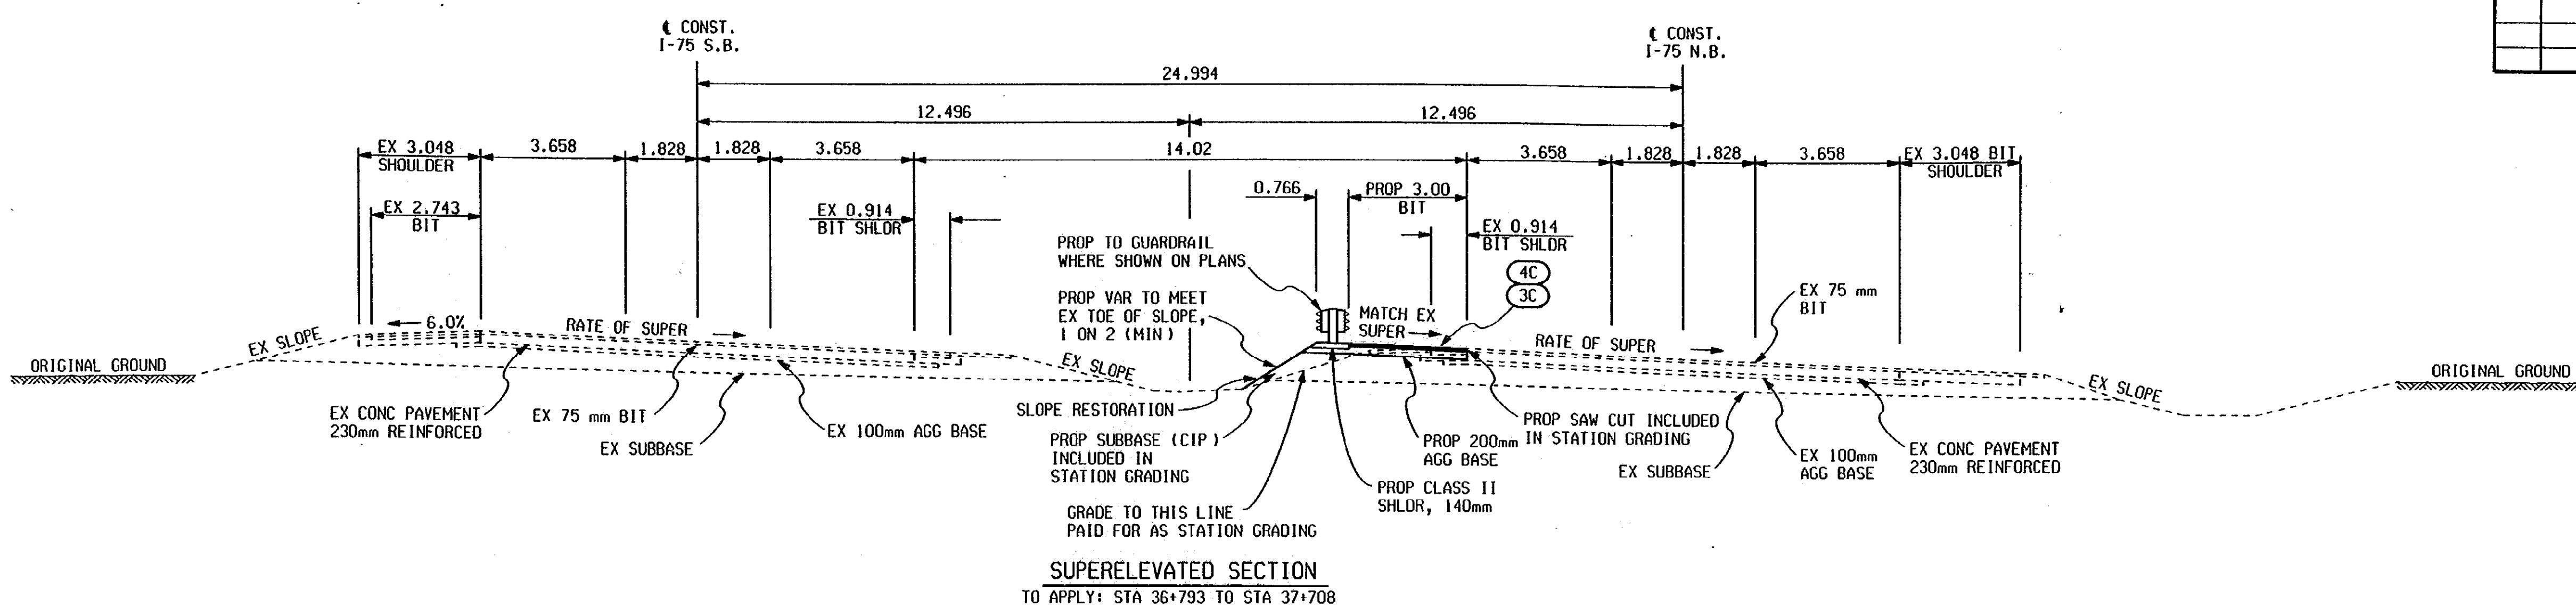

BITUMINOUS APPLICATION ESTIMATE

IDENT NO.	ITEM	RATE PER M ²	PERFORMANCE GRADE	REMARKS
4C	BITUMINOUS MIXTURE, 4C	140 kg	64-22	TOP COURSE
3C	BITUMINOUS MIXTURE, 3C	180 kg	64-22	LEVELING COURSE & BASE
	* BITUMINOUS BOND COAT	0-0.45 L		

*FOR INFORMATION ONLY

EX NORMAL SECTION



TO APPLY: STA 28+502 TO STA 33+533
 STA 34+752 TO STA 36+793
 STA 37+708 TO STA 38+806
 STA 39+047 TO STA 39+323
 STA 39+572 TO STA 40+914
 STA 41+258 TO STA 17+232
 STA 18+257 TO STA 20+221
 STA 20+493 TO STA 20+933
 STA 21+405 TO STA 26+620

NOTE: GUARDRAIL APPLIES TO JN 48647.
 SHOULDER IMPROVEMENTS APPLY TO JN 53697.

	TYPICAL CROSS SECTIONS					
	DATE	SCALE	CONT. SEC.	JOB NO.	DESIGN UNIT	SHEET NO.
	12/18/00	1:100	63174	48647/53697	RICK	R.O.W. 3

EXISTING BY: RICK'S TEAM DATE: 10/31/00
 PROPOSED BY: RICK'S TEAM DATE: 12-07-00
 LAST CORRECTION BY: RICK'S TEAM DATE: 01-11-01

FINAL R.O.W.			
AUTH	DATE	NO.	REVISION


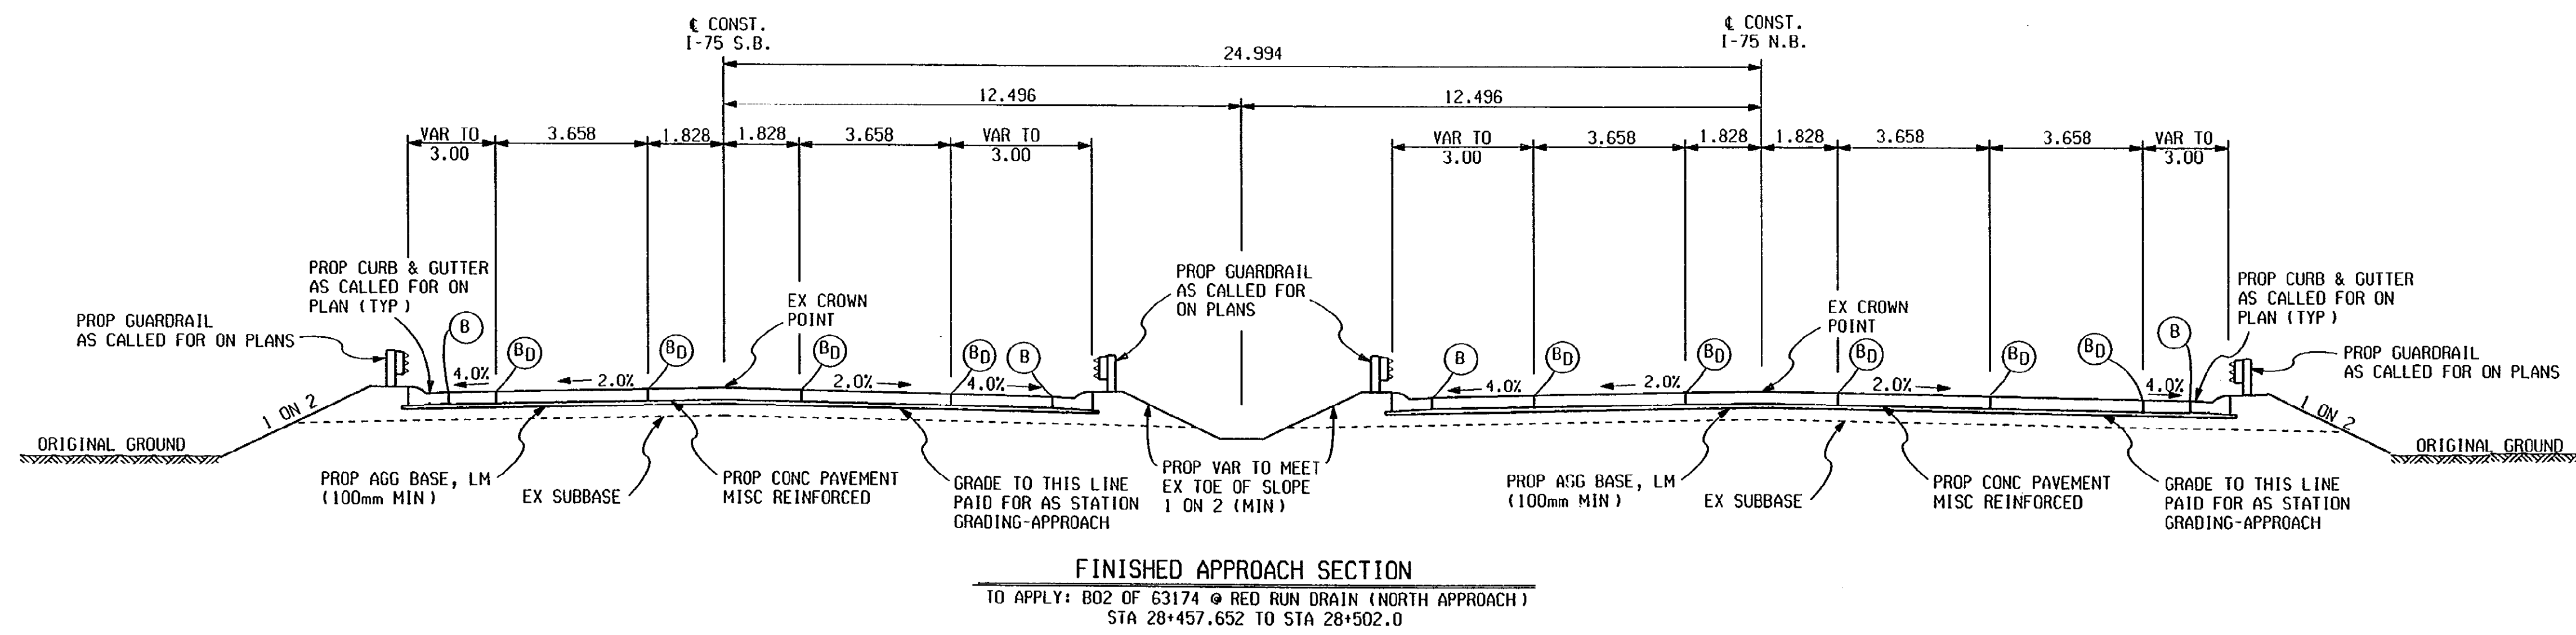
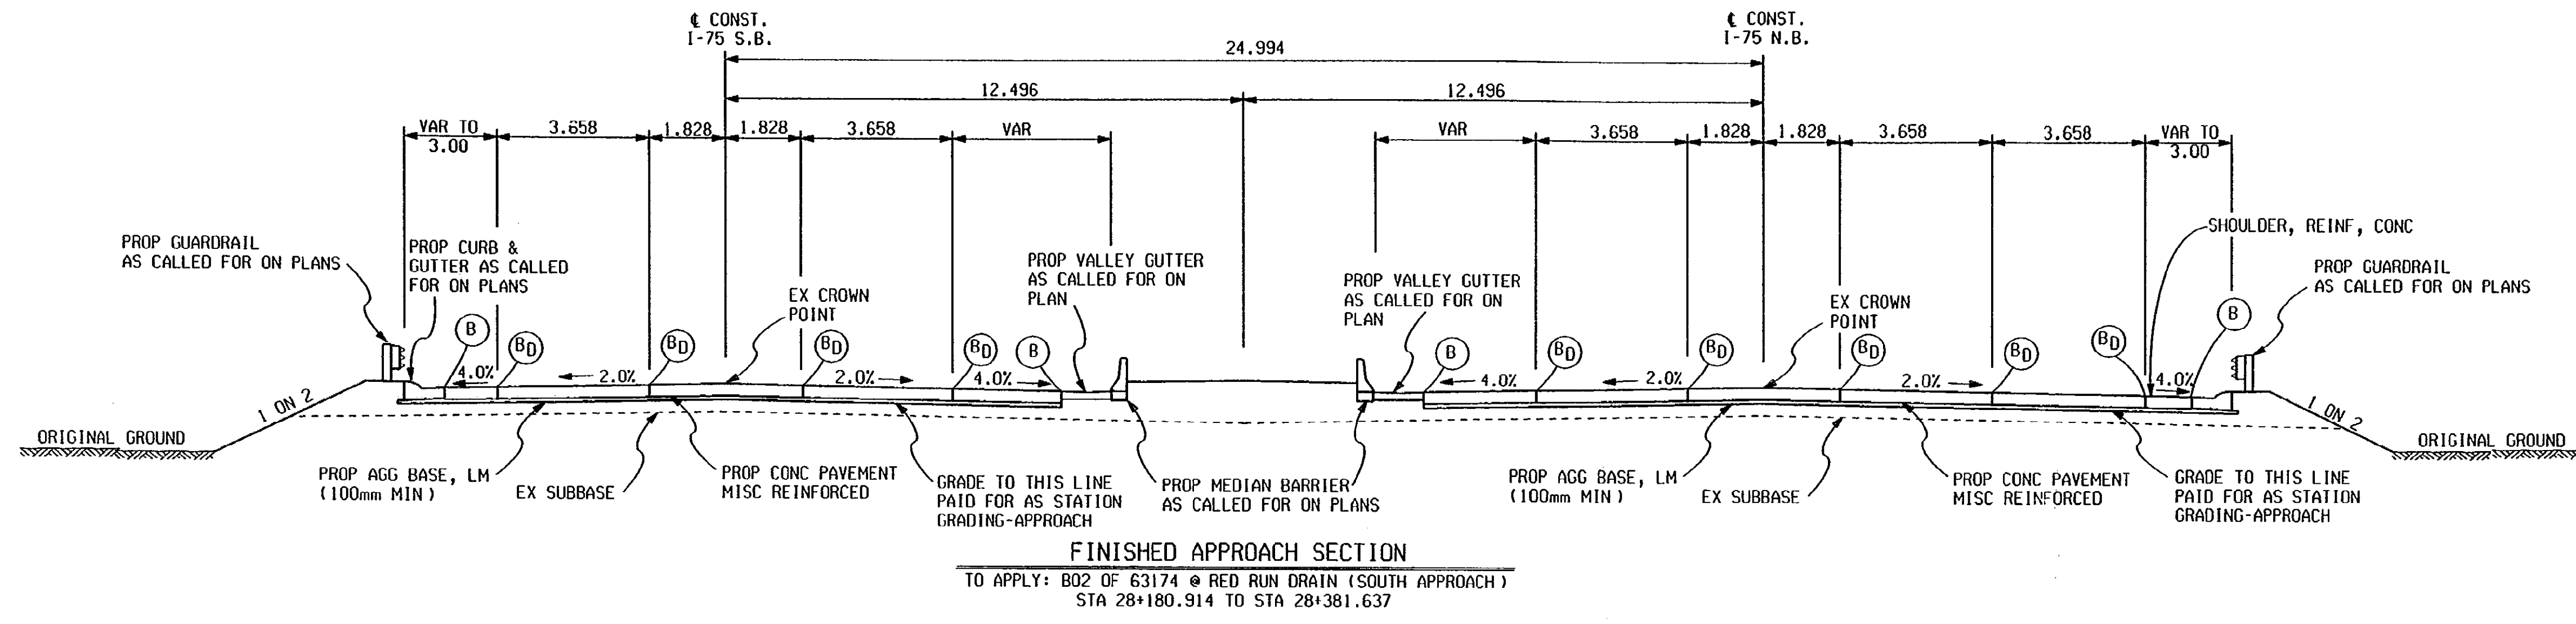


B - LONGITUDINAL BULKHEAD JOINT, SEALED ACCORDING TO STANDARD PLAN R-41 SERIES, SYMBOL (B)
 BD - OPTIONAL B OR D JOINT.

		BRIDGE APPROACH TYPICAL SECTIONS					
		DATE	SCALE	CONT. SEC.	JOB NO.	DESIGN UNIT	SHEET NO.
		12/15/00	1:100	63174	49595	RICK	R.O.W 4

EXISTING BY: RICK'S TEAM
 PROPOSED BY: RICK'S TEAM
 LAST CORRECTION BY: RICK'S TEAM
 DATE: 10/31/00
 DATE: 01-08-01
 DATE: 01-11-01

FINAL R.O.W.			
AUTH	DATE	NO.	REVISION

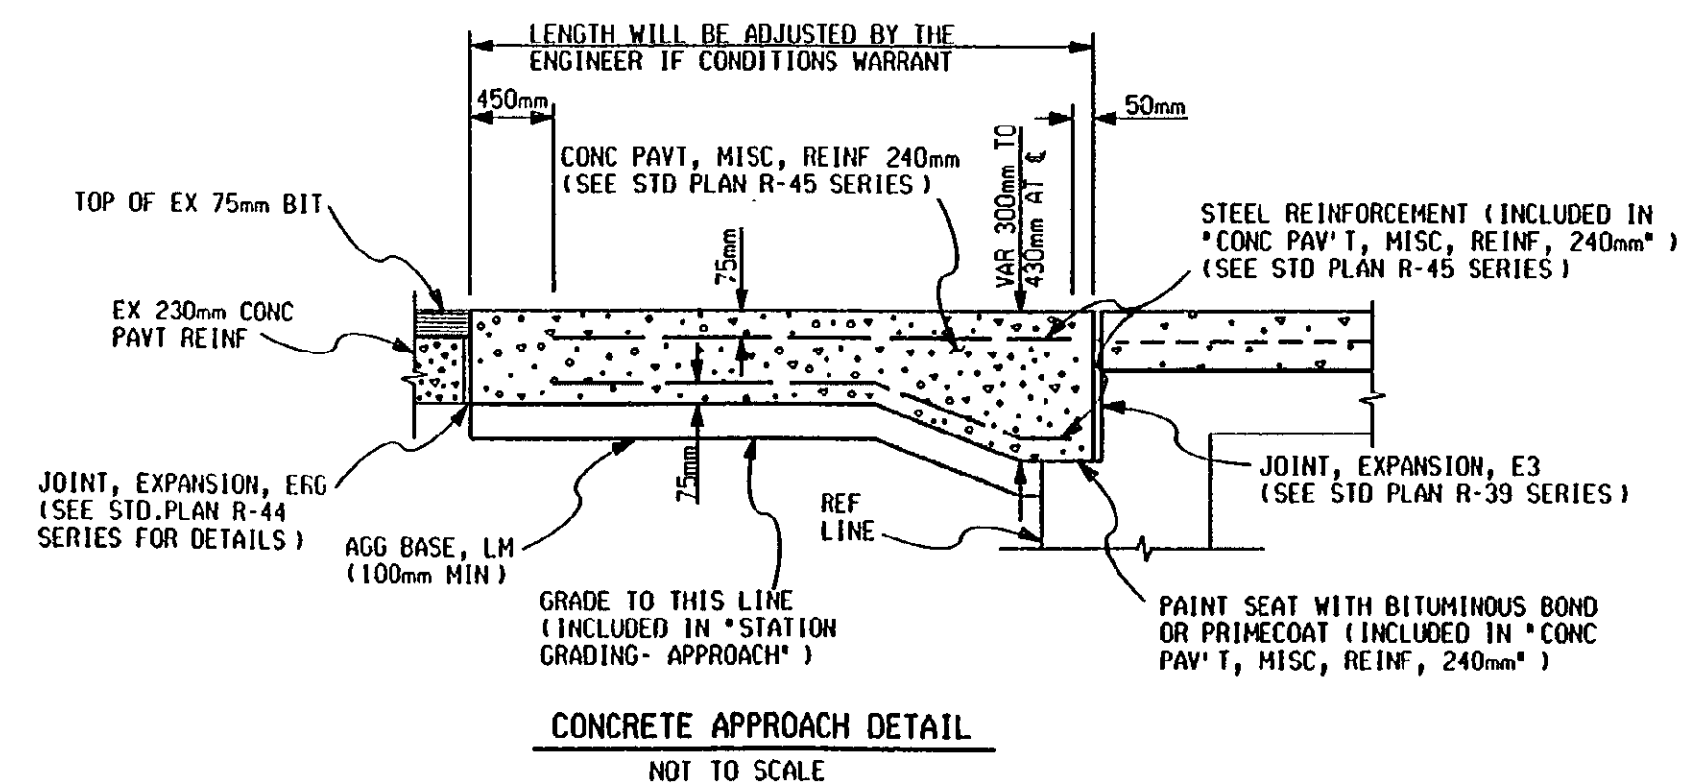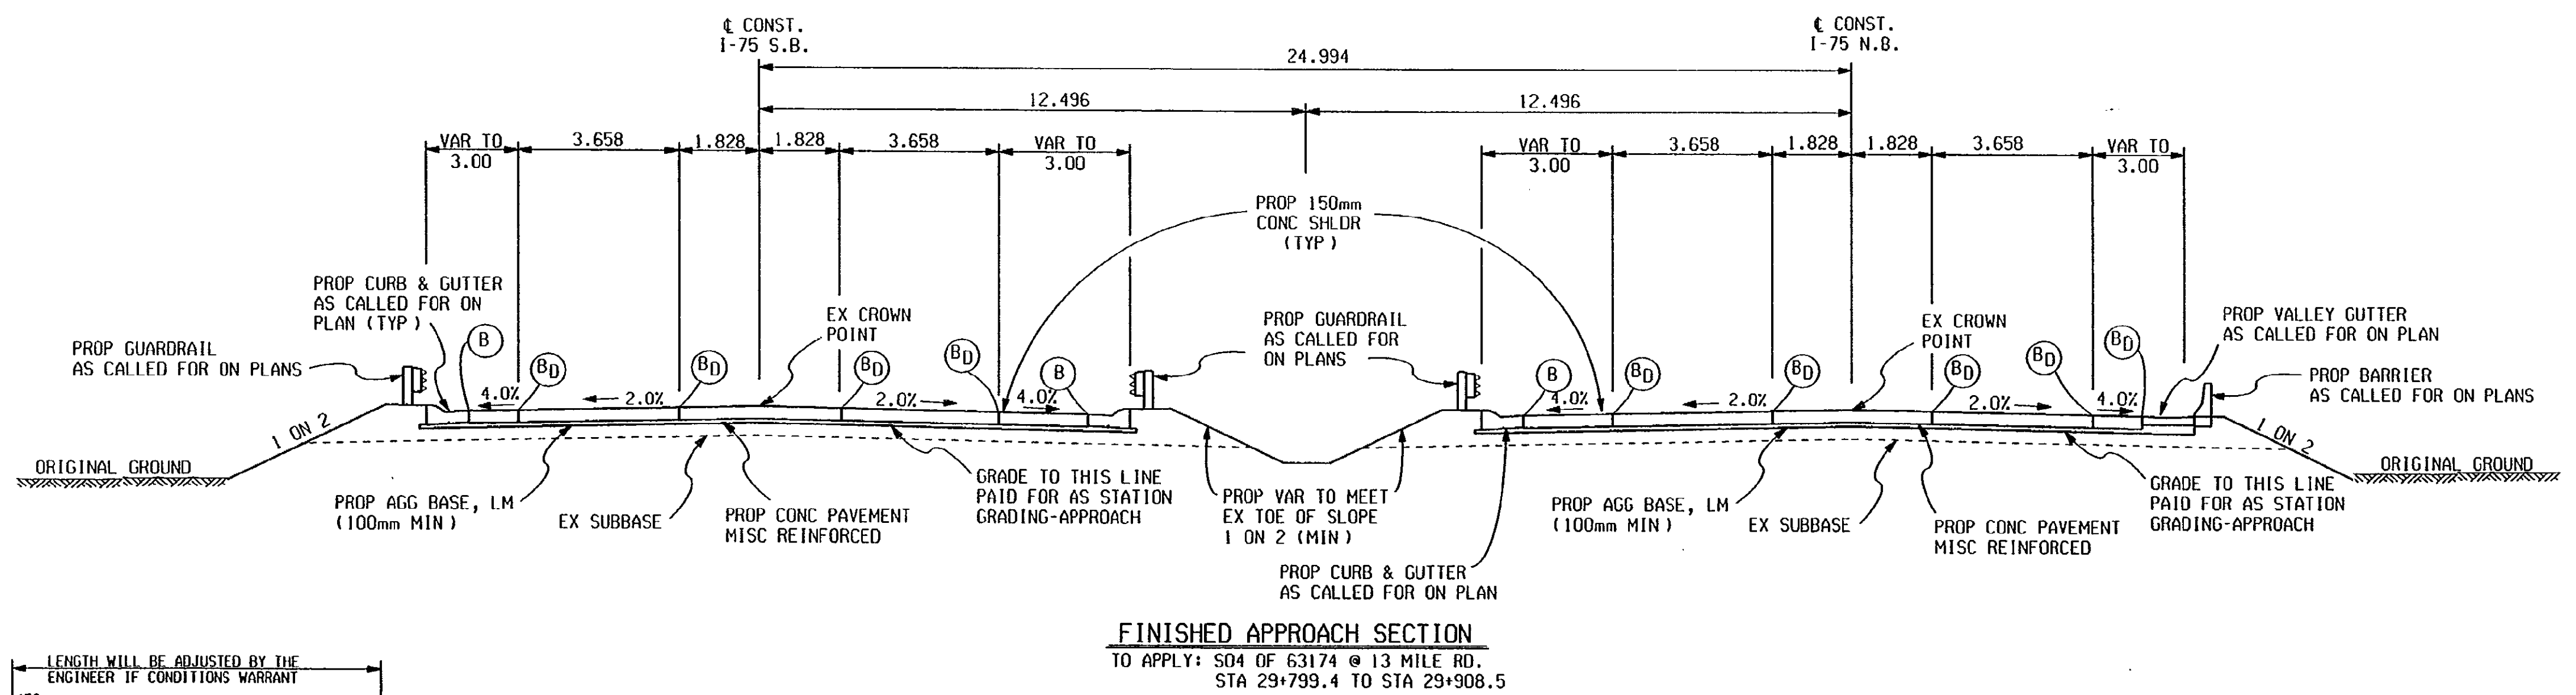
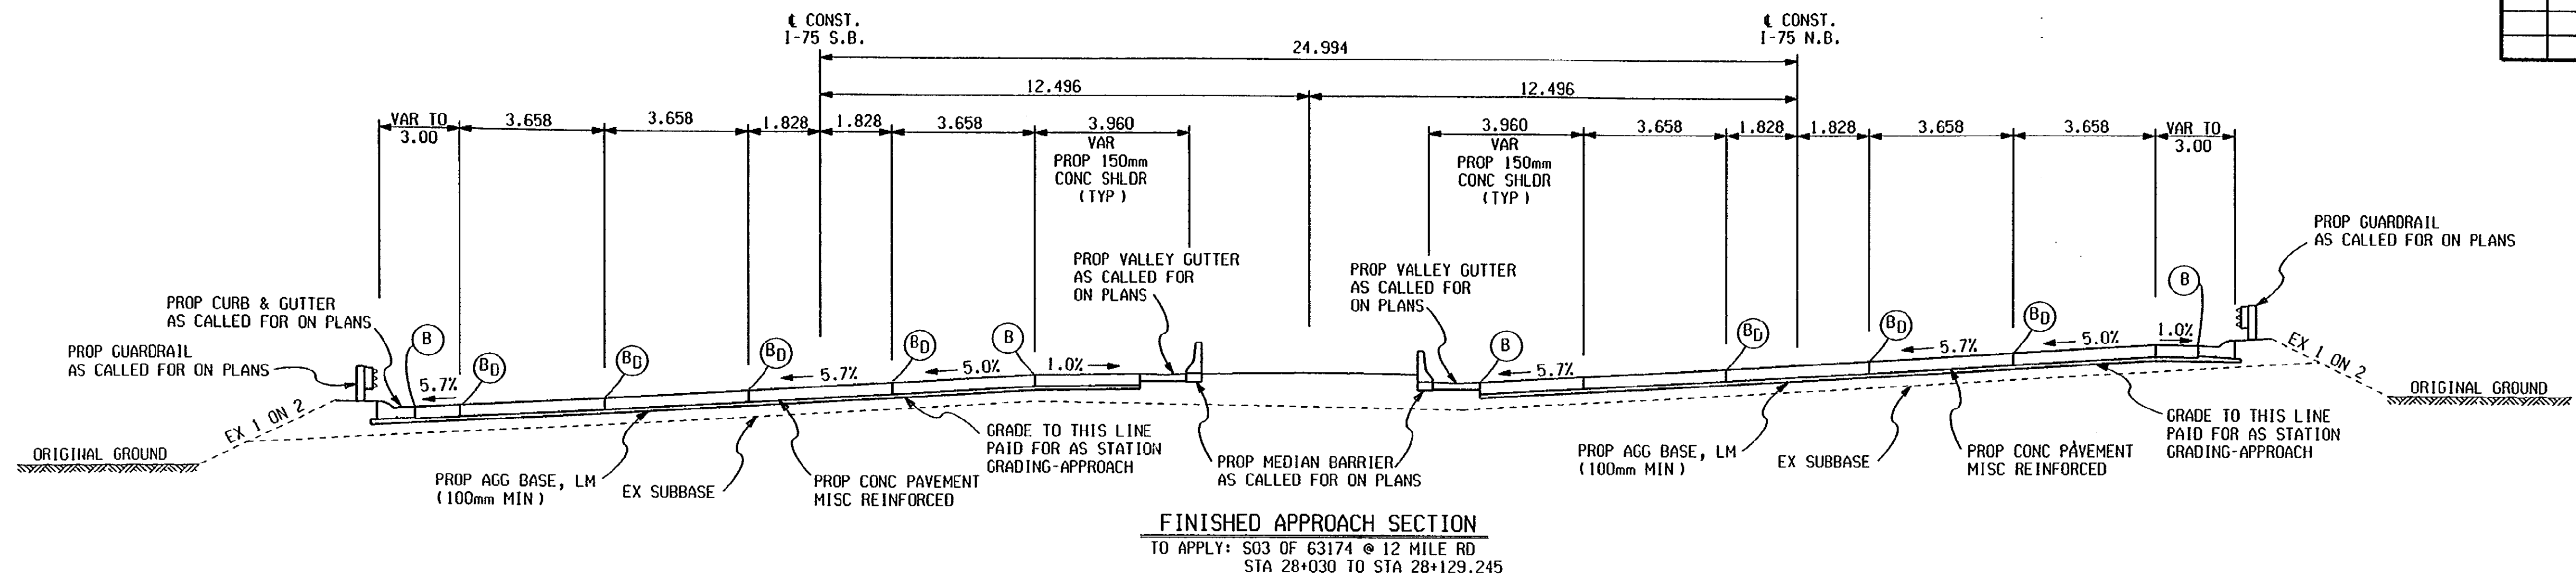


B - LONGITUDINAL BULKHEAD JOINT, SEALED ACCORDING TO STANDARD PLAN R-41 SERIES, SYMBOL (B)
 BD - OPTIONAL B OR D JOINT.

MDOT Michigan Department of Transportation		BRIDGE APPROACH TYPICAL SECTIONS				
DATE	SCALE	CONT. SEC.	JOB NO.	DESIGN UNIT	SHEET NO.	
01/11/01	1:100	63174	49595	RICK	R.O.W. 5	


DATE: 11/03/00
 EXISTING BY: RICK'S TEAM
 PROPOSED BY: RICK'S TEAM
 LAST CORRECTION BY: RICK'S TEAM
 DATE: 01-08-01
 DATE: 01-11-01

FINAL R.O.W.			
AUTH	DATE	NO.	REVISION

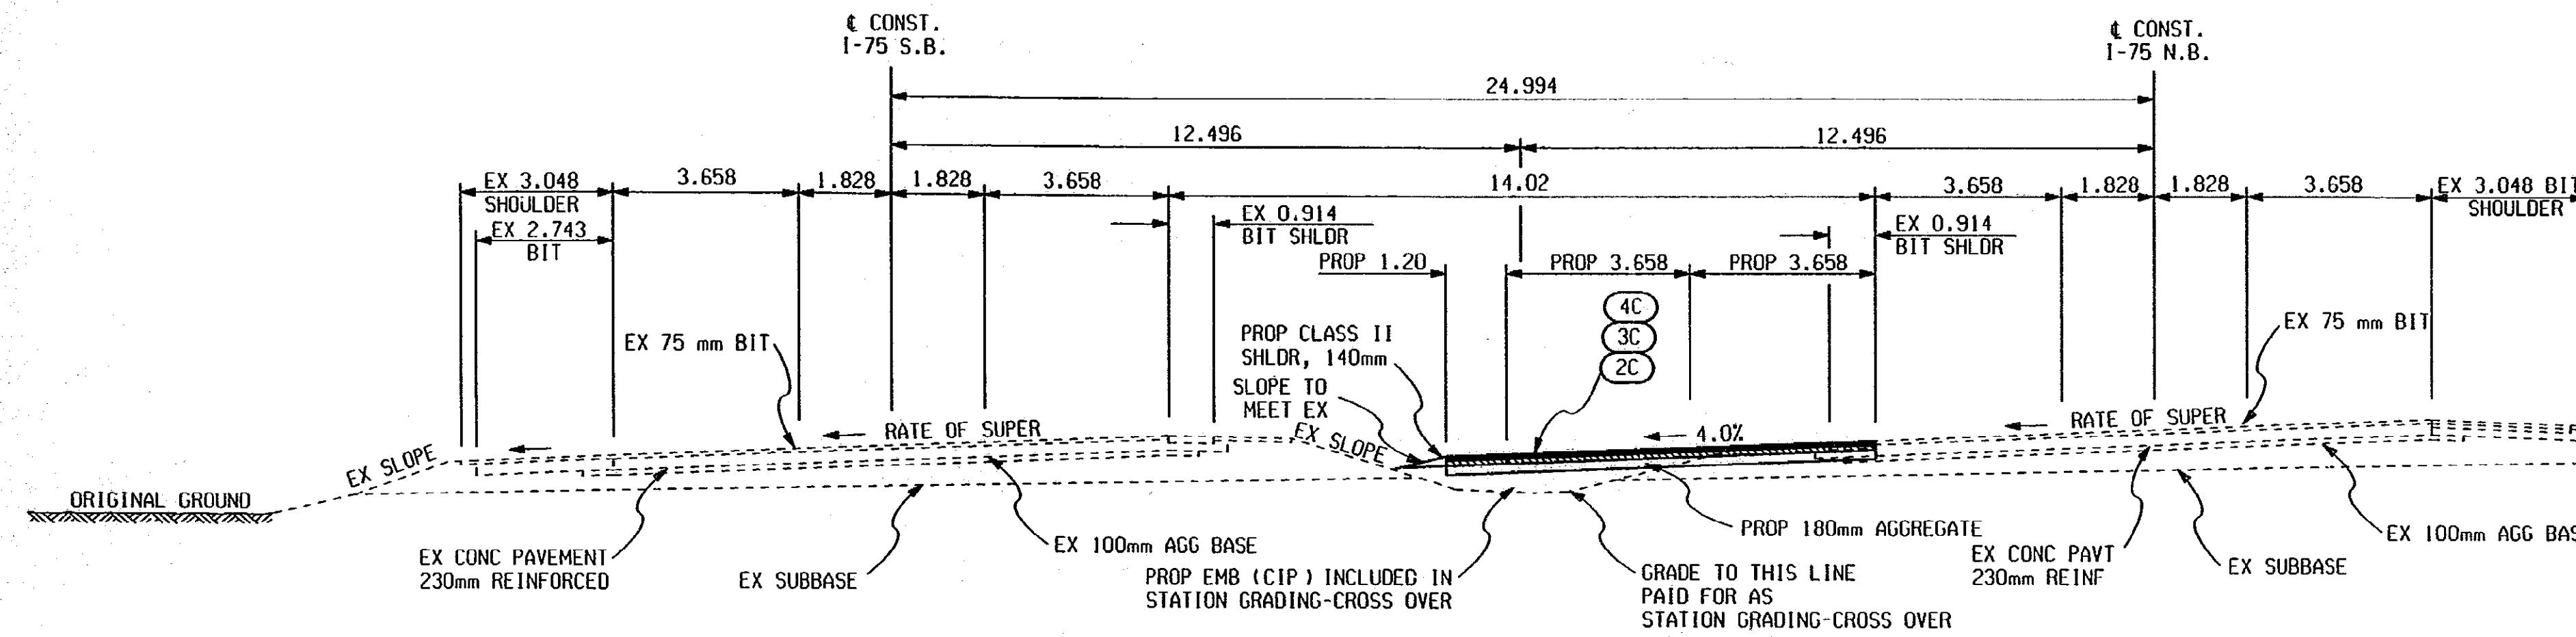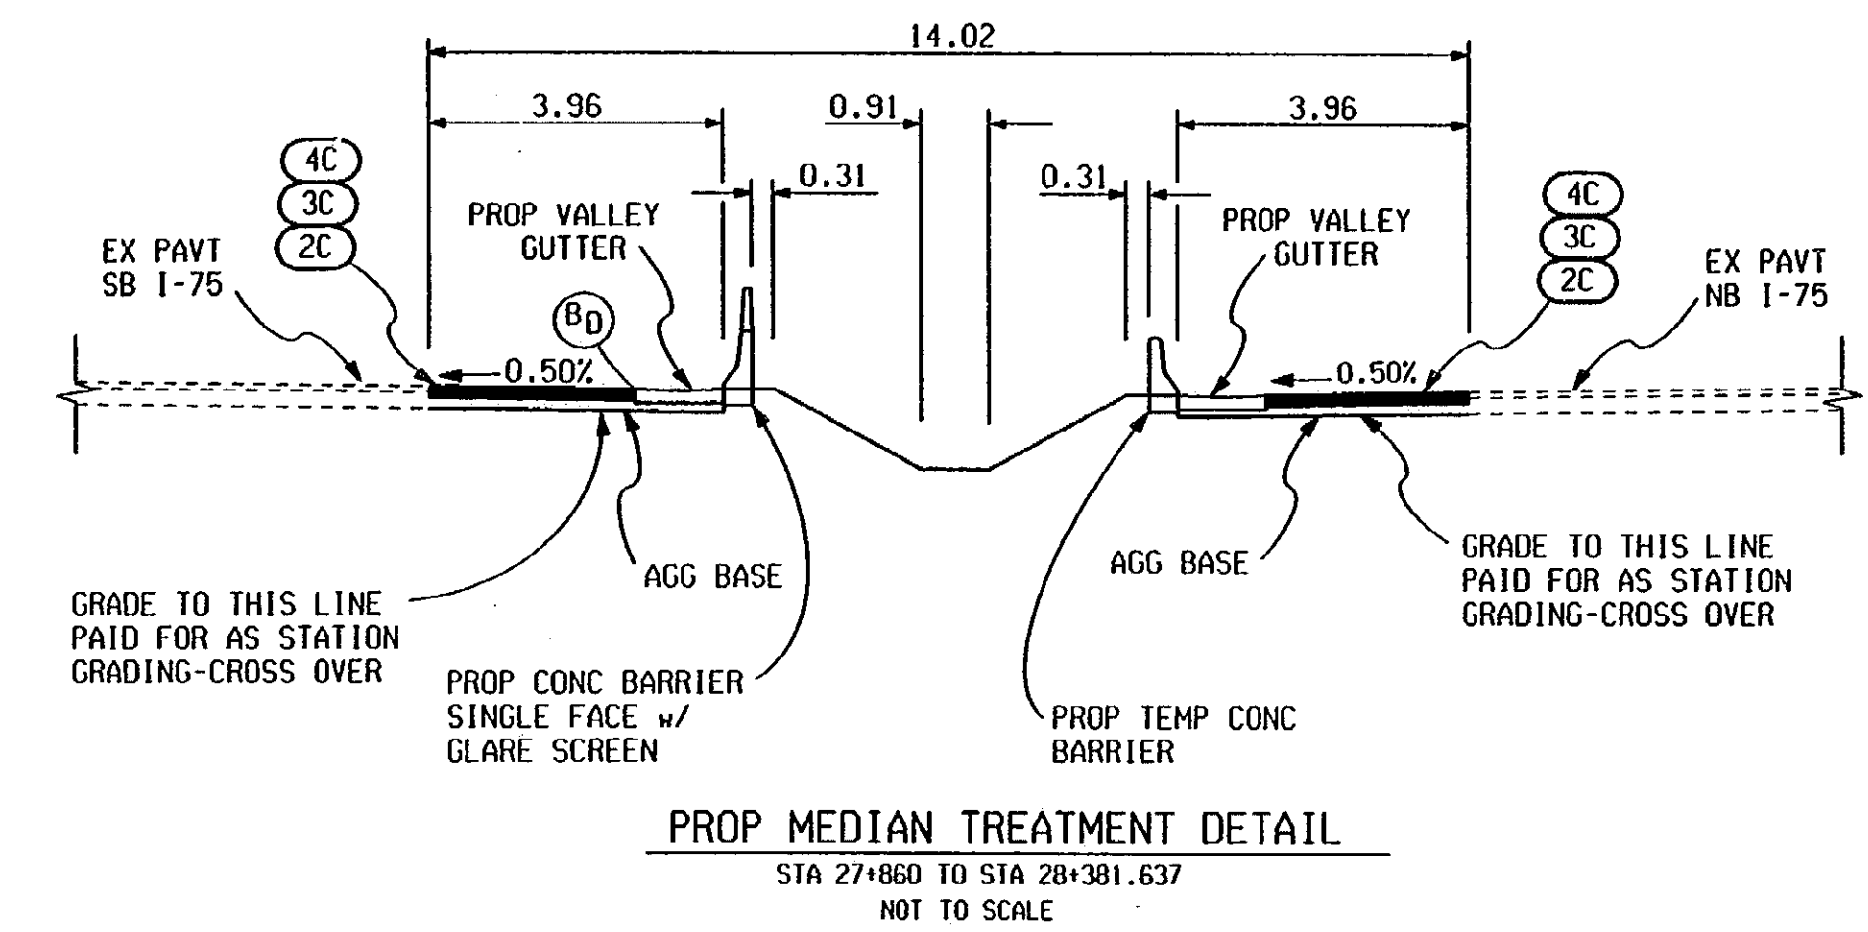


TEMPORARY CROSS OVER SECTION

TO APPLY: SOUTH OF 12-MILE RD.
 STA 10+175 TO STA 10+351.067

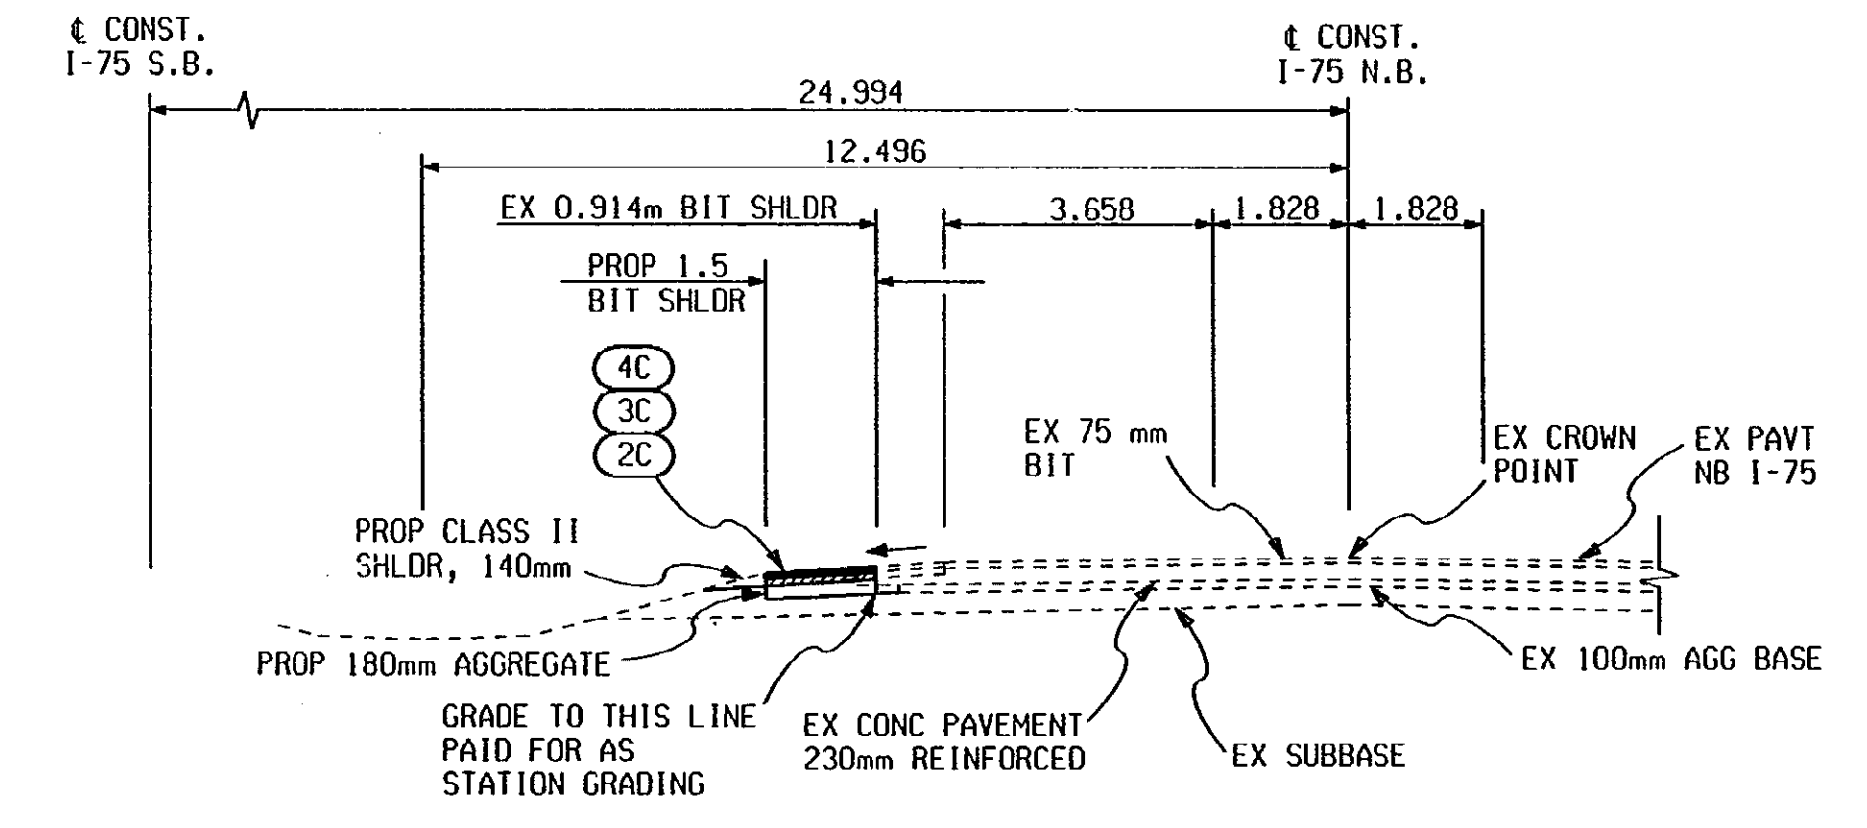

IMPROVED MEDIAN SHOULDER SECTION

TO APPLY: REDRUN TO 13 MILE
 STA 28+457.652 TO STA 30+100

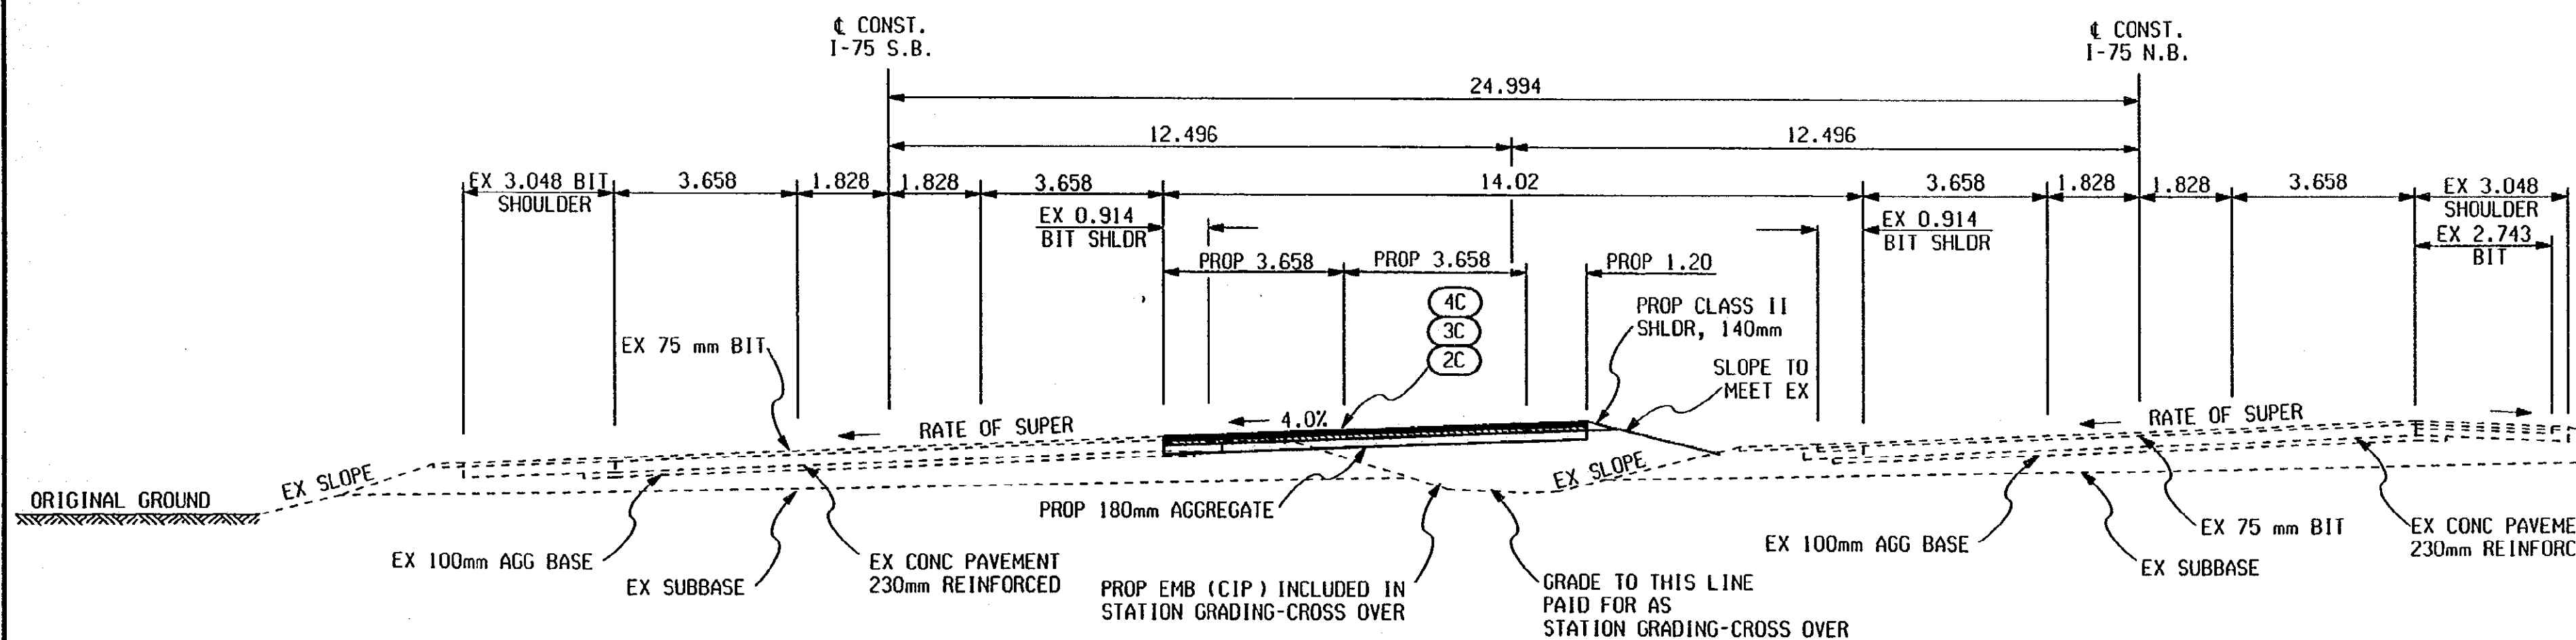

TEMPORARY CROSS OVER SECTION

TO APPLY: SOUTH OF 12 MILE RD.
 STA 10+000 TO STA 10+175

BITUMINOUS APPLICATION ESTIMATE


IDENT NO.	ITEM	RATE PER M ²	PERFORMANCE GRADE	REMARKS	
4C	BITUMINOUS MIXTURE, 4C	90 kg	64-22	TOP COURSE, CROSS OVER	PAID FOR AS BIT APPROACH
3C	BITUMINOUS MIXTURE, 3C	120 kg	64-22	LEVEL COURSE, CROSS OVER	PAID FOR AS BIT APPROACH
2C	BITUMINOUS MIXTURE, 2C	240 kg	64-22	BASE COURSE, CROSS OVER	PAID FOR AS BIT APPROACH
	* BITUMINOUS BOND COAT	0-0.45 L			

*FOR INFORMATION ONLY


MDOT Michigan Department of Transportation		TYPICAL CROSS SECTIONS					
DATE	SCALE	CONT. SEC.	JOB NO.	DESIGN UNIT	SHEET NO.		
01/11/01	1:100	63174	49595	RICK	R.O.W.	6	

EXISTING BY: RICK'S TEAM DATE: 01-10-01
 PROPOSED BY: RICK'S TEAM DATE: 01-10-01
 LAST CORRECTION BY: RICK'S TEAM DATE: 01-10-01

FINAL R.O.W.			
AUTH	DATE	NO.	REVISION

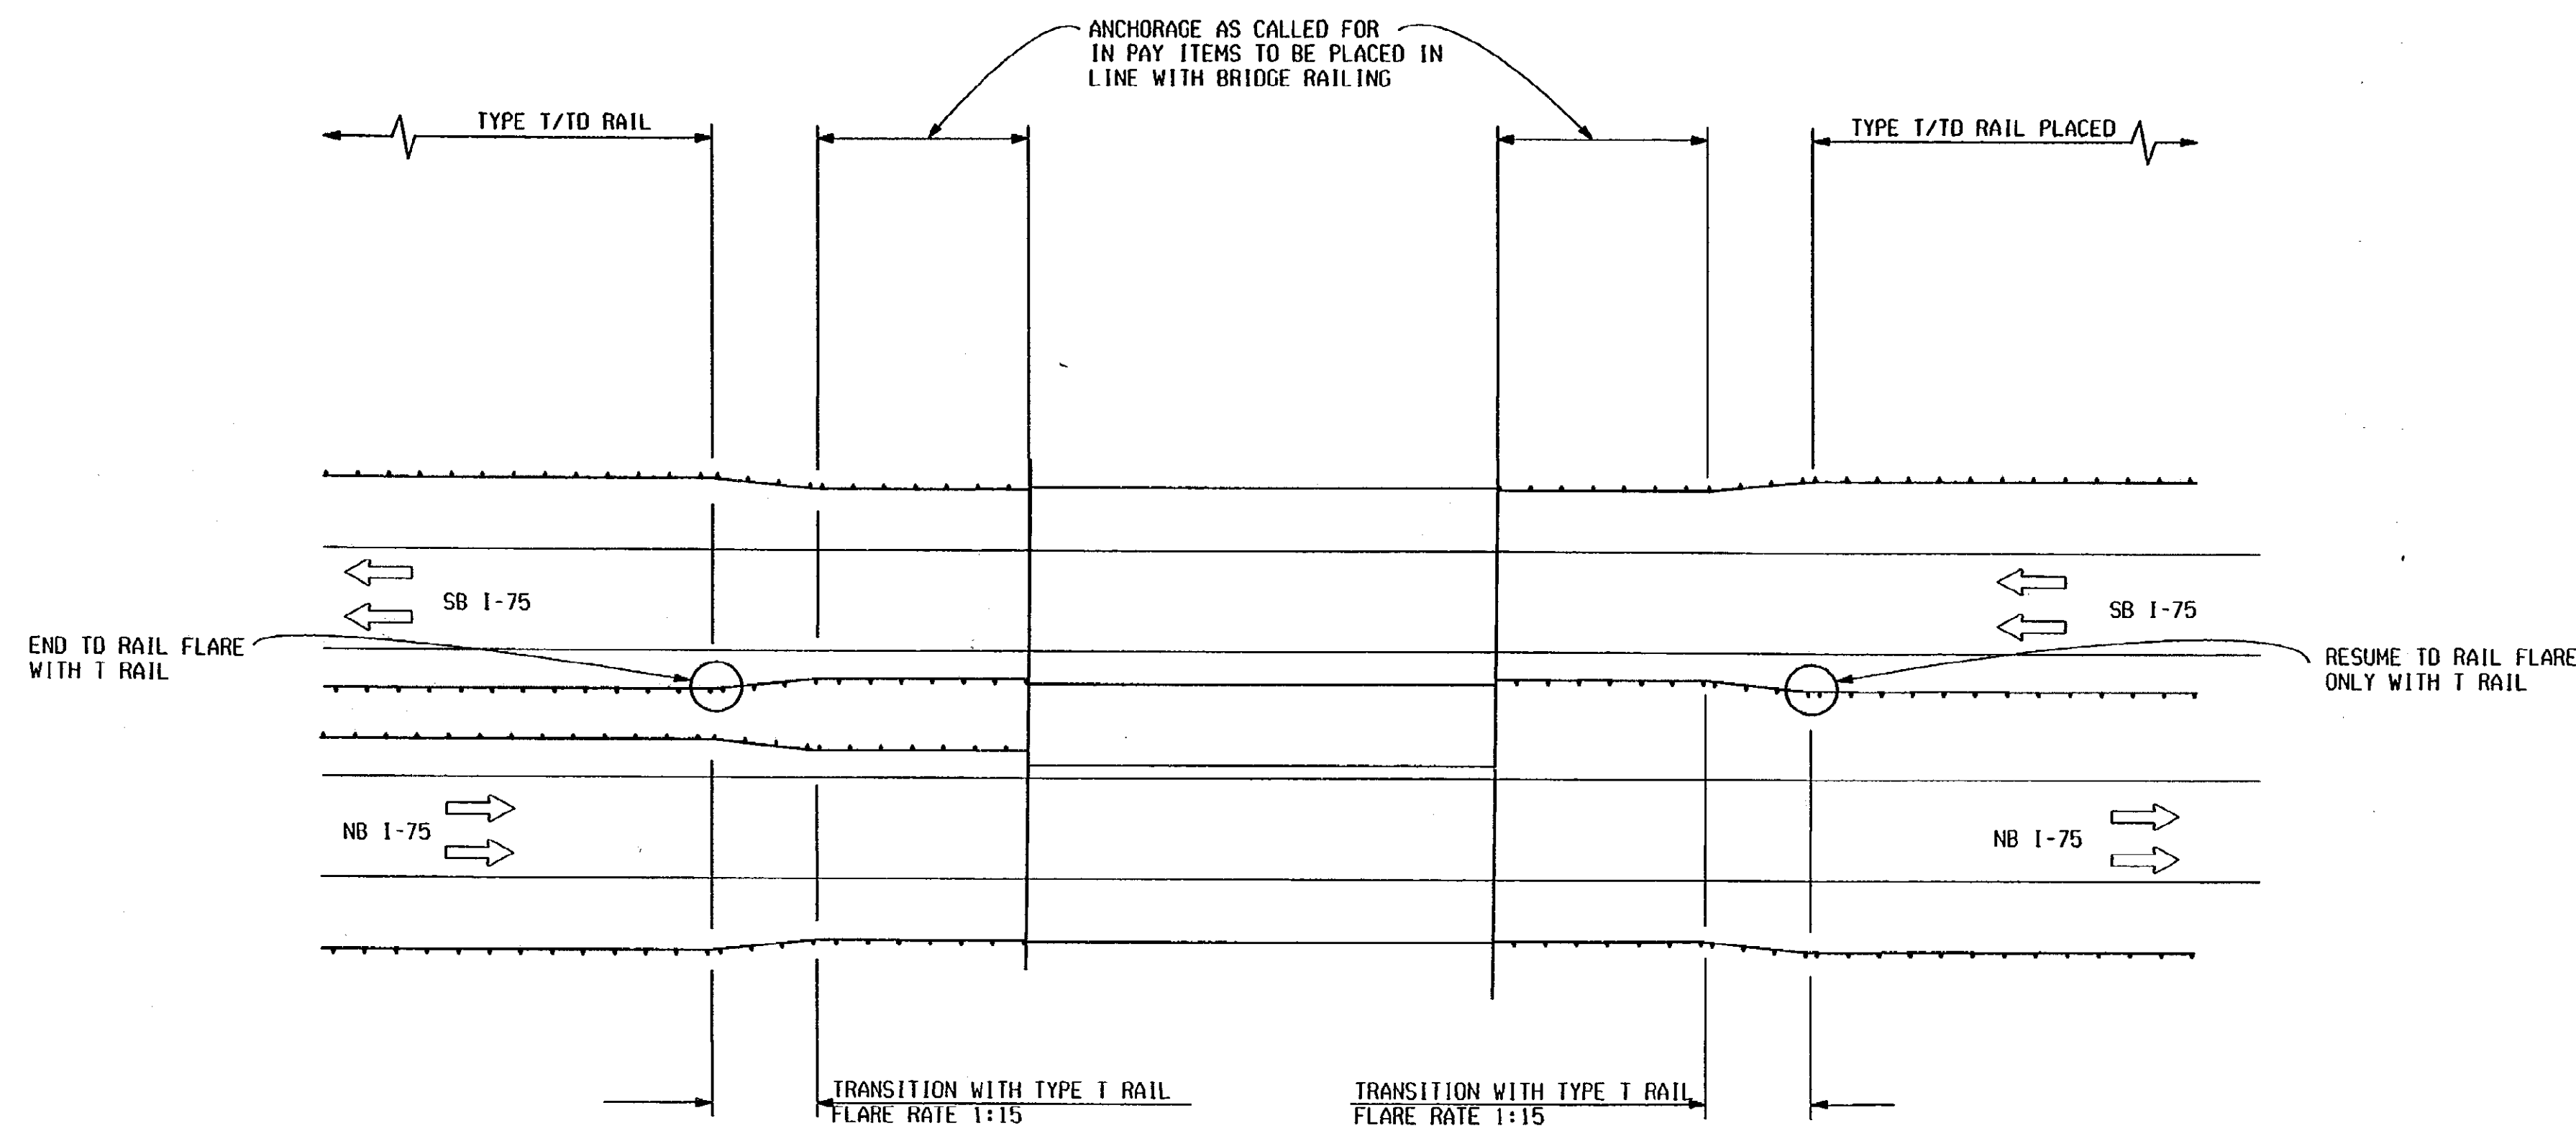

TO APPLY AT ALL STRUCTURES CARRYING I-75 OVER CROSS ROADS
 NOT TO SCALE

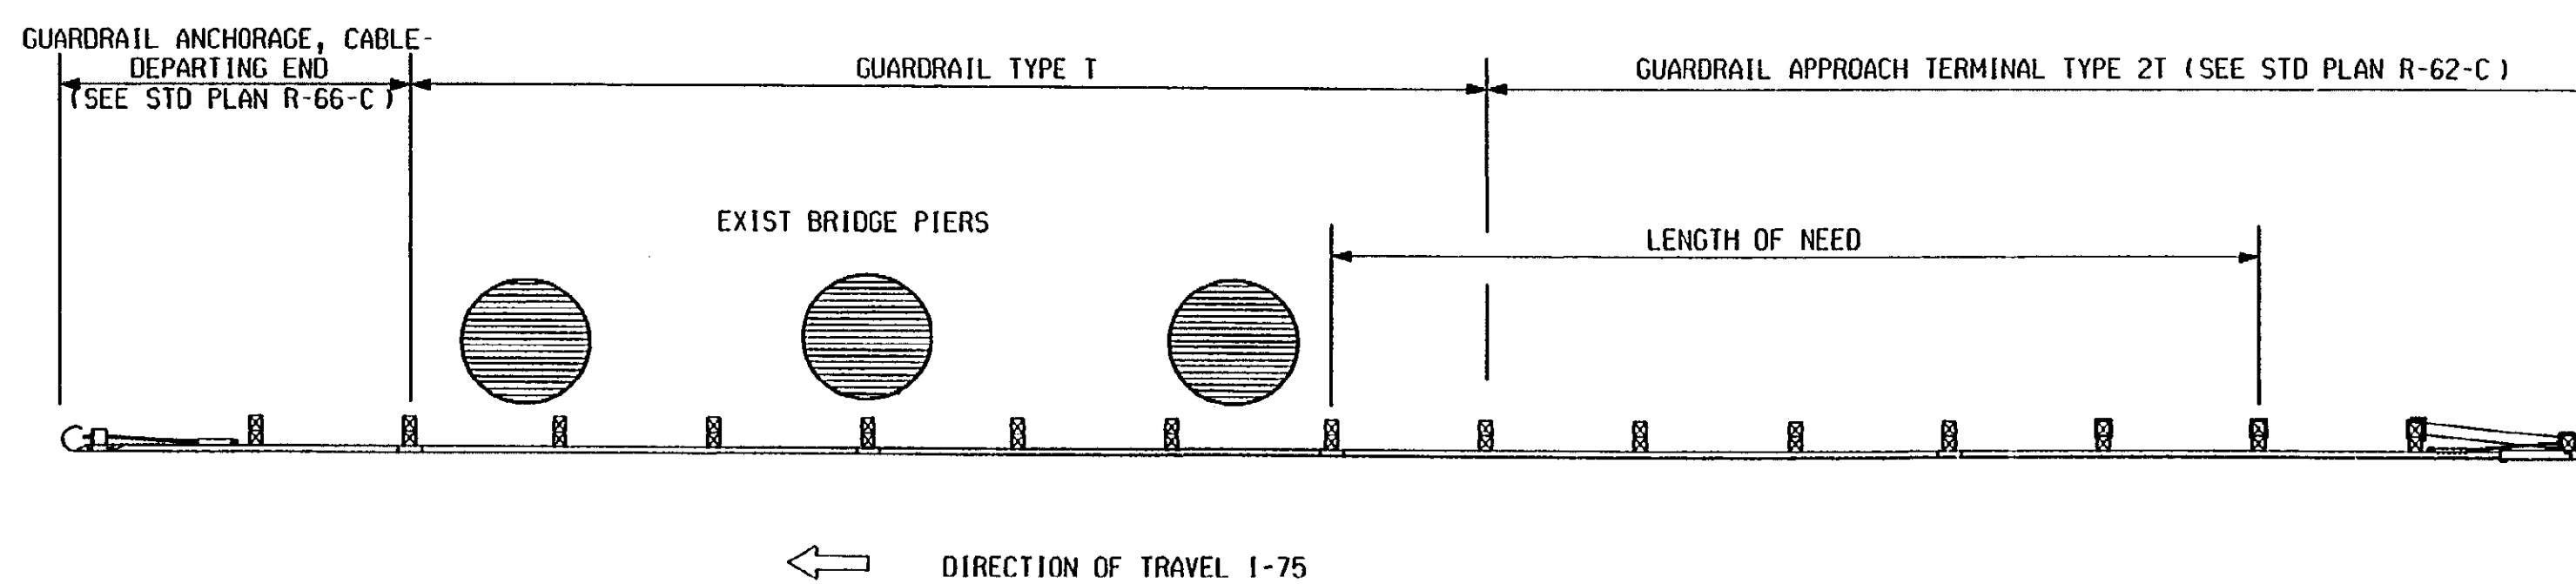

TO APPLY AT ALL STRUCTURES CARRYING I-75 UNDER CROSS ROADS
 NOT TO SCALE

26

FILE NAME: 53697detal1.dgn
 1 2 3 4 11

	GUARDRAIL DETAILS					
	DATE	SCALE	CONT. SEC.	JOB NO.	DESIGN UNIT	SHEET NO.
01/10/01	1:NONE	63174	53697	RICK	R.O.W	7

JOB NO. 53697, 49595 & 48647
 CONTROL SECTION 63174
 SH. NO. 8
 LAST CORRECTION BY: RICK'S TEAM DATE: 01-22-01
 FILE NAME: 49595note.dgn
 1,2

ENGINEERING REPORT NO	ENVIRON IMPACT STMT
METHOD OF SURVEY	YEAR
SURVEY ORDER	SURVEY CHIEF
AERIAL SURVEY NO	YEAR
HORIZ DATUM	VERT DATUM
ROAD DESIGN INITIATED 1999	COMPLETED 2000
PRELIMINARY PLANS BY RICK	FINAL PLANS BY RICK & SCHUSTER
FIELD INSPECTION (G) BY TIM BARRY	DATE 11-01-00
PLANS-IN-HAND BY (FHWA)	AND (MDOT)
	DATE

GENERAL PLAN NOTES

UNDERGROUND UTILITIES
 FOR PROTECTION OF UNDERGROUND UTILITIES AND IN CONFORMANCE WITH PUBLIC ACT 63, 1974, THE CONTRACTOR SHALL DIAL 1-800-482-7171 A MINIMUM OF THREE FULL WORKING DAYS, EXCLUDING SATURDAYS, SUNDAYS, AND HOLIDAYS PRIOR TO BEGINNING EACH EXCAVATION IN AREAS WHERE PUBLIC UTILITIES HAVE NOT BEEN PREVIOUSLY LOCATED. MEMBERS WILL THUS BE ROUTINELY NOTIFIED. THIS DOES NOT RELIEVE THE CONTRACTOR OF THE RESPONSIBILITY OF NOTIFYING UTILITY OWNERS WHO MAY NOT BE A PART OF THE "MISS DIG" ALERT SYSTEM.

MDOT'S FREEWAY LIGHTING SYSTEM, THE SCANDI SYSTEM AND OTHER MISCELLANEOUS ELECTRICAL SYSTEMS ARE NOT A PART OF MISS DIG.

CONTRACTORS WORKING OUTSTATE SHOULD CONTACT THE MAINTENANCE REPRESENTATIVE AT THE MDOT DISTRICT OFFICE TO HAVE LIGHTING SYSTEMS STAKED.

GRADES FOR INTERSECTIONS
 ALL INTERSECTIONS ARE TO BE CONSIDERED AS COMPLETE UNITS AND THEIR GRADES DETERMINED BEFORE CONSTRUCTION IS STARTED.

OLD PLANS
 THE FOLLOWING OLD PLANS WERE REFERRED TO IN THE DESIGN OF THIS PROJECT.

- 63174.C2
- 63174.C4
- 63174.C14
- 63174.C8
- 63174.C3

IN ADDITION, OTHER OLD PLANS THAT PREDATE THIS PROJECT MAY BE AVAILABLE. THESE PLANS MAY BE REVIEWED IN THE LANSING DESIGN OFFICE DURING NORMAL WORKING HOURS.

STATIONING
 STATIONING ON THIS PROJECT WAS CONVERTED FROM OLD PLANS AND IS NOT NECESSARILY CORRECT.

SIGNS
 ANY MDOT SIGNS REQUIRING RELOCATION DUE TO CONSTRUCTION OPERATIONS SHALL BE SALVAGED AND RESET BY THE CONTRACTOR AT LOCATIONS DESIGNATED BY THE ENGINEER. THIS WORK WILL BE CONSIDERED INCLUDED IN PAYMENT FOR OTHER CONTRACT ITEMS.

PAVEMENT REMOVAL QUANTITIES
 PAVEMENT REMOVAL AS SHOWN ON THE PLANS SHALL BE AT THE DISCRETION OF THE ENGINEER. IF IN HIS/HER JUDGEMENT, AREAS OF PAVEMENT MAY BE LEFT IN PLACE, OR ADDITIONAL AREAS ADDED TO PROVIDE THE PROPER CROSS-SECTION AND BASE, CHANGES CAN BE MADE IN THE QUANTITIES.

MILLING PAVEMENT
 PRIOR TO MILLING THE PAVEMENT, THE CONTRACTOR SHALL HAVE AN APPROVED MIX DESIGN AND AN ADEQUATE SUPPLY OF MATERIAL TO INSURE THAT THE FIRST LIFT OF THE SPECIFIED BITUMINOUS MIXTURE CAN BE PLACED ON ALL MILLED SURFACES

MITS
 CALL MITS (313-256-9800) FOR LOCATION OF FIBER OPTIC LINES. IN CASE OF AN EMERGENCY CALL (313) 256-9800 EXT 310

GUARDRAIL POSTS
 ALL GUARDRAIL POSTS EXCEPT APPROACH AND DEPARTING TERMINALS SHALL BE 2440mm IN LENGTH.

SHOULDER CORRUGATIONS
 FOR JOB NUMBER 53697 THE SHOULDER CORRUGATIONS SHALL BE ROLLED IN AT THE TIME OF PAVING AND WILL NOT BE PAID FOR SEPARATELY.
 FOR JOB NUMBER 49595 THE SHOULDER CORRUGATIONS SHALL BE GROUND IN AND PAID FOR SEPARATELY.

REMOVAL OF CROSSOVERS
 EXISTING CROSSOVERS SHALL BE REMOVED UNLESS OTHERWISE NOTED ON THE PLANS. PAYMENT SHALL BE INCLUDED IN THE QUANTITY FOR STATION GRADING.

DETROIT EDISON ELECTRIC
 OVERHEAD & UNDERGROUND DISTRIBUTION:
 DENNIS DOHERTY
 ROYAL OAK SERVICE CENTER
 3425 STARR RD
 ROYAL OAK, MI 48067
 PHONE: (248) 594-710

SYSTEM UNDERGROUND-AREA LEADER:
 DEBORAH SCHWOCHOW
 520 SERVICE BUILDING
 2000 SECOND AVENUE
 DETROIT, MI 48226-1279
 PHONE: (313) 235-6502

OUTDOOR LIGHTING GROUP:
 LARRY LACEY
 108 WESTERN WAYNE SERVICE CENTER
 8001 HAGGERTY RD
 BELLEVILLE, MI 48111
 PHONE: (734) 397-4185

SYSTEM UNDERGROUND-TECHNICIAN:
 GARY GORDON
 520 SERVICE BUILDING
 2000 SECOND AVENUE
 DETROIT, MI 48226
 PHONE: (313) 235-6507

PUBLIC UTILITIES

THE EXISTING UTILITIES LISTED BELOW AND SHOWN ON THESE PLANS REPRESENT THE BEST INFORMATION AVAILABLE AS OBTAINED ON OUR SURVEYS. THIS INFORMATION DOES NOT RELIEVE THE CONTRACTOR OF THE RESPONSIBILITY TO BE SATISFIED AS TO IT'S ACCURACY AND THE LOCATION OF EXISTING UTILITIES.

NAME OF OWNER	KIND OF UTILITY	PHONE
AMERITECH ATTN: MICHAEL KRAUSE PONTIAC/SOUTHFIELD ENGINEERING OFFICE 54 N. HILL ST BOX 33 PONTIAC, MICHIGAN 48342 PHONE: (248) 456-0841		
COMCAST CABLEVISION OF PONTIAC, WATERFORD ATTN: JIM CHURCH 1300 CRESENT LAKE RD WATERFORD, MI 48327 PHONE: (248) 674-0500	CABLE TV	
MEDIA ONE ATTN: STEVE S RUDZINSKI NETWORK DESIGN SUPERVISOR 35155 INDUSTRIAL ROAD LIVONIA, MI 48150 PHONE: (724) 420-4790	PHONE & CABLE TV	
AT&T CABLE SERVICES ATTN: LARRY VALE, MANAGER 4500 DELEMERE BOULEVARD ROYAL OAK, MICHIGAN 48073 PHONE: (248) 549-8288 FAX: (248) 549-6289	CABLE TV	
AT&T (TELEPHONE ONLY) ATTN: TOM WHITECOTTON 866 ROCK CREEK RD PLANO, ILLINOIS 60545 PHONE: (630) 522-4676	TELEPHONE	
COMCAST CABLEVISION OF PONTIAC, WATERFORD ATTN: JIM CHURCH 1300 CRESENT LAKE ROAD WATERFORD, MI 48327 PHONE: (810) 674-0500	CABLE TV	
CHARTER COMMUNICATIONS CO. ATTN: KELLY DYKSTRA 1035 SPALDING AVE., S.E. GRAND RAPIDS, MI 49546 PHONE: (616) 975-7482	TELEPHONE	
McLEOD USA TELCOMMUNICATIONS ATTN: PAUL LABRIE 444 W. BRISTOL RD. FLINT, MI 48907 PHONE: (810) 249-4568	TELEPHONE	
CONSUMERS ENERGY COMPANY ATTN: JOSEPHINE J. VANEPPS REAL ESTATE & RIGHT OF WAY DEPARTMENT 1945 WEST PARNALL ROAD, ROOM P21-400 JACKSON, MI 49201 PHONE: (517) 788-1678	GAS	
CONSUMERS ENERGY CO. ATTN: JEFF GEORGE 1030 FEATHERSTONE ROAD PONTIAC, MI 48151-6684 PHONE: (248) 858-4448		
DETROIT WATER & SEWERAGE DEPARTMENT ATTN: ARNOLD SMEDES SUBURBAN DESIGN SECTION 735 RANDOLPH STREET, ROOM 1307 DETROIT, MI 48226 PHONE: (313) 224-4771	WATER & SAN SEWER	
OAKLAND COUNTY ROAD COMMISSION ATTN: GERALD HOLMBERG 31001 LAHSER ROAD BIRMINGHAM, MI 48010 PHONE: (248) 645-2000		
OAKLAND COUNTY DRAIN COMMISSION ATTN: GLENN R. APPEL ASSISTANT CHIEF ENGINEER BUILDING 95 WEST ONE PUBLIC WORKS DRIVE WATERFORD, MI 48328-1907 PHONE: (248) 858-0958	COUNTY DRAINS, WATER & SAN SEWER	
OAKLAND COUNTY PUBLIC WORKS ATTN: GEORGE W. KUHN ONE PUBLIC WORKS DRIVE WATERFORD, MI 48328 PHONE: (248) 858-0958		
CITY OF ROYAL OAK PUBLIC WORKS ATTN: THOMAS TRICE 211 WILLIAMS STREET P.O. BOX 64 ROYAL OAK, MI 48068-0064	WATER & SAN SEWER	
CITY OF MADISON HEIGHTS ATTN: JON R. AUSTIN, MANAGER 300 W. THIRTEEN MILE ROAD MADISON HEIGHTS, MI 48071-1899 PHONE: (248) 588-1200	WATER & SAN SEWER	

PUBLIC UTILITIES (CONT)

NAME OF OWNER	KIND OF UTILITY
CHARTER TOWNSHIP OF BLOOMFIELD ATTN: FRED KARZAN, SUPERVISOR 4200 TELEGRAPH RD P.O. BOX 489 BLOOMFIELD HILLS, MI 48303-0489 PHONE: (248) 433-7700	
CITY OF MADISON HEIGHTS ATTN: JON R. AUSTIN, MANAGER 300 WEST THIRTEEN MILE RD MADISON HEIGHTS, MI 48071-1899 PHONE: (248) 588-1200	
CITY OF TROY ATTN: JAMES C. BACON JR., MANAGER 500 WEST BIG BEAVER RD TROY, MI 48064-5285 PHONE: (248) 524-3300	
CITY OF AUBURN HILLS ATTN: MR. WILLIAM R. ROSS, MANAGER 1827 NORTH SQUIRREL RD AUBURN HILLS, MI 48320 PHONE: (248) 370-9400	
MITS CENTER ATTN: TOM MULLIN 1050 SIXTH STREET DETROIT, MICHIGAN 48226 PHONE: (313) 256-9800 EXT 312 CELL: (248) 867-7899	ELECTRIC
SUN PIPE LINE COMPANY ATTN: BRIAN AUGUST OPERATIONS ENGINEERING/ONE CALL DEPT TEN PENN CENTER - 26 TH FLOOR 1801 MARKET STREET PHILADELPHIA, PA 19103-1639	OIL

NOTES APPLYING TO STANDARD PLANS

WHERE THE FOLLOWING ITEMS ARE CALLED FOR ON PLANS, THEY ARE TO BE CONSTRUCTED ACCORDING TO THE STANDARD PLAN GIVEN BELOW OPPOSITE EACH ITEM UNLESS OTHERWISE INDICATED.

COVER DX	R-9X-B
BRIDGE APPROACH CURB & GUTTER (USING EX. CATCH BASIN)	R-27-C
CONCRETE CURB AND CONCRETE CURB AND GUTTER	R-30-C
APPROACH CURB & GUTTER, DOWNSPOUTS (FOR BRIDGE APPROACH CURB AND GUTTER)	R-32-C
TRANSVERSE PAVEMENT JOINTS (REINFORCED CONCRETE PAVEMENT)	R-39-E
LONGITUDINAL PAVEMENT JOINTS	R-41-C
LOCATION OF TRANSVERSE JOINTS IN CONCRETE PAVEMENT	R-43-B
CONCRETE PAVEMENT REPAIR	R-44-B
CONVENTIONAL PAVEMENT REINFORCEMENT	R-45-C
TEMPORARY CONCRETE BARRIER	R-52-C
CONCRETE BARRIER, SINGLE FACE	R-54-C
GUARDRAIL AT STRUCTURES AND EMBANKMENTS	R-59-C
GUARDRAIL TYPES A, B, BD, T & TD	R-60-E
GUARDRAIL APPROACH TERMINAL TYPES 2B & 2T	R-62-C
GUARDRAIL APPROACH TERMINAL TYPES 3	R-63-A (SPEC. DET)
GUARDRAIL DEPARTING TERMINAL TYPES B & T	R-66-C
GUARDRAIL ANCHORAGE, BRIDGE, DETAILS	R-67-D
SOIL EROSION & SEDIMENTATION CONTROL MEASURES	R-96-B (SPEC. DET)
SODDING AND SEEDING	R-100-B
LIGHTED ARROWS AND BARRICADES	R-125-A
PLACEMENT OF TEMPORARY CONCRETE BARRIER	R-126-B

MAINTAINING TRAFFIC ITEMS CON'T

53697		49595		
NON PART	MADISON HEIGHTS PART	NON PART	MADISON HEIGHTS PART	
			12 ea	Relocate Sand Barrel Impact Attenuator
			2500 m	Glare Screen, Temp
			100 m	Glare Screen, Replace
			ea	Reconstruct Guardrail Approach Terminal, Type 3
		16	16 ea	Replace Prism Refrflc Lens, Crystal, Monodir (on RPMs)

QUALITY CONTROL ITEMS

6262	12524	59488	dir	Bit Quality Initiative
1789	3578	16997	4688 t	Bit Quality Assurance Testing
			5065 m3	Cono Quality Assurance
			7632 dir	Cono Quality Initiative

MISCELLANEOUS ESTIMATES

THE FOLLOWING ITEMS OF WORK SHALL BE DONE AS THEY APPLY THROUGHOUT THE PROJECT. THESE ITEMS ARE NOT DETAILED OR INCLUDED ON THE PLAN AND PROFILE SHEETS:

JOB NUMBERS					
53697		49595			
100% PART	NON PART	MADISON HEIGHTS PART	TROY PART	NON PART	MADISON HEIGHTS PART
	0.02	0.05	0.21		0.72 LS
	0.02	0.05	0.21		0.72 LS
	3	6	28		95 hr
	1	3	11		38 hr
	2	3	17		57 hr
		1569			m
		235			t
		500			ea
		650			m
	3	7	30		200 m
	1	1	8		20 m
		1	2		2 ea
	33	66	315		276 kg
					15 m
					5 ea
					7 ea
					1000 m
					50 m
					ea
					m
					m2
					ea
					1
					LS
	0.08	0.16	0.76		

MAINTAINING TRAFFIC ITEMS

THE FOLLOWING ITEMS OF WORK ARE ESTIMATED FOR THE ENTIRE PROJECT FOR MAINTAINING TRAFFIC AS DETERMINED BY THE ENGINEER.

1	1	6	20 ea	Barricade, Type III, Lighted, Furn
1	1	6	20 ea	Barricade, Type III, Lighted, Oper
1	1	6	4 ea	Truck Mounted Attenuator, Furnished
1	1	6	4 ea	Truck Mounted Attenuator, Operated
			3700 m	Conc Barrier, Temp, Furn
			3700 m	Conc Barrier, Temp, Oper
			400 m	Conc Barrier, Temp, Relocated
			2140 m	Conc Barrier, Temp, Adjusted
			1 ea	Conc Barrier Reflector Replacement
			6 ea	High Intensity Light, Type B, Furn
			6 ea	High Intensity Light, Type B, Oper
			8 ea	Sign Cover
			20230 m	Pav't Mrkg, Type R, 100 mm, White, Temp
			15950 m	Pav't Mrkg, Type R, 100 mm, Yellow, Temp
			3400 m	Pav't Mrkg, Longit, 125 mm or Less Width, Rem
			500 ea	Raised Pav't Marker, Retrflc, Crystal, Monodirectional
			900 ea	Plastic Drum with High Intensity Sheeting, Lighted, Furn
			900 ea	Plastic Drum with High Intensity Sheeting, Lighted, Oper
			8100	Worksite Traffic Supervisor
	0.02	0.05	0.21	0.72 LS
			m	Pav't Mrkg, Thermopl, 100 mm, White
			5400	Pav't Mrkg, Thermopl, 100 mm, Yellow
			120	Pav't Mrkg, Thermopl, 200 mm, White
			m	Pav't Mrkg, Thermopl, 300 mm, White
			3500	Removing Curbing Compound, for Longit Mrkg
			2	8 ea
			2	8 ea
			1 LS	Lighted Arrow, Type C, Oper
			4 ea	Minor Traf Devices
			4 ea	Sign, Portable, Changeable, Furn
			4 ea	Sign, Portable, Changeable, Oper
			222 m2	Sign, Type B Temp, Prismatic Refrflc Sheeting
			20 ea	Cono Barrier Reflector Replacement
			32 m2	Sign, Type B Temporary, Prismatic, Special
			24 ea	Sand Module Impact Attenuator (Temporary)
			12 ea	Sand Module Impact Attenuator (Replacement)
			12 ea	Relocate Sand Barrel Impact Attenuator
			m2	Sign, Type IIB
			4 m2	Sign, Type A, Temp

NOTE SHEET

DATE	CONT. SEC.	JOB NO.	DESIGN UNIT	SHEET NO.
01/22/00	63174	53697, 49595 & 48647	RICK	R.O.W/CONST. 8



DATE: DATE: DATE:
EXISTING BY: PROPOSED BY: LAST CORRECTION BY:

FILE NAME: 53697159.dgn
1 2 3 4 5 6 7 8 9 10 11 12 13 14 15 16 17 18 19 20 21 22 23 24 25 26 27 28 29 30 31 32 33 34 35 36 37 38 39 40 41 42 43 44 45 46 47 48 49 50 51 52 53 54 55 56 57 58 59 60 61 62 63

FINAL R.O.V.		
AUTH	DATE	NO. REVISION

WATER & DRAINAGE SYMBOLS

- EXISTING CATCH BASIN
- ⊕ PROPOSED CATCH BASIN
- EXISTING MANHOLE
- ⊖ PROPOSED MANHOLE
- △ EXISTING CULVERT END SECTION
- ▲ PROPOSED CULVERT END SECTION
- ┌ EXISTING HEADWALL
- ┐ PROPOSED HEADWALL
- ⊖ WATER SHUTOFF (Service Valve)
- GATE VALVE
- GATEWELL
- ⊕ WATER METER
- ⊗ WATER MANHOLE
- ⊙ EXISTING FIRE HYDRANT
- ⊙ PROPOSED FIRE HYDRANT
- ADJ-HYD ADJUST FIRE HYDRANT
- ADJ ADJUST DRAINAGE STRUCTURE
- ADJ-K ADJUST DRAINAGE STRUCTURE W/COVER
- ADJ-B/O ADJUST DRAINAGE STRUCTURE BY OTHERS
- REC RECONSTRUCT DRAINAGE STRUCTURE
- REC-K RECONSTRUCT DRAINAGE STRUCTURE W/COVER
- REL-B/O RELOCATE - BY OTHERS
- SR-1 SIDEWALK RAMP TYPE
- ∧ CHECK DAM (PROFILES)
- ∩ DIKE (PROFILES)
- W.T. WATER TABLE (PROFILES)
- GUARD POST
- ⊙ WATER WELL

REAL ESTATE SYMBOLS

- PROPERTY OWNERSHIP ARROW
- ↔ CONTIGUOUS PROPERTY SYMBOL
- 123456 PARCEL NUMBER BOX
- PARCEL LINES

UTILITIES SYMBOLS

- POWER POLE
- ◆ TELEPHONE POLE
- GUY POLE
- ⊙ LIGHT POLE
- ⊙ POWER LIGHT POLE
- ⊕ TELEPHONE MANHOLE
- ⊗ POWER TOWER
- ⊗ GAS VALVE
- ⊔ WALK/NO-WALK
- ⊔ DEADMAN FOR GUYWIRE
- R X R RAILROAD SIGNAL
- ⊕ ELECTRICAL MANHOLE
- ⊕ ELECTRICAL HANDHOLE
- ⊕ TELEPHONE PEDESTAL/RISER

MISCELLANEOUS SYMBOLS

- ⊗ RIPRAP
- ⊔ SIGN
- ⊔ STUMP
- ⊔ SWAMP
- ☆ DECIDUOUS TREE
- ☆ EVERGREEN TREE
- MAIL BOX
- ⊕ QUARTER CORNER
- ⊕ SECTION CORNER
- ⊔ HALF QUARTER SECTION
- ⊗ T.H.* TEST HOLE NO.
- 123 BEAM G. R. RUN NUMBER (EXISTING)
- 123 BEAM G. R. RUN NUMBER (PROPOSED)

HAZARDOUS OR FLAMMABLE MATERIAL USED WITH UNDERGROUND GAS & ELECTRICAL LINES

CAUTION - CRITICAL UNDERGROUND UTILITY USED WITH FIBER OPTICS LINES

- PROP 900 mm PROPOSED CULVERT/SEWER
- EX 300 mm CMP EXISTING CULVERT/SEWER

UTILITY PATTERNS

- ELEC ELECTRICAL LINE
- 600 mm GAS GAS LINE
- 300 mm OIL OIL LINE
- TELE TELEPHONE LINE
- 900 mm WM WATER LINE
- CTV CABLE TV
- FO FIBER OPTICS
- POWER TRANSMISSION LINE

R.O.W. PATTERNS

- ** EX. LIMITED ACCESS R.O.W.
- EXISTING R.O.W.
- ** PROP LIMITED ACCESS R.O.W.
- PROP FREE ACCESS R.O.W.
- SECTION LINE

TOPO PATTERNS

- HEDGE LINE
- TREE LINE
- X X EXISTING FENCE
- X X PROPOSED FENCE
- EXISTING GUARD RAIL
- PROPOSED GUARD RAIL
- DRAINAGE CRS/EDGE OF WATER
- WETLANDS AREA
- ABANDON ANY UTILITY
- CITY LIMITS
- RAILROAD
- SOUND ABATEMENT WALL
- CONCRETE MEDIAN BARRIER
- SLOPE STAKE LINE

DRIVE/APPROACH LEGEND

- CONCRETE
- BITUMINOUS
- AGGREGATE

REMOVAL LEGEND

- REMOVING BITUMINOUS
- REMOVING SIDEWALK
- REMOVING PAVEMENT
- COLD-MILLING
- BITUMINOUS BASE CRUSHING AND SHAPING
- REMOVING CURB & GUTTER
- REMOVING (R)
- ABANDONING (A)
- SAVE (S)
- BULKHEAD (B)
- CLEARING (C)

SPECIAL LEGEND THIS PROJECT



LEGEND SHEET


DATE	SCALE	CONT. SEC.	JOB NO.	DESIGN UNIT	SHEET NO.
11/01/00	NONE	63174	53697	RICK	R.O.W CONST. 9

DATE: 11/20/00
 EXISTING BY: RICK'S TEAM
 PROPOSED BY: RICK'S TEAM
 LAST CORRECTION BY: RICK'S TEAM
 DATE: 12-18-00

FILE NAME: 495951277.dgn
 9 10 11 12 13 14 15 16 17 18 19 21 22 24 25 26 27 28 29 30 31 33

SECTION 14
 TIN RILE
 MADISON HEIGHTS

FINAL R.O.W.			
AUTH	DATE	NO.	REVISION

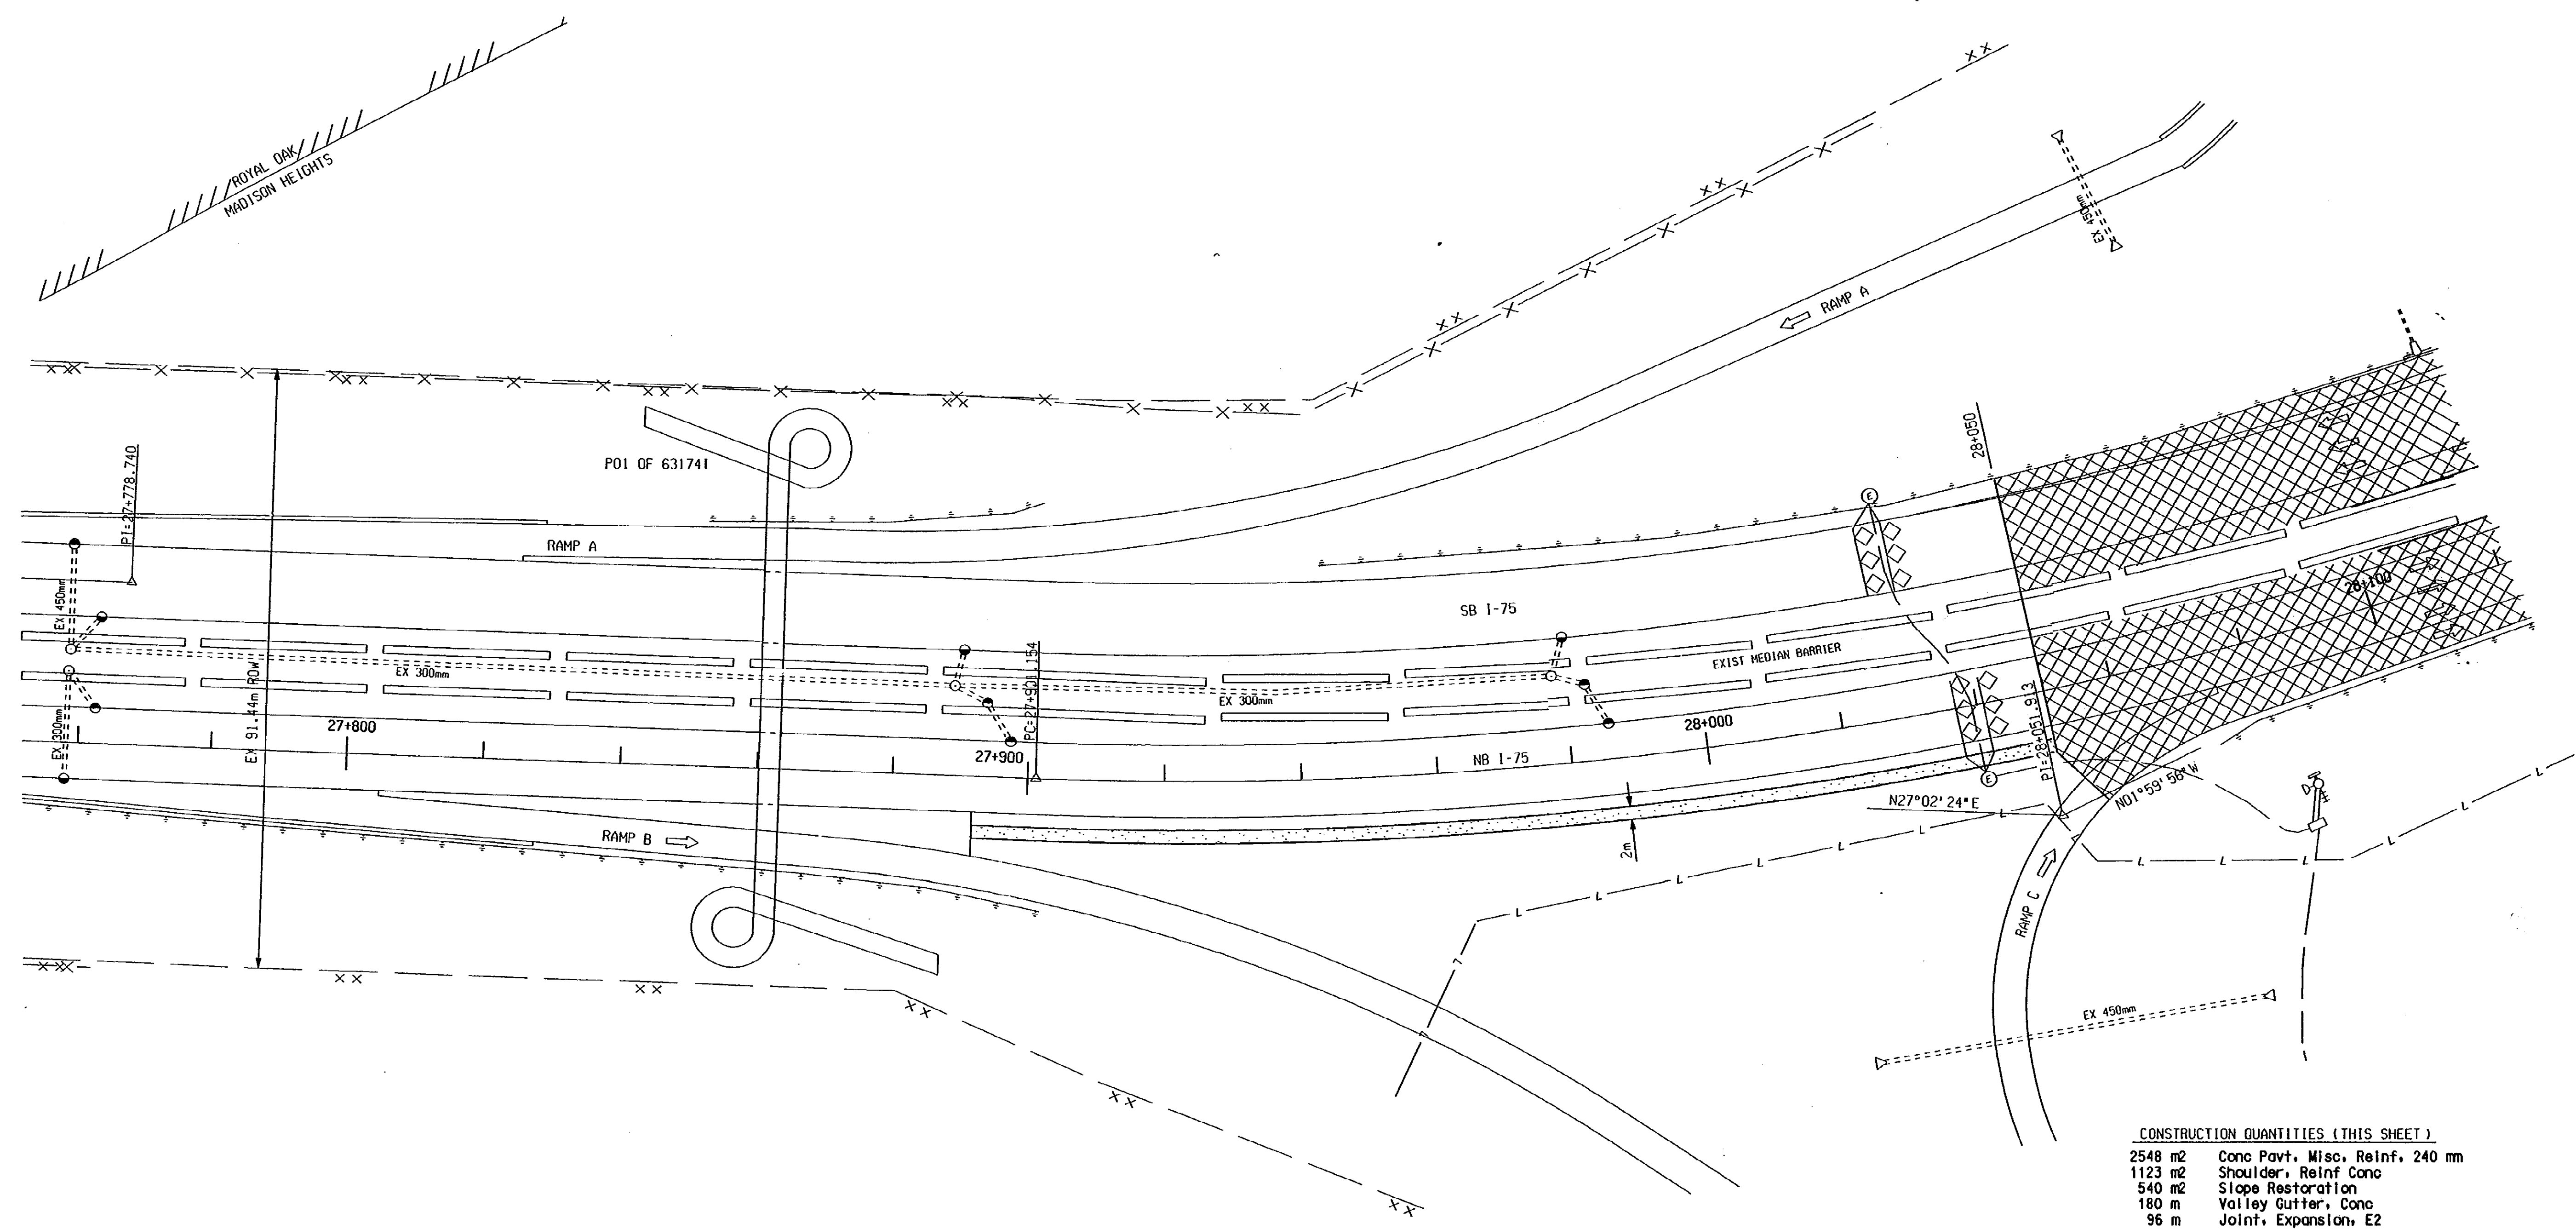

QUANTITIES - TEMP SHOULDER WIDENING

75 m ³	Aggregate Base, LM
171 †	Bit Approach

REMOVAL QUANTITIES (THIS SHEET)

3670 m ²	Pavt, Rem
180 m	Station Grading - Bridge Approach

CONSTRUCTION QUANTITIES (THIS SHEET)

2548 m ²	Conc Pavt, Misc, Reinf, 240 mm
1123 m ²	Shoulder, Reinf Conc
540 m ²	Slope Restoration
180 m	Valley Gutter, Conc
96 m	Joint, Expansion, E2
22 m	Joint, Expansion, E4
205 m	Joint, Contraction, C2
59 m	Joint, Contraction, C4
30 m	Joint, Contraction, Crg
540 m	Joint, External Longit Edge of Pavt
3760 m ³	Aggregate Base, LM
360 m	Shoulder Corr, Ground or Cut, Conc

REMOVAL & CONSTRUCTION SHEET

	BRIDGE APPROACH S03 OF 63174					
	DATE	SCALE	CONT. SEC.	JOB NO.	DESIGN UNIT	SHEET NO.
	01/10/01	1:500	63174	49595	RICK	10

CONTROL SECTION 63174 JOB NO. 49595 SH. NO. 11

DATE: 10/23/00
 PROPOSED BY: RICK'S TEAM
 LAST CORRECTION BY: RICK'S TEAM
 DATE: 12-18-00

FILE NAME: 4959512.ed.dgn
 1.2 7.8.9 11.12.13.14.15.16.17.18.19 21.22.23.24.25.26.27.28.29.30.31.32.33


SECTION 14
 TIN, R11E
 MADISON HEIGHTS

NB I-75
 CURVE DATA
 $\Delta = 29^{\circ}02'20"LT$
 R=582.125
 T=150.757
 L=295.034
 PC =27+901.154
 PI =28+051.911
 PT =28+196.188

SECTION 11
 TIN, R11E
 MADISON HEIGHTS

RED RUN DRAIN

FINAL R.O.W.			
AUTH	DATE	NO.	REVISION

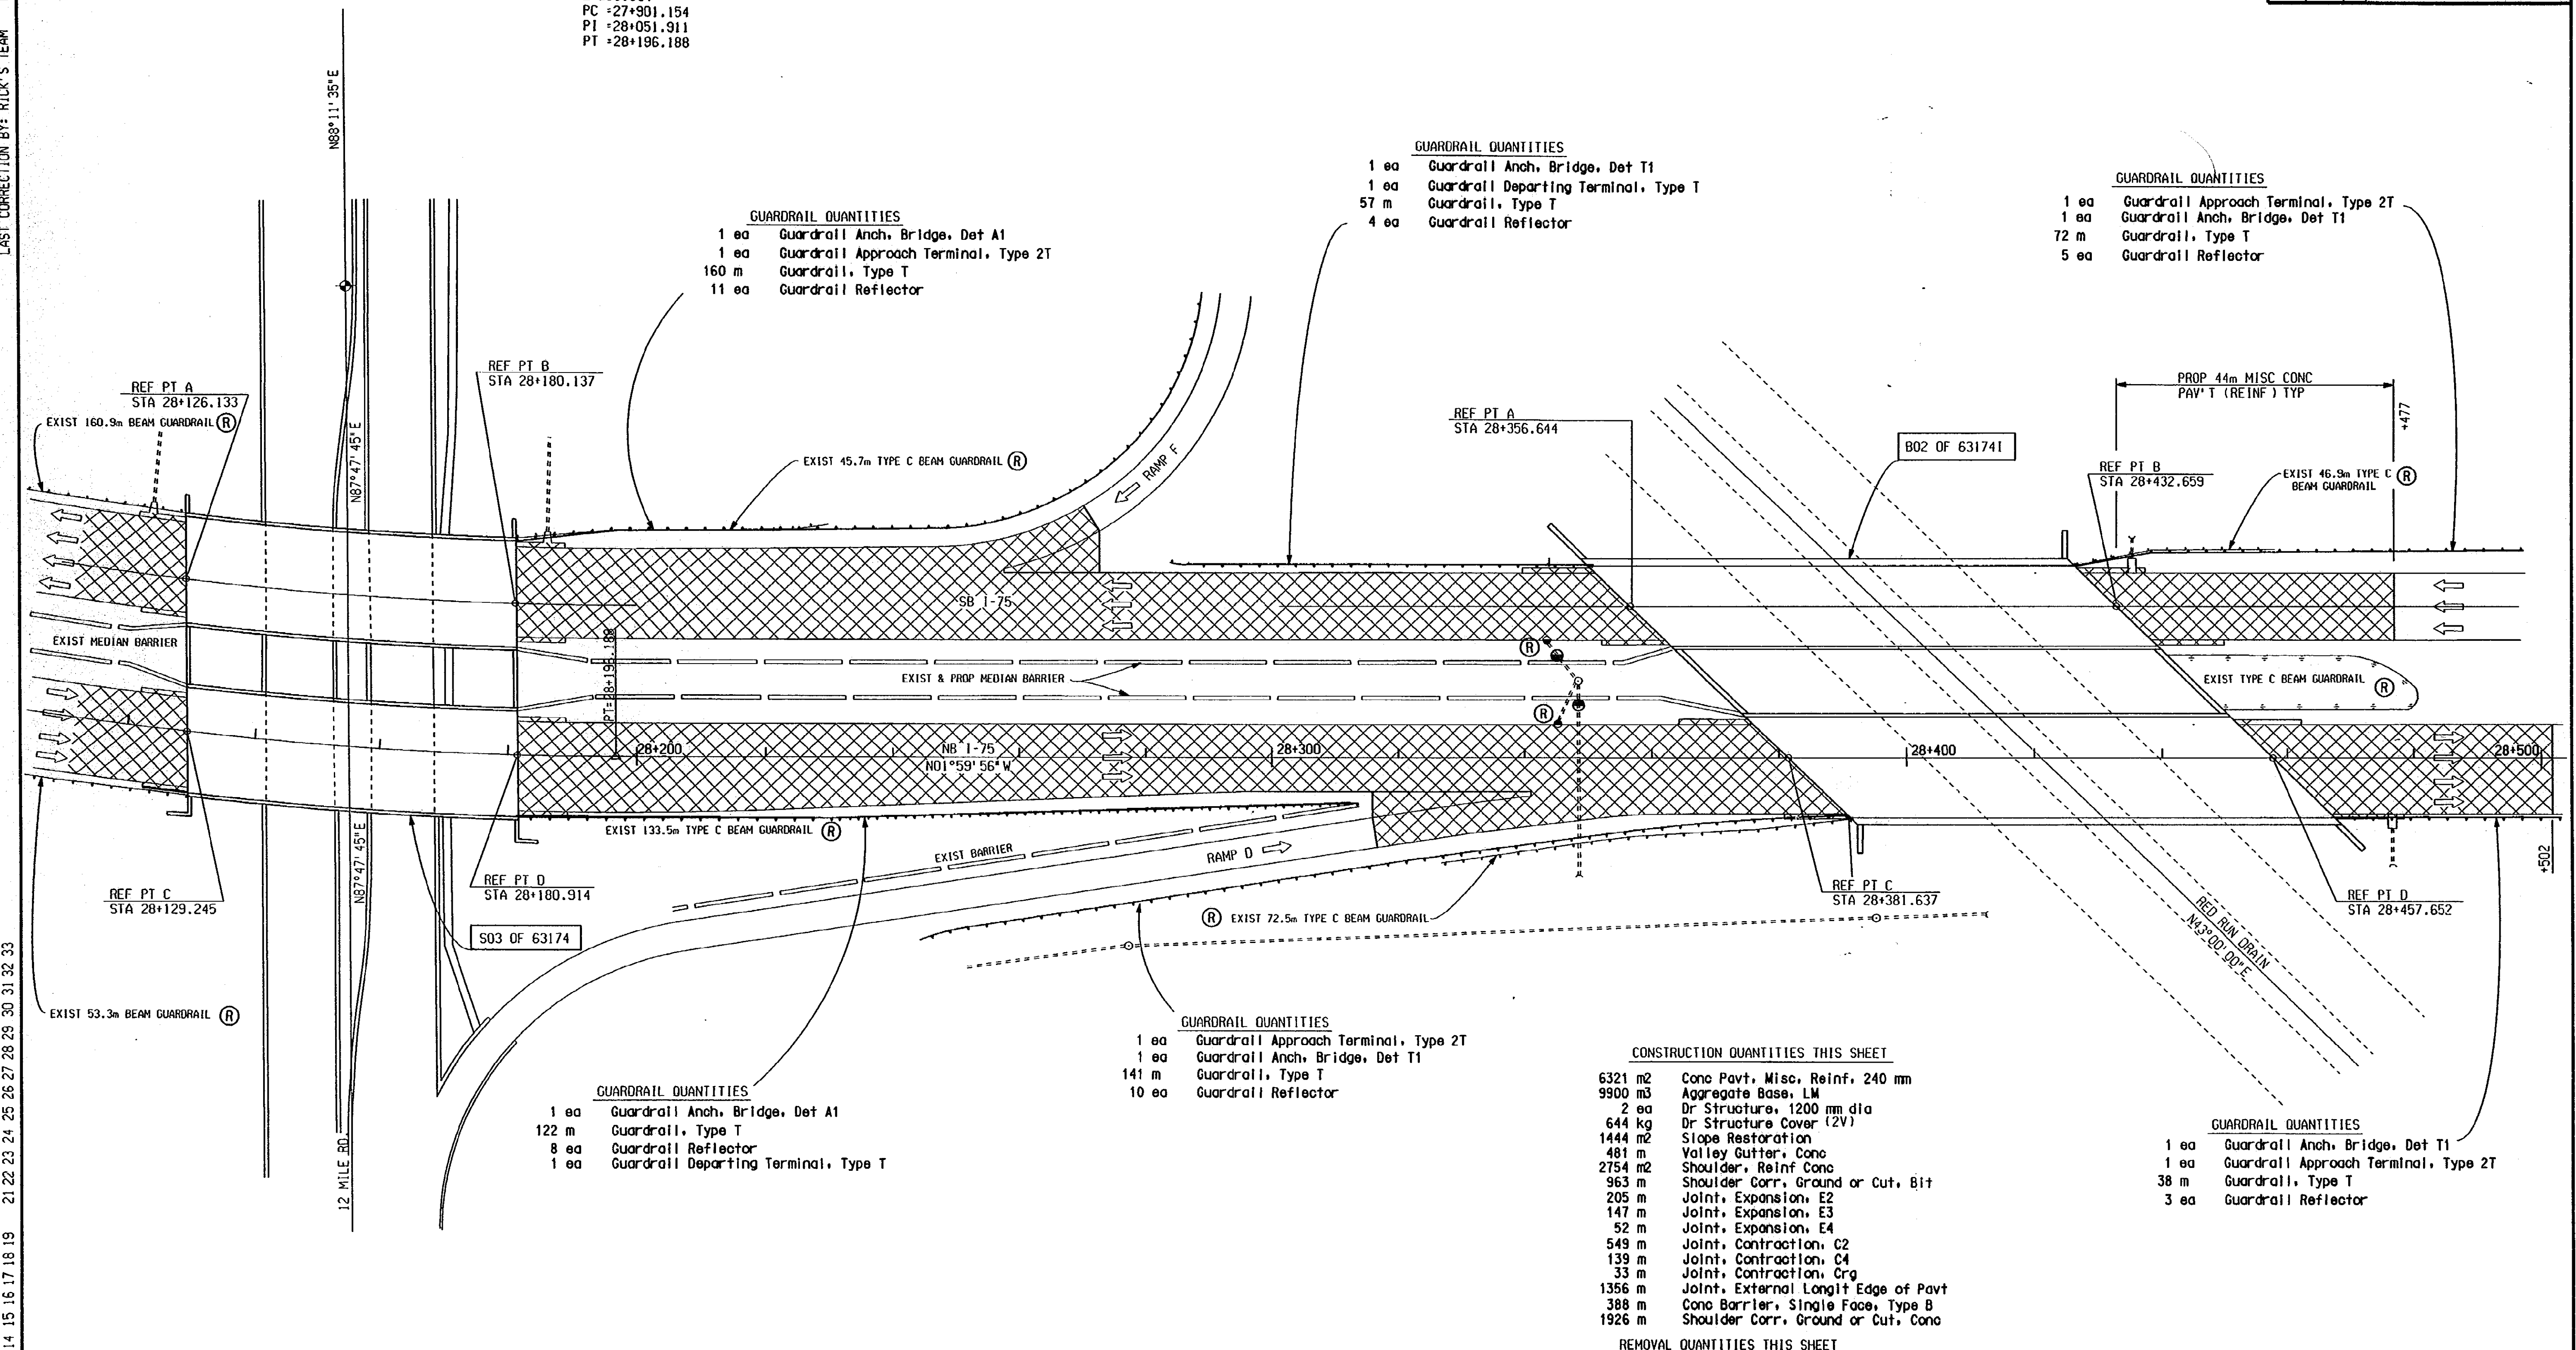

GUARDRAIL QUANTITIES
 1 ea Guardrail Anch. Bridge, Det A1
 1 ea Guardrail Approach Terminal, Type 2T
 160 m Guardrail, Type T
 11 ea Guardrail Reflector

GUARDRAIL QUANTITIES
 1 ea Guardrail Anch. Bridge, Det T1
 1 ea Guardrail Departing Terminal, Type T
 57 m Guardrail, Type T
 4 ea Guardrail Reflector

GUARDRAIL QUANTITIES
 1 ea Guardrail Approach Terminal, Type 2T
 1 ea Guardrail Anch. Bridge, Det T1
 72 m Guardrail, Type T
 5 ea Guardrail Reflector

GUARDRAIL QUANTITIES
 1 ea Guardrail Anch. Bridge, Det A1
 122 m Guardrail, Type T
 8 ea Guardrail Reflector
 1 ea Guardrail Departing Terminal, Type T

GUARDRAIL QUANTITIES
 1 ea Guardrail Approach Terminal, Type 2T
 1 ea Guardrail Anch. Bridge, Det T1
 141 m Guardrail, Type T
 10 ea Guardrail Reflector

GUARDRAIL QUANTITIES
 1 ea Guardrail Anch. Bridge, Det T1
 1 ea Guardrail Approach Terminal, Type 2T
 38 m Guardrail, Type T
 3 ea Guardrail Reflector

CONSTRUCTION QUANTITIES THIS SHEET
 6321 m² Conc Pavt, Misc. Reinf, 240 mm
 9900 m³ Aggregate Base, LM
 2 ea Dr Structure, 1200 mm dia
 644 kg Dr Structure Cover (2V)
 1444 m² Slope Restoration
 481 m Valley Gutter, Conc
 2754 m² Shoulder, Reinf Conc
 963 m Shoulder Corr, Ground or Cut, Bit
 205 m Joint, Expansion, E2
 147 m Joint, Expansion, E3
 52 m Joint, Expansion, E4
 549 m Joint, Contraction, C2
 139 m Joint, Contraction, C4
 33 m Joint, Contraction, Crg
 1356 m Joint, External Longit Edge of Pavt
 388 m Conc Barrier, Single Face, Type B
 1926 m Shoulder Corr, Ground or Cut, Conc

REMOVAL QUANTITIES THIS SHEET
 9075 m² Pavt, Rem
 963 m Station Grading - Bridge Approach
 563 m Guardrail, Rem
 2 ea Dr Structure, Rem
 388 m Barrier Wall, Rem

RED RUN DRAIN
 REMOVAL & CONSTRUCTION SHEET

	BRIDGE APPROACH S03 & B02 OF 63174					
	DATE	SCALE	CONT. SEC.	JOB NO.	DESIGN UNIT	SHEET NO.
	12/08/00	1:500	63174	49595	RICK	11

12 MILE ROAD

DATE: 04/10/00
 DATE: 01-08-01
 EXISTING BY: ZAMCRAB
 PROPOSED BY: RICK'S TEAM
 LAST CORRECTION BY: RICK'S TEAM


FILE NAME: 4959513m.dgn
 12 7 8 9 11 12 13 14 15 16 17 18 19 21 22 23 24 25 26 27 28 29 30 31 32 33

SECTION 11
 TIN, R11E
 MADISON HEIGHTS

13 MILE RD

SECTION 2
 TIN, R11E
 MADISON HEIGHTS

FINAL R.O.W.		
AUTH	DATE	NO. REVISION

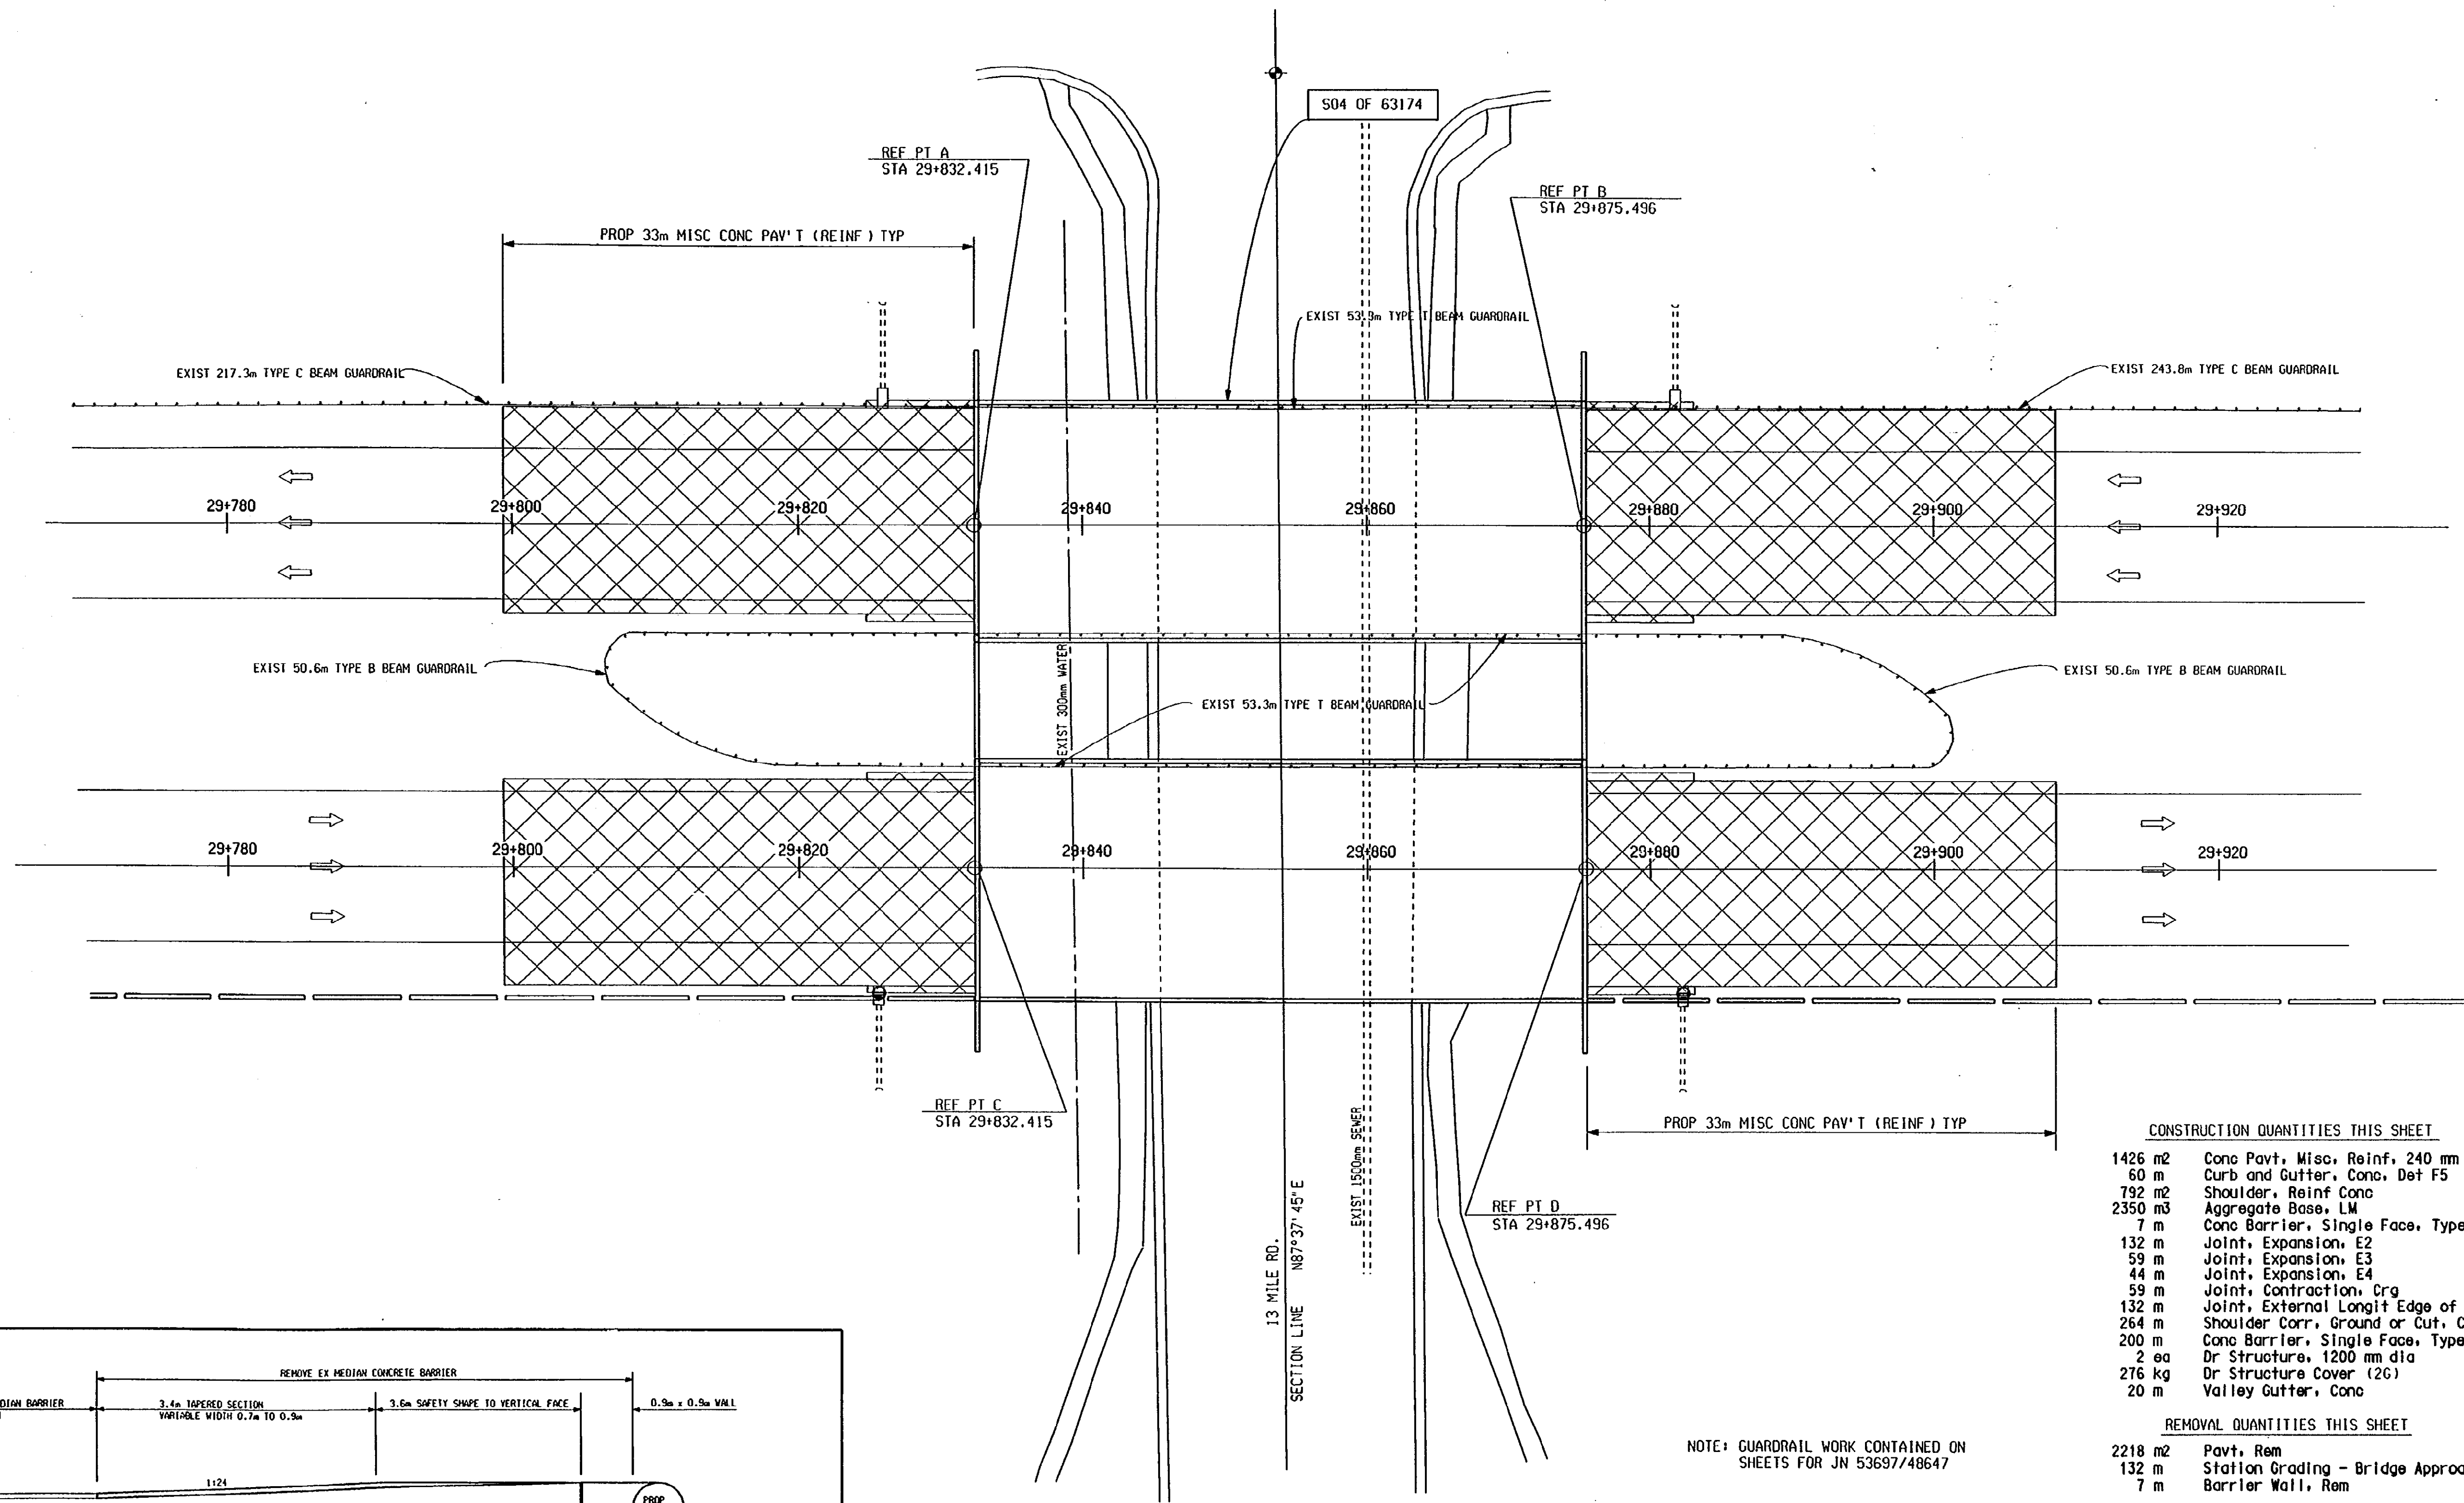

CONSTRUCTION QUANTITIES THIS SHEET


1426 m ²	Conc Pavt, Misc, Reinf, 240 mm
60 m	Curb and Gutter, Conc, Det F5
792 m ²	Shoulder, Reinf Conc
2350 m ³	Aggregate Base, LM
7 m	Conc Barrier, Single Face, Type A, Mod
132 m	Joint, Expansion, E2
59 m	Joint, Expansion, E3
44 m	Joint, Expansion, E4
59 m	Joint, Contraction, Crg
132 m	Joint, External Longit Edge of Pavt
264 m	Shoulder Corr, Ground or Cut, Conc
200 m	Conc Barrier, Single Face, Type C
2 ea	Dr Structure, 1200 mm dia
276 kg	Dr Structure Cover (2G)
20 m	Valley Gutter, Conc

REMOVAL QUANTITIES THIS SHEET

2218 m ²	Pavt, Rem
132 m	Station Grading - Bridge Approach
7 m	Barrier Wall, Rem

NOTE: GUARDRAIL WORK CONTAINED ON SHEETS FOR JN 53697/48647

REMOVAL & CONSTRUCTION SHEET

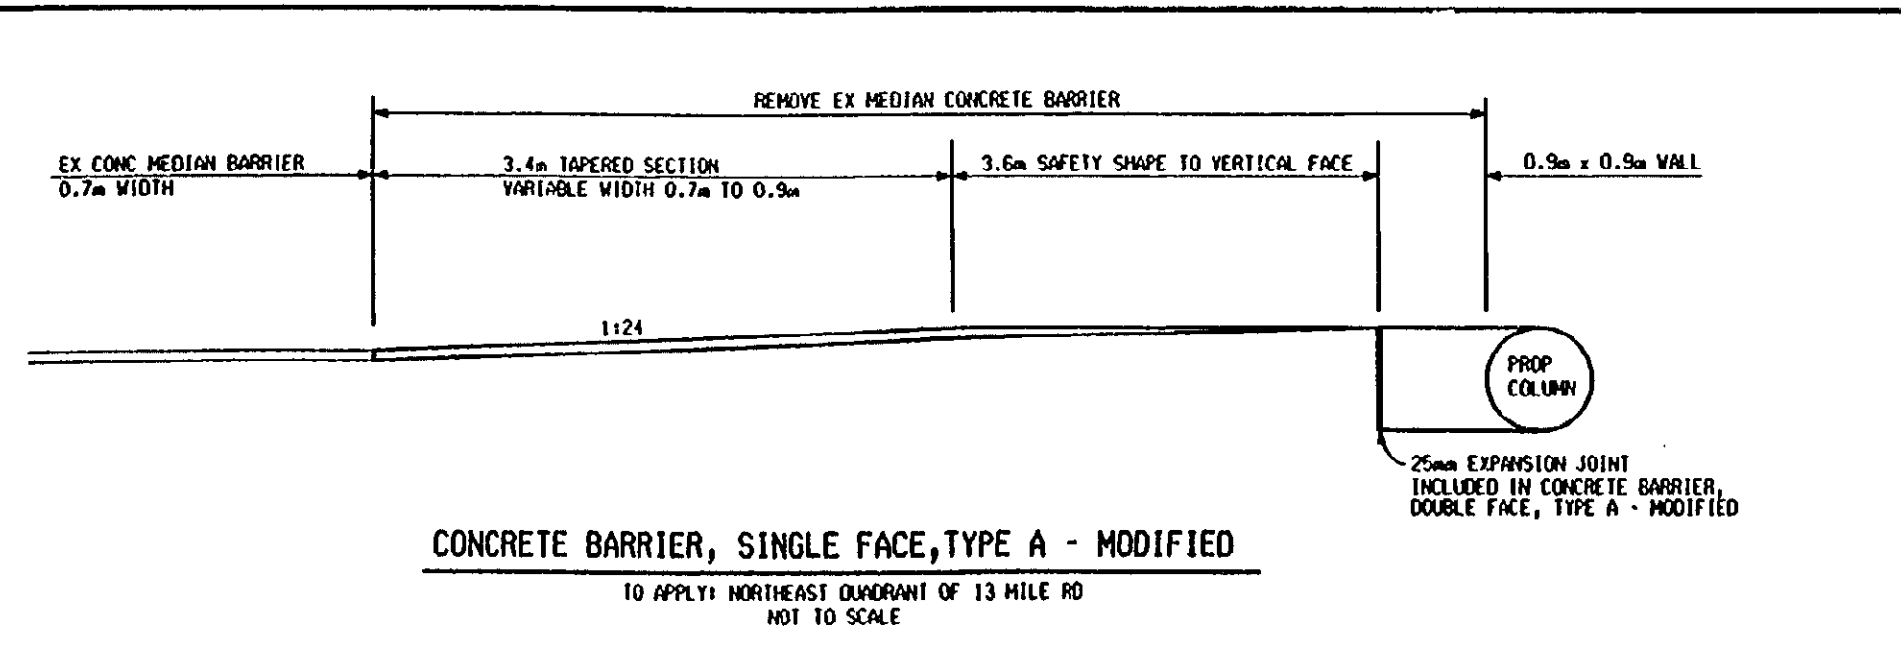

13 MILE RD

	BRIDGE APPROACH S04 OF 63174					
	DATE	SCALE	CONT. SEC.	JOB NO.	DESIGN UNIT	SHEET NO.
	01/08/01	1:250	63174	49595	RICK	R.O.W 12

CENTRAL SECTION 63174 JOB NO. 48647 & 53697 SHEET NO. 13


EXISTING BY: RICK'S TEAM DATE: 10/19/00
 PROPOSED BY: RICK'S TEAM DATE: 10/20/00
 LAST CORRECTION BY: RICK'S TEAM DATE: 12-18-00

FILE NAME: 5369728400.dgn
 9 10 11 12 13 14 15 16 17 18 19 21 22 24 25 26 27 28 29 30 31 33

FINAL R.O.W.			
AUTH	DATE	NO.	REVISION



SECTION 11
 TIN, R11E
 MADISON HEIGHTS

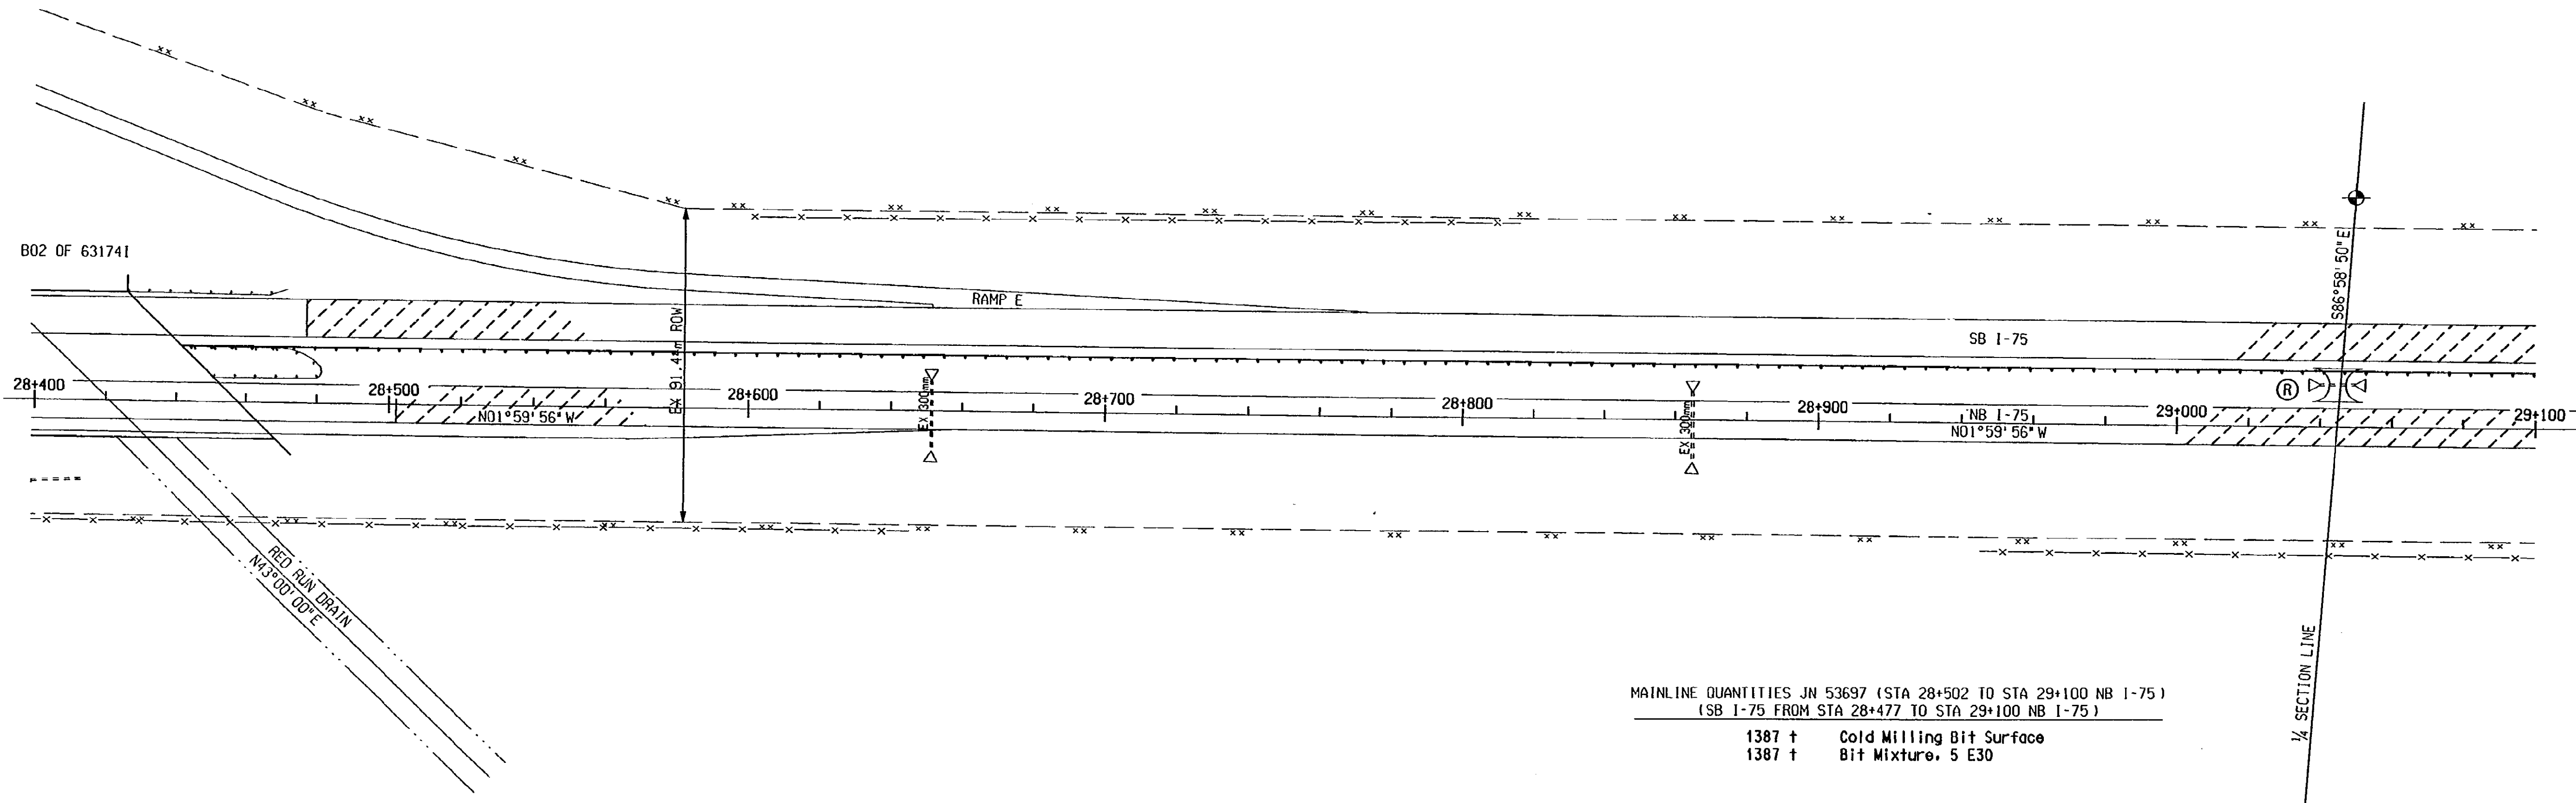

MAINLINE QUANTITIES JN 53697 (STA 28+502 TO STA 29+100 NB I-75)
 (SB I-75 FROM STA 28+477 TO STA 29+100 NB I-75)

1387 + Cold Milling Bit Surface
 1387 + Bit Mixture, 5 E30

GUARDRAIL QUANTITIES JN 48647 (STA 28+502 TO STA 29+100 NB I-75)
 (SB I-75 FROM STA 28+477 TO STA 29+100 NB I-75)

651.51 m Guardrail, Type TD
 86 ea Guardrail Reflector
 1 ea Guardrail Anch, Bridge, Det T1

SHOULDER UPGRADE QUANTITIES JN 53697 (STA 28+502 TO STA 29+100 NB I-75)
 (SB I-75 FROM STA 28+477 TO STA 29+100 NB I-75)

304 + Bit Mixture, 4C
 391 + Bit Mixture, 3C
 2766 m² Aggregate Base, 200 mm
 659 m Station Grading
 2437 m² Slope Restoration
 685 m² Shoulder, CI II, 140 mm

BRIDGE APPROACH WORK @ 12 MILE AND RED RUN DRAIN
 SHOWN ON JOB # 49595 SHEET # 11


REMOVAL & CONSTRUCTION SHEET

	STA 28+400 TO STA 29+100 NB I-75					
	DATE	SCALE	CONT. SEC.	JOB NO.	DESIGN UNIT	SHEET NO.
	12/18/00	1:1000	63174	48647 53697	RICK	R.O.W. 13

EXISTING BY: RICK'S TEAM DATE: 10/19/00
 PROPOSED BY: RICK'S TEAM DATE: 11/10/00
 LAST CORRECTION BY: RICK'S TEAM DATE: 11/15/00

FINAL R.O.W.			
AUTH	DATE	NO.	REVISION

SECTION 11
 TIN, RIIE
 MADISON HEIGHTS

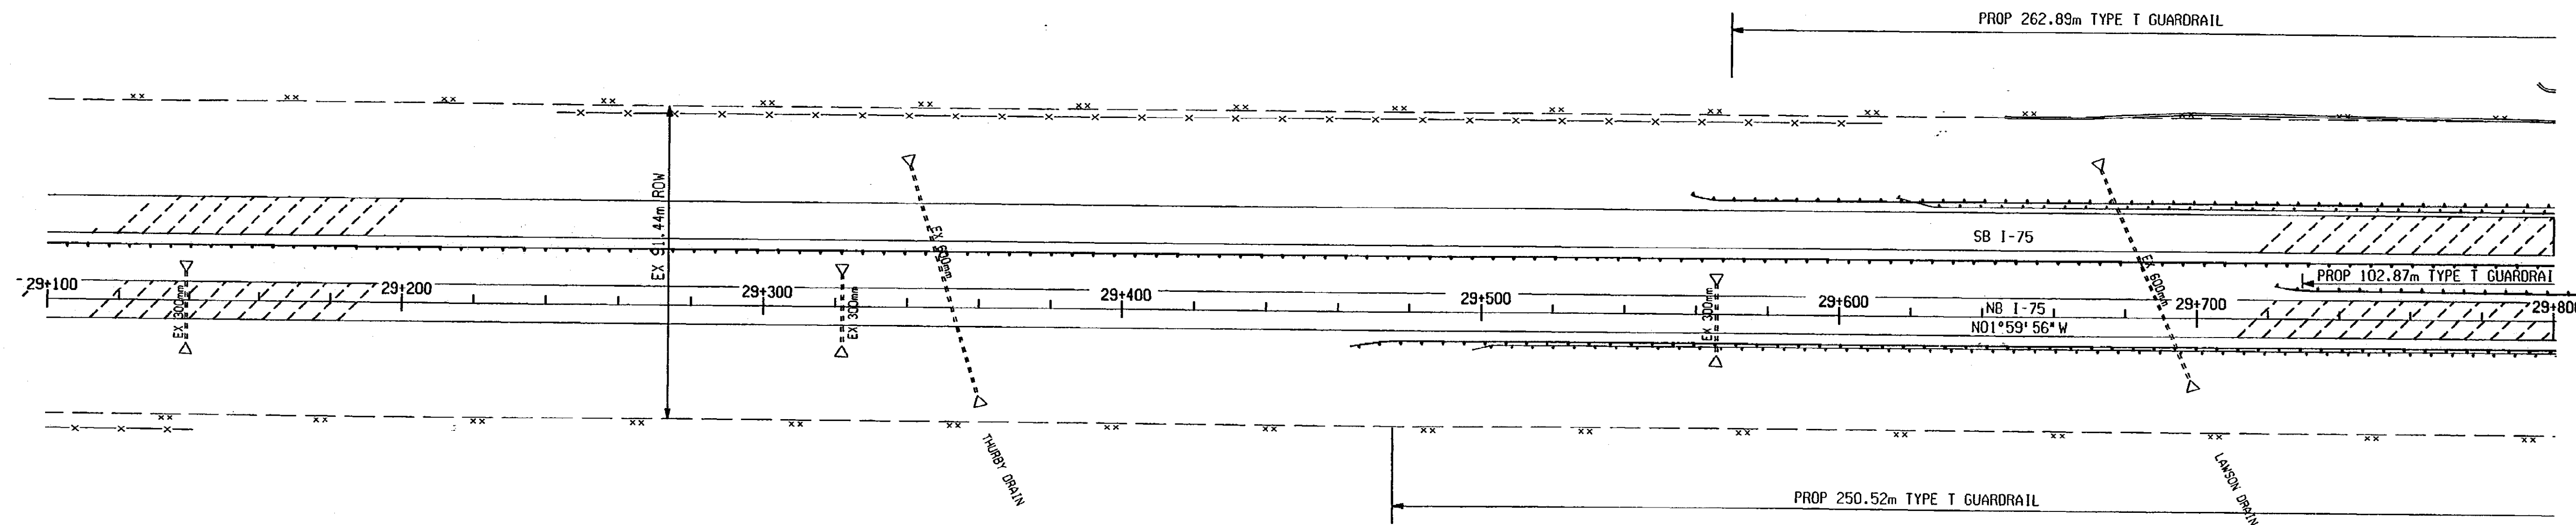

GUARDRAIL QUANTITIES JN 48647 (STA 29+100 POB TO STA 29+800)
 701.04 m Guardrail, Type TD
 92 ea Guardrail Reflector

MAINLINE QUANTITIES JN 53697 (STA 29+100 POB TO STA 29+800)
 1590 t Cold Milling Bit Surface
 1590 t Bit Mixture, 5 E30

SHOULDER UPGRADE QUANTITIES JN 53697 (STA 29+100 POB TO STA 29+800)
 323 t Bit Mixture, 4C
 416 t Bit Mixture, 3C
 2940 m² Aggregate Base, 200 mm
 700 m Station Grading
 2590 m² Slope Restoration
 728 m² Shoulder, C11, 140 mm

REMOVAL & CONSTRUCTION SHEET

STA 29+100 TO STA 29+800 NB I-75

	DATE	SCALE	CONT. SEC.	JOB NO.	DESIGN UNIT	SHEET NO.
	11/15/00	1:1000	63174	48647 53697	RICK	R.O.W. 14

DATE: 10/19/00
 DATE: 10/27/00
 DATE: 12-18-00
 EXISTING BY: RICK'S TEAM
 PROPOSED BY: RICK'S TEAM
 LAST CORRECTION BY: RICK'S TEAM

FINAL R.O.V.			
AUTH	DATE	NO.	REVISION


13 MILE RD



SECTION 2
 TIN,RIIE
 MADISON HEIGHTS

GUARDRAIL QUANTITIES AT STRUCT/EMBANK JN 48647
 SB OUTSIDE

- 575.31 m Guardrail, Type T
- 2 ea Guardrail Anch. Bridge, Det T1
- 1 ea Guardrail Approach Terminal, Type 2T
- 1 ea Guardrail Departing Terminal, Type T
- 39 ea Guardrail Reflector

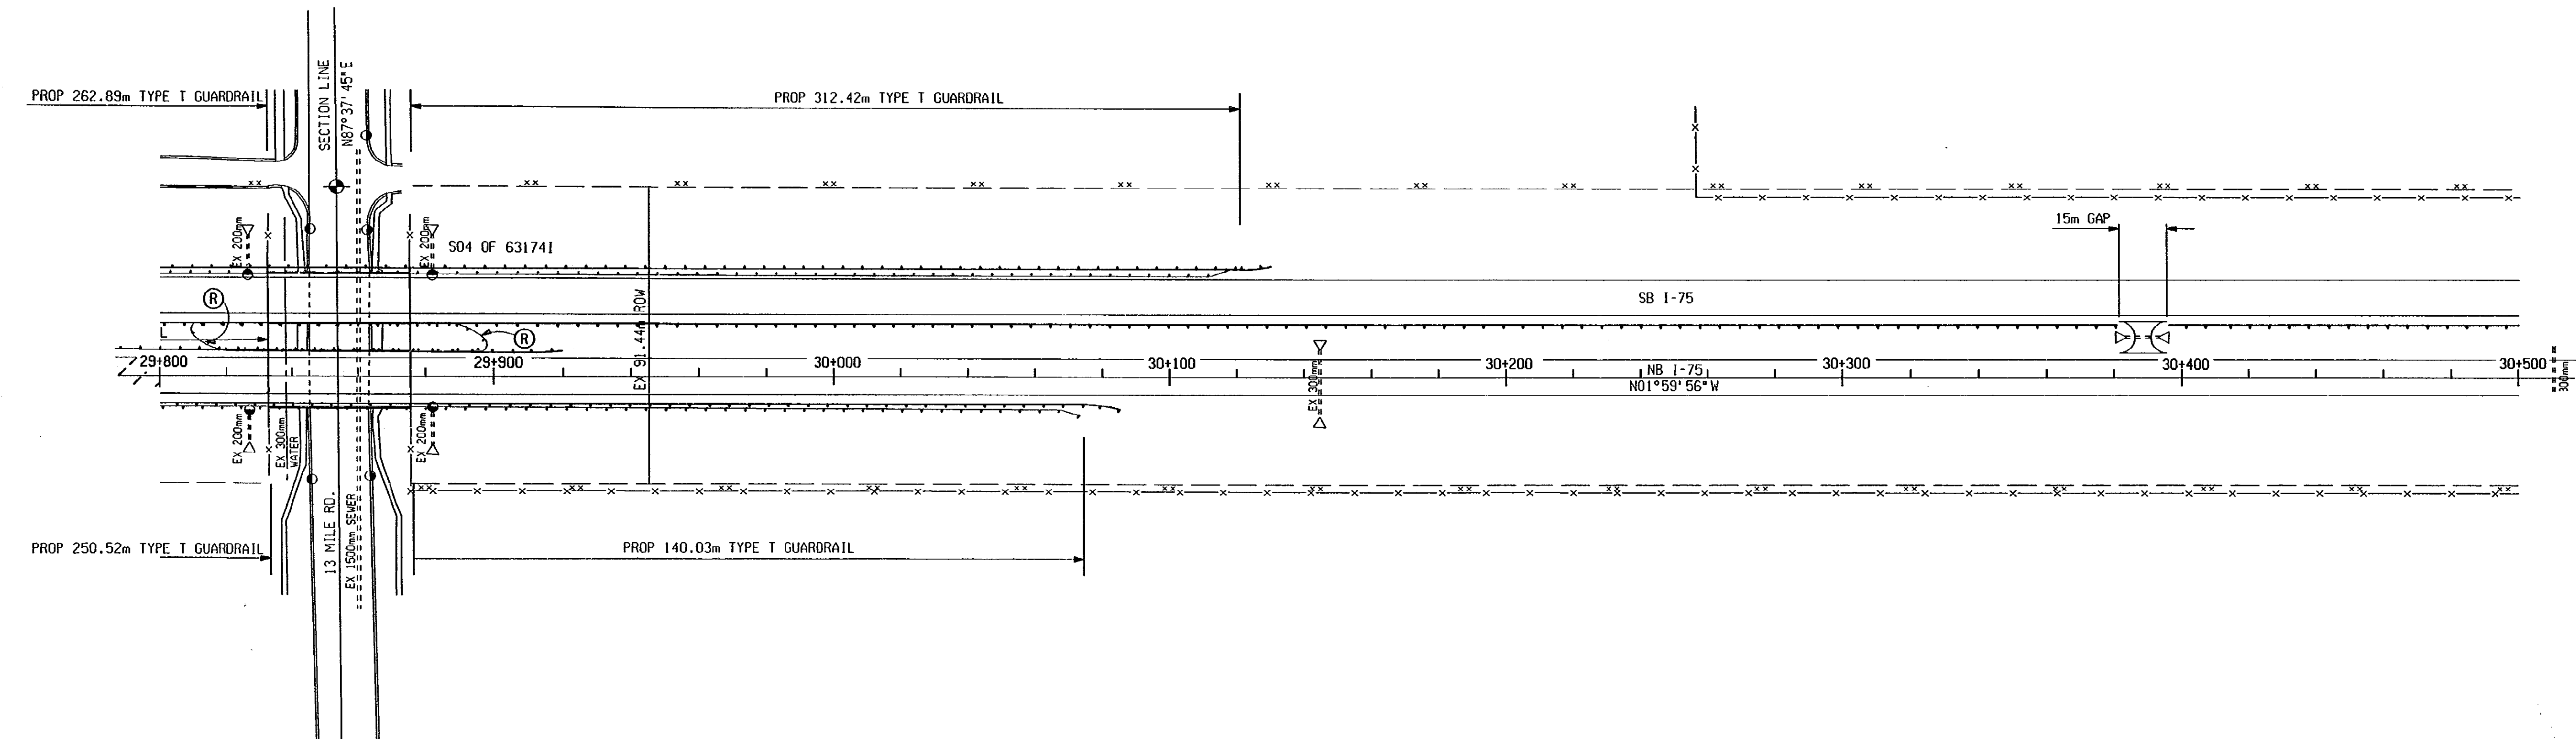

GUARDRAIL QUANTITIES AT STRUCT/EMBANK JN 48647
 NB OUTSIDE

- 391.26 m Guardrail, Type T
- 2 ea Guardrail Anch. Bridge, Det T1
- 1 ea Guardrail Approach Terminal, Type 2T
- 1 ea Guardrail Departing Terminal, Type T
- 40 ea Guardrail Reflector

GUARDRAIL QUANTITIES AT STRUCT/EMBANK JN 48647
 NB INSIDE

- 102.87 m Guardrail, Type T
- 2 ea Guardrail Anch. Bridge, Det T1
- 1 ea Guardrail Approach Terminal, Type 2T
- 1 ea Guardrail Departing Terminal, Type T
- 7 ea Guardrail Reflector

GUARDRAIL QUANTITIES JN 48647 (STA 29+800 POB TO STA 30+500)

- 628.91 m Guardrail, Type TD
- 80 ea Guardrail Reflector
- 2 ea Guardrail Anch. Bridge, Det T1
- 1287 m Guardrail, Rem
- 2 ea Guardrail Approach Terminal, Type 3

SHOULDER UPGRADE QUANTITIES JN 53697 (STA 29+800 POB TO STA 30+500)

- 304 † Bit Mixture, 4C
- 390 † Bit Mixture, 3C
- 2761 m² Aggregate Base, 200 mm
- 657 m Station Grading
- 2432 m² Slope Restoration
- 684 m² Shoulder, CI II, 140 mm

BRIDGE APPROACH WORK @ 13 MILE
 SHOWN ON JOB # 49595.

13 MILE RD


REMOVAL & CONSTRUCTION SHEET

	STA 29+800 TO STA 30+500 NB I-75					
	DATE	SCALE	CONT. SEC.	JOB NO.	DESIGN UNIT	SHEET NO.
	01/12/01	1:1000	63174	48647 53697	RICK	R.O.W 15

DATE: 10/19/00
 DATE: 10/27/00
 DATE: 11/15/00
 EXISTING BY: RICK'S TEAM
 PROPOSED BY: RICK'S TEAM
 LAST CORRECTION BY: RICK'S TEAM

FINAL R.O.W.			
AUTH	DATE	NO.	REVISION

SECTION 2
 TIN, R11E
 MADISON HEIGHTS

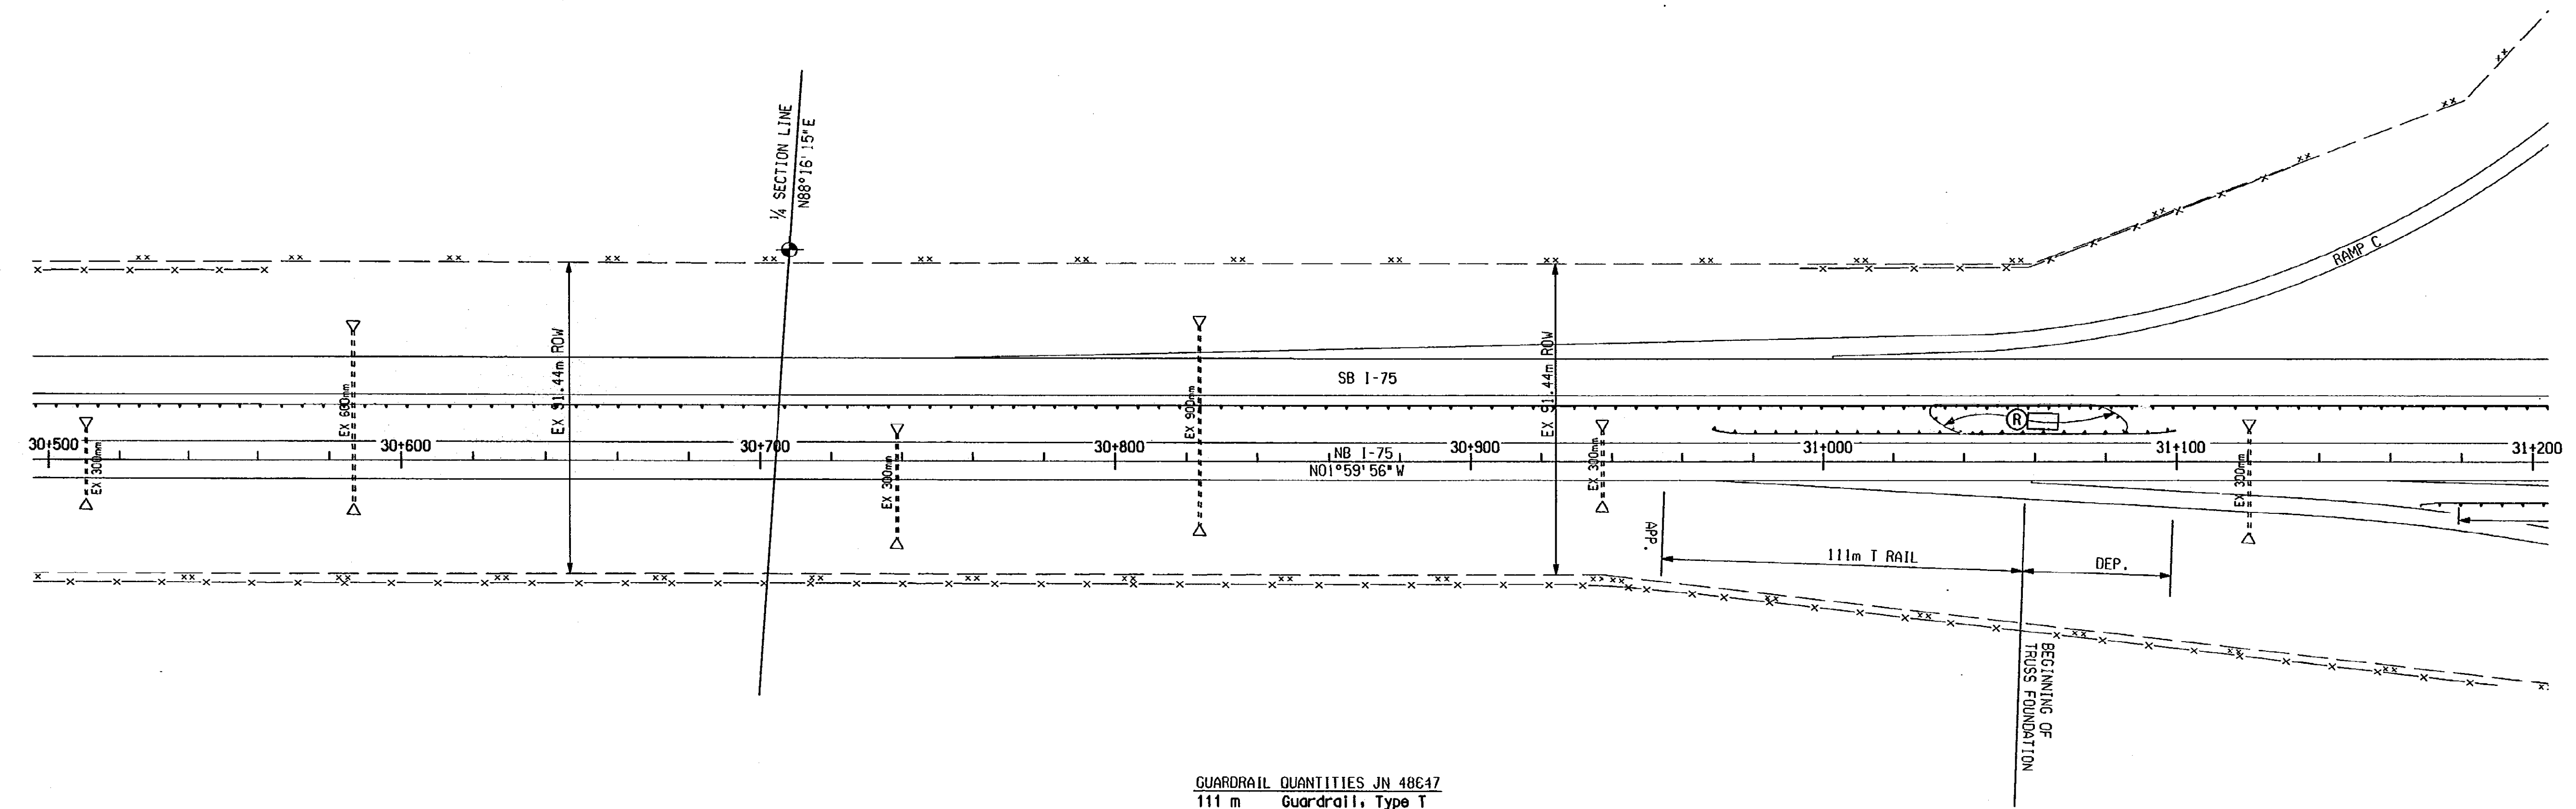


GUARDRAIL QUANTITIES JN 48647
 111 m Guardrail, Type T
 1 ea Guardrail Approach Terminal, Type 2T
 1 ea Guardrail Departing Terminal, Type T
 8 ea Guardrail Reflector

GUARDRAIL QUANTITIES JN 48647 (STA 30+500 TO STA 31+200)
 701 m Guardrail, Type TD
 92 ea Guardrail Reflector
 100 m Guardrail, Rem

SHOULDER UPGRADE QUANTITIES JN 53697 (STA 30+500 TO STA 31+200)
 294 t Bit Mixture, 4C
 378 t Bit Mixture, 3C
 2660 m² Aggregate Base, 200 mm
 700 m Station Grading
 5113 m² Slope Restoration

REMOVAL & CONSTRUCTION SHEET

 Michigan Department of Transportation	STA 30+500 TO STA 31+200 NB I-75				
	DATE	SCALE	CONT. SEC.	JOB NO.	DESIGN UNIT
11/15/00	1:1000	63174	48647 53697	RICK	R.O.W. 16

DATE: 10/19/00
 DATE: 11/07/00
 DATE: 11/16/00
 EXISTING BY: RICK'S TEAM
 PROPOSED BY: RICK'S TEAM
 LAST CORRECTION BY: RICK'S TEAM

FILE NAME: 5369731200.dgn
 9 10 11 12 13 14 15 16 17 18 19 21 22 24 25 26 27 29 30 31 33

SECTION 2
 TIN,RIIE
 MADISON HEIGHTS

14 MILE RD


SECTION 35
 TIN,RIIE
 TROY

FINAL R.O.V.			
AUTH	DATE	NO.	REVISION

GUARDRAIL QUANTITIES JN 48647 (NB STRUCTURE)
 98 m Bridge Railing, Thrie Beam Retrofit
 7 ea Guardrail Reflector

GUARDRAIL QUANTITIES JN 48647 (I-75 SB OUTSIDE)
 1 ea Guardrail Approach Terminal, Type 2T
 2 ea Guardrail Anch, Bridge, Det A1
 1 ea Guardrail Departing Terminal, Type T
 297.18 m Guardrail, Type T
 32 ea Guardrail Reflector

GUARDRAIL QUANTITIES JN 53697 (I-75 NB INSIDE @ TRUSS)
 1 ea Guardrail Approach Terminal, Type 2T
 1 ea Guardrail Departing Terminal, Type T
 86.08 m Guardrail, Type T
 7 ea Guardrail Reflector

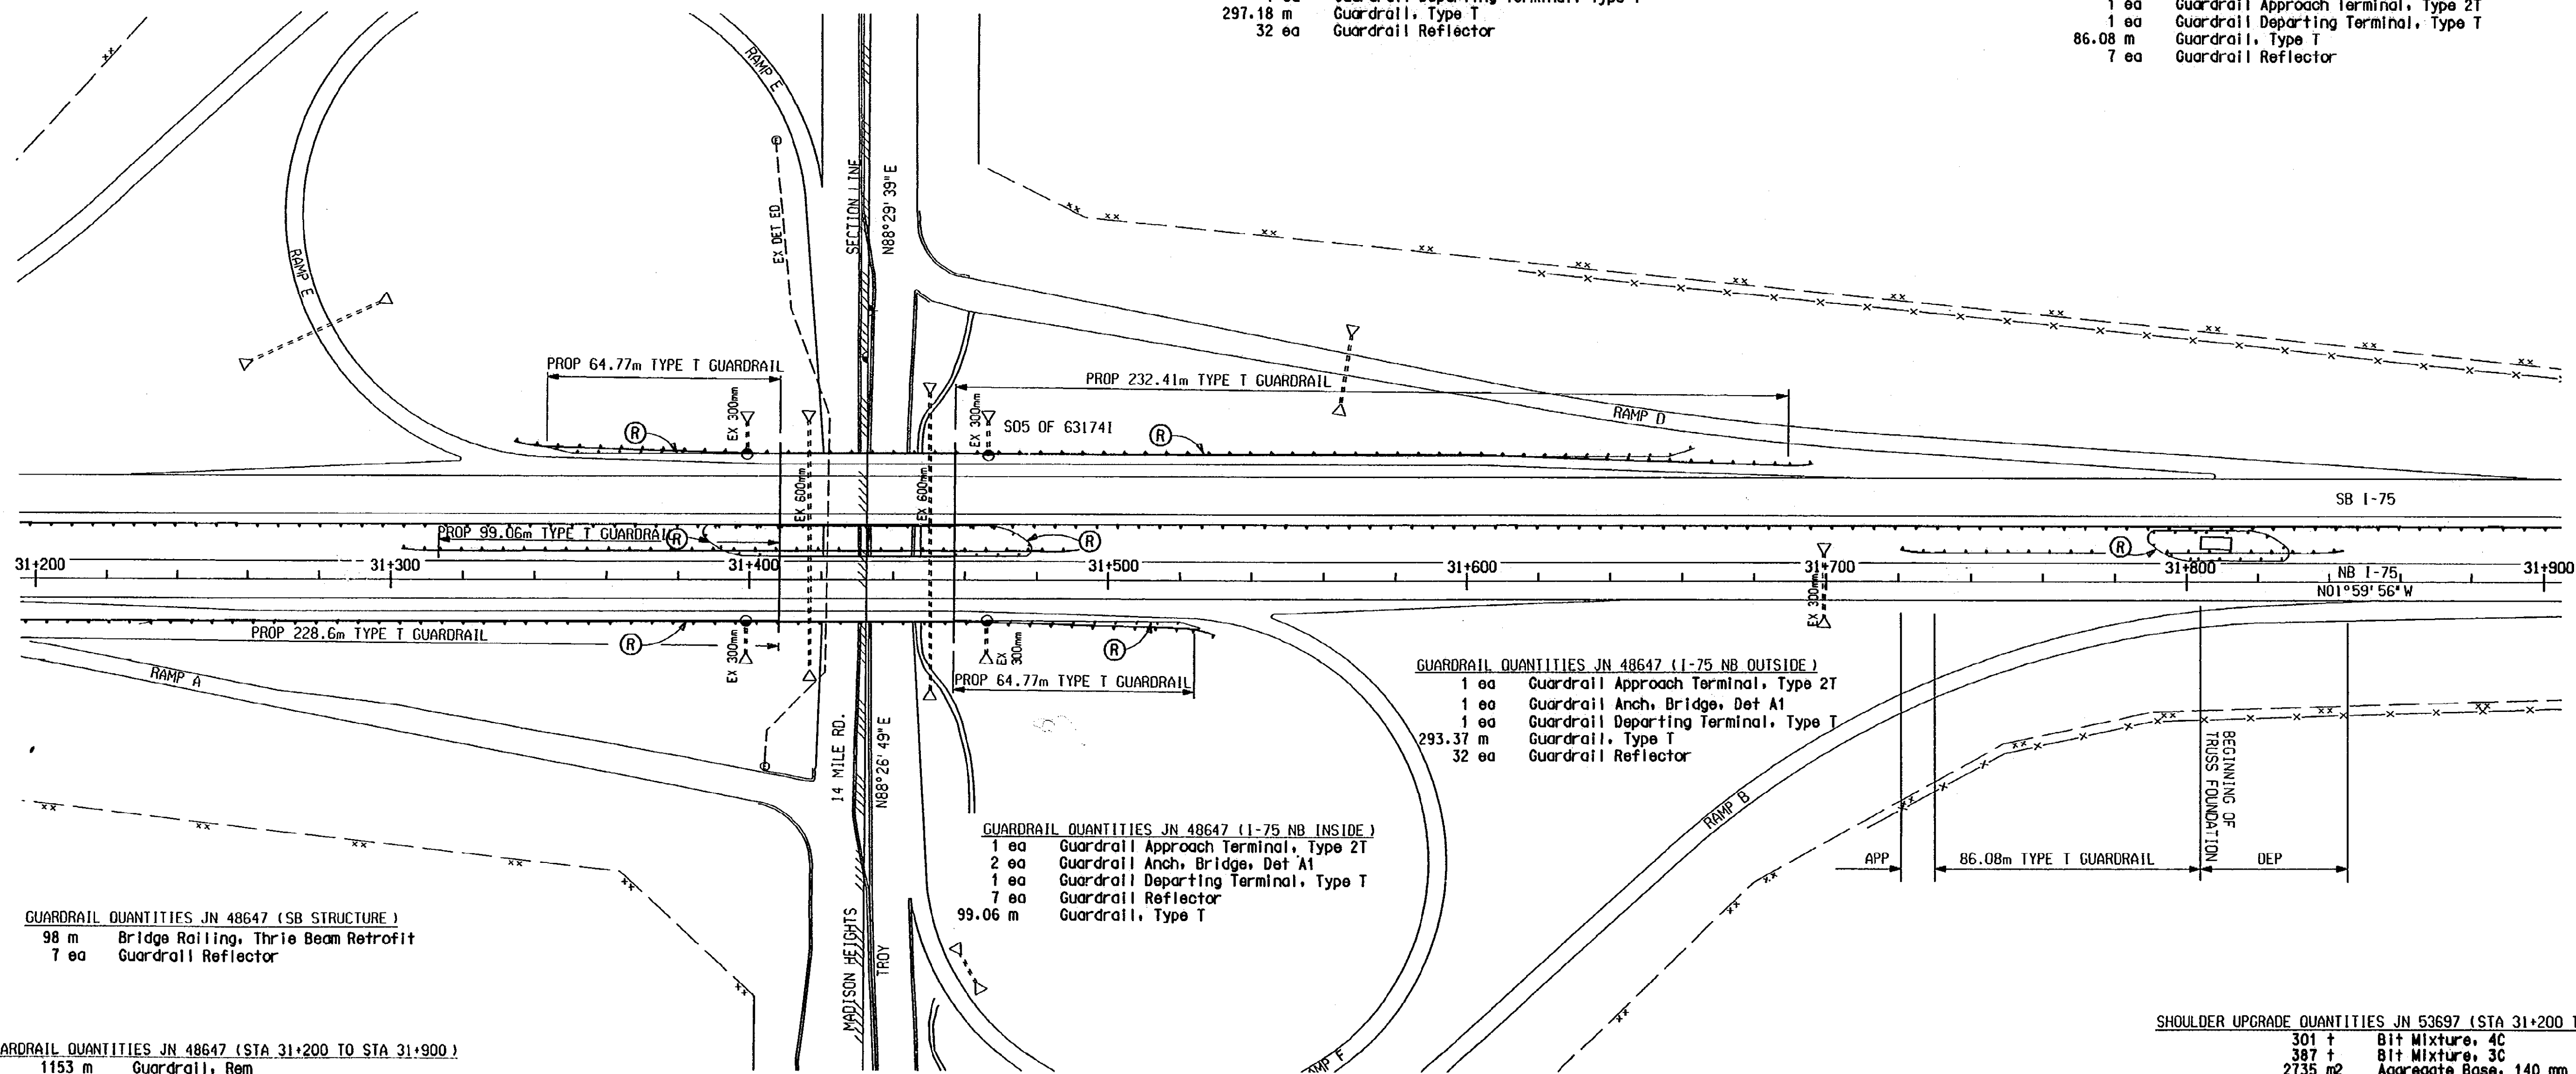

GUARDRAIL QUANTITIES JN 48647 (SB STRUCTURE)
 98 m Bridge Railing, Thrie Beam Retrofit
 7 ea Guardrail Reflector

GUARDRAIL QUANTITIES JN 48647 (STA 31+200 TO STA 31+900)
 1153 m Guardrail, Rem
 636.27 m Guardrail, Type TD
 84 ea Guardrail Reflector
 2 ea Guardrail Anch, Bridge, Det A1

GUARDRAIL QUANTITIES JN 48647 (I-75 NB INSIDE)
 1 ea Guardrail Approach Terminal, Type 2T
 2 ea Guardrail Anch, Bridge, Det A1
 1 ea Guardrail Departing Terminal, Type T
 7 ea Guardrail Reflector
 99.06 m Guardrail, Type T

GUARDRAIL QUANTITIES JN 48647 (I-75 NB OUTSIDE)
 1 ea Guardrail Approach Terminal, Type 2T
 1 ea Guardrail Anch, Bridge, Det A1
 1 ea Guardrail Departing Terminal, Type T
 293.37 m Guardrail, Type T
 32 ea Guardrail Reflector

SHOULDER UPGRADE QUANTITIES JN 53697 (STA 31+200 TO STA 31+900)
 301 t Bit Mixture, 4C
 387 t Bit Mixture, 3C
 2735 m² Aggregate Base, 140 mm
 651 m Station Grading
 2409 m² Slope Restoration
 677 m² Shoulder, C1 II, 140 mm

REMOVAL & CONSTRUCTION SHHET


	STA 31+200 TO STA 31+900 NB I-75				
	DATE	SCALE	CONT. SEC.	JOB NO.	DESIGN UNIT
11/16/00	1:1000	63174	53697	RICK	17

EXISTING BY: RICK'S TEAM
 PROPOSED BY: RICK'S TEAM
 LAST CORRECTION BY:

FILE NAME: 5369731900.dgn
 9 10 11 12 13 14 15 16 17 18 19 21 22 24 25 26 27 28 30 31 33

DATE: 10/20/00
 DATE: 11/11/00
 DATE:

FINL R.O.W.			
AUTH	DATE	NO.	REVISION

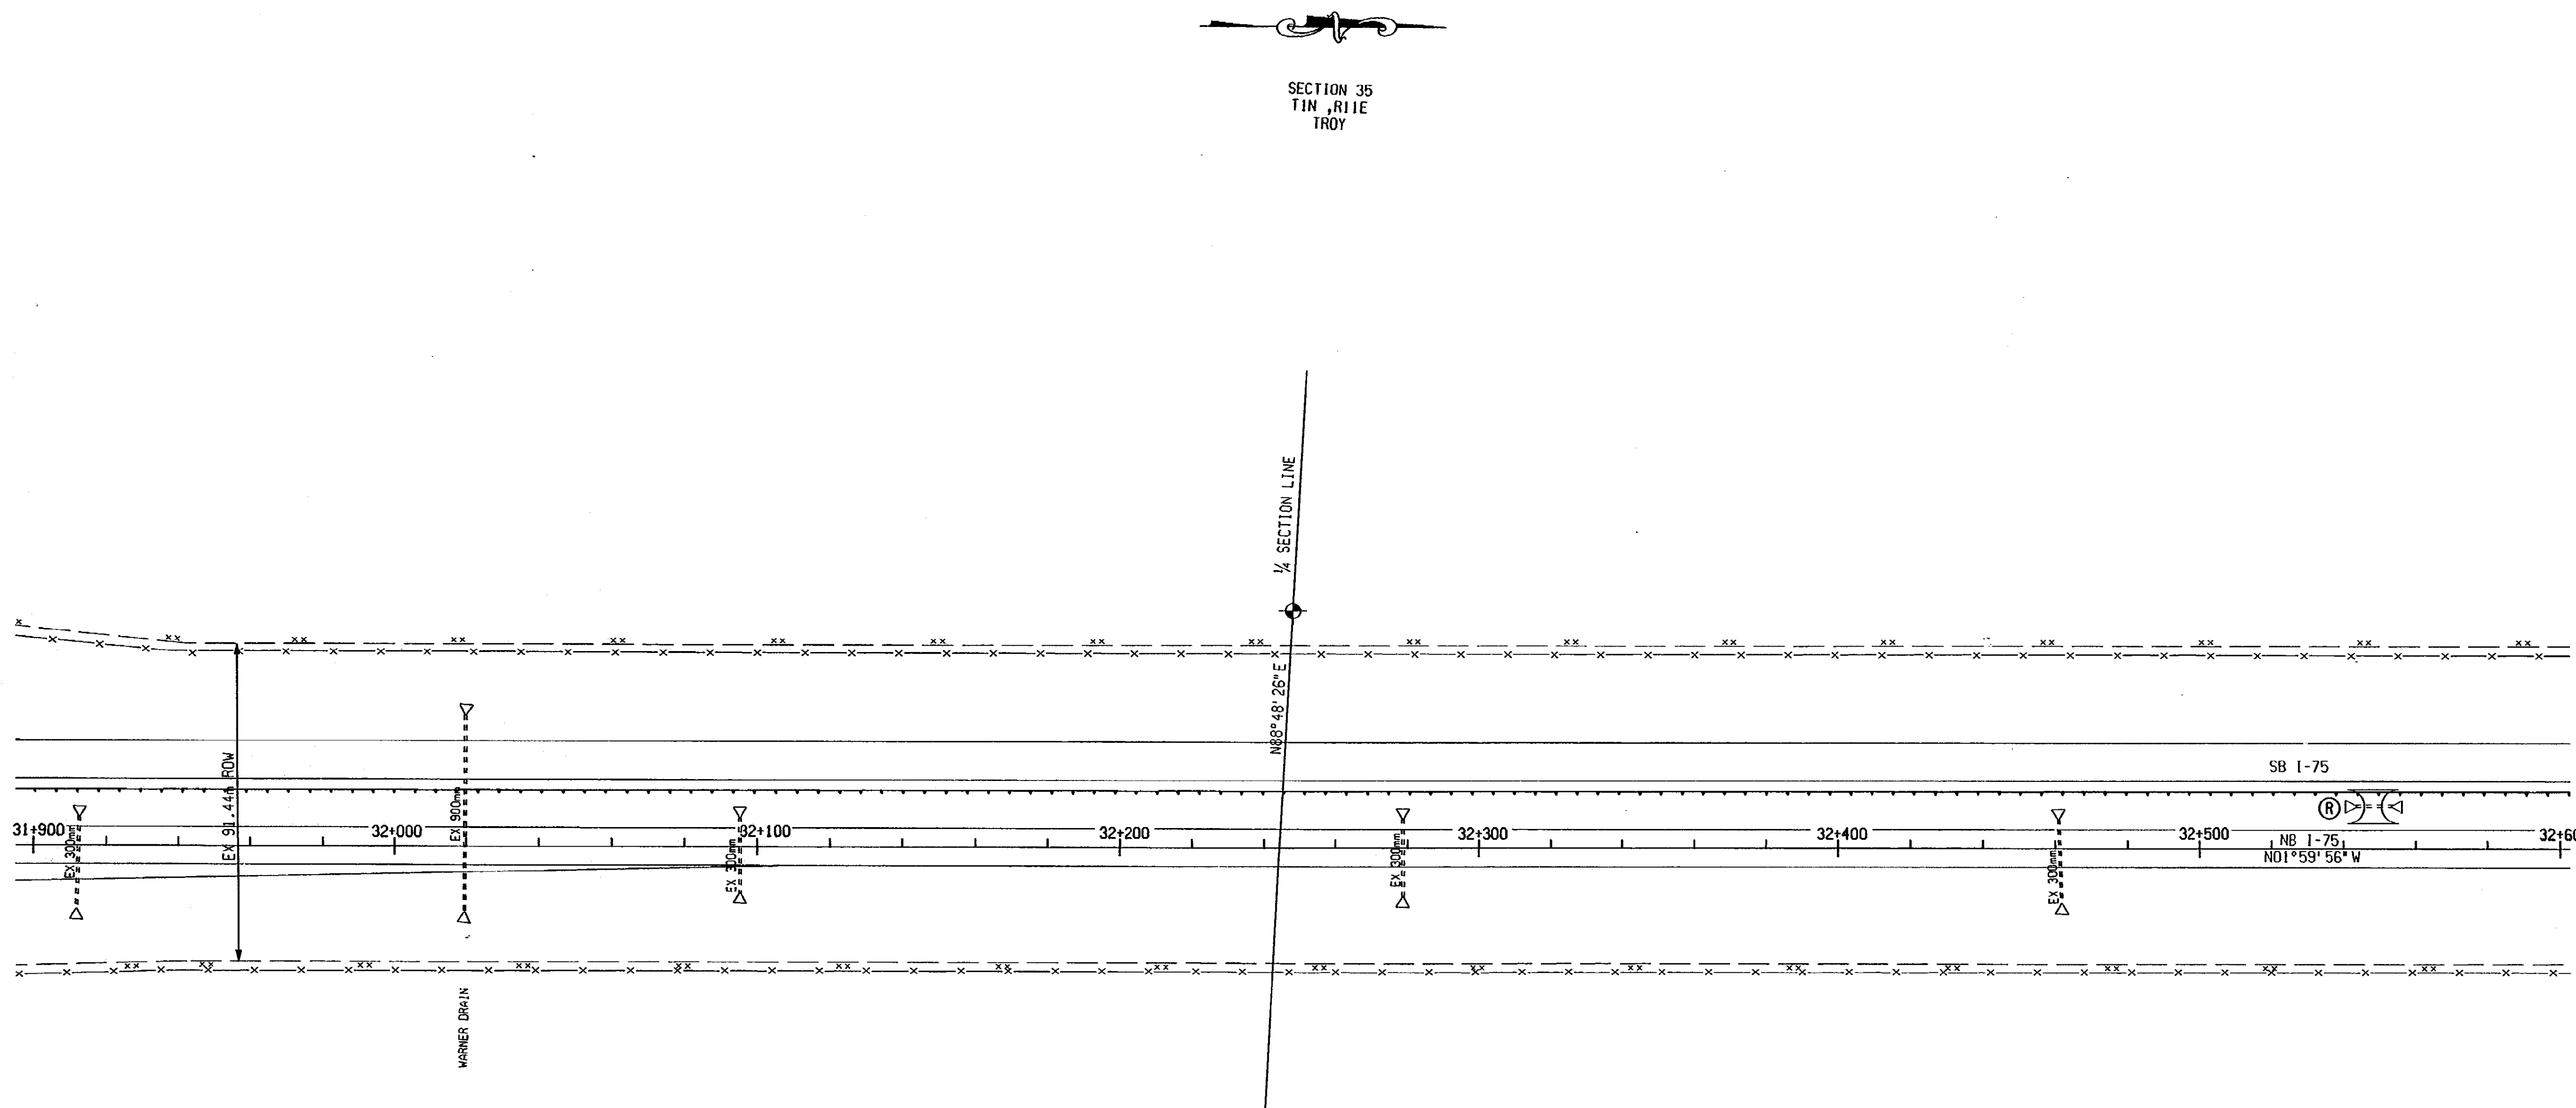

GUARDRAIL QUANTITIES JN 48697 (STA 31+900 TO STA 36+600)
 701.04 m Guardrail, Type TD
 92 ea Guardrail Reflector

SHOULDER UPGRADE QUANTITIES JN 53697 (STA 31+900 TO STA 32+600)
 323 t Bit Mixture, 4C
 416 t Bit Mixture, 3C
 2940 m² Aggregate Base, 200 mm
 700 m Station Grading
 2590 m² Slope Restoration
 728 m² Shoulder, CI 11, 140 mm

REMOVAL & CONSTRUCTION SHEET

	STA 31+900 TO STA 32+600 NB I-75					
	DATE	SCALE	CONT. SEC.	JOB NO.	DESIGN UNIT	SHEET NO.
11/11/00	1:1000	63174	48647 53697	RICK	R.O.W.	18

EXISTING BY: RICK'S TEAM DATE: 10/26/00
 PROPOSED BY: RICK'S TEAM DATE: 11/01/00
 LAST CORRECTION BY: RICK'S TEAM DATE: 11/11/00

FILE NAME: 5369732600.dgn 9:10:11.12 13 14 15 16 17 18 19 21 22 24 25 26 27 29 30 31 33

FINAL R.O.W.			
AUTH	DATE	NO.	REVISION


15 MILE RD



SECTION 35
TIN, R11E
TROY

SECTION 26
TIN, R11E
TROY

- GUARDRAIL QUANTITIES JN 48647 (I-75 SB OUTSIDE)**
- 1 ea Guardrail Approach Terminal, Type 2T
 - 2 ea Guardrail Anch. Bridge, Det A1
 - 1 ea Guardrail Departing Terminal, Type T
 - 487.68 m Guardrail, Type T
 - 32 ea Guardrail Reflector

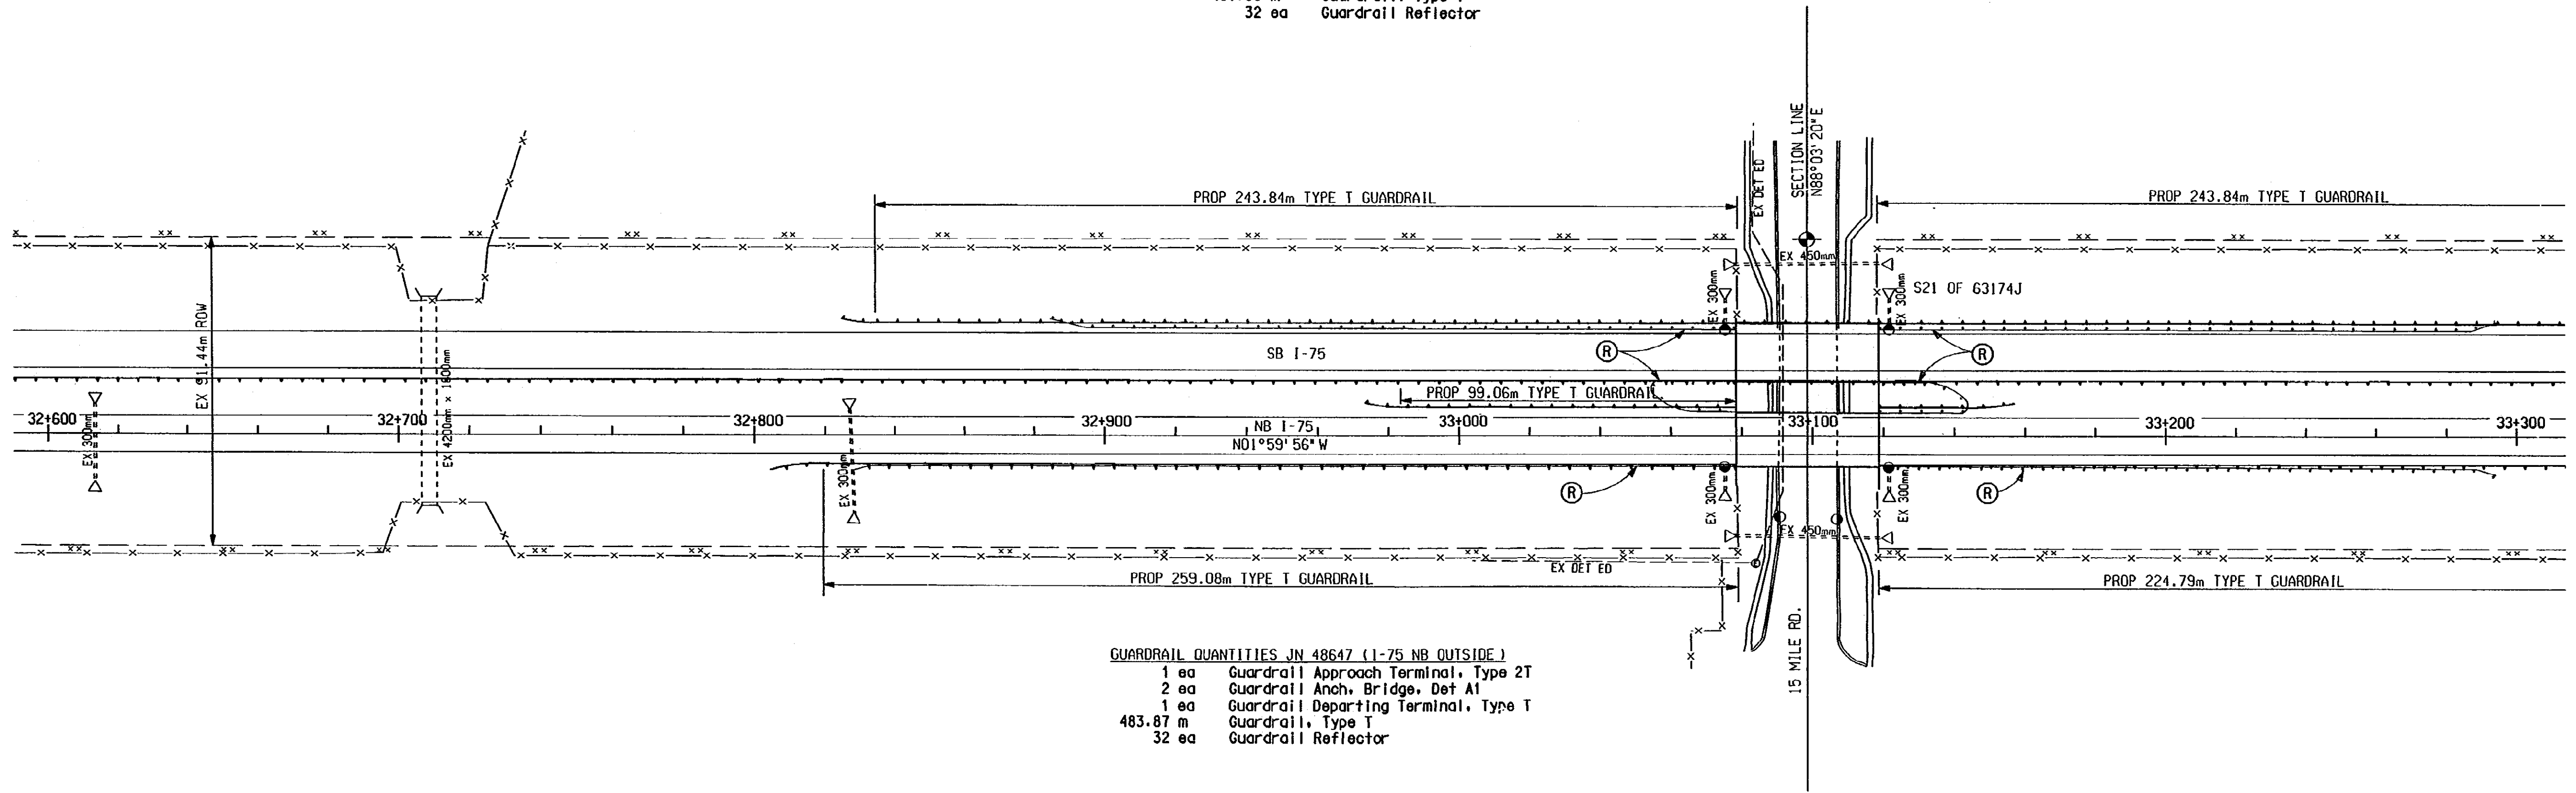

- GUARDRAIL QUANTITIES JN 48647 (I-75 NB OUTSIDE)**
- 1 ea Guardrail Approach Terminal, Type 2T
 - 2 ea Guardrail Anch. Bridge, Det A1
 - 1 ea Guardrail Departing Terminal, Type T
 - 483.87 m Guardrail, Type T
 - 32 ea Guardrail Reflector

- GUARDRAIL QUANTITIES JN 48647 (I-75 NB INSIDE)**
- 1 ea Guardrail Approach Terminal, Type 2T
 - 2 ea Guardrail Anch. Bridge, Det A1
 - 1 ea Guardrail Departing Terminal, Type T
 - 99.06 m Guardrail, Type T
 - 7 ea Guardrail Reflector

- GUARDRAIL QUANTITIES JN 48647 (STA 32+600 TO STA 33+300)**
- 1061 m Guardrail, Rem
 - 685.80 m Guardrail, Type TD
 - 2 ea Guardrail Anch. Bridge, Det A1
 - 90 ea Guardrail Reflector
 - 161 m Bridge Railing, Thrie Beam Retrofit

- SHOULDER UPGRADE QUANTITIES JN 53697 (STA 32+600 TO STA 33+300)**
- 305 t Bit Mixture, 4C
 - 392 t Bit Mixture, 3C
 - 2771 m² Aggregate Base, 200 mm
 - 660 m Station Grading
 - 2441 m² Slope Restoration
 - 686 m² Shoulder, CI II, 140 mm

15 MILE RD

REMOVAL & CONSTRUCTION SHEET



	STA 32+600 TO STA 33+300 NB I-75					
	DATE	SCALE	CONT. SEC.	JOB NO.	DESIGN UNIT	SHEET NO.
	11/11/00	1:100	63174	48647 53697	RICK	R.O.W. 19

DATE: 10/20/00
 DATE: 11/11/00
 EXISTING BY: RICK'S TEAM
 PROPOSED BY: RICK'S TEAM
 LAST CORRECTION BY:

FILE NAME: 536973300.dwg
 9 10 11 12 13 14 15 16 17 18 19 21 22 24 25 26 27 29 30 31 33

I-75 NB CONST
 CURVE DATA
 $\Delta=90^{\circ}00'06"$ LT
 R=776.167
 T=776.189
 L=1219.223
 PC =33+533.067
 P1 =34+309.257
 PT =34+752.290

FINAL R.O.W.			
AUTH	DATE	NO.	REVISION

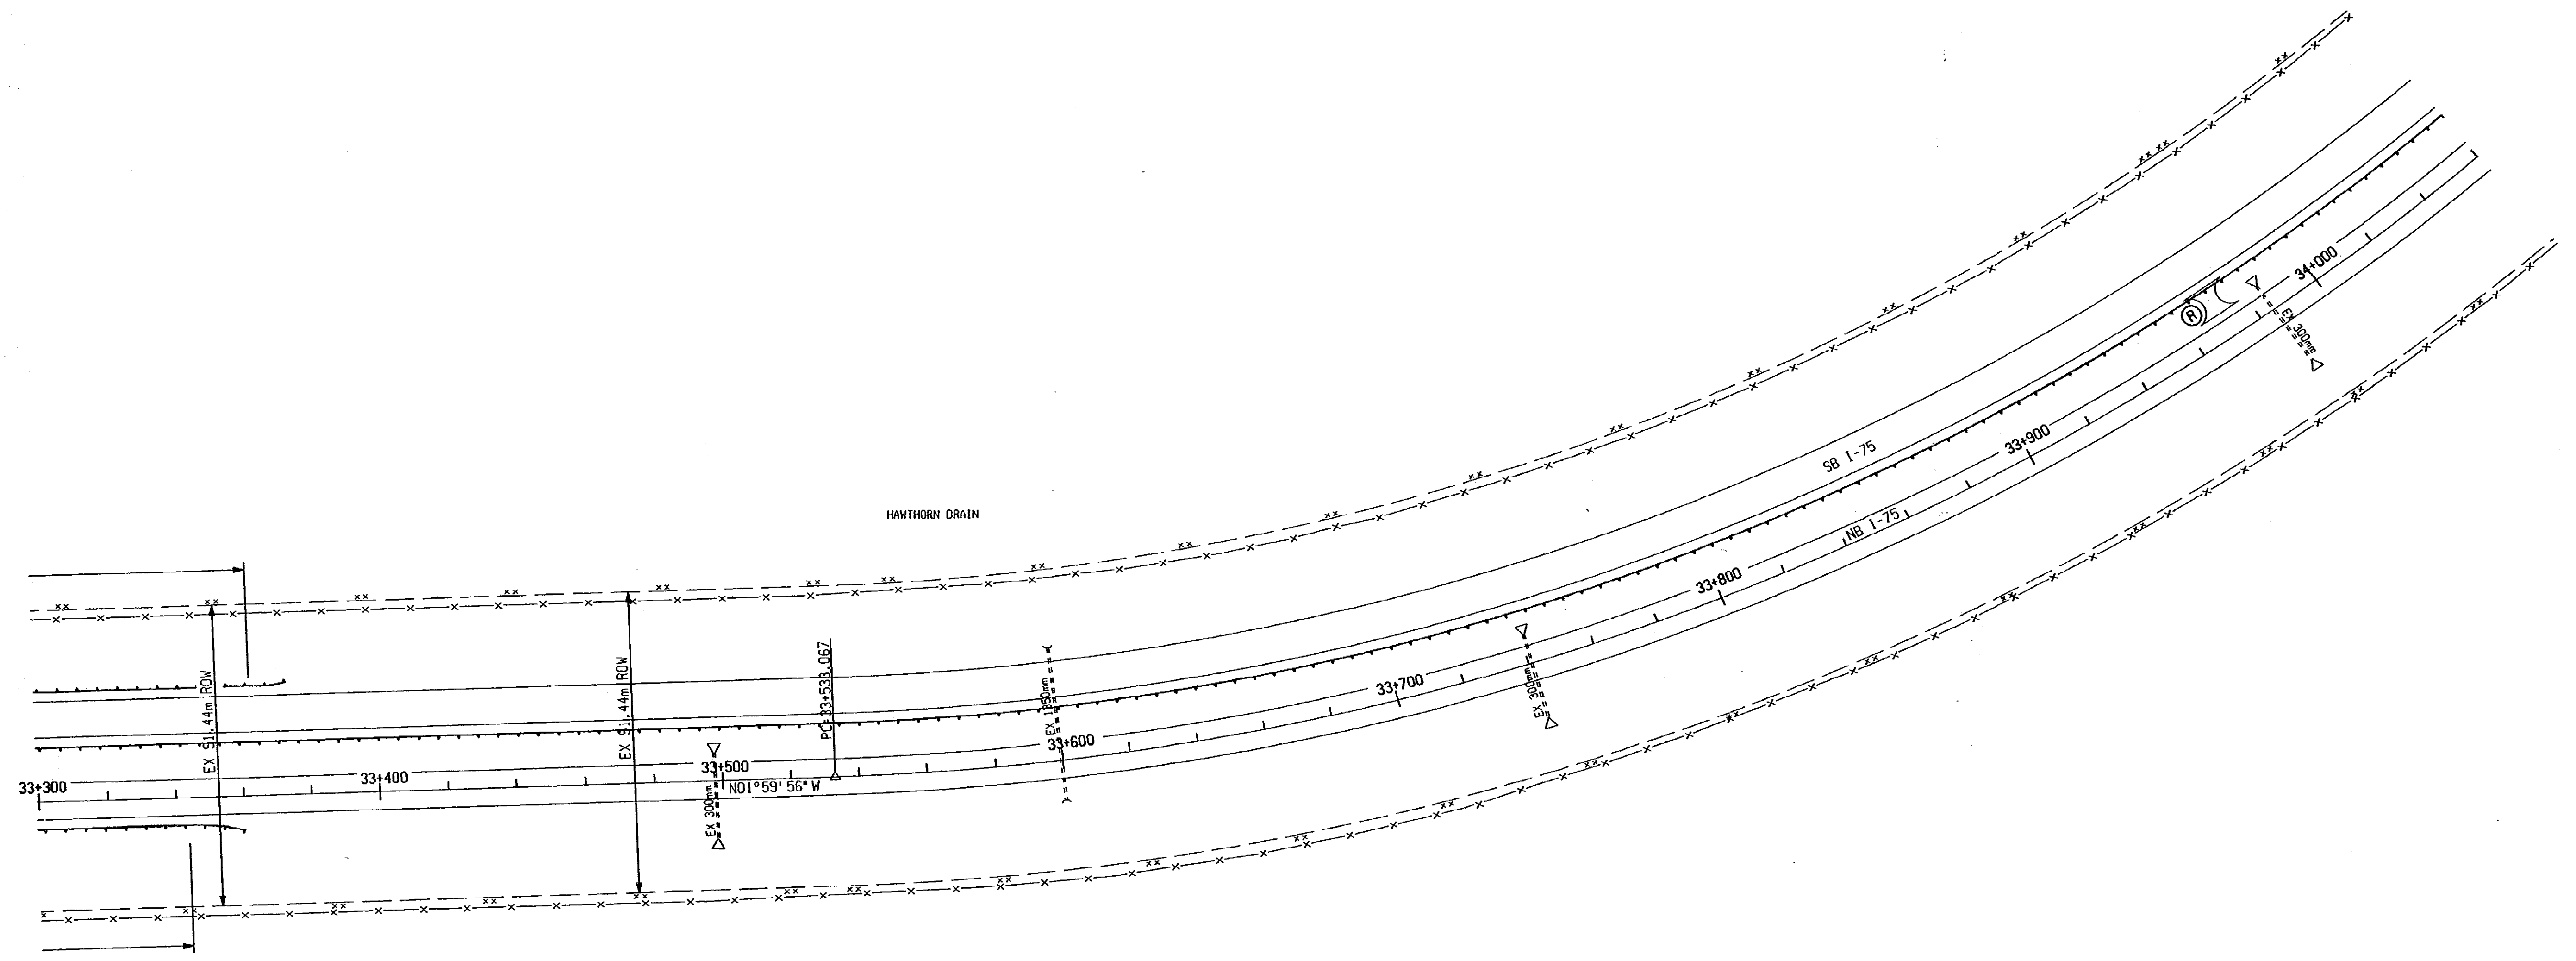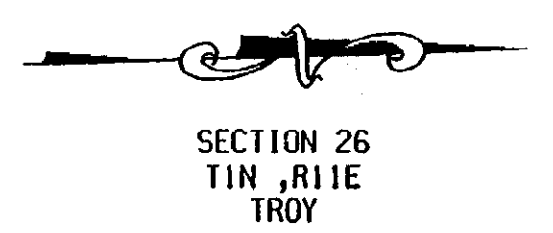

GUARDRAIL QUANTITIES JN 48647 (STA 32+600 TO STA 34+060)
 762 m Guardrail, Type TD
 100 ea Guardrail Reflector

CONSTRUCTION QUANTITIES JN 53697 (STA 32+600 TO STA 34+060)
 351 t Bit Mixture, 4C
 451 t Bit Mixture, 3C
 3192 m² Aggregate Base, 200 mm
 720 m Station Grading
 2812 m² Slope Restoration
 790 m² Shoulder, CI 11, 140 mm

REMOVAL & CONSTRUCTION SHEET

	STA 33+300 TO STA 34+060 NB I-75				
	DATE	SCALE	CONT. SEC.	JOB NO.	DESIGN UNIT
11/11/00	1:1000	63174	48647 53697	RICK	R.O.W. 20

EXISTING BY: RICK'S TEAM
 PROPOSED BY: RICK'S TEAM
 LAST CORRECTION BY: RICK'S TEAM


DATE: 10/20/00
 DATE: 11/11/00
 DATE: 11/17/00

FILE NAME: 5369734060.dgn
 9 10 11 12 13 14 15 16 17 18 19 21 22 24 25 26 27 29 30 31 33

I-75 NB CONST
 CURVE DATA
 $\Delta = 90^{\circ}00'06" \text{ LT}$
 $R = 776.167$
 $T = 776.189$
 $L = 1219.223$
 $PC = 33+533.067$
 $PI = 34+309.257$
 $PT = 34+752.290$

SECTION 26
 TIN, RIIE
 TROY

FINAL R.O.W.			
AUTH	DATE	NO.	REVISION

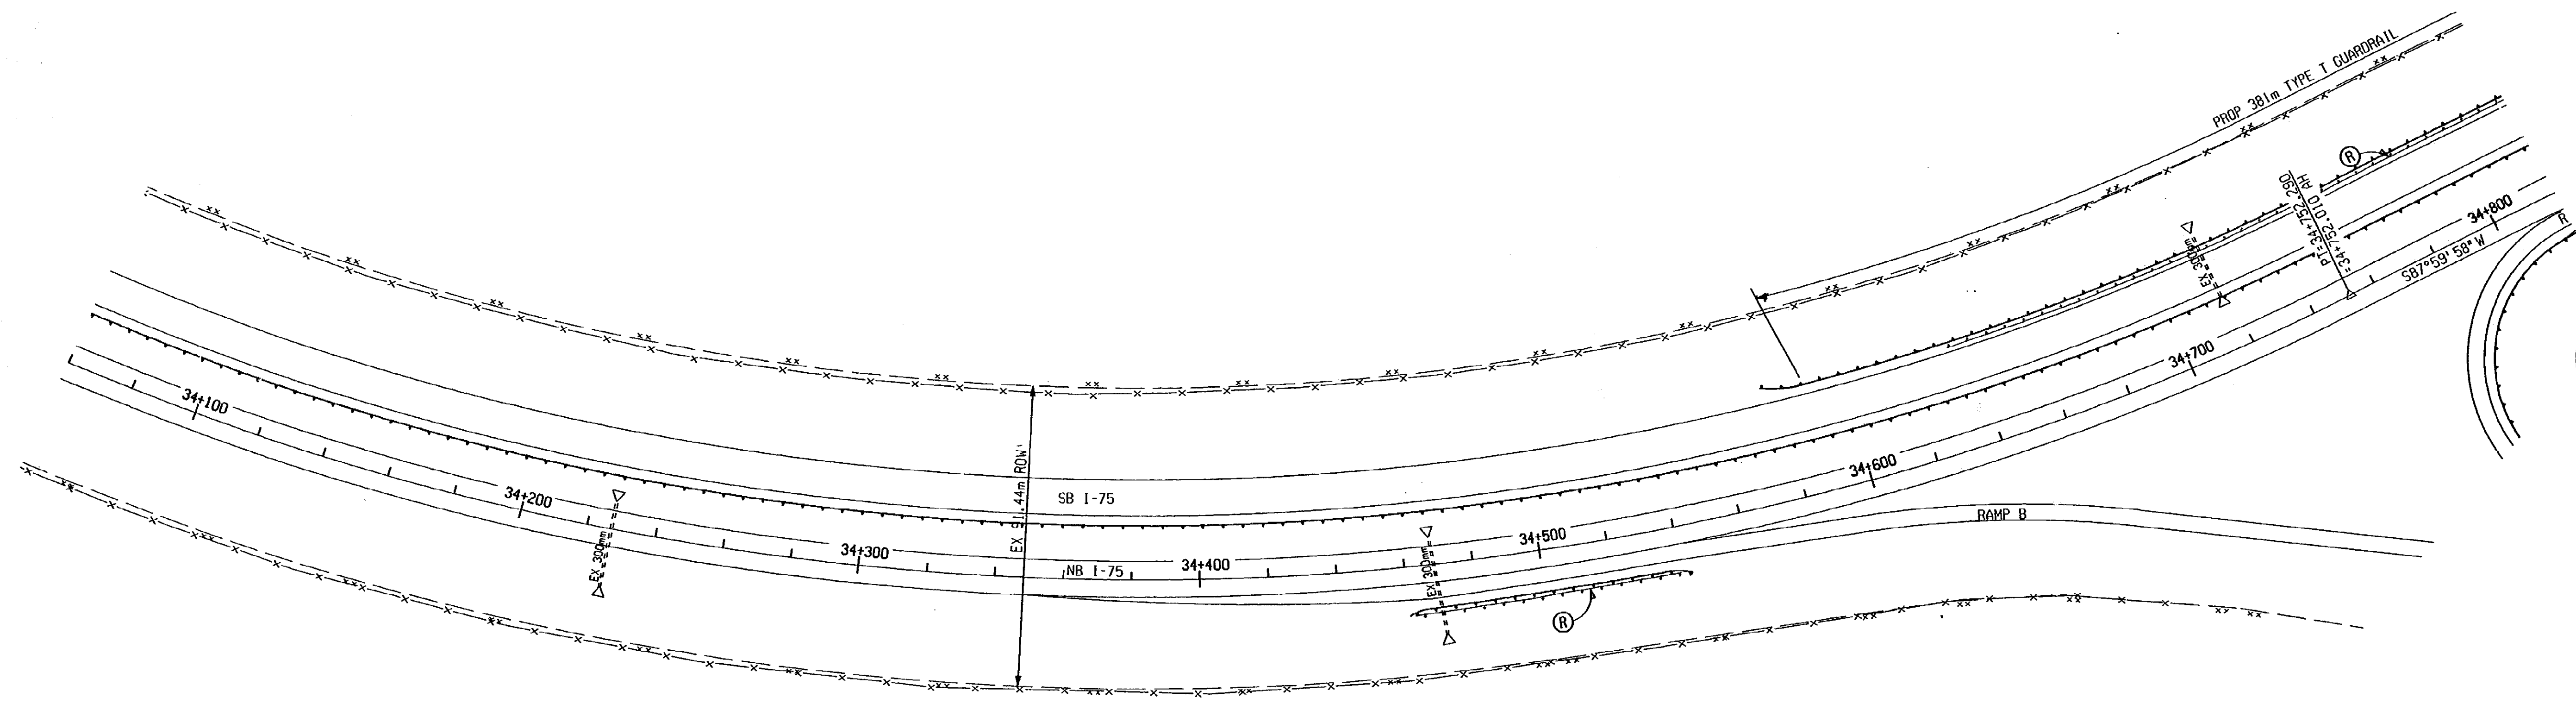

GUARDRAIL QUANTITIES JN 48647 (STA 34+060 TO STA 34+820)
 762 m Guardrail, Type TD
 100 ea Guardrail Reflector

GUARDRAIL QUANTITIES JN 48647 (I-75 NB OUTSIDE)
 79 m Guardrail, Rem
 1 ea Guardrail Approach Terminal, Type 2T
 1 ea Guardrail Departing Terminal, Type T
 72.39 m Guardrail, Type T
 5 ea Guardrail Reflector

CONSTRUCTION QUANTITIES JN 53697 (STA 34+060 TO STA 34+820)
 351 t Bit Mixture, 4C
 451 t Bit Mixture, 3C
 3192 m² Aggregate Base, 200 mm
 760 m Station Grading
 2812 m² Slope Restoration
 790 m² Shoulder, CI 11, 140 mm

REMOVAL & CONSTRUCTION SHEET

	STA 34+060 TO STA 34+820 NB I-75					
	DATE	SCALE	CONT. SEC.	JOB NO.	DESIGN UNIT	SHEET NO.
	11/17/00	1:1000	63174	53697	RICK	R.O.W. 21


STEPHENSON HWY & ROCHESTER RD

FINAL R.O.V.			
AUTH	DATE	NO.	REVISION

SECTION 27
 TIN, R11E
 TROY

GUARDRAIL QUANTITIES JN 48647 (SB STRUCTURE)
 96 m Bridge Railing, Thrie Beam Retrofit
 7 ea Guardrail Reflector

GUARDRAIL QUANTITIES JN 48647 (I-75 SB OUTSIDE)
 1 ea Guardrail Approach Terminal, Type 2T
 1 ea Guardrail Departing Terminal, Type T
 2 ea Guardrail Anch, Bridge, Det A1
 510.54 m Guardrail, Type T
 48 ea Guardrail Reflector

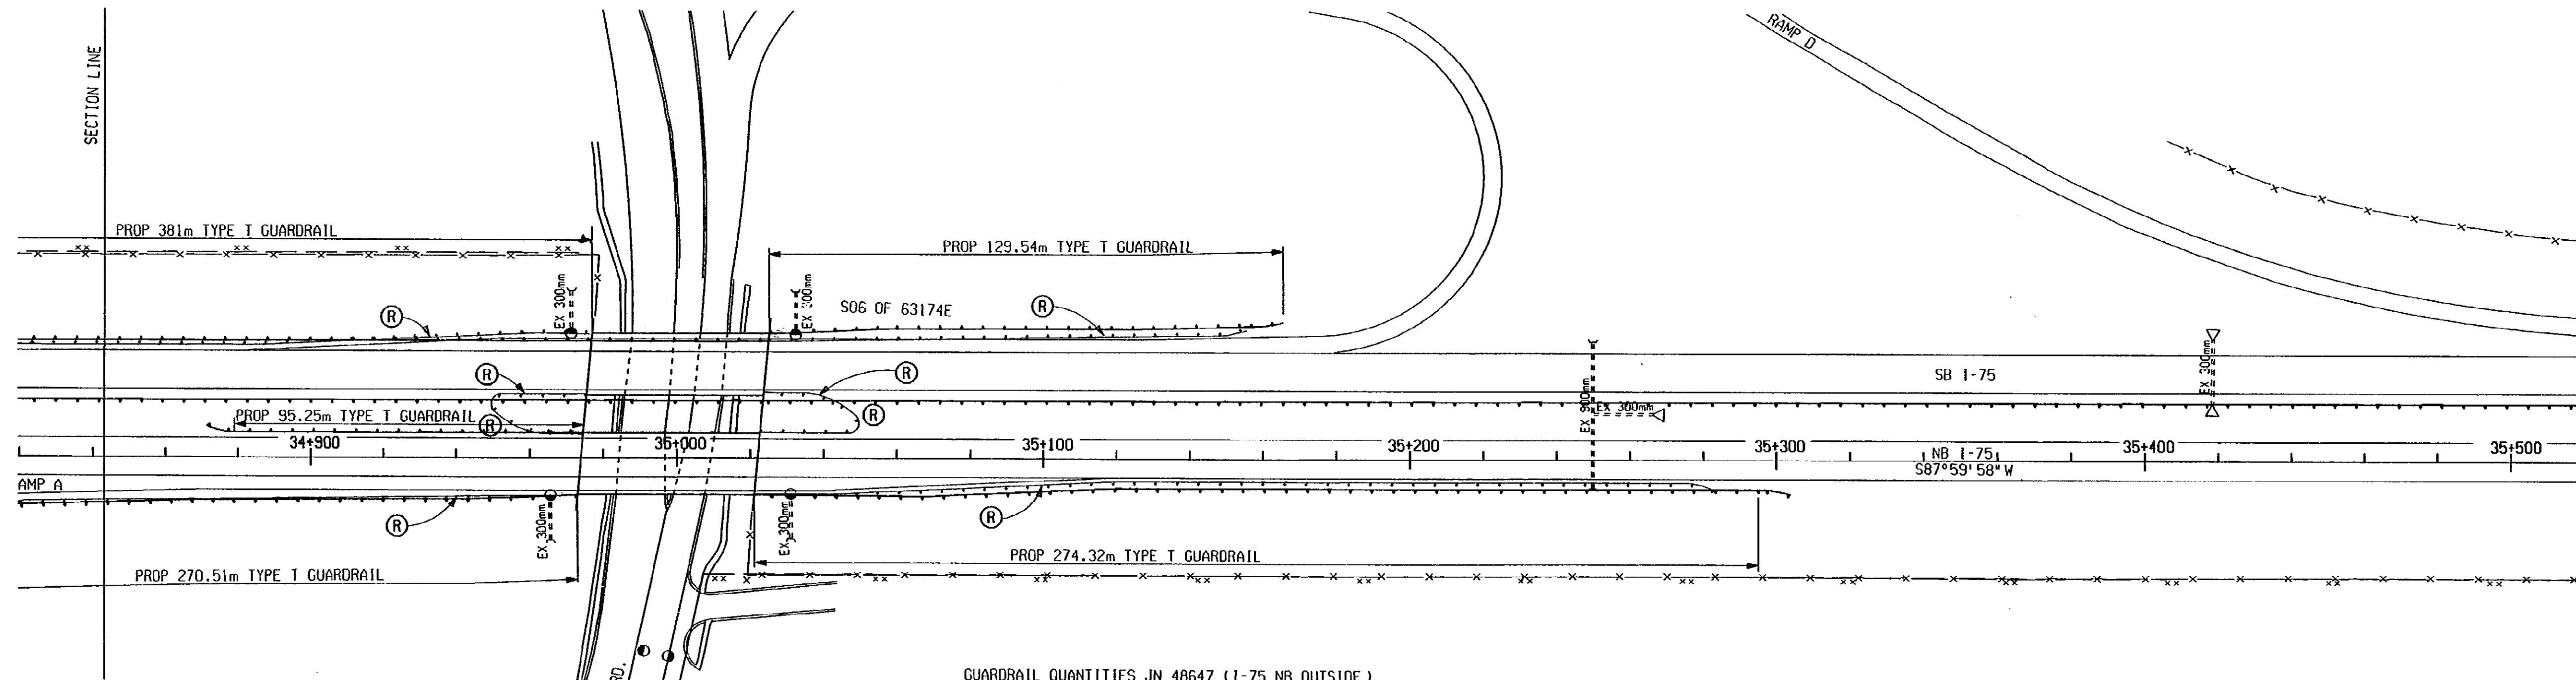

GUARDRAIL QUANTITIES JN 48647 (I-75 NB OUTSIDE)
 1 ea Guardrail Approach Terminal, Type 2T
 2 ea Guardrail Anch, Bridge, Det A1
 1 ea Guardrail Departing Terminal, Type T
 544.83 m Guardrail, Type T
 36 ea Guardrail Reflector

GUARDRAIL QUANTITIES JN 48647 (I-75 NB OUTSIDE)
 1 ea Guardrail Approach Terminal, Type 2T
 1 ea Guardrail Anch, Bridge, Det A1
 95.25 m Guardrail, Type T
 7 ea Guardrail Reflector

GUARDRAIL QUANTITIES JN 48647 (NB STRUCTURE)
 96 m Bridge Railing, Thrie Beam Retrofit
 7 ea Guardrail Reflector

GUARDRAIL QUANTITIES JN 48647 (STA 34+820 TO STA 35+520)
 640.08 m Guardrail, Type TD
 84 ea Guardrail Reflector
 2 ea Guardrail Anch, Bridge, Det A1
 1384 m Guardrail, Rem

MAINLINE QUANTITIES JN 53697 (STA 34+820 TO STA 35+520)
 301 t Bit Mixture, 4C
 387 t Bit Mixture, 3C
 2738 m² Aggregate Base, 200 mm
 652 m Station Grading
 2412 m² Slope Restoration
 678 m² Shoulder, C1 II, 140 mm

STEPHENSON HWY & ROCHESTER RD

REMOVAL & CONSTRUCTION SHEET


	34+820 TO STA 35+520 NB I-75					
	DATE	SCALE	CONT. SEC.	JOB NO.	DESIGN UNIT	SHEET NO.
	01/09/01	1:1000	63174	53697	RICK	22

EXISTING BY: RICK'S TEAM
 PROPOSED BY: RICK'S TEAM
 LAST CORRECTION BY:

DATE: 10/21/00
 DATE: 11/13/00
 DATE:

FINAL R.O.W.			
AUTH	DATE	NO.	REVISION


SECTION 27
 TIN, RIIE
 TROY

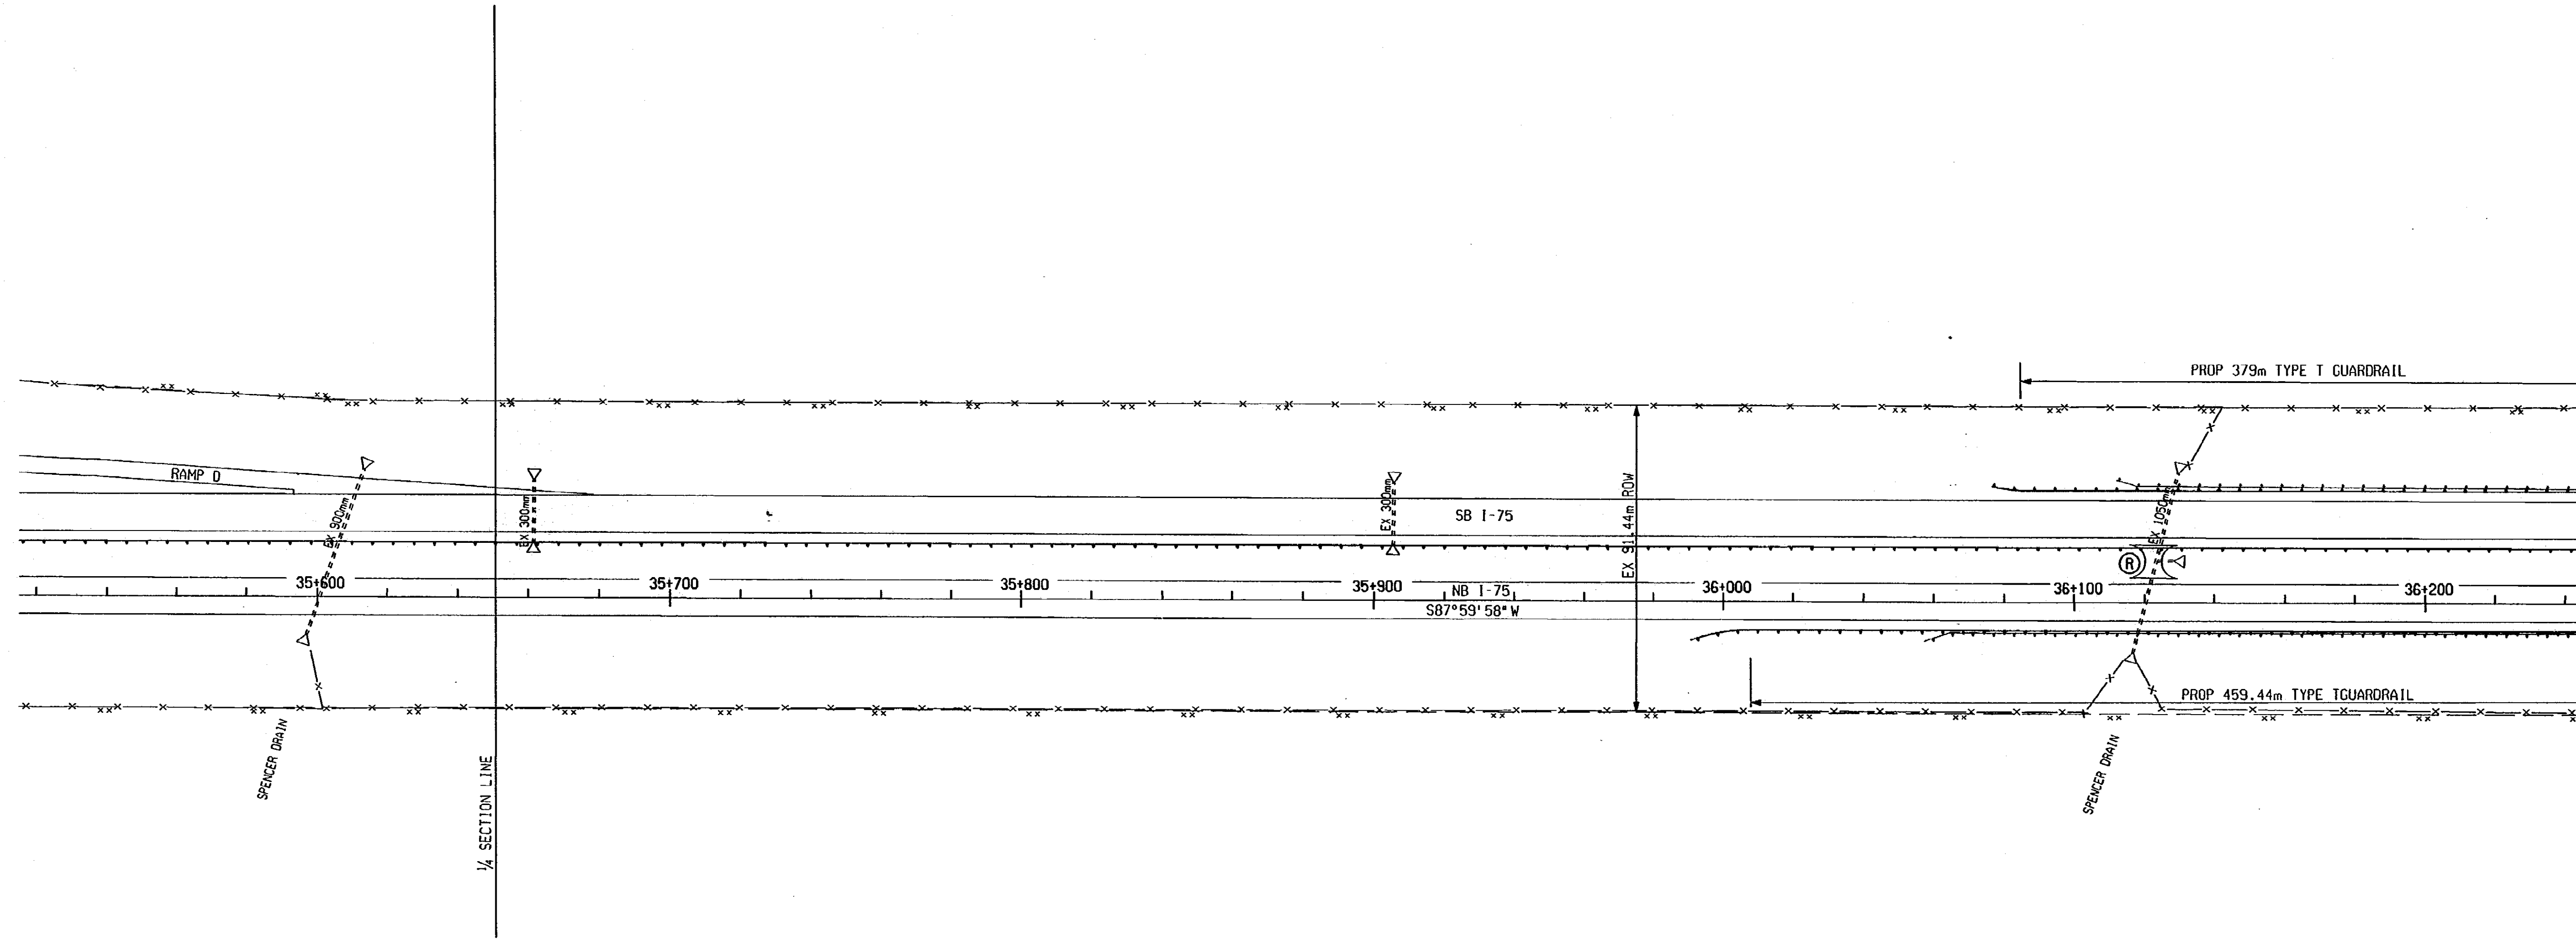

GUARDRAIL QUANTITIES JN 48647 (STA 35+520 TO STA 36+240.)
 702.09 m Guardrail, Type TD
 95 ea Guardrail Reflector

CONSTRUCTION QUANTITIES JN 53697 (STA 35+520 TO STA 36+240.)
 333 t Bit Mixture, 4C
 428 t Bit Mixture, 3C
 3024 m² Aggregate Base, 200 mm
 720 m Station Grading
 2664 m² Slope Restoration
 749 m² Shoulder, CI II, 140 mm

REMOVAL & CONSTRUCTION SHEET

 Michigan Department of Transportation	STA 35+520 TO STA 36+240 NB I-75					
	DATE	SCALE	CONT. SEC.	JOB NO.	DESIGN UNIT	SHEET NO.
11/13/00	1:1000	63174	48647 53697	RICK	R.O.W.	23

DATE: 10/21/00
 DATE: 11/07/00
 DATE: 11/16/00
 EXISTING BY: RICK'S TEAM
 PROPOSED BY: RICK'S TEAM
 LAST CORRECTION BY: RICK'S TEAM

FILE NAME: 5369736240.dgn
 910 11 12 13 14 15 16 17 18 19 21 22 24 25 26 27 29 30 31 33

FINAL R.O.W.			
AUTH	DATE	NO.	REVISION

LIVERNOIS RD

SECTION 27
 TIN, R11E
 TROY

SECTION 28
 TIN, R11E
 TROY



GUARDRAIL QUANTITIES JN 48647 (I-75 SB OUTSIDE)

- 613.65 m Guardrail, Type T
- 40 ea Guardrail Reflector
- 1 ea Guardrail Approach Terminal, Type 2T
- 1 ea Guardrail Departing Terminal, Type T
- 2 ea Guardrail Anch, Bridge, Det A1

GUARDRAIL QUANTITIES JN 48647 (I-75 SB INSIDE)

- 1 ea Guardrail Anch, Bridge, Det A1
- 1 ea Guardrail Approach Terminal, Type 2T
- 102.87 m Guardrail, Type T
- 7 ea Guardrail Reflector

GUARDRAIL QUANTITIES JN 48647 SB STRUCTURE

- 79 m Bridge Railing, Thrie Beam Retrofit
- 6 ea Guardrail Reflector

GUARDRAIL QUANTITIES JN 48647 (I-75 NB OUTSIDE)

- 636.51 m Guardrail, Type T
- 41 ea Guardrail Reflector
- 1 ea Guardrail Approach Terminal, Type 2T
- 1 ea Guardrail Departing Terminal, Type T
- 2 ea Guardrail Anch, Bridge, Det A1

GUARDRAIL QUANTITIES JN 48647 NB STRUCTURE

- 79 m Bridge Railing, Thrie Beam Retrofit
- 6 ea Guardrail Reflector

GUARDRAIL QUANTITIES JN 48647 (I-75 NB INSIDE)


- 102.87 m Guardrail, Type T
- 7 ea Guardrail Reflector
- 1 ea Guardrail Approach Terminal, Type 2T
- 1 ea Guardrail Anch, Bridge, Det A1

GUARDRAIL QUANTITIES JN 48647 (STA 36+240 TO STA 36+960) SB MEDIAN

- 666.75 m Guardrail, Type TD
- 88 ea Guardrail Reflector
- 2 ea Guardrail Anch, Bridge, Det A1
- 1338 m Guardrail, Rem

SHOULDER UPGRADE QUANTITIES JN 53697 (STA 36+240 TO STA 36+960)

- 314 t Bit Mixture, 4C
- 404 t Bit Mixture, 3C
- 2858 m² Aggregate Base, 200 mm
- 681 m Station Grading
- 2518 m² Slope Restoration
- 708 m² Shoulder, C1 II, 140 mm

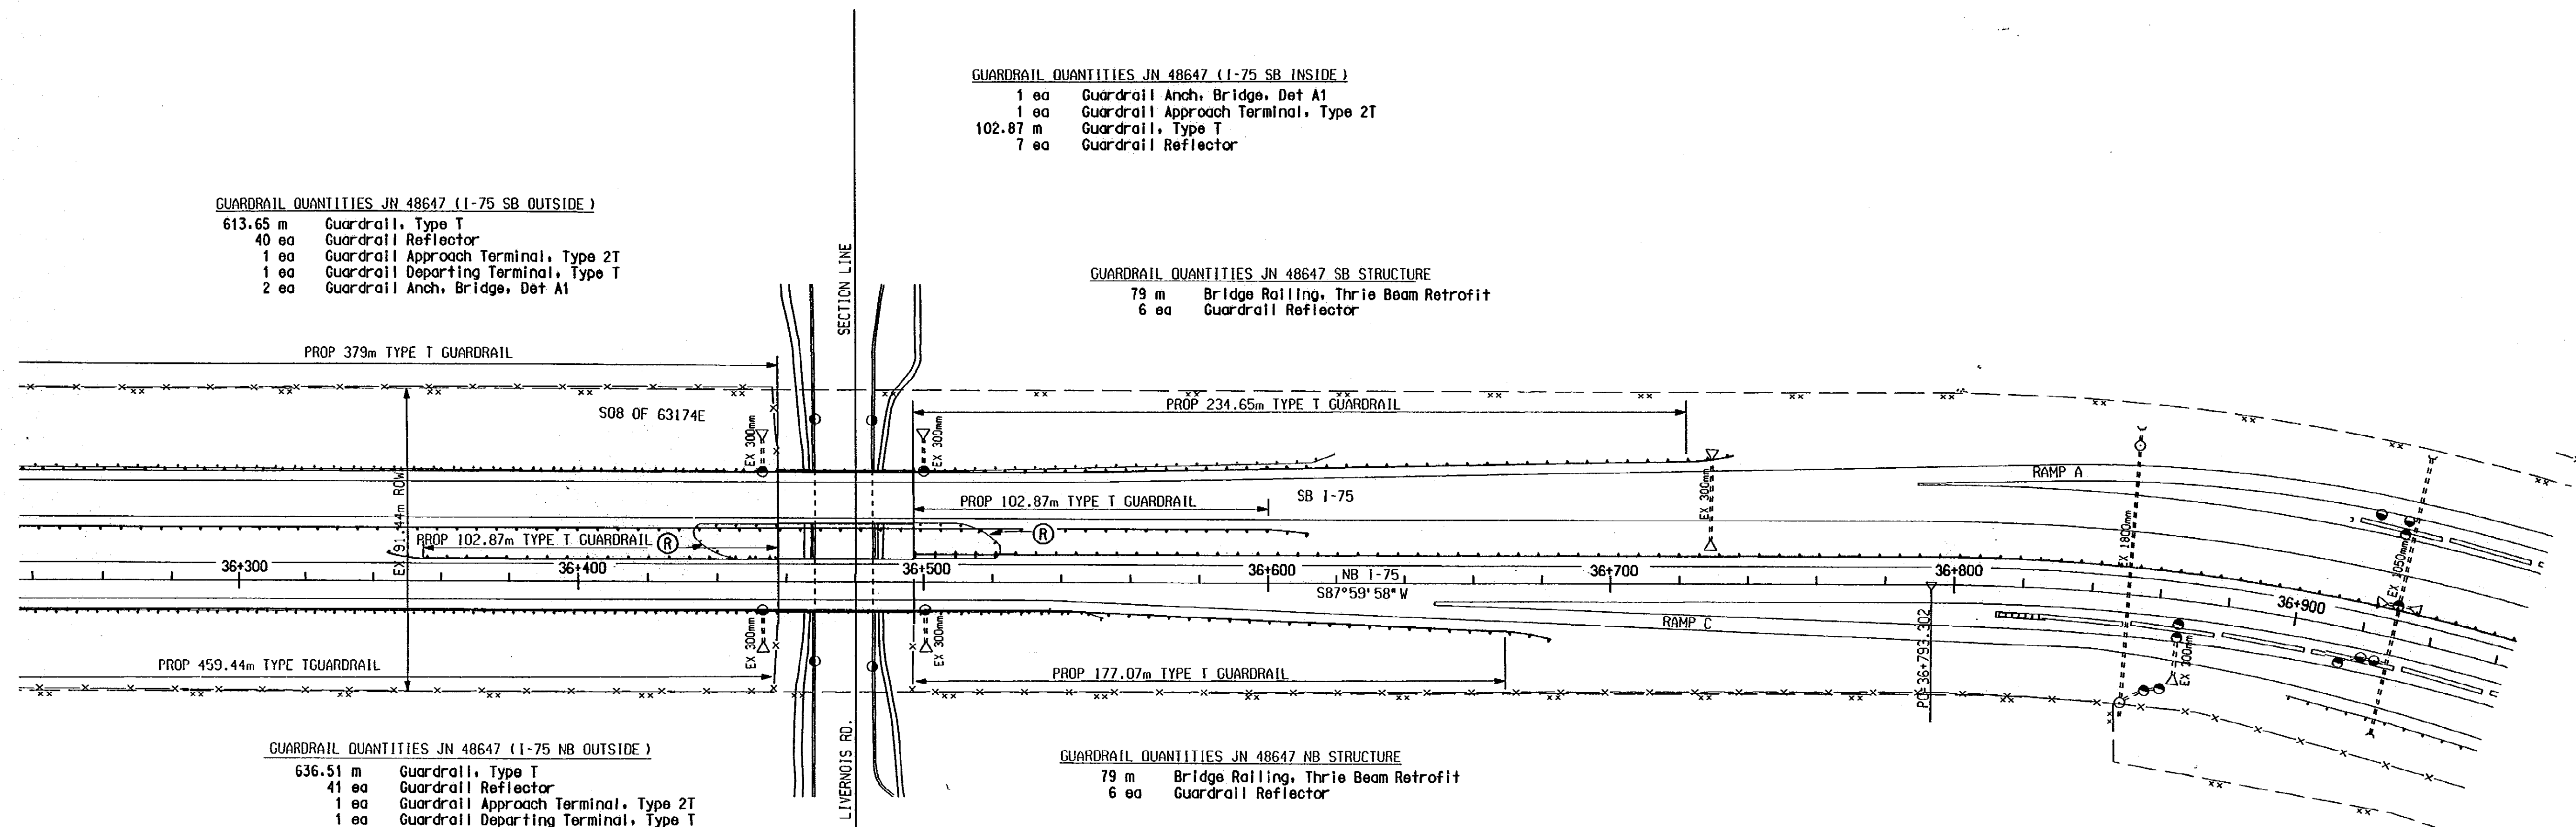

LIVERNOIS RD

REMOVAL & CONSTRUCTION SHEET

	STA 36+240 TO STA 36+960 NB I-75					
	DATE	SCALE	CONT. SEC.	JOB NO.	DESIGN UNIT	SHEET NO.
	11/16/00	1:1000	63174	48647 53697	RICK	R.O.W 24

DATE: 10/21/00
 EXISTING BY: RICK'S TEAM
 PROPOSED BY: RICK'S TEAM
 LAST CORRECTION BY: RICK'S TEAM
 DATE: 11/05/00
 DATE: 11/27/00

FILE NAME: 536973696.dgn
 910 11 12 13 14 15 16 17 18 19 21 22 24 25 26 27 29 30 31 33

SECTION 28
 TIN,RIIE
 TROY

1-75 NB CONST
 CURVE DATA
 $\Delta = 90^{\circ}00'34''$ RT
 R=582.125
 T=582.221
 L=914.496
 PC=36+793.302
 PI=37+375.523
 PT=37+707.798


GUARDRAIL QUANTITIES JN 48647 (I-75 SB OUTSIDE)
 1 ea Guardrail Approach Terminal, Type 2T
 1 ea Guardrail Departing Terminal, Type T
 2 ea Guardrail Anch, Bridge, Det A1
 106.68 m Guardrail, Type T
 7 ea Guardrail Reflector

GUARDRAIL QUANTITIES JN 48647 (I-75 SB STRUCTURE)
 53 m Bridge Railing, Thrie Beam Retrofit
 4 ea Guardrail Reflector

GUARDRAIL QUANTITIES JN 48647 (I-75 SB INSIDE)
 1 ea Guardrail Approach Terminal, Type 2T
 2 ea Guardrail Anch, Bridge, Det A1
 194.31 m Guardrail, Type T
 7 ea Guardrail Reflector
 1 ea Guardrail Departing Terminal, Type T

FINAL R.O.W.			
AUTH	DATE	NO.	REVISION

SECTION 21
 TIN,RIIE
 TROY

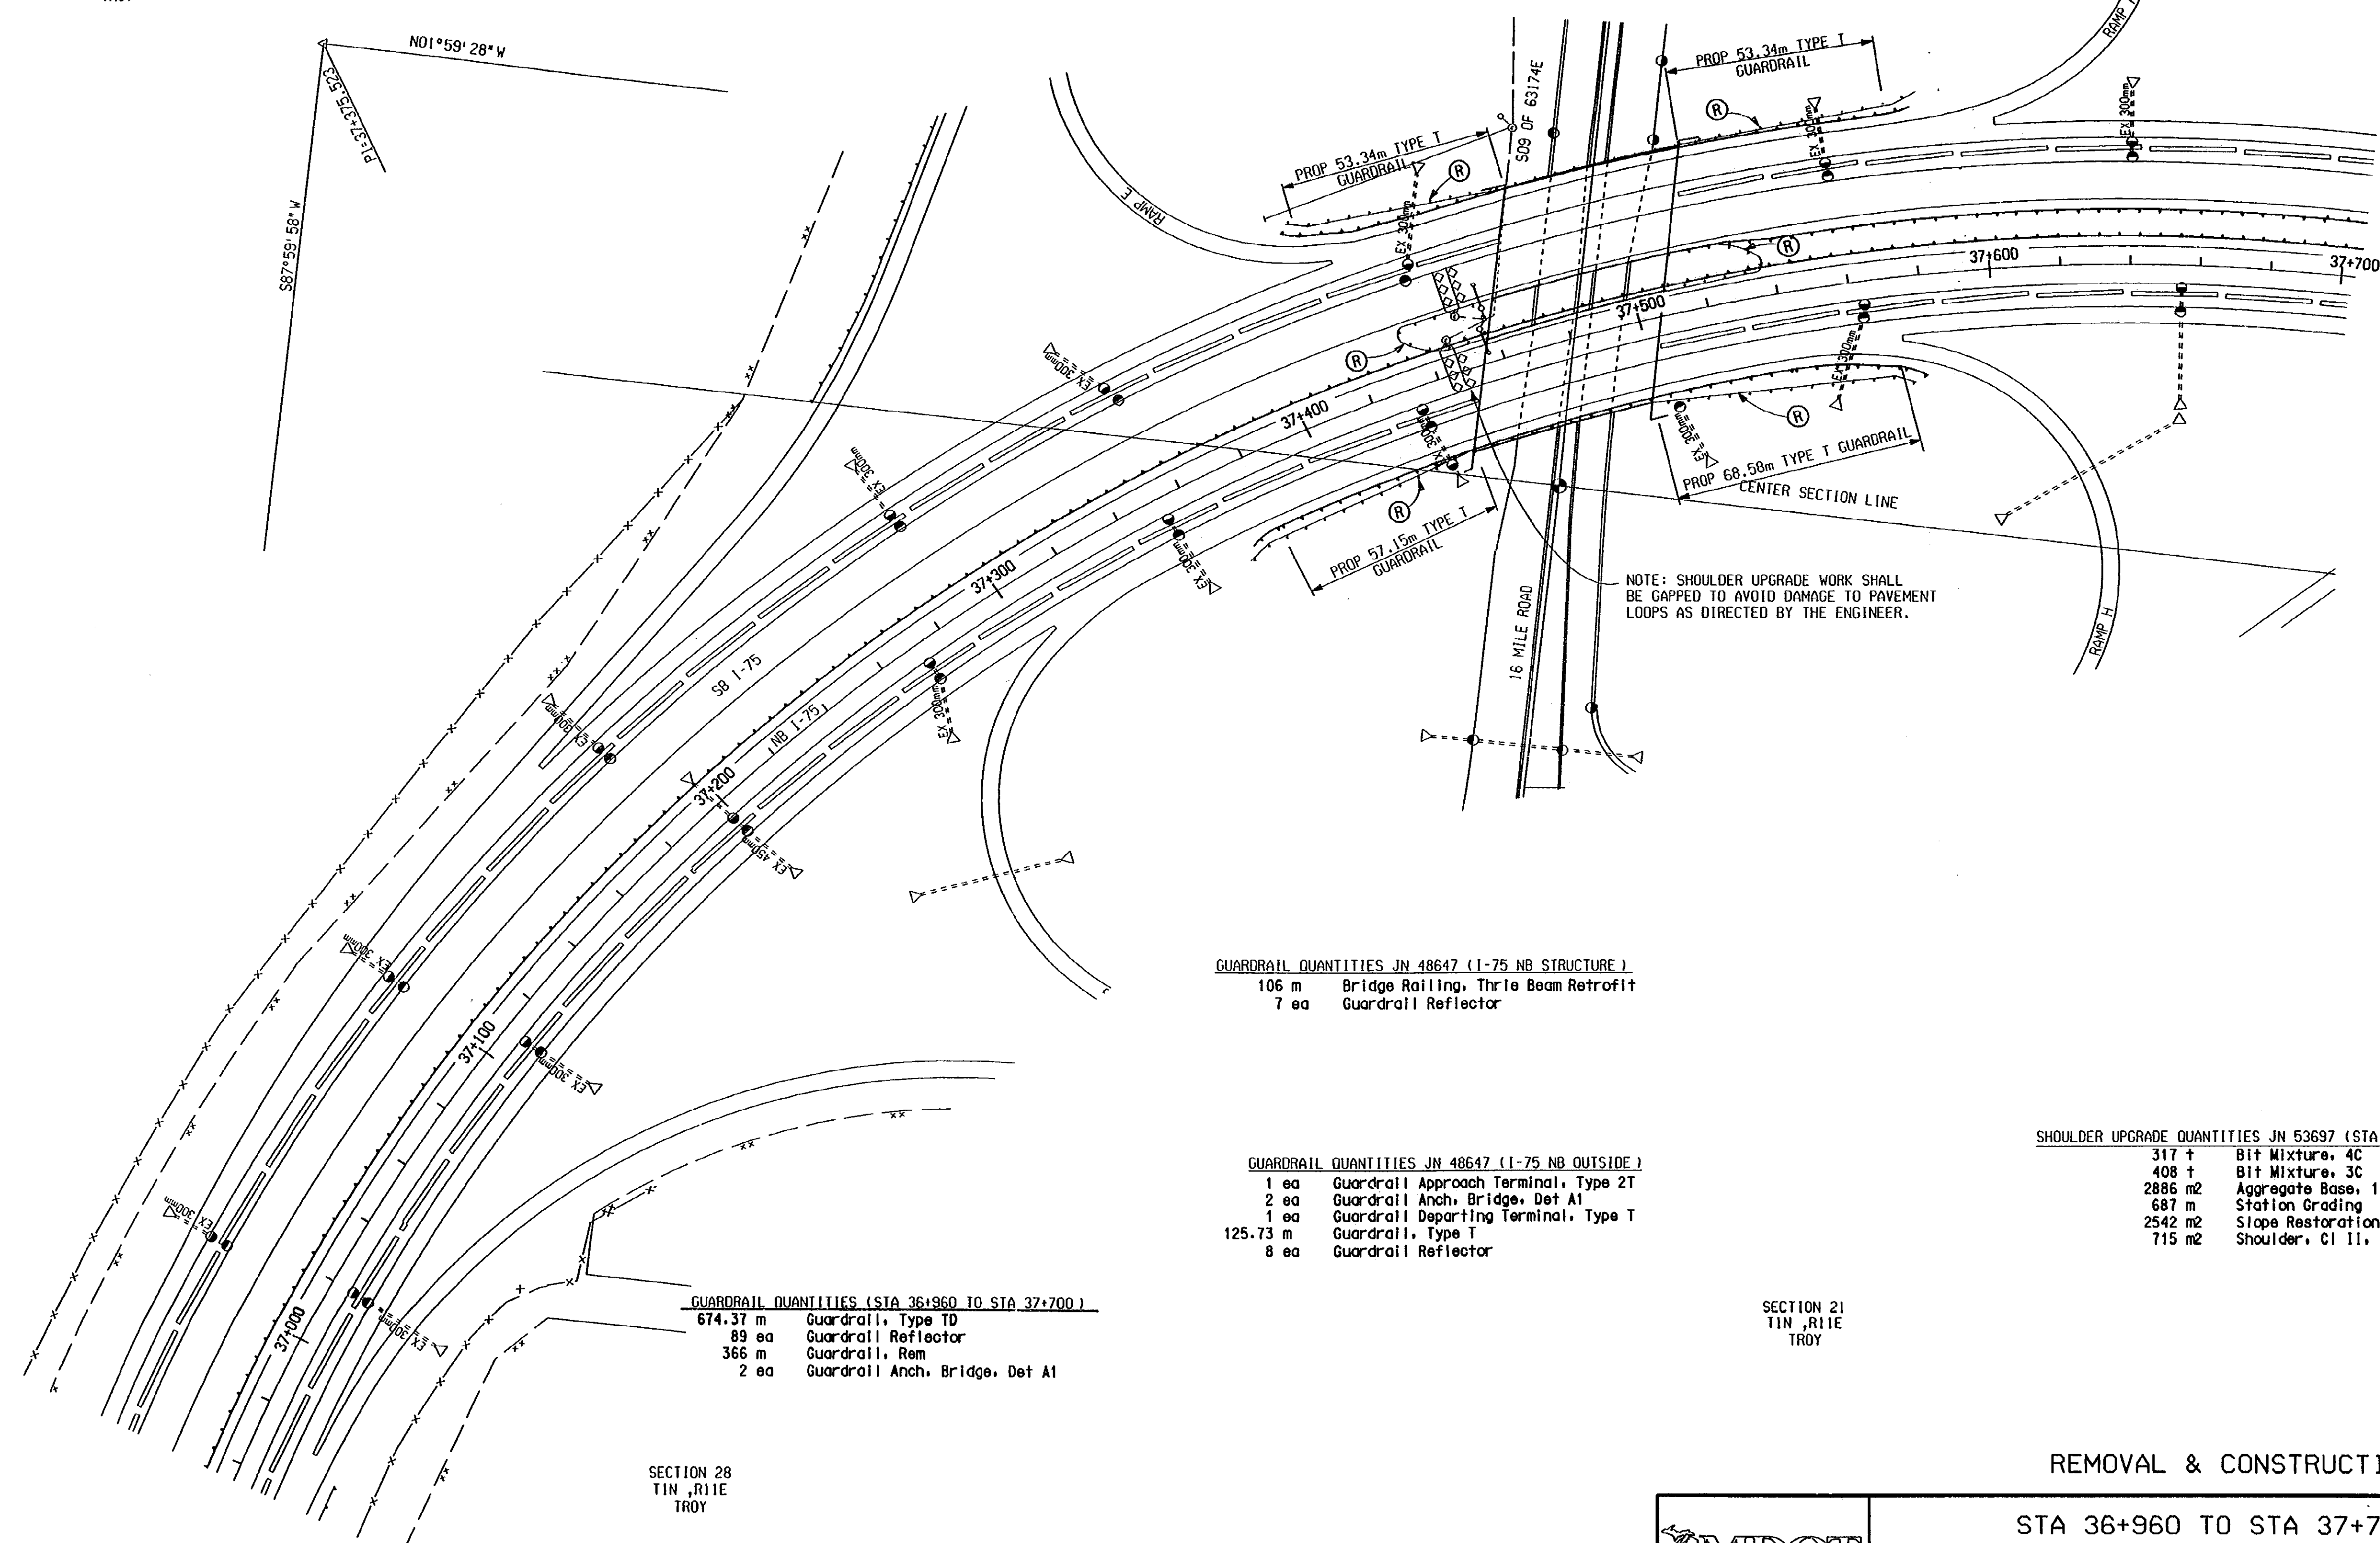

GUARDRAIL QUANTITIES JN 48647 (I-75 NB STRUCTURE)
 106 m Bridge Railing, Thrie Beam Retrofit
 7 ea Guardrail Reflector

GUARDRAIL QUANTITIES JN 48647 (I-75 NB OUTSIDE)
 1 ea Guardrail Approach Terminal, Type 2T
 2 ea Guardrail Anch, Bridge, Det A1
 1 ea Guardrail Departing Terminal, Type T
 125.73 m Guardrail, Type T
 8 ea Guardrail Reflector

GUARDRAIL QUANTITIES (STA 36+960 TO STA 37+700)
 674.37 m Guardrail, Type TD
 89 ea Guardrail Reflector
 366 m Guardrail, Rem
 2 ea Guardrail Anch, Bridge, Det A1

SHOULDER UPGRADE QUANTITIES JN 53697 (STA 36+960 TO STA 37+700)
 317 t Bit Mixture, 4C
 408 t Bit Mixture, 3C
 2886 m² Aggregate Base, 140 mm
 687 m Station Grading
 2542 m² Slope Restoration
 715 m² Shoulder, CI II, 140 mm

SECTION 21
 TIN,RIIE
 TROY

SECTION 28
 TIN,RIIE
 TROY

REMOVAL & CONSTRUCTION SHEET


BIG BEAVER RD

MIDOT Michigan Department of Transportation		STA 36+960 TO STA 37+700 NB I-75			
DATE	SCALE	CONT. SEC.	JOB NO.	DESIGN UNIT	SHEET NO.
11/27/00	1:1000	63174	48647 53697	RICK	R.O.W. 25

EXISTING BY: RICK'S TEAM
 PROPOSED BY: RICK'S TEAM
 LAST CORRECTION BY:

DATE: 10/21/00
 DATE: 11/08/00
 DATE:

FINAL R.O.V.			
AUTH	DATE	NO.	REVISION

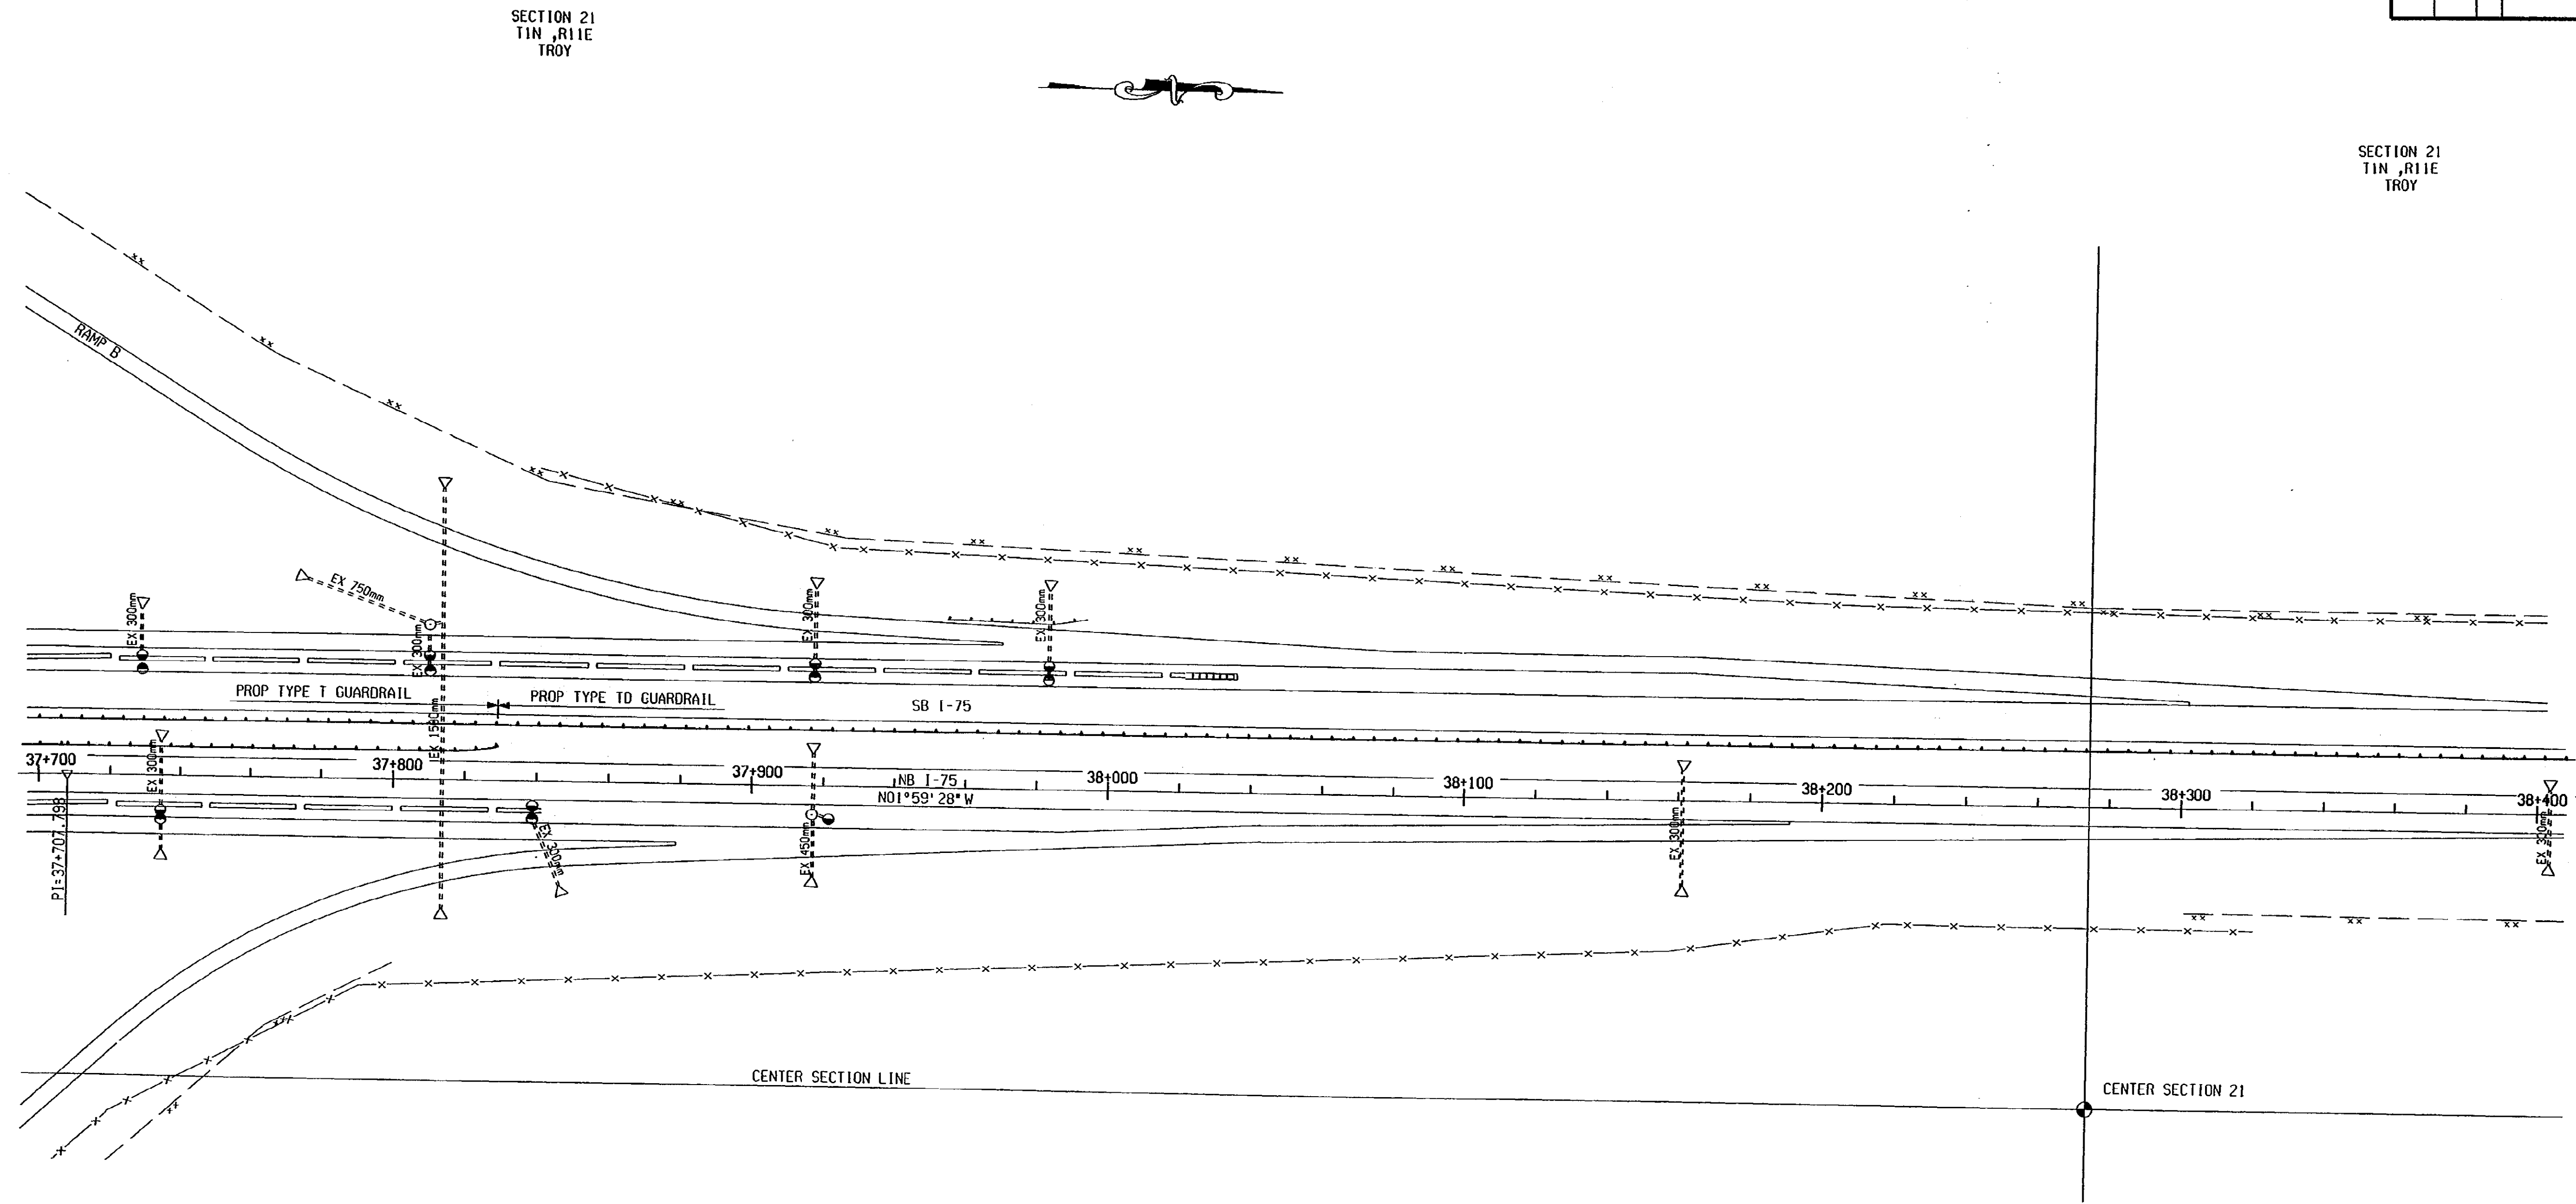

GUARDRAIL QUANTITIES JN 48647 (STA 37+700 TO STA 39+400)

701.04 m	Guardrail, Type TD
92 ea	Guardrail Reflector
1 ea	Guardrail Departing Terminal, Type T
120 m	Guardrail, Type T

SHOULDER UPGRADE QUANTITIES JN 53697 (STA 37+700 TO STA 38+400)

323 t	Bit Mixture, 4C
416 t	Bit Mixture, 3C
2940 m ²	Aggregate Base, 200 mm
700 m	Station Grading
2590 m ²	Slope Restoration
728 m ²	Shoulder, CI 11, 140 mm

SECTION 21
 TIN,RIIE
 TROY

REMOVAL & CONSTRUCTION SHEET

STA 37+700 TO STA 38+400 NB I-75

	DATE	SCALE	CONT. SEC.	JOB NO.	DESIGN UNIT	SHEET NO.
	11/11/00	1:1000	63174	48647 53697	RICK	R.O.W 26


CONTROL SECTION 63174 JOB NO. 48647 & 53697 SH. NO. 27

DATE: 10/23/00
 DATE: 11/13/00
 DATE:
 EXISTING BY: RICK'S TEAM
 PROPOSED BY: RICK'S TEAM
 LAST CORRECTION BY:

SECTION 21
 TIN, R11E
 TROY

I-75 NB CONST &
 CURVE DATA
 $\Delta = 05^{\circ}56'01" RT$
 $R = 2328.501$
 $T = 120.679$
 $L = 241.142$
 $PC = 38+805.702$
 $PI = 38+926.381$
 $PT = 39+046.844$

FINAL R.O.W.			
AUTH	DATE	NO.	REVISION

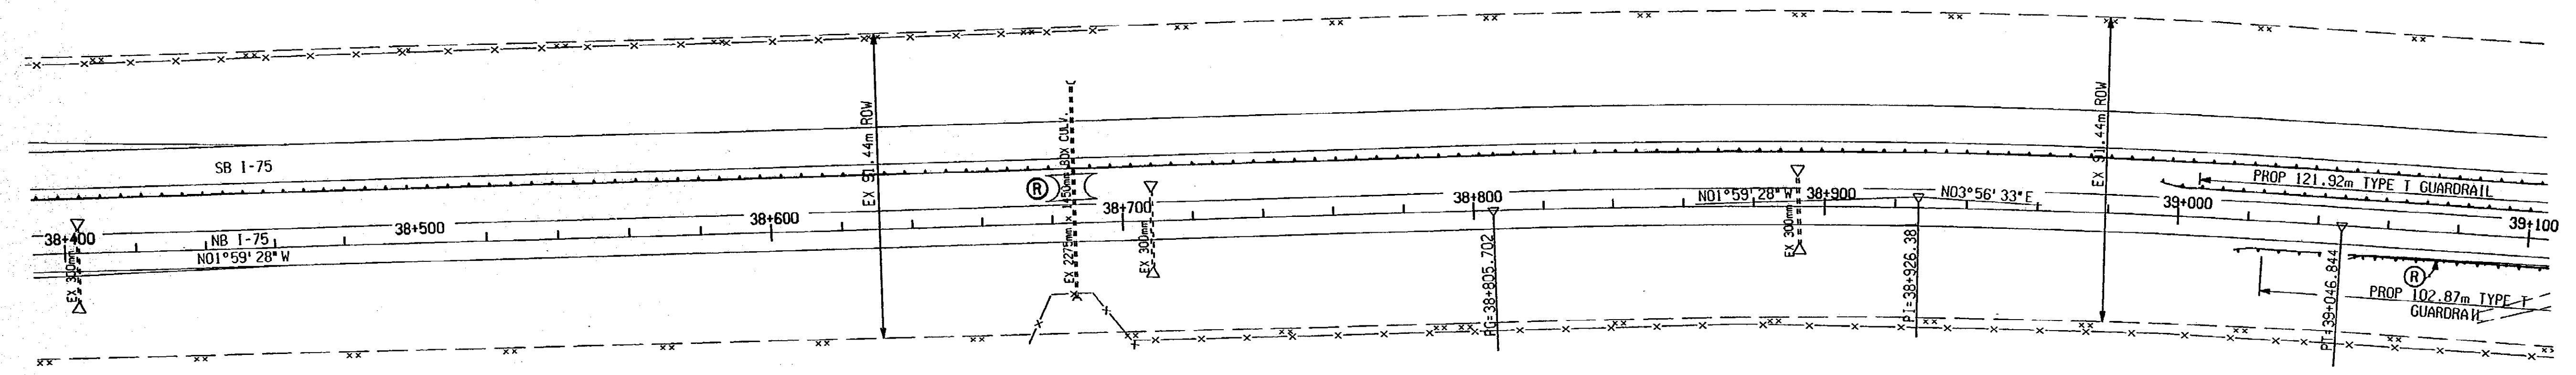

SECTION LINE

SHOULDER UPGRADE QUANTITIES JN 53697 (STA 38+400 TO STA 39+100)

323 t	Bit Mixture, 4C
416 t	Bit Mixture, 3C
2940 m ²	Aggregate Base, 200 mm
700 m	Station Grading
2590 m ²	Slope Restoration
728 m ²	Shoulder, C1 II, 140 mm

GUARDRAIL QUANTITIES JN 48647 (STA 38+400 TO STA 39+100)

701.04 m	Guardrail, Type TD
92 ea	Guardrail Reflector

REMOVAL & CONSTRUCTION SHEET

MIDOT Michigan Department of Transportation		STA 38+400 TO STA 39+100 NB I-75				
DATE	SCALE	CONT. SEC.	JOB NO.	DESIGN UNIT	SHEET NO.	
11/13/00	1:1000	63174	48647 53697	RICK	R.O.W. 27	

FILE NAME: 5369738400.dgn
 9 10 11 12 13 14 15 16 17 18 19 21 22 24 25 26 27 29 30 31 33

DATE: 10/24/00
 DATE: 11/13/00
 DATE: 11/27/00
 EXISTING BY: RICK'S TEAM
 PROPOSED BY: RICK'S TEAM
 LAST CORRECTION BY: RICK'S TEAM

FILE NAME: 536973100.dgn
 9 10 11 12 13 14 15 16 17 18 19 21 22 24 25 26 27 29 30 31 33

17 MILE RD (WATTLES)


SECTION 21
 TIN, R11E
 TROY

I-75 NB CONST €
 CURVE DATA
 Δ: 06°07'11" LT
 R: 2328.501
 T: 124.471
 L: 248.708
 PC: 39+322.826
 PI: 39+447.297
 PT: 39+571.532

SECTION 21
 TIN, R11E
 TROY

FINAL R.O.W.			
AUTH	DATE	NO.	REVISION

GUARDRAIL QUANTITIES JN 48647 (I-75 SB OUTSIDE)
 1 ea Guardrail Approach Terminal, Type 2T
 7 ea Guardrail Reflector
 129.54 m Guardrail, Type T
 1 ea Guardrail Anch. Bridge, Det T1

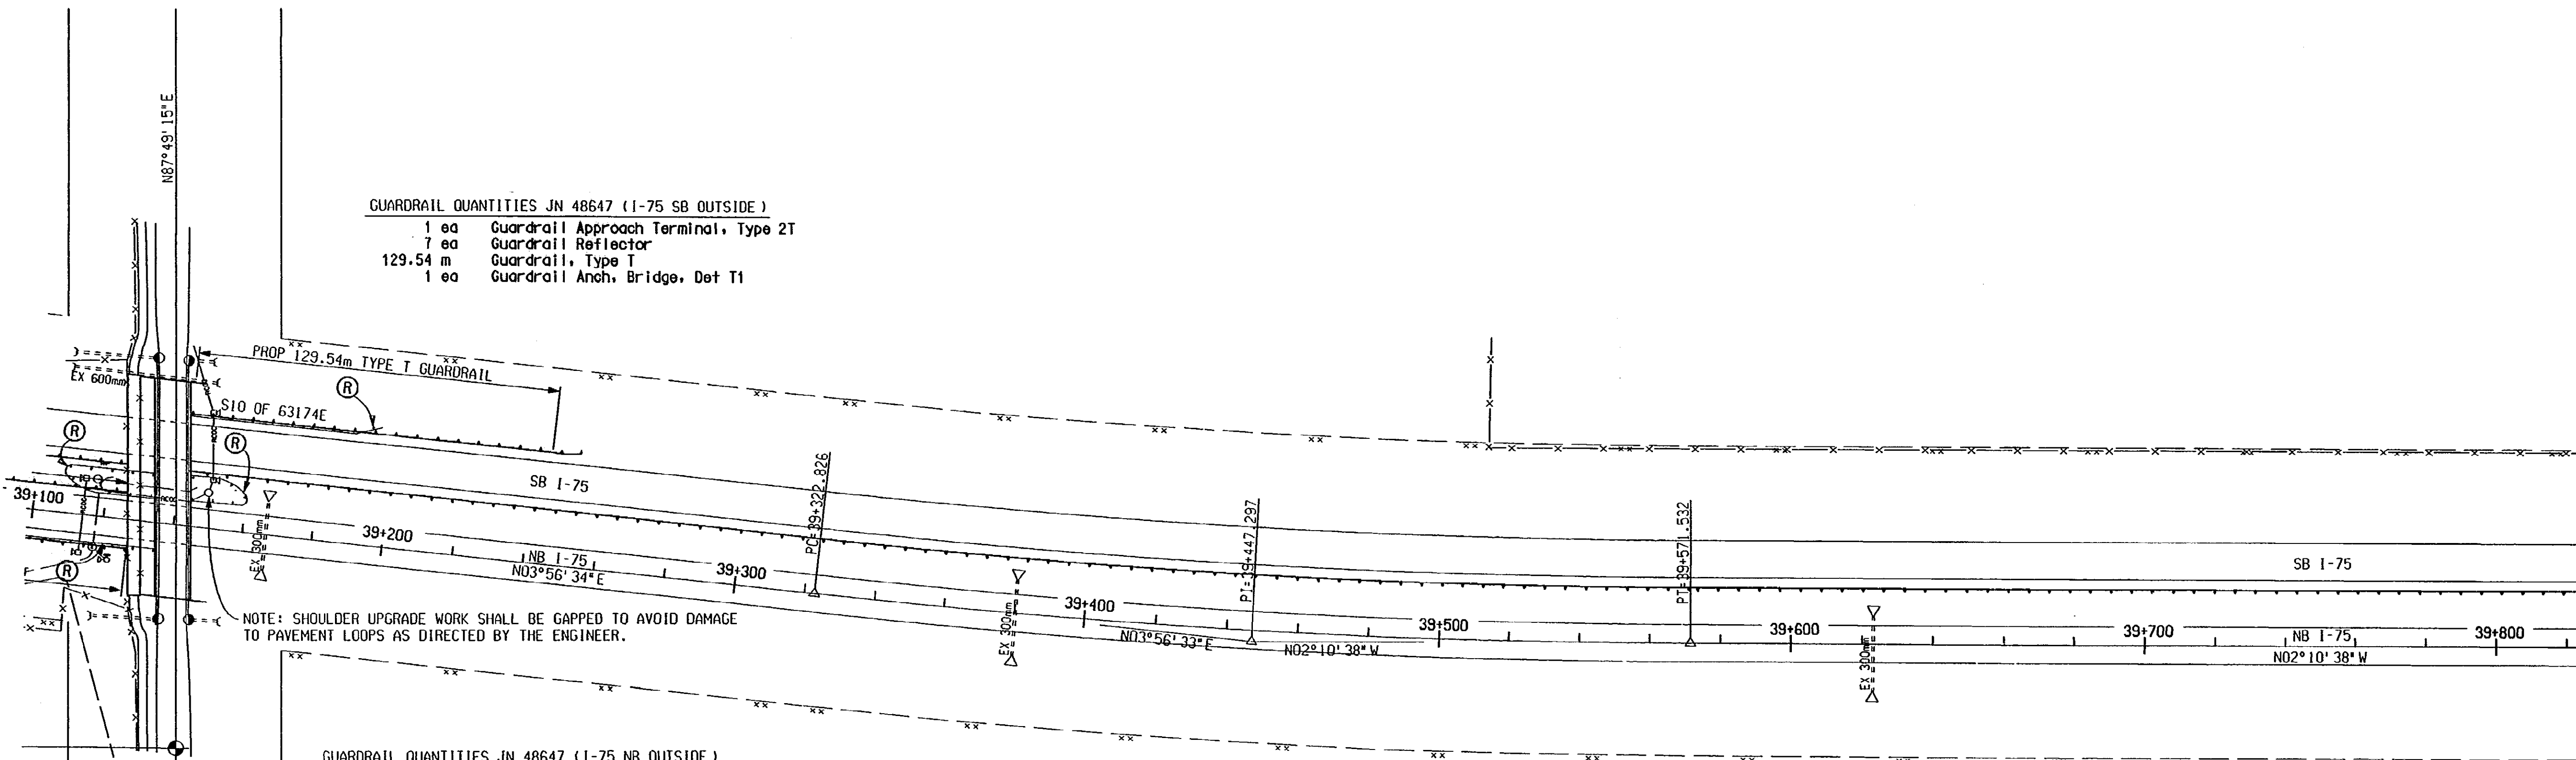

NOTE: SHOULDER UPGRADE WORK SHALL BE GAPPED TO AVOID DAMAGE TO PAVEMENT LOOPS AS DIRECTED BY THE ENGINEER.

GUARDRAIL QUANTITIES JN 48647 (I-75 NB OUTSIDE)
 1 ea Guardrail Approach Terminal, Type 2T
 7 ea Guardrail Reflector
 102.87 m Guardrail, Type T
 1 ea Guardrail Anch. Bridge, Det T1

GUARDRAIL QUANTITIES JN 48647 (I-75 NB INSIDE)
 1 ea Guardrail Approach Terminal, Type 2T
 8 ea Guardrail Reflector
 121.92 m Guardrail, Type T
 1 ea Guardrail Anch. Bridge, Det T1

GUARDRAIL QUANTITIES JN 48647 (STA 39+100 TO STA 39+820.)
 720.09 m Guardrail, Type T
 95 ea Guardrail Reflector
 220 m Guardrail, Rem

SHOULDER UPGRADE QUANTITIES JN 53697 (STA 39+100 TO STA 39+820)
 333 t Bit Mixture, 4C
 428 t Bit Mixture, 3C
 3024 m² Aggregate Base, 200 mm
 720 m Station Grading
 2664 m² Slope Restoration
 749 m² Shoulder, CI II, 140 mm

17 MILE RD (WATTLES)

REMOVAL & CONSTRUCTION SHEET


	STA 39+100 TO STA 39+820 NB I-75				
	DATE	SCALE	CONT. SEC.	JOB NO.	DESIGN UNIT
11/27/00	1:1000	63174	48647 53697	RICK	R.O.W. 28

EXISTING BY: RICK'S TEAM
 PROPOSED BY: RICK'S TEAM
 LAST CORRECTION BY: DATE:

FILE NAME: 5369739820.dgn
 9 10 11 12 13 14 15 16 17 18 19 21 22 24 25 26 27 29 30 31 33

FINAL R.O.V.			
AUTH	DATE	NO.	REVISION


SECTION 21
 TIN, RITE
 TROY

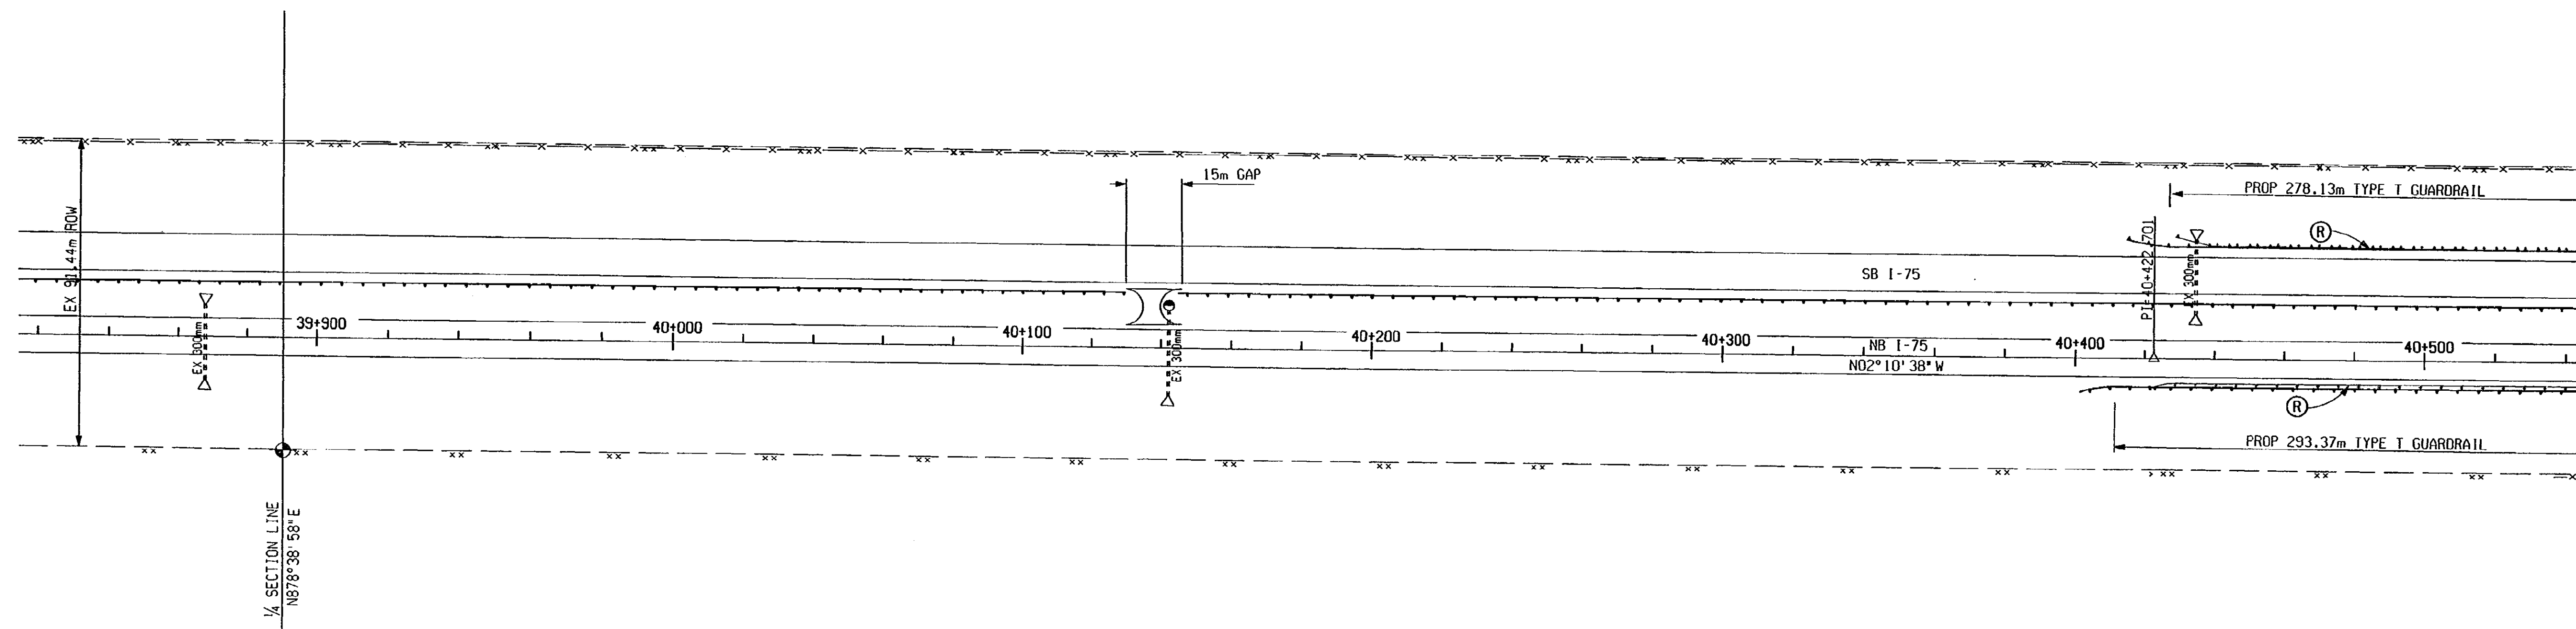

GUARDRAIL QUANTITIES JN 48647 (STA 39+820 TO STA 40+540.)
 704.85 m Guardrail, Type T0
 97 ea Guardrail Reflector
 2 ea Guardrail Approach Terminal, Type 3

SHOULDER UPGRADE QUANTITIES JN 53697 (STA 39+820 TO STA 40+540.)
 333 t Bit Mixture, 4C
 428 t Bit Mixture, 3C
 3024 m² Aggregate Base, 200 mm
 720 m Station Grading
 2664 m² Slope Restoration
 749 m² Shoulder, CI 11, 140 mm

REMOVAL & CONSTRUCTION SHEET

	STA 39+820 TO STA 40+540 NB I-75				
	DATE	SCALE	CONT. SEC.	JOB NO.	DESIGN UNIT
11/17/00	1:1000	63174	48647 53697	RICK	R.O.V. 29

DATE: 10/24/00
 PROPOSED BY: RICK'S TEAM
 LAST CORRECTION BY: RICK'S TEAM

DATE: 11/13/00
 DATE: 11/28/00

EAST LONG LAKE RD


I-75 NB CONST
 CURVE DATA
 $\Delta = 22^{\circ}37'20" \text{ LT}$
 $R = 873.188$
 $T = 174.656$
 $L = 344.763$
 $PC = 40+913.500$
 $PI = 41+088.156$
 $PT = 41+258.262$
 $AH = 16+642.790$

FINAL R.O.W.			
AUTH	DATE	NO.	REVISION

SECTION 21
 TIN, R11E
 TROY

SECTION 9
 TIN, R11E
 TROY

GUARDRAIL QUANTITIES JN 48647 (I-75 SB OUTSIDE)
 1 ea Guardrail Approach Terminal, Type 2T
 2 ea Guardrail Anch, Bridge, Det A1
 1 ea Guardrail Departing Terminal, Type T
 449.58 m Guardrail, Type T
 30 ea Guardrail Reflector

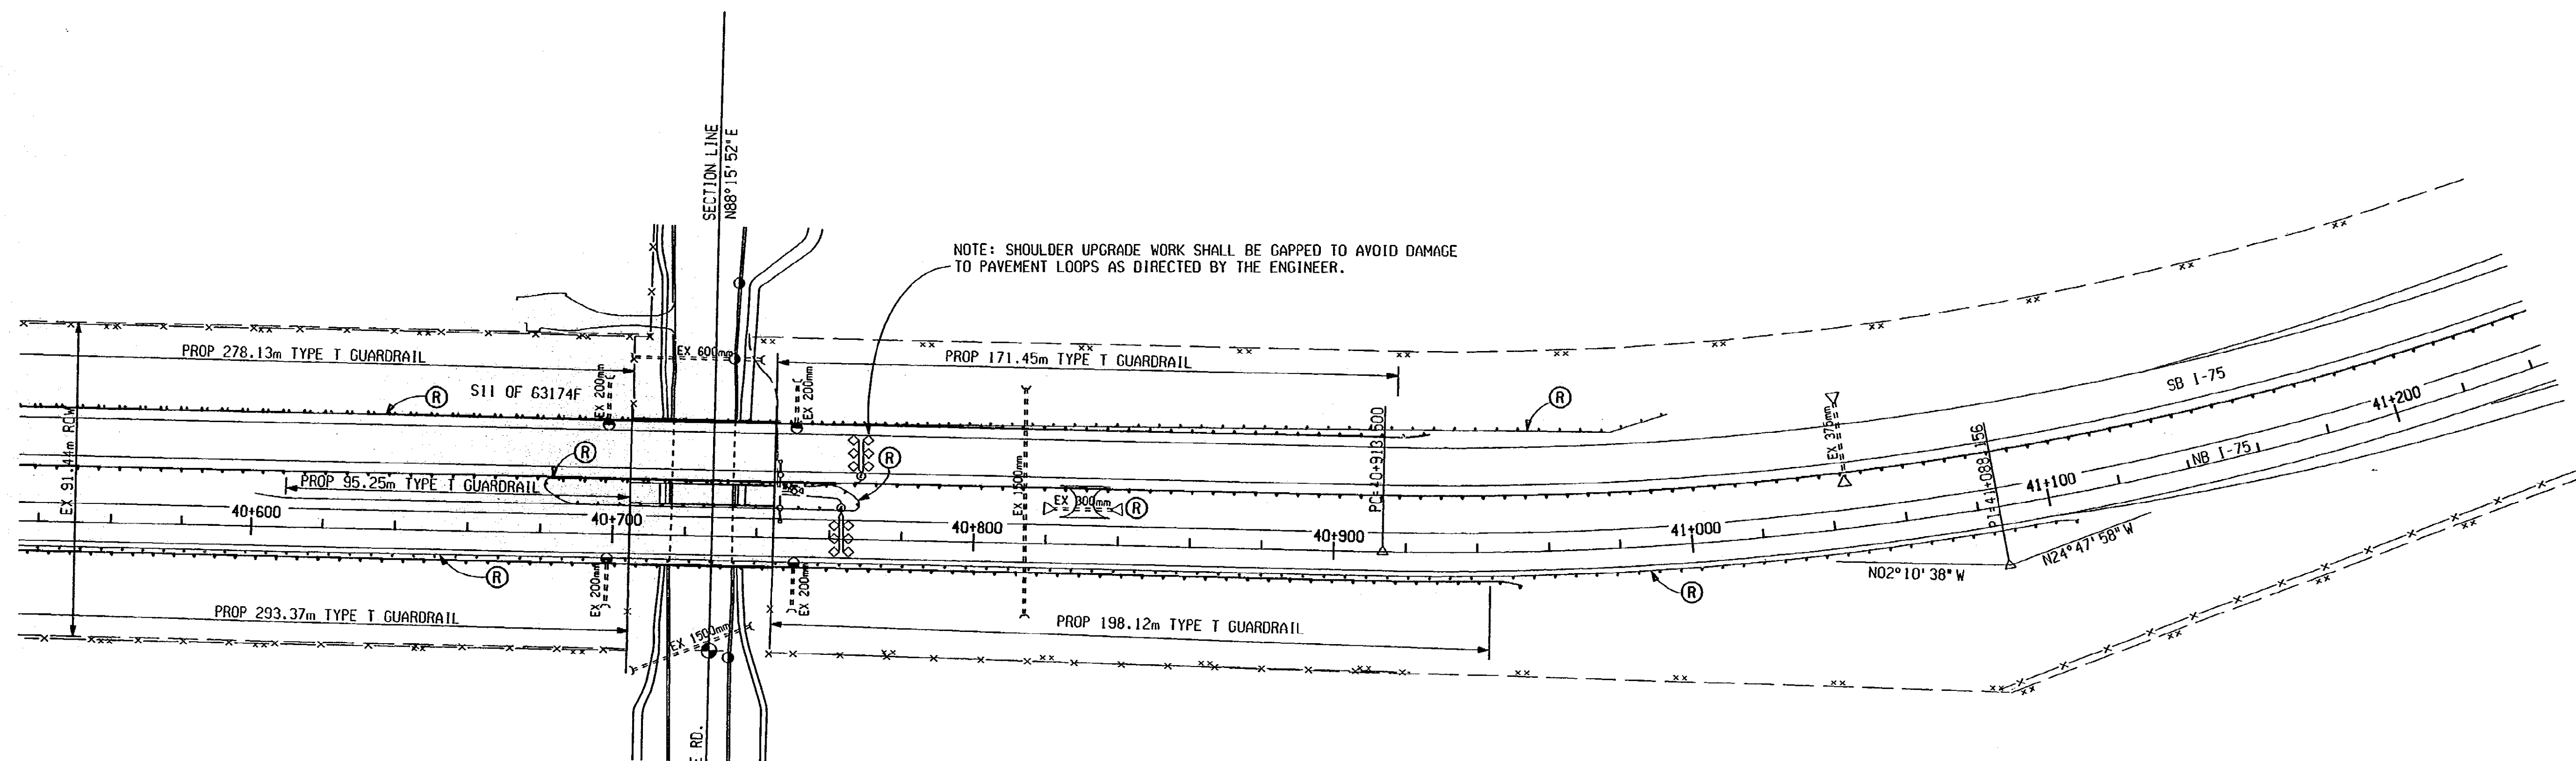

GUARDRAIL QUANTITIES JN 48647 (I-75 NB OUTSIDE)
 1 ea Guardrail Approach Terminal, Type 2T
 2 ea Guardrail Anch, Bridge, Det A1
 1 ea Guardrail Departing Terminal, Type T
 491.49 m Guardrail, Type T
 32 ea Guardrail Reflector

GUARDRAIL QUANTITIES JN 48647 (I-75 NB INSIDE)
 1 ea Guardrail Approach Terminal, Type 2T
 1 ea Guardrail Anch, Bridge, Det A1
 95.25 m Guardrail, Type T
 7 ea Guardrail Reflector

GUARDRAIL QUANTITIES JN 48647 (STA 40+540 TO STA 41+240)
 647.70 m Guardrail, Type TD
 85 ea Guardrail Reflector
 1047 m Guardrail, Rem
 2 ea Guardrail Anch, Bridge, Det A1

SHOULDER UPGRADE QUANTITIES JN 53697 (STA 40+540 TO STA 41+240)
 305 t Bit Mixture, 4C
 392 t Bit Mixture, 3C
 2772 m² Aggregate Base, 200 mm
 660 m Station Grading
 2442 m² Slope Restoration
 687 m² Shoulder, C1 II, 140 mm

EAST LONG LAKE RD

CONSTRUCTION SHEET

	STA 40+540 TO STA 41+240 NB I-75					
	DATE	SCALE	CONT. SEC.	JOB NO.	DESIGN UNIT	SHEET NO.
	11/28/00	1:1000	63174	53697	RICK	R.O.W. 30

DATE: 10/24/00
 DATE: 11/06/00
 DATE: 11/29/00
 EXISTING BY: RICK'S TEAM
 PROPOSED BY: RICK'S TEAM
 LAST CORRECTION BY: RICK'S TEAM


FILE NAME: 5369741240.dgn
 9 10 11 12 13 14 15 16 17 18 19 21 22 24 25 26 27 29 30 31 33

SECTION 9
 TIN, R11E
 TROY

CROOKS RD
 CONNECTOR

FINAL R.O.W.			
AUTH	DATE	NO.	REVISION

GUARDRAIL QUANTITIES JN 48647 (SB I-75 OUTSIDE)
 1 ea Guardrail Approach Terminal, Type 2T
 1 ea Guardrail Anch. Bridge, Det T1
 102.87 m Guardrail, Type T
 7 ea Guardrail Reflector

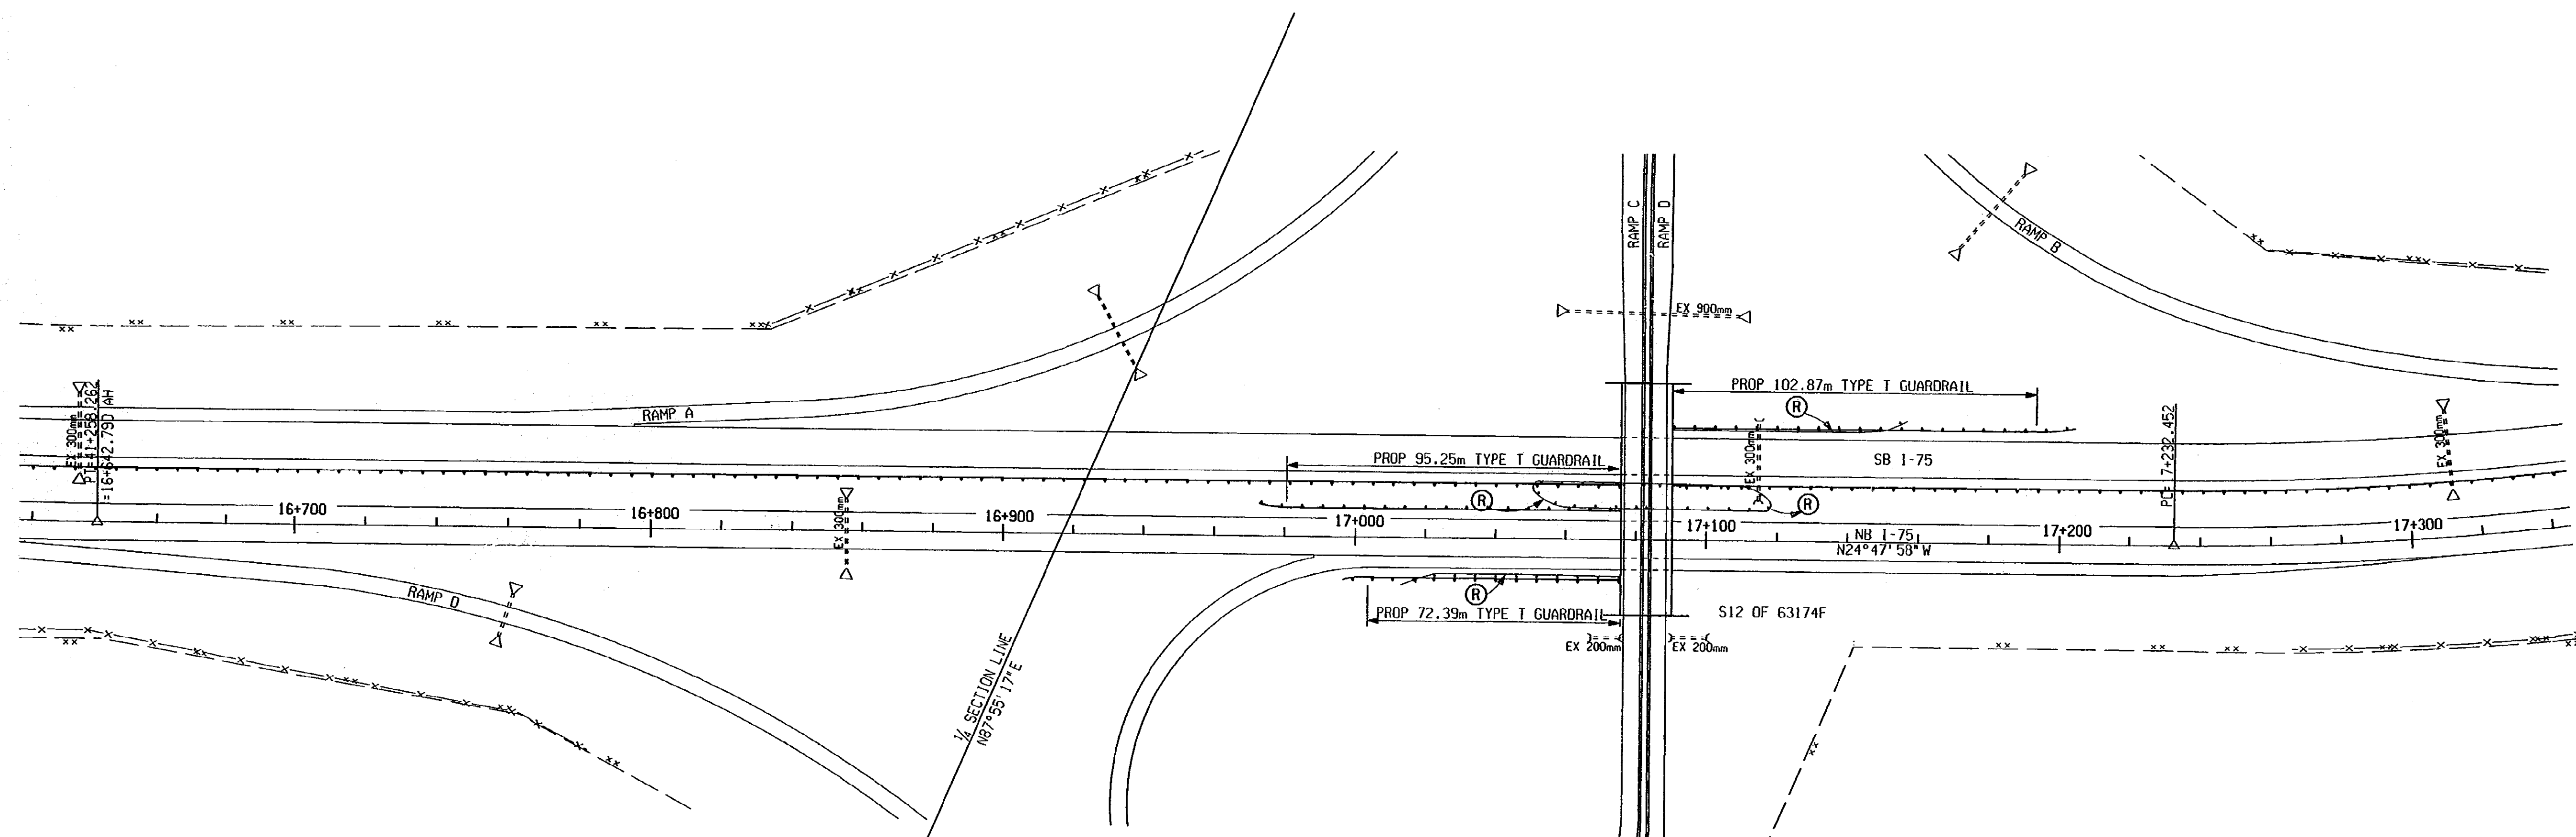

GUARDRAIL QUANTITIES JN 48647 (STA 41+240 TO STA 17+340.)
 230 m Guardrail, Rem
 716.28 m Guardrail, Type TD
 94 ea Guardrail Reflector

GUARDRAIL QUANTITIES JN 48647 (NB I-75 INSIDE)
 1 ea Guardrail Approach Terminal, Type 2T
 1 ea Guardrail Anch. Bridge, Det T1
 95.25 m Guardrail, Type T
 7 ea Guardrail Reflector

GUARDRAIL QUANTITIES JN 48647 (NB I-75 OUTSIDE)
 1 ea Guardrail Approach Terminal, Type 2T
 1 ea Guardrail Anch. Bridge, Det T1
 72.39 m Guardrail, Type T
 5 ea Guardrail Reflector

SHOULDER UPGRADE QUANTITIES JN 53697 (STA 41+240 TO STA 17+340)
 331 t Bit Mixture, 4C
 425 t Bit Mixture, 3C
 3005 m² Aggregate Base, 200 mm
 715 m Station Grading
 2647 m² Slope Restoration
 744 m² Shoulder, C1 II, 140 mm

REMOVAL & CONSTRUCTION SHEET

CROOKS RD
 CONNECTOR

	STA 41+240 TO STA 17+340 NB I-75				
	DATE	SCALE	CONT. SEC.	JOB NO.	DESIGN UNIT
11/29/00	1:1000	63174	48647 53697	RICK	R.O.W. 31

EXISTING BY: RICK'S TEAM DATE: 10/25/00
 PROPOSED BY: RICK'S TEAM DATE: 11/04/00
 LAST CORRECTION BY: RICK'S TEAM DATE: 11/29/00

FILE NAME: 5369717340.dgn
 9 10 11 12 13 14 15 16 17 18 19 21 22 24 25 26 27 29 30 31 33

CROOKS ROAD


1-75 NB CONST C
 CURVE DATA
 $\Delta = 67^\circ 14' 30''$ LT
 R=873.188
 T=580.602
 L=1024.763
 PC = 17+232.452
 PI = 17+813.054
 PT = 18+257.215

FINAL R.O.W.			
AUTH	DATE	NO.	REVISION

SECTION 9
 TIN,RIIE
 TROY

GUARDRAIL QUANTITIES JN 48647 (SB I-75 OUTSIDE)
 1 ea Guardrail Approach Terminal, Type 2T
 1 ea Guardrail Departing Terminal, Type T
 121.92 m Guardrail, Type T
 8 ea Guardrail Reflector

SECTION 5
 TIN,RIIE
 TROY

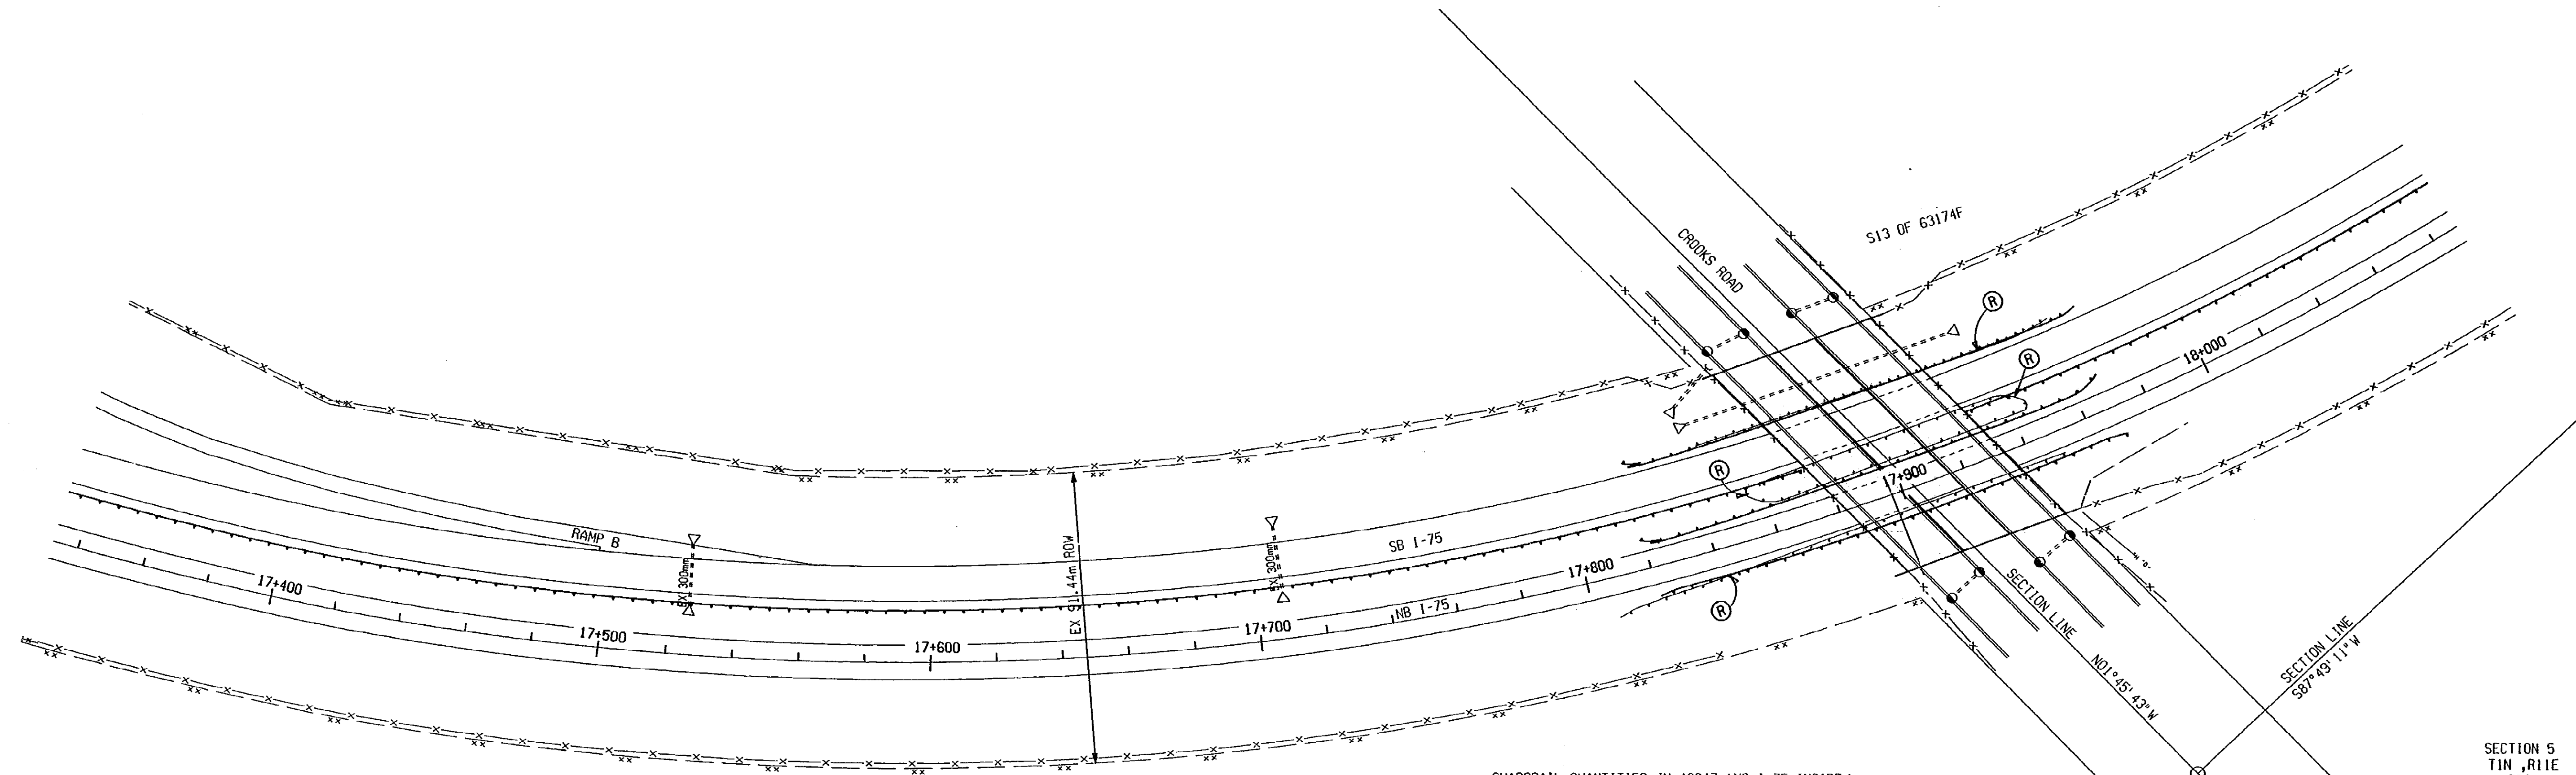

GUARDRAIL QUANTITIES JN 48647 (NB I-75 INSIDE)
 1 ea Guardrail Approach Terminal, Type 2T
 1 ea Guardrail Departing Terminal, Type T
 121.92 m Guardrail, Type T
 8 ea Guardrail Reflector

GUARDRAIL QUANTITIES JN 48647 (NB I-75 OUTSIDE)
 1 ea Guardrail Approach Terminal, Type 2T
 1 ea Guardrail Departing Terminal, Type T
 121.92 m Guardrail, Type T
 8 ea Guardrail Reflector

GUARDRAIL QUANTITIES JN 48647 (STA 17+340 TO STA 18+080)
 742.95 m Guardrail, Type TD
 98 ea Guardrail Reflector
 380 m Guardrail, Rem

SECTION 9
 TIN,RIIE
 TROY

SHOULDER UPGRADE QUANTITIES JN 53697 (STA 17+340 TO STA 18+580)
 342 t Bit Mixture, 4C
 440 t Bit Mixture, 3C
 3108 m² Aggregate Base, 200 mm
 2738 m² Slope Restoration
 740 m Station Grading
 770 m² Shoulder, C1 II, 140 mm

CROOKS ROAD

REMOVAL & CONSTRUCTION SHEET

	STA 17+340 TO STA 18+080 NB I-75					
	DATE	SCALE	CONT. SEC.	JOB NO.	DESIGN UNIT	SHEET NO.
11/29/00	1:1000	63174	48647 53697	RICK	R.O.W.	32

EXISTING BY: RICK'S TEAM DATE: 10/25/00
 PROPOSED BY: RICK'S TEAM DATE: 11/04/00
 LAST CORRECTION BY: RICK'S TEAM DATE: 11/16/00

FILE NAME: 5369718080.dwg 910 11 12 13 14 15 16 17 18 19 21 22 24 25 26 27 28 30 31 33

FINAL R.O.V.			
AUTH	DATE	NO.	REVISION


SECTION 5
 TIN, R11E
 TROY

GUARDRAIL QUANTITIES (SB I-75 OUTSIDE)
 1 ea Guardrail Approach Terminal, Type 2T
 1 ea Guardrail Departing Terminal, Type T
 110.49 m Guardrail, Type T
 8 ea Guardrail Reflector

GUARDRAIL QUANTITIES (NB I-75 OUTSIDE)
 1 ea Guardrail Approach Terminal, Type 2T
 110.49 m Guardrail, Type T
 1 ea Guardrail Departing Terminal, Type T
 8 ea Guardrail Reflector

GUARDRAIL QUANTITIES JN 48647 (STA 18+080 TO STA 18+820)
 742.95 m Guardrail, Type TD
 98 ea Guardrail Reflector
 262 m Guardrail, Rem

SHOULDER UPGRADE QUANTITIES JN 53697 (STA 18+080 TO STA 18+820)
 342 t Bit Mixture, 4C
 440 t Bit Mixture, 3C
 3108 m² Aggregate Base, 200 mm
 740 m Station Grading
 2738 m² Slope Restoration
 770 m² Shoulder, CI II, 140 mm

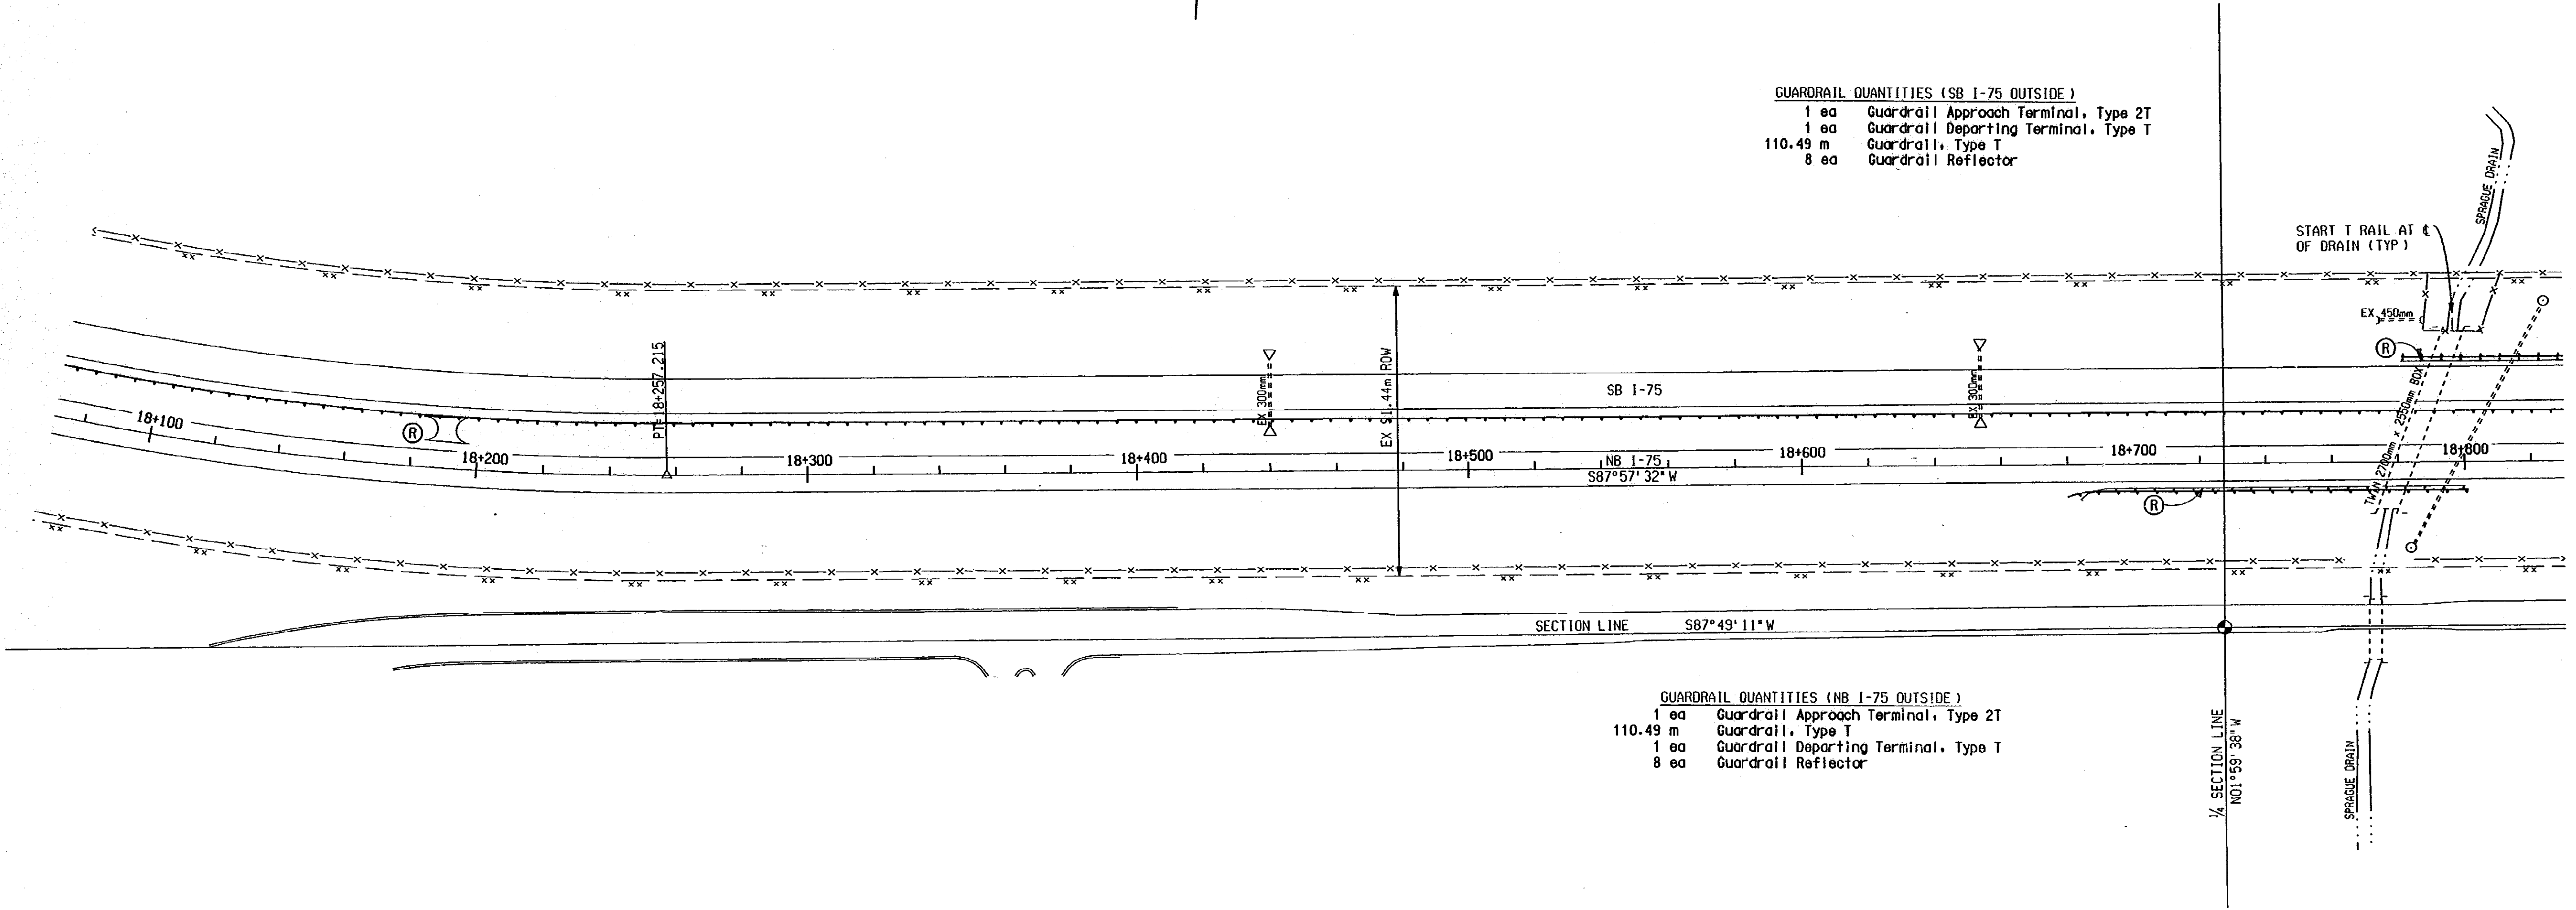

REMOVAL & CONSTRUCTION SHEET

	STA 18+080 TO STA 18+820 NB I-75					
	DATE	SCALE	CONT. SEC.	JOB NO.	DESIGN UNIT	SHEET NO.
	11/16/00	1:1000	63174	48647 53697	RICK	33

EXISTING BY: RICK'S TEAM
 PROPOSED BY: RICK'S TEAM
 LAST CORRECTION BY: RICK'S TEAM

DATE: 10/26/00
 DATE: 11/02/00
 DATE: 11/17/00

FINAL R.O.W.			
AUTH	DATE	NO.	REVISION

SECTION 5
 TIN,RIE
 TROY


COOLIDGE RD

SECTION 6
 TIN,RIE
 TROY

GUARDRAIL QUANTITIES JN 48647 (SB I-75 OUTSIDE)

1 ea	Guardrail Approach Terminal, Type 2T
2 ea	Guardrail Anch. Bridge, Det A1
57 ea	Guardrail Reflector
861.06 m	Guardrail, Type T
1 ea	Guardrail Departing Terminal, Type T

NOTE: SHOULDER UPGRADE WORK SHALL BE GAPPED TO AVOID DAMAGE TO PAVEMENT LOOPS AS DIRECTED BY THE ENGINEER.

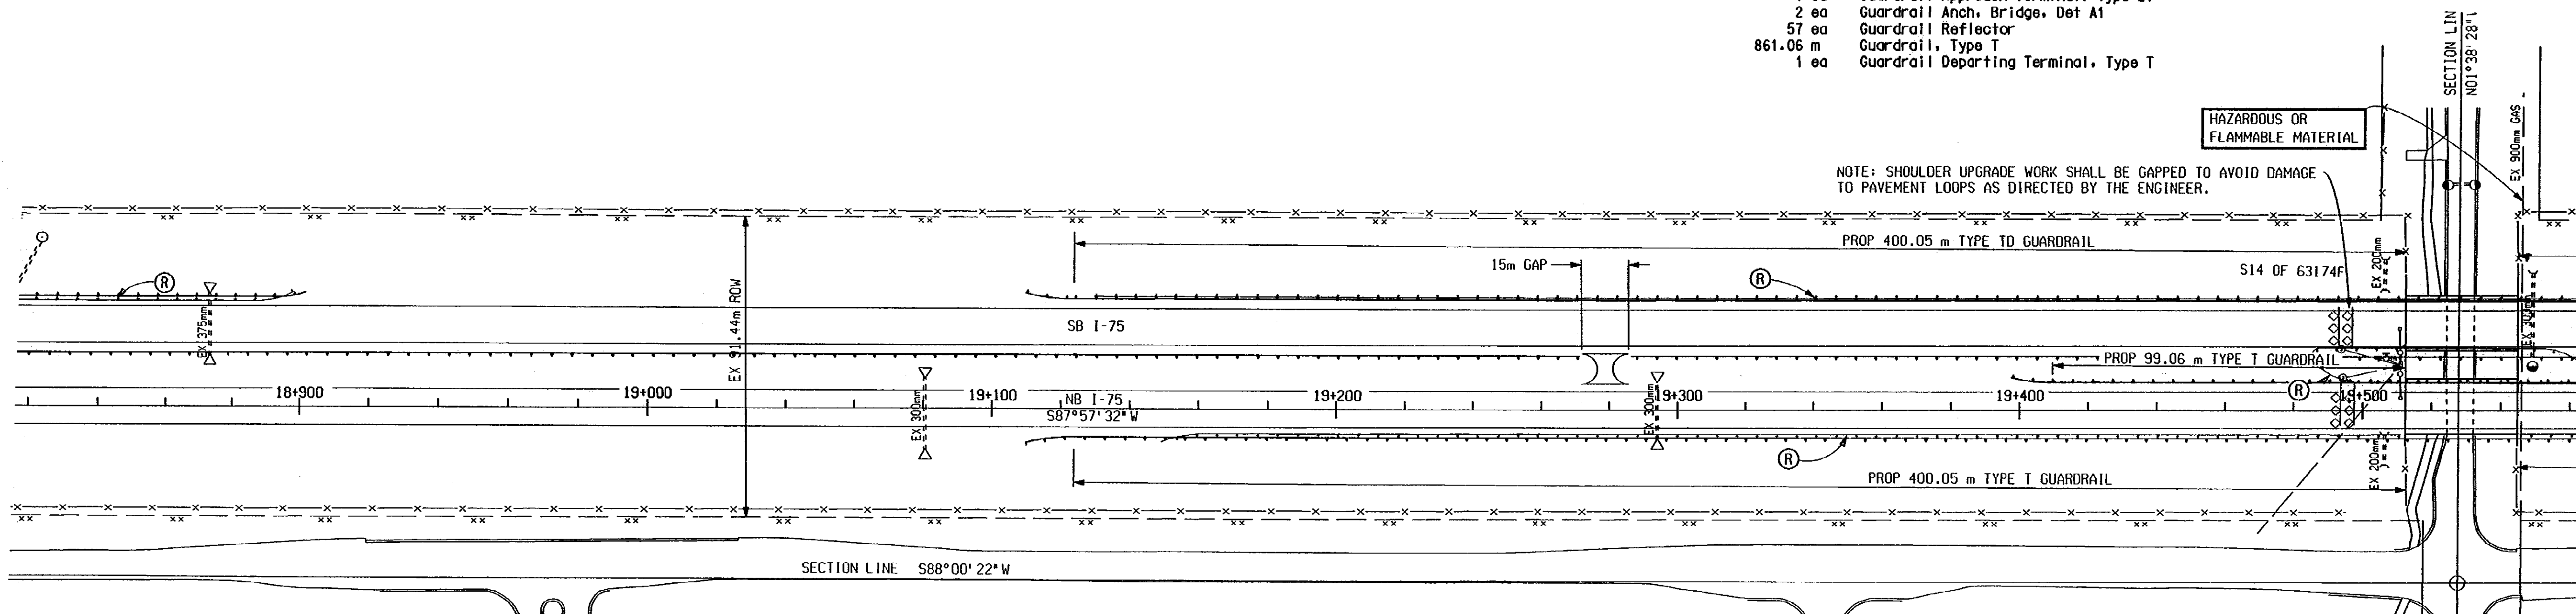

GUARDRAIL QUANTITIES JN 48647 (NB I-75 OUTSIDE)

1 ea	Guardrail Approach Terminal, Type 2T
2 ea	Guardrail Anch. Bridge, Det A1
55 ea	Guardrail Reflector
834.39 m	Guardrail, Type T
1 ea	Guardrail Departing Terminal, Type T

GUARDRAIL QUANTITIES JN 48647 (NB I-75 INSIDE)

1 ea	Guardrail Approach Terminal, Type 2T
2 ea	Guardrail Anch. Bridge, Det A1
7 ea	Guardrail Reflector
99.06 m	Guardrail, Type T
1 ea	Guardrail Departing Terminal, Type T

SHOULDER UPGRADE QUANTITIES JN 53697 (STA 18+820 TO STA 19+520)

327 t	Bit Mixture, 4C
420 t	Bit Mixture, 3C
2972 m ²	Aggregate Base, 200 mm
708 m	Station Grading
2618 m ²	Slope Restoration
736 m ²	Shoulder, CI 11, 140 mm

GUARDRAIL QUANTITIES JN 48647 (STA 18+820 TO STA 19+520)

1852 m	Guardrail, Rem
678.18 m	Guardrail, Type TD
86 ea	Guardrail Reflector
2 ea	Guardrail Anch. Bridge, Det A1
2 ea	Guardrail Approach Terminal, Type 3

COOLIDGE RD


REMOVAL & CONSTRUCTION SHEET

	STA 18+820 TO STA 19+560 NB I-75				
	DATE	SCALE	CONT. SEC.	JOB NO.	DESIGN UNIT
	01/11/01	1:1000	63174	48647 53697	RICK
					SHEET NO. R.O.W. 34

CONTROL SECTION 63174 JOB NO. 48647 & 53697 SH. NO. 35

EXISTING BY: RICK'S TEAM DATE: 10/26/00
 PROPOSED BY: RICK'S TEAM DATE: 11/04/00
 LAST CORRECTION BY: RICK'S TEAM DATE: 11/17/00

FINAL R.O.W.			
AUTH	DATE	NO.	REVISION

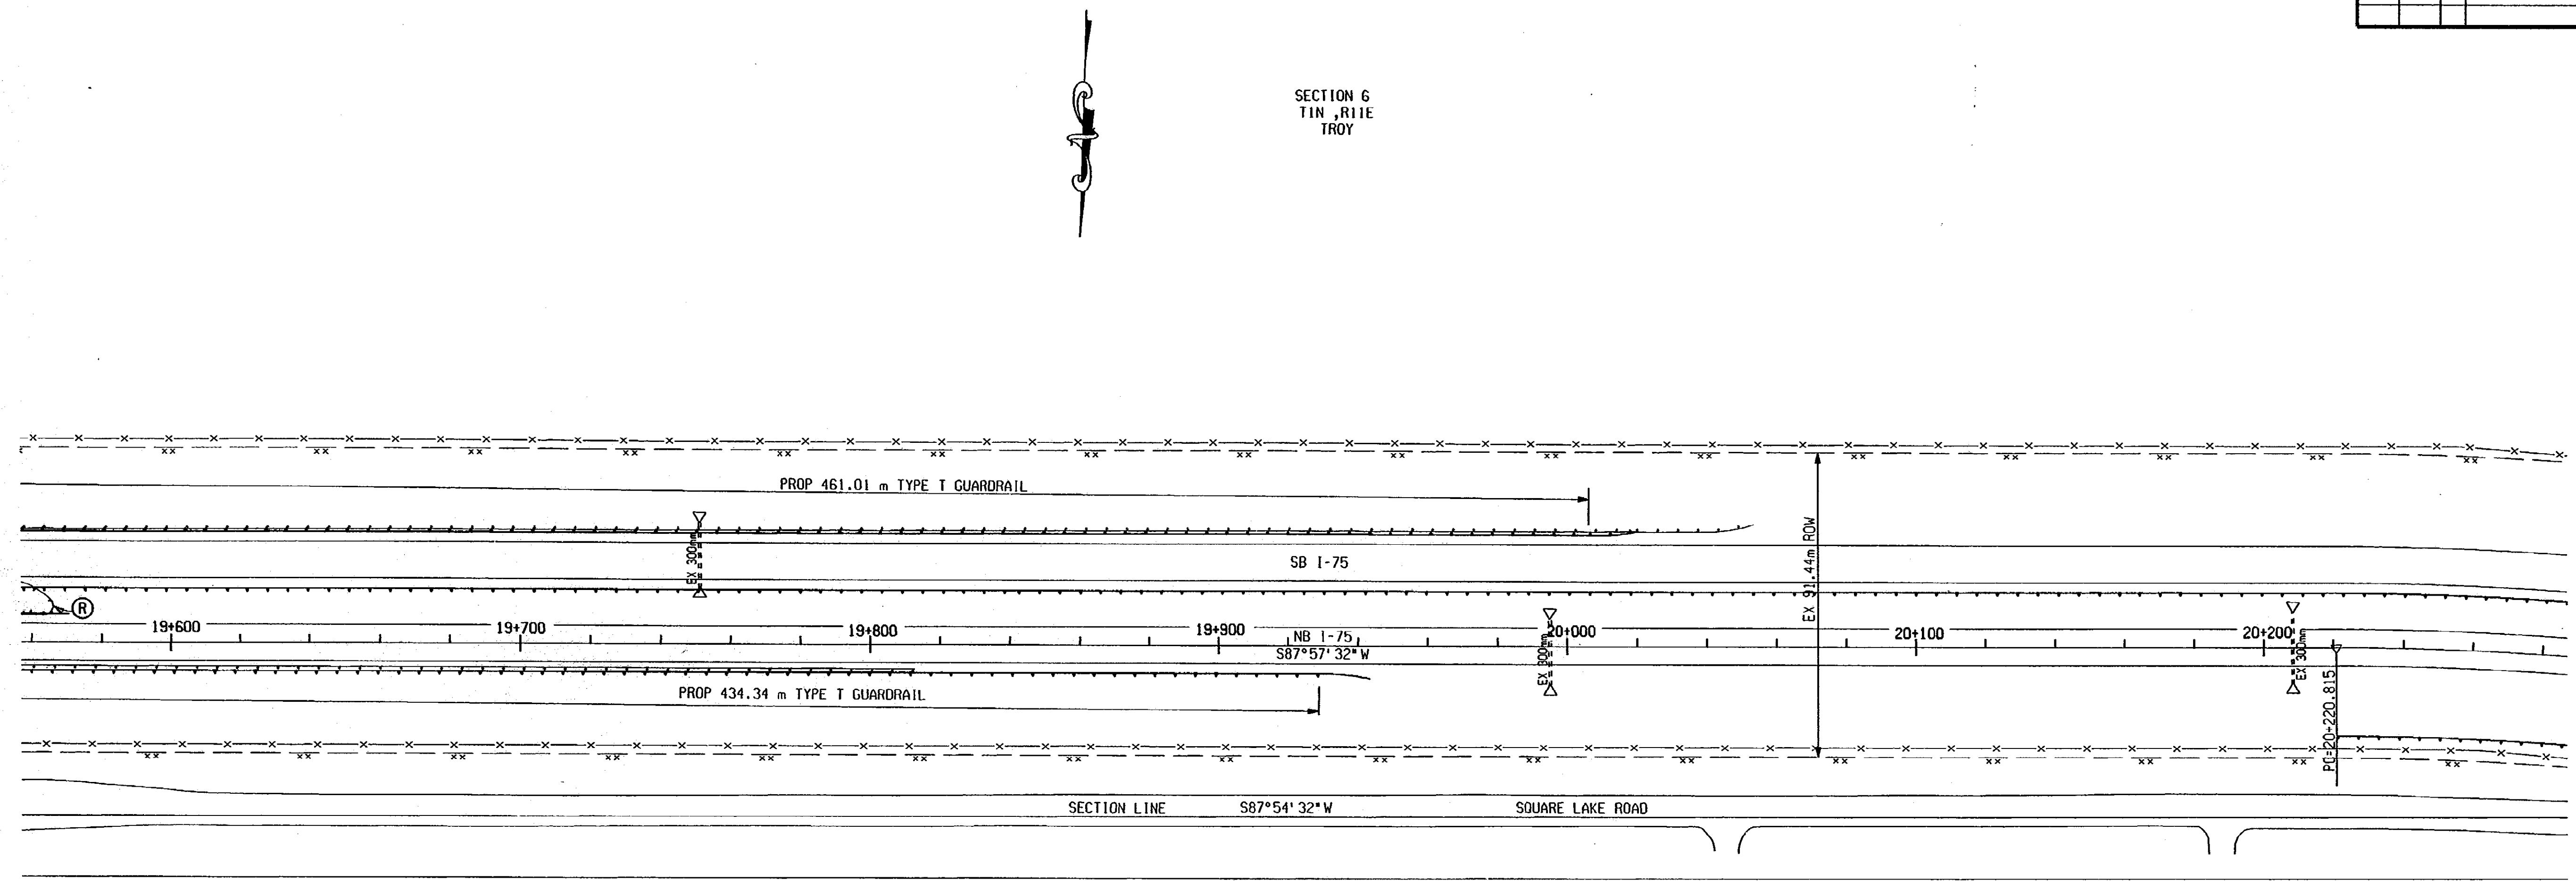


GUARDRAIL QUANTITIES JN 48647 (STA 19+560 TO STA 20+280)
 720.09 m Guardrail, Type TD
 95 ea Guardrail Reflector

SHOULDER UPGRADE QUANTITIES JN 53697 (STA 19+560 TO STA 20+280)
 333 t Bit Mixture, 4C
 428 t Bit Mixture, 3C
 3024 m² Aggregate Base, 200 mm
 720 m Station Grading
 2664 m² Slope Restoration
 749 m² Shoulder, CI 11, 140 mm

REMOVAL & CONSTRUCTION SHEET

STA 19+560 TO STA 20+280 NB I-75

	DATE	SCALE	CONT. SEC.	JOB NO.	DESIGN UNIT	SHEET NO.
	11/17/00	1:1000	63174	48647 53697	RICK	R.O.W. 35

FILE NAME: 5369719560.dwg
 1 9 10 11 12 13 14 15 16 17 18 19 21 22 24 25 26 27 29 30 31 33

CONTRACT NO. 48647 & 53697 SH. NO. 36


DATE: 10/27/00
 DATE: 11/02/00
 DATE: 11/25/00
 EXISTING BY: RICK'S TEAM
 PROPOSED BY: RICK'S TEAM
 LAST CORRECTION BY: RICK'S TEAM

FILE NAME: 5369720280.dgn
 9 10 11 12 13 14 15 16 17 18 19 21 22 24 25 26 27 29 30 31 33

I-75 NB CONST
 CURVE DATA
 $\Delta = 17^{\circ}52'21''$ RT
 R=873.188
 T=137.304
 L=272.377
 PC =20+220.815
 P1 =20+358.119
 PT =20+493.192

SECTION 6
 TIN ,RIE
 TROY

FINAL R.O.W.			
AUTH	DATE	NO.	REVISION

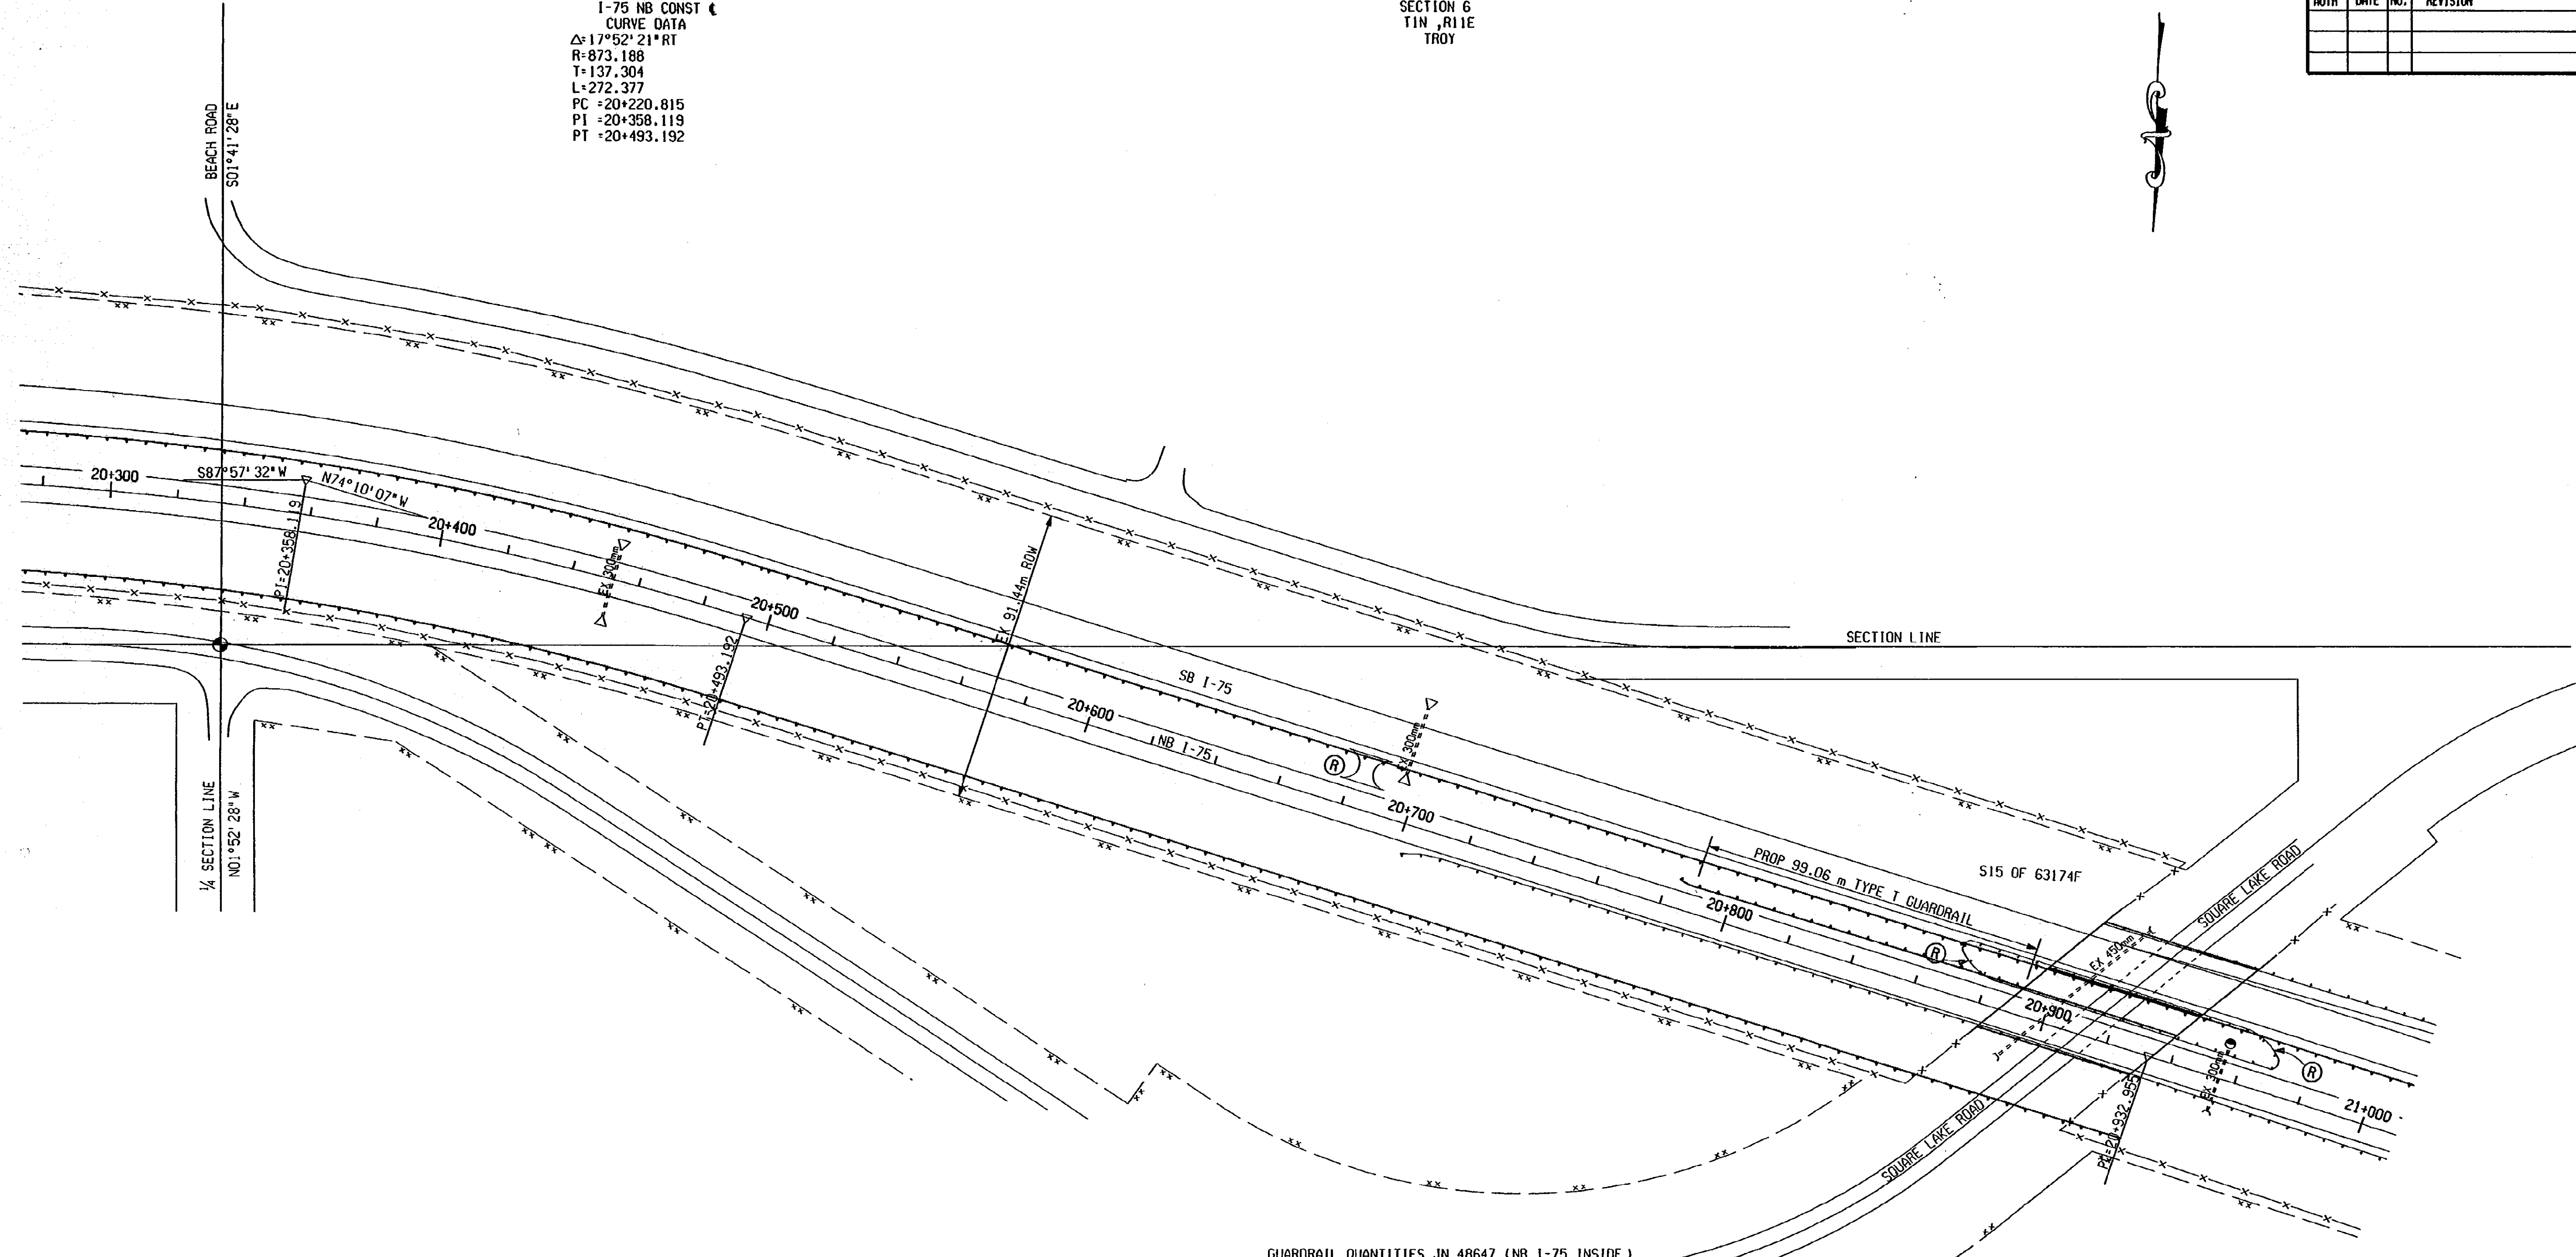

GUARDRAIL QUANTITIES JN 48647 (STA 20+288+600 TO STA 21+000)
 110 m Guardrail, Rem
 659.13 m Guardrail, Type TD
 87 ea Guardrail Reflector

GUARDRAIL QUANTITIES JN 48647 (NB I-75 INSIDE)
 1 ea Guardrail Approach Terminal, Type 2T
 1 ea Guardrail Departing Terminal, Type T
 1 ea Guardrail Anch. Bridge, Det At
 99.06 m Guardrail, Type T
 7 ea Guardrail Reflector

SHOULDER UPGRADE QUANTITIES JN 53697 (STA 20+288+600 TO STA 21+000)
 310 t Bit Mixture, 4C
 399 t Bit Mixture, 3C
 2822 m² Aggregate Base, 200 mm
 672 m Station Grading
 2486 m² Slope Restoration
 699 m² Shoulder, CI 11, 140 mm

REMOVAL & CONSTRUCTION SHEET

	STA 20+280 TO STA 21+000 NB I-75					
	DATE	SCALE	CONT. SEC.	JOB NO.	DESIGN UNIT	SHEET NO.
	11/29/00	1:1000	63174	48647 53697	RICK	R.O.W 36

DATE: 10/27/00
 DATE: 11/09/00
 EXISTING BY: RICK'S TEAM
 PROPOSED BY: RICK'S TEAM
 LAST CORRECTION BY: RICK'S TEAM


FILE NAME: 53697\1000.dwg
 9 10 11 12 13 14 15 16 17 18 19 21 22 24 25 26 27 28 30 31 33

ADAMS RD

SECTION 1
 T2N, R10E
 BLOOMFIELD TWP

1-75 NB CONST
 CURVE DATA
 $\Delta = 03^{\circ}52'08''$ RT
 R=6985.501
 T=235.938
 L=471.696
 PC = 20+932.955
 PI = 21+168.893
 PT = 21+404.652

FINAL R.O.V.			
AUTH	DATE	NO.	REVISION

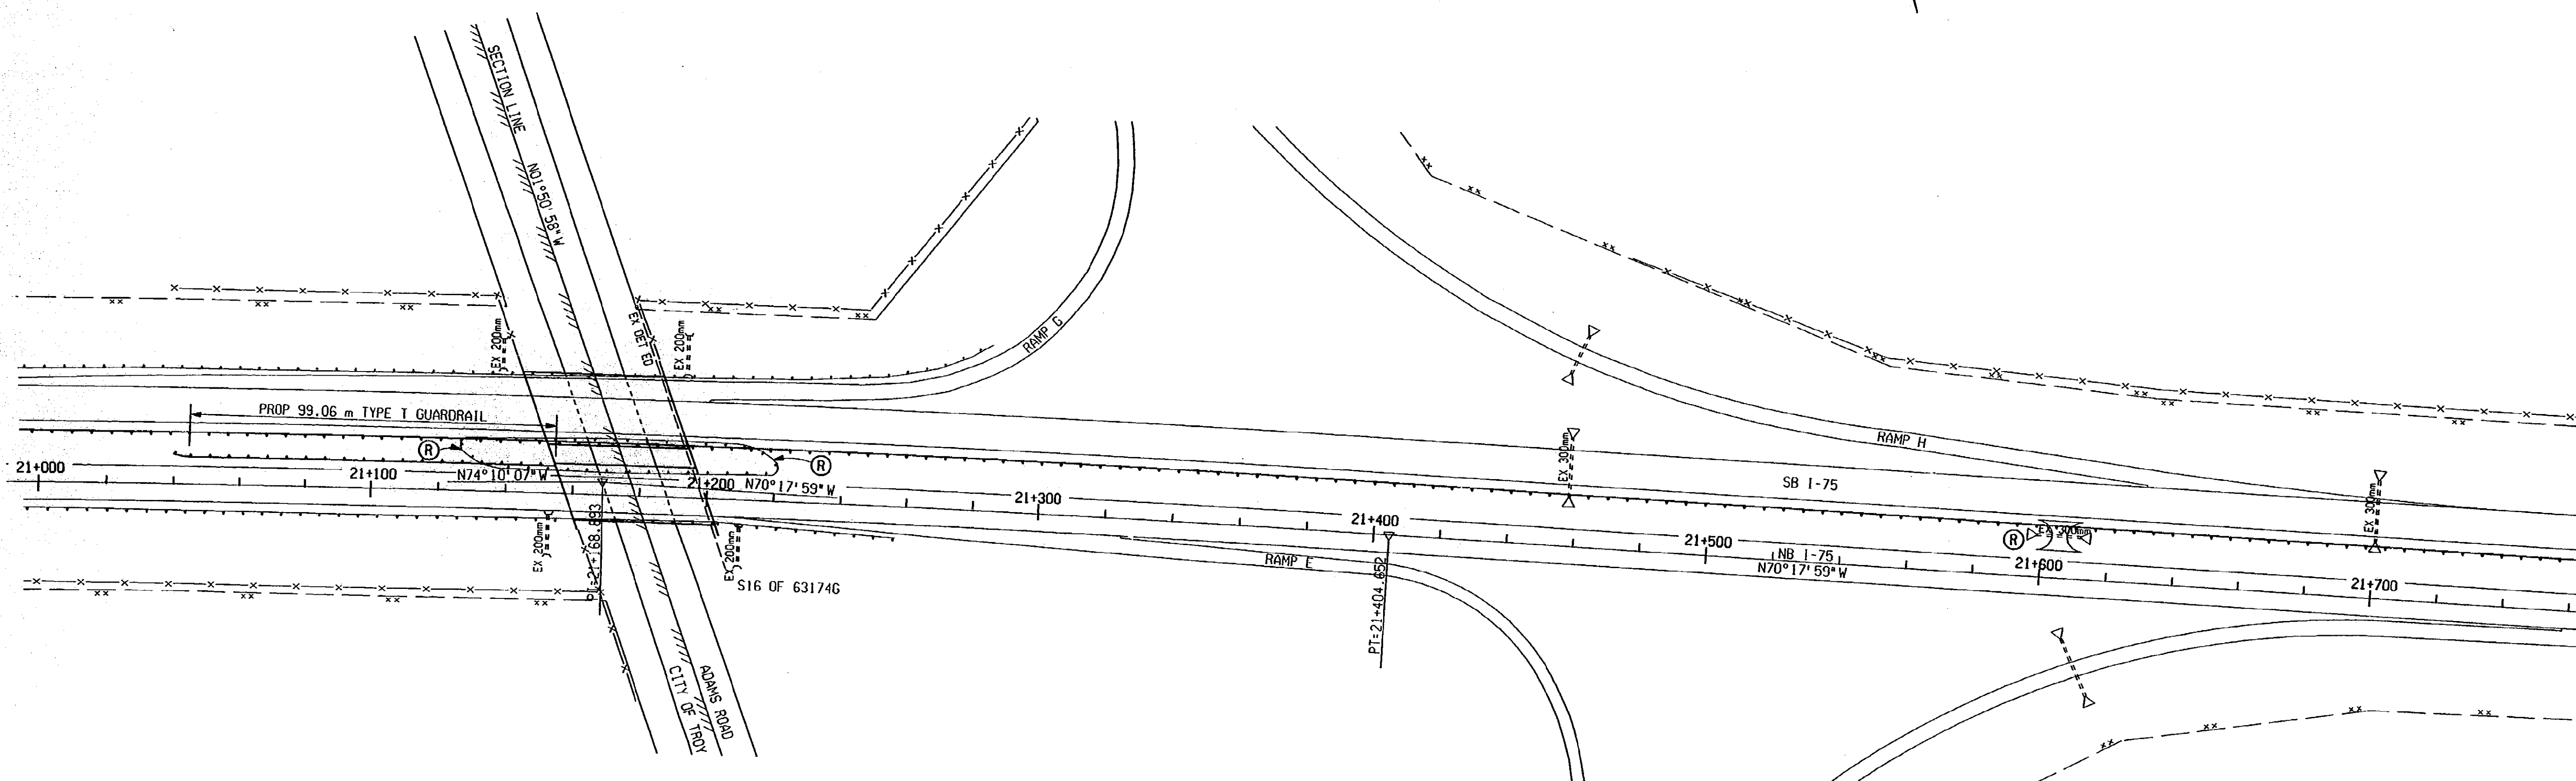

GUARDRAIL QUANTITIES JN 48647 (NB I-75 INSIDE)

- 1 ea Guardrail Approach Terminal, Type 2T
- 1 ea Guardrail Anch, Bridge, Det A1
- 99.06 m Guardrail, Type T
- 7 ea Guardrail Reflector

GUARDRAIL QUANTITIES JN 48647 (STA 21+000 TO STA 21+760)

- 110 m Guardrail, Rem
- 704.85 m Guardrail, Type TD
- 93 ea Guardrail Reflector

SHOULDER UPGRADE QUANTITIES JN 53697 (STA 21+000 TO STA 21+760)

- 332 t Bit Mixture, 4C
- 426 t Bit Mixture, 3C
- 3015 m2 Aggregate Base, 200 mm
- 718 m Station Grading
- 2656 m2 Slope Restoration
- 746 m2 Shoulder, CI II, 140 mm

REMOVAL & CONSTRUCTION SHEET

ADAMS RD

	STA 21+000 TO STA 21+760 NB I-75					
	DATE	SCALE	CONT. SEC.	JOB NO.	DESIGN UNIT	SHEET NO.
	11/29/00	1:1000	63174	48647 53697	RICK	R.O.W. 37

EXISTING BY: RICKY'S TEAM
 PROPOSED BY: RICKY'S TEAM
 LAST CORRECTION BY: RICKY'S TEAM

DATE: 10/26/00
 DATE: 11/09/00
 DATE: 11/30/00

FILE NAME: 5369721760.dgn

24 25 26 27 29 30 31 33

SECTION 1
 T2N R10E
 BLOOMFIELD TWP

SQUIRREL RD

FINAL R.O.W.			
AUTH	DATE	NO.	REVISION

GUARDRAIL QUANTITIES JN 48647 (SB I-75 OUTSIDE)

- 1 ea Guardrail Approach Terminal, Type 2T
- 1 ea Guardrail Anch. Bridge, Det T1
- 106.68 m Guardrail, Type T
- 7 ea Guardrail Reflector

GUARDRAIL QUANTITIES JN 48647 (NB I-75 OUTSIDE)

- 1 ea Guardrail Approach Terminal, Type 2T
- 1 ea Guardrail Anch. Bridge, Det T1
- 102.87 m Guardrail, Type T
- 7 ea Guardrail Reflector

GUARDRAIL QUANTITIES JN 48647 (NB I-75 OUTSIDE)

- 1 ea Guardrail Approach Terminal, Type 2T
- 1 ea Guardrail Departing Terminal, Type T
- 121.92 m Guardrail, Type T
- 8 ea Guardrail Reflector

GUARDRAIL QUANTITIES JN 48647 (STA 21+760 TO STA 22+500)


- 126 m Guardrail, Rem
- 742.95 m Guardrail, Type TD
- 98 ea Guardrail Reflector

SHOULDER UPGRADE QUANTITIES JN 53697 (STA 21+760 TO STA 22+500)

- 342 t Bit Mixture, 4C
- 440 t Bit Mixture, 3C
- 3108 m² Aggregate Base, 200 mm
- 740 m Station Grading
- 2738 m² Slope Restoration
- 770 m² Shoulder, C1 11, 140 mm


REMOVAL & CONSTRUCTION SHEET

	STA 21+760 TO STA 22+500 NB I-75					
	DATE	SCALE	CONT. SEC.	JOB NO.	DESIGN UNIT	SHEET NO.
	11/30/00	1:1000	63174	48647 53697	RICK	R.O.W. 38

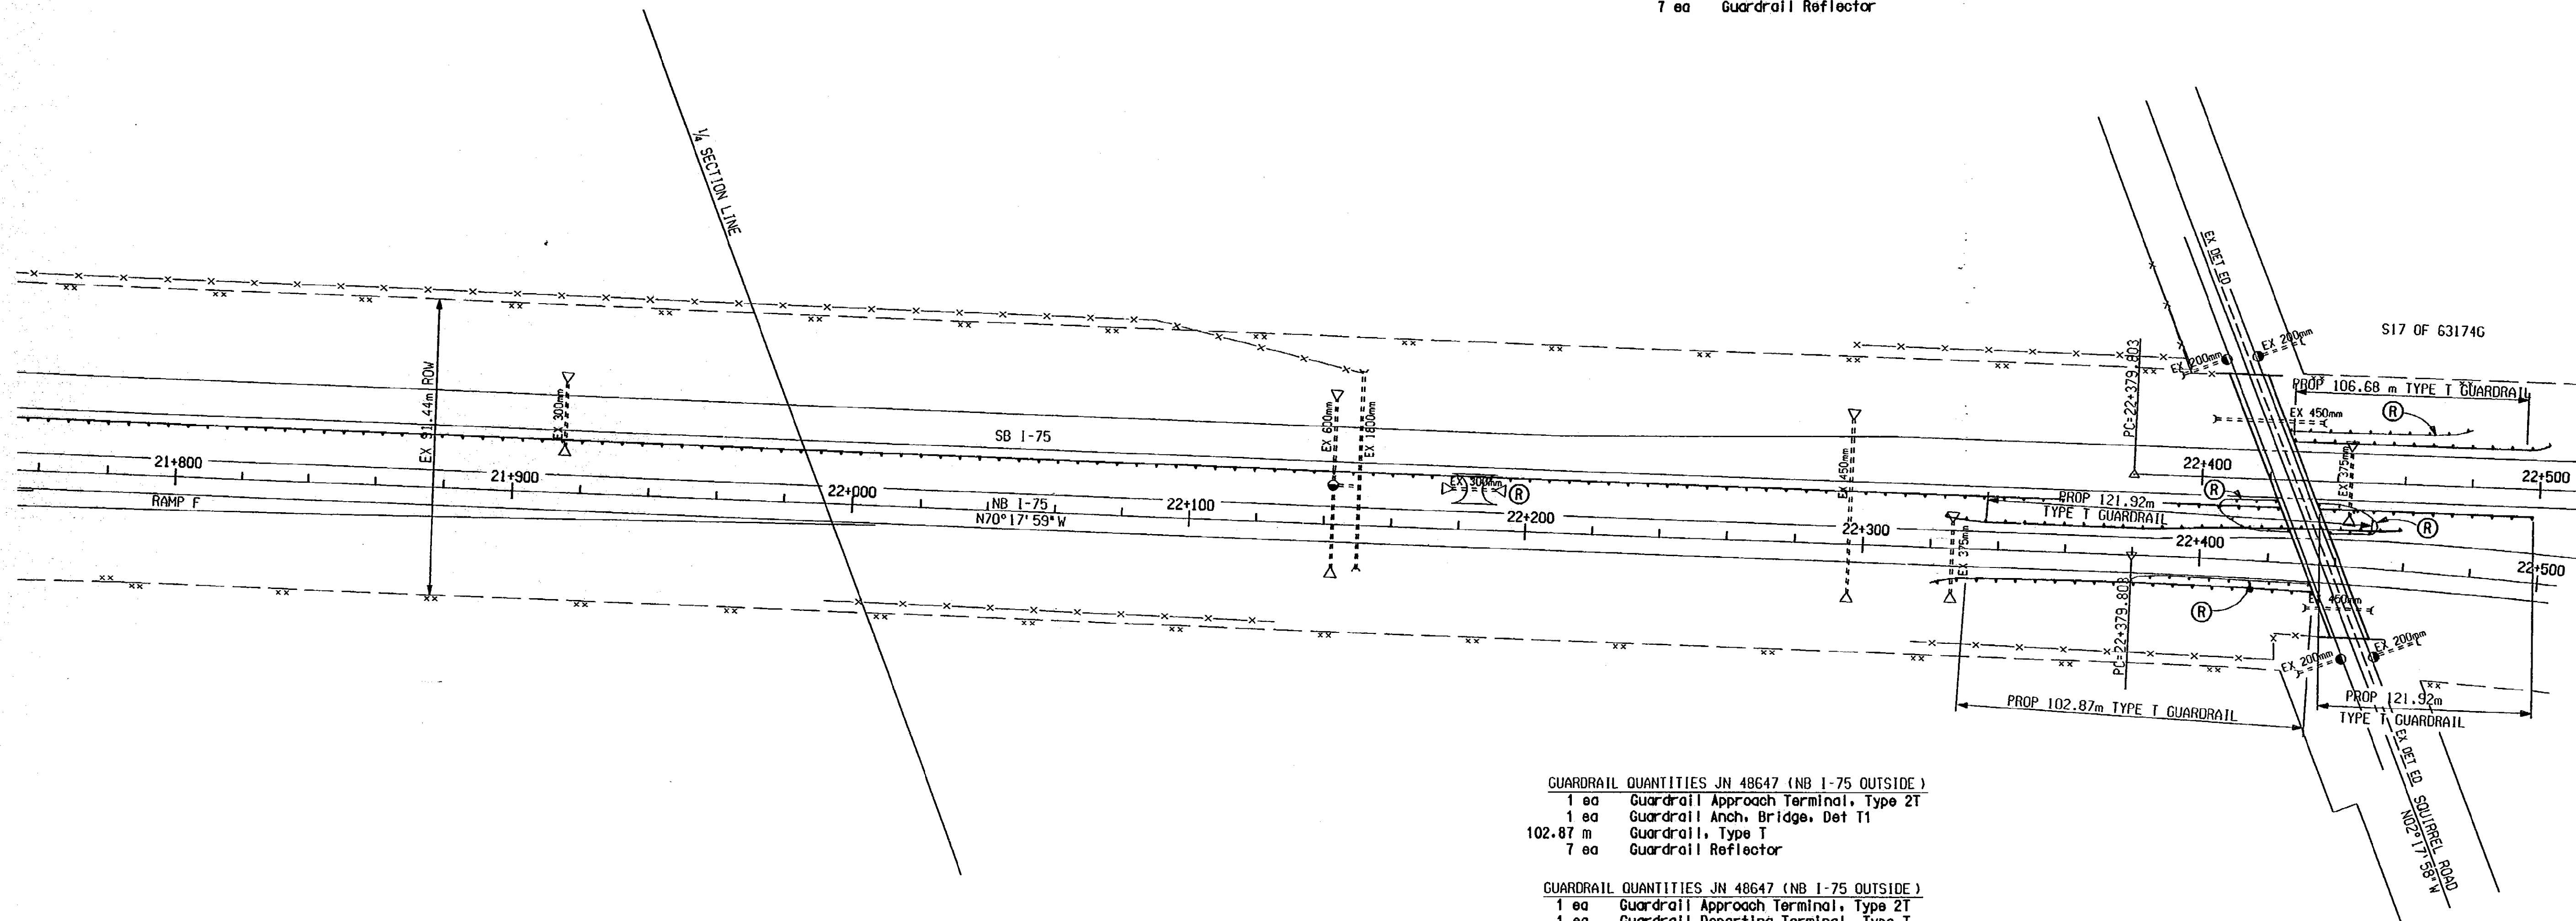

DATE: 10/28/00
 EXISTING BY: RICK'S TEAM
 PROPOSED BY: RICK'S TEAM
 LAST CORRECTION BY: RICK'S TEAM
 DATE: 11/03/00
 DATE: 12-18-00

FINAL R.O.W.			
AUTH	DATE	NO.	REVISION

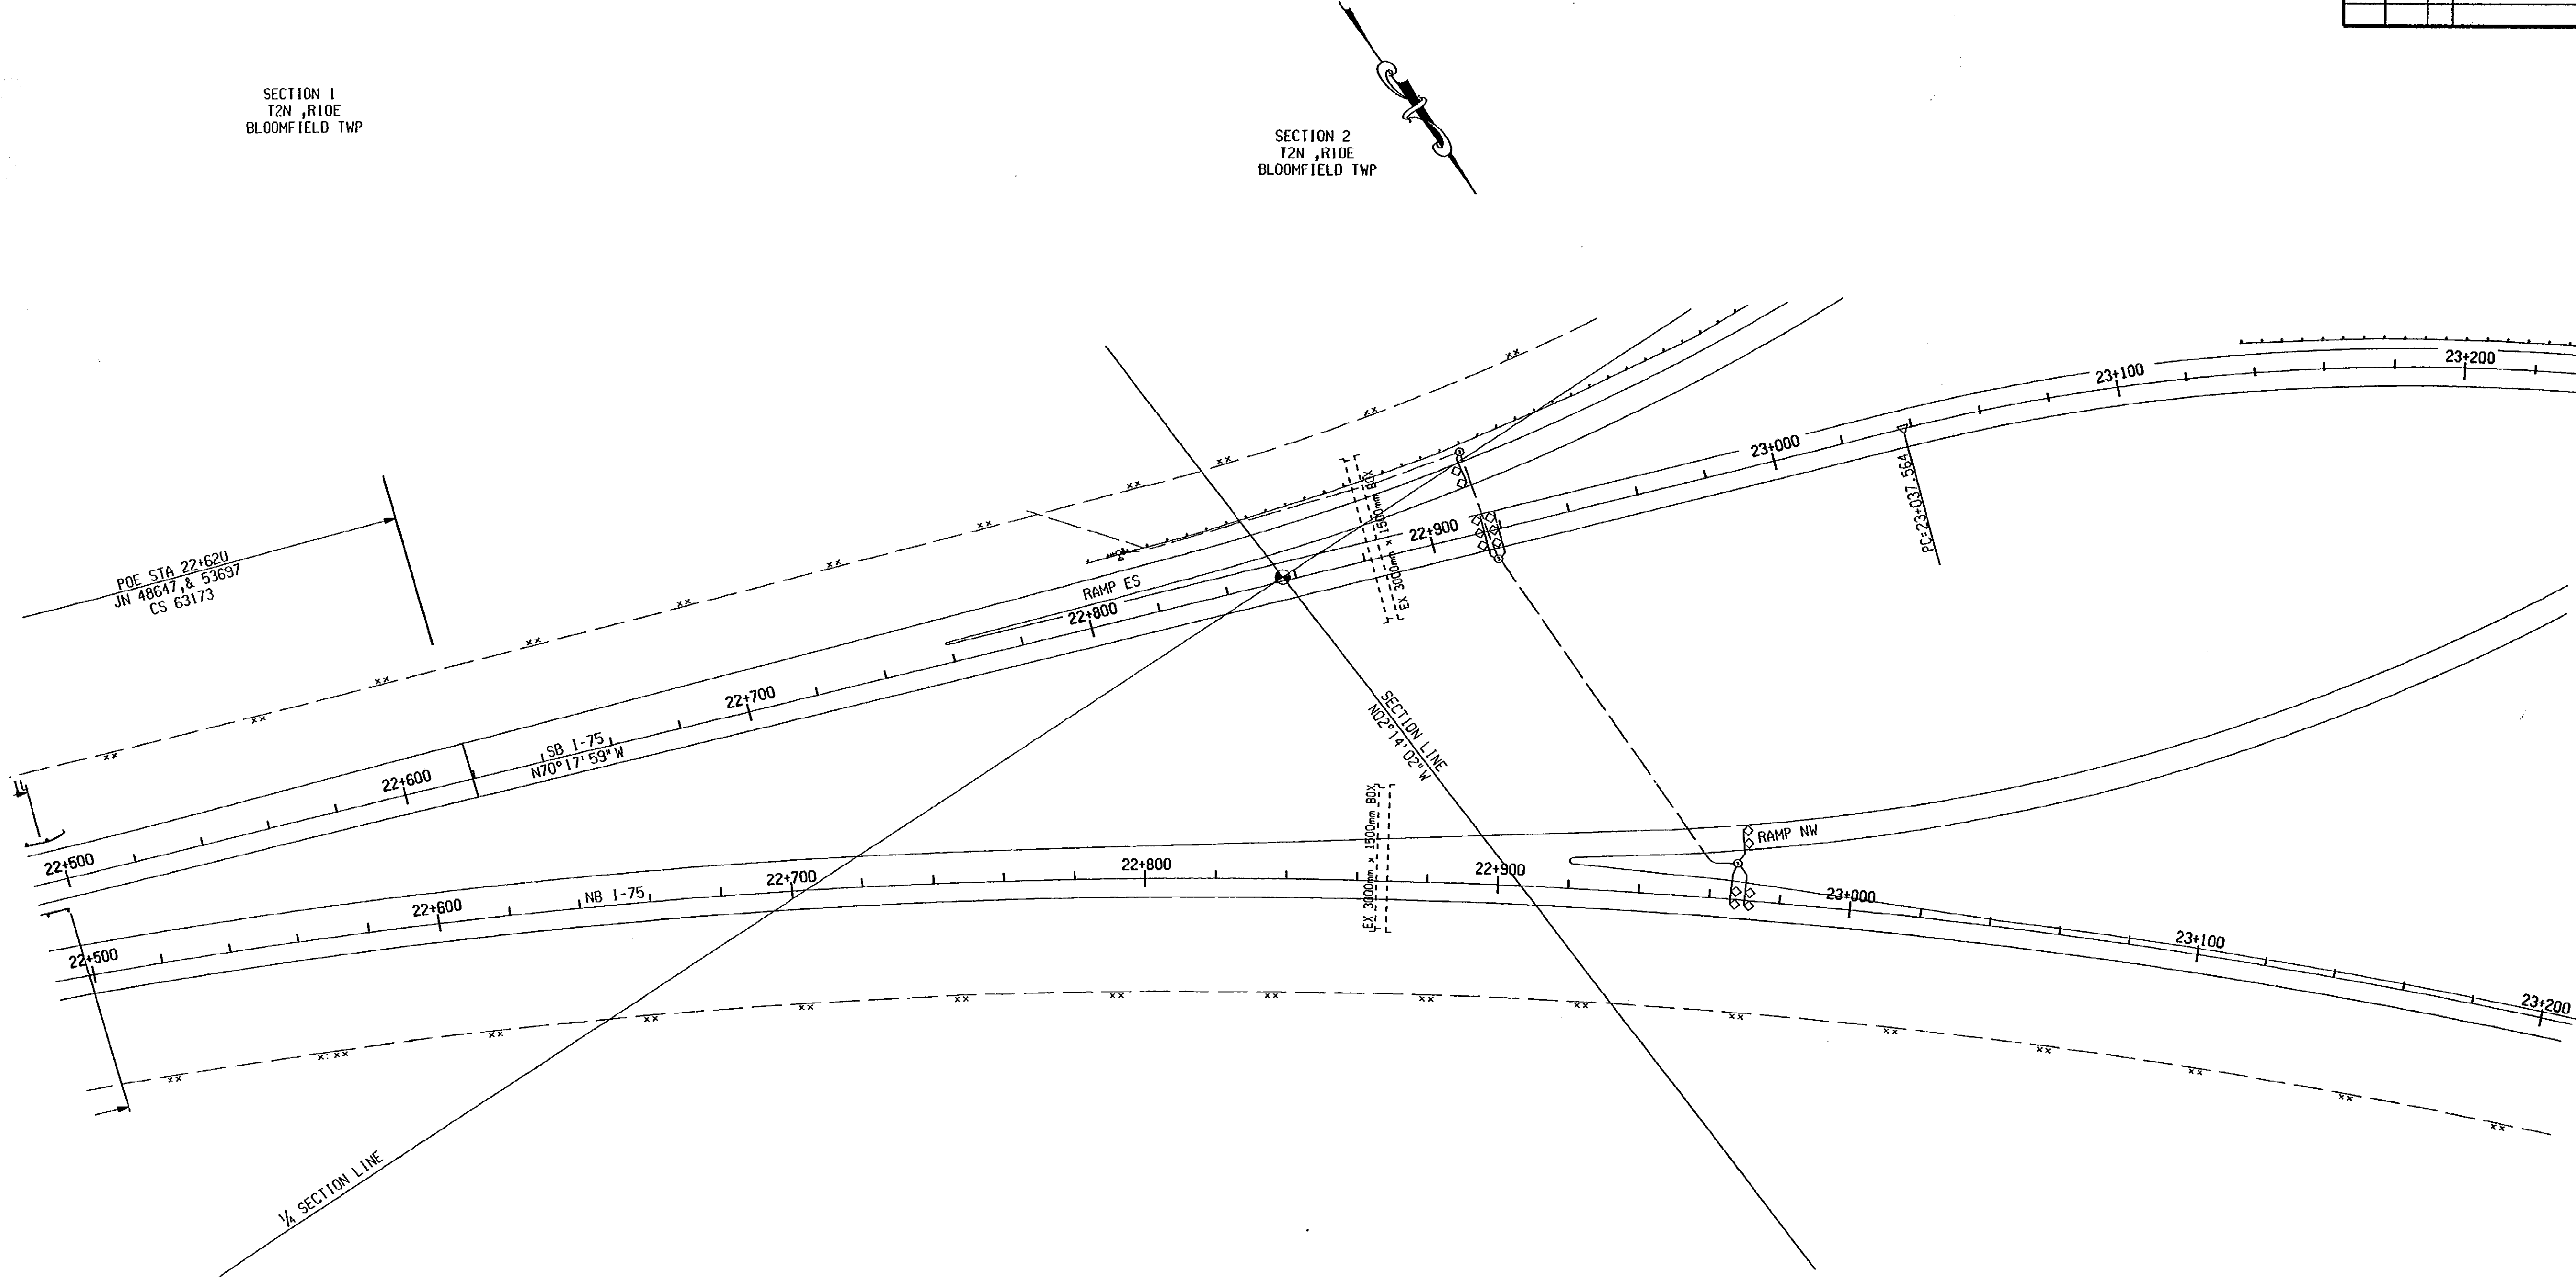

SHOULDER UPGRADE QUANTITIES JN 53697 (STA 22+500 TO STA 23+200)

55 t	Bit Mixture, 4C
71 t	Bit Mixture, 3C
504 m ²	Aggregate Base, 200 mm
125 m	Station Grading
444 m ²	Slope Restoration

REMOVAL & CONSTRUCTION SHEET

STA 22+500 TO STA 22+620 (POE) I-75

	DATE	SCALE	CONT. SEC.	JOB NO.	DESIGN UNIT	SHEET NO.
	12/18/00	1:1000	63174	48647 53697	RICK	R.O.W. 39

FILE NAME: 536972500.dgn
 9 10 11 12 13 14 15 16 17 18 19 21 22 24 25 26 27 28 30 31 33


DATE: 01-11-01
 EXISTING BY: RICK'S TEAM
 PROPOSED BY: RICK'S TEAM
 LAST CORRECTION BY: RICK'S TEAM

FILE NAME: 49595.dwg
 1 2 3 4 5 6 7 8 9 10 11 12 13 14 15 16 17 18 19 20 21 22 23 24 25 26 27 28 30 31 32 35 36

CROSS-OVER CURVE DATA
 $\Delta: 22^{\circ}04'07''$ LT
 $R: 550.600$
 $L: 211.844$
 $PC: 10+138.572$
 $PI: 10+245.823$
 $PT: 10+350.415$

SECTION 14
 TIN, R11E
 MADISON HEIGHTS

AUTH			DATE			NO.			REVISION			FINAL R.O.W.		

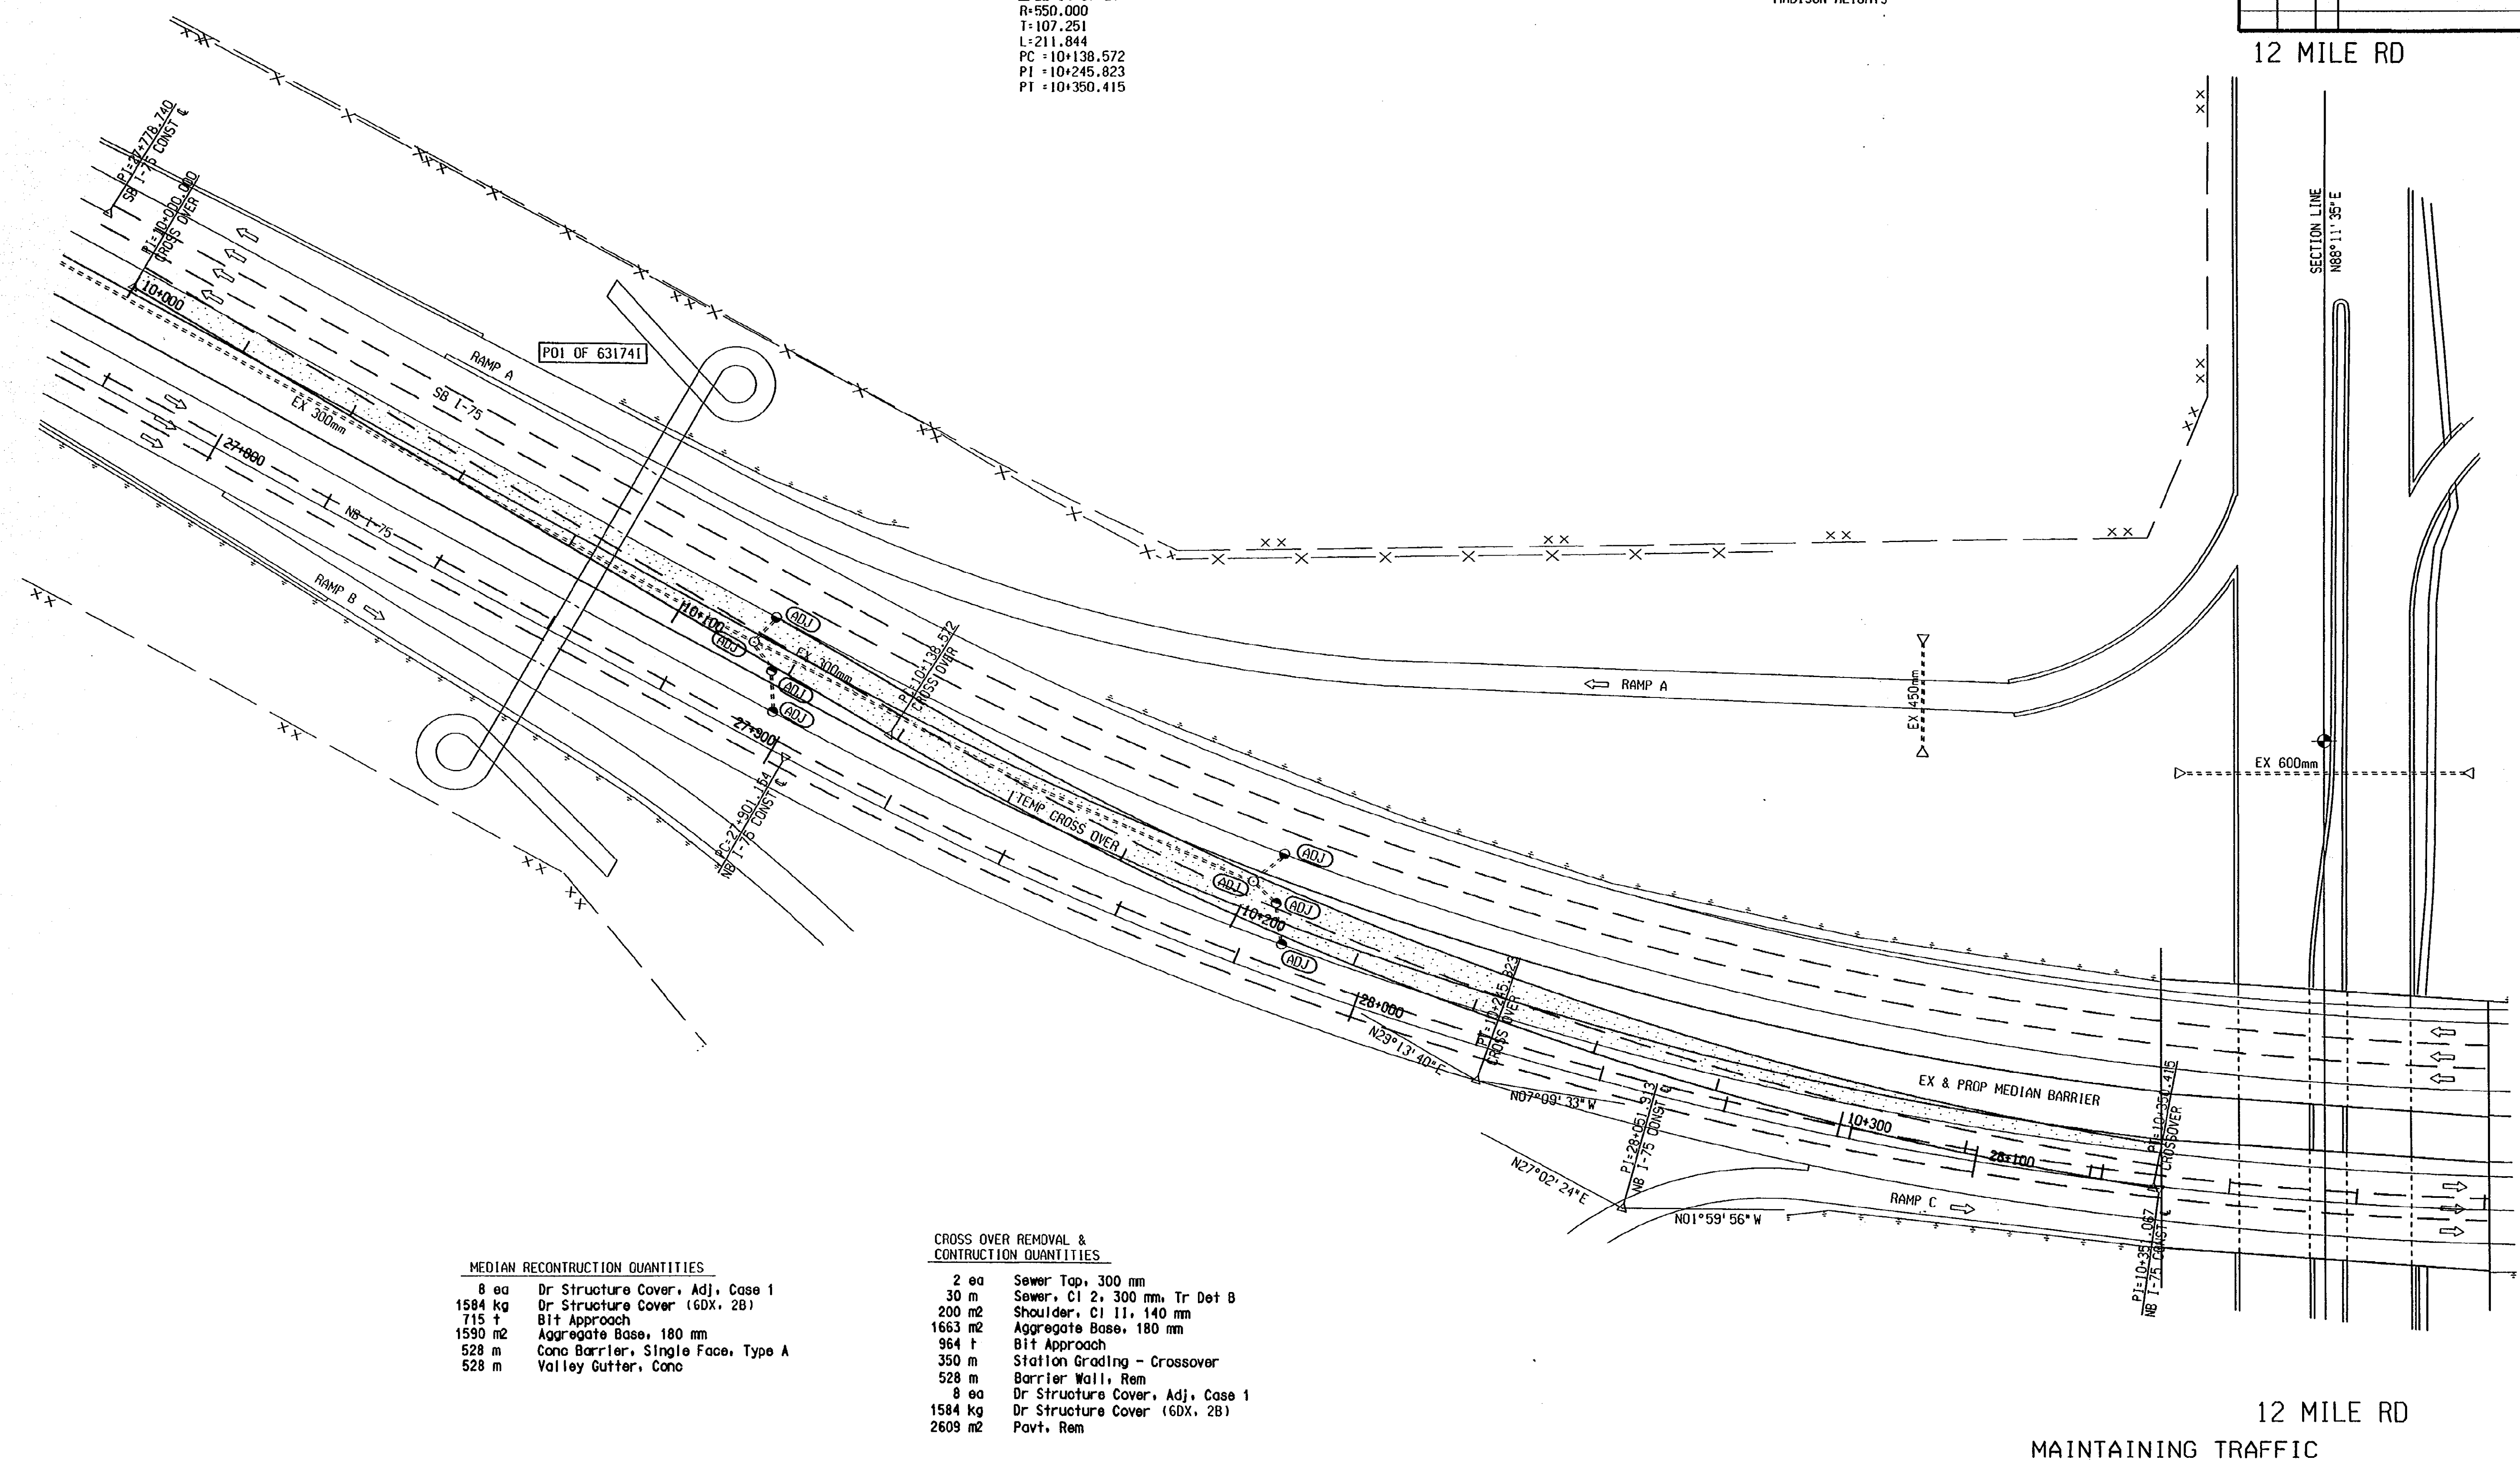

MEDIAN RECONSTRUCTION QUANTITIES

8 ea	Dr Structure Cover, Adj, Case 1
1584 kg	Dr Structure Cover (GDx, 2B)
715 t	Bit Approach
1590 m ²	Aggregate Base, 180 mm
528 m	Conc Barrier, Single Face, Type A
528 m	Valley Gutter, Conc

CROSS OVER REMOVAL & CONSTRUCTION QUANTITIES

2 ea	Sewer Tap, 300 mm
30 m	Sewer, CI 2, 300 mm, Tr Det B
200 m ²	Shoulder, CI II, 140 mm
1663 m ²	Aggregate Base, 180 mm
964 t	Bit Approach
350 m	Station Grading - Crossover
528 m	Barrier Wall, Rem
8 ea	Dr Structure Cover, Adj, Case 1
1584 kg	Dr Structure Cover (GDx, 2B)
2609 m ²	Pavt, Rem

NOTE:
 CONTRACTOR TO PROVIDE RESIDENT ENGINEER WITH VERTICAL ALIGNMENT 3 WEEKS IN ADVANCE OF PROPOSED CONSTRUCTION OF CROSSOVER.

	SOUTH CROSS-OVER I-75					
	DATE	SCALE	CONT. SEC.	JOB NO.	DESIGN UNIT	SHEET NO.
	01/11/01	1:500	63174	49595	RICK	R.O.W 40

12 MILE RD
 MAINTAINING TRAFFIC

DATE: 10/23/00
 DATE: 01/11/01
 EXISTING BY: RICK'S TEAM
 PROPOSED BY: RICK'S TEAM
 LAST CORRECTION BY: RICK'S TEAM

57
 30 31 32 33
 21 22 23 24 25 26 27 28 29
 15 16 17 18 19
 12 13 14 15 16 17 18 19
 FILE NAME: 4959512stg.dgn
 1 2 3 7 8 9 11 12 13 14 15 16 17 18 19

SECTION 14
 TIN, R11E
 MADISON HEIGHTS



12 MILE ROAD

NB I-75
 CURVE DATA
 $\Delta = 29^{\circ}02'20''$ LT
 R=582.125
 T=150.757
 L=295.034
 PC=27+901.154
 PI=28+051.911
 PT=28+196.188

SECTION 11
 TIN, R11E
 MADISON HEIGHTS

RED RUN DRAIN

FINAL R.O.W.			
AUTH	DATE	NO.	REVISION

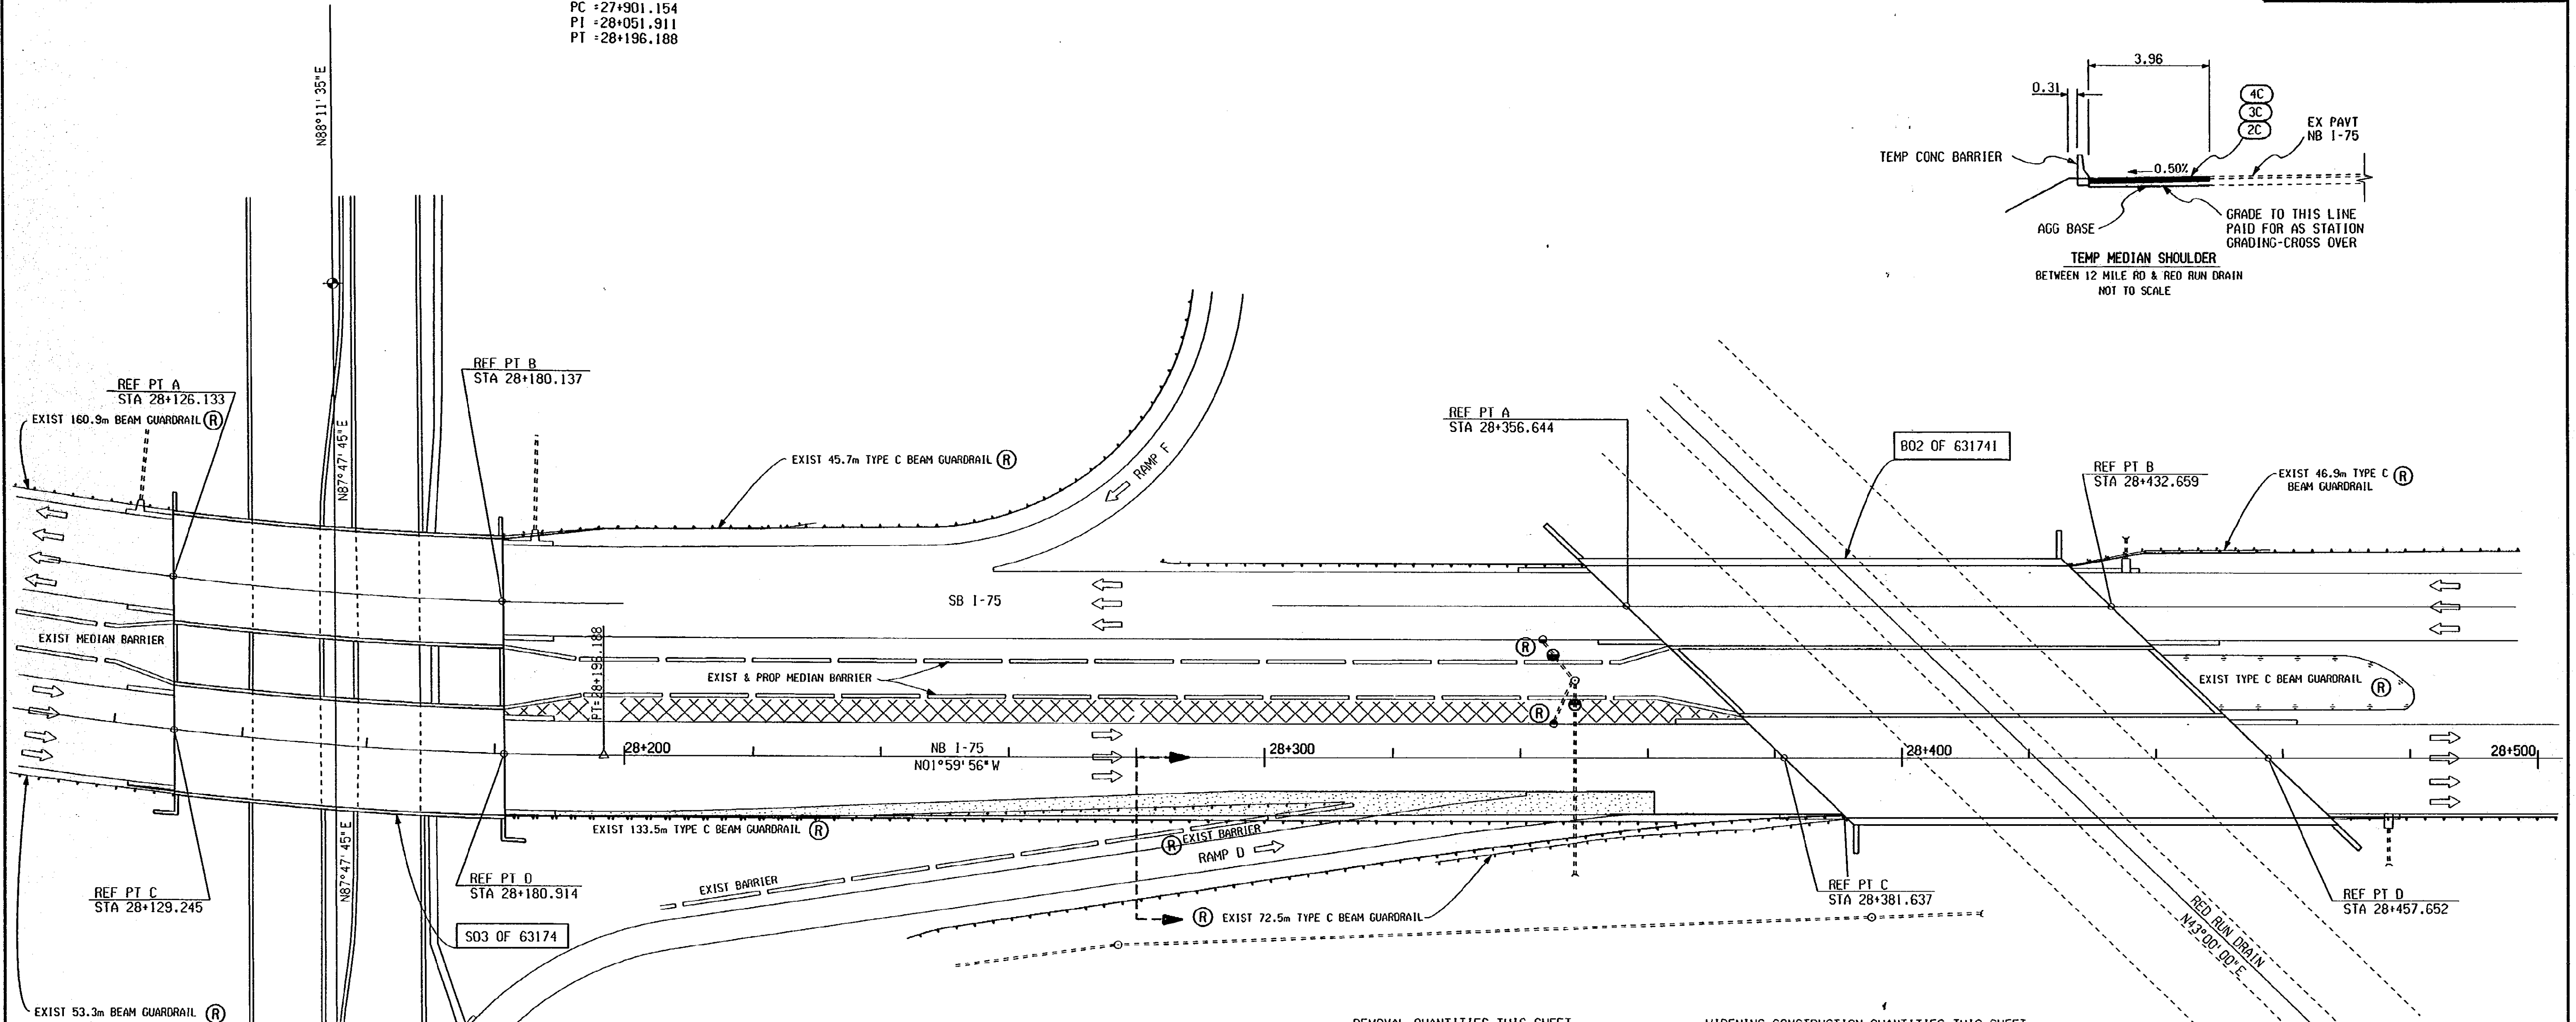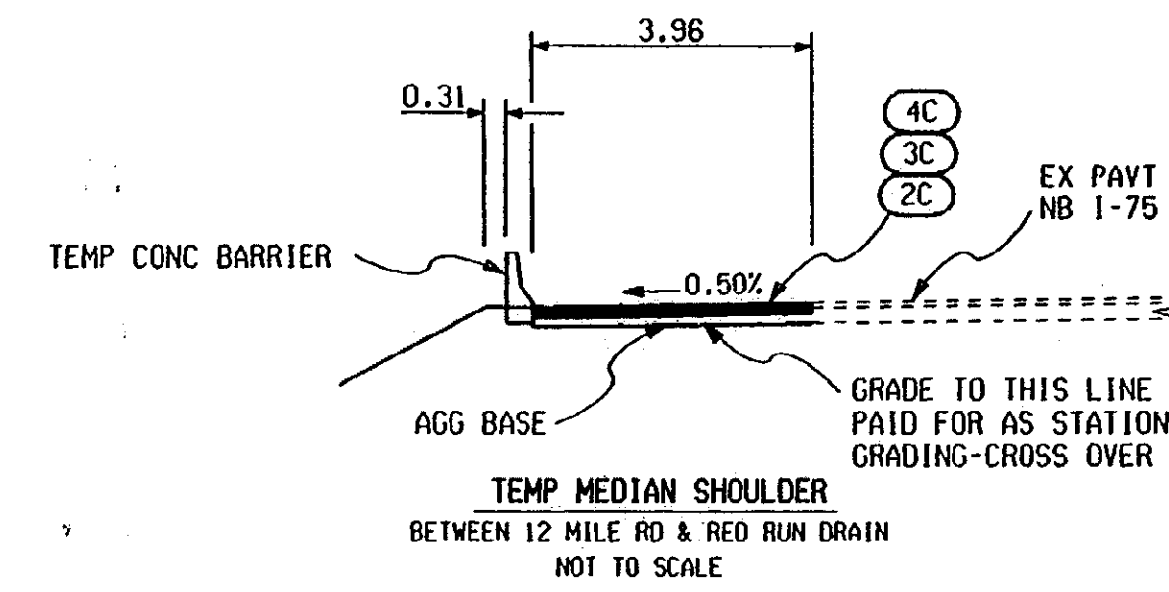

REMOVAL QUANTITIES THIS SHEET


390 m ²	Bit Surface, Rem
70 m	Guardrail, Rem
20 m	Barrier Wall, Rem

WIDENING CONSTRUCTION QUANTITIES THIS SHEET

176 t	Bit Approach
390 m ²	Aggregate Base, 180 mm
420 m	Conc Barrier, Single Face, Type A
200 m	Station Grading - Crossover
211 kg	Dr Structure Cover (1-DX)
1 ea	Dr Structure, 1200 mm dia

SHOULDER CONSTRUCTION QUANTITIES THIS SHEET

792 m ²	Pavt, Rem
357 t	Bit Approach
792 m ²	Aggregate Base, 180 mm

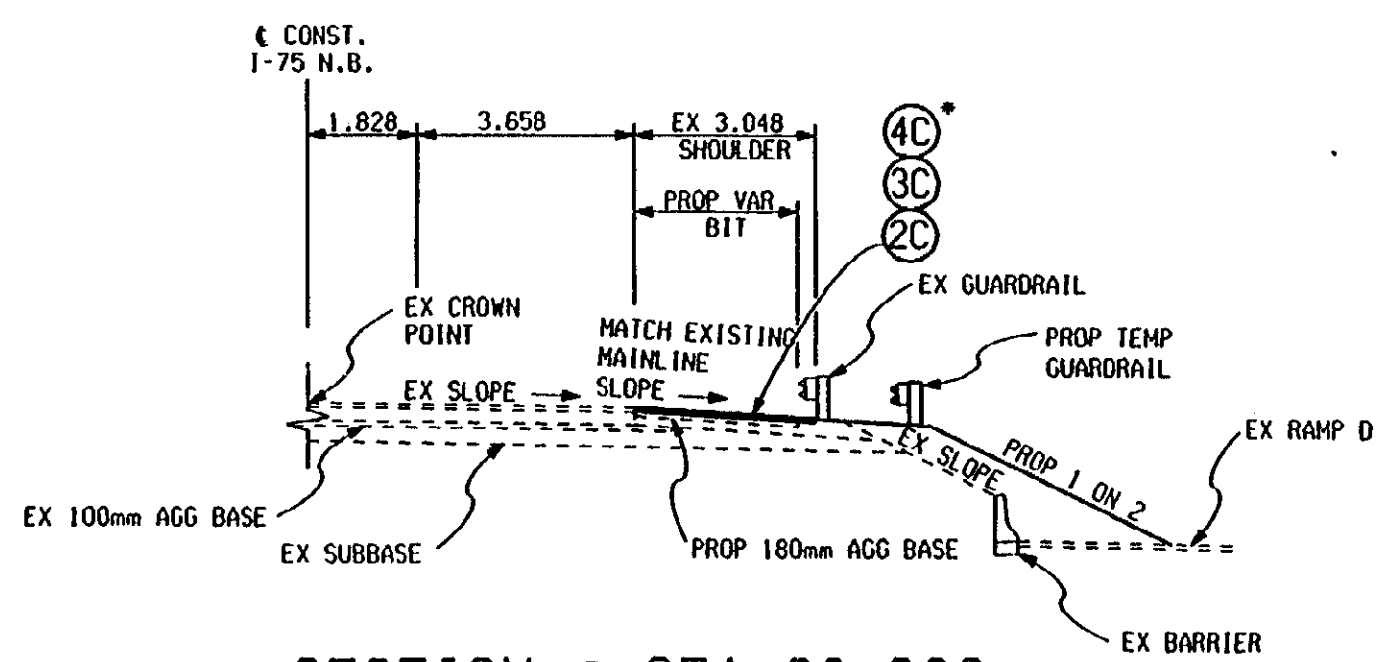

* NOTE: IN THIS LOCATION IT IS ACCEPTABLE TO SUBSTITUTE THE 5E BITUMINOUS MIXTURE FOR THE 4C BITUMINOUS MIXTURE IN ORDER TO ACCOMMODATE FEATHERING.

SECTION @ STA 28+280

12 MILE ROAD

RED RUN DRAIN



I-75 TEMPORARY WIDENING




DATE	SCALE	CONT. SEC.	JOB NO.	DESIGN UNIT	SHEET NO.
01/11/01	1:500	63174	49595	RICK	R.O.W. 41

DATE: 10/23/00
 PROPOSED BY: RICK'S TEAM
 LAST CORRECTION BY: RICK'S TEAM

FILE NAME: 49595-mpxo.dgn
 1 2 3 4 5 6 7 8 9 10 11 12 13 14 15 16 17 18 19 20 21 22 23 24 25 26 27 28 29 30 31 32 33

SECTION 11
 TIN, R11E
 MADISON HEIGHTS

FINAL R.O.W.			
AUTH	DATE	NO.	REVISION

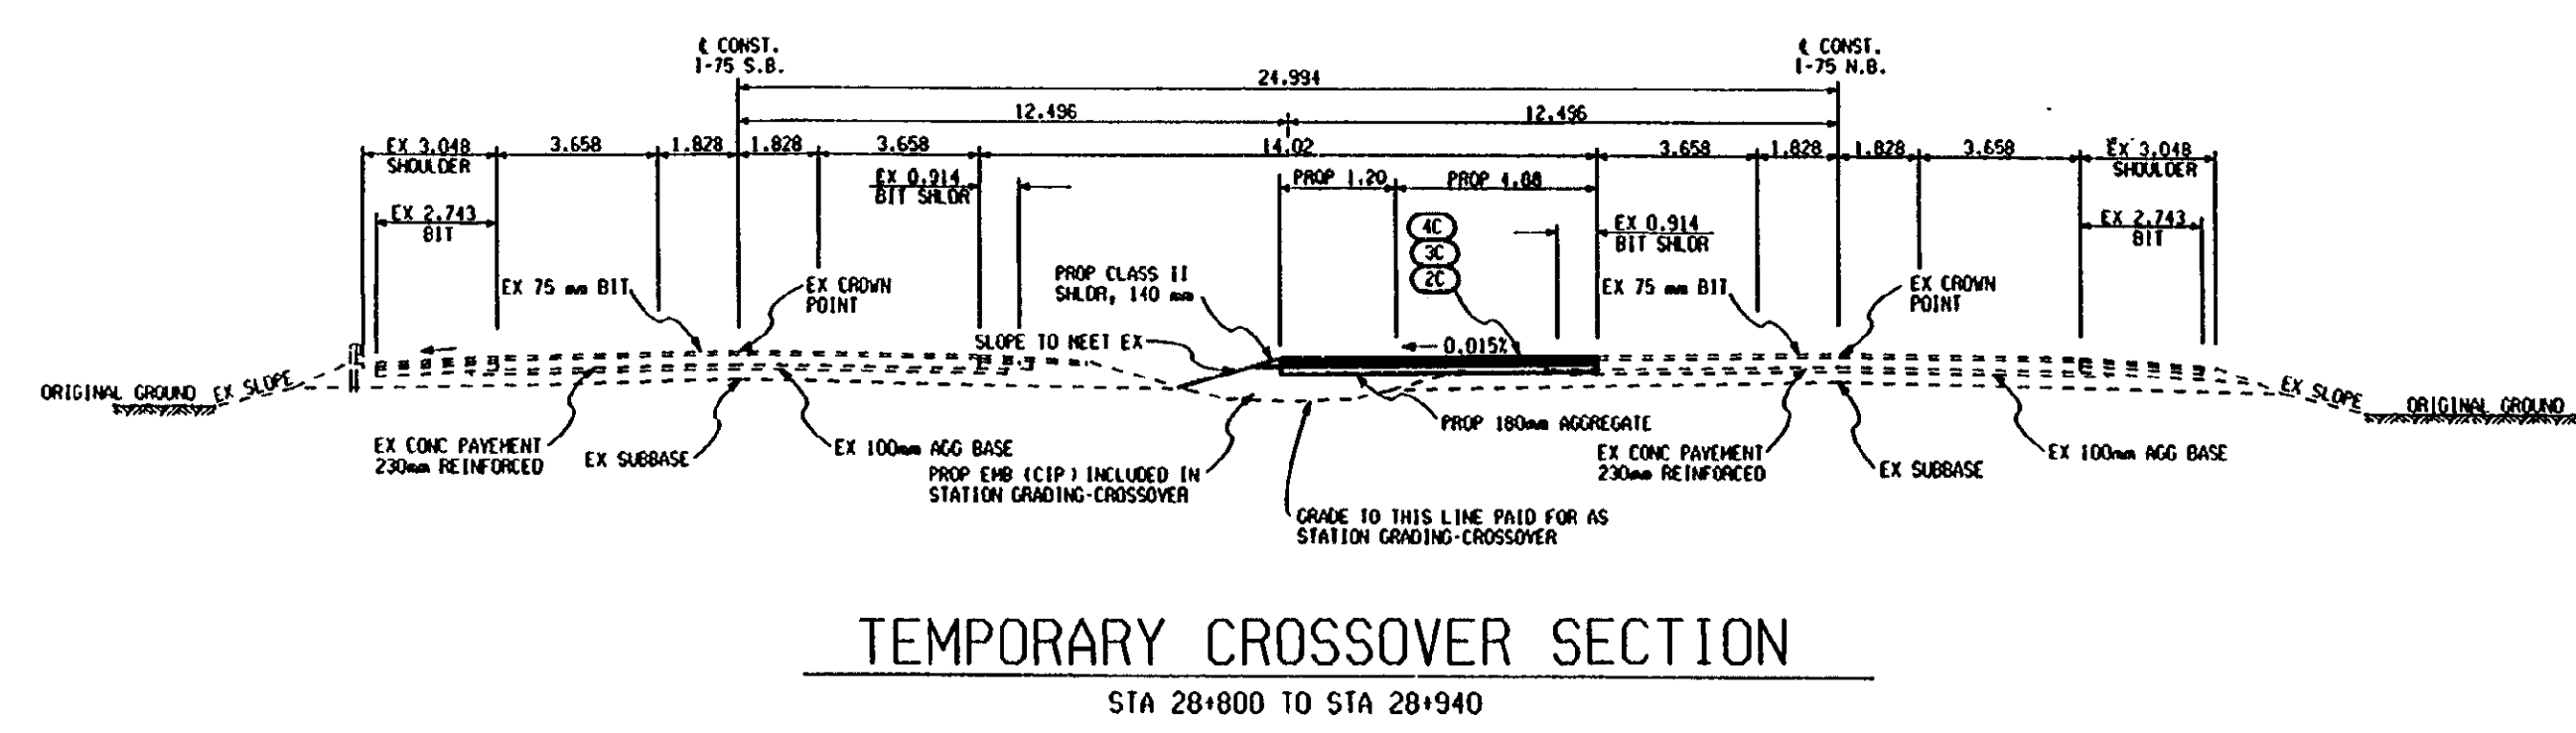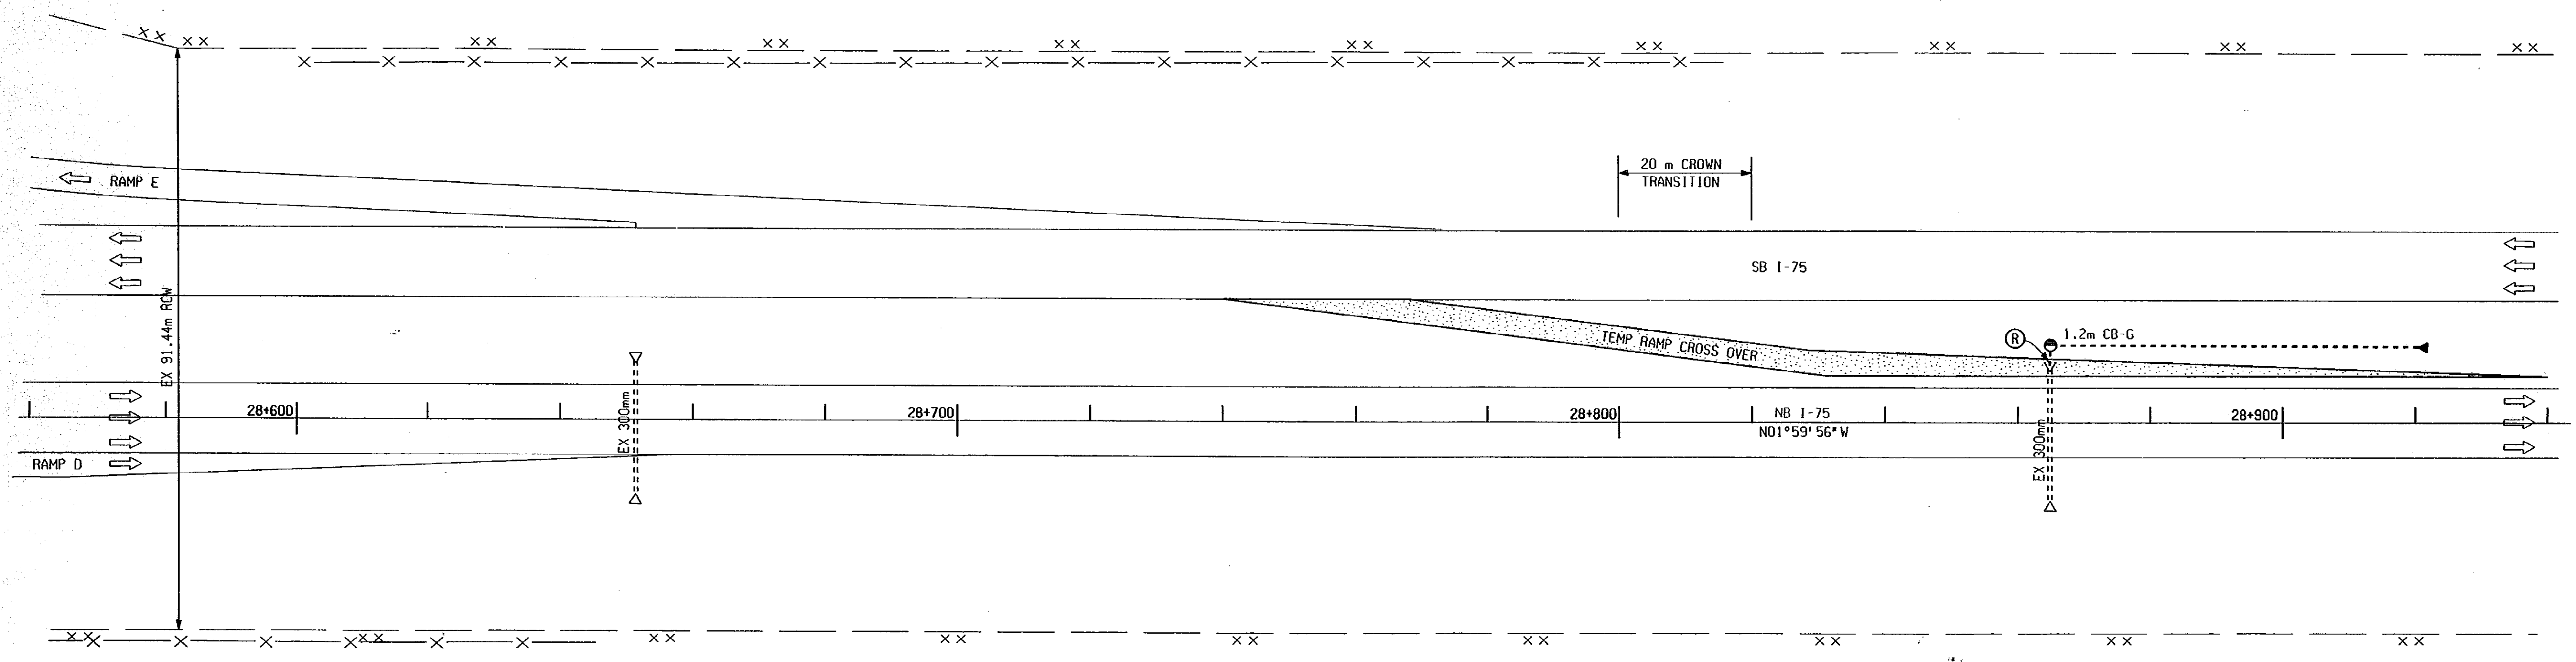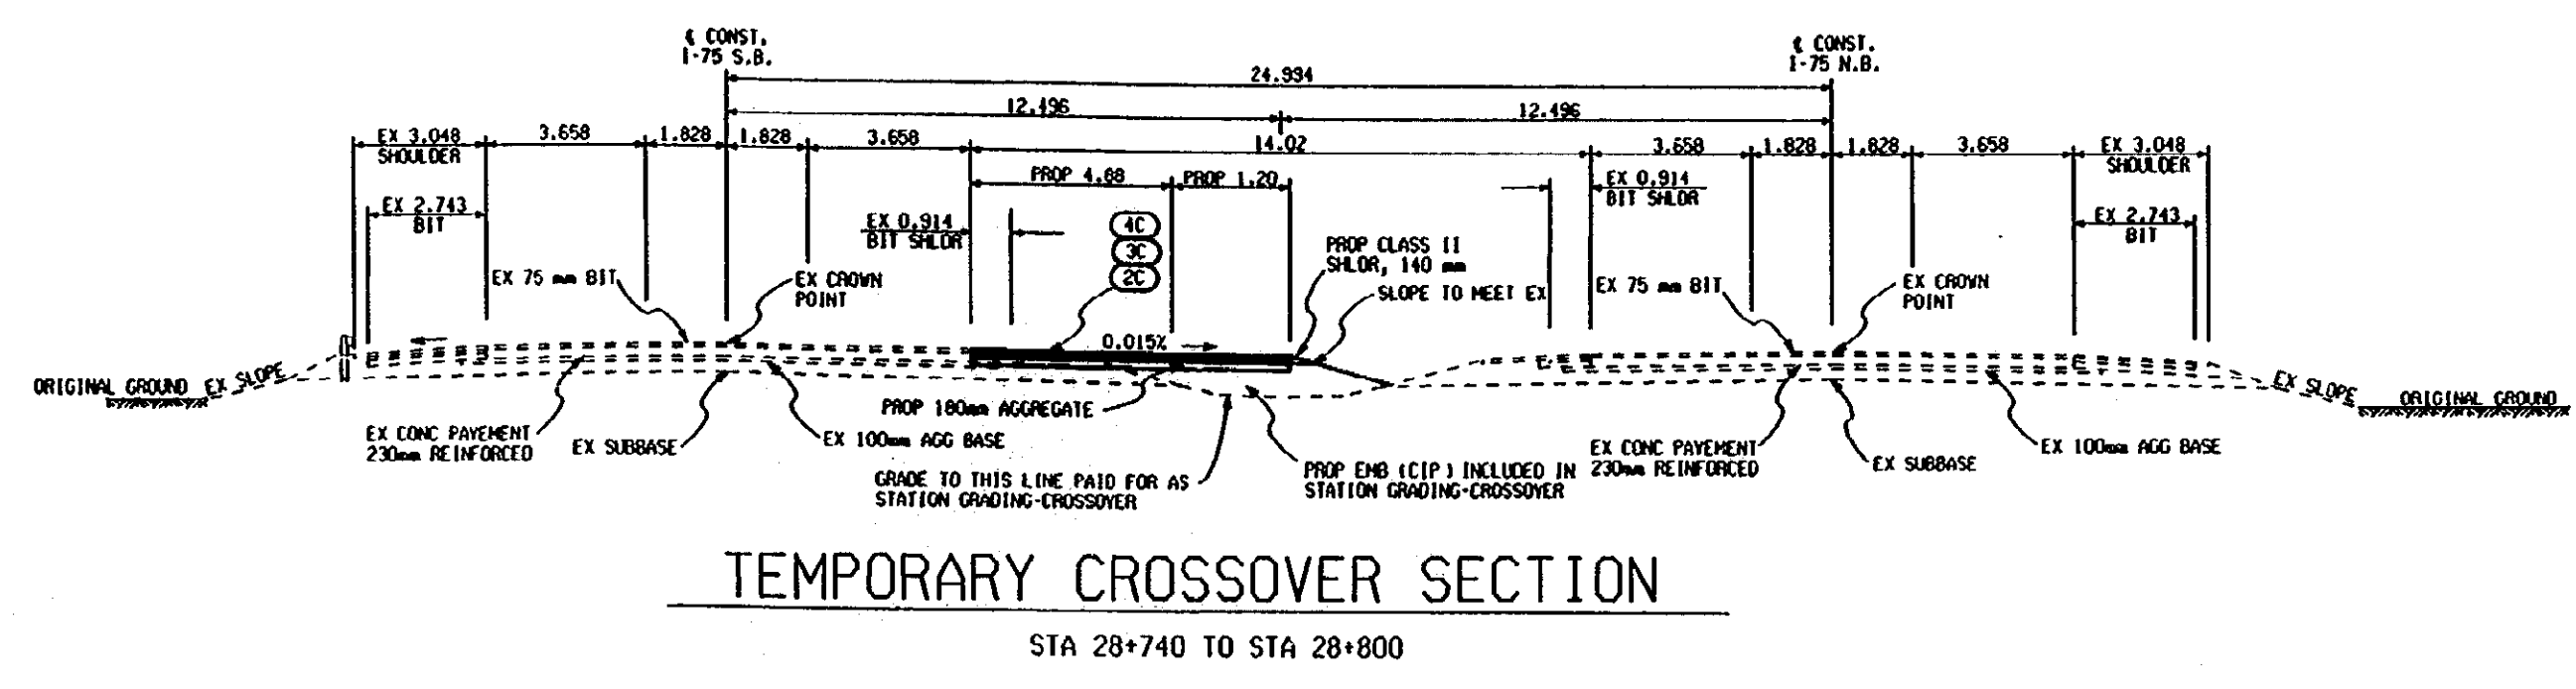

SHOULDER WIDENING FROM RED RUN TO 13 MILE RD
 1109 t Bit Approach
 2465 m² Aggregate Base, 180 mm
 493 m² Shoulder, CI II, 140 mm

CONSTRUCTION QUANTITIES THIS SHEET
 339 t Bit Approach
 225 m Station Grading - Crossover
 121 m² Shoulder, CI II, 140 mm
 917 m² Aggregate Base, 180 mm
 2 ea Culv End, Rem
 1 ea Dr Structure, 1200 mm dia
 138 kg Dr Structure Cover (1C)
 62 m Sewer, CI 2, 300 mm, Tr Det A
 65 m Sewer, Rem
 2 ea Culv End Sect, 300 mm
 1 ea Dr Structure, Rem

STAGING SHEET

	12 MILE RD RAMP CROSS OVER					
	DATE	SCALE	CONT. SEC.	JOB NO.	DESIGN UNIT	SHEET NO.
	01/11/01	1:500	63174	49595	RICK	R.O.W. 42



EXISTING BY: DATE: PROPOSED BY: DATE: LAST CORRECTION BY: RICK'S TEAM DATE: 01-11-01

FILE NAME: 49595\exv1.dgn 1 2 3 4 9 10 11 12 13 14 15 16 17 18 19 21 22 24 25 26 27 28 30 31 35 36

CROSS OVER CURVE DATA
 $\Delta = 03^{\circ}30'08''$ LT
 $R = 975.000$
 $T = 29.808$
 $L = 59.597$
 $PC = 10+098.133$
 $PI = 10+127.941$
 $PT = 10+157.731$

SECTION 2
 TIN, RIIE
 MADISON HEIGHTS

FINAL R.O.W.			
AUTH	DATE	NO.	REVISION

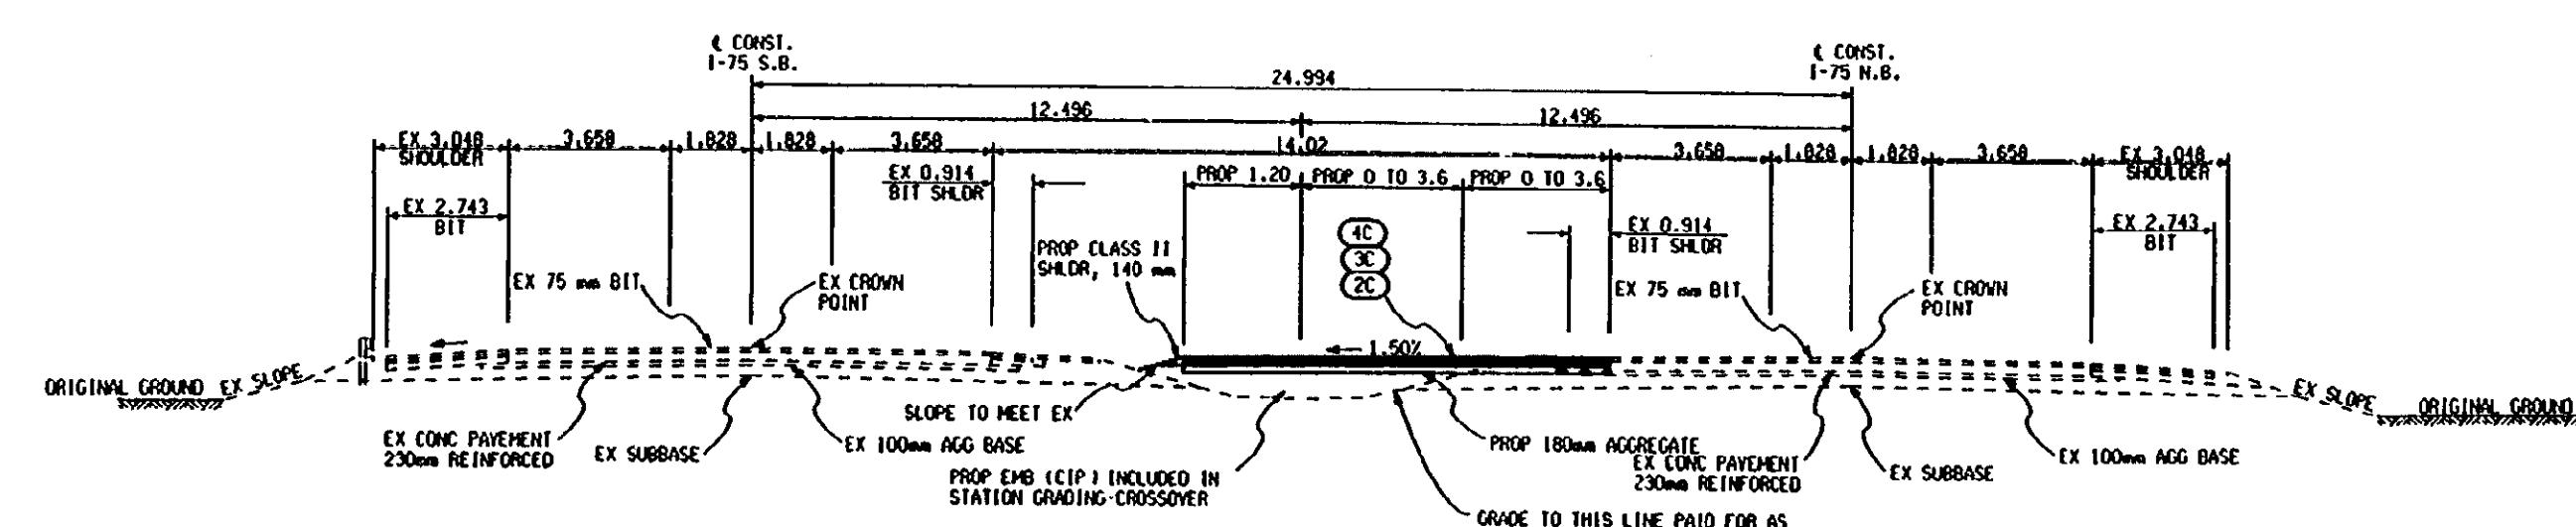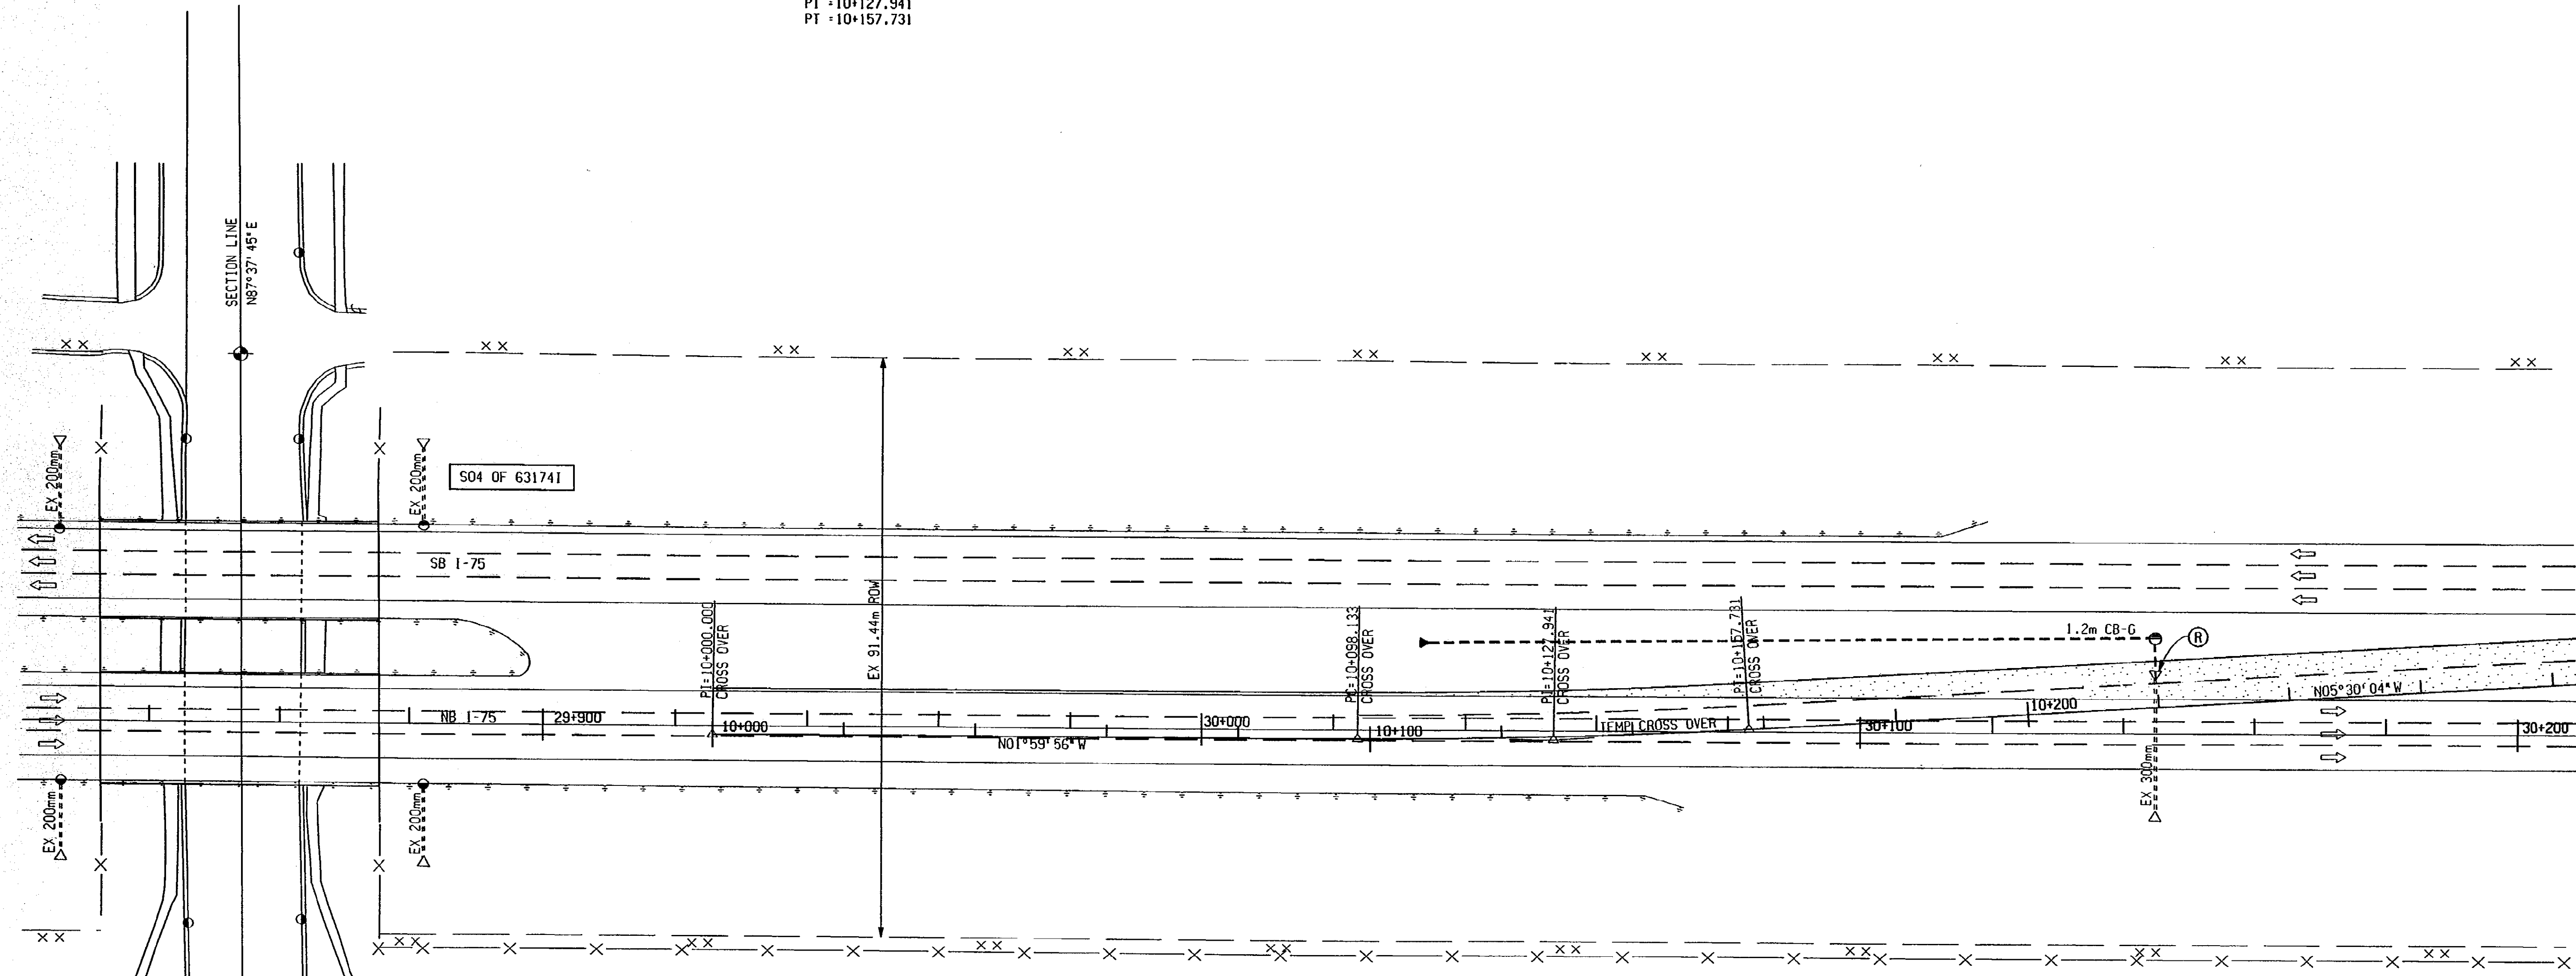

TEMPORARY CROSSOVER SECTION
 STA 10+100 TO STA 10+280

CONSTRUCTION QUANTITIES

576 m	Station Grading - Crossover
326 m ²	Shoulder, C1 11, 140 mm
1883 m ²	Aggregate Base, 180 mm
857 t	Bit Approach
120 m	Culv, C1 2, 300 mm
2 ea	Culv End, Rem
1 ea	Dr Structure, 1200 mm dia
138 kg	Dr Structure Cover (1-6)
2 ea	Culv End Seat, 300 mm
1 ea	Dr Structure, Rem
120 m	Sewer, Rem

MAINTAINING TRAFFIC

NORTH CROSS-OVER I-75



	DATE	SCALE	CONT. SEC.	JOB NO.	DESIGN UNIT	SHEET NO.
	01/11/01	1:500	63174	49595	RICK	43

EXISTING BY: DATE: PROPOSED BY: DATE: LAST CORRECTION BY: RICK'S TEAM DATE: 01-11-01

SECTION 2
TIN RILE
MADISON HEIGHTS

CROSS OVER CURVE DATA
 $\Delta = 03^{\circ} 30' 09''$ RT
 $R = 976,000$
 $T = 29,809$
 $L = 59,600$
 $PC = 10+438,989$
 $PI = 10+468,798$
 $PT = 10+498,589$

FINAL R.O.W.			
AUTH	DATE	NO.	REVISION

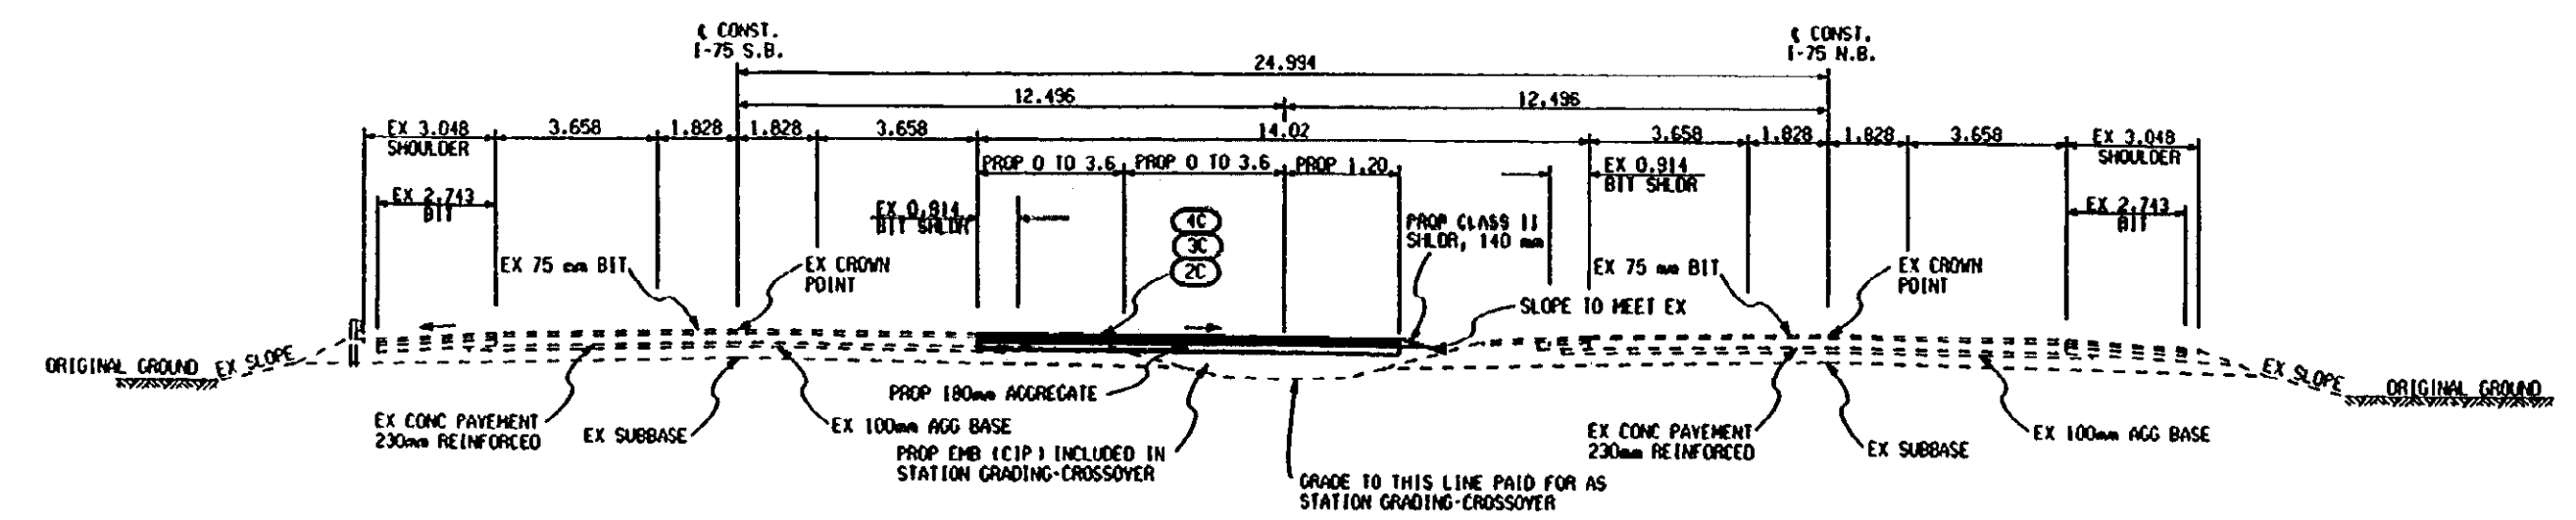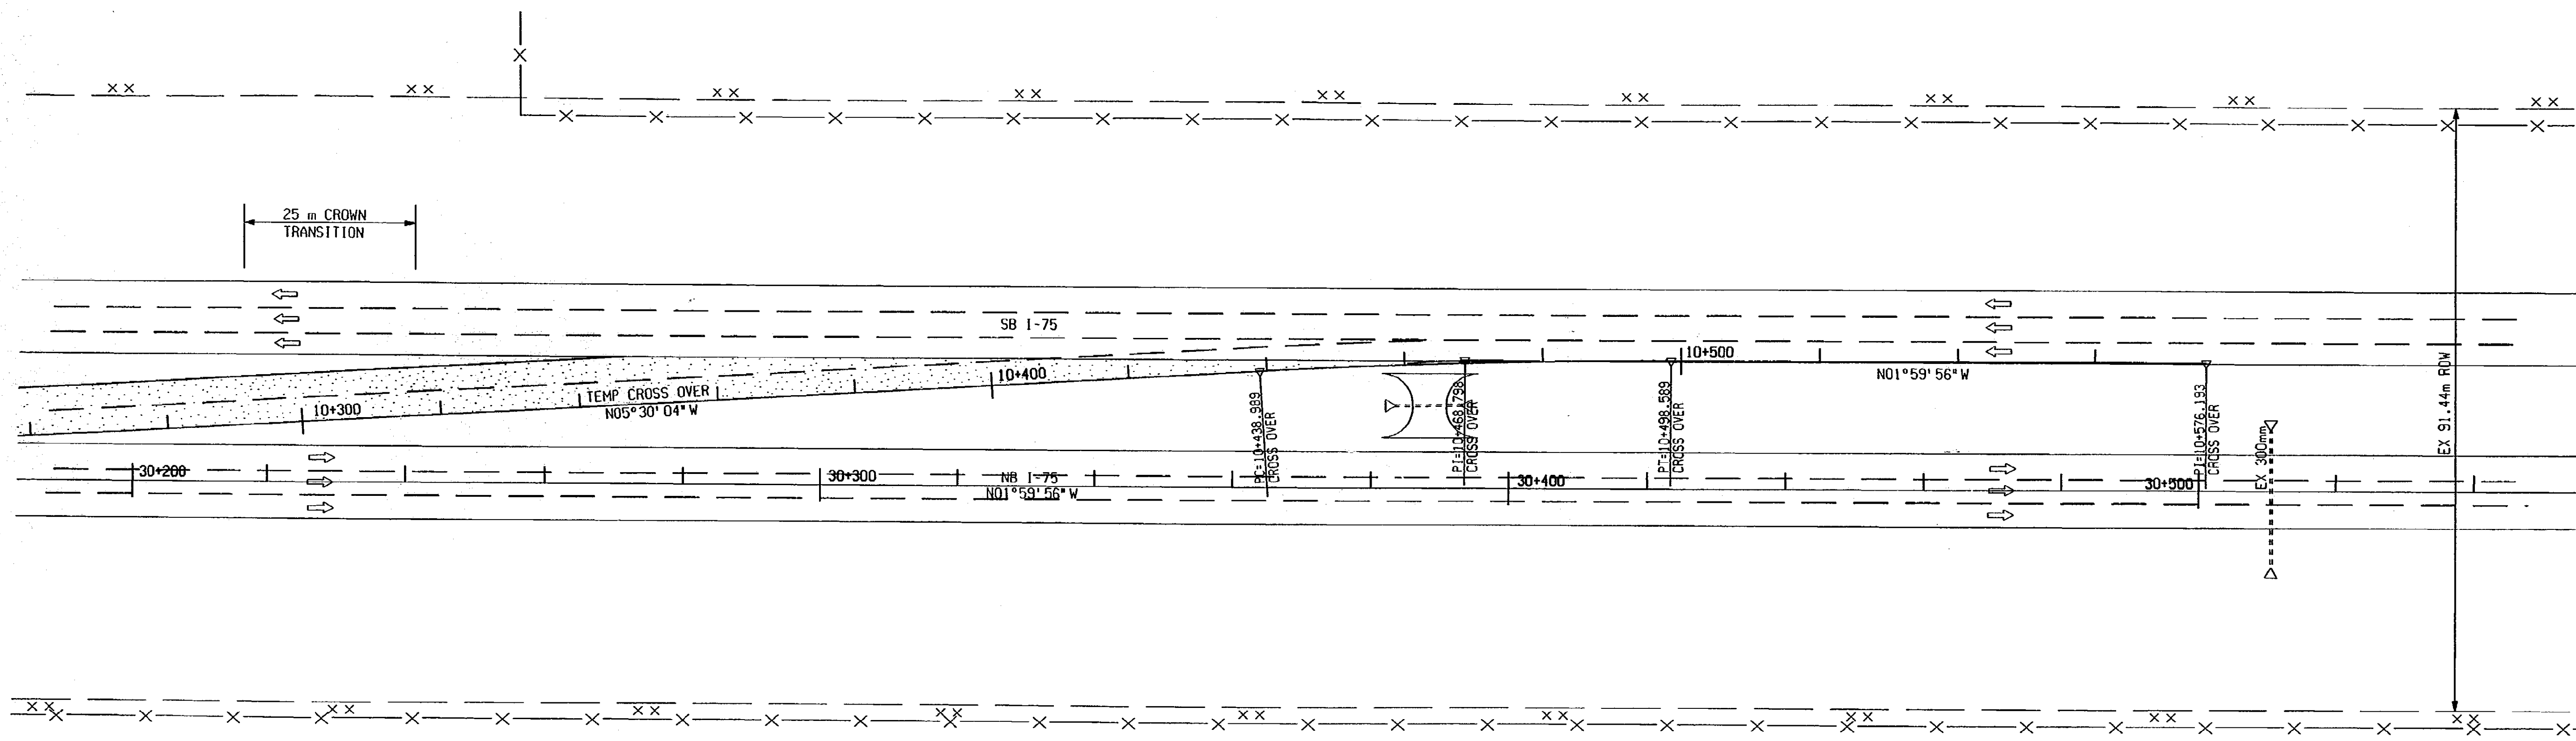

TEMPORARY CROSSOVER SECTION
STA 10+280 TO STA 10+460

NOTE: CONSTRUCTION QUANTITIES ARE SHOWN ON PREVIOUS SHEET.

MAINTAINING TRAFFIC

NORTH CROSS - OVER I-75



DATE	SCALE	CONT. SEC.	JOB NO.	DESIGN UNIT	SHEET NO.
01/11/01	1:500	63174	49595	RICK	R.O.W. 44

FILE NAME: 49595cov2.dgn
 1 2 3 4 9 10 11 12 13 14 15 16 17 18 19 21 22 24 25 27 28 30 31 35 36


EXISTING BY: DATE:
 PROPOSED BY: DATE:
 LAST CORRECTION BY: DATE:

39 40

FILE NAME: 49556maint1.dgn

ELEVEN MILE

FINAL R.O.W.			
AUTH	DATE	NO.	REVISION

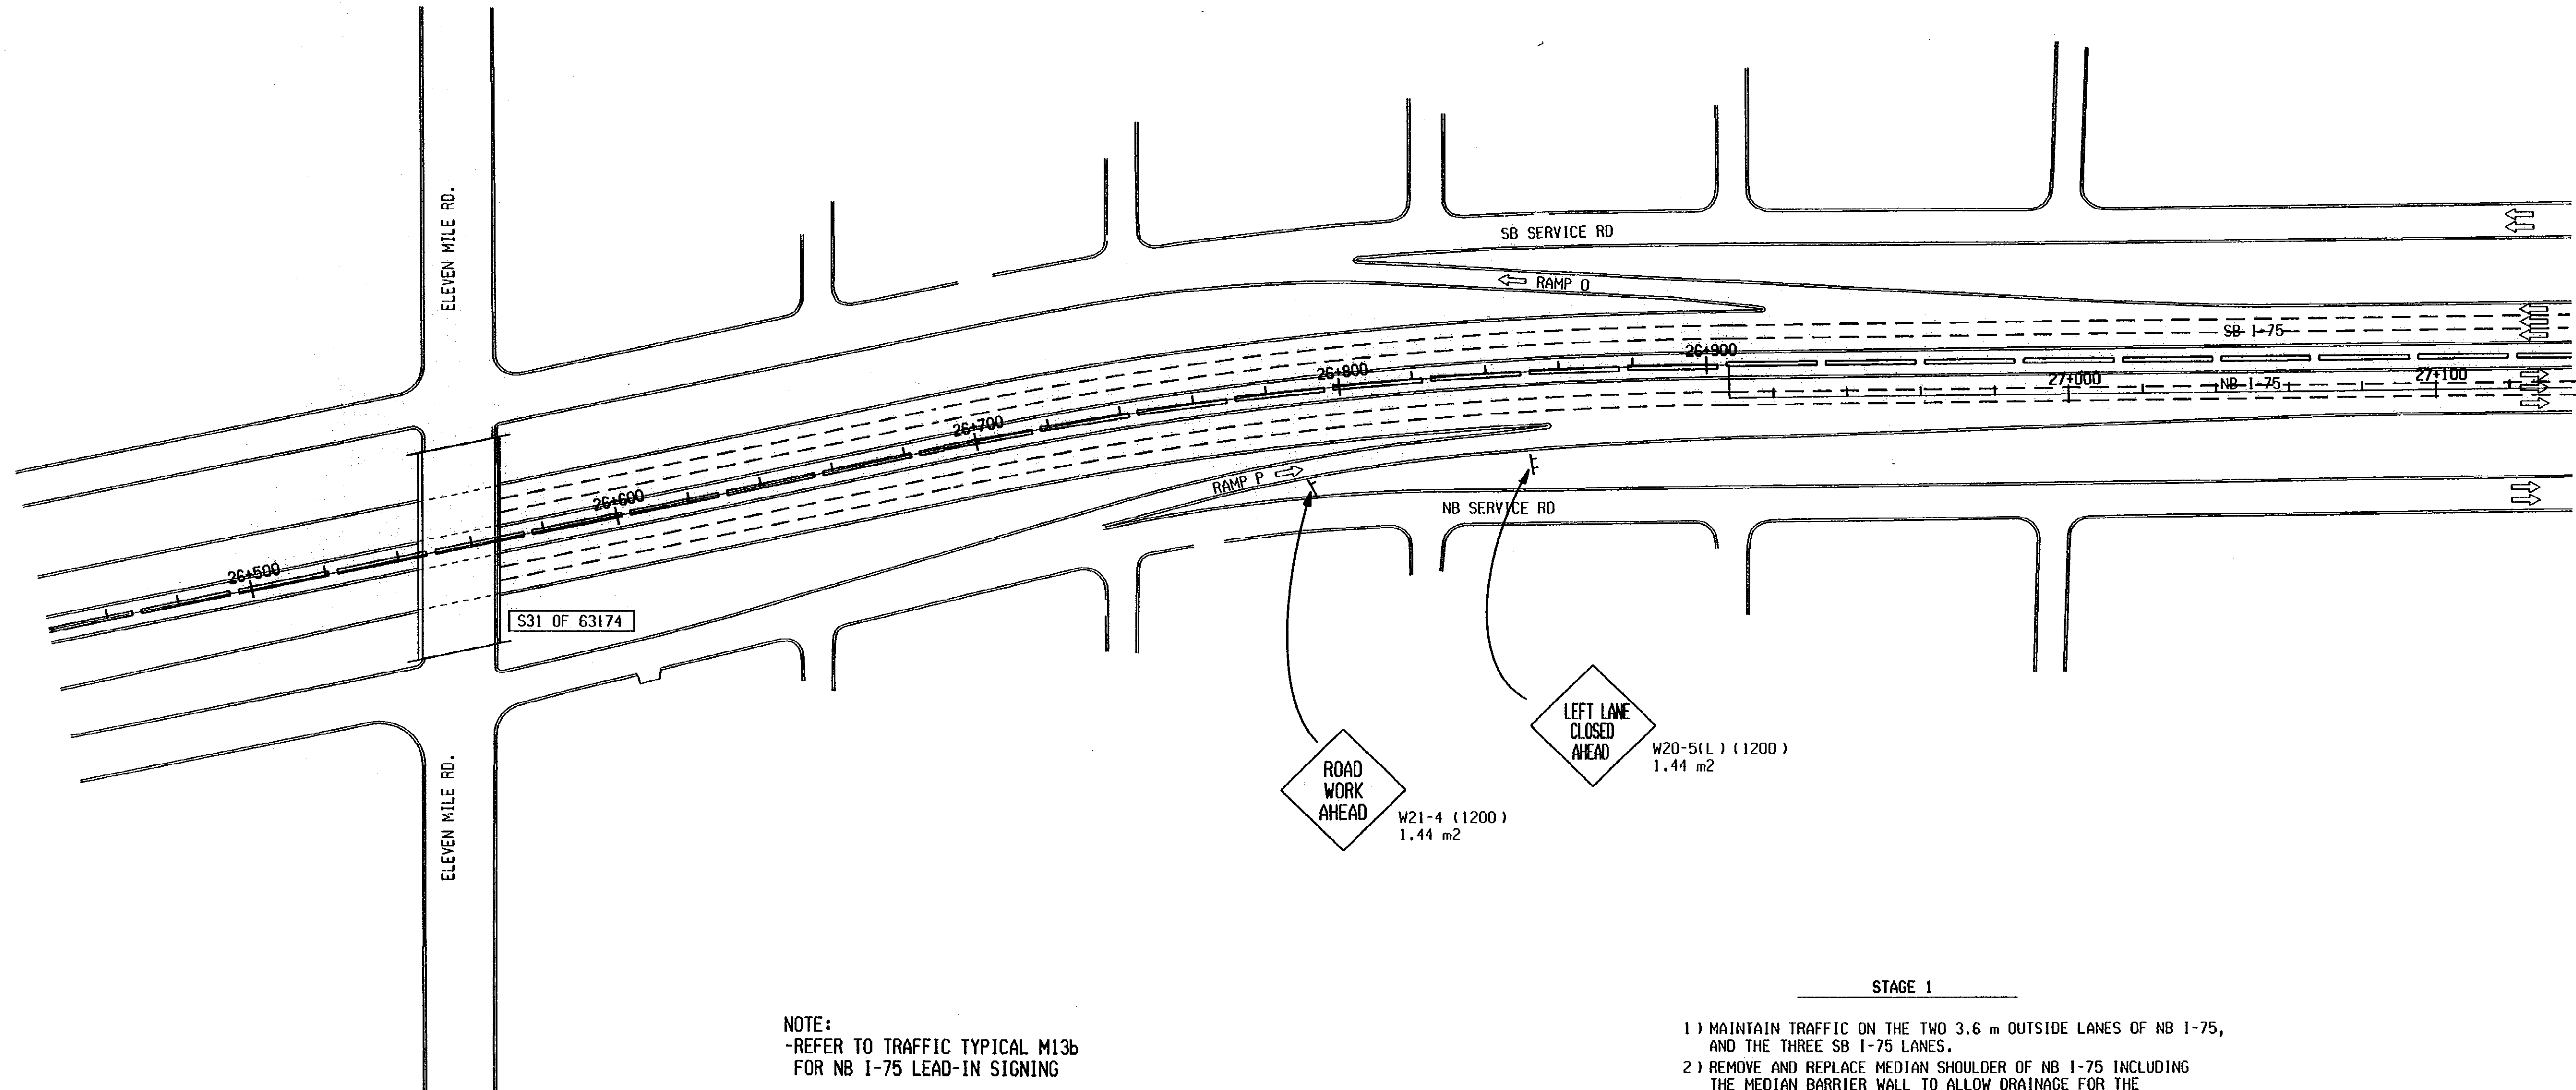

S31 OF 63174

ROAD WORK AHEAD
 W21-4 (1200)
 1.44 m²

LEFT LANE CLOSED AHEAD
 W20-5(L) (1200)
 1.44 m²

NOTE:
 -REFER TO TRAFFIC TYPICAL M13b
 FOR NB I-75 LEAD-IN SIGNING

STAGE 1

- 1) MAINTAIN TRAFFIC ON THE TWO 3.6 m OUTSIDE LANES OF NB I-75, AND THE THREE SB I-75 LANES.
- 2) REMOVE AND REPLACE MEDIAN SHOULDER OF NB I-75 INCLUDING THE MEDIAN BARRIER WALL TO ALLOW DRAINAGE FOR THE FOLLOWING STAGES.
- 3) CHANGE THE MEDIAN SLOPE TO BE FALLING AWAY FROM THE LANES.
- 4) PLACE TEMPORARY CONCRETE BARRIER WALL AND GUARDRAIL CONNECTIONS FOR STAGE 11

MAINTAINING TRAFFIC

STA 26+500 TO STA 27+120 NB I-75

	DATE	SCALE	CONT. SEC.	JOB NO.	DESIGN UNIT	SHEET NO.
	01/05/01	1:1000	63174	49595	OTSC TRAFFIC	R.O.W. 45

11 MILE RD


EXISTING BY: DATE:
 PROPOSED BY: DATE:
 LAST CORRECTION BY: DATE:

39 40

FILE NAME: 49555xover2.dgn

GARDENIA AVE

FINAL R.O.W.		
AUTH	DATE	NO. REVISION

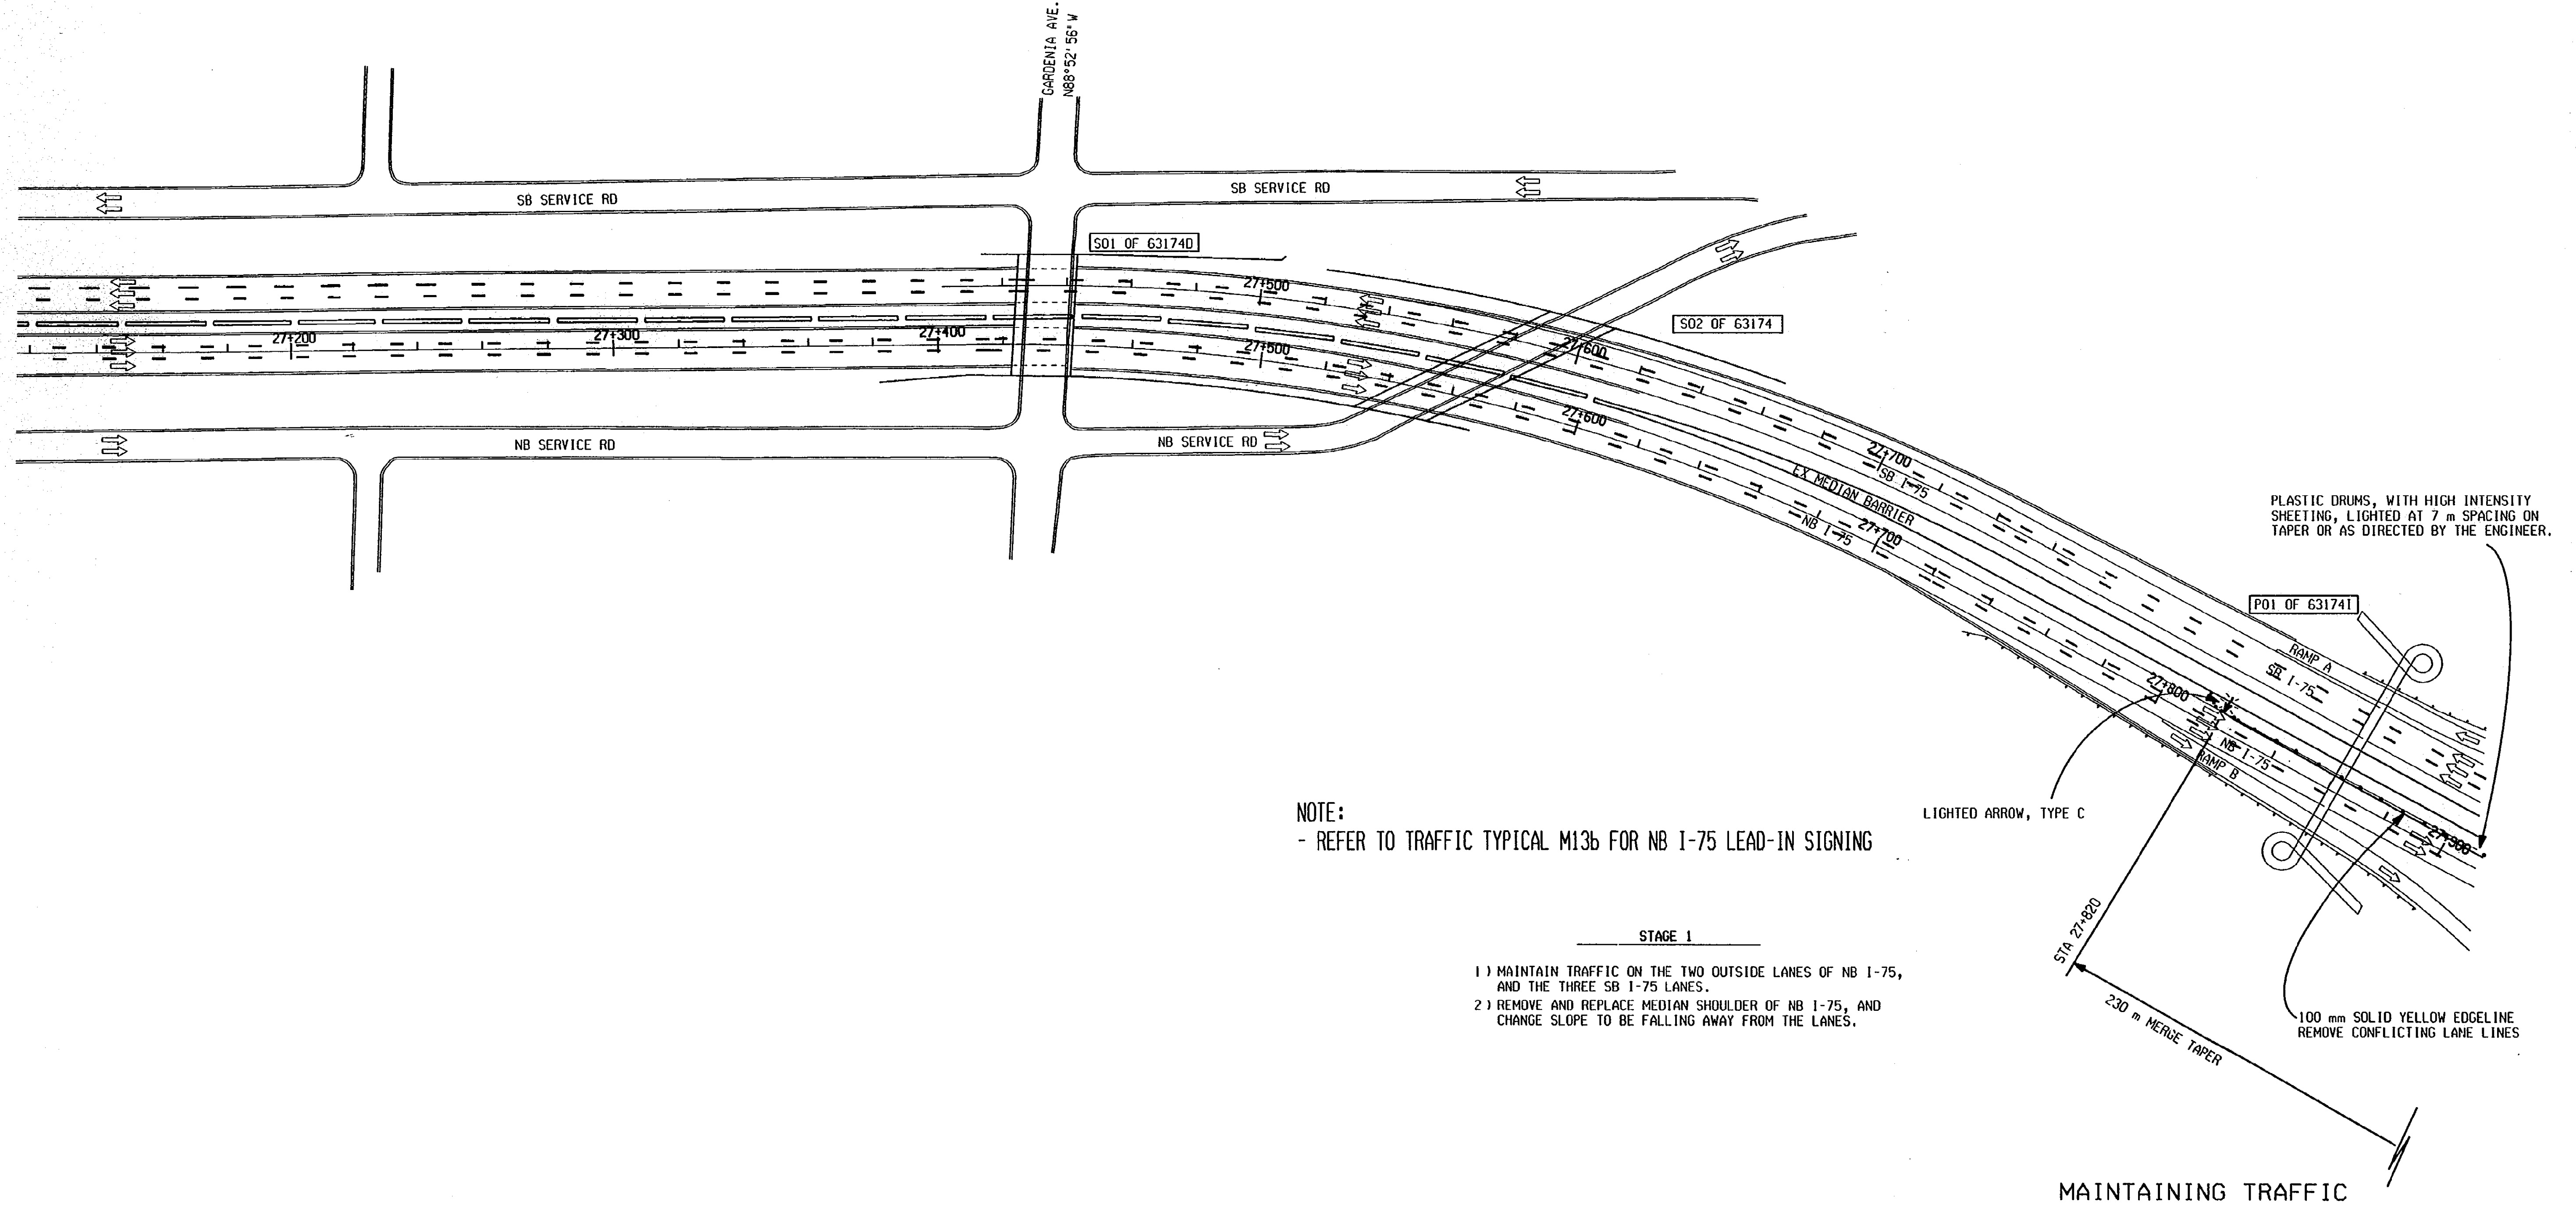

NOTE:
 - REFER TO TRAFFIC TYPICAL M136 FOR NB I-75 LEAD-IN SIGNING

- STAGE 1
- 1) MAINTAIN TRAFFIC ON THE TWO OUTSIDE LANES OF NB I-75, AND THE THREE SB I-75 LANES.
 - 2) REMOVE AND REPLACE MEDIAN SHOULDER OF NB I-75, AND CHANGE SLOPE TO BE FALLING AWAY FROM THE LANES.

LIGHTED ARROW, TYPE C

STA 27+820
 230 m MERGE TAPER

PLASTIC DRUMS, WITH HIGH INTENSITY SHEETING, LIGHTED AT 7 m SPACING ON TAPER OR AS DIRECTED BY THE ENGINEER.

100 mm SOLID YELLOW EDGELINE REMOVE CONFLICTING LANE LINES

MAINTAINING TRAFFIC


GARDENIA AVE

	STA 27+120 TO STA 27+900 NB I-75					
	DATE	SCALE	CONT. SEC.	JOB NO.	DESIGN UNIT	SHEET NO.
	01/05/01	1:1000	63174	49595	DTSC TRAFFIC	46

DATE: 11-04-00
 DATE:
 DATE:
 EXISTING BY: PICK'S TEAM
 PROPOSED BY:
 LAST CORRECTION BY:

FILE NAME: 49595main13.dgn
 1 2 3 4 5 6 7 8 9 10 11 12 13 14 15 16 17 18 19 20 21 22 23 24 25 26 27 28 29 30 31 32 33 34 35 36 37 38 39 40 41 42 43 44 45 46 47 48 49 50 51 52 53 54 55 56 57 58 59 60 61 62 63

FINAL R.O.V.			
AUTH	DATE	NO.	REVISION

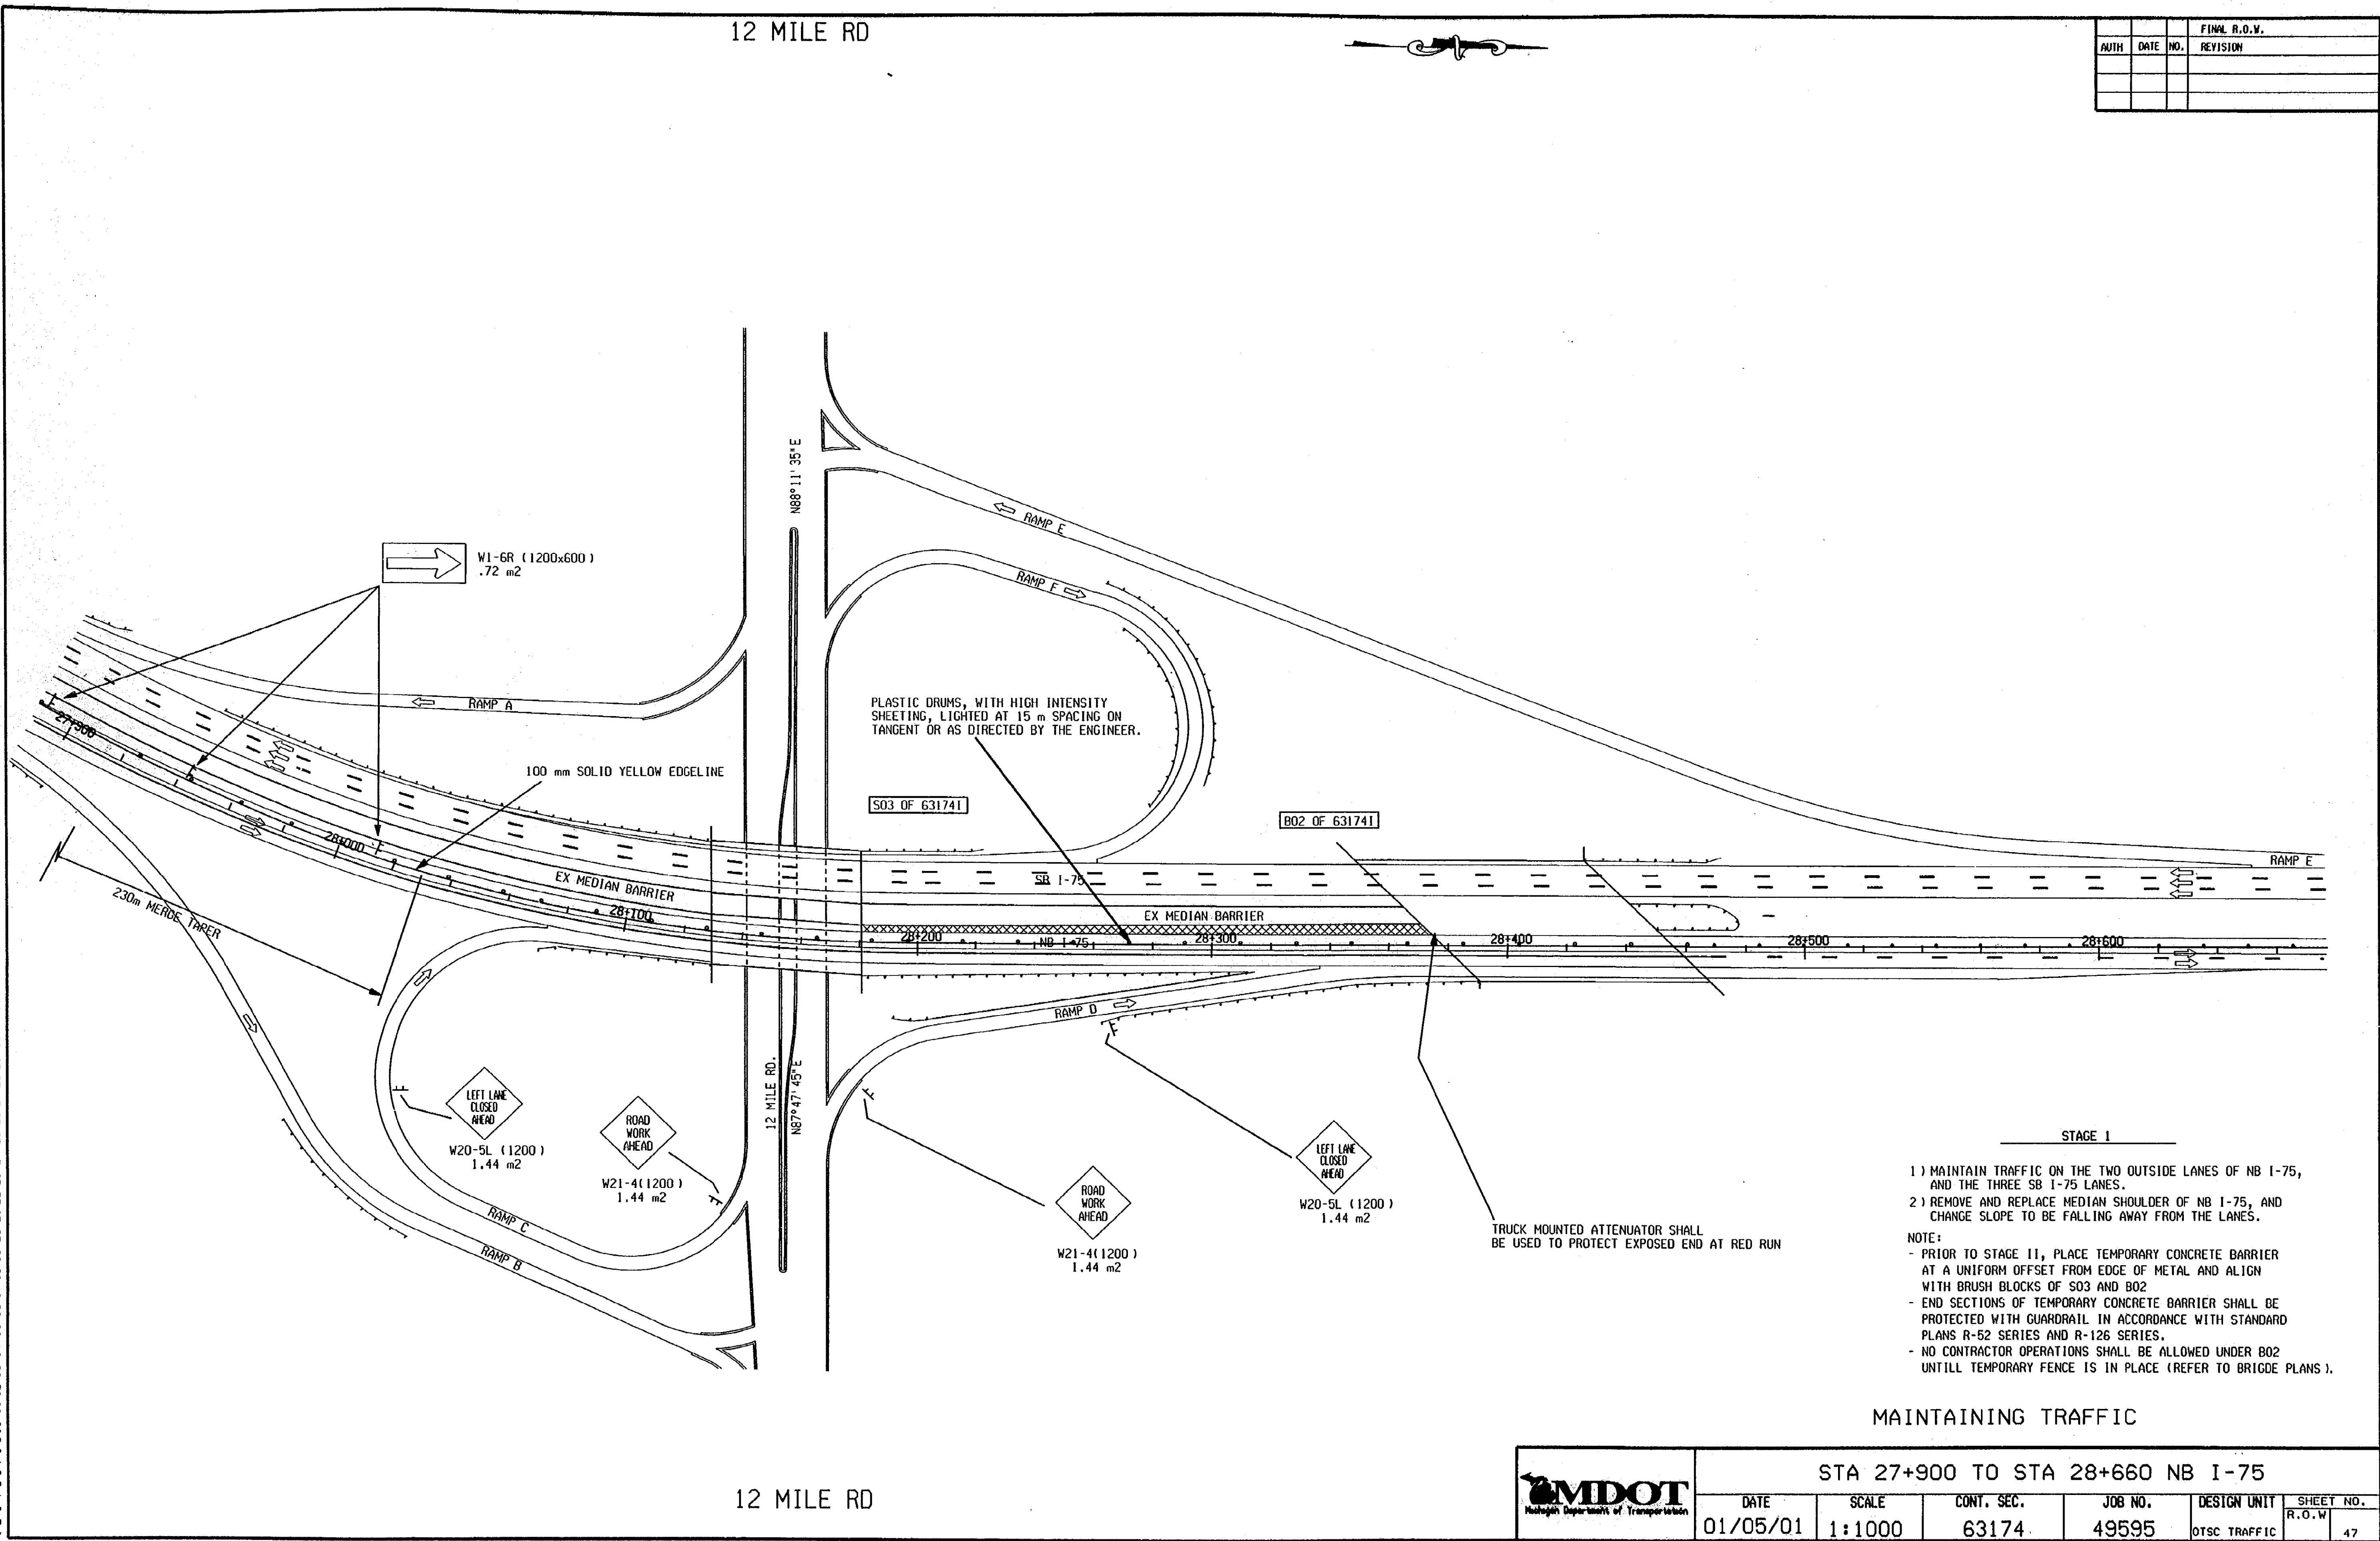

STAGE 1

- 1) MAINTAIN TRAFFIC ON THE TWO OUTSIDE LANES OF NB I-75, AND THE THREE SB I-75 LANES.
- 2) REMOVE AND REPLACE MEDIAN SHOULDER OF NB I-75, AND CHANGE SLOPE TO BE FALLING AWAY FROM THE LANES.

NOTE:

- PRIOR TO STAGE II, PLACE TEMPORARY CONCRETE BARRIER AT A UNIFORM OFFSET FROM EDGE OF METAL AND ALIGN WITH BRUSH BLOCKS OF S03 AND B02
- END SECTIONS OF TEMPORARY CONCRETE BARRIER SHALL BE PROTECTED WITH GUARDRAIL IN ACCORDANCE WITH STANDARD PLANS R-52 SERIES AND R-126 SERIES.
- NO CONTRACTOR OPERATIONS SHALL BE ALLOWED UNDER B02 UNTILL TEMPORARY FENCE IS IN PLACE (REFER TO BRIDGE PLANS).

MAINTAINING TRAFFIC

	STA 27+900 TO STA 28+660 NB I-75					
	DATE	SCALE	CONT. SEC.	JOB NO.	DESIGN UNIT	SHEET NO.
	01/05/01	1:1000	63174	49595	OTSC TRAFFIC	R.O.W 47


12 MILE RD

EXISTING BY: B&B/C&S TEAM
 PROPOSED BY:
 LAST CORRECTION BY:

DATE: 10/08/00
 DATE:
 DATE:

FILE NAME: 49595sheet14.dwg
 1 2 3 4 5 6 7 8 9 10 11 12 13 14 15 16 17 18 19 20 21 22 23 24 25 26 27 28 29 30 31 32 33 34 35 36 37 38 39 40 41 42 43 44 45 46 47 48 49 50 51 52 53 54 55 56 57 58 59 60 61 62 63

FINAL R.O.W.		
AUTH	DATE	NO. REVISION

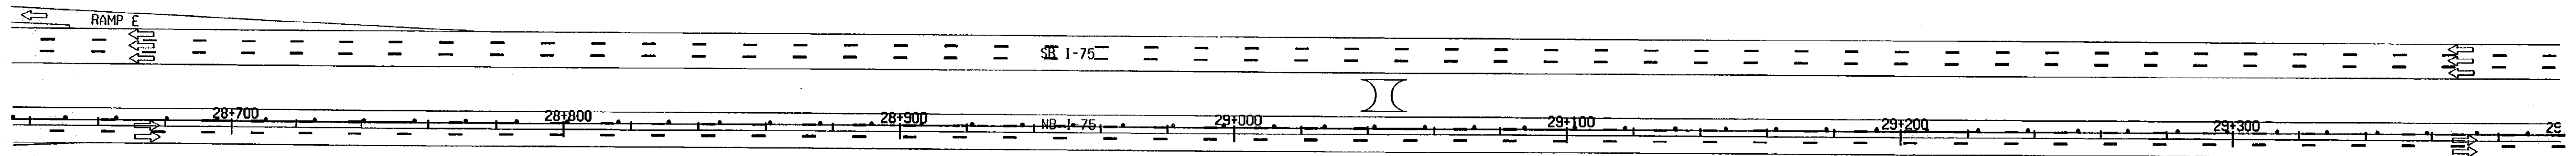

- STAGE 1
- 1) MAINTAIN TRAFFIC ON THE TWO OUTSIDE LANES OF NB I-75, AND THE THREE SB I-75 LANES.
 - 2) REMOVE AND REPLACE MEDIAN SHOULDER OF NB I-75, AND CHANGE SLOPE TO BE FALLING AWAY FROM THE LANES.

MAINTAINING TRAFFIC

	STA 28+660 TO STA 29+380 NB I-75					
	DATE	SCALE	CONT. SEC.	JOB NO.	DESIGN UNIT	SHEET NO.
	01/06/01	1:1000	63174	49595	OTSC TRAFFIC	R.O.W. 48


CONTROL SECTION 63174 JOB NO. 49595 SHEET 49

DATE: 10/04/00
 EXISTING BY: B60445-TEAM
 PROPOSED BY:
 LAST CORRECTION BY:

FILE NAME: 49595main15.dwg
 1 2 3 4 5 6 7 8 9 10 11 12 13 14 15 16 17 18 19 20 21 22 23 24 25 26 27 28 29 30 31 32 33 34 35 36 37 38 39 40 41 42 43 44 45 46 47 48 49 50 51 52 53 54 55 56 57 58 59 60 61 62 63

FINAL R.O.W.			
AUTH	DATE	NO.	REVISION

13 MILE RD

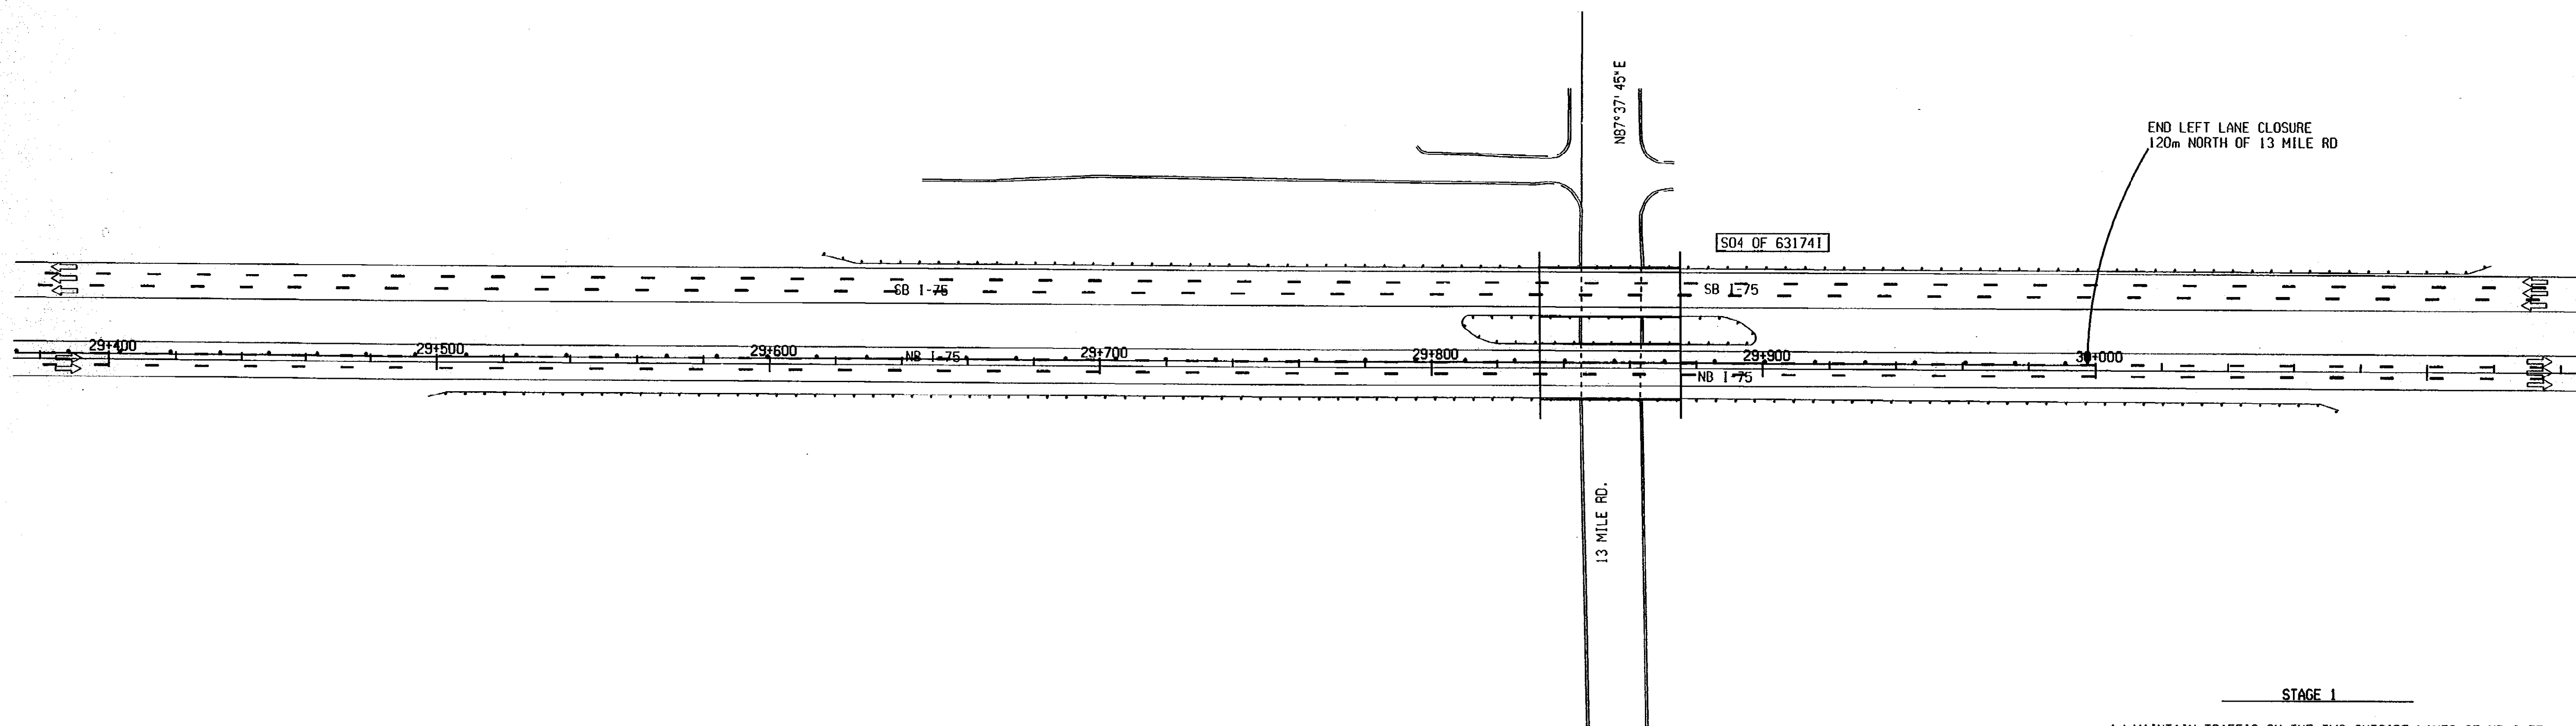

- STAGE 1
- 1) MAINTAIN TRAFFIC ON THE TWO OUTSIDE LANES OF NB I-75, AND THE THREE SB I-75 LANES.
 - 2) REMOVE AND REPLACE MEDIAN SHOULDER OF NB I-75, AND CHANGE SLOPE TO BE FALLING AWAY FROM THE LANES.

MAINTAINING TRAFFIC

13 MILE RD

	STA 29+380 TO STA 30+140 NB I-75					
	DATE	SCALE	CONT. SEC.	JOB NO.	DESIGN UNIT	SHEET NO.
	01/06/01	1:1000	63174	49595	OTSC TRAFFIC	49

EXISTING BY: DATE:
 PROPOSED BY: DATE:
 LAST CORRECTION BY: DATE:


39-40

FILE NAME: 49595maint6.dgn

FINAL R.O.W.			
AUTH	DATE	NO.	REVISION



N88°16'15"E

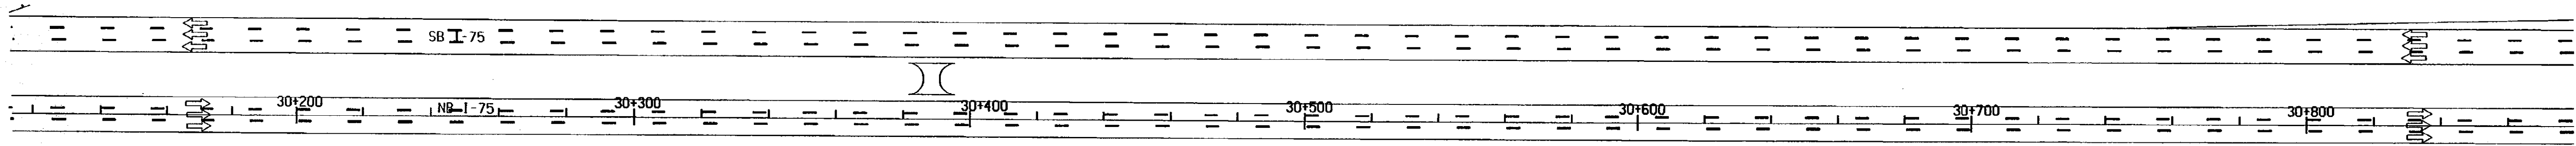

STAGE 1

- 1) MAINTAIN TRAFFIC ON THE TWO OUTSIDE LANES OF NB I-75, AND THE THREE SB I-75 LANES.
- 2) REMOVE AND REPLACE MEDIAN SHOULDER OF NB I-75, AND CHANGE SLOPE TO BE FALLING AWAY FROM THE LANES.


MAINTAINING TRAFFIC

	STA 30+140 TO STA 30+860 NB I-75					
	DATE	SCALE	CONT. SEC.	JOB NO.	DESIGN UNIT	SHEET NO.
	01/06/01	1:1000	63174	49595	OTSC TRAFFIC	R.O.W 50

CONTROL SECTION 63174 JOB NO. 49595 SHEET NO. 51

ELEVEN MILE

FINAL R.O.W.		
AUTH	DATE	REVISION

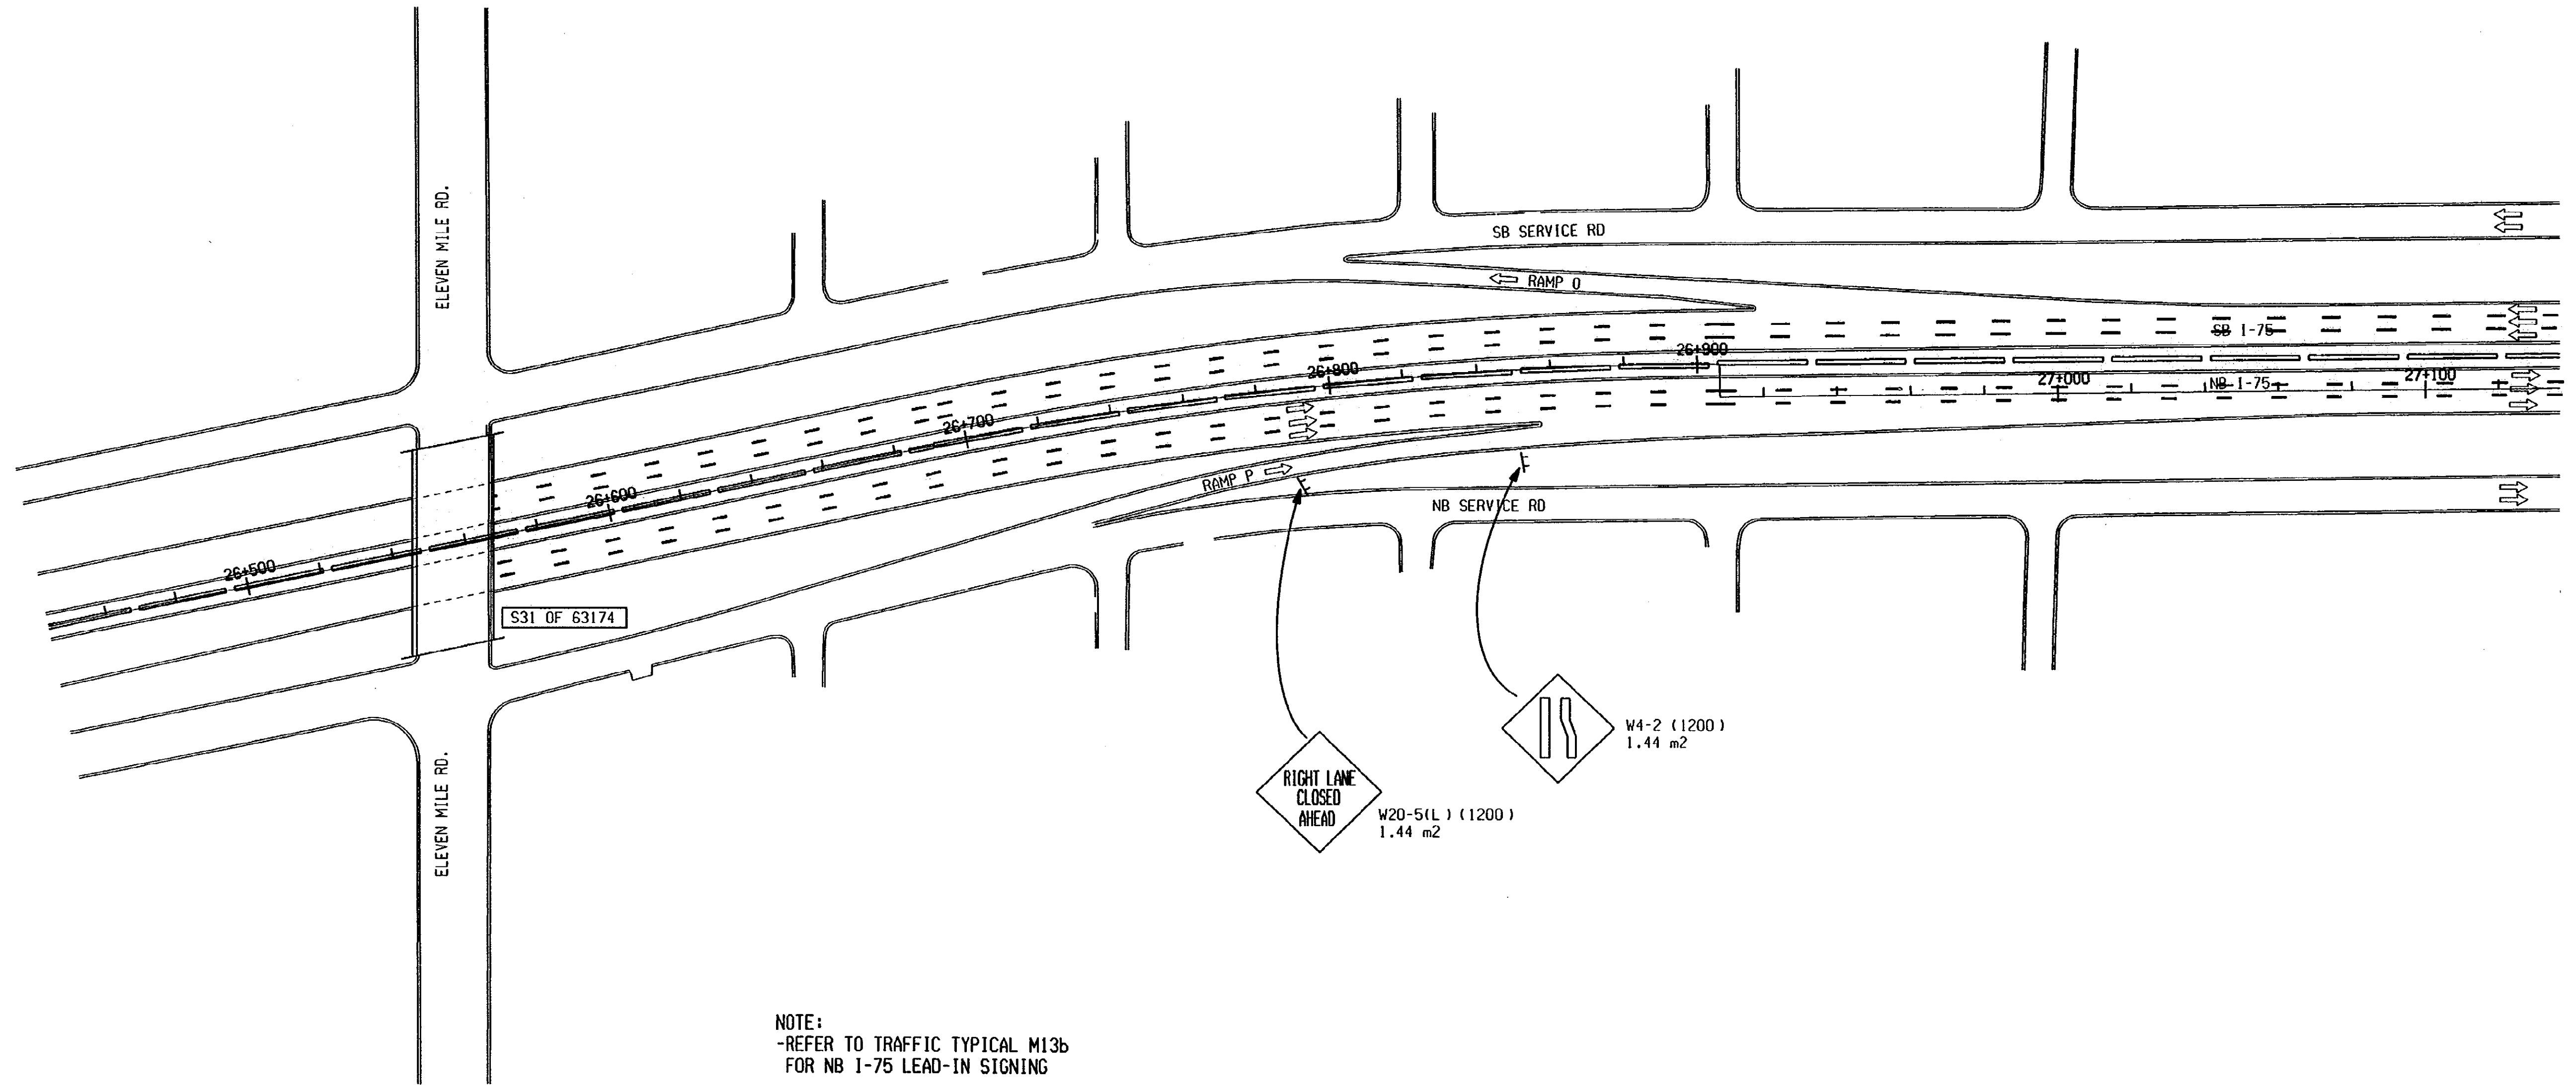

NOTE:
-REFER TO TRAFFIC TYPICAL M13b
FOR NB 1-75 LEAD-IN SIGNING

- STAGE 2
- 1) MAINTAIN TRAFFIC ON THE INSIDE SHOULDER OF NB 1-75, AND THE THREE SB 1-75 LANES.
 - 2) CONSTRUCT OUTSIDE HALF OF NB 1-75.

MAINTAINING TRAFFIC

STA 26+500 TO STA 27+120 NB I-75



DATE	SCALE	CONT. SEC.	JOB NO.	DESIGN UNIT	SHEET NO.
01/05/01	1:1000	63174	49595	OTSC TRAFFIC	R.O.W. 51

11 MILE RD

FILE NAME: 49595maint1.dgn


42 43

42 43

FILE NAME: 49595cover2.dgn

GARDENIA AVE

FINAL R.O.W.			
AUTH	DATE	NO.	REVISION

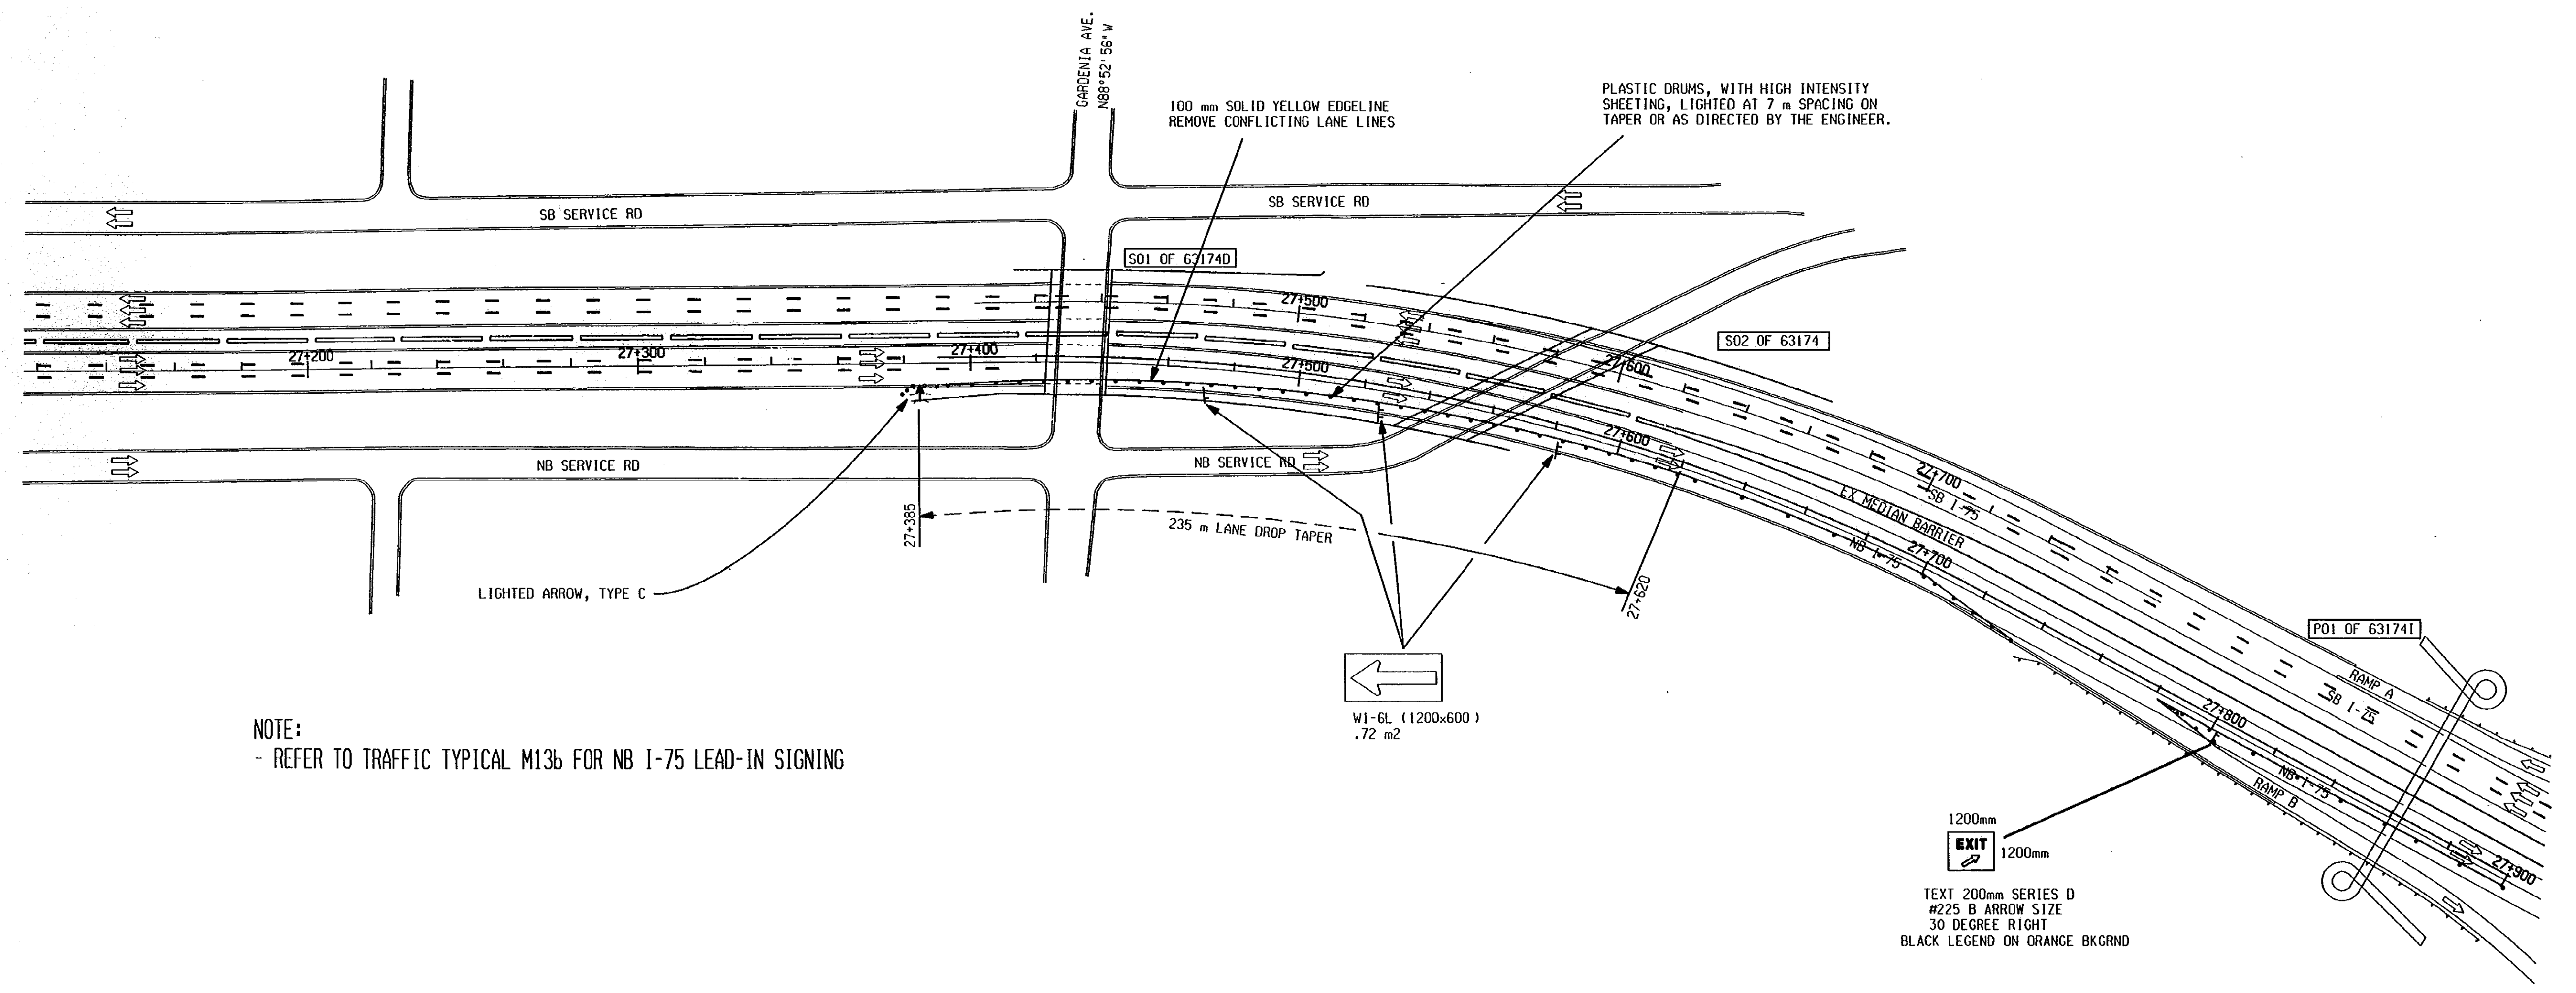

NOTE:
- REFER TO TRAFFIC TYPICAL M13b FOR NB I-75 LEAD-IN SIGNING

STAGE 2

- 1) MAINTAIN TRAFFIC ON THE INSIDE SHOULDER OF NB I-75, AND THE THREE SB I-75 LANES.
- 2) CONSTRUCT OUTSIDE HALF OF NB I-75.


MAINTAINING TRAFFIC

GARDENIA AVE

	STA 27+120 TO STA 27+900 NB I-75					
	DATE	SCALE	CONT. SEC.	JOB NO.	DESIGN UNIT	SHEET NO.
	01/05/01	1:1000	63174	49595	OTSC TRAFFIC	R.O.W. 52

DATE: 11-04-00
 EXISTING BY: RICK'S TEAM
 PROPOSED BY:
 LAST CORRECTION BY:
 FILE NAME: 49595maint3.dgn
 1 2 3 4 5 6 7 8 9 10 11 12 13 14 15 16 17 18 19 20 21 22 23 24 25 26 27 28 29 30 31 32 33 34 35 36 37 38 39 40 41 42 43 44 45 46 47 48 49 50 51 52 53 54 55 56 57 58 59 60 61 62 63

FINAL R.O.W.			
AUTH	DATE	NO.	REVISION

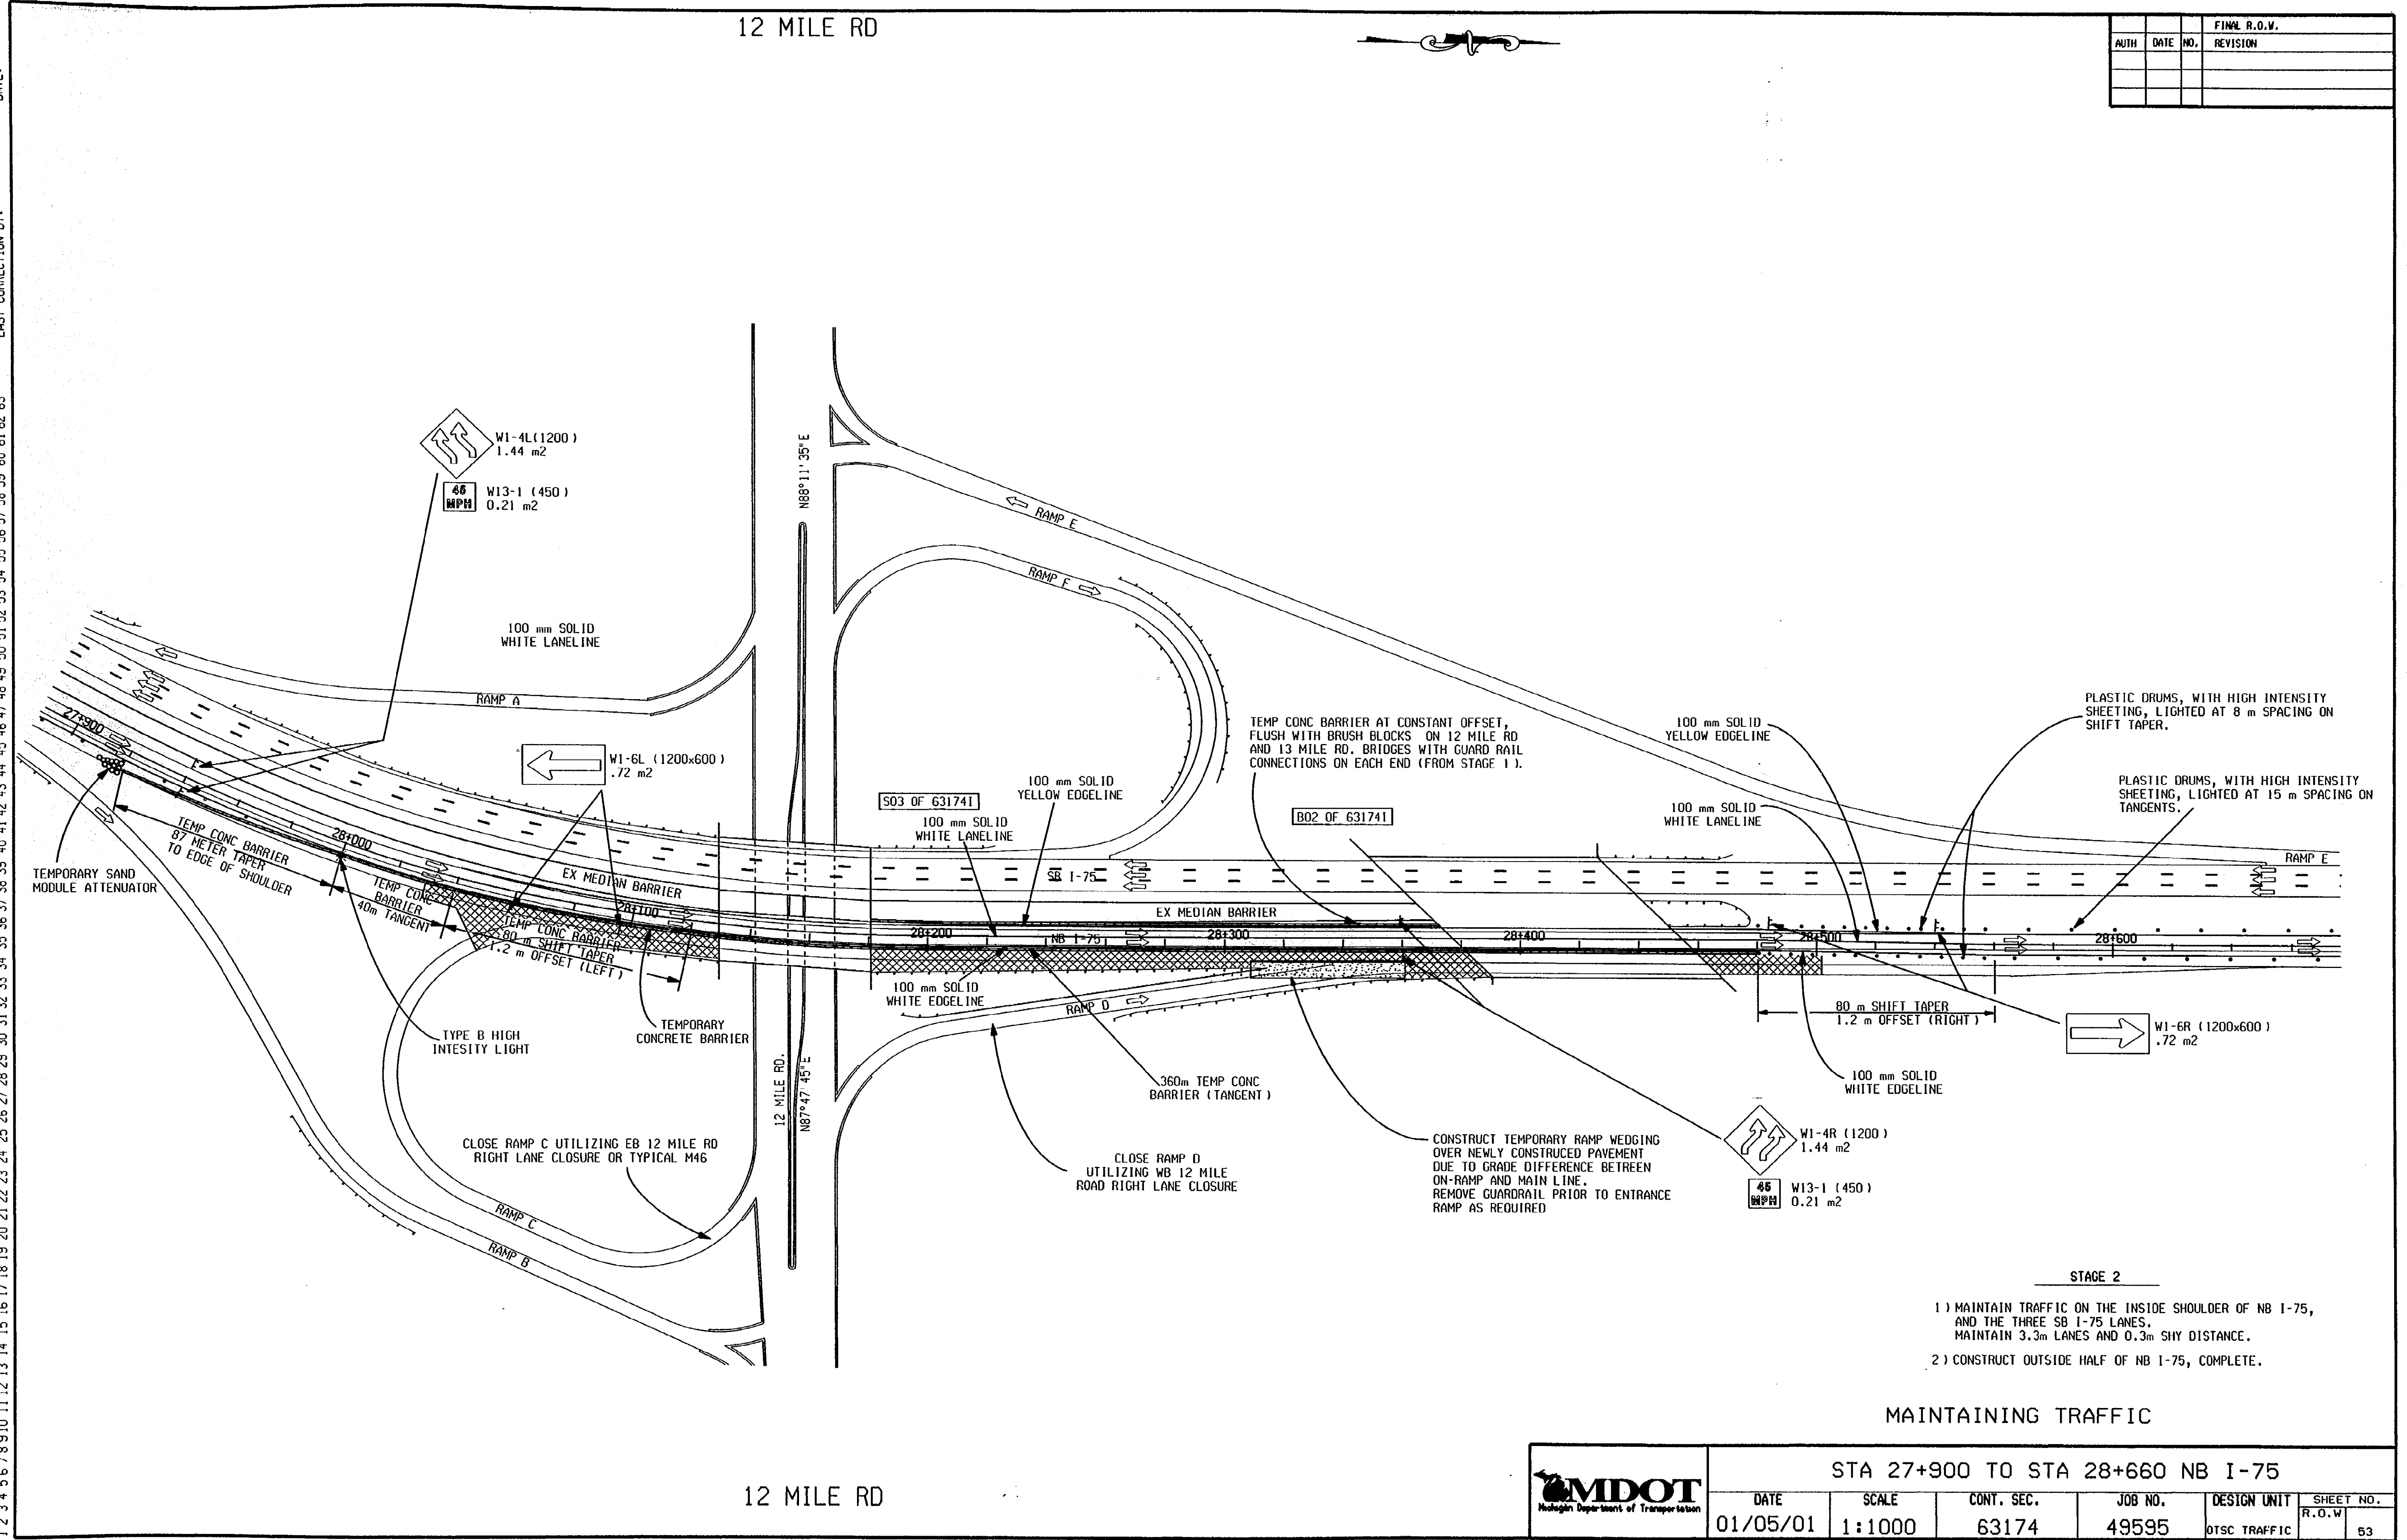

- STAGE 2
- 1) MAINTAIN TRAFFIC ON THE INSIDE SHOULDER OF NB I-75, AND THE THREE SB I-75 LANES. MAINTAIN 3.3m LANES AND 0.3m SHY DISTANCE.
 - 2) CONSTRUCT OUTSIDE HALF OF NB I-75, COMPLETE.

MAINTAINING TRAFFIC


	STA 27+900 TO STA 28+660 NB I-75					
	DATE	SCALE	CONT. SEC.	JOB NO.	DESIGN UNIT	SHEET NO.
	01/05/01	1:1000	63174	49595	OTSC TRAFFIC	R.O.W. 53

CONTROL SECTION 63174 JOB NO. 49595 SHEET NO. 54

DATE: 01/06/01
 DRAWN BY: BAC/MS-TEAM
 PROPOSED BY:
 LAST CORRECTION BY:

FILE NAME: 45595sheet4.dwg
 1 2 3 4 5 6 7 8 9 10 11 12 13 14 15 16 17 18 19 20 21 22 23 24 25 26 27 28 29 30 31 32 33 34 35 36 37 38 39 40 41 42 43 44 45 46 47 48 49 50 51 52 53 54 55 56 57 58 59 60 61 62 63

AUTH			DATE			NO.			REVISION			FINAL R.O.W.					

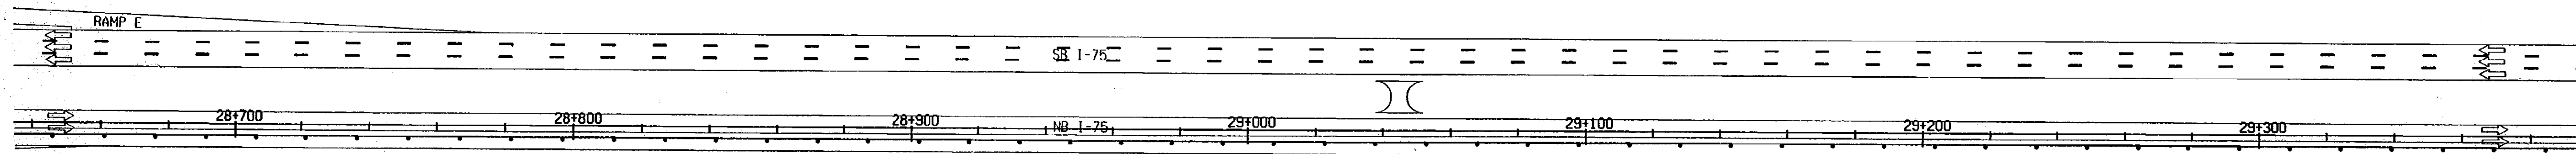

STAGE 2

- 1) MAINTAIN TRAFFIC ON THE INSIDE SHOULDER OF NB I-75, AND THE THREE SB I-75 LANES.
- 2) CONSTRUCT OUTSIDE HALF OF NB I-75.

MAINTAINING TRAFFIC


	STA 28+660 TO STA 29+380 NB I-75					
	DATE	SCALE	CONT. SEC.	JOB NO.	DESIGN UNIT	SHEET NO.
	01/06/01	1:1000	63174	49595	OTSC TRAFFIC	R.O.W 54

EXISTING BY: B66265-TEAM
 PROPOSED BY:
 LAST CORRECTION BY:

DATE: 01/06/01
 DATE:
 DATE:
 FILE NAME: 49595main15.dgn
 1 2 3 4 5 6 7 8 9 10 11 12 13 14 15 16 17 18 19 20 21 22 23 24 25 26 27 28 29 30 31 32 33 34 35 36 37 38 39 40 41 42 43 44 45 46 47 48 49 50 51 52 53 54 55 56 57 58 59 60 61 62 63

FINAL R.O.W.			
AUTH	DATE	NO.	REVISION

13 MILE RD

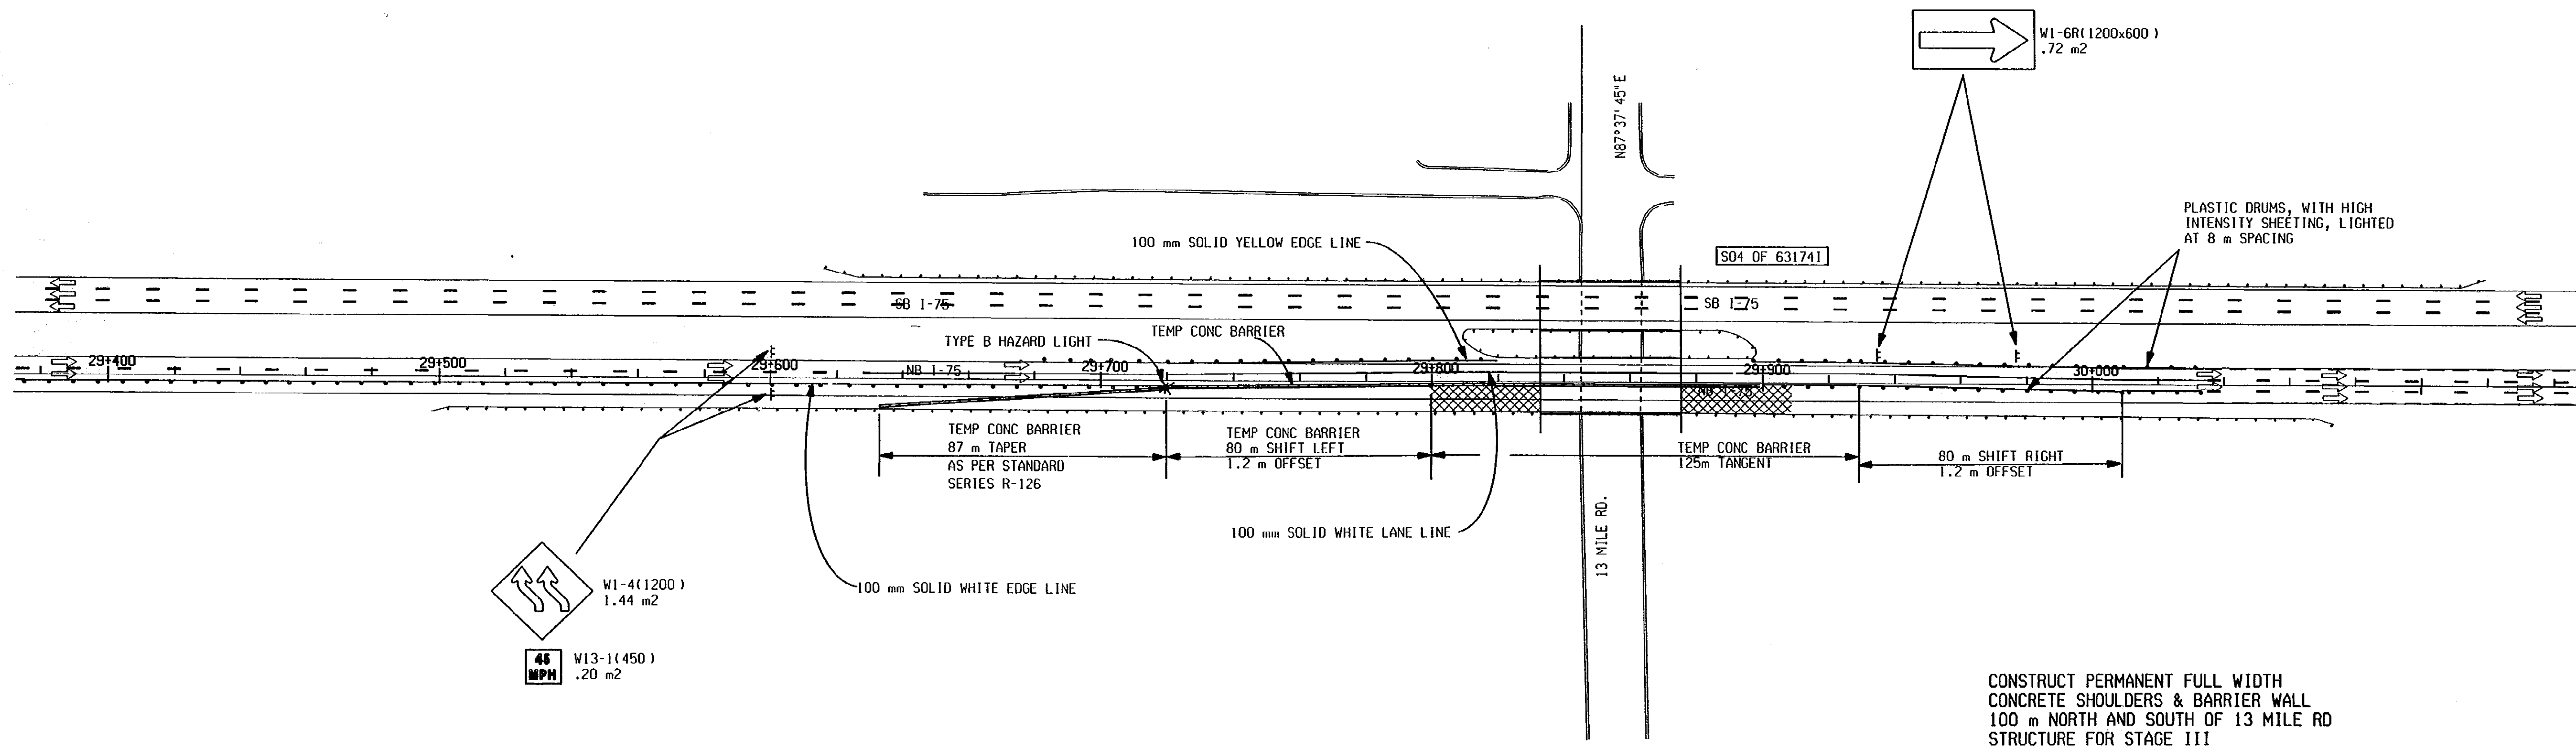

CONSTRUCT PERMANENT FULL WIDTH CONCRETE SHOULDERS & BARRIER WALL 100 m NORTH AND SOUTH OF 13 MILE RD STRUCTURE FOR STAGE III

- STAGE 2
- 1) MAINTAIN TRAFFIC ON THE INSIDE SHOULDER OF NB I-75, AND THE THREE SB I-75 LANES.
 - MAINTAIN 3.3m LANES AND 0.3 m SHY DISTANCE
 - 2) CONSTRUCT OUTSIDE HALF OF NB I-75.


MAINTAINING TRAFFIC

13 MILE RD	MDOT Michigan Department of Transportation		STA 29+380 TO STA 30+140 NB I-75			
	DATE	SCALE	CONT. SEC.	JOB NO.	DESIGN UNIT	SHEET NO.
	01/06/01	1:1000	63174	49595	OTSC TRAFFIC	R.O.W. 55

AUTH			DATE			NO.			FINN. R.O.W.		
AUTH			DATE			NO.			REVISION		



N88°16'15"E

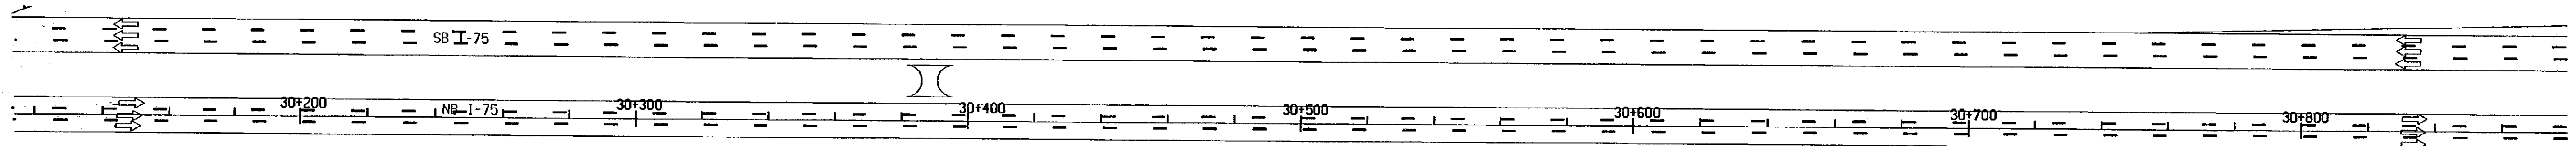

42 43

FILE NAME: 49595maint6.dgn

STAGE 2

- 1) MAINTAIN TRAFFIC ON THE INSIDE SHOULDER OF NB I-75, AND THE THREE SB I-75 LANES.
- 2) CONSTRUCT OUTSIDE HALF OF NB I-75.

MAINTAINING TRAFFIC

	STA 30+140 TO STA 30+860 NB I-75					
	DATE	SCALE	CONT. SEC.	JOB NO.	DESIGN UNIT	SHEET NO.
	01/06/01	1:1000	63174	49595	DTSC TRAFFIC	R.O.W. 56


CONTROL SECTION 63174 JOB NO. 49595 SR. NO. 57

44 45

FILE NAME: 49595maint1.dgn

ELEVEN MILE

FINAL R.O.V.			
AUTH	DATE	NO.	REVISION

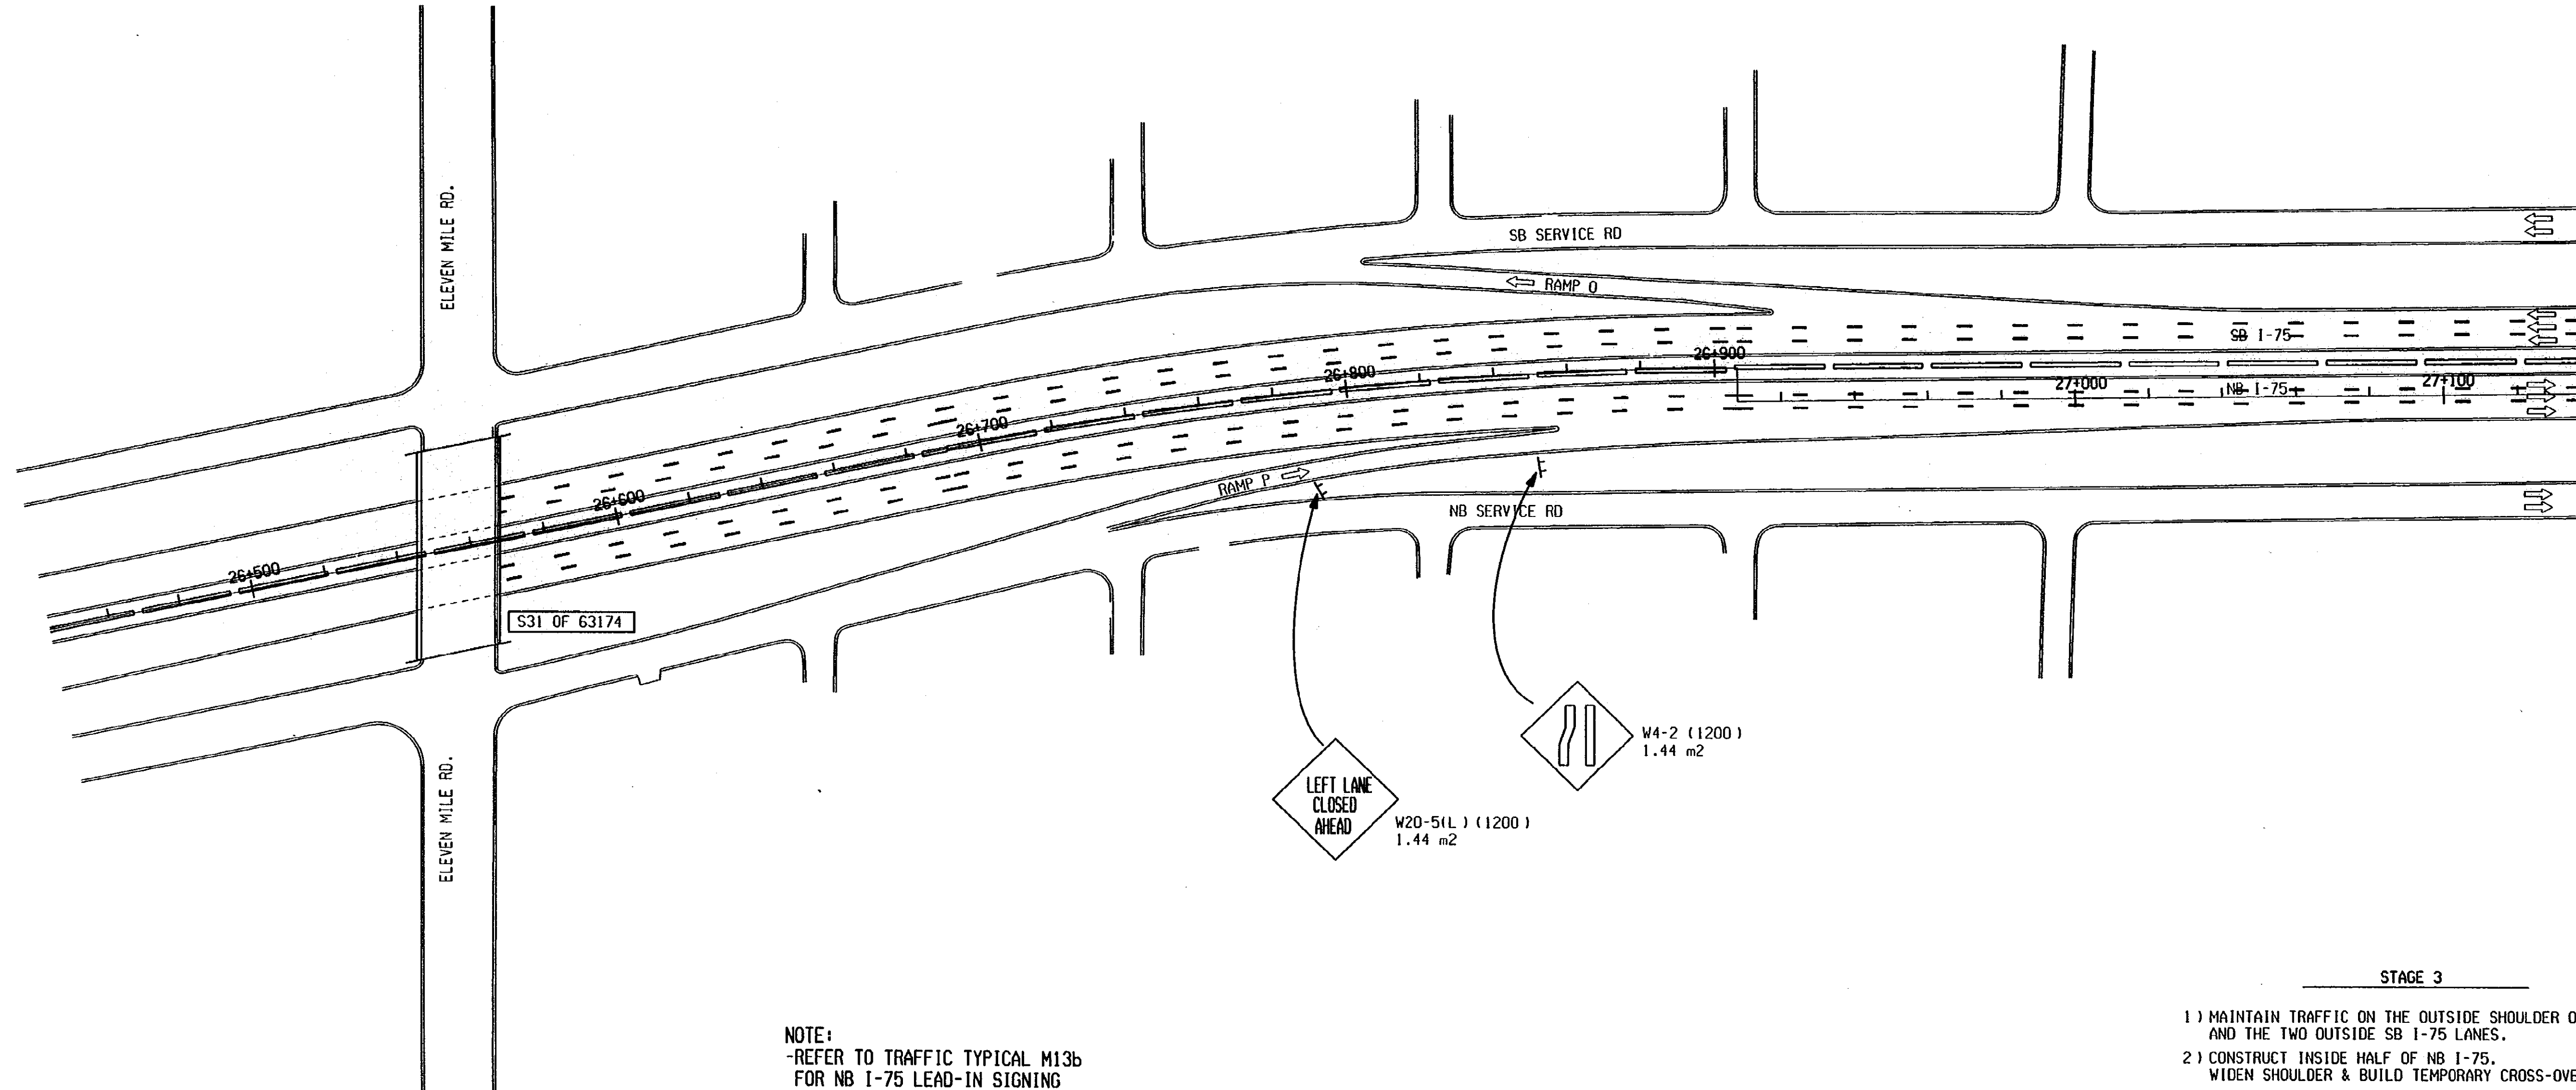

NOTE:
-REFER TO TRAFFIC TYPICAL M13b
FOR NB I-75 LEAD-IN SIGNING

- STAGE 3
- 1) MAINTAIN TRAFFIC ON THE OUTSIDE SHOULDER OF NB I-75, AND THE TWO OUTSIDE SB I-75 LANES.
 - 2) CONSTRUCT INSIDE HALF OF NB I-75. WIDEN SHOULDER & BUILD TEMPORARY CROSS-OVERS.

11 MILE RD


MAINTAINING TRAFFIC

	STA 26+500 TO STA 27+120 NB I-75					
	DATE	SCALE	CONT. SEC.	JOB NO.	DESIGN UNIT	SHEET NO.
	01/05/01	1:1000	63174	49595	OTSC TRAFFIC	R.O.V. 57

CONTROL SECTION
63174 JOB NO. 49595 SHEET NO. 58

GARDENIA AVE

FINAL R.O.W.			
AUTH	DATE	NO.	REVISION

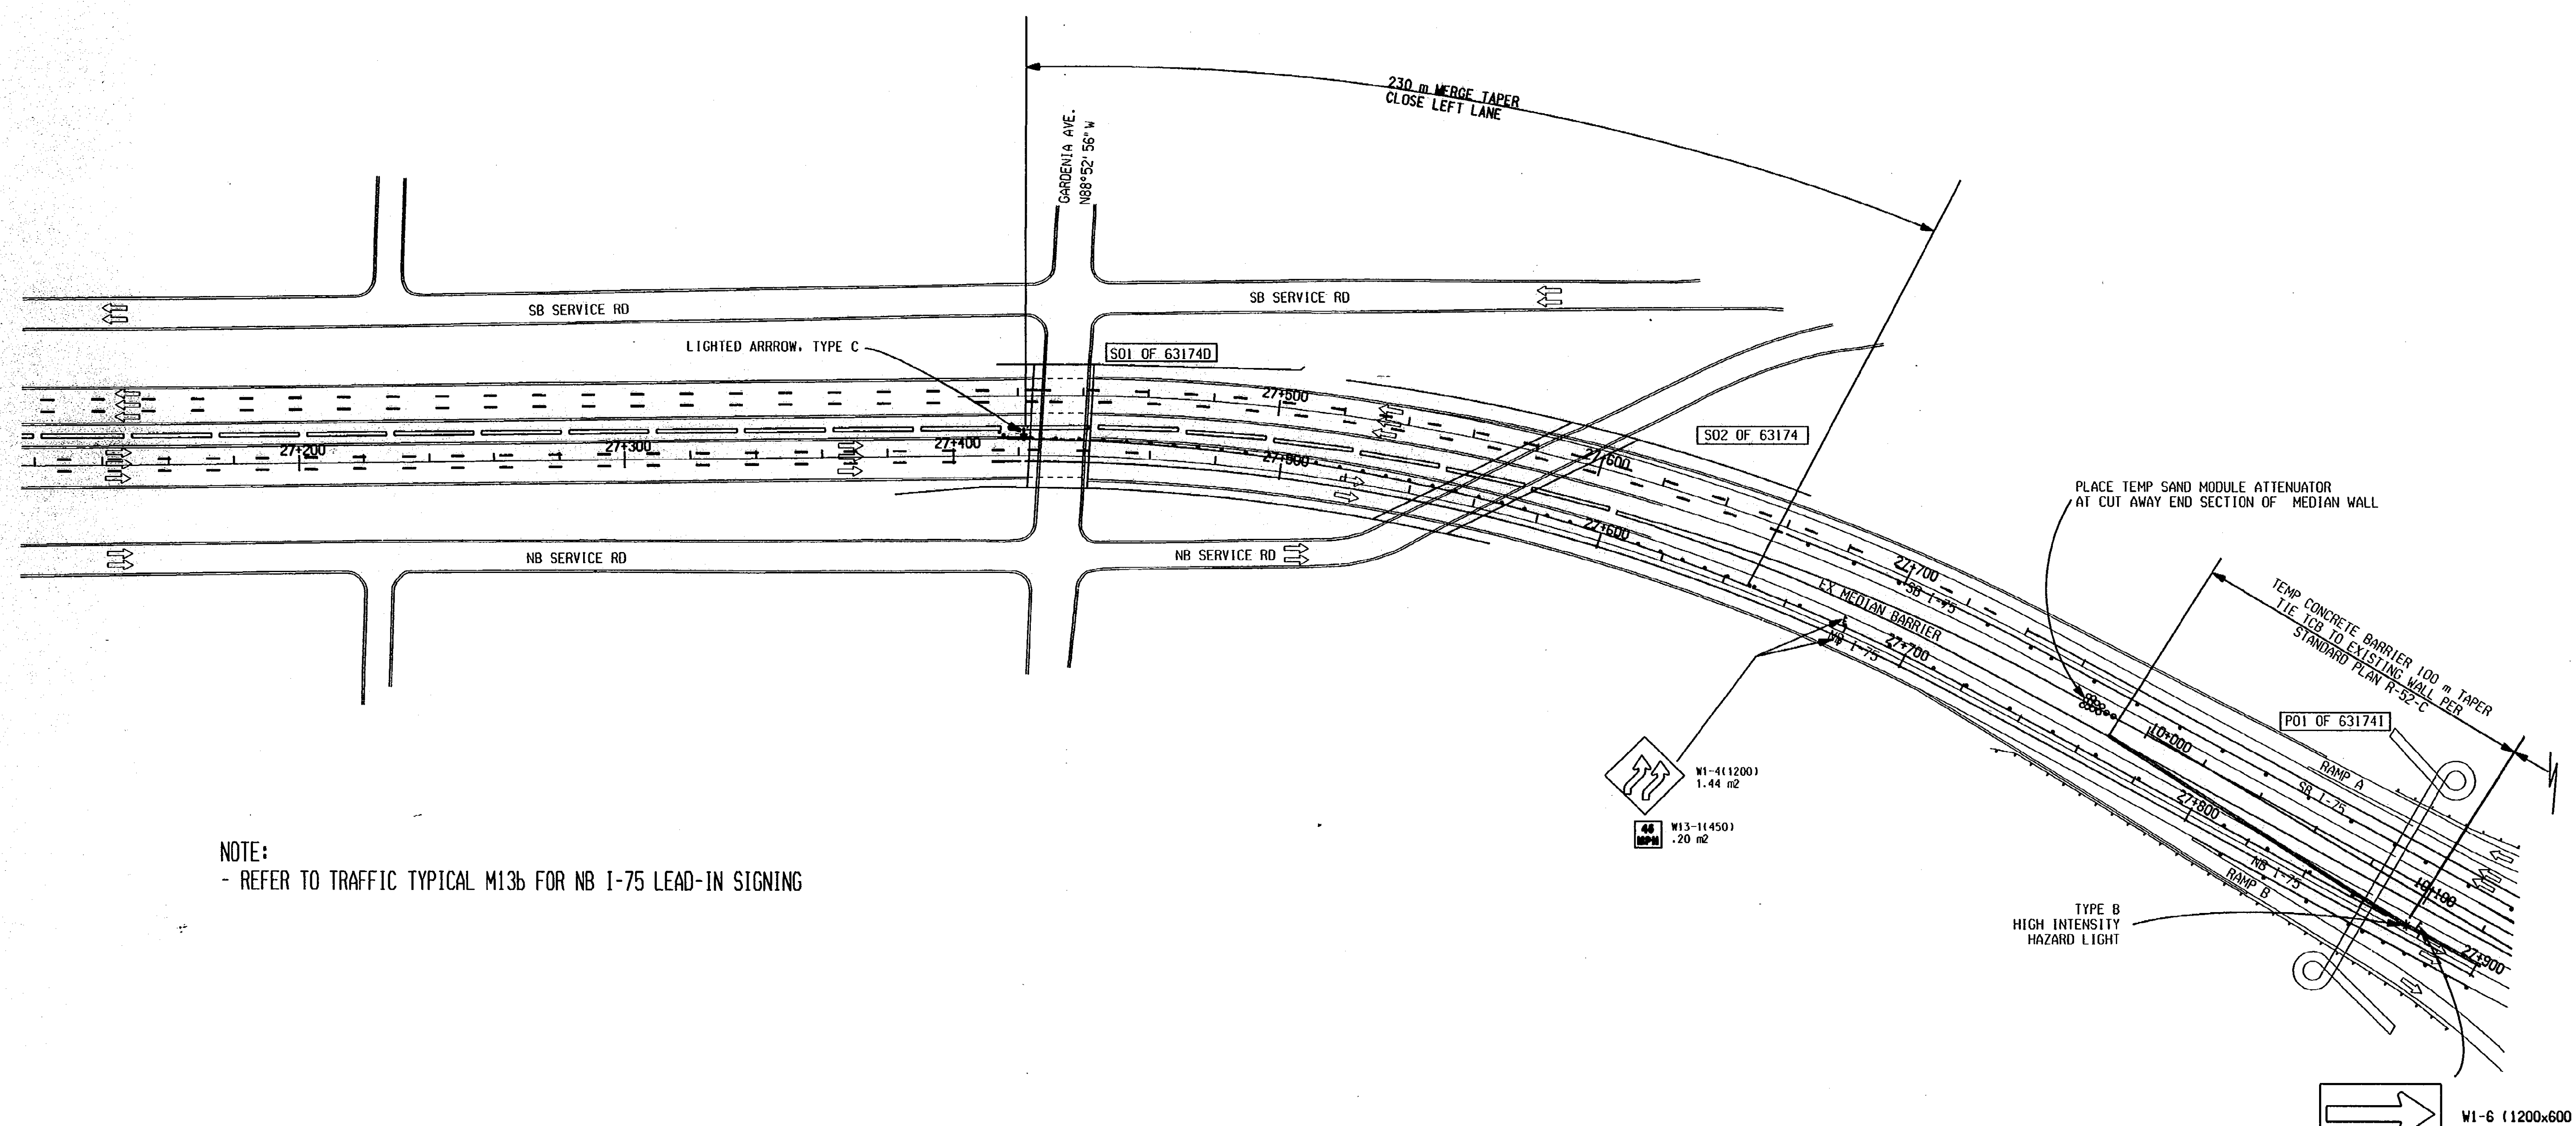

NOTE:
- REFER TO TRAFFIC TYPICAL M13b FOR NB I-75 LEAD-IN SIGNING

- STAGE 3
- 1) MAINTAIN TRAFFIC ON THE OUTSIDE SHOULDER OF NB I-75, AND THE TWO OUTSIDE SB I-75 LANES.
 - 2) CONSTRUCT INSIDE HALF OF NB I-75. WIDEN SHOULDER & BUILD TEMPORARY CROSS-OVERS.

MAINTAINING TRAFFIC

GARDENIA AVE


	STA 27+120 TO STA 27+900 NB I-75					
	DATE	SCALE	CONT. SEC.	JOB NO.	DESIGN UNIT	SHEET NO.
	01/05/01	1:1000	63174	49595	OTSC TRAFFIC	R.O.W. 58

FILE NAME: 49595cover2.dgn 44 45

EXISTING BY: RICK'S TEAM
 PROPOSED BY:
 LAST CORRECTION BY:

DATE: 11-04-00
 DATE:
 DATE:
 FILE NAME: 49595main3.dgn
 1 2 3 4 5 6 7 8 9 10 11 12 13 14 15 16 17 18 19 20 21 22 23 24 25 26 27 28 29 30 31 32 33 34 35 36 37 38 39 40 41 42 43 44 45 46 47 48 49 50 51 52 53 54 55 56 57 58 59 60 61 62 63

FINAL R.O.W.			
AUTH	DATE	NO.	REVISION

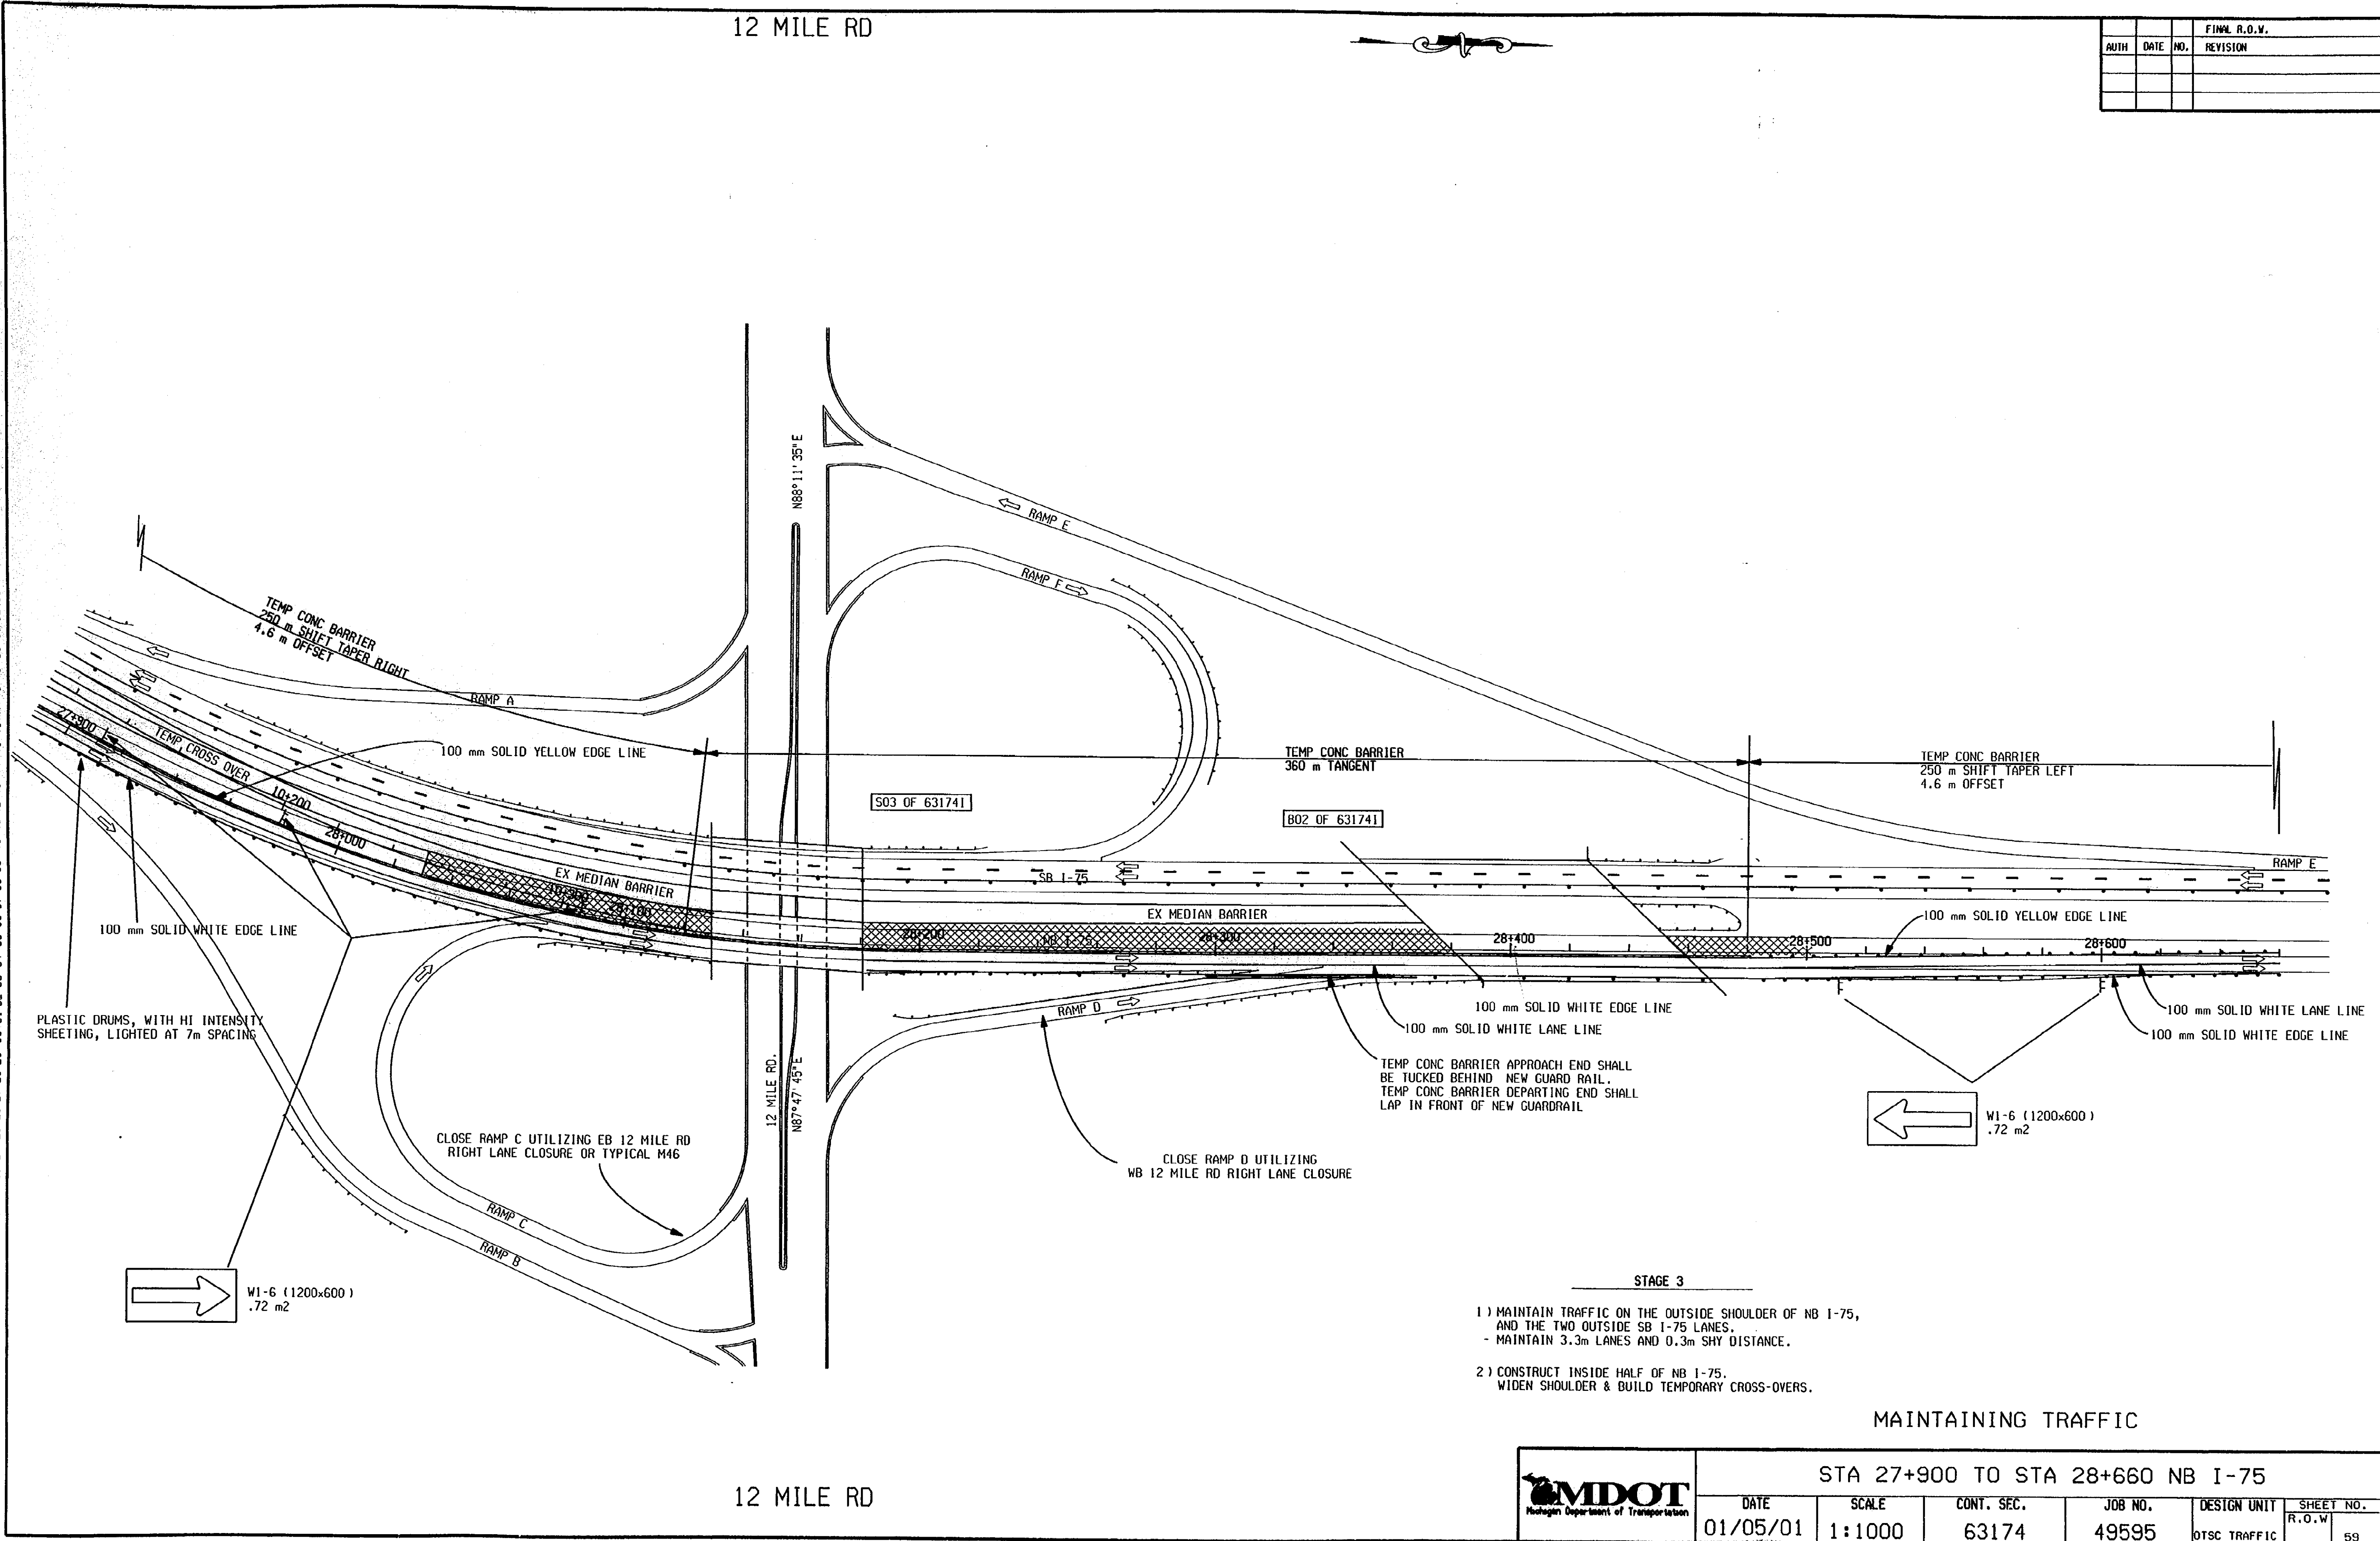

- STAGE 3
- 1) MAINTAIN TRAFFIC ON THE OUTSIDE SHOULDER OF NB I-75, AND THE TWO OUTSIDE SB I-75 LANES.
 - MAINTAIN 3.3m LANES AND 0.3m SHY DISTANCE.
 - 2) CONSTRUCT INSIDE HALF OF NB I-75.
 WIDEN SHOULDER & BUILD TEMPORARY CROSS-OVERS.


MAINTAINING TRAFFIC

	STA 27+900 TO STA 28+660 NB I-75					
	DATE	SCALE	CONT. SEC.	JOB NO.	DESIGN UNIT	SHEET NO.
01/05/01	1:1000	63174	49595	OTSC TRAFFIC	R.O.W	59

EXISTING BY: B&B/C&S TEAM
 PROPOSED BY:
 DATE:
 LAST CORRECTION BY:

FILE NAME: 45535maint4.dgn
 1 2 3 4 5 6 7 8 9 10 11 12 13 14 15 16 17 18 19 20 21 22 23 24 25 26 27 28 29 30 31 32 33 34 35 36 37 38 39 40 41 42 43 44 45 46 47 48 49 50 51 52 53 54 55 56 57 58 59 60 61 62 63

AUTH			DATE			NO.			FINL. R.O.W.		
AUTH			DATE			NO.			REVISION		

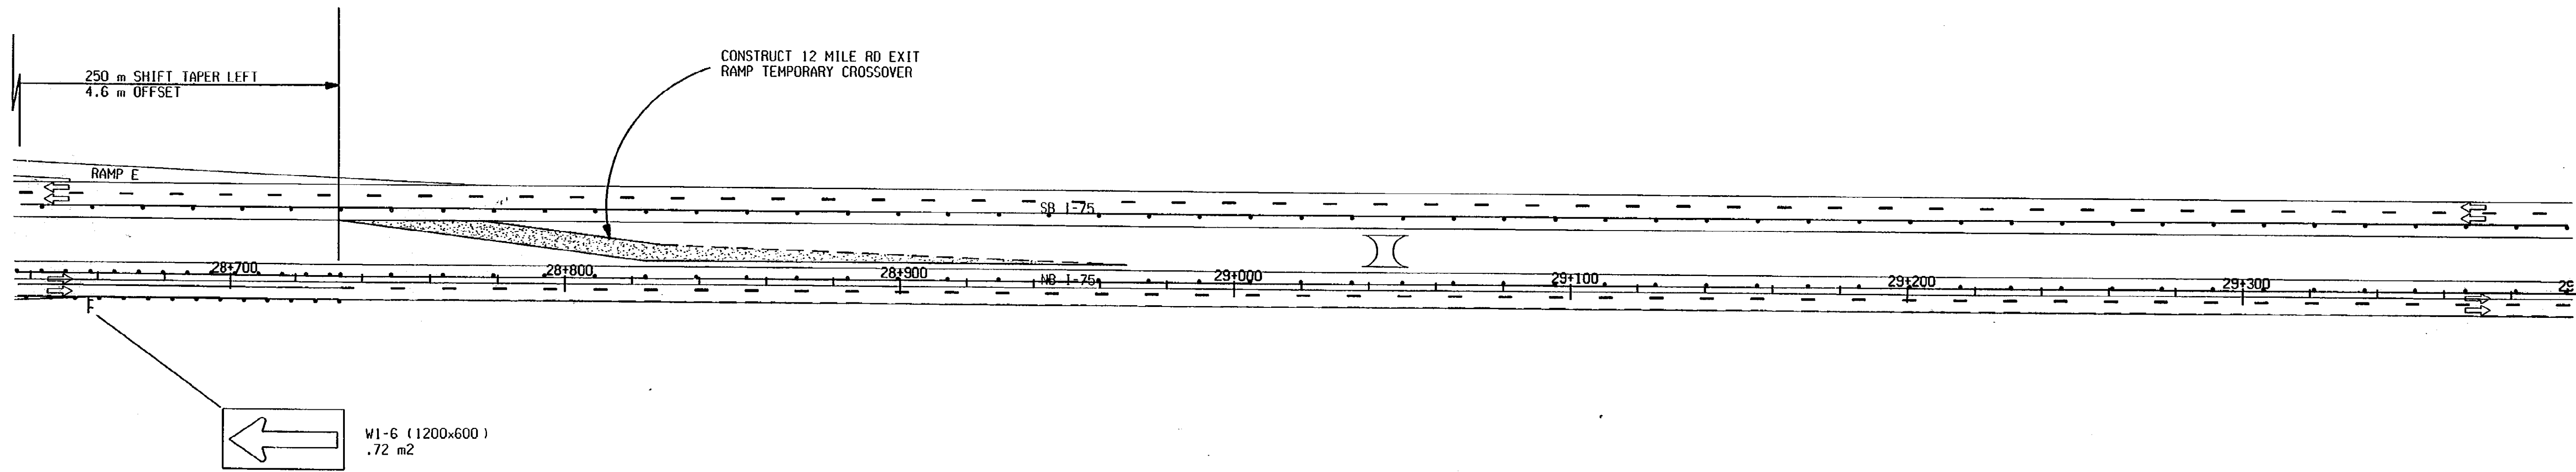

- STAGE 3
- 1) MAINTAIN TRAFFIC ON THE OUTSIDE SHOULDER OF NB I-75, AND THE TWO OUTSIDE SB I-75 LANES.
 - 2) CONSTRUCT INSIDE HALF OF NB I-75, WIDEN SHOULDER & BUILD TEMPORARY CROSS-OVERS.

MAINTAINING TRAFFIC


	STA 28+660 TO STA 29+380 NB I-75					
	DATE	SCALE	CONT. SEC.	JOB NO.	DESIGN UNIT	SHEET NO.
01/06/01	1:1000	63174	49595	DTSC TRAFFIC	R.O.W	60

EXISTING BY: BACKLOG TEAM
 PROPOSED BY:
 LAST CORRECTION BY:

DATE: 01/06/01
 DATE:
 DATE:
 FILE NAME: 49595main15.dgn
 1 2 3 4 5 6 7 8 9 10 11 12 13 14 15 16 17 18 19 20 21 22 23 24 25 26 27 28 29 30 31 32 33 34 35 36 37 38 39 40 41 42 43 44 45 46 47 48 49 50 51 52 53 54 55 56 57 58 59 60 61 62 63

13 MILE RD

FINAL R.O.W.			
AUTH	DATE	NO.	REVISION

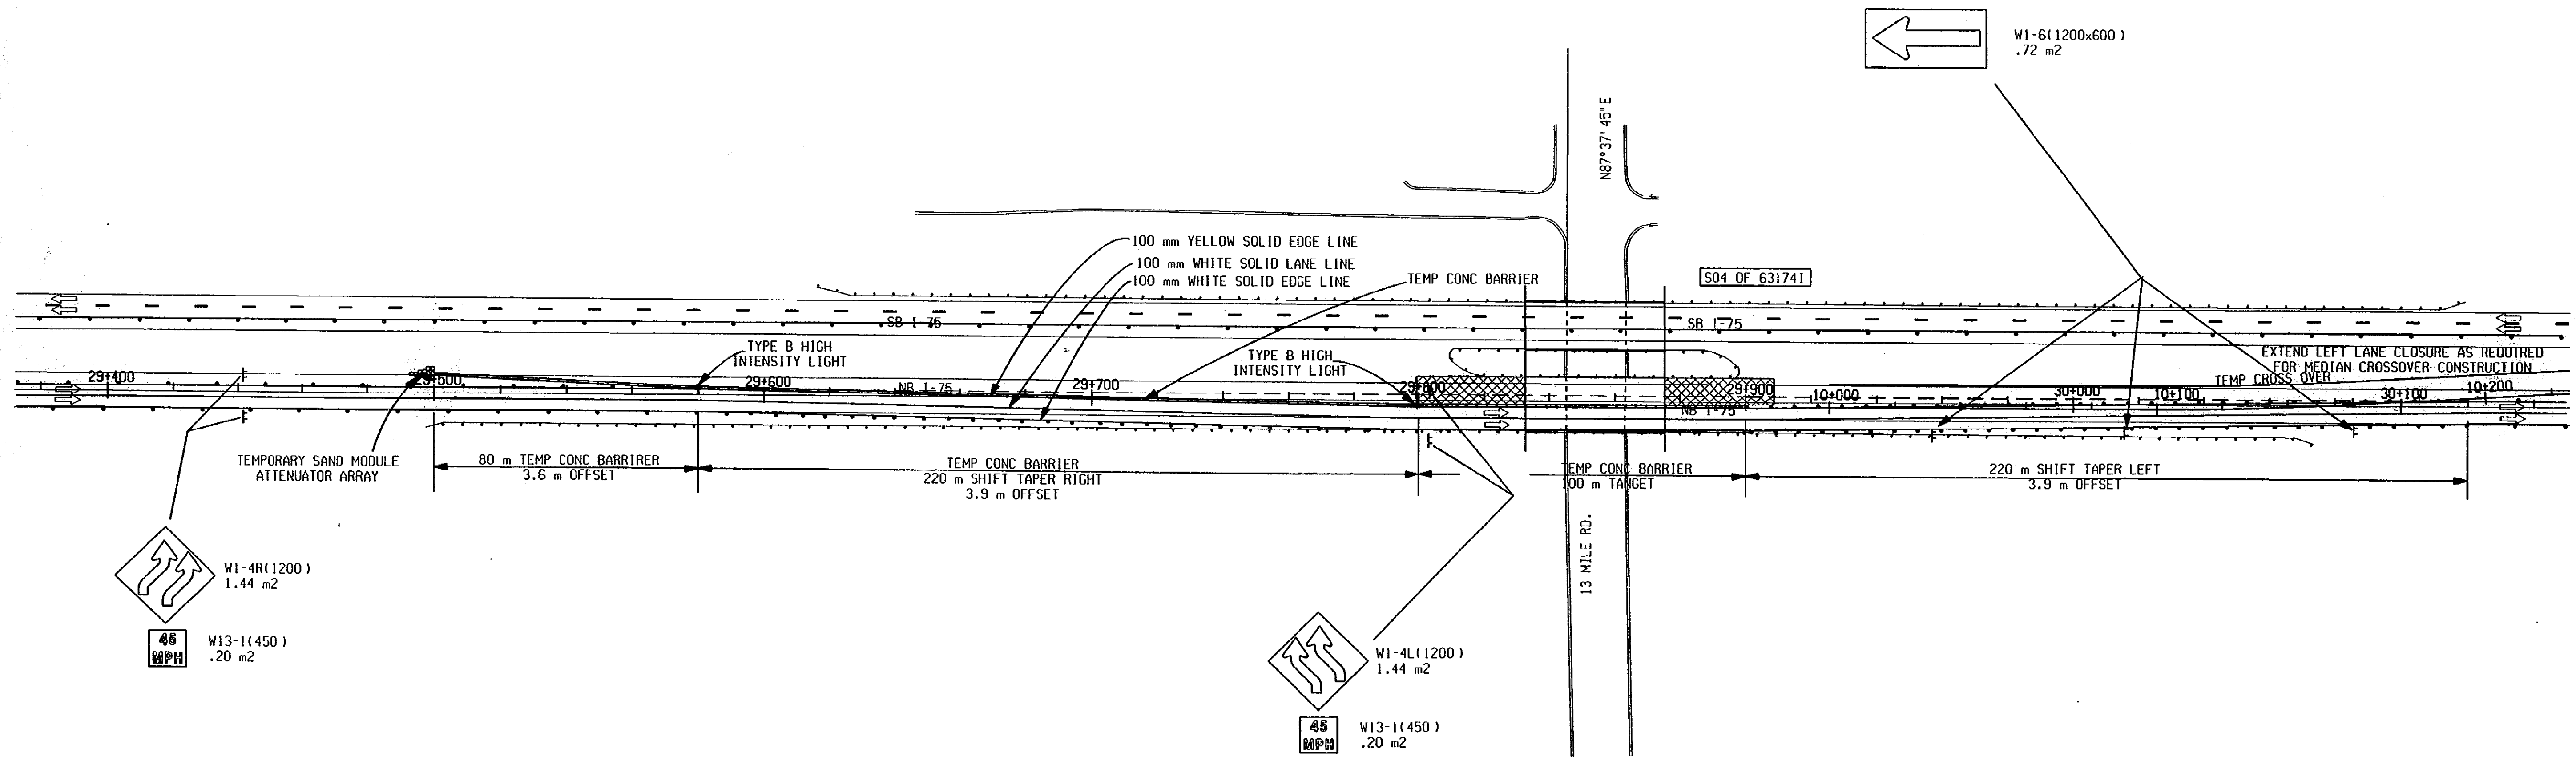


- STAGE 3
- 1) MAINTAIN TRAFFIC ON THE OUTSIDE SHOULDER OF NB I-75, AND THE TWO OUTSIDE SB I-75 LANES.
 - 2) CONSTRUCT INSIDE HALF OF NB I-75. WIDEN SHOULDER & BUILD TEMPORARY CROSS-OVERS.

MAINTAINING TRAFFIC

13 MILE RD

	STA 29+380 TO STA 30+140 NB I-75					
	DATE	SCALE	CONT. SEC.	JOB NO.	DESIGN UNIT	SHEET NO.
01/06/01	1:1000	63174	49595	DTSC TRAFFIC	R.O.W	61

FINAL R.O.V.		
AUTH	DATE	NO. REVISION

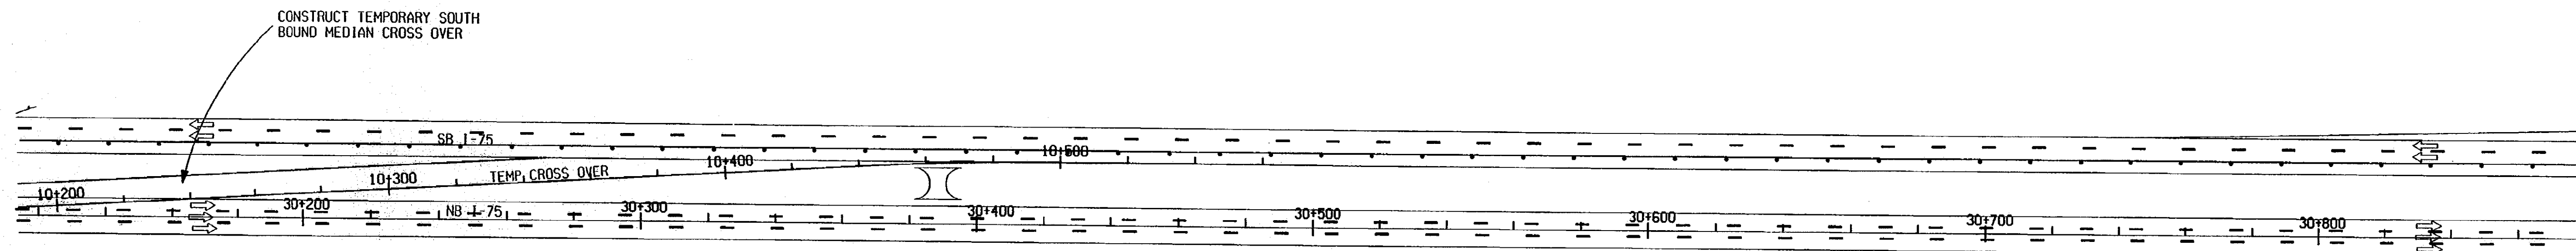

44 45

STAGE 3

- 1) MAINTAIN TRAFFIC ON THE OUTSIDE SHOULDER OF NB I-75, AND THE TWO OUTSIDE SB I-75 LANES.
- 2) CONSTRUCT INSIDE HALF OF NB I-75. WIDEN SHOULDER & BUILD TEMPORARY CROSS-OVERS.

MAINTAINING TRAFFIC

STA 30+140 TO STA 30+860 NB I-75


	DATE	SCALE	CONT. SEC.	JOB NO.	DESIGN UNIT	SHEET NO.
	01/06/01	1:1000	63174	49595	DTSC TRAFFIC	R.O.W 62

CONTROL SECTION 63174 JOB NO. 49595 SHEET NO. 63

14 MILE RD

AUTH			DATE			NO.			FINAL R.O.V.		
AUTH			DATE			NO.			REVISION		

44 45

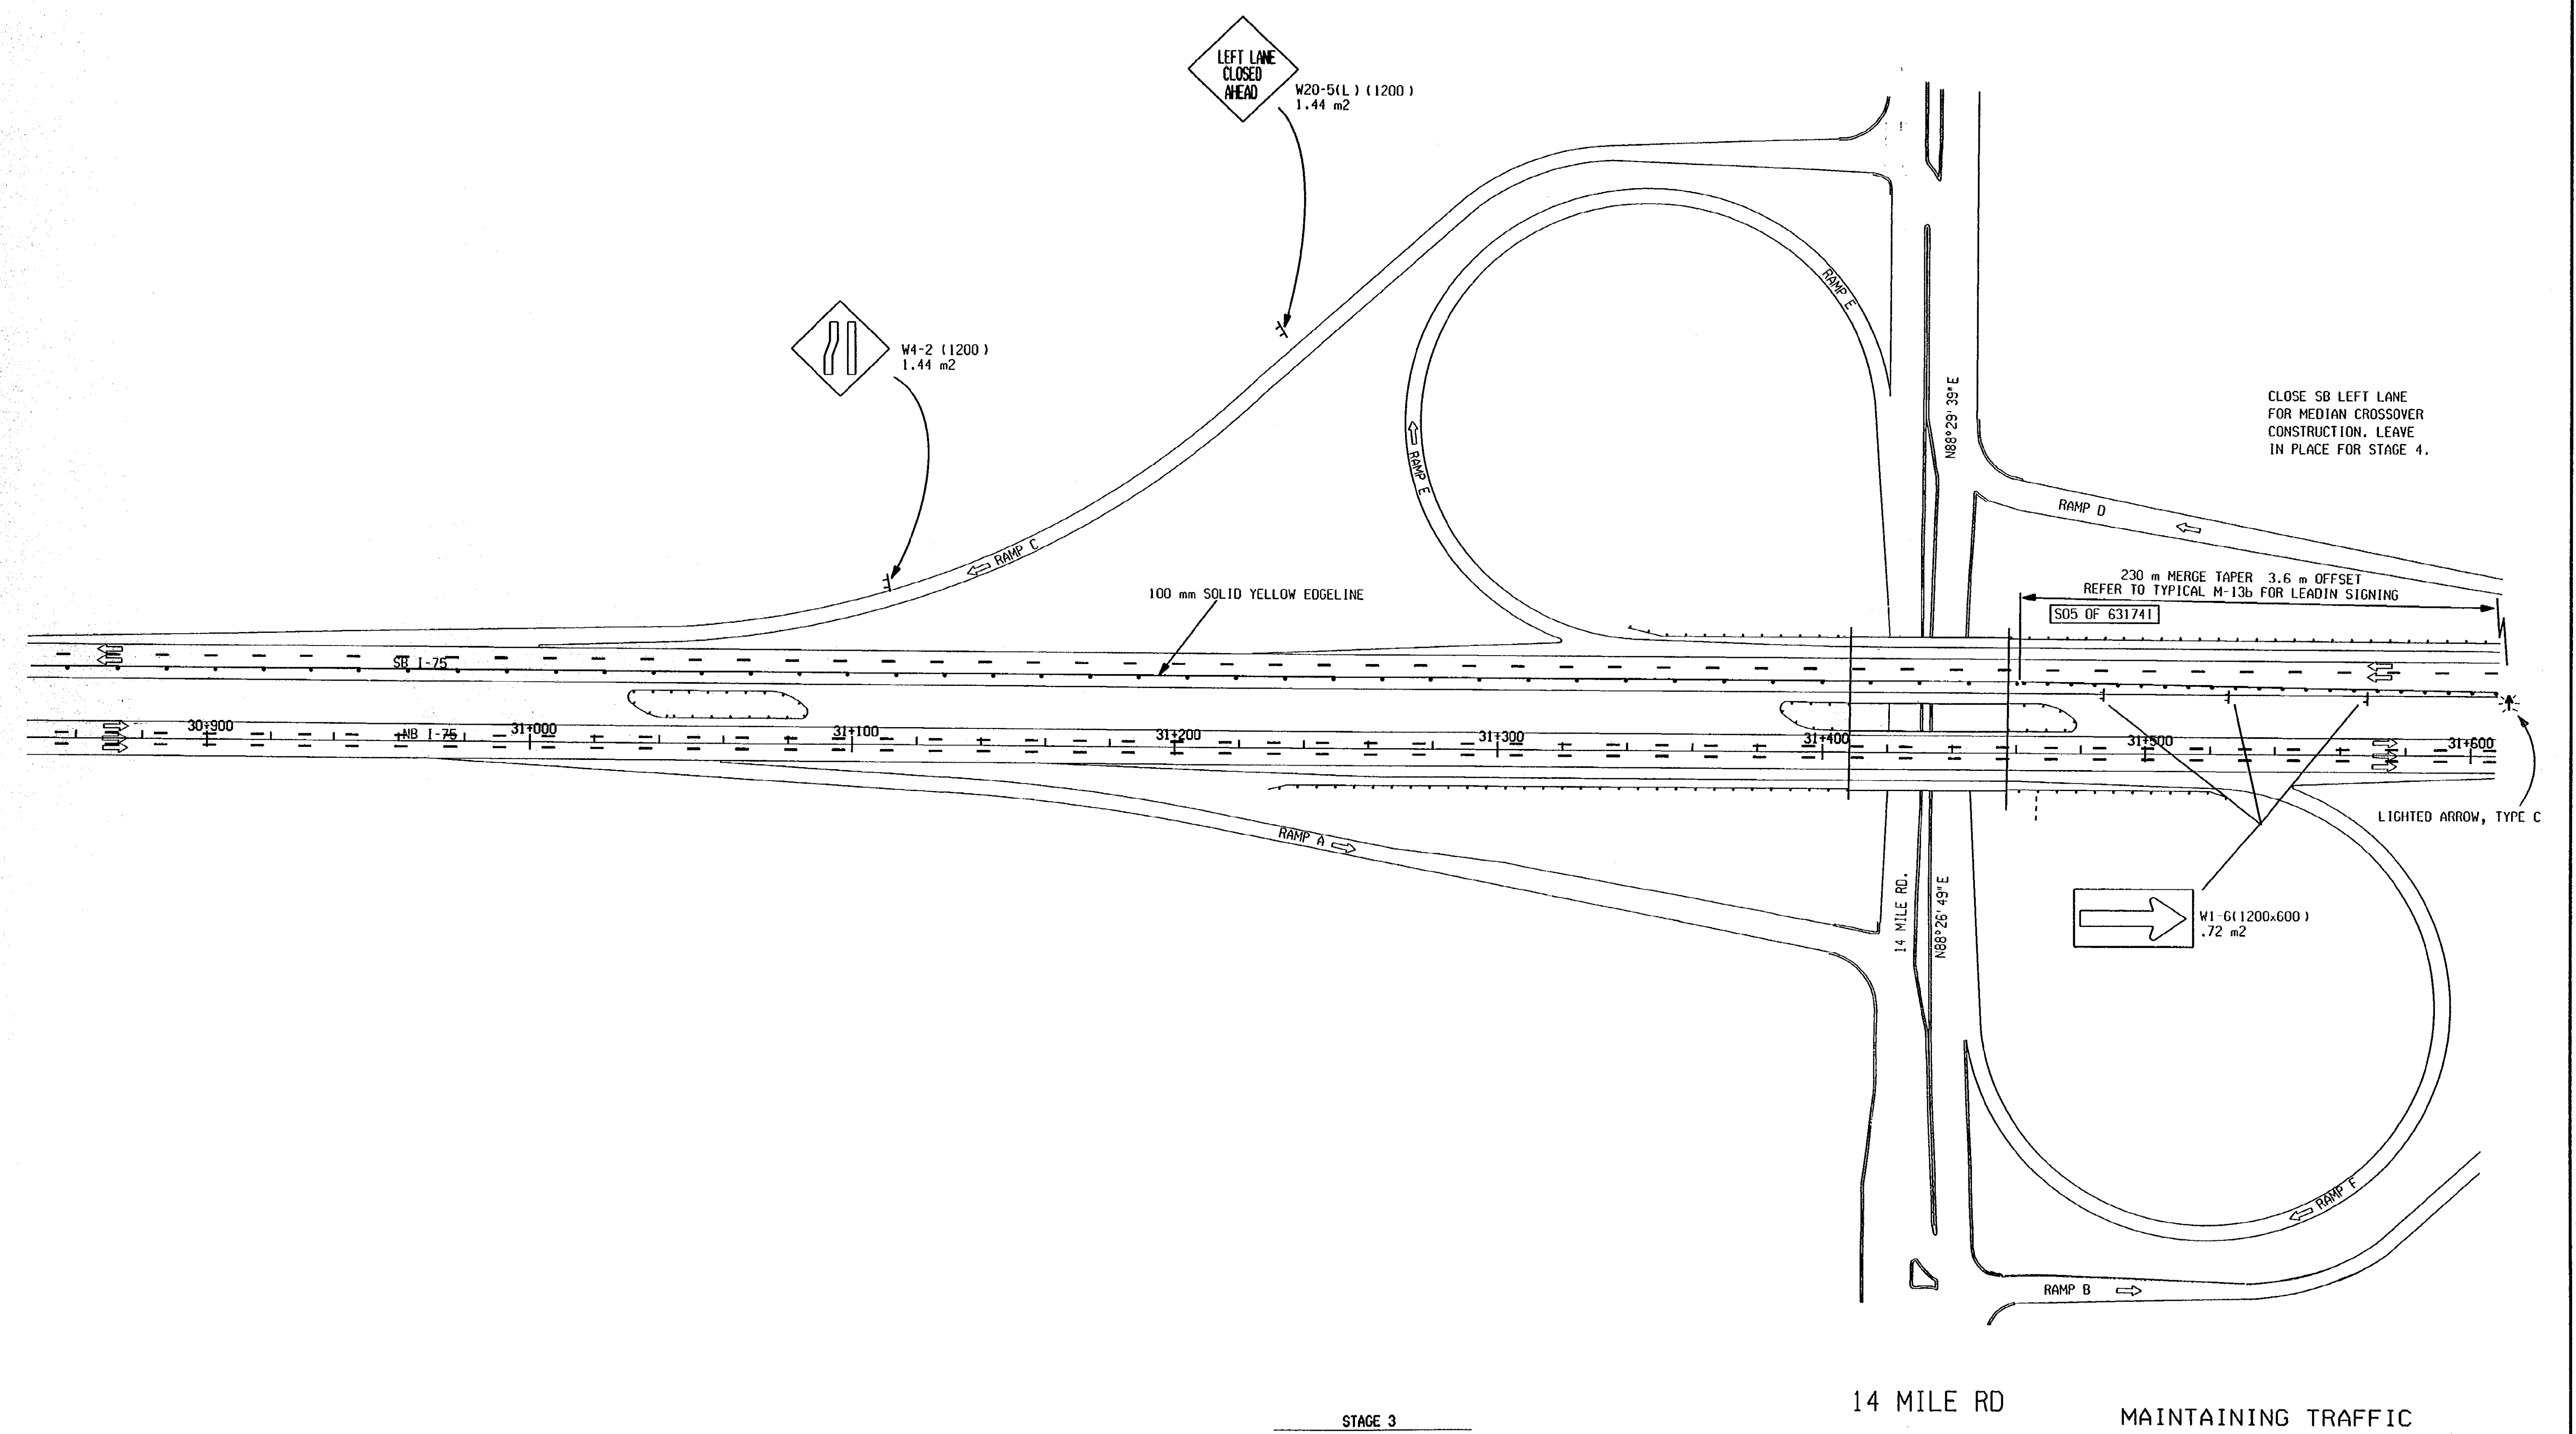

STAGE 3

14 MILE RD

MAINTAINING TRAFFIC

- 1) MAINTAIN TRAFFIC ON THE OUTSIDE SHOULDER OF NB I-75, AND THE TWO OUTSIDE SB I-75 LANES.
- 2) CONSTRUCT INSIDE HALF OF I-75. WIDEN SHOULDER & BUILD TEMPORARY CROSS-OVERS.



STA 30+860 TO STA 31+600 NB I-75					
DATE	SCALE	CONT. SEC.	JOB NO.	DESIGN UNIT	SHEET NO.
01/06/01	1:1000	63174	49595	DTSC TRAFFIC	R.O.W 63



FILE NAME: 49595maint7.dgn

46.47

FILE NAME: 49595maint.i.dgn

ELEVEN MILE

FINAL R.O.W.			
AUTH	DATE	NO.	REVISION

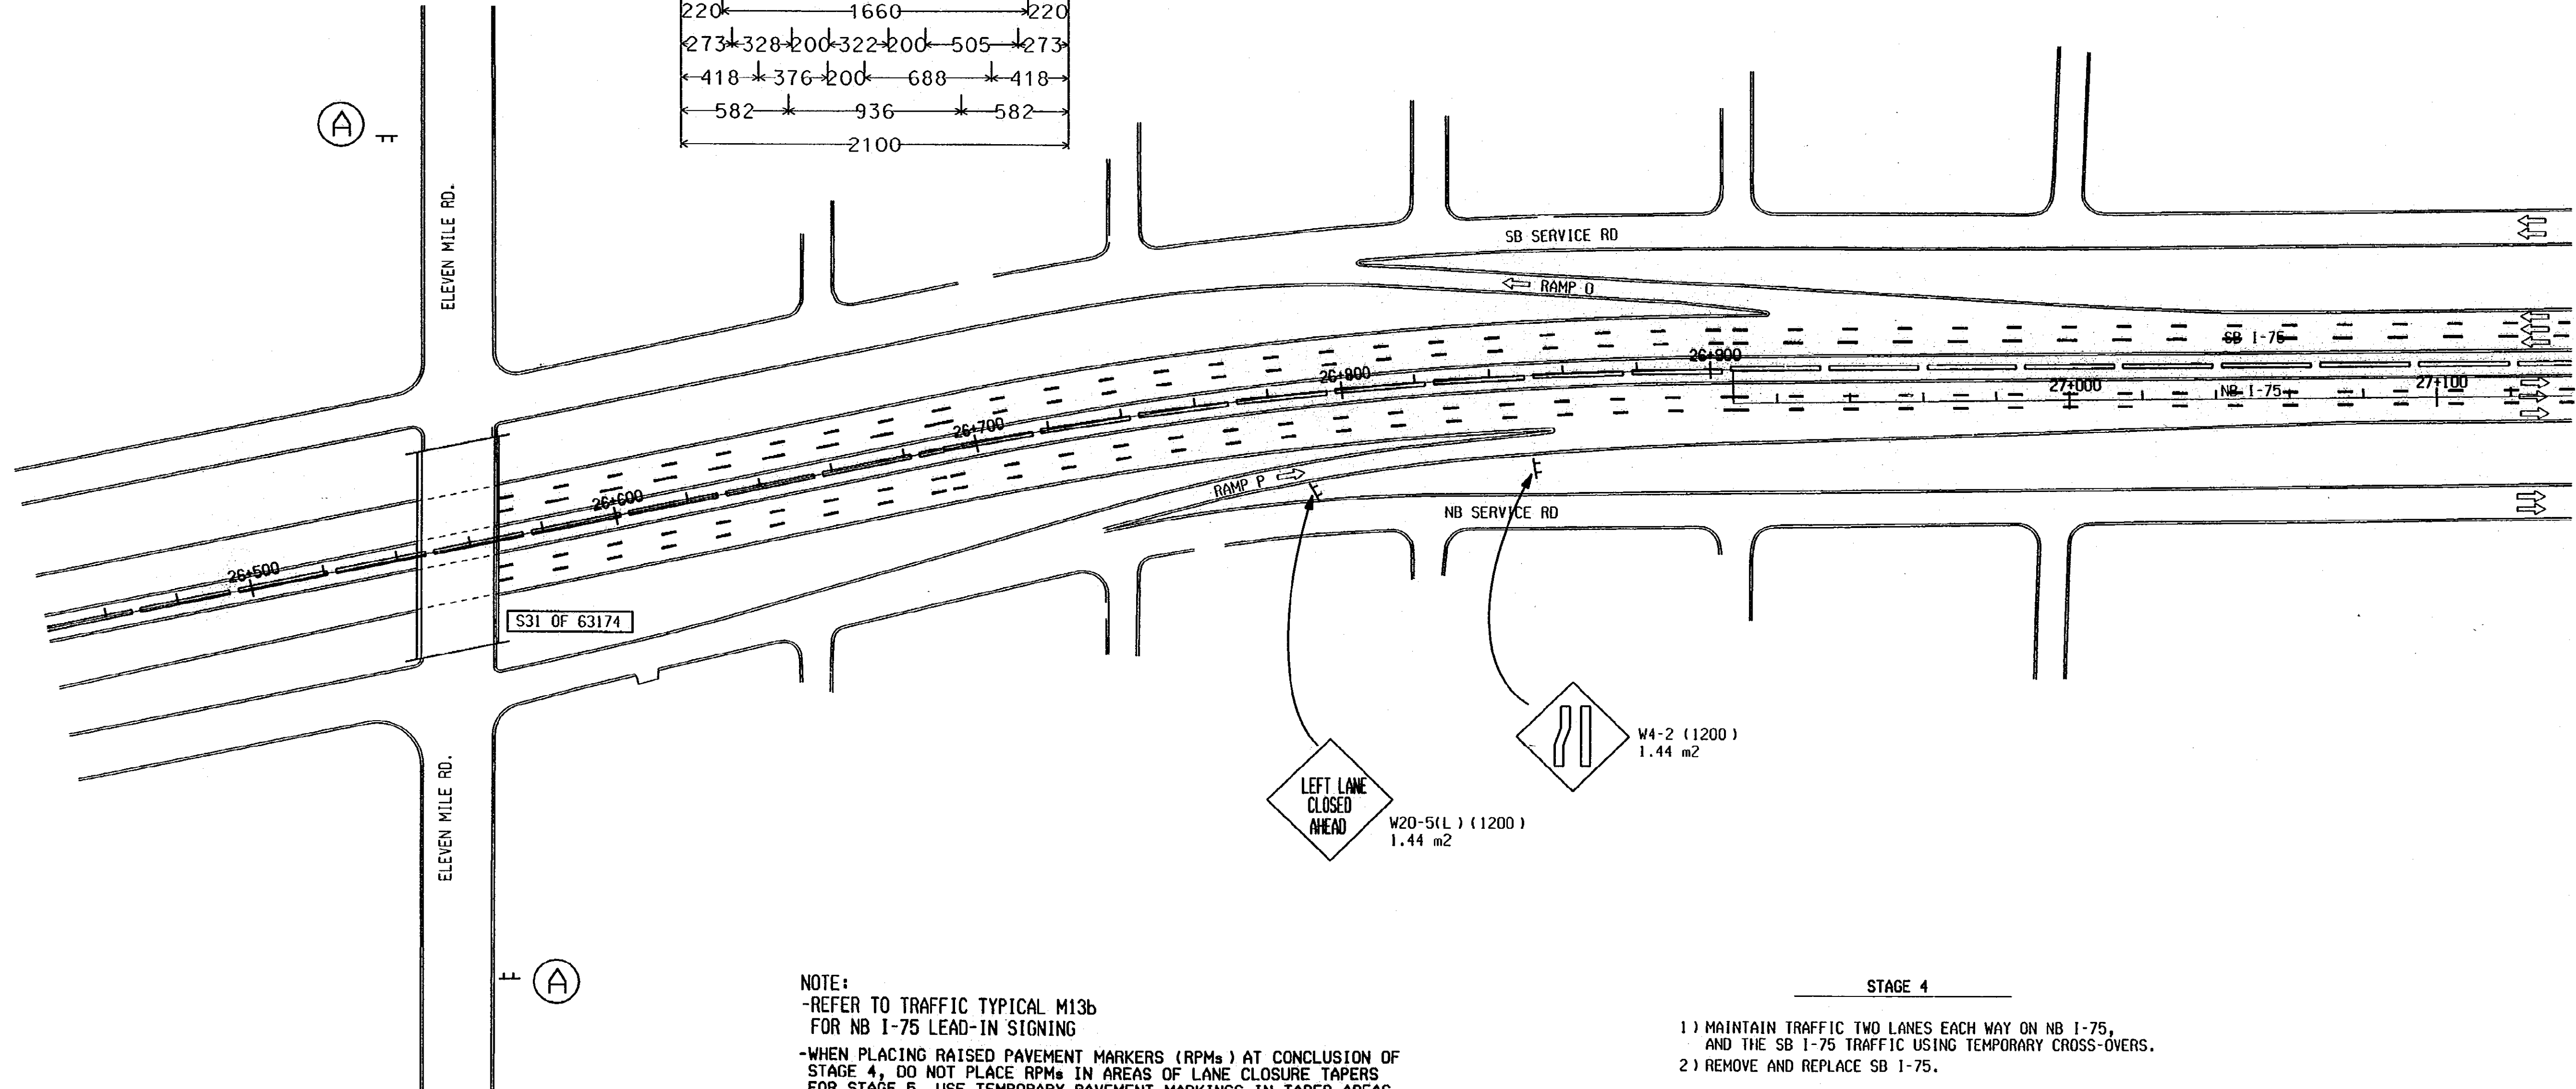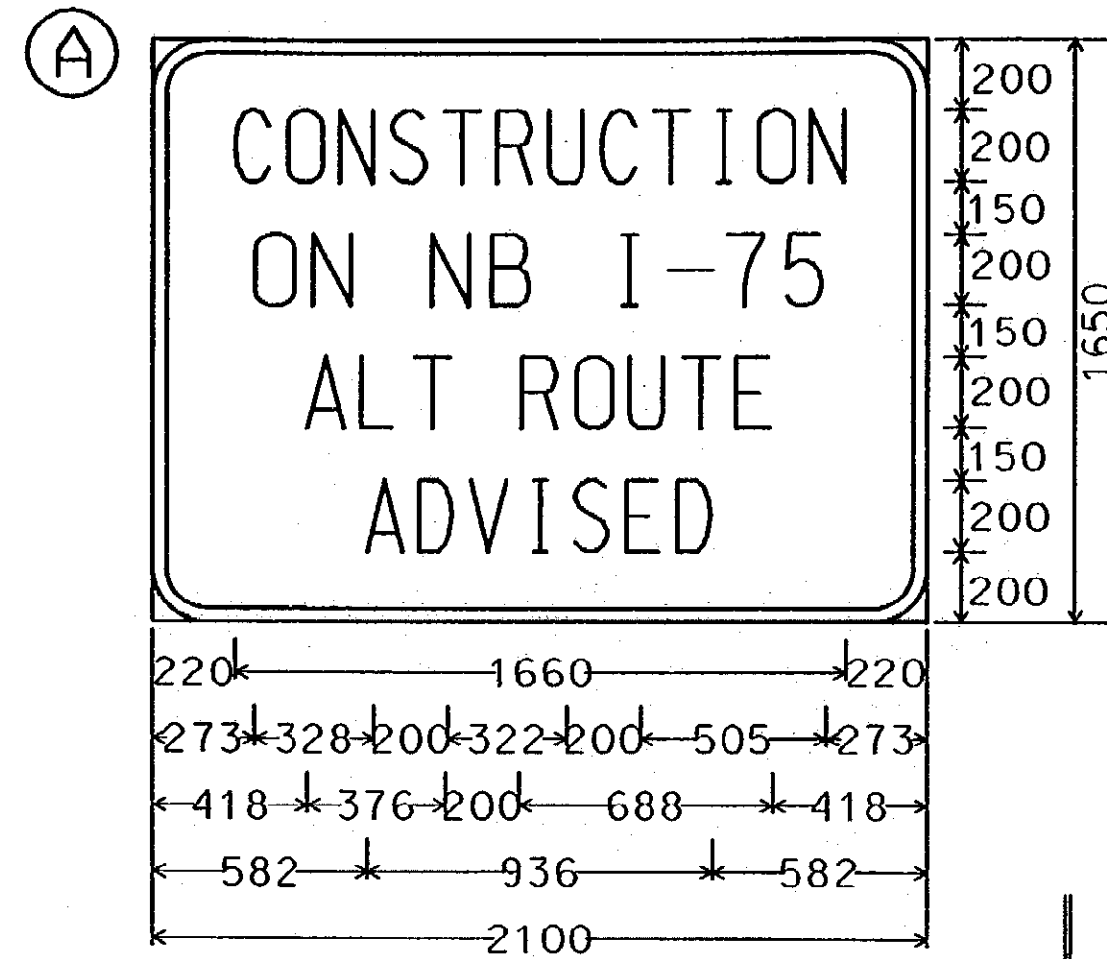

NOTE:
 -REFER TO TRAFFIC TYPICAL M13b FOR NB I-75 LEAD-IN SIGNING
 -WHEN PLACING RAISED PAVEMENT MARKERS (RPMs) AT CONCLUSION OF STAGE 4, DO NOT PLACE RPMs IN AREAS OF LANE CLOSURE TAPERS FOR STAGE 5. USE TEMPORARY PAVEMENT MARKINGS IN TAPER AREAS

- STAGE 4
- 1) MAINTAIN TRAFFIC TWO LANES EACH WAY ON NB I-75, AND THE SB I-75 TRAFFIC USING TEMPORARY CROSS-OVERS.
 - 2) REMOVE AND REPLACE SB I-75.

11 MILE RD


MAINTAINING TRAFFIC

	STA 26+500 TO STA 27+120 NB I-75					
	DATE	SCALE	CONT. SEC.	JOB NO.	DESIGN UNIT	SHEET NO.
01/05/01	1:1000	63174	49595	OTSC TRAFFIC	R.O.W.	64

46 47

GARDENIA AVE

FINAL R.O.W.			
AUTH	DATE	NO.	REVISION

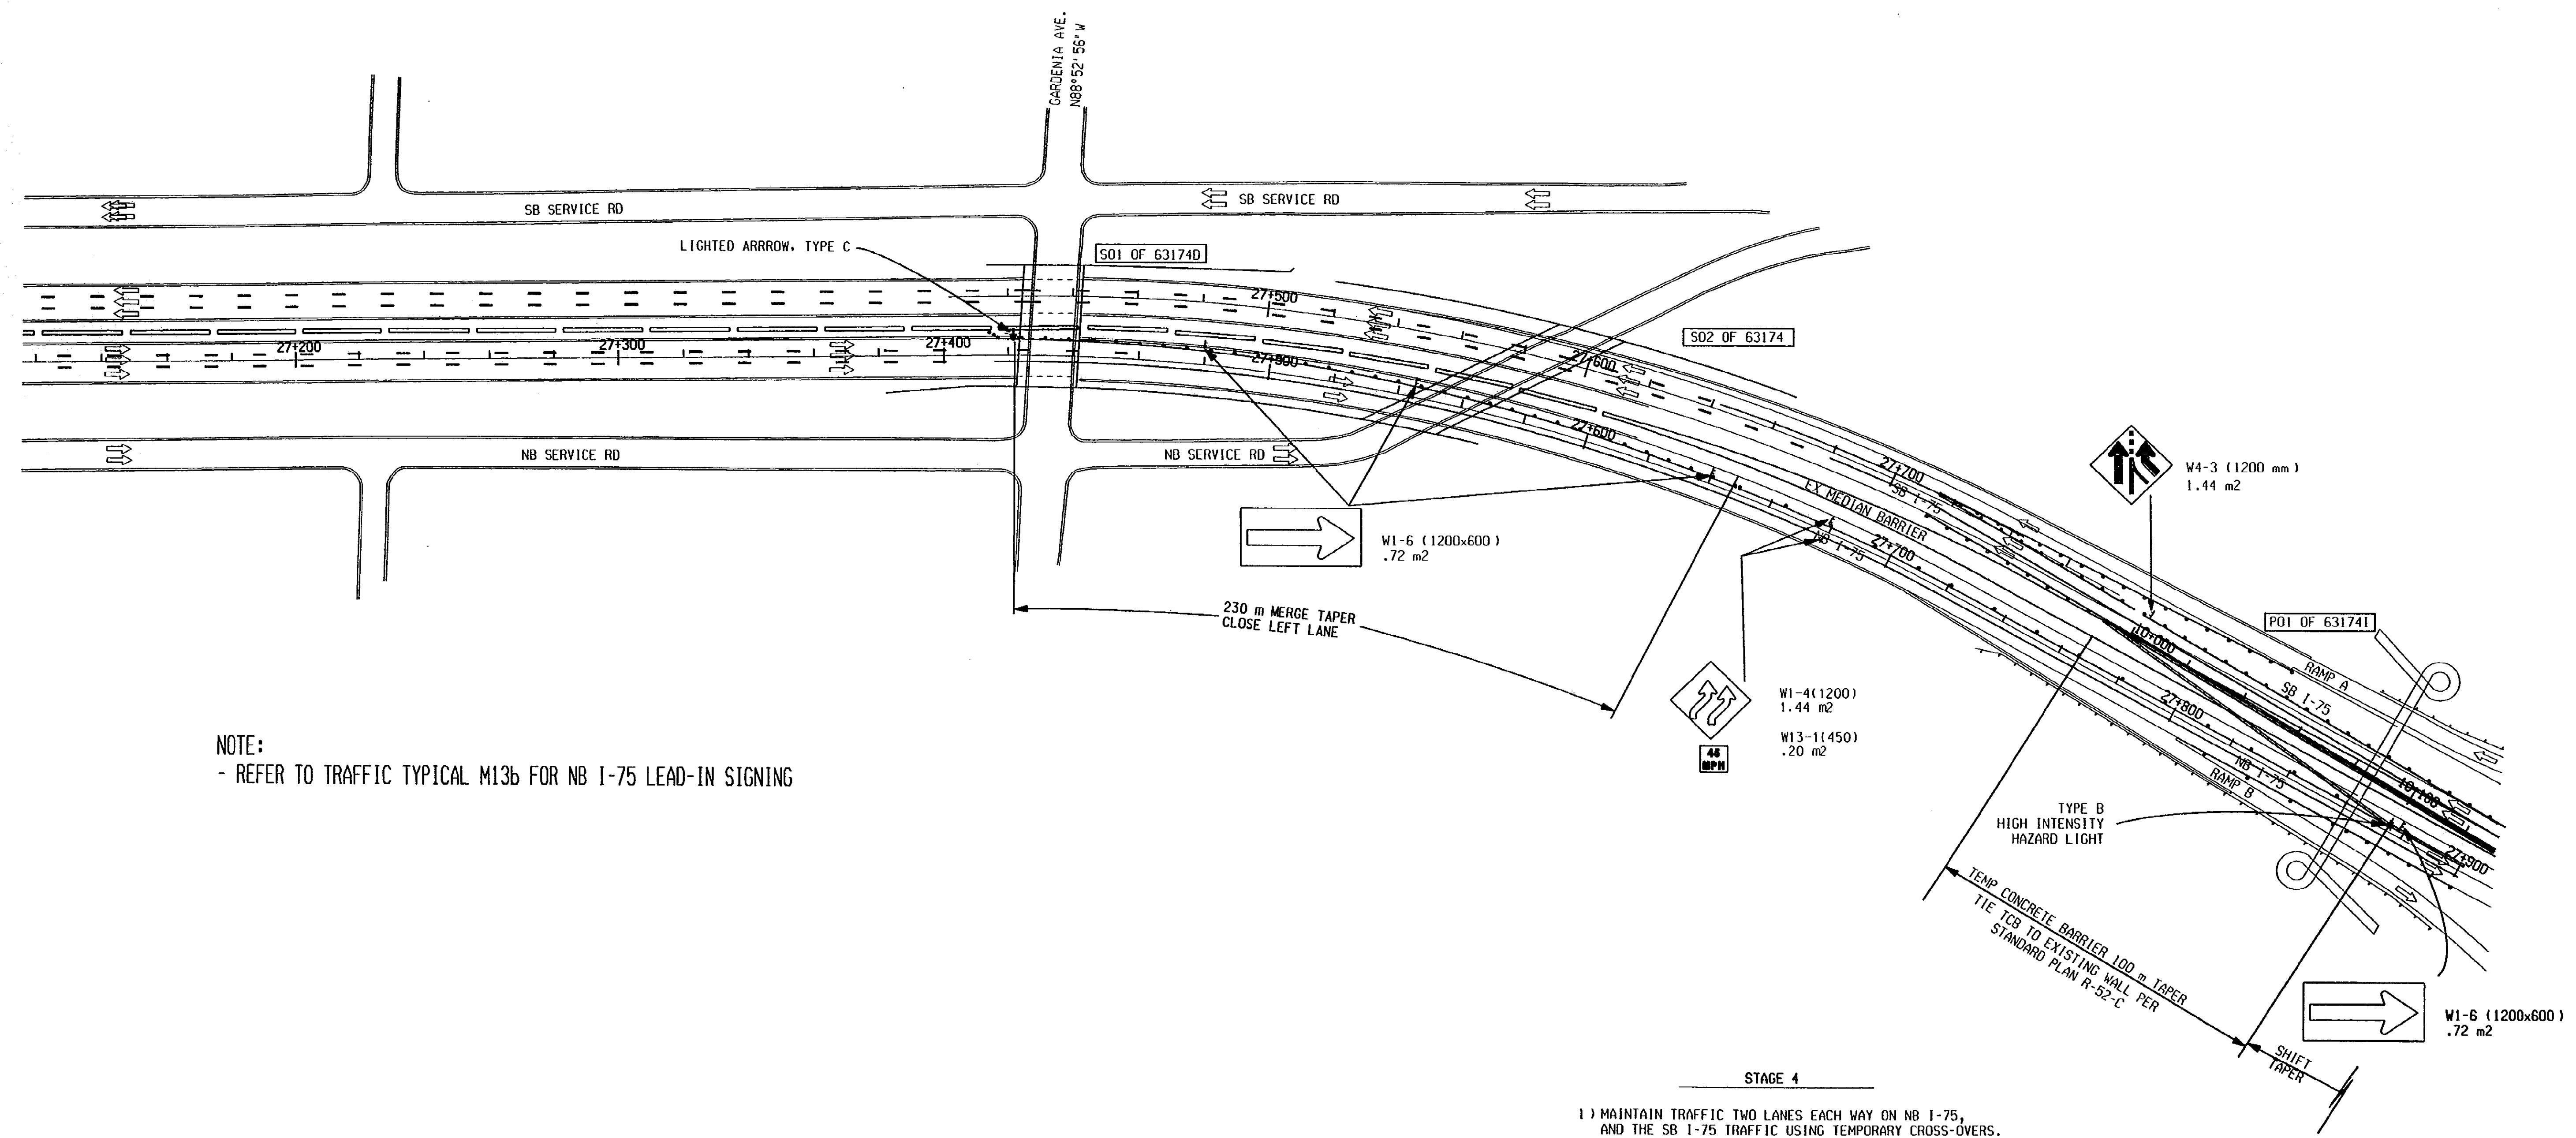

NOTE:
- REFER TO TRAFFIC TYPICAL M13b FOR NB I-75 LEAD-IN SIGNING

- STAGE 4
- 1) MAINTAIN TRAFFIC TWO LANES EACH WAY ON NB I-75, AND THE SB I-75 TRAFFIC USING TEMPORARY CROSS-OVERS.
 - 2) REMOVE AND REPLACE SB I-75.

MAINTAINING TRAFFIC

FILE NAME: 49585xover2.dgn


GARDENIA AVE

	STA 27+120 TO STA 27+900 NB I-75					
	DATE	SCALE	CONT. SEC.	JOB NO.	DESIGN UNIT	SHEET NO.
	01/05/01	1:1000	63174	49595	OTSC TRAFFIC	R.O.W. 65

EXISTING BY: RICK'S TEAM
 PROPOSED BY:
 LAST CORRECTION BY:

DATE: 11-04-00
 DATE:
 DATE:
 FILE NAME: 49595main3.dgn
 1 2 3 4 5 6 7 8 9 10 11 12 13 14 15 16 17 18 19 20 21 22 23 24 25 26 27 28 29 30 31 32 33 34 35 36 37 38 39 40 41 42 43 44 45 46 47 48 49 50 51 52 53 54 55 56 57 58 59 60 61 62 63

FINAL R.O.V.			
AUTH	DATE	NO.	REVISION

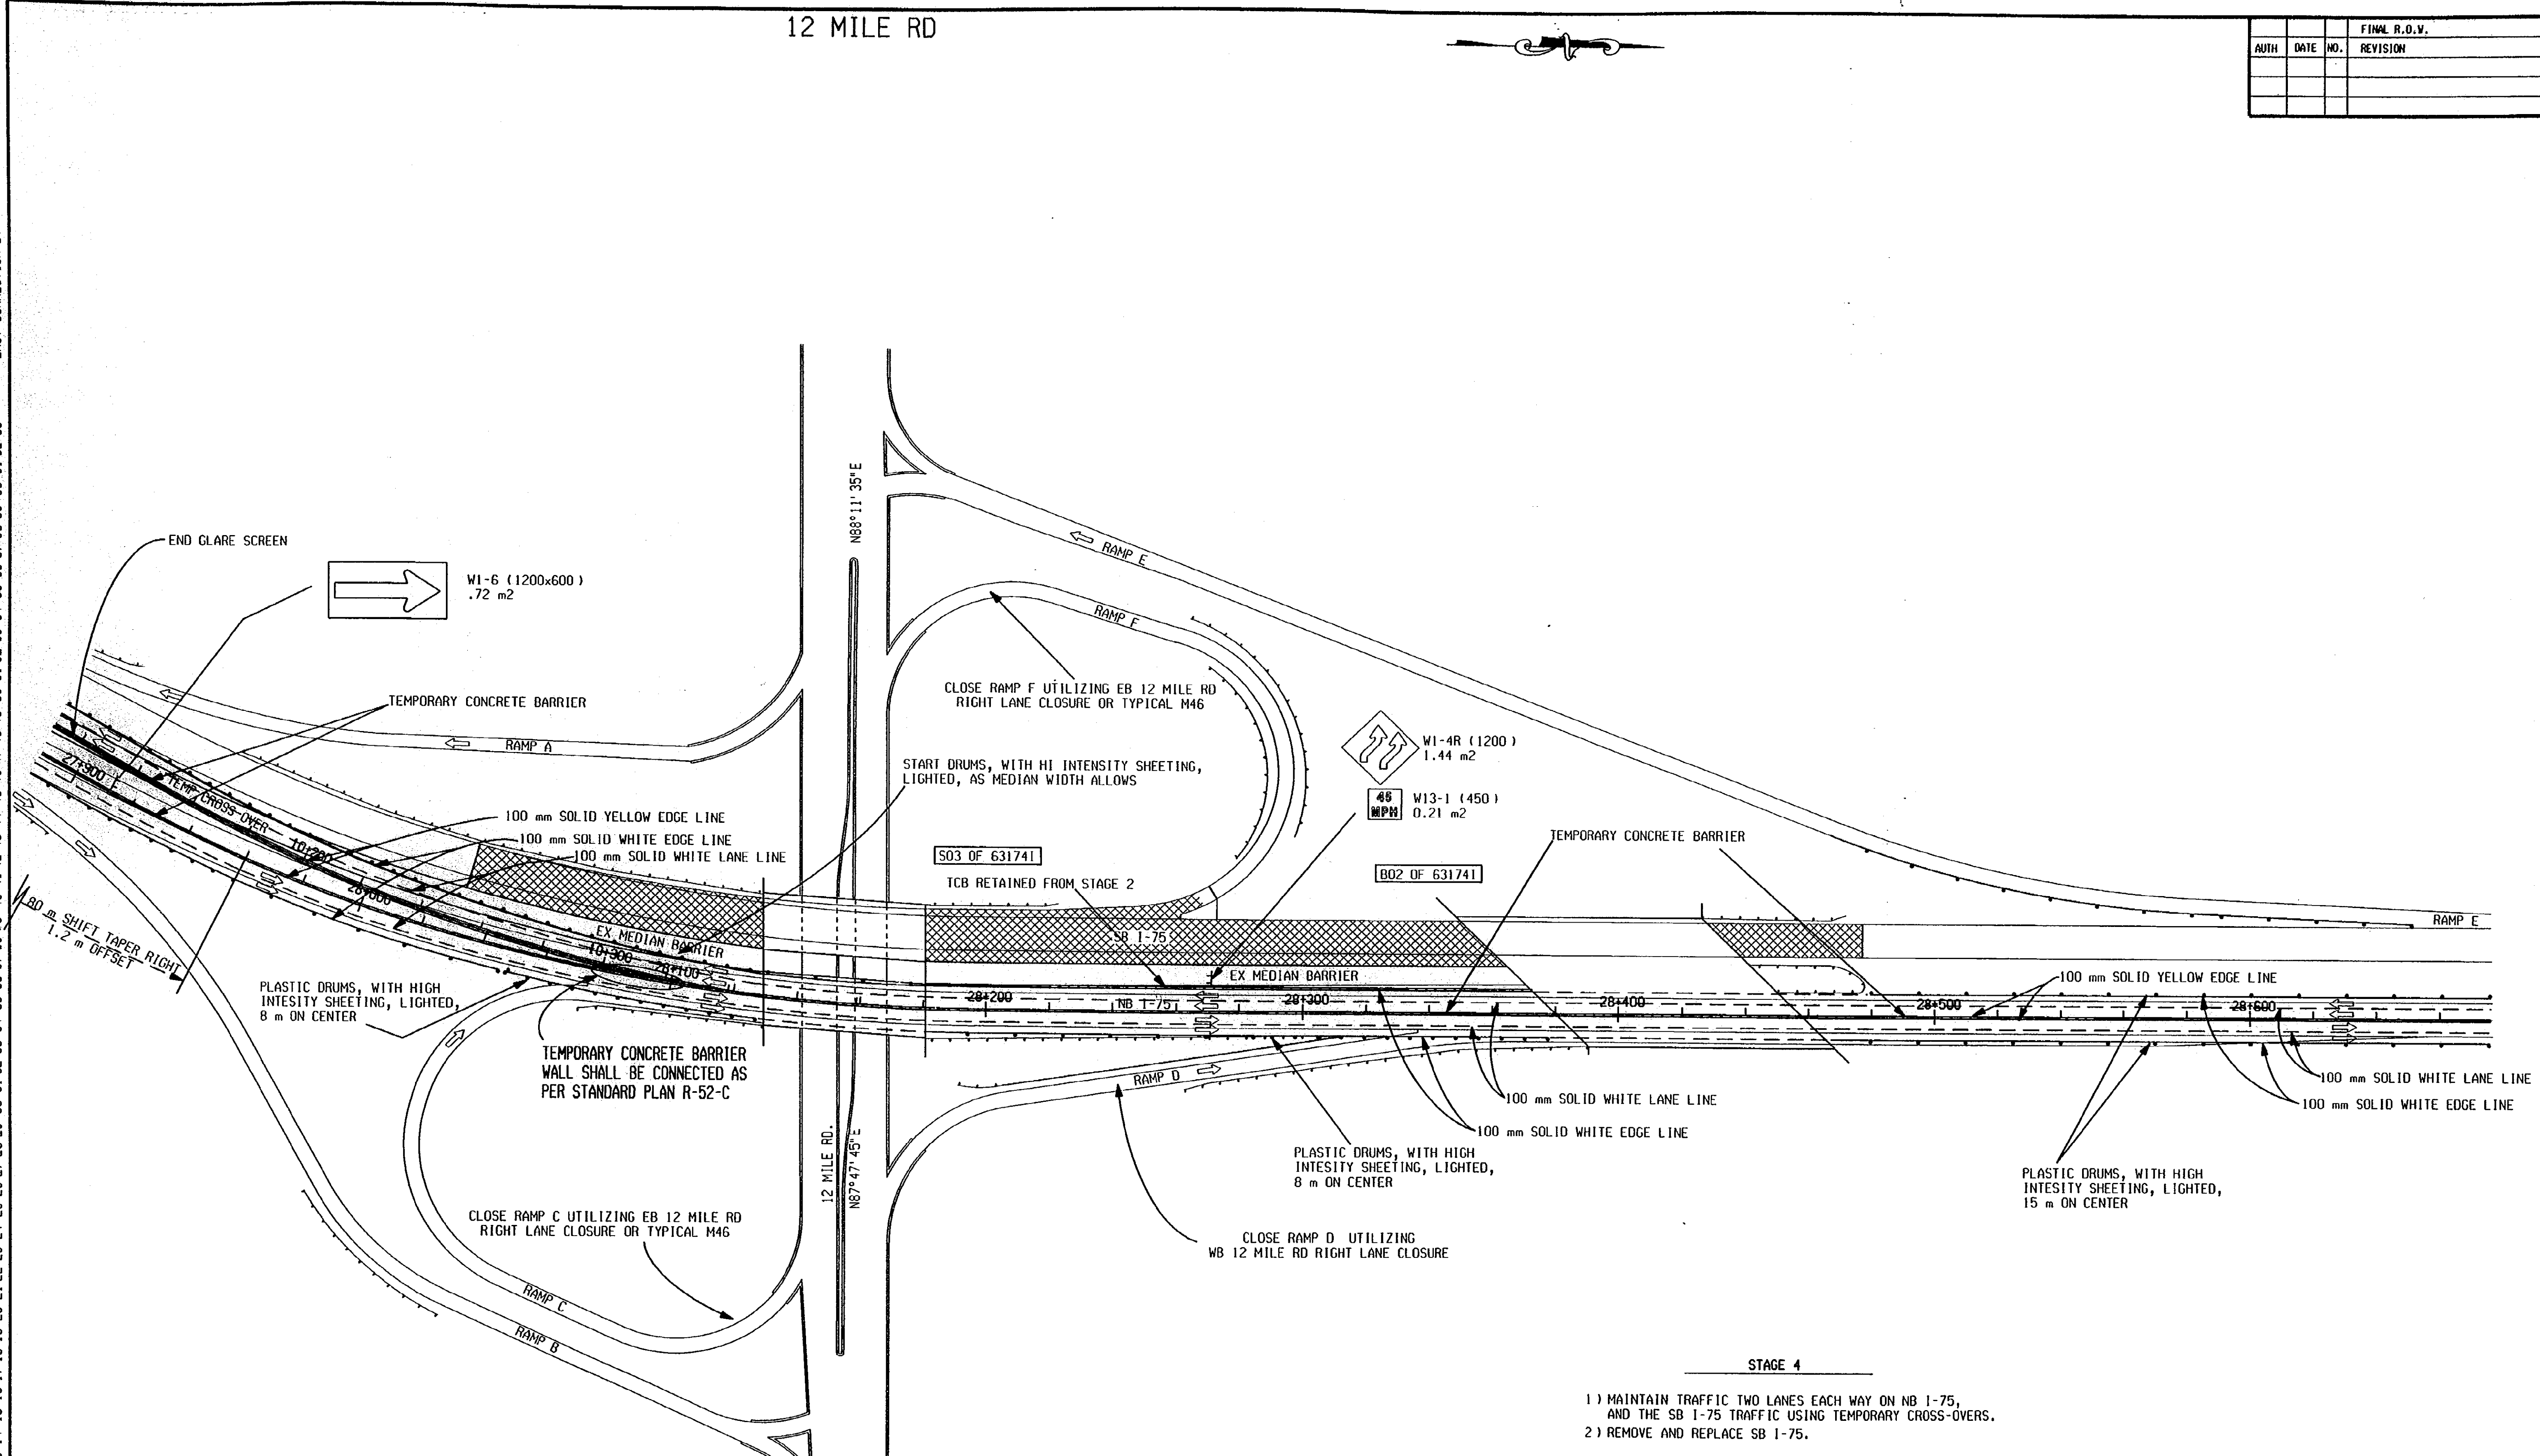

- STAGE 4
- 1) MAINTAIN TRAFFIC TWO LANES EACH WAY ON NB I-75, AND THE SB I-75 TRAFFIC USING TEMPORARY CROSS-OVERS.
 - 2) REMOVE AND REPLACE SB I-75.

MAINTAINING TRAFFIC


	STA 27+900 TO STA 28+660 NB I-75					
	DATE	SCALE	CONT. SEC.	JOB NO.	DESIGN UNITY	SHEET NO.
	01/05/01	1:1000	63174	49595	OTSC TRAFFIC	R.O.W. 66

12 MILE RD

EXISTING BY: BACKLOG TEAM
 PROPOSED BY:
 LAST CORRECTION BY:

FILE NAME: 49595main4.dgn
 1 2 3 4 5 6 7 8 9 10 11 12 13 14 15 16 17 18 19 20 21 22 23 24 25 26 27 28 29 30 31 32 33 34 35 36 37 38 39 40 41 42 43 44 45 46 47 48 49 50 51 52 53 54 55 56 57 58 59 60 61 62 63

FINAL R.O.V.			
AUTH	DATE	NO.	REVISION

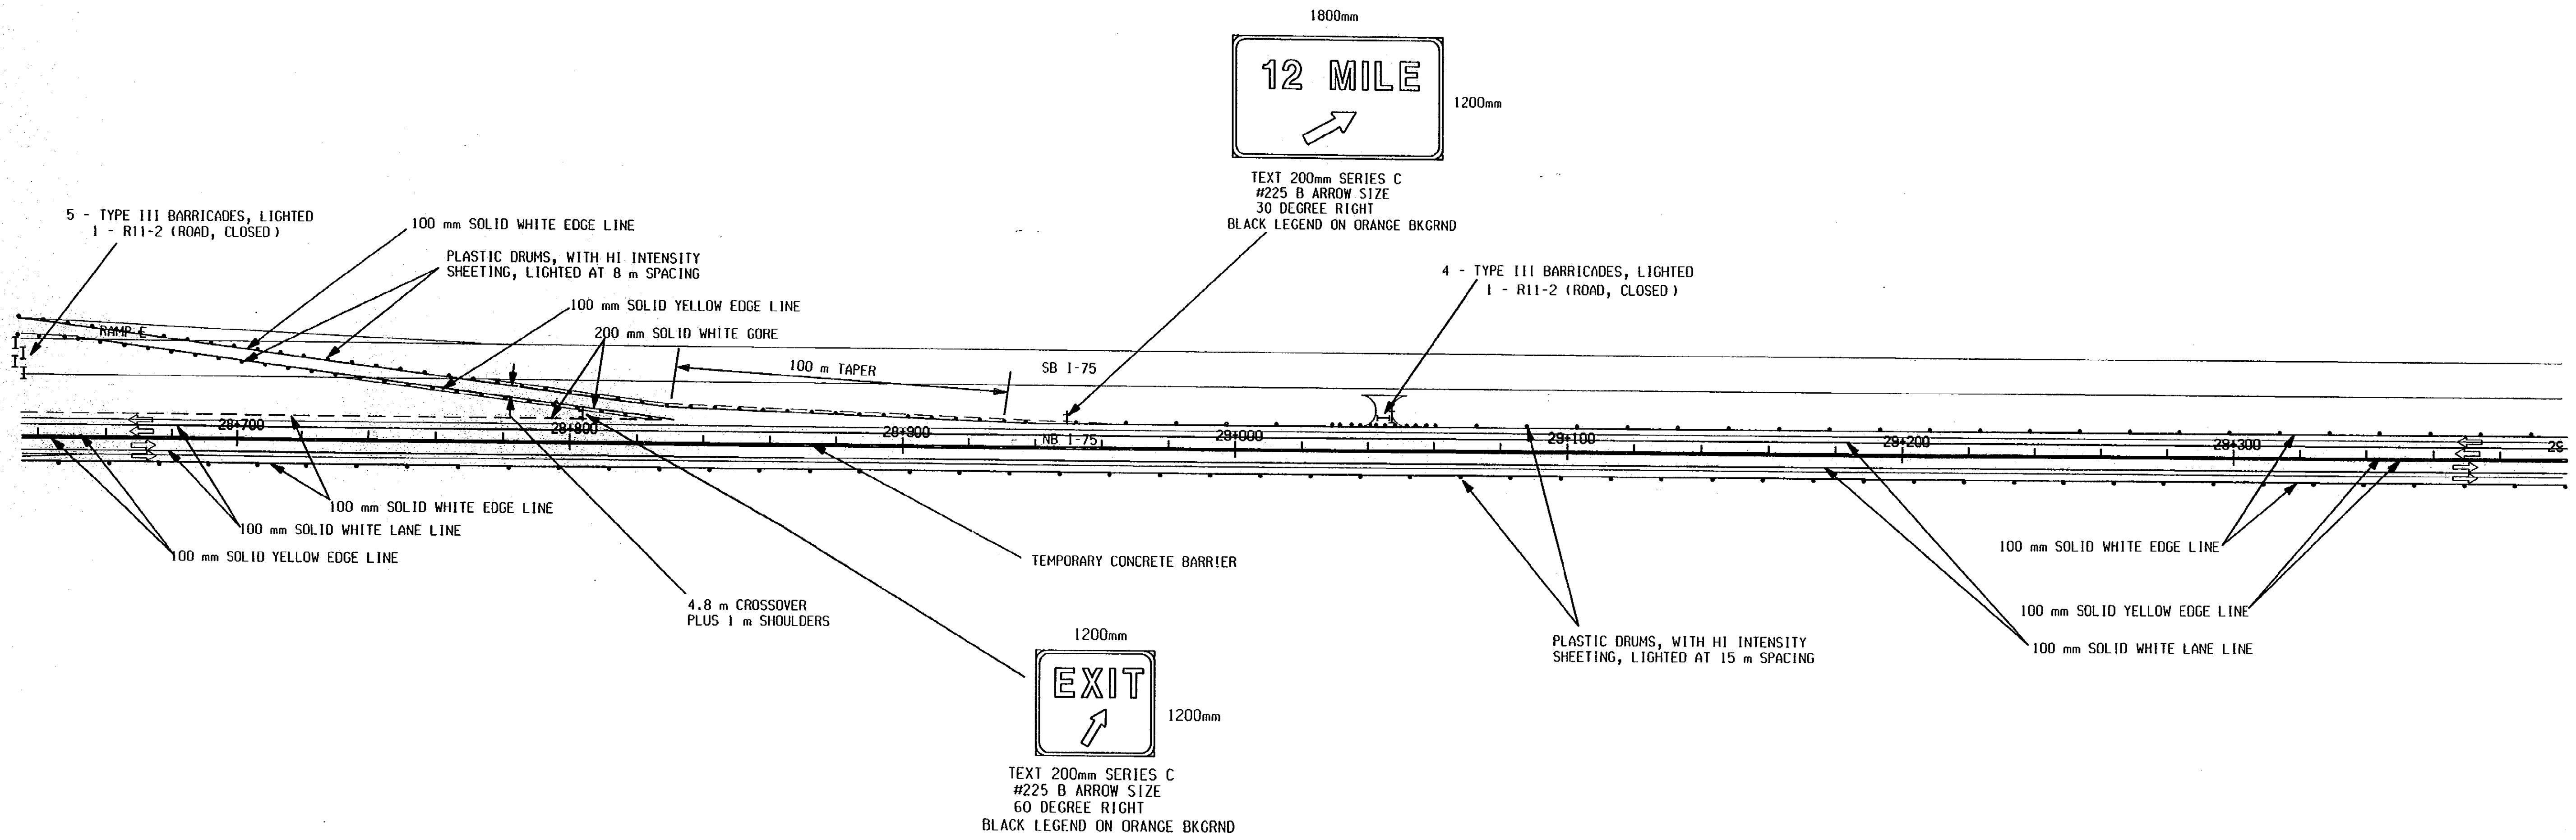

STAGE 4
 STA + TO STA +
 1) MAINTAIN TRAFFIC TWO LANES EACH WAY ON NB I-75,
 AND THE SB I-75 TRAFFIC USING TEMPORARY CROSS-OVERS.
 2) REMOVE AND REPLACE SB I-75.


MAINTAINING TRAFFIC

	STA 28+660 TO STA 29+380 NB I-75					
	DATE	SCALE	CONT. SEC.	JOB NO.	DESIGN UNIT	SHEET NO.
01/06/01	1:1000	63174	49595	OTSC TRAFFIC	R.O.W.	67

FILE NAME: 49595main15.dgn
 1 2 3 4 5 6 7 8 9 10 11 12 13 14 15 16 17 18 19 20 21 22 23 24 25 26 27 28 29 30 31 32 33 34 35 36 37 38 39 40 41 42 43 44 45 46 47 48 49 50 51 52 53 54 55 56 57 58 59 60 61 62 63
 EXISTING BY: BACKUS TEAM
 PROPOSED BY: LAST CORRECTION BY:
 DATE: DATE:

FINAL R.O.V.		
AUTH	DATE	REVISION

13 MILE RD

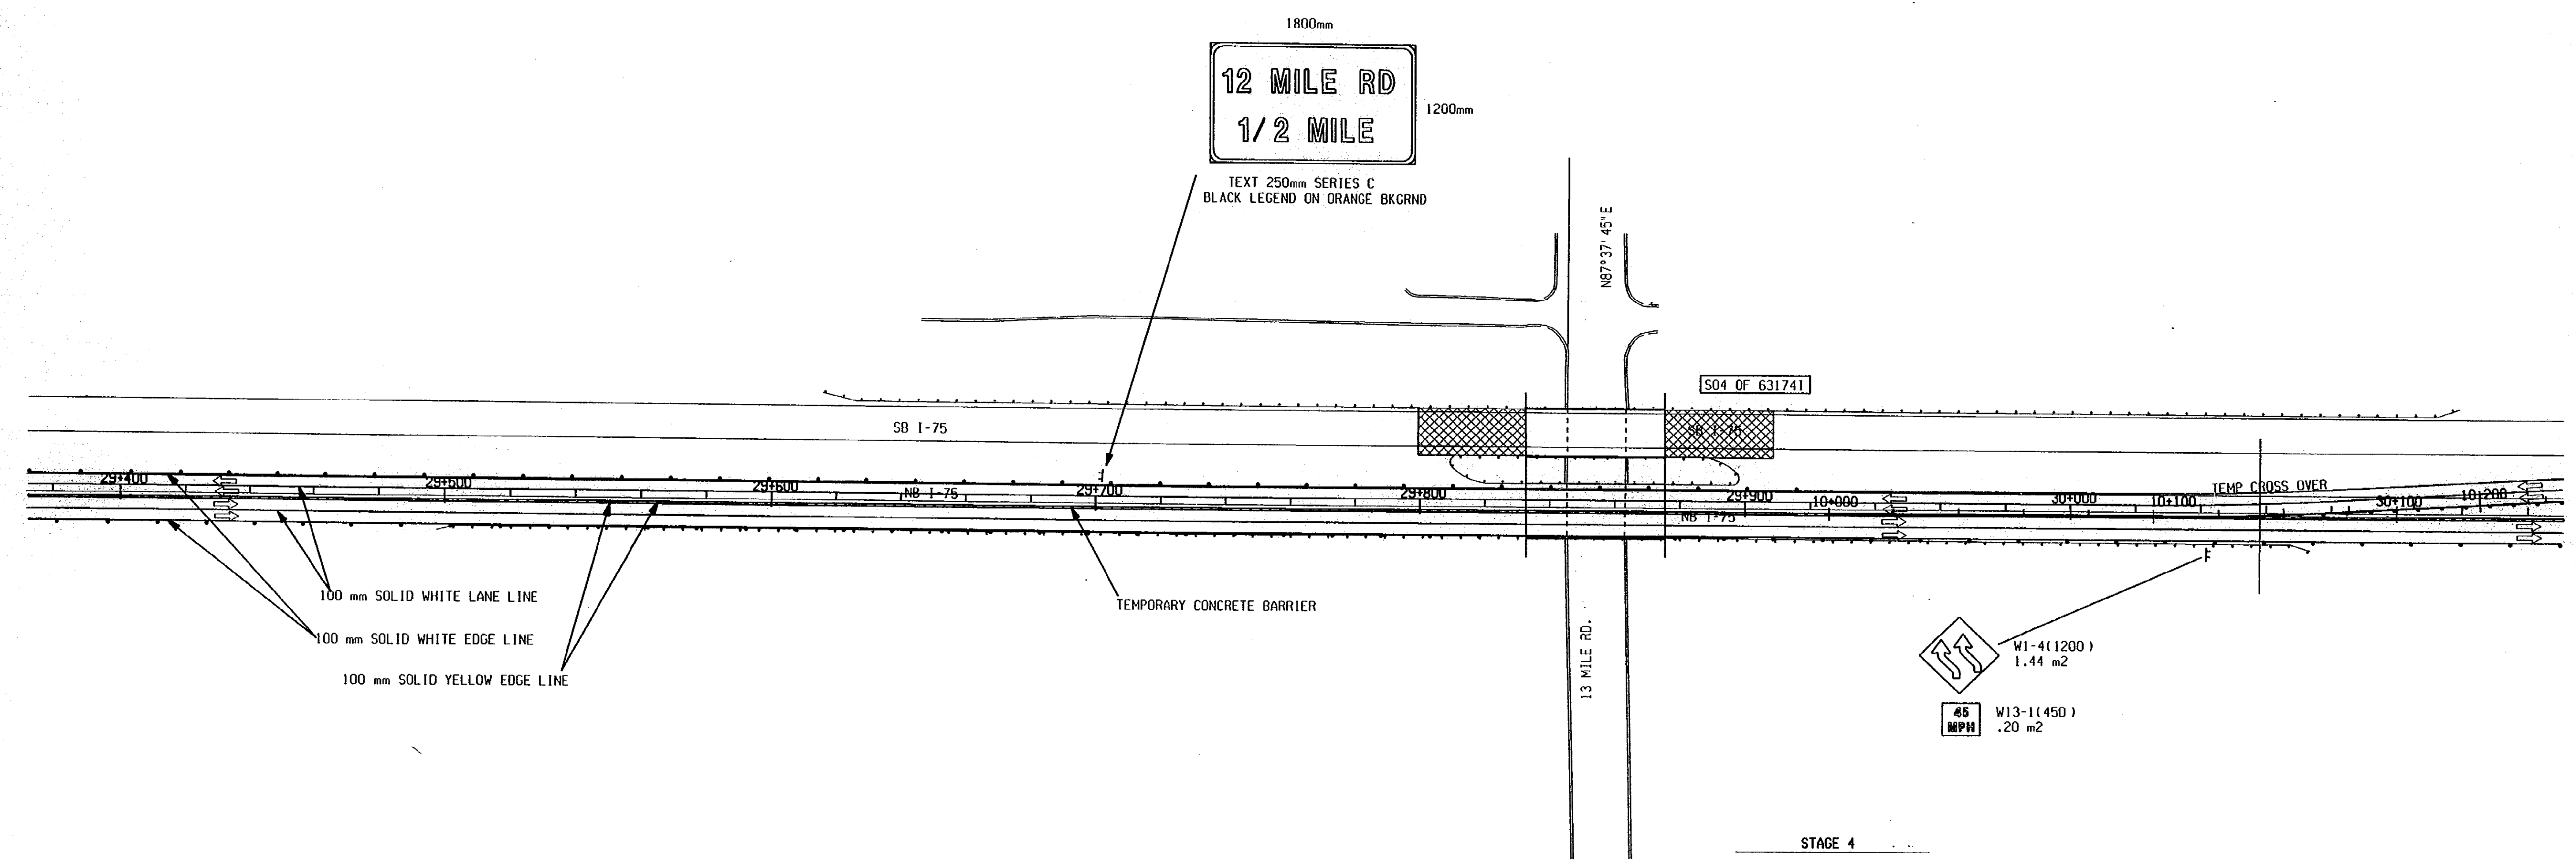

- 1) MAINTAIN TRAFFIC TWO LANES EACH WAY ON NB I-75, AND THE SB I-75 TRAFFIC USING TEMPORARY CROSS-OVERS.
- 2) REMOVE AND REPLACE SB I-75.


MAINTAINING TRAFFIC

13 MILE RD

	STA 29+380 TO STA 30+140 NB I-75				
	DATE	SCALE	CONT. SEC.	JOB NO.	DESIGN UNIT
	01/06/01	1:1000	63174	49595	OTSC TRAFFIC
					SHEET NO. R.O.W. 68

AUTH			DATE			NO.			REVISION		

46 47

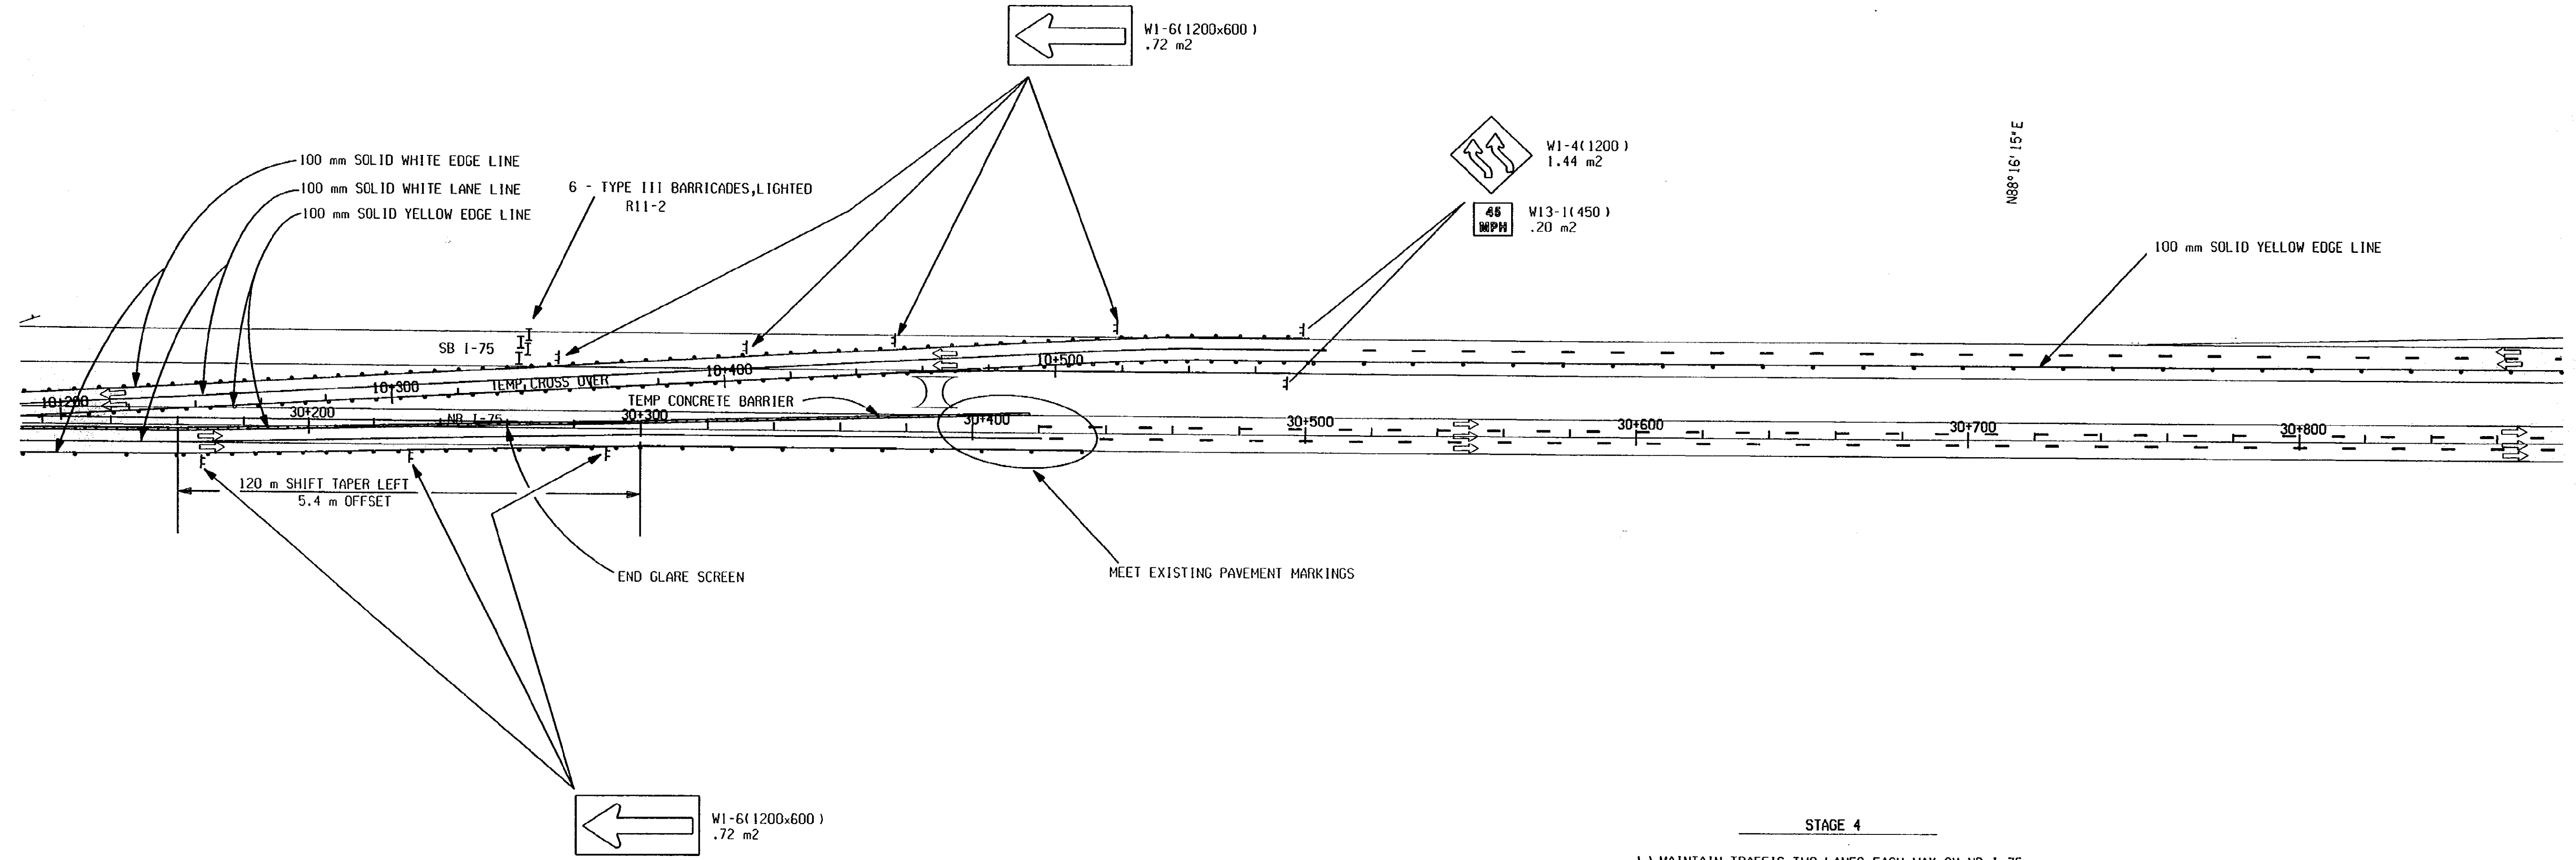


- STAGE 4
- 1) MAINTAIN TRAFFIC TWO LANES EACH WAY ON NB I-75, AND THE SB I-75 TRAFFIC USING TEMPORARY CROSS-OVERS.
 - 2) REMOVE AND REPLACE SB I-75.

MAINTAINING TRAFFIC

	STA 30+140 TO STA 30+860 NB I-75					
	DATE	SCALE	CONT. SEC.	JOB NO.	DESIGN UNITY	SHEET NO.
01/06/01	1:1000	63174	49595	DTSC TRAFFIC	R.O.W	69

FILE NAME: 49595maint6.dgn

FINAL R.O.W.			
AUTH	DATE	NO.	REVISION

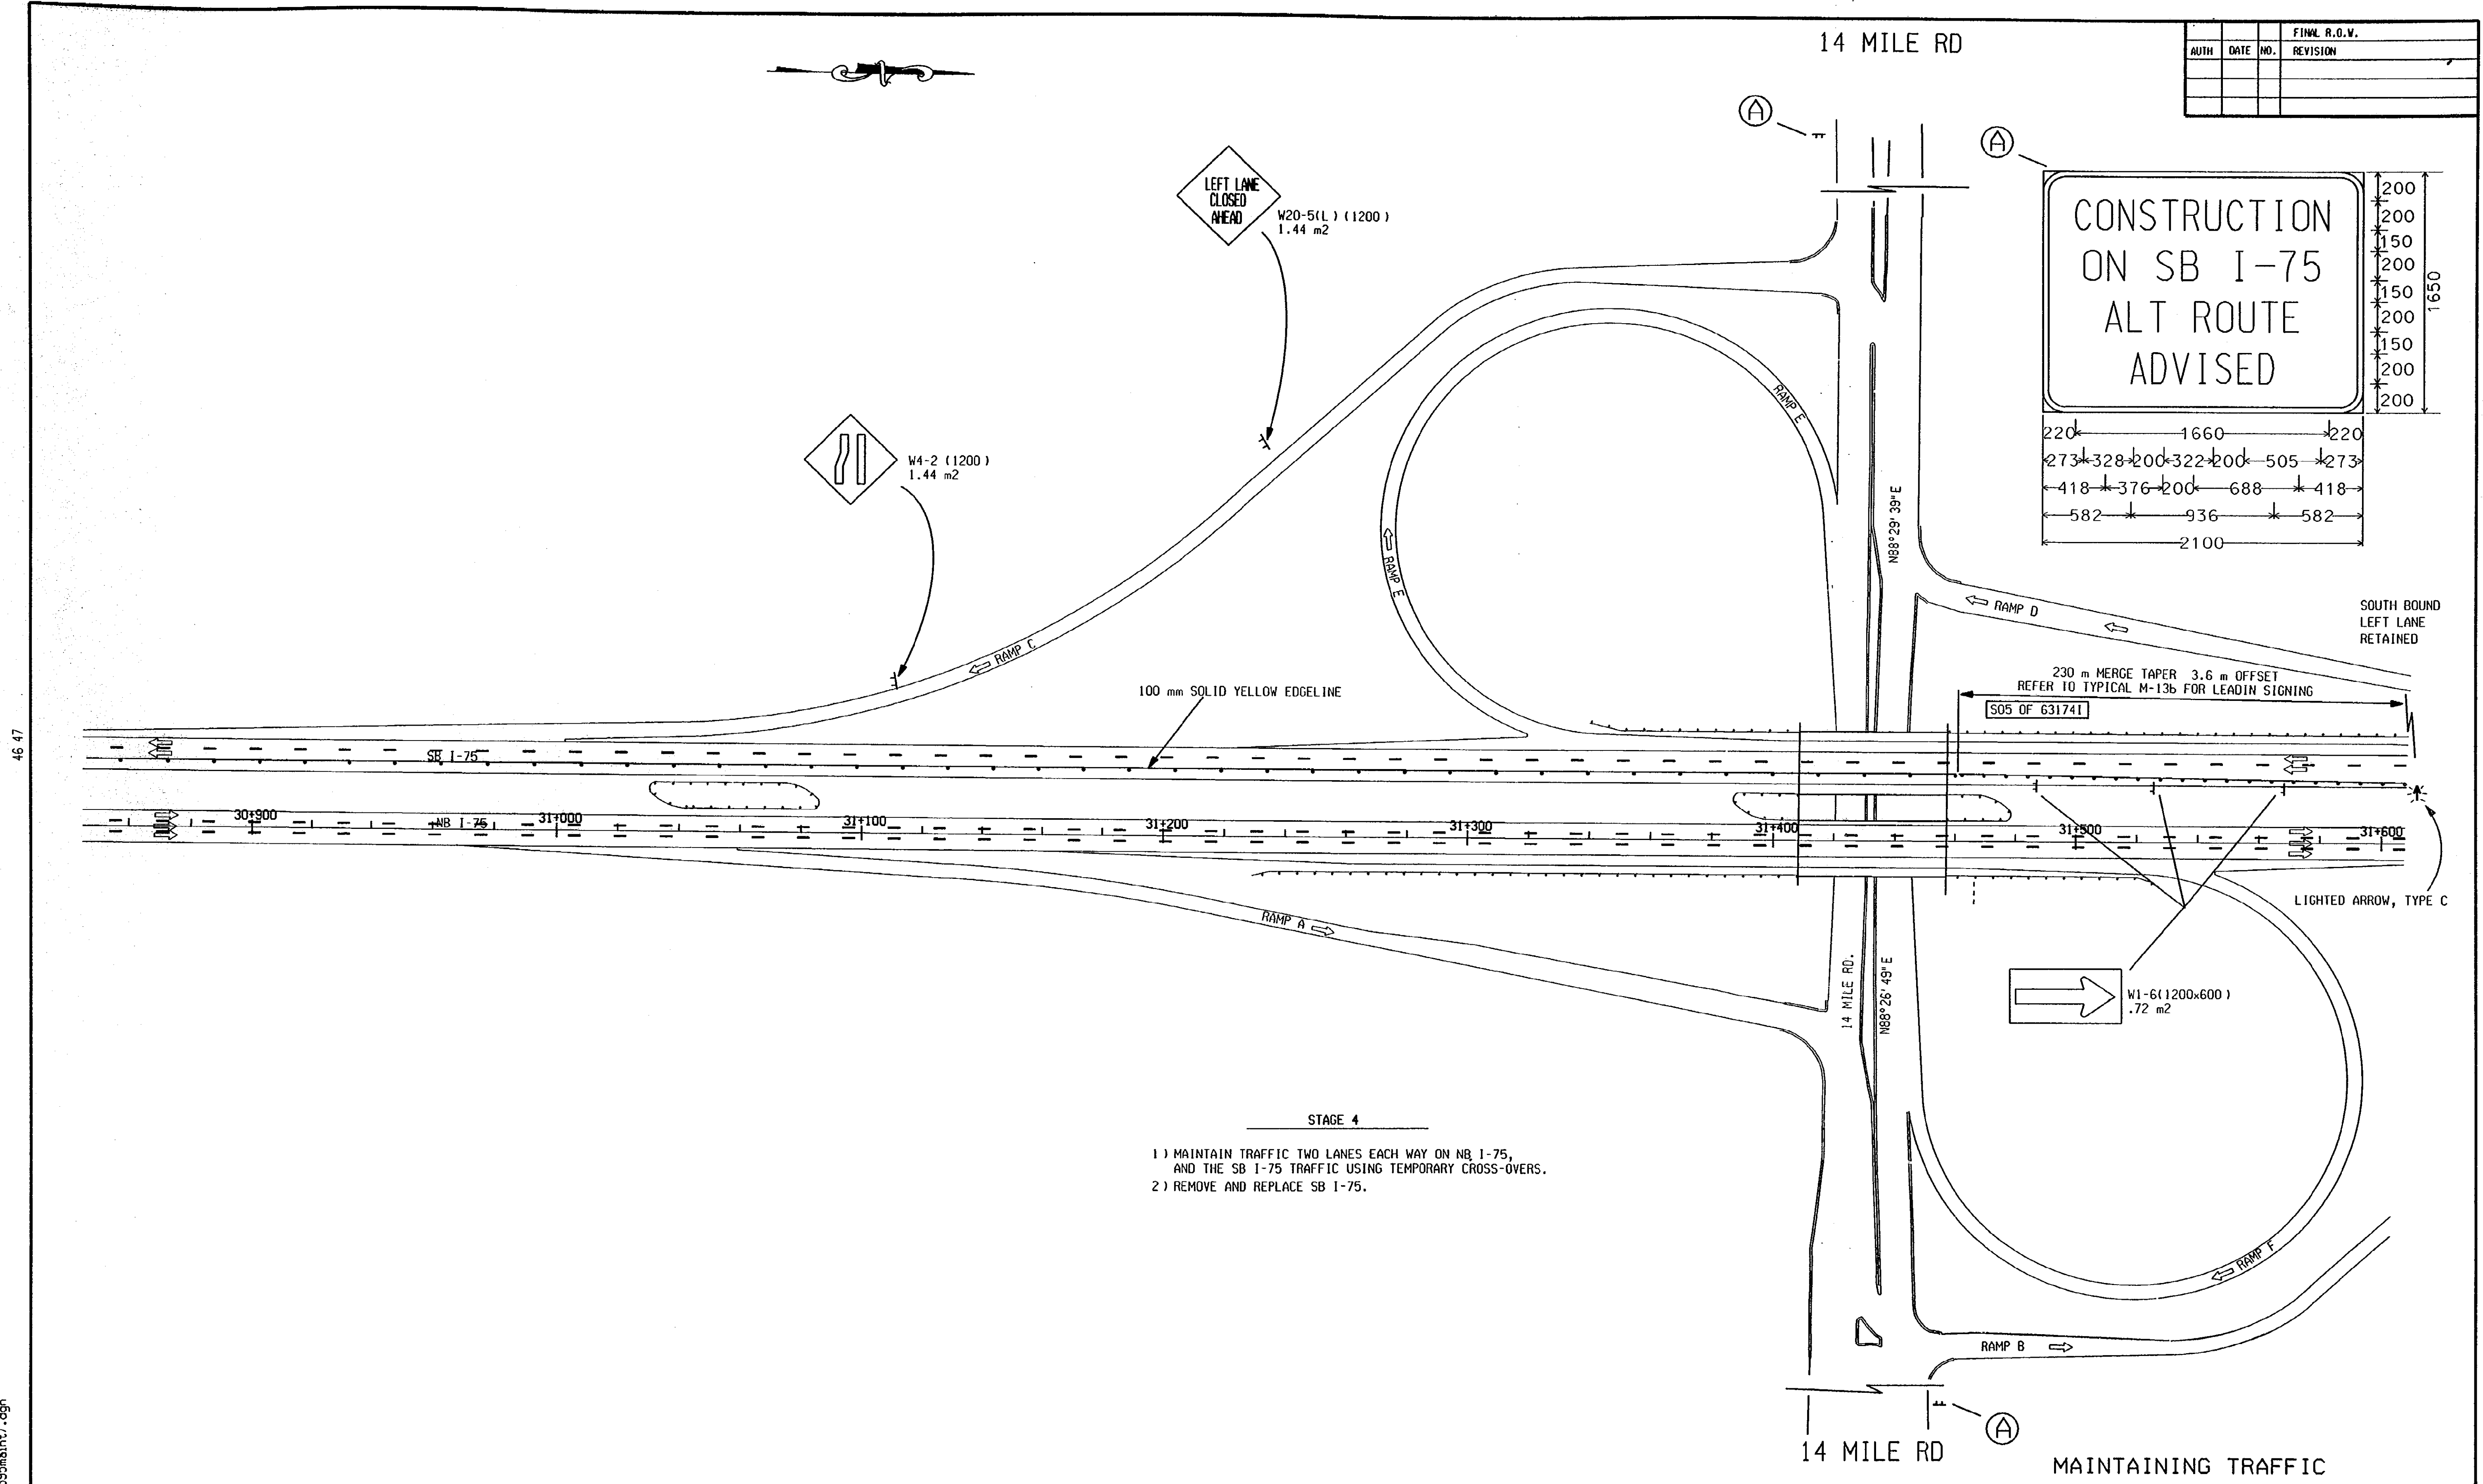

- STAGE 4
- 1) MAINTAIN TRAFFIC TWO LANES EACH WAY ON NB I-75, AND THE SB I-75 TRAFFIC USING TEMPORARY CROSS-OVERS.
 - 2) REMOVE AND REPLACE SB I-75.

46 47

FILE NAME: 49595maint7.dgn

	STA 30+860 TO STA 31+600 NB I-75					
	DATE	SCALE	CONT. SEC.	JOB NO.	DESIGN UNIT	SHEET NO.
	01/06/01	1:1000	63174	49595	DISC TRAFFIC	70


CONTROL SECTION 63174 JOB NO. 49595 SH. NO. 71

47 48 49

FILE NAME: 49595lover2.dgn

GARDENIA AVE

AUTH			DATE			NO.			REVISION			FINAL R.O.V.		

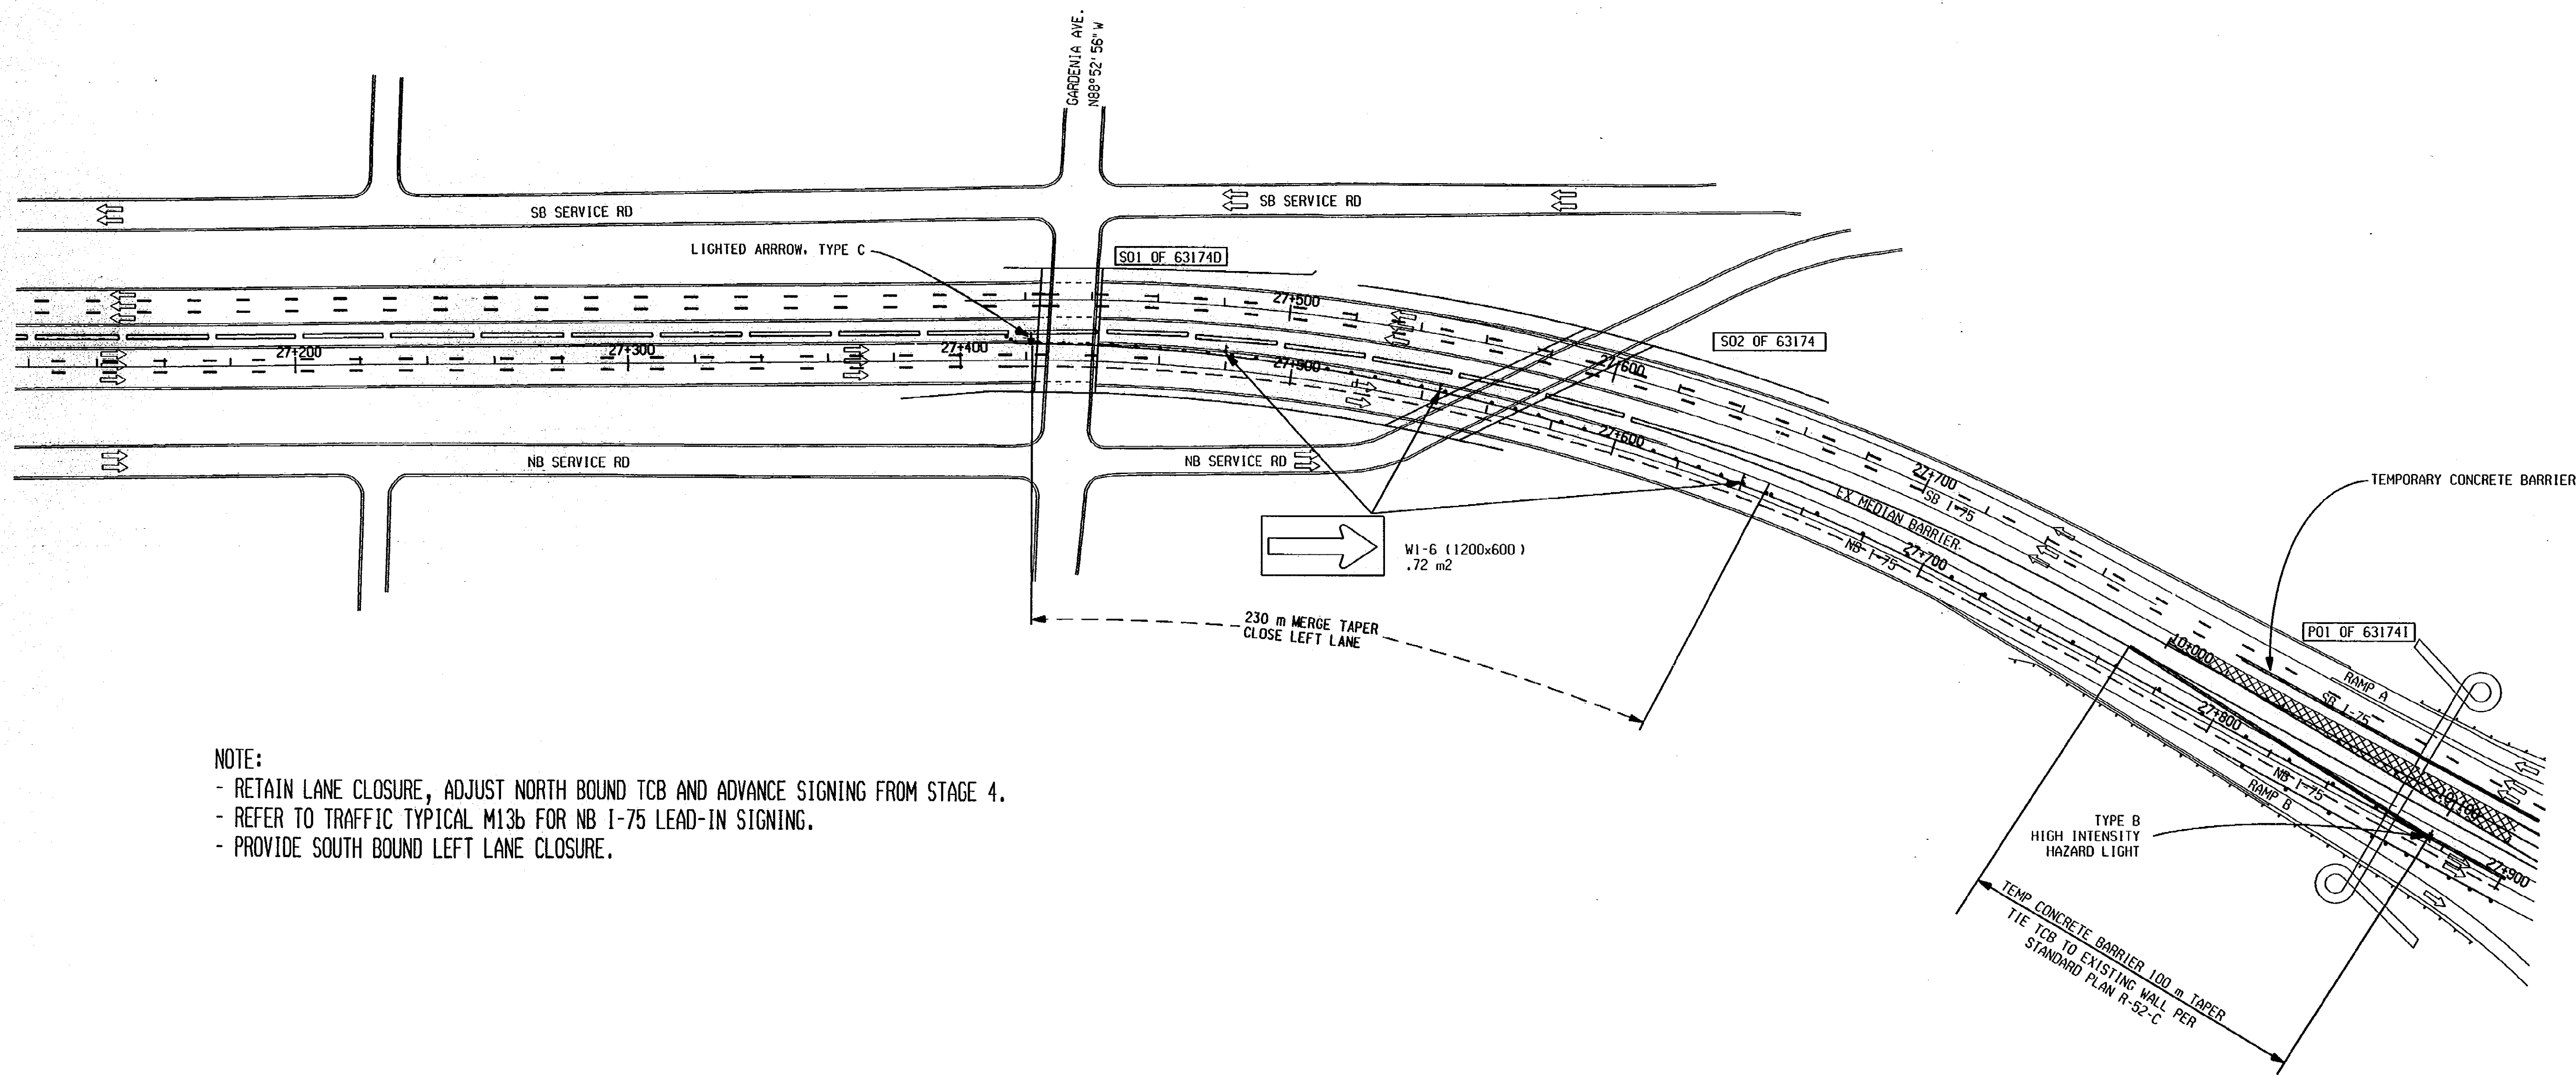

NOTE:
 - RETAIN LANE CLOSURE, ADJUST NORTH BOUND TCB AND ADVANCE SIGNING FROM STAGE 4.
 - REFER TO TRAFFIC TYPICAL M136 FOR NB I-75 LEAD-IN SIGNING.
 - PROVIDE SOUTH BOUND LEFT LANE CLOSURE.

- STAGE 5
- 1) MAINTAIN TRAFFIC ON THE TWO OUTSIDE LANES OF NB I-75 & SB I-75.
 - 2) REMOVE TEMPORARY CROSS-OVERS AND REBUILD MEDIAN BARRIER.

MAINTAINING TRAFFIC


GARDENIA AVE

	STA 27+120 TO STA 27+900 NB I-75							
	DATE	SCALE	CONT. SEC.	JOB NO.	DESIGN UNIT	SHEET NO.		R.O.W.
01/05/01	1:1000	63174	49595	OTSC TRAFFIC	71		71	

CONTROL SECTION 63174 JOB NO. 49595 SK. NO. 72

EXISTING BY: RICK'S TEAM DATE: 11-04-00
 PROPOSED BY: LAST CORRECTION BY: DATE:
 FILE NAME: 49595maint3.dgn
 1 2 3 4 5 6 7 8 9 10 11 12 13 14 15 16 17 18 19 20 21 22 23 24 25 26 27 28 29 30 31 32 33 34 35 36 37 38 39 40 41 42 43 44 45 46 47 48 49 50 51 52 53 54 55 56 57 58 59 60 61 62 63

FINAL R.O.V.			
AUTH	DATE	NO.	REVISION

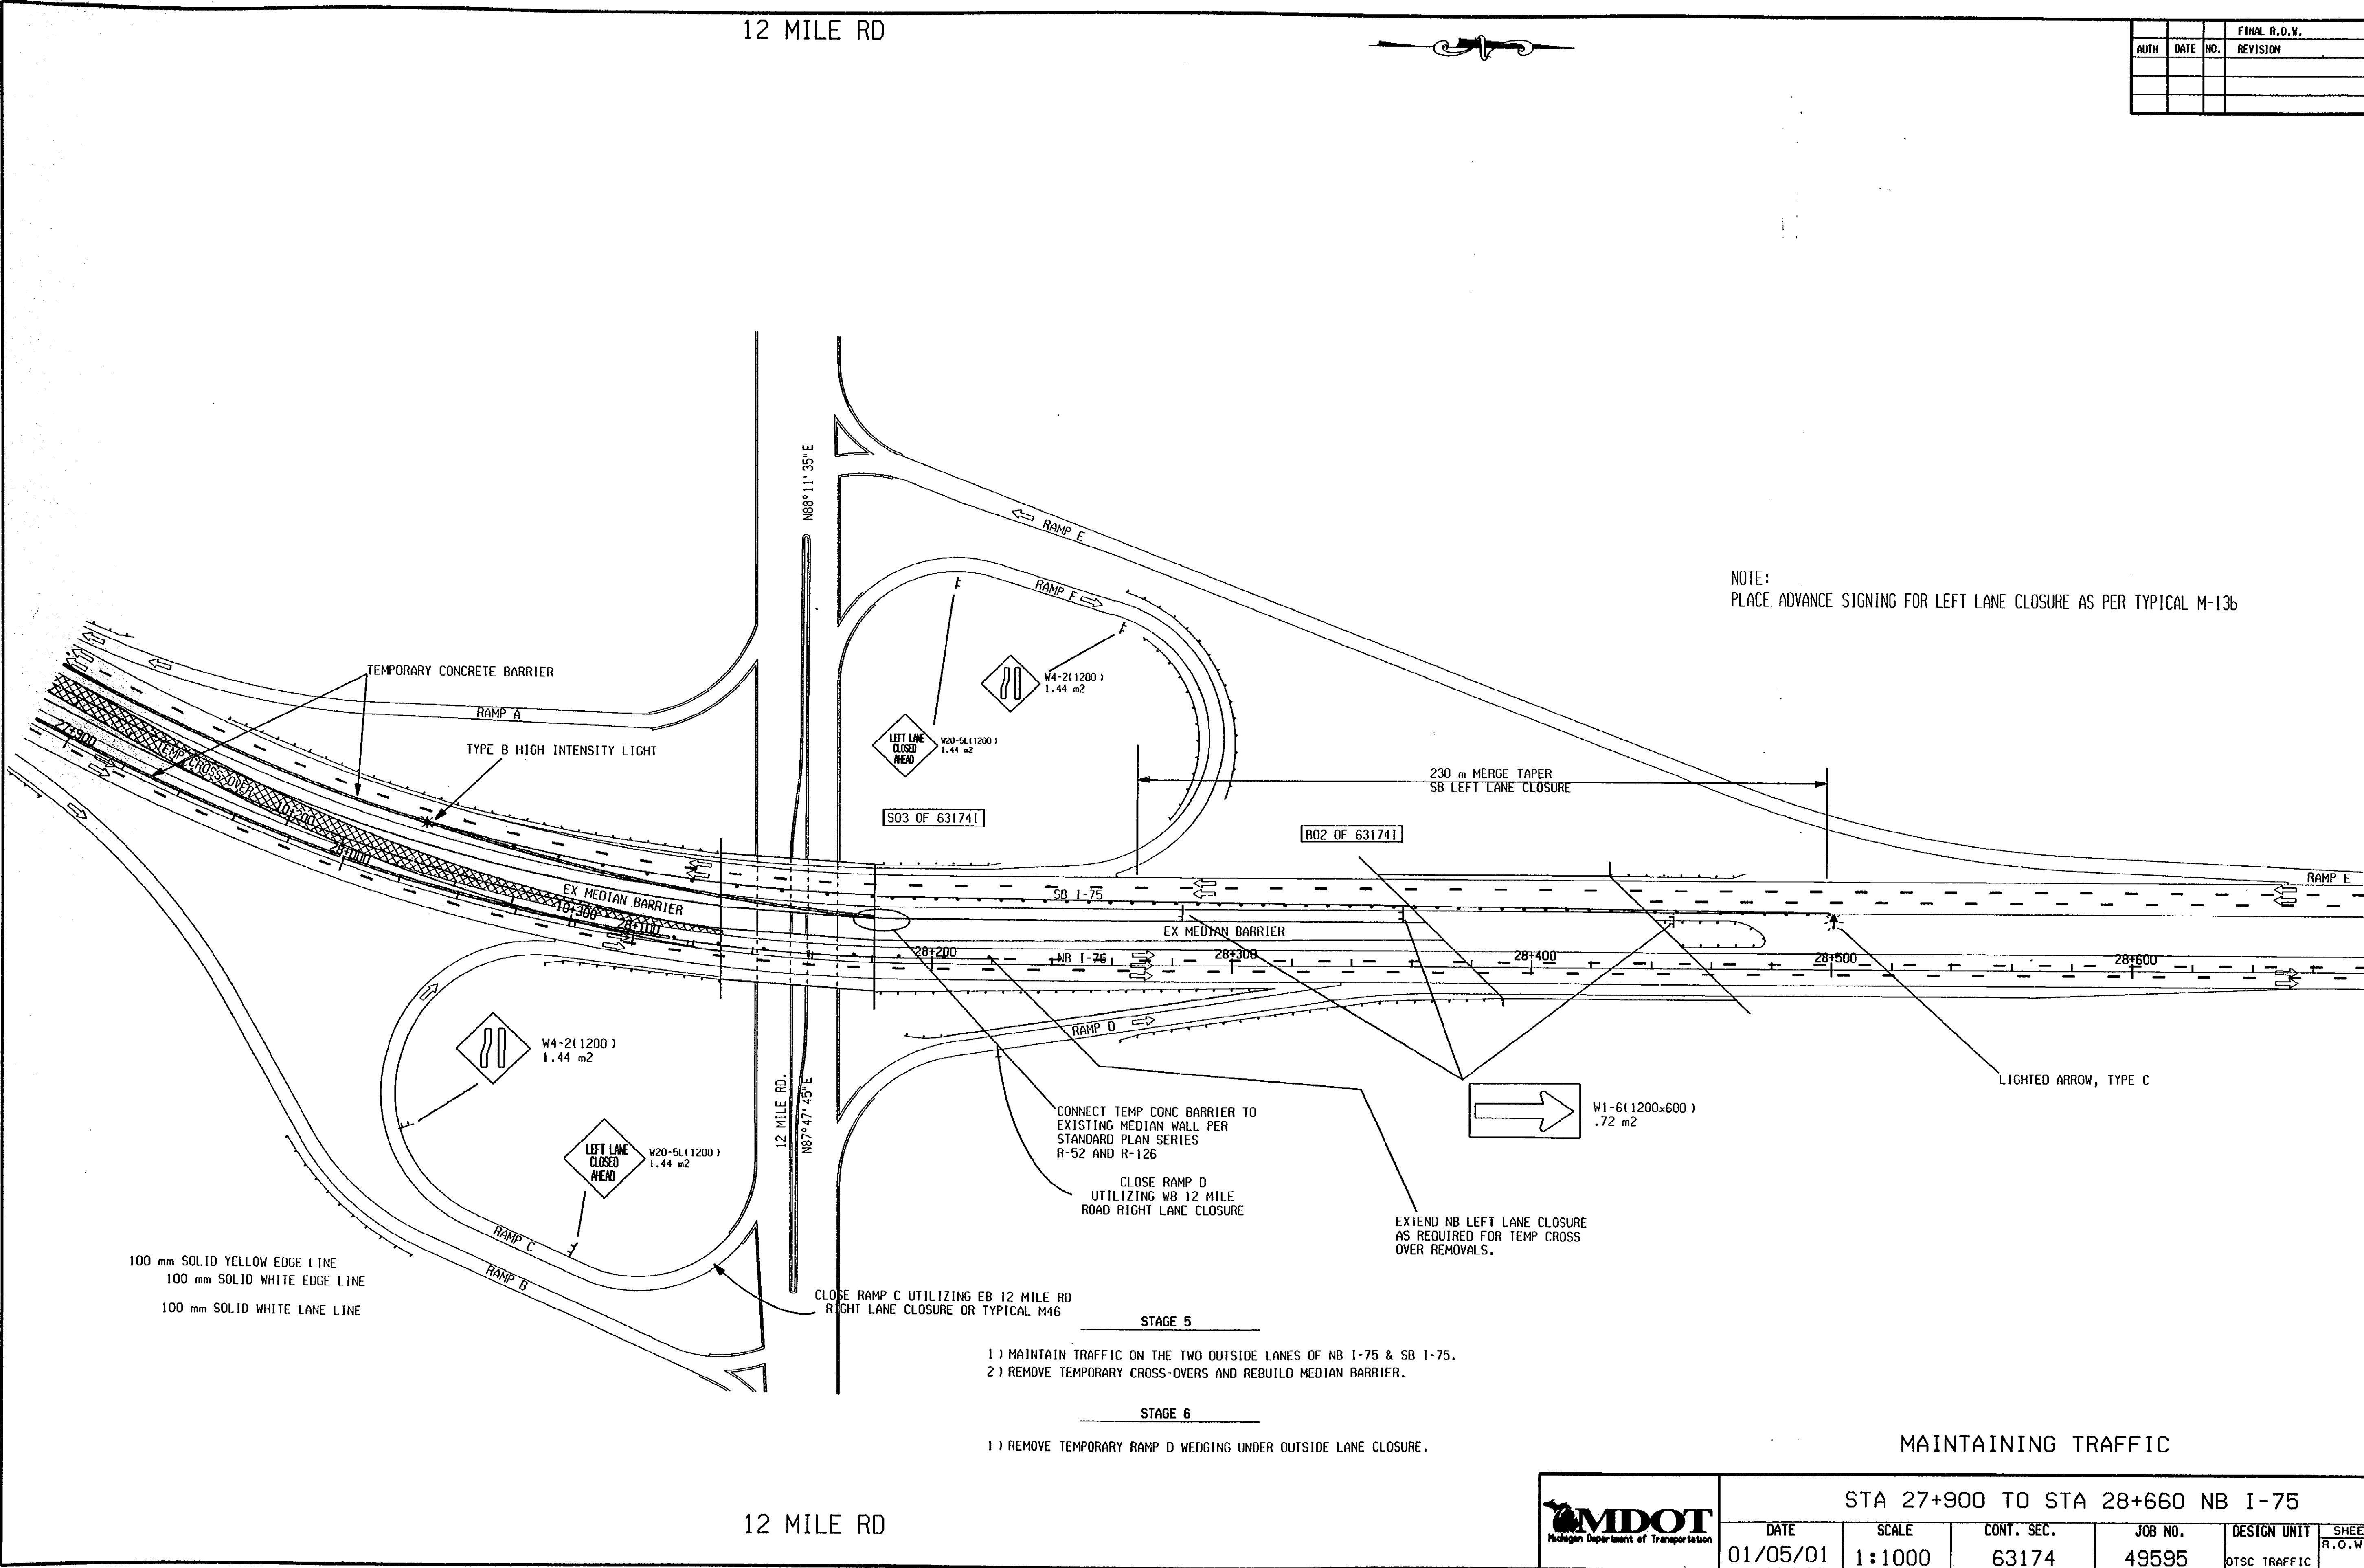

NOTE:
 PLACE ADVANCE SIGNING FOR LEFT LANE CLOSURE AS PER TYPICAL M-136

100 mm SOLID YELLOW EDGE LINE
 100 mm SOLID WHITE EDGE LINE
 100 mm SOLID WHITE LANE LINE

STAGE 5
 1) MAINTAIN TRAFFIC ON THE TWO OUTSIDE LANES OF NB I-75 & SB I-75.
 2) REMOVE TEMPORARY CROSS-OVERS AND REBUILD MEDIAN BARRIER.

STAGE 6
 1) REMOVE TEMPORARY RAMP D WEDGING UNDER OUTSIDE LANE CLOSURE.

MAINTAINING TRAFFIC

	STA 27+900 TO STA 28+660 NB I-75					
	DATE	SCALE	CONT. SEC.	JOB NO.	DESIGN UNIT	SHEET NO.
	01/05/01	1:1000	63174	49595	OTSC TRAFFIC	R.O.W. 72



EXISTING BY: DATE:
 PROPOSED BY: DATE:
 LAST CORRECTION BY: DATE:

36

14

11

FILE NAME:

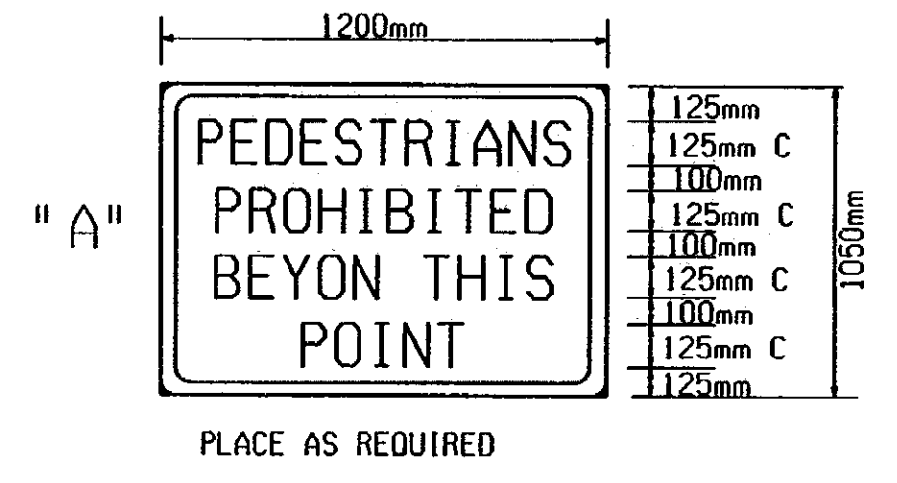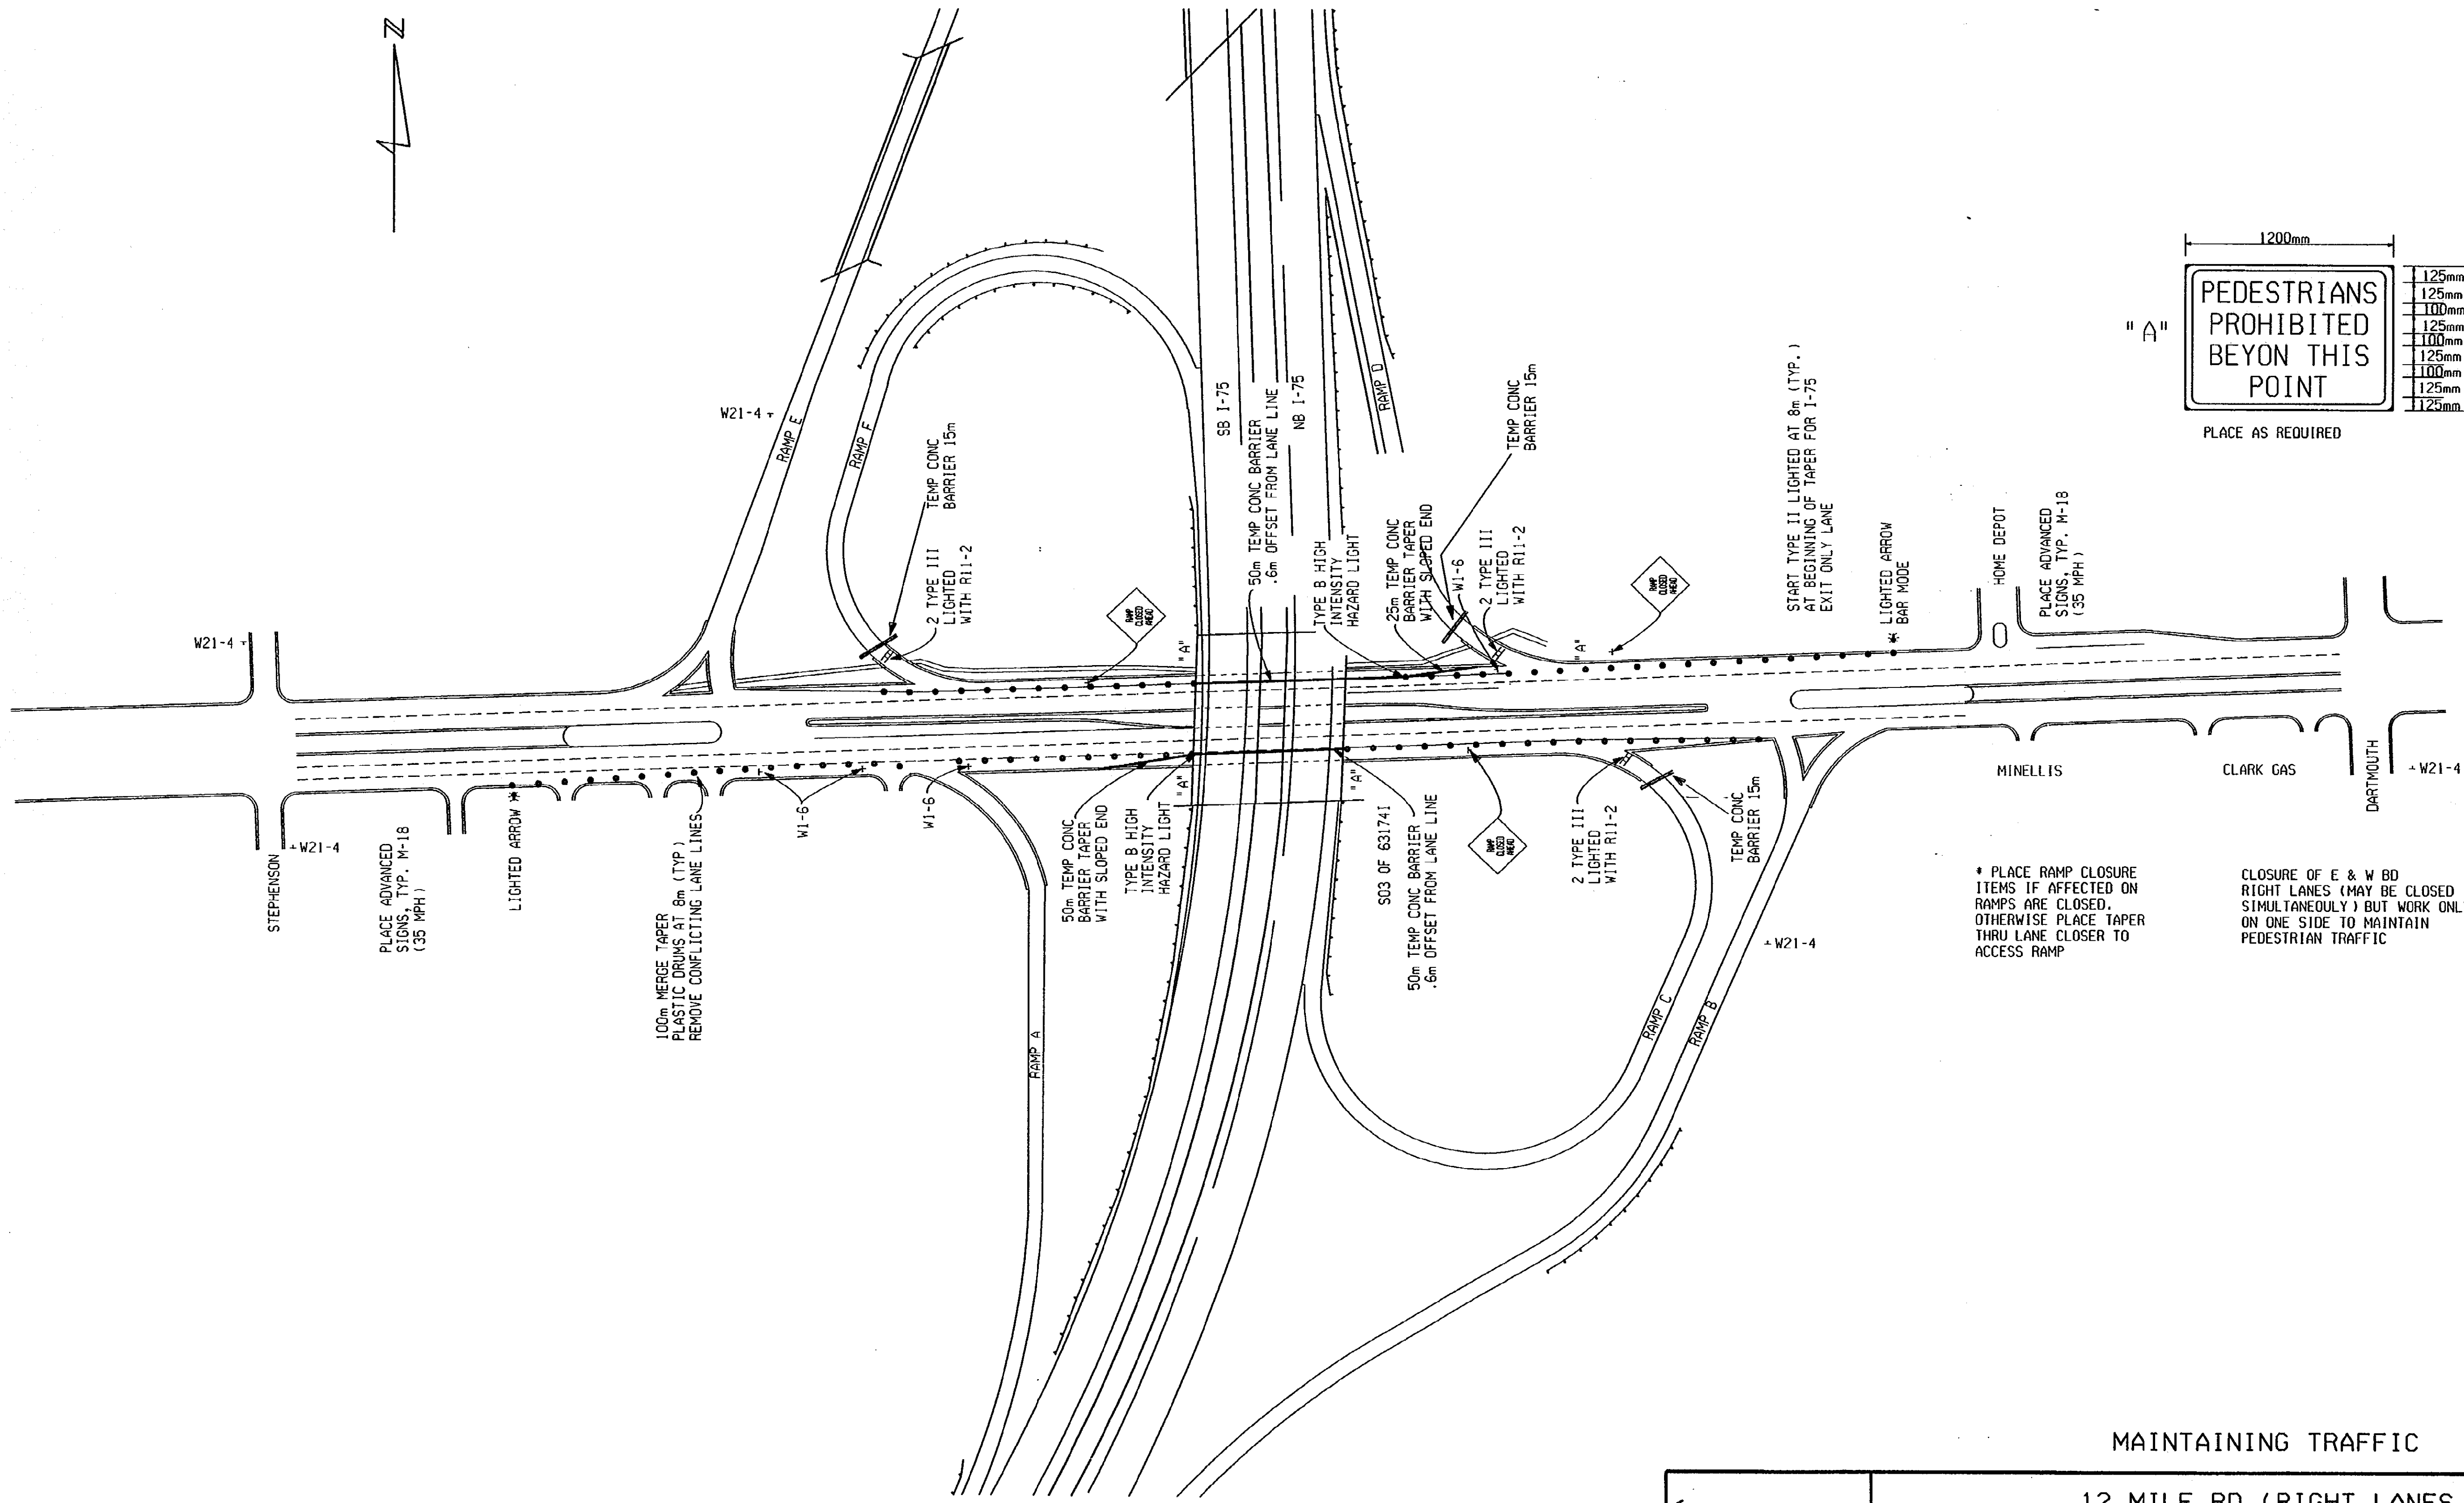

* PLACE RAMP CLOSURE ITEMS IF AFFECTED ON RAMP ARE CLOSED, OTHERWISE PLACE TAPER THRU LANE CLOSER TO ACCESS RAMP

CLOSURE OF E & W BD RIGHT LANES (MAY BE CLOSED SIMULTANEOUSLY) BUT WORK ONLY ON ONE SIDE TO MAINTAIN PEDESTRIAN TRAFFIC

MAINTAINING TRAFFIC

	12 MILE RD (RIGHT LANES)					
	DATE	SCALE	CONT. SEC.	JOB NO.	DESIGN UNIT	SHEET NO.
	01/04/01	1:NONE	N/A	49595	OTSC TRAFFIC	R.O.W. 73

FINAL R.O.W.			
AUTH	DATE	NO.	REVISION

EXISTING BY: DATE: PROPOSED BY: DATE: LAST CORRECTION BY: DATE:

36



14

11

8

FILE NAME:

FINAL R.O.W.			
AUTH	DATE	NO.	REVISION

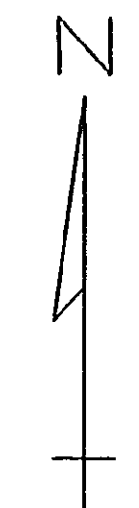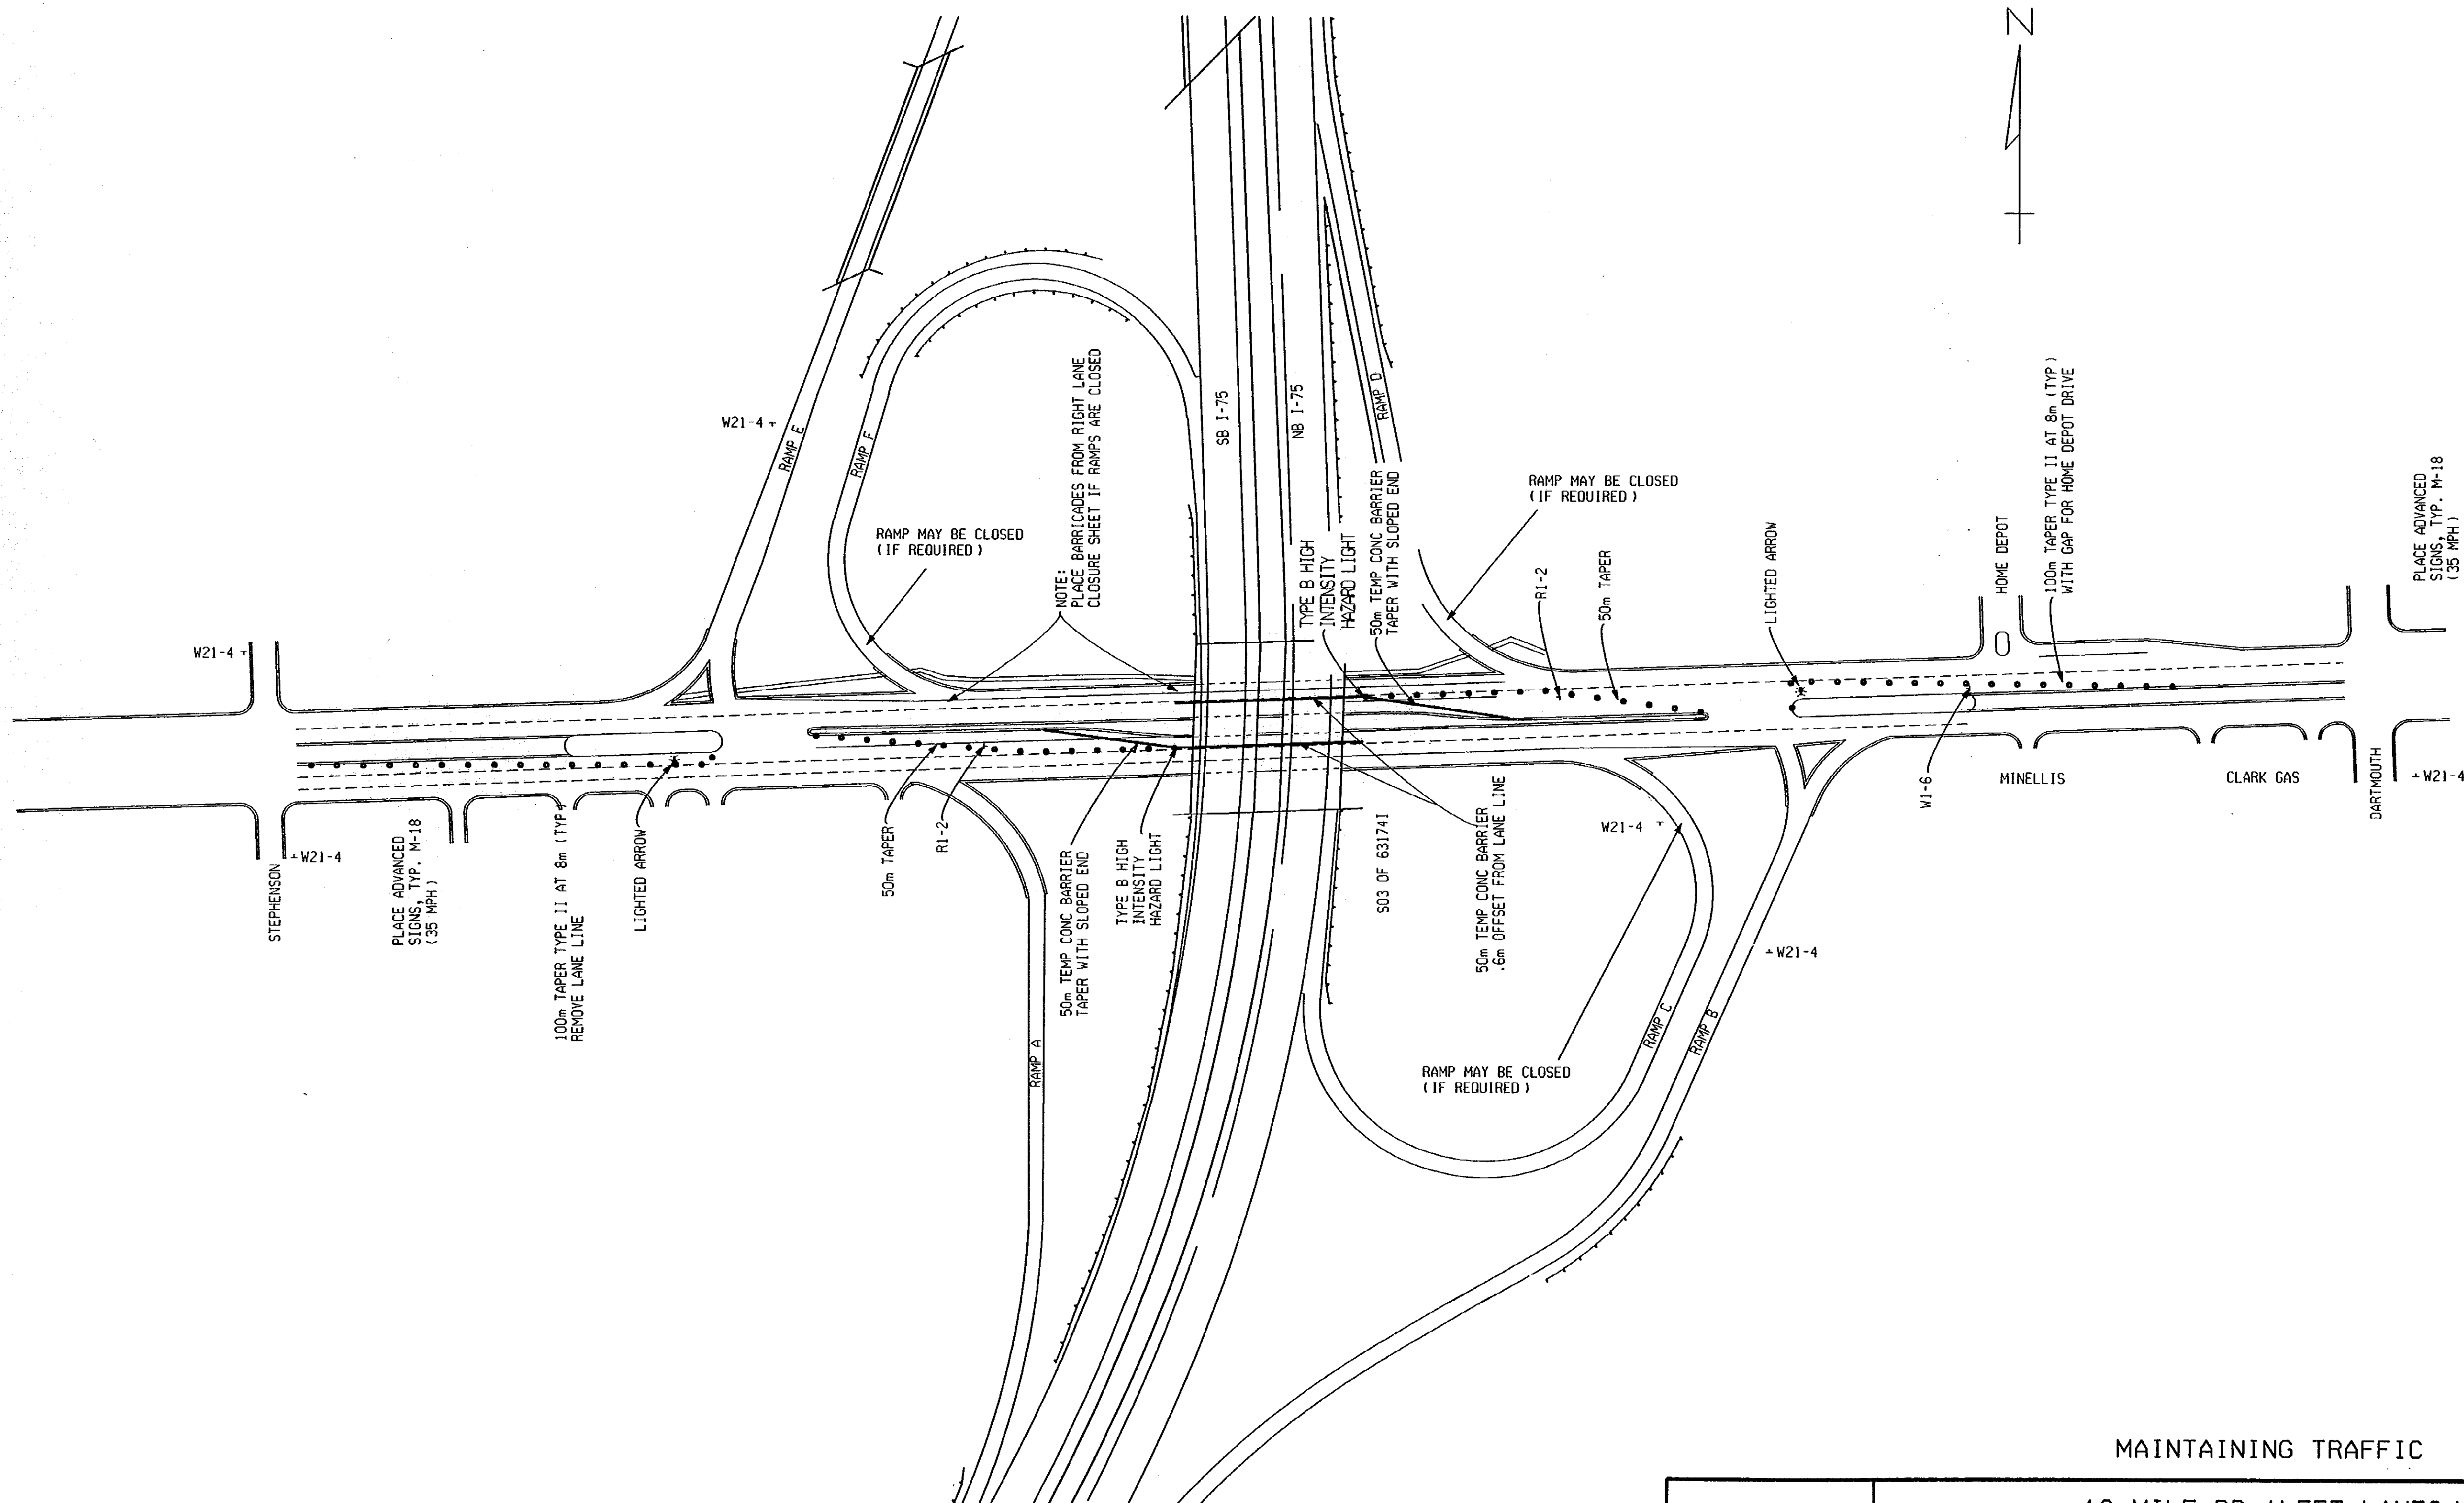

MAINTAINING TRAFFIC

12 MILE RD (LEFT LANES)


	DATE	SCALE	CONT. SEC.	JOB NO.	DESIGN UNIT	SHEET NO.
	01/04/01	1:NONE	N/A	49595	OTSC TRAFFIC	R.O.W. 74

EXISTING BY: DATE:
 PROPOSED BY: DATE:
 LAST CORRECTION BY: DATE:


FINAL R.O.W.			
AUTH	DATE	NO.	REVISION

FILE NAME: 36

11 14

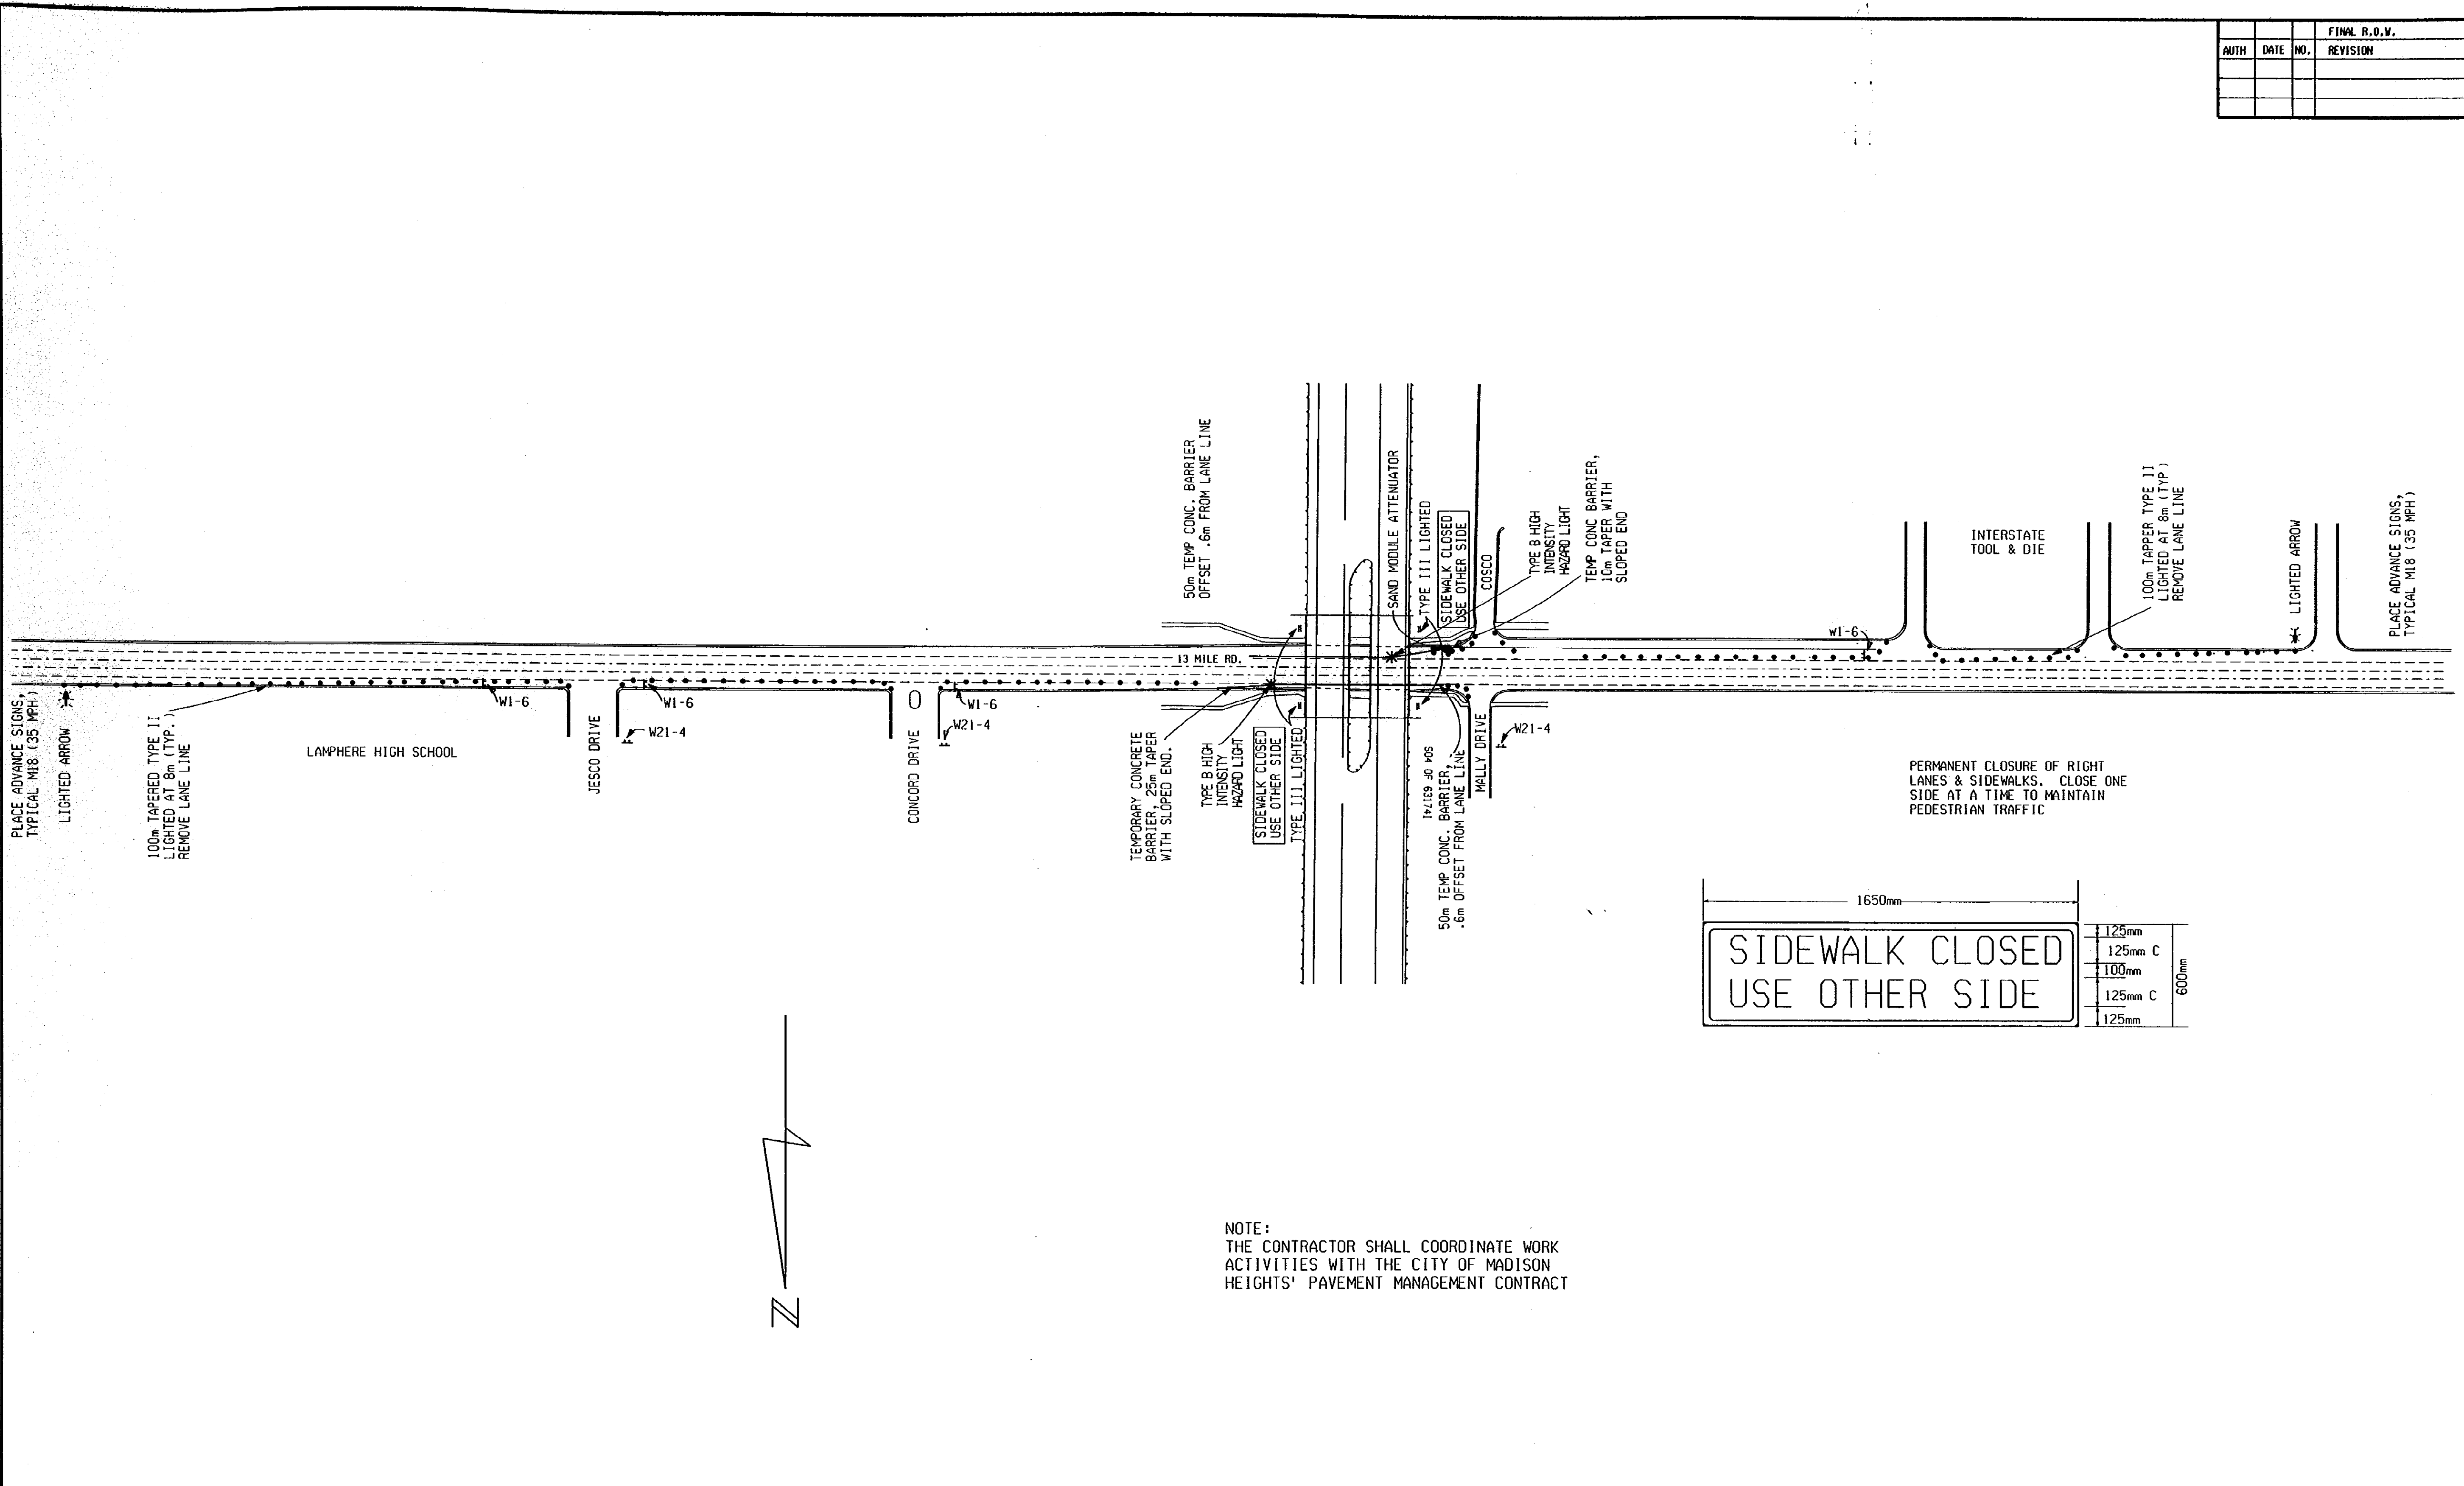

NOTE:
 THE CONTRACTOR SHALL COORDINATE WORK
 ACTIVITIES WITH THE CITY OF MADISON
 HEIGHTS' PAVEMENT MANAGEMENT CONTRACT

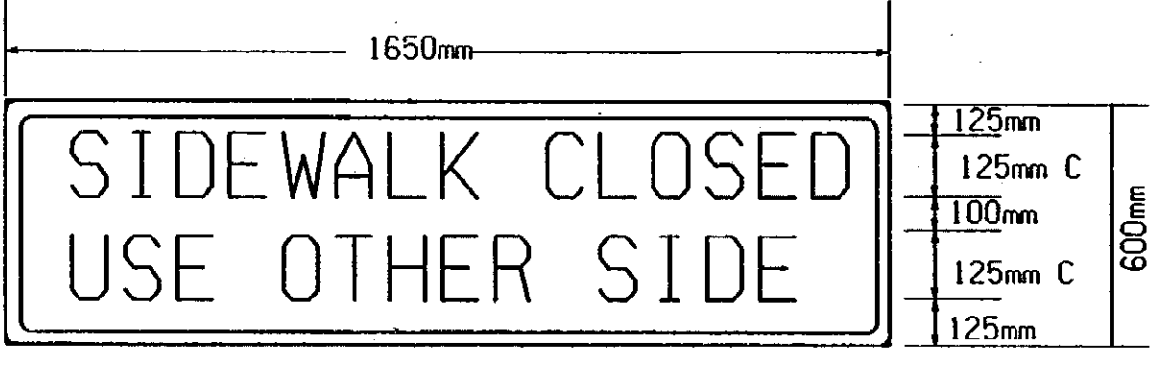

PERMANENT CLOSURE OF RIGHT
 LANES & SIDEWALKS. CLOSE ONE
 SIDE AT A TIME TO MAINTAIN
 PEDESTRIAN TRAFFIC


MAINTAINING TRAFFIC

	13 MILE RD					
	DATE	SCALE	CONT. SEC.	JOB NO.	DESIGN UNIT	SHEET NO.
01/04/01	1:NONE	N/A	49595	OTSC TRAFFIC	R.O.W.	75


DATE: DATE: DATE: 12-8-00
 EXISTING BY: PROPOSED BY: LAST CORRECTION BY: BLOCK K
 FILE NAME: 75cover.ir.dgn
 1 2 3 4 5 6 7 8 9 10 11 12 13 14 15 16 17 18 19 20 21 22 23 24 25 26 27 28 29 30 31 32 33 34 35 36 37 38 39 40 41 42 43 44 45 46 47 48 49 50 51 52 53 54 55 56 57 58 59 60 61 62 63

FINAL R.O.W.			
AUTH	DATE	NO.	REVISION


TEST HOLE NO. Core #52
 STATION 27+970 MEDIAN DITCH
 N. B. 1-75 MEDIAN
 T1N R11E SEC 14 OAKLAND CO.
 DATE DRILLED 10-13-00

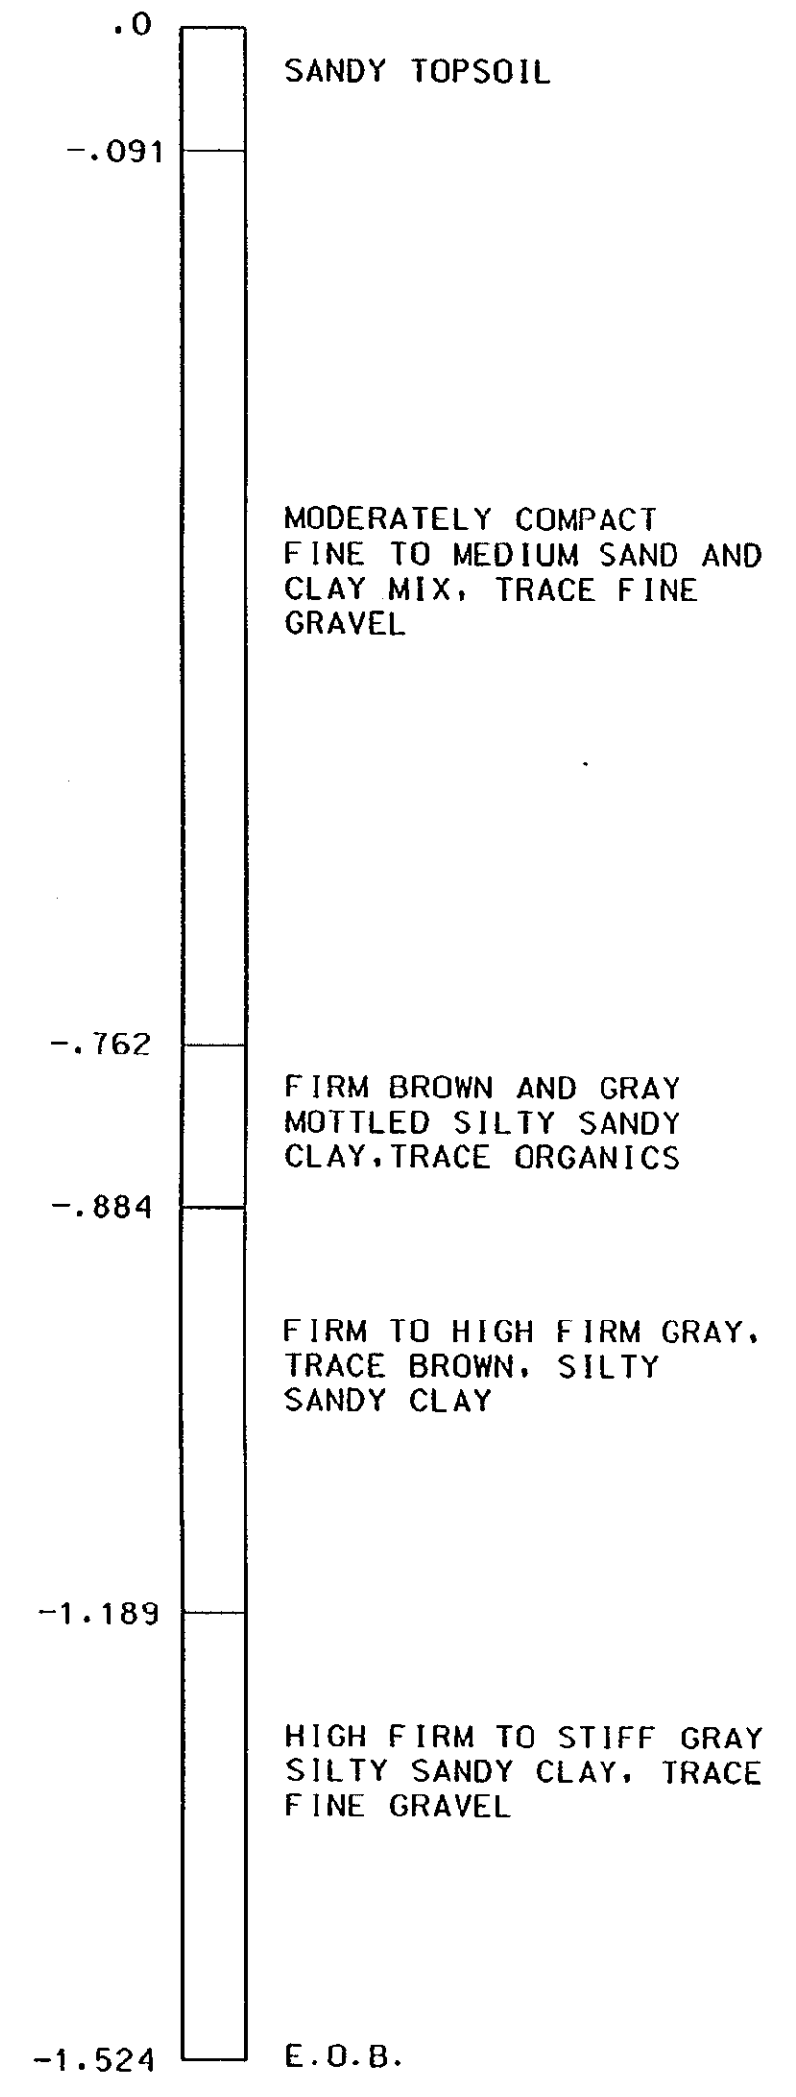


TEST HOLE NO. Core #53
 STATION 30+310 MEDIAN DITCH
 N. B. 1-75 MEDIAN
 T1N R11E SEC 11 OAKLAND CO.
 DATE DRILLED 10-13-00

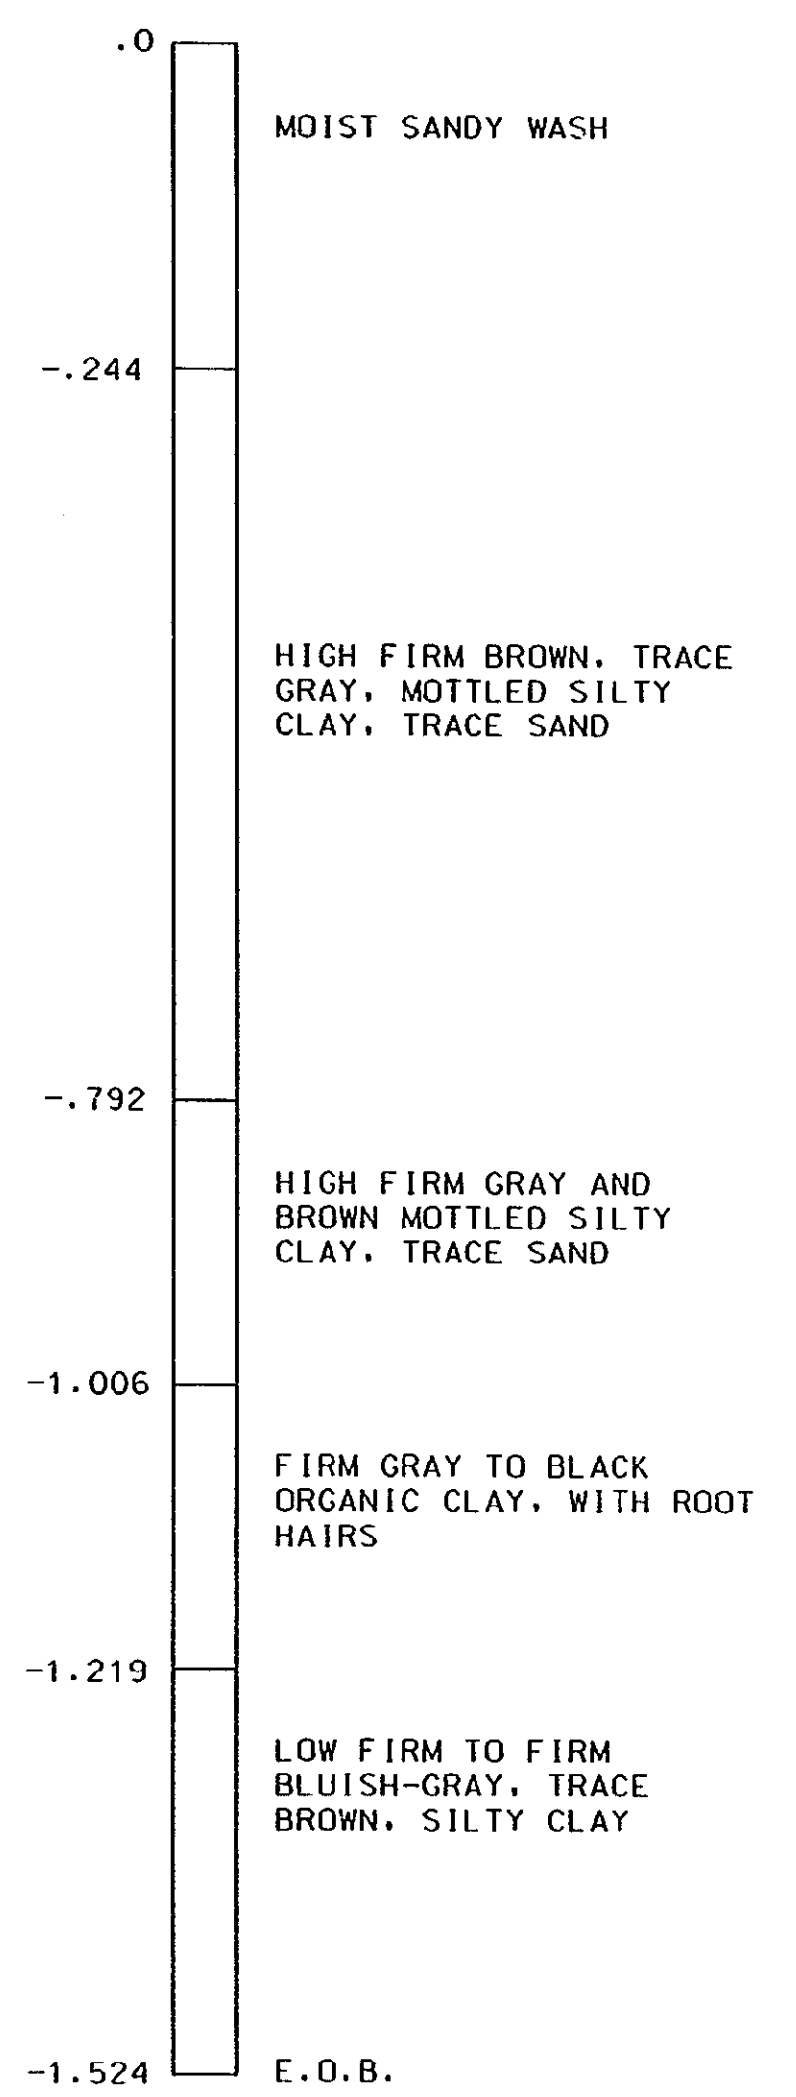


TEST HOLE NO. Core #54
 STATION 28+820 2.30m Lt. OF Lt. E.O.M.
 N. B. 1-75 MEDIAN SHOULDER
 T1N R11E SEC 14 OAKLAND CO.
 DATE DRILLED 10-16-00

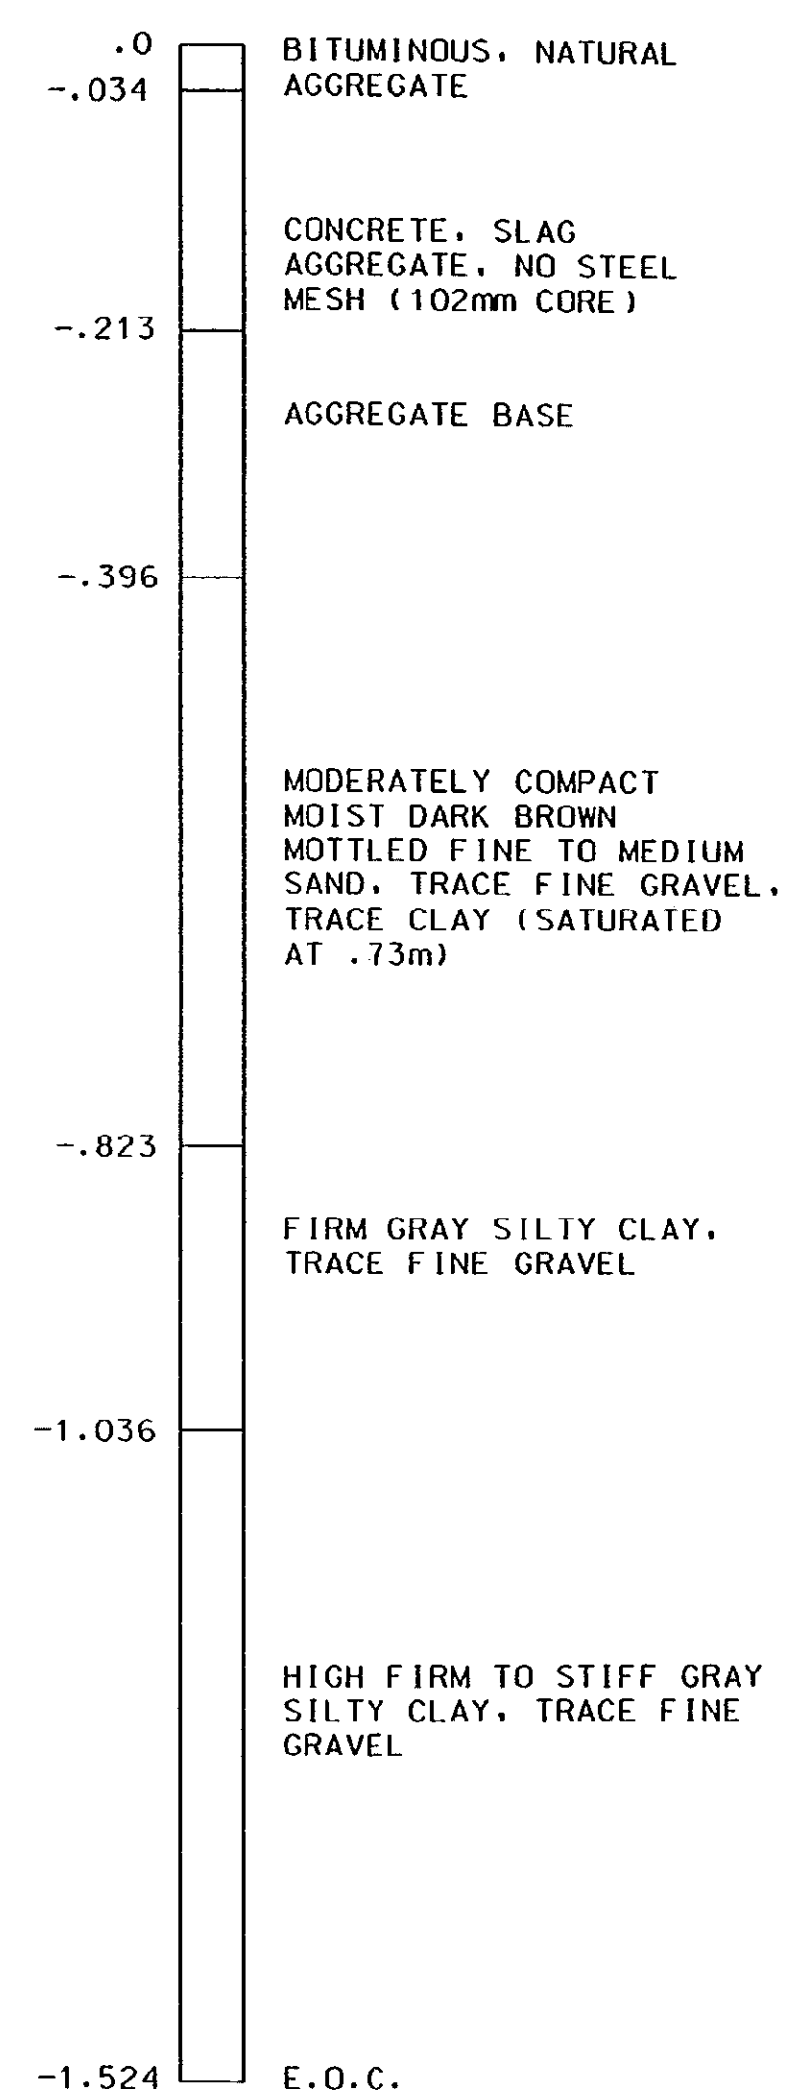

TEST HOLE NO. Core #55
 STATION 30+250 1.30m Lt. OF Lt. E.O.M.
 N. B. 1-75 MEDIAN SHOULDER
 T1N R11E SEC 2 OAKLAND CO.
 DATE DRILLED 10-16-00

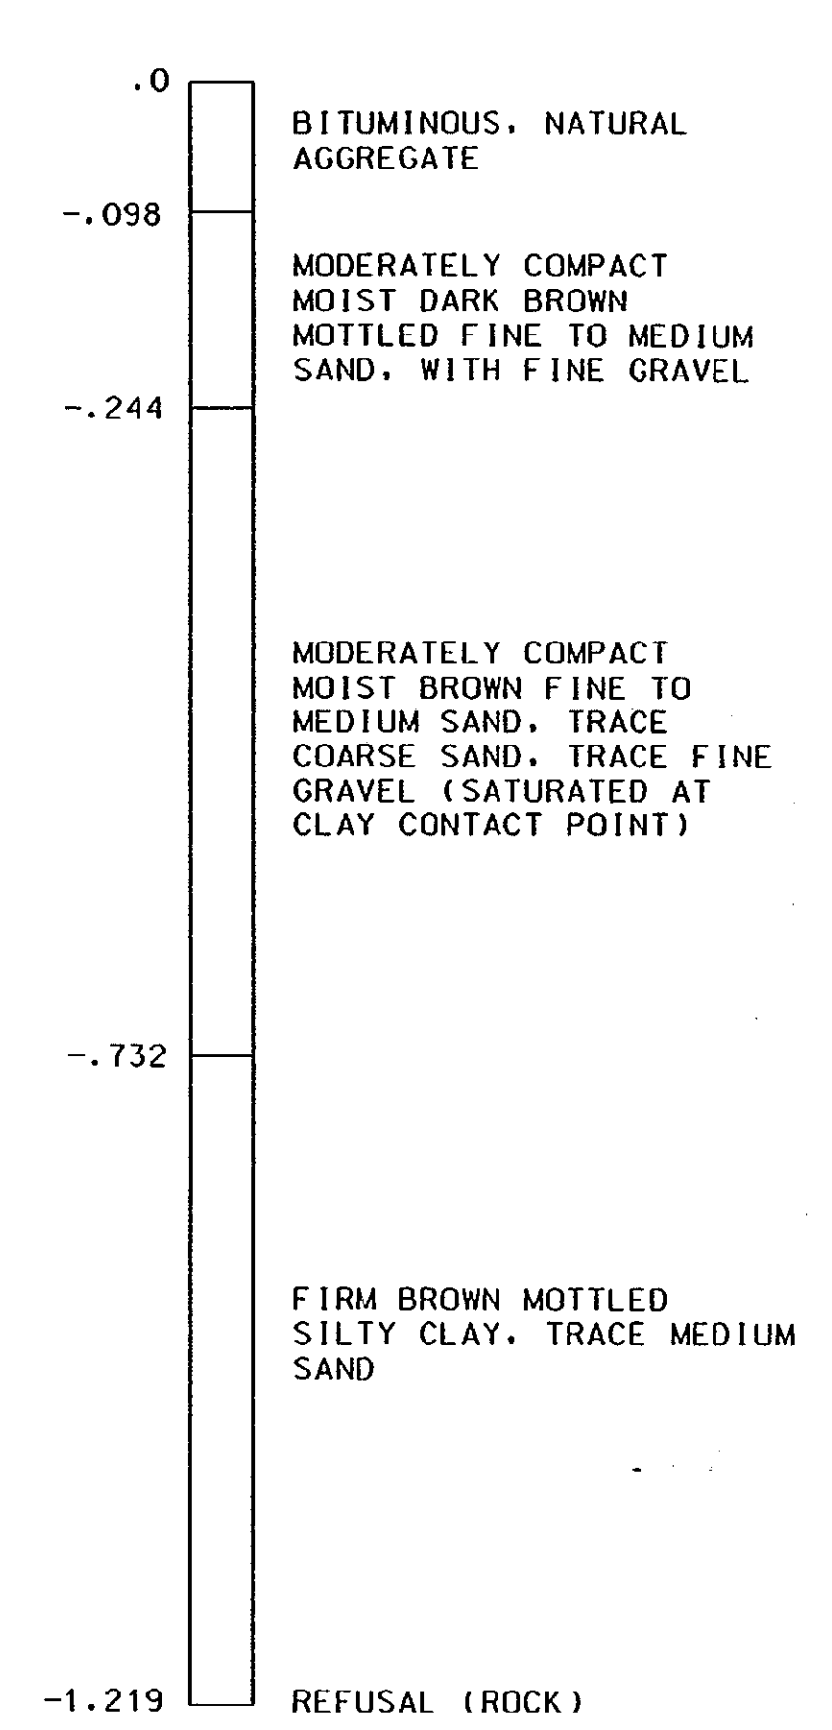

TEST HOLE NO. Core #56
 STATION 30+380 1.40m Rt. OF Rt. E.O.M.
 S. B. 1-75 MEDIAN SHOULDER
 T1N R11E SEC 2 OAKLAND CO.
 DATE DRILLED 10-16-00

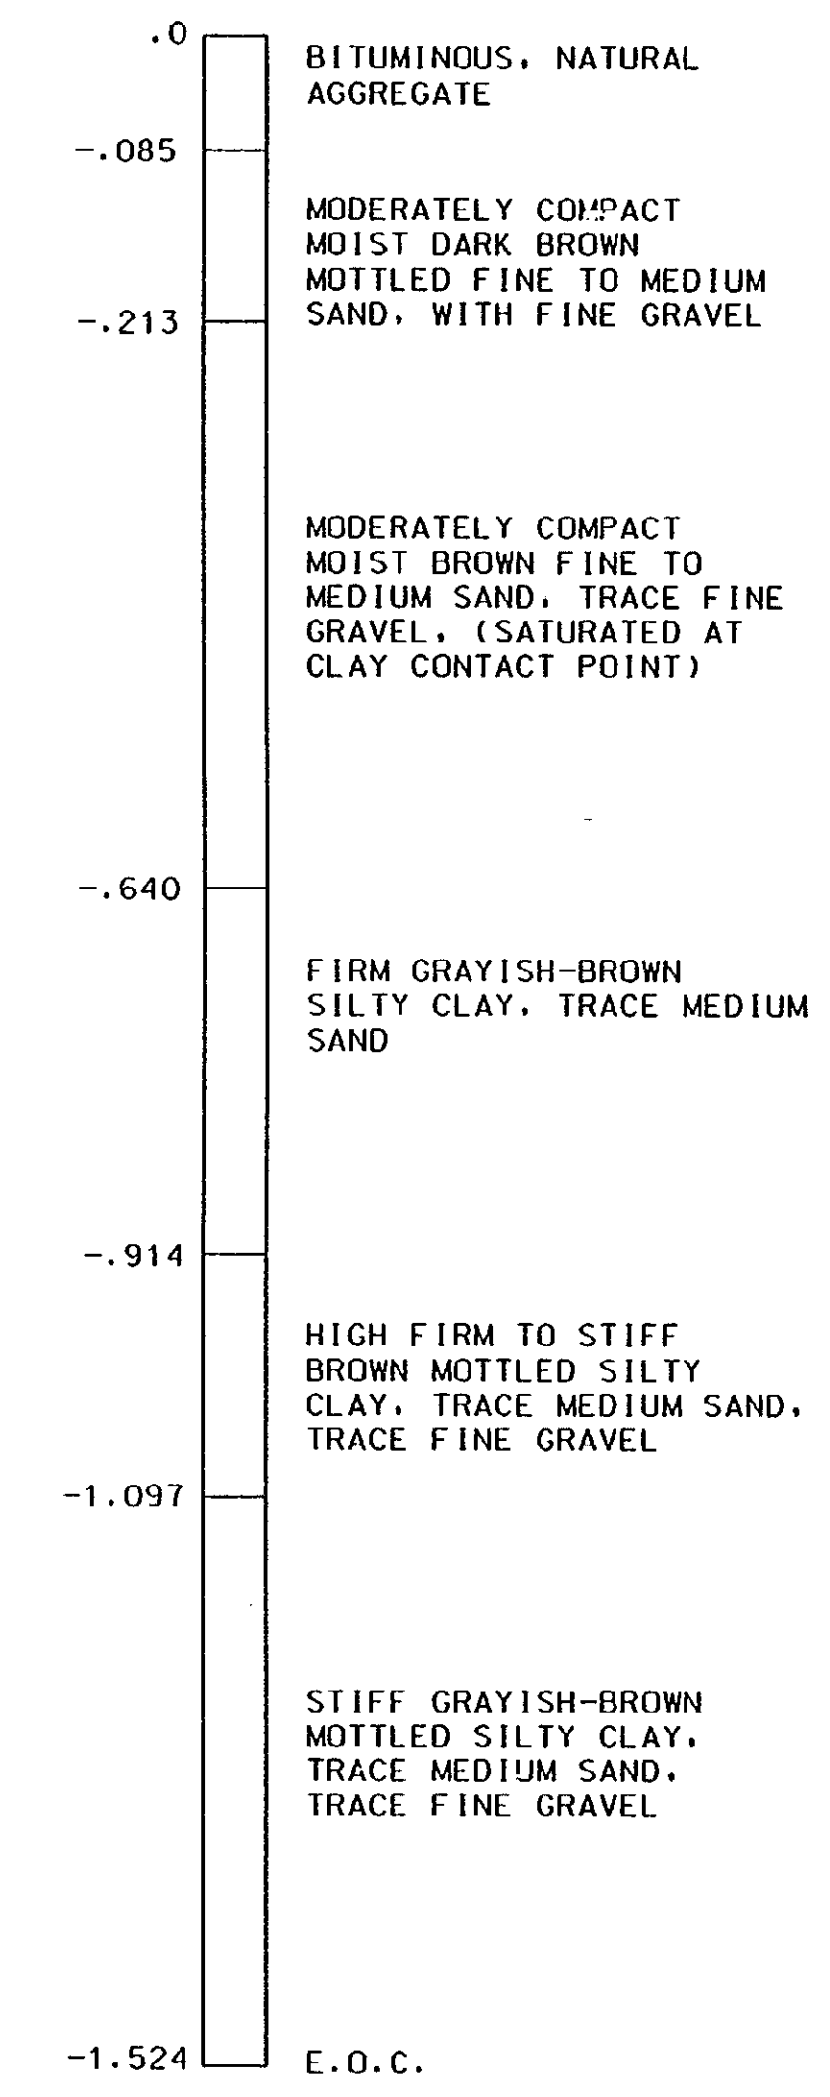

NUMBERS IN CIRCLES DENOTE NUMBER OF BLOWS REQUIRED TO DRIVE A 0.051m O.D. X 0.038m I.D. SPLIT SPOON SAMPLER 3 SUCCESSIVE 0.152m INCREMENTS USING A 63.503kg HAMMER FALLING 0.762m. CONSISTENCY DETERMINED BY INSPECTION OF SAMPLES AND BY SOIL RESISTANCE TO PENETRATION BY JET ROD AND CASING OR AUGER.

WATER LEVELS MAY BE INFLUENCED BY RESIDUAL BORING WATER
 THE SOIL BORING LOGS REPRESENT POINT INFORMATION. PRESENTATION OF THIS INFORMATION IN NO WAY IMPLIES THAT THE SUBSURFACE CONDITIONS ARE THE SAME AT LOCATIONS OTHER THAN THE EXACT LOCATION OF THE BORING.

SOIL BORING DATA						
DATE	SCALE	CONT. SEC.	JOB NO.	DESIGN UNIT	SHEET NO.	
10/23/00	NONE	63174	53697	RICK	R.O.W	76




EXISTING BY: DATE: DATE: DATE: 12-9-00
 PROPOSED BY: LAST CORRECTION BY: BLOCK K

FILE NAME: J5kover2-.dgn
 1 2 3 4 5 6 7 8 9 10 11 12 13 14 15 16 17 18 19 20 21 22 23 24 25 26 27 28 29 30 31 32 33 34 35 36 37 38 39 40 41 42 43 44 45 46 47 48 49 50 51 52 53 54 55 56 57 58 59 60 61 62 63

FINAL R.O.W.			
AUTH	DATE	NO.	REVISION


TEST HOLE NO. Core #57

STATION 27+920 2.20m Rt. OF Rt. E.O.M.
 S. B. I-75 MEDIAN SHOULDER
 T1N R11E SEC 14 OAKLAND CO.
 DATE DRILLED 10-16-00

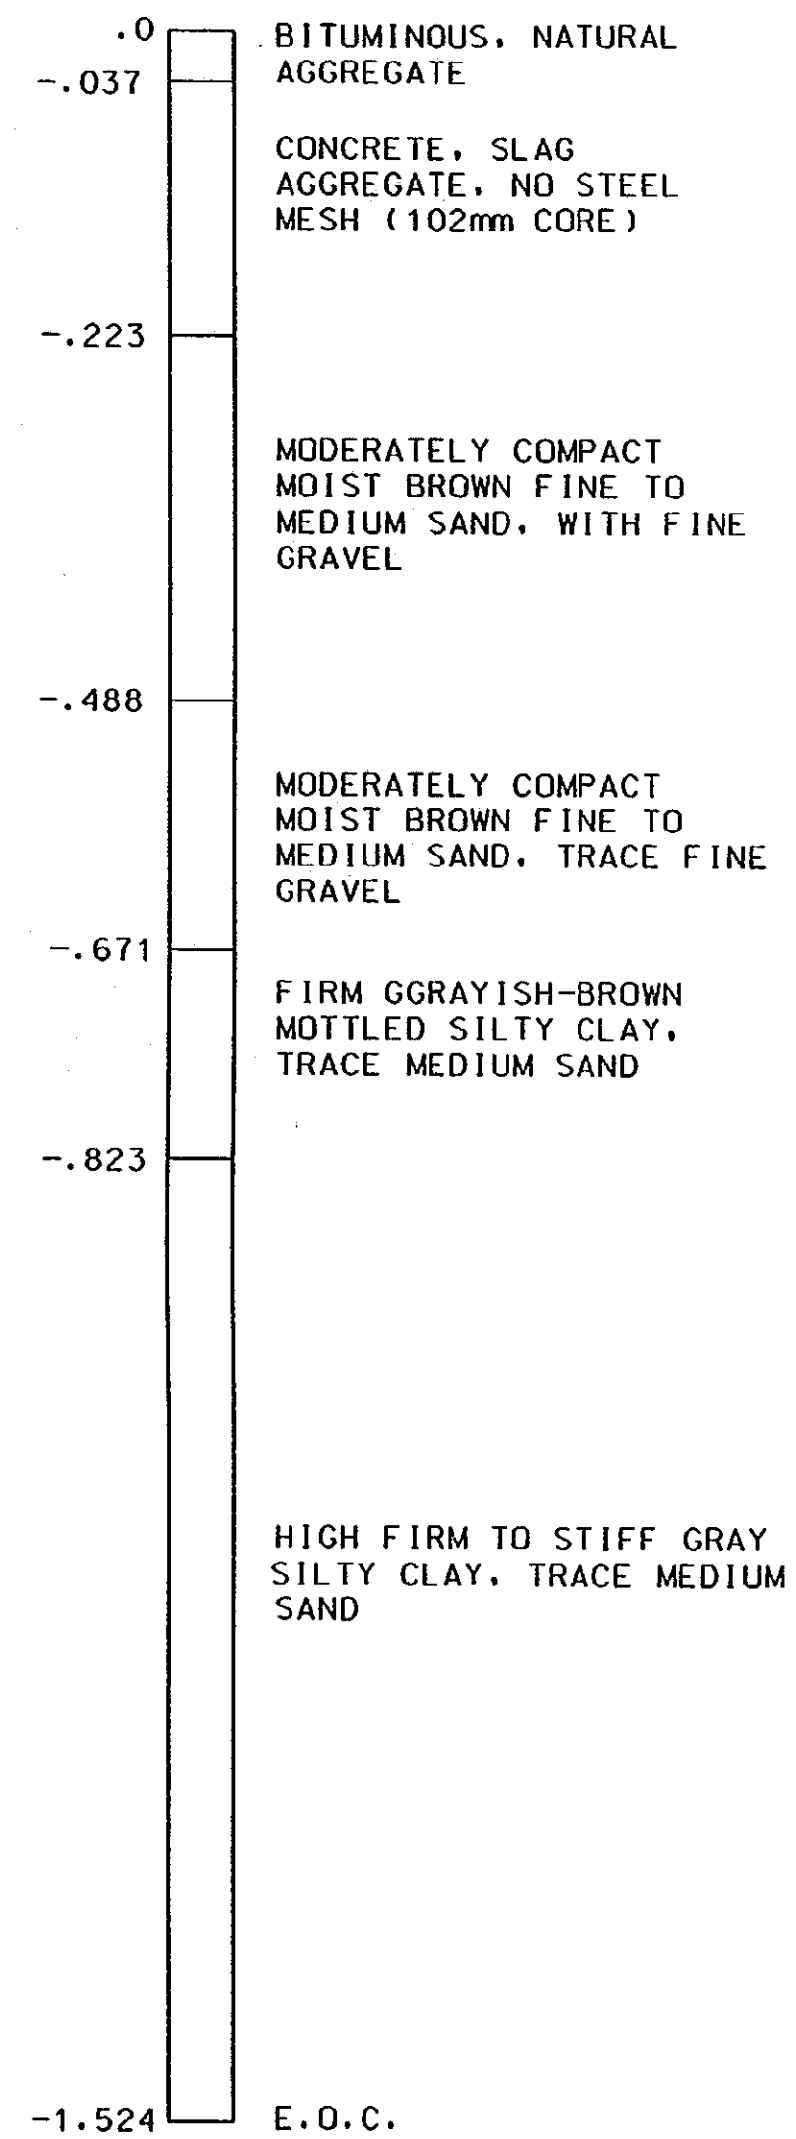


TEST HOLE NO. Core #58

STATION 28+800 1.90m Rt. OF Rt. E.O.M.
 N. B. I-75 SLOWLANE SHOULDER
 T1N R11E SEC 11 OAKLAND CO.
 DATE DRILLED 10-16-00

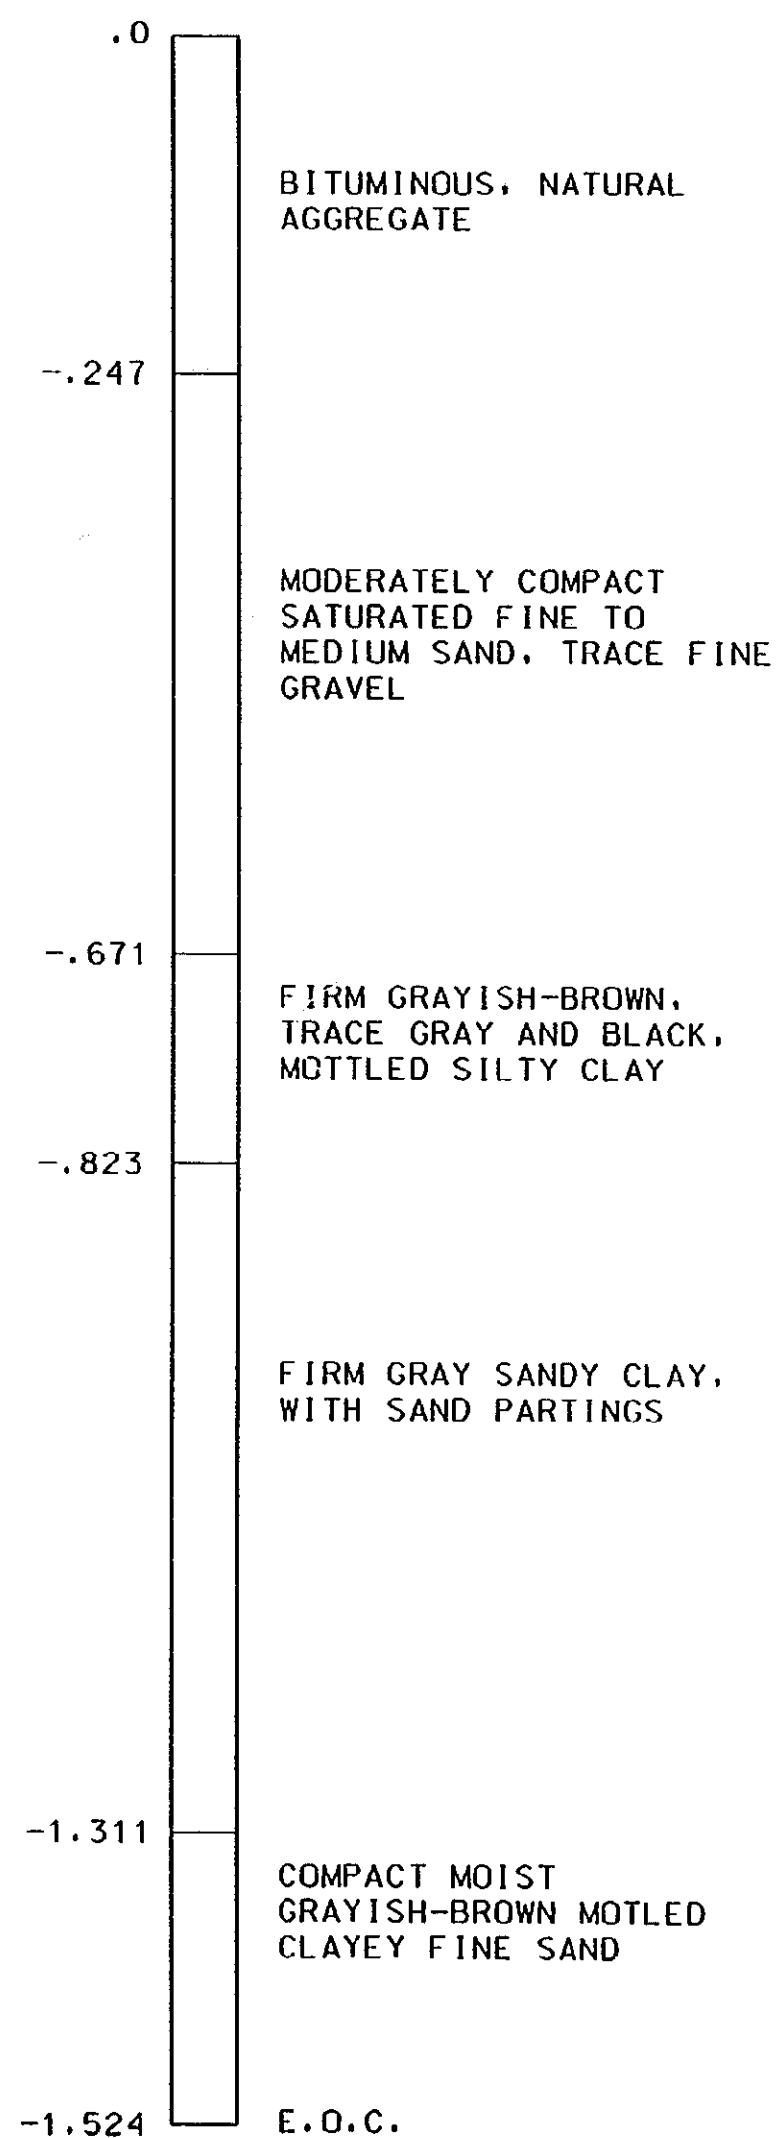


TEST HOLE NO. Core #59

STATION 29+340 1.60m Rt. OF Rt. E.O.M.
 N. B. I-75 SLOWLANE SHOULDER
 T1N R11E SEC 11 OAKLAND CO.
 DATE DRILLED 10-16-00

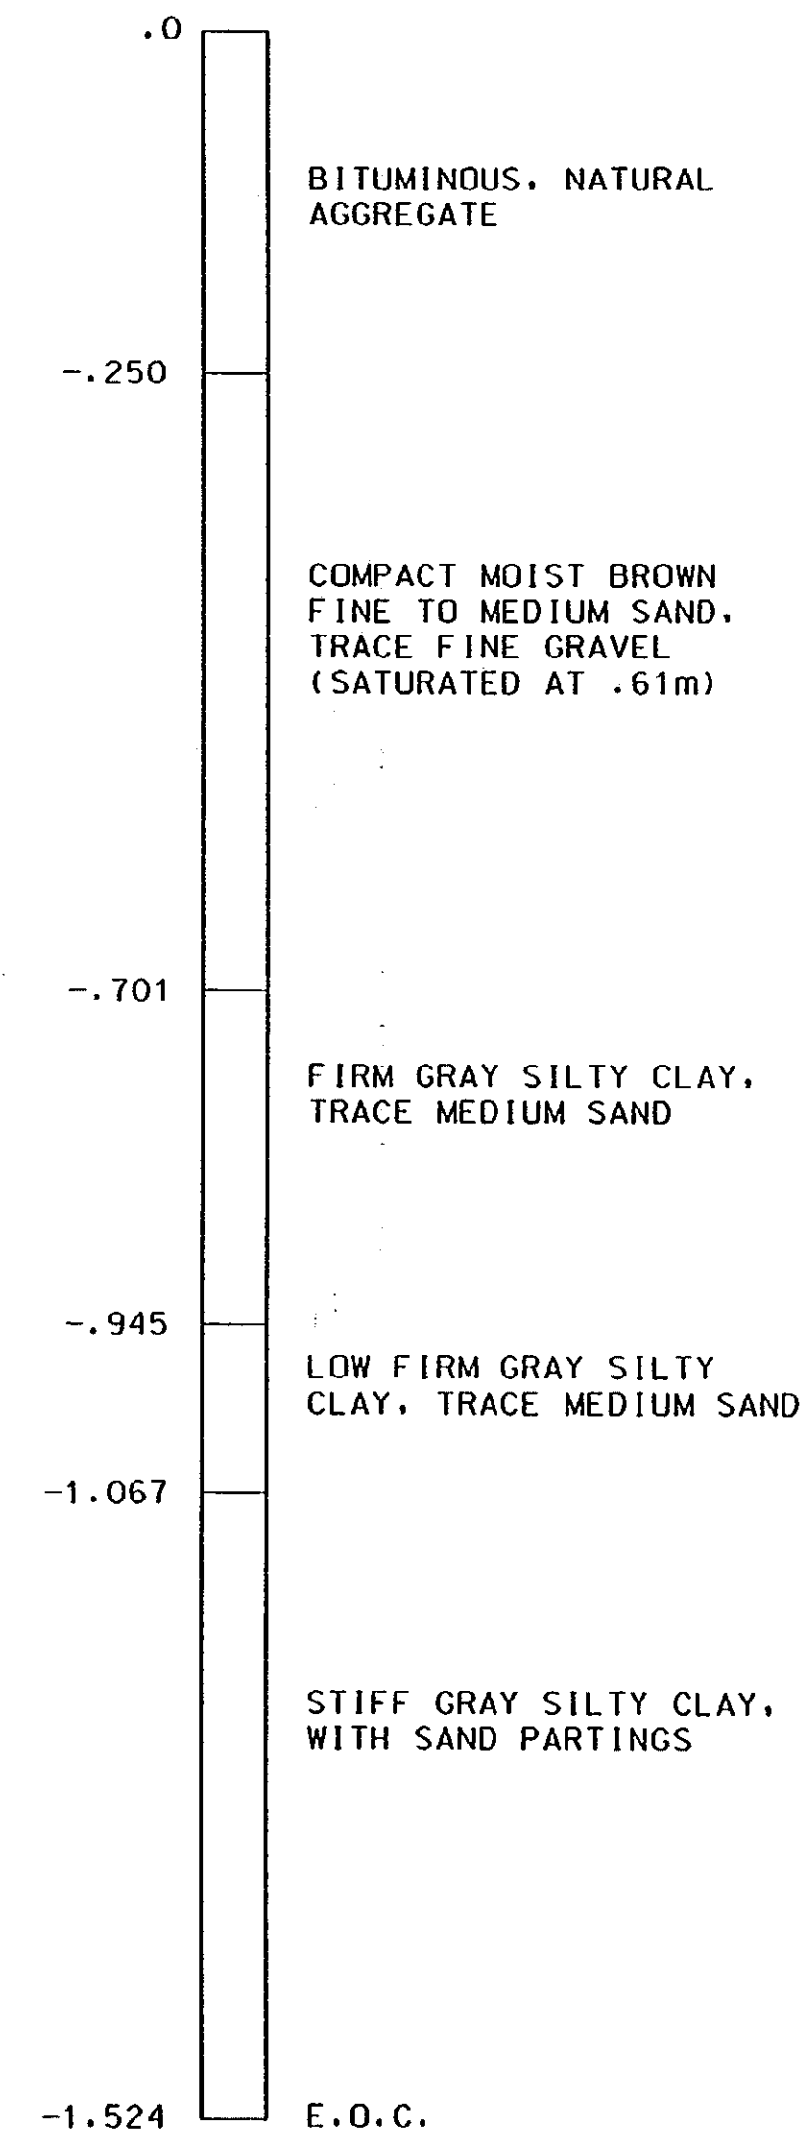

TEST HOLE NO. Core #60

STATION 30+045 1.60m Rt. OF Rt. E.O.M.
 N. B. I-75 SLOWLANE SHOULDER
 T1N R11E SEC 11 OAKLAND CO.
 DATE DRILLED 10-16-00

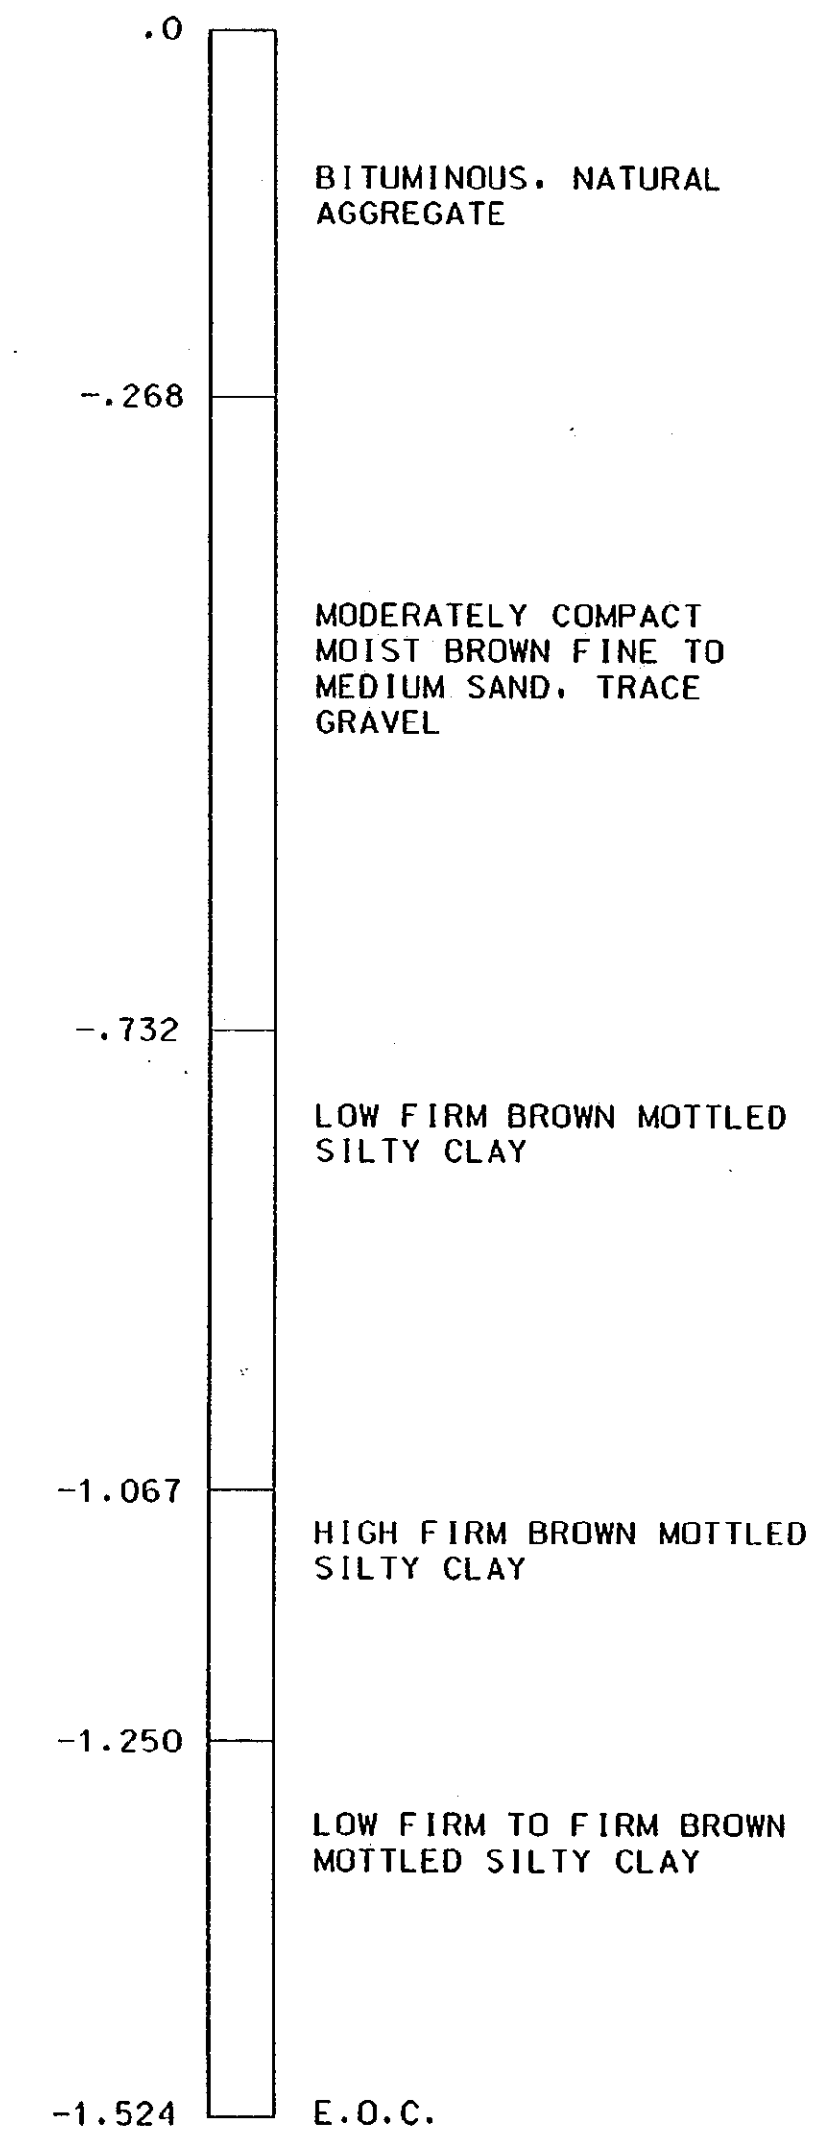

NUMBERS IN CIRCLES DENOTE NUMBER OF BLOWS REQUIRED TO DRIVE A 0.051m O.D. X 0.038m I.D. SPLIT SPOON SAMPLER 3 SUCCESSIVE 0.152m INCREMENTS USING A 63.503kg HAMMER FALLING 0.762m. CONSISTENCY DETERMINED BY INSPECTION OF SAMPLES AND BY SOIL RESISTANCE TO PENETRATION BY JET ROD AND CASING OR AUGER.


WATER LEVELS MAY BE INFLUENCED BY RESIDUAL BORING WATER

THE SOIL BORING LOGS REPRESENT POINT INFORMATION. PRESENTATION OF THIS INFORMATION IN NO WAY IMPLIES THAT THE SUBSURFACE CONDITIONS ARE THE SAME AT LOCATIONS OTHER THAN THE EXACT LOCATION OF THE BORING.




SOIL BORING DATA

DATE	SCALE	CONT. SEC.	JOB NO.	DESIGN UNIT	SHEET NO.
10/23/00	NONE	63174	53697	RICK	R.O.W. 77

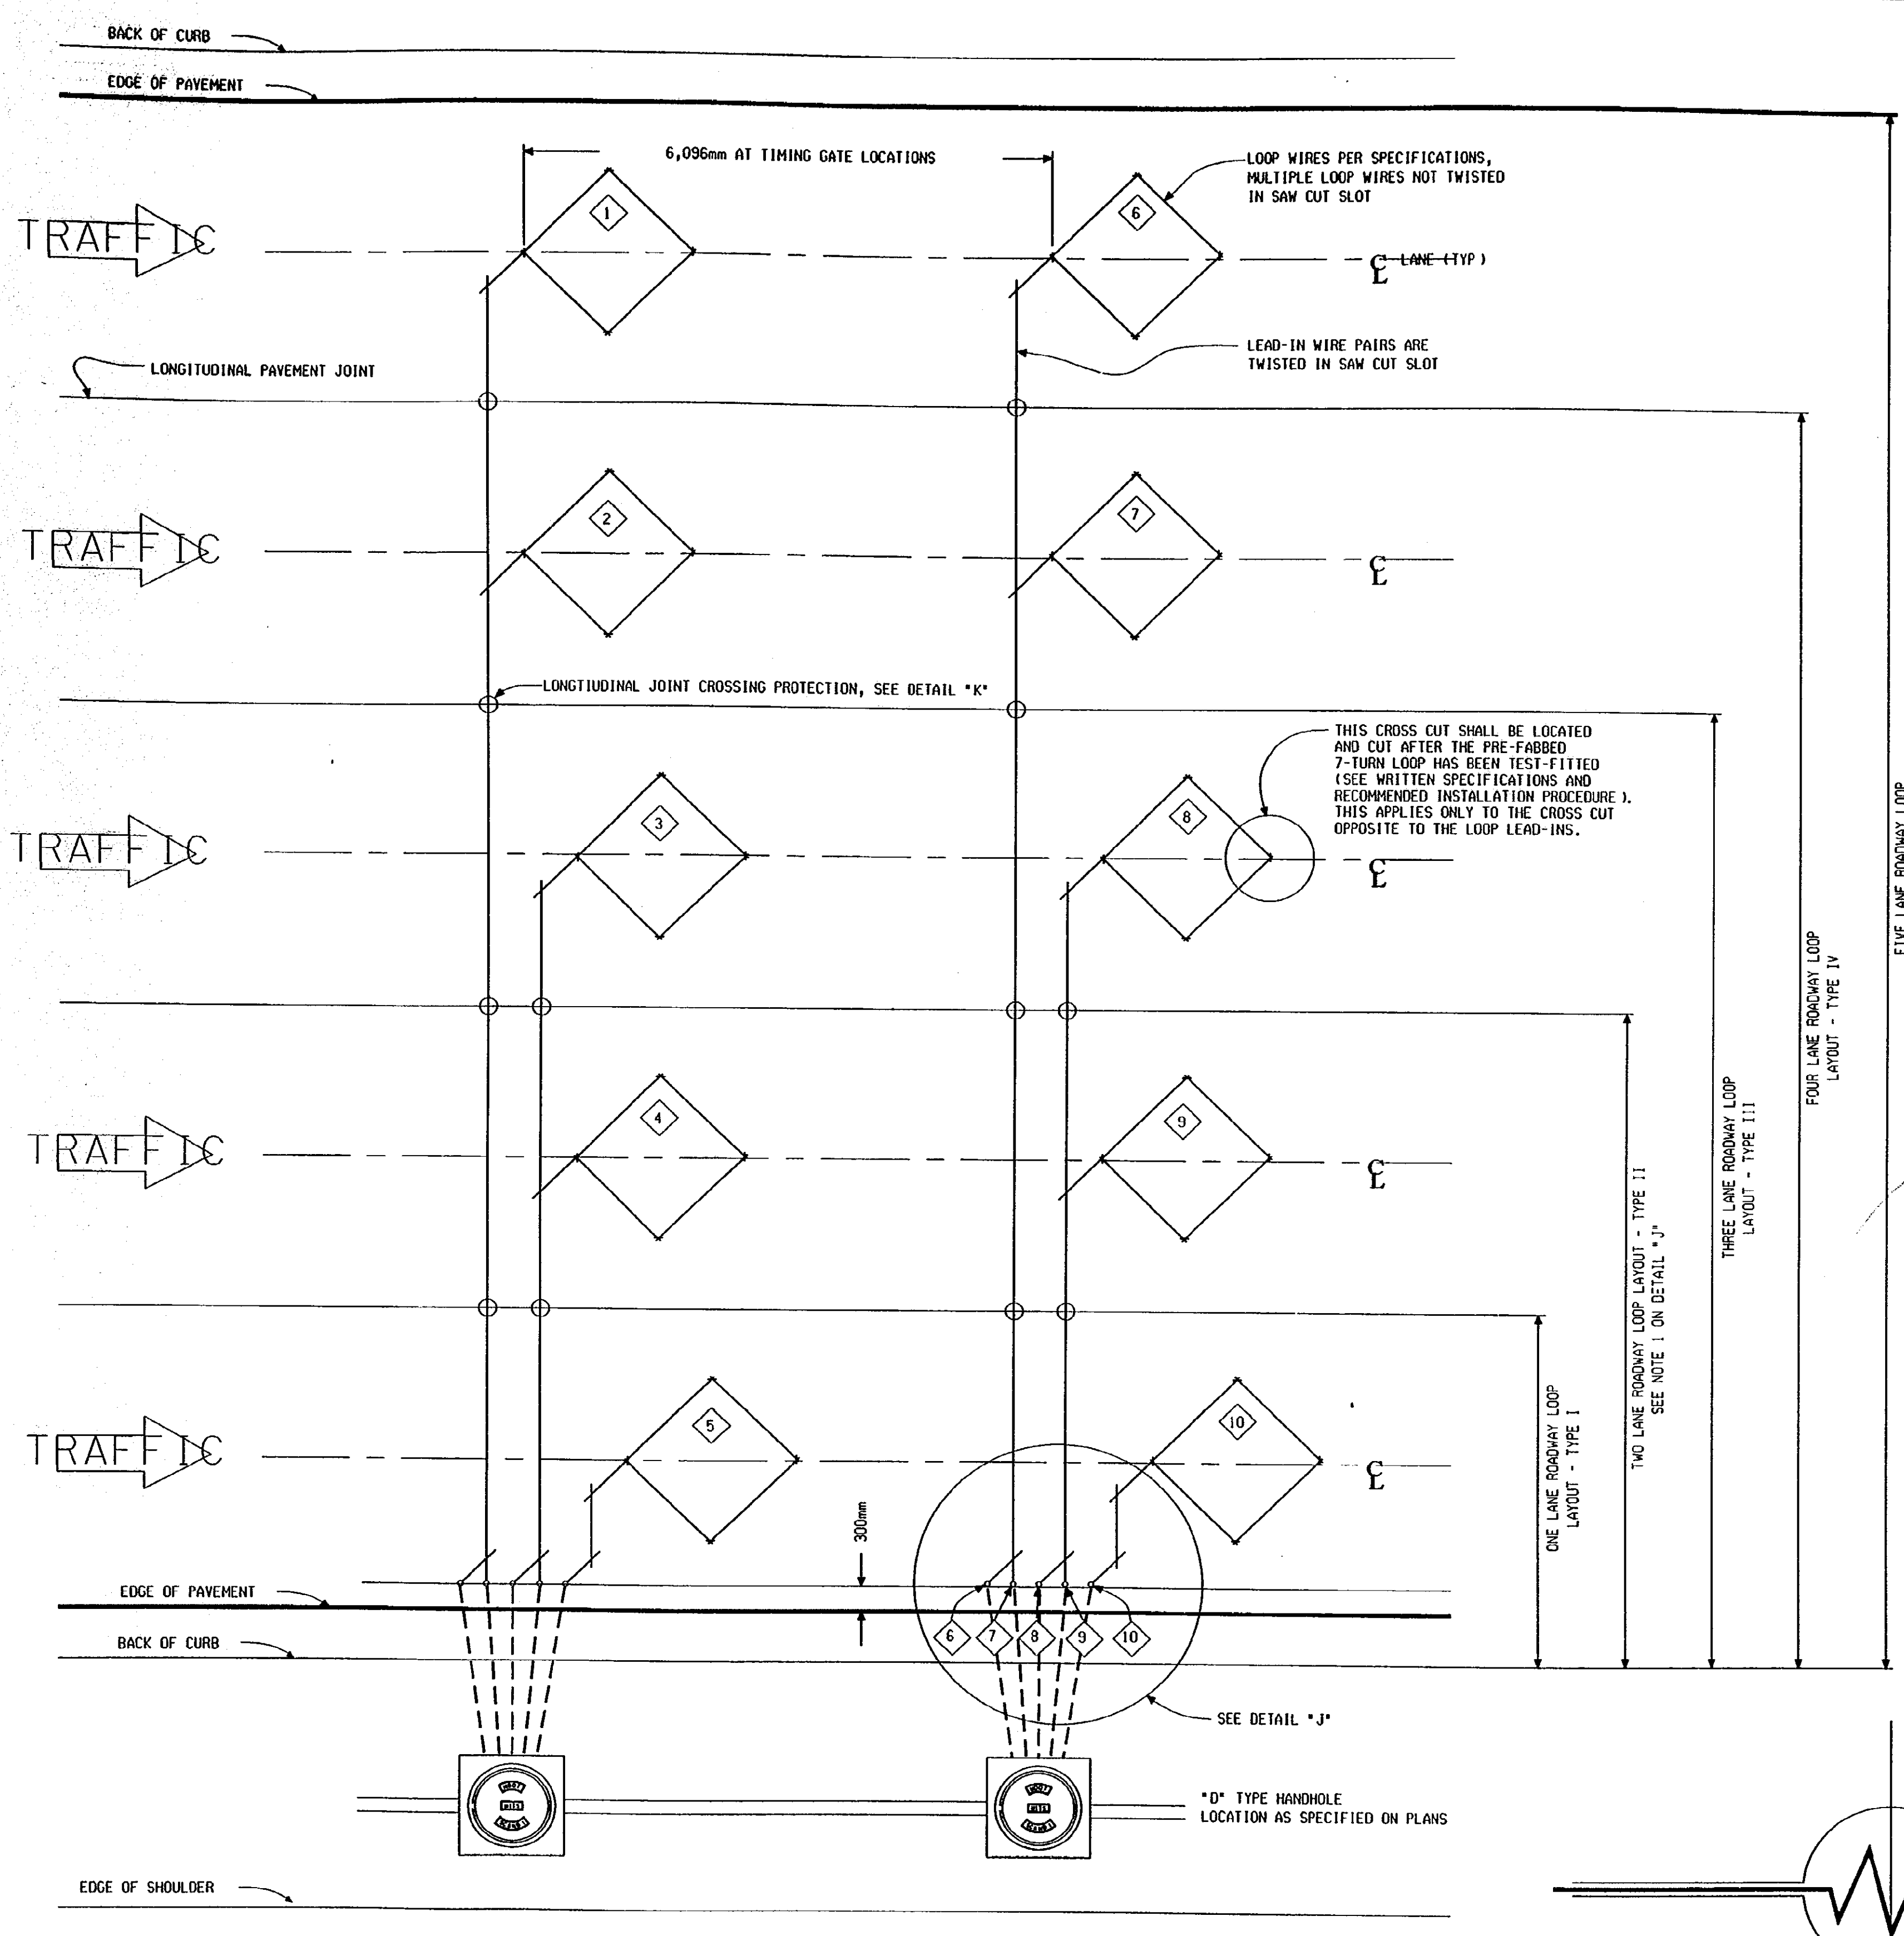


ONE, TWO, THREE, FOUR & FIVE LANE ROADWAY LOOPS SAW-CUTTING DETAIL


NOTE:
LOOPS WILL BE LAID OUT IN THE FIELD BY MOOT PERSONNEL. NOTIFY PROJECT ENGINEER THREE WORK DAYS IN ADVANCE OF ANY SAW CUTTING.

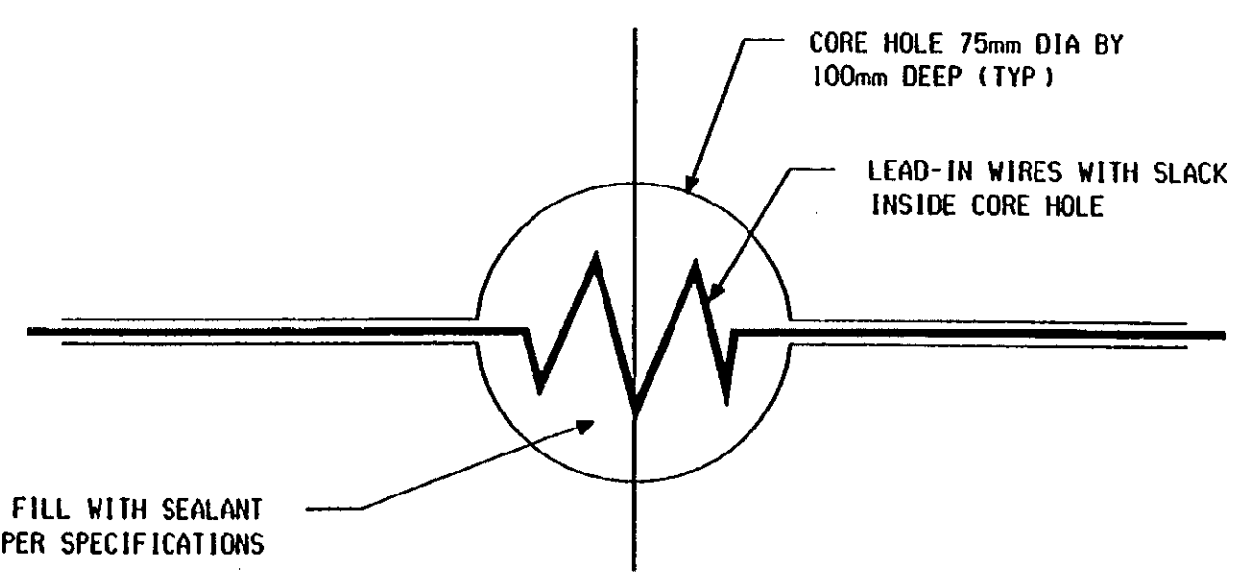


DETAIL "K" LONGITUDINAL JOINT CROSSING PROTECTION

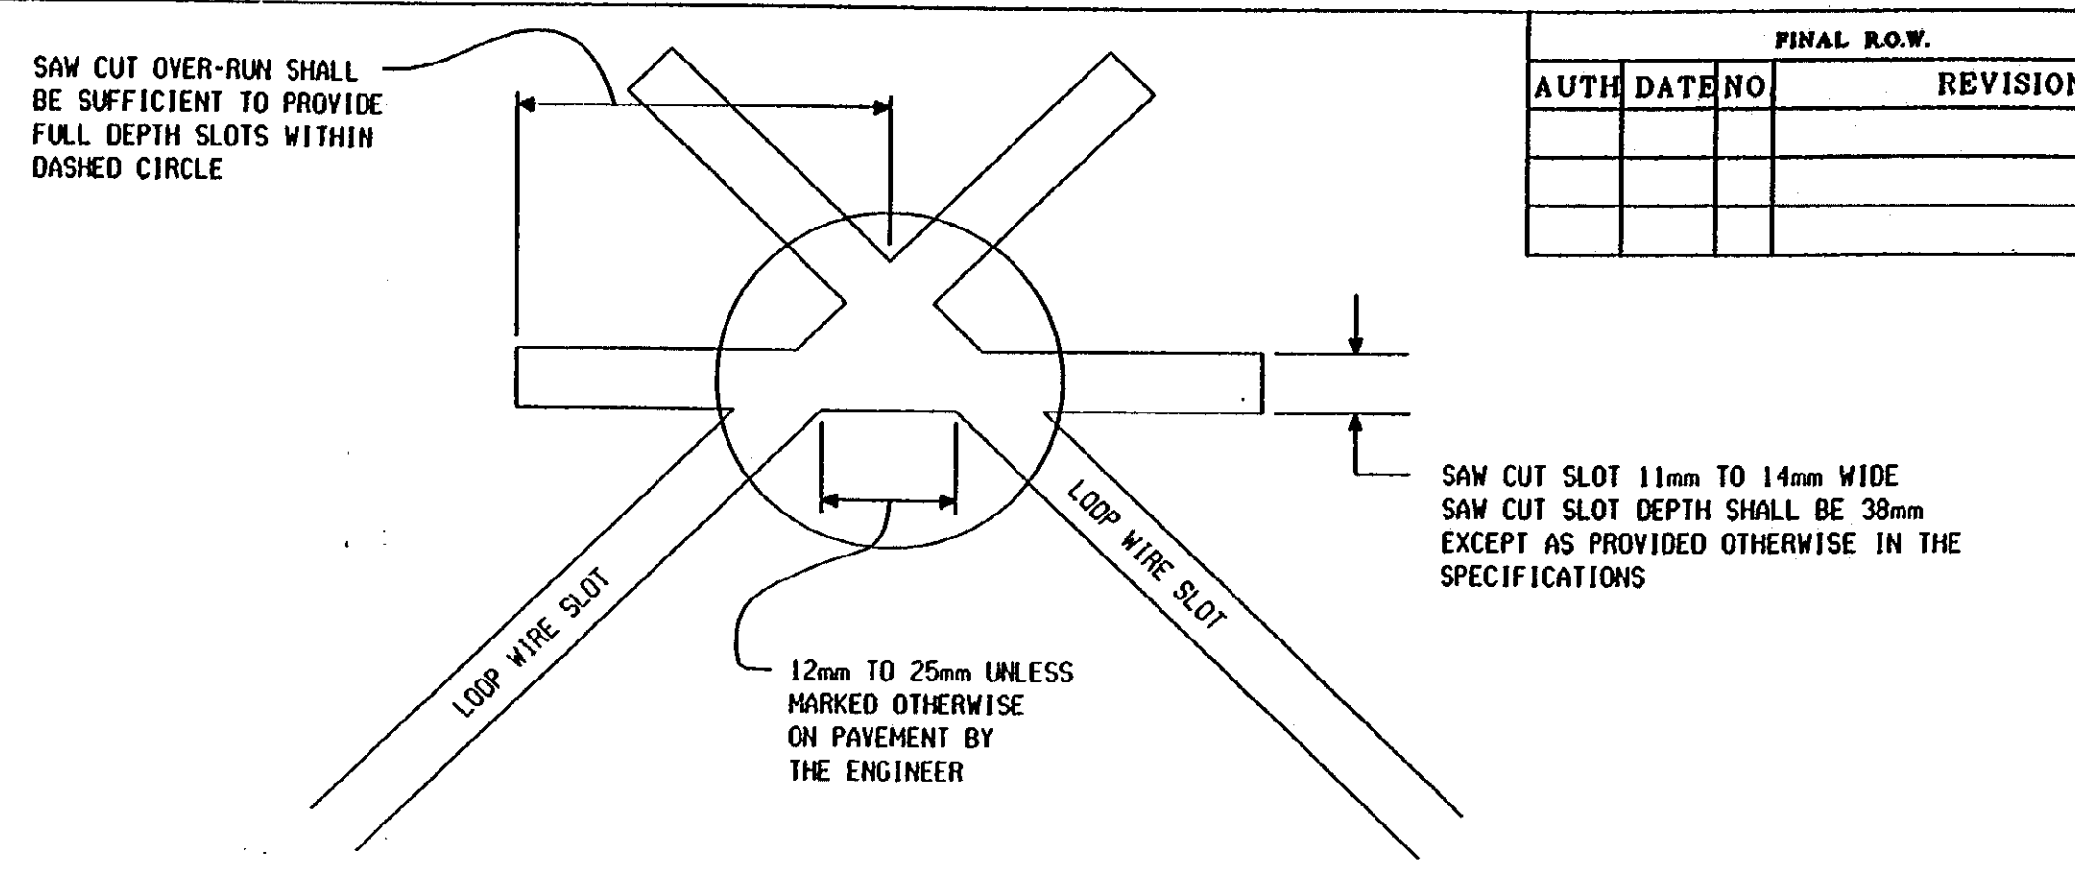

DIAGONAL CORNER CUT DETAIL
OTHER SLOT JOINTS SIMILAR

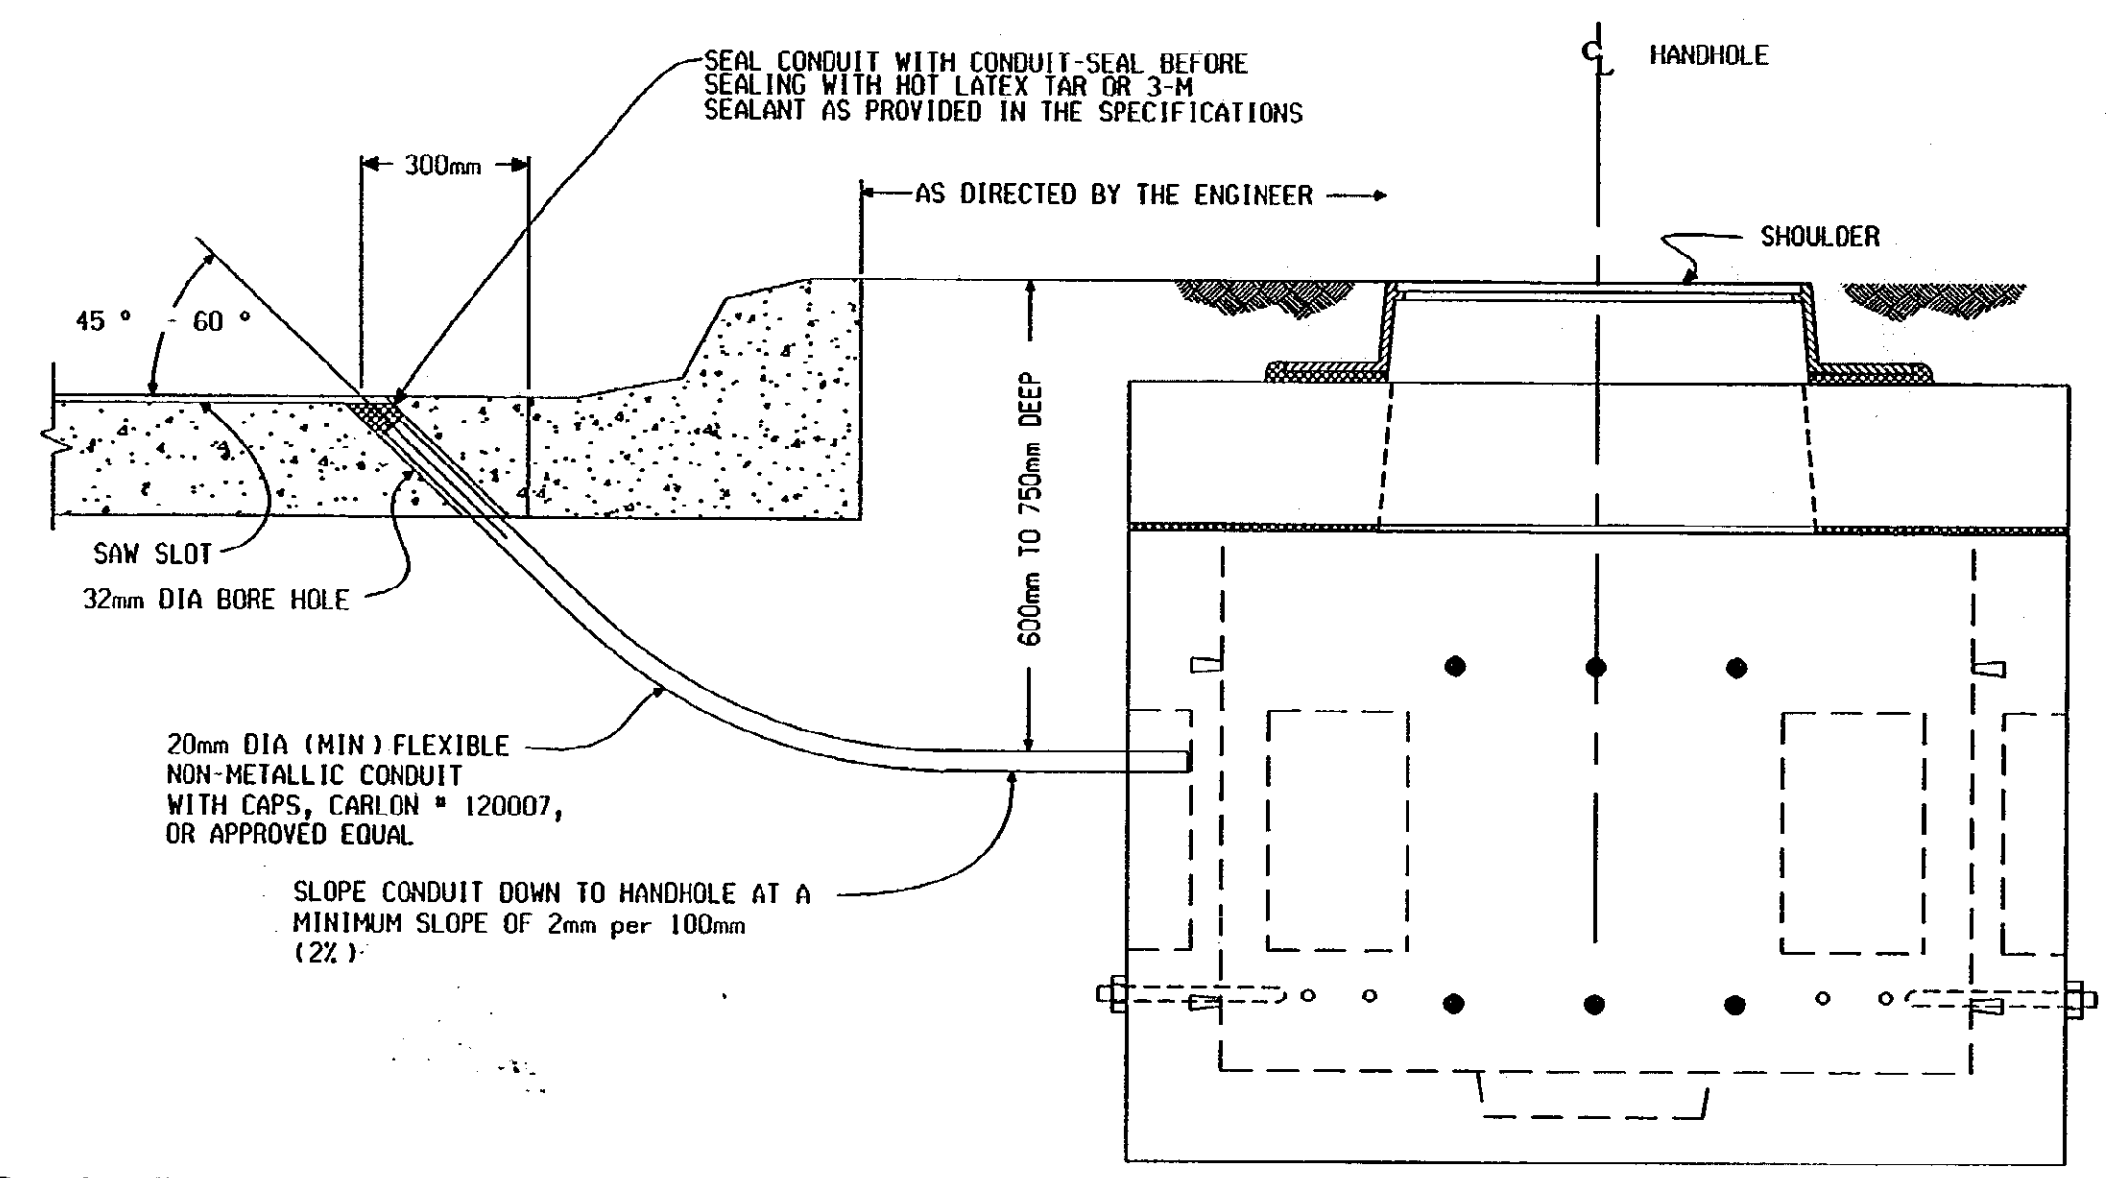

UNDER CURB INSTALLATION DETAIL

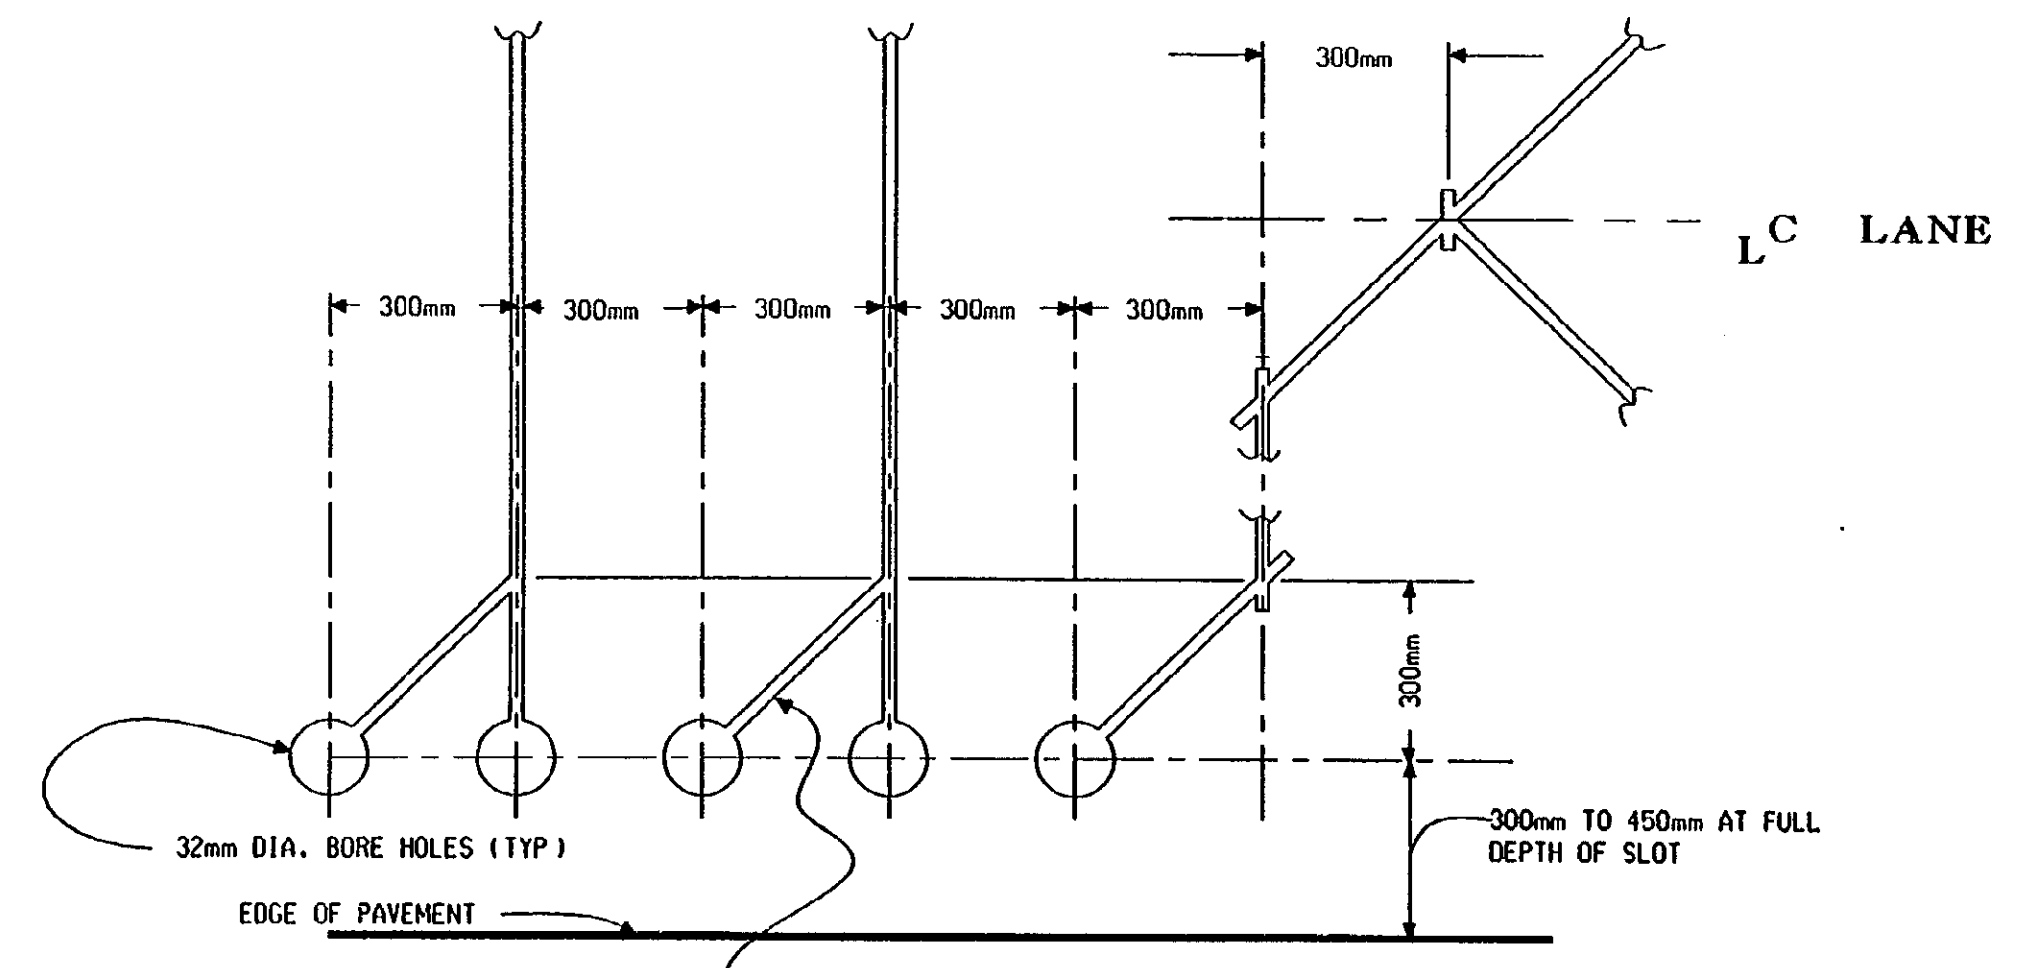

DETAIL "J" TERMINATION OF LEAD-IN SLOTS

FINAL R.O.W.		
AUTH	DATE	NO
		REVISION



LOOP INSTALLATION DETAILS					
DATE	SCALE	CONT. SEC.	JOB NO.	DESIGN UNIT	SHEET NO.
17 Aug 2000	NONE	63174	49595A, 53697A, 48647A	MULLIN	78

MITSC -

LEGEND

- CABINET TYPE 4
- RAMP METER TRAFFIC SIGNAL FOUNDATION
- HANDHOLE TYPE D
- HANDHOLE TYPE III
- VEHICLE DETECTOR, LOOP OR MICRO-LOOP
- EXISTING SCANDI / MITS HANDHOLE TYPE D OR TYPE III
- REPLACE EXISTING DIRECT BURIAL CONDUIT (SIZE AND SCHEDULE AS NOTED ON PLANS)
- INSTALL NEW CONDUIT (SIZE AND SCHEDULE AS NOTED ON PLANS)
- EXISTING CONDUIT TO REMAIN
- RAMP VEHICLE DETECTOR, LOOP OR MICRO-LOOP AS NOTED ON PLANS
- CCTV INSTALLATION -- COMPLETE
- CABINET IDENTIFICATION
- NUMBER OF CABINET
- R. F. TRANSMISSION CABLE NUMBER

GENERAL NOTES

1. CONTRACTOR TO NOTIFY MDT/MTSC MR. THOMAS MULLIN OR MS. VEENA JASUJA, (313) 256-9800 EXT. 310 IN CASE OF DAMAGE TO CABLES OF MITS / SCANDI NETWORK.
2. CONTRACTOR TO CALL "MISS DIG" 72 HRS. PRIOR TO ANY EXCAVATION FOR THE LOCATION OF NON-MDOT UNDERGROUND UTILITIES.
3. THE REPLACEMENT OF ANY CABLE CONDUIT, OR BOTH, SHALL INCLUDE REMOVAL OF THE REPLACED CABLE, CONDUIT, OR BOTH, AT NO ADDITIONAL COST.
4. CONTRACTOR SHALL NOTIFY SYSTEM OPERATING DIVISION OF THE P.L.D. 48 HRS. IN ADVANCE OF ANY WORK INVOLVING P.L.D. FACILITIES.
5. ALL EXISTING P.L.D. FACILITIES SHALL ALWAYS BE MAINTAINED IN AN OPERATIONAL CONDITION.
6. ALL UNOCCUPIED CONDUITS SHALL BE STRUNG AND PLUGGED. ALL ABANDONED CONDUIT SHALL BE PLUGGED AS DIRECTED BY ENGINEER.
7. EXISTING UTILITIES ARE NOT NECESSARILY SHOWN ON PLANS. LOCATIONS OF UTILITIES SHOWN ARE NOT GUARANTEED TO BE ACCURATE.
8. NEW CONDUITS BROKEN INTO EXISTING MANHOLES OR HANDHOLES SHALL NOT INTERFERE WITH RACKING AND/OR SHAPE OF RF CABLES. DO NOT DISTURB OR DAMAGE EXISTING CABLES.
9. ALL CABLES SHALL BE TAGGED IN MANHOLES AND HANDHOLES.
10. SEAL END OF CABLES WATERTIGHT WHERE COILING-UP OF CABLES IS CALLED FOR ON PLANS. (CONTRACTOR SHALL RECEIVE PAYMENT FOR COILED-UP CABLES)
11. A MINIMUM CLEARANCE OF 1067mm HORIZONTAL AND 305mm VERTICAL MUST BE MAINTAINED BETWEEN PROPOSED AND EXISTING WATER AND SEWER FACILITIES.
12. CONDUIT EXPANSION JOINTS SHALL BE INSTALLED ON ALL NEW CONDUITS THAT ARE CROSSING EXISTING EXPANSION JOINTS IN STRUCTURE.
13. CONNECTING EXISTING CONDUITS TO PROPOSED CONDUITS TO BE INCLUDED IN INSTALLATION OF THE FREEWAY MITS (SCANDI) PROJECT.
14. SPLICING OF NEW CABLE TO EXISTING CABLES SHALL BE INCLUDED IN THE VARIOUS PAY ITEMS FOR THOSE CABLES.
15. WHEN DRILLING AND ENTERING PROPOSED CONDUITS INTO EXISTING HANDHOLES, EXERCISE GREAT CAUTION SO AS NOT TO DISTURB EXISTING CABLES.
16. THE COST OF THE REMOVAL SHALL INCLUDE BACKFILLING OF THE HOLE AS DIRECTED BY THE ENGINEER.
17. A COUPLING SHALL BE PLACED ON THE ENDS OF ALL CONDUIT TERMINATIONS AND PLUGGED WITH A SUITABLE REMOVABLE PLUG. A POLYPROPELENE PULL ROPE SHALL BE INSTALLED IN ALL CONDUITS PULLING CABLE AT A LATER TIME. PULL ROPE SHALL BE INCLUDED IN THE PAY ITEM FOR CONDUIT.
18. ALL DIRECT BURIAL CONDUIT SHALL HAVE A 762mm MINIMUM COVER, UNLESS OTHERWISE NOTED.
19. ALL CONDUIT CROSSING PAVEMENT SHALL BE SCH 80 FOR 1219mm BEYOND THE CURB, EDGE OF PAVEMENT, OR PAVED SHOULDER, AND SHALL HAVE 762mm MINIMUM COVER.
20. SMOOTH SURFACE CONDUIT ONLY IS ALLOWED ON THIS JOB.
21. 100mm SCH 80 PVC CONDUIT SLEEVES THROUGH BRIDGE ABUTMENTS FOR THE 75mm CONDUIT ARE INCLUDED IN THE BRIDGE ABUTMENTS.
22. ANCHOR BOLTS, NUTS, AND WASHERS SHALL BE IN ACCORDANCE WITH SECTION 8.07.15 OF MDT "STANDARD SPECIFICATIONS FOR CONSTRUCTION" AND THE SPECIAL PROVISIONS FOR "SIGN SUPPORTS AND LIGHT STANDARD ANCHOR BOLTS", OR "7.6 METER STRAIN POLE", OR "13 METER STRAIN POLE", AS APPLICABLE.
23. CALL MISS DIG BEFORE DIGGING TO LOCATE NON-MDOT OWNED UTILITIES.
24. THE MDT TRAFFIC MONITORING SYSTEM IS NOT PART OF MISS DIG. CALL 248 483-5125 TO HAVE THE MDT SYSTEM LOCATED BEFORE DIGGING. IF NO ANSWER, CALL 313 256-9800 EXT 310.

WIRING DIAGRAMS

Allocation of Coaxial Cables

1	①	NORTH BOUND CHRYSLER
	②	SOUTH BOUND CHRYSLER
	③	WEST BOUND FISHER
	④	EAST BOUND FISHER
2	⑤	WEST BOUND FORD
	⑥	EAST BOUND FORD
	⑦	NORTH BOUND LODGE
	⑧	SOUTH BOUND LODGE
	⑨	FLEXIBLE COAXIAL CABINET LEAD-IN CABLE
	⑩	13mm COAXIAL CABLE

Allocation of Other Cables

①	LOOP WIRES OR MAGNETOMETERS
②	25 PR. MULTICONDUCTOR SIGNAL & AUDIO CABLE, AWC 19.
③	SHIELDED PAIR COMMUNICATIONS CABLE
④	SECONDARY POWER CABLE
⑤	RAMP METERING
⑥	EXISTING CABLES IN EXISTING CONDUIT
⑦	GROUND WIRE

FINAL R.O.W.			
AUTH	DATE	NO.	REVISION

NOTE:

TRAFFIC SIGNAL PRODUCTS, FASTENERS, CONDUIT AND ELECTRICAL WIRING ARE DIMENSIONED IN METRIC UNITS WHERE POSSIBLE. SPECIFIC FASTENERS, ANCHOR BOLTS AND WIRE SIZES ARE STILL GIVEN IN ENGLISH UNITS.


SI All Dimensions are in Millimeters Unless Noted Otherwise

Michigan Department of Transportation


General Notes and Legend					
DATE	SCALE	CONT. SEC.	JOB NO.	DESIGN UNIT	SHEET NO.
17 Aug 2000	None	82025	49595A, 53697A, 48647A	MULL IN	R.O.W 79

SCANDI SHEET

MITSC -

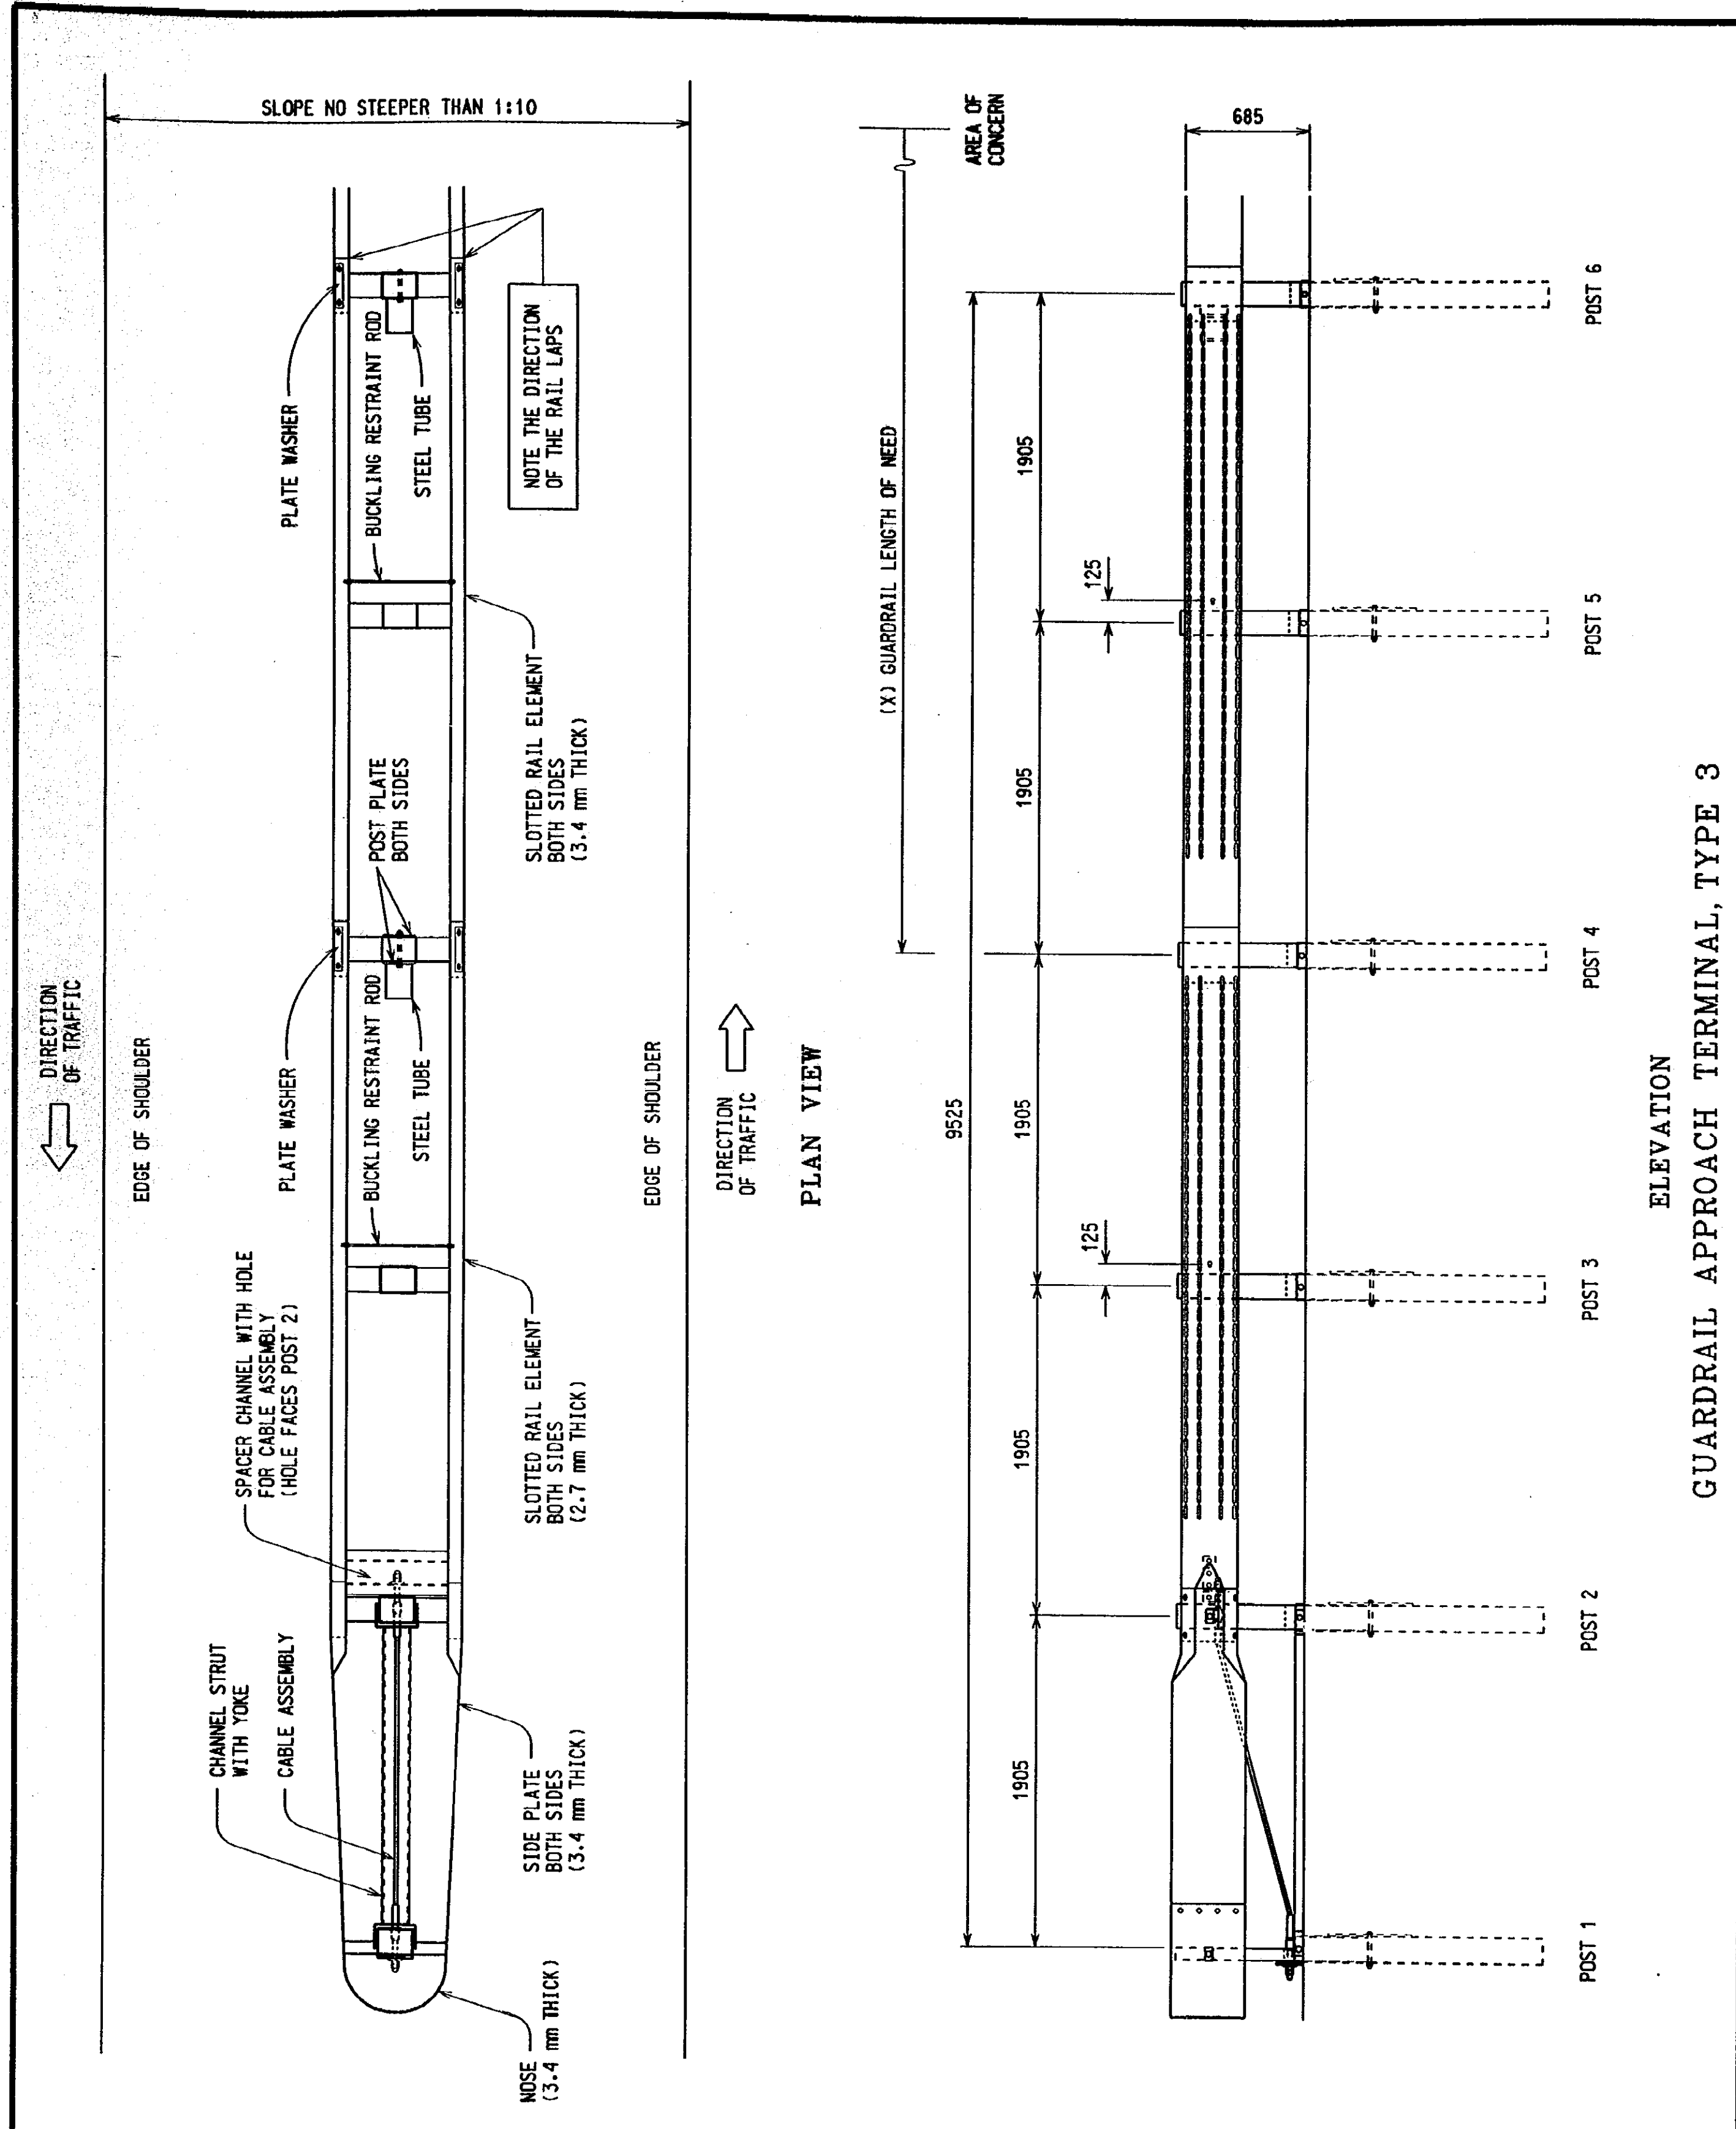

ELEVATION
GUARDRAIL APPROACH TERMINAL, TYPE 3


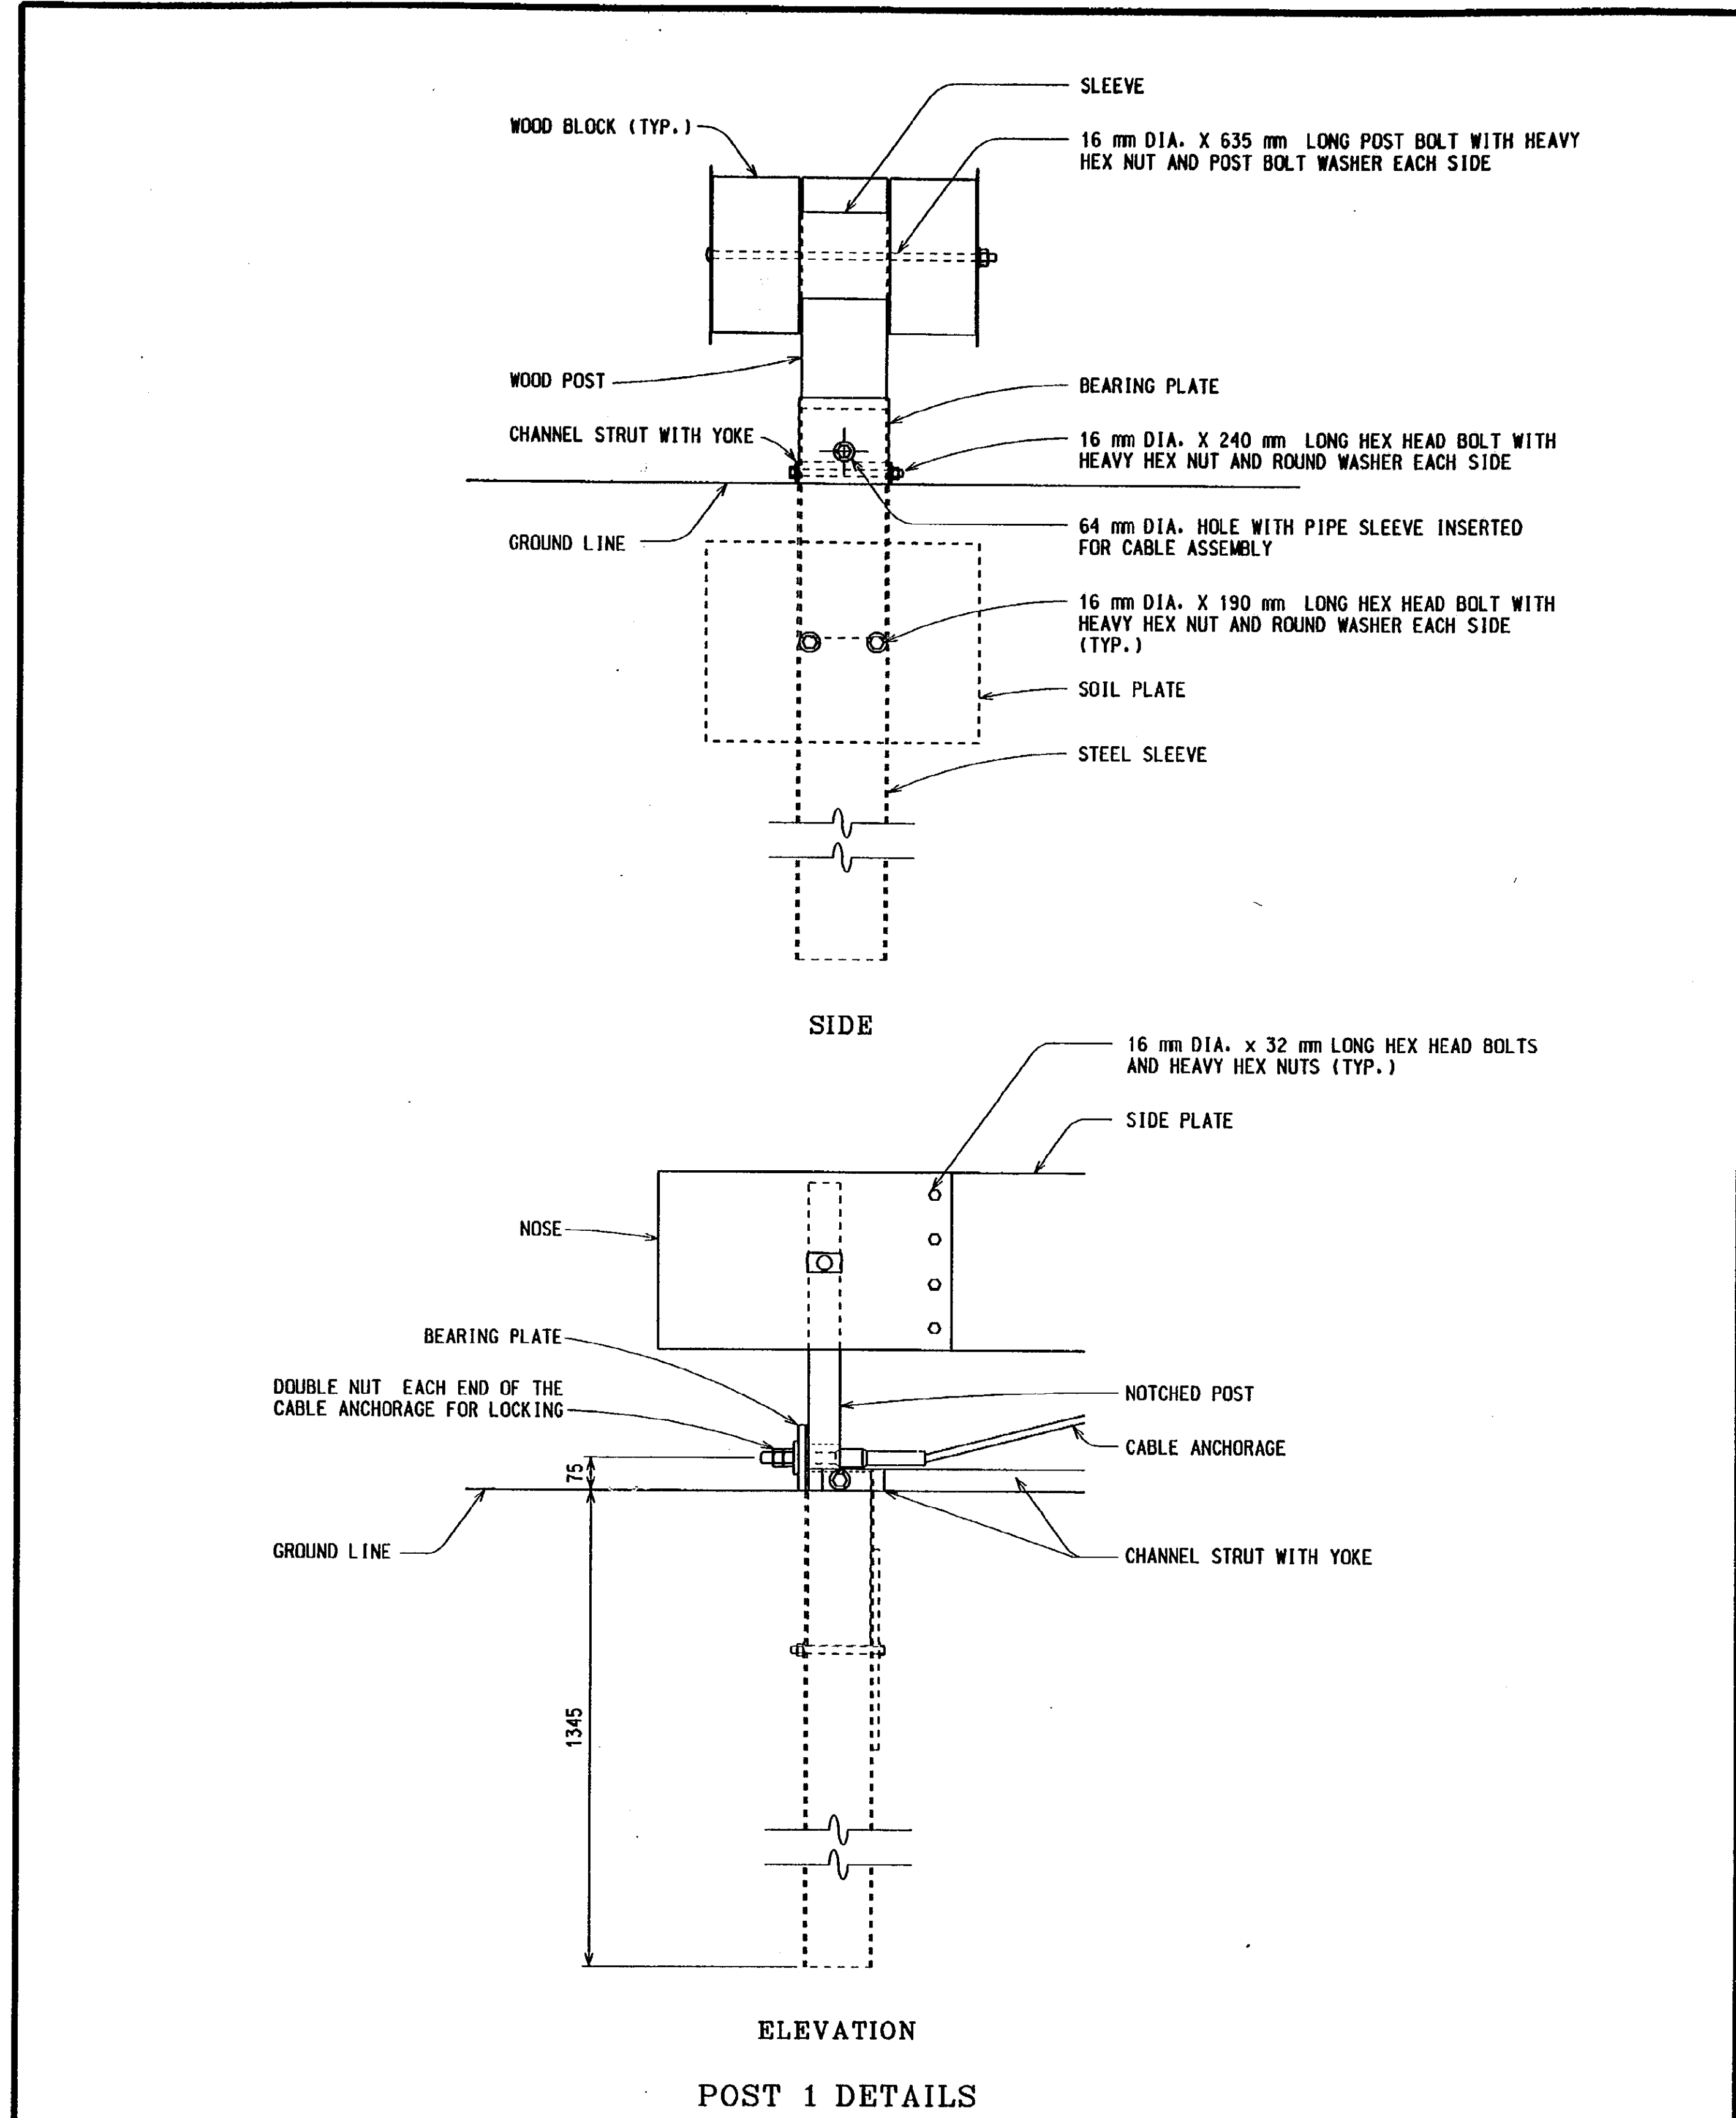


ELEVATION
POST 1 DETAILS

<p>PREPARED BY DESIGN DIVISION</p> <p>DRAWN BY: <u>B.L.T.</u></p> <p>CHECKED BY: <u>W.K.P.</u></p>	<p>ENGINEER OF CONSTRUCTION & TECHNOLOGY</p>	<p>ENGINEER - ROAD DESIGN</p>
	<p>ENGINEER OF MAINTENANCE</p>	<p>ENGINEER OF DESIGN</p> <p>DEPARTMENT DIRECTOR <u>James R. DeSena</u></p>
	<p>ENGINEER OF TRAFFIC AND SAFETY</p>	<p>BY: CHIEF ENGINEER/DEPUTY DIRECTOR</p> <p>BUREAU OF HIGHWAY TECHNICAL SERVICES</p>

<p>MICHIGAN DEPARTMENT OF TRANSPORTATION BUREAU OF HIGHWAY TECHNICAL SERVICES STANDARD PLAN FOR</p>			
<p>GUARDRAIL APPROACH TERMINAL, TYPE 3</p>			
<p>F.H.W.A. APPROVAL</p>	<p>7-13-98 PLAN DATE</p>	<p>R-63-A</p>	<p>SHEET 1 OF 6</p>


<p>MICHIGAN DEPARTMENT OF TRANSPORTATION BUREAU OF HIGHWAY TECHNICAL SERVICES STANDARD PLAN FOR</p>			
<p>GUARDRAIL APPROACH TERMINAL, TYPE 3</p>			
<p>F.H.W.A. APPROVAL</p>	<p>7-13-98 PLAN DATE</p>	<p>R-63-A</p>	<p>SHEET 2 OF 6</p>

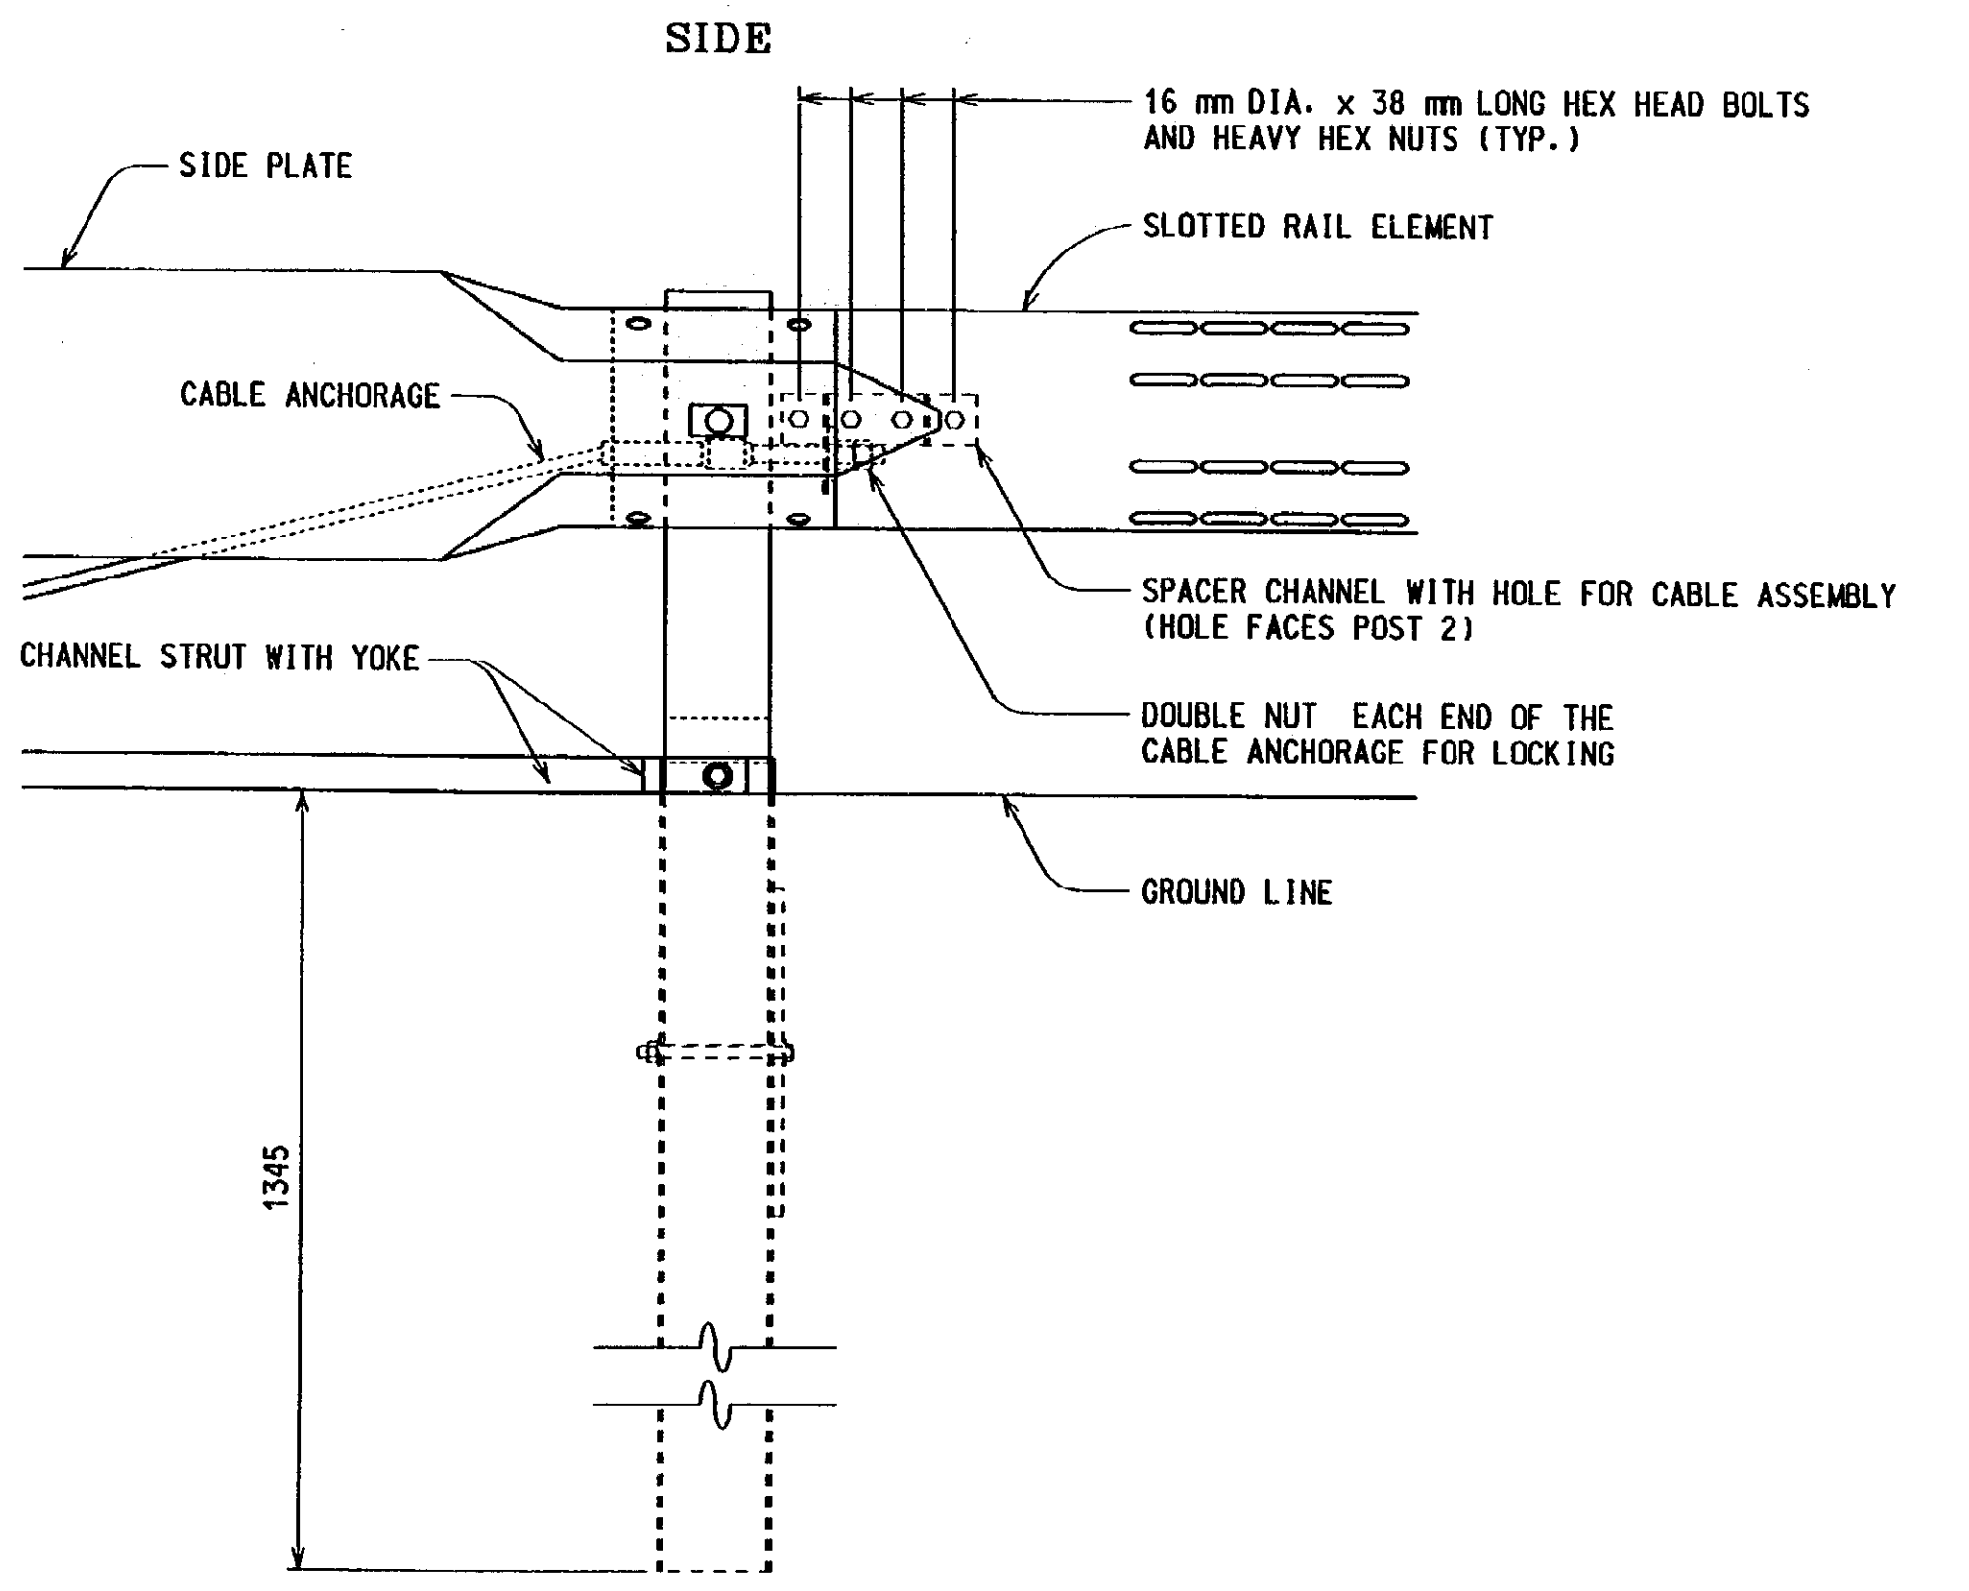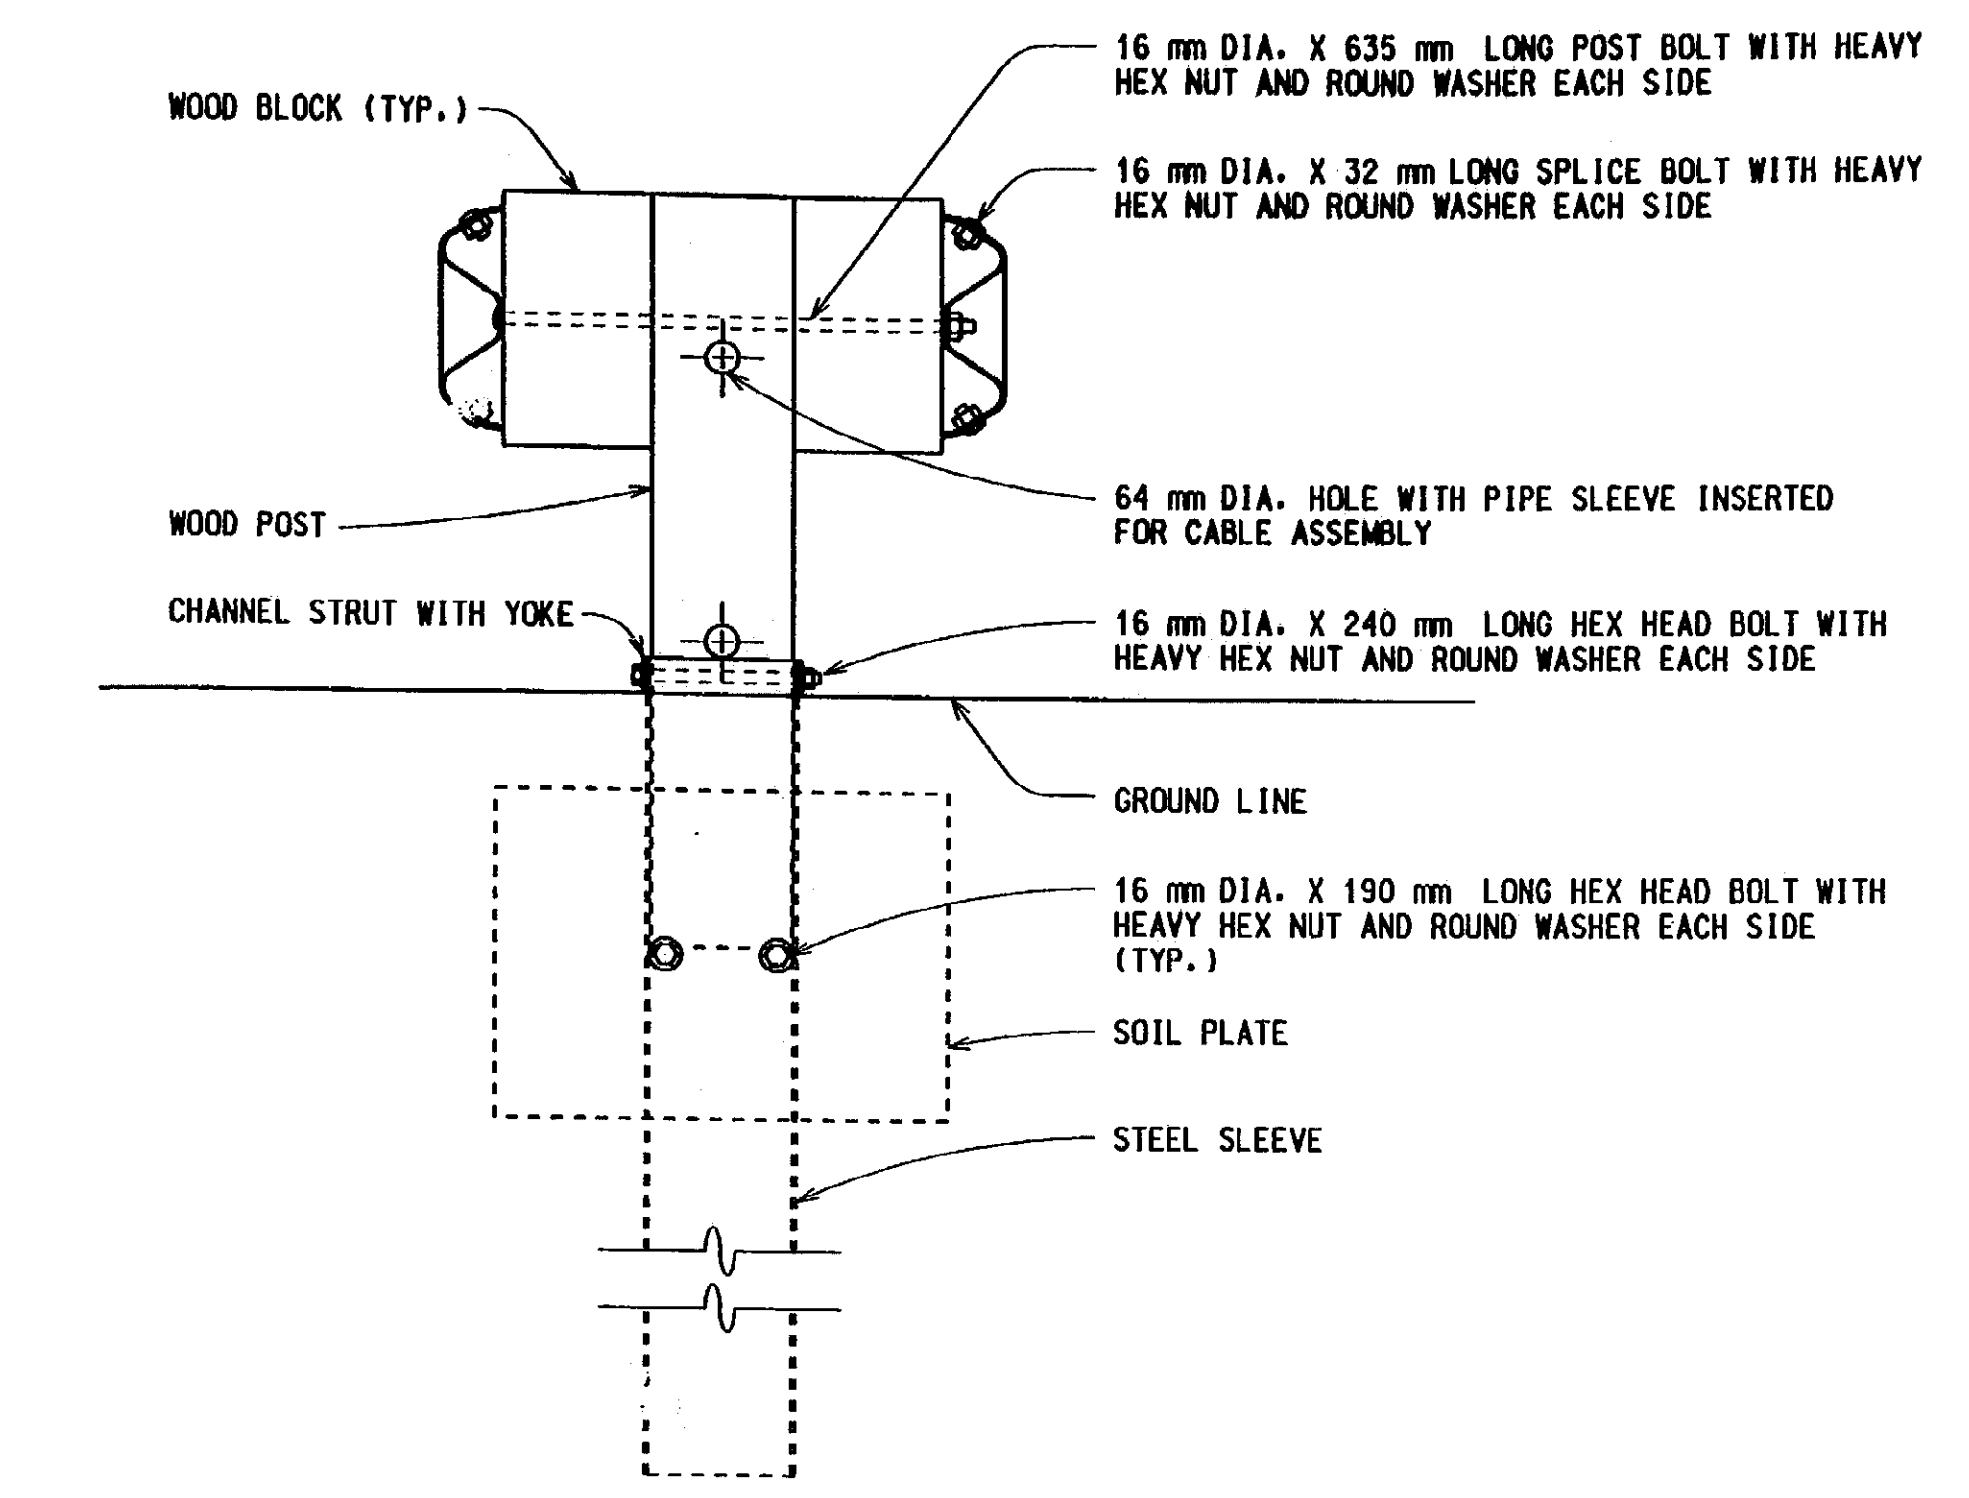


POST 2 DETAILS

MICHIGAN DEPARTMENT OF TRANSPORTATION
BUREAU OF HIGHWAY TECHNICAL SERVICES STANDARD PLAN FOR
**GUARDRAIL APPROACH
TERMINAL, TYPE 3**


F.H.W.A. APPROVAL	7-13-98 PLAN DATE	R-63-A	SHEET 3 OF 6
-------------------	----------------------	--------	-----------------

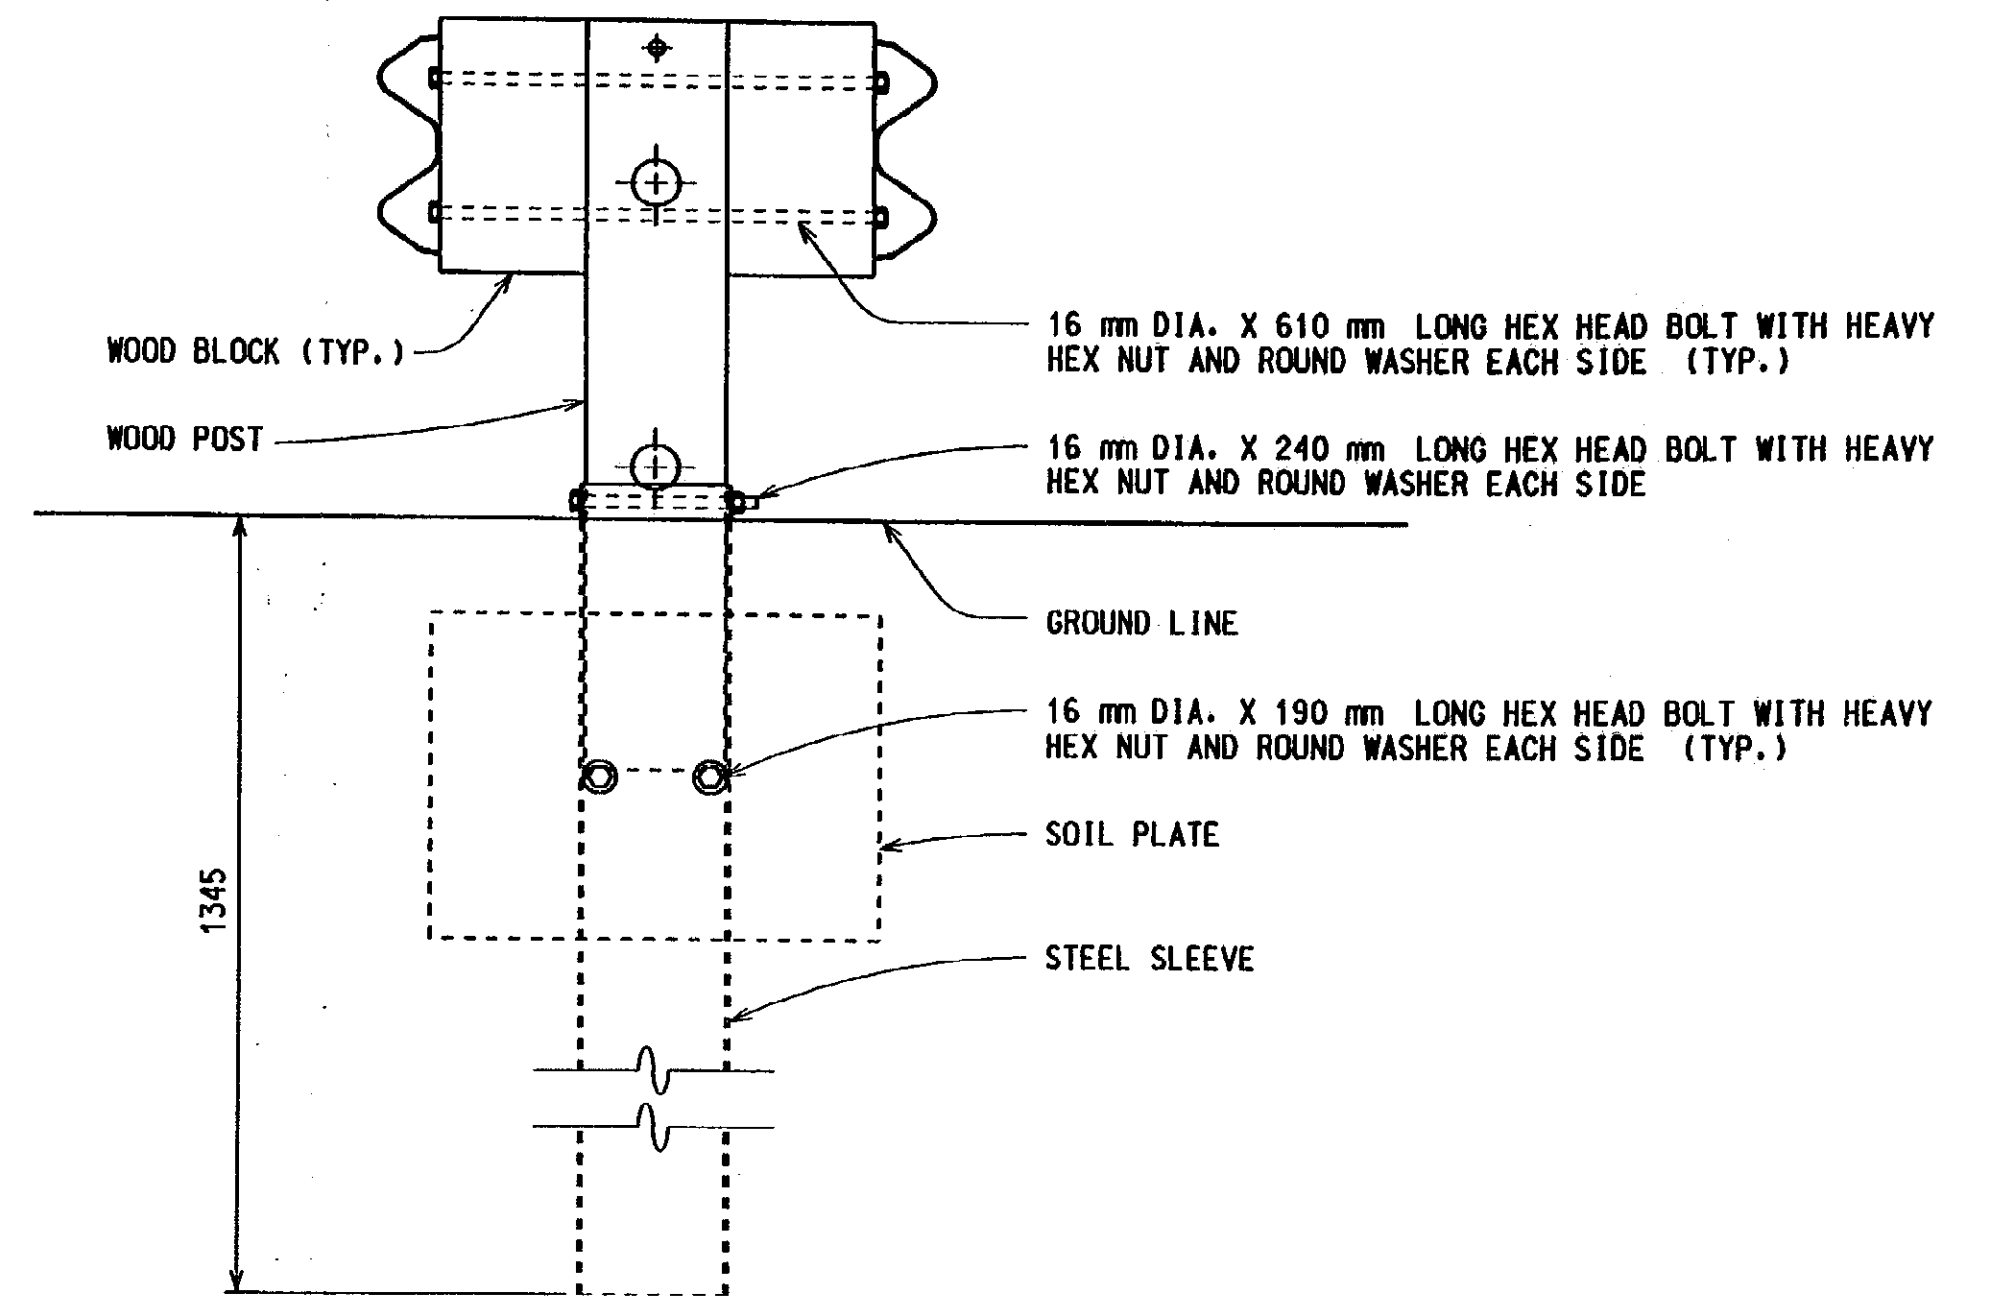

POST 3 AND 5 DETAIL

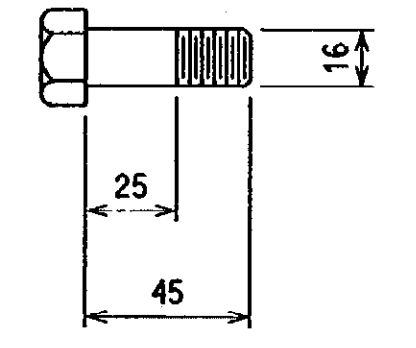


C-A-T SPLICE BOLT
C-A-T SPLICE BOLTS REQUIRED TO ALLOW TELESCOPING ACTION

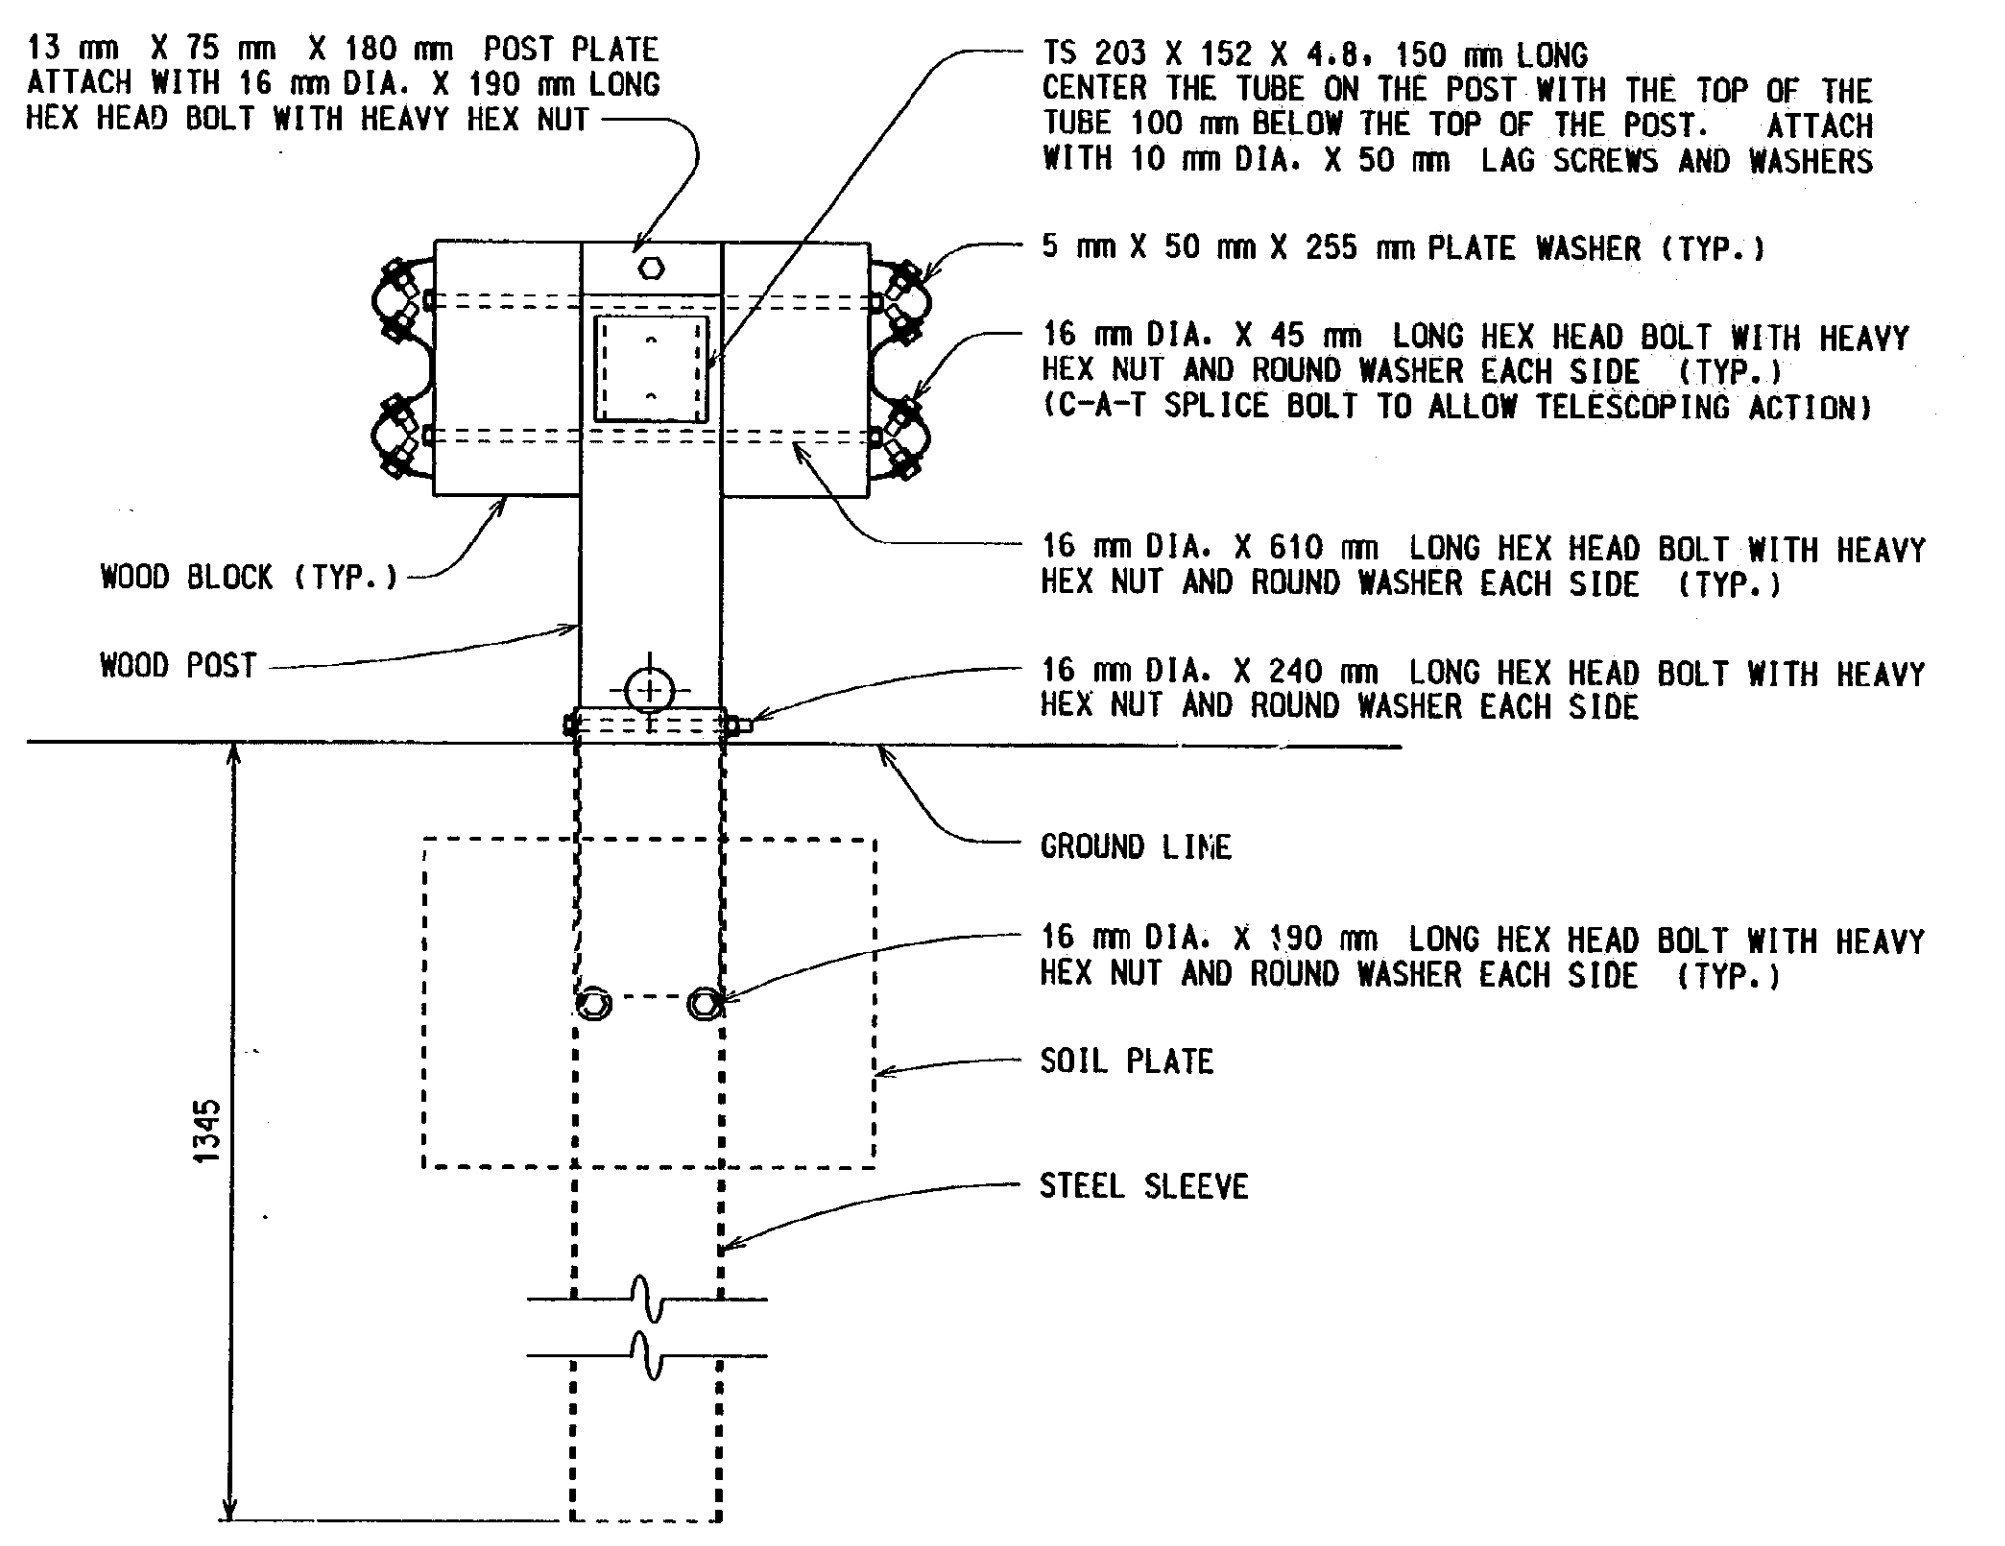


POST 4 DETAIL

MICHIGAN DEPARTMENT OF TRANSPORTATION
BUREAU OF HIGHWAY TECHNICAL SERVICES STANDARD PLAN FOR
**GUARDRAIL APPROACH
TERMINAL, TYPE 3**


F.H.W.A. APPROVAL	7-13-98 PLAN DATE	R-63-A	SHEET 4 OF 6
-------------------	----------------------	--------	-----------------

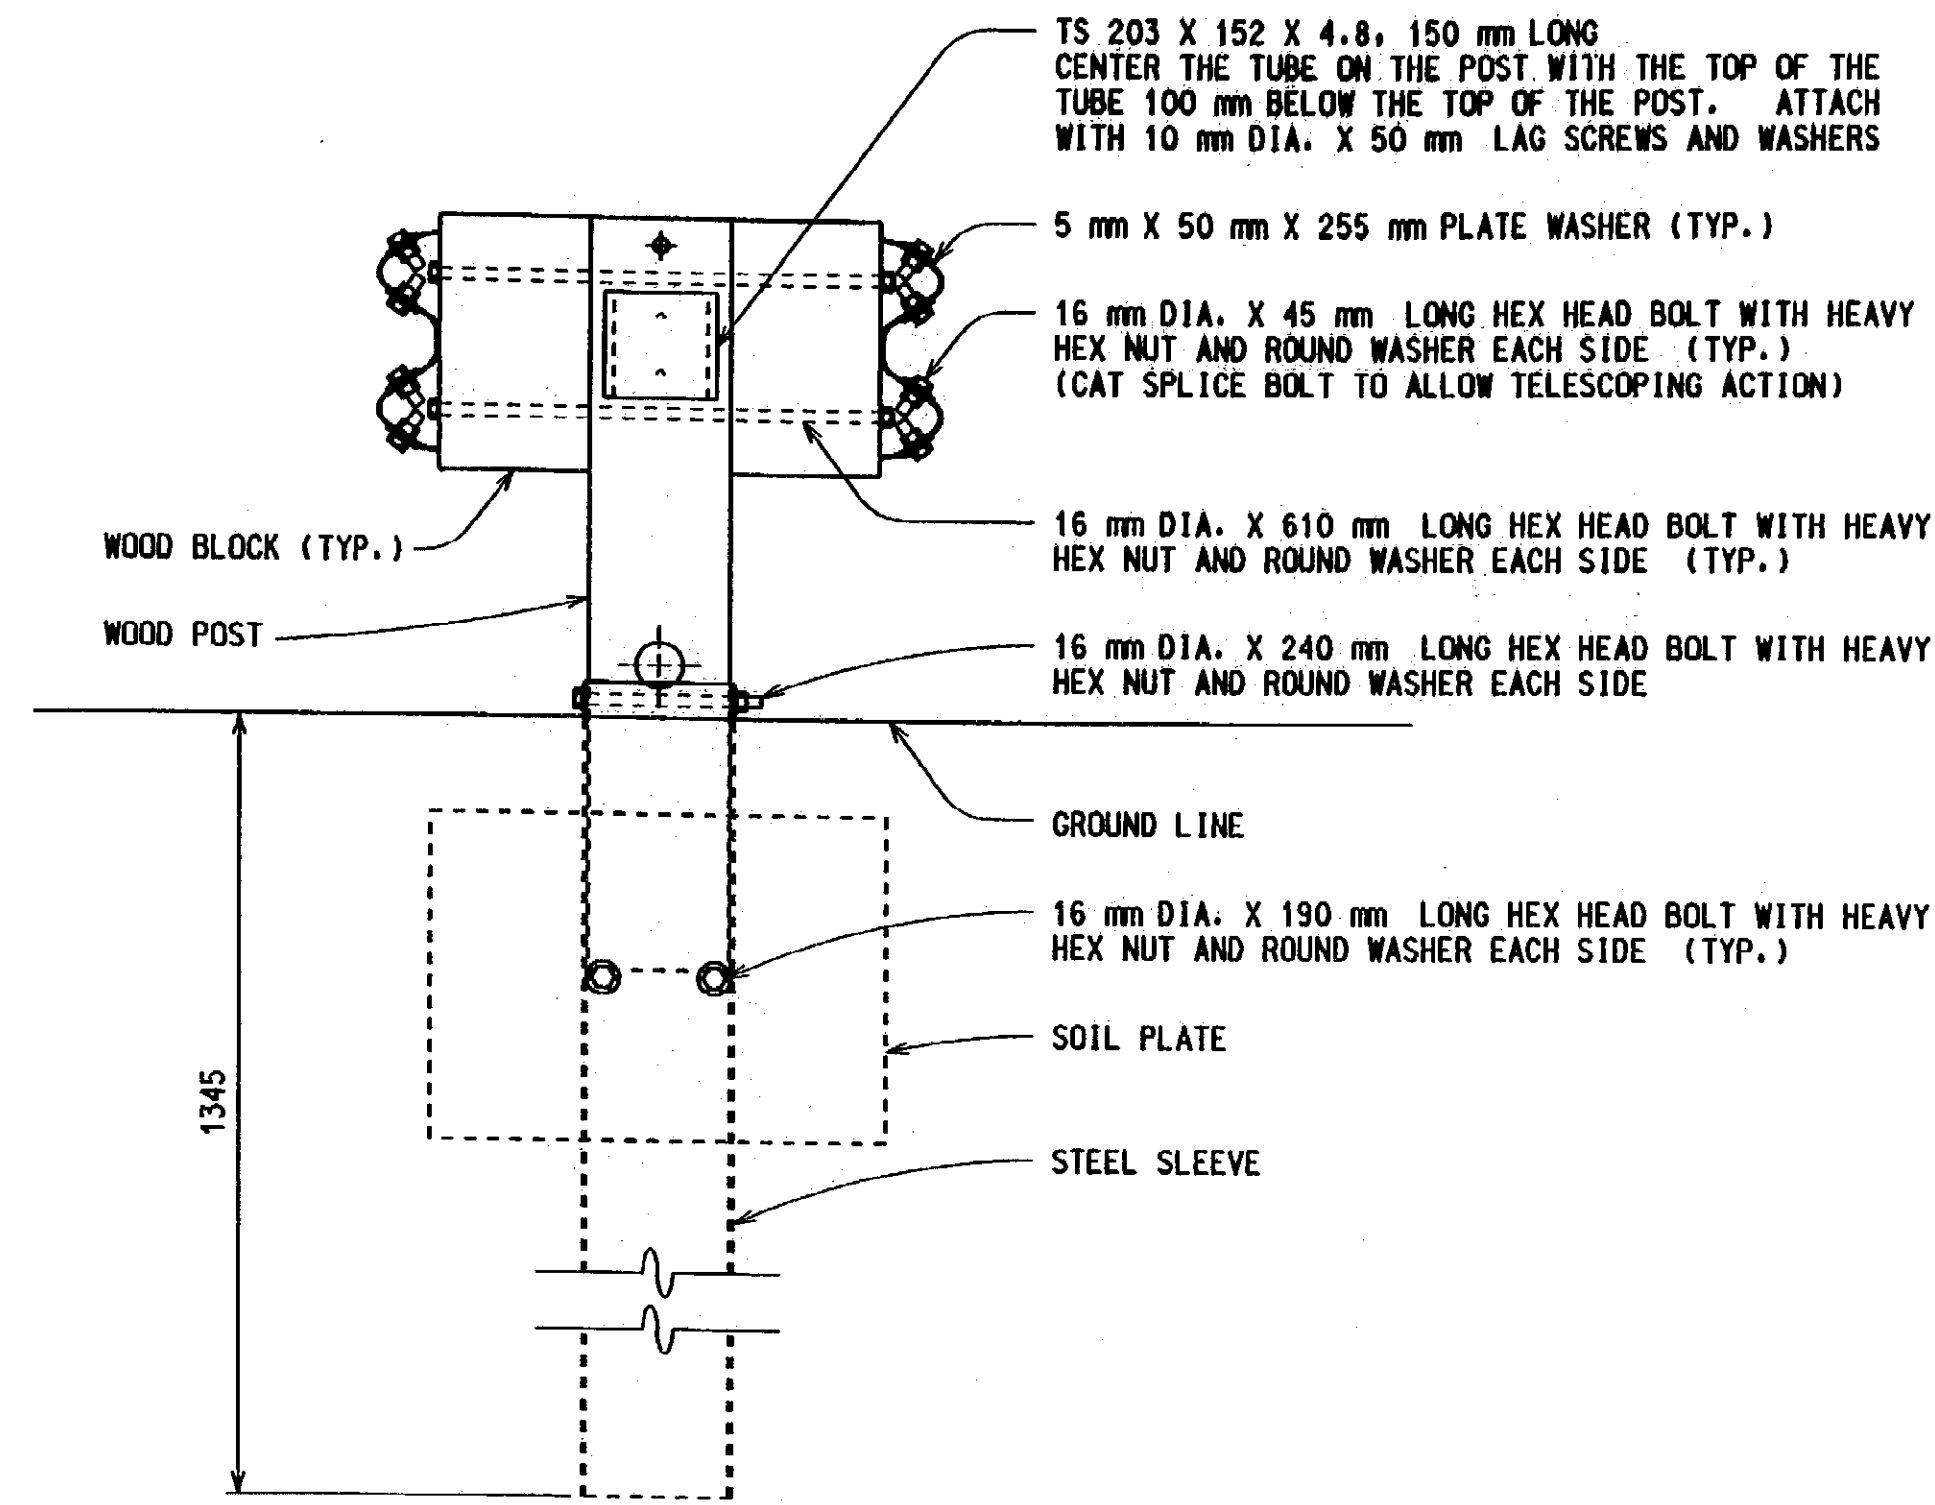

POST 6 DETAIL

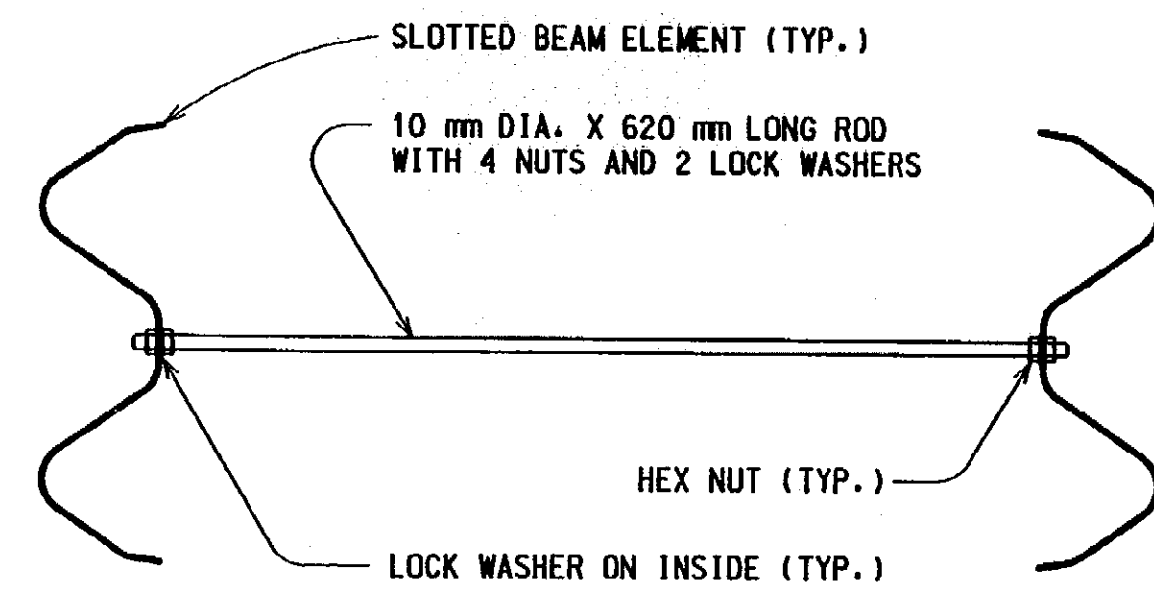

BUCKLING RESTRAINT ROD DETAIL

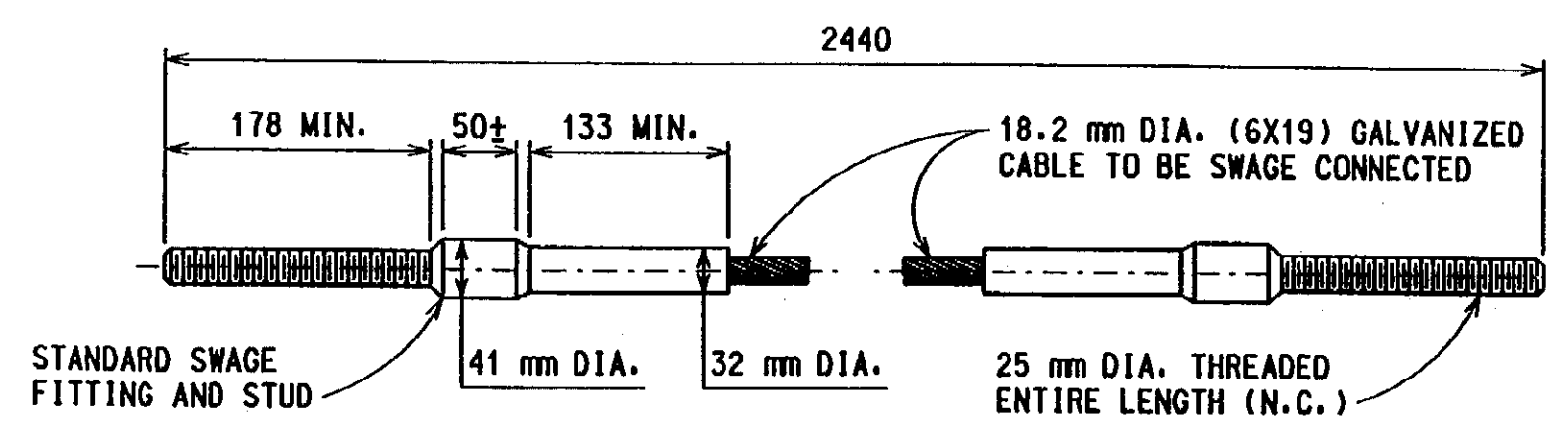


CABLE ASSEMBLY


MICHIGAN DEPARTMENT OF TRANSPORTATION
BUREAU OF HIGHWAY TECHNICAL SERVICES STANDARD PLAN FOR

**GUARDRAIL APPROACH
TERMINAL, TYPE 3**


F.H.W.A. APPROVAL	7-13-98 PLAN DATE	R-63-A	SHEET 5 OF 6
CONTROL SECTION	JOB NO.	SHEET NO.	

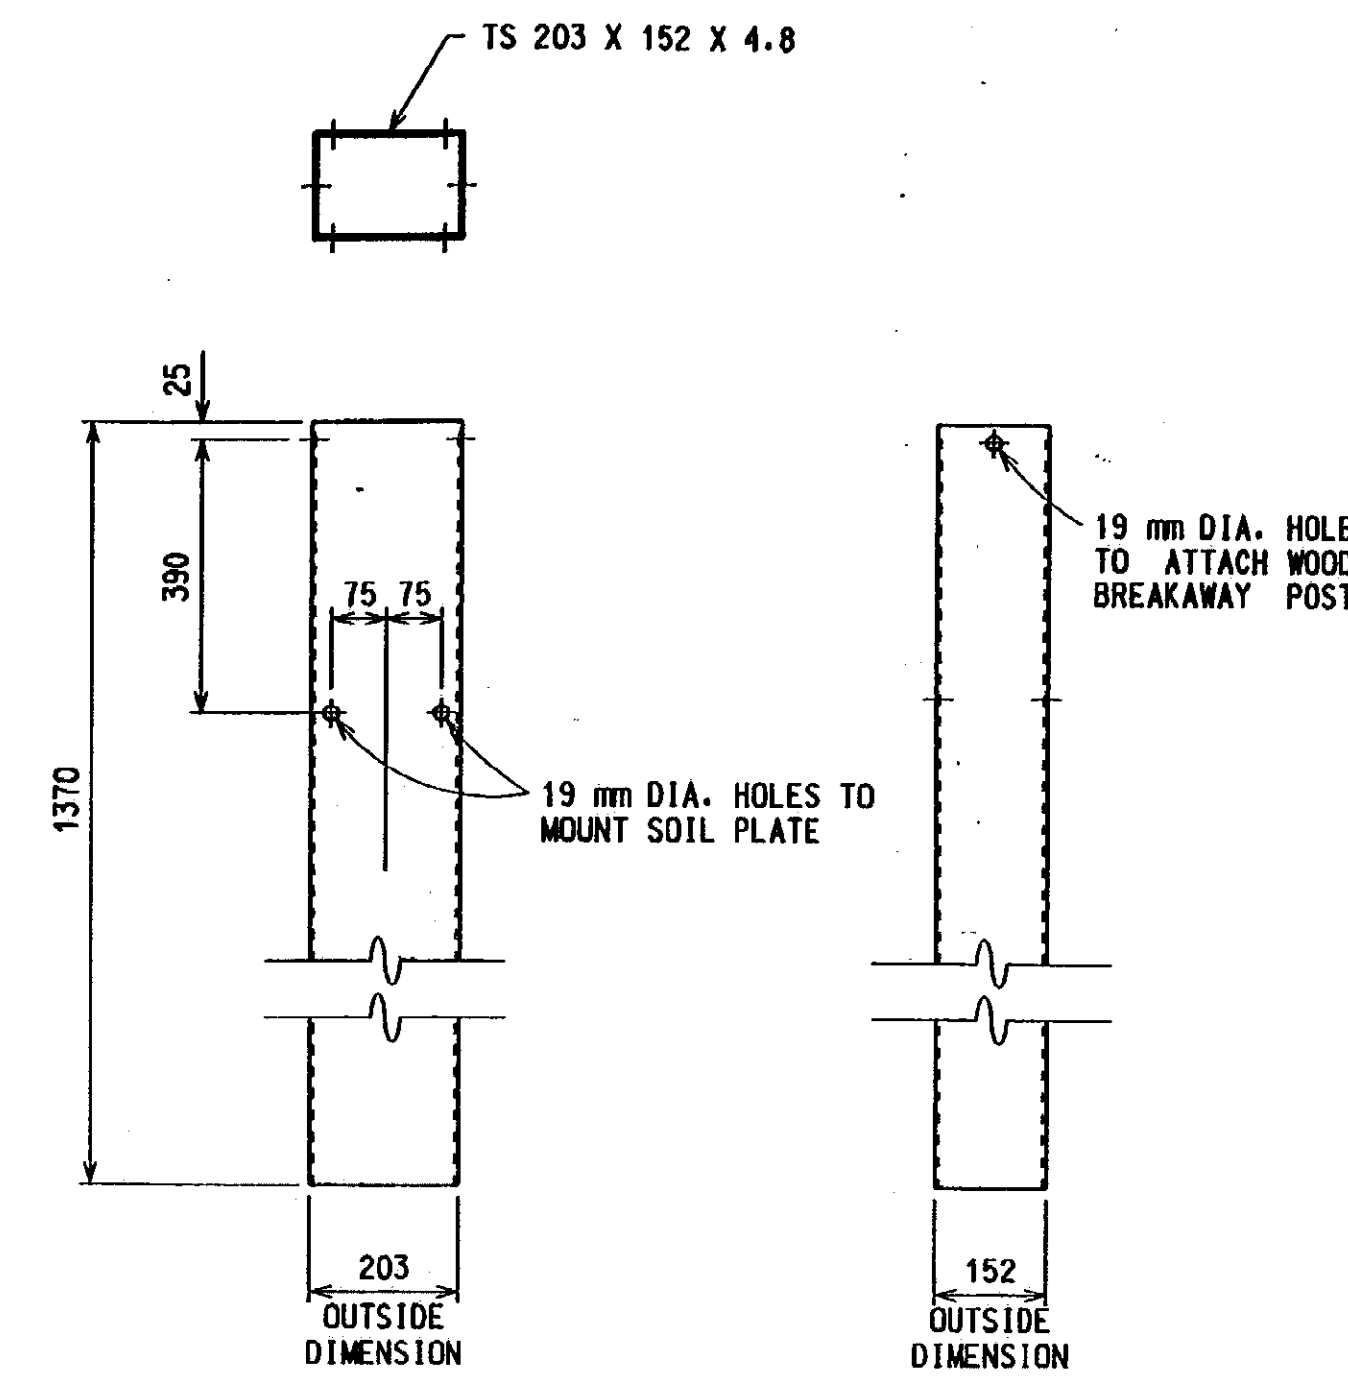


STEEL SLEEVE

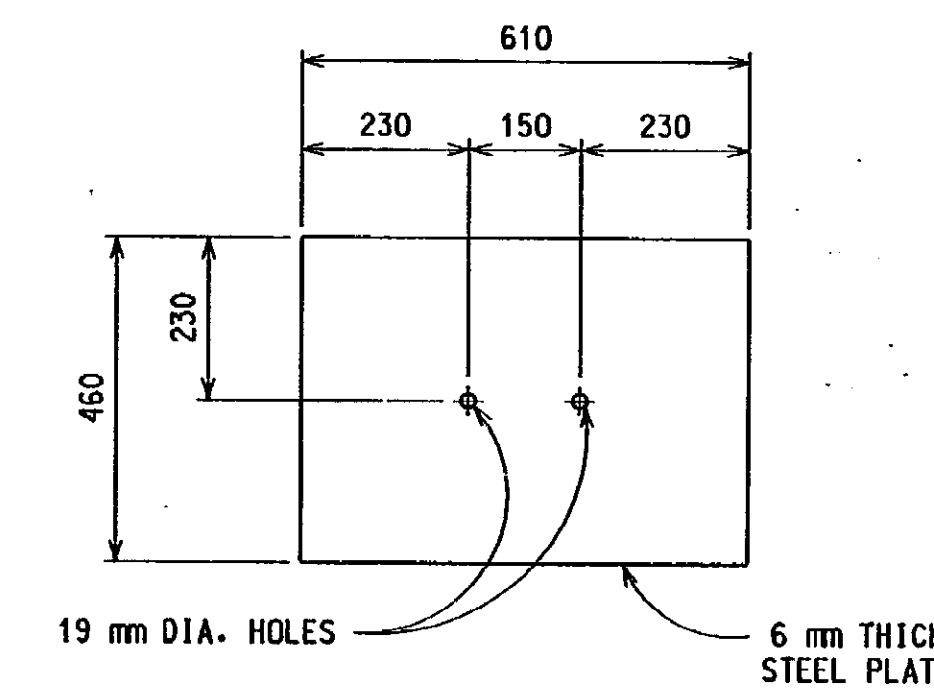


SOIL PLATE

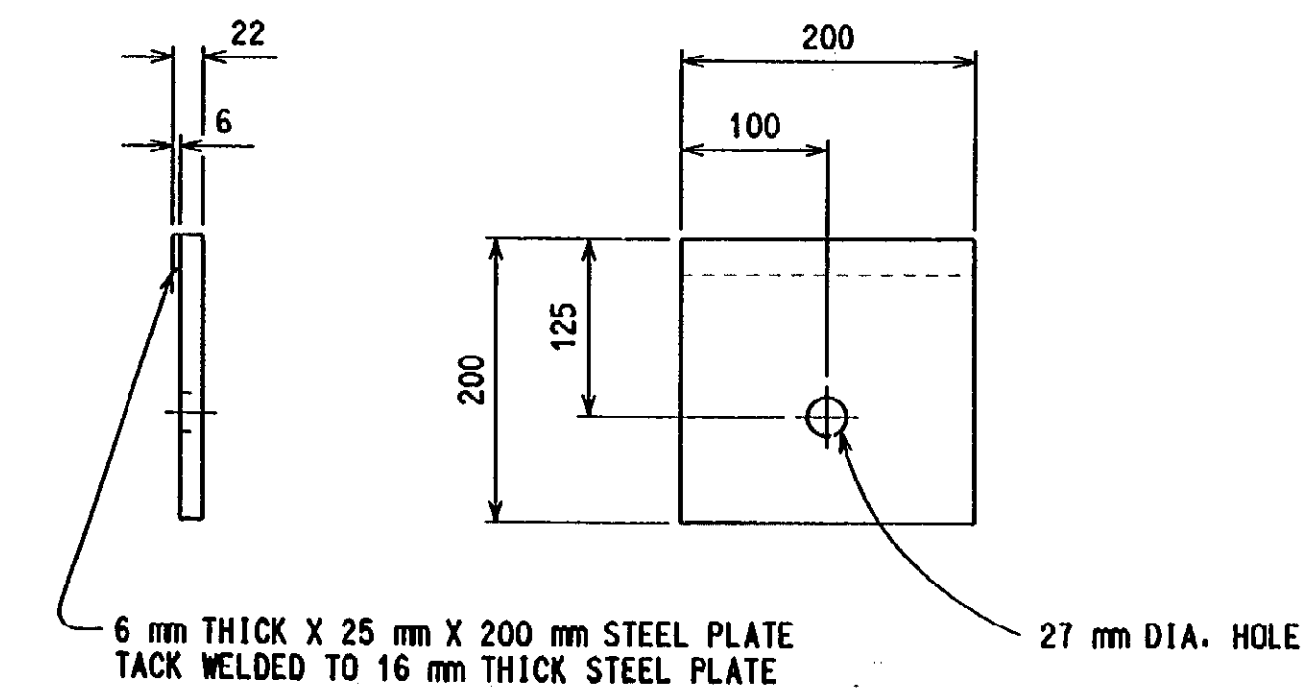

BEARING PLATE

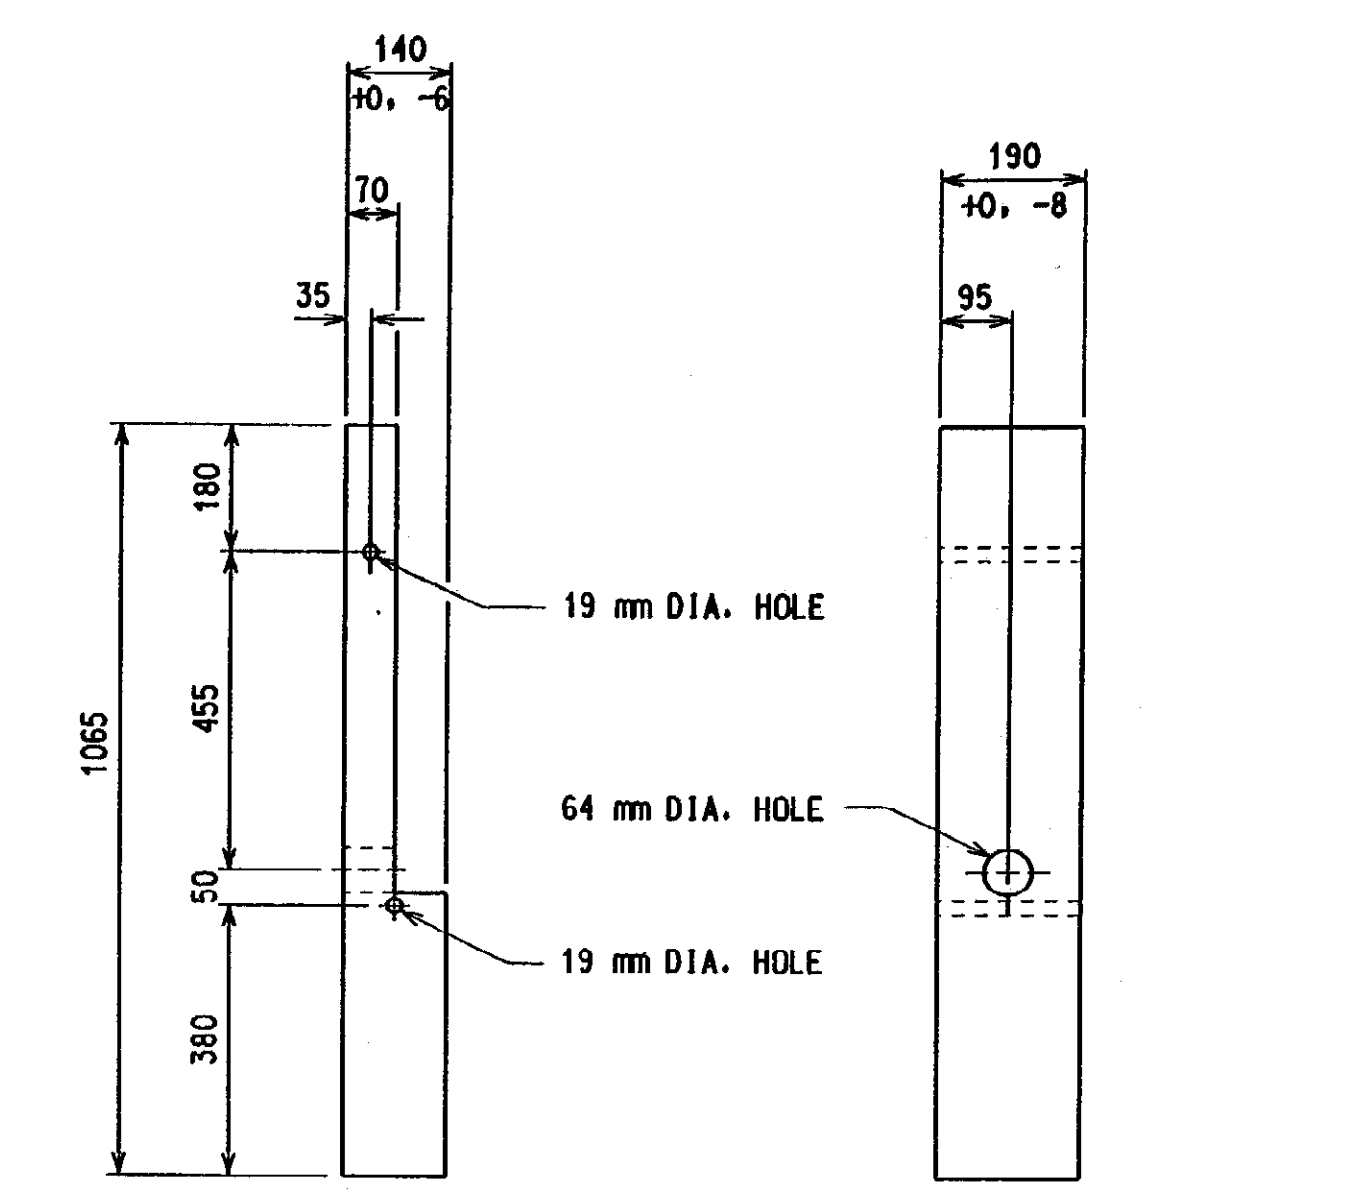

WOOD BREAKAWAY POST
(POST 1)

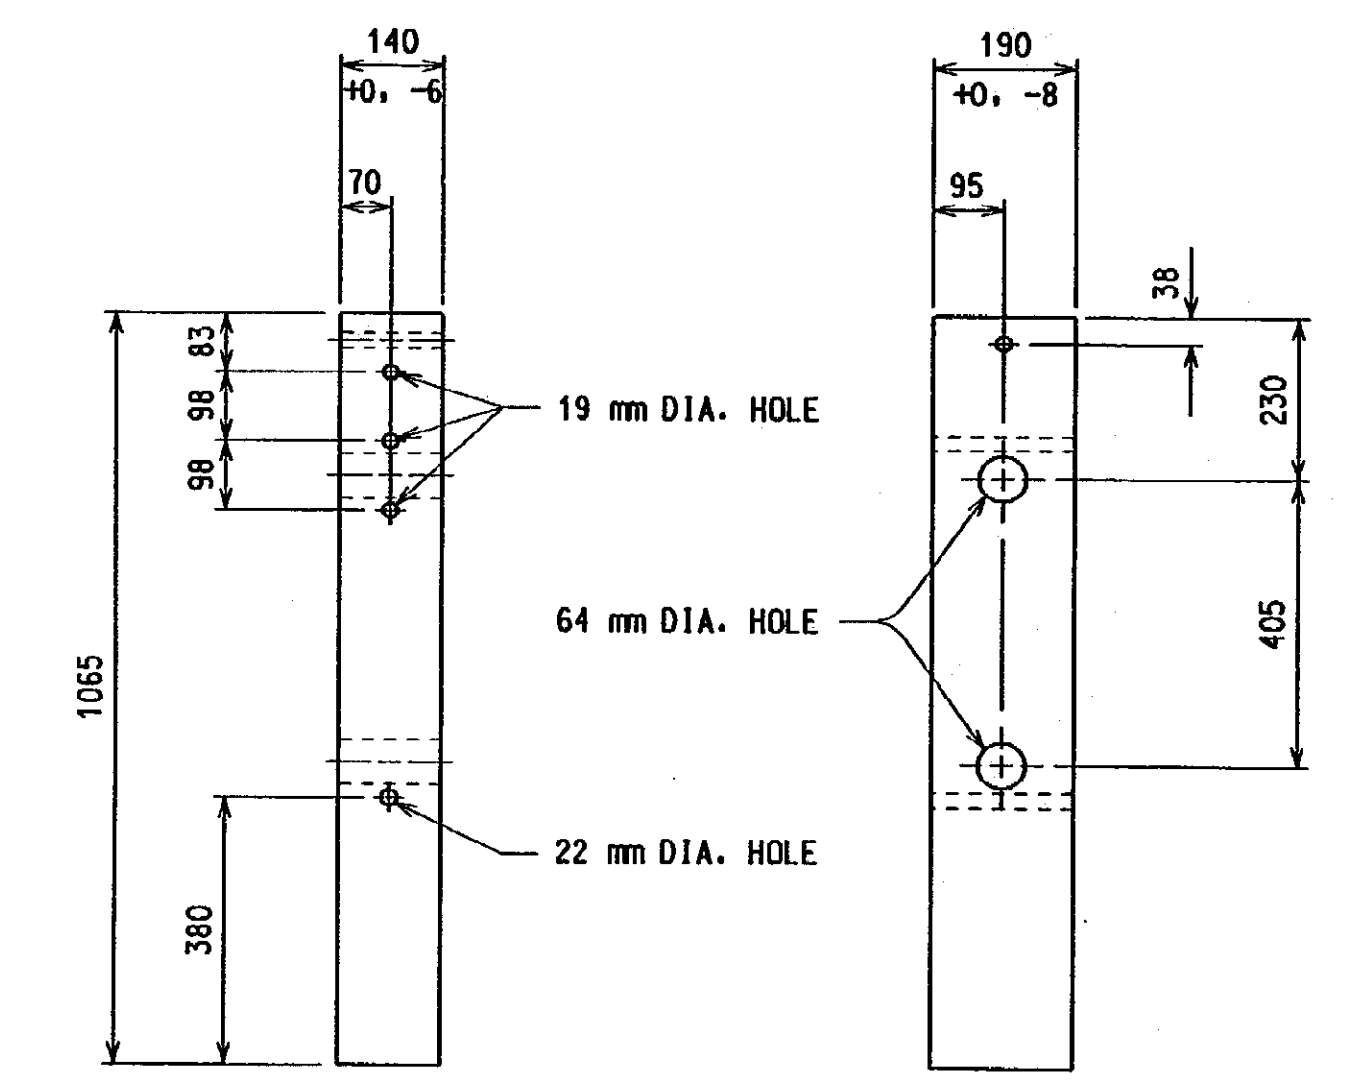

WOOD BREAKAWAY POST
(POST 2 - 6)

NOTES:

ALL POSTS, OFFSET BLOCKS, BEAM AND BACK-UP ELEMENTS, AND HARDWARE (INCLUDING BOLTS, NUTS, AND WASHERS) SHALL CONFORM TO THE CURRENT STANDARD SPECIFICATIONS AND TO THE CURRENT STANDARD PLAN R-60-SERIES, WHERE APPLICABLE, EXCEPT AS SPECIFIED ON THIS STANDARD.

ALL 1:10 SLOPES SHALL BE GRADED TO CLASS A SLOPE TOLERANCES.

FOR DETAILS OF GUARDRAIL PLACEMENT, SEE STANDARD PLAN R-59-SERIES.

AFTER THE CABLE ASSEMBLY HAS BEEN TIGHTENED, A SECOND NUT SHALL BE INSTALLED SO THAT THE CABLE WILL NOT LOOSEN.

HARDWARE BETWEEN POST 1 AND POST 6 ARE PROPRIETARY ITEMS OF THE C-A-T AND MUST BE PURCHASED FROM AN AUTHORIZED DISTRIBUTOR.

ALL DIMENSIONS ARE IN MILLIMETERS (mm) UNLESS OTHERWISE NOTED.





MICHIGAN DEPARTMENT OF TRANSPORTATION
BUREAU OF HIGHWAY TECHNICAL SERVICES STANDARD PLAN FOR

**GUARDRAIL APPROACH
TERMINAL, TYPE 3**

F.H.W.A. APPROVAL	7-13-98 PLAN DATE	R-63-A	SHEET 6 OF 6
CONTROL SECTION	JOB NO.	SHEET NO.	








APPLICABLE SOIL EROSION AND SEDIMENTATION CONTROL MEASURES
 (COMPREHENSIVE DETAILS ARE LOCATED IN SECTION 7 OF THE SOIL EROSION AND SEDIMENTATION CONTROL MANUAL)

- A = SLOPES
- B = STREAMS AND WATERWAYS
- C = SURFACE DRAINAGEWAYS
- D = ENCLOSED DRAINAGE (INLET & OUTFALL CONTROL)
- E = LARGE FLAT SURFACE AREAS
- F = BORROW AND STOCKPILE AREAS
- G = MDEQ PERMIT MAY BE REQUIRED


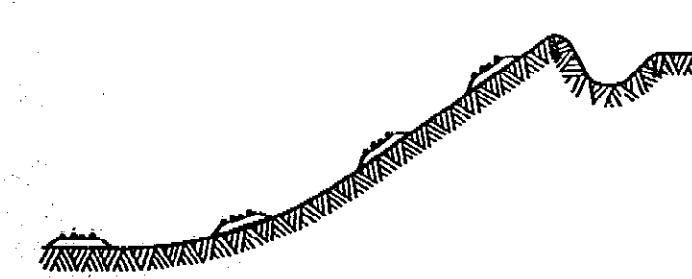
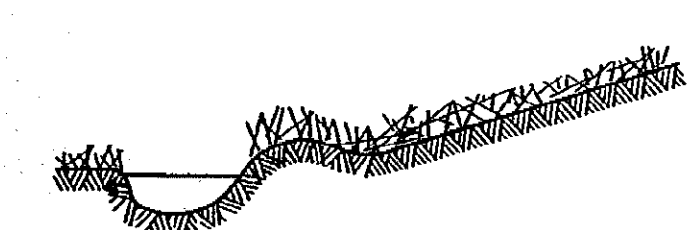
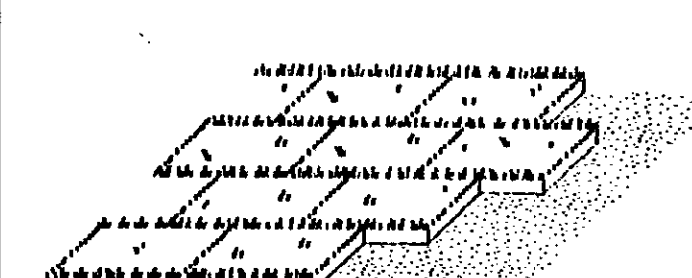
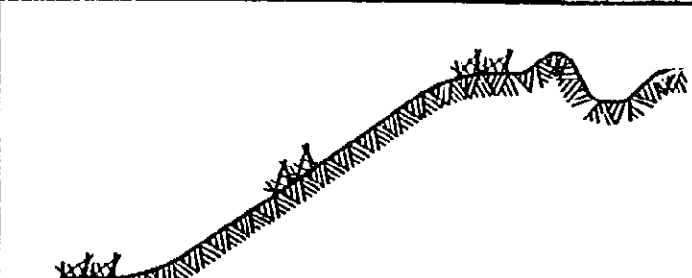

KEY	DETAIL	CHARACTERISTICS	A	B	C	D	E	F	G
1	DELETED SELECTIVE GRADING AND SHAPING	DELETED Refer instead to VEGETATED BUFFER STRIPS (KEY 6)							
2	 GRUBBING OMITTED	Retains existing root mat which assists in stabilizing slopes. Assists in the revegetation process by providing sprout growth. Reduces sheet flow velocities preventing rilling and gulying. Discourages off-road vehicle use.	•				•		
3	 PERMANENT/TEMPORARY SEEDING	Inexpensive but effective erosion control measure to stabilize flat areas and mild slopes. Permits runoff to infiltrate soil reducing runoff volumes. Proper preparation on the seed bed, fertilizing, mulching and watering is critical to its success.	•		•		•	•	
4	DELETED SELECTIVE GRADING AND SHAPING	DELETED Refer instead to VEGETATED BUFFER STRIPS (KEY 6)							
5	 SODDING	Provides immediate vegetative cover such as at spillways and ditch bottoms. Proper preparation of the topsoil, placement of the sod, and watering is critical to its success.	•				•	•	
6	 VEGETATED BUFFER STRIPS	Reduces sheet flow velocities preventing rilling and gulying. Assists in the collection of sediments by filtering runoff. Assists in the establishment of a permanent vegetative cover.	•				•		

MDOT Michigan Department of Transportation
 ENGINEER OF CONSTRUCTION & TECHNOLOGY
 PREPARED BY DESIGN DIVISION
 DRAWN BY: B.L.T./J.J.R.
 CHECKED BY: W.K.P.
 ENGINEER OF MAINTENANCE
 ENGINEER OF ROAD DESIGN
 ENGINEER OF DESIGN
 DEPARTMENT DIRECTOR
 James R. DeSana
 BY: CHIEF ENGINEER/DEPUTY DIRECTOR
 BUREAU OF HIGHWAY TECHNICAL SERVICES

MICHIGAN DEPARTMENT OF TRANSPORTATION
 BUREAU OF HIGHWAY TECHNICAL SERVICES STANDARD PLAN FOR
SOIL EROSION & SEDIMENTATION CONTROL MEASURES
 F.H.W.A. APPROVAL
 4-28-2000
 PLAN DATE
R-96-B
 SHEET 1 OF 8

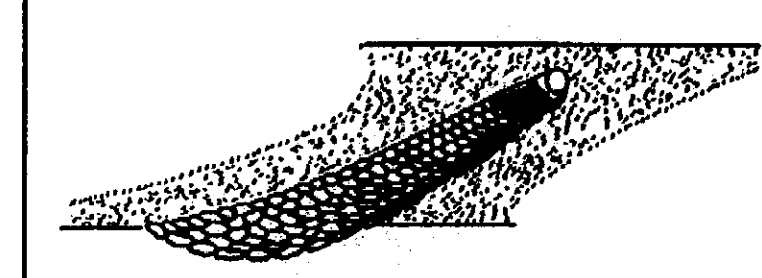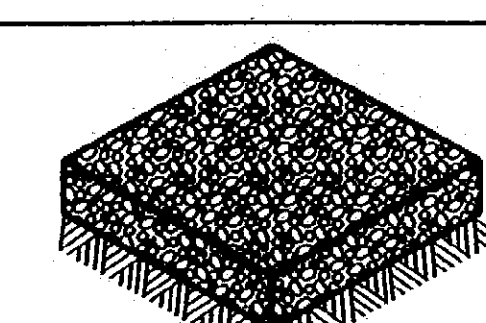
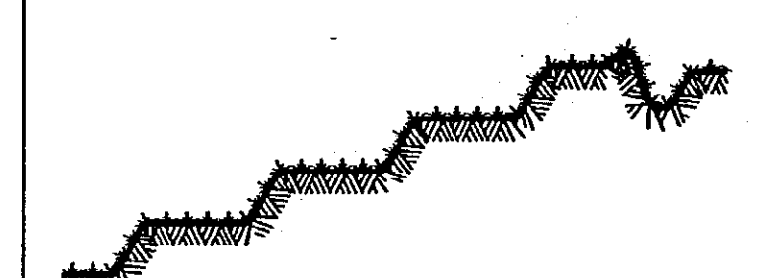
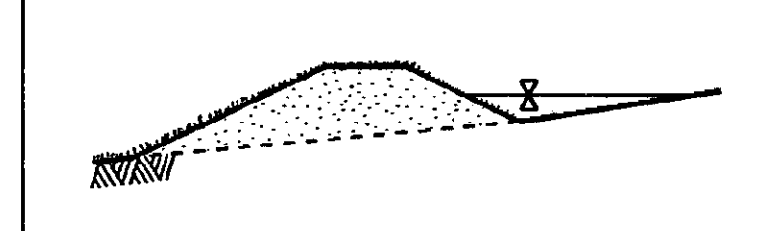
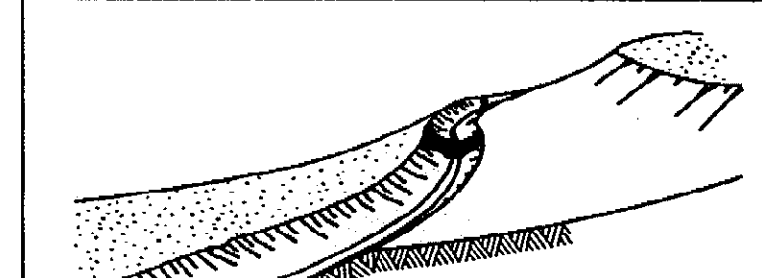
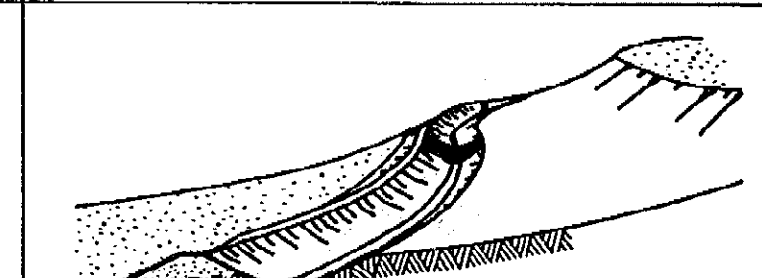
KEY	DETAIL	CHARACTERISTICS	A	B	C	D	E	F	G
7	 RIPRAP	Used where vegetation cannot be established. Very effective in containing high velocity flows. Dissipates water energy at discharge points. Should be placed over a Geotextile Filter Fabric.	•	•	•	•			•
8	 AGGREGATE COVER	Can be used in any area where a stable condition is needed for construction operations, equipment storage or in heavy traffic areas. Reduces potential soil erosion and fugitive dust by stabilizing raw areas.	•				•	•	
9	 BENCHES	Reduces sheet flow velocities preventing rilling and gulying. Assists in the collection and filtering of sediments. Provides access for stabilizing slopes.	•						•
10	 DIVERSION DIKE	Assists in the diversion of runoff to a stable outlet or sediment control device. Reduces sheet flow velocities preventing rilling and gulying. Collects and diverts runoff to properly stabilized drainage ways. Works well with DIVERSION DITCH (KEY 11)	•					•	•
11	 DIVERSION DITCH	Assists in the diversion of runoff to a stable outlet or sediment control device. Reduces sheet flow velocities preventing rilling and gulying. Works well with DIVERSION DIKE (KEY 10)	•					•	•
12	 DIVERSION DITCH AND DIKE	Assists in the diversion of runoff to a stable outlet or sediment control device. Reduces sheet flow velocities preventing rilling and gulying.	•					•	•
13	 GRAVEL FILTER BERMS	Useful in filtering flow prior to its reentry into a lake, stream or wetland. Works well with SEDIMENTATION TRAP (KEY 20) and TEMPORARY BYPASS CHANNEL (KEY 35). Not to be used in lieu of a CHECK DAM (KEY 37) in a ditch.	•		•				•
14	DELETED BRUSH FILTERS	DELETED Ineffective erosion control device. Refer instead to GRAVEL FILTER BERMS (KEY 13)							

MICHIGAN DEPARTMENT OF TRANSPORTATION
 BUREAU OF HIGHWAY TECHNICAL SERVICES STANDARD PLAN FOR
SOIL EROSION & SEDIMENTATION CONTROL MEASURES
 F.H.W.A. APPROVAL
 4-28-2000
 PLAN DATE
R-96-B
 SHEET 2 OF 8

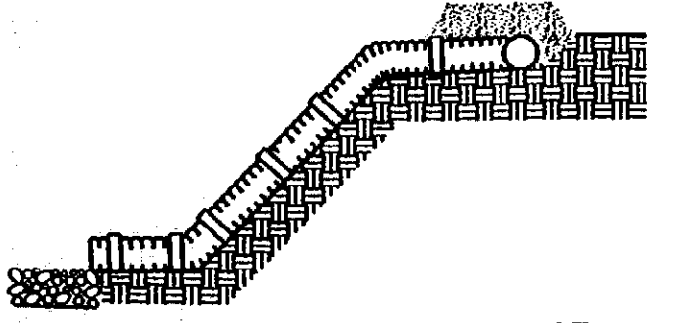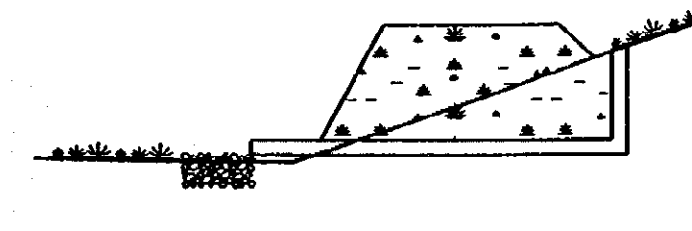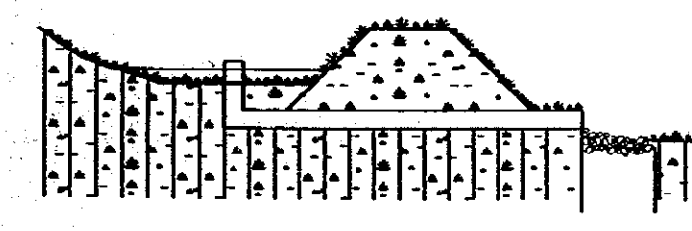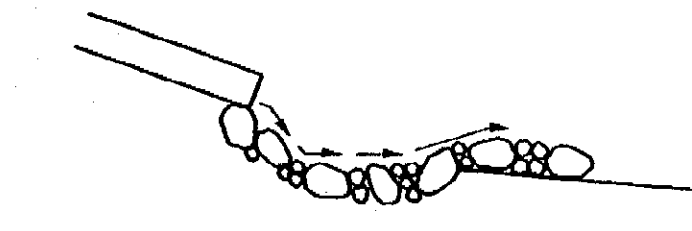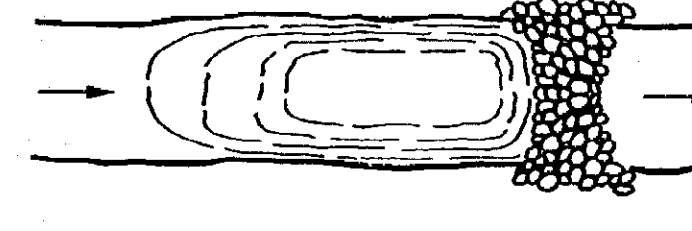KEY	DETAIL	CHARACTERISTICS	A	B	C	D	E	F	G
15	 SLOPE DRAIN SURFACE	Excellent device for carrying water down slopes without creating an erosive condition. Generally used in conjunction with DIVERSION DIKE (KEY 10), DIVERSION DITCH (KEY 11) and DIVERSION DITCH AND DIKE (KEY 12) to direct flow to a stable discharge area or SEDIMENT TRAP (KEY 20).	•		•				
16	 SLOPE DRAIN SUBSURFACE	Effective way to allow water to drop in elevation very rapidly without causing an erosive condition. May be left in place as a permanent erosion control device. Must have a stable outlet which is generally constructed of plain riprap.	•		•				
17	 PIPE DROP	Effective way to allow water to drop in elevation very rapidly without causing an erosive condition. Also works as a sediment collector device. May be left in place as a permanent erosion control device.	•		•				
18	DELETED PIPE SPILLWAY	DELETED Can create excessive water velocities. Refer instead to SLOPE DRAIN SURFACE (KEY 15) SLOPE DRAIN SUBSURFACE (KEY 16) PIPE DROP (KEY 17)							
19	 ENERGY DISSIPATORS	A device to prevent the erosive force of water from eroding soils. Used at outlets of culverts, drainage pipes or other conduits to reduce the velocity of the water. Prevents structure scouring and undermining.	•	•	•	•			
20	 SEDIMENT TRAP	Used to intercept concentrated flows and prevent sediments from being transported off site or into a watercourse or wetland. The size of a Sediment Trap is 5m ³ or less. Works well when used with CHECK DAM (KEY 37).	•		•	•			
21	 SEDIMENT BASIN	A Sediment Basin is used to trap sediments from an upstream construction site. Requires periodic inspections, repairs, and maintenance. Where practical, sediments should be contained on site. A Sediment Basin should be the last choice of sediment control. The size of a Sediment Basin is greater than 5m ³ .			•				•
22	DELETED SOD INLET FILTER	DELETED Refer instead to DROP INLET SEDIMENT TRAP (KEY 31) INLET PROTECTION FABRIC DROP (KEY 39A) INLET PROTECTION GEOTEXTILE AND STONE (KEY 39B)							








MICHIGAN DEPARTMENT OF TRANSPORTATION
 BUREAU OF HIGHWAY TECHNICAL SERVICES STANDARD PLAN FOR
SOIL EROSION & SEDIMENTATION CONTROL MEASURES

F.H.W.A. APPROVAL	4-28-2000 PLAN DATE	R-96-B	SHEET 3 OF 8
-------------------	------------------------	--------	-----------------

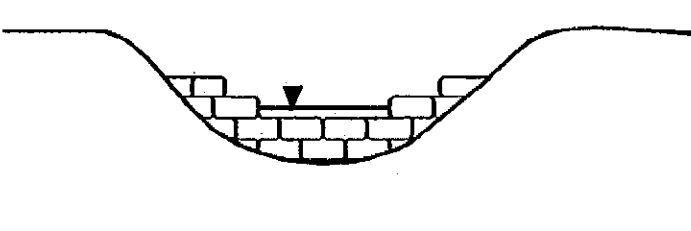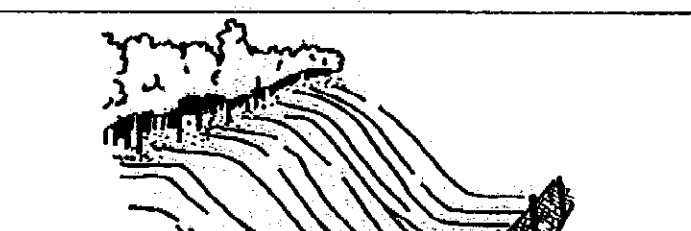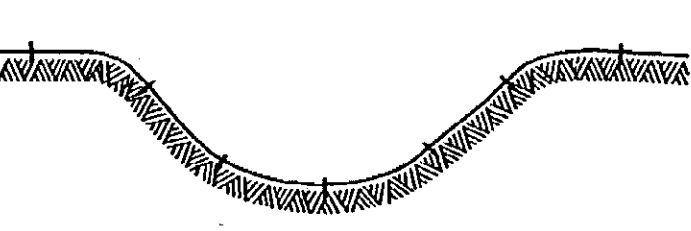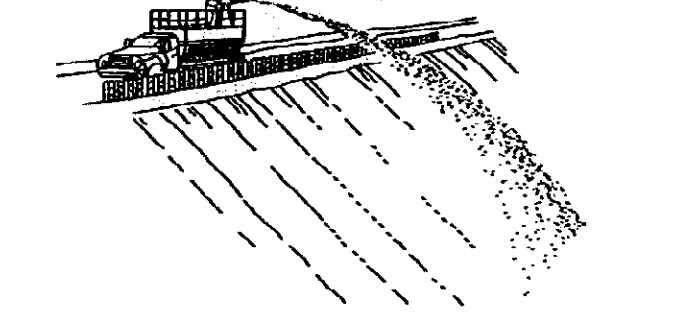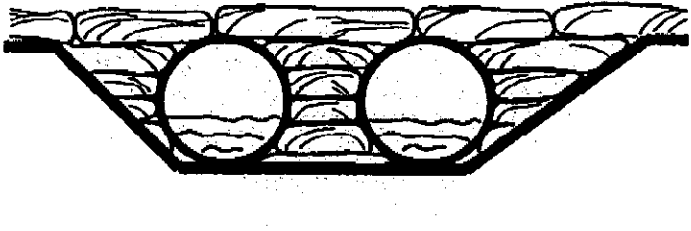KEY	DETAIL	CHARACTERISTICS	A	B	C	D	E	F	G
23	DELETED BALE FILTERS	DELETED Refer instead to GRAVEL FILTER BERMS (KEY 13) CHECK DAMS (KEY 37)							
24	 SAND AND STONE BAGS	Sand and stone bags are a useful tool in the prevention of erosion. Can be used to divert water around a construction site by creating a DIVERSION DIKE (KEY 10). Works well for creating a CONSTRUCTION DAM (KEY 36) and temporary culvert end fill.	•	•	•	•	•	•	•
25	DELETED EROSION CONTROL FENCE	DELETED Refer instead to SAND FENCE AND DUNE STABILIZATION (KEY 45)							
26	 GEOTEXTILE SILT FENCE	A permeable barrier erected below disturbed areas to capture sediments from sheet flow. Can be used to divert small volumes of water to stable outlets. Ineffective as a filter and should never be placed across streams or ditches where flow is concentrated.	•					•	•
27	 PLASTIC SHEETS	Plastic Sheets can be used to create a liner in temporary channels. Can also be used to create a temporary cover to prevent erosion on stockpiled materials.	•	•	•				•
28	 MULCHING AND MULCH ANCHORING	Anchored mulch provides erosion protection against rain and wind. Mulch must be used on seeded areas to promote water retention and growth. Should be inspected after every rainstorm and repaired as necessary until vegetation is well established.	•		•			•	•
29	 TEMPORARY STREAM CROSSING WITH CULVERTS	Provides a stable access across a watercourse for construction equipment. Must be sufficient in size to pass anticipated stream flows. Must provide adequate top width to prevent sloughing at culvert ends.			•	•			•
30	DELETED CULVERT SEDIMENT TRAP	DELETED Refer instead to SAND AND STONE BAGS (KEY 24) SEDIMENT BASIN (KEY 21)							









MICHIGAN DEPARTMENT OF TRANSPORTATION
 BUREAU OF HIGHWAY TECHNICAL SERVICES STANDARD PLAN FOR
SOIL EROSION & SEDIMENTATION CONTROL MEASURES

F.H.W.A. APPROVAL	4-28-2000 PLAN DATE	R-96-B	SHEET 4 OF 8
-------------------	------------------------	--------	-----------------

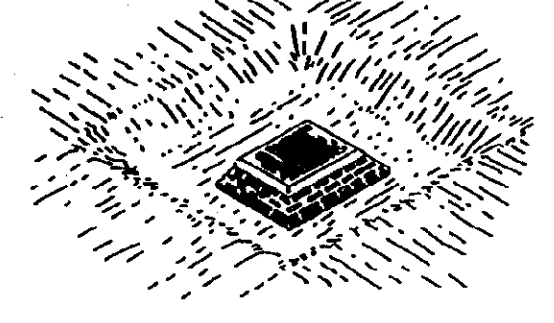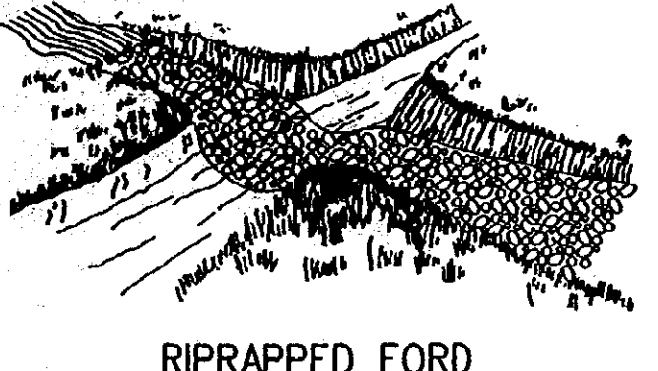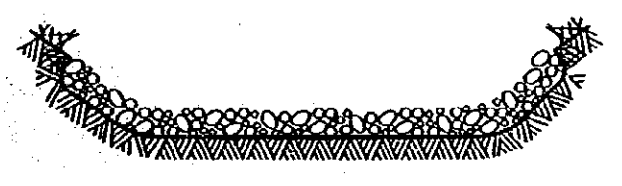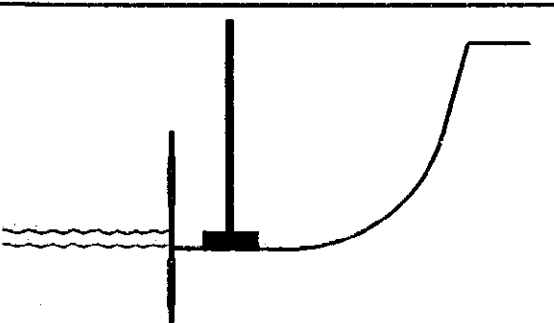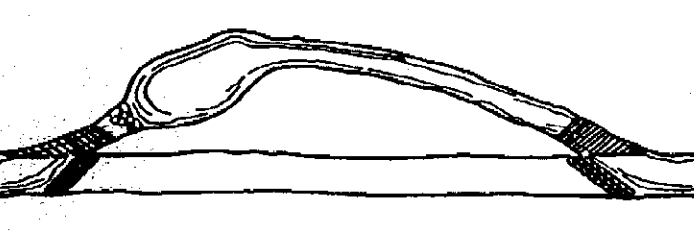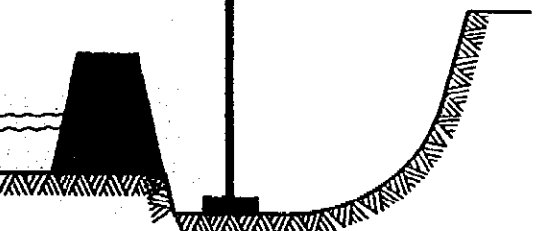KEY	DETAIL	CHARACTERISTICS	A	B	C	D	E	F	G
31	 DROP INLET SEDIMENT TRAP	A Drop Inlet Sediment Trap is a temporary device that can be used in areas where medium flows are anticipated. Effective in trapping small quantities of sediments prior to water entering the drainage system. Can be used in areas of low to medium flows.			•		•		
32	 RIPRAPPED FORD	Used to minimize erosion in areas where a stream will be crossed a minimum number of times by vehicles or equipment. Geotextile Filter Fabric must first be placed on the stream bottom before riprap is placed. For frequent crossings of a watercourse use a TEMPORARY STREAM CROSSING WITH CULVERTS (KEY 29) or TEMPORARY STREAM CROSSING WITH BRIDGE (KEY 40).		•				•	
33	 STREAM BED PROTECTION	Placing Stream Bed Protection is an effective method of stabilizing high quality streams and rivers, which have been disturbed through construction activities, or is in a raw or eroding condition as a result of construction activities.		•				•	
34	 STEEL SHEET PILING COFFERDAM	Used to create a dry construction site and protect the stream from raw erodible areas. Must be pumped dry or dewatered according to DEWATERING (KEY 55).		•				•	
35	 TEMPORARY BYPASS CHANNEL	Utilized when a dry construction area is needed. Isolates and protects stream flows from raw erodible areas minimizing erosion and subsequent siltation. Can incorporate a large SEDIMENT BASIN (KEY 21) and multiple GRAVEL FILTER BERMS (KEY 13) to remove sediments from water.		•				•	
36	 CONSTRUCTION DAM	Used to create a dry or slack water area for construction. Protects the stream from raw erodible areas. Can be created out of any non-erodible materials such as SAND AND STONE BAGS (KEY 24), a gravel dike with clay core or plastic liner, steel plates or plywood.		•				•	
37	 CHECK DAM	Can be constructed across ditches or any area of concentrated flow. Protects vegetation in early stages of growth. A Check Dam is intended to reduce water velocities and capture sediment. A Check Dam is not a filtering device.		•	•			•	
38	DELETED WEIR	DELETED Refer instead to SEDIMENT TRAP (KEY 20) SEDIMENT BASIN (KEY 21) SAND AND STONE BAGS (KEY 24)							









MICHIGAN DEPARTMENT OF TRANSPORTATION
 BUREAU OF HIGHWAY TECHNICAL SERVICES STANDARD PLAN FOR
SOIL EROSION & SEDIMENTATION CONTROL MEASURES

F.H.W.A. APPROVAL	4-28-2000 PLAN DATE	R-96-B	SHEET 5 OF 8
-------------------	------------------------	---------------	-----------------

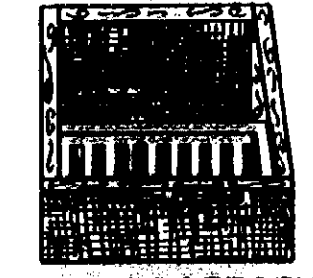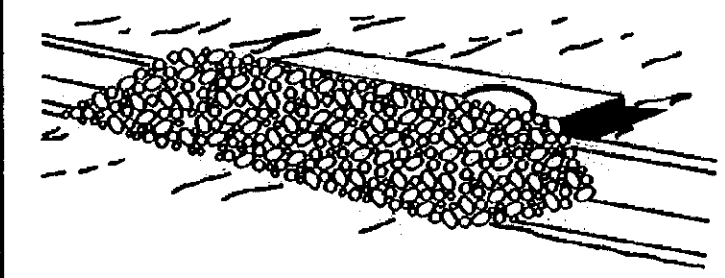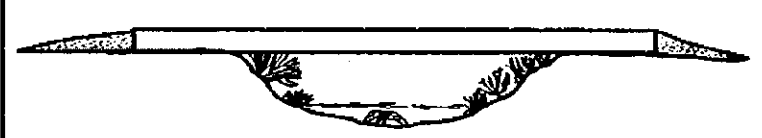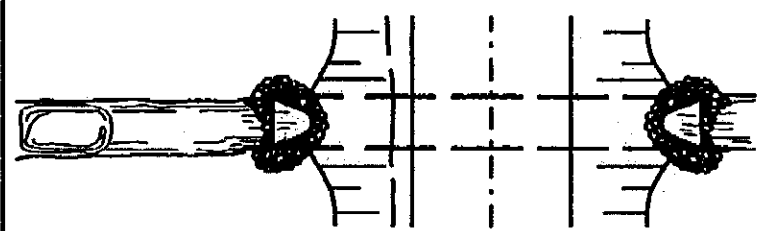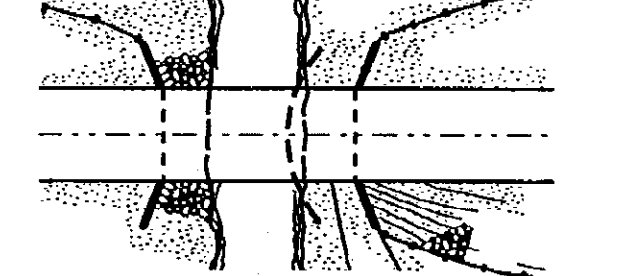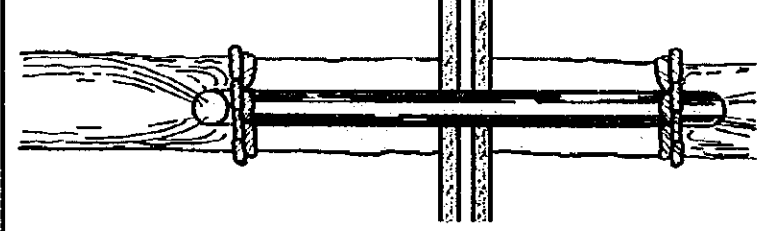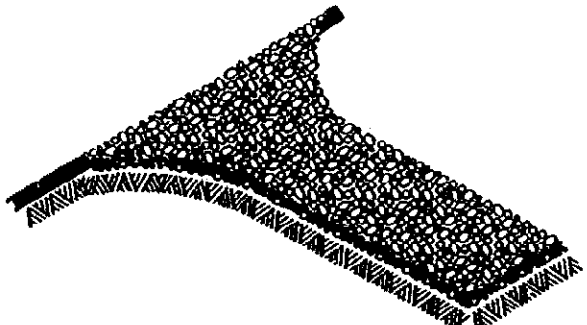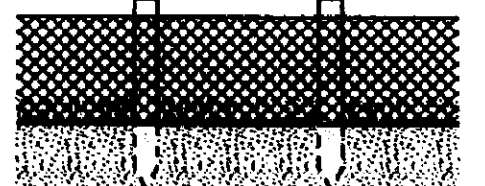KEY	DETAIL	CHARACTERISTICS	A	B	C	D	E	F	G
39A	 INLET PROTECTION FABRIC DROP	Provides settling and filtering of silt laden water prior to its entry into the drainage system. Consists of Inlet Protection Fabric Drop or Inlet Protection Geotextile and Stone. Allows for early use of drainage systems prior to project completion.			•		•		
39B	 INLET PROTECTION GEOTEXTILE AND STONE								
40	 TEMPORARY STREAM CROSSING WITH BRIDGE	Provides a stable access across a watercourse for construction equipment. Minimizes risk of erosion during installation. Native vegetation can be protected. Stabilization of raw areas after removal is minimized.		•				•	
41	 PERMANENT STREAM CROSSING WITH CULVERT	A typical detail depicting proper construction and stabilization techniques to be used in the installation of a permanent culvert. Properly installed and stabilized, a culvert provides an excellent crossing on small watercourses.		•				•	
42	 PERMANENT STREAM CROSSING WITH BRIDGE	A typical detail depicting proper construction and stabilization techniques to be used in the construction of a permanent bridge. This is a preferred permanent stream crossing method since it maintains normal stream widths, has minimal impact on stream flows, maintains a natural stream bottom and minimizes erosion risks during construction.		•				•	
43	 STREAM CROSSING PIPELINE	A method of crossing a watercourse with pipelines and cables which minimizes erosion and subsequent siltation. Allows for a dry work area.		•				•	
44	 GRAVEL ACCESS ROAD	Provides a stable access to roadways minimizing fugitive dust and tracking of materials onto public streets and highways.						•	•
45	 SAND FENCE AND DUNE STABILIZATION	A Sand Fence traps blowing sand by reducing wind velocities. Can be used to prevent sand from blowing onto roads. Must be maintained until sand source is stabilized.		•				•	•



MICHIGAN DEPARTMENT OF TRANSPORTATION
 BUREAU OF HIGHWAY TECHNICAL SERVICES STANDARD PLAN FOR
SOIL EROSION & SEDIMENTATION CONTROL MEASURES

F.H.W.A. APPROVAL	4-28-2000 PLAN DATE	R-96-B	SHEET 6 OF 8
-------------------	------------------------	---------------	-----------------

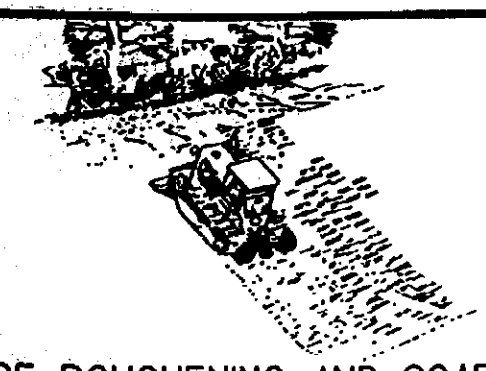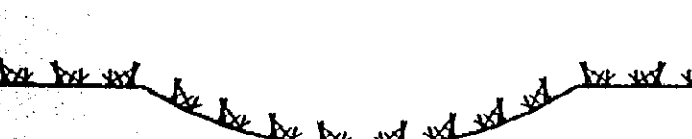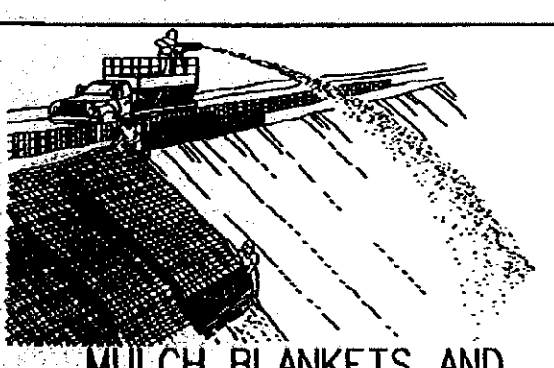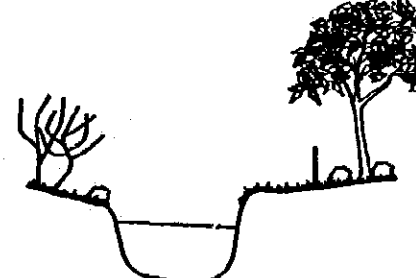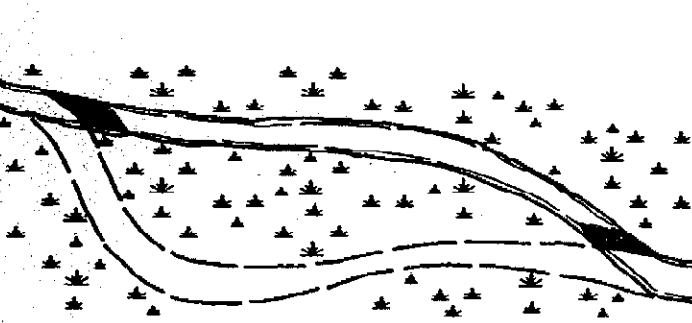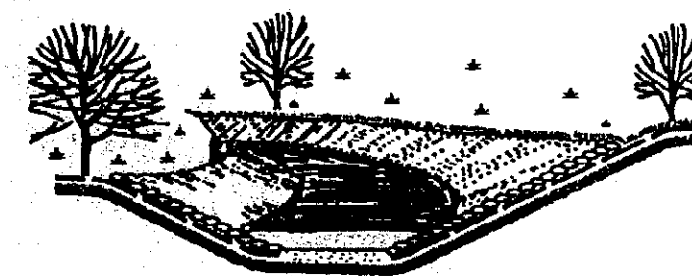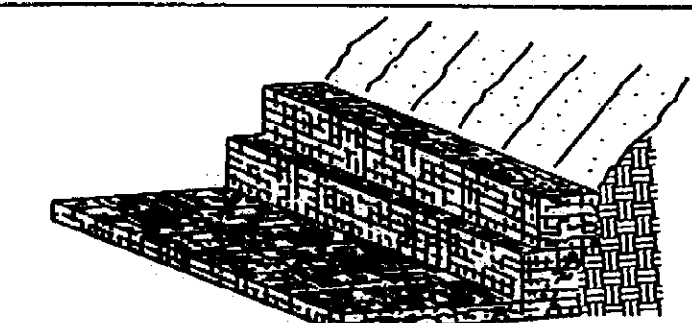KEY	DETAIL	CHARACTERISTICS	A	B	C	D	E	F	G
46	 SLOPE ROUGHENING AND SCARIFICATION	A simple and economical way to reduce soil erosion by wind and water. Can be accomplished by harrowing with a disk, back blading, or tracking with a dozer perpendicular to the slope.	•				•	•	
47	 VEGETATED CHANNELS	A Vegetated Channel is constructed in stable low areas to conform with the natural drainage system. High Velocity Mulch Blankets and seed are used. Must be designed and constructed without sharp bends or steep grades.			•				
48	 MULCH BLANKETS AND HIGH VELOCITY MULCH BLANKETS	Mulch blankets provide an immediate and effective cover over raw erodible slopes affording excellent protection against rain and wind erosion. High velocity mulch blankets work well for stabilizing the bottom of ditches in waterways.	•		•		•	•	
49	 VEGETATIVE BUFFER AT WATERCOURSE	This practice is used to maintain a vegetative buffer adjacent to a watercourse. When utilized with GEOTEXTILE SILT FENCE (KEY 26) it will prevent siltation from leaving the construction site.	•	•	•		•	•	
50	 STREAM RECONSTRUCTION	A detail depicting the proper procedures for STREAM RECONSTRUCTION. Maintains same width, depth, and flow velocity as the natural stream. Stabilize stream bed with STREAM BED PROTECTION (KEY 33). Revegetate banks with RIPRAP (KEY 7), PERMANENT/TEMPORARY SEEDING (KEY 3), MULCH BLANKETS AND HIGH VELOCITY MULCH BLANKETS (KEY 48) and woody plants to shade the stream.			•				•
51	 STREAM BANK STABILIZATION	Used to restore disturbed stream banks. Stream banks should be stabilized using plain or heavy RIPRAP (KEY 7) over Geotextile Filter Fabric. Riprap must be well toed in at the bottom of slope and extend 1 meter vertically above the ordinary highwater mark or to the top of the bank.			•				•
52	 GABION WALLS	Works well on steep banks or to protect areas from severe erosion. Allows for the use of very steep slopes in confined construction areas. Withstands high water velocity.	•	•					•
53	 TREES, SHRUBS, VINES AND GROUNDCOVER	Trees, shrubs, vines and groundcover can provide low maintenance long term erosion protection. These plants may be particularly useful where site aesthetics are important along the roadside slopes.	•				•		

MICHIGAN DEPARTMENT OF TRANSPORTATION
 BUREAU OF HIGHWAY TECHNICAL SERVICES STANDARD PLAN FOR
SOIL EROSION & SEDIMENTATION CONTROL MEASURES

F.H.W.A. APPROVAL _____ 4-28-2000 PLAN DATE
R-96-B SHEET 7 OF 8

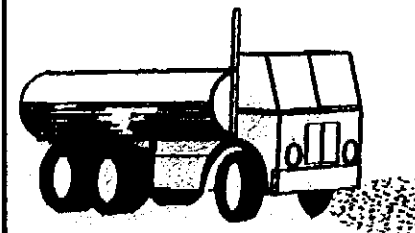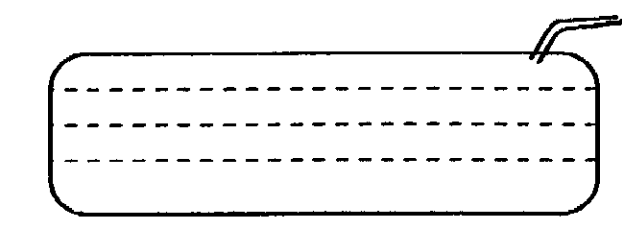KEY	DETAIL	CHARACTERISTICS	A	B	C	D	E	F	G
54	 DUST CONTROL	Dust control can be accomplished by watering, applying calcium chloride, and SLOPE ROUGHENING AND SCARIFICATION (KEY 46). The disturbed areas should be kept to a minimum. PERMANENT/TEMPORARY SEEDING (KEY 3) should be applied as soon as possible.	•					•	•
55	 DEWATERING	It may be necessary to dewater from behind a cofferdam or construction dam to create a dry work site. Discharged water must be pumped to a SEDIMENTATION BASIN (KEY 21) with GRAVEL FILTER BERMS (KEY 13) or through a Filter Bag to allow adequate settling and filtering prior to entering any stream or wetland.		•					•

NOTES:

THIS STANDARD PLAN WILL SERVE AS A KEY IN THE SELECTION OF THE APPROPRIATE SOIL EROSION AND SEDIMENTATION CONTROL DETAILS. THIS PLAN ALSO PROVIDES THE KEY TO THE NUMBERED EROSION CONTROL ITEMS SPECIFIED ON THE CONSTRUCTION PLANS.

REFER TO THE MDOT SOIL EROSION AND SEDIMENTATION CONTROL MANUAL, SECTION 7, FOR SPECIFIC DETAILS, CONTRACT ITEMS (PAY ITEMS) AND PAY UNITS. ACTUAL CONSTRUCTION MAY BE VARIED TO REFLECT MATERIALS USED AND SPECIFIC SITE PROBLEMS, SUBJECT TO THE APPROVAL OF THE ENGINEER.

COLLECTED SILT AND SEDIMENT SHALL BE REMOVED PERIODICALLY TO MAINTAIN THE EFFECTIVENESS OF THE SEDIMENT BASIN.

TEMPORARY EROSION AND POLLUTION CONTROL PROVISIONS SHALL BE COORDINATED WITH THE PERMANENT CONTROL FEATURES TO ASSURE EFFECTIVE CONTROL OF WATER POLLUTION DURING CONSTRUCTION OF THE PROJECT.

IN PLANNING SEDIMENT TRAPS AND SEDIMENTATION BASINS, THE WATERWAY AREA MUST BE INCREASED SO AS TO EFFECTIVELY REDUCE THE STREAM VELOCITY.

AGGREGATES PLACED IN STREAMS SHOULD CONTAIN A MINIMUM OF FINES.

ALL TEMPORARY EROSION CONTROL MEASURES SHALL BE REMOVED AT THE COMPLETION OF CONSTRUCTION UNLESS ORDERED BY THE ENGINEER TO BE LEFT IN PLACE. CARE SHALL BE TAKEN DURING REMOVAL TO MINIMIZE SILTATION IN NEARBY DRAINAGE COURSES.

MICHIGAN DEPARTMENT OF TRANSPORTATION
 BUREAU OF HIGHWAY TECHNICAL SERVICES STANDARD PLAN FOR
SOIL EROSION & SEDIMENTATION CONTROL MEASURES

F.H.W.A. APPROVAL _____ 4-28-2000 PLAN DATE
R-96-B SHEET 8 OF 8

MICHIGAN DEPARTMENT OF TRANSPORTATION

PLANS OF PROPOSED BRIDGE RECONSTRUCTION

MICHIGAN PROJECT **BHI 0163 (017)**

CONTROL SECTION 63174

JOB NUMBER 49595A

I-75

CITIES OF MADISON HEIGHTS AND ROYAL OAK
OAKLAND COUNTY

GENERAL NOTES

THE RECONSTRUCTION DESIGN IS BASED ON CURRENT AASHTO STANDARD SPECIFICATIONS FOR HIGHWAY BRIDGES MS23 LOADING. LIVE LOAD PLUS IMPACT DEFLECTION DOES NOT EXCEED 1/800 OF SPAN LENGTH. THE ALLOWABLE STRESS METHOD OF DESIGN WAS USED FOR THIS DESIGN. THE ORIGINAL STRUCTURE WAS DESIGNED FOR MS18 AND ALTERNATE MILITARY LOADING.

EXCEPT WHERE OTHERWISE INDICATED ON THESE PLANS, OR IN THE PROPOSAL AND SUPPLEMENTAL SPECIFICATIONS CONTAINED HEREIN, ALL MATERIALS AND WORKMANSHIP SHALL BE ACCORDING TO THE MICHIGAN DEPARTMENT OF TRANSPORTATION STANDARD SPECIFICATIONS FOR CONSTRUCTION 1996 EDITION.

THE STATIONING AS SHOWN ON THESE PLANS FOR THE INTERSECTION OF THE CENTERLINE OF BRIDGE AND ROADWAY CENTERLINE IS BELIEVED TO BE CORRECT. IT SHALL, HOWEVER, BE CHECKED AT THE TIME OF STARTING CONSTRUCTION, AND IF THE STATIONING SHOWN ON THE PLANS IS INCORRECT, IT SHALL BE REPORTED TO THE DESIGN OFFICE IN LANSING, AND THE STRUCTURE SHALL BE STAKED OUT USING THE ACTUAL INTERSECTION OF THE CENTERLINE OF BRIDGE AND ROADWAY CENTERLINE AS THE CONTROL POINT.

THE DESIGN OF THE STRUCTURAL MEMBERS IS BASED ON MATERIAL OF THE FOLLOWING GRADES AND STRESSES:

CONCRETE: GRADE S2	f'c = 21 MPa
CONCRETE: GRADE D	f'c = 28 MPa
STEEL REINFORCEMENT	fy = 400 MPa
STRUCTURAL STEEL: AASHTO M270 Grade 250	fy = 250 MPa

PROPOSED PLAN SHEET DIMENSIONS ARE IN MILLIMETERS UNLESS OTHERWISE SHOWN. ELEVATIONS, COORDINATES AND CURVE ALIGNMENT DATA ARE IN METERS. STATIONS ARE IN KILOMETERS + METERS. EXISTING PLAN SHEET DIMENSIONS ARE IN CUSTOMARY U. S. UNITS.

ALL EXPOSED CONCRETE CORNERS SHOWN SQUARE ON THE PLANS SHALL BE BEVELED WITH 13 mm TRIANGULAR MOLDINGS EXCEPT AS OTHERWISE NOTED.

THE REGULATED WASTE ACTIVITY IDENTIFICATION NUMBERS FOR THIS PROJECT ARE AS FOLLOWS:

CONTROL SECTION	NUMBER
B02-63174	MIR000041798

1999 TRAFFIC DISTRIBUTION

8%	COMMERCIAL
175,120	TOTAL TRAFFIC


STANDARD PLANS

WHERE THE FOLLOWING ITEMS ARE CALLED FOR ON THE PLANS THEY ARE TO BE CONSTRUCTED ACCORDING TO THE STANDARD PLAN GIVEN BELOW OPPOSITE EACH ITEM UNLESS OTHERWISE INDICATED.

- B-17-B BRIDGE BARRIER RAILING, TYPE 4
- B-23-B BRIDGE RAILING, THREE BEAM RETROFIT
- B-103-B MOLDING, BEVAL, LIGHT STANDARD ANCHOR BOLT ASSEMBLY AND NAME PLATE DETAILS

TITLE SHEET LEGEND

PROPOSED PROJECT	=====
EXISTING ROADS	=====
PAVED	=====
BITUMINOUS	-----
GRAVEL	-----
UNIMPROVED OR CITY STREET	-----
SECTION LINE	=====
TOWNSHIP LINE	-----
COUNTY LINE	-----
CITY OR VILLAGE LIMITS	-----
RAILROADS	-----

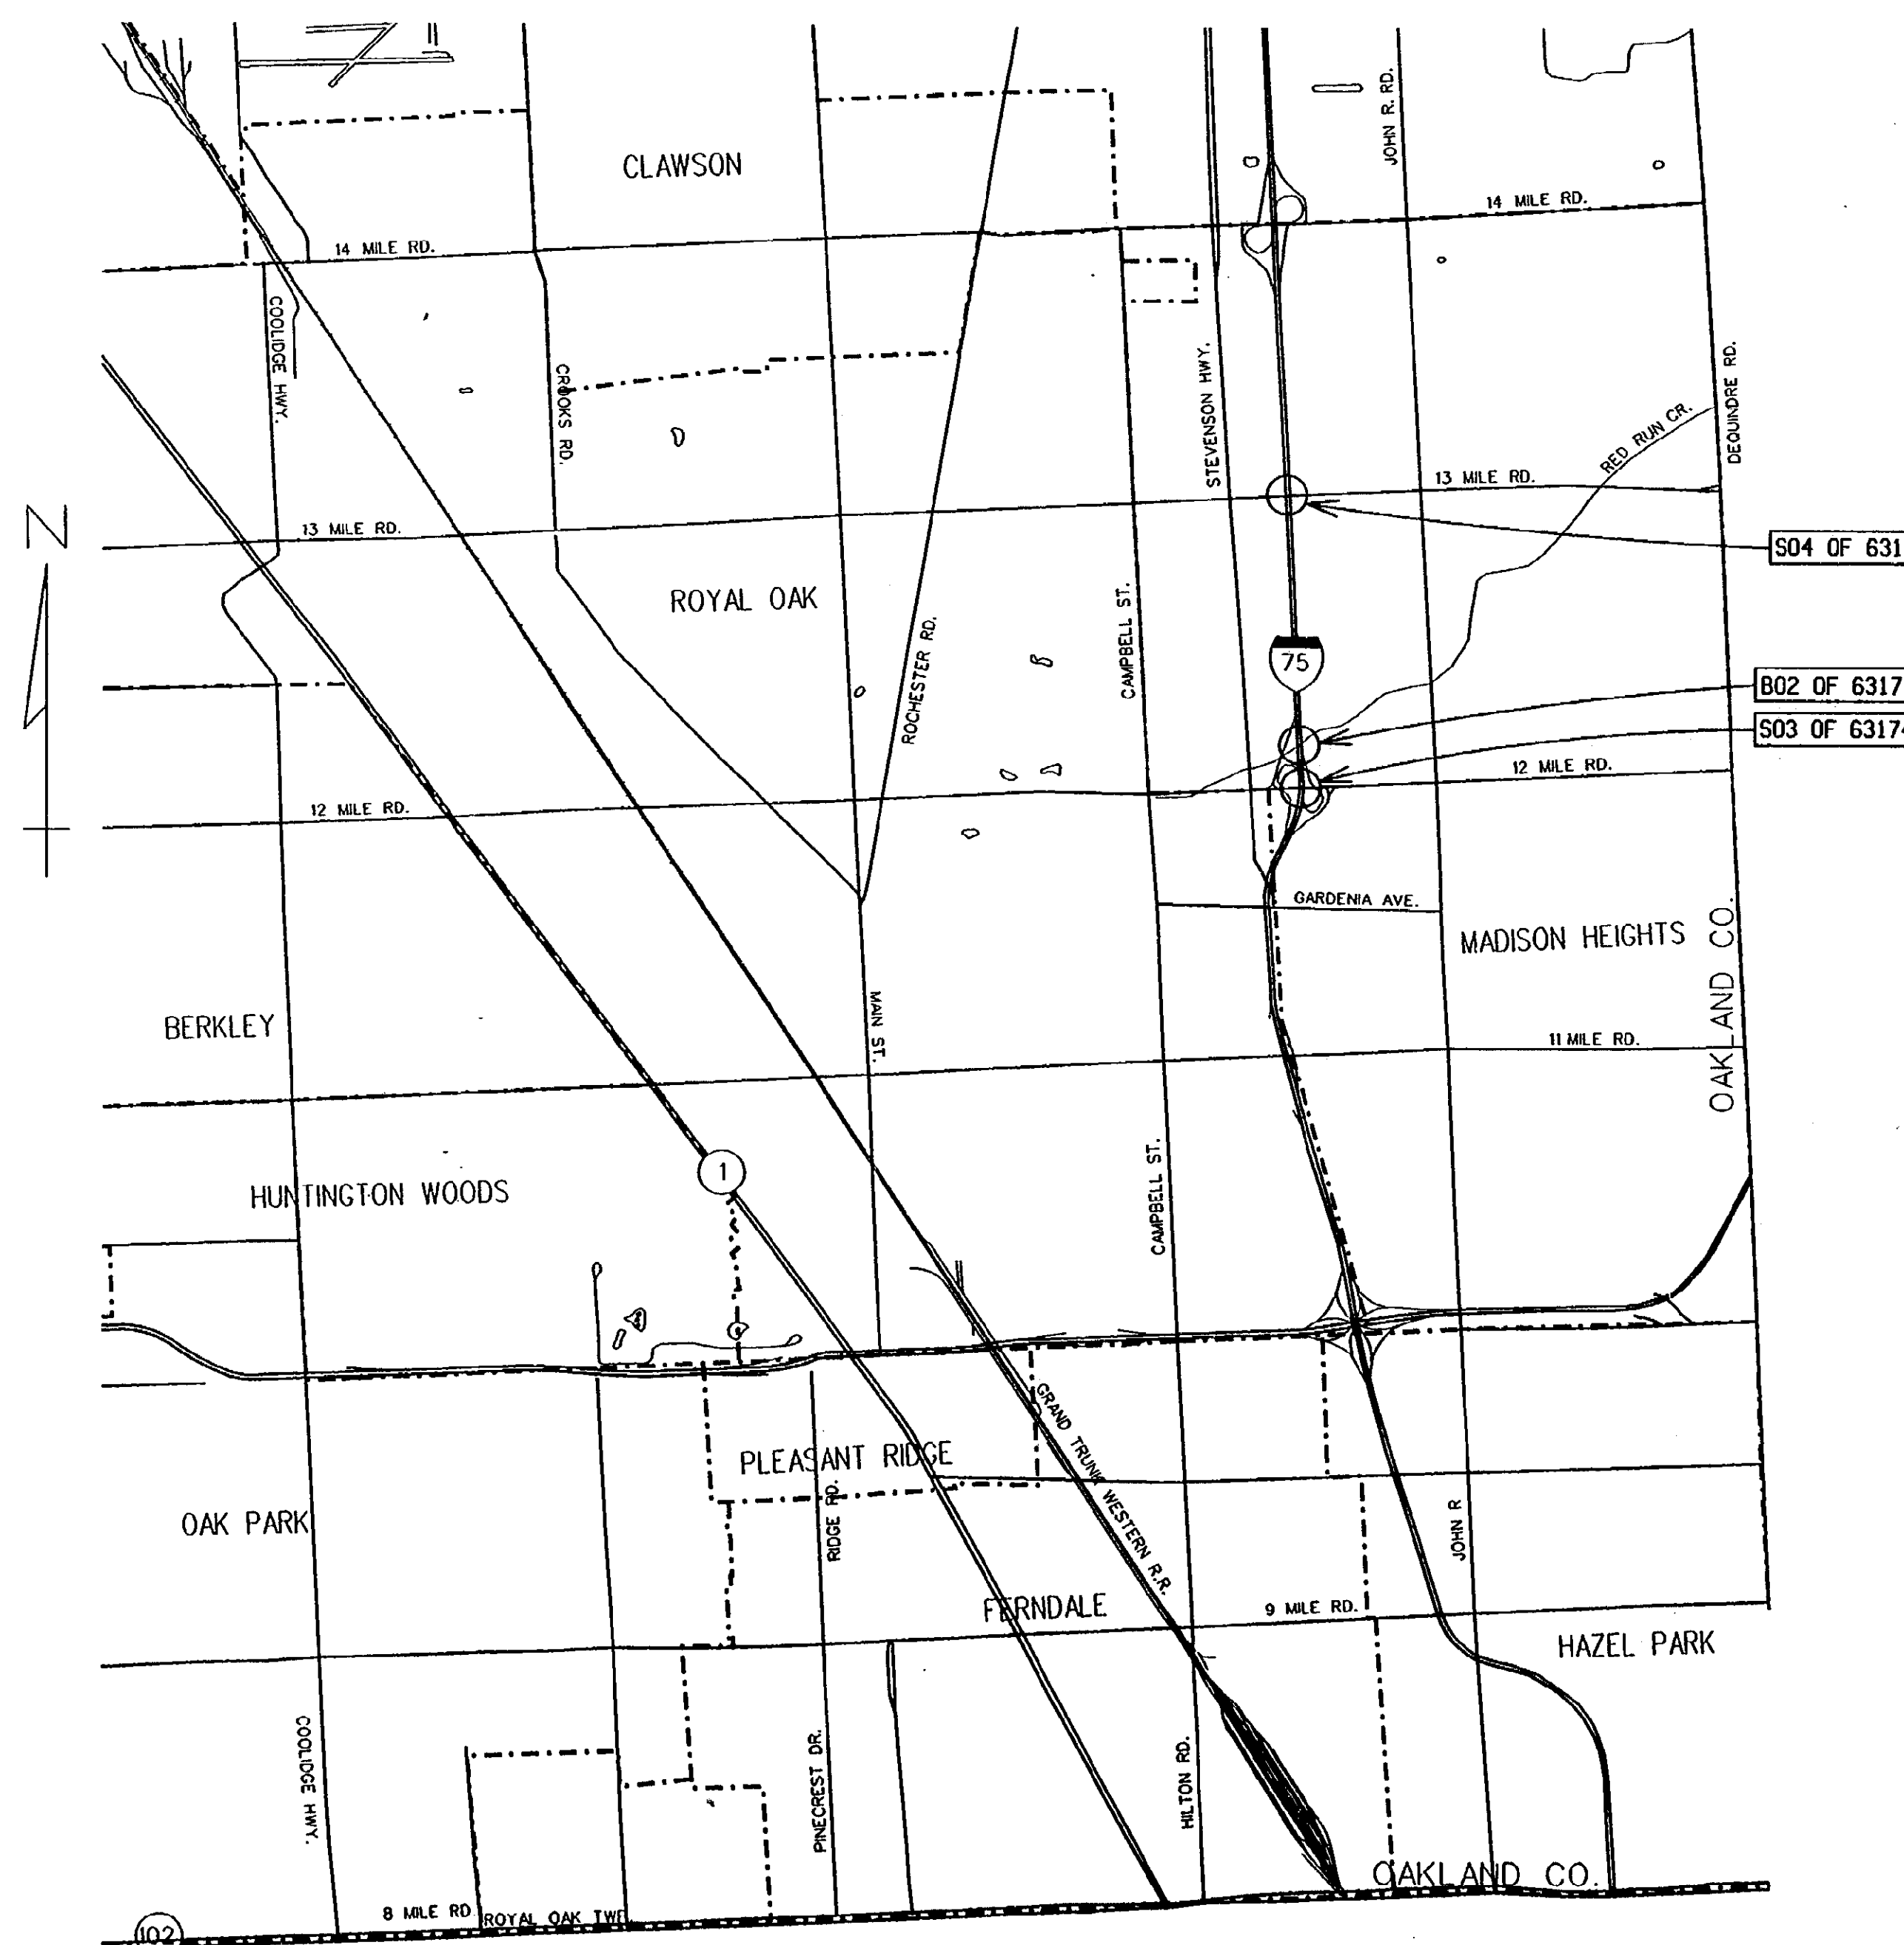

CONTRACT FOR: DECK REPLACEMENT, OVERLAY, PAINTING, CONCRETE BEAM REPAIR, SUBSTRUCTURE REPAIR, THREE BEAM RETROFIT AND APPROACH WORK

APPROVALS

RECOMMENDED FOR APPROVAL	<i>Ali Mahdavi</i>	1-10-01
	PROJECT MANAGER	DATE
RECOMMENDED FOR APPROVAL	<i>Mark Stuch</i>	1-10-01
	RESIDENT ENGINEER	DATE

**MICHIGAN
DEPARTMENT OF TRANSPORTATION**
GREGORY J. ROSINE - DIRECTOR

APPROVED BY *Gregory J. Rosine* 1/22/2001
DEPUTY DIRECTOR, HIGHWAYS DATE

MDOT Michigan Department of Transportation
MDOT DESIGN COORDINATOR
MAHDAVI
DESIGN UNIT

CONTROL SECTION	JOB NUMBER	FEDERAL NUMBER	ITEM	SHEET NO.
B02, B03 & B04 OF 63174	49595A	BHI 0163 (017)	RR2739	1

DATE: 1-24-00
DATE: 12-7-00

DRAWN BY: CASLER
CHECKED BY: WAK
CORRECTED BY: CASLER/ INDR
FILE: B0263174.1B

B02, B03, & B04 OF 63174-49595A

CONTROL SECTION NUMBER
B02, B03, & B04 OF 63174.1B

FILE: B0263174.1B

REVISIONS			
NO.	DESCRIPTION	DATE	BY

PLAN INDEX	
SHEET NO.	DESCRIPTION
1	TITLE SHEET
1A	PLAN INDEX SHEET
1B-1Z	EXISTING DETAILS-FOR INFORMATION ONLY B02 OF 63174 (NB & SB)
1AA-1AH	EXISTING DETAILS-FOR INFORMATION ONLY S04 OF 63174 (NB & SB)
1AI-1AZ	EXISTING DETAILS-FOR INFORMATION ONLY S03 OF 63174 (NB & SB)

B02 OF 63174 N.B.	
SHEET NO.	DESCRIPTION
2	EXISTING GENERAL PLAN OF SITE-FOR INFORMATION ONLY
3-4	GENERAL PLAN OF STRUCTURE
5	CONSTRUCTION STAGING DETAILS
6-7	EXISTING GENERAL PLAN OF STRUCTURE-REMOVAL PORTIONS
8	EXPANSION JOINT DETAILS
9-14	DECK REPLACEMENT DETAILS
15	SLAB AND SCREED DETAILS
16	STEEL REINFORCEMENT DETAILS


S04 OF 63174 N.B.	
SHEET NO.	DESCRIPTION
2	EXISTING GENERAL PLAN OF SITE-FOR INFORMATION ONLY
3-4	GENERAL PLAN OF STRUCTURE
5	CONSTRUCTION STAGING DETAILS
6	EXISTING GENERAL PLAN OF STRUCTURE-REMOVAL PORTIONS
7-8	BEAM REPAIR DETAILS
9	TEMPORARY SUPPORT DETAILS
10	EXPANSION JOINT DETAILS
11-14	DECK REPLACEMENT DETAILS
15	SLAB AND SCREED DETAILS
16	STEEL REINFORCEMENT DETAILS


S03 OF 63174 N.B.	
SHEET NO.	DESCRIPTION
2	EXISTING GENERAL PLAN OF SITE-FOR INFORMATION ONLY
3	EXISTING GENERAL PLAN OF STRUCTURE-FOR INFORMATION ONLY
4	PIER REPAIR DETAILS
5	TEMPORARY SUPPORT DETAILS
6	EXPANSION JOINT DETAILS
7-8	DECK RESURFACING DETAILS

B02 OF 63174 S.B.	
SHEET NO.	DESCRIPTION
2	EXISTING GENERAL PLAN OF SITE-FOR INFORMATION ONLY
3-4	GENERAL PLAN OF STRUCTURE
5-6	EXISTING GENERAL PLAN OF STRUCTURE-REMOVAL PORTIONS
7	EXPANSION JOINT DETAILS
8-13	DECK REPLACEMENT DETAILS
14	SLAB AND SCREED DETAILS
15	STEEL REINFORCEMENT DETAILS

S04 OF 63174 S.B.	
SHEET NO.	DESCRIPTION
2	EXISTING GENERAL PLAN OF SITE-FOR INFORMATION ONLY
3-4	GENERAL PLAN OF STRUCTURE
5	EXISTING GENERAL PLAN OF STRUCTURE-REMOVAL PORTIONS
6-7	BEAM REPAIR DETAILS
8	TEMPORARY SUPPORT DETAILS
9	EXPANSION JOINT DETAILS
10-13	DECK REPLACEMENT DETAILS
14	SLAB AND SCREED DETAILS
15	STEEL REINFORCEMENT DETAILS

S03 OF 63174 S.B.	
SHEET NO.	DESCRIPTION
2	EXISTING GENERAL PLAN OF SITE-FOR INFORMATION ONLY
3	EXISTING GENERAL PLAN OF STRUCTURE-FOR INFORMATION ONLY
4-5	BEAM REPAIR DETAILS
6	TEMPORARY SUPPORT DETAILS
7	EXPANSION JOINT DETAILS
8-9	DECK RESURFACING DETAILS

PLAN INDEX				
	DATE	CONT. SEC.	JOB NO.	DESIGN UNIT
	01-09-01	B02, S03 & S04 OF 63174	49595A	MAHDAVI
			SHEET	1A OF

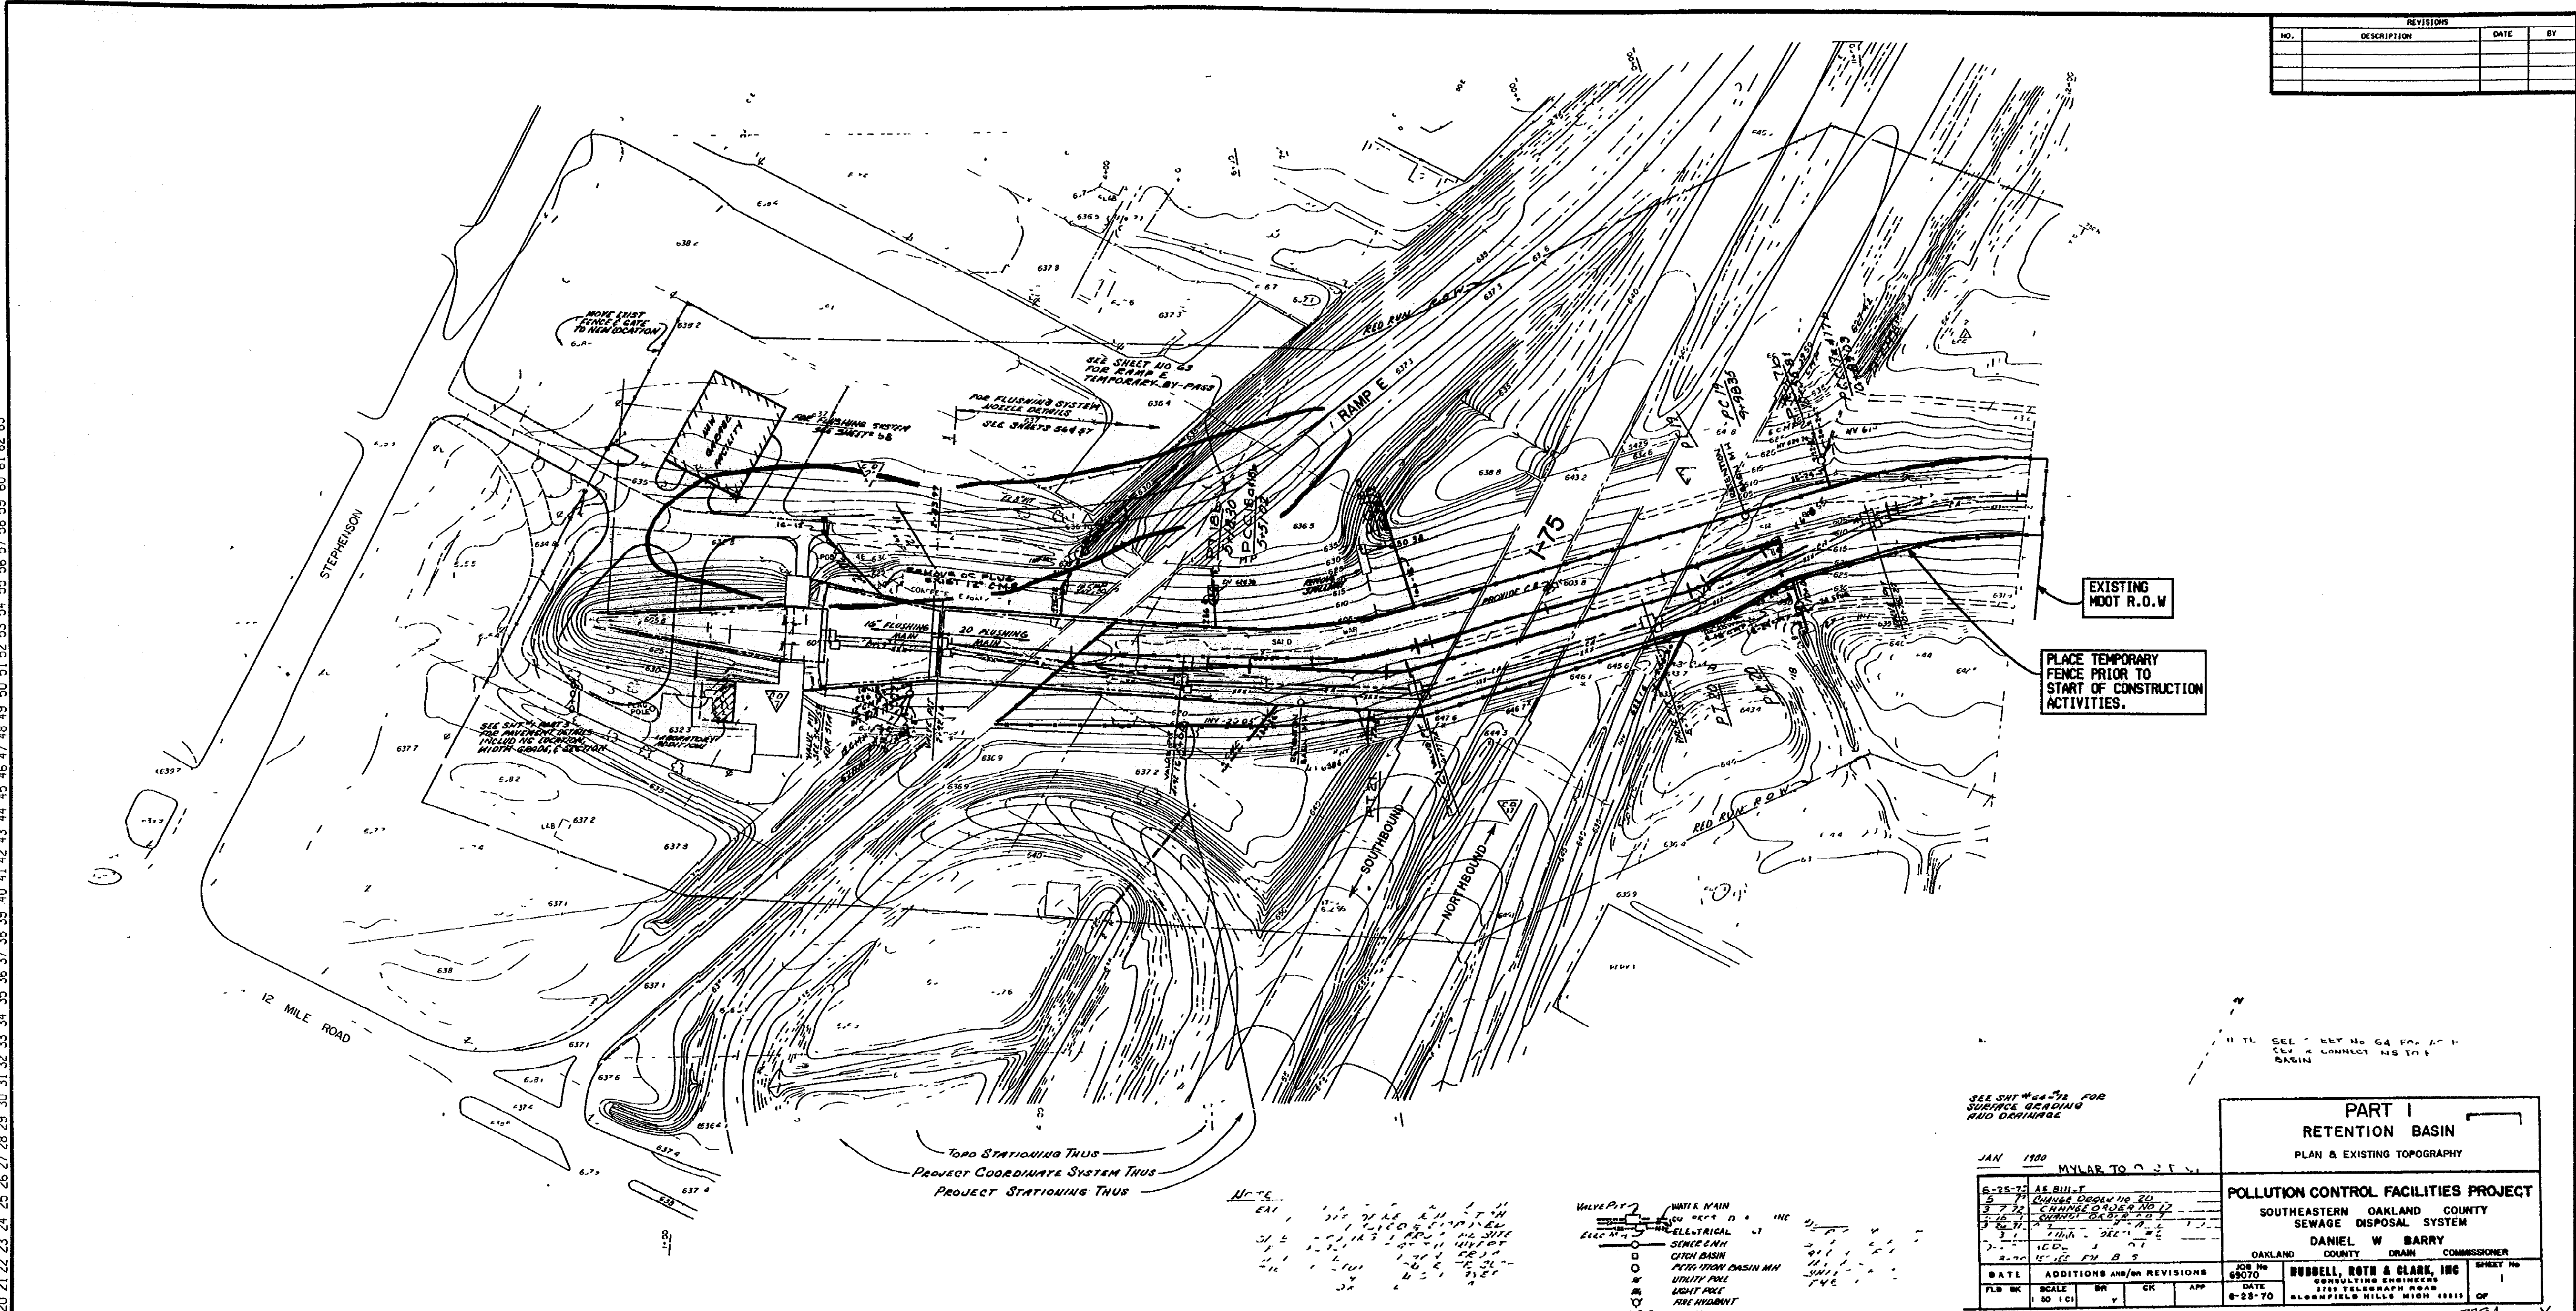

REVISIONS			
NO.	DESCRIPTION	DATE	BY

SEE SHEET # 64 7/8 FOR SURFACE GRADING AND DRAINAGE

JAN 1980 MSCALE TO 1" = 20' ±

6-25-77	AS BUILT
5-7-78	CHANGE ORDER NO. 20
3-16-78	CHANGE ORDER NO. 17
3-16-78	CHANGE ORDER NO. 16
2-27-78	CHANGE ORDER NO. 15
2-27-78	CHANGE ORDER NO. 14
2-27-78	CHANGE ORDER NO. 13
2-27-78	CHANGE ORDER NO. 12
2-27-78	CHANGE ORDER NO. 11
2-27-78	CHANGE ORDER NO. 10
2-27-78	CHANGE ORDER NO. 9
2-27-78	CHANGE ORDER NO. 8
2-27-78	CHANGE ORDER NO. 7
2-27-78	CHANGE ORDER NO. 6
2-27-78	CHANGE ORDER NO. 5
2-27-78	CHANGE ORDER NO. 4
2-27-78	CHANGE ORDER NO. 3
2-27-78	CHANGE ORDER NO. 2
2-27-78	CHANGE ORDER NO. 1

PART I RETENTION BASIN PLAN & EXISTING TOPOGRAPHY	
POLLUTION CONTROL FACILITIES PROJECT SOUTHEASTERN OAKLAND COUNTY SEWAGE DISPOSAL SYSTEM DANIEL W. BARRY OAKLAND COUNTY COMMISSIONER	
JOB NO. 63070	SHEET NO. 1
DATE 6-23-70	DRAWN BY MAHDAVI

- NOTE**
- EX - EXISTING
 - PRO - PROPOSED
 - RE - REMOVAL
 - UT - UTILITY
 - W - WATER
 - E - ELECTRICAL
 - S - SEWER
 - O - OIL
 - G - GAS
 - U - UTILITY
 - P - PUMP
 - M - MANHOLE
 - F - FENCE
 - W - WATER
 - E - ELECTRICAL
 - S - SEWER
 - O - OIL
 - G - GAS
 - U - UTILITY
 - P - PUMP
 - M - MANHOLE
 - F - FENCE
 - W - WATER
 - E - ELECTRICAL
 - S - SEWER
 - O - OIL
 - G - GAS
 - U - UTILITY
 - P - PUMP
 - M - MANHOLE
 - F - FENCE

THE ONLY ITEMS OF WORK TO BE DONE FROM THIS SHEET ARE IDENTIFIED BY THE LEGEND BOX BELOW, LABELED WITH THIS PROJECT'S JOB NUMBER.


JOB NO. 49595A

DENOTES REMOVAL PORTIONS	PROPOSED WORK
--------------------------	---------------




TEMPORARY FENCE DETAILS				
DATE	CONT. SEC.	JOB NO.	DESIGN UNIT	SHEET
01-09-01	B02 OF 63174	49595A	MAHDAVI	1B OF


1 2 3 4 5 6 7 8 9 10 11 12 13 14 15 16 17 18 19 20 21 22 23 24 25 26 27 28 29 30 31 32 33 34 35 36 37 38 39 40 41 42 43 44 45 46 47 48 49 50 51 52 53 54 55 56 57 58 59 60 61 62 63

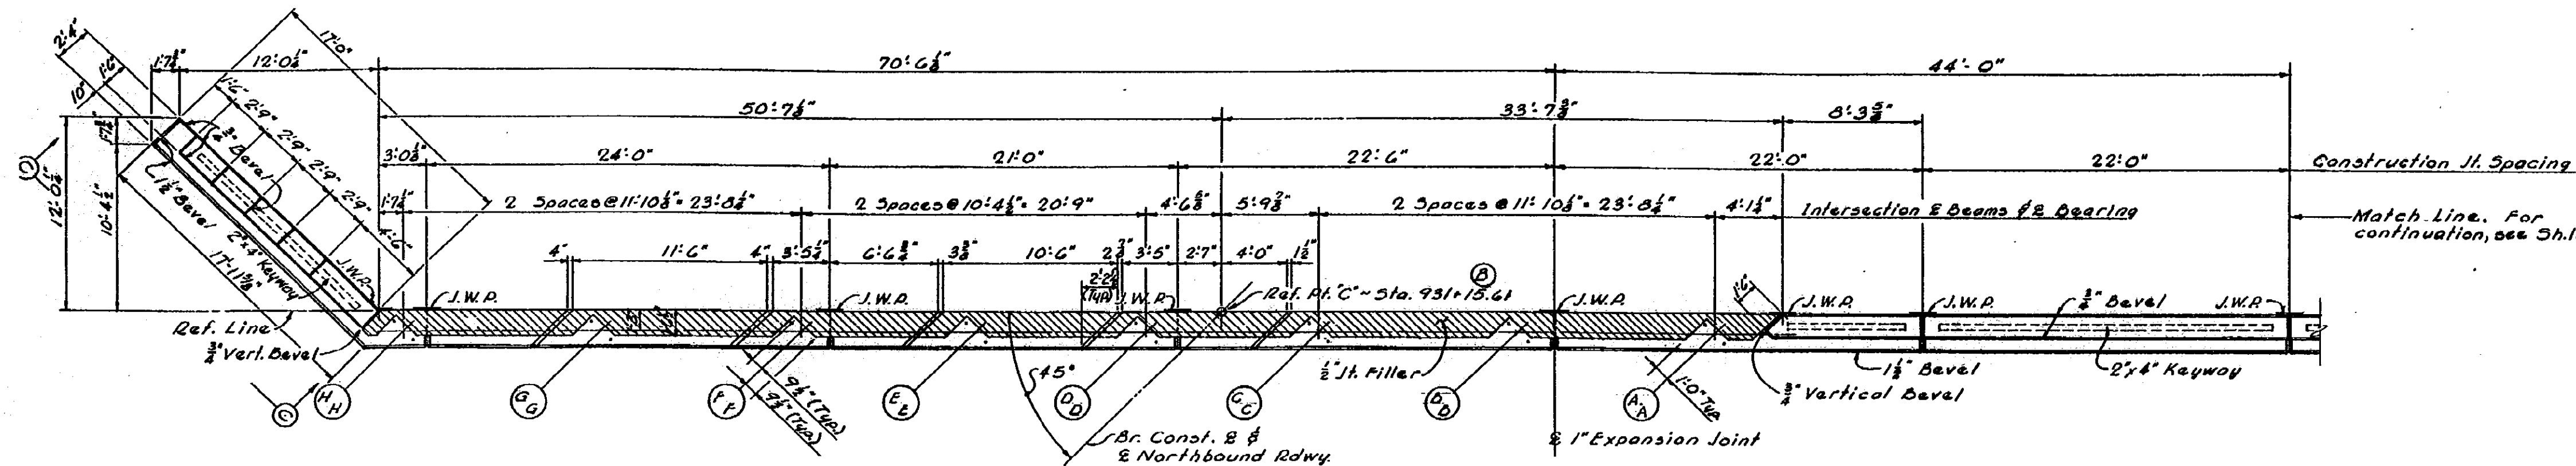


PART PLAN OF TOP (EAST END)

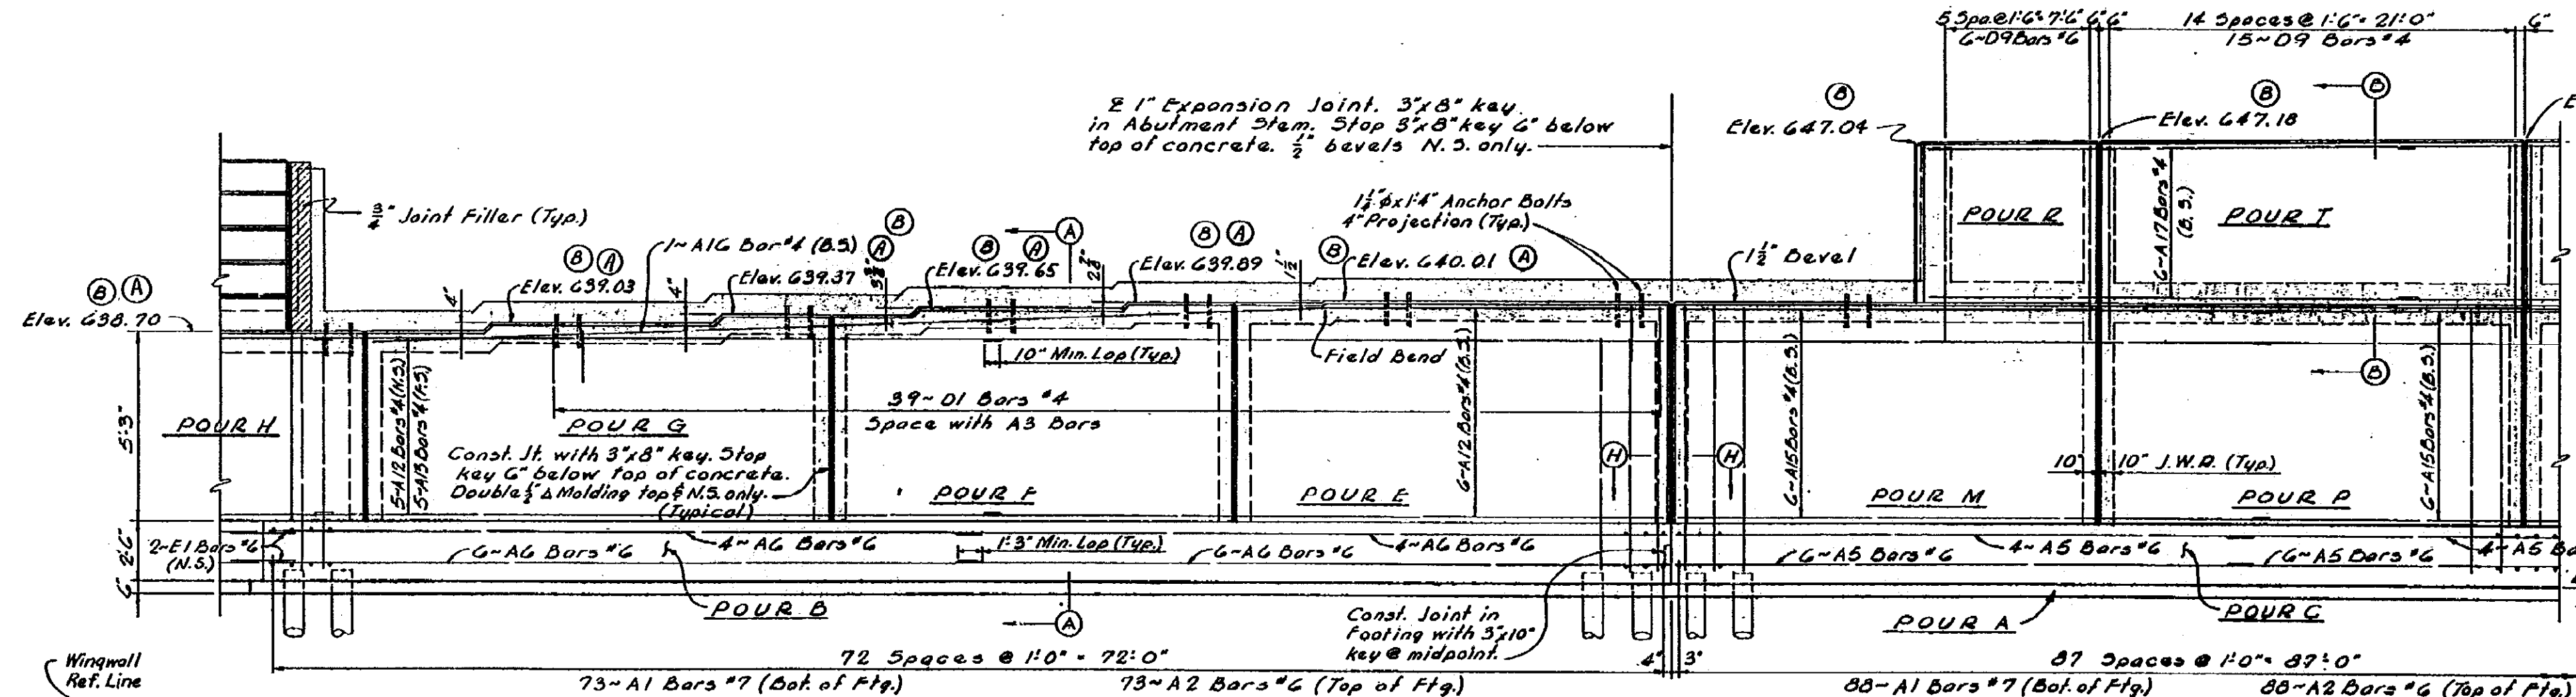

PART ELEVATION (EAST END)

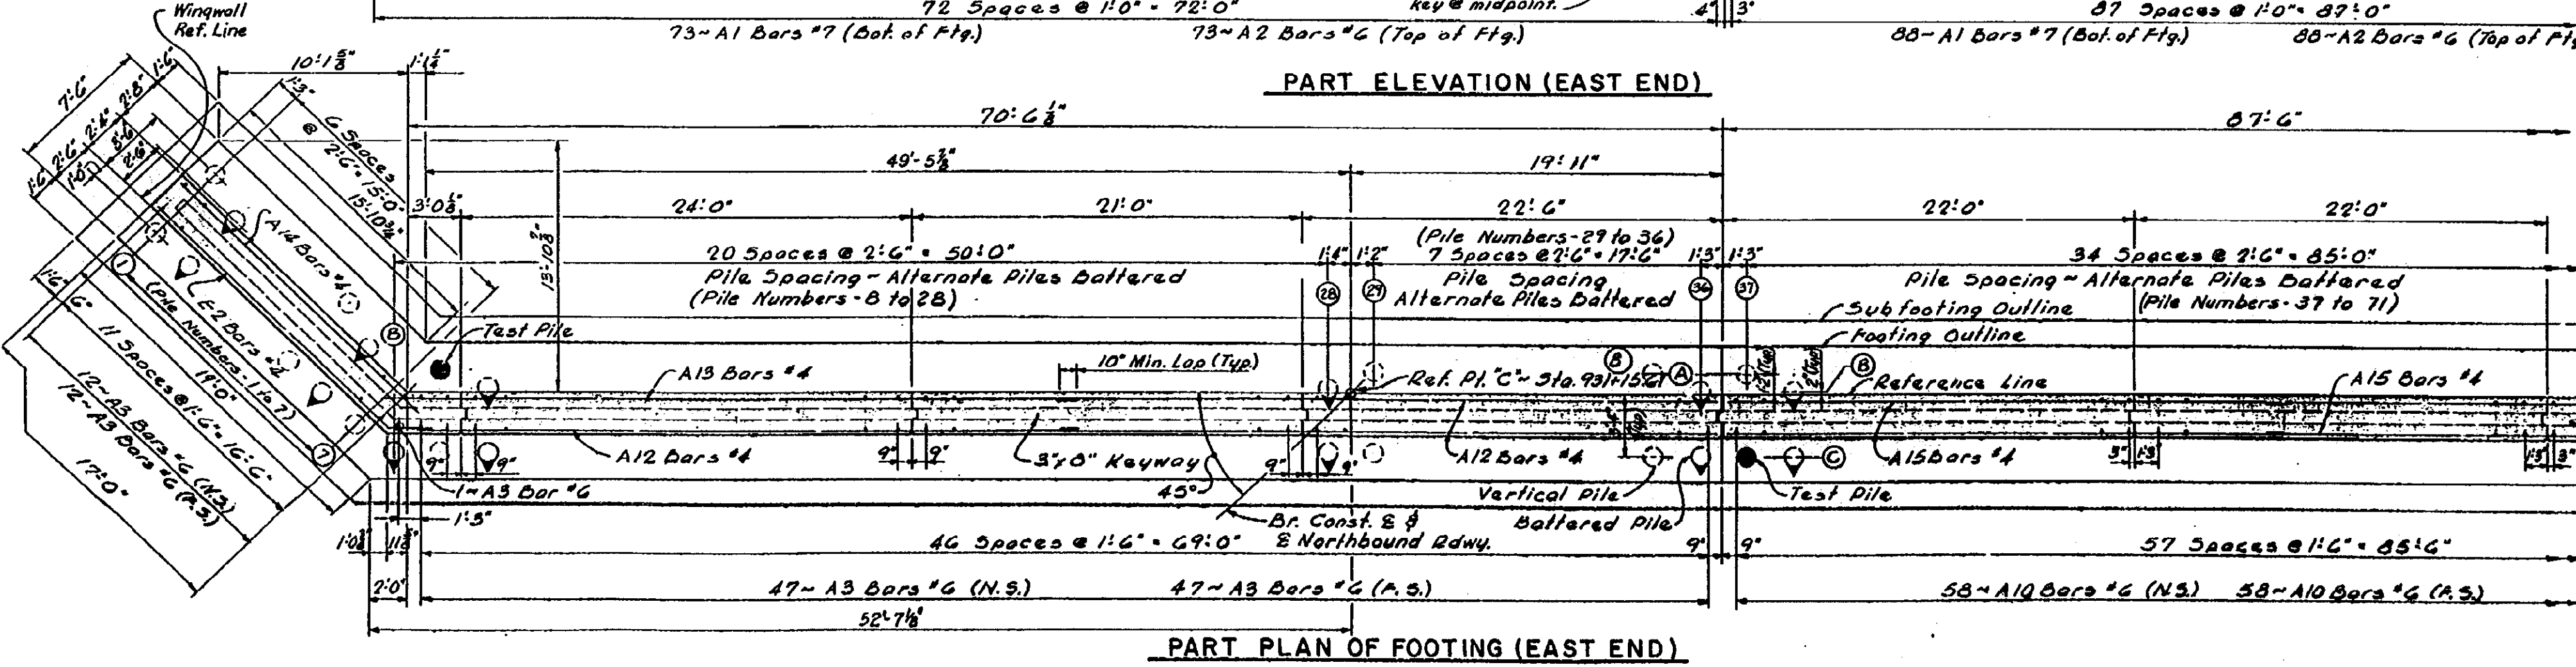

PART PLAN OF FOOTING (EAST END)

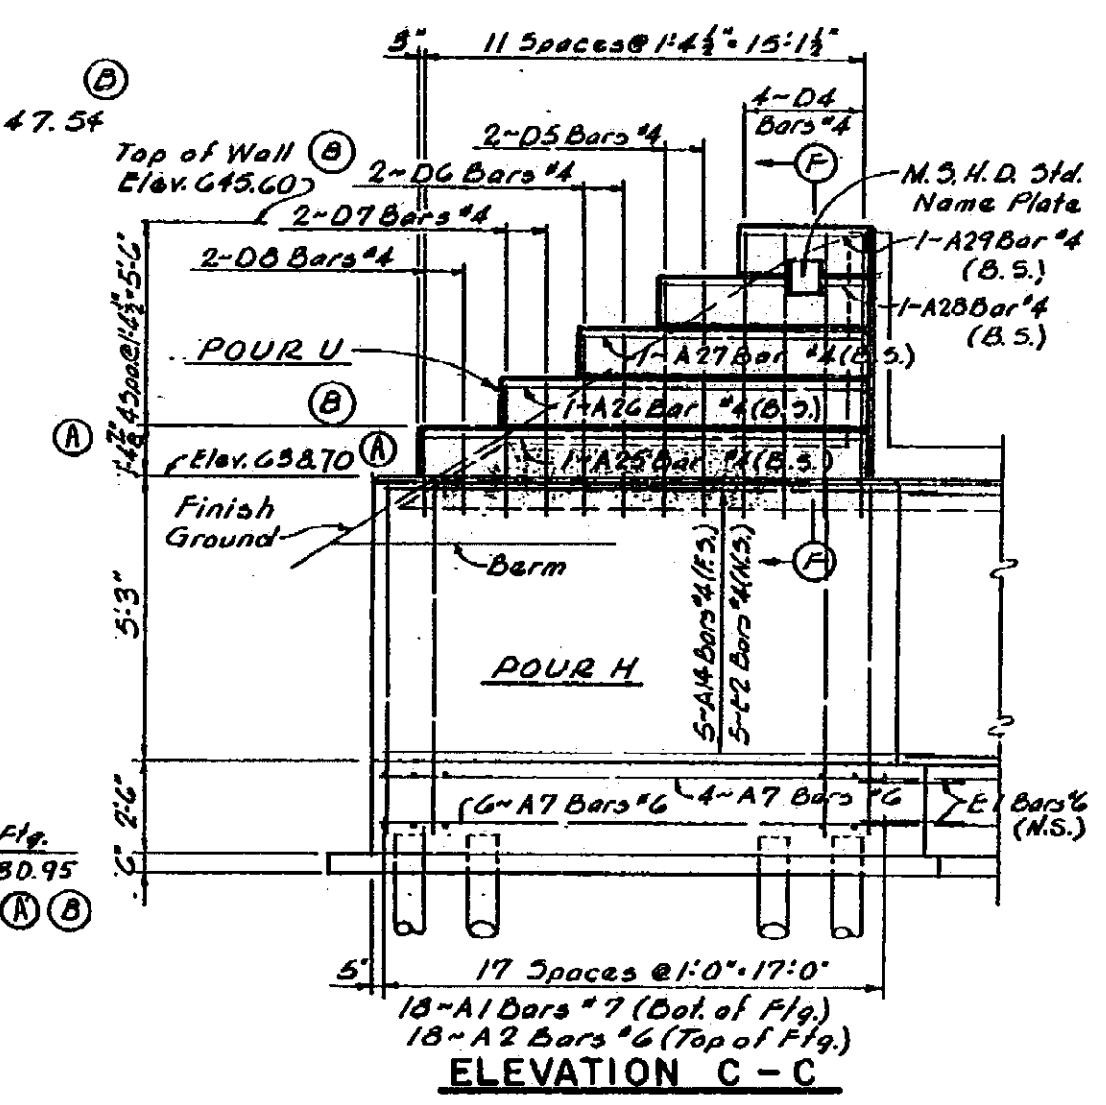

ELEVATION C-C

REVISIONS table with columns for NO., DESCRIPTION, DATE, and BY.

MICHIGAN STATE HIGHWAY DEPARTMENT ABUTMENT A DETAILS. Includes project info, TECON ENGINEERS, INC., and revision history.






NOTE: DO NOT WORK FROM THIS SHEET. THE INFORMATION SHOWN HERE IS FOR REFERENCE ONLY. NO PAY ITEMS ARE SHOWN.



FOR INFORMATION ONLY table with columns: DATE (02-14-00), CONT. SEC. (B02 OF 63174), JOB NO. (49595A), DESIGN UNIT (MAHDAVI), SHEET (1C OF).

DATE: 02-11-00 CHECKED BY: INDER CORRECTED BY: INDER DATE: FILE NAME: B0263174en

REVISIONS			
NO.	DESCRIPTION	DATE	BY

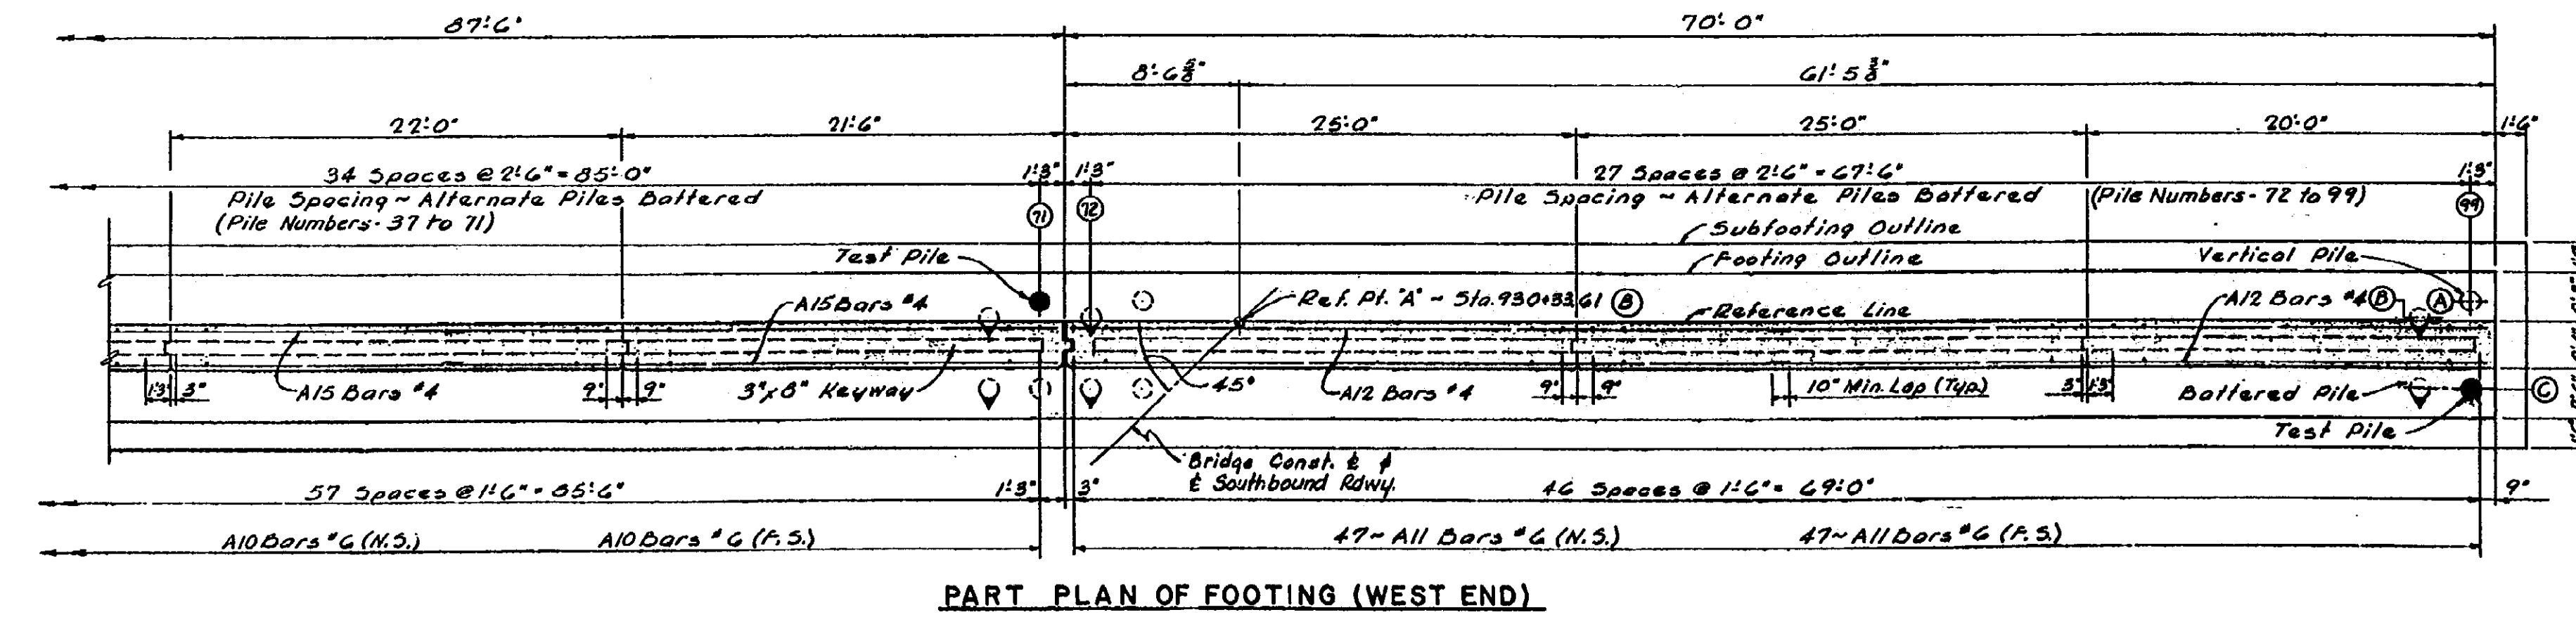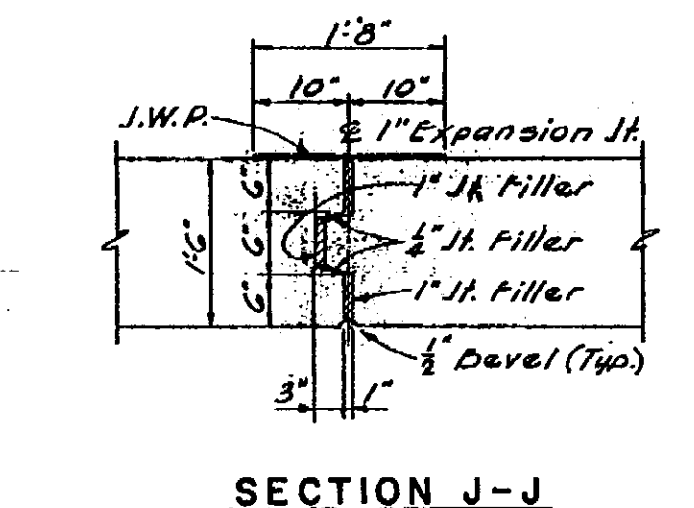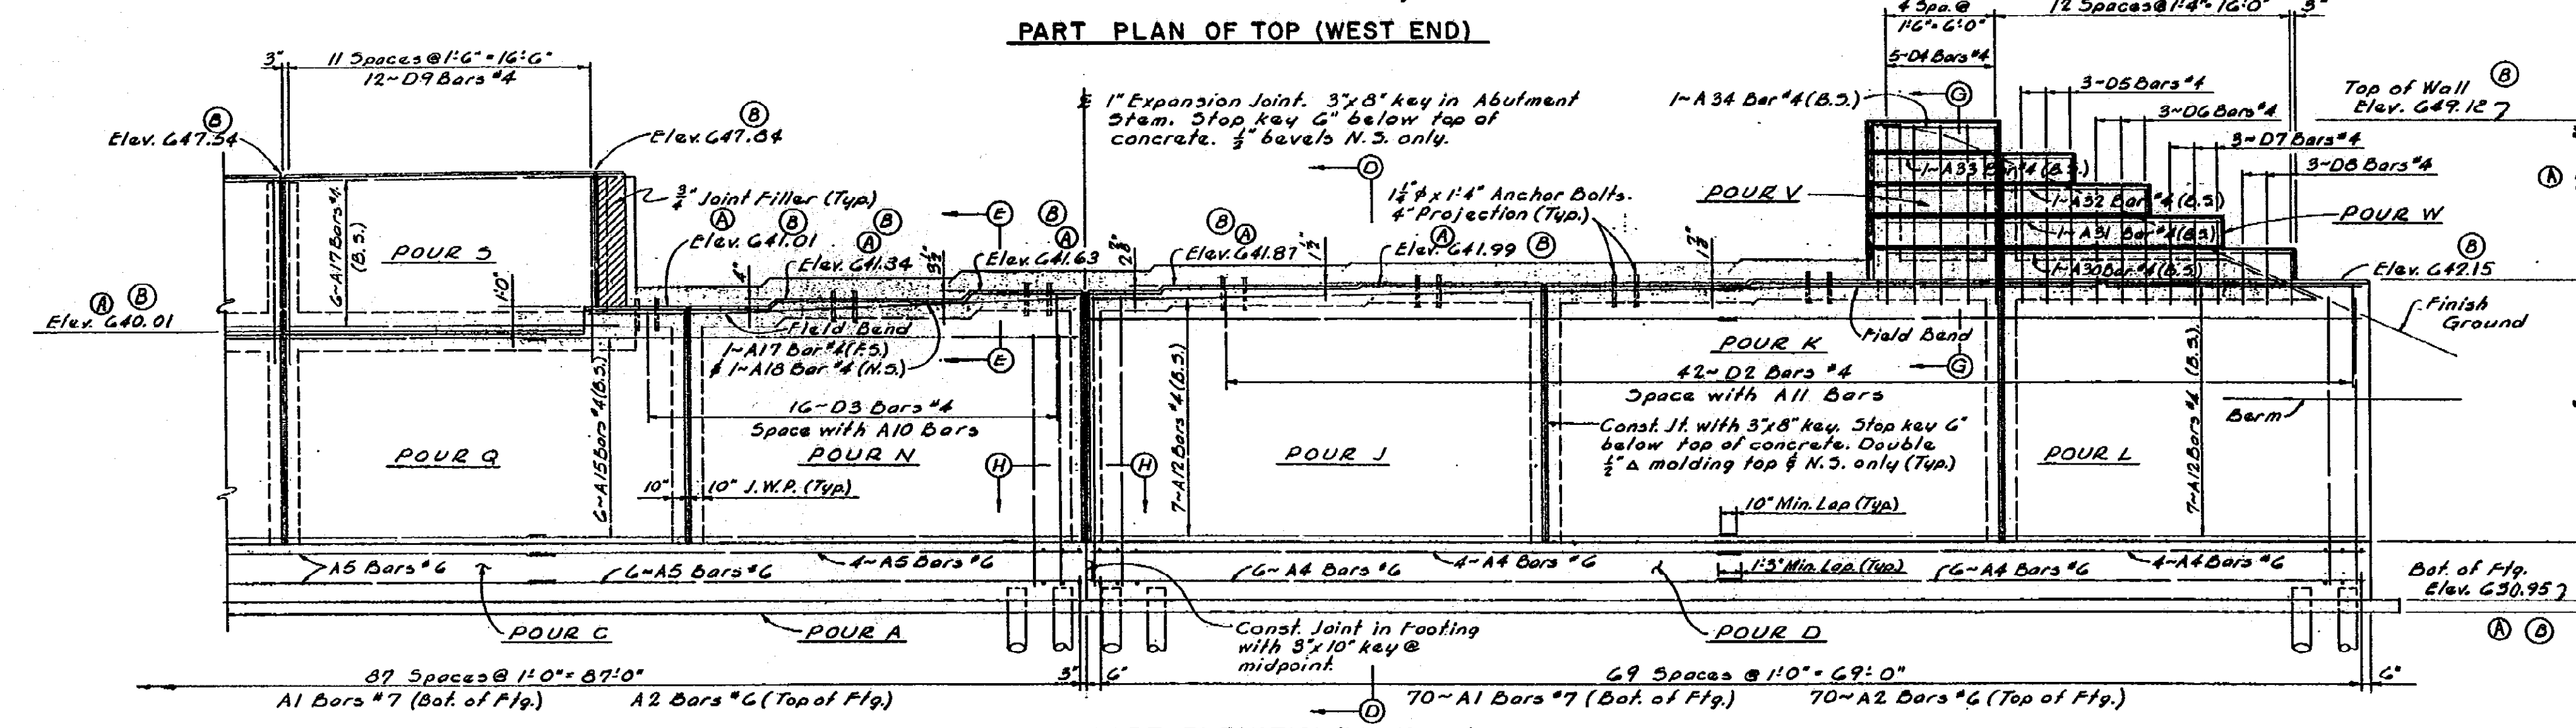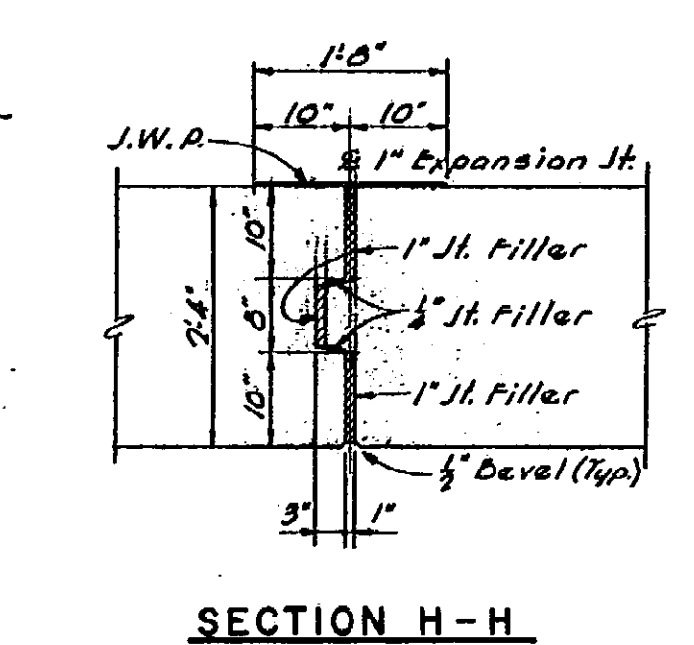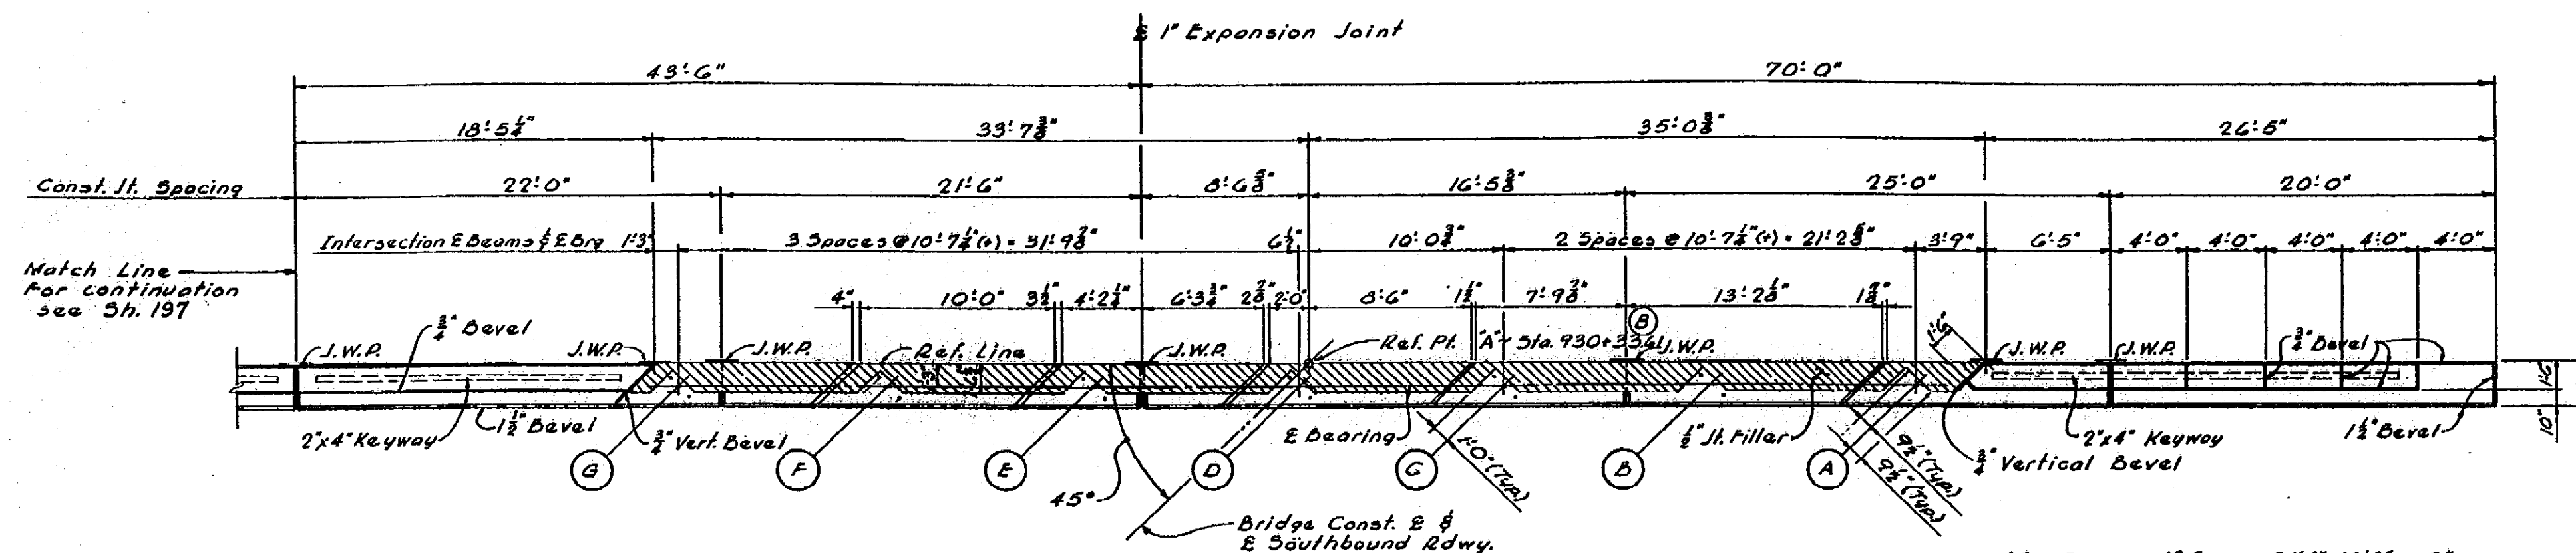

Work this sheet with sheets 197, 201 & 220

MICHIGAN STATE HIGHWAY DEPT.

ABUTMENT A DETAILS

TECON ENGINEERS, INC.

REVISIONS			
NO.	DESCRIPTION	DATE	BY

8 Revis. only 1 Rev. elevs. 11-6-81 R.E. 9-22-75

9 Corrected Pile 197 Plan

B02C





NOTE:
DO NOT WORK FROM THIS SHEET. THE INFORMATION SHOWN HERE IS FOR REFERENCE ONLY. NO PAY ITEMS ARE SHOWN.



FOR INFORMATION ONLY				
DATE	CONT. SEC.	JOB NO.	DESIGN UNIT	SHEET
02-14-00	B02 OF 63174	49595A	MAHDAVI	10 OF

DRAWN BY: INDER CHECKED BY: DATE: 02-11-00 CORRECTED BY: INDER DATE:

REVISIONS			
NO.	DESCRIPTION	DATE	BY

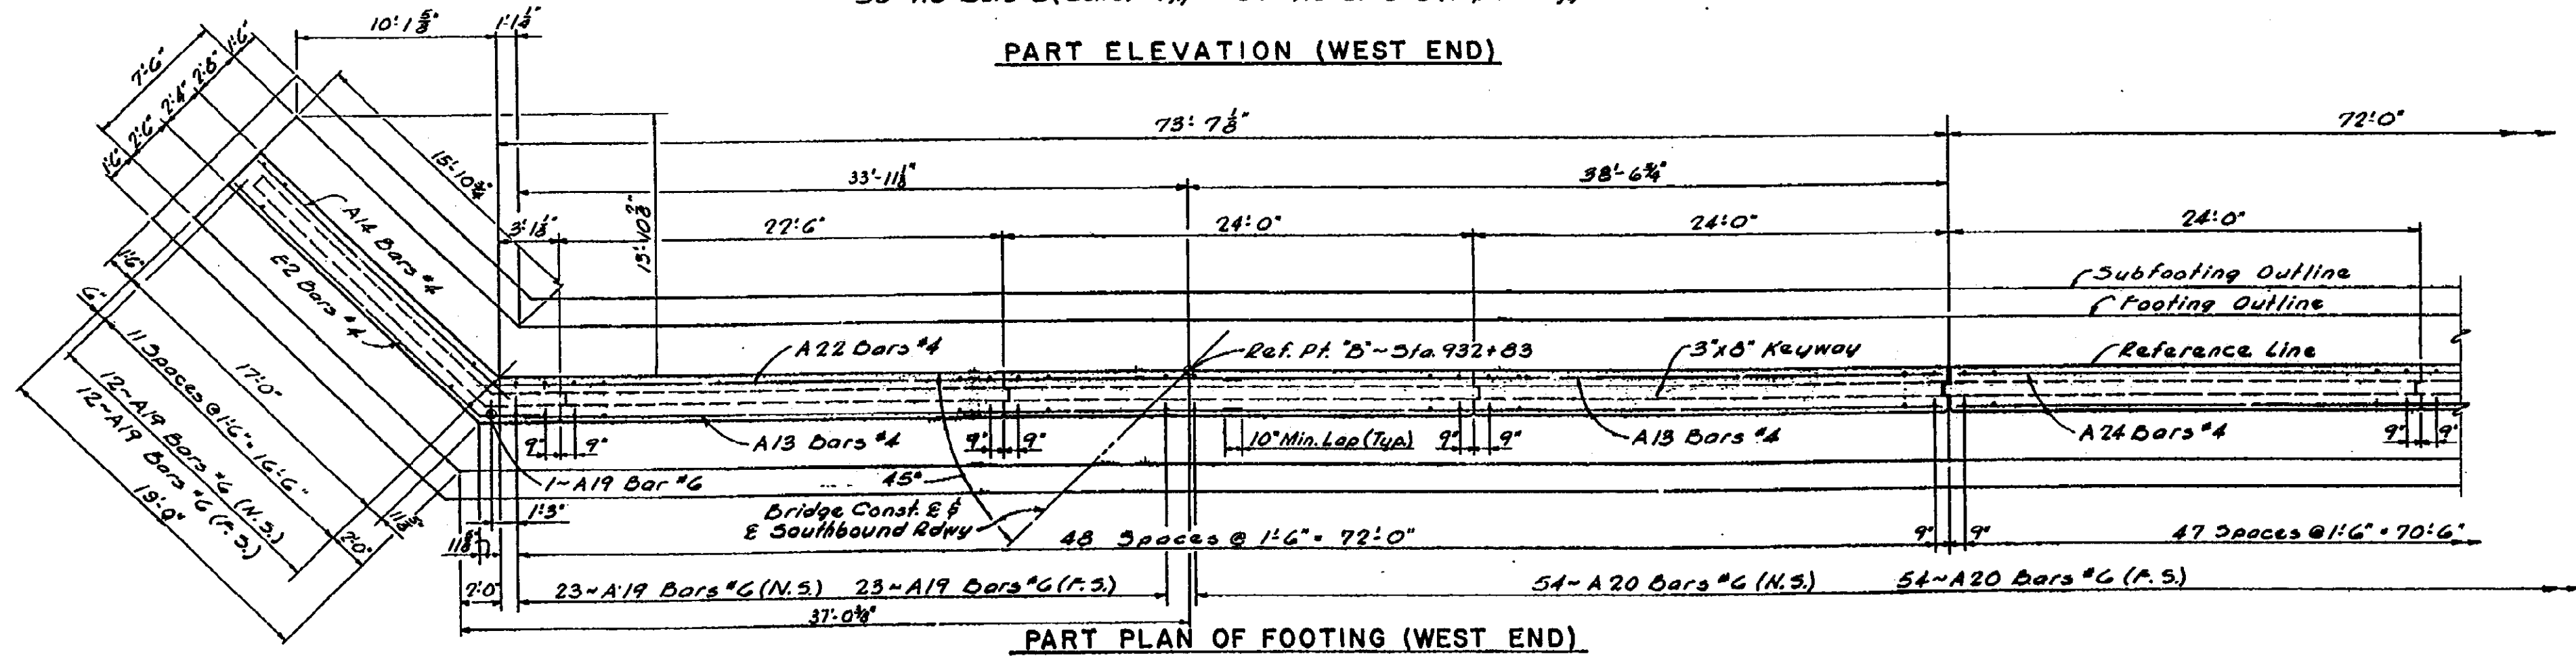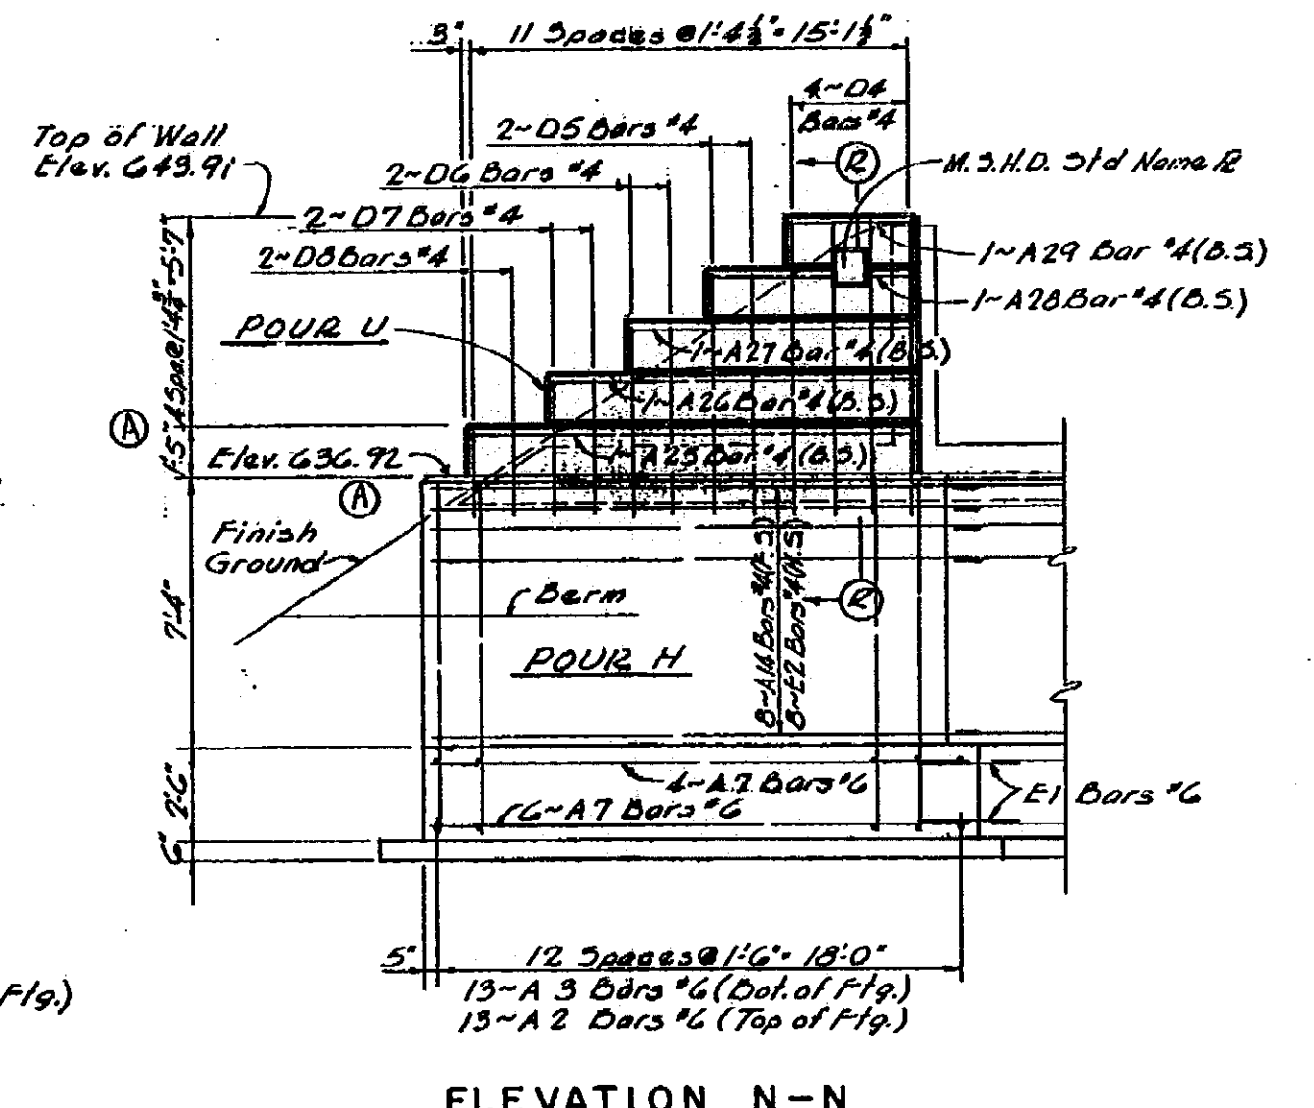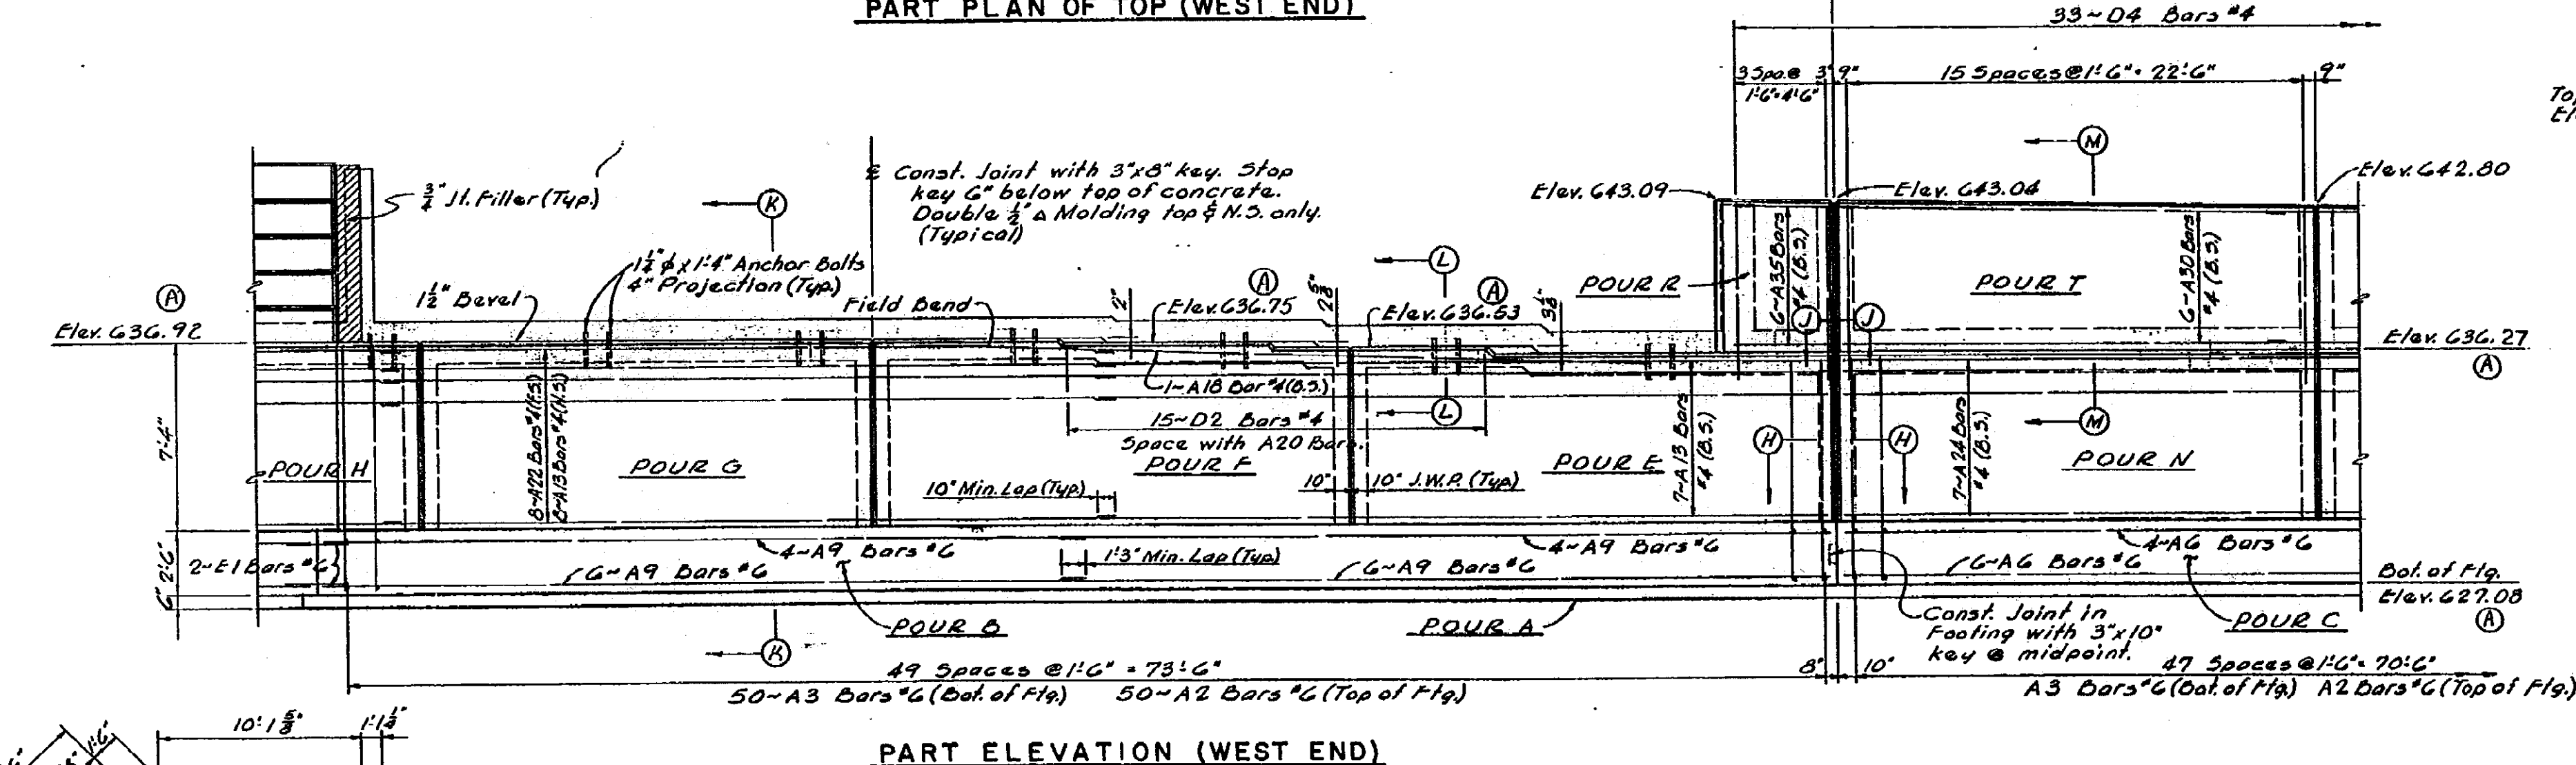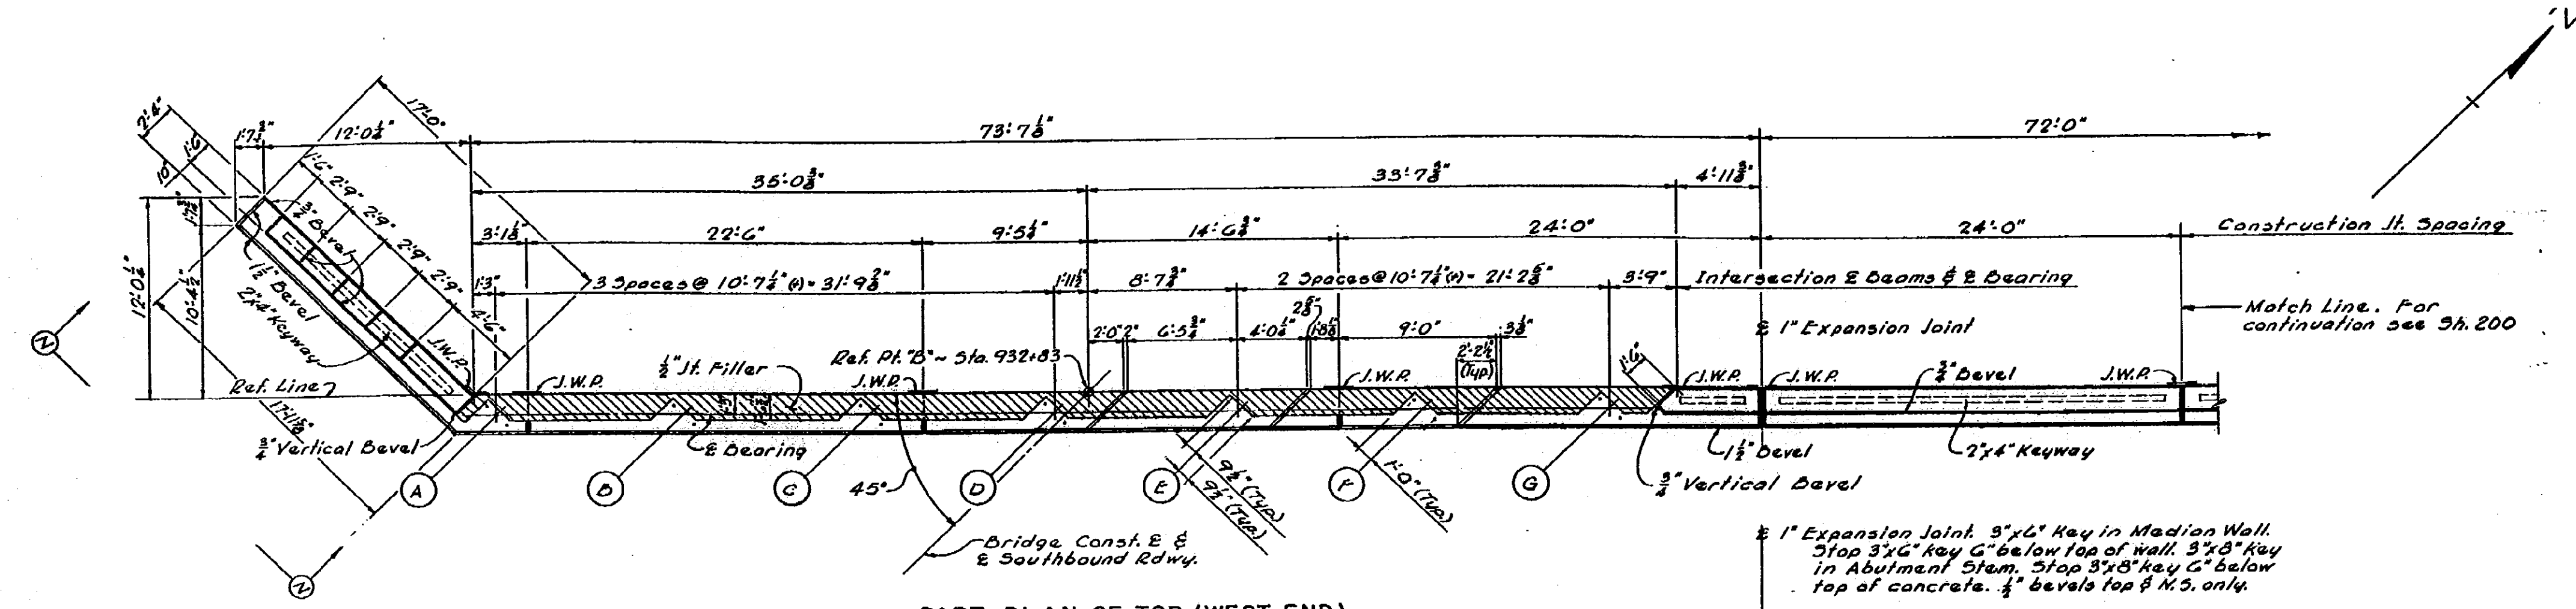

This design is based on a maximum foundation pressure of 3650 pounds per square foot and a maximum average foundation pressure of 2500 pounds per square foot. For additional notes see sheet 201.

Work this sheet with sheets 198, 200, 201 & 220

MICHIGAN STATE HIGHWAY DEPARTMENT

ABUTMENT B DETAILS

TECON ENGINEERS, INC.

NO.	DESCRIPTION	DATE	BY

DESIGNED BY: J.P.K. 1/25/01
 DRAWN BY: J.P.K. 1/25/01
 CHECKED BY: J.P.K. 1/25/01
 DATE: 1/25/01

B02 OF 63174 I













NOTE:
 DO NOT WORK FROM THIS SHEET. THE INFORMATION SHOWN HERE IS FOR REFERENCE ONLY. NO PAY ITEMS ARE SHOWN.



FOR INFORMATION ONLY

DATE	CONT. SEC.	JOB NO.	DESIGN UNIT	SHEET
02-14-00	B02 OF 63174	49595A	MAHDAVI	1E OF

DRAWN BY: INDER DATE: 02-11-00 CHECKED BY: INDER DATE: 02-11-00 CORRECTED BY: INDER DATE: 02-11-00 FILE NAME: B0263174.dgn

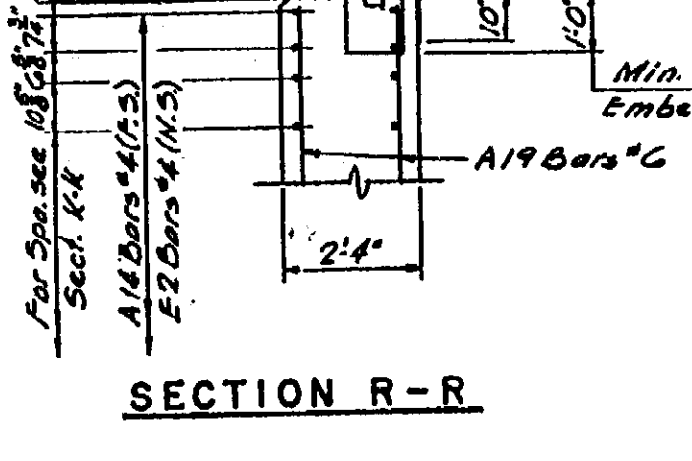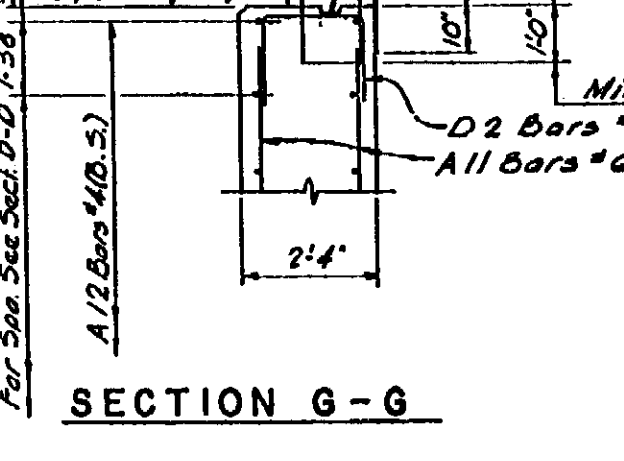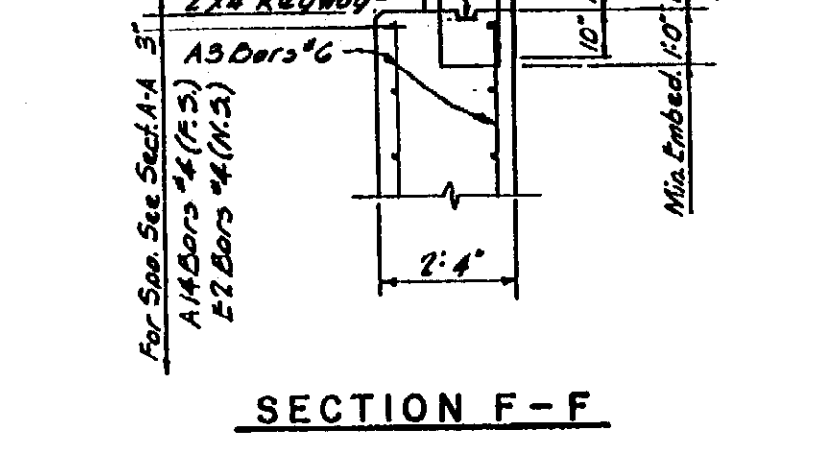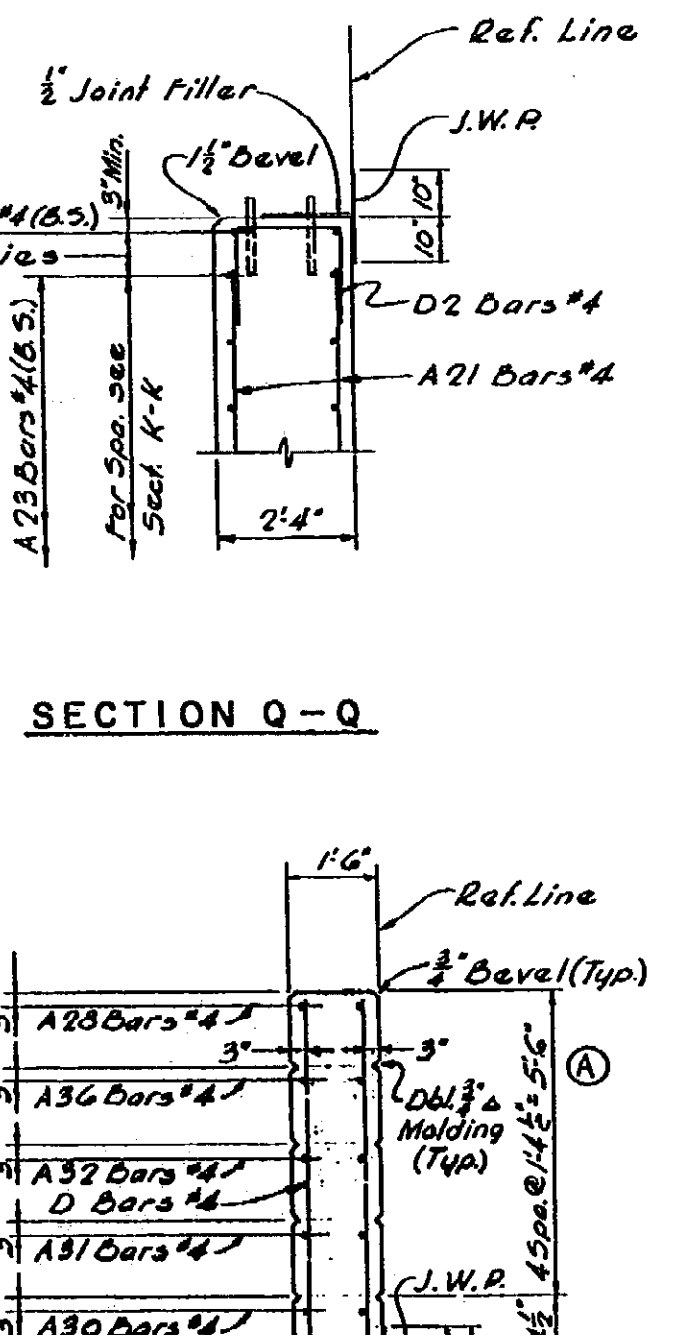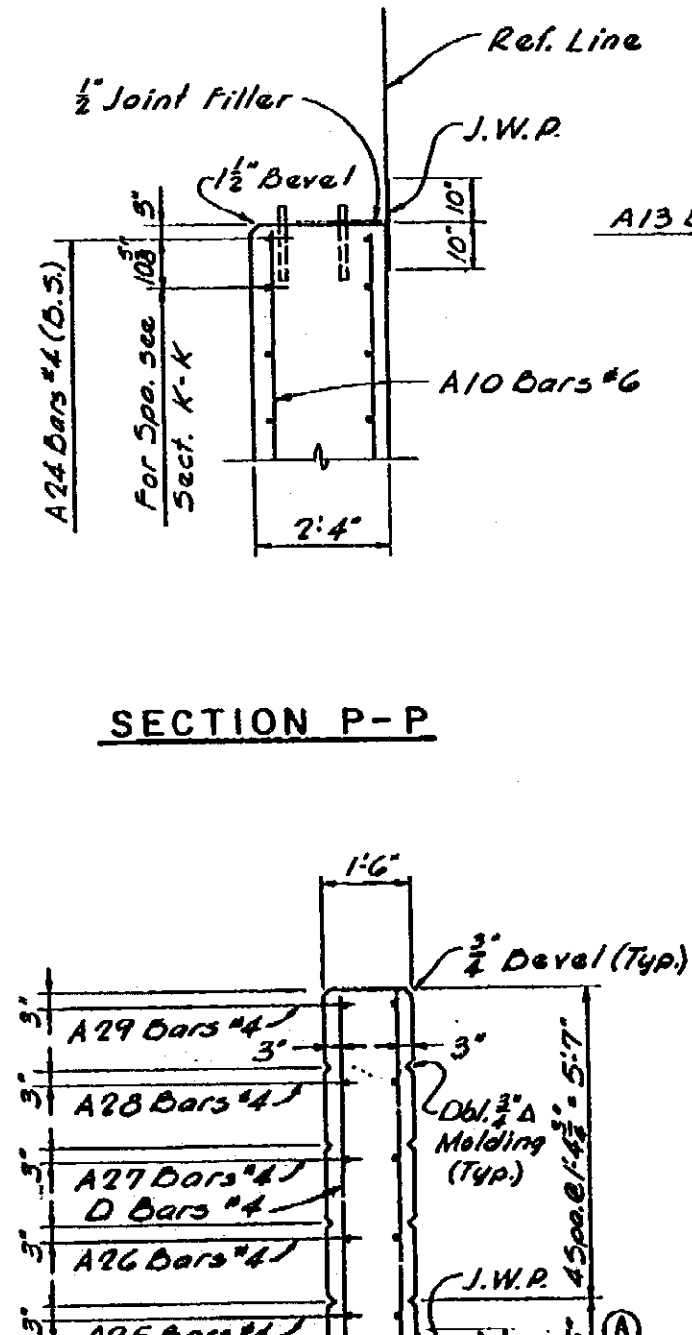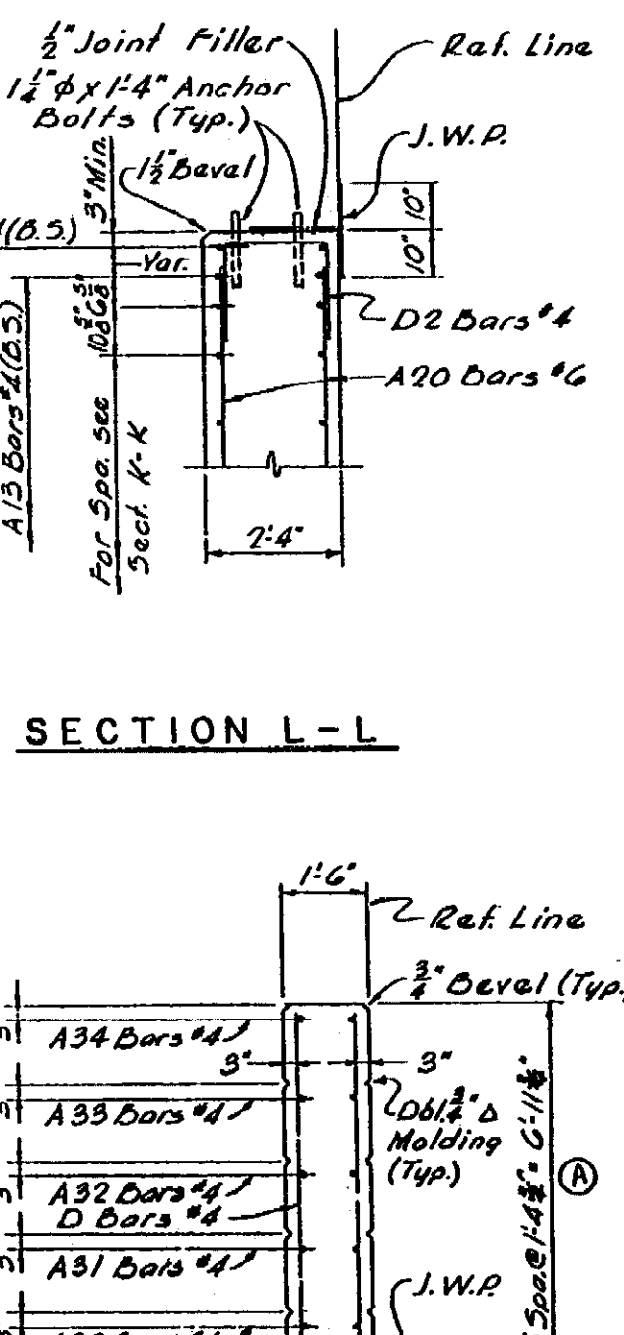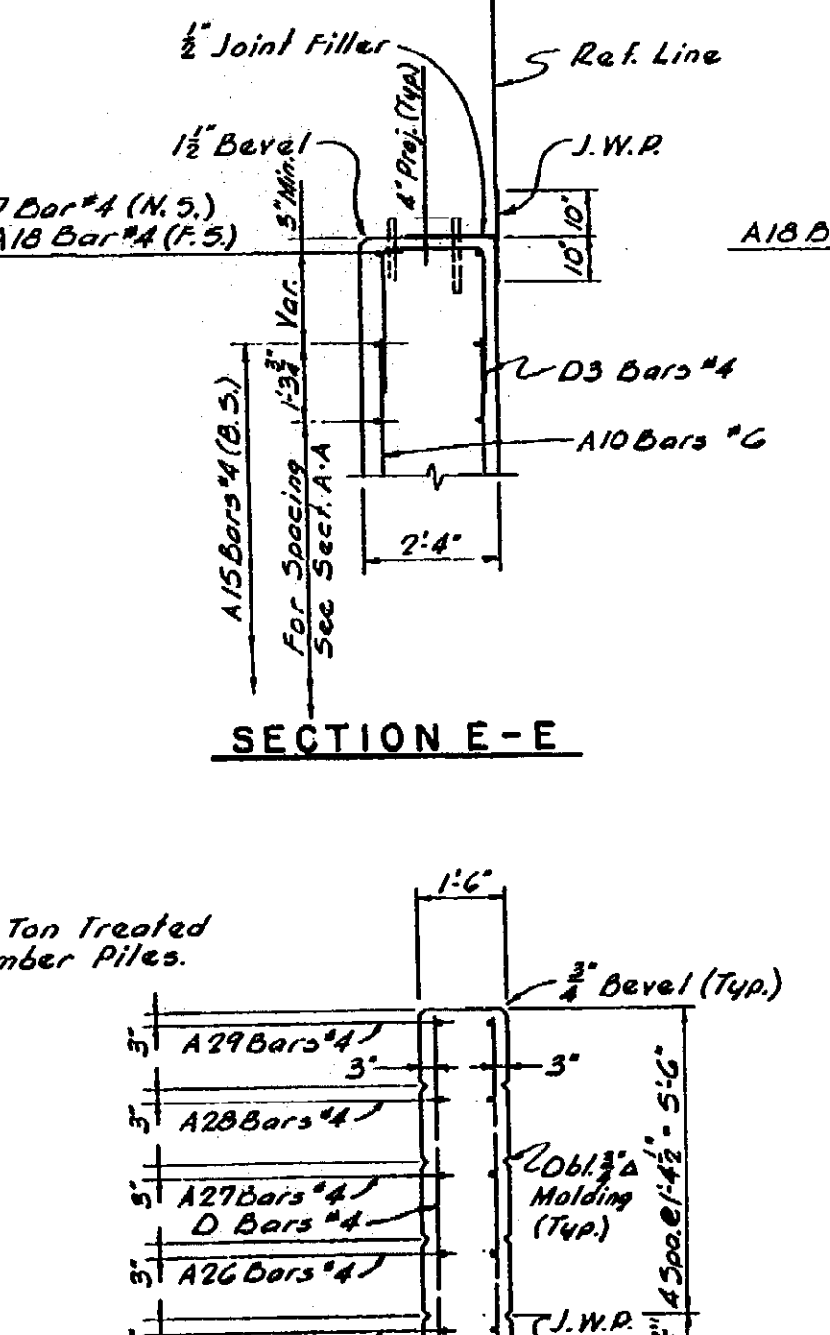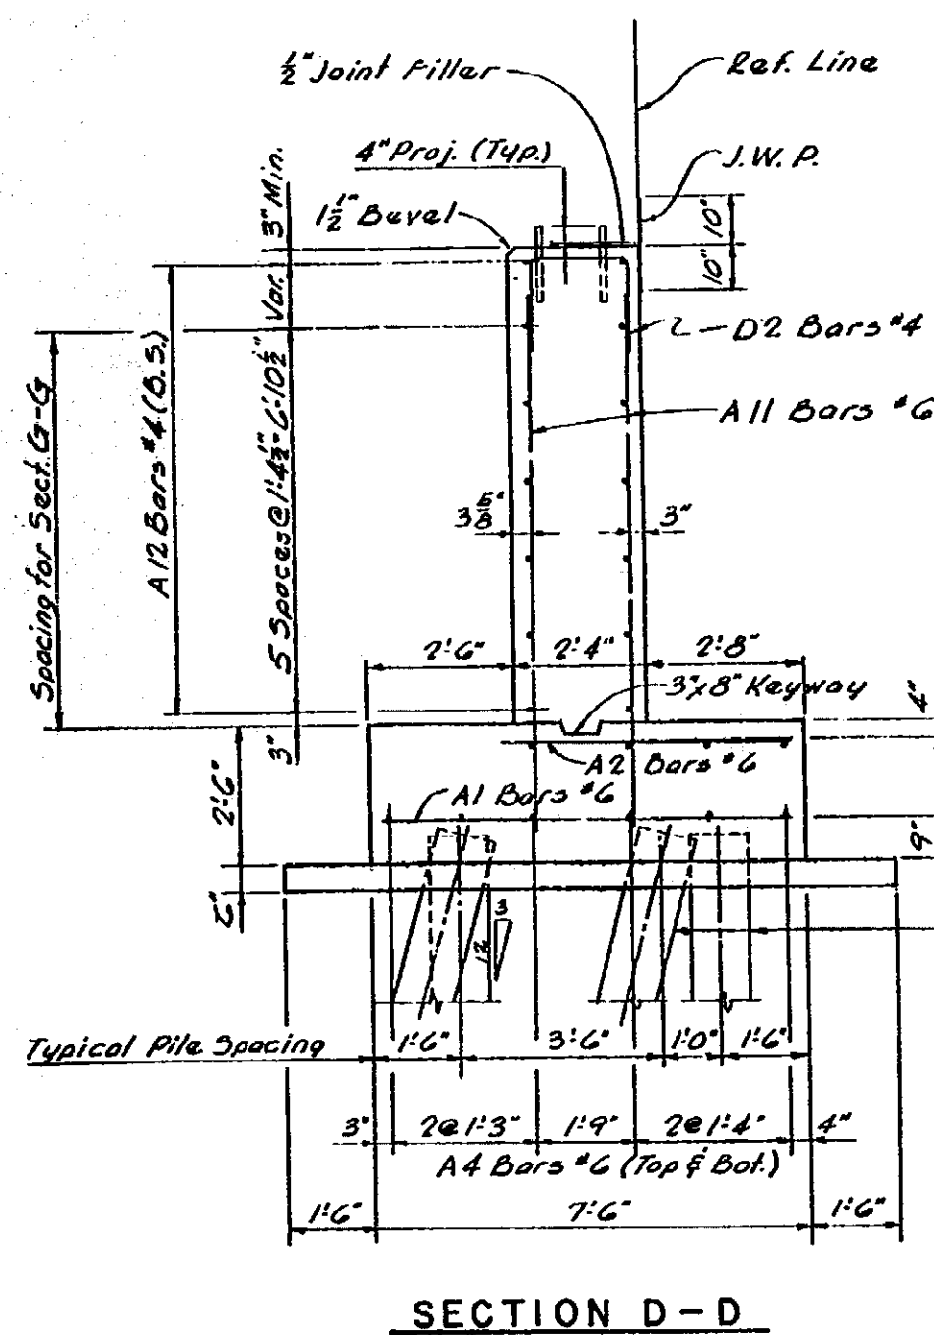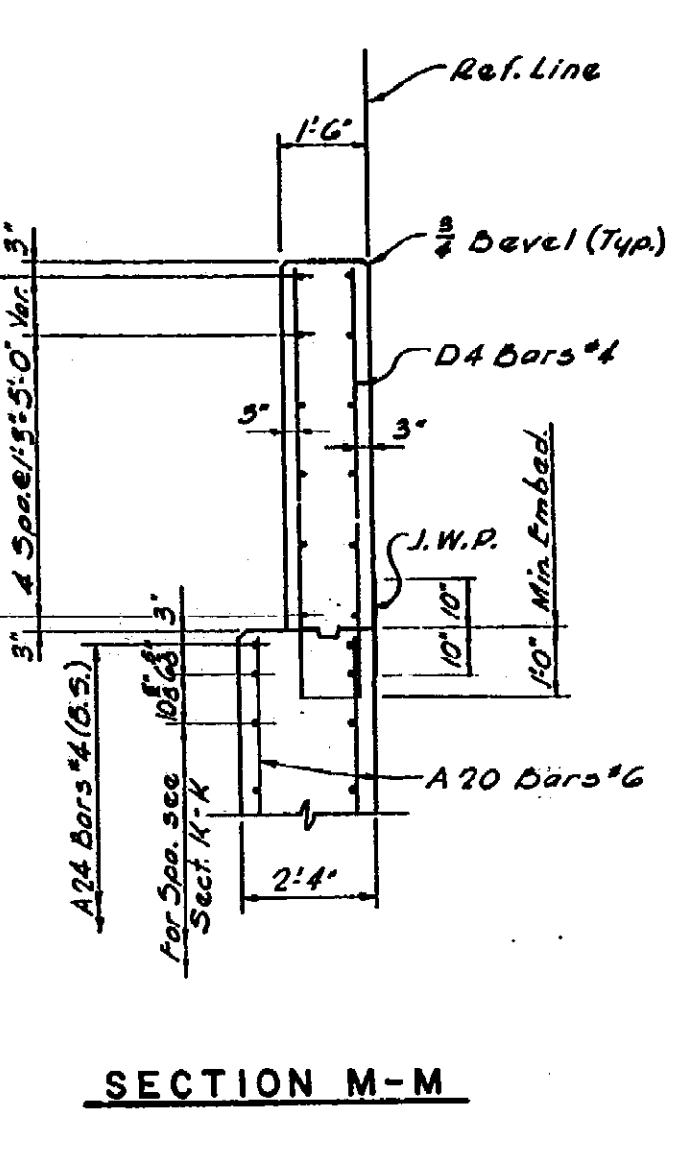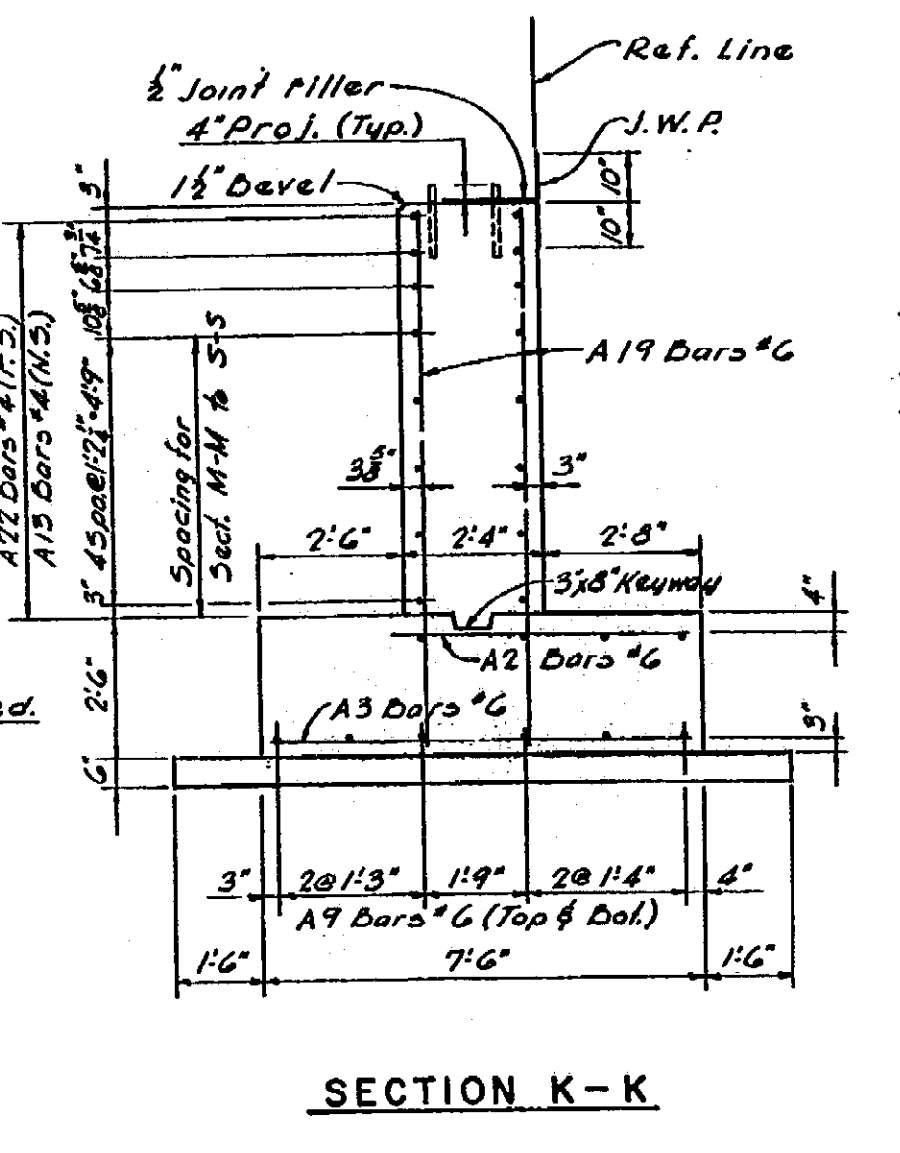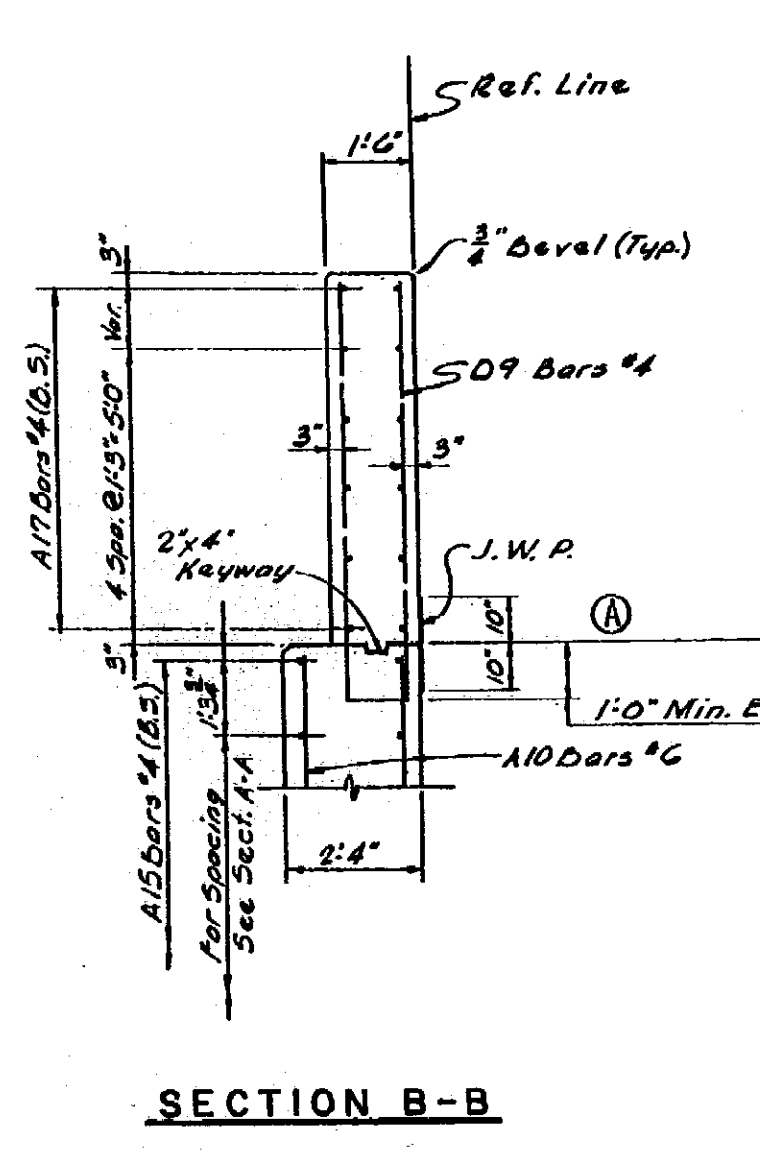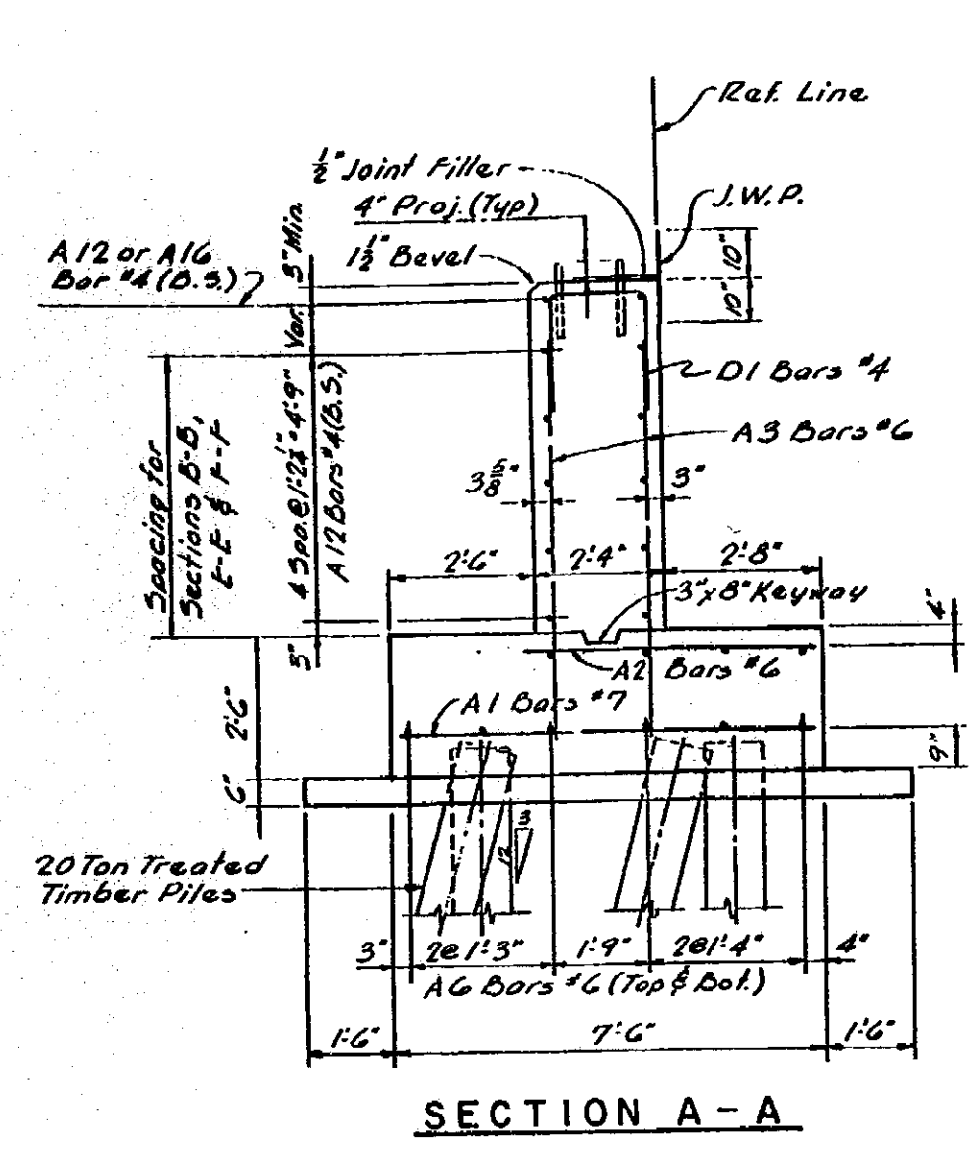

LOCATION	TYPE OF PILE	NUMBER OF PILES	ESTIMATED LENGTH EACH PILE		TOTAL LENGTH (FT)		CUT-OFFS	CUT-OFF ELEVATION
			DRIVEN	CUT-OFF	DRIVEN	FURNISHED		
ABUT. A	VERTICAL	95	40	0	3800	3990	95	
	BATTERED	97	40	2	3800	4074	97	631.45
	TEST	2	40	10	50	160	2	
TOTAL		194			7640	8264	194	

ITEM	UNIT	ABUT. A	ABUT. B	TOTAL
1" Joint Filler	Sq. Ft.	5	6	11
1/2" Joint Filler	Sq. Ft.	235	235	470
1" Joint Filler	Sq. Ft.	60	50	110
1" Joint Filler	Sq. Ft.	35	40	75
Joint Waterproofing	Sq. Ft.	580	555	1125
Unclassified Excavation	Cu Yds.	—	580	580
Treated Timber	Each	4	—	4

POUR	ABUT. A		ABUT. B	
	A (6A)	A (6AA)	A (6A)	A (6AA)
A	43.4	47.9	47.9	47.9
B	61.5	63.6	63.6	63.6
C	60.8	50.0	50.0	50.0
D	48.6	55.8	55.8	55.8
E		12.7		14.0
F		11.2		14.9
G		11.5		14.3
H		9.5		13.3
J		11.1		11.0
K		10.6		10.2
L		13.3		9.6
M		12.5		7.5
N		14.6		13.9
D		12.5		12.7
Q		12.9		13.6
R		3.6		2.1
S		7.5		4.7
T		3.8		3.8
U		3.8		3.9
V		3.1		2.9
W		2.8		2.9
Total	219.3	173.7	216.7	162.3

NOTES:
 J.W.P. denotes joint waterproofing.
 N.S. denotes near side.
 F.S. denotes far side.
 B.S. denotes both sides.
 For Devel and Molding Details, see Standard Sheet R11.
 For location of Name Plates, see General Plan of Structure Sheet 1 for mounting details, see Standard Sheet R11.
 Median walls and slope walls are to be cast after superstructure is complete to top of curbs.
 Anchor Bolts shall be set accurately to a template.
 The top of abutments shall be finished to a true plane of the elevations shown and shall not vary more than 1/8" under a ten foot straight edge nor more than 1/4" under any bearing.
 All piles shall be driven to minimum bearing capacity of 20 Tons.

Work this sheet with sheets 197, 198, 199, 200 & 220

MICHIGAN STATE HIGHWAY DEPARTMENT

ABUTMENT DETAILS

TECON ENGINEERS, INC.

NO.	DESCRIPTION	DATE	BY


BO2 OF 63174

NOTE:
 DO NOT WORK FROM THIS SHEET. THE INFORMATION SHOWN HERE IS FOR REFERENCE ONLY. NO PAY ITEMS ARE SHOWN.




DATE	CONT. SEC.	JOB NO.	DESIGN UNIT	SHEET
02-14-00	B02 OF 63174	49595A	MAHDAVI	16 OF 16


DATE: _____ CORRECTED BY: INDER DATE: 02-11-00 CHECKED BY: _____ DRAWN BY: INDER FILE NAME: B0263174.dgn

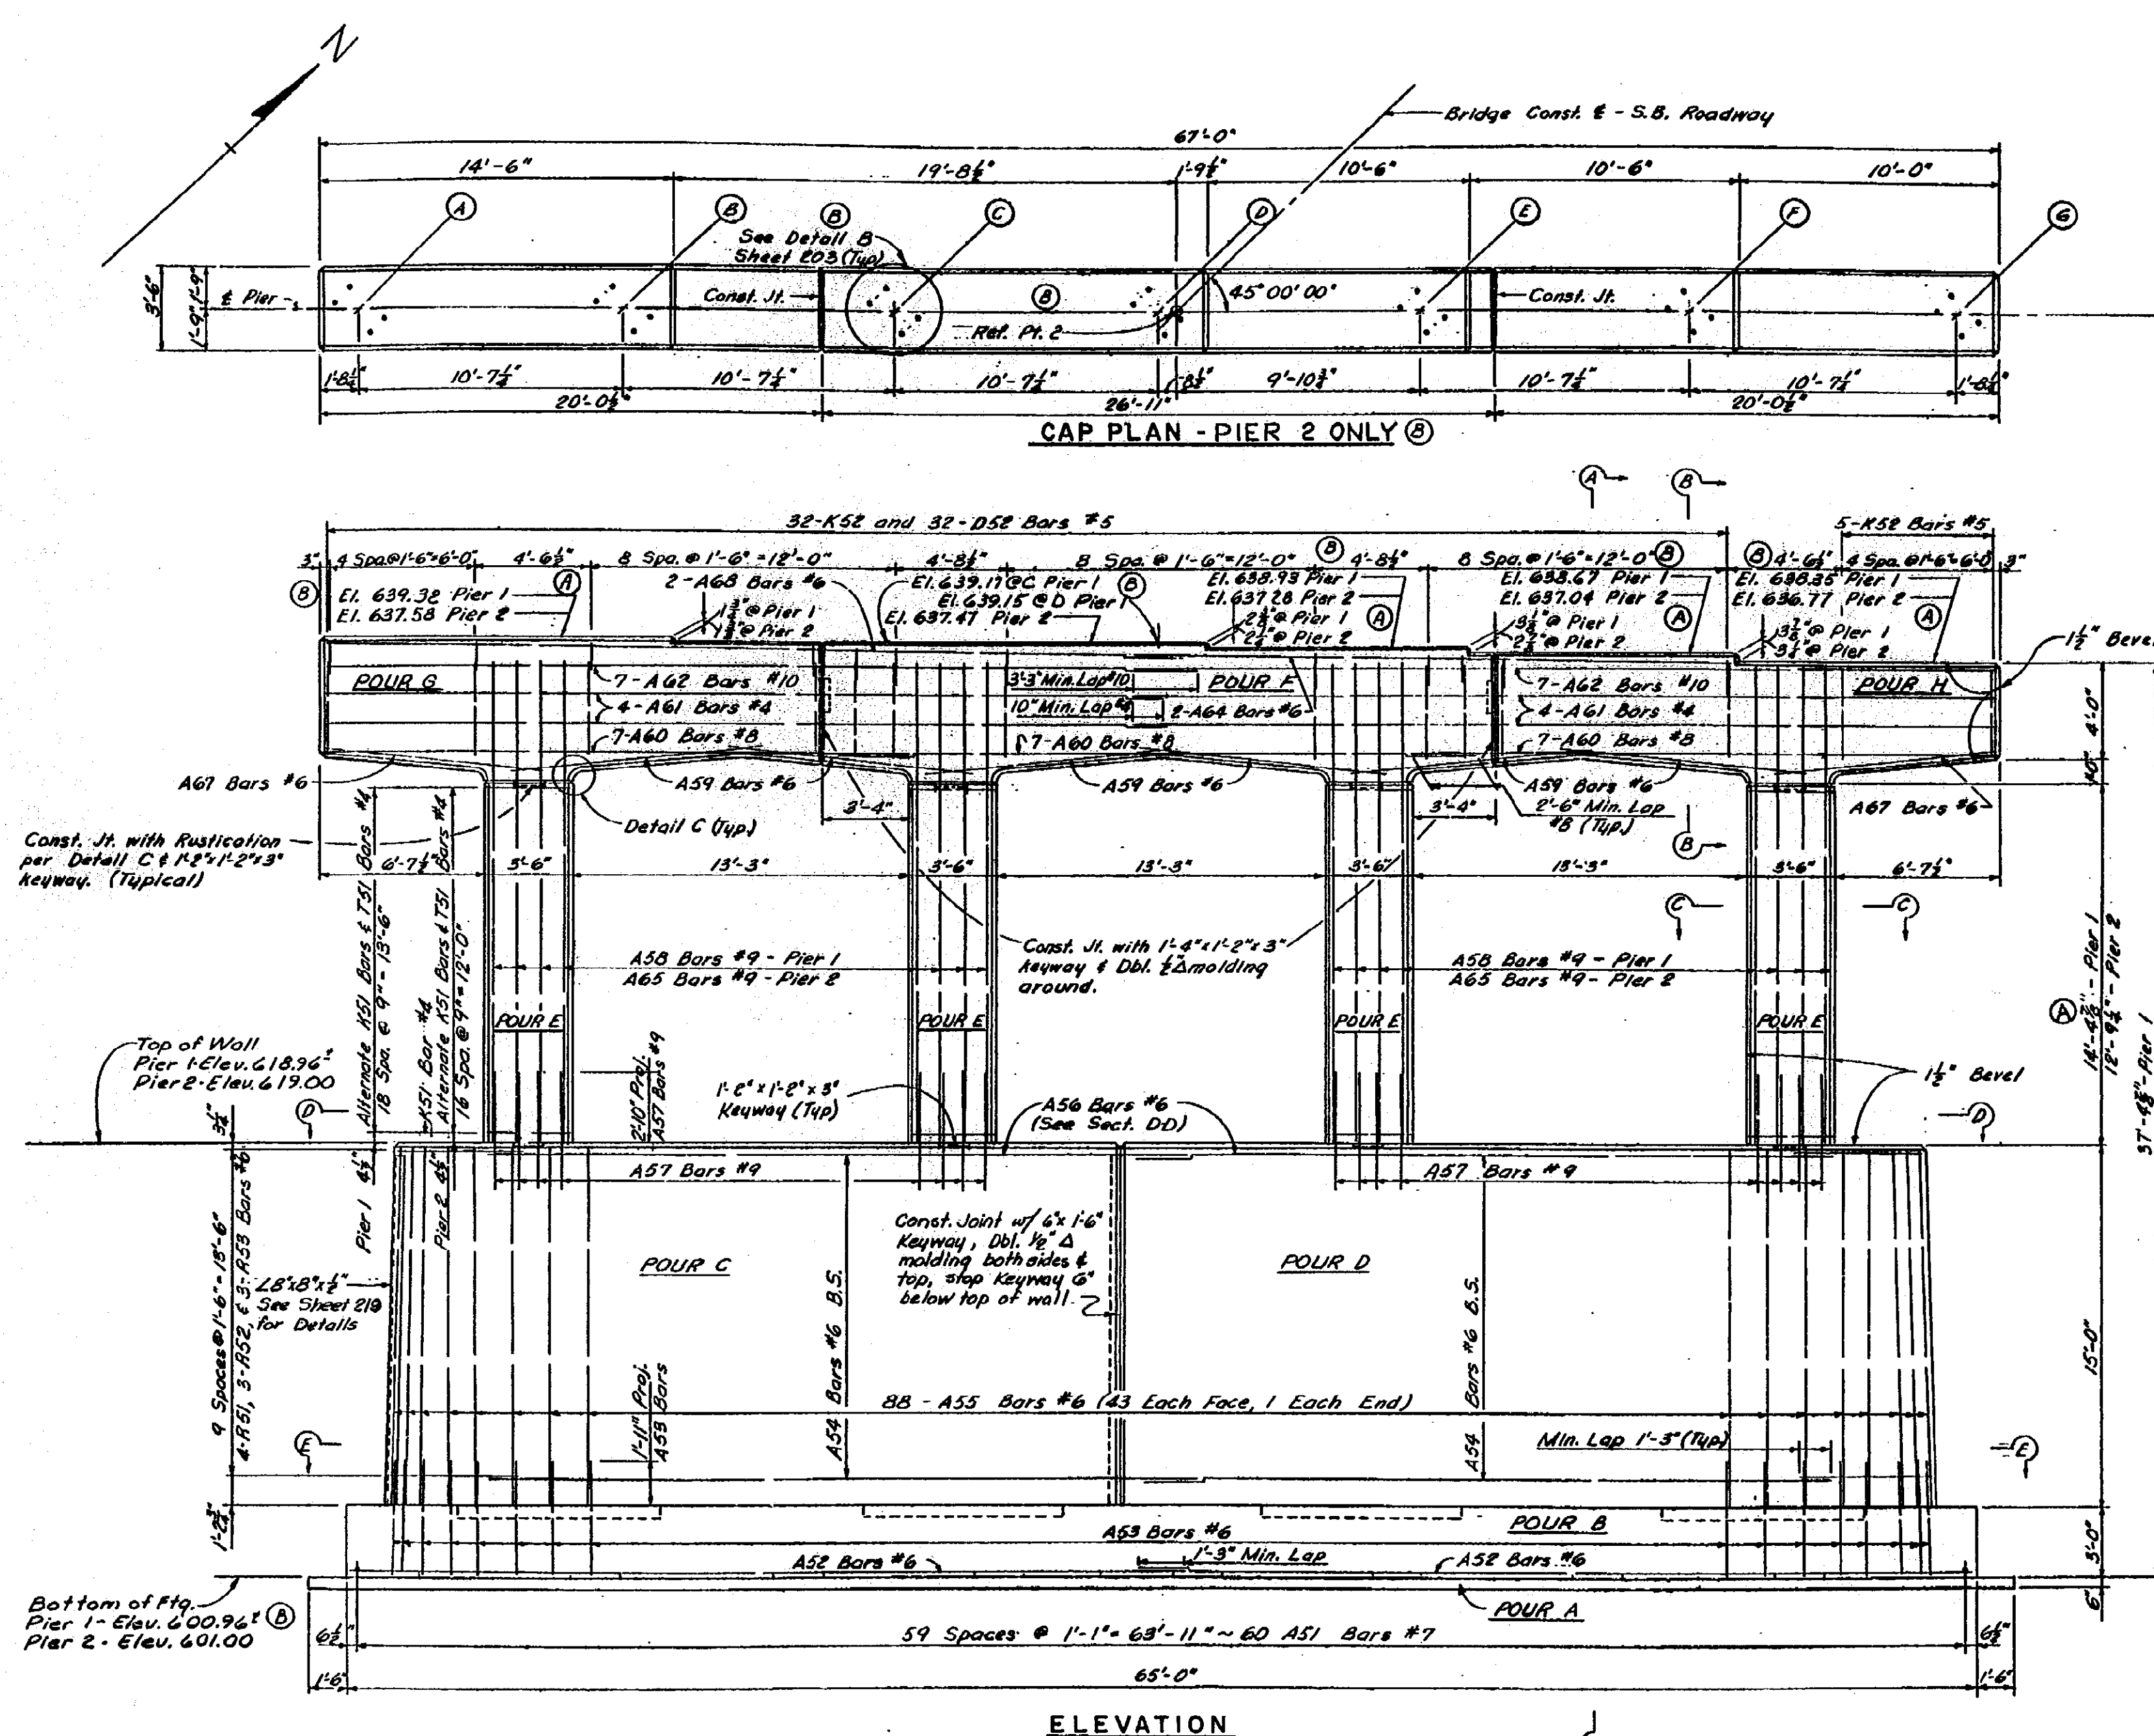

NOTE:
DO NOT WORK FROM THIS SHEET. THE INFORMATION SHOWN
HERE IS FOR REFERENCE ONLY. NO PAY ITEMS ARE SHOWN.

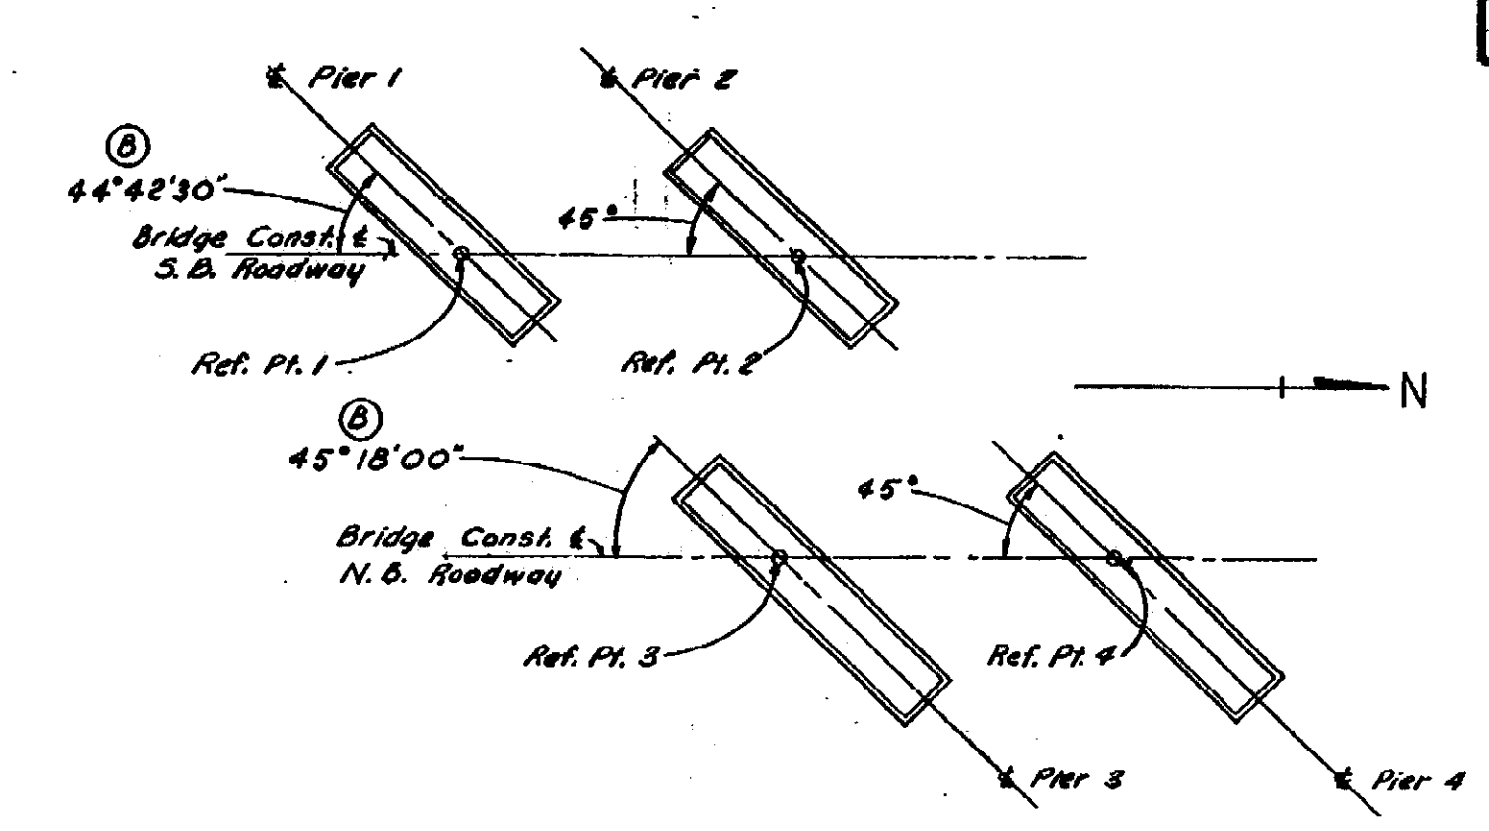

LOCATION SKETCH

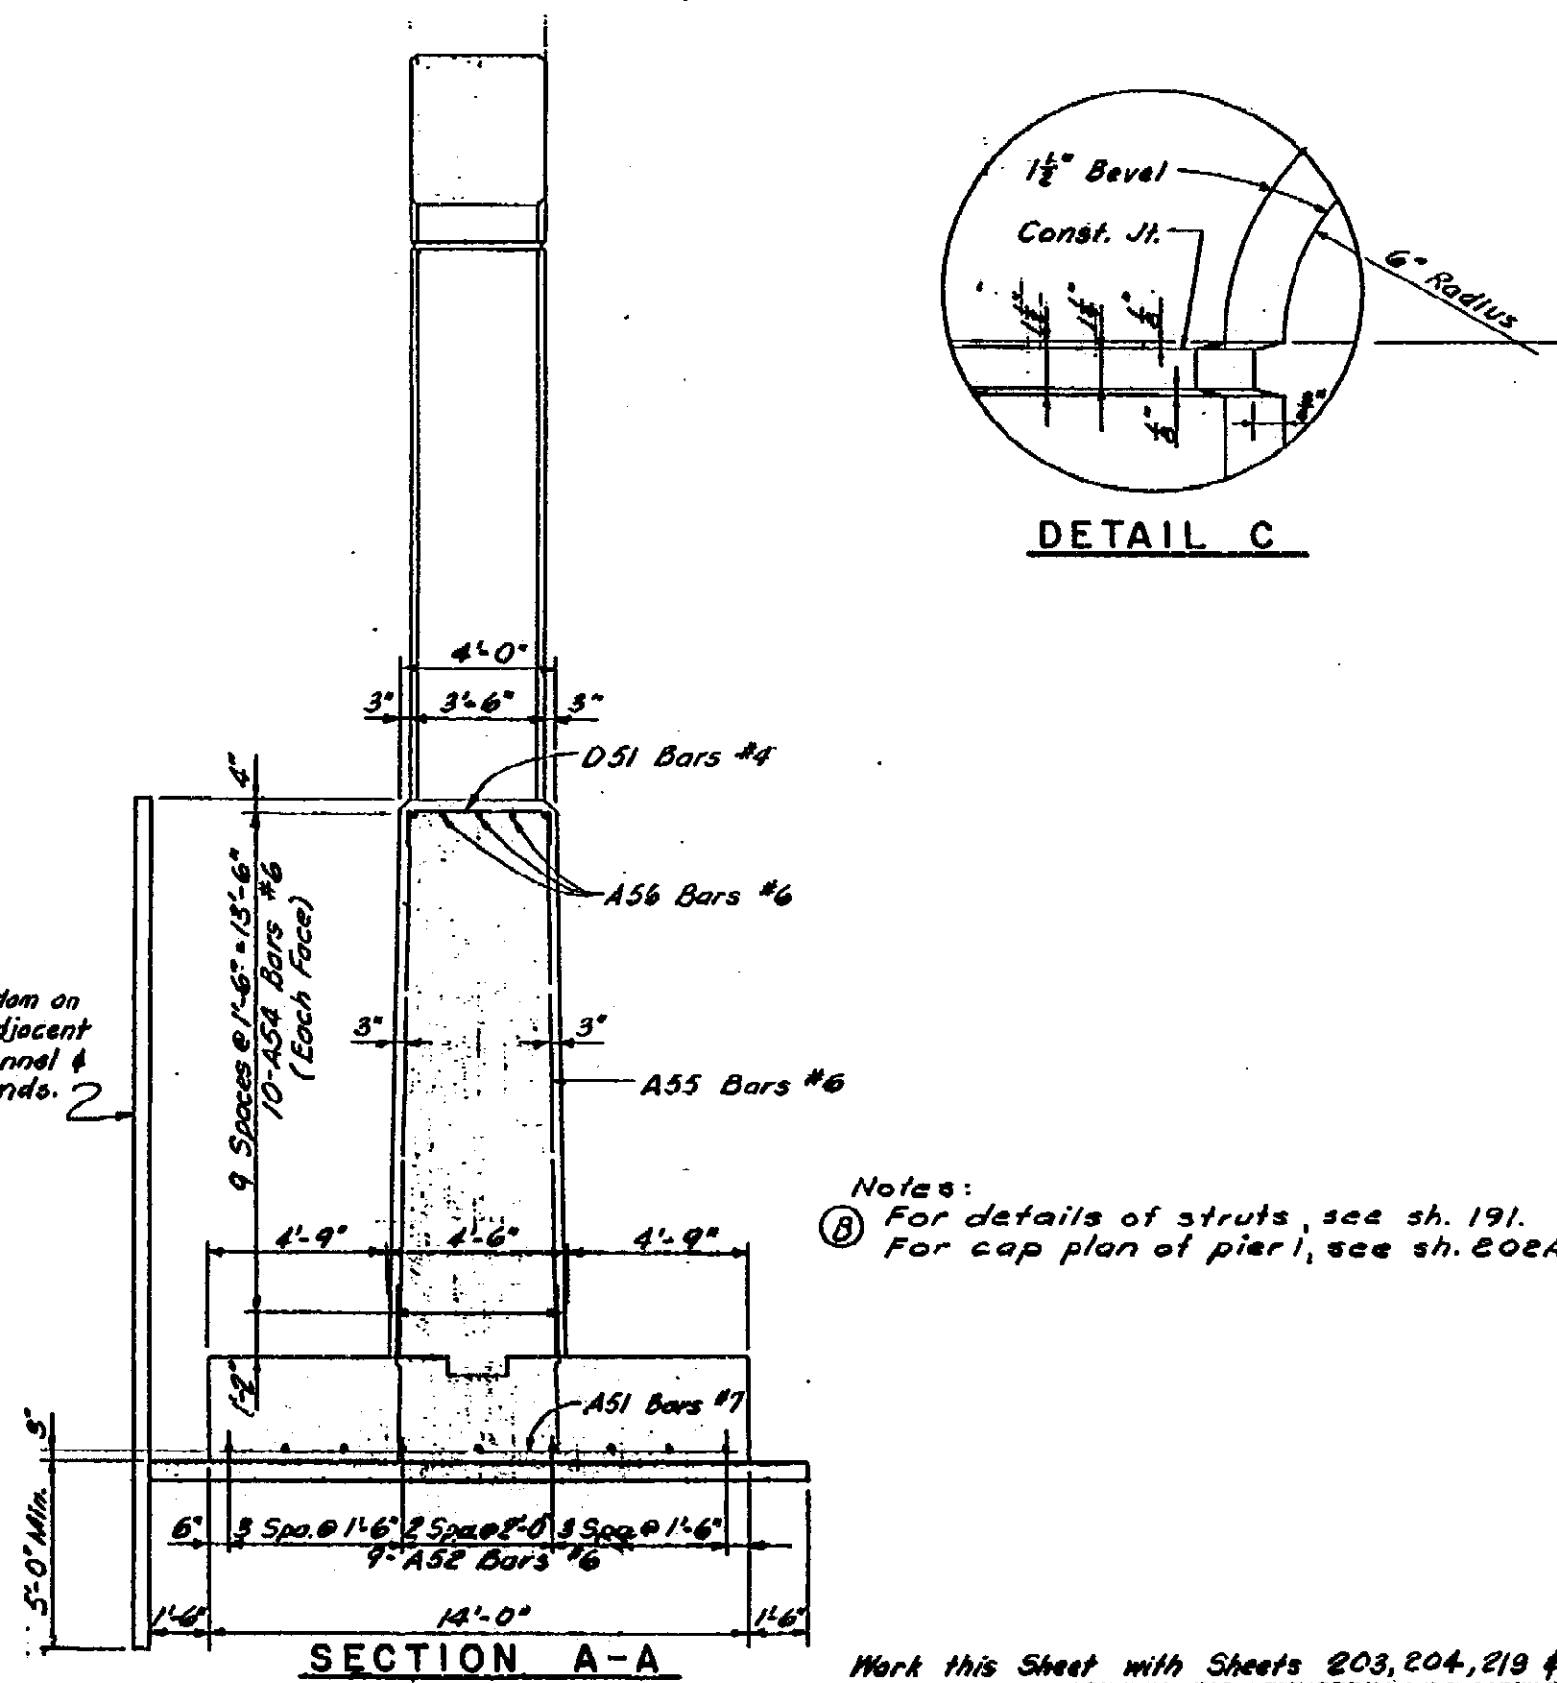

SECTION A-A

Notes:
① For details of struts, see sh. 191.
② For cap plan of pier 1, see sh. 202A.

Mark this Sheet with Sheets 203, 204, 210 & 220

MICHIGAN STATE HIGHWAY DEPARTMENT
PIER DETAILS
PIER NO. 1 & 2
TECON ENGINEERS, INC.

REVISIONS			
NO.	DESCRIPTION	DATE	BY
1	Revised pier 1 layout	11-63	R.A.
2	Cap Plan of Pier 1	11-63	R.A.


B02 of 63174 I

FOR INFORMATION ONLY


DATE	CONT. SEC.	JOB NO.	DESIGN UNIT	SHEET
02-14-00	B02 OF 63174	49595A	MAHDAVI	1H OF



REVISIONS			
NO.	DESCRIPTION	DATE	BY


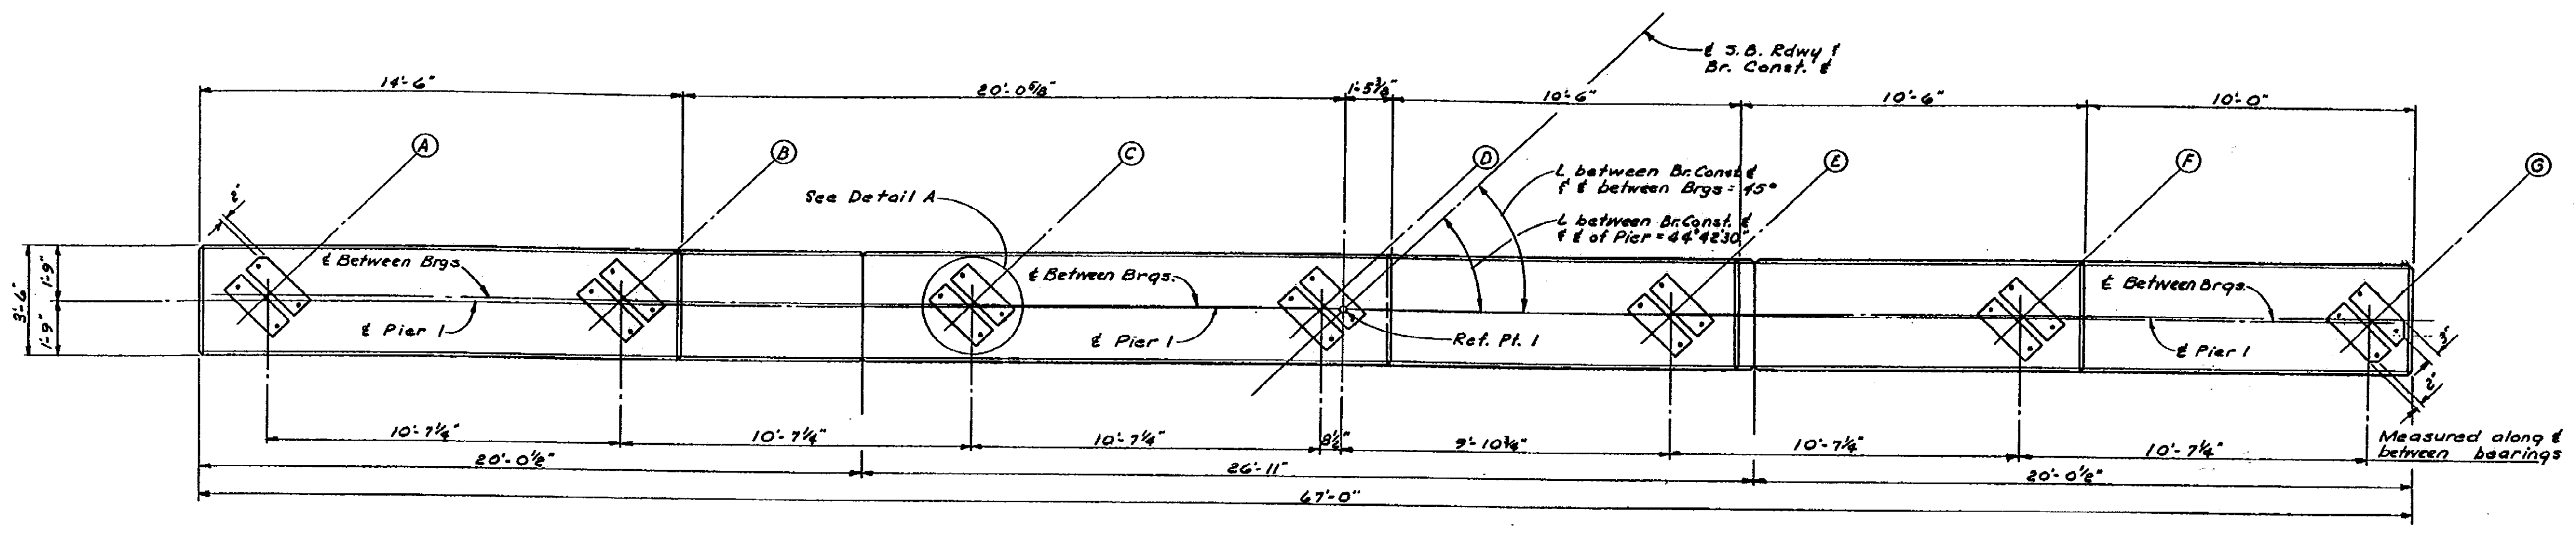


PLAN OF CAP - PIER 1

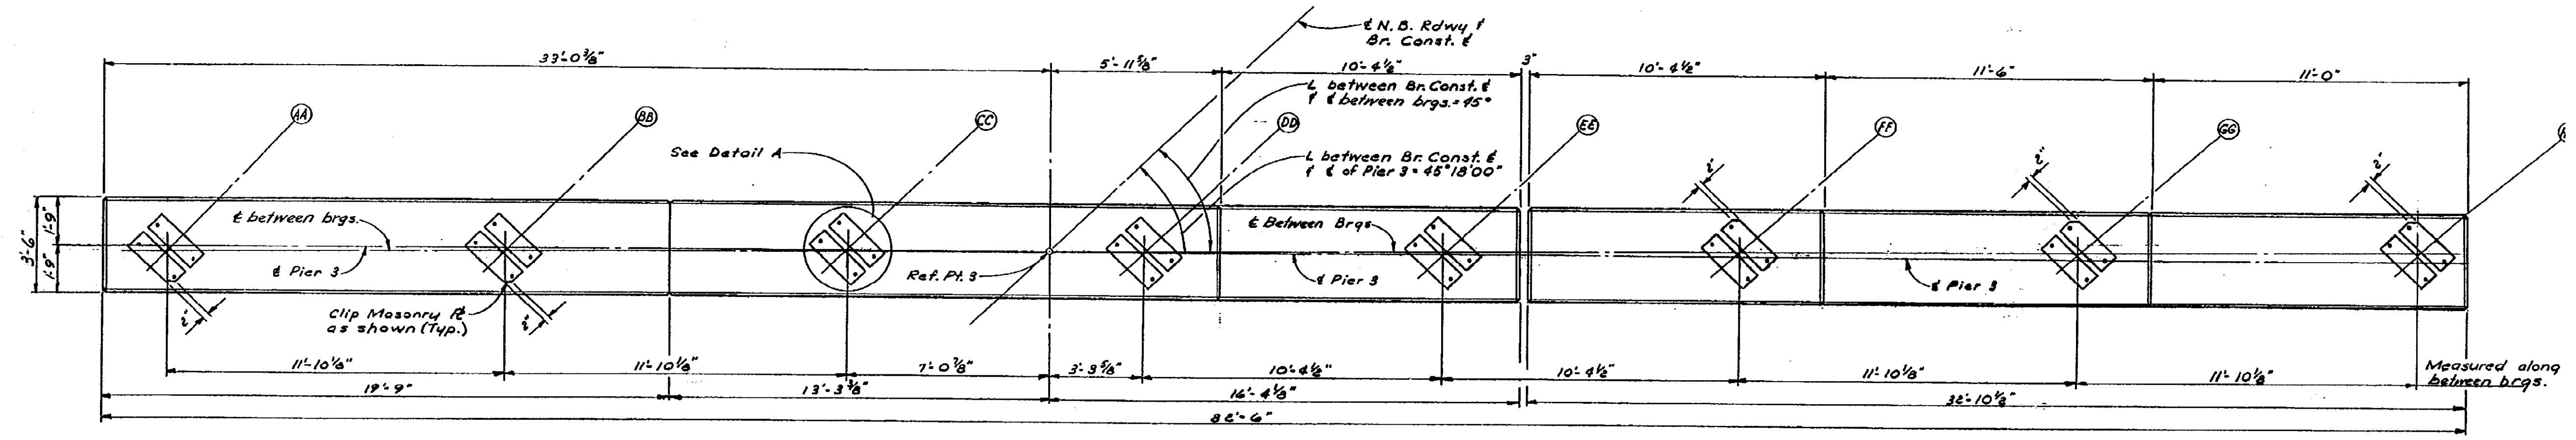

PLAN OF CAP - PIER 3

NOTE: Existing anchor bolts shall be cut off and new anchor bolts placed.

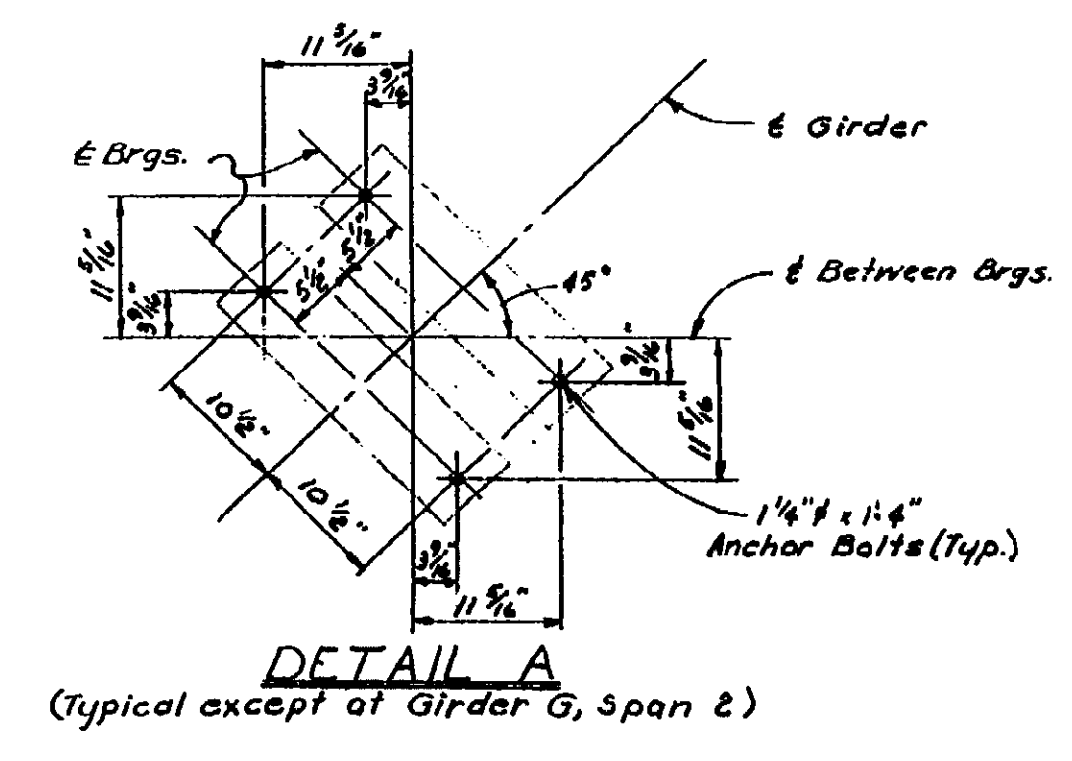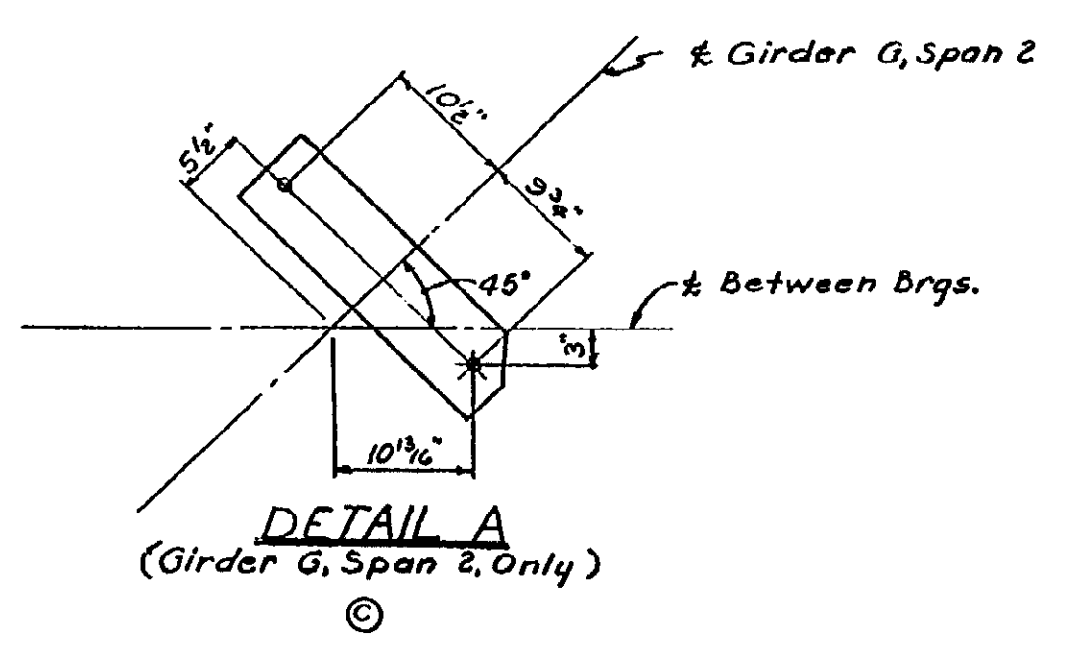

MICHIGAN STATE HIGHWAY DEPARTMENT
PIERS 1 & 3 CAP DETAILS

REVISIONS			
NO.	DESCRIPTION	DATE	BY
C	Det. A for Girder G added	1/16/63	ECF
B	This sheet added to contract drawings	1/16/63	R.E.

DRAWN BY: RORAU, BIR
CHECKED BY: R.E.
B02 OF 63174




NOTE:
DO NOT WORK FROM THIS SHEET. THE INFORMATION SHOWN
HERE IS FOR REFERENCE ONLY. NO PAY ITEMS ARE SHOWN.

FOR INFORMATION ONLY

	DATE	CONT. SEC.	JOB NO.	DESIGN UNIT	SHEET
	02-14-00	B02 OF 63174	49595A	MAHDAVI	IJ OF

1 2 3 4 5 6 7 8 9 10 11 12 13 14 15 16 17 18 19 20 21 22 23 24 25 26 27 28 29 30 31 32 33 34 35 36 37 38 39 40 41 42 43 44 45 46 47 48 49 50 51 52 53 54 55 56 57 58 59 60 61 62 63

REVISIONS			
NO.	DESCRIPTION	DATE	BY

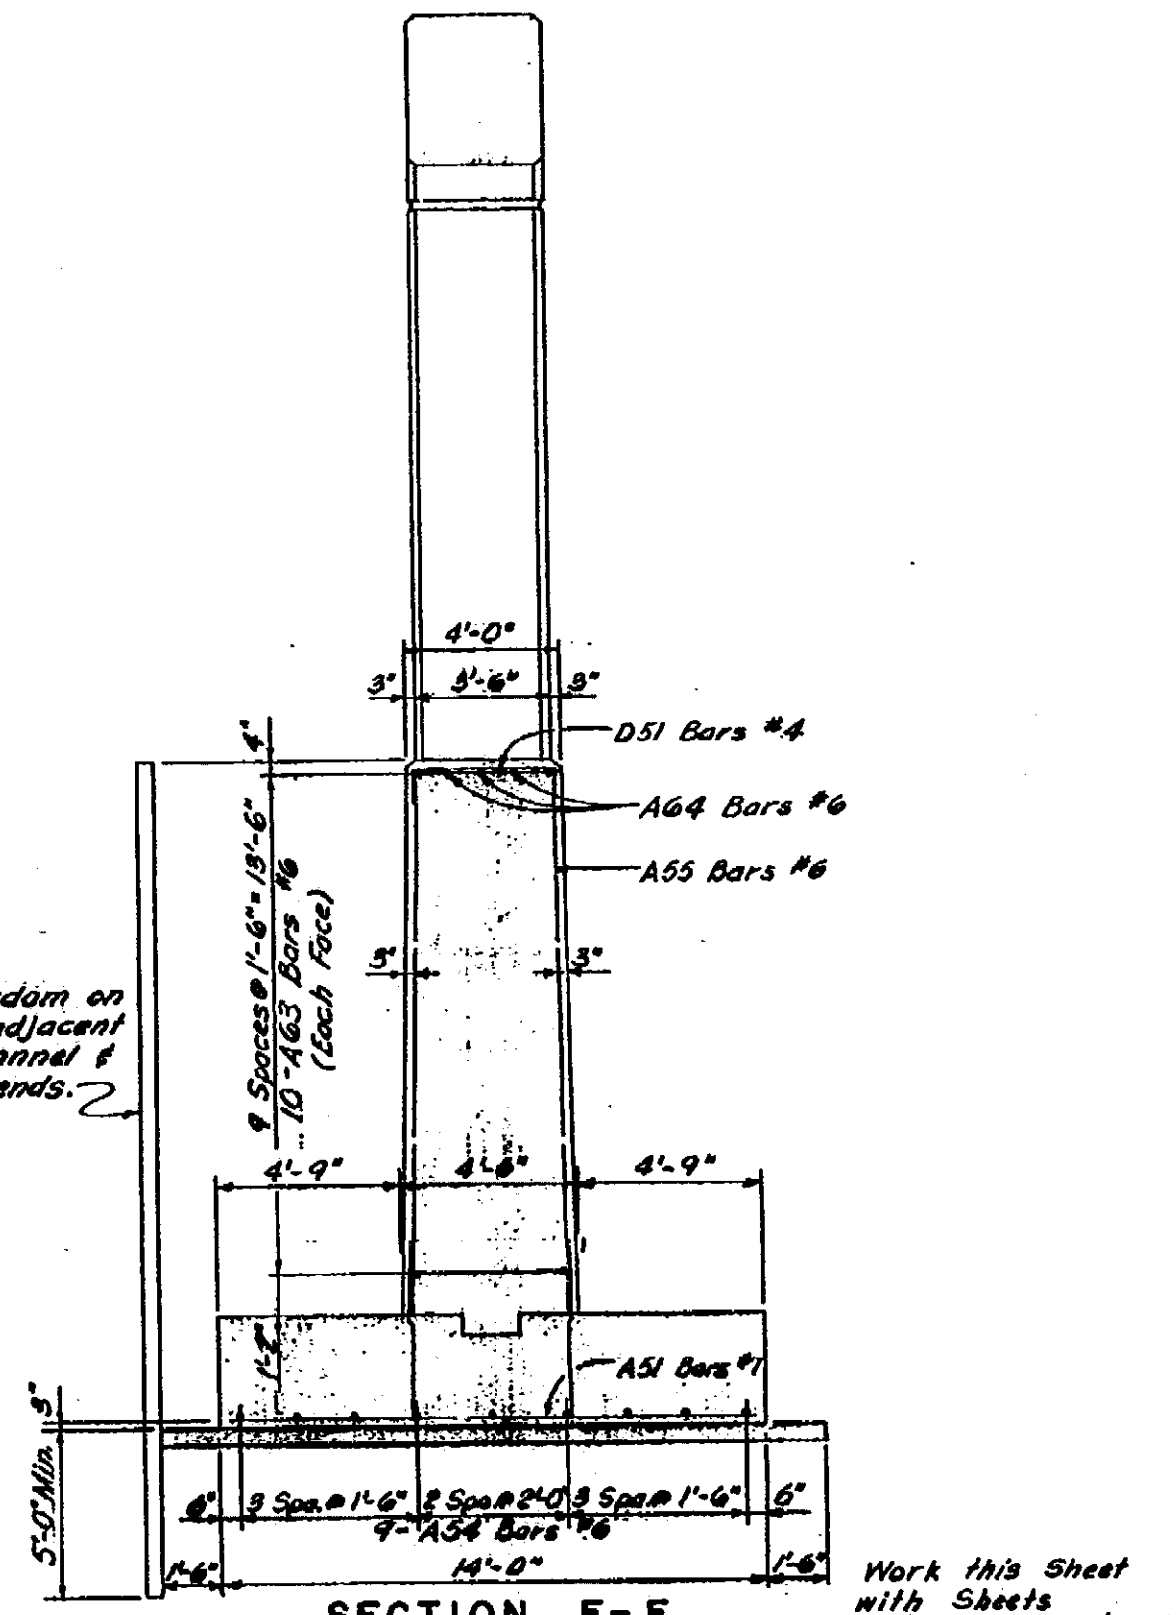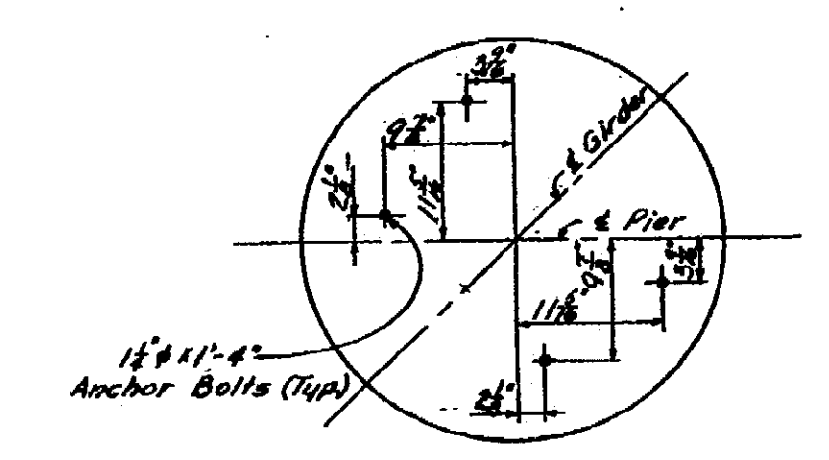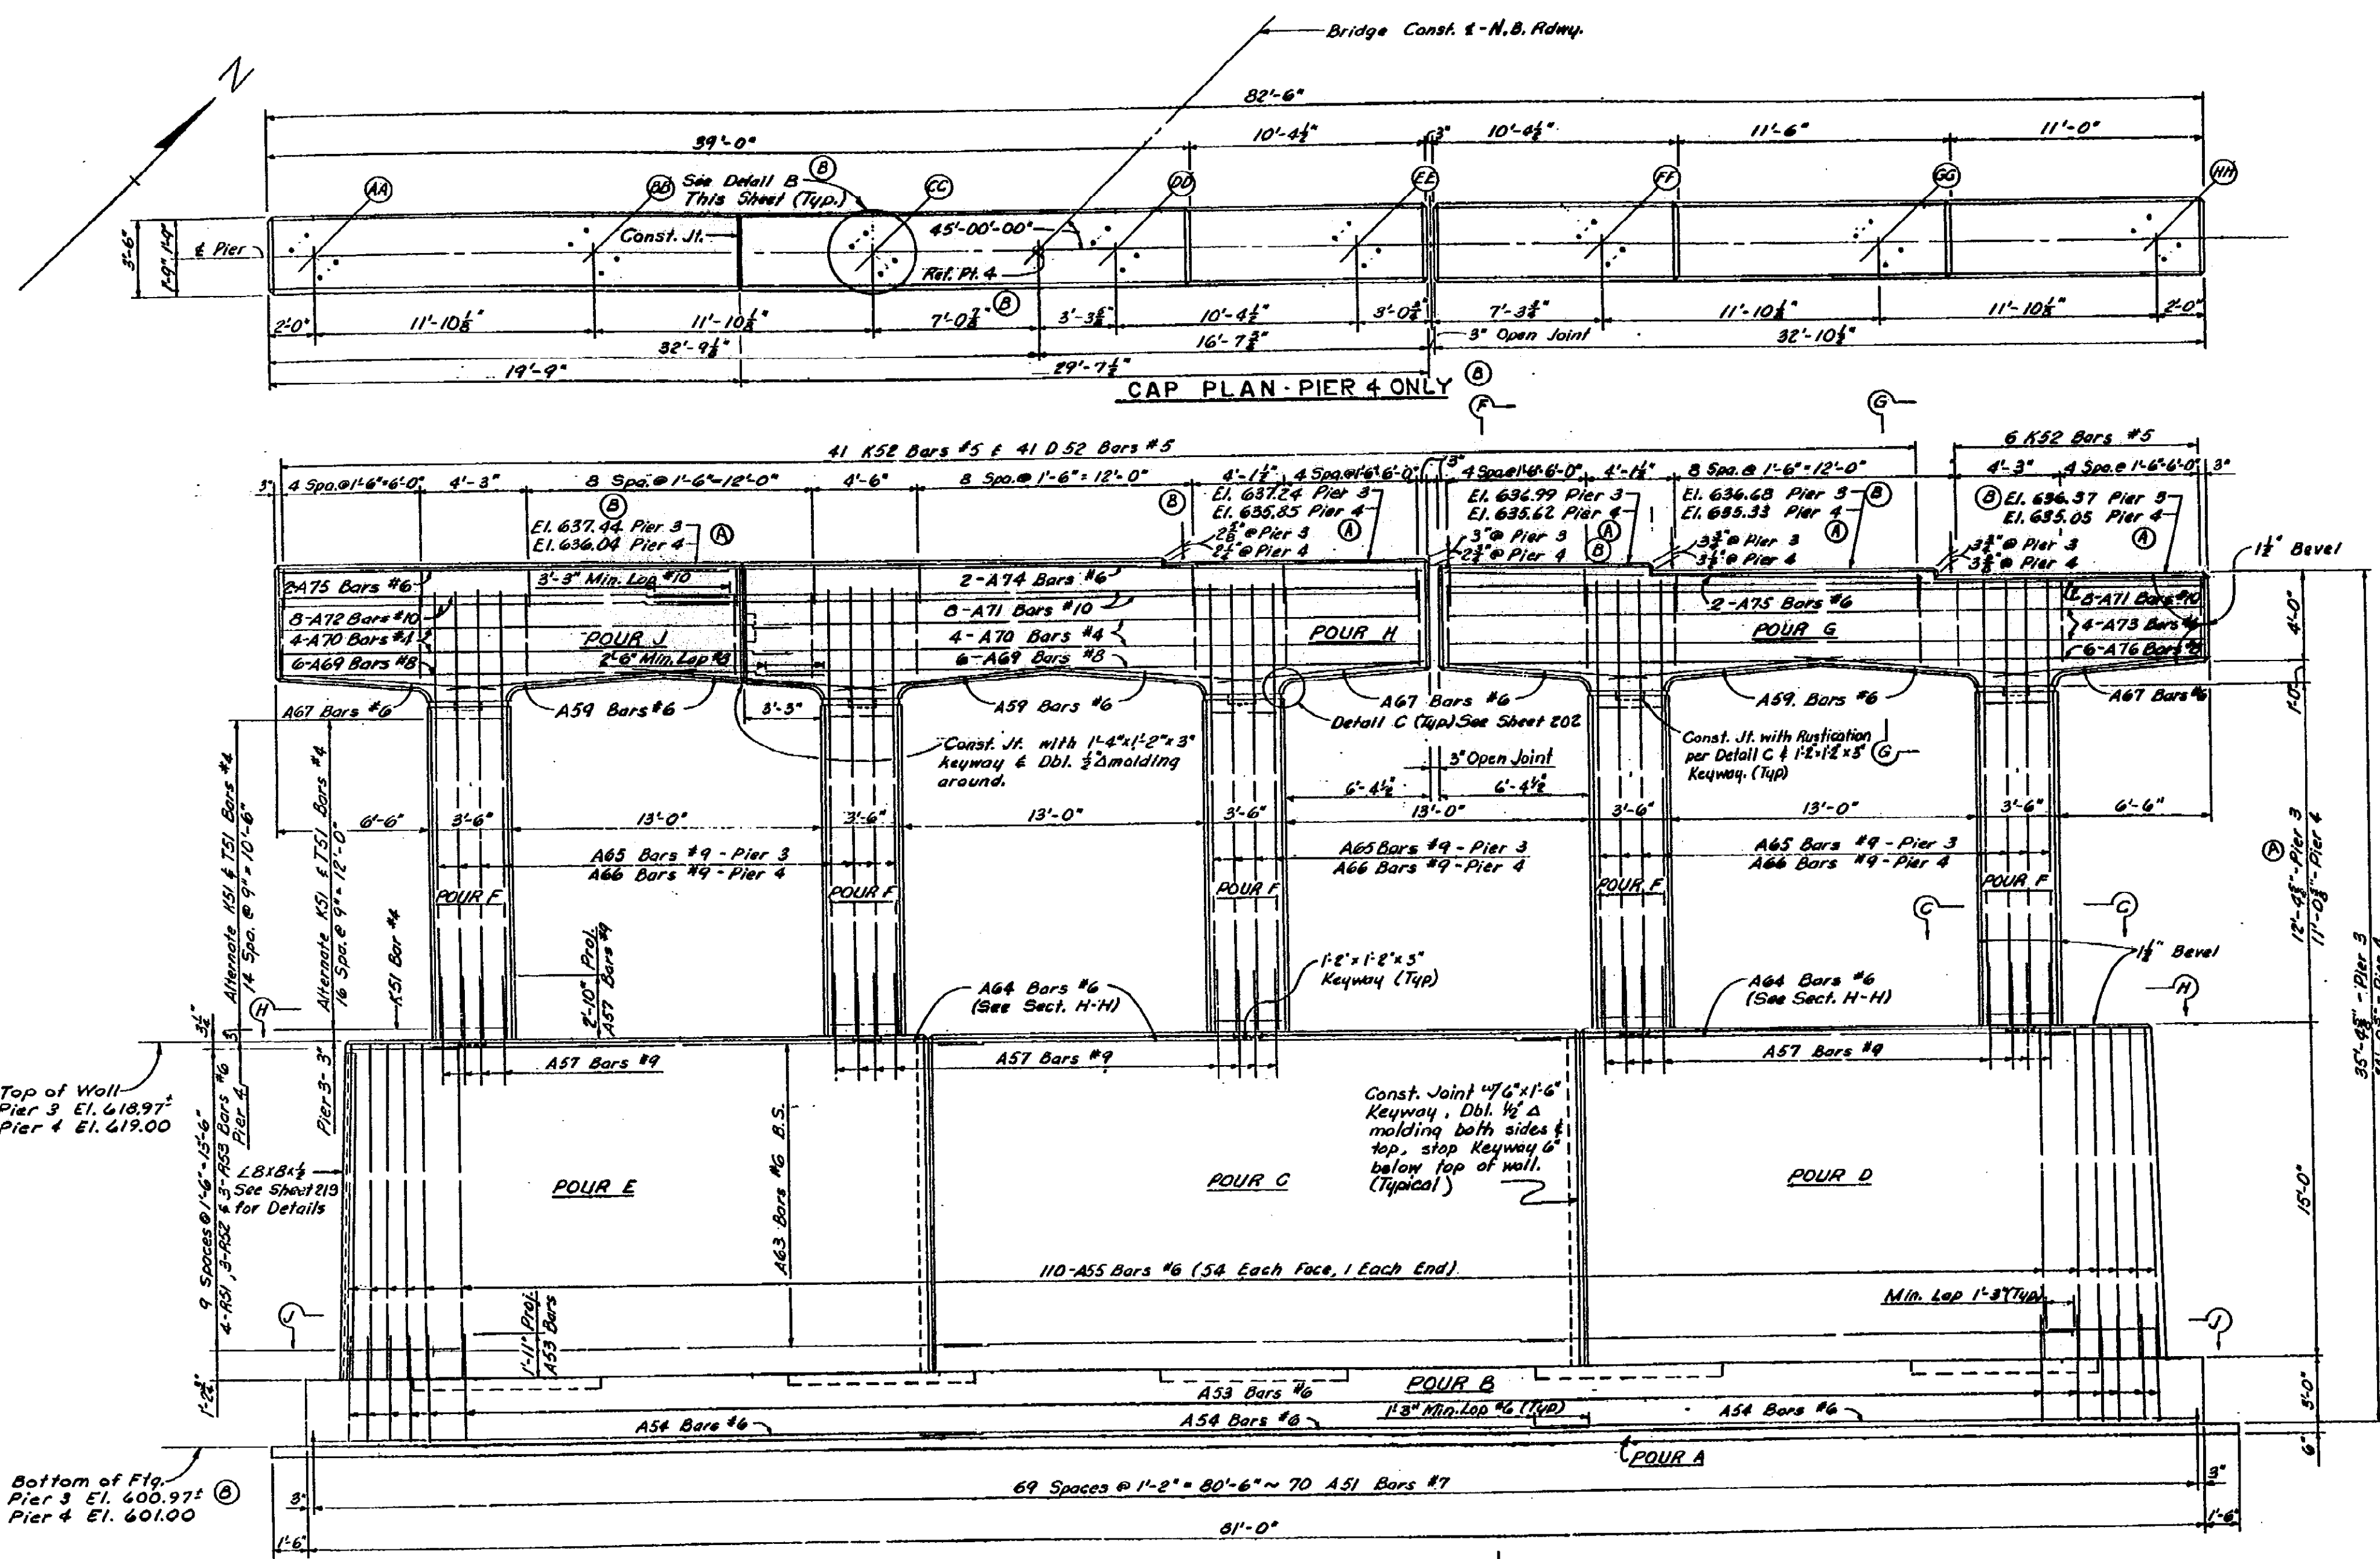

ELEVATION

MICHIGAN STATE HIGHWAY DEPARTMENT
PIER DETAILS
PIER NO. 3 & 4

TECON ENGINEERS, INC.

DATE	CON. SEC.	JOB NO.	DESIGN UNIT	SHEET
02-14-00	B02 OF 63174	49595A	MAHDAVI	1K OF








NOTE:
DO NOT WORK FROM THIS SHEET. THE INFORMATION SHOWN HERE IS FOR REFERENCE ONLY. NO PAY ITEMS ARE SHOWN.



DATE	CON. SEC.	JOB NO.	DESIGN UNIT	SHEET
02-14-00	B02 OF 63174	49595A	MAHDAVI	1K OF

DRAWN BY: INDER DATE: 02-11-00 CHECKED BY: INDER DATE: 02-11-00 CORRECTED BY: INDER DATE: 02-11-00

1 2 3 4 5 6 7 8 9 10 11 12 13 14 15 16 17 18 19 20 21 22 23 24 25 26 27 28 29 30 31 32 33 34 35 36 37 38 39 40 41 42 43 44 45 46 47 48 49 50 51 52 53 54 55 56 57 58 59 60 61 62 63

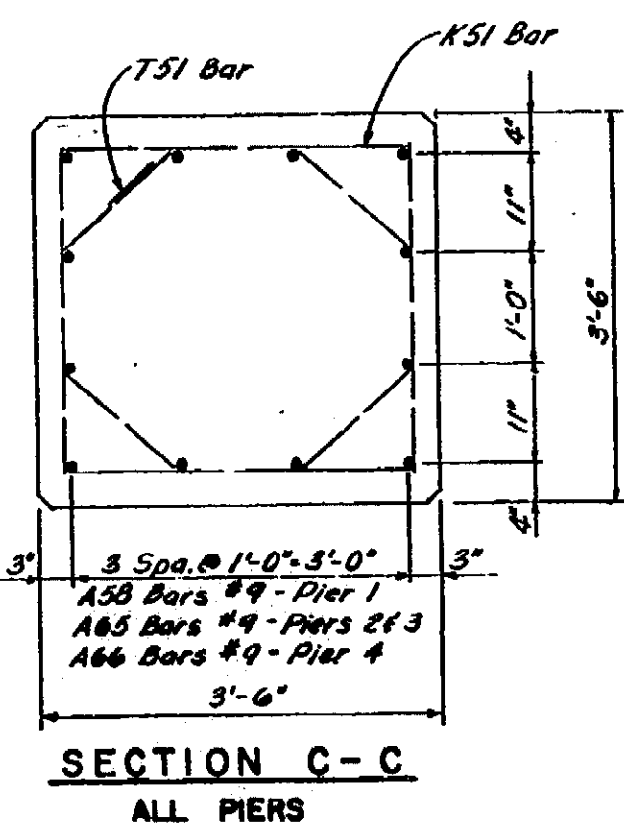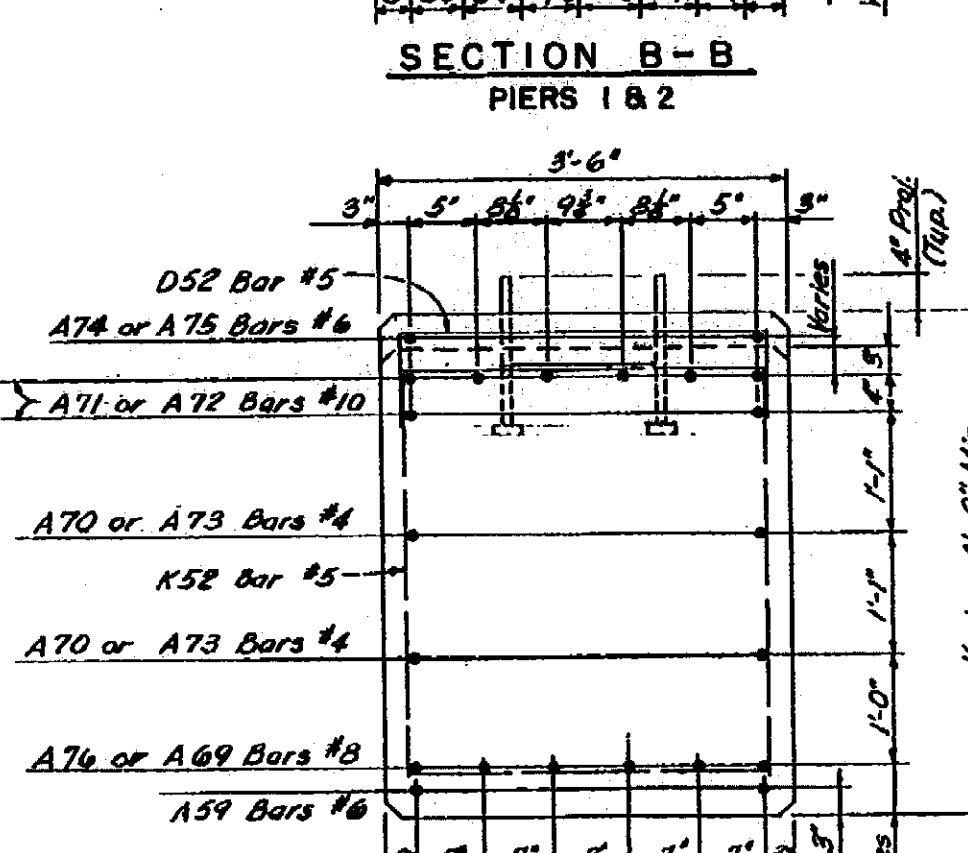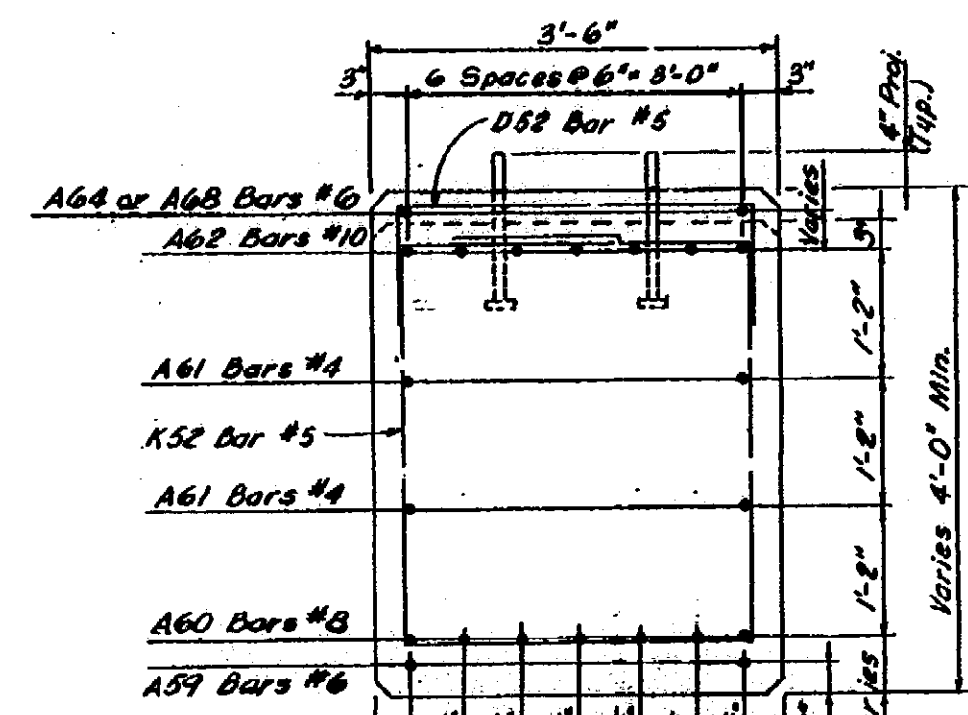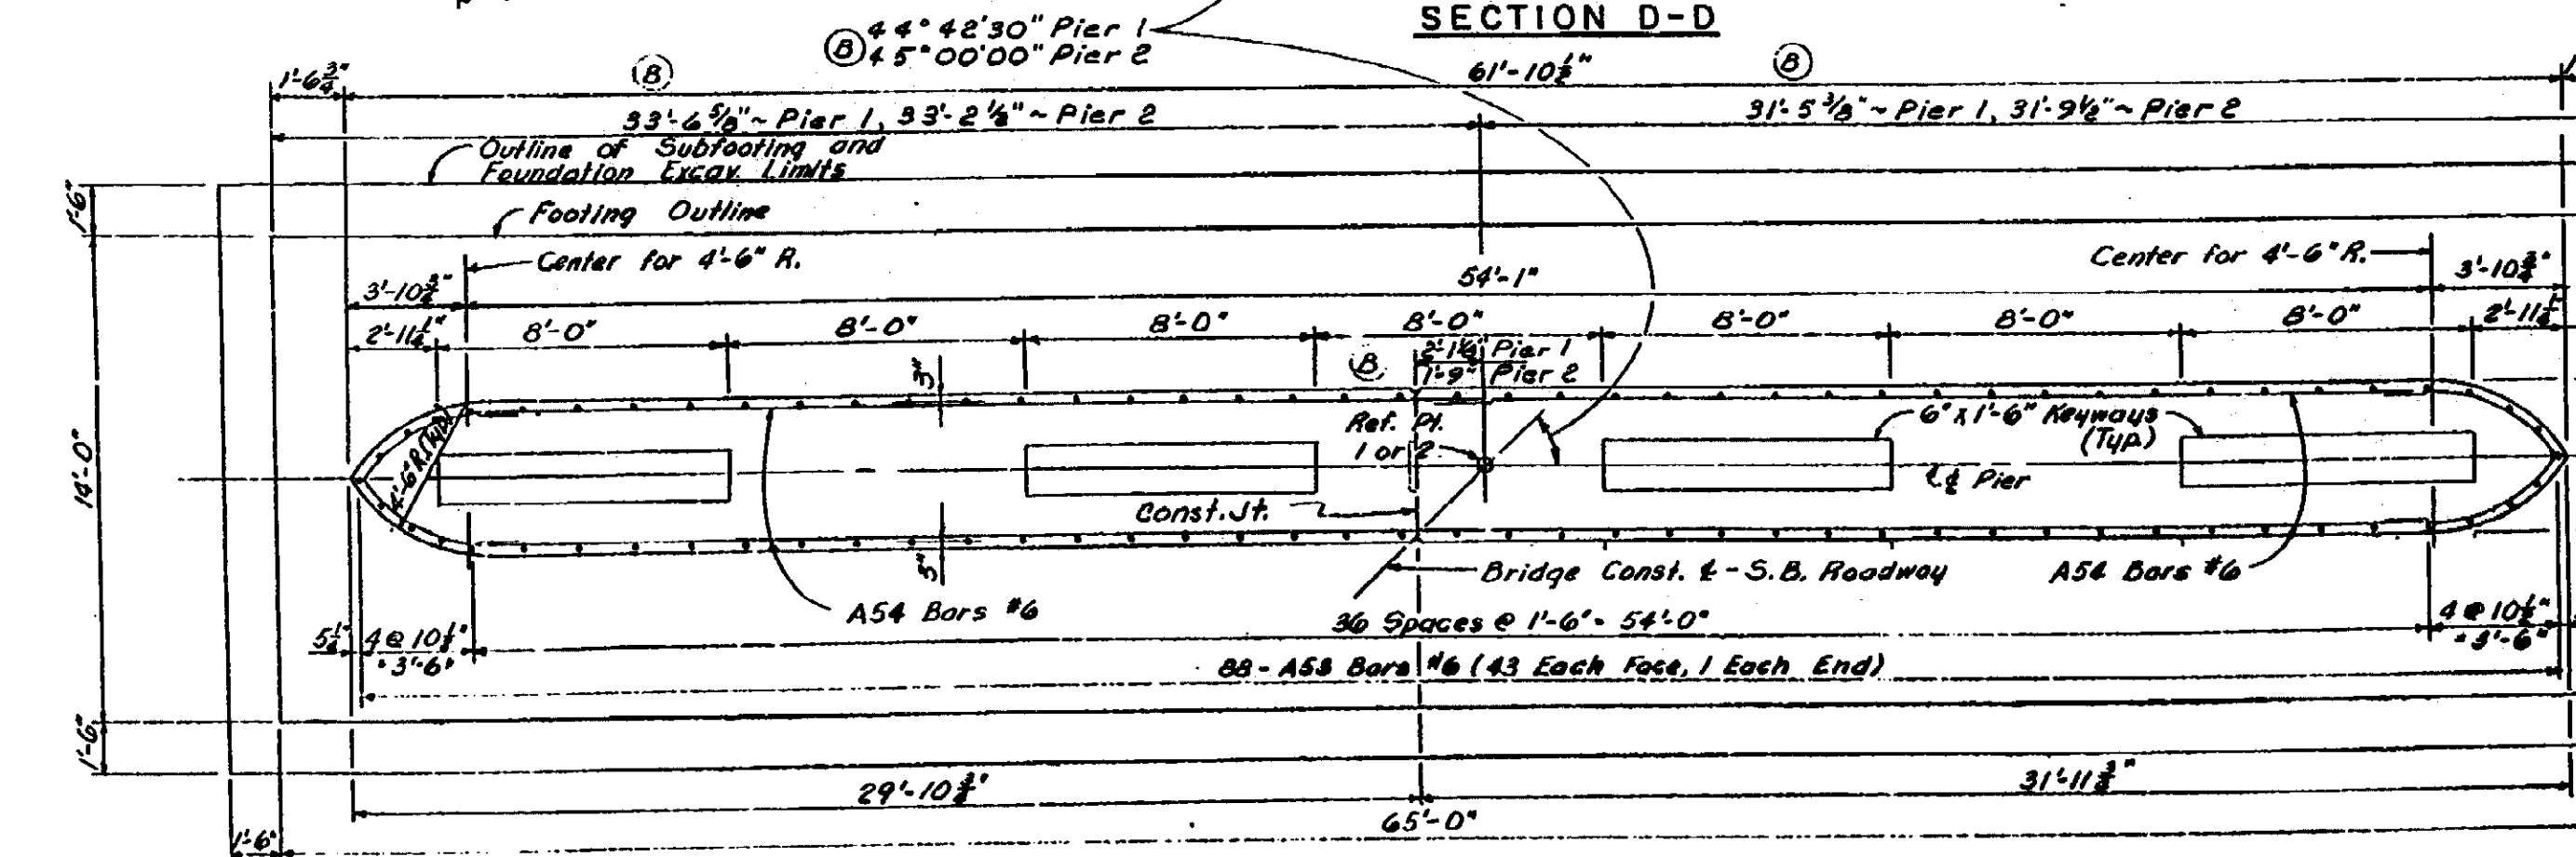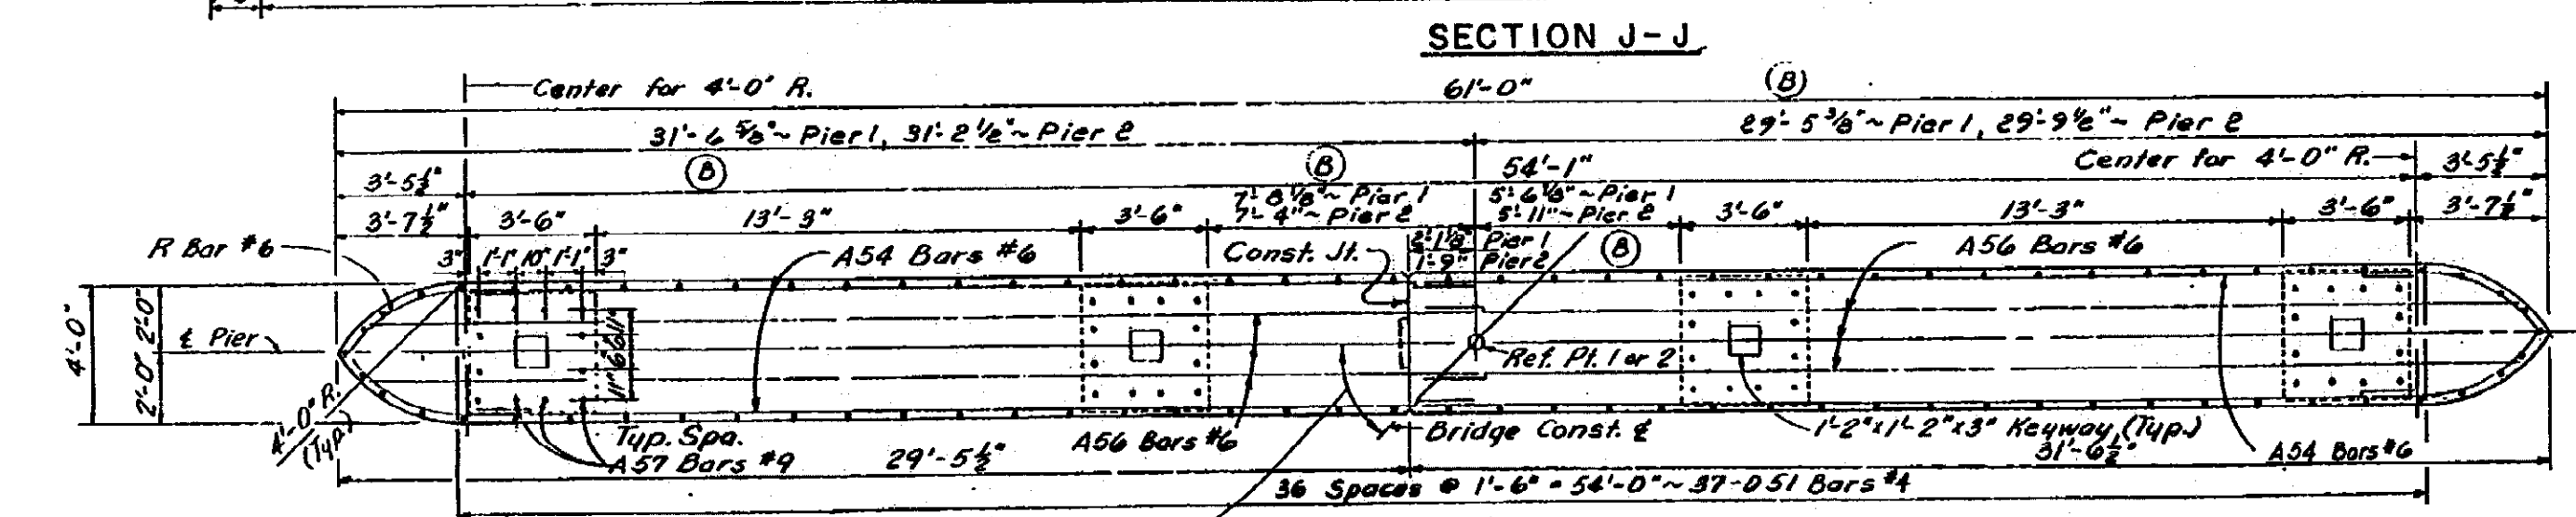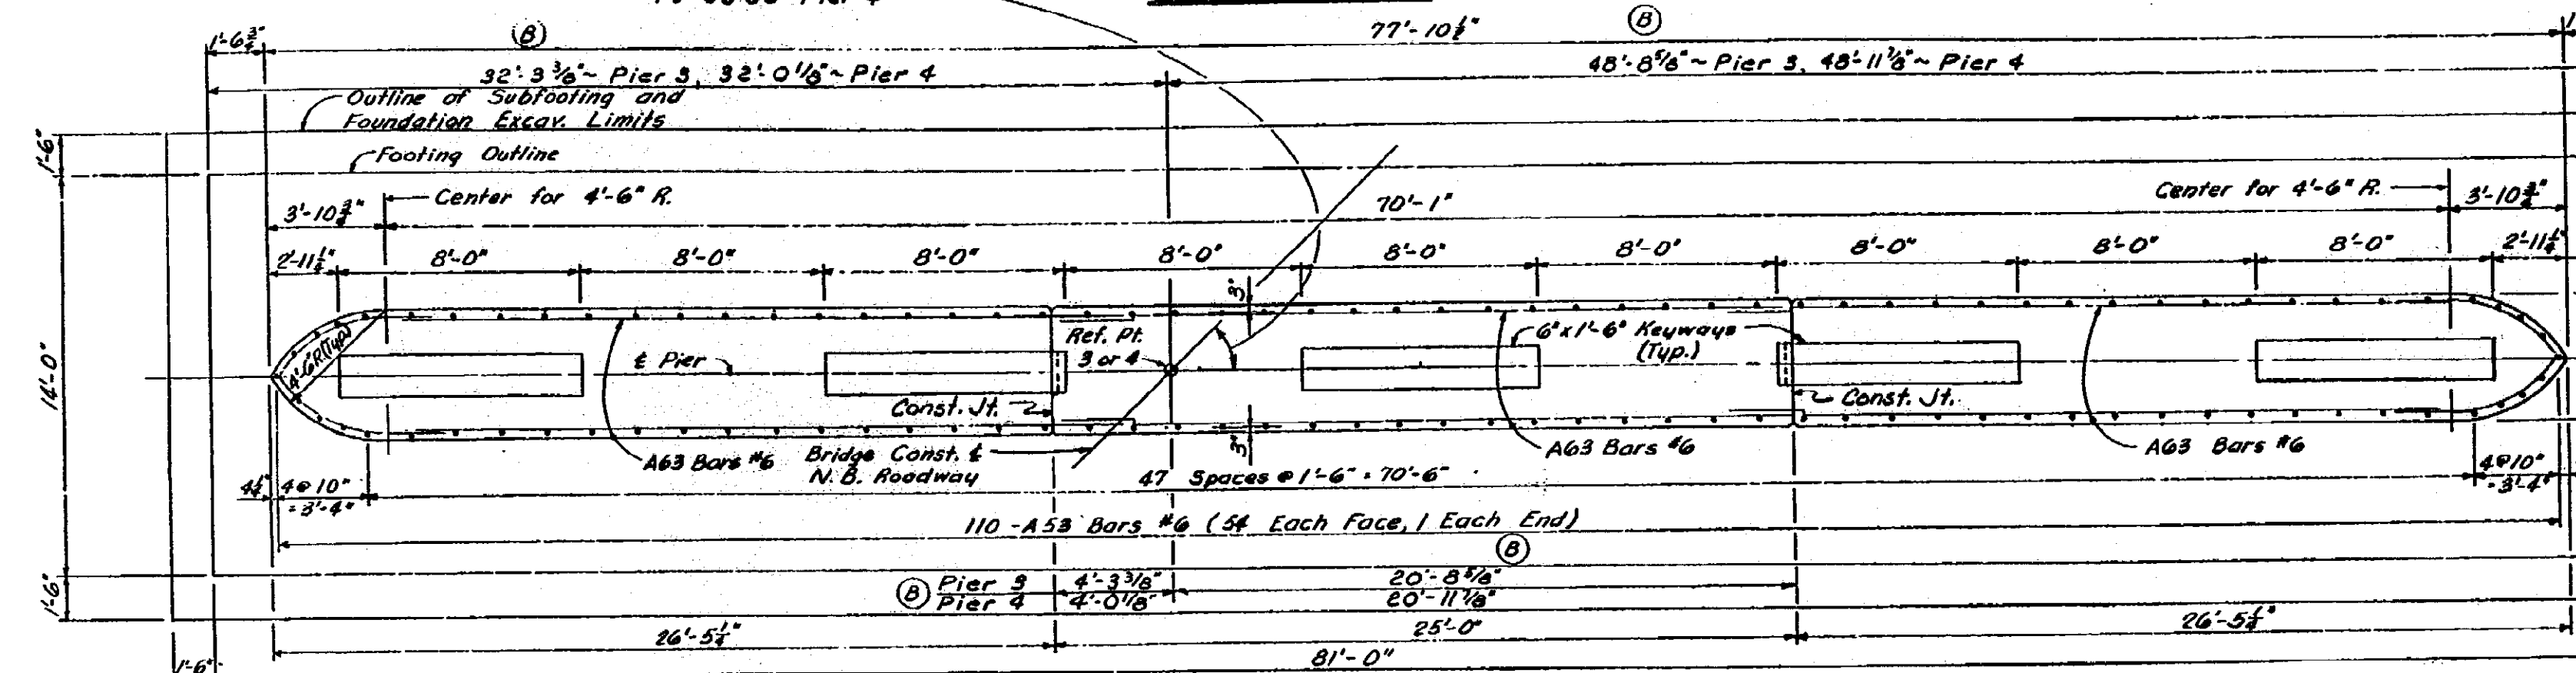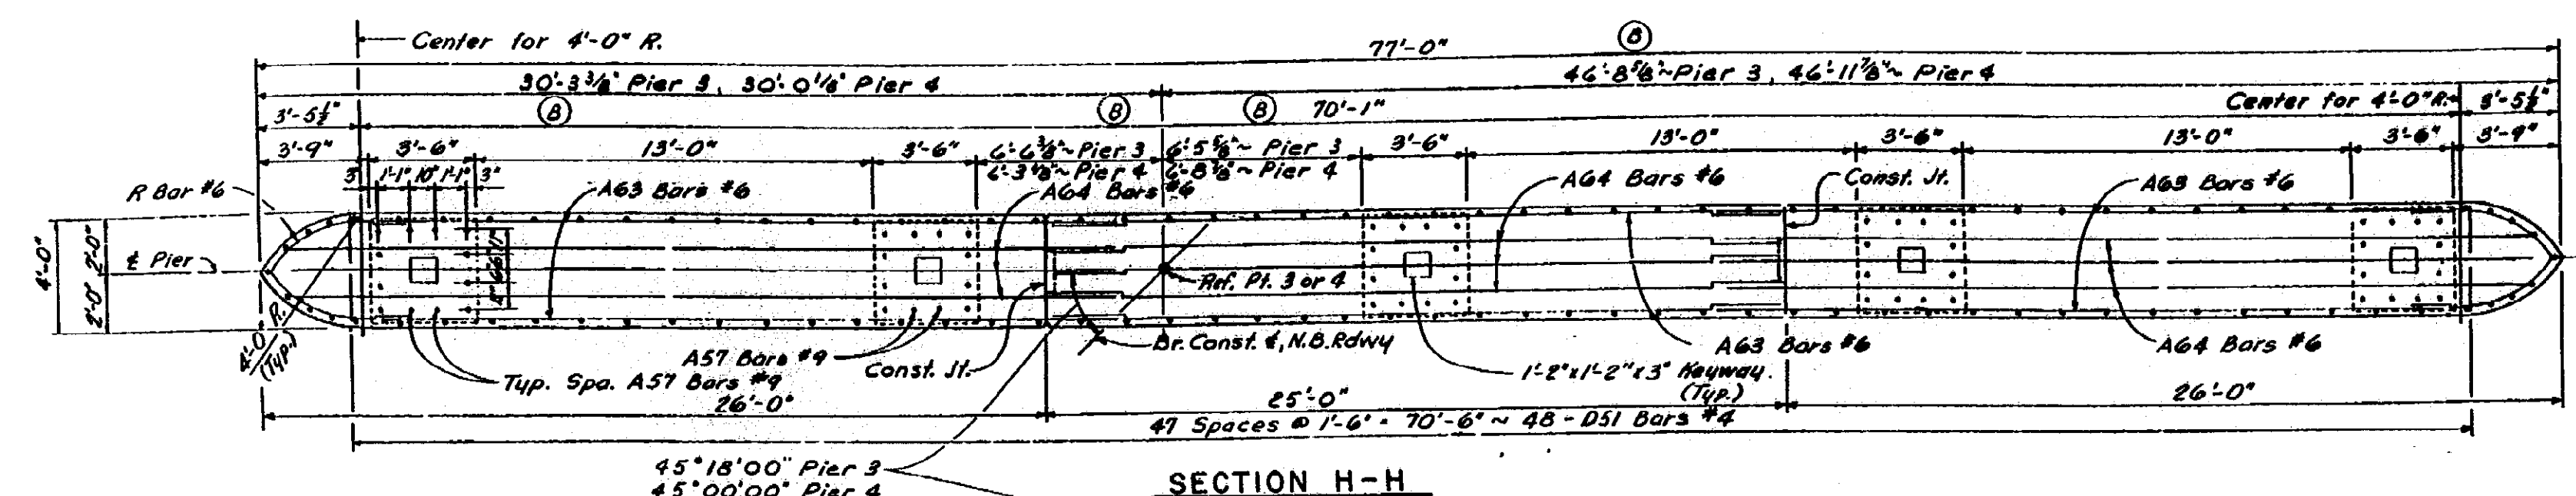

POUR	GRADE A(6A)				GRADE A(6AA)			
	A	B	C	D	E	F	G	H
Pier 1	21.4	101.2	67.6	72.5	26.2	17.4	18.6	11.7
Pier 2	21.4	101.2	67.6	72.5	28.3	17.5	18.4	11.7
Pier 3	26.4	126.1	59.0	59.4	24.2	20.0	20.9	14.0
Pier 4	26.4	126.1	59.0	59.4	25.2	20.0	20.5	13.8
Totals	115.6	454.6	253.2	276.8	100.1	74.9	78.4	41.2

ITEM	MISCELLANEOUS QUANTITIES				TOTAL	
	UNITS	PIER 1	PIER 2	PIER 3		PIER 4
Unclassified Excavation	Cu.Yds.	410	410	500	500	1820
Cofferdams	Lump Sum					

NOTES:
 For Bevel and Molding Details, see Standard Sheet P11. Anchor Bolts shall be set accurately to a template. The Project Engineer shall adjust the spacing of the reinforcing steel as required to permit placing of Anchor Bolts. The top of pier shall be finished to a true plane at the elevation shown and shall not vary more than 3" under a ten foot straight edge nor more than 1/4" under any bearing. This design is based on a maximum foundation pressure of 3250 #/ft.² at Piers 1 & 2, 3100 #/ft.² at Piers 3 & 4, and a maximum average foundation pressure of 3000 #/ft.² at Piers 1 & 2 & 3000 #/ft.² at Piers 3 & 4.
 For details of struts at Piers, see sheet 191.
 Work this Sheet with Sheets 202, 203 & 220

MICHIGAN STATE HIGHWAY DEPARTMENT

TECON ENGINEERS, INC.

PIER DETAILS
ALL PIERS

REVISIONS

NO.	DESCRIPTION	DATE	BY

B020F631741


NOTE:
DO NOT WORK FROM THIS SHEET. THE INFORMATION SHOWN HERE IS FOR REFERENCE ONLY. NO PAY ITEMS ARE SHOWN.

FOR INFORMATION ONLY

DATE	CONT. SEC.	JOB NO.	DESIGN UNIT	SHEET
02-14-00	B02 OF 63174	49595A	MAHDAVI	11 OF

DATE: _____ CHECKED BY: _____ CORRECTED BY: INDER _____ DRAWN BY: INDER _____ FILE NAME: B02031745n

REVISIONS			
NO.	DESCRIPTION	DATE	BY

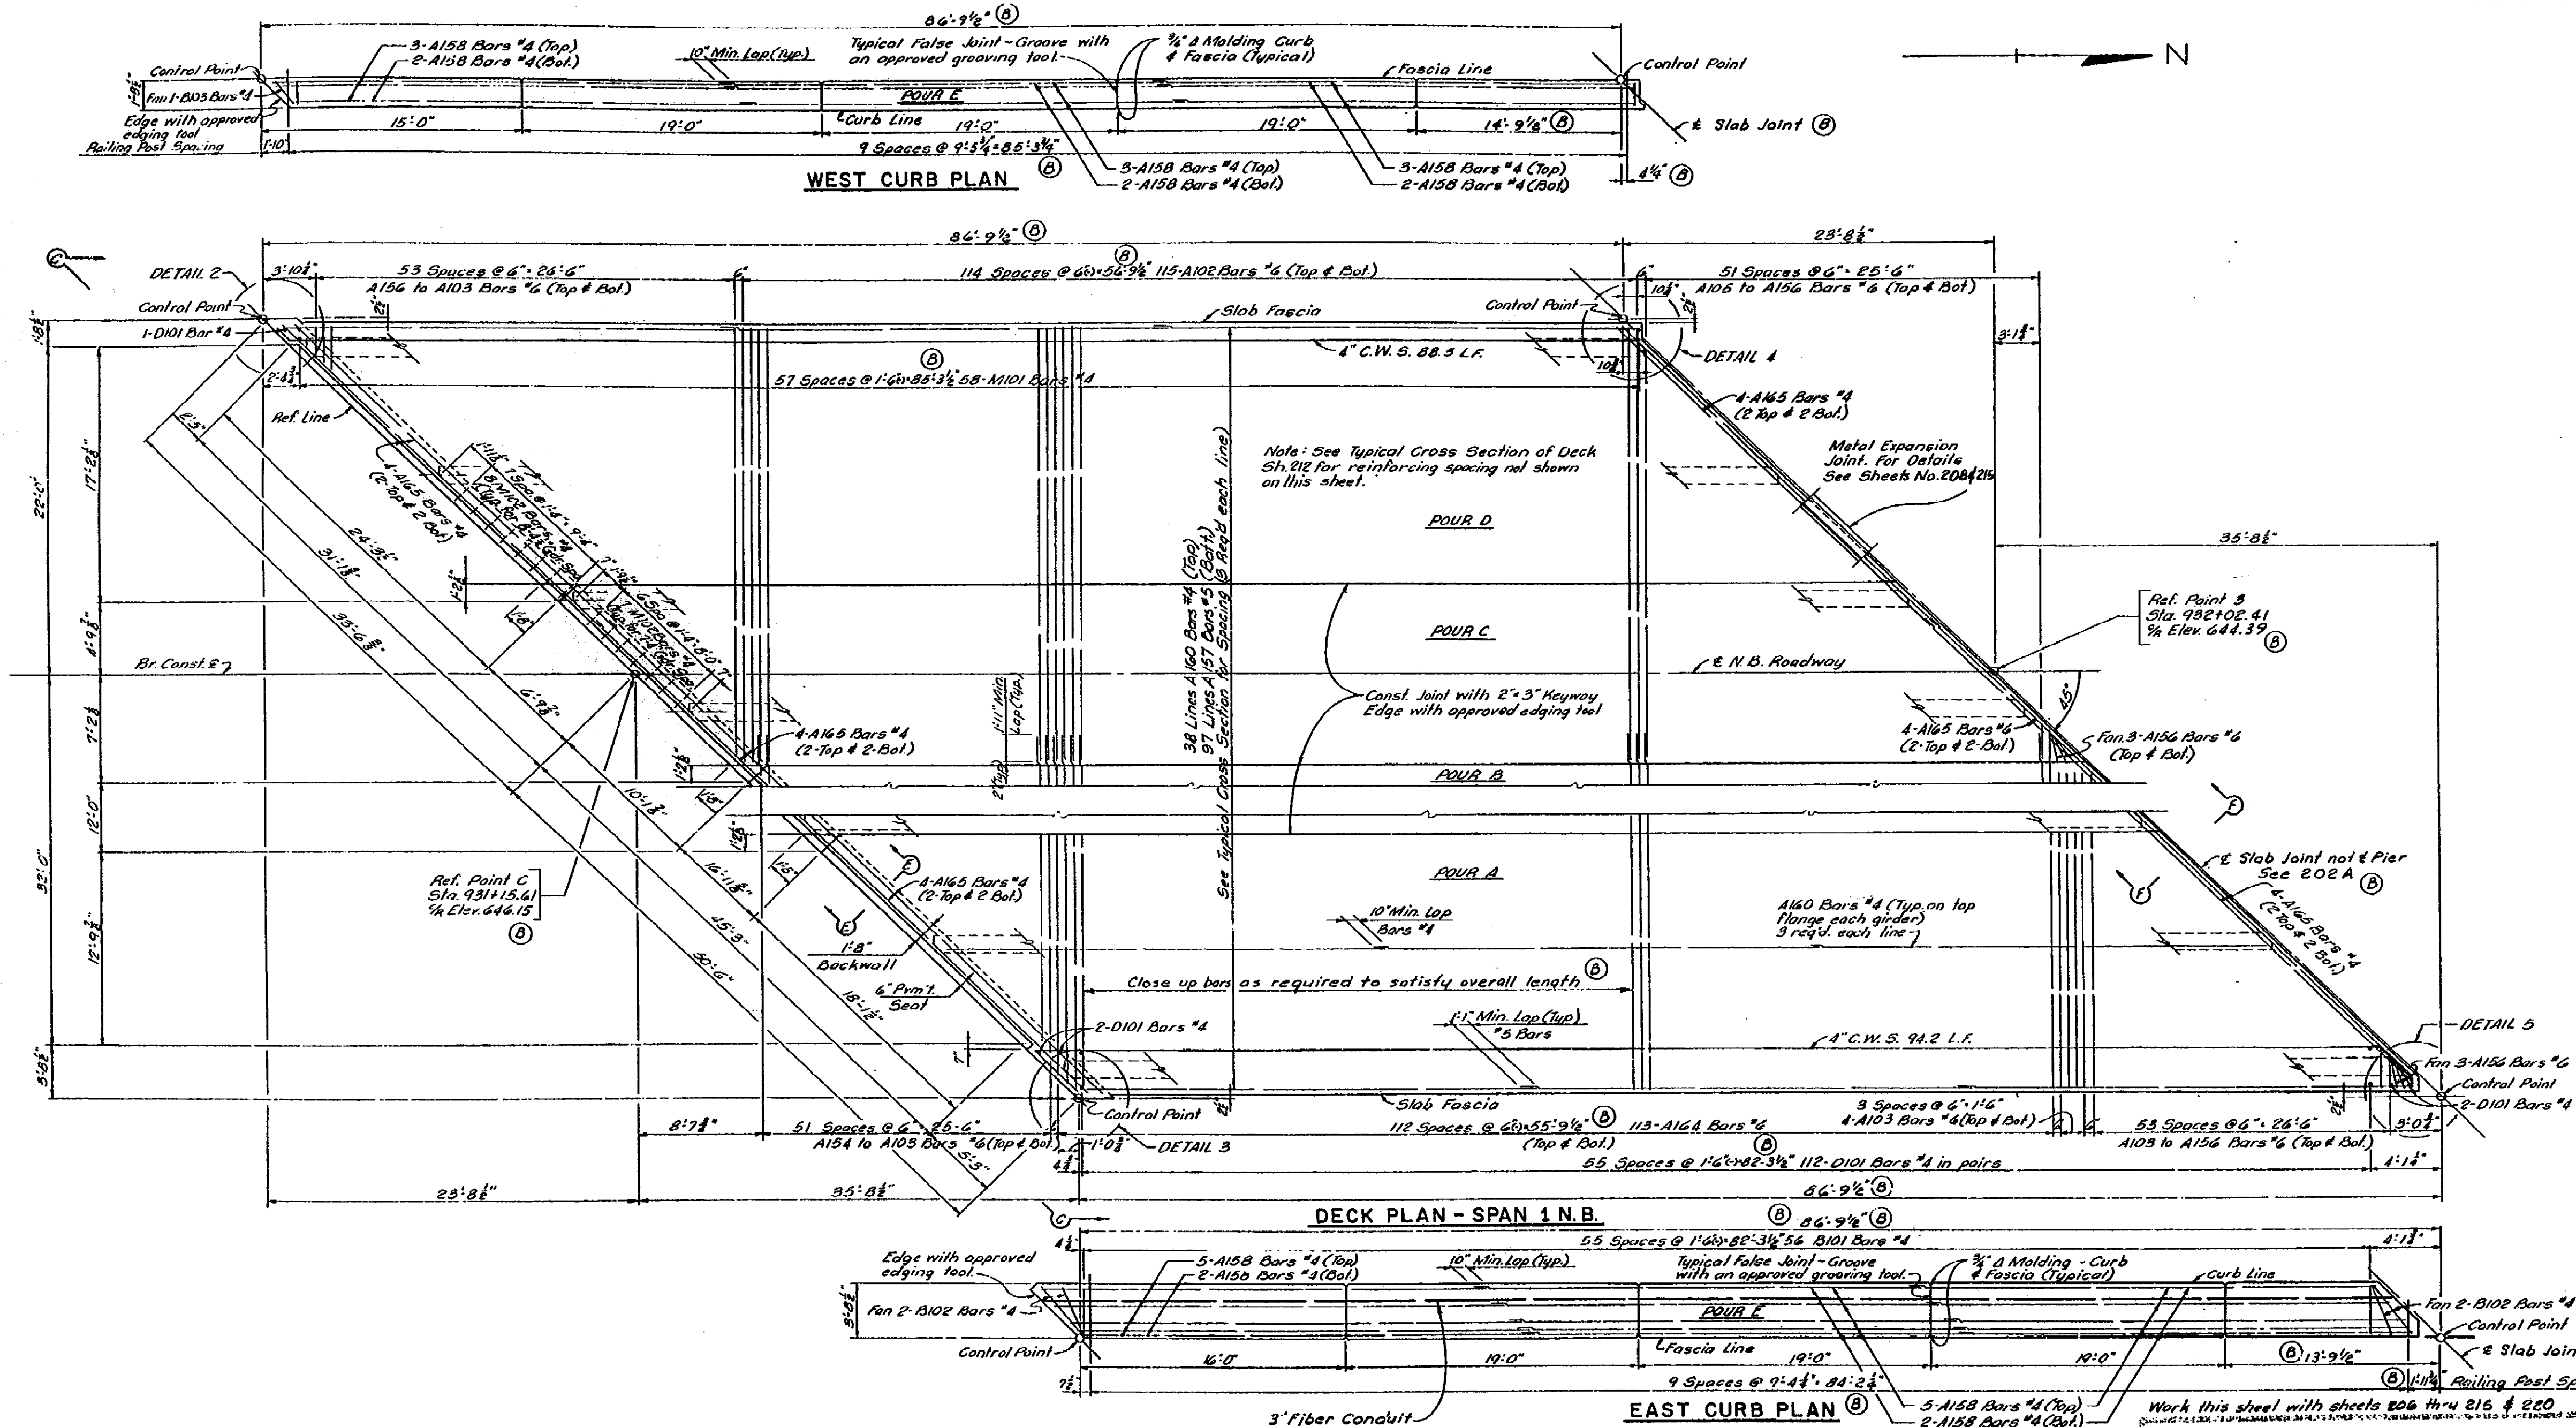

Work this sheet with sheets 606 thru 616 & 620

MICHIGAN STATE HIGHWAY DEPARTMENT

SUPERSTRUCTURE DETAILS

NORTHBOUND ROADWAY - SPAN 1

TECON ENGINEERS, INC.

JDC 3-26-01
D.A.S. 3-15-02
FDN 3-23-02
ROS JIC

8 Reloc. ref. p. C13 and 1-1463 R.E. changed span lengths.

802 of 631741


NOTE:
DO NOT WORK FROM THIS SHEET. THE INFORMATION SHOWN
HERE IS FOR REFERENCE ONLY. NO PAY ITEMS ARE SHOWN.



FOR INFORMATION ONLY				
DATE	CONT. SEC.	JOB NO.	DESIGN UNIT	SHEET
02-14-00	B02 OF 63174	49595A	MAHDAVI	1M OF

DRAWN BY: INDER CHECKED BY: DATE: 02-11-00 CORRECTED BY: INDER DATE: FILE NAME: B02631745n

REVISIONS			
NO.	DESCRIPTION	DATE	BY

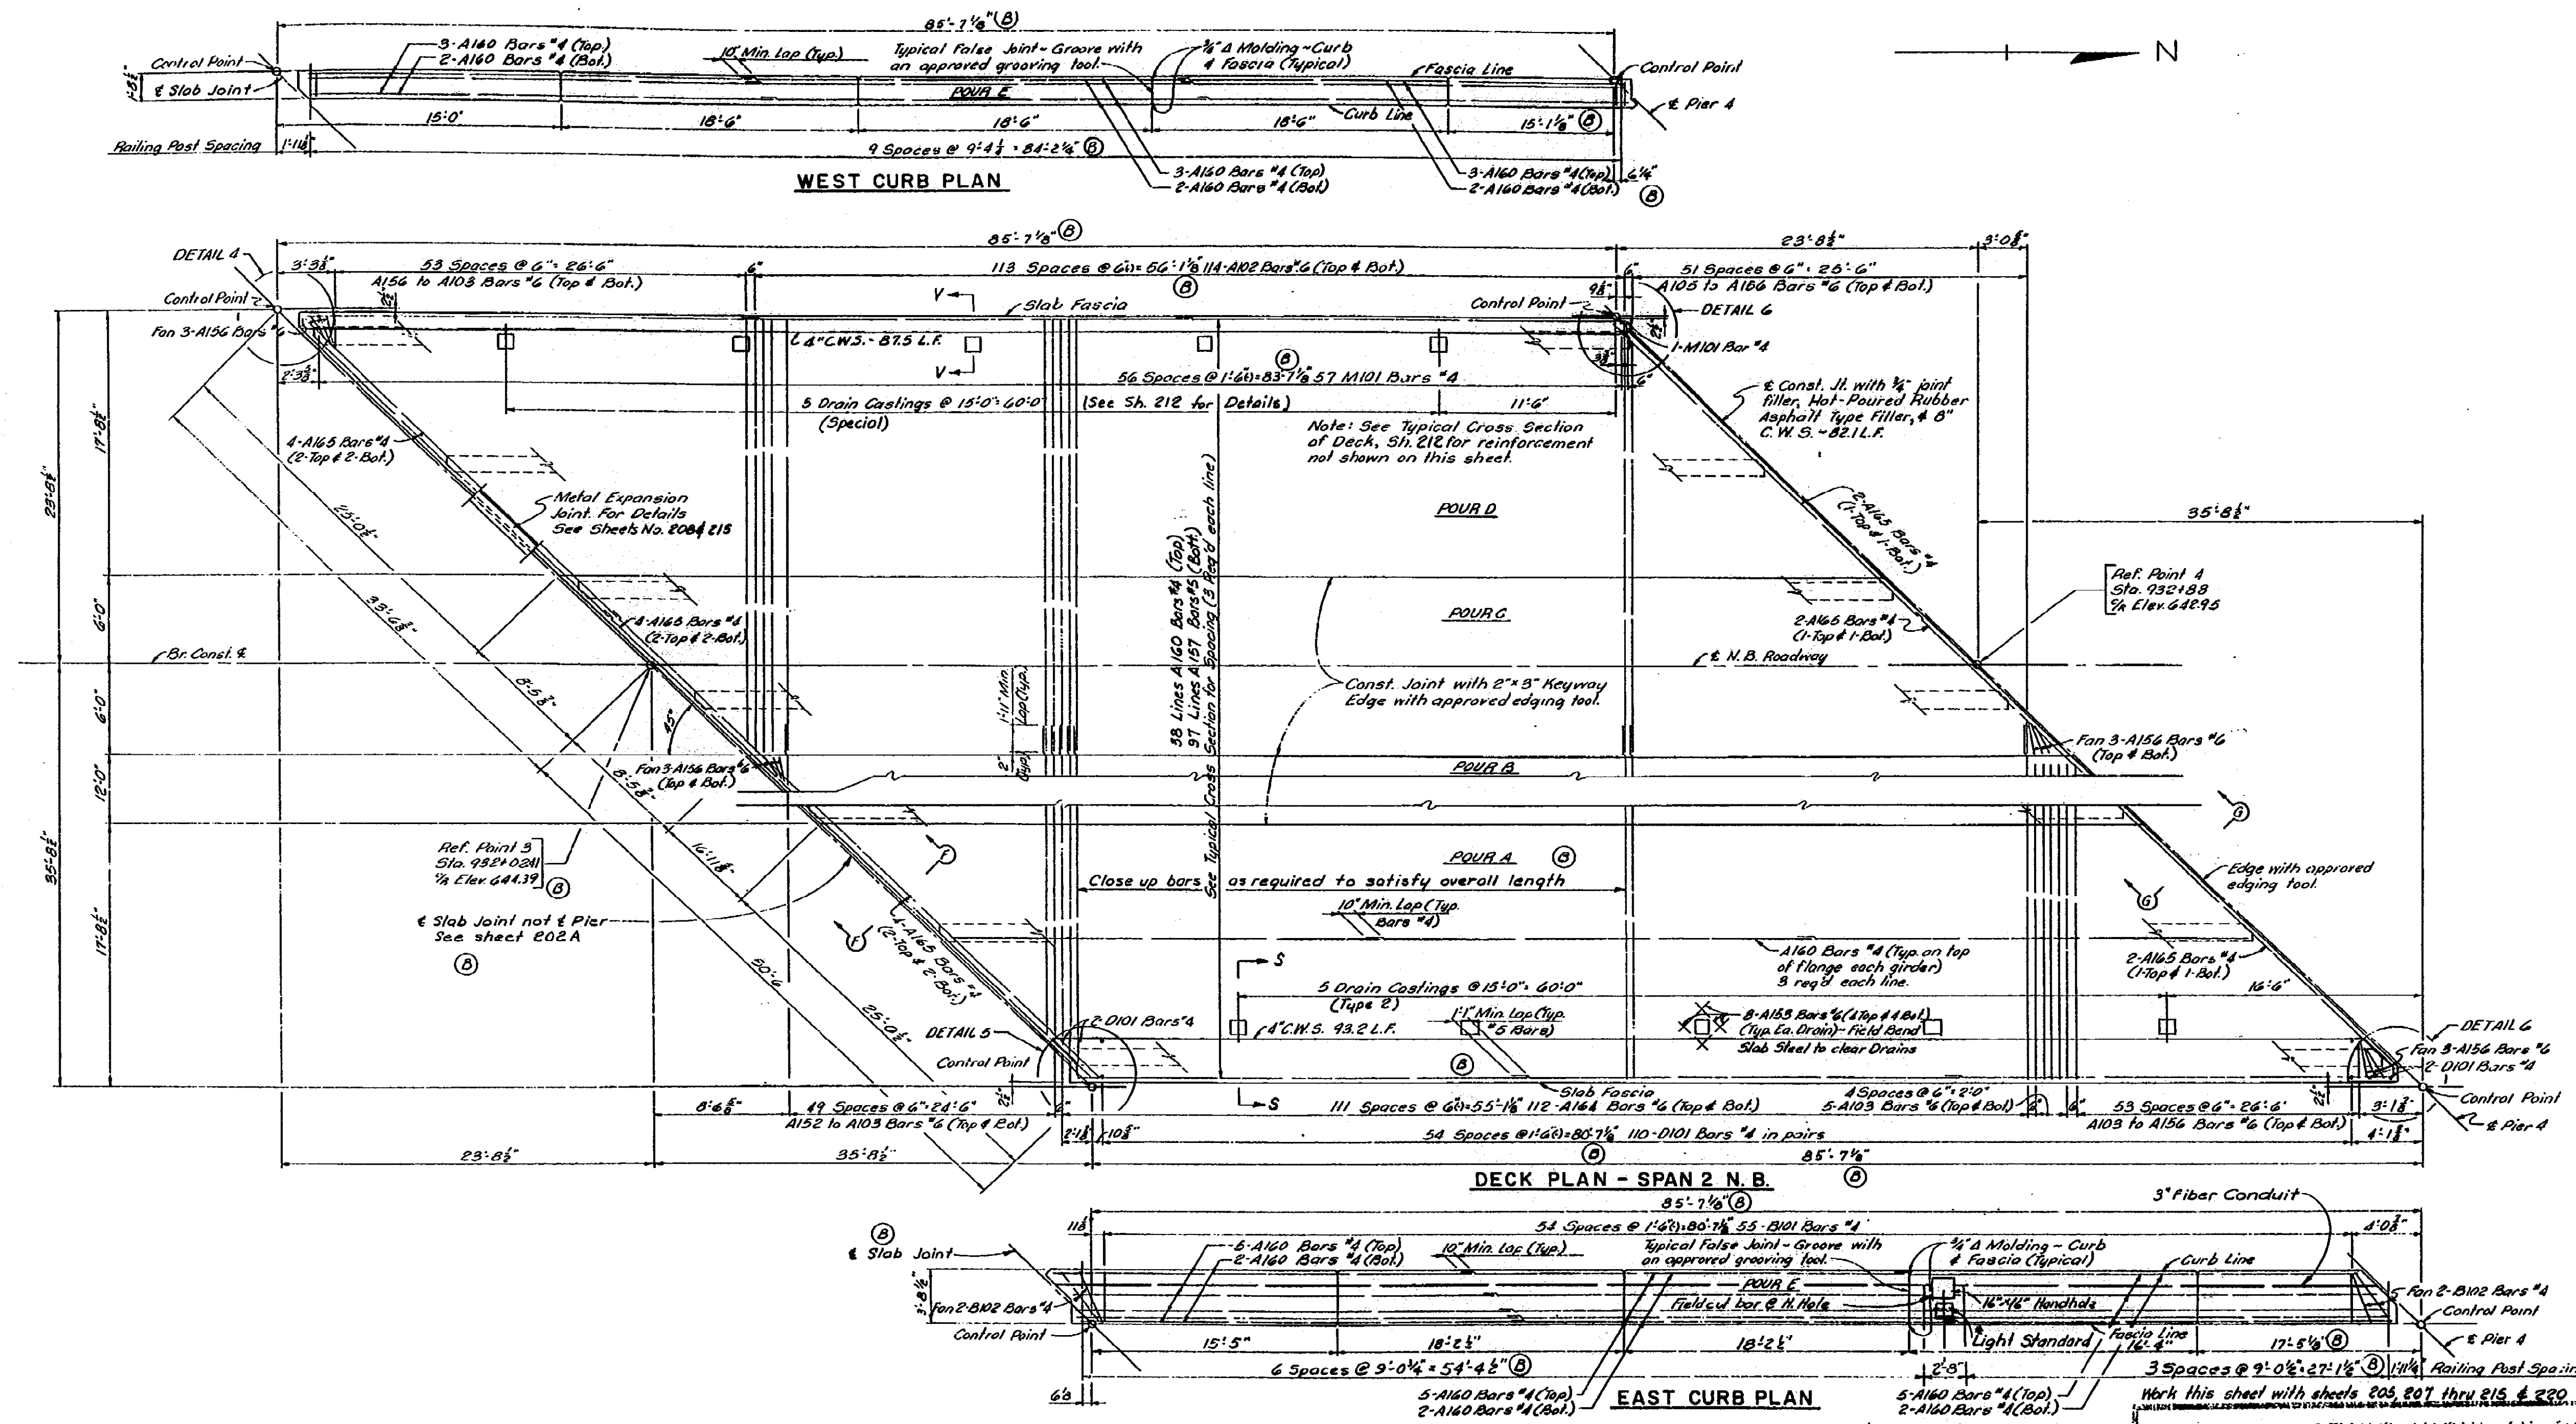

Work this sheet with sheets 205, 207, 210, 215 & 220

MICHIGAN STATE HIGHWAY DEPARTMENT
SUPERSTRUCTURE DETAILS
 NORTHBOUND ROADWAY - SPAN 2

TECON ENGINEERS, INC.
 JDL 3-26-64
 D.R.S. 3-16-62
 F.D.H. 3-23-62
 206 JLE

8 Relocated ref. pt. 5 and changed span length. 114-43 R.E. B02 OF 63174 I

NOTE:
 DO NOT WORK FROM THIS SHEET. THE INFORMATION SHOWN HERE IS FOR REFERENCE ONLY. NO PAY ITEMS ARE SHOWN.









FOR INFORMATION ONLY				
DATE	CONT. SEC.	JOB NO.	DESIGN UNIT	SHEET
02-14-00	B02 OF 63174	49595A	MAHDAVI	IN OF

DATE: 02-11-00 CHECKED BY: INDER
 DATE: 02-11-00 CHECKED BY: INDER
 DATE: 02-11-00 CHECKED BY: INDER
 FILE NAME: B0263174.dwg

1 2 3 4 5 6 7 8 9 10 11 12 13 14 15 16 17 18 19 20 21 22 23 24 25 26 27 28 29 30 31 32 33 34 35 36 37 38 39 40 41 42 43 44 45 46 47 48 49 50 51 52 53 54 55 56 57 58 59 60 61 62 63

REVISIONS			
NO.	DESCRIPTION	DATE	BY

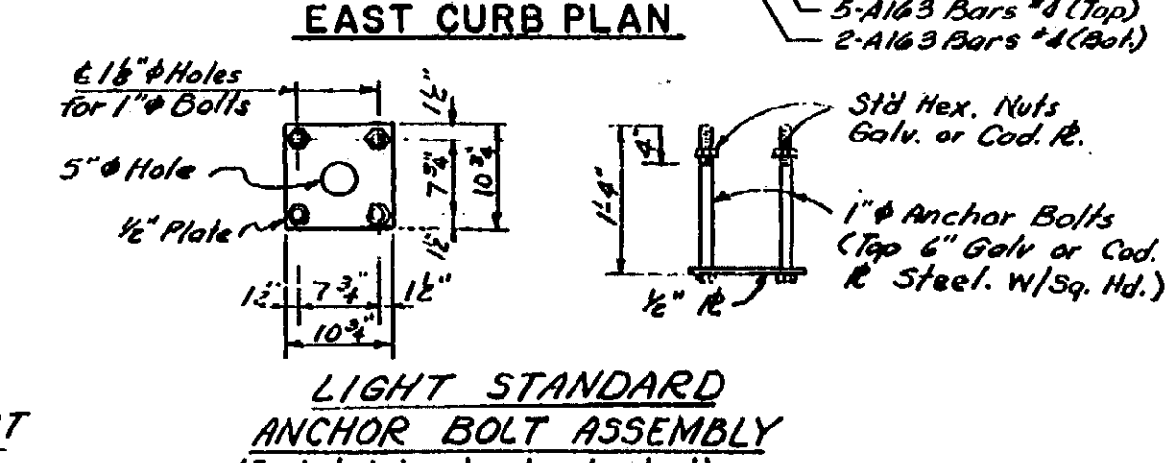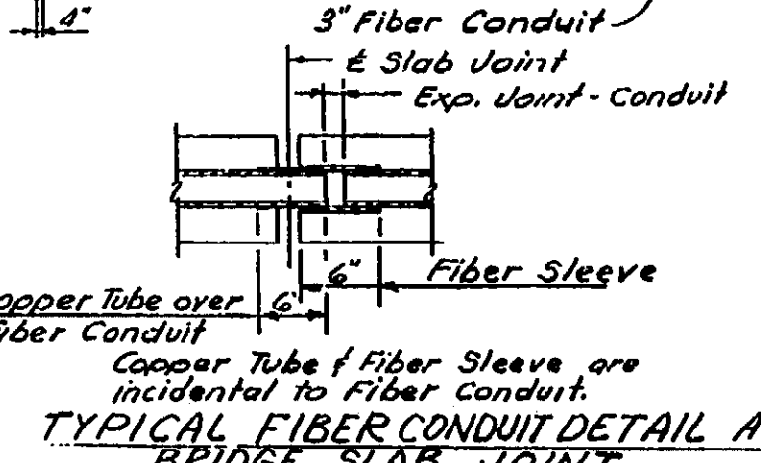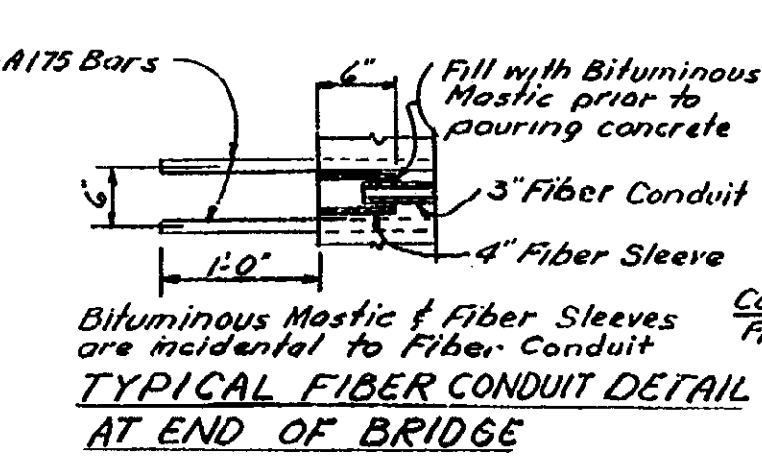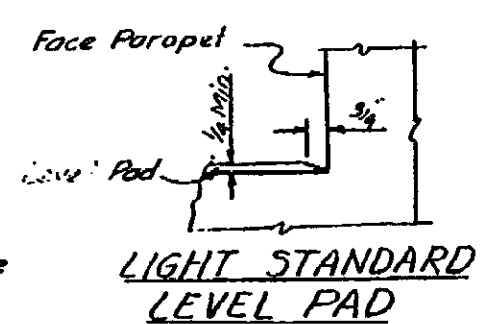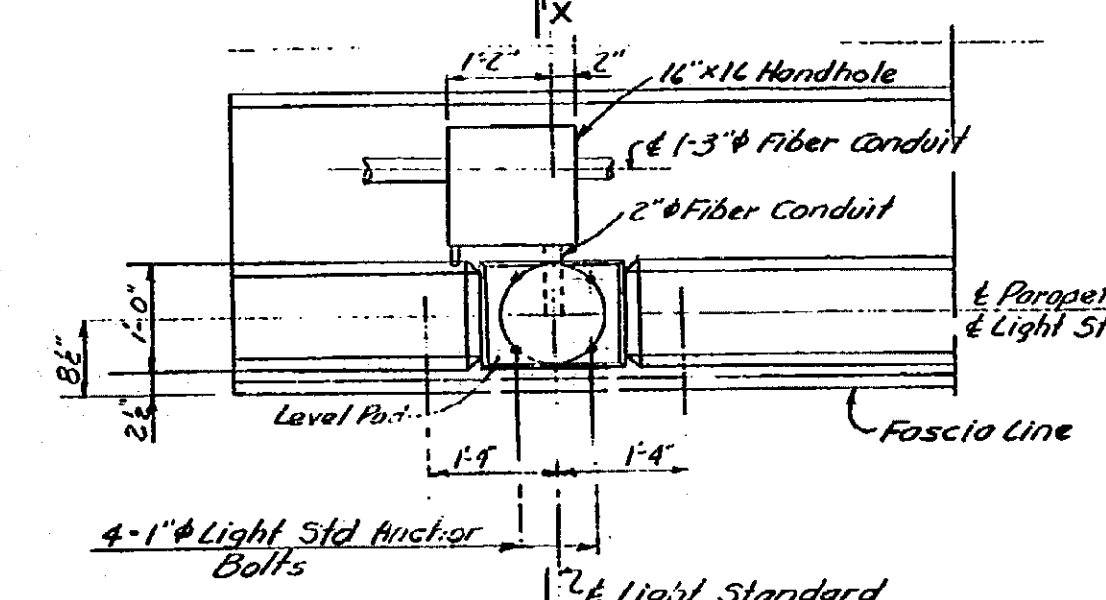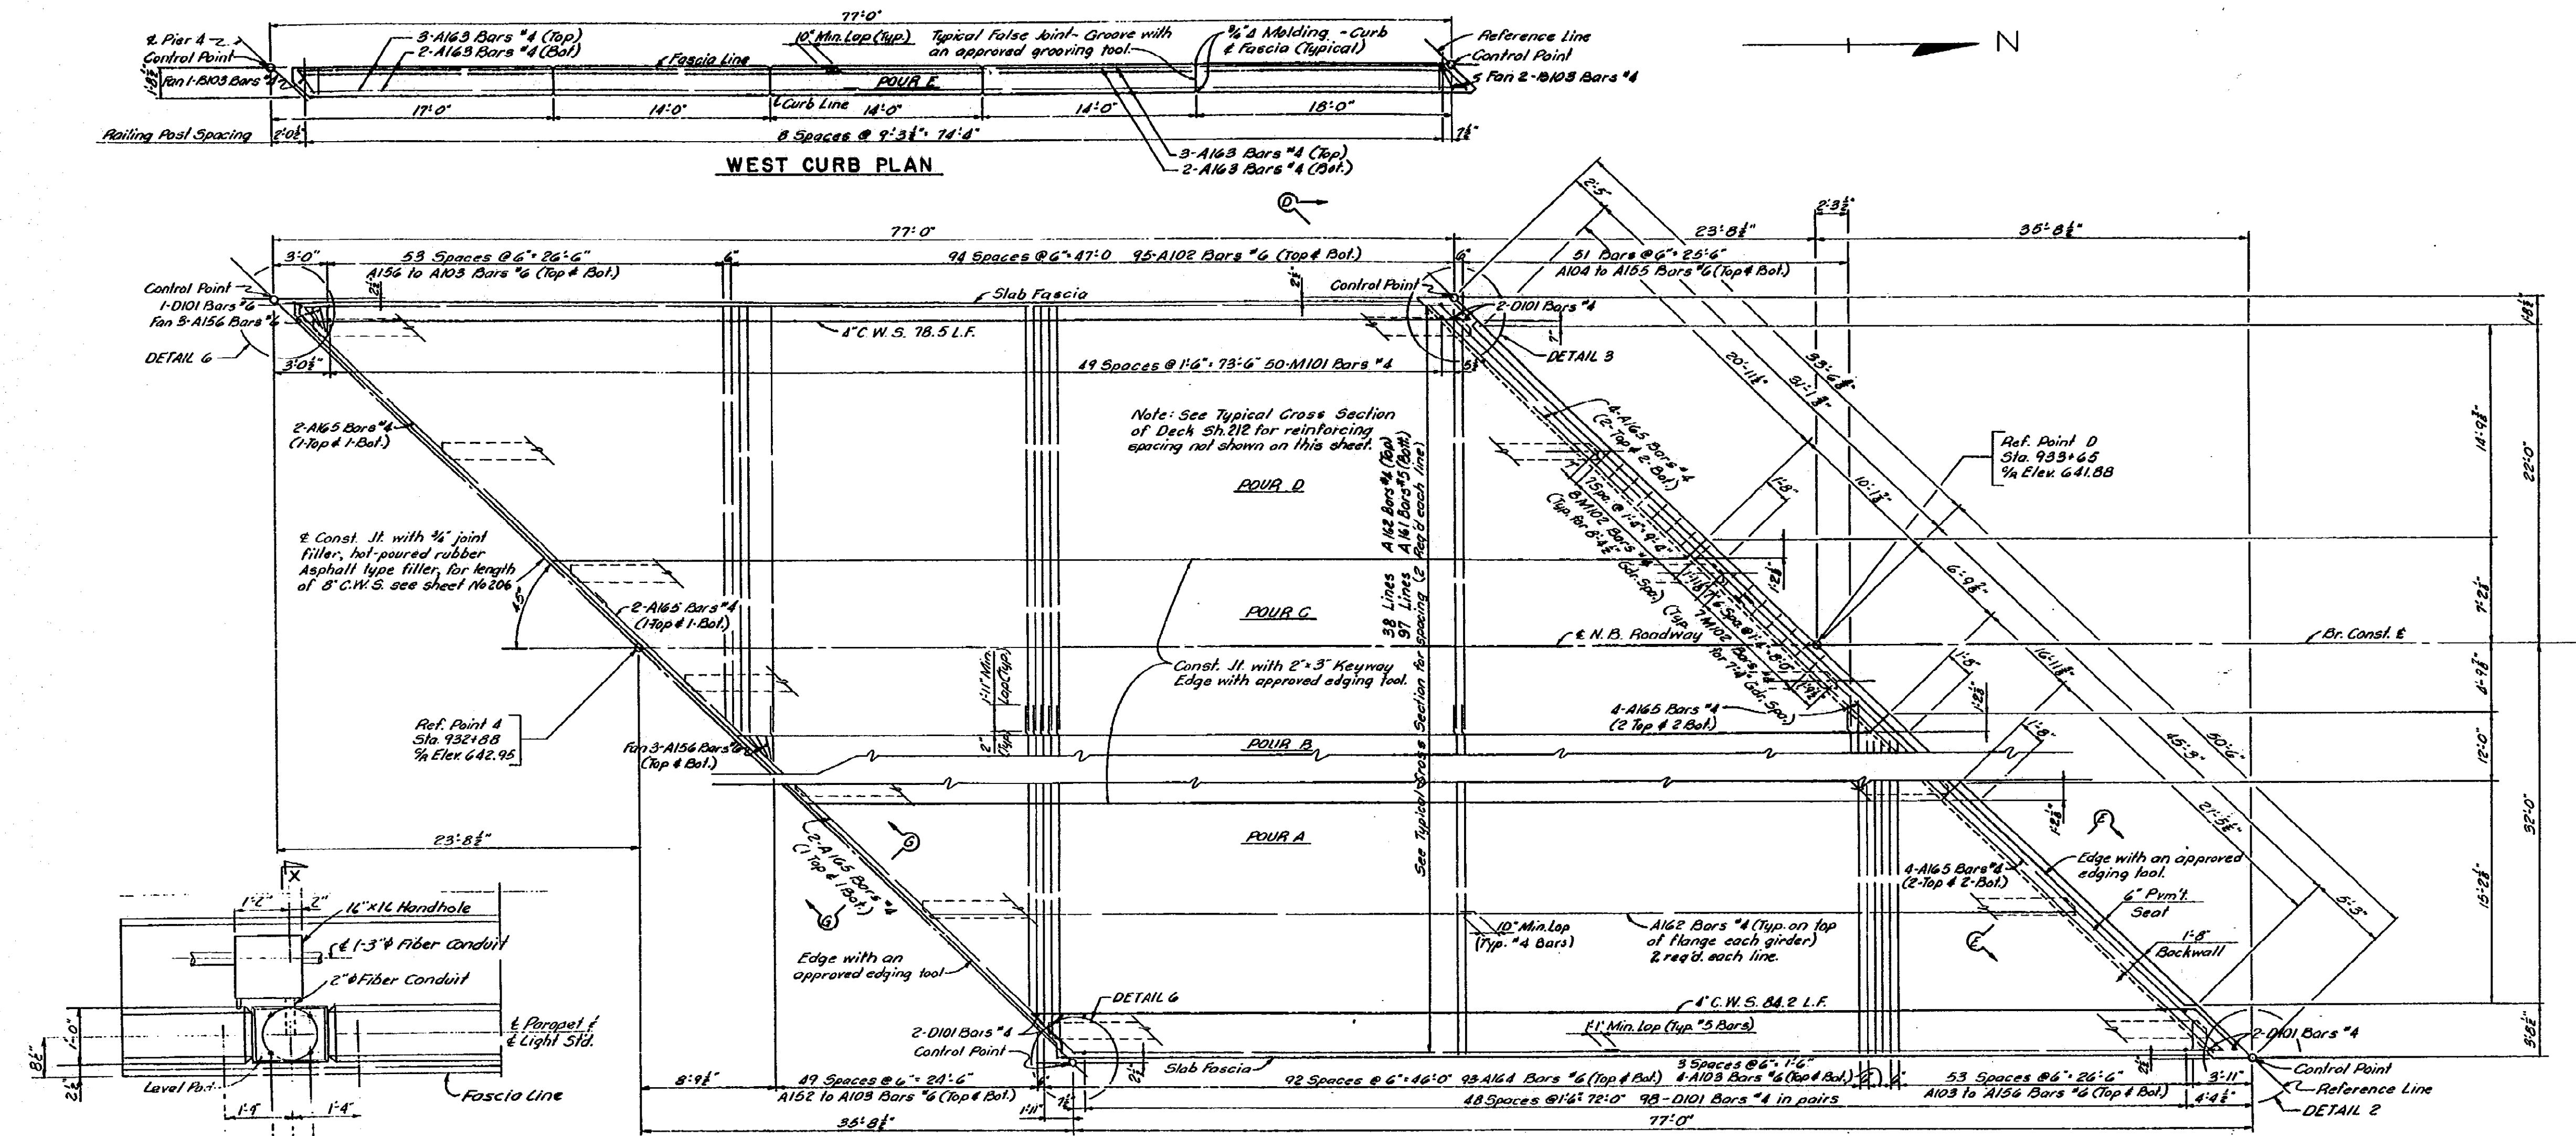

Work this sheet with sheets 206, 209 thru 214 & 220

MICHIGAN STATE HIGHWAY DEPARTMENT

SUPERSTRUCTURE DETAILS

NORTHBOUND ROADWAY - SPAN 3

TECON ENGINEERS, INC.

DATE: 3/16/04
D.A.S.: 3/16/04
P.O.N.: 3/23/02
BY: 207/312


B02 OF 63174 I

NOTE:
DO NOT WORK FROM THIS SHEET. THE INFORMATION SHOWN HERE IS FOR REFERENCE ONLY. NO PAY ITEMS ARE SHOWN.



FOR INFORMATION ONLY				
DATE	CONT. SEC.	JOB NO.	DESIGN UNIT	SHEET
02-14-00	B02 OF 63174	49595A	MAHDAVI	1P OF

DATE: 02-11-00 CHECKED BY: INGER DATE: 02-11-00 CORRECTED BY: INGER DATE: 02-11-00 FILE NAME: 60263174.dgn

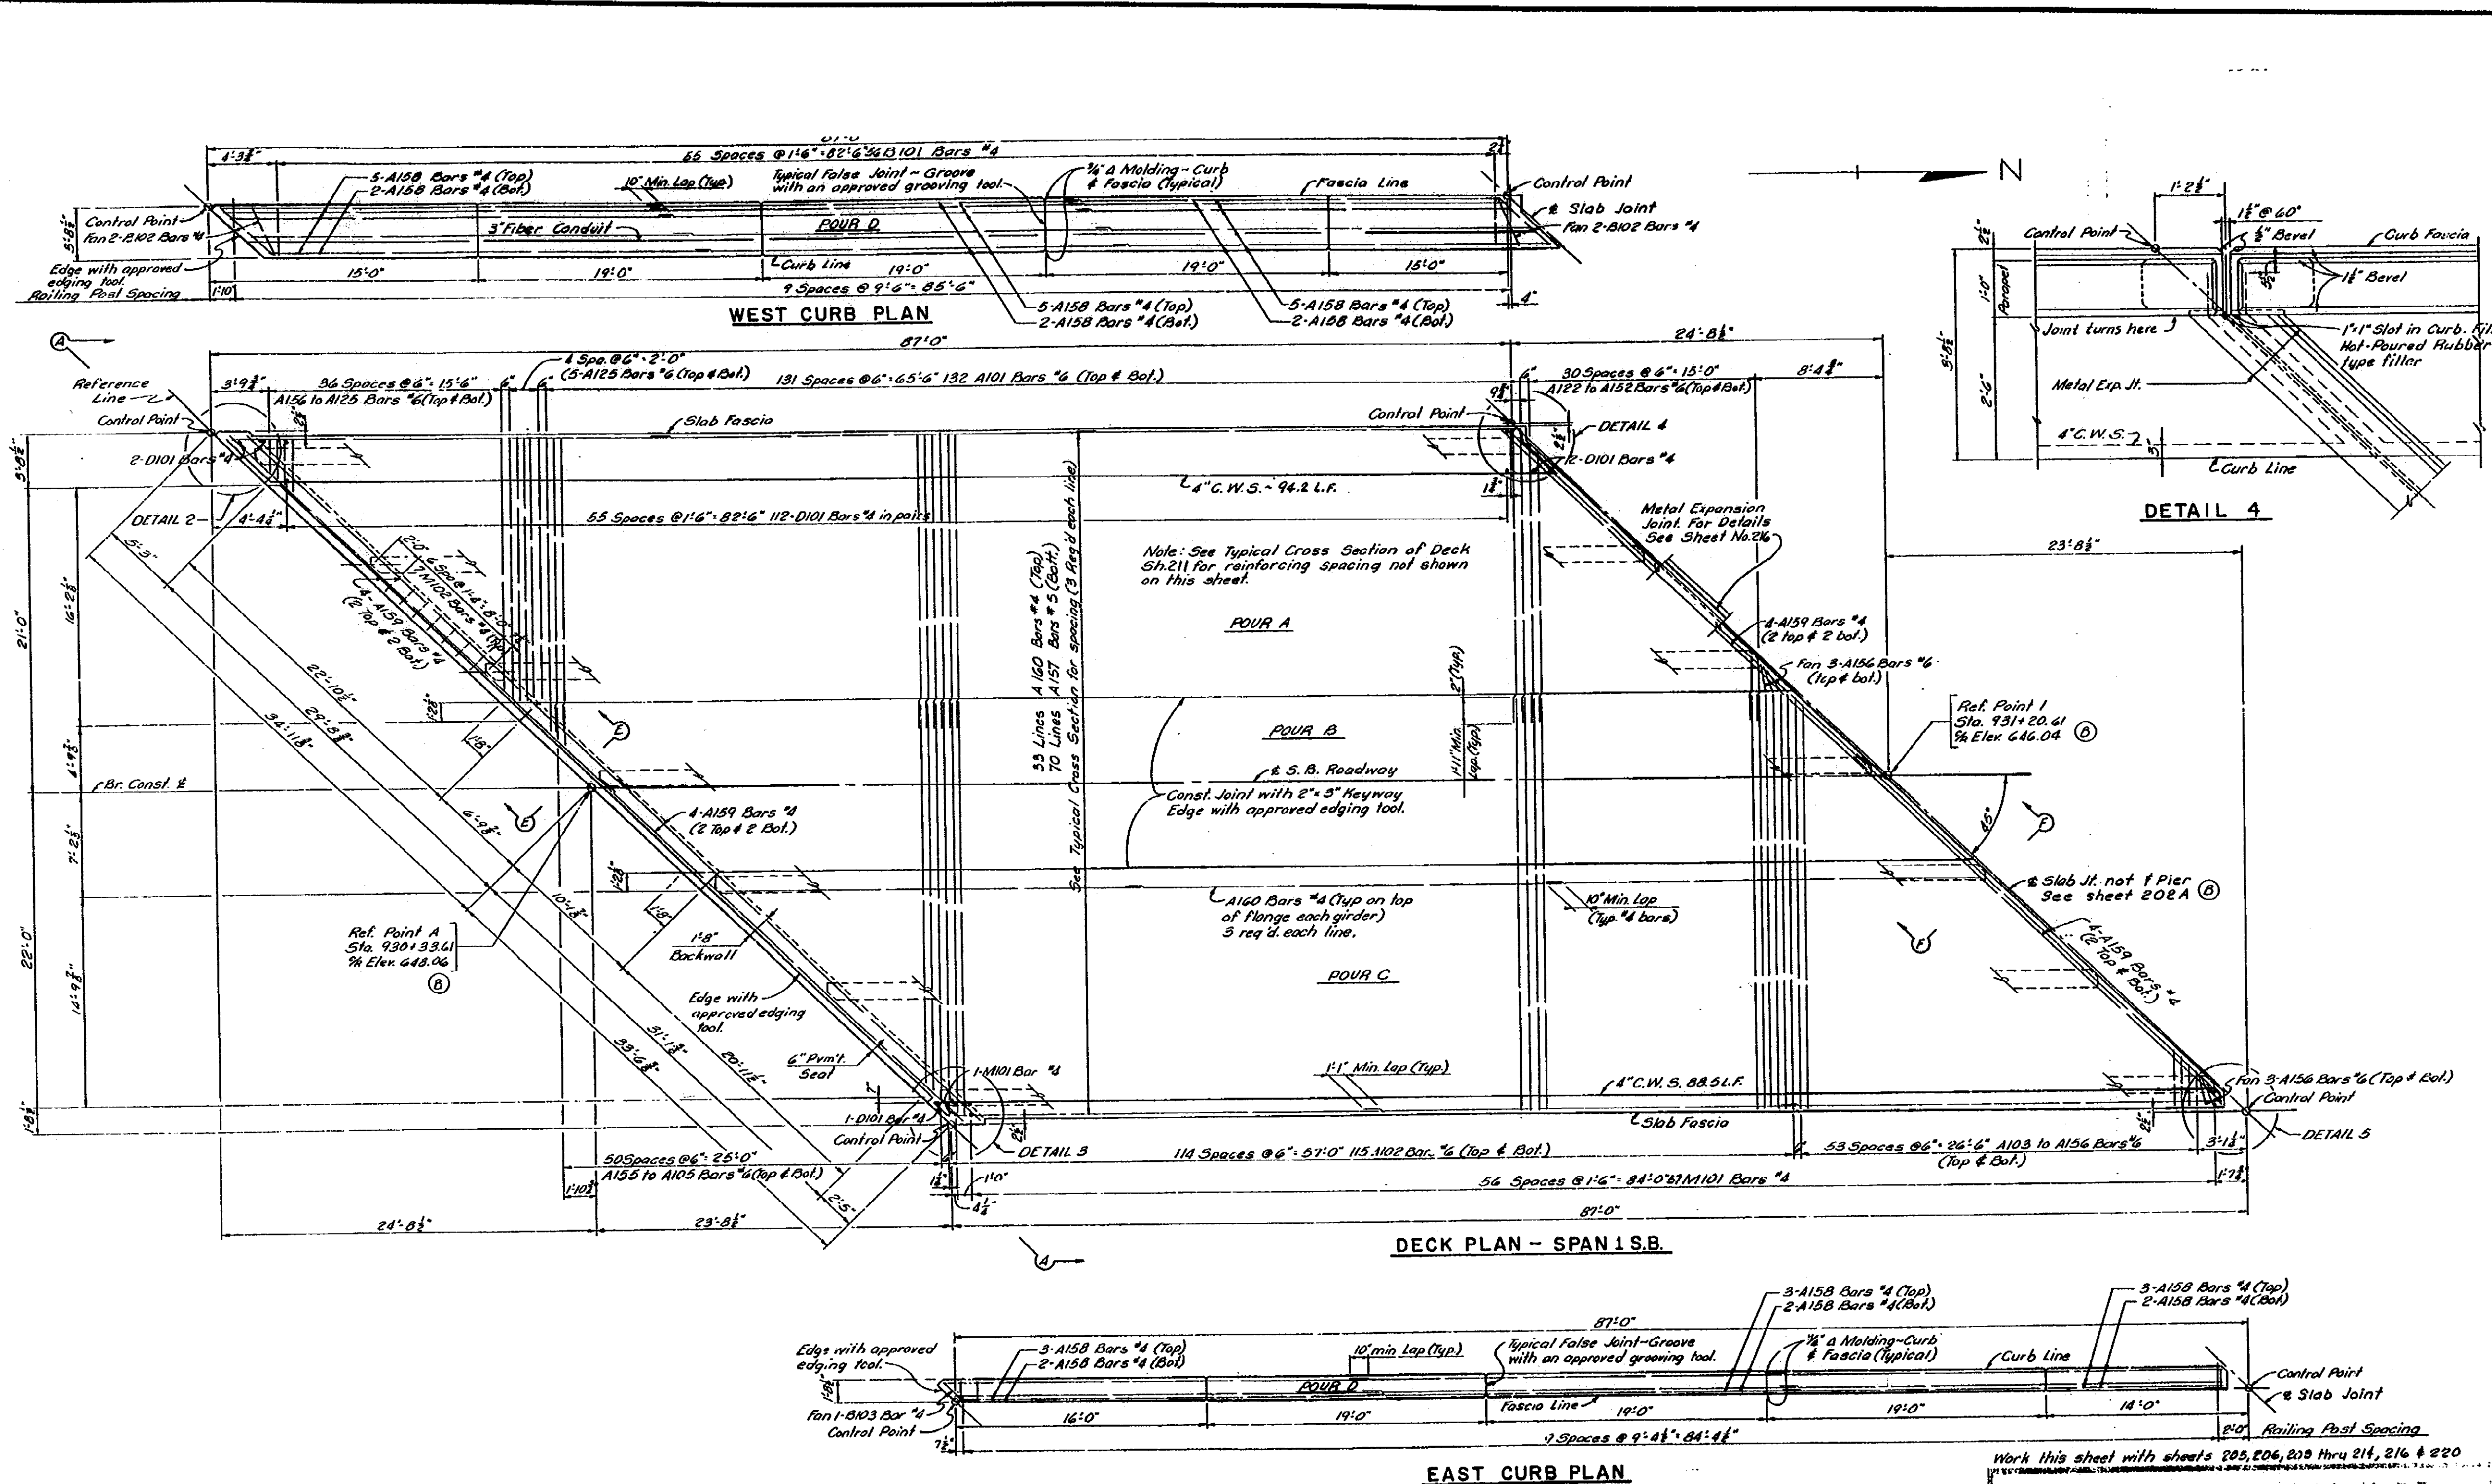

REVISIONS			
NO.	DESCRIPTION	DATE	BY

Work this sheet with sheets 205, 206, 209 thru 214, 216 & 220

MICHIGAN STATE HIGHWAY DEPARTMENT
SUPERSTRUCTURE DETAILS
 SOUTHBOUND ROADWAY - SPAN 1

TECON ENGINEERS, INC.
 3120 N. ZEEB RD.
 EAST LANSING, MI 48106
 TEL: (313) 486-1111

JLC 3-20-61
 D.R.S. 3-23-62
 FDN 3-23-62
 ROB 3-23-62

B02 OF 63174 I

B Relocated ref. pts. A11, 1-16-63, R.E.

NOTE:
 DO NOT WORK FROM THIS SHEET. THE INFORMATION SHOWN
 HERE IS FOR REFERENCE ONLY. NO PAY ITEMS ARE SHOWN.






FOR INFORMATION ONLY				
DATE	CONT. SEC.	JOB NO.	DESIGN UNIT	SHEET
02-14-00	B02 OF 63174	49595A	MAHDAVI	10 OF

FILE NAME: 60263174.spl DRAWN BY: INDER CHECKED BY: INDER DATE: 02-11-00 CORRECTED BY: INDER DATE:

CONTROL B02 OF 63174 JOB NO. 49595A

1 2 3 4 5 6 7 8 9 10 11 12 13 14 15 16 17 18 19 20 21 22 23 24 25 26 27 28 29 30 31 32 33 34 35 36 37 38 39 40 41 42 43 44 45 46 47 48 49 50 51 52 53 54 55 56 57 58 59 60 61 62 63

REVISIONS			
NO.	DESCRIPTION	DATE	BY

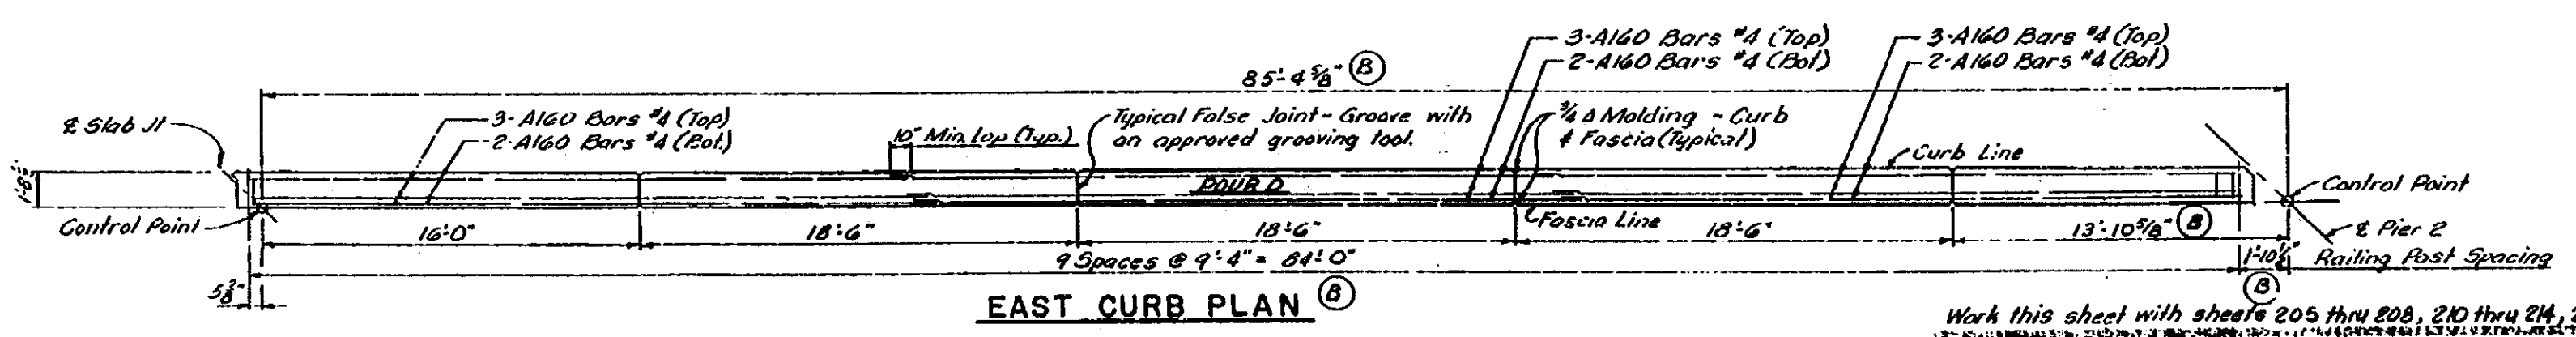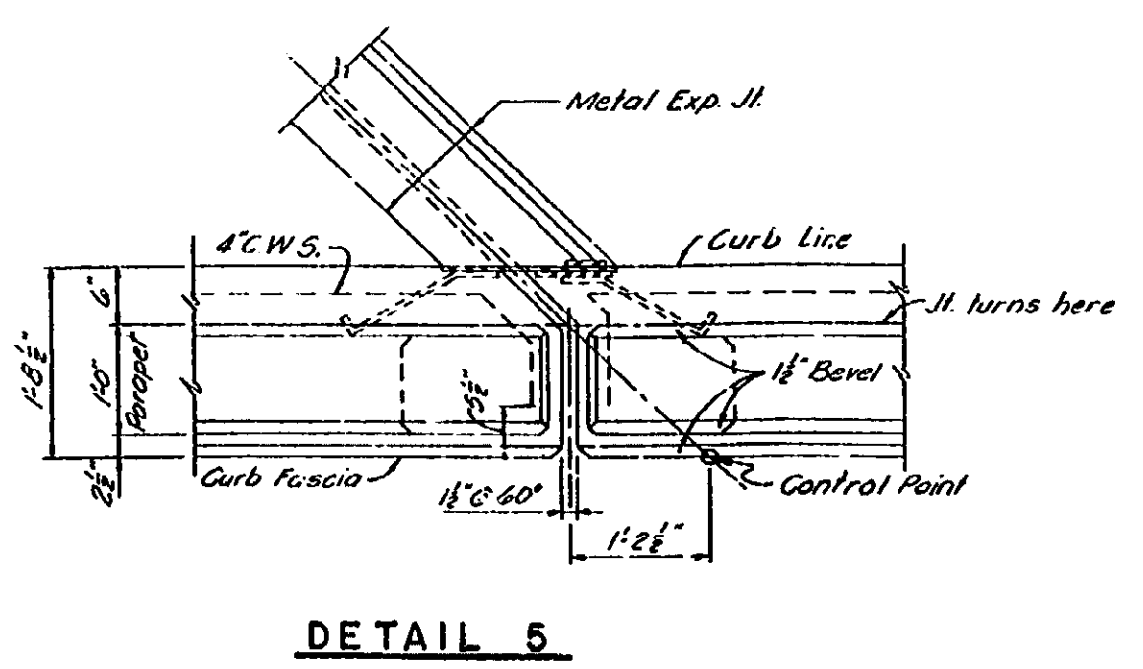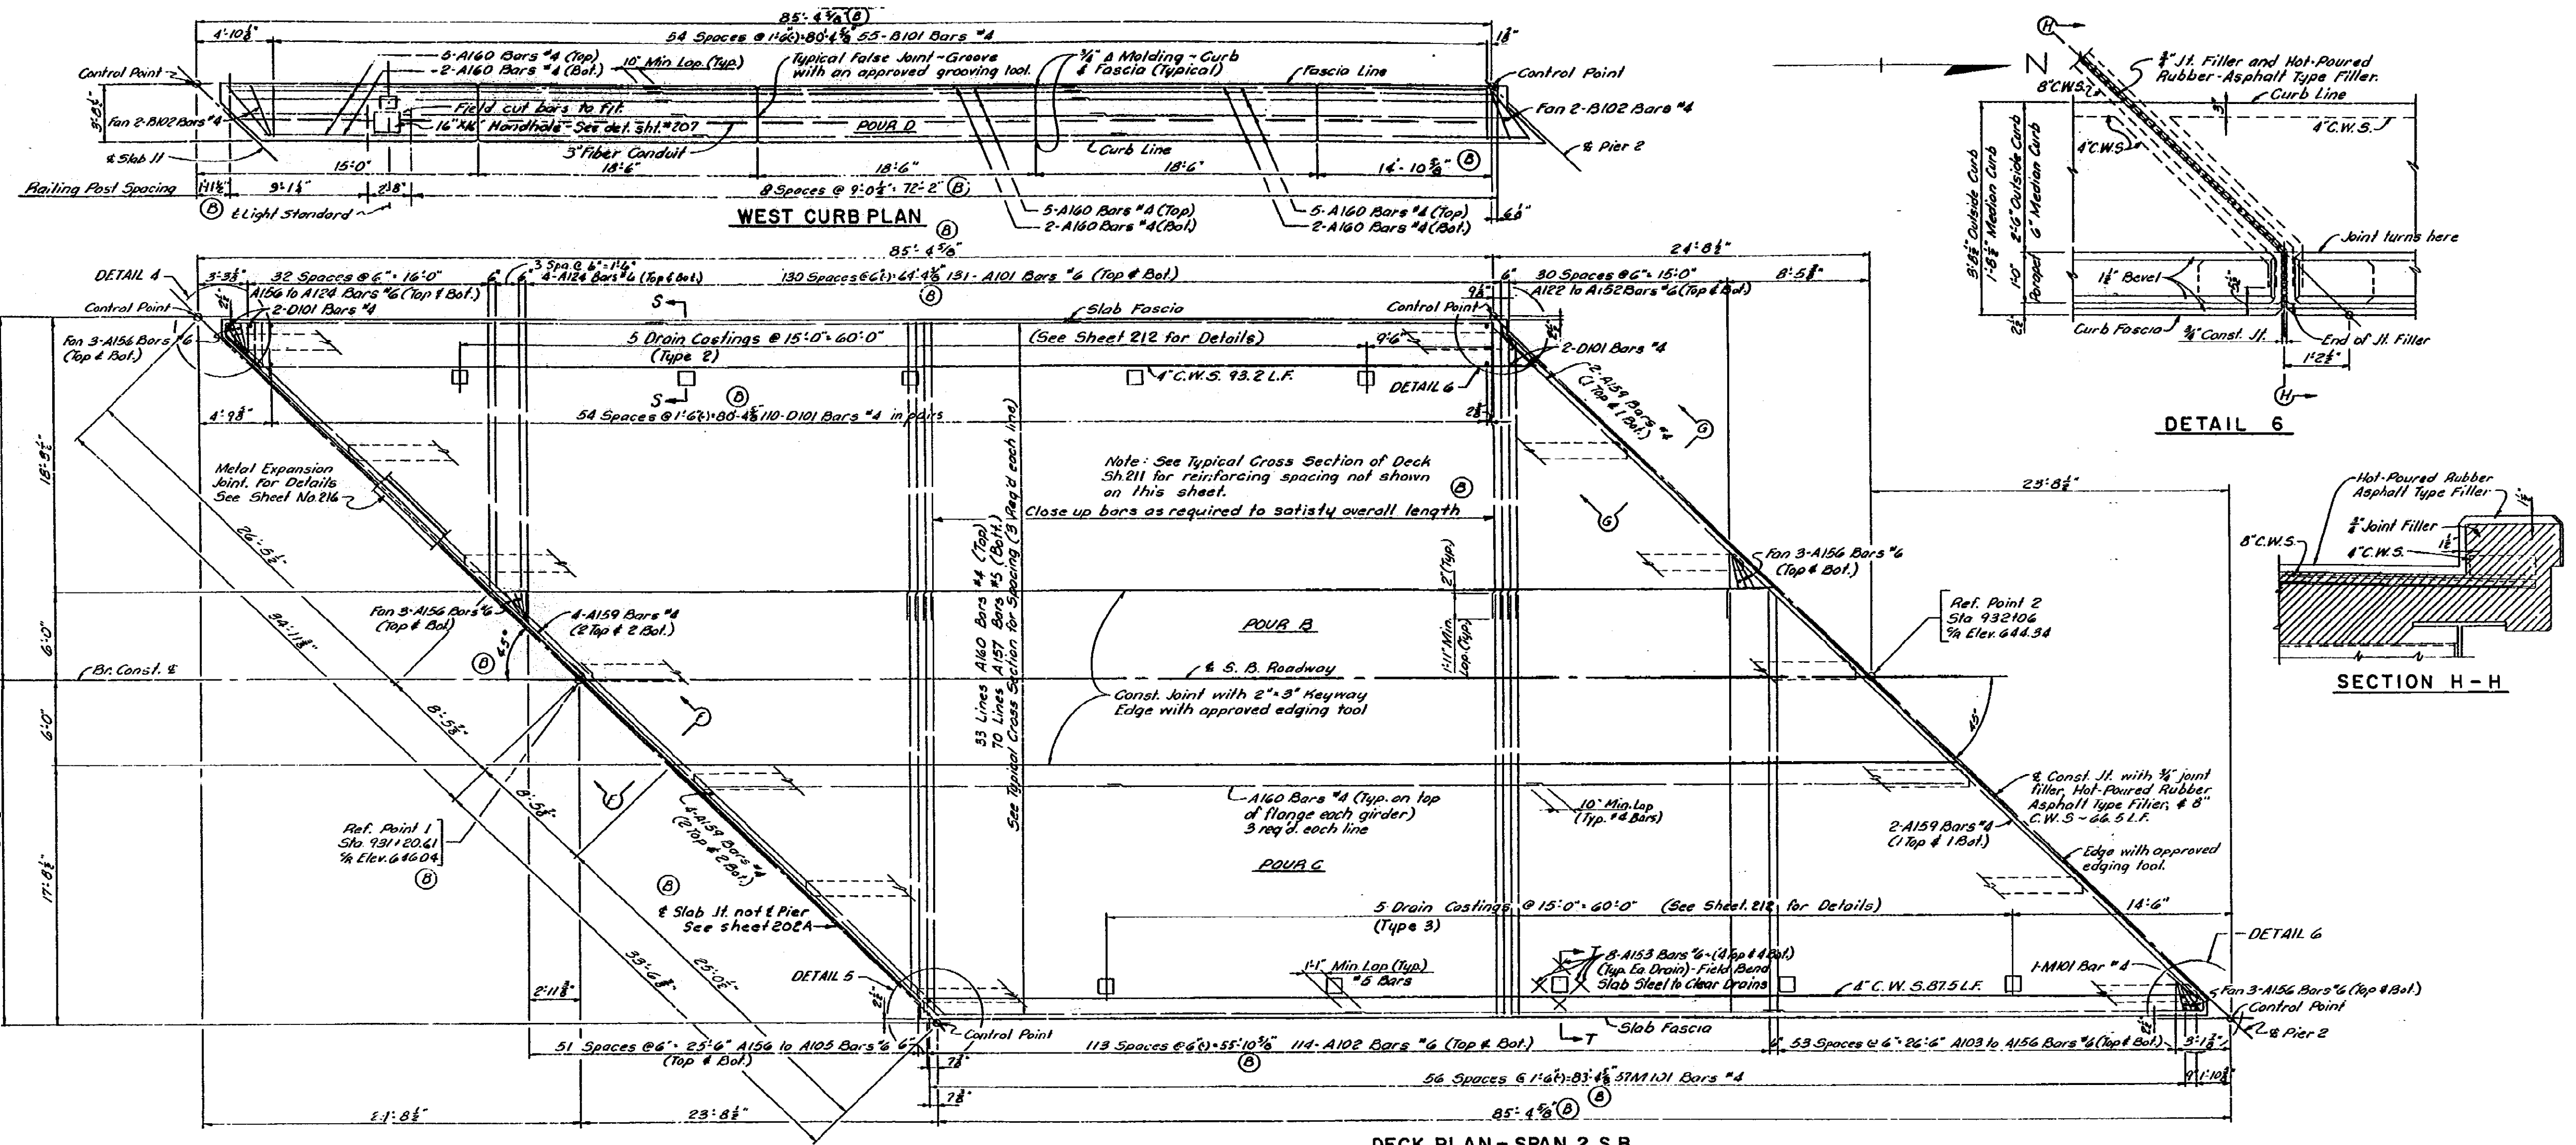

Work this sheet with sheets 205 thru 208, 210 thru 214, 216 & 220
MICHIGAN STATE HIGHWAY DEPARTMENT
SUPERSTRUCTURE DETAILS
 SOUTHBOUND ROADWAY - SPAN 2
TECON ENGINEERS, INC.
 JDC 3-16-62
 D.R.S. 3-15-61
 PDH 3-23-62
 209 3/2
B02 OF 63174 I


NOTE:
 DO NOT WORK FROM THIS SHEET. THE INFORMATION SHOWN
 HERE IS FOR REFERENCE ONLY. NO PAY ITEMS ARE SHOWN.



FOR INFORMATION ONLY				
DATE	CONT. SEC.	JOB NO.	DESIGN UNIT	SHEET
02-14-00	B02 OF 63174	49595A	MAHDAVI	1R OF

DATE: 02-11-00 CHECKED BY: INDER CORRECTED BY: INDER DATE: FILE NAME: 60263174.dgn

REVISIONS			
NO.	DESCRIPTION	DATE	BY

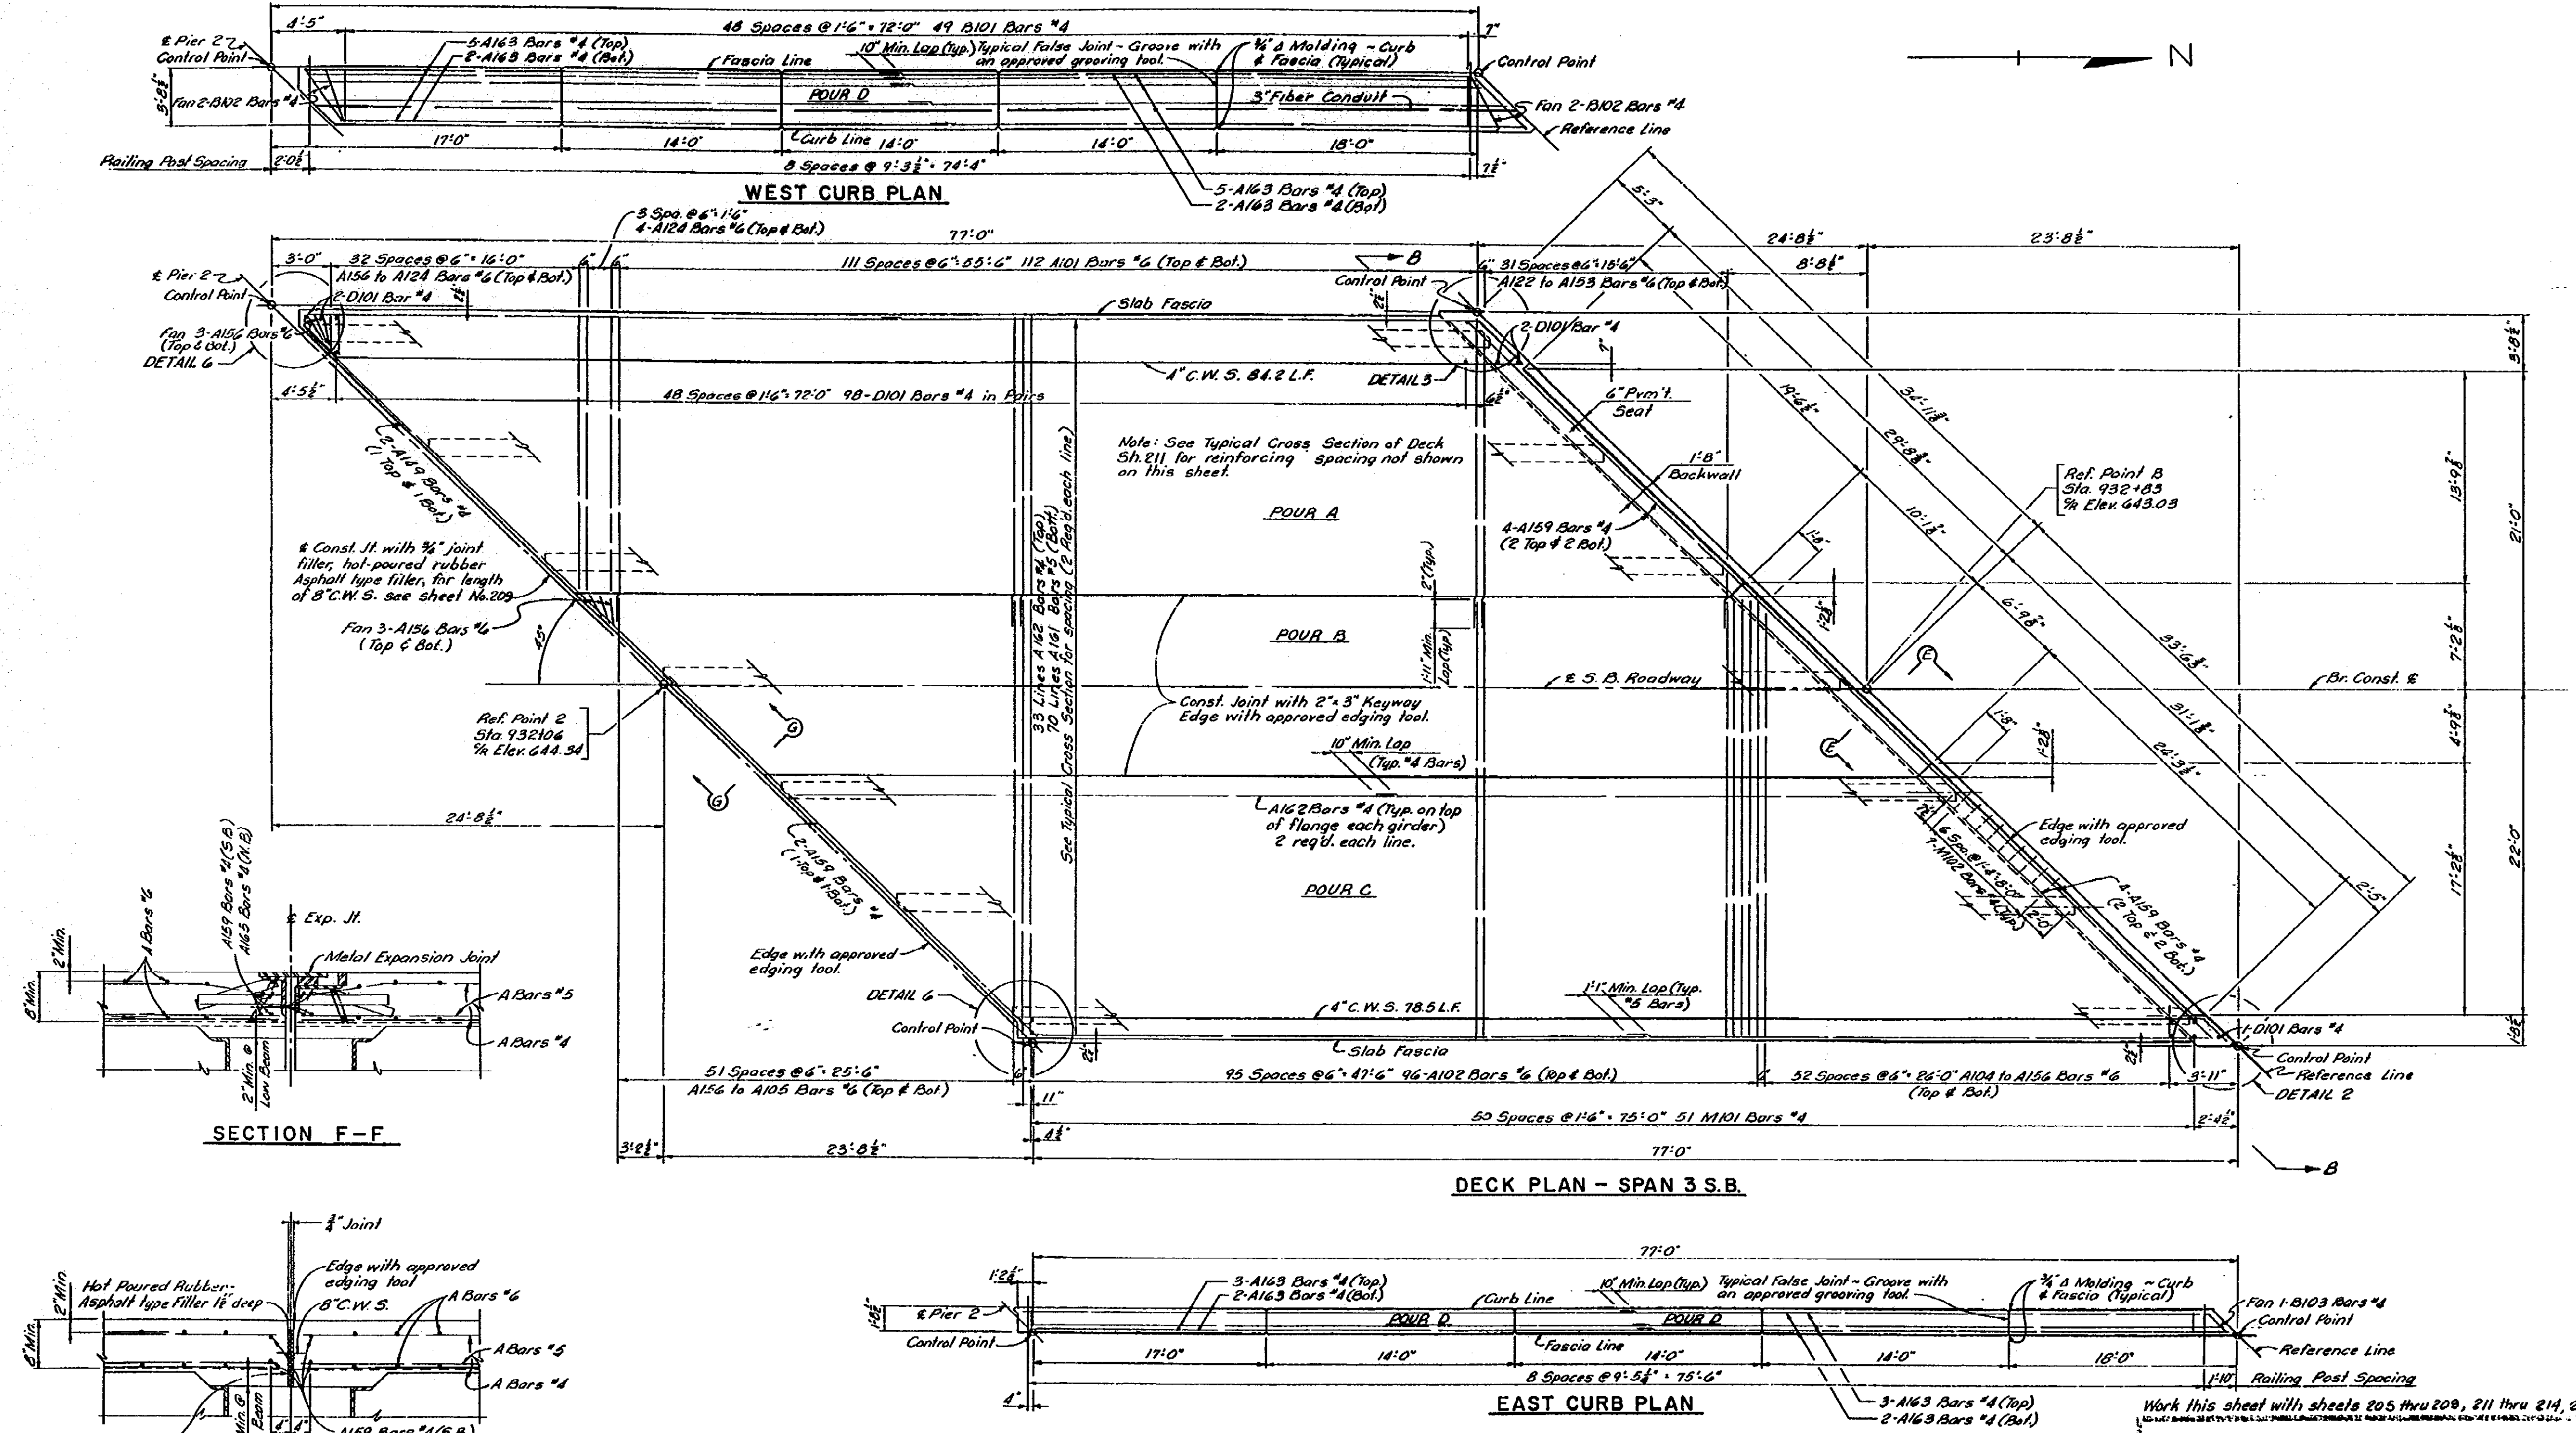

Work this sheet with sheets 205 thru 209, 211 thru 214, 216 & 220

MICHIGAN STATE HIGHWAY DEPARTMENT

SUPERSTRUCTURE DETAILS

SOUTHBOUND ROADWAY - SPAN 3

TECON ENGINEERS, INC.

JDC 3-12-02
D.G.S. 3-11-02
FDN 3-23-02
RJO 3-12-02

B02 of 63174 I

NOTE:
DO NOT WORK FROM THIS SHEET. THE INFORMATION SHOWN HERE IS FOR REFERENCE ONLY. NO PAY ITEMS ARE SHOWN.




FOR INFORMATION ONLY				
DATE	CONT. SEC.	JOB NO.	DESIGN UNIT	SHEET
02-14-00	B02 OF 63174	49595A	MAHDAVI	15 OF

DATE: 02-11-00 CHECKED BY: INDER DATE: 02-11-00 CORRECTED BY: INDER DATE: FILE NAME: 60263175.n


CONTROL B02 OF 63174 NO. 49595A

1 2 3 4 5 6 7 8 9 10 11 12 13 14 15 16 17 18 19 20 21 22 23 24 25 26 27 28 29 30 31 32 33 34 35 36 37 38 39 40 41 42 43 44 45 46 47 48 49 50 51 52 53 54 55 56 57 58 59 60 61 62 63


REVISIONS			
NO.	DESCRIPTION	DATE	BY

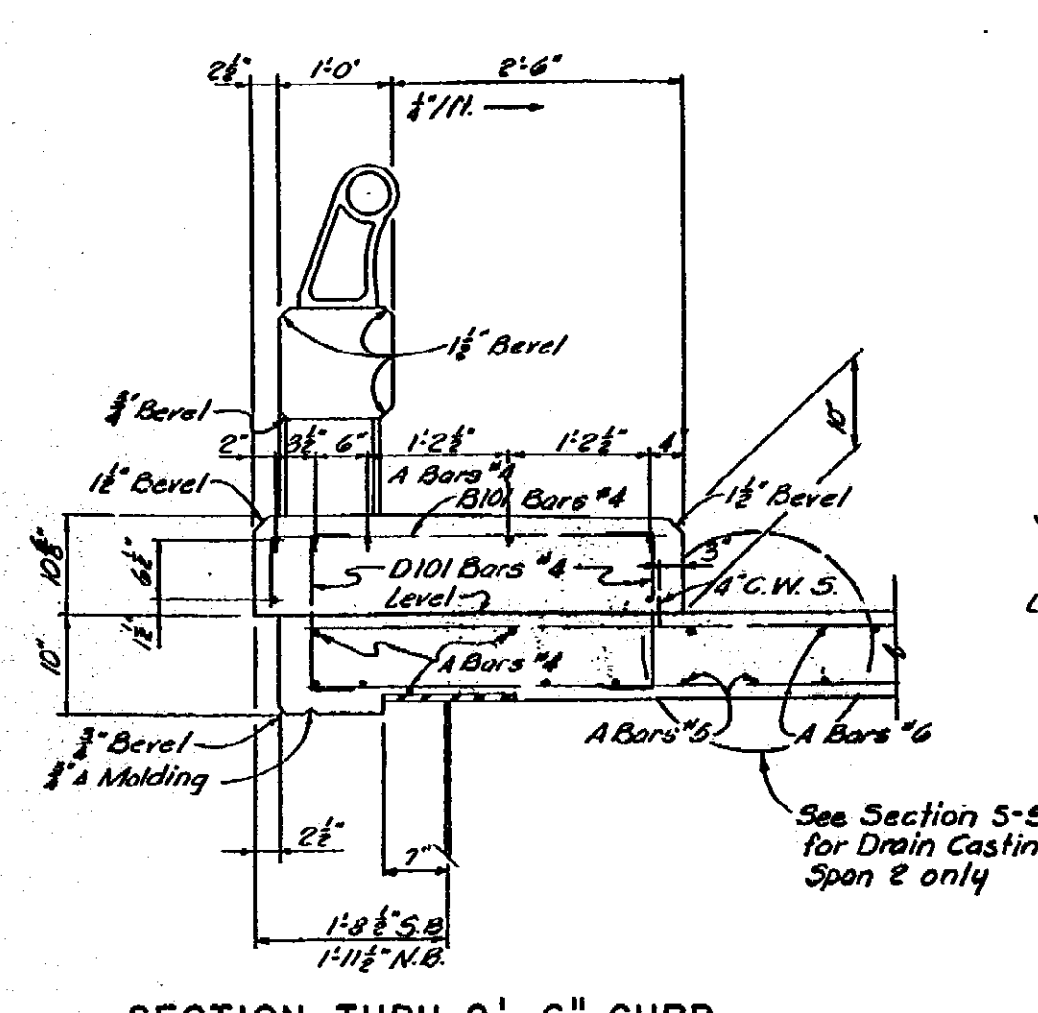


SECTION THRU 2'-6" CURB

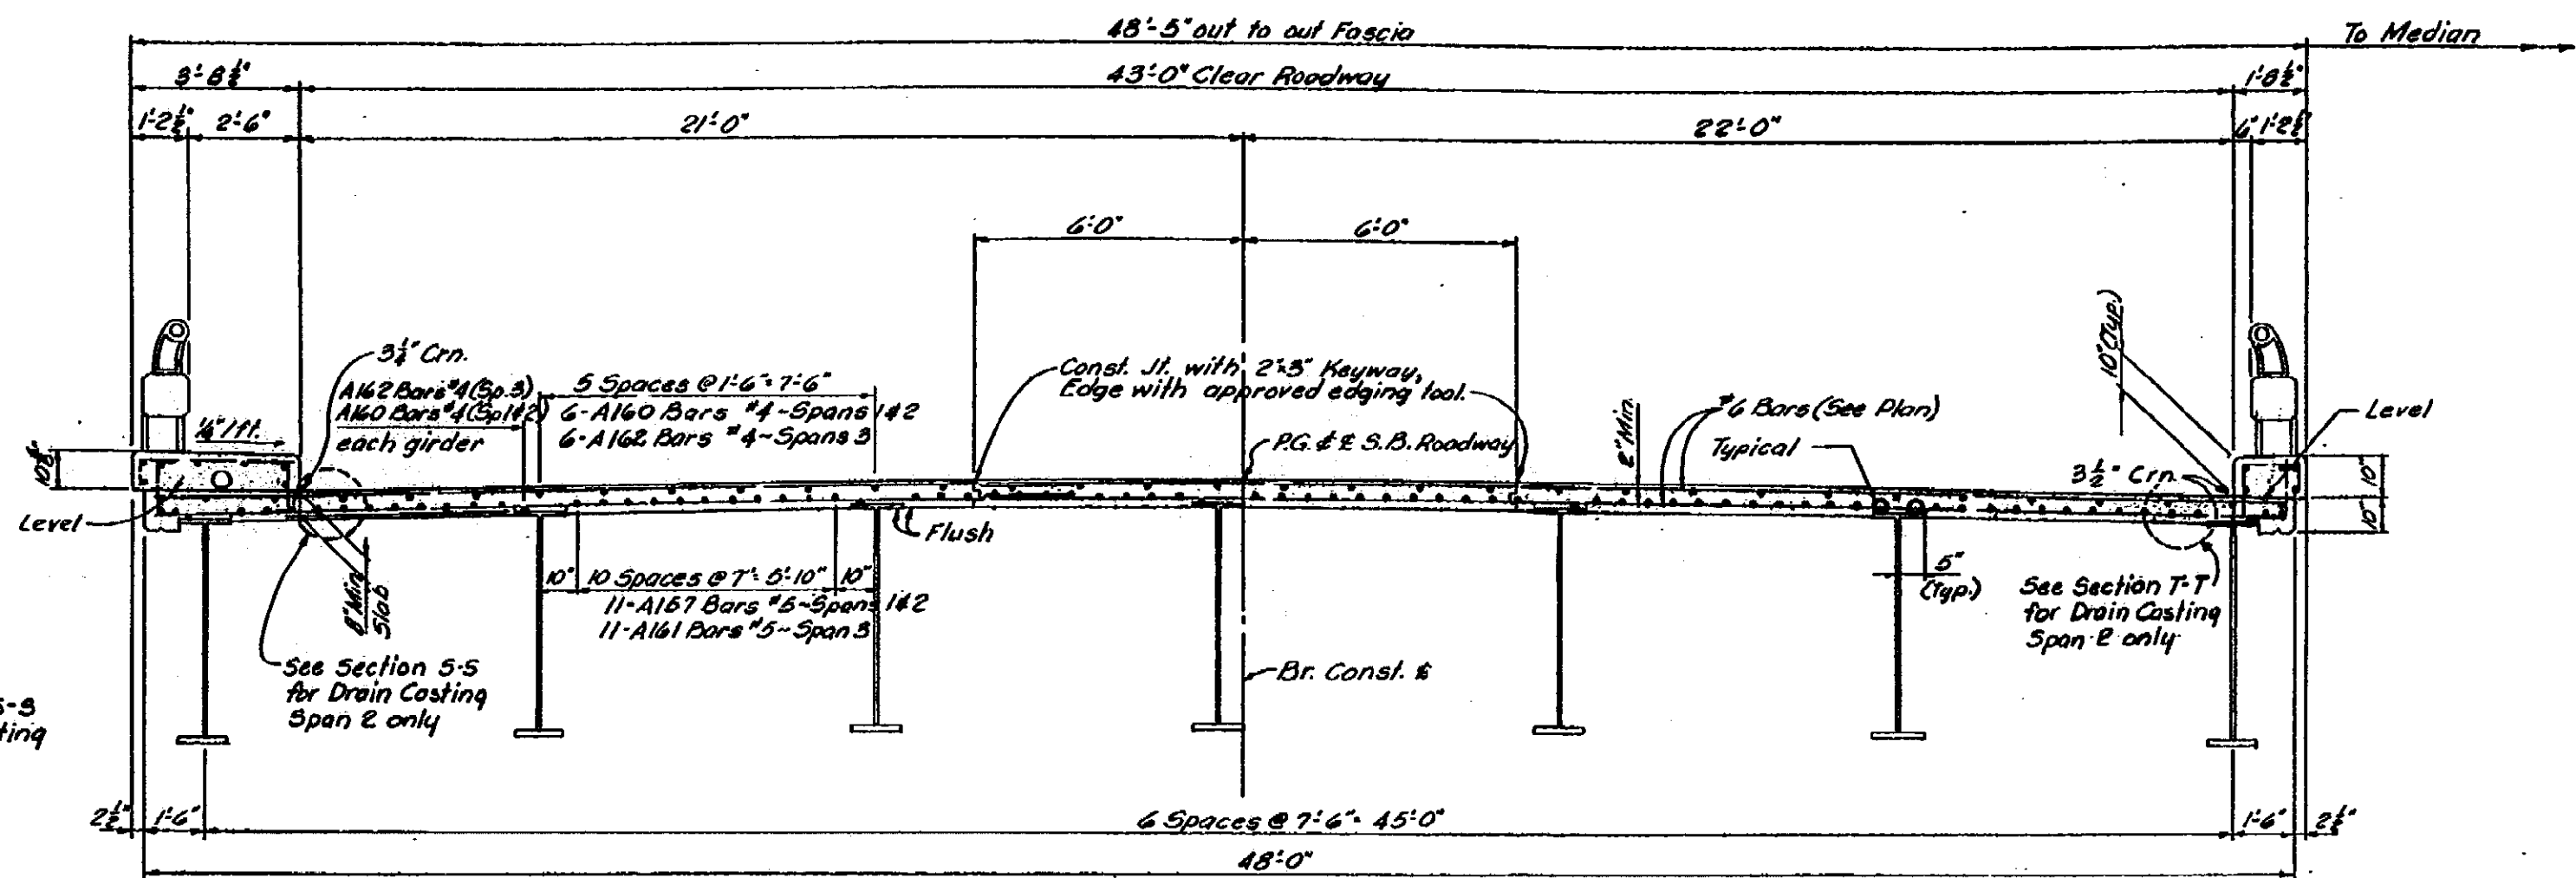


SOUTHBOUND ROADWAY
TYPICAL CROSS SECTION

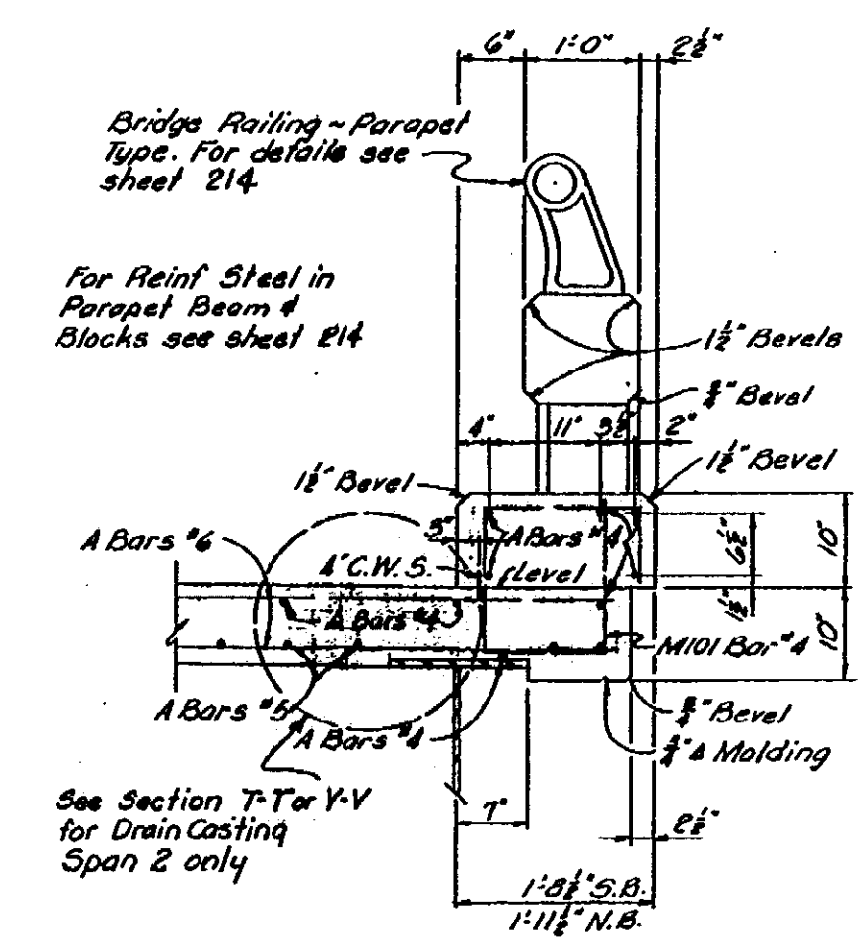

SECTION THRU 6" CURB

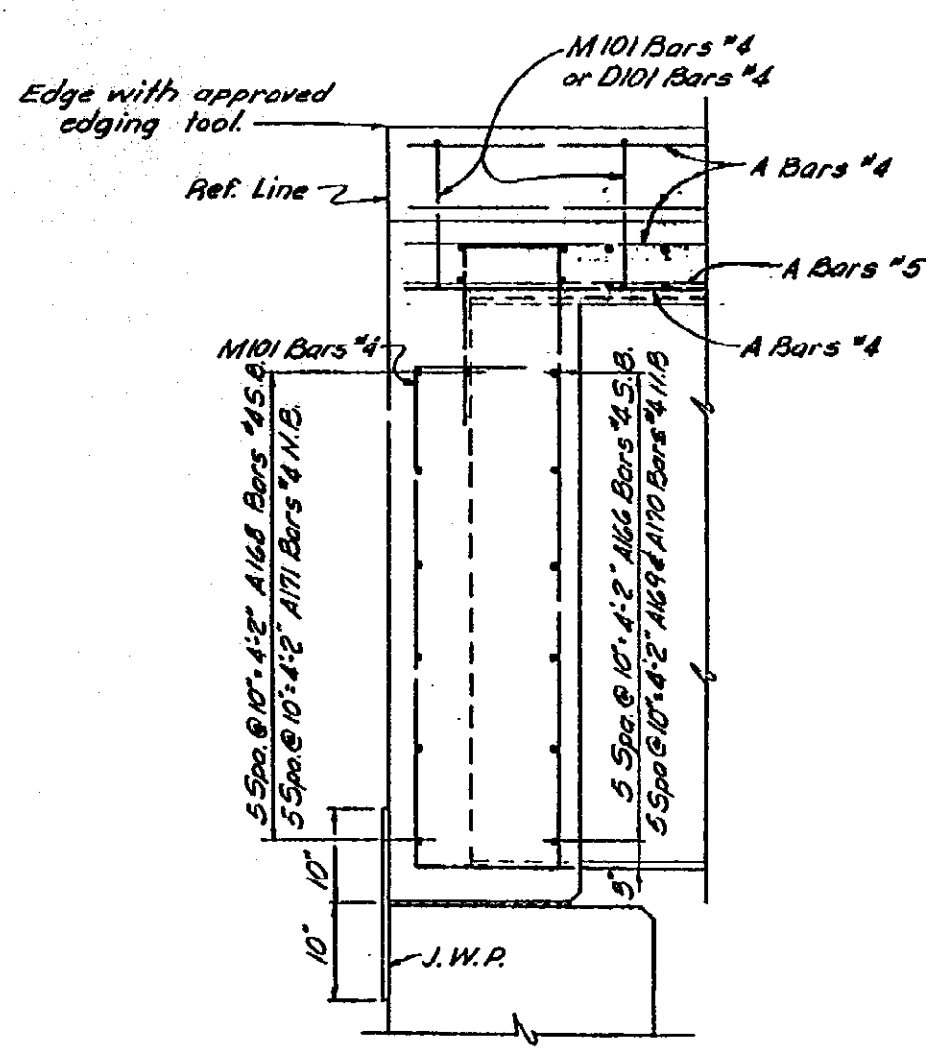


SECTION THRU BACKWALL
AT FASCIA BEAM

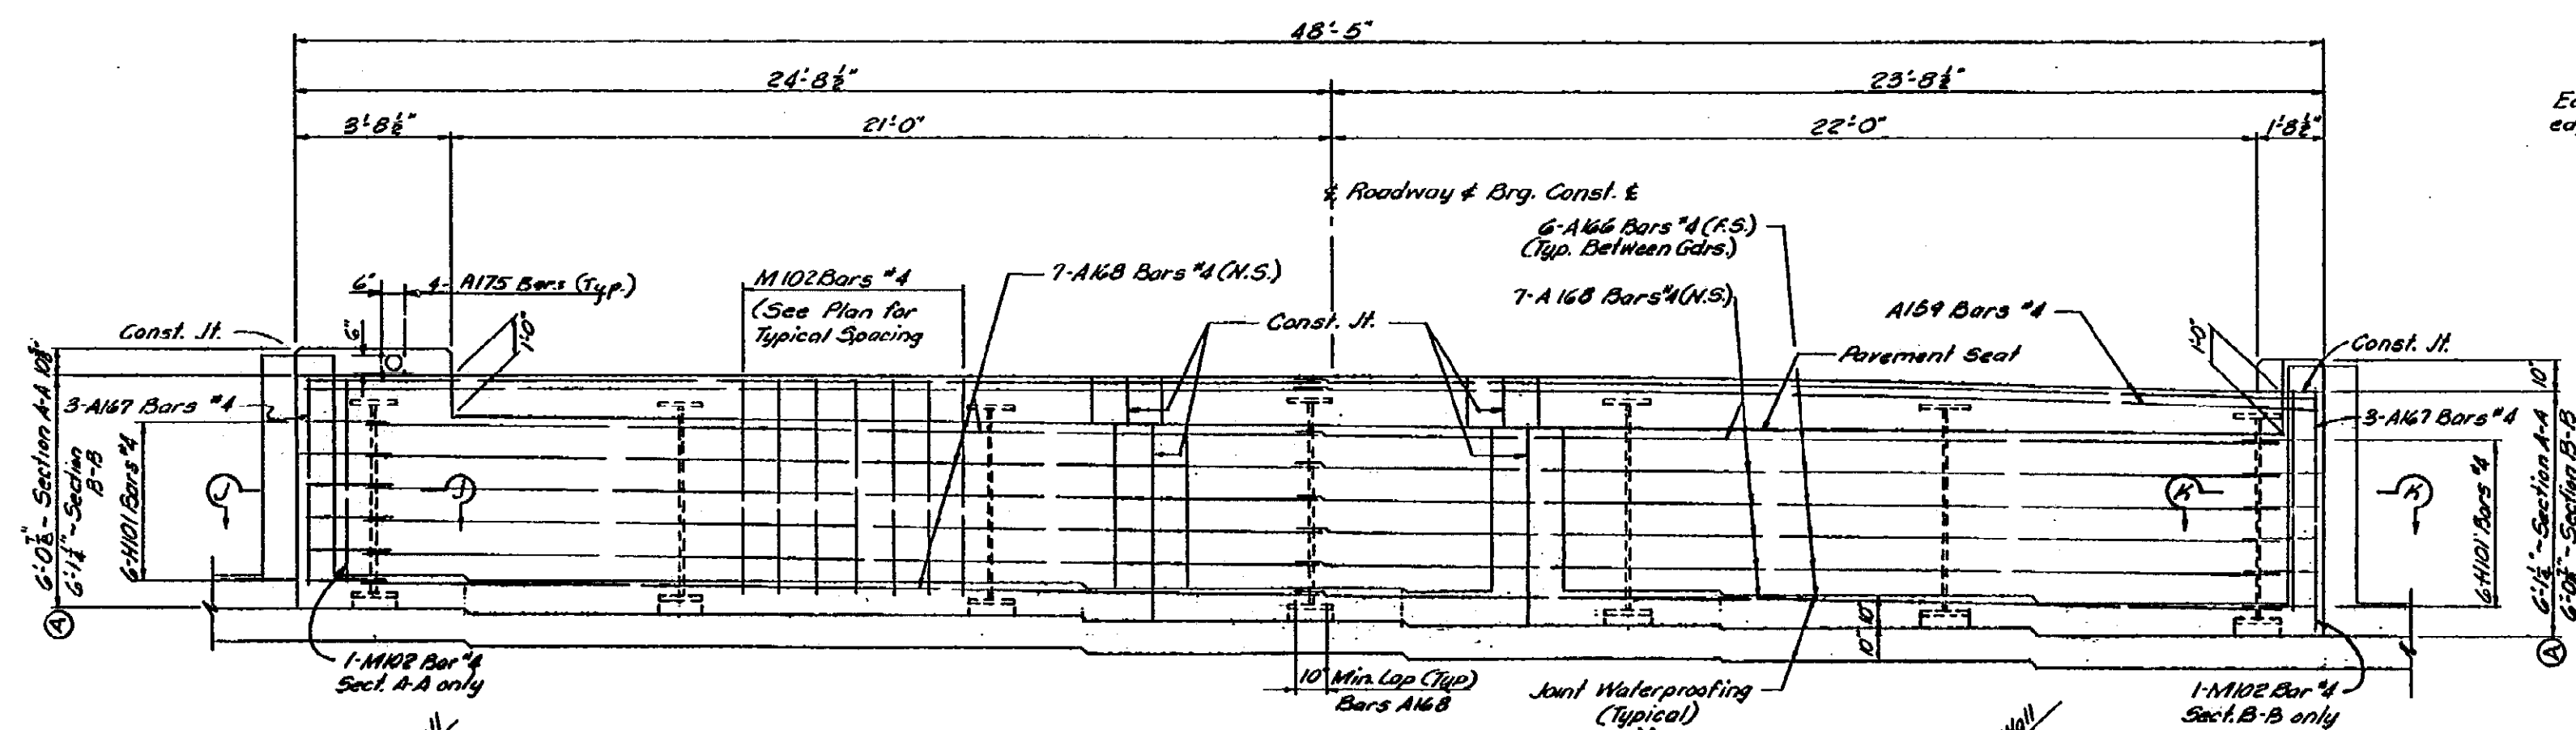


SECTION A-A & SECTION B-B

* View shown for section A-A (from approach side of Backwall)
Section B-B is similar except taken from Structure side of Backwall.

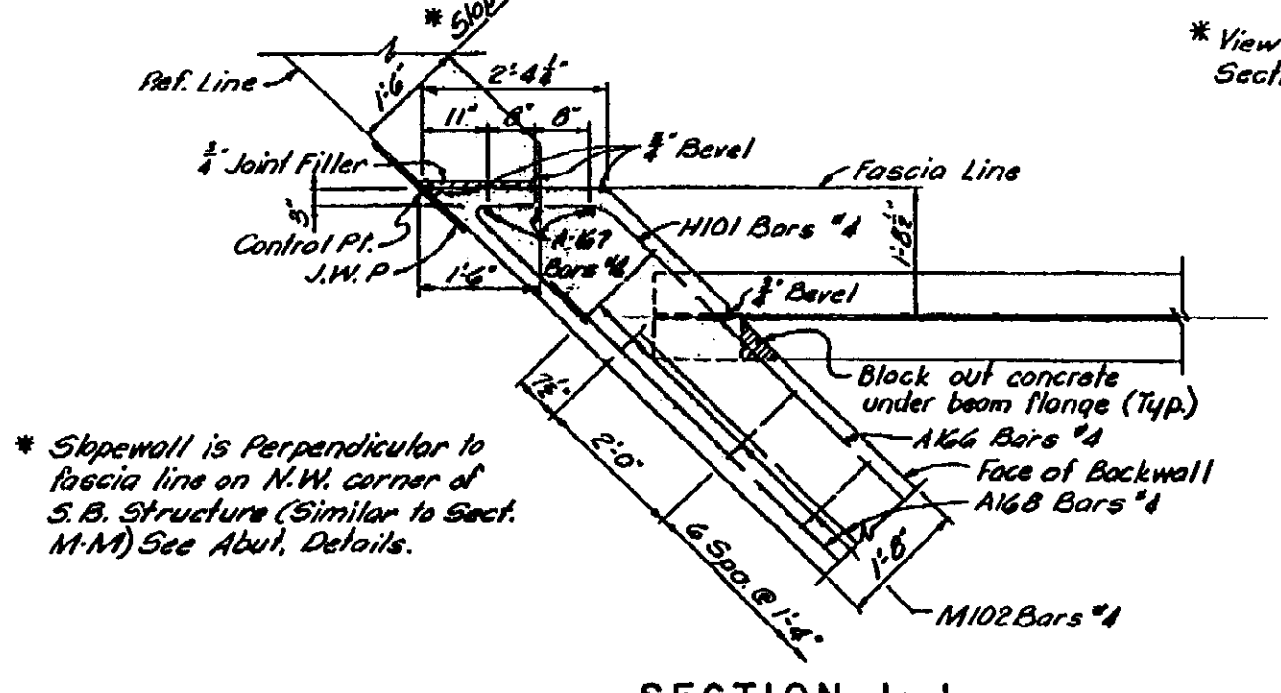


SECTION J-J

* Skipwall is perpendicular to fascia line on NW corner of S.B. Structures (Similar to Sect. M-M) See A-101 Details.

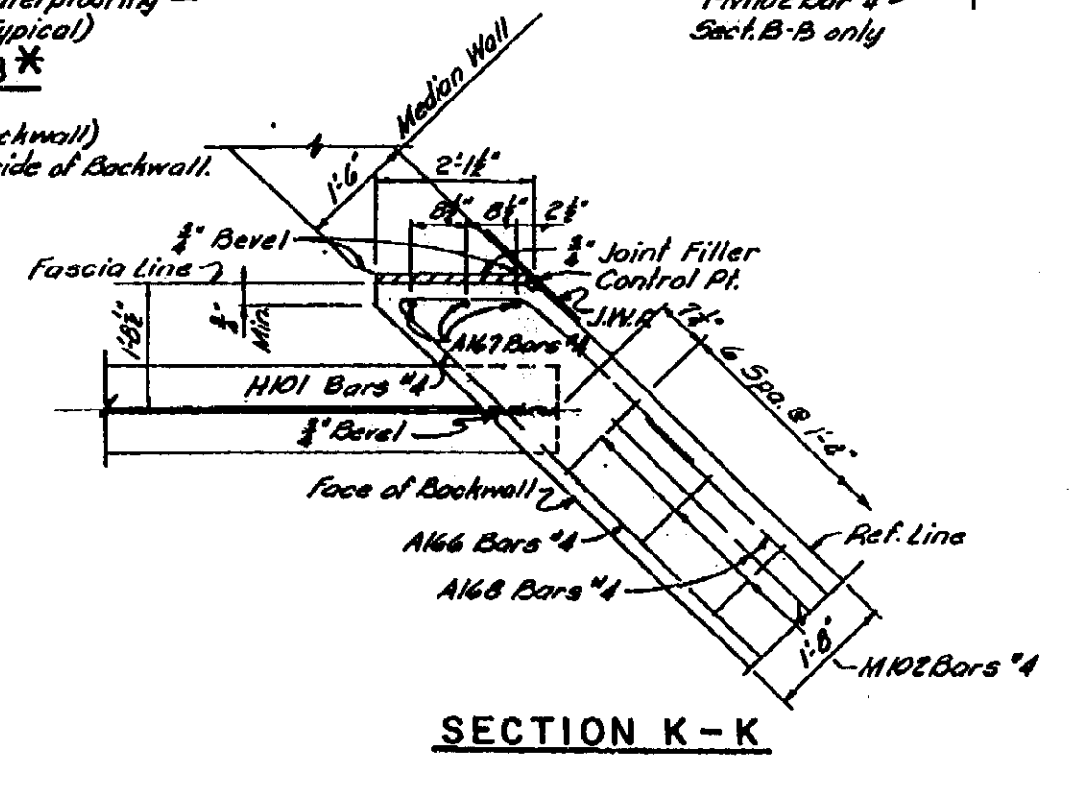

SECTION K-K

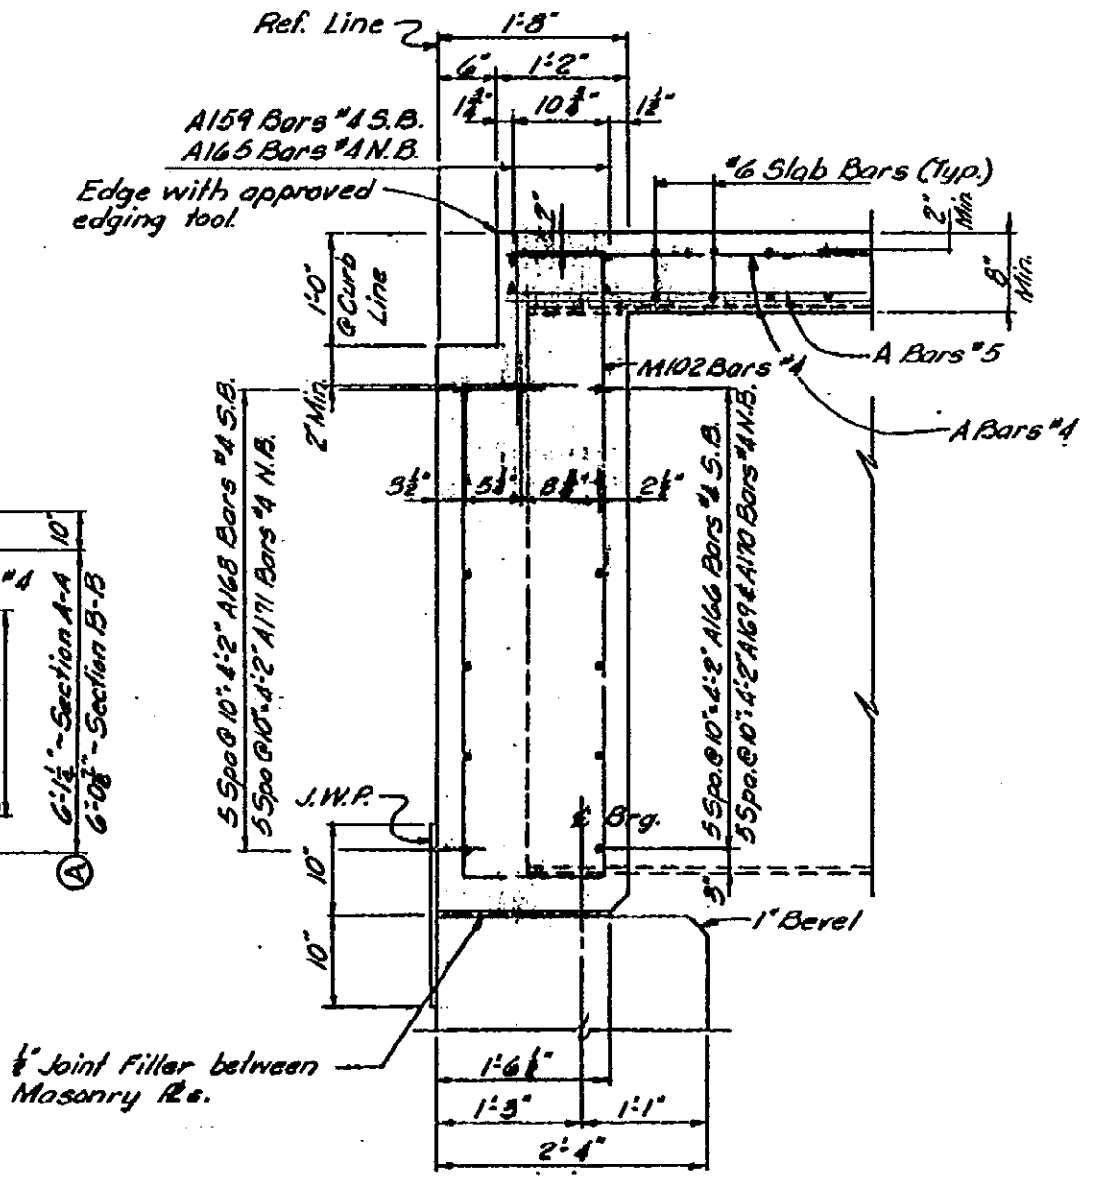

SECTION E-E

Work this sheet with sheets 205 thru 210, 212 thru 214 & 220

MICHIGAN STATE HIGHWAY DEPARTMENT
SUPERSTRUCTURE DETAILS

TECON ENGINEERS, INC.

NO.	DESCRIPTION	DATE	BY

B02 OF 631741

NOTE:
DO NOT WORK FROM THIS SHEET. THE INFORMATION SHOWN
HERE IS FOR REFERENCE ONLY. NO PAY ITEMS ARE SHOWN.





FOR INFORMATION ONLY				
DATE	CONT. SEC.	JOB NO.	DESIGN UNIT	SHEET
02-14-00	B02 OF 63174	49595A	MAHDAVI	1T OF

DRAWN BY: INDER DATE: 02-11-00 CHECKED BY: DATE: CORRECTED BY: INDER DATE:

1 2 3 4 5 6 7 8 9 10 11 12 13 14 15 16 17 18 19 20 21 22 23 24 25 26 27 28 29 30 31 32 33 34 35 36 37 38 39 40 41 42 43 44 45 46 47 48 49 50 51 52 53 54 55 56 57 58 59 60 61 62 63

REVISIONS			
NO.	DESCRIPTION	DATE	BY

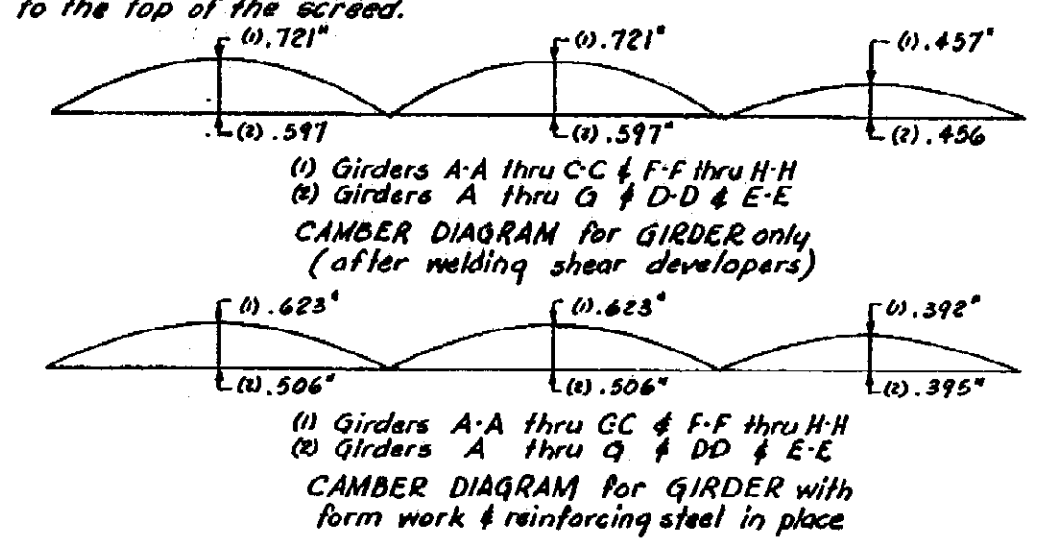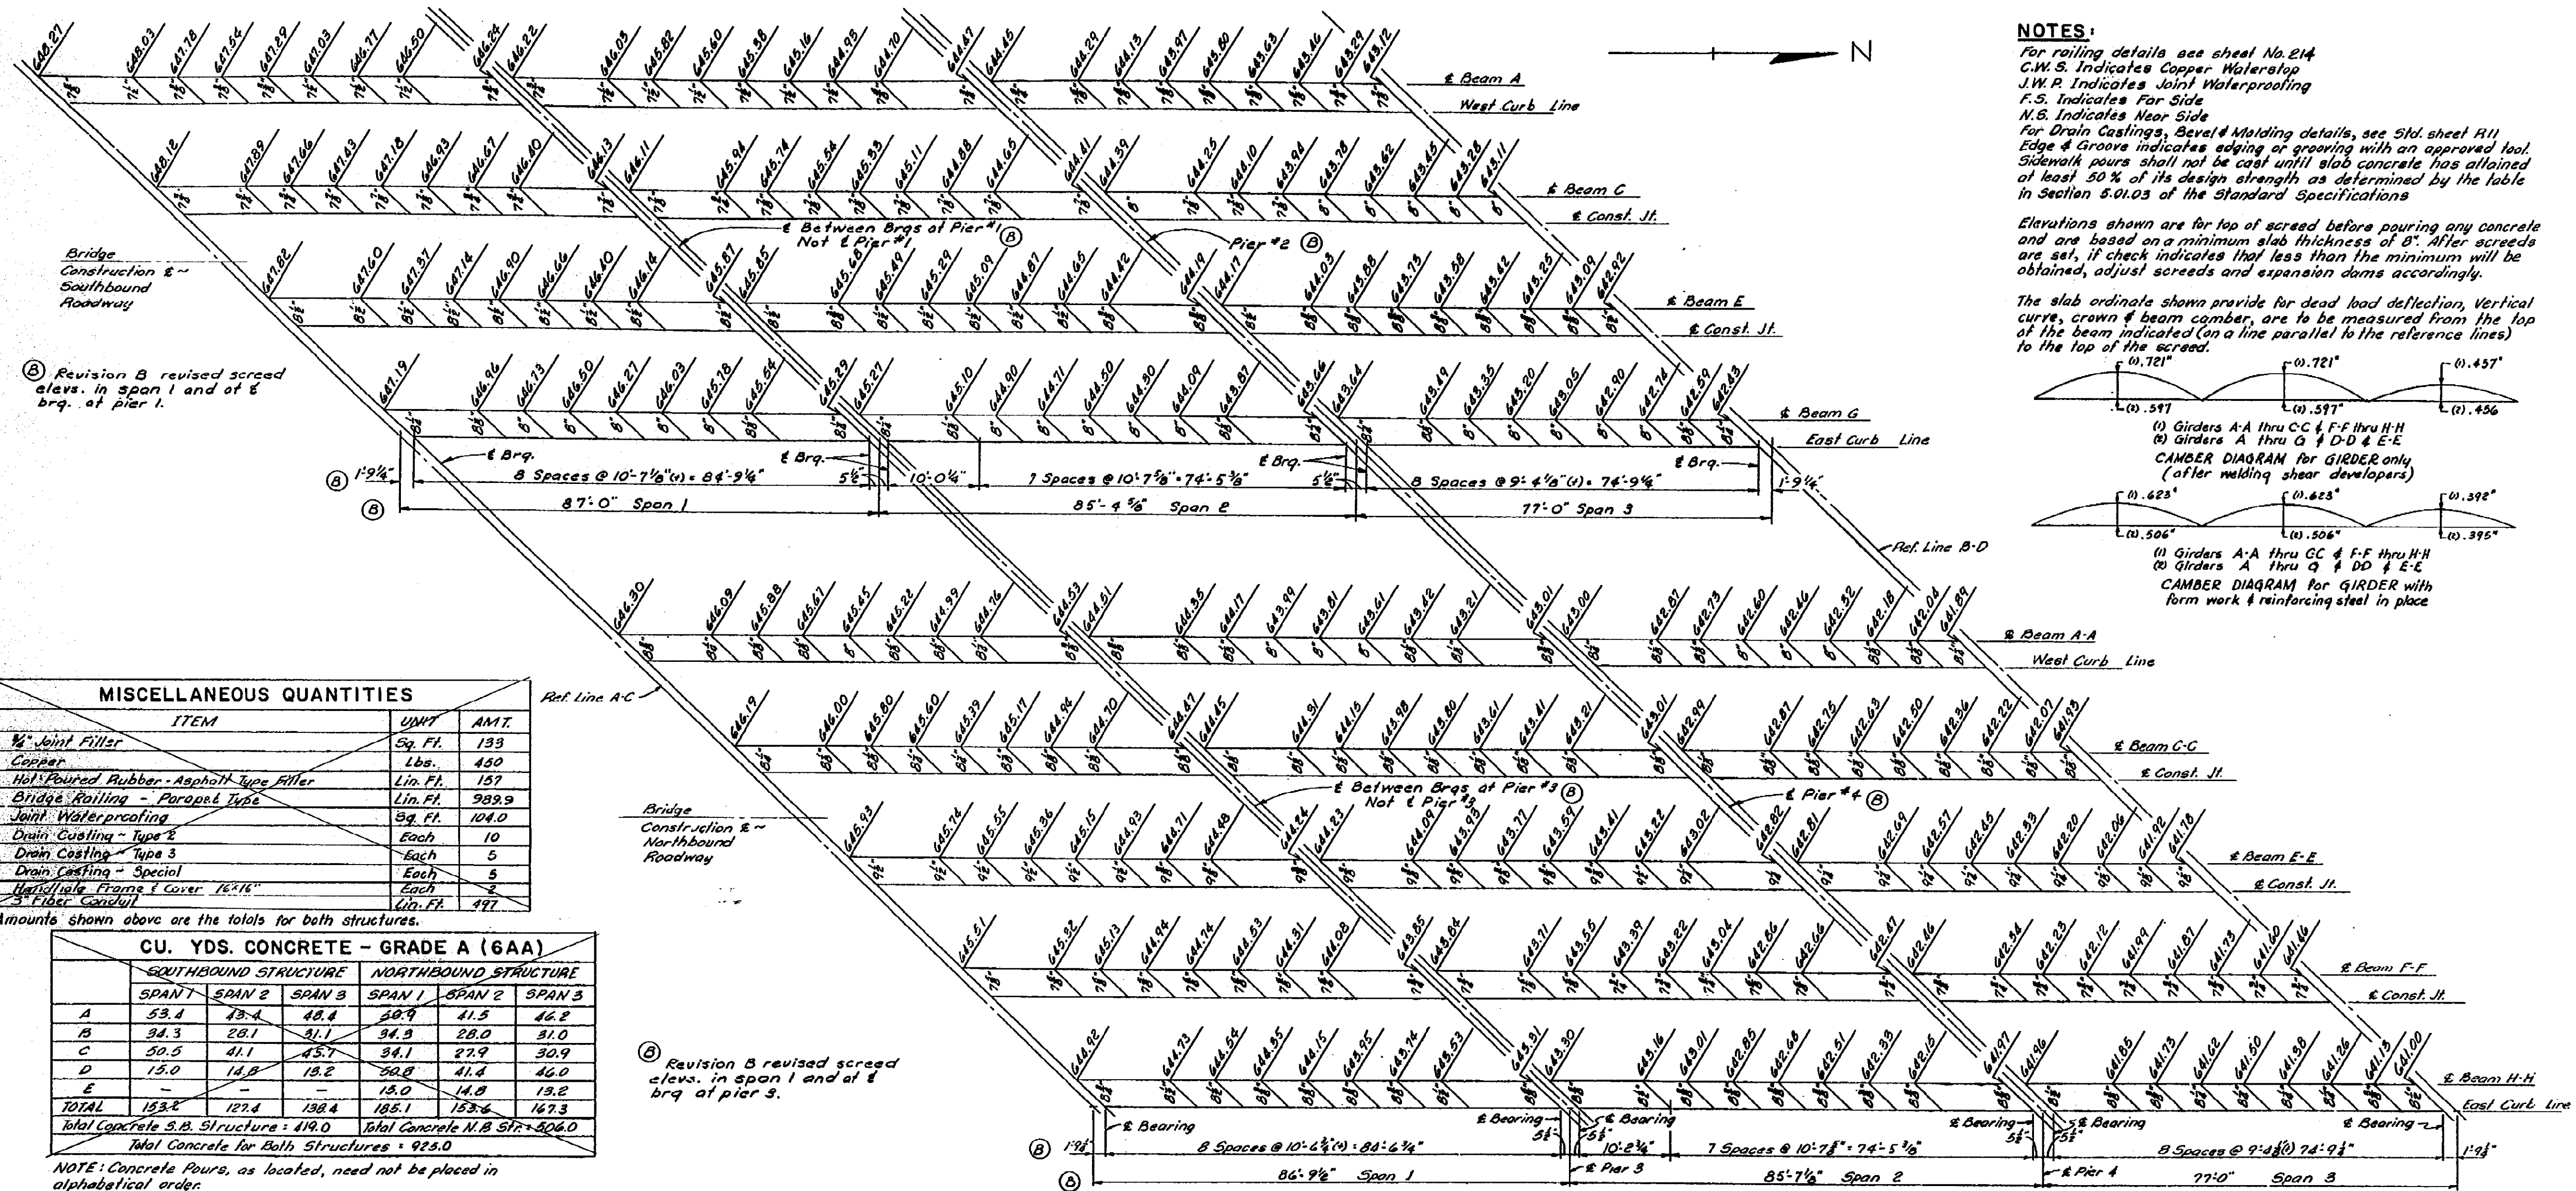


MISCELLANEOUS QUANTITIES		
ITEM	UNIT	AMT.
1/2" Joint Filler	Sq. Ft.	139
Copper	Lbs.	430
Hot Poured Rubber Asphalt Type Filler	Lin. Ft.	137
Bridge Railing - Parapet Type	Lin. Ft.	939.9
Joint Waterproofing	Sq. Ft.	104.0
Drain Casting - Type 2	Each	10
Drain Casting - Type 3	Each	5
Drain Casting - Special	Each	5
Reinforcing Bars & Cover 1/2" x 1/2"	Each	2
3" Fiber Concrete	Lin. Ft.	497

Amounts shown above are the totals for both structures.

CU. YDS. CONCRETE - GRADE A (6AA)						
SPAN	SOUTHBOUND STRUCTURE			NORTHBOUND STRUCTURE		
	SPAN 1	SPAN 2	SPAN 3	SPAN 1	SPAN 2	SPAN 3
A	53.4	73.4	48.4	50.9	41.5	46.2
B	34.3	28.1	31.1	34.3	28.0	31.0
C	50.5	41.1	45.7	34.1	27.9	30.9
D	15.0	14.8	15.2	50.8	41.4	46.0
E	-	-	-	15.0	14.8	15.2
TOTAL	153.2	127.4	138.4	185.1	153.6	167.3

Total Concrete S.B. Structure = 419.0
 Total Concrete N.B. Structure = 506.0
 Total Concrete for Both Structures = 925.0

NOTE: Concrete Pours, as located, need not be placed in alphabetical order.

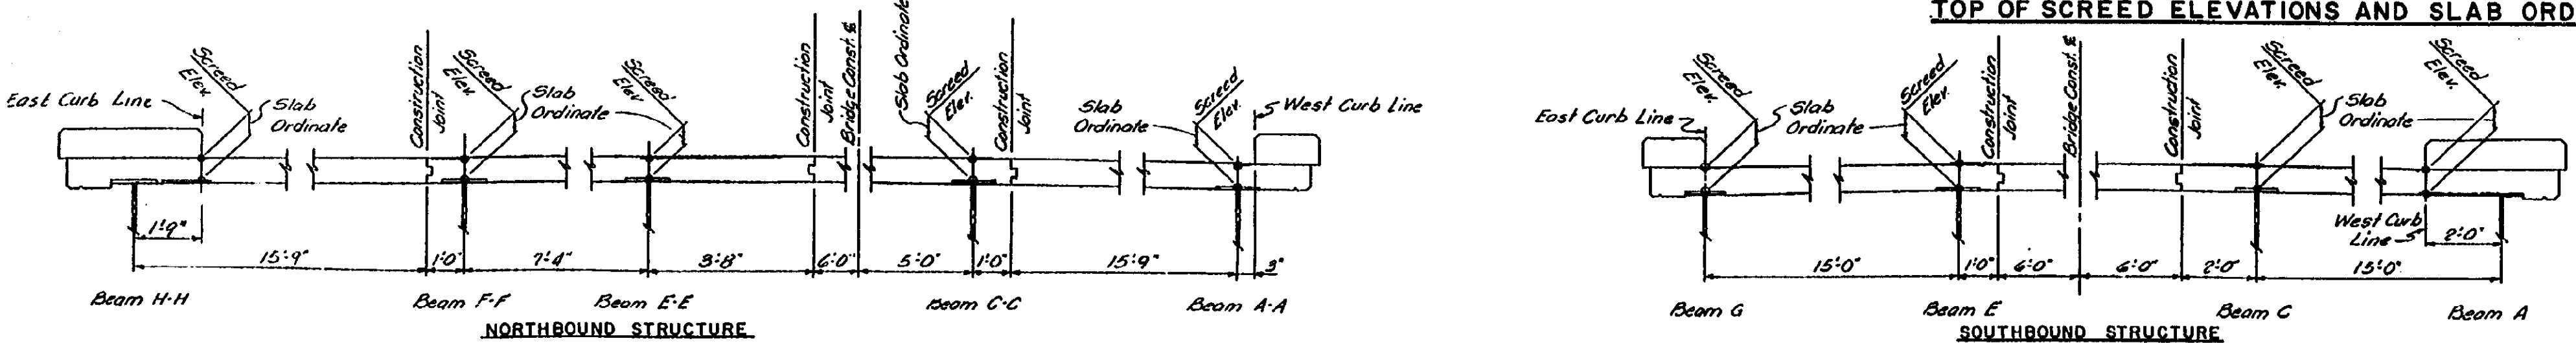

NOTE:
 DO NOT WORK FROM THIS SHEET. THE INFORMATION SHOWN HERE IS FOR REFERENCE ONLY. NO PAY ITEMS ARE SHOWN.

Work this sheet with sheets 205 thru 212, 214 & 215

MICHIGAN STATE HIGHWAY DEPARTMENT

SUPERSTRUCTURE DETAILS

TECON ENGINEERS, INC.

DATE: JCC 3-20-00
 D.H.S. 8-15-01
 P.D.H. 3-23-01
 E.H.S. 3/2

B02 OF 631741

FOR INFORMATION ONLY				
DATE	CONT. SEC.	JOB NO.	DESIGN UNIT	SHEET
02-14-00	B02 OF 63174	49595A	MAHDAVI	IV OF




DATE: 02-11-00
 CHECKED BY: INDER
 CORRECTED BY: INDER
 DRAWN BY: INDER
 FILE NAME: 602631745n



SECTION B02 OF 63174 NO. 49595A

1 2 3 4 5 6 7 8 9 10 11 12 13 14 15 16 17 18 19 20 21 22 23 24 25 26 27 28 29 30 31 32 33 34 35 36 37 38 39 40 41 42 43 44 45 46 47 48 49 50 51 52 53 54 55 56 57 58 59 60 61 62 63

REVISIONS			
NO.	DESCRIPTION	DATE	BY

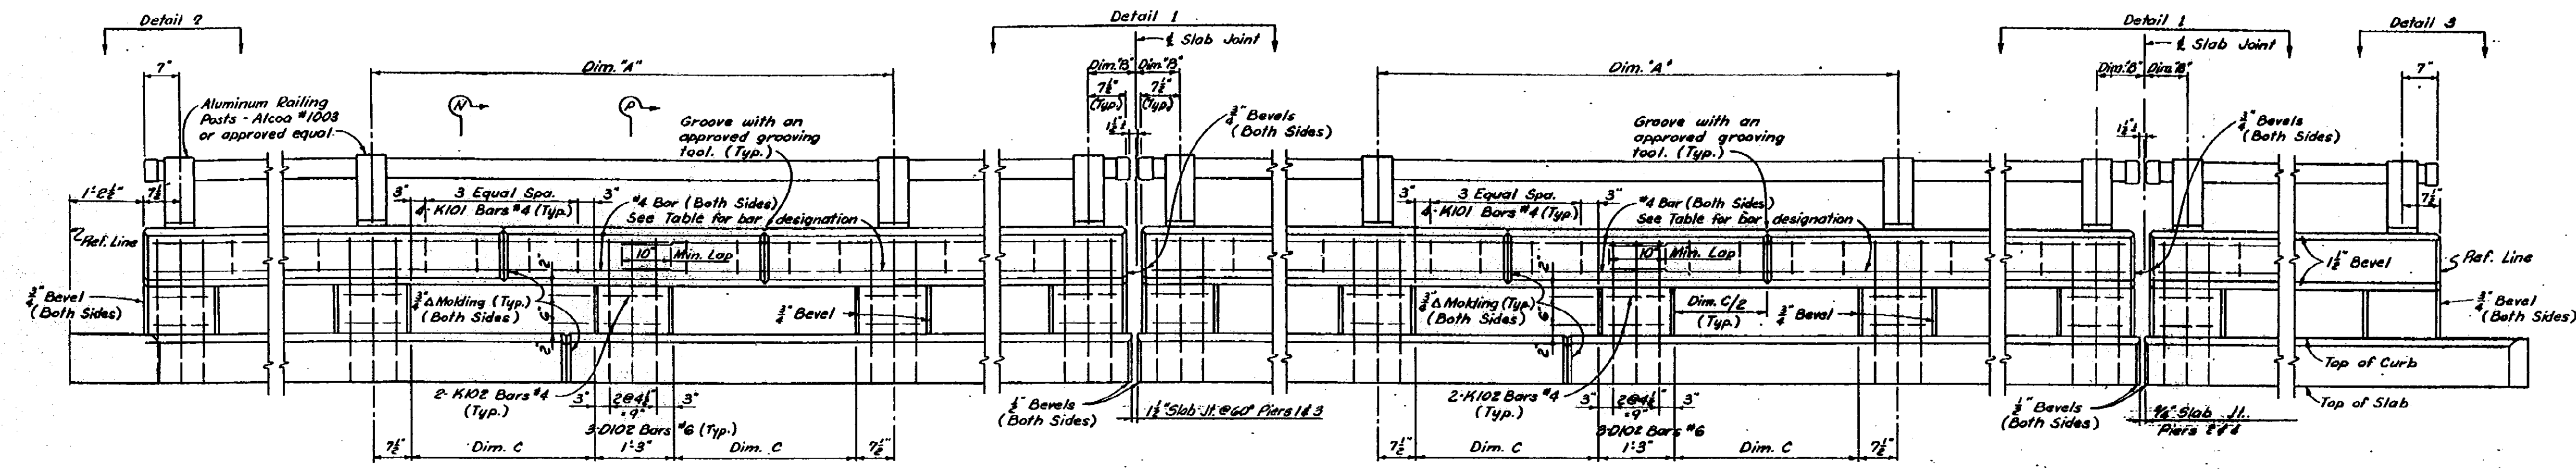


INSIDE ELEVATION - BRIDGE RAILING - PARAPET TYPE

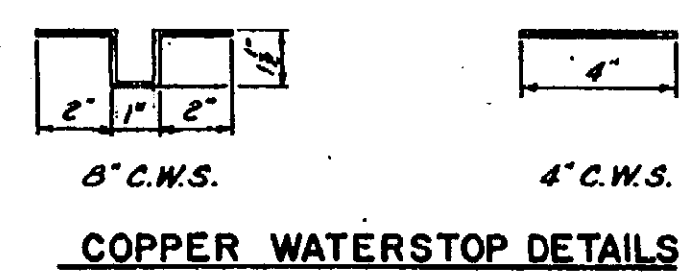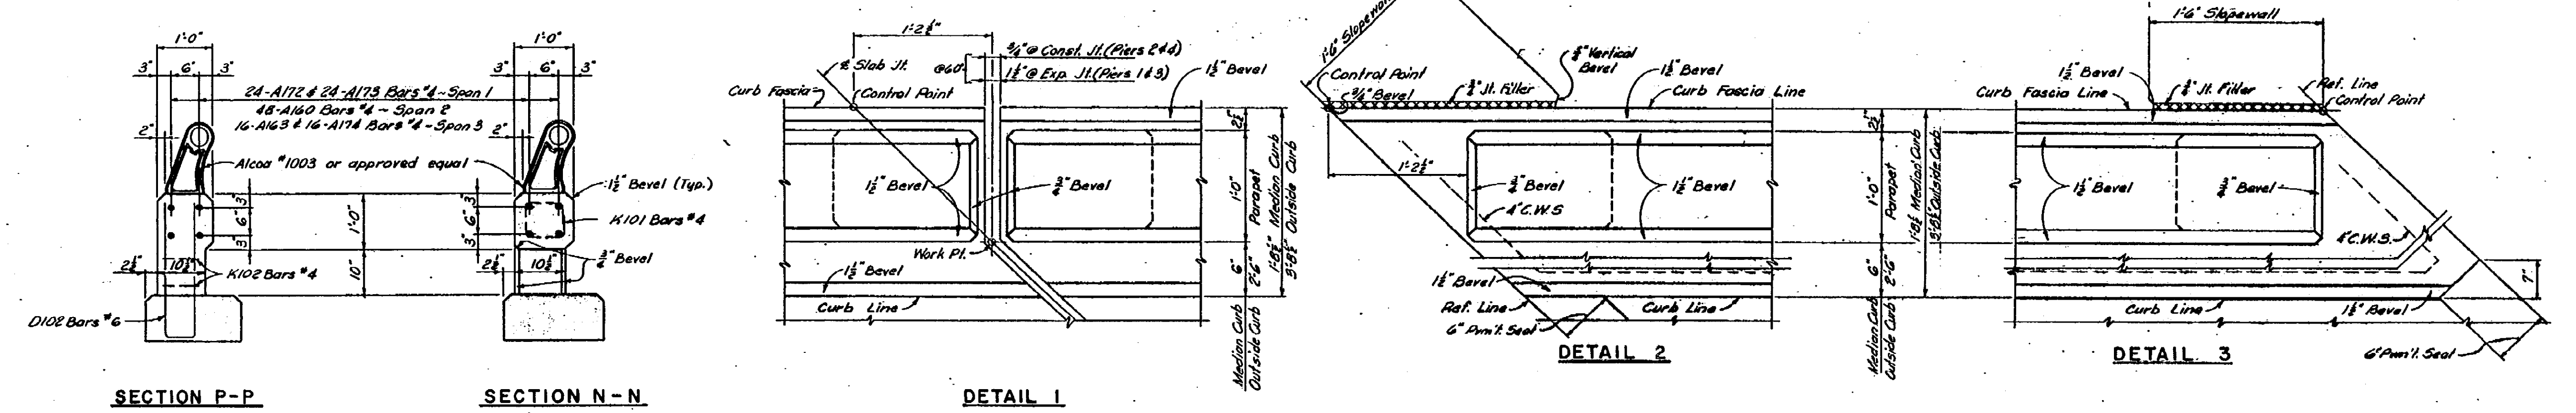

Span	S-B STRUCTURE				N-B STRUCTURE							
	EAST FASCIA		WEST FASCIA		EAST FASCIA		WEST FASCIA					
Dim. A	Dim. B	Dim. C	Length Steel	Dim. A	Dim. B	Dim. C	Length Steel	Dim. A	Dim. B	Dim. C	Length Steel	
1	4'-4"	9'-2"	5'-5 1/2"	A172	4'-4"	9'-2"	5'-5 1/2"	A172	4'-4"	9'-2"	5'-5 1/2"	A172
2	9'-4"	10'-2"	5'-5 1/2"	A160	9'-4"	10'-2"	5'-5 1/2"	A160	9'-4"	10'-2"	5'-5 1/2"	A160
3	9'-4"	10'-2"	5'-5 1/2"	A168	9'-4"	10'-2"	5'-5 1/2"	A168	9'-4"	10'-2"	5'-5 1/2"	A168

- ⓐ Use A165 in long section, A176 in short section
- ⓑ Use A174 in long section, A169 in short section
- * 9\"/>
- ** 8 1/4\"/>
- *** 8 3/8\"/>
- ⓓ 6 3/8\"/>

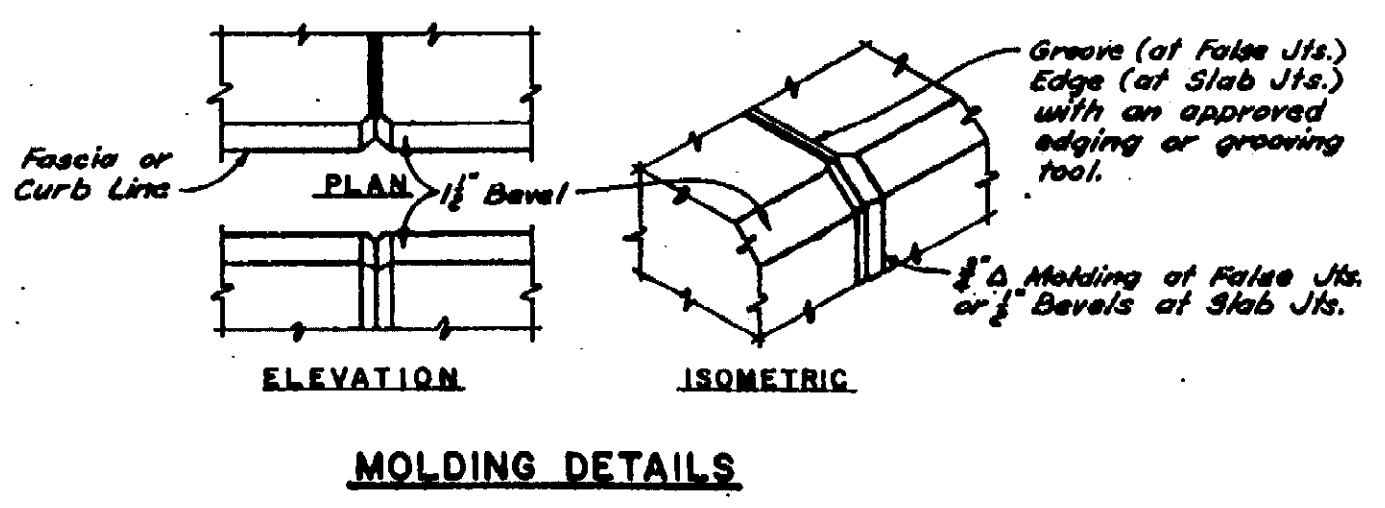

Work this sheet with sheets 205 thru 213

**MICHIGAN STATE HIGHWAY DEPARTMENT
SUPERSTRUCTURE DETAILS**

TECON ENGINEERS, INC.
REVISIONS

NO.	DESCRIPTION	DATE	BY

DESIGNED BY: J.P.G. 1-20-62
 CHECKED BY: Q.A.S. 5-18-62
 DRAWN BY: J.D.V. 5-18-62
 DATE: 5-18-62

B02 of 63174

NOTE:
DO NOT WORK FROM THIS SHEET. THE INFORMATION SHOWN HERE IS FOR REFERENCE ONLY. NO PAY ITEMS ARE SHOWN.



FOR INFORMATION ONLY


DATE	CONT. SEC.	JOB NO.	DESIGN UNIT	SHEET
02-14-00	B02 OF 63174	49595A	MAHDAVI	1W OF

DRAWN BY: INDER DATE: 02-11-00 CHECKED BY: INDER DATE: 02-11-00 CORRECTED BY: INDER DATE: 02-11-00

SECTION B02 OF 63174 JOB 49595A

1 2 3 4 5 6 7 8 9 10 11 12 13 14 15 16 17 18 19 20 21 22 23 24 25 26 27 28 29 30 31 32 33 34 35 36 37 38 39 40 41 42 43 44 45 46 47 48 49 50 51 52 53 54 55 56 57 58 59 60 61 62 63

REVISIONS			
NO.	DESCRIPTION	DATE	BY

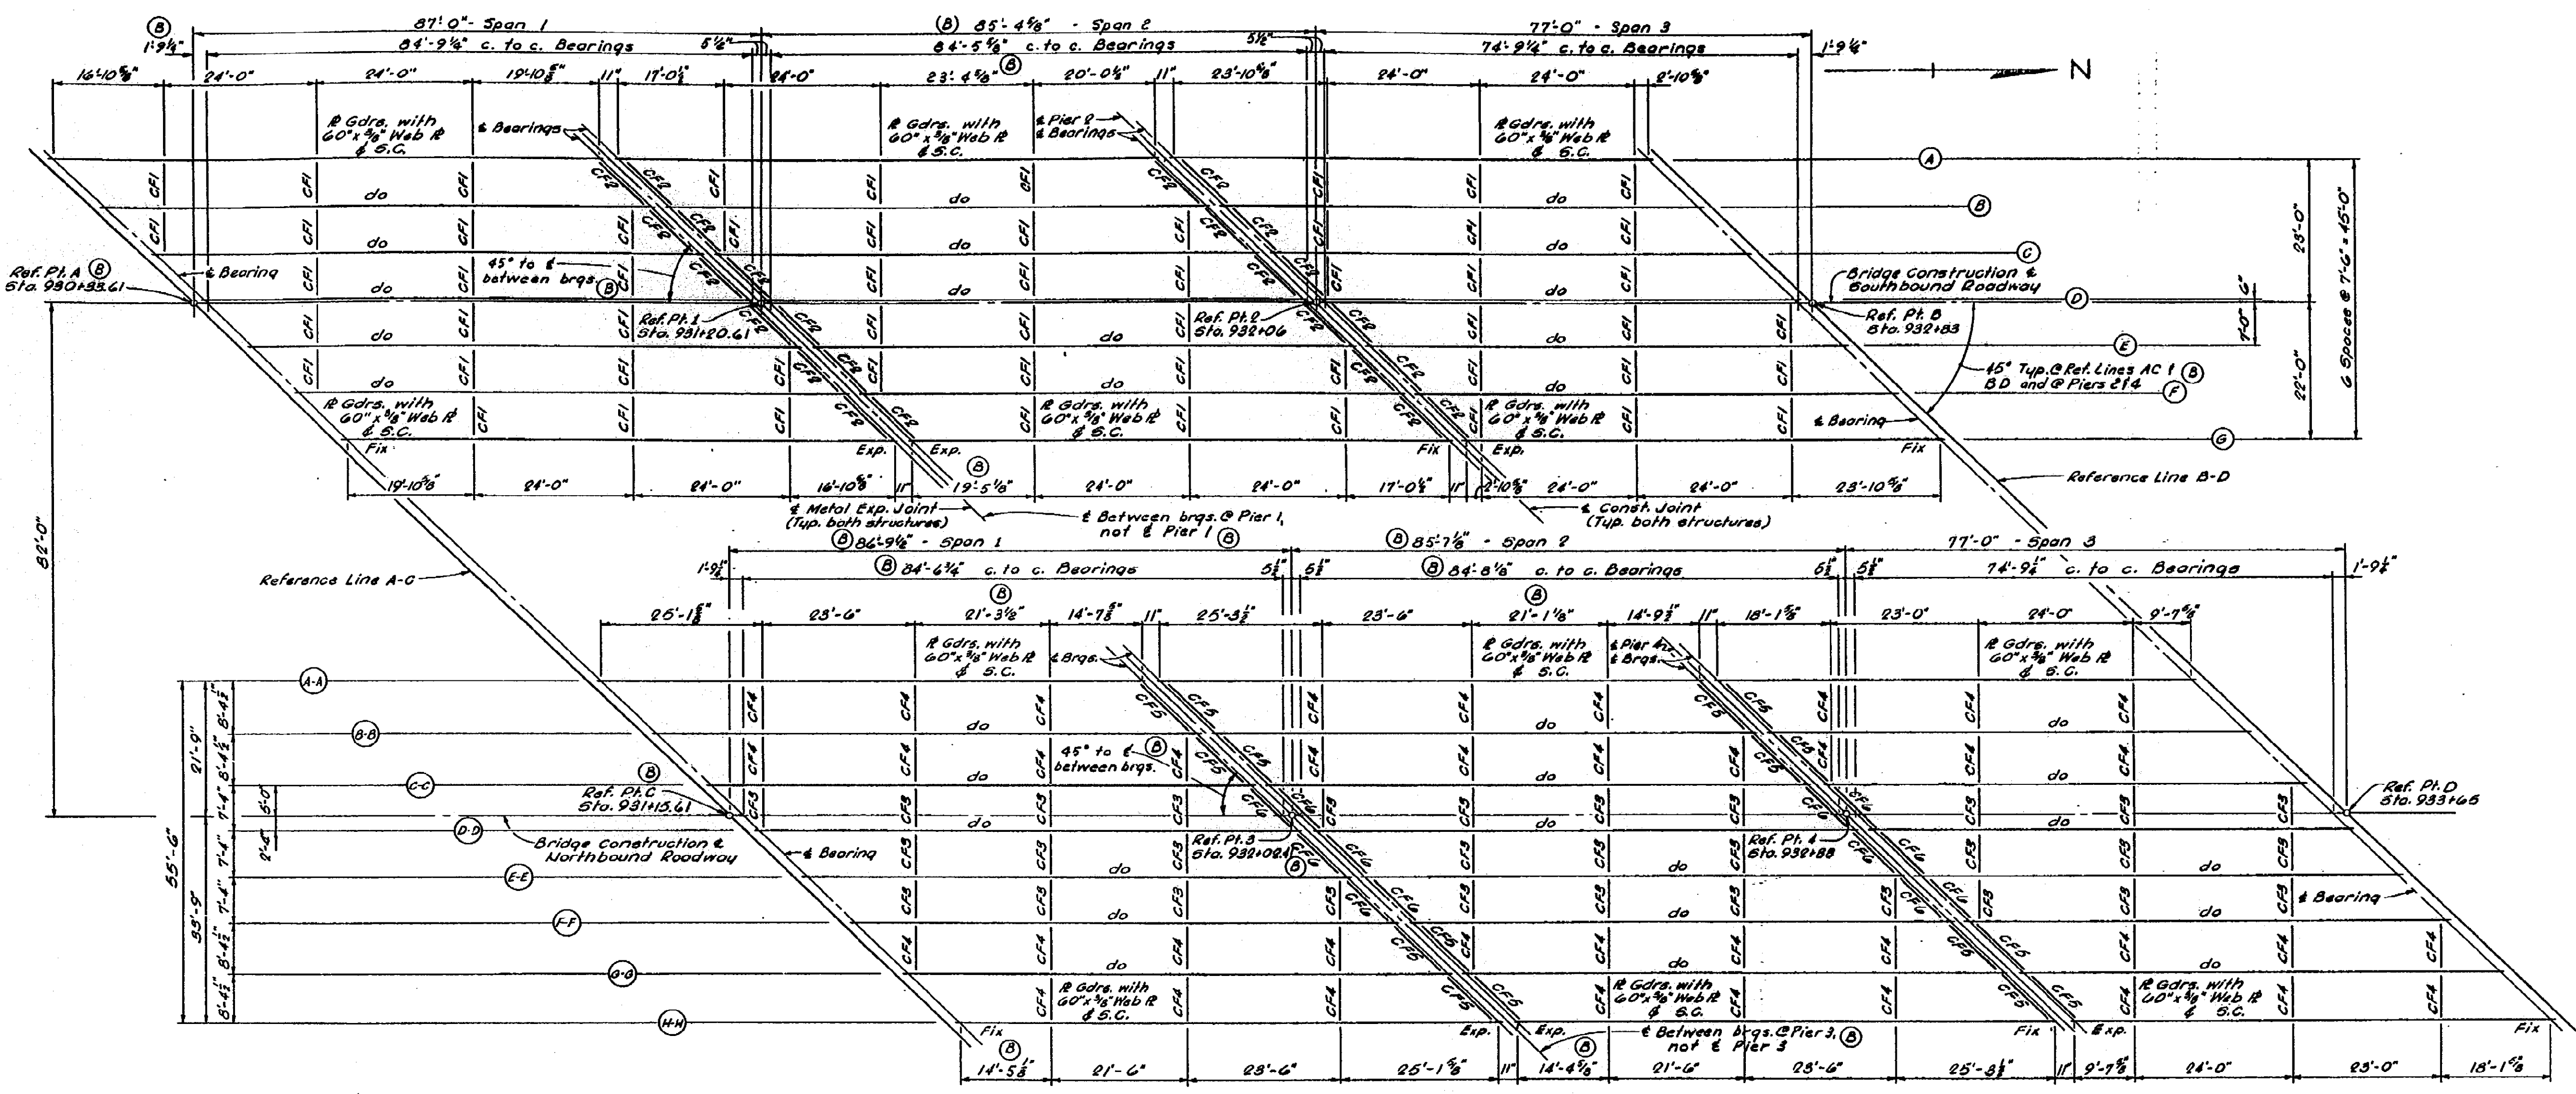

ERECTOR DIAGRAM

Note: For relationship of ϵ between bearings of Piers 1 & 3 and ϵ of Piers 1 & 3, see sheet 202A.

STRUCTURAL STEEL NOTES:

Fabrication: Michigan State Highway Department's Standard Specifications for Road and Bridge Construction - 1960 Edition.
Design: Michigan State Highway Department's Specifications for Design of Highway Bridges - 1958 Edition. M20-516-44
 Loading & alternate military loading. Allowable live load plus impact deflection = Span \pm 1000.
Shop Connections: All shop connections shall be welded or riveted as shown on the plans.
Field Connections: Field connections, unless otherwise noted, shall be bolted with high-strength bolts. Contact surfaces shall be thoroughly cleaned immediately prior to assembly of joints. High-Strength Bolts - $\frac{3}{4}$ "
Open Holes: Open holes for high-strength bolts shall be $\frac{1}{16}$ " unless otherwise noted.
Shop Paint: In addition to the shop paint provisions of the standard Specifications the top surfaces of masonry plates shall be coated in accordance with the requirements for machine finished surfaces. Top surfaces of all girders shall receive one coat of bolted lined oil only. Metal floor joints shall not be painted in shop except as noted on the plans.
Combar: The girders shall be cambered as shown on the plans.
Sole Plates: Sole plates 3" or more in thickness may be built up by welding together plates not less than $\frac{1}{4}$ " in thickness. Edges must be beveled $\frac{1}{4}$ " and welded, with a continuous weld, for the full perimeter. Welds shall be ground flush with face of plate.
 All Web Plates, Flange Plates and stiffeners shall conform to the requirements for welding (A.S.T.M. A-373). All other steel shall be A-37.
 The quantity "Structural Steel - Furnishing and Fabricating" includes:
 105,800# A-7 Steel (Includes Wt. Metal Exp. Jt. of light standard anchor bolt assembly)
 597,250# A-373 Steel (For details of light standard anchor bolt assembly see sh. # 207)
 850# Lead Plates
 Total 805,900# Structural Steel - Furnishing & Fabricating
 Total 805,900# Structural Steel - Erection
 Field Painting - Lump Sum
 Spiral Shear Developers - 1251#
 Camber and other dimensional tolerances are to be in accordance with American Welding Society Specifications. The Contractor may substitute studs for the spiral shear developers shown on the drawings if he submits details of the proposed substitution and obtains approval of the M.S.H.D. Design Office prior to making the substitution.

Work this sheet with sheets 215, 216, 218 & 219

MICHIGAN STATE HIGHWAY DEPARTMENT
STRUCTURAL STEEL DETAILS

TECON ENGINEERS, INC.

REVISIONS	
NO.	DESCRIPTION

DATE: 02-14-00
 DRAWN BY: INDER
 CHECKED BY: INDER
 CORRECTED BY: INDER
 DATE: 02-11-00

FILE NAME: B0263174s

NOTE:
 DO NOT WORK FROM THIS SHEET. THE INFORMATION SHOWN HERE IS FOR REFERENCE ONLY. NO PAY ITEMS ARE SHOWN.



FOR INFORMATION ONLY				
DATE	CONT. SEC.	JOB NO.	DESIGN UNIT	SHEET
02-14-00	B02 OF 63174	49595A	MAHDAVI	1X OF

1 2 3 4 5 6 7 8 9 10 11 12 13 14 15 16 17 18 19 20 21 22 23 24 25 26 27 28 29 30 31 32 33 34 35 36 37 38 39 40 41 42 43 44 45 46 47 48 49 50 51 52 53 54 55 56 57 58 59 60 61 62 63

REVISIONS			
NO.	DESCRIPTION	DATE	BY







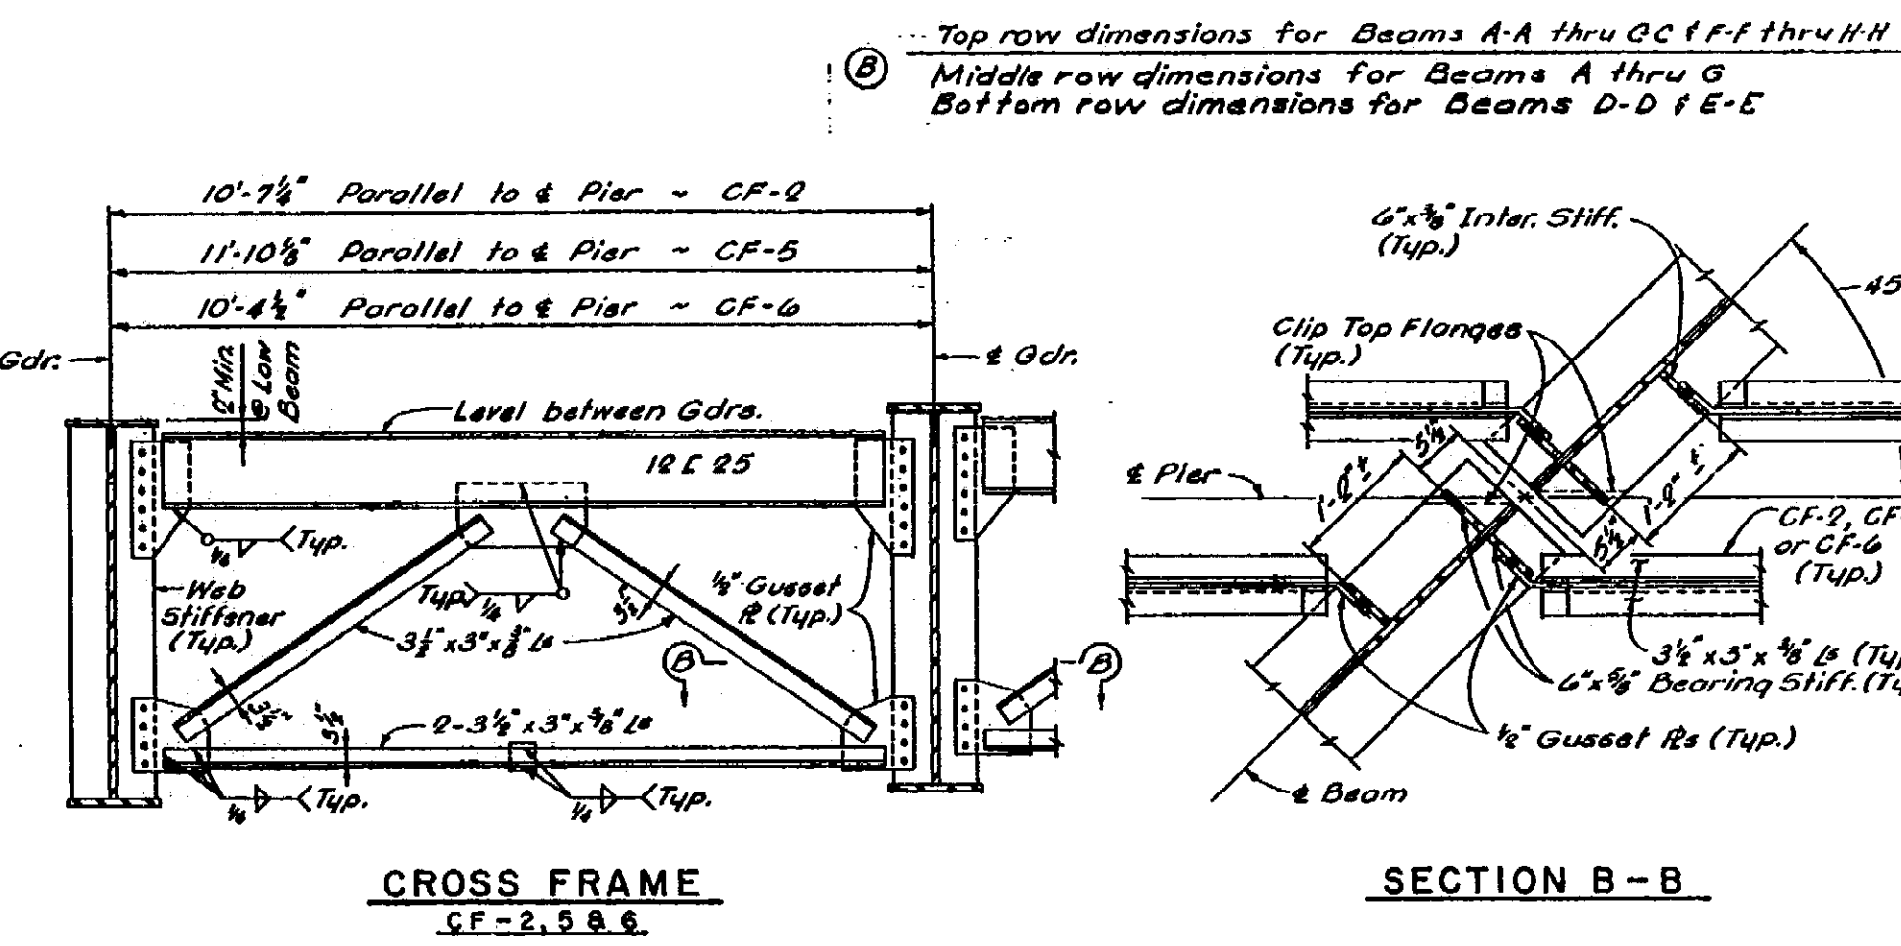


TABLE OF THEORETICAL CAMBER

CONSTRUCTION STAGE	GIRDER	GIRDER POSITION				GIRDER POSITION			
		SPAN 1		SPAN 2		SPAN 1		SPAN 2	
		FLAT	UPRIGHT	FLAT	UPRIGHT	FLAT	UPRIGHT	FLAT	UPRIGHT
After cutting web and assembling	A thru G	1.125	.875	.875	.700	A thru G	1.250	.875	.875
After welding flanges & stiffeners	D thru G	1.125	.847	.875	.700	C thru F	1.250	.891	.875
After welding shear connectors	E thru G		.597		.456	H thru H		.721	

NOTE: At this stage camber should be corrected within $\pm \frac{1}{8}$ " tolerance by heating in the shop.

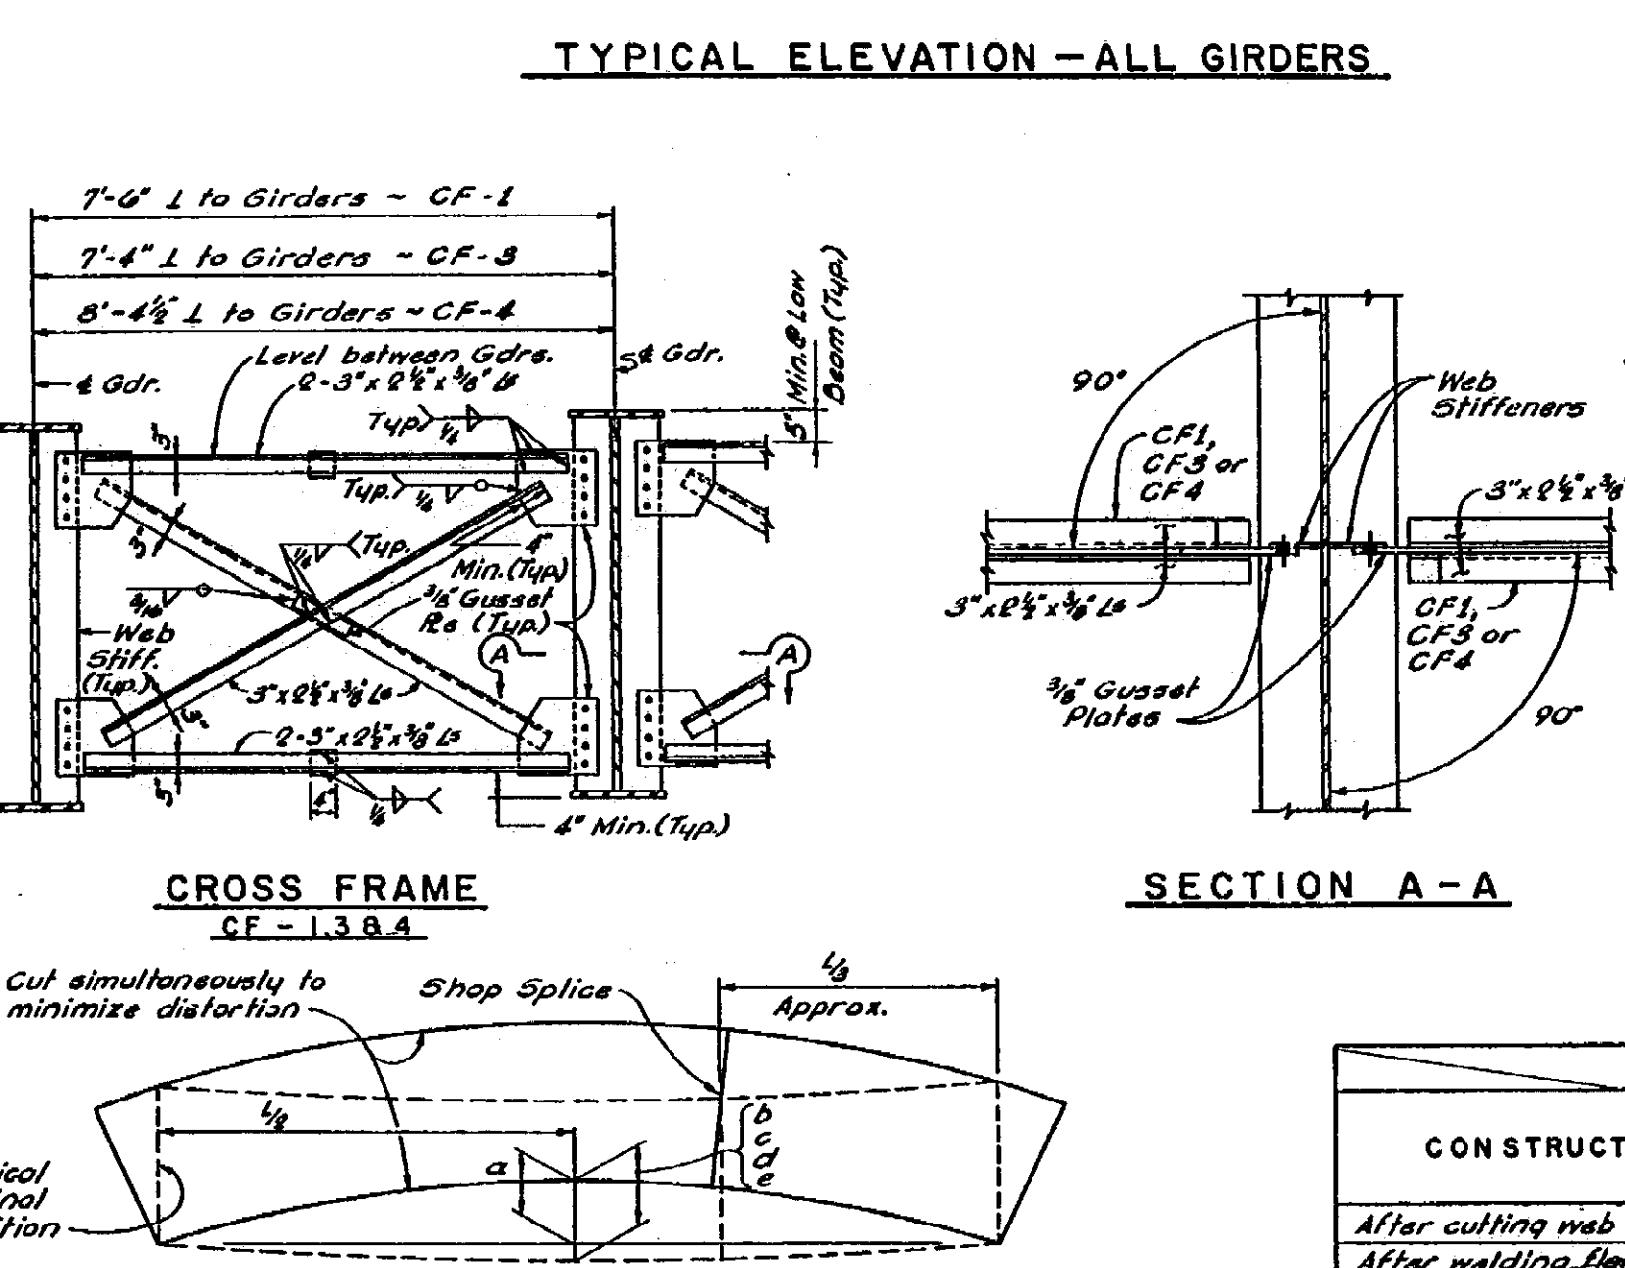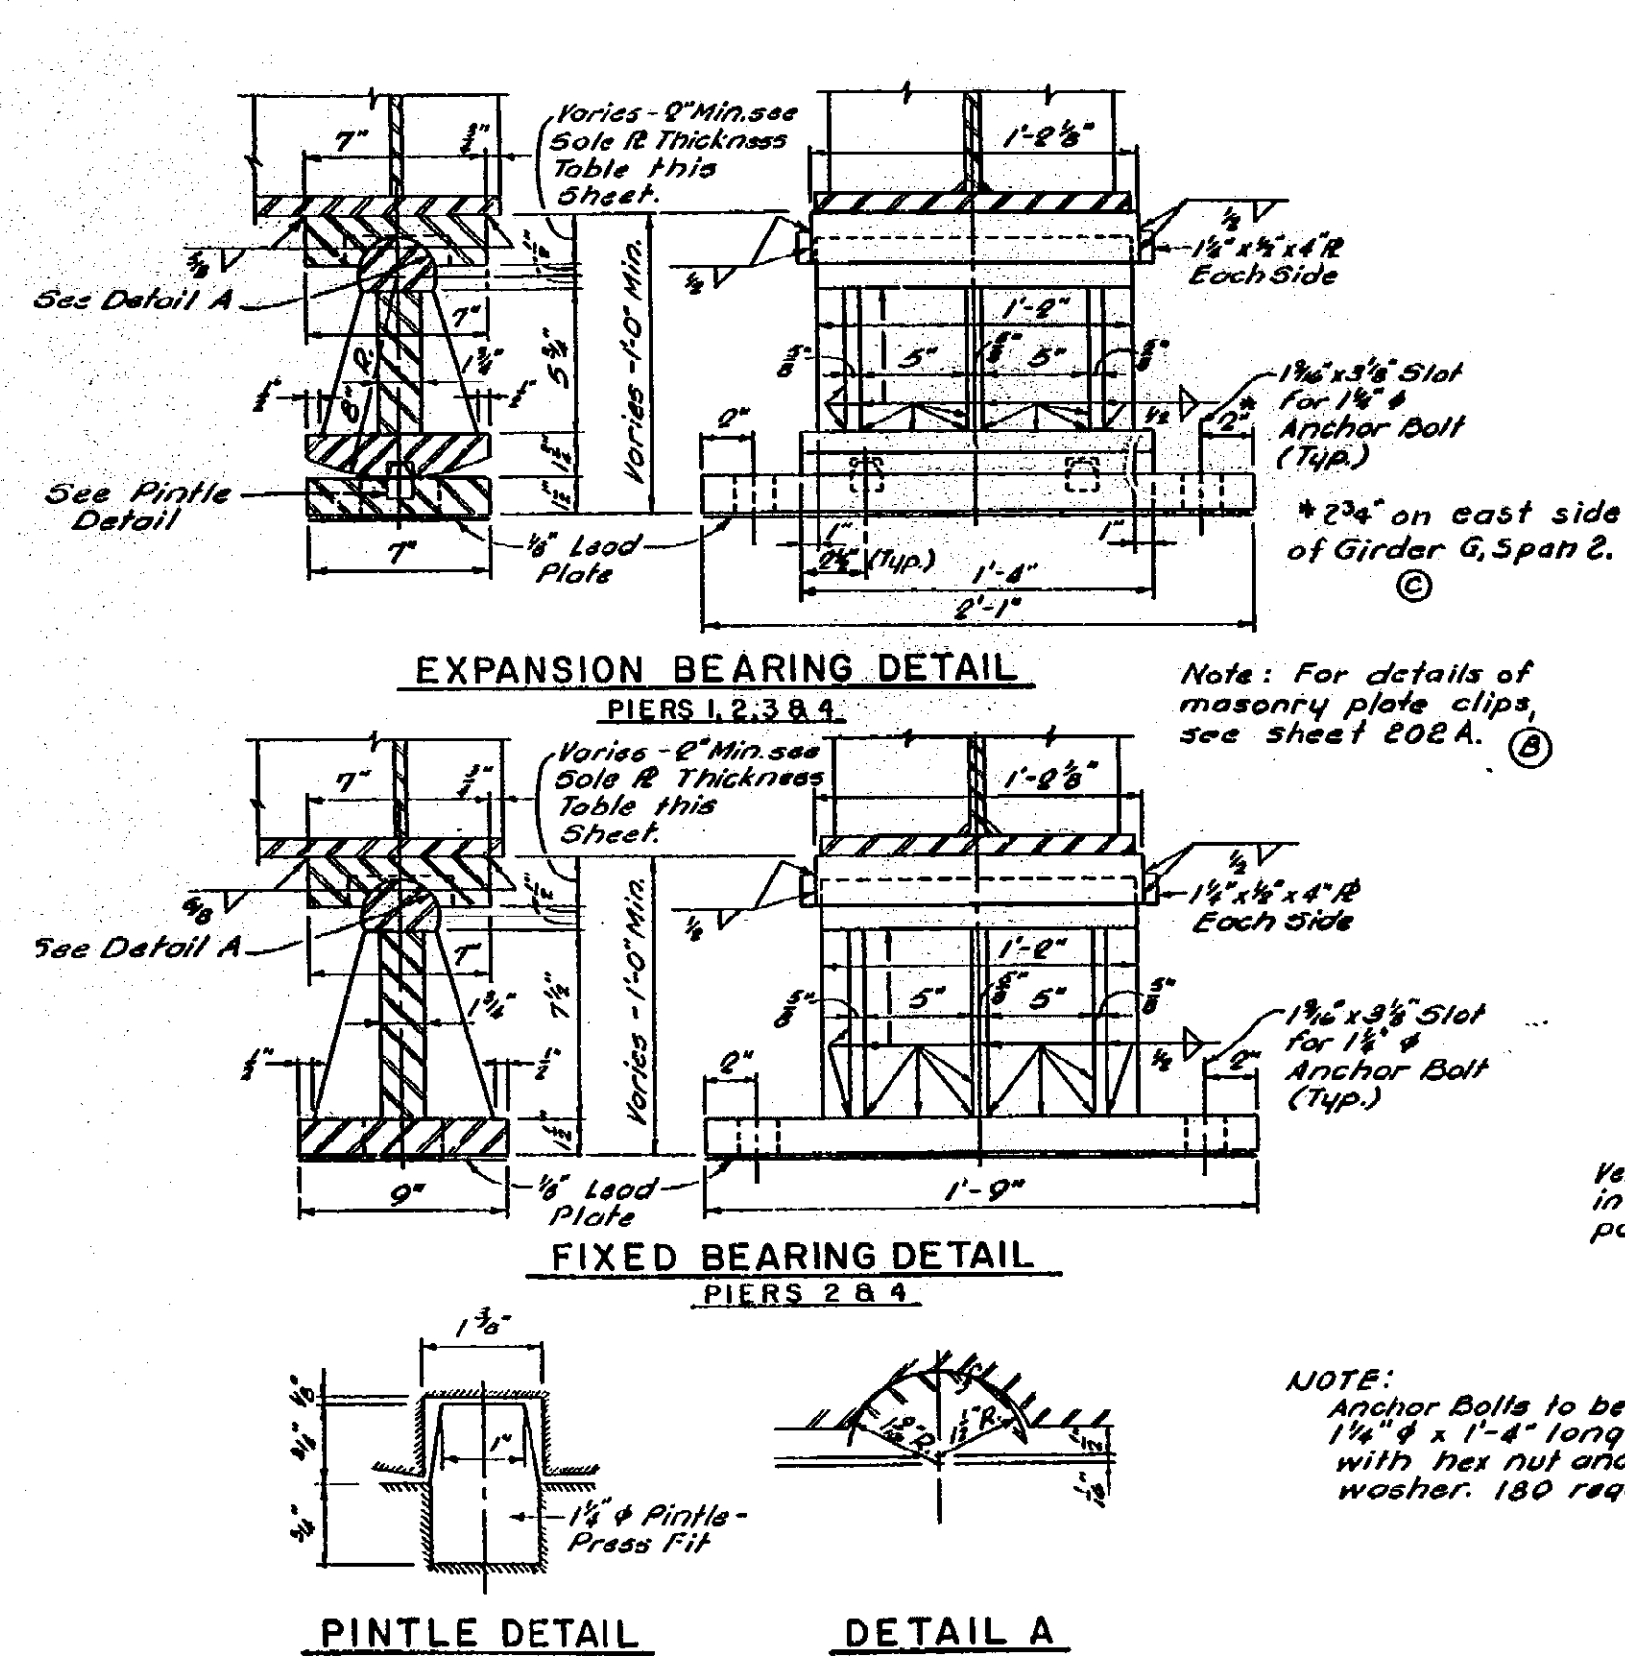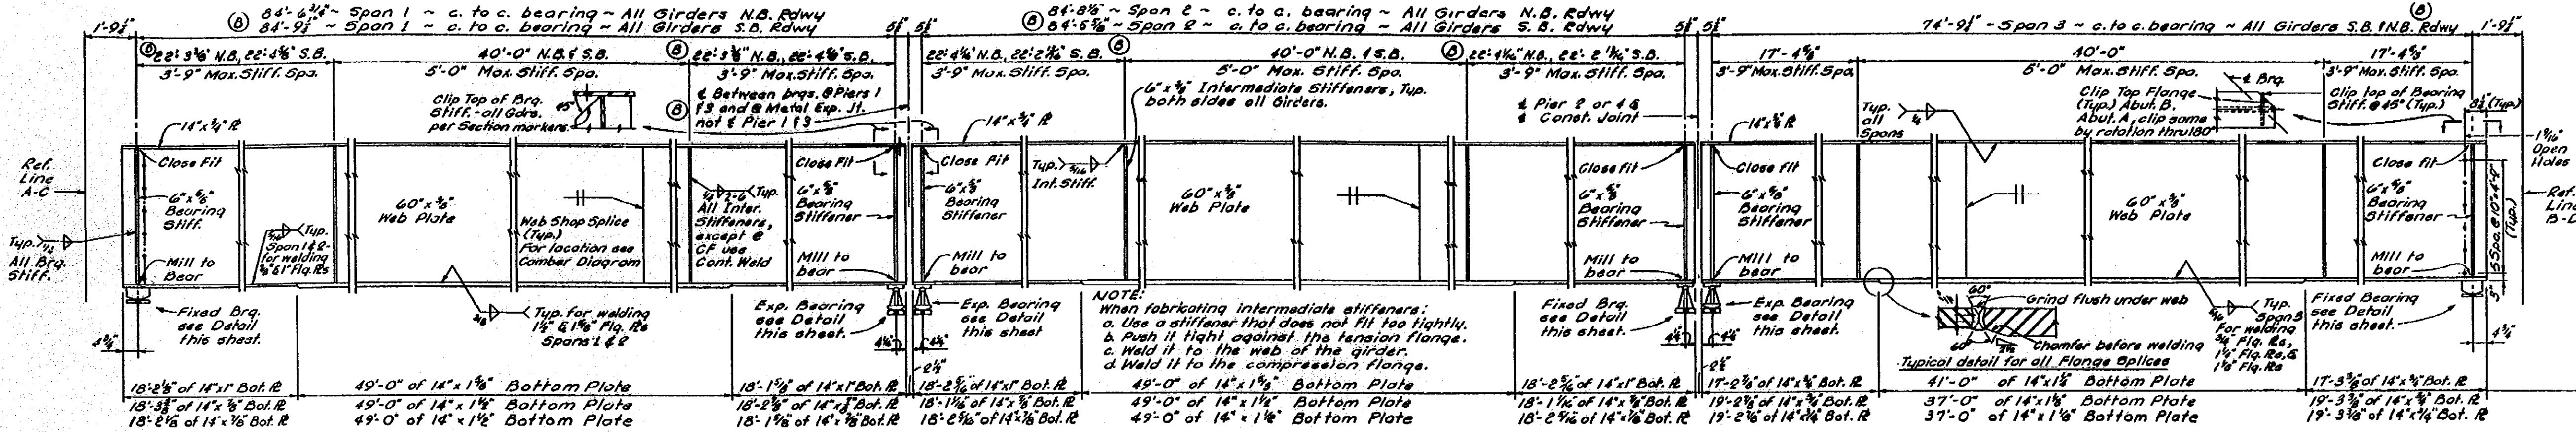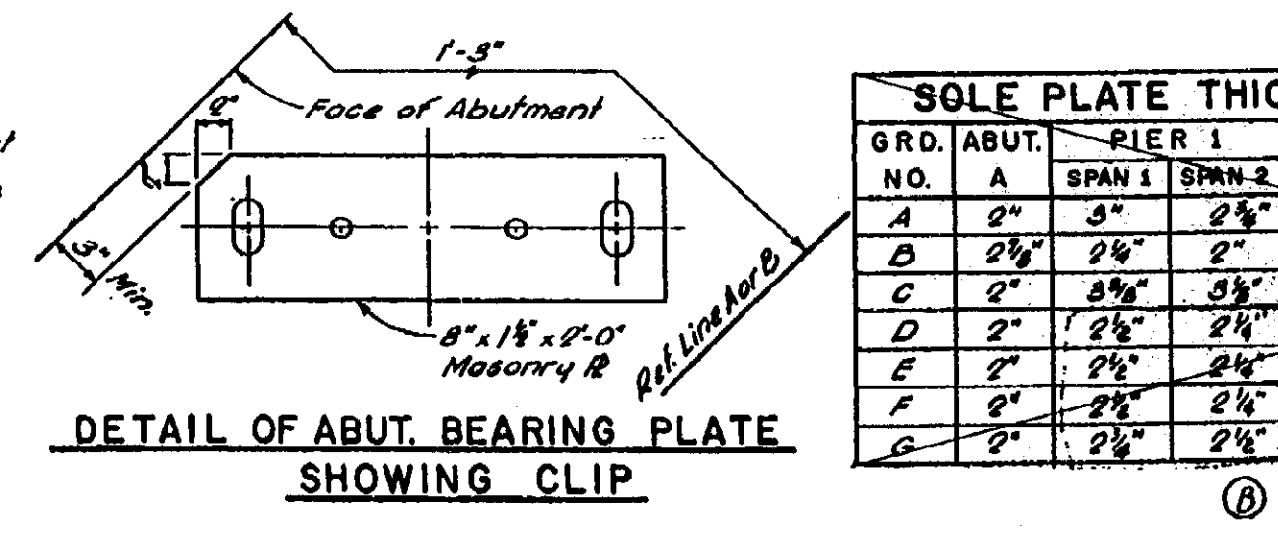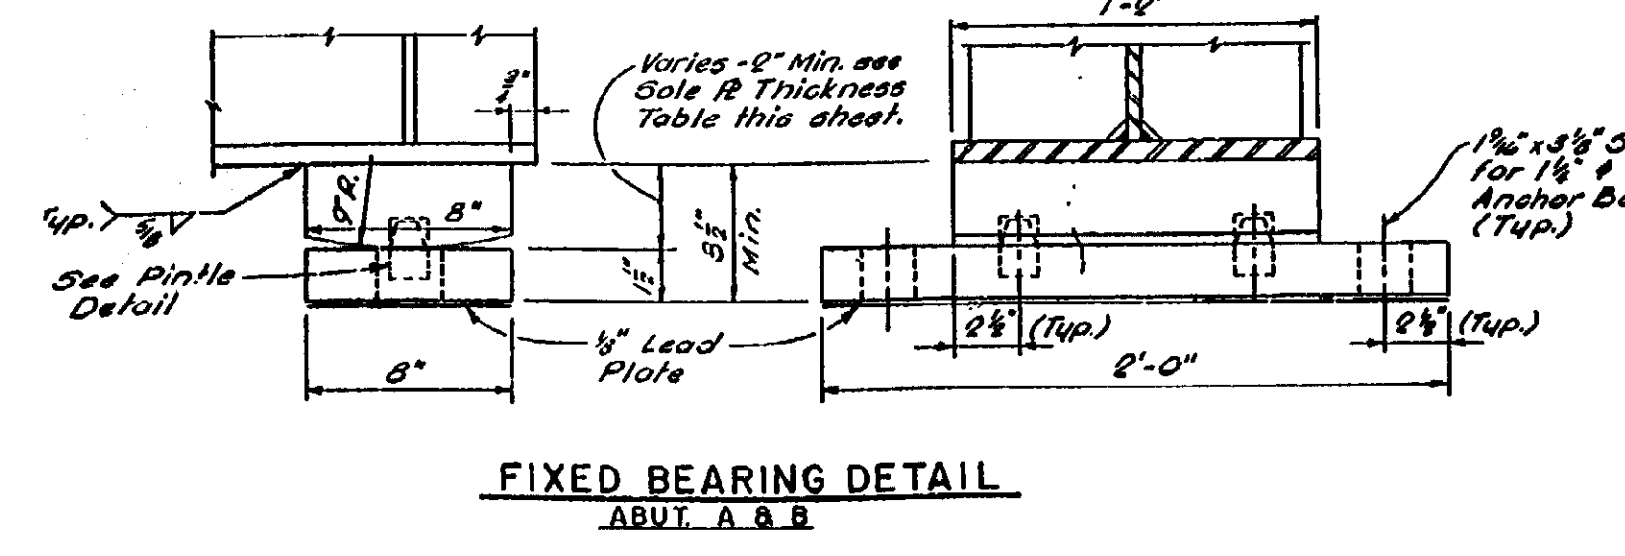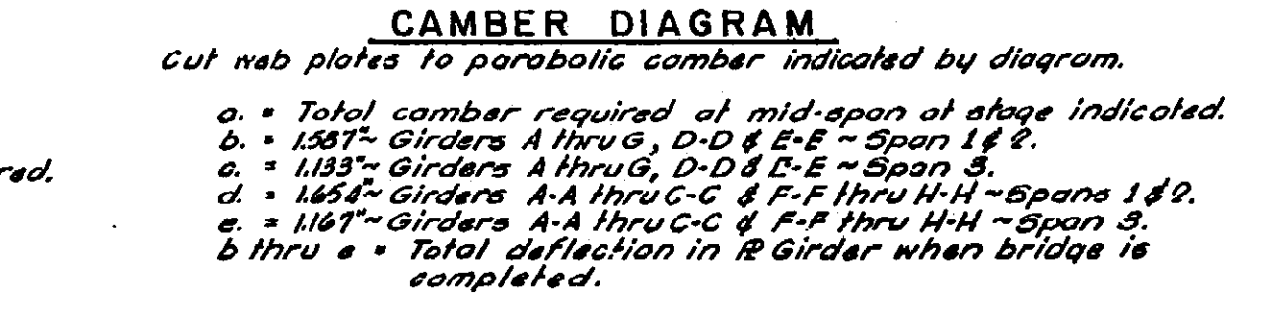

SOLE PLATE THICKNESS TABLE

GRD. NO.	ABUT.	PIER 1	PIER 2	ABUT.
A	B	SPAN 1	SPAN 2	SPAN 3
A	2"	3"	2"	2"
B	2"	2"	2"	2"
C	2"	2"	2"	2"
D	2"	2"	2"	2"
E	2"	2"	2"	2"
F	2"	2"	2"	2"
G	2"	2"	2"	2"

SOLE PLATE THICKNESS TABLE

GRD. NO.	ABUT.	PIER 3	PIER 4	ABUT.
A-A	B	SPAN 1	SPAN 2	SPAN 3
A-A	3"	4"	4"	2"
B	2"	2"	2"	2"
C	2"	2"	2"	2"
D	2"	2"	2"	2"
E	2"	2"	2"	2"
F	2"	2"	2"	2"
G	2"	2"	2"	2"

Work this sheet with sheets 217, & 219

MICHIGAN STATE HIGHWAY DEPARTMENT

STRUCTURAL STEEL DETAILS

TECON ENGINEERS, INC.

REVISIONS

NO.	DESCRIPTION	DATE	BY
1	Rev. anchor bolt dia.	2/28/00	RGE
2	Revised span lengths spans 1 & 2	2/28/00	R.G.
3	1/8" and rev. sole plates	2/28/00	JEB

B02 OF 63174

NOTE: DO NOT WORK FROM THIS SHEET. THE INFORMATION SHOWN HERE IS FOR REFERENCE ONLY. NO PAY ITEMS ARE SHOWN.


FOR INFORMATION ONLY

DATE	CONT. SEC.	JOB NO.	DESIGN UNIT	SHEET
02-14-00	B02 OF 63174	49595A	MAHDAVI	11 OF 19

FILE NAME: 60263174sn DRAWN BY: INGER CHECKED BY: DATE: 02-11-00 CORRECTED BY: INGER DATE:


1 2 3 4 5 6 7 8 9 10 11 12 13 14 15 16 17 18 19 20 21 22 23 24 25 26 27 28 29 30 31 32 33 34 35 36 37 38 39 40 41 42 43 44 45 46 47 48 49 50 51 52 53 54 55 56 57 58 59 60 61 62 63

REVISIONS			
NO.	DESCRIPTION	DATE	BY

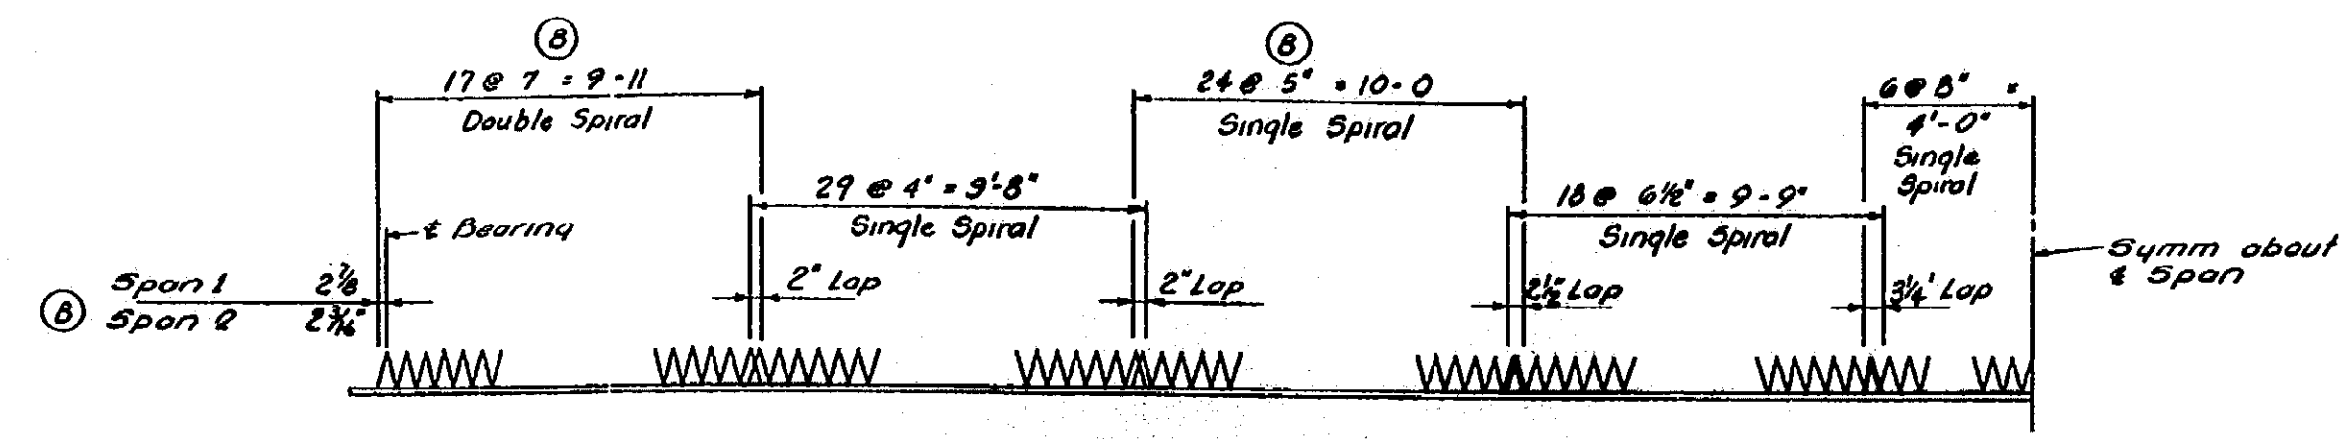


SPIRAL SHEAR DEVELOPERS
SPANS 1 & 2 N-B, GIRDERS A-A THRU C-C & F-F THRU H-H
5/8" # Spiral - 4 1/2" mean #


NOTE Stop shear connectors short of Top Flg. clip & Metal Clip Jt Conn

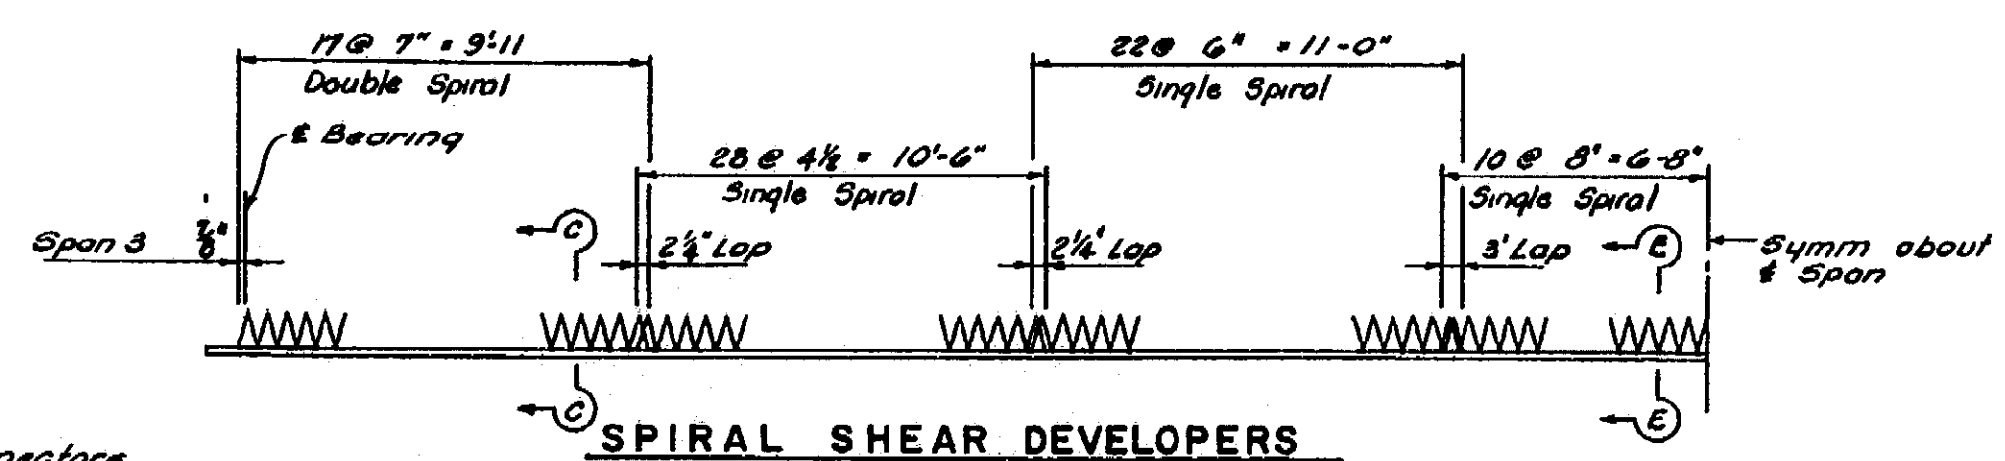


SPIRAL SHEAR DEVELOPERS
SPAN 3 N-B & S-B, GIRDERS A THRU G & A-A THRU H-H
5/8" # Spiral - 4 1/2" mean #

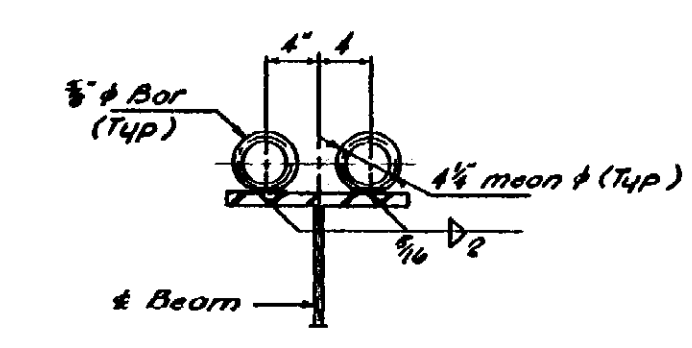


SECTION C-C

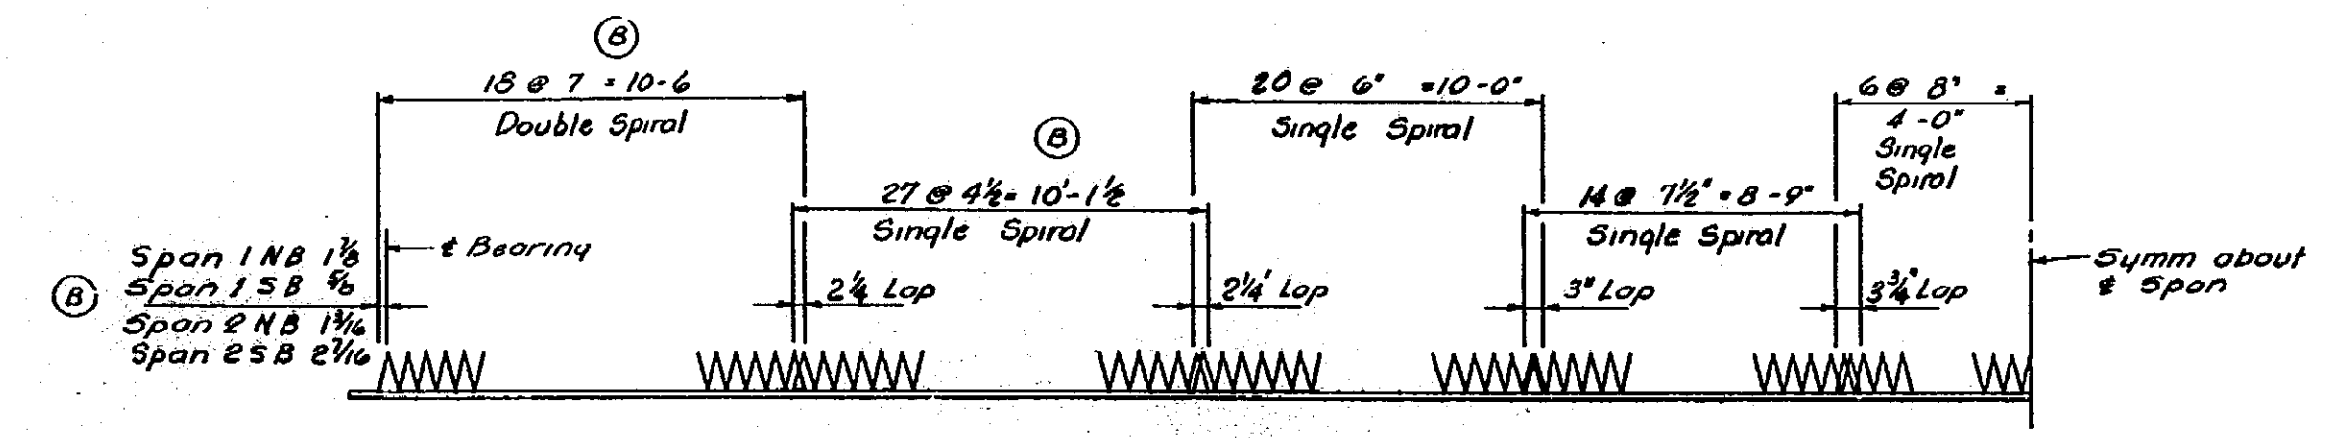


SPIRAL SHEAR DEVELOPERS
SPANS 1 & 2 N-B & S-B, GIRDERS A THRU G, D-D & E-E
5/8" # Spiral - 4 1/2" mean #

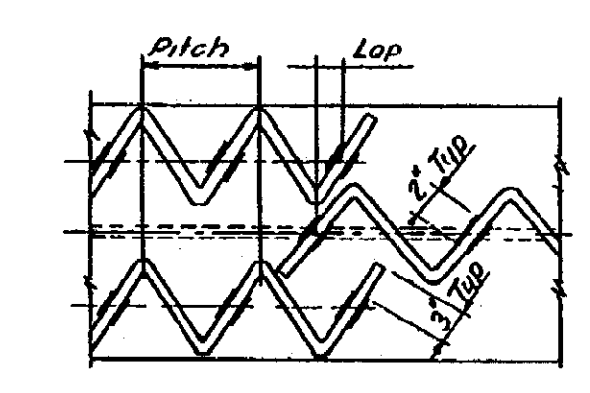

PART PLAN
SINGLE DOUBLE SPIRAL SHEAR DEVELOPER

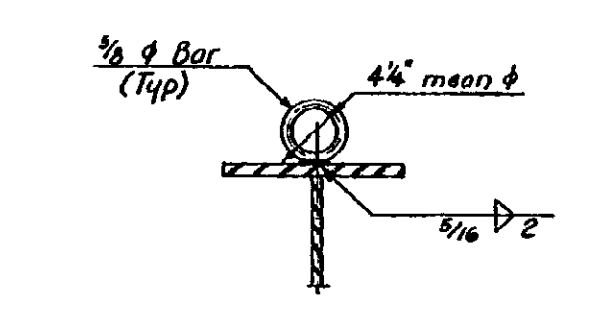


SECTION E-E

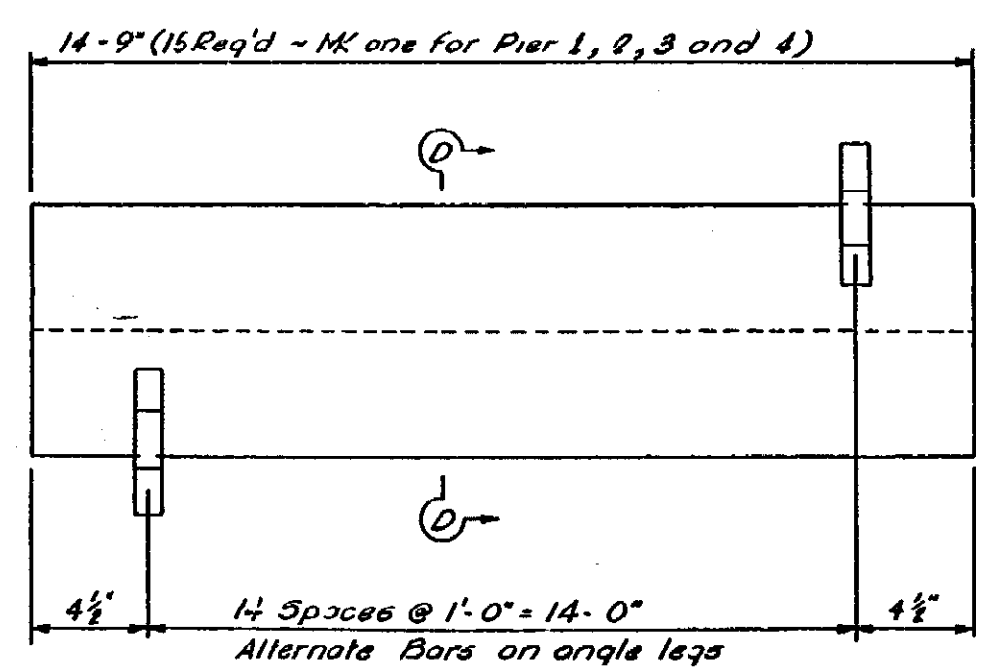

PIER NOSING DETAIL

NOTE Painting of Pier nosings is included in item Field Painting

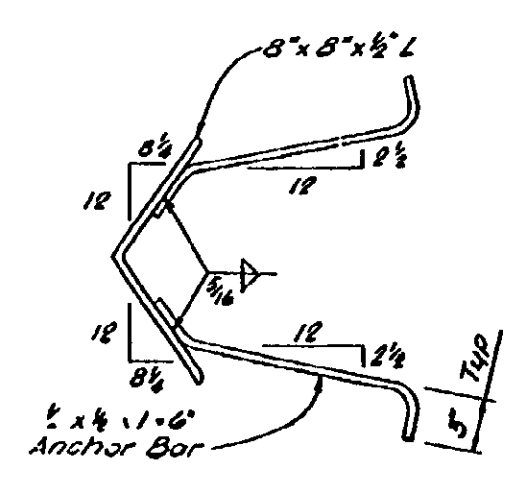

SECTION D-D

Work this sheet with sheets 202, 203, 217 & 218

MICHIGAN STATE HIGHWAY DEPARTMENT

STRUCTURAL STEEL DETAILS

TECON ENGINEERS, INC.

JDC 3/26/02
MBA
ADG 8/27/02
2/19 3/12

B. Revised spirals spans 1 & 2 1/6 43 P.E.

B02 OF 63174I


NOTE:
DO NOT WORK FROM THIS SHEET. THE INFORMATION SHOWN
HERE IS FOR REFERENCE ONLY. NO PAY ITEMS ARE SHOWN.

FOR INFORMATION ONLY				
DATE	CONT. SEC.	JOB NO.	DESIGN UNIT	SHEET
02-14-00	B02 OF 63174	49595A	MAHDAVI	12 OF




DATE: _____ CORRECTED BY: INDER DATE: _____ CHECKED BY: _____ DATE: 02-11-00 DRAWN BY: INDER FILE NAME: 602631746n

REVISIONS			
NO.	DESCRIPTION	DATE	BY

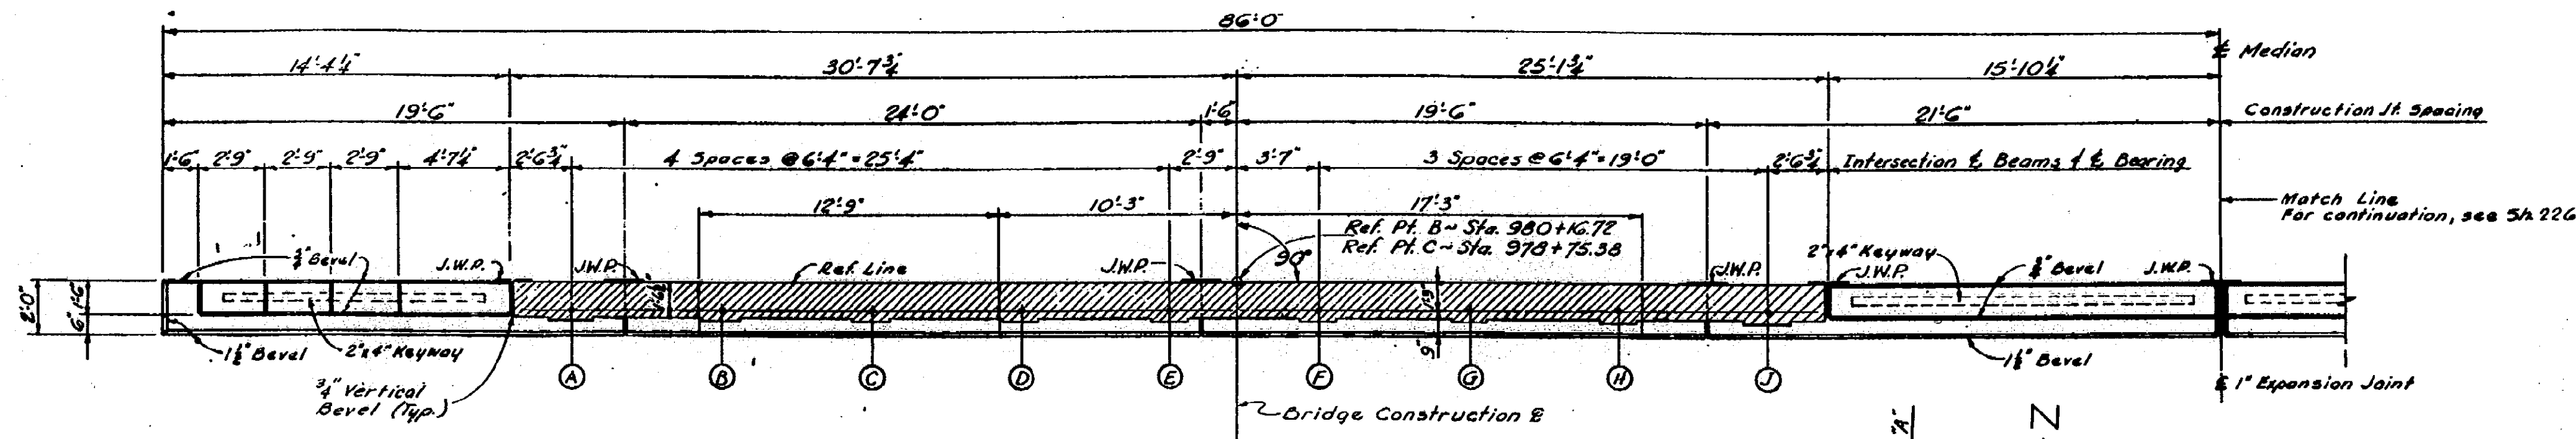

POUR	ABUT. A		ABUT. B	
	A (GA)	A (GAA)	A (GA)	A (GAA)
A	29.2		29.2	
B	76.3		76.3	
C		10.4		10.4
D		11.4		11.4
E		12.7		12.7
F		9.4		9.4
G		10.4		10.4
H		11.4		11.4
J		12.9		12.9
K		9.4		9.4
L		4.8		4.8
M		4.8		4.8
N		2.6		2.6
P		2.6		2.6
Total	105.5	103.0	105.5	103.0


ABUTMENT "A" - HALF PLAN OF TOP (EAST END)
 ABUTMENT "B" - HALF PLAN OF TOP (WEST END)

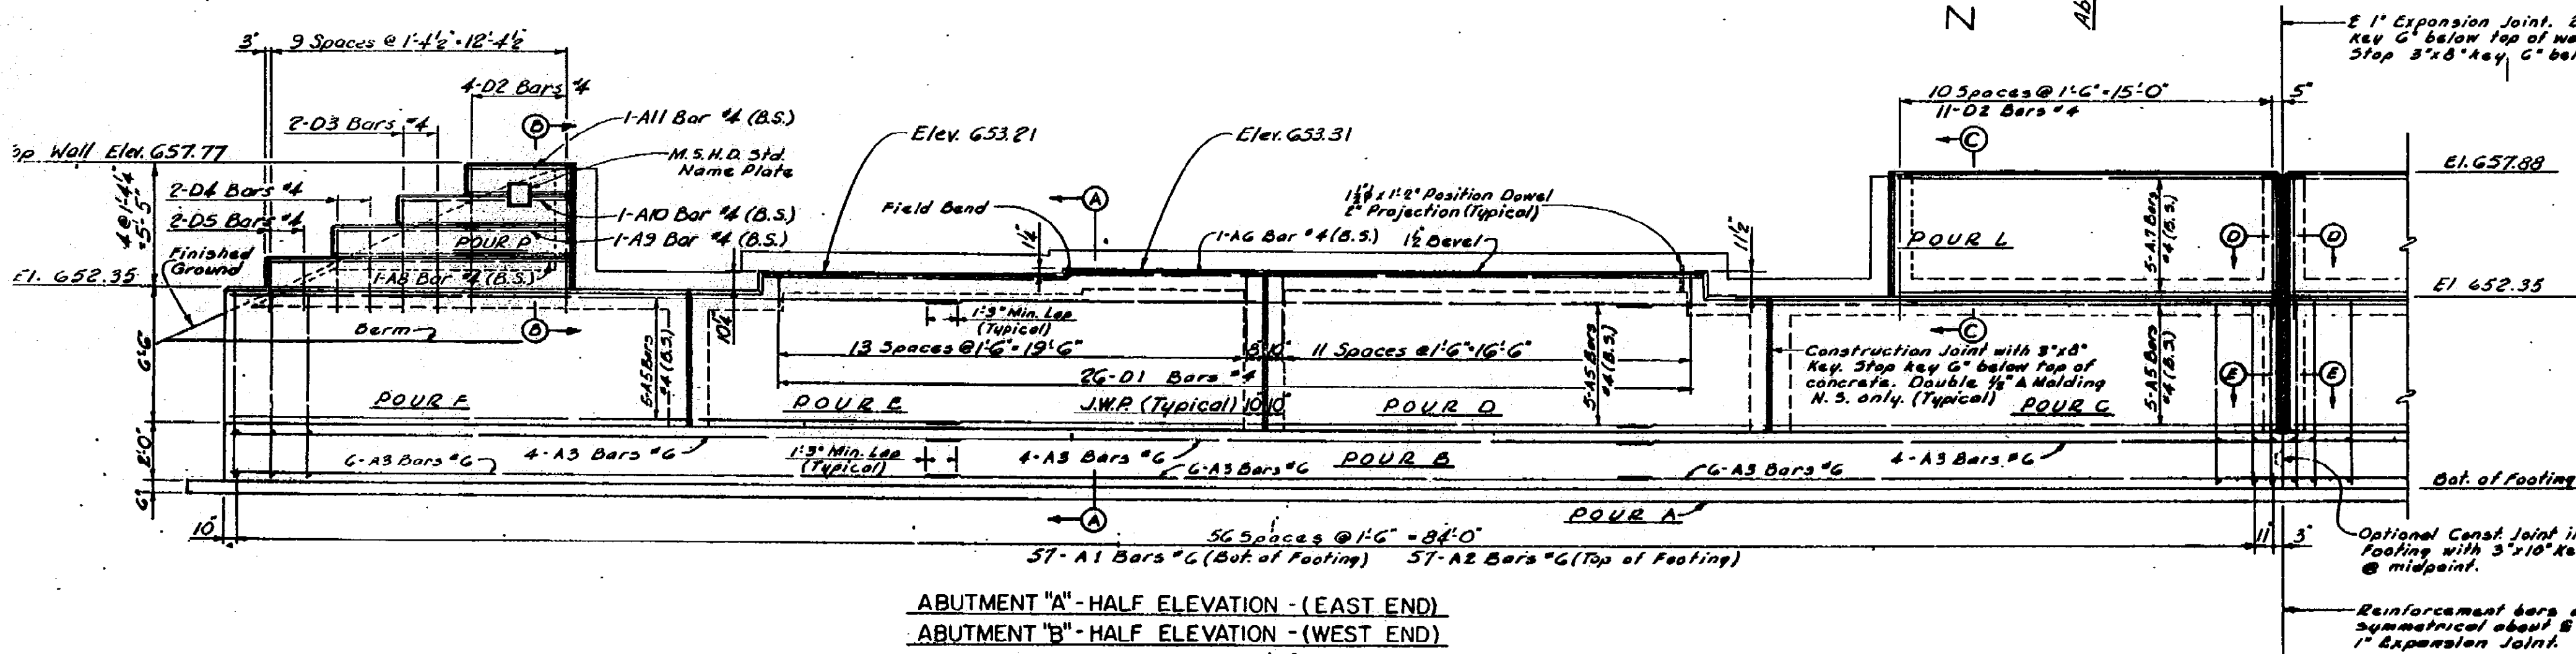

ITEM	UNIT	ABUT. A	ABUT. B	TOTAL
1/2" Joint Filler	Sq. Ft.	5	5	10
3/4" Joint Filler	Sq. Ft.	172	172	344
1" Joint Filler	Sq. Ft.	31	31	62
1" Joint Filler	Sq. Ft.	21	21	42
Jt. Waterproofing	Sq. Ft.	386	386	772

NOTES
 J.W.P. denotes joint waterproofing.
 N.S. denotes near side.
 R.S. denotes far side.
 B.S. denotes both sides.
 For Bevel and Molding Details, see Std. Sheet R11.
 For location of Name Plates, see General Plan of Structure Sheet; for mounting details, see Std. Sheet R11.
 Parapet walls and slopewalls are to be cast after superstructure is complete to top of curbs.
 Position Dowels shall be set accurately to a template.
 Furnishing and setting of Position Dowels is incidental to substructure concrete.
 The Top Concrete shall be finished to a true plane at the elevation shown and shall not vary more than 8" under a ten foot straight edge.
 This design is based on a maximum foundation pressure of 3650 pounds per square foot and a maximum average foundation pressure of 2950 pounds per square foot.

ABUTMENT "A" - HALF ELEVATION - (EAST END)
 ABUTMENT "B" - HALF ELEVATION - (WEST END)

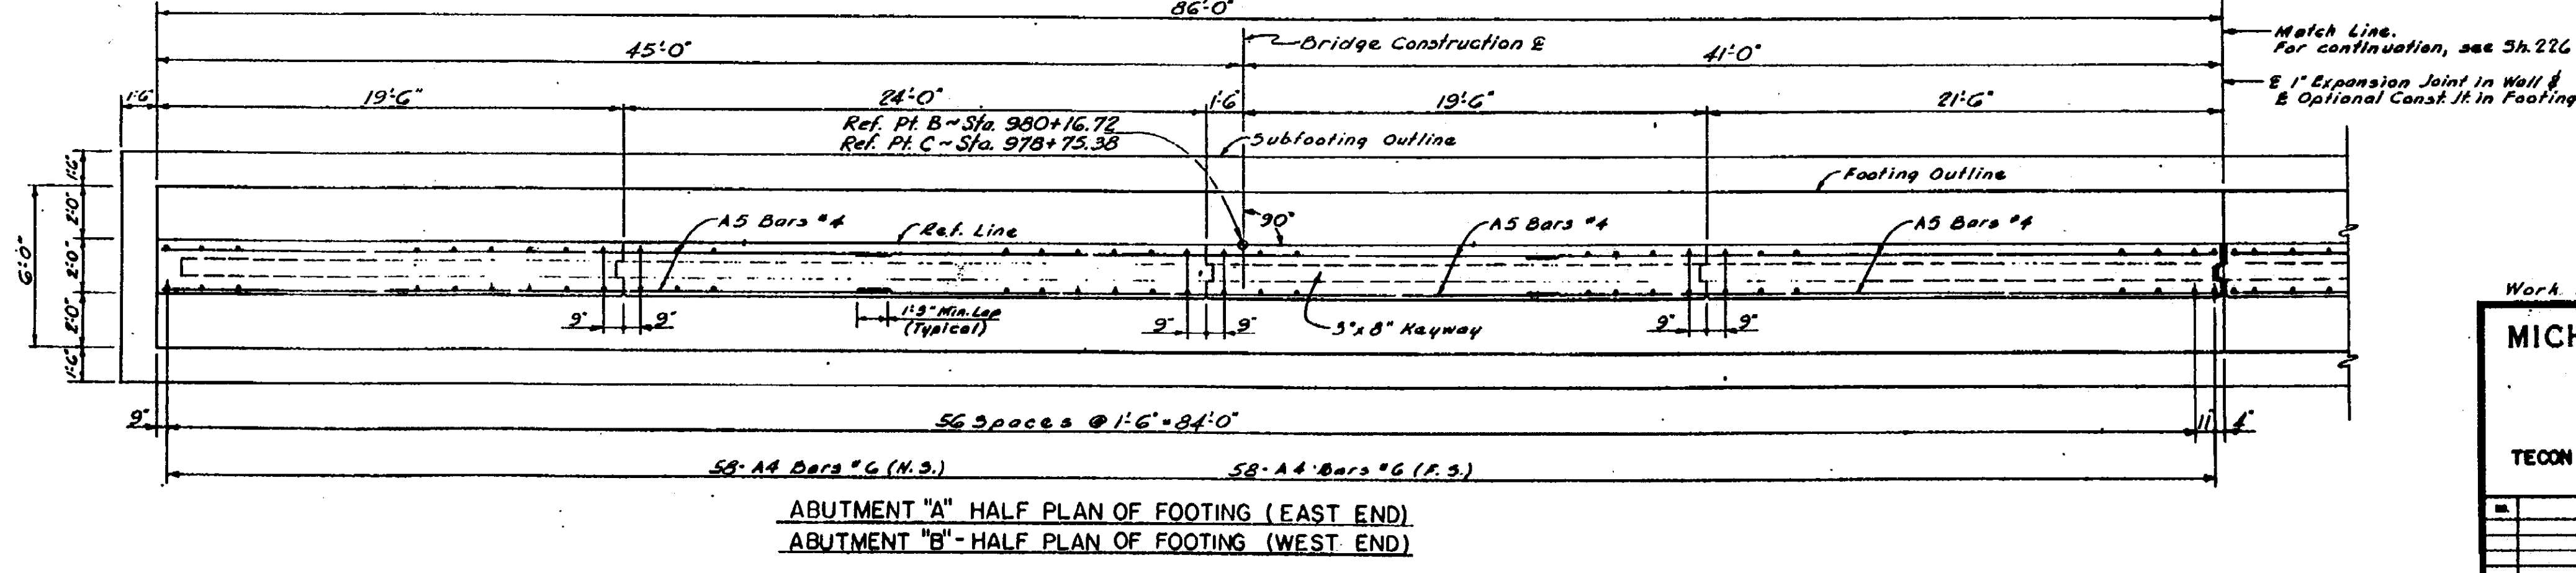

ABUTMENT "A" - HALF PLAN OF FOOTING (EAST END)
 ABUTMENT "B" - HALF PLAN OF FOOTING (WEST END)

Work this sheet with sheet 226

MICHIGAN STATE HIGHWAY DEPARTMENT

ABUTMENT DETAILS

TECON ENGINEERS, INC.

REVISIONS			
NO.	DESCRIPTION	DATE	BY

SO4 OF 63174 I.

NOTE:
 DO NOT WORK FROM THIS SHEET. THE INFORMATION SHOWN HERE IS FOR REFERENCE ONLY. NO PAY ITEMS ARE SHOWN.





FOR INFORMATION ONLY				
DATE	CONT. SEC.	JOB NO.	DESIGN UNIT	SHEET
04-12-00	SO4 OF 63174	49595A	MAHDAVI	1AA OF

DATE: _____ CORRECTED BY: _____ DATE: _____ CHECKED BY: _____ DATE: 04-12-00 DRAWN BY: INDER FILE NAME: s0462174sn.

1 2 3 4 5 6 7 8 9 10 11 12 13 14 15 16 17 18 19 20 21 22 23 24 25 26 27 28 29 30 31 32 33 34 35 36 37 38 39 40 41 42 43 44 45 46 47 48 49 50 51 52 53 54 55 56 57 58 59 60 61 62 63

REVISIONS			
NO.	DESCRIPTION	DATE	BY

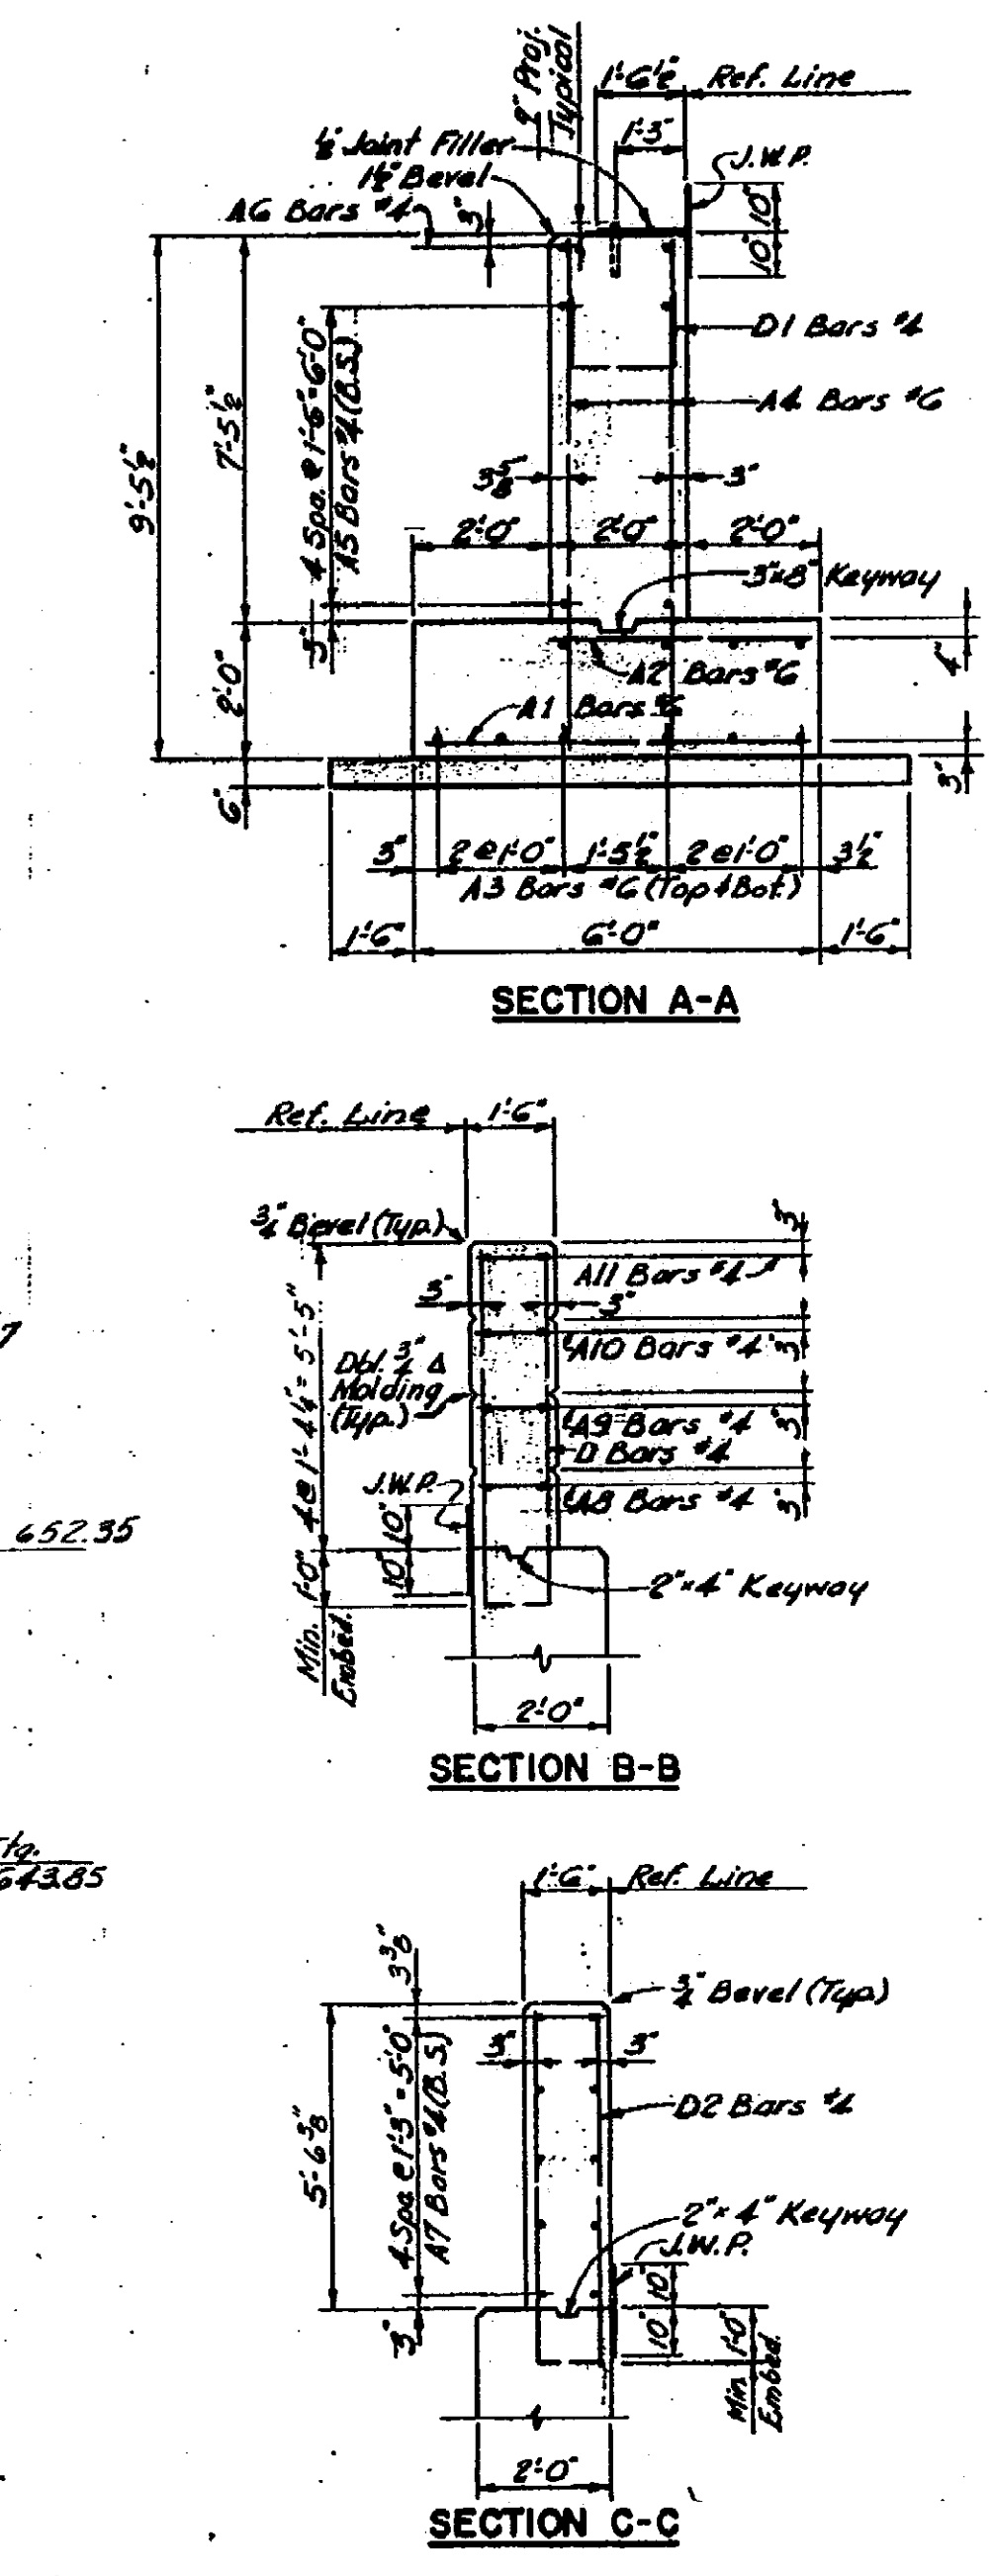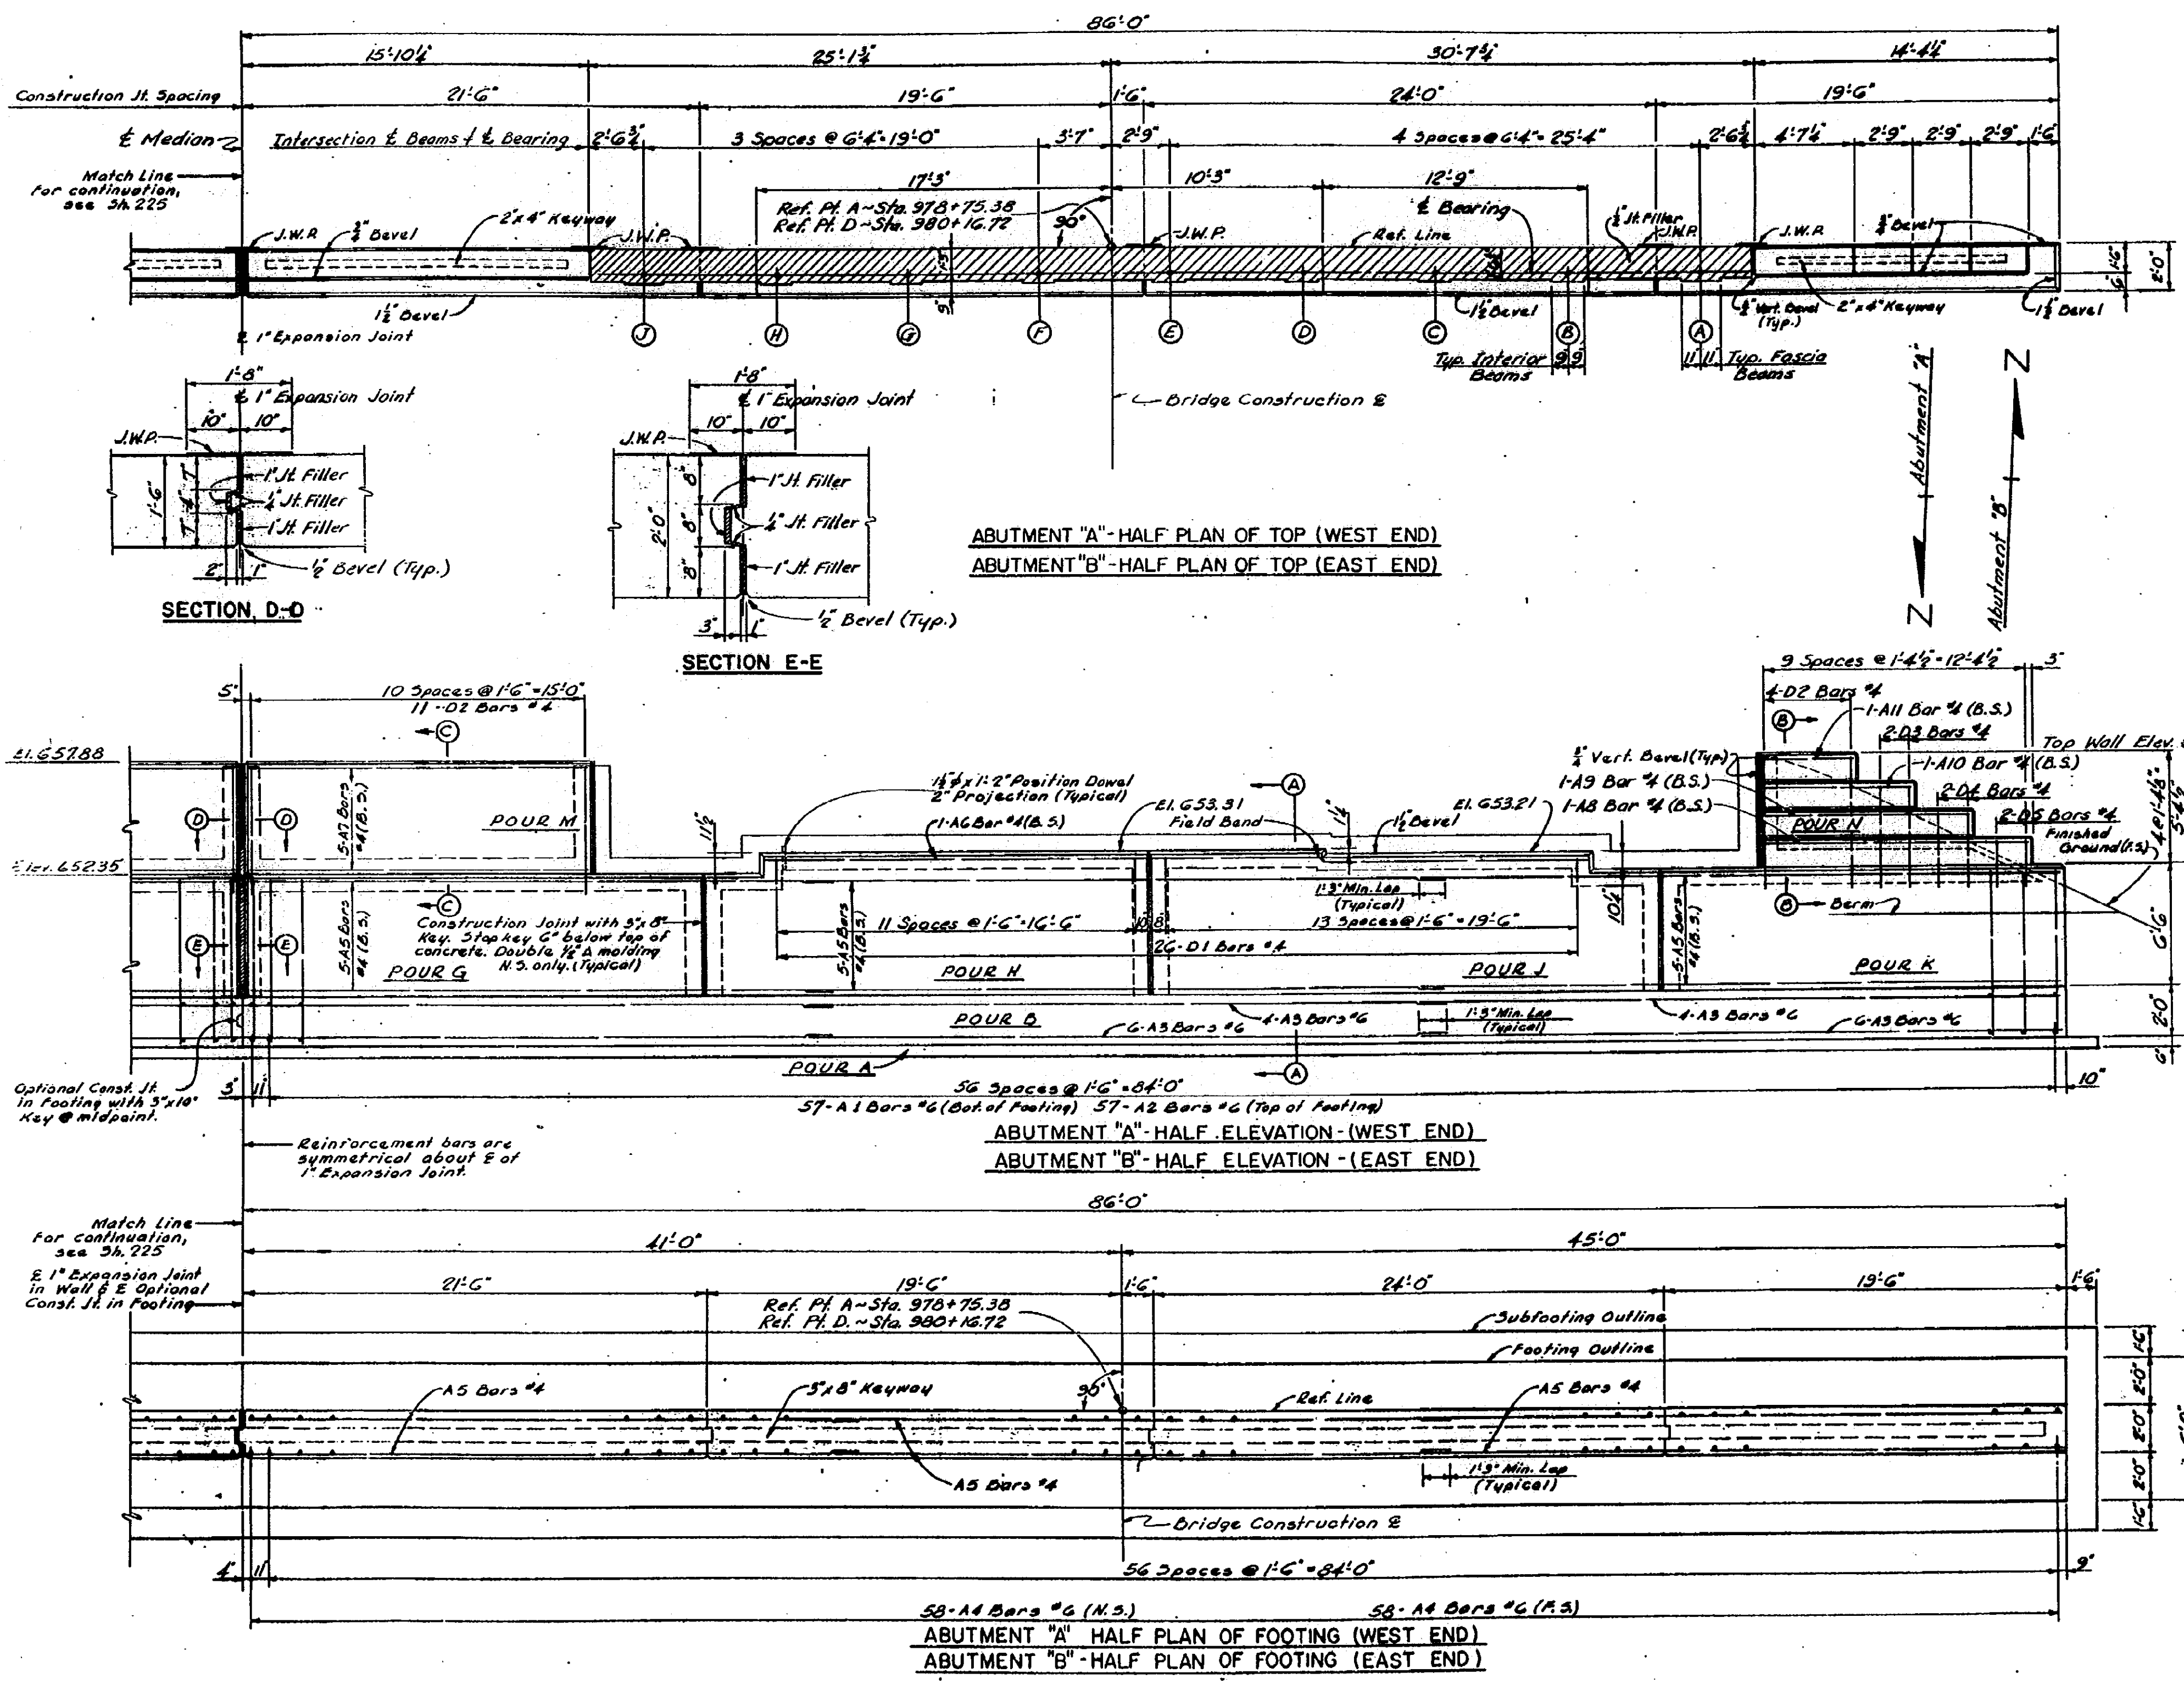

Work this sheet with sheet 225

MICHIGAN STATE HIGHWAY DEPARTMENT

ABUTMENT DETAILS

TECON ENGINEERS, INC.

REVISIONS			
NO.	DESCRIPTION	DATE	BY


S04 of 63174 I

NOTE:
 DO NOT WORK FROM THIS SHEET. THE INFORMATION SHOWN
 HERE IS FOR REFERENCE ONLY. NO PAY ITEMS ARE SHOWN.




FOR INFORMATION ONLY				
DATE	CONT. SEC.	JOB NO.	DESIGN UNIT	SHEET
04-12-00	S04 OF 63174	49595A	MAHDAVI	1AB OF


FILE NAME: S0463174sp. DRAWN BY: INDER. CHECKED BY: DATE: 04-12-00. CORRECTED BY: DATE: DATE:

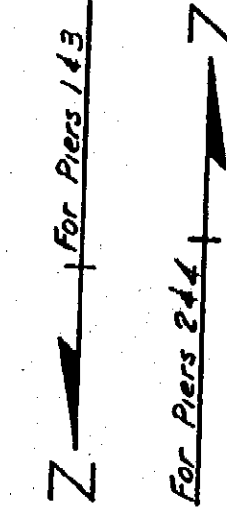


REVISIONS			
NO.	DESCRIPTION	DATE	BY

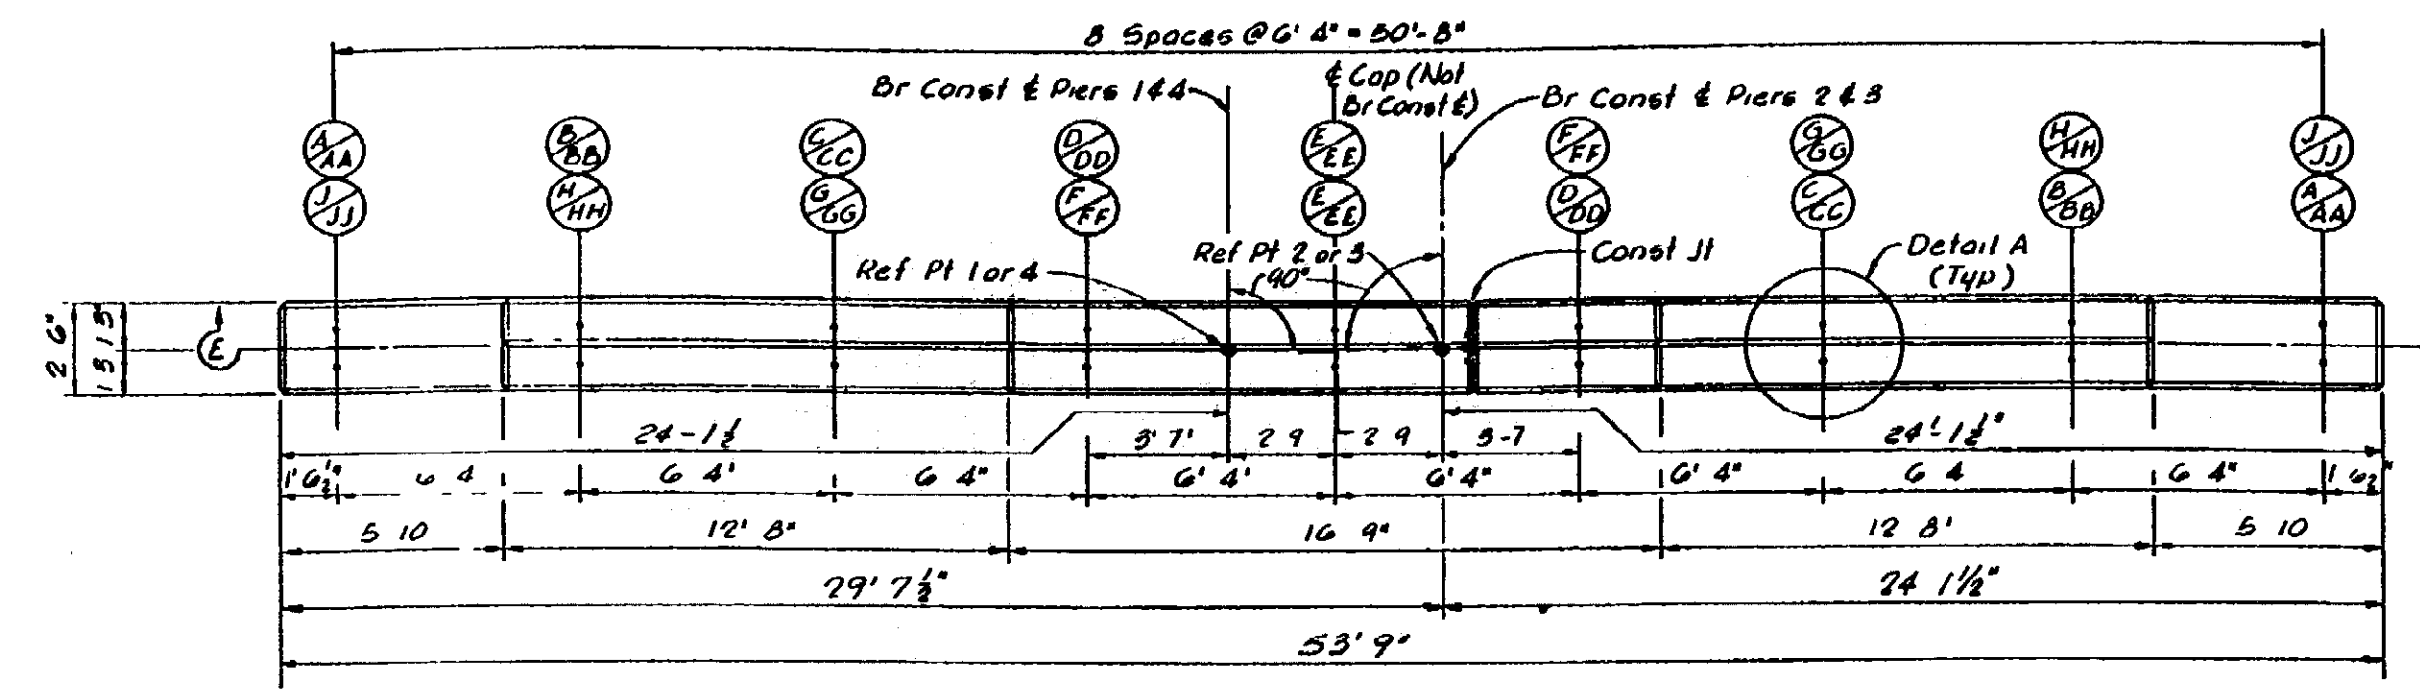


CAP PLAN

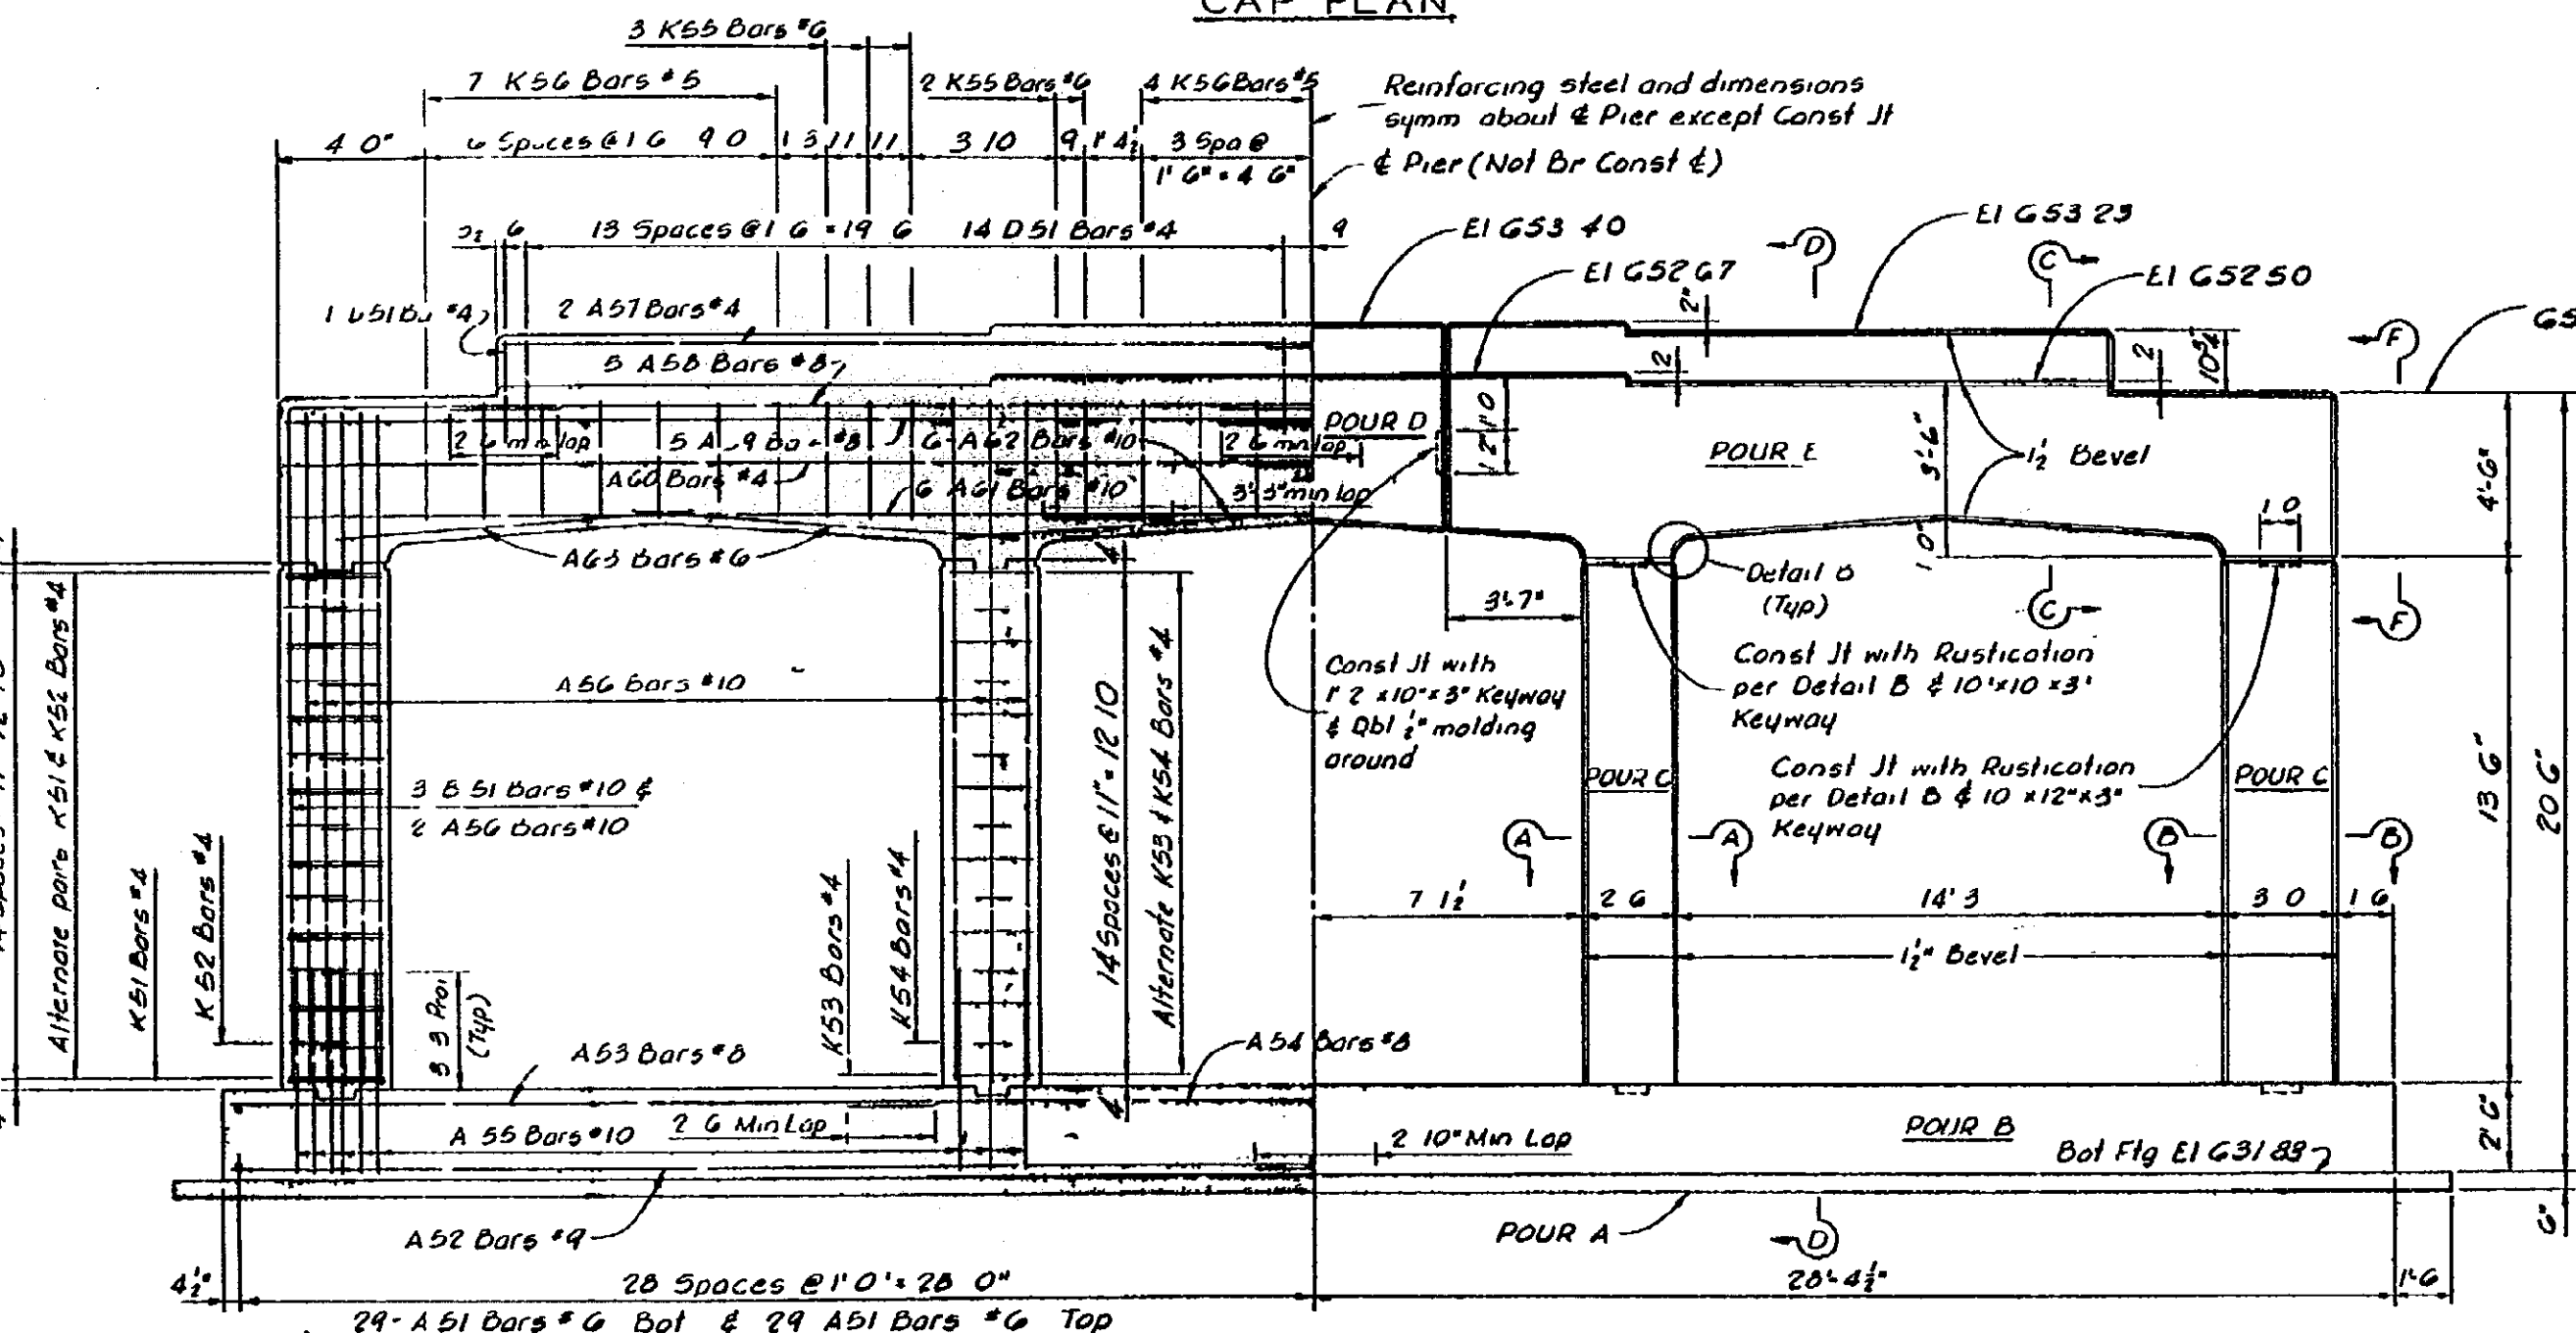

SECTION E-E

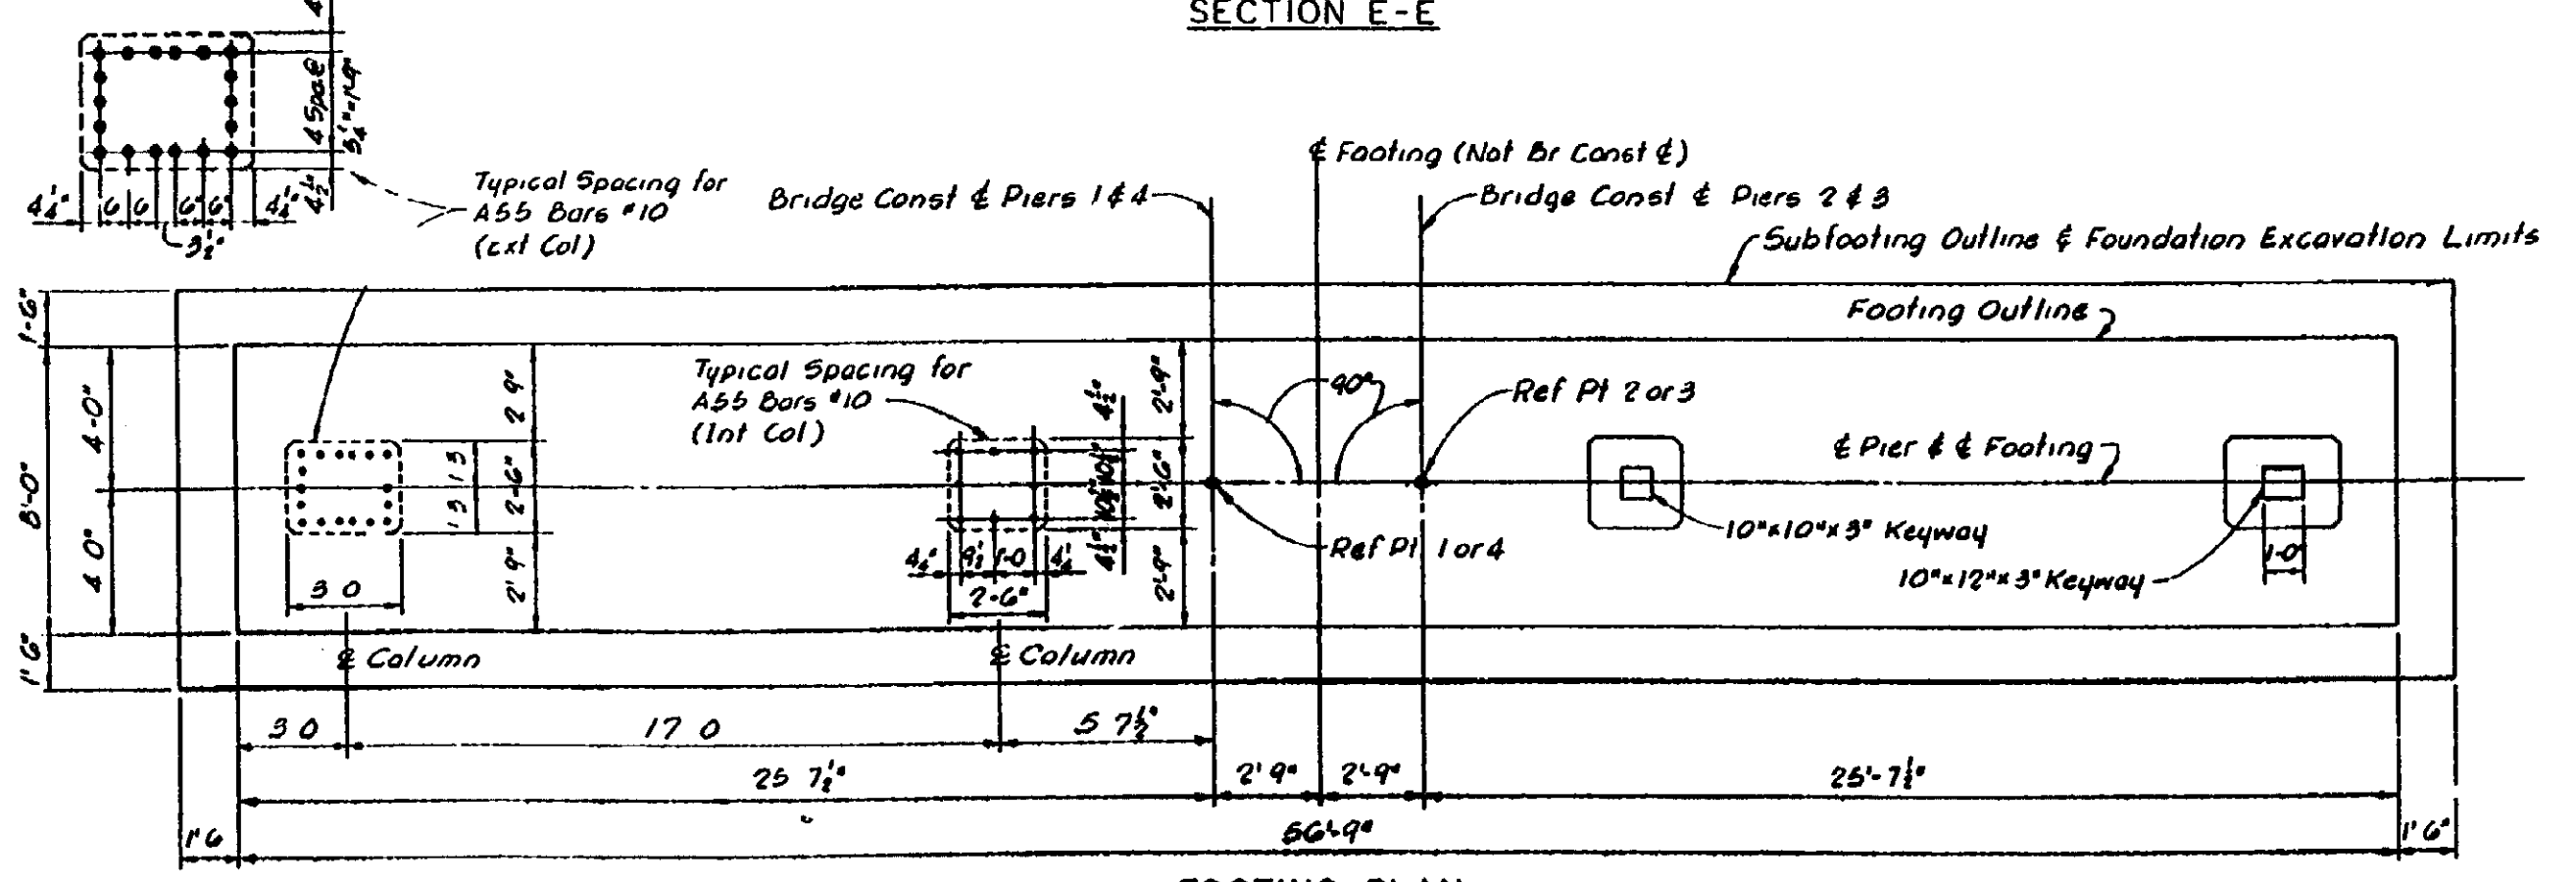


FOOTING PLAN

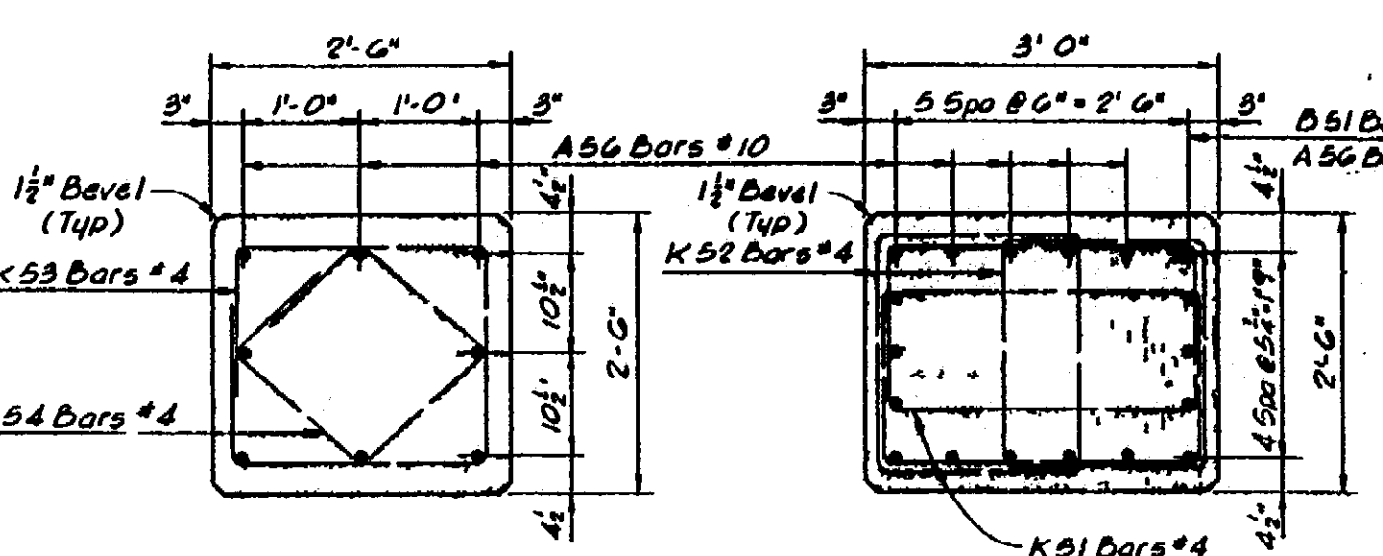


SECTION A-A


SECTION B-B

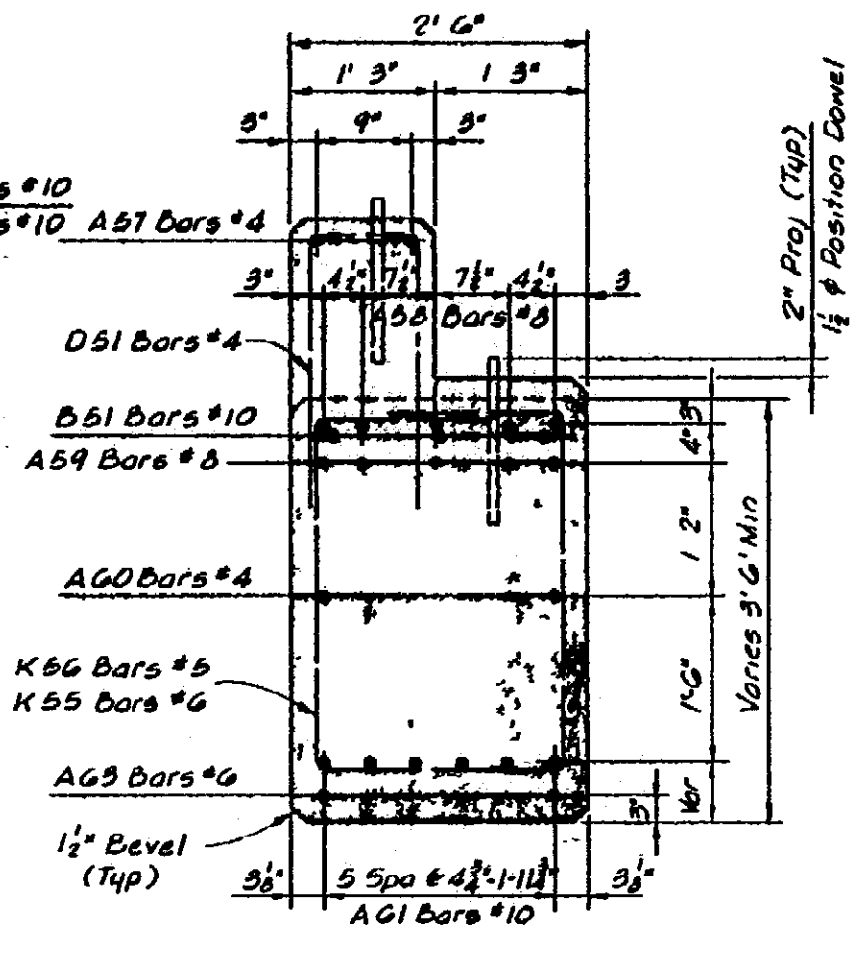


SECTION C-C

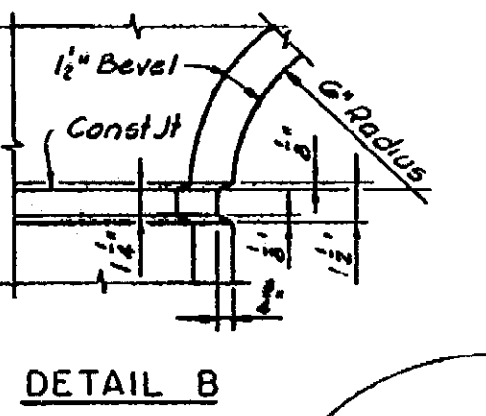

DETAIL B

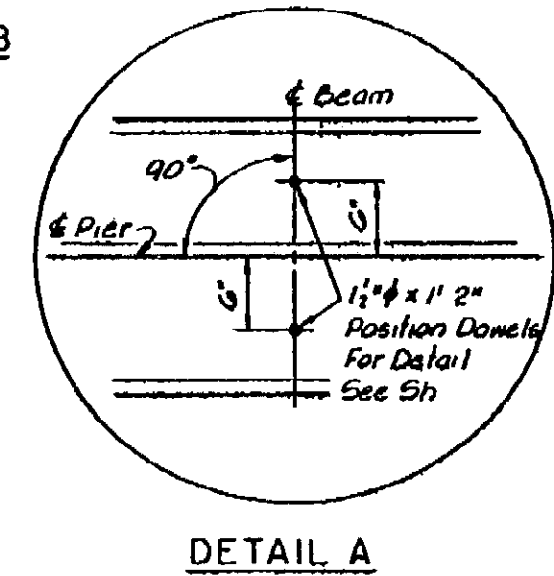


DETAIL A

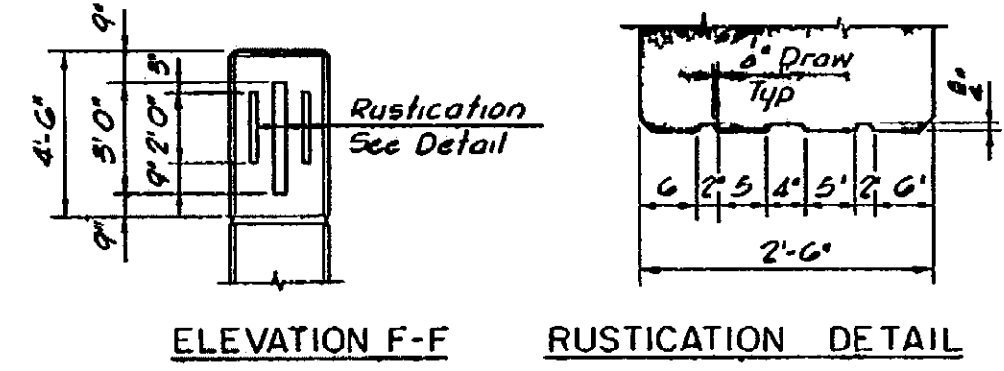


ELEVATION F-F

RUSTICATION DETAIL

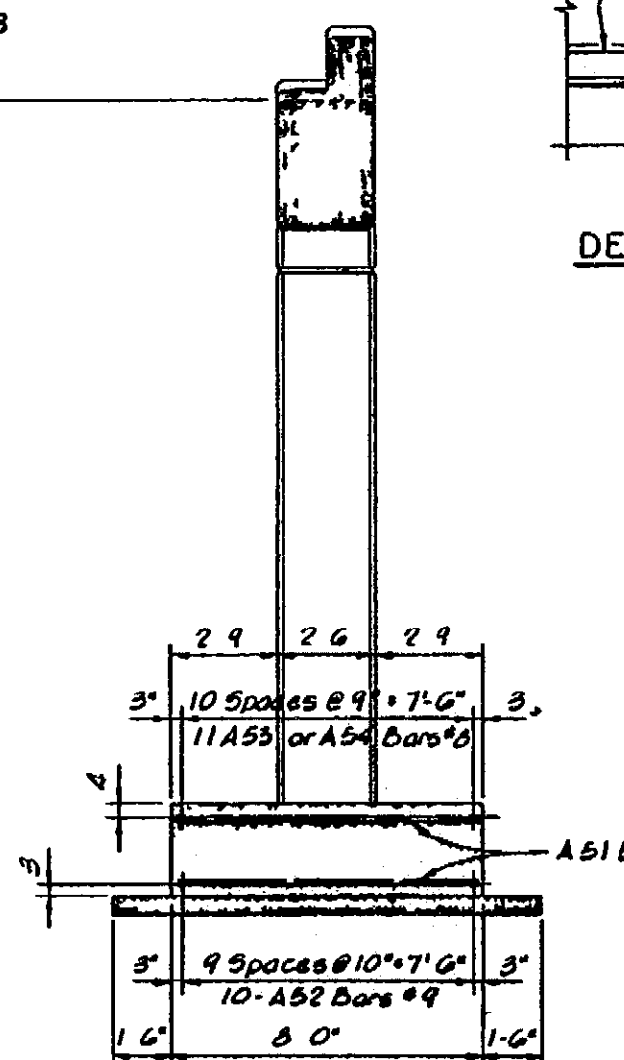

SECTION D-D

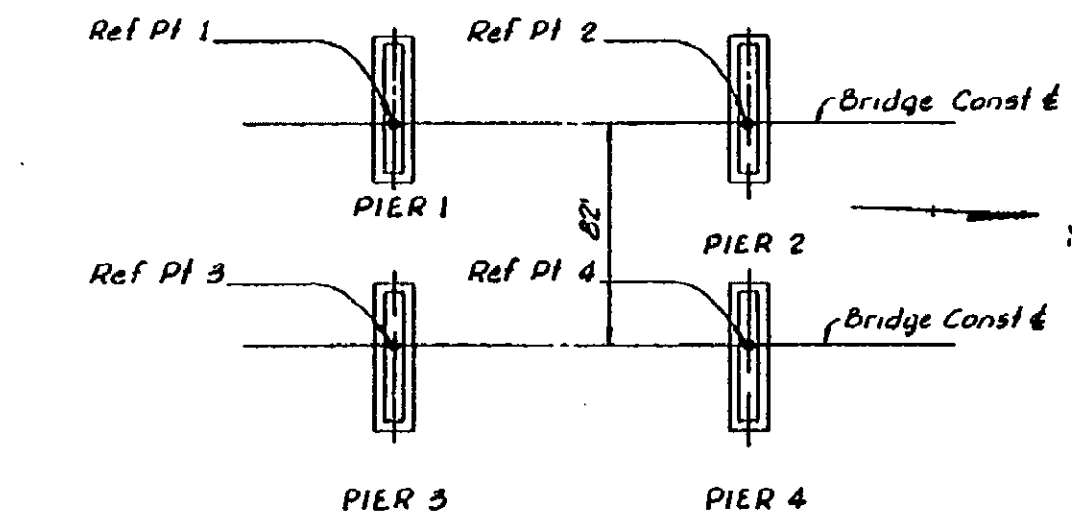

LOCATION DIAGRAM

NOTES

For Bevel and Molding Details, see Standard Sheet R11. Position Dowels shall be set accurately to a template, furnishing and setting of position dowels is incidental to substructure concrete. The Project Engineer shall adjust the spacing of the reinforcing steel as required to permit placing of the position dowels. The top of pier shall be finished to a true slope of the elevations shown and shall not vary more than 1/4" under a ten foot straight edge. This design is based on a maximum foundation pressure of 3950 $\frac{lb}{ft^2}$ and a maximum average foundation pressure of 3350 $\frac{lb}{ft^2}$.

CONCRETE QUANTITIES - CUBIC YARDS									
POUR	LOCATION	PIER 1		PIER 2		PIER 3		PIER 4	
		GR	AB	GR	AB	GR	AB	GR	AB
A	Subfooting	180	120	120	120	180	180	180	180
B	Footing	420	420	420	420	420	420	420	420
C	Columns	139	139	139	139	139	139	139	139
D	Cap*	125	125	125	125	125	125	125	125
E	Cap*	96	96	96	96	96	96	96	96
TOTALS		640	360	640	360	640	360	640	360

MISCELLANEOUS QUANTITIES					
ITEM	UNITS	PIER 1	PIER 2	PIER 3	PIER 4
Foundation Excavation	Cu Yds	140	140	140	140

MICHIGAN STATE HIGHWAY DEPARTMENT
PIERS NO. 1, 2, 3 & 4 DETAILS

TECON ENGINEERS, INC.
DESIGNER

DATE: 04-12-00
DRAWN BY: INDER

NO. DESCRIPTION DATE BY


SO4 OF 63174 I.

NOTE:
DO NOT WORK FROM THIS SHEET. THE INFORMATION SHOWN HERE IS FOR REFERENCE ONLY. NO PAY ITEMS ARE SHOWN.




FOR INFORMATION ONLY

DATE	CONT. SEC.	JOB NO.	DESIGN UNIT	SHEET
04-12-00	SO4 OF 63174	49595A	MAHDAVI	IAC OF

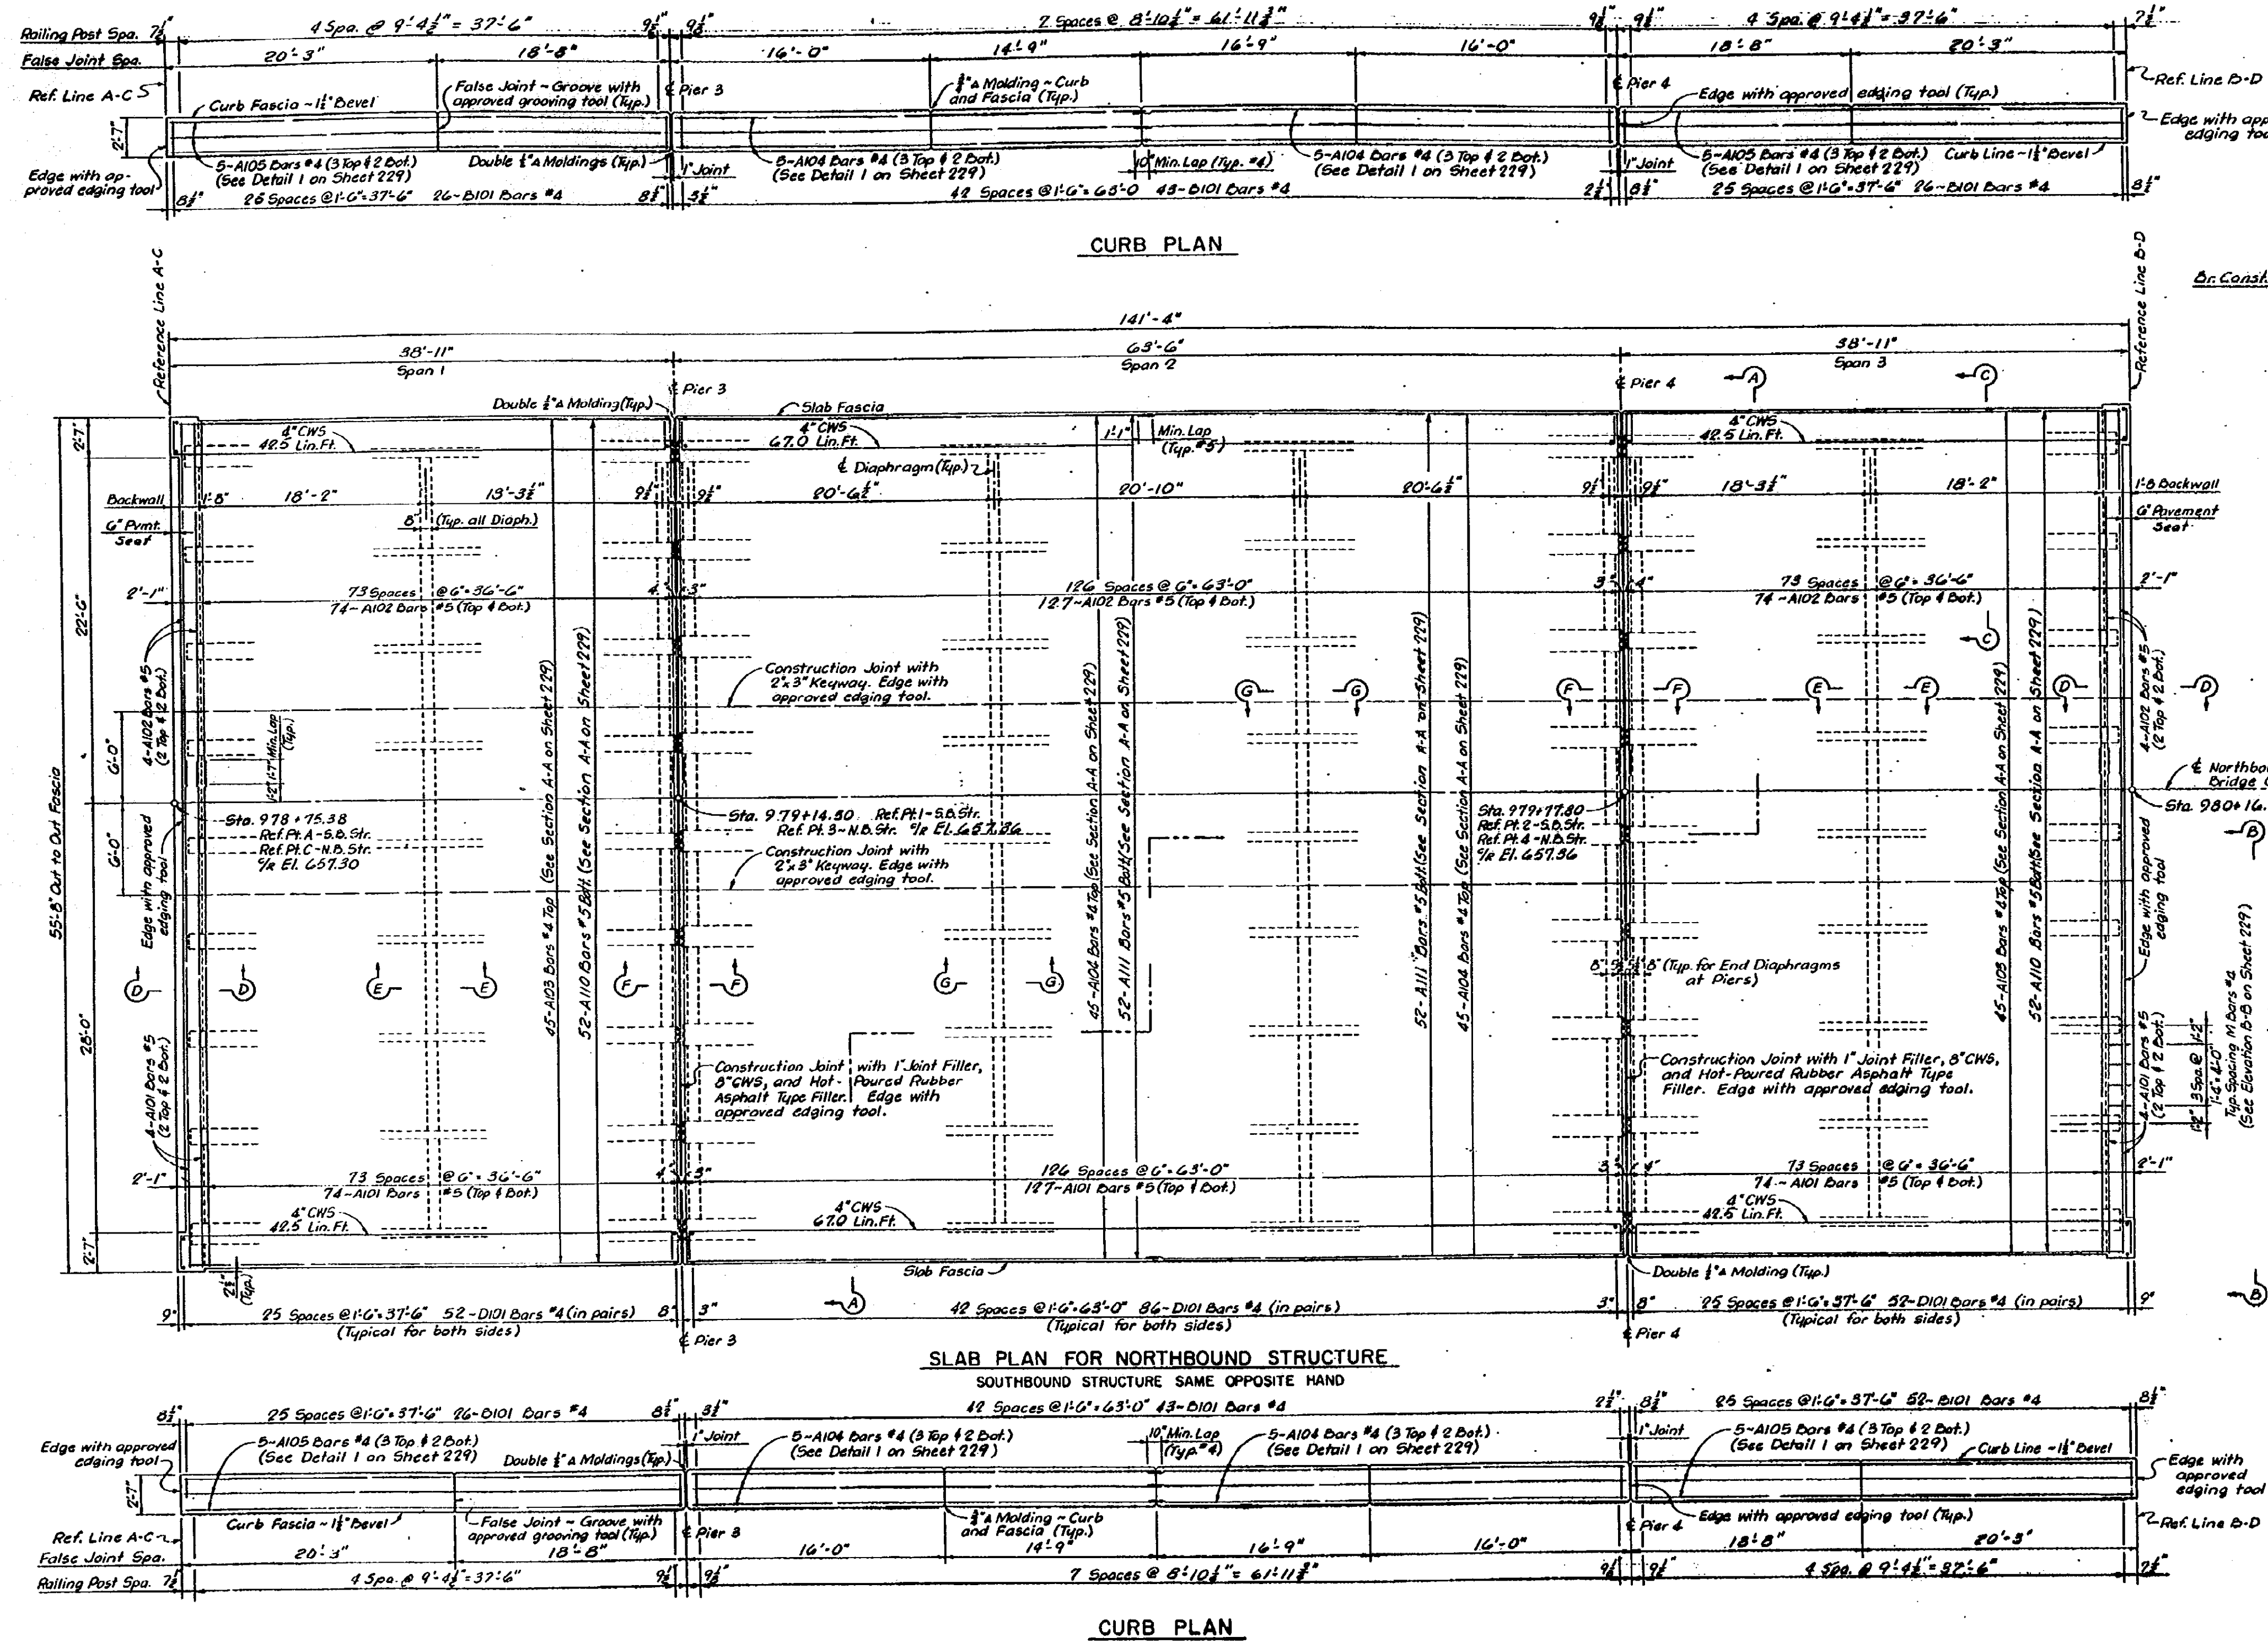

REVISIONS			
ID.	DESCRIPTION	DATE	BY

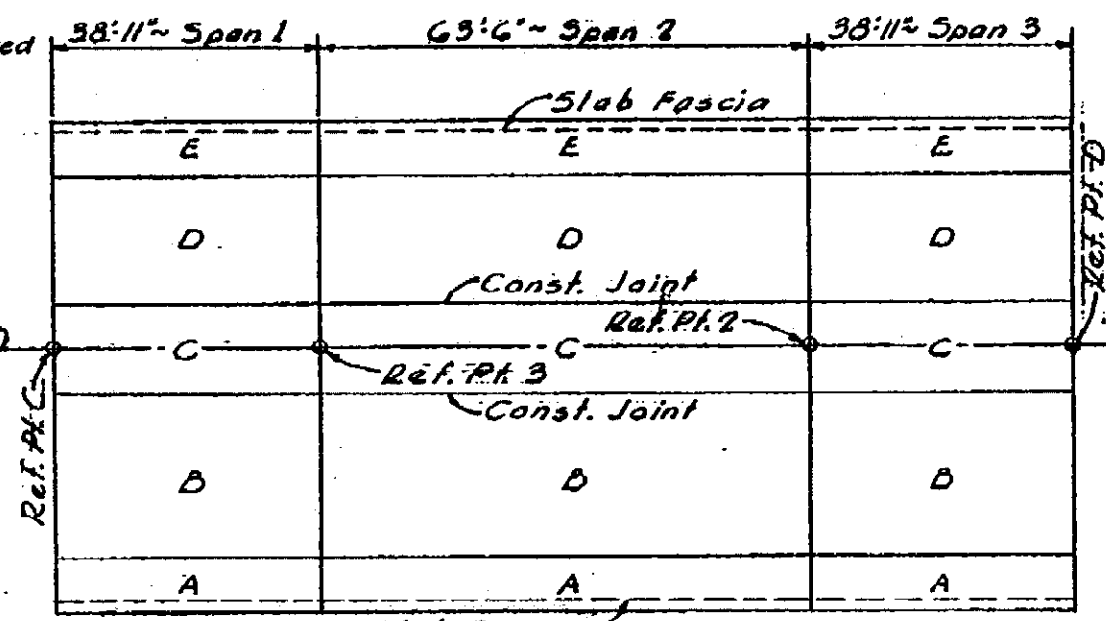

CU. YDS. CONCRETE - GR. A (GAA)
N.B. Structure shown, S.B. Structure similar by rotation.

POUR	SPAN 1	SPAN 2	SPAN 3
A	3.1	3.1	3.1
B	29.9	22.8	29.9
C	14.2	20.7	14.2
D	23.4	33.0	23.4
E	3.1	3.1	3.1
Diaphragm	4.4	10.0	4.4
Total	78.3	112.7	78.3
Total Concrete - N.B. Structure: 278.0			
Total Concrete - S.B. Structure: 278.0			

Concrete pours need not be placed in alphabetical order.

MISCELLANEOUS QUANTITIES

ITEM	UNIT	AMT.
1" Joint Filler	Sq. Ft.	138
Hot-Poured Rubber Asphalt Type Filler	Lin. Ft.	250
Copper	Lbs.	346
Bridge Railing - Parquet Type	Lin. Ft.	583.4

Amounts shown above are the totals for both structures.

GENERAL NOTES

For Railing Details, see Sheet 251.
CWS denotes Copper Waterstop.
JWP denotes Joint Waterproofing.
For Bevel and Molding Details, see Sheet 211.
Edge and Groove denote Edging or Grooving with an approved tool.
Curb pours shall not be cast until slab concrete has attained at least 50% of its design strength as determined by the table in Section 501.03 of the Standard Specifications.

Work this sheet with sheets 229, 230, 231 & 232

MICHIGAN STATE HIGHWAY DEPARTMENT
SUPERSTRUCTURE DETAILS

TECON ENGINEERS, INC.

REVISIONS			
ID.	DESCRIPTION	DATE	BY

ISSUED BY	STC	DATE	1-6-91
DRAWN BY	JPB	DATE	1-6-91
CHECKED BY	STC	DATE	3-2-91
DATE	SHEET 229 OF 212		

S04 OF 63174 I

NOTE:
DO NOT WORK FROM THIS SHEET. THE INFORMATION SHOWN HERE IS FOR REFERENCE ONLY. NO PAY ITEMS ARE SHOWN.








FOR INFORMATION ONLY

DATE	CONT. SEC.	JOB NO.	DESIGN UNIT	SHEET
04-12-00	S04 OF 63174	49595A	MAHDAVI	1AD OF







DATE: _____ CORRECTED BY: _____ DATE: _____ CHECKED BY: _____ DATE: 04-12-00 DRAWN BY: INDER FILE NAME: s0462174sn.

1 2 3 4 5 6 7 8 9 10 11 12 13 14 15 16 17 18 19 20 21 22 23 24 25 26 27 28 29 30 31 32 33 34 35 36 37 38 39 40 41 42 43 44 45 46 47 48 49 50 51 52 53 54 55 56 57 58 59 60 61 62 63

REVISIONS			
NO.	DESCRIPTION	DATE	BY

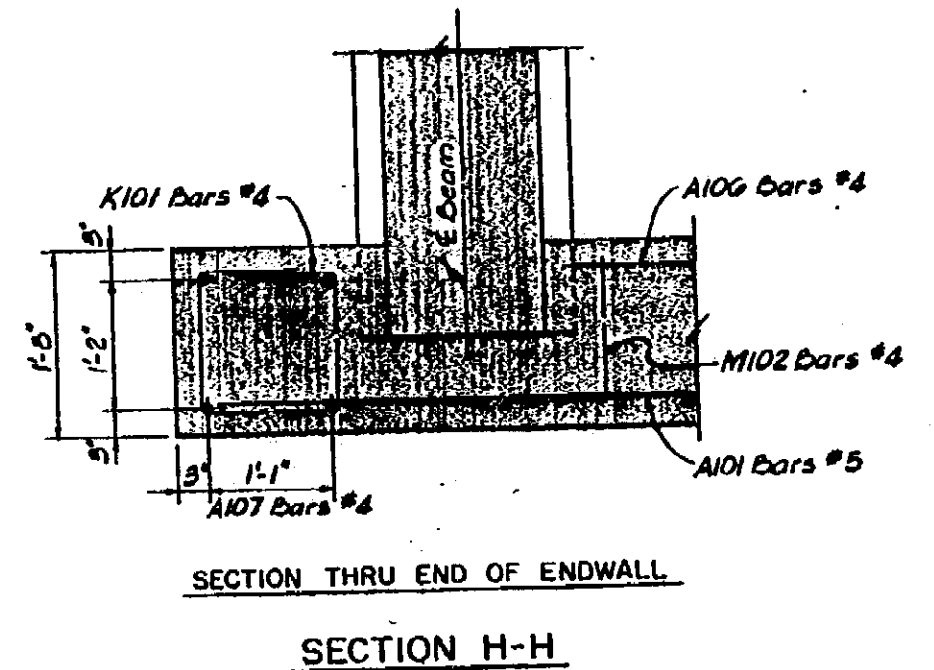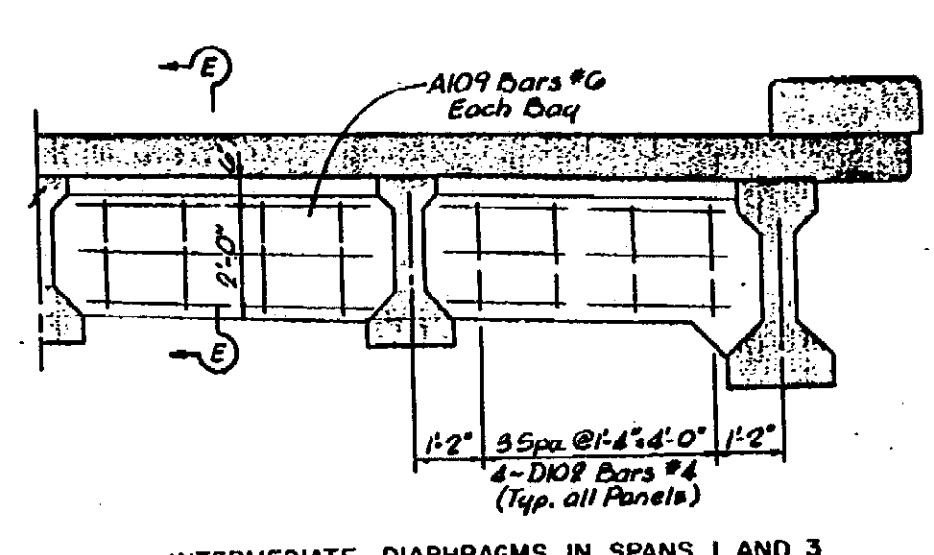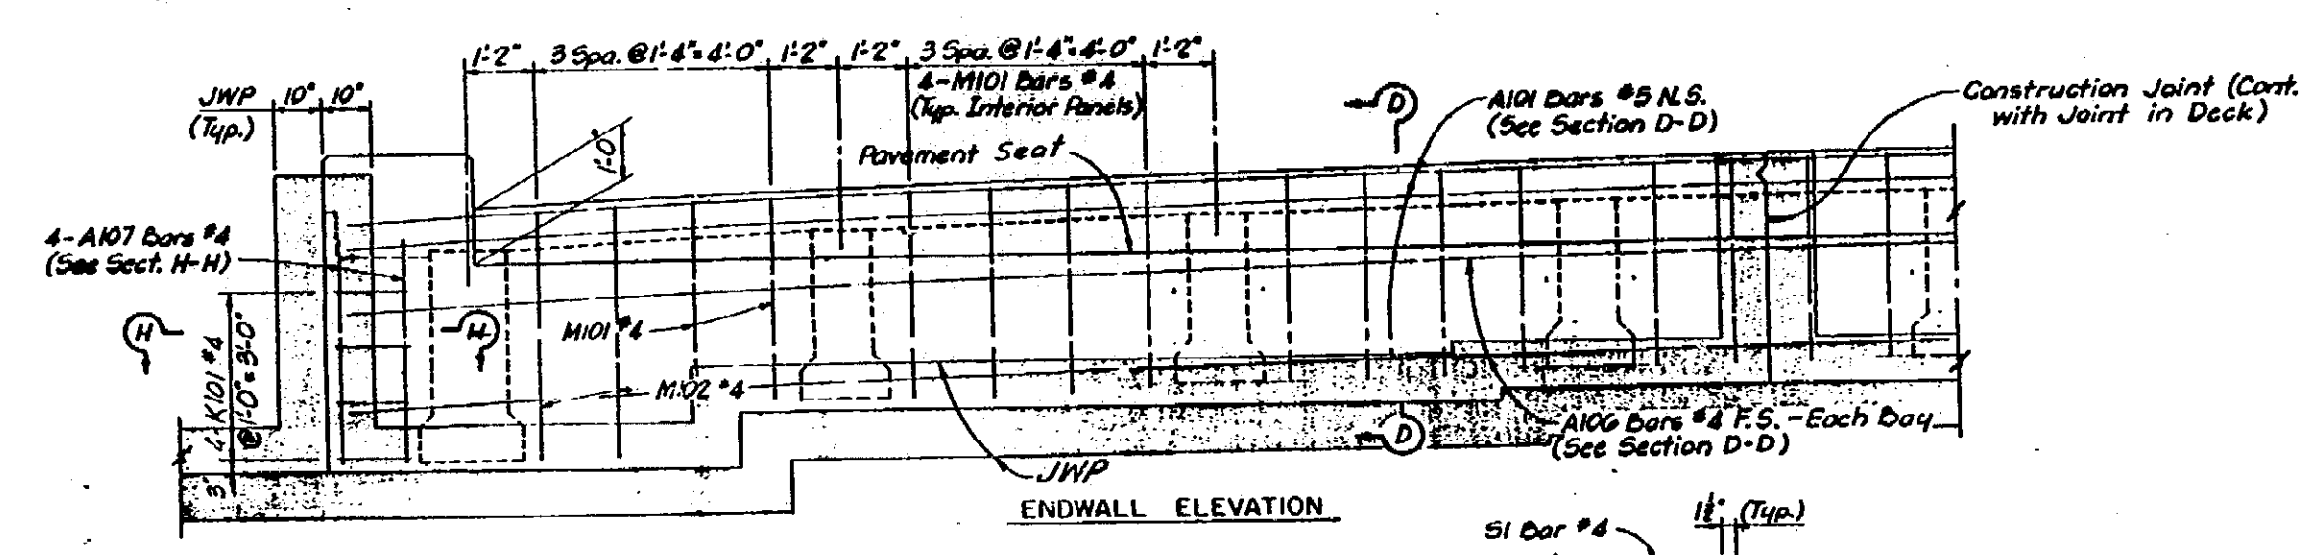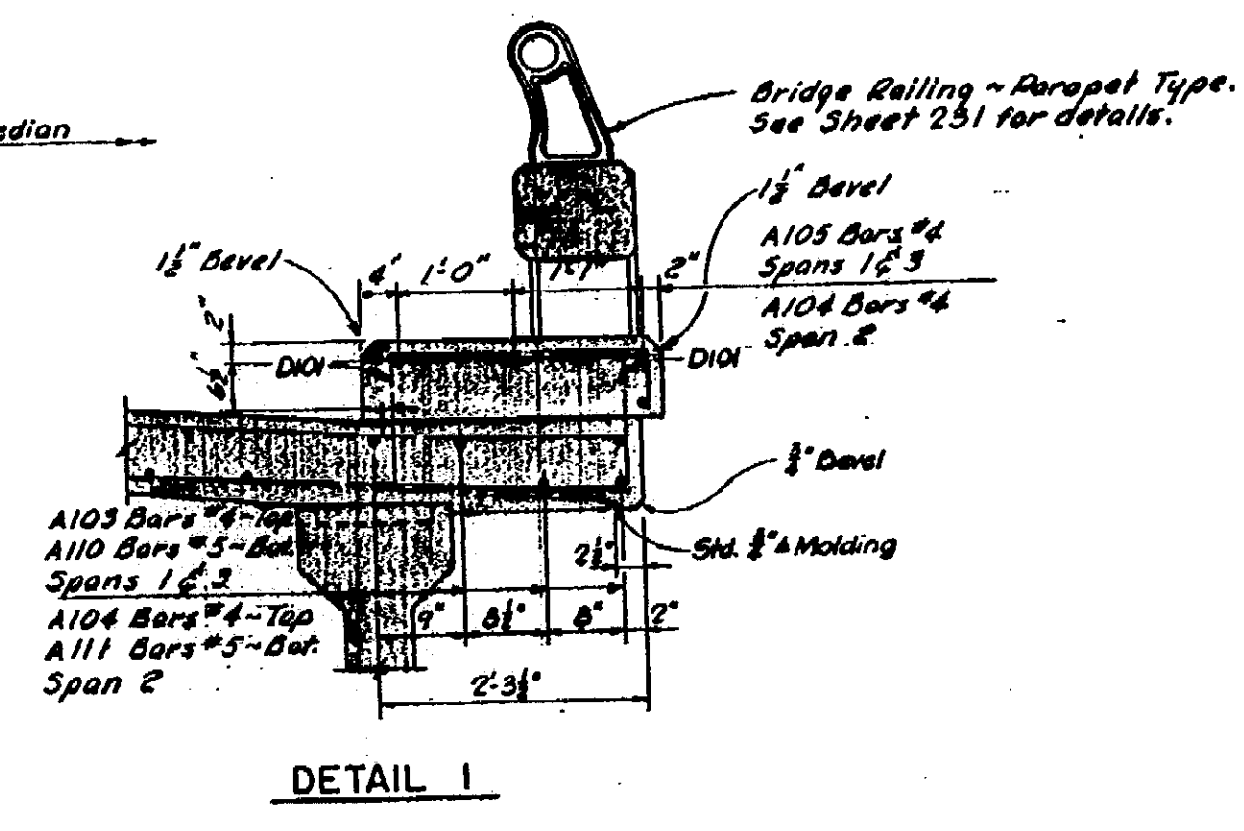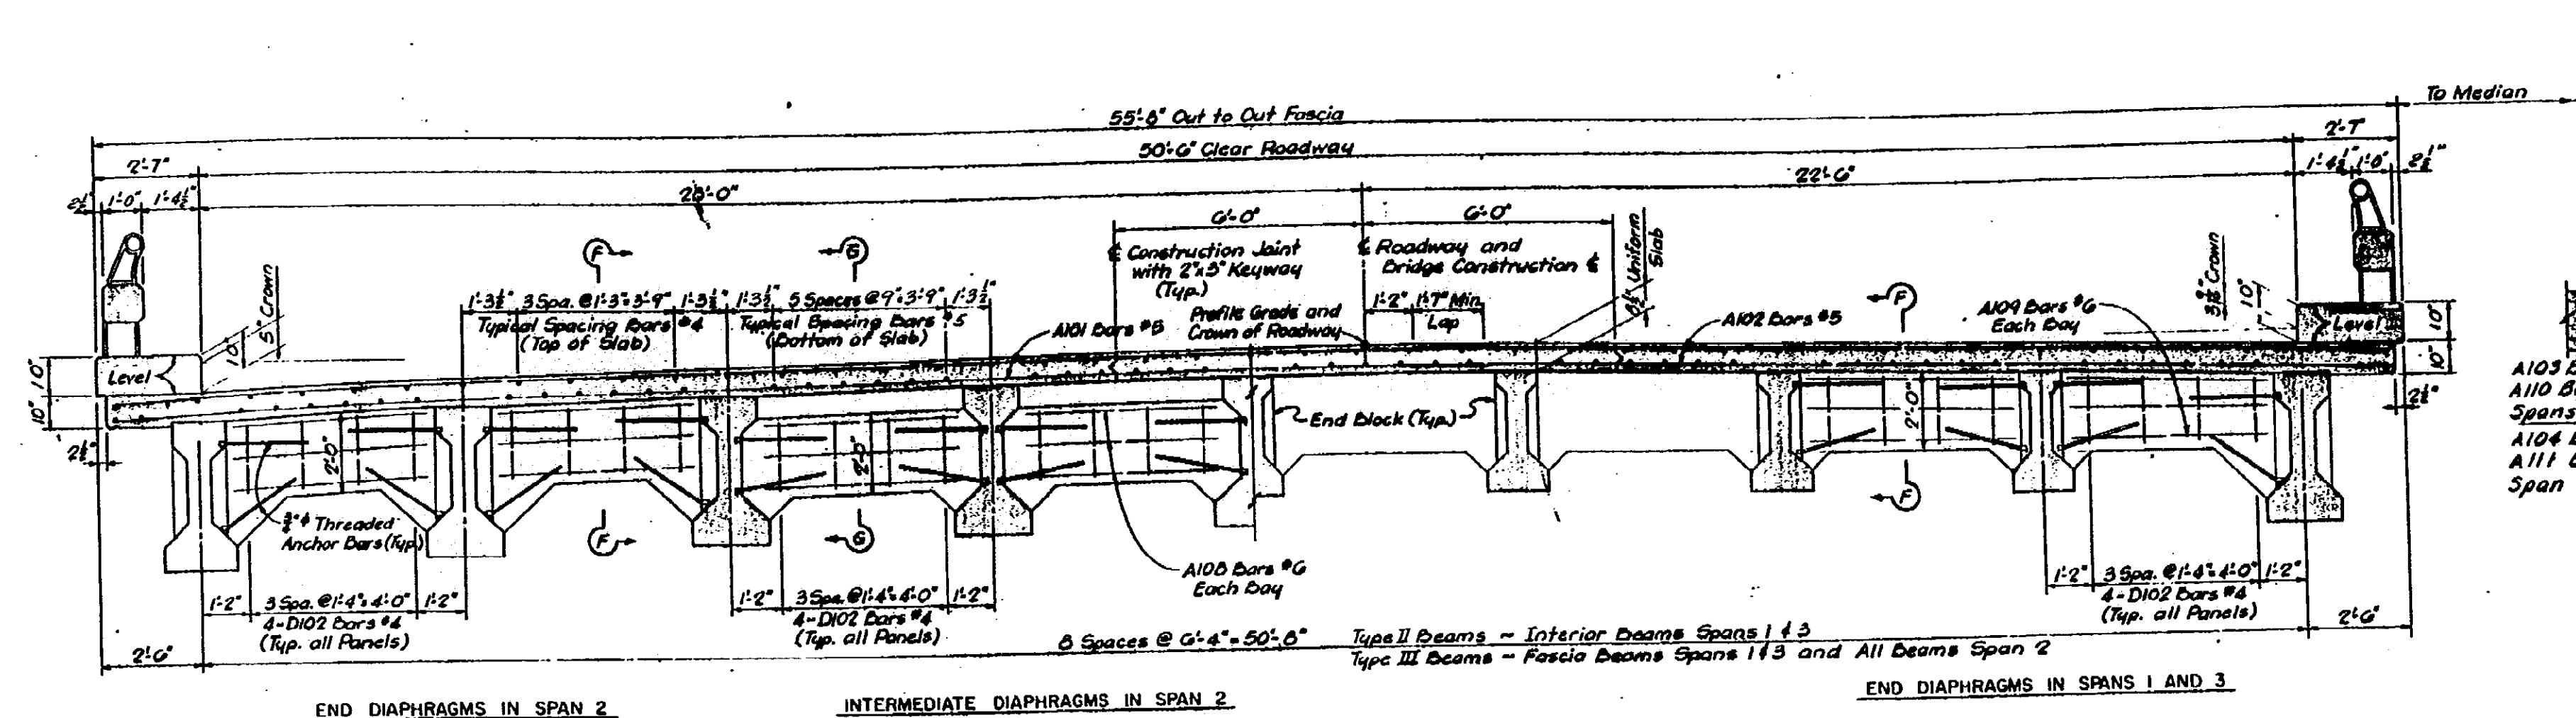

Bar	Dim.	Beam Type		Bar	Dim.	Beam Type	
		II	III			II	III
S1	a	3 1/2"	6"	S3	b	2'-7"	3'-4"
S1	b	10"	11"	S4	c	3"	3"
S1	c	9"	17 1/2"	S4	d	3 1/2"	5"
S2	a	7 1/2"	10 1/2"	S4	b	2'-7"	3'-4"
S2	b	5"	5"	S4	c	3"	3"
S2	c	1-3 1/2"	1-7 1/2"	S5	a	9"	1-1 1/2"
S2	d	5 1/2"	7 1/2"				

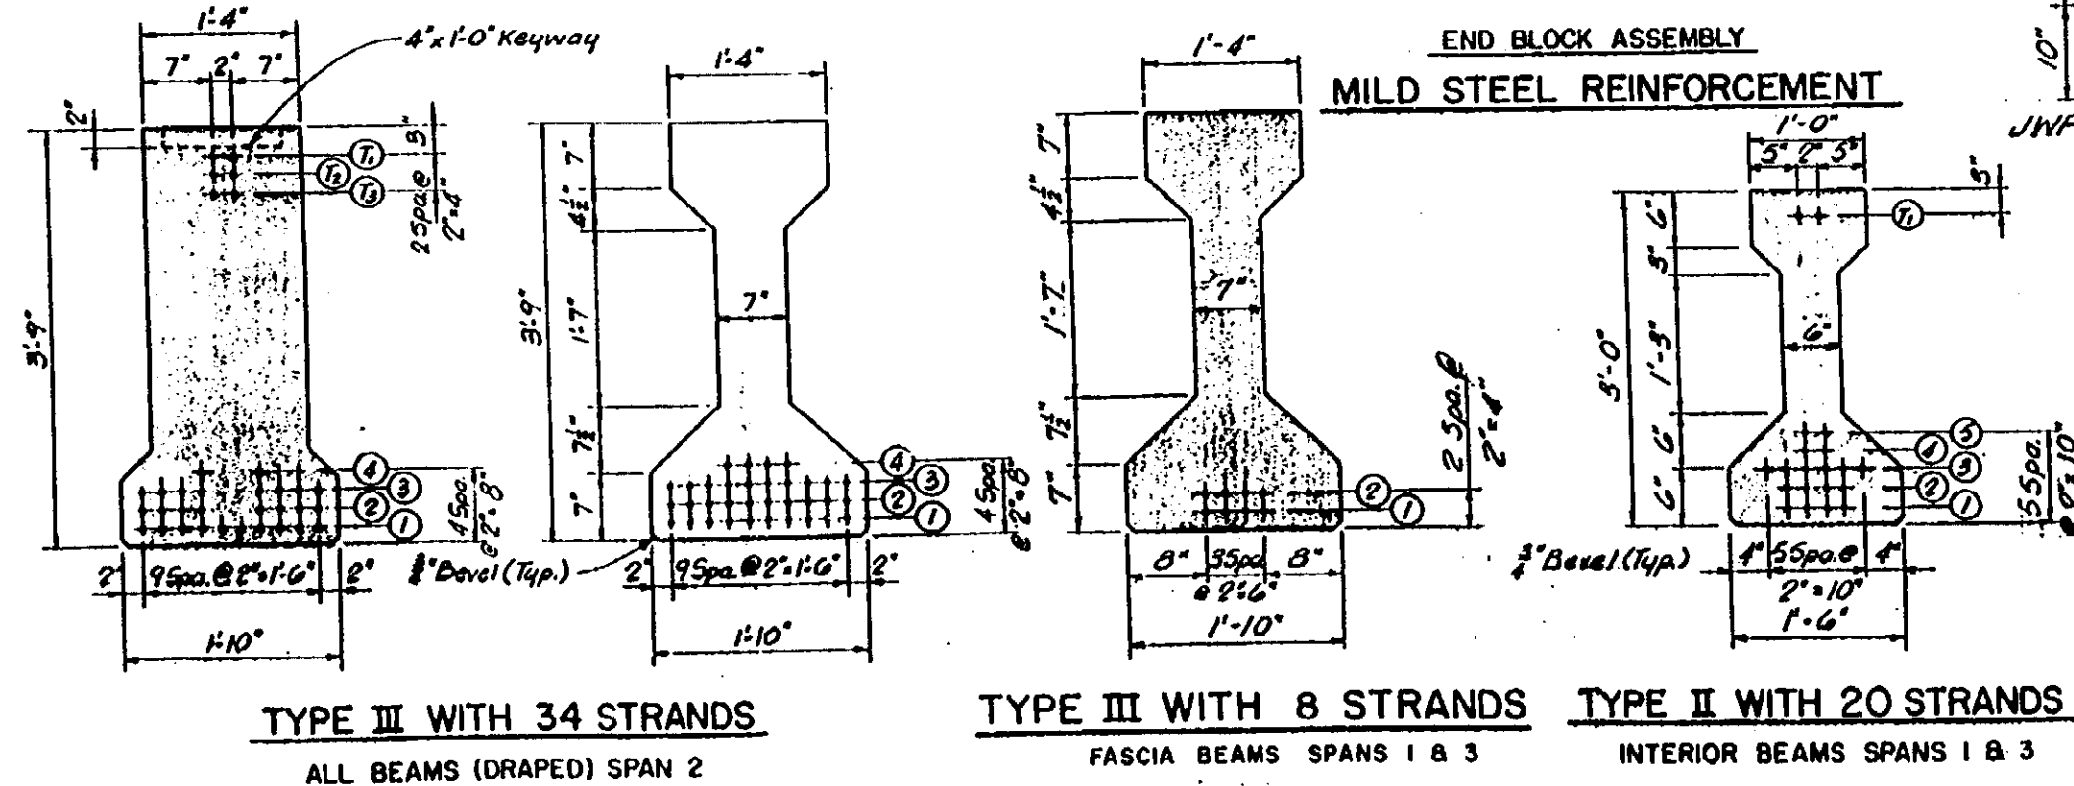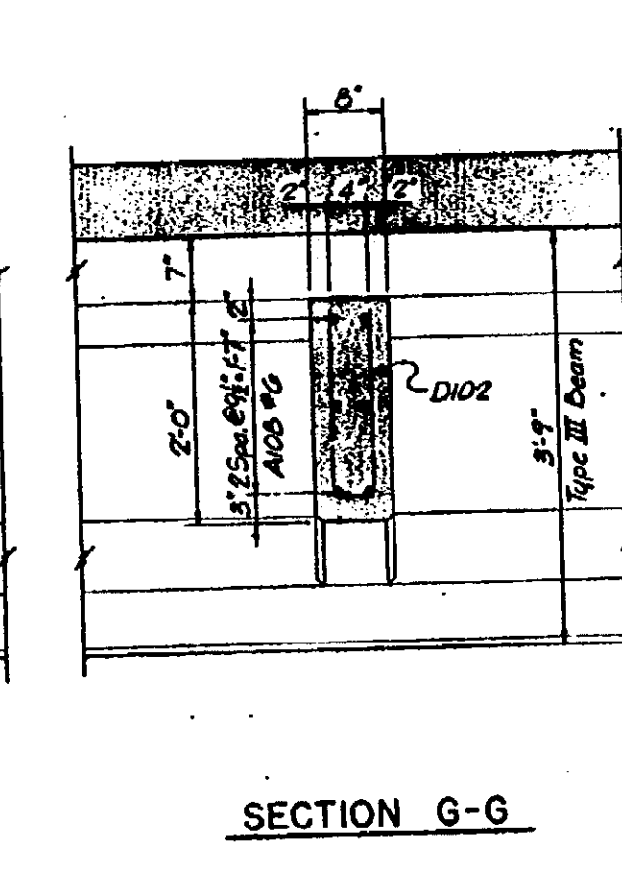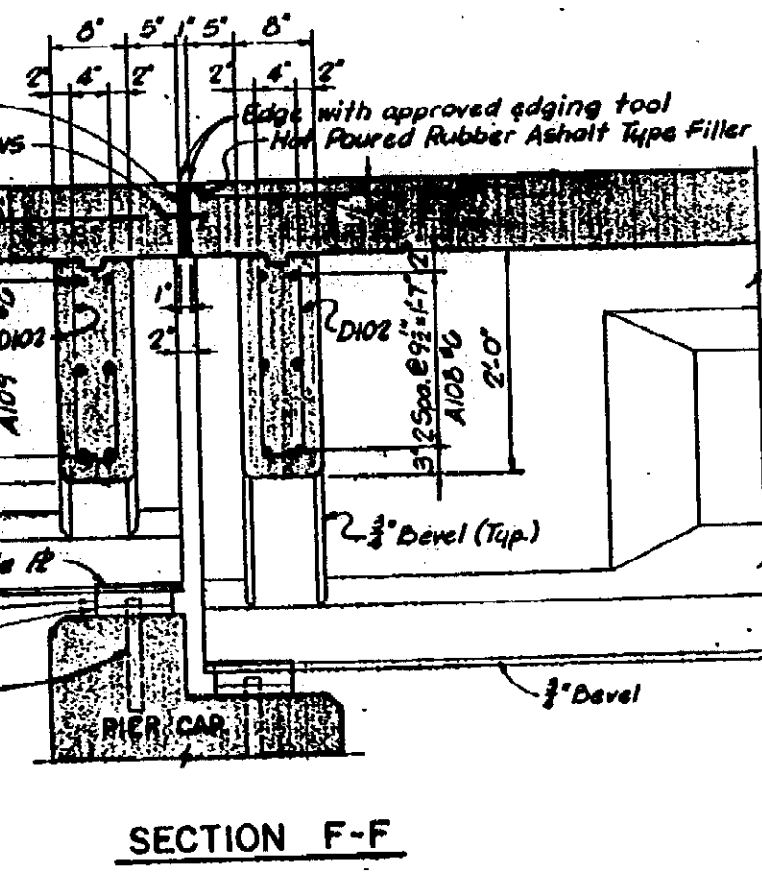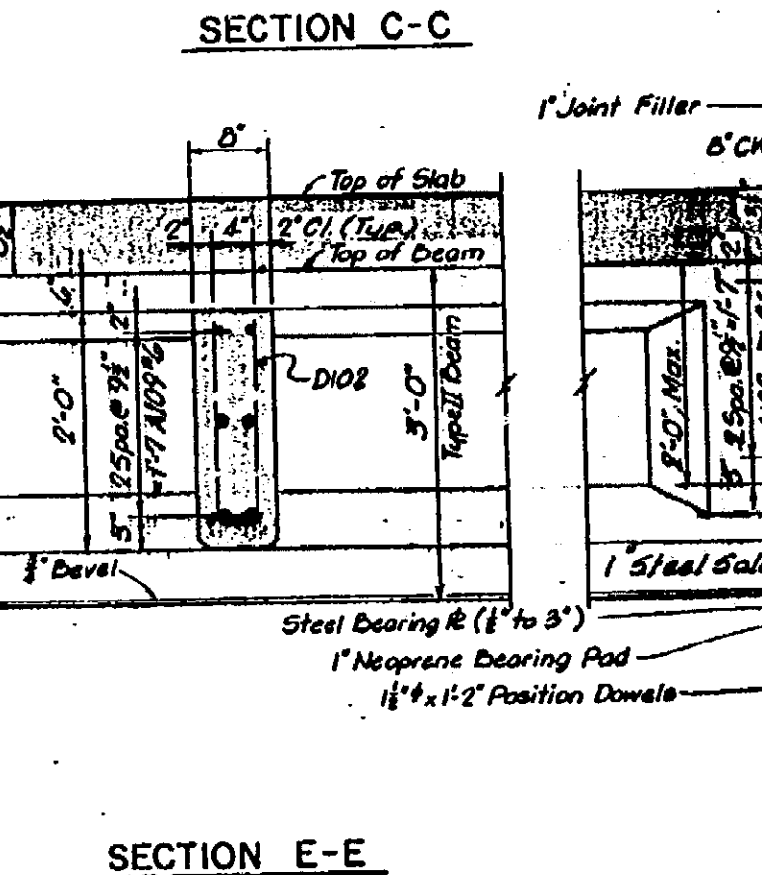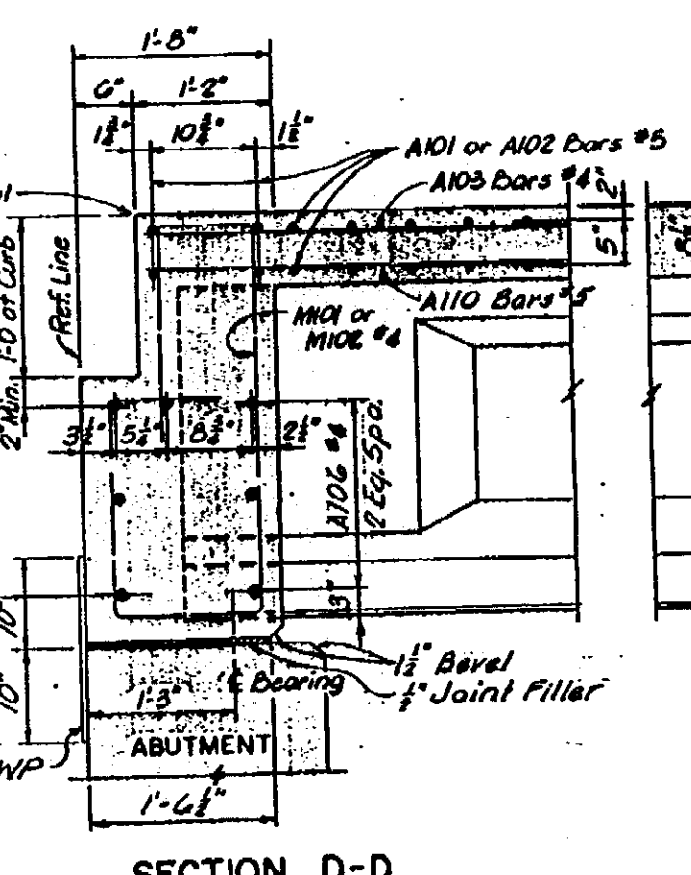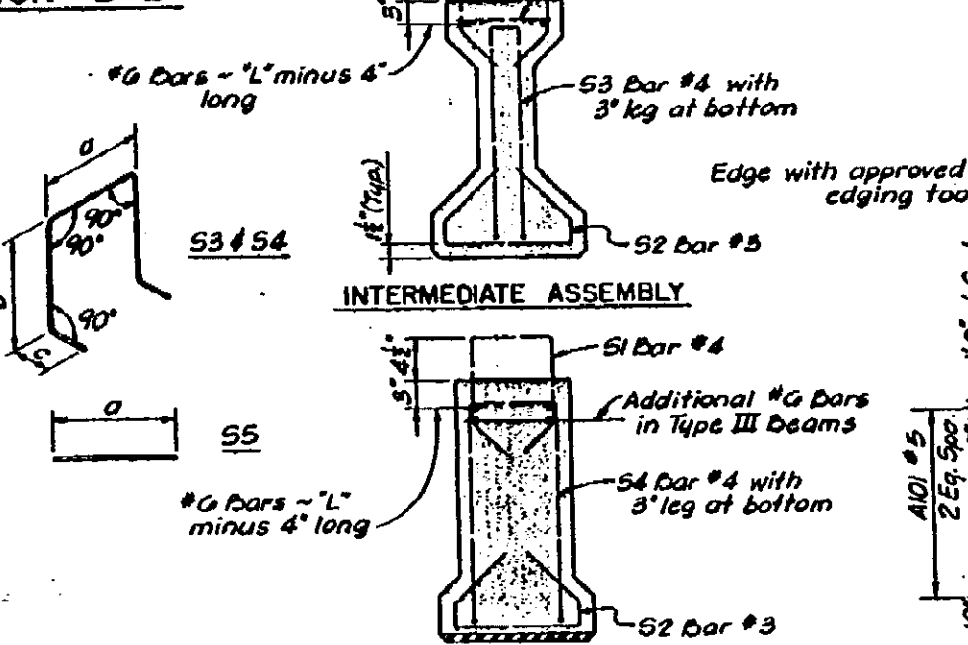

Type Beam	No. of Strands	Row Number													
		1	2	3	4	5	6	7	8	9	10				
II	20	1	1	6	2	2	-	2	-	-	-	-	-	-	-
III	34	4	4	-	-	-	-	-	-	-	-	-	-	-	-
III (Draped)	34	10	10	10	4	-	-	-	-	-	-	-	-	-	-
	End	10	0	0	2	-	-	2	2	2	-	-	-	-	-

Work this sheet with sheets 228, 230, 231, & 232

MICHIGAN STATE HIGHWAY DEPARTMENT
SUPERSTRUCTURE DETAILS

TECON ENGINEERS, INC.

REVISIONS			
NO.	DESCRIPTION	DATE	BY

S04 OF 63174 I



NOTE:
DO NOT WORK FROM THIS SHEET. THE INFORMATION SHOWN
HERE IS FOR REFERENCE ONLY. NO PAY ITEMS ARE SHOWN.



FOR INFORMATION ONLY				
DATE	CONT. SEC.	JOB NO.	DESIGN UNIT	SHEET
04-12-00	S04 OF 63174	49595A	MAHDAVI	1AE OF

DATE: _____ CORRECTED BY: _____ DATE: _____ CHECKED BY: _____ DATE: 04-12-00 DRAWN BY: INDER

1 2 3 4 5 6 7 8 9 10 11 12 13 14 15 16 17 18 19 20 21 22 23 24 25 26 27 28 29 30 31 32 33 34 35 36 37 38 39 40 41 42 43 44 45 46 47 48 49 50 51 52 53 54 55 56 57 58 59 60 61 62 63

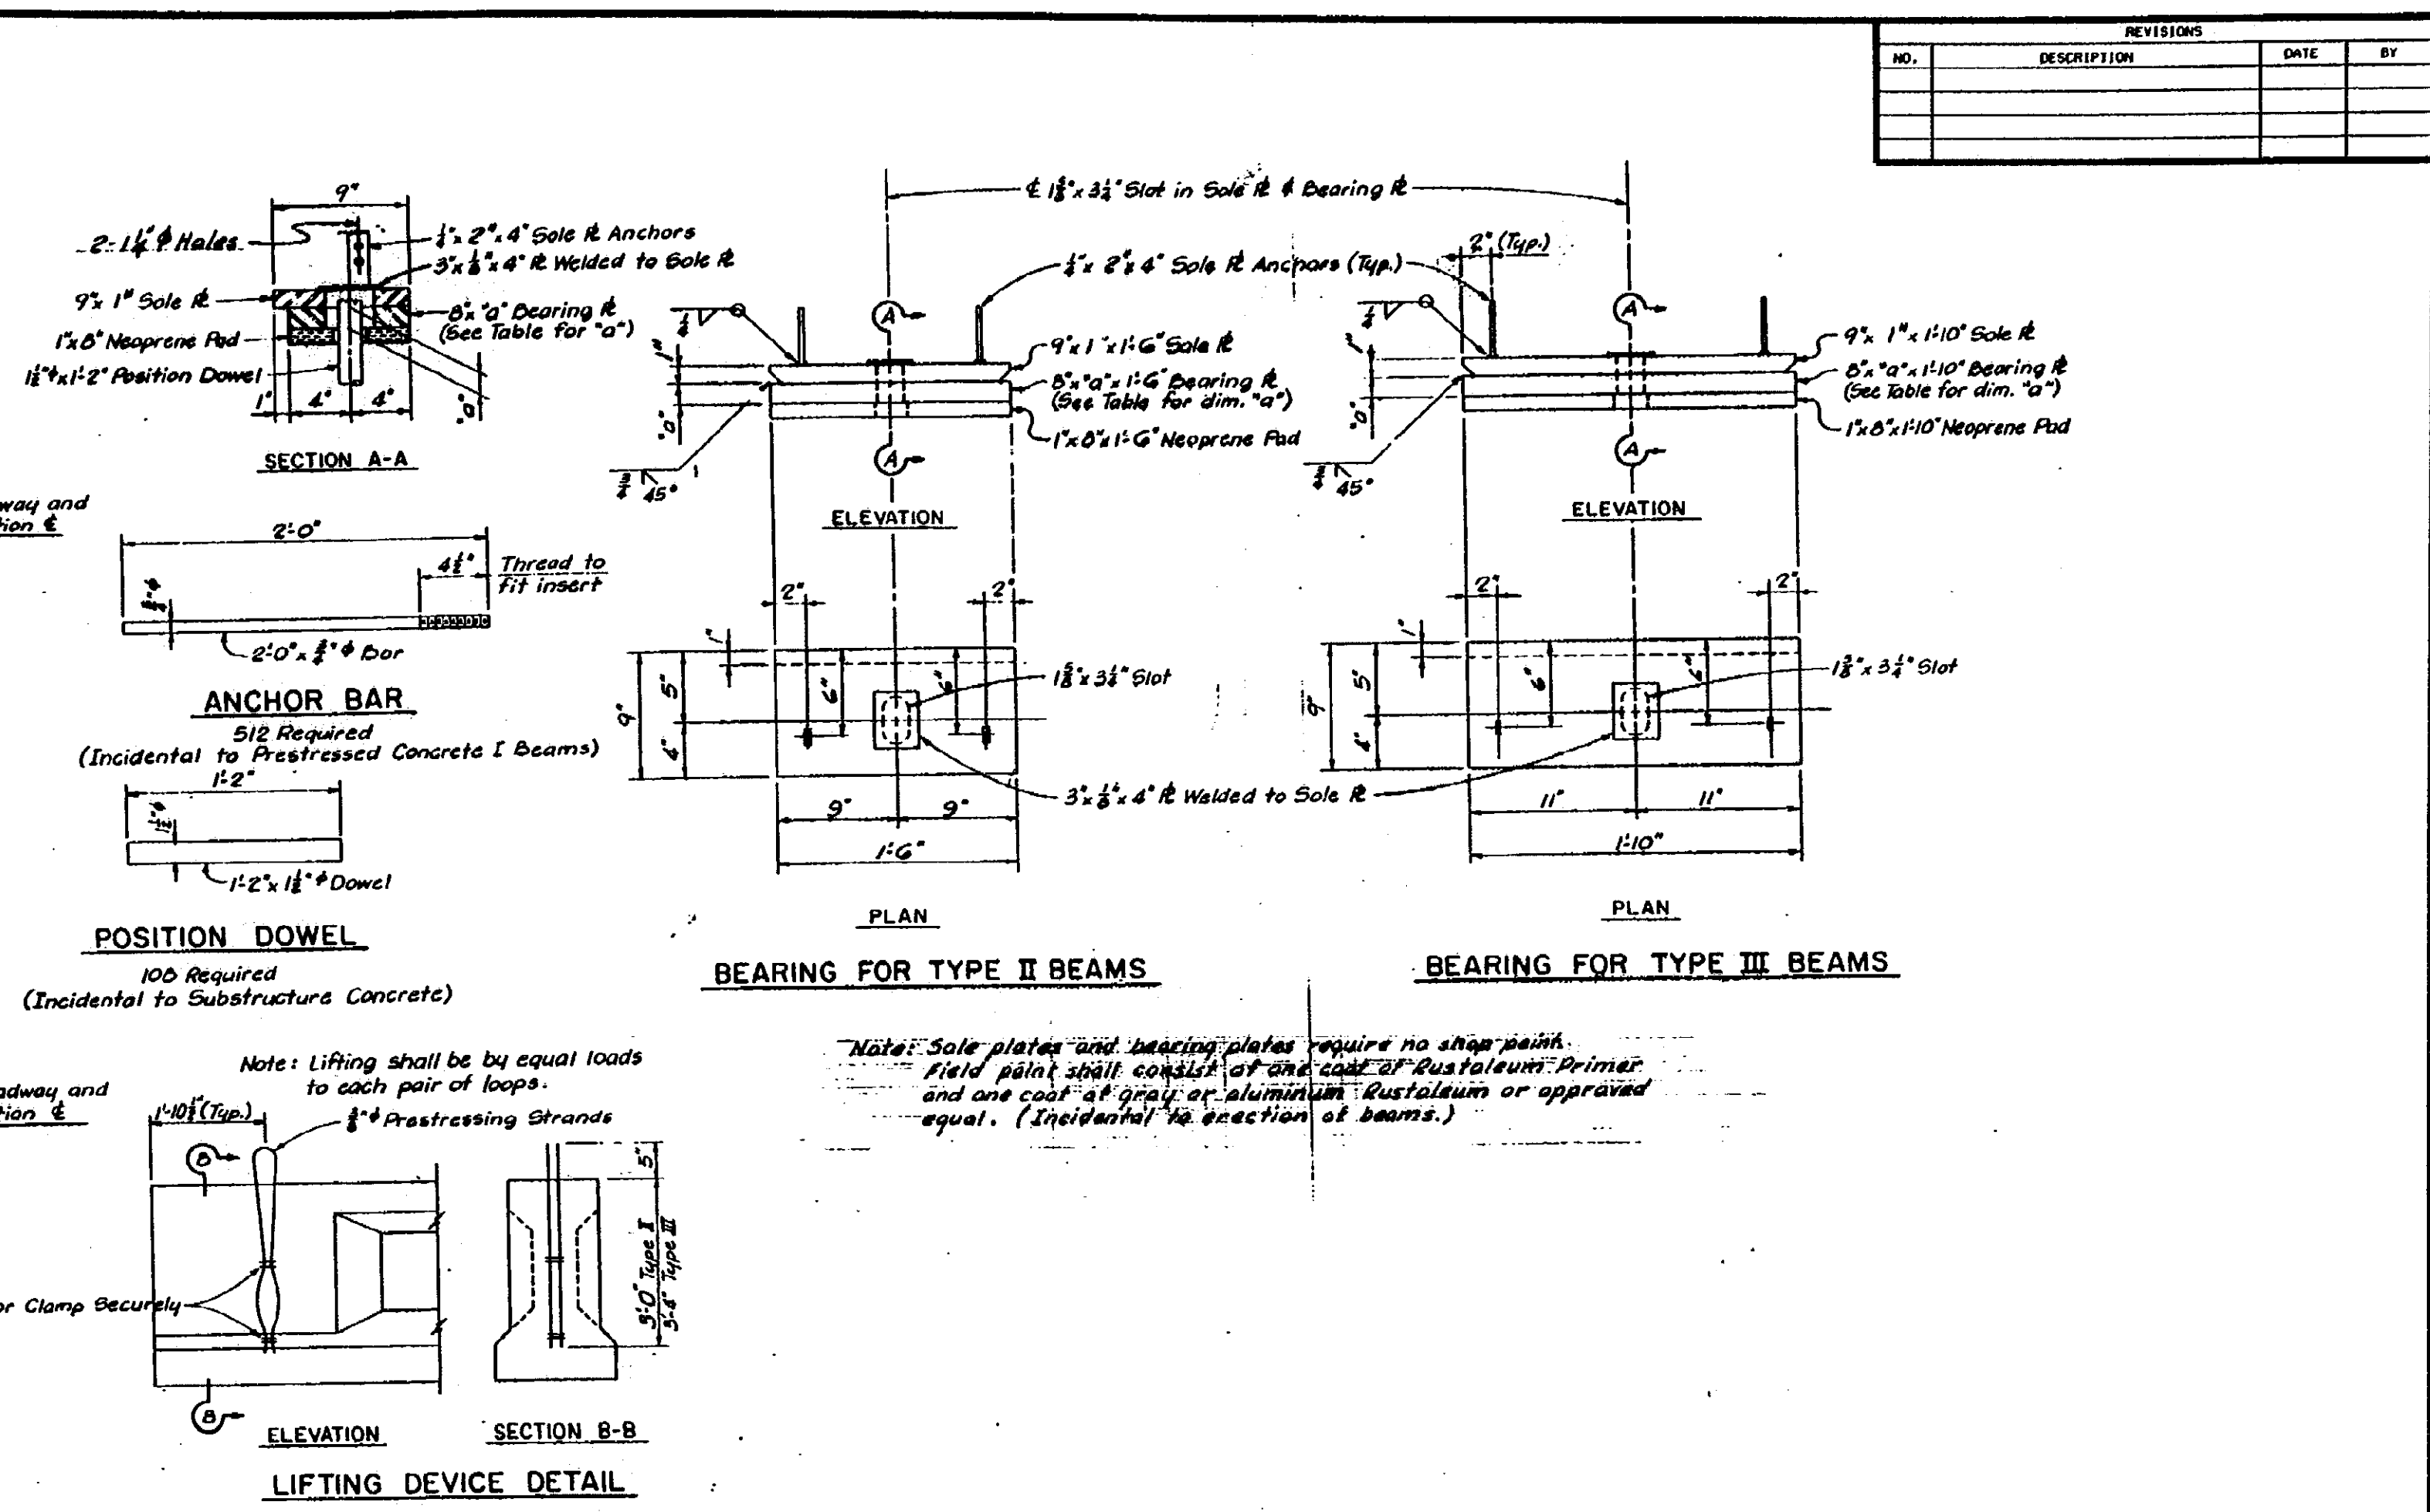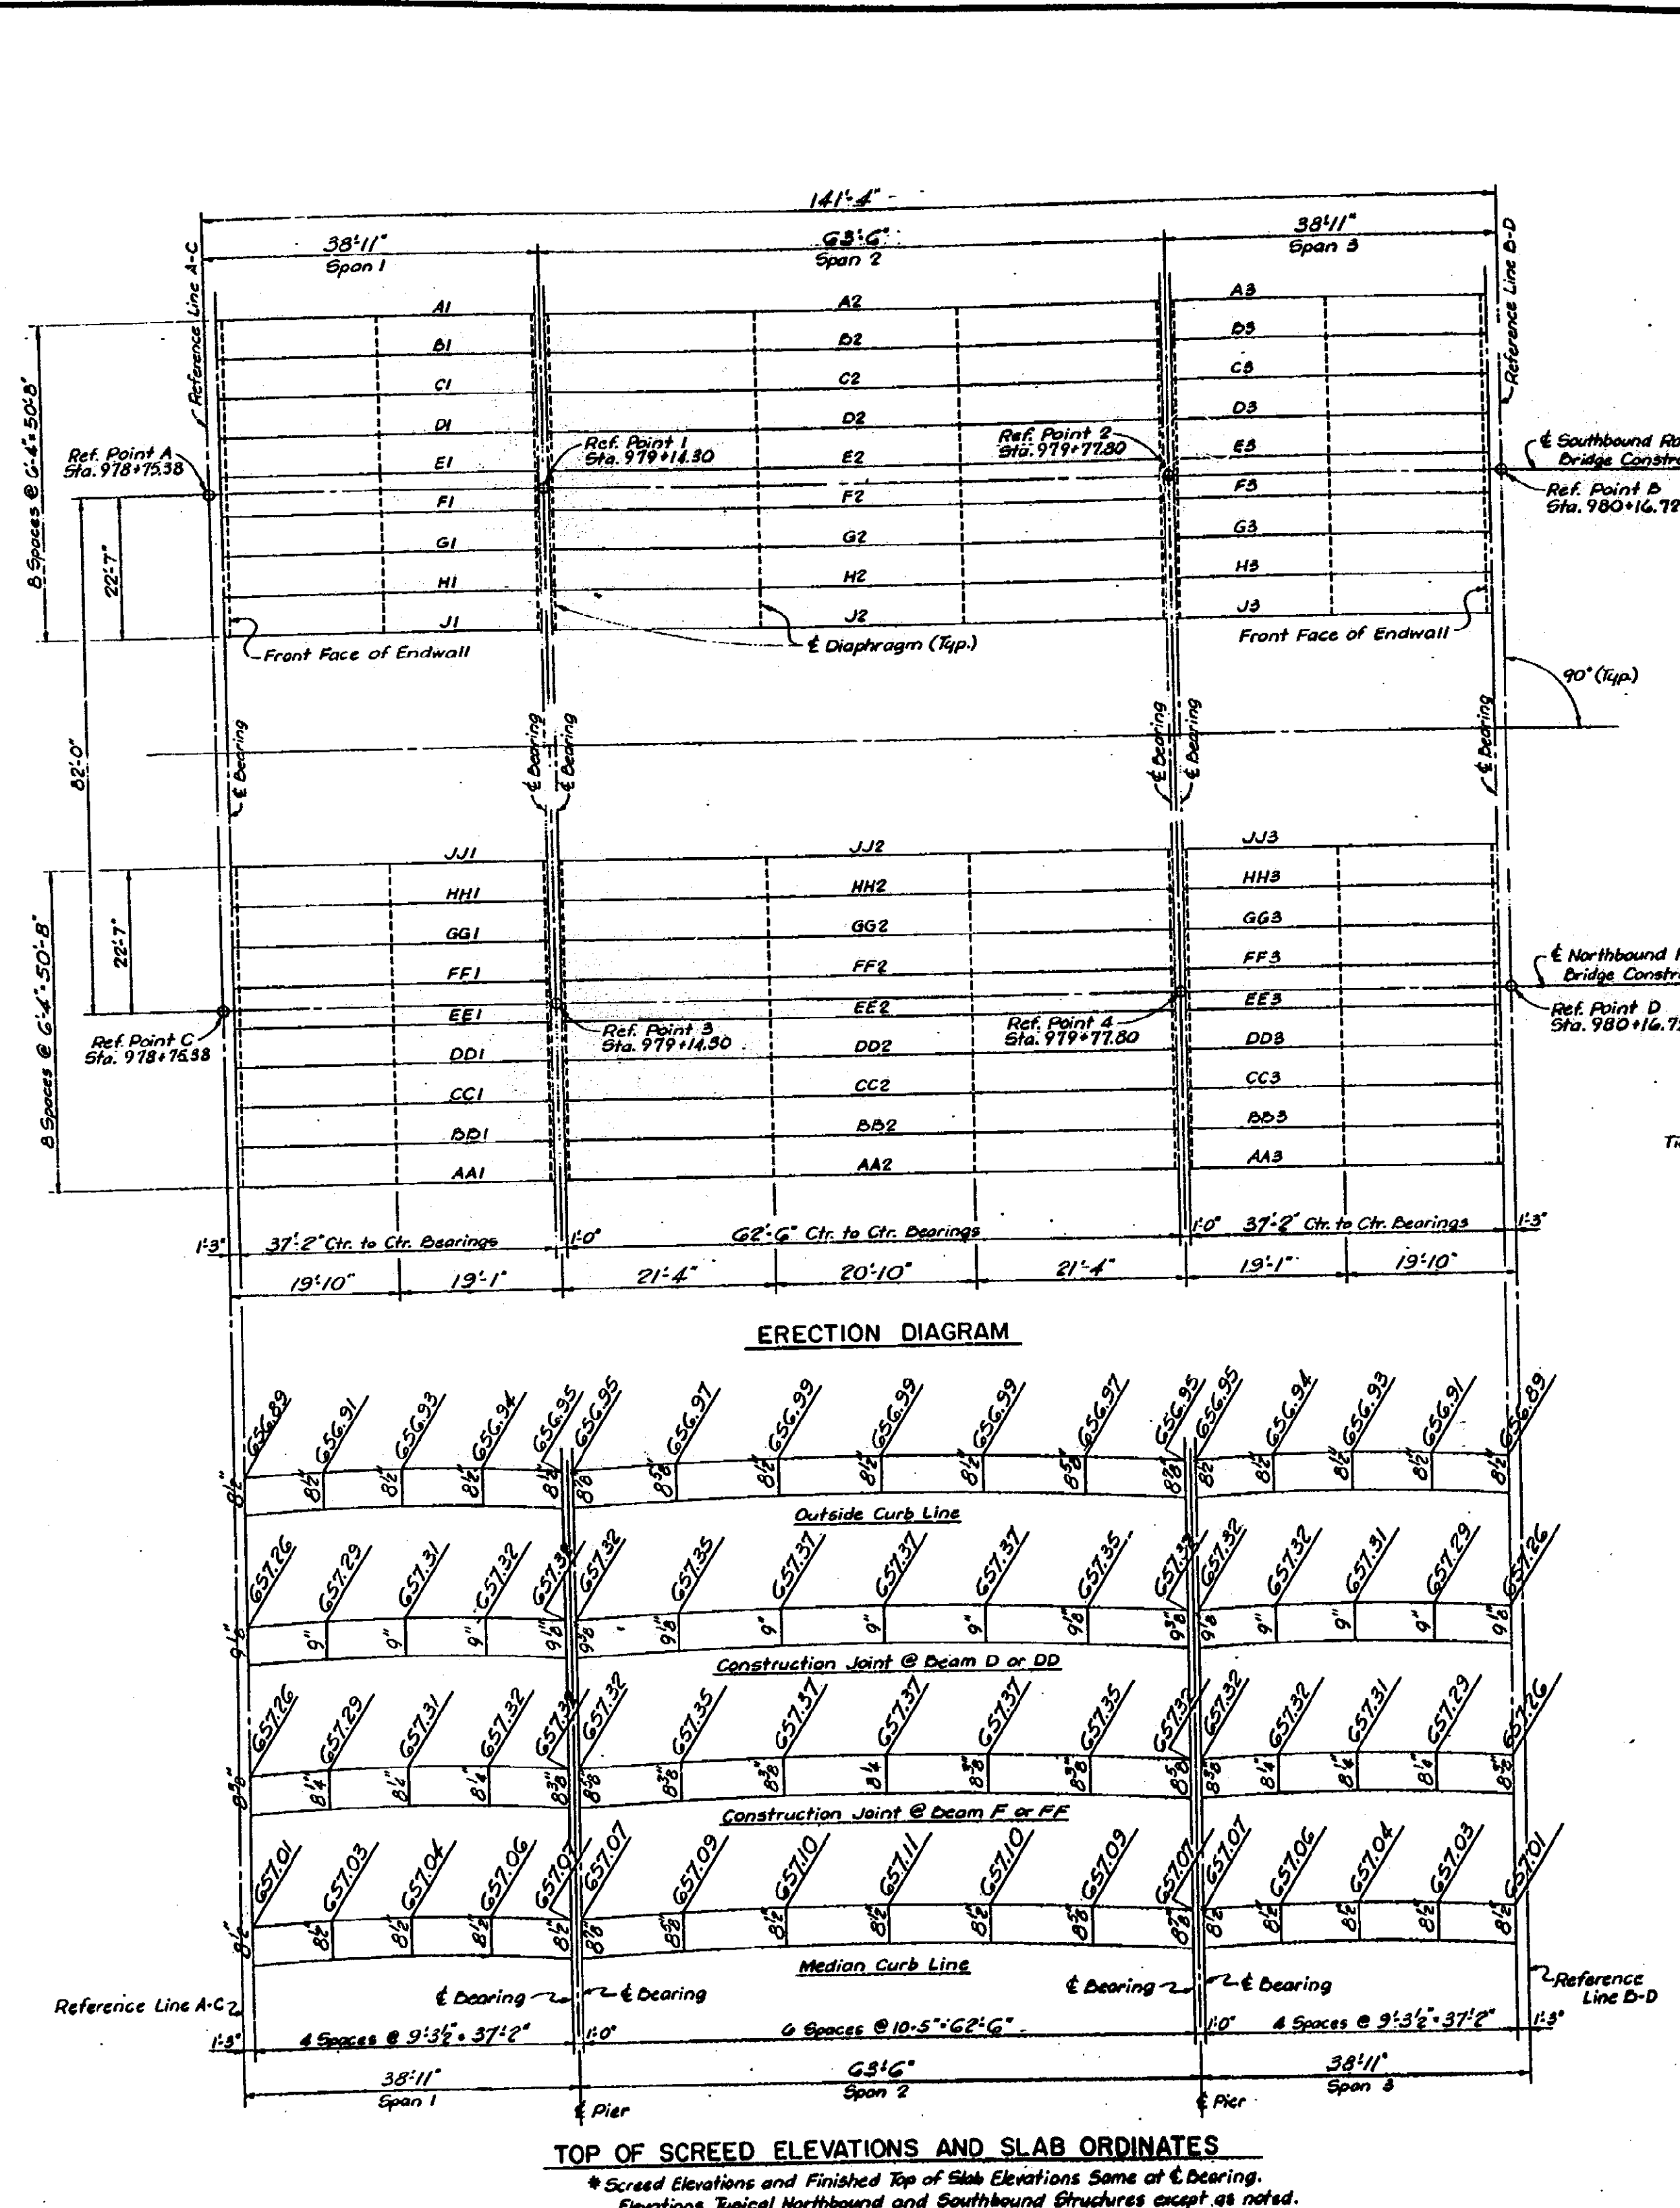


BEAM TABLE

Span	Position of Beams	Number of Beams Required	Depth of Beams	Length of Beams End to End	Number of 7/8" Strands	Initial Prestressing Force per Strand (pounds)	Total Initial Prestressing Force in Beam (pounds)	Approx. Weight of each Beam (pounds)
1	Interior	14	3'-0"	38'-0"	20	19,075	381,500	15,100
1	Fascia	4	3'-9"	38'-0"	8	18,500	148,000	23,900
2	All	18	3'-0"	63'-6"	34	19,075	648,550	34,200
3	Interior	14	3'-0"	38'-0"	20	19,075	381,500	15,100
3	Fascia	4	3'-9"	38'-0"	8	18,500	148,000	23,900

* Reduce Initial Prestressing Force so that stress after losses equals 150,000 psi.

BEARING PLATE THICKNESS TABLE ("a")

Beam	Span 1		Span 2		Span 3	
	Abuts. A	Piers 115	Piers 115	Piers 214	Piers 214	Abuts. D
A or AA	3"	1"	2"	2"	1"	3"
B or BB	4"	1"	0"	0"	1"	3"
C or CC	2 1/2"	1 1/2"	1 1/2"	1 1/2"	1 1/2"	2 1/2"
D or DD	2 1/2"	1"	1"	1"	1"	2 1/2"
E or EE	2 1/2"	1 1/2"	1 1/2"	1 1/2"	1 1/2"	2 1/2"
F or FF	2 1/2"	1 1/2"	1 1/2"	1 1/2"	1 1/2"	2 1/2"
G or GG	2"	2 1/2"	2 1/2"	2 1/2"	2 1/2"	2"
H or HH	3 1/2"	1 1/2"	1 1/2"	1 1/2"	1 1/2"	3 1/2"
J or JJ	2 1/2"	2 1/2"	2"	2"	2 1/2"	2 1/2"

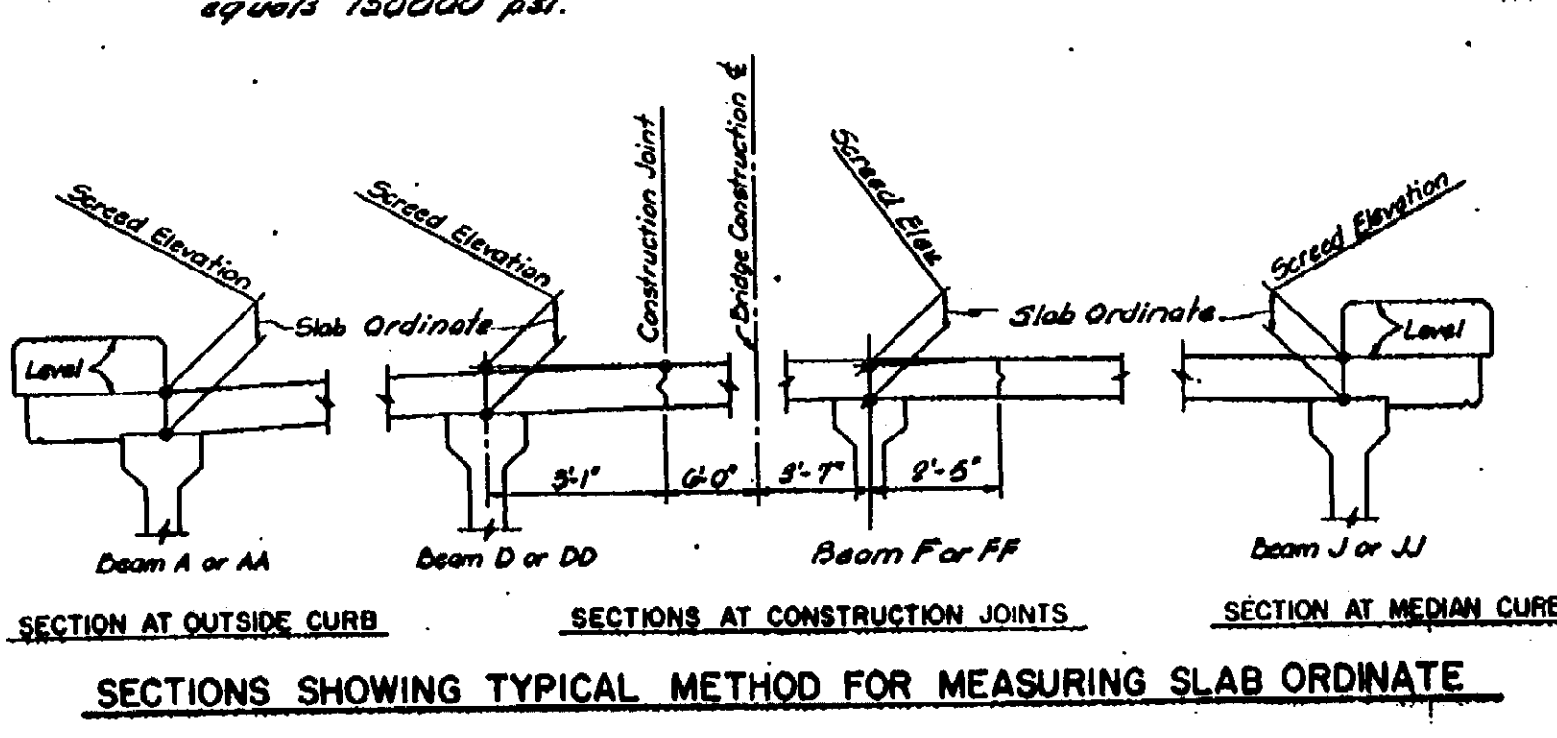

Elevations shown are for top of screed before pouring any concrete and are based on a minimum slab thickness of 8". After screeds are set, if check indicates that less than the minimum thickness will be obtained, adjust the screeds accordingly.

The slab ordinates shown provide for dead load deflection, vertical curve, and crown, and are to be measured from the top of the beam indicated to the top of the screed (on a line parallel to the reference lines).

Work this sheet with sheets 228, 229, 231, & 232

MICHIGAN STATE HIGHWAY DEPARTMENT

SUPERSTRUCTURE DETAILS

TECOM ENGINEERS, INC.

REVISIONS

NO.	DESCRIPTION	DATE	BY
1	ISSUED	04-12-00	JPD
2	REVISED	07-23-00	GTC
3	REVISED	08-12-00	JPD

S04 OF 63174 I

NOTE:
DO NOT WORK FROM THIS SHEET. THE INFORMATION SHOWN HERE IS FOR REFERENCE ONLY. NO PAY ITEMS ARE SHOWN.

FOR INFORMATION ONLY

MICHIGAN DEPARTMENT OF TRANSPORTATION

DATE	CONT. SEC.	JOB NO.	DESIGN UNIT	SHEET
04-12-00	S04 OF 63174	49595A	MAHDAVI	1AF OF

NO. DESCRIPTION DATE BY


DATE: 04-12-00 CHECKED BY: INDER

DATE: CORRECTED BY:

FILE NAME: s0462174sn.

1 2 3 4 5 6 7 8 9 10 11 12 13 14 15 16 17 18 19 20 21 22 23 24 25 26 27 28 29 30 31 32 33 34 35 36 37 38 39 40 41 42 43 44 45 46 47 48 49 50 51 52 53 54 55 56 57 58 59 60 61 62 63

REVISIONS			
NO.	DESCRIPTION	DATE	BY

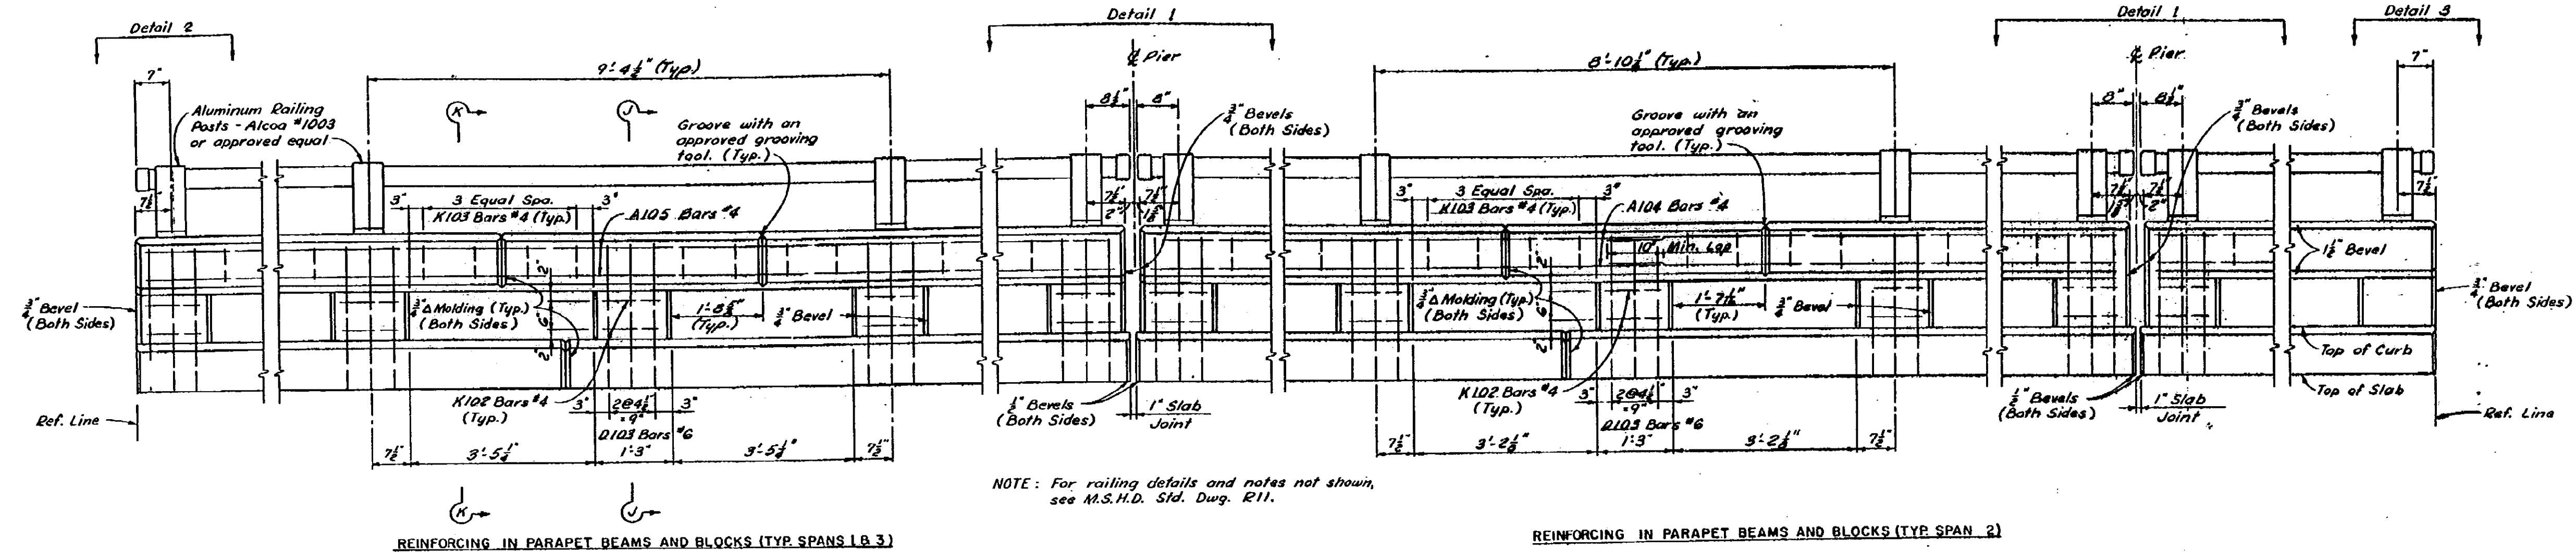


NOTE: For railing details and notes not shown, see M.S.H.D. Std. Dwg. R11.


REINFORCING IN PARAPET BEAMS AND BLOCKS (TYP SPANS 1 & 3)

REINFORCING IN PARAPET BEAMS AND BLOCKS (TYP SPAN 2)


INSIDE ELEVATION - BRIDGE RAILING - PARAPET TYPE

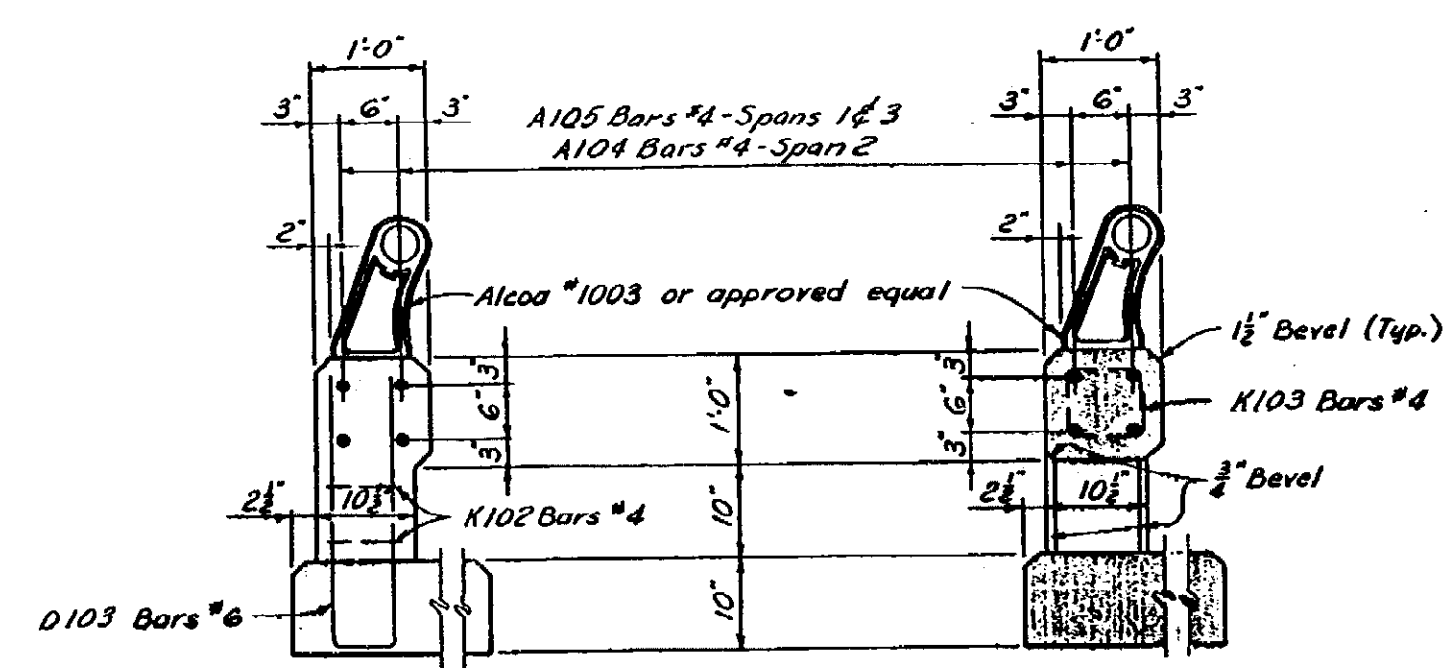

SECTION J-J SECTION K-K

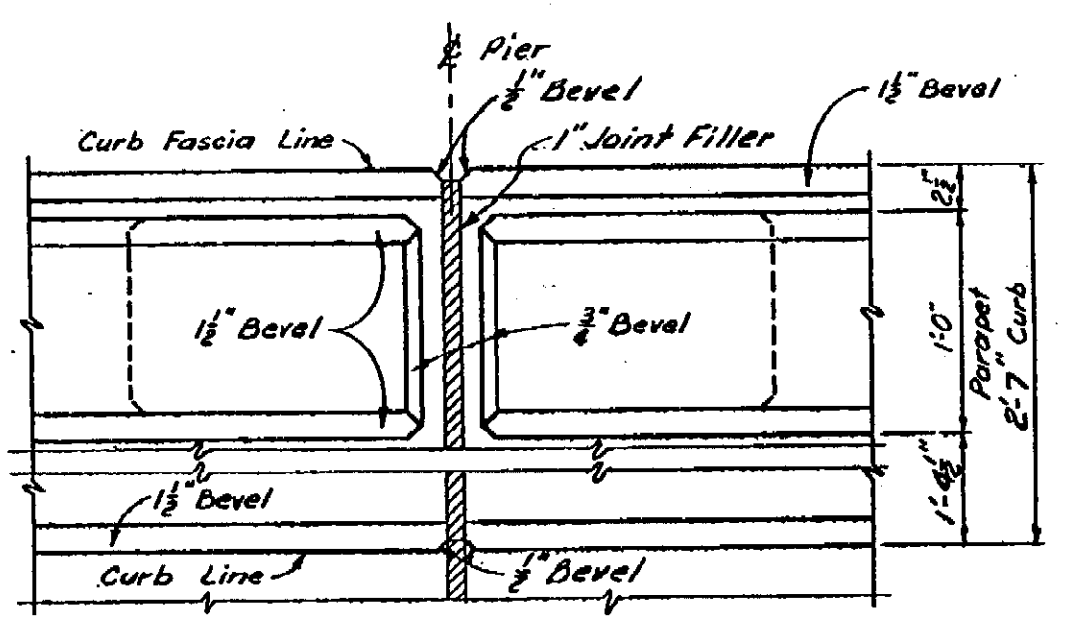


DETAIL I

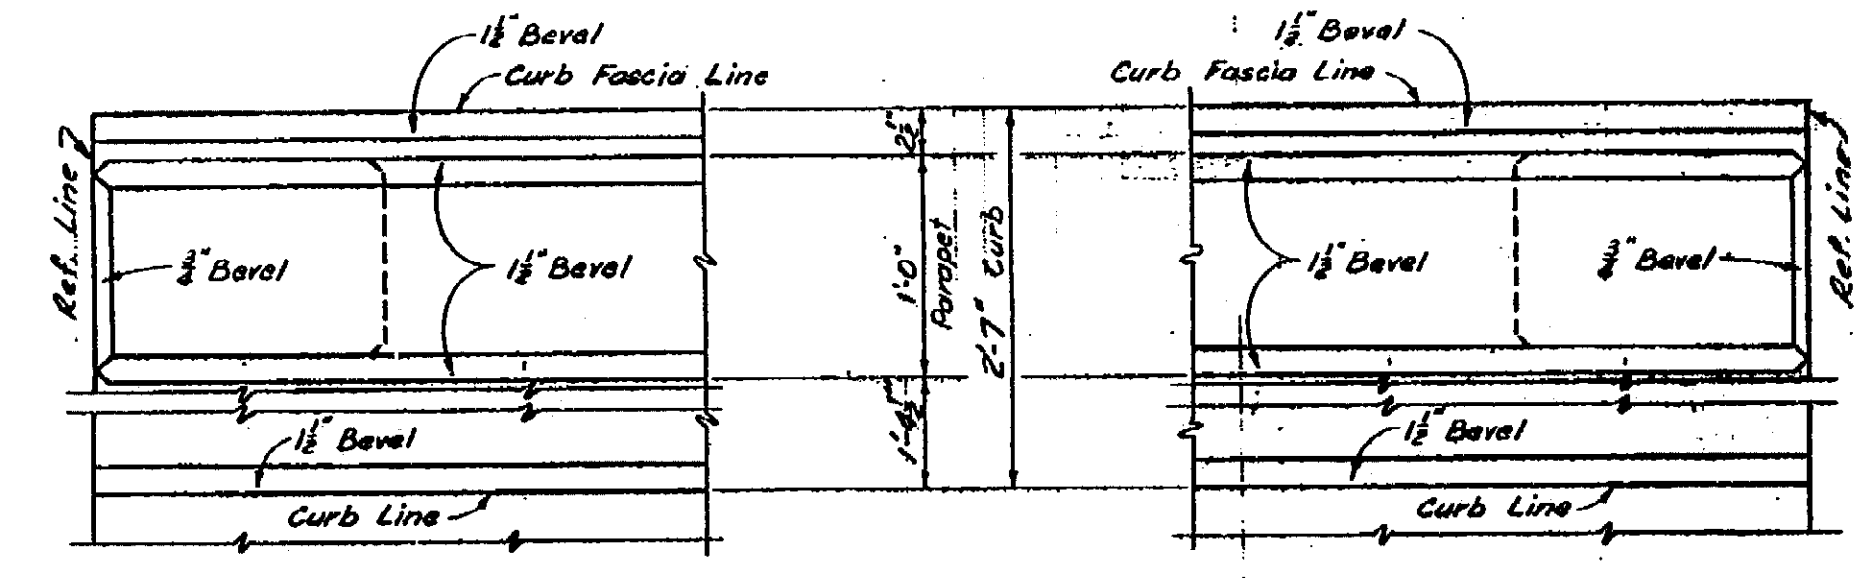

DETAIL 2 DETAIL 3



COPPER WATERSTOP DETAILS

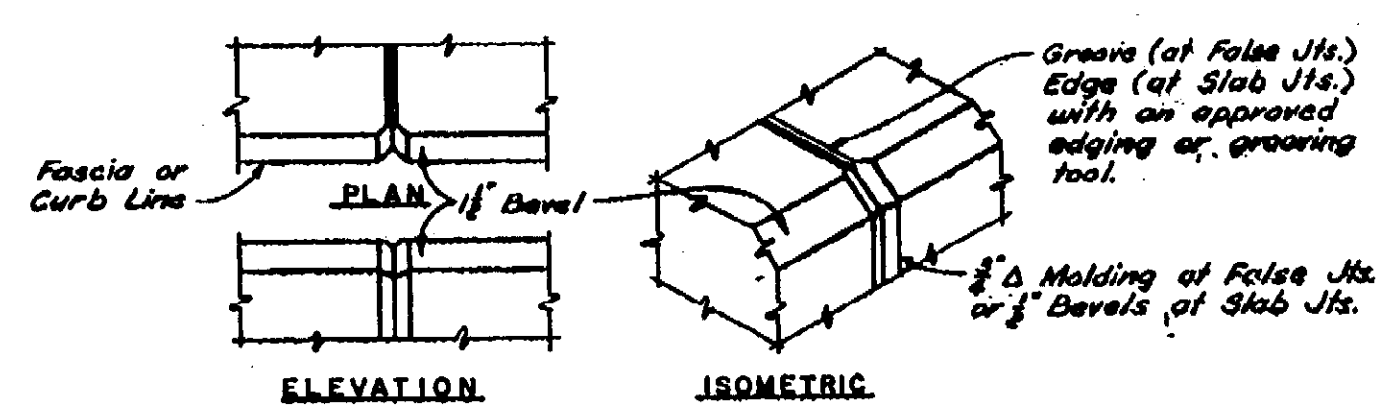

MOLDING DETAILS

Work this sheet with sheets 226 thru 230, & 232

MICHIGAN STATE HIGHWAY DEPARTMENT
SUPERSTRUCTURE DETAILS

TECON ENGINEERS, INC.

NO.	DESCRIPTION	DATE	BY



DATE: 04-12-00
DRAWN BY: INDBR
CHECKED BY: DATE: 04-12-00
FILE NAME: s0462174sn.

NOTE:
DO NOT WORK FROM THIS SHEET. THE INFORMATION SHOWN
HERE IS FOR REFERENCE ONLY. NO PAY ITEMS ARE SHOWN.



FOR INFORMATION ONLY

DATE	CONT. SEC.	JOB NO.	DESIGN UNIT	SHEET
04-12-00	S04 OF 63174	49595A	MAHDAVI	1AG OF

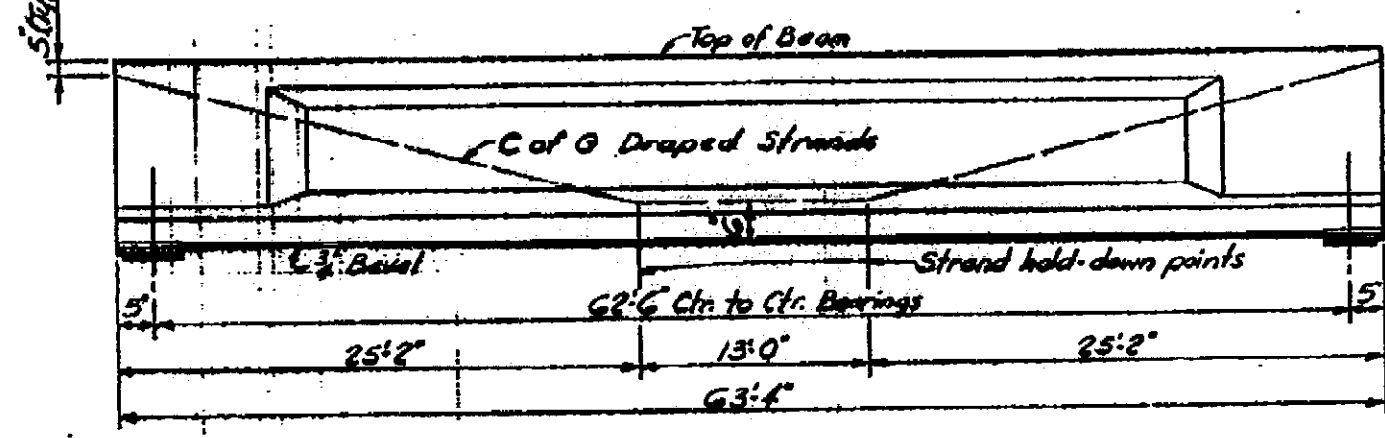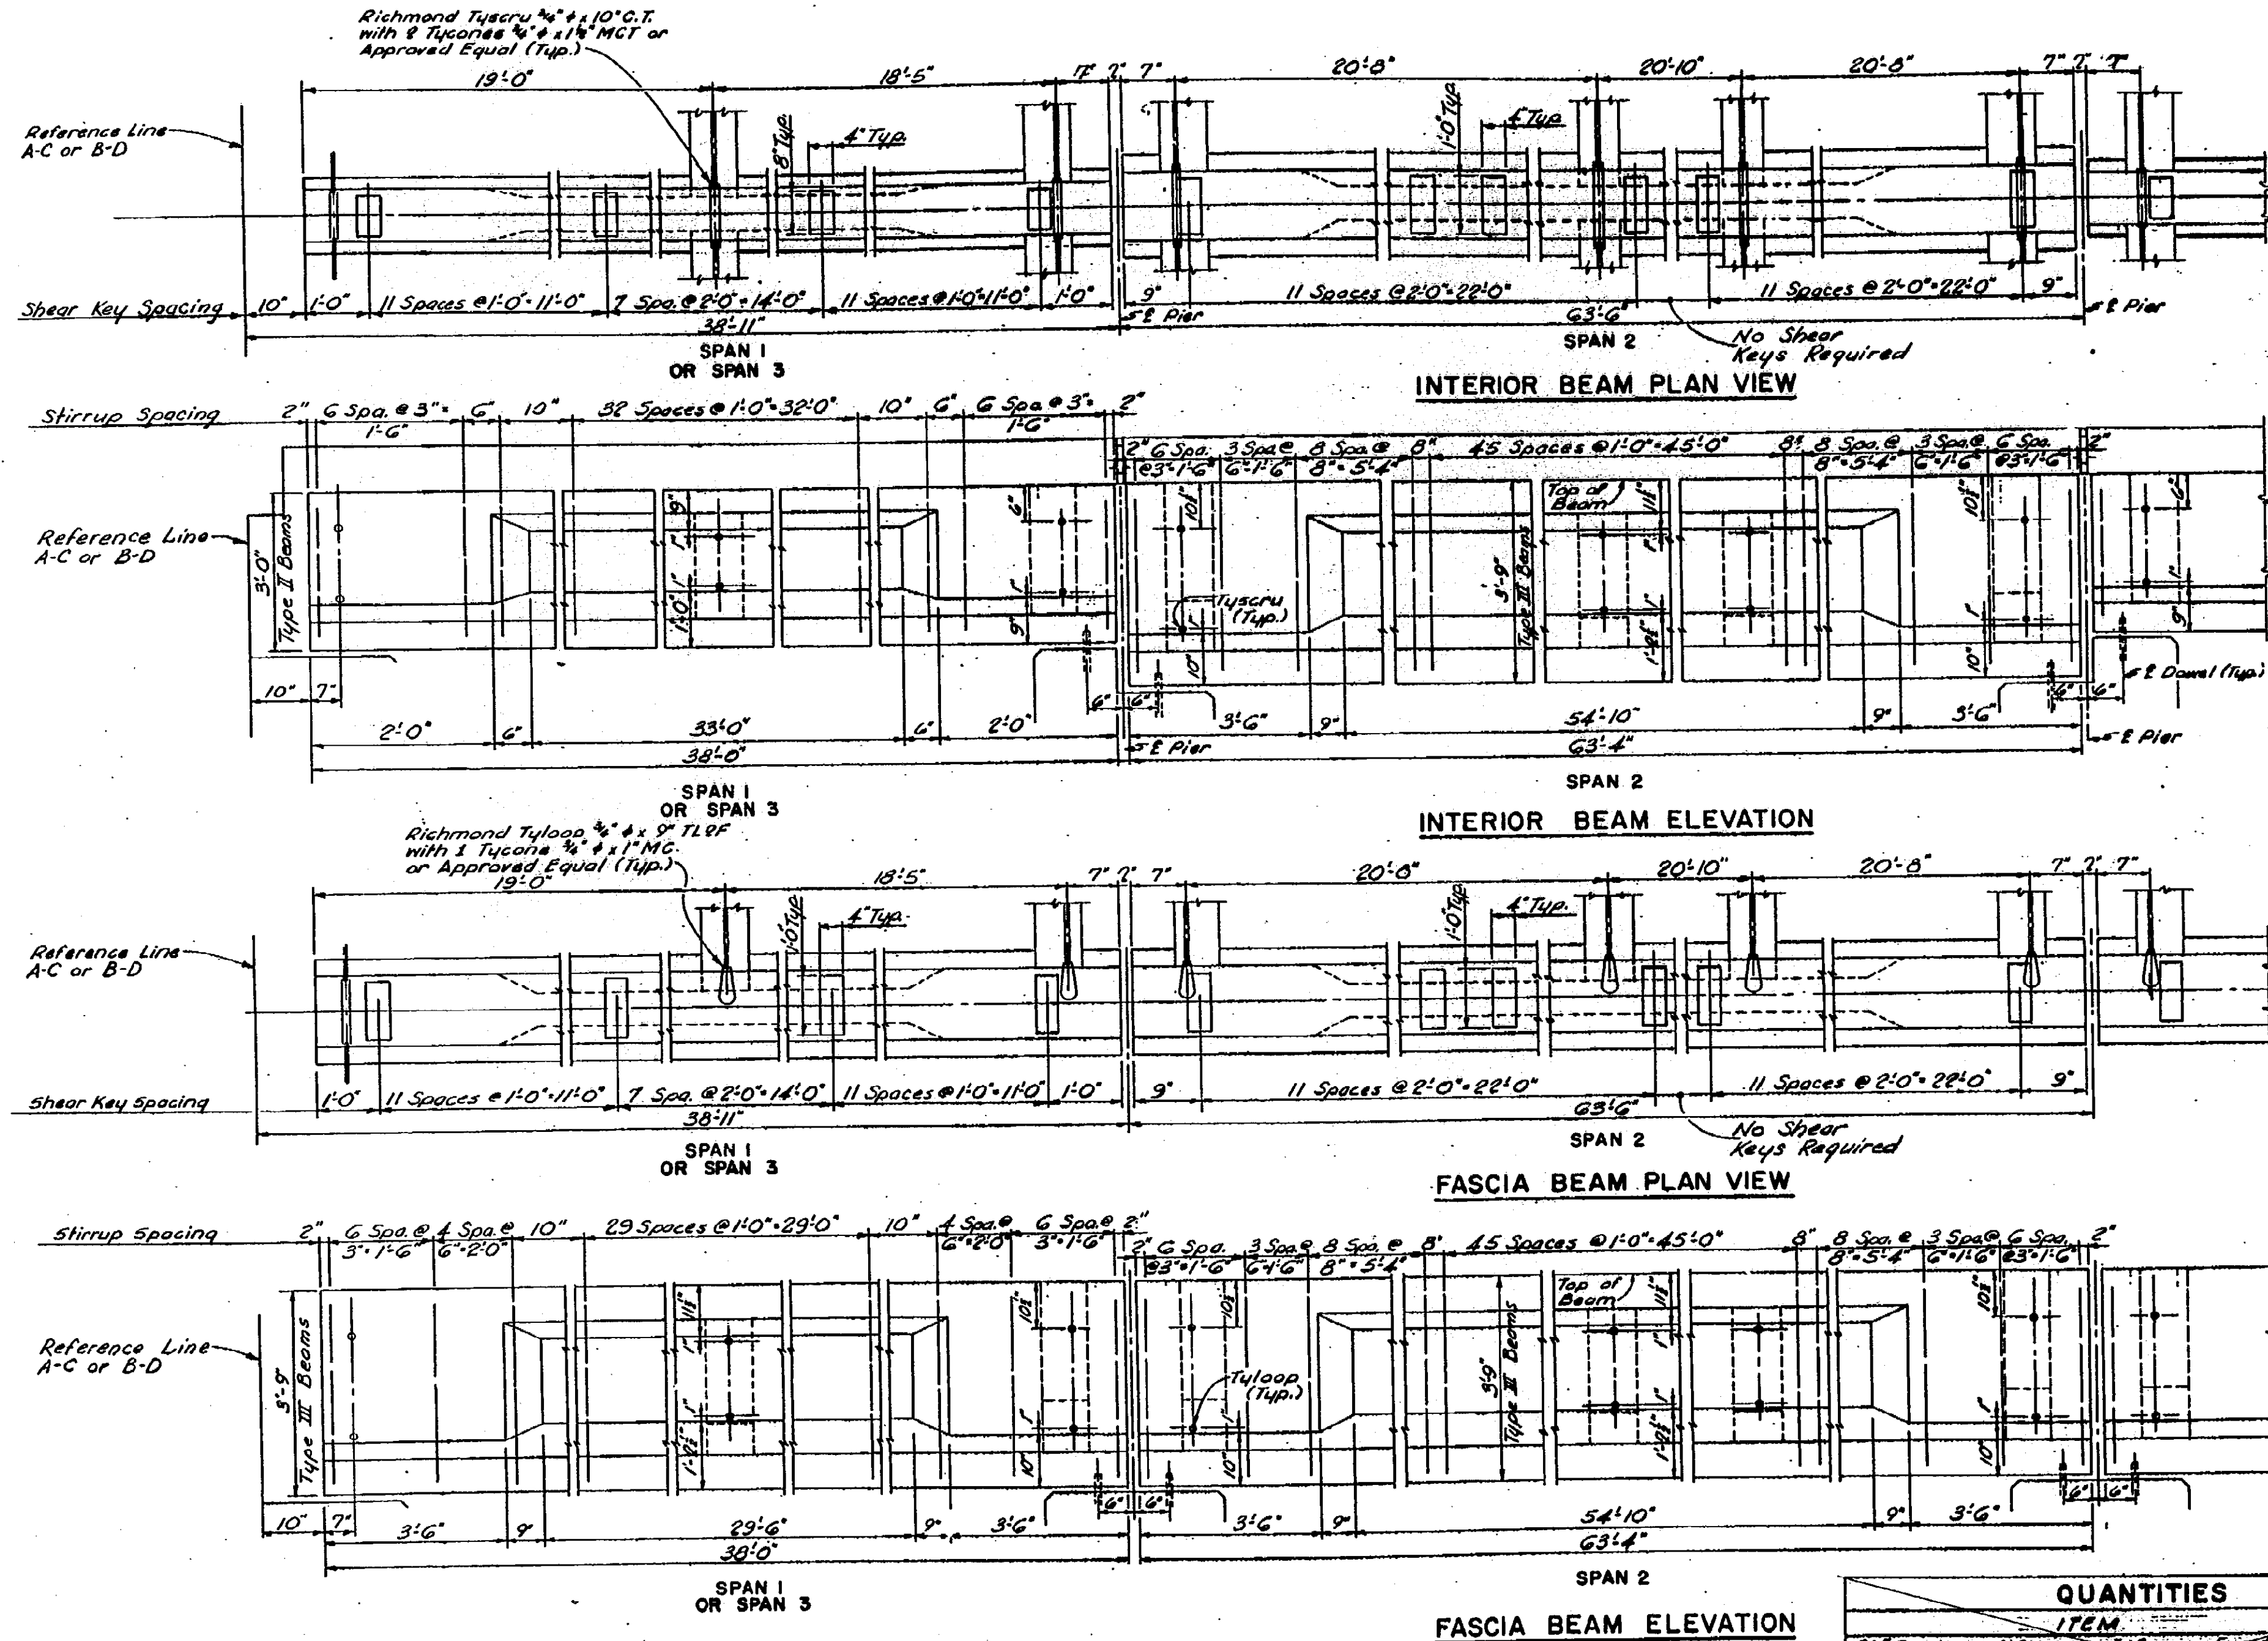

NOTES: Shop plans shall include a diagram of casting bed layout. Where the "pull-down" method is used, the jacking force for draped strands, together with appropriate computations shall also be submitted by the fabricator. The value of "E" used in calculating strand elongation shall be as recommended by the strand manufacturer. Strands shall be placed symmetrically about the centerline of beam. An allowance of .0008L shall be made for shortening of the beams due to shrinkage and elastic elongation. Strands shall be Richmond Type CT Inserts TLEA Insert, Superior #4 Coil Ties or coil with flared loop or equal.

NOTES:
 Fabrication: Michigan State Highway Department's Standard Specifications for Road and Bridge Construction-1960 Edition.
 Design: Michigan State Highway Department's Specifications for Design of Highway Bridges-1958 Edition, H20-S1C-44 and alternate military loading.
 Furnishing anchor bars is incidental to Prestressed Concrete I Beams - Furnished.
 Installation of anchor bars is incidental to Superstructure Concrete.
 Furnishing and installation of sole plates, bearing plates, lifting devices and other connected fixtures are incidental to Prestressed Concrete I Beams. (See supplemental specs.)
 The estimated beam camber 1" for Spans 1 & 3, and 2" for Span 2. A check should be made of the actual camber when beam is in erected position, and if different than estimated, adjustments to screeds are to be made to provide for required slab thickness, for materials, construction, care and handling procedure, see supplemental specs.
 Lifting devices different than as shown on the plans may be used provided they are approved by the M.S.H.D.
 Minor cracks in the end sections of the beams may be permitted subject to inspection by M.S.H.D.
 Beams with honeycomb of such extent as to affect the strength or resistance to deterioration will be accepted.
 For additional notes see sheet nos. 229 & 230.

ITEM	UNIT	AMOUNT
36" Prestressed Concrete Beams - Erected	Lin. Ft.	1964.0
36" Prestressed Concrete Beams - Furnished	Lin. Ft.	1964.0
45" Prestressed Concrete Beams - Erected	Lin. Ft.	1440.0
45" Prestressed Concrete Beams - Furnished	Lin. Ft.	1440.0
1" Neoprene Bearing Pads	Sq. Ft.	182

Work this sheet with sheets 228 thru 231

MICHIGAN STATE HIGHWAY DEPARTMENT

BEAM LAYOUT

DATE	BY	CHKD BY
04-12-00	JBC	JBC
DESIGNED BY	DATE	CHKD BY
GTC	04-12-00	JBC

TECON ENGINEERS, INC.
1110 S. W. 11th St., Ft. Lauderdale, FL 33304
PH: 305-463-1111

S04 OF 63174 I

NOTE:
 DO NOT WORK FROM THIS SHEET. THE INFORMATION SHOWN HERE IS FOR REFERENCE ONLY. NO PAY ITEMS ARE SHOWN.



FOR INFORMATION ONLY				
DATE	CONT. SEC.	JOB NO.	DESIGN UNIT	SHEET
04-12-00	S04 OF 63174	49595A	MAHDAVI	1AH OF

DATE: _____ CORRECTED BY: _____ DATE: _____ CHECKED BY: _____ DATE: 04-12-00 INDOR DRAWN BY: _____

1 2 3 4 5 6 7 8 9 10 11 12 13 14 15 16 17 18 19 20 21 22 23 24 25 26 27 28 29 30 31 32 33 34 35 36 37 38 39 40 41 42 43 44 45 46 47 48 49 50 51 52 53 54 55 56 57 58 59 60 61 62 63



REVISIONS			
NO.	DESCRIPTION	DATE	BY

MARK	TYPE	NO.	DIMENSIONS										APPROX. WT. EACH
			F	G	H	J	K	L	a	b	M		
1S1	III	I	0	15'-4"	0	15'-4"	10'-0"	30'-7"	31'-5"	0	25'-2"	0	20,050
1S10	III	I	0	15'-5"	0	15'-5"	10'-0"	30'-7"	31'-5"	0	25'-2"	0	20,050
1S2 thru 1S9	I	0	15'-5"	7'-1"	15'-4"	10'-0"	30'-7"	31'-5"	0	17'-2"	0	9,450	
1N1	III	I	0	15'-5"	0	15'-5"	10'-0"	30'-7"	31'-5"	0	25'-2"	0	20,050
1N10	III	I	0	15'-5"	0	15'-5"	10'-0"	30'-7"	31'-5"	0	25'-2"	0	20,050
1N2 thru 1N9	I	0	15'-5"	7'-1"	15'-4"	10'-0"	30'-7"	31'-5"	0	17'-2"	0	9,450	
2S1	III	I	0	25'-10"	0	25'-10"	18'-0"	51'-4"	52'-4"	10'	29'-5"	0	32,850
2S10	III	I	0	25'-10"	0	25'-10"	18'-0"	51'-4"	52'-4"	10'	29'-5"	0	32,850
2S2 thru 2S9	III	0	25'-10"	7'-1"	25'-10"	18'-0"	51'-4"	52'-4"	10'	29'-5"	0	32,850	
2N1	III	I	0	25'-10"	0	25'-10"	18'-0"	51'-4"	52'-4"	10'	29'-5"	0	32,850
2N10	III	I	0	25'-10"	0	25'-10"	18'-0"	51'-4"	52'-4"	10'	29'-5"	0	32,850
2N2 thru 2N9	III	0	25'-10"	7'-1"	25'-10"	18'-0"	51'-4"	52'-4"	10'	29'-5"	0	32,850	
3S1	III	I	0	25'-11"	0	25'-11"	18'-0"	51'-4"	52'-2"	10'	29'-5"	0	32,150
3S10	III	I	0	25'-11"	0	25'-11"	18'-0"	51'-4"	52'-2"	10'	29'-5"	0	32,150
3S2 thru 3S9	III	0	25'-11"	7'-1"	25'-11"	18'-0"	51'-4"	52'-2"	10'	29'-5"	0	32,150	
3N1	III	I	0	25'-11"	0	25'-11"	18'-0"	51'-4"	52'-2"	10'	29'-5"	0	32,150
3N10	III	I	0	25'-11"	0	25'-11"	18'-0"	51'-4"	52'-2"	10'	29'-5"	0	32,150
3N2 thru 3N9	III	0	25'-11"	7'-1"	25'-11"	18'-0"	51'-4"	52'-2"	10'	29'-5"	0	32,150	
4S1	III	I	0	15'-6"	0	15'-6"	10'-0"	30'-5"	31'-3"	0	25'-0"	0	20,000
4S10	III	I	0	15'-6"	0	15'-6"	10'-0"	30'-5"	31'-3"	0	25'-0"	0	20,000
4S2 thru 4S9	I	0	15'-6"	3'-8"	15'-6"	10'-0"	30'-5"	31'-3"	0	17'-0"	0	9,400	
4N1	III	I	0	15'-6"	0	15'-6"	10'-0"	30'-5"	31'-3"	0	25'-0"	0	20,000
4N10	III	I	0	15'-6"	0	15'-6"	10'-0"	30'-5"	31'-3"	0	25'-0"	0	20,000
4N2 thru 4N9	I	0	15'-6"	3'-8"	15'-6"	10'-0"	30'-5"	31'-3"	0	17'-0"	0	9,400	

*No Inserts this side.


Note: Lifting shall be by equal loads to each pair of loops.
Other types of lifting devices may be used subject to approval by the Michigan State Highway Department.

STRAND SIZE	NO. OF STRANDS	ALLOWABLE WT. OF BEAM
5/8"	2	20 Tons
7/16"	2	27 Tons
3/8"	3	30 Tons
1/2"	3	40.5 Tons

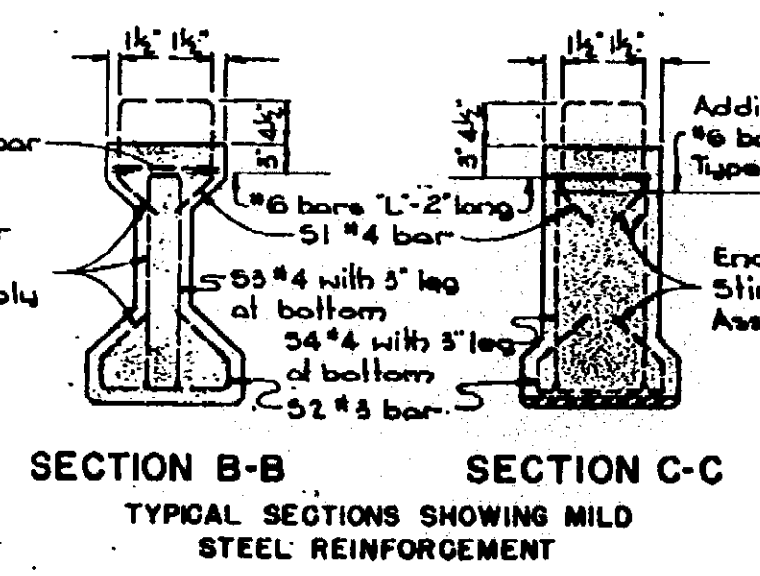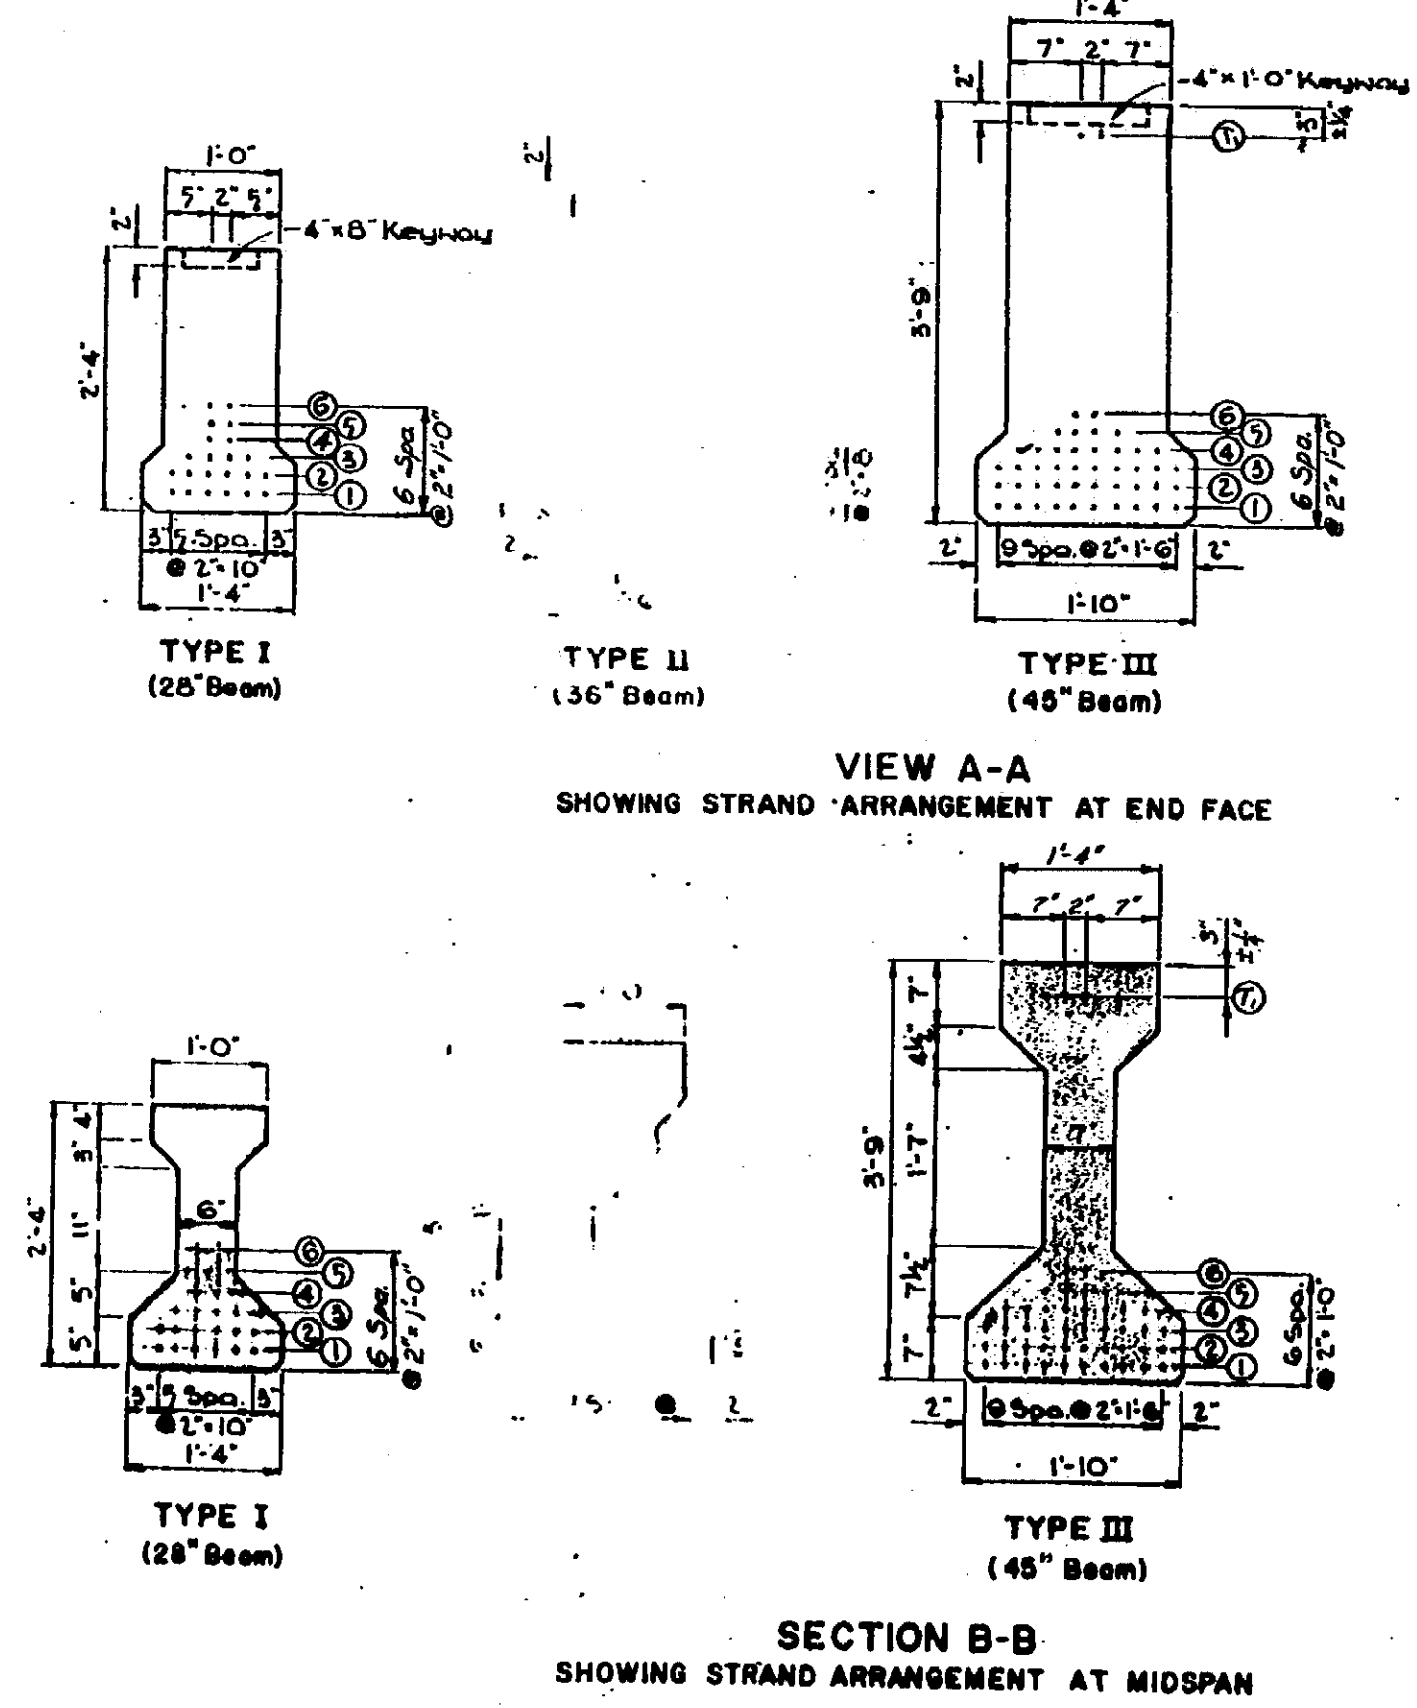


MARK	TYPE	NUMBER OF 7/16 @ 7 WIRE STRANDS IN INDICATED ROW						Total No.	Initial Prestress Force (lbs.)			
		MIDSPAN (Section B-B)			END (View A-A)							
		BOTTOM	TOP	TOP	BOTTOM	TOP	TOP					
1S2 thru 1S9, 1N2 thru 1N9	I	4	4	2	2	4	4	2	2	16	17050	
4S2 thru 4S9, 4N2 thru 4N9	I	4	4	2	2	4	4	2	2	16	17050	
1S1, 1S10, 1N1, 1N10, 4S1, 4S10, 4N1, 4N10	III	0	2			0	2			2	10	18620
2S1 thru 2S10, 2N1 thru 2N10	III	6	6	0	0	2	6	6	4	2	26	17050
3S1 thru 3S10, 3N1 thru 3N10	III	6	6	0	0	2	6	6	4	2	26	17050

NOTE: Shop plans shall include a diagram of casting bed layout. Strands shall be placed symmetrically about the centerline of beam.

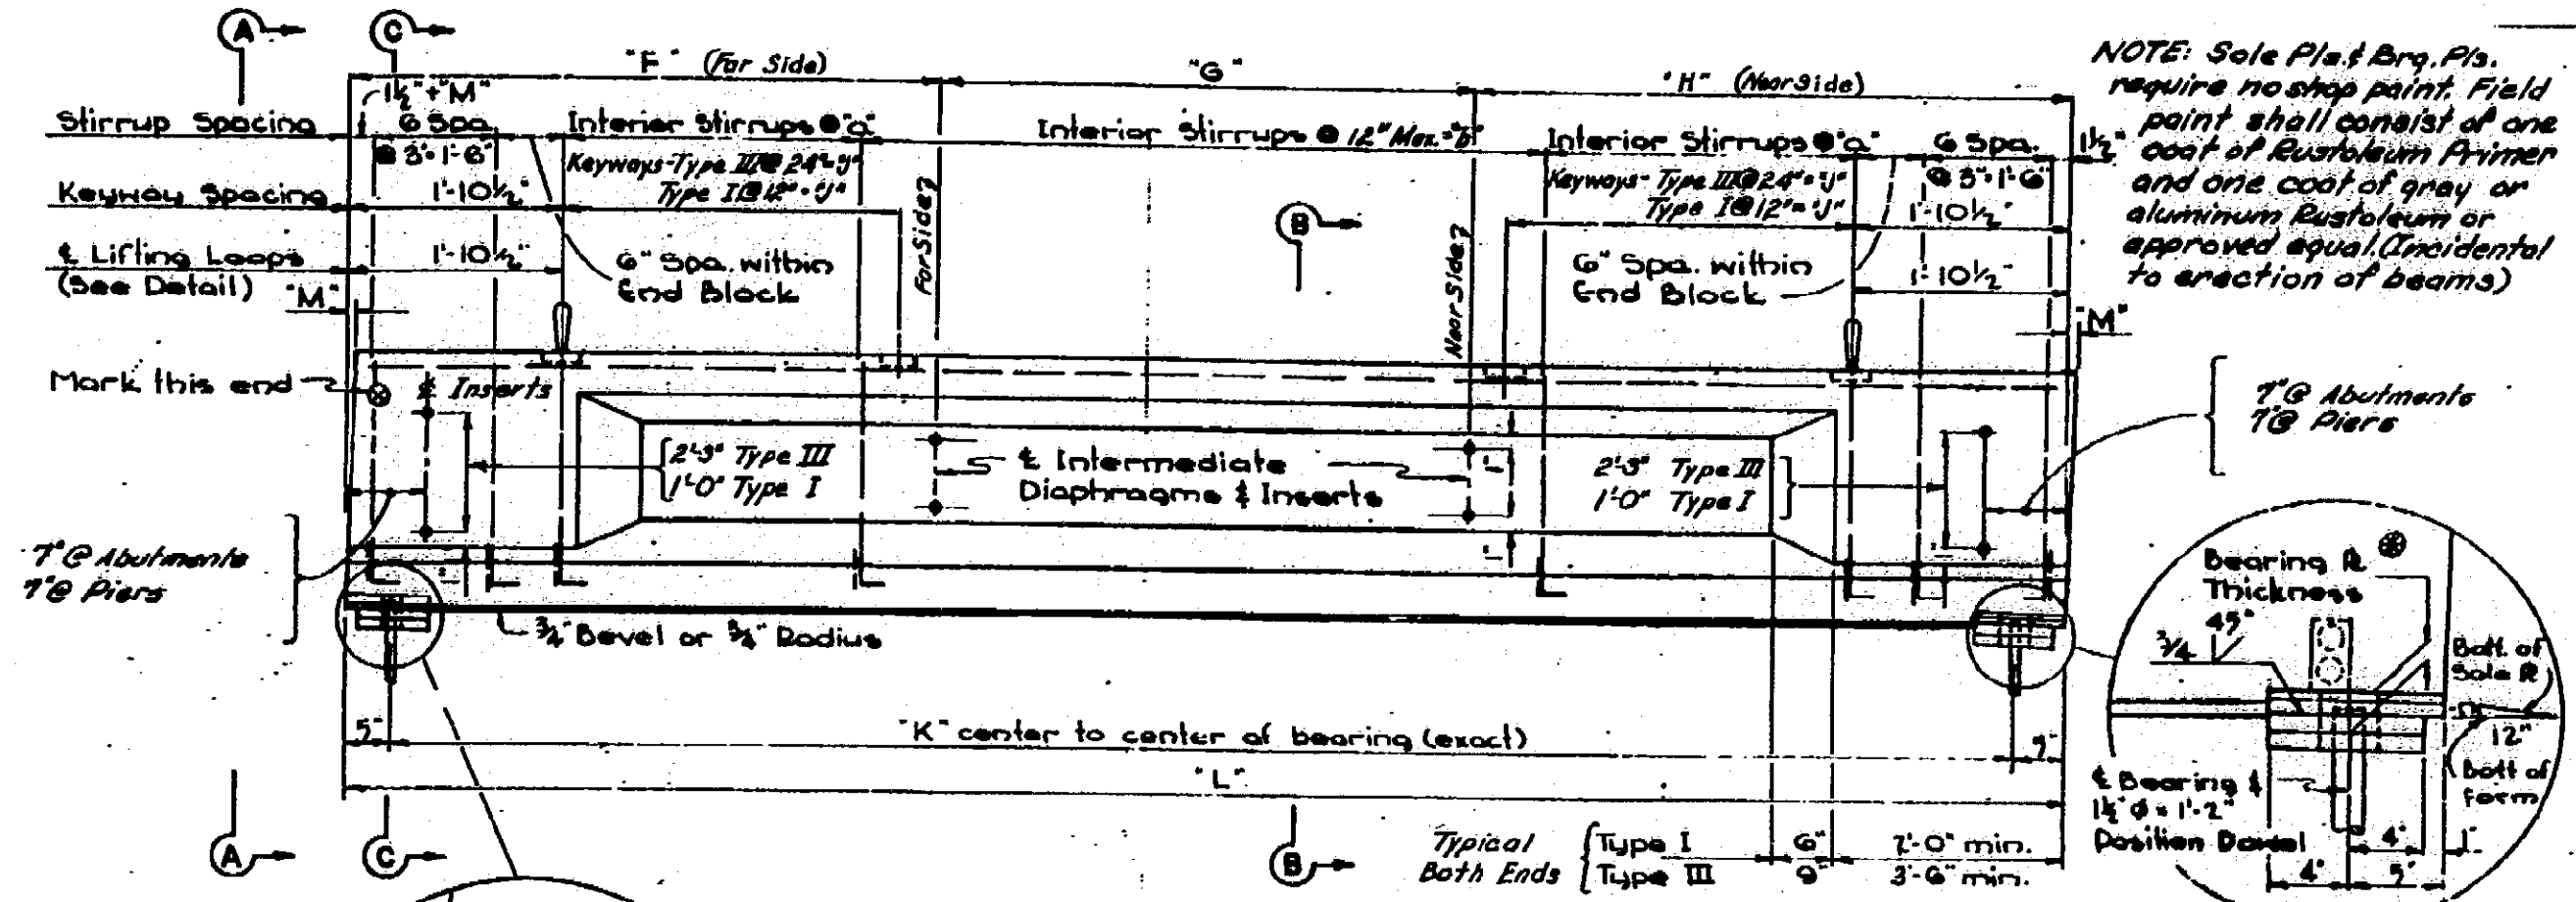

NOTE: Sole Plat Brg. Pls. require no shop paint. Field joint shall consist of one coat of Epoxy Primer and one coat of gray or aluminum Epoxy Primer or approved equal. (Incidental to erection of beams)

BEAM LINE	SPAN 1		SPAN 2		SPAN 3		SPAN 4	
	ABUT. A	PIER 1	PIER 1	PIER 2	PIER 2	PIER 3	PIER 3	ABUT. B
S1	0	0	0	0	0	0	0	0
S2	0	0	0	0	0	0	0	0
S3	0	0	0	0	0	0	0	0
S4	0	0	0	0	0	0	0	0
S5	0	0	0	0	0	0	0	0
S6	0	0	0	0	0	0	0	0
S7	0	0	0	0	0	0	0	0
S8	0	0	0	0	0	0	0	0
S9	0	0	0	0	0	0	0	0
S10	0	0	0	0	0	0	0	0
N1	0	0	0	0	0	0	0	0
N2	0	0	0	0	0	0	0	0
N3	0	0	0	0	0	0	0	0
N4	0	0	0	0	0	0	0	0
N5	0	0	0	0	0	0	0	0
N6	0	0	0	0	0	0	0	0
N7	0	0	0	0	0	0	0	0
N8	0	0	0	0	0	0	0	0
N9	0	0	0	0	0	0	0	0
N10	0	0	0	0	0	0	0	0

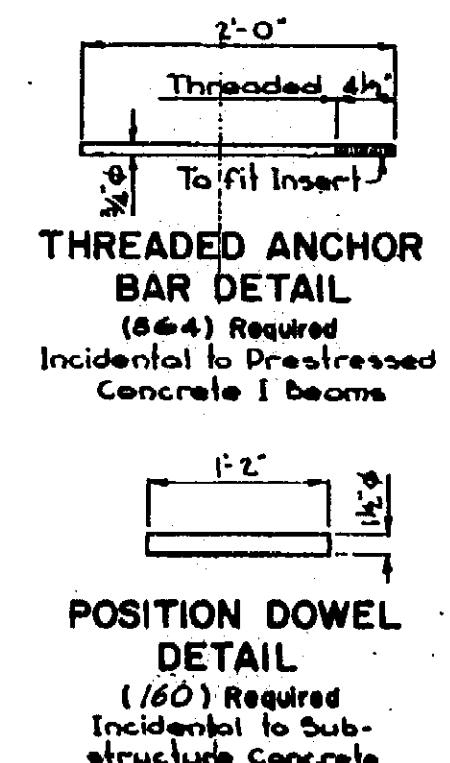

Work this Sheet with Sheet 17E.

MICHIGAN STATE HIGHWAY DEPARTMENT

PRESTRESSED CONCRETE I BEAM DETAILS

TECON ENGINEERS, INC.

REVISIONS:

NO.	DESCRIPTION	DATE	BY

S03 of 63174

NOTE: DO NOT WORK FROM THIS SHEET. THE INFORMATION SHOWN HERE IS FOR REFERENCE ONLY. NO PAY ITEMS ARE SHOWN.

FOR INFORMATION ONLY


DATE	CONT. SEC.	JOB NO.	DESIGN UNIT	SHEET
12-07-00	S03 OF 63174	49595A	MADHAVI	1A1 OF

MIDOT
Michigan Department of Transportation

FILE NAME: s0363174sn.nb DRAWN BY: nder CHECKED BY: AM. DATE: 12-07-00 CORRECTED BY: INDER DATE: 12-07-00

1 2 3 4 5 6 7 8 9 10 11 12 13 14 15 16 17 18 19 20 21 22 23 24 25 26 27 28 29 30 31 32 33 34 35 36 37 38 39 40 41 42 43 44 45 46 47 48 49 50 51 52 53 54 55 56 57 58 59 60 61 62 63

REVISIONS			
NO.	DESCRIPTION	DATE	BY

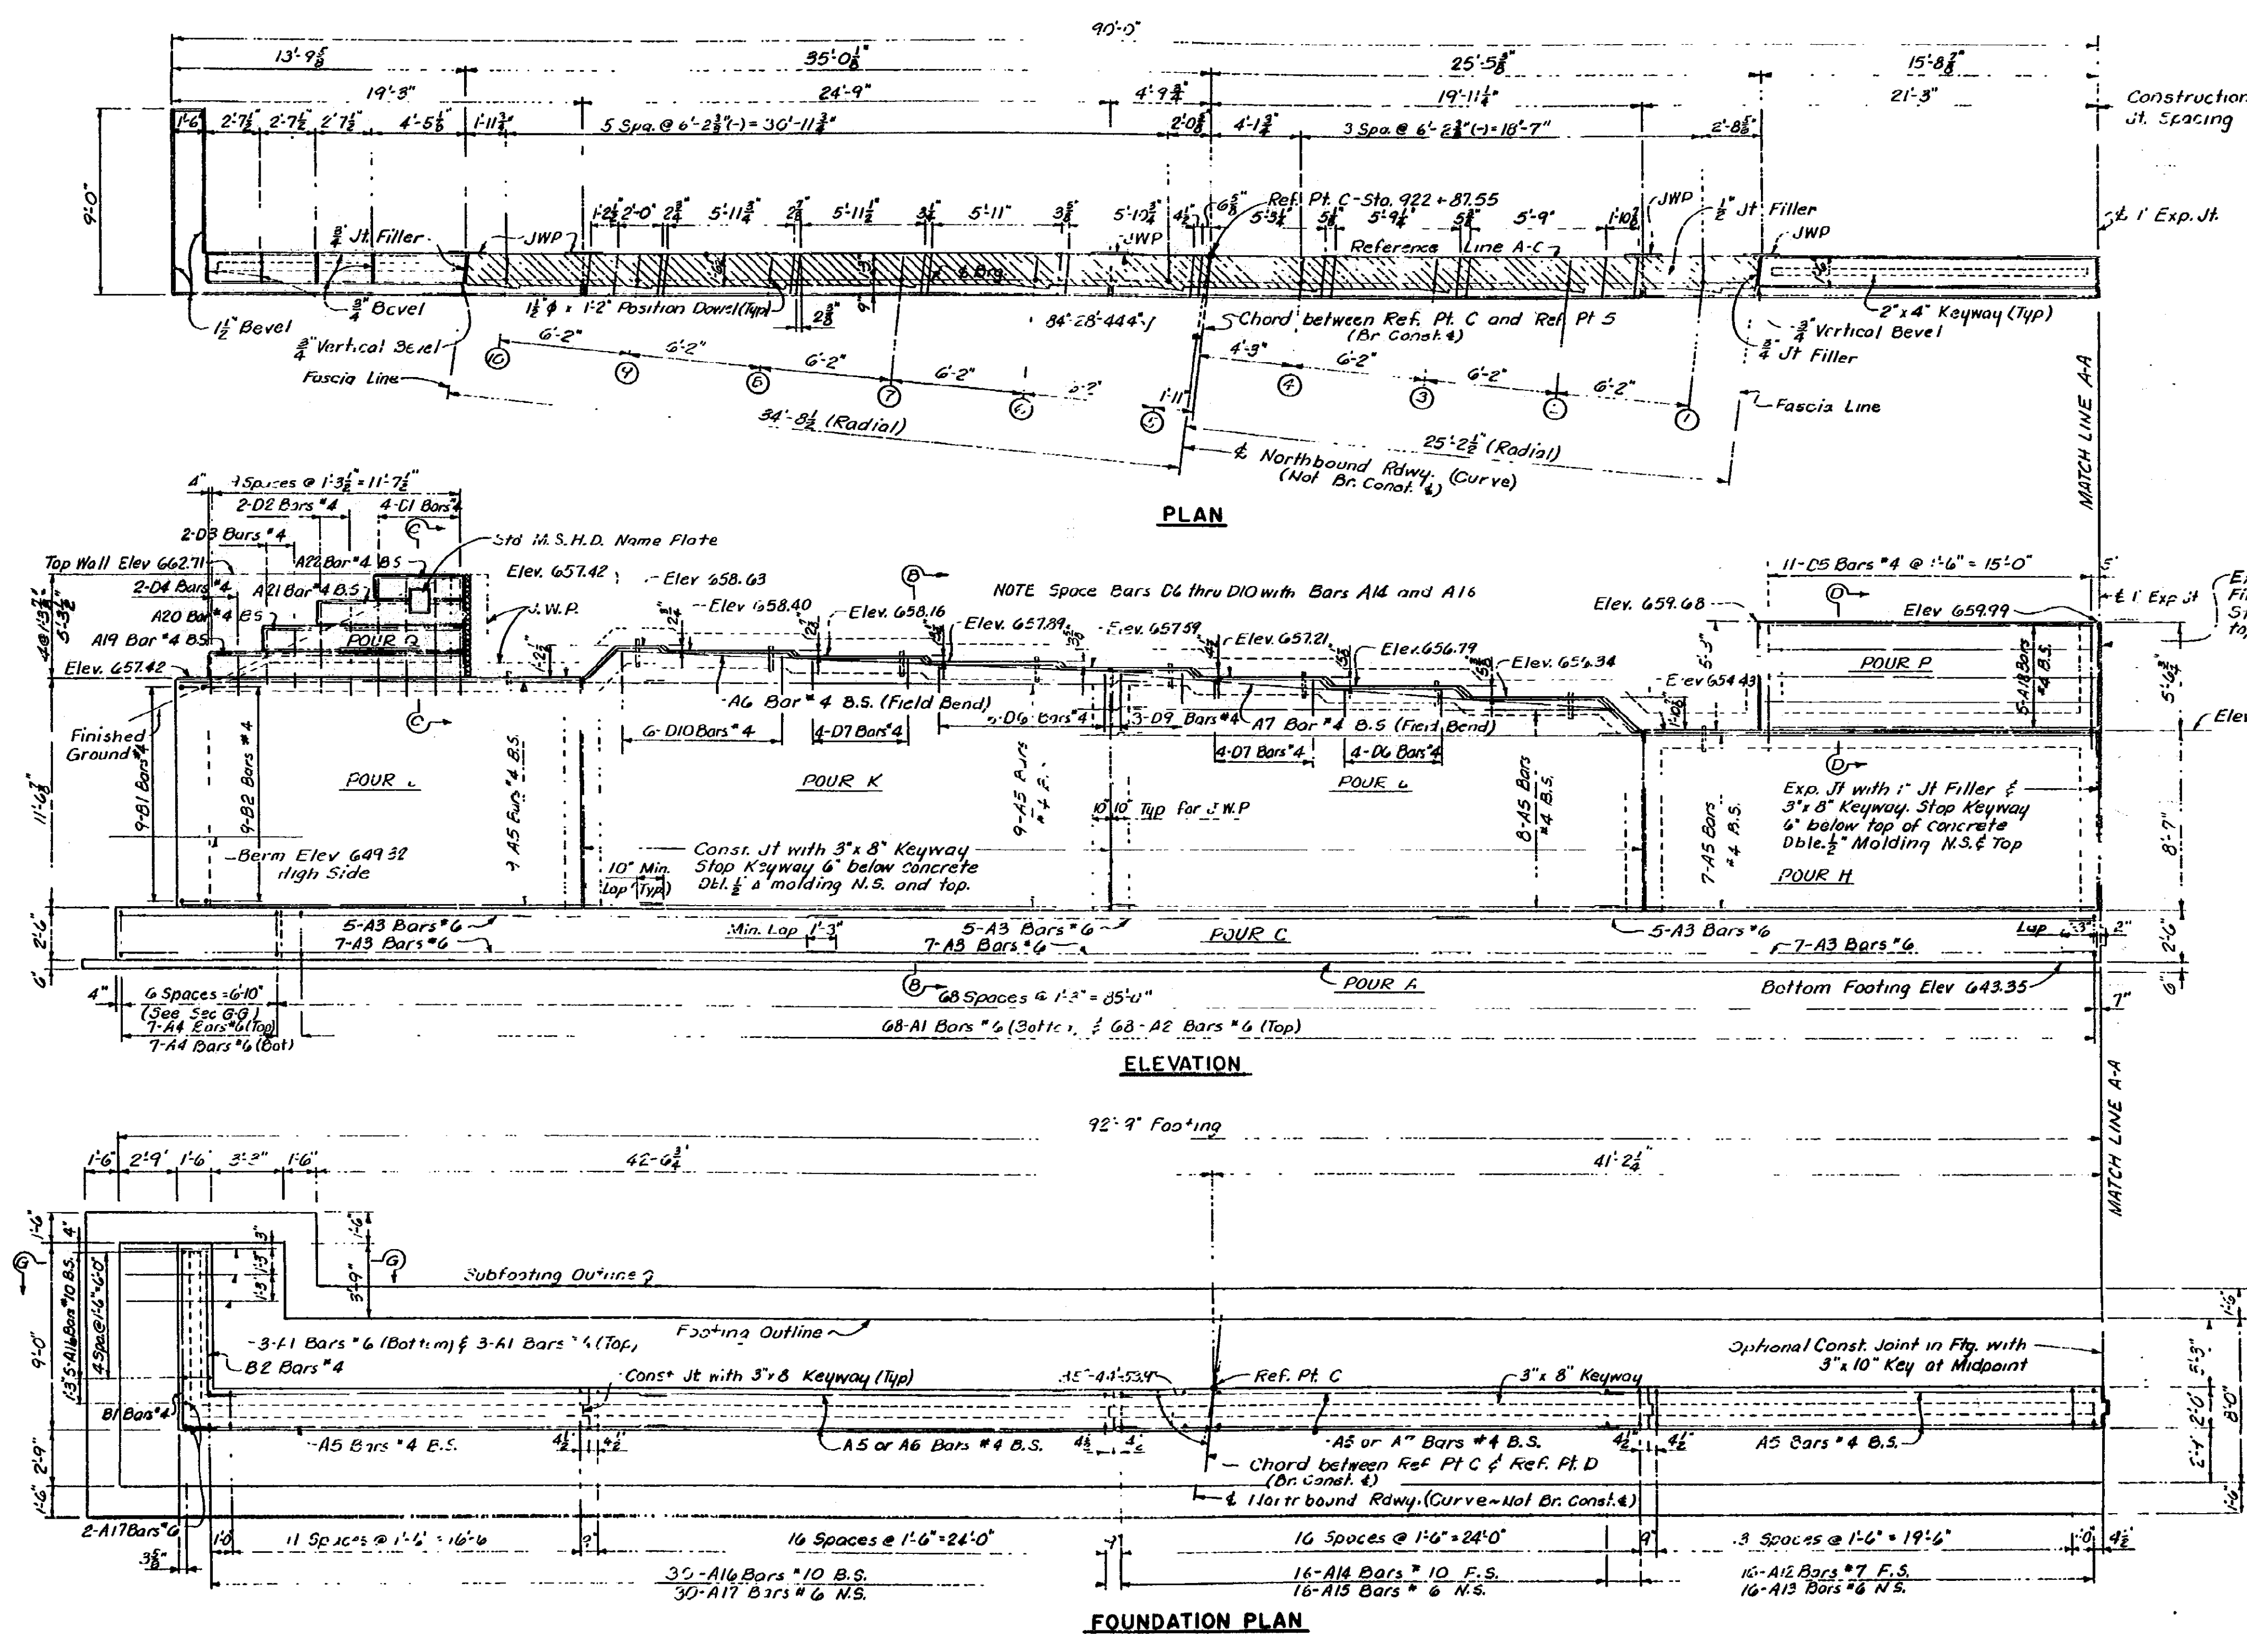

Work this sheet with sheets 155, 156, 158, 159, 160

ABUTMENT A DETAILS

TECON ENGINEERS, INC.
 JWC RFC 3-28-62
 JWC 3-3-62
 157 3/6
S03 OF 63174 I

NOTE:
 DO NOT WORK FROM THIS SHEET. THE INFORMATION SHOWN
 HERE IS FOR REFERENCE ONLY. NO PAY ITEMS ARE SHOWN.




FOR INFORMATION ONLY				
DATE	CONT. SEC.	JOB NO.	DESIGN UNIT	SHEET
	S03 OF 63174	49595A	MADHAVI	1AK OF


FILE NAME: s0363174sn.nb DRAWN BY: under CHECKED BY: DATE: CORRECTED BY: DATE:

1 2 3 4 5 6 7 8 9 10 11 12 13 14 15 16 17 18 19 20 21 22 23 24 25 26 27 28 29 30 31 32 33 34 35 36 37 38 39 40 41 42 43 44 45 46 47 48 49 50 51 52 53 54 55 56 57 58 59 60 61 62 63


REVISIONS			
NO.	DESCRIPTION	DATE	BY

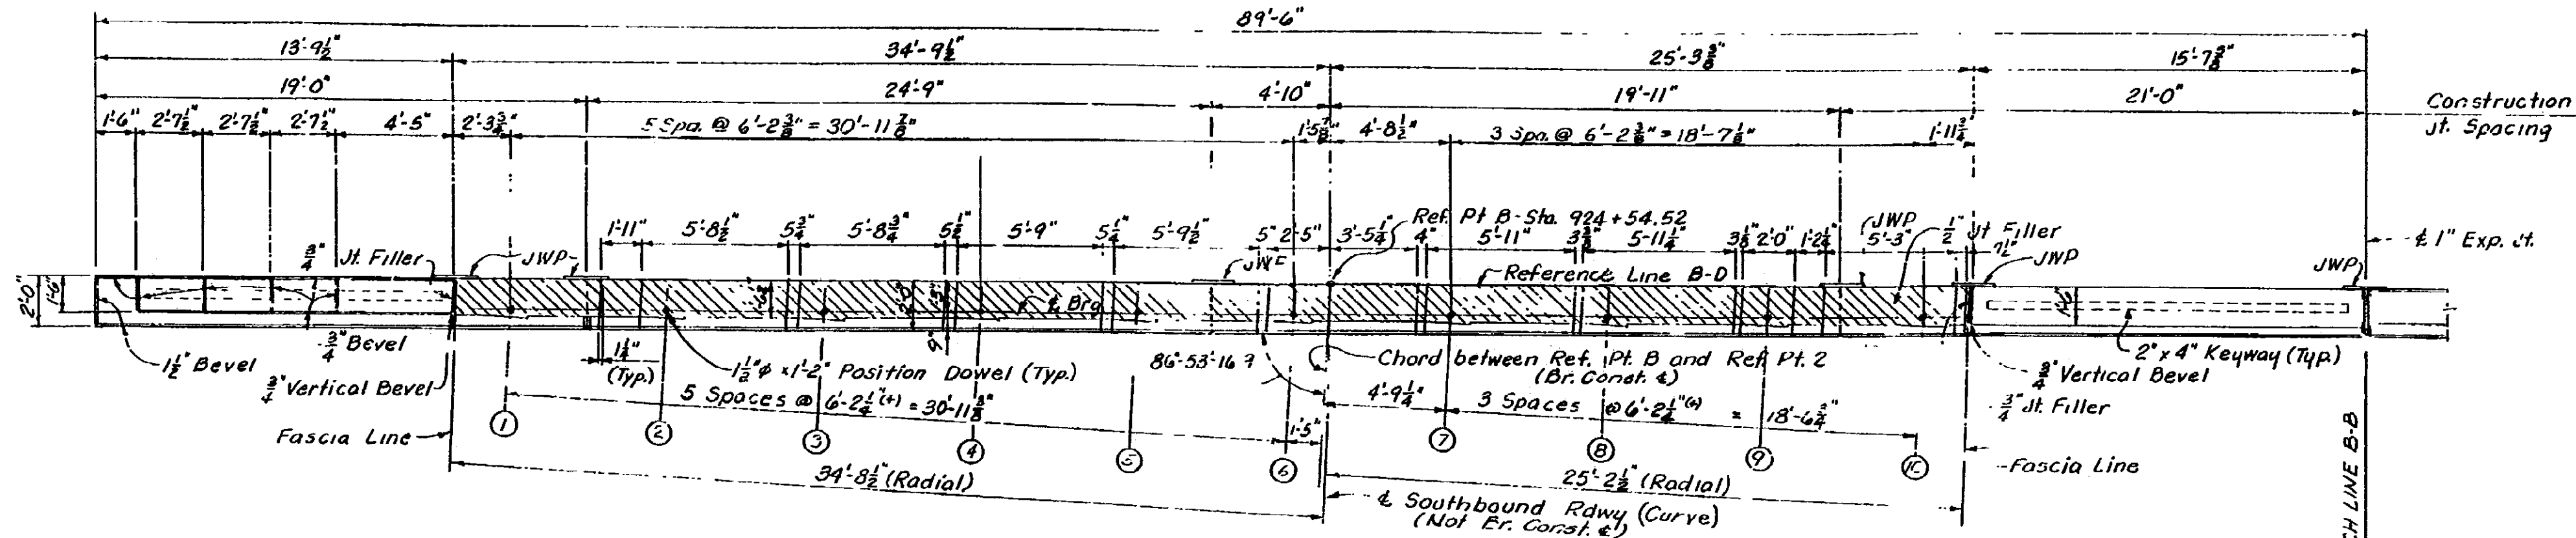

PLAN

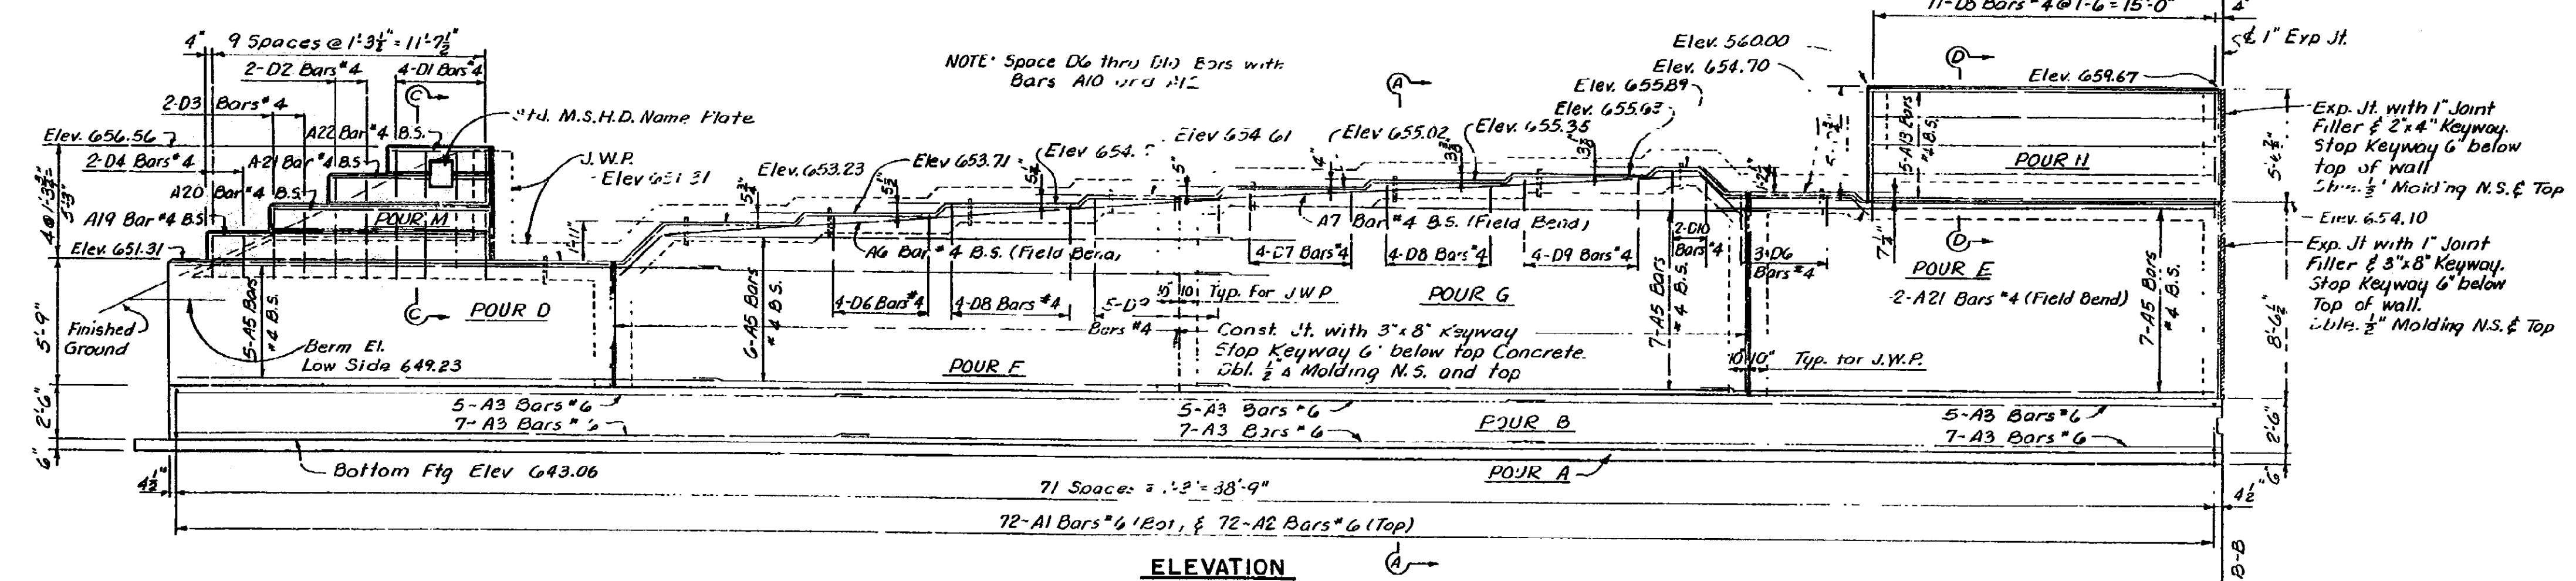

ELEVATION

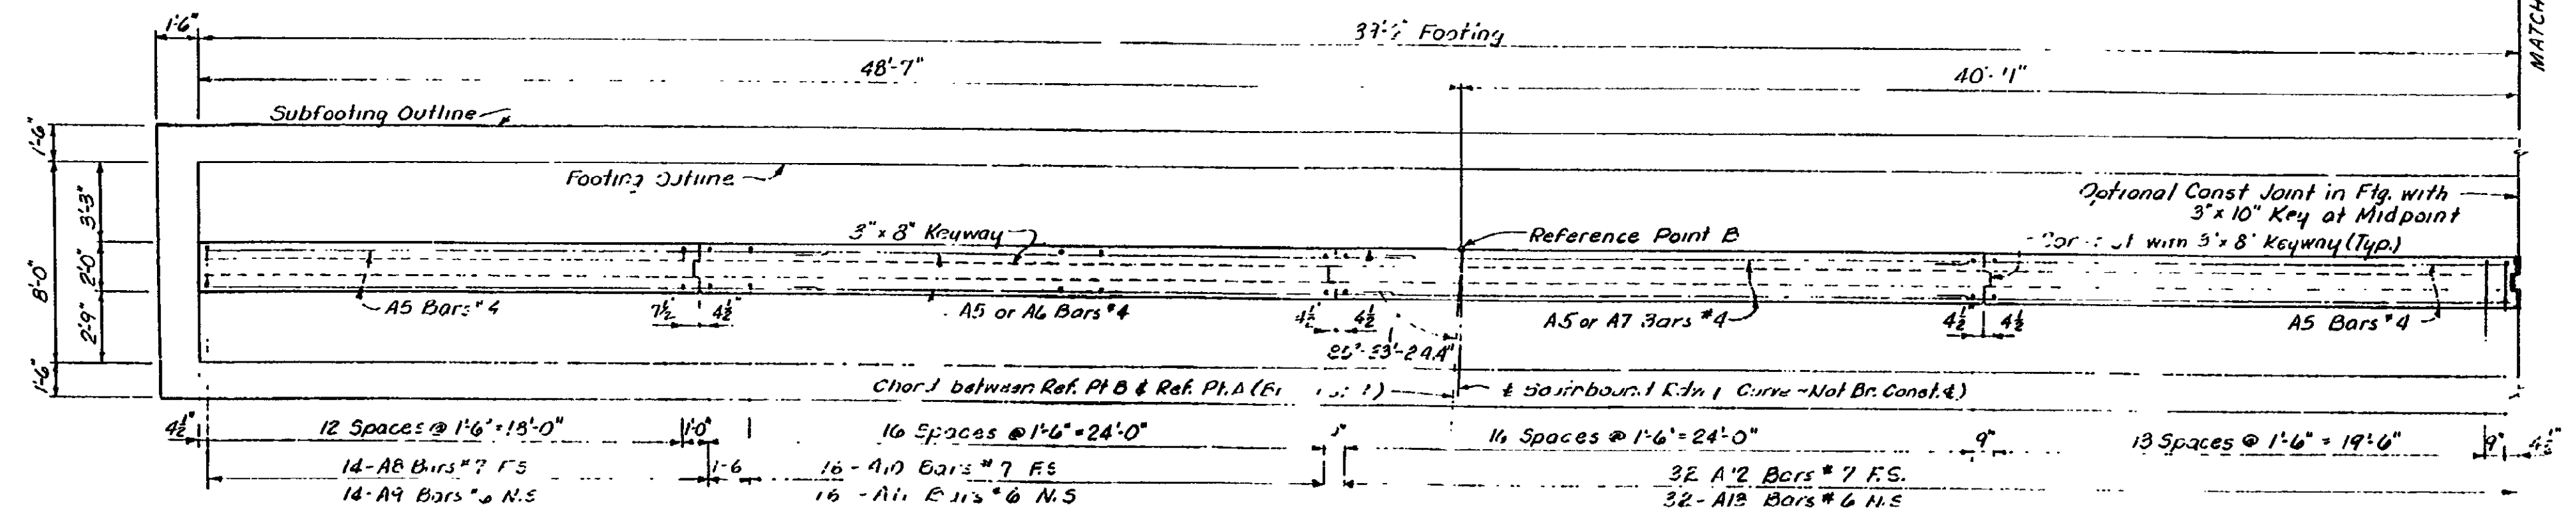

FOUNDATION PLAN

Work this sheet with Sheets # 155, 156, 157, 159 & 160

ABUTMENT B DETAILS

TECON ENGINEERS, INC.

WDC 5-28-67
KFC
LHC 8-3-67
LSB 3/8

S03 OF 63174 I

NOTE:
DO NOT WORK FROM THIS SHEET. THE INFORMATION SHOWN
HERE IS FOR REFERENCE ONLY. NO PAY ITEMS ARE SHOWN.




FOR INFORMATION ONLY				
DATE	CONT. SEC.	JOB NO.	DESIGN UNIT	SHEET
	S03 OF 63174	49595A	MADHAVI	1AL OF

DRAWN BY: under DATE: CHECKED BY: DATE: CORRECTED BY: DATE: FILE NAME: s03s317asn.rb

1 2 3 4 5 6 7 8 9 10 11 12 13 14 15 16 17 18 19 20 21 22 23 24 25 26 27 28 29 30 31 32 33 34 35 36 37 38 39 40 41 42 43 44 45 46 47 48 49 50 51 52 53 54 55 56 57 58 59 60 61 62 63

REVISIONS			
NO.	DESCRIPTION	DATE	BY

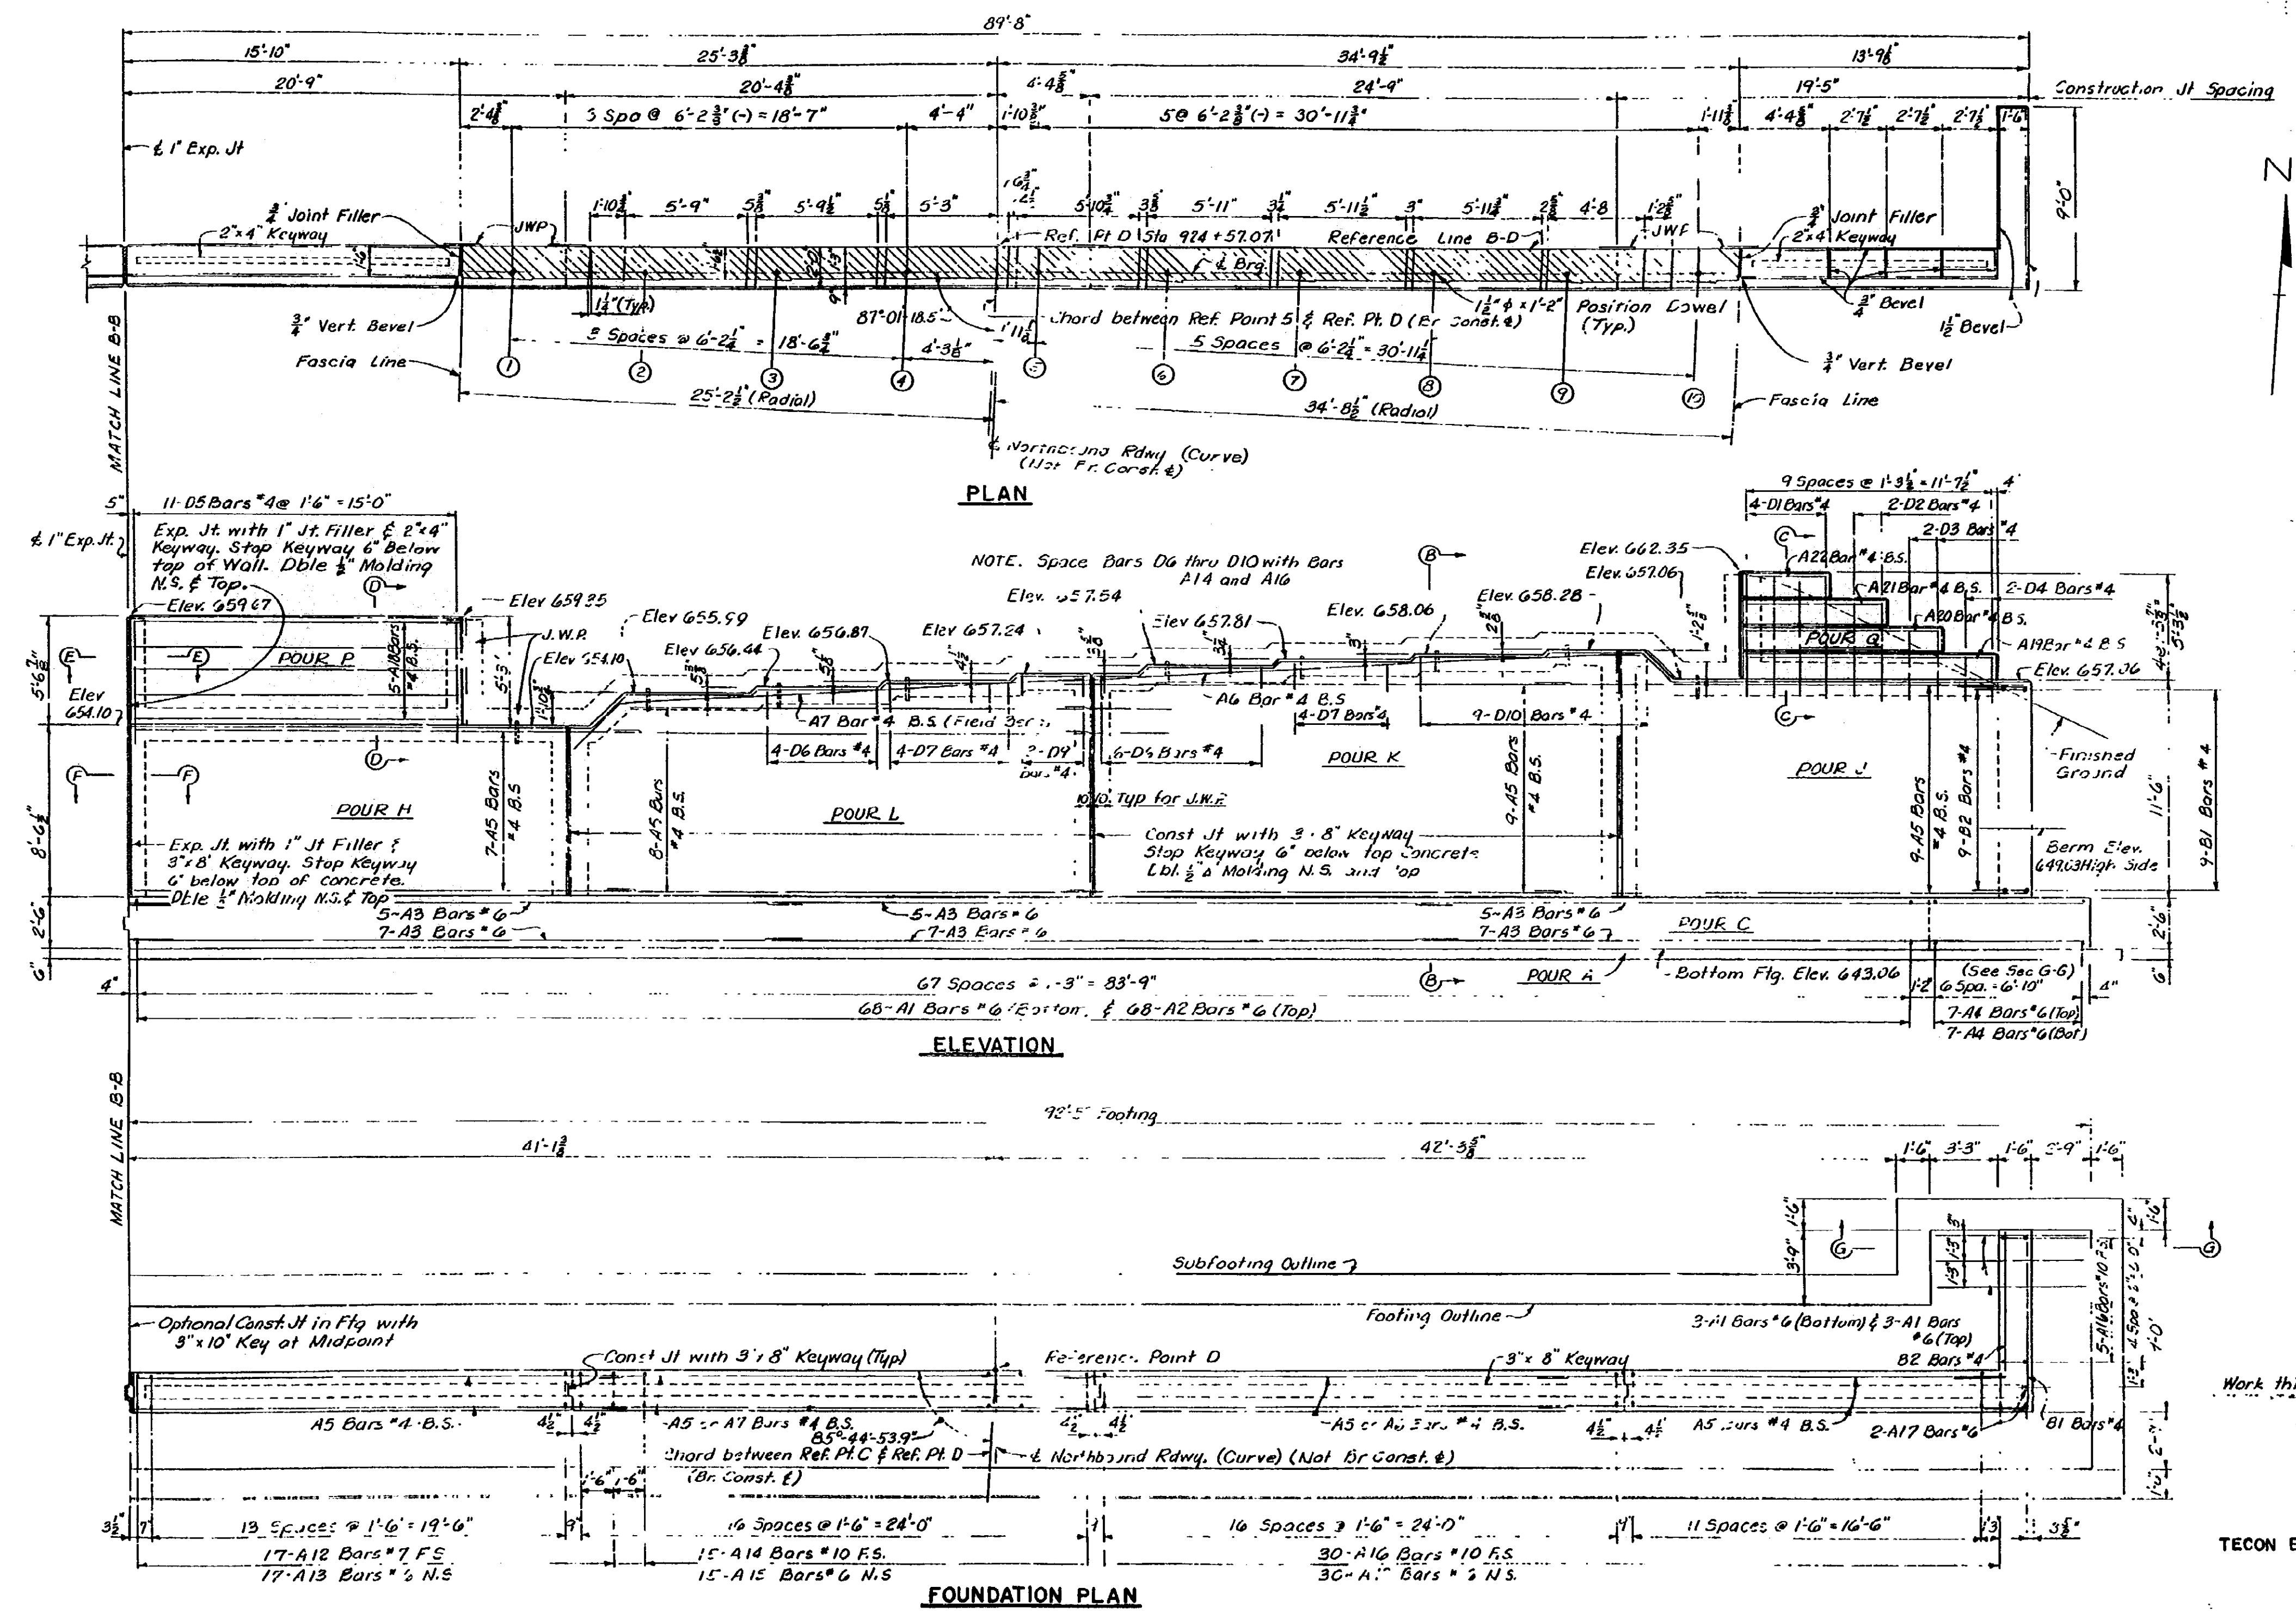

NOTE:
DO NOT WORK FROM THIS SHEET. THE INFORMATION SHOWN
HERE IS FOR REFERENCE ONLY. NO PAY ITEMS ARE SHOWN.

Work this sheet with Sheets #155 through #160

ABUTMENT B DETAILS

TECON ENGINEERS, INC.

JPL RFO 5-28-67
JMC 3-3-62
31E
S03 OF 63174




FOR INFORMATION ONLY				
DATE	CONT. SEC.	JOB NO.	DESIGN UNIT	SHEET
	S03 OF 63174	49595A	MADHAVI	I AM OF


DATE: _____ CORRECTED BY: _____ DATE: _____ CHECKED BY: _____ DATE: _____ DRAWN BY: j.moder

FILE NAME: s03s3174en.rtb


1 2 3 4 5 6 7 8 9 10 11 12 13 14 15 16 17 18 19 20 21 22 23 24 25 26 27 28 29 30 31 32 33 34 35 36 37 38 39 40 41 42 43 44 45 46 47 48 49 50 51 52 53 54 55 56 57 58 59 60 61 62 63

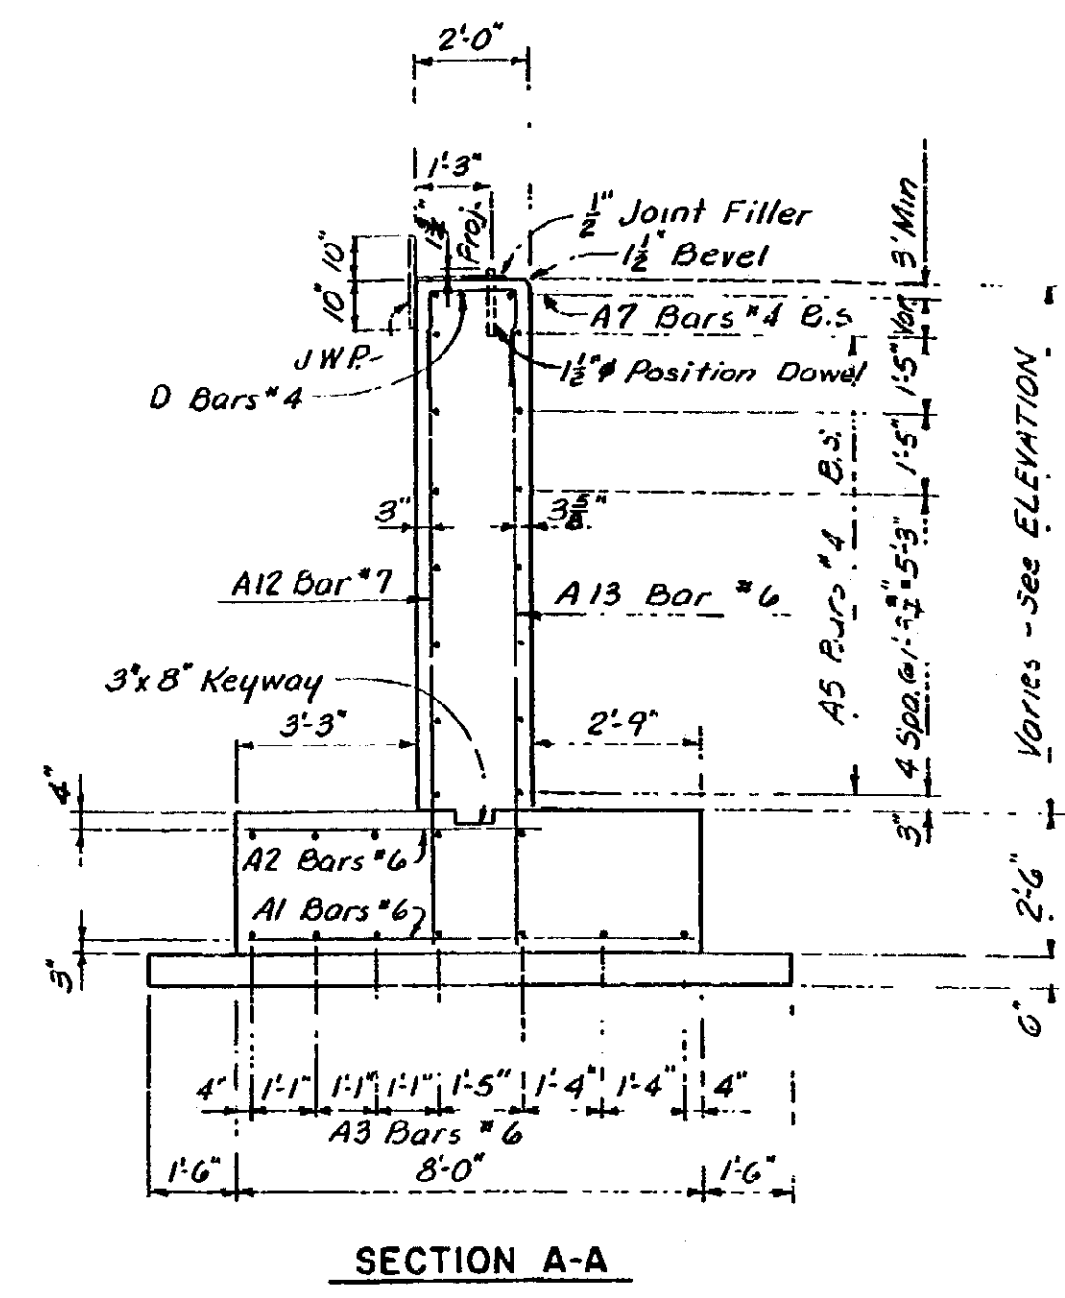

SECTION A-A

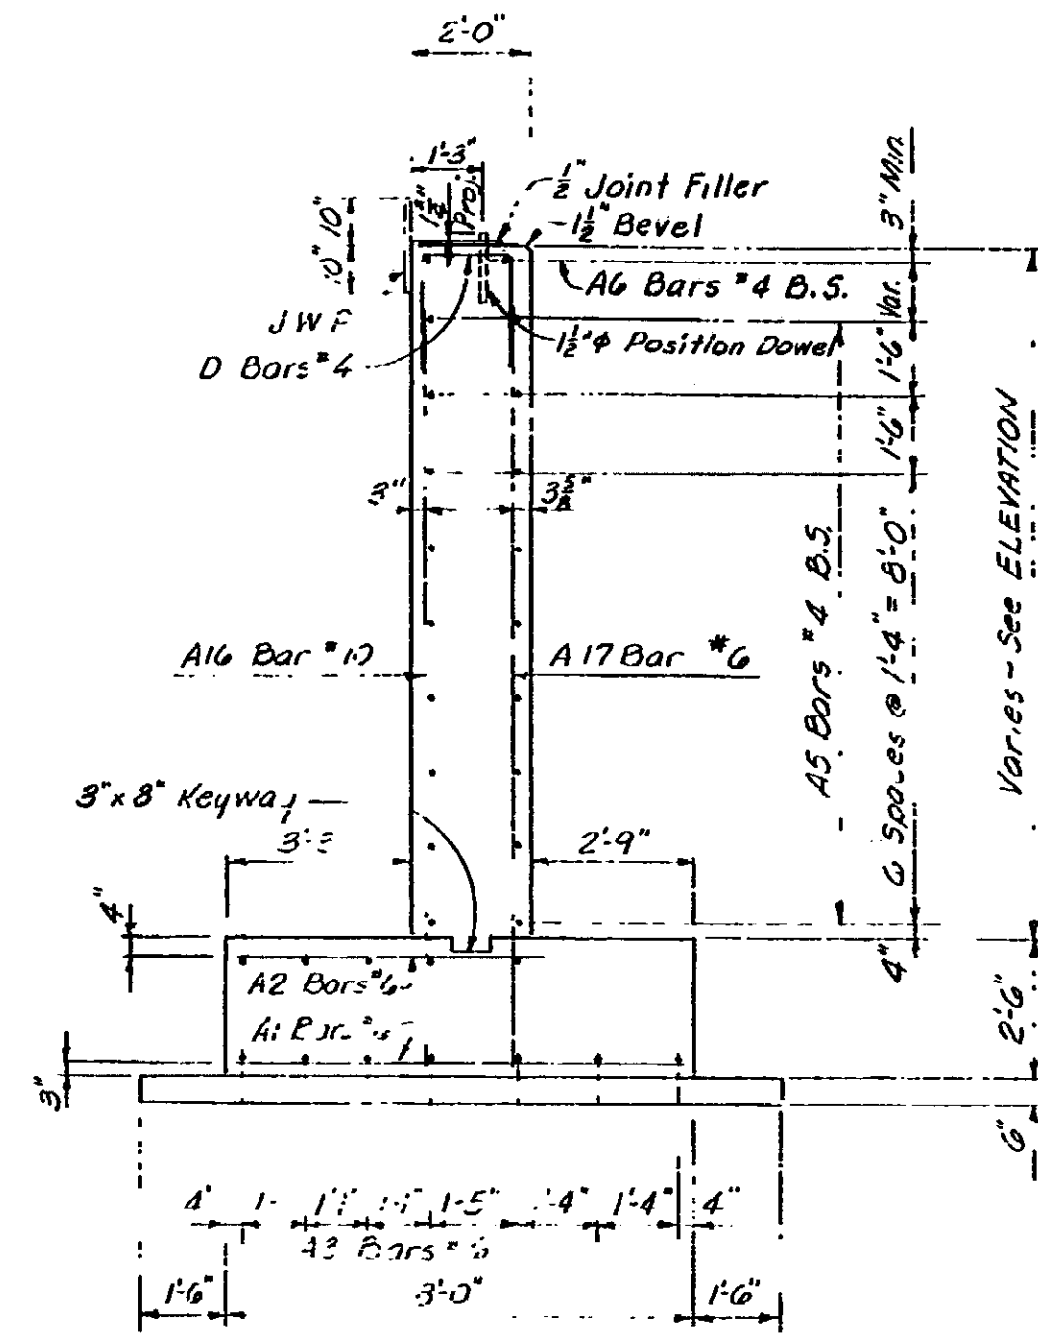

SECTION B-B

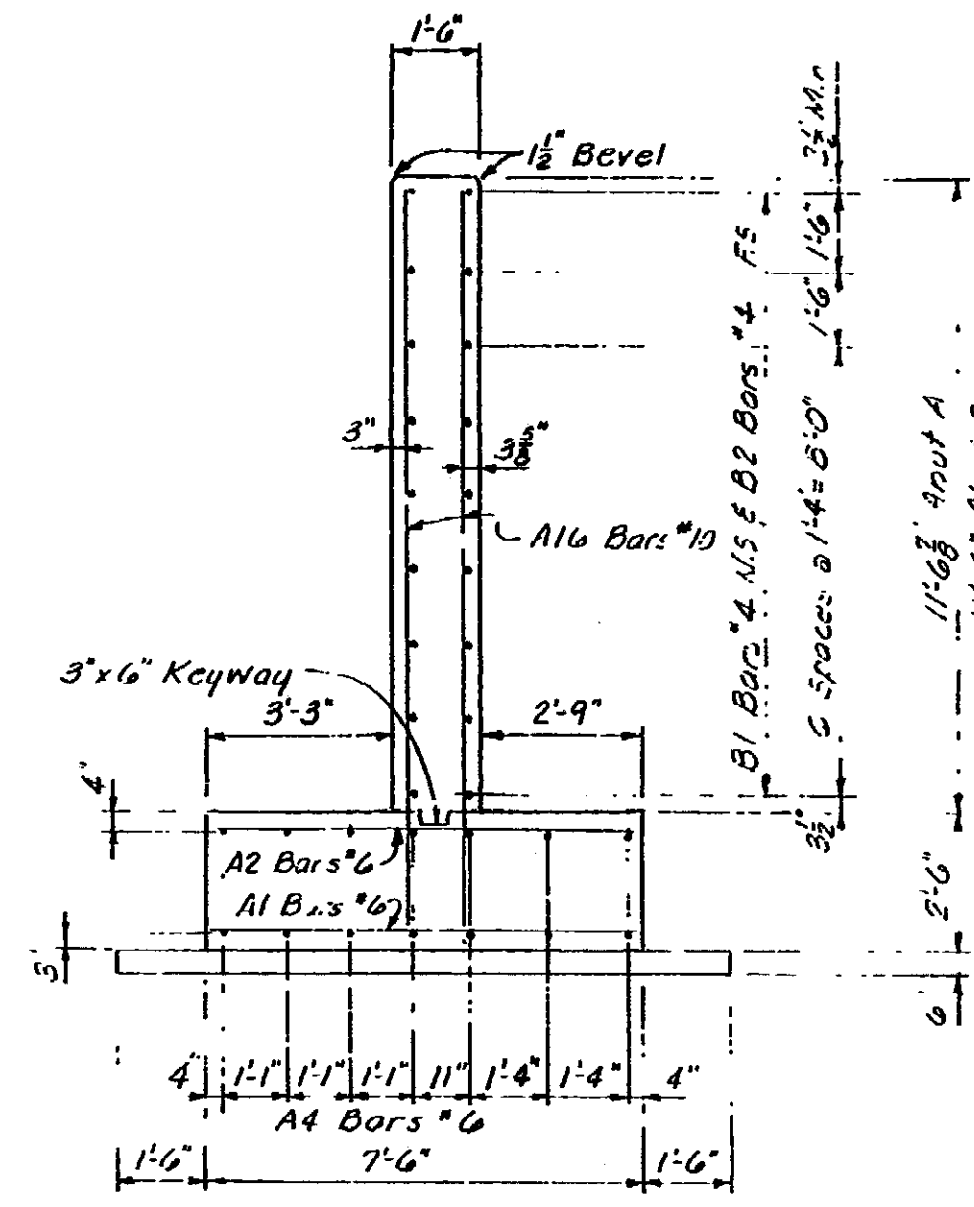

SECTION G-G

REVISIONS			
NO.	DESCRIPTION	DATE	BY

POUR	CONCRETE QUANTITIES - CU. YDS.	
	ABUTMENT A	ABUTMENT B
A	38.6	38.4
B	67.0	66.4
C	71.4	71.2
D	8.3	8.1
E	15.0	14.9
F	13.7	13.5
G	17.9	17.8
H	13.5	13.1
J	21.1	21.3
K	22.6	22.6
L	19.9	19.7
M	2.4	2.4
N	5.0	5.0
P	4.7	4.7
Q	2.4	2.4
Total	177.0	176.0

MISCELLANEOUS QUANTITIES			
Item	Abut. A	Abut. B	Total
1/2" Joint Filler	430	430	860
1" Joint Filler	26	26	52
3/4" Joint Filler	33	33	66
1/4" Joint Filler	100	100	200
1/2" Joint Filler	4	4	8

GENERAL NOTES

J.W.P. denotes joint waterproofing.
 N.S. denotes near side.
 F.S. denotes far side.
 B.S. denotes both sides.
 For Bevel and molding details see Standard Sheet R11.
 For location of name plates see General Plan of Structure; for mounting details see standard sheet R11.
 Parapet Walls & Sloped walls are to be cast after superstructure is complete to top of sidewalks.
 Position Dowels shall be set accurately to a template. Furnishing and setting Position Dowels is incidental to substructure concrete.
 The Project Engineer shall adjust the spacing of reinforcing steel as required to permit placing of Position Dowels. The top of abutment shall be finished to a true plane at the elevation shown and shall not vary more than 1/8" under a ten foot straight edge.
 This design is based on a maximum foundation pressure of 3810 pounds per square foot and a maximum average foundation pressure of 3360 pounds per square foot.

Work this sheet with sheets #156 thru 159

ABUTMENT DETAILS

TECON ENGINEERS, INC.

JOC 3-28-62
 RFC
 WMC 3-2-62
 160 3/12

S03 OF 631741


NOTE:
 DO NOT WORK FROM THIS SHEET. THE INFORMATION SHOWN HERE IS FOR REFERENCE ONLY. NO PAY ITEMS ARE SHOWN.




FOR INFORMATION ONLY				
DATE	CONT. SEC.	JOB NO.	DESIGN UNIT	SHEET
	S03 OF 63174	49595A	MADHAVI	1AN OF

DRAWN BY: jander DATE: 3-2-62 CHECKED BY: DATE: CORRECTED BY: DATE: FILE NAME: s0363174a-n.dwg


1 2 3 4 5 6 7 8 9 10 11 12 13 14 15 16 17 18 19 20 21 22 23 24 25 26 27 28 29 30 31 32 33 34 35 36 37 38 39 40 41 42 43 44 45 46 47 48 49 50 51 52 53 54 55 56 57 58 59 60 61 62 63

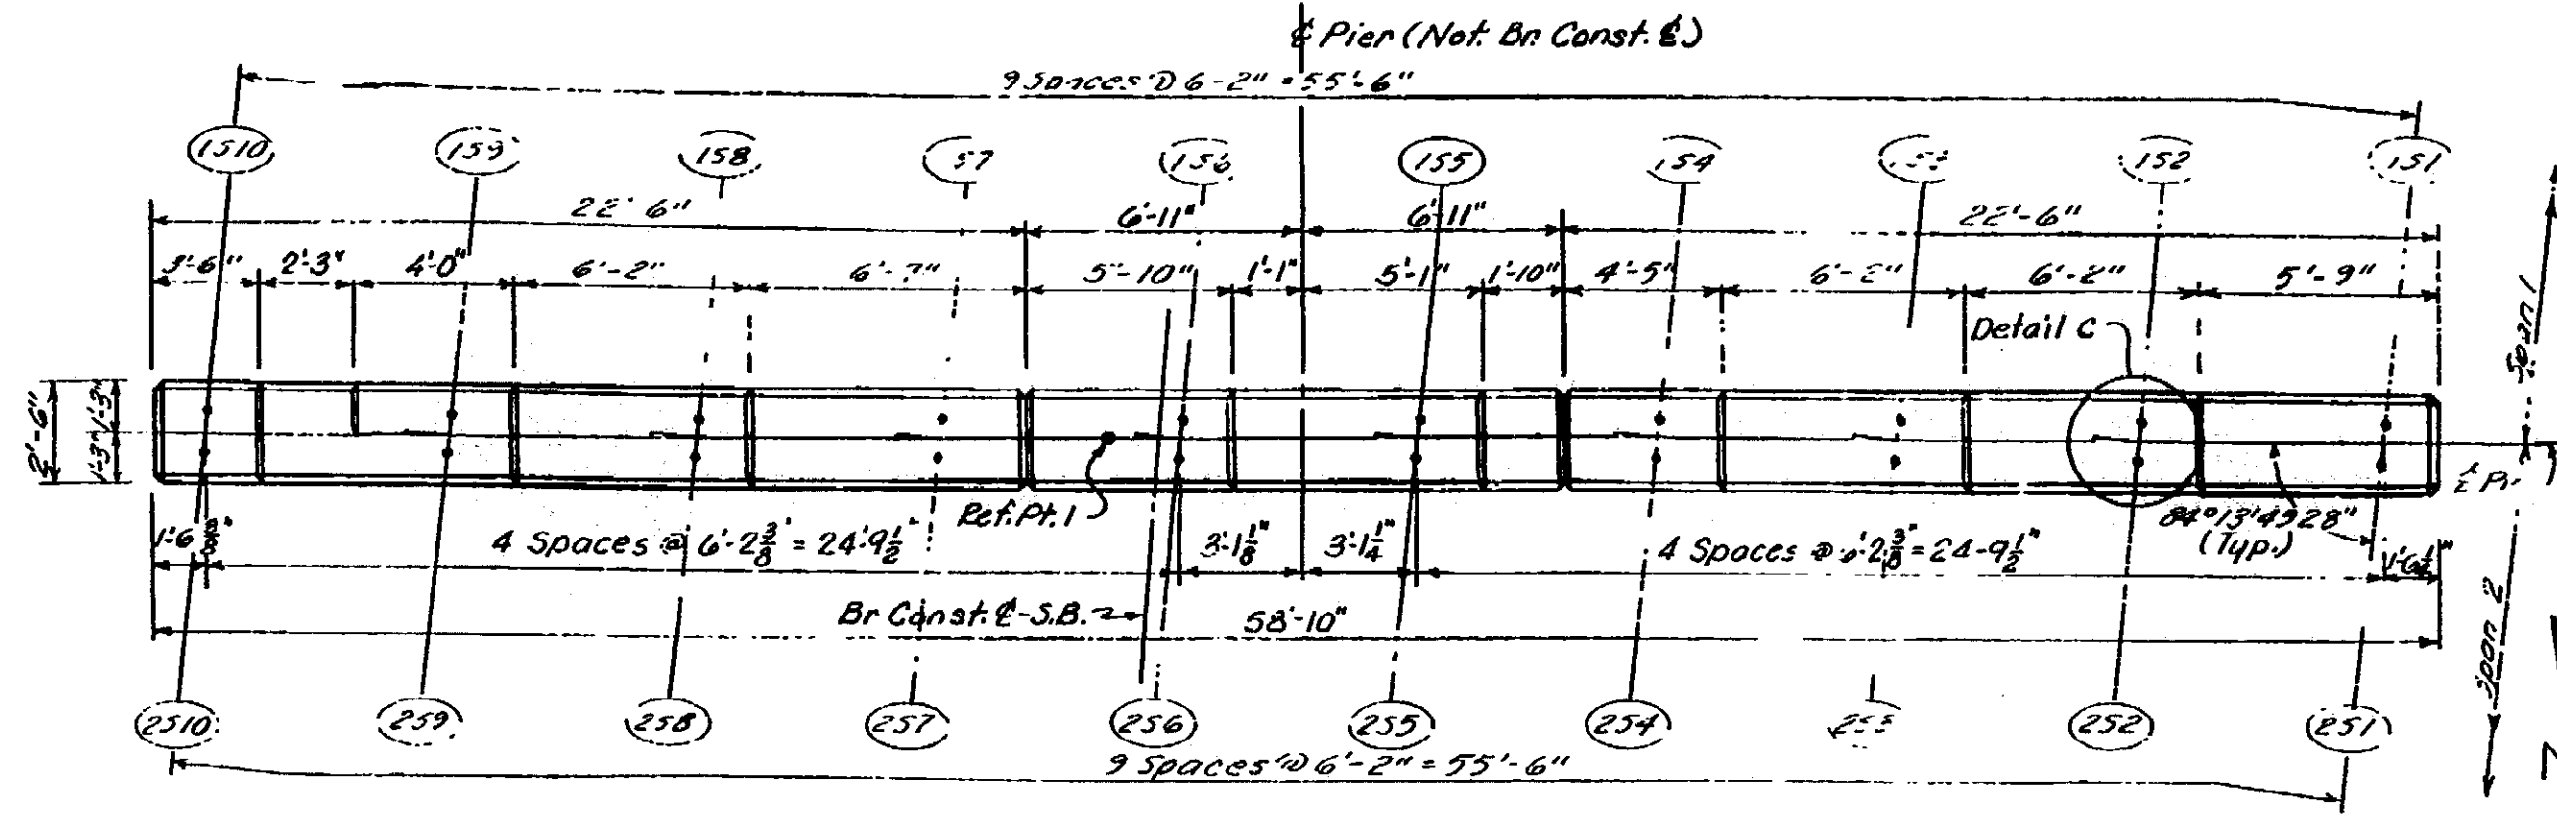


CAP PLAN - PIER 1

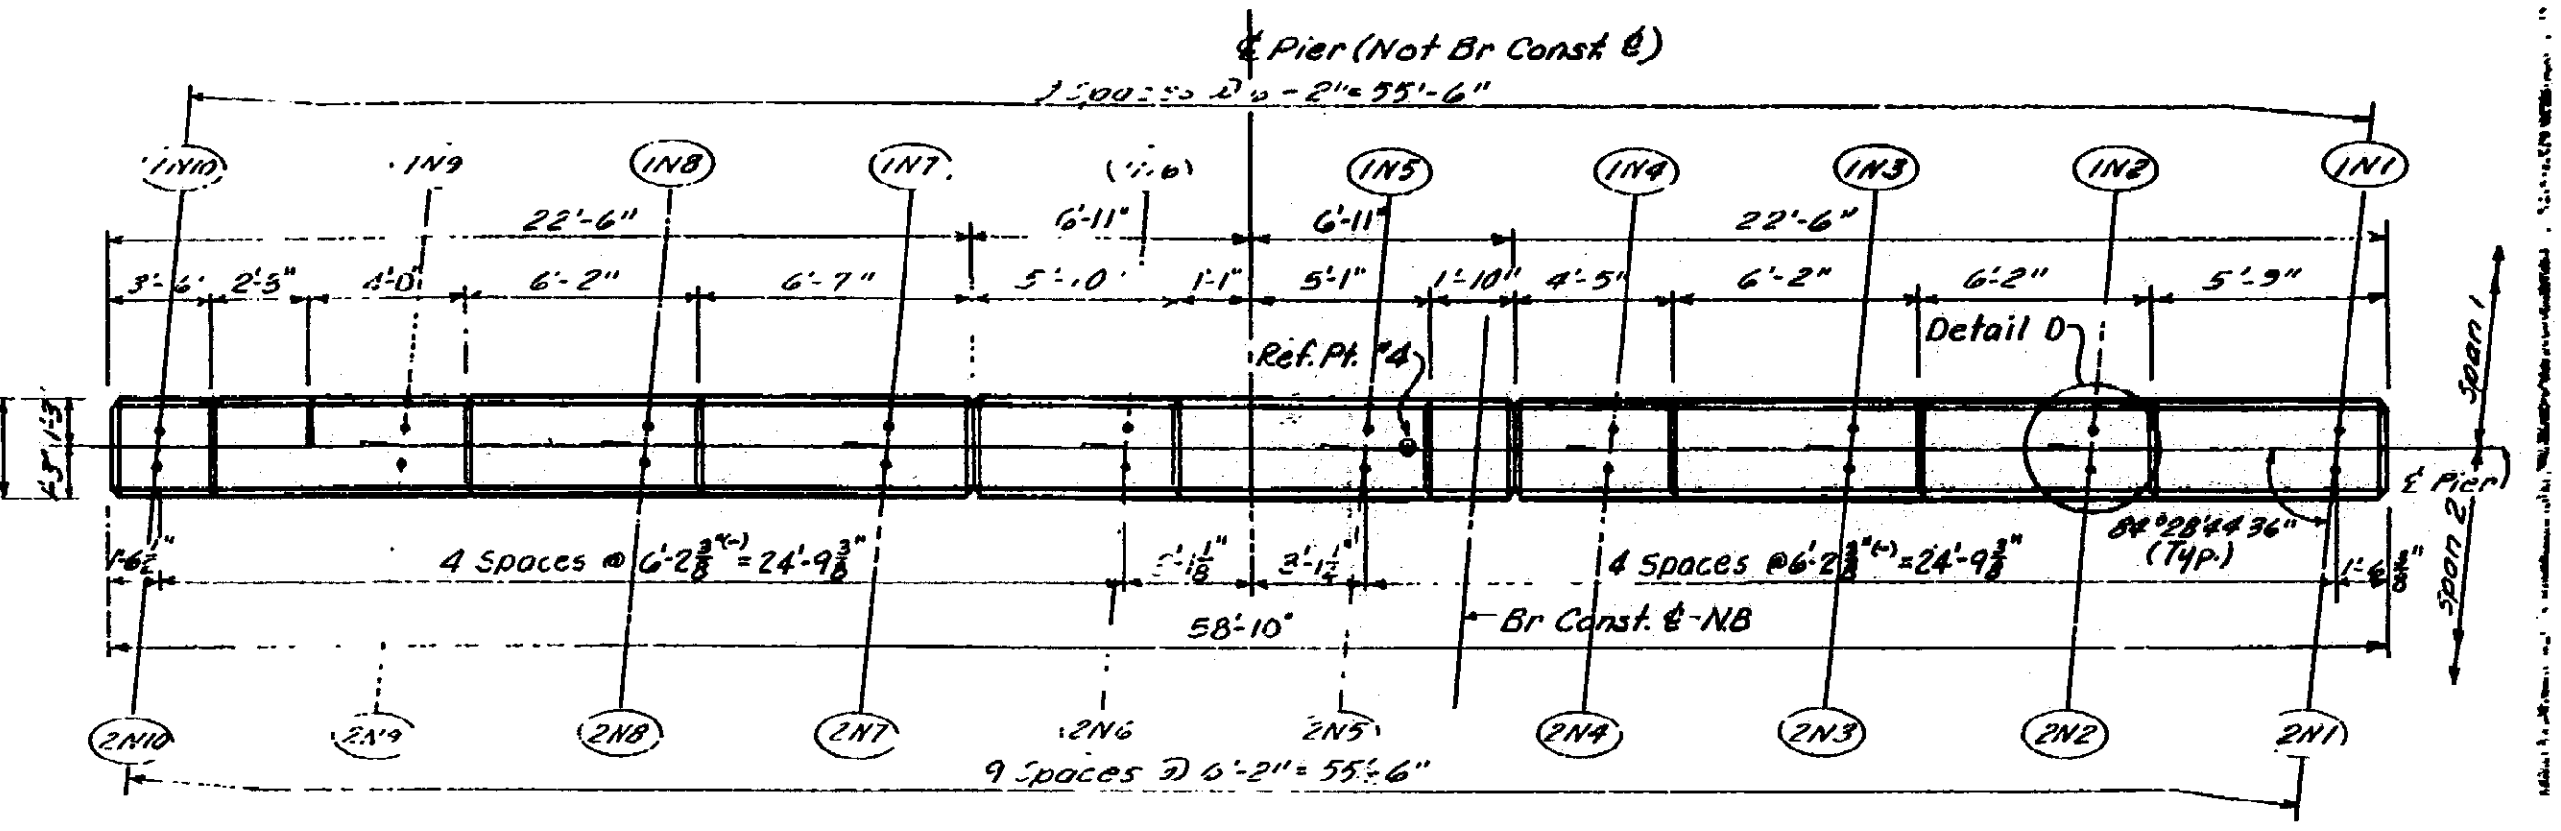


CAP PLAN PIER 4

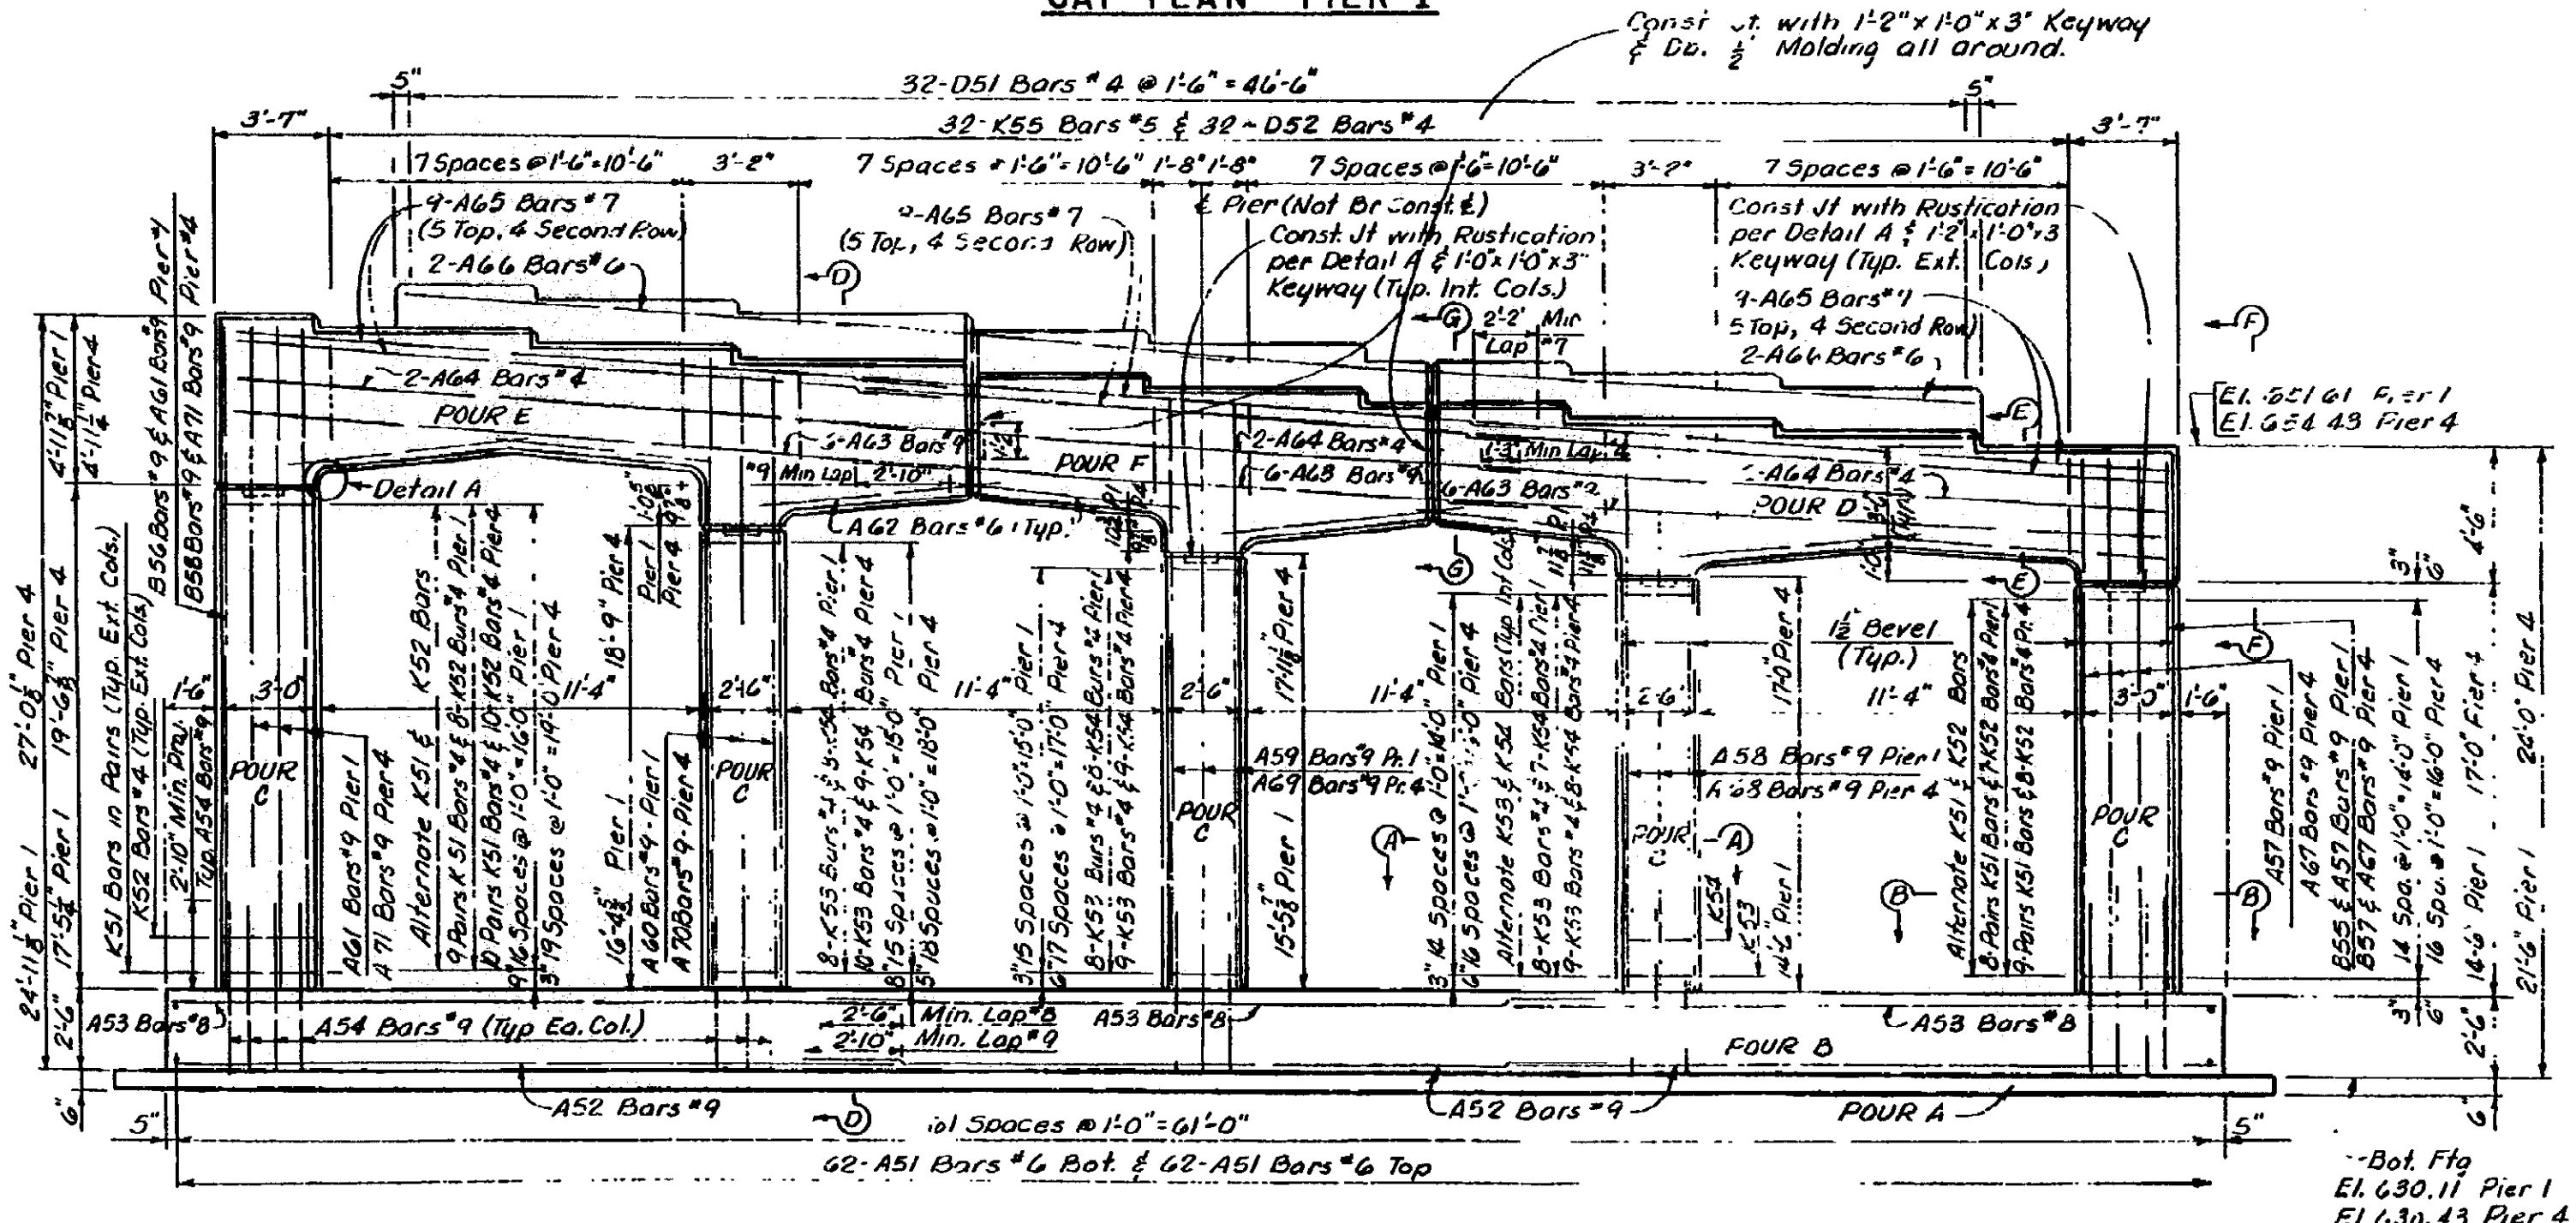


ELEVATION

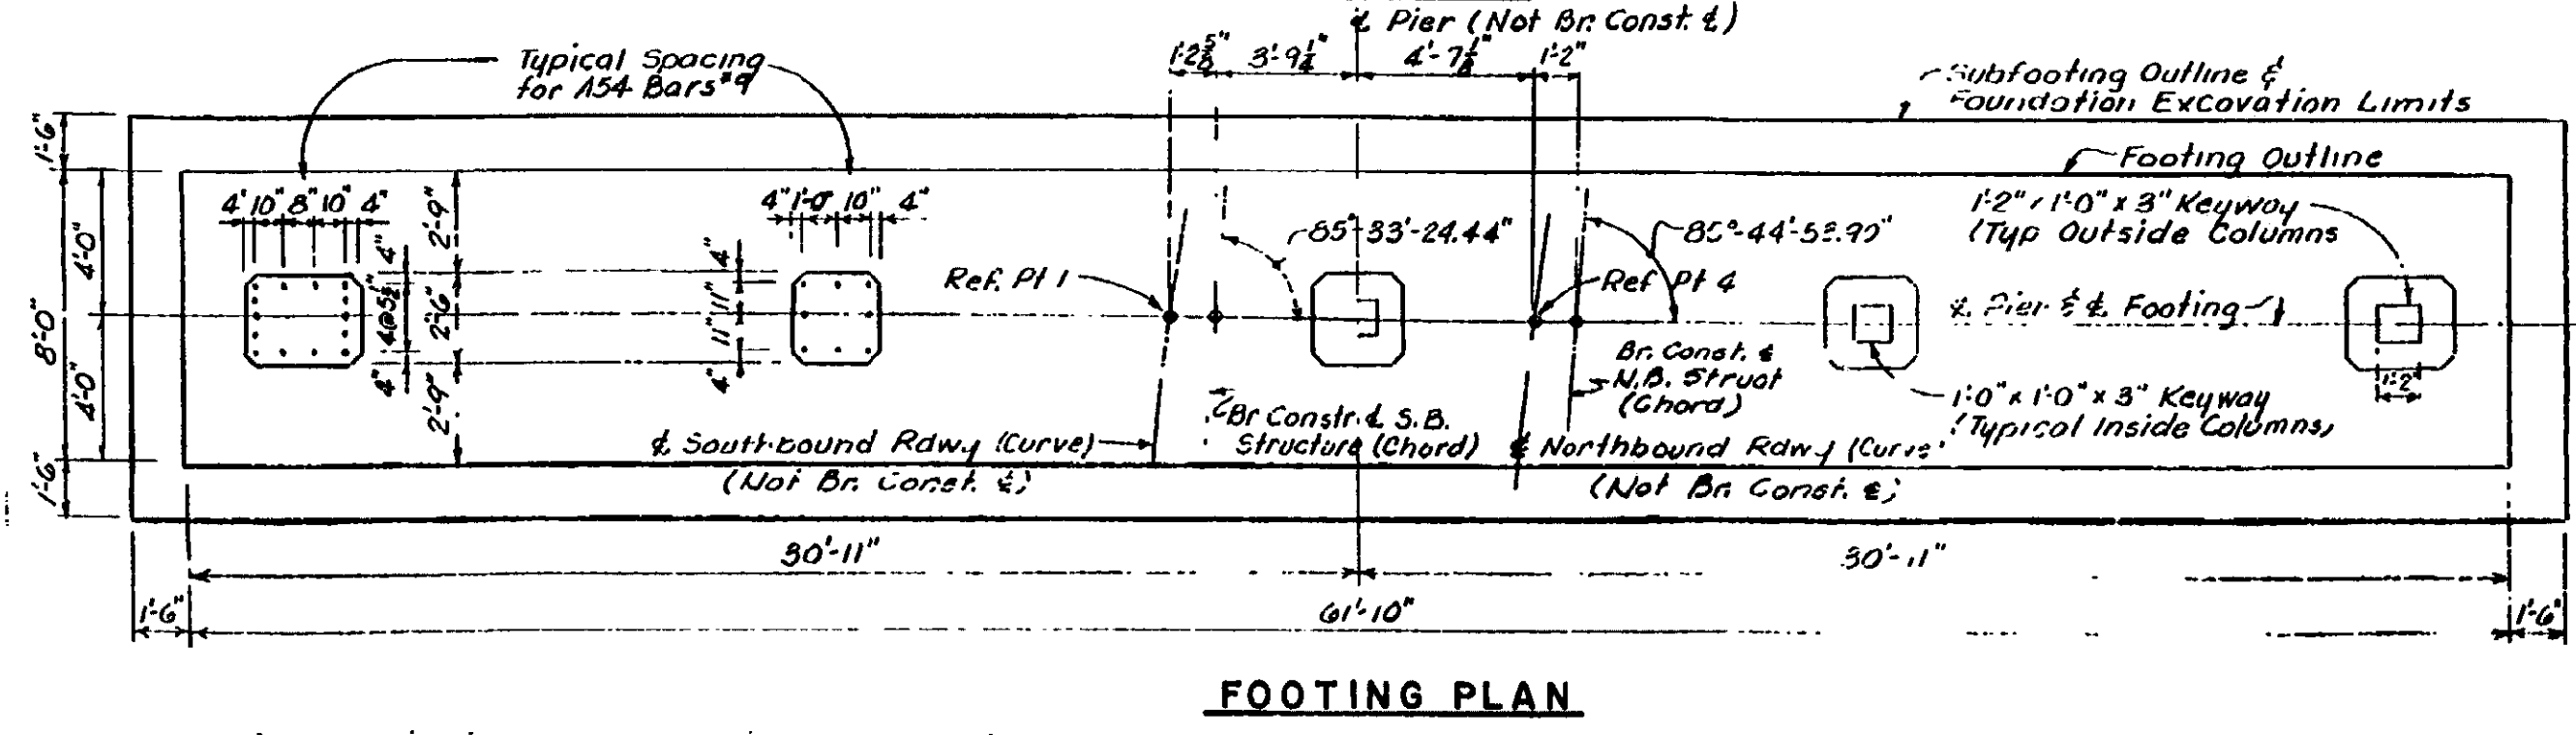


FOOTING PLAN

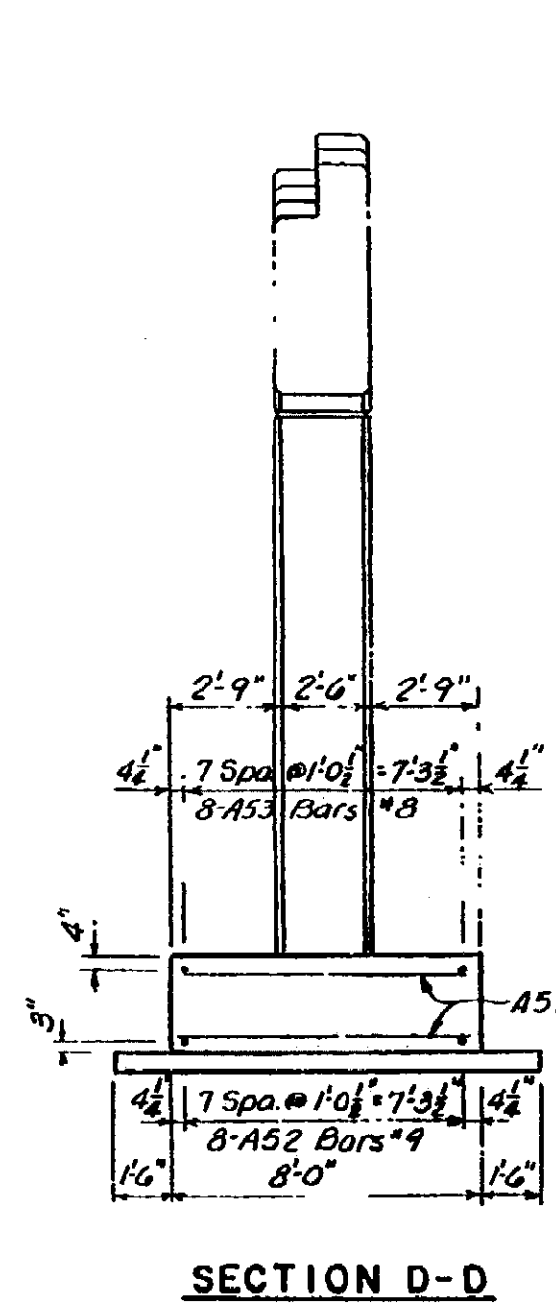


SECTION D-D

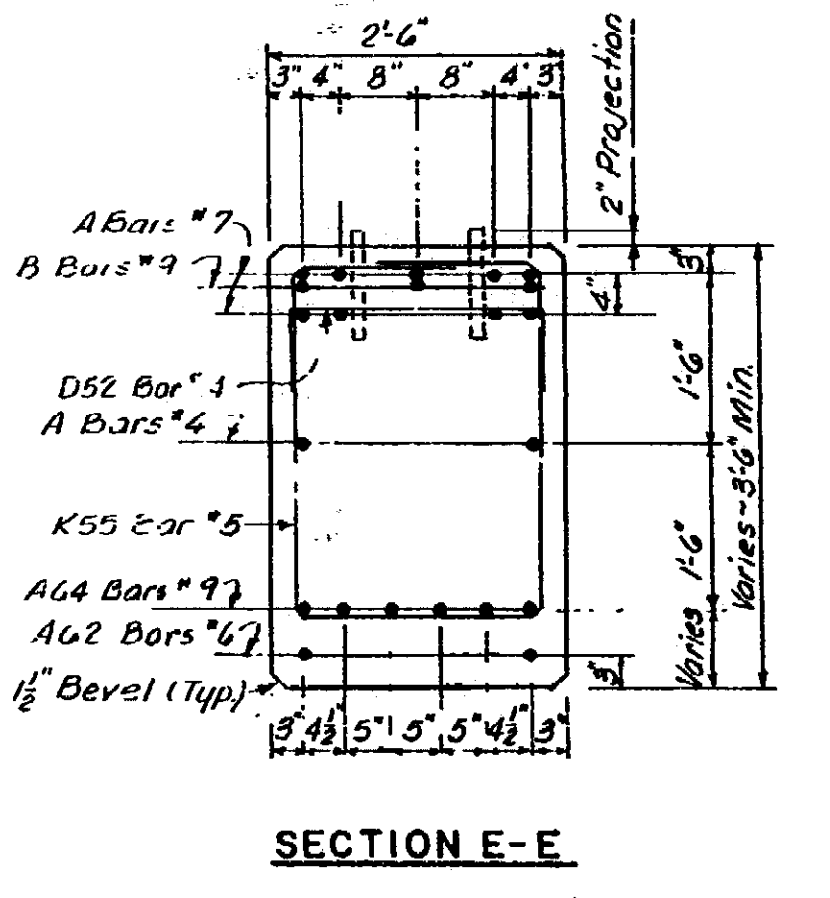


SECTION E-E

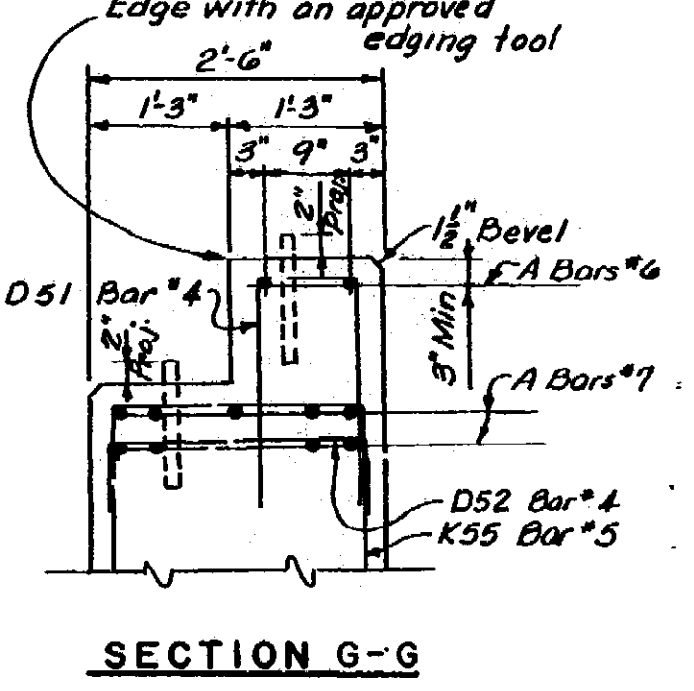

SECTION G-G

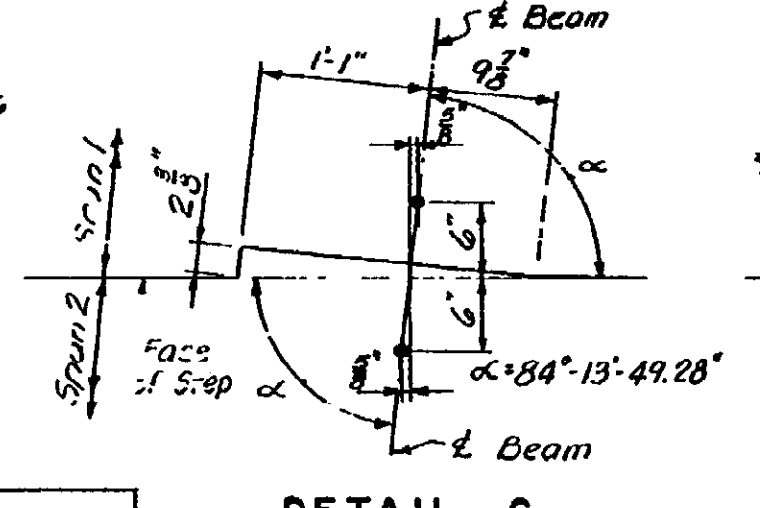

DETAIL C

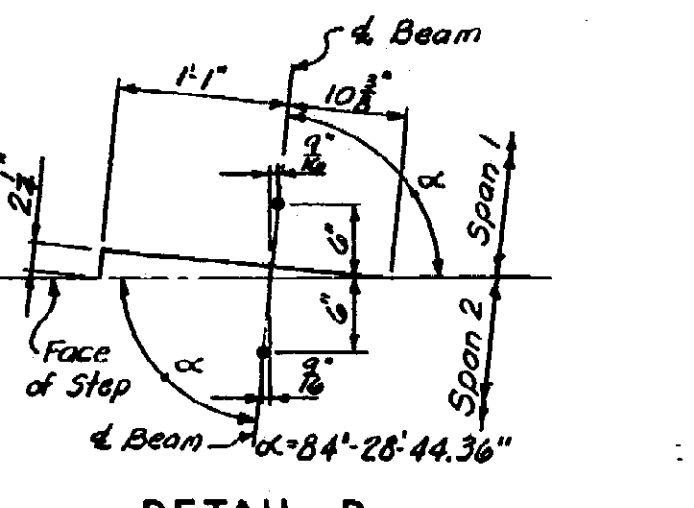

DETAIL D

TABLE OF ELEVATIONS & RISERS

PIER 1					PIER 4				
Beam Elev	Riser	Beam Elev	Riser	Beam Elev	Riser	Beam Elev	Riser	Beam Elev	Riser
157 651.61	251 651.61	1N1 654.43	1111	2N1 654.43					
158 653.36	252 652.12	1N2 656.33	1112	2N2 654.91					
159 654.04	253 652.60	1N3 656.80	1113	2N3 655.36					
154 654.19	254 653.06	1N4 657.22	1114	2N4 655.74					
155 654.94	255 653.50	1N5 657.61	1115	2N5 656.19					
156 655.25	256 653.92	1N6 657.91	1116	2N6 656.48					
157 655.69	257 654.26	1N7 658.18	1117	2N7 656.75					
158 655.98	258 654.55	1N8 658.43	1118	2N8 657.00					
159 656.24	259 654.81	1N9 658.65	1119	2N9 657.23					
150 655.04	250 655.04	1N10 657.44	1120	2N10 657.44					

Work this sheet with Sheets 155, 162 & 163

PIER DETAILS

NO. 1 & 4

TECON ENGINEERS, INC.

JOC 3-28-67
RFG
WJC 3-6-62
BIC
S03 OF 631741


NOTE:
DO NOT WORK FROM THIS SHEET. THE INFORMATION SHOWN
HERE IS FOR REFERENCE ONLY. NO PAY ITEMS ARE SHOWN.




FOR INFORMATION ONLY

DATE	CONT. SEC.	JOB NO.	DESIGN UNIT	SHEET
	S03 OF 63174	49595A	MADHAVI	1A0 OF


DATE: _____ CORRECTED BY: _____ CHECKED BY: _____ DATE: _____ DRAWN BY: indr FILE NAME: s0363174en.nb

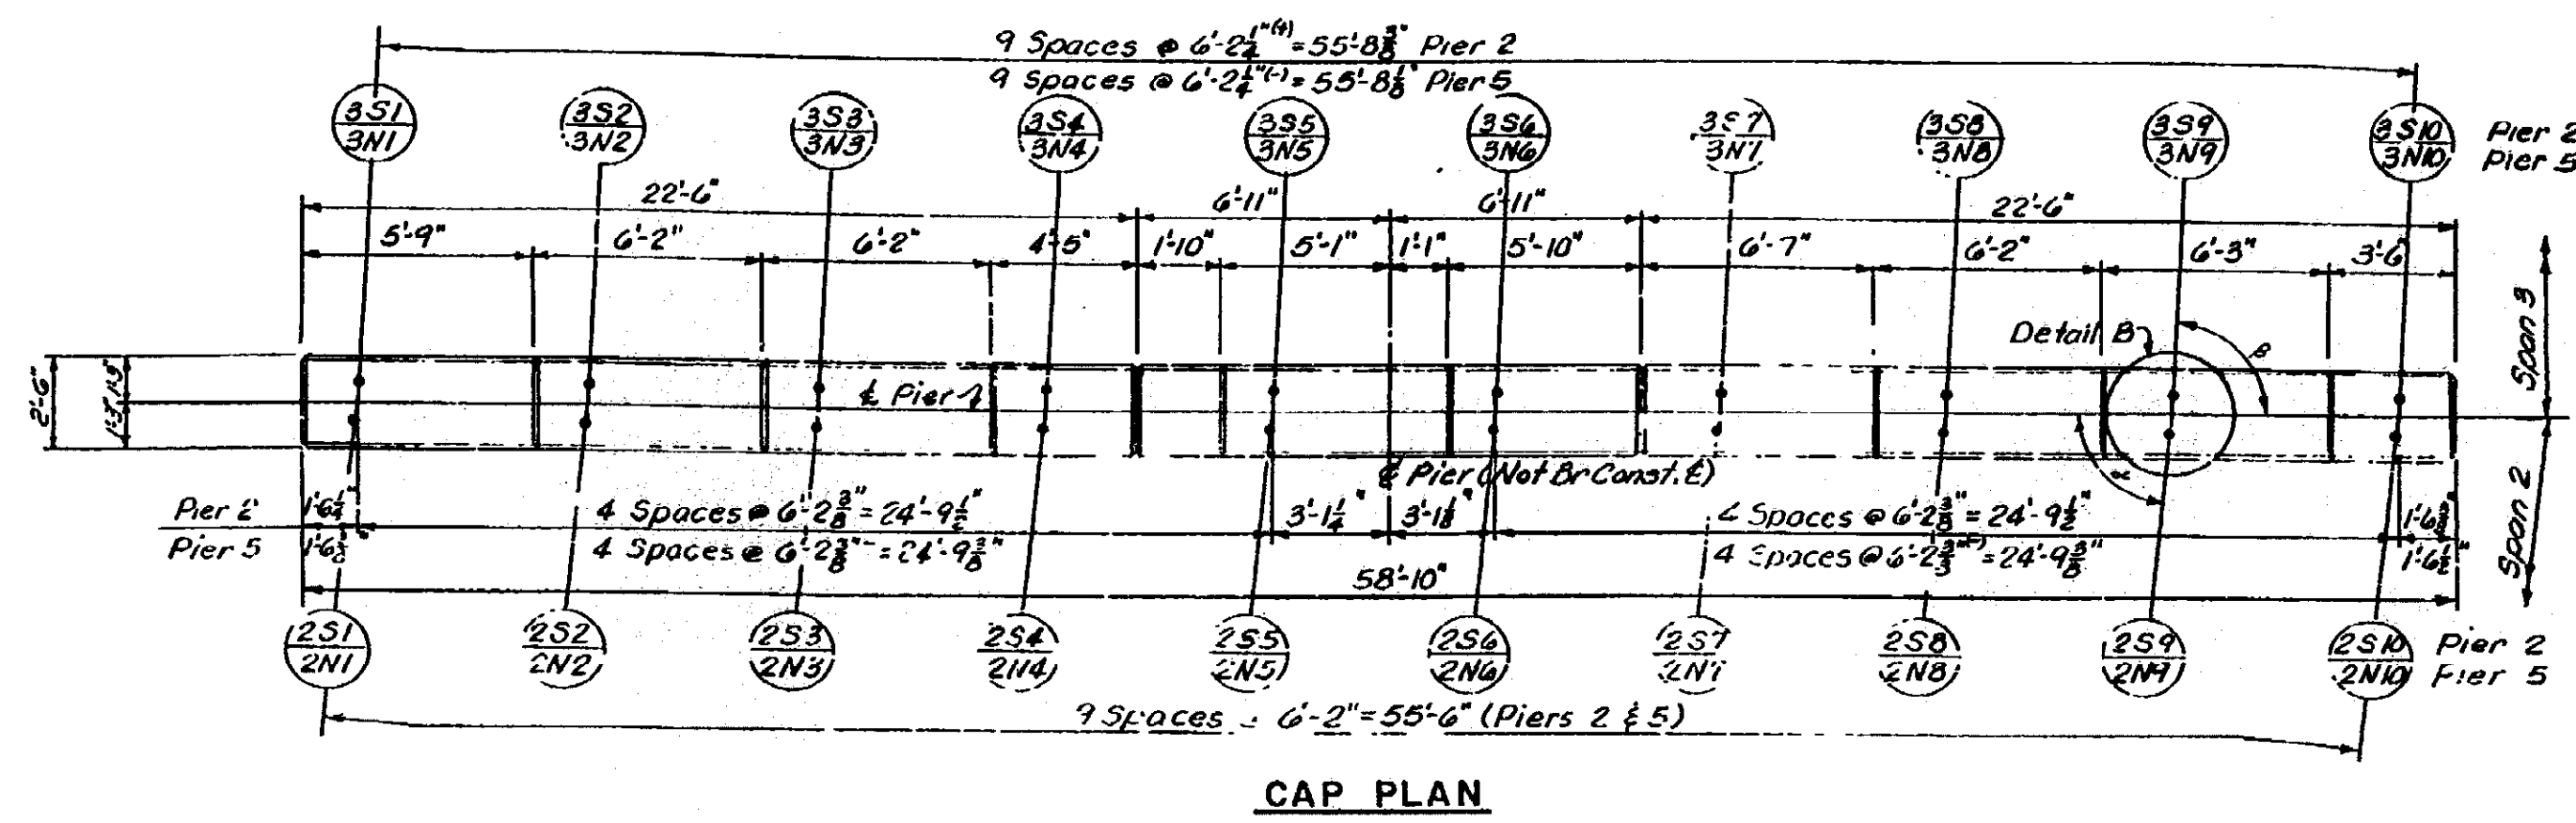


CAP PLAN

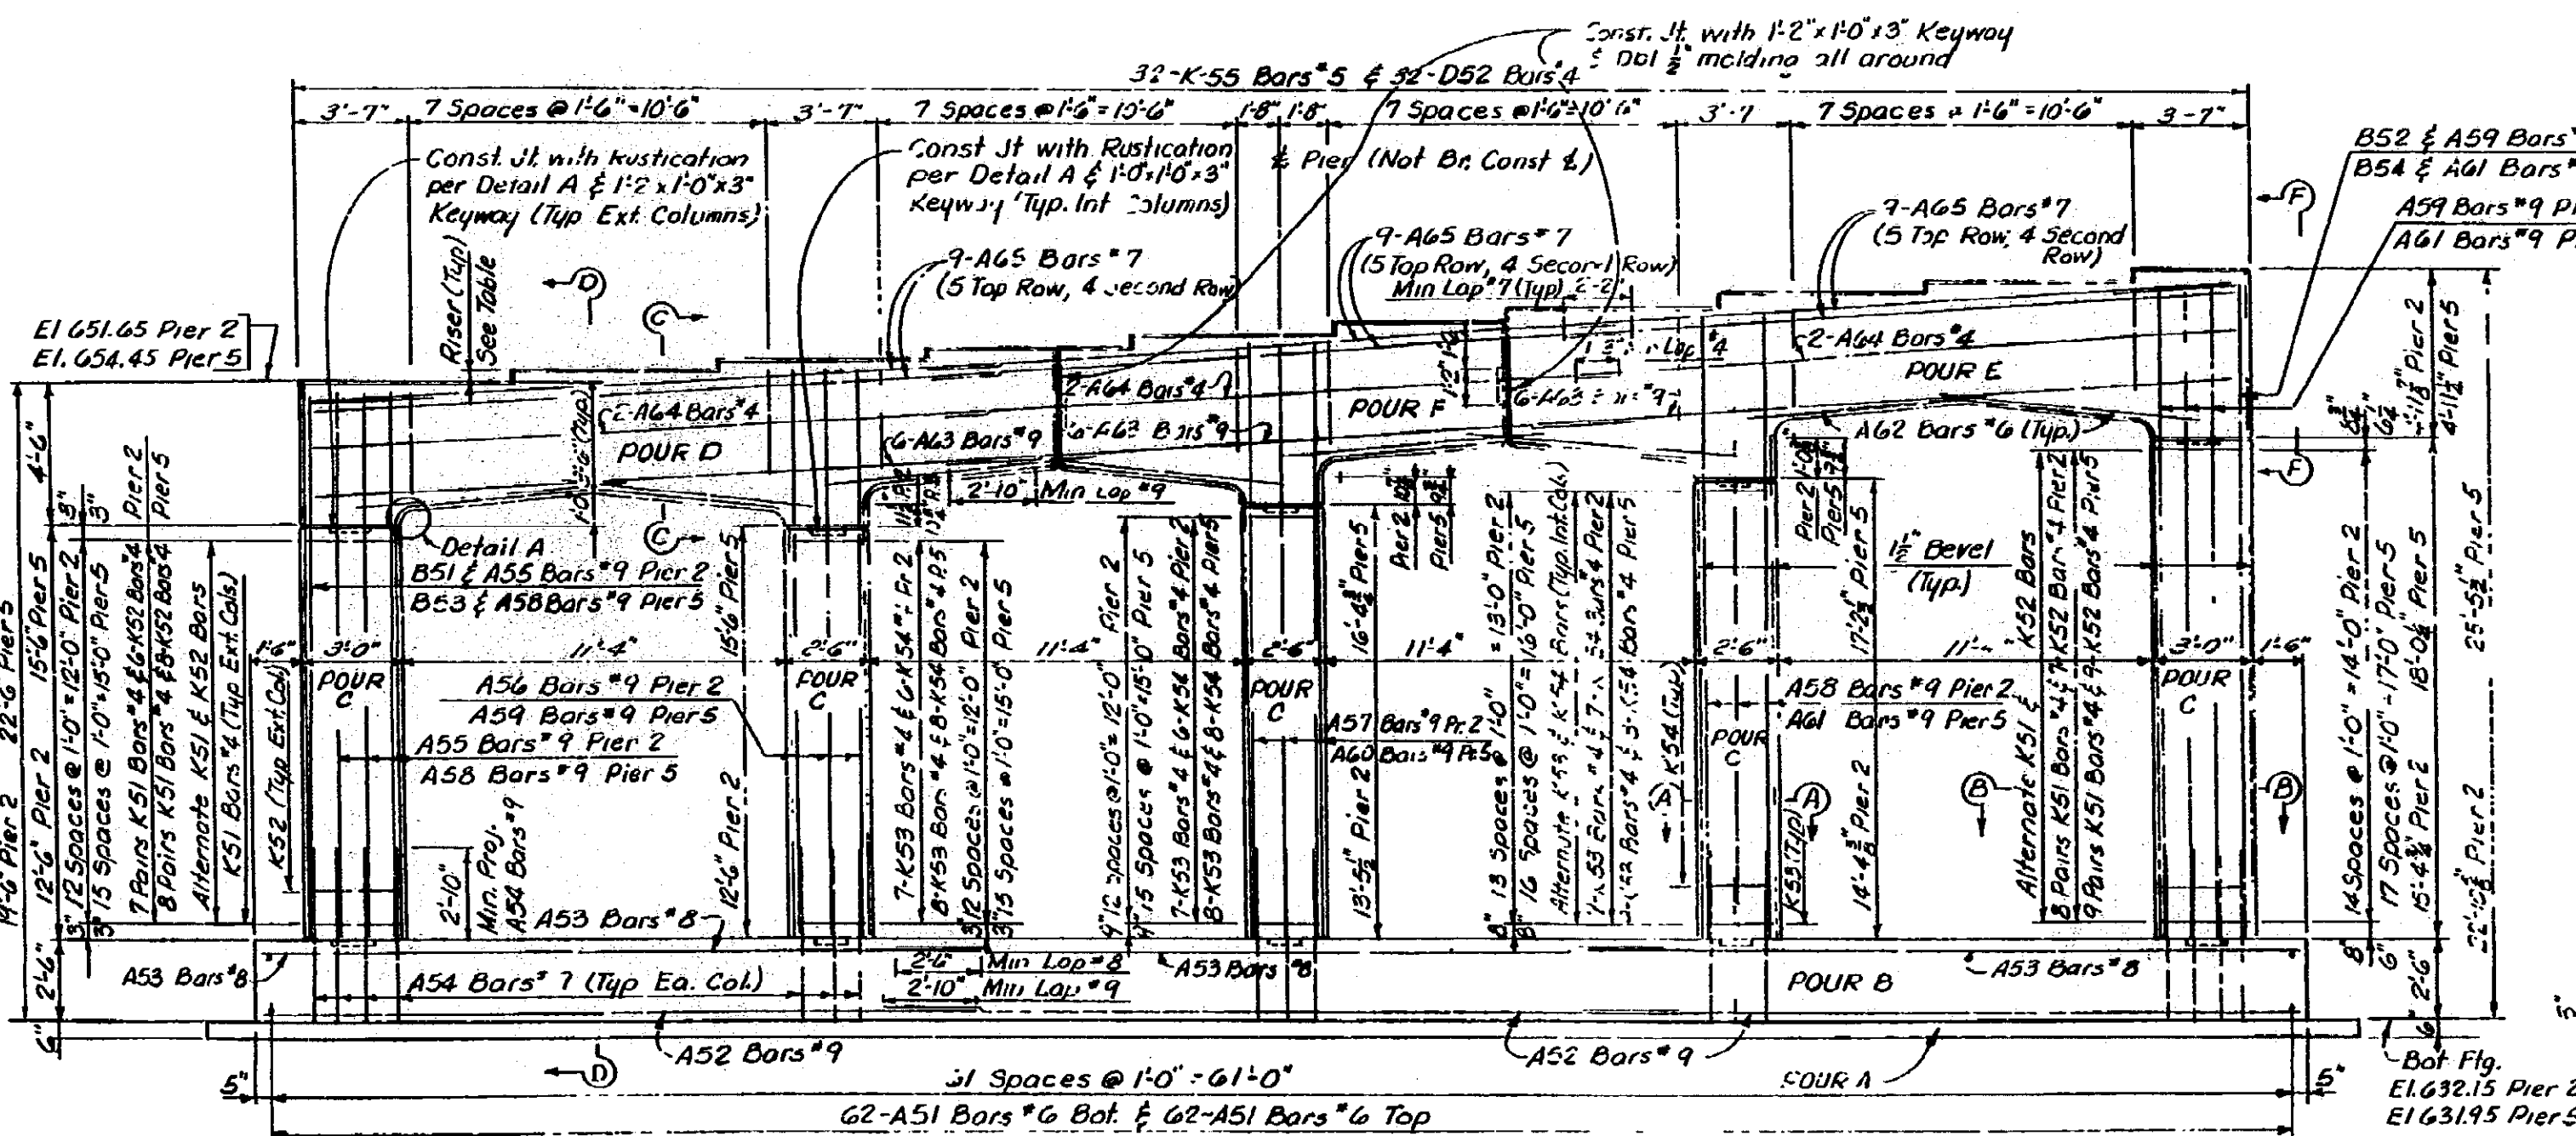

ELEVATION

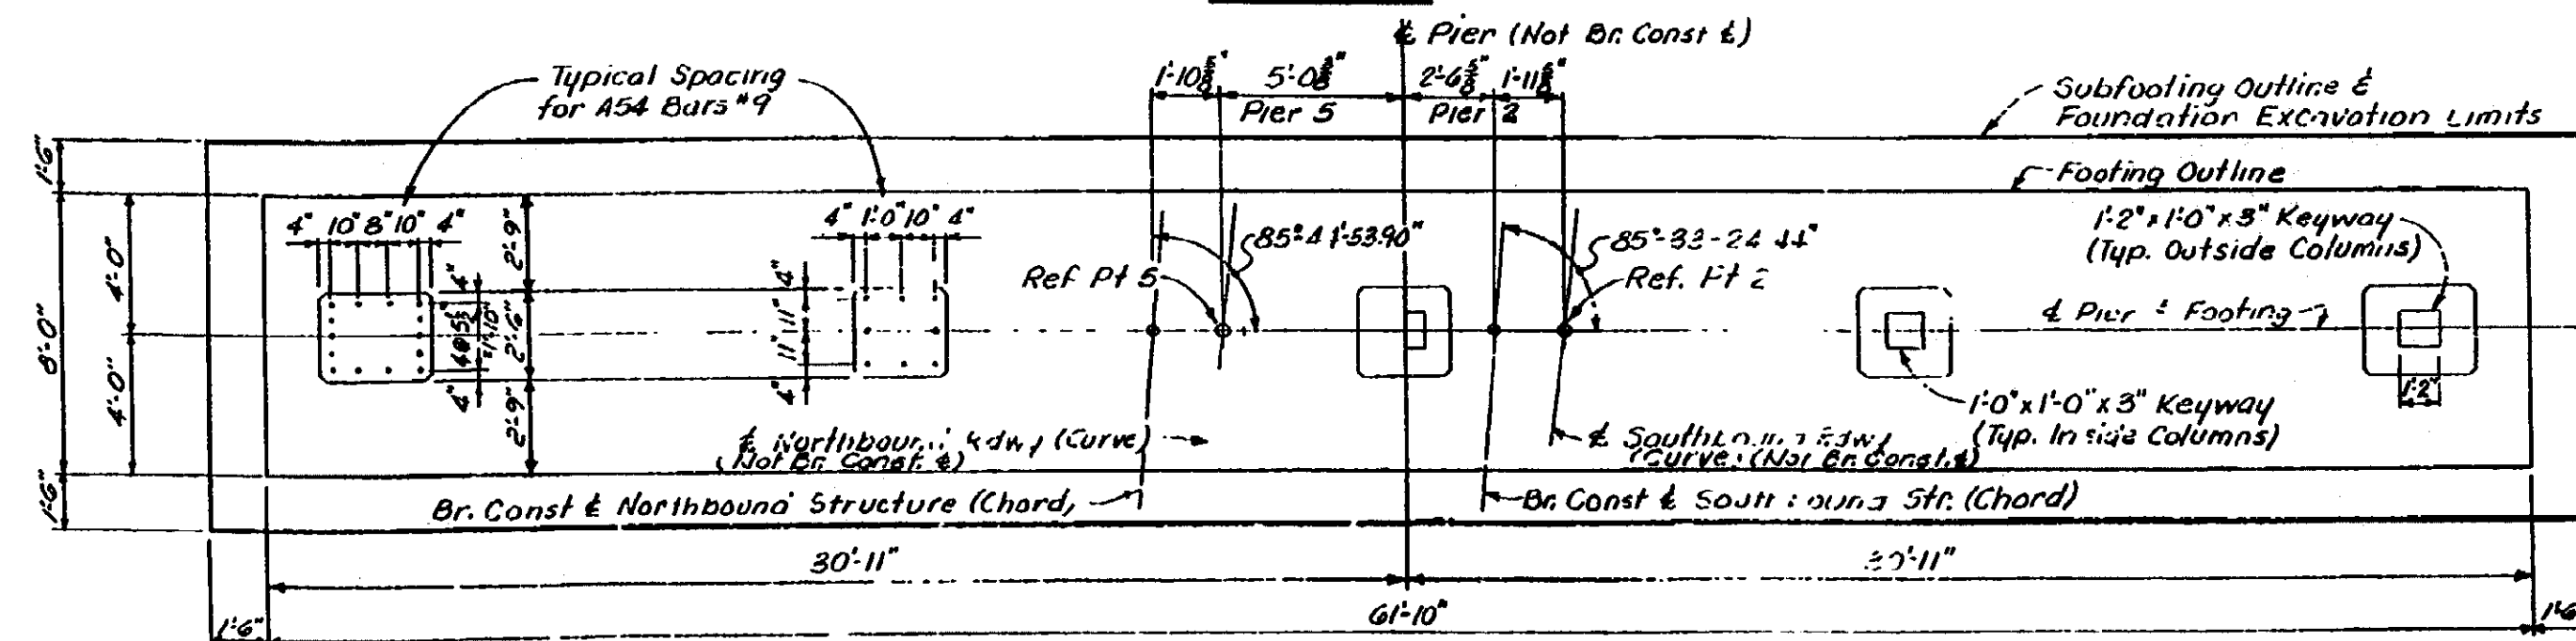


FOOTING PLAN

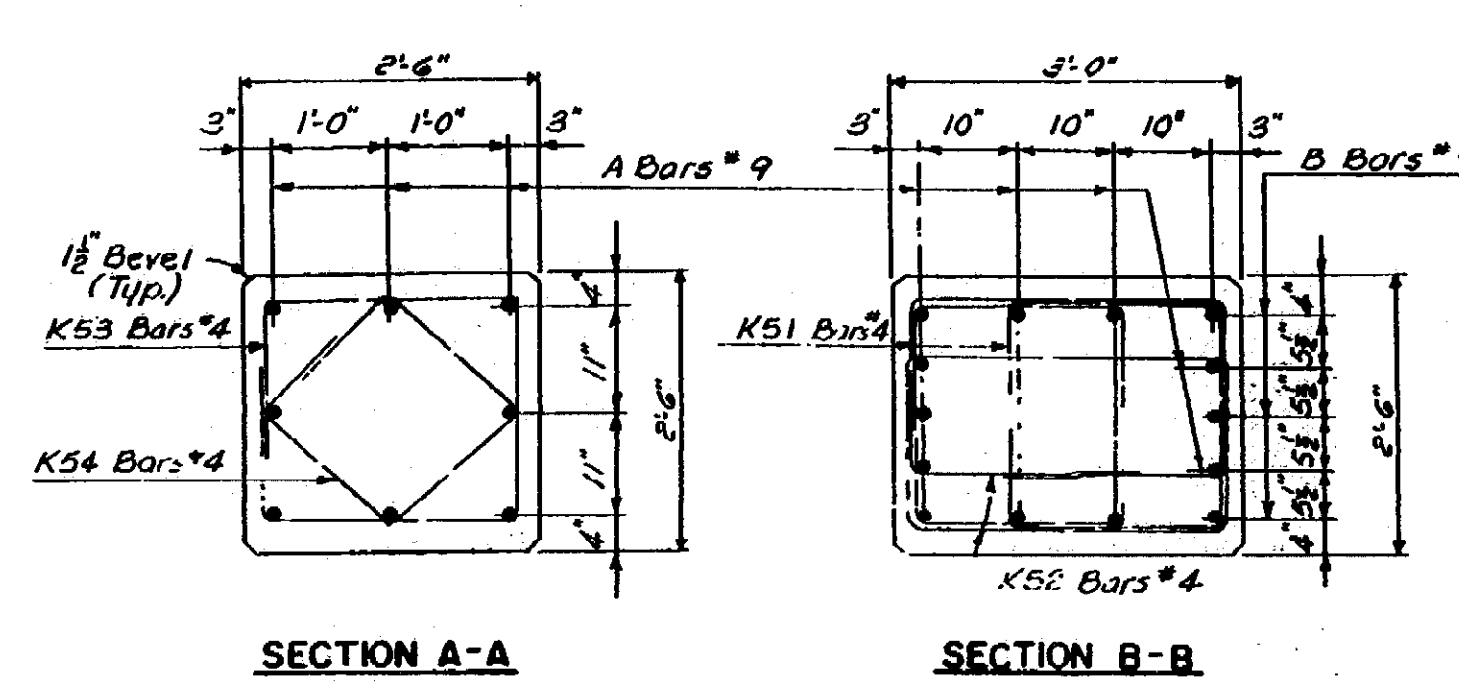


SECTION A-A


SECTION B-B

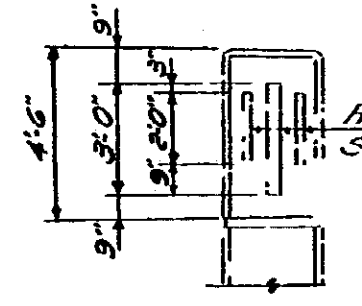


ELEVATION F-F

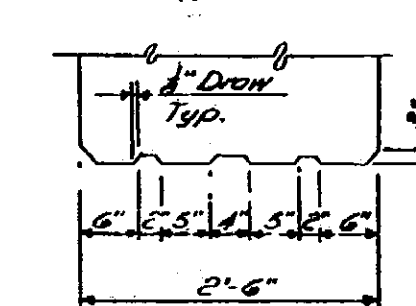


RUSTICATION DETAIL

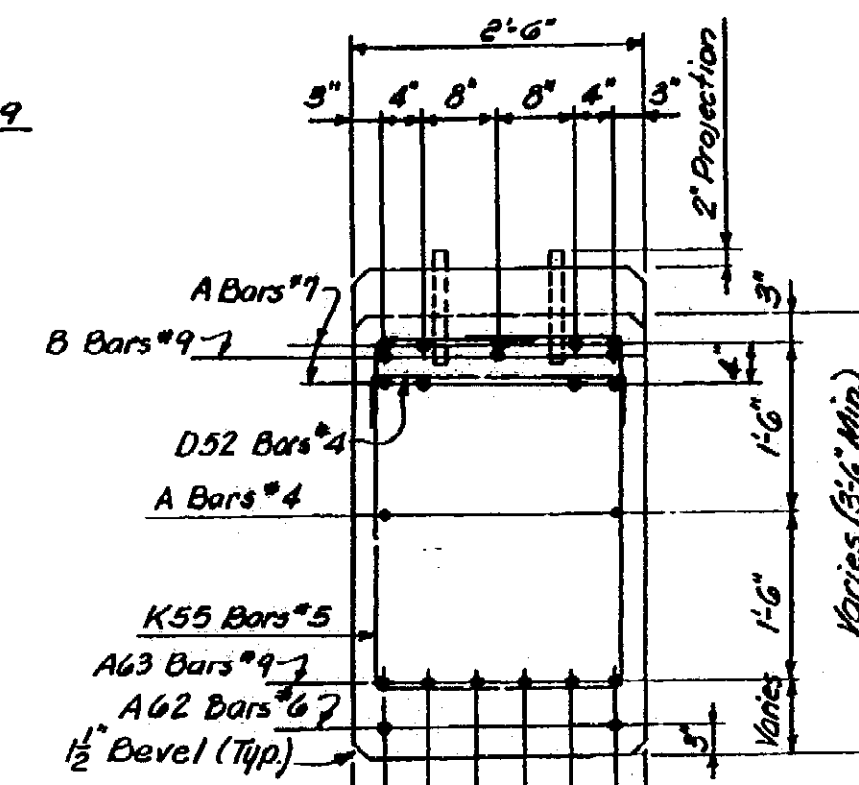

SECTION C-C

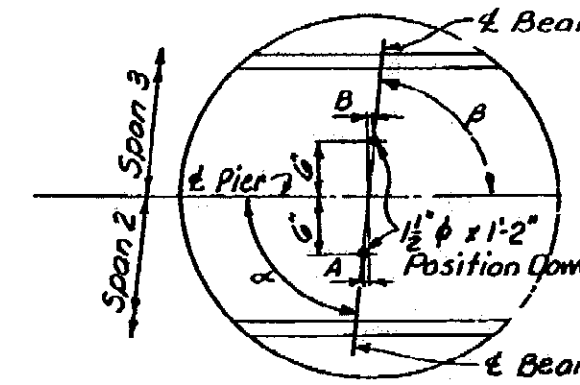

DETAIL B

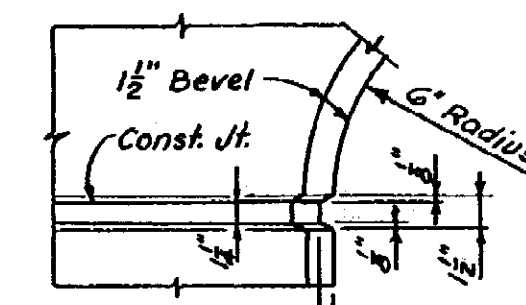

DETAIL A

TABLE OF ELEVATIONS & RISERS

PIER 2		PIER 5	
Beam Elev	Riser	Beam Elev	Riser
251	51.15	2N1	654.45
252	52.14	2N2	654.90
253	52.00	2N3	655.35
254	53.07	2N4	655.78
255	53.51	2N5	656.16
256	53.92	2N6	656.46
257	54.26	2N7	656.73
258	654.55	2N8	656.97
259	54.80	2N9	657.20
2510	55.22	2N10	657.41

POUR LOCATION	CONCRETE QUANTITIES - CUBIC YARDS					
	PIER 1	PIER 2	PIER 3	PIER 4	PIER 5	PIER 6
A Subfooting	13.2	13.2	13.2	13.2	13.2	13.2
B Footing	45.8	45.8	45.8	45.8	45.8	45.8
C Columns	18.5	18.5	18.5	18.5	18.5	18.5
D Cap	10.2	10.2	10.2	10.2	10.2	10.2
E Cap	10.2	10.2	10.2	10.2	10.2	10.2
FOP	6.7	6.7	6.7	6.7	6.7	6.7
TOTAL	114.6	114.6	114.6	114.6	114.6	114.6

NOTES

1. Reinforcement details shall be as shown on this sheet unless otherwise noted.
 2. All bars shall be lap spliced in accordance with ACI 308.
 3. The top of pier shall be finished to a true plane at the elevations shown and shall not vary more than 3/8" under a ten foot straight edge.
 4. The pier shall be cast on a maximum foundation of 3.5 x 3.5 x 1.0 feet square and a maximum foundation pressure of 360 pounds per square foot.

Work this sheet with sheets 155, 161 & 163

PIER DETAILS
NO. 2 & 5

TECON ENGINEERS, INC.

JOC 5/28/67
EAT 6/10/67

WJC 5/26/67
GSR 5/12/67

S03 of 63174 I



NOTE:
DO NOT WORK FROM THIS SHEET. THE INFORMATION SHOWN HERE IS FOR REFERENCE ONLY. NO PAY ITEMS ARE SHOWN.



FOR INFORMATION ONLY				
DATE	CONT. SEC.	JOB NO.	DESIGN UNIT	SHEET
	S03 OF 63174	49595A	MADHAVI	1AP OF

1 2 3 4 5 6 7 8 9 10 11 12 13 14 15 16 17 18 19 20 21 22 23 24 25 26 27 28 29 30 31 32 33 34 35 36 37 38 39 40 41 42 43 44 45 46 47 48 49 50 51 52 53 54 55 56 57 58 59 60 61 62 63

REVISIONS			
NO.	DESCRIPTION	DATE	BY

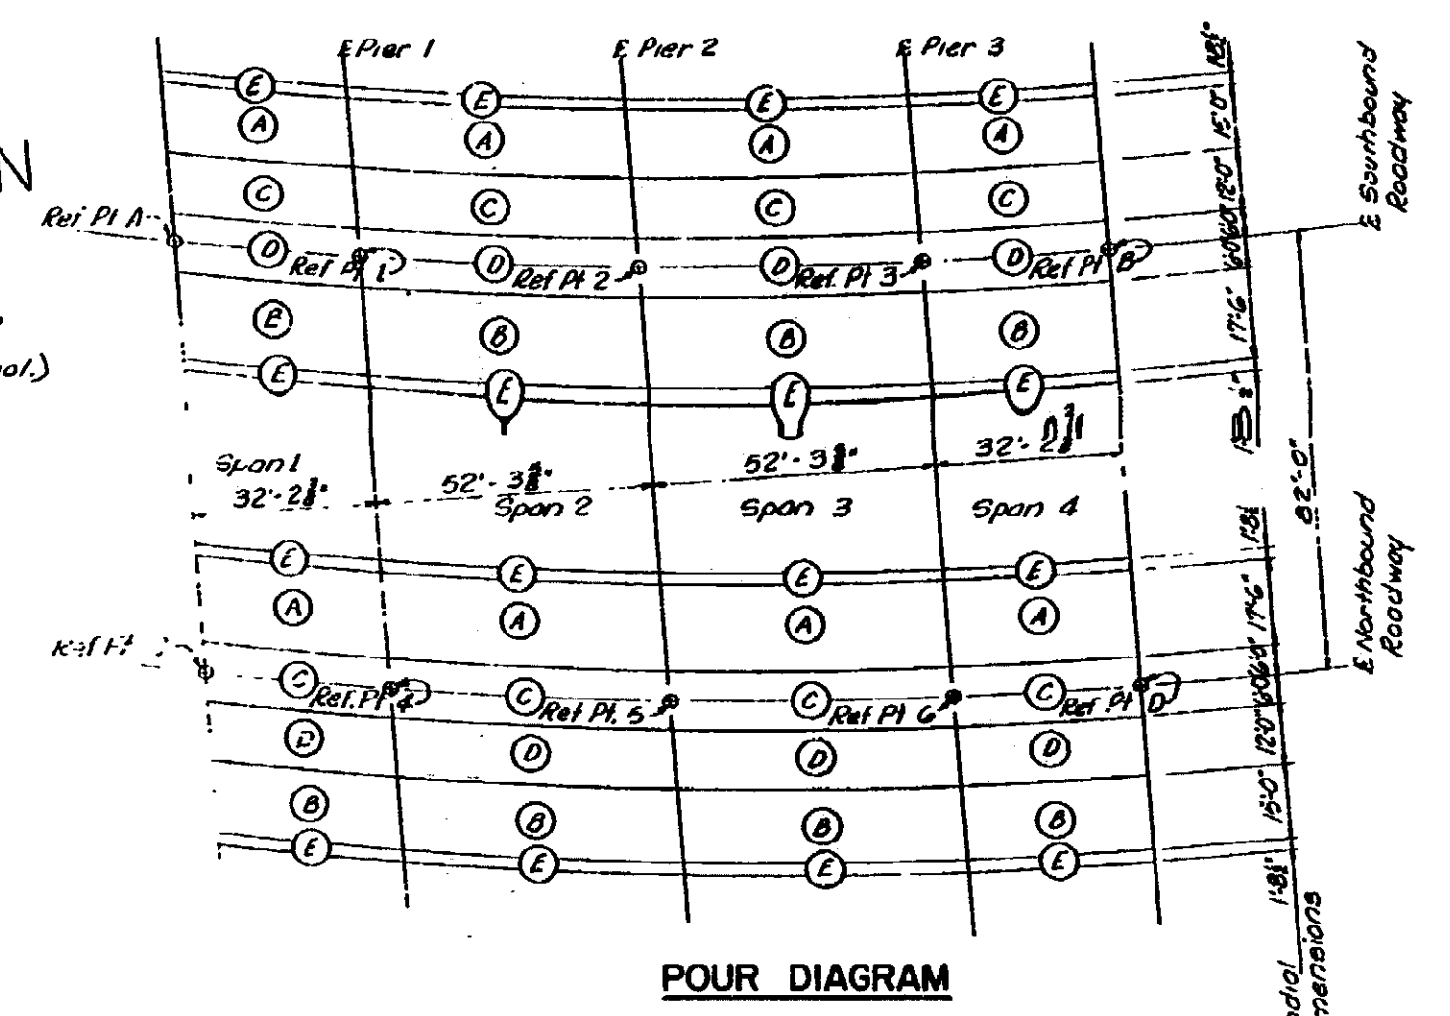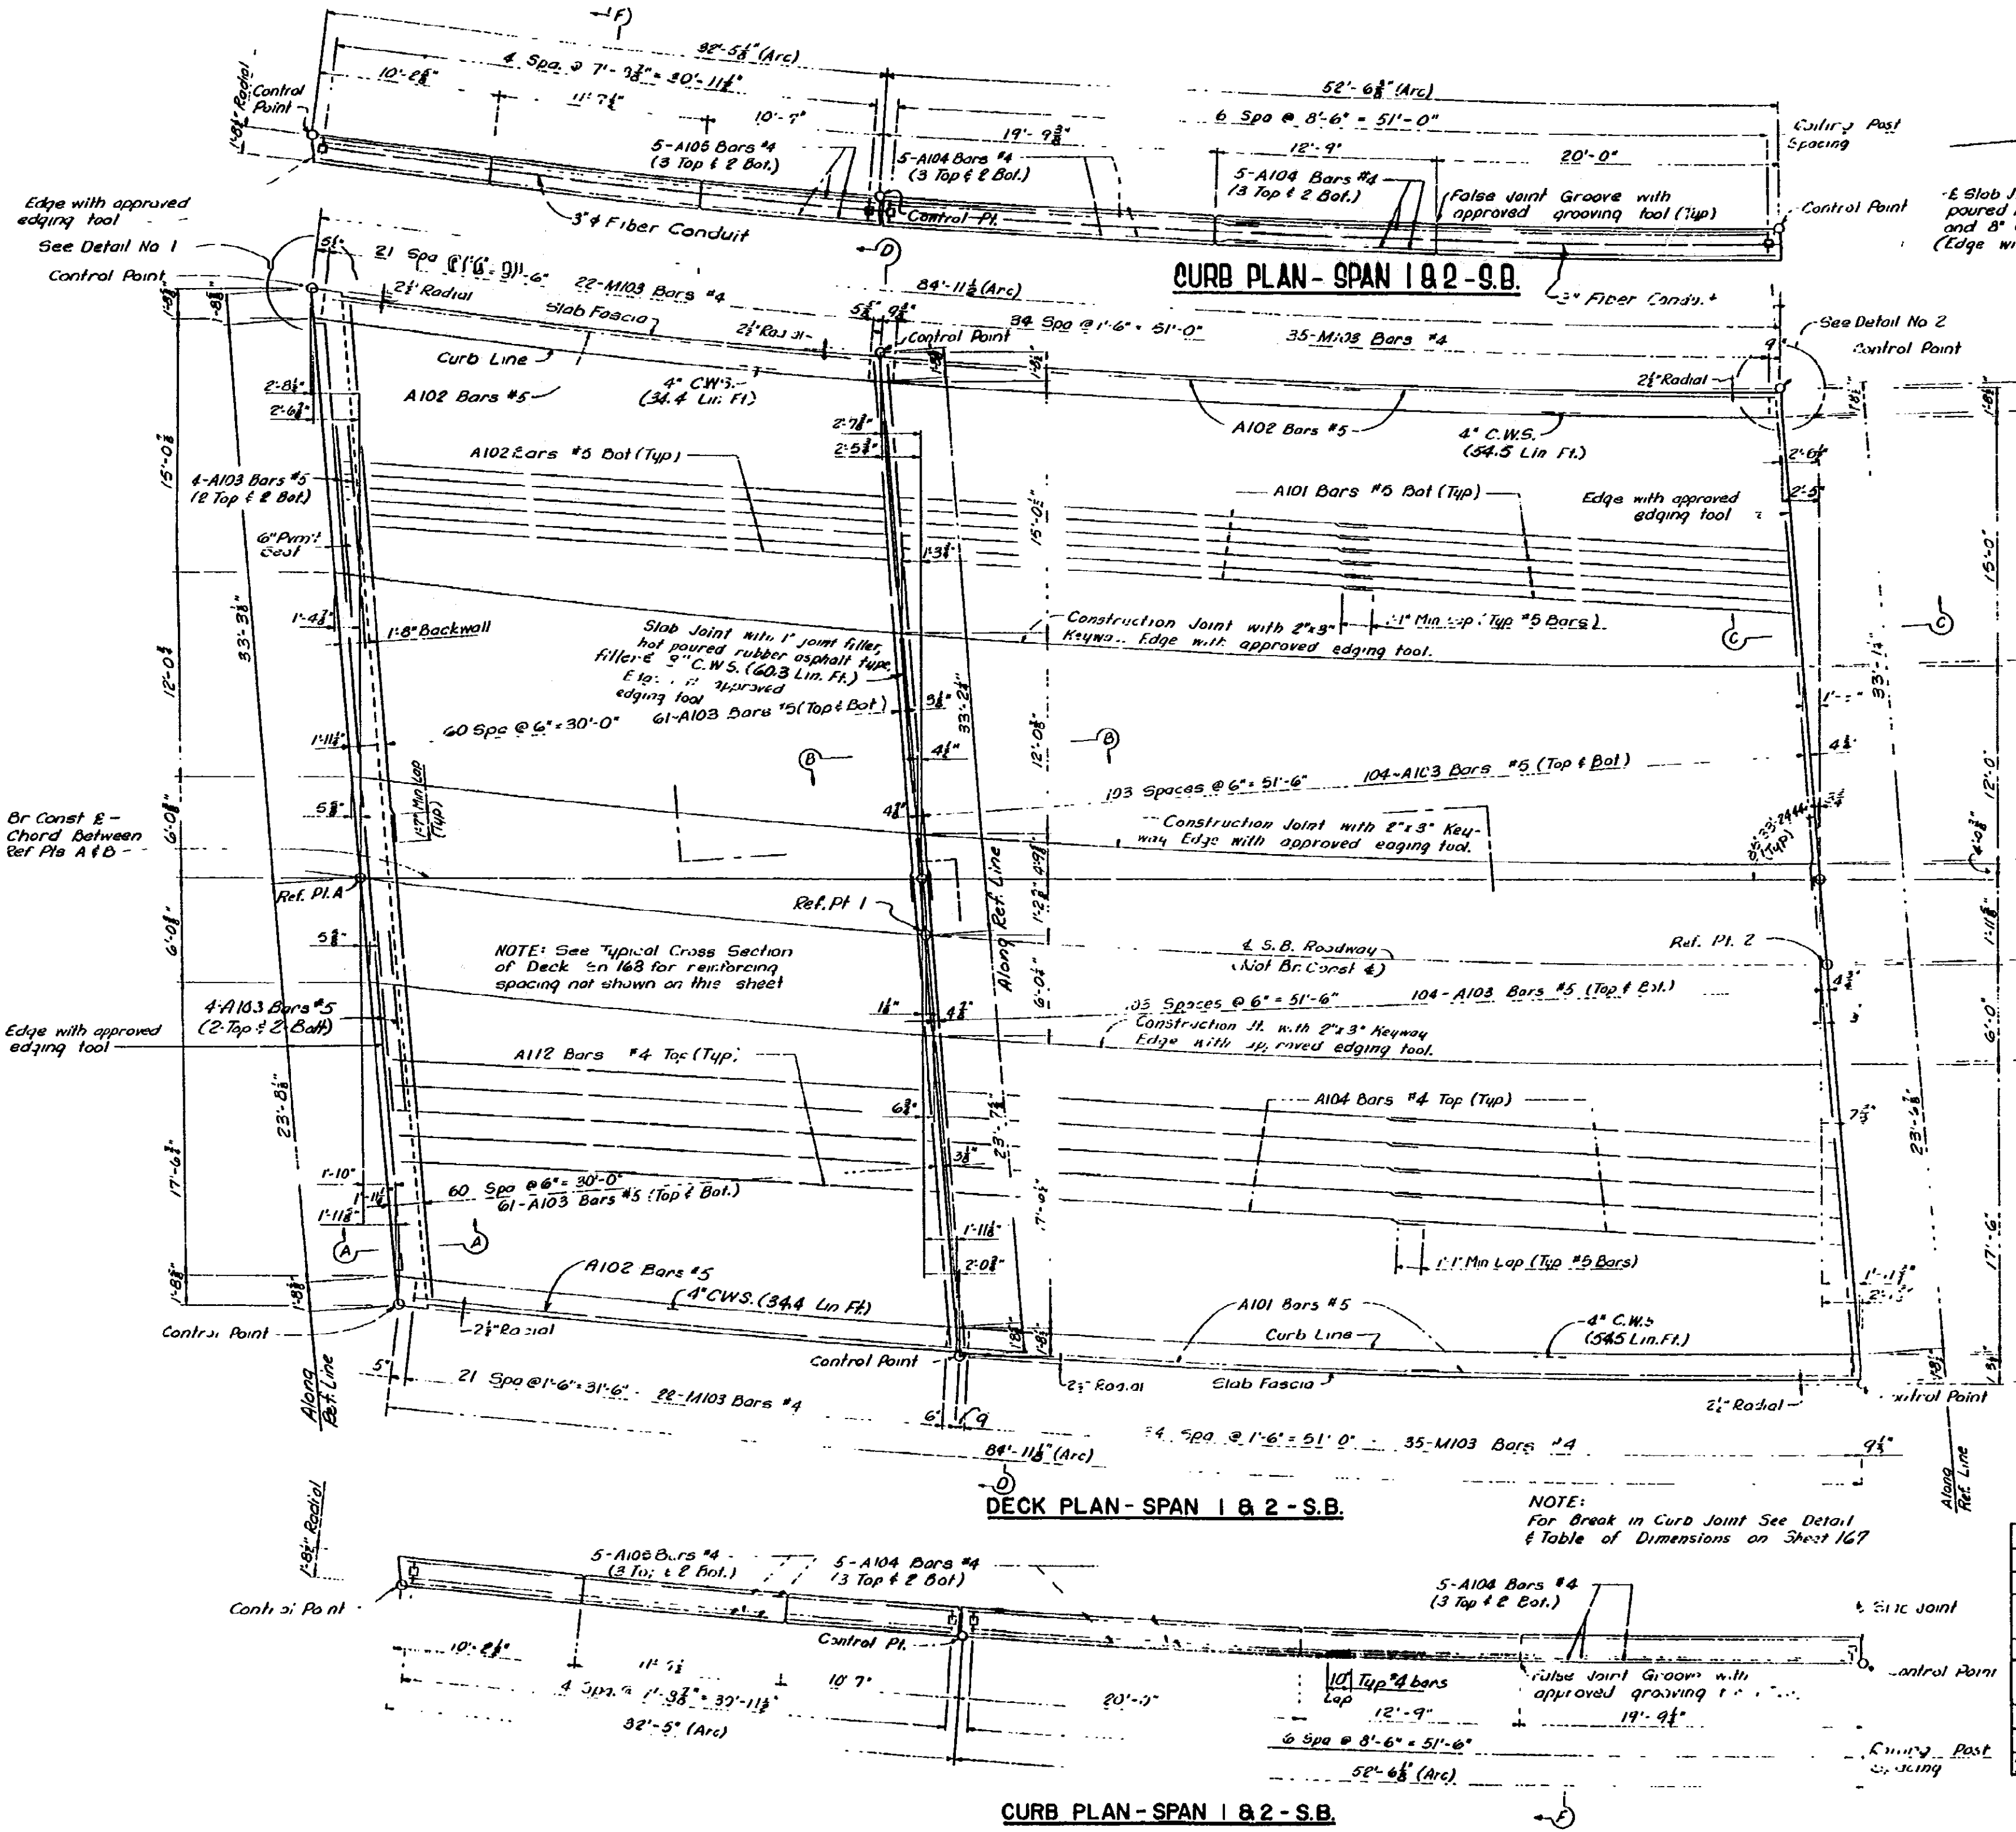

POUR	CU. YDS. CONCRETE GRADE A (6AA)							
	S. B. STRUCTURE				N. B. STRUCTURE			
	SPAN 1	SPAN 2	SPAN 3	SPAN 4	SPAN 1	SPAN 2	SPAN 3	SPAN 4
A	13.7	24.7	24.6	14.8	17.1	28.2	28.1	16.9
B	16.6	27.4	27.3	16.4	14.3	29.7	23.6	14.2
C	10.6	17.6	17.6	10.5	10.5	17.4	17.4	10.4
D	12.5	17.4	17.4	10.4	10.4	17.2	17.2	10.3
E	3.4	5.5	5.5	3.4	3.4	5.5	5.5	3.4
Disph.	4.2	7.7	7.8	4.2	4.2	7.7	7.8	4.2
Total	53.2	100.3	100.2	59.7	59.9	99.7	99.6	59.4
Total Concrete S.B. Structure	320.4				Total Concrete N.B. Structure 318.5			
Total Concrete for both Structures	639.0							

NOTE: Concrete Pours, as located, need not be placed in alphabetical order.

GENERAL NOTES

1. Check and install proper Waterproofing.

2. For details of Joint Waterproofing, see MSHD Std Dwg. R11.

3. Edging Details not shown, see MSHD Std Dwg. R11.

4. Edging or grooving with an approved tool.

5. Slab concrete shall not be placed until slab concrete has attained its design strength as determined by the table Section 502.2 of the Standard Specifications.

6. All dimensions laid out parallel or perpendicular to Bridge Construction & (chord between Ref. Pts. A and B on Southbound Structure and between Ref. Pts. C and D on the Northbound Structure), except as noted or shown. Place transverse slab reinforcing parallel to & Piers and Abutments, and longitudinal slab reinforcing parallel to & Beams, except as noted.

7. For Railing Details See Sheet 171.

MISCELLANEOUS ITEM	UNIT	S. B.	N. B.	AMT.
1" Joint Filler	Sq. Ft.	106	106	212
Hot-Poured Rubber Asphalt Tape Filler	Lin. Ft.	185	185	370
Copper	Lbs.	239	239	478
Bridge Reinforcing Paper	Sq. Yds.	55	55	110
3" Fiber Conduit	L.F.	16	16	32
Handhole Frame/Cover	Each	1	1	2

Work this Sheet with Sheets 165 thru 171

SUPERSTRUCTURE DETAILS
SOUTHBOUND - SPANS 1 & 2

TECON ENGINEERS, INC.

JWC 3-28-64
PFL
LWHC 2-28-62
PFL 3/12
S03 OF 631741




NOTE:
DO NOT WORK FROM THIS SHEET. THE INFORMATION SHOWN
HERE IS FOR REFERENCE ONLY. NO PAY ITEMS ARE SHOWN.




FOR INFORMATION ONLY				
DATE	CONT. SEC.	JOB NO.	DESIGN UNIT	SHEET
	S03 OF 63174	49595A	MADHAVI	IAR OF

FILE NAME: s03s317asn.nb
DRAWN BY: [blank]
CHECKED BY: [blank]
CORRECTED BY: [blank]
DATE: [blank]

REVISIONS			
NO.	DESCRIPTION	DATE	BY

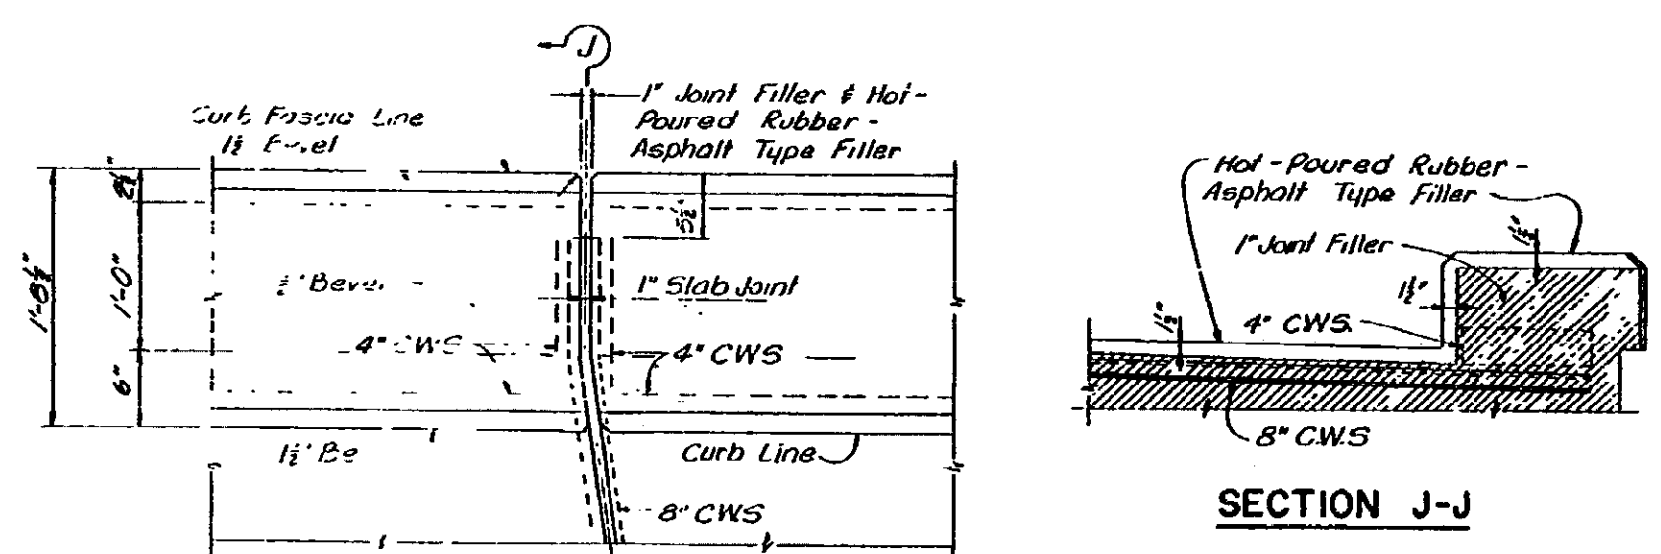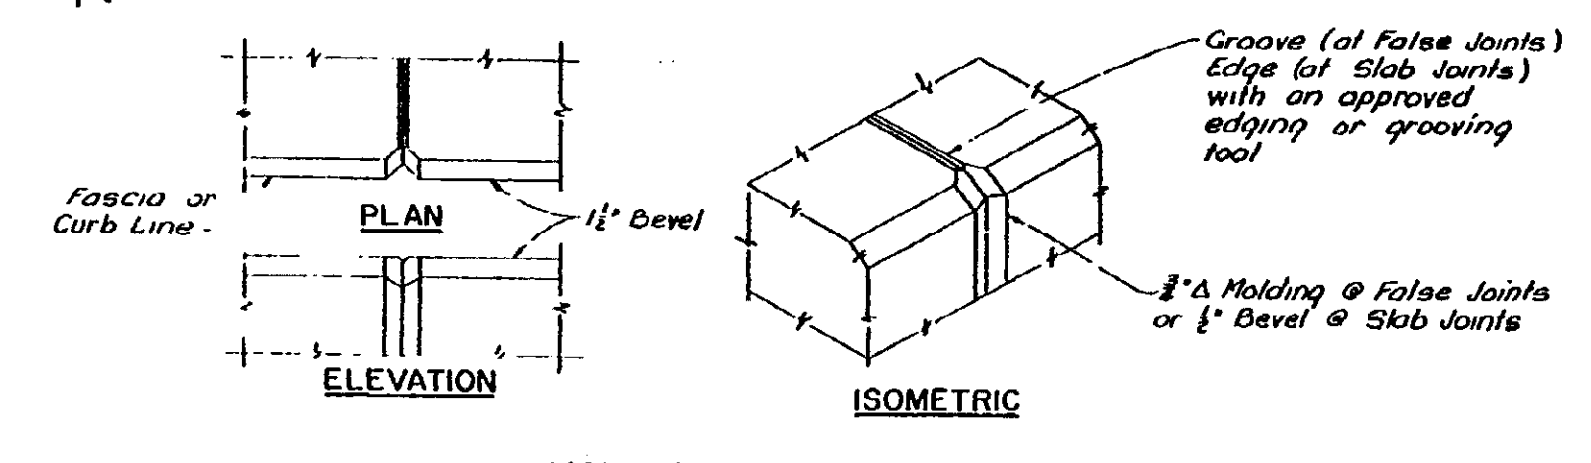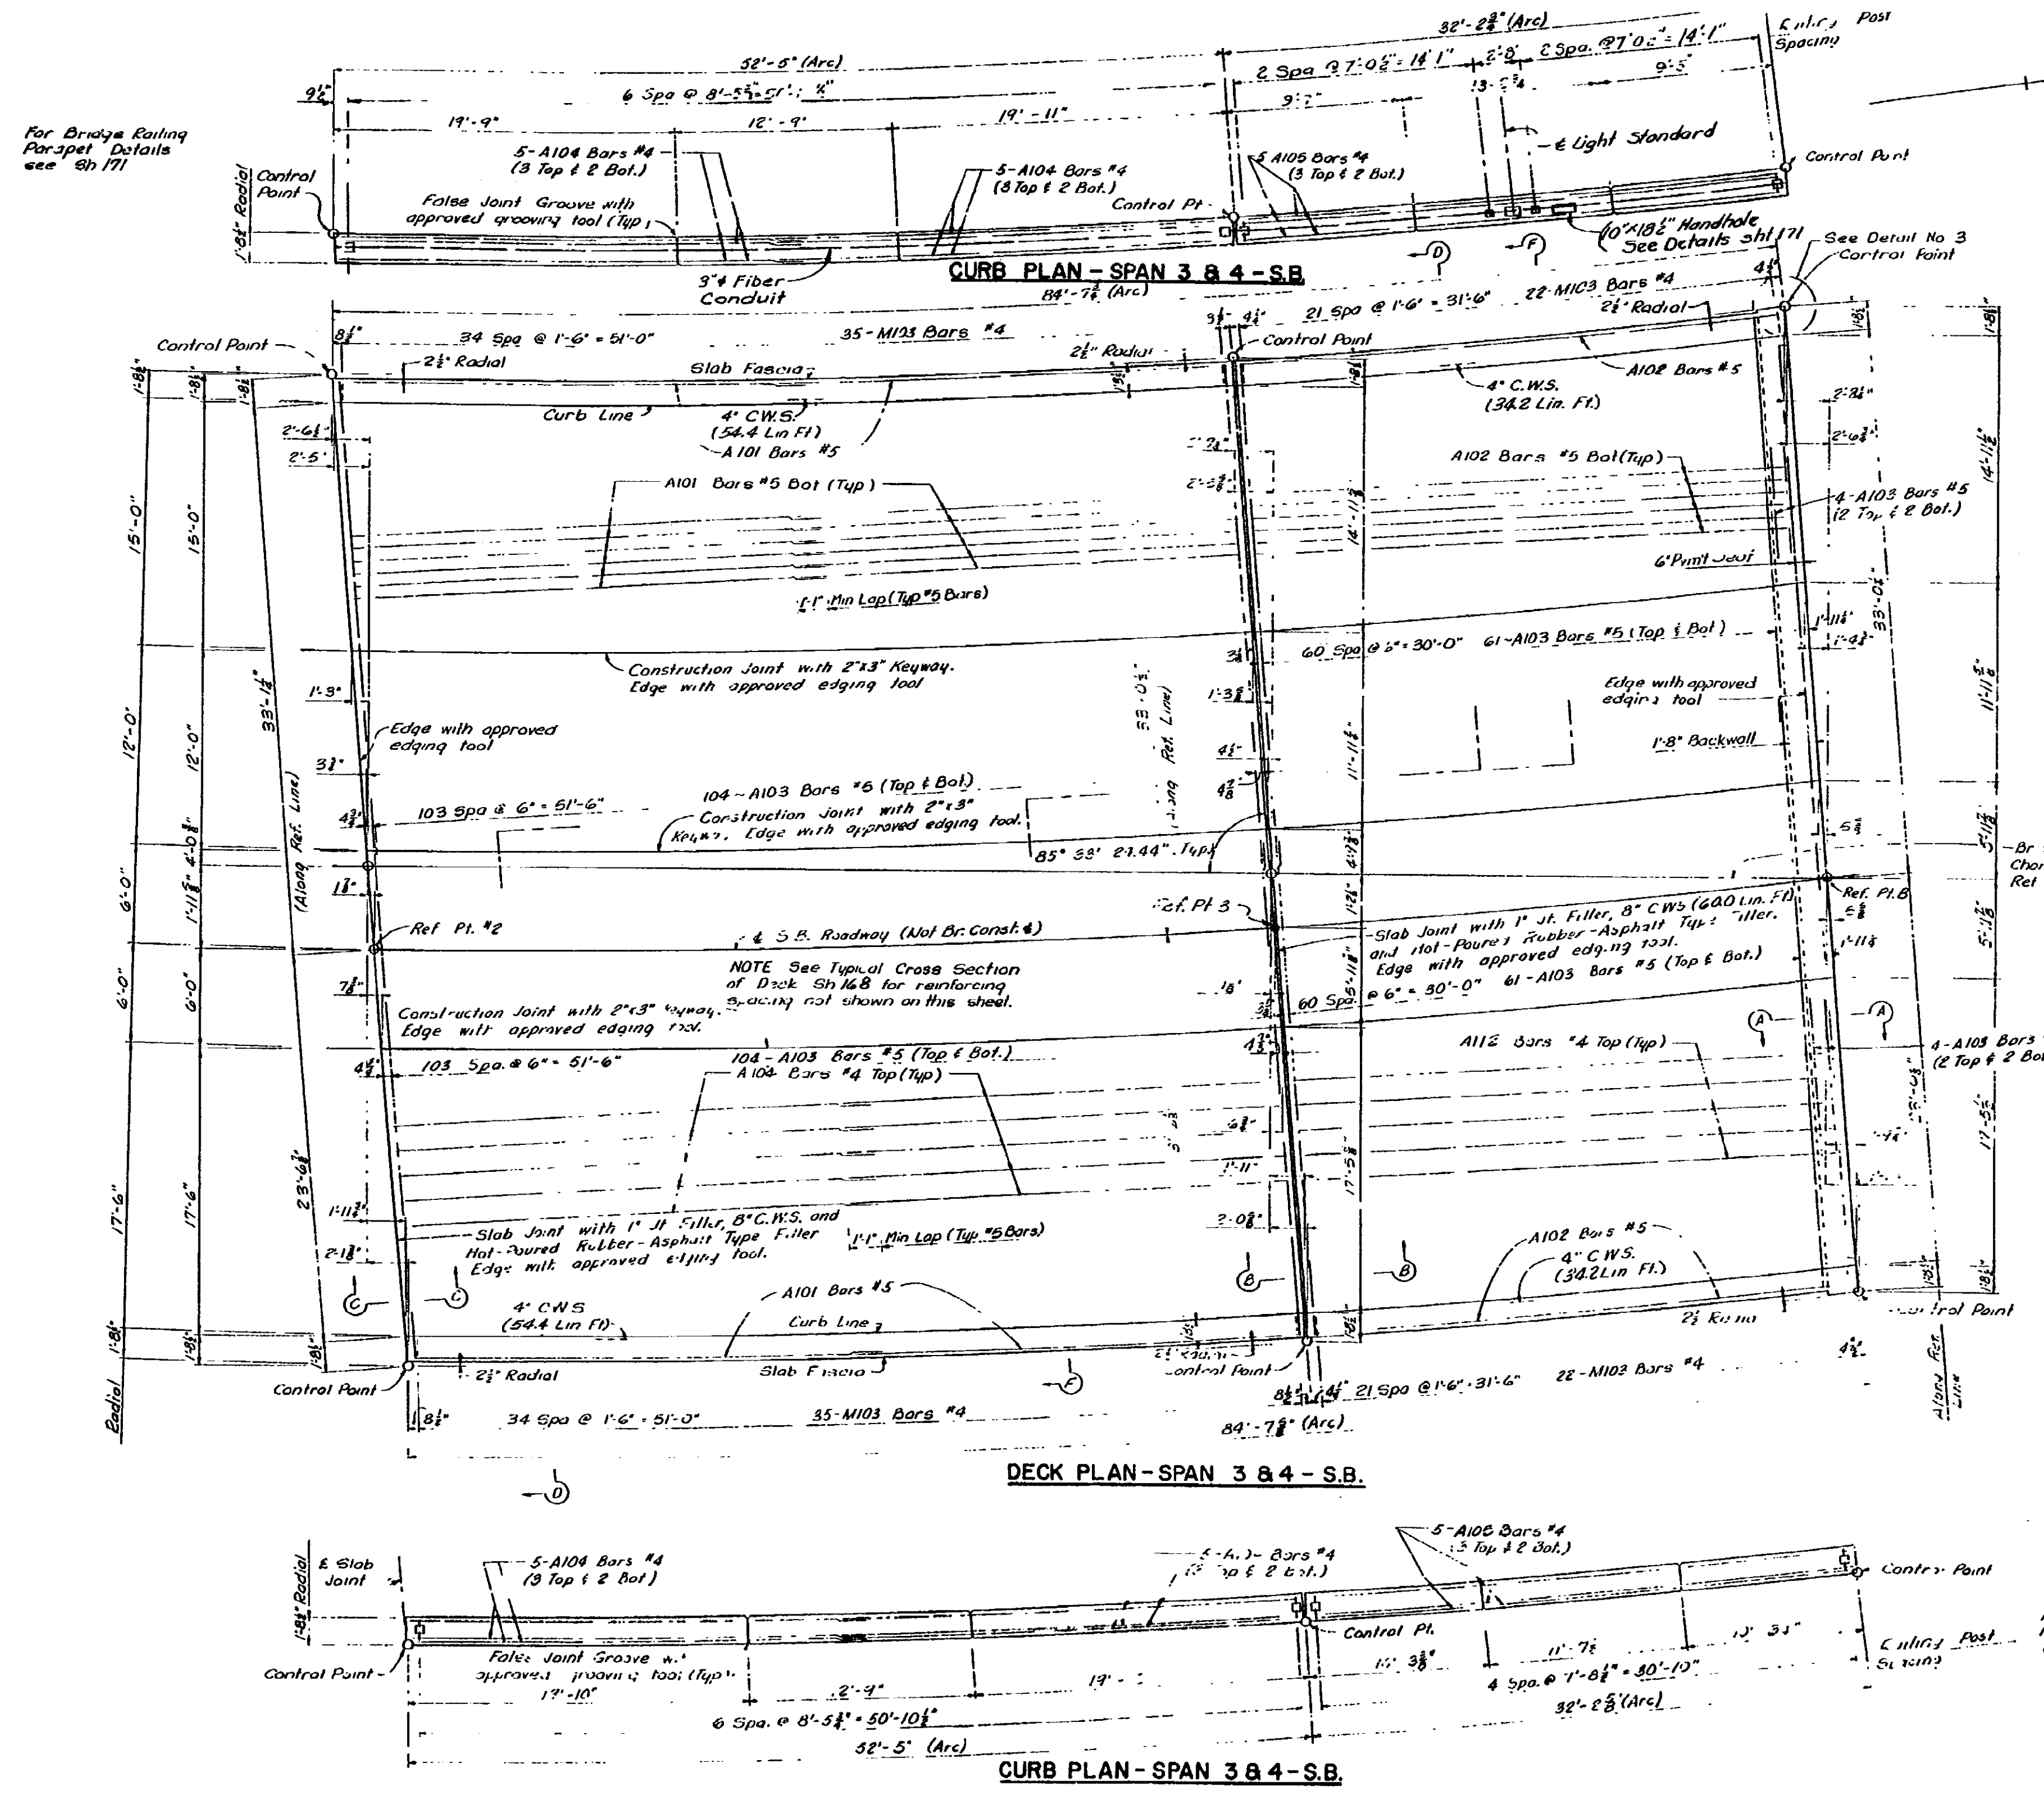

DETAIL NO. 2

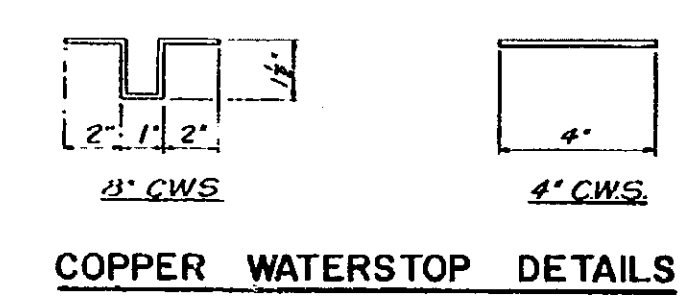

Work this Sheet with Sheets 164 and 164 thru 171



TECON ENGINEERS, INC
 JVC 5-28-62
 FEL
 WJC 3-1-62
 165 312
S03 OF 63174 I

NOTE:
 DO NOT WORK FROM THIS SHEET. THE INFORMATION SHOWN
 HERE IS FOR REFERENCE ONLY. NO PAY ITEMS ARE SHOWN.








FOR INFORMATION ONLY				
DATE	CONT. SEC.	JOB NO.	DESIGN UNIT	SHEET

DATE: CORRECTED BY: DATE: CHECKED BY: DATE: DRAWN BY: inder FILE NAME: s0363174en.nb

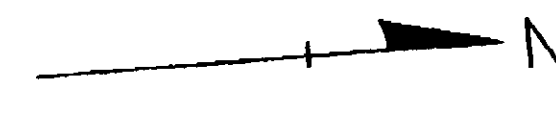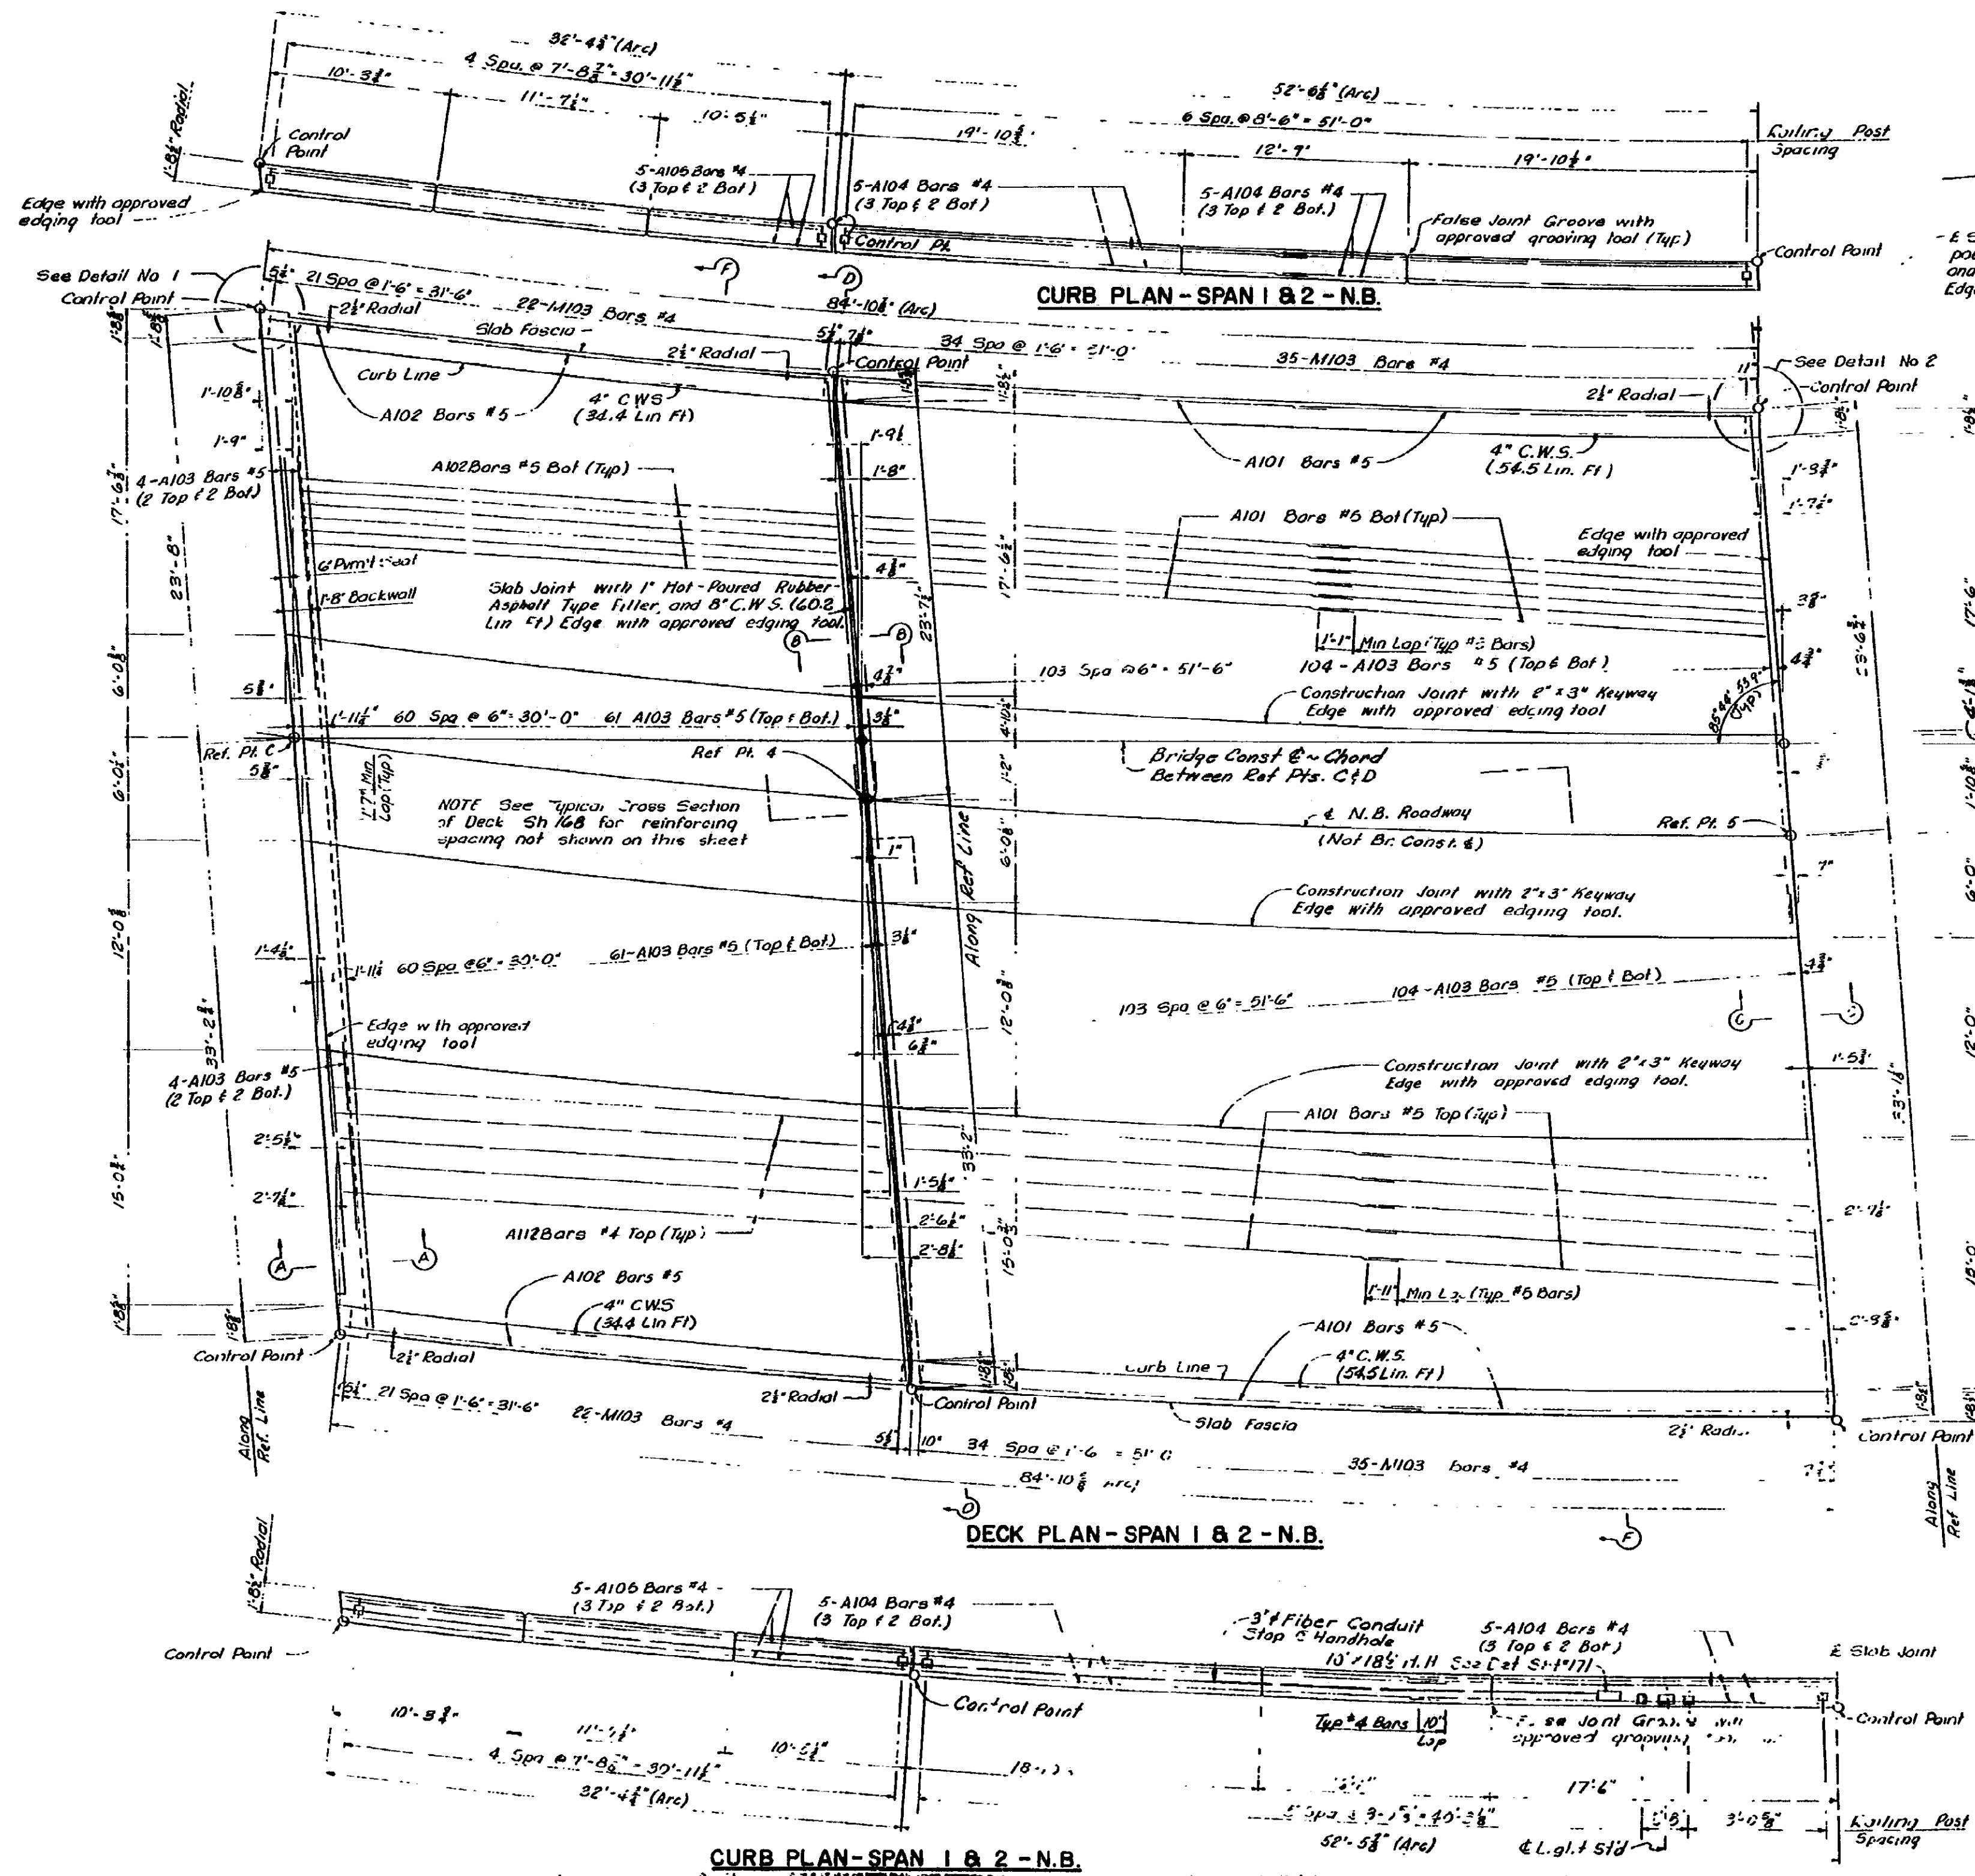

REVISIONS			
NO.	DESCRIPTION	DATE	BY

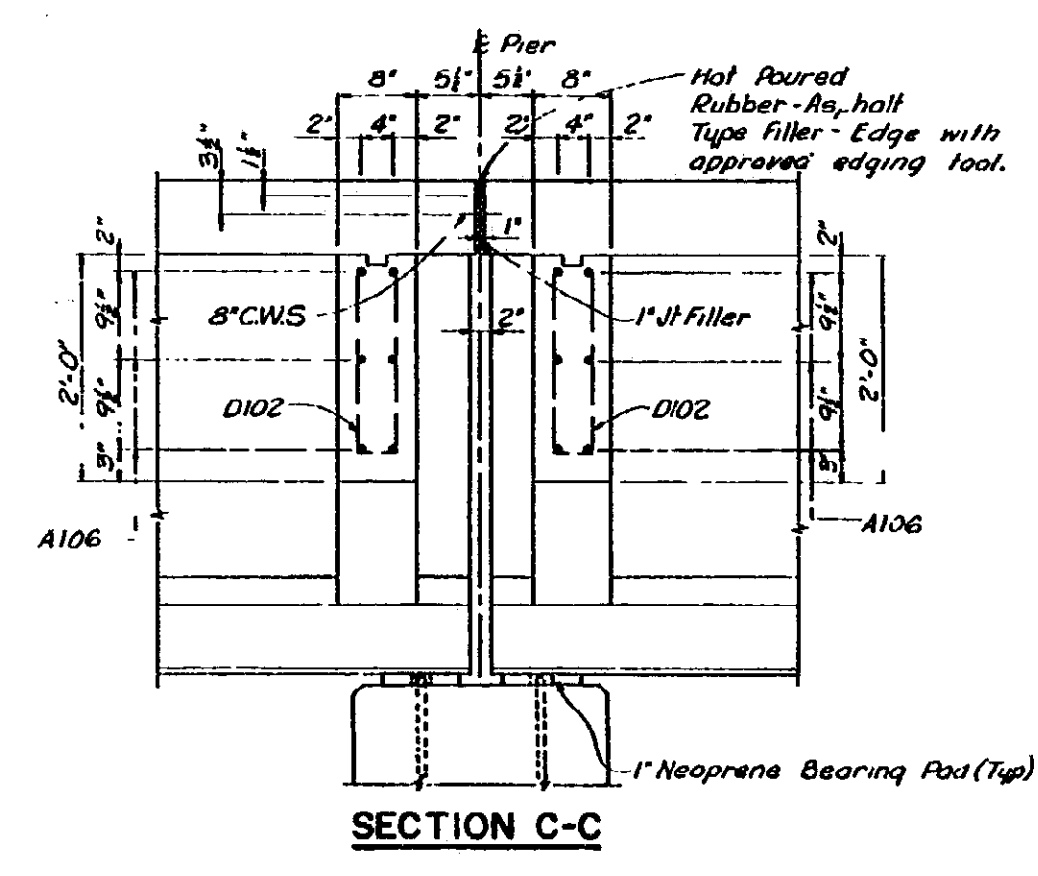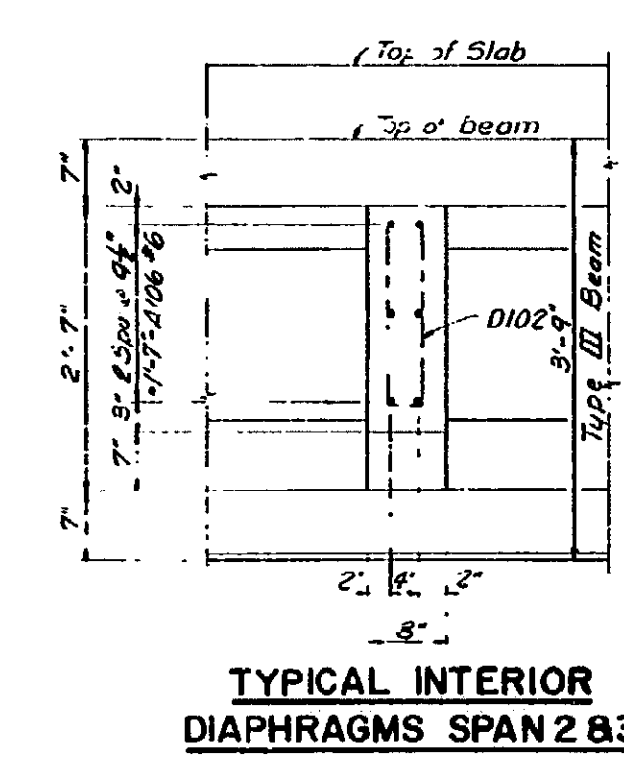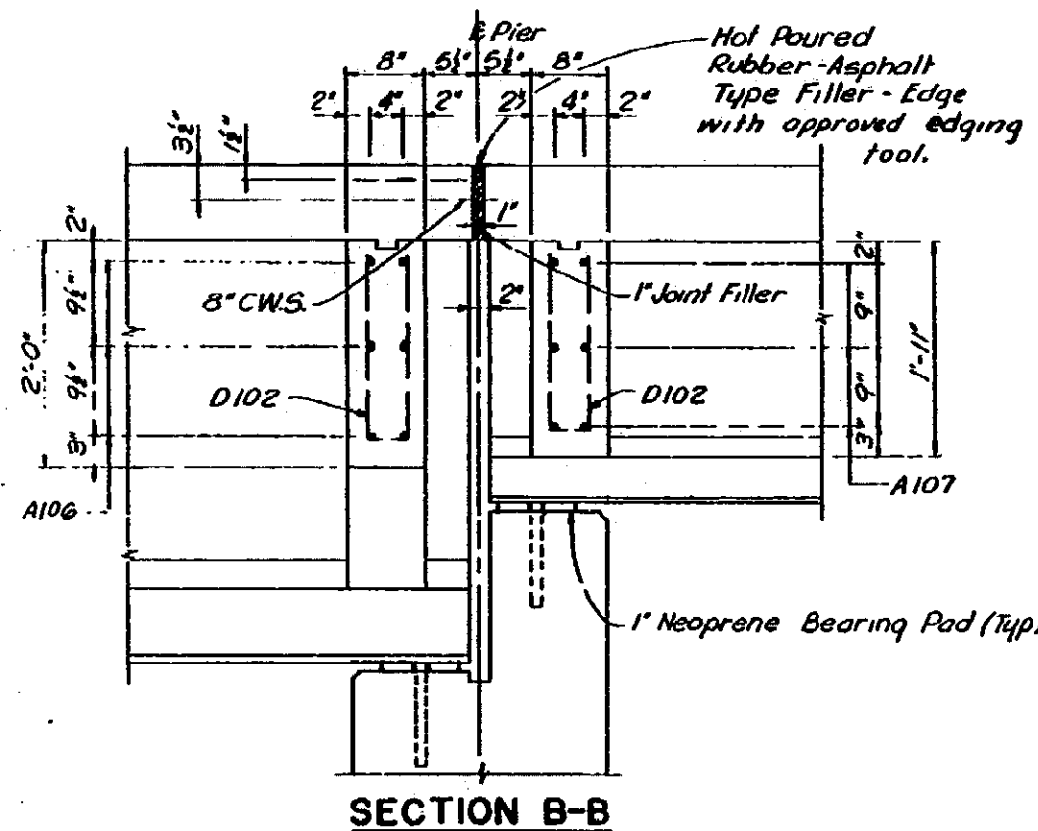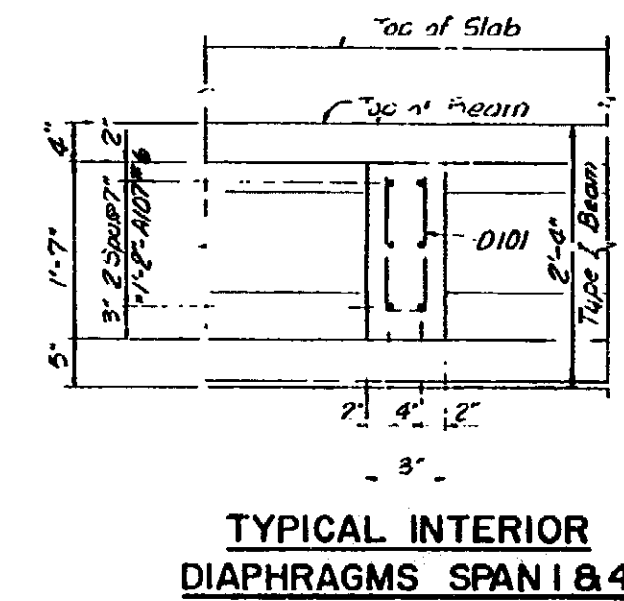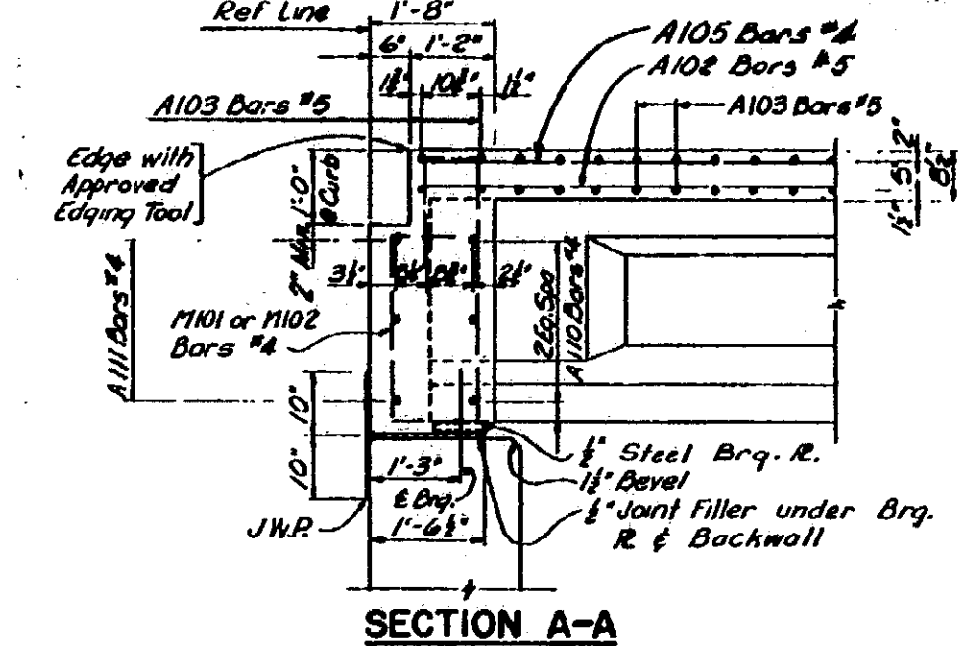

Work this Sheet with Sheets 164, 165 and 167 thru 171

NOTE: For Brack in Curb see Detail & Table of Dimensions on sheet 167

SUPERSTRUCTURE DETAILS
NORTHBOUND - SPANS 1 & 2

TECON ENGINEERS, INC.

WPC 3-28-62
PBL
WMC 3-2-62
160
SO3 OF 63174 I

NOTE:
DO NOT WORK FROM THIS SHEET. THE INFORMATION SHOWN
HERE IS FOR REFERENCE ONLY. NO PAY ITEMS ARE SHOWN.





FOR INFORMATION ONLY				
DATE	CONT. SEC.	JOB NO.	DESIGN UNIT	SHEET
	SO3 OF 63174	49595A	MADHAVI	1A1 OF

DRAWN BY: under DATE: CHECKED BY: DATE: CORRECTED BY: DATE: FILE NAME: s0363174en.nb

REVISIONS			
NO.	DESCRIPTION	DATE	BY

NOTE:
For Bridge Railing Parapet
Details See Sh 171

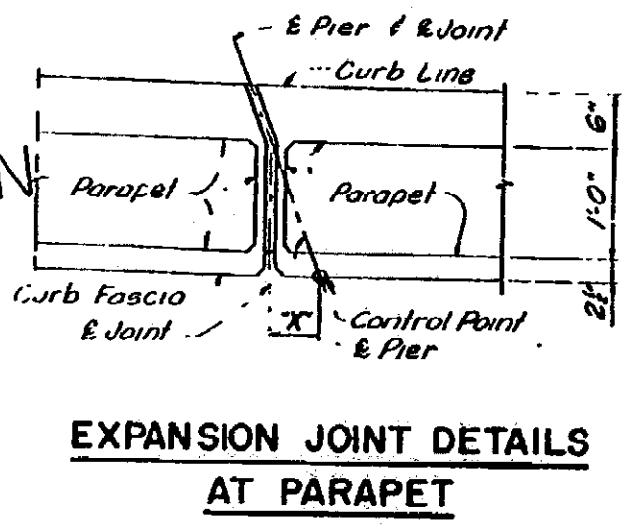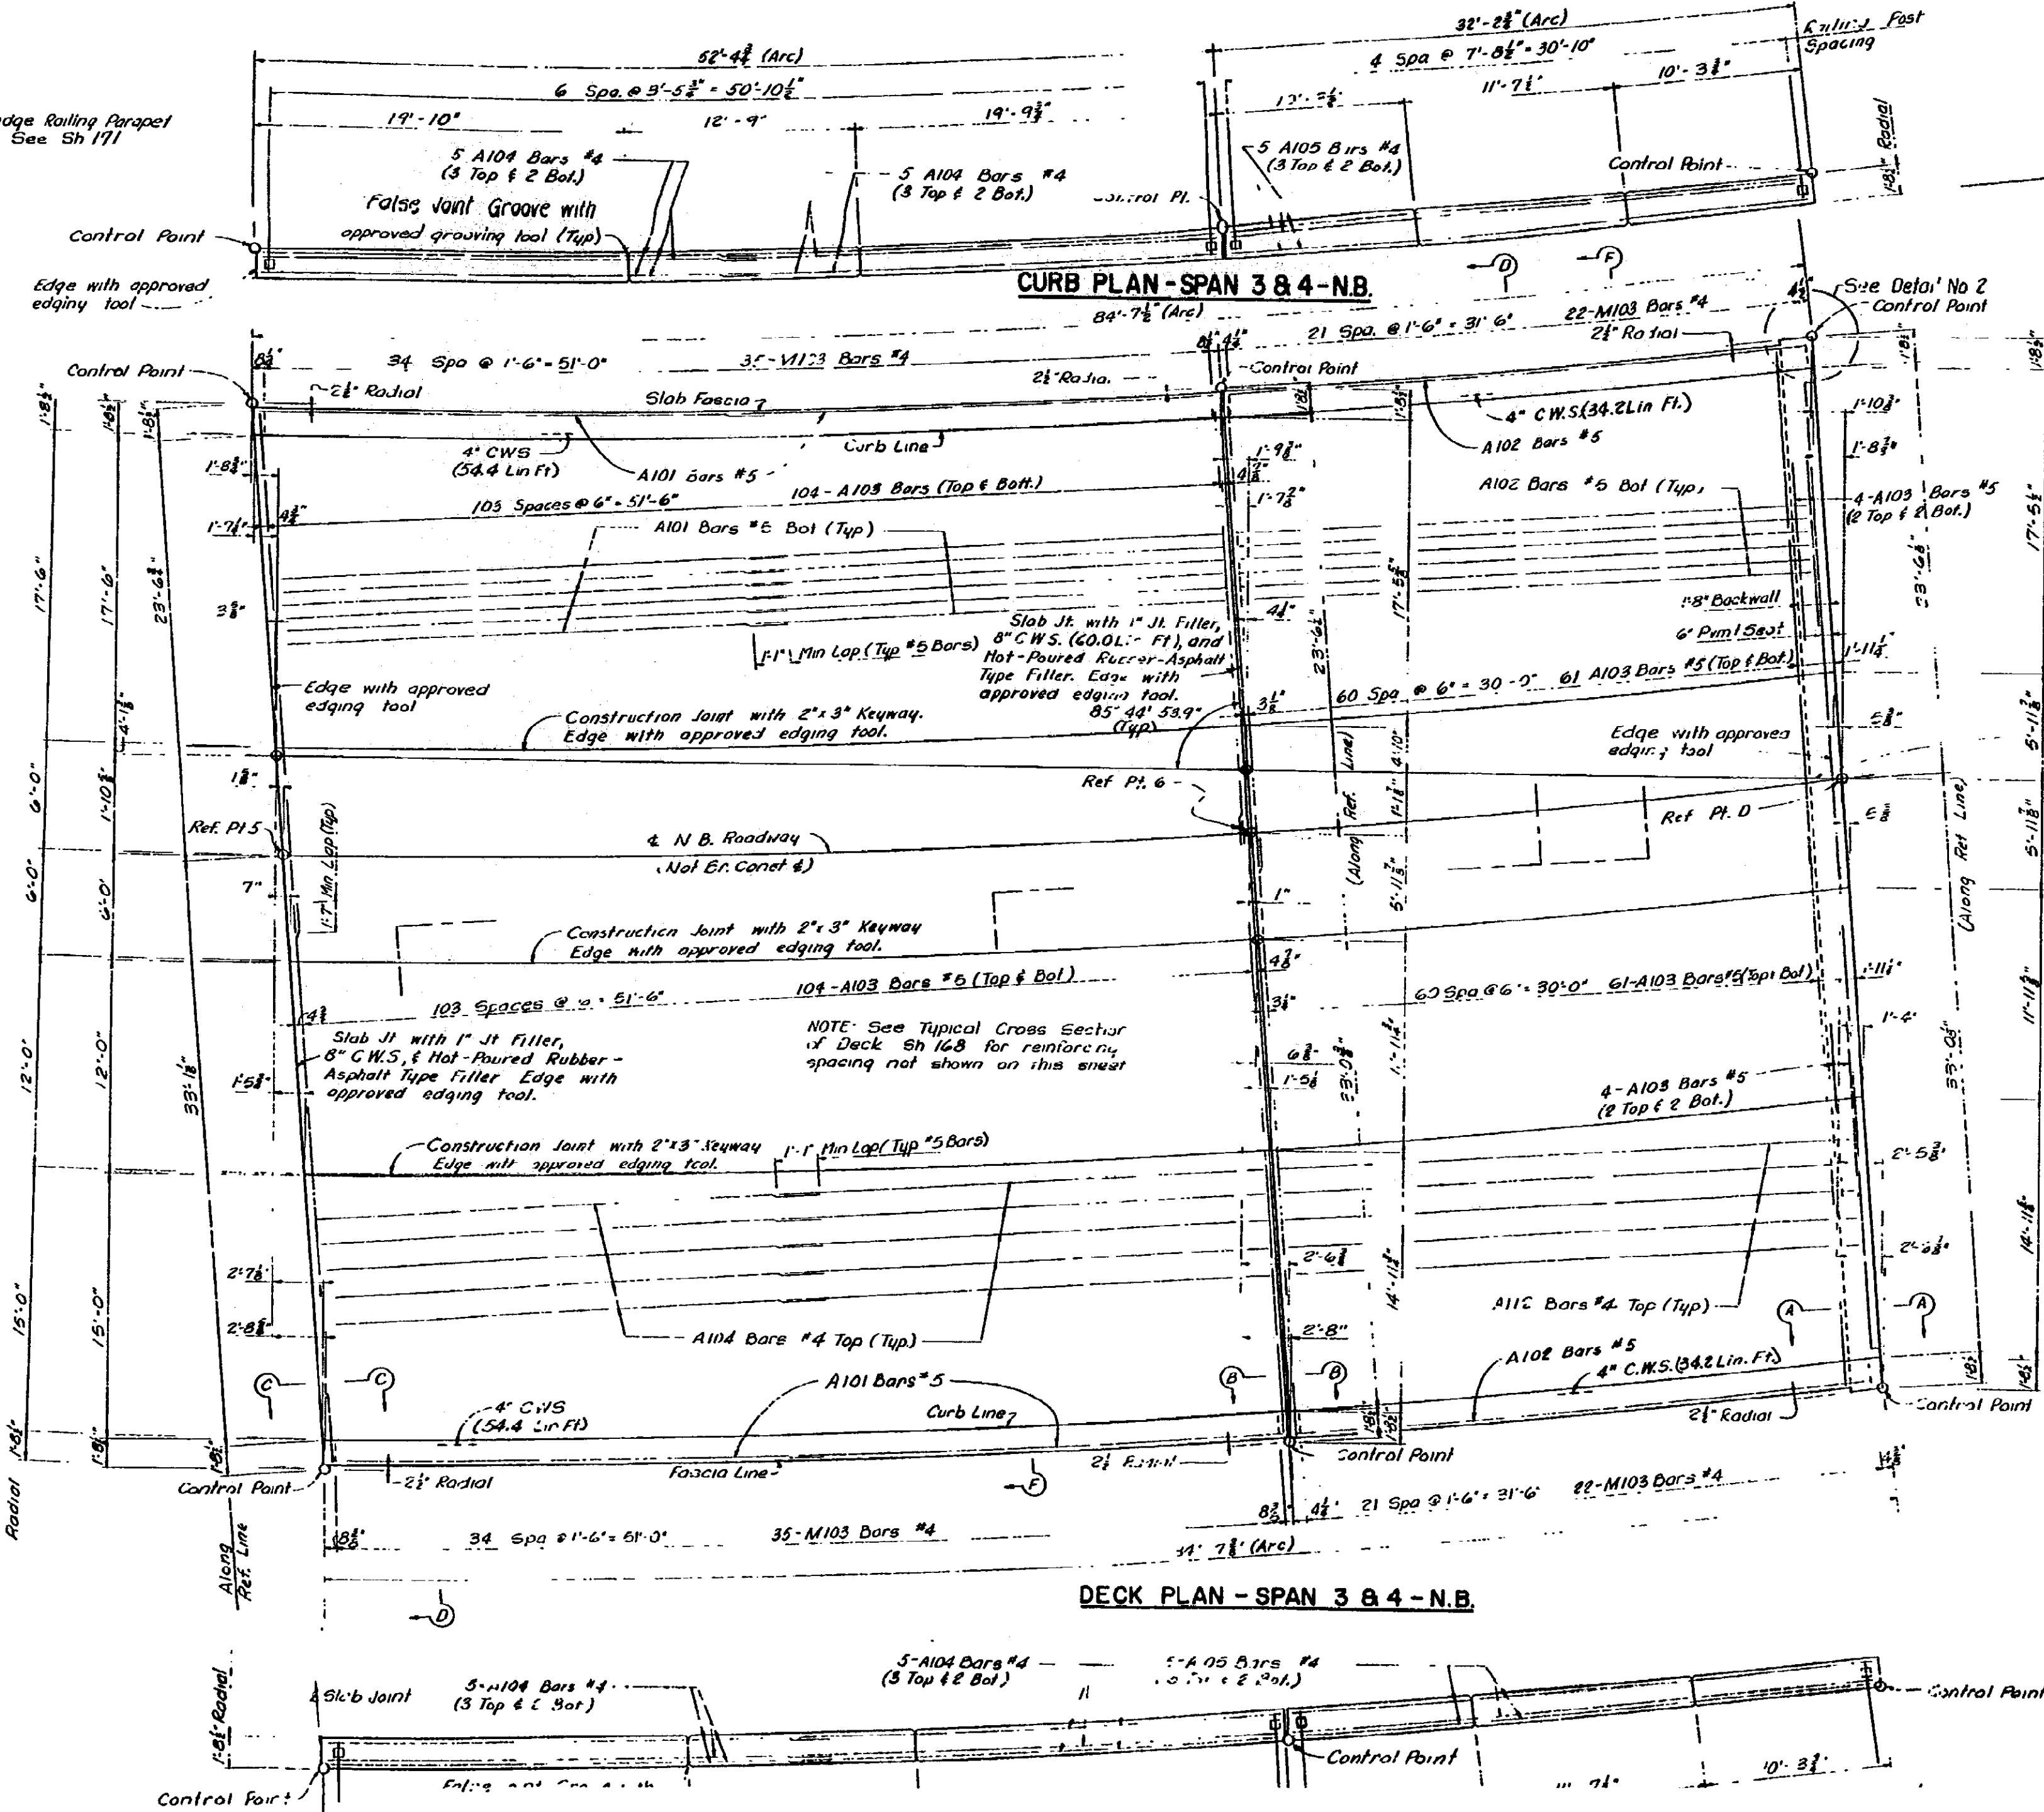

DIMENSION "X"

SB STR	NB STR
Pier 1-4	1 1/2"
Pier 2-5	1 1/2"
Pier 3-6	1 1/2"
Dimension "X" is measured along the Curb Fascia	

NOTE:
DO NOT WORK FROM THIS SHEET. THE INFORMATION SHOWN
HERE IS FOR REFERENCE ONLY. NO PAY ITEMS ARE SHOWN.

Work this Sheet with Sheets 164 thru 166 and 168 thru 171




FOR INFORMATION ONLY				
DATE	CONT. SEC.	JOB NO.	DESIGN UNIT	SHEET
	503 OF 63174	49595A	MADHAVI	14U OF

DRAWN BY: inder DATE: CHECKED BY: DATE: CORRECTED BY: DATE:

FILE NAME: s0353174n.n5

REVISIONS			
NO.	DESCRIPTION	DATE	BY

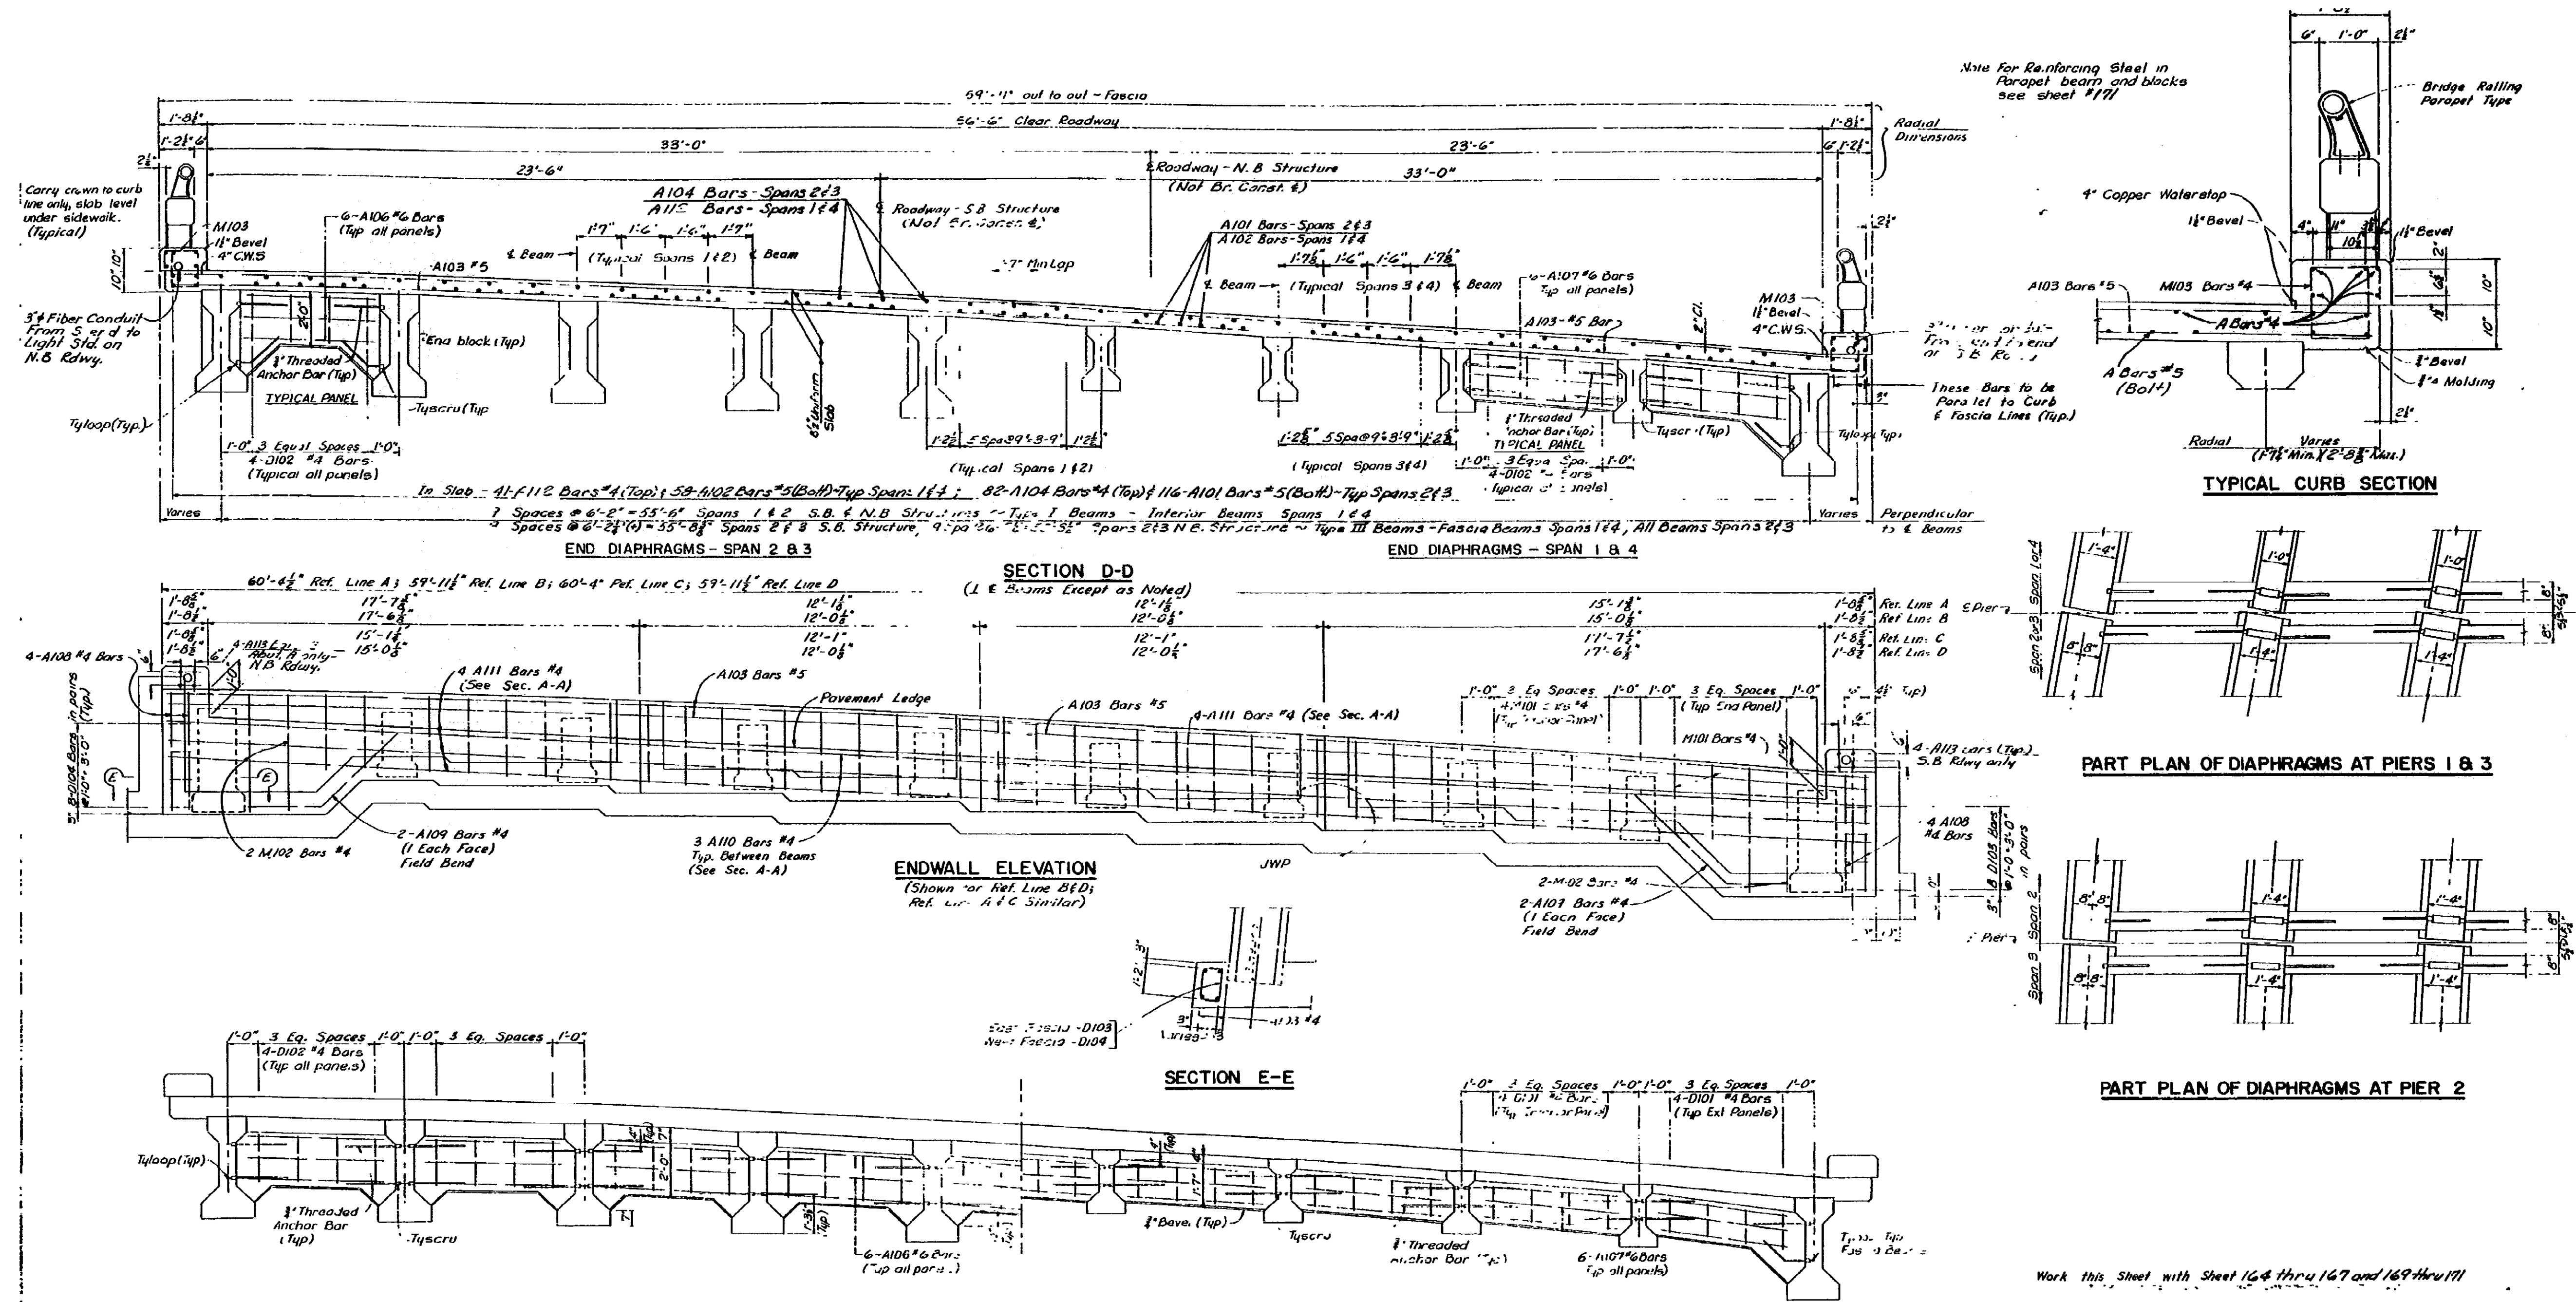

Note for Reinforcing Steel in Parapet beam and blocks see sheet #177

Work this Sheet with Sheet 164 thru 167 and 169 thru 171

SUPERSTRUCTURE DETAILS

TECON ENGINEERS, INC.

JDC 5-28-67
 REC
 NHC 2-28-62
 3/82
S03 OF 63174 I


NOTE:
 DO NOT WORK FROM THIS SHEET. THE INFORMATION SHOWN
 HERE IS FOR REFERENCE ONLY. NO PAY ITEMS ARE SHOWN.



FOR INFORMATION ONLY				
DATE	CONT. SEC.	JOB NO.	DESIGN UNIT	SHEET
	S03 OF 63174	49595A	MADHAVI	1AV OF


DATE: _____ CORRECTED BY: _____ DATE: _____ CHECKED BY: _____ DATE: _____ DRAWN BY: mander FILE NAME: s0363174sn.rdb

1 2 3 4 5 6 7 8 9 10 11 12 13 14 15 16 17 18 19 20 21 22 23 24 25 26 27 28 29 30 31 32 33 34 35 36 37 38 39 40 41 42 43 44 45 46 47 48 49 50 51 52 53 54 55 56 57 58 59 60 61 62 63

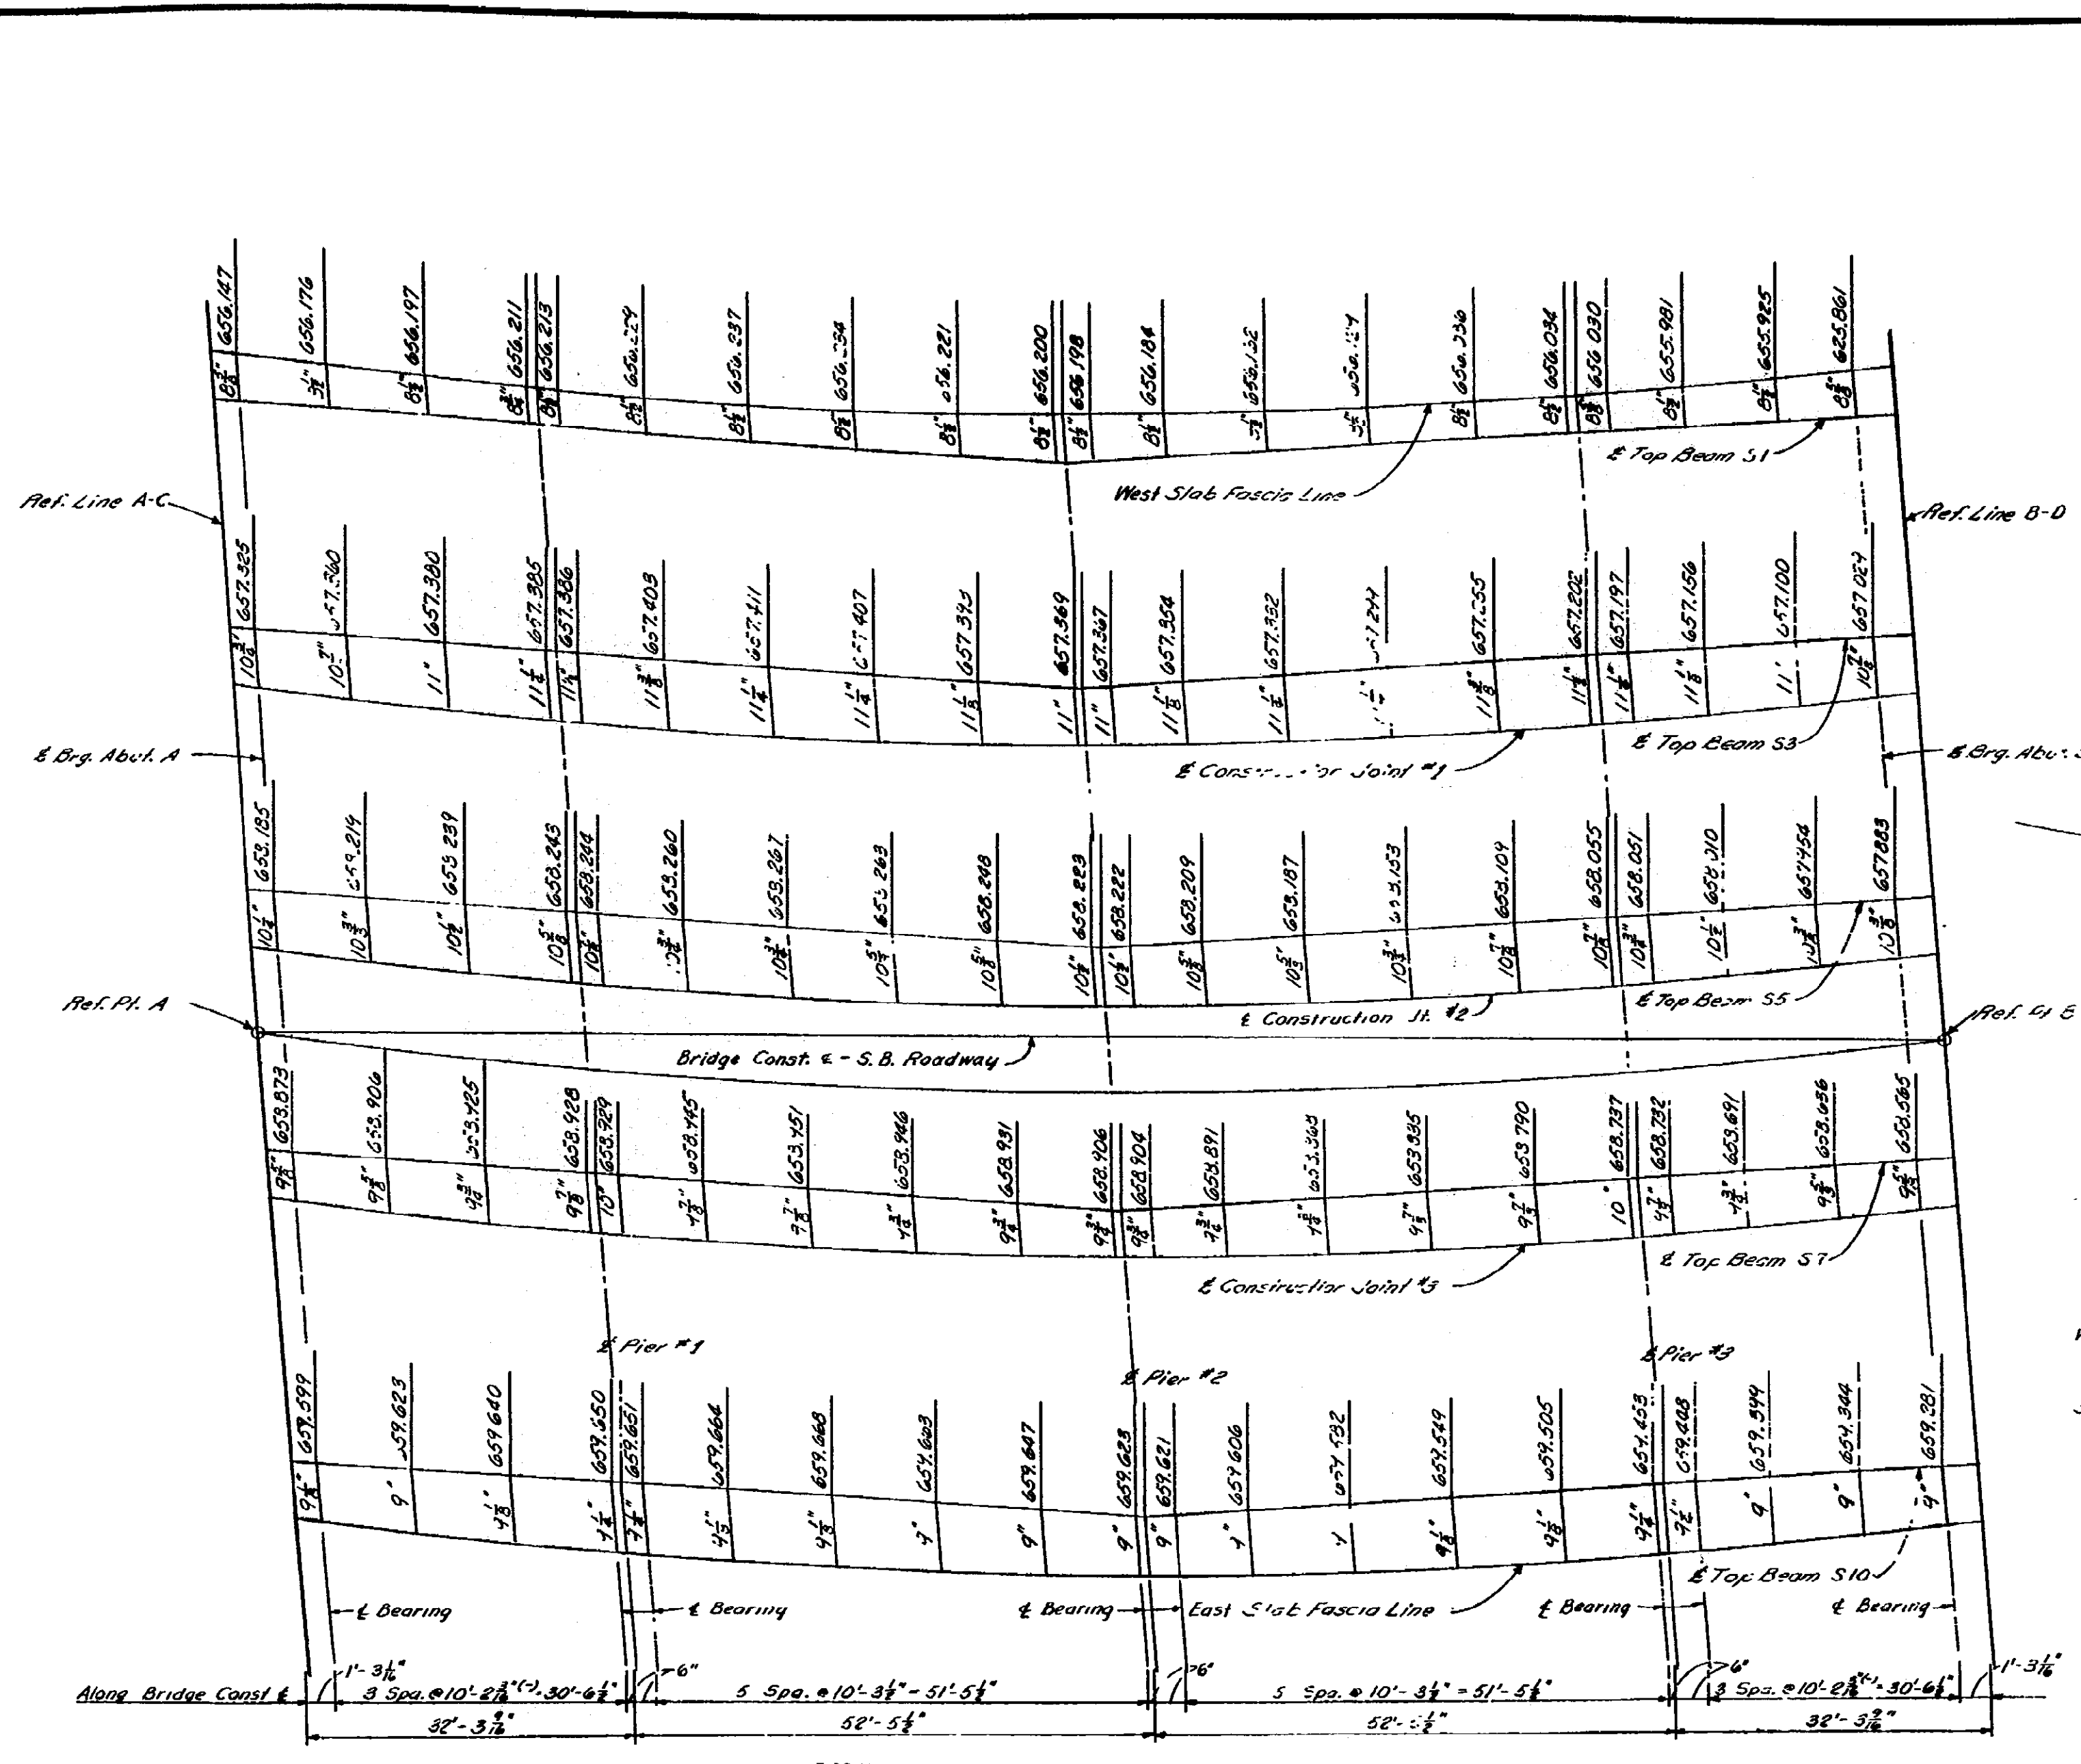


SCREED ELEVATION AND SLAB ORDINATE DIAGRAM

TABLE OF ORDINATES FOR SLAB LAYOUT DIAGRAM		1	2	3	4	5	6	7	8	9	10	11	12	13	14	15	16	17	18	19	20	Line B
W. Slab Fascia	a	170'-11 1/2"	160'-0 3/4"	155'-0 1/2"	140'-0 3/4"	131'-0 1/2"	118'-0 1/2"	105'-0 1/2"	92'-0 1/2"	87'-0 1/2"	86'-0 1/2"	76'-0 1/2"	66'-0 1/2"	55'-0 1/2"	42'-0 1/2"	32'-0 1/2"	22'-0 1/2"	17'-0 1/2"	14'-0 1/2"	12'-0 1/2"	11'-0 1/2"	8'-0 1/2"
	b	54'-7 1/2"	34'-1 1/2"	35'-0 1/2"	33'-0 1/2"	33'-1 1/2"	32'-0 1/2"	32'-0 1/2"	32'-0 1/2"	32'-0 1/2"	32'-0 1/2"	32'-0 1/2"	32'-0 1/2"	32'-0 1/2"	32'-0 1/2"	32'-0 1/2"	32'-0 1/2"	32'-0 1/2"	32'-0 1/2"	32'-0 1/2"	32'-0 1/2"	32'-0 1/2"
Const. Jt. #1	a	169'-7 1/2"	159'-0 1/2"	149'-0 1/2"	139'-0 1/2"	129'-0 1/2"	119'-0 1/2"	109'-0 1/2"	99'-0 1/2"	89'-0 1/2"	84'-0 1/2"	74'-0 1/2"	64'-0 1/2"	54'-0 1/2"	44'-0 1/2"	34'-0 1/2"	24'-0 1/2"	19'-0 1/2"	16'-0 1/2"	14'-0 1/2"	12'-0 1/2"	9'-0 1/2"
	b	18'-0 1/2"	17'-0 1/2"	17'-0 1/2"	16'-0 1/2"	16'-0 1/2"	16'-0 1/2"	16'-0 1/2"	16'-0 1/2"	16'-0 1/2"	16'-0 1/2"	16'-0 1/2"	16'-0 1/2"	16'-0 1/2"	16'-0 1/2"	16'-0 1/2"	16'-0 1/2"	16'-0 1/2"	16'-0 1/2"	16'-0 1/2"	16'-0 1/2"	16'-0 1/2"
Const. Jt. #2	a	165'-0 1/2"	145'-0 1/2"	135'-0 1/2"	125'-0 1/2"	115'-0 1/2"	105'-0 1/2"	95'-0 1/2"	85'-0 1/2"	75'-0 1/2"	70'-0 1/2"	60'-0 1/2"	50'-0 1/2"	40'-0 1/2"	30'-0 1/2"	20'-0 1/2"	15'-0 1/2"	12'-0 1/2"	10'-0 1/2"	9'-0 1/2"	8'-0 1/2"	6'-0 1/2"
	b	5'-11 1/2"	5'-0 1/2"	5'-1 1/2"	4'-0 1/2"	4'-0 1/2"	4'-0 1/2"	4'-0 1/2"	4'-0 1/2"	4'-0 1/2"	4'-0 1/2"	4'-0 1/2"	4'-0 1/2"	4'-0 1/2"	4'-0 1/2"	4'-0 1/2"	4'-0 1/2"	4'-0 1/2"	4'-0 1/2"	4'-0 1/2"	4'-0 1/2"	4'-0 1/2"
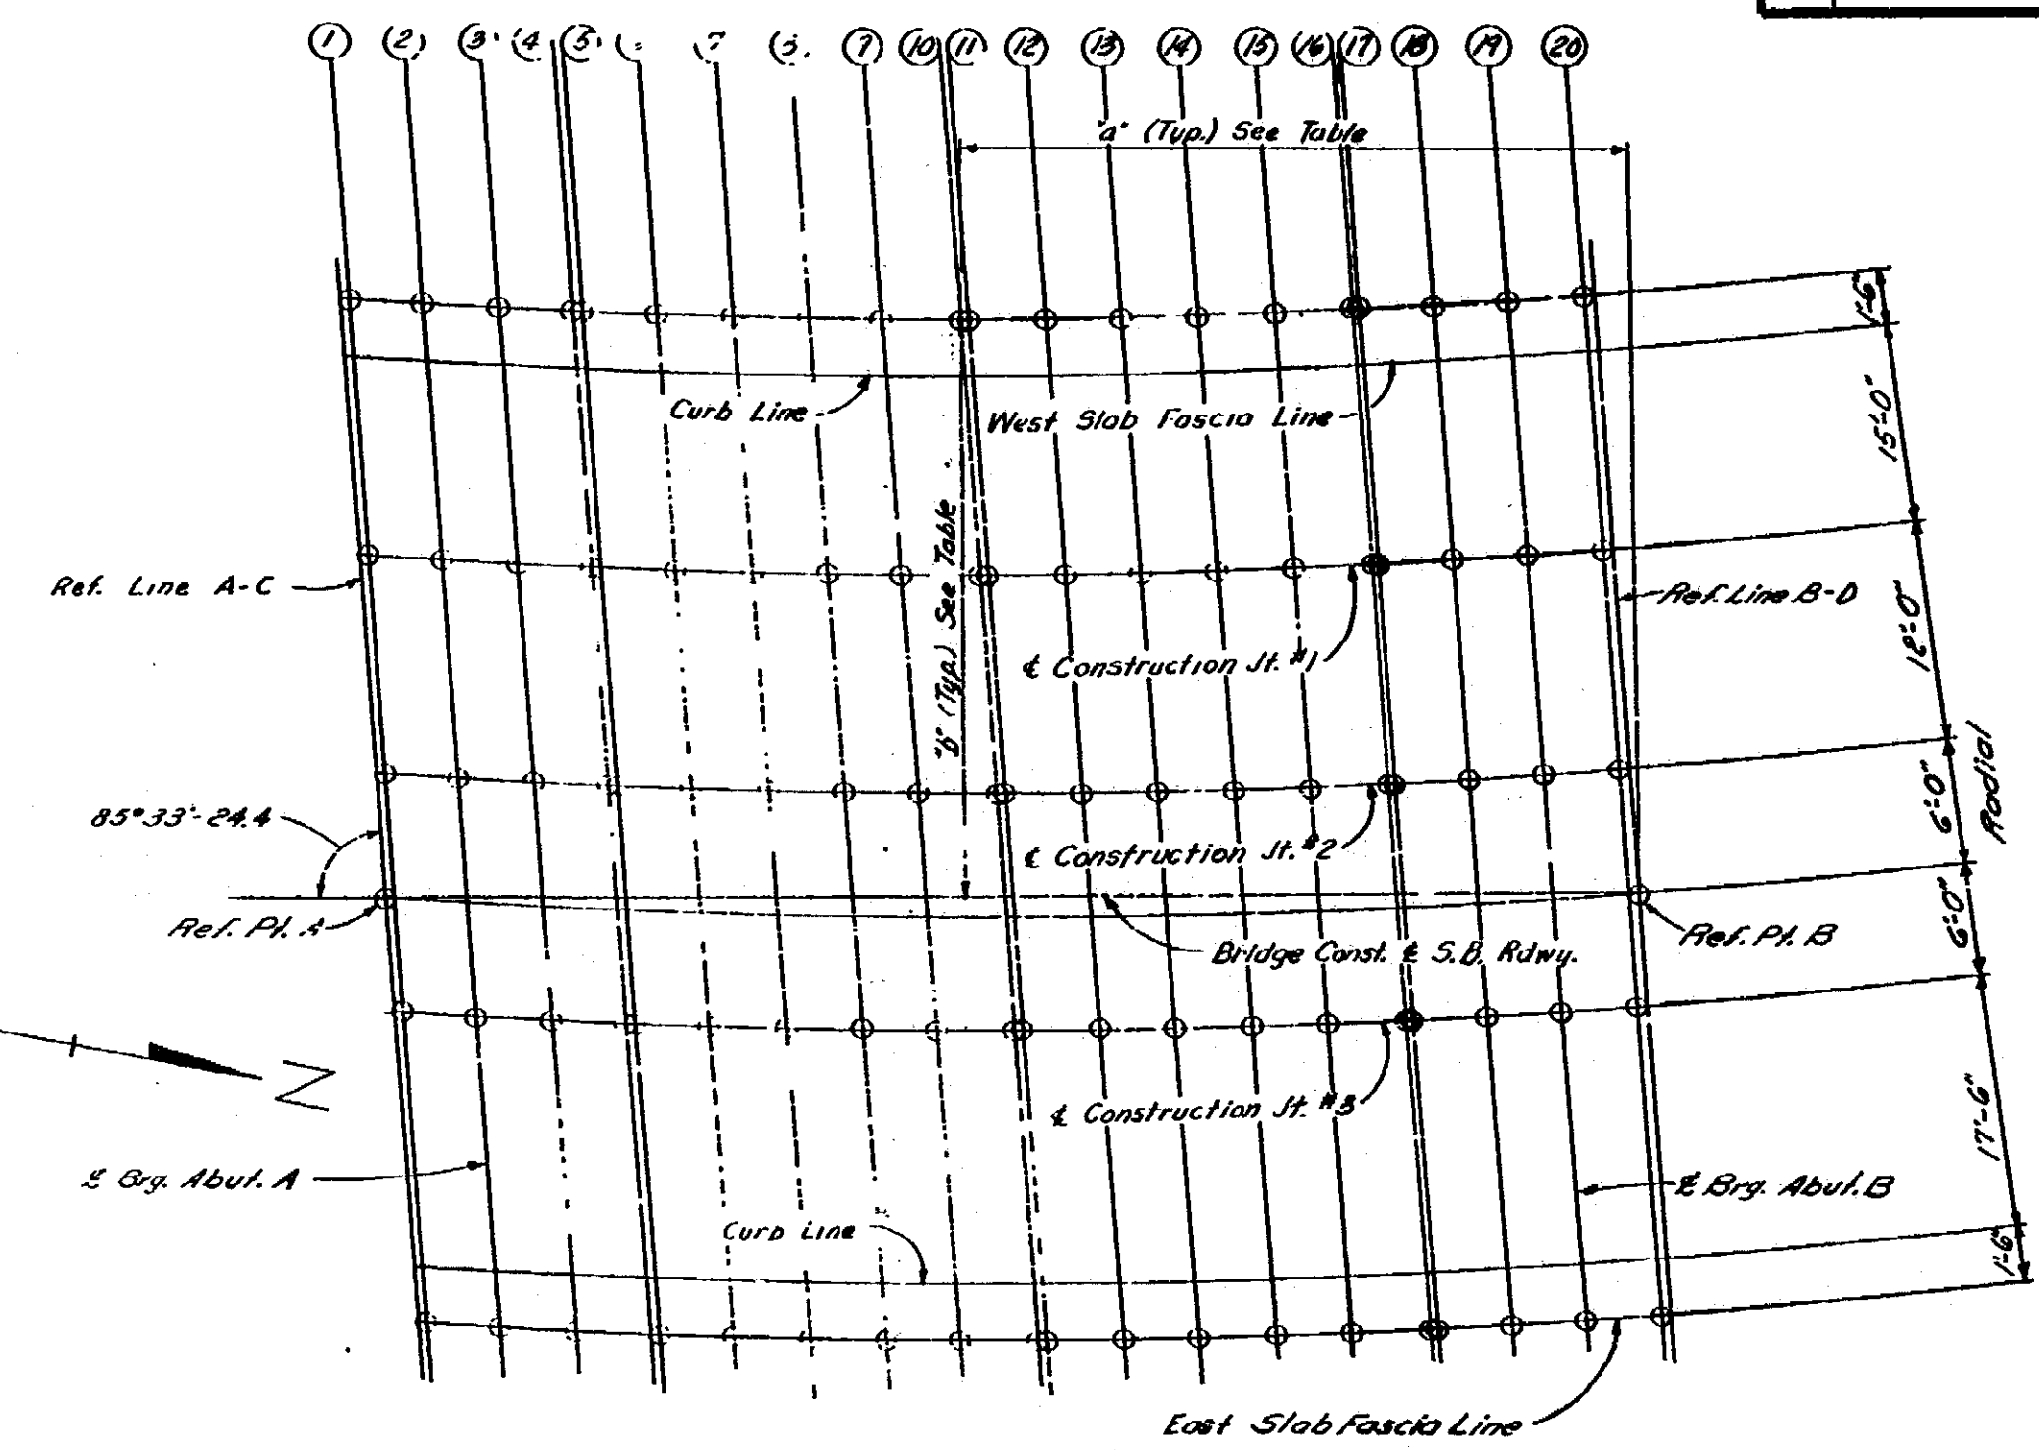

SLAB LAYOUT DIAGRAM
NOTE: DIMENSION 1/2" PARALLEL TO BRIDGE CONST. &
DIMENSION 1/2" PERPENDICULAR TO BRIDGE CONST. &

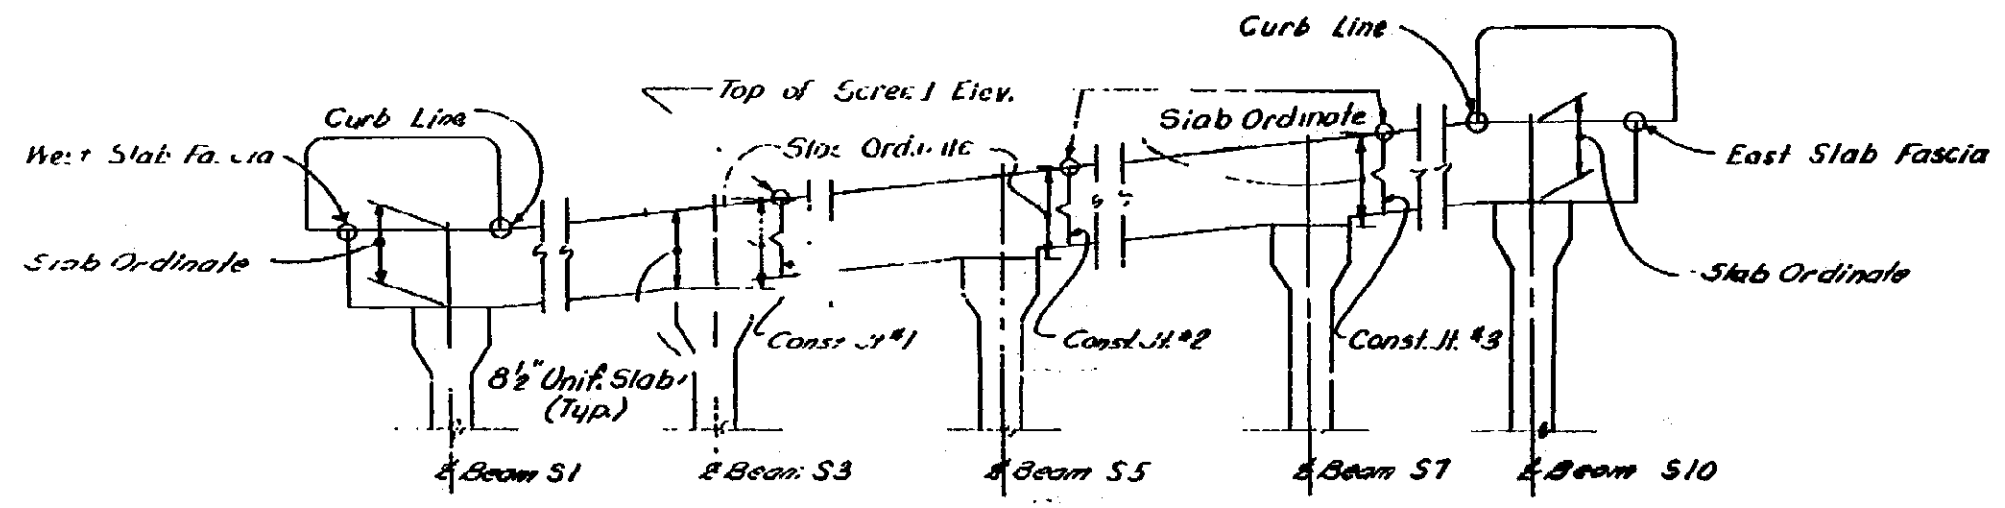

SHOWING HOW SLAB ORDINATES AND SCREED ELEVATIONS ARE TAKEN

Work this Sheet with Sheets 64, 148, 170 & 171

SUPERSTRUCTURE DETAILS
S. B. STRUCTURE

JUL 5 2004
E.S.A.
REC 3-10-02
169 312
S03 OF 63174


NOTE:
DO NOT WORK FROM THIS SHEET. THE INFORMATION SHOWN
HERE IS FOR REFERENCE ONLY. NO PAY ITEMS ARE SHOWN.



FOR INFORMATION ONLY				
DATE	CONT. SEC.	JOB NO.	DESIGN UNIT	SHEET
	S03 OF 63174	49595A	MADHAVI	1AW OF


REVISIONS: NO. DESCRIPTION DATE BY
CORRECTED BY: DATE: CHECKED BY: DATE: DRAWN BY: UNDER

1 2 3 4 5 6 7 8 9 10 11 12 13 14 15 16 17 18 19 20 21 22 23 24 25 26 27 28 29 30 31 32 33 34 35 36 37 38 39 40 41 42 43 44 45 46 47 48 49 50 51 52 53 54 55 56 57 58 59 60 61 62 63

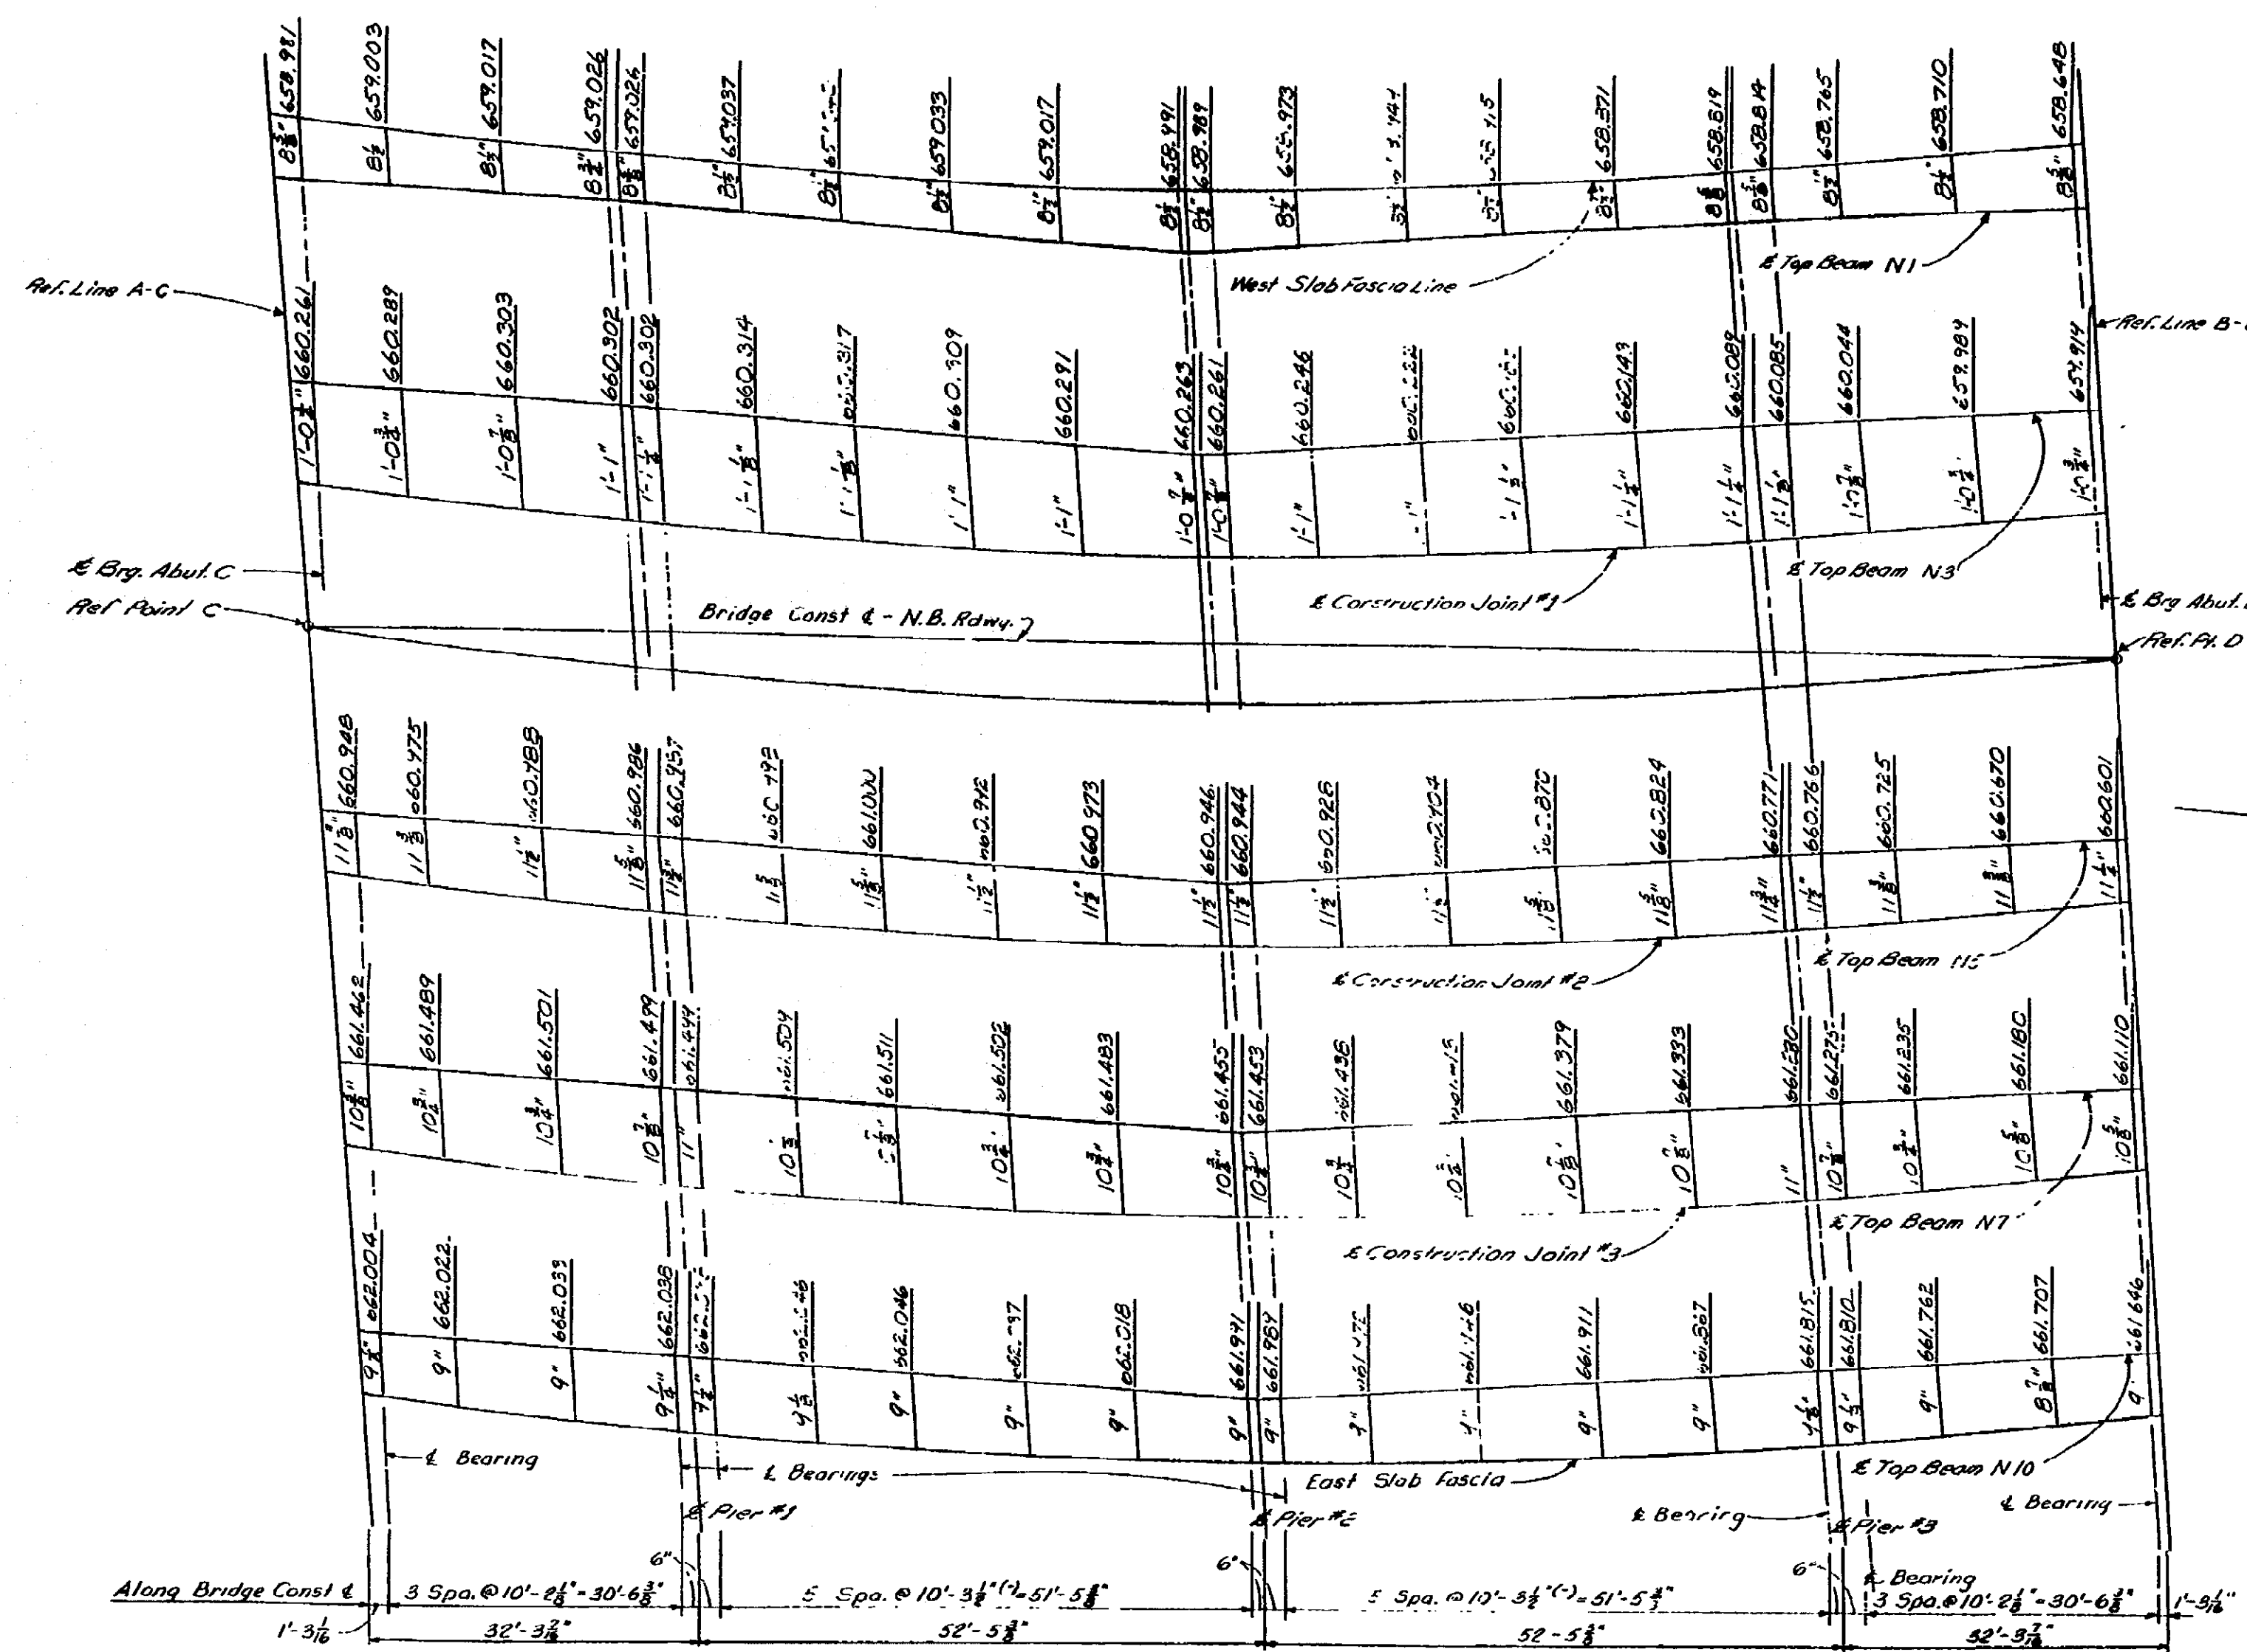


SCREENED ELEVATION AND SLAB ORDNATE DIAGRAM

TABLE OF ORDNATES FOR SLAB LAYOUT DIAGRAM																							
Screeed Lines	Line C	1	2	3	4	5	6	7	8	9	10	11	12	13	14	15	16	17	18	19	20	Line D	
W. Slab Fascia	'a'	110'-0"	109'-10"	109'-0"	108'-0"	107'-0"	106'-0"	105'-0"	104'-0"	103'-0"	102'-0"	101'-0"	100'-0"	99'-0"	98'-0"	97'-0"	96'-0"	95'-0"	94'-0"	93'-0"	92'-0"	91'-0"	90'-0"
Const. Jt. #1	'a'	25'-0"	24'-10"	24'-0"	23'-0"	22'-0"	21'-0"	20'-0"	19'-0"	18'-0"	17'-0"	16'-0"	15'-0"	14'-0"	13'-0"	12'-0"	11'-0"	10'-0"	9'-0"	8'-0"	7'-0"	6'-0"	5'-0"
Const. Jt. #2	'a'	5'-0"	4'-10"	4'-0"	3'-0"	2'-0"	1'-0"	0'-0"	0'-0"	0'-0"	0'-0"	0'-0"	0'-0"	0'-0"	0'-0"	0'-0"	0'-0"	0'-0"	0'-0"	0'-0"	0'-0"	0'-0"	0'-0"
Const. Jt. #3	'a'	167'-0"	167'-0"	167'-0"	167'-0"	167'-0"	167'-0"	167'-0"	167'-0"	167'-0"	167'-0"	167'-0"	167'-0"	167'-0"	167'-0"	167'-0"	167'-0"	167'-0"	167'-0"	167'-0"	167'-0"	167'-0"	167'-0"
E. Slab Fascia	'a'	165'-0"	164'-0"	163'-0"	162'-0"	161'-0"	160'-0"	159'-0"	158'-0"	157'-0"	156'-0"	155'-0"	154'-0"	153'-0"	152'-0"	151'-0"	150'-0"	149'-0"	148'-0"	147'-0"	146'-0"	145'-0"	144'-0"
	'b'	54'-0"	53'-0"	52'-0"	51'-0"	50'-0"	49'-0"	48'-0"	47'-0"	46'-0"	45'-0"	44'-0"	43'-0"	42'-0"	41'-0"	40'-0"	39'-0"	38'-0"	37'-0"	36'-0"	35'-0"	34'-0"	33'-0"

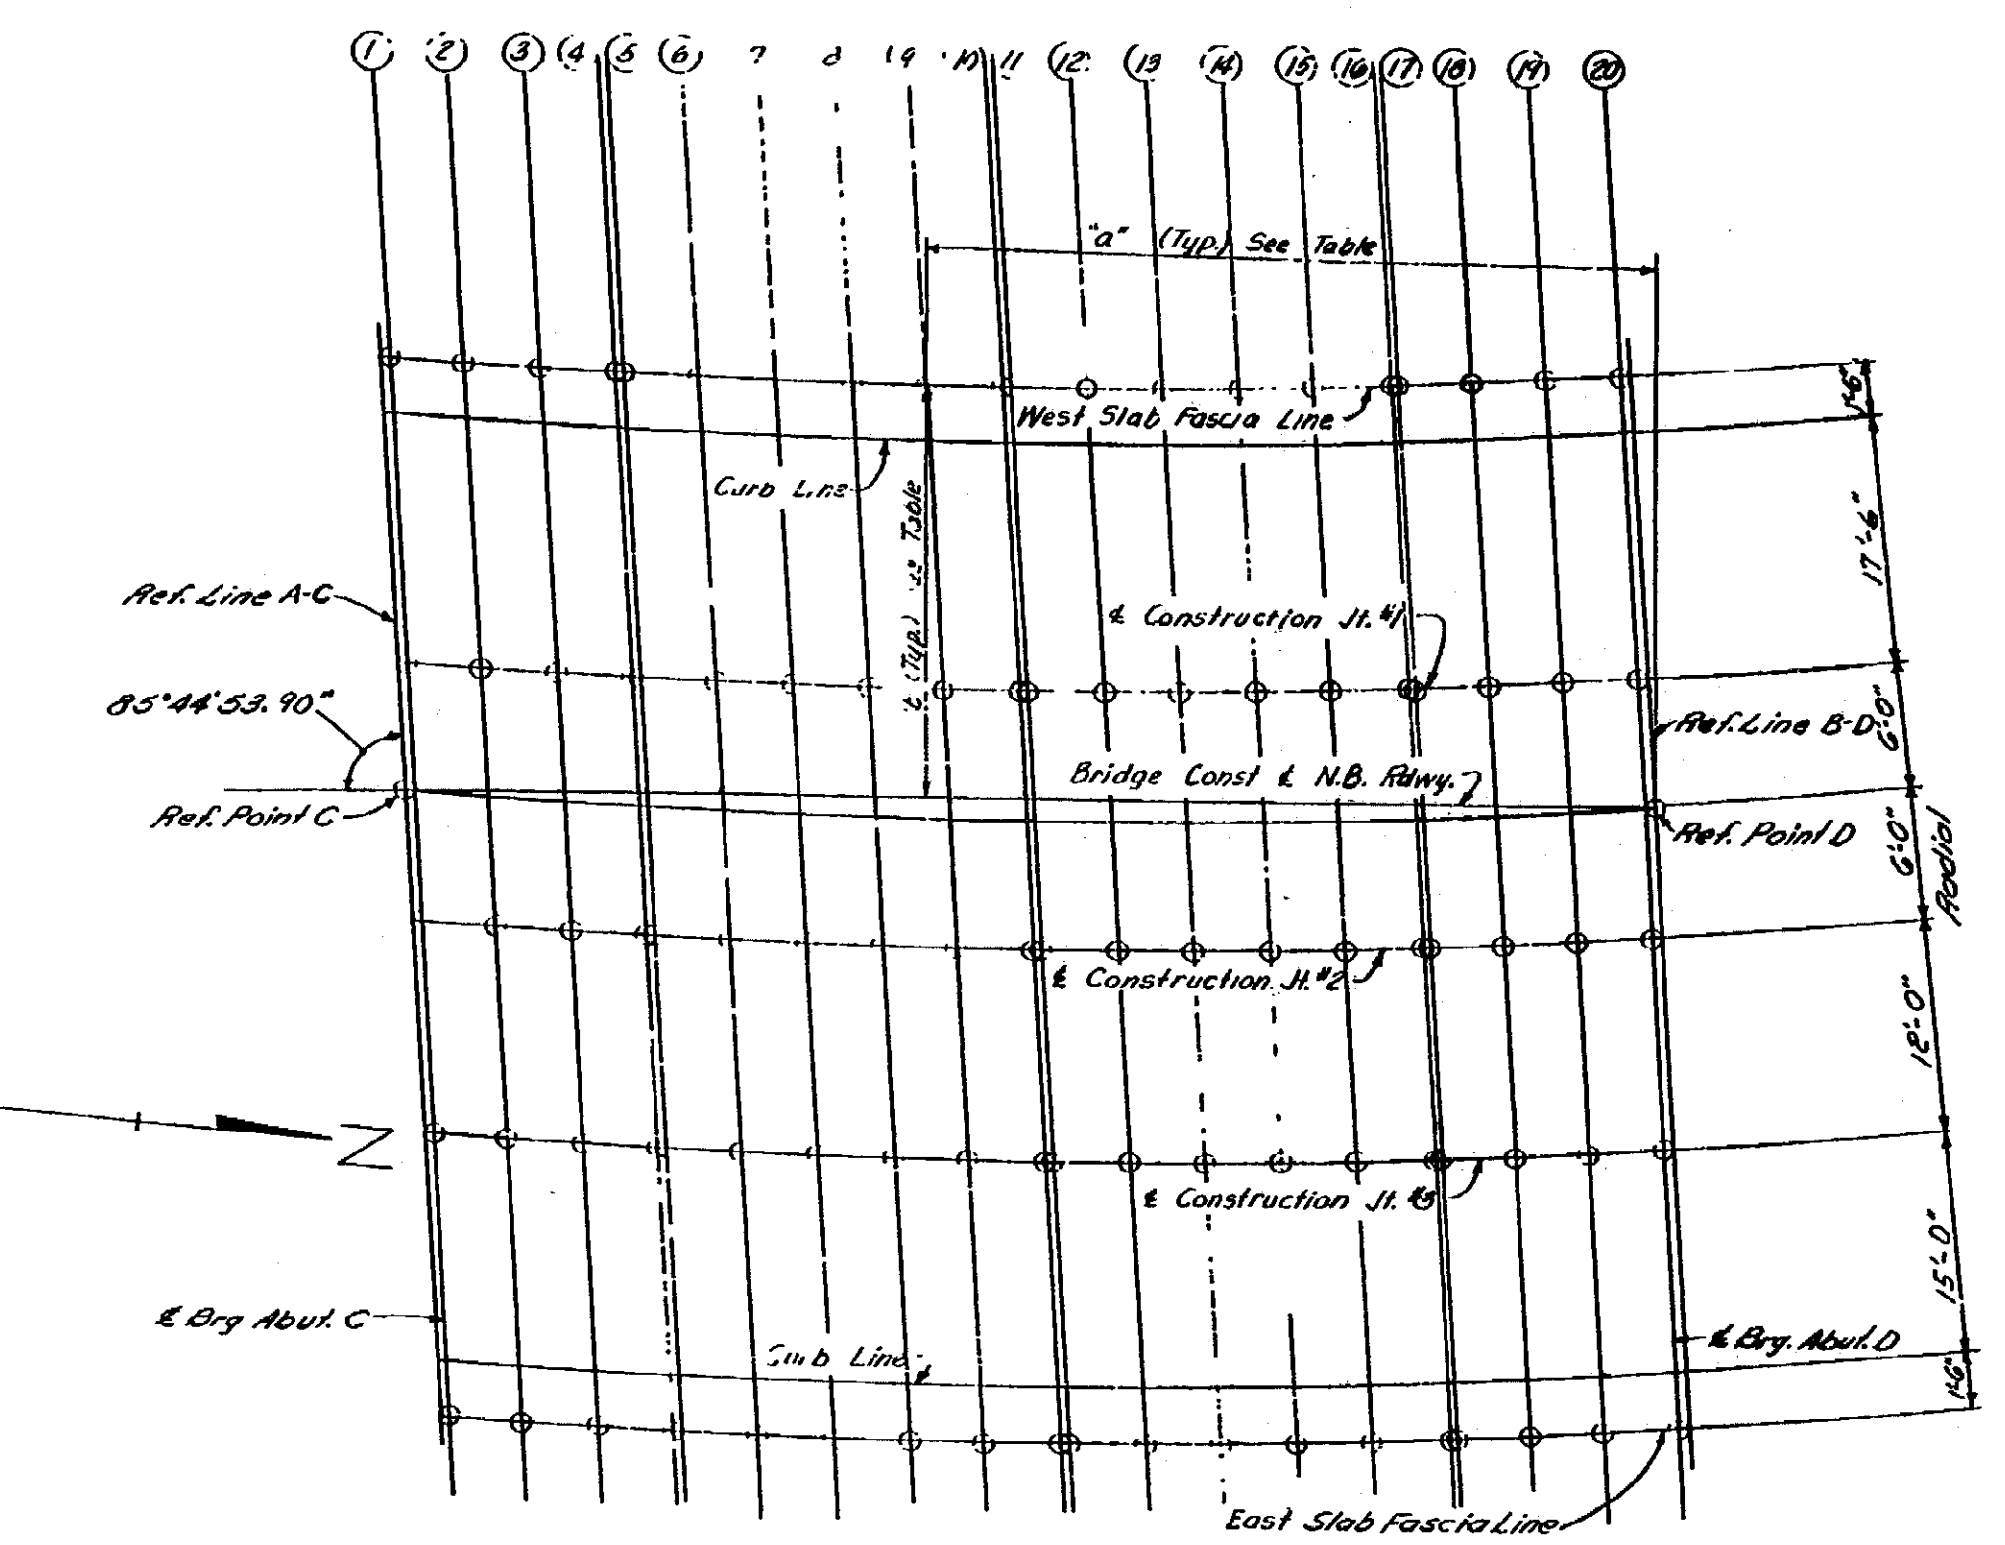

SLAB LAYOUT DIAGRAM
NOTES: DIMENSIONS PARALLEL TO BRIDGE CONST. C.
DIMENSIONS PERPENDICULAR TO BRIDGE CONST. C.

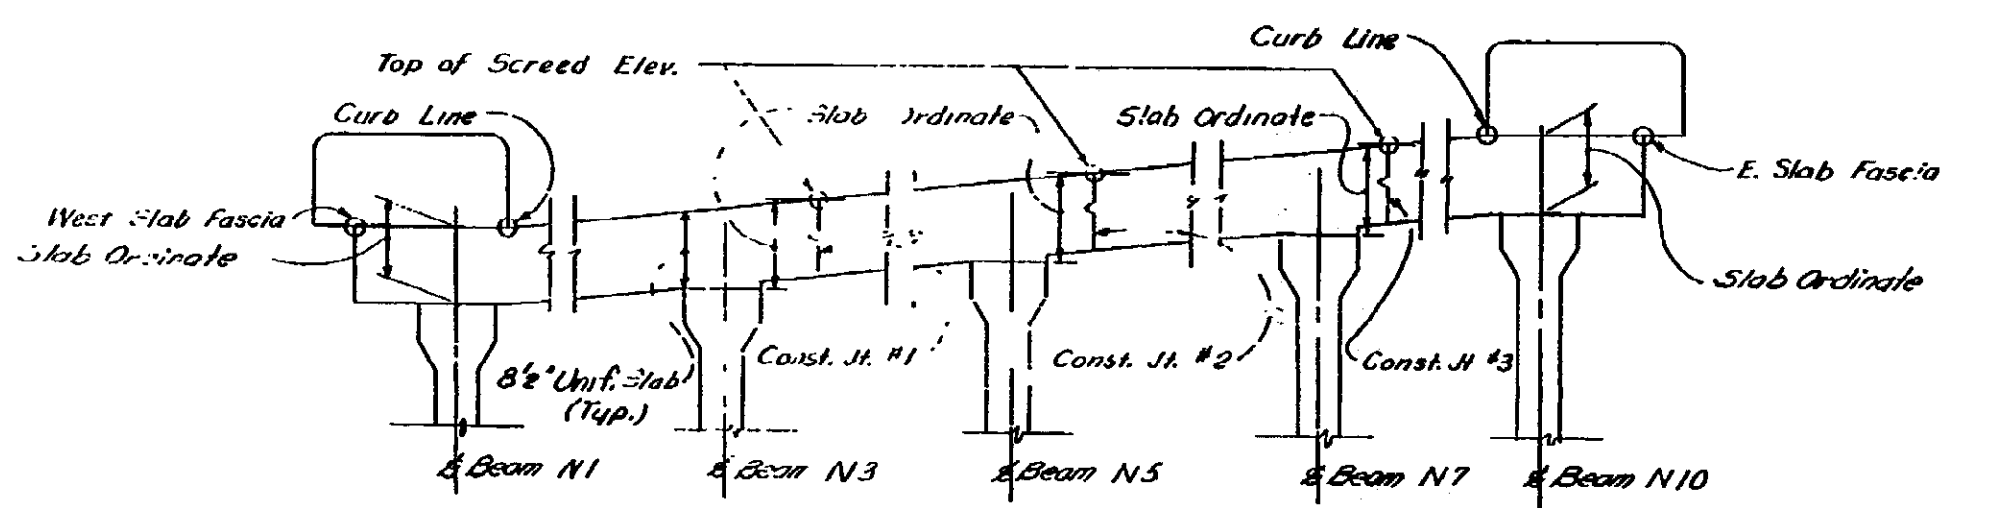

SHOWING HOW SLAB ORDNATES AND SCREED ELEVATIONS ARE TAKEN

GENERAL NOTES
Screed elevations shall not be cast until slab concrete has attained at least 50% of its design strength as determined by the tests in Section 5.0.2 of the Standard Specifications.
Elevations shown are for top of screed before pouring the concrete. If 9/8" steel are set, if check into site that has been the case, the elevations will be obtained, adjust screed accordingly.
The slab ordinates shown provide for dead load due to 12" x 24" curb, 24" x 24" beam, 6" x 6" x 6" superstructure and are to be measured from the top of the beam. The elevations are on a line parallel to the reference line to the top of the screed.

Work this Sheet with Sheets 164, 169, and 171

SUPERSTRUCTURE DETAILS
N. B. STRUCTURE

JDC 3-28-62
RFC 3-10-62
170 3/16
S03 OF 63174

NOTE:
DO NOT WORK FROM THIS SHEET. THE INFORMATION SHOWN HERE IS FOR REFERENCE ONLY. NO PAY ITEMS ARE SHOWN.


FOR INFORMATION ONLY				
DATE	CONT. SEC.	JOB NO.	DESIGN UNIT	SHEET
	S03 OF 63174	49595A	MADHAVI	1 AX OF

REVISIONS			
NO.	DESCRIPTION	DATE	BY

DATE: _____ CORRECTED BY: _____ DATE: _____ CHECKED BY: _____ DATE: _____ DRAWN BY: _____

1 2 3 4 5 6 7 8 9 10 11 12 13 14 15 16 17 18 19 20 21 22 23 24 25 26 27 28 29 30 31 32 33 34 35 36 37 38 39 40 41 42 43 44 45 46 47 48 49 50 51 52 53 54 55 56 57 58 59 60 61 62 63


REVISIONS			
NO.	DESCRIPTION	DATE	BY

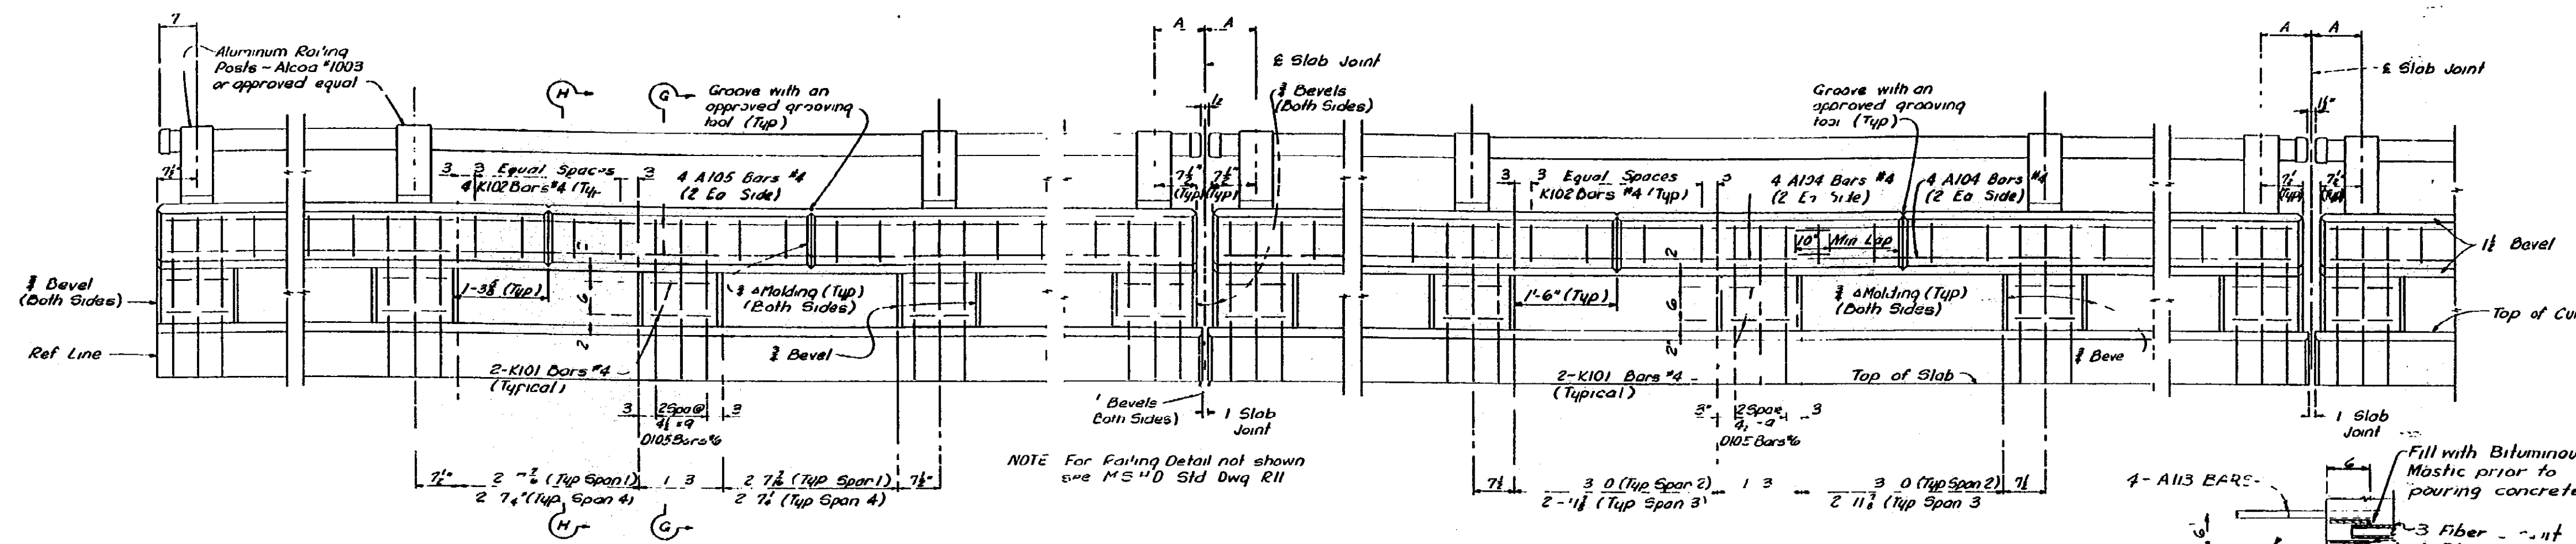

NOTE: Longitudinal bars thru parapet shown here are typical except as follows:
 For Span 4 SB in the west railing use 4 #114 Bars (2 Ea Side) in each of the two sections of parapet.
 For Span 2 NB in East railing use 8 #115 Bars (4 Ea Side with 10 lap) for the long section and 4 #116 Bars (2 Ea Side) for the short section.

REINFORCING STEEL IN PARAPET BEAMS & BLOCKS - SPAN 1 & 4
 REINFORCING STEEL IN PARAPET BEAMS & BLOCKS - SPAN 2 & 3

ELEVATION - BRIDGE RAILING - PARAPET TYPE

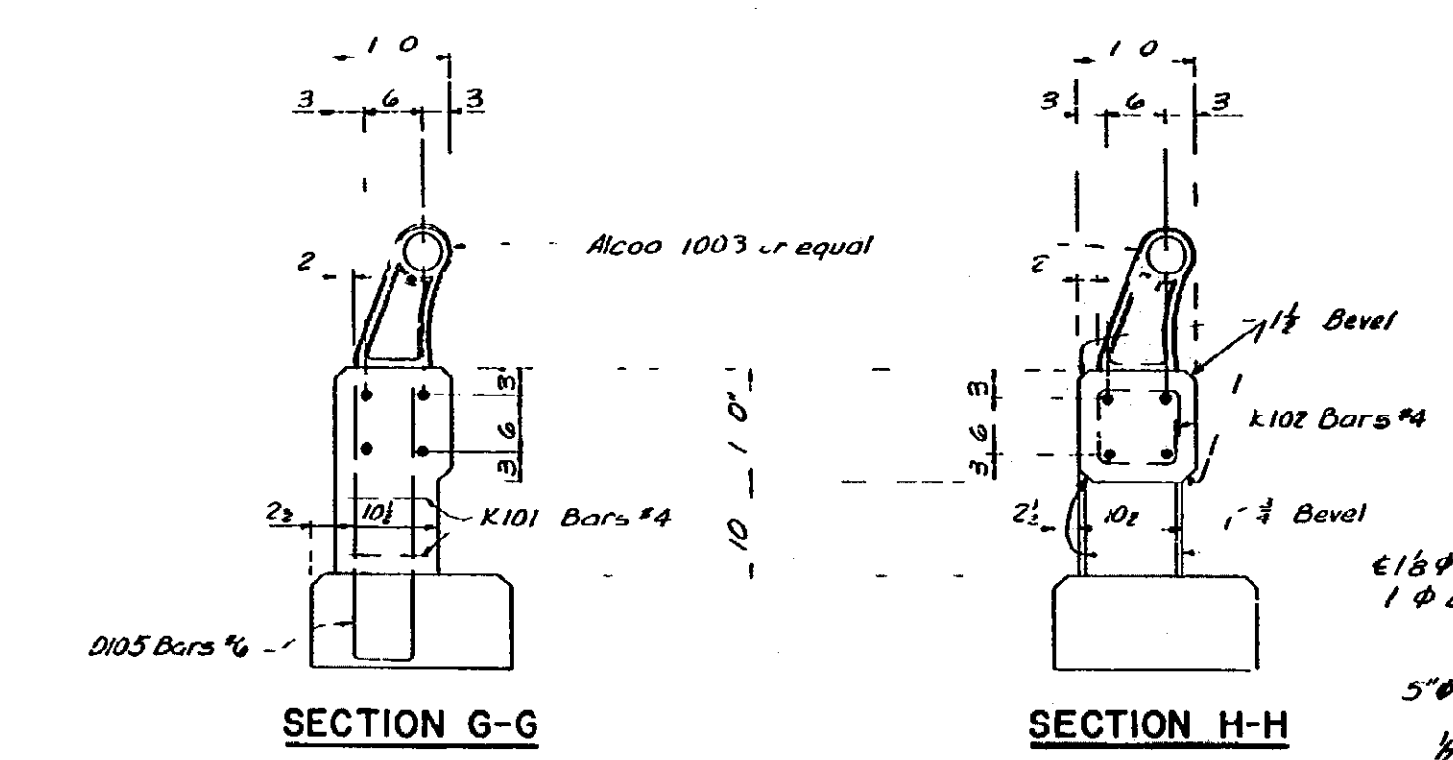


SECTION G-G

SECTION H-H

* RAILING DIMENSION "A"



SPAN	SOUTHBOUND STR		NORTHBOUND STR	
	WEST CURB	EAST CURB	WEST CURB	EAST CURB
1	9'	8'	9'	8'
2	9'	9'	9'	7'
3	9'	9'	8'	9'
4	9'	9'	8'	9'

* A is a curb fascia line

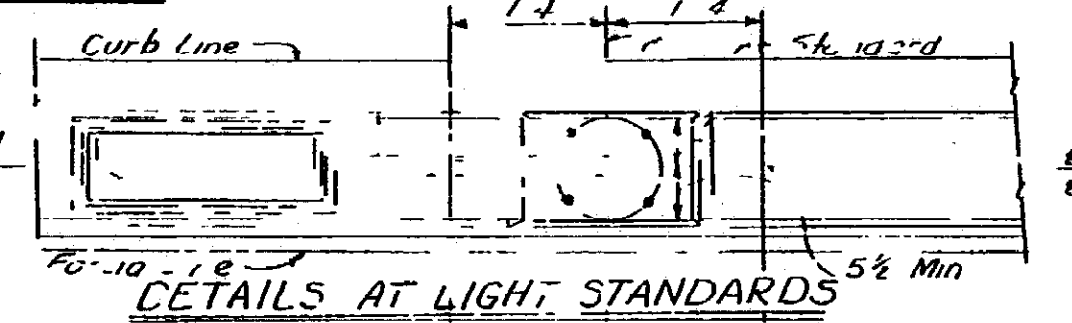


DETAILS AT LIGHT STANDARDS


LIGHT STANDARD ANCHOR BOLT ASSEMBLY

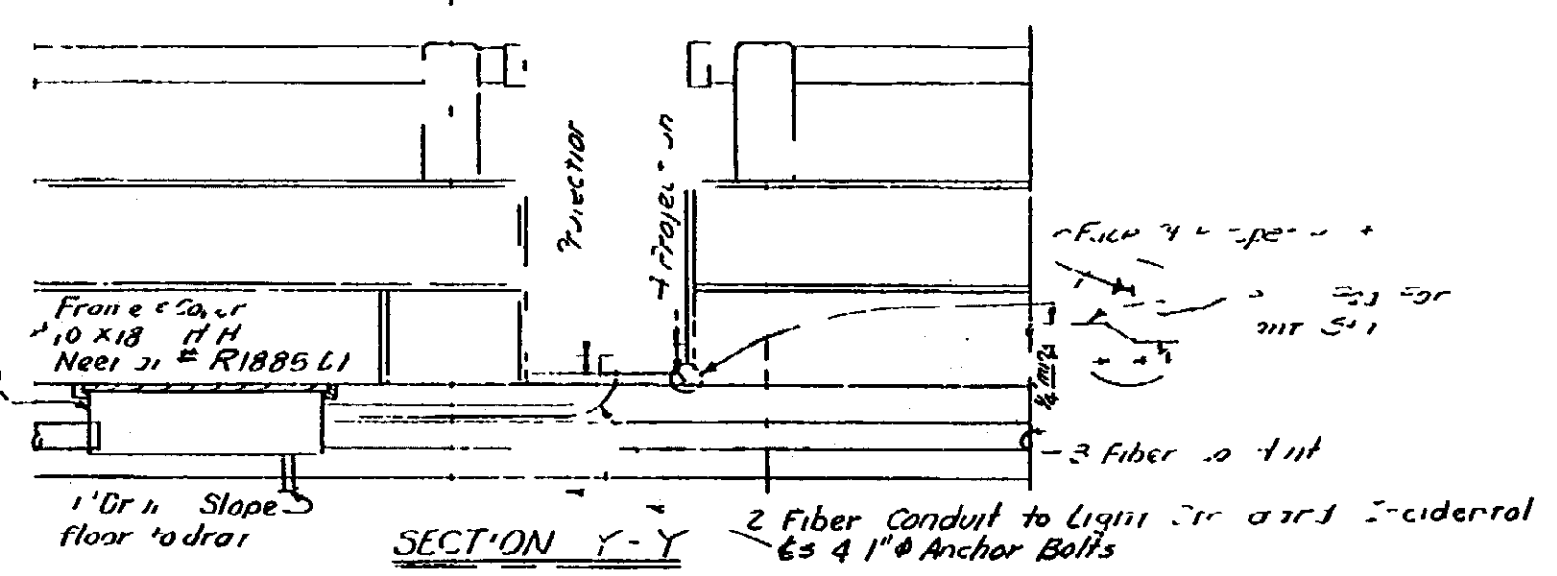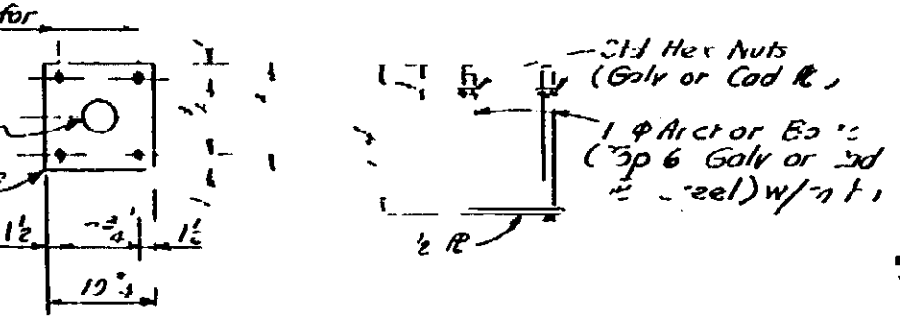


SECTION Y-Y

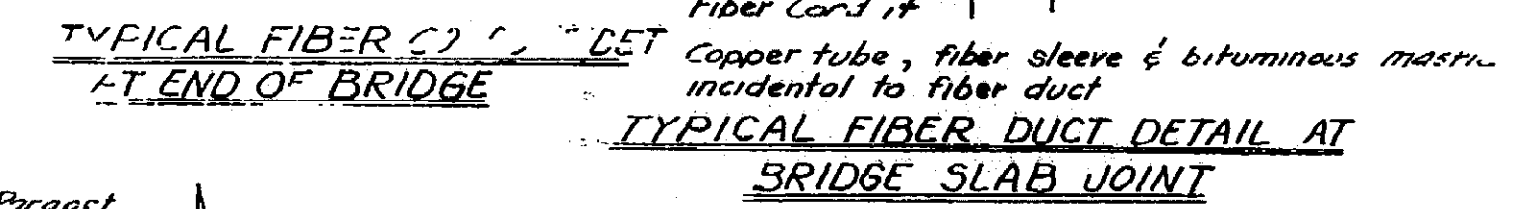


TYPICAL FIBER DUCT DETAIL AT BRIDGE SLAB JOINT

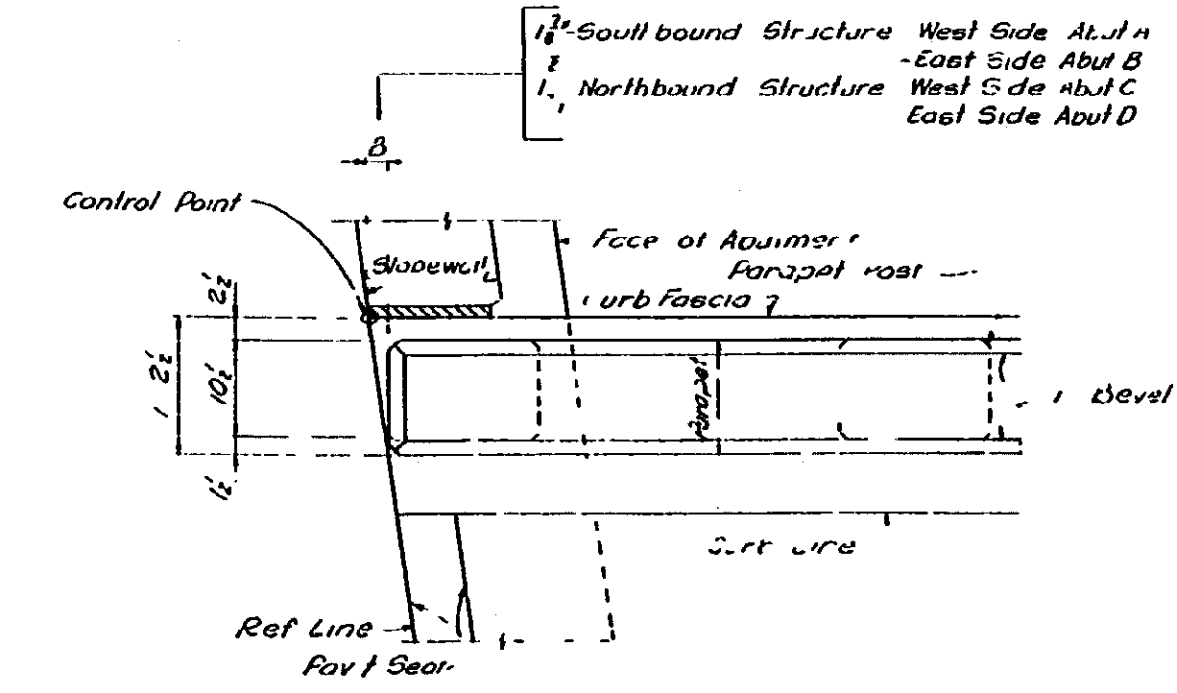

DETAIL NO 1

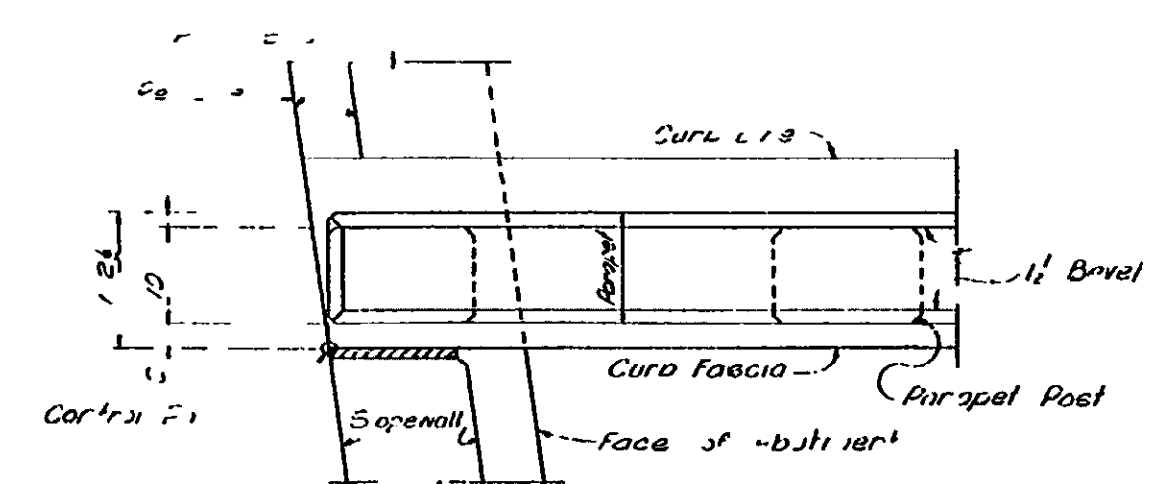

DETAIL NO 3

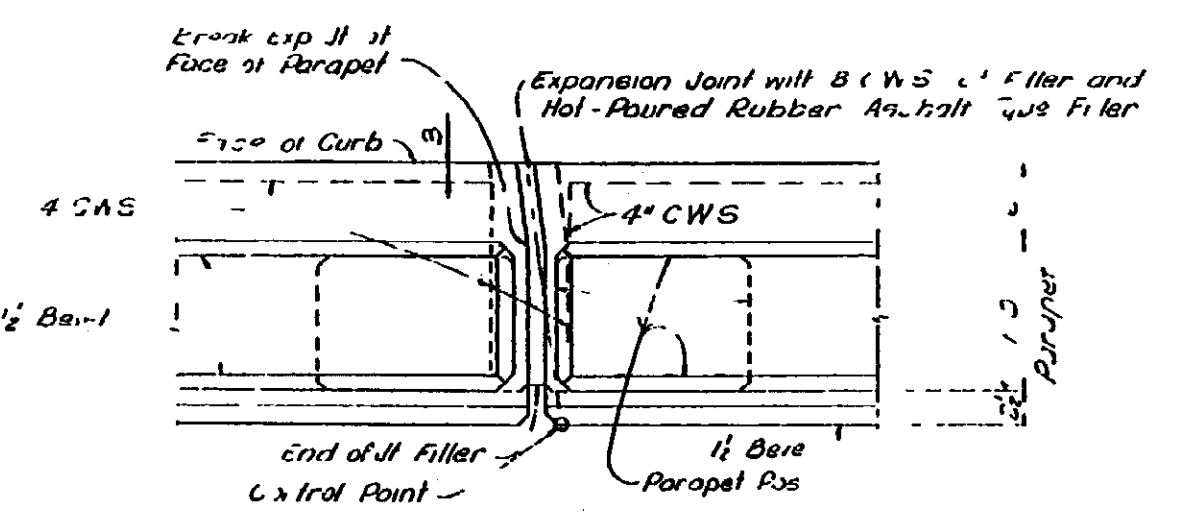

DETAIL NO 2
(Top of Piers)

SUPERSTRUCTURE DETAILS

TECON ENGINEERS, INC

JPL 5/18/67
 REL
 WAC 2/27/62
 1/1
 S03 OF 63174 I

FOR INFORMATION ONLY				
DATE	CONT. SEC.	JOB NO.	DESIGN UNIT	SHEET
	S03 OF 63174	49595A	MADHAVI	1AY OF


NOTE: DO NOT WORK FROM THIS SHEET. THE INFORMATION SHOWN HERE IS FOR REFERENCE ONLY. NO PAY ITEMS ARE SHOWN.



DATE: _____ CORRECTED BY: _____ DATE: _____ CHECKED BY: _____ DATE: _____ DRAWN BY: jander

1 2 3 4 5 6 7 8 9 10 11 12 13 14 15 16 17 18 19 20 21 22 23 24 25 26 27 28 29 30 31 32 33 34 35 36 37 38 39 40 41 42 43 44 45 46 47 48 49 50 51 52 53 54 55 56 57 58 59 60 61 62 63

REVISIONS			
NO.	DESCRIPTION	DATE	BY

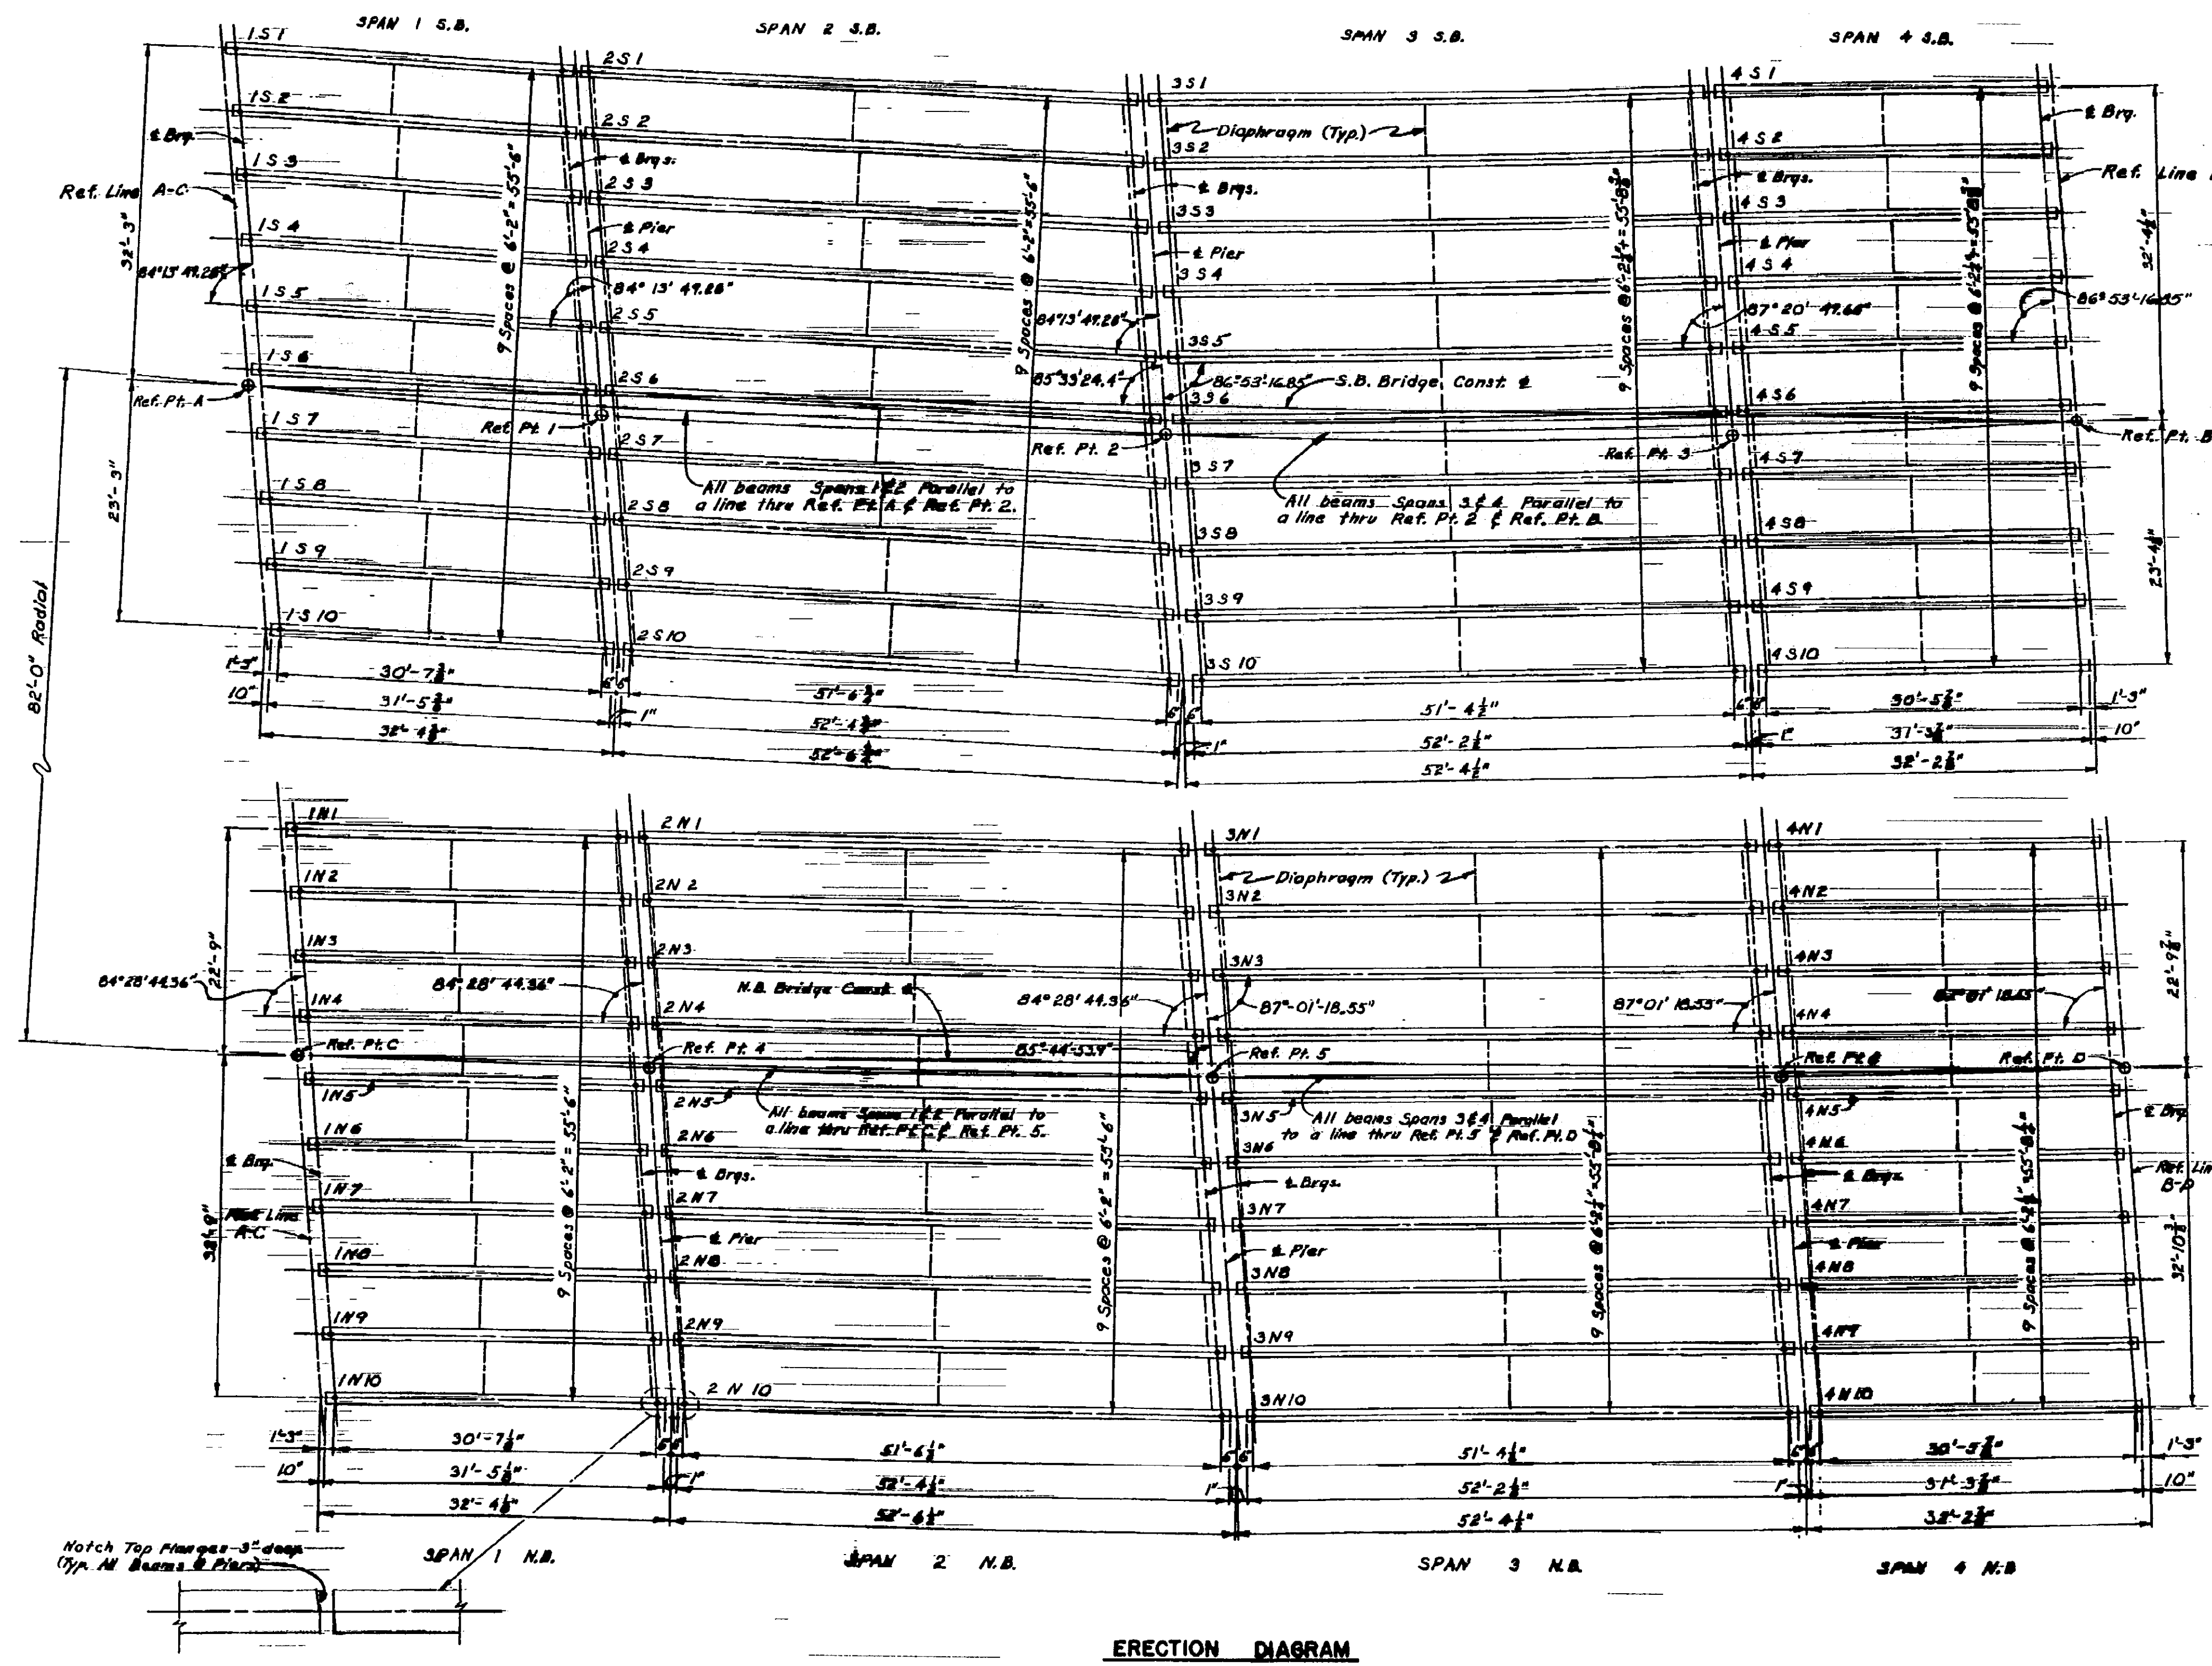

QUANTITIES		
ITEM	QTY	UNIT
28" Prestressed Concrete I Beams - Span 1	10	LINEAL FT.
28" Prestressed Concrete I Beams - Span 2	10	LINEAL FT.
45" Prestressed Concrete I Beams - Span 3	10	LINEAL FT.
45" Prestressed Concrete I Beams - Span 4	10	LINEAL FT.
1" Neoprene Bridge Pads (8"x14")	50	PCS
1" Neoprene Bridge Pads (8"x14")	50	PCS
Inserts - T.L.F. (or Equal)	100	PCS

NOTES:

The design of this structure is based on the Michigan State Highway Department's Specifications for the Design of Highway Bridges, 1988 Edition and Supplemental Specifications (MSD-91-88 Loading and L.L. Vibration Specifications, etc.).

For materials, construction, and testing procedures, see Supplemental Specifications.

Installation of anchor bars in prestressed concrete. Finishing and installation of all pipes, blocks, joints, lifting devices, and other components shall conform to Prestressed Concrete I Beams (See Specifications).

Allow cracks in the end connections of the beams may be permitted subject to inspection by the Michigan State Highway Department.

Beams with honeycomb of such extent as to affect the strength or resistance to deterioration will not be acceptable.

An allowance of 0.005 L shall be made for shortening of the beams due to shrinkage and elastic camber.

Where called for, inserts shall be Highway Type T.L.F. Insert, Superior® or Call Bridge cast with Florida Map, or equal.

Work this sheet with sheet 700

MICHIGAN STATE HIGHWAY DEPARTMENT

PRESTRESSED CONCRETE I BEAM DETAILS

TECON ENGINEERS, INC.
127, 110 S.W.

DATE: 11/18/88
DESIGNER: J. M. ...
CHECKED BY: J. M. ...
DRAWN BY: J. M. ...

S03 OF 63174

NOTE:
DO NOT WORK FROM THIS SHEET. THE INFORMATION SHOWN HERE IS FOR REFERENCE ONLY. NO PAY ITEMS ARE SHOWN.

FOR INFORMATION ONLY				
DATE	CONT. SEC.	JOB NO.	DESIGN UNIT	SHEET
	S03 OF 63174	49595A	MADHAVI	1AZ OF








DATE: _____ CORRECTED BY: _____ DATE: _____ CHECKED BY: _____ DATE: _____ DRAWN BY: J. M. ...

CONTROL B02 OF 63174 JOB NO. 49595A
 SHEET NO. 2


1 2 3 4 5 6 7 8 9 10 11 12 13 14 15 16 17 18 19 20 21 22 23 24 25 26 27 28 29 30 31 32 33 34 35 36 37 38 39 40 41 42 43 44 45 46 47 48 49 50 51 52 53 54 55 56 57 58 59 60 61 62 63

BENCH MARKS	
B.M. #69	El. 637.34 M.S.H.D. B.M. Top in Root of 15' Elm 158' Rt. of R.V. 100 N.B. Rdwy.
B.M. #68	El. 636.31 M.S.H.D. B.M. Top in Root of 24' Elm 24' left of R.V. 143 N.B. Rdwy.

WATER DATA
 H.W. Elev. 619.00
 Max. Flow 4500 cfs
 Average Velocity - 5'/sec.
 (Varies 6' to 18')
 Date - April 25, 1956
 Area Below H.W. Elev. (new channel) = 850 ft²

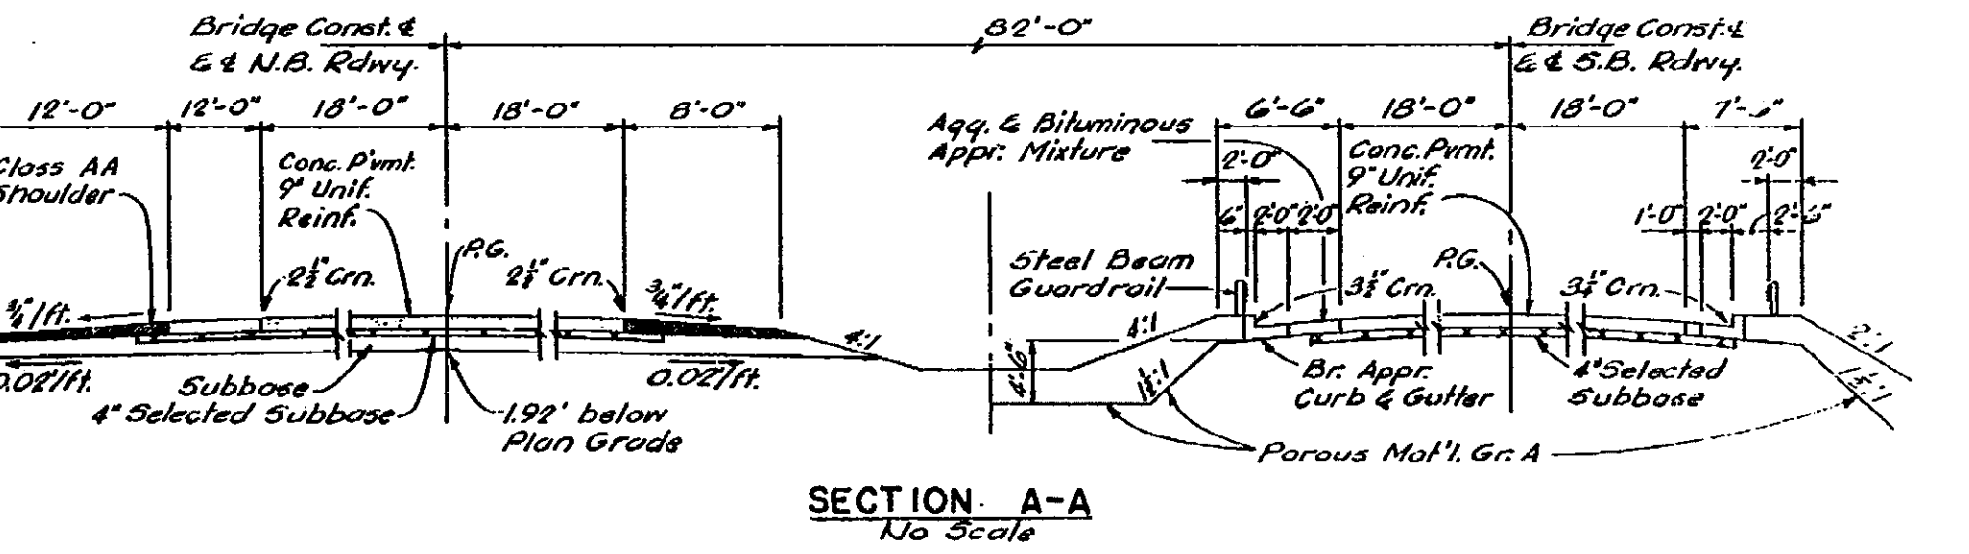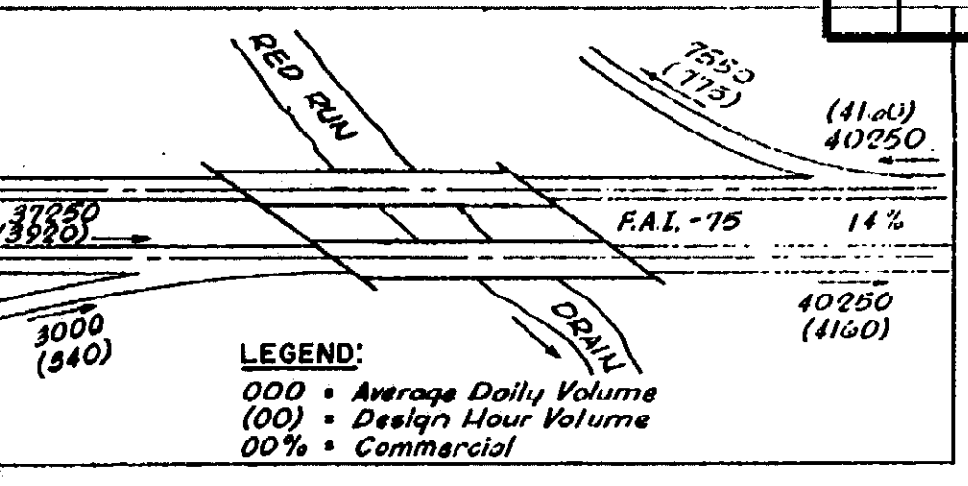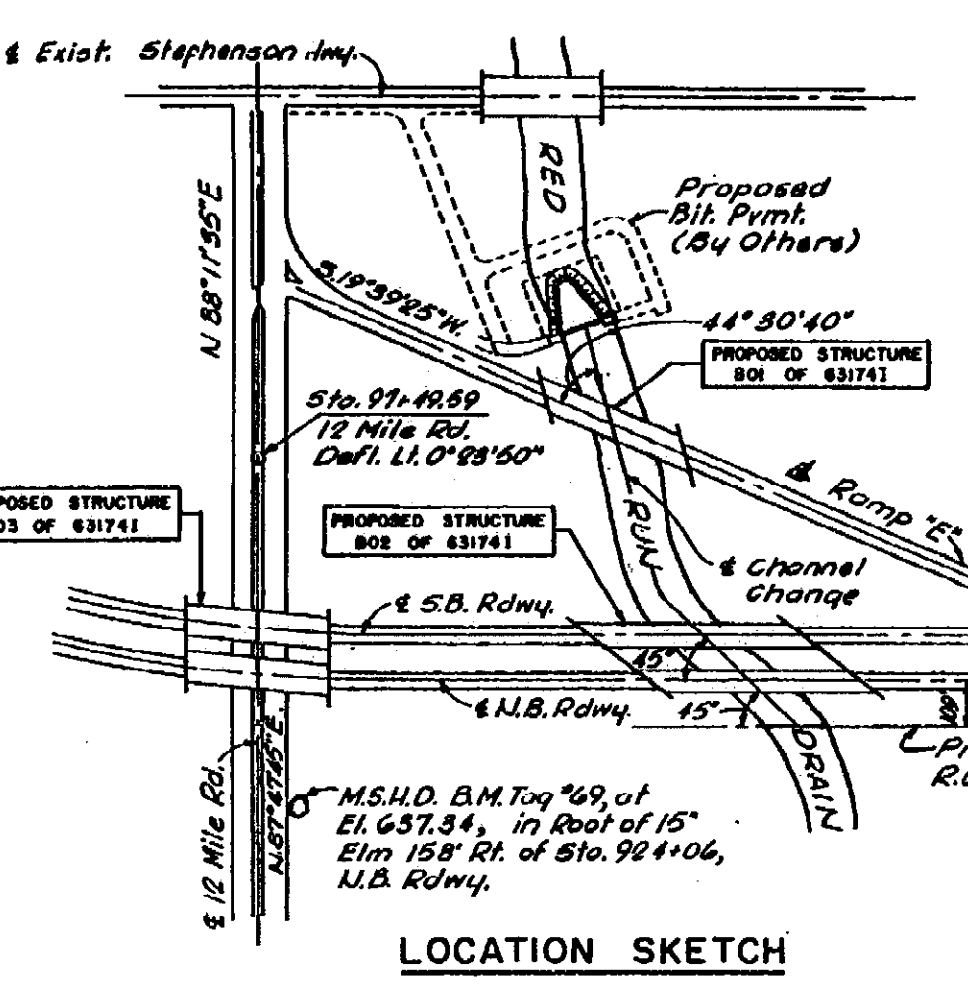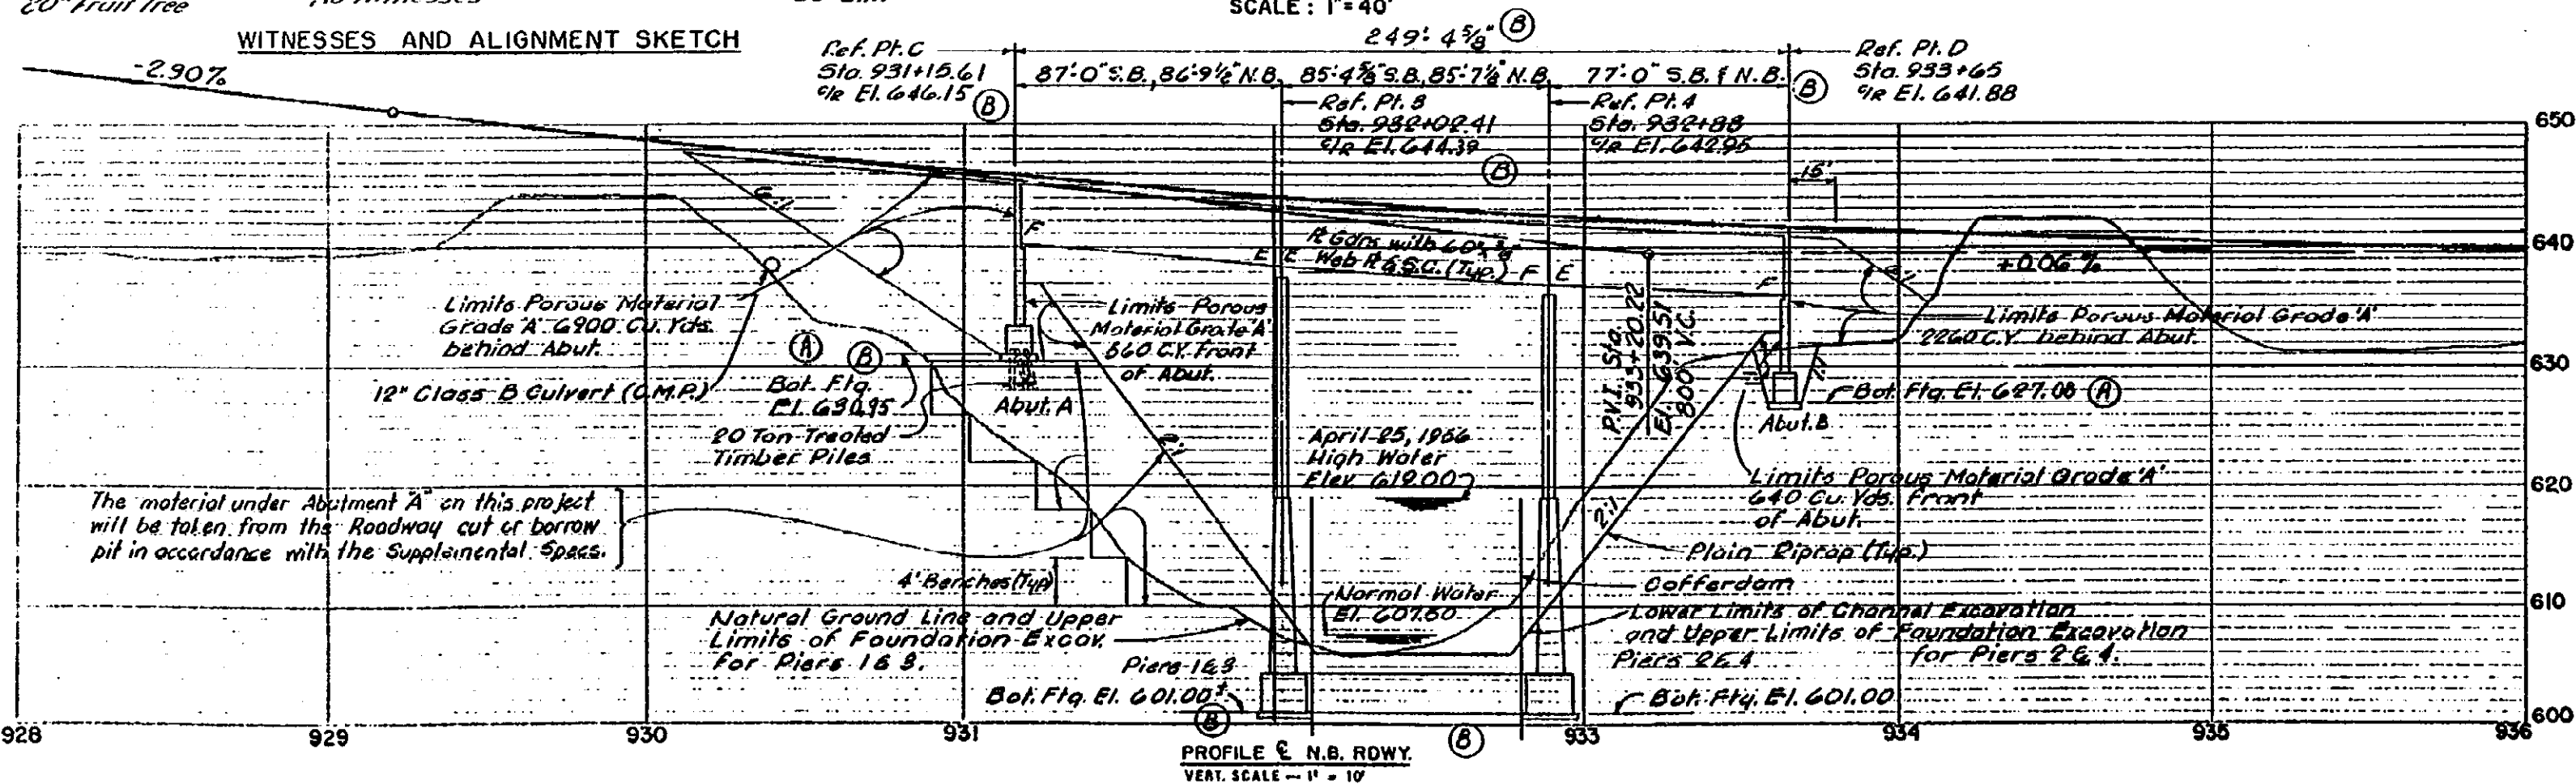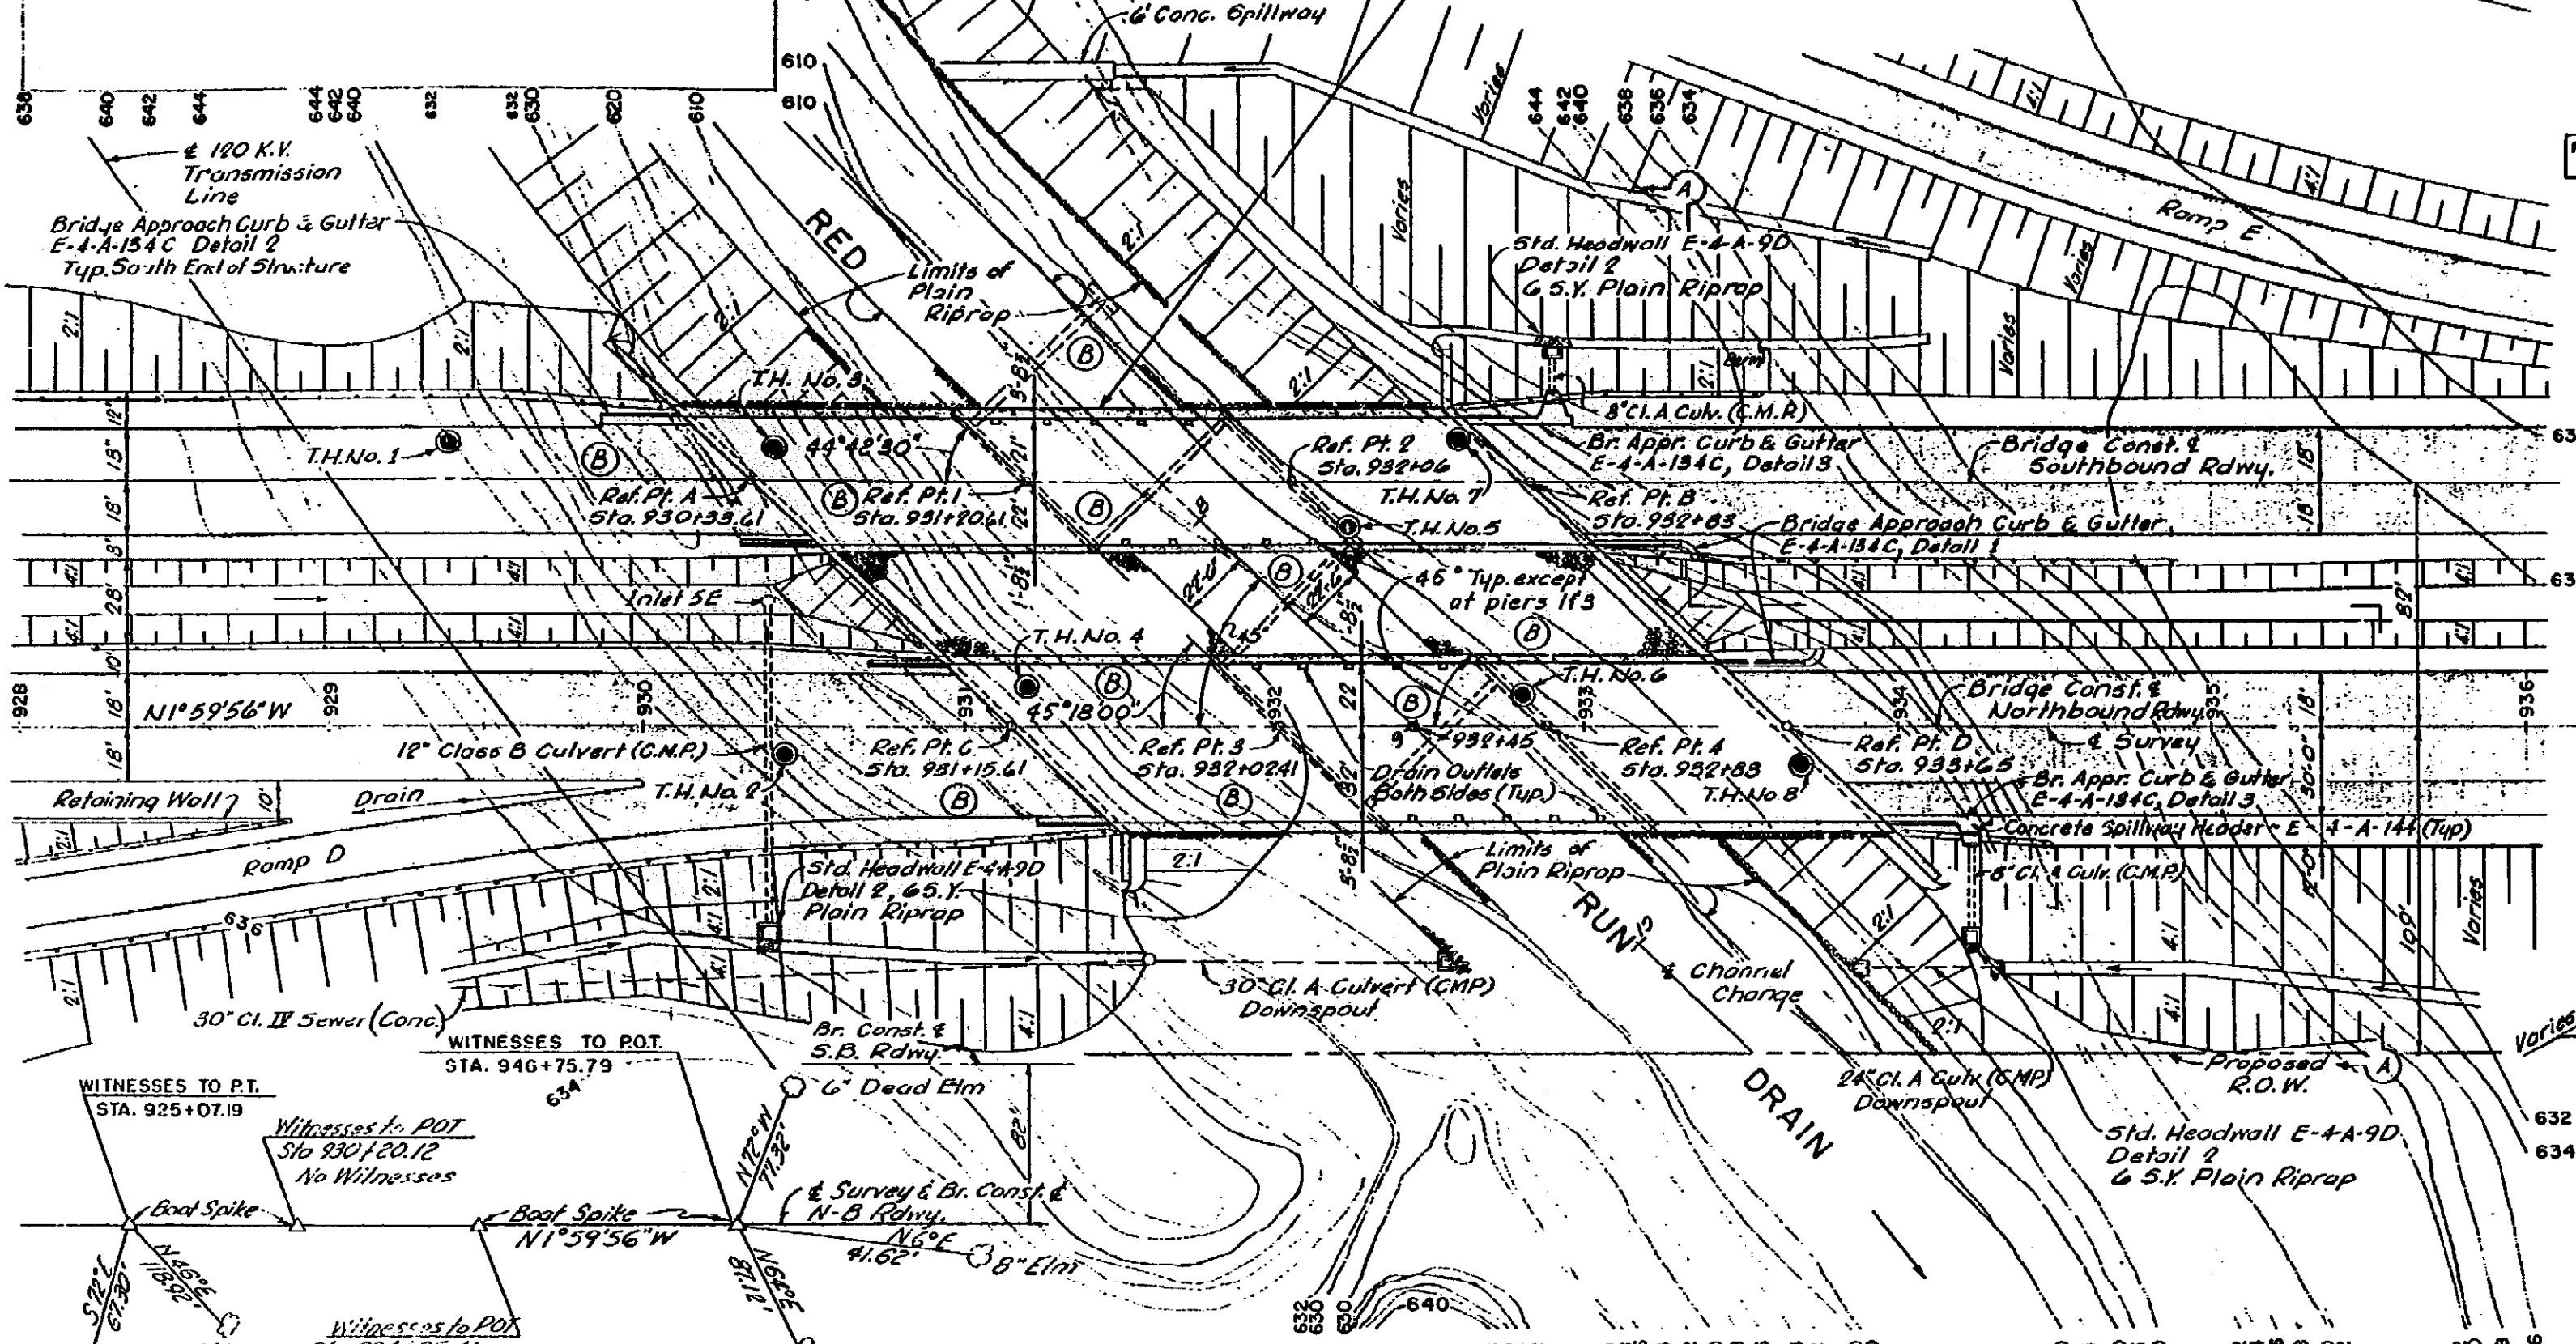

GENERAL NOTES:
 Fences, and utilities are to be moved by others.
 Datum refers to U.S.G.S. Datum.
 Place riprap, El. 600.00 to El. 620.00.
 All piers shall be constructed and back filled prior to construction of the abutments.
 The work covered by these plans includes channel excavation, construction of the proposed bridge, placing porous material, and placing riprap to the limits shown.
 All work not listed above is included in the Road Plans.

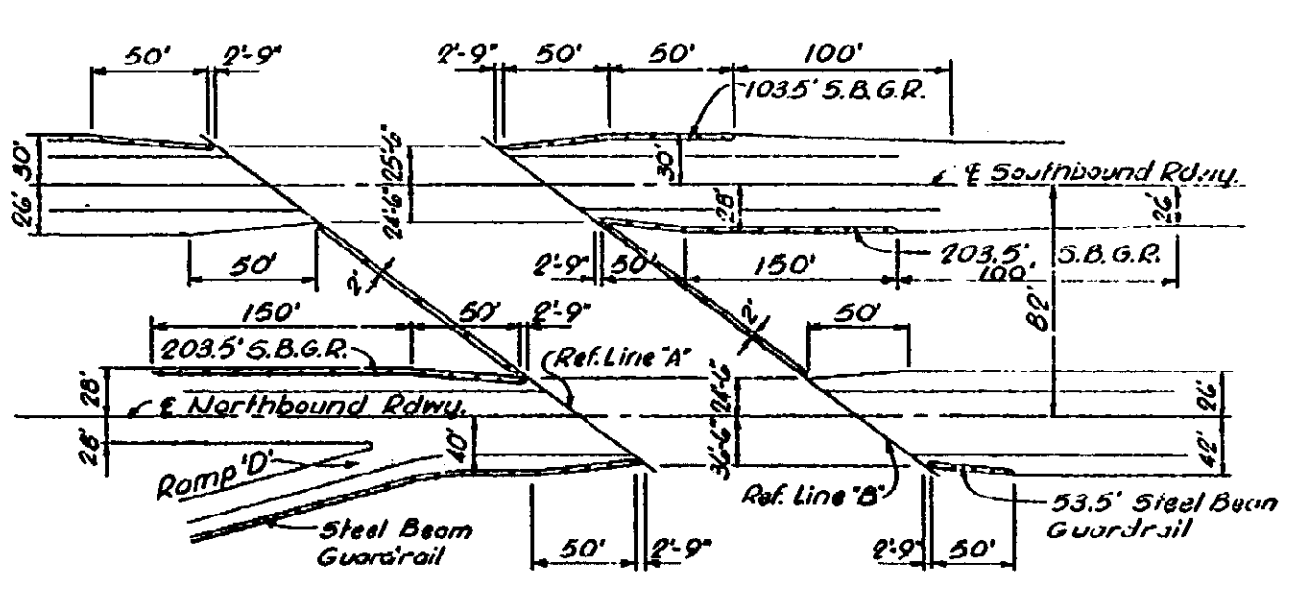

CONTROL SECTION 631741
MICHIGAN STATE HIGHWAY DEPARTMENT
 1-75 OVER RED RUN DRAIN IN THE CITY OF MADISON HEIGHTS
GENERAL PLAN OF SITE


TECON ENGINEERS, INC. APPROVED: <i>J. W. Murray</i> 6-5-62 ENGINEER OF DESIGN - CONSULTANTS		G.T.C. 1-16-61 G.T.C. 1-16-61 189 3-312
BO2 OF 631741		

NOTE:
 DO NOT WORK FROM THIS SHEET. THE INFORMATION SHOWN
 HERE IS FOR REFERENCE ONLY. NO PAY ITEMS ARE SHOWN.

FOR INFORMATION ONLY			
NORTH BOUND			
DATE	CONT. SEC.	JOB NO.	DESIGN UNIT
02-14-00	B02 OF 63174	49595A	MAHDAVI
SHEET		2 OF 16	

DATE: _____ CORRECTED BY: INDER DATE: _____ CHECKED BY: INDER DATE: 02-11-00 DRAWN BY: INDER FILE NAME: B02631745n

1 2 3 4 5 6 7 8 9 10 11 12 13 14 15 16 17 18 19 20 21 22 23 24 25 26 27 28 29 30 31 32 33 34 35 36 37 38 39 40 41 42 43 44 45 46 47 48 49 50 51 52 53 54 55 56 57 58 59 60 61 62 63

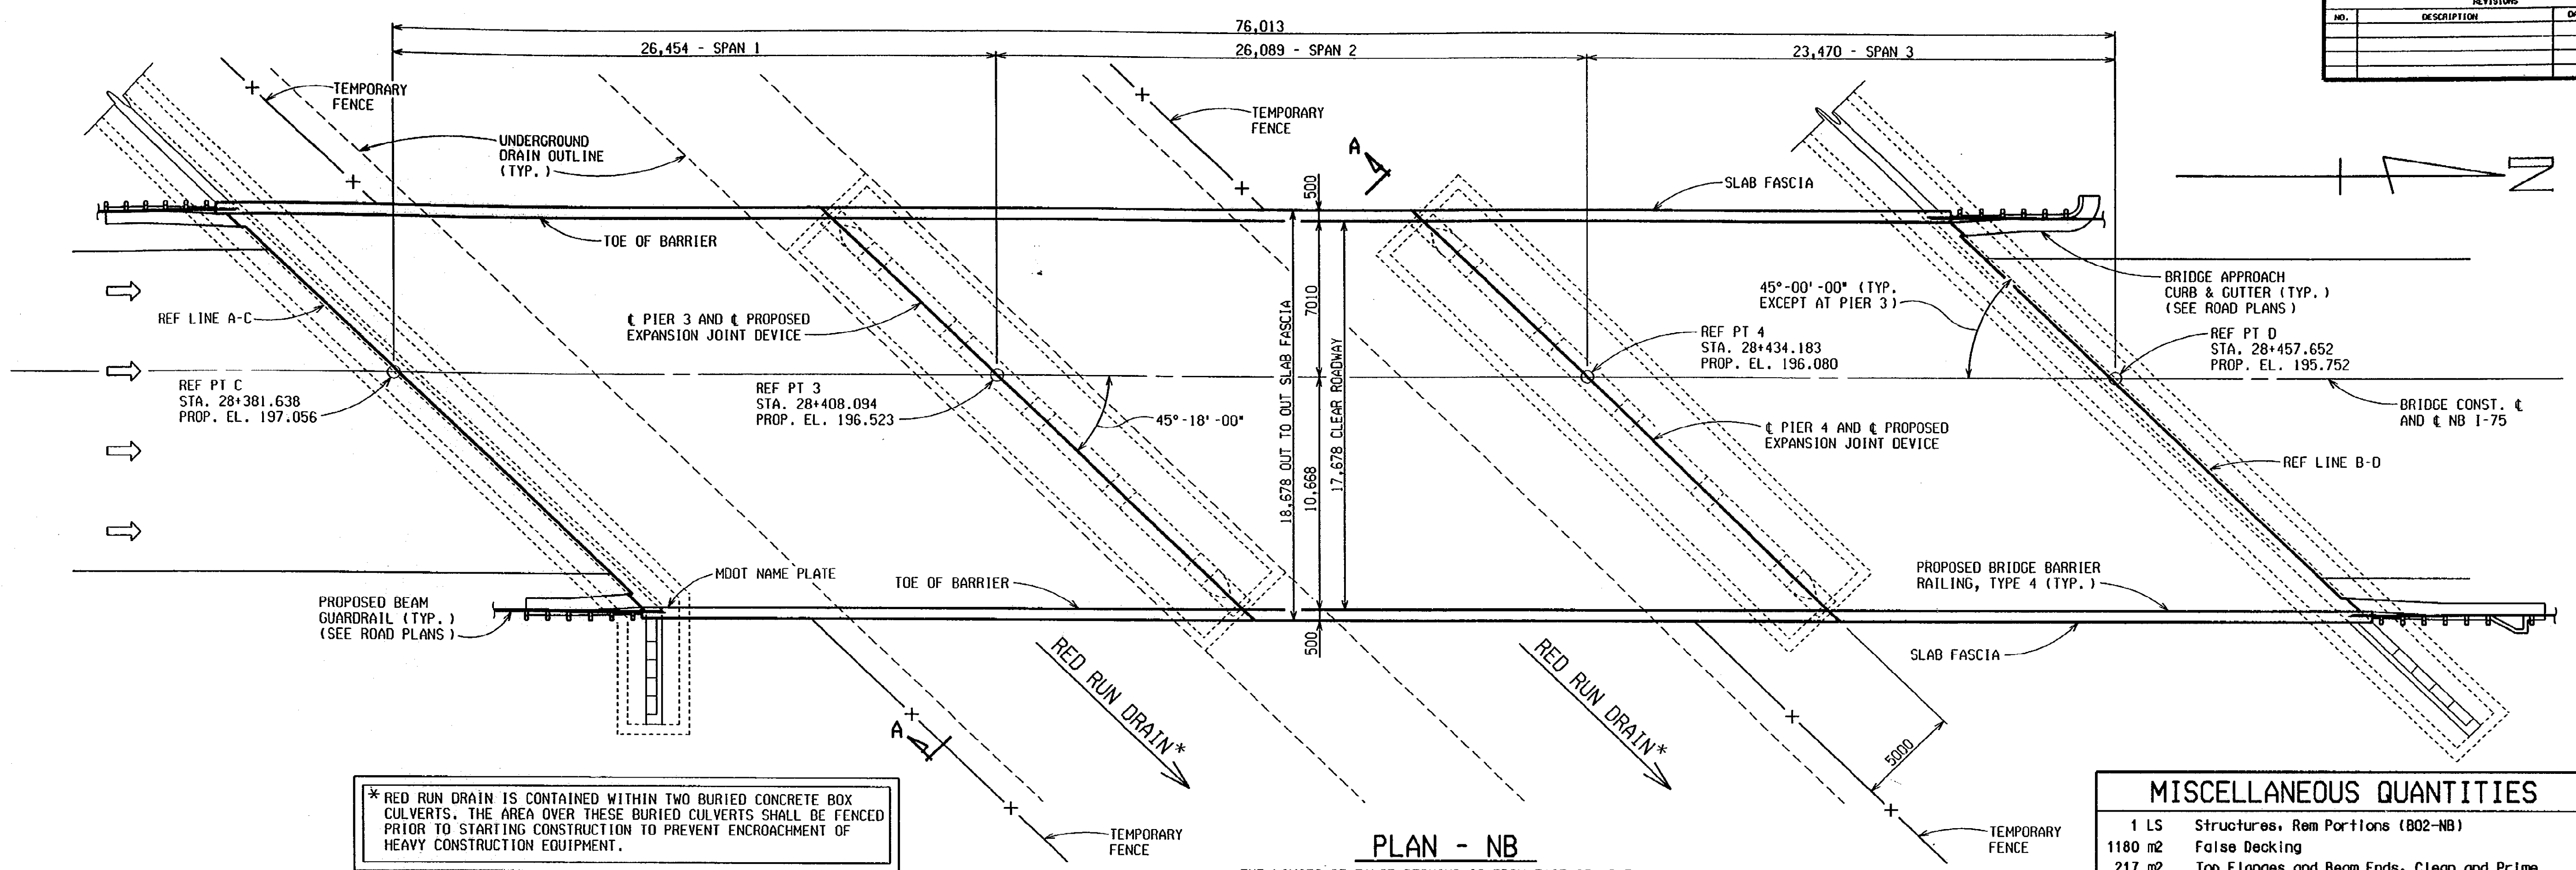

* RED RUN DRAIN IS CONTAINED WITHIN TWO BURIED CONCRETE BOX CULVERTS. THE AREA OVER THESE BURIED CULVERTS SHALL BE FENCED PRIOR TO STARTING CONSTRUCTION TO PREVENT ENCROACHMENT OF HEAVY CONSTRUCTION EQUIPMENT.

MISCELLANEOUS QUANTITIES	
1 LS	Structures, Rem Portions (B02-NB)
1180 m ²	False Decking
217 m ²	Top Flanges and Beam Ends, Clean and Prime
1 LS	Penetrating Water Repellent Treatment (B02-NB)
1 LS	Substructure Horizontal Surface Sealer (B02-NB)
1 LS	Steel Structures, Cleaning, Type 4 (B02-NB)
1 LS	Steel Structures, Coating, Type 4 (B02-NB)
180 m	Beam Plate, Seal Perimeter
3 m ³	Hand Chipping, Other Than Deck
30 m ²	Patching Conc. LM
30 m ²	Patch, Forming
*150 m	Fence, Temporary

* SEE SHEET 18 FOR LOCATION.

THIS BRIDGE IS COATED WITH LEAD BASED PAINT.

SEE SUBSECTION 715 OF THE STANDARD SPECIFICATIONS FOR PROTECTION OF WORK AND ENVIRONMENT DURING THE BLAST CLEANING OF STRUCTURES.

THE ENGINEER SHALL INSPECT THE STRUCTURAL STEEL PARTS THAT HAVE BEEN BLAST CLEANED FOR EVIDENCE OF CRACKS OR LOSS OF SECTION DUE TO CORROSION OF MORE THAN 25 PERCENT. SUCH DETERIORATION SHALL BE REPORTED IN WRITING TO THE ENGINEER, STRUCTURES AND ROAD MAINTENANCE OF THE MAINTENANCE DIVISION IN LANSING.

THE ESTIMATED AREA OF STRUCTURAL STEEL TO BE COATED IS 2880 SQUARE METERS.

SEALANT SHALL BE APPLIED AROUND THE PERIMETER OF BEARING PLATES TO CONCRETE CONTACT SURFACES AFTER CUTTING AWAY ANY PROTRUDING PORTION OF LEAD PLATE.

SEALANT SHALL BE APPLIED AROUND THE PERIMETER OF BOLTED END DIAPHRAGM CONNECTION PLATES AND ANGLES.

SEALANT SHALL BE APPLIED AROUND THE PERIMETER OF ALL BEAM ENDS WHERE ENCASED IN THE BACKWALLS.

THE COLOR OF THE URETHANE PROTECTIVE COAT SHALL BE LIGHT GRAY, FEDERAL STANDARD 595B COLOR NUMBER 16440.

THE CONTRACTOR SHALL TAKE NECESSARY MEASURES TO AVOID OVERSPRAY ON ADJACENT SUBSTRUCTURE AND SUPERSTRUCTURE CONCRETE SURFACES AND ON SIGNS ATTACHED TO THE STRUCTURE. INCLUDED IN THE BID ITEM "STEEL STRUCTURE, COATING, TYPE 4" (B02-NB)".

NOTES:

THE WORK COVERED BY THESE PLANS INCLUDES DECK REPLACEMENT, WIDENING, SUBSTRUCTURE REPAIR, PAINTING OF THE EXISTING STRUCTURAL STEEL, MAINTAINING TRAFFIC AND APPROACH WORK.

THE REHABILITATION DESIGN IS BASED ON CURRENT AASHTO STANDARD SPECIFICATIONS FOR HIGHWAY BRIDGES MS23. LIVE LOAD PLUS IMPACT DEFLECTION DOES NOT EXCEED 1/800 OF SPAN LENGTH. THE ALLOWABLE STRESS METHOD WAS USED FOR THIS DESIGN. THE ORIGINAL STRUCTURE WAS DESIGNED FOR MS18 LOADING.

MEASURES SHALL BE TAKEN TO PREVENT DEBRIS FROM FALLING FROM THE STRUCTURE.

THE CONTRACTOR SHALL LOCATE ALL ACTIVE UNDERGROUND UTILITIES PRIOR TO STARTING WORK AND SHALL CONDUCT HIS OPERATIONS IN SUCH A MANNER AS TO ENSURE THAT THOSE UTILITIES NOT REQUIRING RELOCATION WILL NOT BE DISTURBED.


NB 1-75 TRAFFIC IS TO BE MAINTAINED OVER THE BRIDGE BY PART-WIDTH CONSTRUCTION.

THE TOP HORIZONTAL SURFACES OF ALL PIER CAPS SHALL BE COATED WITH SUBSTRUCTURE HORIZONTAL SURFACE SEALER. THE ESTIMATED AREA IS 54m².

PENETRATING WATER REPELLENT TREATMENT SHALL BE APPLIED TO ALL SURFACES OF PIERS EXCEPT TOPS OF PIERS. THE ESTIMATED AREA FOR PENETRATING WATER REPELLENT APPLICATION IS 325m².

FORMS FOR LARGE PATCHES SHALL BE INSTALLED IN 600mm TO 1200mm HIGH SECTIONS WITH THE TOP OF FORM NO MORE THAN 1200mm ABOVE THE LEVEL OF CONCRETE AS THE POUR PROGRESSES.

FALSE DECKING SHALL INCLUDE THE AREA OF SPANS 1, 2 AND 3. THE ESTIMATED AREA IS 1180 SQUARE METERS DURING REMOVAL AND PROPOSED CONSTRUCTION.

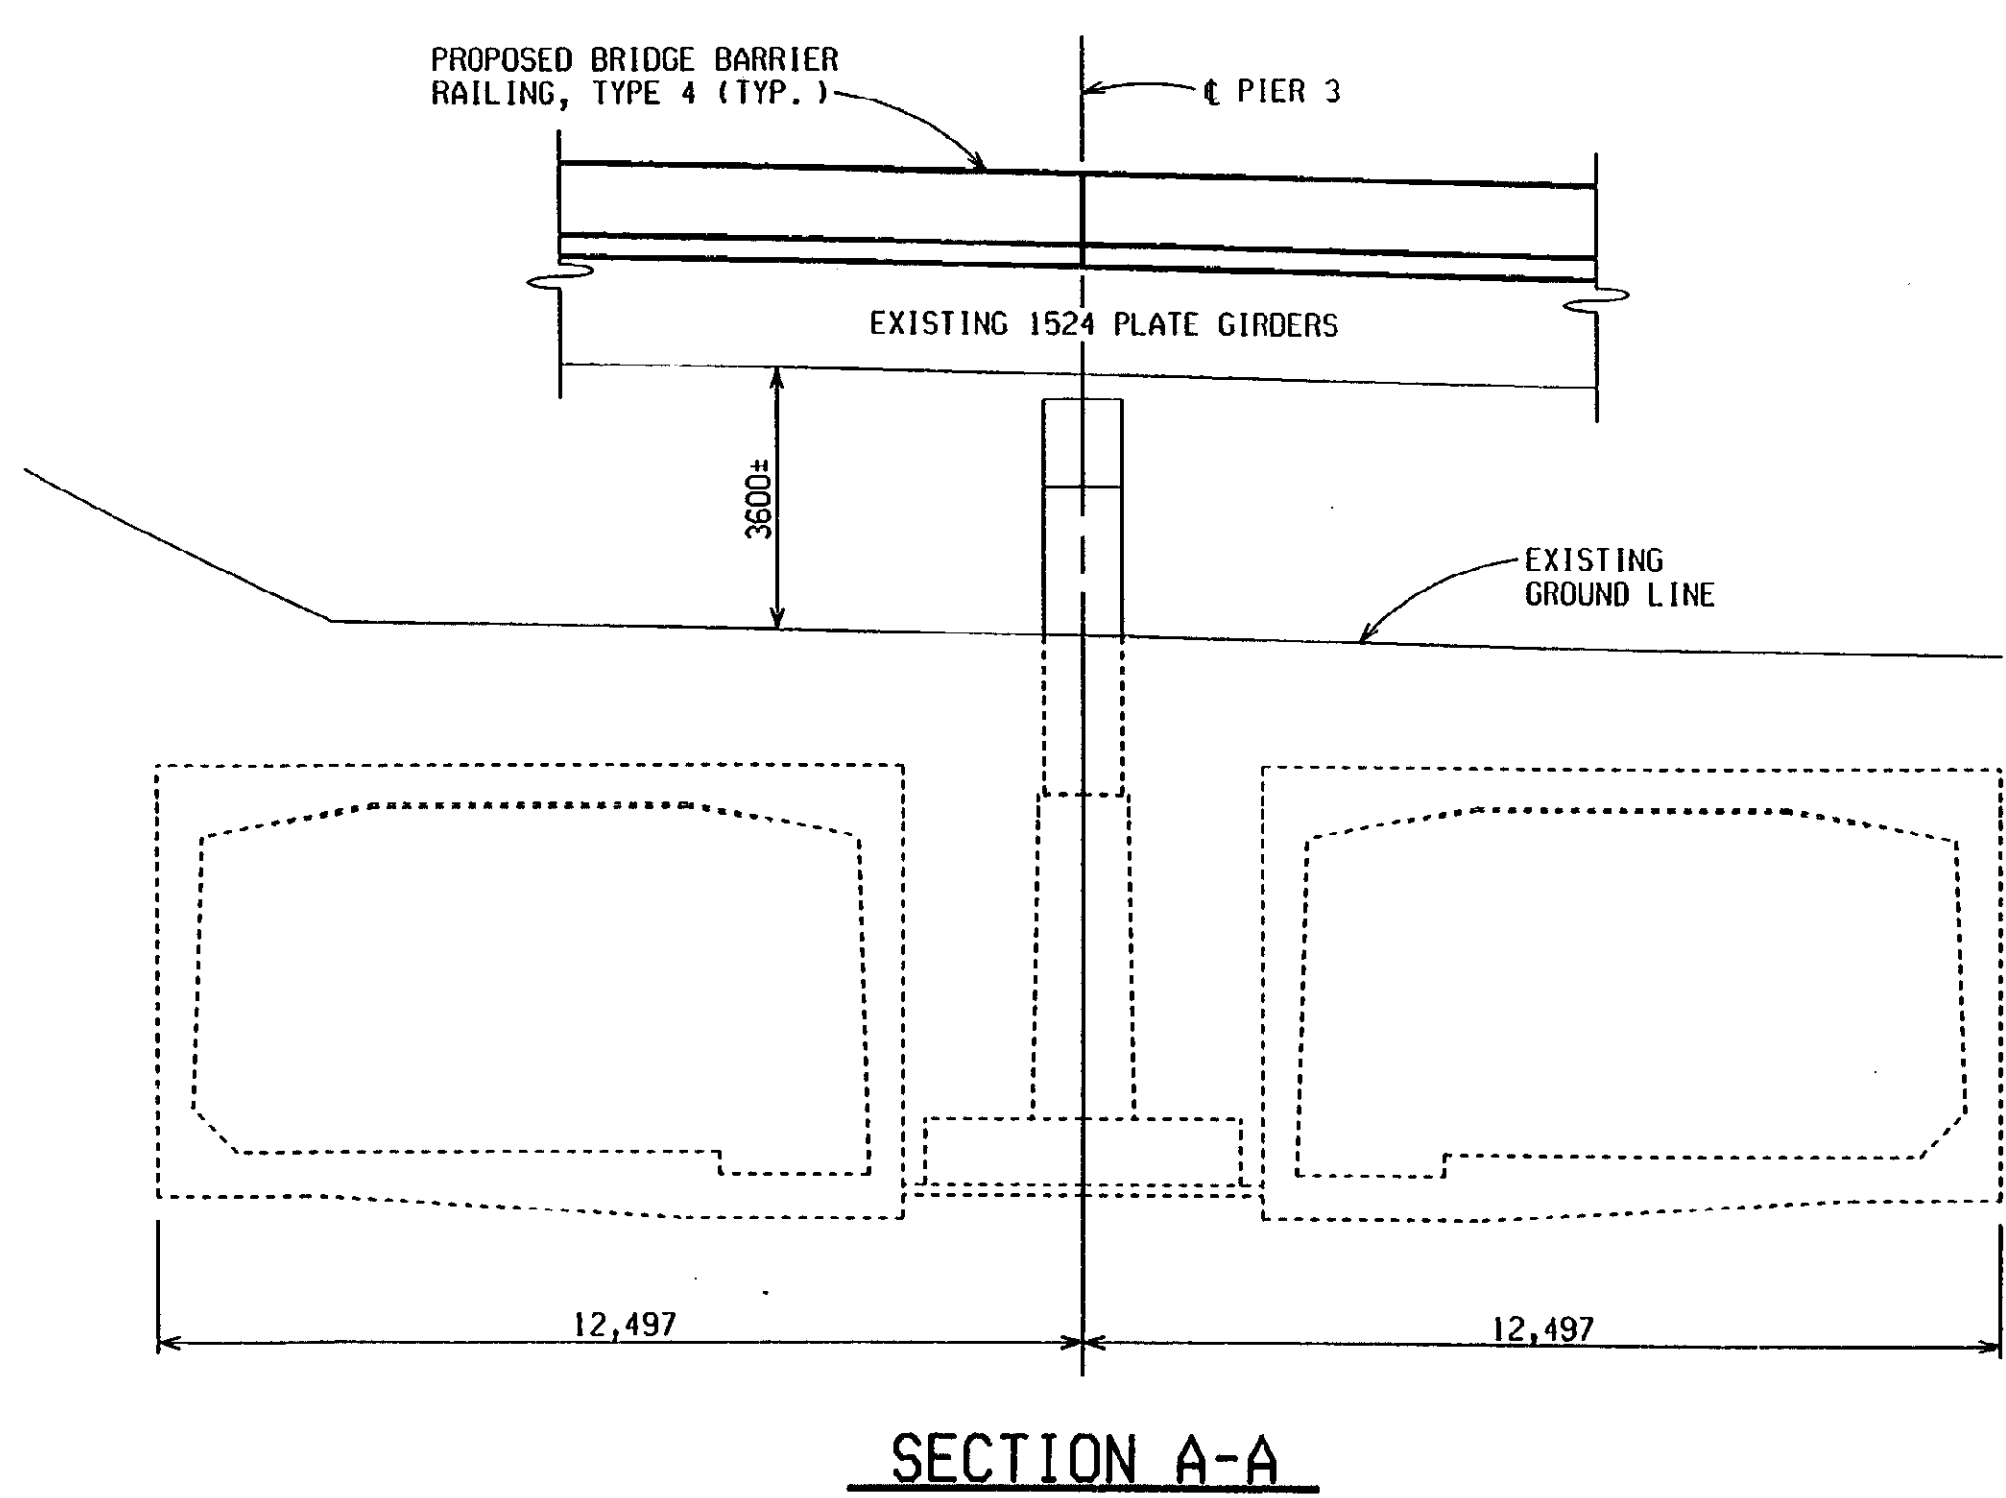

THE LIMITS OF FALSE DECKING IS FROM FACE OF ABUT. A TO FACE OF ABUT. B AND BETWEEN SLAB FASCIAS.


GENERAL PLAN OF STRUCTURE				
NB 1-75 OVER RED RUN DRAIN IN MADISON HIEGHTS.				
DATE	CONT. SEC.	JOB NO.	DESIGN UNIT	SHEET
1-9-01	B02 OF 63174	49595A	MAHDAVI	3 OF 16

APPROVED *Steven P. Beeb* 1/10/01
DESIGN SUPERVISING ENGINEER



DATE: 1-9-01
CORRECTED BY: R. PRATT
DATE:
CHECKED BY: MIKUCKI
DATE: 4-6-00
DRAWN BY: R. PRATT
FILE NAME: b026317.dwg


REVISIONS			
NO.	DESCRIPTION	DATE	BY

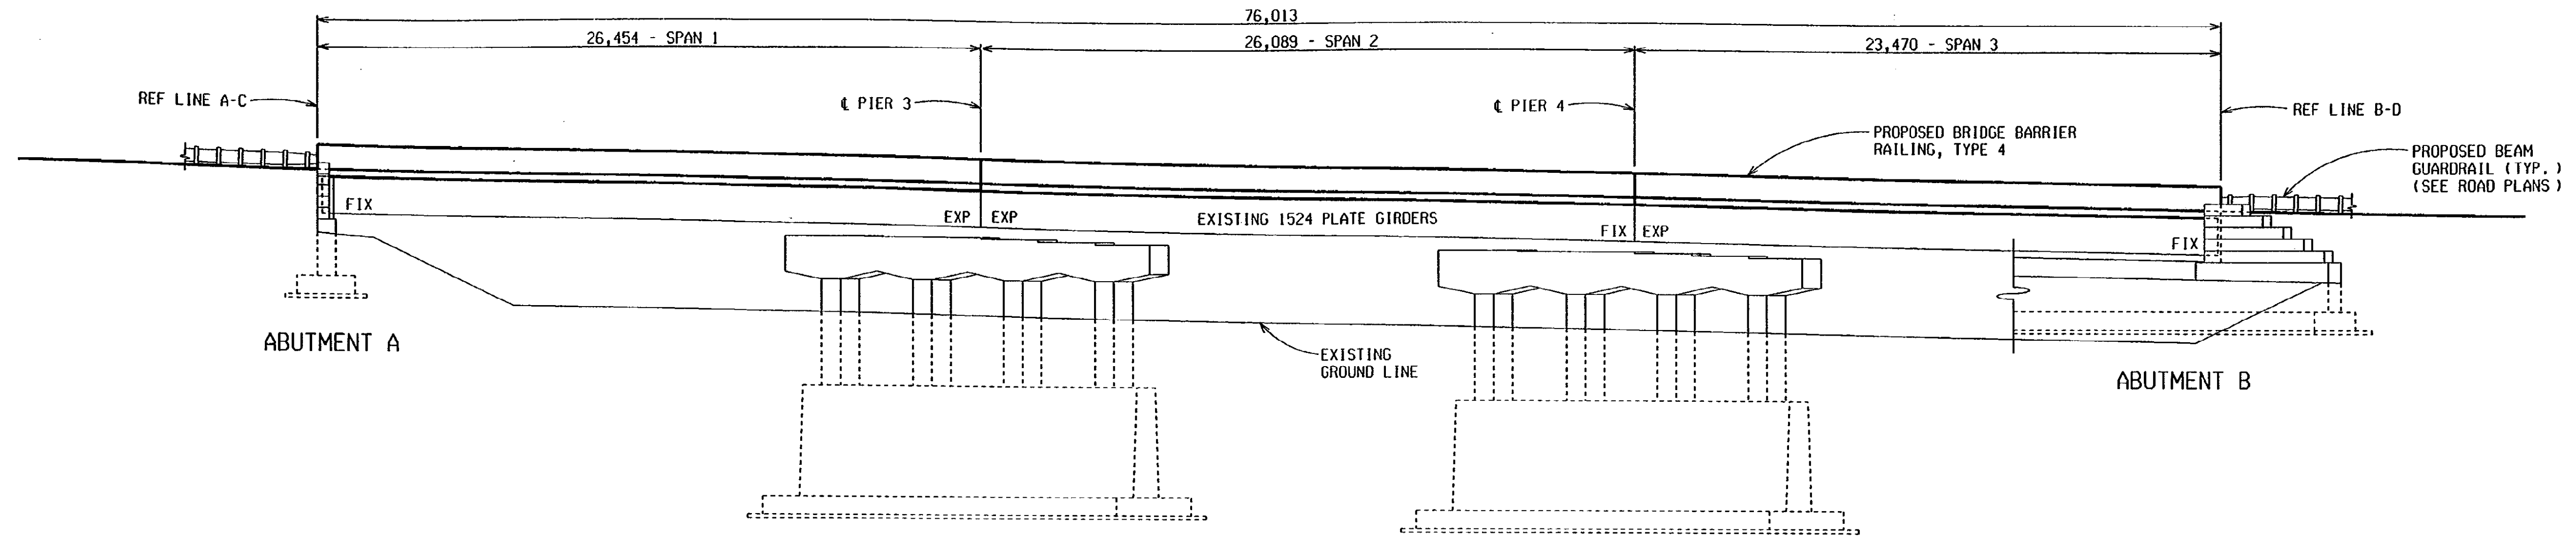


PIER 3

PIER 4

ELEVATION - NB
 (SHOWN NORMAL TO BRIDGE CONST. ϵ)

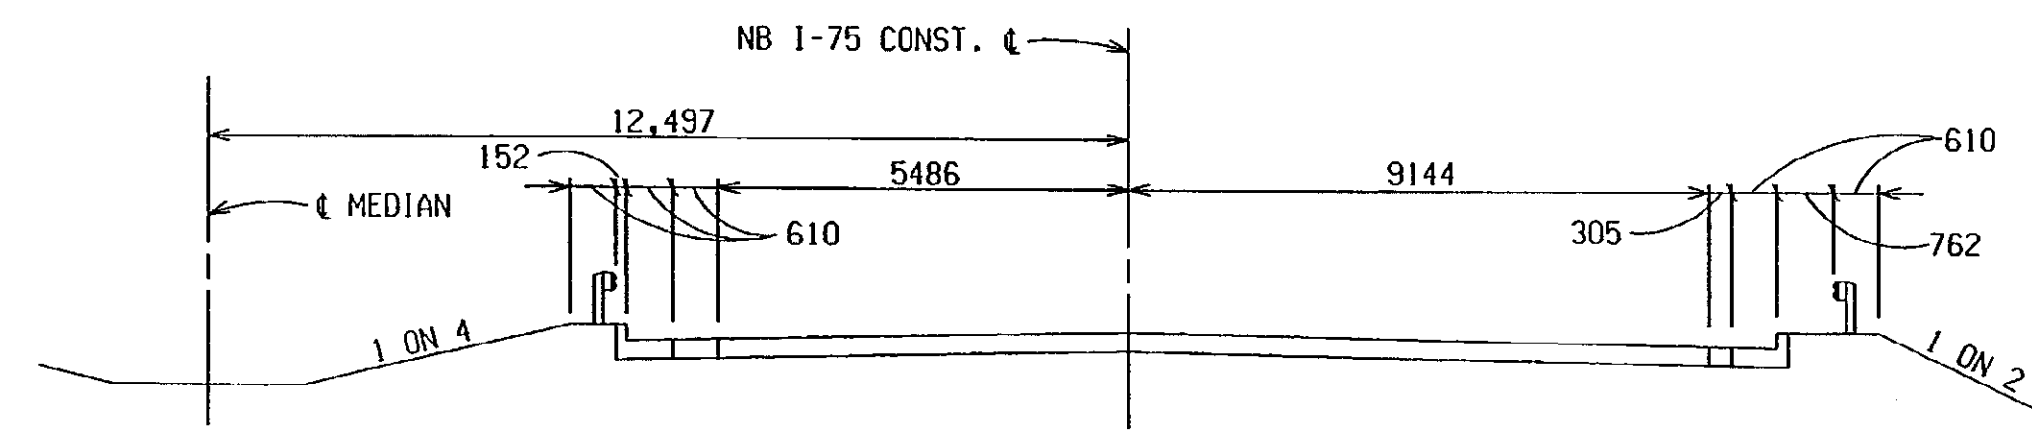


TYPICAL APPROACH SECTION
 (LOOKING NORTH)

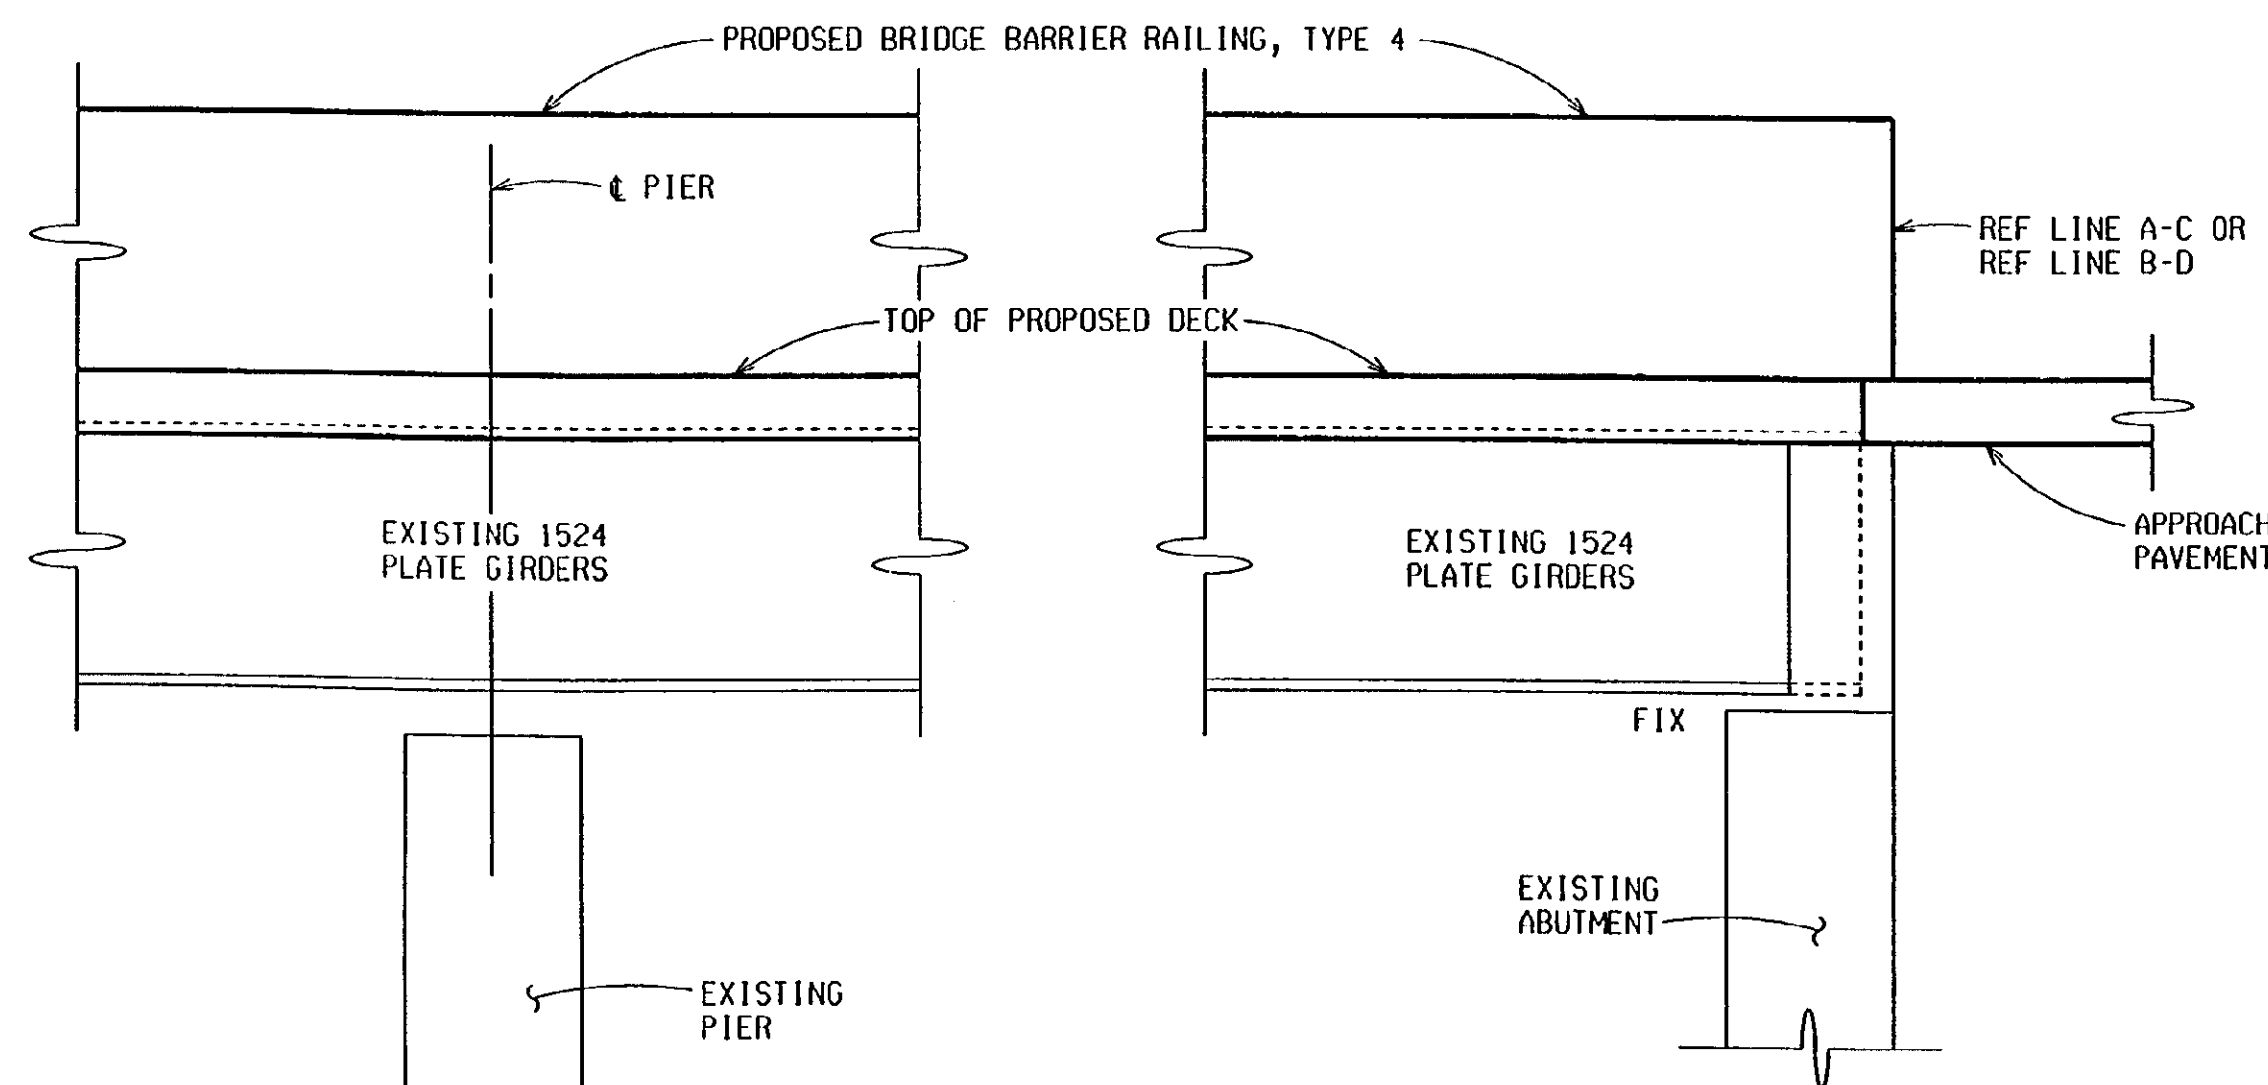

SECTION AT ABUTMENT

SECTION AT PIER

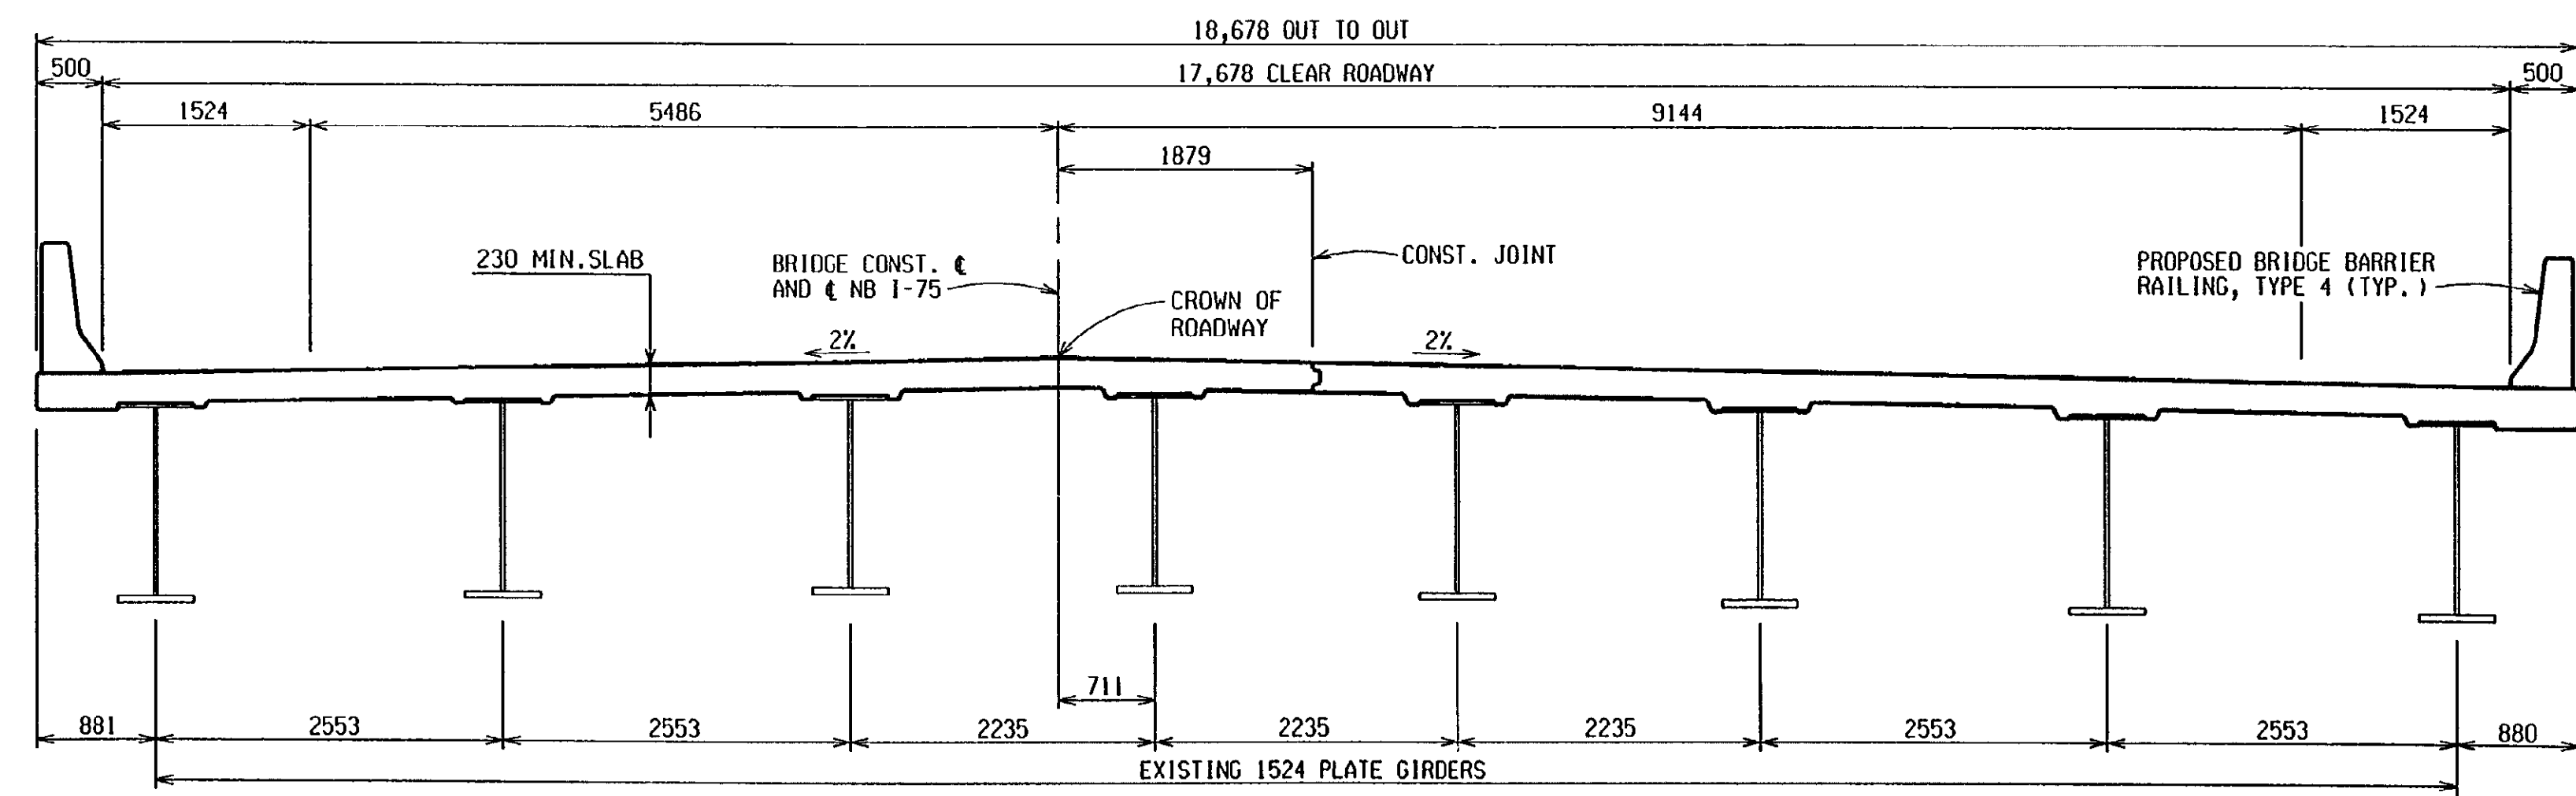






TYPICAL DECK SECTION - NB
 (LOOKING NORTH)

GENERAL PLAN OF STRUCTURE				
NB I-75 OVER RED RUN DRAIN IN MADISON HIEGHTS.				
DATE	CONT. SEC.	JOB NO.	DESIGN UNIT	SHEET
1-9-01	B02 OF 63174	49595A	MAHDAVI	4 OF 16

APPROVED *Steve P. Mader*
 DESIGN SUPERVISING ENGINEER




REVISIONS			
NO.	DESCRIPTION	DATE	BY

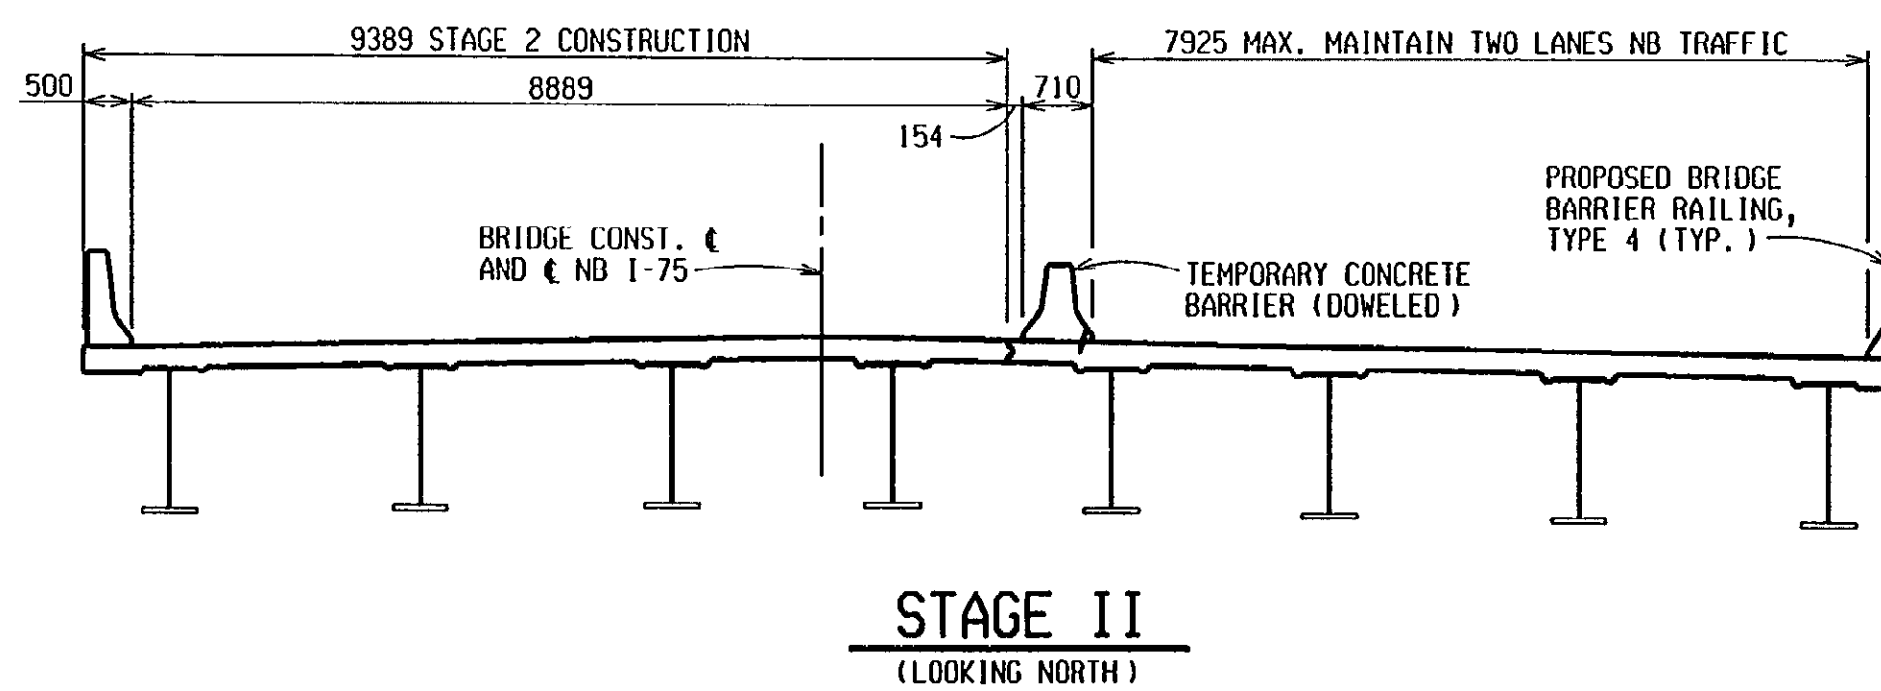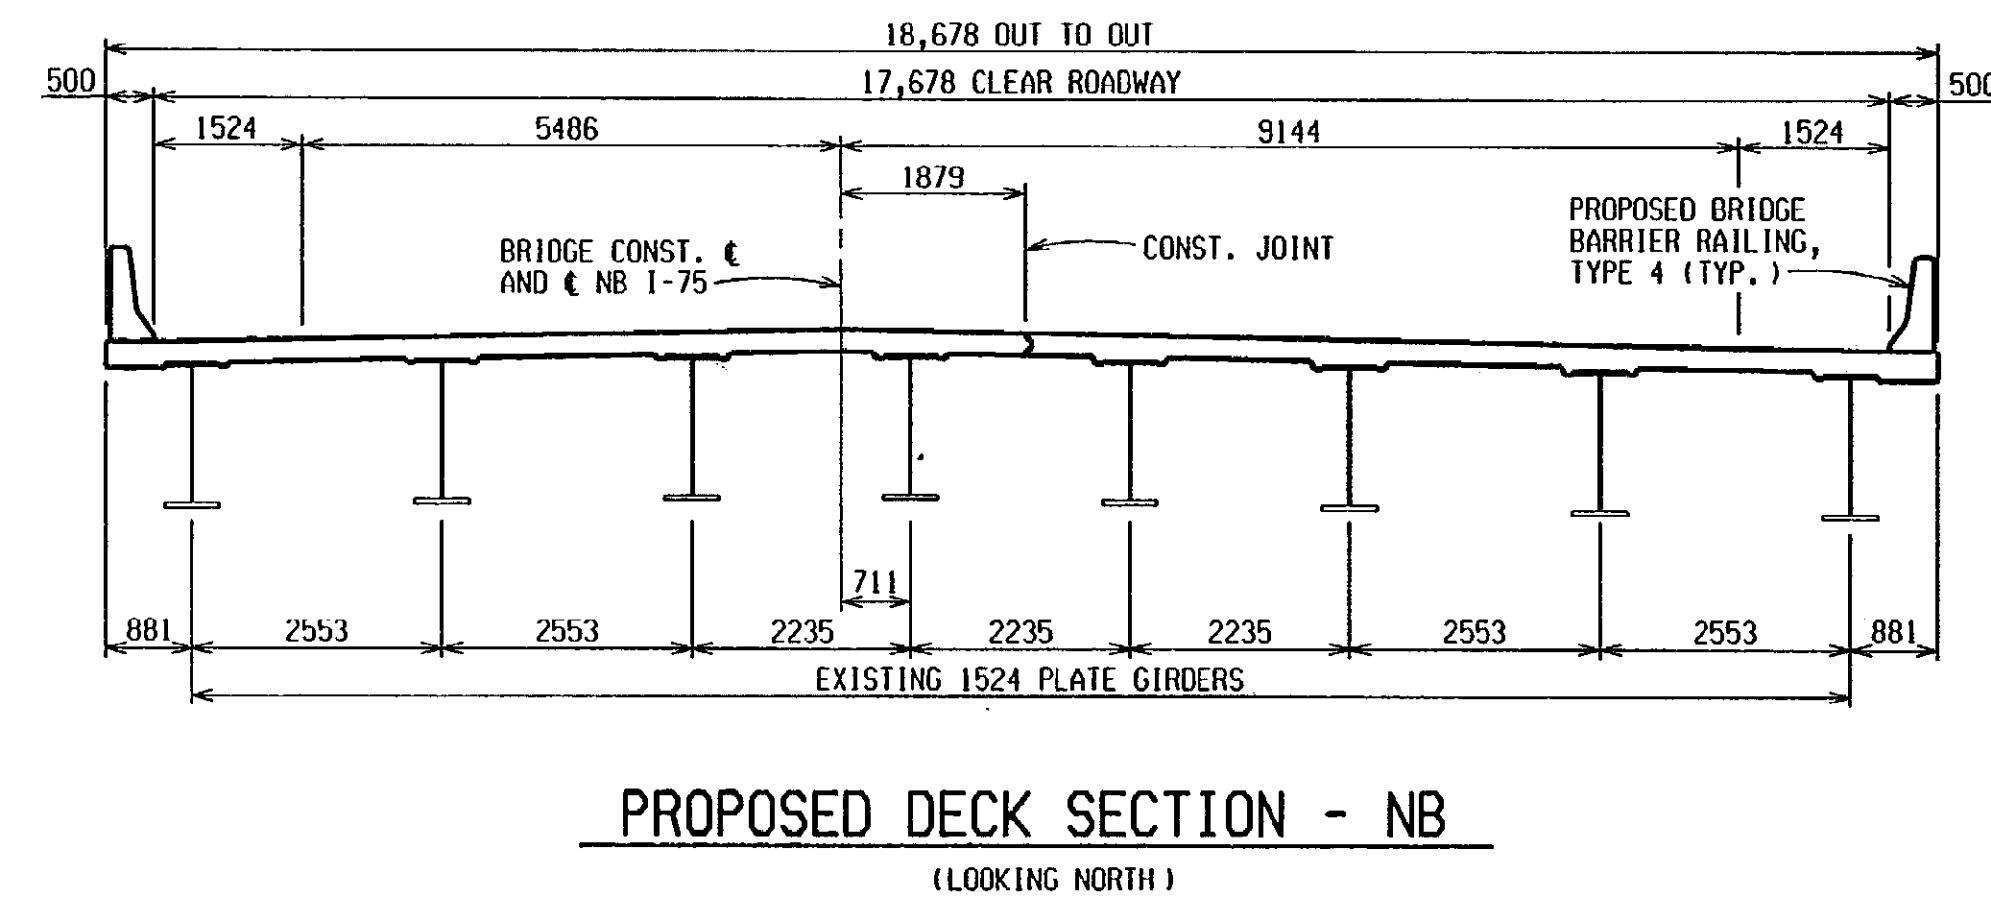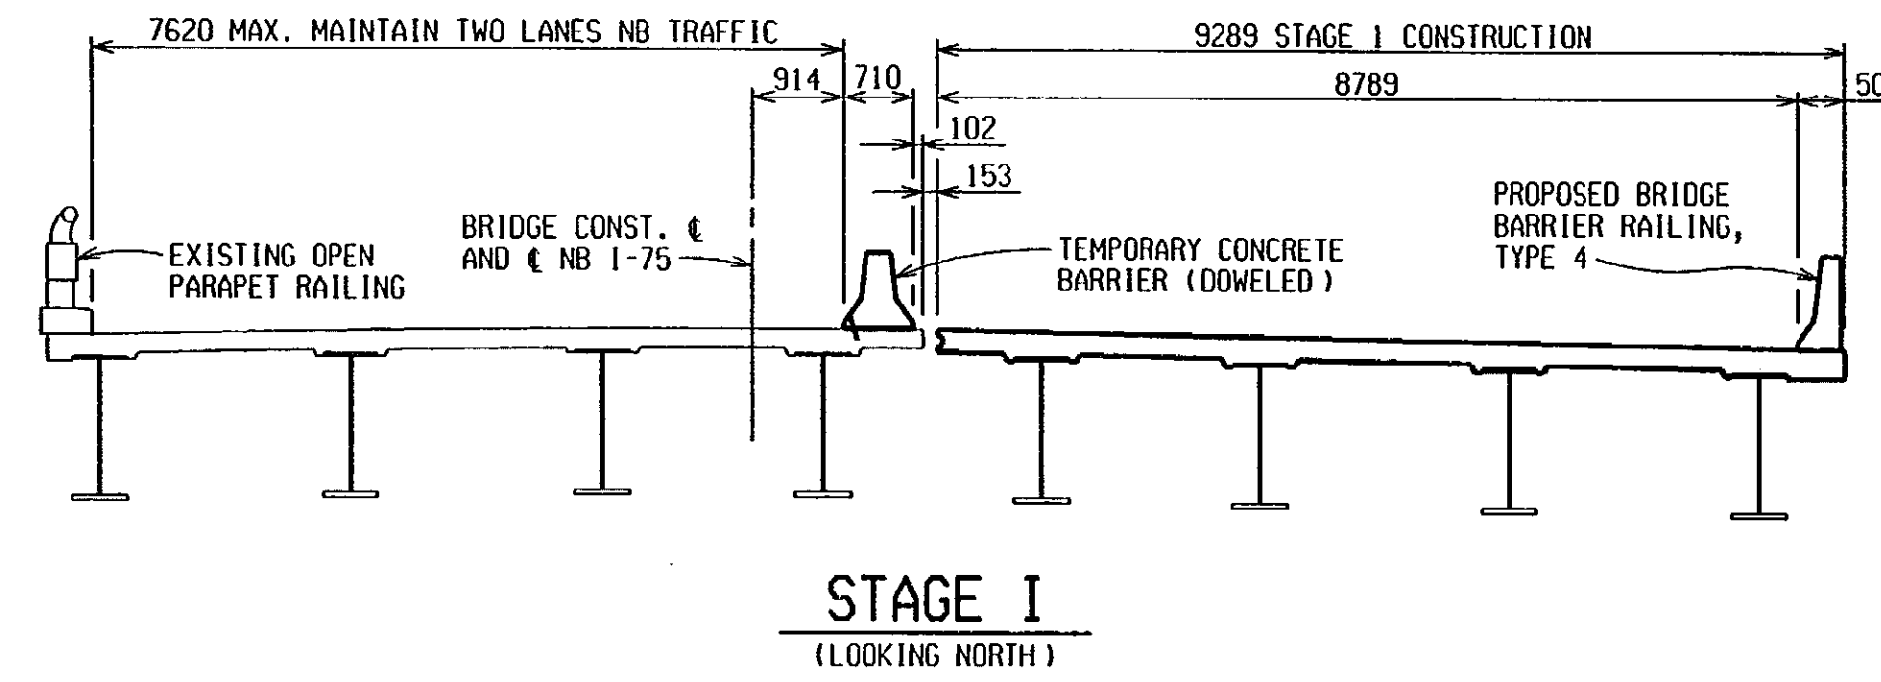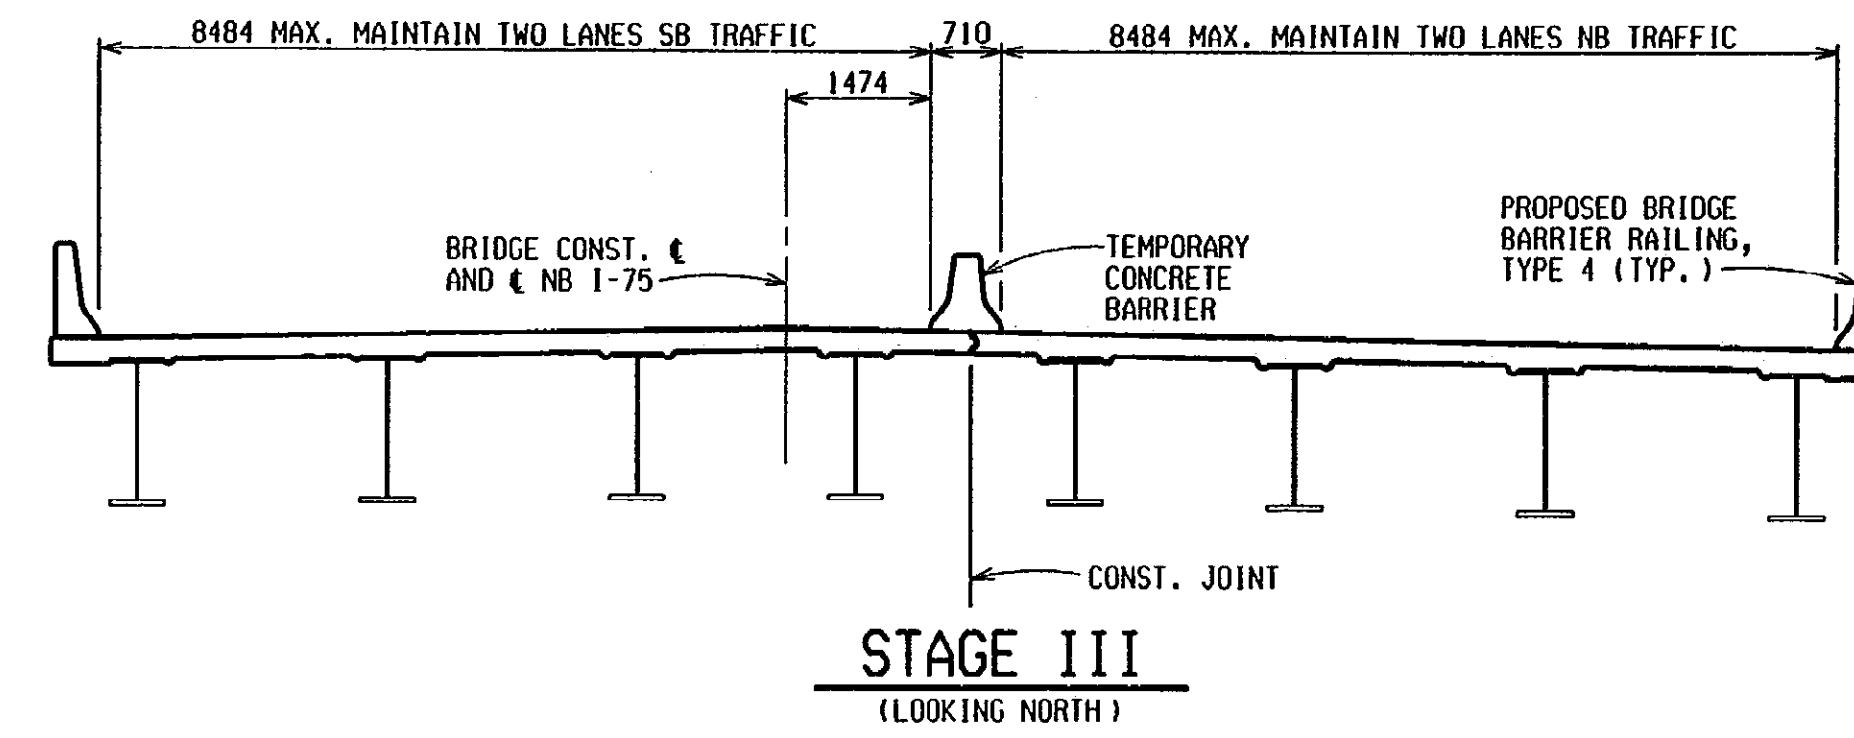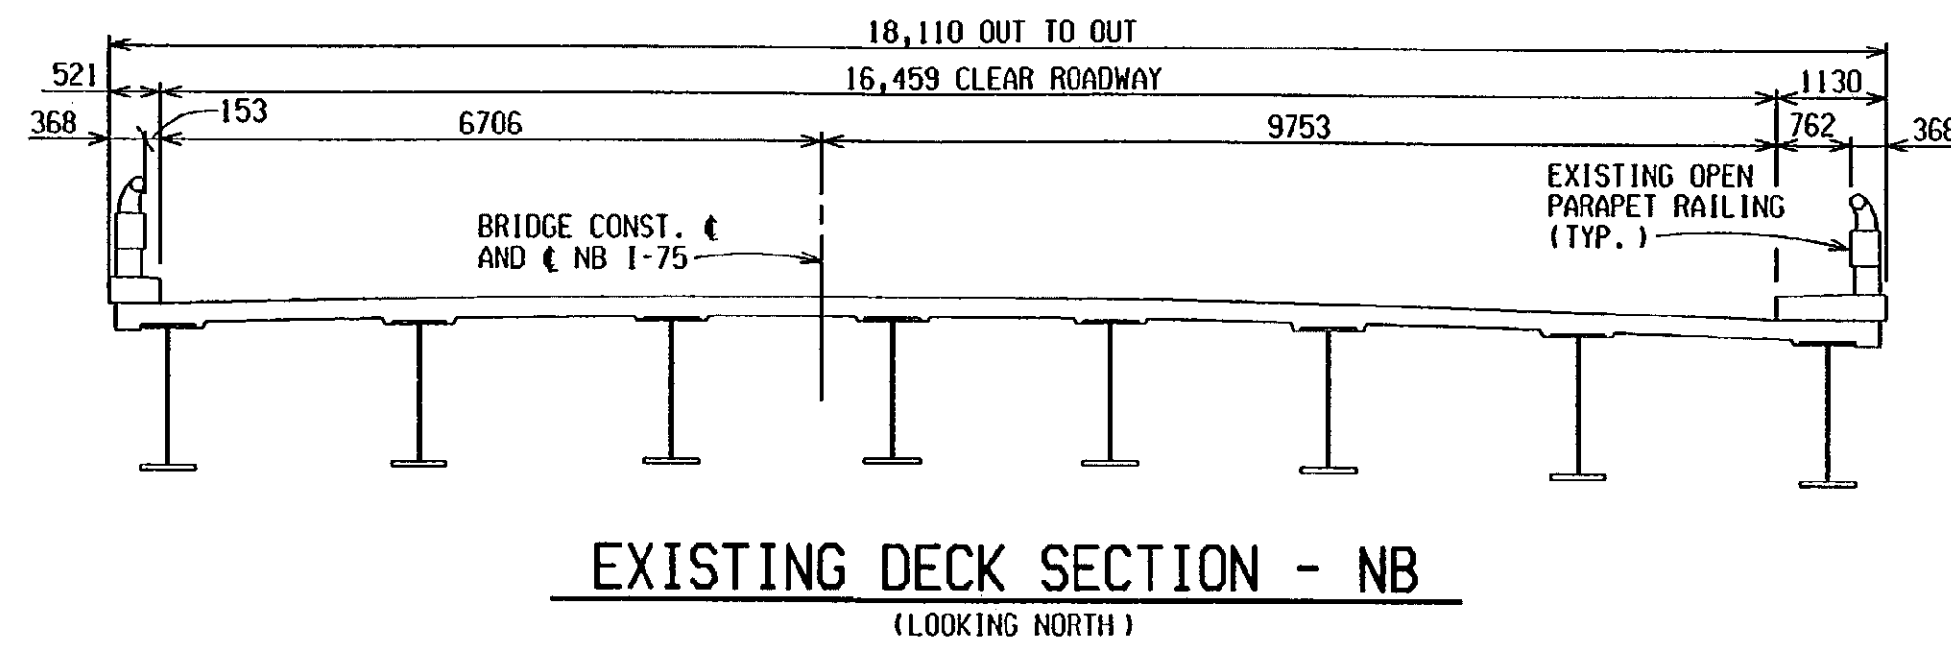

NOTES:


PLACEMENT OF TEMPORARY BARRIER SHALL BE ACCORDING TO STANDARD PLAN R-126 SERIES OR AS APPROVED BY THE ENGINEER. (INCLUDED IN THE PAY ITEM "CONCRETE BARRIER, TEMPORARY, FURNISHED")

THE TEMPORARY CONCRETE BARRIER SHALL BE ANCHORED TO THE DECK. FOR ANCHORAGE, DRILL HOLES IN THE LOWER SLOPING PORTION OF EACH BARRIER SECTION NEAR THE ENDS, ON THE TRAFFIC SIDE OF THE BARRIER AND CONTINUING INTO THE CONCRETE BELOW, THAT WILL ALLOW FOR 25mm STEEL DOWELS OR PEGS TO BE INSERTED. THESE DOWELS SHOULD BE EXTENDED 100mm INTO THE BARRIER, BUT NOT PROTRUDE ABOVE THE BARRIER SURFACE. AFTER REMOVAL OF THE TEMPORARY BARRIER AND STEEL DOWELS OR PEGS FROM THE NEW DECK, THE HOLES IN THE DECK SHALL BE FILLED WITH PATCHING MORTAR OR CONCRETE. THIS WORK SHALL BE INCLUDED IN THE BID ITEM "CONCRETE BARRIER, TEMP, FURN".


CONSTRUCTION STAGING DETAILS				
NB I-75 OVER RED RUN DRAIN IN MADISON HEIGHTS.				
	DATE	CONT. SEC.	JOB NO.	DESIGN UNIT
	1-9-01	B02 OF 63174	49595A	MAHDAVI
	SHEET			
	5 OF 16			

1 2 3 4 5 6 7 8 9 10 11 12 13 14 15 16 17 18 19 20 21 22 23 24 25 26 27 28 29 30 31 32 33 34 35 36 37 38 39 40 41 42 43 44 45 46 47 48 49 50 51 52 53 54 55 56 57 58 59 60 61 62 63


REVISIONS			
NO.	DESCRIPTION	DATE	BY

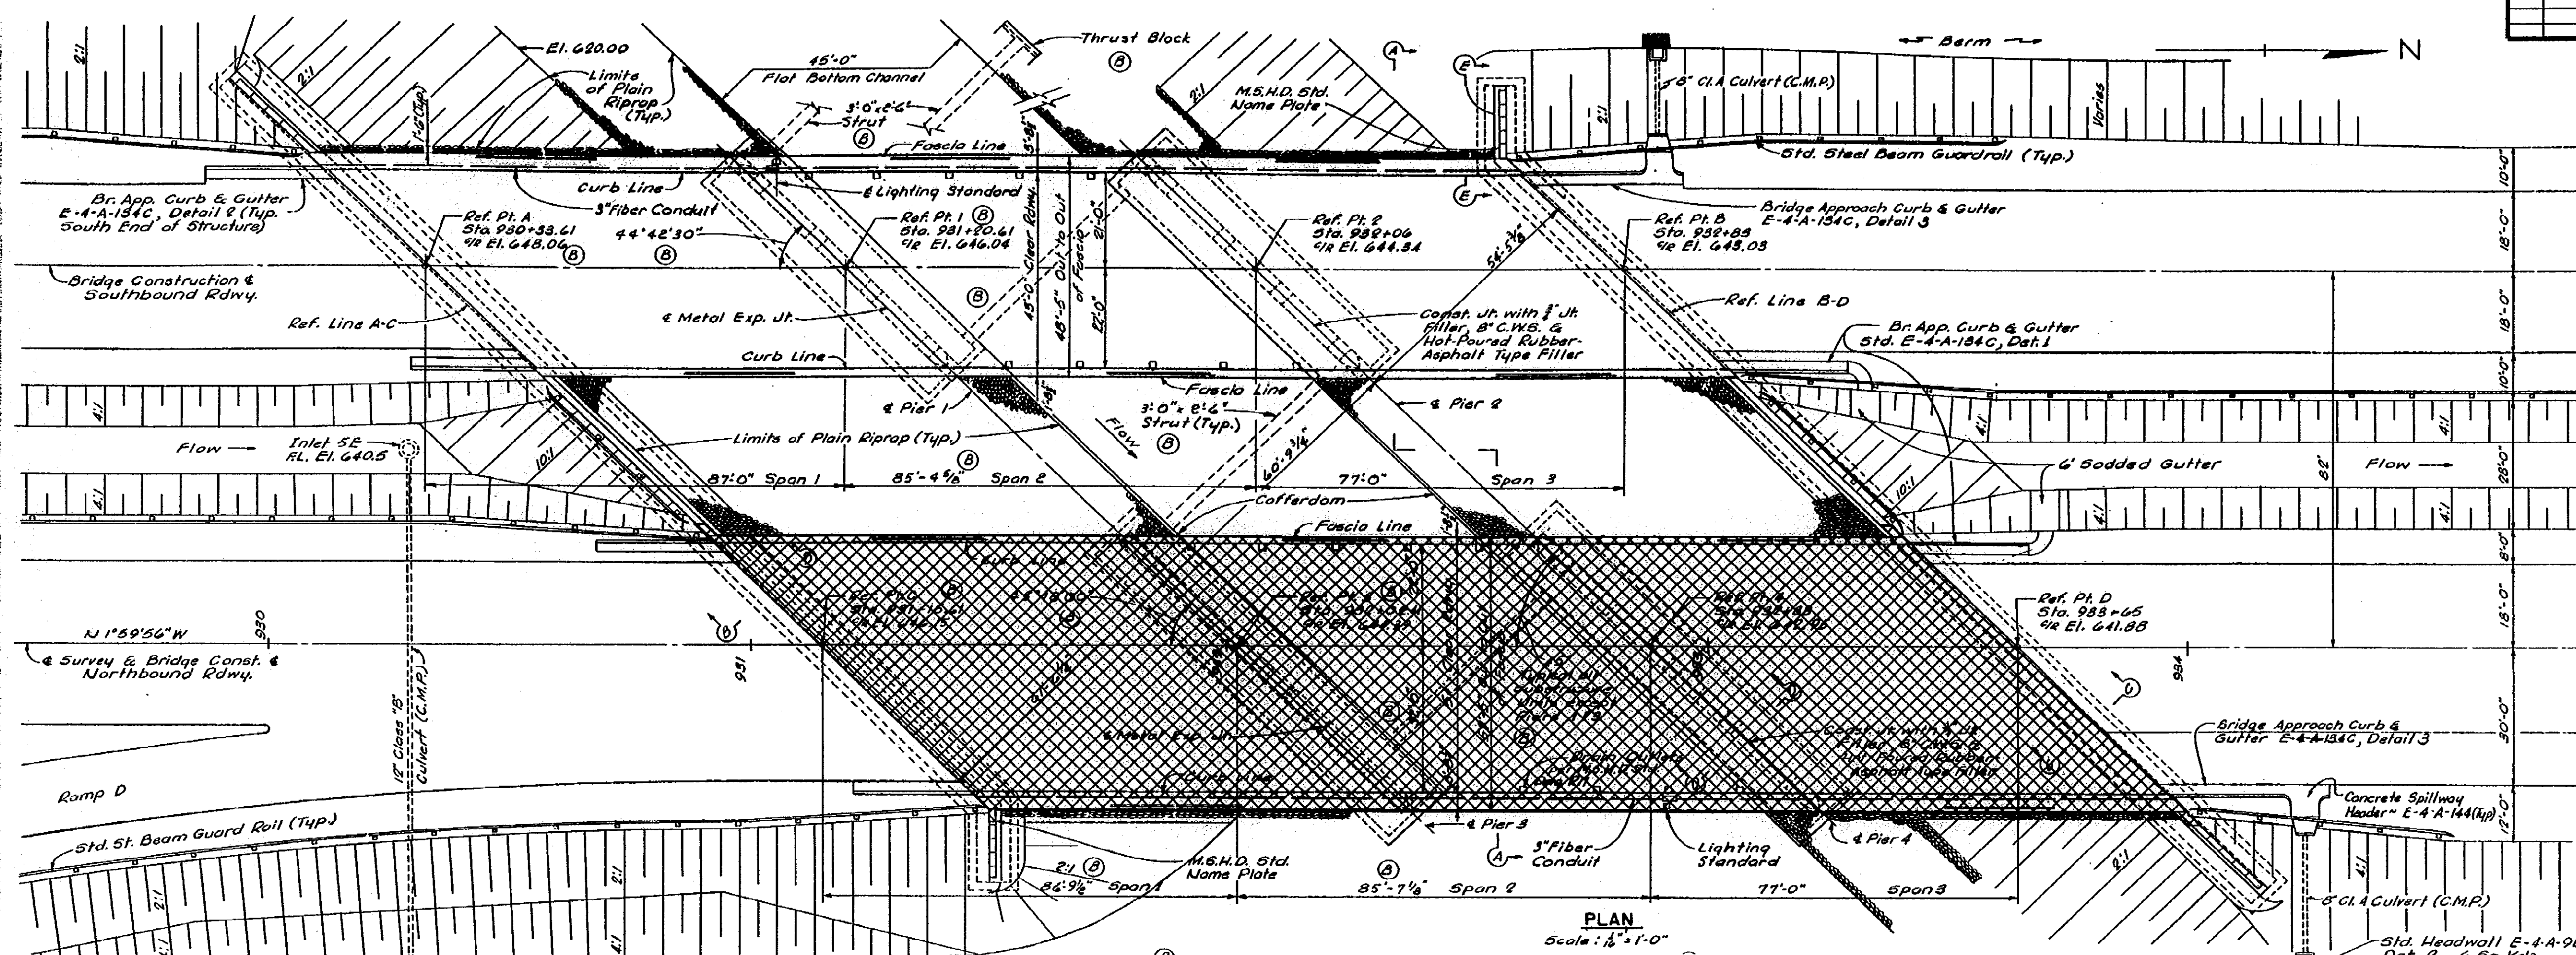

PLAN
Scale: 1/8" = 1'-0"
249'-4 3/8" (B)

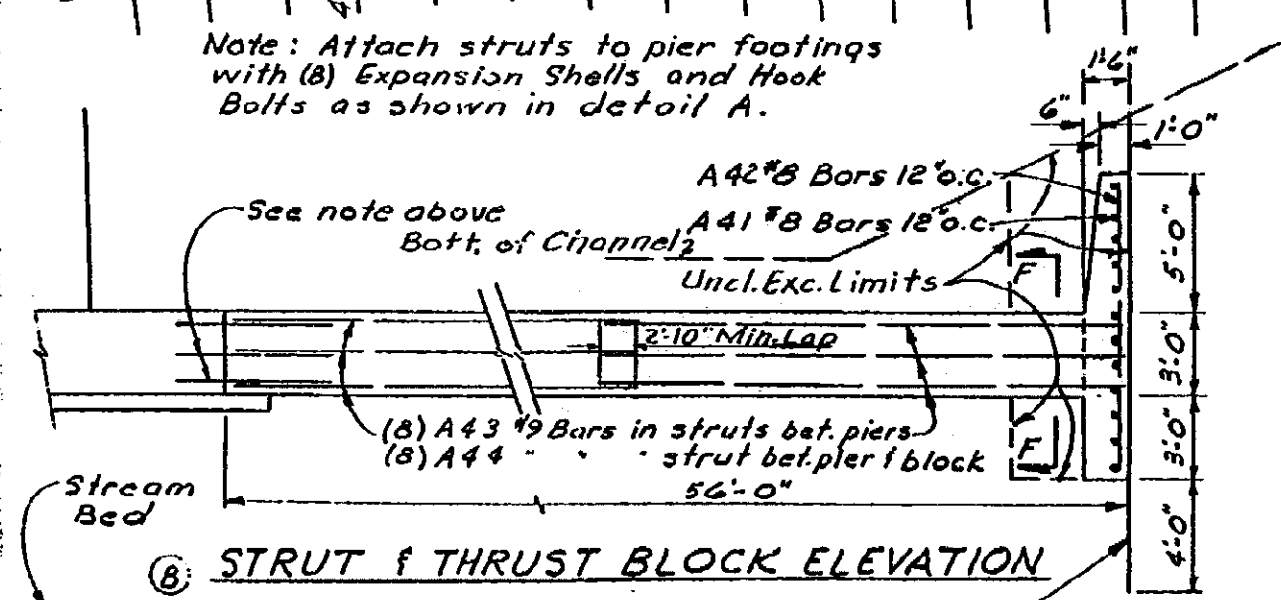

SECTION F-F

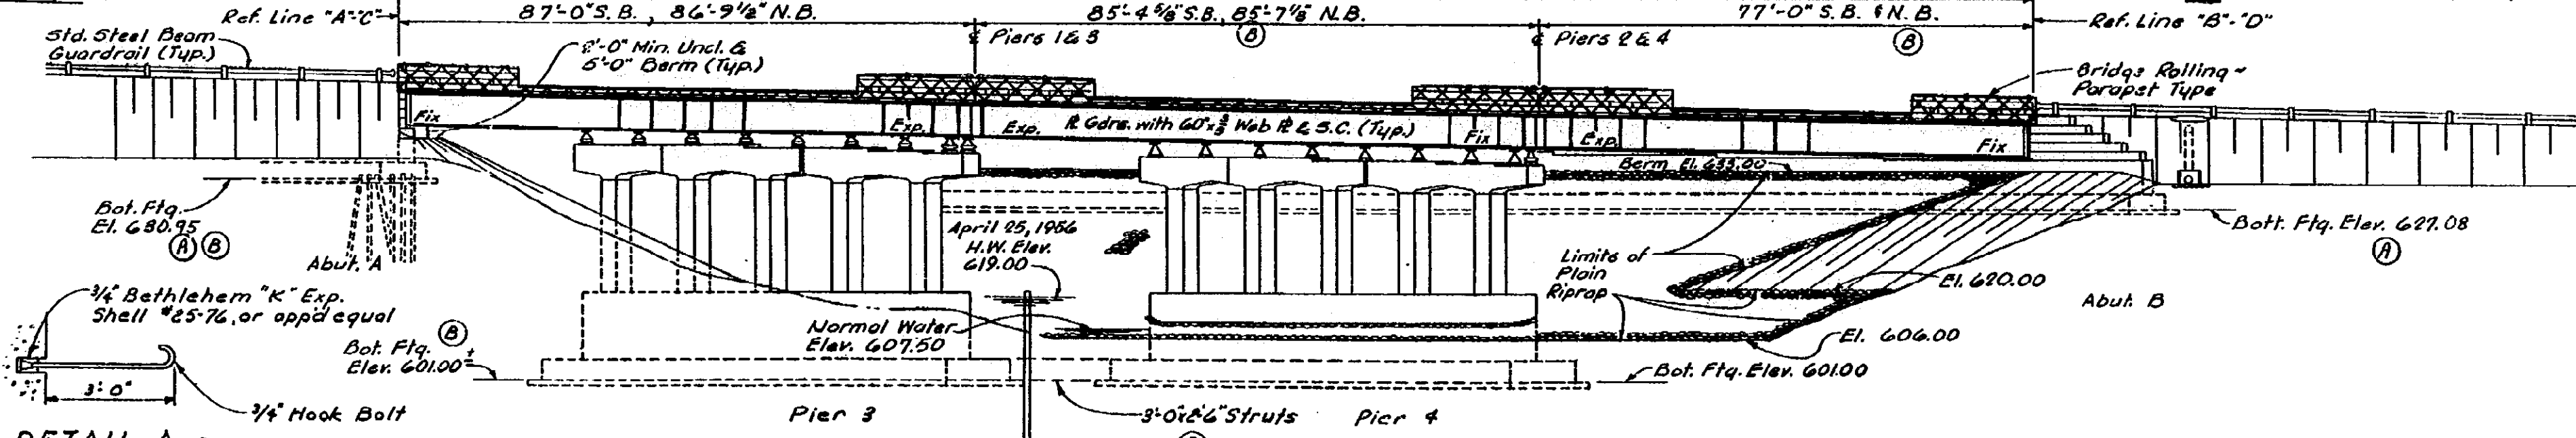

MISCELLANEOUS QUANTITIES		
ITEM	UNITS	AMOUNT
Parous Material Grade "A" (Compacted in Place)	Cu Yds	10360
Plain Riprap	Sq. Yds	1685*

* Quantity shown is for Plain Riprap under structure & above Elev. 620.00
Uncl. Exc. Limits

STRUT & THRUST BLOCK MISC. QUANT.		
Item	Unit	Amount
Unclassified Excavation	c.y.	200
6" A(4) Conc. Strut	c.y.	60
1/2" Expansion Shells	Each	56
1/4" Hook Bolts	Each	56
Steel Sheet Piling - Left in Place	s.f.	324

** Concrete for Thrust Block included in item G1A(4) Conc. - Strut

ELEVATION
Scale: 1/8" = 1'-0"

CONTROL SECTION 631741
MICHIGAN STATE HIGHWAY DEPARTMENT
 1-75 OVER RED RUN DRAIN IN THE CITY OF MADISON HEIGHTS
GENERAL PLAN OF STRUCTURE
TECON ENGINEERS, INC.
 APPROVED: *J.L. Murray* 6-5-62
 COORDINATING ENGINEER
 APPROVED: _____
 ENGINEER OF DESIGN - CONSULTANTS
 B02 OF 631741

THE ONLY ITEMS OF WORK TO BE DONE FROM THIS SHEET ARE IDENTIFIED BY THE LEGEND BOX BELOW, LABELED WITH THIS PROJECT'S JOB NUMBER.
JOB NO. 49595A
 [Hatched Box] DENOTES REMOVAL PORTIONS
 [White Box] PROPOSED WORK




REMOVAL PORTIONS - NB STRUCTURE				
DATE	CONT. SEC.	JOB NO.	DESIGN UNIT	SHEET
1-9-01	B02 OF 63174	49595A	MAHDAVI	6 OF 16


DATE: _____ CORRECTED BY: INDER CHECKED BY: INDER DATE: 02-11-00 DRAWN BY: INDER FILE NAME: 60263174.dwg

1 2 3 4 5 6 7 8 9 10 11 12 13 14 15 16 17 18 19 20 21 22 23 24 25 26 27 28 29 30 31 32 33 34 35 36 37 38 39 40 41 42 43 44 45 46 47 48 49 50 51 52 53 54 55 56 57 58 59 60 61 62 63


REVISIONS			
NO.	DESCRIPTION	DATE	BY

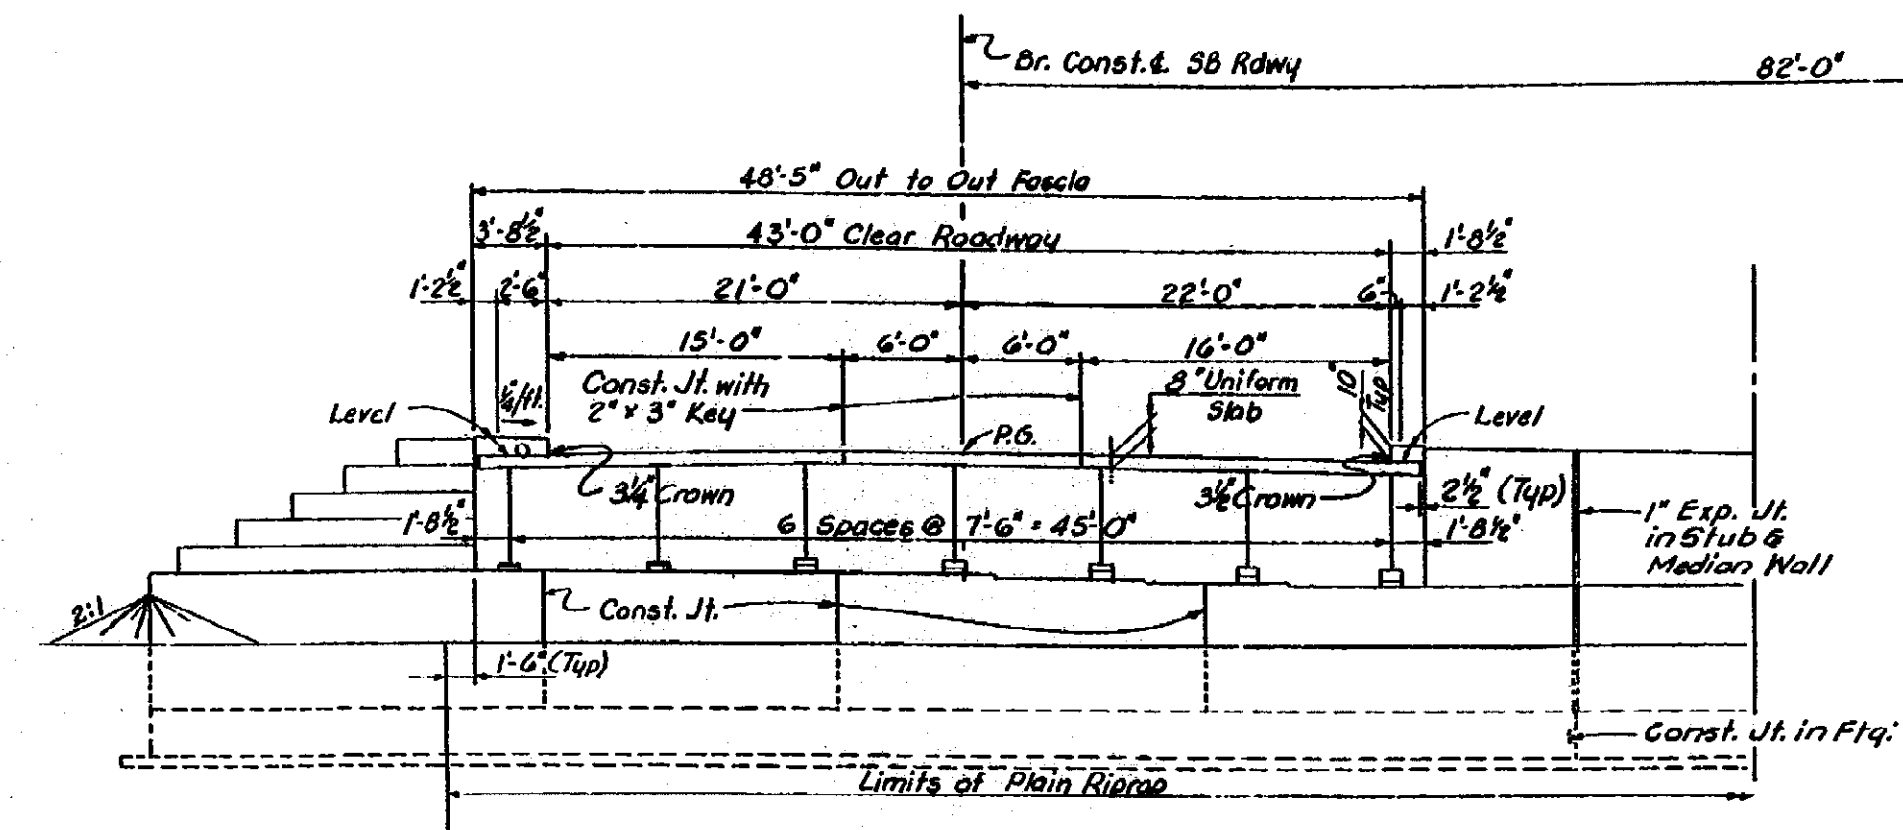


SECTION A-A
Scale: 1/8" = 1'-0"

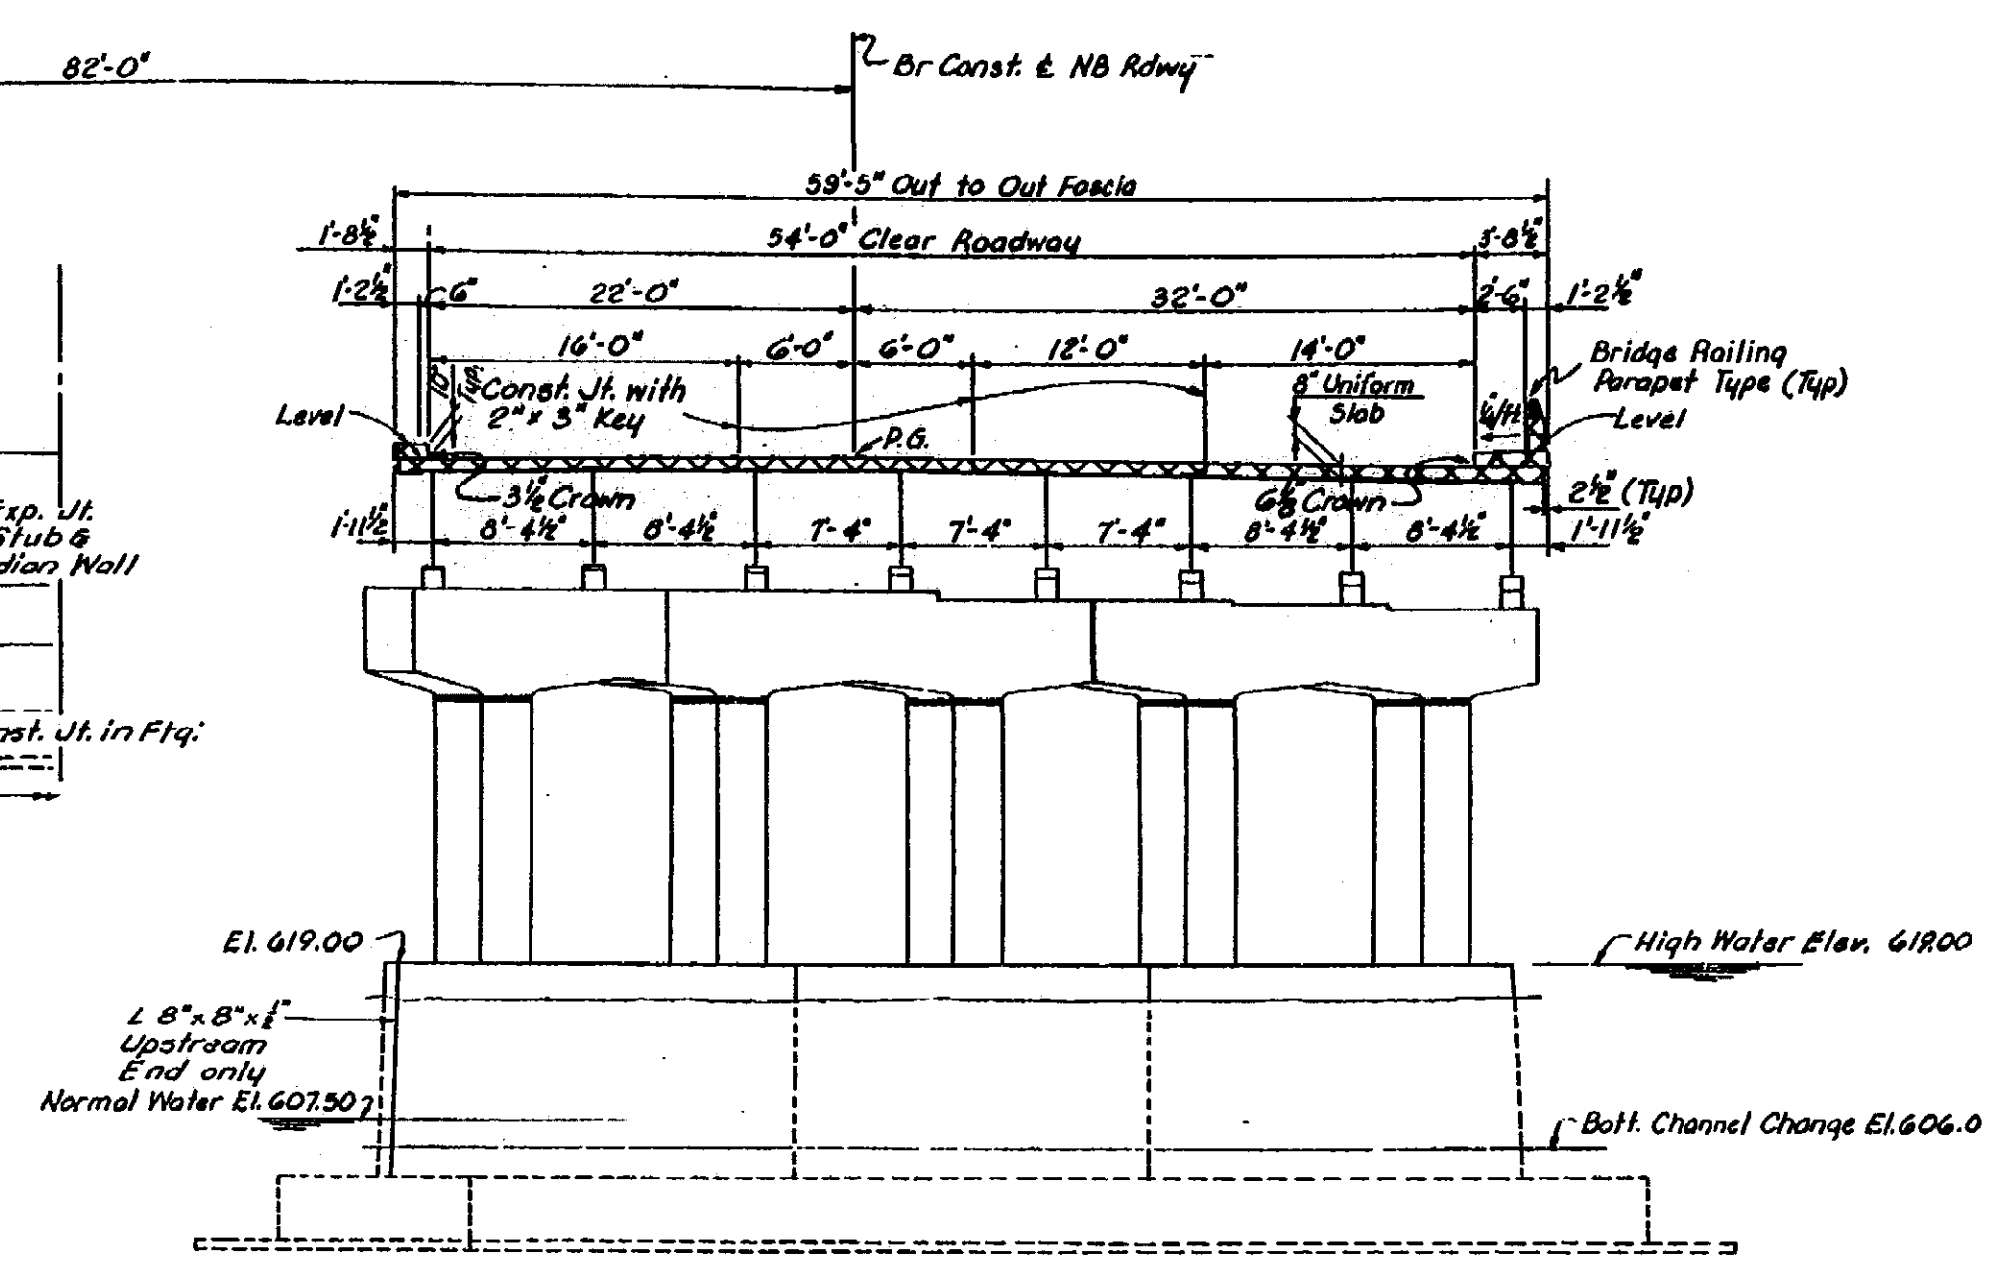


SECTION A-A
Scale: 1/8" = 1'-0"

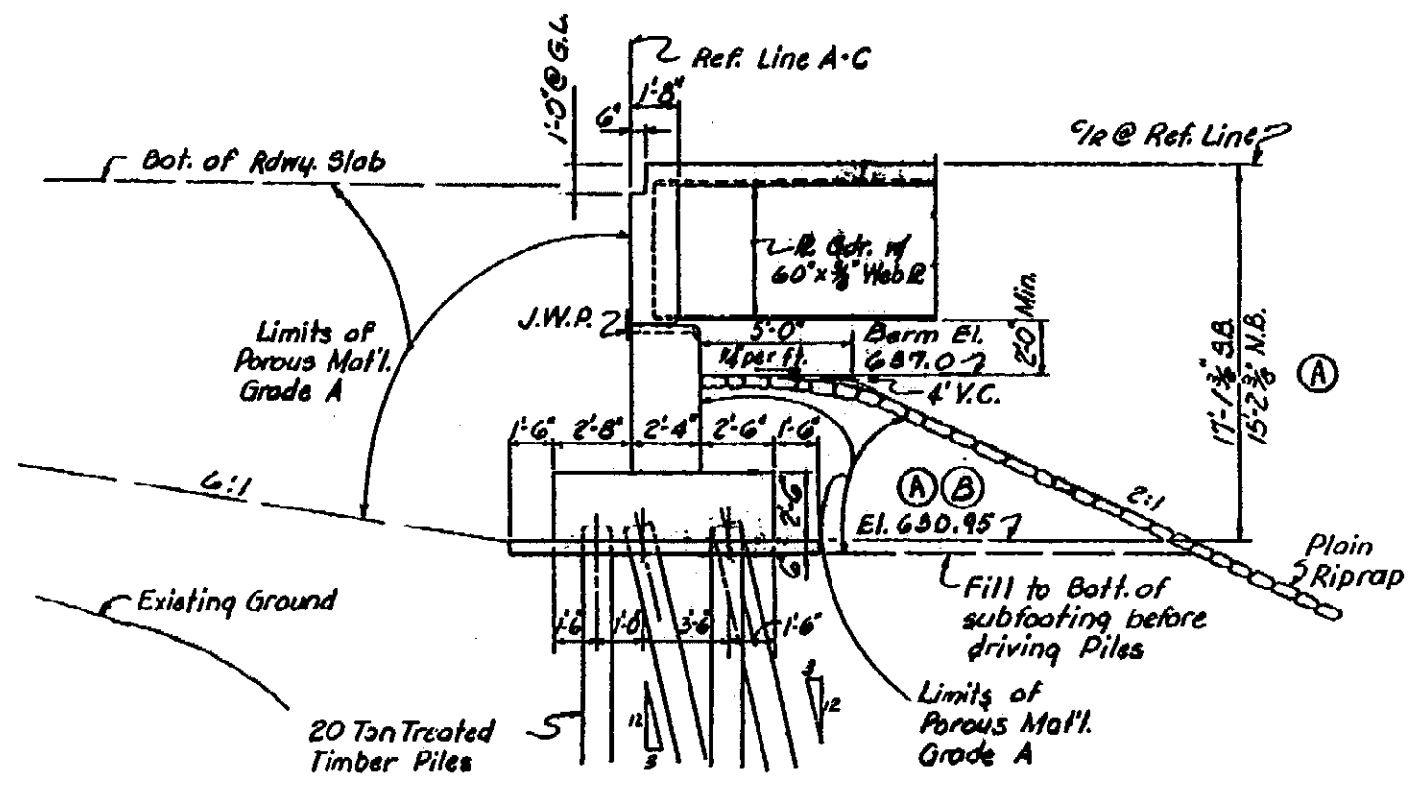

SECTION B-B
Scale: 1/16" = 1'-0"

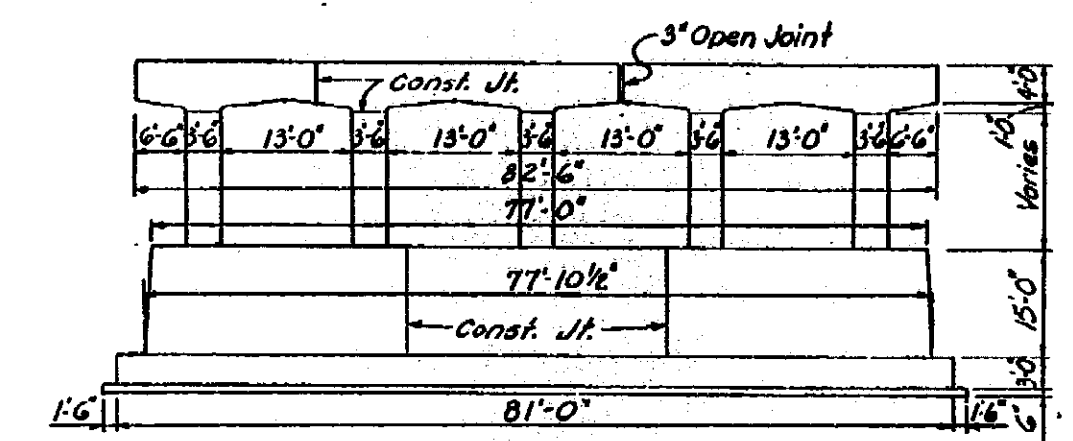


ELEVATION PIERS 3 & 4
No Scale

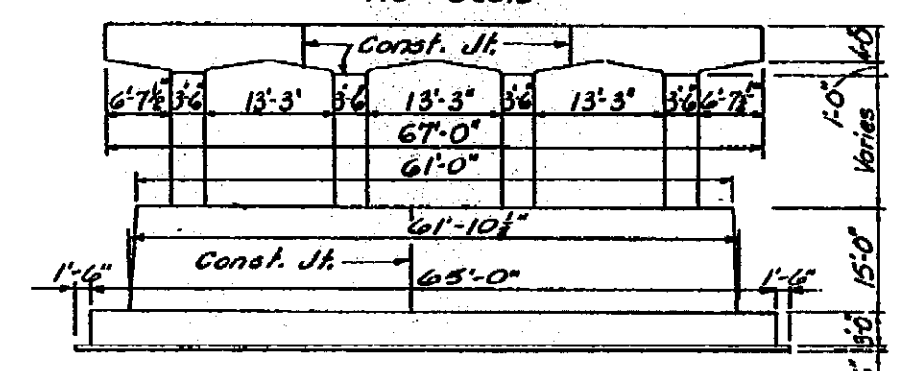


ELEVATION PIERS 1 & 2
No Scale


SAW CUT AND REMOVE EXISTING WALLS 300mm WIDE AND 584mm DEEP. (TYP. ALL QUADRANTS)

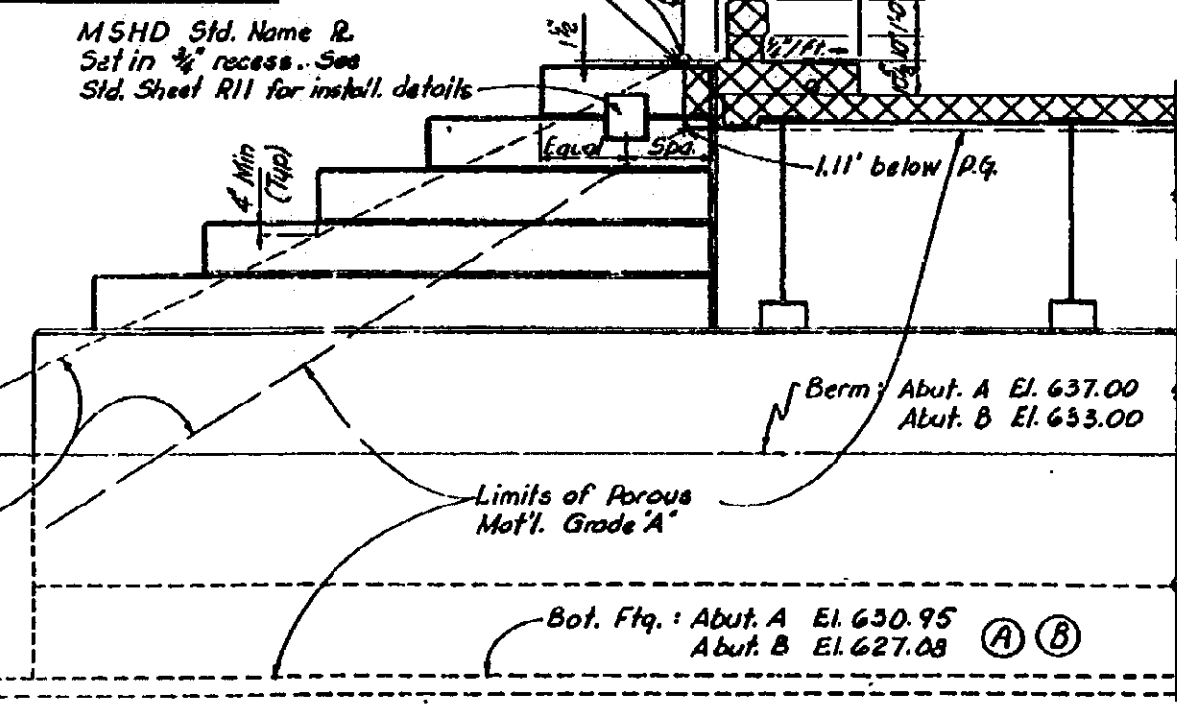


SECTION E-E
Scale: 1/4" = 1'-0"

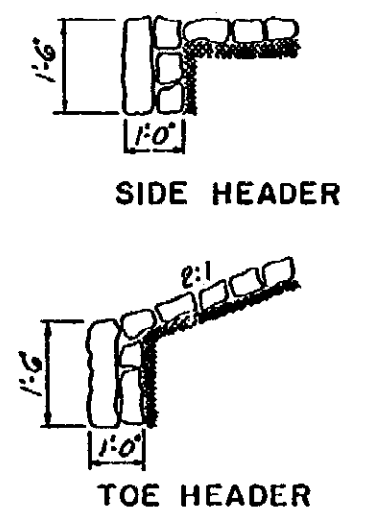

RIPRAP HEADER DETAILS
(Incidental to Plain Riprap)

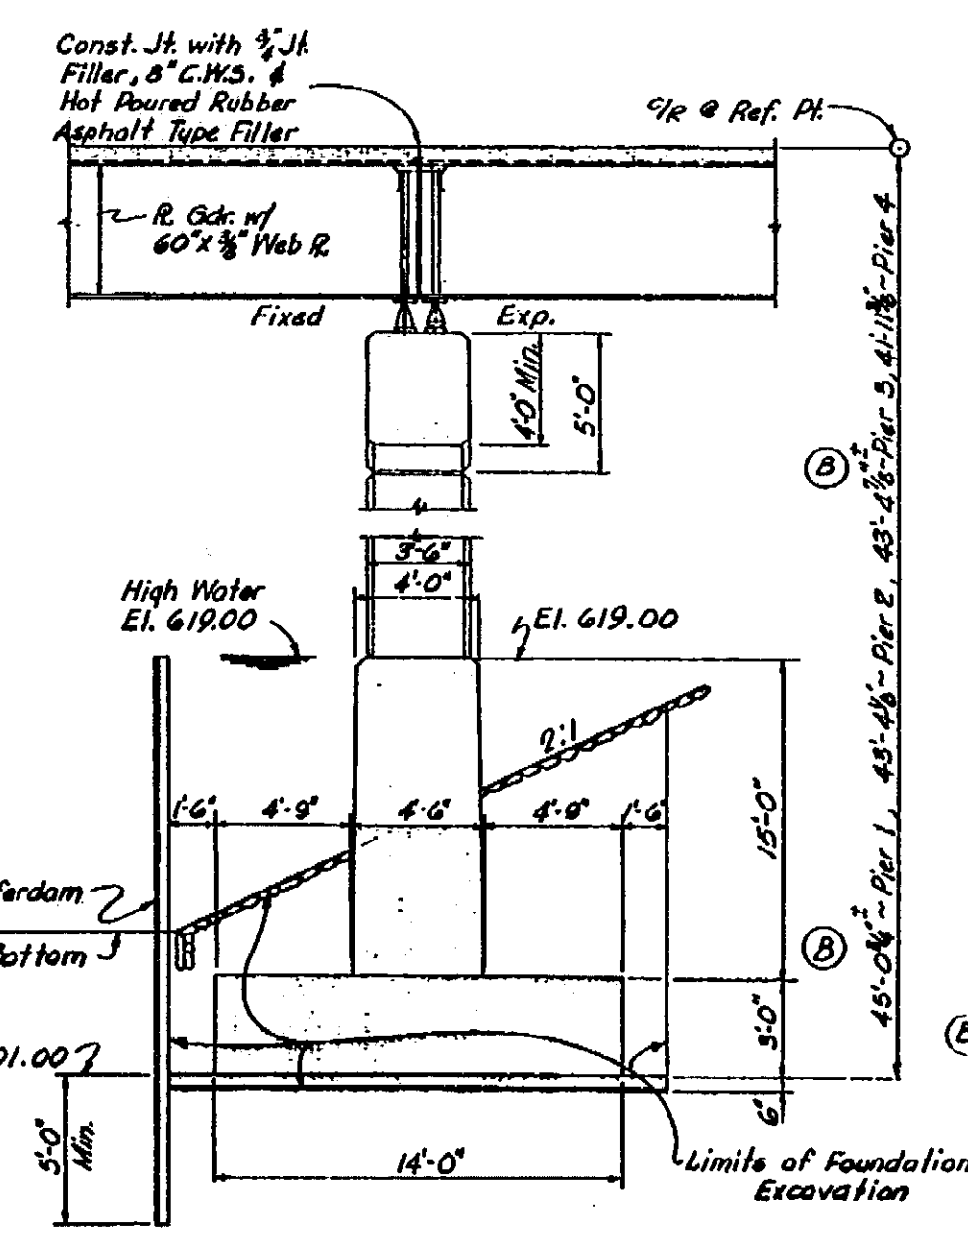

SECTION D-D
Scale: 1/16" = 1'-0"

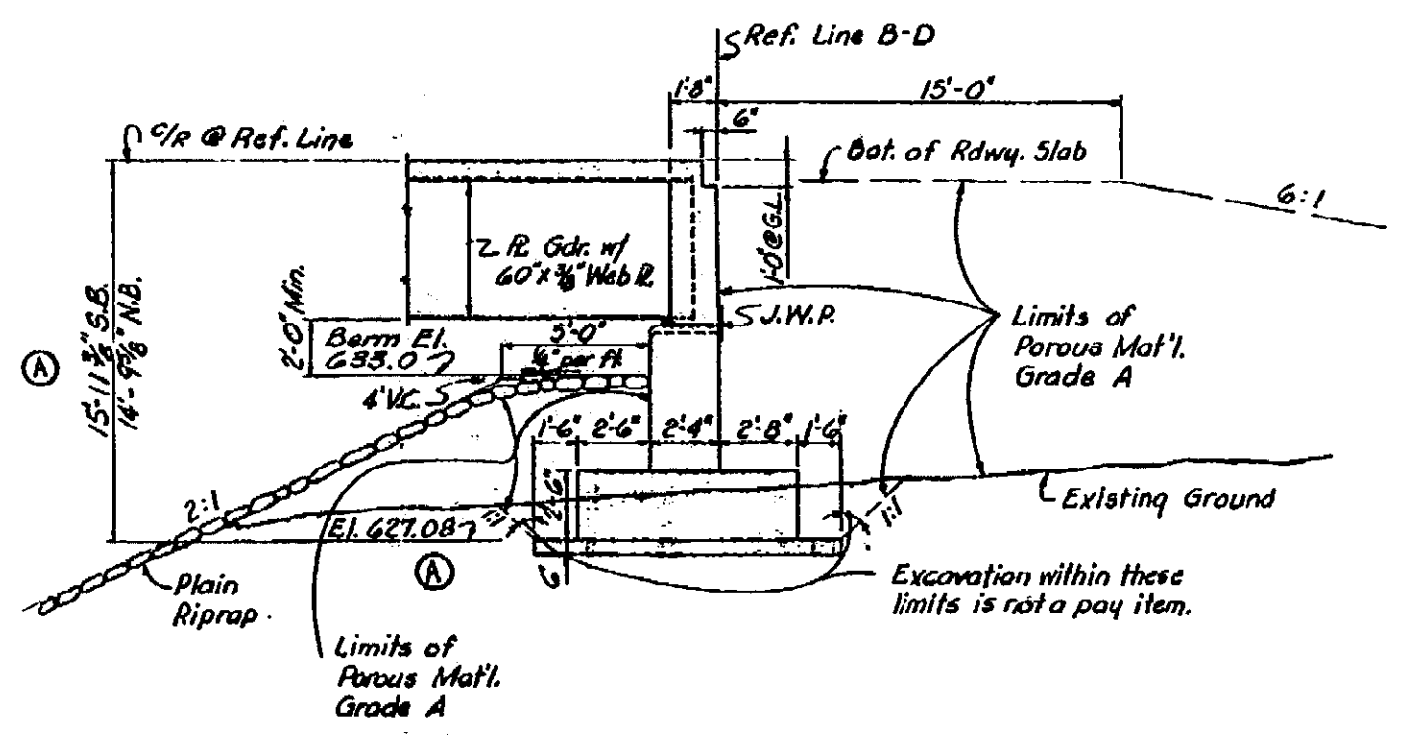

SECTION C-C
Scale: 1/16" = 1'-0"

GENERAL NOTES
The waterway area supplied below high water elevation 619.00 is 850 square feet. Top of roadway slab and tops of curbs are parallel to the vertical curve. Proposed pavements, curb and gutter, guard rail, drainage structures, earth fill, and sand sub-base on the expressway and ramp are not a part of this contract. The design of this structure is based on the M.S.H.D. Standard Specifications for the Design of Highway Bridges - 1988 Edition - H20-516-44 and alternate military loading. Live load plus impact deflection = 1/1000 of span length.
(B) For strut details, see sh. 191.


THE ONLY ITEMS OF WORK TO BE DONE FROM THIS SHEET ARE IDENTIFIED BY THE LEGEND BOX BELOW, LABELED WITH THIS PROJECT'S JOB NUMBER.
JOB NO. 49595A
[Hatched Box] DENOTES REMOVAL PORTIONS
[Solid Box] PROPOSED WORK

CONTROL SECTION 631741
MICHIGAN STATE HIGHWAY DEPARTMENT
175 OVER RED RUN DRAIN IN THE CITY OF MADISON HEIGHTS
GENERAL PLAN OF STRUCTURE
TECON ENGINEERS, INC.
APPROVED: *J.W. Murray* 6-5-62
ENGINEER OF DESIGN - CONSULTANTS
BO2 OF 631741


REMOVAL PORTIONS - NB STRUCTURE				
DATE	CONT. SEC.	JOB NO.	DESIGN UNIT	SHEET
1-9-01	BO2 OF 63174	49595A	MAHDAVI	7 OF 16



DATE: _____ CHECKED BY: _____ CORRECTED BY: _____ INDCR DATE: _____ FILE NAME: 602631745n

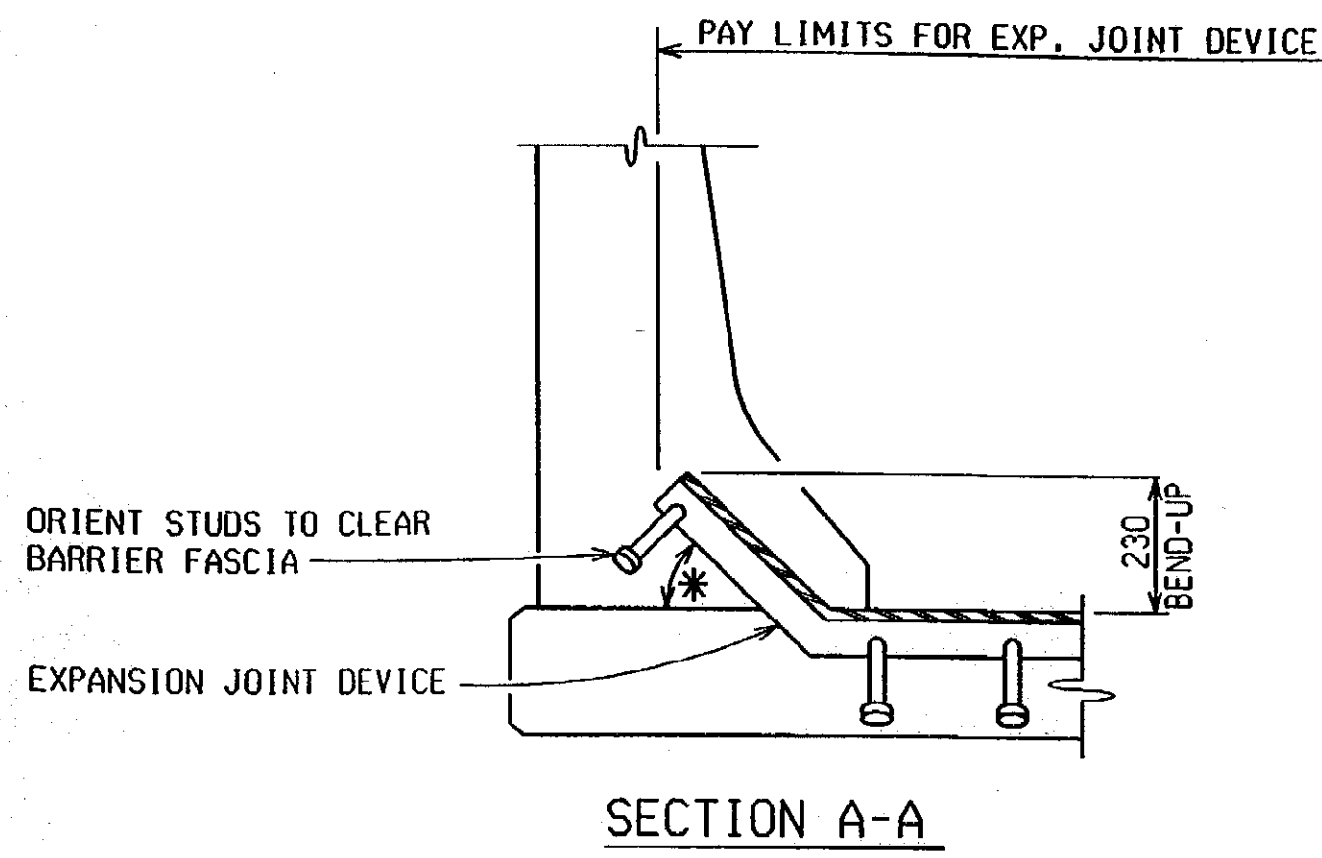

*-FOR ANGLES OF CROSSING FROM 90° TO 45° INCLUSIVE, BEND ANCHORAGE UP 45° ALONG C EXPANSION JT. FOR ANGLES OF CROSSING LESS THAN 45°, A SPECIAL ENDING MAY BE REQUIRED.

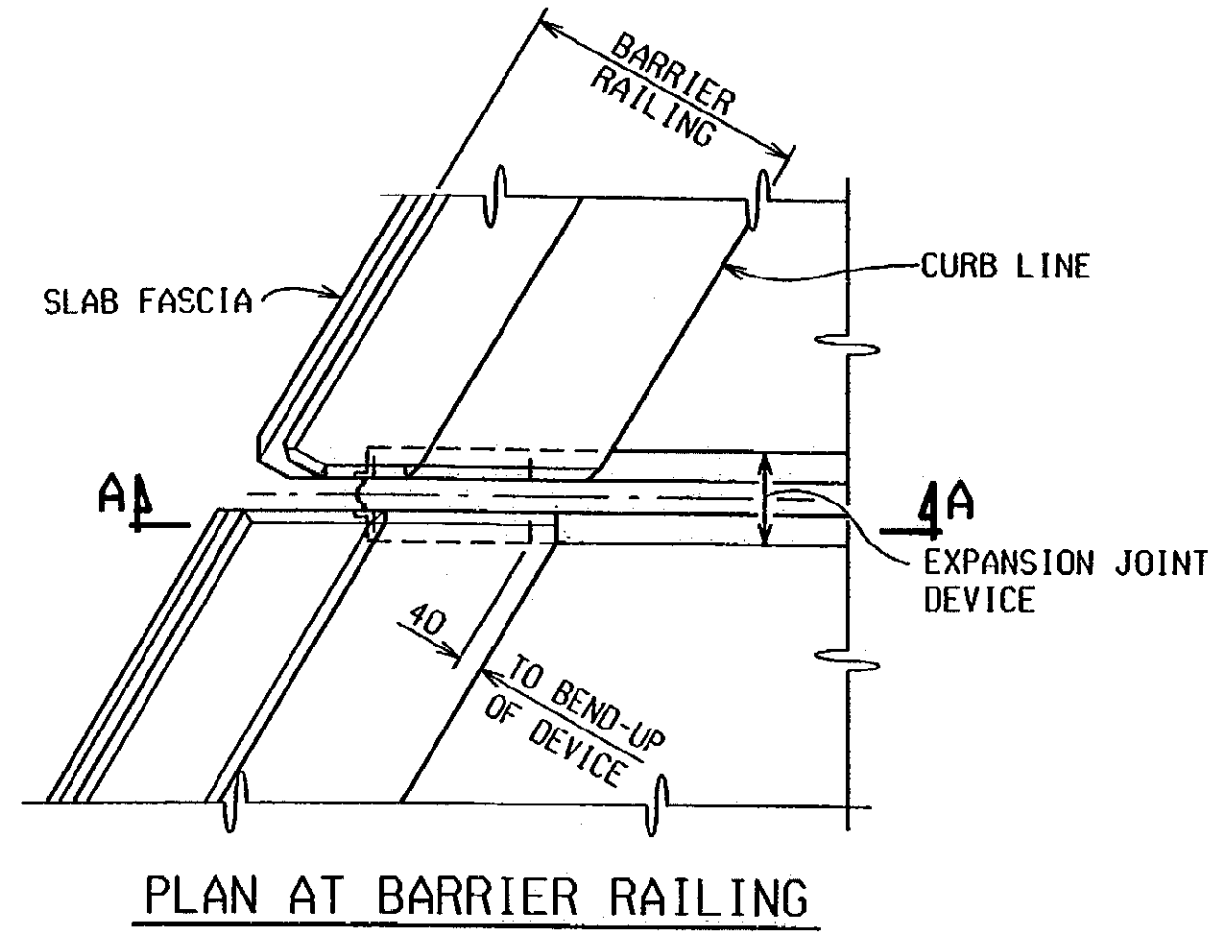

BARRIER TREATMENT

NOTES:

JOINT TYPES:

THE EXPANSION JOINT DEVICE SHALL BE OF A TYPE THAT INCLUDES A CONTINUOUS NEOPRENE (OR EQUIVALENT) SEAL ACROSS THE DECK. UNLESS OTHERWISE NOTED ON THE PLANS, THE CONTRACTOR HAS THE OPTION OF USING ANY OF THE DEVICES LISTED BELOW:

DEVICE	MANUFACTURER
WABO STRIP SEAL	WATSON-BOWMAN & ACME, INC.
PRO-SPAN	FEL-PRO, INC.
STEEFLLEX-SSA2	D.S. BROWN
STEEFLLEX-SSCM	D.S. BROWN
STEEFLLEX-RS	D.S. BROWN
ONFLEX 40 SS	STRUCTURAL RUBBER PRODUCTS CO.
STRUPCO 400L	STRUCTURAL RUBBER PRODUCTS CO.

THE MODEL OF THE JOINT TYPE SELECTED SHALL BE SUITABLE TO ACCOMMODATE THE TOTAL MOVEMENT NOTED ON THE PLANS.

COMPLETE WORKING DRAWINGS OF ALL DETAILS OF FABRICATION OF THE EXPANSION JOINT DEVICE SHALL BE SUBMITTED FOR REVIEW IN ACCORDANCE WITH STANDARD SPECIFICATION 104.02. THIS REQUIREMENT IS WAIVED FOR EXPANSION JOINT DEVICES FOR WHICH A SET OF STANDARD INSTALLATION DETAILS HAS BEEN APPROVED. STANDARD INSTALLATION DETAILS CAN BE OBTAINED FROM THE DESIGN DIVISION.

FABRICATION AND INSTALLATION:

THE EXPANSION JOINT SHALL BE SHOP FABRICATED TO CONFORM TO THE CONTOUR OF THE BRIDGE DECK, BARRIERS, ETC. IT SHALL BE INSTALLED IN ACCORDANCE WITH MANUFACTURER'S RECOMMENDATIONS SUBJECT TO NOTES HEREIN AND THE APPROVAL OF THE ENGINEER.

THE TOP OF THE ELASTOMERIC JOINT DEVICE SHALL BE SET 3 - 6 mm BELOW THE CONCRETE SLAB (PAVEMENT) WITH A TOLERANCE OF ± 3 mm.

THE STEEL ANCHORAGE FOR STRIP SEAL GLANDS SHALL BE HOT DIP GALVANIZED IN ACCORDANCE WITH SUBSECTION 707.16 OF THE STANDARD SPECIFICATIONS.

THE PRO-SPAN DEVICE MUST INCORPORATE A CAST-IN-PLACE STEEL SEAT.

THE AREA OF THE STEEL ANCHORAGE AND SEALING GLAND WHICH WILL BE IN CONTACT WITH A SEALANT, OR LUBRICANT-ADHESIVE SHALL BE CLEANED WITH TOLUENE OR OTHER APPROVED SOLVENT.

WHERE THE SEALING GLAND IS LOCKED INTO A STEEL ANCHORAGE, A LUBRICANT-ADHESIVE CONFORMING TO STANDARD SPECIFICATION 914.4-E SHALL BE REQUIRED BETWEEN THE SEAL AND STEEL ANCHORAGE.

ALL BOLT WELL CAVITIES SHALL BE FILLED WITH AN APPROVED FLEXIBLE EPOXY OR A SEALANT CONFORMING TO FEDERAL SPECIFICATION TT-S-00230C.

IN THE EVENT THAT THE CONSTRUCTION SEQUENCE REQUIRES SPLICING THE SEALING GLAND, IT SHALL BE SPLICED BY AN APPROVED METHOD (SUCH AS COLD VULCANIZATION) BY A TRAINED REPRESENTATIVE OF THE MANUFACTURER.


DETAILS AT CURBS OR BARRIERS:

THE DETAILS ON THIS SHEET SHOW AN APPROVED MEANS OF TERMINATING THE EXPANSION JOINT DEVICE AT CURBS OR BARRIERS. VARIATIONS OR ALTERNATIVE SCHEMES WILL BE CONSIDERED AND MAY BE USED IF APPROVED BY THE ENGINEER.


MATERIALS:

THE COST OF ALL MATERIALS AND LABOR REQUIRED FOR PROPER INSTALLATION OF THE EXPANSION JOINT AND THE TERMINAL ASSEMBLIES AT THE CURBS, SIDEWALKS, OR BARRIERS IS INCLUDED IN THE PAYMENT FOR THE EXPANSION JOINT DEVICE.

ITEM	QUANTITY	UNIT	AMOUNT
EXPANSION JOINT DEVICE		m	53

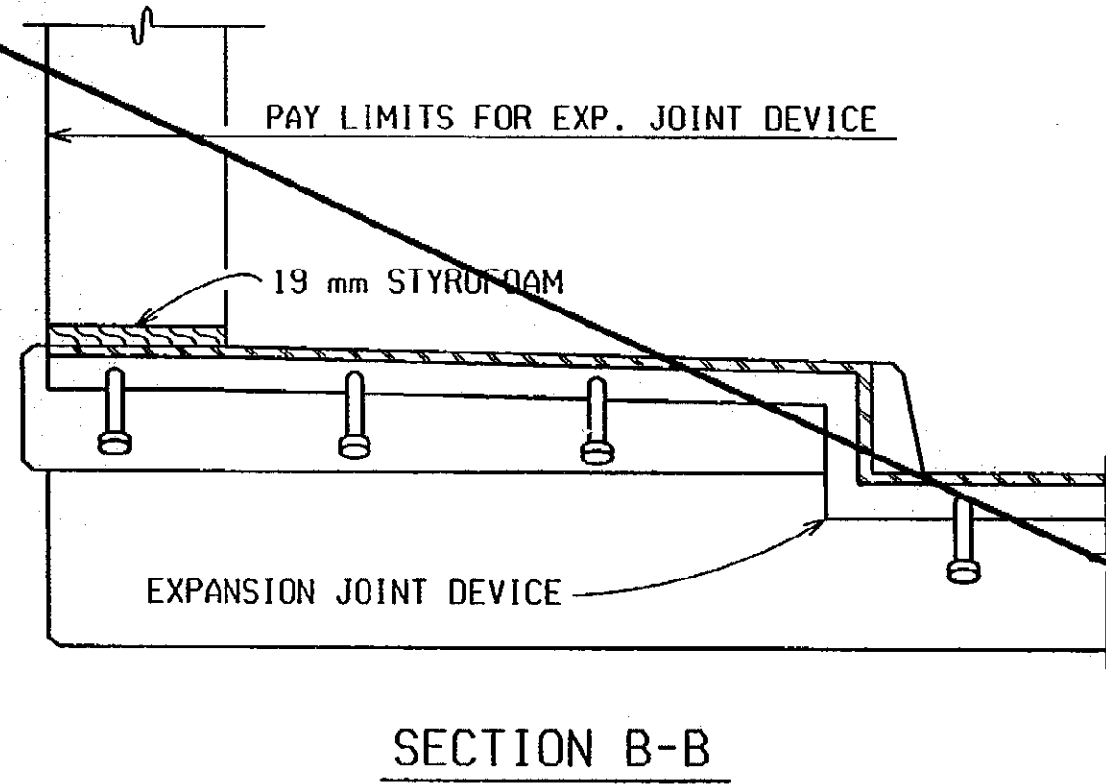


SECTION B-B

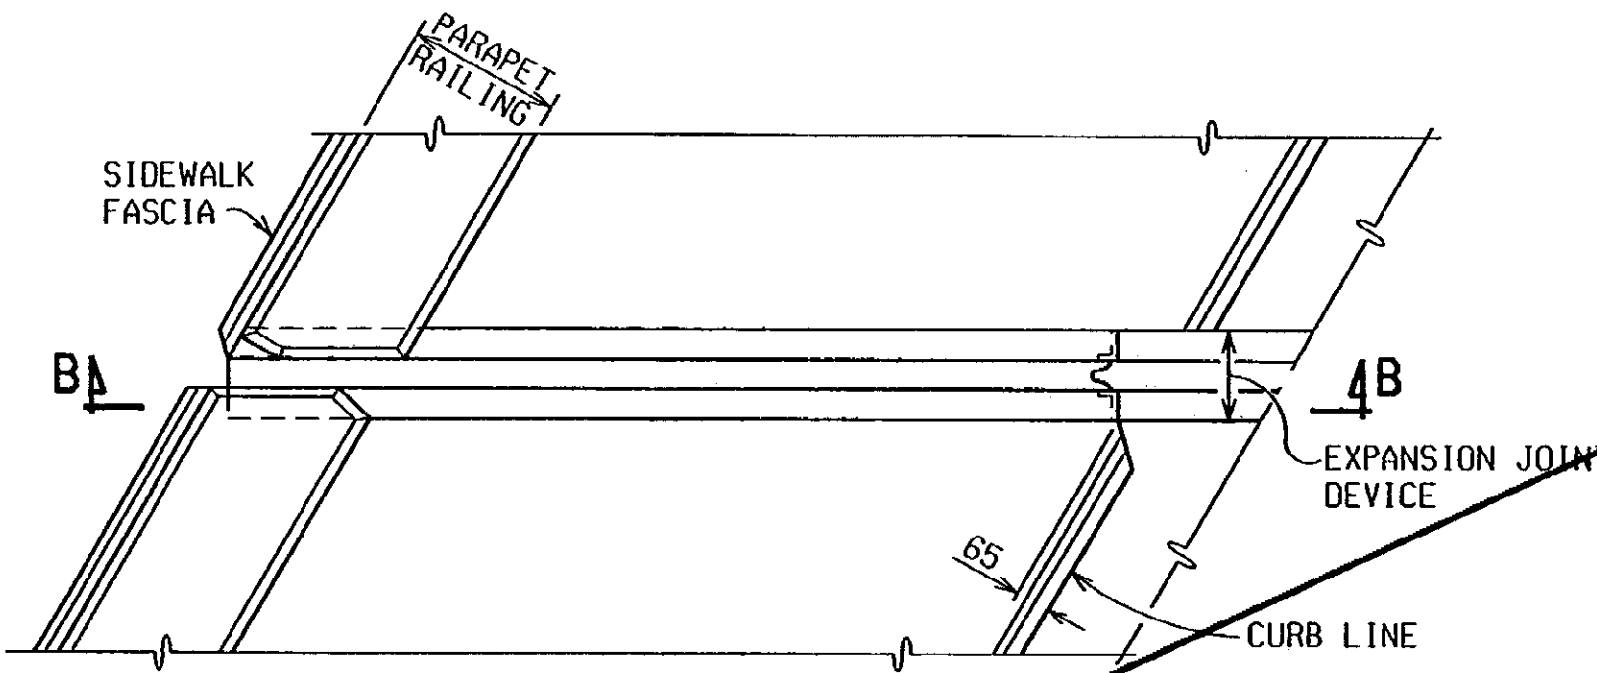


PLAN AT PARAPET RAILING
(DETAILS ARE SIMILAR FOR BRIDGE RAILING, 5 TUBE)

SIDEWALK TREATMENT

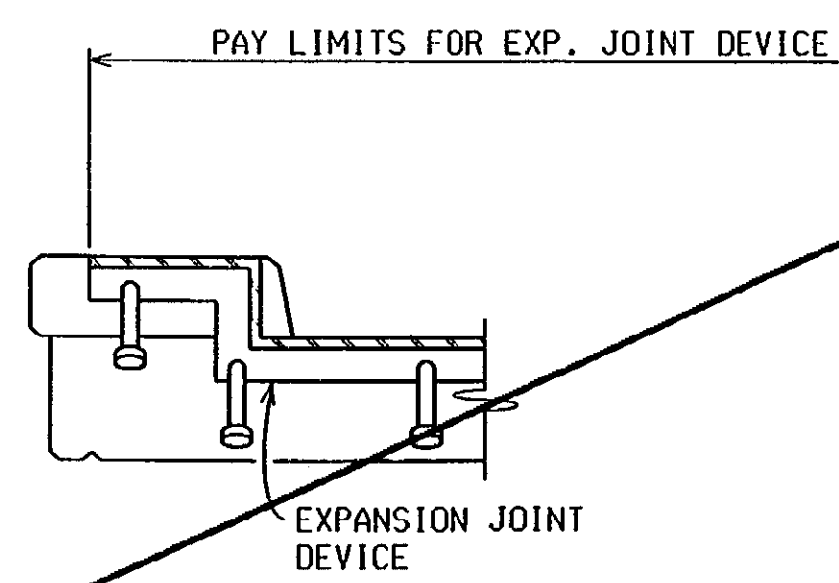


SECTION C-C

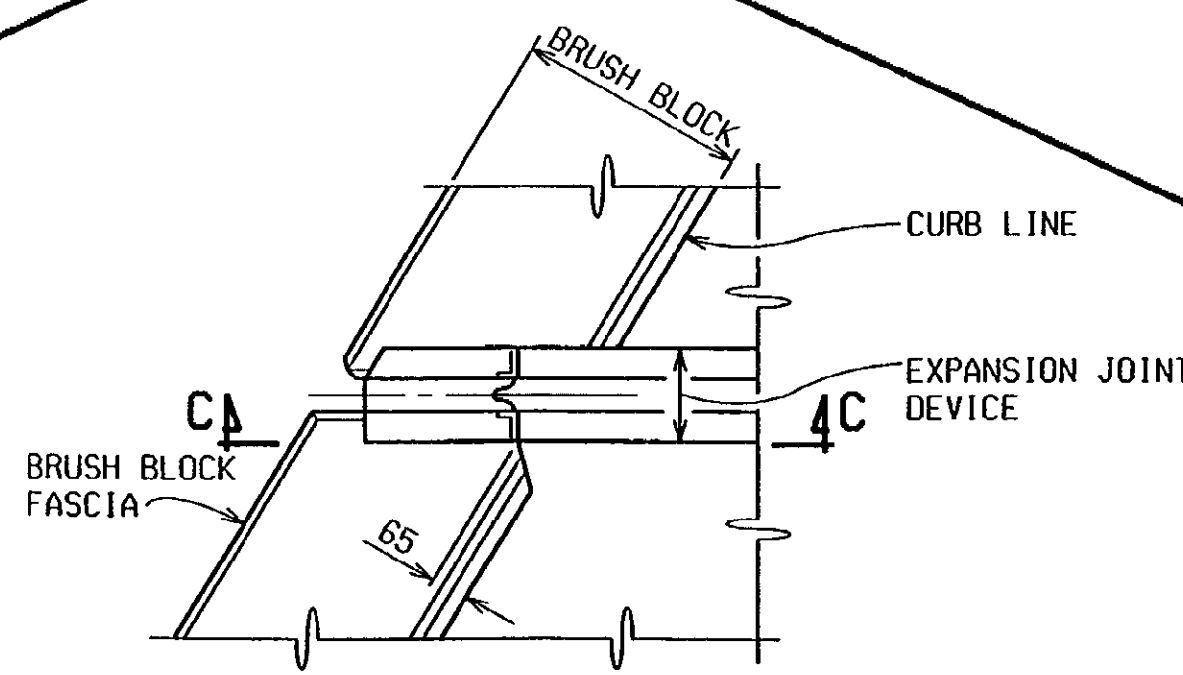

PLAN AT BRIDGE RAILING, 2 TUBE

BRUSH BLOCK TREATMENT


STRUCTURE NUMBER	ANGLE OF CROSSING TO NEAREST 10°	LOCATION OF JOINT	MIN. TOT. TRAVEL ALONG CENTERLINE OF BRIDGE	REQUIRED LENGTH OF EXPANSION JOINT DEVICE
B02	40	PIER 3	55mm	26.5
B02	40	PIER 4	25mm	26.5

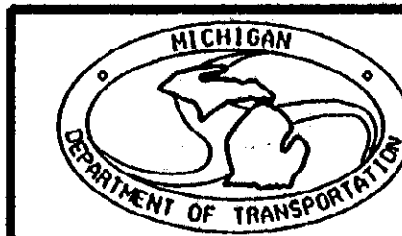


EXPANSION JOINT DETAILS - NB STRUCTURE				
DATE	CONT. SEC.	JOB NO.	DESIGN UNIT	SHEET
1-9-01	B02 OF 63174	49595A	MAHDAVI	8 OF 16

EJ3T (11-17-97)

REVISIONS			
NO.	DESCRIPTION	DATE	BY

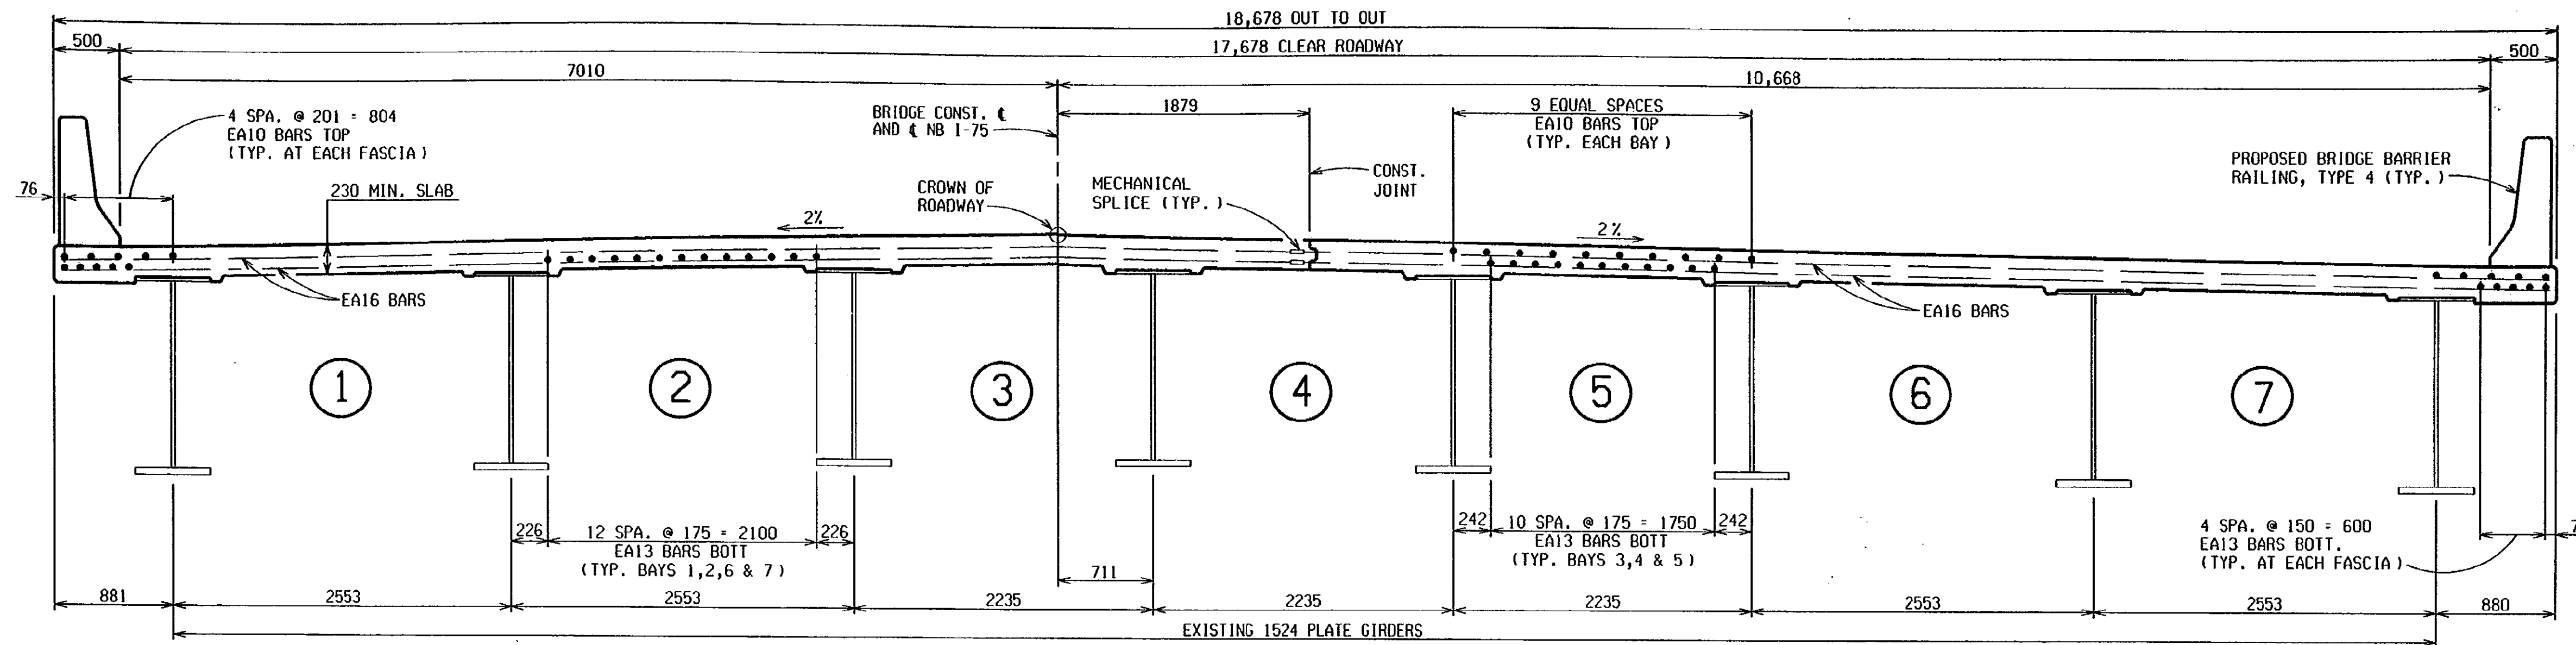

TYPICAL DECK SECTION - NB
(LOOKING NORTH)

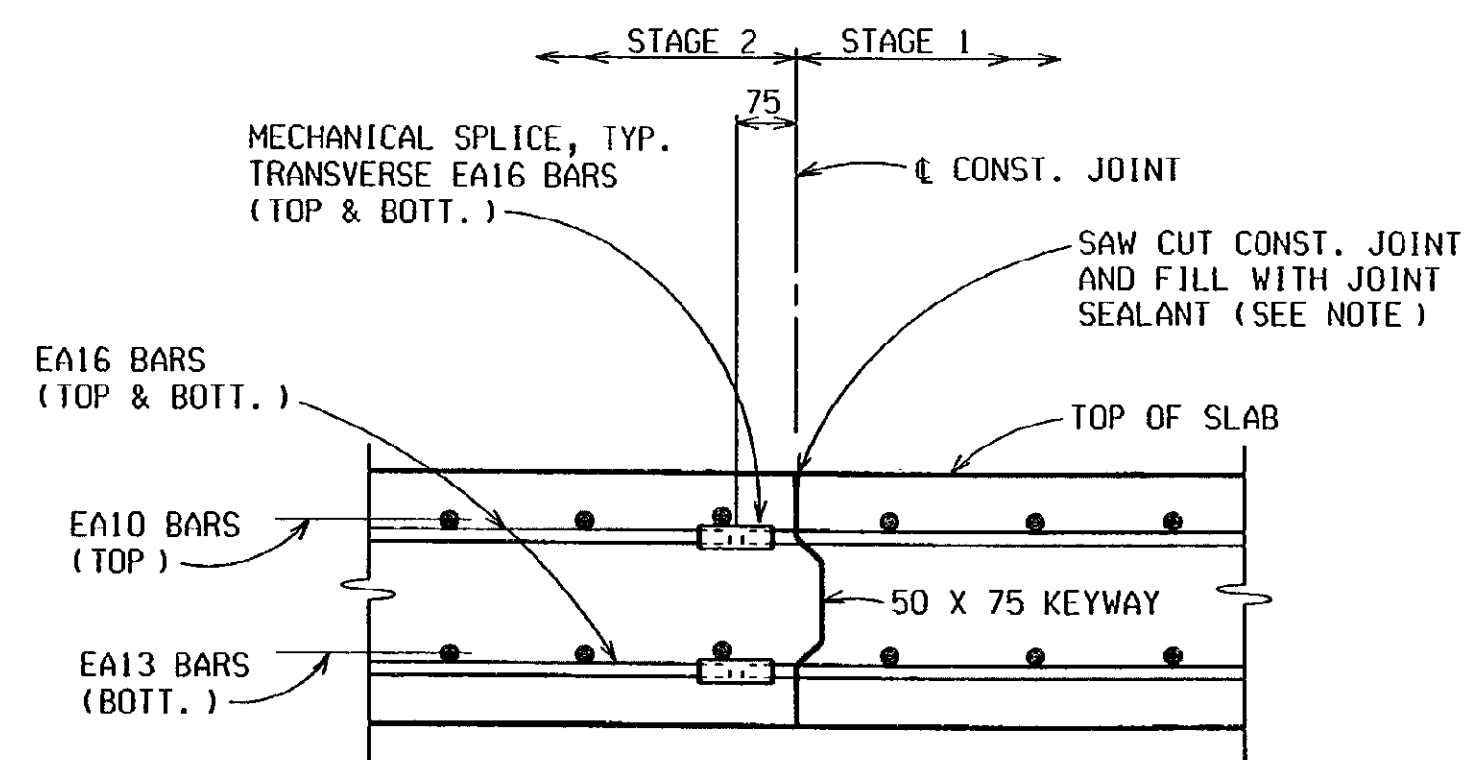

LONGITUDINAL CONSTRUCTION JOINT IN SLAB


MISCELLANEOUS QUANTITIES	
152	m Bridge Barrier Railing, Type 4
23	m ² Joint Waterproofing
341	m ³ Bridge Ltg, Oper and Maintain
1	LS Bridge Ltg, Furn and Rem (B02-NB)
1	LS Superstructure Conc, Form, Finish and Cure, Night Casting (B02-NB)
1	LS Shear Developers (B02-NB)
800	ea Reinforcement, Mechanical Splices

NOTES:

HPJS DENOTES HOT-POURED JOINT SEALANT.
 FOR NAME PLATE LOCATION, SEE GENERAL PLAN OF STRUCTURE SHEET.
 EDGE OR *GROOVE* DENOTES EDGING OR GROOVING WITH AN APPROVED TOOL.
 ALPHABETICAL DESIGNATION OF POURS IS NOT TO BE CONSTRUED AS A POUR SEQUENCE.
 FOR BRIDGE RAILING, ANCHORAGE FOR GUARDRAIL, NAME PLATE MOUNTING, MOLDING AND BEVEL DETAILS, SEE STANDARD SHEET B-17 AND B-103. BARRIER RAILING IS TO BE BRIDGE BARRIER RAILING, TYPE 4.
 THIS DECK POUR IS DESIGNATED A NIGHT POUR, AND THEREFORE SUBJECT TO THE RESTRICTIONS OF SECTION 706.03J OF THE STANDARD SPECIFICATIONS.
 WHERE CAST-IN-ANCHORAGE IS USED FOR EXPANSION JOINT DEVICES, IT IS RECOMMENDED THAT THE PLACING OF DECK CONCRETE PROGRESS TOWARD THE JOINT SO THAT THE EFFECTS OF DEAD LOAD DEFLECTION WILL OCCUR BEFORE CONCRETE IS PLACED AT THE ANCHORAGE.

SUPERSTRUCTURE CONCRETE QUANTITIES NIGHT CASTING	
POUR	AMT (m ³)
A	58.8
B	58.5
C	52.3
D	59.5
E	59.2
F	52.7
TOTAL CONC.:	341 m ³

THE CONTRACTOR MAY USE METAL STAY IN PLACE FORMS. IF USED, ELIMINATING THE POLYSTYRENE AND FILLING THE CORRUGATIONS WITH CONCRETE IS PROHIBITED.
 JWP DENOTES JOINT WATERPROOFING.
 THE CONTRACTOR IS TO PROVIDE A SAWED JOINT 12mm DEEP BY 3mm WIDE (MINIMUM) IN THE TOP OF SLAB AT LONGITUDINAL CONSTRUCTION JOINT. THE JOINT IS TO BE SAWED BEFORE CASTING OF BARRIERS AND IS TO BE FILLED WITH HOT-POURED JOINT SEALANT OR COLD-APPLIED JOINT SEALANT, SINGLE COMPONENT TYPE IN ACCORDANCE WITH STANDARD SPECIFICATION SUBSECTION 9.14.04.
 SHEAR DEVELOPERS SHALL BE 19mm DIAMETER STUDS.
 IF EXISTING SHEAR DEVELOPERS DO NOT INTERFERE WITH PROPOSED SHEAR DEVELOPERS AND REINFORCEMENT, THEY MAY BE CLEANED AND LEFT IN PLACE INSTEAD OF REMOVED. THE CONTRACTOR SHALL INSTALL ALL PROPOSED SHEAR DEVELOPERS REGARDLESS OF WHETHER OR NOT THE EXISTING SHEAR DEVELOPERS REMAIN.

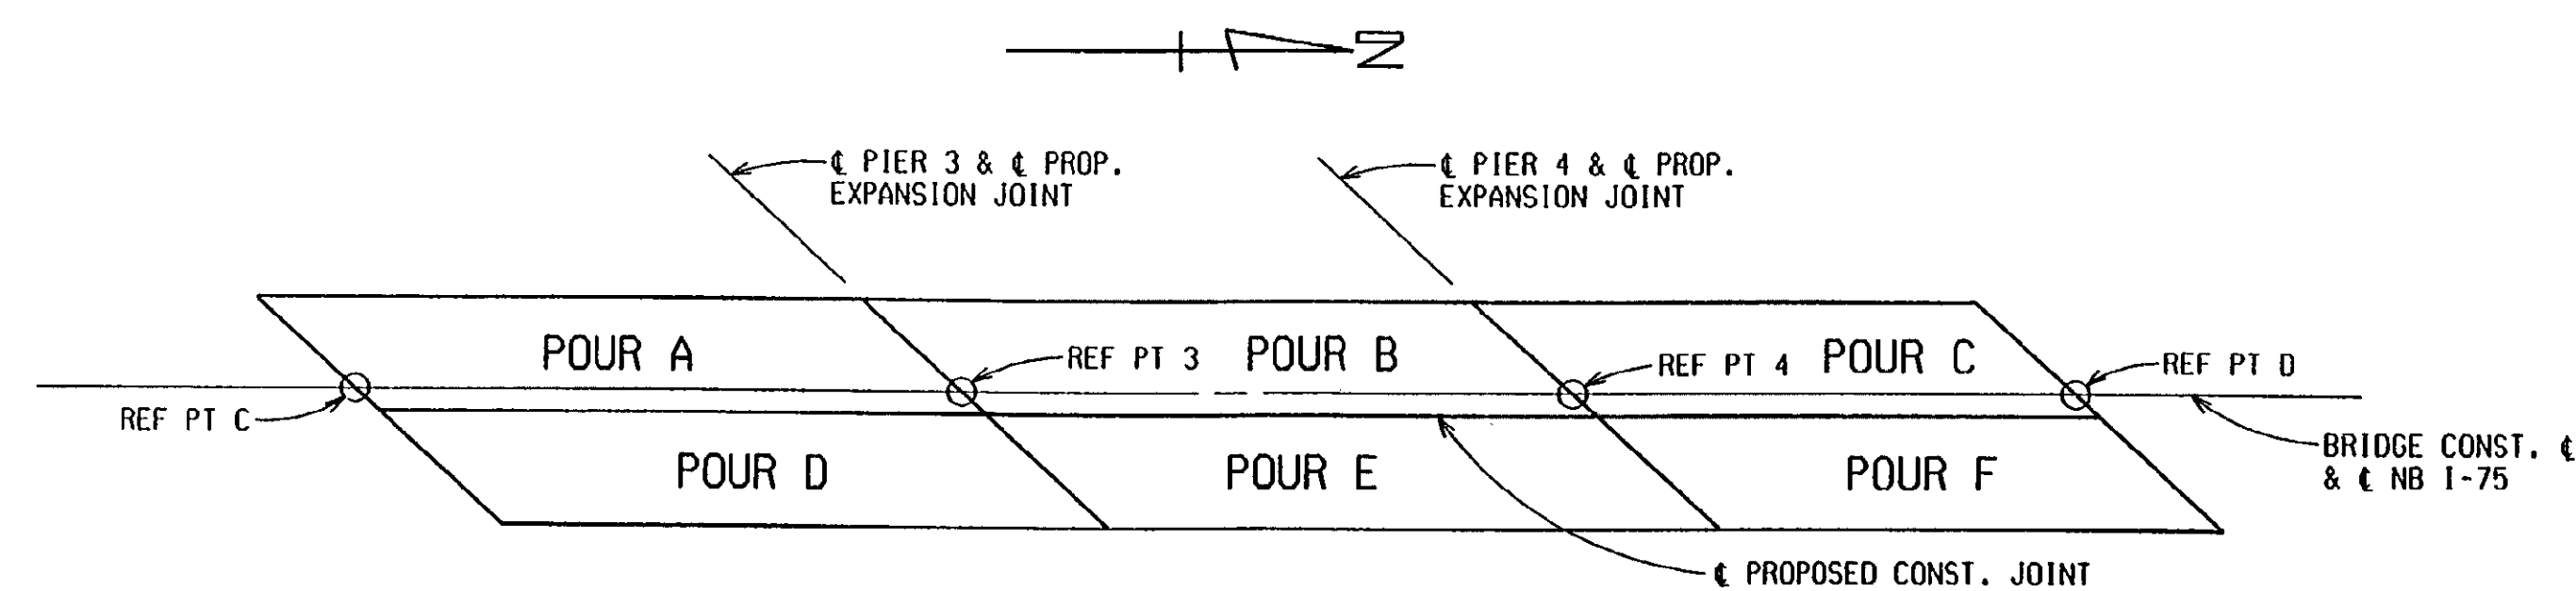

POUR DIAGRAM

DECK REPLACEMENT DETAILS - NB STRUCTURE




DATE	CONT. SEC.	JOB NO.	DESIGN UNIT	SHEET
1-9-01	B02 OF 63174	49595A	MAHDAVI	9 OF 16


CONTRACT NO. 63174 JOB NO. 49595A SHEET NO. 10

1 2 3 4 5 6 7 8 9 10 11 12 13 14 15 16 17 18 19 20 21 22 23 24 25 26 27 28 29 30 31 32 33 34 35 36 37 38 39 40 41 42 43 44 45 46 47 48 49 50 51 52 53 54 55 56 57 58 59 60 61 62 63


REVISIONS			
NO.	DESCRIPTION	DATE	BY

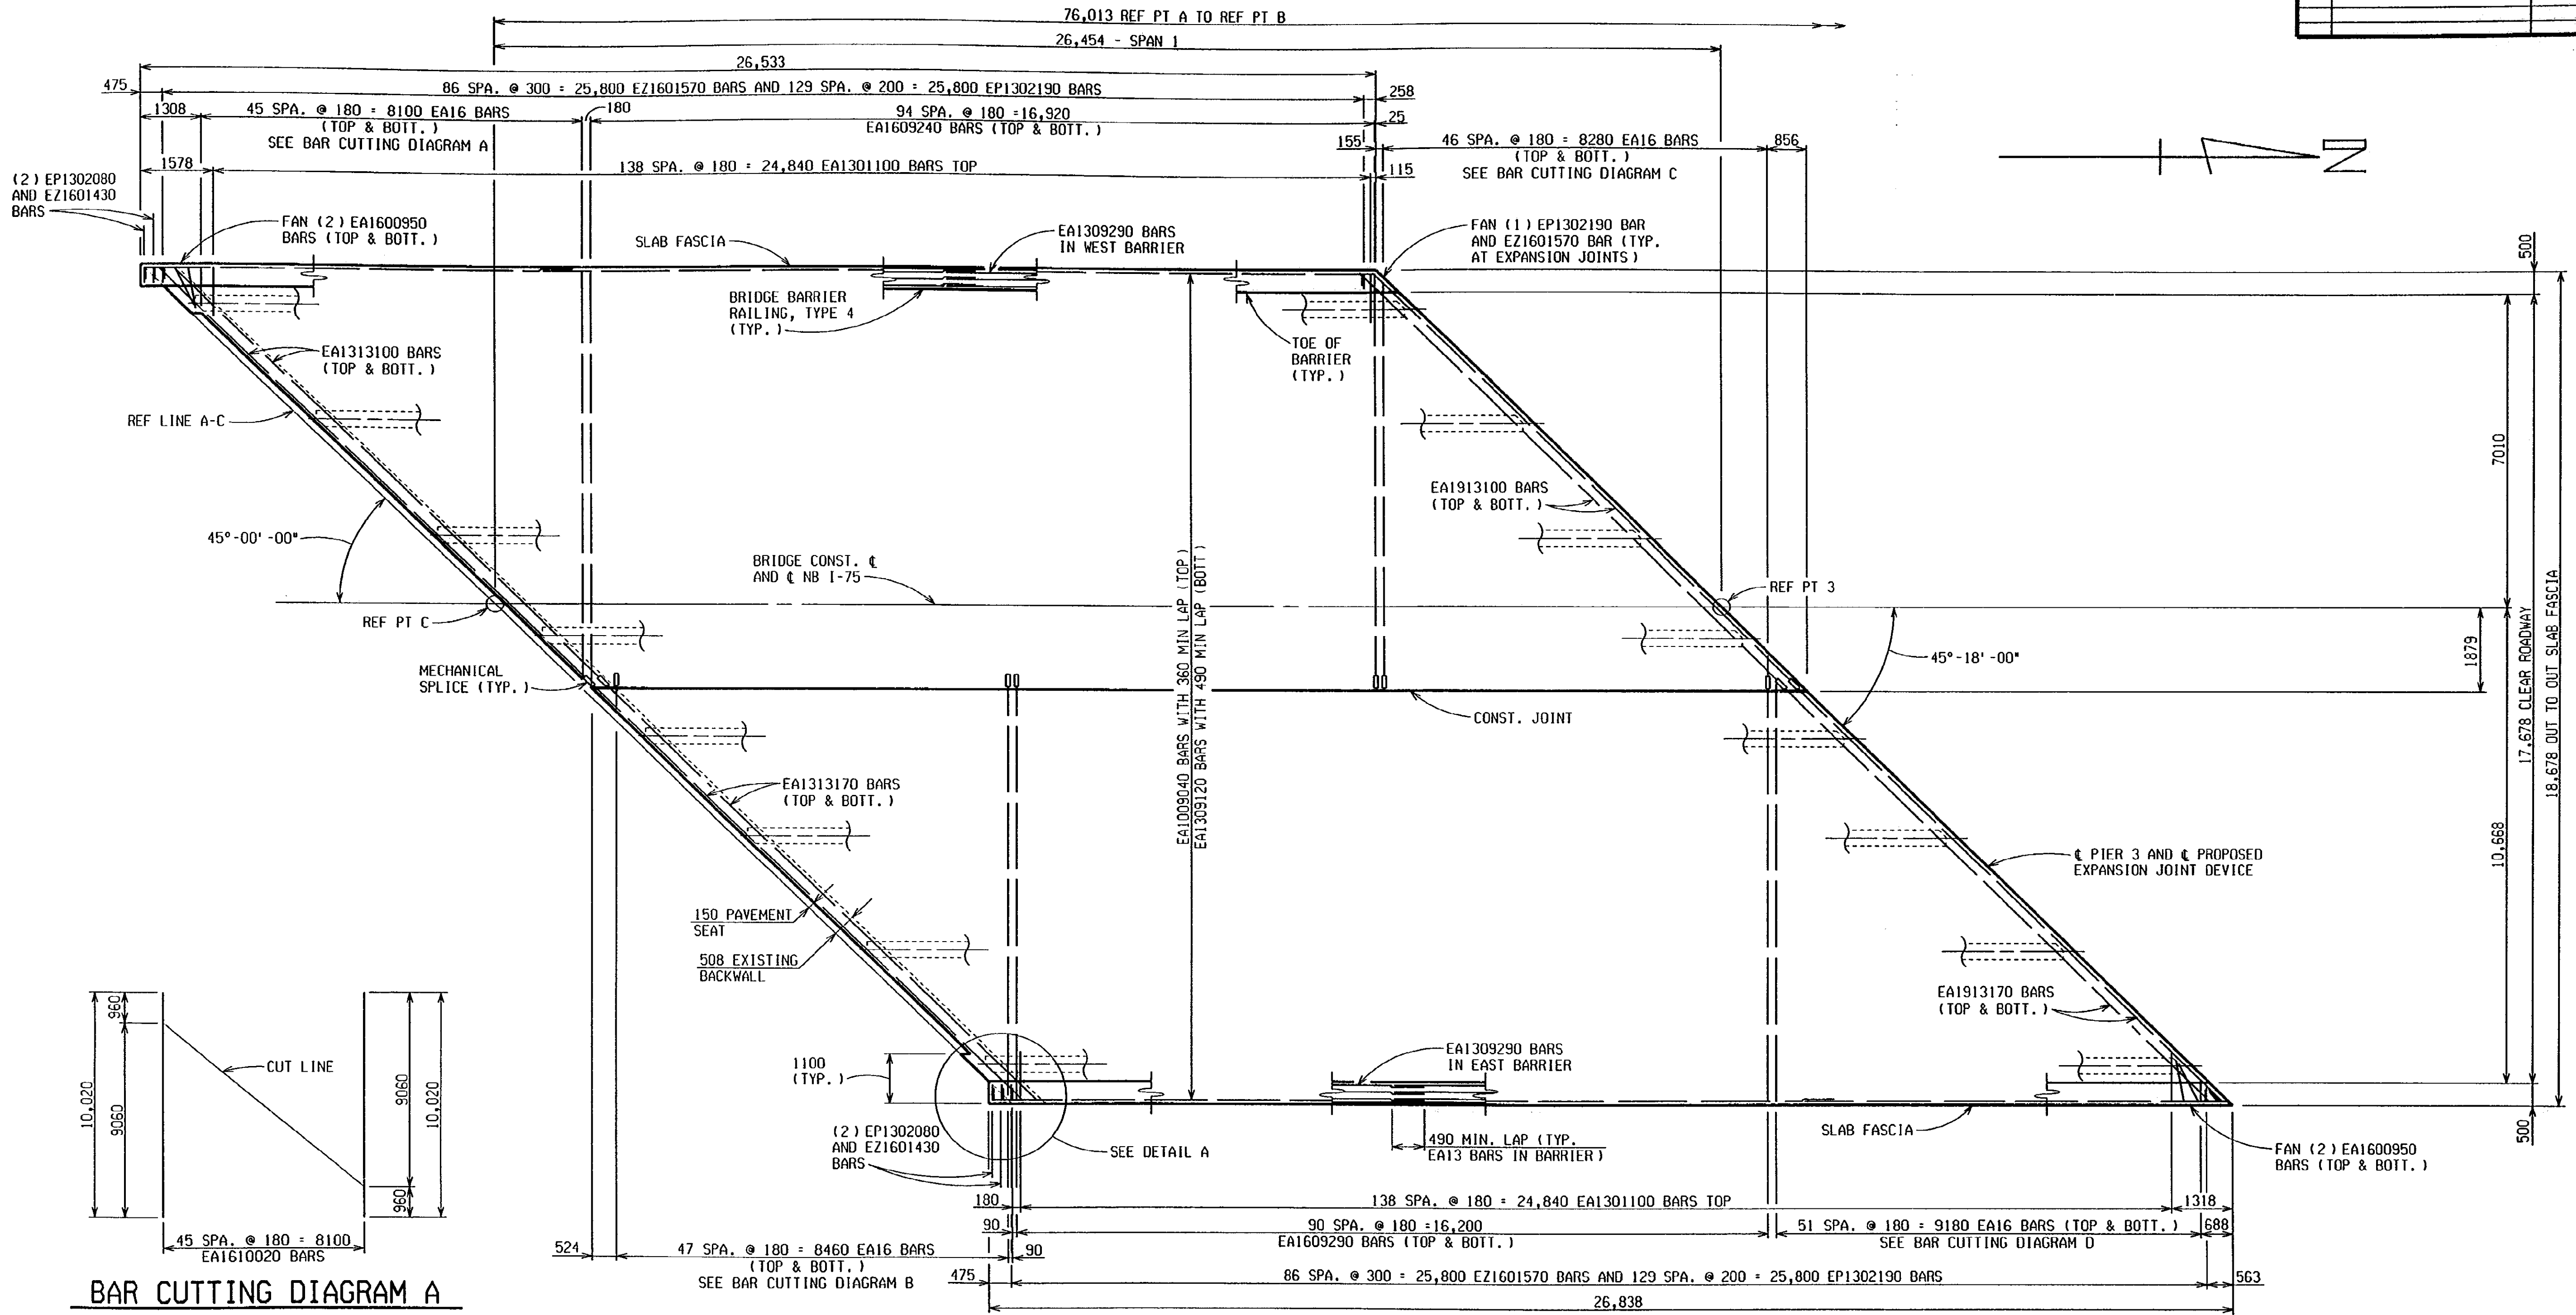


BAR CUTTING DIAGRAM A

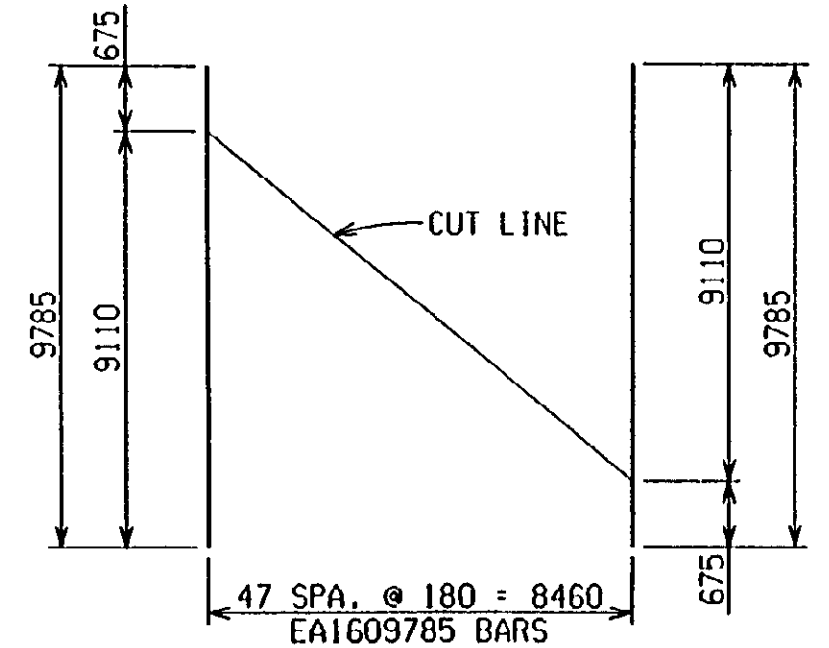

BAR CUTTING DIAGRAM B

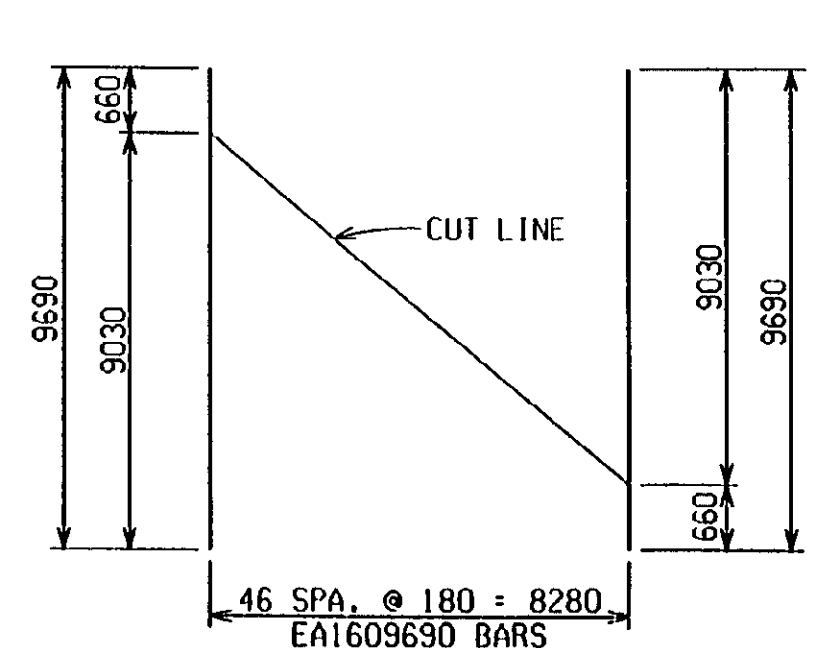

BAR CUTTING DIAGRAM C

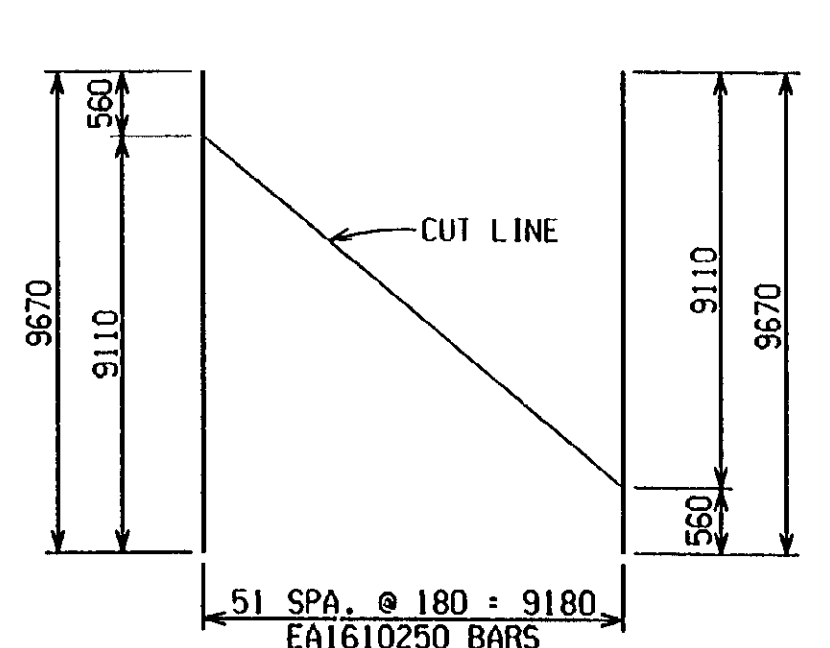

BAR CUTTING DIAGRAM D

DECK PLAN - SPAN 1

NOTE:
REINFORCEMENT IS TO BE SHOP CUT AS SHOWN. THE EPOXY COATING SHALL BE REPAIRED ACCORDING TO THE STANDARD SPECIFICATIONS.

DECK REPLACEMENT DETAILS - NB STRUCTURE				
DATE	CONT. SEC.	JOB NO.	DESIGN UNIT	SHEET
1-9-01	802 OF 63174	49595A	MAHDAVI	10 OF 16




DRAWN BY: R. PRATT DATE: 8-1-00 CHECKED BY: MIKUCKI DATE: 1-3-01 CORRECTED BY: R. PRATT

FILE NAME: b026317n.dwg

SECTION B02 OF 63174 NO. 49595A

1 2 3 4 5 6 7 8 9 10 11 12 13 14 15 16 17 18 19 20 21 22 23 24 25 26 27 28 29 30 31 32 33 34 35 36 37 38 39 40 41 42 43 44 45 46 47 48 49 50 51 52 53 54 55 56 57 58 59 60 61 62 63

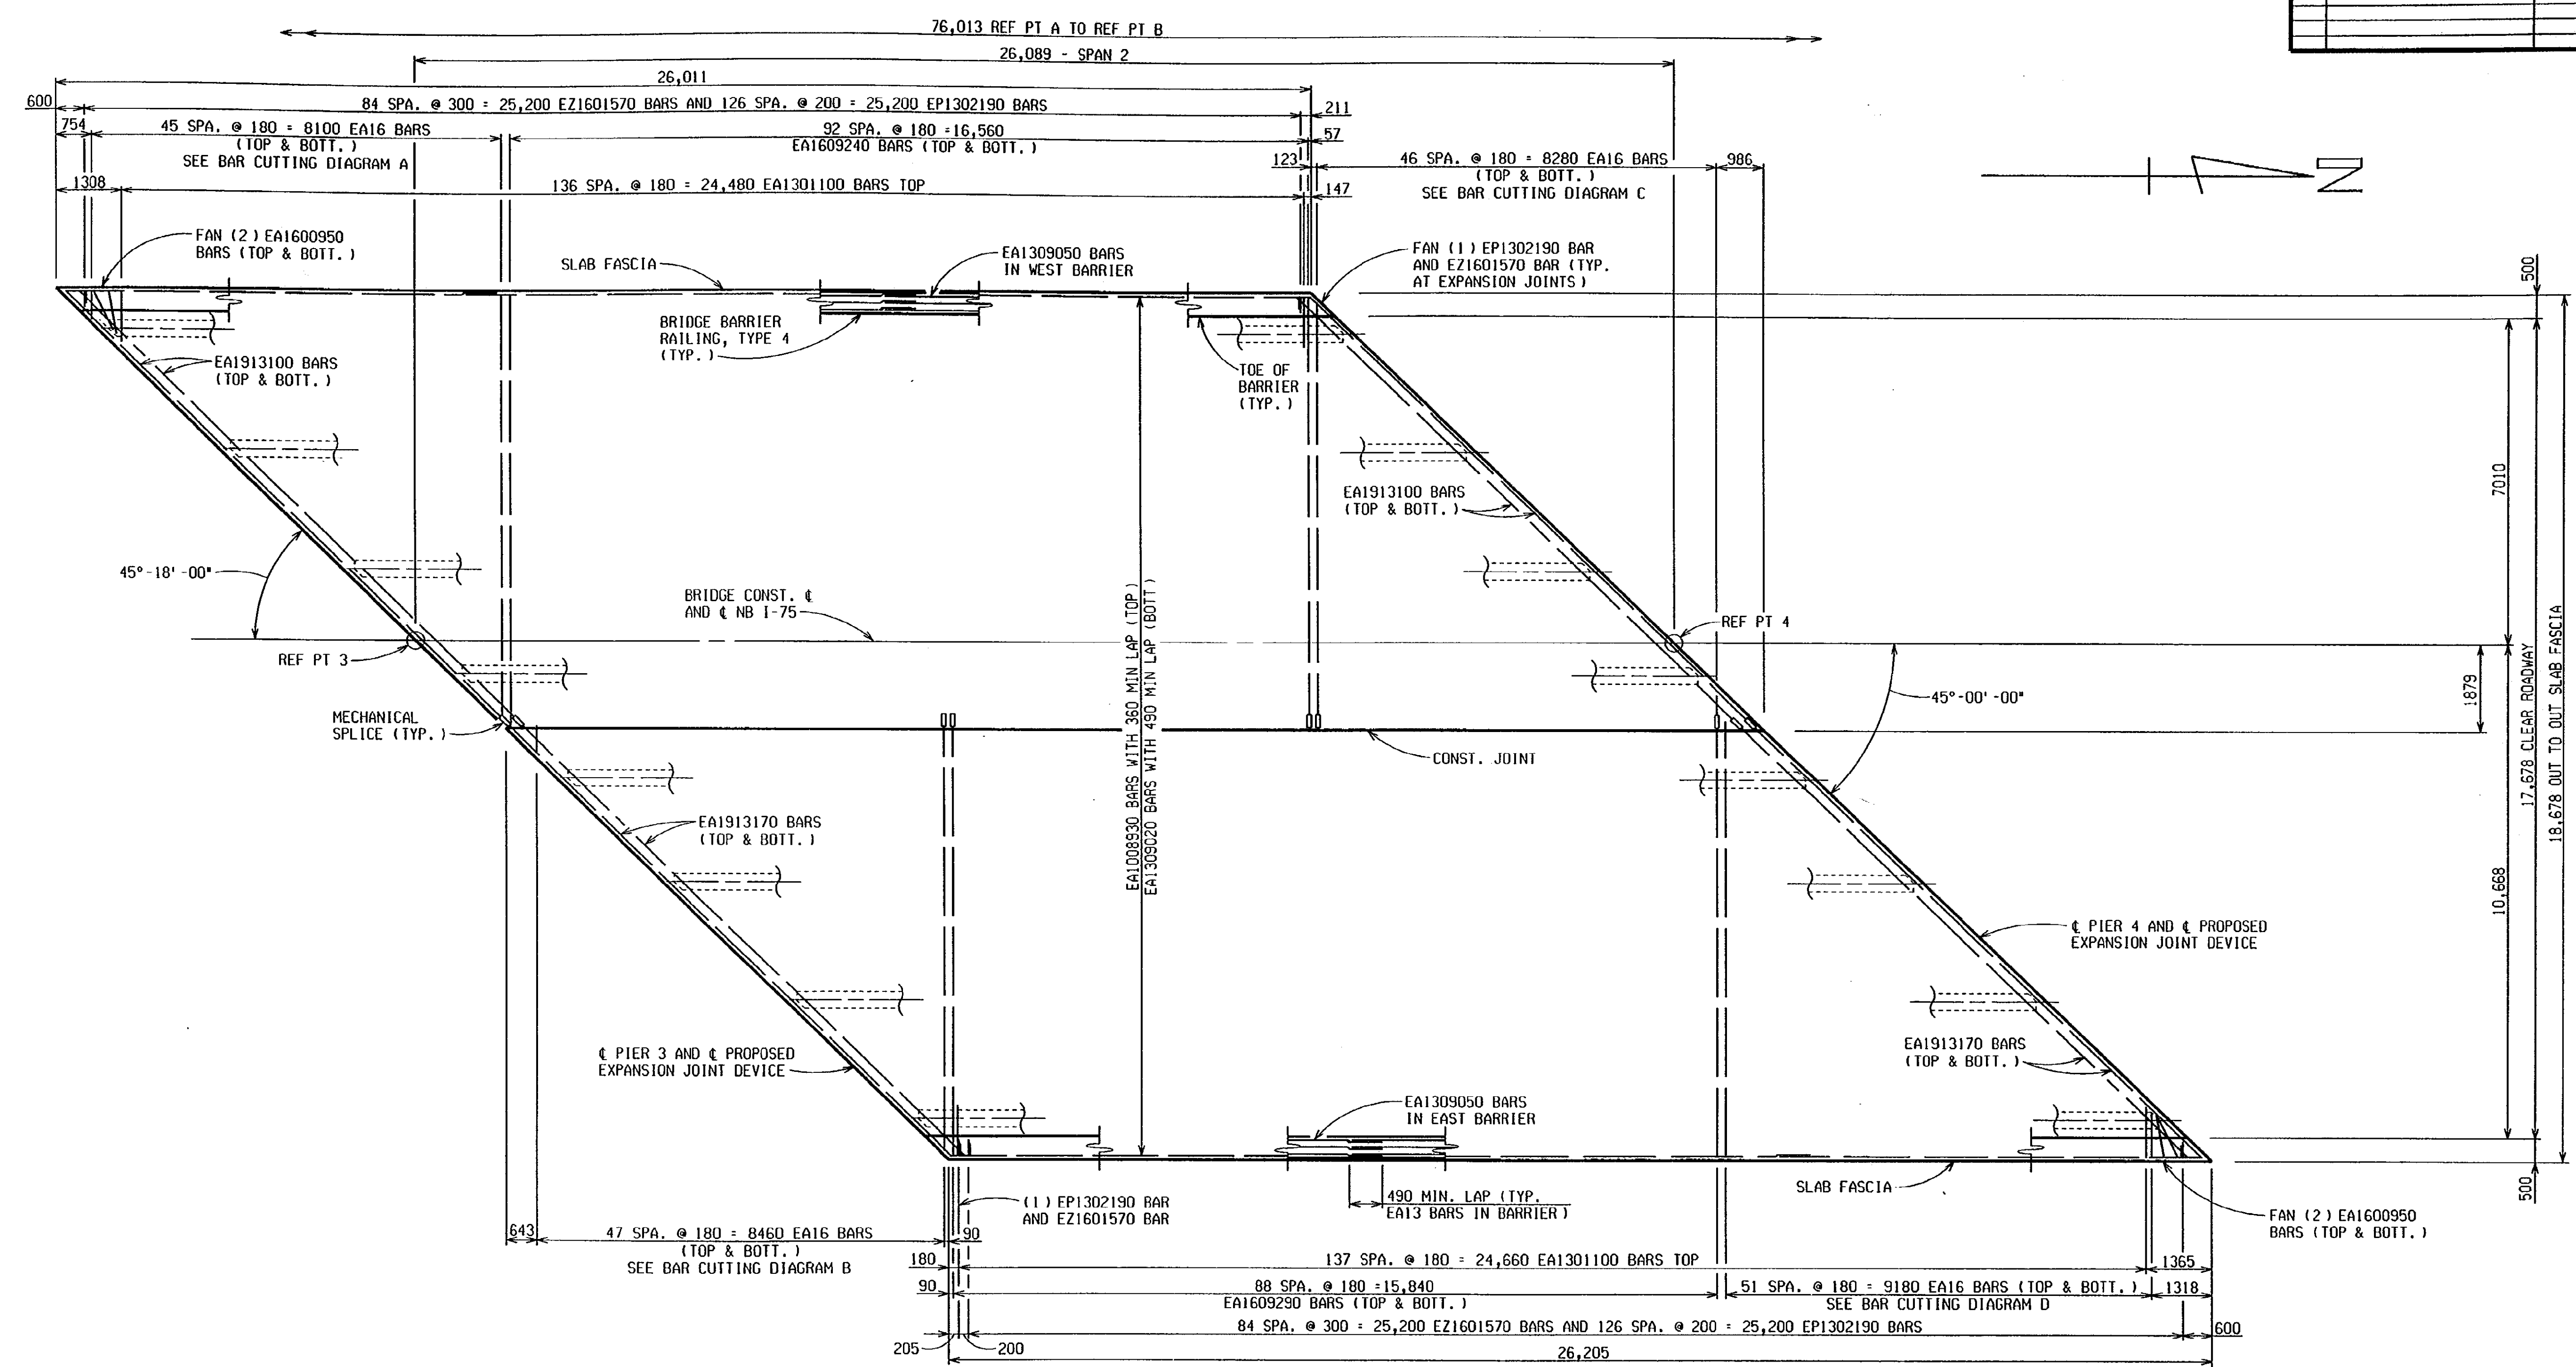

REVISIONS			
NO.	DESCRIPTION	DATE	BY


DECK PLAN - SPAN 2

DECK REPLACEMENT DETAILS - NB STRUCTURE				
DATE	CONT. SEC.	JOB NO.	DESIGN UNIT	SHEET
1-9-01	B02 OF 63174	49595A	MAHDAVI	11 OF 16



DRAWN BY: R. PRATT DATE: 8-1-00 CHECKED BY: MIKUCKI DATE: 1-3-01 CORRECTED BY: R. PRATT DATE: 1-3-01 FILE NAME: B0263174n.dwg

REVISIONS			
NO.	DESCRIPTION	DATE	BY

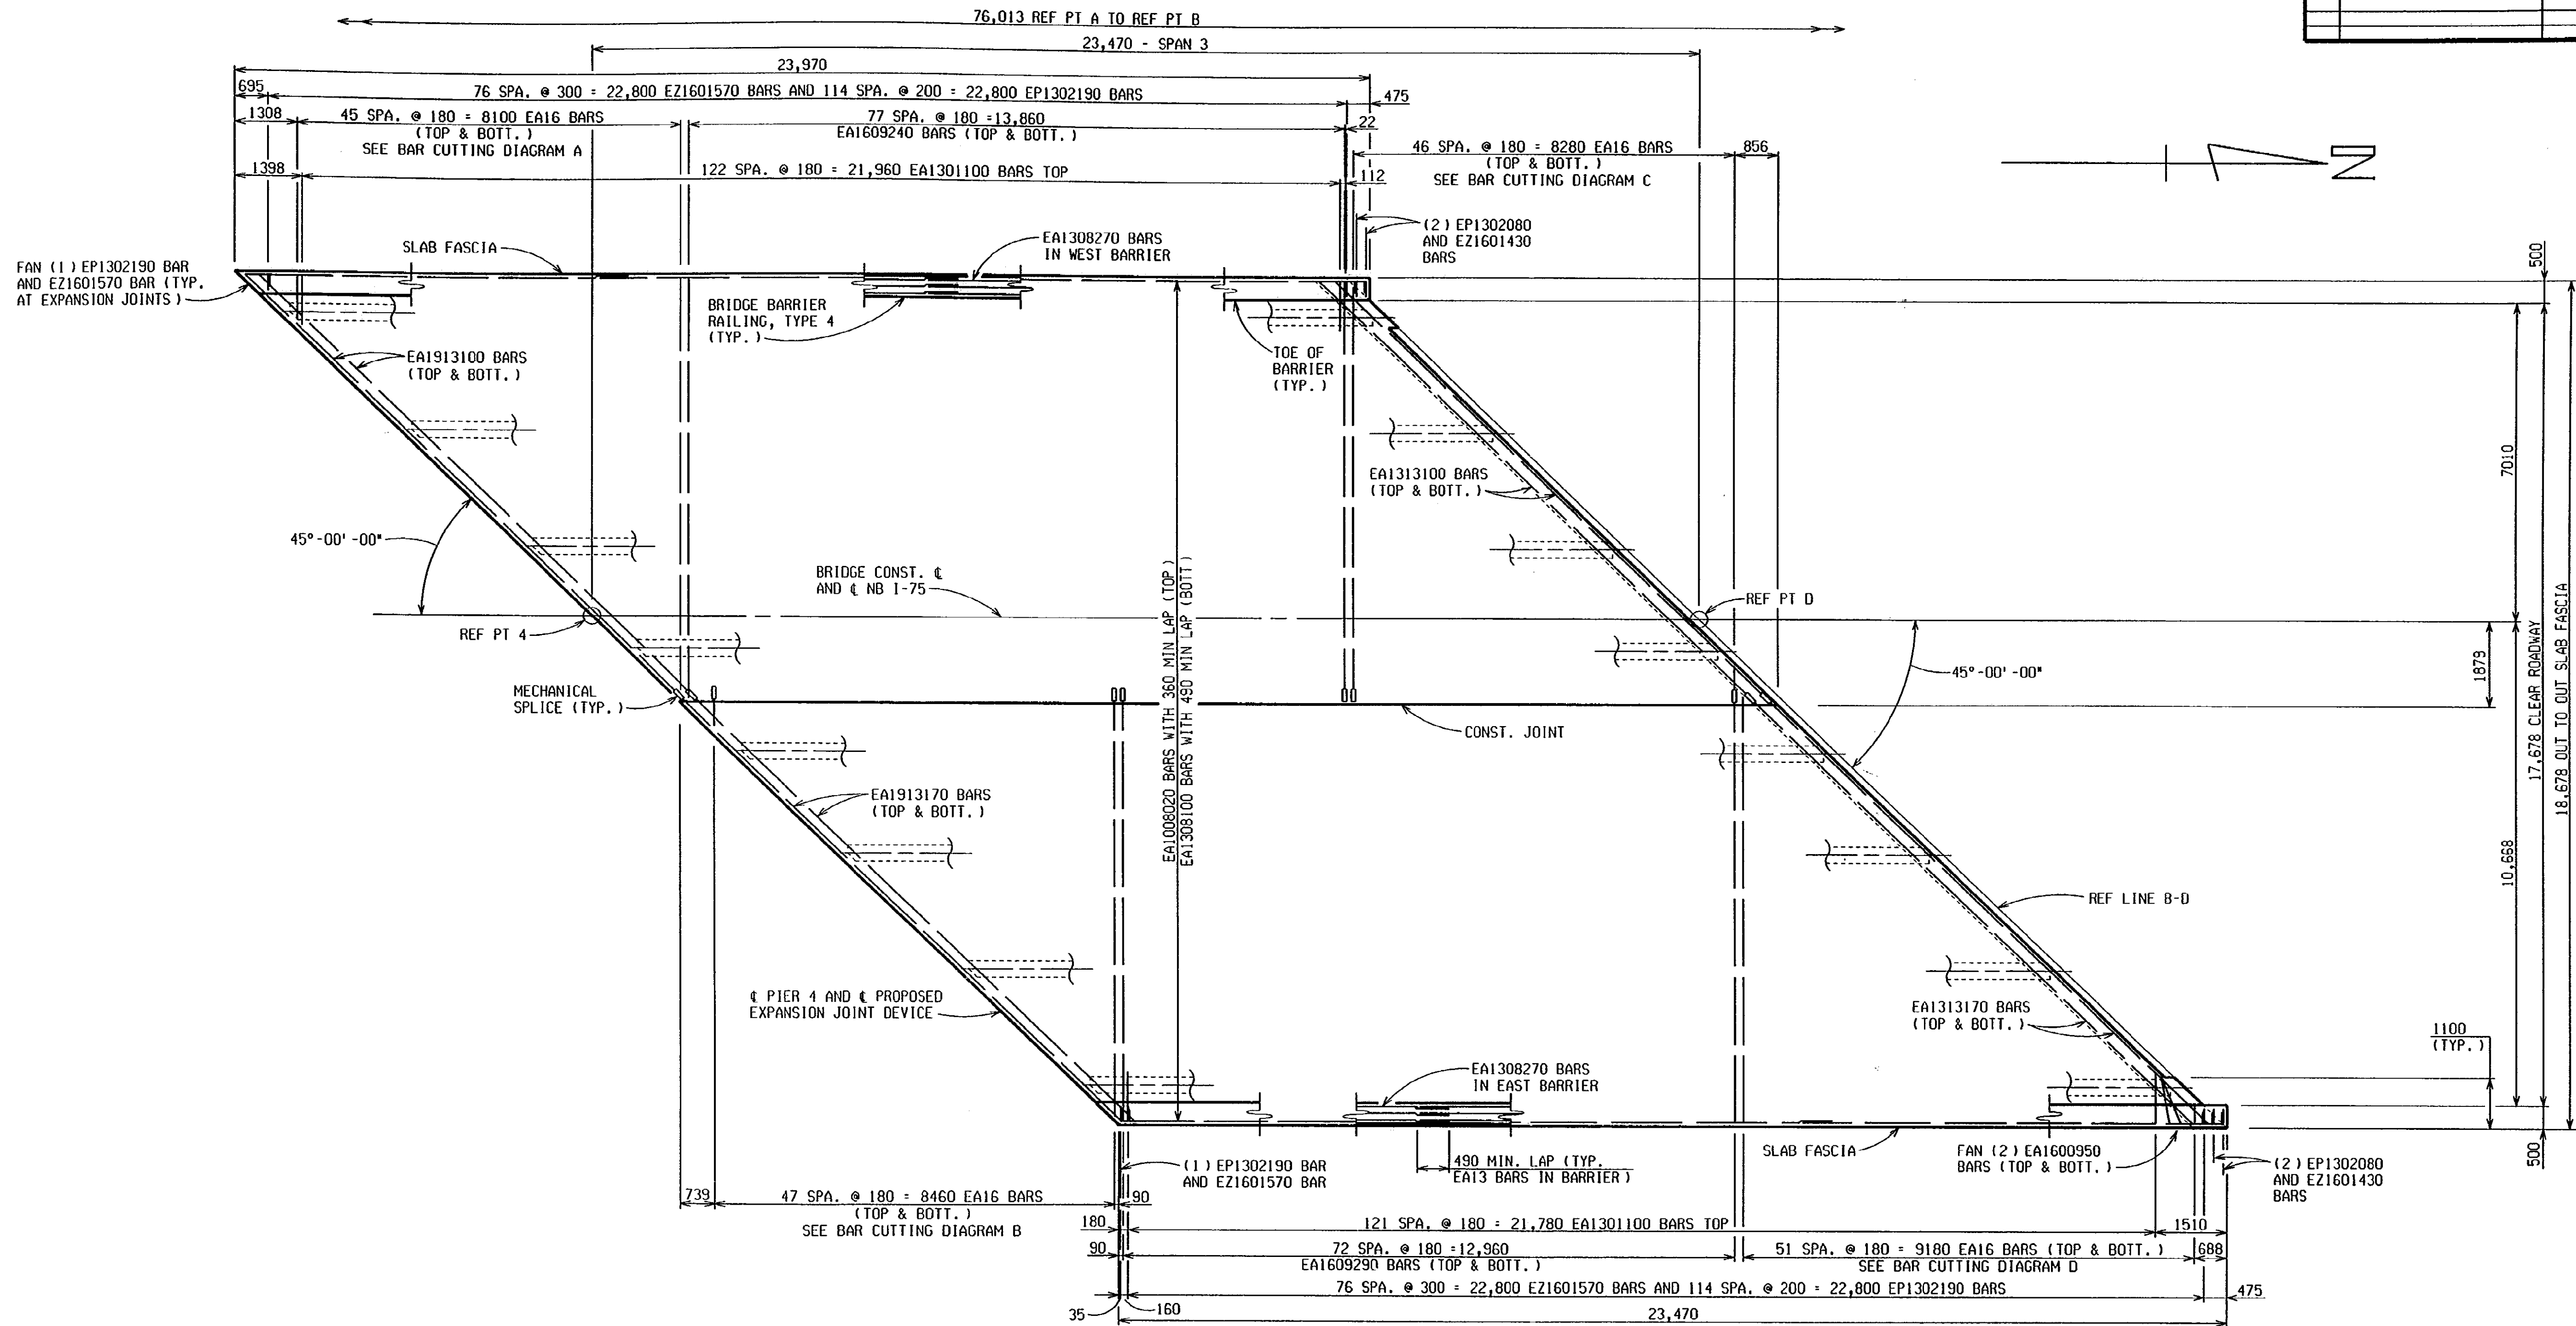


DECK PLAN - SPAN 3




DECK REPLACEMENT DETAILS - NB STRUCTURE				
DATE	CONT. SEC.	JOB NO.	DESIGN UNIT	SHEET
1-9-01	B02 OF 63174	49595A	MAHDAVI	12 OF 16

FILE NAME: 60263174n.dwg
 DRAWN BY: R. PRATT
 CHECKED BY: MIKUCKI
 DATE: 8-1-00
 CORRECTED BY: R. PRATT
 DATE: 1-3-01


REVISIONS			
NO.	DESCRIPTION	DATE	BY

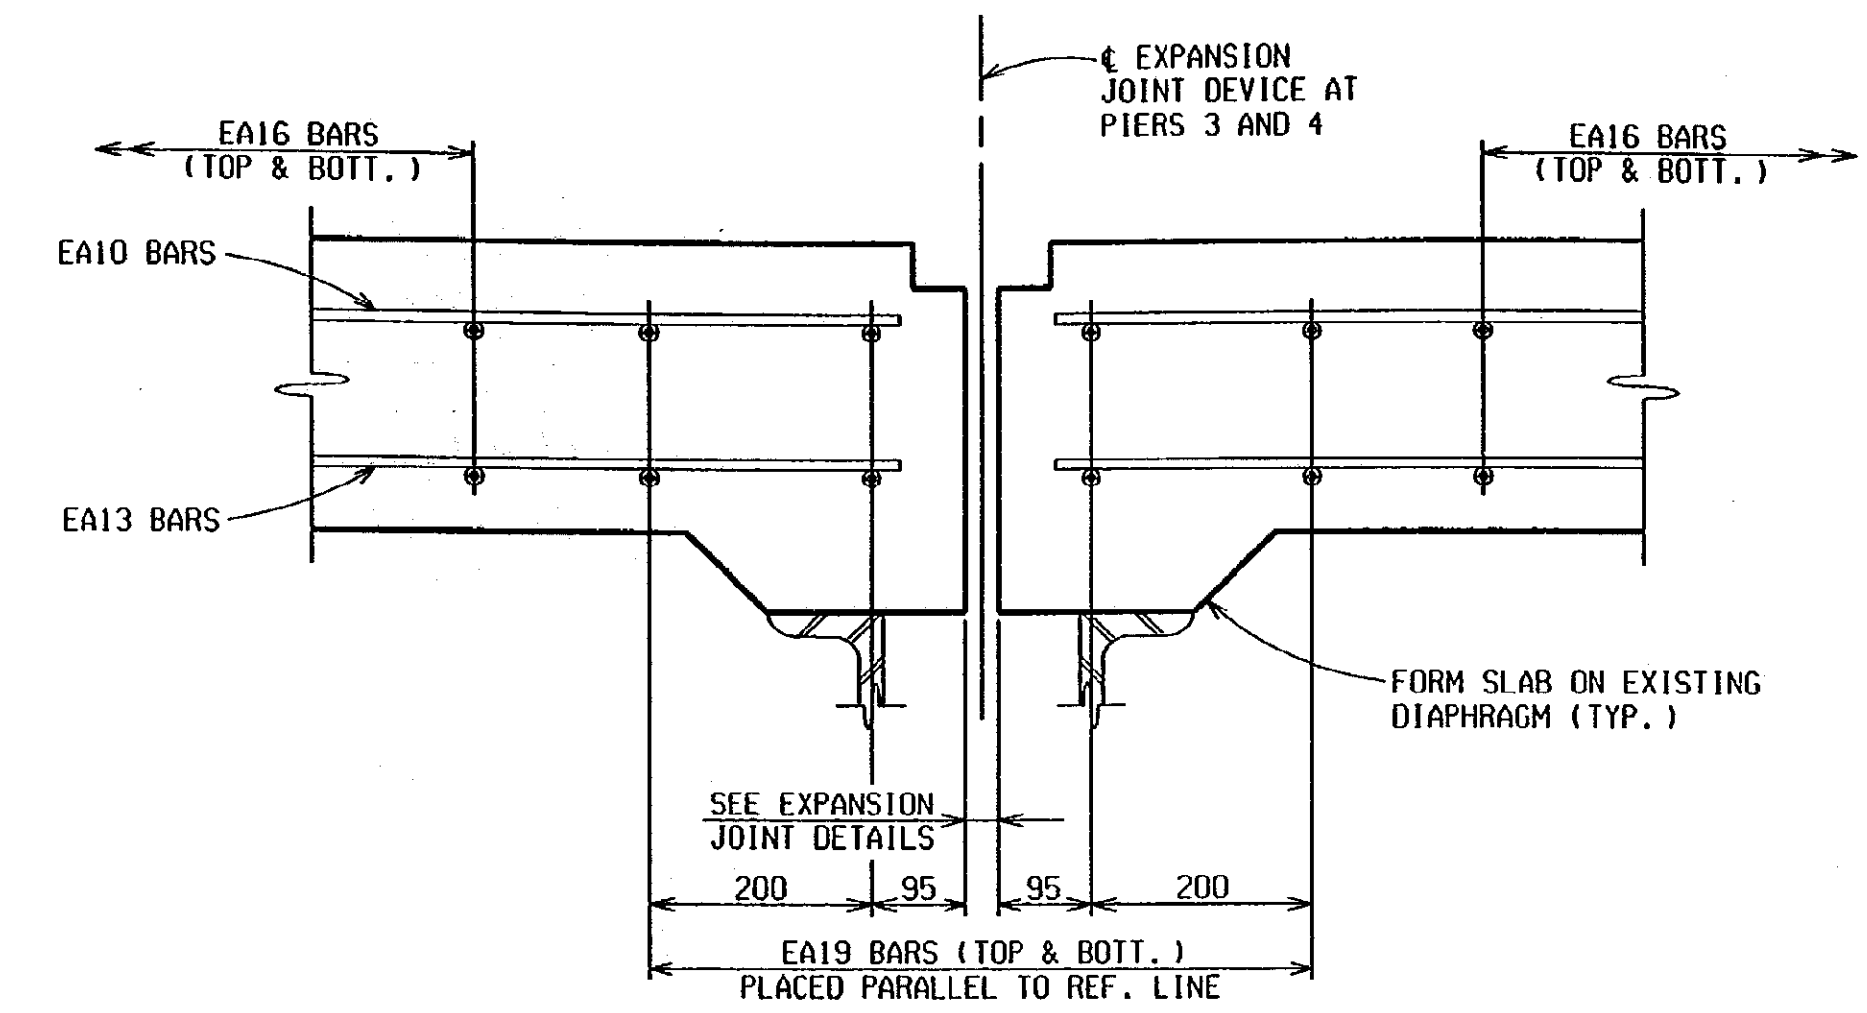


TYPICAL SECTION THRU EXPANSION JOINT

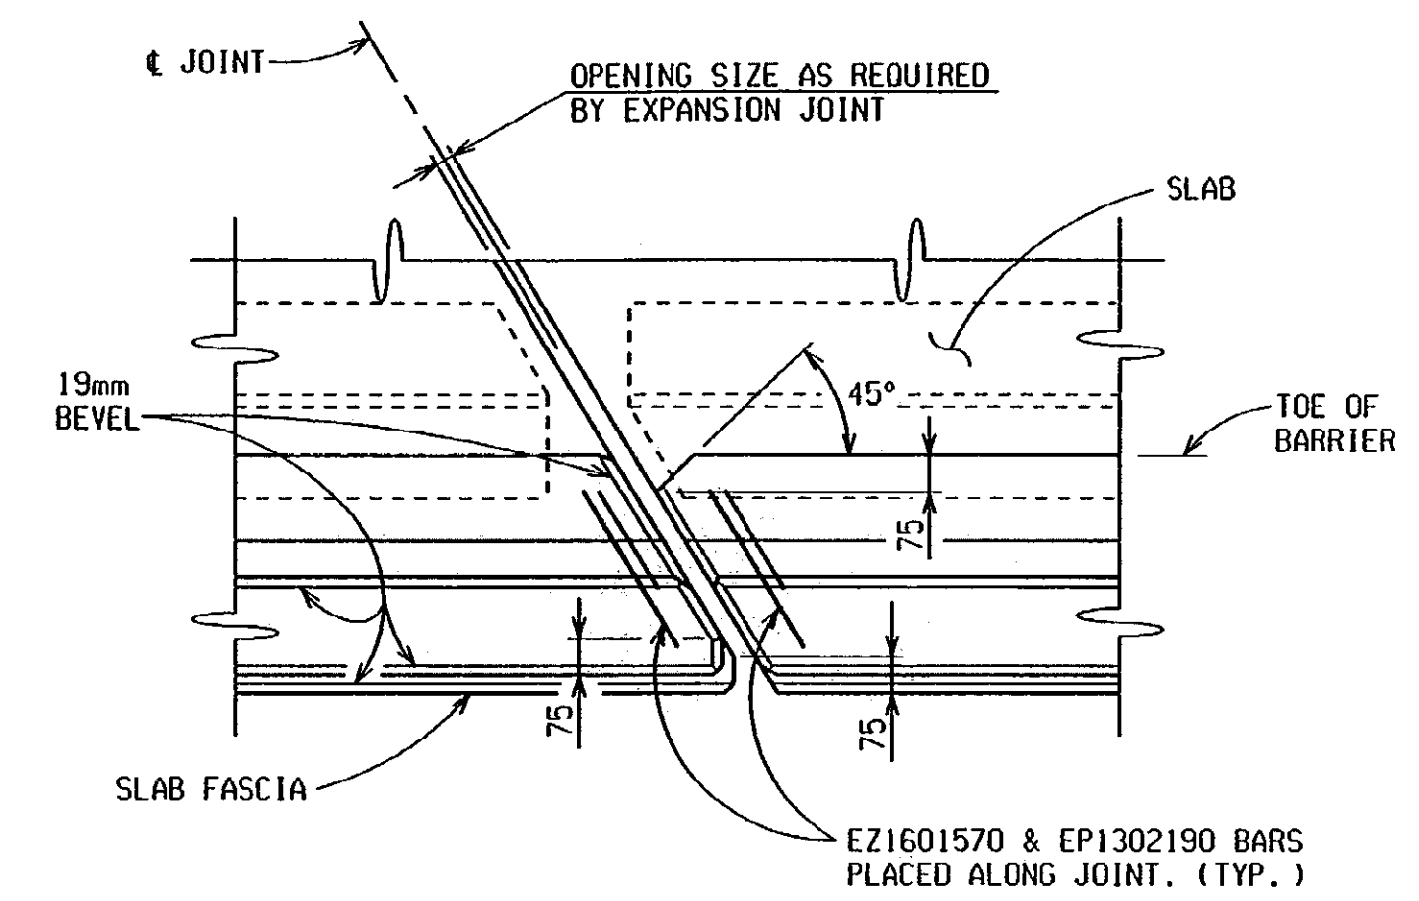


PLAN OF BARRIER

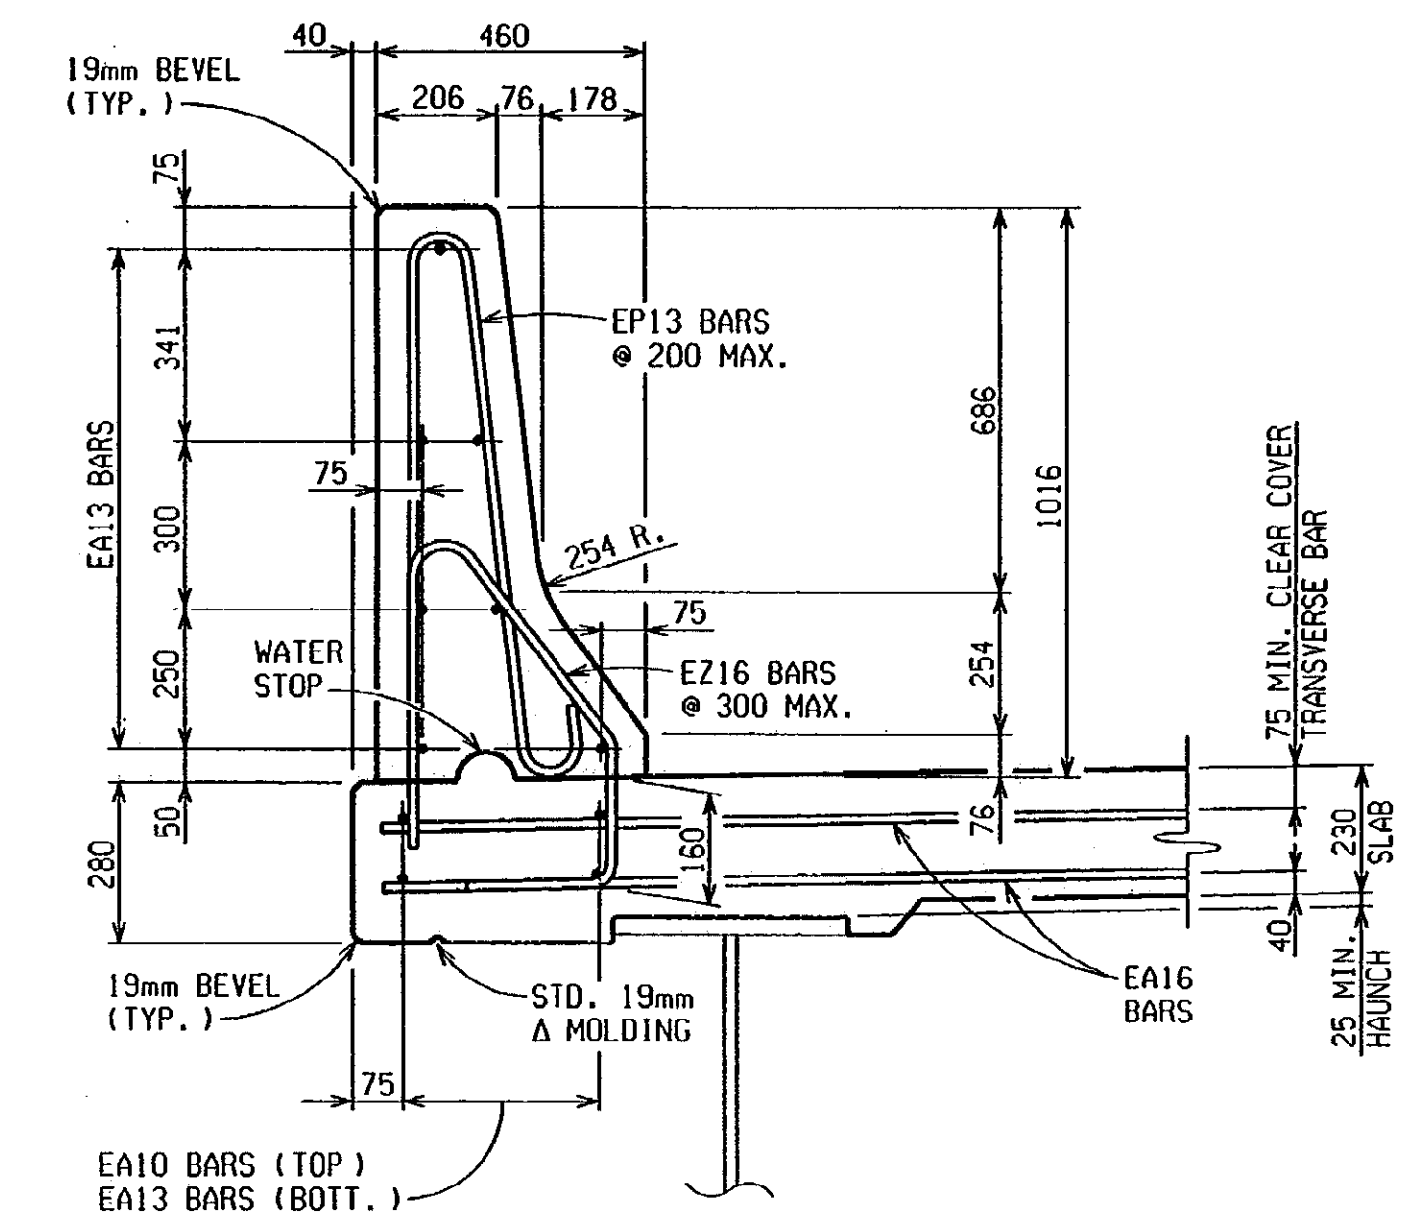


TYPICAL SECTION THRU BARRIER

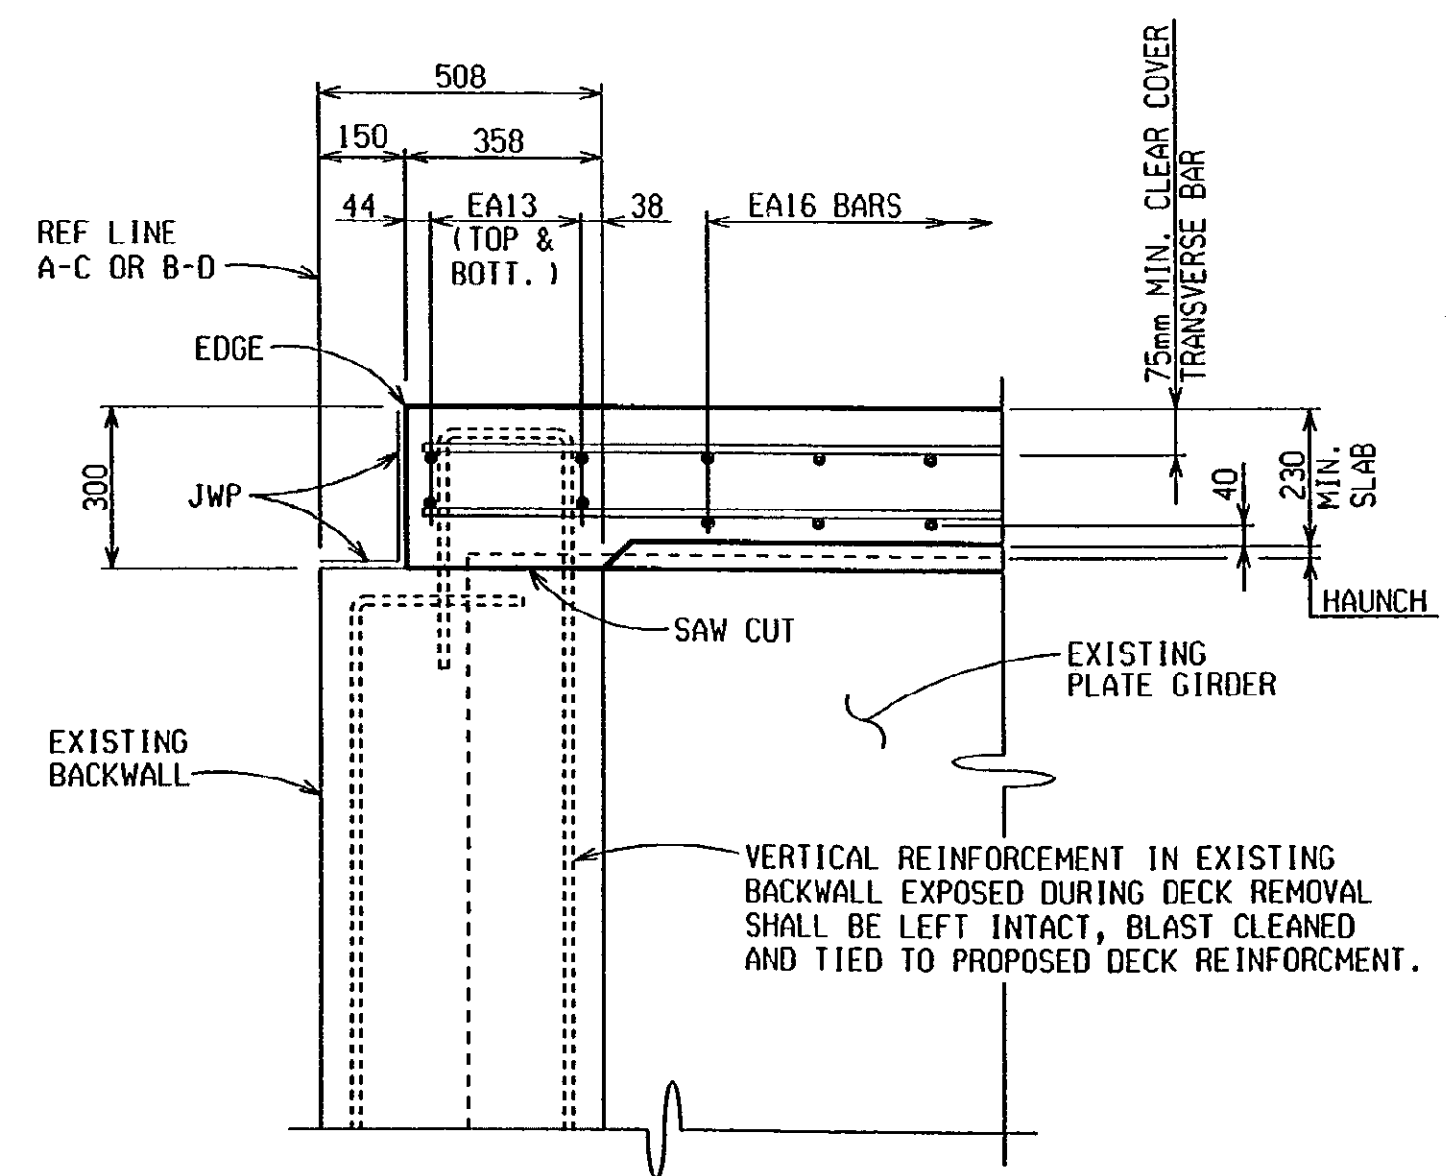

TYPICAL SECTION THRU BACKWALL

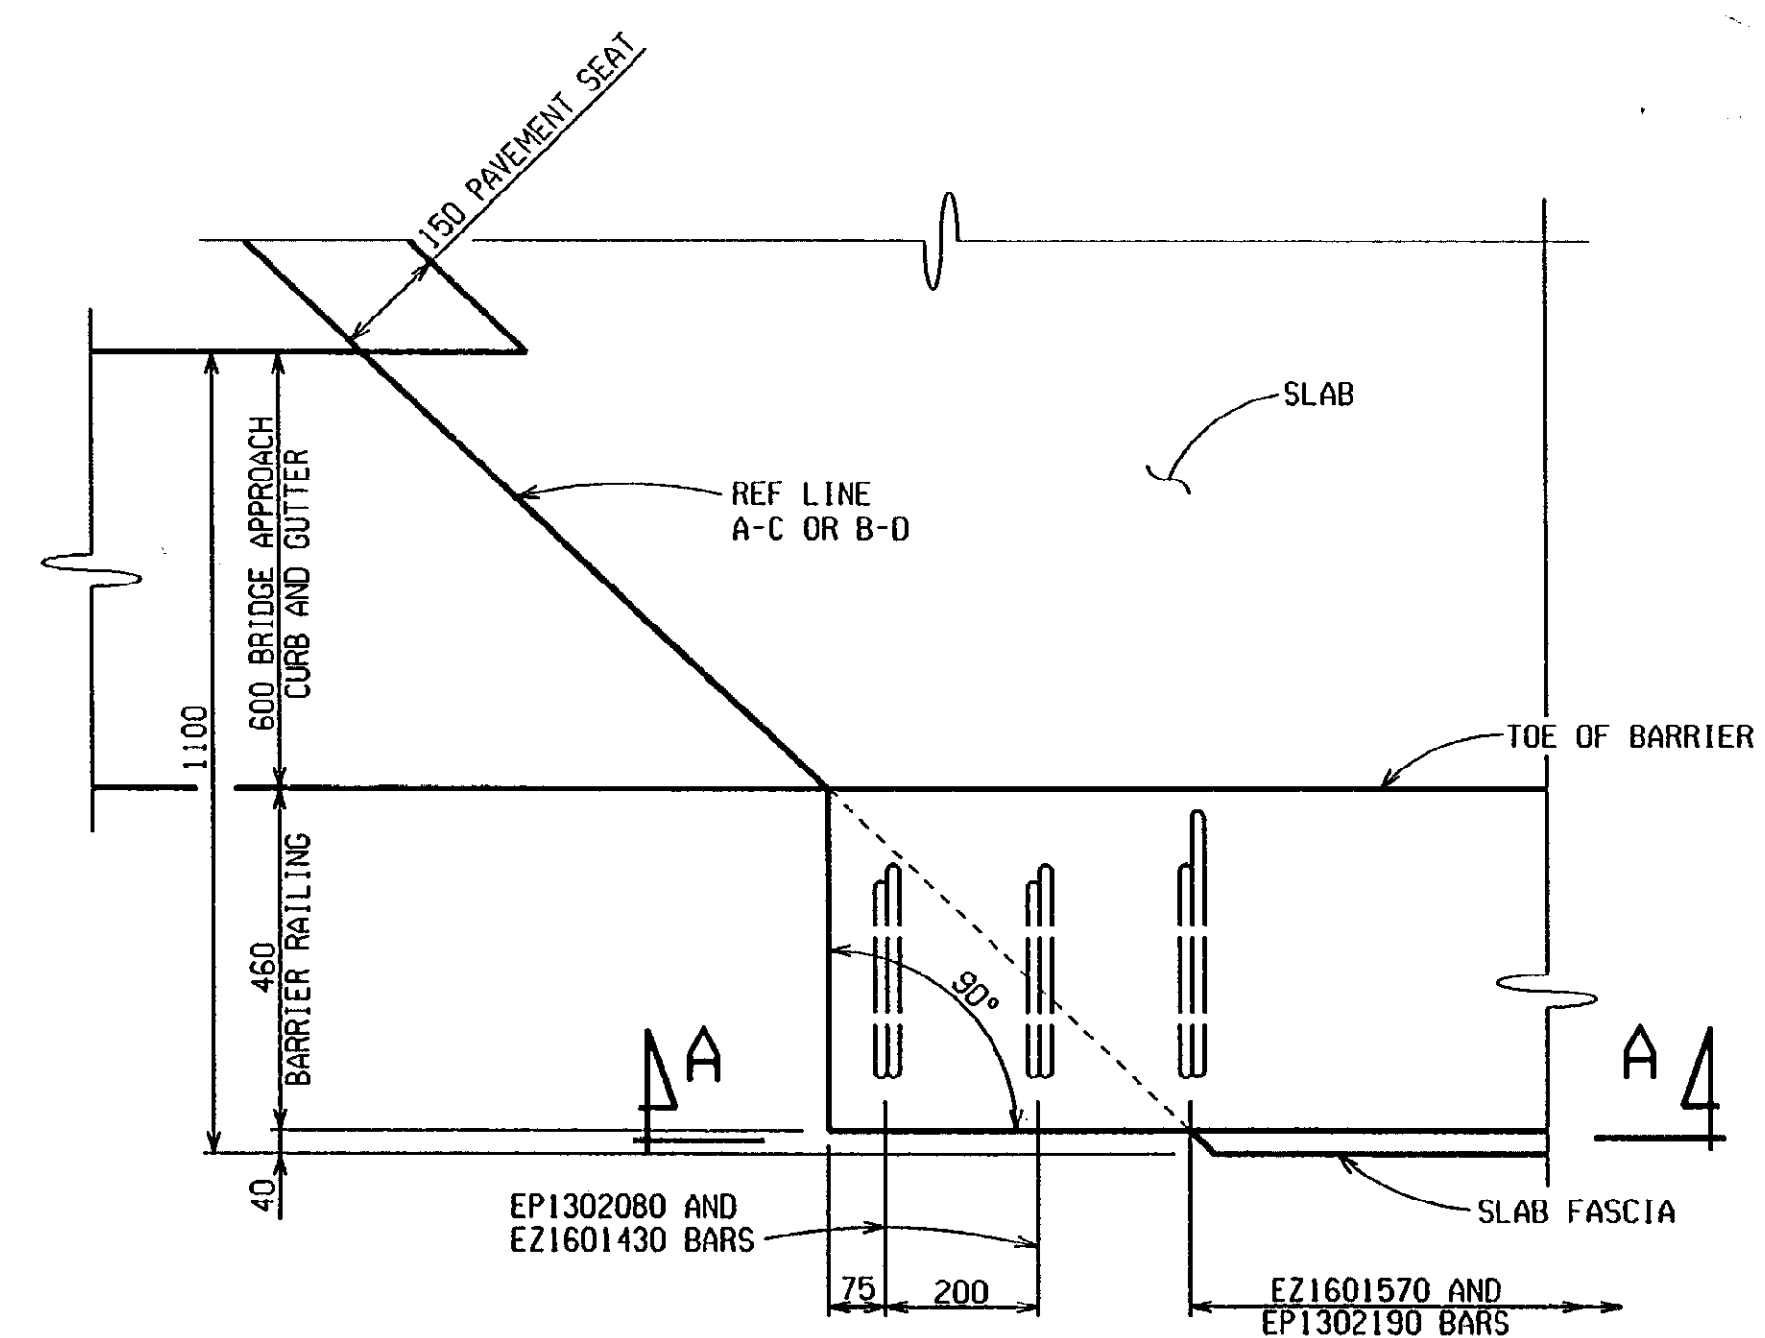

DETAIL A
(TYP. ALL 4 QUADRANTS)

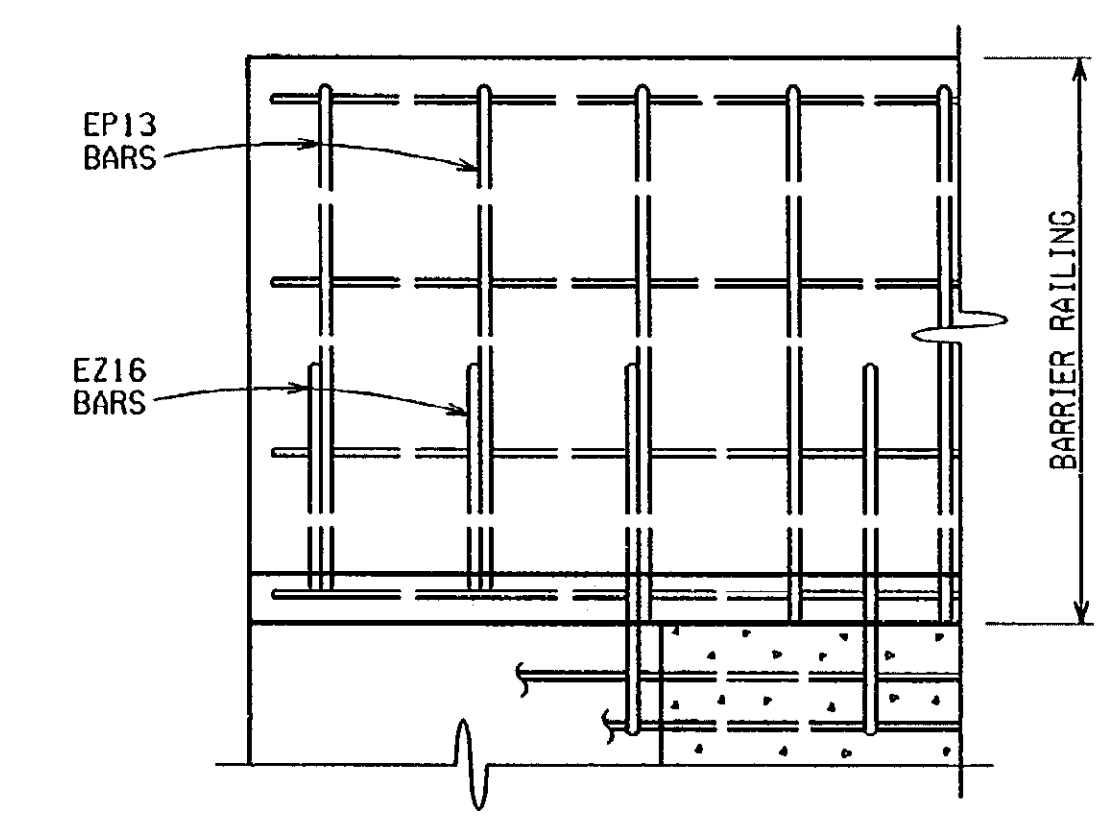

SECTION A-A







DECK REPLACEMENT DETAILS - NB STRUCTURE				
DATE	CONT. SEC.	JOB NO.	DESIGN UNIT	SHEET
1-9-01	B02 OF 63174	49595A	MAHDAVI	13 OF 16



CONTROL NO. OF 63174 JOB NO. 49595A SH. NO. 14 SECTION

1 2 3 4 5 6 7 8 9 10 11 12 13 14 15 16 17 18 19 20 21 22 23 24 25 26 27 28 29 30 31 32 33 34 35 36 37 38 39 40 41 42 43 44 45 46 47 48 49 50 51 52 53 54 55 56 57 58 59 60 61 62 63

REVISIONS			
NO.	DESCRIPTION	DATE	BY

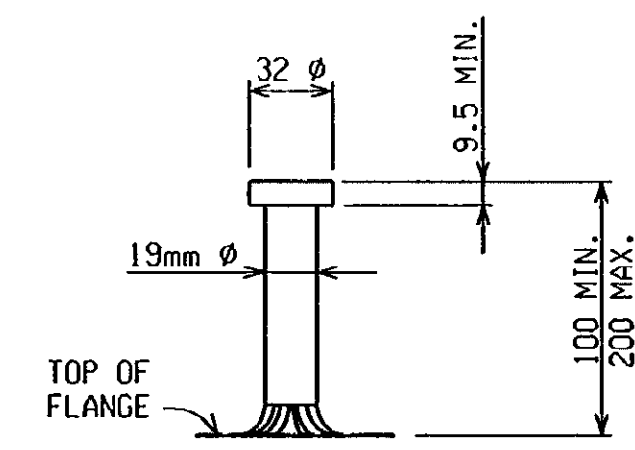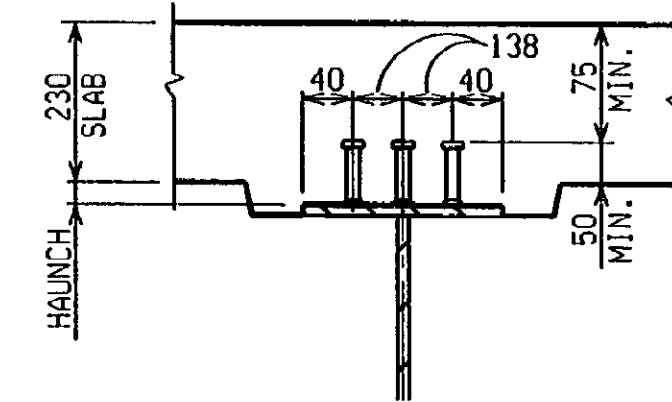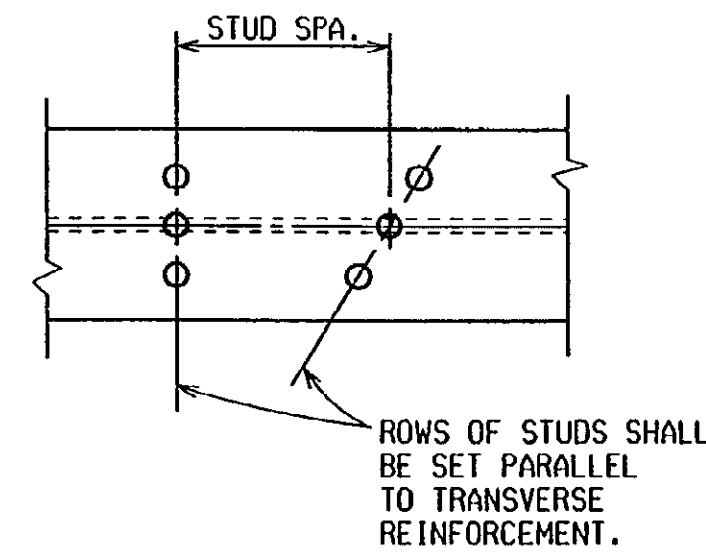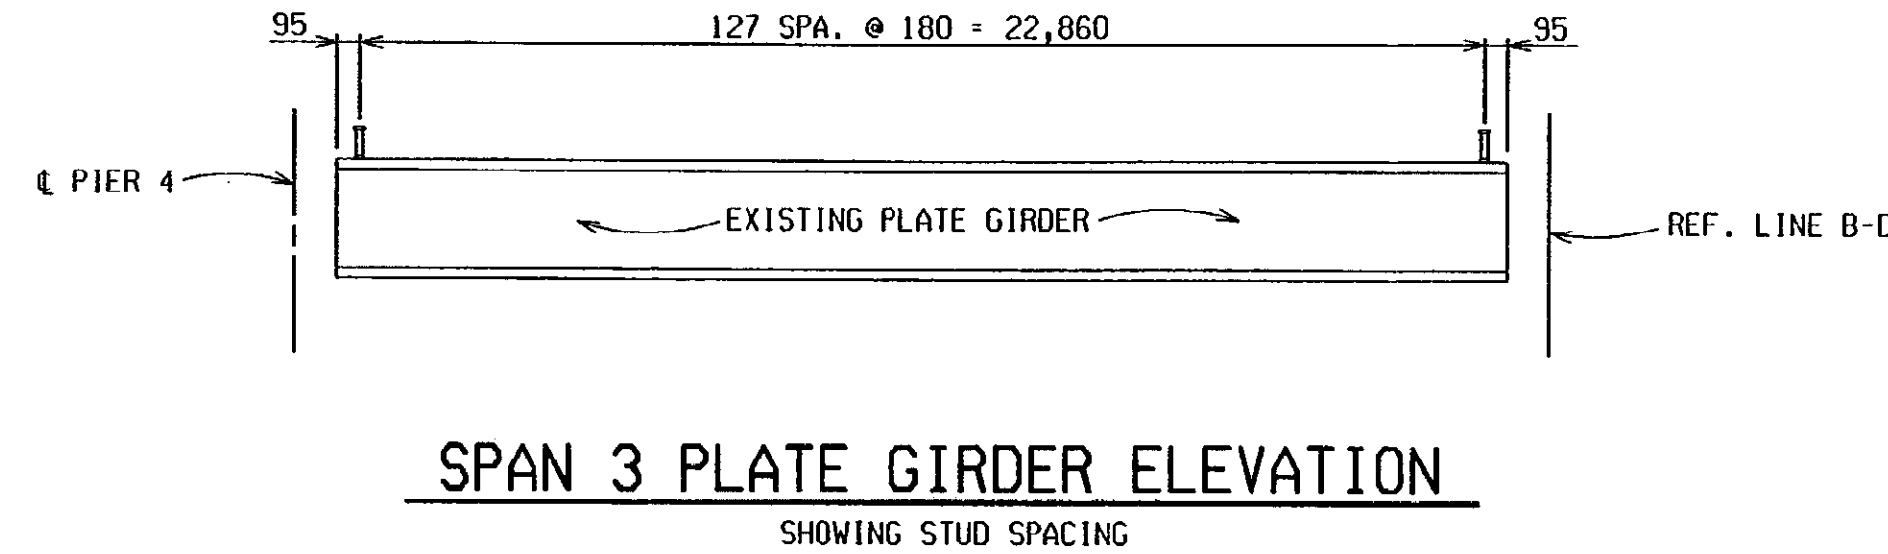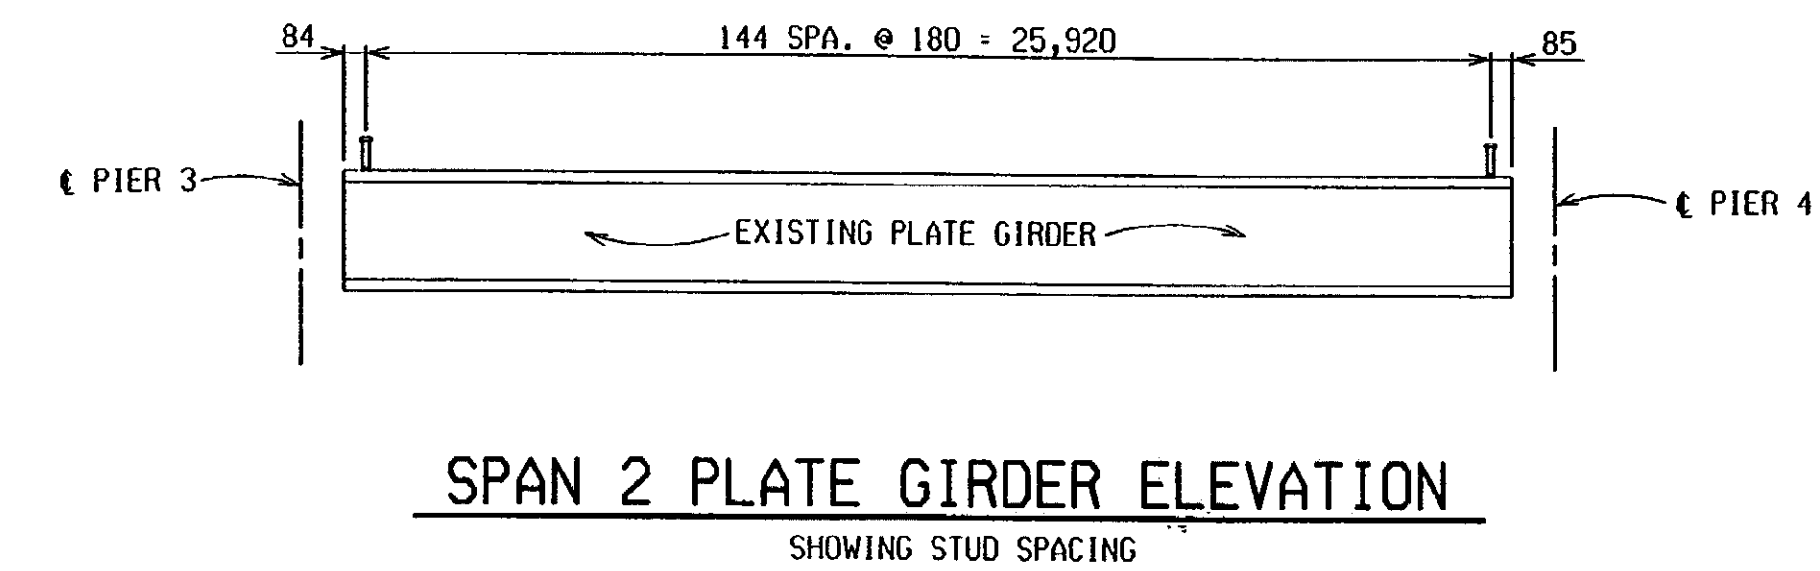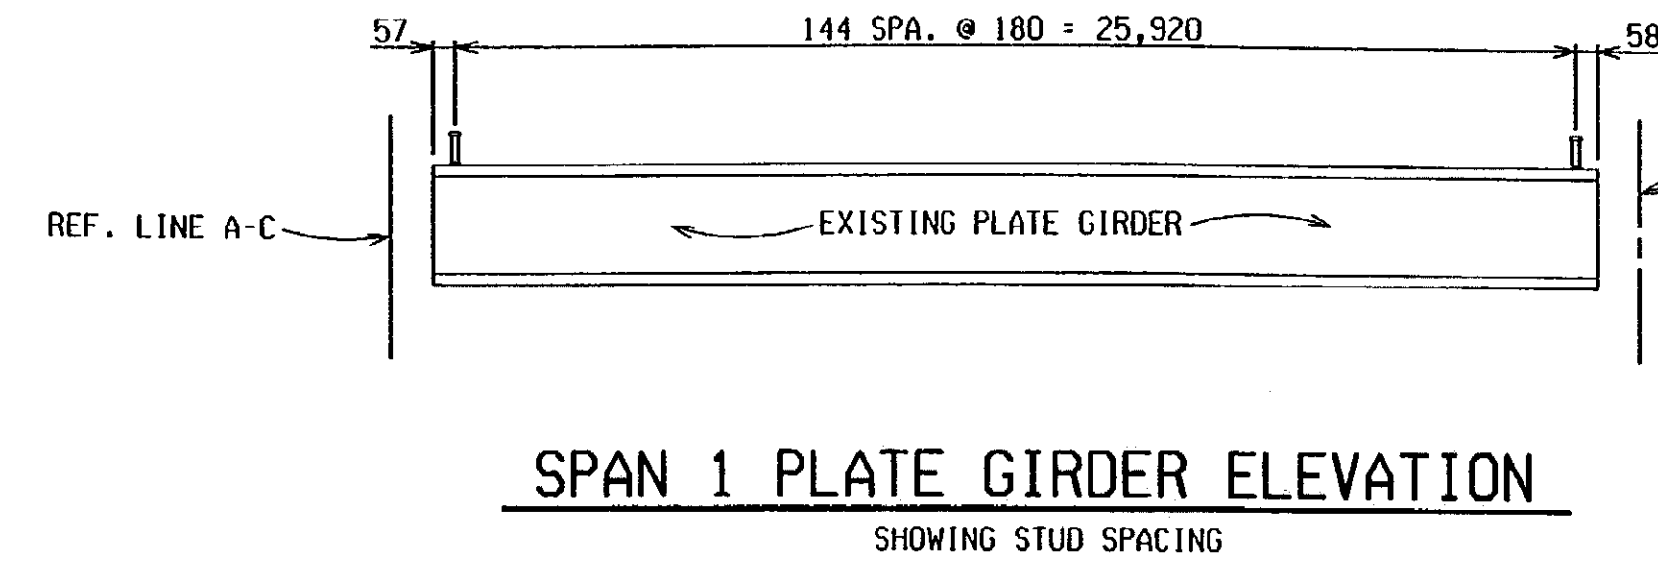

STUD SHEAR DEVELOPER DETAILS



DECK REPLACEMENT DETAILS - NB STRUCTURE				
DATE	CONT. SEC.	JOB NO.	DESIGN UNIT	SHEET
1-9-01	B02 OF 63174	49595A	MAHDAVI	14 OF 16

FILE NAME: 50263174n.dwg DRAWN BY: R. PRATT CHECKED BY: MIKUCKI DATE: 12-7-00 CORRECTED BY: DATE: DATE:



REVISIONS			
NO.	DESCRIPTION	DATE	BY

BOTTOM OF SLAB ELEVATIONS

	SPAN 1								SPAN 2								SPAN 3										
	0	1	2	3	4	5	6	7	0	1	2	3	4	5	6	7	0	1	2	3	4	5	6	7	8		
A FASCIA	196.766	196.707	196.646	196.583	196.518	196.448	196.376	196.302	196.227	196.218	196.169	196.119	196.067	196.012	195.953	195.891	195.827	195.763	195.757	195.719	195.680	195.641	195.600	195.557	195.512	195.466	195.420
B RIGHT	196.834	196.774	196.713	196.650	196.585	196.516	196.443	196.369	196.294	196.285	196.236	196.186	196.134	196.079	196.020	195.959	195.895	195.830	195.824	195.786	195.748	195.708	195.667	195.624	195.579	195.534	195.488
C LEFT	196.818	196.759	196.699	196.638	196.573	196.505	196.434	196.360	196.286	196.278	196.229	196.180	196.129	196.075	196.017	195.956	195.893	195.829	195.824	195.786	195.749	195.710	195.670	195.628	195.584	195.539	195.494
D RIGHT	196.828	196.769	196.710	196.648	196.583	196.515	196.444	196.370	196.296	196.288	196.240	196.190	196.139	196.085	196.027	195.966	195.903	195.839	195.834	195.797	195.759	195.720	195.680	195.638	195.594	195.549	195.504
E LEFT	196.813	196.755	196.696	196.636	196.572	196.505	196.435	196.362	196.289	196.281	196.233	196.185	196.135	196.081	196.025	195.965	195.902	195.839	195.834	195.798	195.761	195.723	195.683	195.642	195.599	195.555	195.511
F RIGHT	196.823	196.765	196.707	196.646	196.582	196.515	196.445	196.372	196.299	196.291	196.244	196.195	196.145	196.092	196.035	195.975	195.913	195.850	195.844	195.808	195.771	195.733	195.694	195.652	195.609	195.565	195.521
G LEFT	196.794	196.737	196.679	196.620	196.557	196.491	196.422	196.350	196.278	196.270	196.223	196.176	196.127	196.074	196.018	195.959	195.898	195.836	195.830	195.795	195.759	195.722	195.683	195.643	195.600	195.557	195.514
H RIGHT	196.784	196.727	196.669	196.610	196.547	196.481	196.411	196.340	196.268	196.260	196.213	196.166	196.116	196.064	196.008	195.949	195.888	195.826	195.820	195.785	195.749	195.712	195.673	195.632	195.590	195.547	195.504
I LEFT	196.694	196.638	196.581	196.523	196.461	196.396	196.327	196.257	196.186	196.178	196.132	196.086	196.037	195.985	195.930	195.872	195.812	195.751	195.745	195.711	195.676	195.639	195.601	195.562	195.521	195.478	195.435
J RIGHT	196.683	196.628	196.571	196.512	196.451	196.385	196.317	196.247	196.176	196.168	196.122	196.076	196.027	195.975	195.920	195.862	195.802	195.740	195.735	195.700	195.665	195.629	195.591	195.552	195.510	195.468	195.425
K LEFT	196.594	196.539	196.484	196.426	196.365	196.301	196.234	196.164	196.094	196.086	196.042	195.996	195.948	195.898	195.843	195.786	195.727	195.666	195.661	195.627	195.593	195.558	195.521	195.482	195.441	195.400	195.358
L RIGHT	196.584	196.529	196.474	196.416	196.355	196.291	196.224	196.154	196.084	196.076	196.031	195.986	195.938	195.887	195.833	195.776	195.716	195.656	195.651	195.617	195.583	195.547	195.510	195.472	195.431	195.390	195.348
M LEFT	196.495	196.441	196.387	196.330	196.270	196.207	196.141	196.073	196.003	195.996	195.952	195.907	195.860	195.810	195.757	195.701	195.642	195.583	195.578	195.544	195.511	195.477	195.440	195.402	195.363	195.322	195.281
N RIGHT	196.485	196.431	196.377	196.320	196.260	196.197	196.131	196.062	195.993	195.986	195.942	195.897	195.850	195.800	195.747	195.690	195.632	195.573	195.568	195.534	195.501	195.466	195.430	195.392	195.353	195.312	195.271
O LEFT	196.397	196.344	196.291	196.235	196.176	196.114	196.049	195.981	195.913	195.906	195.863	195.819	195.773	195.724	195.671	195.616	195.558	195.500	195.495	195.462	195.430	195.396	195.361	195.324	195.285	195.245	195.205
P FASCIA	196.330	196.277	196.224	196.168	196.109	196.047	195.982	195.914	195.846	195.838	195.795	195.752	195.706	195.657	195.604	195.549	195.491	195.433	195.428	195.395	195.363	195.329	195.294	195.257	195.218	195.178	195.138

SCREED ELEVATIONS

LEFT	197.059	196.998	196.935	196.872	196.805	196.736	196.665	196.592	196.518	196.510	196.459	196.407	196.354	196.298	196.240	196.179	196.116	196.053	196.048	196.008	195.969	195.929	195.887	195.844	195.800	195.755	195.710
CENTER	196.966	196.908	196.850	196.790	196.727	196.662	196.594	196.525	196.455	196.447	196.399	196.351	196.300	196.248	196.193	196.135	196.076	196.016	196.011	195.975	195.938	195.901	195.863	195.823	195.782	195.740	195.698
RIGHT	196.607	196.552	196.497	196.441	196.382	196.320	196.256	196.190	196.124	196.116	196.072	196.027	195.980	195.930	195.879	195.824	195.768	195.712	195.707	195.673	195.640	195.606	195.570	195.534	195.496	195.457	195.418

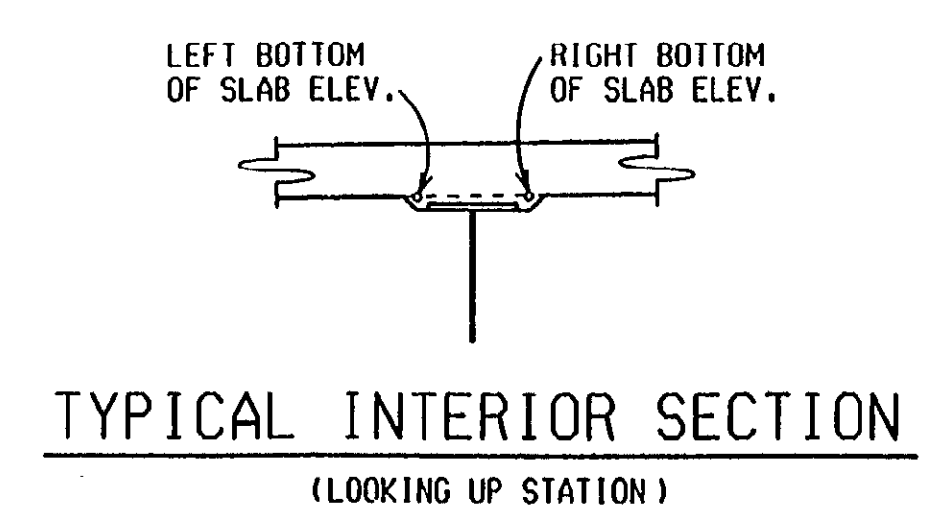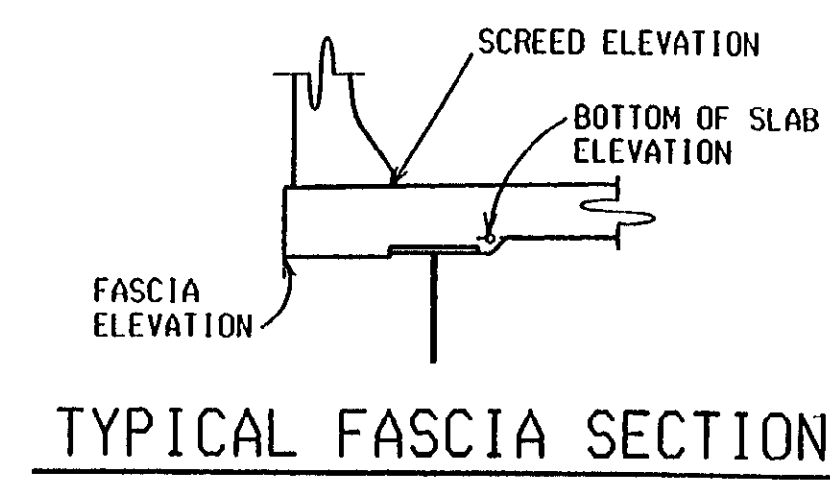

BULKHEAD ELEVATIONS

	ABUT. A		ABUT. B	
A	197.061	196.515	196.052	195.711
B	197.056	196.517	196.062	195.727
C	197.051	196.520	196.072	195.744
D	197.021	196.499	196.058	195.737
E	196.921	196.407	195.973	195.659
F	196.822	196.315	195.889	195.581
G	196.723	196.224	195.805	195.504
H	196.625	196.134	195.722	195.428



SLAB AND SCREED DATA - NB STRUCTURE				
DATE	CONT. SEC.	JOB NO.	DESIGN UNIT	SHEET
1-9-01	B02 OF 63174	49595A	MAHDAVI	15 OF 16

SCREED ELEVATIONS ARE BASED ON THE CONDITION THAT NO SLAB CONCRETE HAS BEEN CAST AND THAT FORMWORK AND STEEL REINFORCEMENT ARE IN PLACE AND THE TEMPORARY SUPPORTS ARE BROUGHT TO A SNUG FIT UNDER EACH BEAM.



THE TRANSVERSE FINISHING SHALL BE PARALLEL TO REFERENCE LINES.

SECTIONS FOR BOTTOM OF SLAB AND/OR SCREED ELEVATIONS ARE GIVEN ALONG BEAM CENTERLINES FROM CENTERLINE OF BEARING OR PIN & HANGER TO CENTERLINE OF BEARING OR PIN & HANGER AS APPLICABLE AT EQUAL SPACINGS.




1 2 3 4 5 6 7 8 9 10 11 12 13 14 15 16 17 18 19 20 21 22 23 24 25 26 27 28 29 30 31 32 33 34 35 36 37 38 39 40 41 42 43 44 45 46 47 48 49 50 51 52 53 54 55 56 57 58 59 60 61 62 63

BENCH MARKS
 B.M. #69 El. 637.34 M.S.H.D. B.M. Top in Root of 15' Elm
 150' W of P.M. 106 N.B. Rdwy.
 B.M. #68 El. 639.31 M.S.H.D. B.M. Top in Root of 24' Elm
 24' W of 1st of 839.43 N.B. Rdwy.


UTILITIES
 Detroit Edison, High Voltage Line crossing & at
 Sta. 929+60

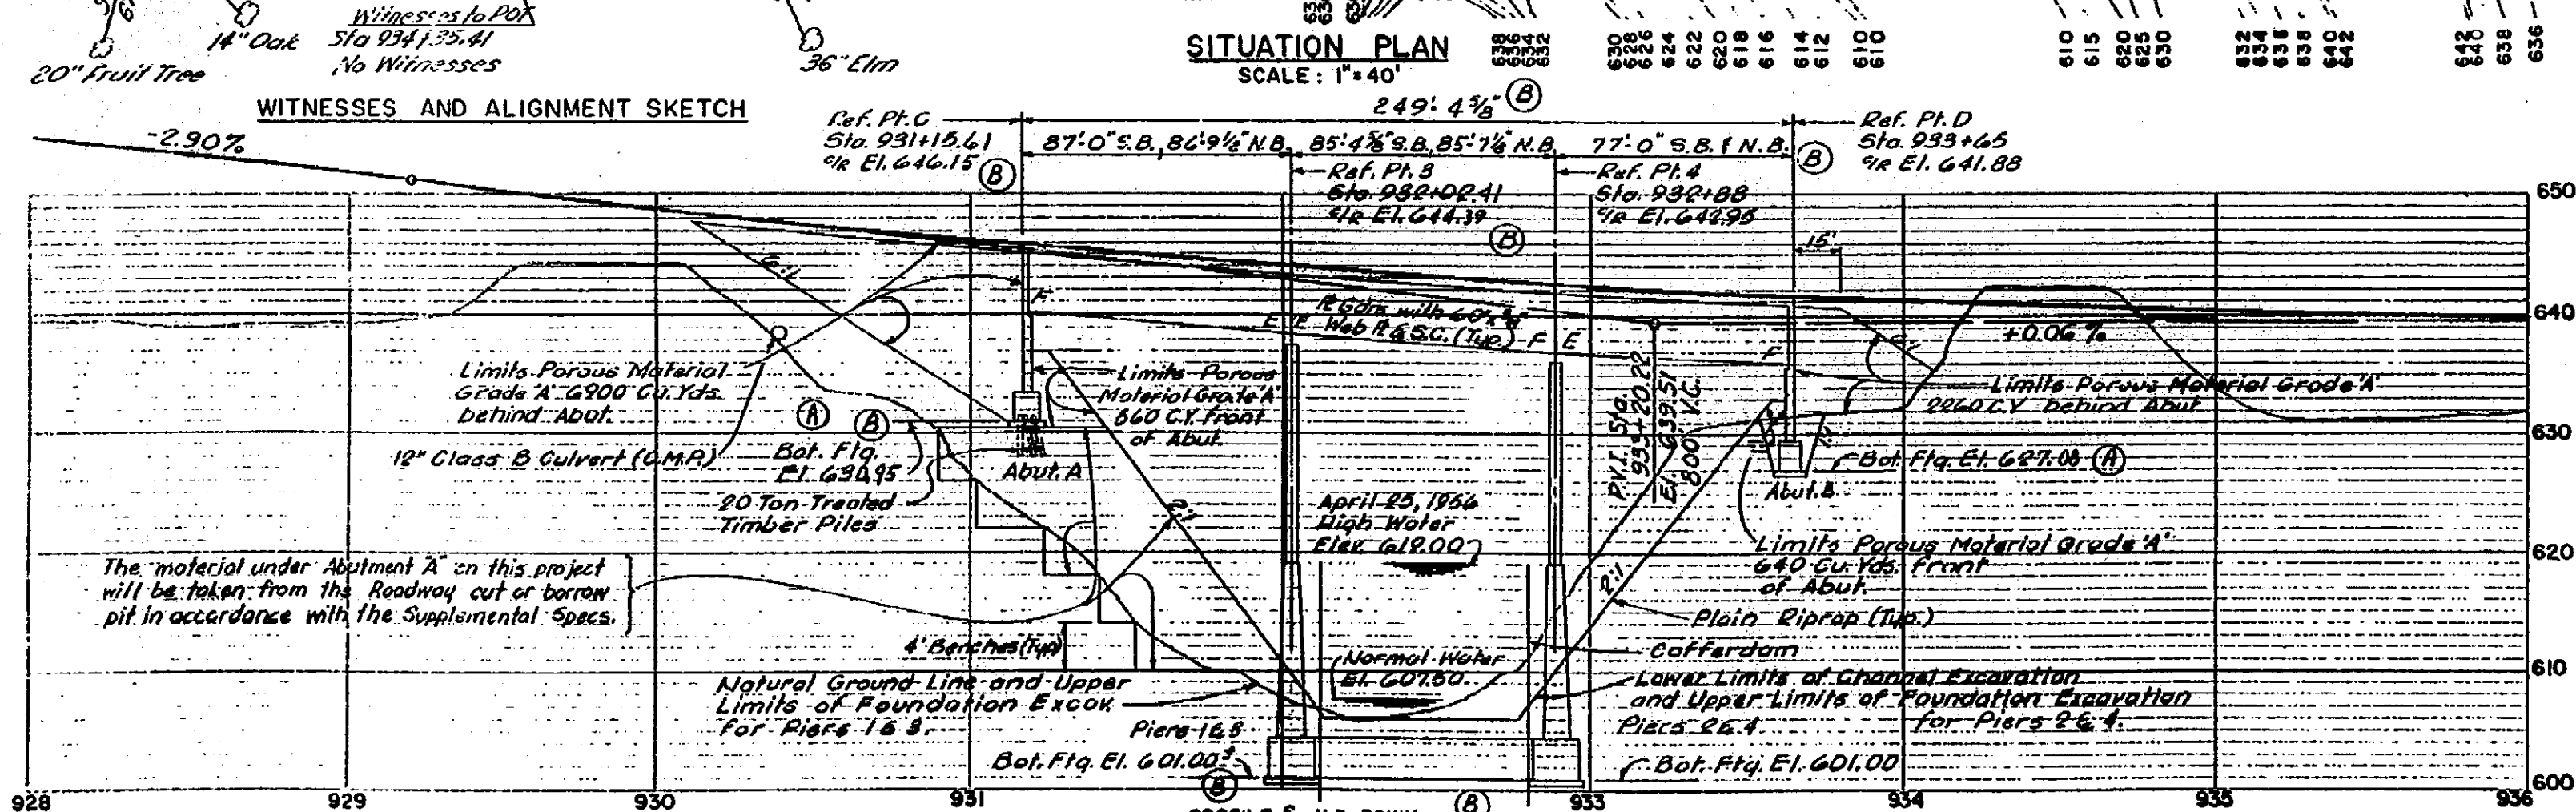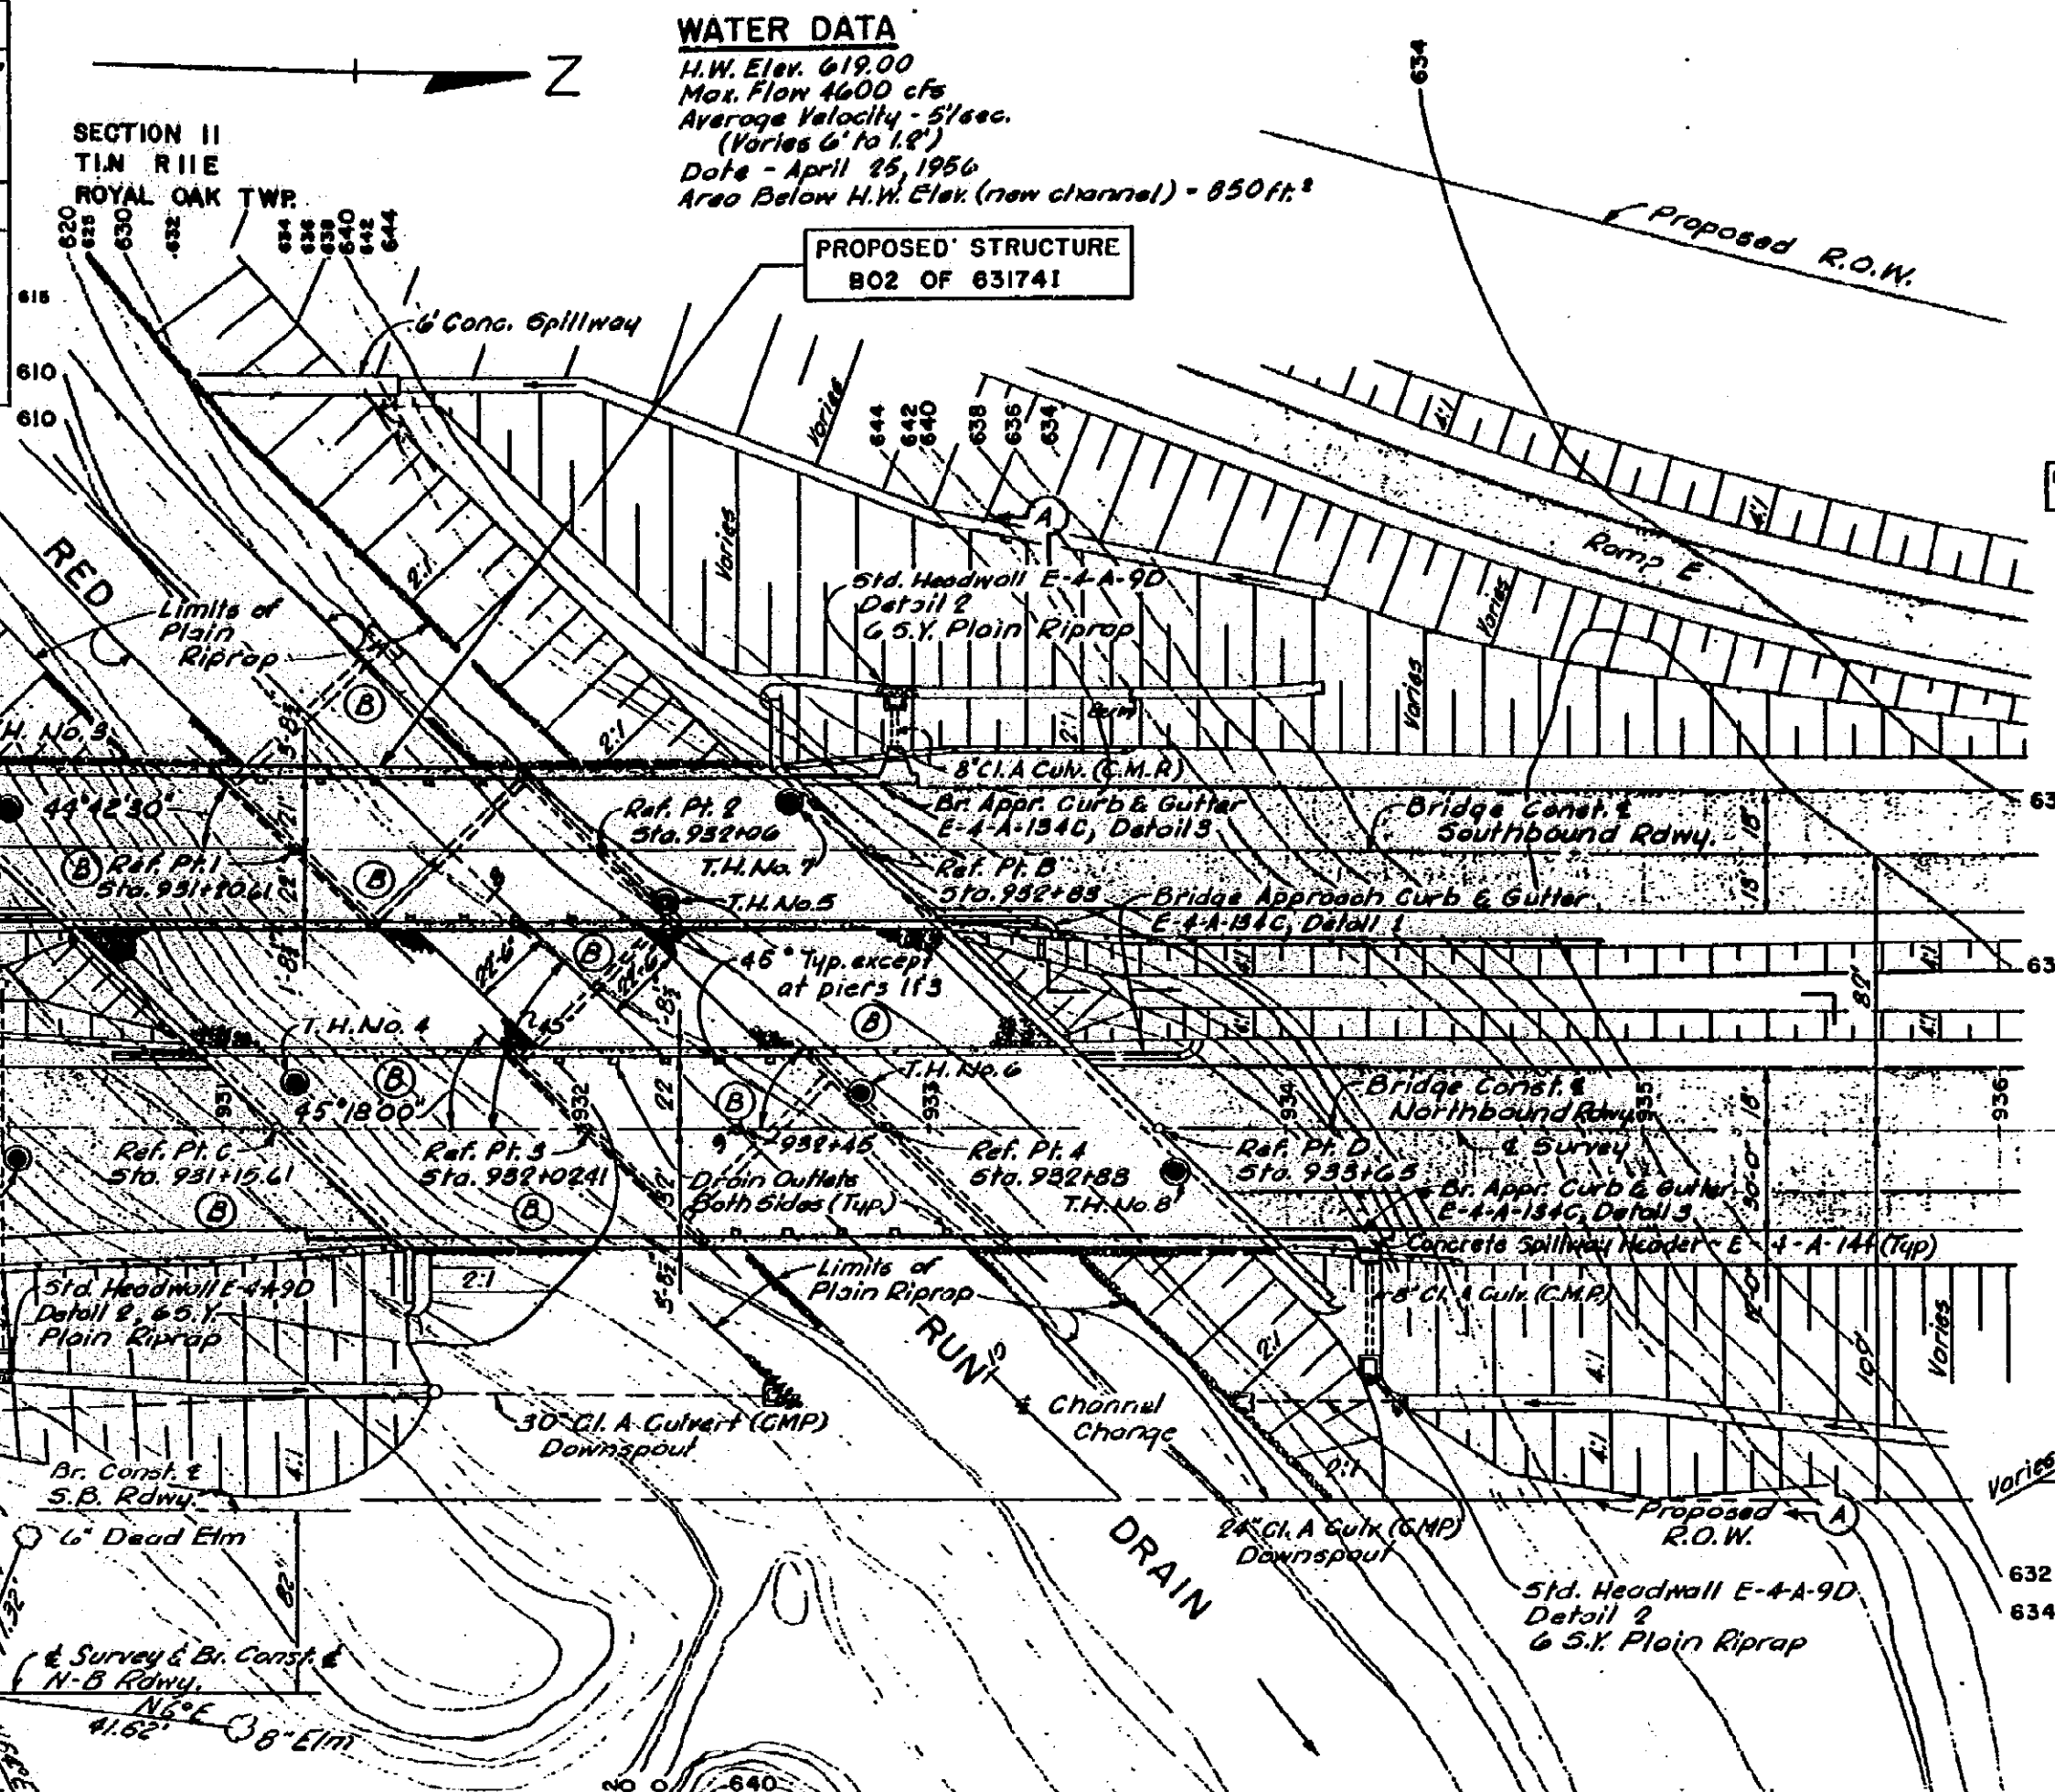

NOTE:
 DO NOT WORK FROM THIS SHEET. THE INFORMATION SHOWN
 HERE IS FOR REFERENCE ONLY. NO PAY ITEMS ARE SHOWN.

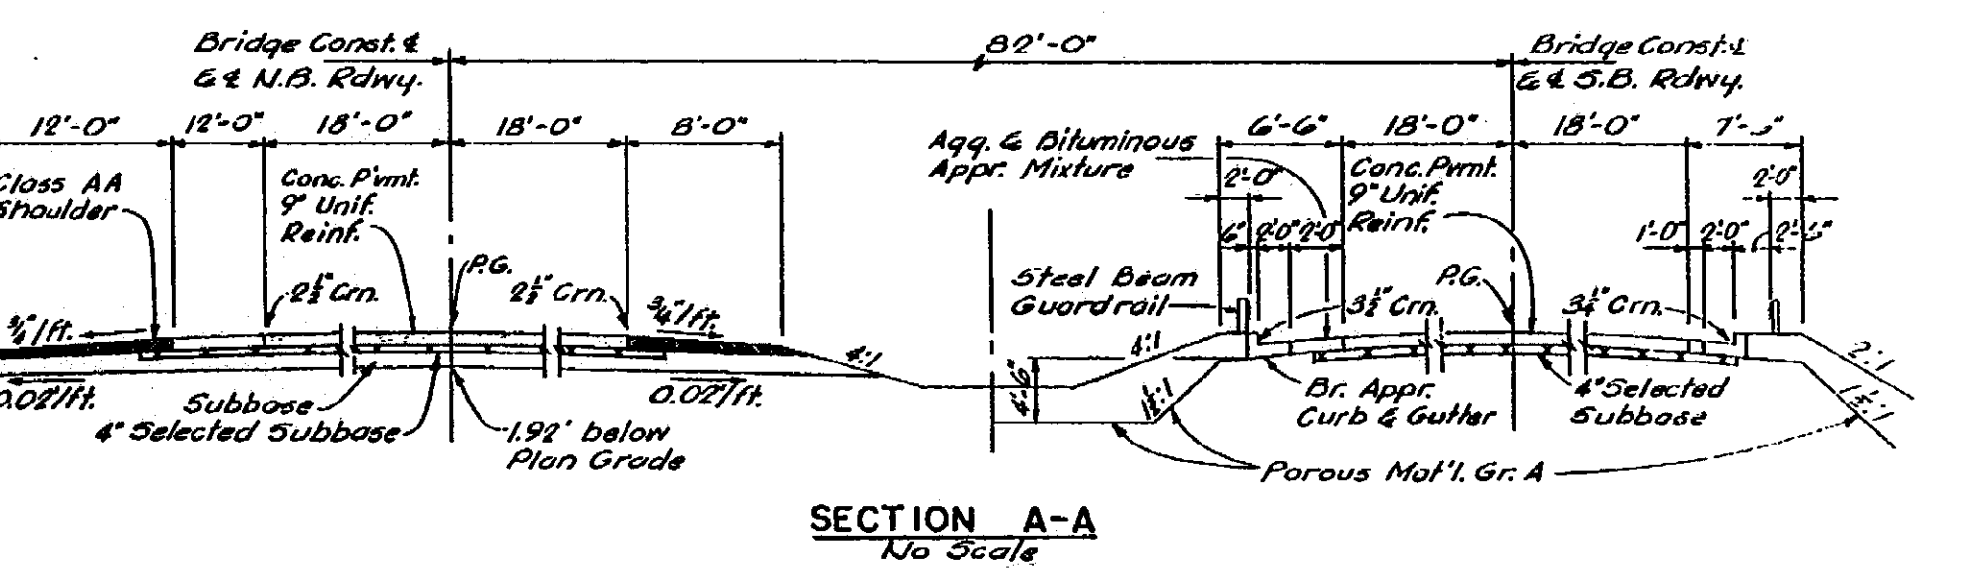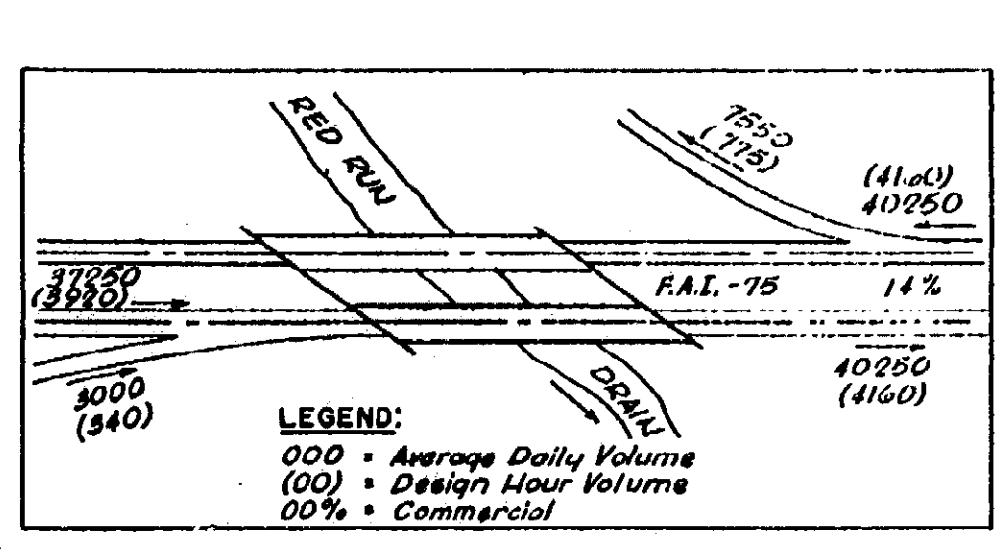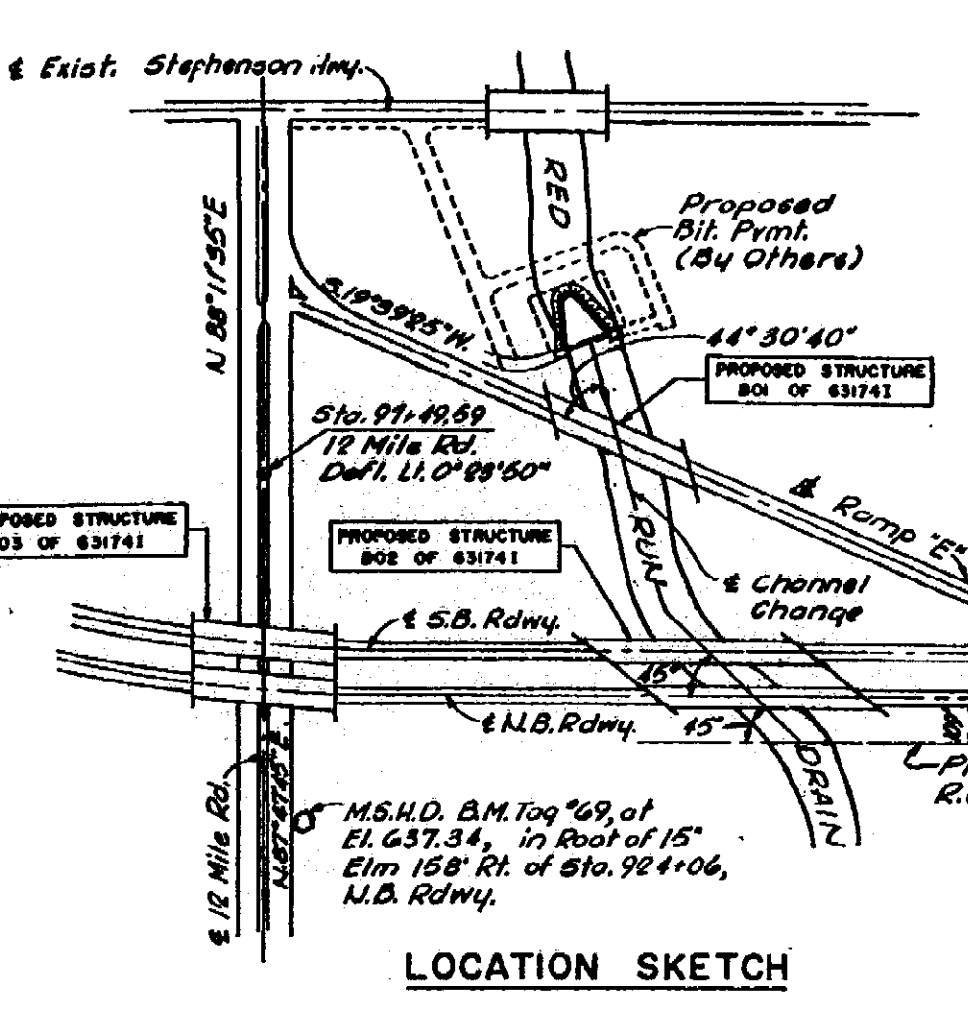

GENERAL NOTES:
 Fences, and utilities are to be moved by others.
 Datum refers to U.S.G.S. Datum.
 Place riprap El. 604.00 to El. 620.00.
 All Piers shall be constructed and back-filled prior to construction of the abutments.
 The work covered by these plans includes channel excavation, construction of the proposed bridge, placing porous material, and placing riprap to the limits shown.
 All work not listed above is included in the Road Plans.

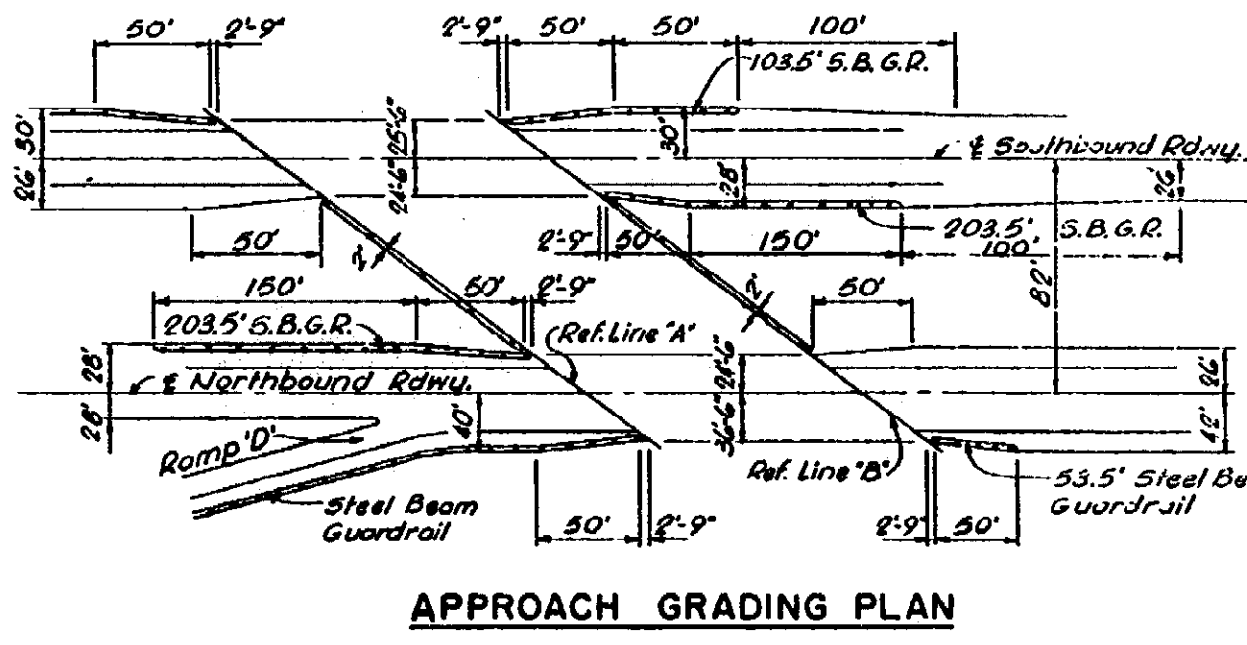

CONTROL SECTION 631741

MICHIGAN STATE HIGHWAY DEPARTMENT
 1-75 OVER RED RUN DRAIN IN THE CITY OF MADISON HEIGHTS
GENERAL PLAN OF SITE


TECON ENGINEERS, INC.
 APPROVED: *J. L. Murray* 6.5.62
 ENGINEER OF DESIGN - CONSULTANTS

BO2 OF 631741



FOR INFORMATION ONLY				
SOUTH BOUND				
DATE	CONT. SEC.	JOB NO.	DESIGN UNIT	SHEET
1-9-01	B02 OF 63174	49595A	MAHDAVI	2 OF 15

DATE: _____ CORRECTED BY: INDER DATE: _____ CHECKED BY: _____ DATE: 02-11-00 DRAWN BY: INDER FILE NAME: B02631745n

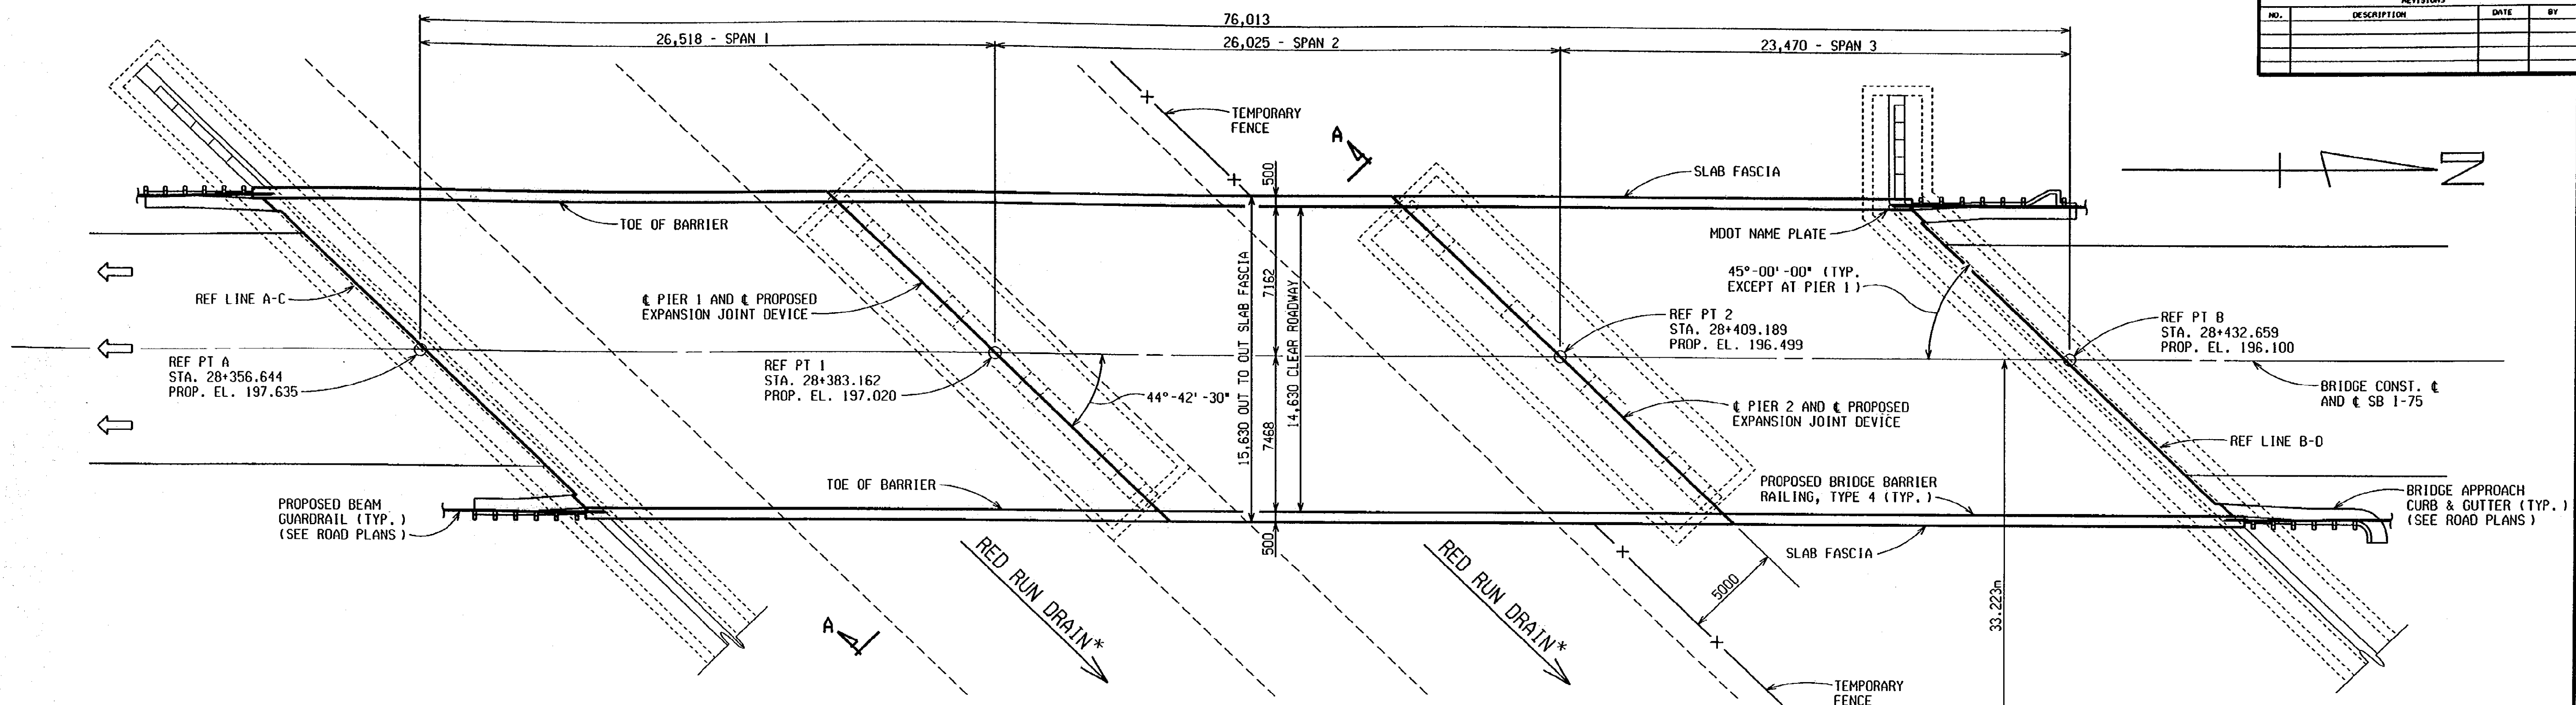


REVISIONS			
NO.	DESCRIPTION	DATE	BY

* RED RUN DRAIN IS CONTAINED WITHIN TWO BURIED CONCRETE BOX CULVERTS. THE AREA OVER THESE BURIED CULVERTS SHALL BE FENCED PRIOR TO STARTING CONSTRUCTION TO PREVENT ENCROACHMENT OF HEAVY CONSTRUCTION EQUIPMENT.

PLAN - SB
 THE LIMITS OF FALSE DECKING IS FROM FACE OF ABUT. A TO FACE OF ABUT. B AND BETWEEN SLAB FASCIAS.

MISCELLANEOUS QUANTITIES	
1 LS	Structures, Rem Portions (B02-SB)
1180 m ²	False Decking
190 m ²	Top Flanges and Beam Ends, Clean and Prime
1 LS	Penetrating Water Repellent Treatment (B02-SB)
1 LS	Substructure Horizontal Surface Sealer (B02-SB)
1 LS	Steel Structures, Cleaning, Type 4 (B02-SB)
1 LS	Steel Structures, Coating, Type 4 (B02-SB)
160 m	Beam Plate, Seal Perimeter
3 m ³	Hand Chipping, Other Than Deck
3 m ³	Patching Conc. LM
30 m ²	Patch, Forming
*150 m	Fence, Temporary

*SEE SHEET 18 FOR LOCATION.

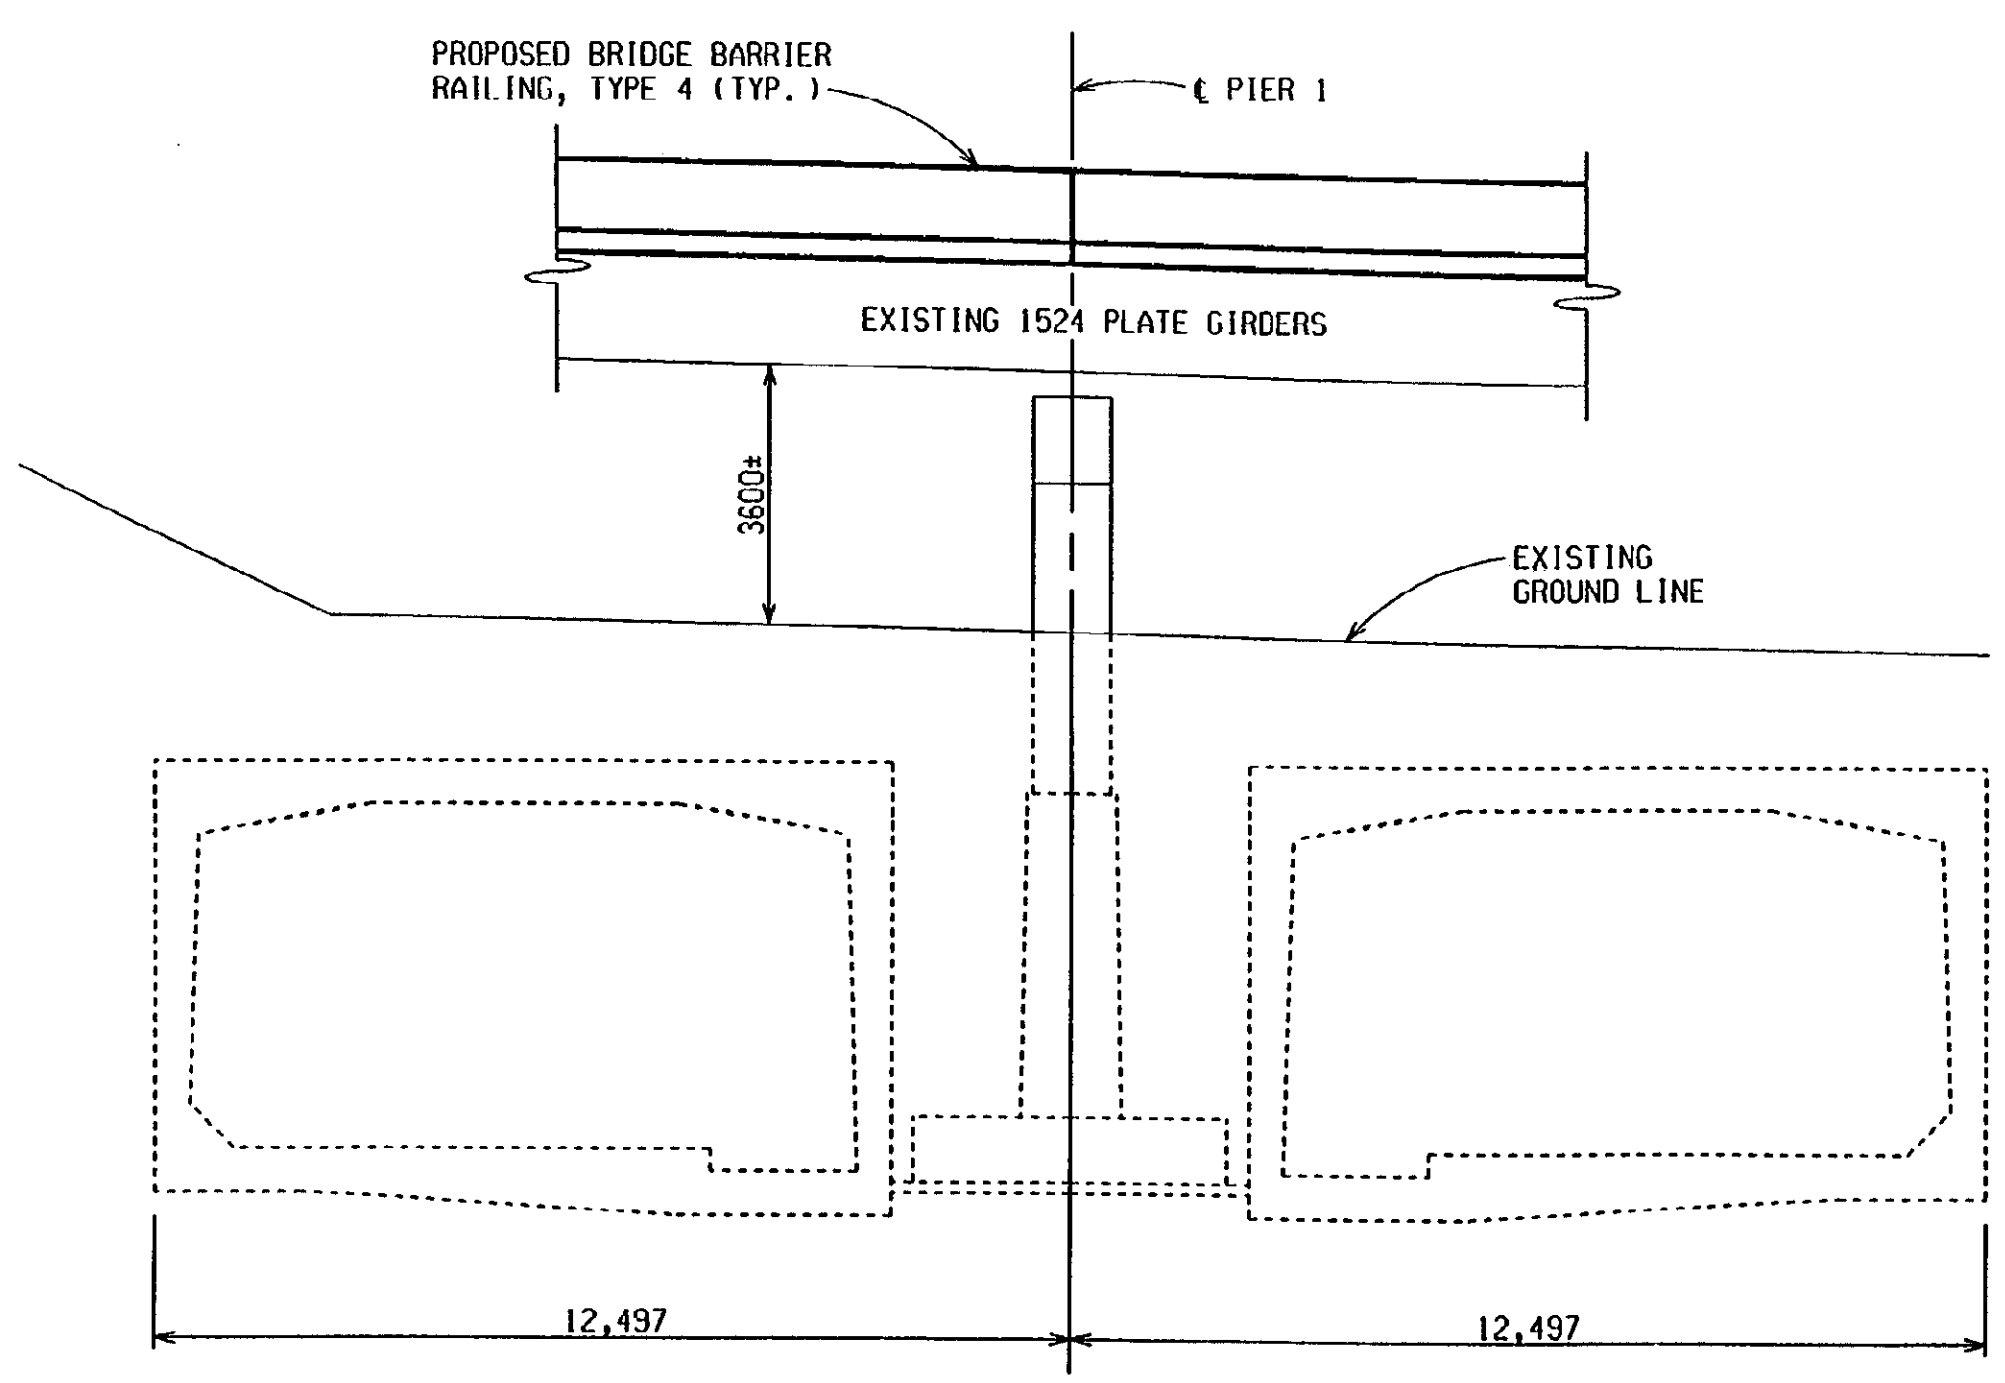

SECTION A-A


NOTES:

- THE WORK COVERED BY THESE PLANS INCLUDES DECK REPLACEMENT, WIDENING, SUBSTRUCTURE REPAIR, PAINTING OF THE EXISTING STRUCTURAL STEEL, MAINTAINING TRAFFIC AND APPROACH WORK.
- THE REHABILITATION DESIGN IS BASED ON CURRENT AASHTO STANDARD SPECIFICATIONS FOR HIGHWAY BRIDGES MS23. LIVE LOAD PLUS IMPACT DEFLECTION DOES NOT EXCEED 1/800 OF SPAN LENGTH. THE ALLOWABLE STRESS METHOD WAS USED FOR THIS DESIGN. THE ORIGINAL STRUCTURE WAS DESIGNED FOR MS18 LOADING.
- MEASURES SHALL BE TAKEN TO PREVENT DEBRIS FROM FALLING FROM THE STRUCTURE.
- THE CONTRACTOR SHALL LOCATE ALL ACTIVE UNDERGROUND UTILITIES PRIOR TO STARTING WORK AND SHALL CONDUCT HIS OPERATIONS IN SUCH A MANNER AS TO ENSURE THAT THOSE UTILITIES NOT REQUIRING RELOCATION WILL NOT BE DISTURBED.
- SB I-75 TRAFFIC IS TO BE DETOURED OVER THE NB BRIDGE.
- THE TOP HORIZONTAL SURFACES OF ALL PIER CAPS SHALL BE COATED WITH SUBSTRUCTURE HORIZONTAL SURFACE SEALER. THE ESTIMATED AREA IS 44m².
- PENETRATING WATER REPELLENT TREATMENT SHALL BE APPLIED TO ALL SURFACES OF PIERS EXCEPT TOPS OF PIERS. THE ESTIMATED AREA FOR PENETRATING WATER REPELLENT APPLICATION IS 264m².
- FORMS FOR LARGE PATCHES SHALL BE INSTALLED IN 600mm TO 1200mm HIGH SECTIONS WITH THE TOP OF FORM NO MORE THAN 1200mm ABOVE THE LEVEL OF CONCRETE AS THE POUR PROGRESSES.
- FALSE DECKING SHALL INCLUDE THE AREA OF SPANS 1, 2 AND 3. THE ESTIMATED AREA IS 1180 SQUARE METERS DURING REMOVAL AND PROPOSED CONSTRUCTION.
- THIS BRIDGE IS COATED WITH LEAD BASED PAINT.
- SEE SUBSECTION 715 OF THE STANDARD SPECIFICATIONS FOR PROTECTION OF WORK AND ENVIRONMENT DURING THE BLAST CLEANING OF STRUCTURES.
- THE ENGINEER SHALL INSPECT THE STRUCTURAL STEEL PARTS THAT HAVE BEEN BLAST CLEANED FOR EVIDENCE OF CRACKS OR LOSS OF SECTION DUE TO CORROSION OF MORE THAN 25 PERCENT. SUCH DETERIORATION SHALL BE REPORTED IN WRITING TO THE ENGINEER, STRUCTURES AND ROAD MAINTENANCE OF THE MAINTENANCE DIVISION IN LANSING.
- THE ESTIMATED AREA OF STRUCTURAL STEEL TO BE COATED IS 2520 SQUARE METERS.
- SEALANT SHALL BE APPLIED AROUND THE PERIMETER OF BEARING PLATES TO CONCRETE CONTACT SURFACES AFTER CUTTING AWAY ANY PROTRUDING PORTION OF LEAD PLATE.
- SEALANT SHALL BE APPLIED AROUND THE PERIMETER OF BOLTED END DIAPHRAGM CONNECTION PLATES AND ANGLES.
- SEALANT SHALL BE APPLIED AROUND THE PERIMETER OF ALL BEAM ENDS WHERE ENCASED IN THE BACKWALLS.
- THE COLOR OF THE URETHANE PROTECTIVE COAT SHALL BE LIGHT GRAY. FEDERAL STANDARD 595B COLOR NUMBER 16440.
- THE CONTRACTOR SHALL TAKE NECESSARY MEASURES TO AVOID OVERSPRAY ON ADJACENT SUBSTRUCTURE AND SUPERSTRUCTURE CONCRETE SURFACES AND ON SIGNS ATTACHED TO THE STRUCTURE. INCLUDED IN THE BID ITEM *STEEL STRUCTURE, COATING, TYPE 4 (B02-SB P.




GENERAL PLAN OF STRUCTURE				
SB I-75 OVER RED RUN DRAIN IN MADISON HEIGHTS.				
DATE	CONT. SEC.	JOB NO.	DESIGN UNIT	SHEET
1-9-01	B02 OF 63174	49595A	MAHDAVI	3 OF 15

APPROVED *Stem P. Beck* 1/8/01
 DESIGN SUPERVISING ENGINEER



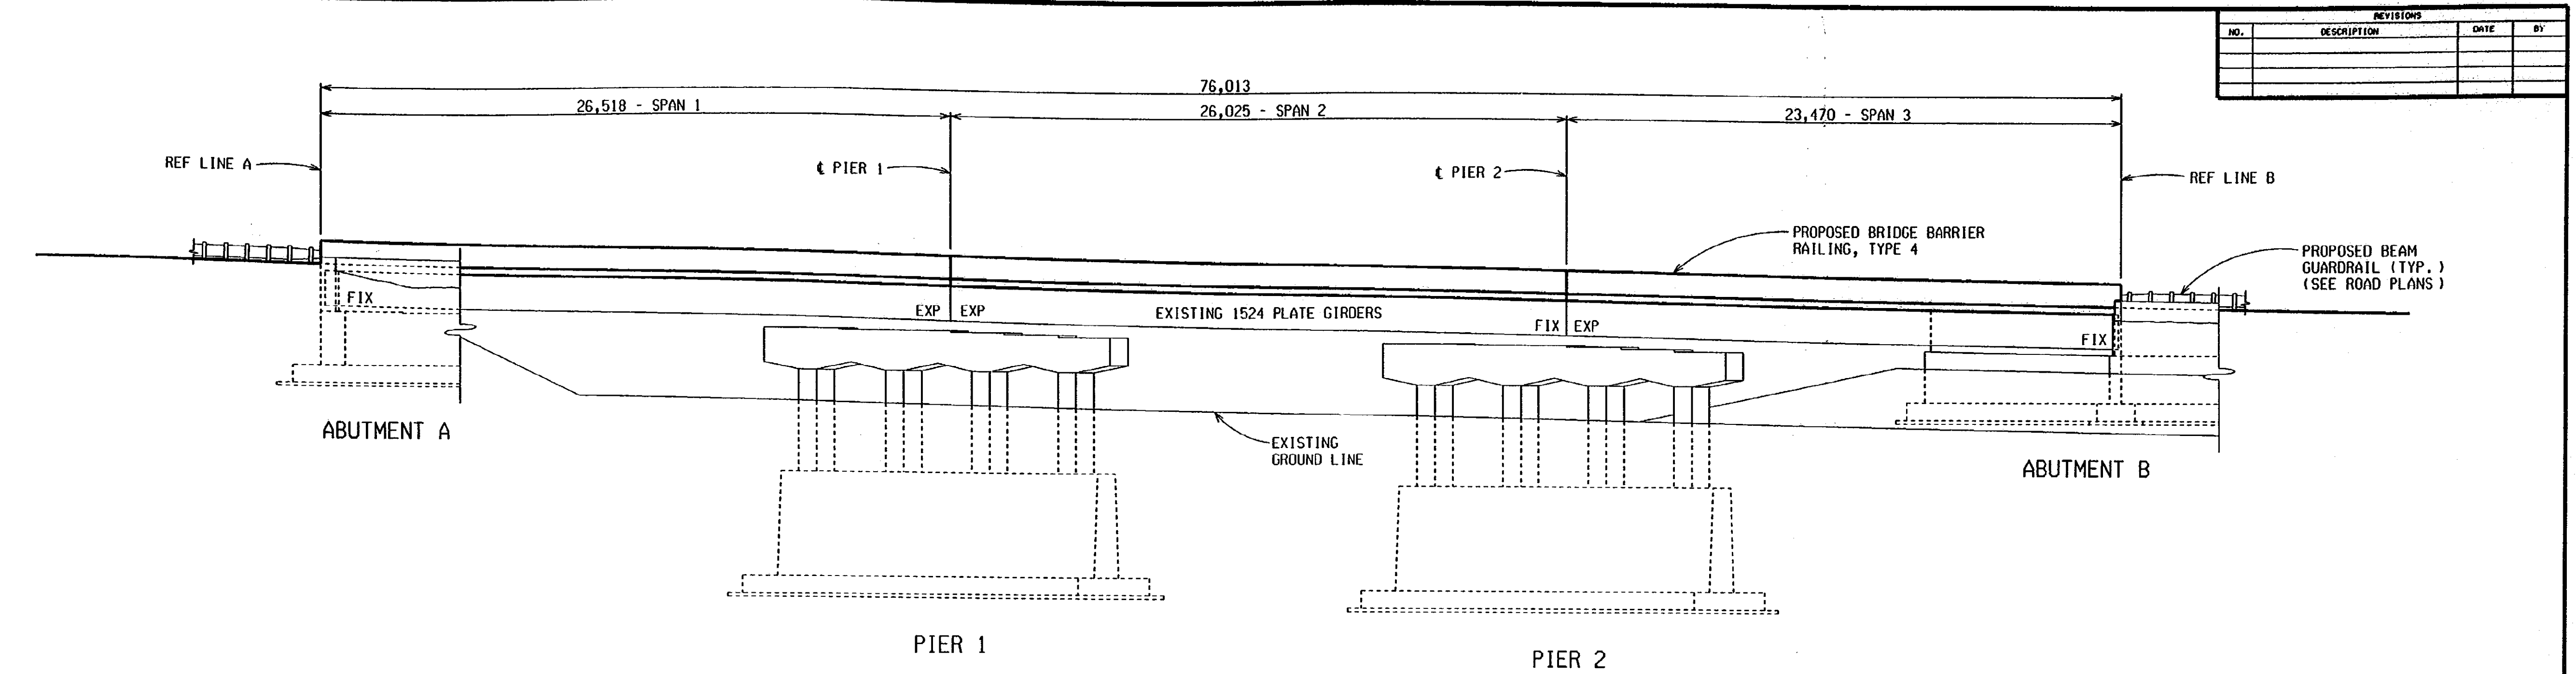


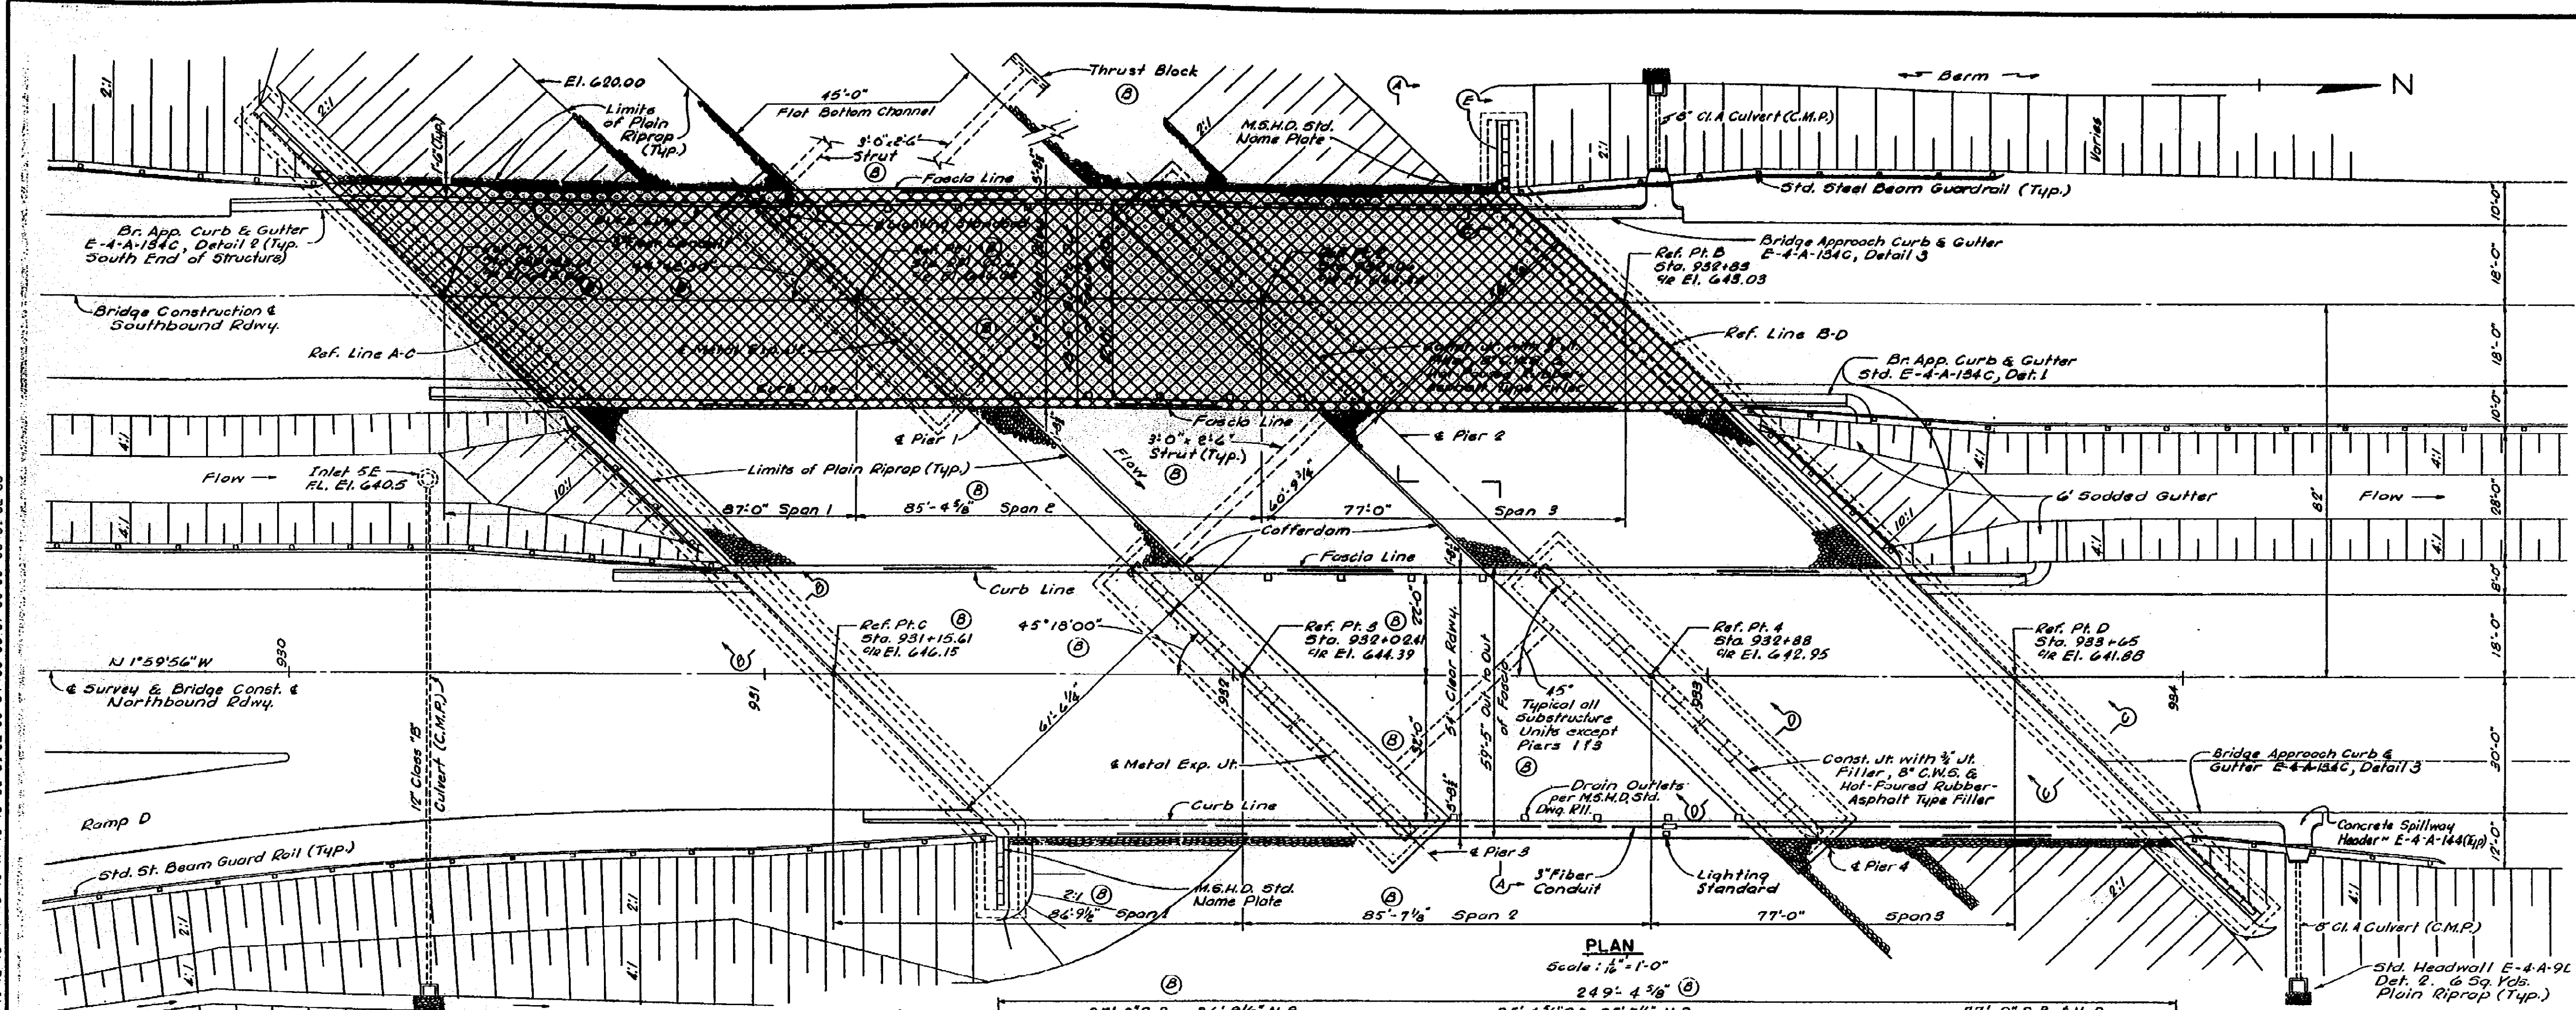
REVISIONS			
NO.	DESCRIPTION	DATE	BY

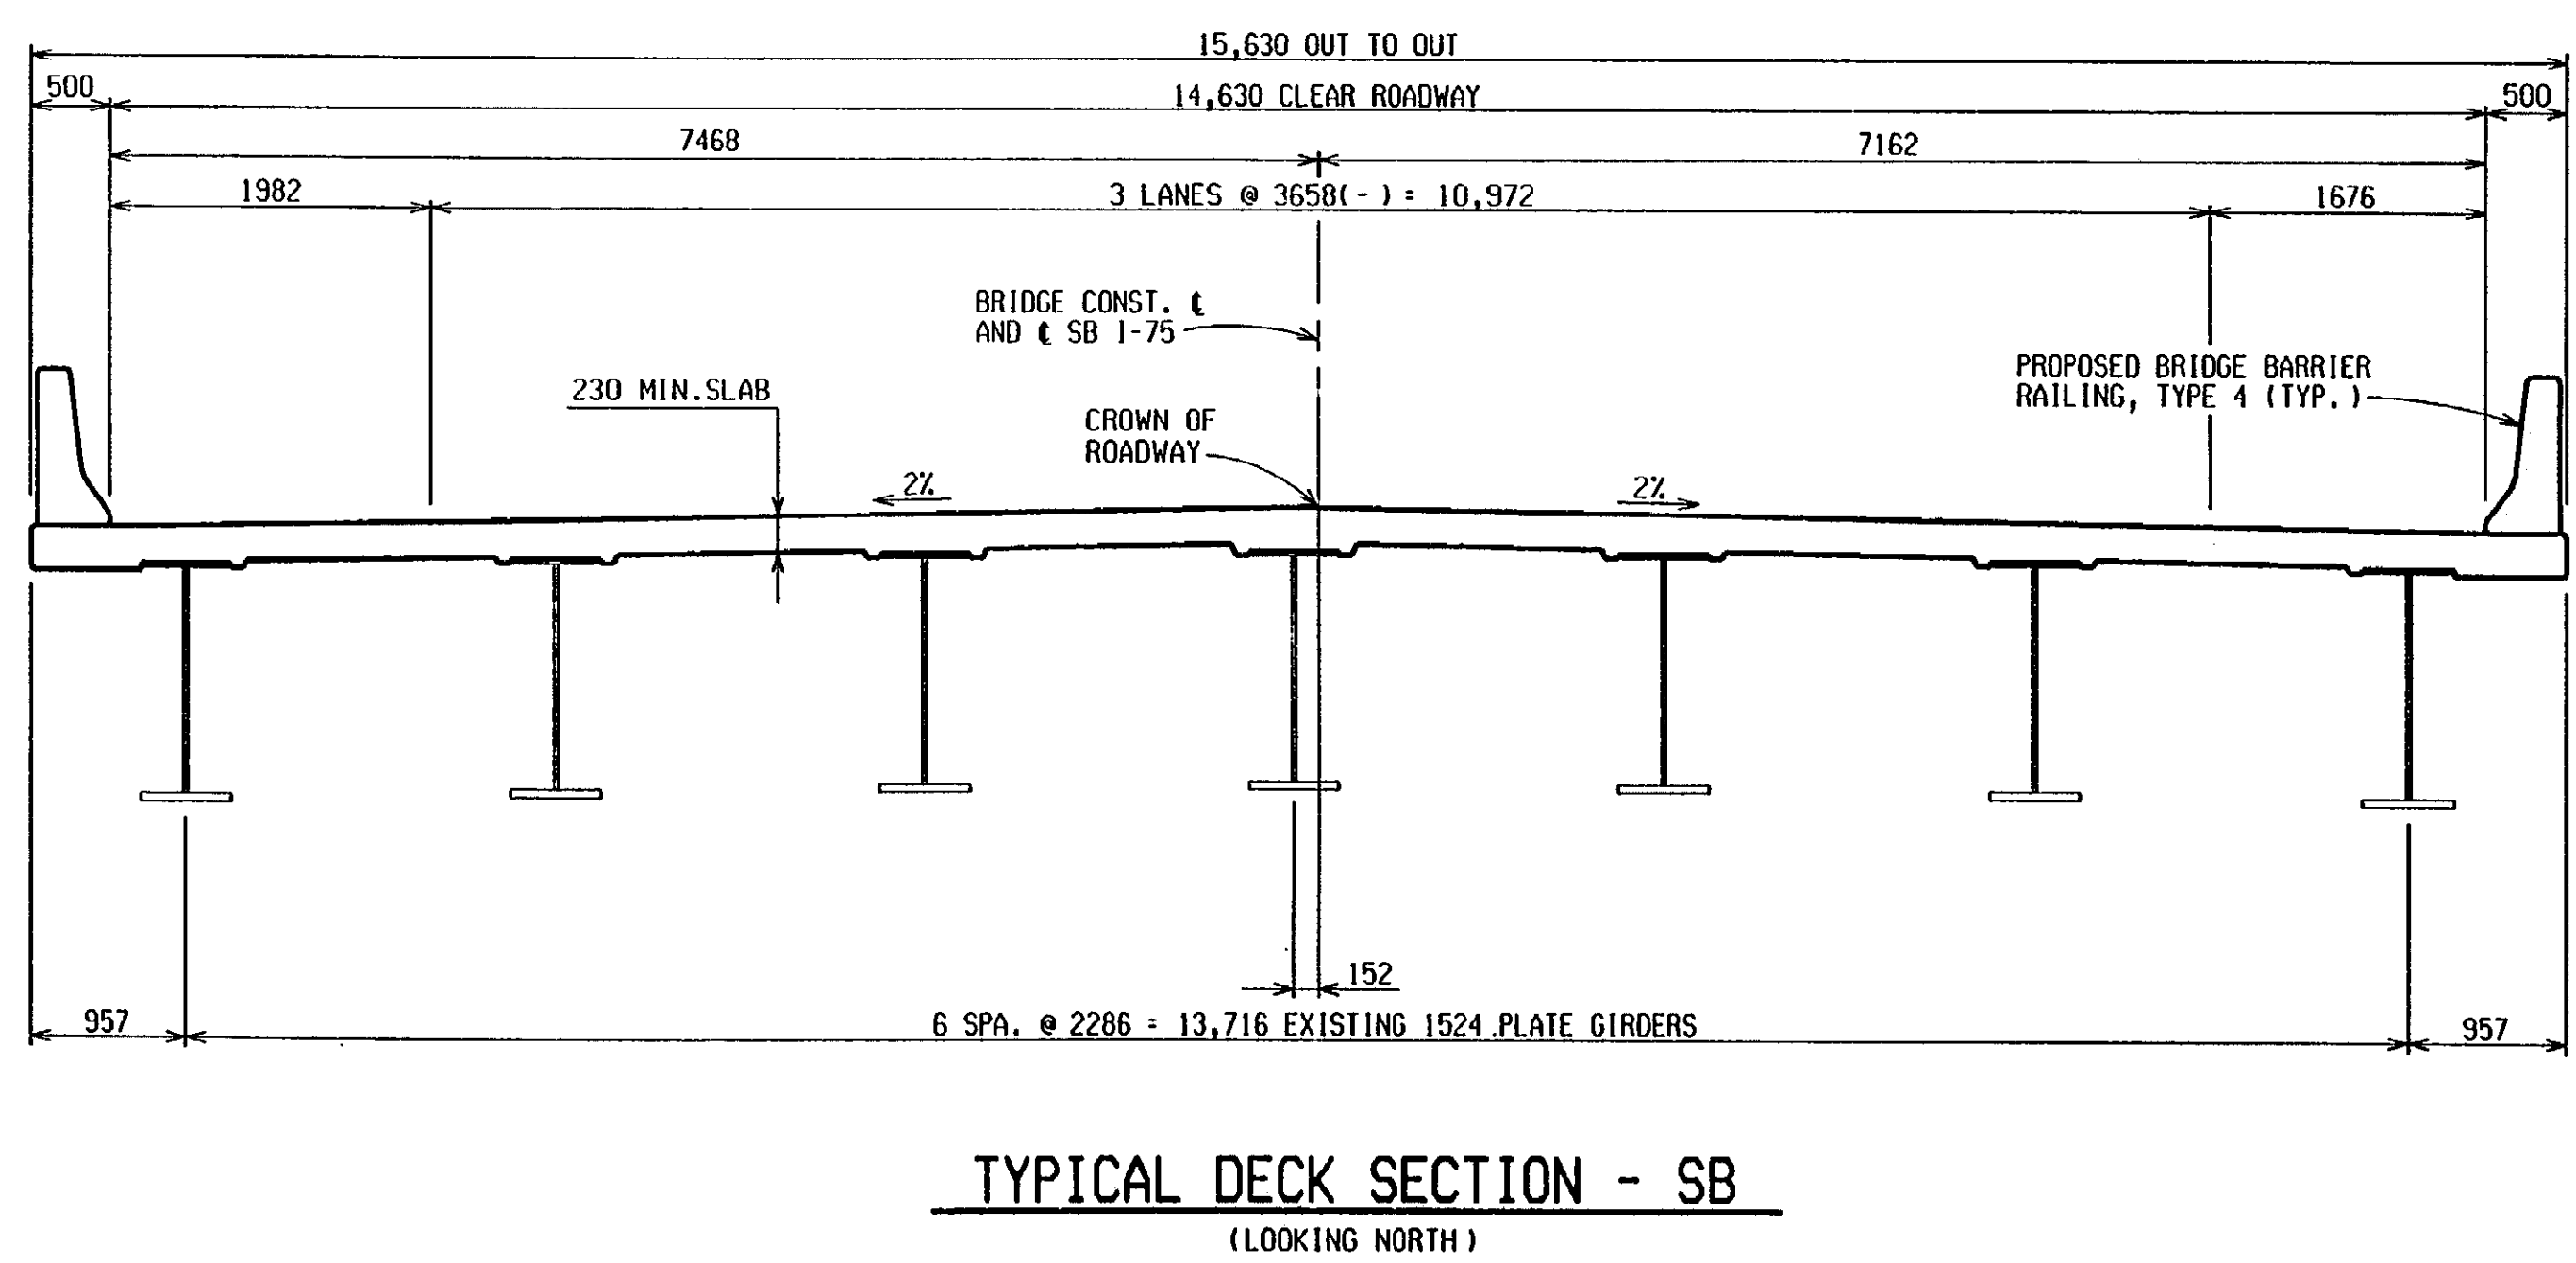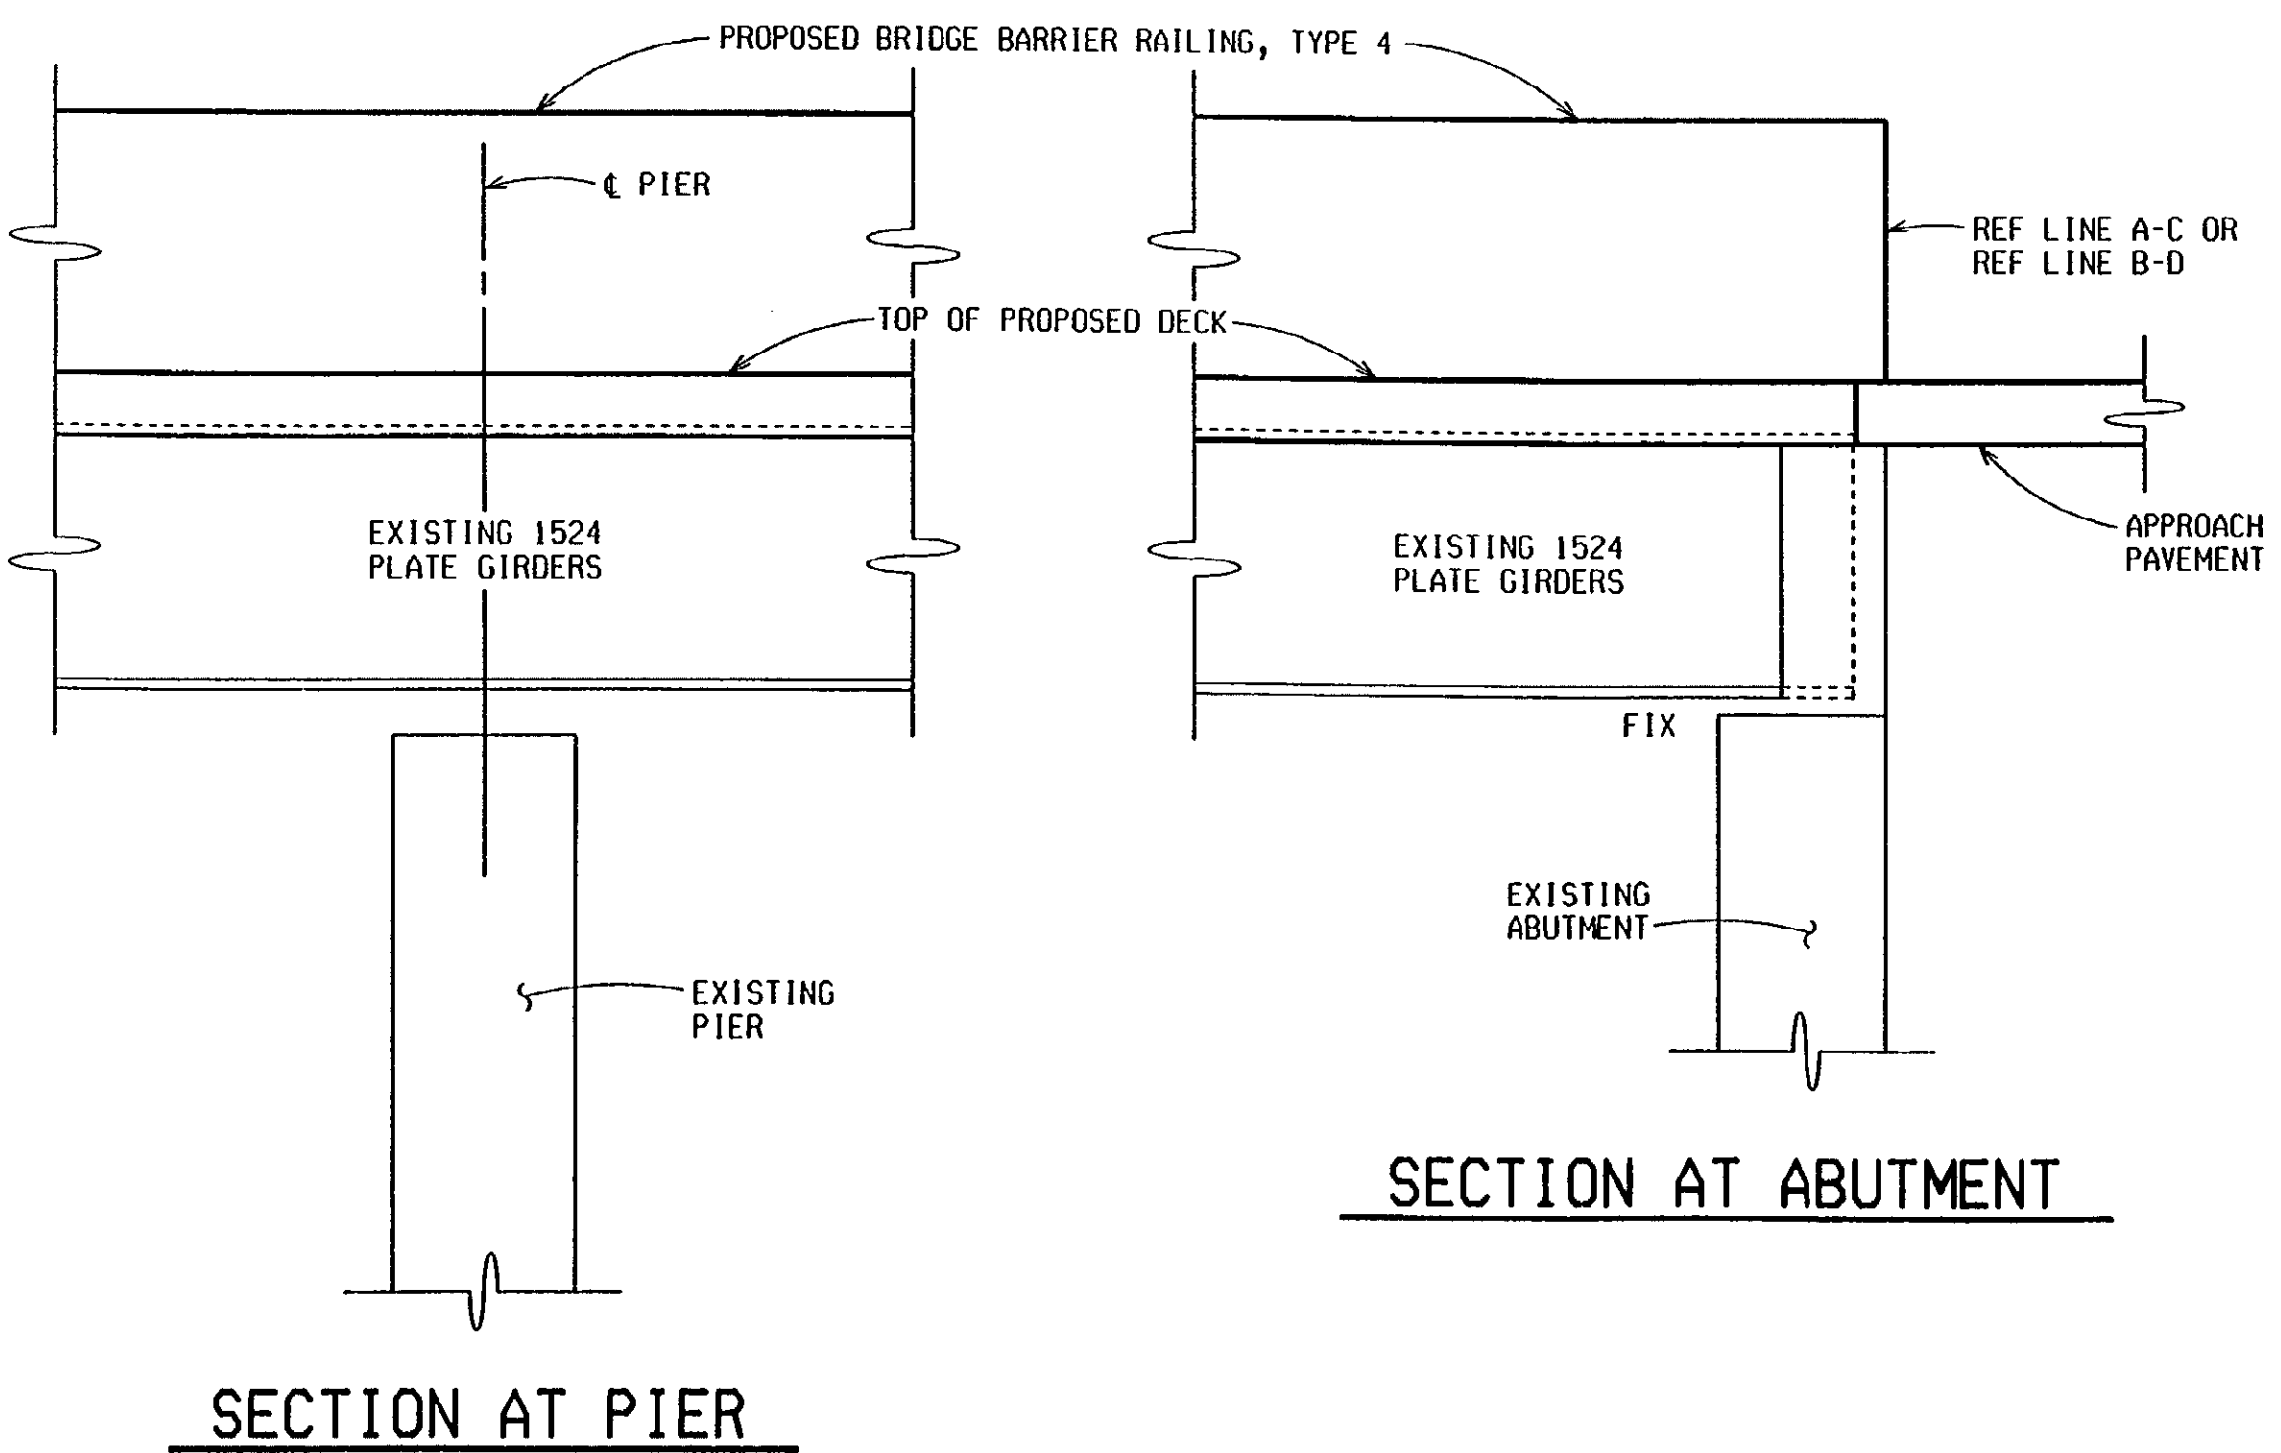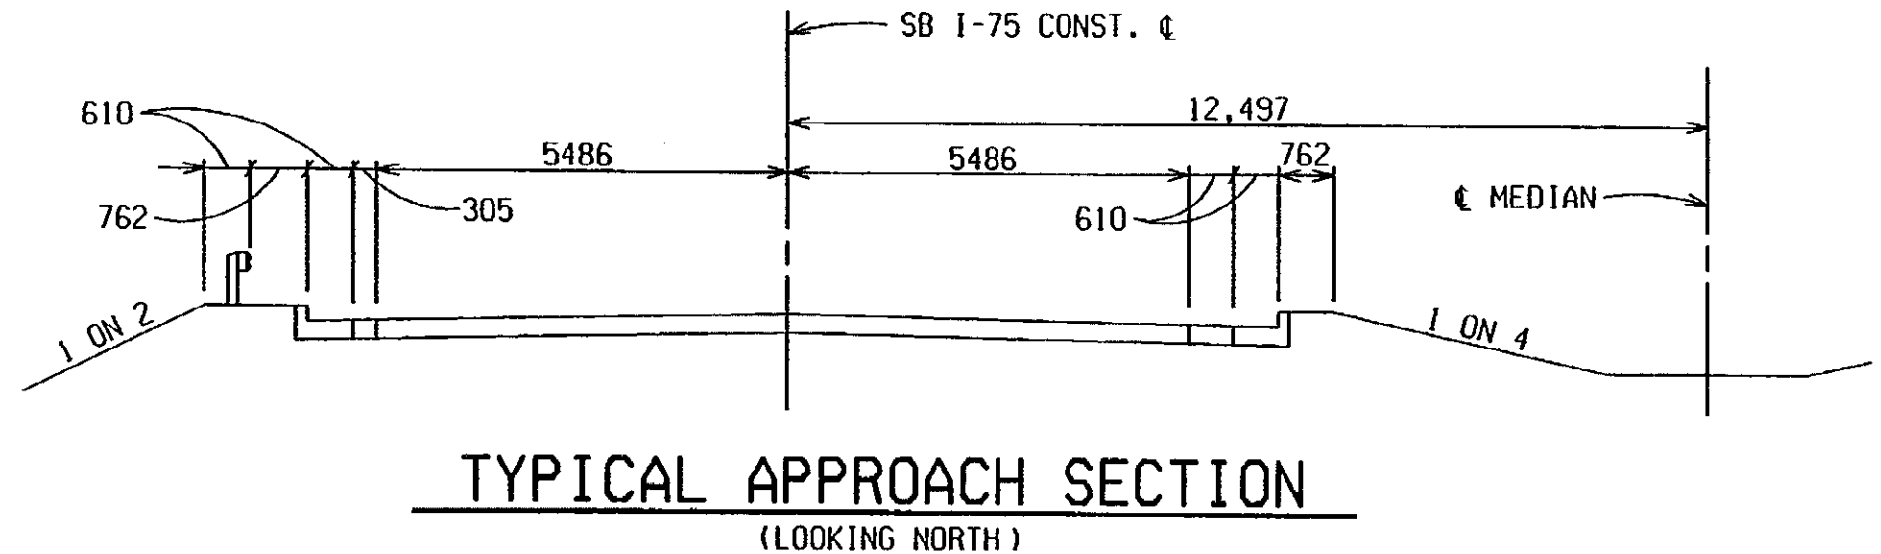


DATE: 12-6-00
CORRECTED BY: R. PRATT
DATE:
CHECKED BY: MIKUCKI
DATE: 4-4-00
DRAWN BY: R. PRATT
FILE NAME: b0263174s-st

APPROVED <i>Steve P. Bel 1/6/01</i> DESIGN SUPERVISING ENGINEER				GENERAL PLAN OF STRUCTURE			
SB I-75 OVER RED RUN DRAIN IN MADISON HEIGHTS.							
DATE	CONT. SEC.	JOB NO.	DESIGN UNIT	SHEET			
1-9-01	B02 OF 63174	49595A	MAHDAVI	4 OF 15			

1 2 3 4 5 6 7 8 9 10 11 12 13 14 15 16 17 18 19 20 21 22 23 24 25 26 27 28 29 30 31 32 33 34 35 36 37 38 39 40 41 42 43 44 45 46 47 48 49 50 51 52 53 54 55 56 57 58 59 60 61 62 63




REVISIONS			
NO.	DESCRIPTION	DATE	BY

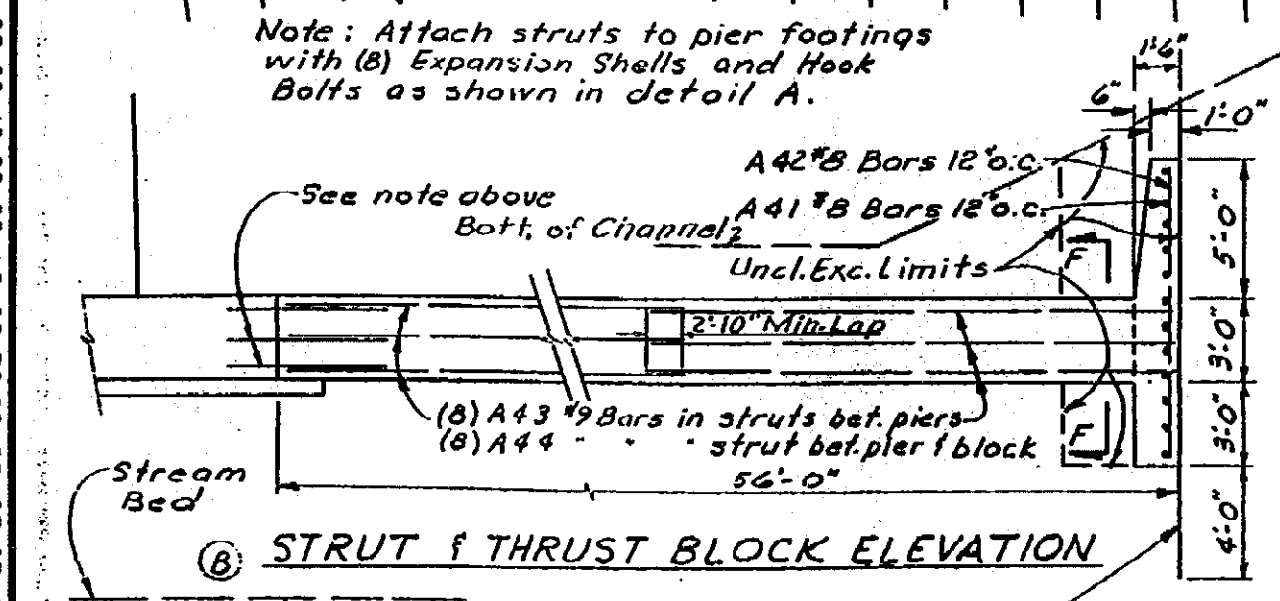

MISCELLANEOUS QUANTITIES		
ITEM	UNITS	AMOUNT
Porous Material Gravel (Compacted in Place)	Cu Yds	10360
Plain Riprap	Sq. Yds	1685 *

STRUT & THRUST BLOCK MISC. QUANT.		
Item	Unit	Amount
Unclassified Excavation	c.y.	200
5\"/>		

ELEVATION Scale: 1/8" = 1'-0"

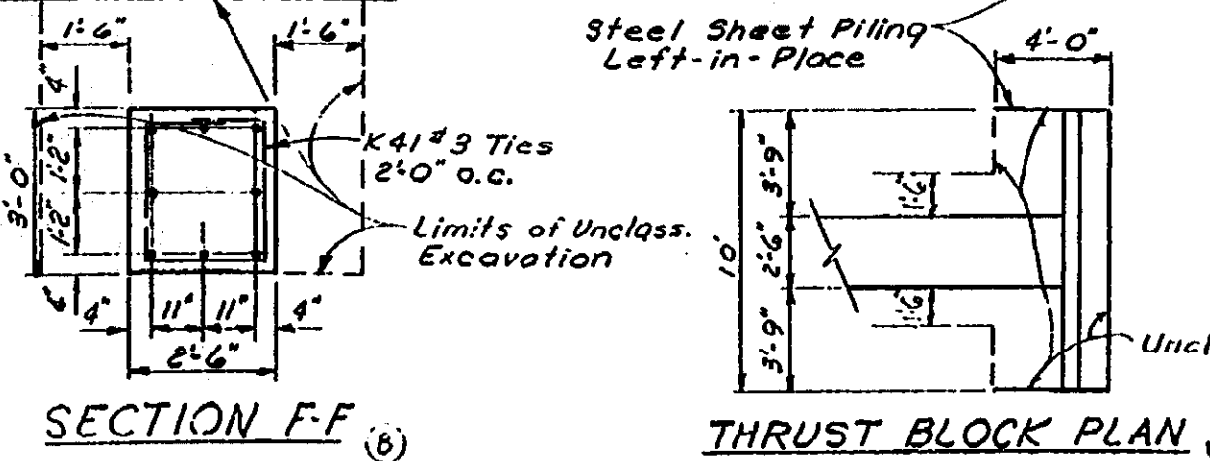

CONTROL SECTION 63174

MICHIGAN STATE HIGHWAY DEPARTMENT

1-75 OVER RED RUN DRAIN IN THE CITY OF MADISON HEIGHTS

GENERAL PLAN OF STRUCTURE

TECON ENGINEERS, INC.

APPROVED: *J. U. Murray* 6-5-62
COORDINATING ENGINEER

APPROVED: _____
ENGINEER OF DESIGN - CONSULTANTS

B02 OF 63174

THE ONLY ITEMS OF WORK TO BE DONE FROM THIS SHEET ARE IDENTIFIED BY THE LEGEND BOX BELOW, LABELED WITH THIS PROJECT'S JOB NUMBER.

JOB NO. 49595A

■ DENOTES REMOVAL PORTIONS

□ PROPOSED WORK










REMOVAL PORTIONS - SB STRUCTURE				
DATE	CONT. SEC.	JOB NO.	DESIGN UNIT	SHEET
12-13-00	B02 OF 63174	49595A	MAHDAVI	5 OF 15



DATE: 12-13-00
CORRECTED BY: SHAFFER
DATE:
CHECKED BY:
DATE: 02-11-00
DRAWN BY: INDER

CONTROL B02 OF 63174 JOB NO. 49595A NO. 6

1 2 3 4 5 6 7 8 9 10 11 12 13 14 15 16 17 18 19 20 21 22 23 24 25 26 27 28 29 30 31 32 33 34 35 36 37 38 39 40 41 42 43 44 45 46 47 48 49 50 51 52 53 54 55 56 57 58 59 60 61 62 63

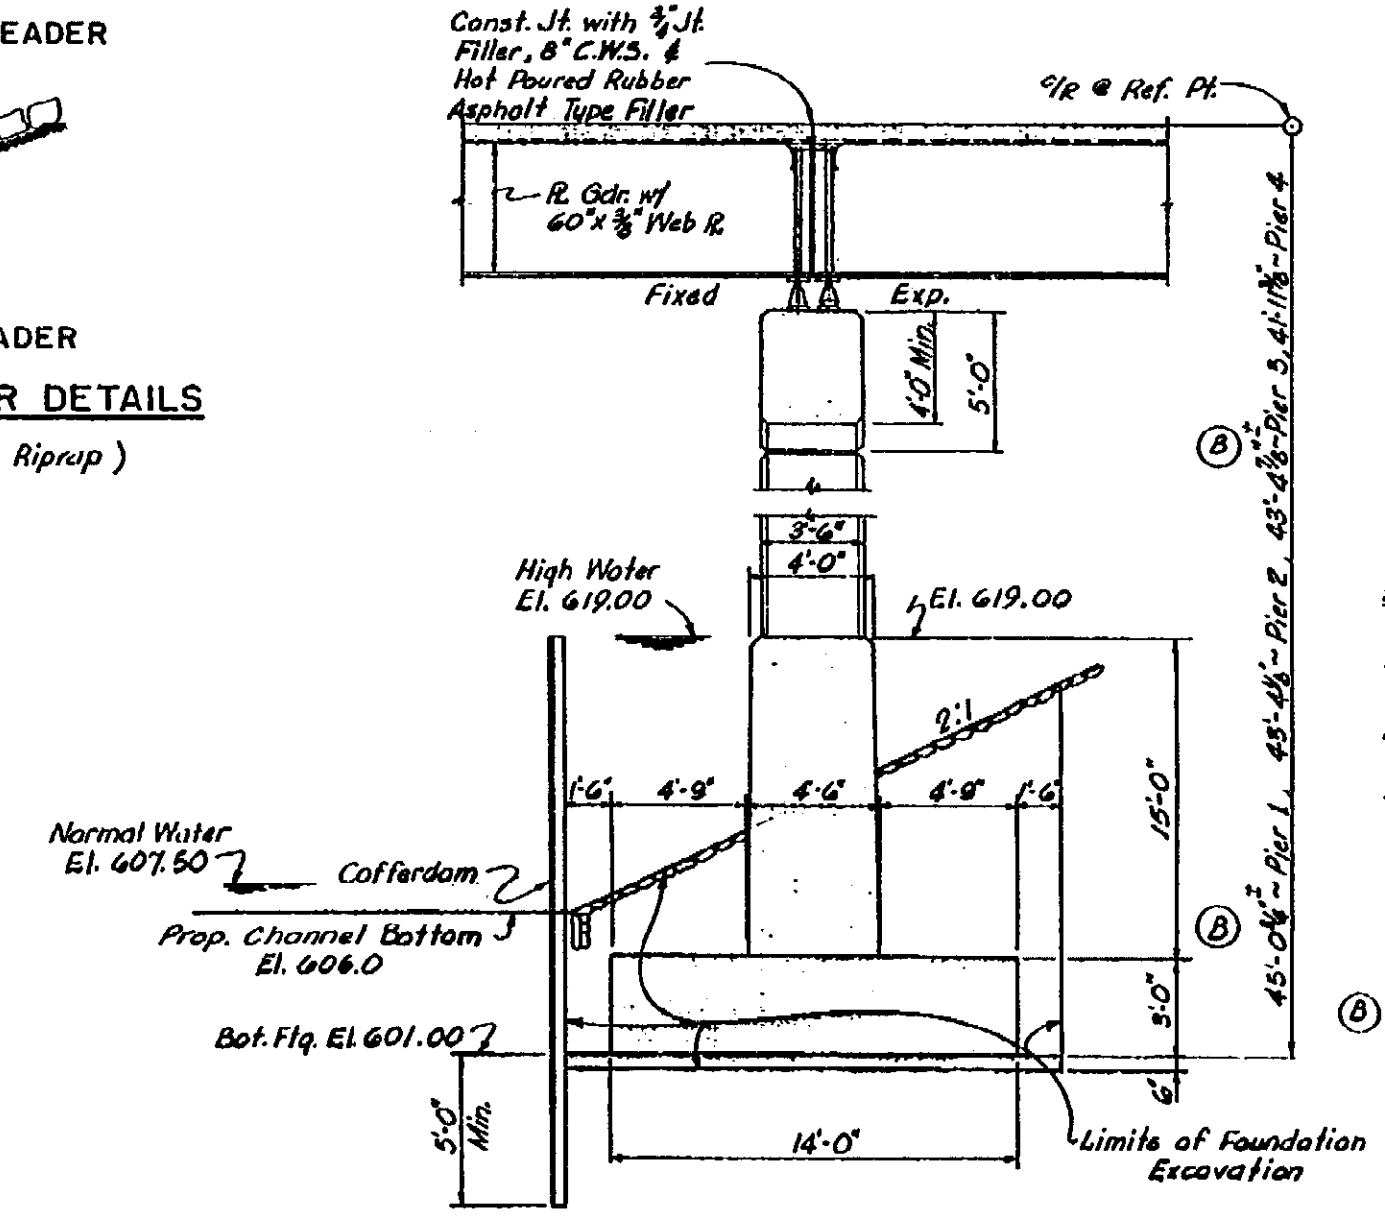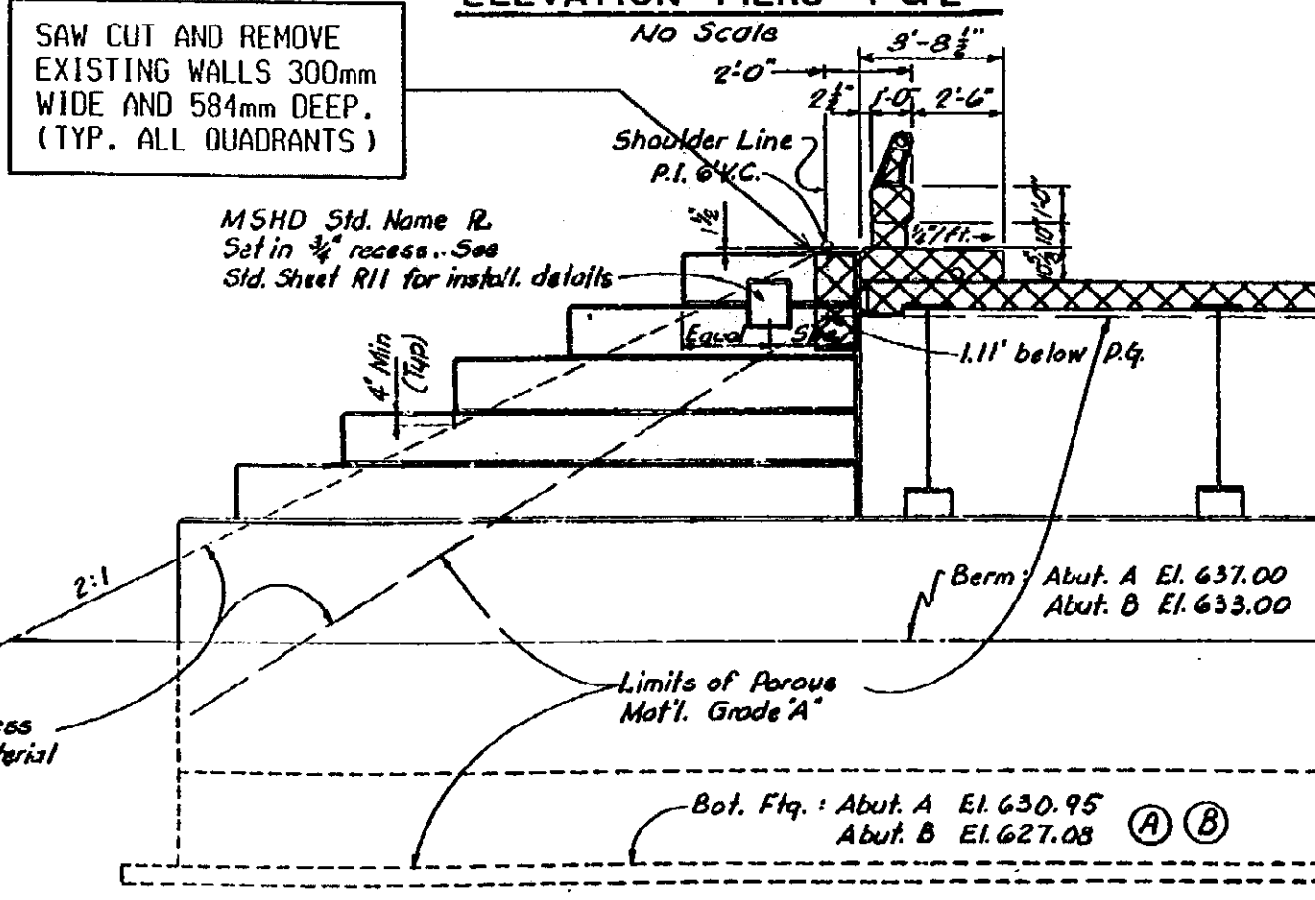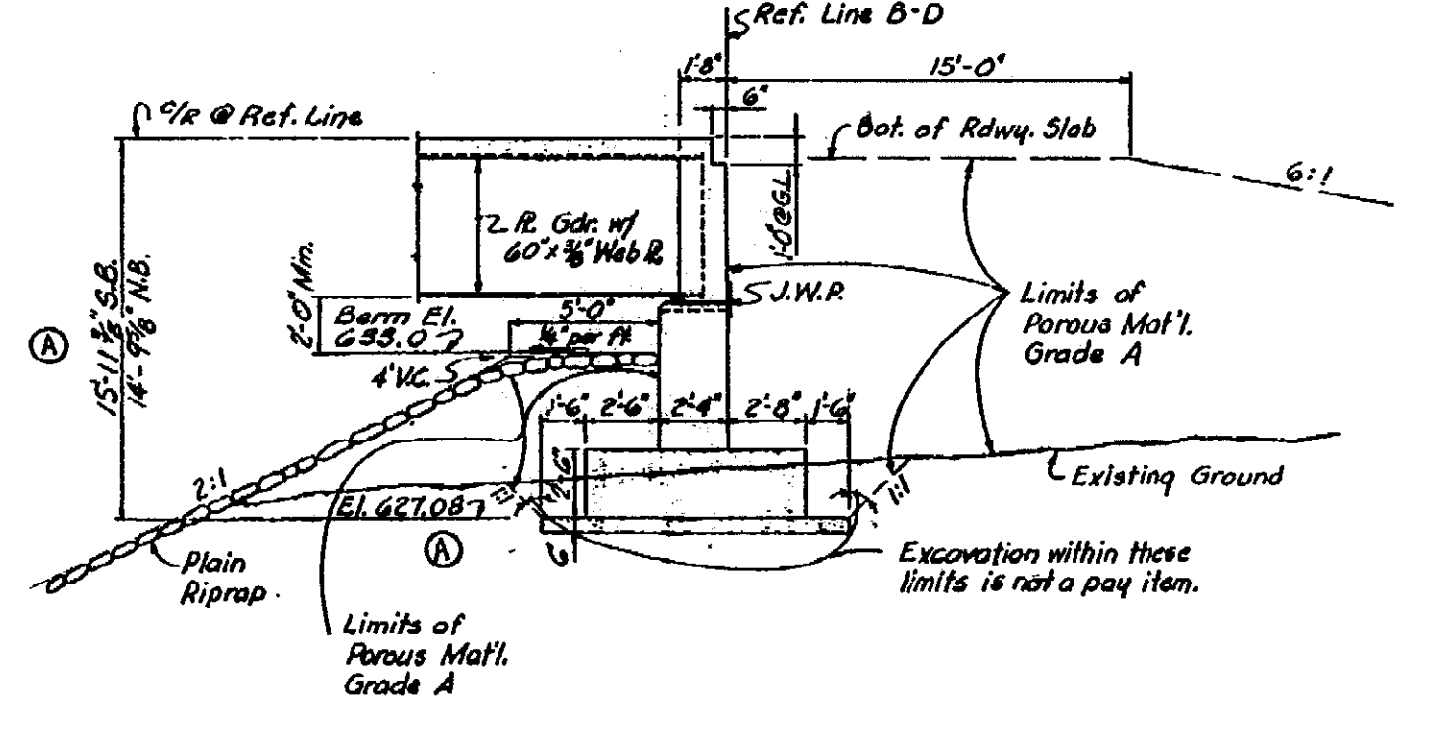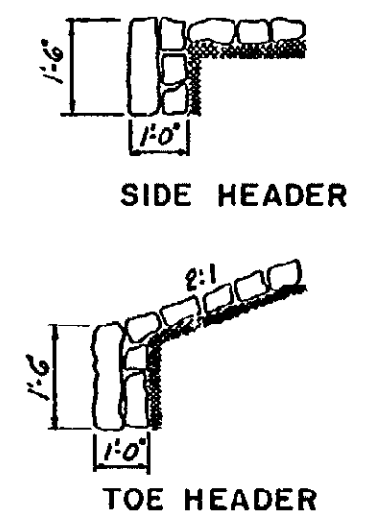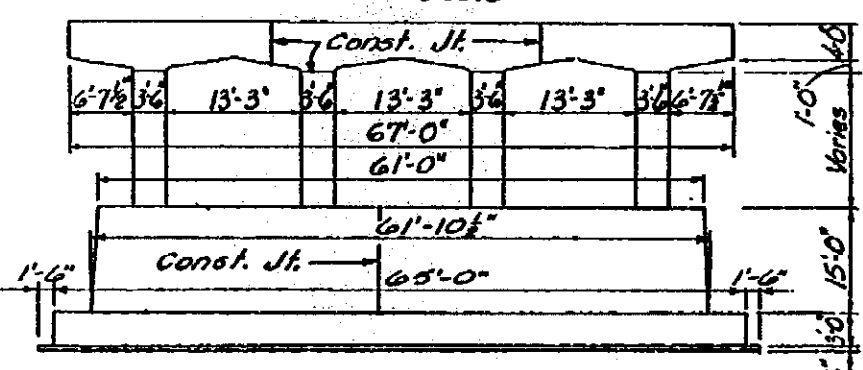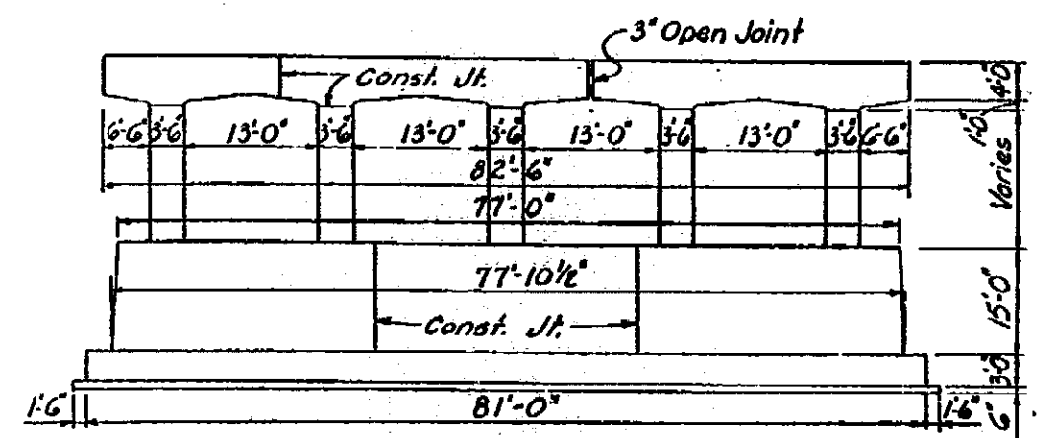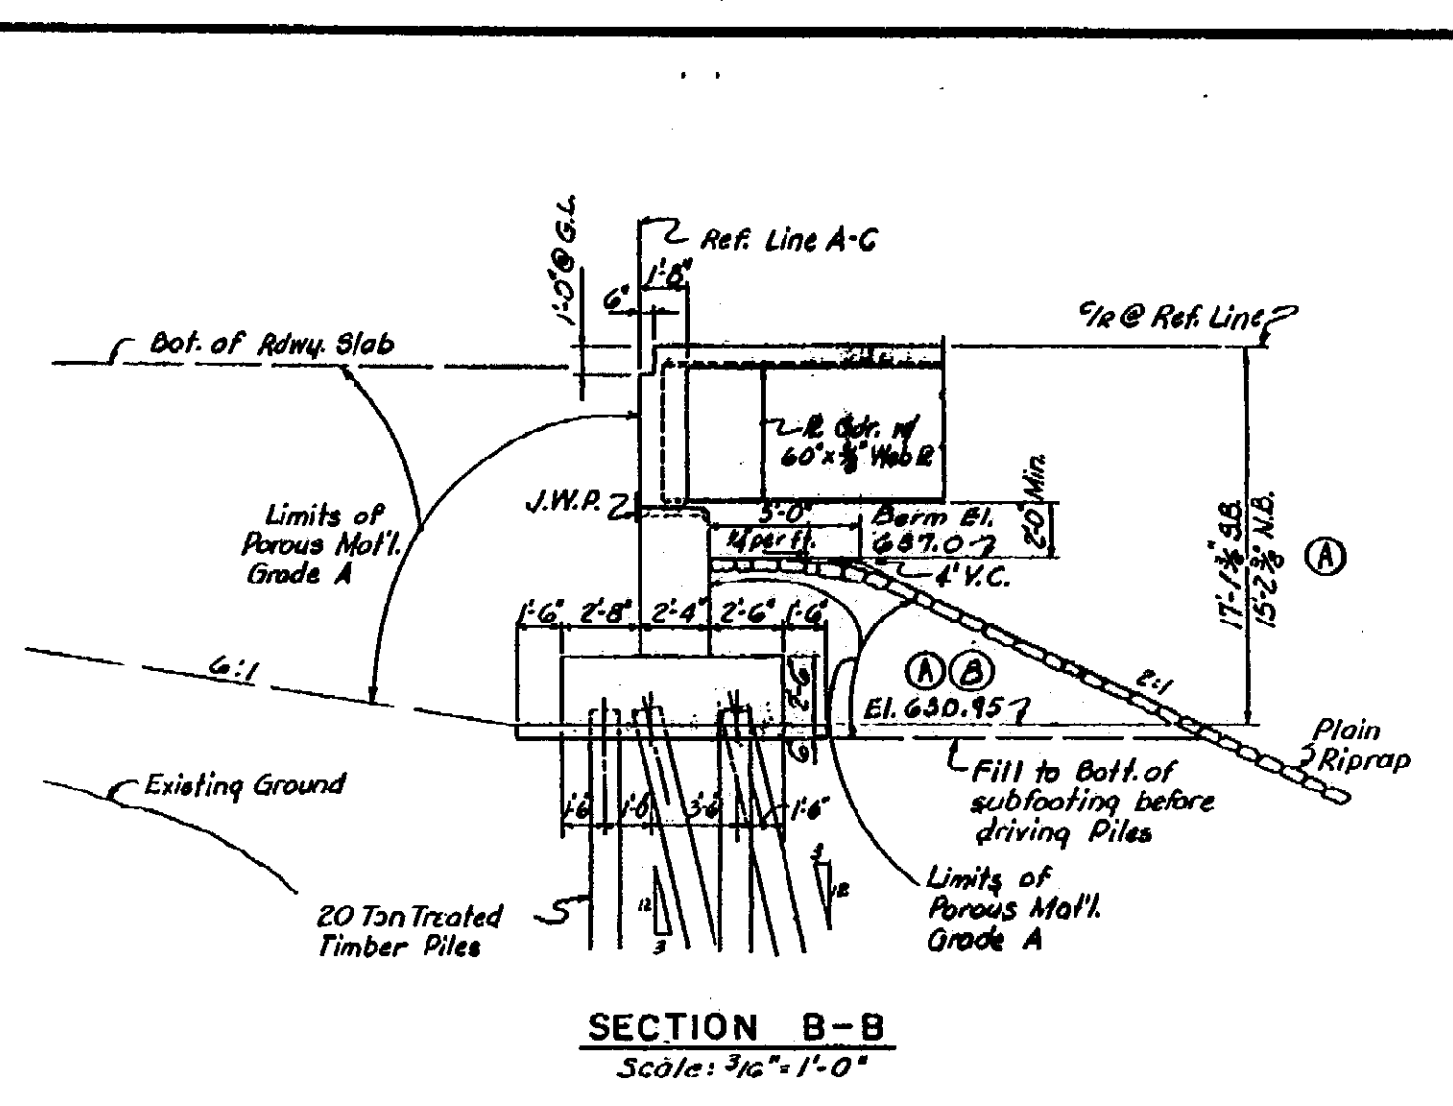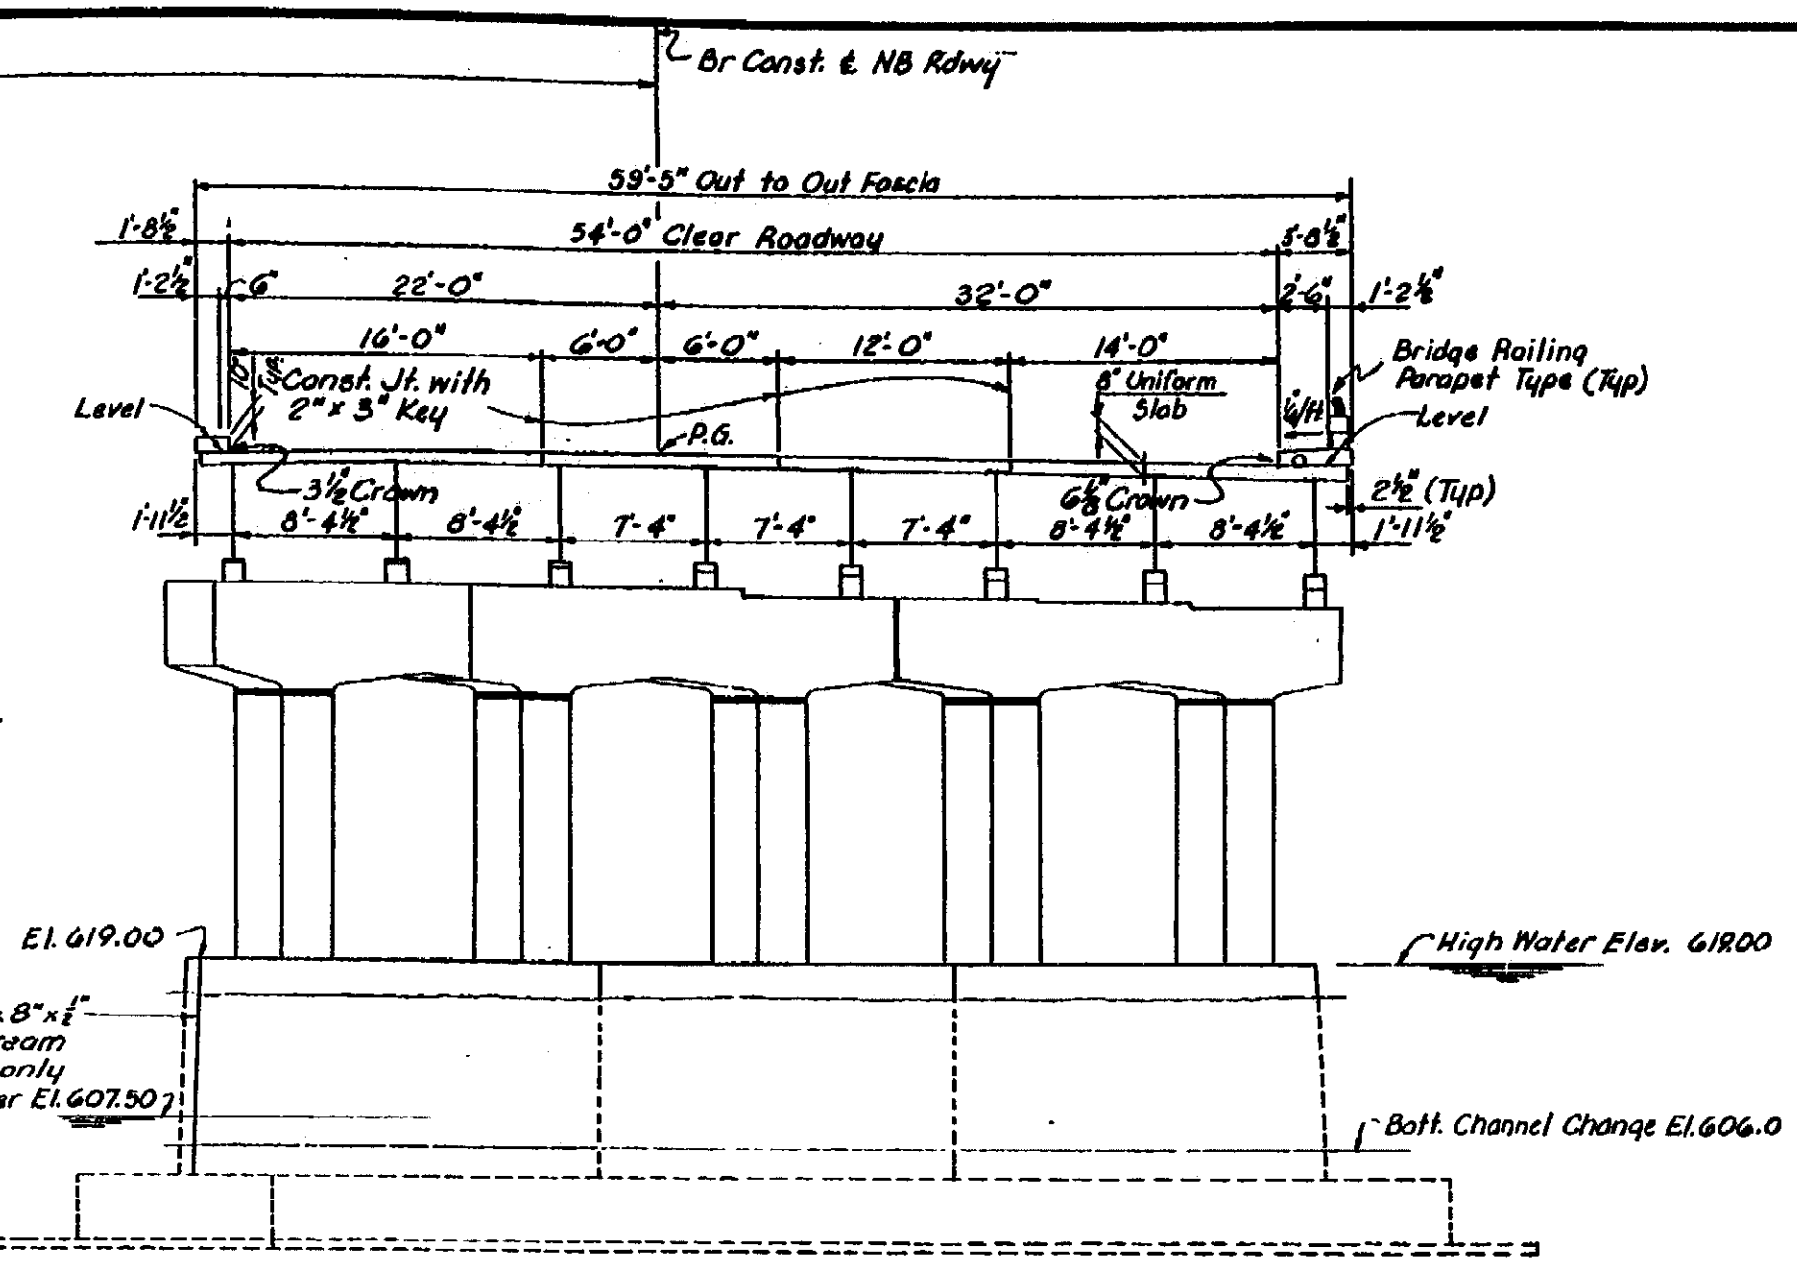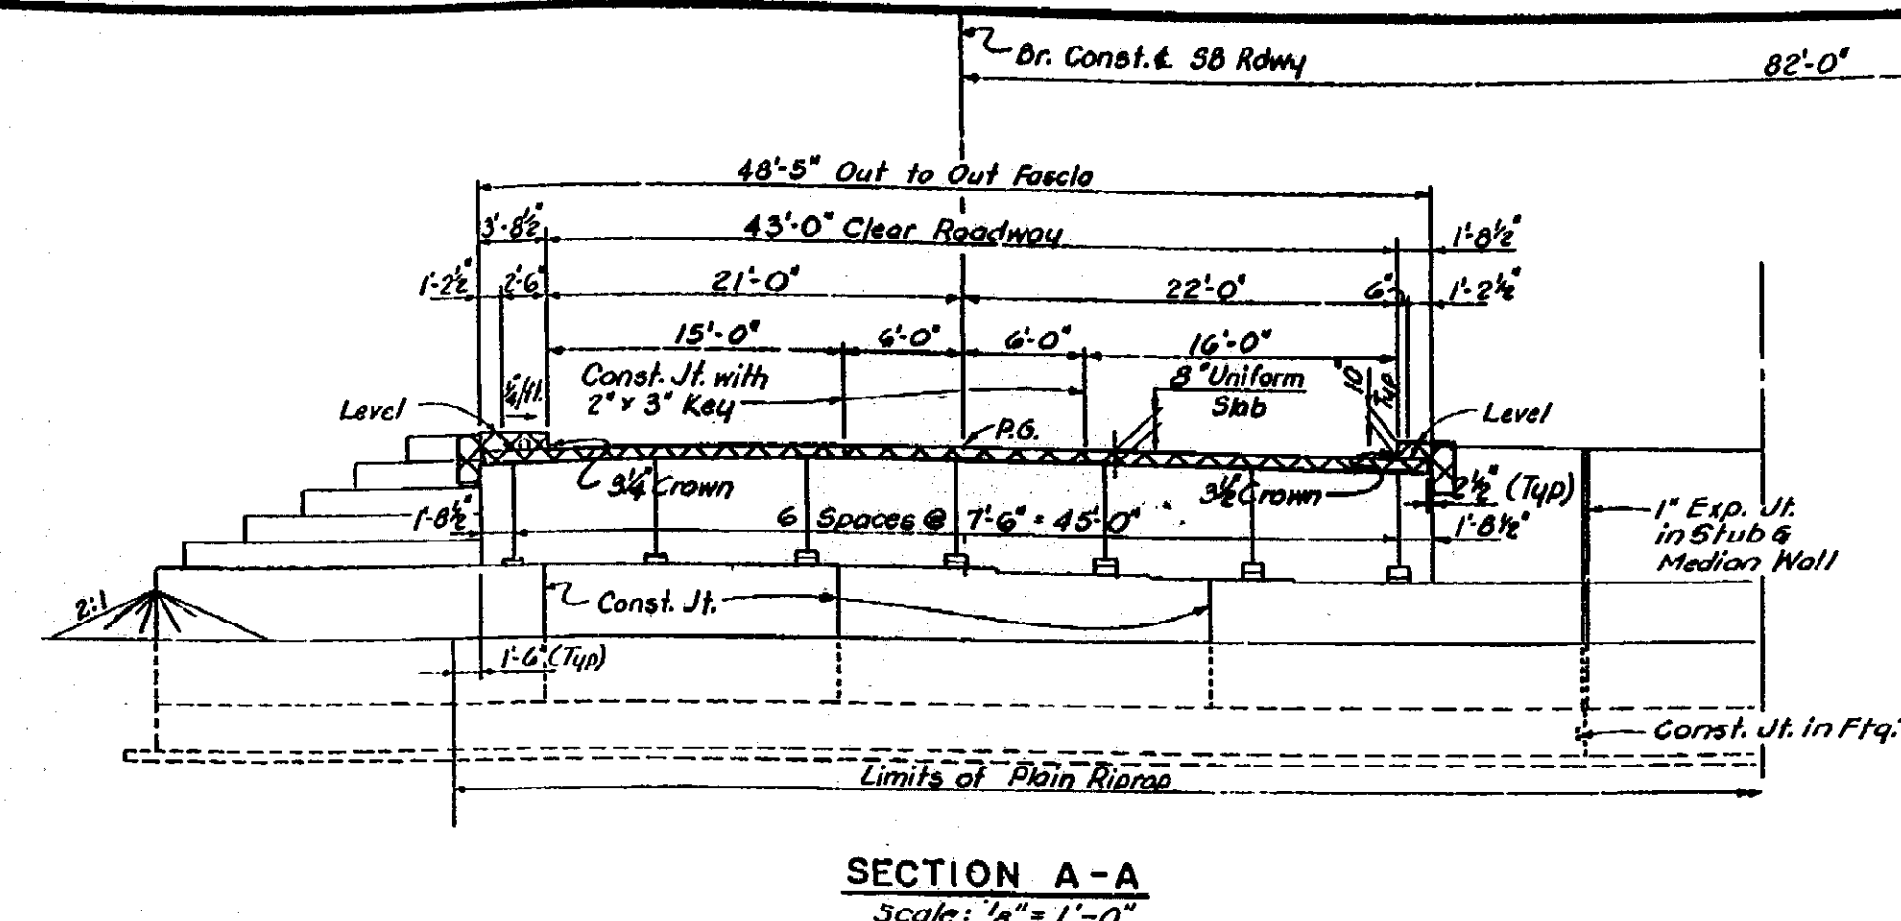

GENERAL NOTES
The roadway area supplied below high water elevation 619.00 is 850 square feet. Top of roadway slab and tops of curbs are parallel to the vertical curve. Proposed pavements, curbs and quarter guard rail, drainage structures, earth fill, and road sub-base on the expressway and ramp are not a part of this Contract. The design of this structure is based on the M.S.H.D. Standard Specifications for the Design of Highway Bridges - 1958 Edition - H20-S16-44 and alternate military loading. Live load plus impact deflection = 1/1000 of span length.
② For strut details, see sh. 191.

CONTROL SECTION 63174

MICHIGAN STATE HIGHWAY DEPARTMENT

175 OVER RED RUN DRAIN IN THE CITY OF MADISON HEIGHTS

GENERAL PLAN OF STRUCTURE

TECON ENGINEERS, INC.

APPROVED: *J.V. Murray* 6-5-62
COORDINATING ENGINEER

APPROVED: _____
ENGINEER OF DESIGN - CONSULTANTS

B02 of 63174

THE ONLY ITEMS OF WORK TO BE DONE FROM THIS SHEET ARE IDENTIFIED BY THE LEGEND BOX BELOW, LABELED WITH THIS PROJECT'S JOB NUMBER.

JOB NO. 49595A


■ DENOTES REMOVAL PORTIONS

□ PROPOSED WORK




REMOVAL PORTIONS - SB STRUCTURE				
DATE	CONT. SEC.	JOB NO.	DESIGN UNIT	SHEET
1-9-01	B02 OF 63174	49595A	MAHDAVI	6 OF 15

DATE: _____ CORRECTED BY: INDER CHECKED BY: DATE: 02-11-00 DRAWN BY: INDER FILE NAME: B0263174.dwg

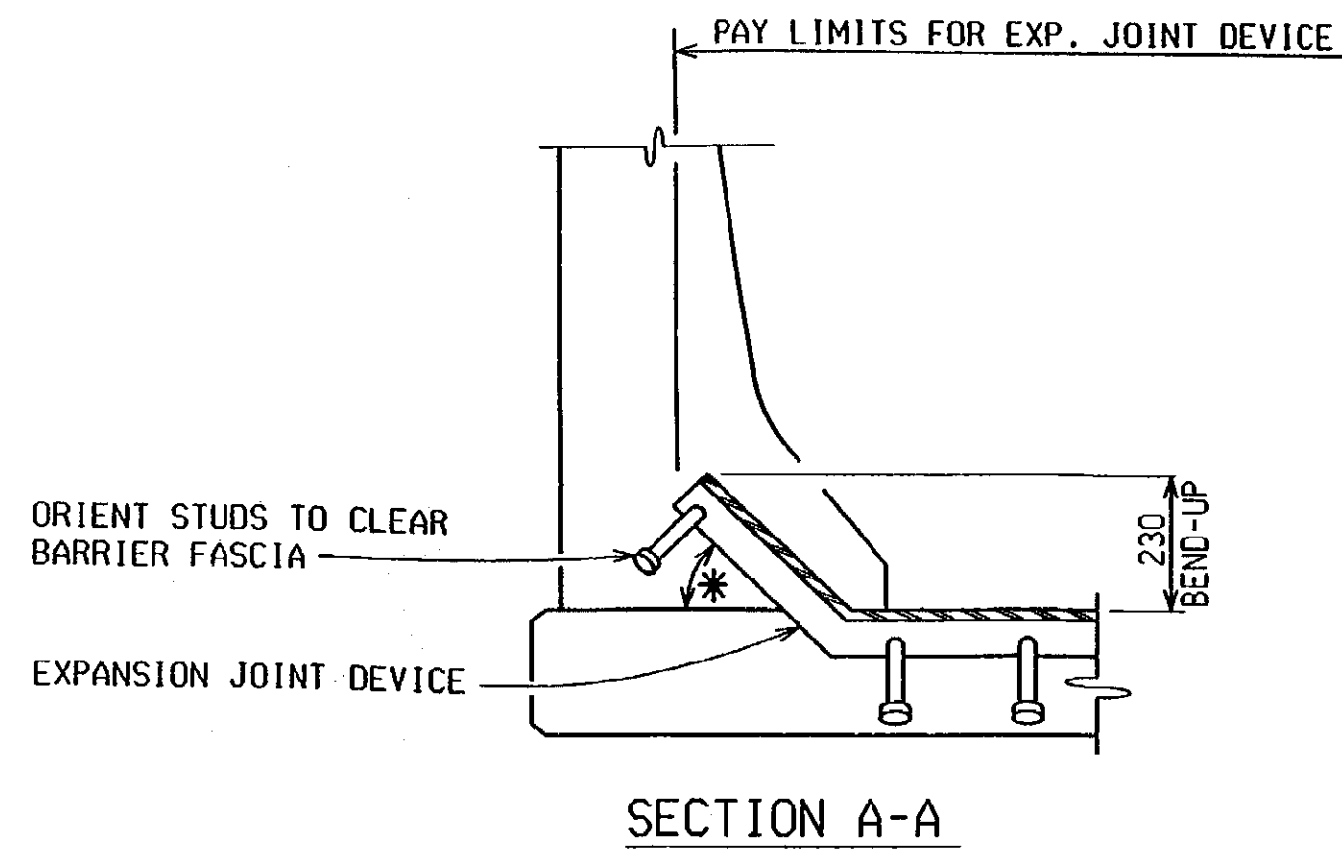

* FOR ANGLES OF CROSSING FROM 90° TO 45° INCLUSIVE, BEND ANCHORAGE UP 45° ALONG EXPANSION JT. FOR ANGLES OF CROSSING LESS THAN 45°, A SPECIAL ENDING MAY BE REQUIRED.

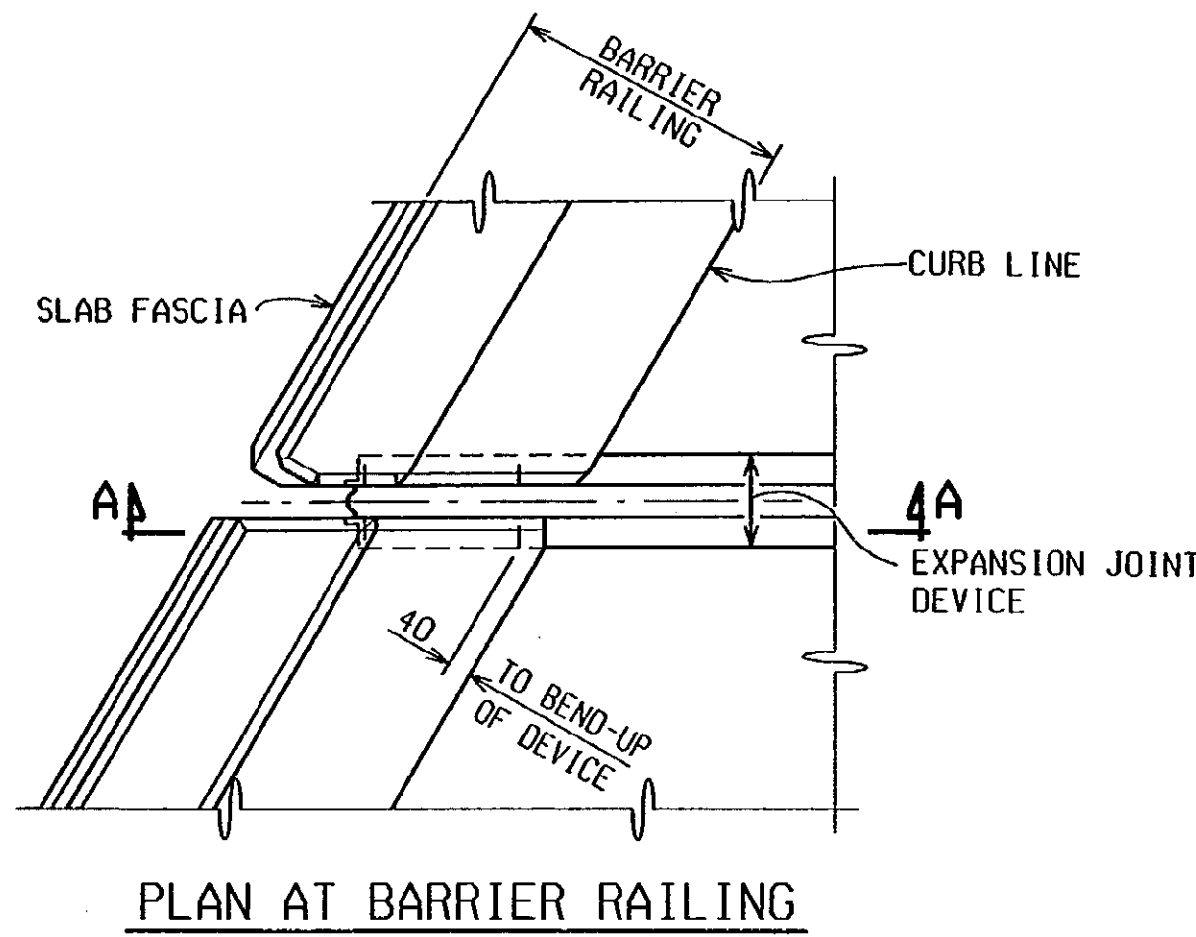

BARRIER TREATMENT

NOTES:

JOINT TYPES:

THE EXPANSION JOINT DEVICE SHALL BE OF A TYPE THAT INCLUDES A CONTINUOUS NEOPRENE (OR EQUIVALENT) SEAL ACROSS THE DECK. UNLESS OTHERWISE NOTED ON THE PLANS, THE CONTRACTOR HAS THE OPTION OF USING ANY OF THE DEVICES LISTED BELOW:

DEVICE	MANUFACTURER
WABO STRIP SEAL	WATSON-BOWMAN & ACME, INC.
PRO-SPAN	FEL-PRO, INC.
STEELFLEX-SSA2	D.S. BROWN
STEELFLEX-SSCM	D.S. BROWN
STEELFLEX-RS	D.S. BROWN
ONFLEX 40 SS	STRUCTURAL RUBBER PRODUCTS CO.
STRUPCO 400L	STRUCTURAL RUBBER PRODUCTS CO.

THE MODEL OF THE JOINT TYPE SELECTED SHALL BE SUITABLE TO ACCOMMODATE THE TOTAL MOVEMENT NOTED ON THE PLANS.

COMPLETE WORKING DRAWINGS OF ALL DETAILS OF FABRICATION OF THE EXPANSION JOINT DEVICE SHALL BE SUBMITTED FOR REVIEW IN ACCORDANCE WITH STANDARD SPECIFICATION 104.02. THIS REQUIREMENT IS WAIVED FOR EXPANSION JOINT DEVICES FOR WHICH A SET OF STANDARD INSTALLATION DETAILS HAS BEEN APPROVED. STANDARD INSTALLATION DETAILS CAN BE OBTAINED FROM THE DESIGN DIVISION.

FABRICATION AND INSTALLATION:

THE EXPANSION JOINT SHALL BE SHOP FABRICATED TO CONFORM TO THE CONTOUR OF THE BRIDGE DECK, BARRIERS, ETC. IT SHALL BE INSTALLED IN ACCORDANCE WITH MANUFACTURER'S RECOMMENDATIONS SUBJECT TO NOTES HEREIN AND THE APPROVAL OF THE ENGINEER.

THE TOP OF THE ELASTOMERIC JOINT DEVICE SHALL BE SET 3 - 6 mm BELOW THE CONCRETE SLAB (PAVEMENT) WITH A TOLERANCE OF ± 3 mm.

THE STEEL ANCHORAGE FOR STRIP SEAL GLANDS SHALL BE HOT DIP GALVANIZED IN ACCORDANCE WITH SUBSECTION 707.16 OF THE STANDARD SPECIFICATIONS.

THE PRO-SPAN DEVICE MUST INCORPORATE A CAST-IN-PLACE STEEL SEAT.

THE AREA OF THE STEEL ANCHORAGE AND SEALING GLAND WHICH WILL BE IN CONTACT WITH A SEALANT, OR LUBRICANT-ADHESIVE SHALL BE CLEANED WITH TOLUENE OR OTHER APPROVED SOLVENT.

WHERE THE SEALING GLAND IS LOCKED INTO A STEEL ANCHORAGE, A LUBRICANT-ADHESIVE CONFORMING TO STANDARD SPECIFICATION 914.4-E SHALL BE REQUIRED BETWEEN THE SEAL AND STEEL ANCHORAGE.

ALL BOLT WELL CAVITIES SHALL BE FILLED WITH AN APPROVED FLEXIBLE EPOXY OR A SEALANT CONFORMING TO FEDERAL SPECIFICATION TT-S-00230C.

IN THE EVENT THAT THE CONSTRUCTION SEQUENCE REQUIRES SPLICING THE SEALING GLAND, IT SHALL BE SPLICED BY AN APPROVED METHOD (SUCH AS COLD VULCANIZATION) BY A TRAINED REPRESENTATIVE OF THE MANUFACTURER.


DETAILS AT CURBS OR BARRIERS:

THE DETAILS ON THIS SHEET SHOW AN APPROVED MEANS OF TERMINATING THE EXPANSION JOINT DEVICE AT CURBS OR BARRIERS. VARIATIONS OR ALTERNATIVE SCHEMES WILL BE CONSIDERED AND MAY BE USED IF APPROVED BY THE ENGINEER.


MATERIALS:

THE COST OF ALL MATERIALS AND LABOR REQUIRED FOR PROPER INSTALLATION OF THE EXPANSION JOINT AND THE TERMINAL ASSEMBLIES AT THE CURBS, SIDEWALKS, OR BARRIERS IS INCLUDED IN THE PAYMENT FOR THE EXPANSION JOINT DEVICE.

ITEM	QUANTITY	UNIT	AMOUNT
EXPANSION JOINT DEVICE		m	45

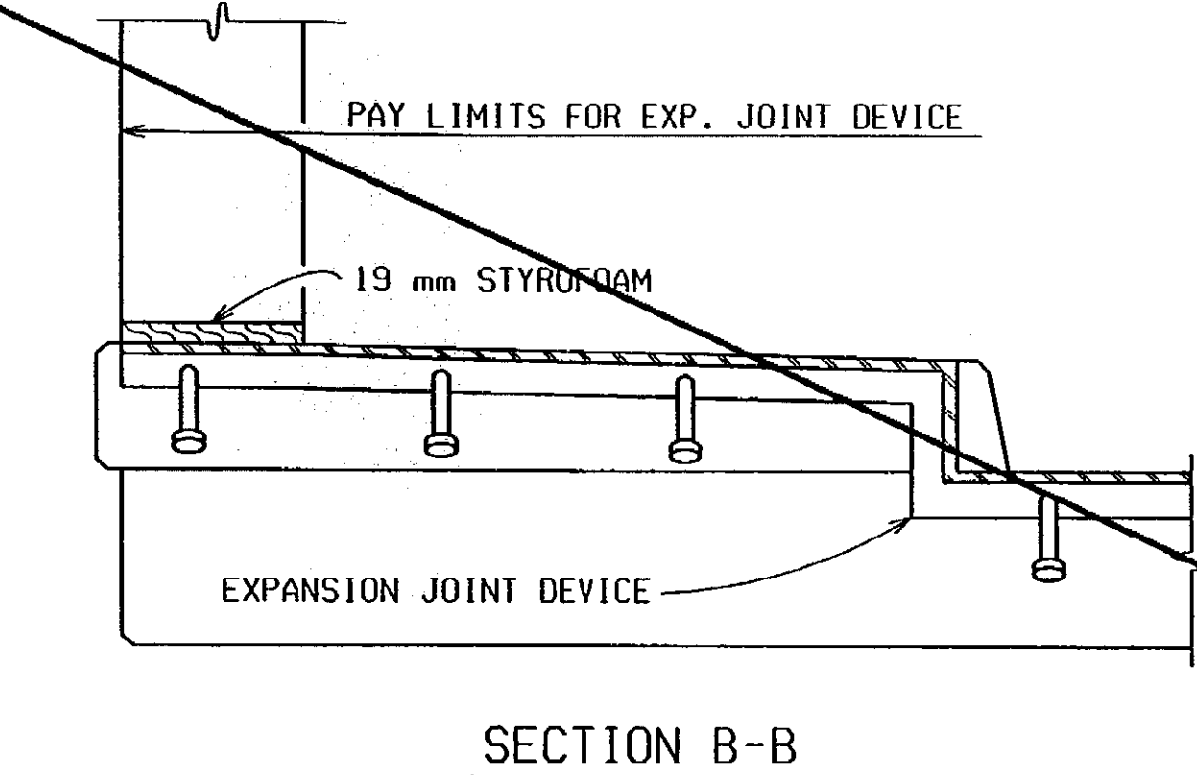


SECTION B-B

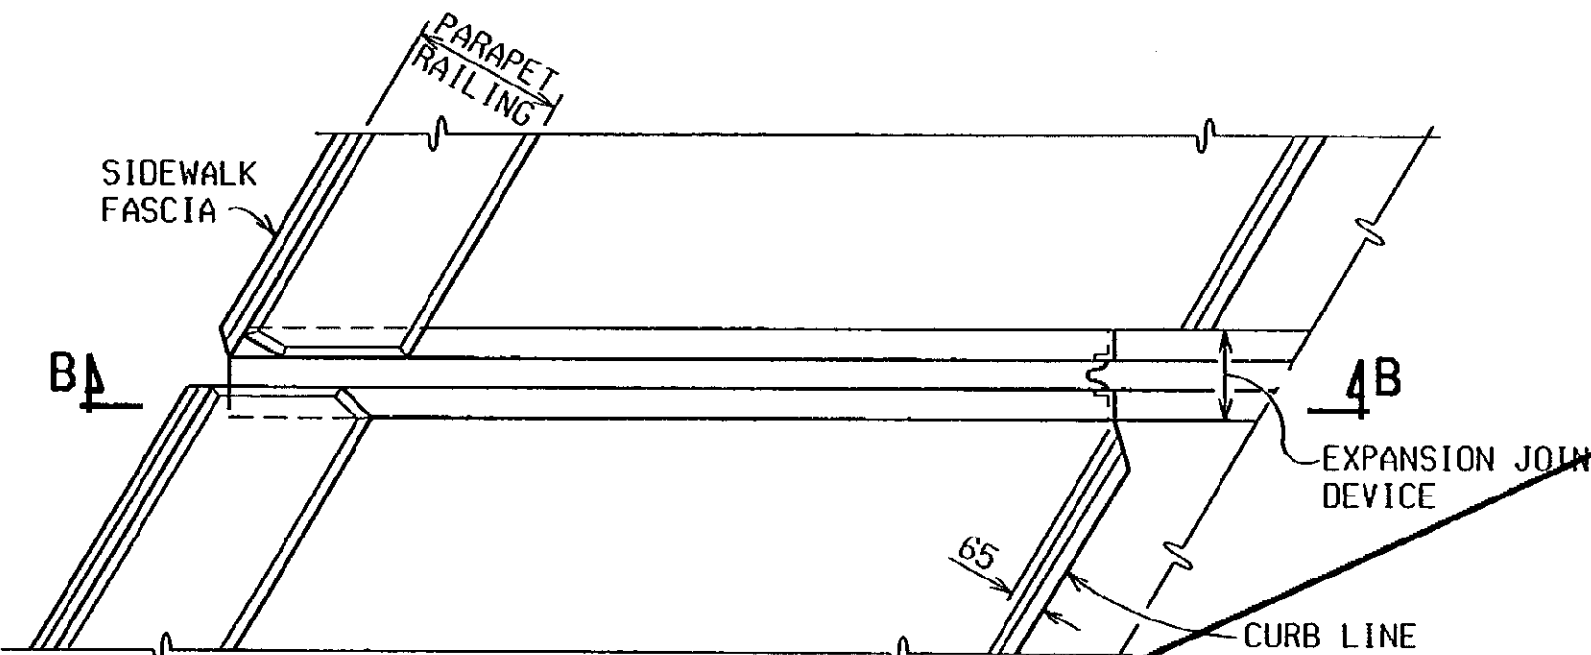


PLAN AT PARAPET RAILING
(DETAILS ARE SIMILAR FOR BRIDGE RAILING, 5 TUBE)

SIDEWALK TREATMENT

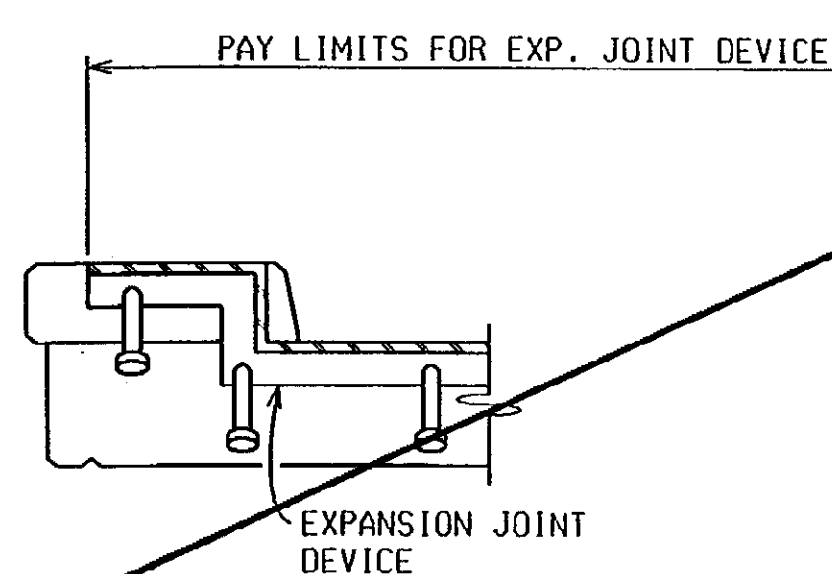


SECTION C-C

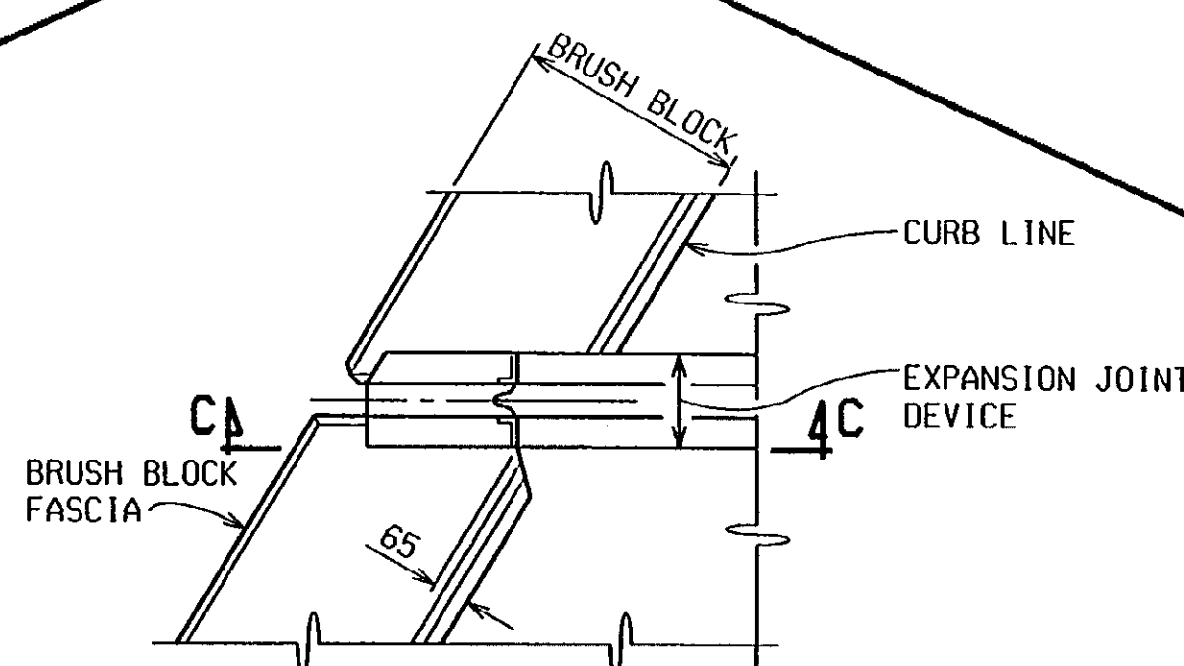

PLAN AT BRIDGE RAILING, 2 TUBE

BRUSH BLOCK TREATMENT


STRUCTURE NUMBER	ANGLE OF CROSSING TO NEAREST 10°	LOCATION OF JOINT	MIN. TOT. TRAVEL ALONG CENTERLINE OF BRIDGE	REQUIRED LENGTH OF EXPANSION JOINT DEVICE
B02	40	PIER 1	55mm	22.5
B02	40	PIER 2	25mm	22.5

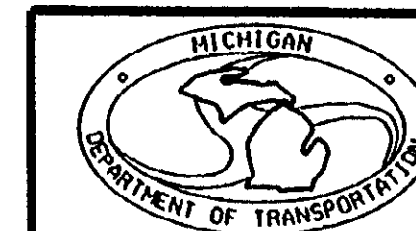

EXPANSION JOINT DETAILS - SB STRUCTURE				
DATE	CONT. SEC.	JOB NO.	DESIGN UNIT	SHEET
1-9-01	B02 OF 63174	49595A	MAHDAVI	7 OF 15

EJ3T (11-17-97)

REVISIONS			
NO.	DESCRIPTION	DATE	BY

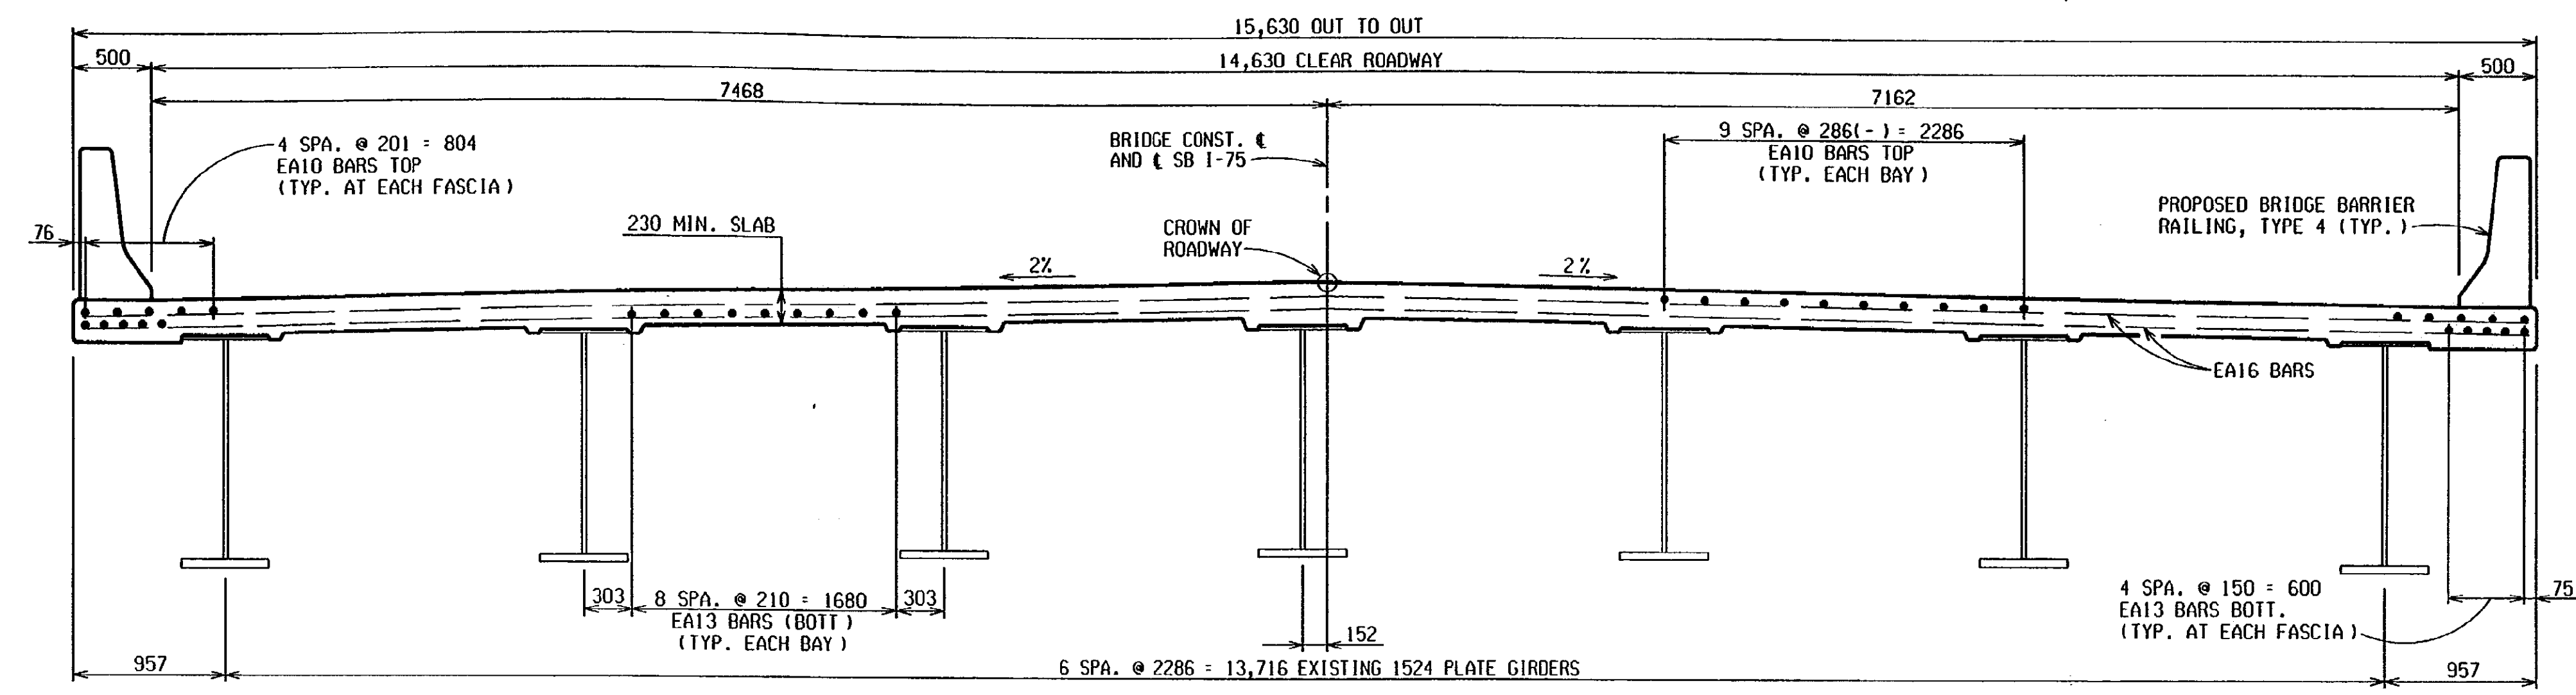

TYPICAL DECK SECTION - SB
(LOOKING NORTH)

SUPERSTRUCTURE CONCRETE QUANTITIES NIGHT CASTING


POUR	AMT (m3)
A	100
B	100
C	90
TOTAL CONC. : 290 m3	

MISCELLANEOUS QUANTITIES

152	m	Bridge Barrier Railing, Type 4
20	m2	Joint Waterproofing
290	m3	Bridge Ltg, Oper and Maintain
1	LS	Bridge Ltg, Furn and Rem (B02-SB)
1	LS	Superstructure Conc, Form, Finish and Cure, Night Casting (B02-SB)
1	LS	Shear Developers (B02-SB)

NOTES:

- FOR NAME PLATE LOCATION, SEE GENERAL PLAN OF STRUCTURE SHEET.
- *EDGE* OR *GROOVE* DENOTES EDGING OR GROOVING WITH AN APPROVED TOOL.
- ALPHABETICAL DESIGNATION OF POURS IS NOT TO BE CONSTRUED AS A POUR SEQUENCE.
- FOR BRIDGE RAILING, ANCHORAGE FOR GUARDRAIL, NAME PLATE MOUNTING, MOLDING AND BEVEL DETAILS, SEE STANDARD SHEET B-17 AND B-103. BARRIER RAILING IS TO BE BRIDGE BARRIER RAILING, TYPE 4.
- THIS DECK POUR IS DESIGNATED A NIGHT POUR, AND THEREFORE SUBJECT TO THE RESTRICTIONS OF SECTION 706.03J OF THE STANDARD SPECIFICATIONS.
- WHERE CAST-IN-ANCHORAGE IS USED FOR EXPANSION JOINT DEVICES, IT IS RECOMMENDED THAT THE PLACING OF DECK CONCRETE PROGRESS TOWARD THE JOINT SO THAT THE EFFECTS OF DEAD LOAD DEFLECTION WILL OCCUR BEFORE CONCRETE IS PLACED AT THE ANCHORAGE.
- JWP DENOTES JOINT WATERPROOFING.
- SHEAR DEVELOPERS SHALL BE 19mm DIAMETER STUDS.
- IF EXISTING SHEAR DEVELOPERS DO NOT INTERFERE WITH PROPOSED SHEAR DEVELOPERS AND REINFORCEMENT, THEY MAY BE CLEANED AND LEFT IN PLACE INSTEAD OF REMOVED. THE CONTRACTOR SHALL INSTALL ALL PROPOSED SHEAR DEVELOPERS REGARDLESS OF WHETHER OR NOT THE EXISTING SHEAR DEVELOPERS REMAIN.
- THE CONTRACTOR MAY USE METAL STAY IN PLACE FORMS. IF USED, ELIMINATING THE POLYSTYRENE AND FILLING THE CORRUGATIONS WITH CONCRETE IS PROHIBITED.

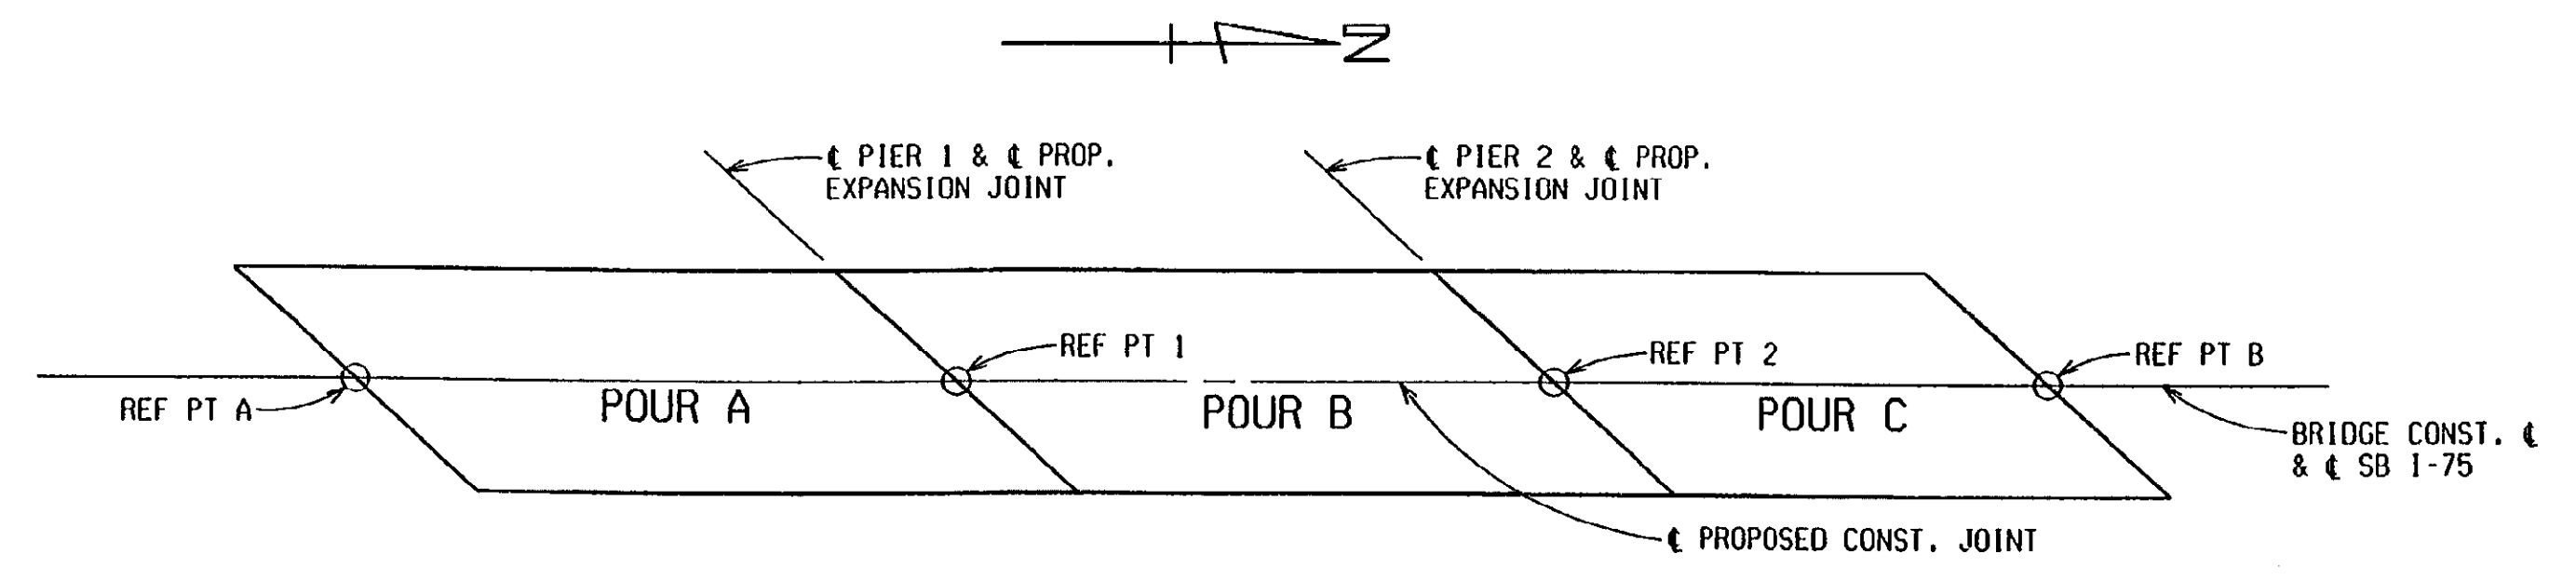


POUR DIAGRAM

DECK REPLACEMENT DETAILS - SB STRUCTURE


DATE	CONT. SEC.	JOB NO.	DESIGN UNIT	SHEET
1-9-01	B02 OF 63174	49595A	MAHDAVI	8 OF 15



1 2 3 4 5 6 7 8 9 10 11 12 13 14 15 16 17 18 19 20 21 22 23 24 25 26 27 28 29 30 31 32 33 34 35 36 37 38 39 40 41 42 43 44 45 46 47 48 49 50 51 52 53 54 55 56 57 58 59 60 61 62 63

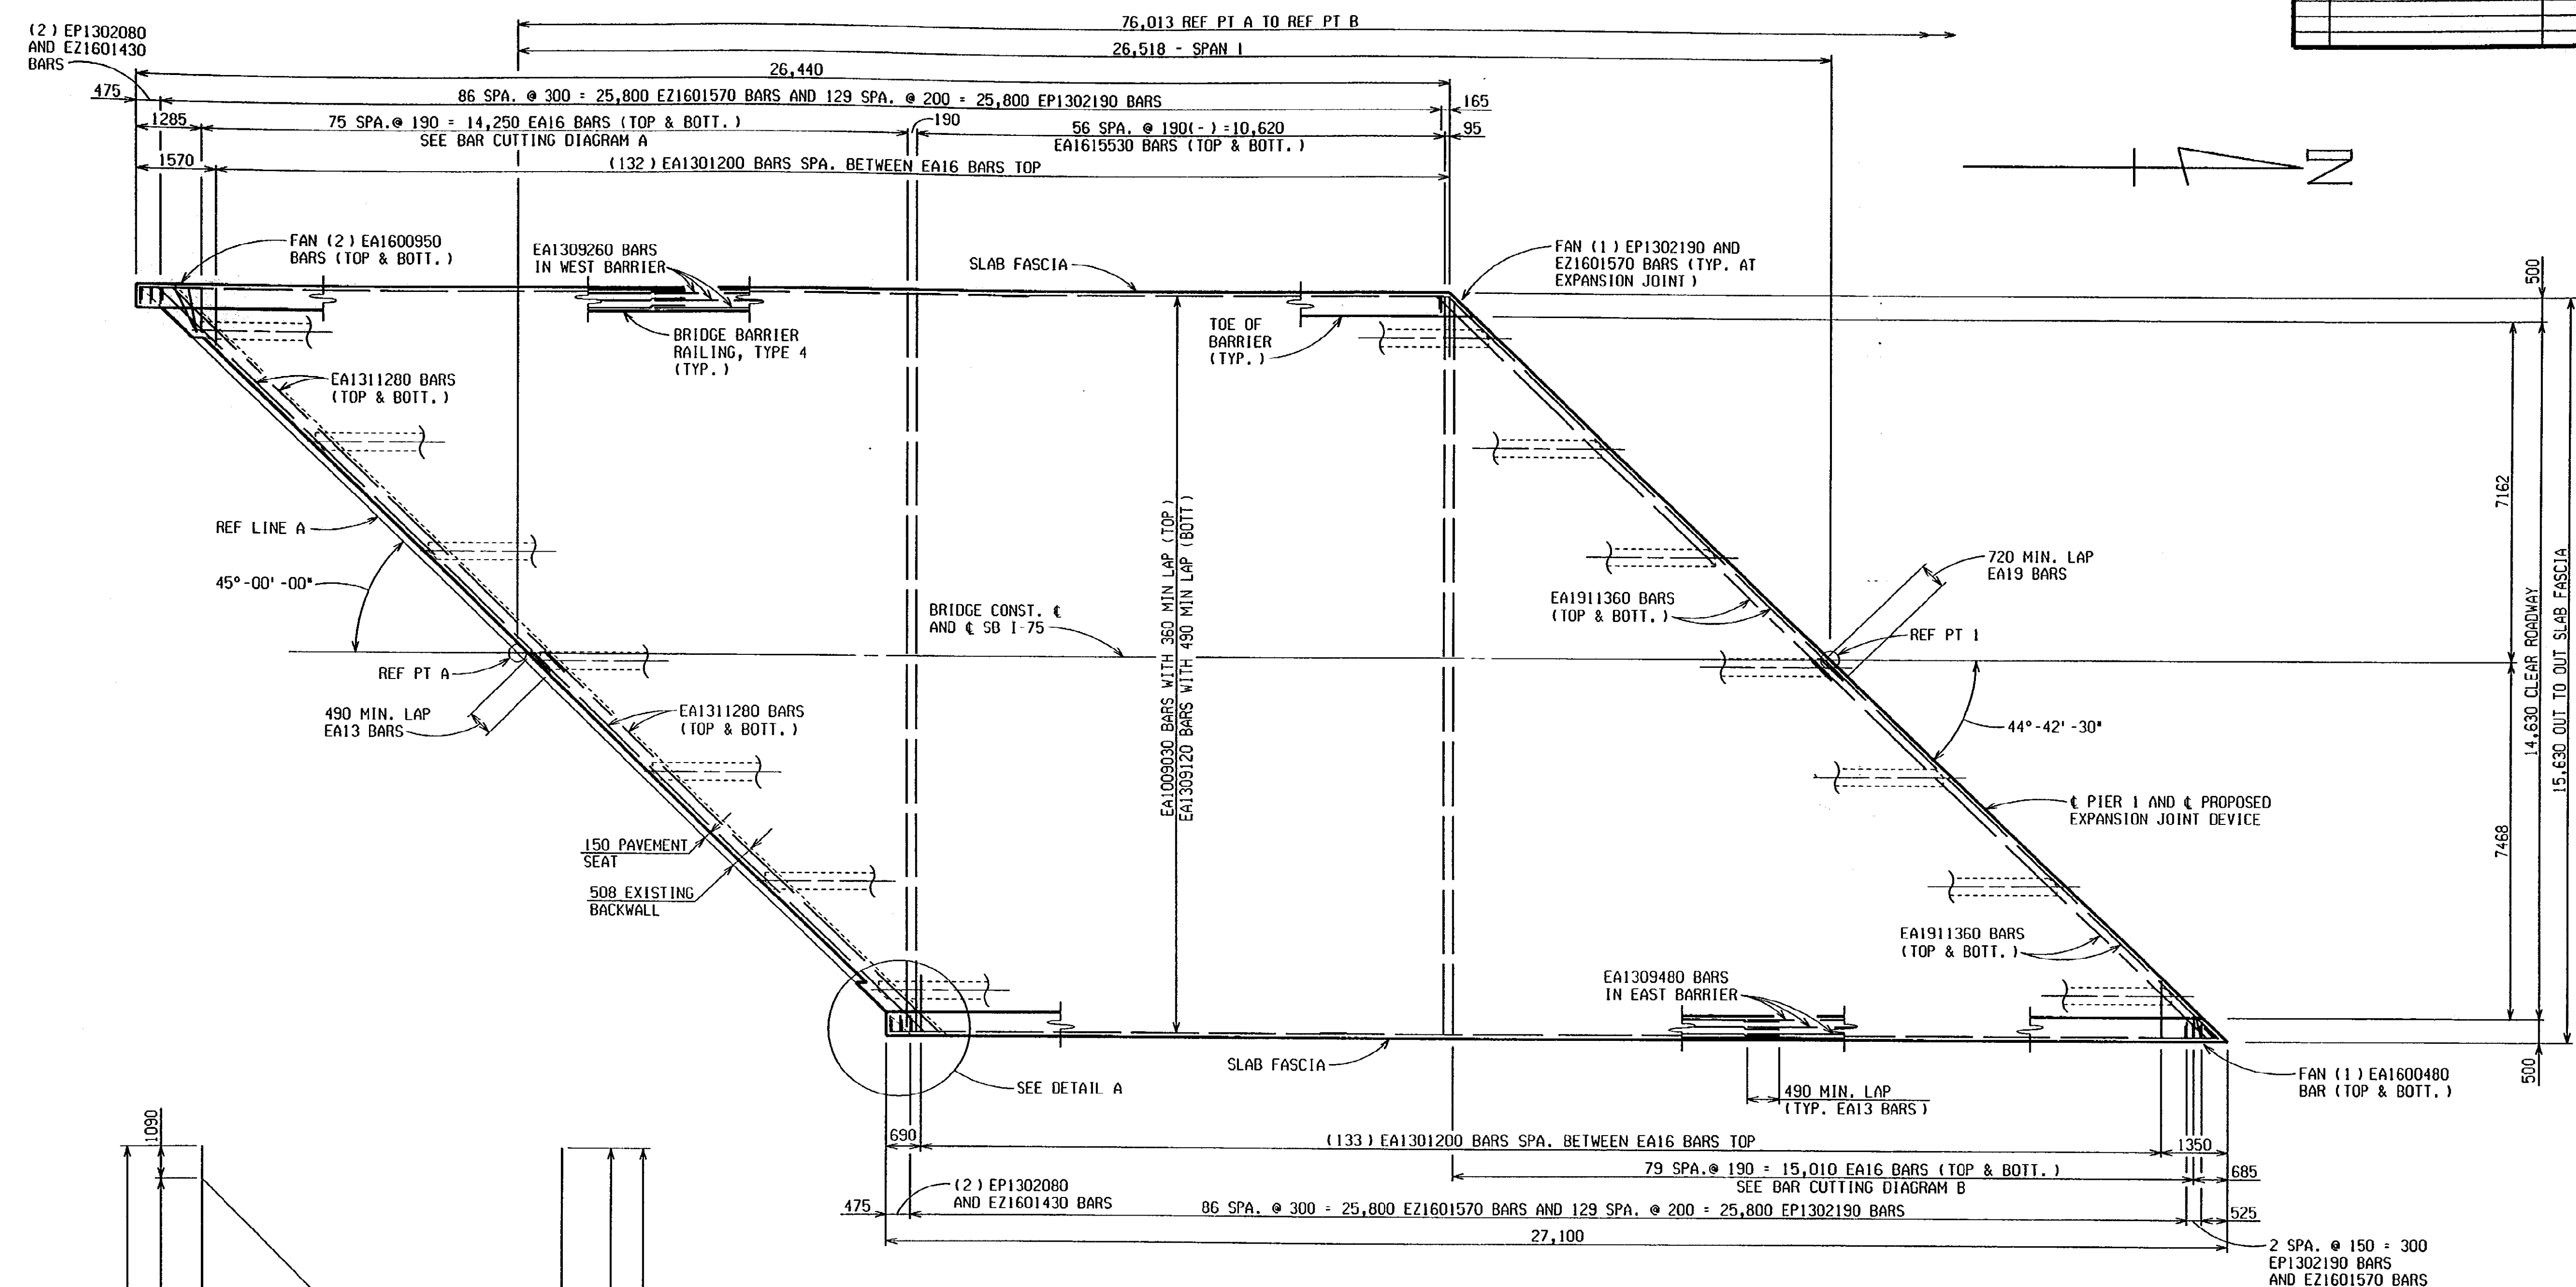

REVISIONS			
NO.	DESCRIPTION	DATE	BY

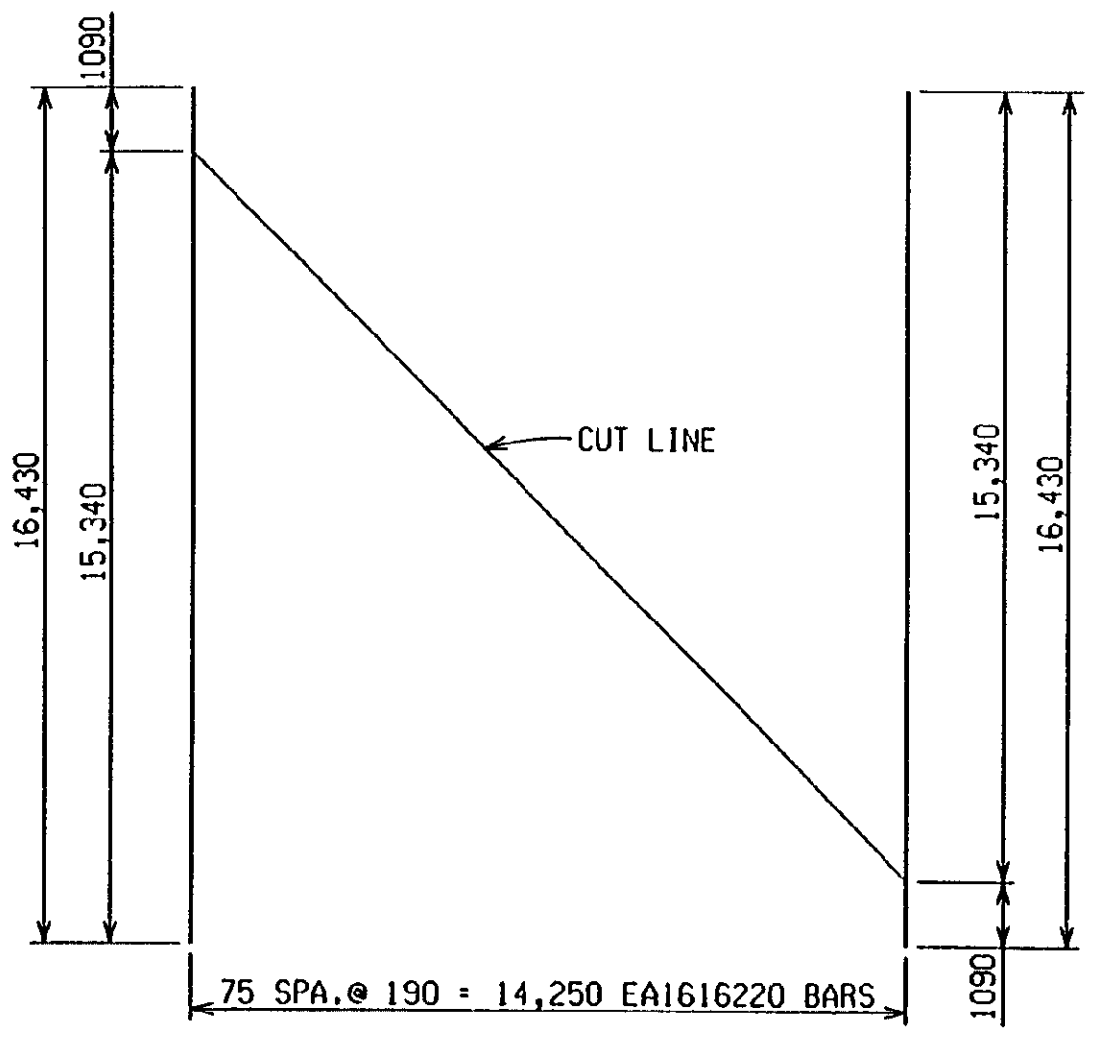

BAR CUTTING DIAGRAM A



DECK PLAN - SPAN 1



DECK REPLACEMENT DETAILS - SB STRUCTURE				
DATE	CONT. SEC.	JOB NO.	DESIGN UNIT	SHEET
1-9-01	B02 OF 63174	49595A	MAHDAVI	9 OF 15

FILE NAME: 60263174s.dwg
DRAWN BY: R. PRATT
CHECKED BY: MIKLUCKI
DATE: 6-22-00
CORRECTED BY: R. PRATT
DATE: 12-18-00


1 2 3 4 5 6 7 8 9 10 11 12 13 14 15 16 17 18 19 20 21 22 23 24 25 26 27 28 29 30 31 32 33 34 35 36 37 38 39 40 41 42 43 44 45 46 47 48 49 50 51 52 53 54 55 56 57 58 59 60 61 62 63

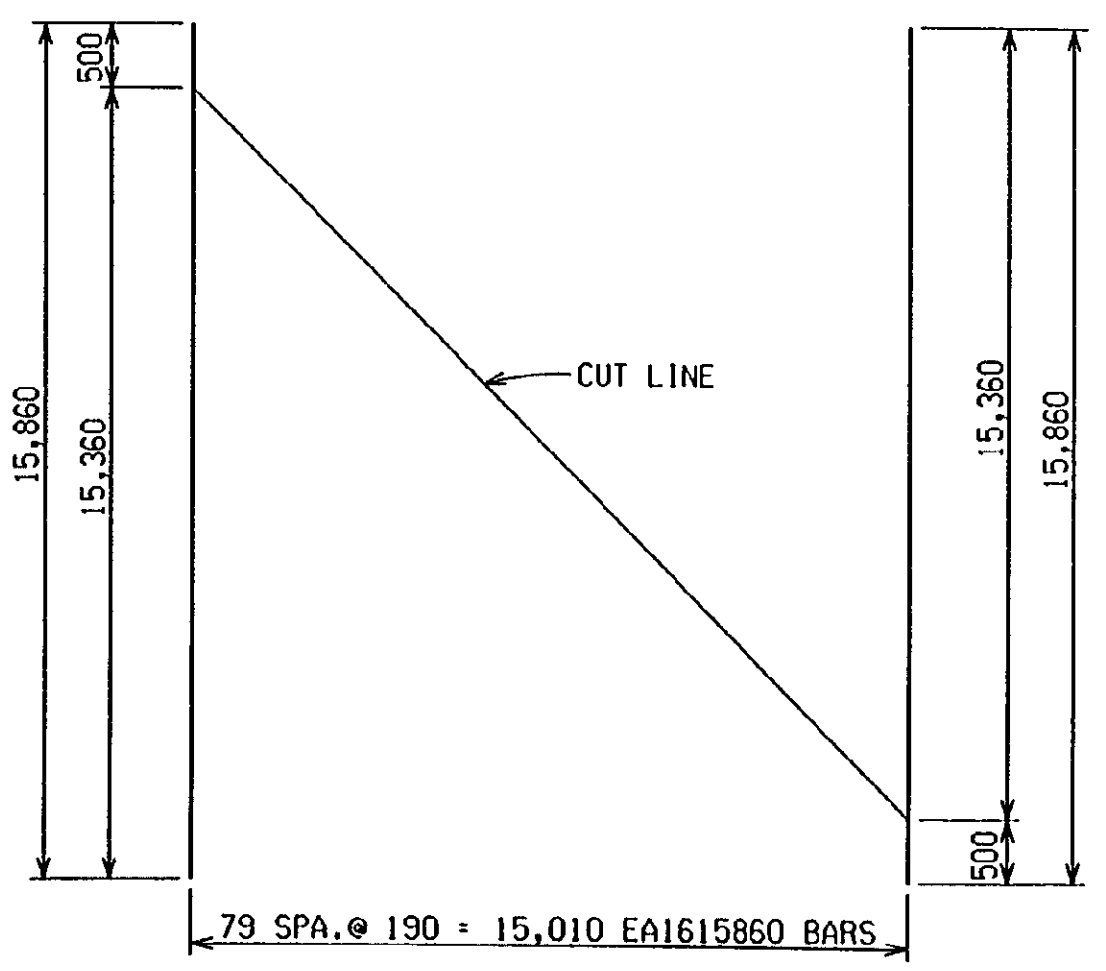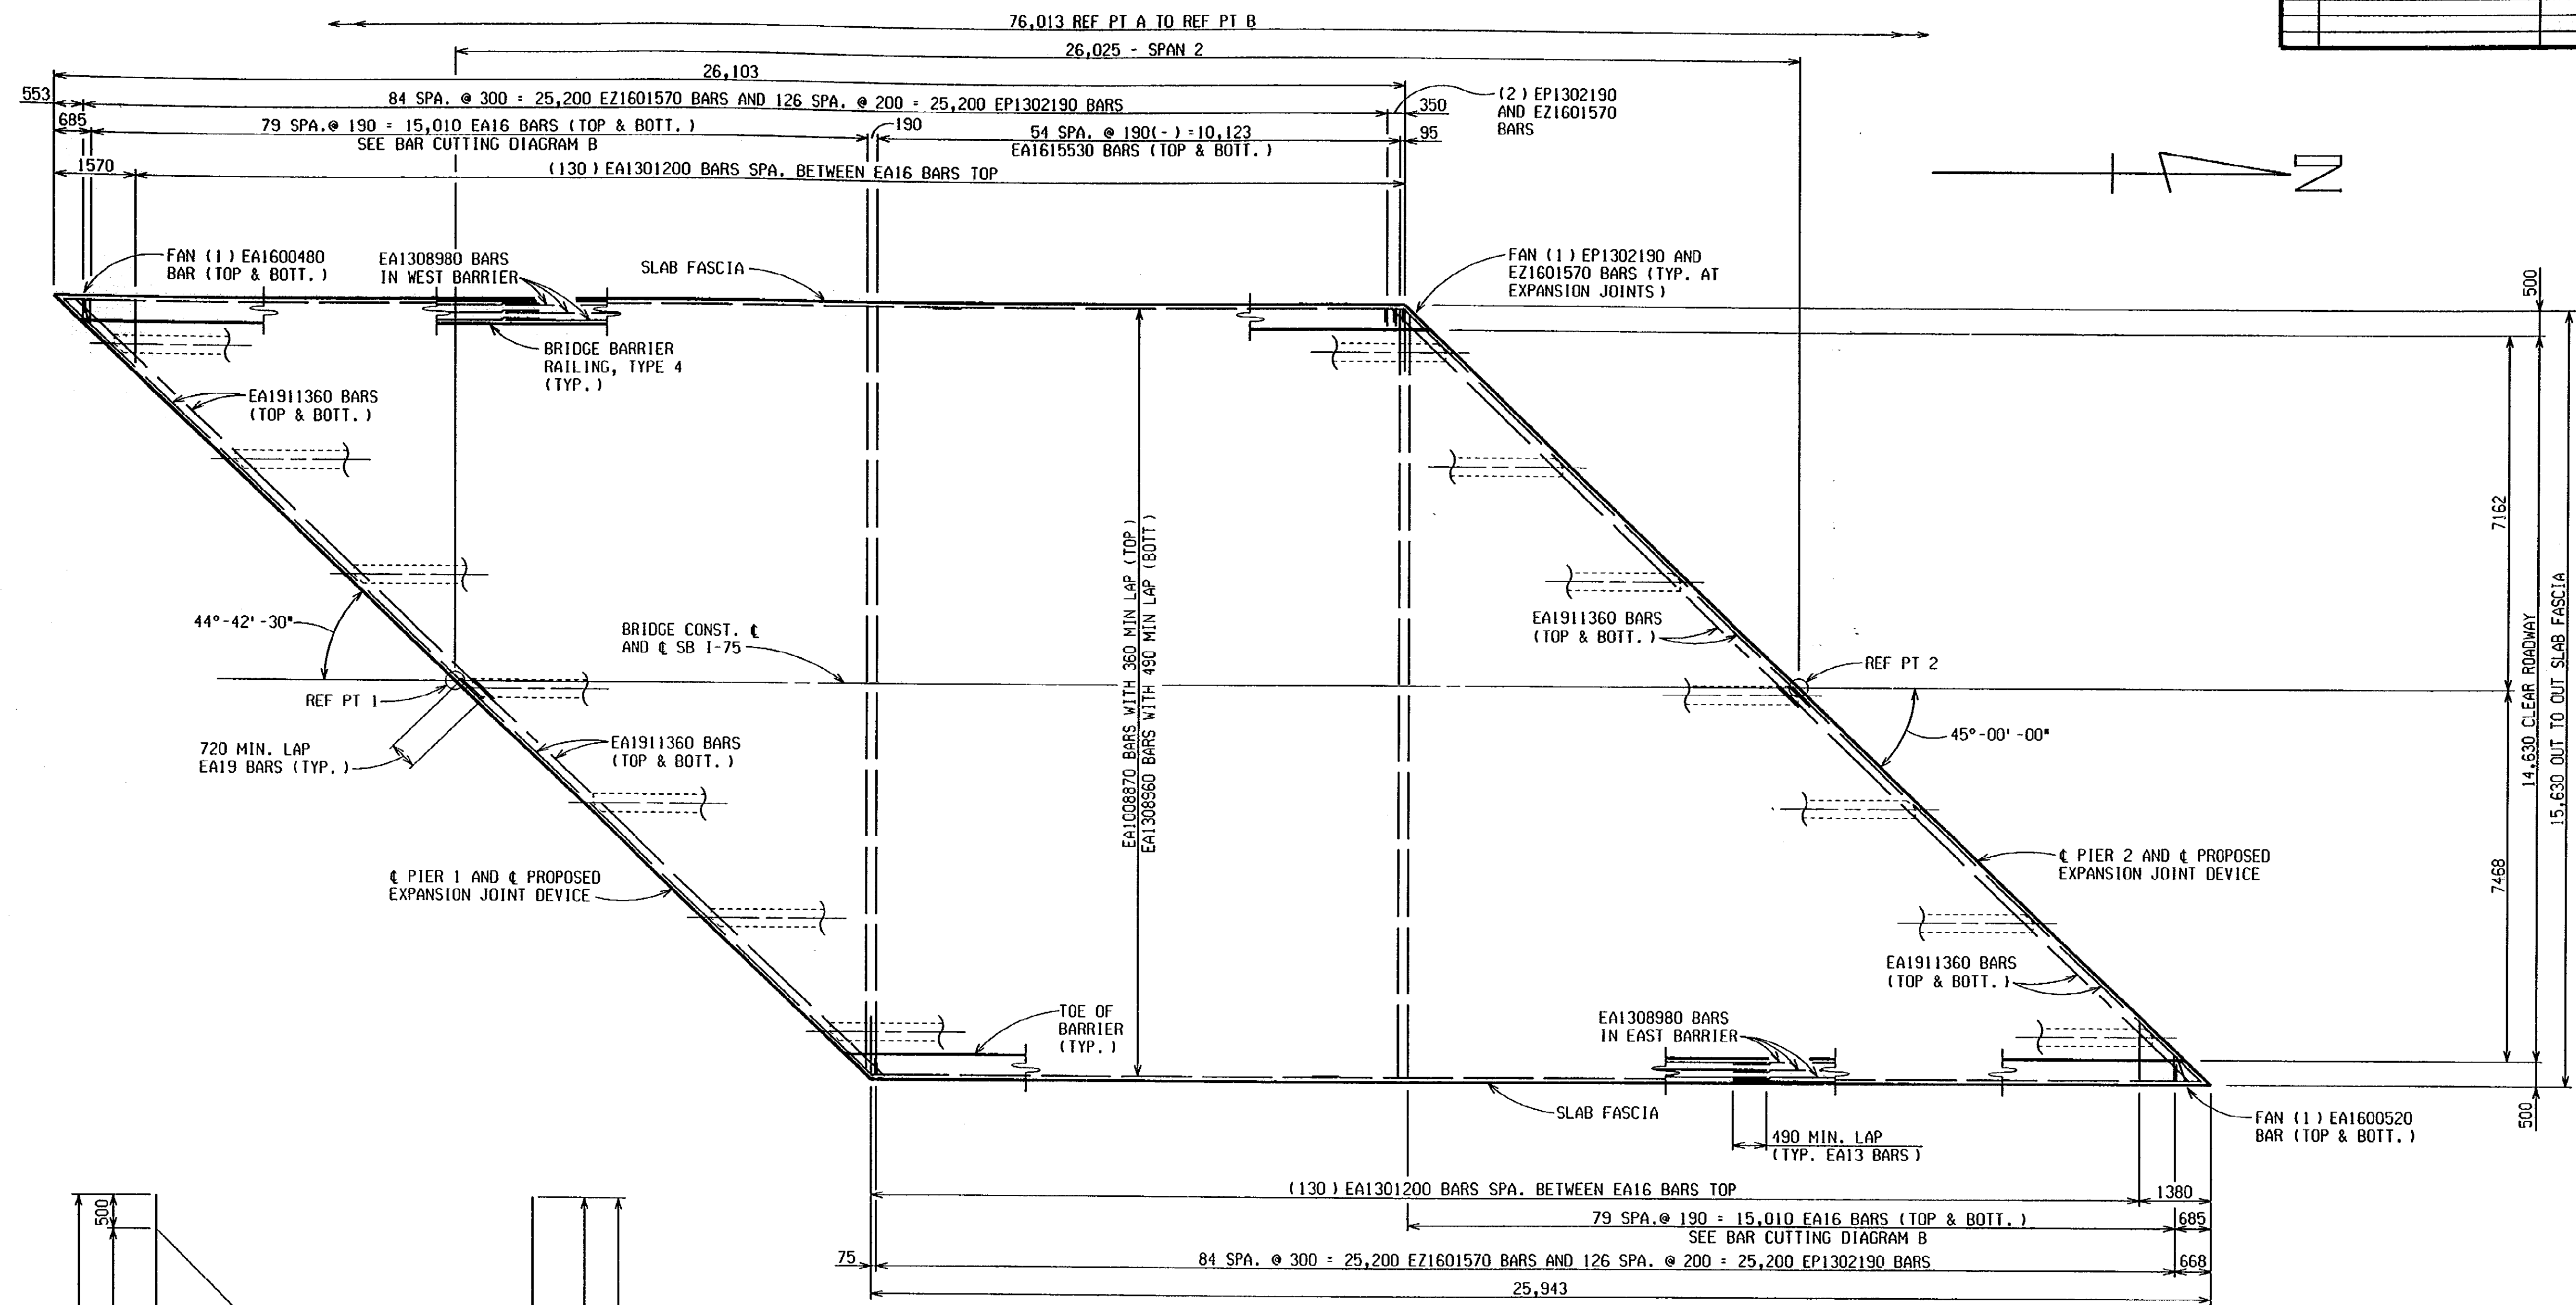


BAR CUTTING DIAGRAM B

DECK PLAN - SPAN 2

REVISIONS			
NO.	DESCRIPTION	DATE	BY

DECK REPLACEMENT DETAILS - SB STRUCTURE				
 Michigan Department of Transportation	DATE	CONT. SEC.	JOB NO.	DESIGN UNIT
	1-9-01	B02 OF 63174	49595A	MAHDAVI
				SHEET
				10 OF 15

FILE NAME: 50263174s.dk DRAWN BY: R. PRATT CHECKED BY: MIKICKI DATE: 6-22-00 CORRECTED BY: R. PRATT DATE: 1-3-01

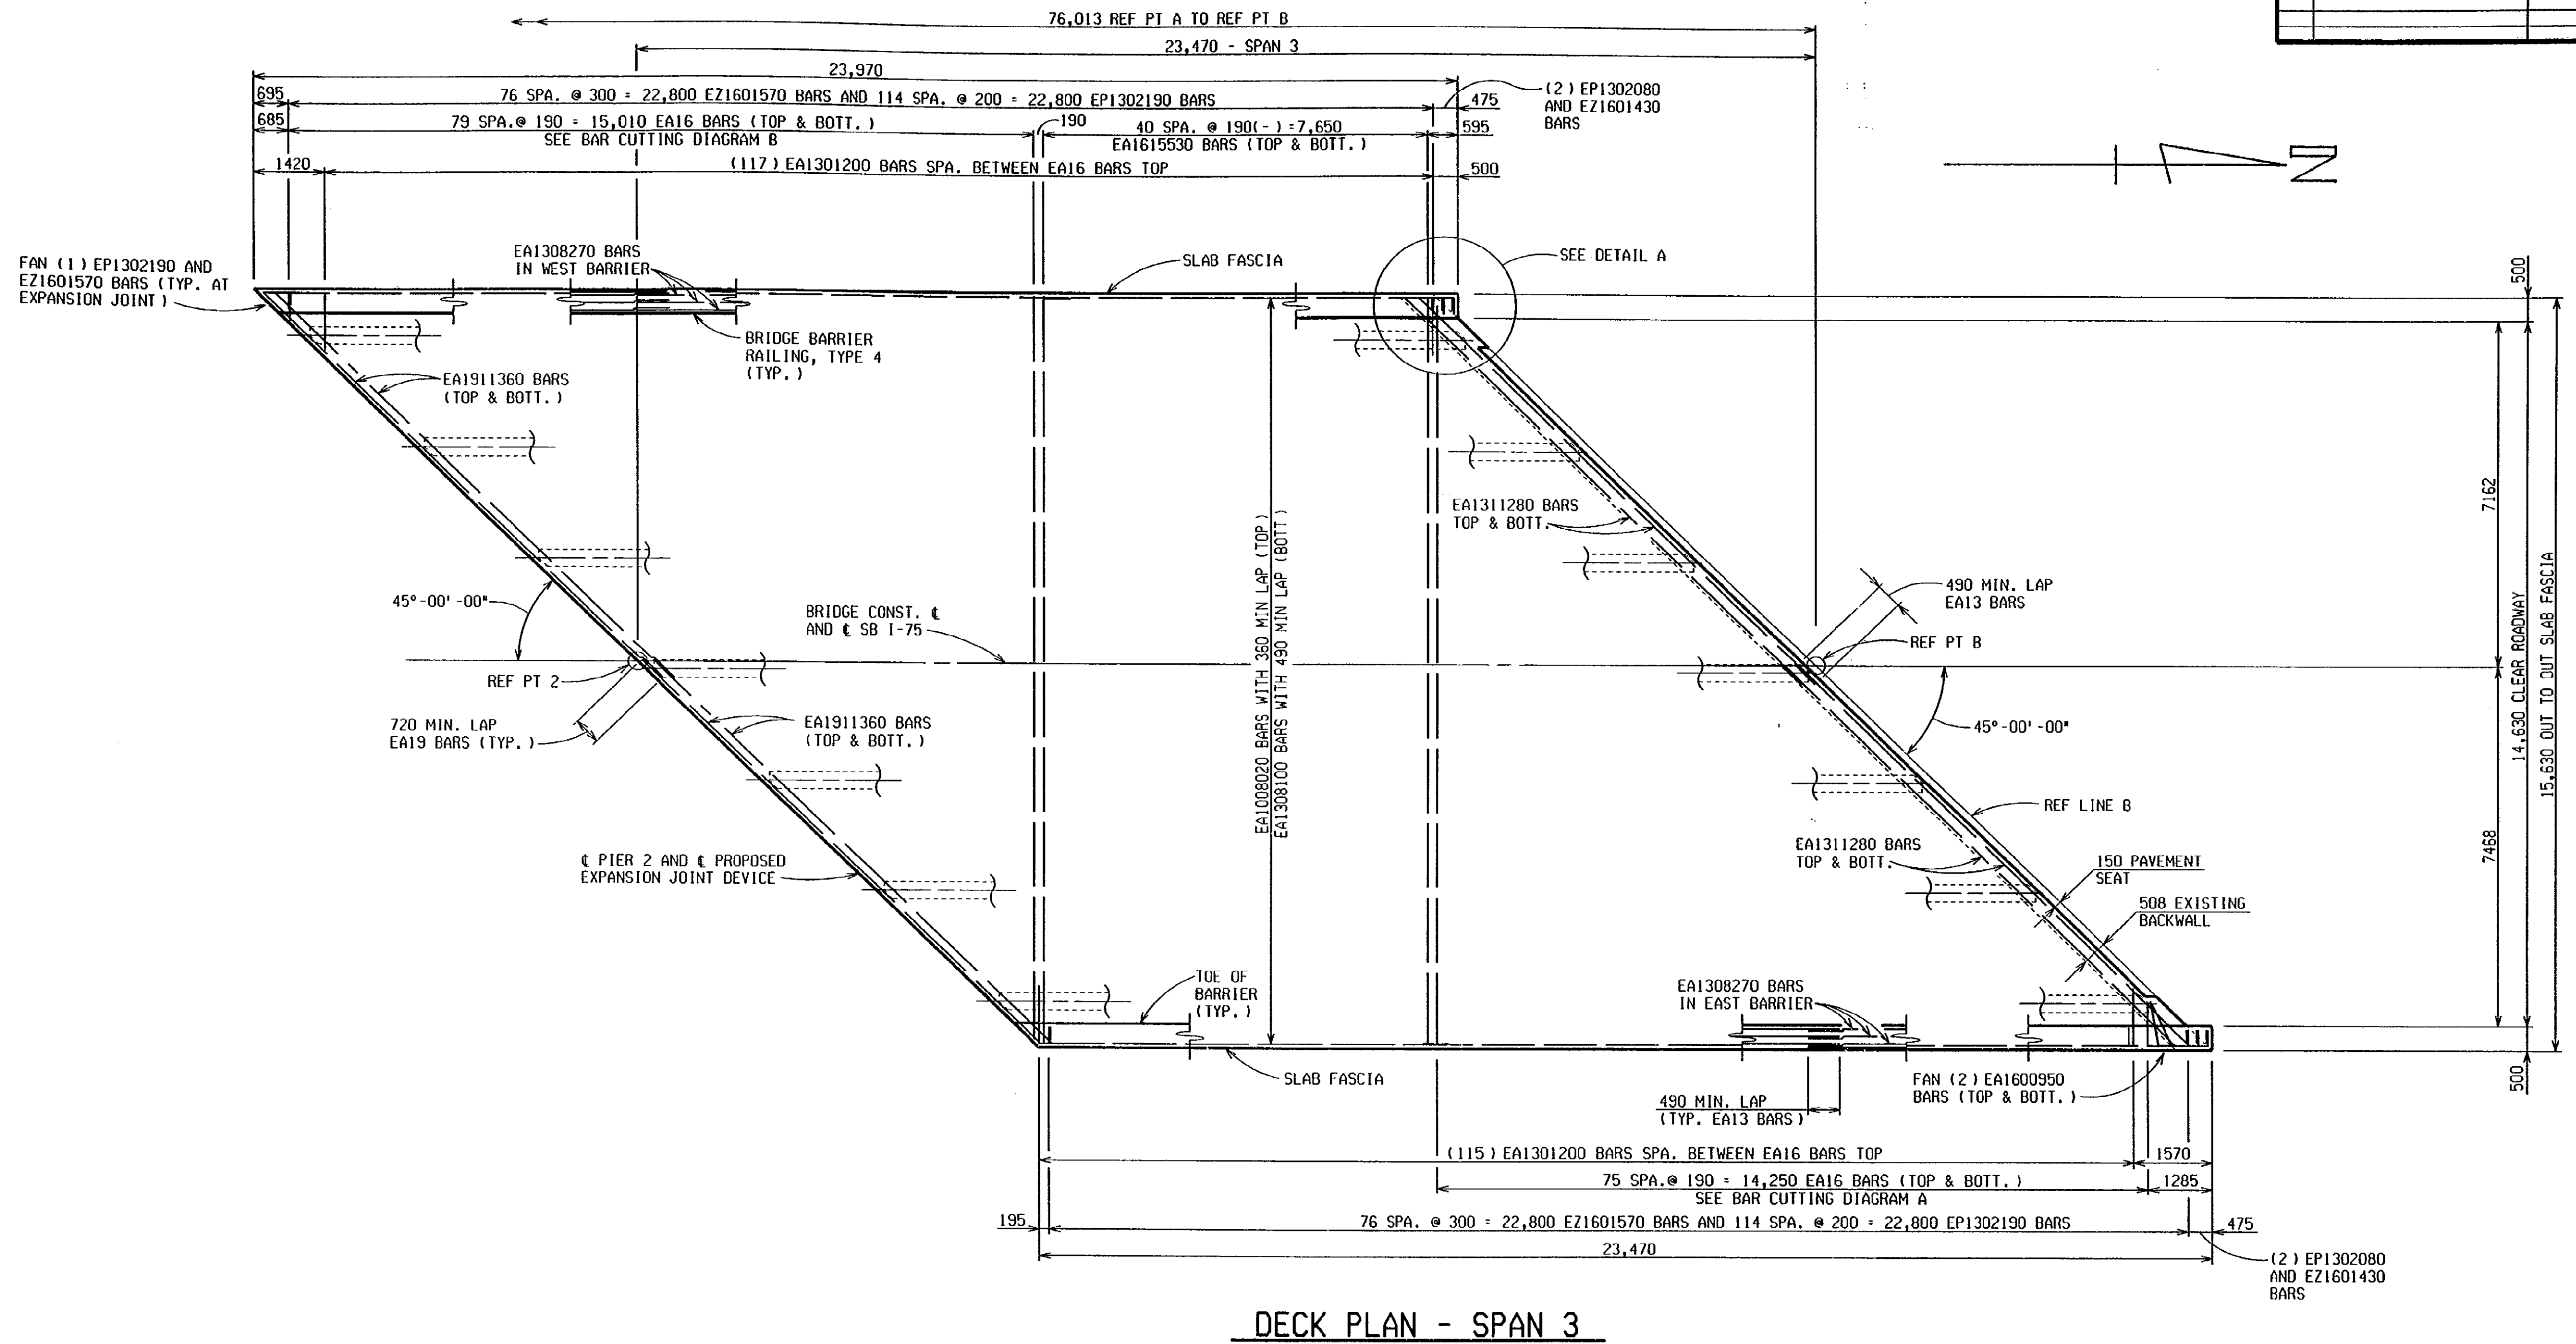


DECK PLAN - SPAN 3




DECK REPLACEMENT DETAILS - SB STRUCTURE

DATE	CONT. SEC.	JOB NO.	DESIGN UNIT	SHEET
1-9-01	B02 OF 63174	49595A	MAHDAVI	11 OF 15


REVISIONS			
NO.	DESCRIPTION	DATE	BY

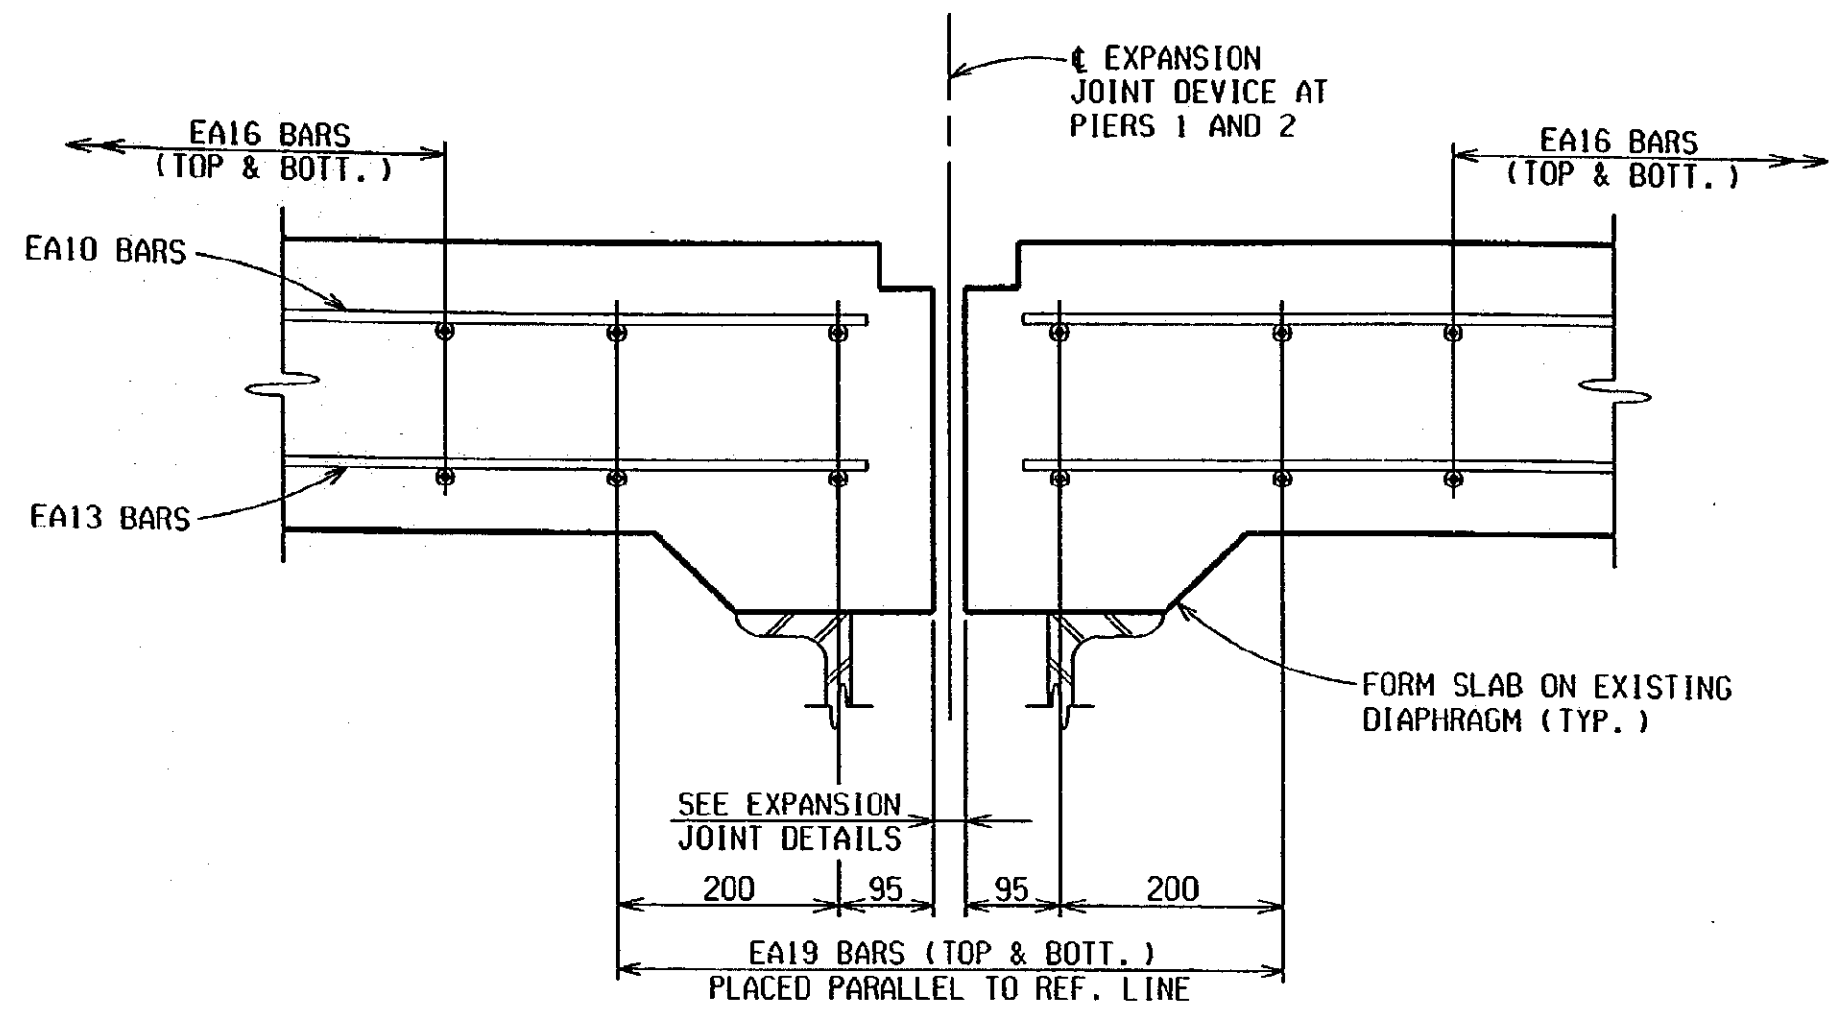


TYPICAL SECTION THRU EXPANSION JOINT

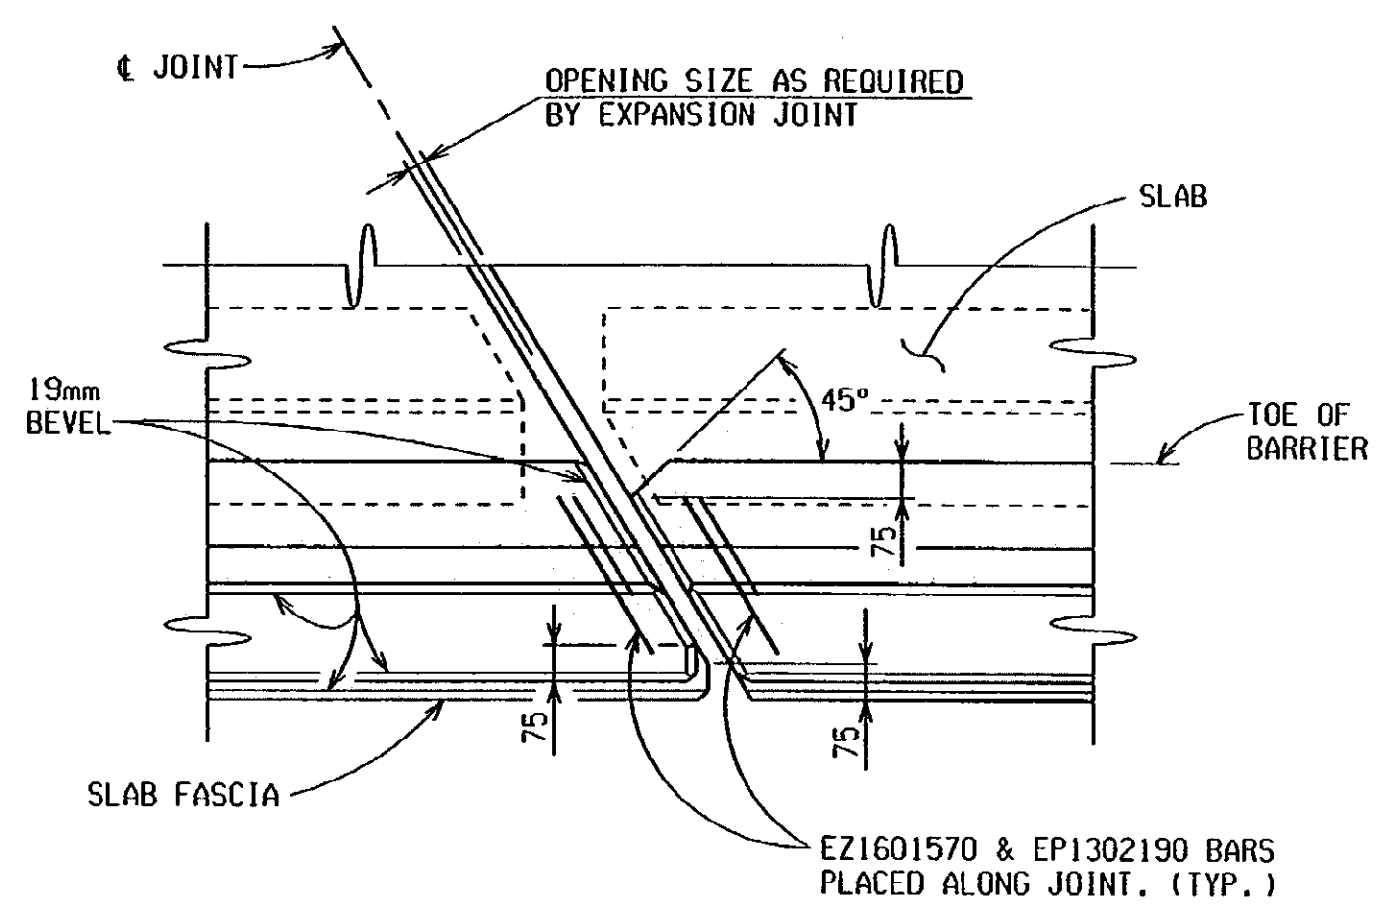


PLAN OF BARRIER

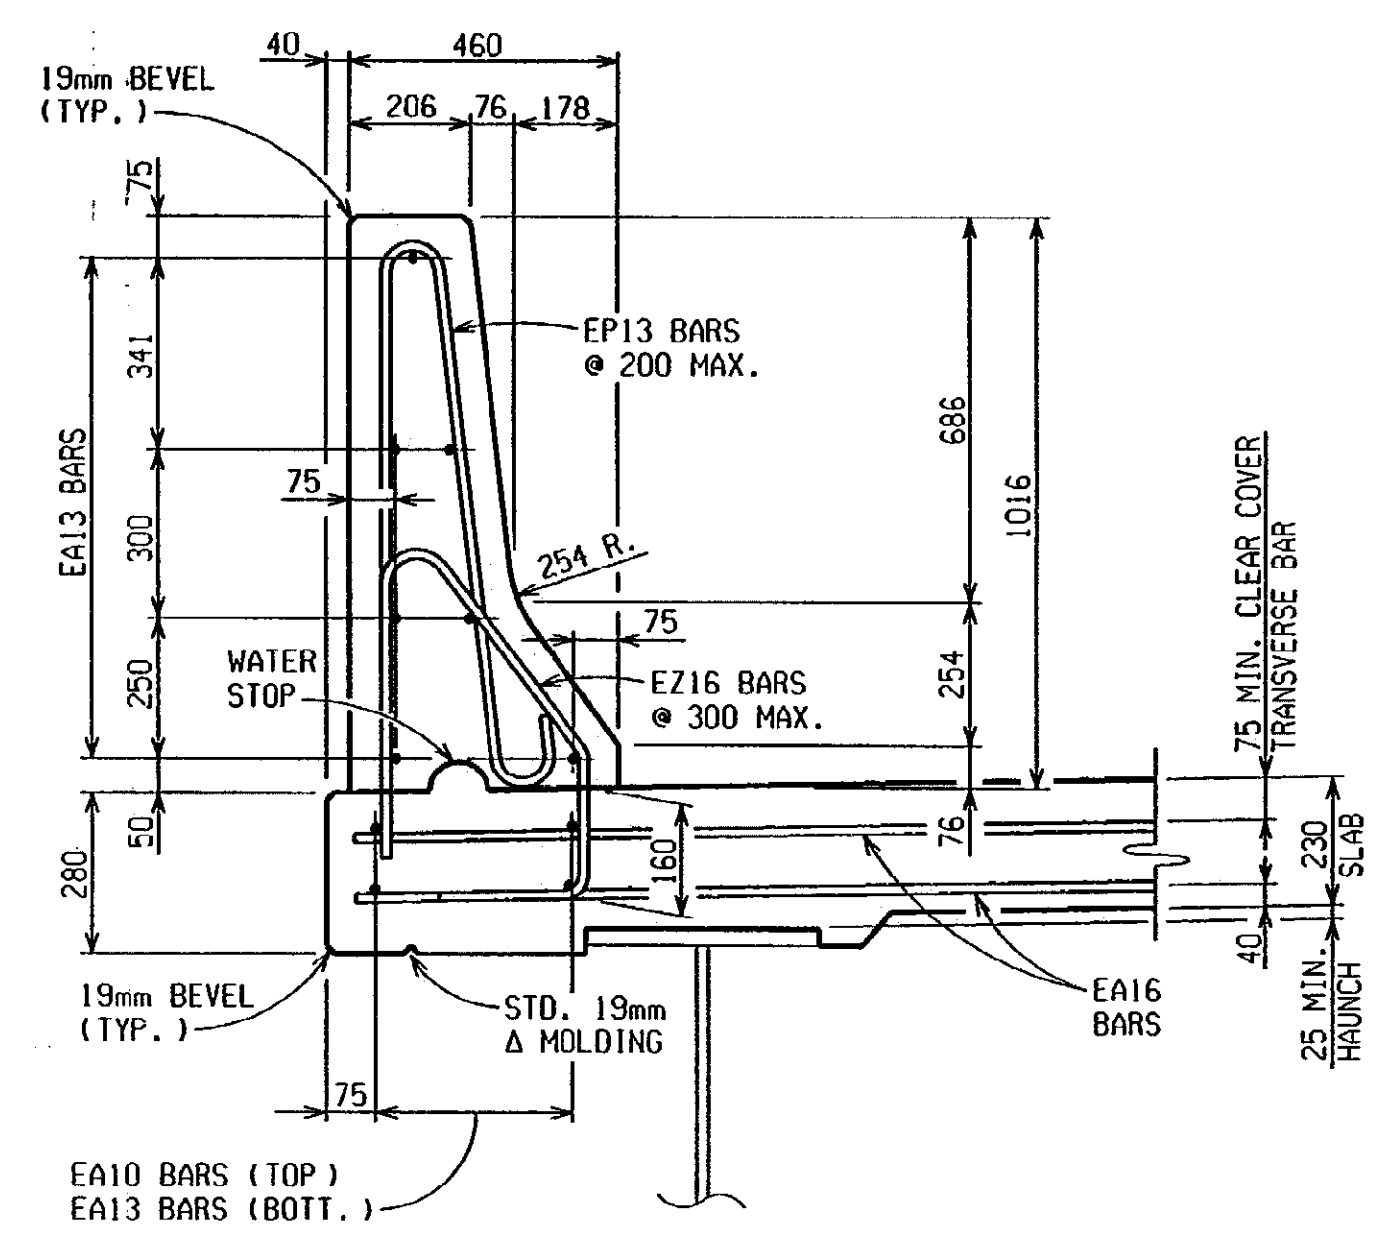


TYPICAL SECTION THRU BARRIER

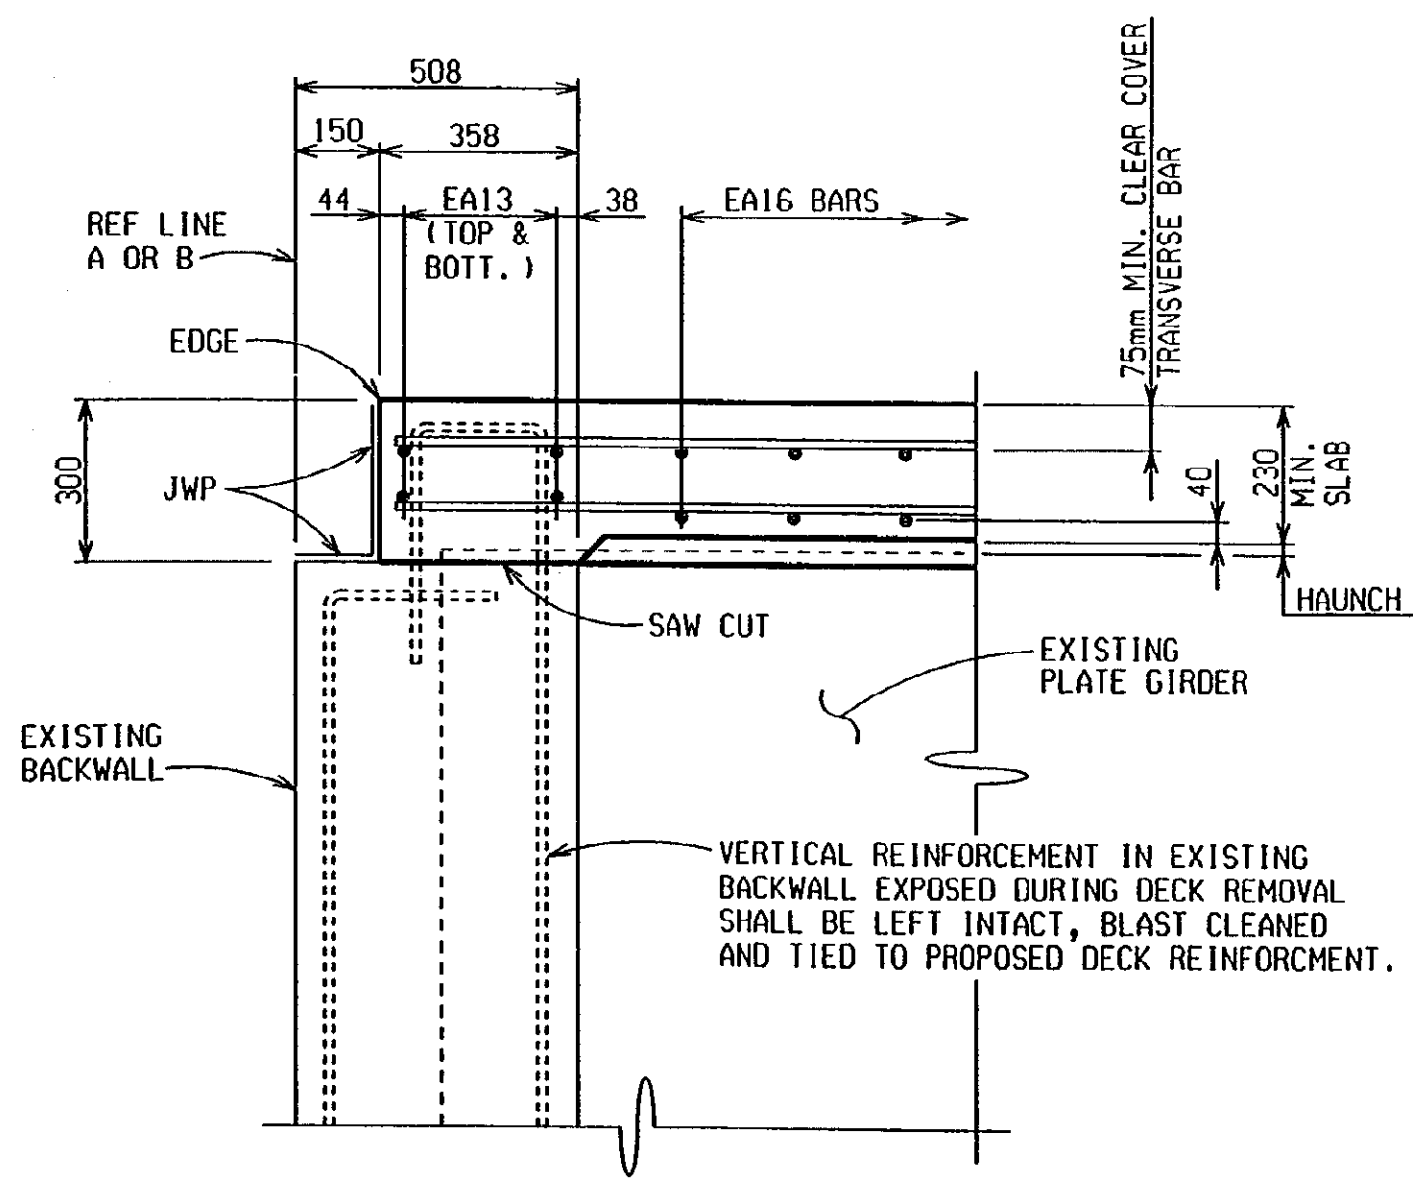

TYPICAL SECTION THRU BACKWALL

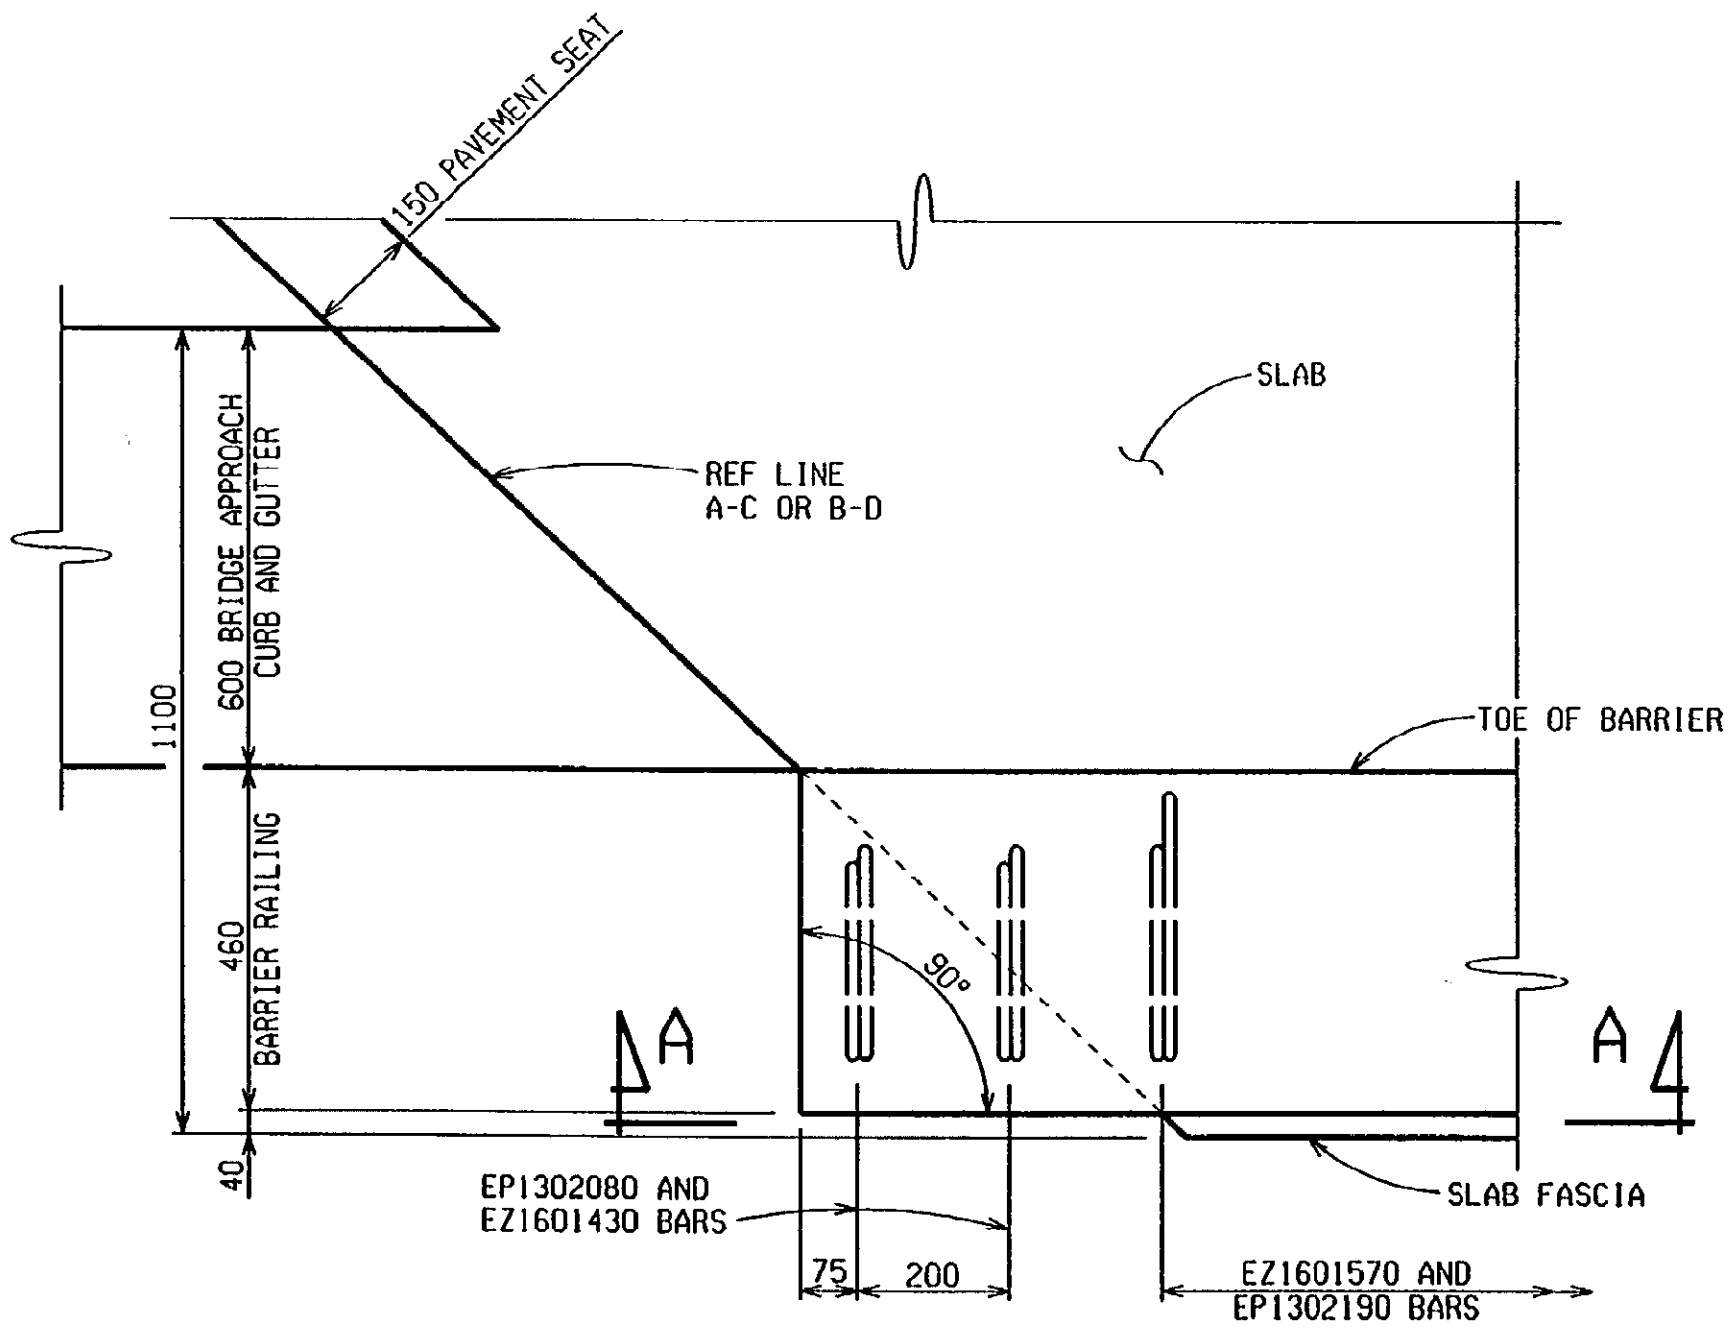

DETAIL A
(TYP. ALL 4 QUADRANTS)

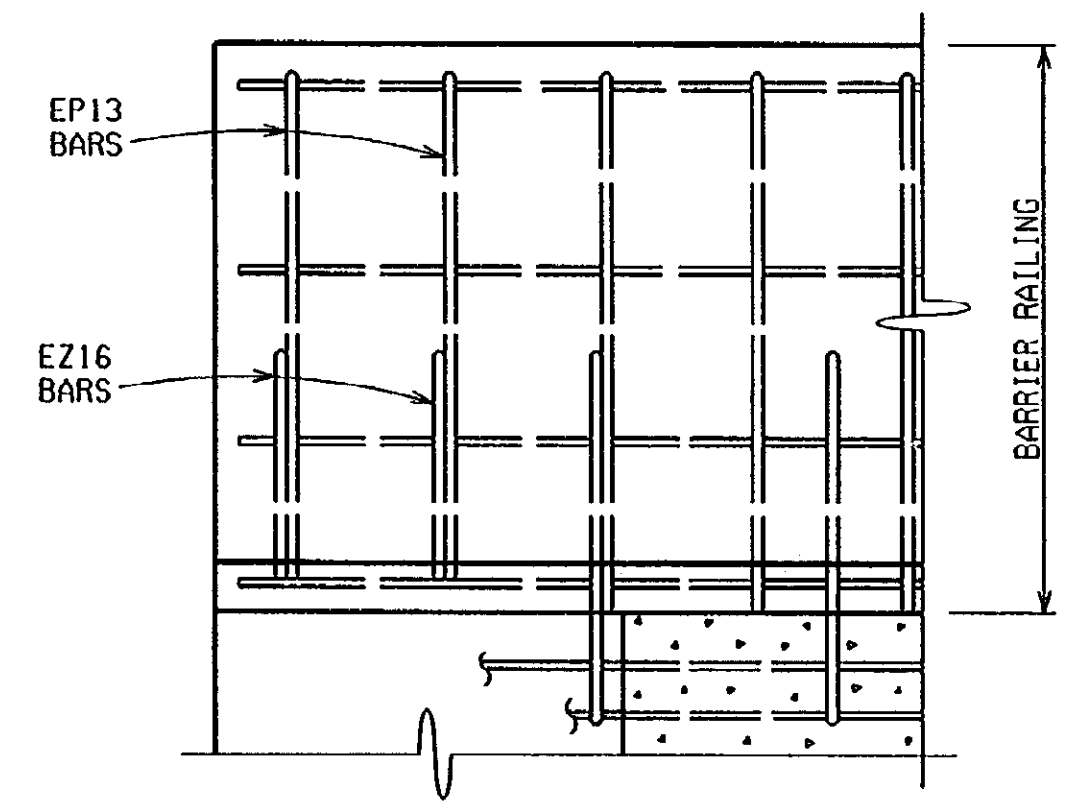


SECTION A-A

DECK REPLACEMENT DETAILS - SB STRUCTURE




DATE	CONT. SEC.	JOB NO.	DESIGN UNIT	SHEET
1-9-01	B02 OF 63174	49595A	MAHDAVI	12 OF 15


REVISIONS			
NO.	DESCRIPTION	DATE	BY

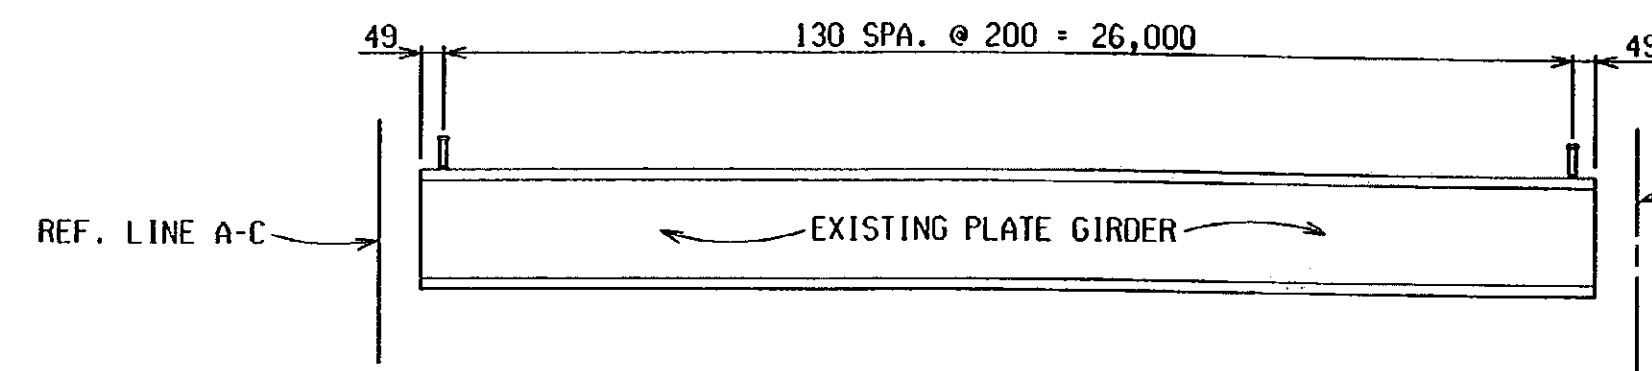


SPAN 1 PLATE GIRDER ELEVATION
SHOWING STUD SPACING

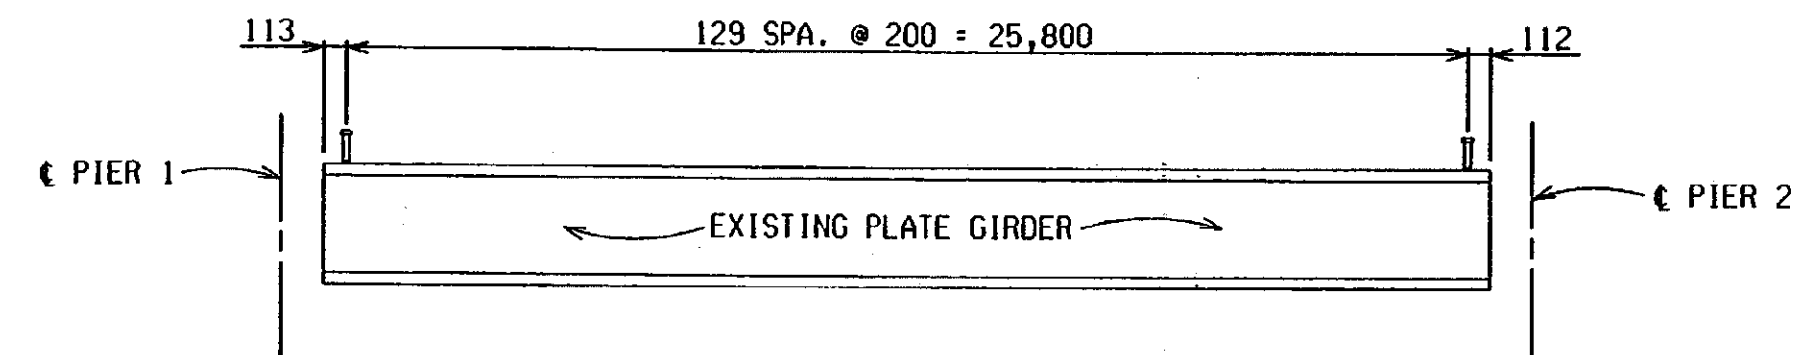

SPAN 2 PLATE GIRDER ELEVATION
SHOWING STUD SPACING

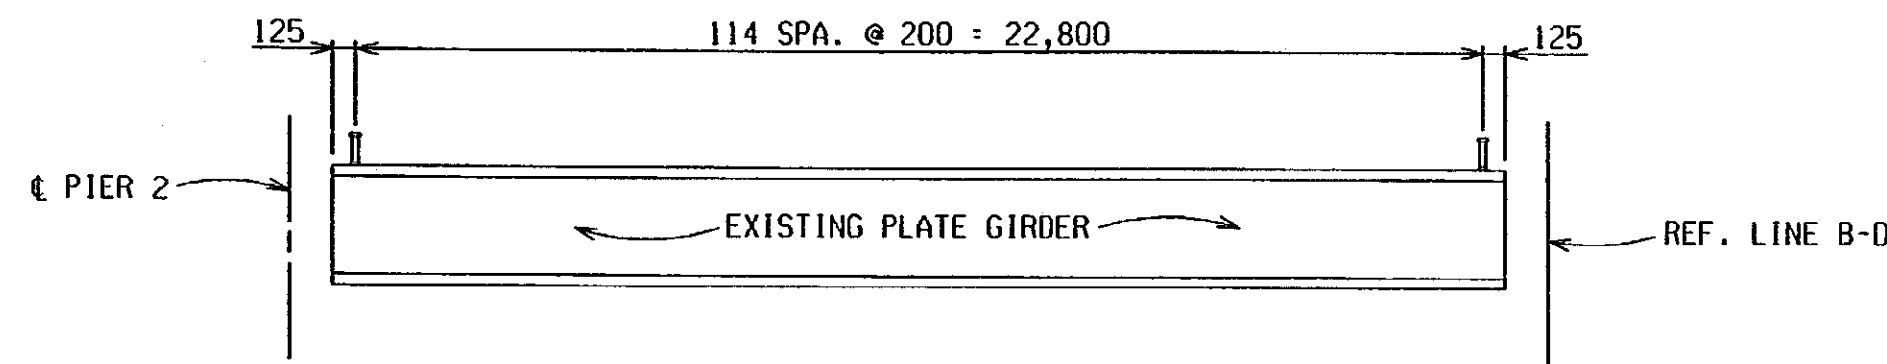


SPAN 3 PLATE GIRDER ELEVATION
SHOWING STUD SPACING

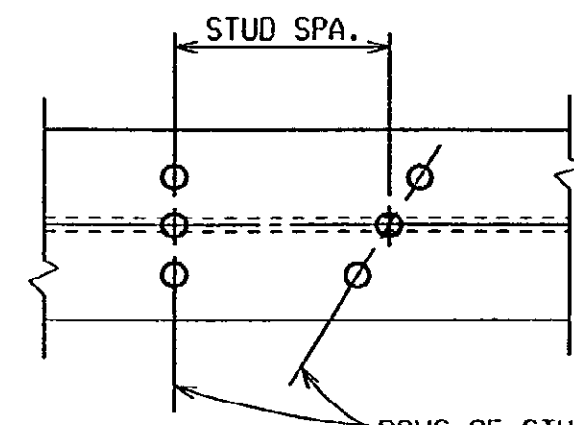


ROWS OF STUDS SHALL BE SET PARALLEL TO TRANSVERSE REINFORCEMENT.

PLAN

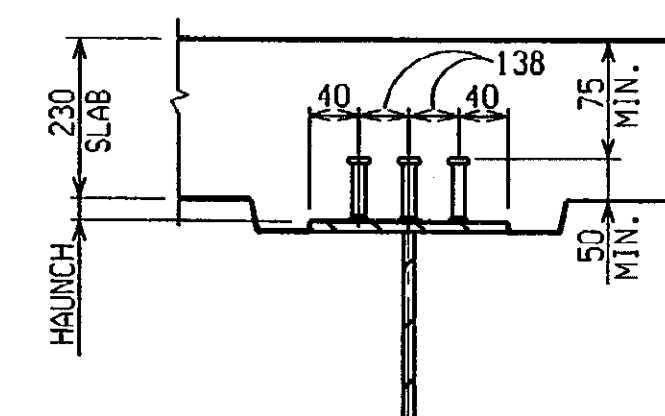

SECTION THRU 1524 PLATE GIRDER ALL SPANS

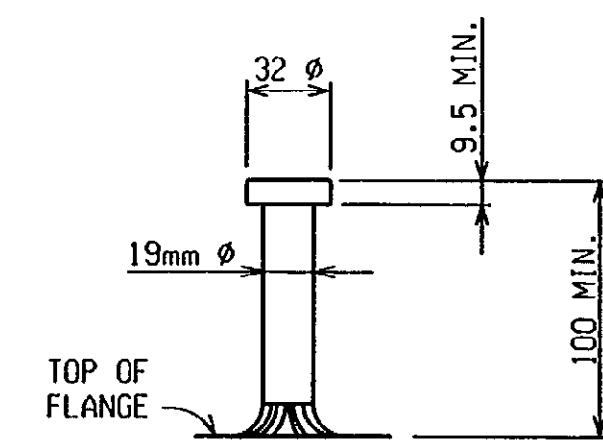

STUD DETAIL

STUD SHEAR DEVELOPER DETAILS

DECK REPLACEMENT DETAILS - SB STRUCTURE



DATE	CONT. SEC.	JOB NO.	DESIGN UNIT	SHEET
1-9-01	B02 OF 63174	49595A	MAHDAVI	13 OF 15



REVISIONS			
NO.	DESCRIPTION	DATE	BY

BOTTOM OF SLAB ELEVATIONS

	SPAN 1								SPAN 2								SPAN 3										
	0	1	2	3	4	5	6	7	0	1	2	3	4	5	6	7	0	1	2	3	4	5	6	7	8		
A FASCIA	197.357	197.287	197.217	197.144	197.068	196.989	196.907	196.823	196.738	196.654	196.570	196.486	196.402	196.318	196.234	196.150	196.066	195.982	195.898	195.814	195.730	195.646	195.562	195.478	195.394	195.310	195.226
B RIGHT	197.424	197.354	197.284	197.211	197.135	197.056	196.974	196.890	196.805	196.721	196.637	196.553	196.469	196.385	196.301	196.217	196.133	196.049	195.965	195.881	195.797	195.713	195.629	195.545	195.461	195.377	195.293
C LEFT	197.401	197.332	197.263	197.191	197.116	197.038	196.957	196.874	196.790	196.706	196.622	196.538	196.454	196.370	196.286	196.202	196.118	196.034	195.950	195.866	195.782	195.698	195.614	195.530	195.446	195.362	195.278
D RIGHT	197.412	197.343	197.273	197.201	197.126	197.048	196.967	196.884	196.800	196.716	196.632	196.548	196.464	196.380	196.296	196.212	196.128	196.044	195.960	195.876	195.792	195.708	195.624	195.540	195.456	195.372	195.288
E LEFT	197.390	197.322	197.253	197.182	197.108	197.031	196.950	196.868	196.785	196.701	196.617	196.533	196.449	196.365	196.281	196.197	196.113	196.029	195.945	195.861	195.777	195.693	195.609	195.525	195.441	195.357	195.273
F RIGHT	197.400	197.332	197.263	197.192	197.118	197.041	196.961	196.878	196.795	196.711	196.627	196.543	196.459	196.375	196.291	196.207	196.123	196.039	195.955	195.871	195.787	195.703	195.619	195.535	195.451	195.367	195.283
G LEFT	197.378	197.311	197.243	197.173	197.100	197.024	196.945	196.863	196.781	196.697	196.613	196.529	196.445	196.361	196.277	196.193	196.109	196.025	195.941	195.857	195.773	195.689	195.605	195.521	195.437	195.353	195.269
H RIGHT	197.384	197.317	197.249	197.179	197.106	197.030	196.951	196.869	196.787	196.703	196.619	196.535	196.451	196.367	196.283	196.199	196.115	196.031	195.947	195.863	195.779	195.695	195.611	195.527	195.443	195.359	195.275
I LEFT	197.293	197.226	197.159	197.090	197.018	196.943	196.864	196.784	196.702	196.620	196.538	196.456	196.374	196.292	196.210	196.128	196.046	195.964	195.882	195.800	195.718	195.636	195.554	195.472	195.390	195.308	195.226
J RIGHT	197.283	197.216	197.149	197.080	197.008	196.932	196.854	196.773	196.692	196.611	196.530	196.449	196.368	196.287	196.206	196.125	196.044	195.963	195.882	195.801	195.720	195.639	195.558	195.477	195.396	195.315	195.234
K LEFT	197.191	197.126	197.060	196.992	196.920	196.846	196.768	196.689	196.608	196.527	196.446	196.365	196.284	196.203	196.122	196.041	195.960	195.879	195.798	195.717	195.636	195.555	195.474	195.393	195.312	195.231	195.150
L RIGHT	197.181	197.116	197.050	196.981	196.910	196.836	196.758	196.678	196.598	196.517	196.436	196.355	196.274	196.193	196.112	196.031	195.950	195.869	195.788	195.707	195.626	195.545	195.464	195.383	195.302	195.221	195.140
M LEFT	197.091	197.026	196.961	196.894	196.823	196.749	196.673	196.594	196.515	196.436	196.357	196.278	196.199	196.120	196.041	195.962	195.883	195.804	195.725	195.646	195.567	195.488	195.409	195.330	195.251	195.172	195.093
N FASCIA	197.024	196.959	196.894	196.827	196.756	196.683	196.606	196.527	196.448	196.369	196.290	196.211	196.132	196.053	195.974	195.895	195.816	195.737	195.658	195.579	195.500	195.421	195.342	195.263	195.184	195.105	195.026

SCREED ELEVATIONS

LEFT	197.652	197.580	197.507	197.434	197.357	197.279	197.197	197.114	197.031	197.021	196.960	196.898	196.835	196.769	196.701	196.630	196.558	196.485	196.479	196.430	196.382	196.333	196.283	196.231	196.178	196.124	196.071
RIGHT	197.295	197.229	197.163	197.095	197.024	196.951	196.875	196.798	196.721	196.712	196.656	196.600	196.542	196.482	196.419	196.355	196.288	196.221	196.215	196.172	196.129	196.085	196.039	195.993	195.945	195.896	195.848

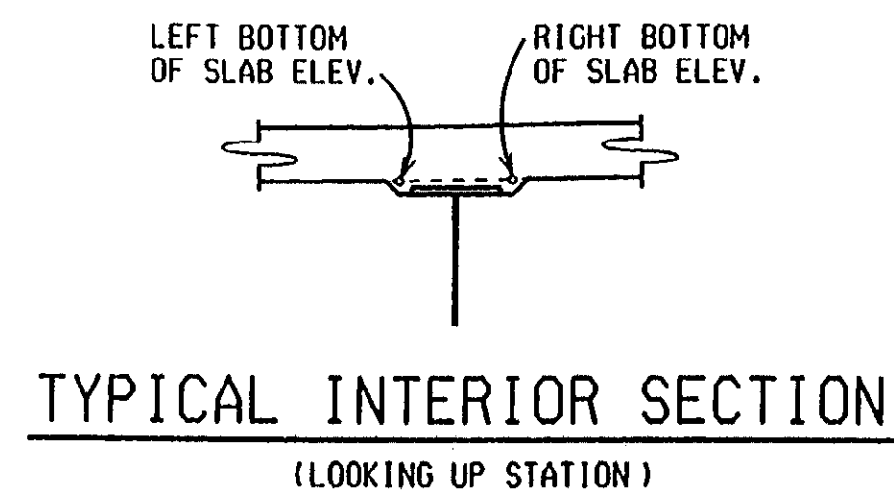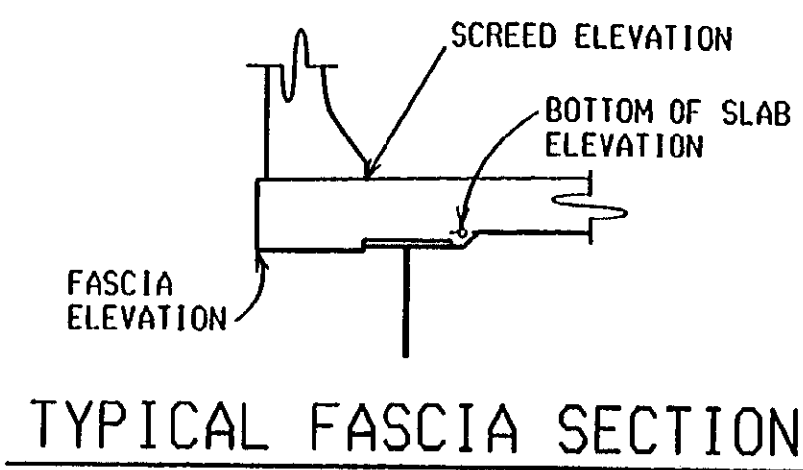

BULKHEAD ELEVATIONS

	ABUT. A	ABUT. B
A	197.652	197.025
B	197.640	197.020
C	197.628	197.015
D	197.617	197.011
E	197.521	196.923
F	197.419	196.828
G	197.319	196.735



SLAB AND SCREED DATA - SB STRUCTURE				
DATE	CONT. SEC.	JOB NO.	DESIGN UNIT	SHEET
1-9-01	B02 OF 63174	495954	MAHDAVI	14 OF 15

SCREED ELEVATIONS ARE BASED ON THE CONDITION THAT NO SLAB CONCRETE HAS BEEN CAST AND THAT FORMWORK AND STEEL REINFORCEMENT ARE IN PLACE AND THE TEMPORARY SUPPORTS ARE BROUGHT TO A SNUG FIT UNDER EACH BEAM.

THE TRANSVERSE FINISHING SHALL BE PARALLEL TO REFERENCE LINES.



SECTIONS FOR BOTTOM OF SLAB AND/OR SCREED ELEVATIONS ARE GIVEN ALONG BEAM CENTERLINES FROM CENTERLINE OF BEARING OR PIN & HANGER TO CENTERLINE OF BEARING OR PIN & HANGER AS APPLICABLE AT EQUAL SPACINGS.

DATE: _____ CORRECTED BY: MIKUCKI DATE: _____ CHECKED BY: MIKUCKI DATE: _____ DRAWN BY: _____ FILE NAME: 50263174-ss

1 2 3 4 5 6 7 8 9 10 11 12 13 14 15 16 17 18 19 20 21 22 23 24 25 26 27 28 29 30 31 32 33 34 35 36 37 38 39 40 41 42 43 44 45 46 47 48 49 50 51 52 53 54 55 56 57 58 59 60 61 62 63




BENCH MARKS
 B.M. #65 E. 636.862 M.S.N.D. B.M. Peg in Roof of 18' x 12' 209' LI. of 205123 N-B Rdwy.
 B.M. #61 E. 639.789 M.S.N.D. B.M. Peg in Roof of 21' Oak 171' LI. of 207110 N-B Rdwy.

UTILITIES
 Michigan Bell Telephone 53' south & Parallel to 13 Mile Road.
 Detroit Edison runs parallel with and 192' North of E. of 13 Mile Road (3 Wires)
 Consumers Power Co. 24" H.P. Gas Main running East & West 12' South of & parallel to 13 Mile Rd. and crossing @ Sta. 77+00
 12" Water Main running East & West 44' North of and parallel to 13 Mile Road.
 Detroit Edison Co. Future 120 KV Pipe Lines 25' N. & S. of E. of 13 Mile Road.

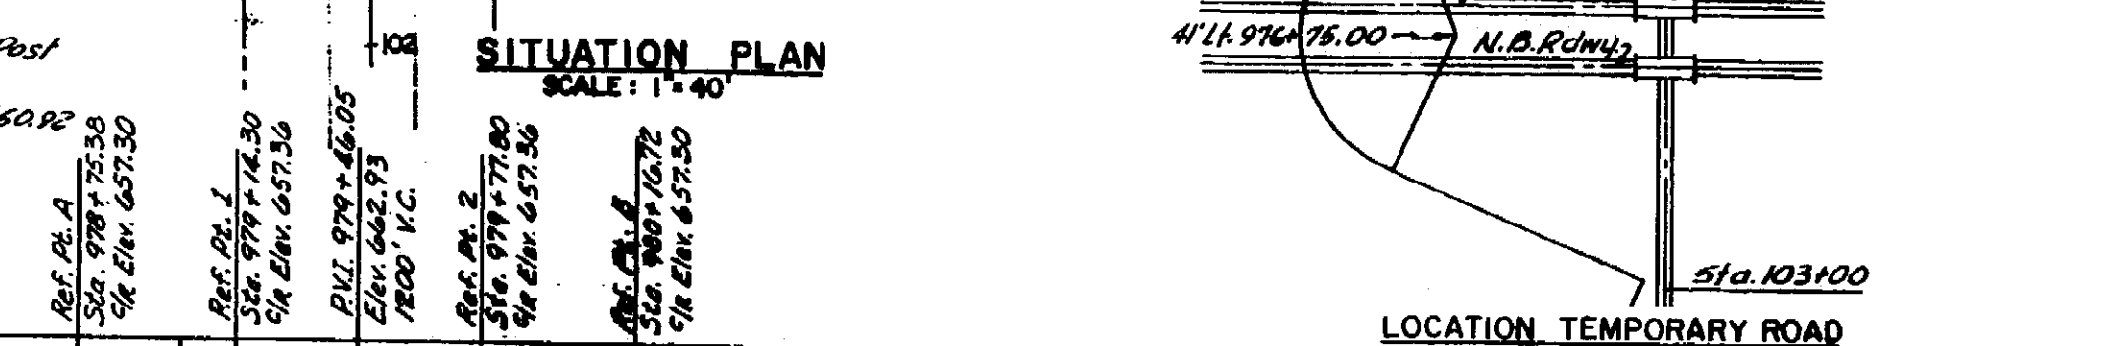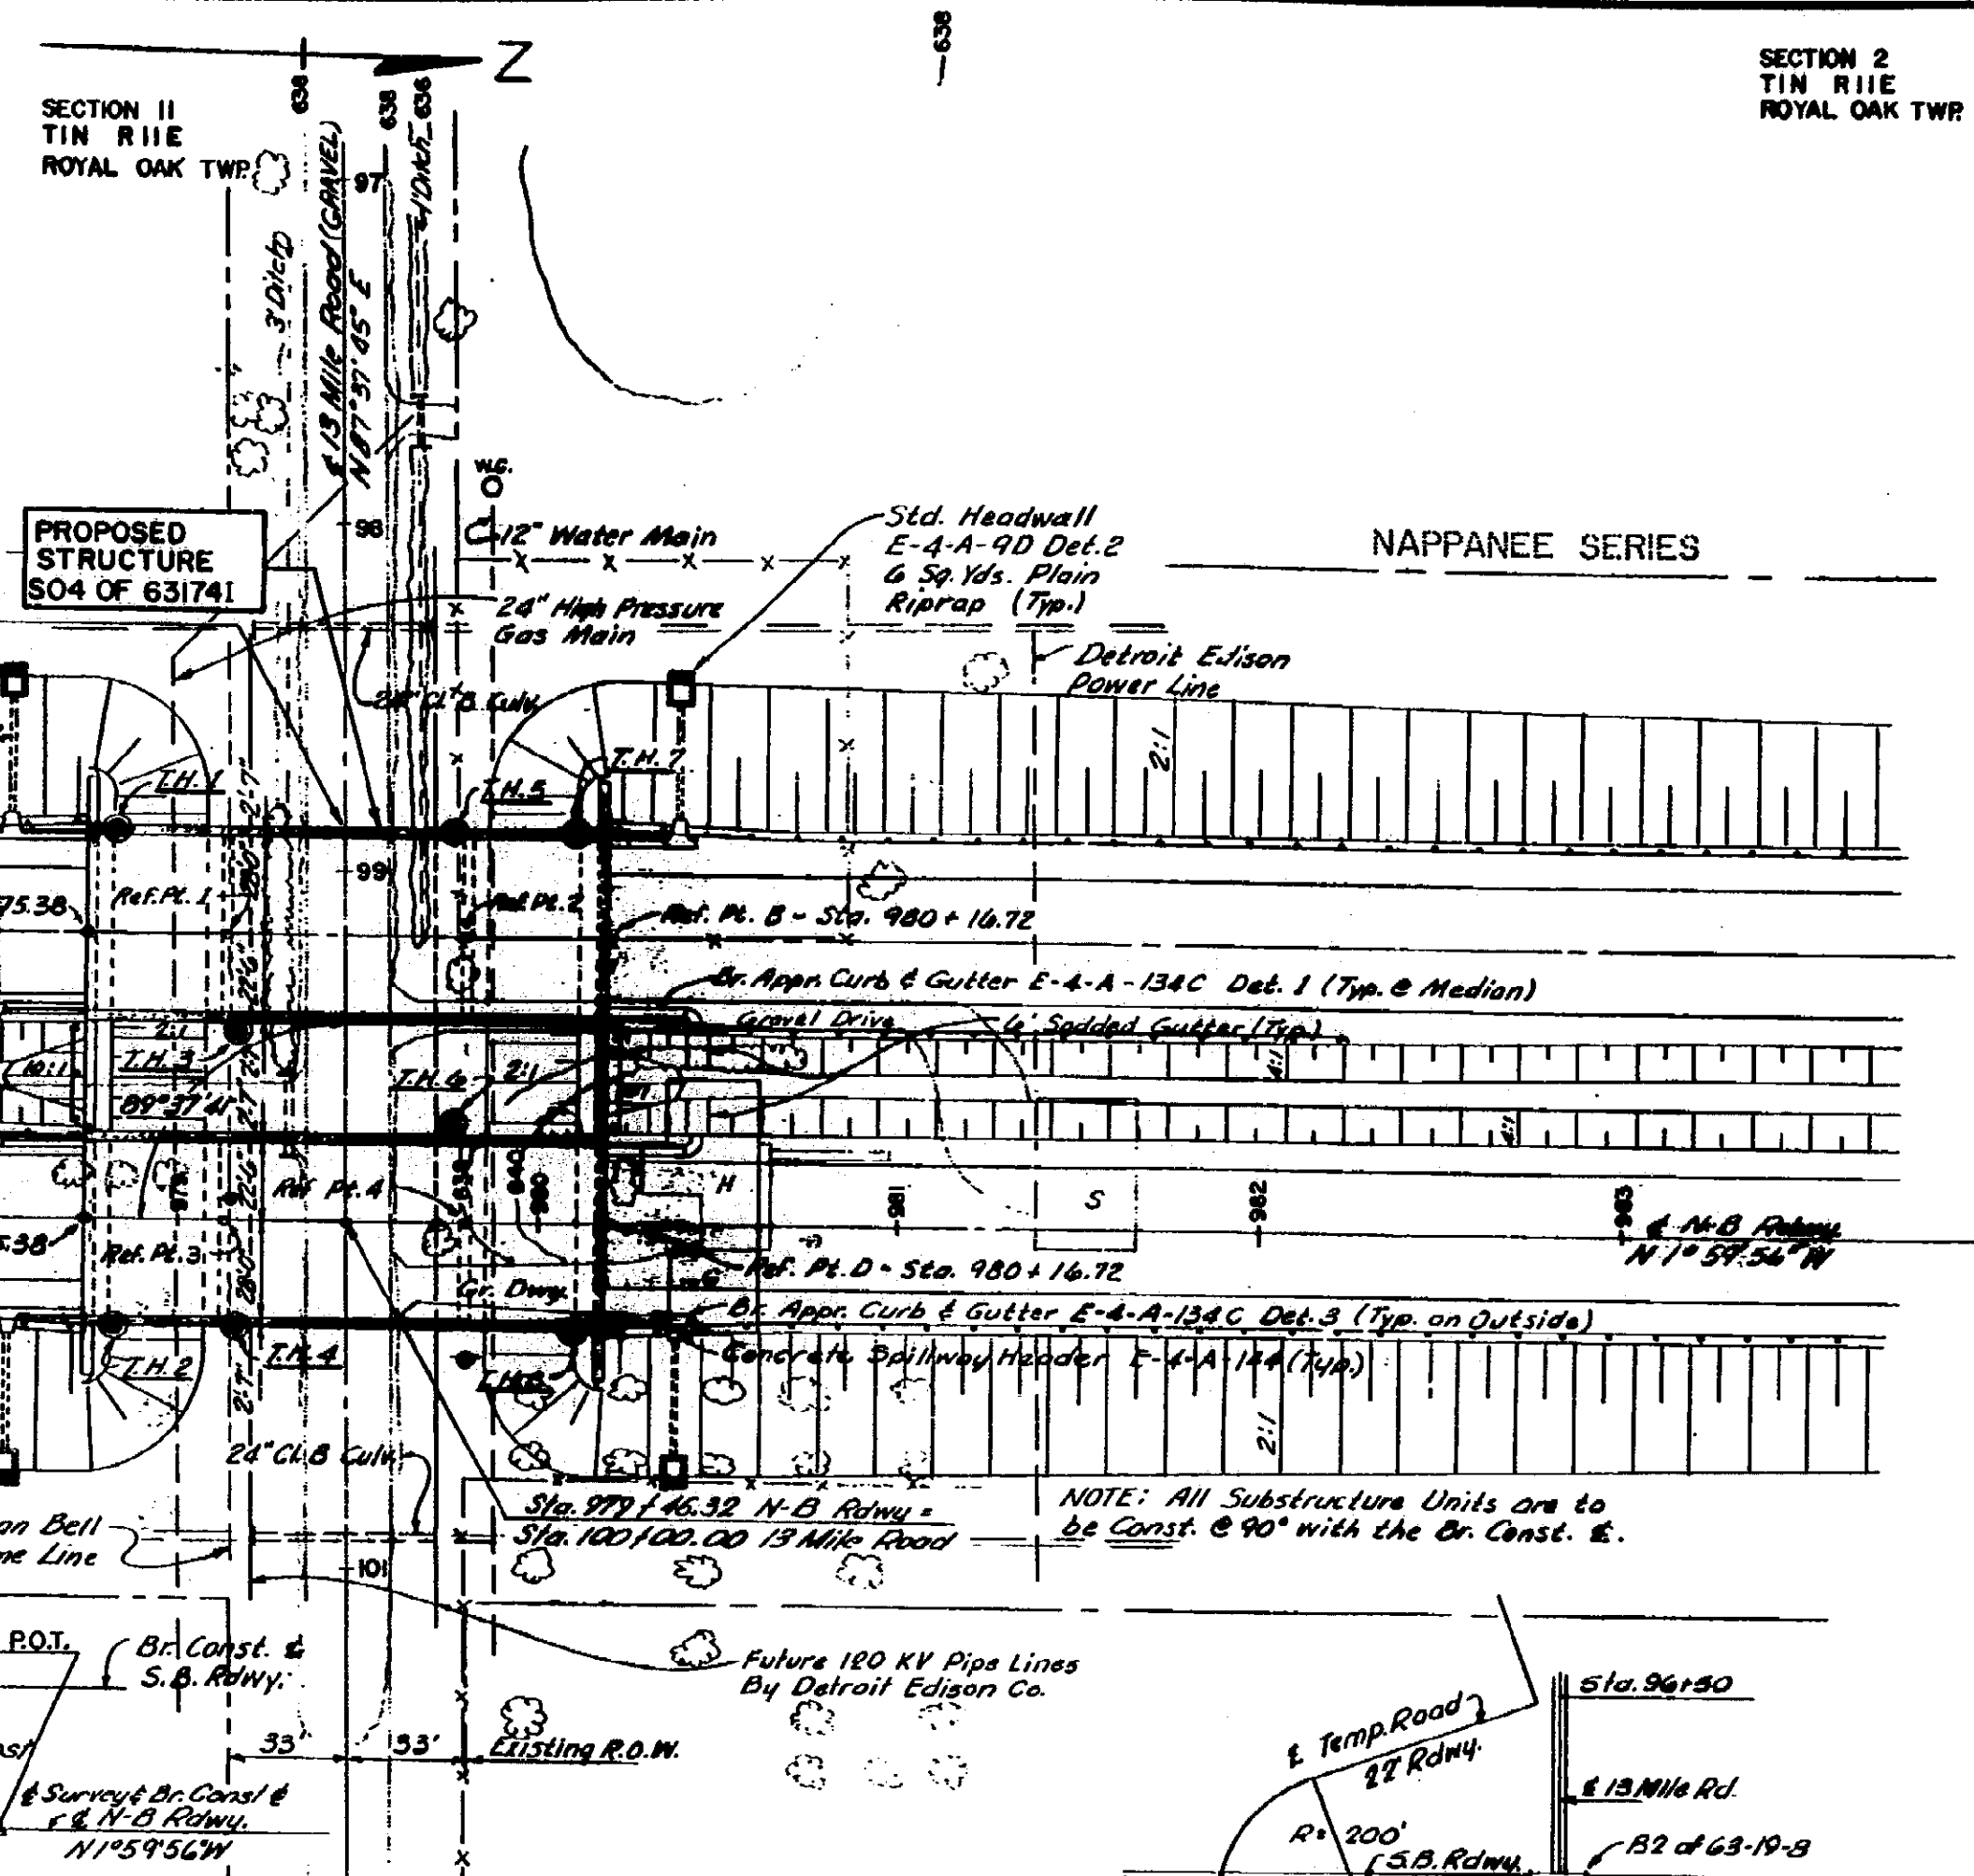


WITNESSES AND ALIGNMENT SKETCH

Station	Witness	Remarks
Sta. 97+45.01	Bootspike	Witnesses to POT
Sta. 98+75.1	Bootspike	Witnesses to POT
Sta. 99+41.31.22	Bootspike	Witnesses to POT
Sta. 100+00.00	Bootspike	Witnesses to POT
Sta. 101+00.00	Bootspike	Witnesses to POT
Sta. 102+00.00	Bootspike	Witnesses to POT
Sta. 103+00.00	Bootspike	Witnesses to POT
Sta. 104+00.00	Bootspike	Witnesses to POT
Sta. 105+00.00	Bootspike	Witnesses to POT
Sta. 106+00.00	Bootspike	Witnesses to POT
Sta. 107+00.00	Bootspike	Witnesses to POT
Sta. 108+00.00	Bootspike	Witnesses to POT
Sta. 109+00.00	Bootspike	Witnesses to POT
Sta. 110+00.00	Bootspike	Witnesses to POT

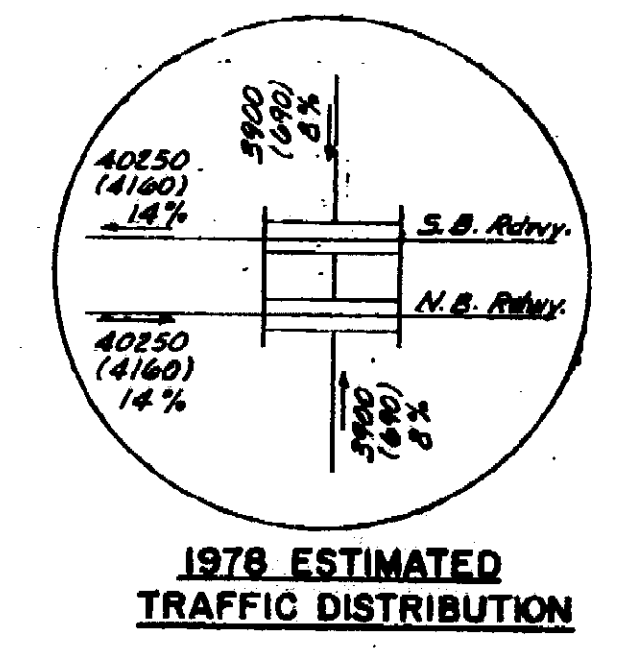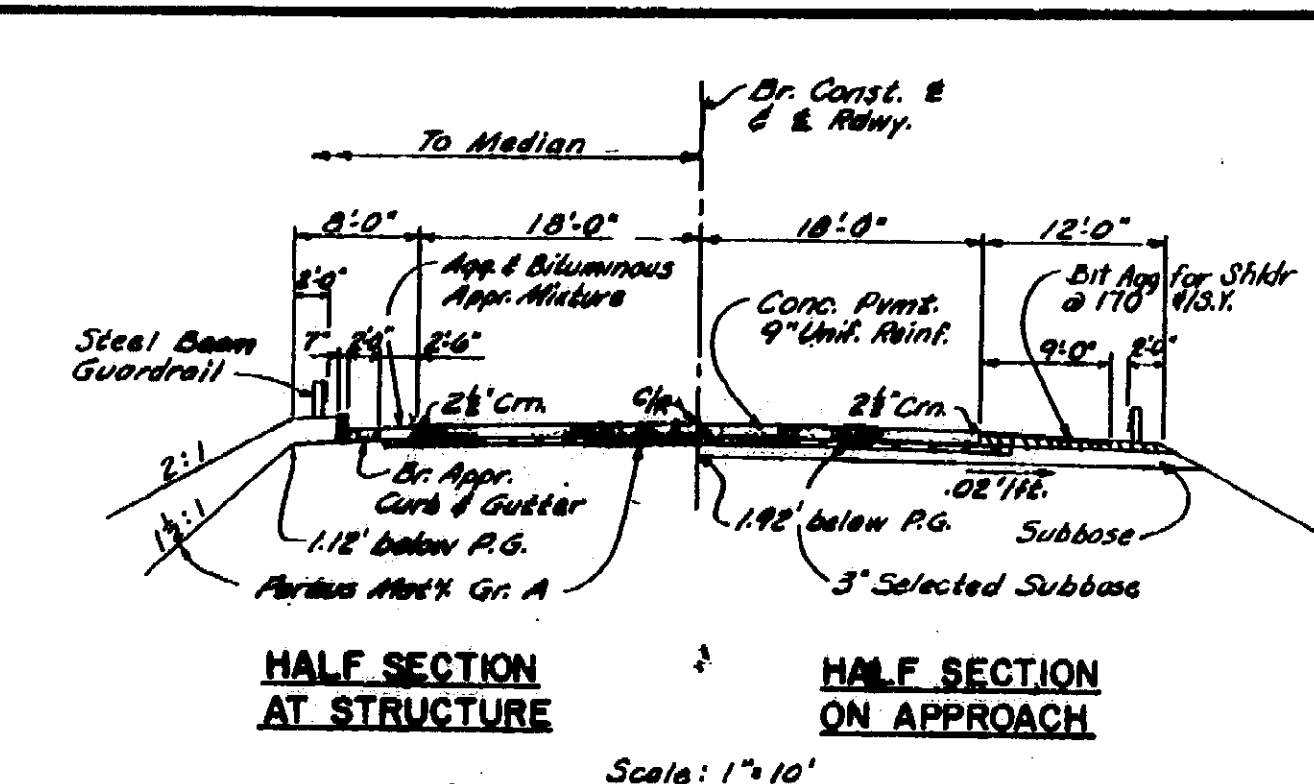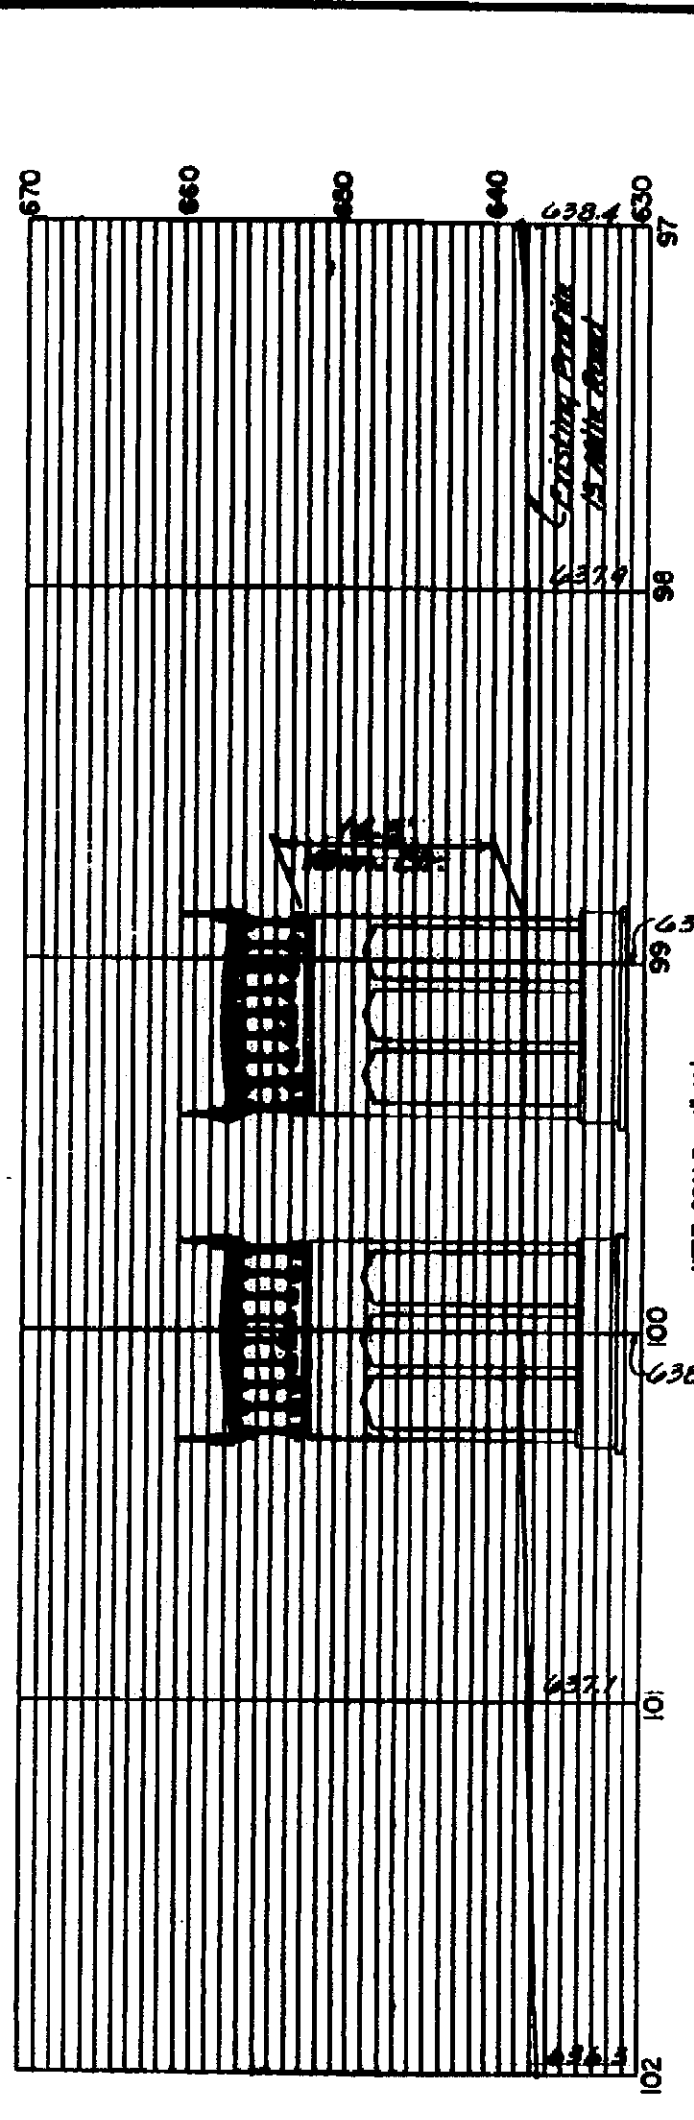

LEGEND
 000 - Average Daily Traffic
 (00) - Design Hourly Volume
 00% - % Commercial

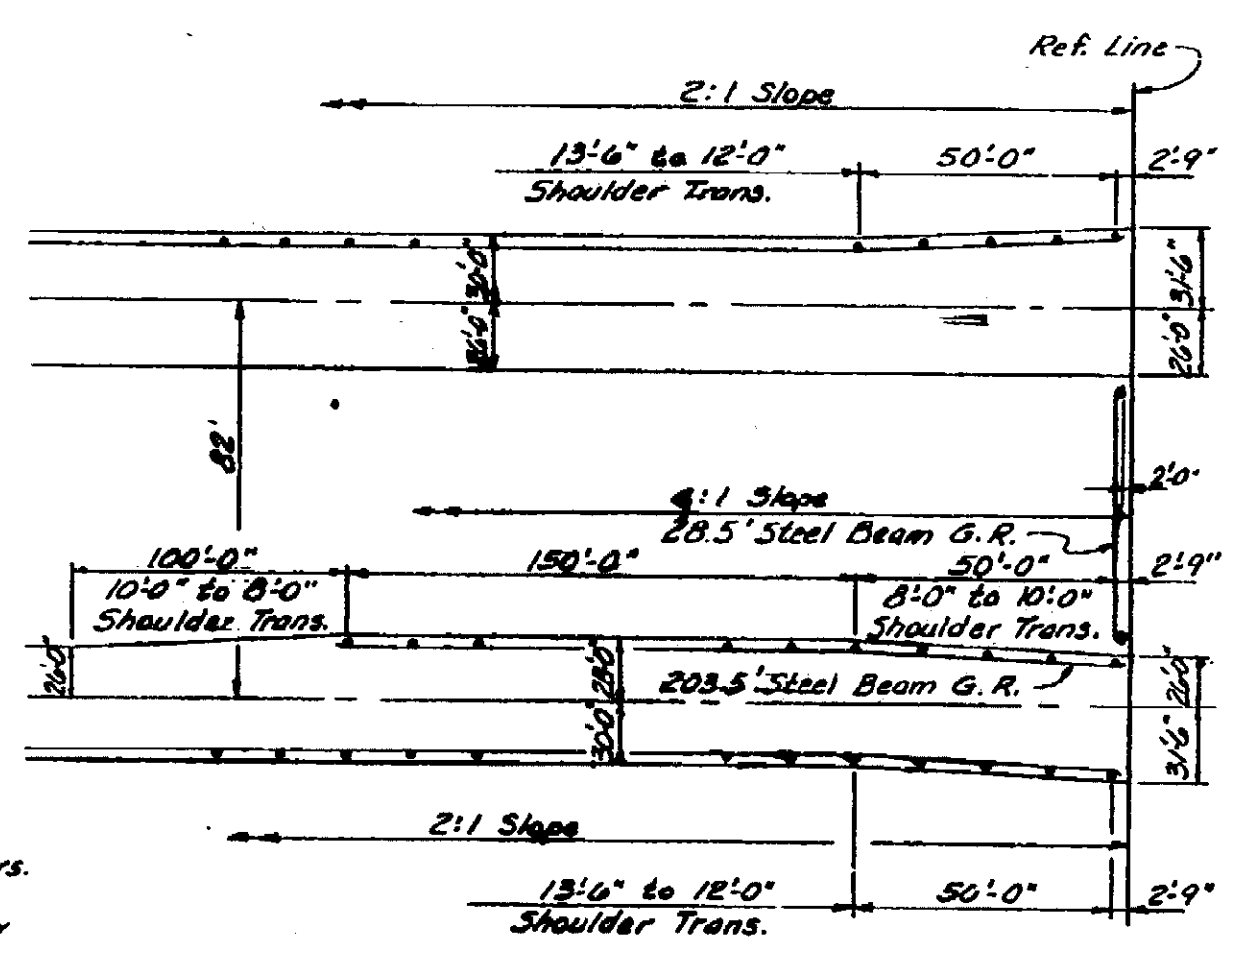

GENERAL NOTES
 Fences and utilities are to be moved by others. Buildings are to be removed by others. Traffic is to be maintained over the temporary road.
 Top soil or suitable material under abutments shall be removed and backfilled with suitable granular material.
 Piers 1, 2, 3 & 4 shall be constructed and backfilled prior to placing the abutment fills.
 The work covered by these plans includes construction of the proposed bridge, placing porous material and placing slope protection Class A to the limits shown.
 Datum refers to U.S.G.S. datum.

MICHIGAN STATE HIGHWAY DEPARTMENT
 I-75 OVER 13 MILE ROAD IN THE CITY OF MADISON HEIGHTS
 GENERAL PLAN OF SITE

TECON ENGINEERS, INC.
 APPROVED: [Signature] 6-5-02
 ENGINEER OF RECORD - CONSULTANT

DATE: 6-5-02
 DRAWN BY: [Signature]
 CHECKED BY: [Signature]
 SCALE: 20' = 1" (1/8" = 1')

S04 OF 63174 I


NOTE:
 DO NOT WORK FROM THIS SHEET. THE INFORMATION SHOWN HERE IS FOR REFERENCE ONLY. NO PAY ITEMS ARE SHOWN.



DATE	CONT. SEC.	JOB NO.	DESIGN UNIT	SHEET
1-9-01	S04 OF 63174	49595A	MAHDAVI	2 OF 16


REVISIONS: NO. DESCRIPTION DATE BY
 DATE: 04-12-00
 CHECKED BY:
 CORRECTED BY:
 DATE:
 DRAWN BY: INDER
 FILE NAME: s0462174sp.

REVISIONS			
NO.	DESCRIPTION	DATE	BY

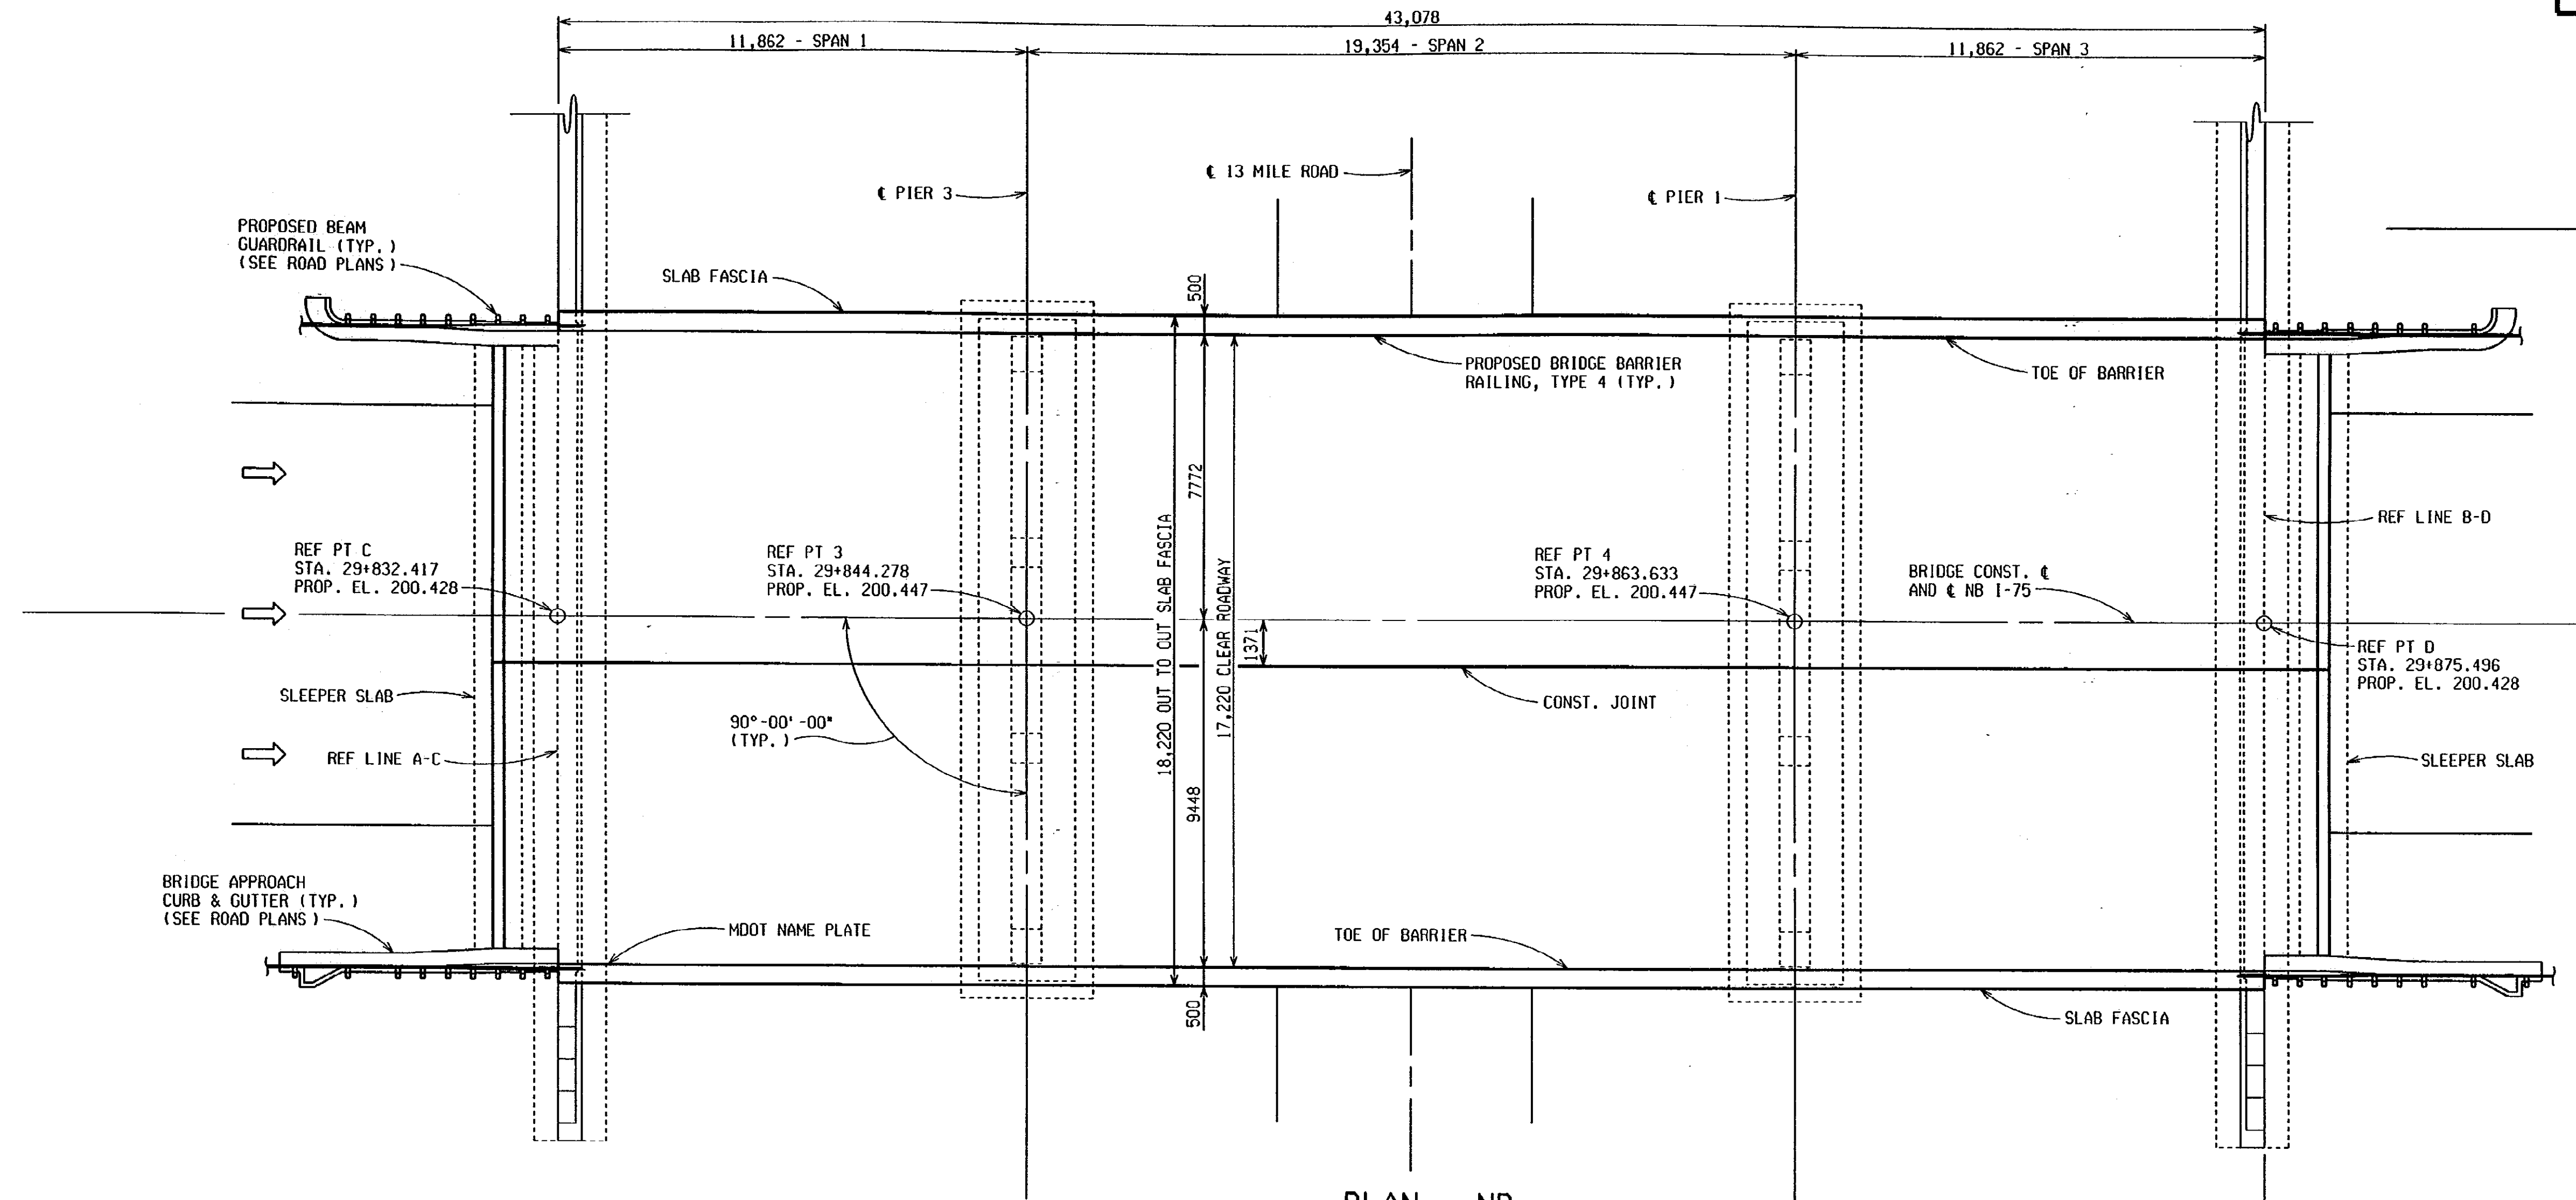

PLAN - NB

THE LIMITS OF FALSE DECKING IS FROM FACE OF ABUT. A TO FACE OF ABUT. B AND BETWEEN SLAB FASCIAS.

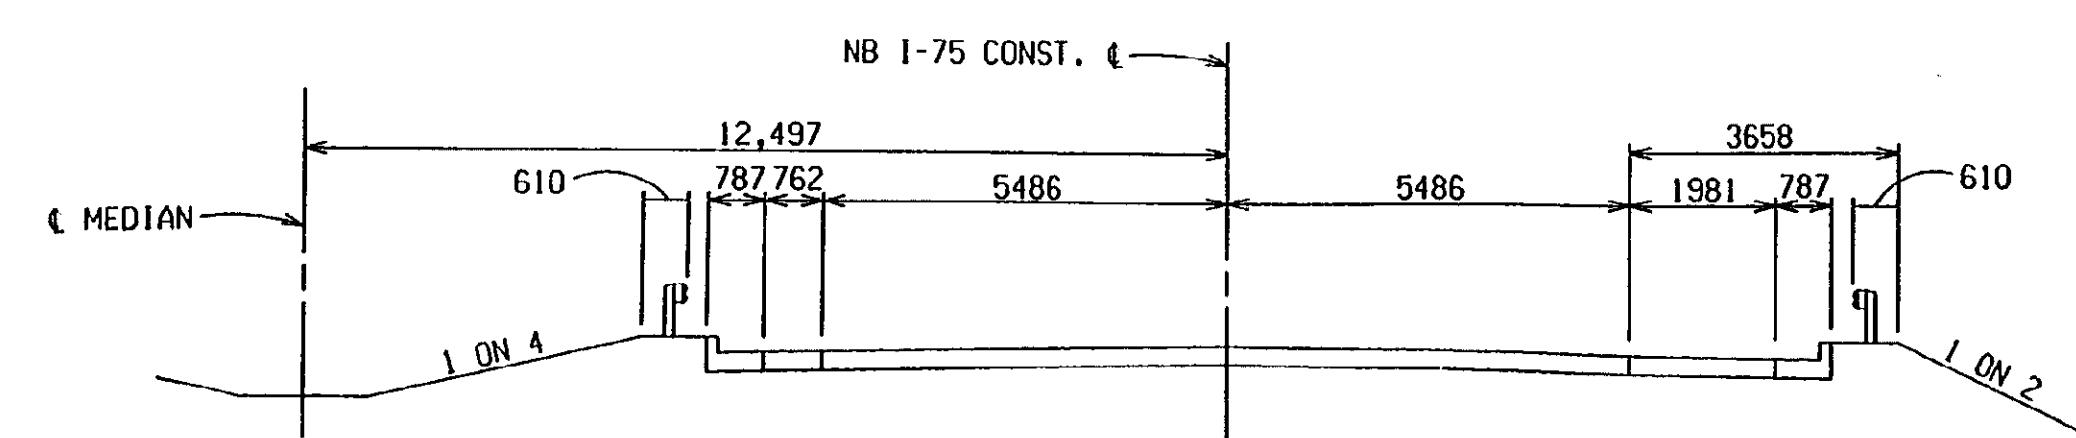

TYPICAL APPROACH SECTION (LOOKING NORTH)

MISCELLANEOUS QUANTITIES	
1 LS	Structures, Rem Portions (S04-NB)
734 m2	False Decking
1 LS	Penetrating Water Repellent Treatment (S04-NB)

NOTES:

THE WORK COVERED BY THESE PLANS INCLUDES DECK REPLACEMENT, WIDENING, SUBSTRUCTURE REPAIR, CONCRETE BEAM END REPAIR, AND MAINTAINING TRAFFIC. ALL OTHER WORK IS INCLUDED IN THE ROAD PLANS THAT ARE A PART OF THIS CONTRACT.

THE REHABILITATION DESIGN IS BASED ON CURRENT AASHTO STANDARD SPECIFICATIONS FOR HIGHWAY BRIDGES MS23. LIVE LOAD PLUS IMPACT DEFLECTION DOES NOT EXCEED 1/800 OF SPAN LENGTH. THE ALLOWABLE STRESS METHOD WAS USED FOR THIS DESIGN. THE ORIGINAL STRUCTURE WAS DESIGNED FOR HS18 LOADING.

MEASURES SHALL BE TAKEN TO PREVENT DEBRIS FROM FALLING FROM THE STRUCTURE.

THE CONTRACTOR SHALL LOCATE ALL ACTIVE UNDERGROUND UTILITIES PRIOR TO STARTING WORK AND SHALL CONDUCT HIS OPERATIONS IN SUCH A MANNER AS TO ENSURE THAT THOSE UTILITIES NOT REQUIRING RELOCATION WILL NOT BE DISTURBED.




NB I-75 TRAFFIC IS TO BE MAINTAINED OVER THE BRIDGE BY PART WIDTH CONSTRUCTION.

PENETRATING WATER REPELLANT TREATMENT SHALL BE APPLIED TO ENTIRE SURFACE OF PIERS. ESTIMATED AREA IS 272 SQUARE METERS. (SEE SPECIAL PROVISION).

GENERAL PLAN OF STRUCTURE				
NB I-75 OVER 13 MILE ROAD IN MADISON HEIGHTS.				
DATE	CONT. SEC.	JOB NO.	DESIGN UNIT	SHEET
1-9-01	S04 OF 63174	49595A	MAHDAVI	3 OF 16

APPROVED *Steven P. Beck* 1/10/01
DESIGN SUPERVISING ENGINEER



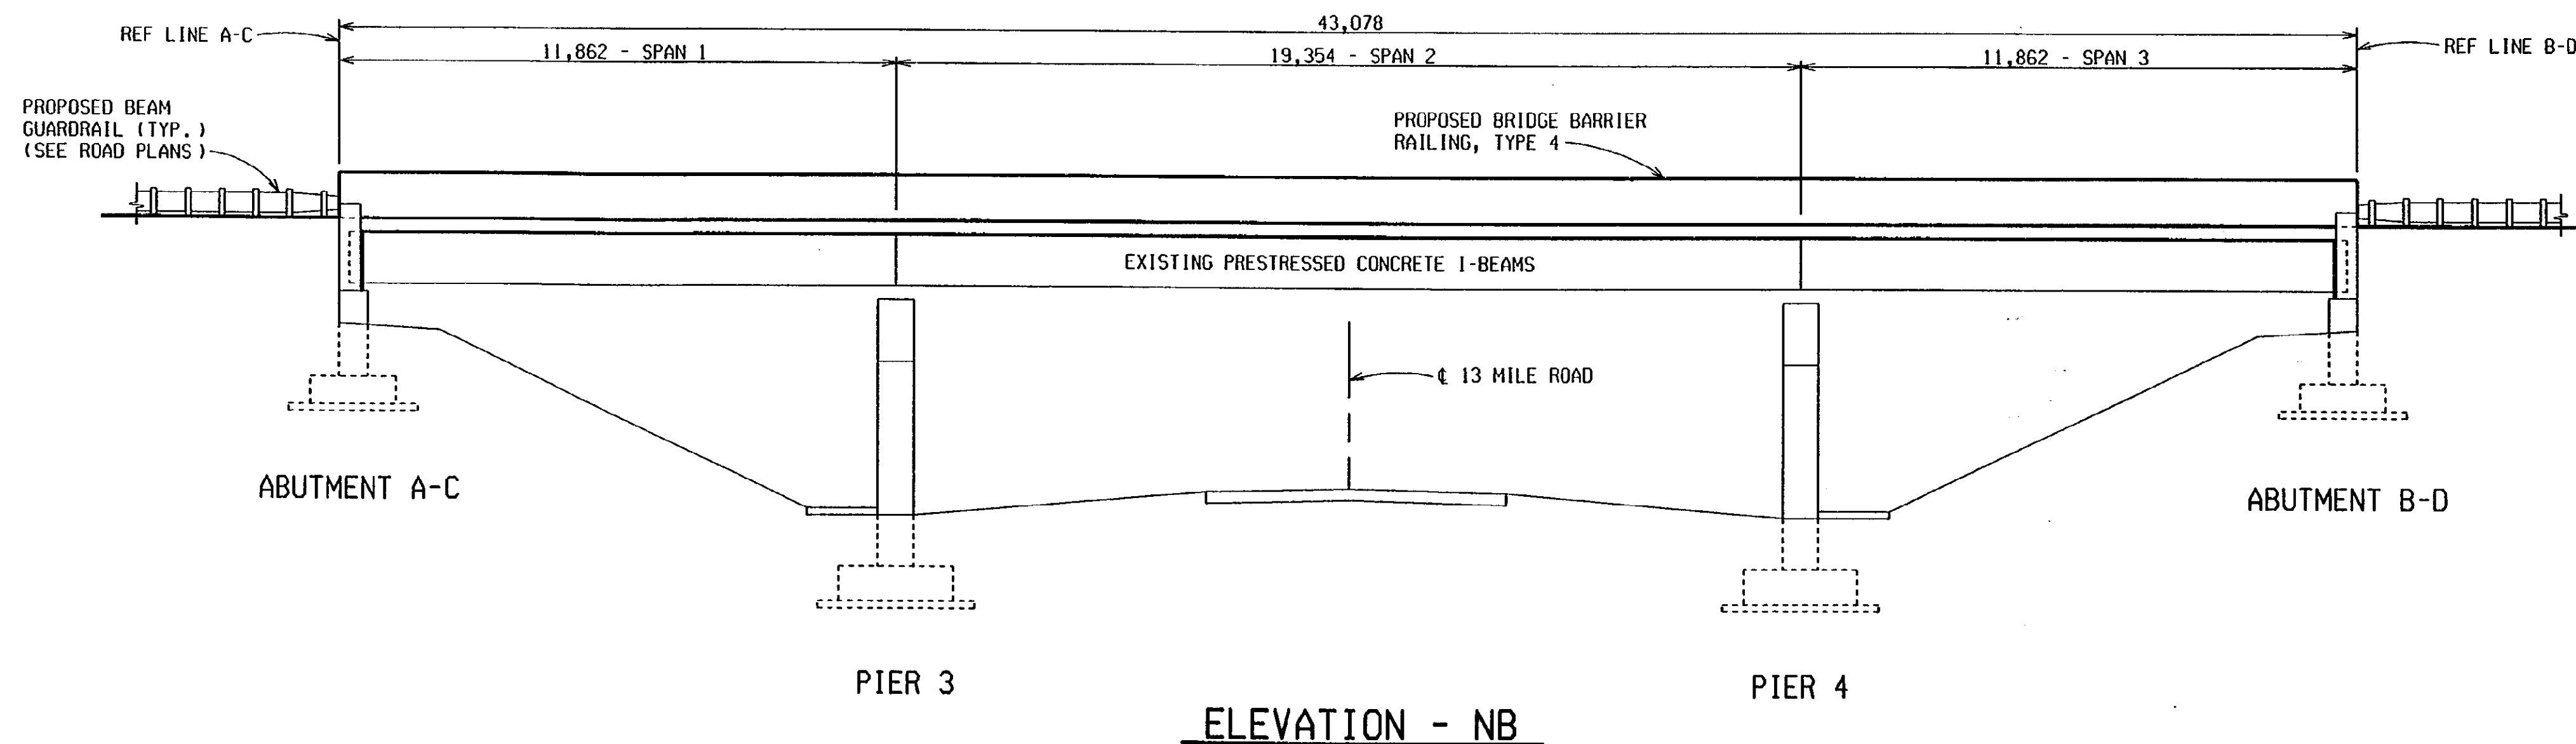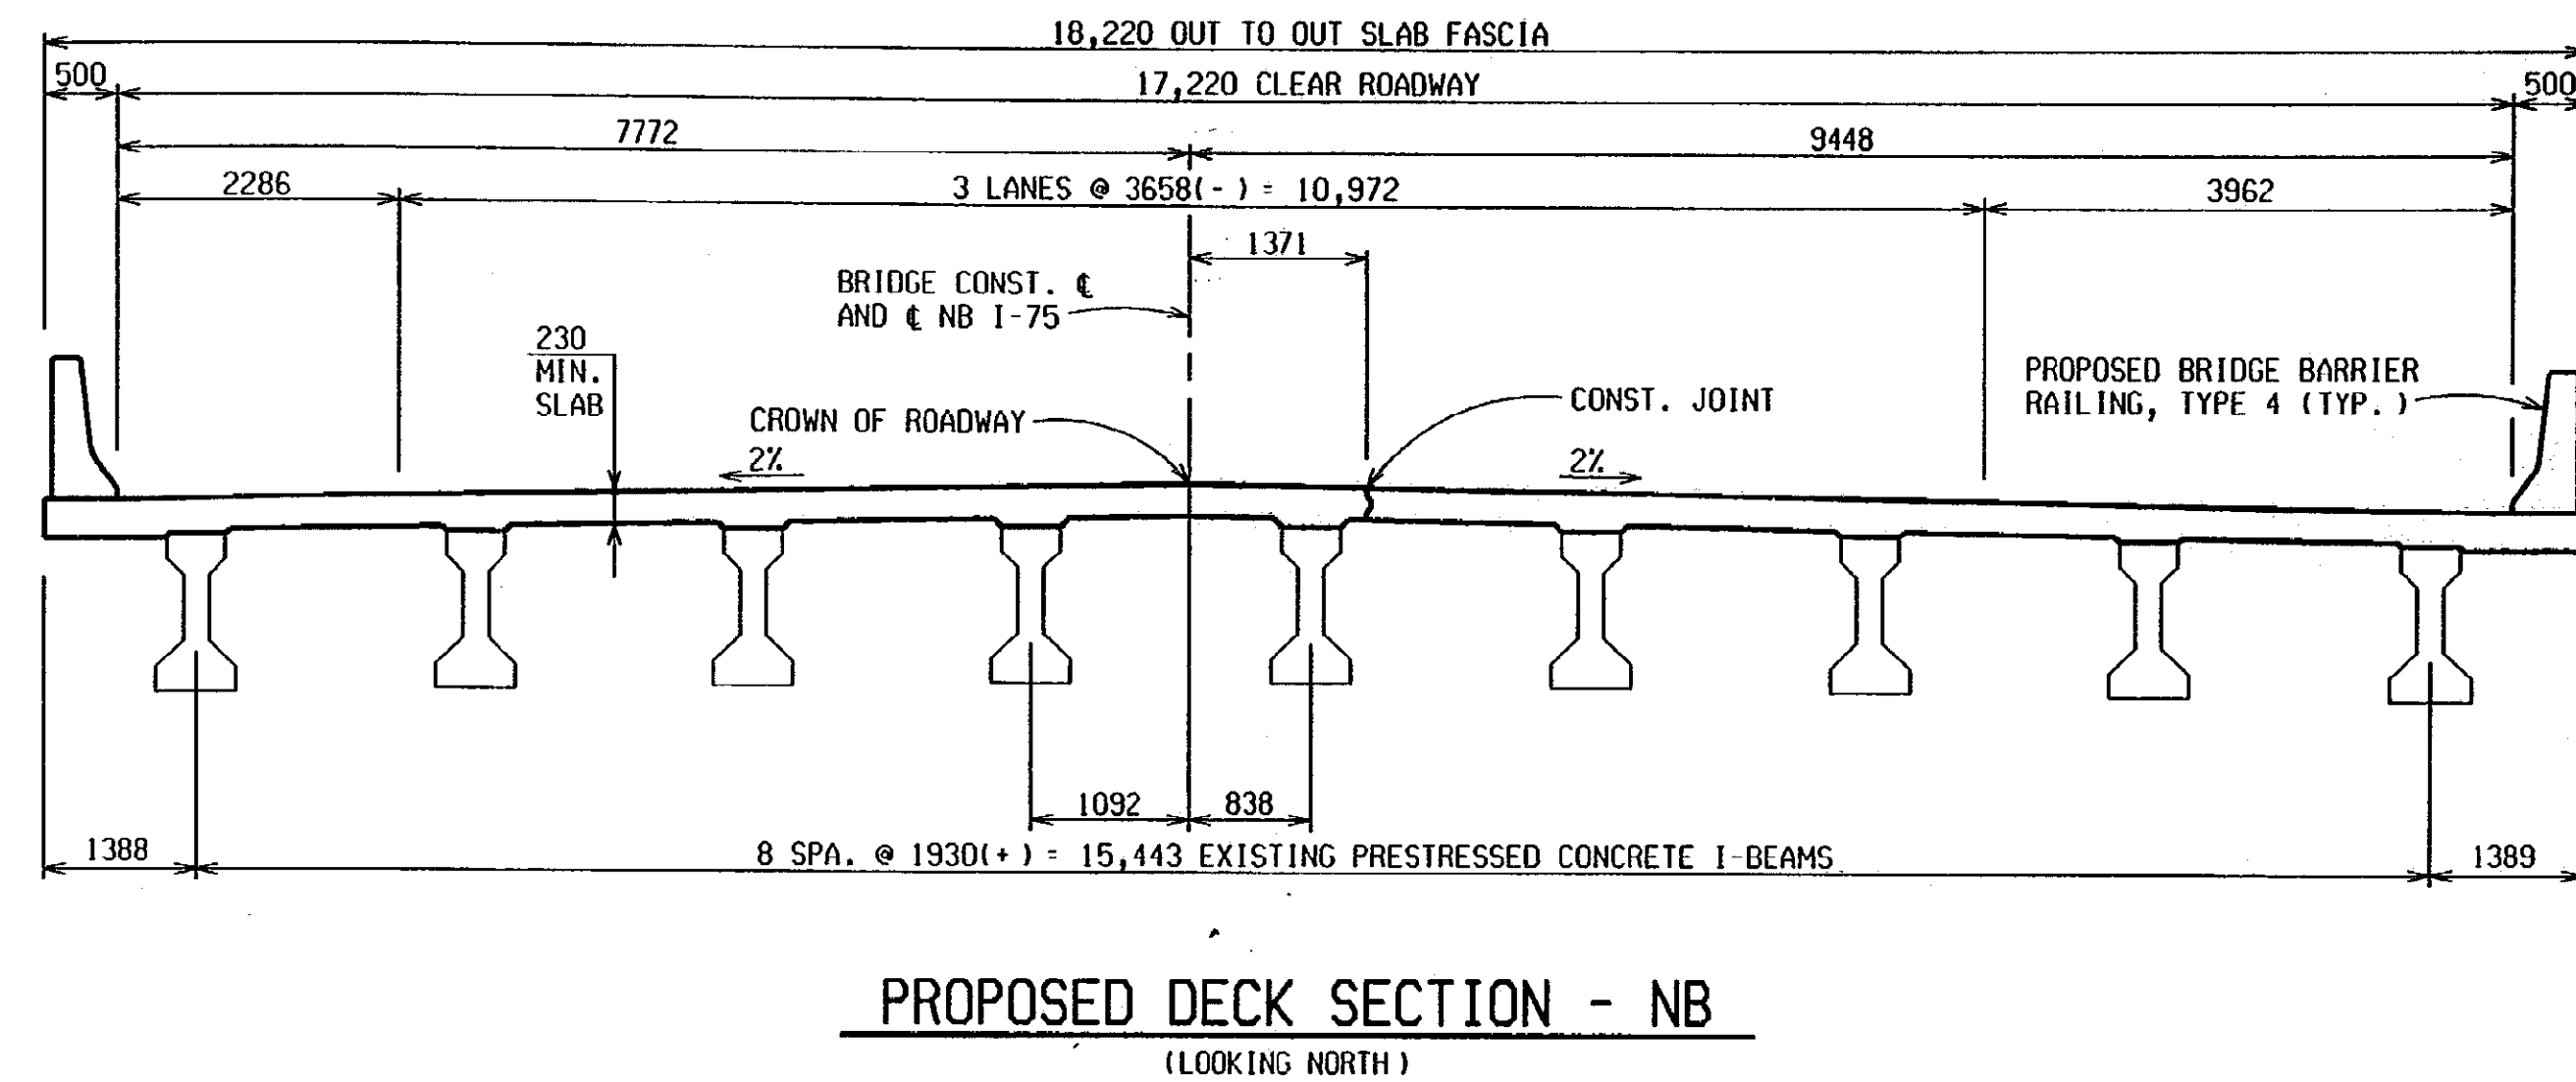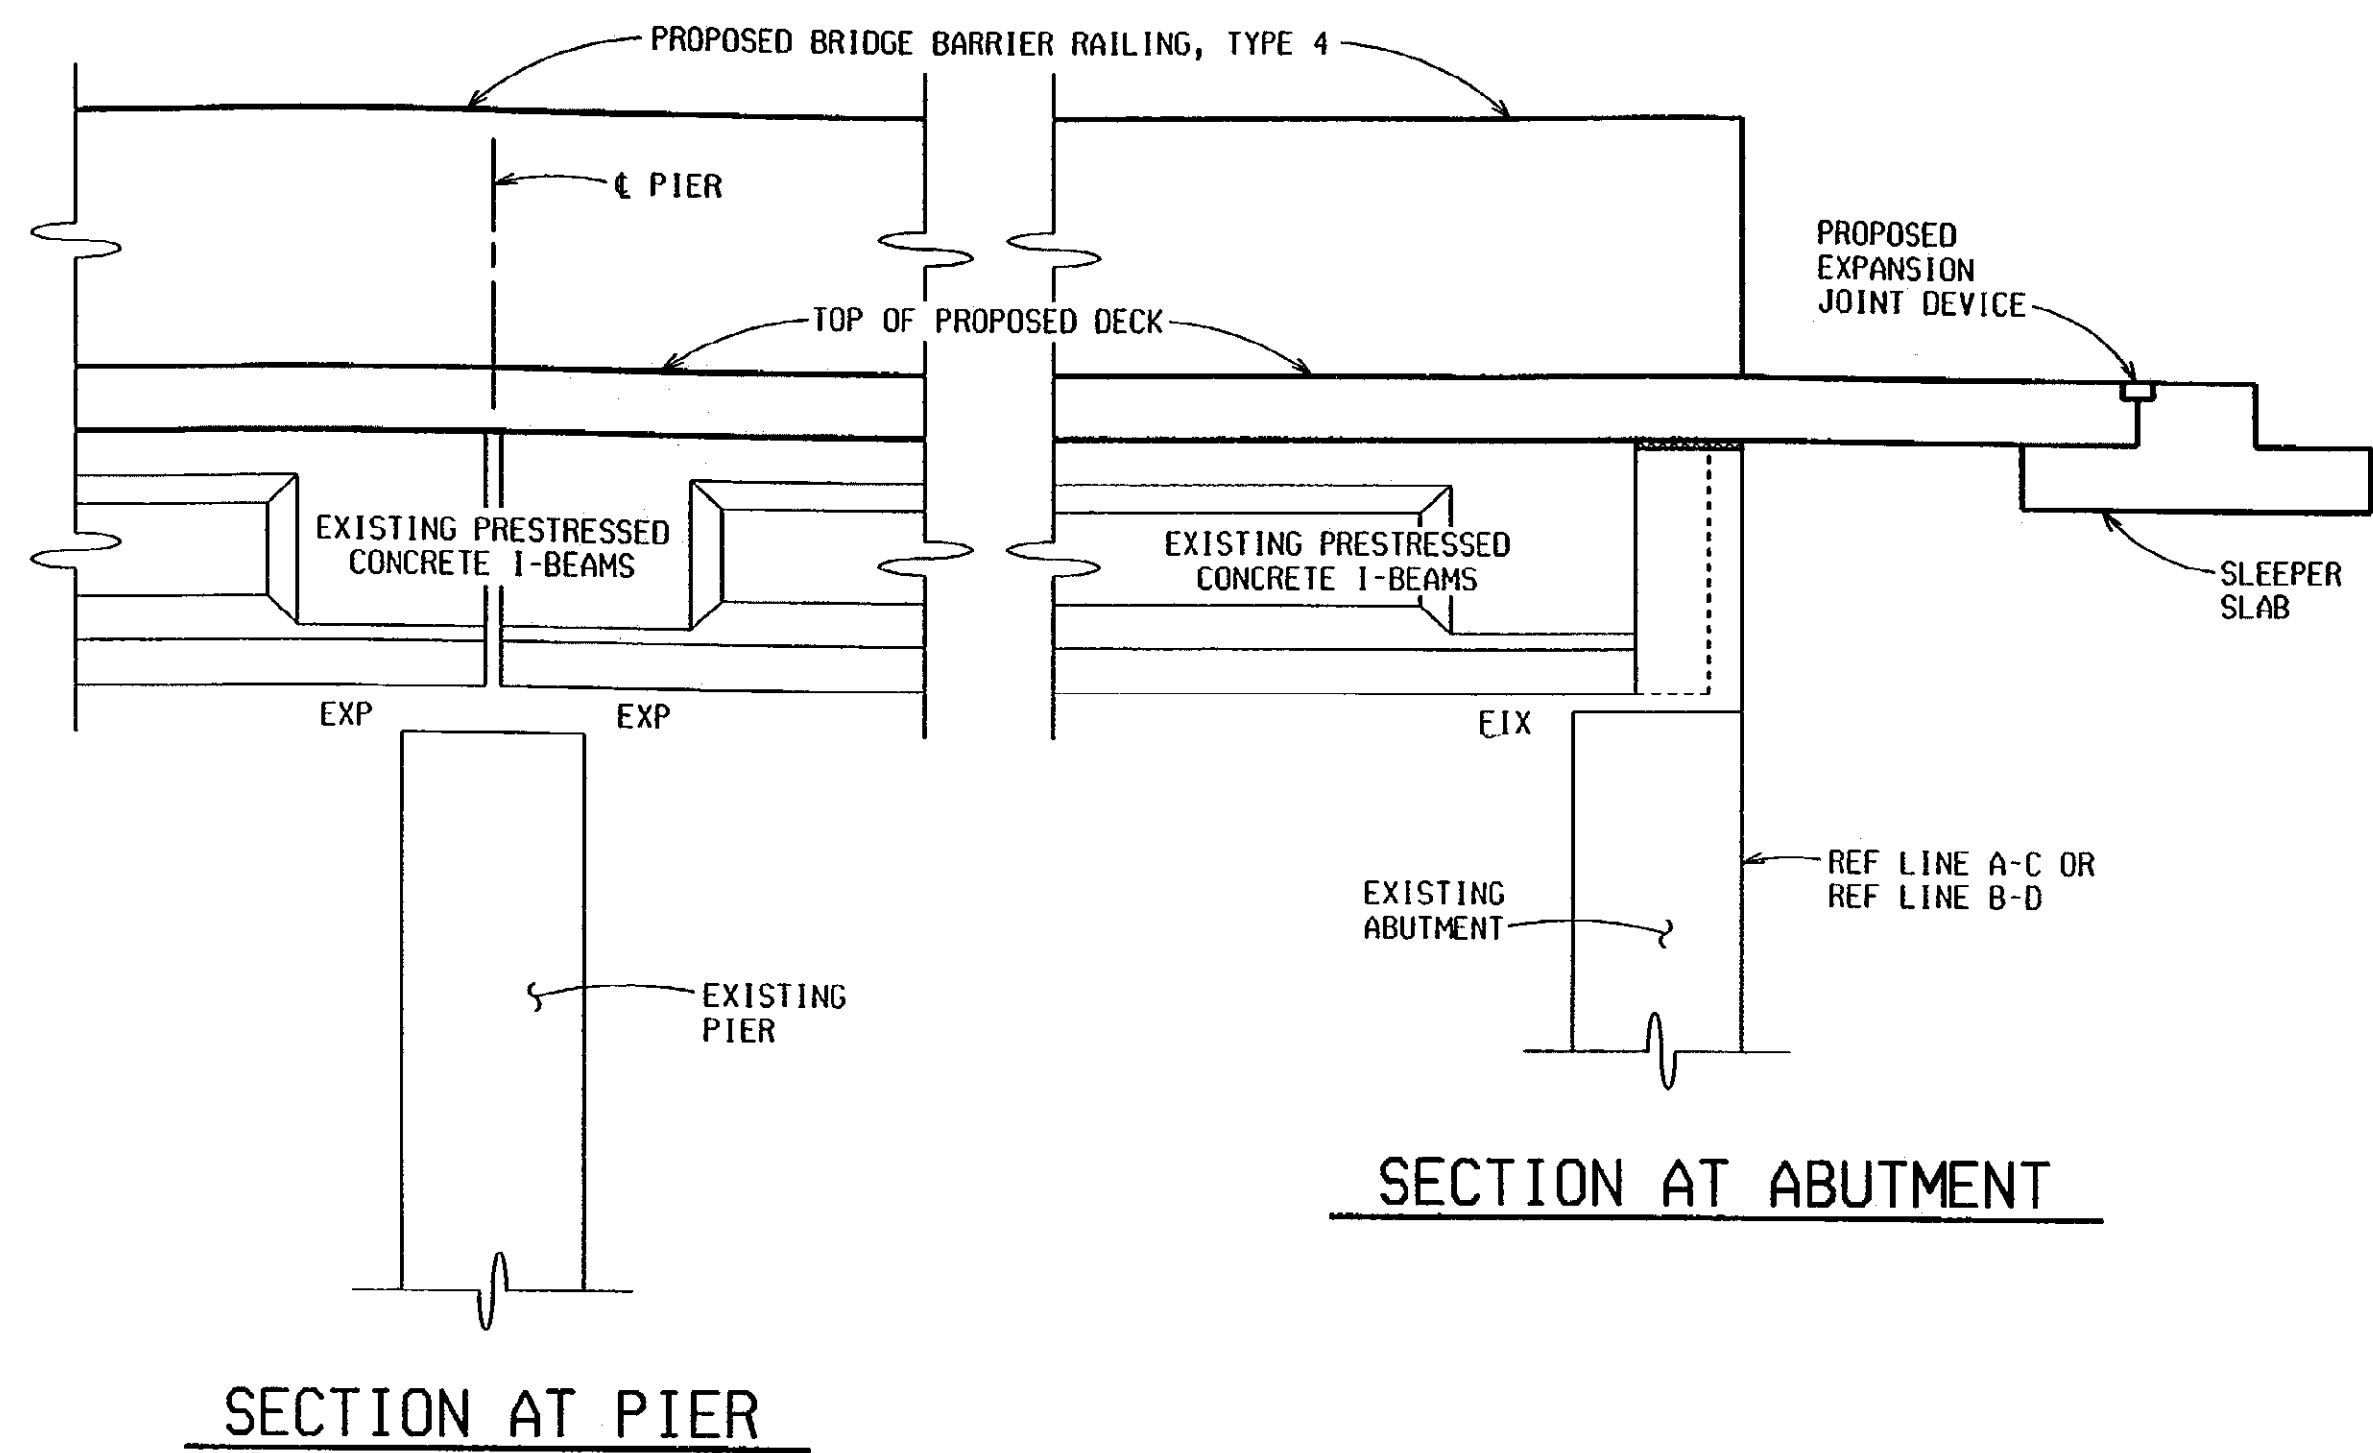


REVISIONS			
NO.	DESCRIPTION	DATE	BY

GENERAL PLAN OF STRUCTURE				
NB I-75 OVER 13 MILE ROAD IN MADISON HEIGHTS.				
DATE	CONT. SEC.	JOB NO.	DESIGN UNIT	SHEET
1-9-01	S04 OF 63174	49595A	MAHDAVI	4 OF 16


APPROVED *Stuart P. Beck* / *Uta*
DESIGN SUPERVISING ENGINEER




FILE NAME: s0463174n.st
DRAWN BY: R. PRATT
CHECKED BY:
DATE: 4-12-00
CORRECTED BY: R. PRATT
DATE: 11-6-00

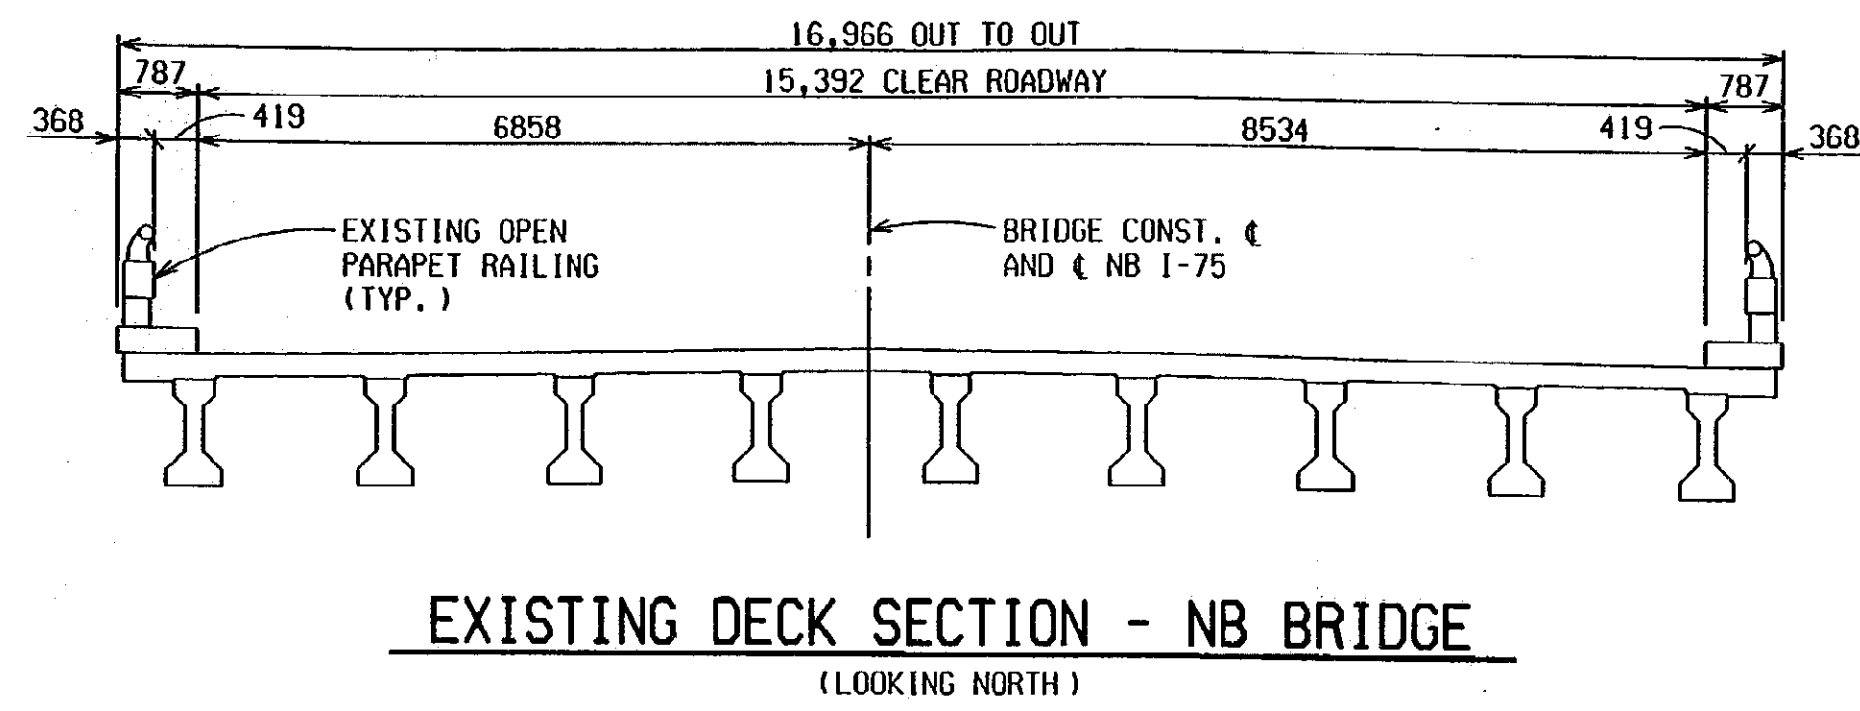

EXISTING DECK SECTION - NB BRIDGE
(LOOKING NORTH)

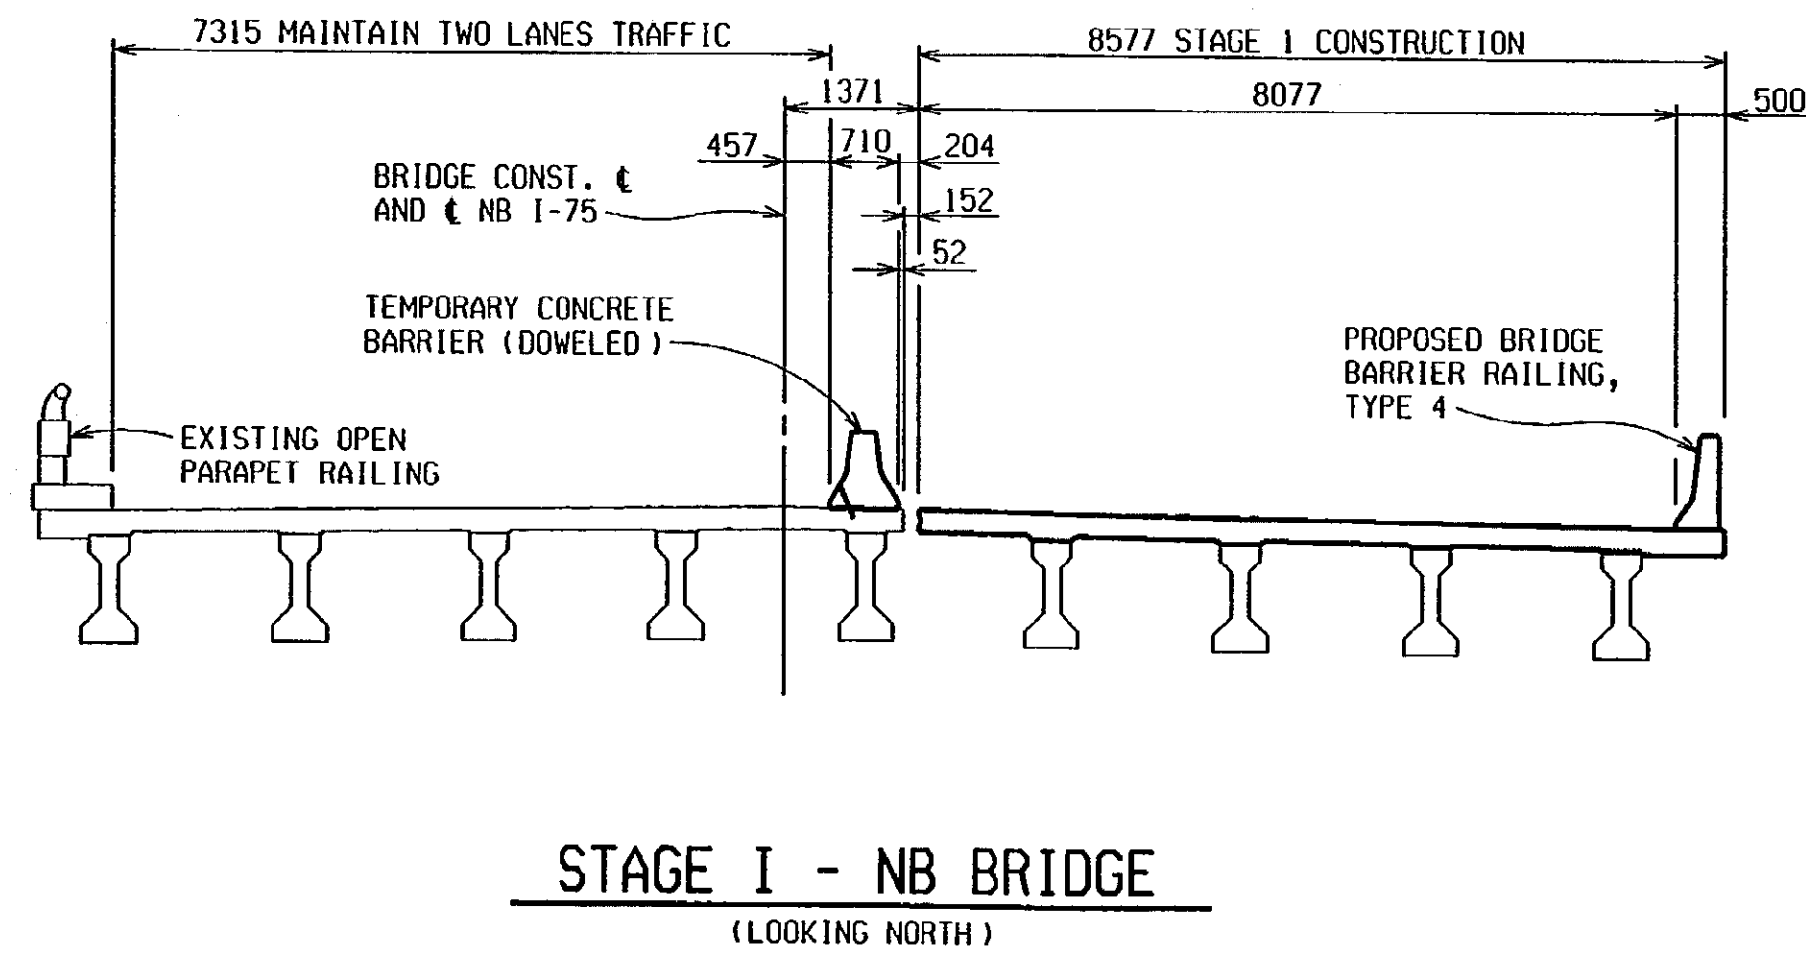


STAGE I - NB BRIDGE
(LOOKING NORTH)

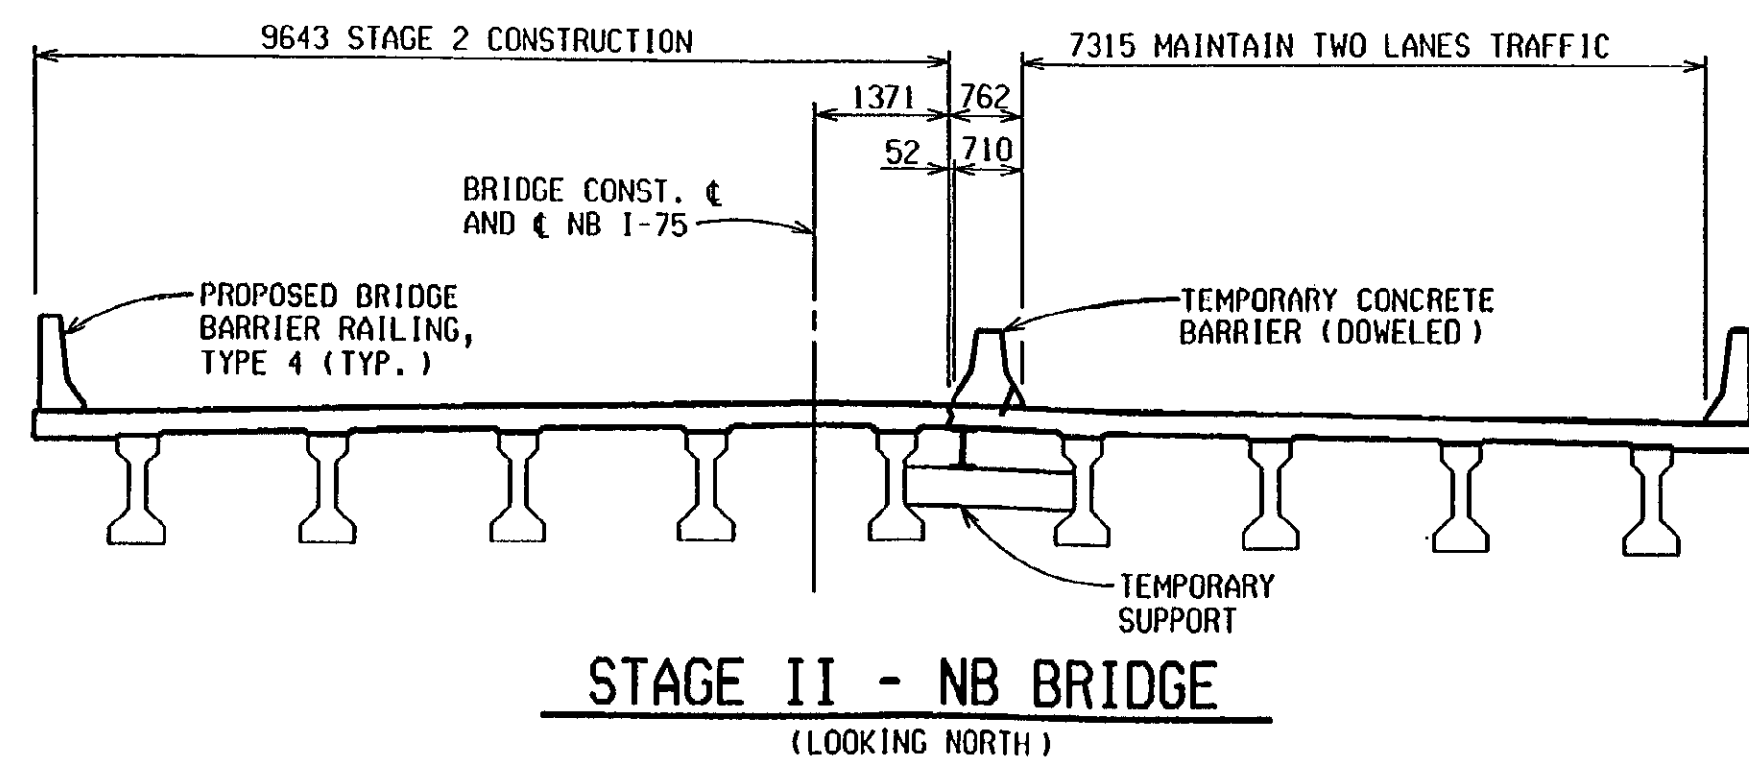


STAGE II - NB BRIDGE
(LOOKING NORTH)

REVISIONS			
NO.	DESCRIPTION	DATE	BY

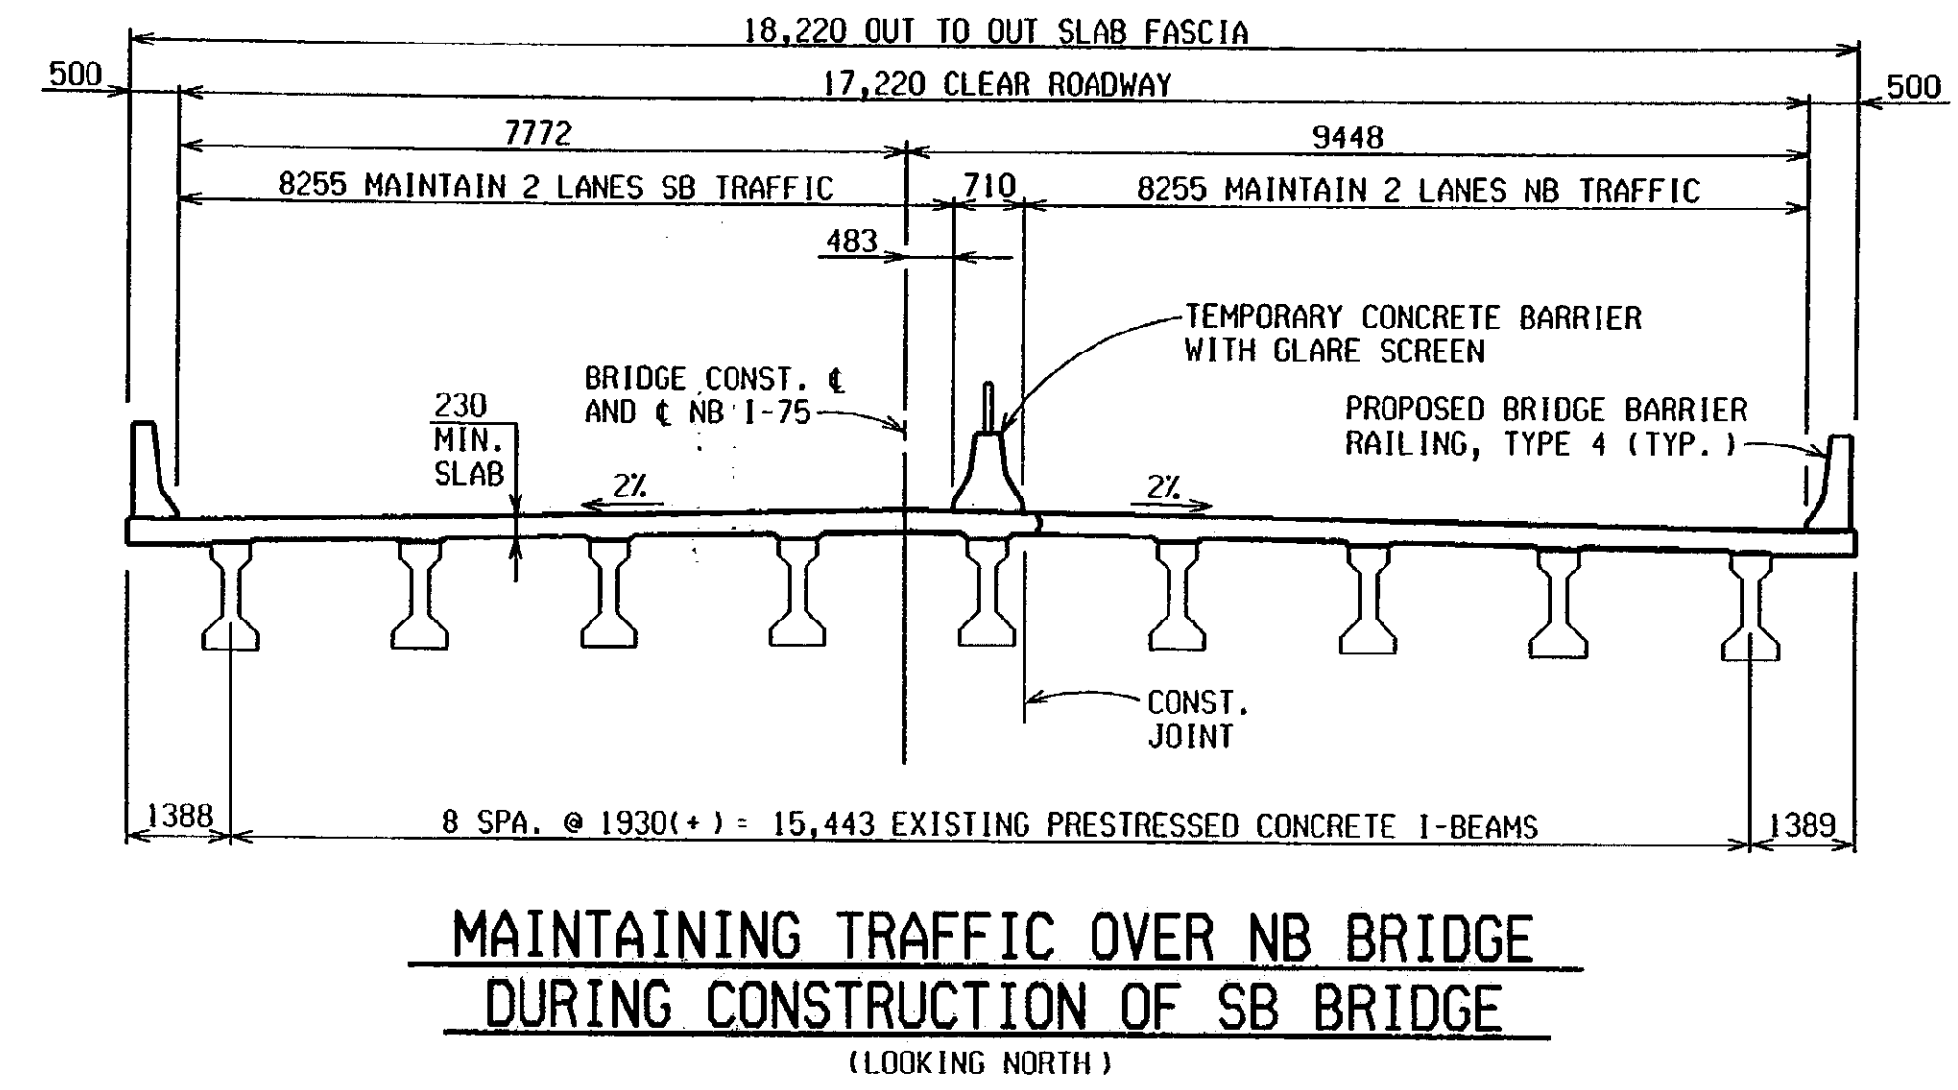

MAINTAINING TRAFFIC OVER NB BRIDGE DURING CONSTRUCTION OF SB BRIDGE
(LOOKING NORTH)

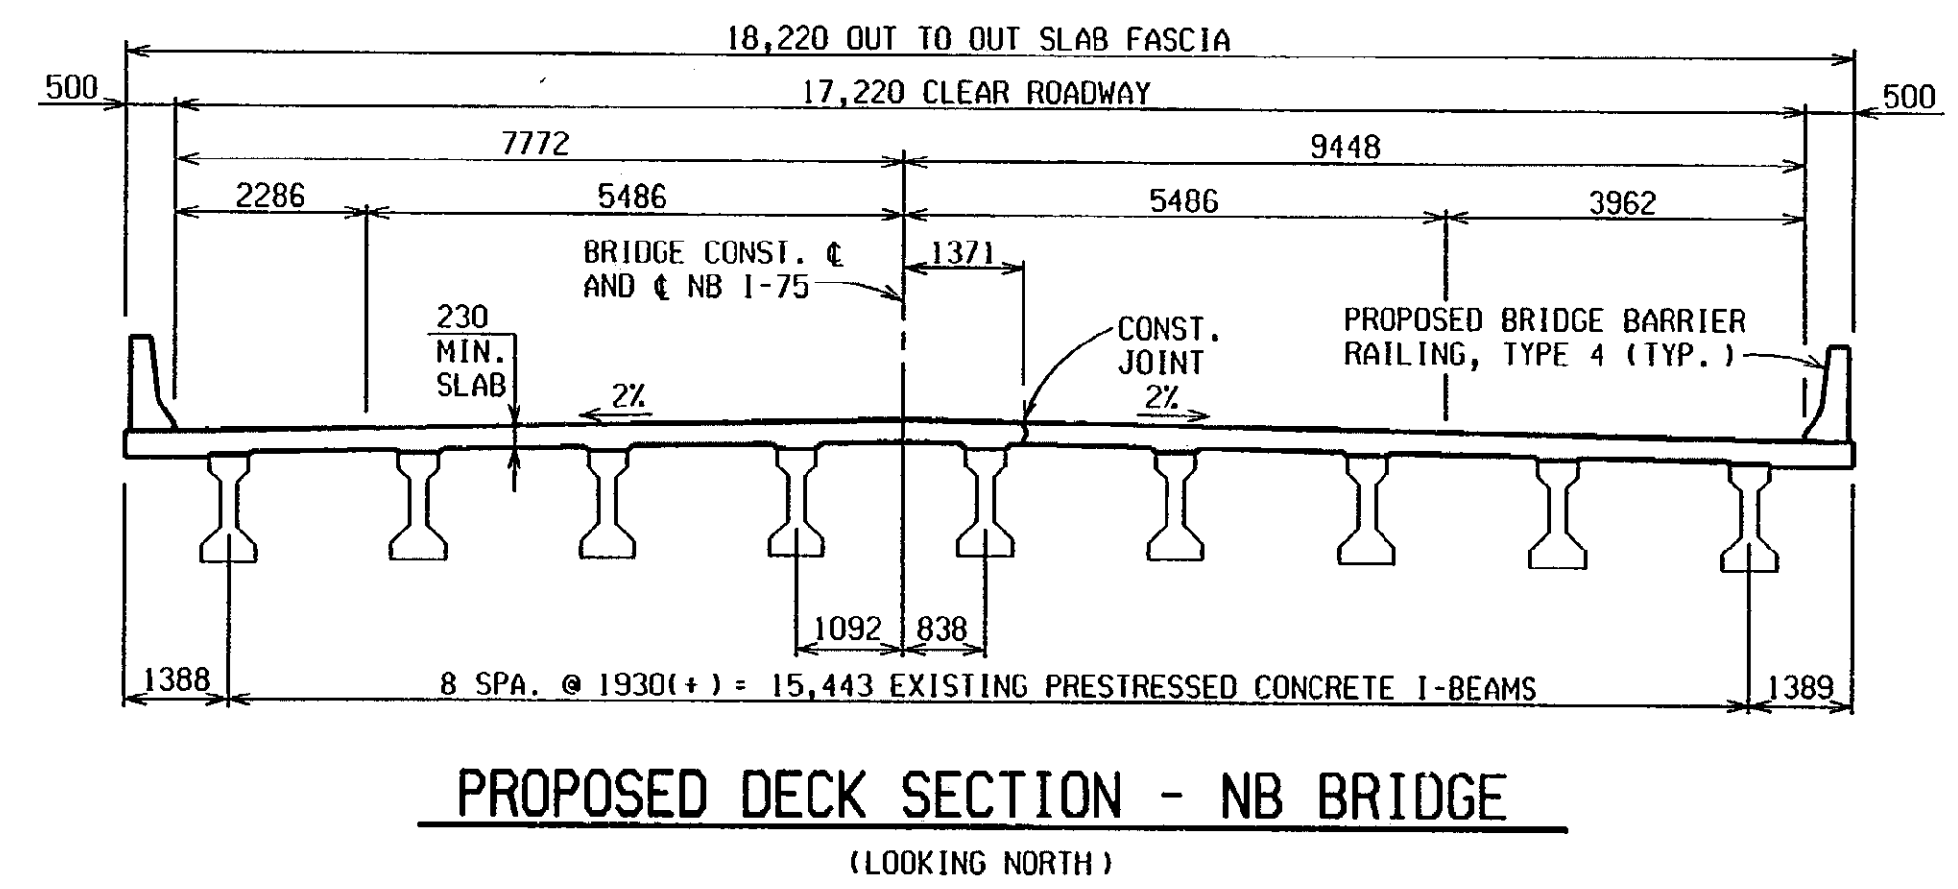

PROPOSED DECK SECTION - NB BRIDGE
(LOOKING NORTH)

NOTES:

CONSTRUCTION STAGING FOR THE NORTHBOUND STRUCTURE IS SHOWN. THE SOUTHBOUND TRAFFIC WILL BE MAINTAINED OVER THE COMPLETED NORTHBOUND BRIDGE USING CROSSOVERS.

TEMPORARY SUPPORT DETAILS FOR THE DECK OVERHANG IN STAGE II CONSTRUCTION MUST BE SUBMITTED BY THE CONTRACTOR FOR REVIEW AND APPROVAL BY THE ENGINEER. THE SPACING BETWEEN SUCCESSIVE SUPPORTS SHALL NOT EXCEED 2000mm. THE PAYMENT FOR THE TEMPORARY SUPPORTS IS INCLUDED IN THE PAY ITEM *SUPERSTRUCTURE CONCRETE, FORM, FINISH AND CURE, NIGHT CASTING* (S04-NB)


PLACEMENT OF TEMPORARY BARRIER SHALL BE ACCORDING TO STANDARD PLAN R-126 SERIES OR AS APPROVED BY THE ENGINEER. (INCLUDED IN THE PAY ITEM *CONCRETE BARRIER, TEMPORARY, FURNISHED*)

THE TEMPORARY CONCRETE BARRIER SHALL BE ANCHORED TO THE DECK. FOR ANCHORAGE, DRILL HOLES IN THE LOWER SLOPING PORTION OF EACH BARRIER SECTION NEAR THE ENDS, ON THE TRAFFIC SIDE OF THE BARRIER AND CONTINUING INTO THE CONCRETE BELOW, THAT WILL ALLOW FOR 25mm STEEL DOWELS OR PEGS TO BE INSERTED. THESE DOWELS SHOULD BE EXTENDED 100mm INTO THE BARRIER, BUT NOT PROTRUDE ABOVE THE BARRIER SURFACE. AFTER REMOVAL OF THE TEMPORARY BARRIER AND STEEL DOWELS OR PEGS FROM THE NEW DECK, THE HOLES IN THE DECK SHALL BE FILLED WITH PATCHING MORTAR OR CONCRETE. THIS WORK SHALL BE INCLUDED IN THE BID ITEM *CONCRETE BARRIER, TEMP, FURN*.









CONSTRUCTION STAGING DETAILS				
DATE	CONT. SEC.	JOB NO.	DESIGN UNIT	SHEET
1-9-01	S04 OF 63174	49595A	MAHDAVI	5 OF 16

1 2 3 4 5 6 7 8 9 10 11 12 13 14 15 16 17 18 19 20 21 22 23 24 25 26 27 28 29 30 31 32 33 34 35 36 37 38 39 40 41 42 43 44 45 46 47 48 49 50 51 52 53 54 55 56 57 58 59 60 61 62 63

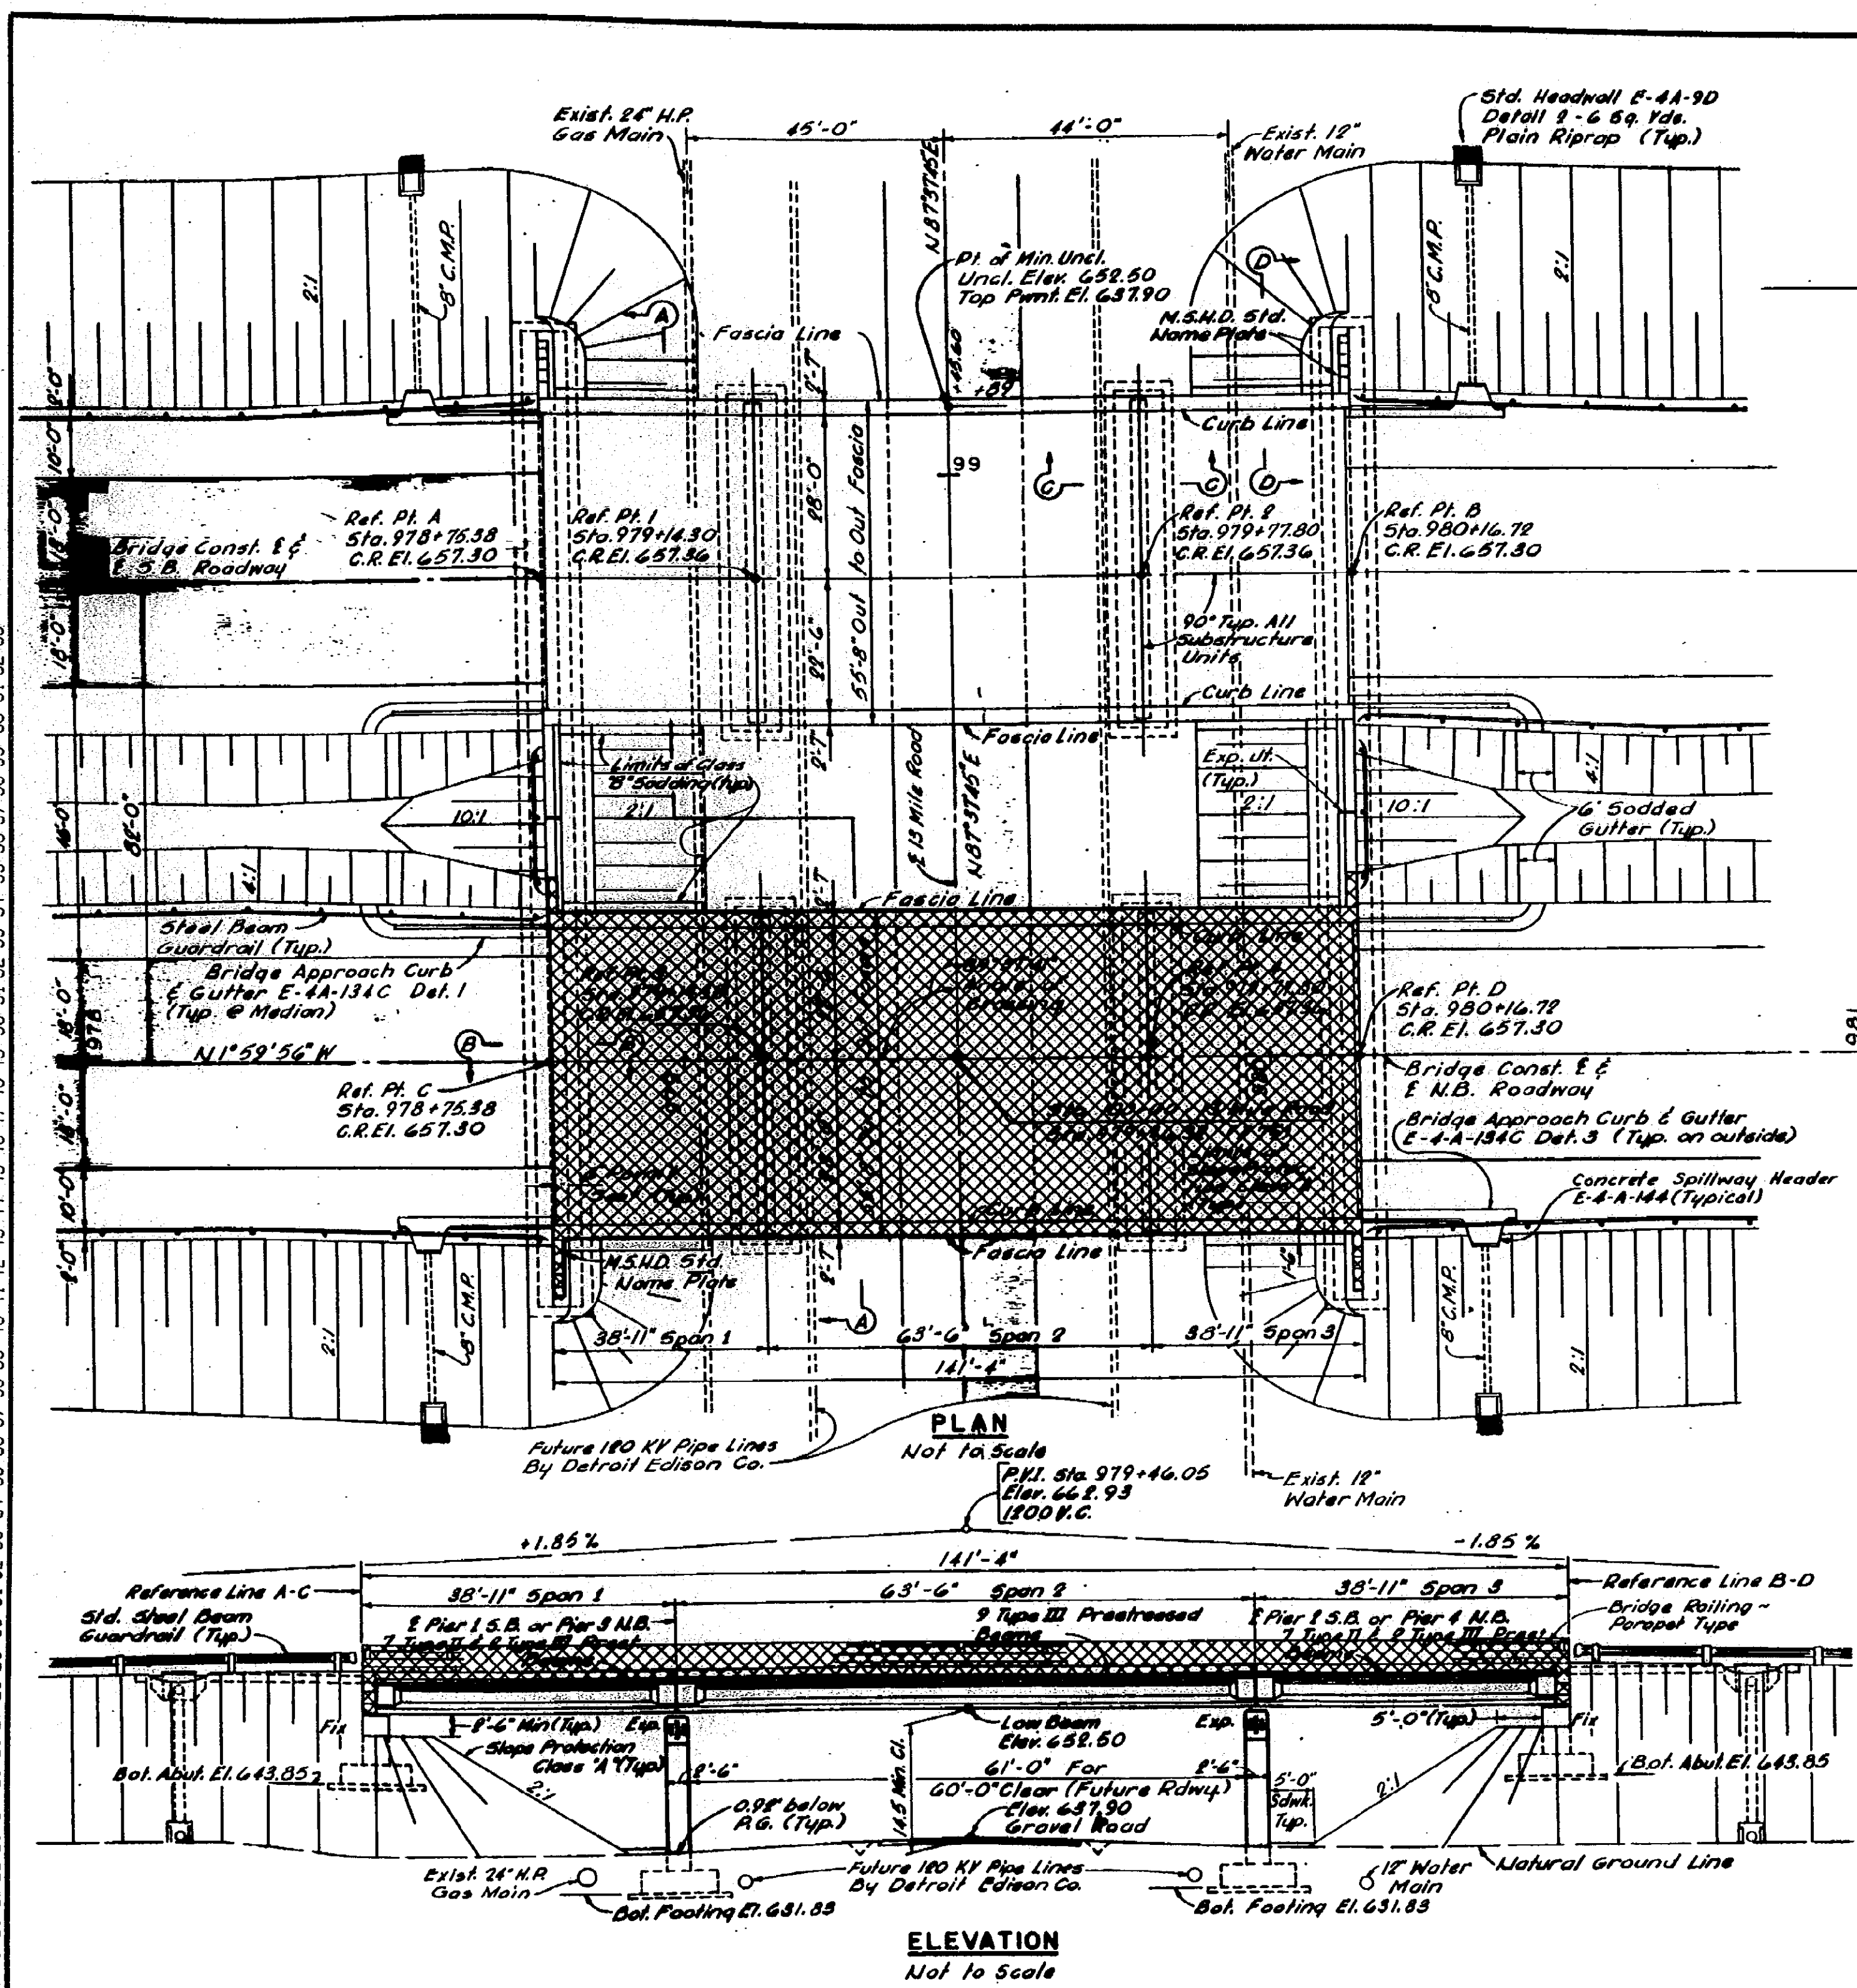

MISCELLANEOUS QUANTITIES		
ITEM	UNIT	AMOUNT
Slope Protection Class A	Sq. Yds.	886
Porous Material Grade A	Cu. Yds.	2720

* Grouted Riprap shall not be used on this project.

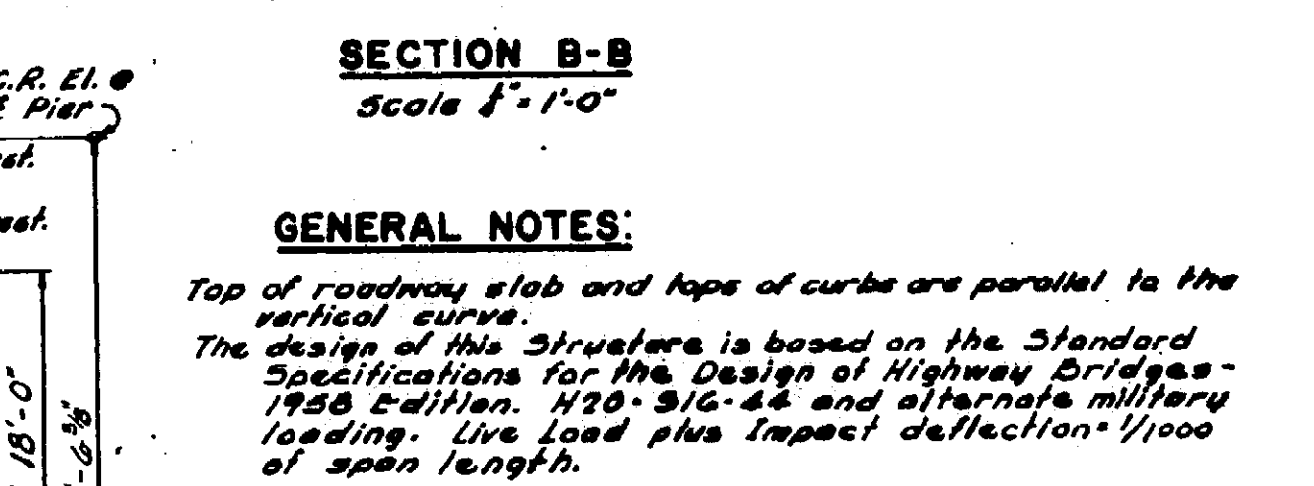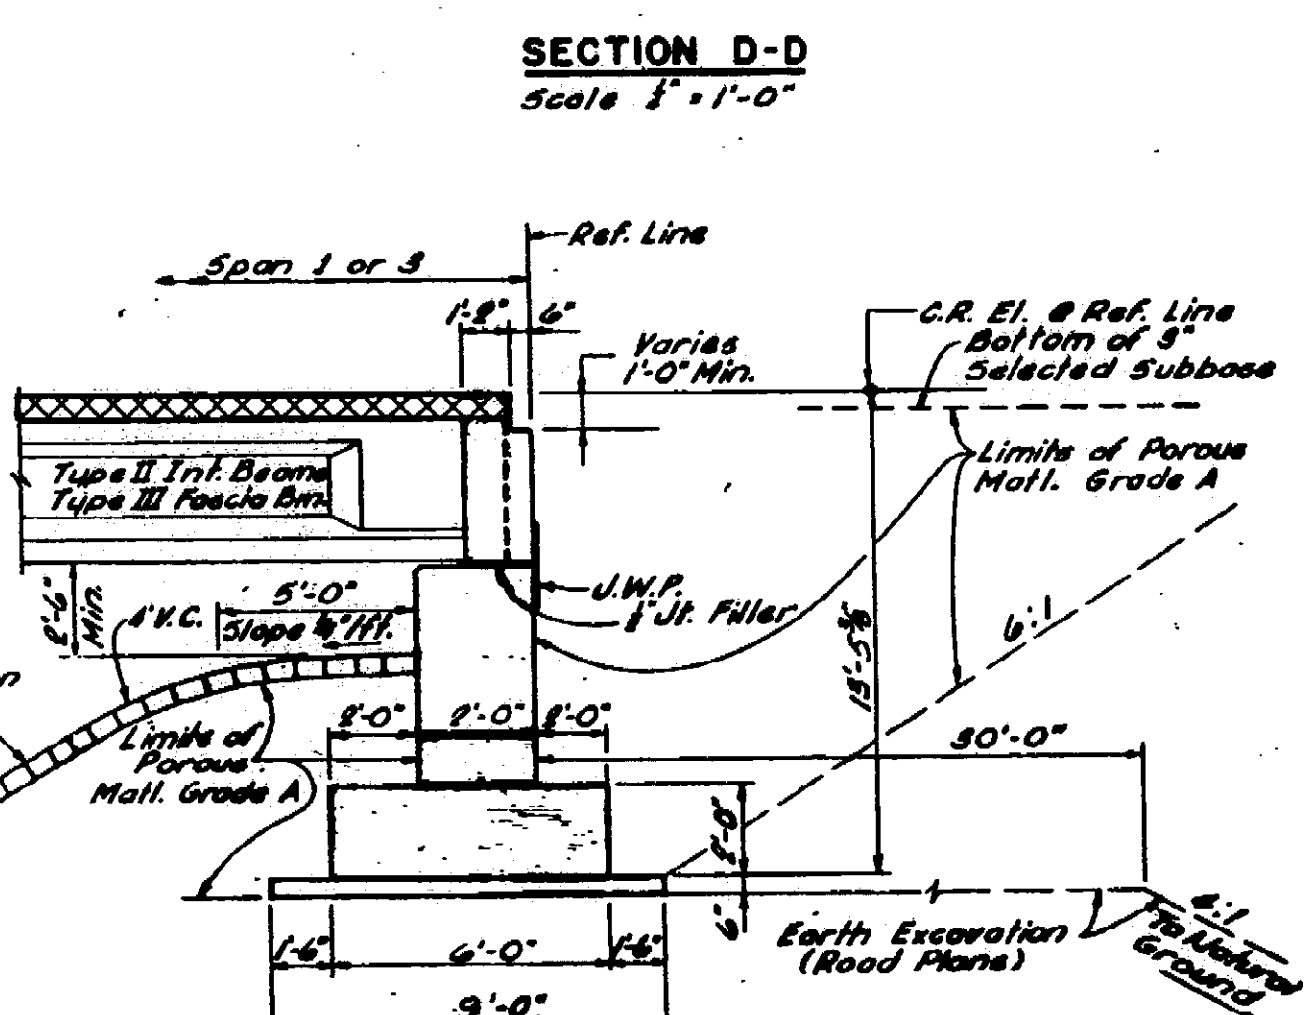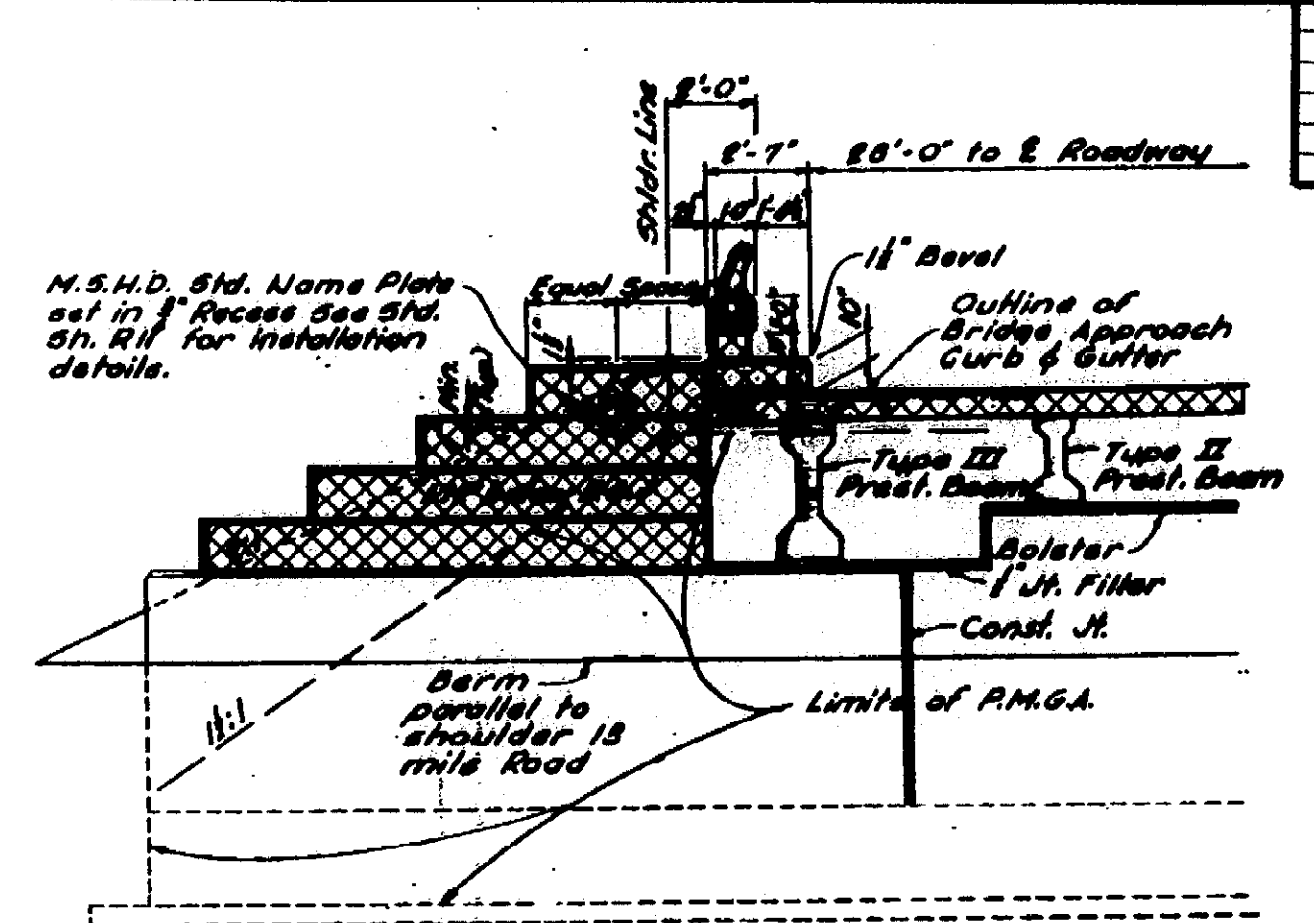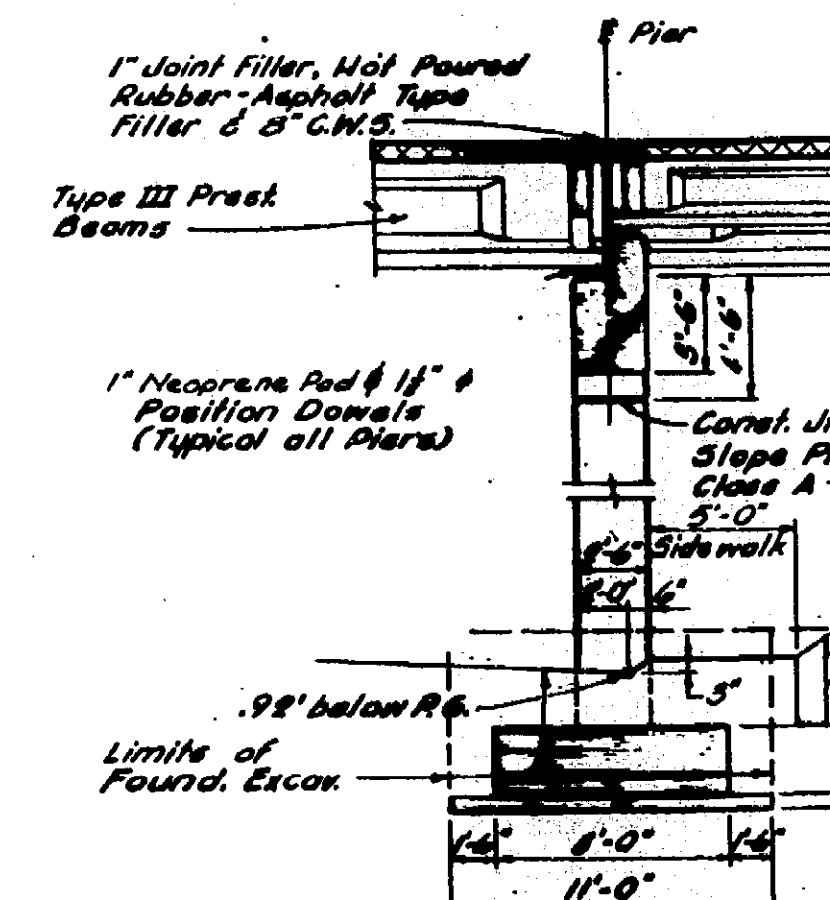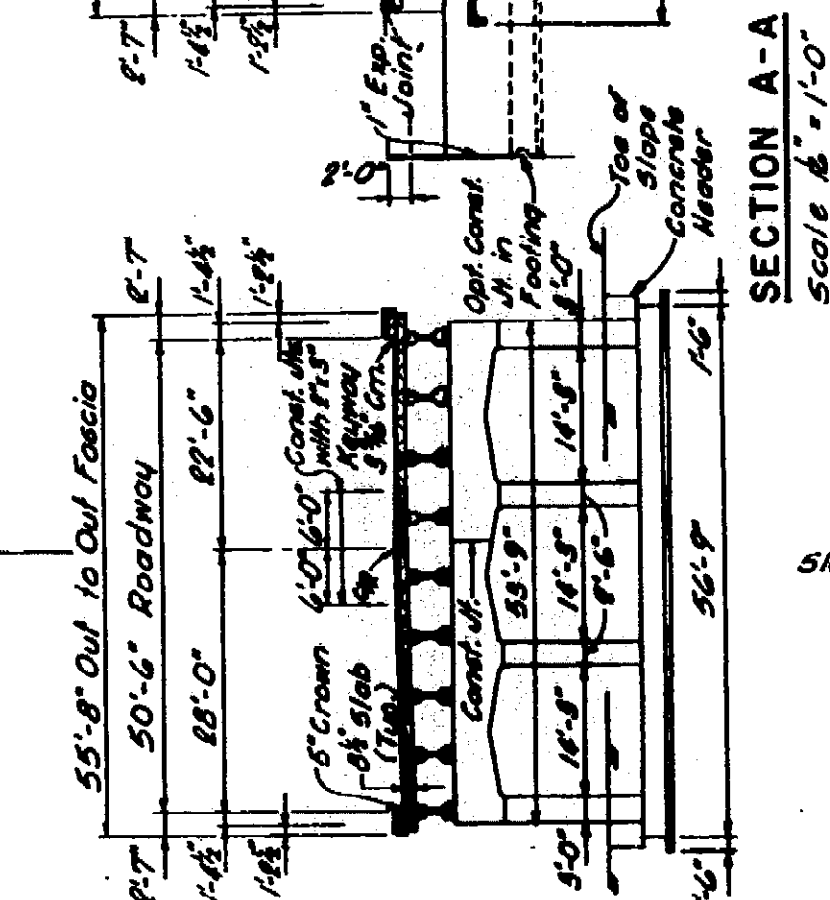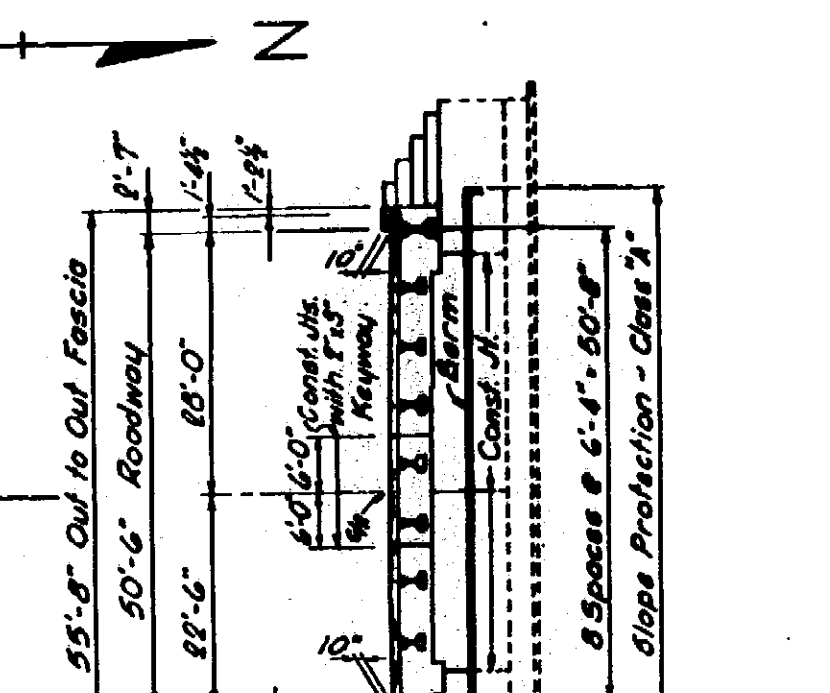

GENERAL NOTES:
Top of roadway slab and tops of curbs are parallel to the vertical curve.
The design of this structure is based on the Standard Specifications for the Design of Highway Bridges - 1988 Edition, N70-316-42 and alternate military loading. Live load plus impact deflection 1/1000 of span length.

CONTROL SECTION 63174

MICHIGAN STATE HIGHWAY DEPARTMENT
175 OVER 13 MILE ROAD IN THE CITY OF MADISON HEIGHTS

GENERAL PLAN OF STRUCTURE
TECON ENGINEERS, INC.

APPROVED: *J. H. Dunning* 6-5-22
DATE: 6-5-22

S04 OF 63174 I

THE ONLY ITEMS OF WORK TO BE DONE FROM THIS SHEET ARE IDENTIFIED BY THE LEGEND BOX BELOW, LABELED WITH THIS PROJECT'S JOB NUMBER.

JOB NO. 49595A

■ DENOTES REMOVAL PORTIONS
□ PROPOSED WORK


REMOVAL PORTIONS - NB STRUCTURE				
DATE	CONT. SEC.	JOB NO.	DESIGN UNIT	SHEET
1-9-01	S04 OF 63174	49595A	MAHDAVI	6 OF 16

REVISIONS

NO.	DESCRIPTION	DATE	BY

DATE: 10-26-00
CORRECTED BY: R. PRATT
DATE:
CHECKED BY:
DATE: 04-12-00
DRAWN BY: INDER
FILE NAME: S04621746n.

REVISIONS			
NO.	DESCRIPTION	DATE	BY

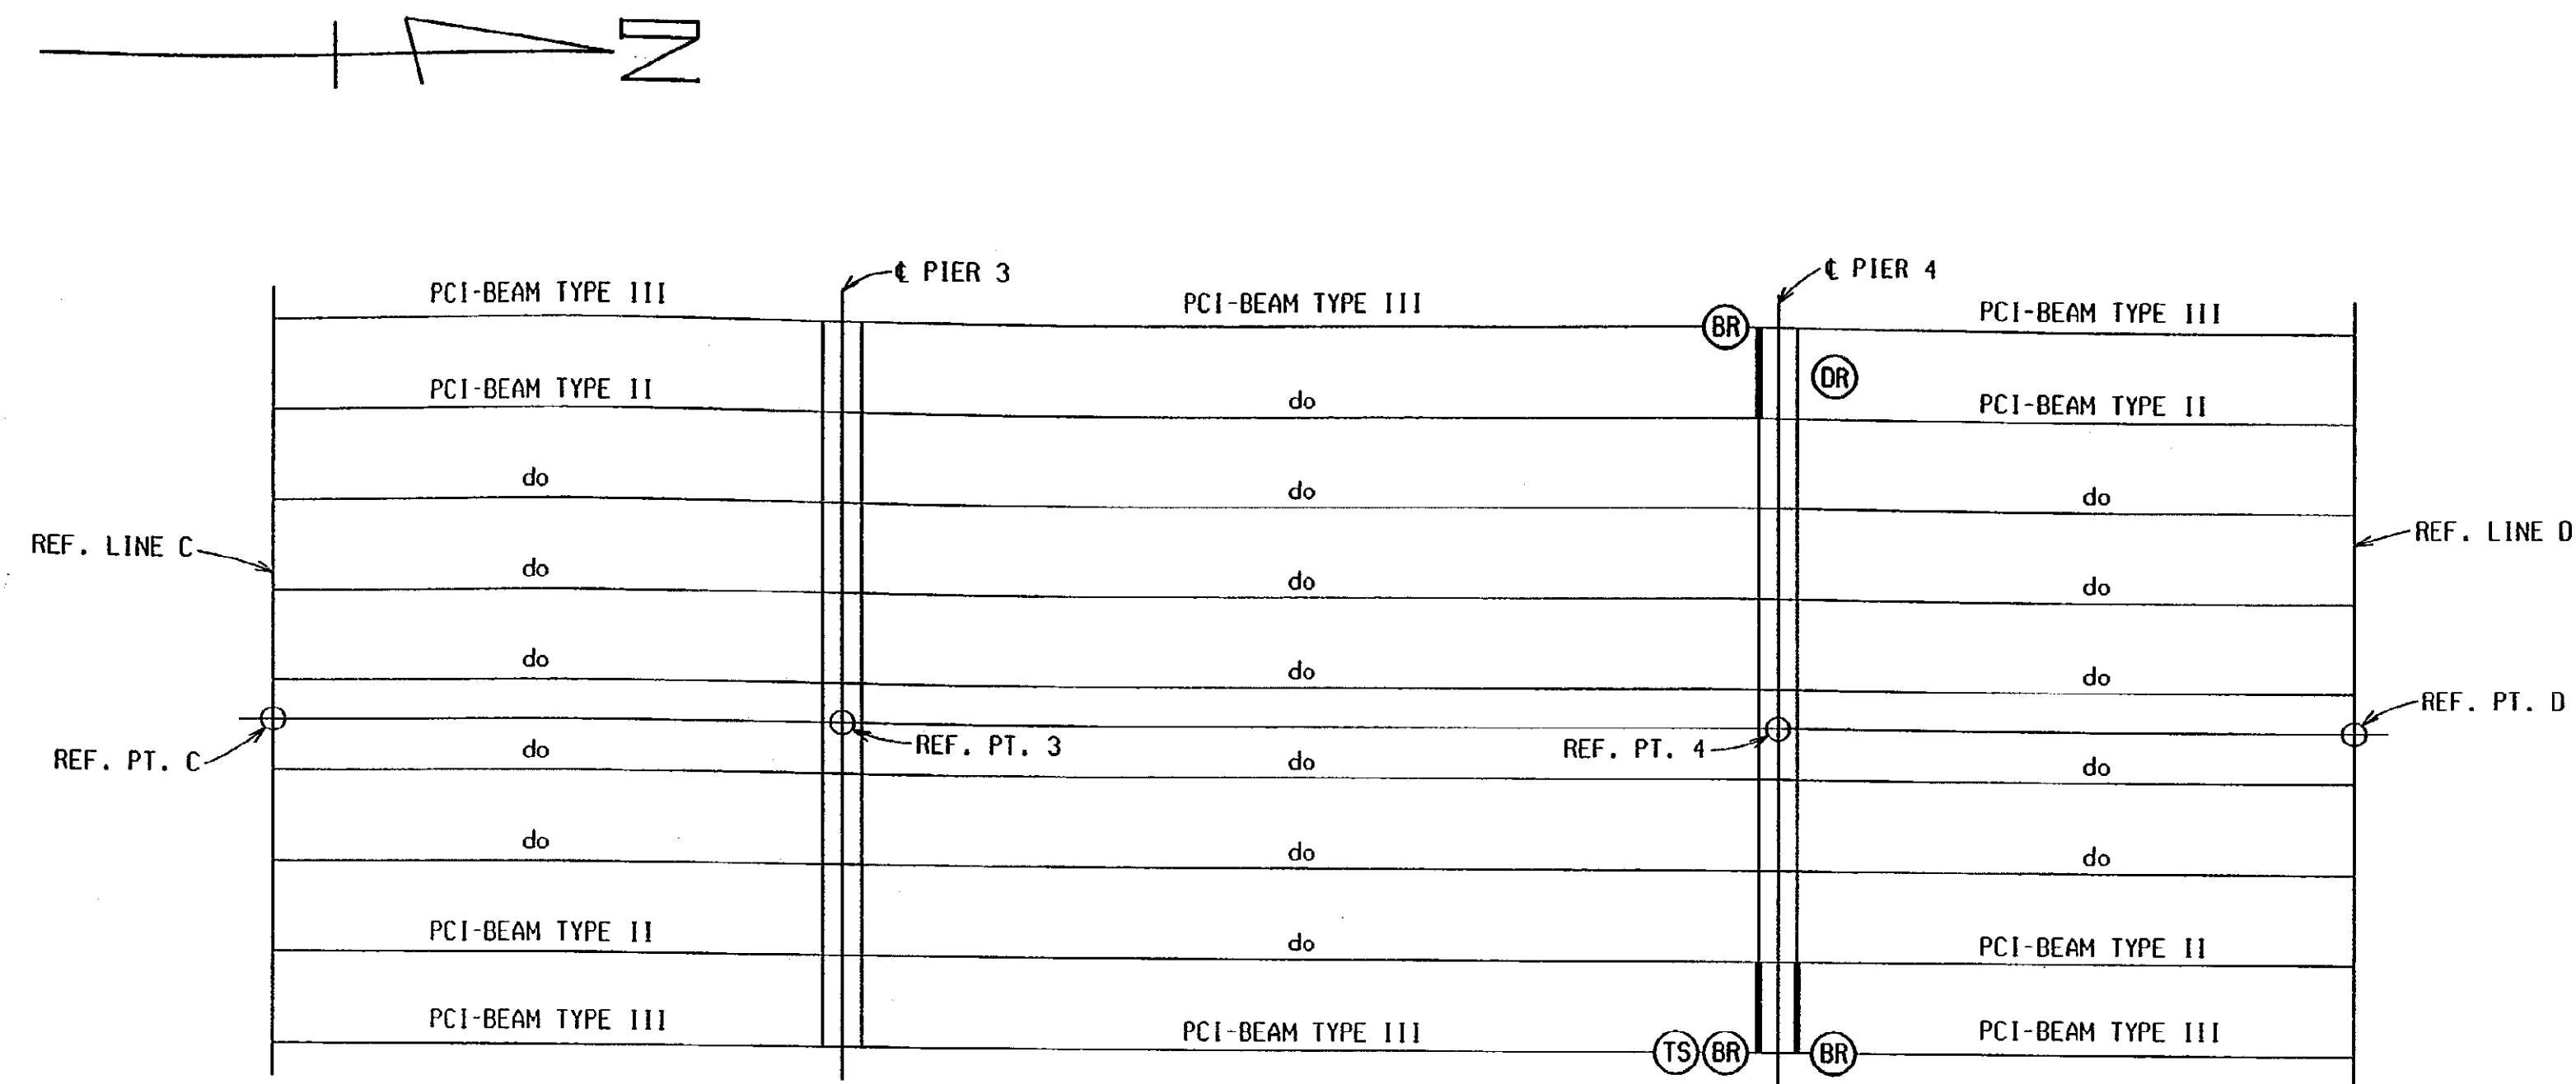


PLAN

- BEAM END REPAIR
 (BR) DENOTES BEAM END REPAIR
 (DR) DENOTES DIAPHRAGM REPAIR
 (TS) DENOTES TEMPORARY SUPPORT


MISCELLANEOUS QUANTITIES	
5 m ²	Patch, Forming
3 ea	Removal, Beam End Repair *
1 m ³	Hand Chipping, Other Than Deck
220 kg	Reinforcement, Steel, Epoxy Coated
2 m ³	Patching Cono, LM ***
14 m ²	Forming, Beam End Repair *
1 LS	Concrete Surface Sealer **

*REFER TO SPECIAL PROVISION FOR PRESTRESSED CONCRETE BEAM END REPAIR.
 **REFER TO SPECIAL PROVISION FOR CONCRETE SURFACE SEALERS.
 ***REFER TO SPECIAL PROVISION FOR STRUCTURAL REPAIR WITH LATEX MODIFIED CONCRETE.

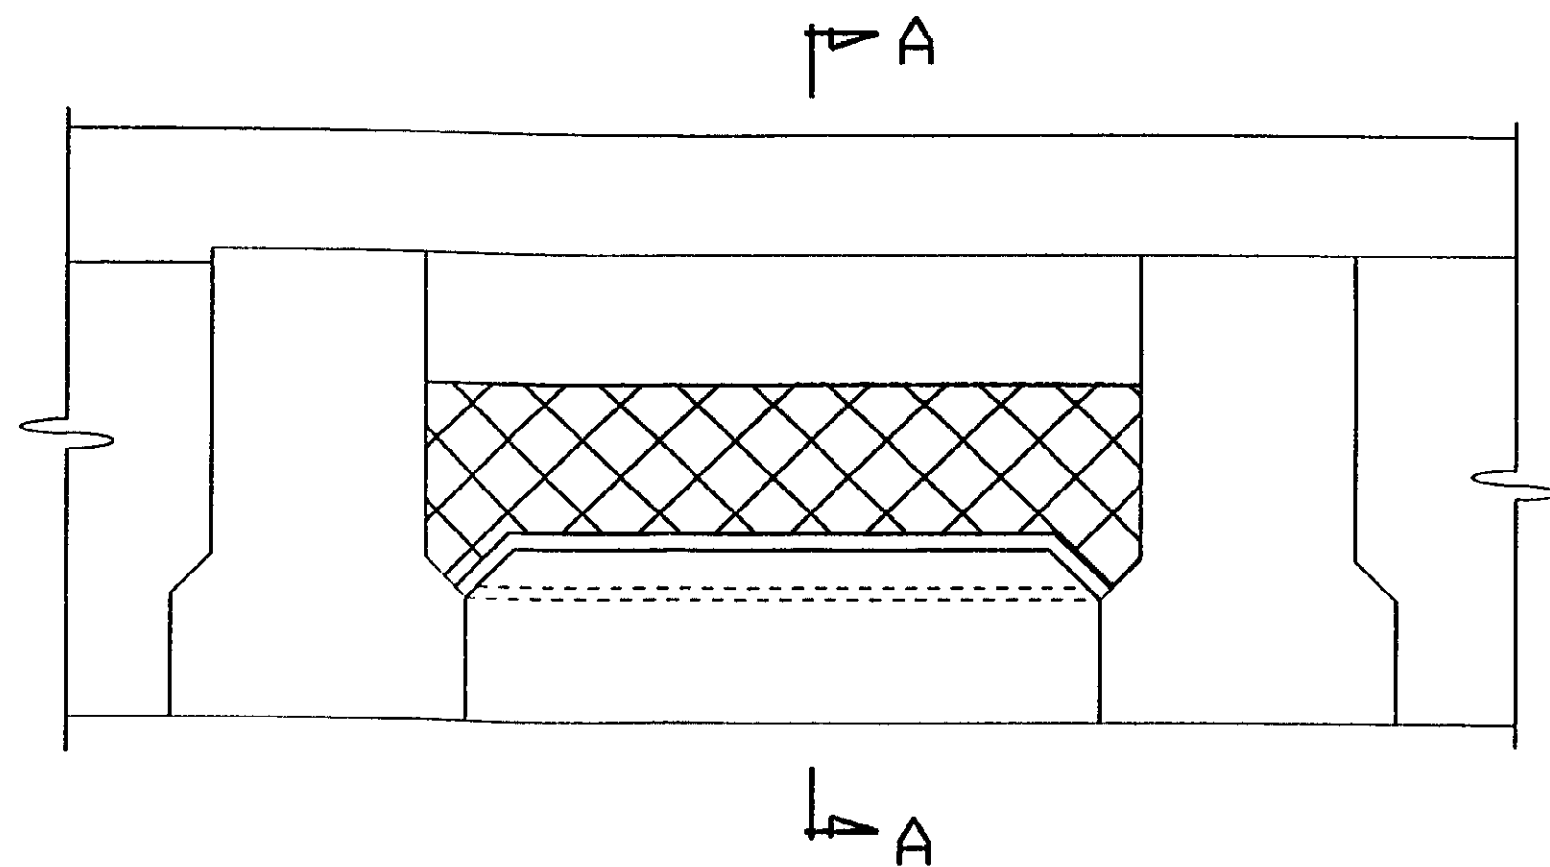

LIMITS OF HAND CHIPPING, OTHER THAN DECK.

END DIAPHRAGM

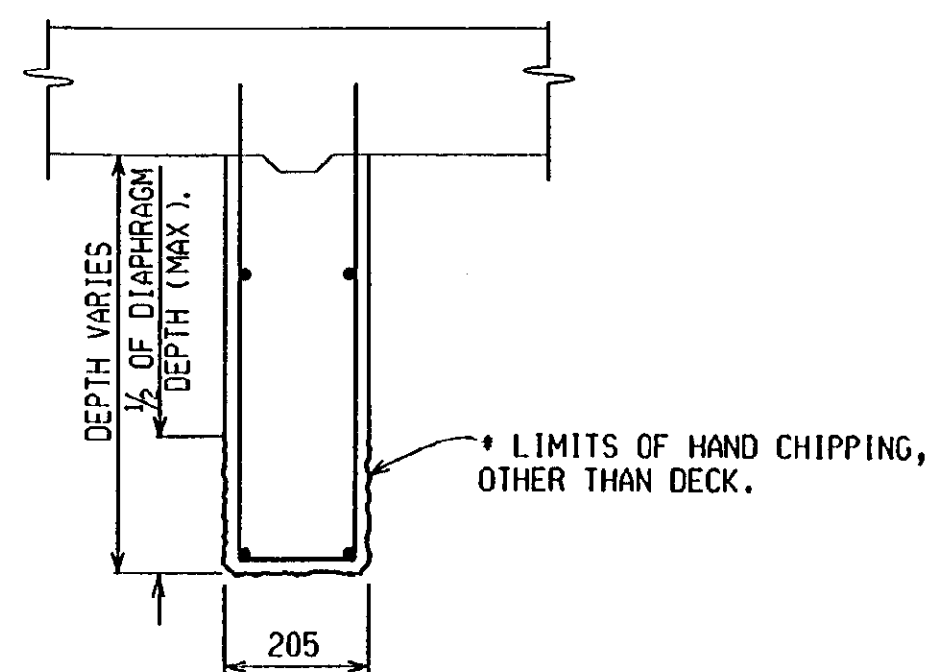

* LIMITS OF HAND CHIPPING SHALL BE FIELD VERIFIED AND AS DIRECTED BY THE ENGINEER.

SECTION A-A


NOTES:

- IF THE CONTRACTOR ELECTS TO REPAIR MORE THAN ONE BEAM END AT A TIME, WORK SHALL NOT BE DONE ON THE SAME END OF ANY ADJACENT BEAM OR AT THE OPPOSITE END OF THE BEAM BEING REPAIRED.
- ES DENOTES EACH SIDE.
- ADHESIVE ANCHOR EB13 BARS INTO 38mm Ø HOLES IN BEAM WEB.
- DRILLING OF HOLES SHALL NOT BE PERMITTED, EXCEPT AS NOTED.
- THE LIMITS OF THE CONCRETE SEALER SHALL INCLUDE THE OUTSIDE FACE FOR THE FULL LENGTH OF THE FASCIA BEAMS AND ALL SURFACES OF ALL BEAM ENDS NOT BEING REPAIRED FOR A LENGTH NOT LESS THAN TWICE THE BEAM DEPTH. REFER TO SPECIAL PROVISION FOR CONCRETE SURFACE SEALERS FOR PRODUCT INFORMATION AND SURFACE PREPARATION. THE ESTIMATED QUANTITY IS 230 m².
- WHERE A DIAPHRAGM IS REMOVED IN A BAY FROM THE SIDE OF A BEAM THAT IS NOT BEING REPAIRED, THE EXISTING INSERT HOLES SHALL BE FILLED WITH CAULK AND THE PROPOSED DIAPHRAGM REINFORCEMENT SHALL BE EPOXY ANCHORED TO THE BEAM IN THE NEW LOCATION. INCLUDED IN THE BID ITEM "Removal, Beam End Repair".

BEAM REPAIR DETAILS				
NORTH BOUND				
DATE	CONT. SEC.	JOB NO.	DESIGN UNIT	SHEET
1-9-01	S04 OF 63174	49595A	MAHDAVI	7 OF 16



1 2 3 4 5 6 7 8 9 10 11 12 13 14 15 16 17 18 19 20 21 22 23 24 25 26 27 28 29 30 31 32 33 34 35 36 37 38 39 40 41 42 43 44 45 46 47 48 49 50 51 52 53 54 55 56 57 58 59 60 61 62 63

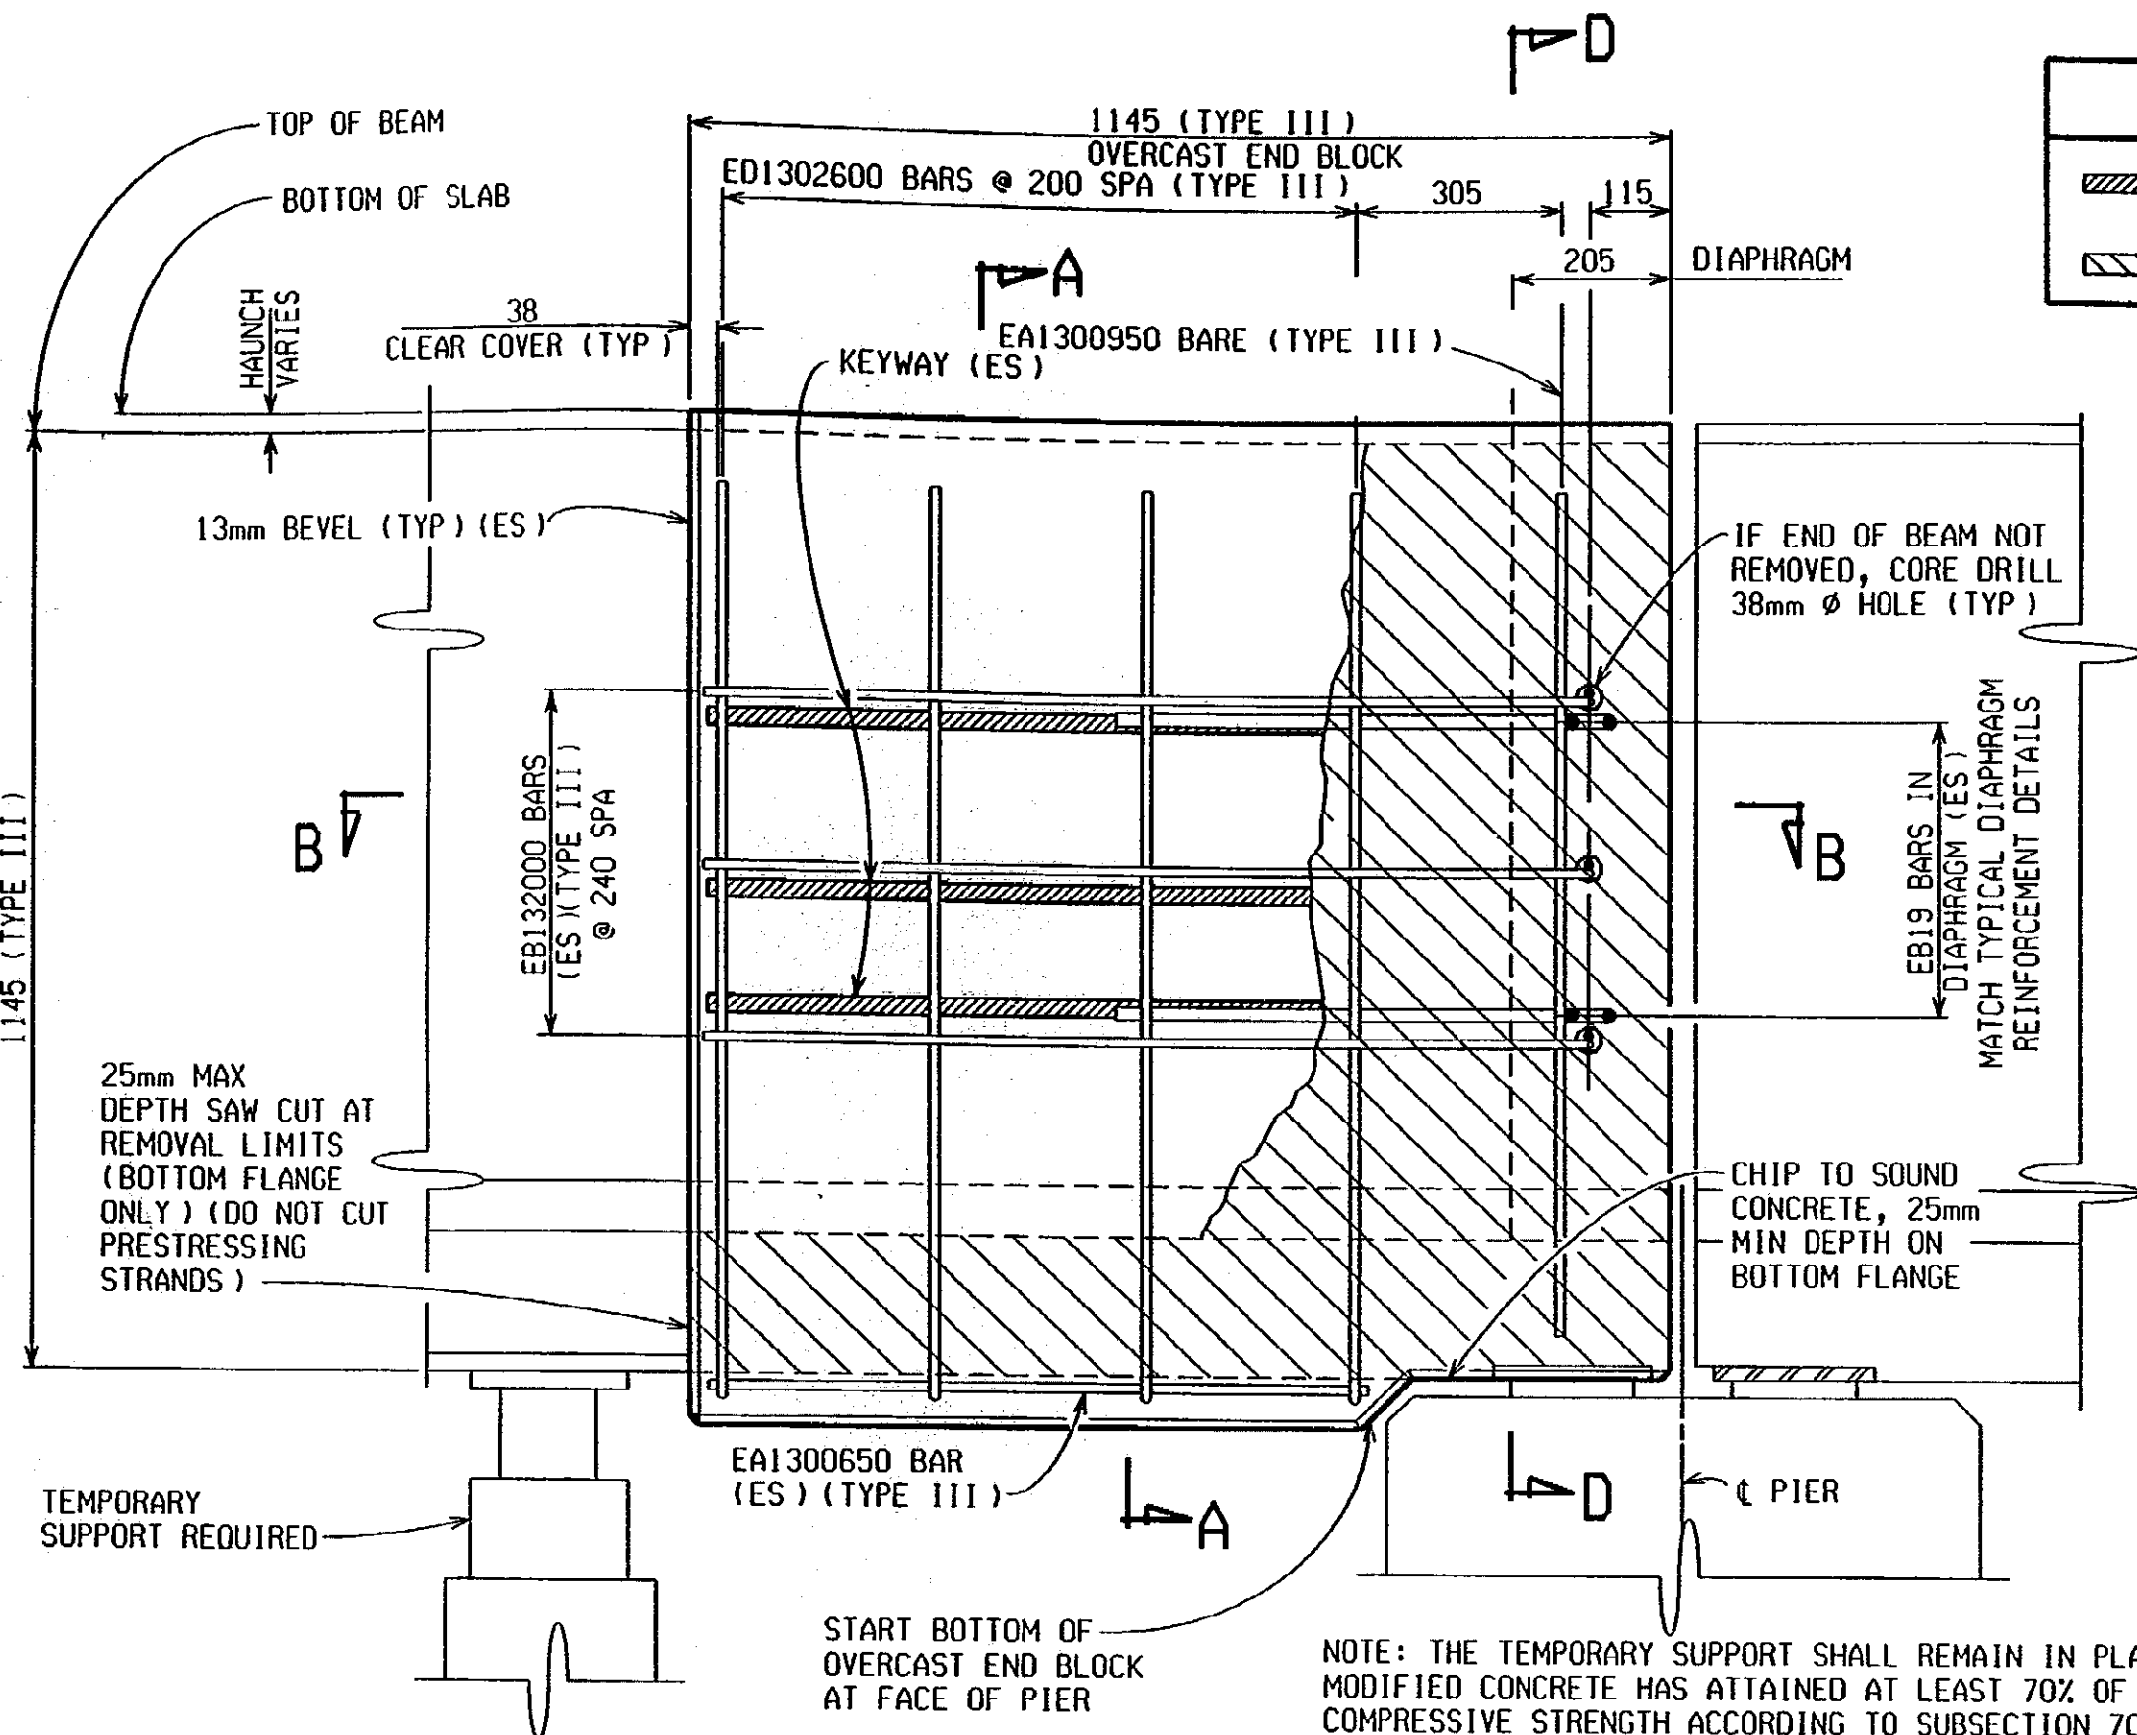

BEAM END ELEVATION

NOTE: THE TEMPORARY SUPPORT SHALL REMAIN IN PLACE UNTILL THE LATEST MODIFIED CONCRETE HAS ATTAINED AT LEAST 70% OF ITS MINIMUM 28-DAY COMPRESSIVE STRENGTH ACCORDING TO SUBSECTION 701.03.F.6 OF THE STANDARD SPECIFICATIONS FOR CONSTRUCTION, 1996 EDITION.


LEGEND

- KEYWAY, 13mm DEEP x 25mm WIDE SAWCUT
- CHIPPED CONCRETE


LEGEND

- KEYWAY, 13mm DEEP x 25mm WIDE SAWCUT
- CHIPPED CONCRETE


CHIPPED SURFACE OF EXISTING BEAM FLANGE (CHIP TO SOUND CONCRETE) (TYP)

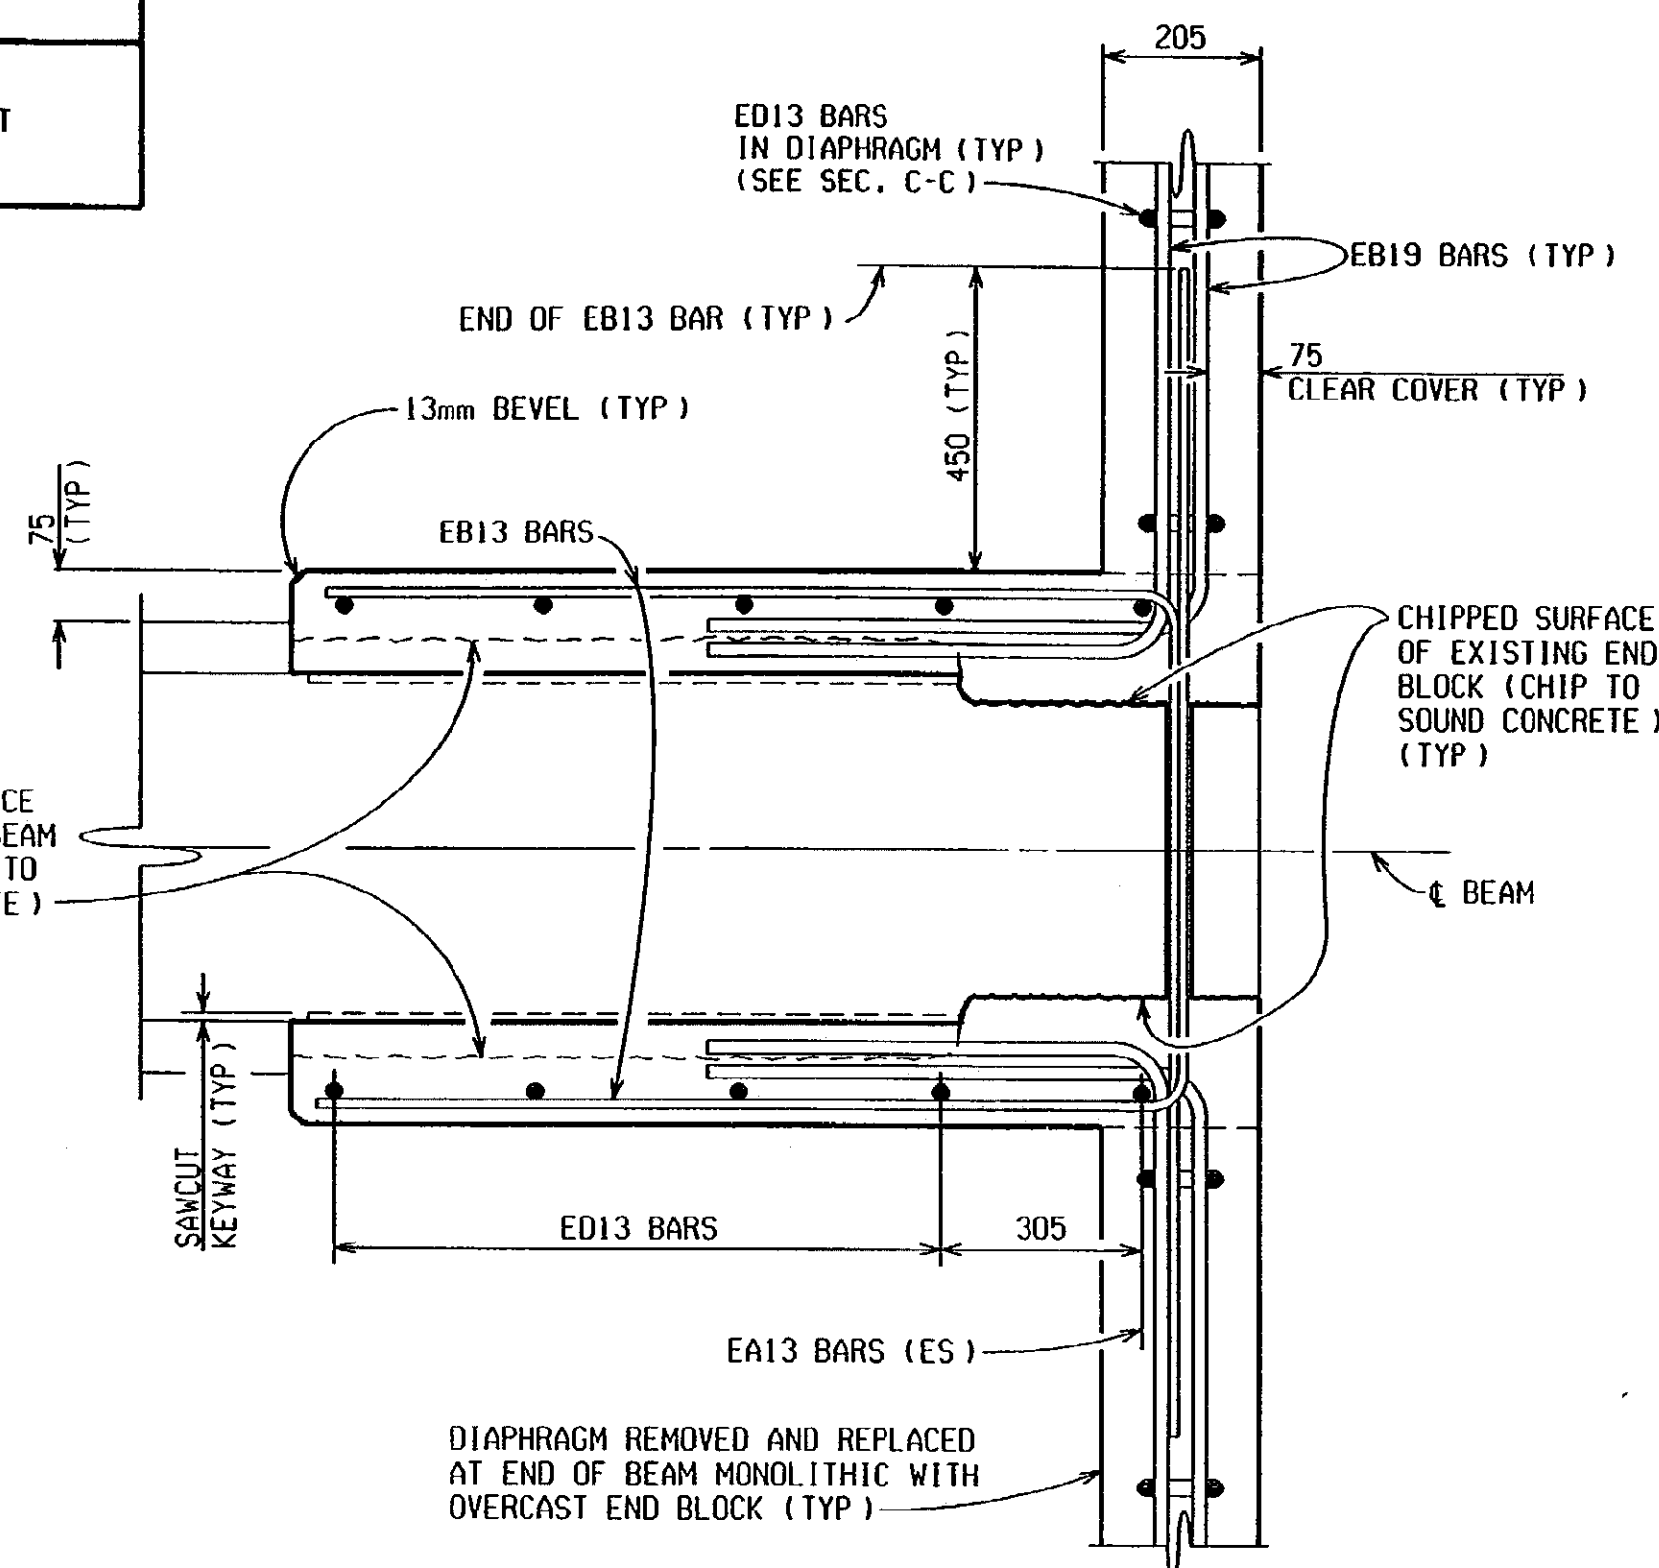

SECTION B-B

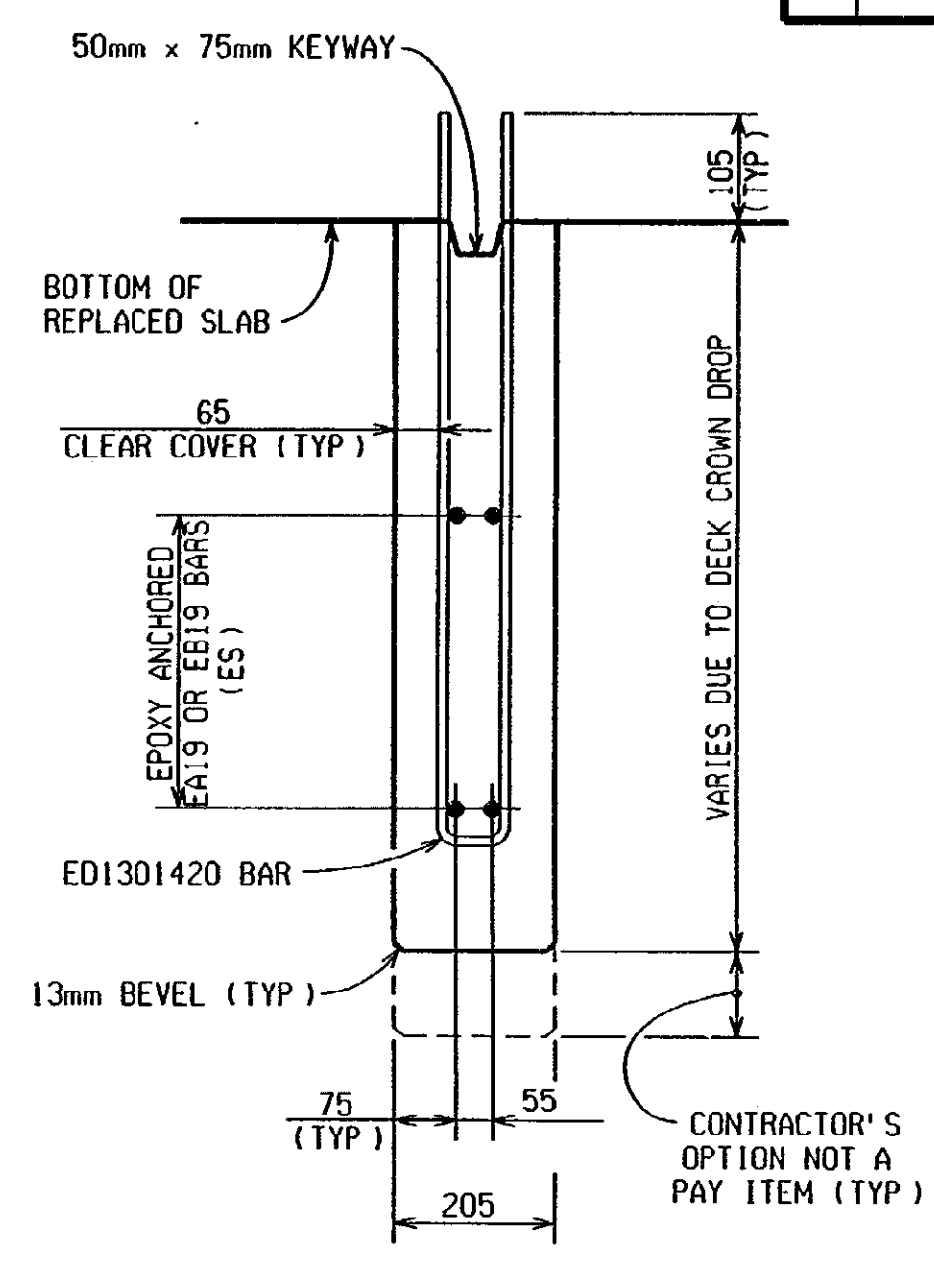


SECTION C-C

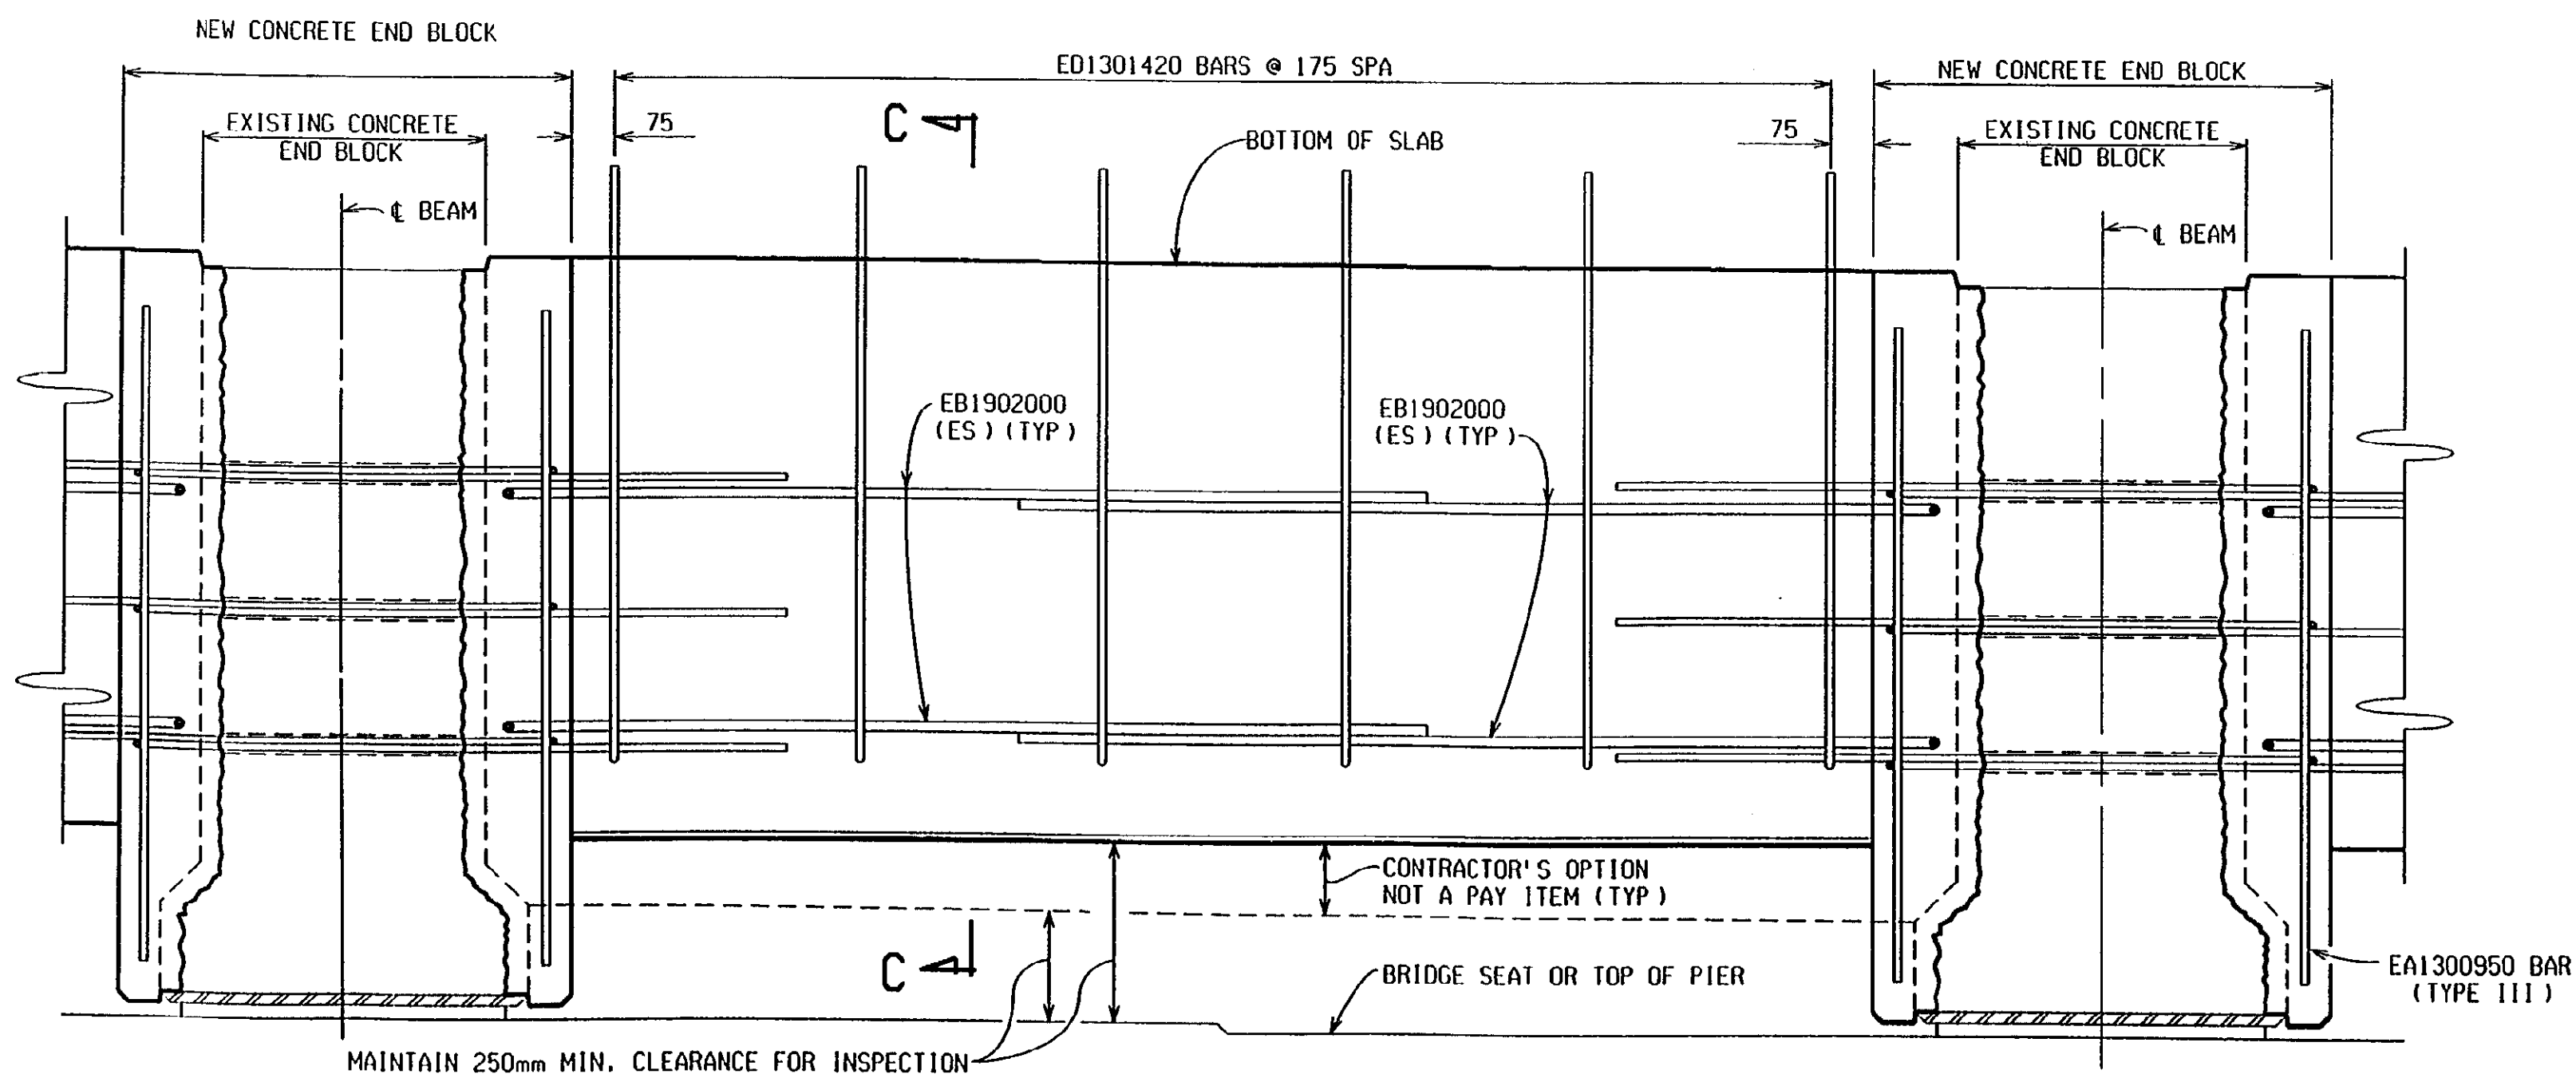

SECTION D-D (DIAPHRAGM ELEVATION)
(SHOWING STEEL REINFORCEMENT)

NOTE: REPLACE DECK OVER BEAM END REPAIR AREA.

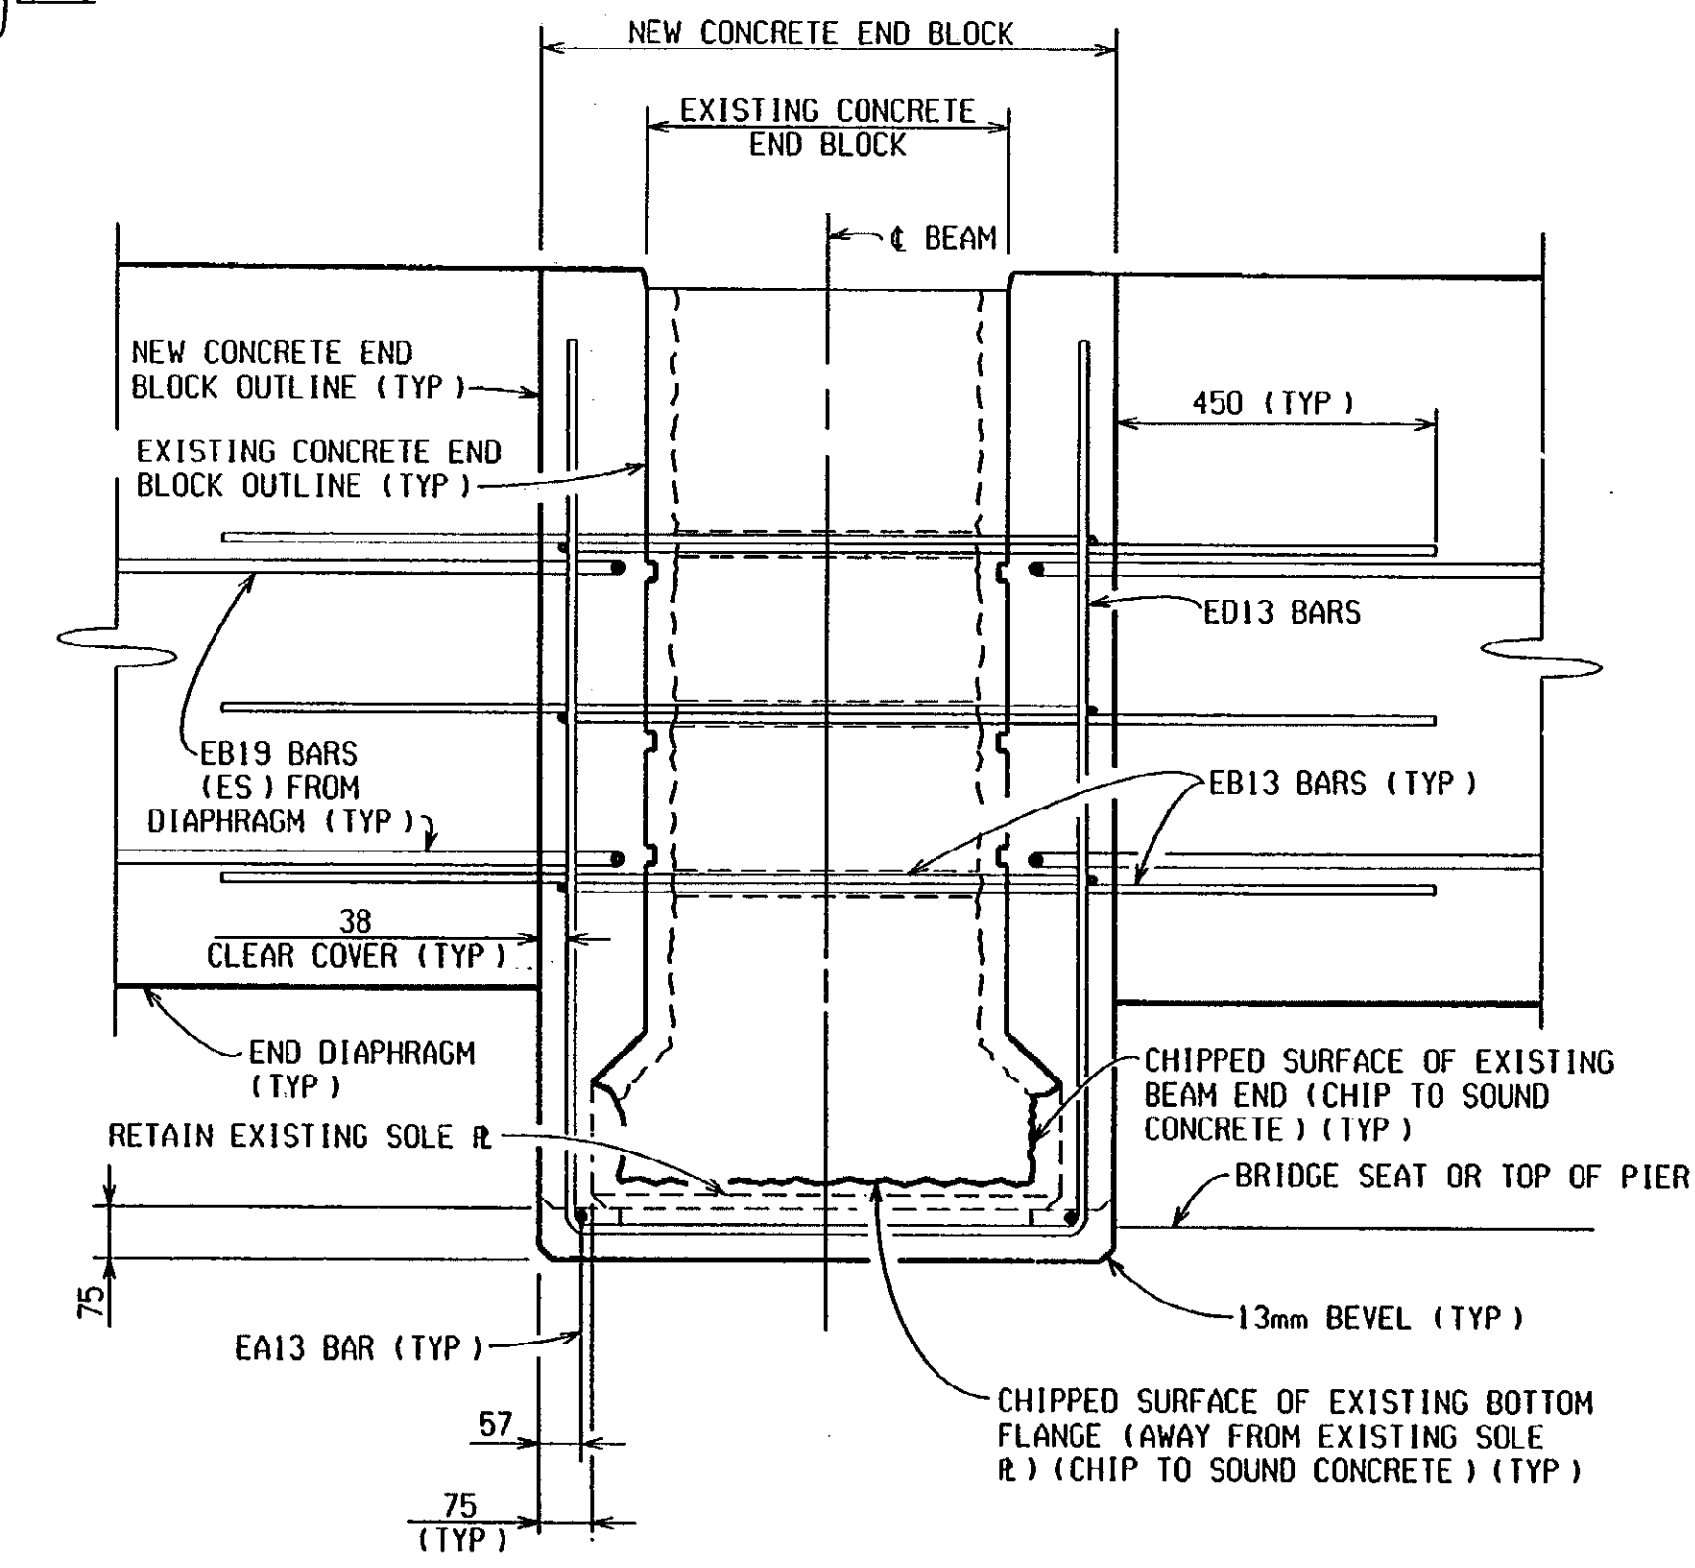


SECTION A-A
(ED13 BARS IN DIAPHRAGMS NOT SHOWN)

REVISIONS			
NO.	DESCRIPTION	DATE	BY

BEAM REPAIR DETAILS				
NORTH BOUND				
DATE	CONT. SEC.	JOB NO.	DESIGN UNIT	SHEET
1-9-01	S04 OF 63174	49595A	MAHDAVI	8 OF 16


FILE NAME: s0463174n-br DRAWN BY: R.K. OLIN CHECKED BY: DATE: 12/2000 CORRECTED BY: SHAFFER DATE: 12-13-00

1 2 3 4 5 6 7 8 9 10 11 12 13 14 15 16 17 18 19 20 21 22 23 24 25 26 27 28 29 30 31 32 33 34 35 36 37 38 39 40 41 42 43 44 45 46 47 48 49 50 51 52 53 54 55 56 57 58 59 60 61 62 63


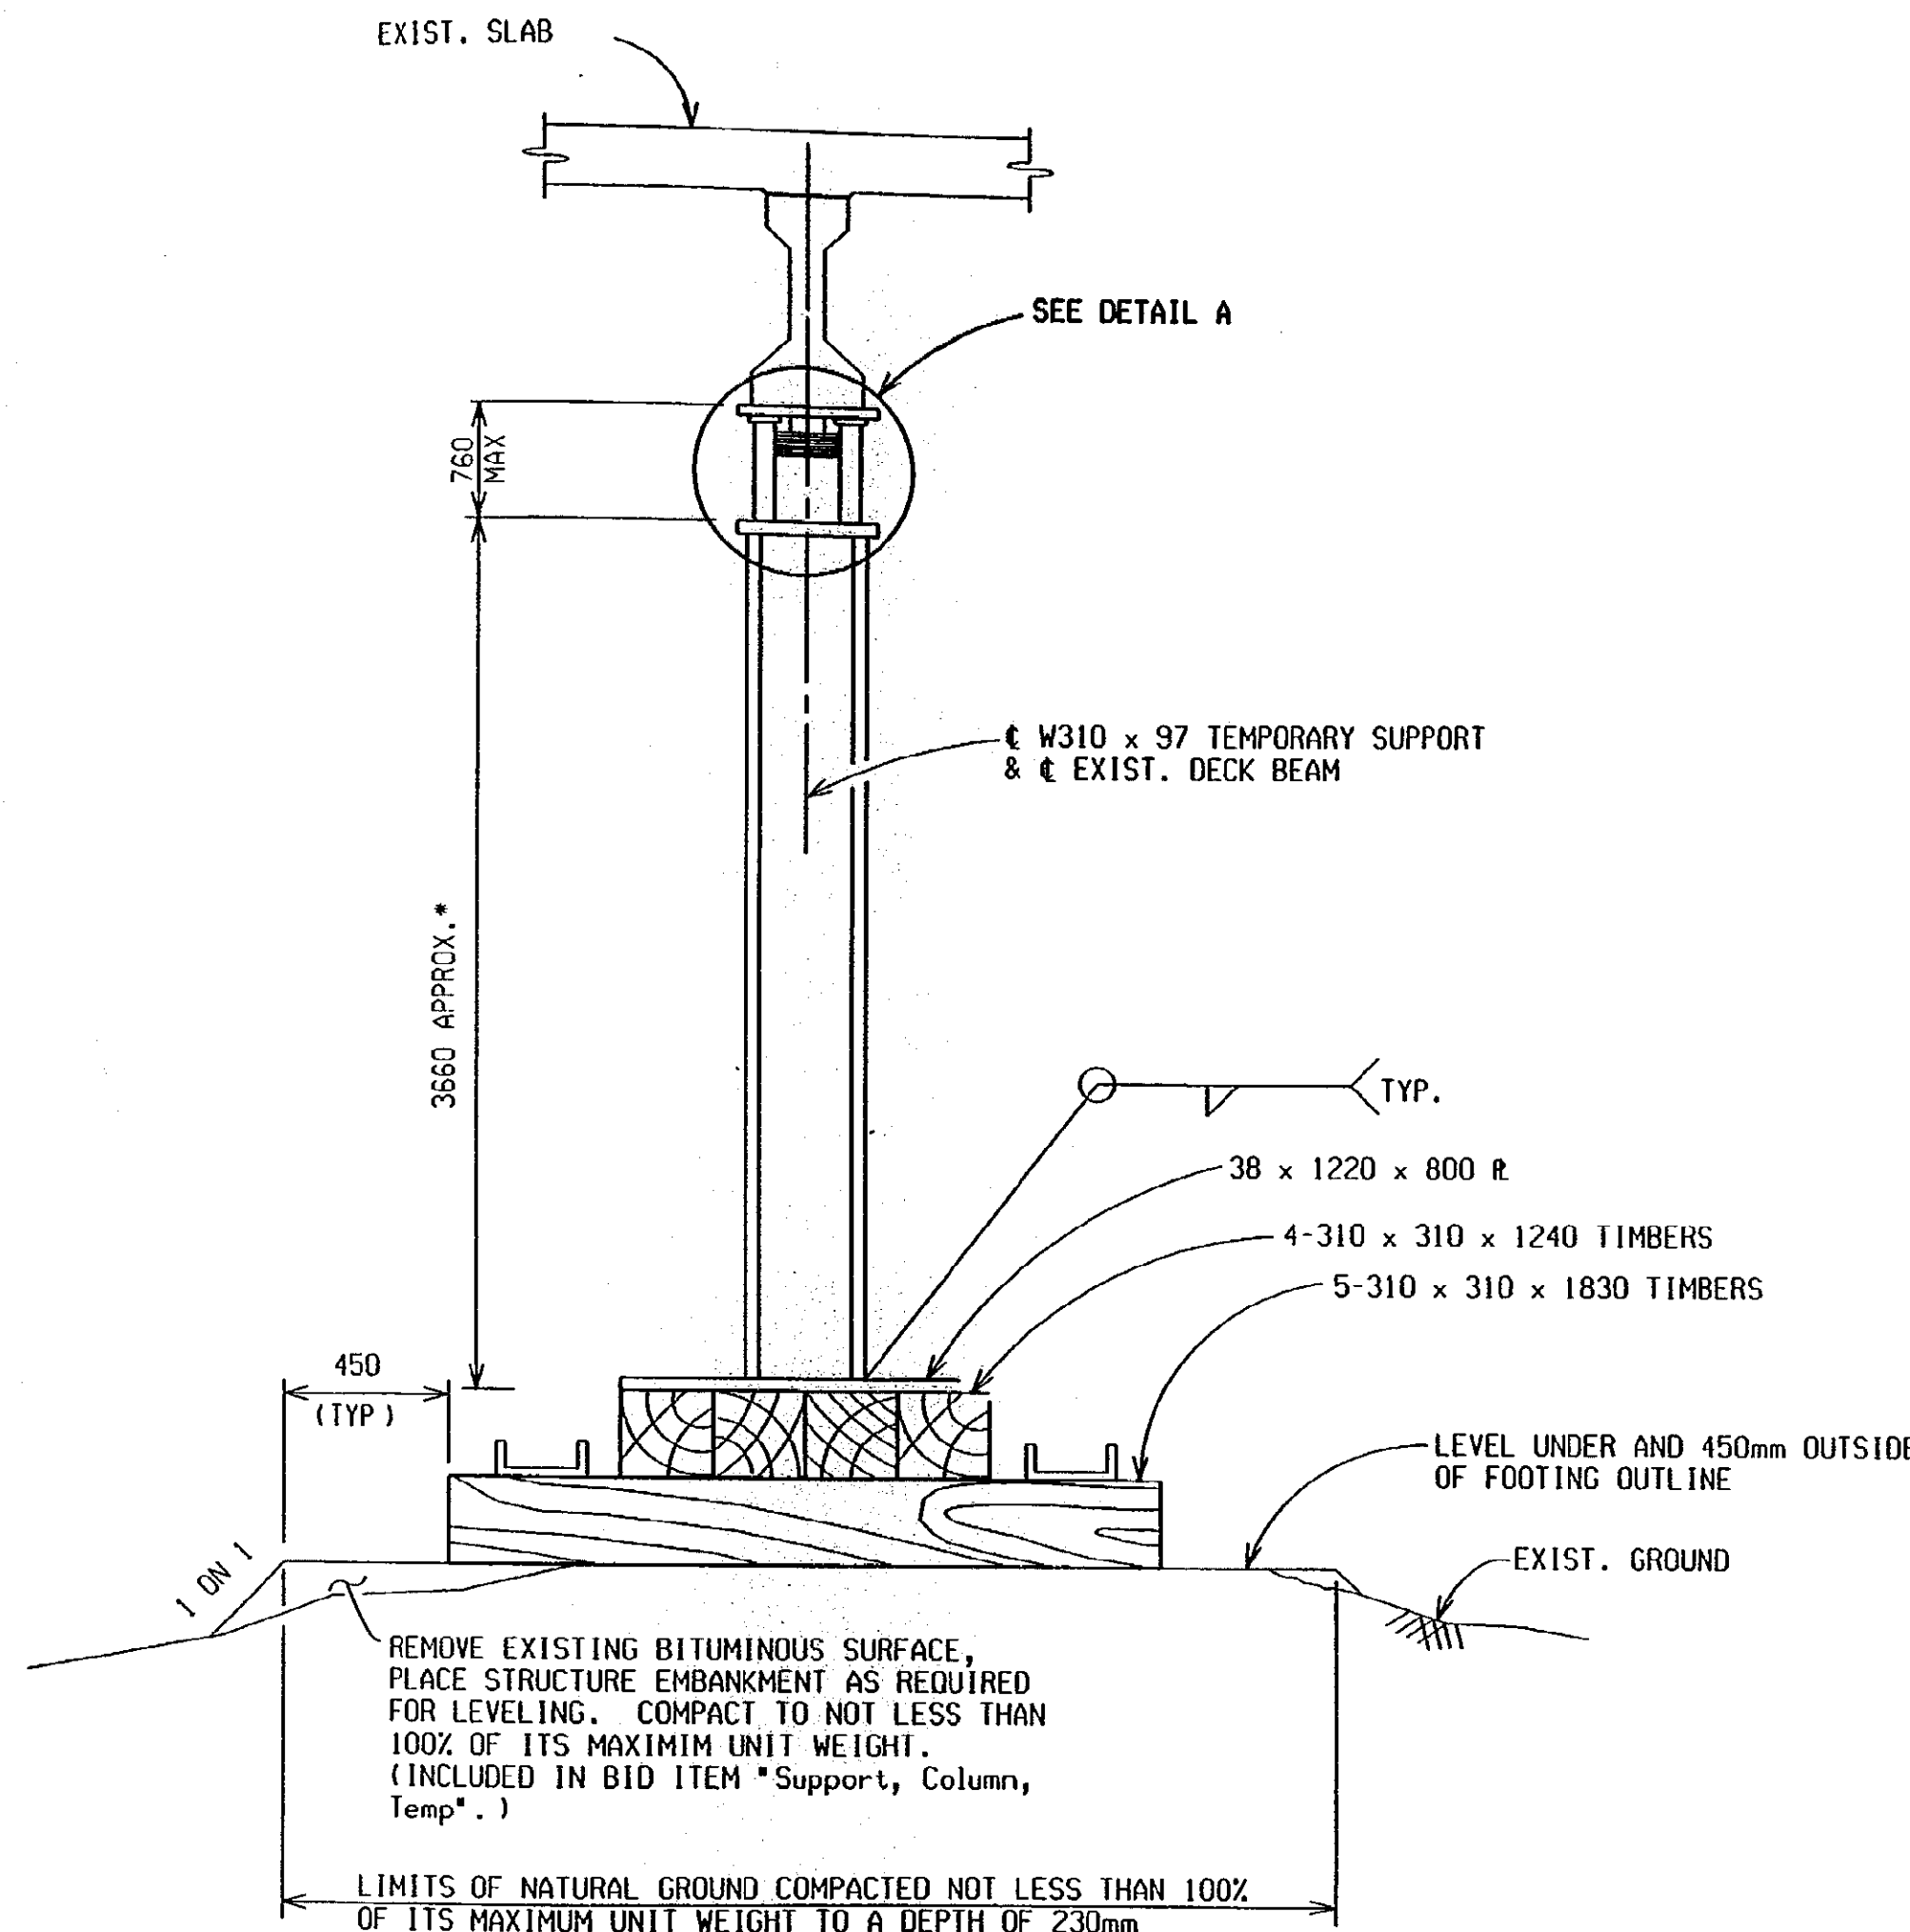


TIMBER FOOTING ON NATURAL GROUND


* EXACT HEIGHT TO BE DETERMINED BY CONTRACTOR. HEIGHT NOT TO EXCEED 4270mm.

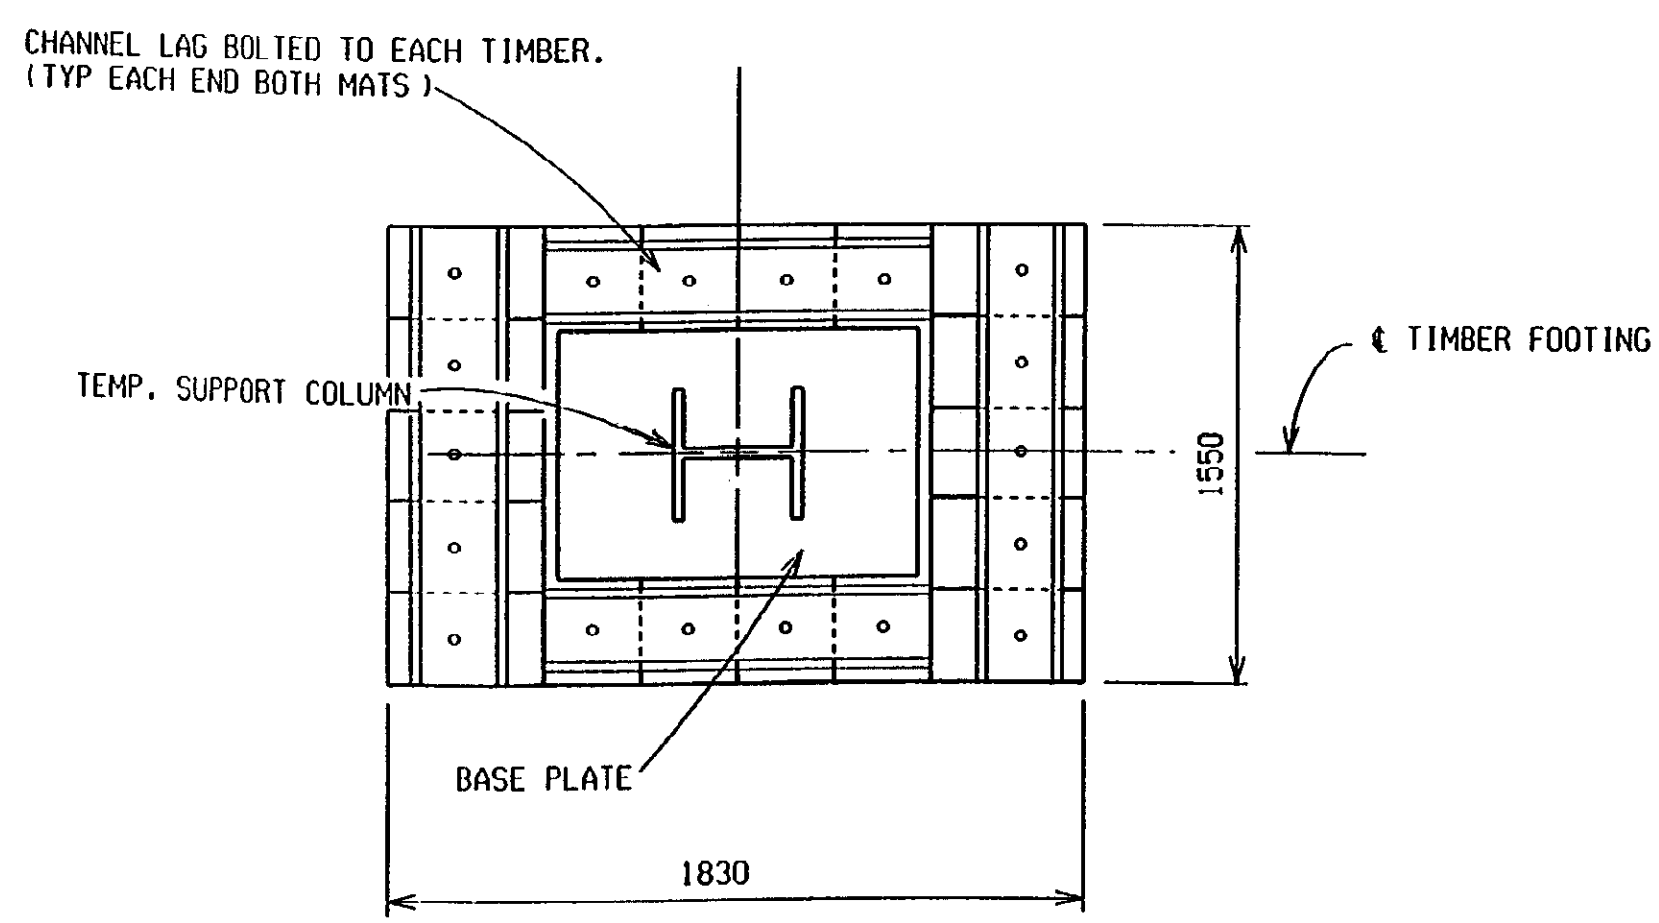

TIMBER FOOTING PLAN

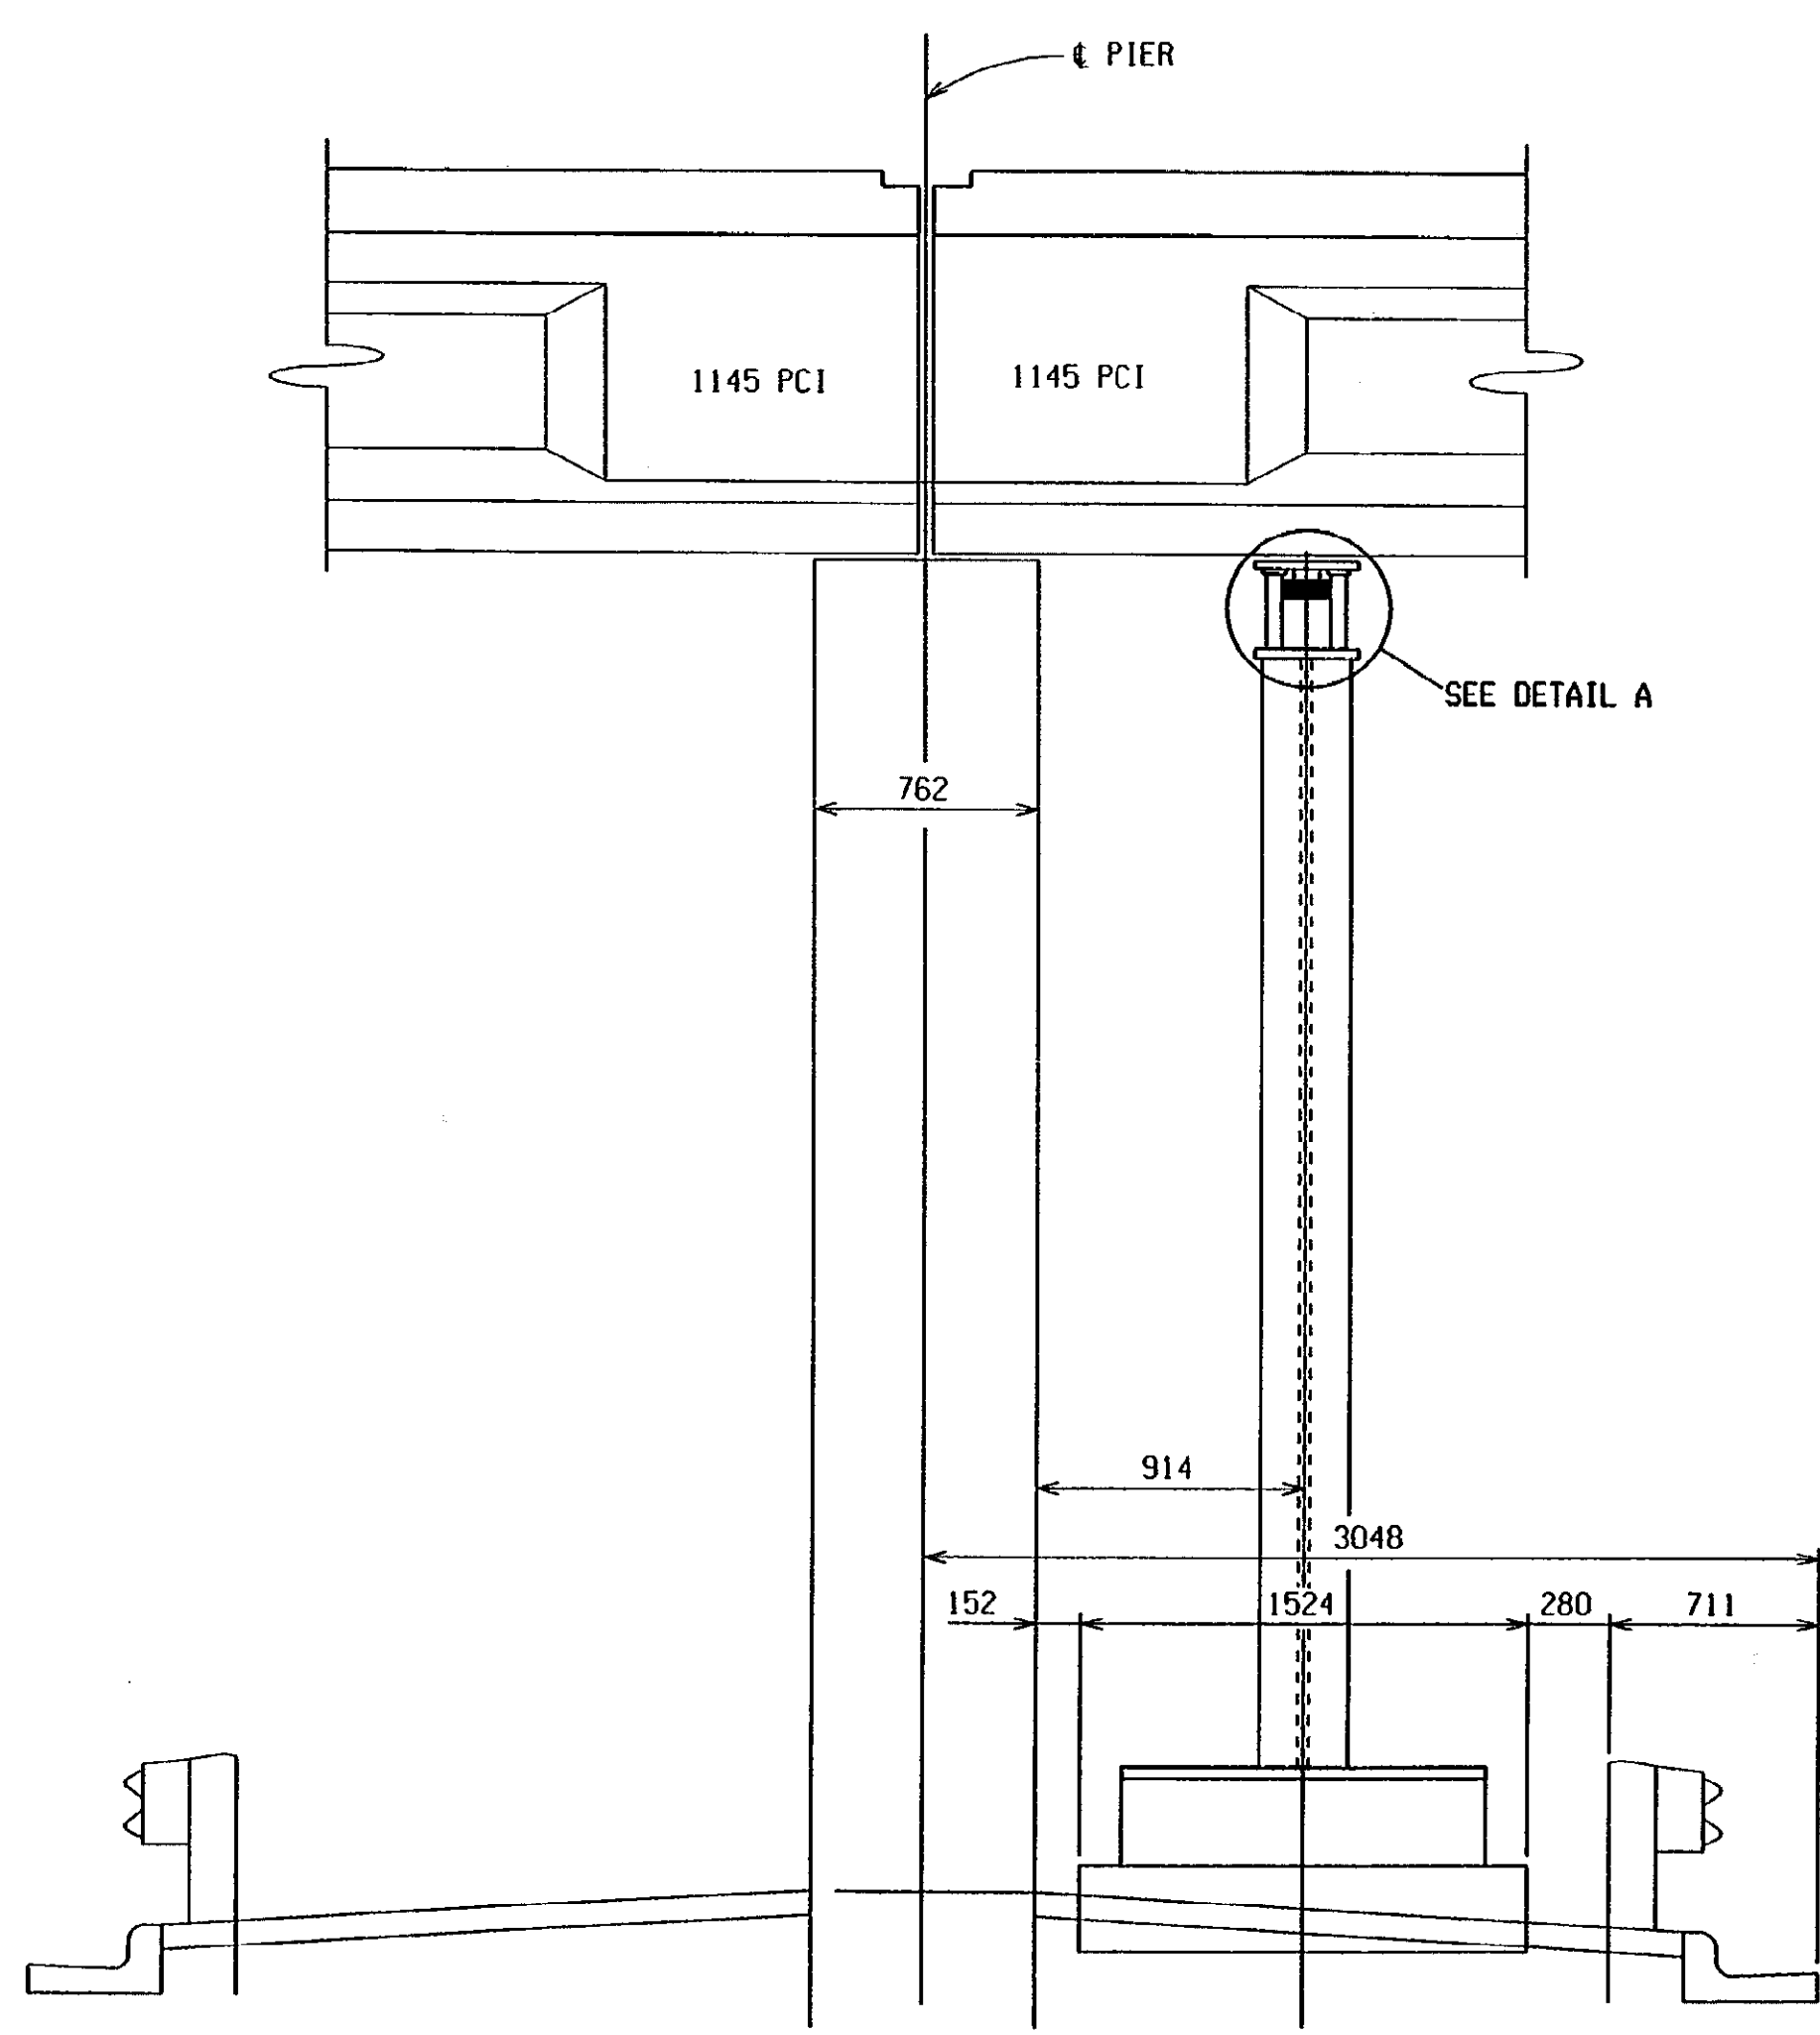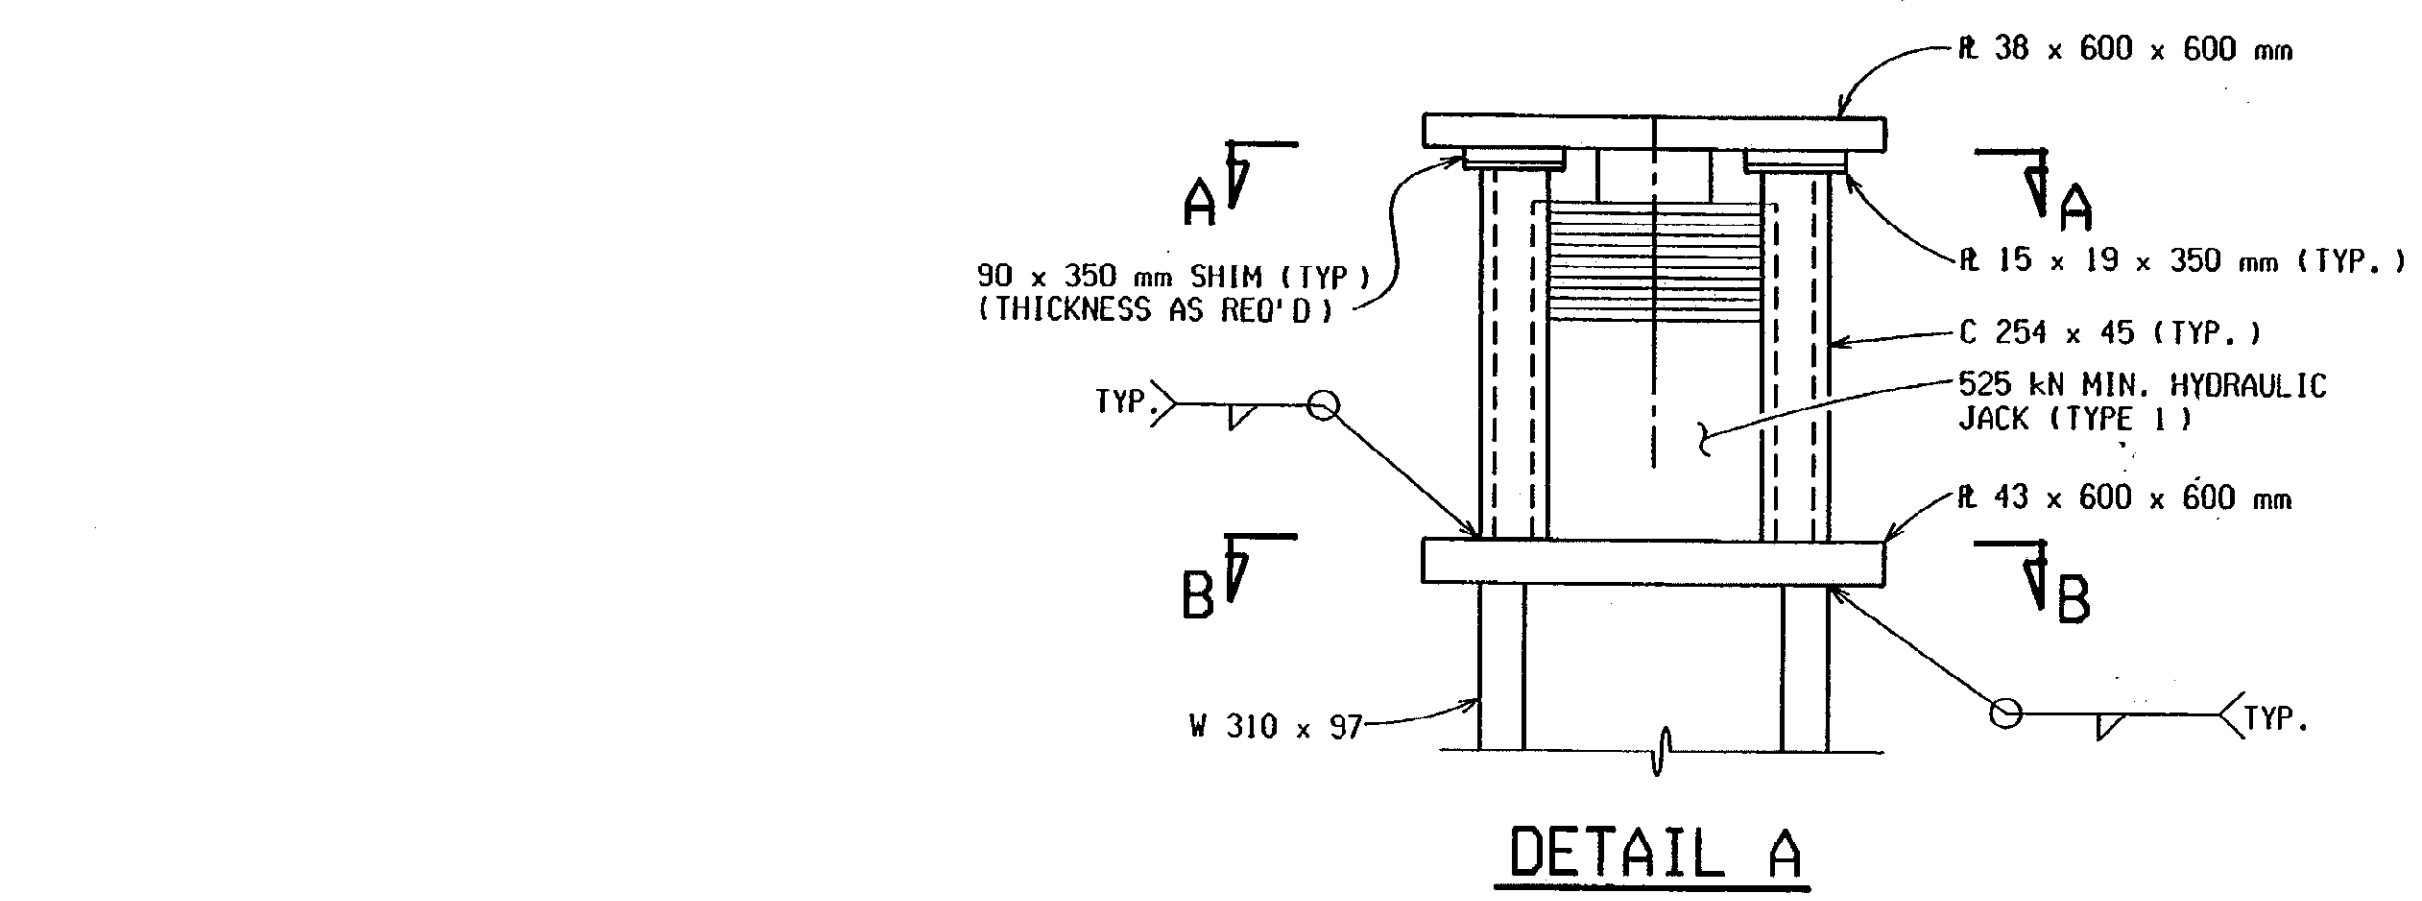


TEMPORARY SUPPORT AT PIER

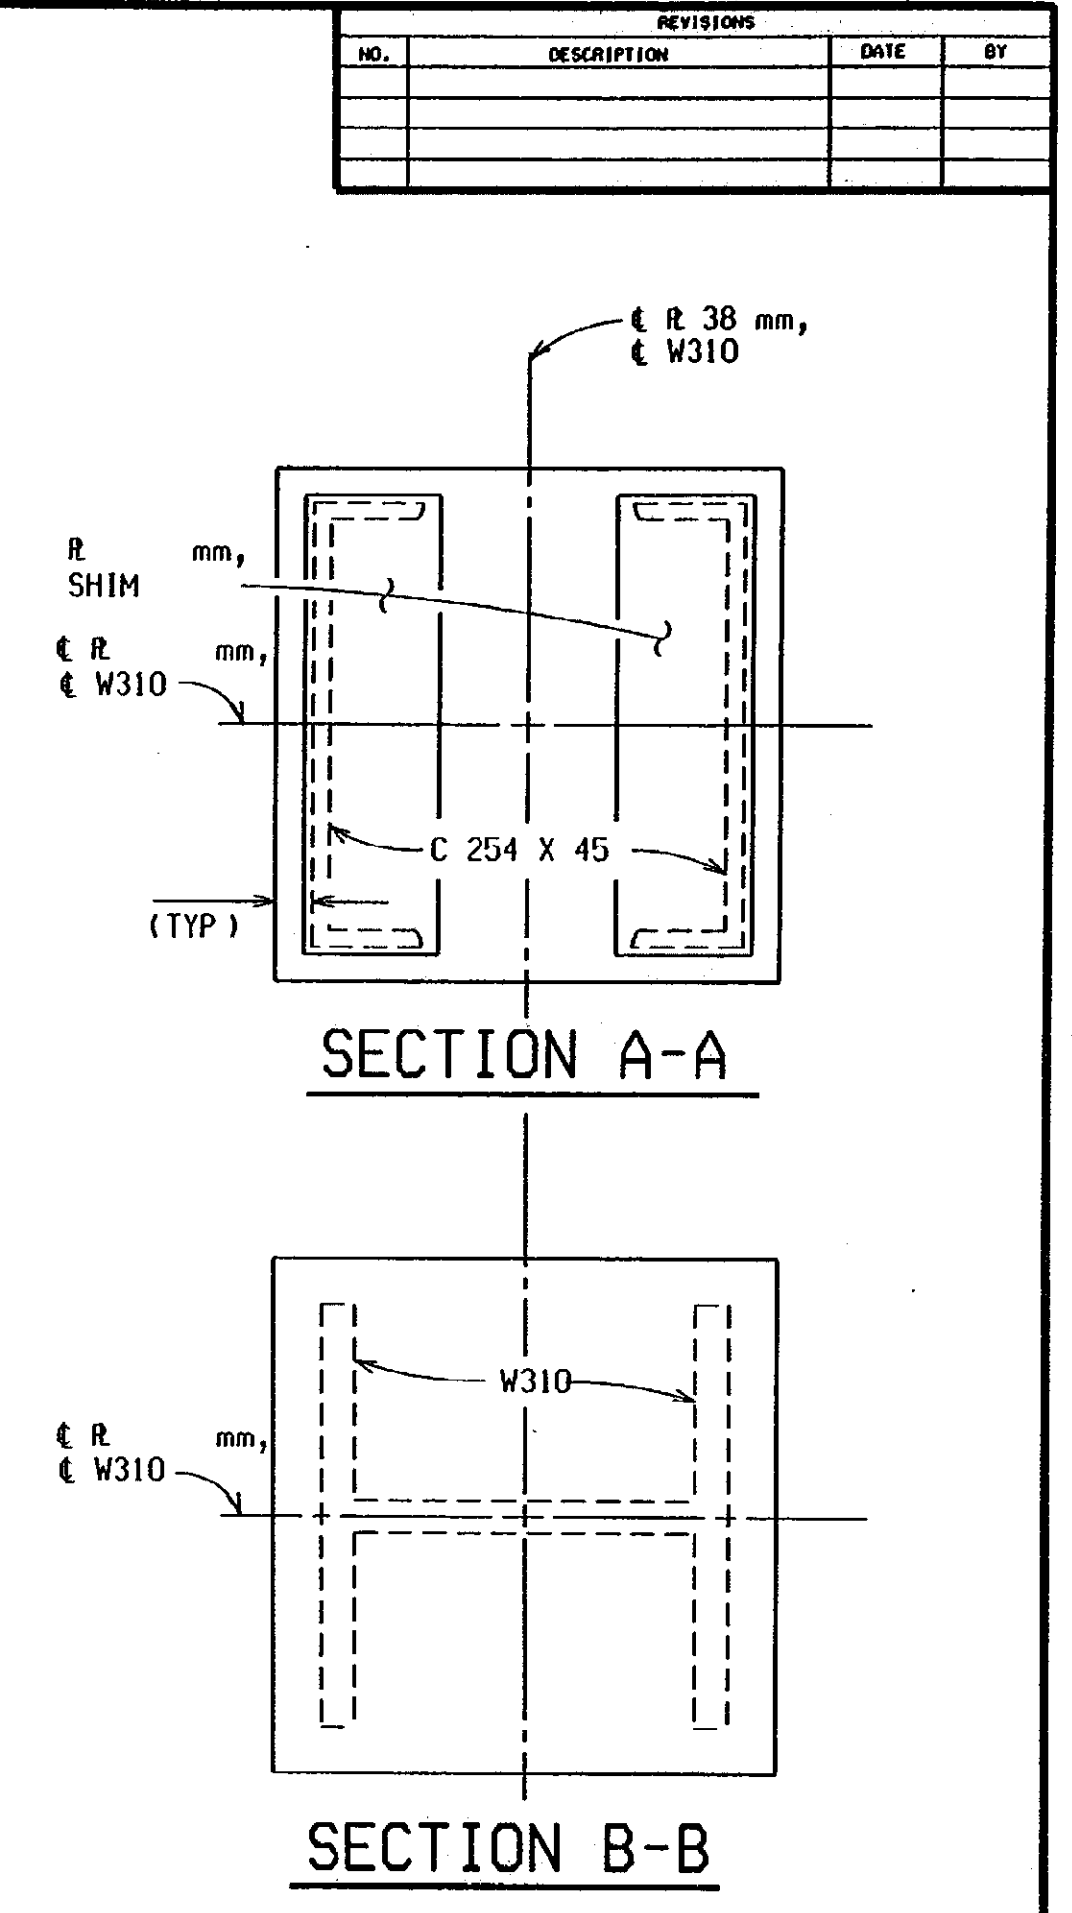


TEMPORARY SUPPORT DETAILS				
NORTH BOUND				
DATE	CONT. SEC.	JOB NO.	DESIGN UNIT	SHEET
1-9-01	S04 OF 63174	49595A	MAHDAVI	9 OF 16




DATE: _____ CORRECTED BY: R.K.OLIN CHECKED BY: _____ DATE: 12/2000 DRAWN BY: R.K.OLIN FILE NAME: s0463174n.br

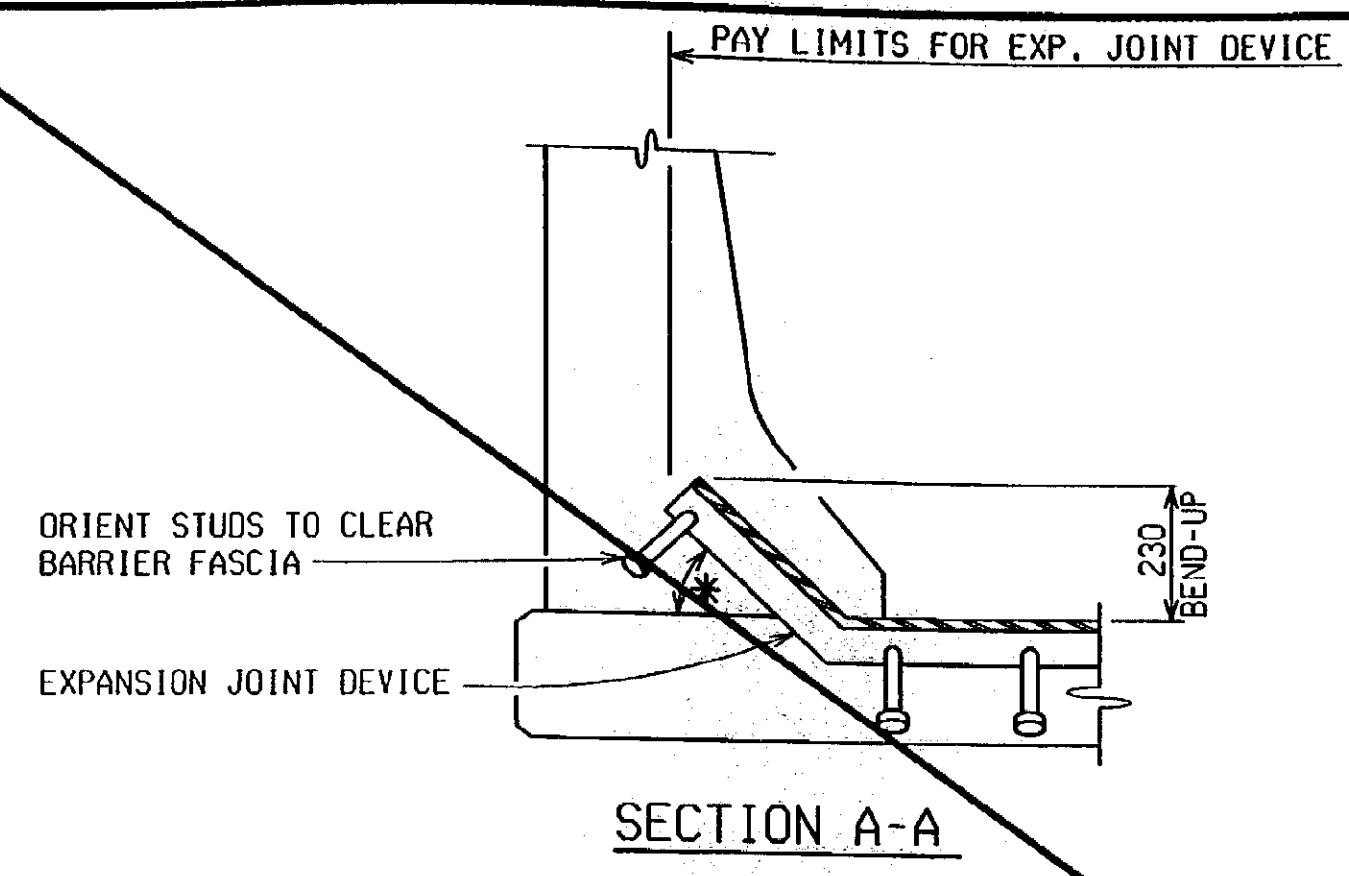


*-FOR ANGLES OF CROSSING FROM 90° TO 45° INCLUSIVE, BEND ANCHORAGE UP 45° ALONG EXPANSION JT. FOR ANGLES OF CROSSING LESS THAN 45°, A SPECIAL ENDING MAY BE REQUIRED.

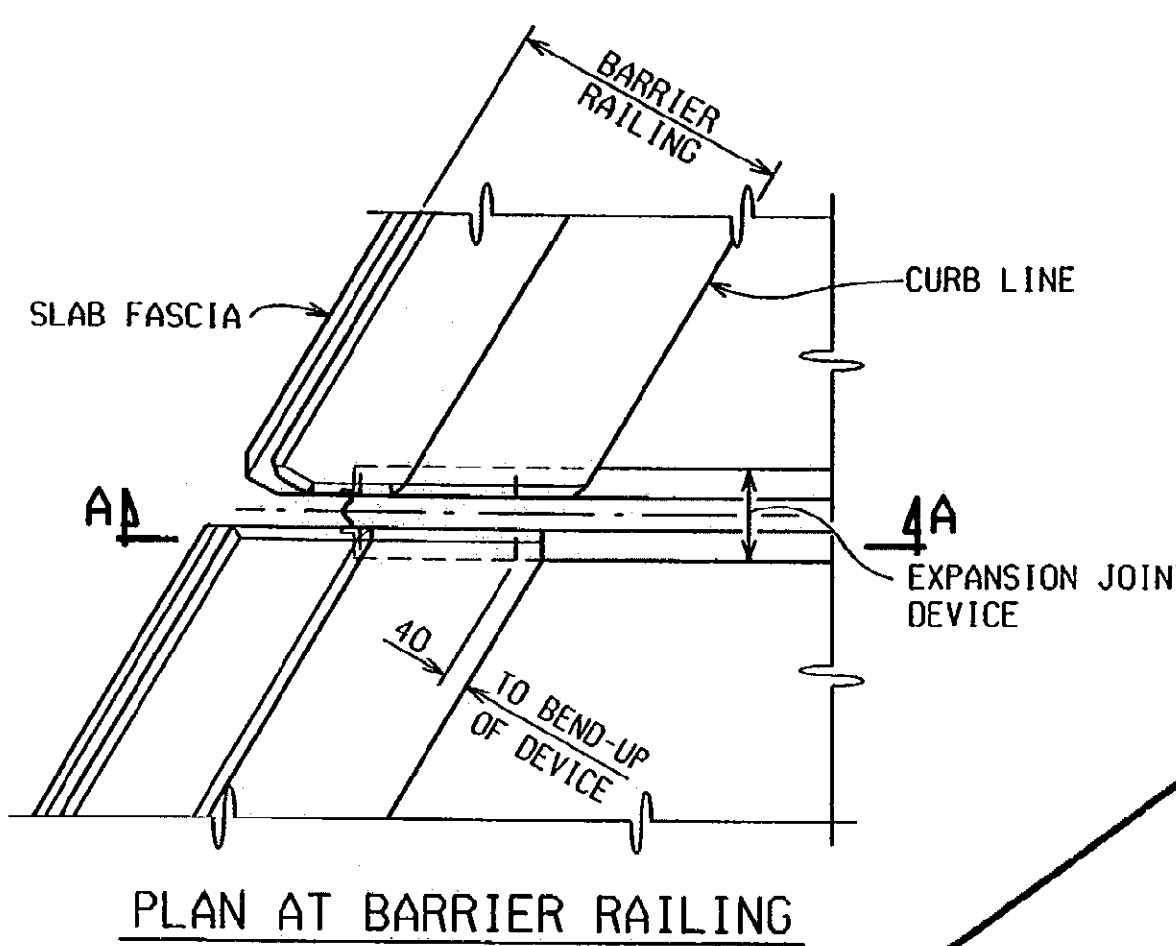

BARRIER TREATMENT

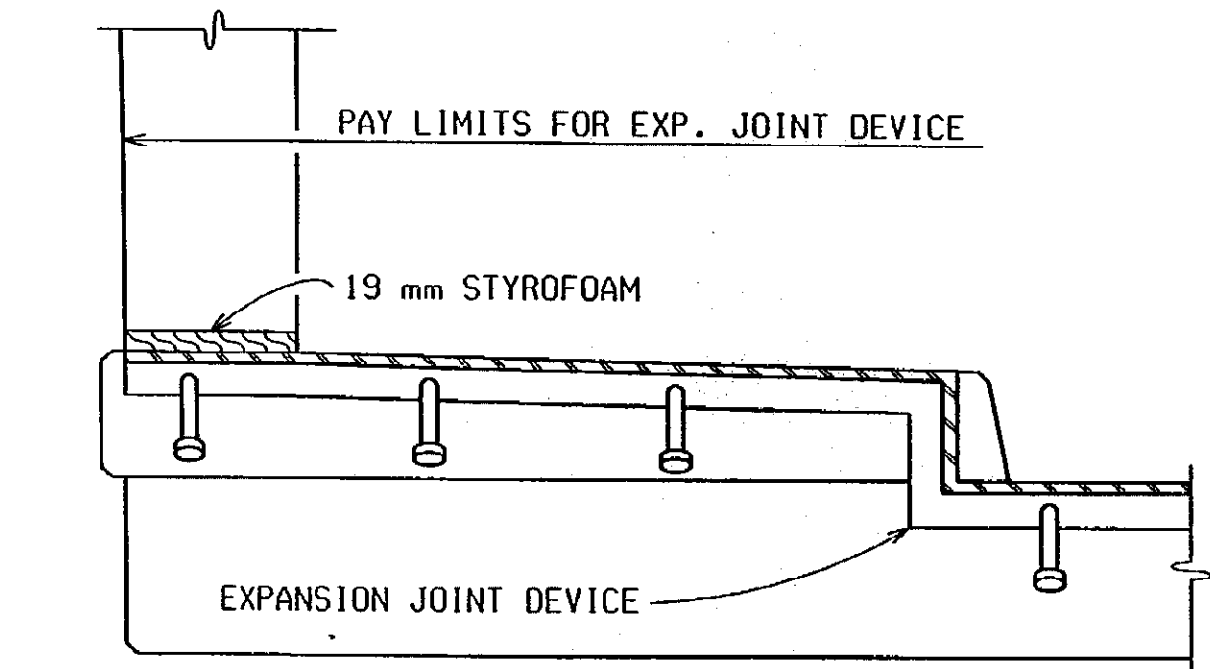


SECTION B-B

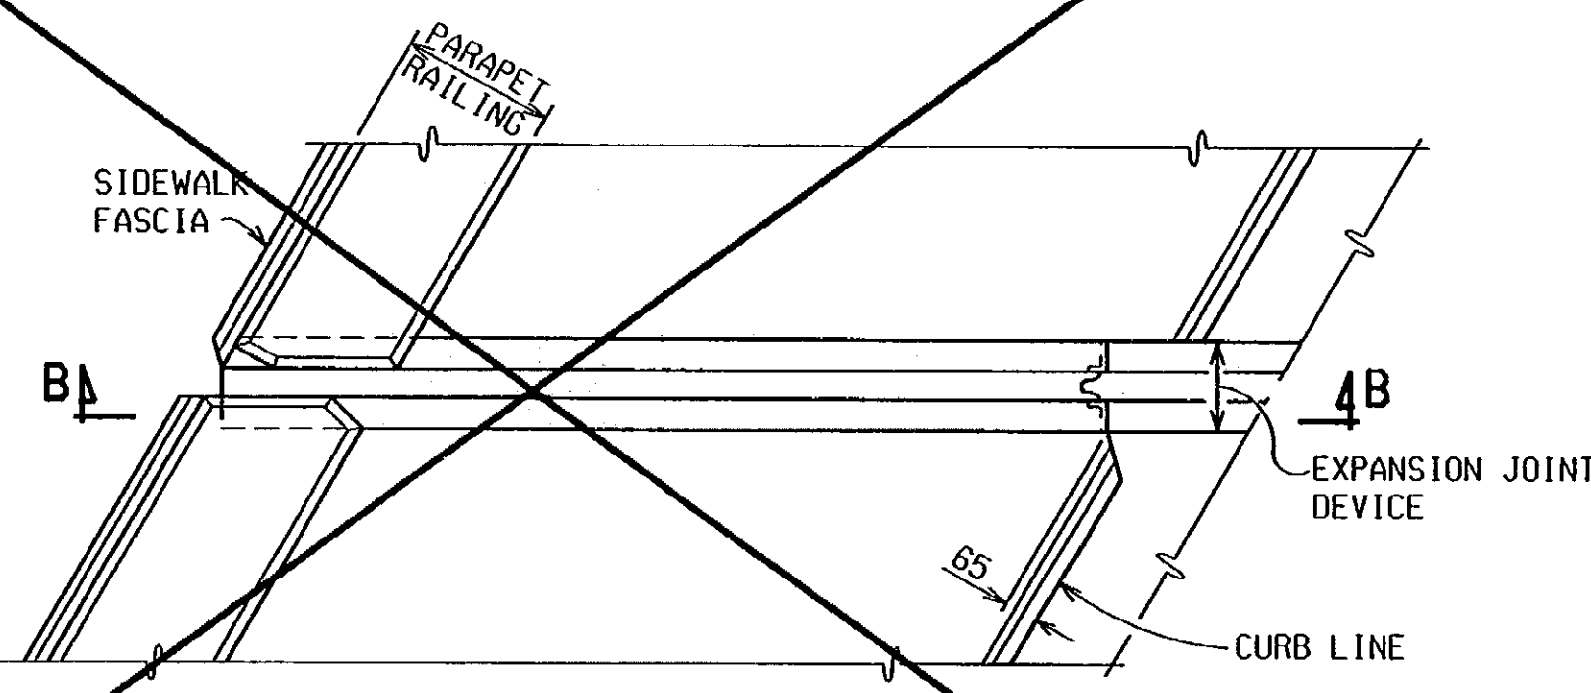


PLAN AT PARAPET RAILING
(DETAILS ARE SIMILAR FOR BRIDGE RAILING, 5 TUBE)

SIDEWALK TREATMENT

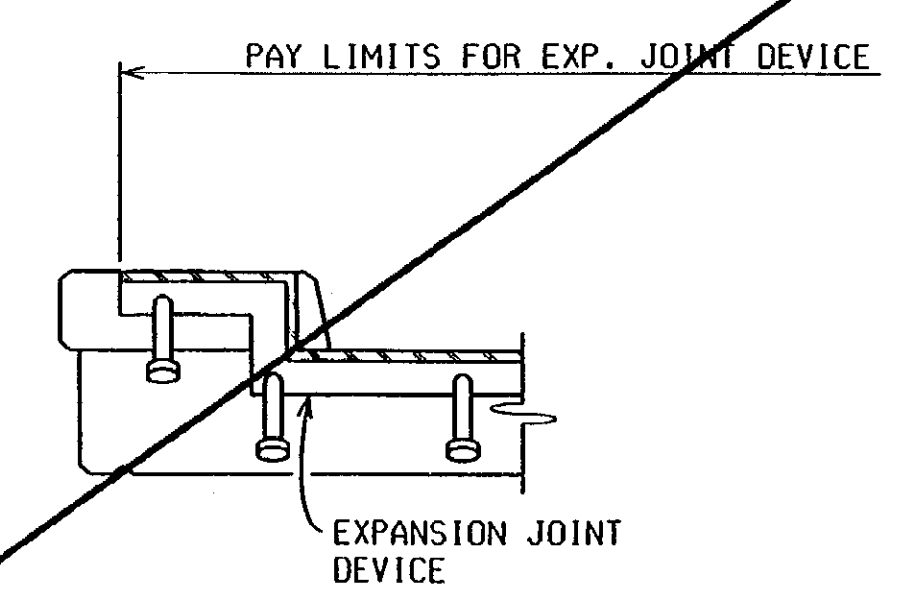


SECTION C-C

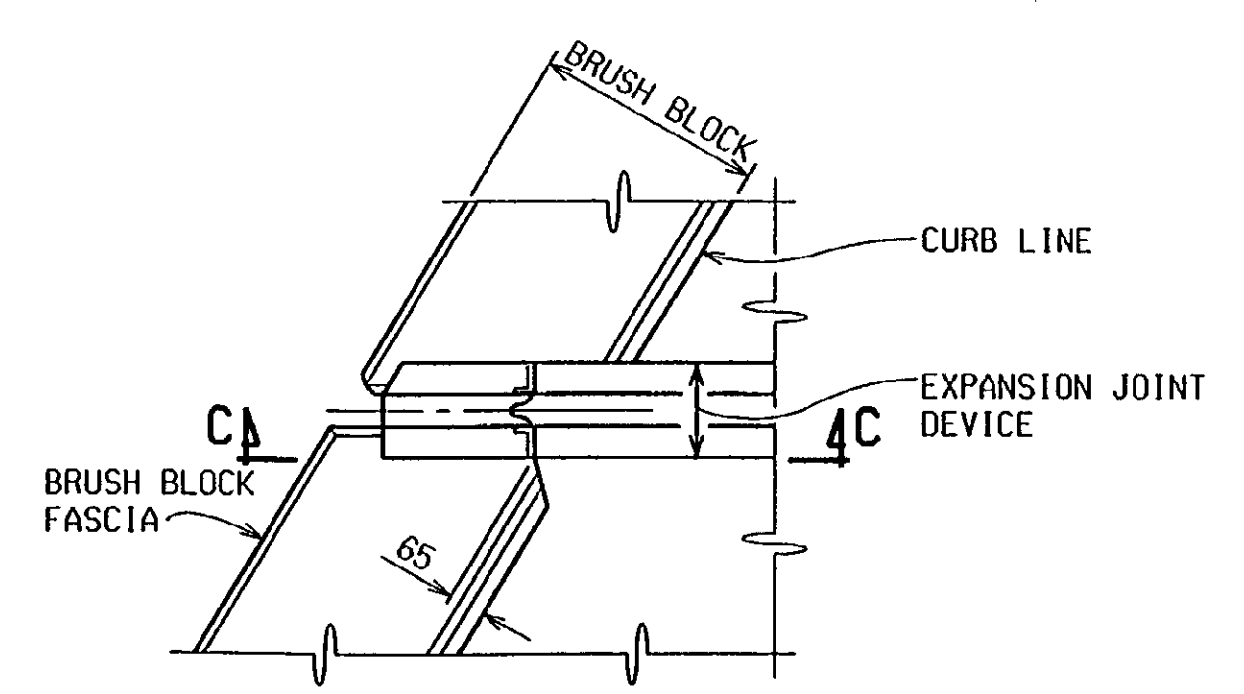

PLAN AT BRIDGE RAILING, 2 TUBE

BRUSH BLOCK TREATMENT

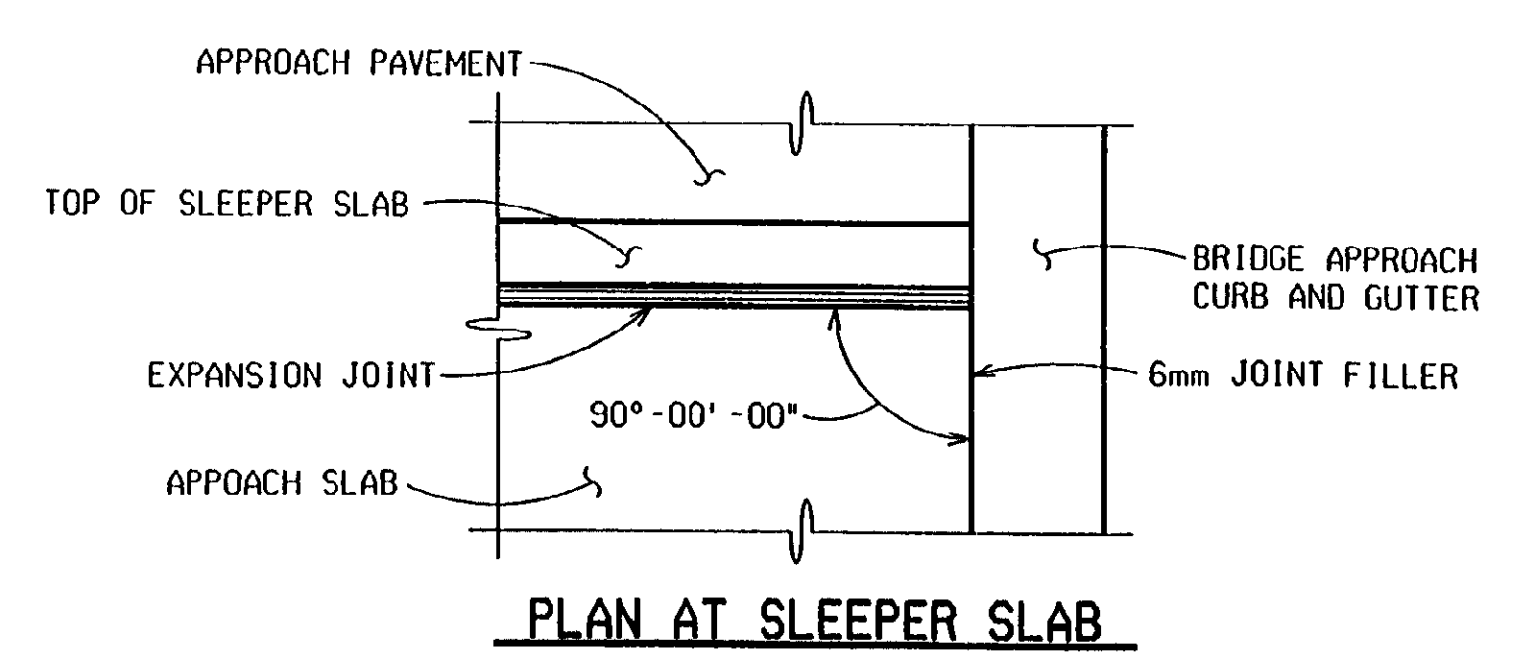

PLAN AT SLEEPER SLAB

STRUCTURE NUMBER	ANGLE OF CROSSING TO NEAREST 10°	LOCATION OF JOINT	MIN. TOT. TRAVEL ALONG CENTERLINE OF BRIDGE	REQUIRED LENGTH OF EXPANSION JOINT DEVICE
S04	90	SLEEPER SLAB	25mm	16
S04	90	SLEEPER SLAB	25mm	16

REVISIONS			
NO.	DESCRIPTION	DATE	BY

NOTES:

JOINT TYPES:

THE EXPANSION JOINT DEVICE SHALL BE OF A TYPE THAT INCLUDES A CONTINUOUS NEOPRENE (OR EQUIVALENT) SEAL ACROSS THE DECK. UNLESS OTHERWISE NOTED ON THE PLANS, THE CONTRACTOR HAS THE OPTION OF USING ANY OF THE DEVICES LISTED BELOW:

DEVICE	MANUFACTURER
WABO STRIP SEAL	WATSON-BOWMAN & ACME, INC.
PRO-SPAN	FEL-PRO, INC.
STEEFLEX-SSA2	D.S. BROWN
STEEFLEX-SSCM	D.S. BROWN
STEEFLEX-RS	D.S. BROWN
ONFLEX 40 SS	STRUCTURAL RUBBER PRODUCTS CO.
STRUPCO 400L	STRUCTURAL RUBBER PRODUCTS CO.

THE MODEL OF THE JOINT TYPE SELECTED SHALL BE SUITABLE TO ACCOMMODATE THE TOTAL MOVEMENT NOTED ON THE PLANS.

COMPLETE WORKING DRAWINGS OF ALL DETAILS OF FABRICATION OF THE EXPANSION JOINT DEVICE SHALL BE SUBMITTED FOR REVIEW IN ACCORDANCE WITH STANDARD SPECIFICATION 104.02. THIS REQUIREMENT IS WAIVED FOR EXPANSION JOINT DEVICES FOR WHICH A SET OF STANDARD INSTALLATION DETAILS HAS BEEN APPROVED. STANDARD INSTALLATION DETAILS CAN BE OBTAINED FROM THE DESIGN DIVISION.

FABRICATION AND INSTALLATION:

THE EXPANSION JOINT SHALL BE SHOP FABRICATED TO CONFORM TO THE CONTOUR OF THE BRIDGE DECK, BARRIERS, ETC. IT SHALL BE INSTALLED IN ACCORDANCE WITH MANUFACTURER'S RECOMMENDATIONS SUBJECT TO NOTES HEREIN AND THE APPROVAL OF THE ENGINEER.

THE TOP OF THE ELASTOMERIC JOINT DEVICE SHALL BE SET 3 - 6 mm BELOW THE CONCRETE SLAB (PAVEMENT) WITH A TOLERANCE OF ± 3 mm.

THE STEEL ANCHORAGE FOR STRIP SEAL GLANDS SHALL BE HOT DIP GALVANIZED IN ACCORDANCE WITH SUBSECTION 707.16 OF THE STANDARD SPECIFICATIONS.

THE PRO-SPAN DEVICE MUST INCORPORATE A CAST-IN-PLACE STEEL SEAT.

THE AREA OF THE STEEL ANCHORAGE AND SEALING GLAND WHICH WILL BE IN CONTACT WITH A SEALANT, OR LUBRICANT-ADHESIVE SHALL BE CLEANED WITH TOLUENE OR OTHER APPROVED SOLVENT.

WHERE THE SEALING GLAND IS LOCKED INTO A STEEL ANCHORAGE, A LUBRICANT-ADHESIVE CONFORMING TO STANDARD SPECIFICATION 914.4-E SHALL BE REQUIRED BETWEEN THE SEAL AND STEEL ANCHORAGE.

ALL BOLT WELL CAVITIES SHALL BE FILLED WITH AN APPROVED FLEXIBLE EPOXY OR A SEALANT CONFORMING TO FEDERAL SPECIFICATION TT-S-00230C.

IN THE EVENT THAT THE CONSTRUCTION SEQUENCE REQUIRES SPLICING THE SEALING GLAND, IT SHALL BE SPLICED BY AN APPROVED METHOD (SUCH AS COLD VULCANIZATION) BY A TRAINED REPRESENTATIVE OF THE MANUFACTURER.


DETAILS AT CURBS OR BARRIERS:

THE DETAILS ON THIS SHEET SHOW AN APPROVED MEANS OF TERMINATING THE EXPANSION JOINT DEVICE AT CURBS OR BARRIERS. VARIATIONS OR ALTERNATIVE SCHEMES WILL BE CONSIDERED AND MAY BE USED IF APPROVED BY THE ENGINEER.

MATERIALS:

THE COST OF ALL MATERIALS AND LABOR REQUIRED FOR PROPER INSTALLATION OF THE EXPANSION JOINT AND THE TERMINAL ASSEMBLIES AT THE CURBS, SIDEWALKS, OR BARRIERS IS INCLUDED IN THE PAYMENT FOR THE EXPANSION JOINT DEVICE.

ITEM	QUANTITY	UNIT	AMOUNT
EXPANSION JOINT DEVICE		m	32

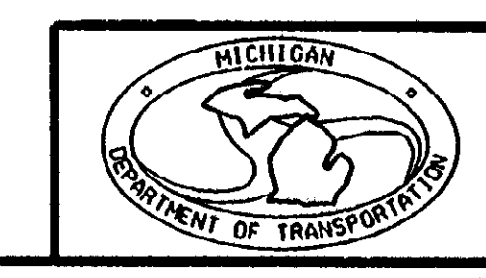

EXPANSION JOINT DETAILS - NB STRUCTURE

DATE	CONT. SEC.	JOB NO.	DESIGN UNIT	SHEET
1-9-01	S04 OF 63174	49595A	MAHDAVI	10 OF 16

EJ3T (11-17-97)

REVISIONS			
NO.	DESCRIPTION	DATE	BY

POUR	AMT (m3)
A	2.8
B	2.8
C	3.2
D	3.2
TOTAL CONC.:	12 m3


POUR	AMT (m3)
E	19.4
F	15.8
G	20.0
H	15.8
J	19.4
K	21.8
L	17.7
M	22.6
N	17.7
P	21.8
TOTAL CONC.:	192 m3

86	m	Bridge Barrier Railing, Type 4
192	m3	Bridge Ltg, Oper and Maintain
1	LS	Bridge Ltg, Furn and Rem (S04-NB)
1	LS	Superstructure Conc, Form, Finish and Cure, Night Casting (S04-NB)
50	m	Underdrain, Fdn, 100mm
2	ea	Underdrain, Outlet Ending, 100mm
1	LS	Superstructure Conc, Form, Finish and Cure (S04-NB)
* 2	m3	Hand Chipping, Other Than Deck
* 20	m2	Patch, Forming
* 2	m3	Patching Conc, LM

* SUBSTRUCTURE REPAIR AS DIRECTED BY THE ENGINEER.

NOTES:

- ES DENOTES EACH SIDE.
- FS DENOTES FAR SIDE.
- NS DENOTES NEAR SIDE.
- FOR NAME PLATE LOCATION, SEE GENERAL PLAN OF STRUCTURE SHEET.
- *EDGE* OR *GROOVE* DENOTES EDGING OR GROOVING WITH AN APPROVED TOOL.
- FOR BRIDGE RAILING, ANCHORAGE FOR GUARDRAIL, NAME PLATE MOUNTING, MOLDING AND BEVEL DETAILS, SEE STANDARD SHEET B-17 AND B-103. BARRIER RAILING IS TO BE BRIDGE BARRIER RAILING, TYPE 4.
- THIS DECK POUR IS DESIGNATED A NIGHT POUR, AND THEREFORE SUBJECT TO THE RESTRICTIONS OF SECTION 706.03J OF THE STANDARD SPECIFICATIONS.
- NO PORTION OF THE DECK FORMWORK SHALL ENCRANCH ON THE EXISTING UNDERCLEARANCE.
- WHERE CAST-IN-ANCHORAGE IS USED FOR EXPANSION JOINT DEVICES, IT IS RECOMMENDED THAT THE PLACING OF DECK CONCRETE PROGRESS TOWARD THE JOINT SO THAT THE EFFECTS OF DEAD LOAD DEFLECTION WILL OCCUR BEFORE CONCRETE IS PLACED AT THE ANCHORAGE.
- THE CONTRACTOR MAY USE METAL STAY IN PLACE FORMS. IF USED, ELIMINATING THE POLYSTYRENE AND FILLING THE CORRUGATIONS WITH CONCRETE IS PROHIBITED.
- THE CONTRACTOR IS TO PROVIDE A SAWED JOINT 12mm DEEP BY 3mm WIDE (MINIMUM) IN THE TOP OF SLAB AT LONGITUDINAL AND TRANSVERSE CONSTRUCTION JOINTS. THE JOINT IS TO BE SAWED BEFORE CASTING OF BARRIERS AND IS TO BE FILLED WITH HOT-POURED JOINT SEALANT OR COLD-APPLIED JOINT SEALANT, SINGLE COMPONENT TYPE IN ACCORDANCE WITH STANDARD SPECIFICATION SUBSECTION 9.14.04. (INCLUDED IN THE BID ITEM *SUPERSTRUCTURE CONC, FORM, FINISH AND CURE, NIGHT CASTING (S04-NB)*.
- ALPHABETICAL DESIGNATION OF DECK POURS IS NOT A POUR SEQUENCE. CAST DECK POURS OVER PIERS AFTER OTHER DECK POURS HAVE BEEN CAST.
- THE CONTRACTOR SHALL PROVIDE TEMPORARY SUPPORTS FOR THE DECK FASCIA OVERHANG FORMS TO ACHIEVE ZERO DEFLECTIONS IN THE DECK. THE CONTRACTOR SHALL SUBMIT THE DESIGN AND DETAILS FOR THE TEMPORARY SUPPORTS TO THE ENGINEER FOR REVIEW AND APPROVAL, 15 WORKING DAYS PRIOR TO START OF THE DECK POURS. INCLUDED IN THE BID ITEM *SUPERSTRUCTURE CONC, FORM, FINISH AND CURE, NIGHT CASTING (S04-NB)*.

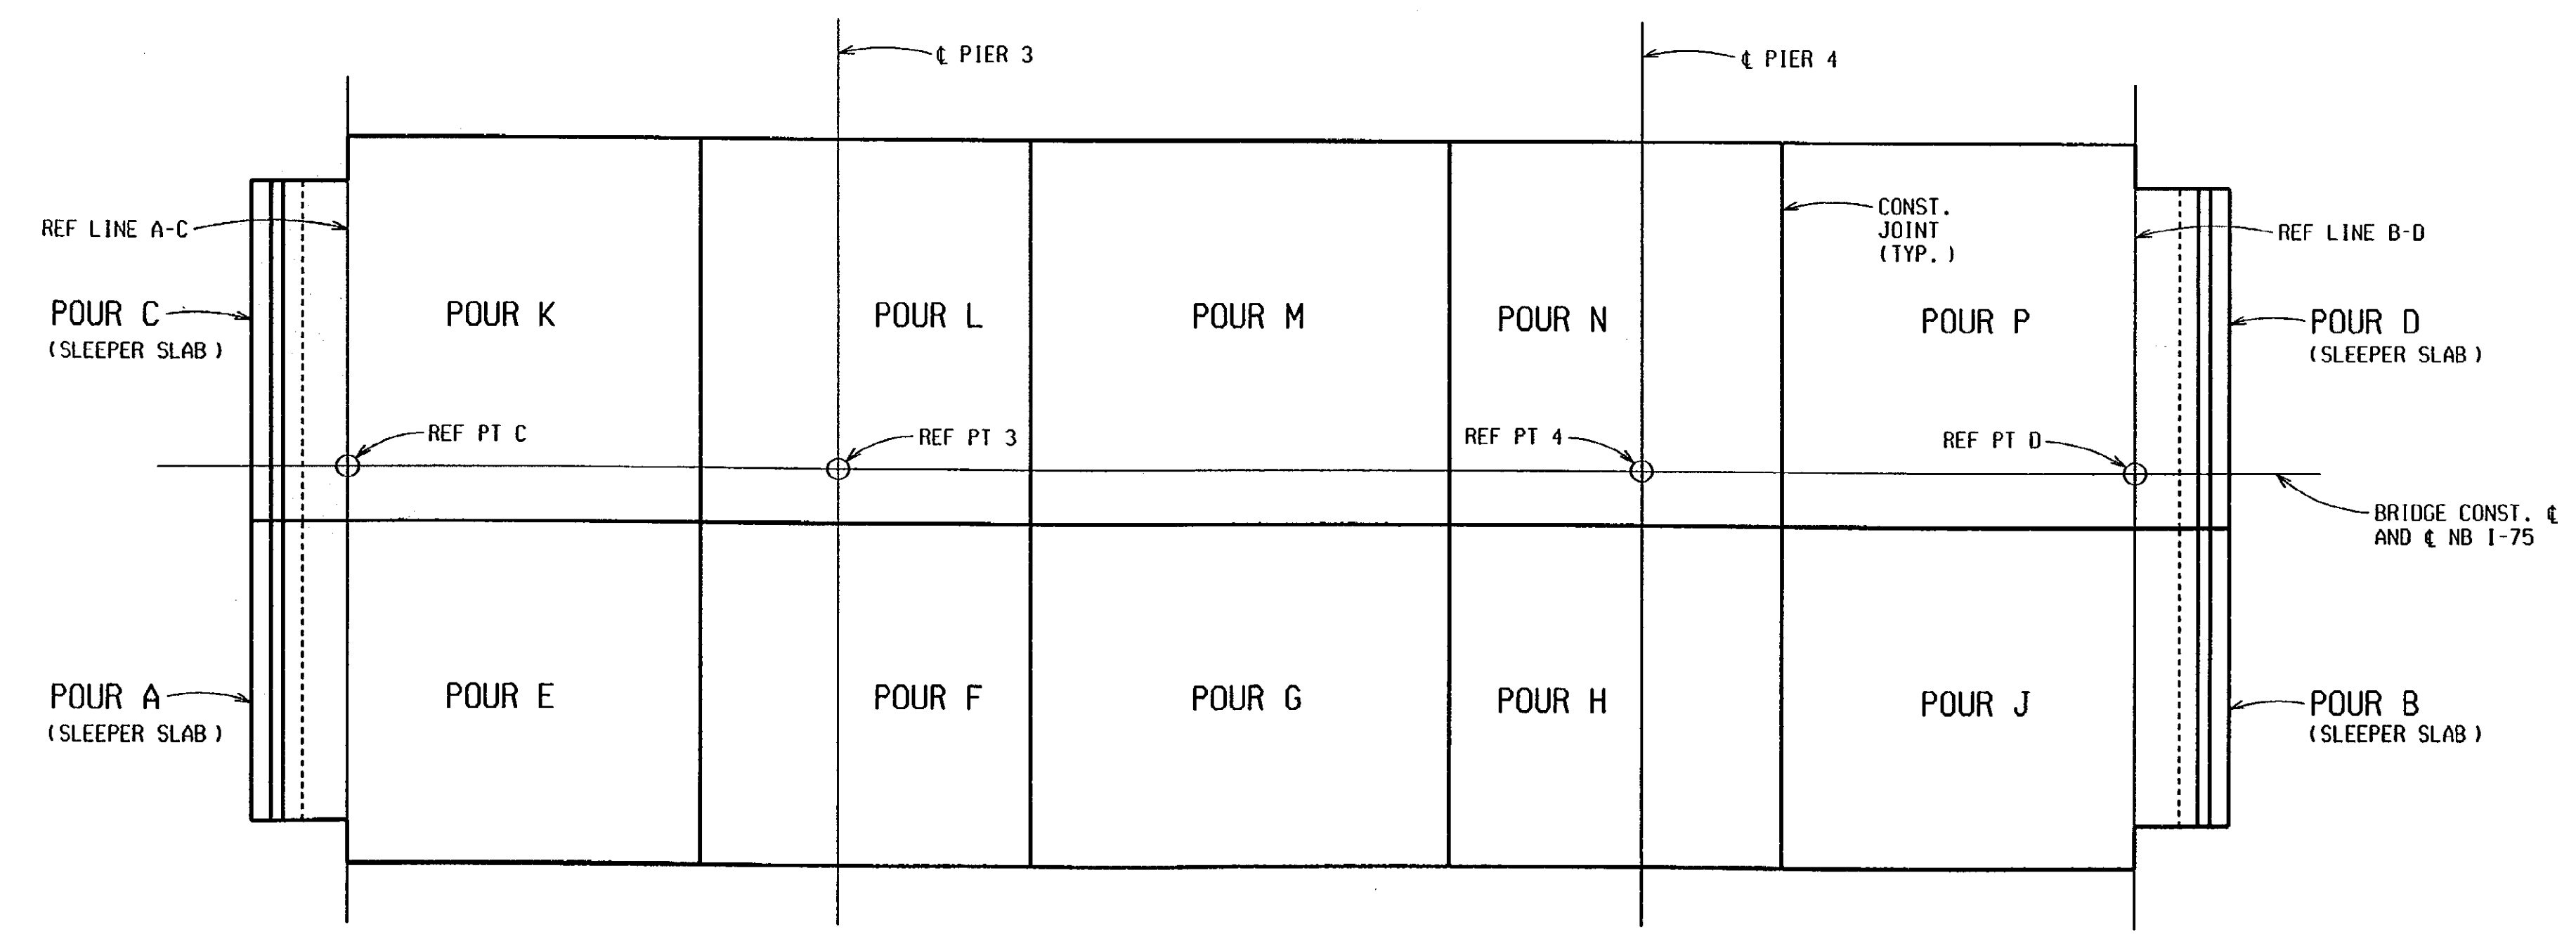


POUR DIAGRAM




DECK REPLACEMENT DETAILS - NB STRUCTURE				
DATE	CONT. SEC.	JOB NO.	DESIGN UNIT	SHEET
1-9-01	S04 OF 63174	49595A	MAHDAVI	11 OF 16

REVISIONS			
NO.	DESCRIPTION	DATE	BY

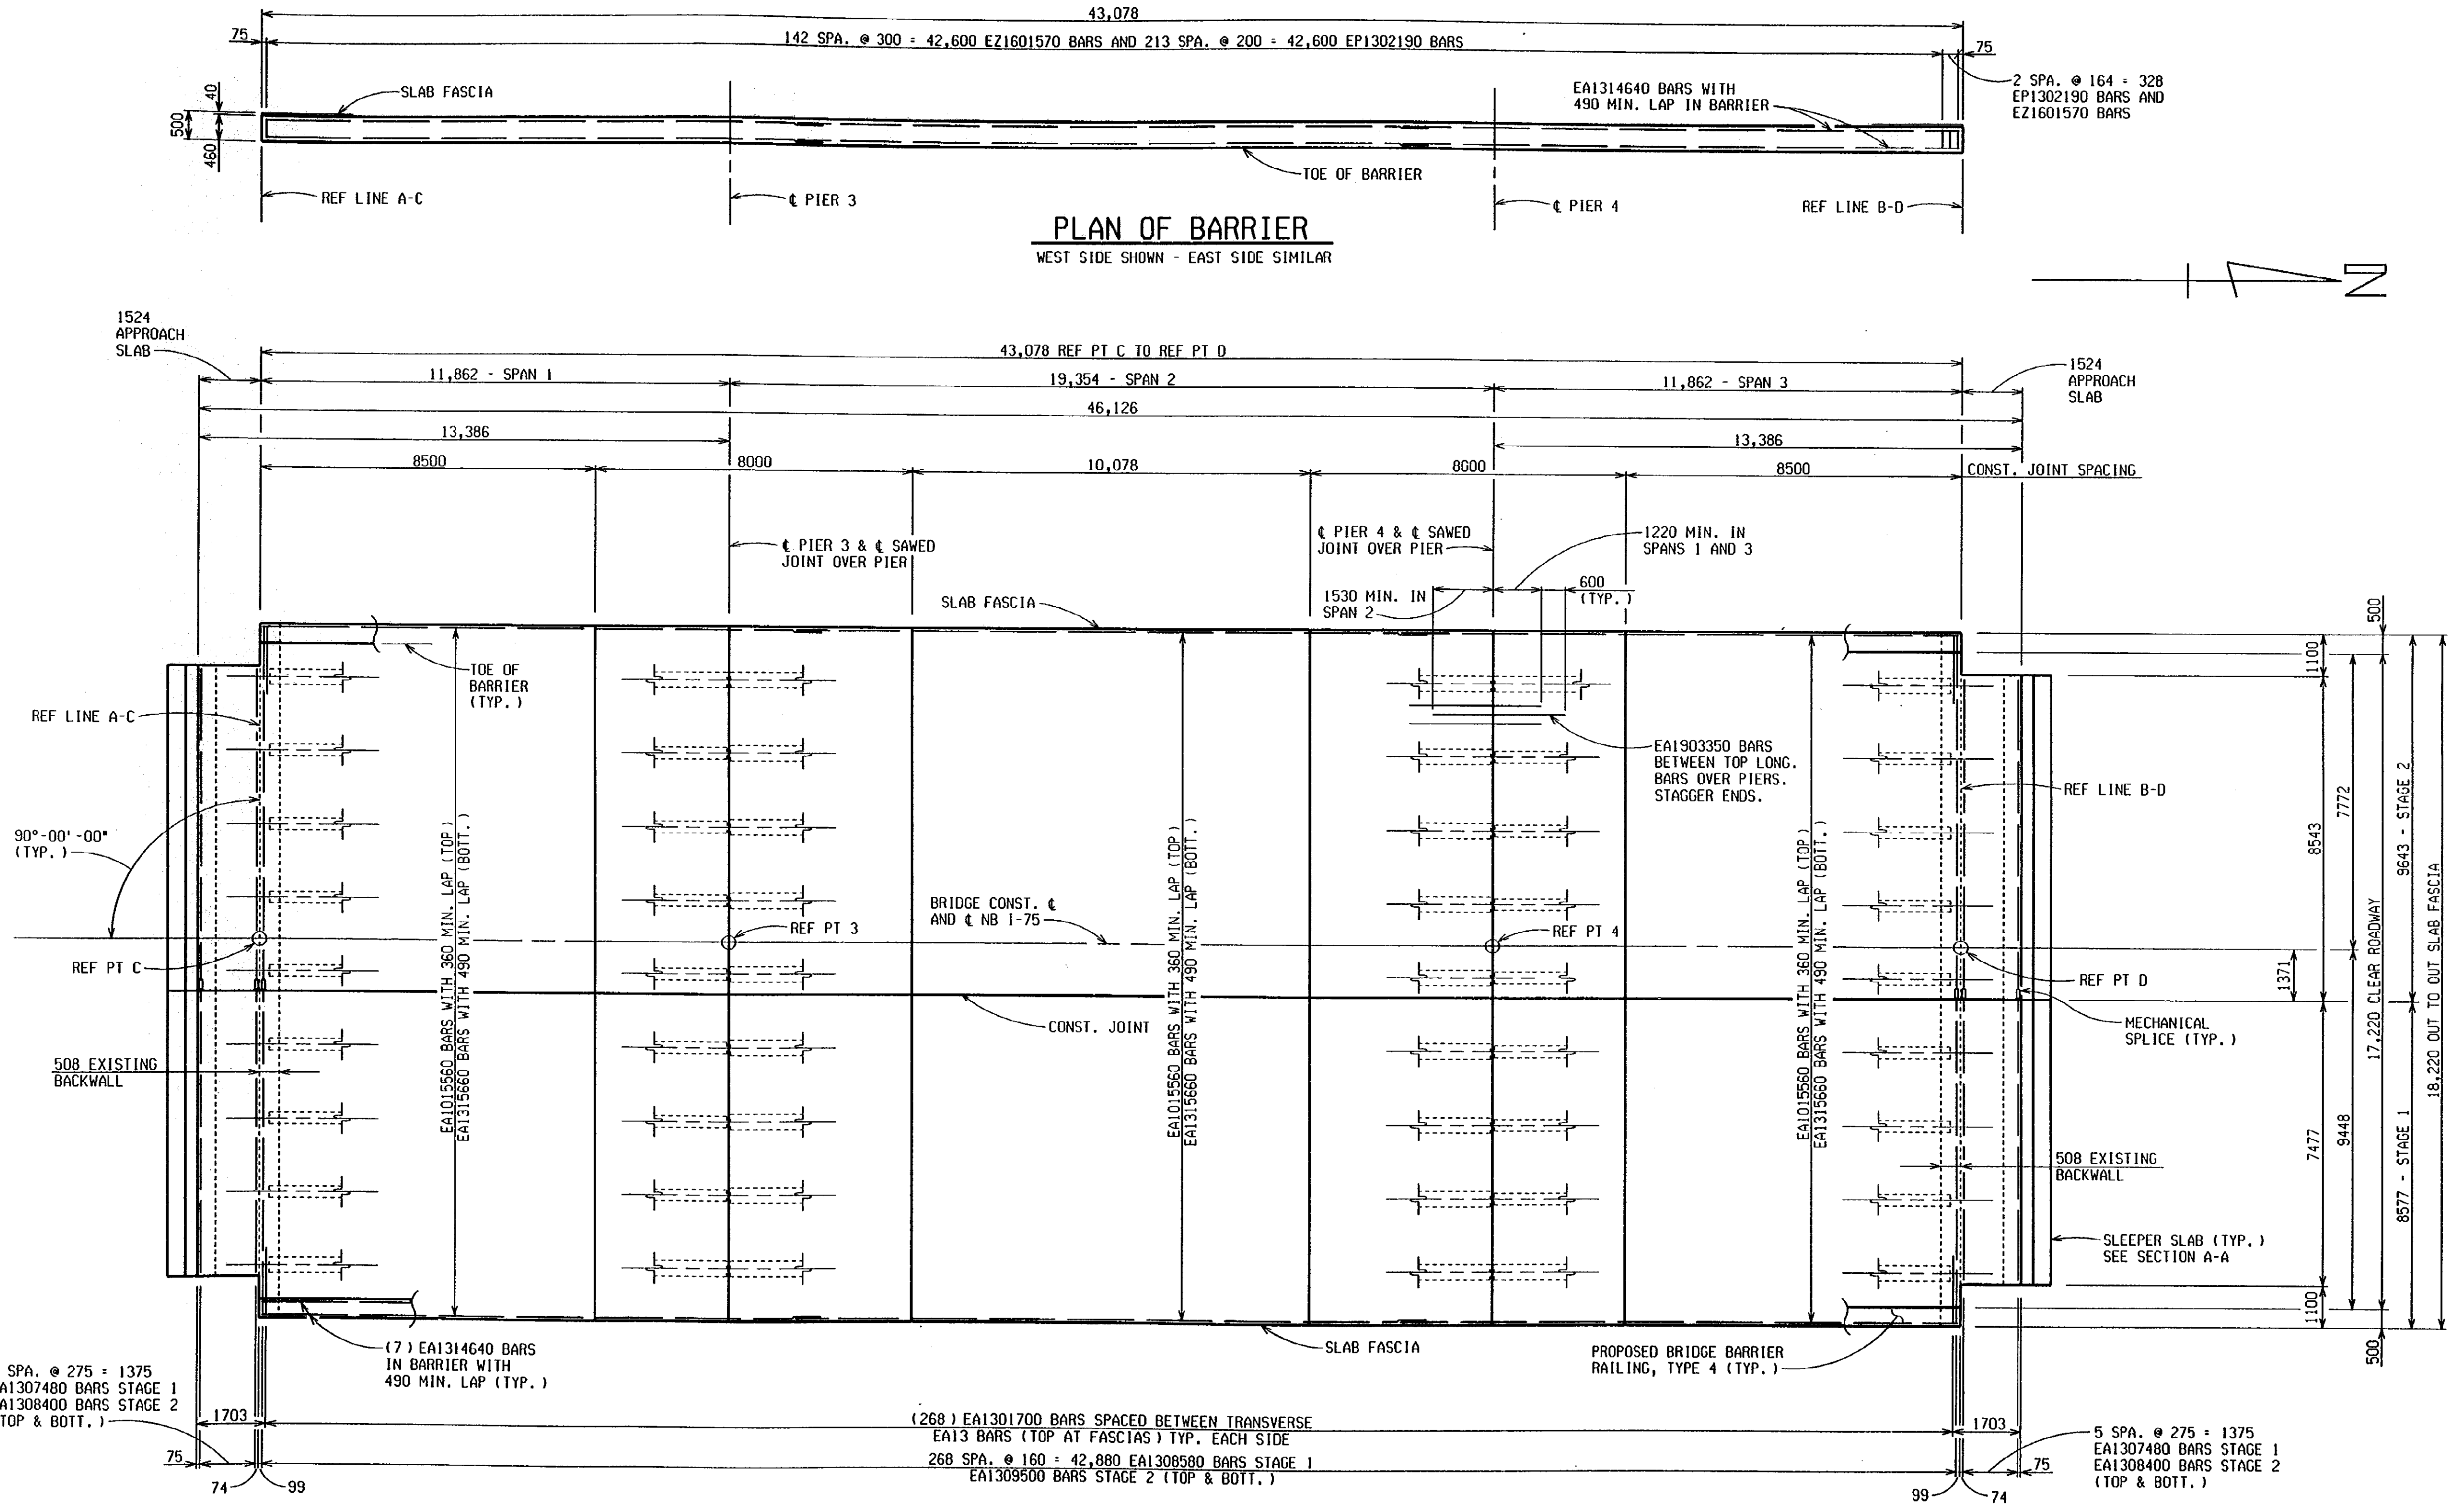


DATE: 11-30-00
CORRECTED BY: R. PRATT
DATE:
CHECKED BY: MIKUCKI
DATE:
DRAWN BY: R. PRATT
FILE NAME: s0463174n.dk

				
DATE	CONT. SEC.	JOB NO.	DESIGN UNIT	SHEET
1-9-01	S04 OF 63174	49595A	MAHDAVI	12 OF 16


CONTROL SECTION 04 OF 63174 JOB NO. 49595A SP. NO. 13

1 2 3 4 5 6 7 8 9 10 11 12 13 14 15 16 17 18 19 20 21 22 23 24 25 26 27 28 29 30 31 32 33 34 35 36 37 38 39 40 41 42 43 44 45 46 47 48 49 50 51 52 53 54 55 56 57 58 59 60 61 62 63


REVISIONS			
NO.	DESCRIPTION	DATE	BY

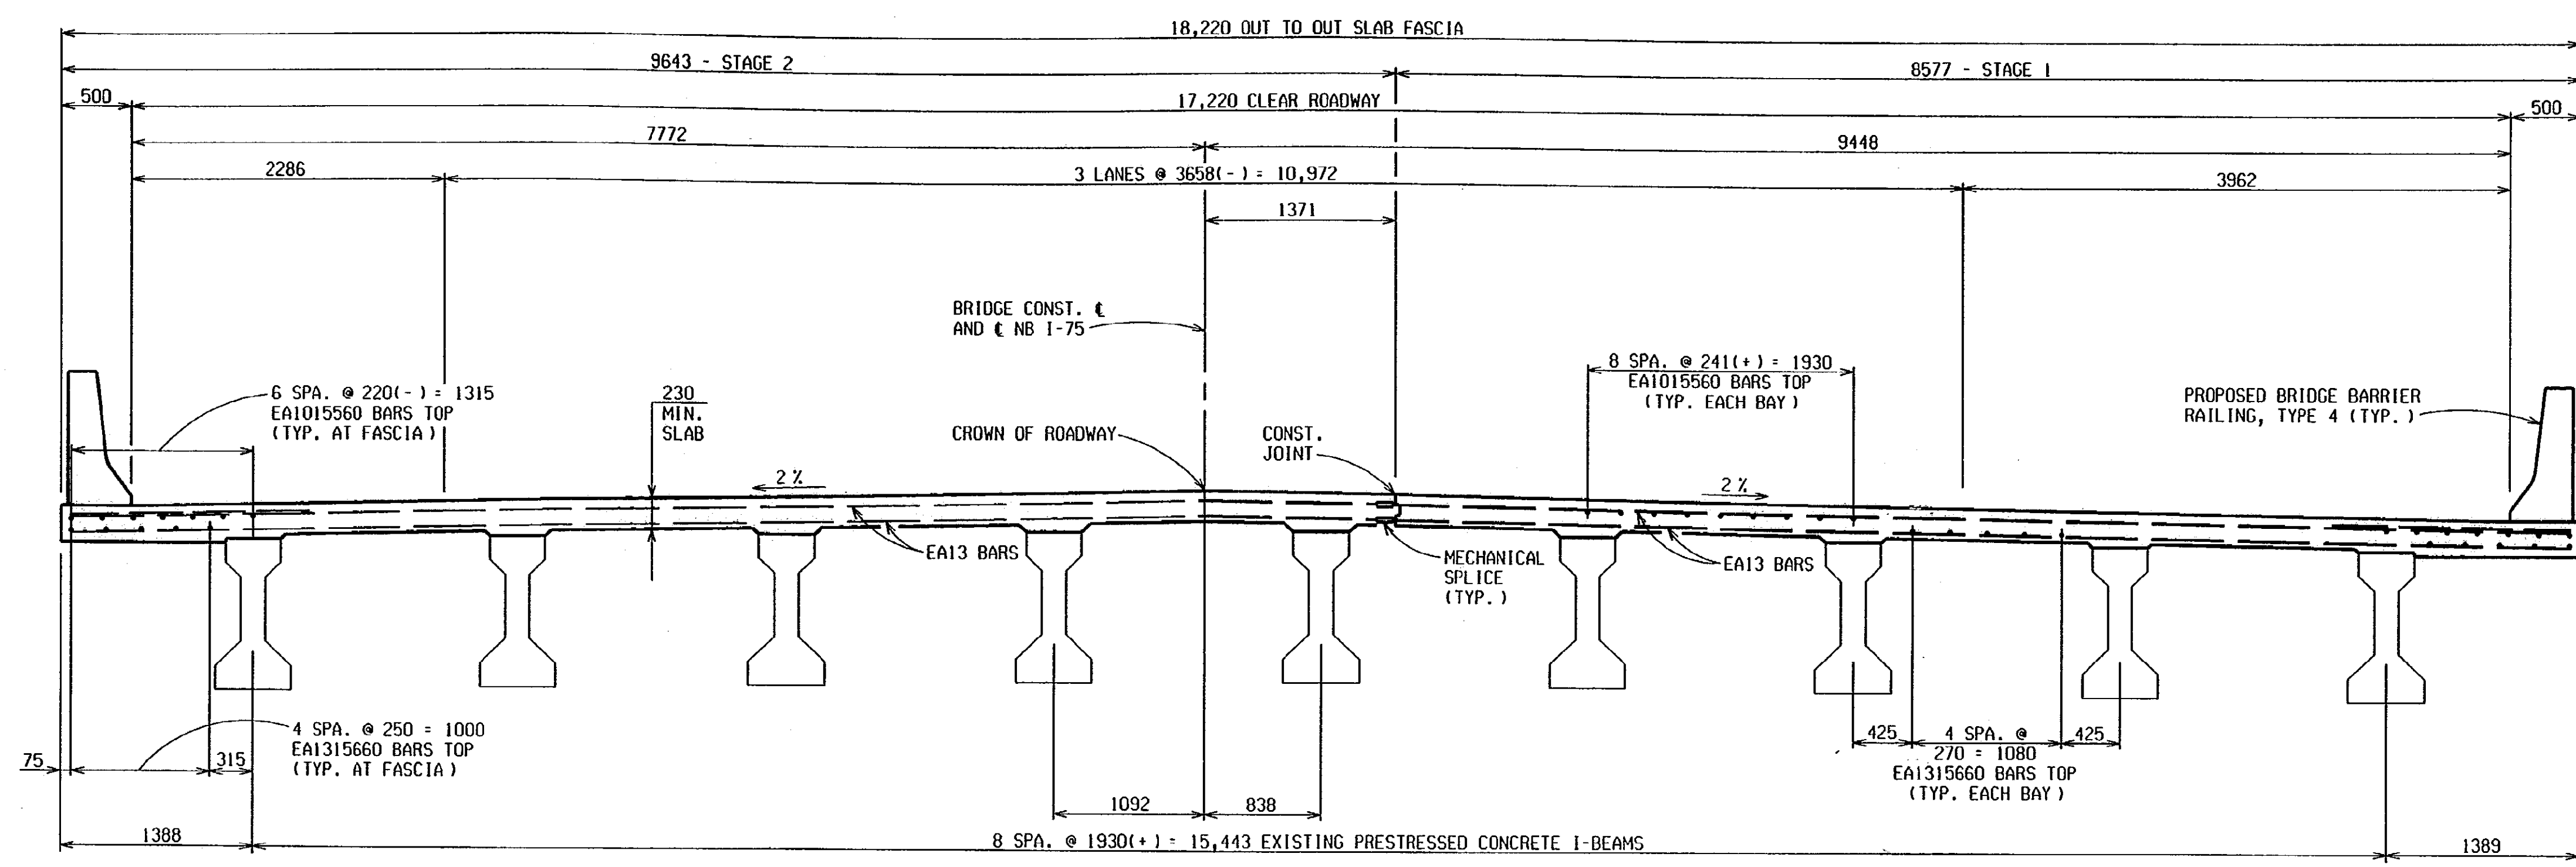


PROPOSED DECK SECTION - NB
(LOOKING NORTH)

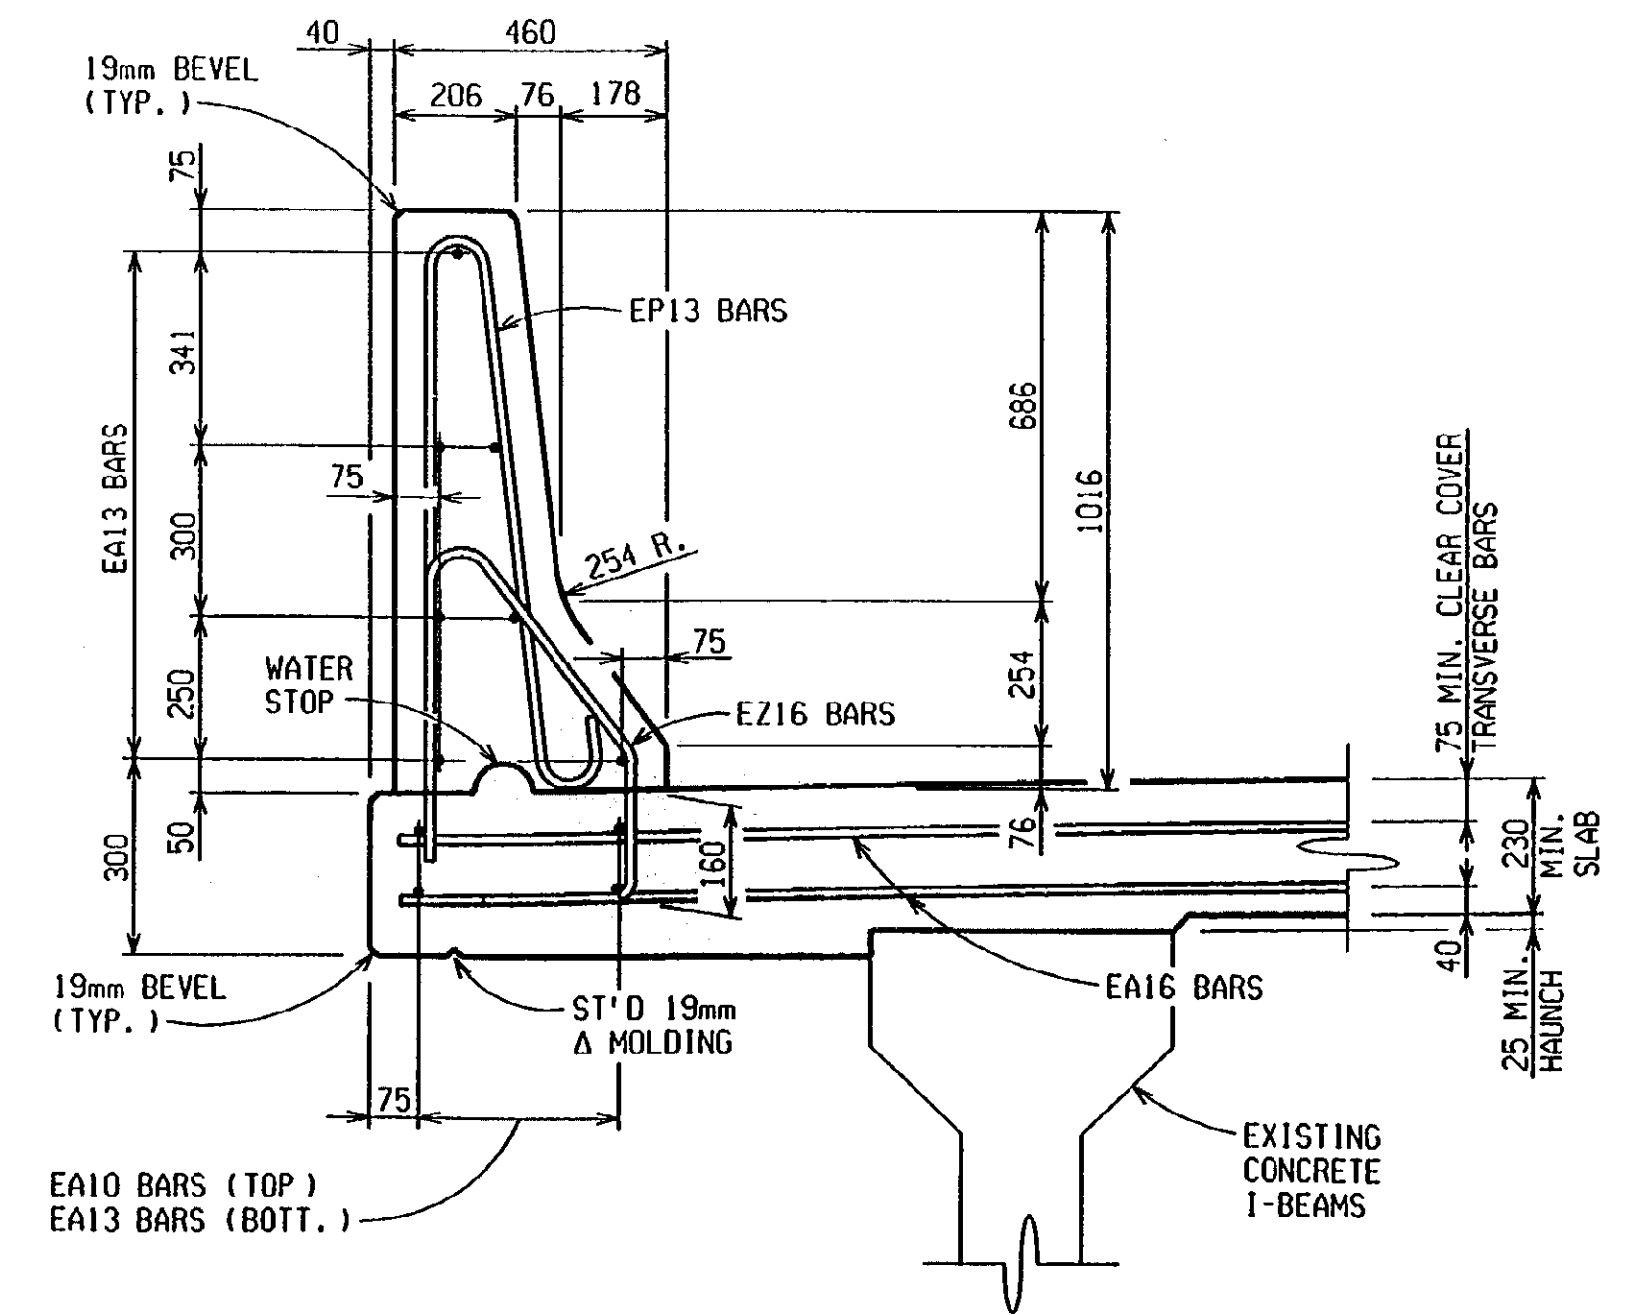

TYPICAL BARRIER SECTION

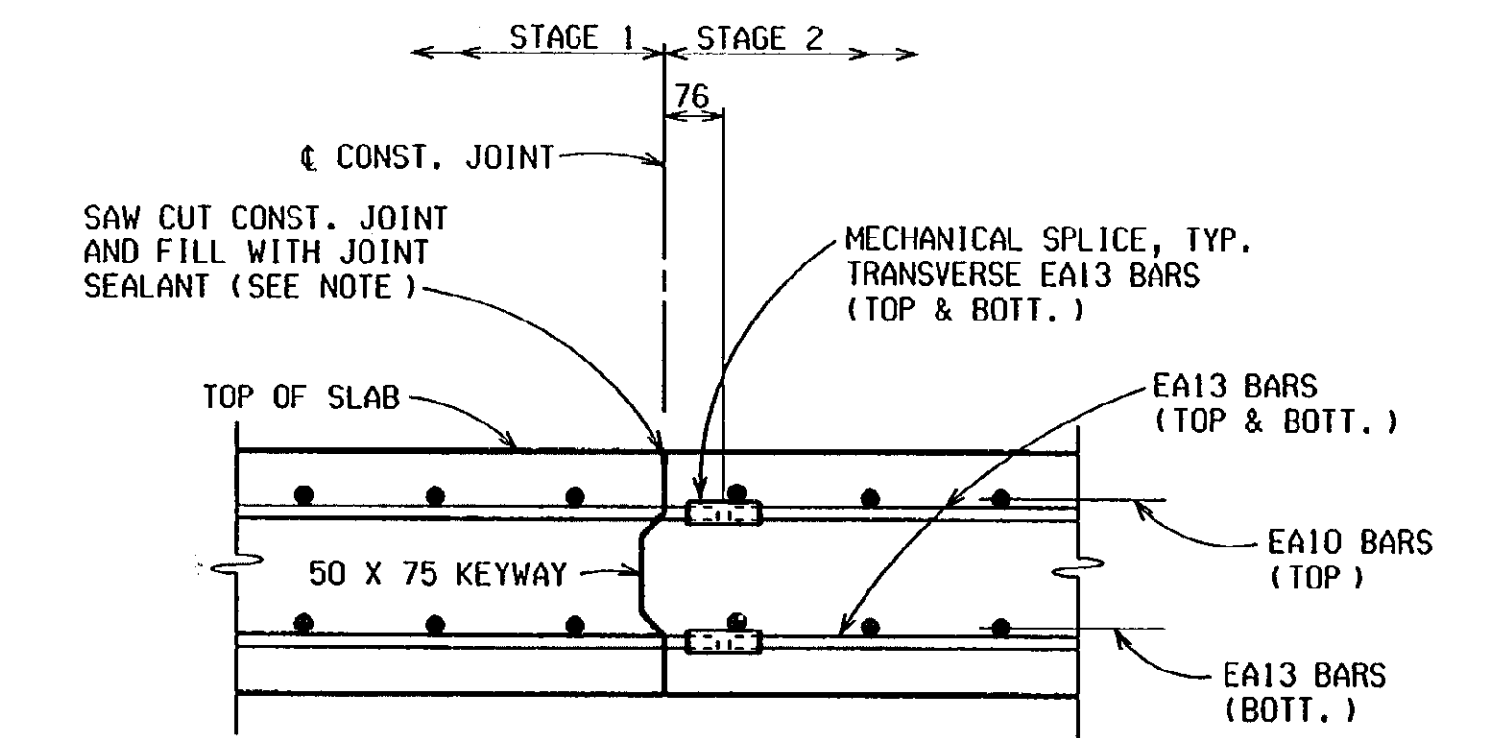


LONGITUDINAL CONSTRUCTION JOINT IN SLAB

DECK REPLACEMENT DETAILS - NB STRUCTURE				
	DATE	CONT. SEC.	JOB NO.	DESIGN UNIT
	1-9-01	S04 OF 63174	49595A	MAHDAVI
				SHEET 13 OF 16


DATE: 10-24-00
 CORRECTED BY: R. PRATT
 DATE:
 CHECKED BY: MIKUCKI
 DATE: 9-1-00
 DRAWN BY: R. PRATT
 FILE NAME: s0463174n.dk

REVISIONS			
NO.	DESCRIPTION	DATE	BY

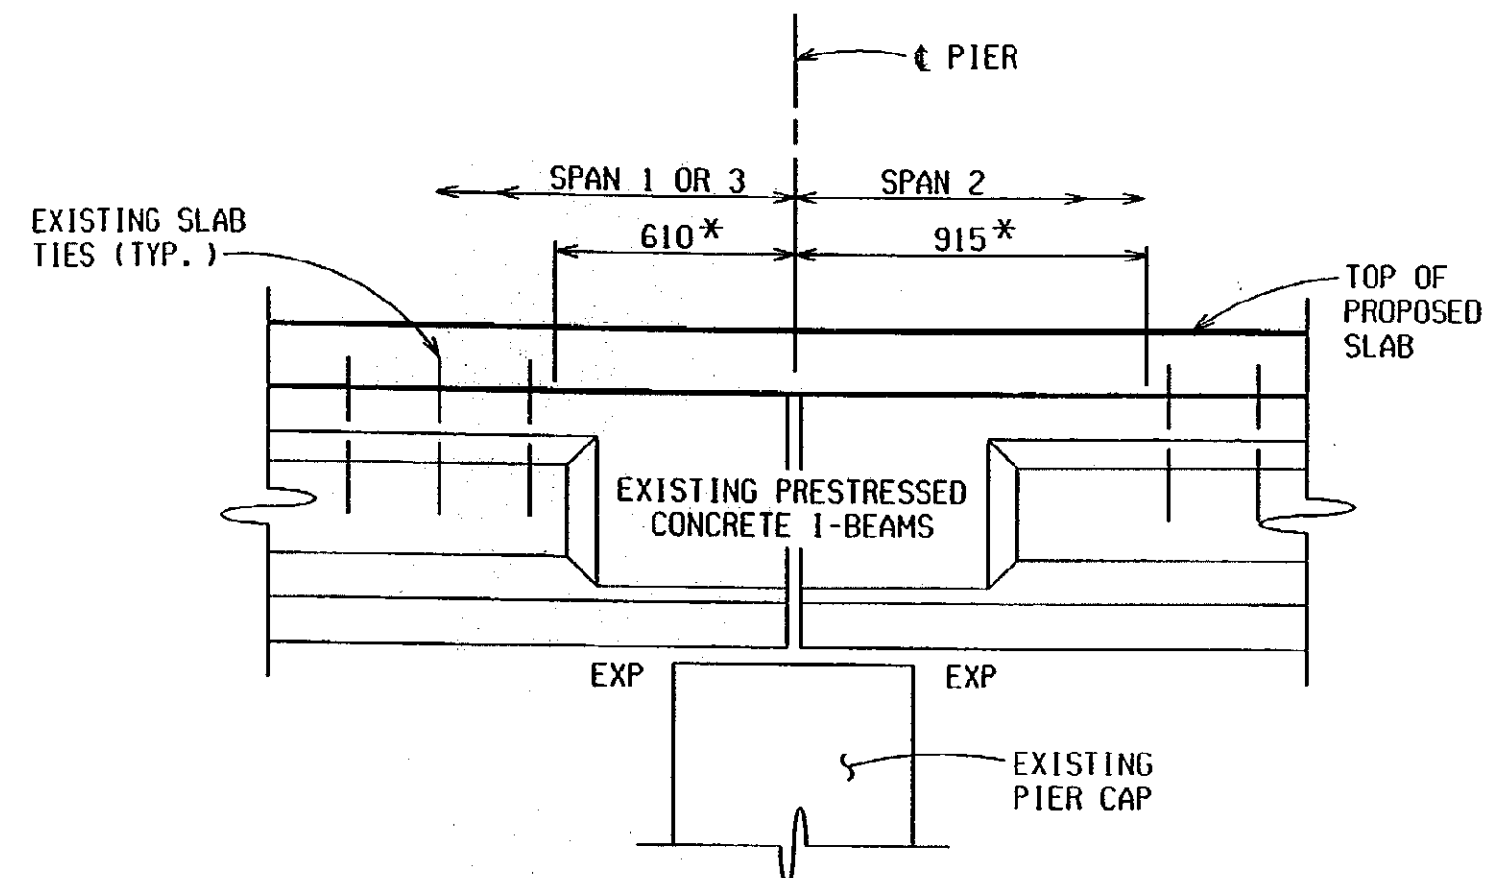


SECTION THRU LINK SLAB AT PIER


* LIMITS FOR REMOVAL OF EXISTING SLAB TIES AND FOR DEBONDING BETWEEN EXISTING BEAMS AND PROPOSED DECK. DEBOND BY PLACING 2 LAYERS OF 6 MIL PLASTIC SHEET SECURED TO THE TOP OF BEAMS PRIOR TO POURING THE DECK. PAYMENT FOR SLAB TIE REMOVAL AND DEBONDING IS INCLUDED IN THE BID ITEM *SUPERSTRUCTURE CONC, FORM, FINISH AND CURE, NIGHT CASTING (S04-NB)*.

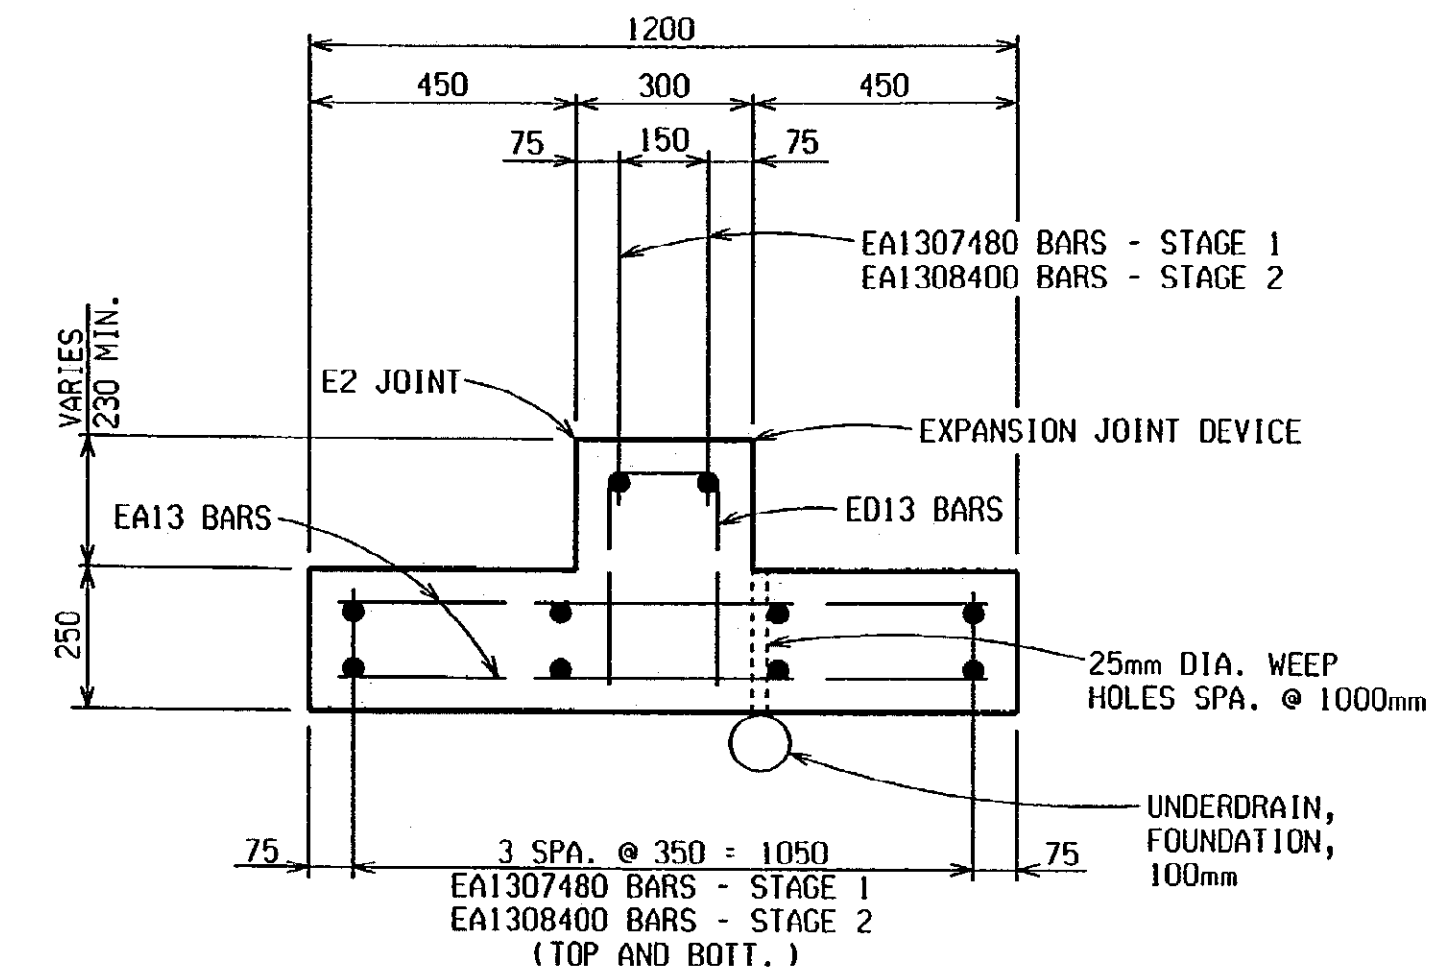

SECTION A-A

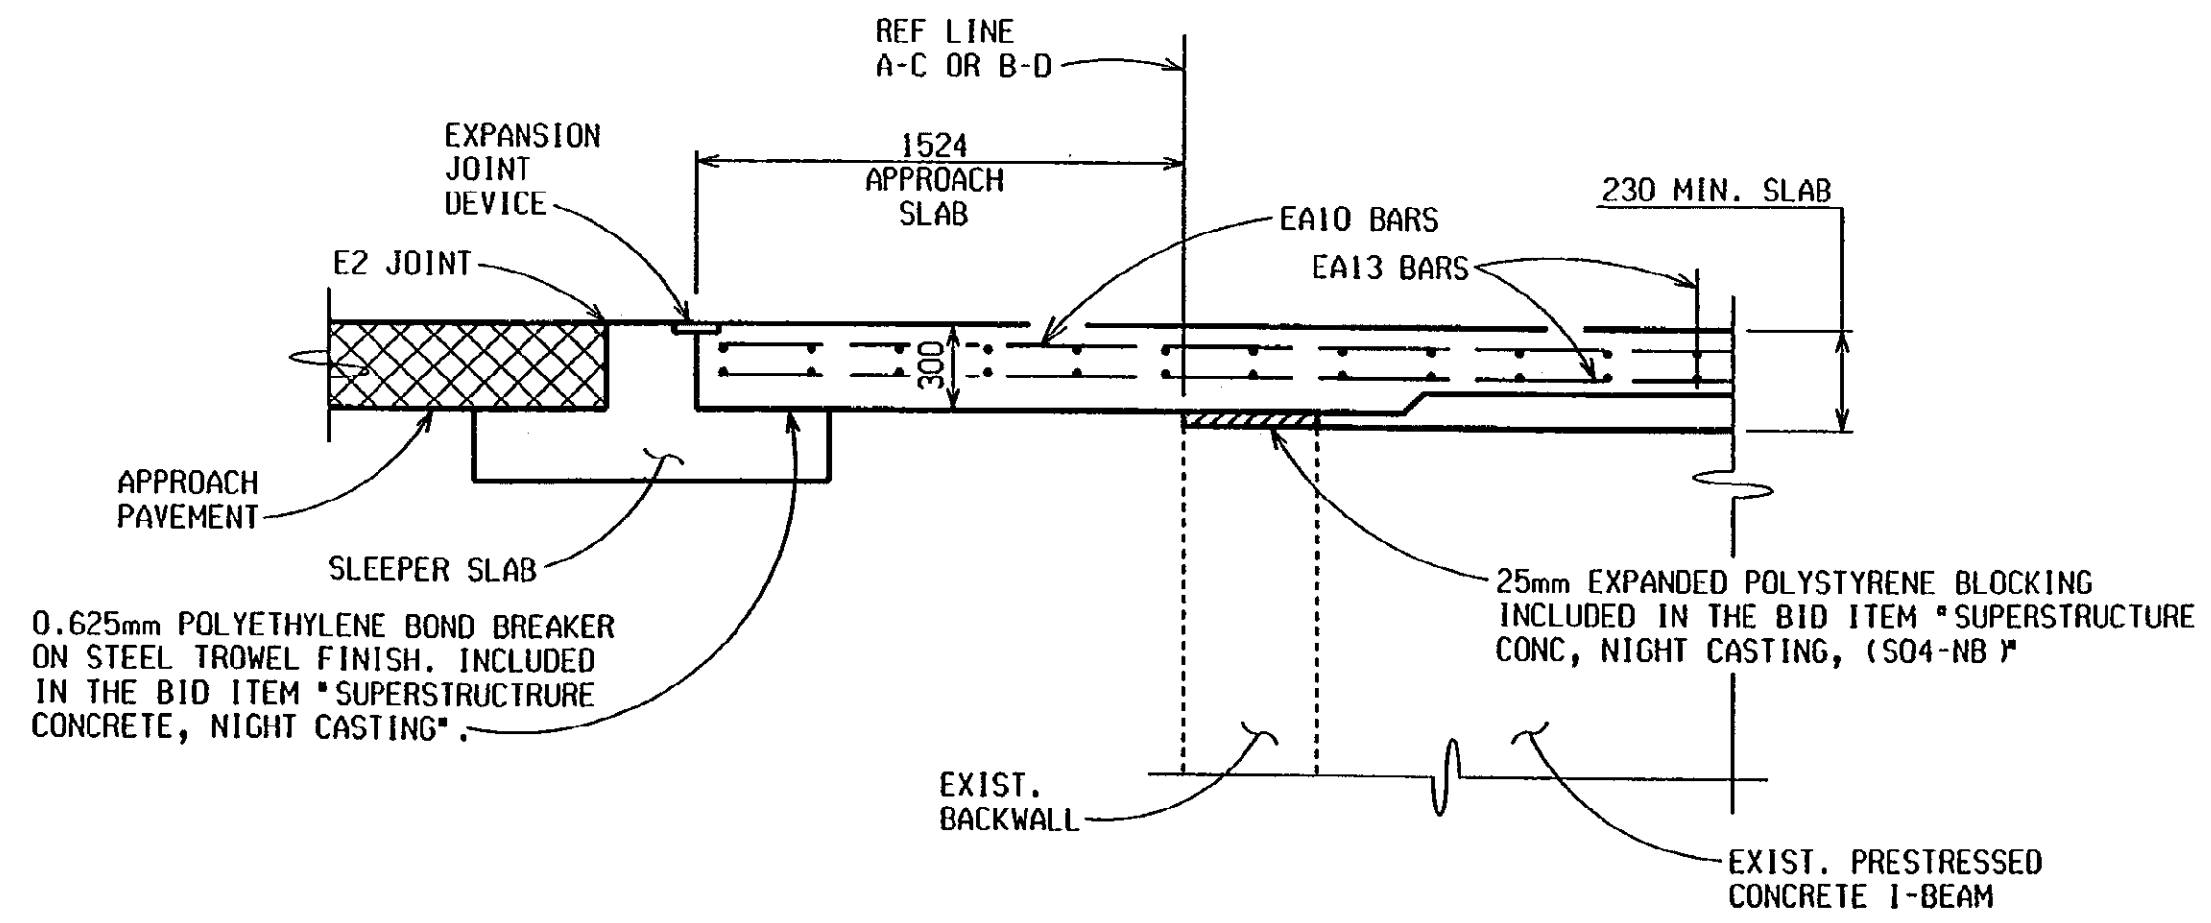

TYPICAL SECTION AT BRIDGE APPROACH

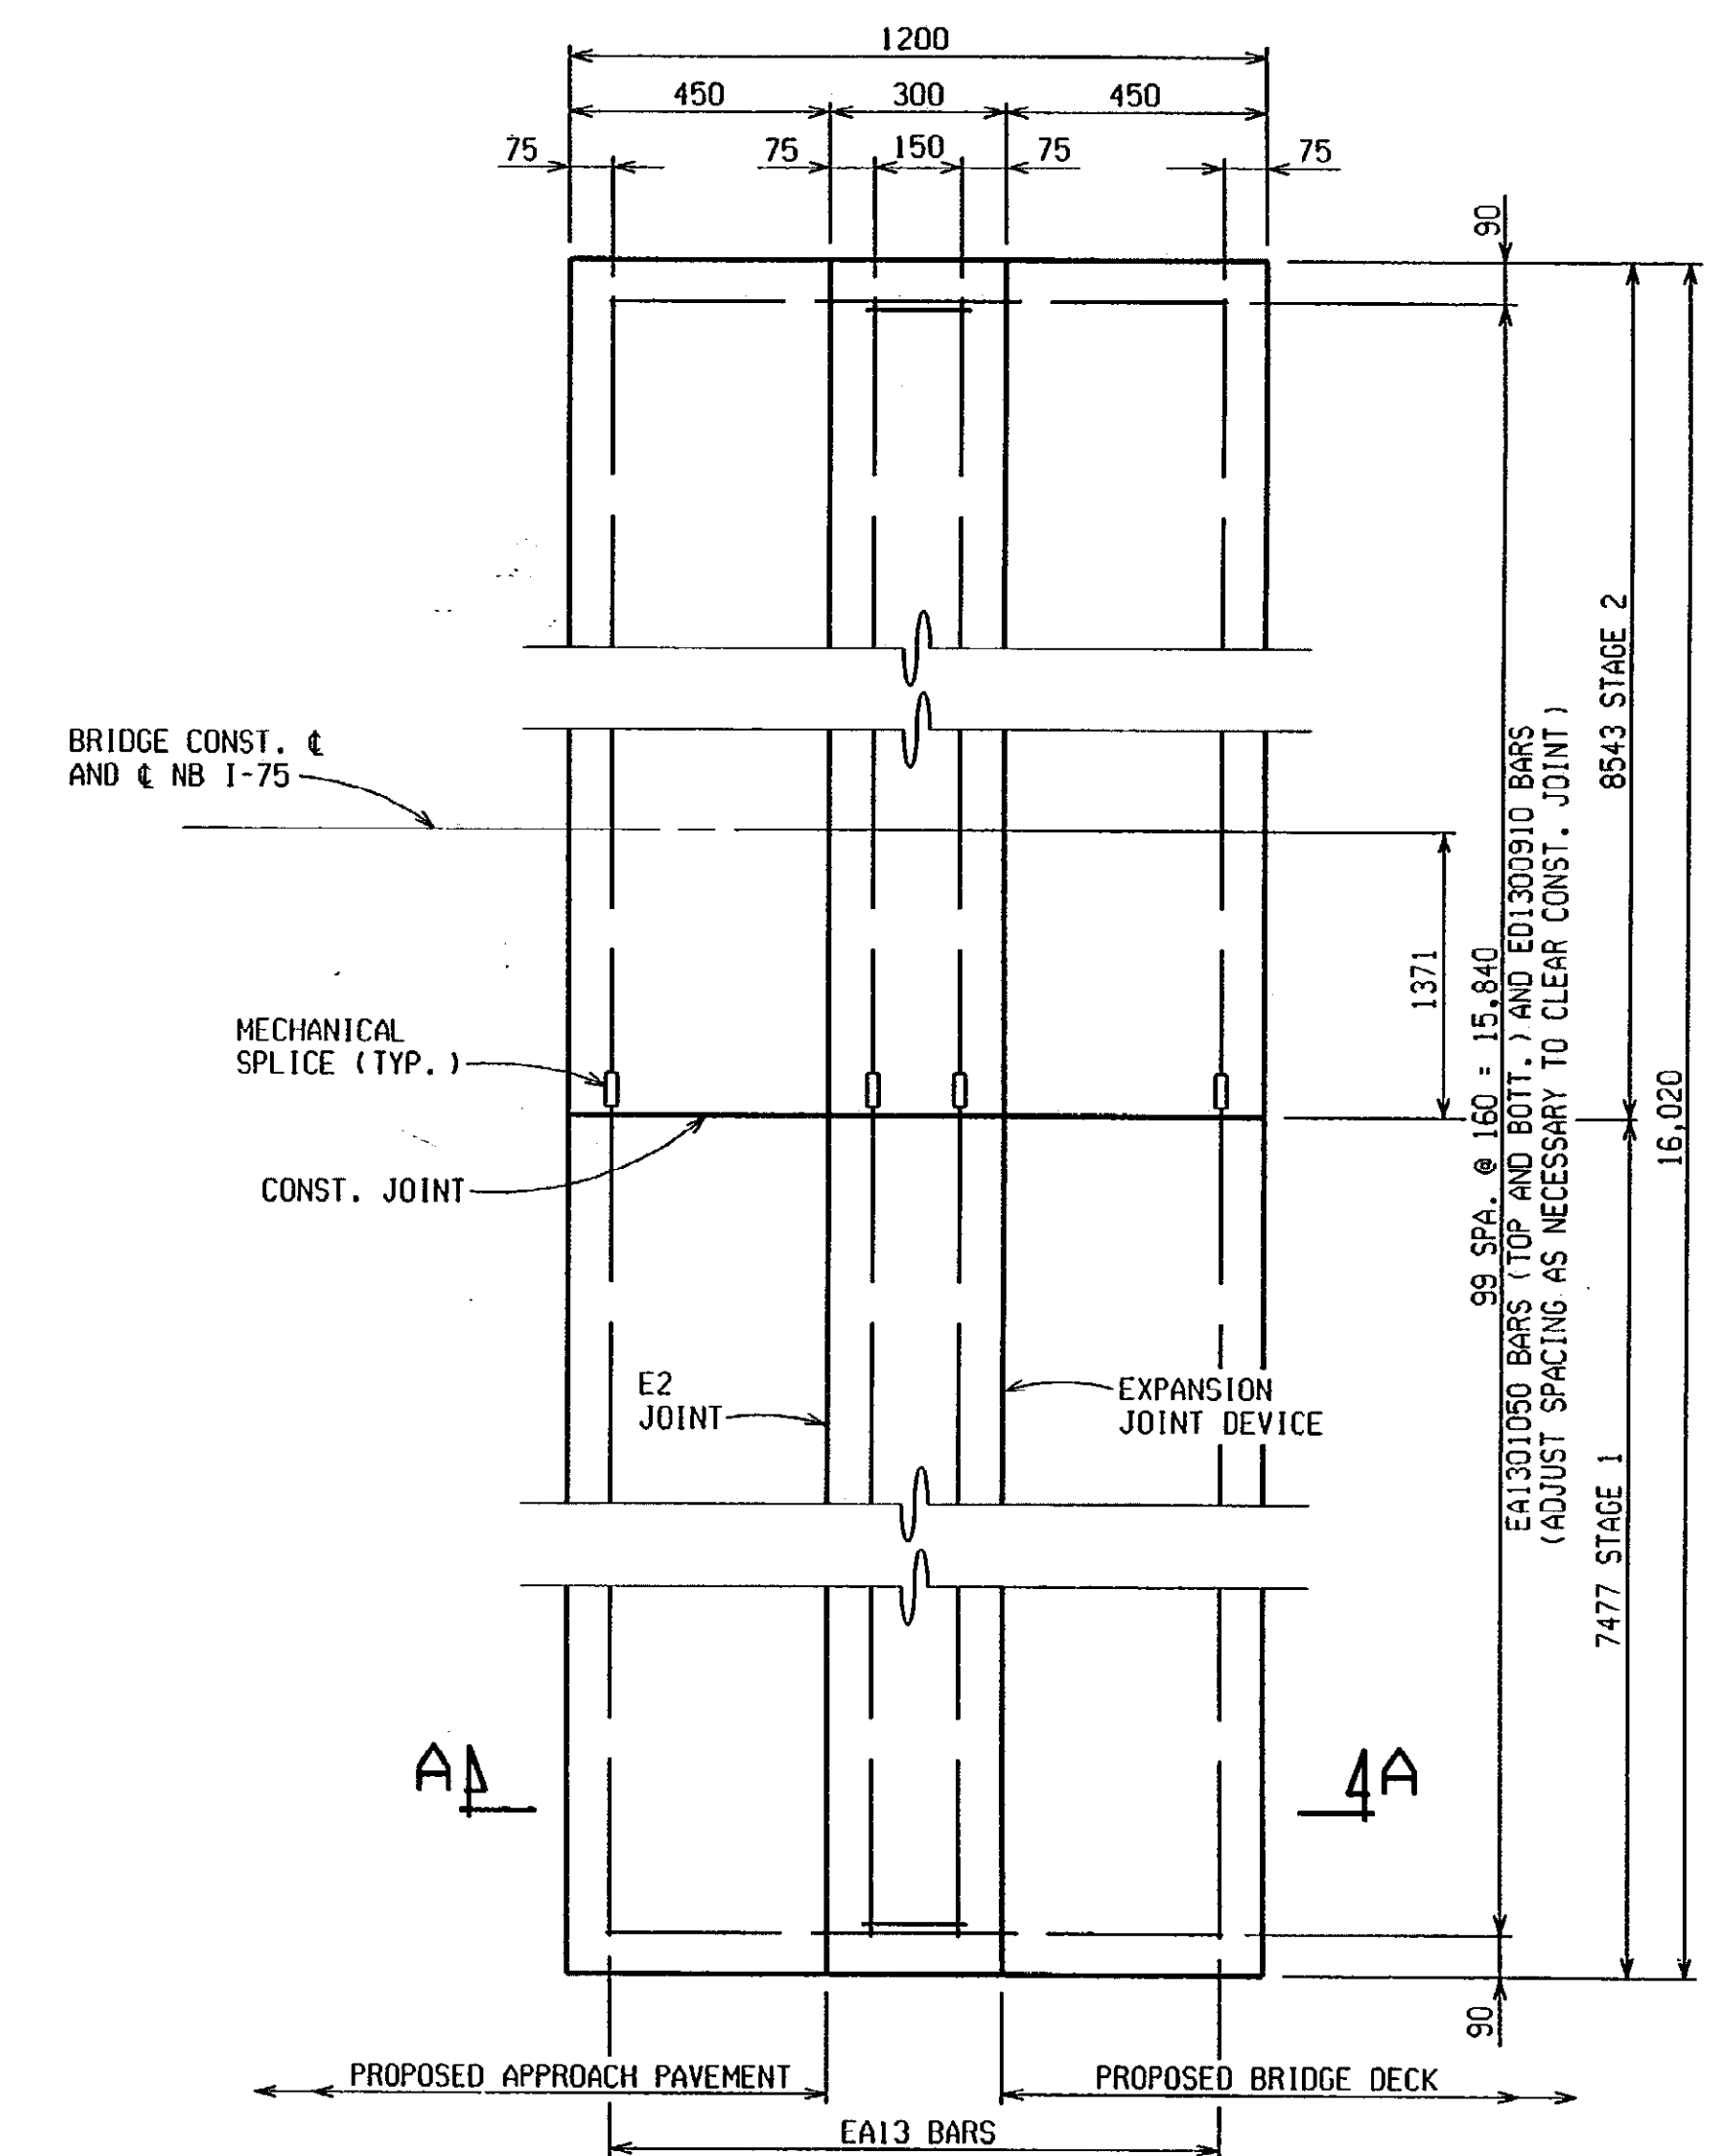

PLAN OF SLEEPER SLAB

DECK REPLACEMENT DETAILS - NB STRUCTURE				
DATE	CONT. SEC.	JOB NO.	DESIGN UNIT	SHEET
1-9-01	S04 OF 63174	49595A	MAHDAVI	14 OF 16



1 2 3 4 5 6 7 8 9 10 11 12 13 14 15 16 17 18 19 20 21 22 23 24 25 26 27 28 29 30 31 32 33 34 35 36 37 38 39 40 41 42 43 44 45 46 47 48 49 50 51 52 53 54 55 56 57 58 59 60 61 62 63



BOTTOM OF SLAB ELEVATIONS

	SPAN 1					SPAN 2						SPAN 3					
	0	1	2	3	4	0	1	2	3	4	5	6	0	1	2	3	4
A FASCIA	199.993	200.001	200.007	200.010	200.011	200.012	200.026	200.036	200.040	200.036	200.026	200.012	200.011	200.010	200.007	200.001	199.993
B LEFT	200.096	200.103	200.109	200.112	200.114	200.114	200.127	200.136	200.139	200.136	200.127	200.114	200.114	200.112	200.109	200.103	200.096
C LEFT	200.135	200.142	200.148	200.151	200.152	200.153	200.166	200.175	200.178	200.175	200.166	200.153	200.152	200.151	200.148	200.142	200.135
D LEFT	200.173	200.181	200.186	200.190	200.191	200.191	200.204	200.213	200.216	200.213	200.204	200.191	200.191	200.190	200.186	200.181	200.173
E LEFT	200.186	200.194	200.199	200.203	200.204	200.204	200.217	200.226	200.229	200.226	200.217	200.204	200.204	200.203	200.199	200.194	200.186
F LEFT	200.148	200.155	200.161	200.164	200.166	200.166	200.179	200.188	200.191	200.188	200.179	200.166	200.166	200.164	200.161	200.155	200.148
G LEFT	200.109	200.117	200.122	200.126	200.127	200.127	200.140	200.149	200.152	200.149	200.140	200.127	200.127	200.126	200.122	200.117	200.109
H LEFT	200.071	200.078	200.084	200.087	200.088	200.089	200.102	200.110	200.114	200.110	200.102	200.089	200.088	200.087	200.084	200.078	200.071
J LEFT	200.032	200.039	200.045	200.048	200.050	200.050	200.065	200.075	200.079	200.075	200.065	200.050	200.050	200.048	200.045	200.039	200.032
FASCIA	199.960	199.967	199.973	199.976	199.978	199.978	199.993	200.003	200.007	200.003	199.993	199.978	199.978	199.976	199.973	199.967	199.960

REVISIONS			
NO.	DESCRIPTION	DATE	BY

SCREED ELEVATIONS

LEFT	200.274	200.281	200.286	200.290	200.291	200.292	200.305	200.315	200.318	200.315	200.305	200.292	200.291	200.290	200.286	200.281	200.274
RIGHT	200.240	200.247	200.253	200.256	200.258	200.258	200.272	200.281	200.285	200.281	200.272	200.258	200.258	200.256	200.253	200.247	200.240

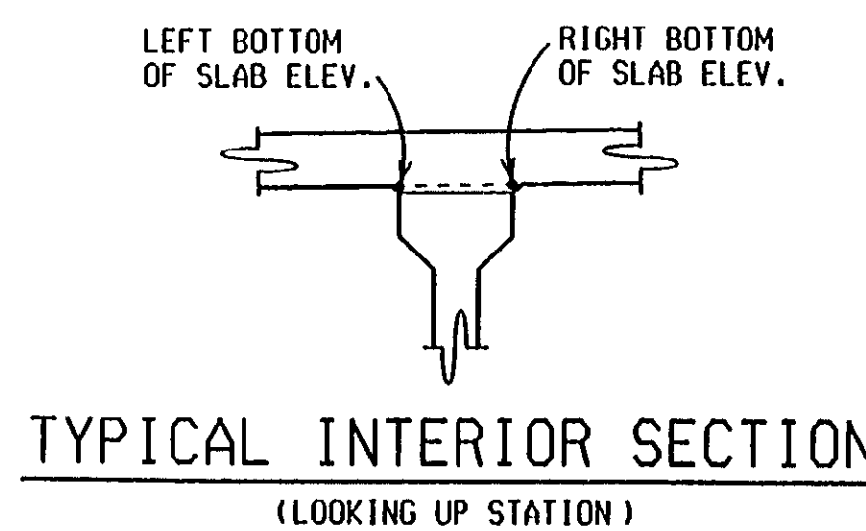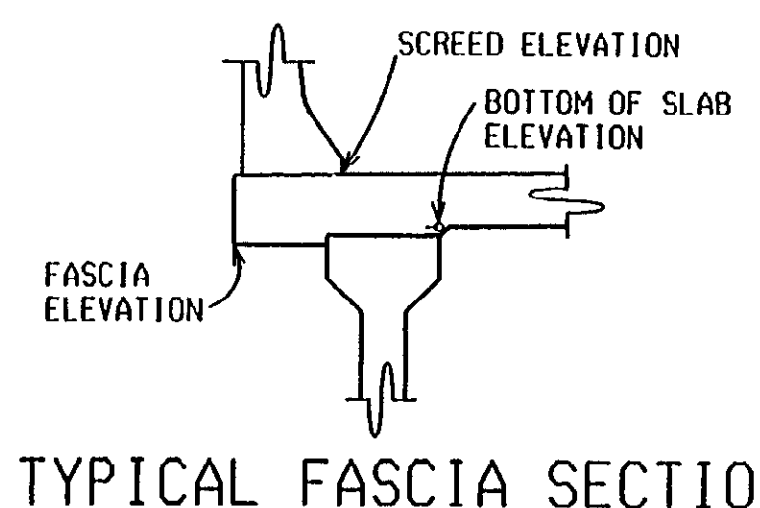

BULKHEAD ELEVATIONS

	ABUT. A		ABUT. B
A	200.291	200.309	200.291
B	200.330	200.348	200.330
C	200.368	200.387	200.368
D	200.407	200.425	200.407
E	200.412	200.430	200.412
F	200.373	200.392	200.373
G	200.335	200.353	200.335
H	200.296	200.314	200.296
J	200.258	200.276	200.258

SCREEDS AFFECTED BY LOADS IN OTHER SPANS ARE TO BE SET TO THE ELEVATIONS SHOWN BEFORE CASTING ANY CONCRETE.

SCREED ELEVATIONS ARE BASED ON THE CONDITION THAT NO SLAB CONCRETE HAS BEEN CAST AND THAT FORMWORK AND STEEL REINFORCEMENT ARE IN PLACE (AND THE TEMPORARY SUPPORTS ARE BROUGHT TO A SNUG FIT UNDER EACH BEAM).


SECTIONS FOR BOTTOM OF SLAB AND/OR SCREED ELEVATIONS ARE GIVEN ALONG BEAM CENTERLINES FROM CENTERLINE OF BEARING OR PIN & HANGER TO CENTERLINE OF BEARING OR PIN & HANGER AS APPLICABLE AT EQUAL SPACINGS.



SLAB AND SCREED DATA - NB STRUCTURE				
DATE	CONT. SEC.	JOB NO.	DESIGN UNIT	SHEET
1-9-01	S04 OF 63174	49595A	MAHDAVI	15 OF 16

DRAWN BY: DATE: CHECKED BY: MTKUCKI DATE: CORRECTED BY: R. PRATT DATE: 12-4-00


1 2 3 4 5 6 7 8 9 10 11 12 13 14 15 16 17 18 19 20 21 22 23 24 25 26 27 28 29 30 31 32 33 34 35 36 37 38 39 40 41 42 43 44 45 46 47 48 49 50 51 52 53 54 55 56 57 58 59 60 61 62 63

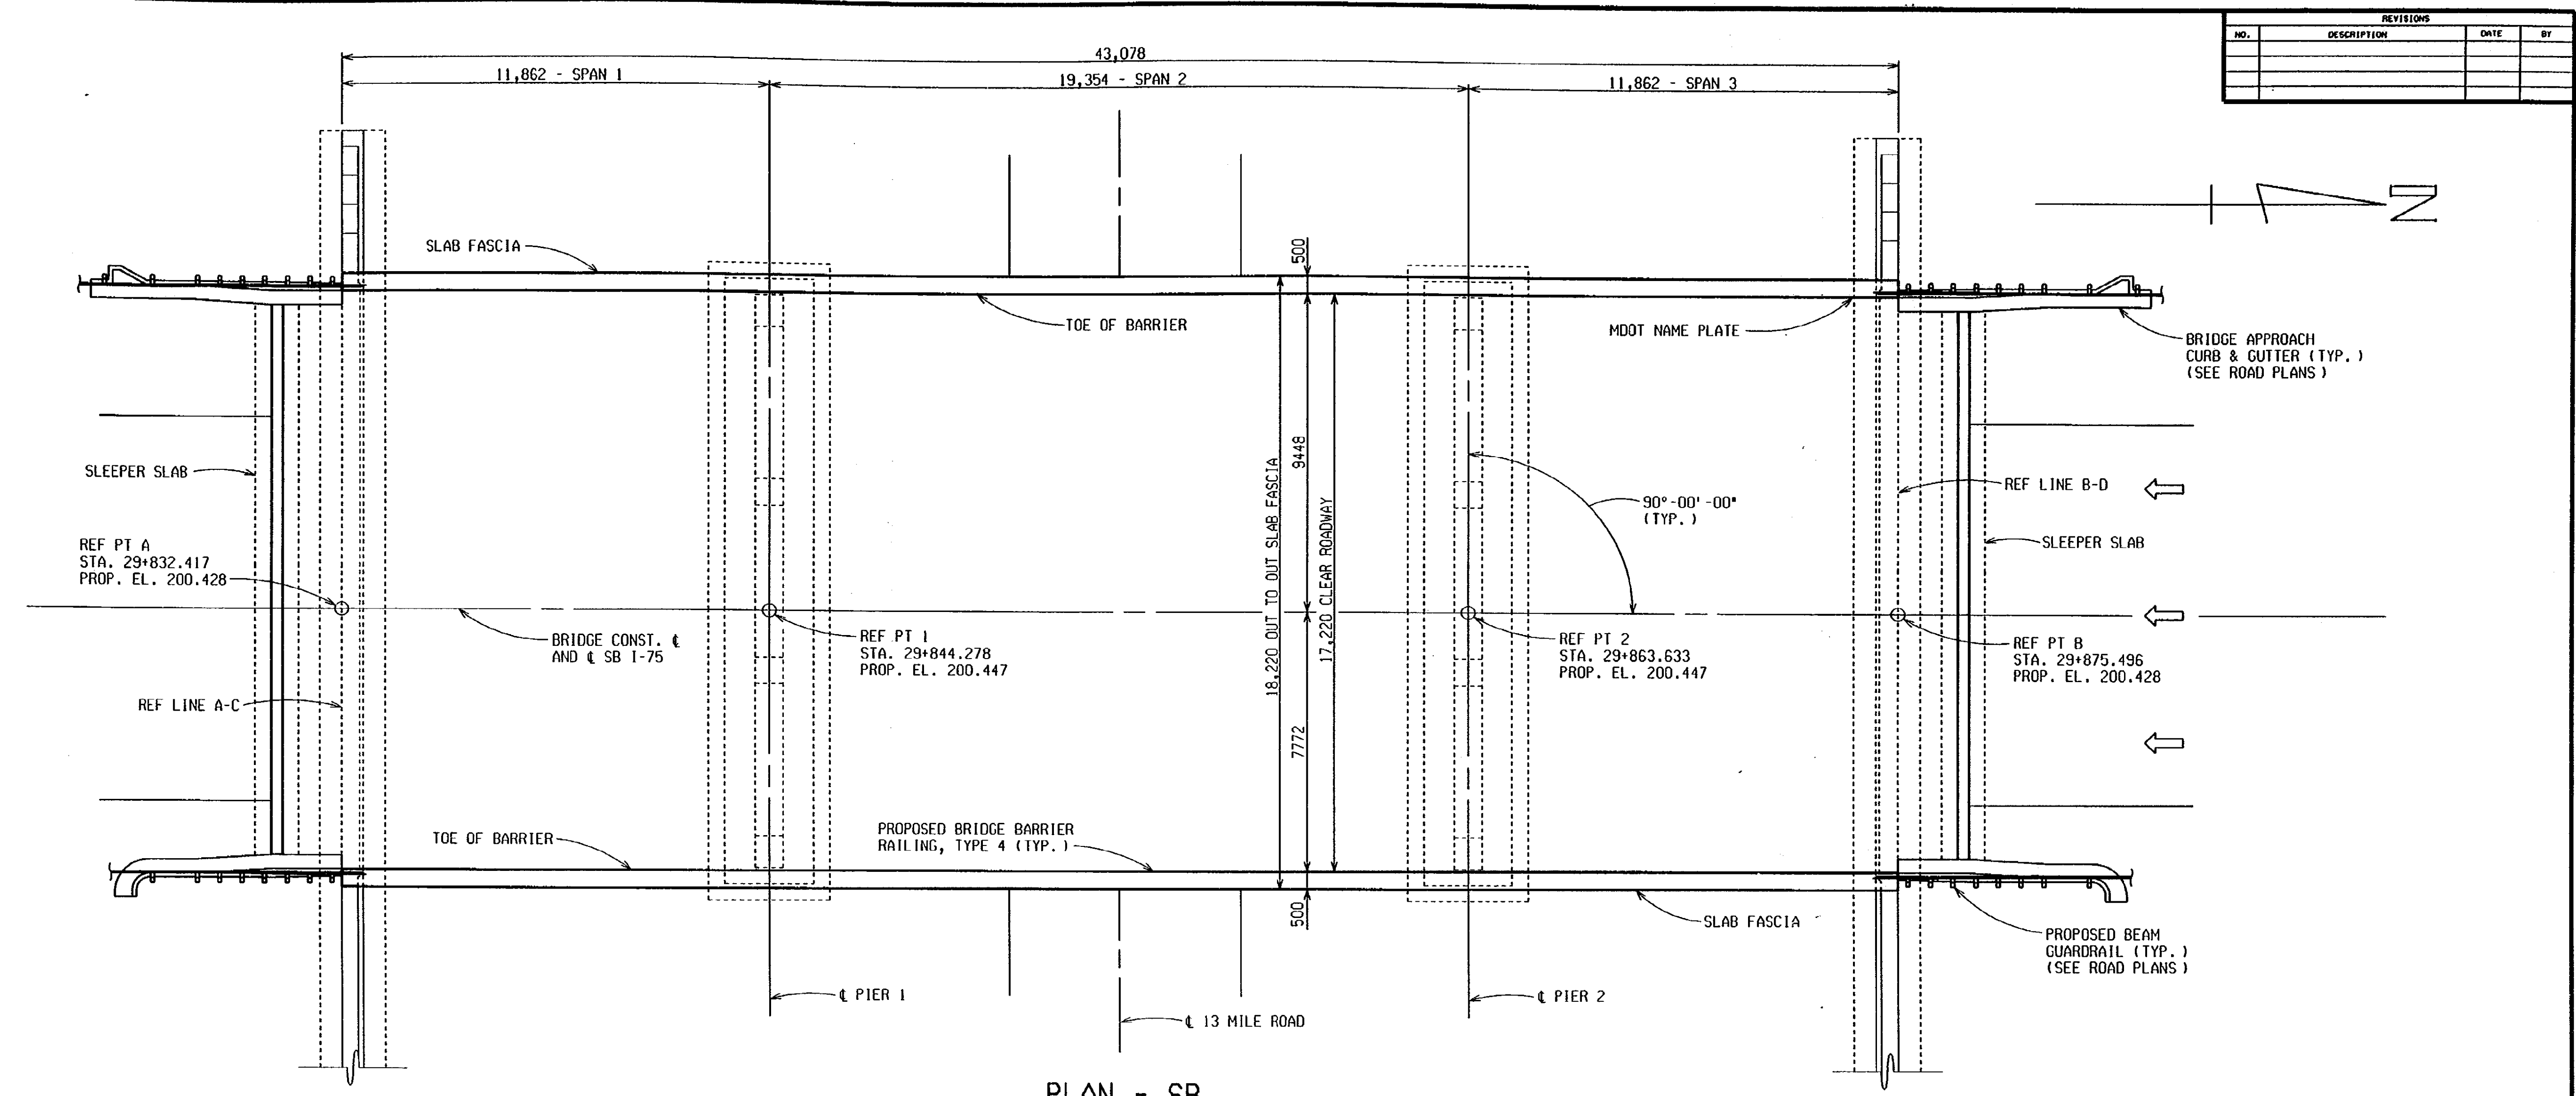

REVISIONS			
NO.	DESCRIPTION	DATE	BY

PLAN - SB

THE LIMITS OF FALSE DECKING IS FROM FACE OF ABUT. A TO FACE OF ABUT. B AND BETWEEN SLAB FASCIAS.

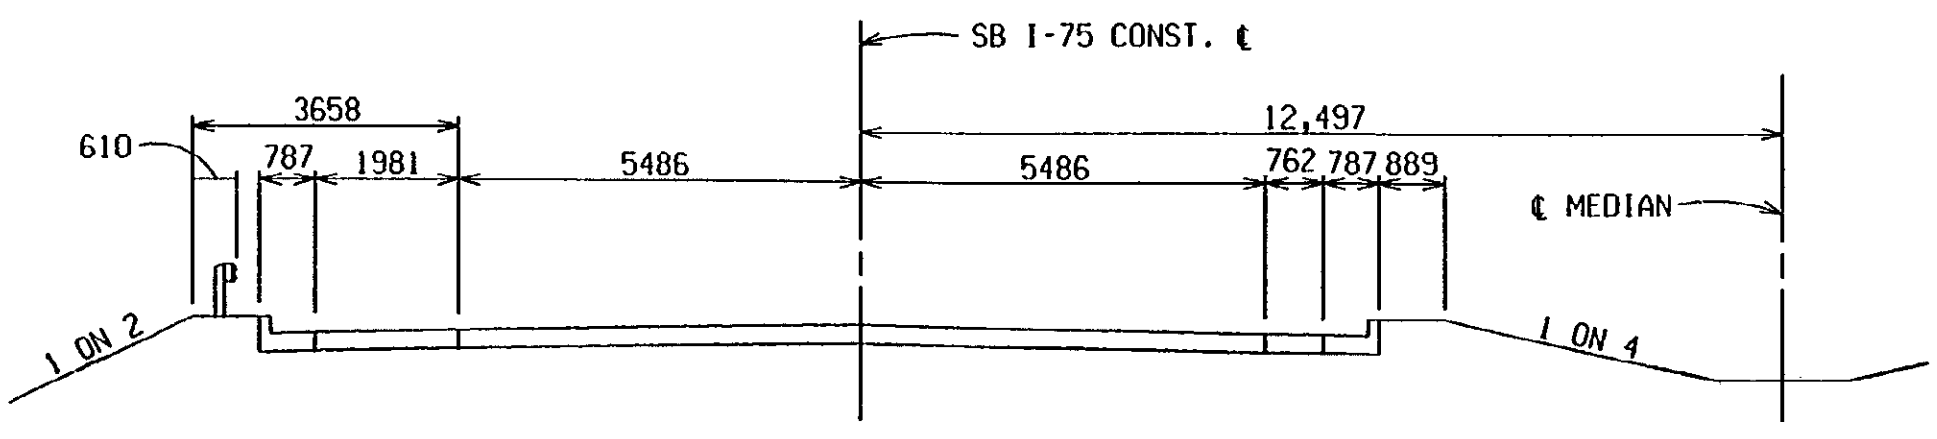

TYPICAL APPROACH SECTION
(LOOKING NORTH)

MISCELLANEOUS QUANTITIES	
1 LS	Structures, Rem Portions (S04-SB)
734 m ²	False Decking
1 LS	Penetrating Water Repellent Treatment (S04-SB)

NOTES:

THE WORK COVERED BY THESE PLANS INCLUDES DECK REPLACEMENT, WIDENING, SUBSTRUCTURE REPAIR, CONCRETE BEAM END REPAIR, AND MAINTAINING TRAFFIC. ALL OTHER WORK IS INCLUDED IN THE ROAD PLANS THAT ARE A PART OF THIS CONTRACT.

THE REHABILITATION DESIGN IS BASED ON CURRENT AASHTO STANDARD SPECIFICATIONS FOR HIGHWAY BRIDGES MS23. LIVE LOAD PLUS IMPACT DEFLECTION DOES NOT EXCEED 1/800 OF SPAN LENGTH. THE ALLOWABLE STRESS METHOD WAS USED FOR THIS DESIGN. THE ORIGINAL STRUCTURE WAS DESIGNED FOR MS18 LOADING.

MEASURES SHALL BE TAKEN TO PREVENT DEBRIS FROM FALLING FROM THE STRUCTURE.

THE CONTRACTOR SHALL LOCATE ALL ACTIVE UNDERGROUND UTILITIES PRIOR TO STARTING WORK AND SHALL CONDUCT HIS OPERATIONS IN SUCH A MANNER AS TO ENSURE THAT THOSE UTILITIES NOT REQUIRING RELOCATION WILL NOT BE DISTURBED.

SB I-75 TRAFFIC IS TO BE DETOURED OVER THE NB BRIDGE.

PENETRATING WATER REPELLANT TREATMENT SHALL BE APPLIED TO ALL OTHER SURFACES EXCEPT FOR THE TOP OF PIERS. ESTIMATED AREA IS 272 SQUARE METERS (SEE SPECIAL PROVISION).

GENERAL PLAN OF STRUCTURE				
SB I-75 OVER 13 MILE ROAD IN MADISON HEIGHTS.				
DATE	CONT. SEC.	JOB NO.	DESIGN UNIT	SHEET
1-9-01	S04 OF 63174	49595A	MAHDAVI	3 OF 15




APPROVED *Stevan P. Beck* 1/11/01
DESIGN SUPERVISING ENGINEER




DATE: 12-13-00
CORRECTED BY: SHIFFER
DATE:
CHECKED BY: MIKUCKI
DATE: 4-11-00
DRAWN BY: R. PRATT
FILE NAME: s0463174s.st

1 2 3 4 5 6 7 8 9 10 11 12 13 14 15 16 17 18 19 20 21 22 23 24 25 26 27 28 29 30 31 32 33 34 35 36 37 38 39 40 41 42 43 44 45 46 47 48 49 50 51 52 53 54 55 56 57 58 59 60 61 62 63

REVISIONS			
NO.	DESCRIPTION	DATE	BY

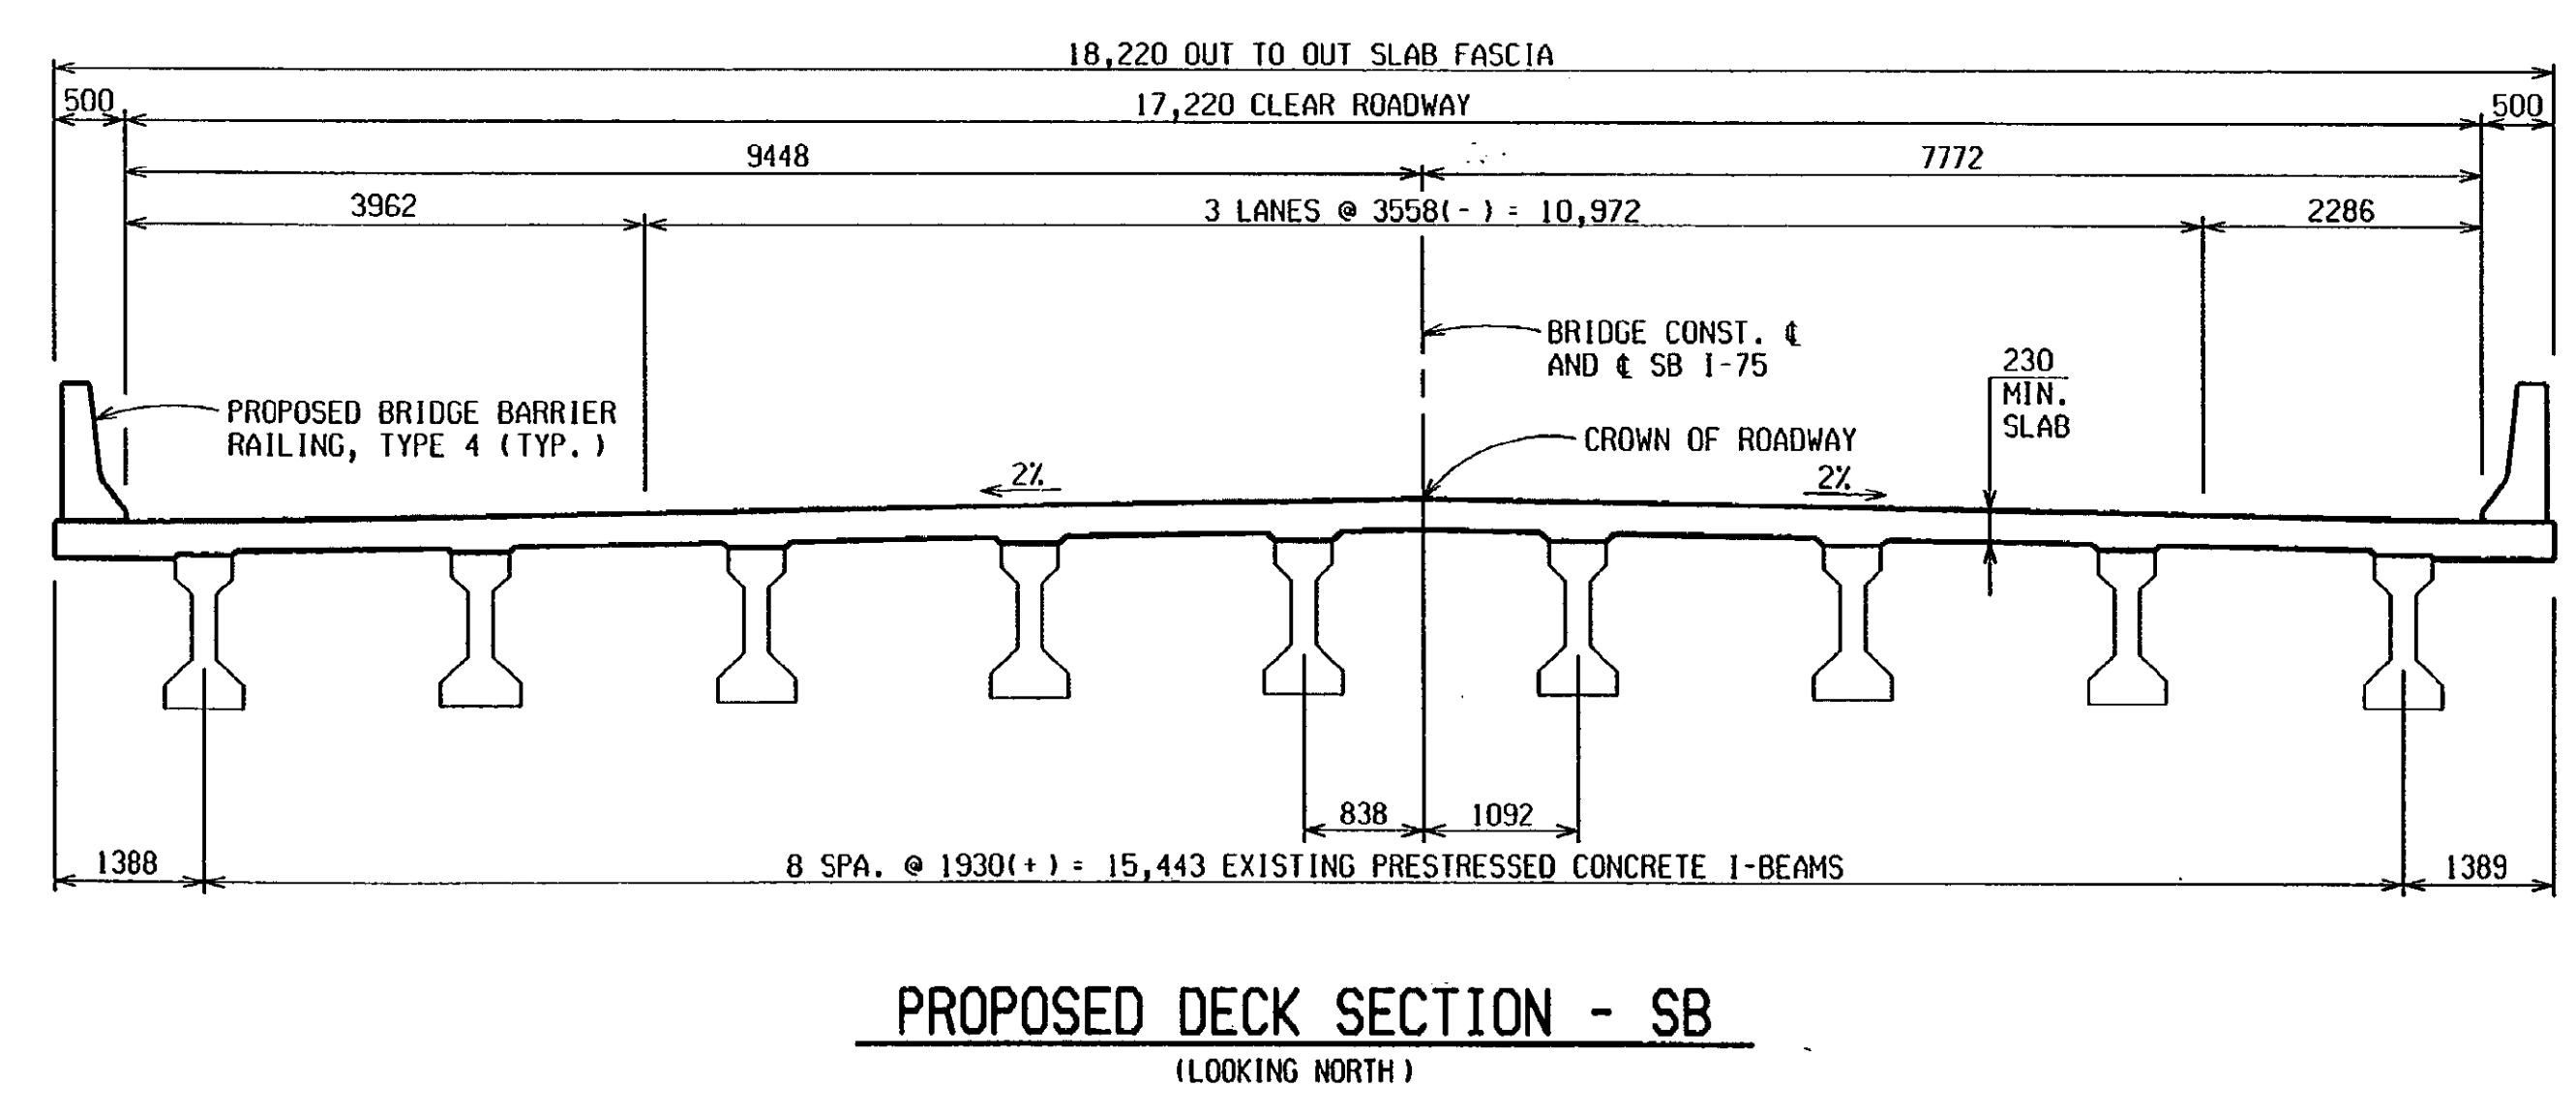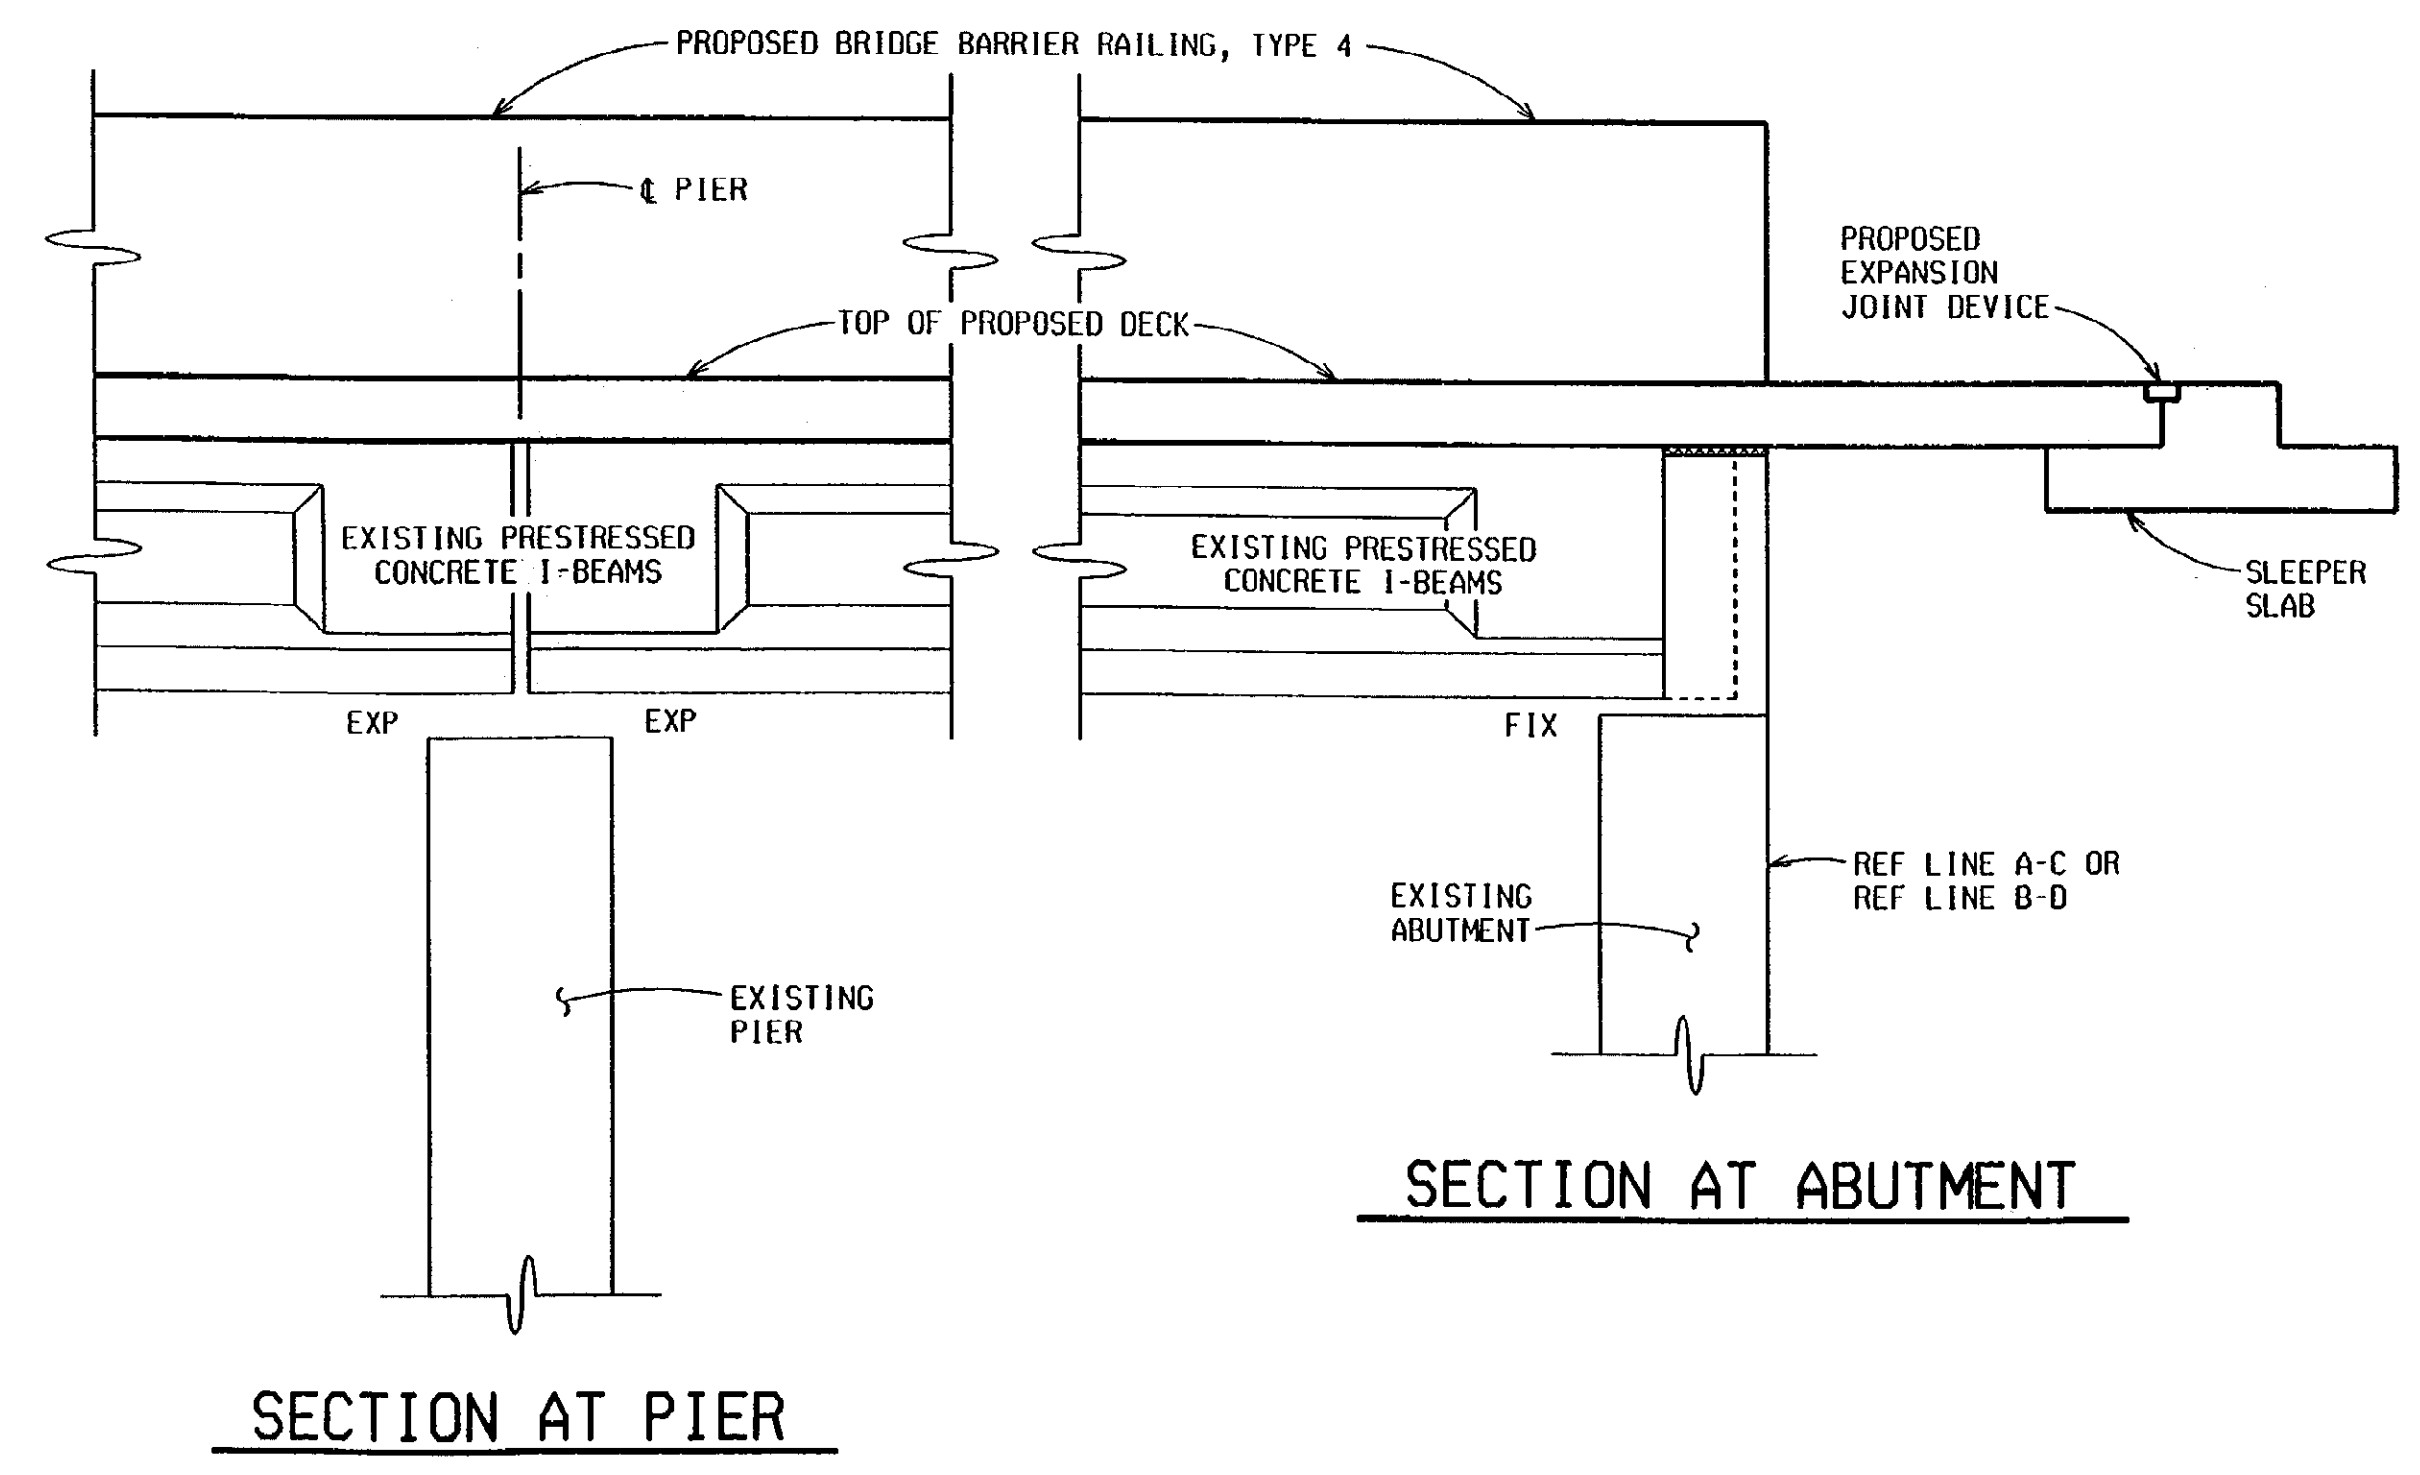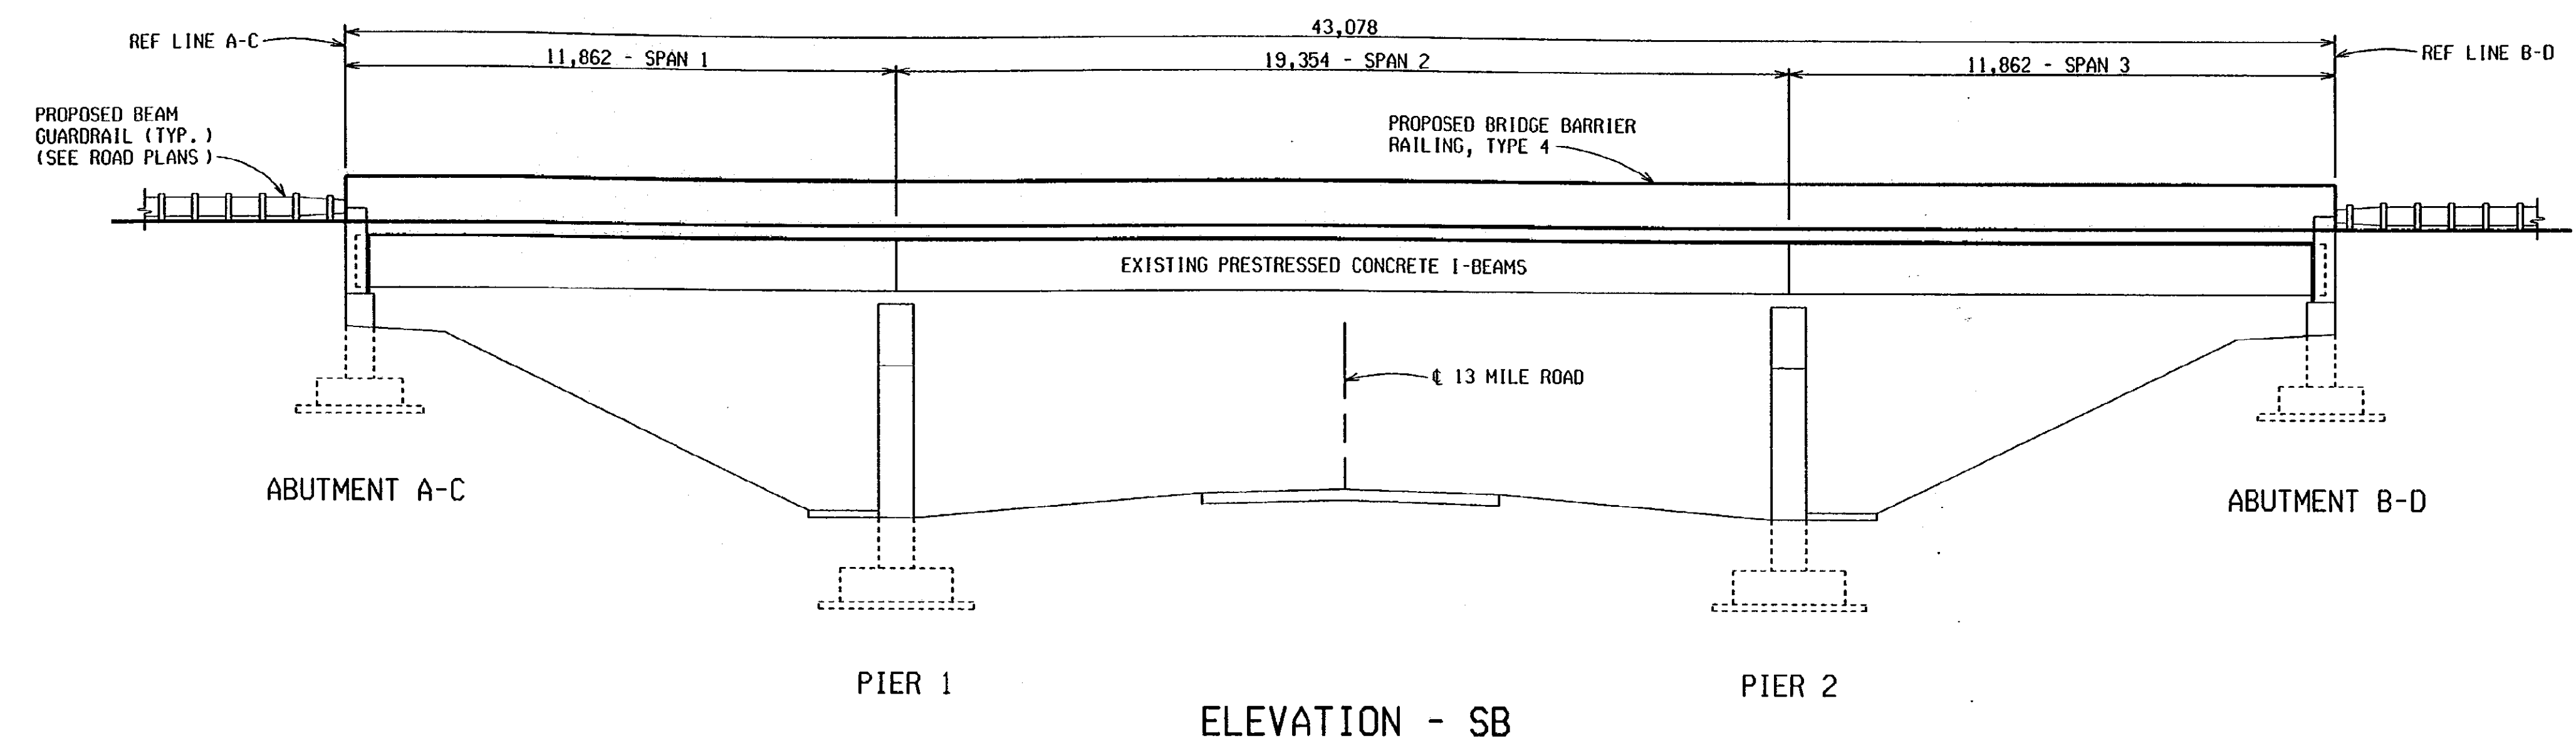


DATE: 11-28-00
CORRECTED BY: R. PRAIT
DATE:
CHECKED BY: MIKUCKI
DATE: 4-11-00
DRAWN BY: R. PRAIT
FILE NAME: s0463174s.st

APPROVED <i>Steven P. Beck</i> 1/11/01 DESIGN SUPERVISING ENGINEER				GENERAL PLAN OF STRUCTURE	
SB I-75 OVER 13 MILE ROAD IN MADISON HEIGHTS.		DATE	CONT. SEC.	JOB NO.	DESIGN UNIT
		1-9-01	S04 OF 63174	49595A	MAHDAVI
					SHEET 4 OF 15







SECTION S04 OF 63174 NO. 49595A

1 2 3 4 5 6 7 8 9 10 11 12 13 14 15 16 17 18 19 20 21 22 23 24 25 26 27 28 29 30 31 32 33 34 35 36 37 38 39 40 41 42 43 44 45 46 47 48 49 50 51 52 53 54 55 56 57 58 59 60 61 62 63

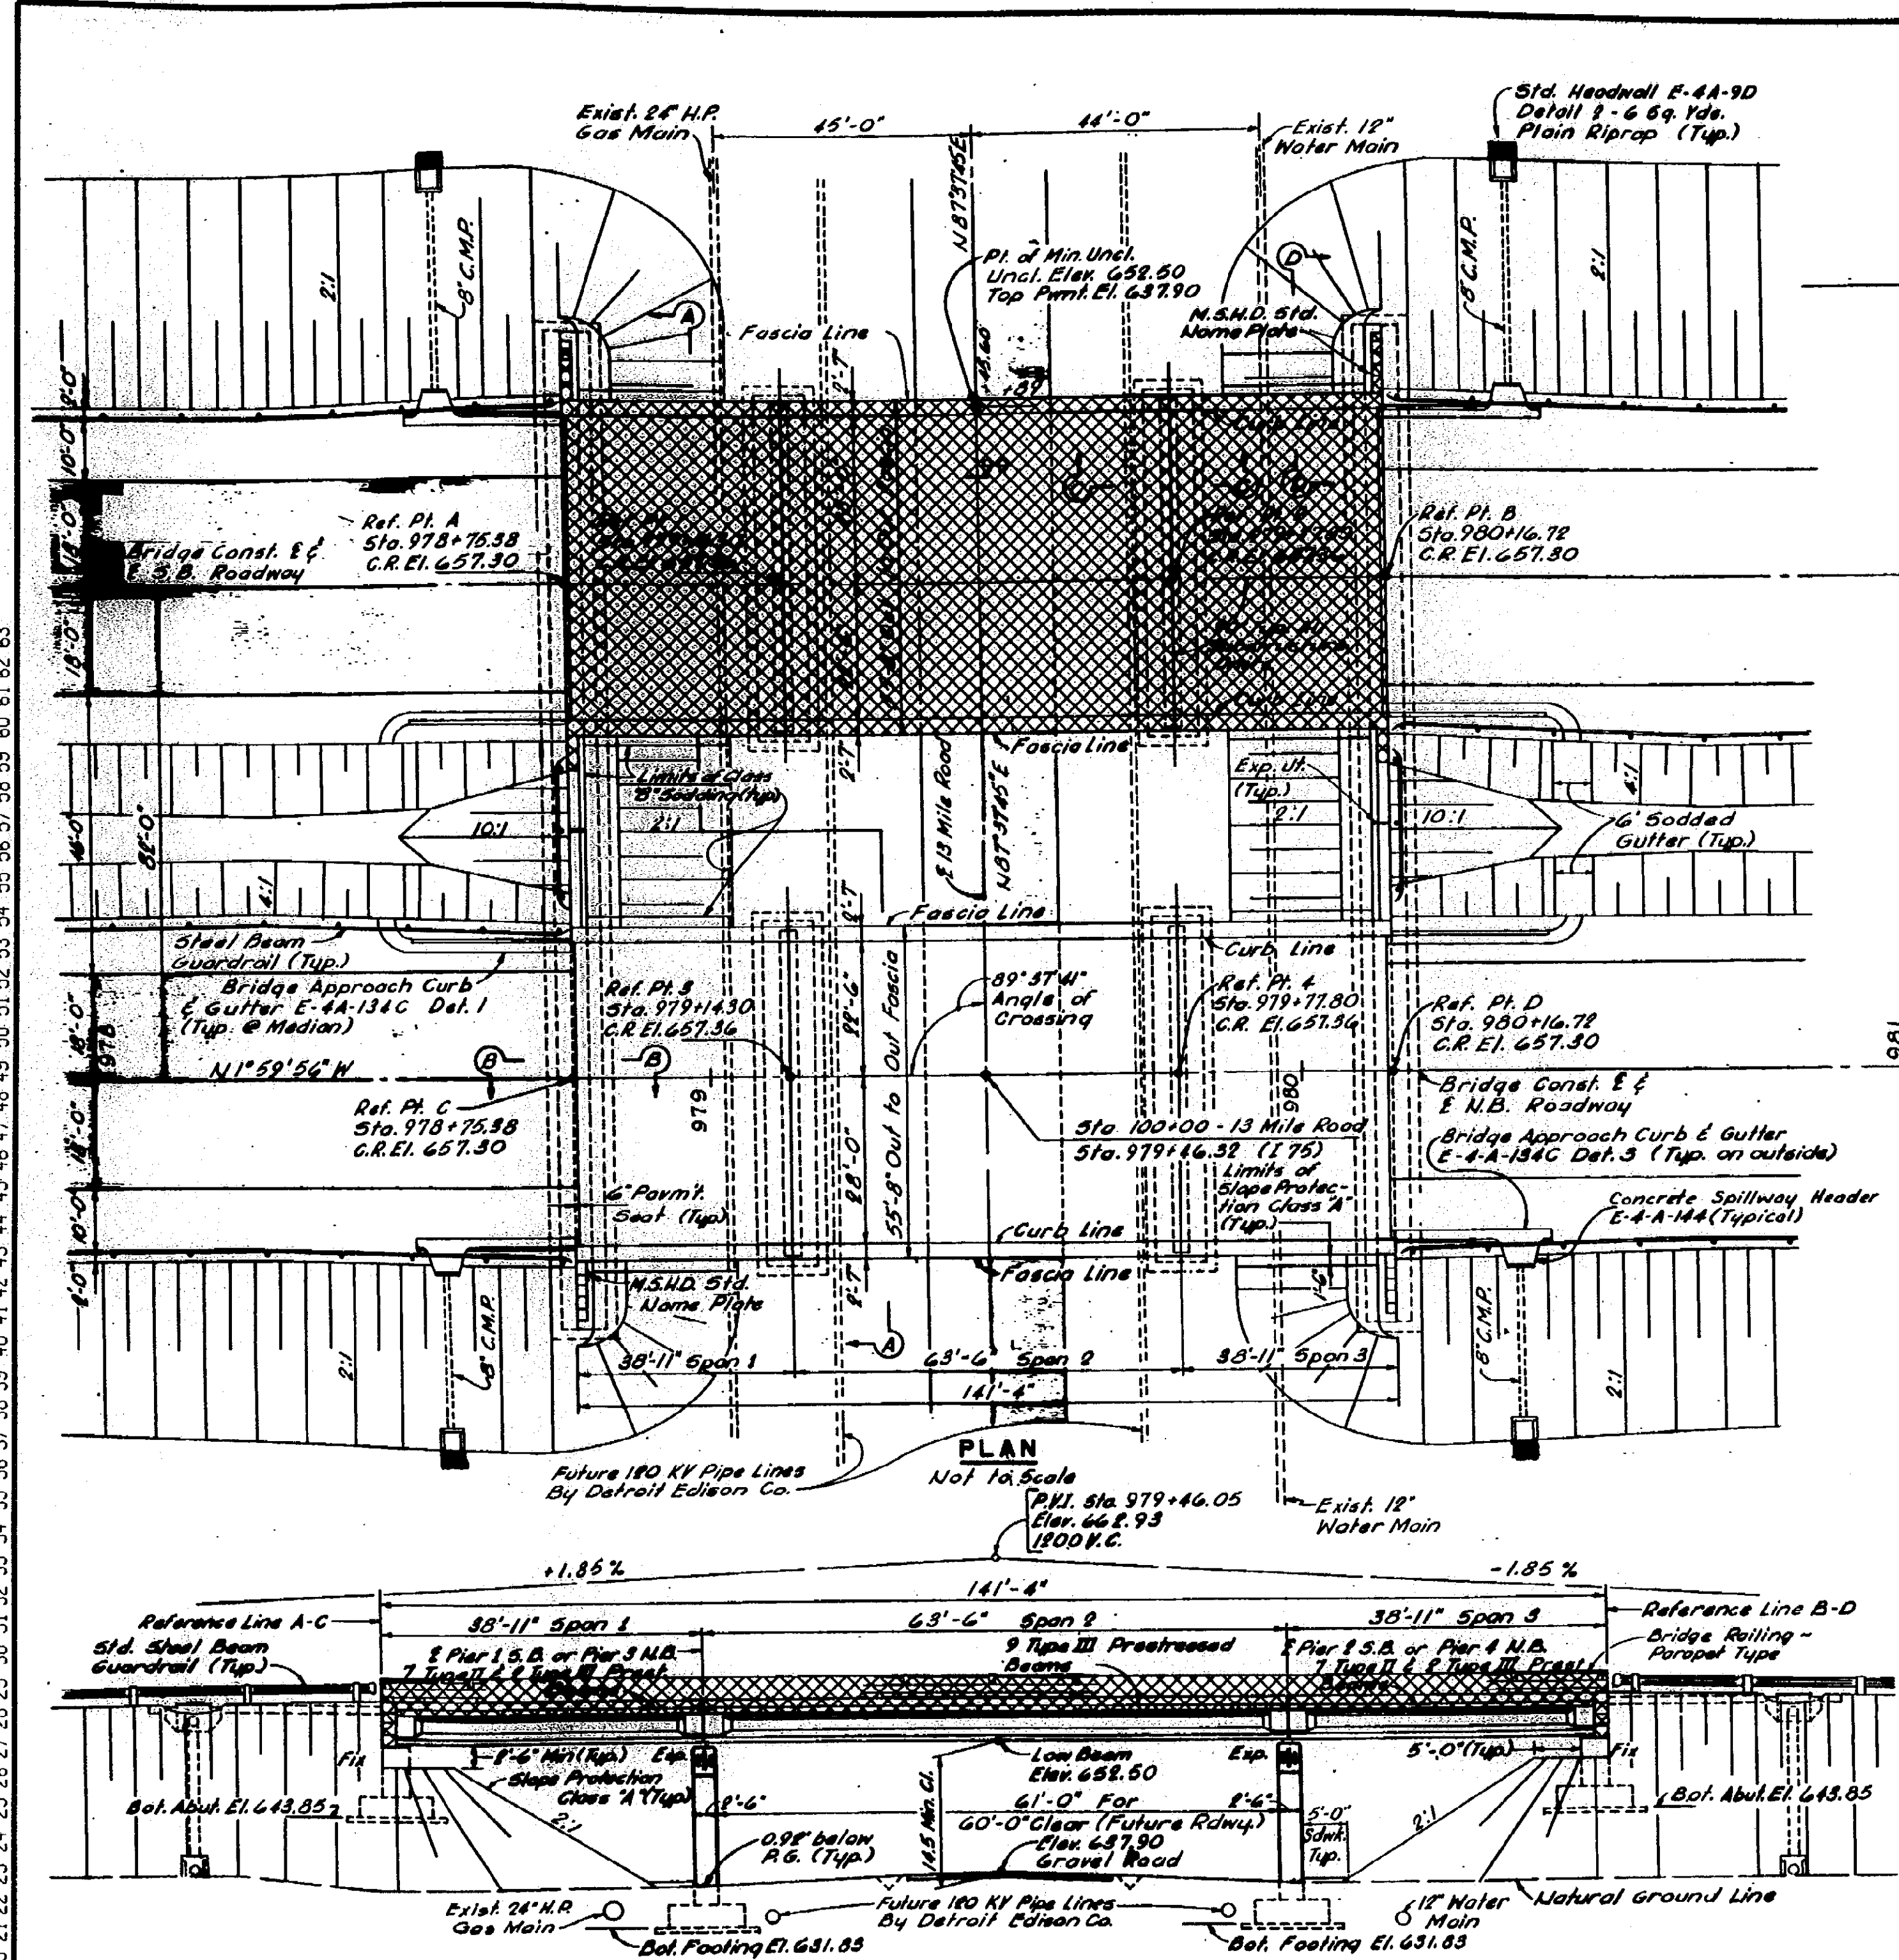

MISCELLANEOUS QUANTITIES		
ITEM	UNIT	AMOUNT
Slope Protection Class A	Sq. Yds.	386
Porous Material Grade A (Compacted in Place)	Cu. Yds.	270

* Grouted Riprap shall not be used on this Project.

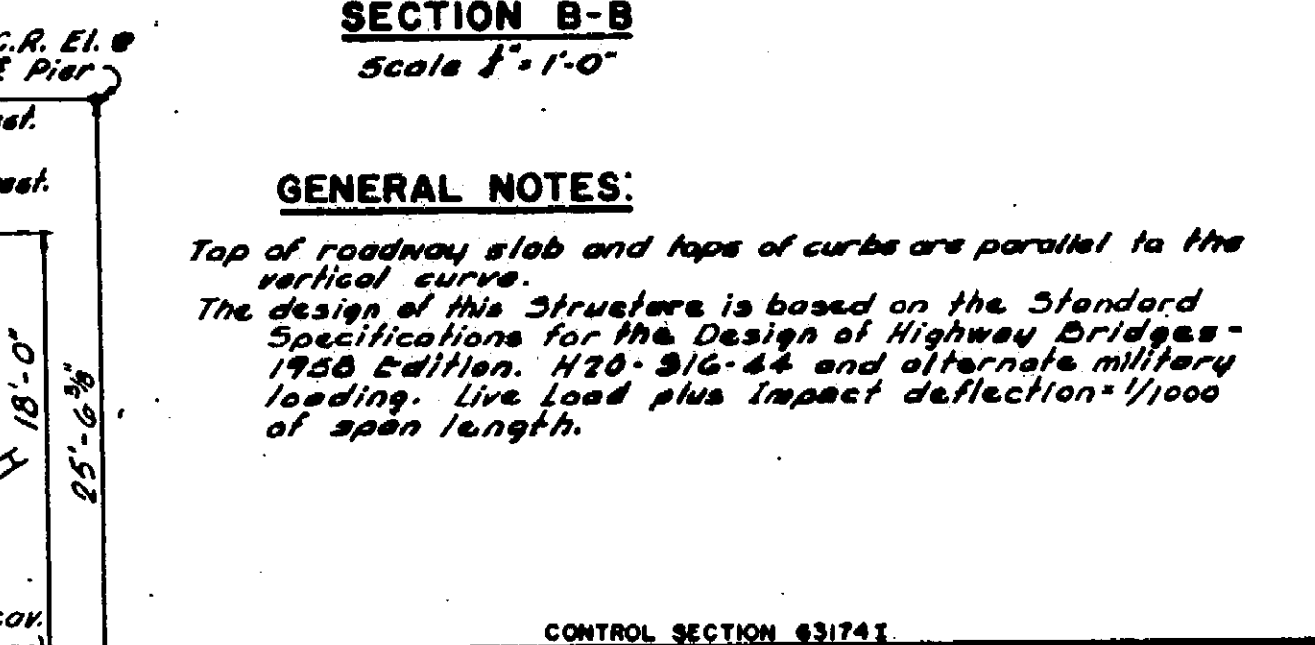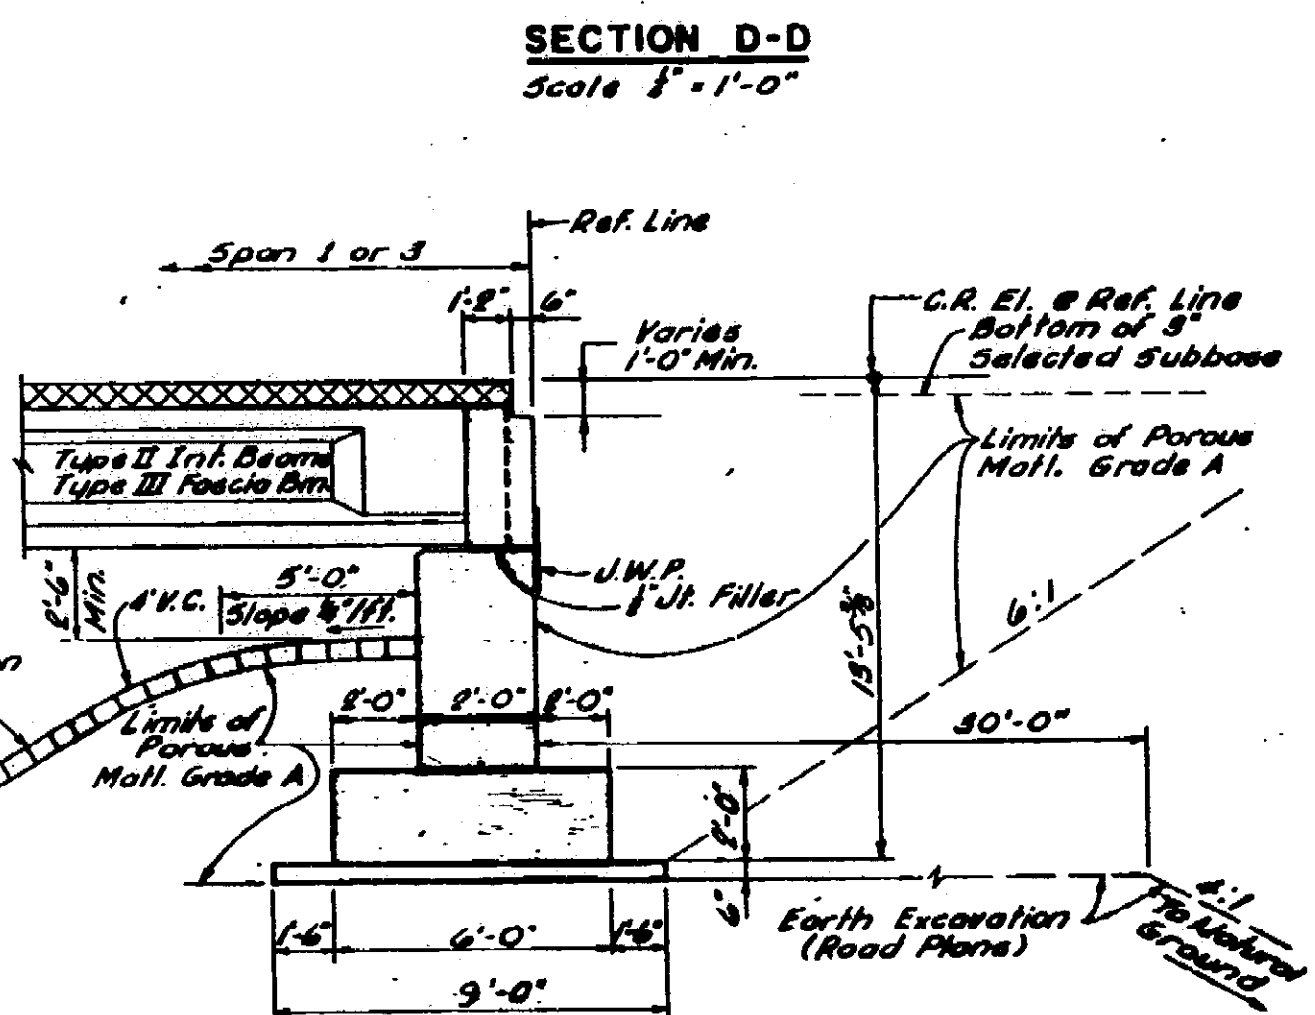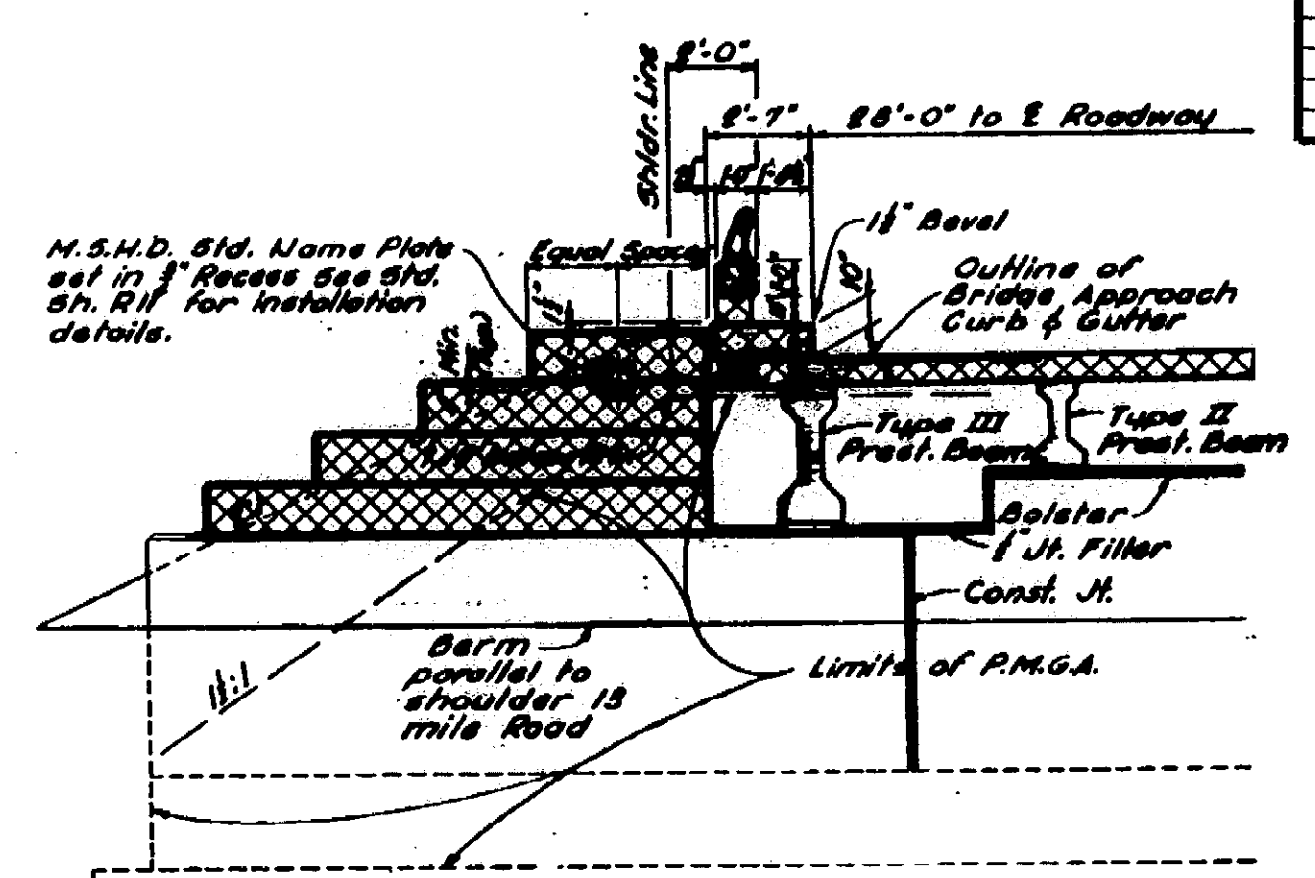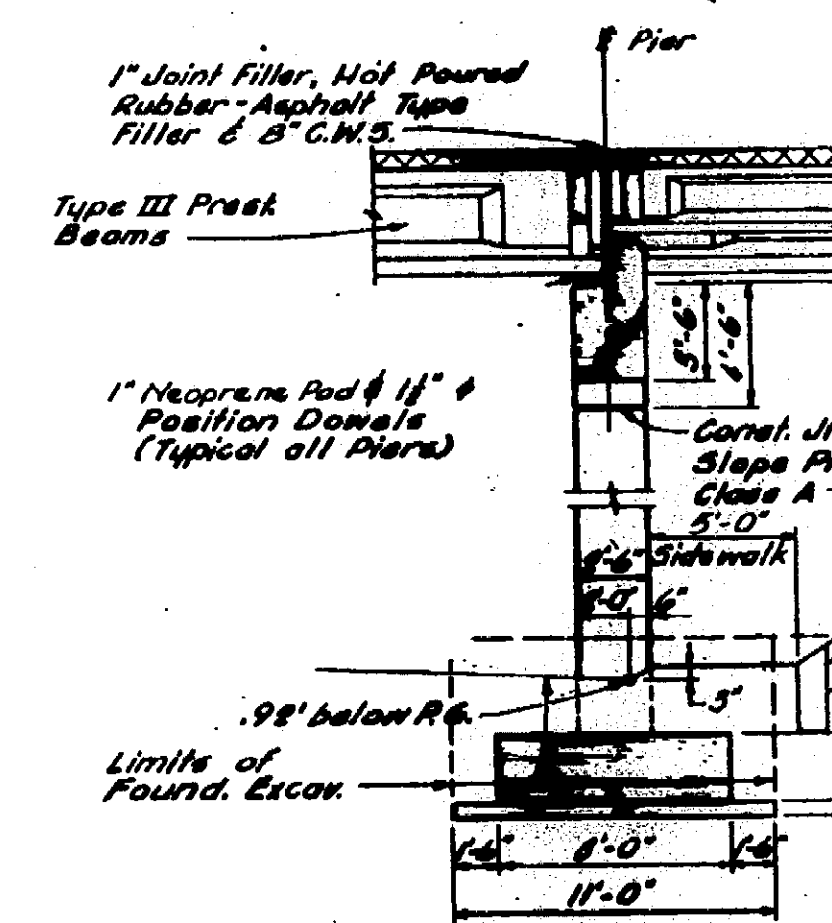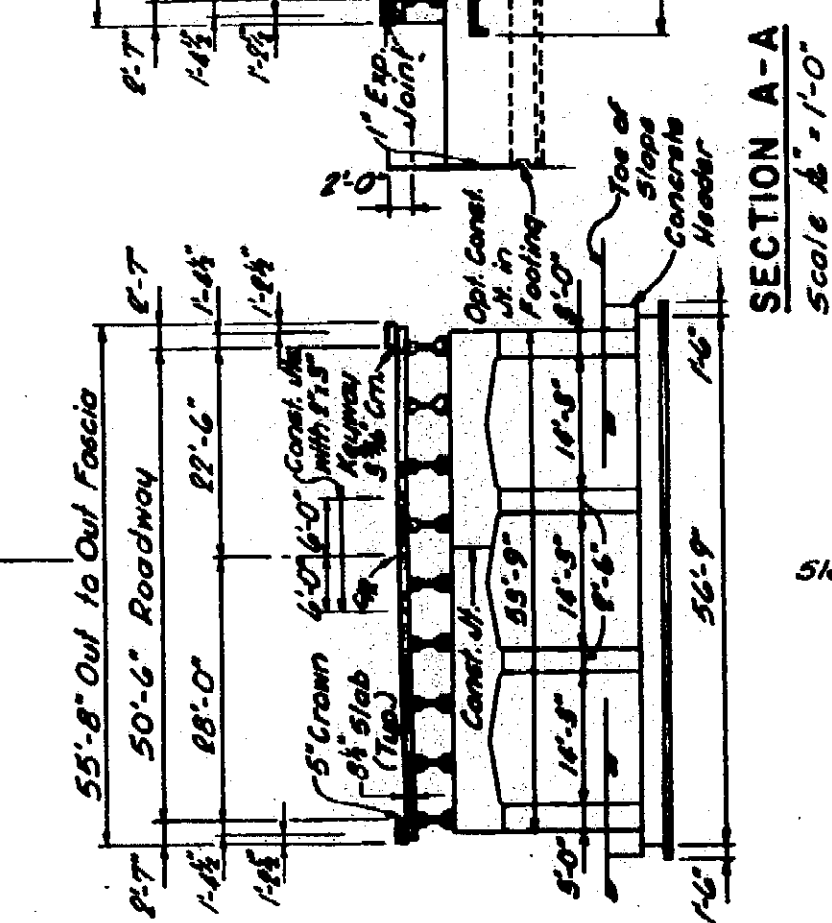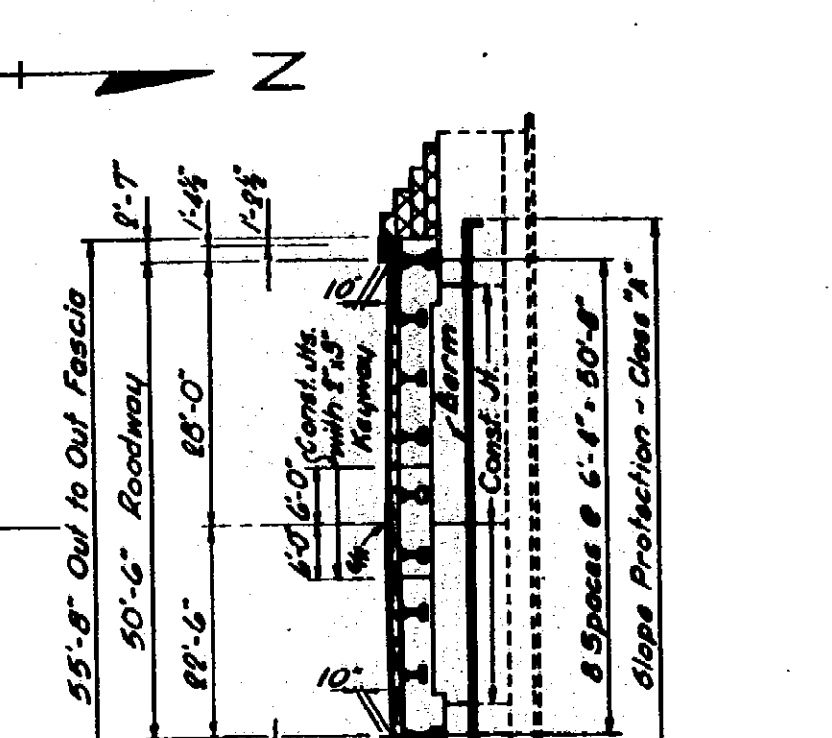

GENERAL NOTES:
 Top of roadway slab and tops of curbs are parallel to the vertical curve.
 The design of this structure is based on the Standard Specifications for the Design of Highway Bridges - 1958 Edition, N20-316-42 and alternate military loading. Live Load plus Impact deflection = 1/1000 of span length.

THE ONLY ITEMS OF WORK TO BE DONE FROM THIS SHEET ARE IDENTIFIED BY THE LEGEND BOX BELOW, LABELED WITH THIS PROJECT'S JOB NUMBER.

JOB NO. 49595A

■ DENOTES REMOVAL PORTIONS
 □ PROPOSED WORK

CONTROL SECTION 63174

MICHIGAN STATE HIGHWAY DEPARTMENT
 175 OVER 13 MILE ROAD IN THE CITY OF MADISON HEIGHTS

GENERAL PLAN OF STRUCTURE
 TECOM ENGINEERS, INC.

APPROVED: *J. H. Murray* 6-5-62
 DATE: 6-5-62


NO. 504 OF 63174

REMOVAL PORTIONS - SB STRUCTURE				
DATE	CONT. SEC.	JOB NO.	DESIGN UNIT	SHEET
1-9-01	S04 OF 63174	49595A	MAHDAVI	5 OF 15




DATE: _____ CORRECTED BY: R. PRATT CHECKED BY: MIKUCKI DATE: 04-12-00 DRAWN BY: INDER FILE NAME: s0462174sp.

1 2 3 4 5 6 7 8 9 10 11 12 13 14 15 16 17 18 19 20 21 22 23 24 25 26 27 28 29 30 31 32 33 34 35 36 37 38 39 40 41 42 43 44 45 46 47 48 49 50 51 52 53 54 55 56 57 58 59 60 61 62 63

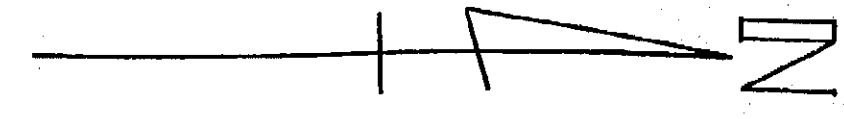

REVISIONS			
NO.	DESCRIPTION	DATE	BY

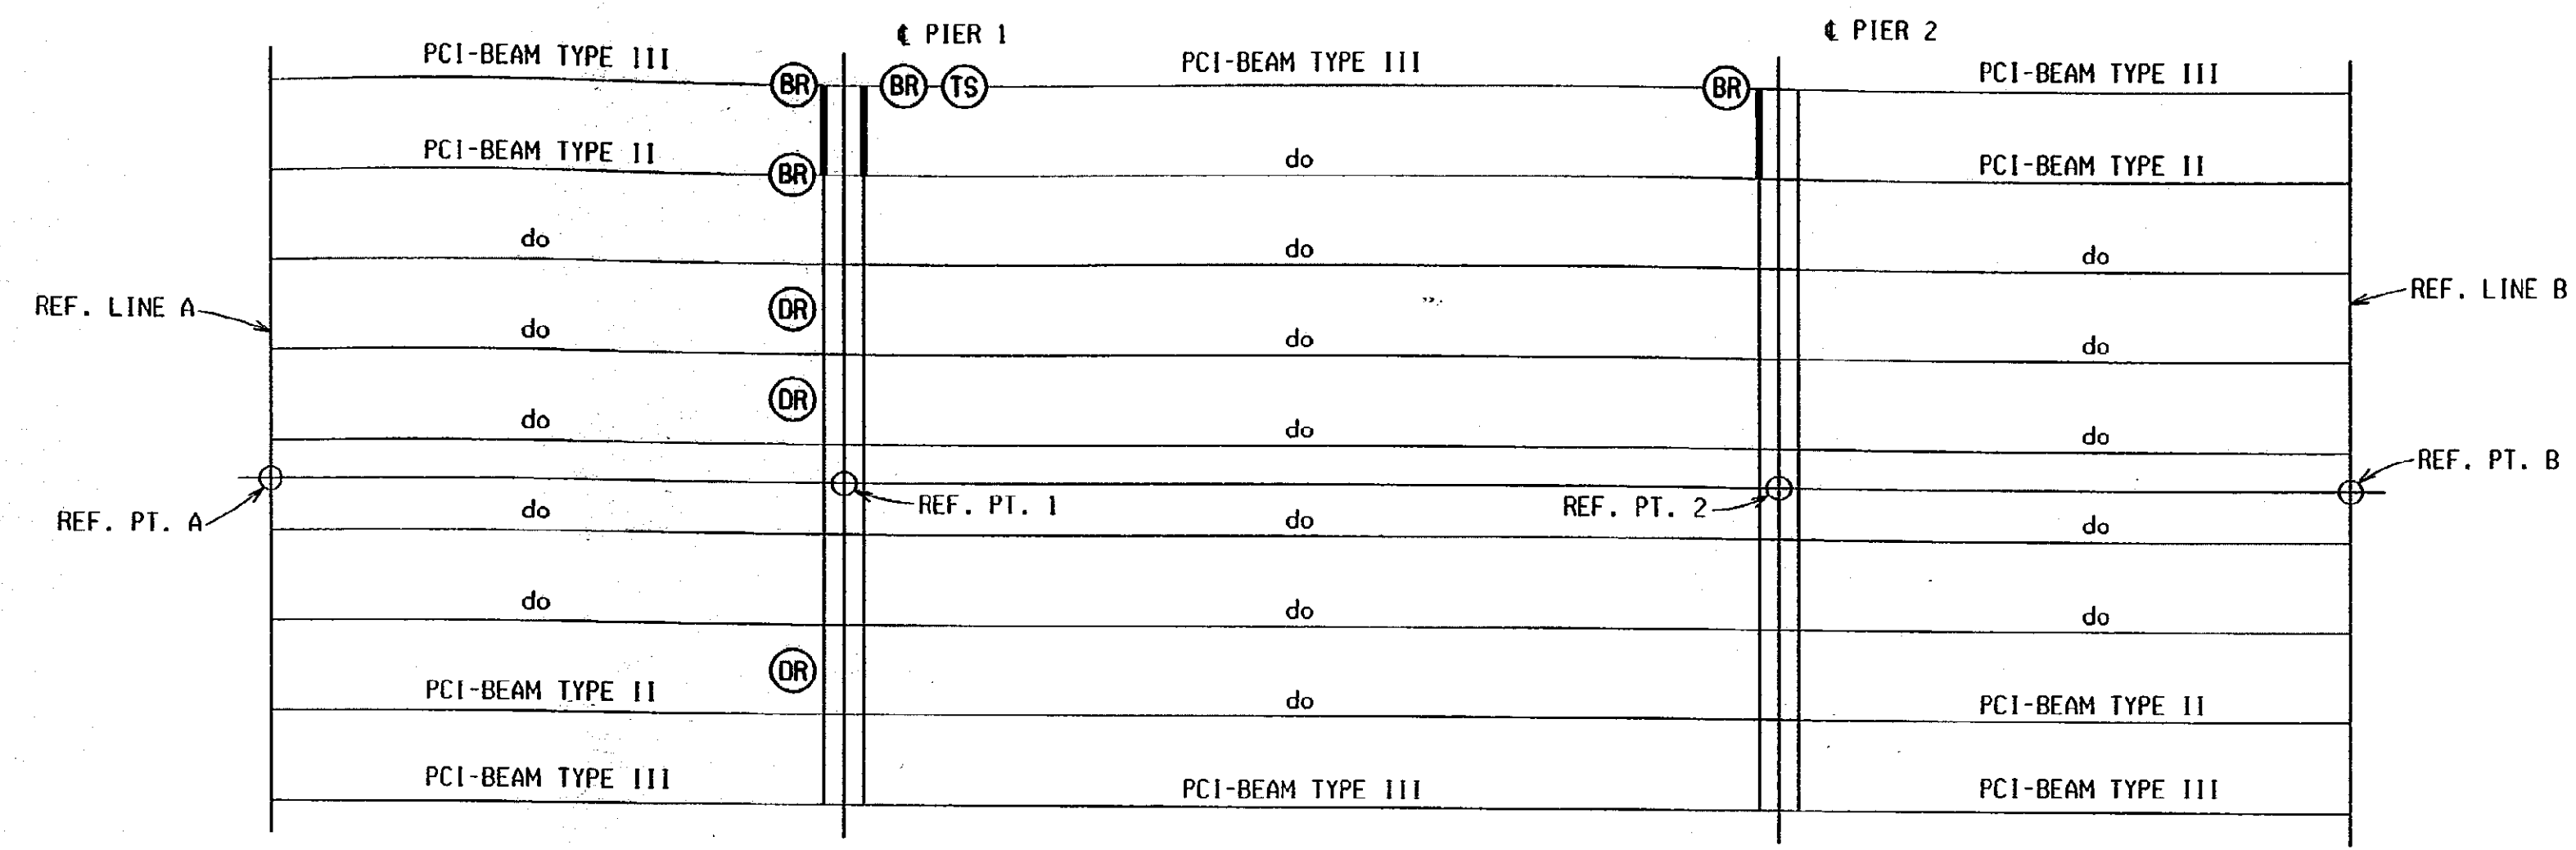


PLAN
BEAM END REPAIR

- (BR) DENOTES BEAM END REPAIR
- (DR) DENOTES DIAPHRAGM REPAIR
- (TS) DENOTES TEMPORARY SUPPORT


MISCELLANEOUS QUANTITIES	
5 m ²	Patch, Forming
4 ea	Removal, Beam End Repair *
1 m ³	Hand Chipping, Other Than Deck
350 kg	Reinforcement, Steel, Epoxy Coated
3 m ³	Patching Cono, LM ***
12 m ²	Forming, Beam End Repair *
1 LS	Concrete Surface Sealer **

*REFER TO SPECIAL PROVISION FOR PRESSTRESSED CONCRETE BEAM END REPAIR.
 **REFER TO SPECIAL PROVISION FOR CONCRETE SURFACE SEALERS.
 ***REFER TO SPECIAL PROVISION FOR STRUCTURAL REPAIR WITH LATEX MODIFIED CONCRETE.

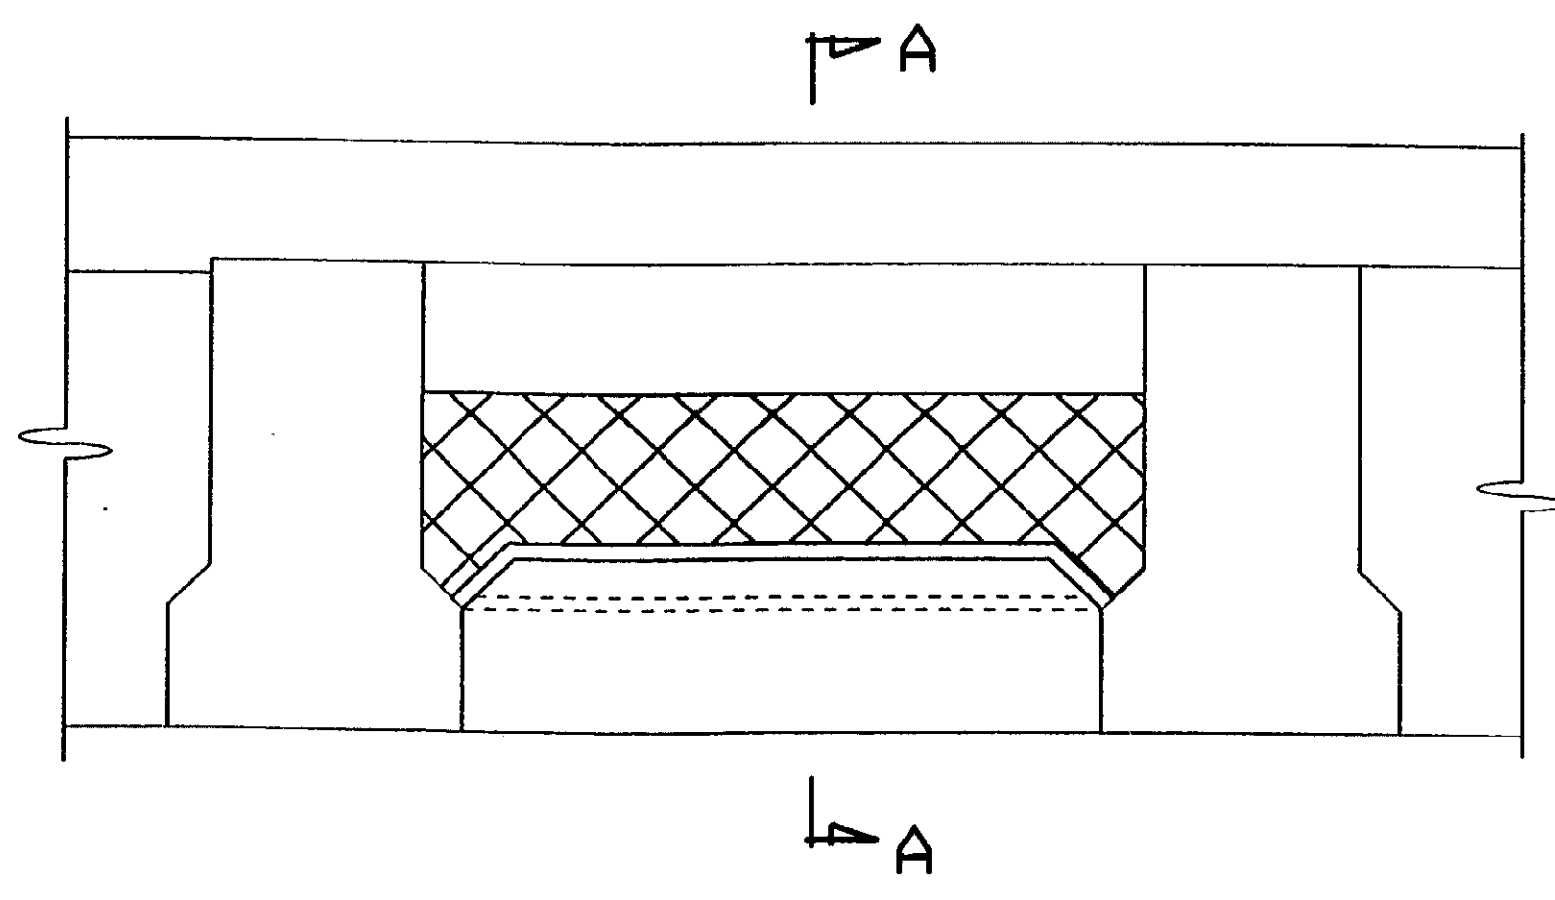

LIMITS OF HAND CHIPPING, OTHER THAN DECK.

END DIAPHRAGM

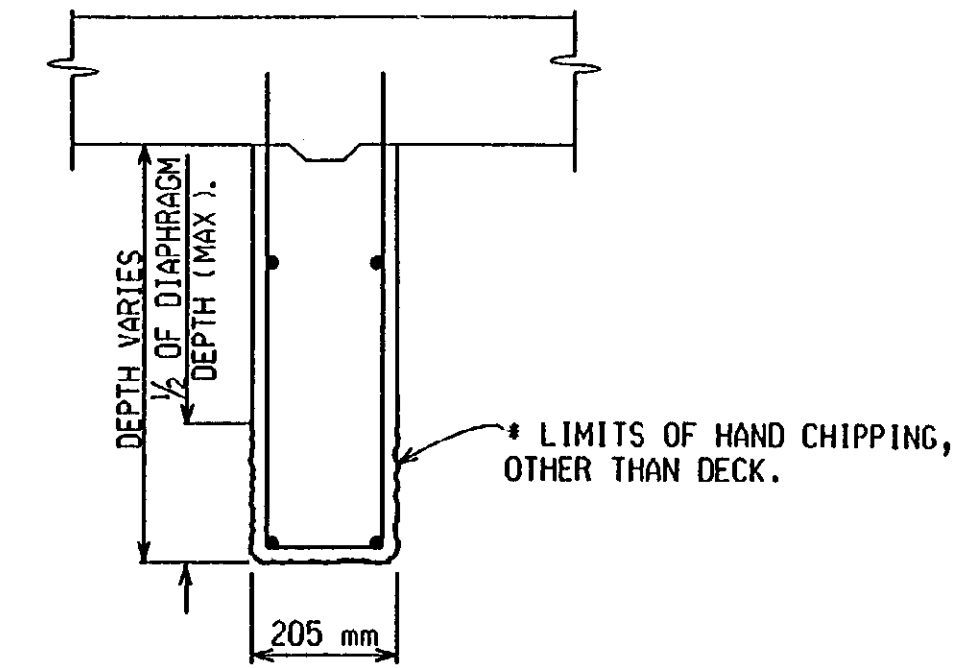

* LIMITS OF HAND CHIPPING SHALL BE FIELD VERIFIED AND AS DIRECTED BY THE ENGINEER.

SECTION A-A

NOTES:


- IF THE CONTRACTOR ELECTS TO REPAIR MORE THAN ONE BEAM END AT A TIME, WORK SHALL NOT BE DONE ON THE SAME END OF ANY ADJACENT BEAM OR AT THE OPPOSITE END OF THE BEAM BEING REPAIRED.
- ES DENOTES EACH SIDE.
- ADHESIVE ANCHOR EB13 BARS INTO 38mm Ø HOLES IN BEAM WEB.
- DRILLING OF HOLES SHALL NOT BE PERMITTED, EXCEPT AS NOTED.
- THE LIMITS OF THE CONCRETE SEALER SHALL INCLUDE THE OUTSIDE FACE FOR THE FULL LENGTH OF THE FASCIA BEAMS AND ALL SURFACES OF ALL BEAM ENDS NOT BEING REPAIRED FOR A LENGTH NOT LESS THAN TWICE THE BEAM DEPTH. REFER TO SPECIAL PROVISION FOR CONCRETE SURFACE SEALERS FOR PRODUCT INFORMATION AND SURFACE PREPARATION. THE ESTIMATED QUANTITY IS 230m².
- WHERE A DIAPHRAGM IS REMOVED IN A BAY FROM THE SIDE OF A BEAM THAT IS NOT BEING REPAIRED, THE EXISTING INSERT HOLES SHALL BE FILLED WITH CAULK AND THE PROPOSED DIAPHRAGM REINFORCEMENT SHALL BE EPOXY ANCHORED TO THE BEAM IN THE NEW LOCATION. INCLUDED IN THE BID ITEM "Removal, Beam End Repair".



BEAM REPAIR DETAILS				
SOUTH BOUND				
DATE	CONT. SEC.	JOB NO.	DESIGN UNIT	SHEET
1-9-01	S04 OF 63174	49595A	MAHDAVI	6 OF 15

DATE: 12-20-00 CORRECTED BY: R.K.OLIN CHECKED BY: WM DATE: 12/2000 DRAWN BY: R.K.OLIN FILE NAME: s0463174s.br

1 2 3 4 5 6 7 8 9 10 11 12 13 14 15 16 17 18 19 20 21 22 23 24 25 26 27 28 29 30 31 32 33 34 35 36 37 38 39 40 41 42 43 44 45 46 47 48 49 50 51 52 53 54 55 56 57 58 59 60 61 62 63

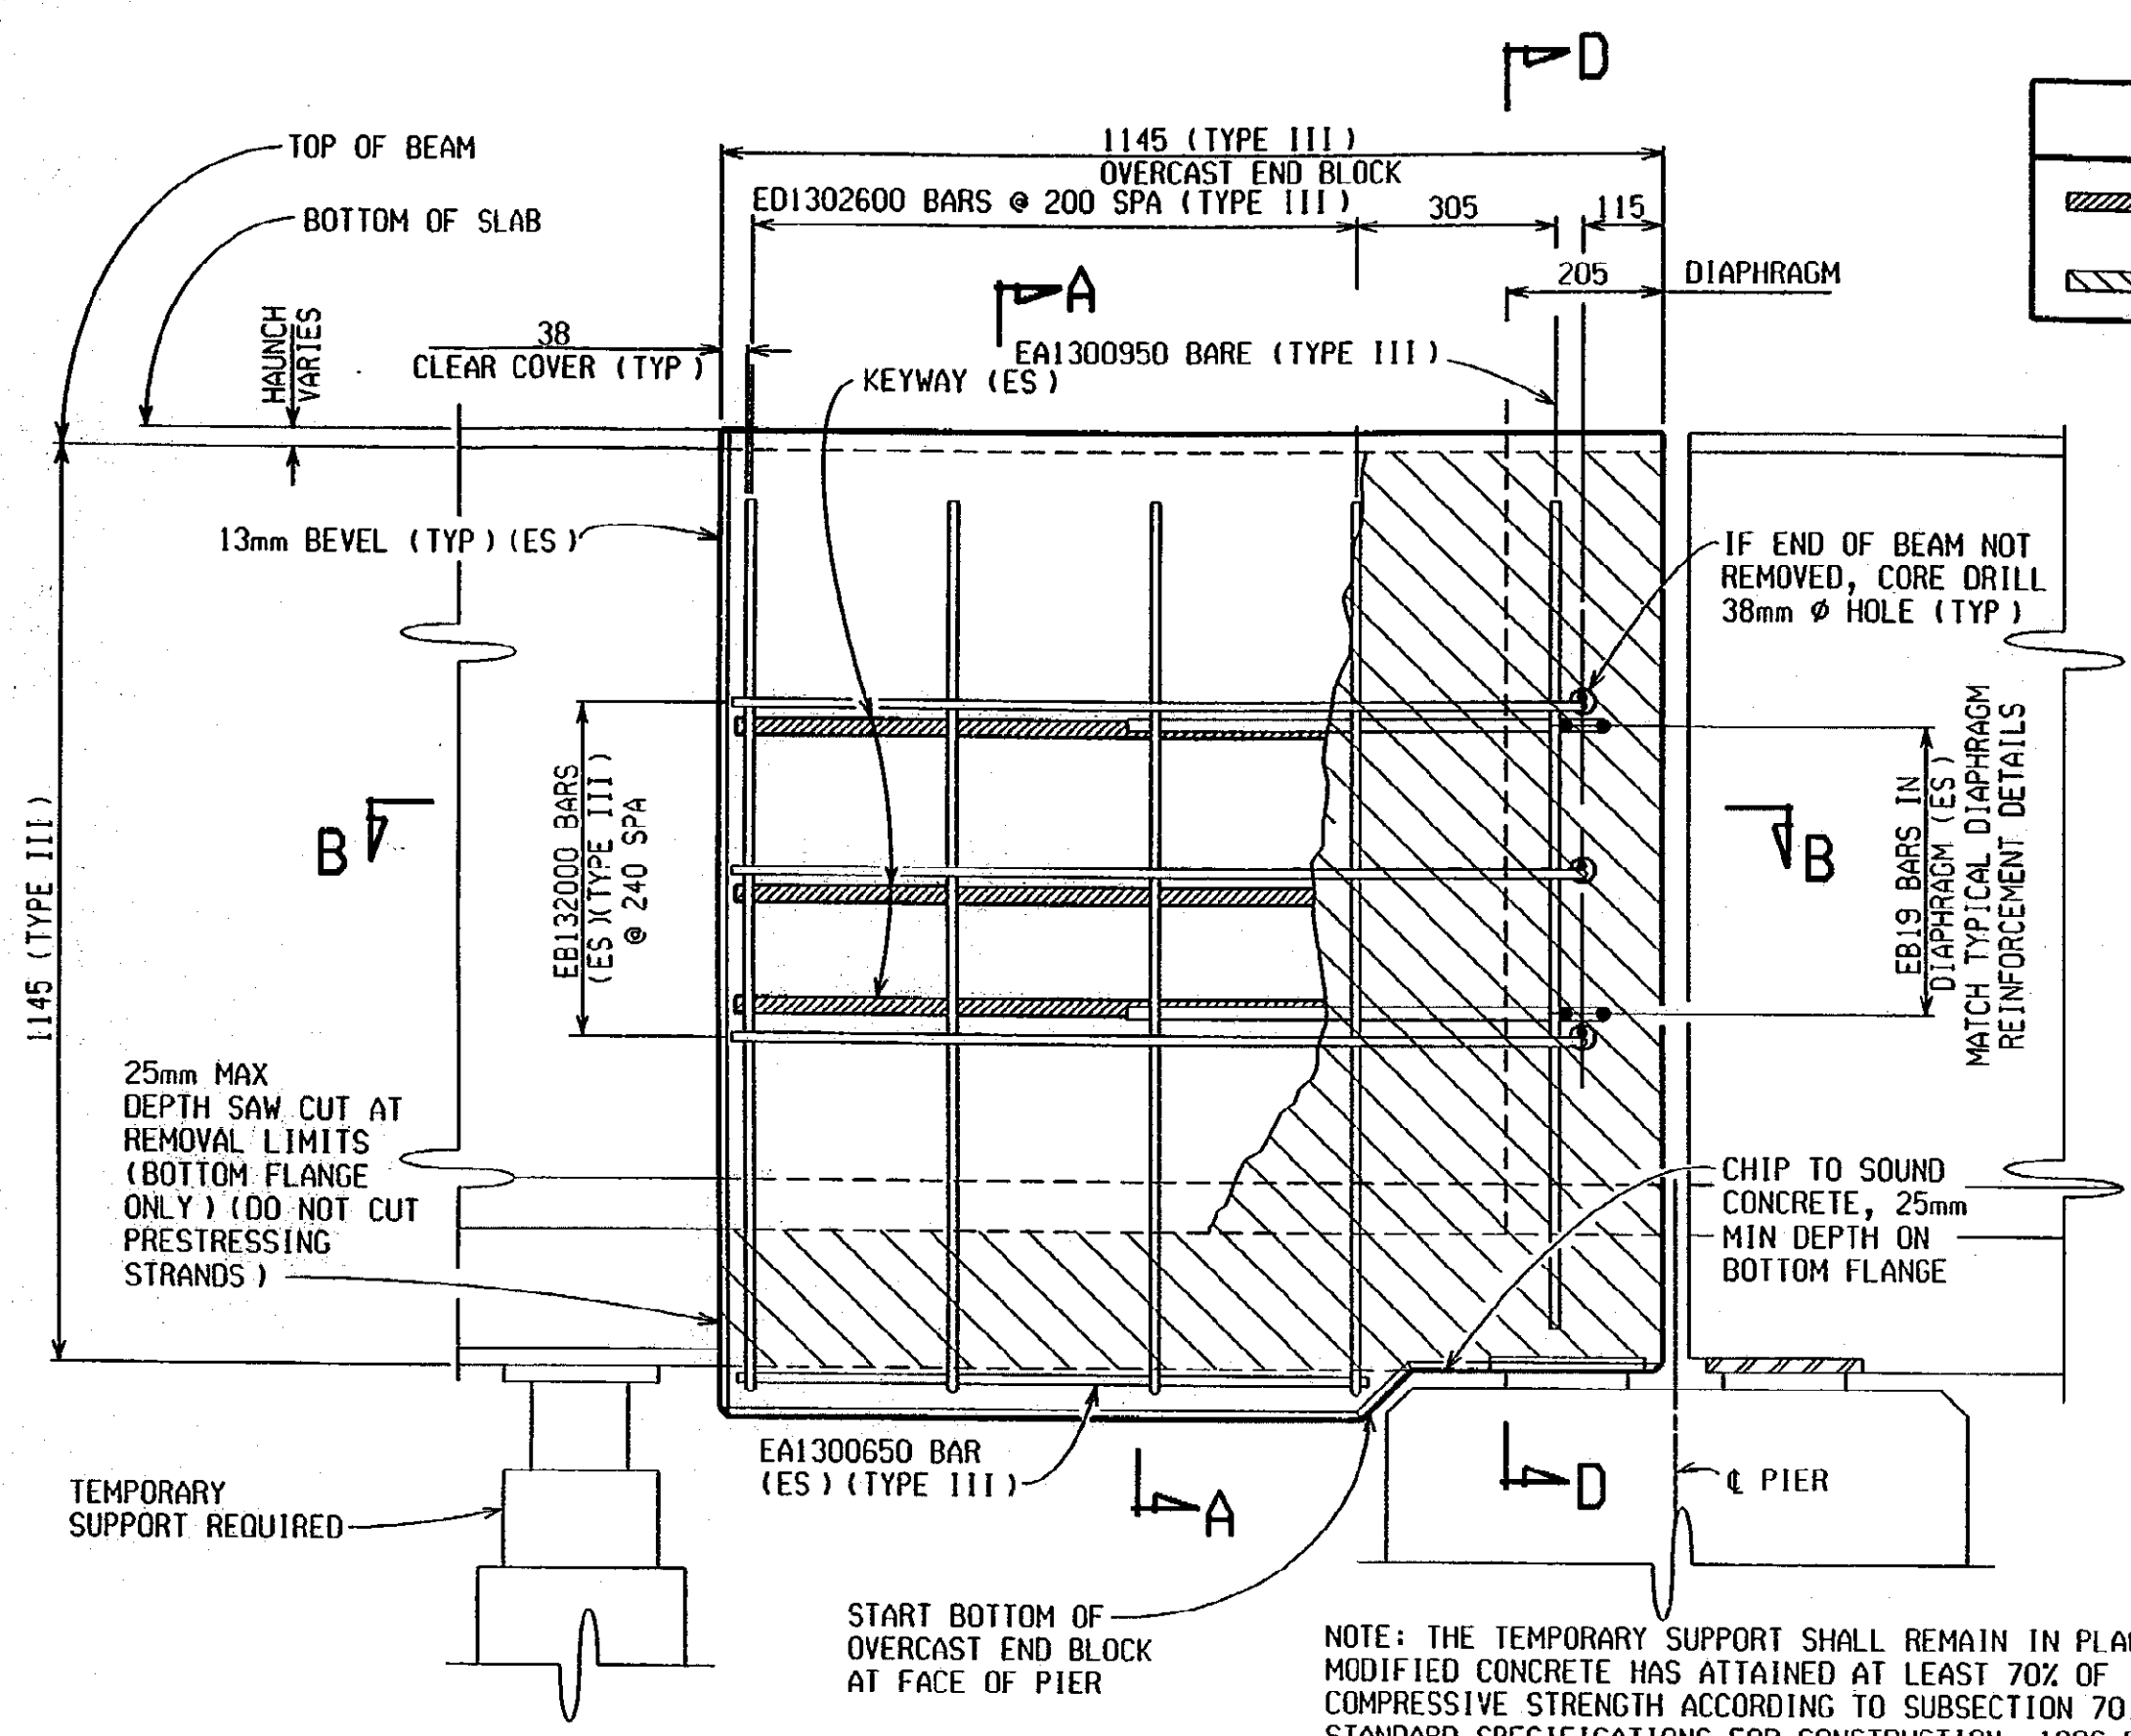


BEAM END ELEVATION


LEGEND

	KEYWAY, 13mm DEEP x 25mm WIDE SAWCUT
	CHIPPED CONCRETE


NOTE: THE TEMPORARY SUPPORT SHALL REMAIN IN PLACE UNTILL THE LATEX MODIFIED CONCRETE HAS ATTAINED AT LEAST 70% OF ITS MINIMUM 28-DAY COMPRESSIVE STRENGTH ACCORDING TO SUBSECTION 701.03.F.6 OF THE STANDARD SPECIFICATIONS FOR CONSTRUCTION, 1996 EDITION.

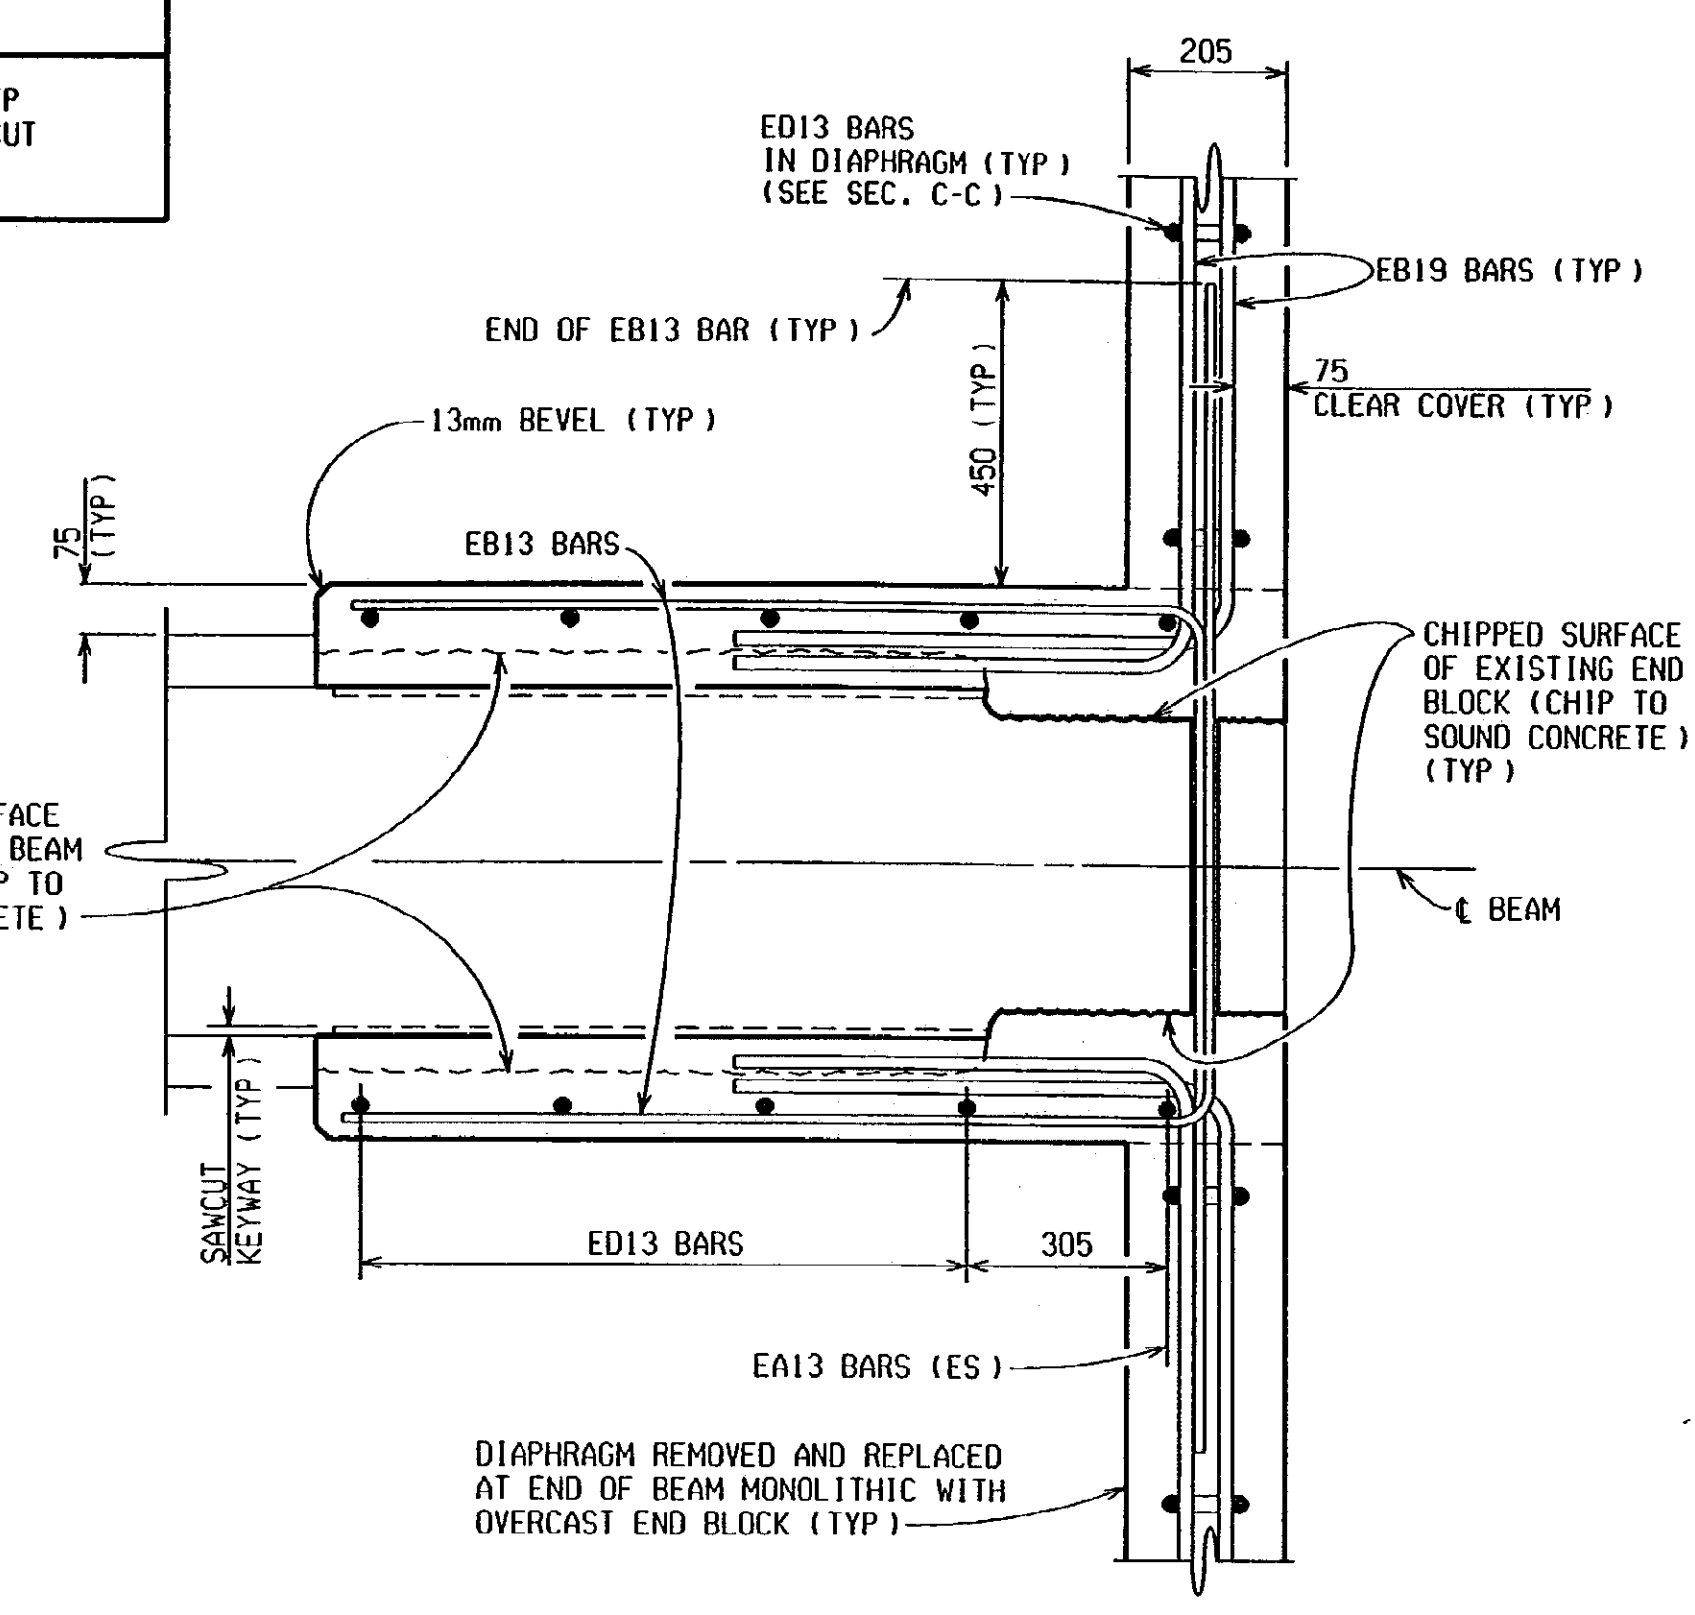

SECTION B-B

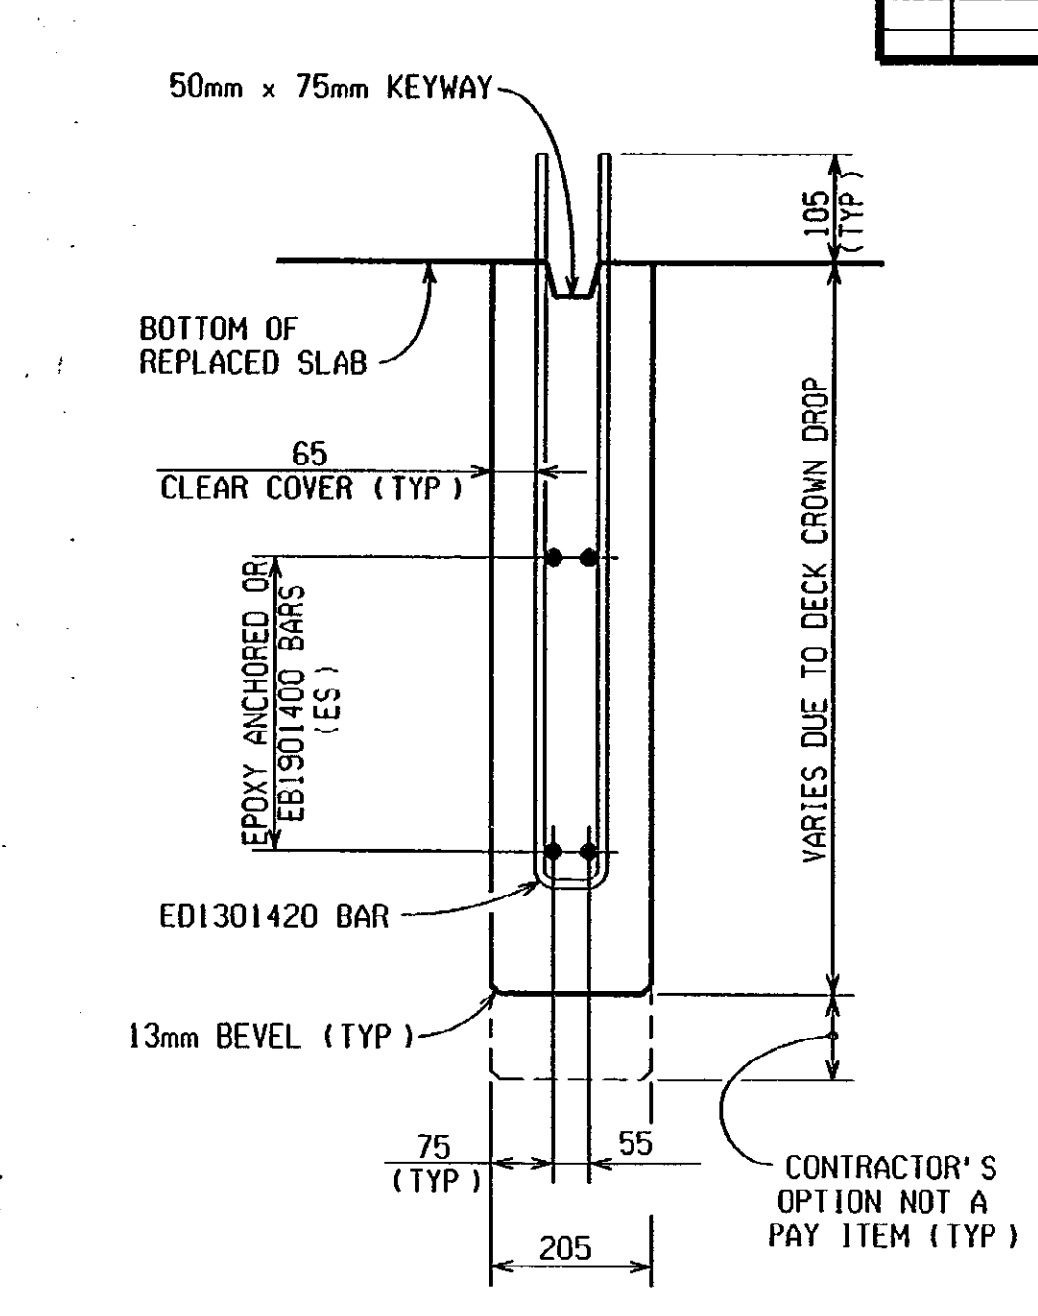


SECTION C-C

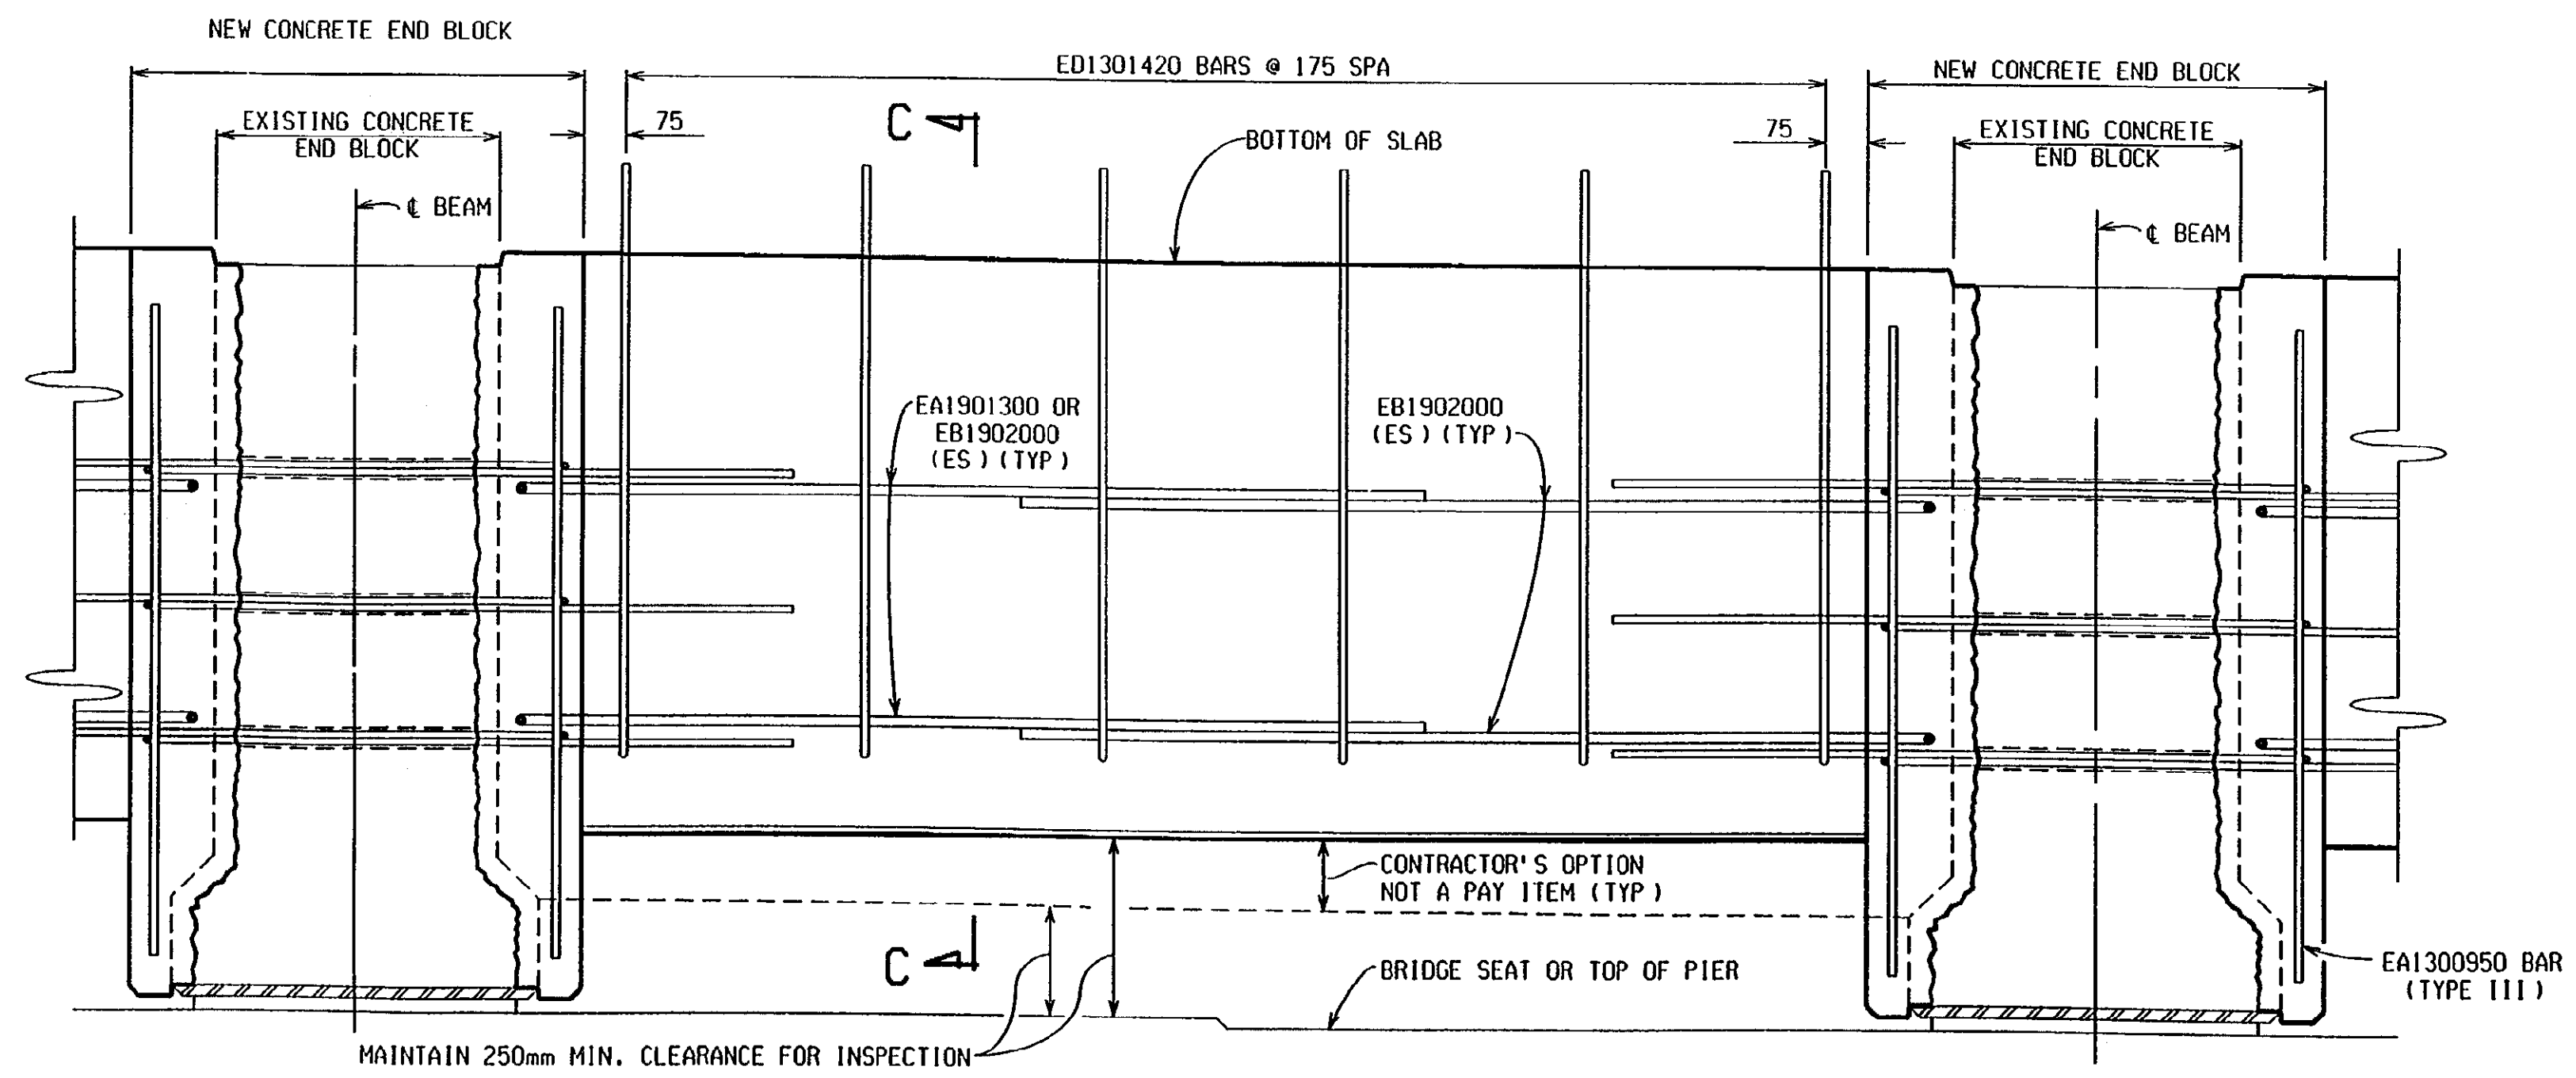

SECTION D-D (DIAPHRAGM ELEVATION)
(SHOWING STEEL REINFORCEMENT)

NOTE: REPLACE DECK OVER BEAM END REPAIR AREA.

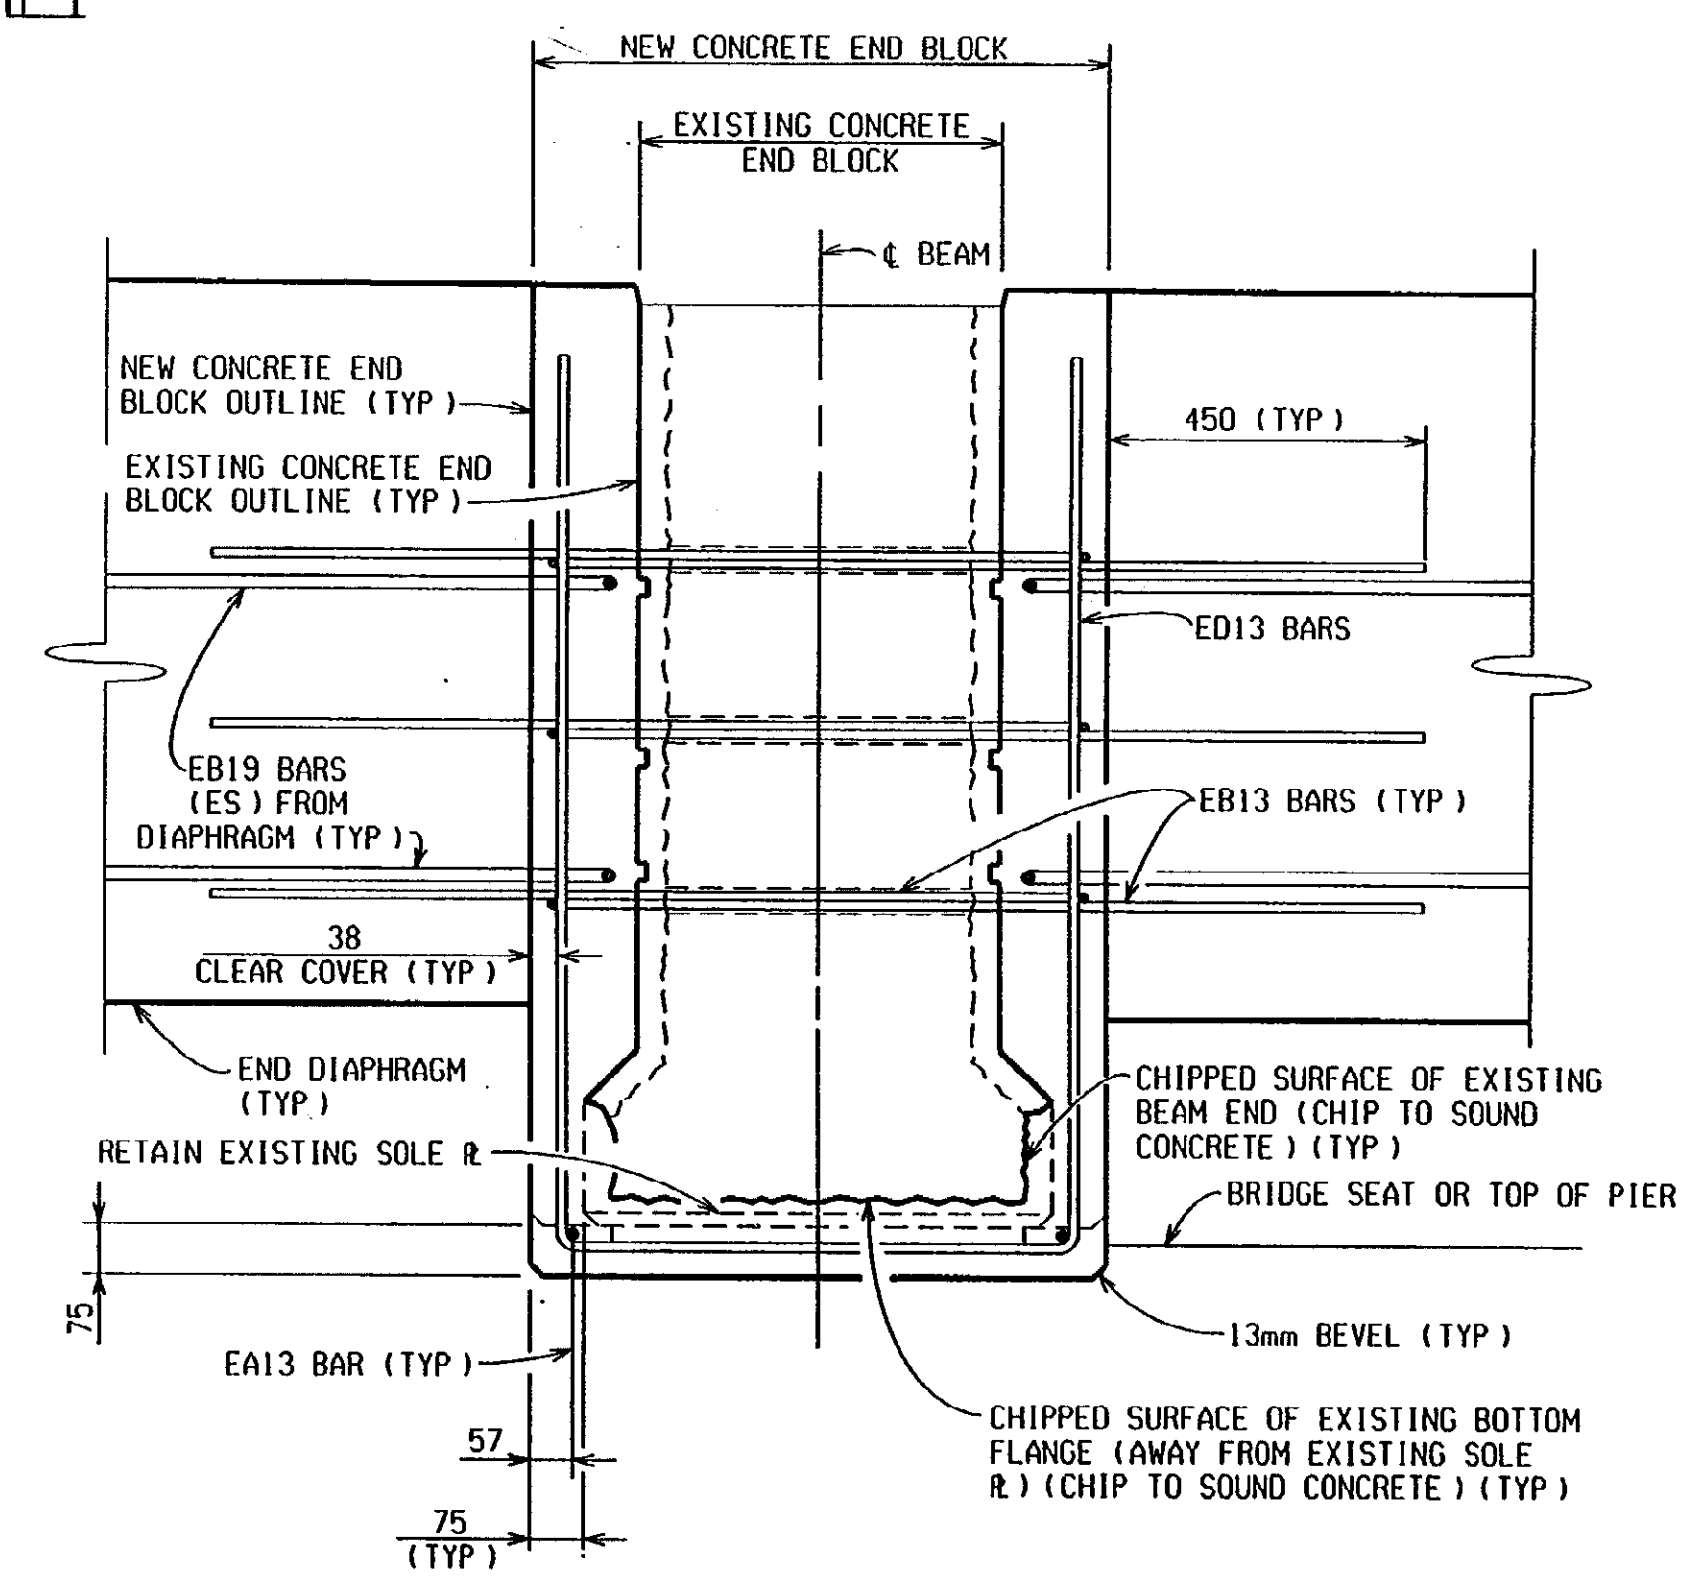

SECTION A-A
(ED13 BARS IN DIAPHRAGMS NOT SHOWN)







REVISIONS			
NO.	DESCRIPTION	DATE	BY

BEAM REPAIR DETAILS				
SOUTH BOUND				
DATE	CONT. SEC.	JOB NO.	DESIGN UNIT	SHEET
1-9-01	SO4 OF 63174	49595A	MAHDAVI	7 OF 15



DATE: _____
 CORRECTED BY: R.K. OLIN
 DATE: _____
 CHECKED BY: _____
 DATE: 12/2000
 DRAWN BY: R.K. OLIN
 FILE NAME: s0463174s.b-

1 2 3 4 5 6 7 8 9 10 11 12 13 14 15 16 17 18 19 20 21 22 23 24 25 26 27 28 29 30 31 32 33 34 35 36 37 38 39 40 41 42 43 44 45 46 47 48 49 50 51 52 53 54 55 56 57 58 59 60 61 62 63

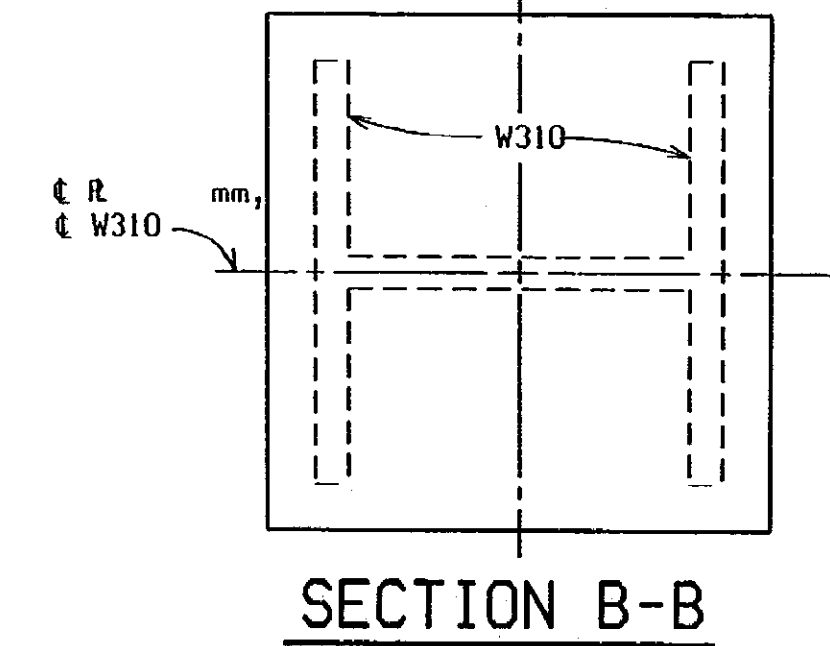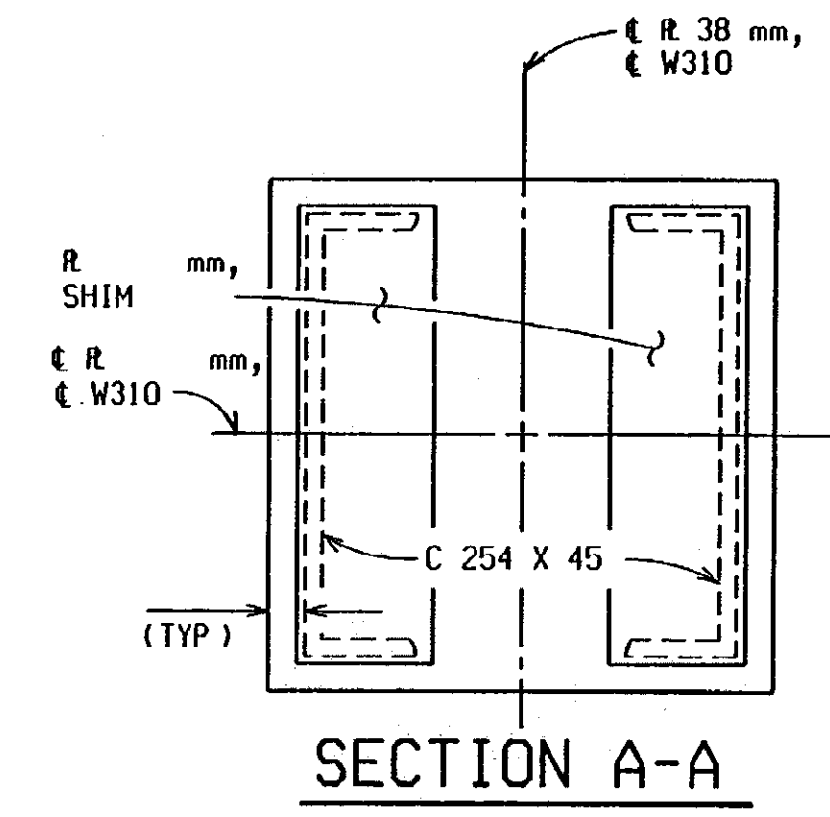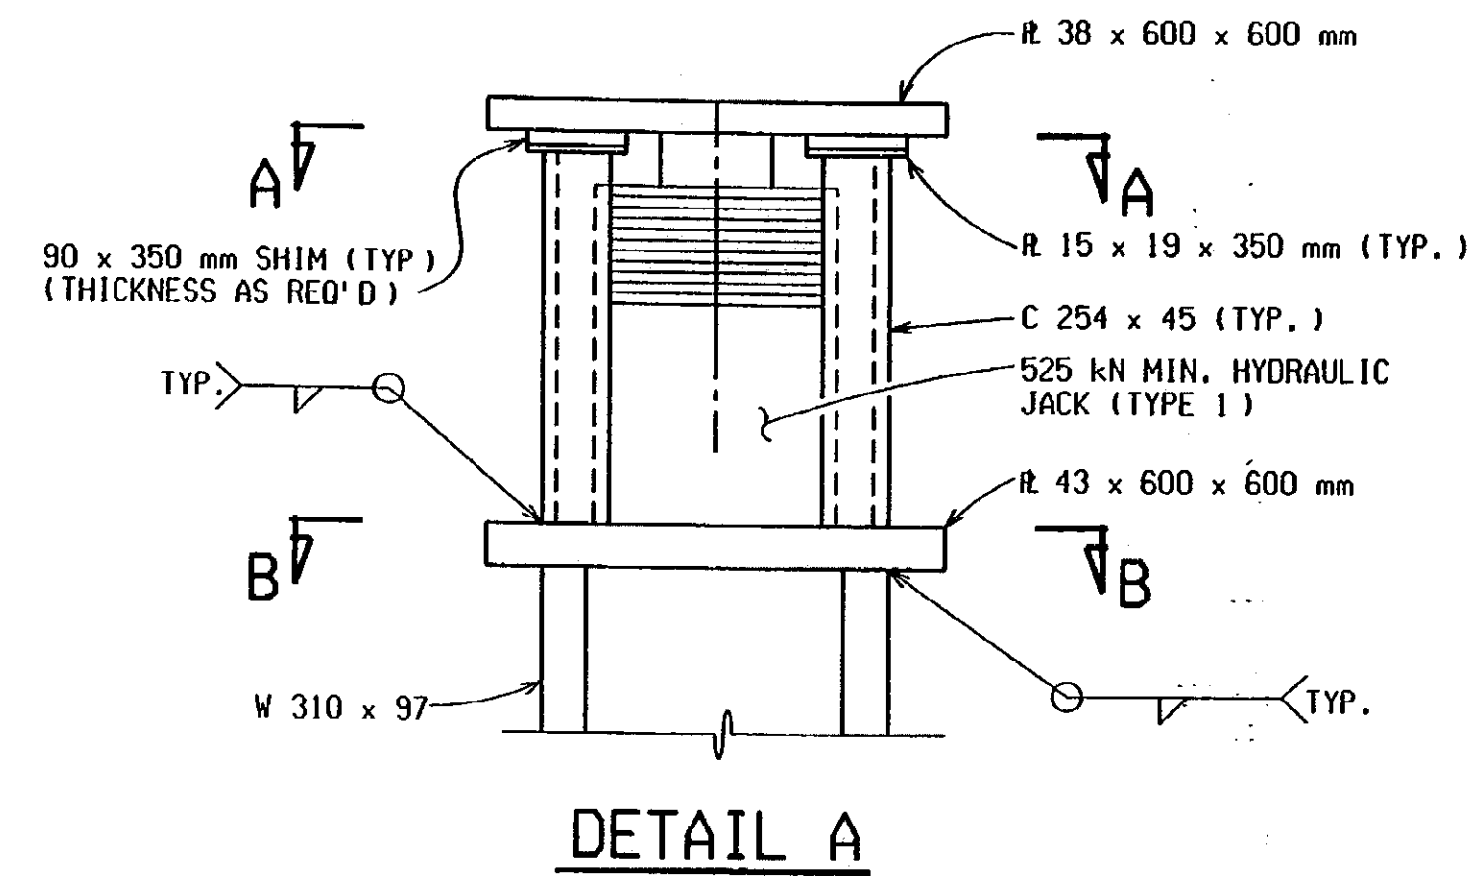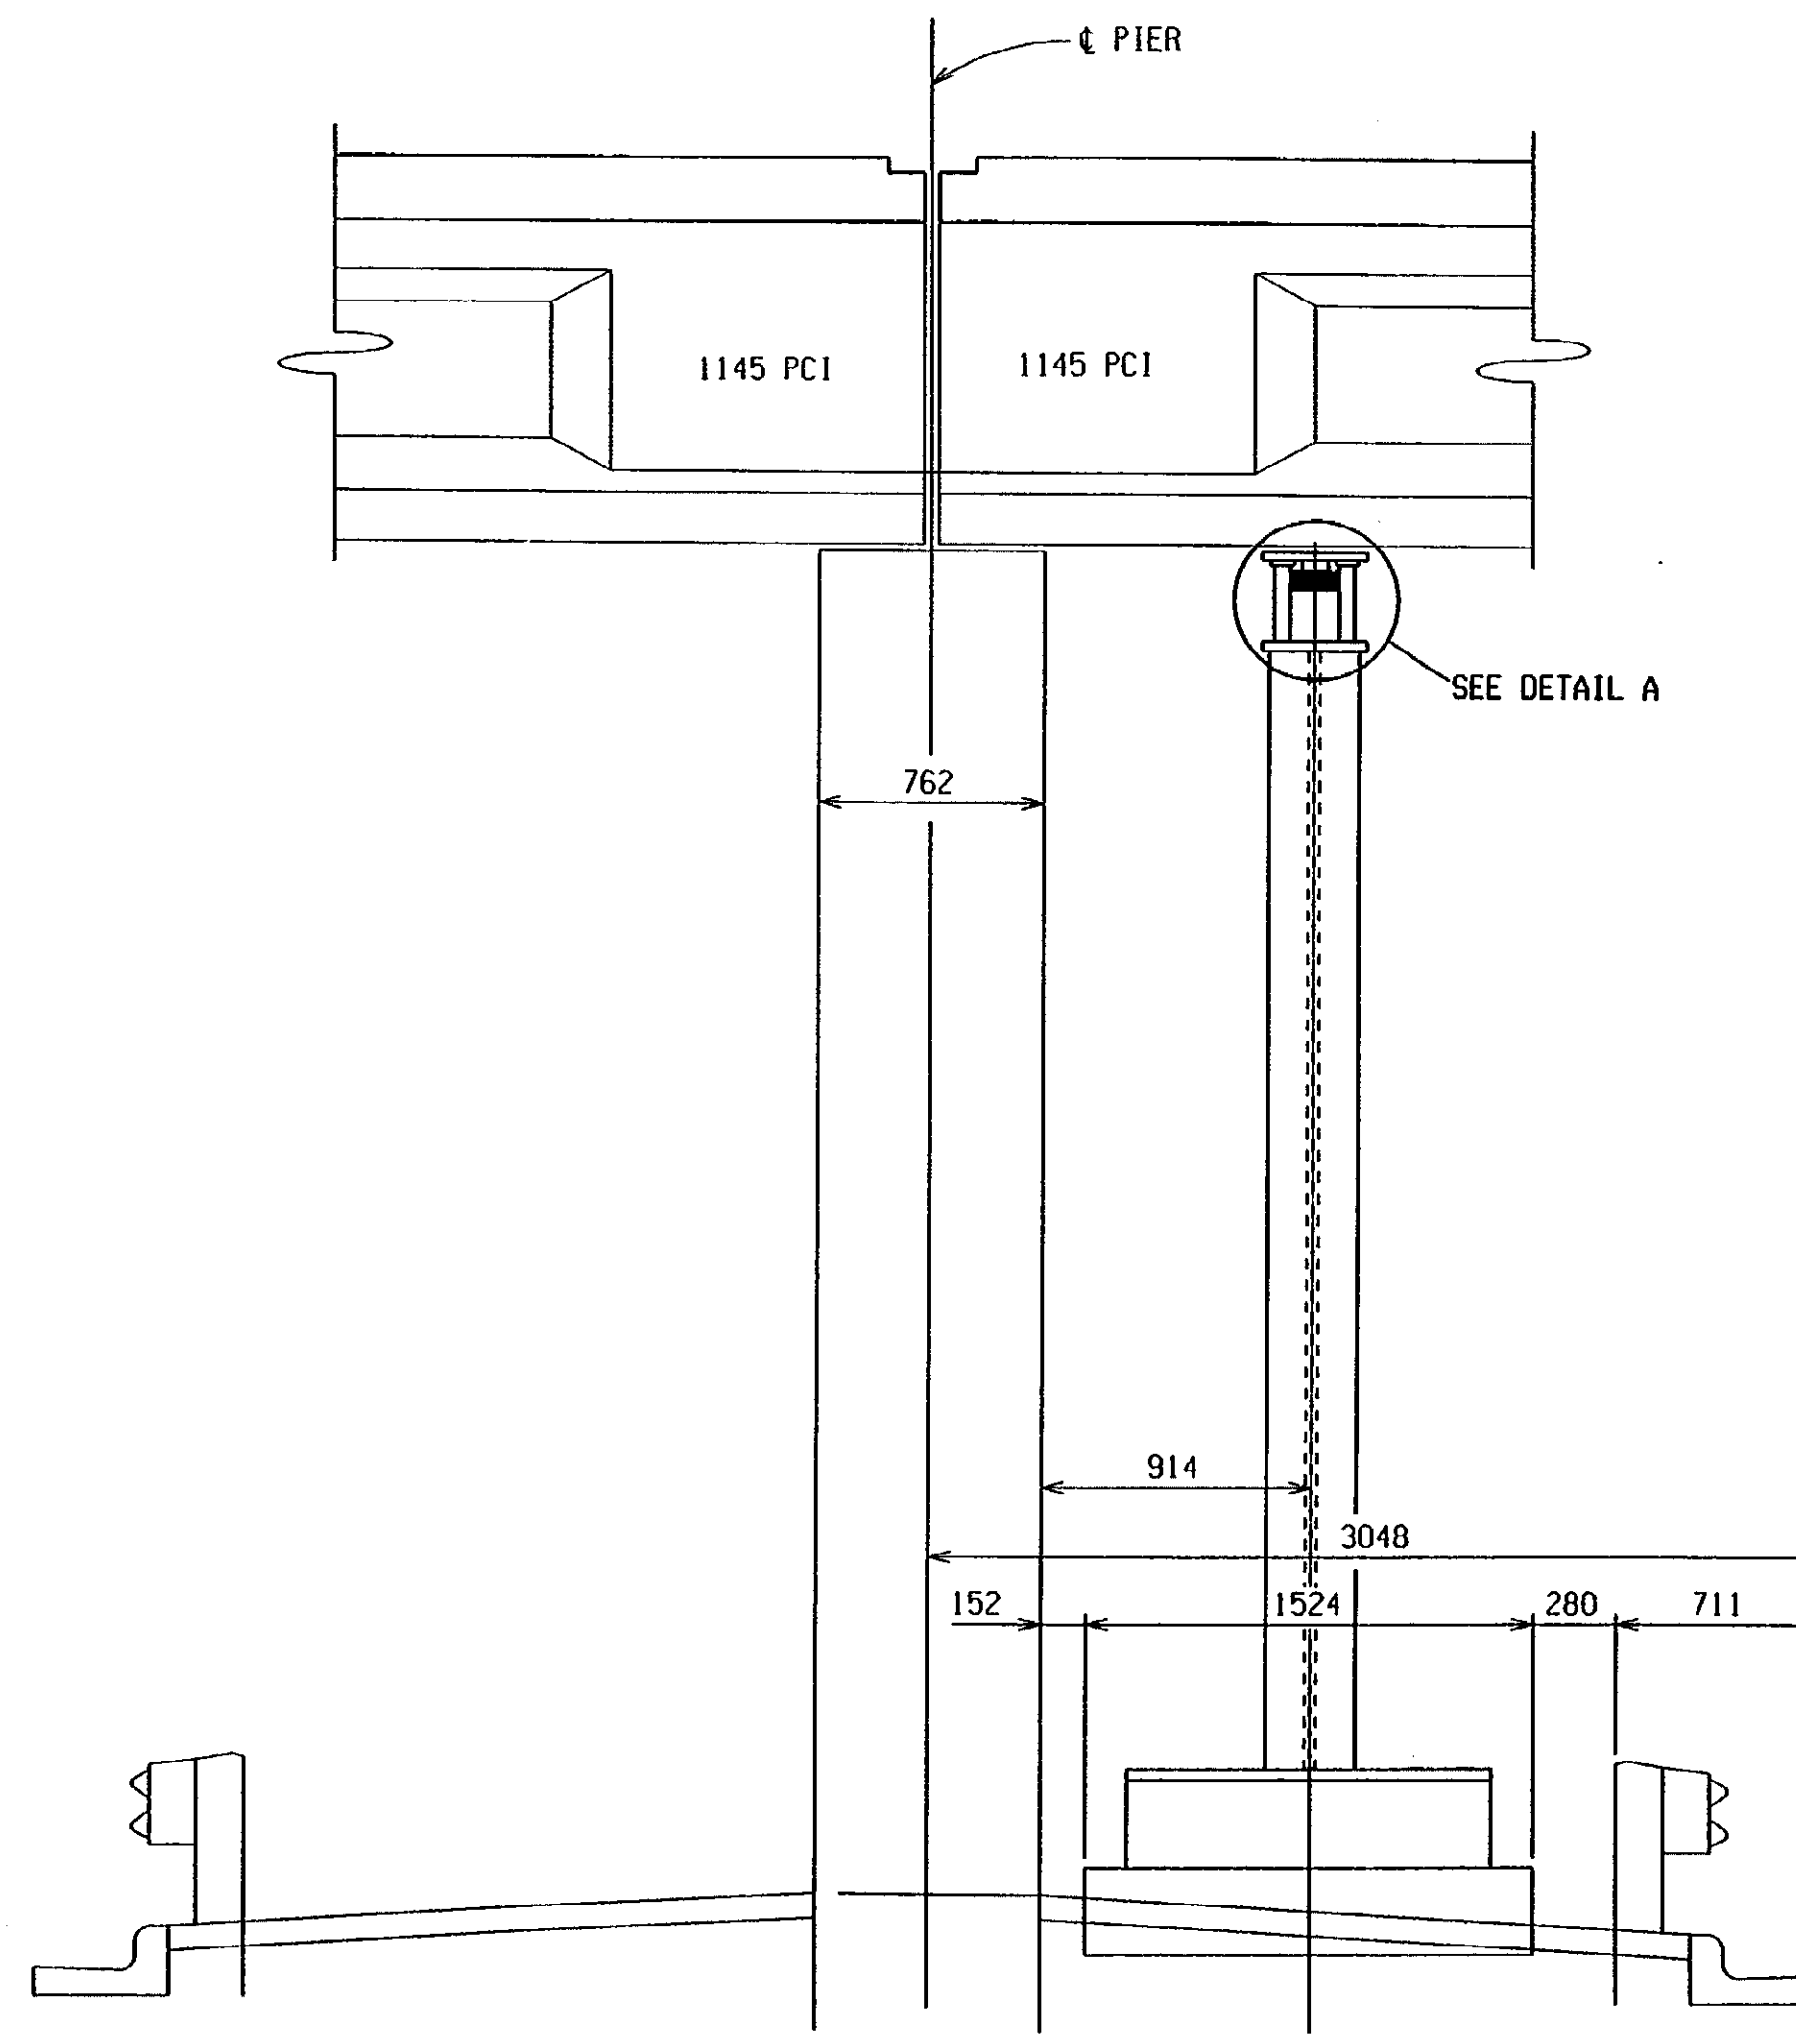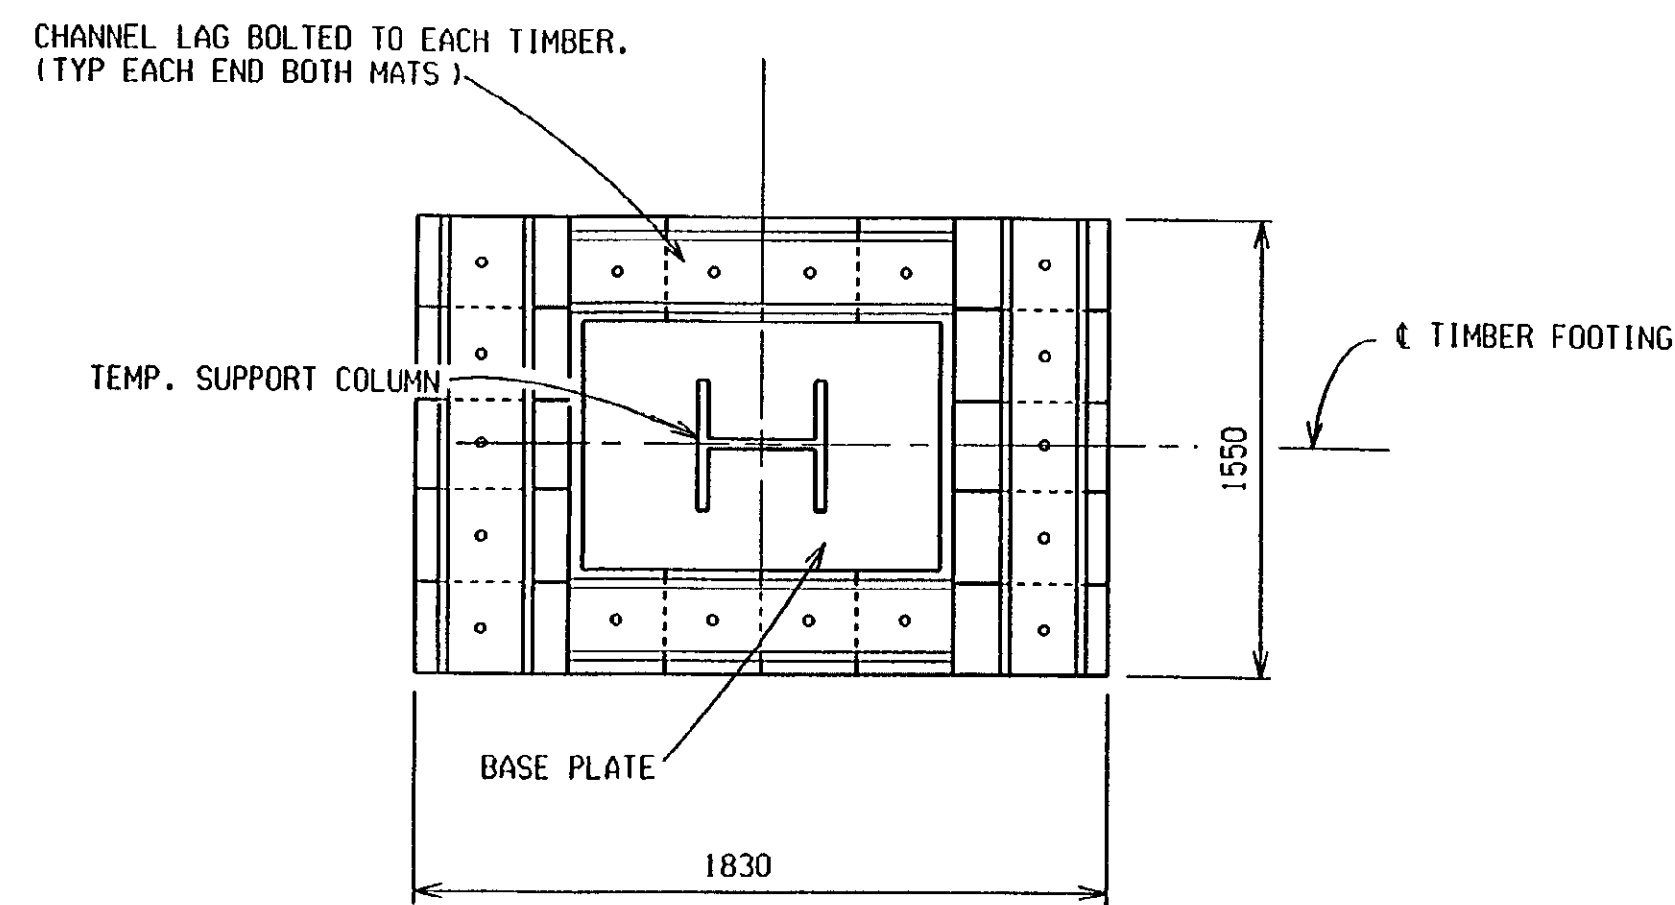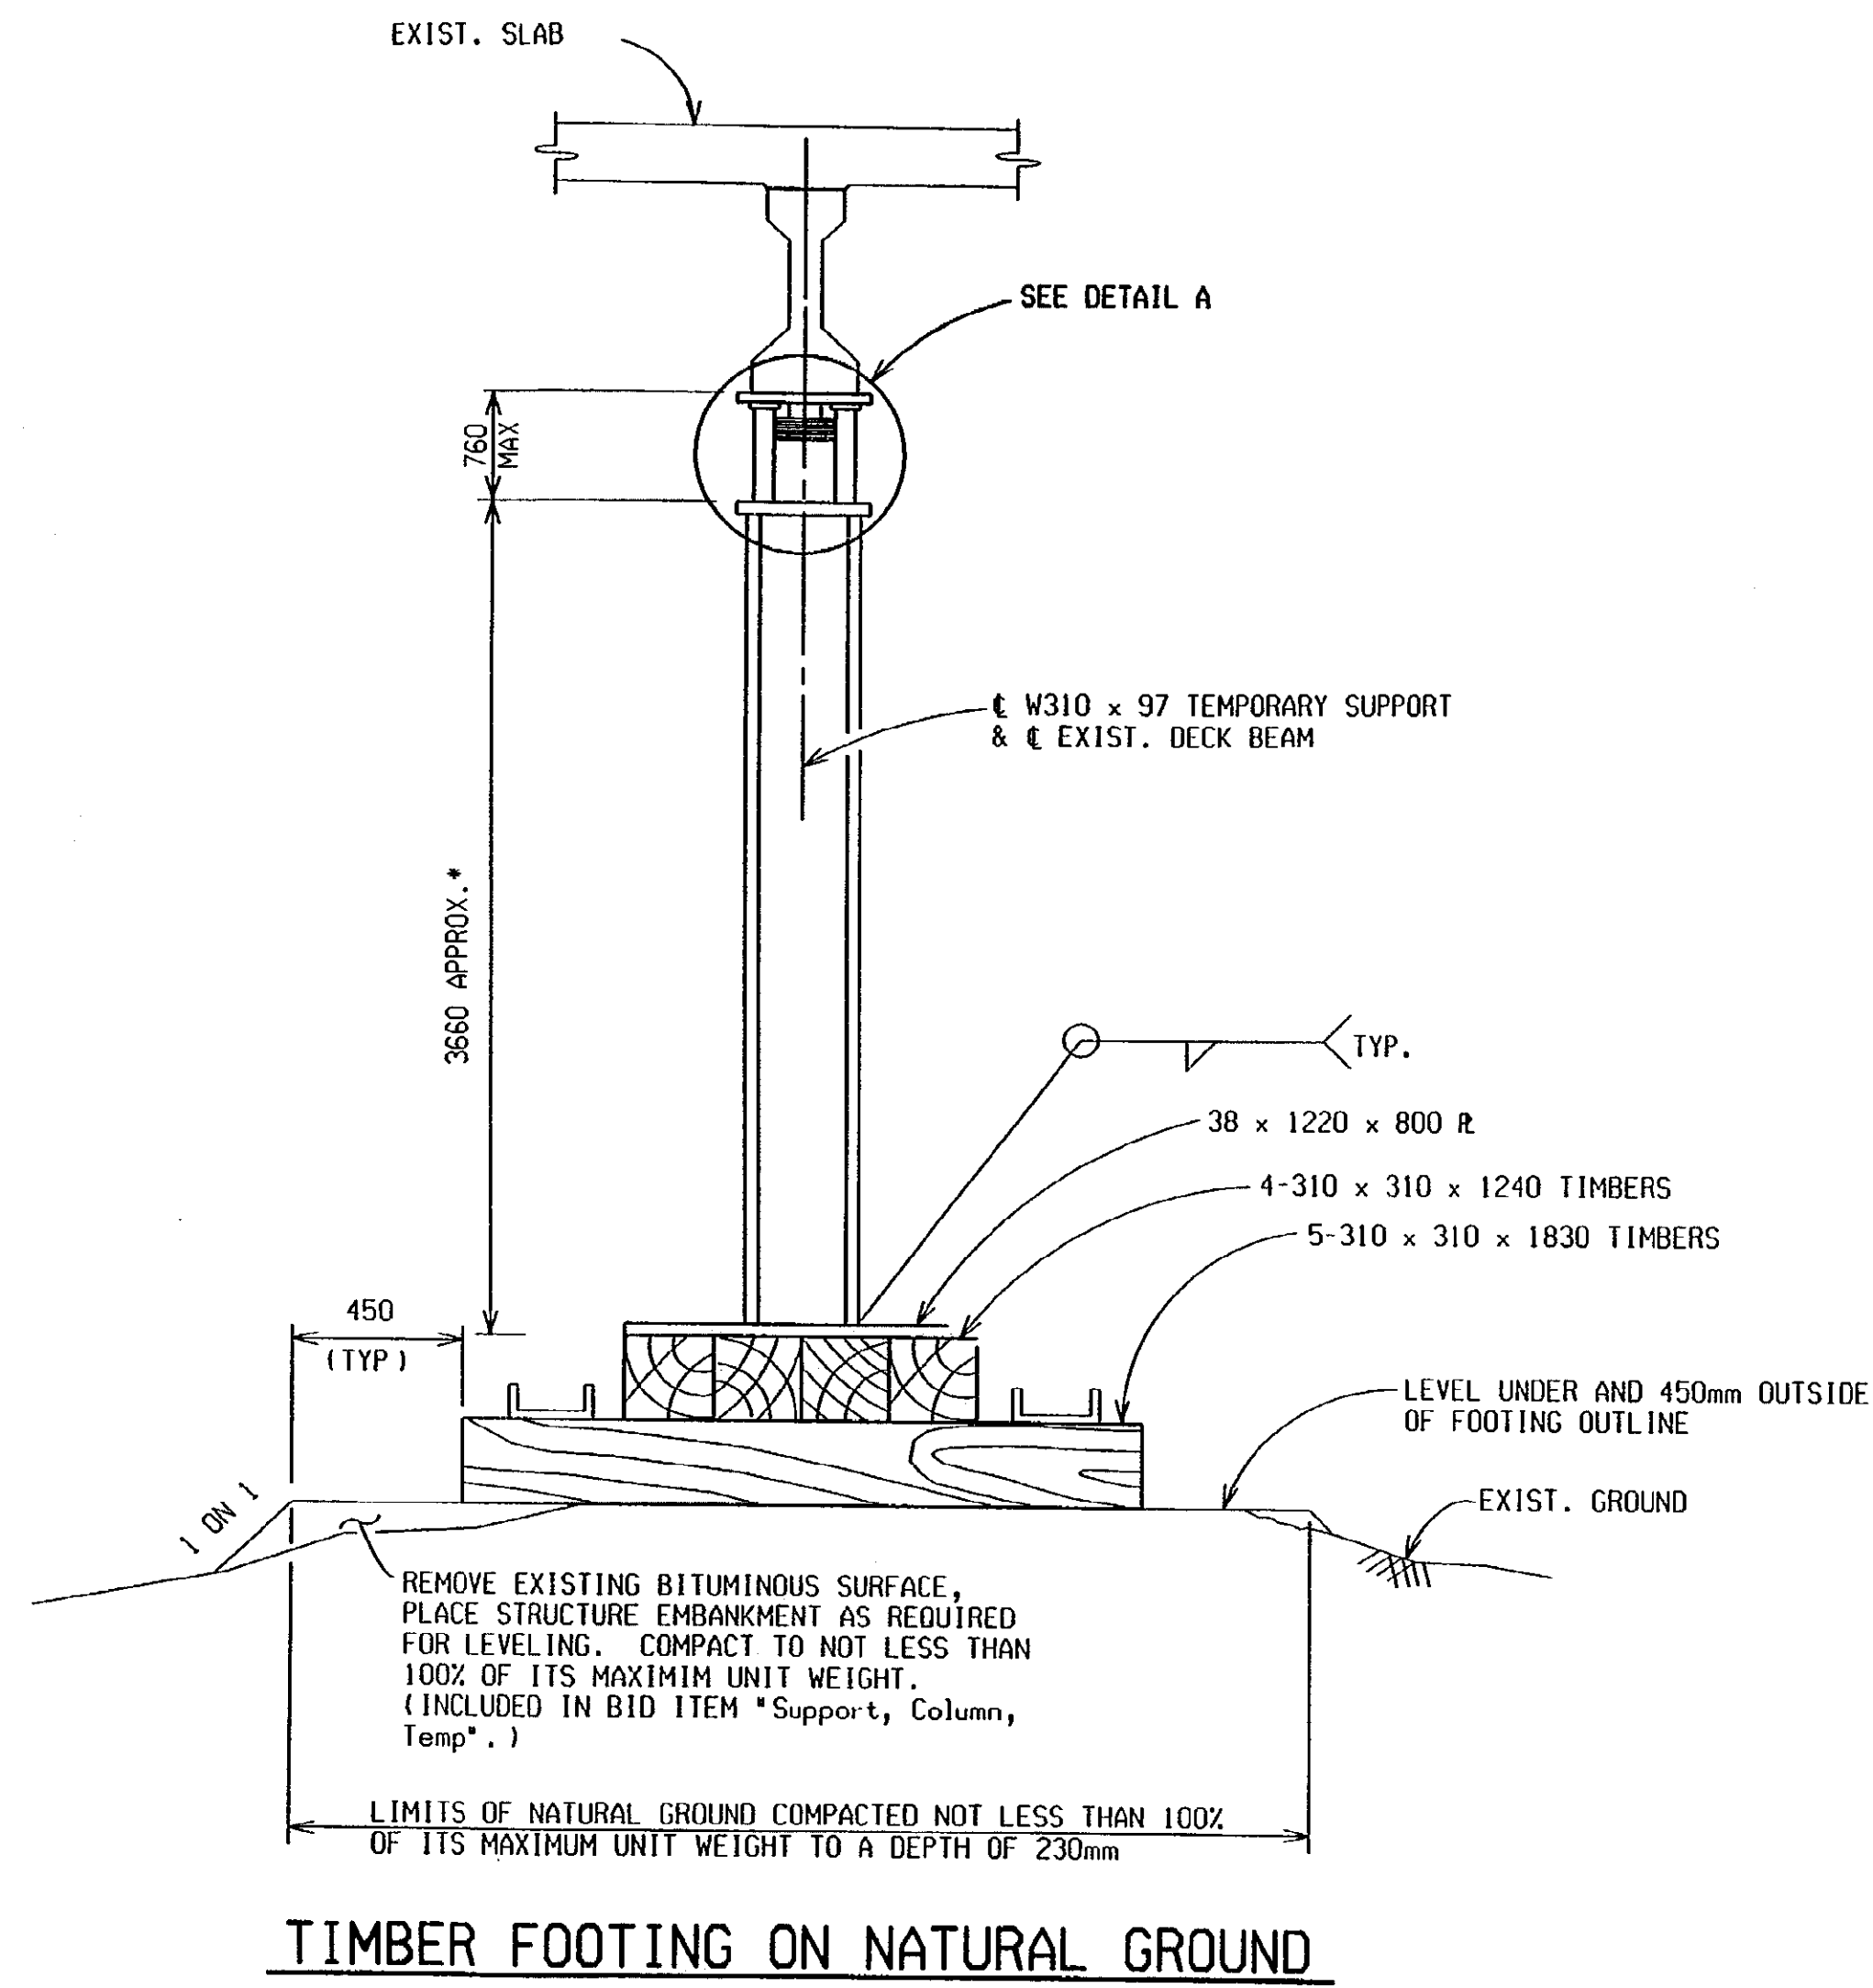

REVISIONS			
NO.	DESCRIPTION	DATE	BY

TEMPORARY SUPPORT DETAILS				
SOUTH BOUND				
DATE	CONT. SEC.	JOB NO.	DESIGN UNIT	SHEET
1-9-01	S04 OF 63174	49595A	MAHDAVI	8 OF 15



DATE: _____ CORRECTED BY: R. K. OLIN CHECKED BY: _____ DATE: 12/2000 DRAWN BY: R. K. OLIN FILE NAME: s0463174s.br

1 2 3 4 5 6 7 8 9 10 11 12 13 14 15 16 17 18 19 20 21 22 23 24 25 26 27 28 29 30 31 32 33 34 35 36 37 38 39 40 41 42 43 44 45 46 47 48 49 50 51 52 53 54 55 56 57 58 59 60 61 62 63

REVISIONS			
NO.	DESCRIPTION	DATE	BY

NOTES:

JOINT TYPES:

THE EXPANSION JOINT DEVICE SHALL BE OF A TYPE THAT INCLUDES A CONTINUOUS NEOPRENE (OR EQUIVALENT) SEAL ACROSS THE DECK. UNLESS OTHERWISE NOTED ON THE PLANS, THE CONTRACTOR HAS THE OPTION OF USING ANY OF THE DEVICES LISTED BELOW:

DEVICE	MANUFACTURER
WABO STRIP SEAL	WATSON-BOWMAN & ACME, INC.
PRO-SPAN	FEL-PRO, INC.
STEEFLEX-SSA2	D.S. BROWN
STEEFLEX-SSCM	D.S. BROWN
STEEFLEX-RS	D.S. BROWN
ONFLEX 40 SS	STRUCTURAL RUBBER PRODUCTS CO.
STRUPCO 400L	STRUCTURAL RUBBER PRODUCTS CO.

THE MODEL OF THE JOINT TYPE SELECTED SHALL BE SUITABLE TO ACCOMMODATE THE TOTAL MOVEMENT NOTED ON THE PLANS.

COMPLETE WORKING DRAWINGS OF ALL DETAILS OF FABRICATION OF THE EXPANSION JOINT DEVICE SHALL BE SUBMITTED FOR REVIEW IN ACCORDANCE WITH STANDARD SPECIFICATION 104.02. THIS REQUIREMENT IS WAIVED FOR EXPANSION JOINT DEVICES FOR WHICH A SET OF STANDARD INSTALLATION DETAILS HAS BEEN APPROVED. STANDARD INSTALLATION DETAILS CAN BE OBTAINED FROM THE DESIGN DIVISION.

FABRICATION AND INSTALLATION:

THE EXPANSION JOINT SHALL BE SHOP FABRICATED TO CONFORM TO THE CONTOUR OF THE BRIDGE DECK, BARRIERS, ETC. IT SHALL BE INSTALLED IN ACCORDANCE WITH MANUFACTURER'S RECOMMENDATIONS SUBJECT TO NOTES HEREIN AND THE APPROVAL OF THE ENGINEER.

THE TOP OF THE ELASTOMERIC JOINT DEVICE SHALL BE SET 3 - 6 mm BELOW THE CONCRETE SLAB (PAVEMENT) WITH A TOLERANCE OF ± 3 mm.

THE STEEL ANCHORAGE FOR STRIP SEAL GLANDS SHALL BE HOT DIP GALVANIZED IN ACCORDANCE WITH SUBSECTION 707.16 OF THE STANDARD SPECIFICATIONS.

THE PRO-SPAN DEVICE MUST INCORPORATE A CAST-IN-PLACE STEEL SEAT.

THE AREA OF THE STEEL ANCHORAGE AND SEALING GLAND WHICH WILL BE IN CONTACT WITH A SEALANT, OR LUBRICANT-ADHESIVE SHALL BE CLEANED WITH TOLUENE OR OTHER APPROVED SOLVENT.

WHERE THE SEALING GLAND IS LOCKED INTO A STEEL ANCHORAGE, A LUBRICANT-ADHESIVE CONFORMING TO STANDARD SPECIFICATION 914.4-E SHALL BE REQUIRED BETWEEN THE SEAL AND STEEL ANCHORAGE.

ALL BOLT WELL CAVITIES SHALL BE FILLED WITH AN APPROVED FLEXIBLE EPOXY OR A SEALANT CONFORMING TO FEDERAL SPECIFICATION 11-S-00230C.

IN THE EVENT THAT THE CONSTRUCTION SEQUENCE REQUIRES SPLICING THE SEALING GLAND, IT SHALL BE SPLICED BY AN APPROVED METHOD (SUCH AS COLD VULCANIZATION) BY A TRAINED REPRESENTATIVE OF THE MANUFACTURER.

DETAILS AT CURBS OR BARRIERS:


THE DETAILS ON THIS SHEET SHOW AN APPROVED MEANS OF TERMINATING THE EXPANSION JOINT DEVICE AT CURBS OR BARRIERS. VARIATIONS OR ALTERNATIVE SCHEMES WILL BE CONSIDERED AND MAY BE USED IF APPROVED BY THE ENGINEER.

MATERIALS:


THE COST OF ALL MATERIALS AND LABOR REQUIRED FOR PROPER INSTALLATION OF THE EXPANSION JOINT AND THE TERMINAL ASSEMBLIES AT THE CURBS, SIDEWALKS, OR BARRIERS IS INCLUDED IN THE PAYMENT FOR THE EXPANSION JOINT DEVICE.

ITEM	QUANTITY	UNIT	AMOUNT
EXPANSION JOINT DEVICE		m	32



BARRIER TREATMENT

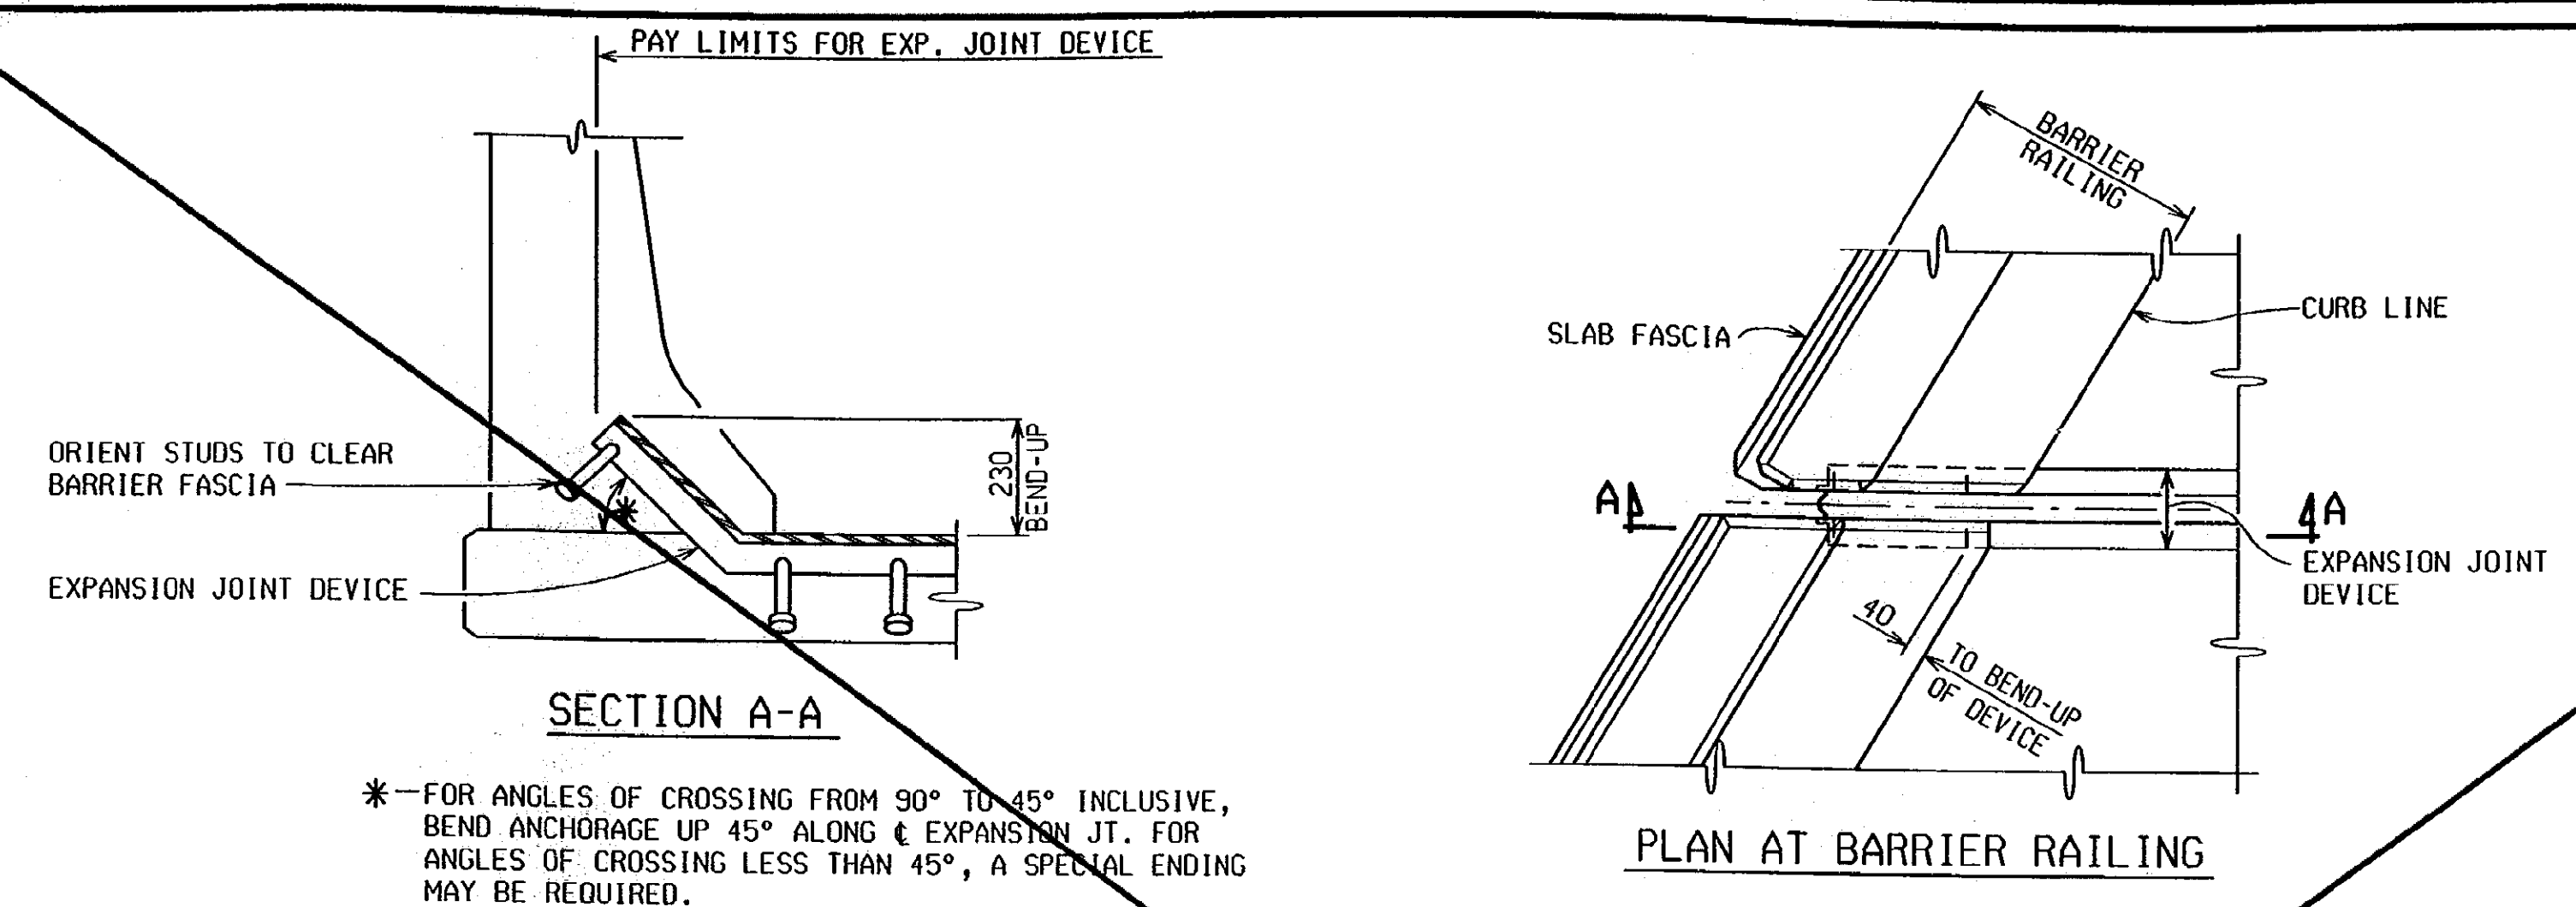


SIDEWALK TREATMENT

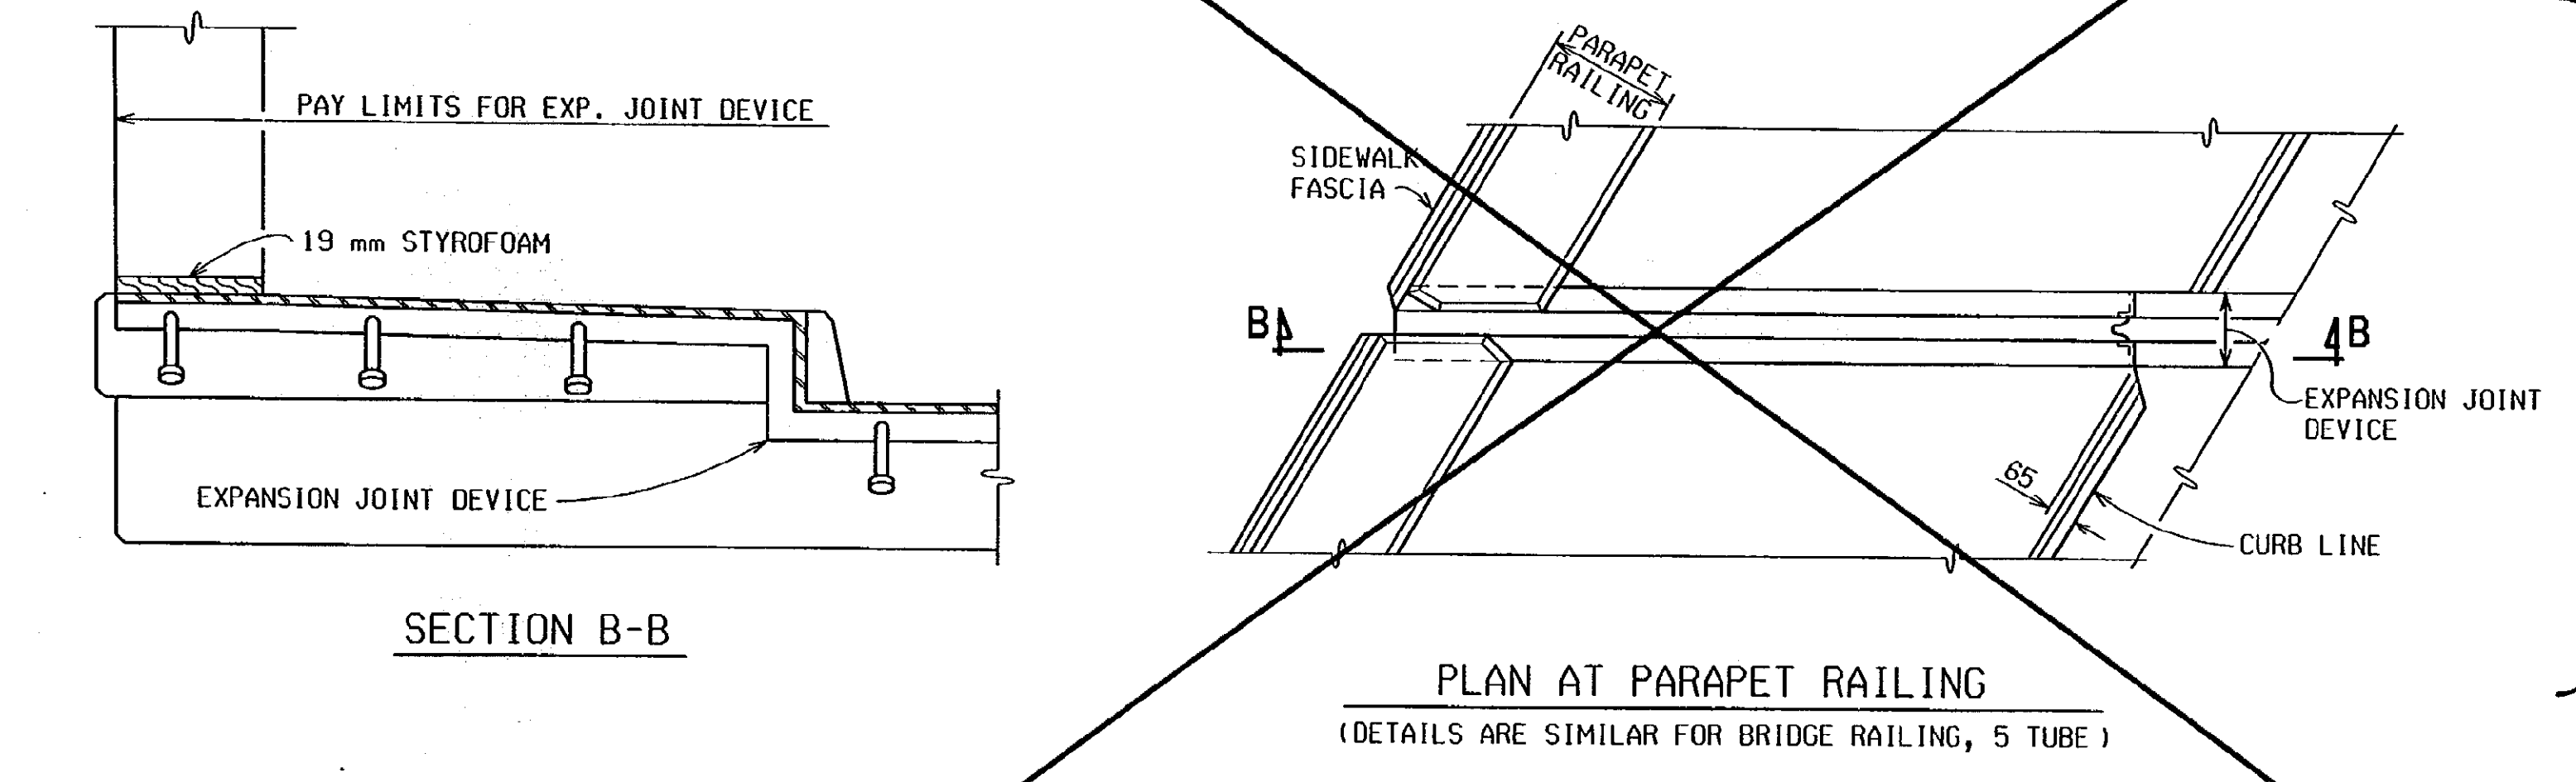

BRUSH BLOCK TREATMENT

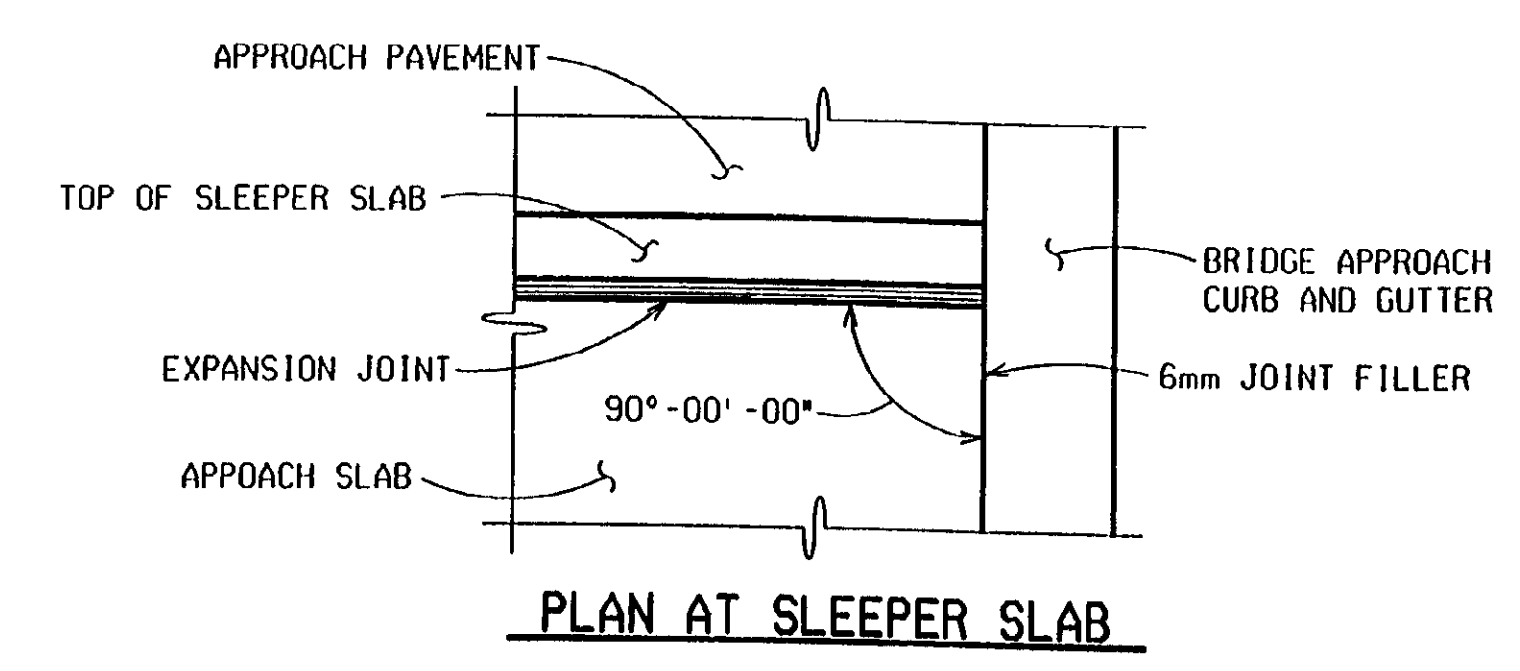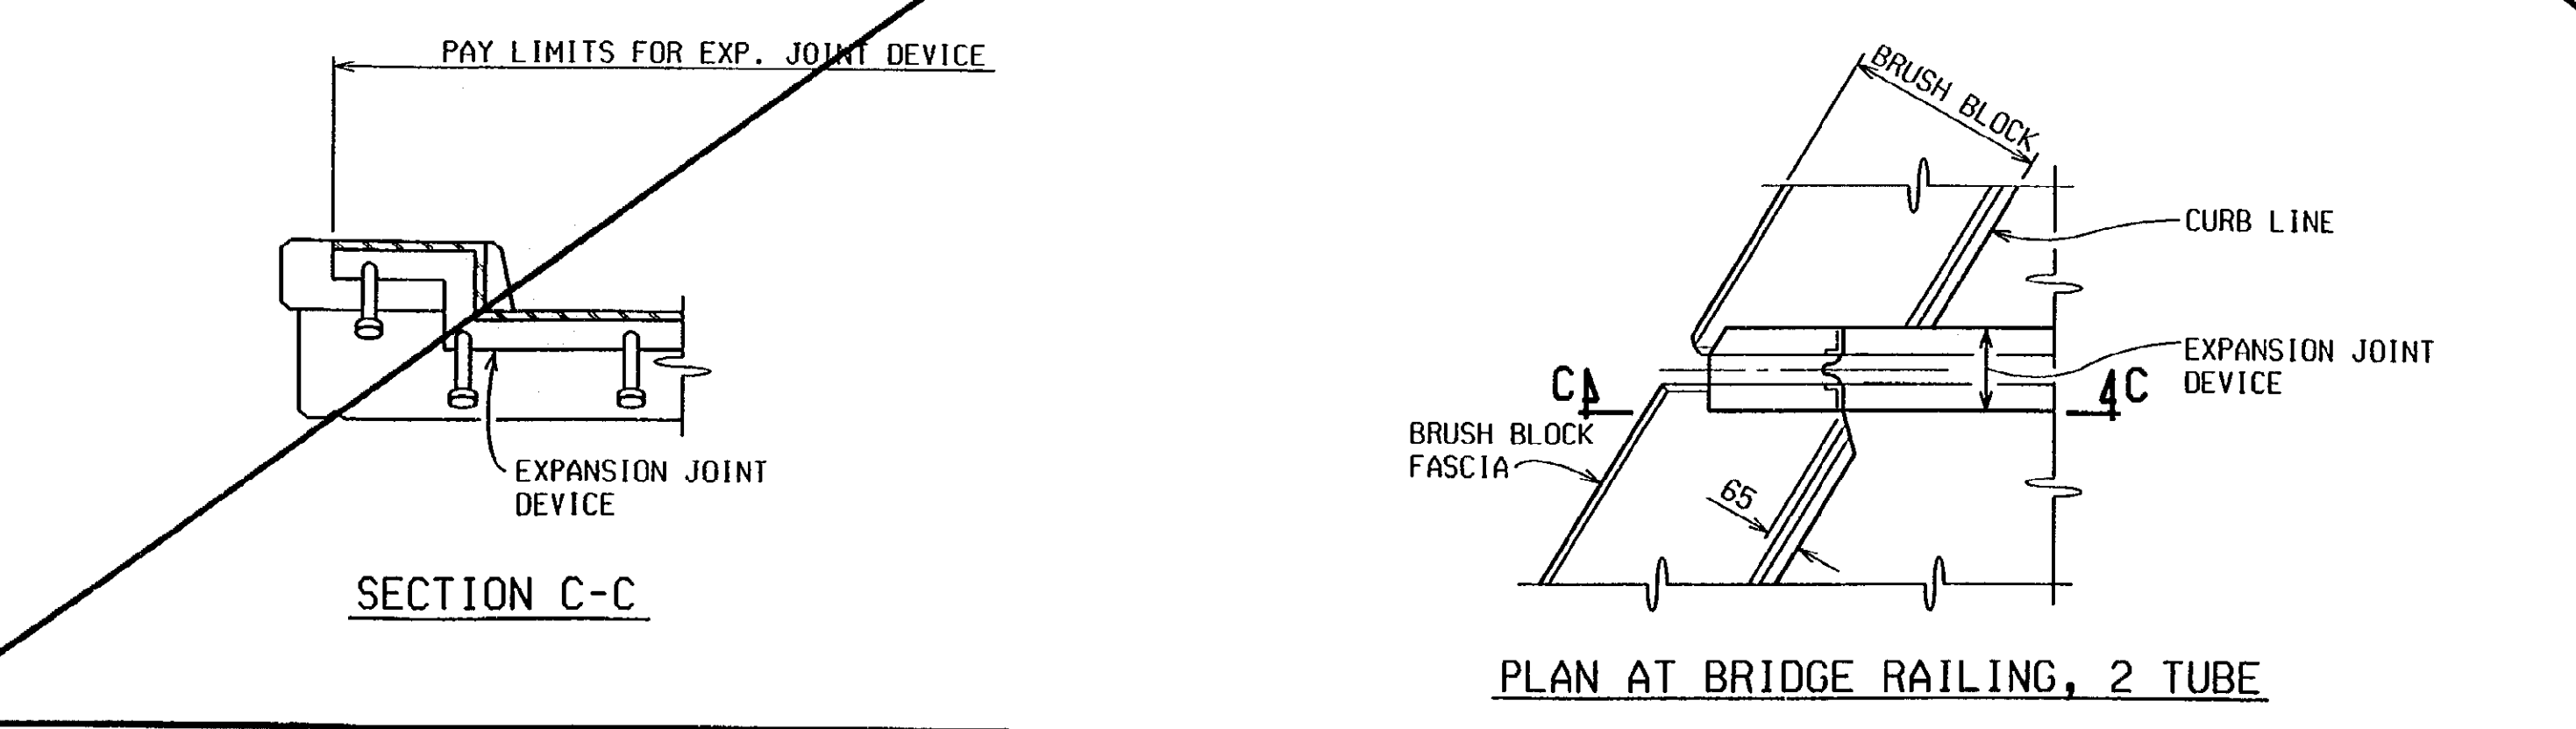

STRUCTURE NUMBER	ANGLE OF CROSSING TO NEAREST 10°	LOCATION OF JOINT	MIN. TOT. TRAVEL ALONG CENTERLINE OF BRIDGE	REQUIRED LENGTH OF EXPANSION JOINT DEVICE
S04	90	SLEEPER SLAB	25mm	16
S04	90	SLEEPER SLAB	25mm	16

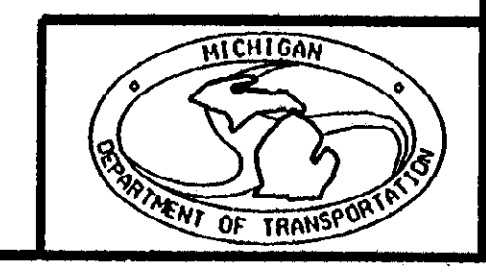

EXPANSION JOINT DETAILS - SB STRUCTURE

DATE	CONT. SEC.	JOB NO.	DESIGN UNIT	SHEET
1-9-01	S04 OF 63174	49595A	MAHDAVI	9 OF 15

EJ3T (11-17-97)

DATE: 12-8-00
CORRECTED BY: R. PRATT
DATE: 07-16-96
CHECKED BY: VZ/SPB
DATE:
DRAWN BY: FILE NAME: s0463174s.e.j


REVISIONS			
NO.	DESCRIPTION	DATE	BY

SUPERSTRUCTURE CONCRETE QUANTITIES	
POUR	AMT (m3)
A	6
B	6
TOTAL CONC. : 12 m3	

SUPERSTRUCTURE CONCRETE QUANTITIES NIGHT CASTING	
POUR	AMT (m3)
C	56
D	34
E	43
F	34
G	56
TOTAL CONC. : 223 m3	

MISCELLANEOUS QUANTITIES	
86	m Bridge Barrier Railing, Type 4
223	m3 Bridge Ltg, Oper and Maintain
1	LS Bridge Ltg, Furn and Rem (S04-SB)
1	LS Superstructure Conc, Form, Finish and Cure, Night Casting (S04-NB)
50	m Underdrain, Fdn, 100mm
2	ea Underdrain, Outlet Ending, 100mm
1	LS Superstructure Conc, Form, Finish and Cure (S04-SB)
* 2	m3 Hand Chipping, Other Than Deck
*20	m2 Patch, Forming
* 2	m3 Patching Conco, LM

*SUBSTRUCTURE REPAIR AS DIRECTED BY THE ENGINEER.

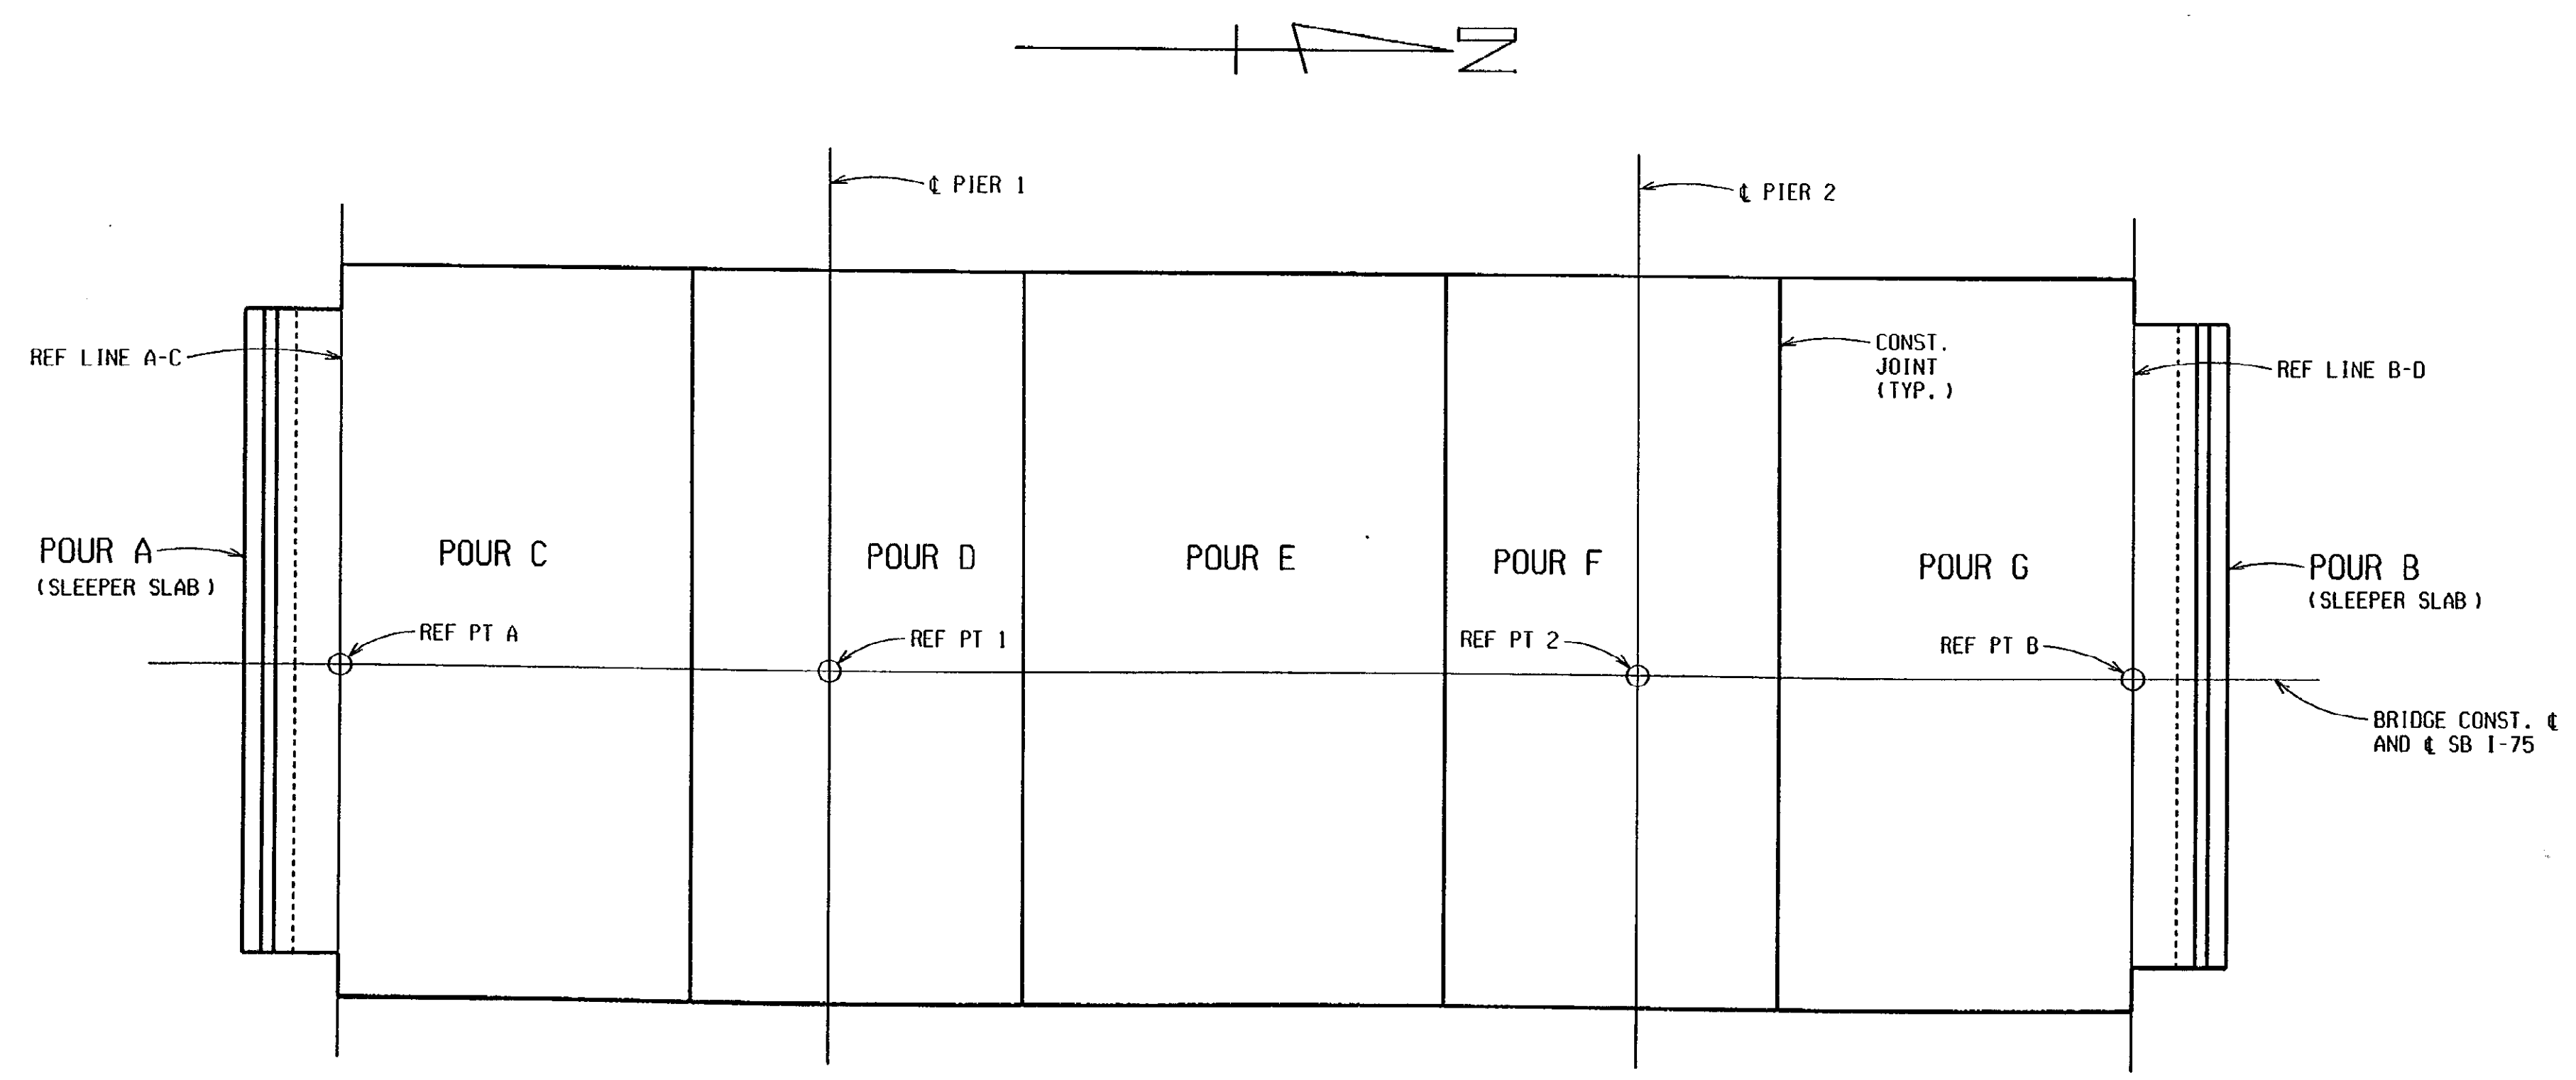

POUR DIAGRAM

NOTES:



- ES DENOTES EACH SIDE.
- FS DENOTES FAR SIDE.
- NS DENOTES NEAR SIDE.
- FOR NAME PLATE LOCATION, SEE GENERAL PLAN OF STRUCTURE SHEET.
- *EDGE* OR *GROOVE* DENOTES EDGING OR GROOVING WITH AN APPROVED TOOL.
- FOR BRIDGE RAILING, ANCHORAGE FOR GUARDRAIL, NAME PLATE MOUNTING, MOLDING AND BEVEL DETAILS, SEE STANDARD SHEET B-17 AND B-103. BARRIER RAILING IS TO BE BRIDGE BARRIER RAILING, TYPE 4.
- THIS DECK POUR IS DESIGNATED A NIGHT POUR, AND THEREFORE SUBJECT TO THE RESTRICTIONS OF SECTION 706.03J OF THE STANDARD SPECIFICATIONS.
- NO PORTION OF THE DECK FORMWORK SHALL ENCR OACH ON THE EXISTING UNDERCLEARANCE.
- THE CONTRACTOR MAY USE METAL STAY IN PLACE FORMS. IF USED, ELIMINATING THE POLYSTYRENE AND FILLING THE CORRUGATIONS WITH CONCRETE IS PROHIBITED.
- THE CONTRACTOR IS TO PROVIDE A SAWED JOINT 12mm DEEP BY 3mm WIDE (MINIMUM) IN THE TOP OF SLAB AT TRANSVERSE CONSTRUCTION JOINTS. THE JOINT IS TO BE SAWED BEFORE CASTING OF BARRIERS AND IS TO BE FILLED WITH HOT-POURED JOINT SEALANT OR COLD-APPLIED JOINT SEALANT, SINGLE COMPONENT TYPE IN ACCORDANCE WITH STANDARD SPECIFICATION SUBSECTION 9.14.04. (INCLUDED IN THE BID ITEM *SUPERSTRUCTURE CONC, FORM, FINISH AND CURE, NIGHT CASTING (S04-SB)*.
- ALPHABETICAL DESIGNATION OF DECK POURS IS NOT A POUR SEQUENCE. CAST DECK POURS OVER PIERS AFTER OTHER DECK POURS HAVE BEEN CAST.
- THE CONTRACTOR SHALL PROVIDE TEMPORARY SUPPORTS FOR THE DECK FASCIA OVERHANG FORMS TO ACHIEVE ZERO DEFLECTIONS IN THE DECK. THE CONTRACTOR SHALL SUBMIT THE DESIGN AND DETAILS FOR THE TEMPORARY SUPPORTS TO THE ENGINEER FOR REVIEW AND APPROVAL, 15 WORKING DAYS PRIOR TO START OF THE DECK POURS. (INCLUDED IN THE BID ITEM *SUPERSTRUCTURE CONC, FORM, FINISH AND CURE, NIGHT CASTING (S04-SB)*.



DECK REPLACEMENT DETAILS - SB STRUCTURE				
DATE	CONT. SEC.	JOB NO.	DESIGN UNIT	SHEET
1-9-01	S04 OF 63174	49595A	MAHDAVI	10 OF 15

1 2 3 4 5 6 7 8 9 10 11 12 13 14 15 16 17 18 19 20 21 22 23 24 25 26 27 28 29 30 31 32 33 34 35 36 37 38 39 40 41 42 43 44 45 46 47 48 49 50 51 52 53 54 55 56 57 58 59 60 61 62 63

REVISIONS			
NO.	DESCRIPTION	DATE	BY

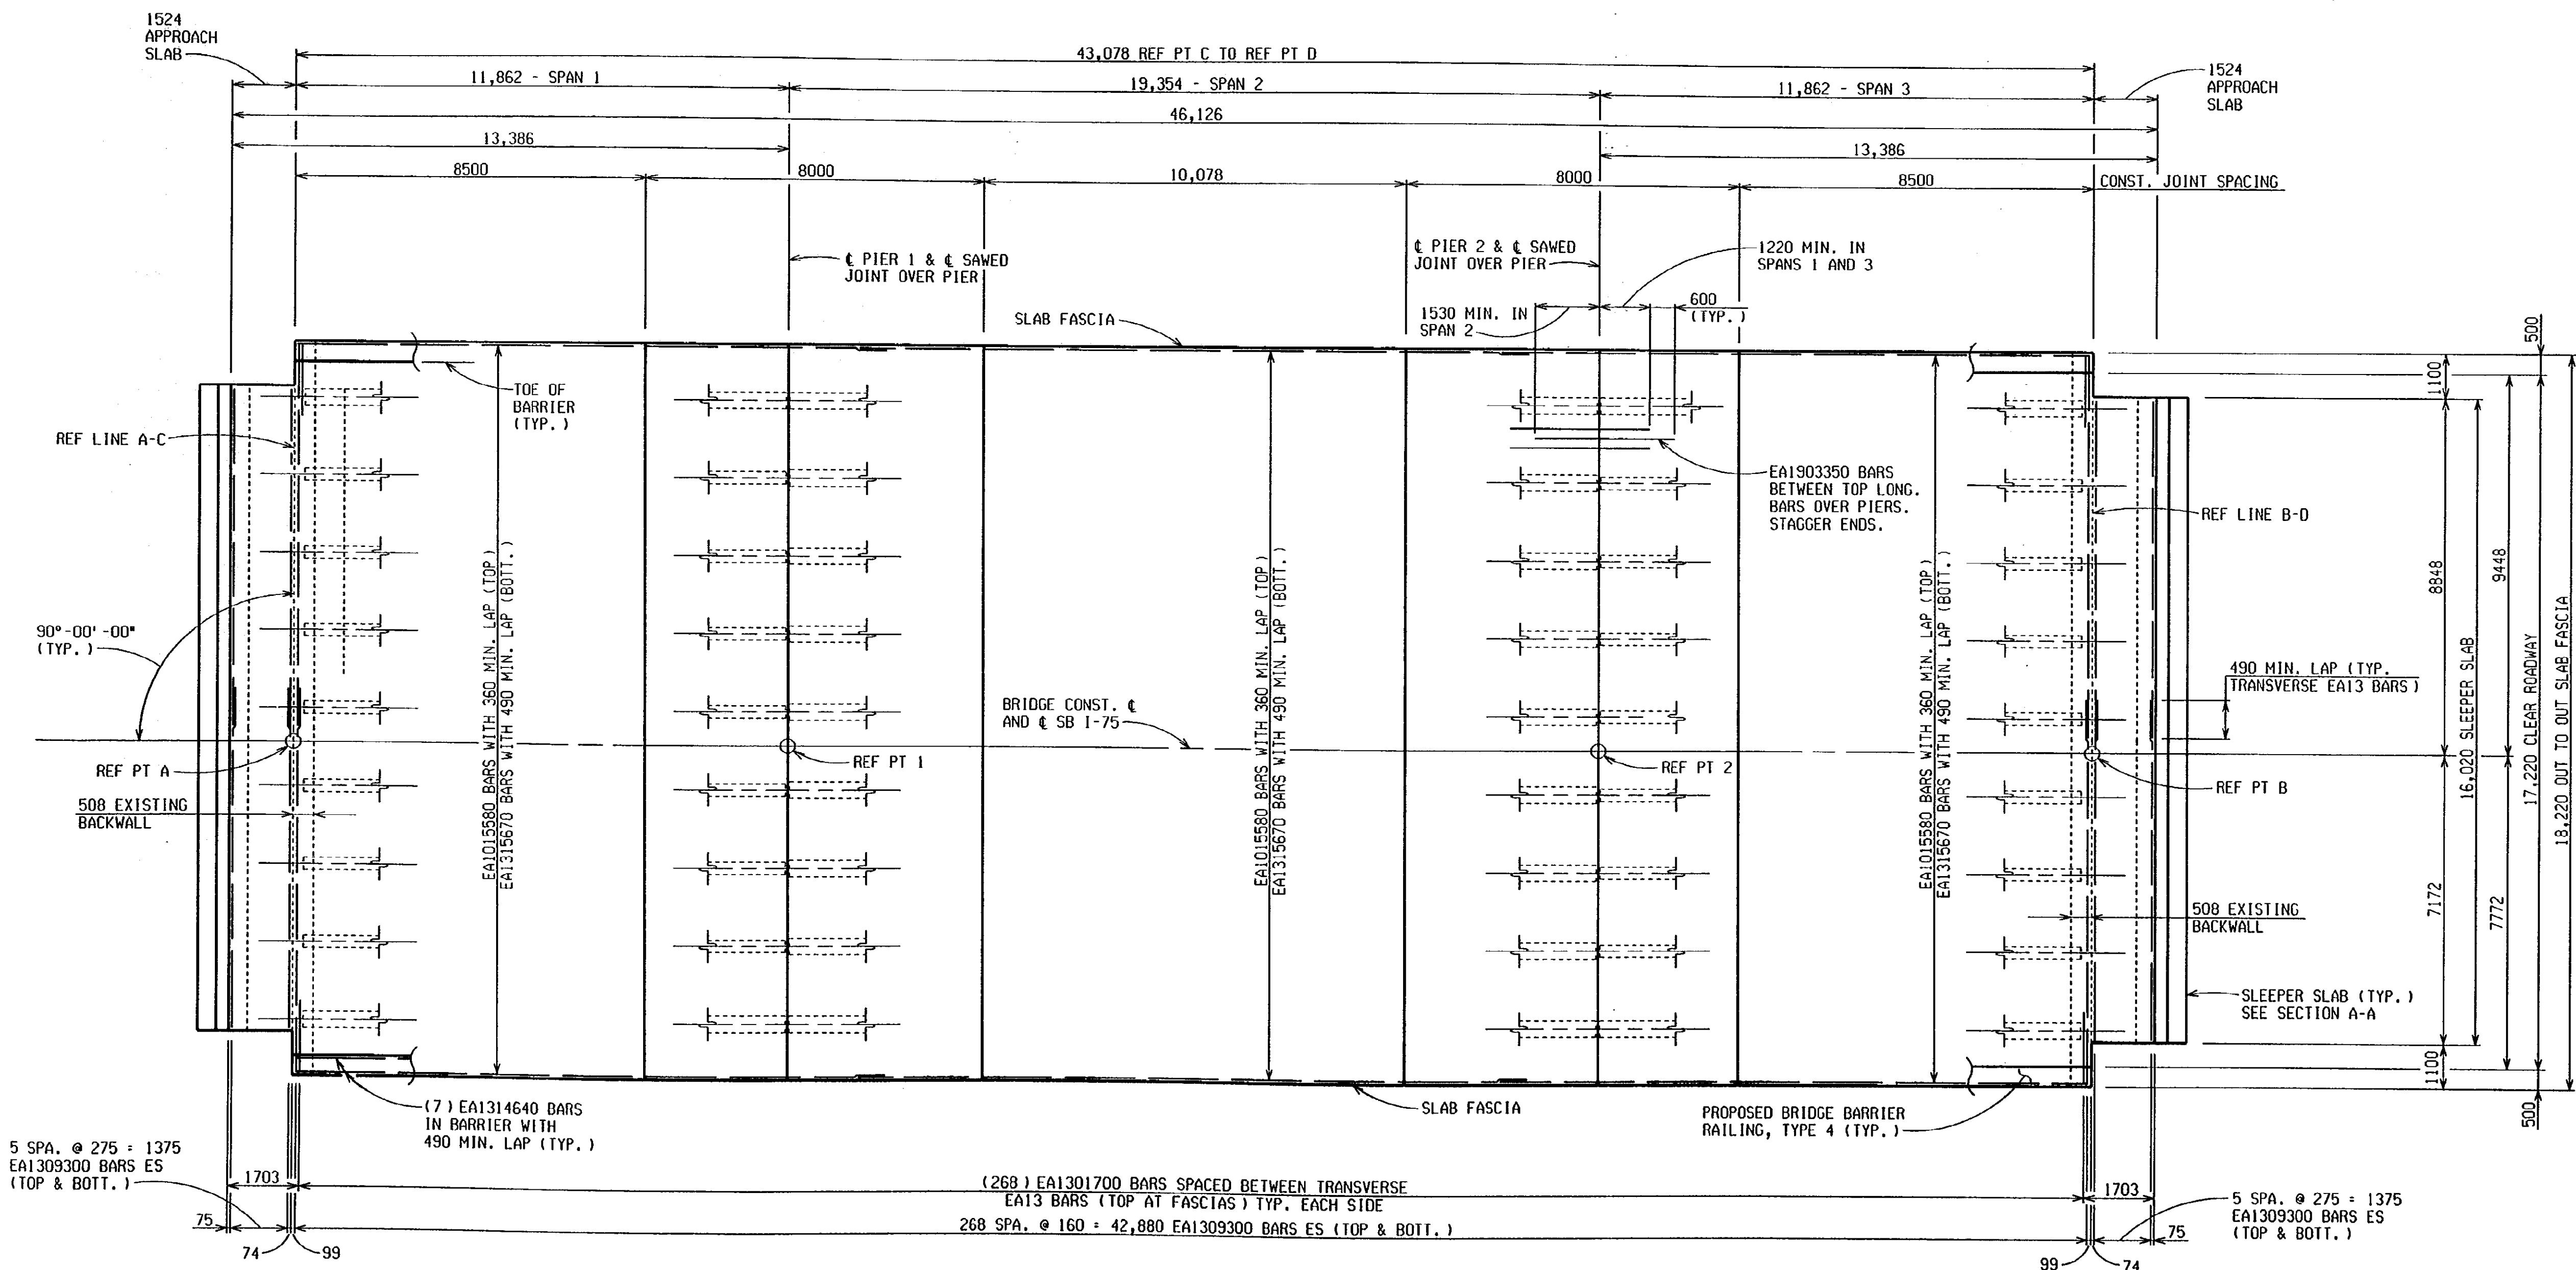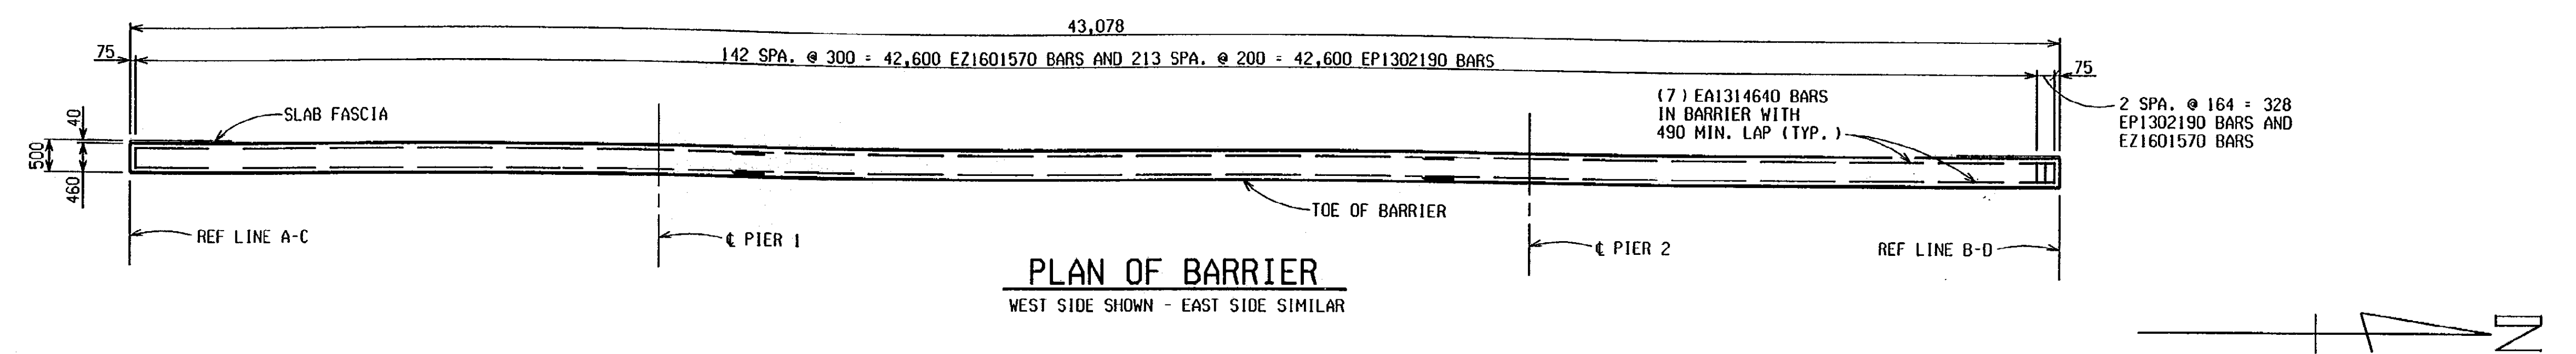


DECK REPLACEMENT DETAILS - SB STRUCTURE				
DATE	CONT. SEC.	JOB NO.	DESIGN UNIT	SHEET
1-9-01	504 OF 63174	49595A	MAHDAVI	11 OF 15




DATE: 12-4-00
CORRECTED BY: R. PRATT
DATE:
CHECKED BY: MIKUCKI
DATE: 11-28-00
DRAWN BY: R. PRATT
FILE NAME: s0463174s.dk

REVISIONS			
NO.	DESCRIPTION	DATE	BY

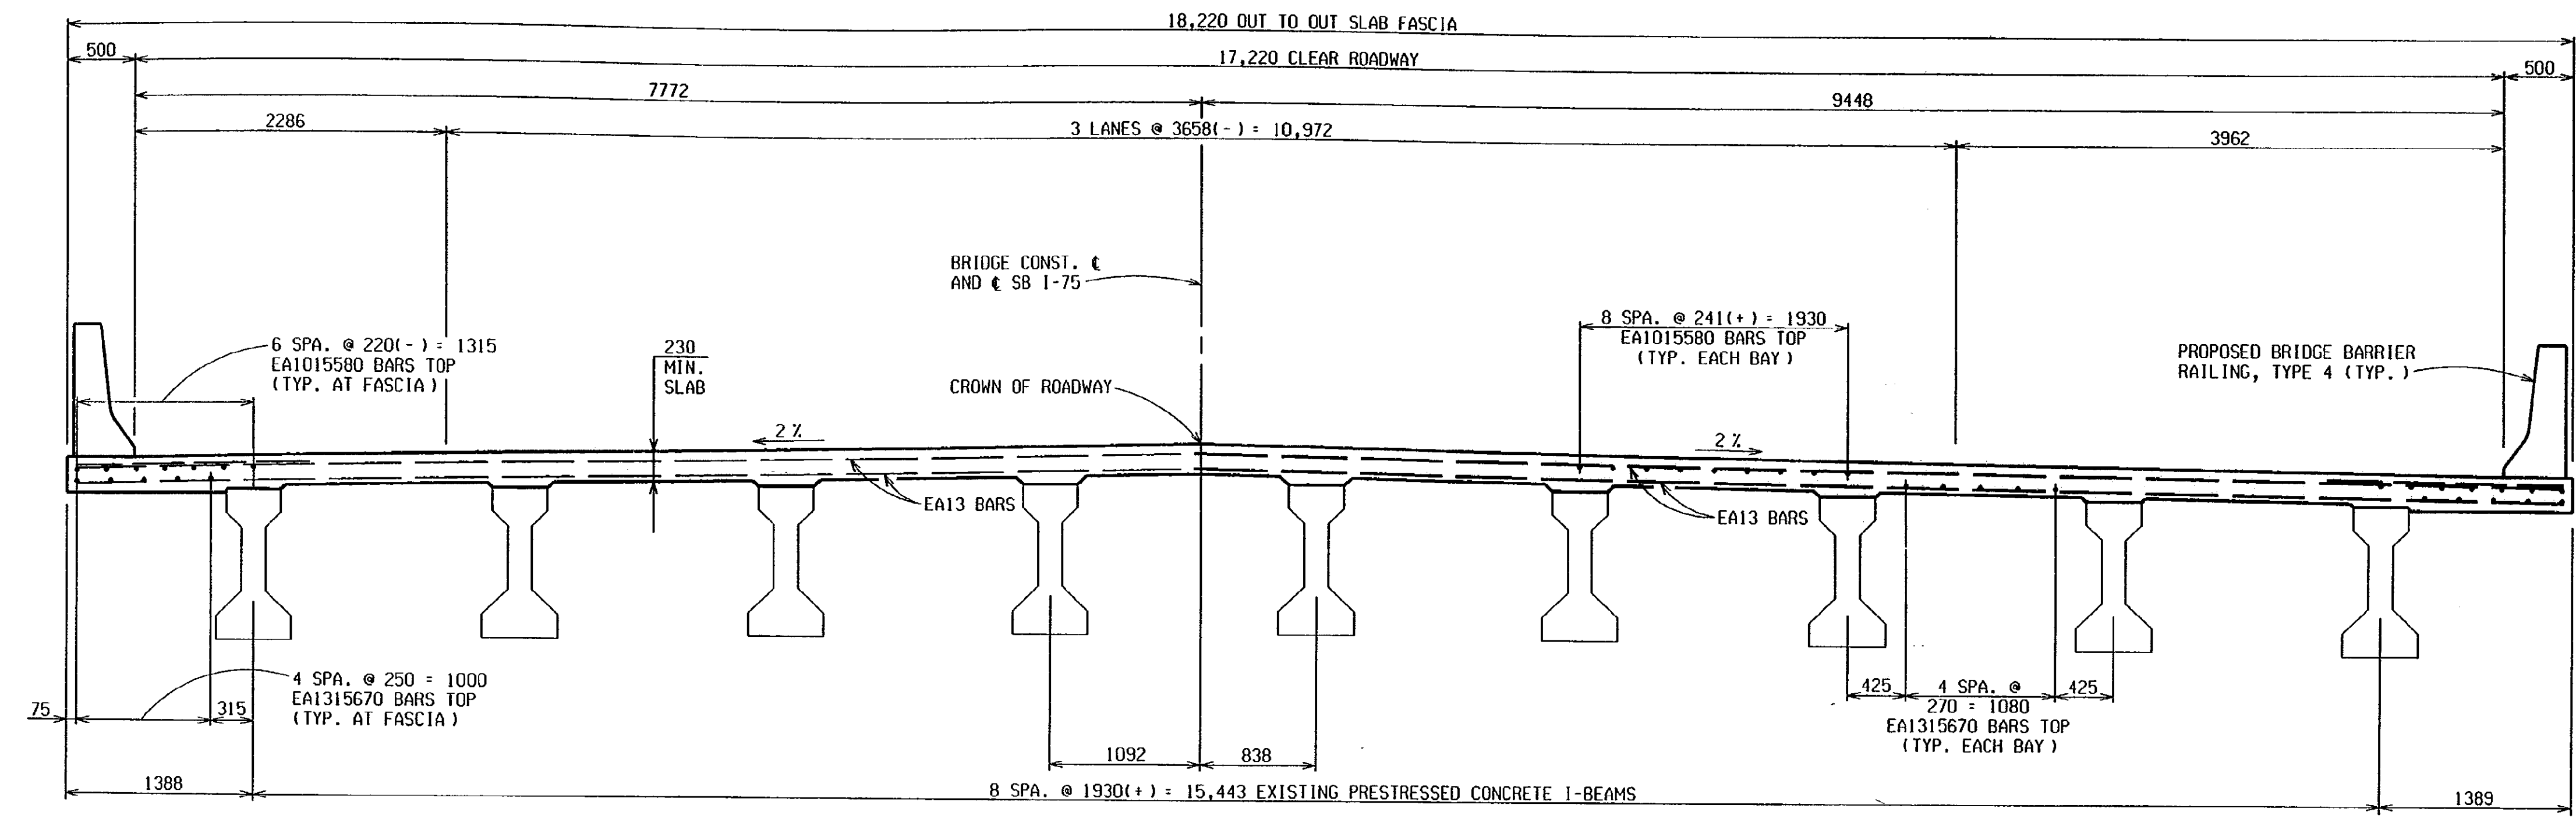

PROPOSED DECK SECTION - SB
(LOOKING SOUTH)

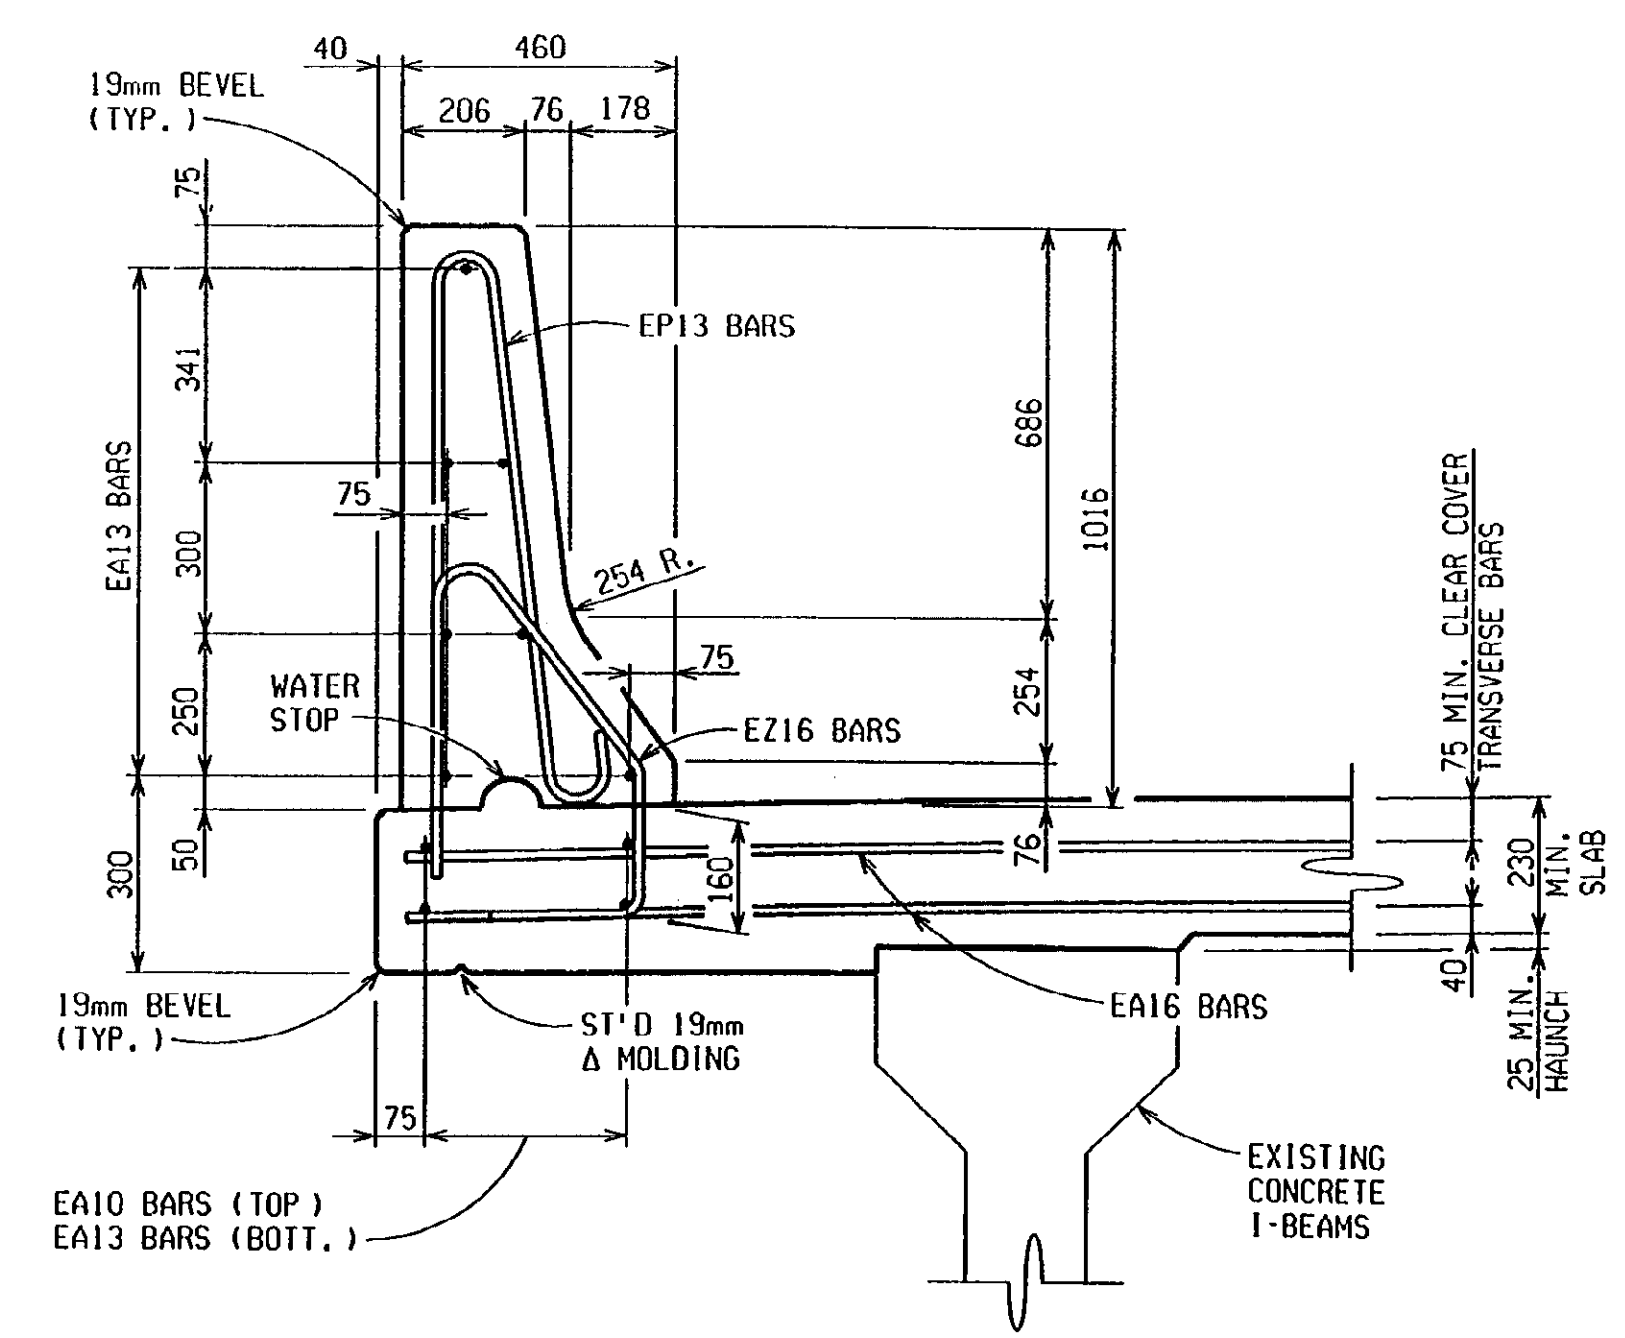


TYPICAL BARRIER SECTION

DECK REPLACEMENT DETAILS - SB STRUCTURE				
DATE	CONT. SEC.	JOB NO.	DESIGN UNIT	SHEET
1-9-01	S04 OF 63174	49595A	MAHDAVI	12 OF 15




1 2 3 4 5 6 7 8 9 10 11 12 13 14 15 16 17 18 19 20 21 22 23 24 25 26 27 28 29 30 31 32 33 34 35 36 37 38 39 40 41 42 43 44 45 46 47 48 49 50 51 52 53 54 55 56 57 58 59 60 61 62 63

REVISIONS			
NO.	DESCRIPTION	DATE	BY

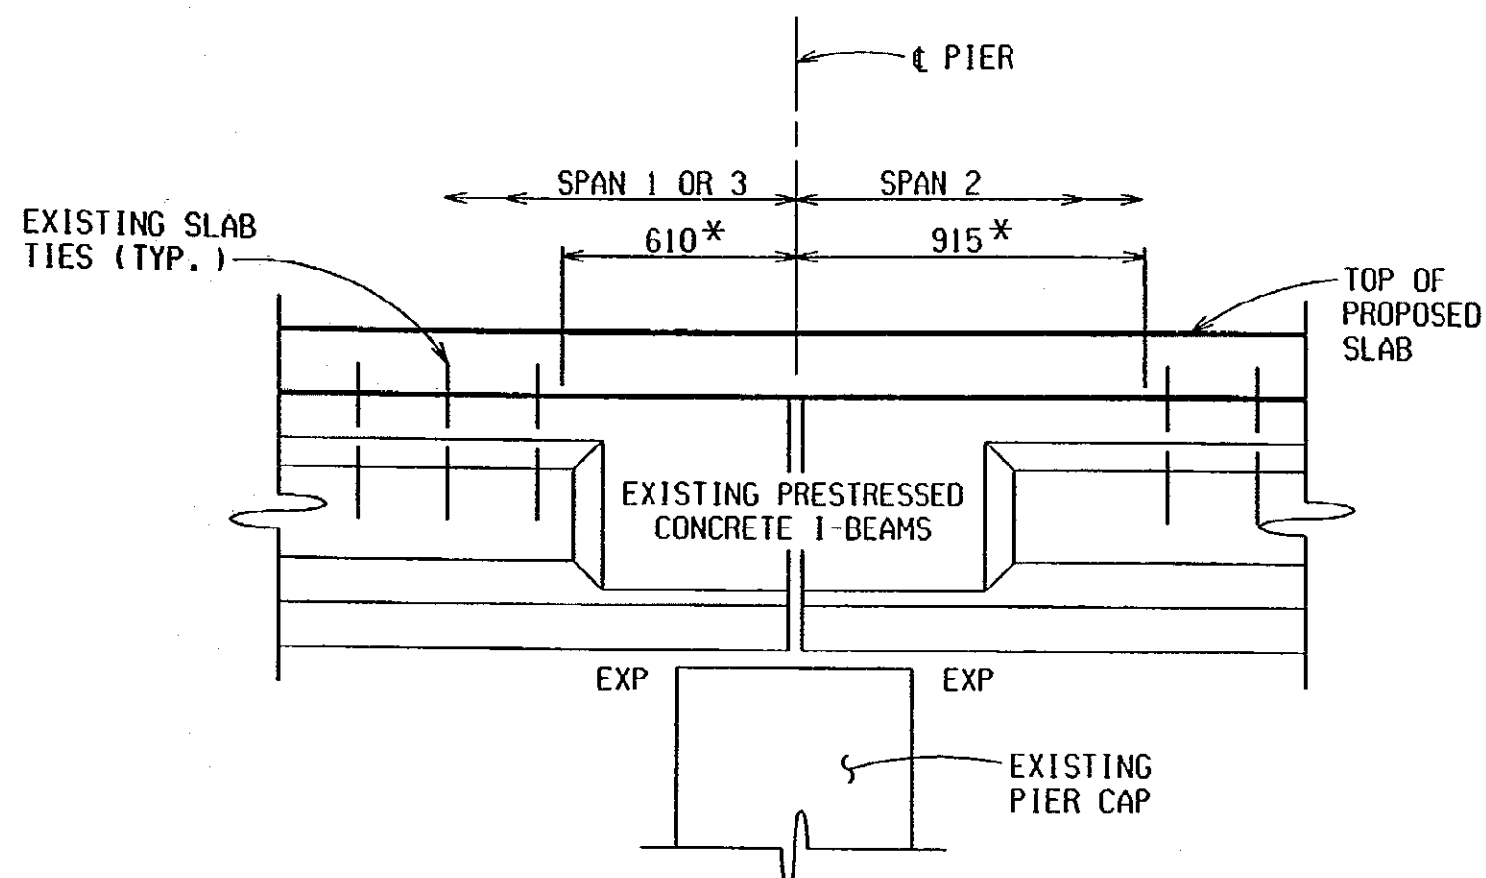


SECTION THRU LINK SLAB AT PIER


* LIMITS FOR REMOVAL OF EXISTING SLAB TIES AND FOR DEBONDING BETWEEN EXISTING BEAMS AND PROPOSED DECK. DEBOND BY PLACING 2 LAYERS OF 6 MIL PLASTIC SHEET SECURED TO THE TOP OF BEAMS PRIOR TO POURING THE DECK. PAYMENT FOR SLAB TIE REMOVAL AND DEBONDING IS INCLUDED IN THE BID ITEM *SUPERSTRUCTURE CONC, FORM, FINISH AND CURE, NIGHT CASTING (S04-SB)*.

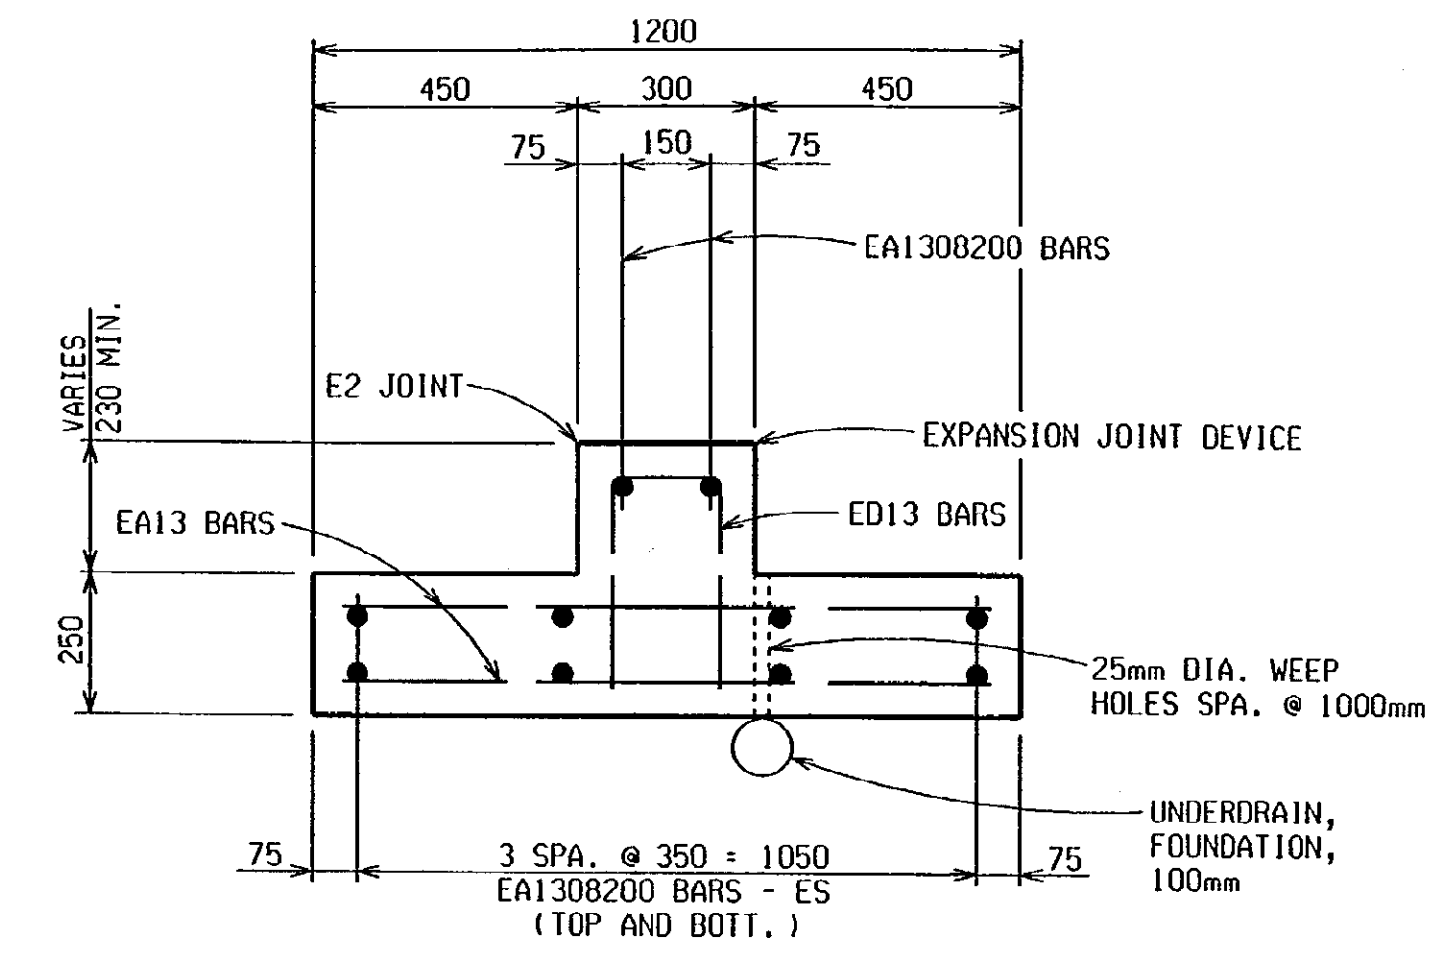

SECTION A-A

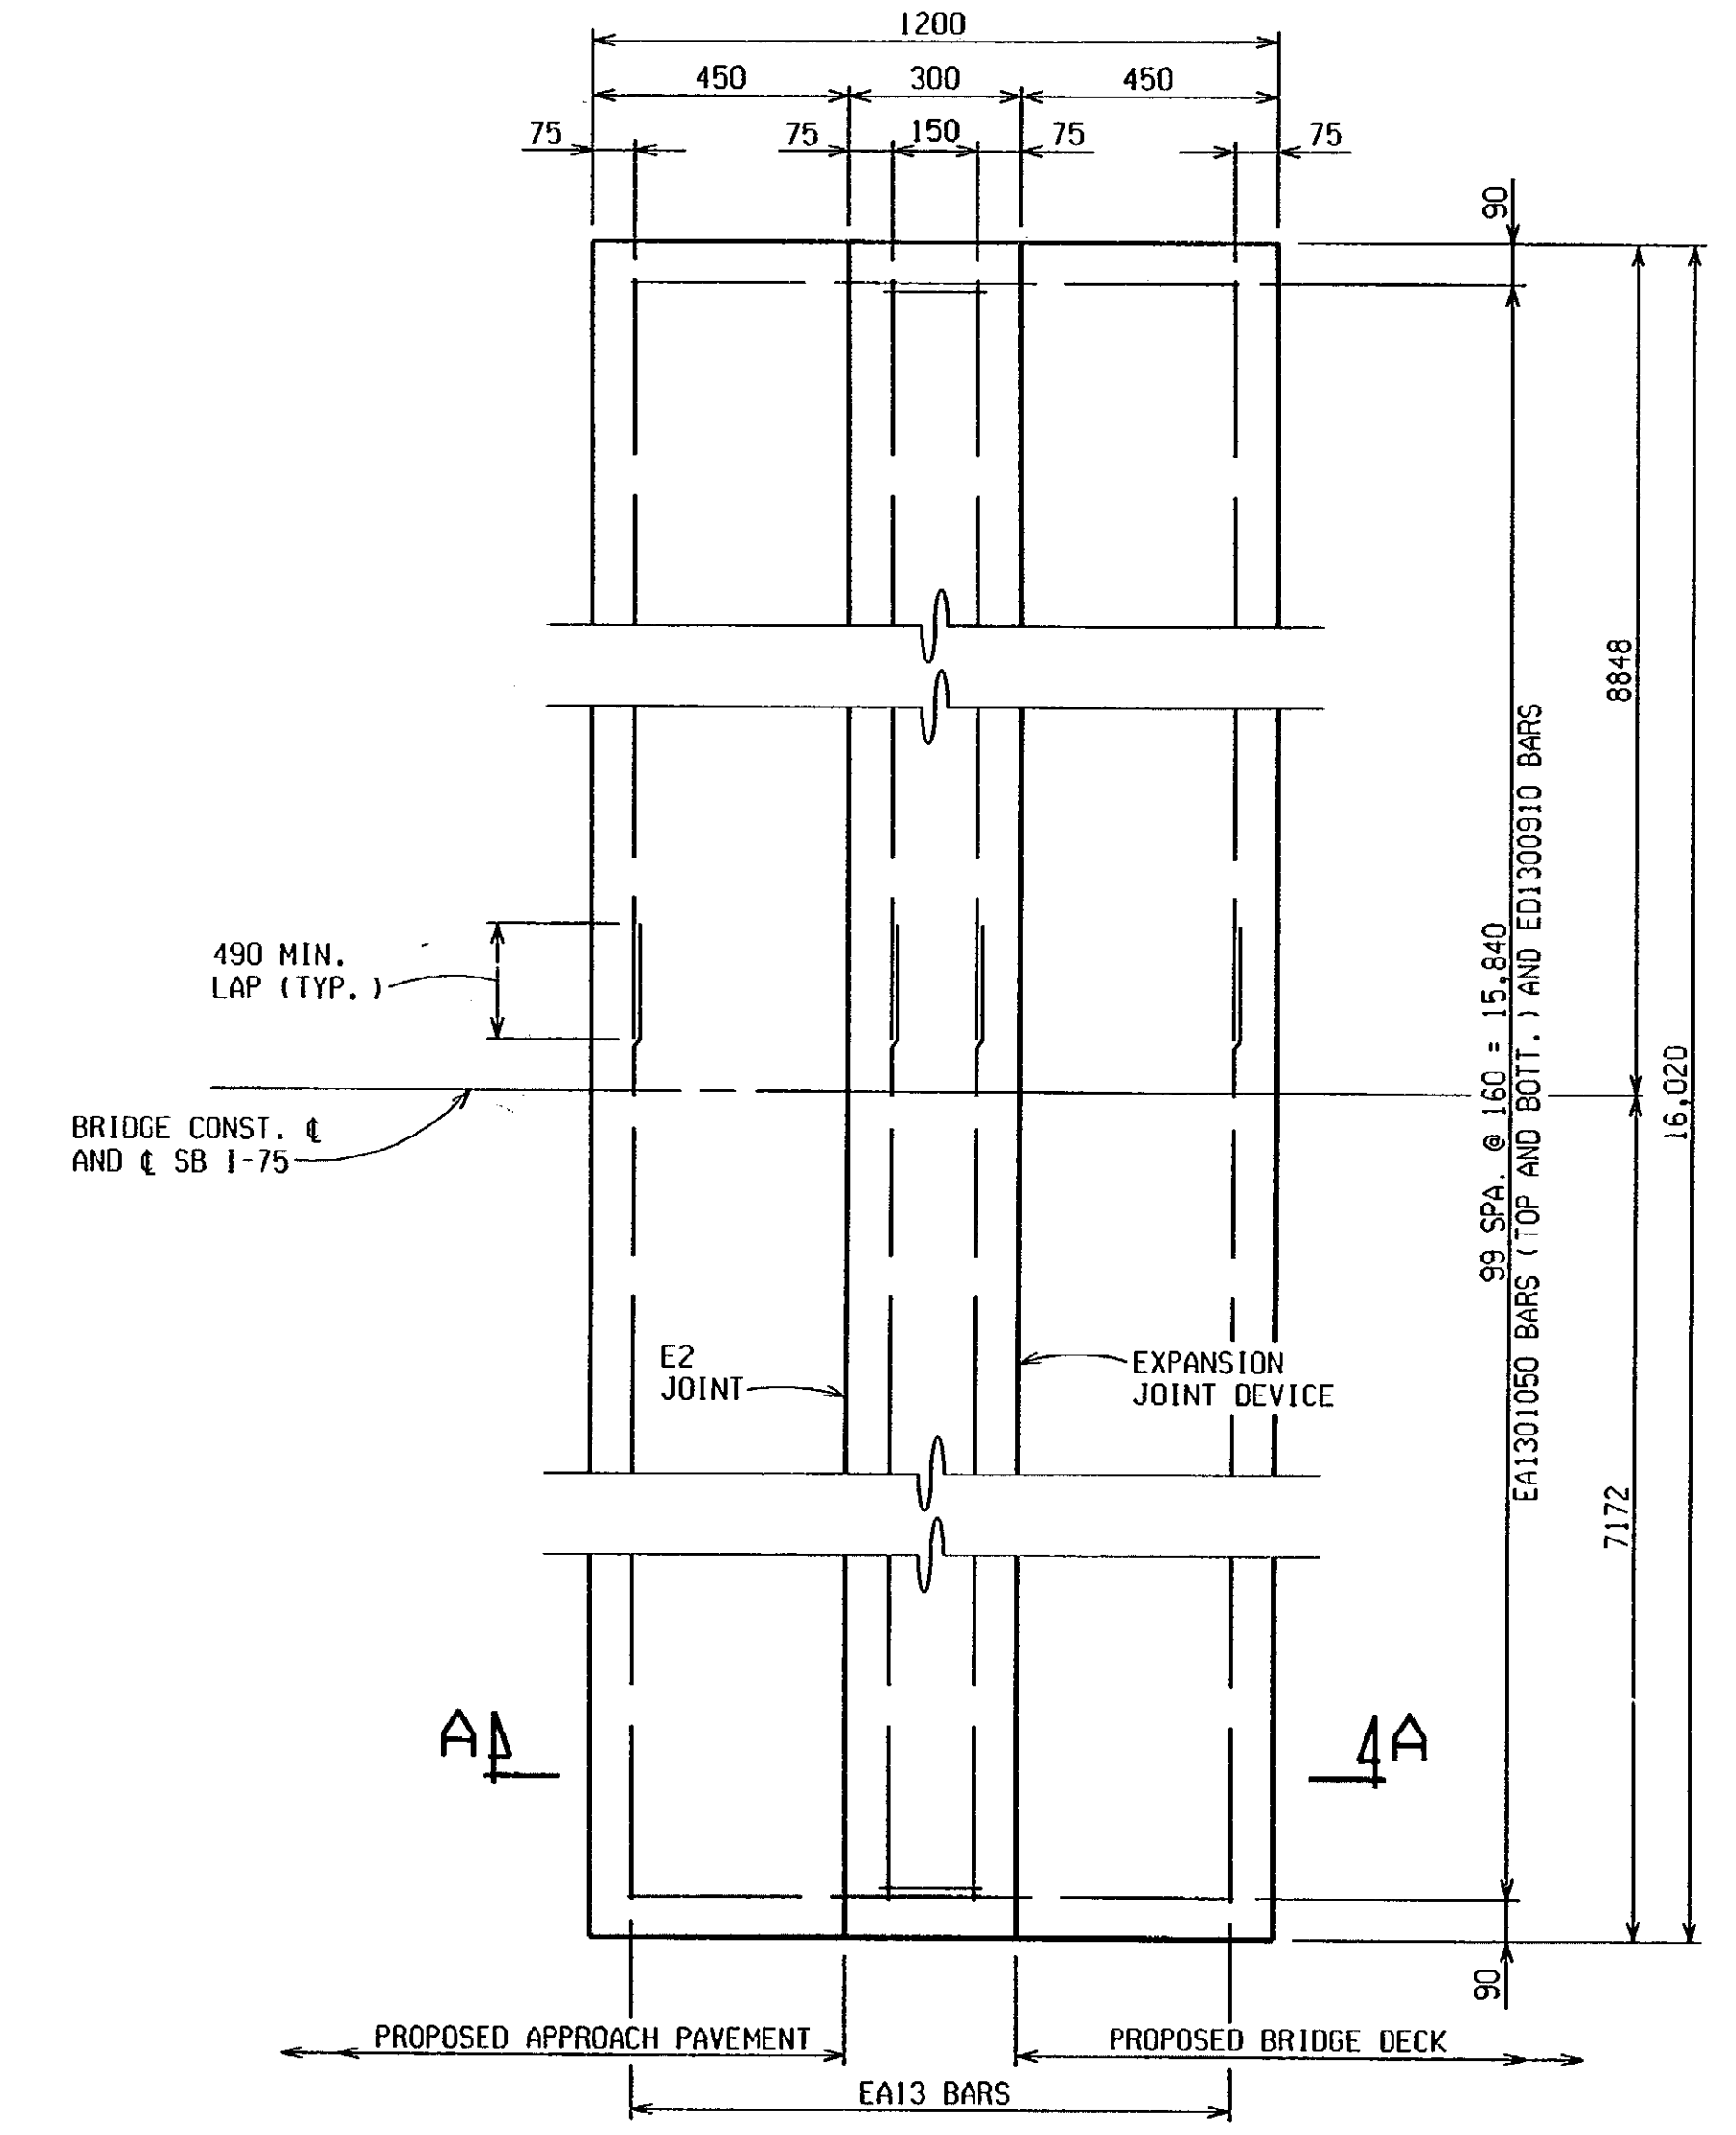

PLAN OF SLEEPER SLAB

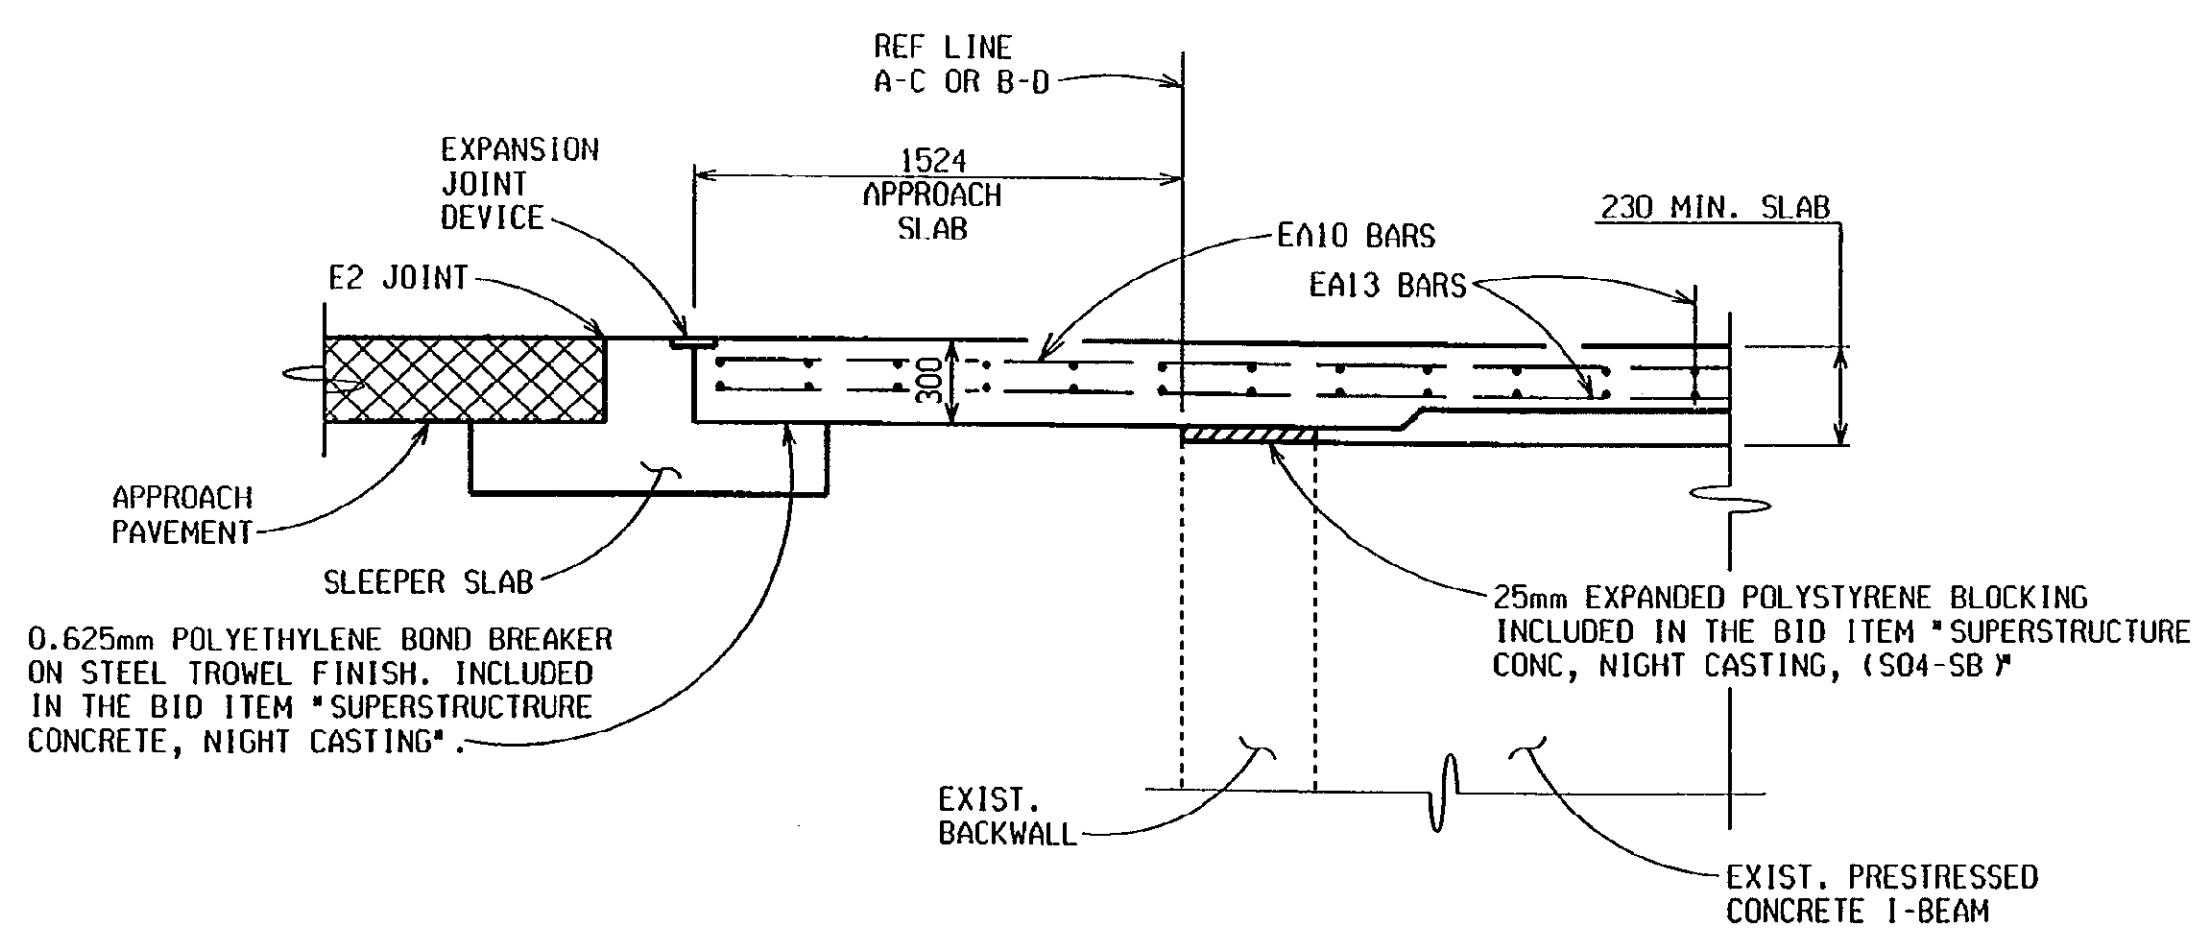

TYPICAL SECTION AT BRIDGE APPROACH



DECK REPLACEMENT DETAILS - SB STRUCTURE				
DATE	CONT. SEC.	JOB NO.	DESIGN UNIT	SHEET
1-9-01	S04 OF 63174	49595A	MAHDAVI	13 OF 15

FILE NAME: s0463174s.dk DRAWN BY: R. PRATT CHECKED BY: MIKUCKI DATE: 11-28-00 CORRECTED BY: R. PRATT DATE: 12-4-00


BOTTOM OF SLAB ELEVATIONS

	SPAN 1					SPAN 2						SPAN 3					
	0	1	2	3	4	0	1	2	3	4	5	6	0	1	2	3	4
A FASCIA	199.960	199.967	199.973	199.976	199.978	199.978	199.983	200.003	200.007	200.003	199.993	199.978	199.978	199.976	199.973	199.967	199.960
B RIGHT	200.032	200.039	200.045	200.048	200.050	200.050	200.065	200.075	200.079	200.075	200.065	200.050	200.050	200.048	200.045	200.039	200.032
C LEFT	200.062	200.070	200.075	200.079	200.080	200.081	200.093	200.102	200.106	200.102	200.093	200.081	200.080	200.079	200.075	200.070	200.062
D RIGHT	200.071	200.078	200.084	200.087	200.088	200.089	200.102	200.110	200.114	200.110	200.102	200.089	200.088	200.087	200.084	200.078	200.071
E LEFT	200.101	200.109	200.114	200.117	200.119	200.119	200.132	200.141	200.144	200.141	200.132	200.119	200.119	200.117	200.114	200.109	200.101
F RIGHT	200.109	200.117	200.122	200.126	200.127	200.127	200.140	200.149	200.152	200.149	200.140	200.127	200.126	200.122	200.117	200.109	200.101
G LEFT	200.140	200.147	200.153	200.156	200.157	200.158	200.171	200.180	200.183	200.180	200.171	200.158	200.157	200.156	200.153	200.147	200.140
H RIGHT	200.148	200.155	200.161	200.164	200.166	200.166	200.179	200.188	200.191	200.188	200.179	200.166	200.166	200.164	200.161	200.155	200.148
I LEFT	200.178	200.186	200.191	200.195	200.196	200.196	200.209	200.218	200.221	200.218	200.209	200.196	200.196	200.195	200.191	200.186	200.178
J RIGHT	200.186	200.194	200.199	200.203	200.204	200.204	200.217	200.226	200.229	200.226	200.217	200.204	200.204	200.203	200.199	200.194	200.186
K LEFT	200.181	200.189	200.194	200.198	200.199	200.199	200.212	200.221	200.224	200.221	200.212	200.199	200.199	200.198	200.194	200.189	200.181
L RIGHT	200.173	200.181	200.186	200.190	200.191	200.191	200.204	200.213	200.216	200.213	200.204	200.191	200.191	200.190	200.186	200.181	200.173
M LEFT	200.143	200.150	200.156	200.159	200.160	200.161	200.174	200.183	200.186	200.183	200.174	200.161	200.160	200.159	200.156	200.150	200.143
N RIGHT	200.135	200.142	200.148	200.151	200.152	200.153	200.166	200.175	200.178	200.175	200.166	200.153	200.152	200.151	200.148	200.142	200.135
O LEFT	200.104	200.112	200.117	200.120	200.122	200.122	200.135	200.144	200.147	200.144	200.135	200.122	200.122	200.120	200.117	200.112	200.104
P RIGHT	200.096	200.103	200.109	200.112	200.114	200.114	200.127	200.136	200.139	200.136	200.127	200.114	200.114	200.112	200.109	200.103	200.096
Q LEFT	200.065	200.073	200.079	200.082	200.083	200.084	200.098	200.109	200.112	200.109	200.098	200.084	200.083	200.082	200.079	200.073	200.065
R FASCIA	199.993	200.001	200.007	200.010	200.011	200.012	200.026	200.036	200.040	200.036	200.026	200.012	200.011	200.010	200.007	200.001	199.993

REVISIONS			
NO.	DESCRIPTION	DATE	BY

SCREED ELEVATIONS

LEFT	200.240	200.247	200.253	200.256	200.258	200.258	200.272	200.281	200.285	200.281	200.272	200.258	200.258	200.256	200.253	200.247	200.240
RIGHT	200.274	200.281	200.286	200.290	200.291	200.292	200.305	200.315	200.318	200.315	200.305	200.292	200.291	200.290	200.286	200.281	200.274

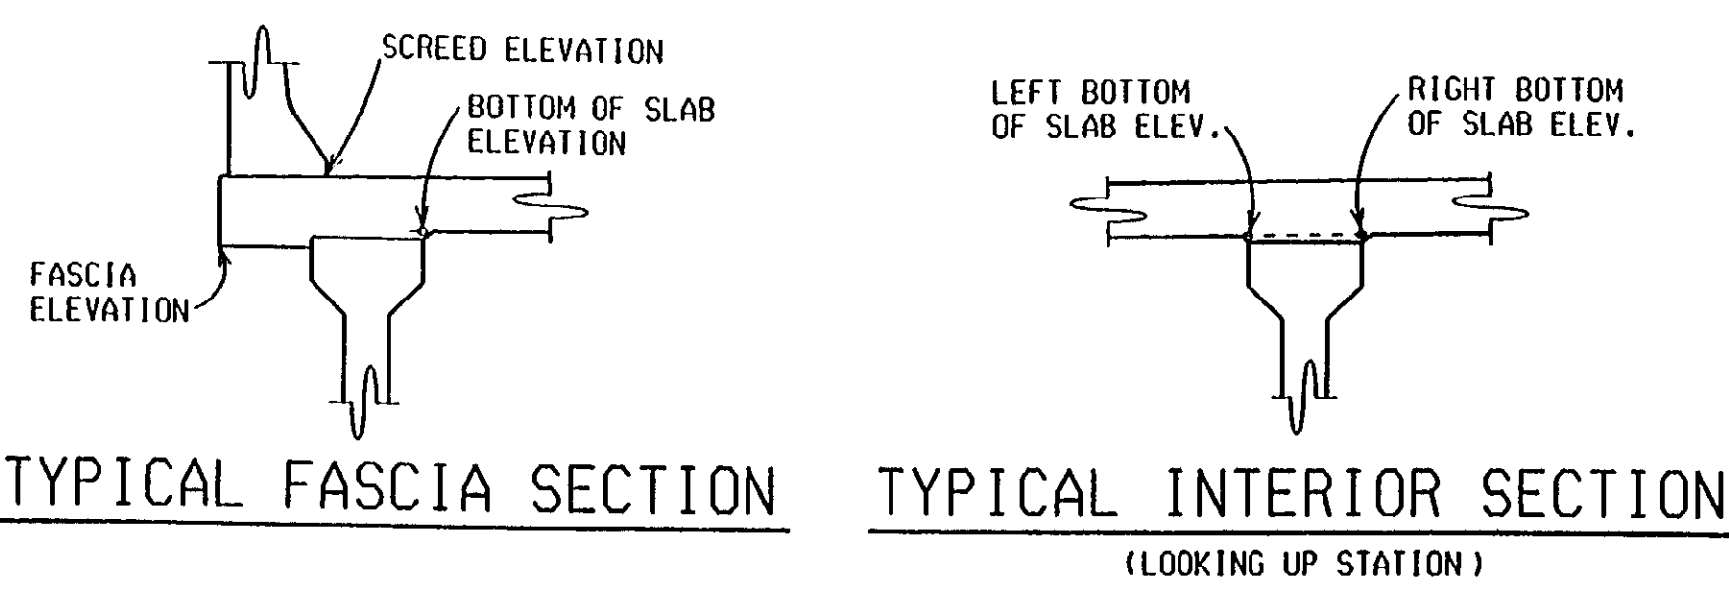

BULKHEAD ELEVATIONS

	ABUT. A		ABUT. B	
A	200.258	200.276	200.276	200.258
B	200.296	200.314	200.314	200.296
C	200.335	200.353	200.353	200.335
D	200.373	200.392	200.392	200.373
E	200.412	200.430	200.430	200.412
F	200.407	200.425	200.425	200.407
G	200.368	200.387	200.387	200.368
H	200.330	200.348	200.348	200.330
J	200.291	200.309	200.309	200.291

SCREEDS AFFECTED BY LOADS IN OTHER SPANS ARE TO BE SET TO THE ELEVATIONS SHOWN BEFORE CASTING ANY CONCRETE.

SCREED ELEVATIONS ARE BASED ON THE CONDITION THAT NO SLAB CONCRETE HAS BEEN CAST AND THAT FORMWORK AND STEEL REINFORCEMENT ARE IN PLACE (AND THE TEMPORARY SUPPORTS ARE BROUGHT TO A SNUG FIT UNDER EACH BEAM).

SECTIONS FOR BOTTOM OF SLAB AND/OR SCREED ELEVATIONS ARE GIVEN ALONG BEAM CENTERLINES FROM CENTERLINE OF BEARING OR PIN & HANGER TO CENTERLINE OF BEARING OR PIN & HANGER AS APPLICABLE AT EQUAL SPACINGS.

SLAB AND SCREED DATA - SB STRUCTURE				
DATE	CONT. SEC.	JOB NO.	DESIGN UNIT	SHEET
1-9-01	S04 OF 63174	49595A	MAHDAVI	14 OF 15








BENCH MARKS	
B.M. #71 E.L. 63A33	MS&A B.M. Peg in Roof of 24' Elm
167' RT. of 92160 N.B. Rdwy.	
B.M. #69 E.L. 63T14	MS&A B.M. Peg in Roof of 15' Elm
158' RT. of 92106 N.B. Rdwy.	

UTILITIES	
Michigan Bell Telephone 30' North & Parallel to 12 Mile Road	
Detroit Edison 36' S.W. 28' N.W. and 48' N.W. All Lines parallel to 12 Mile Road.	
Detroit Water Board 12' Water Main 45' North & parallel to 12 Mile Road.	
City of Madison Heights 32" x 48" Sewer 15' South & parallel to 12 Mile Road. E.L. 607.50 @ N.B. Rdwy.	
Consumers Power Co. 6" Steel Medium Pressure Gas Line, 16' North of @ 12 Mile Rd.	


SECTION II
TIN RIE
ROYAL OAK TWP

Curve Data
 Δ 39°02'30"
 R 3°00'00"
 P 1909.86
 T 494.61
 L 967.96
 E 63.01
 PC 915.38.23
 PI 920.33.84
 PT 925.07.19
 S_e 2.057H

SECTION II
TIN RIE
ROYAL OAK TWP

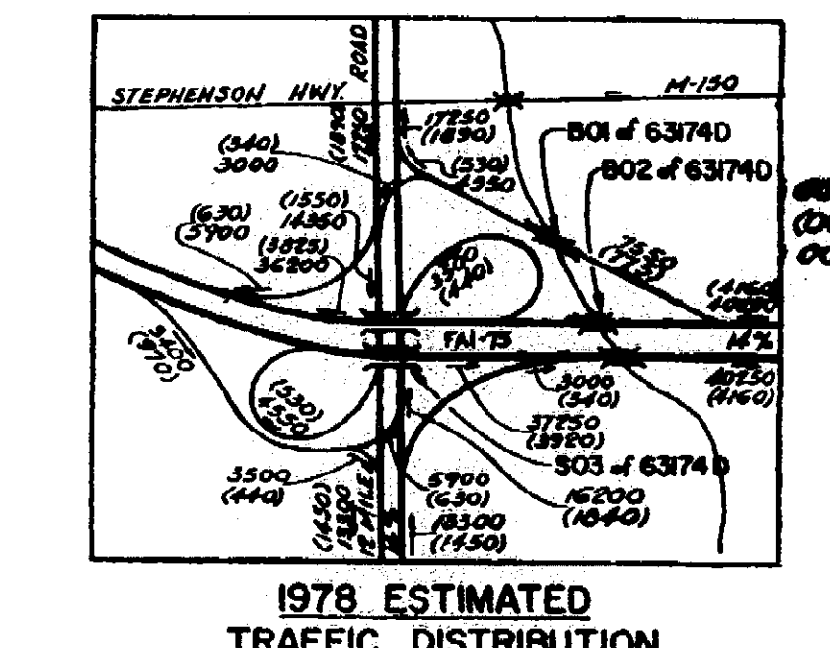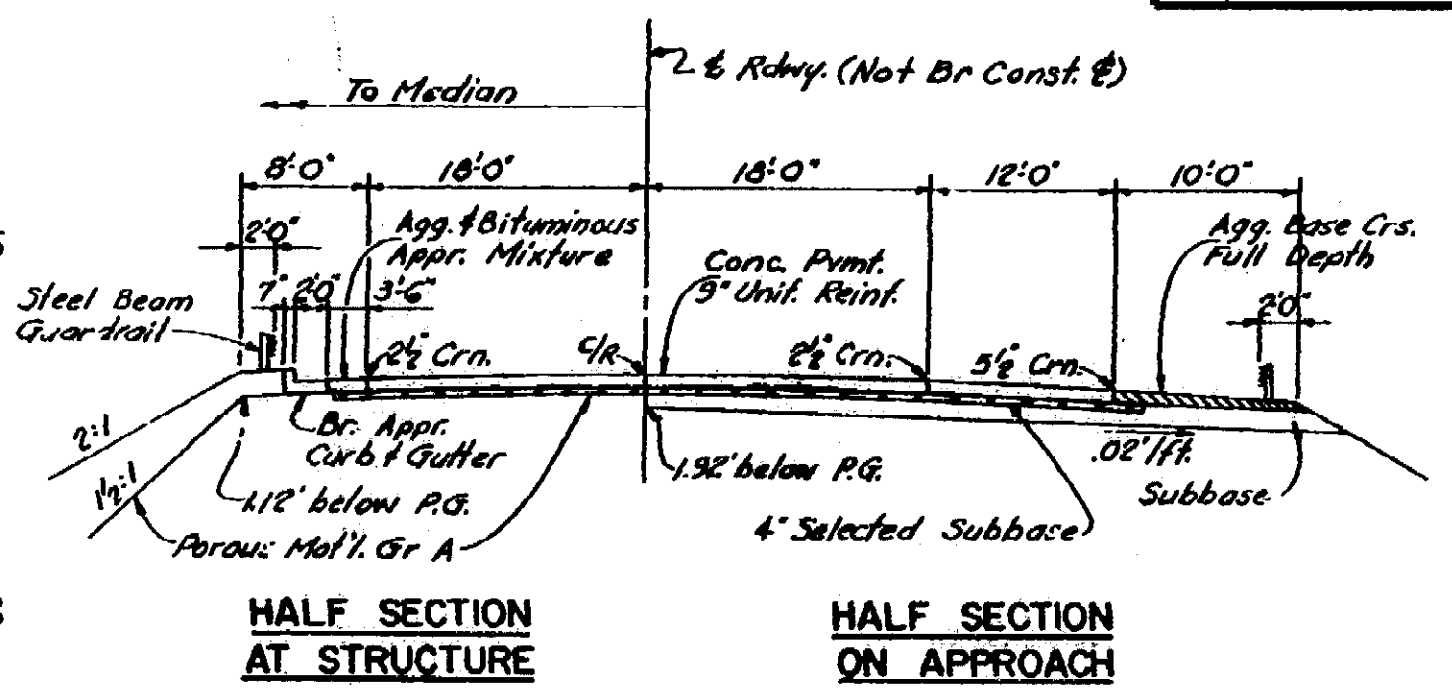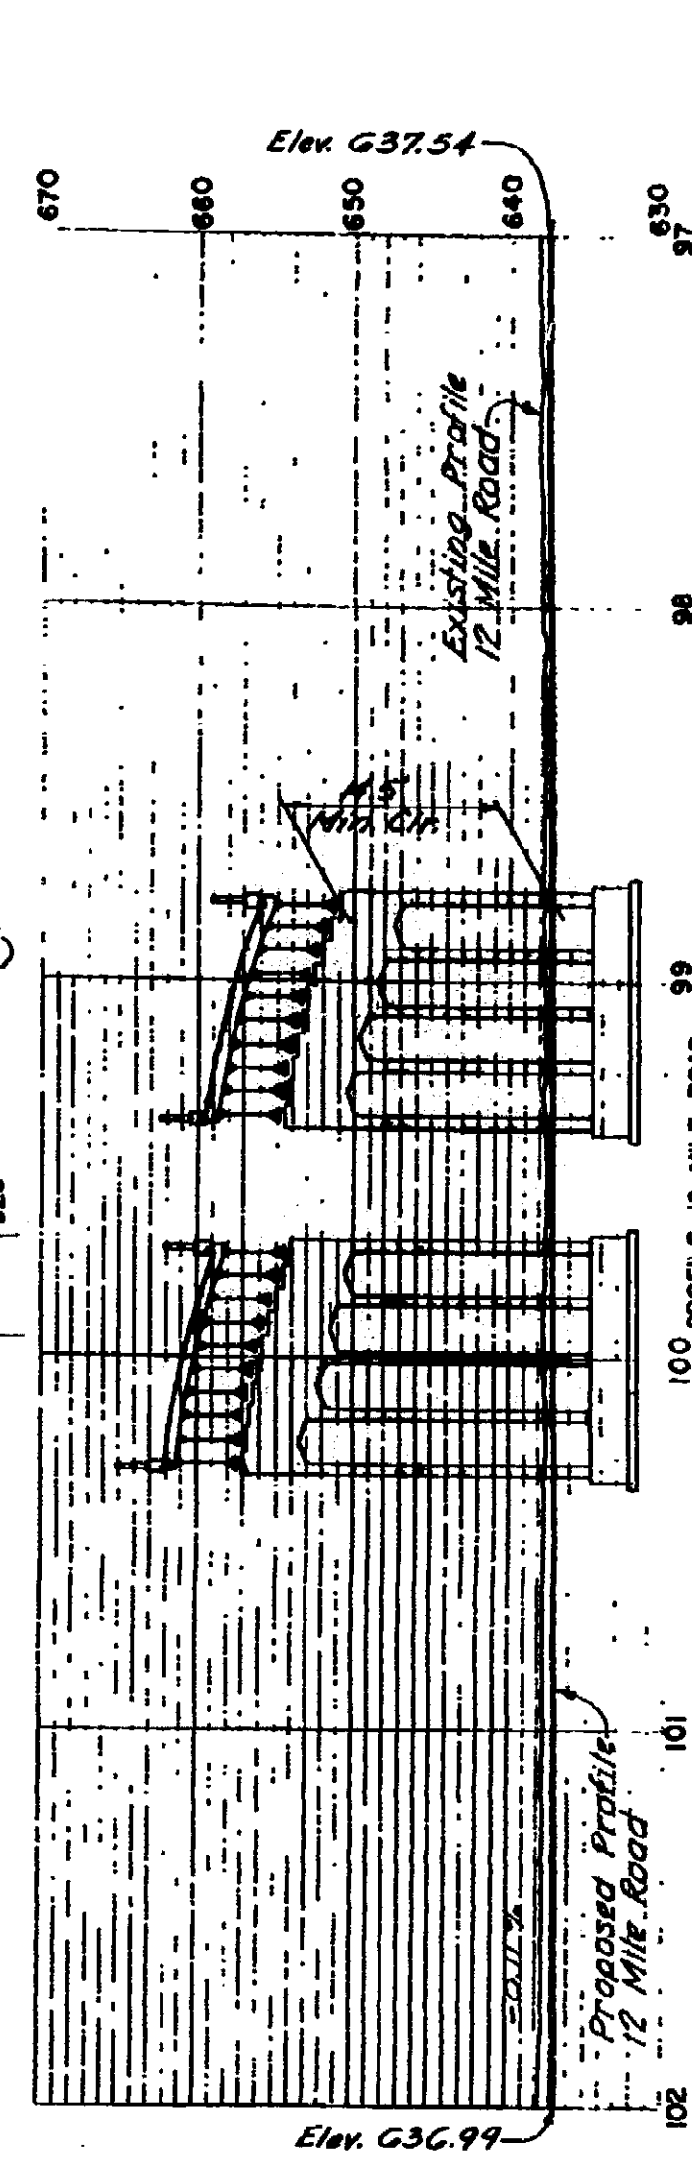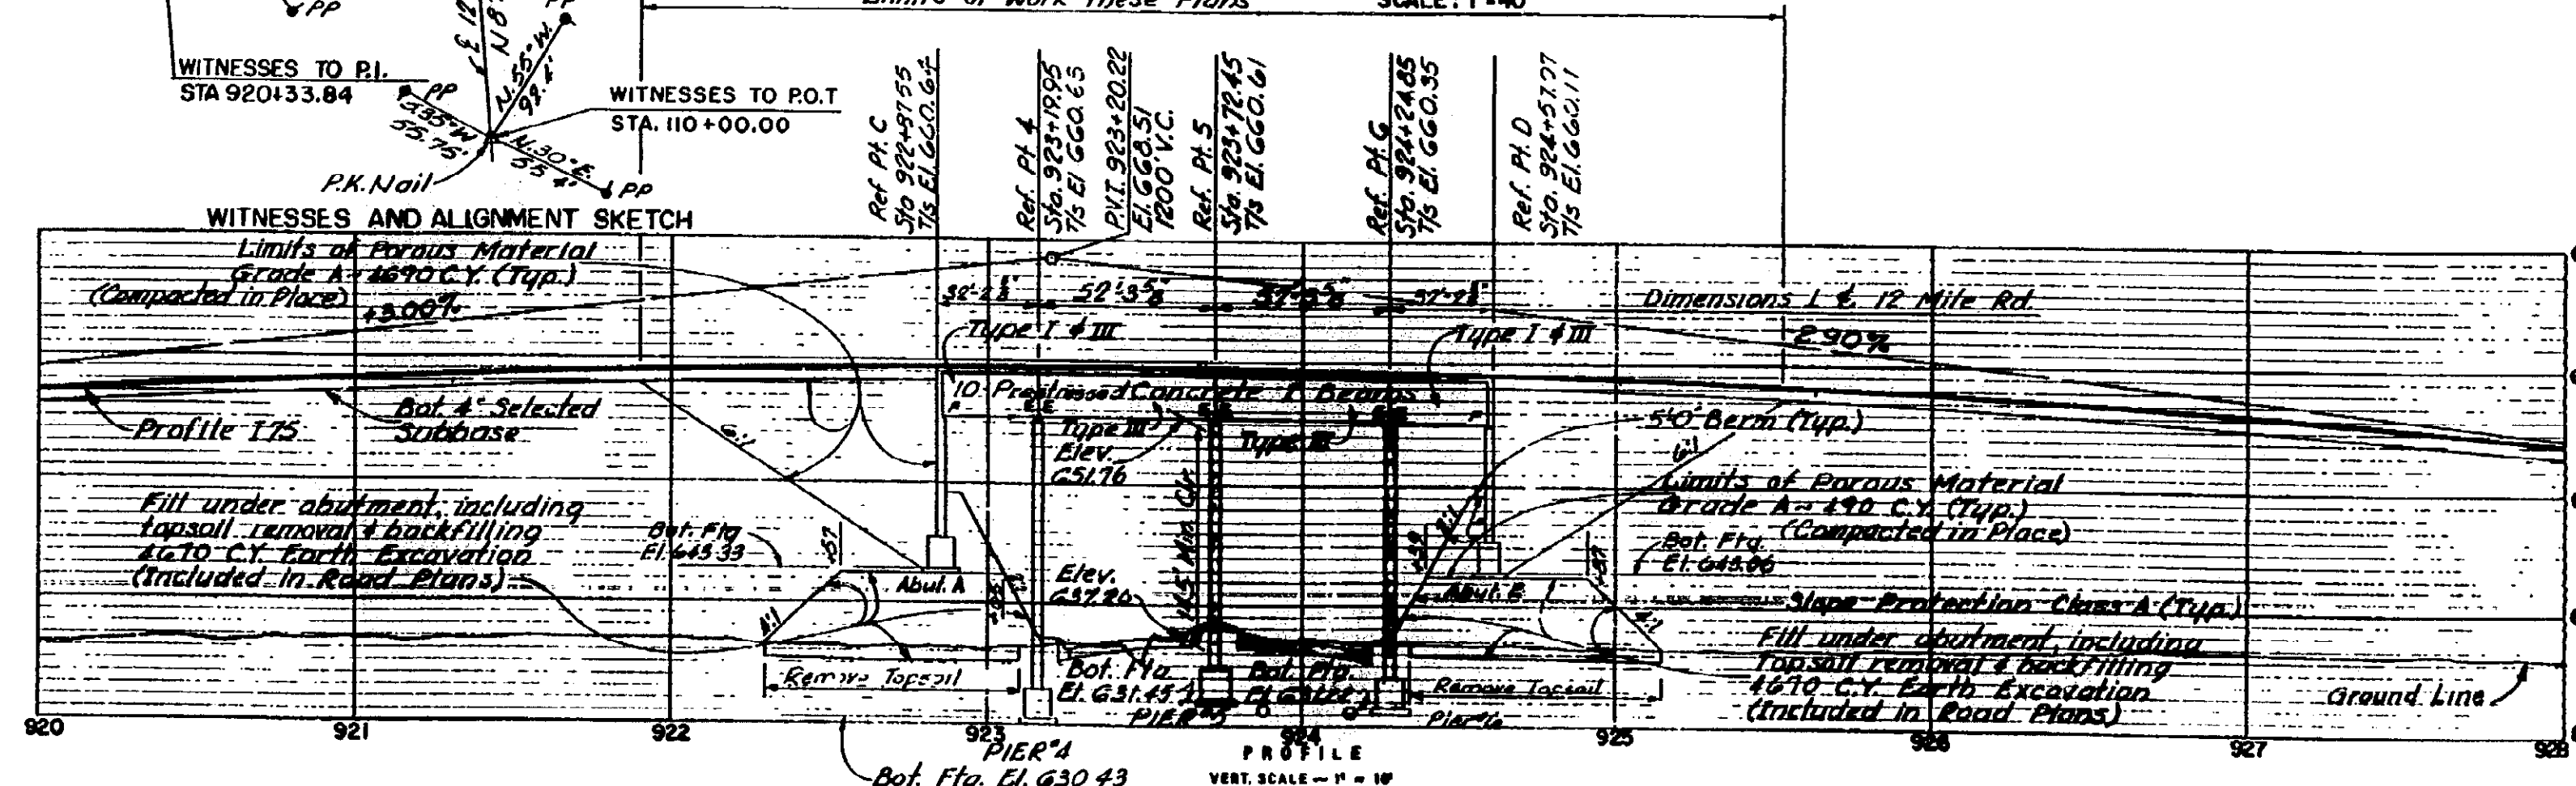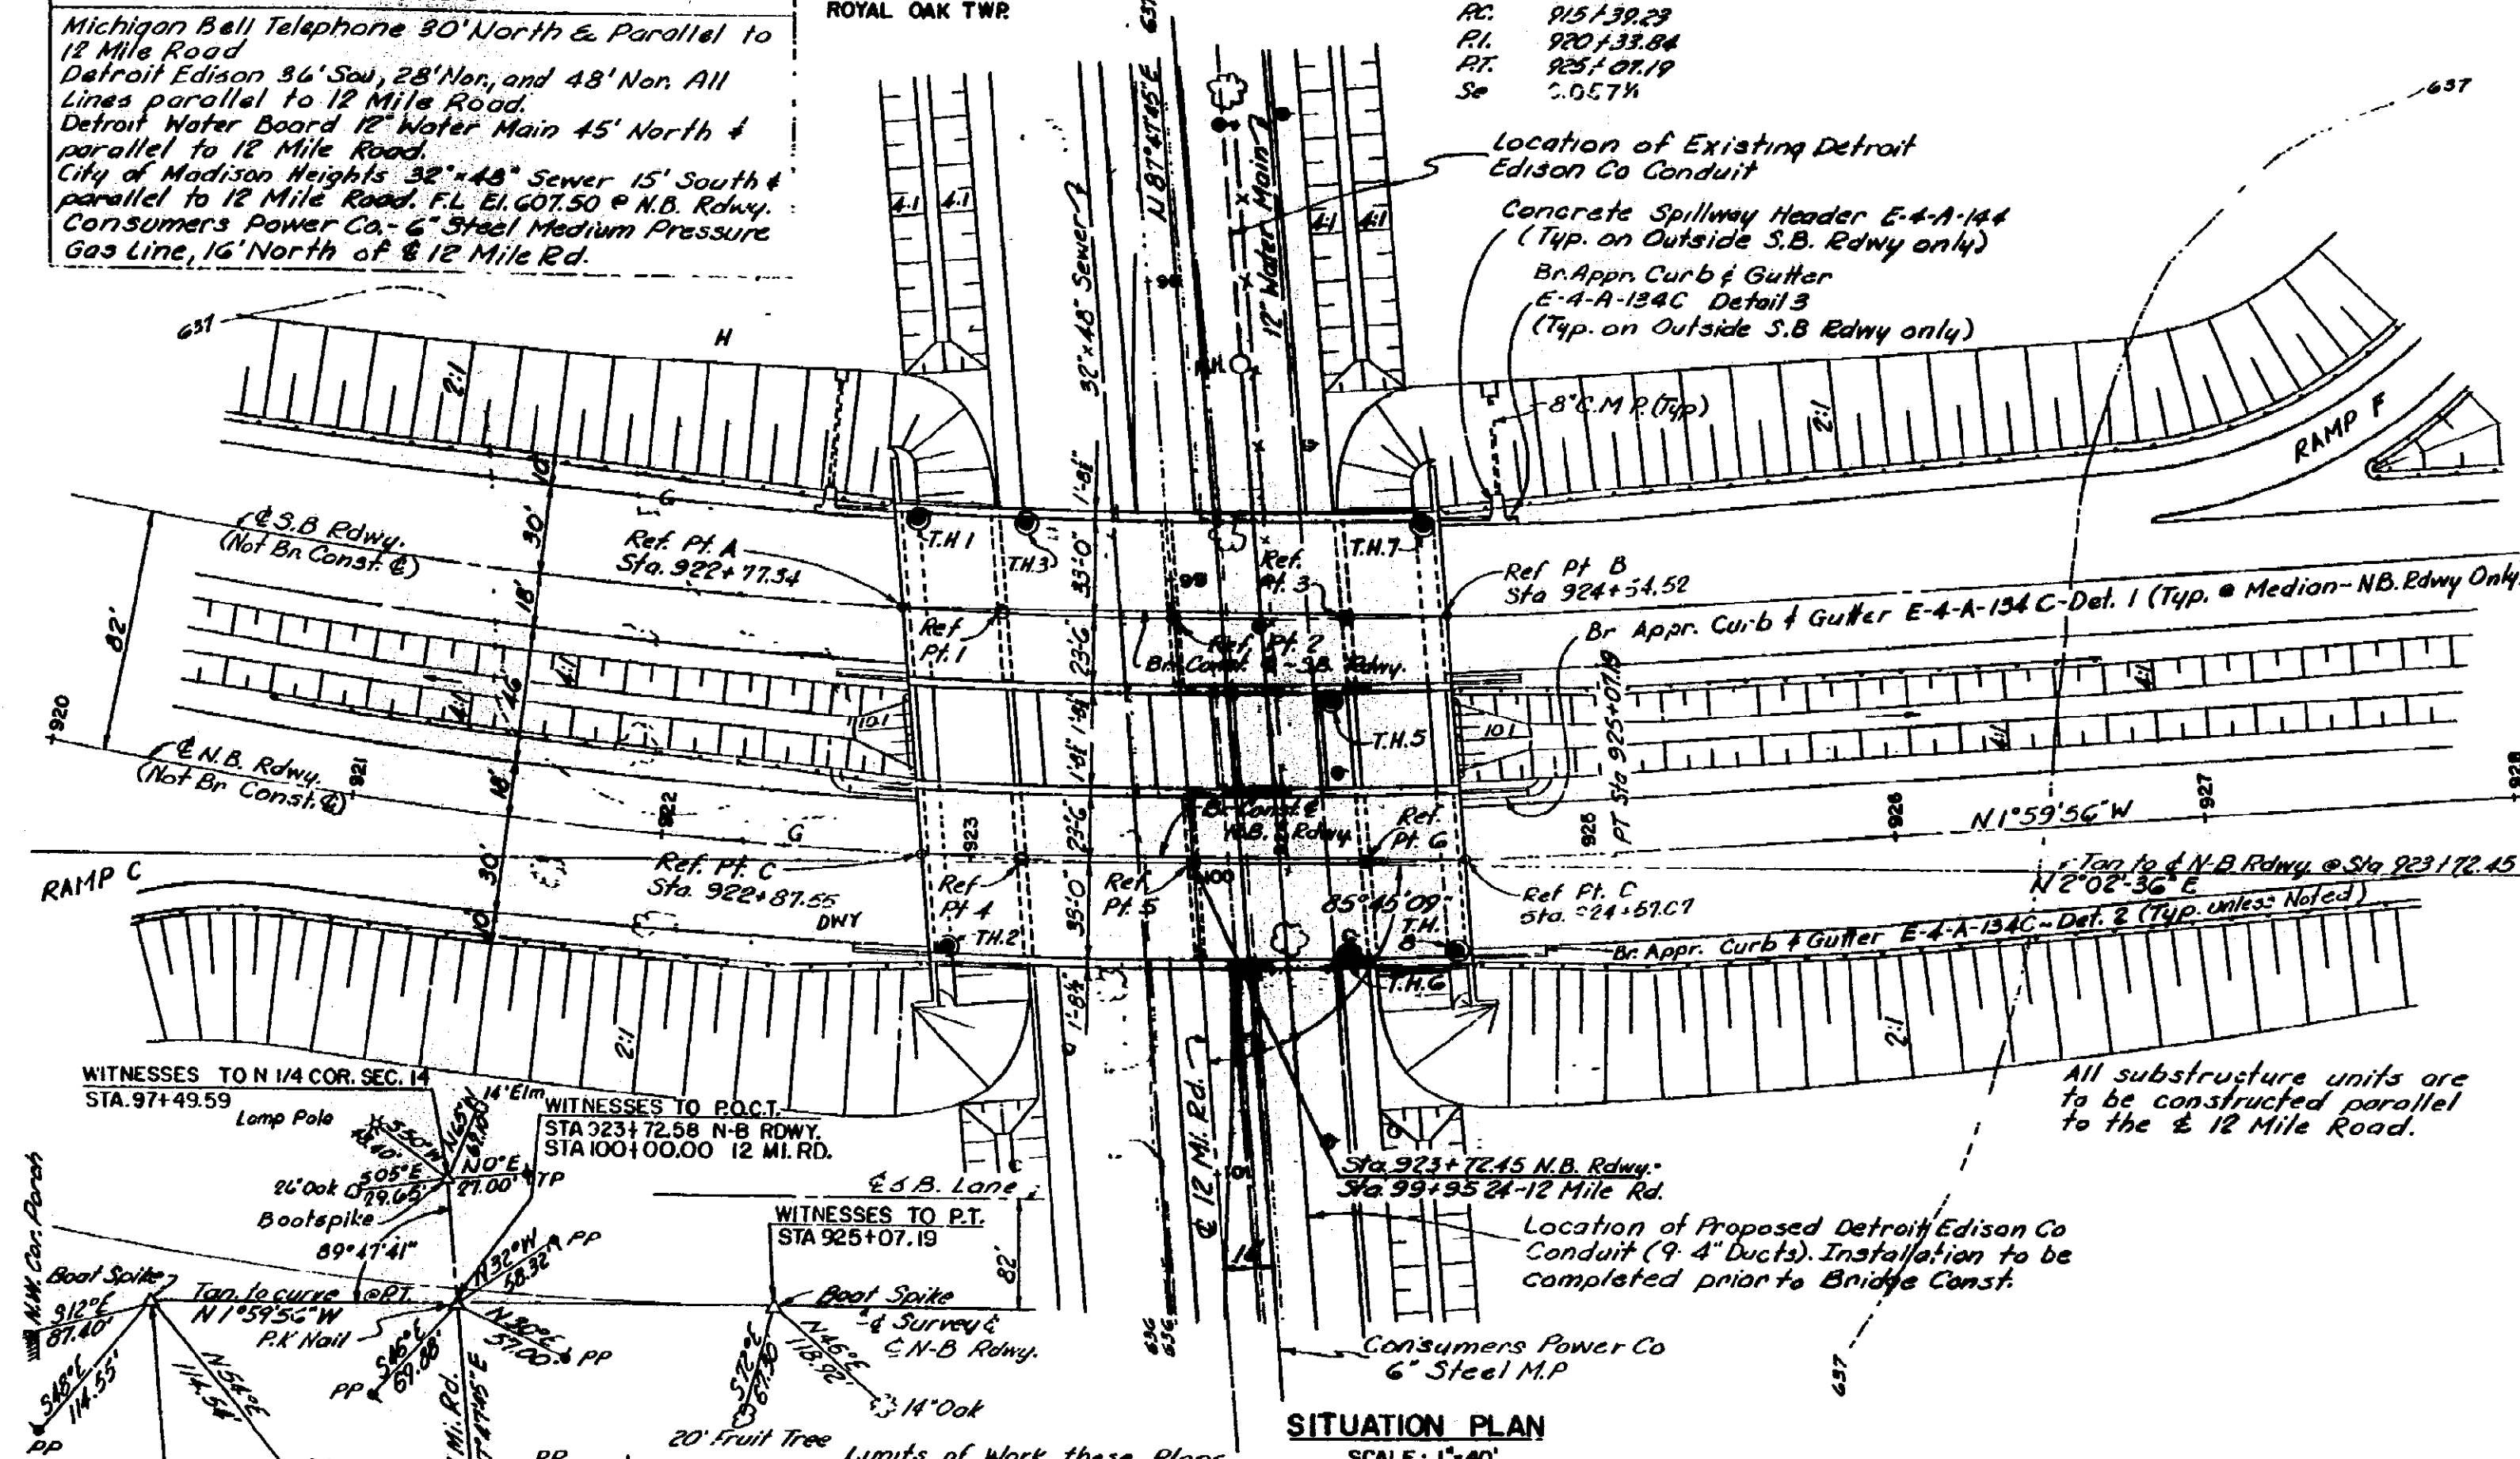

LEGEND
 (V) - Average Daily Traffic
 (D) - Design Hourly Volume
 (C) - % Commercial

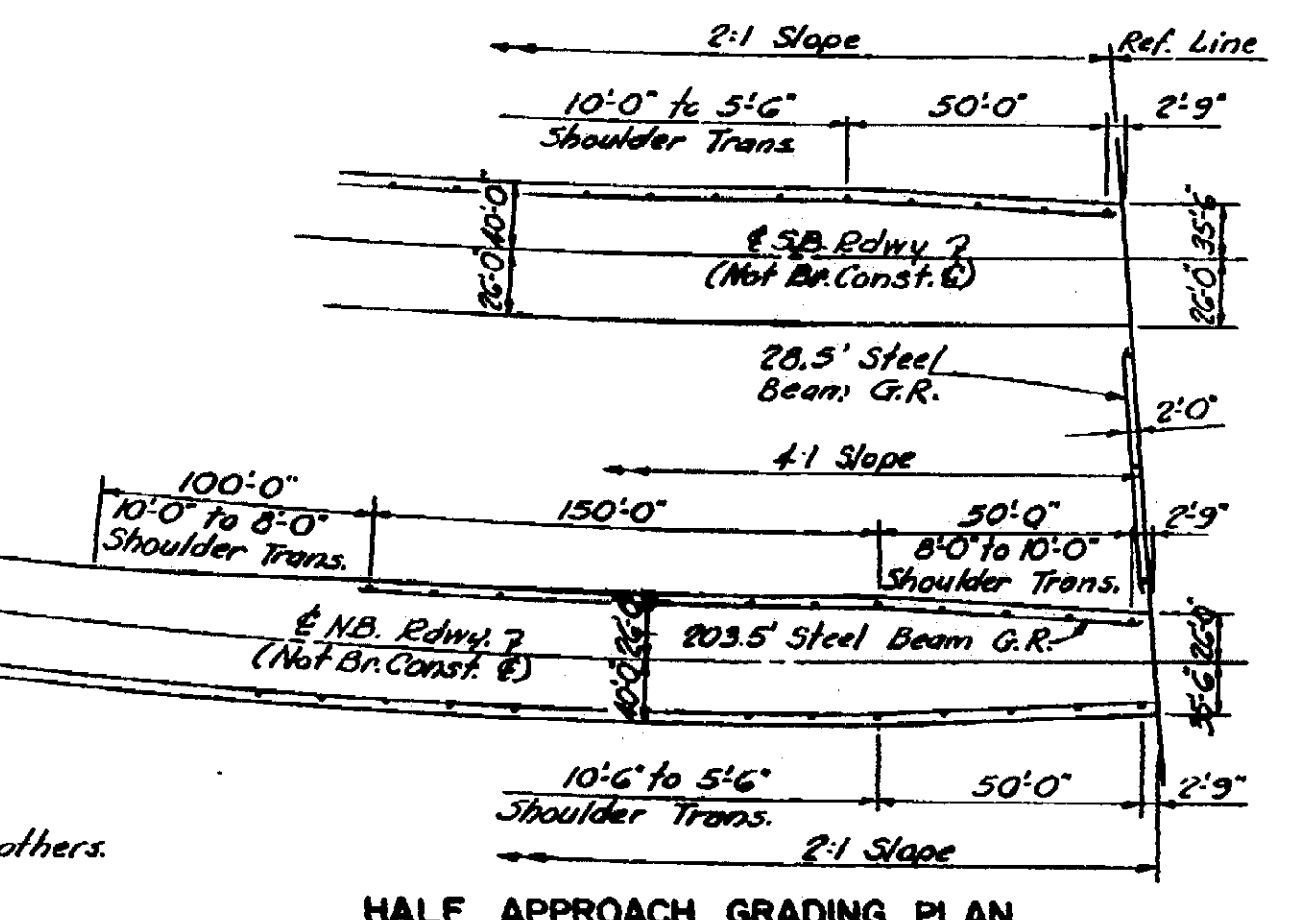

GENERAL NOTES
 Fences and utilities are to be moved by others. Buildings are to be removed by others. Datum refers to U.S.G.S. datum. Traffic is to be maintained over the temporary road until half the structure is complete. This bridge is part of an interchange and all the area shown is within MS&A R.O.W. Piers #1, 3, 4 & 6 shall be constructed and back filled prior to construction of the abutment fills. The work covered by these plans includes construction of the proposed bridge, placing porous material and placing slope protection class A to the limits shown. All work not listed above is included in the road plans. Hamden Road to be closed at edge of interchange R.O.W.

CONTROL SECTION 63174 I

MICHIGAN STATE HIGHWAY DEPARTMENT
 I 75 OVER 12 MILE ROAD IN THE CITY OF MADISON HEIGHTS

GENERAL PLAN OF SITE

TECON ENGINEERS, INC.
 APPROVED: *J. V. Murray* 6-5-62
 ENGINEER OF DESIGN - CONSULTANT

S03 OF 63174 I

NOTE:
 DO NOT WORK FROM THIS SHEET. THE INFORMATION SHOWN HERE IS FOR REFERENCE ONLY. NO PAY ITEMS ARE SHOWN.




FOR INFORMATION ONLY				
NORTH BOUND				
DATE	CONT. SEC.	JOB NO.	DESIGN UNIT	SHEET
01-10-01	S03 OF 63174	49595A	MADHAVI	2 OF 8






DATE: 01-10-01
 CORRECTED BY: INDER
 DATE:
 CHECKED BY:
 DATE:
 DRAWN BY: inder
 FILE NAME: s0363174asn.d

1 2 3 4 5 6 7 8 9 10 11 12 13 14 15 16 17 18 19 20 21 22 23 24 25 26 27 28 29 30 31 32 33 34 35 36 37 38 39 40 41 42 43 44 45 46 47 48 49 50 51 52 53 54 55 56 57 58 59 60 61 62 63

REVISIONS			
NO.	DESCRIPTION	DATE	BY

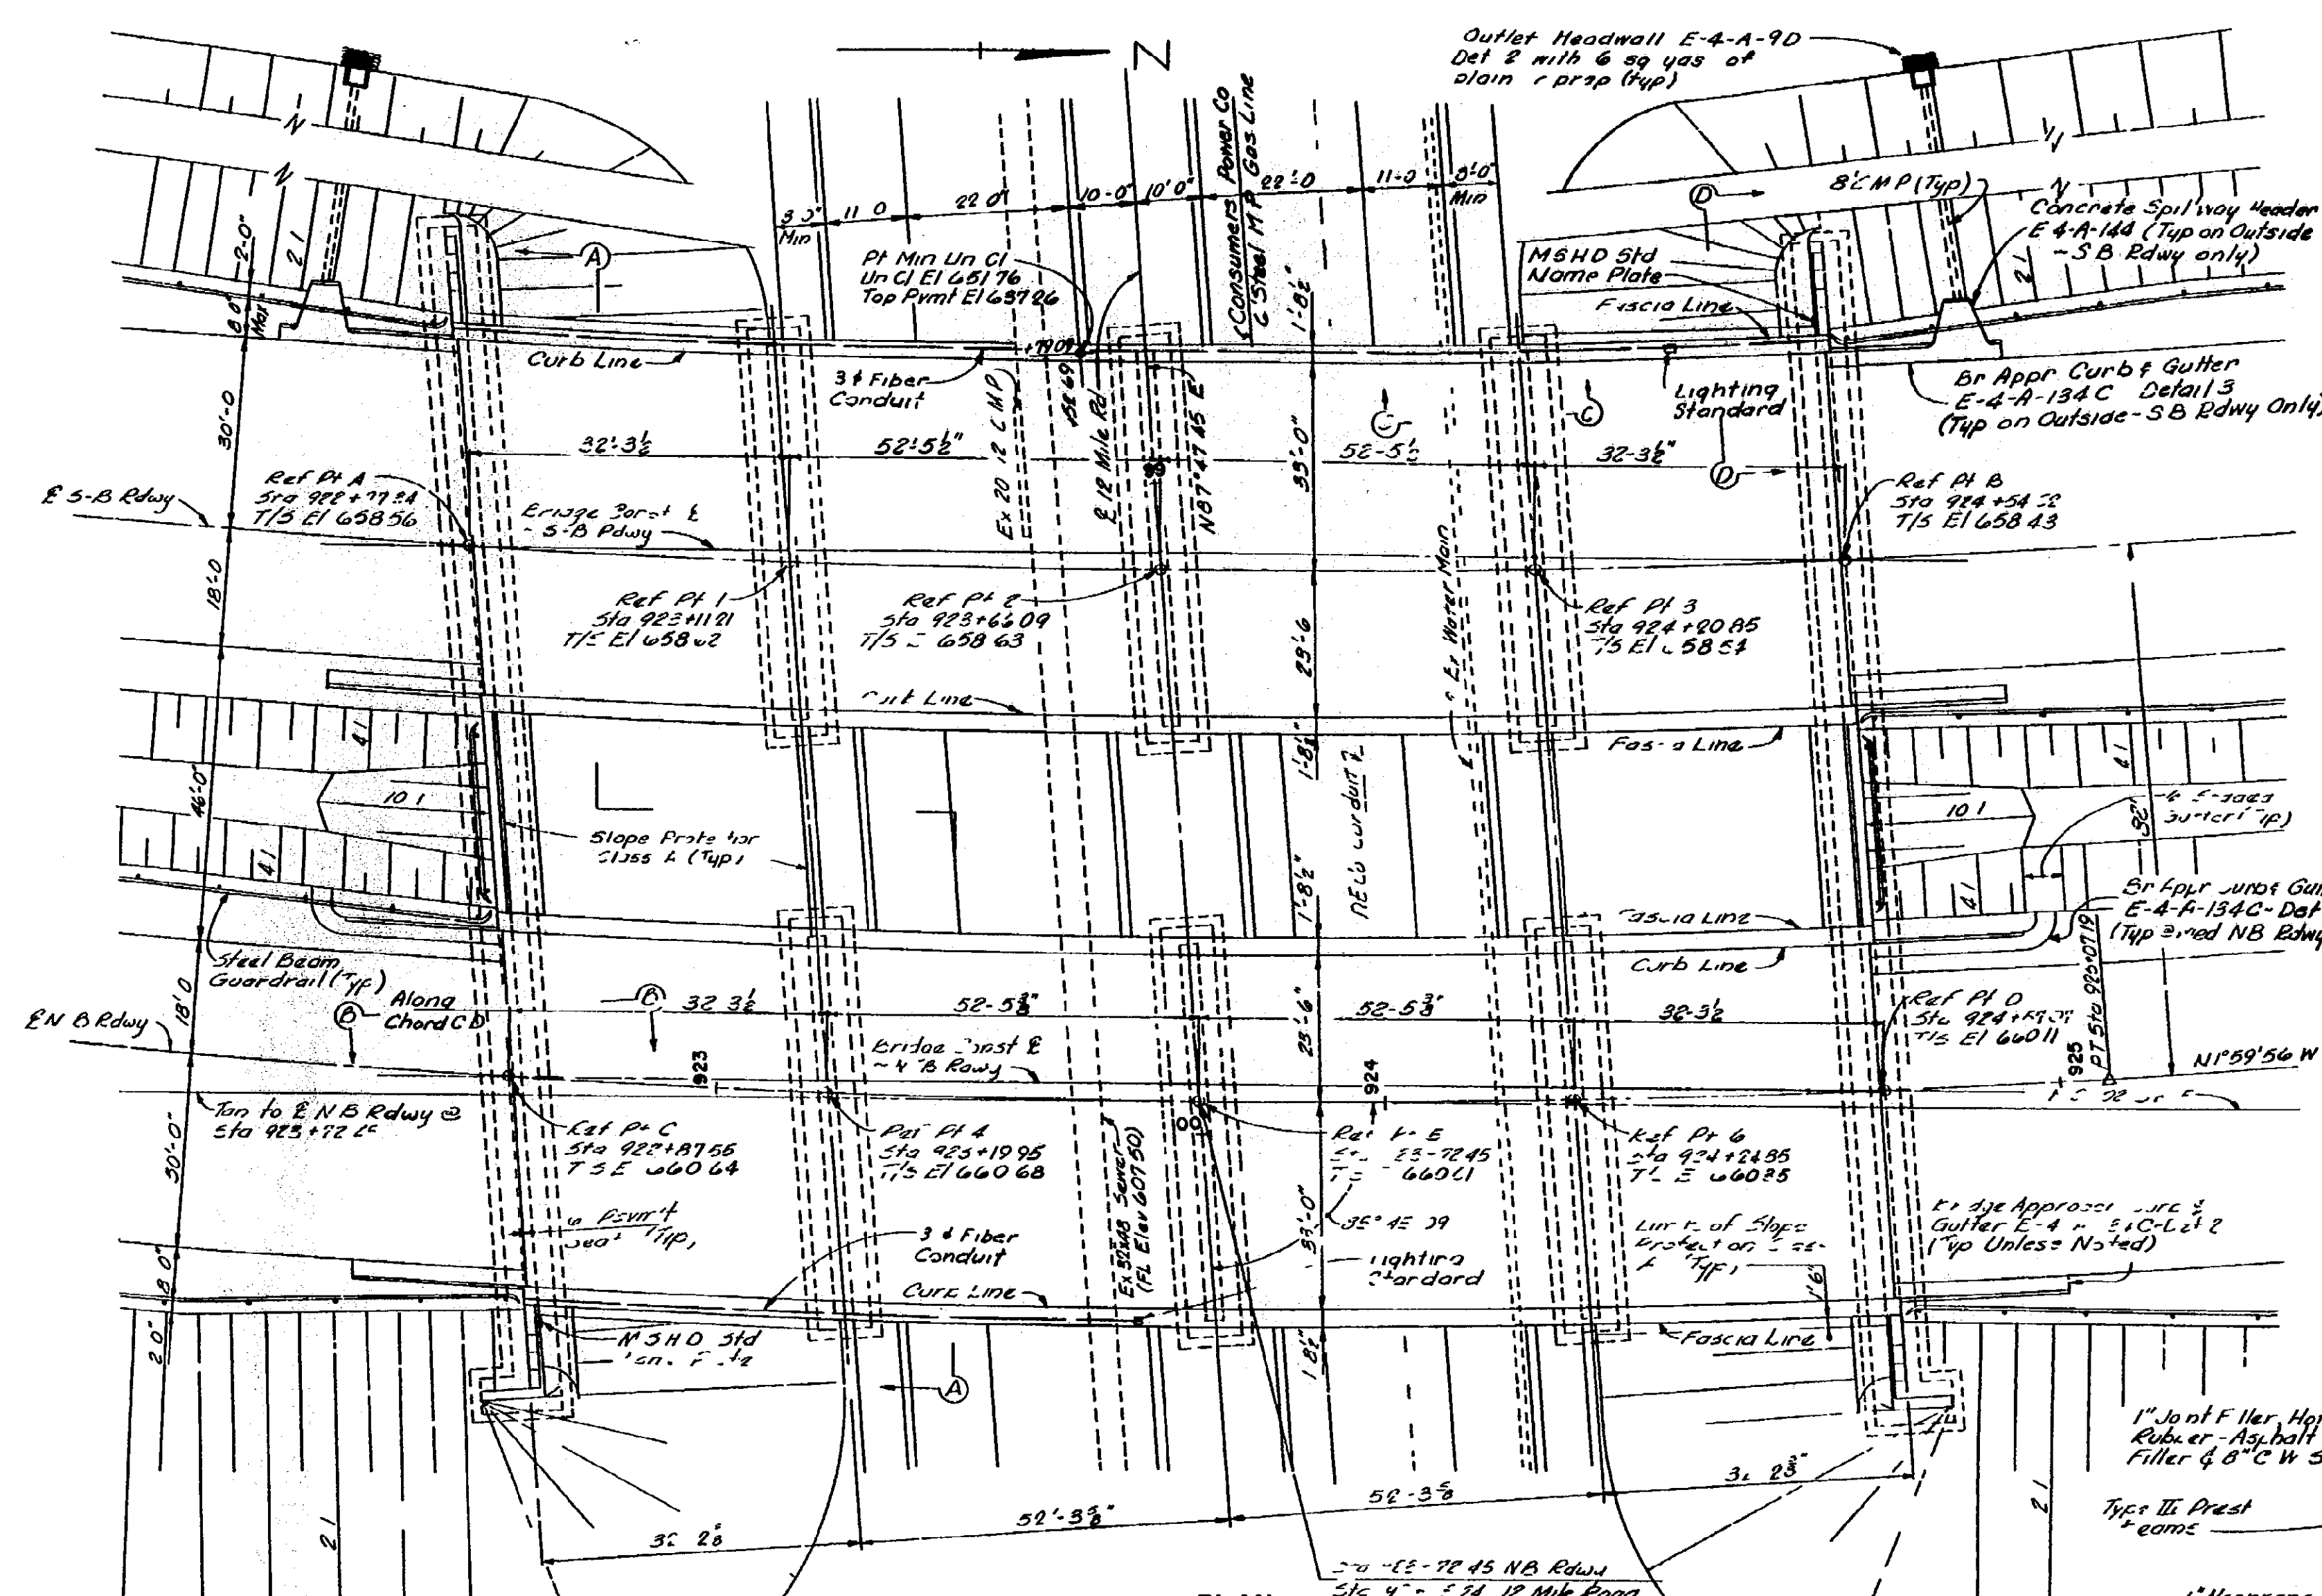

MISCELLANEOUS QUANTITIES		
ITEM	UNIT	AMOUNT
Slope Protection Class A	Sq Yds	1110
Porous Material Grade A Compacted-in-Place	Sq Yds	1100

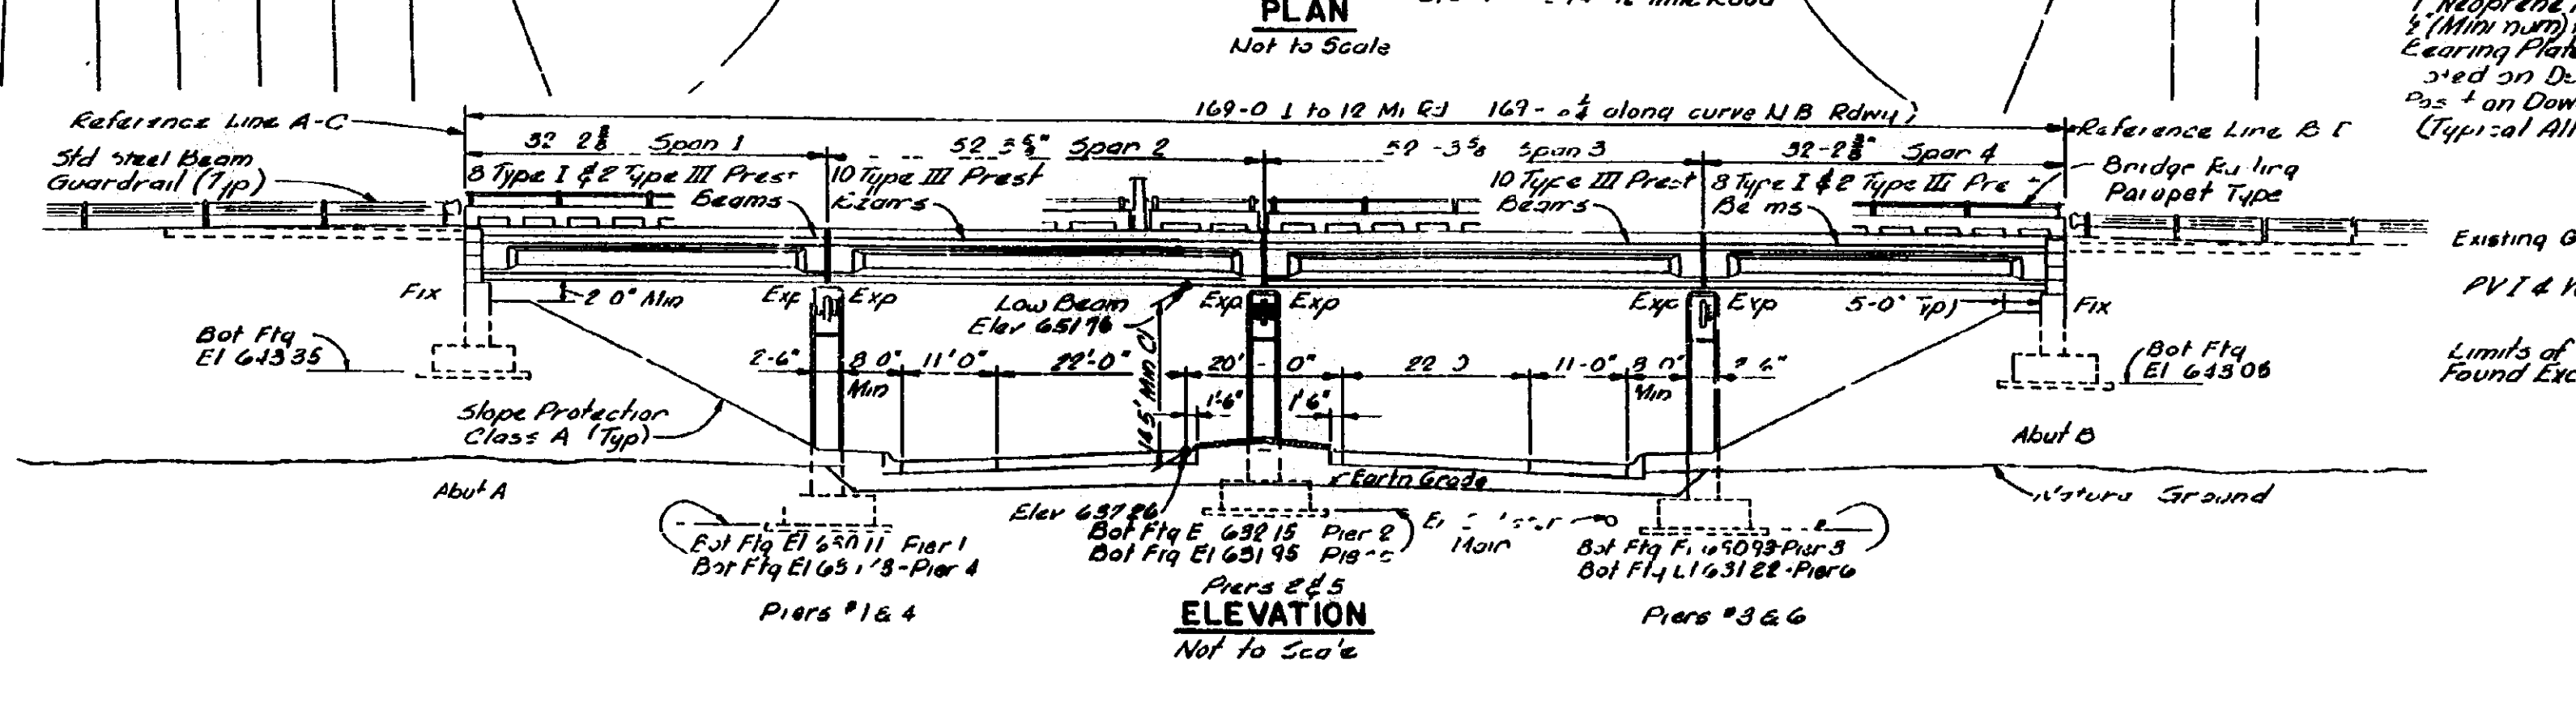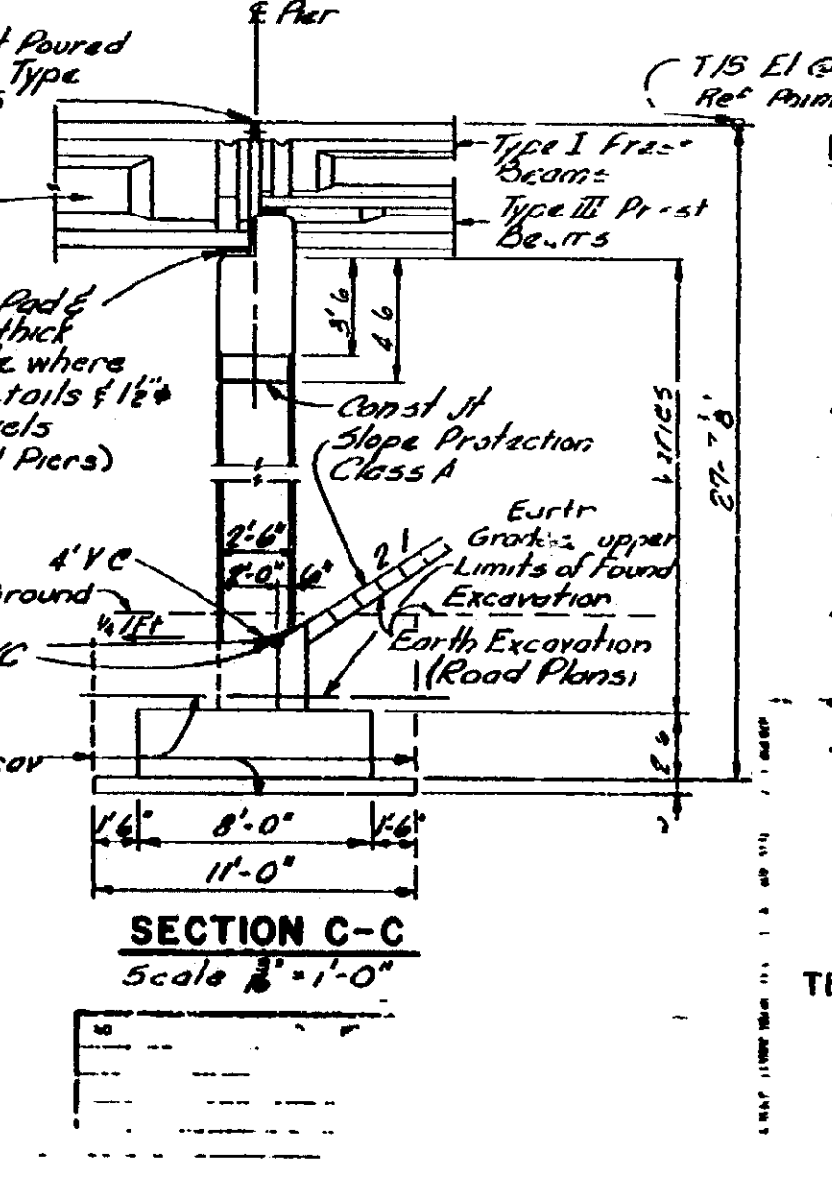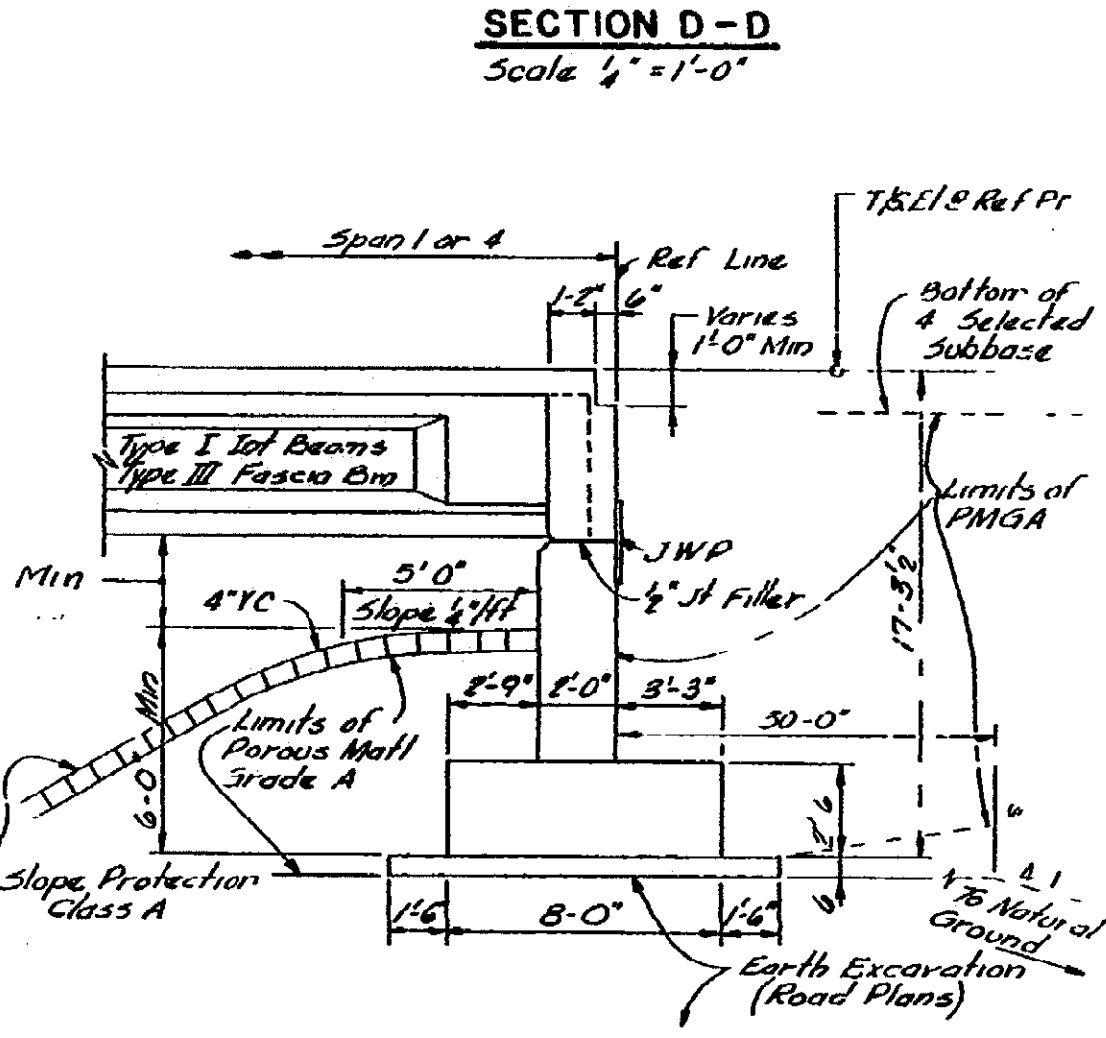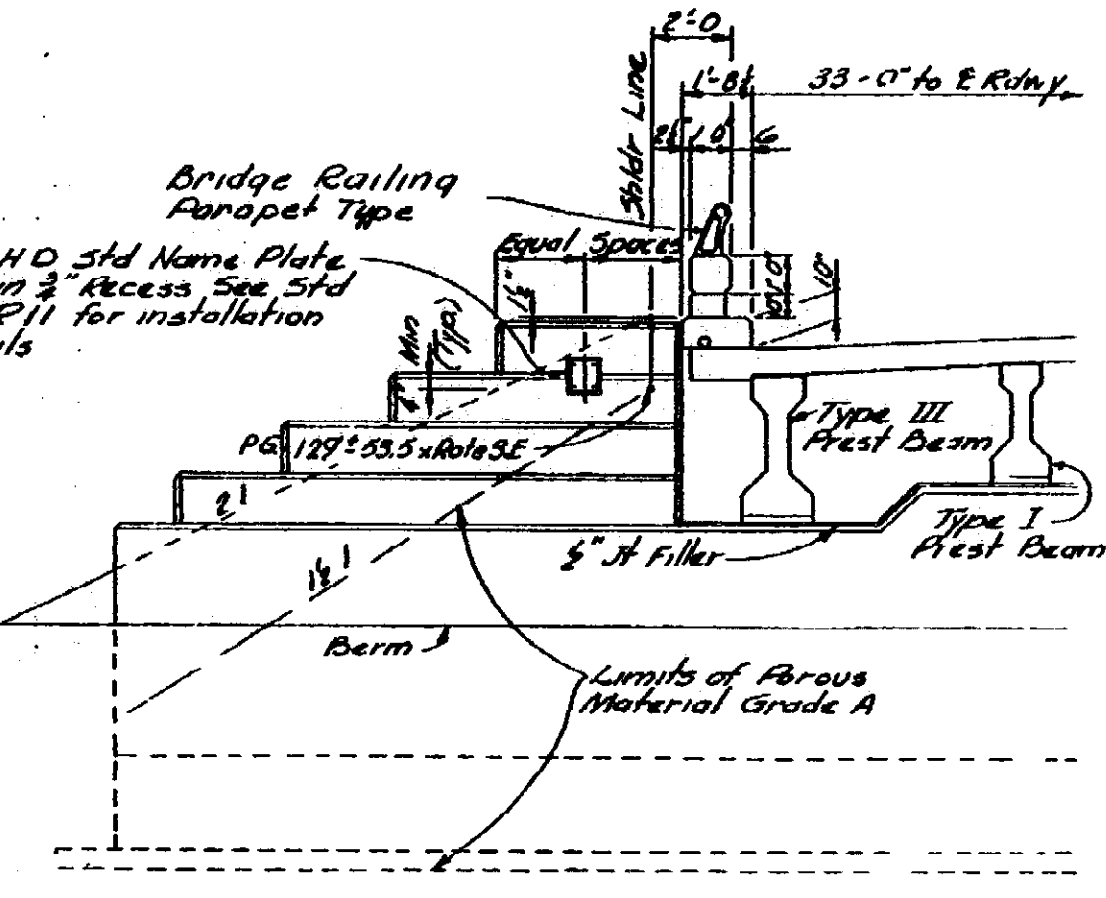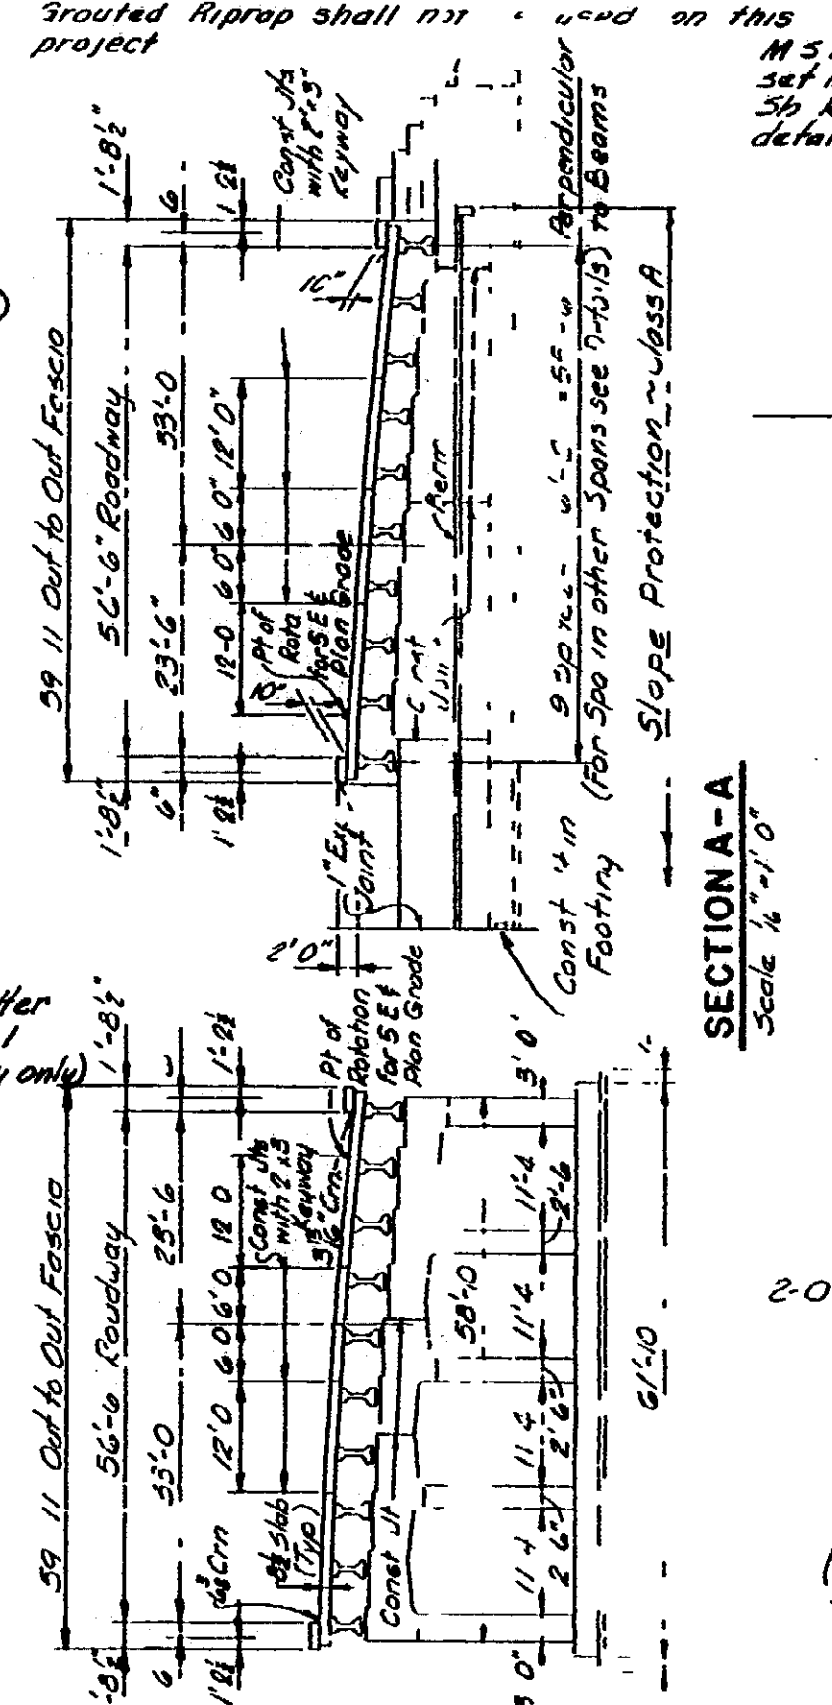

NOTES
 Top of roadway slab and tops of curbs are parallel to the vertical curve, except as modified by superelevation transition.
 This structure is on a horizontal curve. The fascia lines, curb lines and longitudinal deck construction joints are parallel to the curve.
 Proposed pavements, curb and gutter, guard rail, drainage structures, earth fill, and sand sub-base on the expressway and ramp are not a part of this Contract.
 The design of this structure is based on M.S.H.D. Standard Specifications for the Design of Highway Bridges-1958 Edition (MSD-516-44 and alternate military loading).
 Live load plus impact deflection = 1/1000 of span length.

CONTROL SECTION 63174 I
 175 OVER 12 MILE ROAD IN THE CITY OF MADISON HEIGHTS
 TECO ENGINEERS, INC.
 J. V. ... 6-5-62
 CONSULTANTS
 S03 of 63174 I

NOTE:
 DO NOT WORK FROM THIS SHEET. THE INFORMATION SHOWN HERE IS FOR REFERENCE ONLY. NO PAY ITEMS ARE SHOWN.


FOR INFORMATION ONLY
 NORTH BOUND

DATE	CONT. SEC.	JOB NO.	DESIGN UNIT	SHEET
01-10-01	S03 OF 63174	49595A	MADHAVI	3 OF 8


MDOT
 Michigan Department of Transportation

FILE NAME: s0363174sn.rdb
 DRAWN BY: under
 CHECKED BY:
 DATE:
 CORRECTED BY:
 DATE:

1 2 3 4 5 6 7 8 9 10 11 12 13 14 15 16 17 18 19 20 21 22 23 24 25 26 27 28 29 30 31 32 33 34 35 36 37 38 39 40 41 42 43 44 45 46 47 48 49 50 51 52 53 54 55 56 57 58 59 60 61 62 63

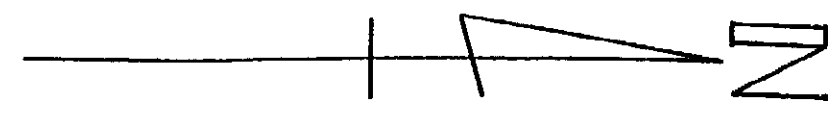

REVISIONS			
NO.	DESCRIPTION	DATE	BY

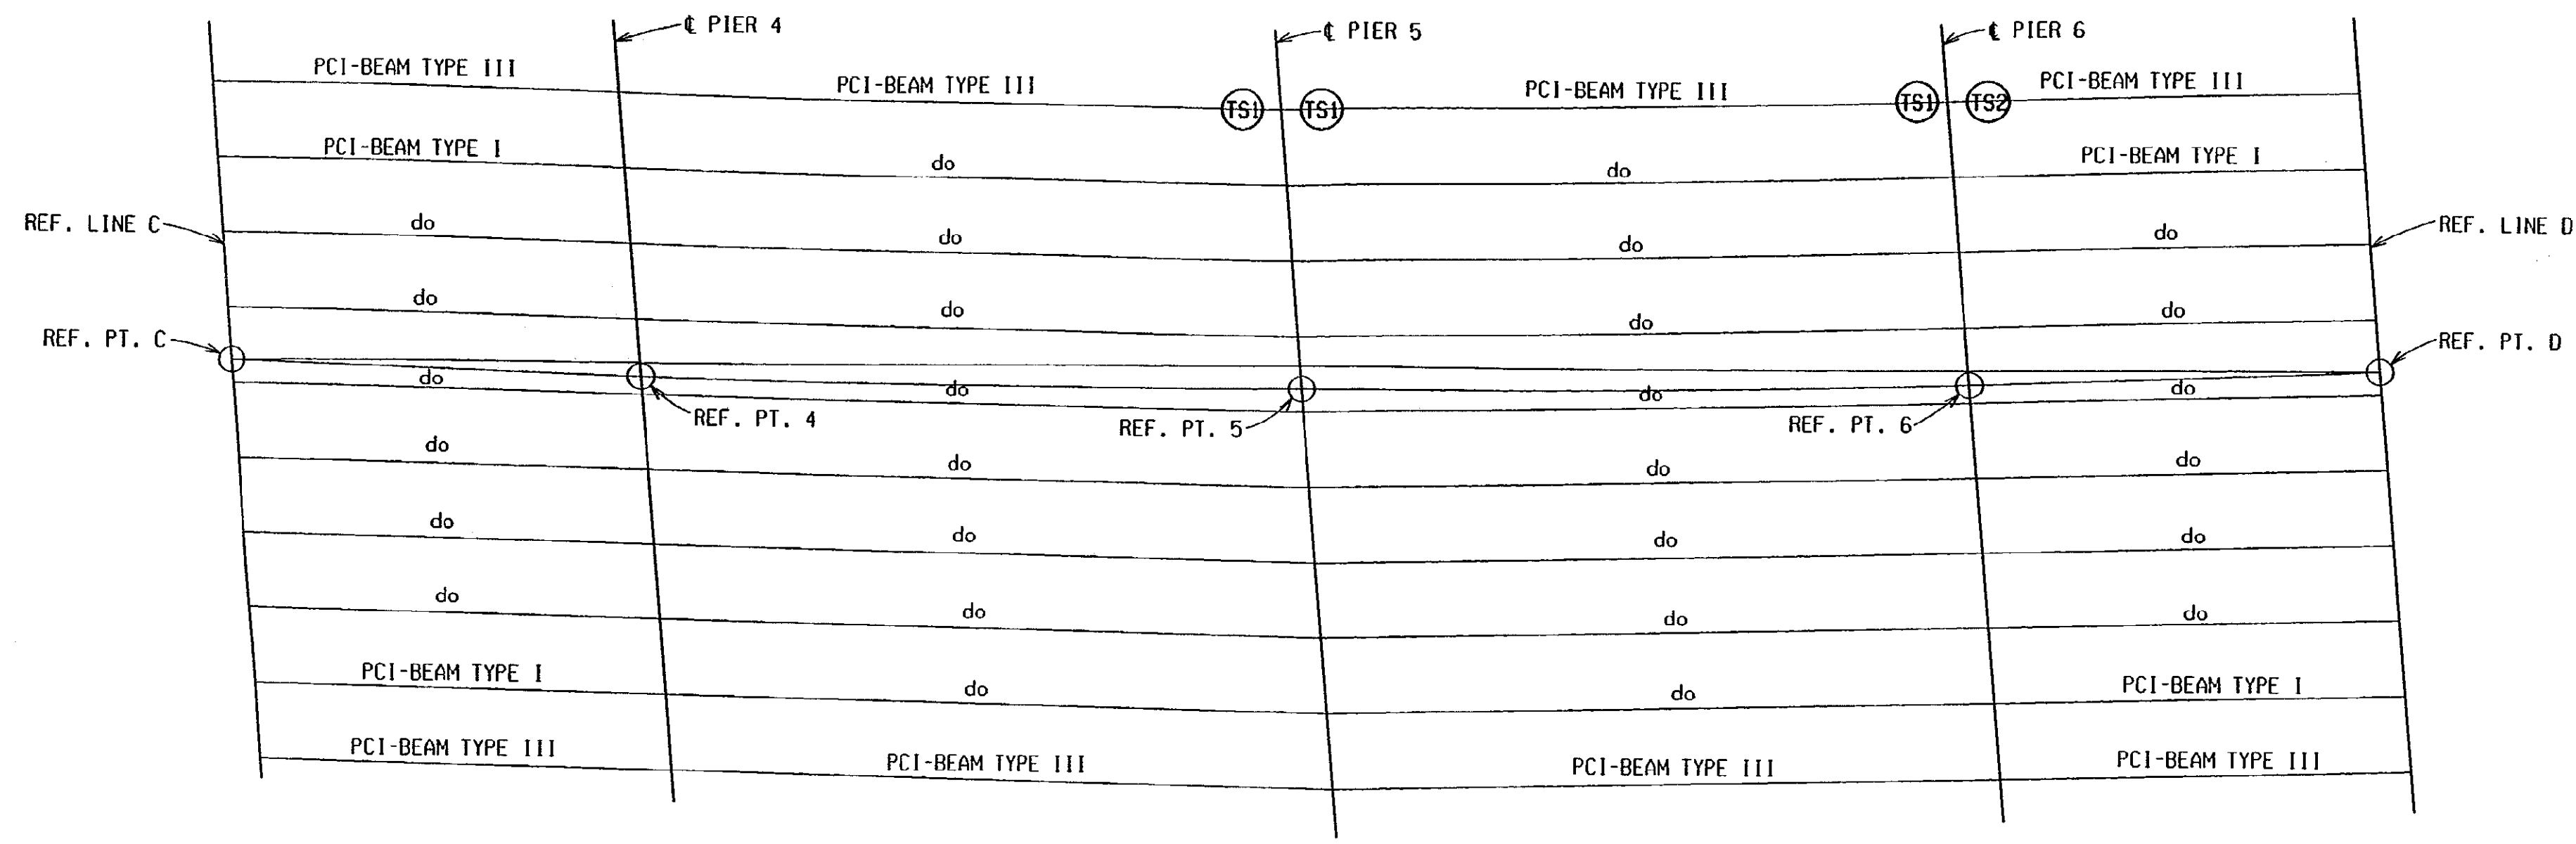

PLAN

(TS1) DENOTES TEMPORARY SUPPORT TYPE 1
 (TS2) DENOTES TEMPORARY SUPPORT TYPE 2

MISCELLANEOUS QUANTITIES	
4 ea	Support, Column, Temp
#50 m2	Patch, Forming
#5 m3	Hand Chipping, Other Than Deck
#5 m3	Patching Conc, LM
1 LS	Penetrating Water Repellent Treatment (S03-NB)
1 LS	Substructure Horizontal Surface Sealer (S03-NB)
58 m2	Slope Paving, Conc
25 m	Slope Paving Header

* SUBSTRUCTURE REPAIR AS DIRECTED BY THE ENGINEER.


NOTES:

THE WORK COVERED BY THESE PLANS INCLUDES RESURFACING THE EXISTING BRIDGE DECK, EXPANSION JOINT REPLACEMENT, SUBSTRUCTURE REPAIR, AND MAINTAINING TRAFFIC. ALL OTHER WORK IS INCLUDED IN THE ROAD PLANS THAT ARE A PART OF THIS CONTRACT.

THE TOP OF HORIZONTAL SURFACES OF ALL PIER CAPS SHALL BE COATED WITH SUBSTRUCTURE HORIZONTAL SURFACE SEALER. THE ESTIMATED AREA IS 41 m2.


PENETRATING WATER REPELLENT TREATMENT SHALL BE APPLIED TO ALL SURFACES OF PIERS EXCEPT TOPS OF PIERS. THE ESTIMATED AREA FOR PENETRATING WATER REPELLENT APPLICATION IS 390 m2.

FORMS FOR LARGE PATCHES SHALL BE INSTALLED IN 600 mm TO 1200 mm HIGH SECTIONS WITH THE TOP OF FORM NO MORE THAN 1200 mm ABOVE THE LEVEL OF CONCRETE AS THE POUR PROGRESSES.


PIER REPAIR DETAILS				
NORTH BOUND				
	DATE	CONT. SEC.	JOB NO.	DESIGN UNIT
	01-10-01	S03 OF 63174	49595A	MAHDAVI
			SHEET	4 OF 8

DRAWN BY: R.K.OLIN CHECKED BY: MN DATE: 11/2000 CORRECTED BY: INDER DATE: 01-10-01 FILE NAME: s0363174n.pj


1 2 3 4 5 6 7 8 9 10 11 12 13 14 15 16 17 18 19 20 21 22 23 24 25 26 27 28 29 30 31 32 33 34 35 36 37 38 39 40 41 42 43 44 45 46 47 48 49 50 51 52 53 54 55 56 57 58 59 60 61 62 63

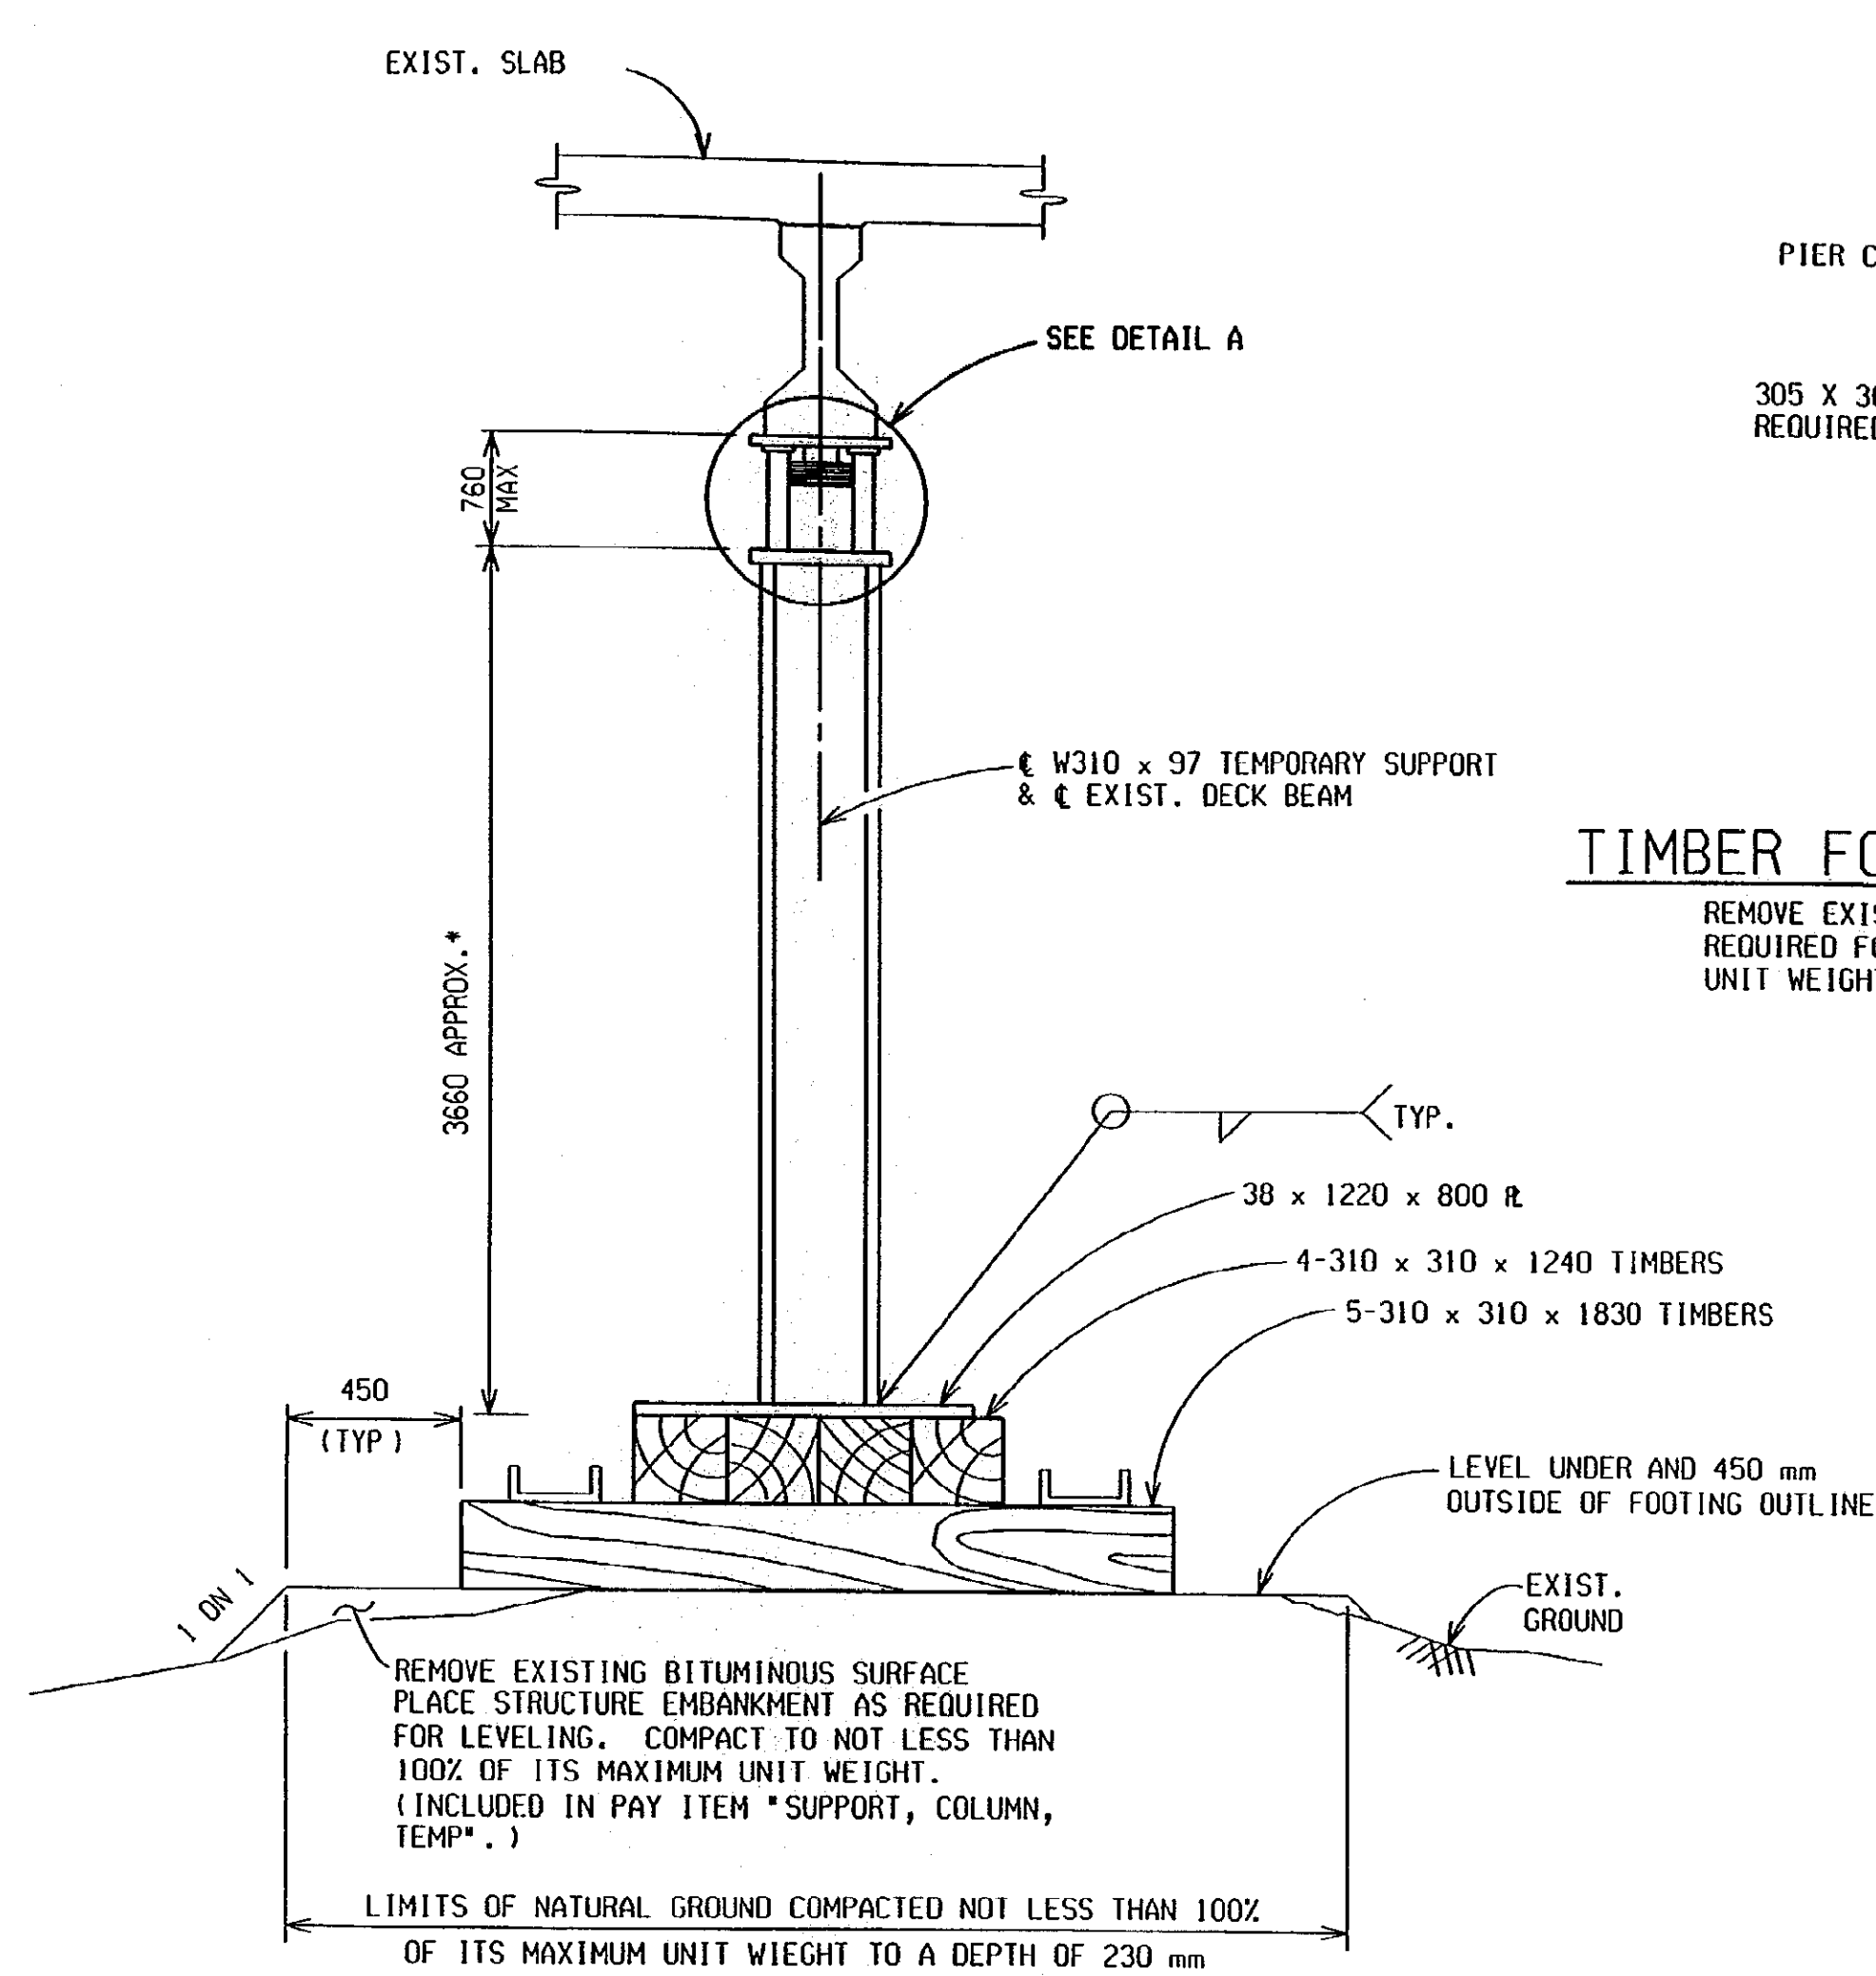


TIMBER FOOTING ON NATURAL GROUND-TS 1
 * EXACT HEIGHT TO BE DETERMINED BY CONTRACTOR. HEIGHT NOT TO EXCEED 4270mm.

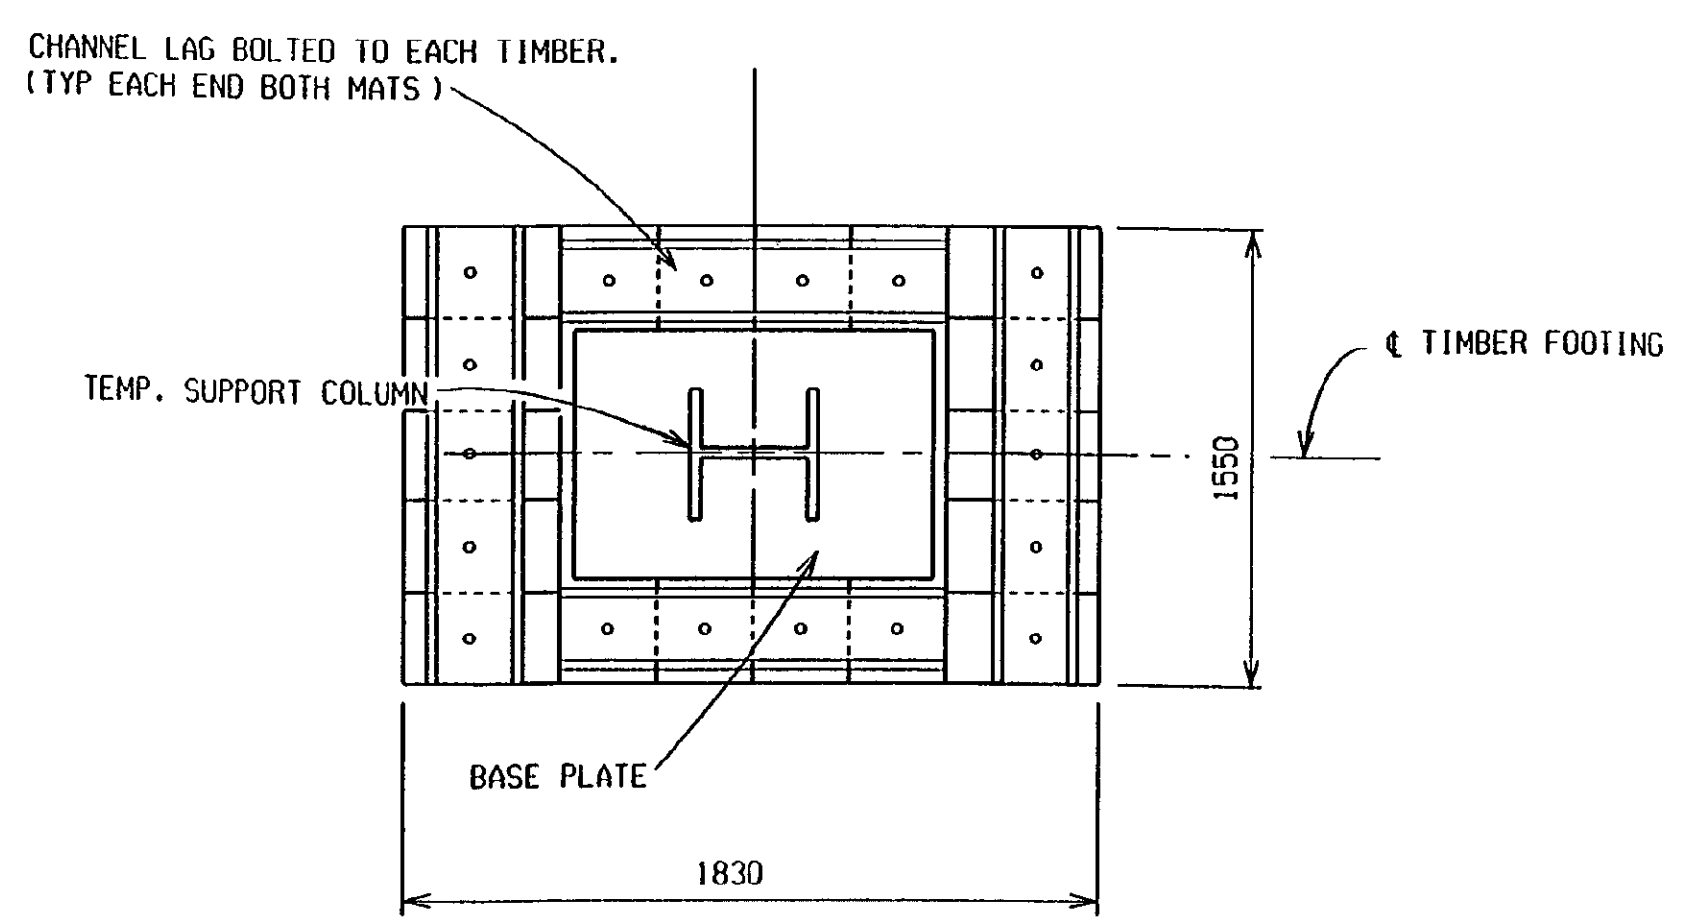


TIMBER FOOTING PLAN

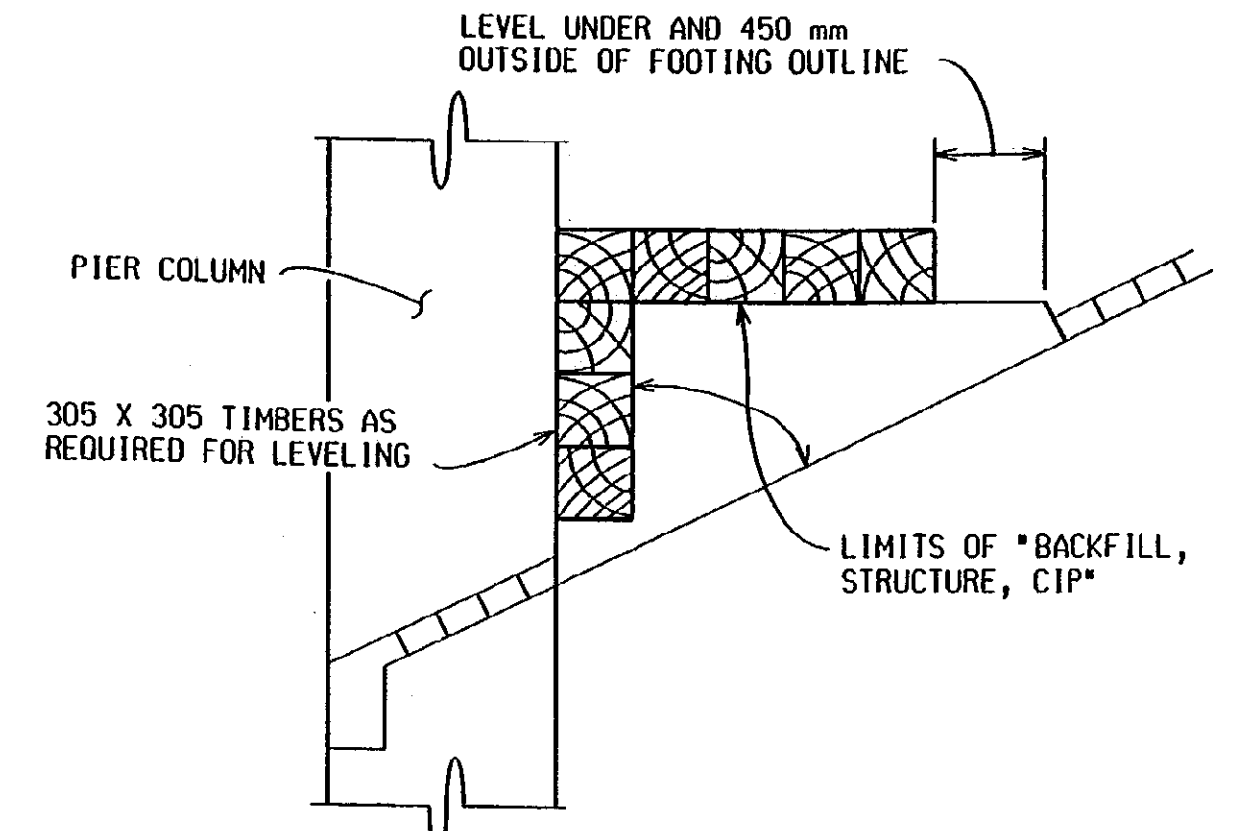


TIMBER FOOTING ON SLOPE PAVING-TS 2
 REMOVE EXISTING SLOPE PAVING, PLACE STRUCTURE EMBANKMENT AS REQUIRED FOR LEVELING COMPACT TO NOT LESS THAN 100% OF ITS MAX. UNIT WEIGHT (INCLUDED IN THE PAY ITEM *SUPPORT, COLUMN, TEMP*).

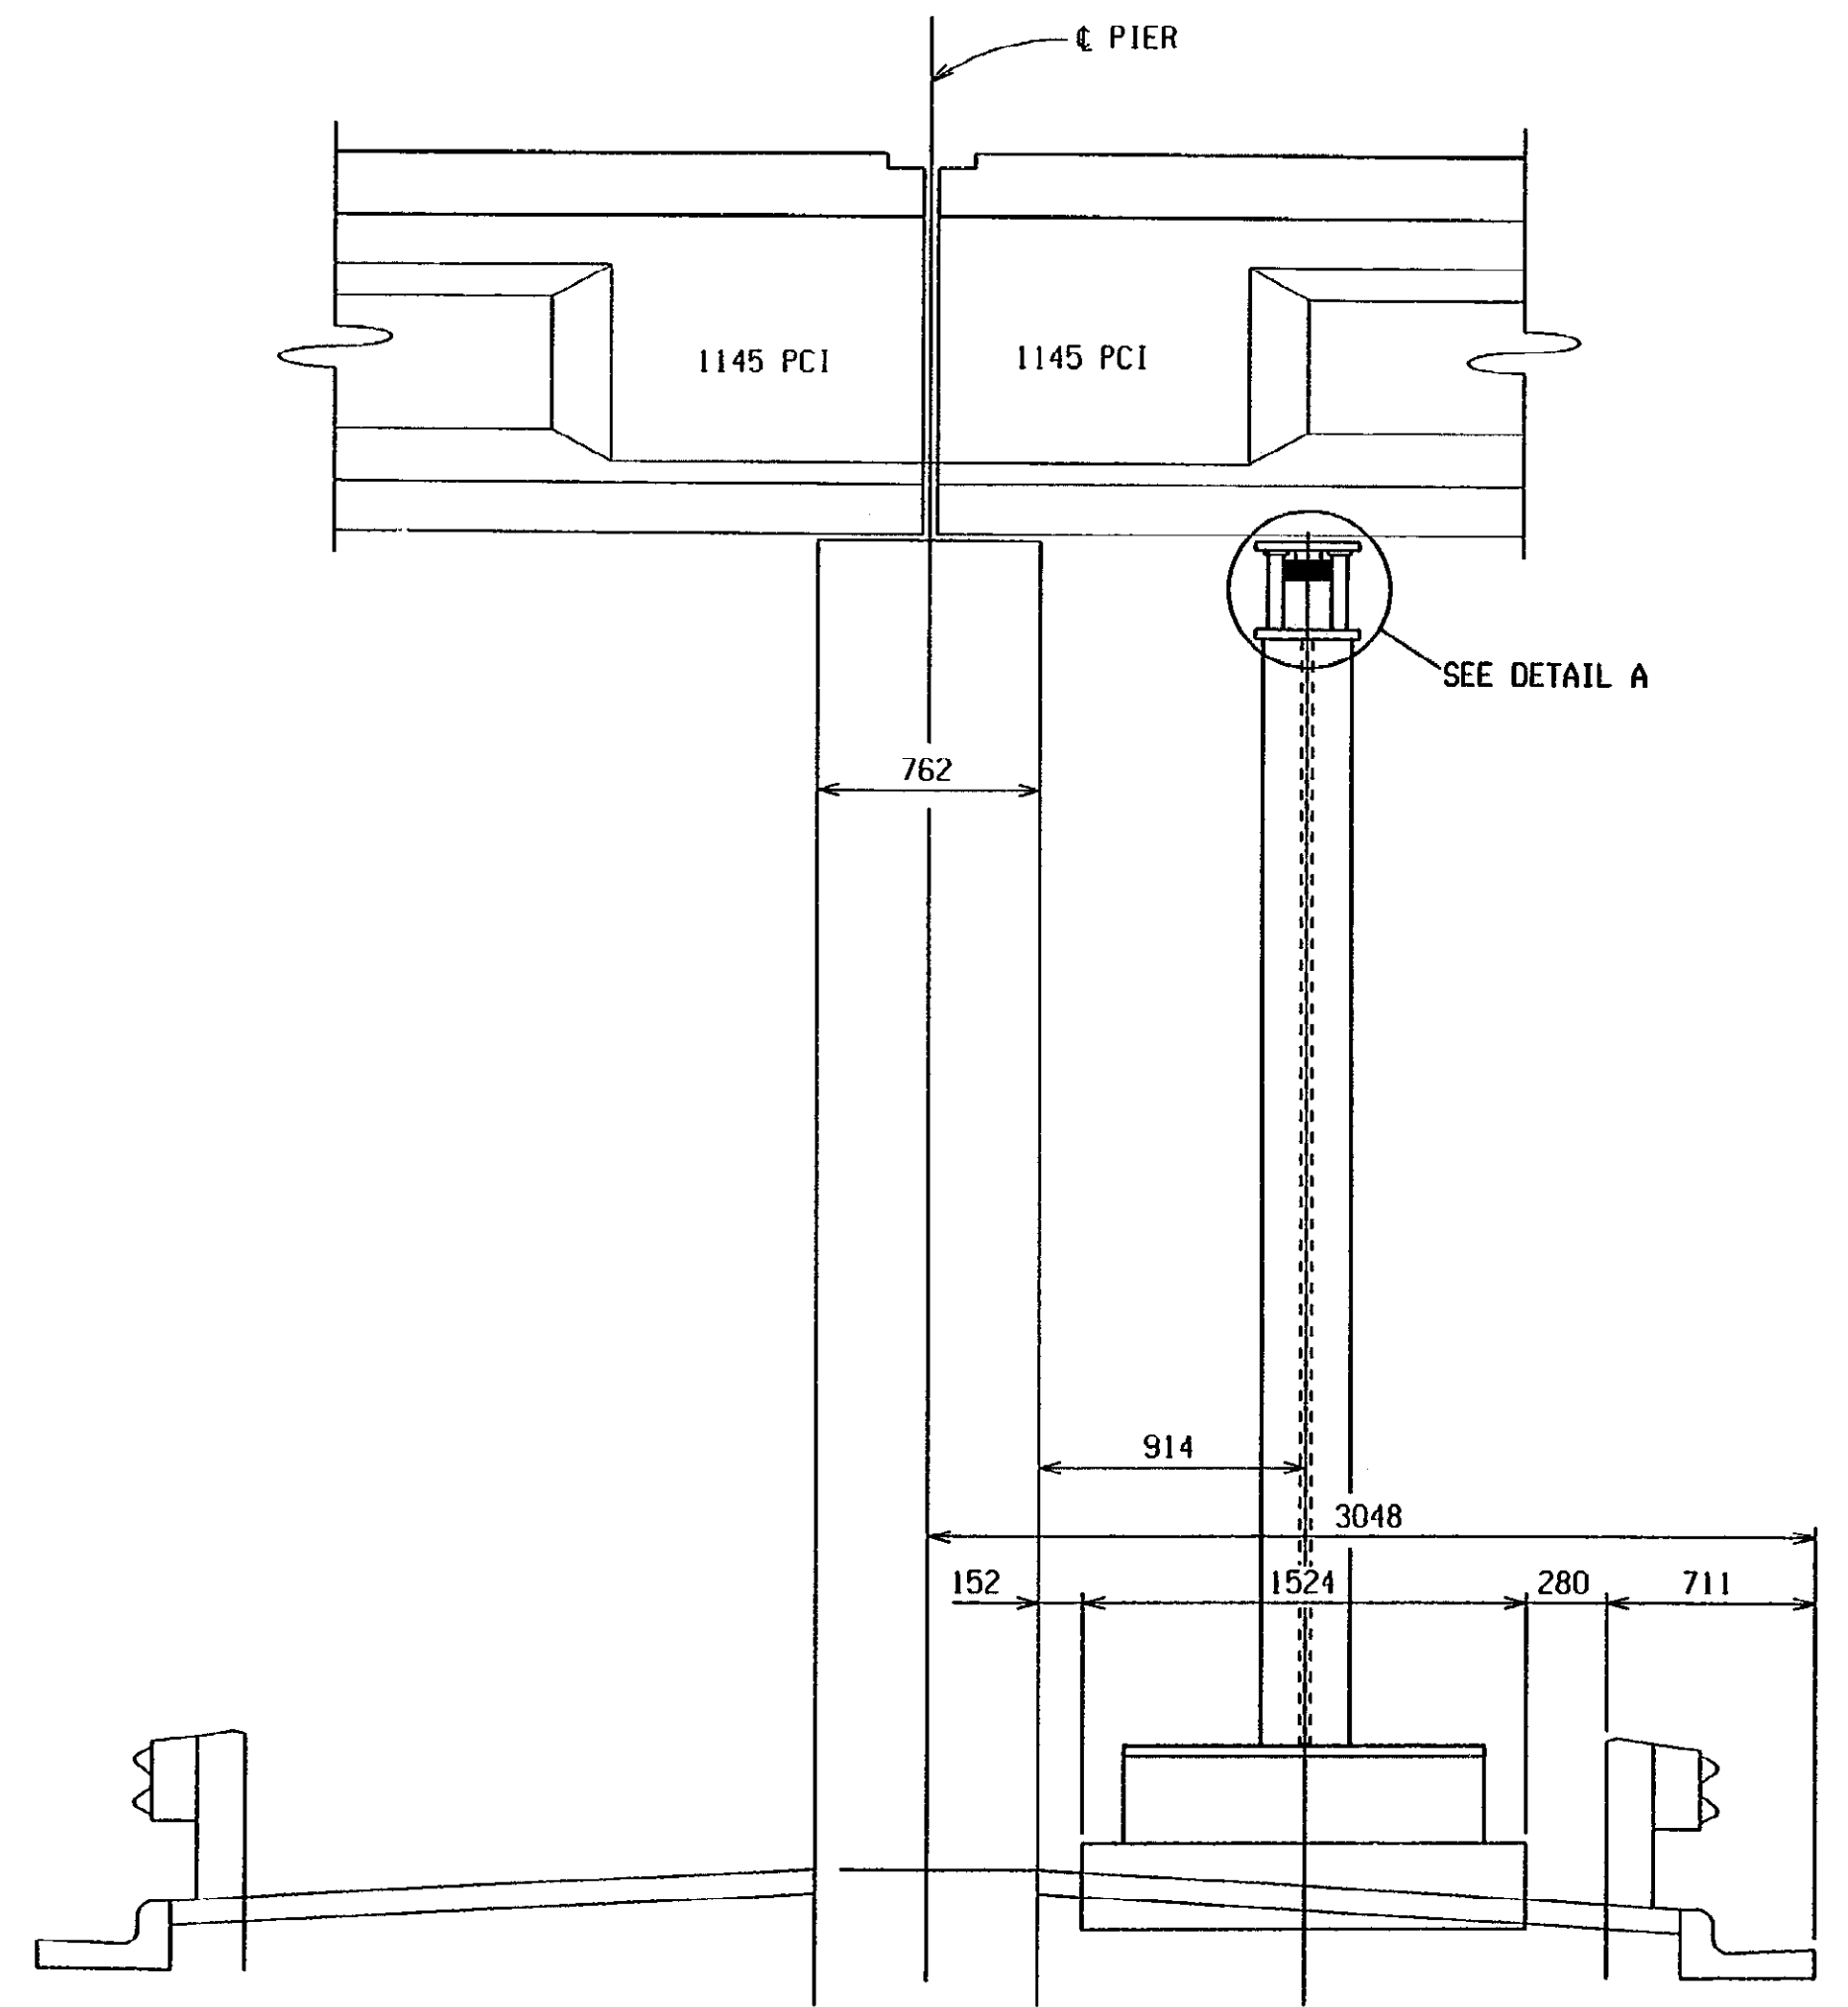

TEMPORARY SUPPORT AT PIER-TS 1

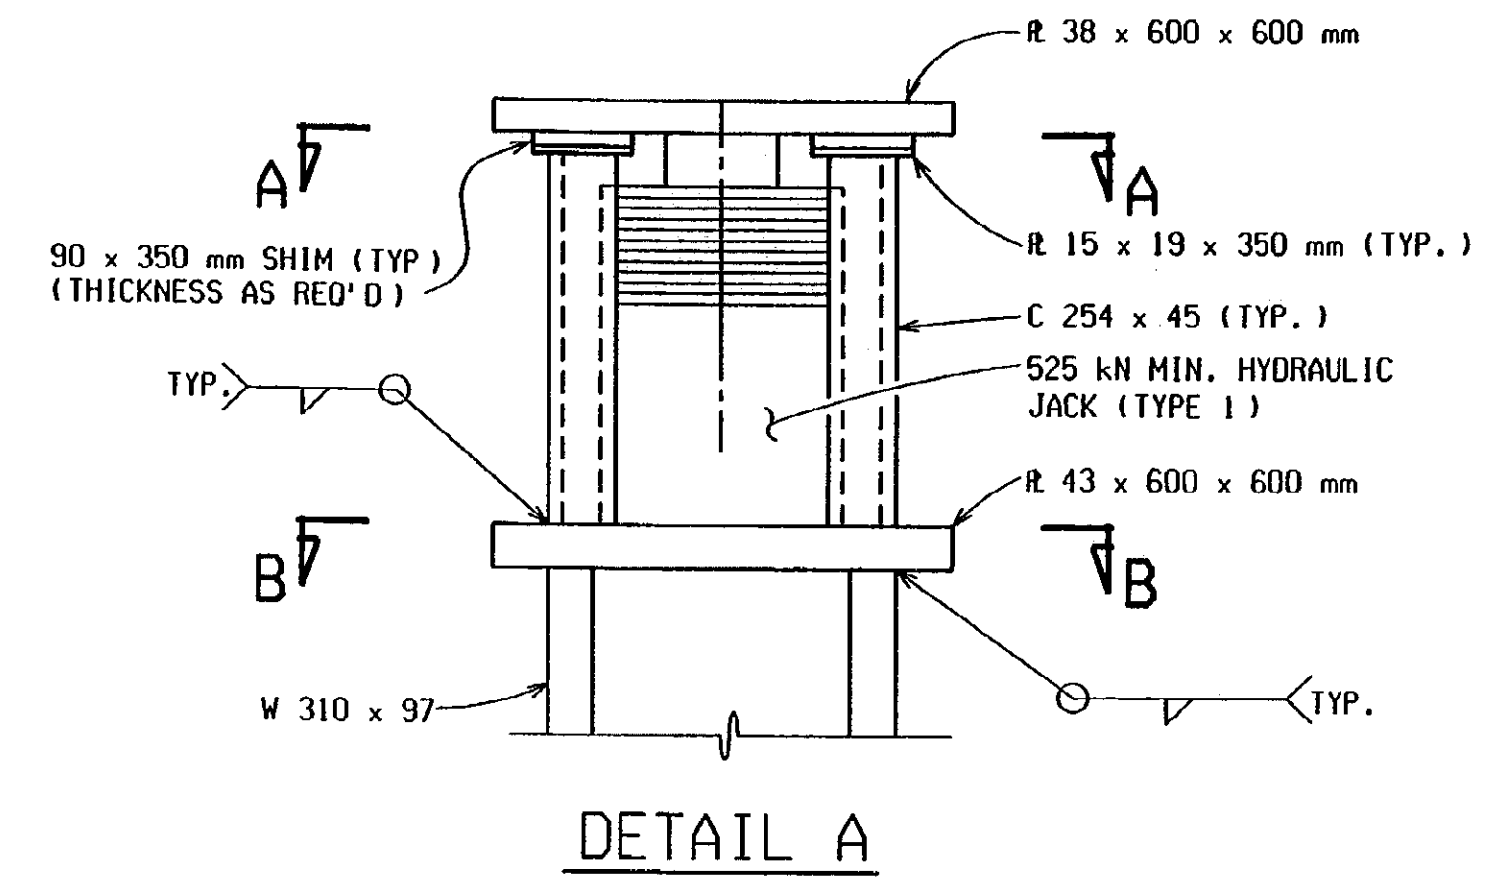

DETAIL A

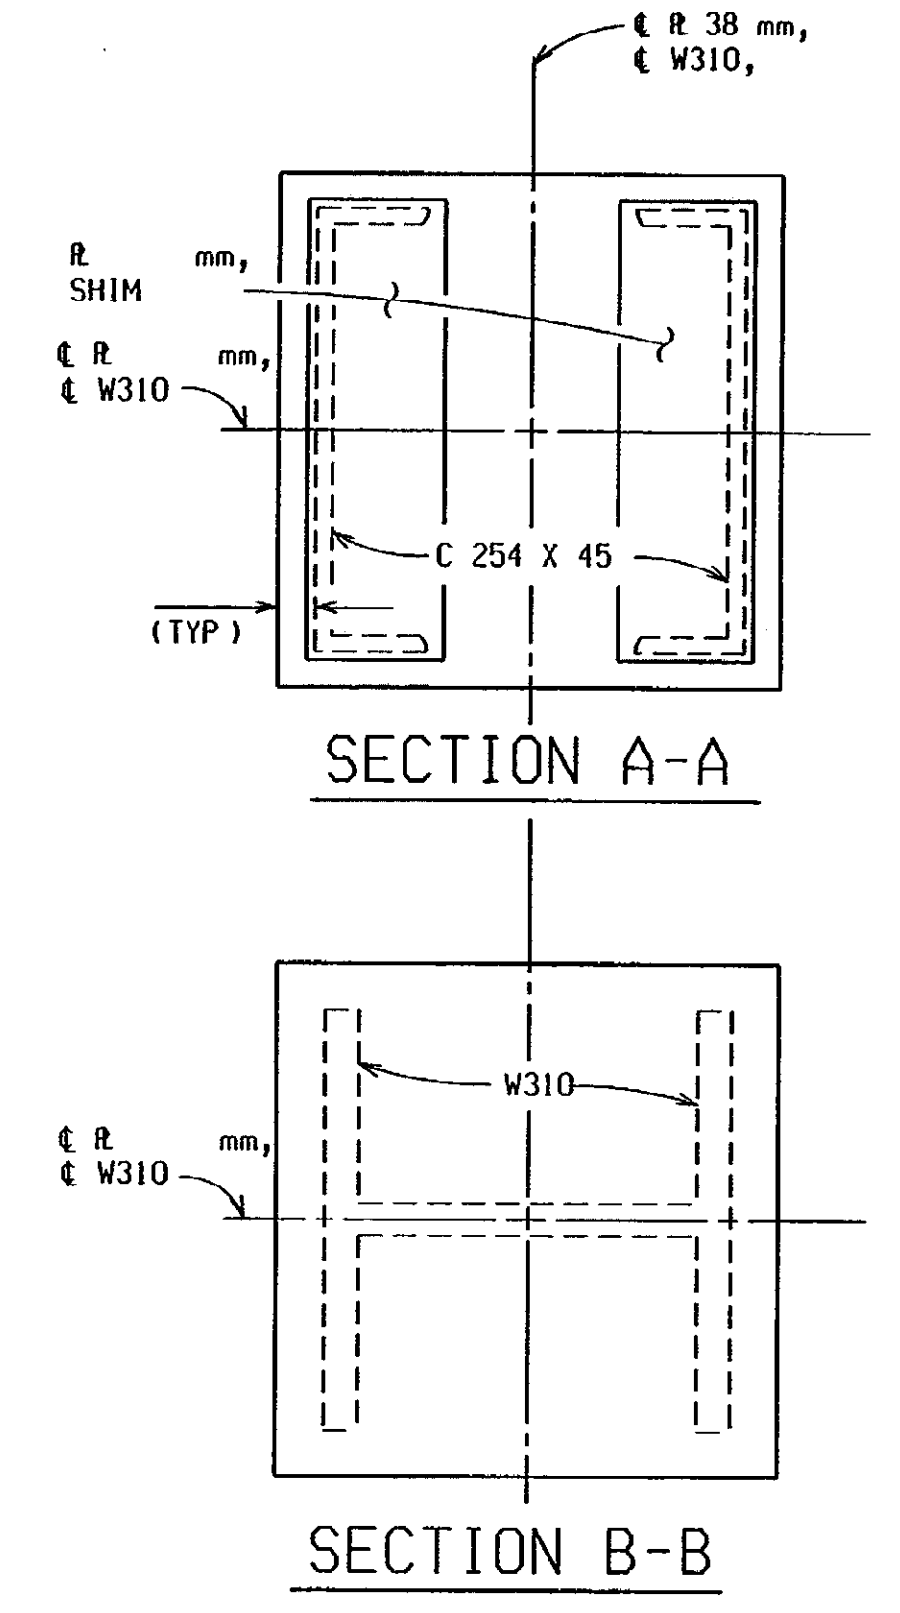

SECTION A-A

SECTION B-B


NOTES:
 THE CONTRACTOR SHALL PROVIDE A TEMPORARY SUPPORT AT EACH POINT SHOWN ON THE PLANS.
 TEMPORARY SUPPORTS SHALL SUPPORT THE BEAMS AT THEIR ELEVATION PRIOR TO POURING CONCRETE. EACH SUPPORT SHALL BE DESIGNED TO SUSTAIN A VERTICAL LOAD OF 525 kN. THE SOIL PRESSURE UNDER THE FOOT OR SILL OF EACH SUPPORT SHALL NOT EXCEED 144 kPa.
 ALL TEMPORARY SUPPORTS SHALL MEET THE APPROVAL OF THE ENGINEER.

TEMPORARY SUPPORT DETAILS				
NORTH BOUND				
DATE	CONT. SEC.	JOB NO.	DESIGN UNIT	SHEET
01-10-01	S03 OF 63174	49595A	MAHDAVI	5 OF 8




DRAWN BY: R.K. OLIN
 CHECKED BY: WM
 DATE: 11/2000
 CORRECTED BY: INDER
 DATE: 01-10-01
 FILE NAME: s0363174n.pl
 DATE: 01-10-01


1 2 3 4 5 6 7 8 9 10 11 12 13 14 15 16 17 18 19 20 21 22 23 24 25 26 27 28 29 30 31 32 33 34 35 36 37 38 39 40 41 42 43 44 45 46 47 48 49 50 51 52 53 54 55 56 57 58 59 60 61 62 63

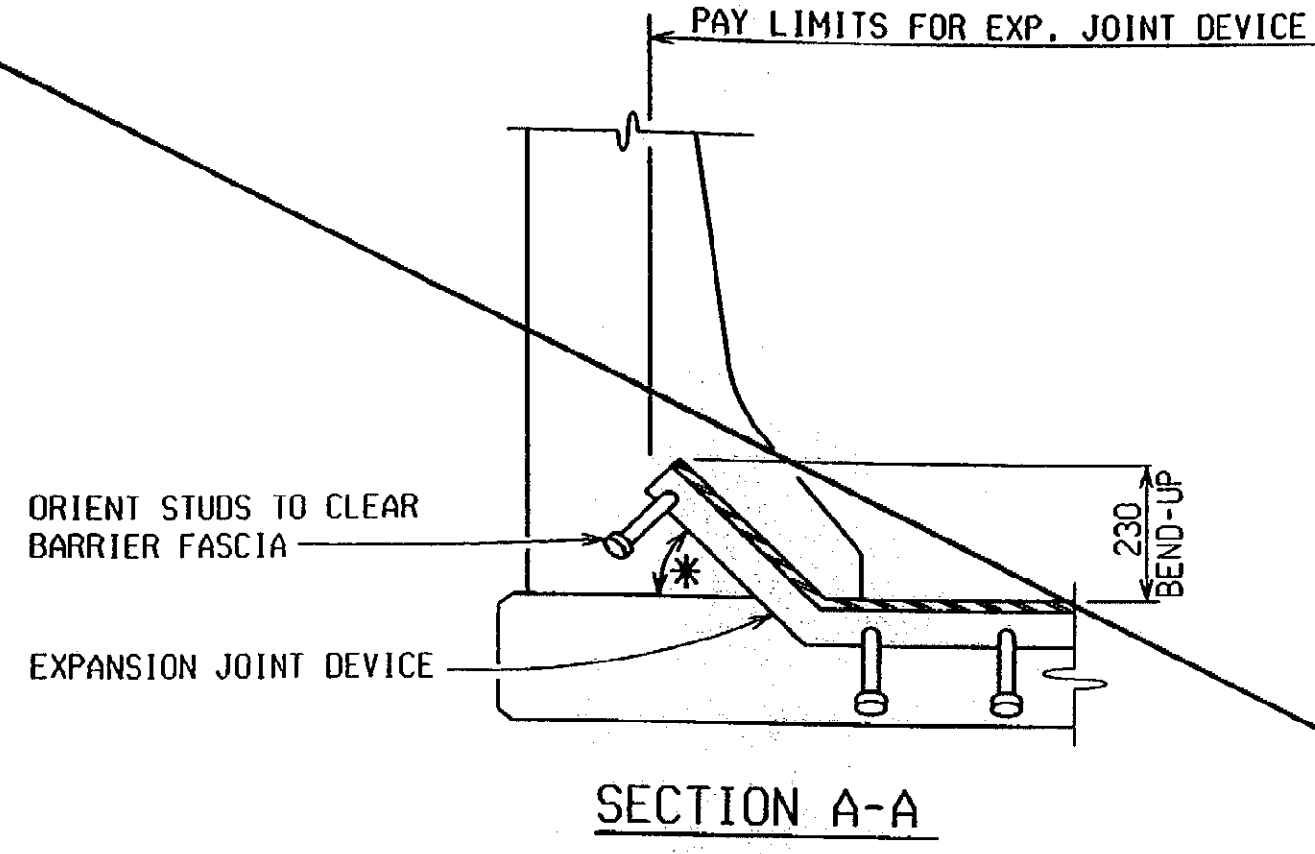


SECTION A-A
 * - FOR ANGLES OF CROSSING FROM 90° TO 45° INCLUSIVE, BEND ANCHORAGE UP 45° ALONG EXPANSION JT. FOR ANGLES OF CROSSING LESS THAN 45°, A SPECIAL ENDING MAY BE REQUIRED.

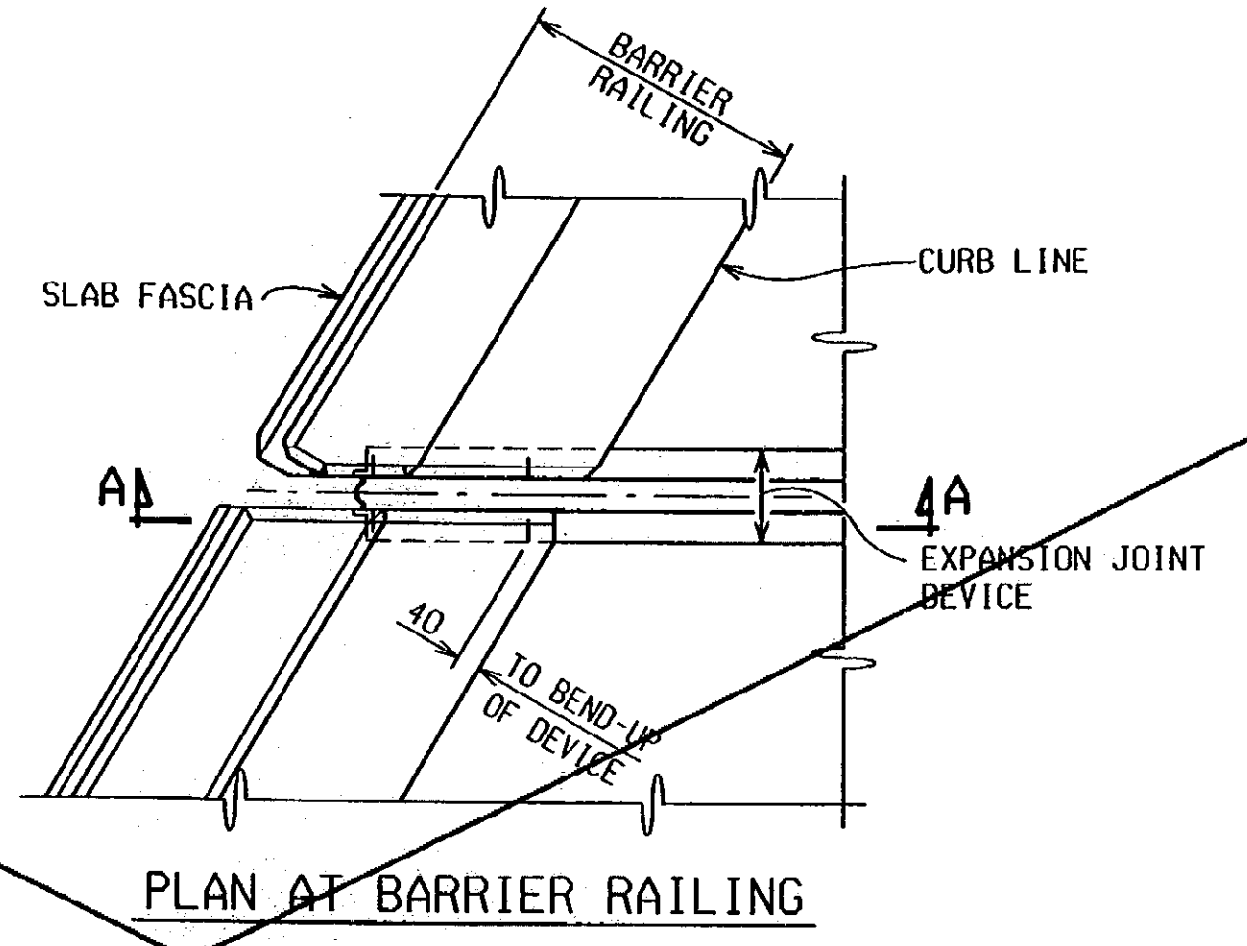

BARRIER TREATMENT

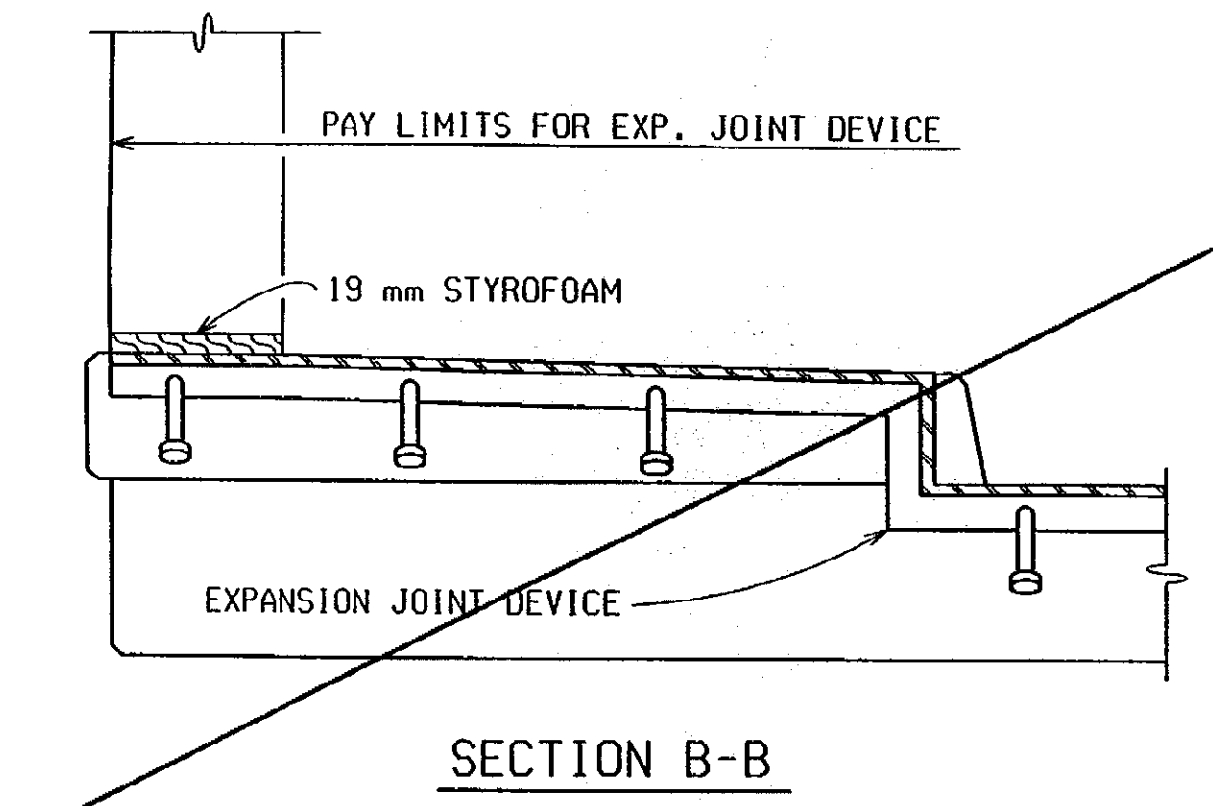


SECTION B-B

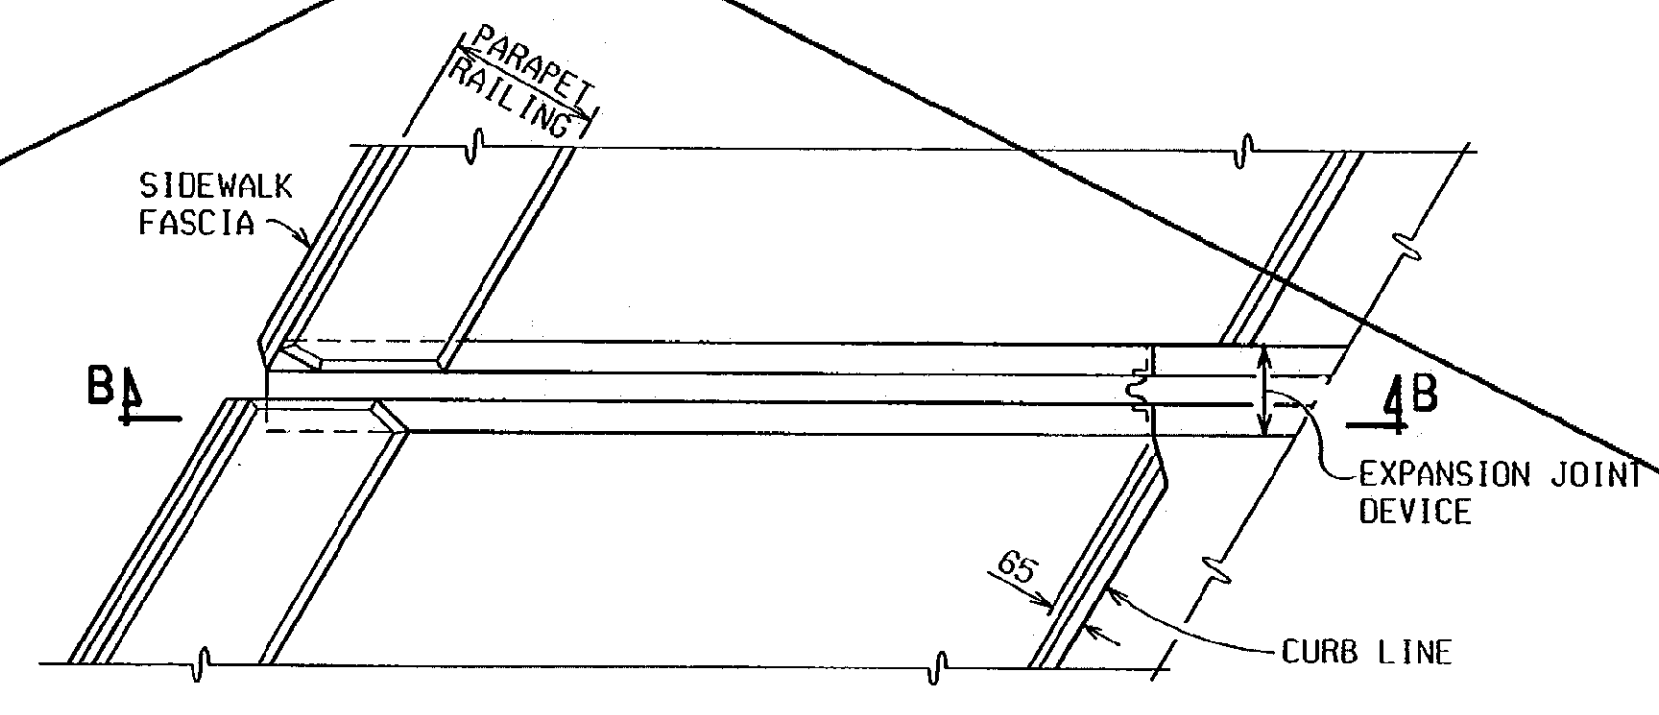


PLAN AT PARAPET RAILING
 (DETAILS ARE SIMILAR FOR BRIDGE RAILING, 5 TUBE)

SIDEWALK TREATMENT

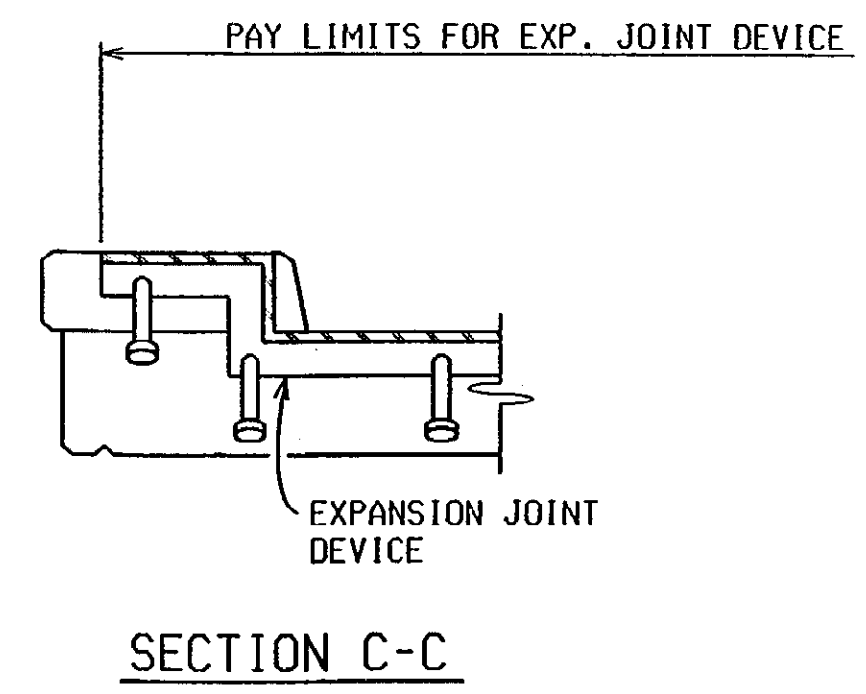

SECTION C-C

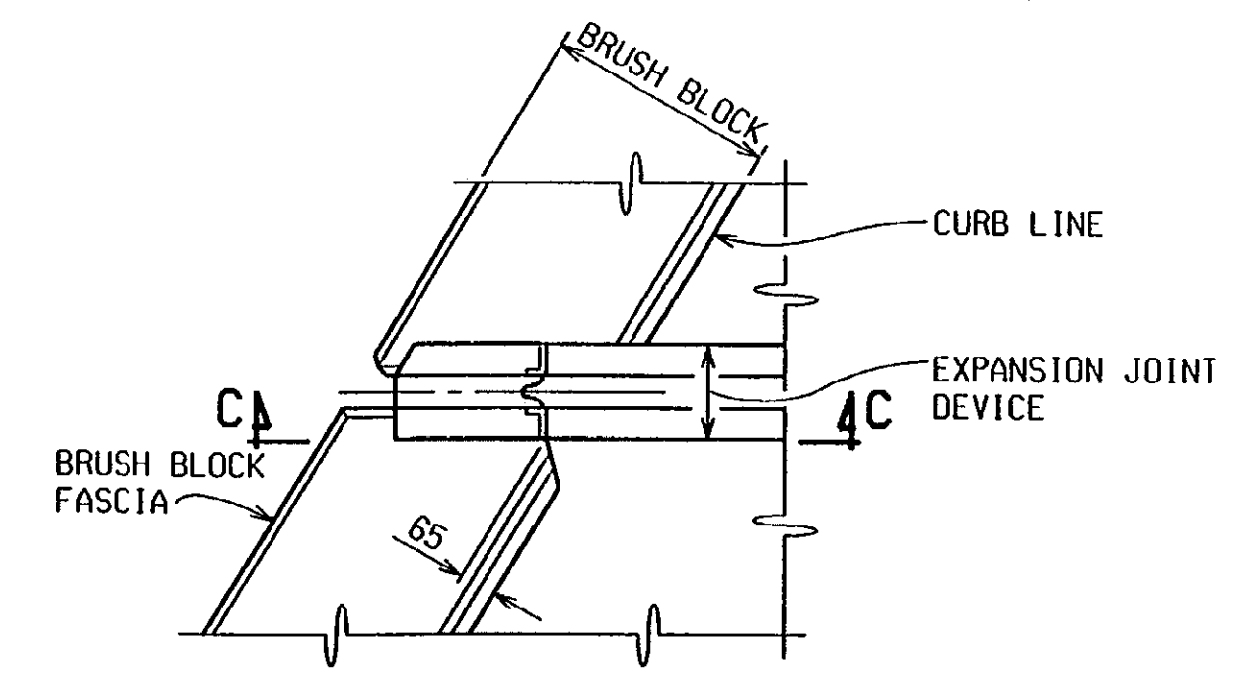

PLAN AT BRIDGE RAILING, 2 TUBE

BRUSH BLOCK TREATMENT

STRUCTURE NUMBER	ANGLE OF CROSSING TO NEAREST 10°	LOCATION OF JOINT	MIN. TOT. TRAVEL ALONG CENTERLINE OF BRIDGE	REQUIRED LENGTH OF EXPANSION JOINT DEVICE
S03 NB	90°	PIER 4	14 mm	18.4 m
S03 NB	90°	PIER 5	14 mm	18.3 m
S03 NB	90°	PIER 6	14 mm	18.3 m

REVISIONS			
NO.	DESCRIPTION	DATE	BY

NOTES:

JOINT TYPES:
 THE EXPANSION JOINT DEVICE SHALL BE OF A TYPE THAT INCLUDES A CONTINUOUS NEOPRENE (OR EQUIVALENT) SEAL ACROSS THE DECK. UNLESS OTHERWISE NOTED ON THE PLANS, THE CONTRACTOR HAS THE OPTION OF USING ANY OF THE DEVICES LISTED BELOW:

DEVICE	MANUFACTURER
WARO STRIP SEAL	WATSON-BOWMAN & ACME, INC.
PRO-SPAN	FEL-PRO, INC.
STEELFLEX-SSA2	D.S. BROWN
STEELFLEX-SSCM	D.S. BROWN
STEELFLEX-RS	D.S. BROWN
ONFLEX 40 SS	STRUCTURAL RUBBER PRODUCTS CO.
STRUPCO 400L	STRUCTURAL RUBBER PRODUCTS CO.

THE MODEL OF THE JOINT TYPE SELECTED SHALL BE SUITABLE TO ACCOMMODATE THE TOTAL MOVEMENT NOTED ON THE PLANS.

COMPLETE WORKING DRAWINGS OF ALL DETAILS OF FABRICATION OF THE EXPANSION JOINT DEVICE SHALL BE SUBMITTED FOR REVIEW IN ACCORDANCE WITH STANDARD SPECIFICATION 104.02. THIS REQUIREMENT IS WAIVED FOR EXPANSION JOINT DEVICES FOR WHICH A SET OF STANDARD INSTALLATION DETAILS HAS BEEN APPROVED. STANDARD INSTALLATION DETAILS CAN BE OBTAINED FROM THE DESIGN DIVISION.

FABRICATION AND INSTALLATION:

THE EXPANSION JOINT SHALL BE SHOP FABRICATED TO CONFORM TO THE CONTOUR OF THE BRIDGE DECK, BARRIERS, ETC. IT SHALL BE INSTALLED IN ACCORDANCE WITH MANUFACTURER'S RECOMMENDATIONS SUBJECT TO NOTES HEREIN AND THE APPROVAL OF THE ENGINEER.

THE TOP OF THE ELASTOMERIC JOINT DEVICE SHALL BE SET 3 - 6 mm BELOW THE CONCRETE SLAB (PAVEMENT) WITH A TOLERANCE OF ± 3 mm.

THE STEEL ANCHORAGE FOR STRIP SEAL GLANDS SHALL BE HOT DIP GALVANIZED IN ACCORDANCE WITH SUBSECTION 707.16 OF THE STANDARD SPECIFICATIONS.

THE PRO-SPAN DEVICE MUST INCORPORATE A CAST-IN-PLACE STEEL SEAT.

THE AREA OF THE STEEL ANCHORAGE AND SEALING GLAND WHICH WILL BE IN CONTACT WITH A SEALANT, OR LUBRICANT-ADHESIVE SHALL BE CLEANED WITH TOLUENE OR OTHER APPROVED SOLVENT.

WHERE THE SEALING GLAND IS LOCKED INTO A STEEL ANCHORAGE, A LUBRICANT-ADHESIVE CONFORMING TO STANDARD SPECIFICATION 914.4-E SHALL BE REQUIRED BETWEEN THE SEAL AND STEEL ANCHORAGE.

ALL BOLT WELL CAVITIES SHALL BE FILLED WITH AN APPROVED FLEXIBLE EPOXY OR A SEALANT CONFORMING TO FEDERAL SPECIFICATION TT-S-00230C.

IN THE EVENT THAT THE CONSTRUCTION SEQUENCE REQUIRES SPLICING THE SEALING GLAND, IT SHALL BE SPLICED BY AN APPROVED METHOD (SUCH AS COLD VULCANIZATION) BY A TRAINED REPRESENTATIVE OF THE MANUFACTURER.


DETAILS AT CURBS OR BARRIERS:

THE DETAILS ON THIS SHEET SHOW AN APPROVED MEANS OF TERMINATING THE EXPANSION JOINT DEVICE AT CURBS OR BARRIERS. VARIATIONS OR ALTERNATIVE SCHEMES WILL BE CONSIDERED AND MAY BE USED IF APPROVED BY THE ENGINEER.

MATERIALS:

THE COST OF ALL MATERIALS AND LABOR REQUIRED FOR PROPER INSTALLATION OF THE EXPANSION JOINT AND THE TERMINAL ASSEMBLIES AT THE CURBS, SIDEWALKS, OR BARRIERS IS INCLUDED IN THE PAYMENT FOR THE EXPANSION JOINT DEVICE.

ITEM	QUANTITY	UNIT	AMOUNT
EXPANSION JOINT DEVICE		m	55

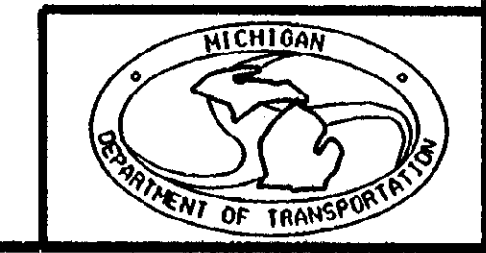


EXPANSION JOINT DETAILS N.B.				
DATE	CONT. SEC.	JOB NO.	DESIGN UNIT	SHEET
01-10-01	S03 OF 63174	49595A	MAHDAVI	6 OF 8


EJ3T (11-17-97)

DATE: 01-10-01
 CORRECTED BY: INDER
 DATE:
 CHECKED BY: WM
 DATE: 4-2-99
 DRAWN BY: INDER
 FILE NAME: s0363174n.ej

1 2 3 4 5 6 7 8 9 10 11 12 13 14 15 16 17 18 19 20 21 22 23 24 25 26 27 28 29 30 31 32 33 34 35 36 37 38 39 40 41 42 43 44 45 46 47 48 49 50 51 52 53 54 55 56 57 58 59 60 61 62 63

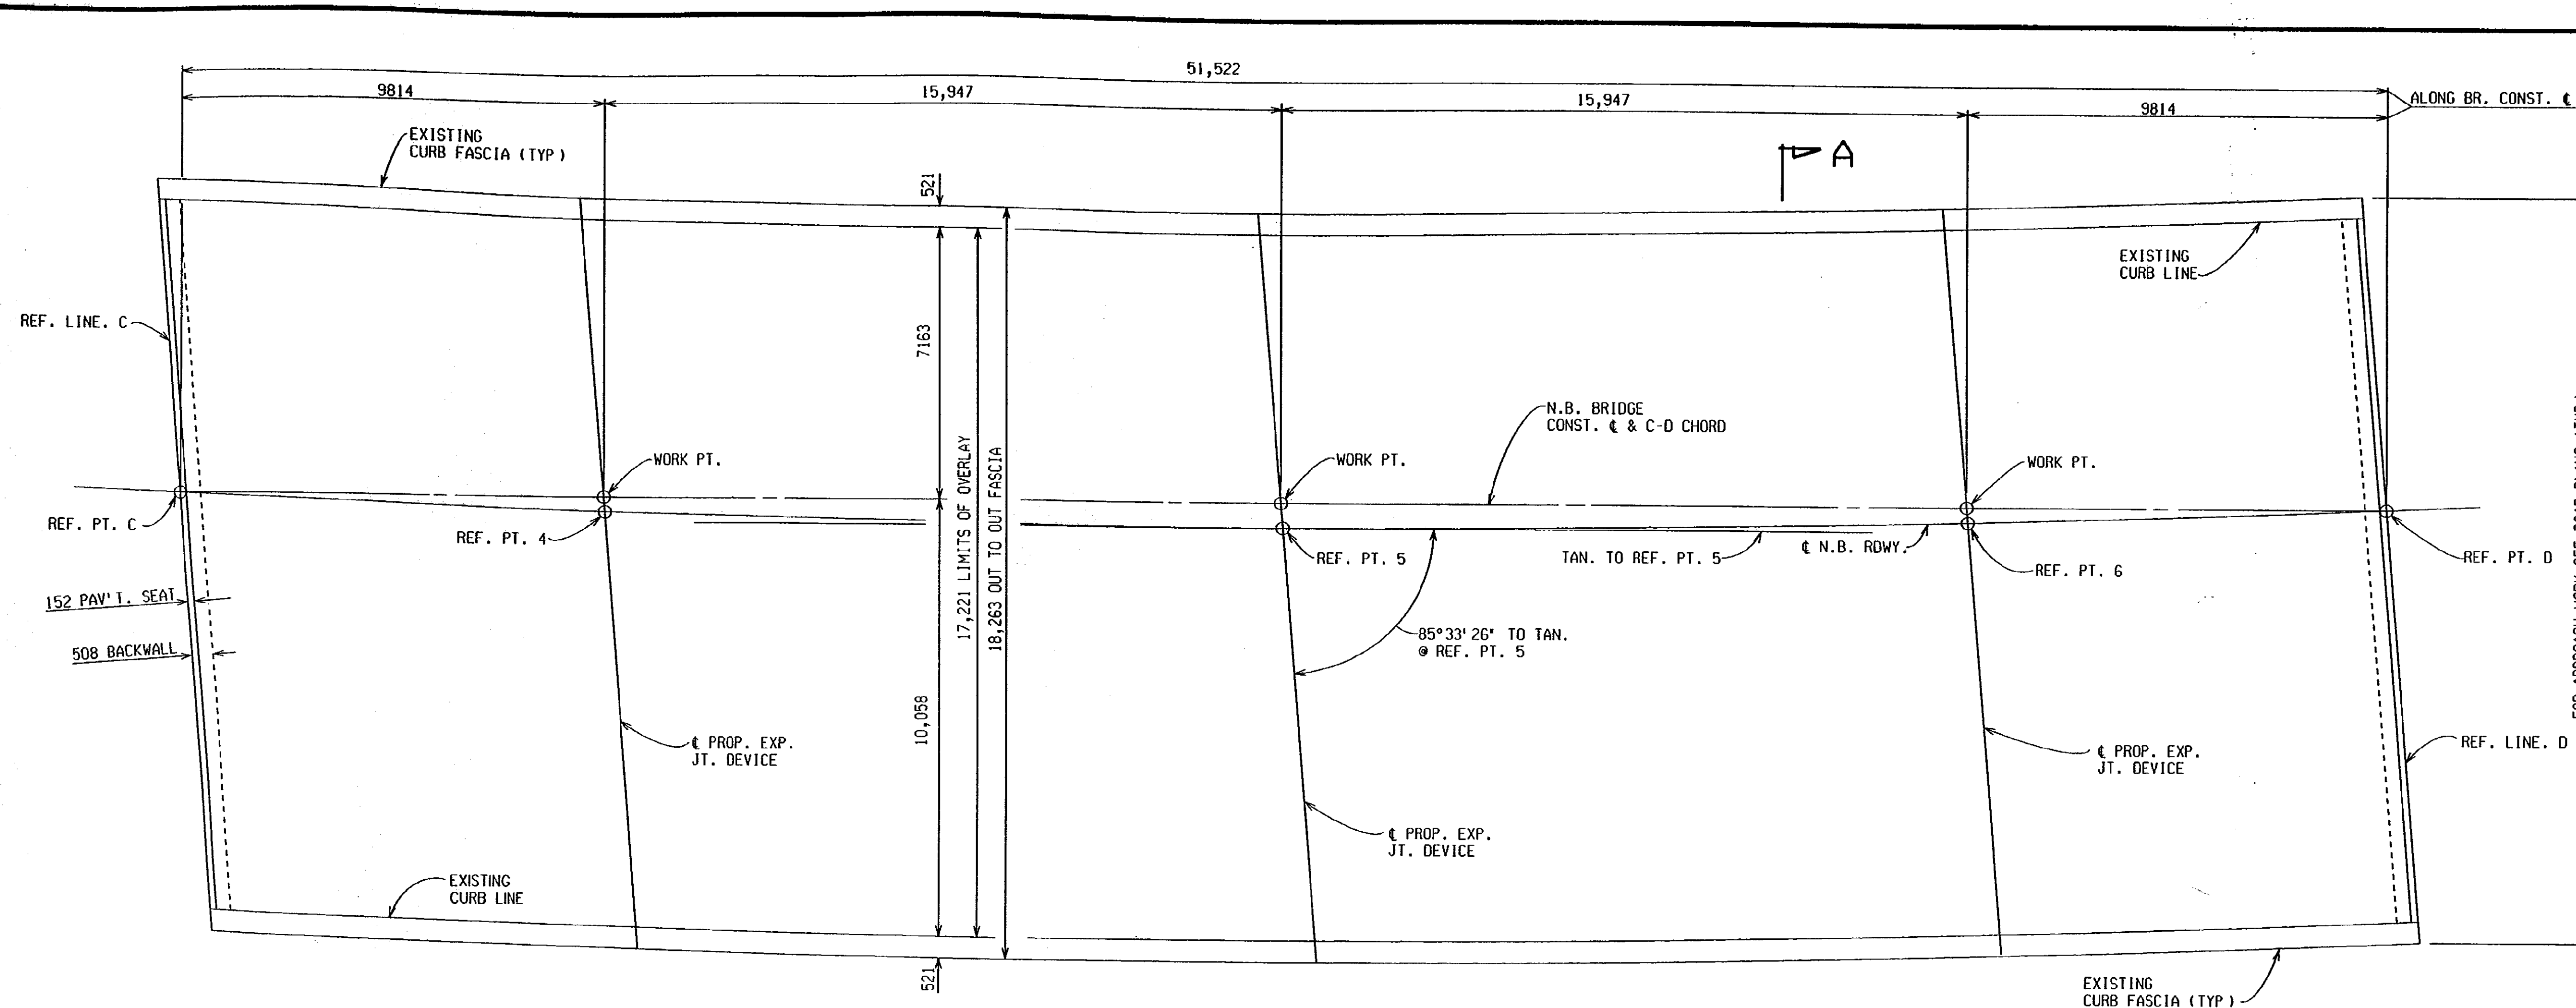

REVISIONS			
NO.	DESCRIPTION	DATE	BY

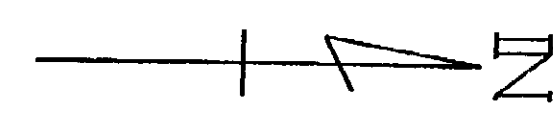


PLAN OF DECK (NORTH BOUND)

LIMITS OF FALSE DECKING ARE OUT TO OUT OF SLAB FASCIA AND PIER 4 TO PIER 6

MISCELLANEOUS QUANTITIES	
20 m ²	Bit Patch, Rem
890 m ²	Scarifying
890 m ²	Hydrodemolition, First Pass
36 m ²	Hydrodemolition, Second Pass
890 m ²	Bridge Deck Surface Construction
940 m ²	False Decking
55 m	Deck Joint, Rem
13 m ³	Conc. Grade D.
38 m ³	Conc. Bridge Deck Overlay
10 m ²	Hand Chipping, Deep

THE ACTUAL QUANTITY OF "CONCRETE BRIDGE DECK OVERLAY" PLACED ON THE DECK WAS CUBIC METERS. (THIS INFORMATION IS TO BE FILLED IN BY THE ENGINEER WHEN SUBMITTING "AS CONSTRUCTED" PLANS.)

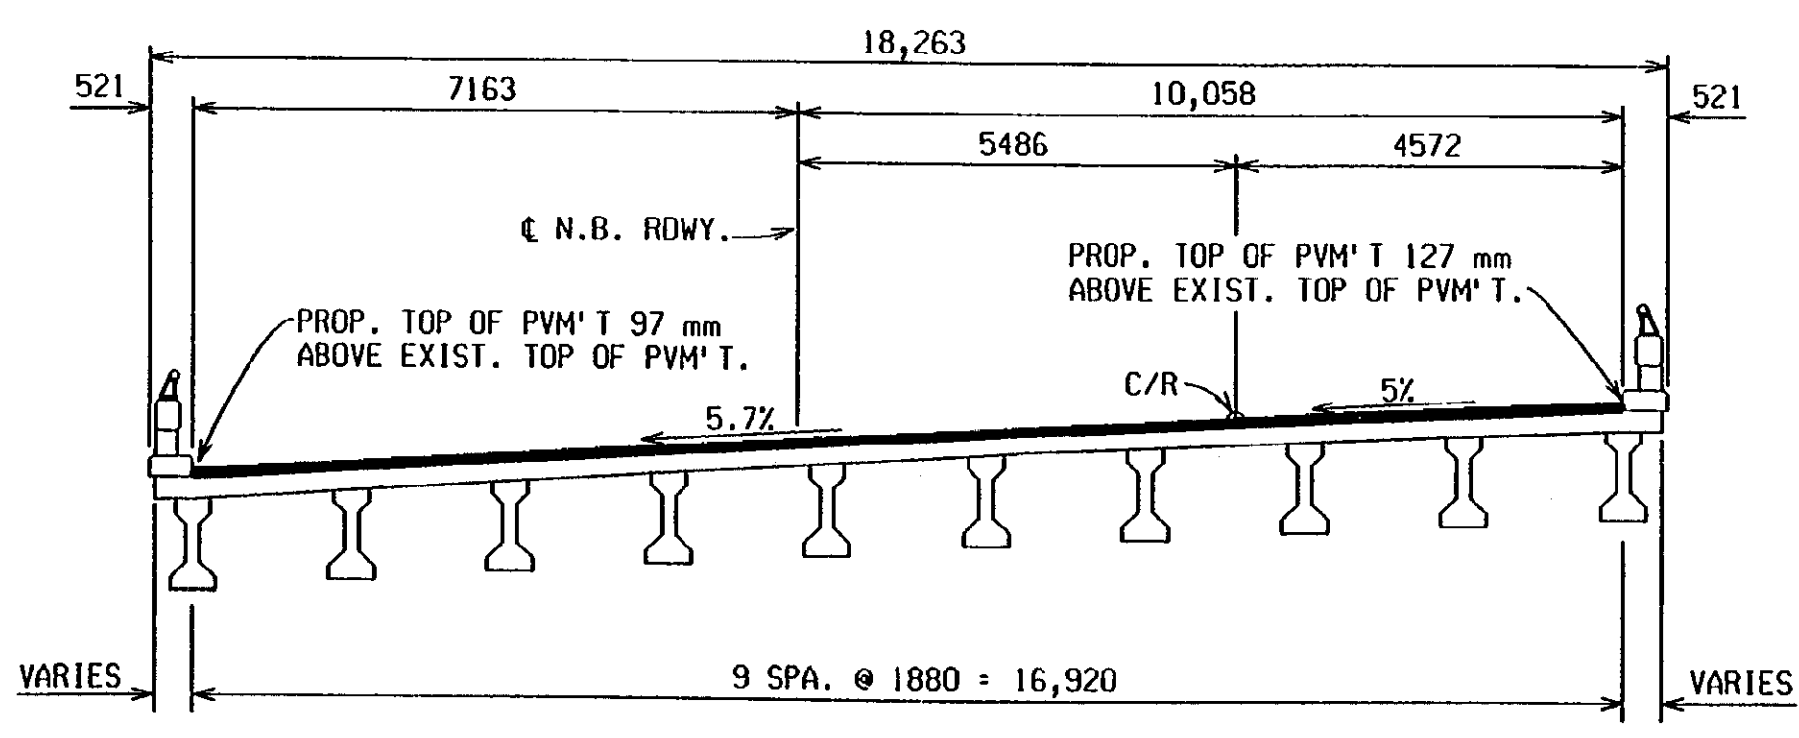

SECTION A-A

NOTES:

- WHERE STRUCTURAL STEEL IS EXPOSED DURING JOINT REMOVAL, IT SHALL BE CLEANED AND COATED. CLEANING, COATING AND PROTECTION OF WORK AND ENVIRONMENT ARE INCLUDED IN THE BID ITEM "DECK JOINT, REM".
- THE ITEM "DECK JOINT, REM" INCLUDES HAND CHIPPING WITHIN LIMITS REQUIRED FOR REMOVAL.
- 1-75 NB TRAFFIC IS TO BE MAINTAINED BY PART-WIDTH CONSTRUCTION.
- WHERE STRUCTURAL STEEL IS EXPOSED DURING THE REMOVAL OF UNSOUND DECK CONCRETE, IT SHALL BE CLEANED AND COATED. CLEANING SHALL BE BY BLASTING OR POWER TOOLS. THE PROTECTION OF WORK AND ENVIRONMENT DURING CLEANING WILL BE PAID FOR AS EXTRA WORK.
- THE CONTRACTOR SHALL REMOVE AND REPLACE ONLY THAT PORTION OF THE CURB THAT IS NECESSARY FOR INSTALLATION OF THE DECK JOINT. PAYMENT FOR THIS WORK IS INCLUDED IN THAT FOR EXPANSION JOINT DEVICE.
- APPROXIMATE INCREASE OF THE & ELEVATION IS 20 mm.
- THE VOLUME OF CONCRETE BRIDGE DECK OVERLAY IS BASED ON THE OVERLAY AND AN ESTIMATED QUANTITY TO REPLACE UNSOUND CONCRETE AND TO MAKE GRADE ADJUSTMENTS AS DETERMINED BY THE ENGINEER.
- MEASURES SHALL BE TAKEN TO PREVENT DEBRIS FROM FALLING FROM THE STRUCTURE.
- BEFORE OVERLAYING, SOUND CONCRETE TO DETERMINE WHETHER 450 mm REMOVAL AT EITHER SIDE OF TRANSVERSE JOINTS WILL BE ADEQUATE. INCREASE THE REMOVAL LIMITS IF NECESSARY.
- SILICA FUME MODIFIED CONCRETE OR LATEX MODIFIED CONCRETE MAY BE SELECTED FOR THE BRIDGE DECK OVERLAY CONCRETE, SEE SPECIAL PROVISION.



DECK RESURFACING DETAILS N.B.				
DATE	CONT. SEC.	JOB NO.	DESIGN UNIT	SHEET
01-10-01	S03 OF 63174	49595A	MAHDAVI	7 OF 8

DATE: 01-10-01 CORRECTED BY: INDER
 DATE: 01-10-01 CORRECTED BY: INDER
 DATE: 03-10-99 CHECKED BY: WM
 DATE: 03-10-99 CHECKED BY: INDER
 FILE NAME: s0363174n.ov

1 2 3 4 5 6 7 8 9 10 11 12 13 14 15 16 17 18 19 20 21 22 23 24 25 26 27 28 29 30 31 32 33 34 35 36 37 38 39 40 41 42 43 44 45 46 47 48 49 50 51 52 53 54 55 56 57 58 59 60 61 62 63

REVISIONS			
NO.	DESCRIPTION	DATE	BY






BENCH MARKS
 B.M. #71 El. 638.34 M.S.H.D. B.M. Top in Roof of 24' Elm
 15' W of W 1/2 12 Mile Rd.
 B.M. #89 El. 637.34 M.S.H.D. B.M. Top in Roof of 15' Elm
 158' W of 924 1/2 N-B Rdwy.

UTILITIES
 Michigan Bell Telephone 30' North & Parallel to 12 Mile Road
 Detroit Edison 36' S, 28' N, and 48' N. All Lines parallel to 12 Mile Road.
 Detroit Water Board 12" Water Main 45' North & parallel to 12 Mile Road.
 City of Madison Heights 36" x 48" Sewer 15' South & parallel to 12 Mile Road. FL El. 607.50 @ N-B Rdwy.
 Consumers Power Co. 6" Steel Medium Pressure Gas Line, 16' North of 12 Mile Rd.


SECTION II
 TIN R I I E
 ROYAL OAK TWR

Curve Data
 Δ 39°02'20"
 D 3700'
 R 1909.86
 T 494.61
 L 967.96
 E 63.01
 PC 915+39.23
 PI 920+33.84
 PT 925+07.19
 Se 2.057H

SECTION II
 TIN R I I E
 ROYAL OAK TWR

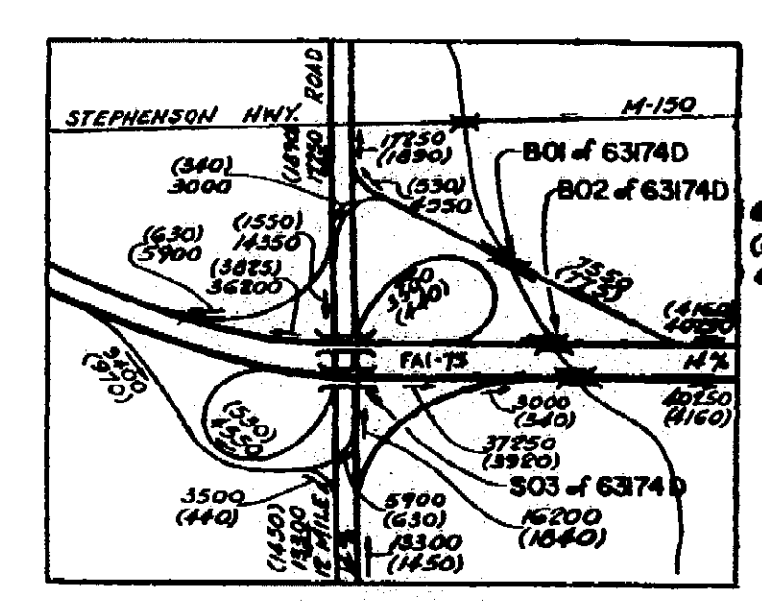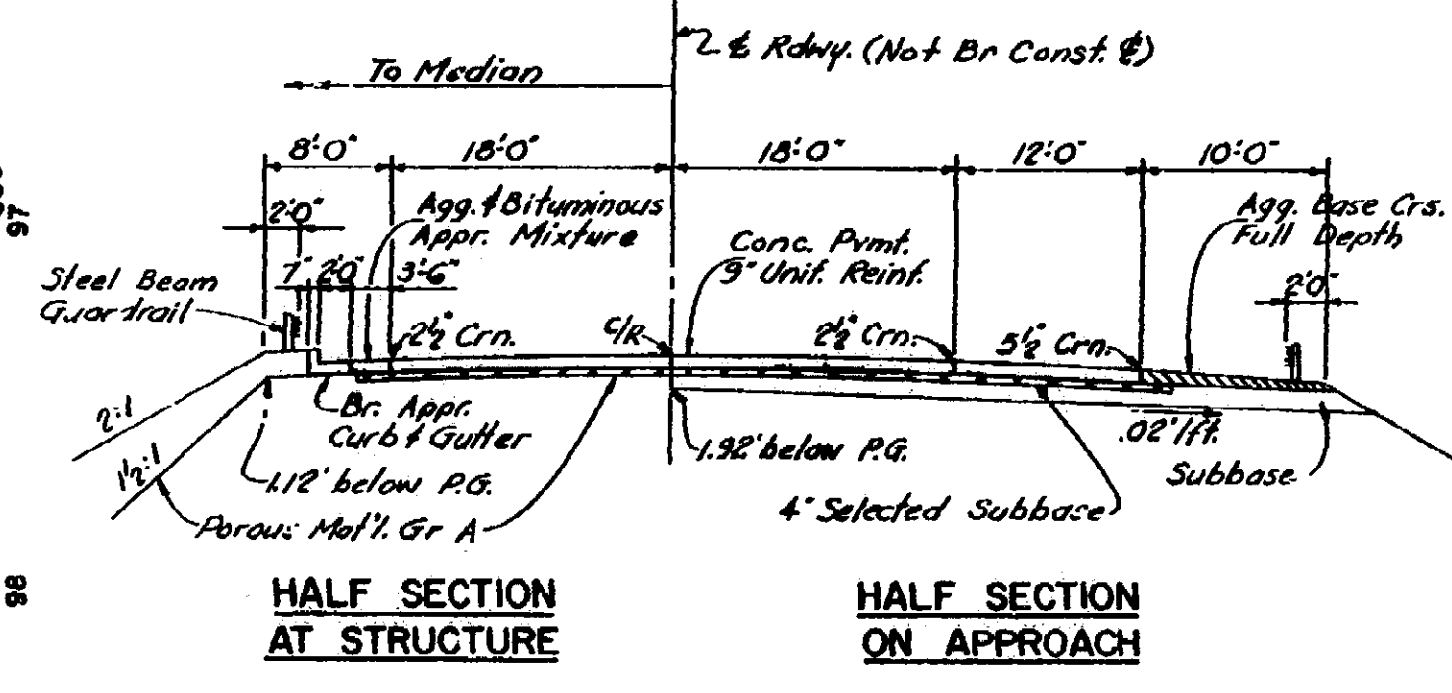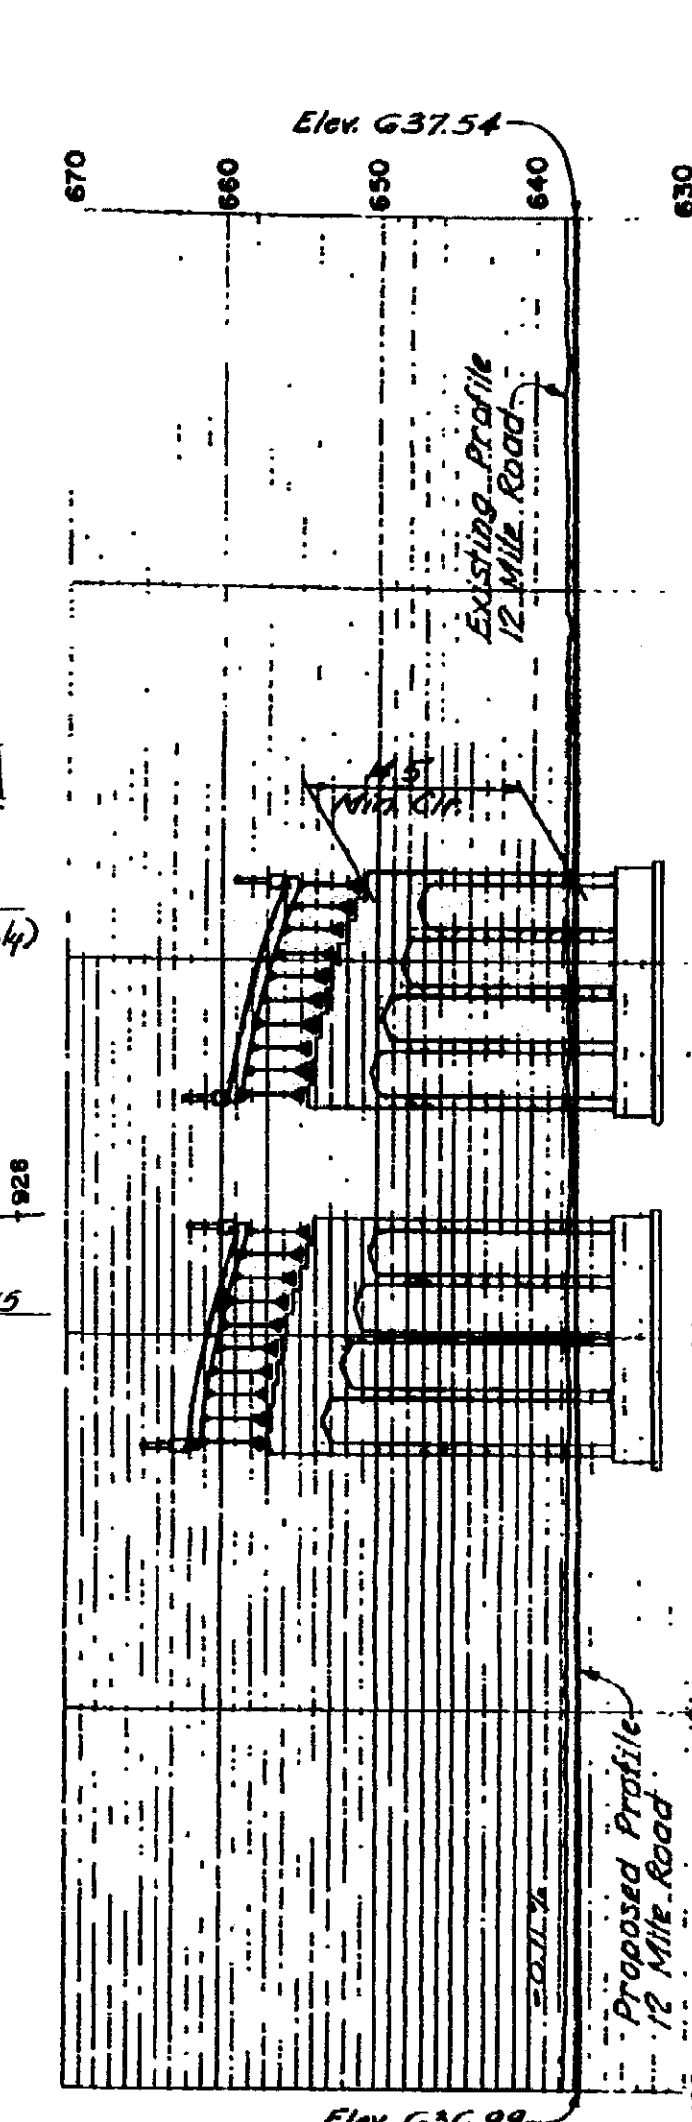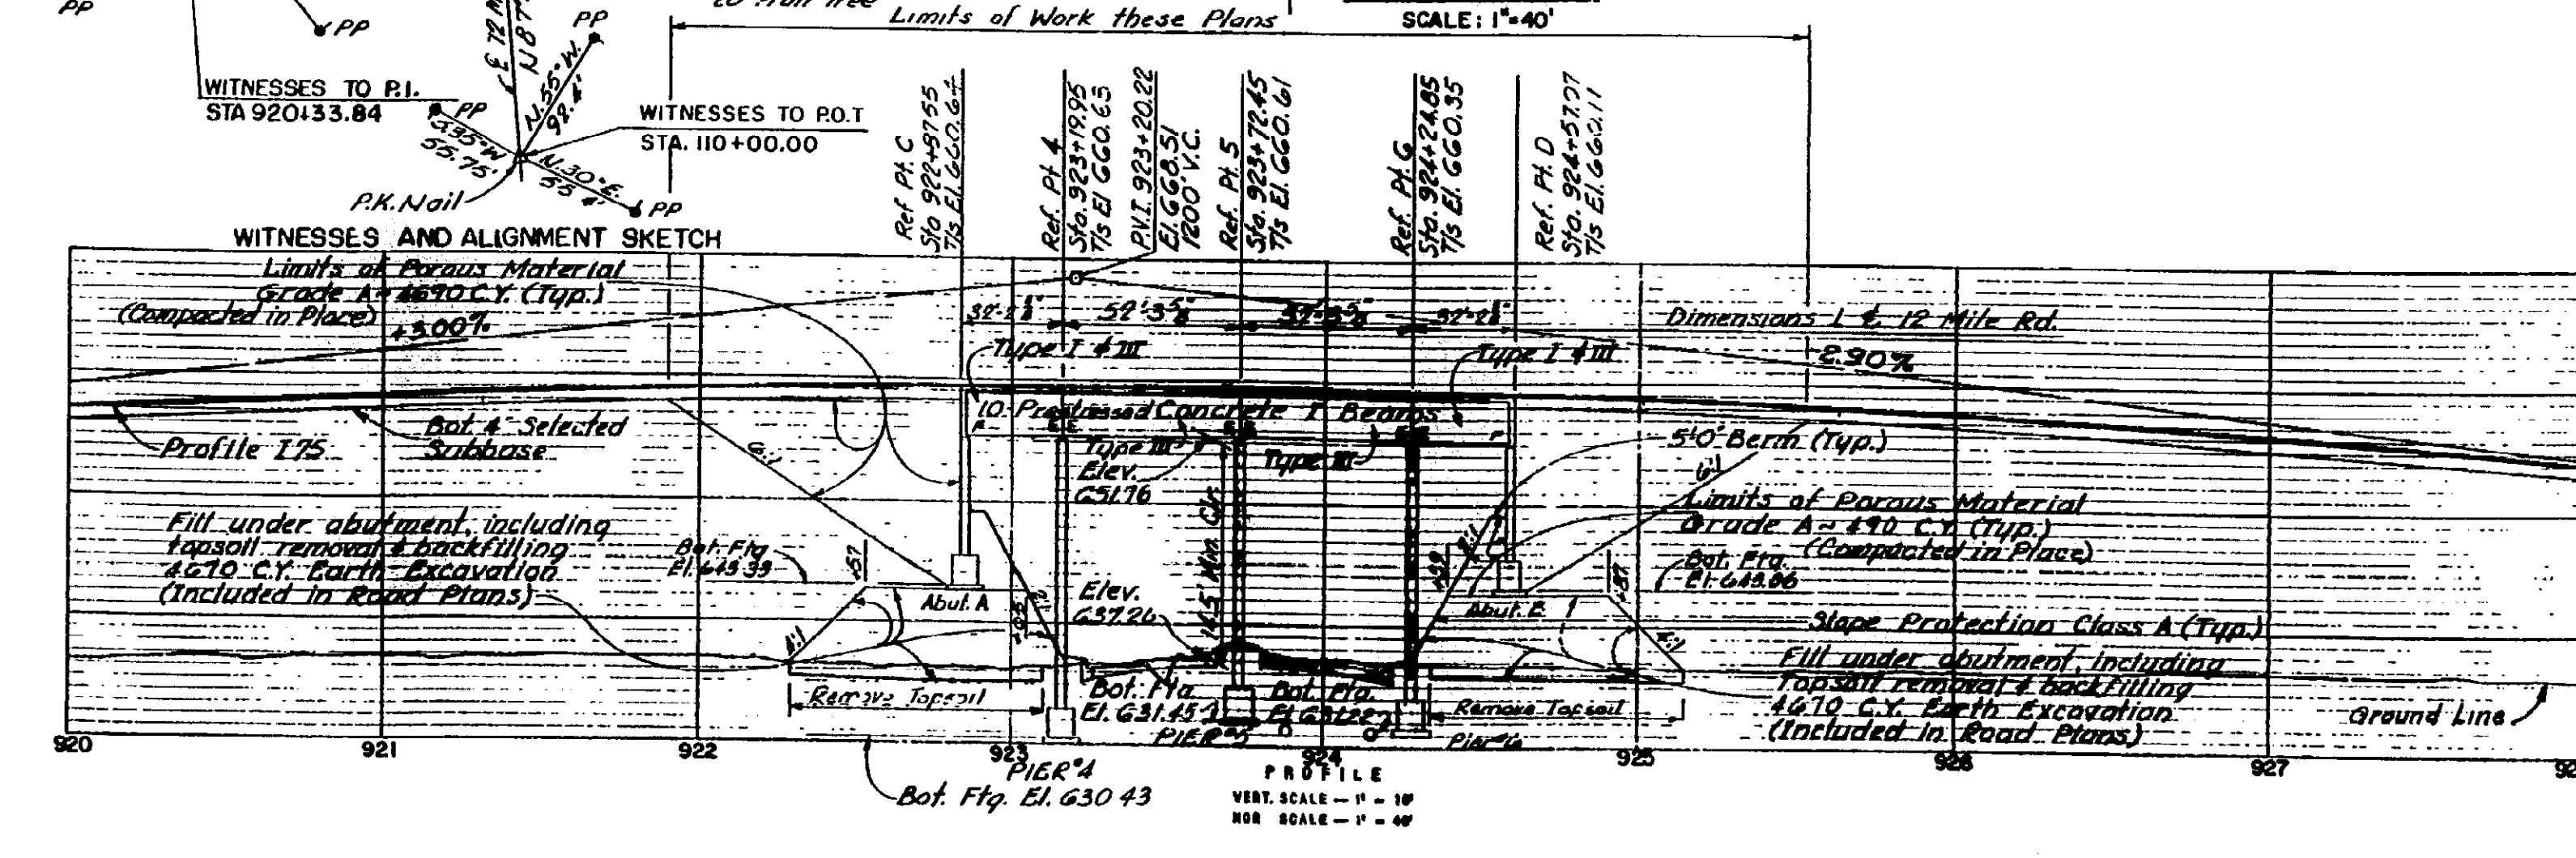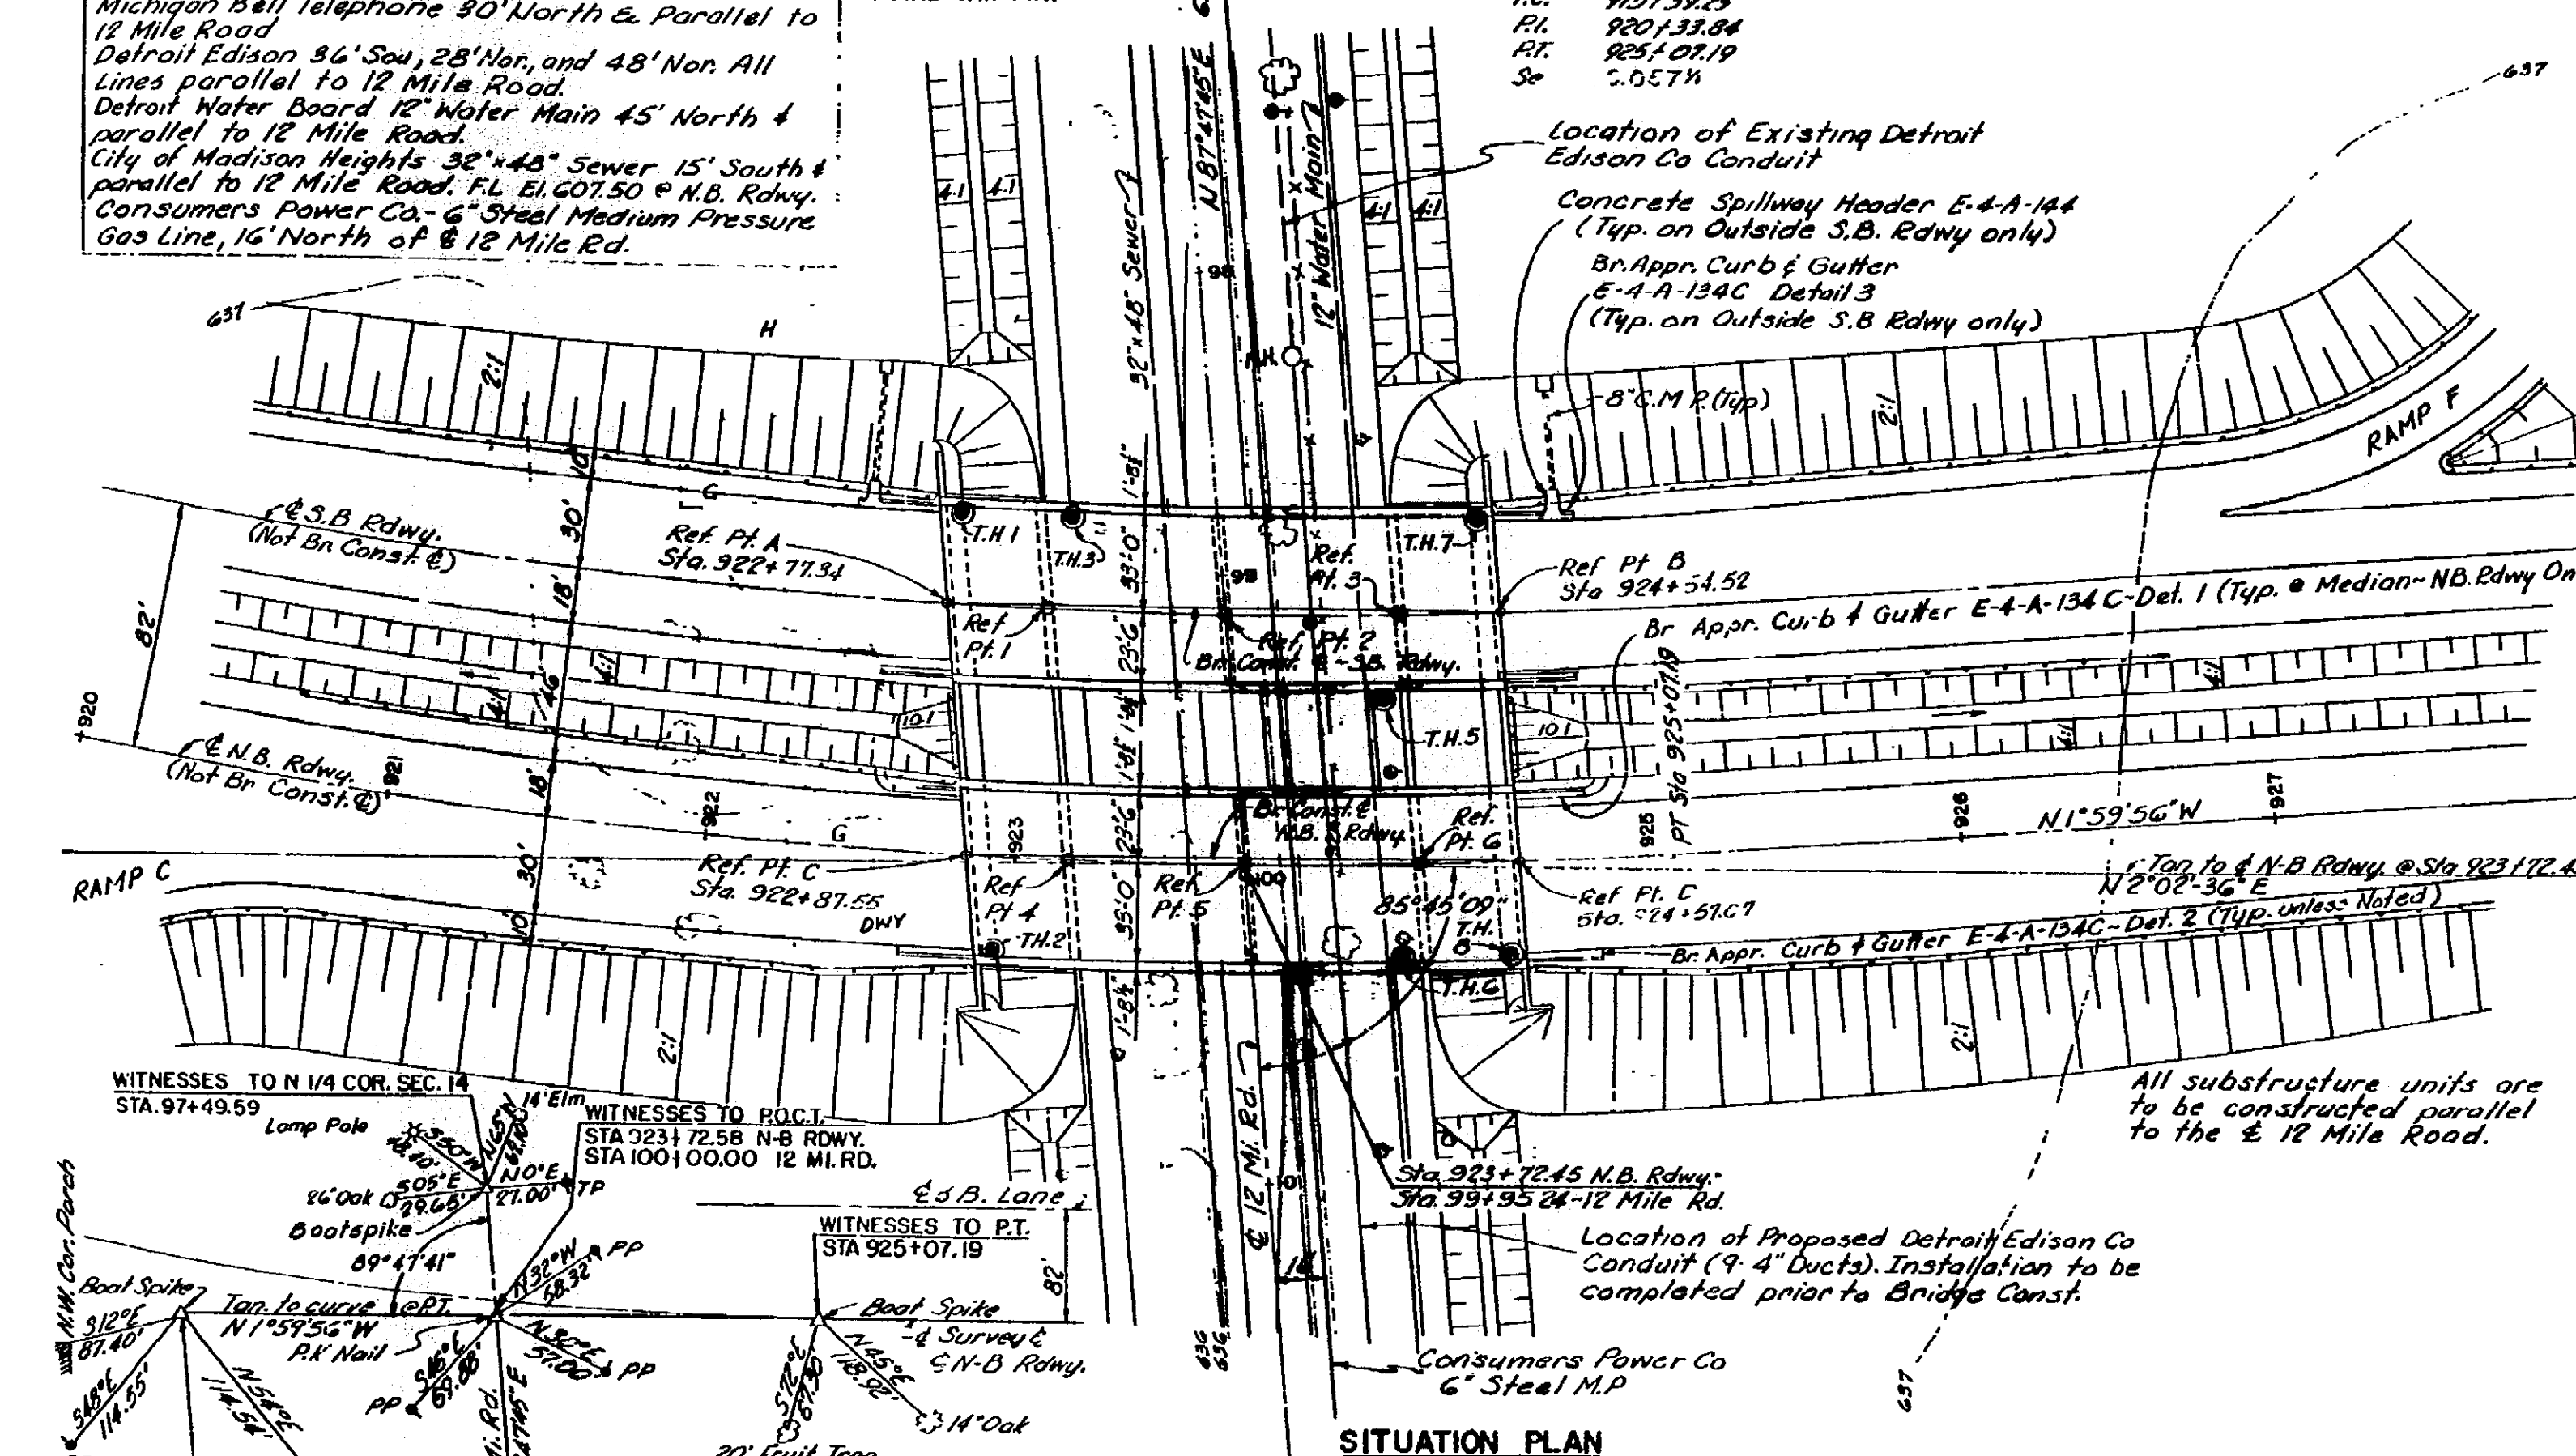

LEGEND
 (ADT) Average Daily Traffic
 (DHV) Design Hourly Volume
 (C) % Commercial

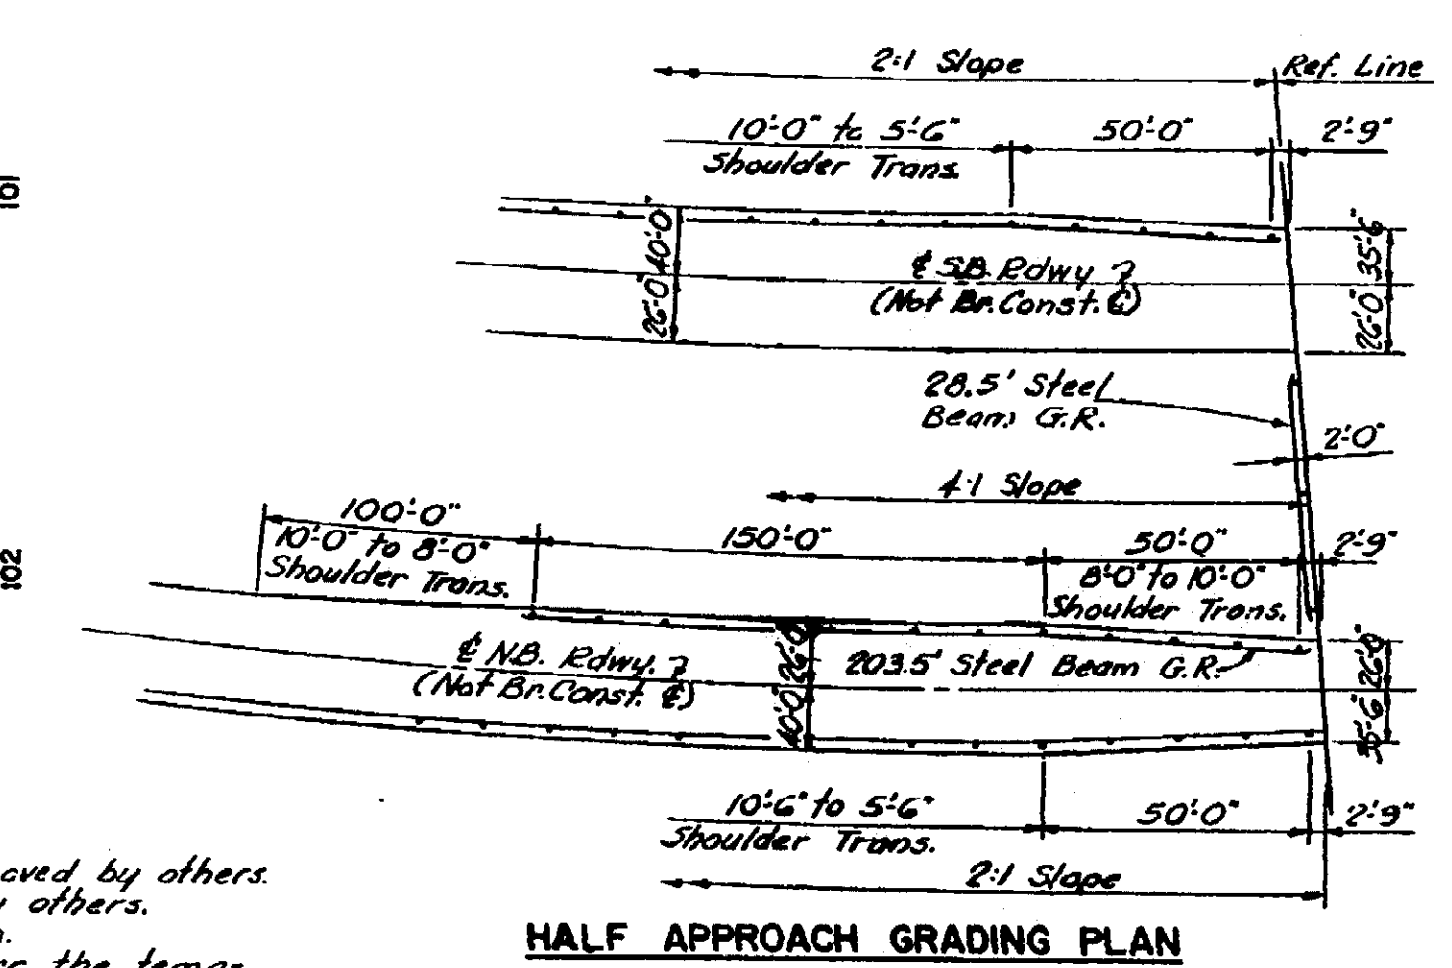

GENERAL NOTES
 Fences and utilities are to be moved by others. Buildings are to be removed by others. Datum refers to U.S.C.S. datum. Traffic is to be maintained over the temporary road until half the structure is complete. This bridge is part of an interchange and all the area shown is within M.S.H.D. R.O.W. Piers #1, 5, & 6 shall be constructed and back filled prior to construction of the abutment fills. The work covered by these plans includes construction of the proposed bridge, placing porous material on a slope protection class A to the limits shown. All work not listed above is included in the road plans. Homden Road to be closed at edge of interchange R.O.W.

CONTROL SECTION 63174 I


MICHIGAN STATE HIGHWAY DEPARTMENT
 175 OVER 12 MILE ROAD IN THE CITY OF MADISON HEIGHTS

GENERAL PLAN OF SITE

TECON ENGINEERS, INC.
 APPROVED: *J. V. Murray* 6-5-62
 ENGINEER OF DESIGN - CONSULTANT

S03 OF 63174 I

NOTE:
 DO NOT WORK FROM THIS SHEET. THE INFORMATION SHOWN HERE IS FOR REFERENCE ONLY. NO PAY ITEMS ARE SHOWN.

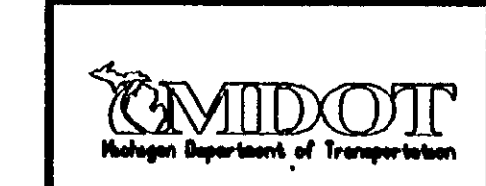

FOR INFORMATION ONLY


SOUTH BOUND

DATE	CONT. SEC.	JOB NO.	DESIGN UNIT	SHEET
01-10-01-	S03 OF 63174	49595A	MADHAVI	2 OF 9


DATE: 01-10-01
 CORRECTED BY: INDER
 DATE:
 CHECKED BY:
 DATE:
 DRAWN BY: INDER
 FILE NAME: s0363174sn.nb

1 2 3 4 5 6 7 8 9 10 11 12 13 14 15 16 17 18 19 20 21 22 23 24 25 26 27 28 29 30 31 32 33 34 35 36 37 38 39 40 41 42 43 44 45 46 47 48 49 50 51 52 53 54 55 56 57 58 59 60 61 62 63

REVISIONS			
NO.	DESCRIPTION	DATE	BY

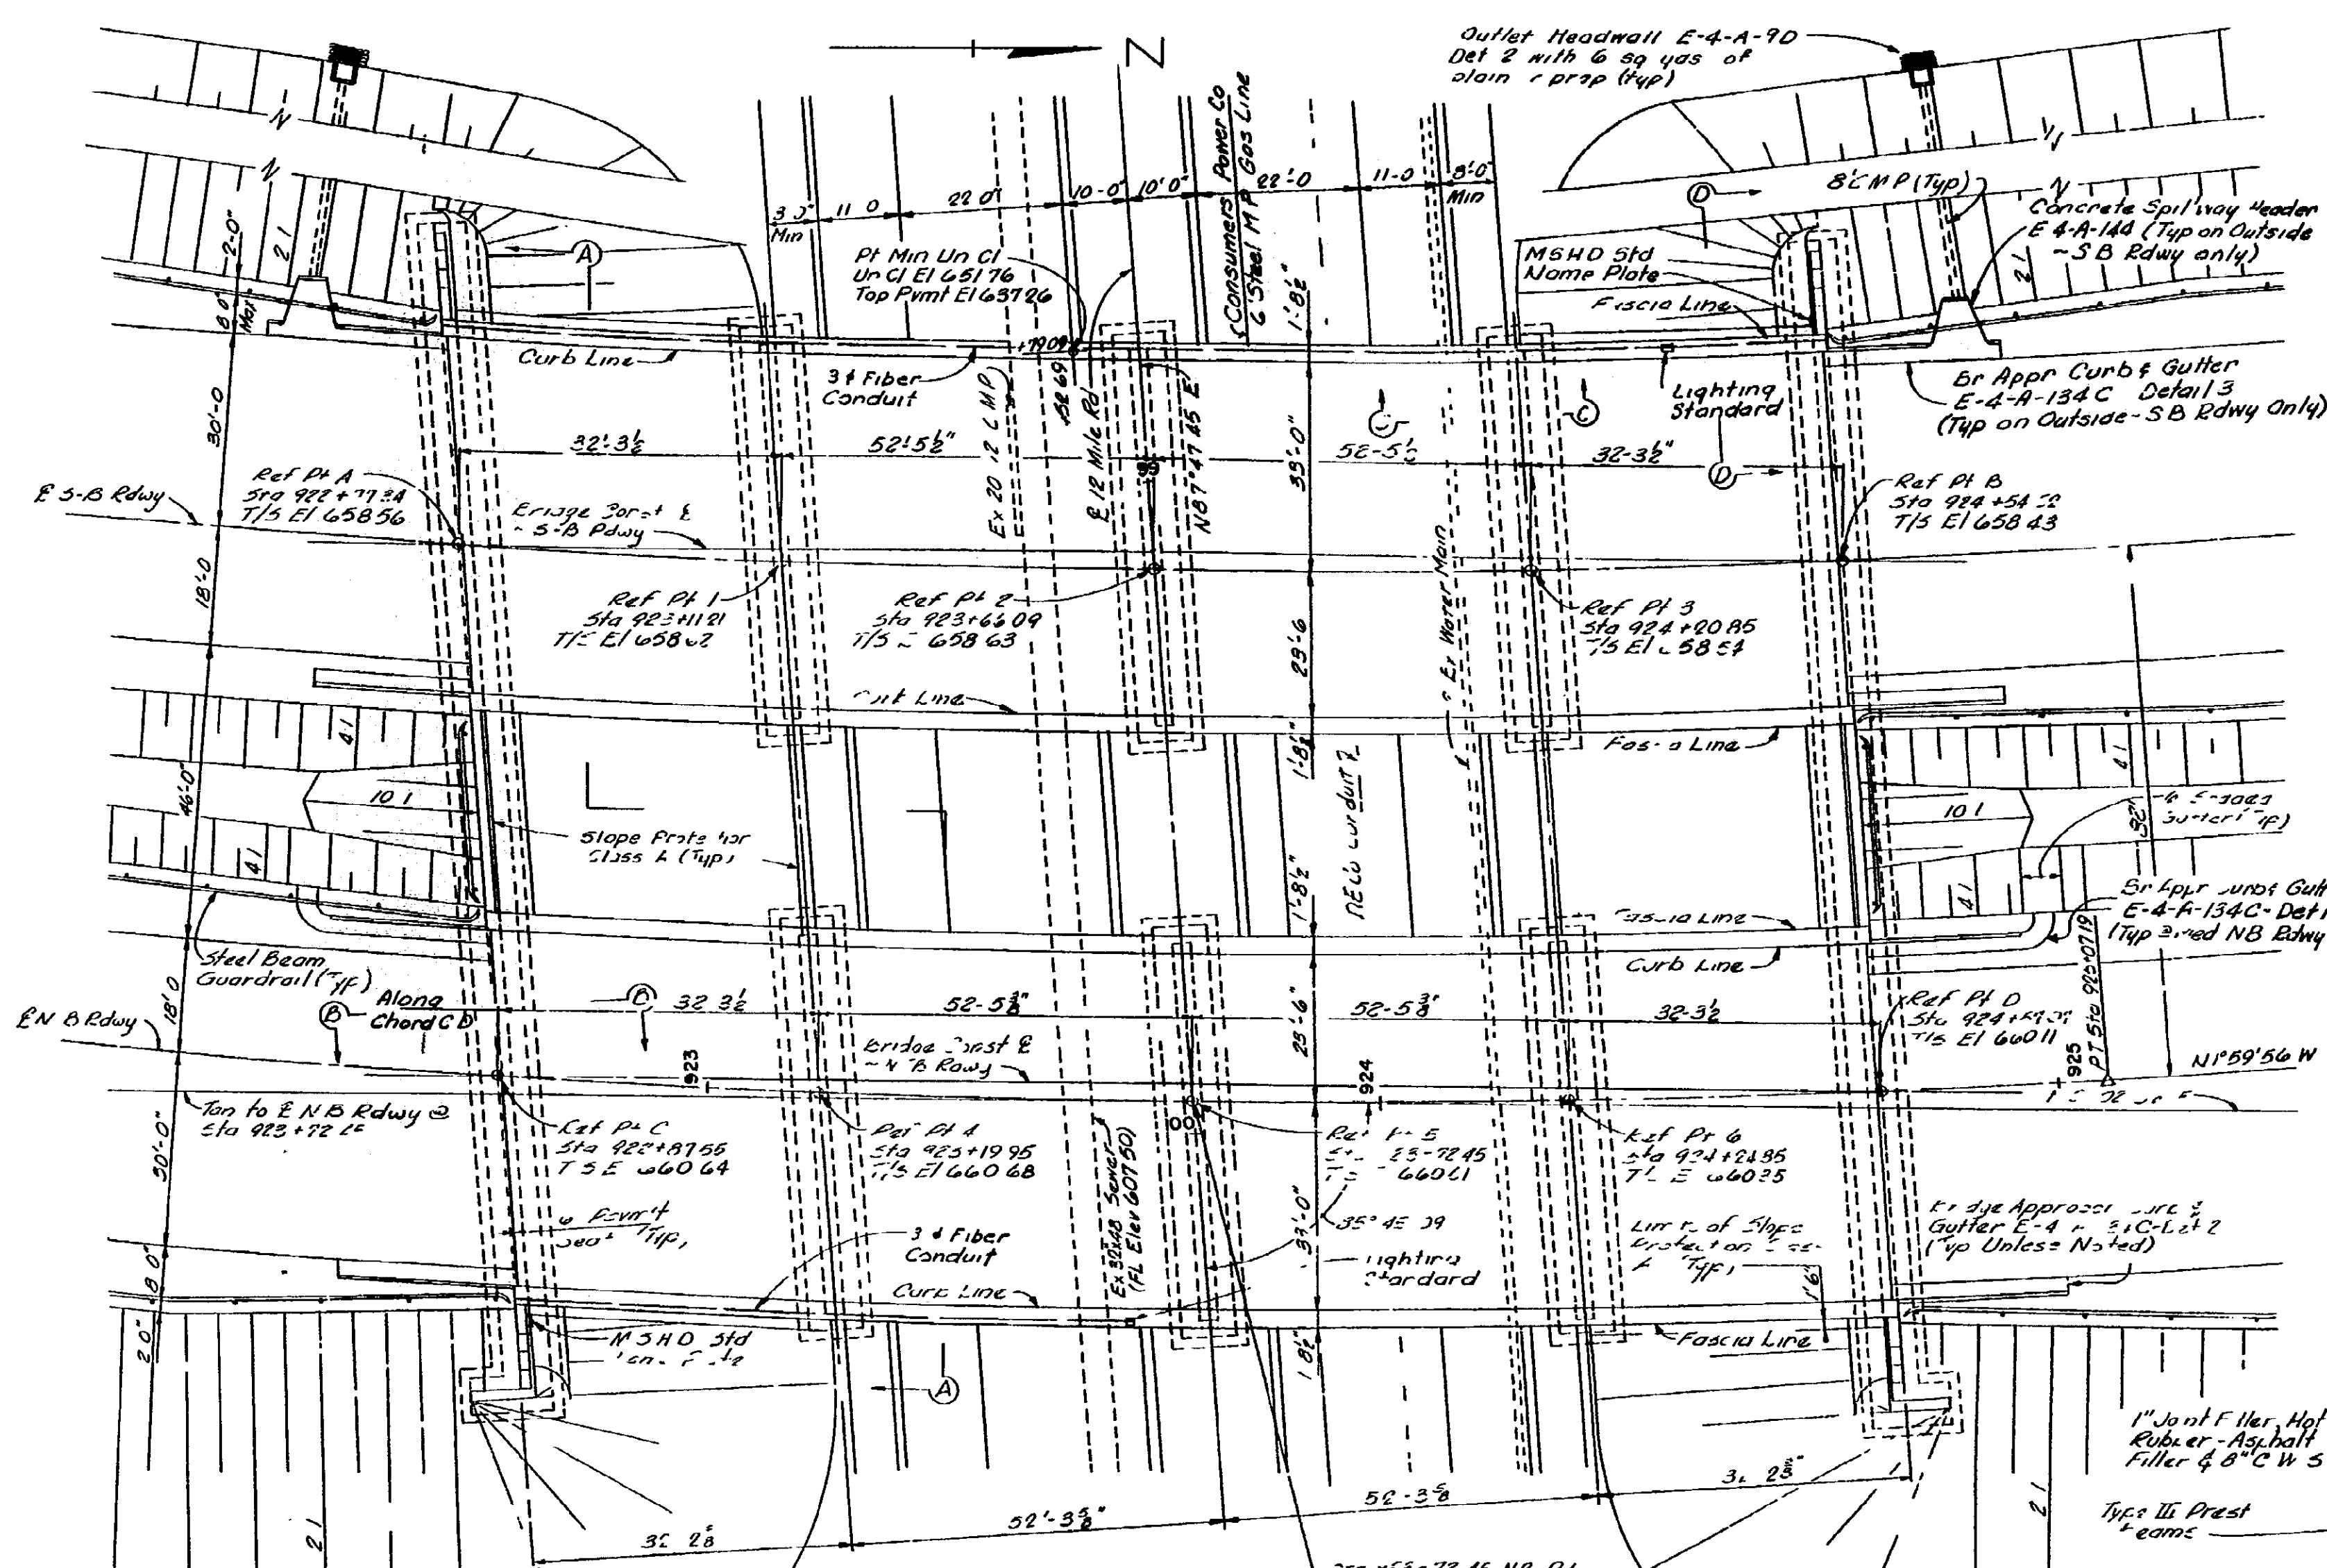


PLAN
Not to Scale

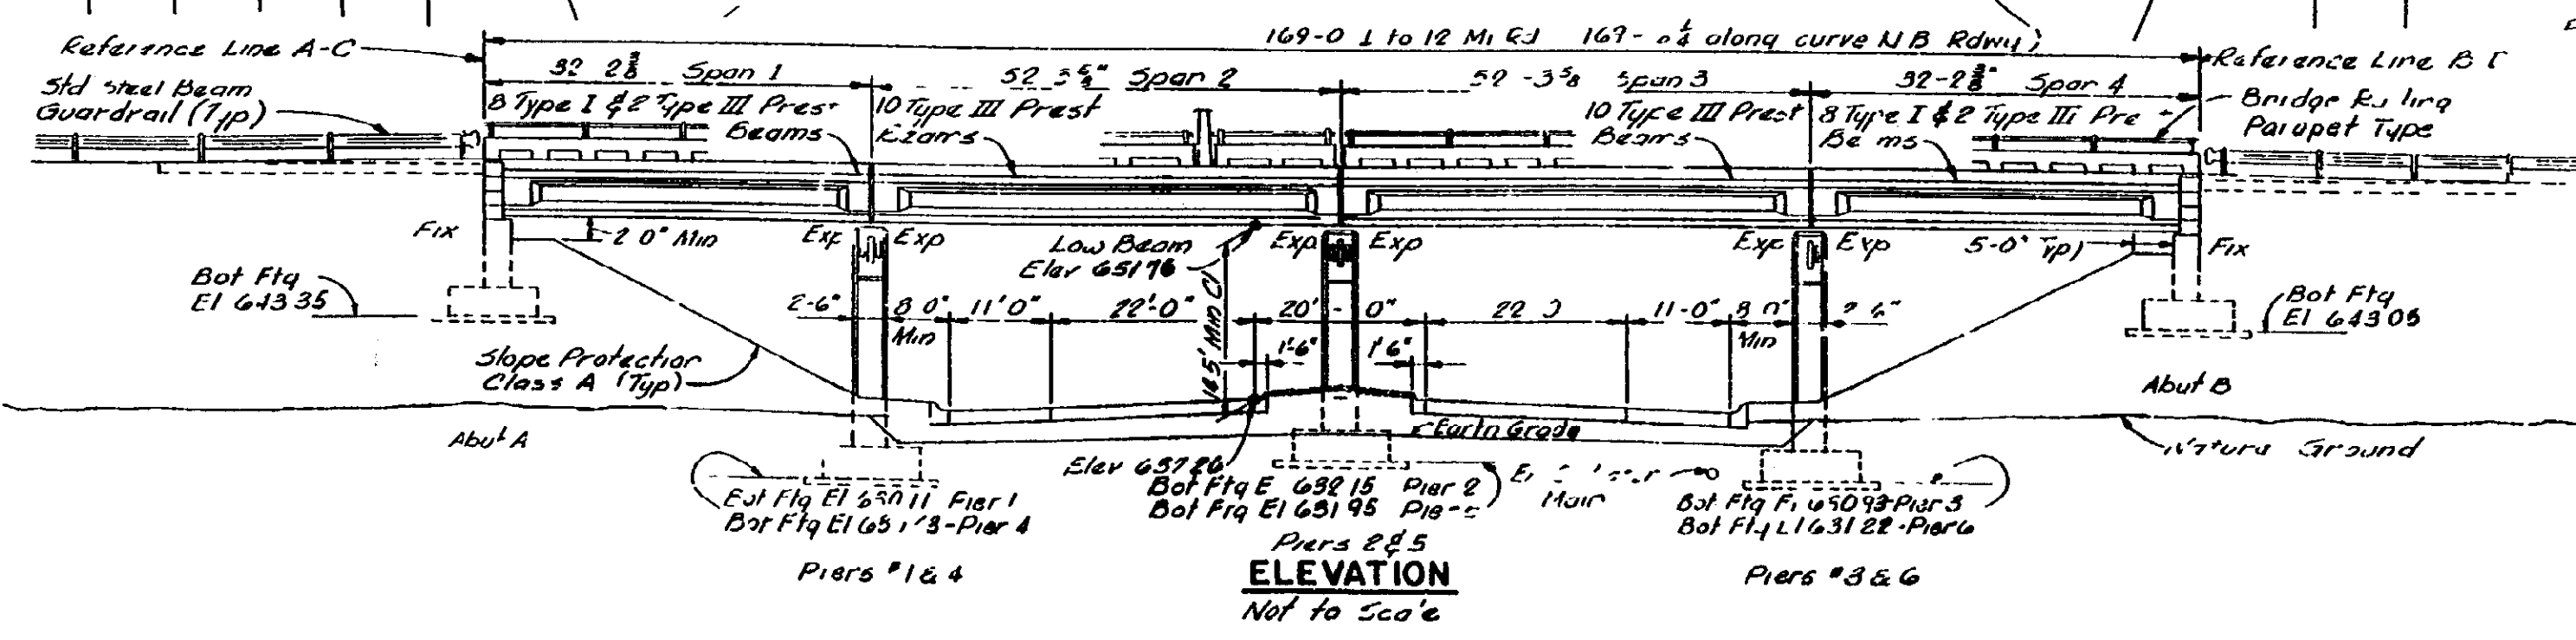


ELEVATION
Not to Scale

MISCELLANEOUS QUANTITIES		
ITEM	UNIT	AMOUNT
* Slope Protection Class A	Sq Yds	1110
Porous Material Grade A Compacted-in-Place	Cu Yds	1,500


GROUTED RIPRAP SHALL NOT BE USED ON THIS PROJECT

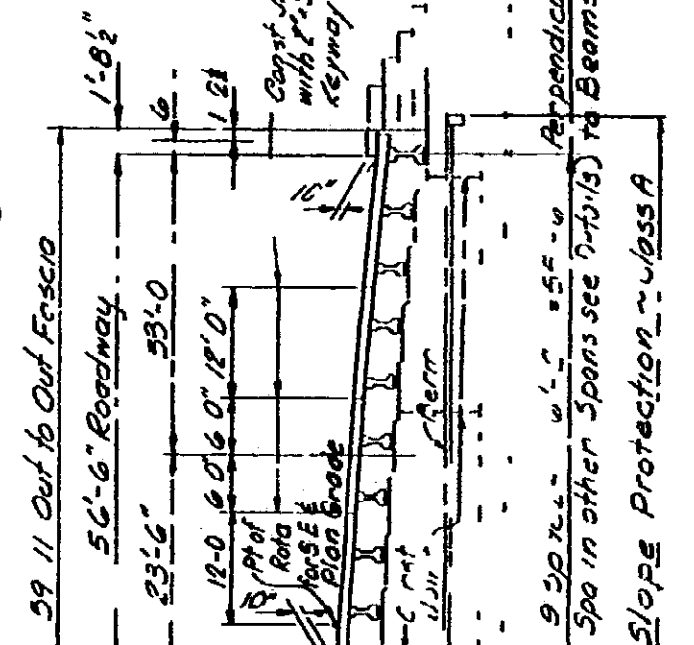


SECTION A-A
Scale 1/2"=1'-0"

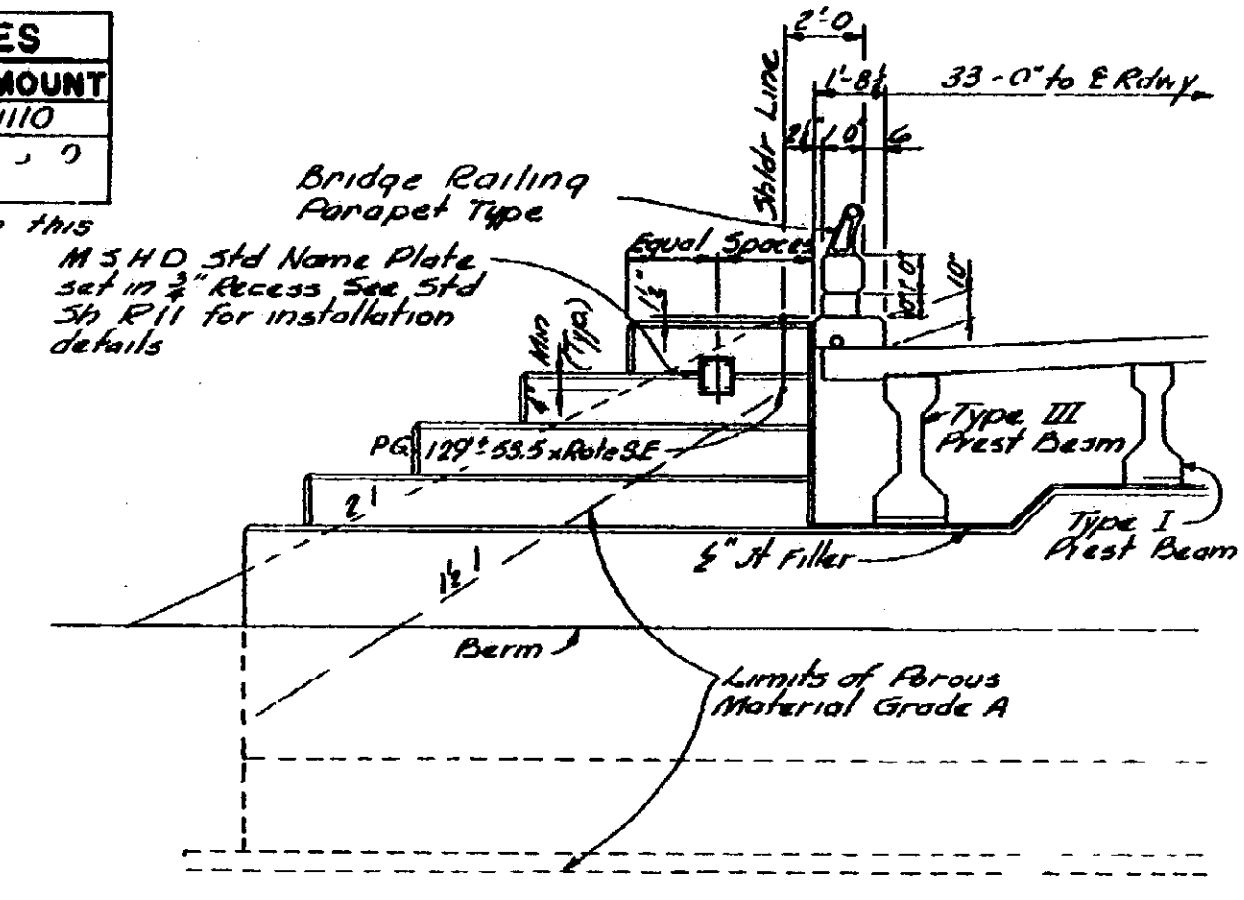

SECTION D-D
Scale 1/2"=1'-0"

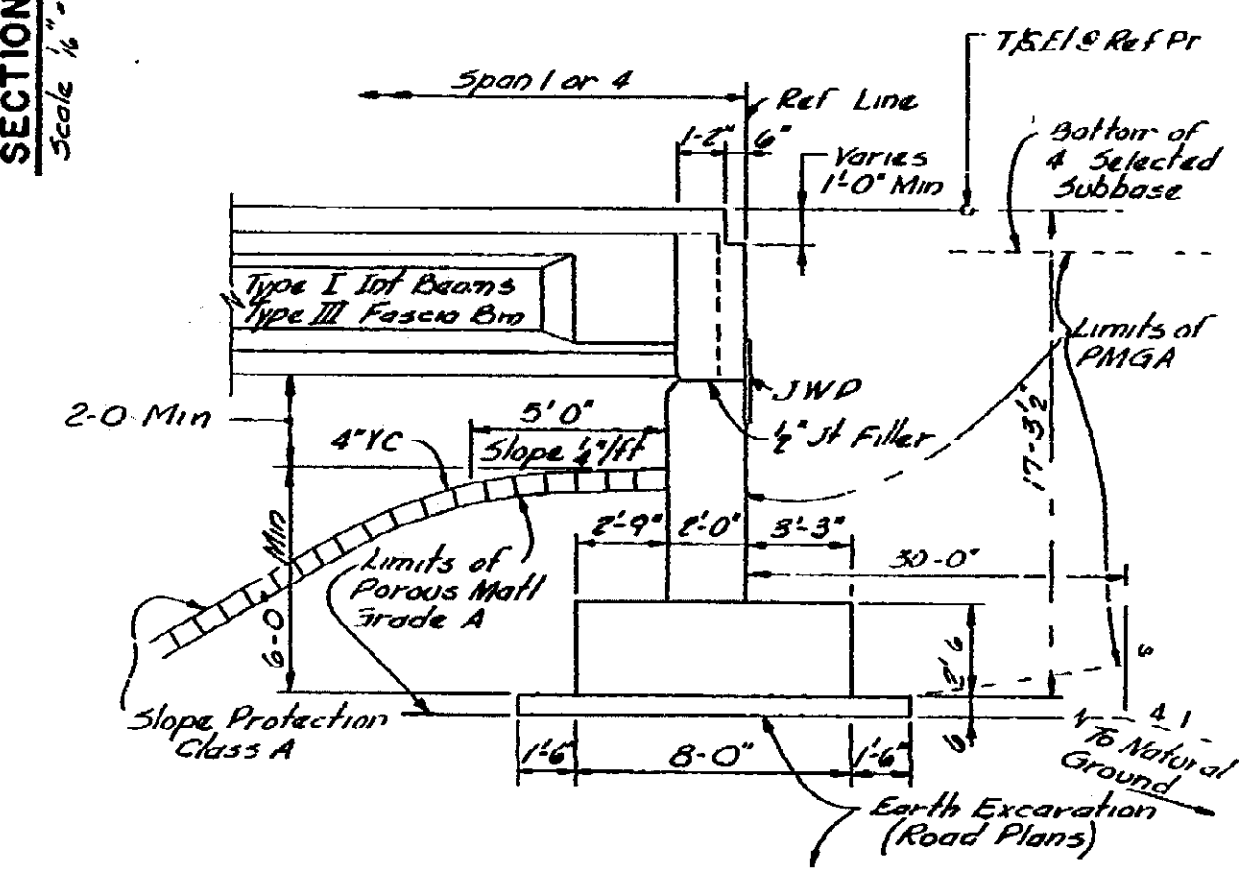

SECTION B-B
Scale 1/2"=1'-0"

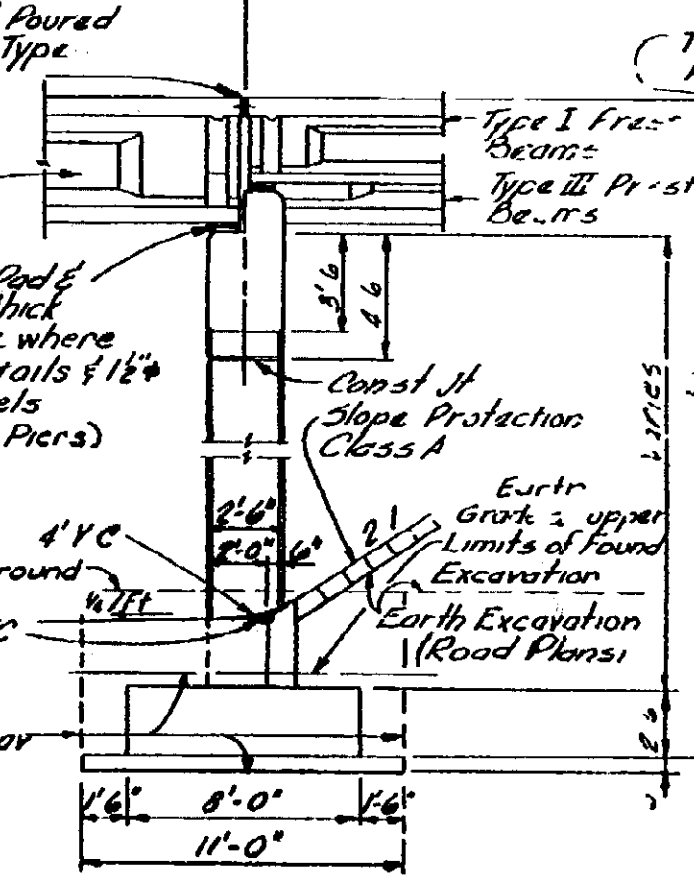

SECTION C-C
Scale 1/2"=1'-0"

NOTES

- Top of roadway slab and tops of curbs are parallel to the vertical curve, except as modified by superelevation transition.
- This structure is on a horizontal curve. The fascia lines, curb lines and longitudinal deck construction joints are parallel to the curve.
- Proposed pavements, curb and gutter, guard rail, drainage structures, earth fill, and sand sub-base on the expressway and ramp are not a part of this contract.
- The design of this structure is based on M.S.H.D. Standard Specifications for the Design of Highway Bridges-1958 Edition (MCO-516-44 and alternate military loading).
- Live load plus impact deflection - 1/1000 of span length.

CONTROL SECTION 631741

175 OVER 12 MILE ROAD IN THE CITY OF MADISON HEIGHTS

TECON ENGINEERS, INC.
J. V. MURPHY 6-5-62
COORDINATING ENGINEER
ENGINEER OF DESIGN-CONSULTANTS
R.L.T.
153 312
S03 OF 63174 I


NOTE:
DO NOT WORK FROM THIS SHEET. THE INFORMATION SHOWN HERE IS FOR REFERENCE ONLY. NO PAY ITEMS ARE SHOWN.



FOR INFORMATION ONLY				
SOUTH BOUND				
DATE	CONT. SEC.	JOB NO.	DESIGN UNIT	SHEET
02-05-99	S03 OF 63174	49595A	MADHAVI	3 OF 9

DATE: 01-10-01
CORRECTED BY: INDER
DATE:
CHECKED BY:
DATE:
DRAWN BY: inder
FILE NAME: s0363174sn.nb

1 2 3 4 5 6 7 8 9 10 11 12 13 14 15 16 17 18 19 20 21 22 23 24 25 26 27 28 29 30 31 32 33 34 35 36 37 38 39 40 41 42 43 44 45 46 47 48 49 50 51 52 53 54 55 56 57 58 59 60 61 62 63

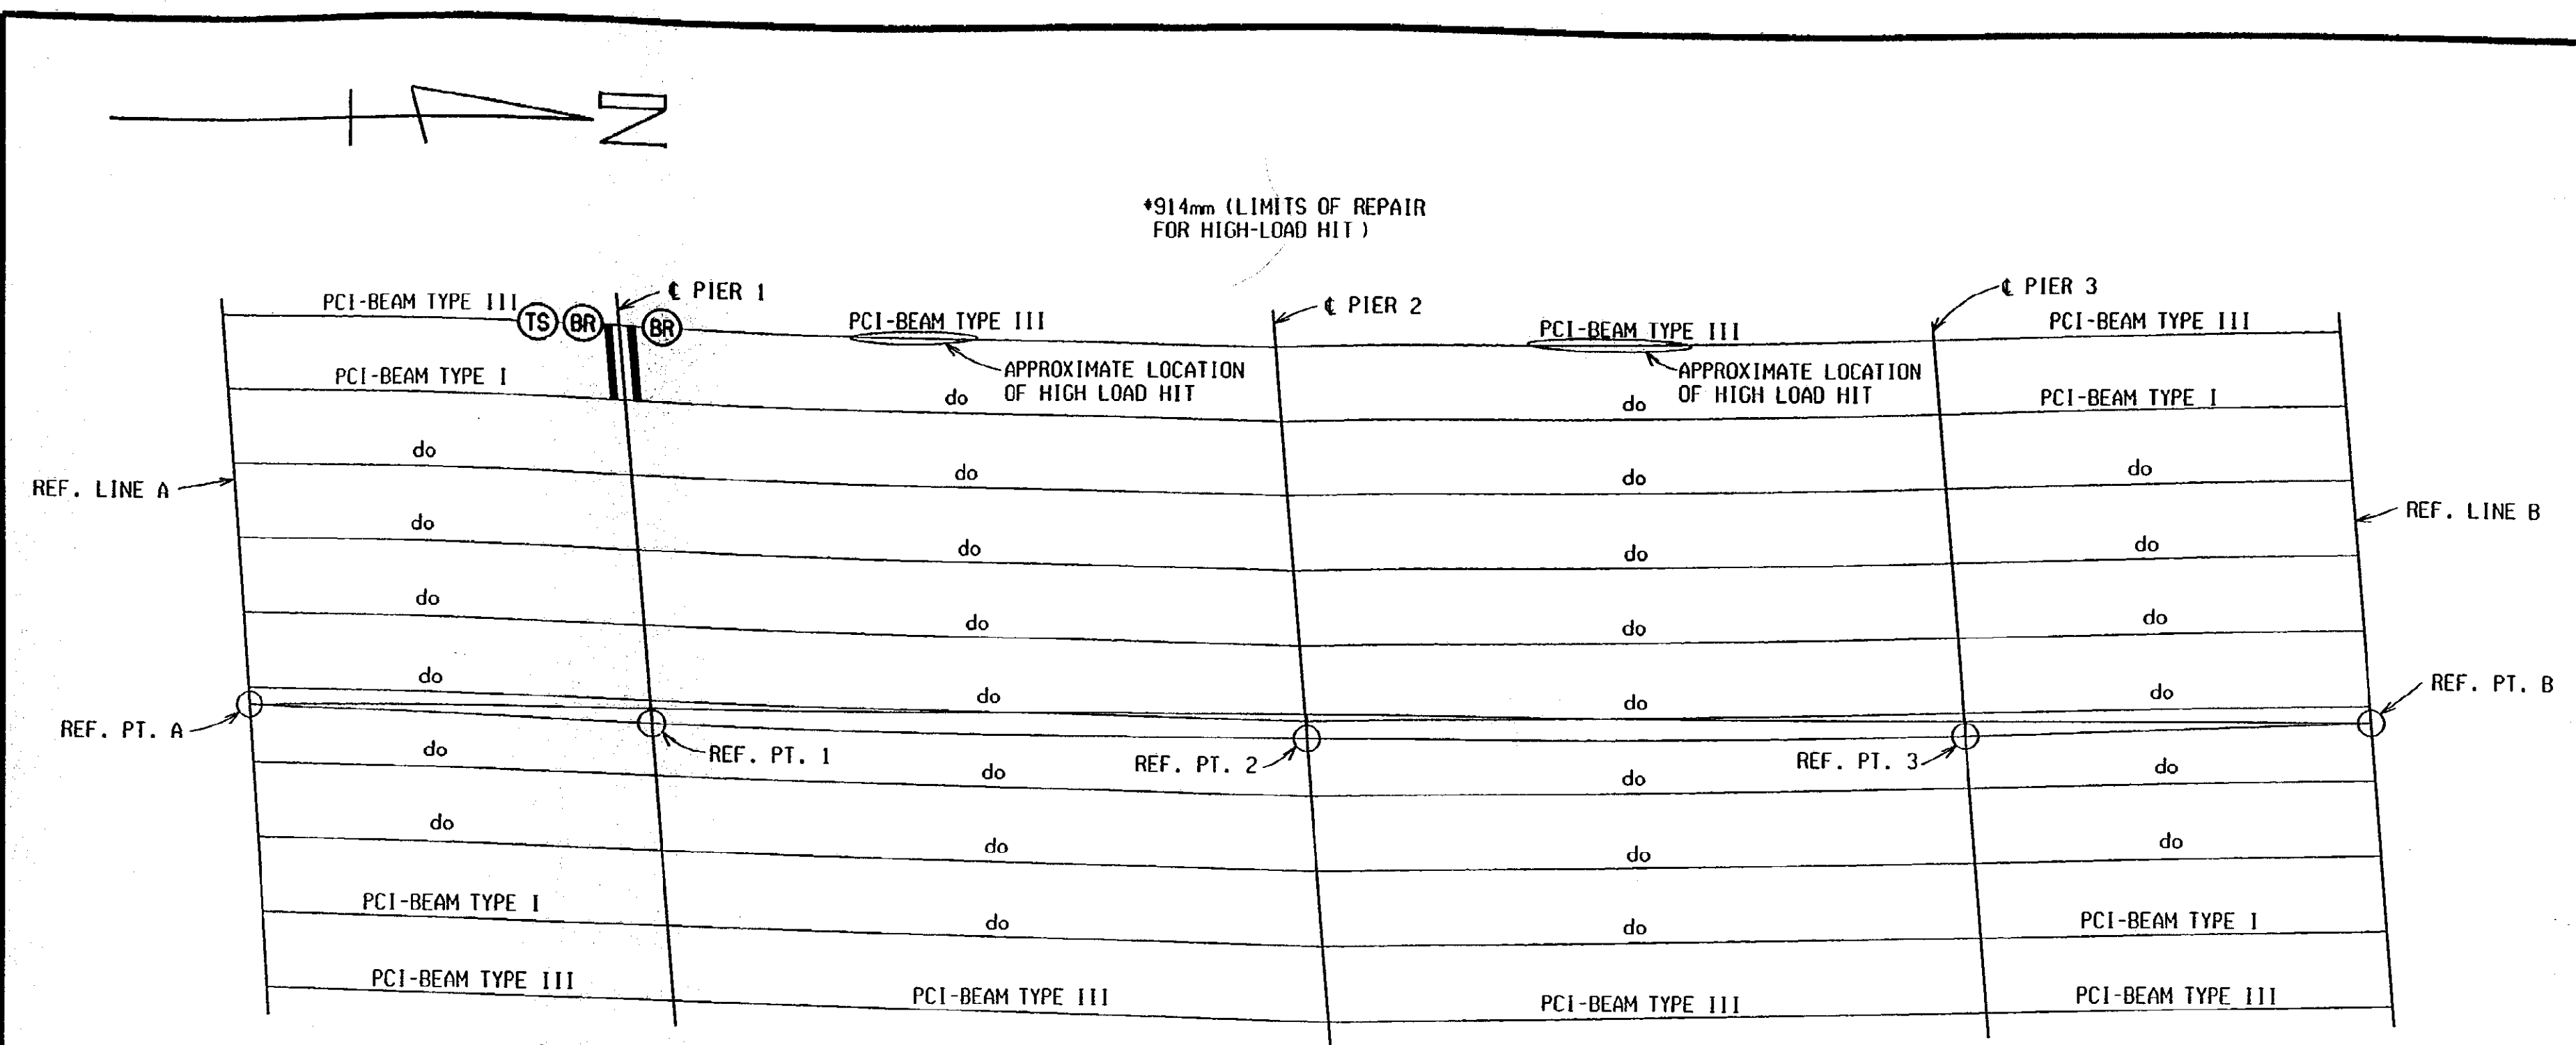

PLAN
BEAM END REPAIR


- (BR) DENOTES BEAM END REPAIR
- (DR) DENOTES DIAPHRAGM REPAIR
- (TS) DENOTES TEMPORARY SUPPORT

* LIMITS OF HIGH-LOAD HIT REPAIR SHALL BE FIELD VERIFIED AND REPAIRED AS DIRECTED BY THE ENGINEER.


MISCELLANEOUS QUANTITIES

6 m ²	Patch, Forming
2 ea	Removal, Beam End Repair *
1 m ³	Hand Chipping, Other Than Deck
132 kg	Reinforcement, Steel, Epoxy Coated
3 m ³	Patching Concrete, LM ***
1 m ³	Conc, Grade D
6 m ²	Forming, Beam End Repair*
1 LS	Concrete Surface Sealer **
1 LS	Structures, Rehabilitation, Rem Portions (S03, SB)
2 m ³	Hand Chipping, Special +
1 ea	Strand Splicing +
58 m ²	Slope Paving, Conc
25 m	Slope Paving Header

* REFER TO SPECIAL PROVISION FOR PRESTRESSED CONCRETE BEAM END REPAIR.
 ** REFER TO SPECIAL PROVISION FOR CONCRETE SURFACE SEALERS.
 *** REFER TO SPECIAL PROVISION FOR STRUCTURAL REPAIR WITH LATEX MODIFIED CONCRETE.
 + FOR REPAIR OF HIGH LOAD HIT ON THE FASCIA BEAMS (SEE SPECIAL PROVISION FOR "Prestressed Concrete Beam Repair").

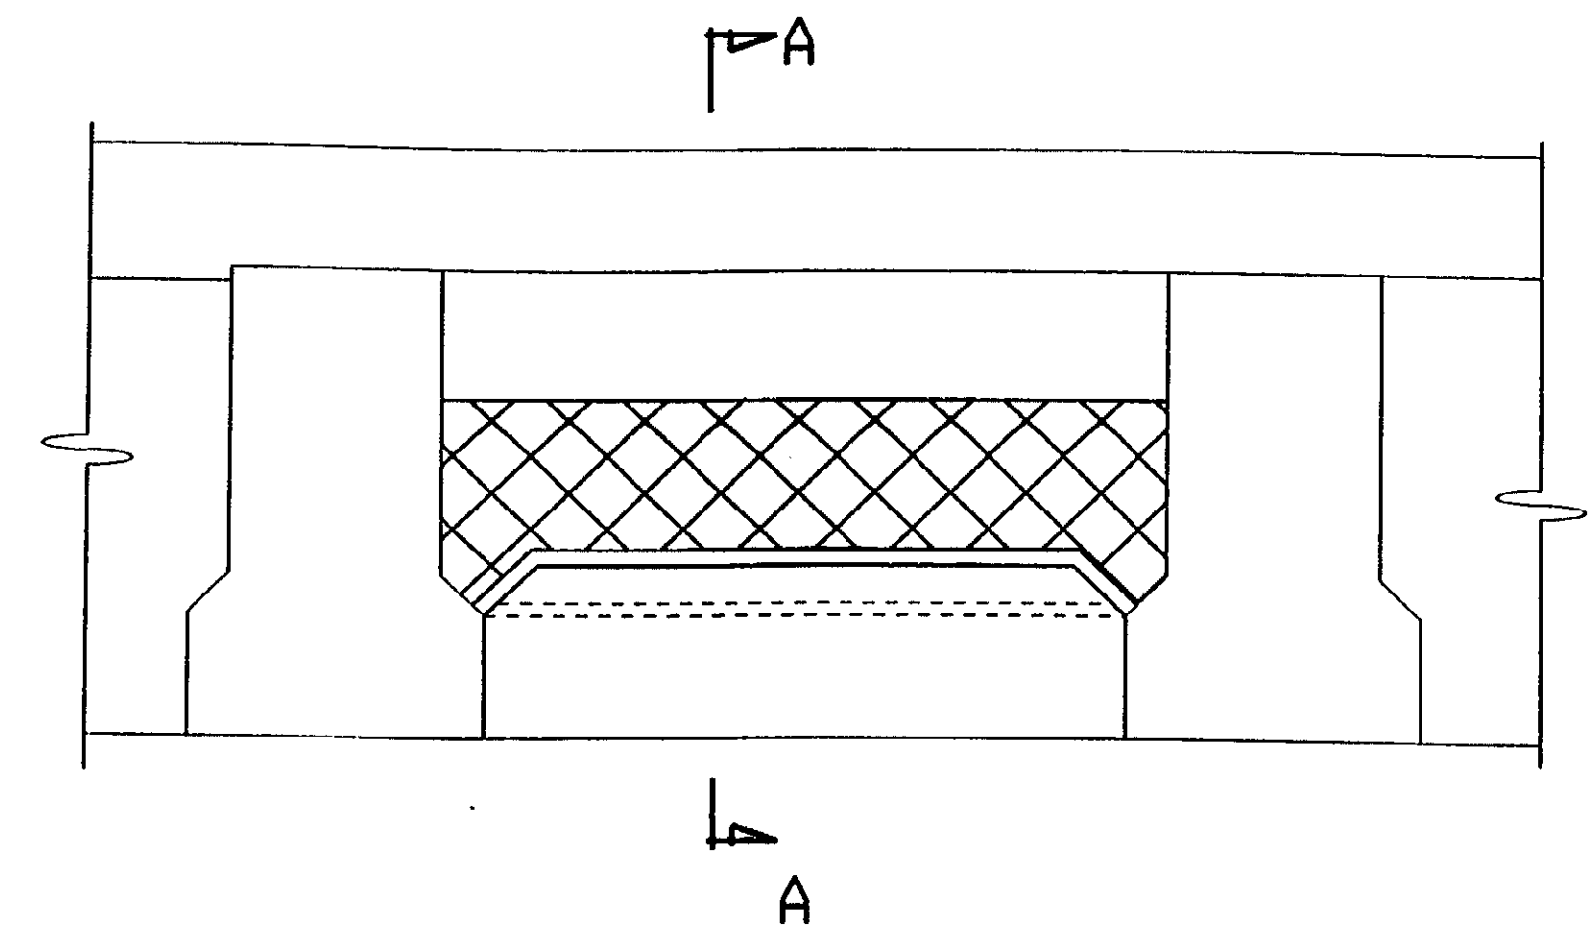


END DIAPHRAGM

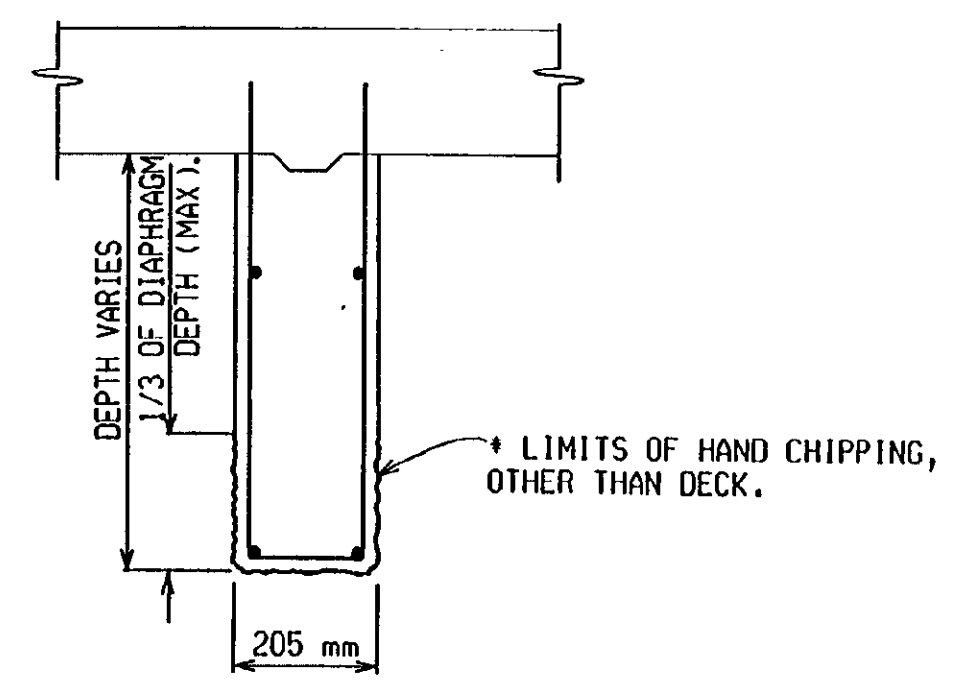

* LIMITS OF HAND CHIPPING AND LOCATION SHALL BE FIELD VERIFIED AND AS DIRECTED BY THE ENGINEER.

SECTION A-A

REVISIONS			
NO.	DESCRIPTION	DATE	BY

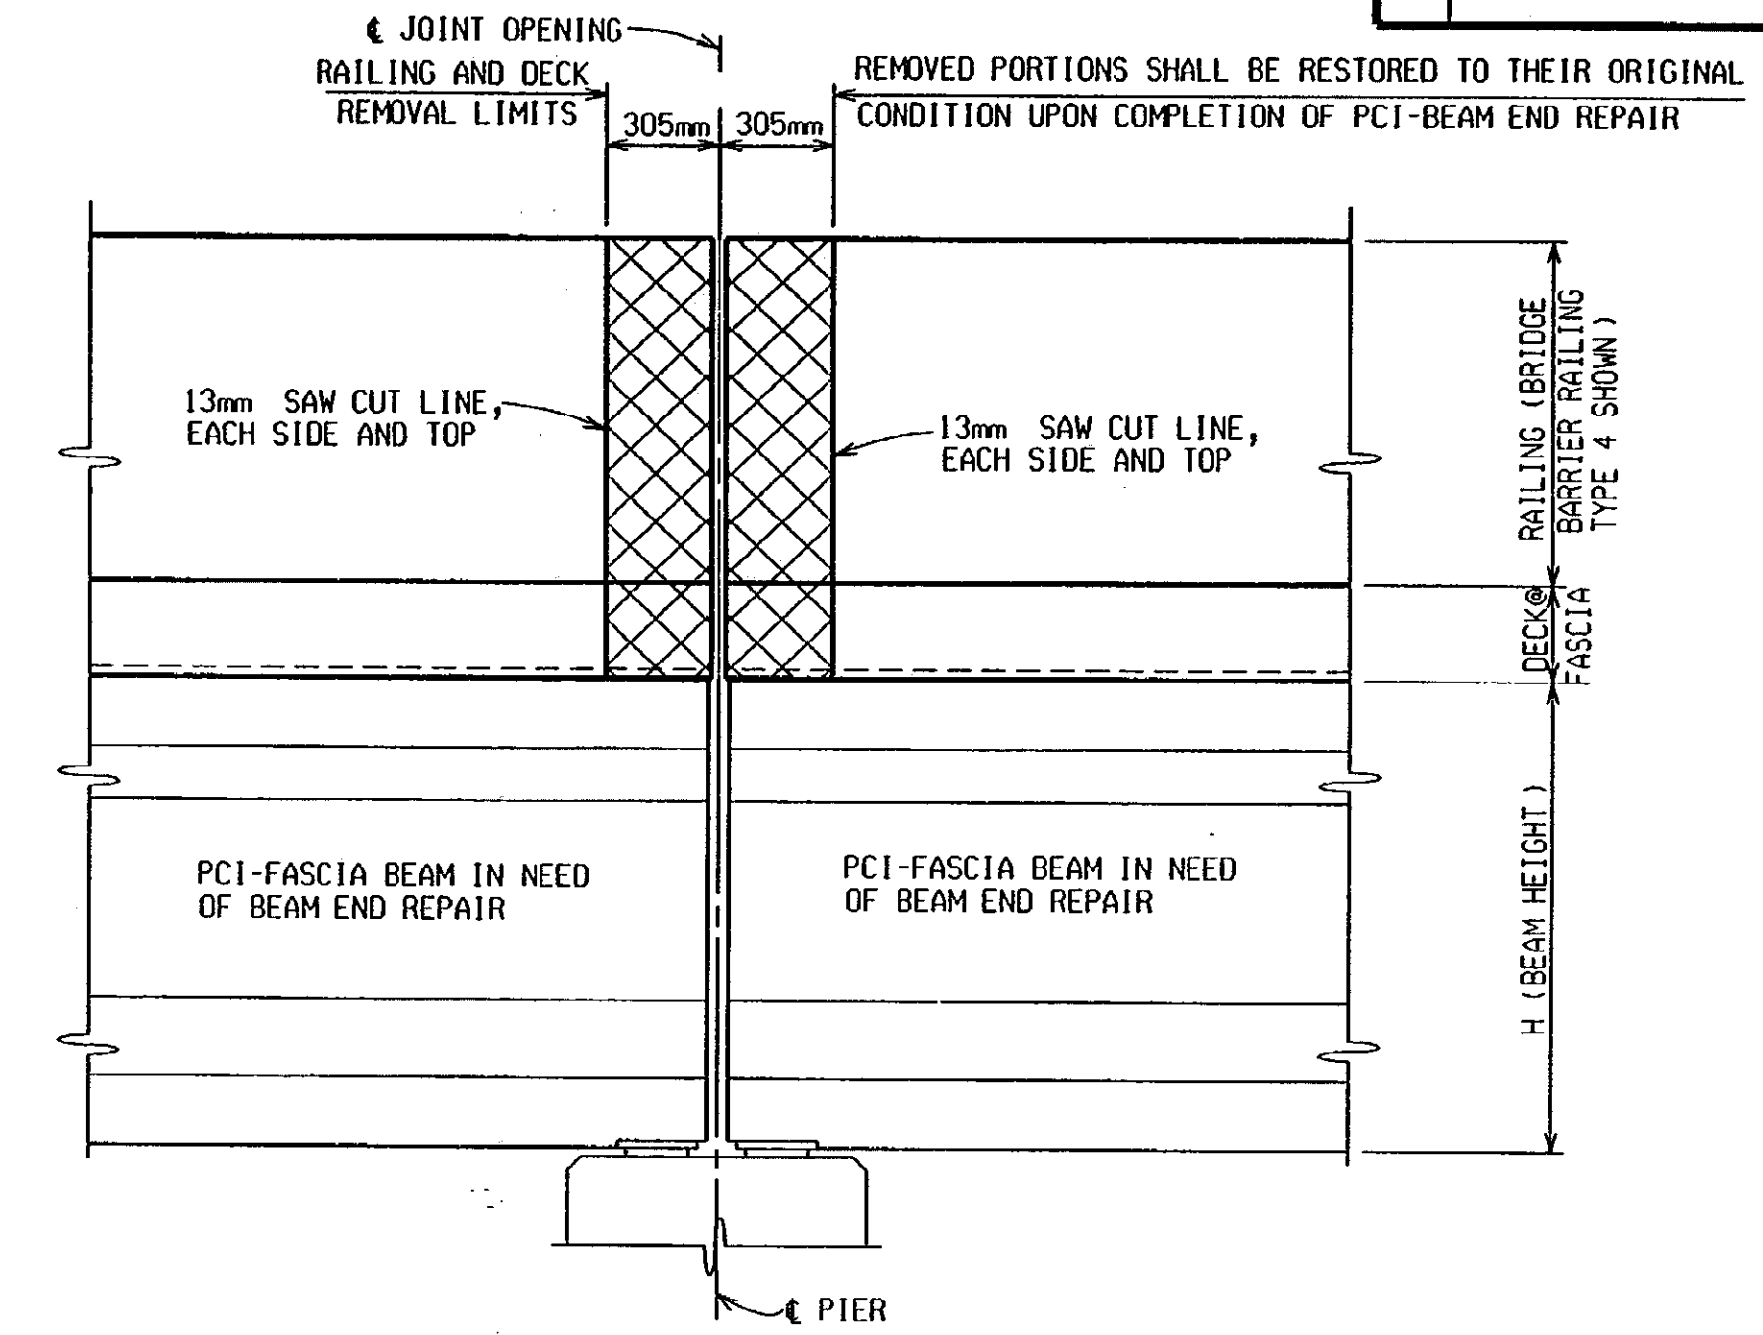

ELEVATION OF FASCIA SHOWING SLAB AND RAILING REMOVAL LIMITS

(BRIDGE BARRIER RAILING, TYPE 4 IS SHOWN. SITUATION USING OTHER RAILING TYPES, INCLUDING RAILINGS ON BRUSH BLOCKS OR SIDEWALKS, IS SIMILAR)

XXXX DENOTES REMOVAL LIMITS REQUIRED FOR PROPER PLACEMENT OF CONCRETE DURING EXTERIOR PORTION OF FASCIA BEAM REPAIR.

PORTION OF RAILING, BRUSH BLOCK IF REQUIRED, AND SLAB SHALL BE REMOVED AS SHOWN, ONLY IF EXTERIOR SIDE OF FASCIA BEAM WILL RECEIVE PCI-BEAM END REPAIR. INCLUDED IN THE BID ITEM "Structure, Rehabilitation, Rem Portions (S03, SB)".

DURING REMOVAL, CARE SHALL BE TAKEN TO AVOID DAMAGING THE EXISTING STEEL REINFORCEMENT IN THE RAILING, BRUSH BLOCK IF REQUIRED, AND PORTION OF SLAB. ONCE THE PCI-FASCIA BEAM REPAIR IS COMPLETED, THE EXPOSED STEEL REINFORCEMENT SHALL BE CLEANED, STRAIGHTENED AND RECAST INTO PROPOSED CONCRETE, NOT PAID FOR SEPARATELY BUT INCLUDED IN THE BID ITEM "Concrete, Grade D".

COST OF FORMING FOR THE PORTION OF BRIDGE RAILING AND BRUSH BLOCK SHALL BE INCLUDED IN THE BID ITEM "Conc, Grade D".

STEEL RAILING POSTS, TUBES AND ATTACHMENT HARDWARE REQUIRING REMOVAL, SHALL BE SALVAGED AND REINSTALLED, NOT PAID FOR SEPARATELY BUT INCLUDED IN THE BID ITEM "Concrete, Grade D".

REMOVAL AND REPLACEMENT LIMITS MAY BE INCREASED AT THE CONTRACTORS EXPENSE.

NOTES:

THE WORK COVERED BY THESE PLANS INCLUDES RESURFACING THE EXISTING BRIDGE DECK, THREE BEAM RETROFIT, EXPANSION JOINT REPLACEMENT, CONCRETE BEAM END REPAIR, SUBSTRUCTURE REPAIR AND MAINTAINING TRAFFIC. ALL OTHER WORK IS INCLUDED IN THE ROAD PLANS THAT ARE A PART OF THIS CONTRACT.

IF THE CONTRACTOR ELECTS TO REPAIR MORE THAN ONE BEAM END AT A TIME, WORK SHALL NOT BE DONE ON THE SAME END OF ANY ADJACENT BEAM OR AT THE OPPOSITE END OF THE BEAM BEING REPAIRED.

ES DENOTES EACH SIDE.

ADHESIVE ANCHOR EB13 BARS INTO 38 mm Ø HOLES IN BEAM WEB.

DRILLING OF HOLES SHALL NOT BE PERMITTED, EXCEPT AS NOTED.

THE LIMITS OF THE CONCRETE SEALER SHALL INCLUDE THE OUTSIDE FACE FOR THE FULL LENGTH OF THE FASCIA BEAMS AND ALL SURFACES OF ALL BEAM ENDS NOT BEING REPAIRED FOR A LENGTH NOT LESS THAN TWICE THE BEAM DEPTH. REFER TO SPECIAL PROVISION FOR CONCRETE SURFACE SEALERS FOR PRODUCT INFORMATION AND SURFACE PREPARATION. THE ESTIMATED QUANTITY IS 310m².


WHERE A DIAPHRAGM IS REMOVED IN A BAY FROM THE SIDE OF A BEAM THAT IS NOT BEING REPAIRED, THE EXISTING INSERT HOLES SHALL BE FILLED WITH CAULK AND THE PROPOSED DIAPHRAGM REINFORCEMENT SHALL BE EPOXY ANCHORED TO THE BEAM IN THE NEW LOCATION. INCLUDED IN THE PAY ITEM "Removal, Beam End Repair".



BEAM REPAIR DETAILS				
SOUTH BOUND				
DATE	CONT. SEC.	JOB NO.	DESIGN UNIT	SHEET
01-10-01	S03 OF 63174	49595A	MAHDAVI	4 OF 9

DATE: 01-10-01 CORRECTED BY: INDER DATE: 01-10-01 CHECKED BY: WM DATE: 11/2000 DRAWN BY: R.K-OLIN FILE NAME: s0363174s.br


1 2 3 4 5 6 7 8 9 10 11 12 13 14 15 16 17 18 19 20 21 22 23 24 25 26 27 28 29 30 31 32 33 34 35 36 37 38 39 40 41 42 43 44 45 46 47 48 49 50 51 52 53 54 55 56 57 58 59 60 61 62 63

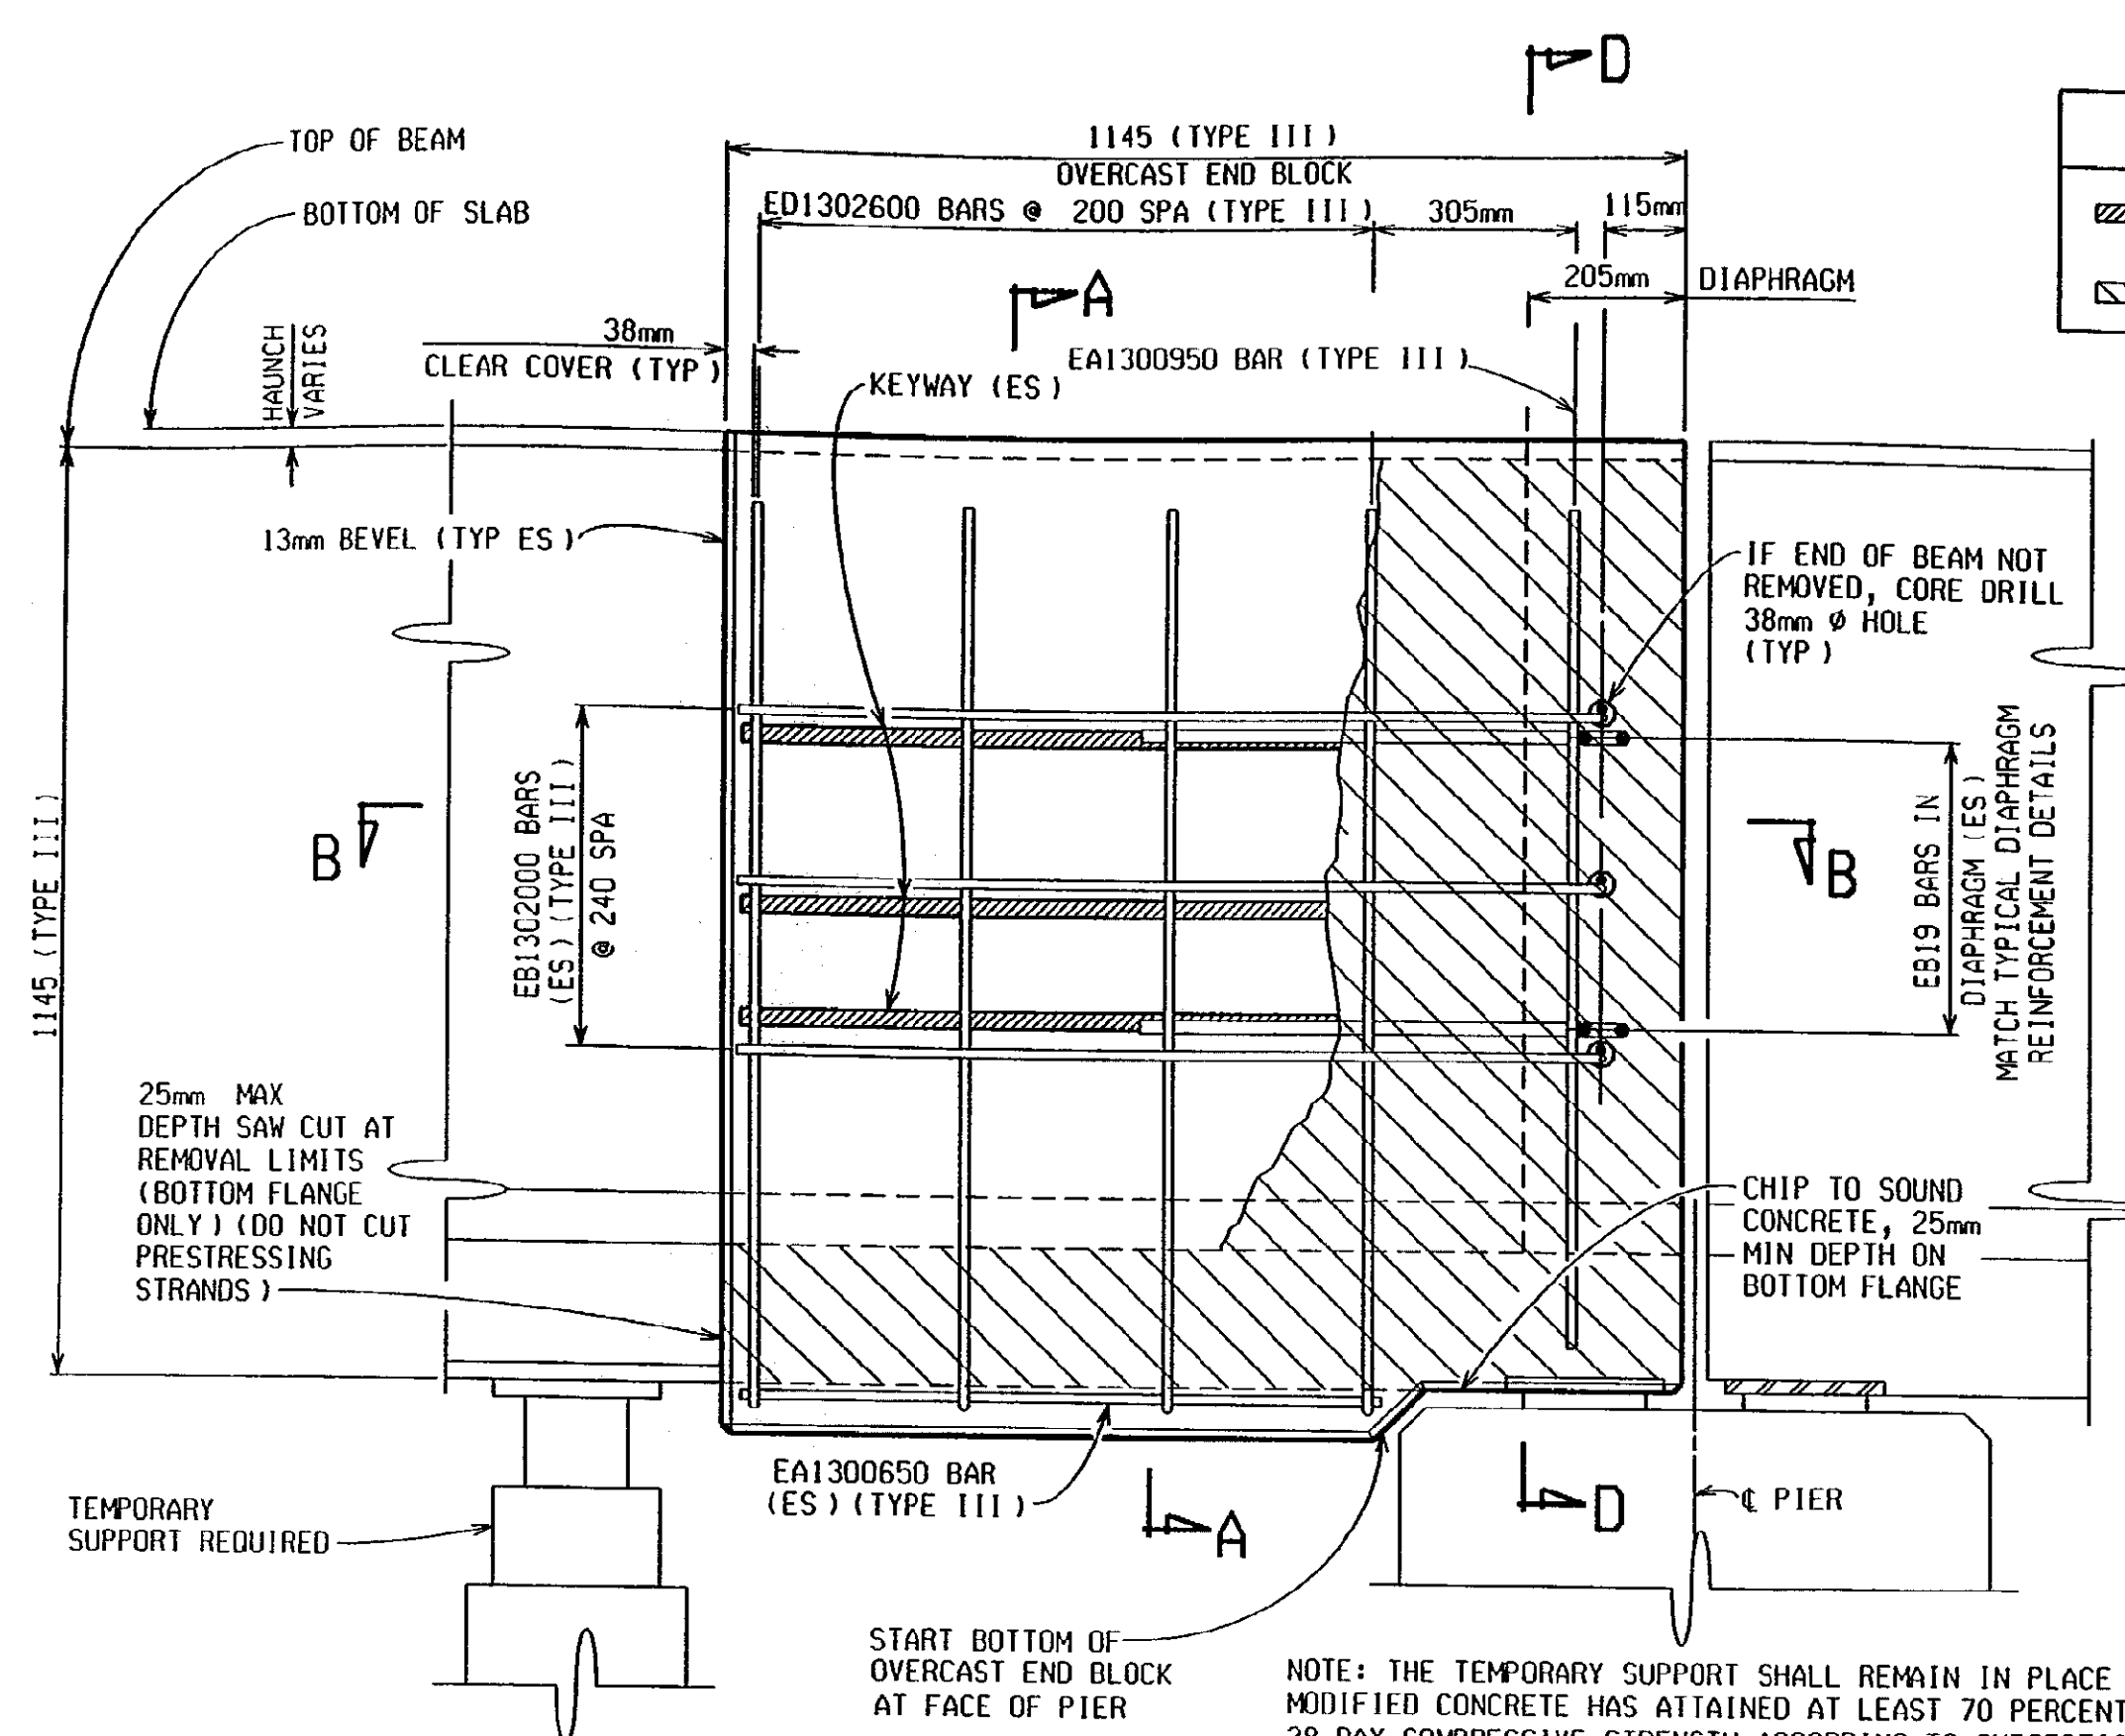


BEAM END ELEVATION
(SITUATION AT PIER IS SHOWN. SITUATION AT ABUTMENT WITH INDEPENDENT BACKWALL IS SIMILAR).

LEGEND


	KEYWAY, 13mm DEEP X 25mm WIDE SAW CUT
	CHIPPED CONCRETE

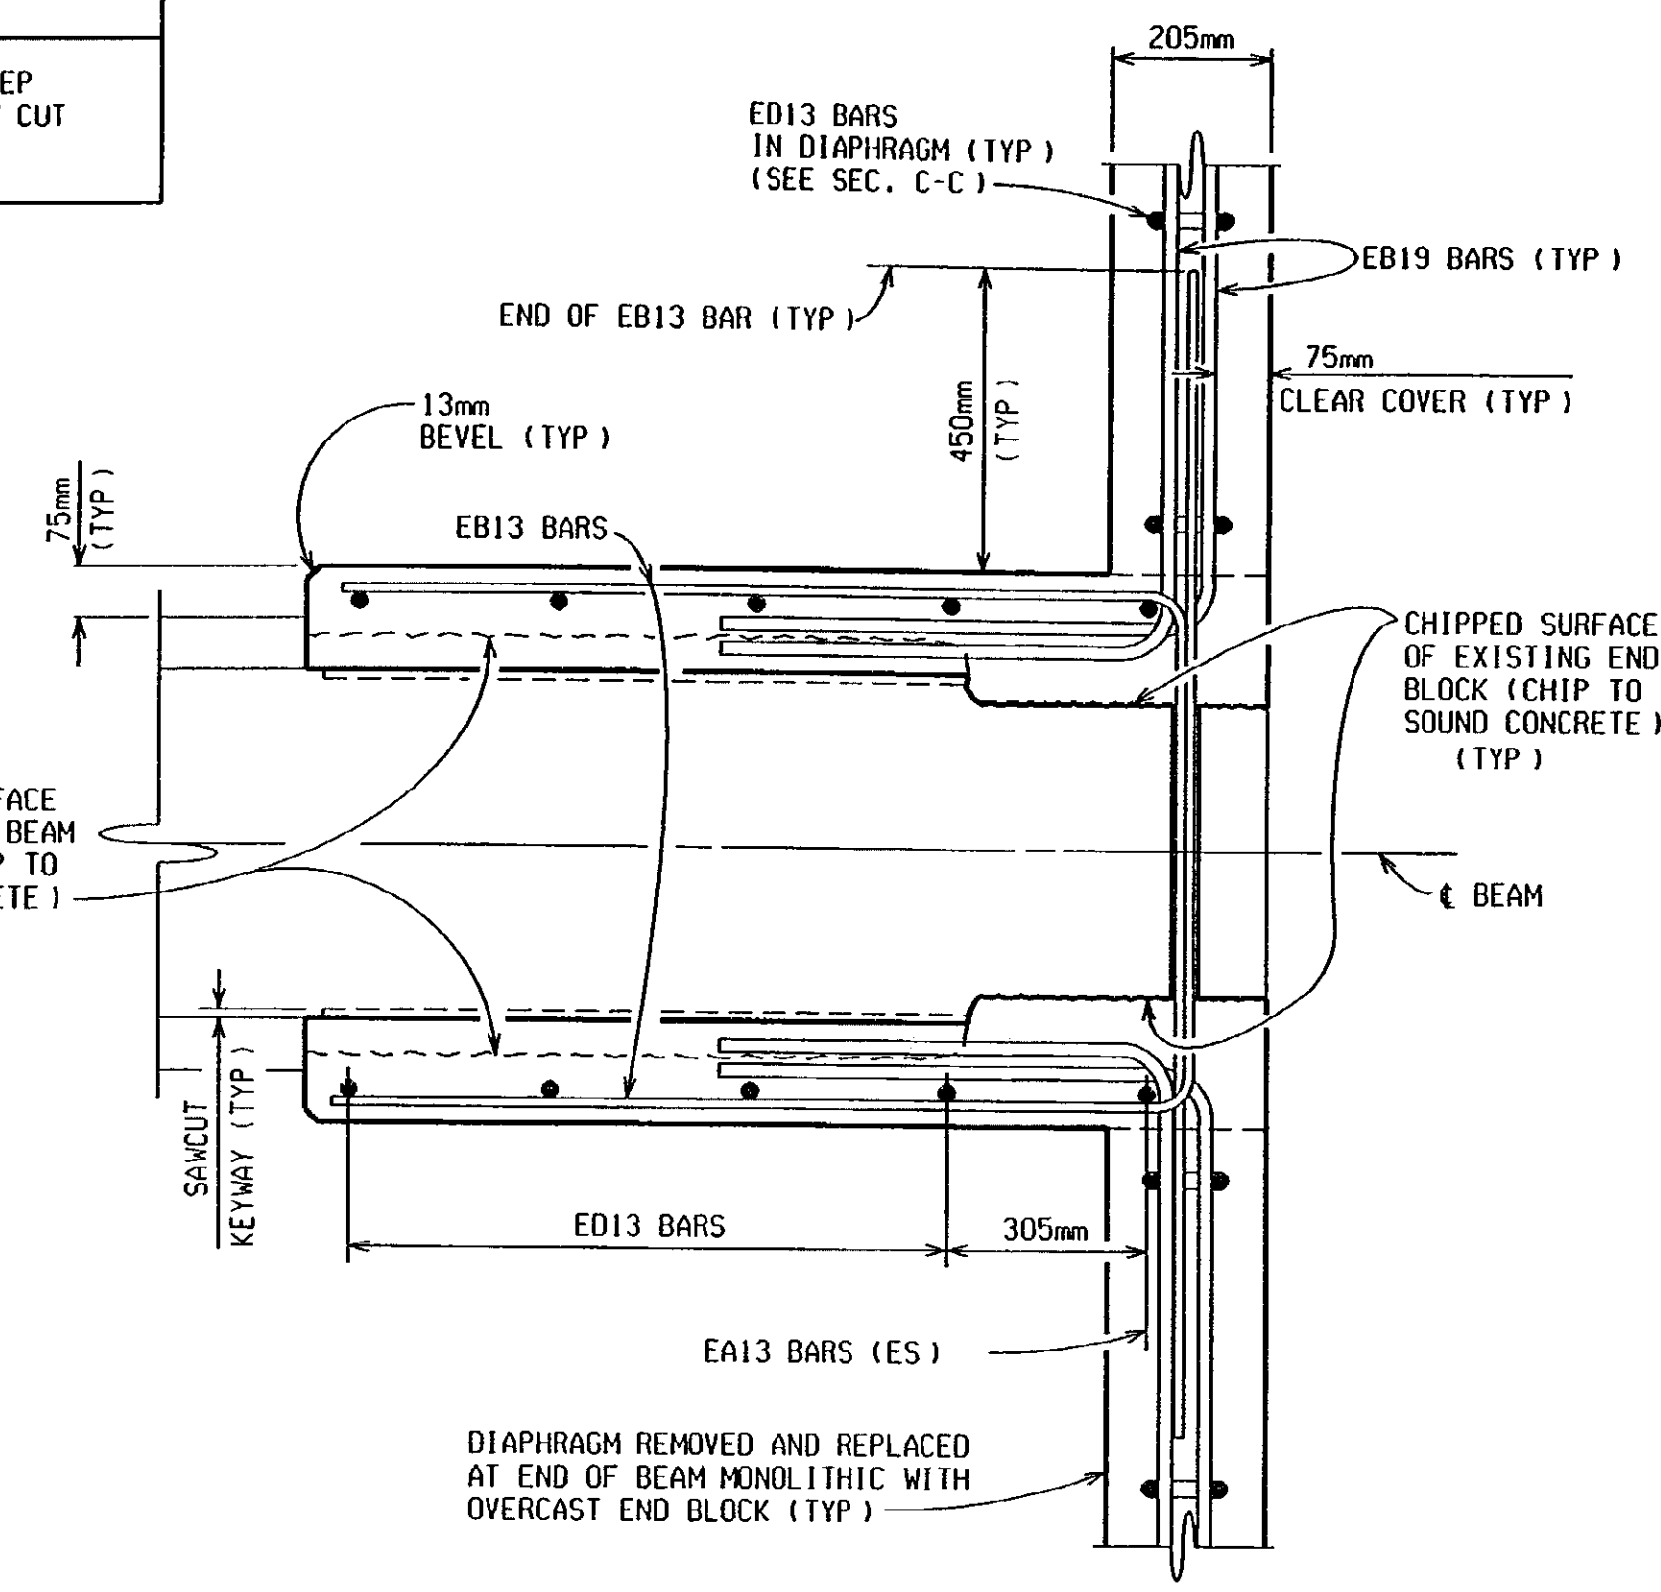

SECTION B-B

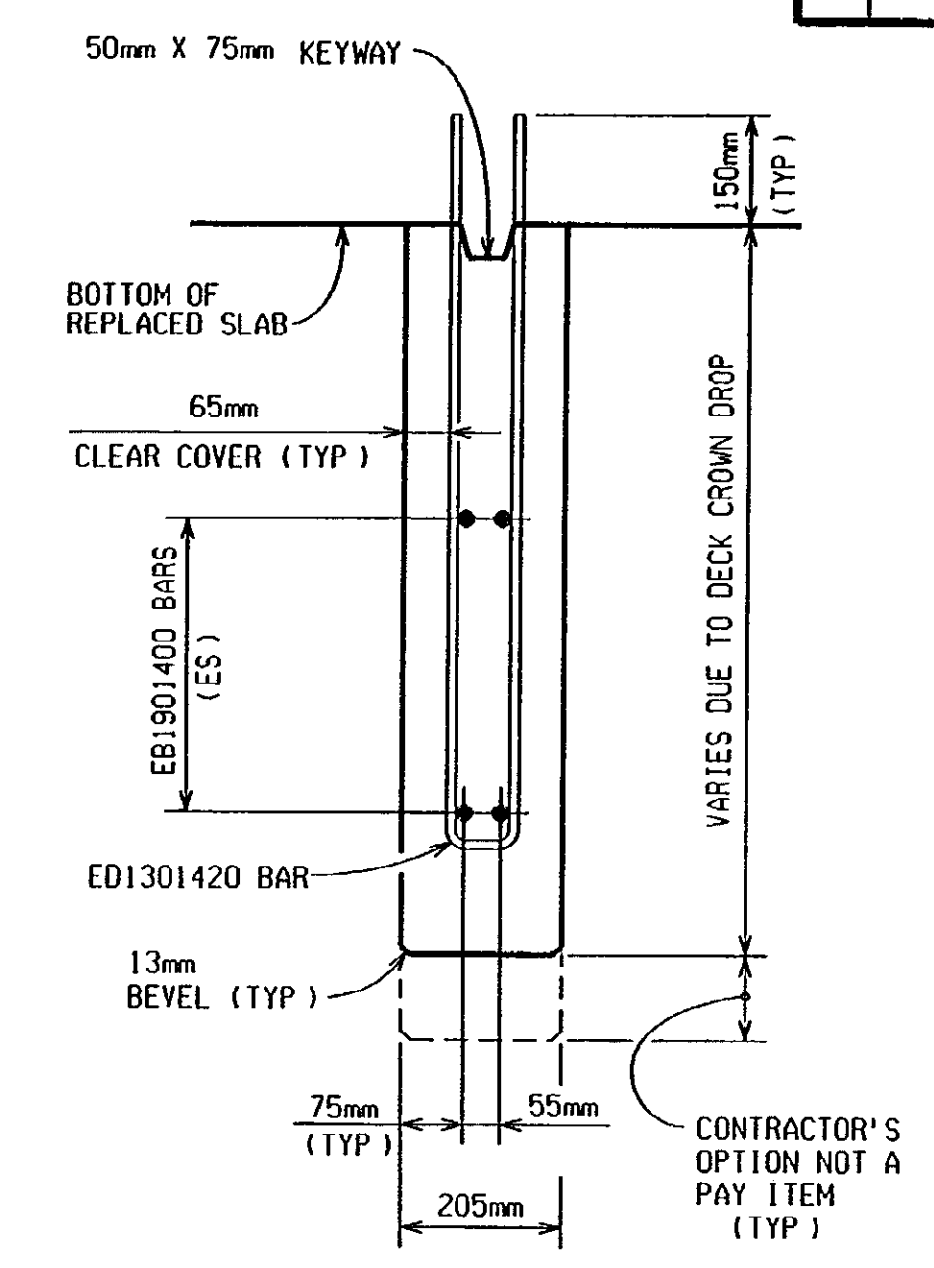


SECTION C-C

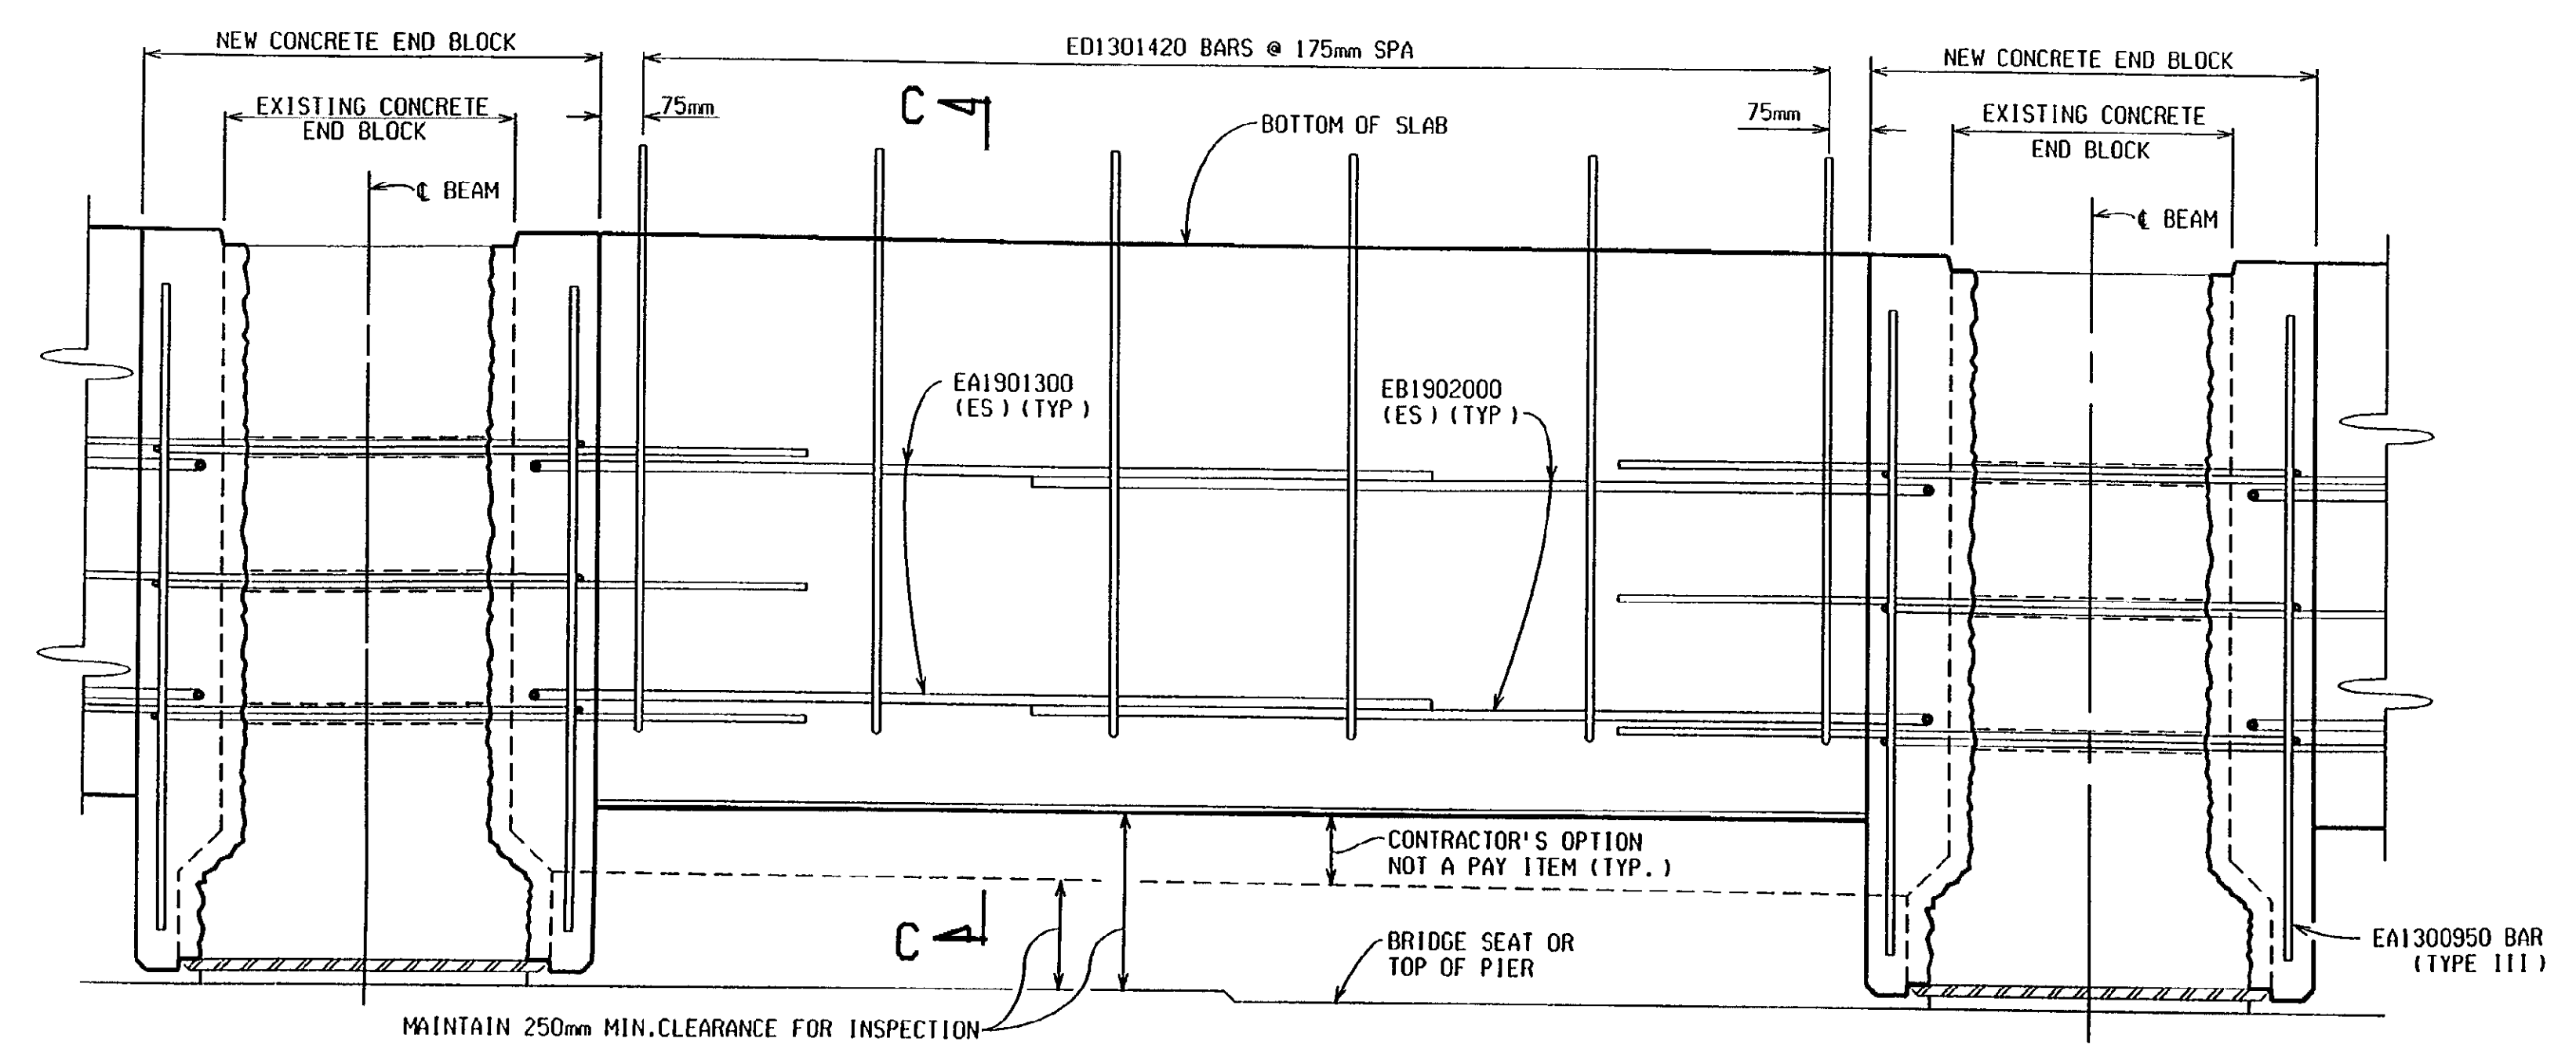

SECTION D-D (DIAPHRAGM ELEVATION)
(SHOWING STEEL REINFORCEMENT)

NOTE: REPLACE DECK OVER BEAM END REPAIR AREA.

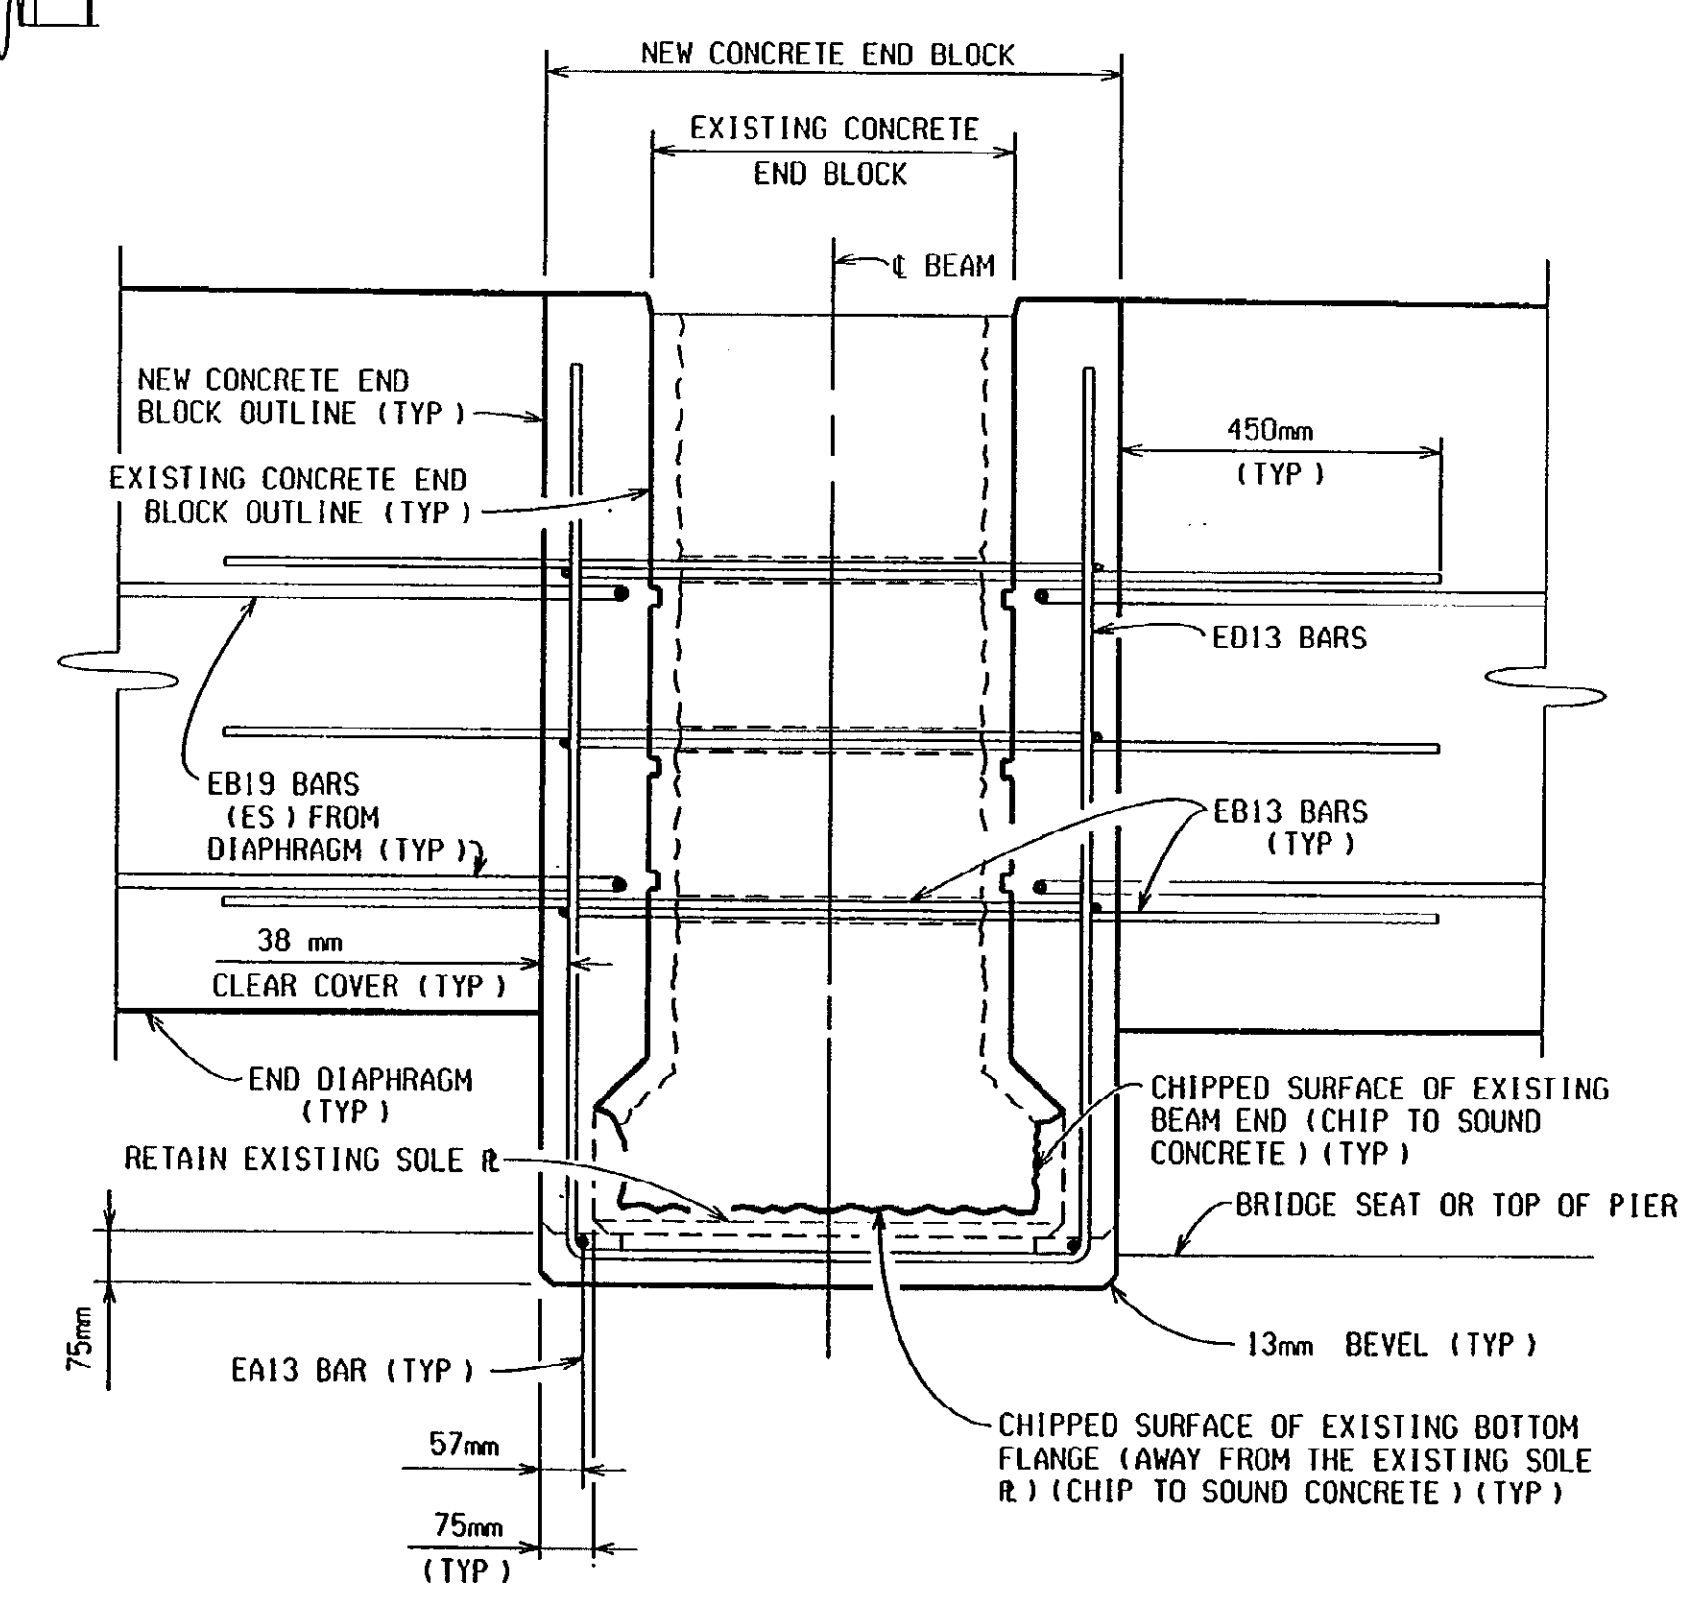

SECTION A-A
(ED13 BARS IN DIAPHRAGMS NOT SHOWN)


REVISIONS

NO.	DESCRIPTION	DATE	BY

BEAM REPAIR DETAILS				
SOUTH BOUND				
DATE	CONT. SEC.	JOB NO.	DESIGN UNIT	SHEET
01-10-01	S03 OF 63174	49595A	MAHDAVI	5 OF 9


DATE: 12-1-00
CORRECTED BY: R.K. OLIN
DATE:
CHECKED BY: MM
DATE: 11/2000
DRAWN BY: R.K. OLIN
FILE NAME: s03s3174s.br

1 2 3 4 5 6 7 8 9 10 11 12 13 14 15 16 17 18 19 20 21 22 23 24 25 26 27 28 29 30 31 32 33 34 35 36 37 38 39 40 41 42 43 44 45 46 47 48 49 50 51 52 53 54 55 56 57 58 59 60 61 62 63


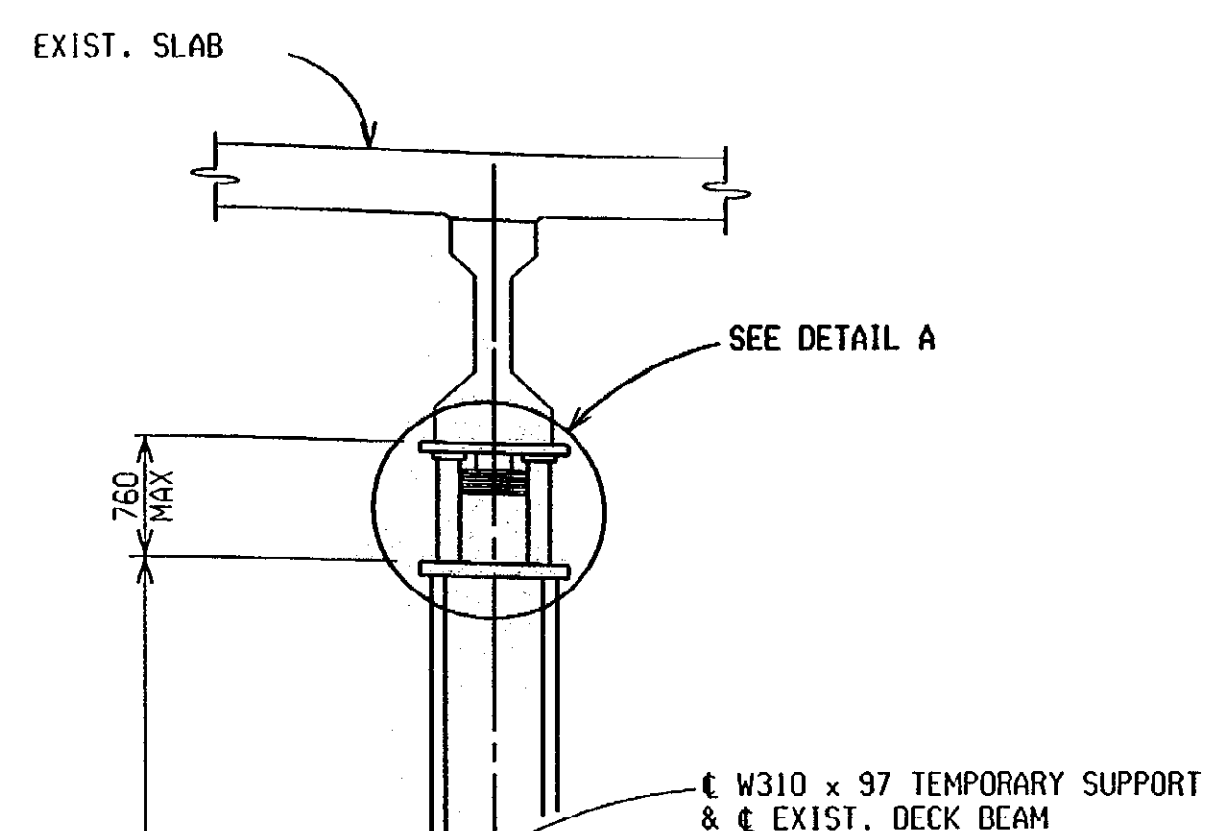


TIMBER FOOTING ON NATURAL GROUND-TS 1

* EXACT HEIGHT TO BE DETERMINED BY CONTRACTOR. HEIGHT NOT TO EXCEED 4270mm.

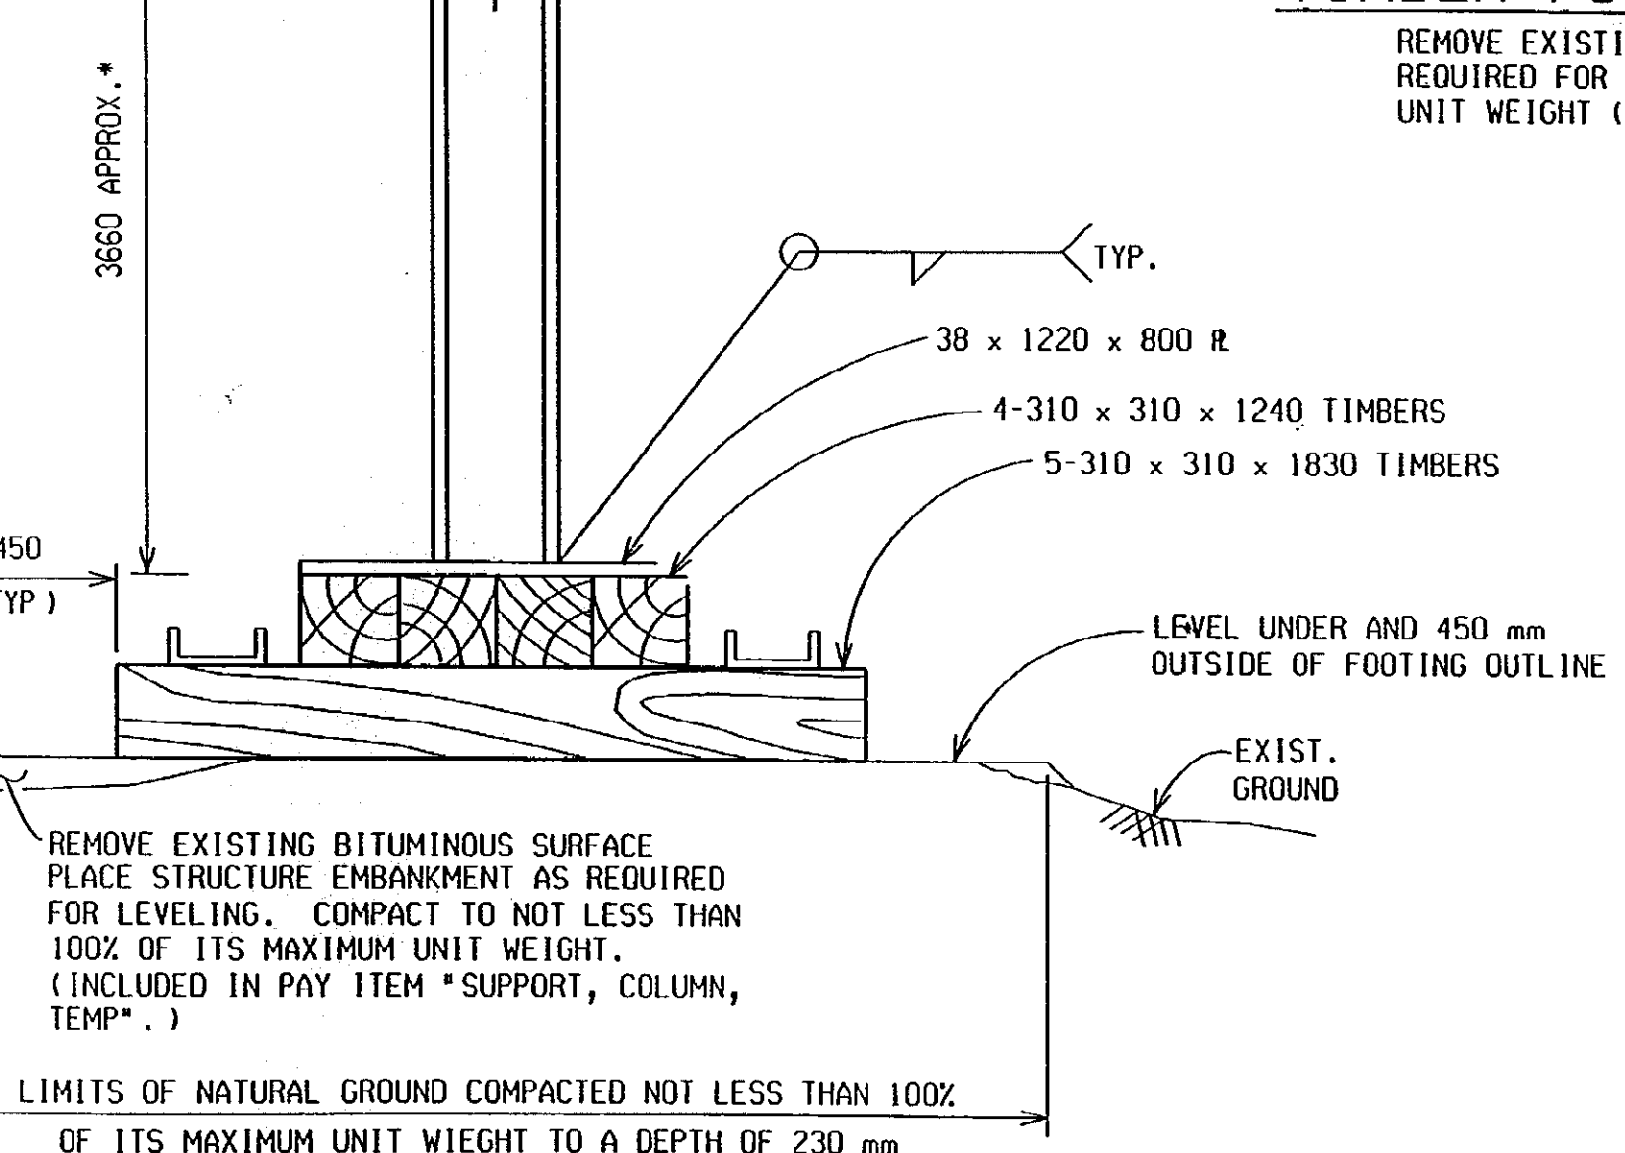


TIMBER FOOTING PLAN

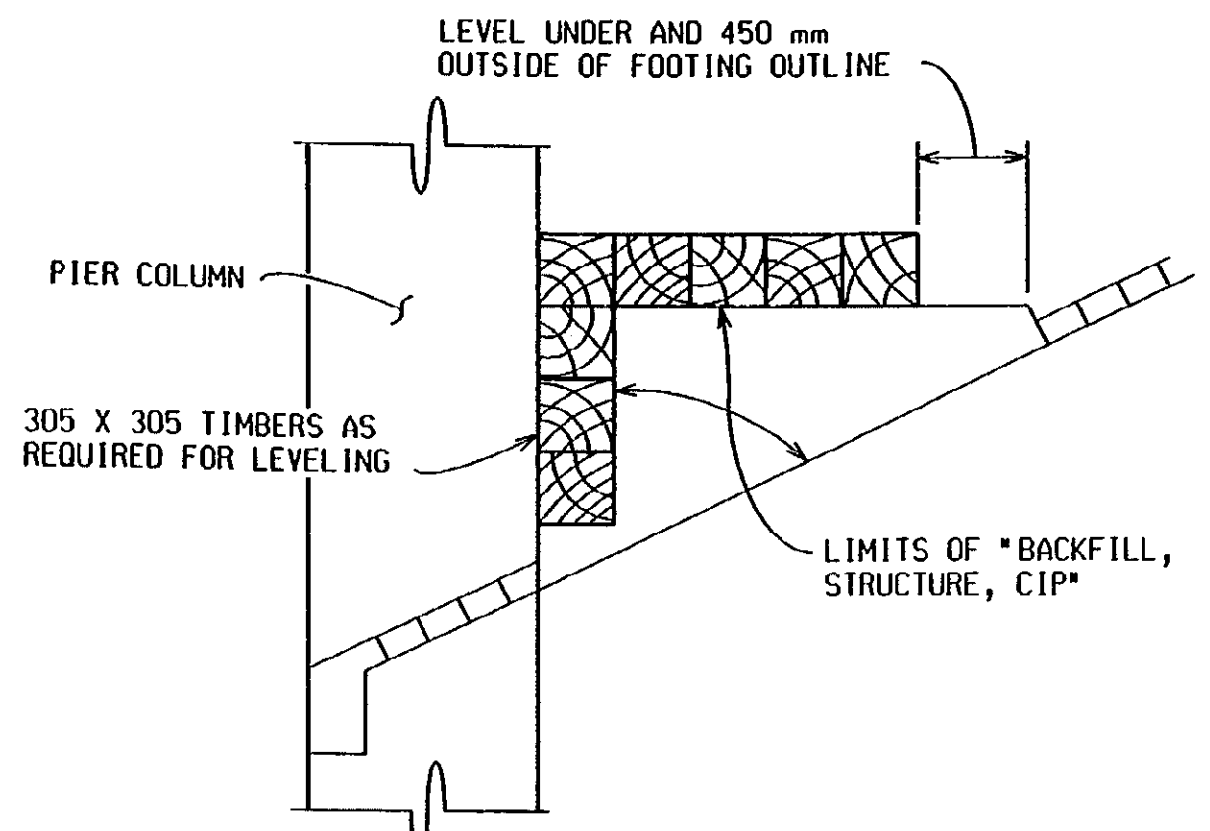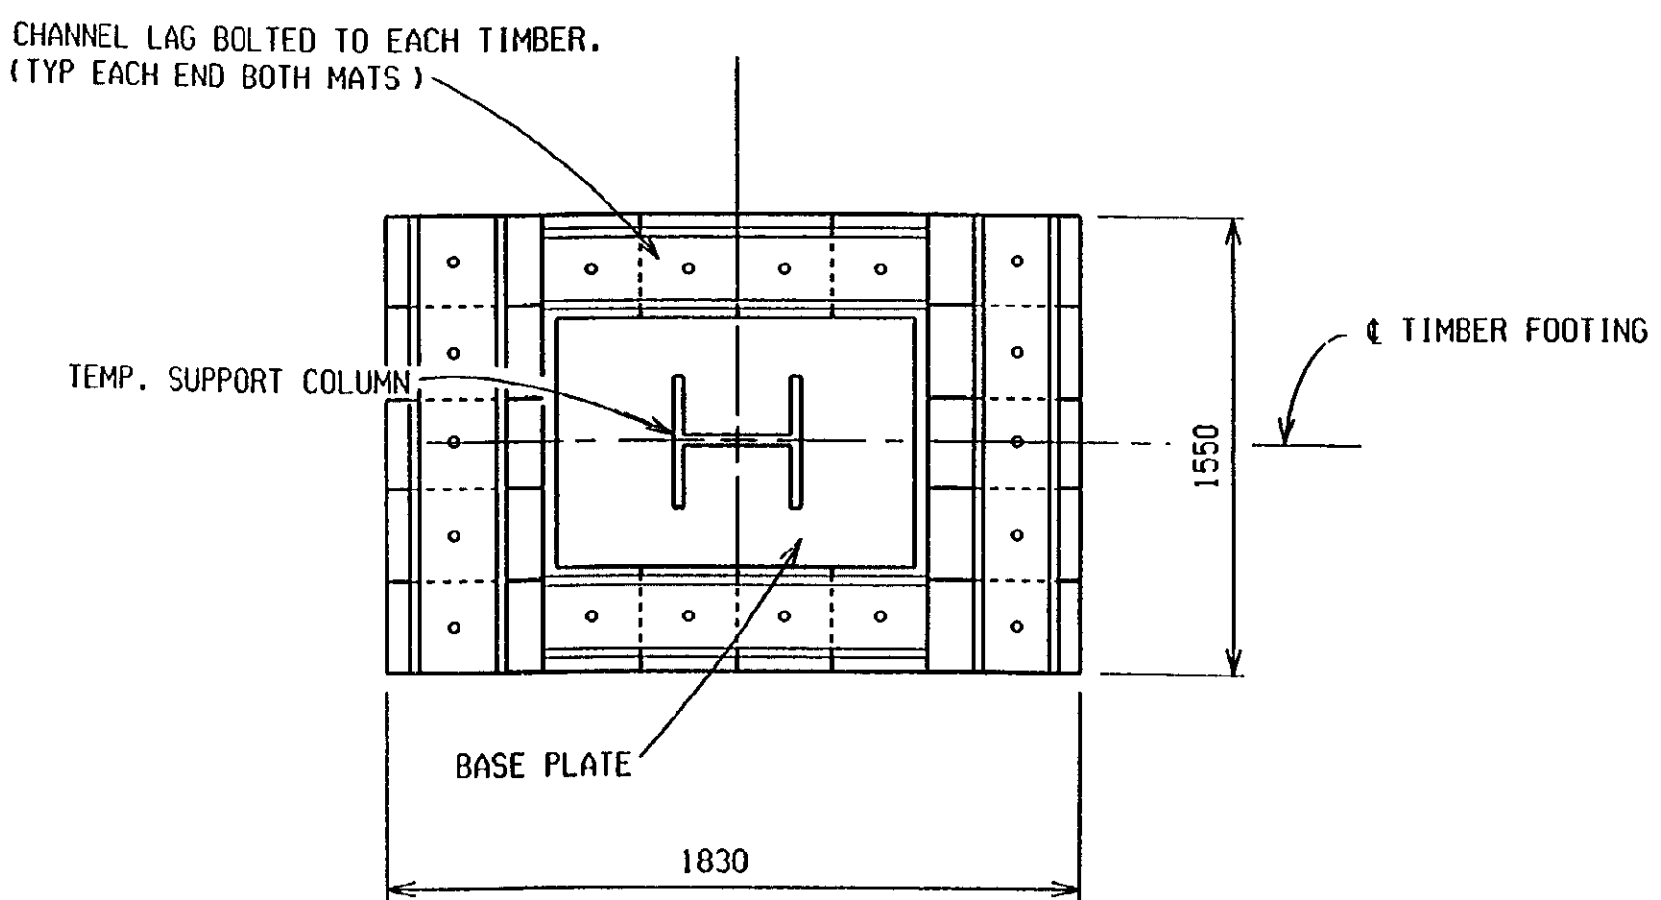


TIMBER FOOTING ON SLOPE PAVING-TS 2

REMOVE EXISTING SLOPE PAVING, PLACE STRUCTURE EMBANKMENT AS REQUIRED FOR LEVELING COMPACT TO NOT LESS THAN 100% OF ITS MAX. UNIT WEIGHT (INCLUDED IN THE PAY ITEM *SUPPORT, COLUMN, TEMP*.)

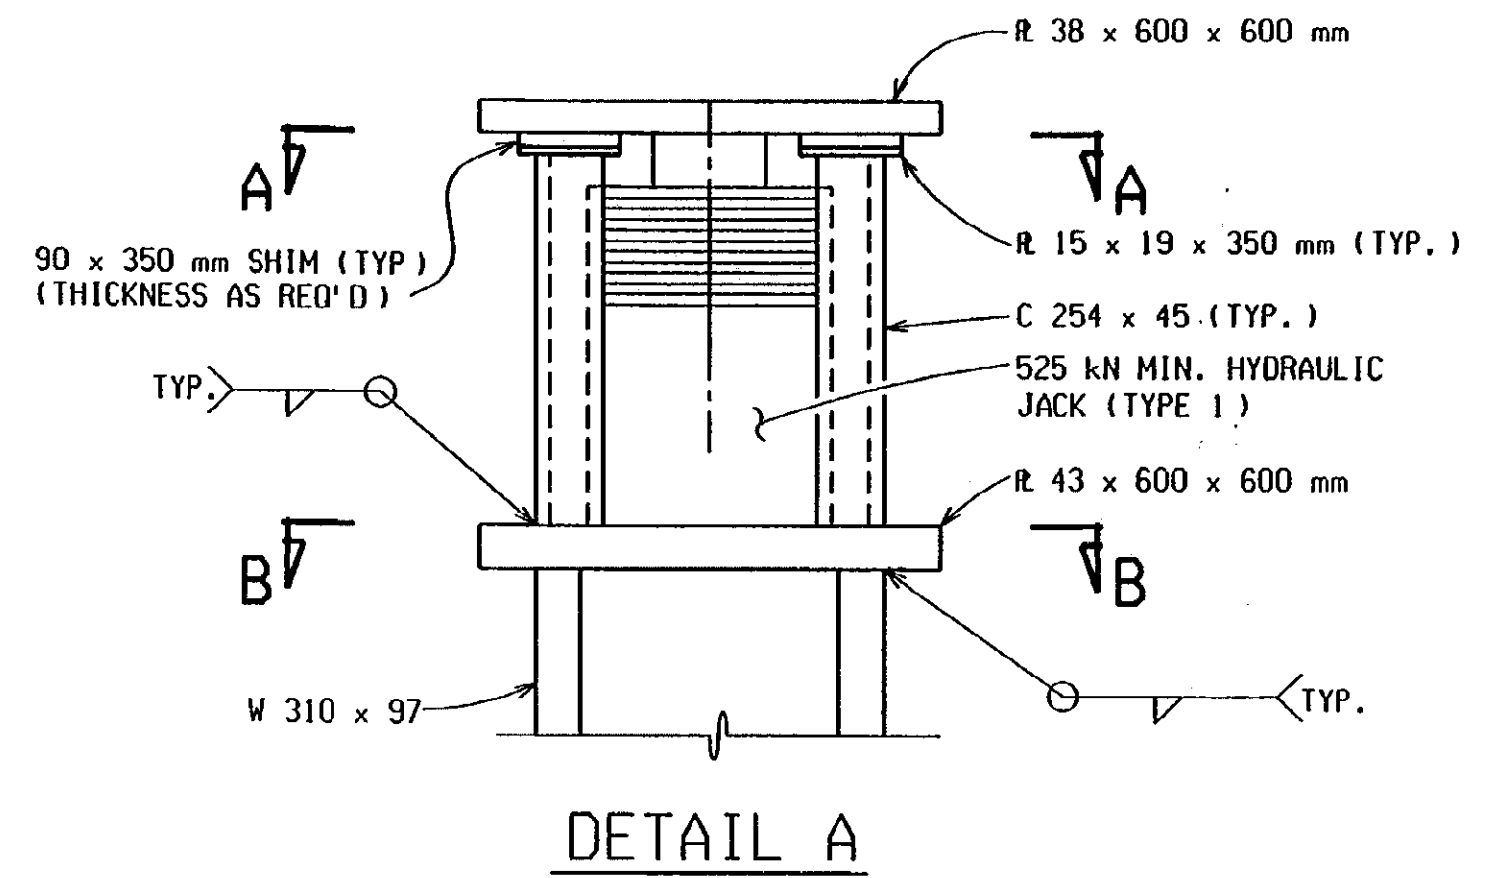


DETAIL A

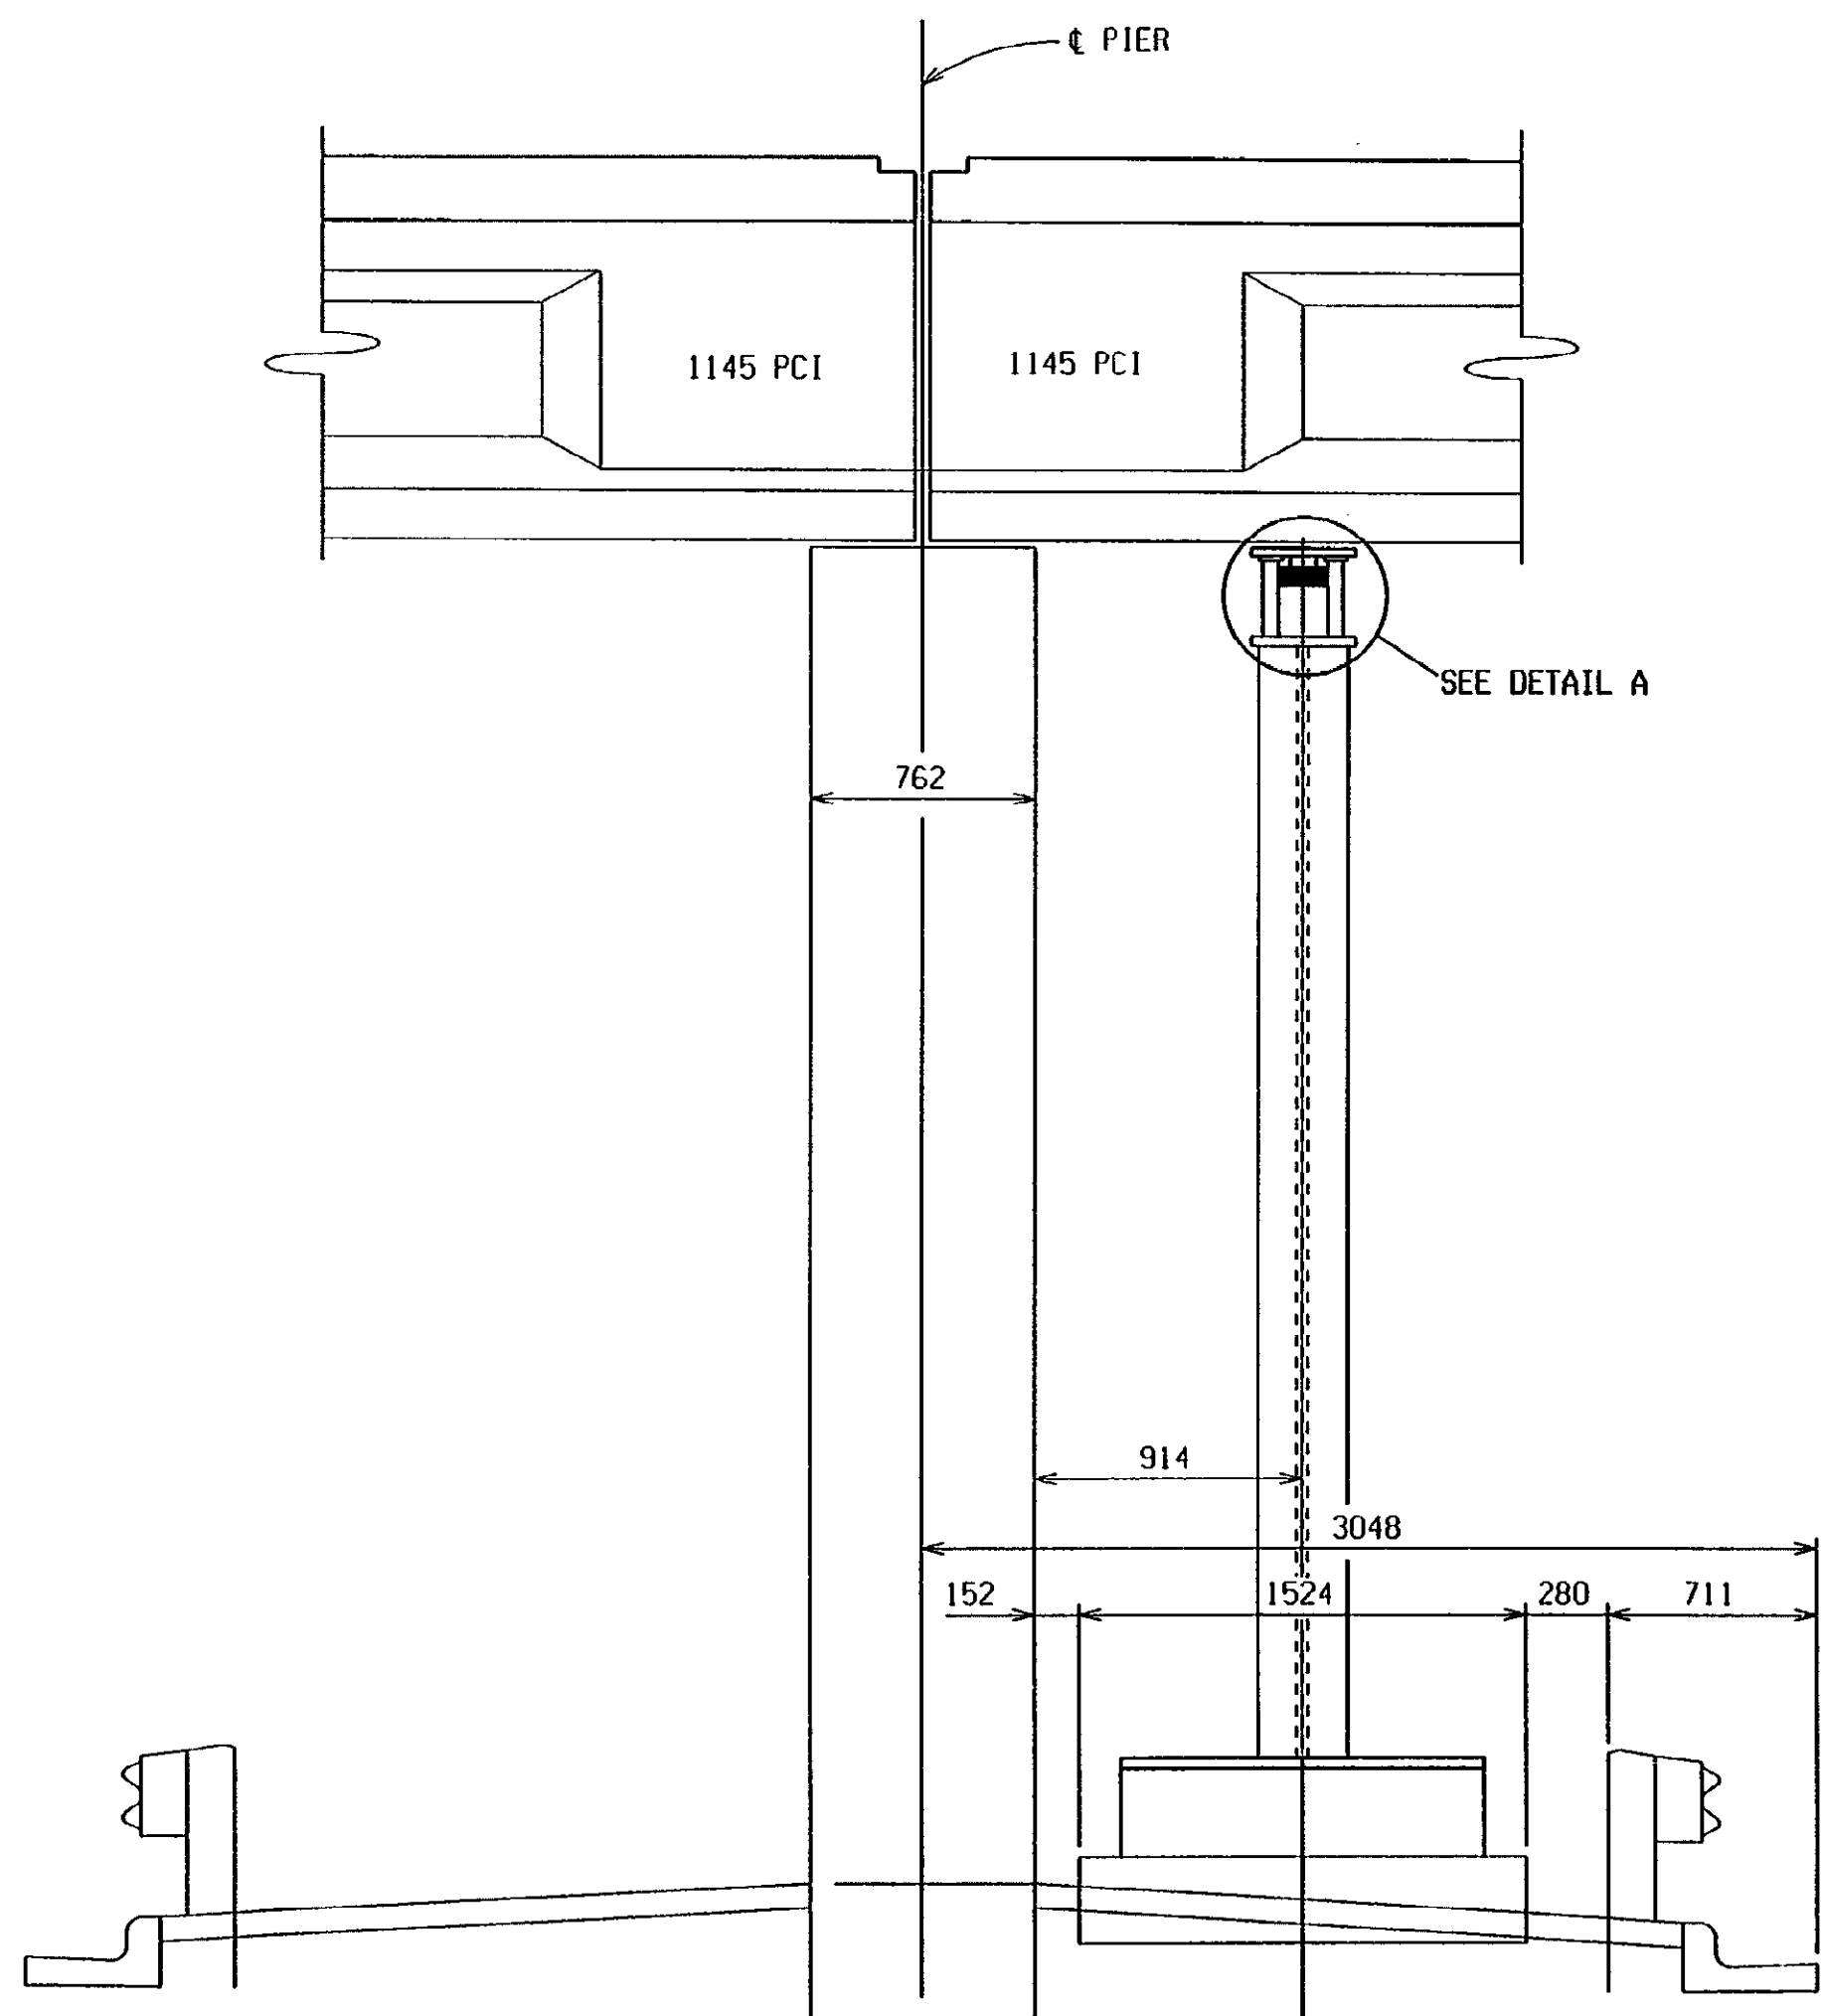


TEMPORARY SUPPORT AT PIER-TS 1

REVISIONS			
NO.	DESCRIPTION	DATE	BY

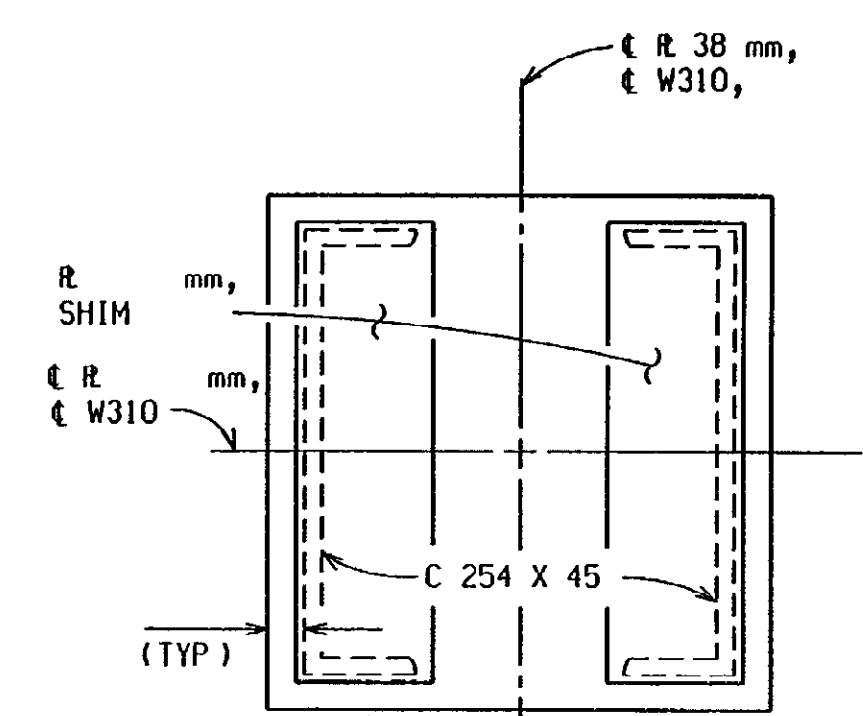

SECTION A-A

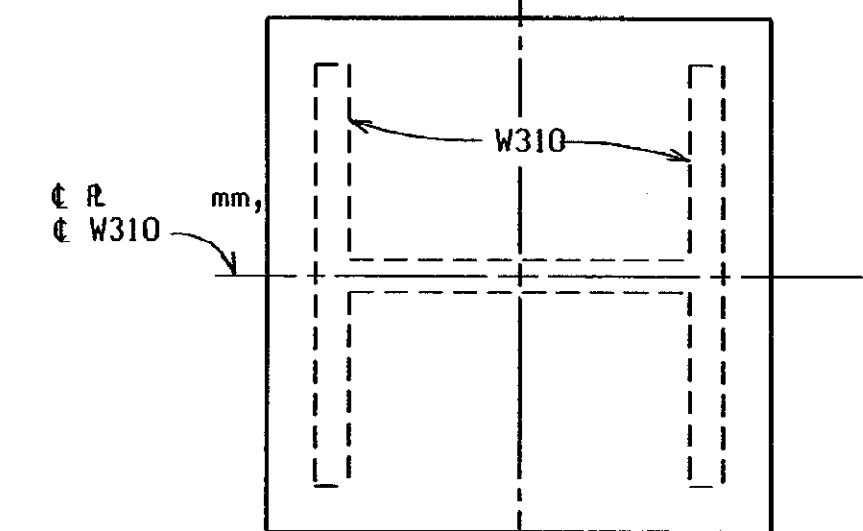


SECTION B-B




TEMPORARY SUPPORT DETAILS				
SOUTH BOUND				
DATE	CONT. SEC.	JOB NO.	DESIGN UNIT	SHEET
01-10-01	S03 OF 63174	49595A	MAHDAVI	6 OF 9

FILE NAME: s0363174s.br DRAWN BY: R.K.OLIN CHECKED BY: WM DATE: 11/2000 CORRECTED BY: QONDER DATE: 01-10-01 DATE: 01-10-01



REVISIONS			
NO.	DESCRIPTION	DATE	BY

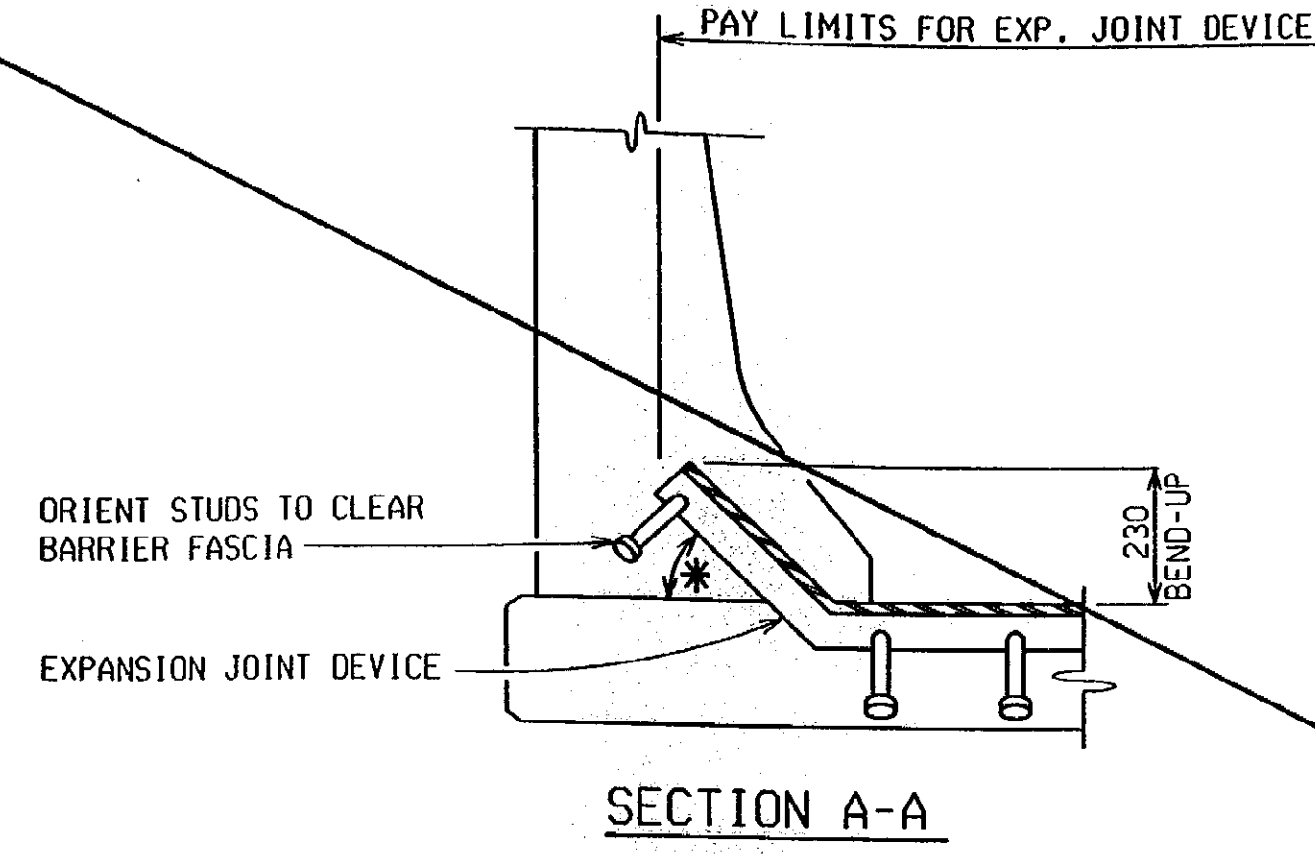



*-FOR ANGLES OF CROSSING FROM 90° TO 45° INCLUSIVE, BEND ANCHORAGE UP 45° ALONG EXPANSION JT. FOR ANGLES OF CROSSING LESS THAN 45°, A SPECIAL ENDING MAY BE REQUIRED.

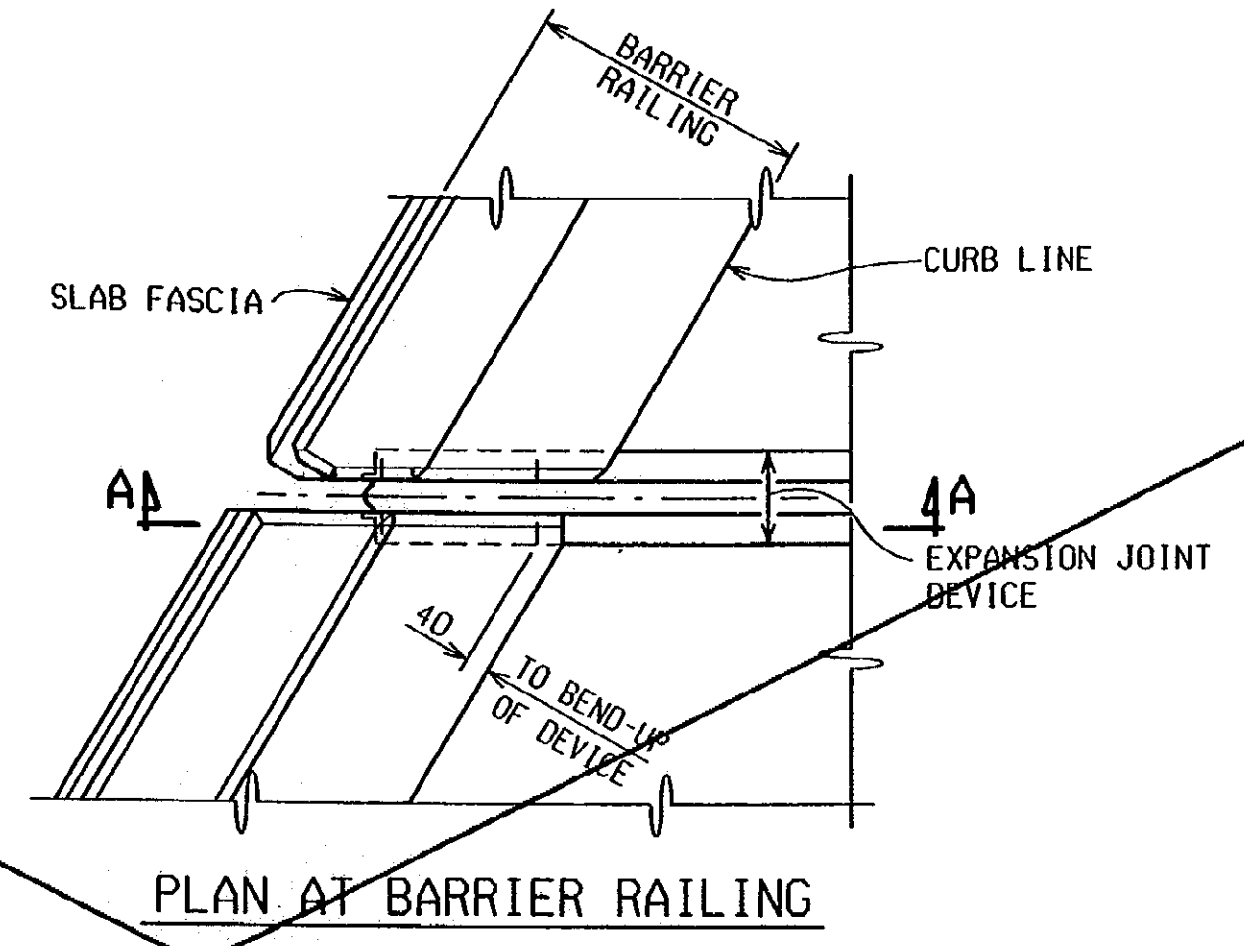

BARRIER TREATMENT

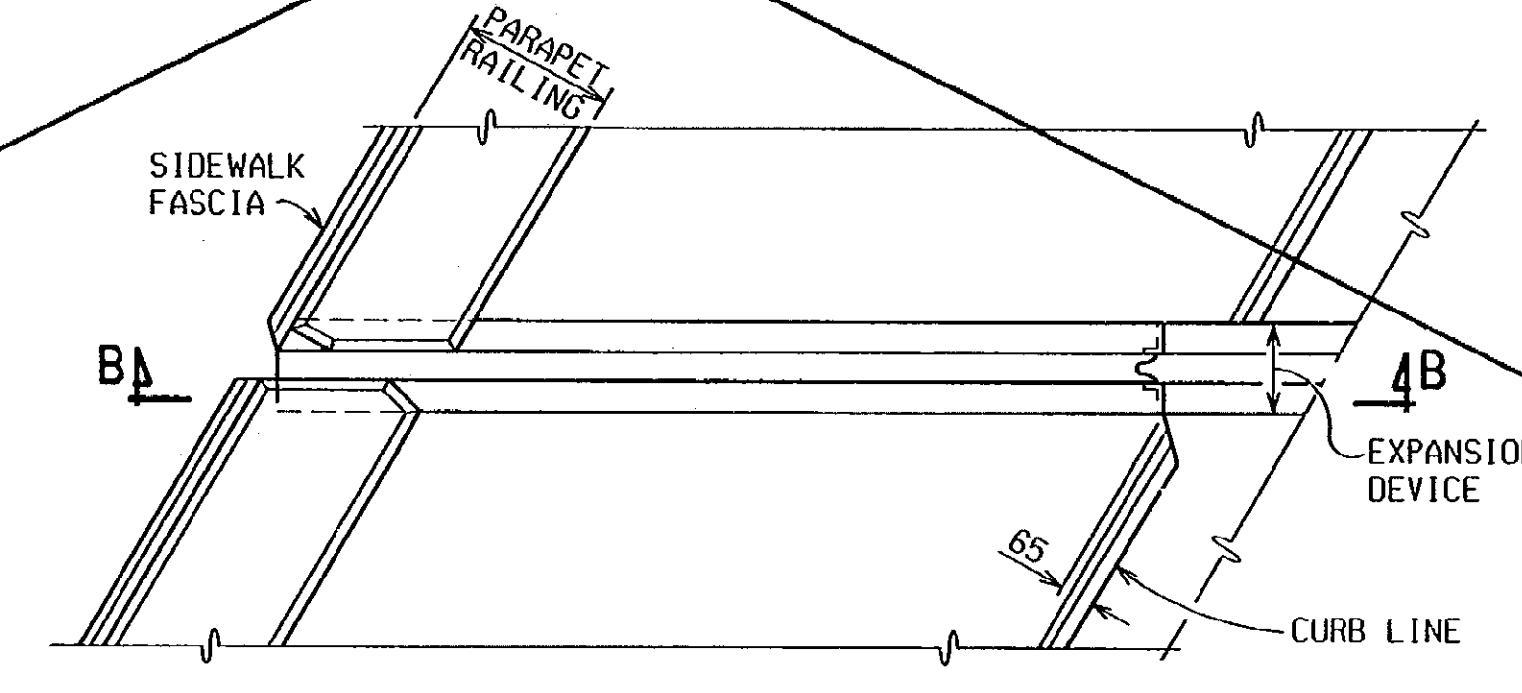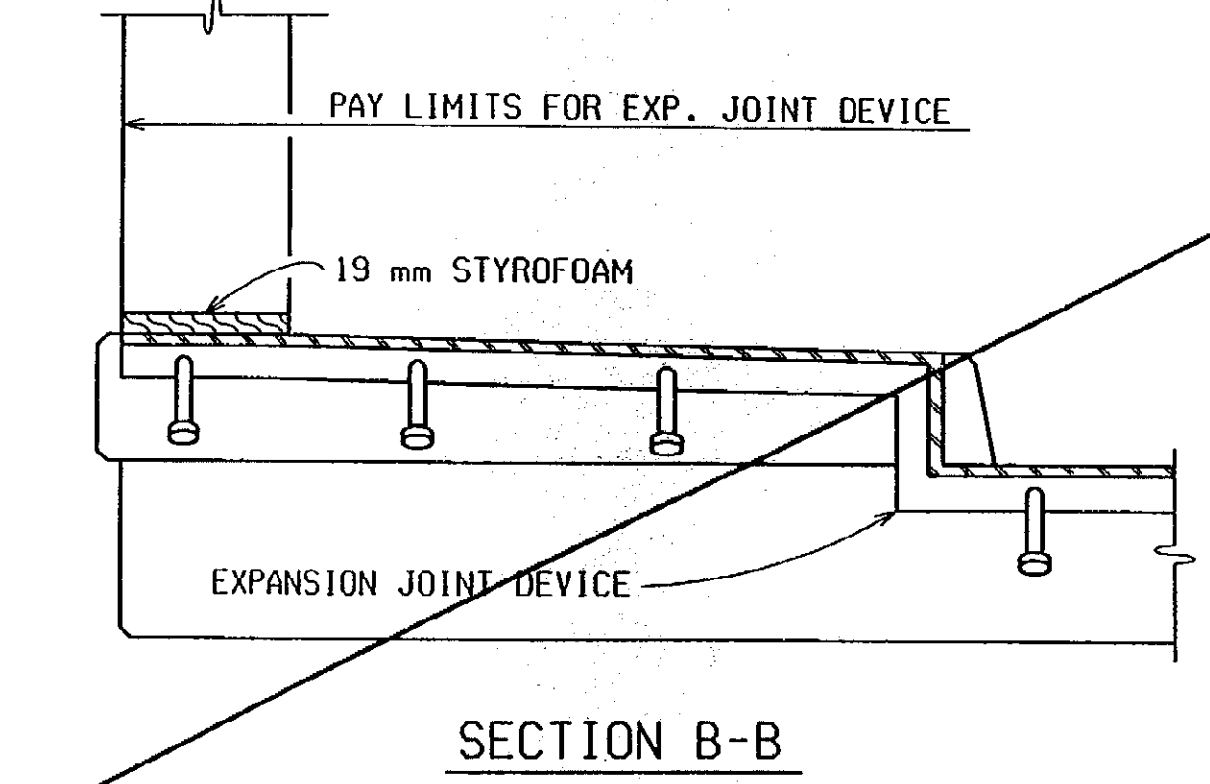

SIDEWALK TREATMENT

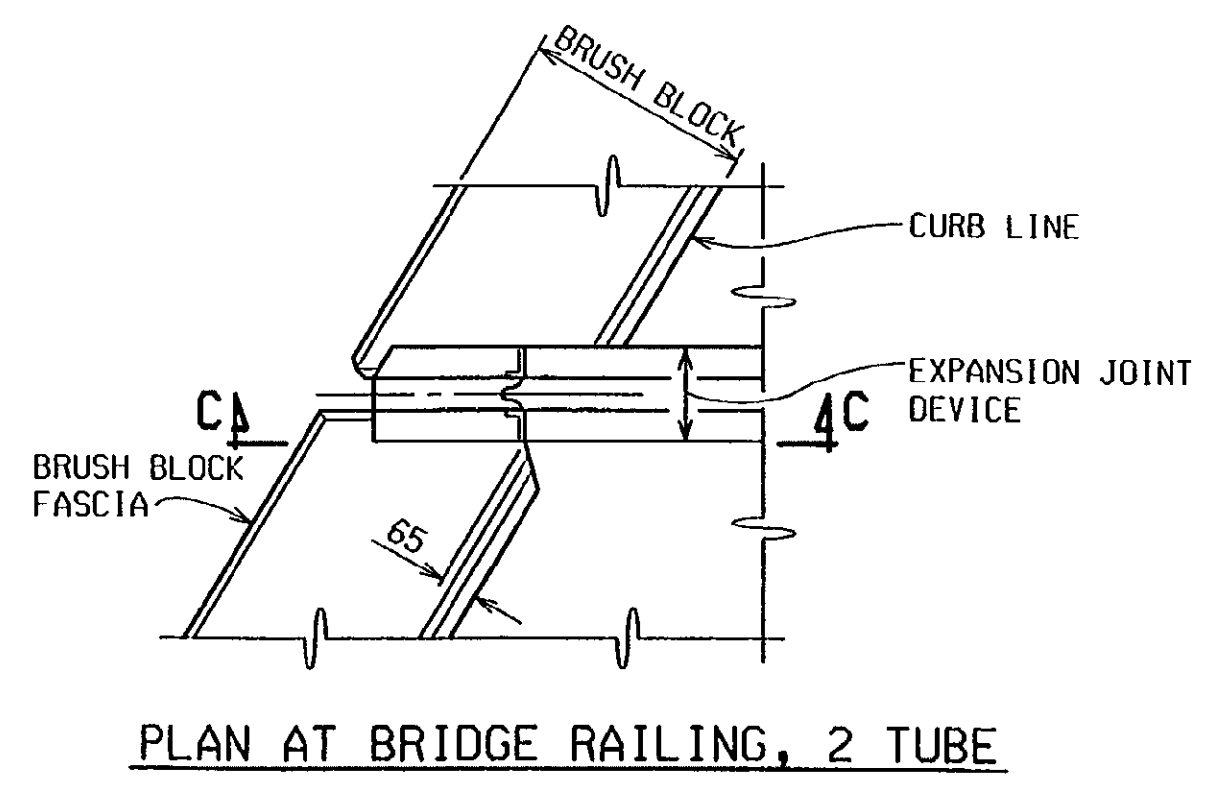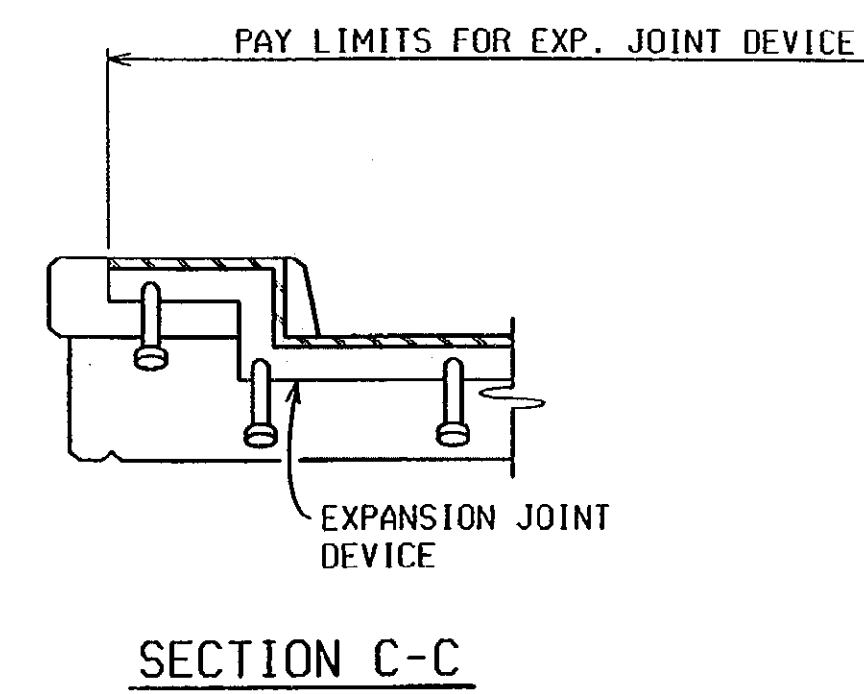

BRUSH BLOCK TREATMENT

STRUCTURE NUMBER	ANGLE OF CROSSING TO NEAREST 10°	LOCATION OF JOINT	MIN. TOT. TRAVEL ALONG CENTERLINE OF BRIDGE	REQUIRED LENGTH OF EXPANSION JOINT DEVICE
S03 SB	90°	PIER 1	14 mm	18.4 m
S03 SB	90°	PIER 2	14 mm	18.3 m
S03 SB	90°	PIER 3	14 mm	18.3 m

NOTES:

JOINT TYPES:

THE EXPANSION JOINT DEVICE SHALL BE OF A TYPE THAT INCLUDES A CONTINUOUS NEOPRENE (OR EQUIVALENT) SEAL ACROSS THE DECK. UNLESS OTHERWISE NOTED ON THE PLANS, THE CONTRACTOR HAS THE OPTION OF USING ANY OF THE DEVICES LISTED BELOW:

DEVICE	MANUFACTURER
WABO STRIP SEAL	WATSON-BOWMAN & ACME, INC.
PRO-SPAN	FEL-PRO, INC.
STEELFLEX-SSA2	D.S. BROWN
STEELFLEX-SSCM	D.S. BROWN
STEELFLEX-RS	D.S. BROWN
ONFLEX 40 SS	STRUCTURAL RUBBER PRODUCTS CO.
STRUPCO 400L	STRUCTURAL RUBBER PRODUCTS CO.

THE MODEL OF THE JOINT TYPE SELECTED SHALL BE SUITABLE TO ACCOMMODATE THE TOTAL MOVEMENT NOTED ON THE PLANS.

COMPLETE WORKING DRAWINGS OF ALL DETAILS OF FABRICATION OF THE EXPANSION JOINT DEVICE SHALL BE SUBMITTED FOR REVIEW IN ACCORDANCE WITH STANDARD SPECIFICATION 104.02. THIS REQUIREMENT IS WAIVED FOR EXPANSION JOINT DEVICES FOR WHICH A SET OF STANDARD INSTALLATION DETAILS HAS BEEN APPROVED. STANDARD INSTALLATION DETAILS CAN BE OBTAINED FROM THE DESIGN DIVISION.

FABRICATION AND INSTALLATION:

THE EXPANSION JOINT SHALL BE SHOP FABRICATED TO CONFORM TO THE CONTOUR OF THE BRIDGE DECK, BARRIERS, ETC. IT SHALL BE INSTALLED IN ACCORDANCE WITH MANUFACTURER'S RECOMMENDATIONS SUBJECT TO NOTES HEREIN AND THE APPROVAL OF THE ENGINEER.

THE TOP OF THE ELASTOMERIC JOINT DEVICE SHALL BE SET 3 - 6 mm BELOW THE CONCRETE SLAB (PAVEMENT) WITH A TOLERANCE OF ± 3 mm.

THE STEEL ANCHORAGE FOR STRIP SEAL GLANDS SHALL BE HOT DIP GALVANIZED IN ACCORDANCE WITH SUBSECTION 707.16 OF THE STANDARD SPECIFICATIONS.

THE PRO-SPAN DEVICE MUST INCORPORATE A CAST-IN-PLACE STEEL SEAT.

THE AREA OF THE STEEL ANCHORAGE AND SEALING GLAND WHICH WILL BE IN CONTACT WITH A SEALANT, OR LUBRICANT-ADHESIVE SHALL BE CLEANED WITH TOLUENE OR OTHER APPROVED SOLVENT.

WHERE THE SEALING GLAND IS LOCKED INTO A STEEL ANCHORAGE, A LUBRICANT-ADHESIVE CONFORMING TO STANDARD SPECIFICATION 914.4-E SHALL BE REQUIRED BETWEEN THE SEAL AND STEEL ANCHORAGE.

ALL BOLT WELL CAVITIES SHALL BE FILLED WITH AN APPROVED FLEXIBLE EPOXY OR A SEALANT CONFORMING TO FEDERAL SPECIFICATION TT-S-00230C.

IN THE EVENT THAT THE CONSTRUCTION SEQUENCE REQUIRES SPLICING THE SEALING GLAND, IT SHALL BE SPLICED BY AN APPROVED METHOD (SUCH AS COLD VULCANIZATION) BY A TRAINED REPRESENTATIVE OF THE MANUFACTURER.


DETAILS AT CURBS OR BARRIERS:

THE DETAILS ON THIS SHEET SHOW AN APPROVED MEANS OF TERMINATING THE EXPANSION JOINT DEVICE AT CURBS OR BARRIERS. VARIATIONS OR ALTERNATIVE SCHEMES WILL BE CONSIDERED AND MAY BE USED IF APPROVED BY THE ENGINEER.

MATERIALS:

THE COST OF ALL MATERIALS AND LABOR REQUIRED FOR PROPER INSTALLATION OF THE EXPANSION JOINT AND THE TERMINAL ASSEMBLIES AT THE CURBS, SIDEWALKS, OR BARRIERS IS INCLUDED IN THE PAYMENT FOR THE EXPANSION JOINT DEVICE.

ITEM	QUANTITY	UNIT	AMOUNT
EXPANSION JOINT DEVICE		m	55

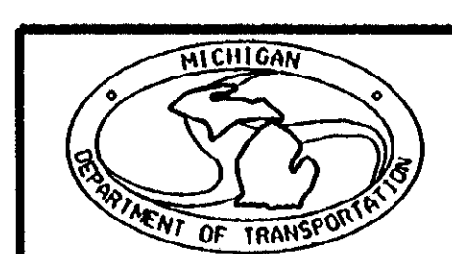


EXPANSION JOINT DETAILS S.B.				
DATE	CONT. SEC.	JOB NO.	DESIGN UNIT	SHEET OF 9
01-10-01	S03 OF 63174	49595A	MAHDAVI	7

EJ3T (11-17-97)

1 2 3 4 5 6 7 8 9 10 11 12 13 14 15 16 17 18 19 20 21 22 23 24 25 26 27 28 29 30 31 32 33 34 35 36 37 38 39 40 41 42 43 44 45 46 47 48 49 50 51 52 53 54 55 56 57 58 59 60 61 62 63

REVISIONS			
NO.	DESCRIPTION	DATE	BY

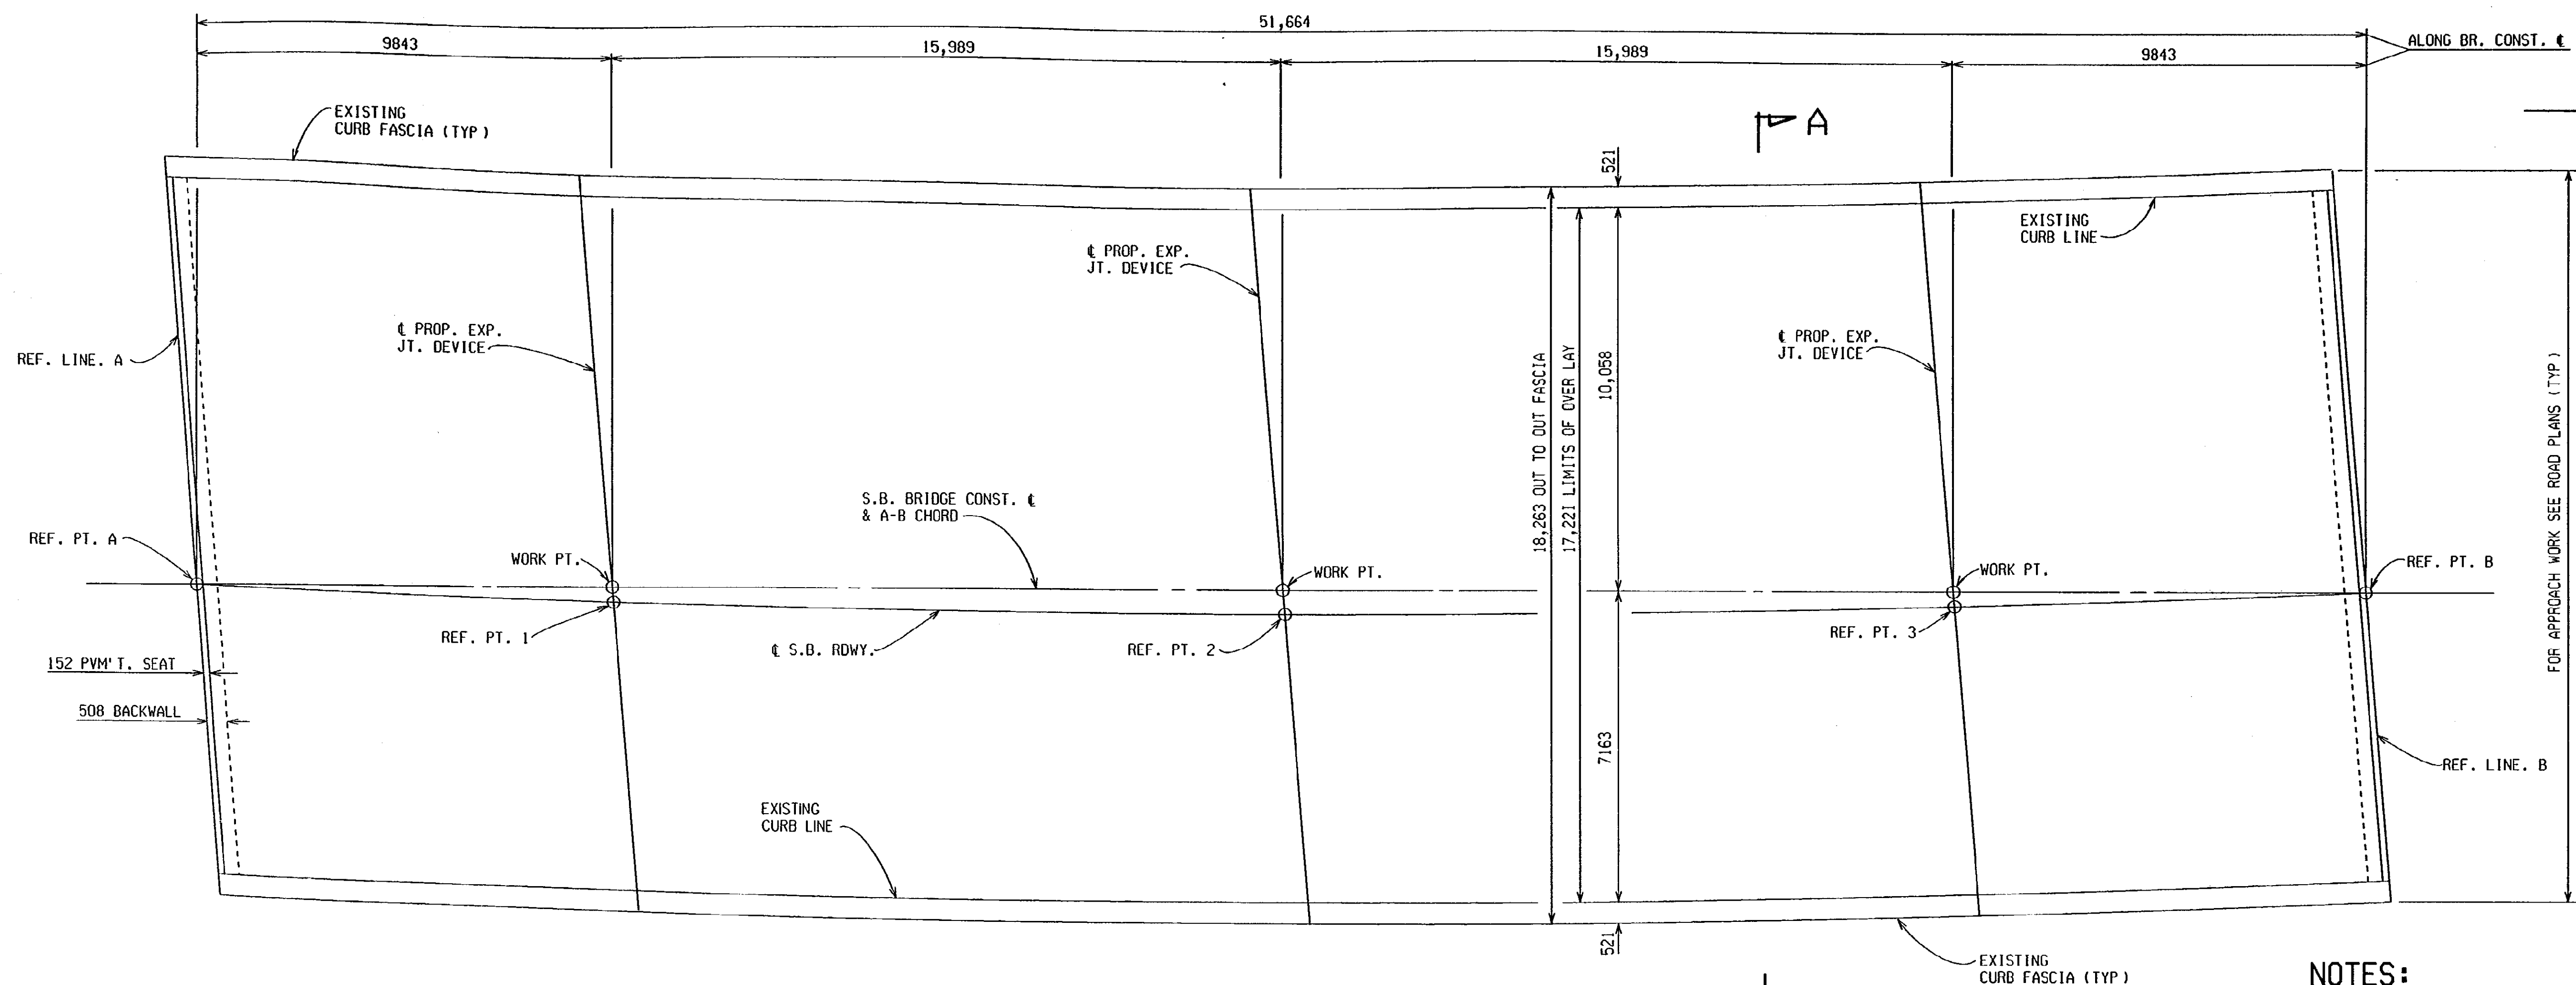

PLAN OF DECK (SOUTH BOUND)


LIMITS OF FALSE DECKING ARE OUT TO OUT OF SLAB FASCIA AND PIER 1 TO PIER 3

MISCELLANEOUS QUANTITIES

20 m2	Bit Patch, Rem
890 m2	Scarifying
890 m2	Hydrodemolition, First Pass
36 m2	Hydrodemolition, Second Pass
890 m2	Bridge Deck Surface Construction
940 m2	False Decking
55 m	Deck Joint, Rem
13 m3	Conc. Grade D.
50 m2	Patch, Forming
5 m3	Hand Chipping, Other Than Deck
5 m3	Patching Conc. LM. Mixture
10 m2	Hand Chipping, Deep
38 m3	Conc. Bridge Deck Overlay
1 LS	Penetrating Water Repellent Treatment (S03-SB)
1 LS	Substructure Horizontal Surface Sealer (S03-SB)
36 ea	Reinforcement, Mechanical Splice

THE ACTUAL QUANTITY OF "CONCRETE BRIDGE DECK OVERLAY" PLACED ON THE DECK WAS CUBIC METERS. (THIS INFORMATION IS TO BE FILLED IN BY THE ENGINEER WHEN SUBMITTING "AS CONSTRUCTED" PLANS.)

*SUBSTRUCTURE REPAIR AS DIRECTED BY THE ENGINEER.

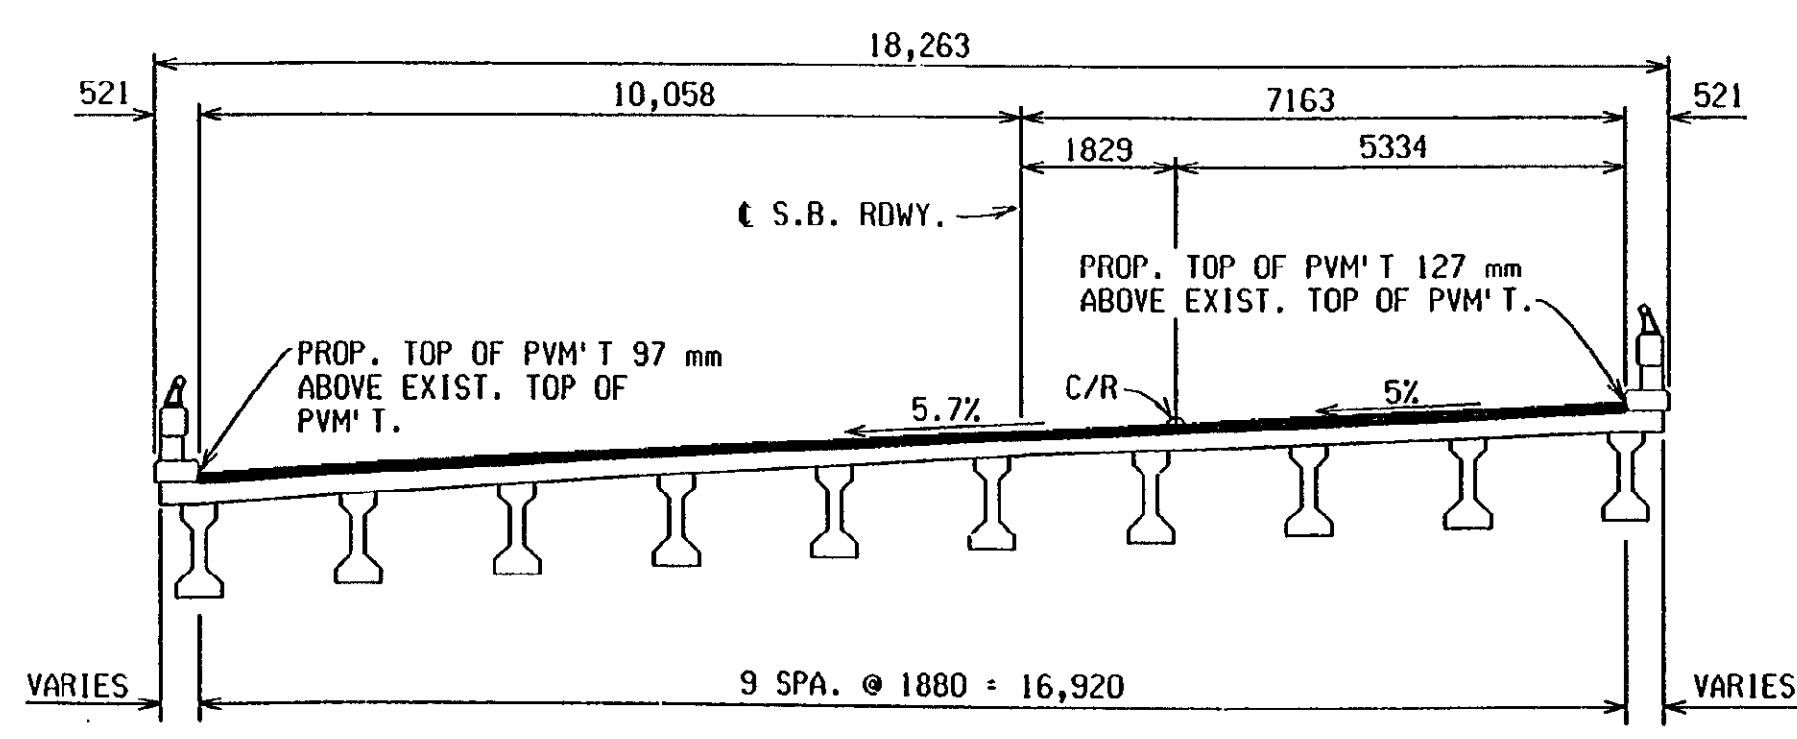

NOTES:

WHERE STRUCTURAL STEEL IS EXPOSED DURING JOINT REMOVAL, IT SHALL BE CLEANED AND COATED. CLEANING, COATING AND PROTECTION OF WORK AND ENVIRONMENT ARE INCLUDED IN THE BID ITEM "DECK JOINT, REM".

THE ITEM "DECK JOINT, REM" INCLUDES HAND CHIPPING WITHIN LIMITS REQUIRED FOR REMOVAL.

1-75 SB TRAFFIC IS TO BE MAINTAINED BY PART-WIDTH CONSTRUCTION.

APPROX. INCREASE OF THE ELEVATION IS 20 mm.

WHERE STRUCTURAL STEEL IS EXPOSED DURING THE REMOVAL OF UNSOUND CONCRETE, IT SHALL BE CLEANED AND COATED. CLEANING SHALL BE BY BLASTING OR POWER TOOLS. THE PROTECTION OF WORK AND ENVIRONMENT DURING CLEANING WILL BE PAID FOR AS EXTRA WORK.

THE CONTRACTOR SHALL REMOVE AND REPLACE ONLY THAT PORTION OF THE CURB THAT IS NECESSARY FOR INSTALLATION OF THE DECK JOINT. PAYMENT FOR THIS WORK IS INCLUDED IN THAT FOR EXPANSION JOINT DEVICE.

THE VOLUME OF CONCRETE BRIDGE DECK OVERLAY IS BASED ON THE OVERLAY AND AN ESTIMATED QUANTITY TO REPLACE UNSOUND CONCRETE AND TO MAKE GRADE ADJUSTMENTS AS DETERMINED BY THE ENGINEER.

MEASURES SHALL BE TAKEN TO PREVENT DEBRIS FROM FALLING FROM THE STRUCTURE.

BEFORE OVERLAYING, SOUND CONCRETE TO DETERMINE WHETHER 450 mm REMOVAL AT EITHER SIDE OF TRANSVERSE JOINTS WILL BE ADEQUATE. INCREASE THE REMOVAL LIMITS IF NECESSARY.

SILICA FUME MODIFIED CONCRETE OR LATEX MODIFIED CONCRETE MAY BE SELECTED FOR THE BRIDGE DECK OVERLAY CONCRETE, SEE SPECIAL PROVISION.

THE TOP HORIZONTAL SURFACES OF ALL PIER CAPS SHALL BE COATED WITH SUBSTRUCTURE HORIZONTAL SURFACE SEALER. THE ESTIMATED AREA IS 41 m2.

PENETRATING WATER REPELLENT TREATMENT SHALL BE APPLIED TO ALL SURFACES OF PIERS EXCEPT TOPS OF PIERS. THE ESTIMATED AREA FOR PENETRATING WATER REPELLENT APPLICATION IS 390 m2.

DECK RESURFACING DETAILS S.B.				
DATE	CONT. SEC.	JOB NO.	DESIGN UNIT	SHEET
01-10-01	S03 OF 63174	49595A	MAHDAVI	8 OF 9

DATE: 01-10-01
CORRECTED BY: INDER
DATE: 01-10-01
CHECKED BY: INDER
DATE: 3-10-98
DRAWN BY: inder
FILE NAME: s03s417s.ov

