


NOTE:
 UTILITIES LOCATIONS ARE APPROXIMATE
 FIELD VERIFY PRIOR TO DIGGING!

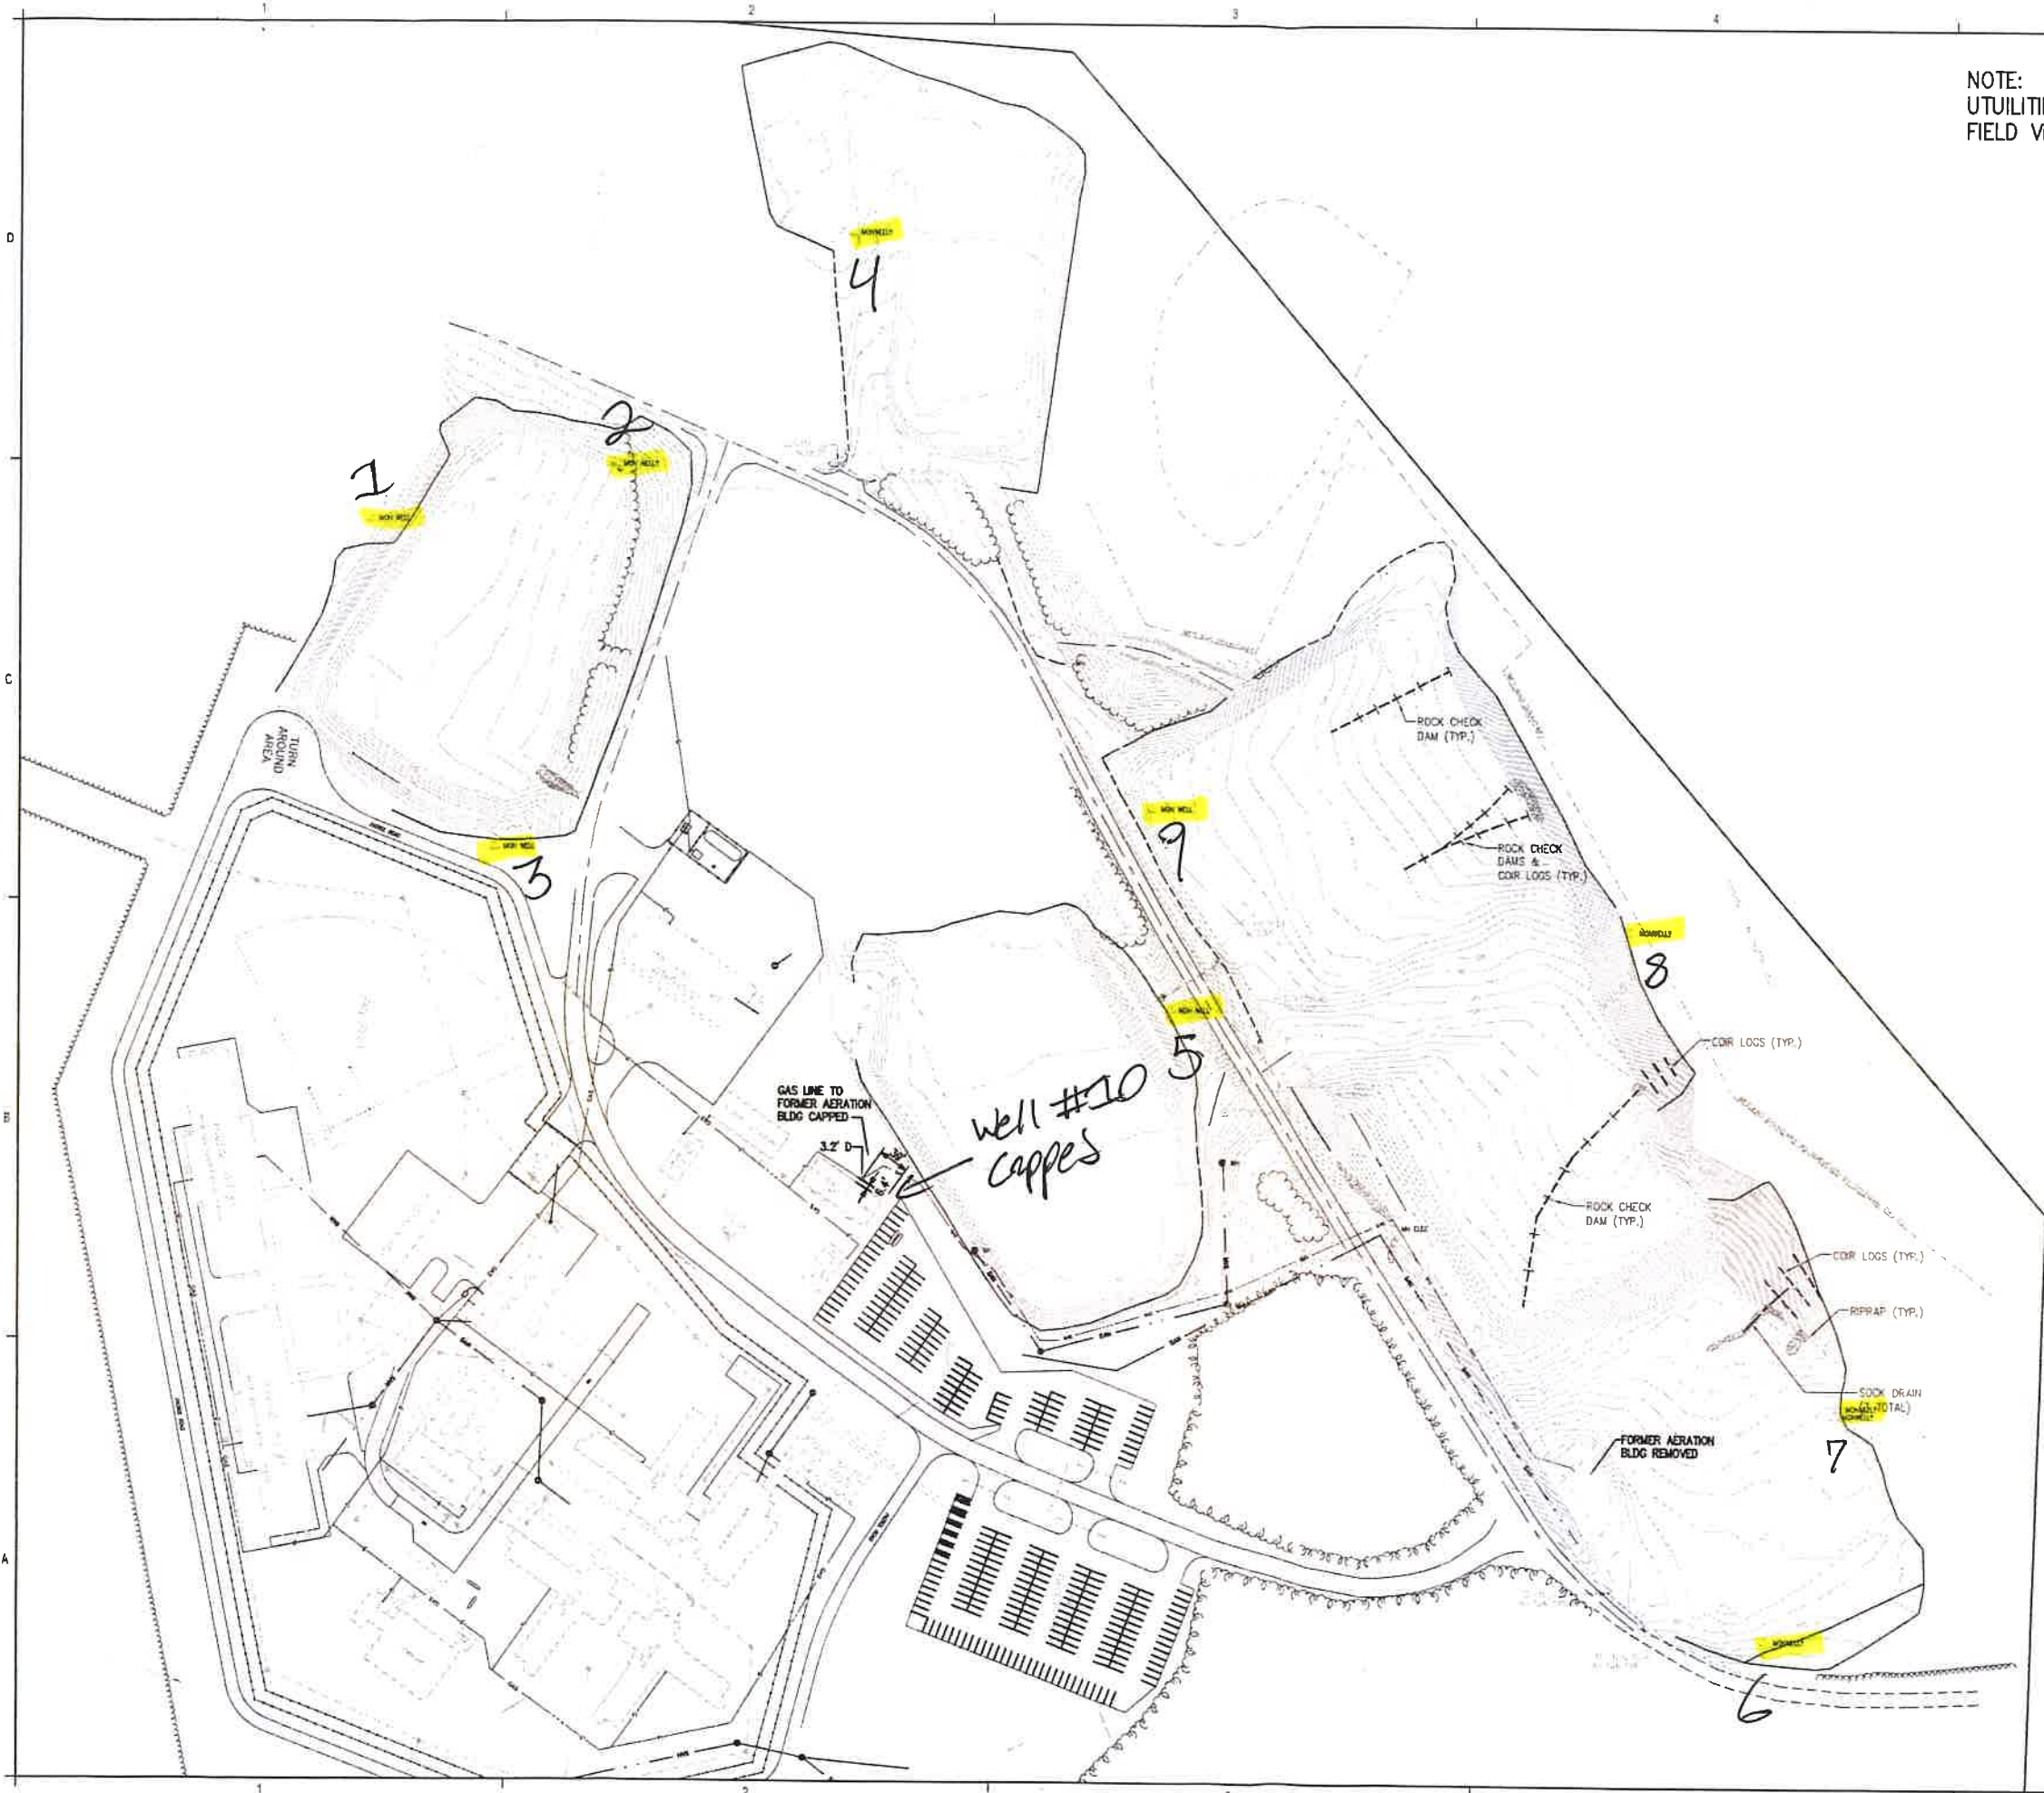

**OJIBWAY CORRECTIONAL FACILITY
 WASTEWATER LAGOON DEMOLITION**
 MICHIGAN DEPARTMENT OF CORRECTIONS
 N5705 OJIBWAY ROAD MARENISCO, MICHIGAN

ISSUED FOR:	DATE:
SOFT REVIEW	05/20/19
30% REVIEW	06/14/19
60% REVIEW	06/14/19
100% REVIEW	06/14/19
AS-BUILT	06/08/20

OJIBWAY CORRECTIONAL FACILITY WASTEWATER LAGOON DEMOLITION MICHIGAN DEPARTMENT OF CORRECTIONS	PROJECT NO: M12-19220	DESIGNED BY: CLH	MEP
		DRAWN BY: CLH	CLH
		CHECKED: CLH	CLH
		APPROVED: CLH	CLH

**AS-BUILT
 SITE PLAN**

C102



