


CAMP OJIBWAY CORRECTIONAL FACILITY

Marenisco, Michigan

Number	Name	Function	Year Constructed or Improved	Gross Area (Sq. Ft.)
1	Administration	Administration	x	16,985
2	A-Unit	Housing	x	18,570
3	B-Unit	Housing	x	18,570
4	C-Unit	Housing	x	18,570
5	E/D-Units	Housing	x	20,544
6	F/G-Units	Housing	x	20,544
7	Food Service	Service	x	8,560
8	Education	Education	x	10,658
9	Gymnasium	Education	x	10,634
10	Warehouse	Storage/Maintenance	x	9,800
11	Training	Education	x	1,800
12	Maintenance	Storage/Maintenance	x	4,160
13	Main./Wood Shop	Educ/Maintenance	x	4,000
14	Store	Service	x	1,870
15	Maintenance	Maintenance	x	<u>1,325</u>
				196,290

June 2011

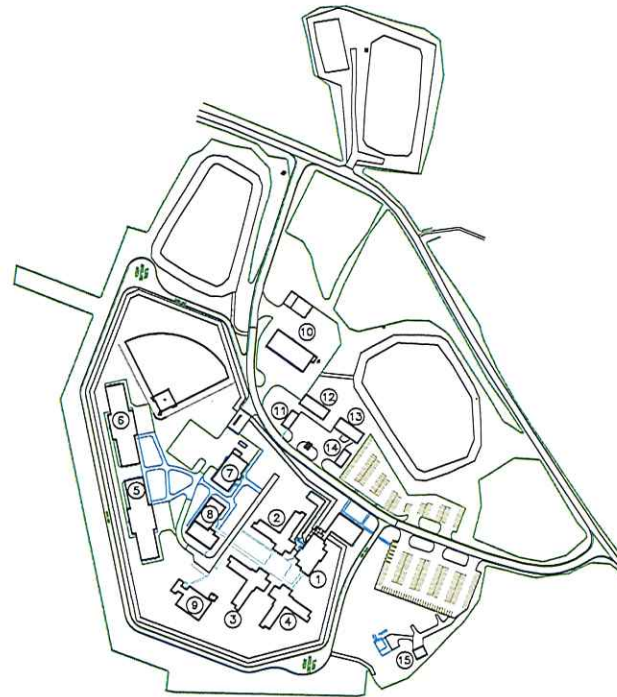


LEGEND


- PROPERTY LINE
- FENCE
- BUILDING
- ③ BUILDING NUMBER
- PAVED ROAD/PARKING
- UNPAVED ROAD
- RAILROAD
- WATER

CAMP OJIBWAY CORRECTIONAL FACILITY

MARENISCO, MICHIGAN

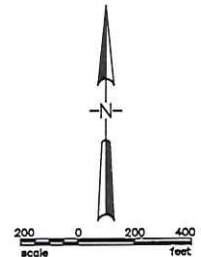

STATE of MICHIGAN
DEPARTMENT of TECHNOLOGY, MANAGEMENT and BUDGET
Facilities Administration
LANSING, MICHIGAN 48909

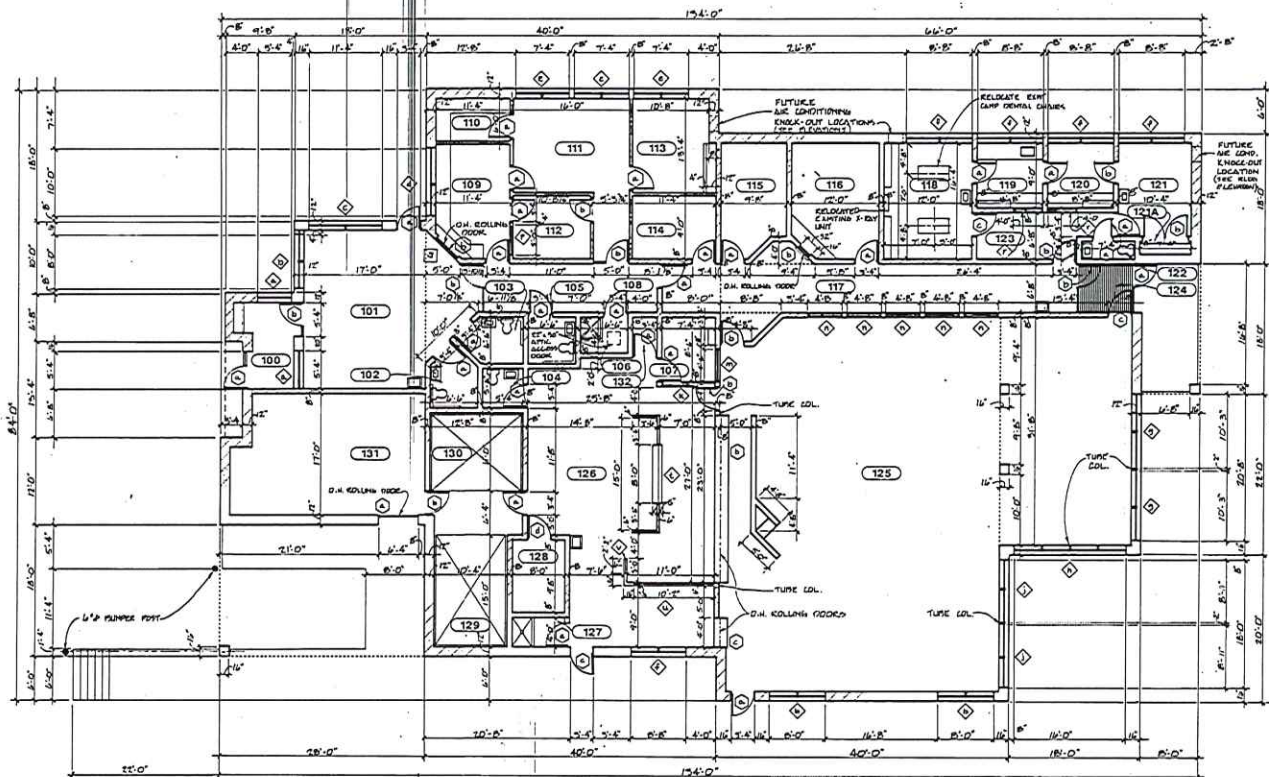

SHEET	IDENTIFICATION NO.	ISSUED FOR	DATE	DESIGNED
PROJECT	PRELIMINARY	☐		DRAWN
STATE ACCOUNT	CONSTRUCTION	☐		CHECKED
	FINAL RECORD	☐		APPROVED

FLOOR PLAN W/DIMENSIONS AND DOOR & WINDOW DESIGNATIONS
SCALE: 1/8" = 1'-0"



**Sundberg, Carlson
and Associates, Inc.**

Architects • Engineers • Land Surveyors • Planners

INITIALS	DATE
DESIGN D.H.	1/22/87
DRAWN G.H.	1/30/87
CHECKED D.H.	1/30/87
APPROVED	/ /

CAMP OJIBWAY
MARENISCO, MICHIGAN

NO.	ISSUED FOR	REVISIONS	DATE	BY	DATE	CONTROL
1	ISSUED FOR					
2						
3						
4						
5						
6						
7						
8						
9						
10						

**FLOOR PLAN W/DIMENSIONS AND
DOOR & WINDOW DESIGNATIONS**


PROJ. NO. 8606-310 REV. NO.

A-3

ROOM FINISH SCHEDULE										
NO.	ROOM NAME	FLOOR		WALL FINISH				CEILING		REMARKS
		FINISH	BASE	A	B	C	D	FINISH	HEIGHT	
E1	OFFICE	C	V	P	P	P	P	TC	8'-0"	
E2	TREATMENT DIRECTOR	C	V	P	P	P	P	TC	8'-0"	
E3	STORAGE	C	N	P	P	P	P	GG	8'-0"	
E4	BARBER	C	V	P	P	P	P	TC	8'-0"	
E5	CORRIDOR	C	V	P	P	P	P	GG	8'-0"	
E10	PRIVATE TOILET	GP	EP	EP	EP	EP	EP	GG	8'-0"	
E11	JANITOR	C	N	P	P	P	P	OT	8'-4"	
E12	STAFF TOILET/MEN	V	V	EP	EP	EP	EP	GG	8'-0"	
E13	MECHANICAL	C	N	P	P	P	P	OT	8'-11 1/2"	
E14	VOCATIONAL CLASSROOM	C	N	P	P	P	P	TC	8'-0"	
E16	VOCATIONAL CLASSROOM	C	N	P	P	P	P	TC	8'-0"	
E17	LIBRARY	C	V	P	P	P	P	TC	8'-0"	
E18	CORRIDOR	C	V	P	P	P	P	GG	8'-0"	
E19	CORRIDOR	C	V	P	P	P	P	GG	8'-0"	
E20	OFFICE	C	V	P	P	P	P	TC	8'-0"	
E21	OFFICE	C	V	P	P	P	P	TC	8'-0"	
E23	STAFF TOILET/WOMEN	V	V	EP	EP	EP	EP	GG	8'-0"	
E24	VESTIBULE	C	N	P	P	P	P	GG	8'-0"	
E25	CLASSROOM	EX	EX	P	P	P	P	EX	8'-0"	
E26	CLASSROOM	EX	EX	P	P	P	P	EX	8'-0"	
E27	CLASSROOM	EX	EX	P	P	P	P	EX	8'-0"	NEW EXIST. TILE & NEW WALL
E28	CLASSROOM	EX	EX	P	P	P	P	EX	8'-0"	
E29	VESTIBULE	C	NONE	P	P	P	P	TC	8'-0"	
E30	VESTIBULE	C	NONE	P	P	P	P	EX	-	

DOOR & FRAME SCHEDULE										
NO.	TYPE	DOOR		ELECT.	FRAME		DETAILS		HDMR	LABEL
		SIZE	TYPE		SIZE	TYPE	GLZNG	HEAD		
1	DR/LT	3'-0" x 6'-8"	D	45	SEE ELEV.	3	45	6/107	7/107	14
2	DR	3'-0" x 6'-8"	D	45	3'-4" x 6'-10"	1	45	6/107	7/107	14
4A	DR	3'-0" x 6'-8"	D	45W	3'-4" x 6'-10"	1	45W	6/107	7/107	9
4B	LT	-	-	-	6'-0" x 3'-5"	9	45W	5/107	4/107	-
6A	DR/P	3'-0" x 6'-8"	D	45W	6'-4" x 6'-10"	2	45W	6/107	7/107	1
6B	DR/P	3'-0" x 7'-2"	D	160	6'-4" x 7'-4"	1	-	1/107	2/107	15
10	DR	3'-0" x 6'-8"	D	45W	3'-4" x 6'-10"	1	45W	6/107	7/107	6
11	DR	3'-0" x 6'-8"	D	-	3'-4" x 6'-10"	1	45W	6/107	7/107	14
12	DR	3'-0" x 6'-8"	D	-	3'-4" x 6'-10"	1	45W	6/107	7/107	31
13	DR	3'-0" x 7'-2"	D	-	3'-4" x 7'-4"	1	45W	1/107	2/107	20
14A	DR/LT	3'-0" x 6'-8"	D	45W	SEE ELEV.	3	45W	6/107	7/107	21
14B	LT	-	-	-	6'-0" x 3'-5"	9	45W	5/107	4/107	-
14C	LT	-	-	-	6'-0" x 3'-5"	9	45W	5/107	4/107	-
14D	LT	-	-	-	6'-0" x 3'-5"	9	45W	5/107	4/107	-
15A	DR/LT	3'-0" x 6'-8"	D	45W	SEE ELEV.	3	45W	6/107	7/107	21
15B	LT	-	-	-	6'-0" x 3'-5"	9	45W	5/107	4/107	-
15C	LT	-	-	-	6'-0" x 3'-5"	9	45W	5/107	4/107	-
15D	LT	-	-	-	6'-0" x 3'-5"	9	45W	5/107	4/107	-
15E	LT	-	-	-	6'-0" x 3'-5"	9	45W	5/107	4/107	-
15F	LT	-	-	-	6'-0" x 3'-5"	9	45W	5/107	4/107	-
16	DR/LT	3'-0" x 6'-8"	D	45W	SEE ELEV.	3	45W	6/107	7/107	21
17A	DR/LT	3'-0" x 6'-8"	D	45W	SEE ELEV.	3	45W	6/107	7/107	21
17B	LT	-	-	-	6'-0" x 3'-5"	11	45W	5/107	4/107	-
18	NOT USED									
19A	DR	3'-0" x 6'-8"	D	45W	3'-4" x 6'-10"	1	45W	6/107	7/107	7
19B	DR	3'-0" x 7'-2"	D	161	3'-4" x 7'-4"	1	45W	1/107	2/107	7
20A	DR	3'-0" x 6'-8"	D	45W	3'-4" x 6'-10"	1	45W	6/107	7/107	9
20B	LT	-	-	-	6'-0" x 3'-5"	9	45W	5/107	4/107	-
20C	LT	-	-	-	6'-0" x 3'-5"	9	45W	5/107	4/107	-
20D	LT	-	-	-	6'-0" x 3'-5"	9	45W	5/107	4/107	-
21	DR/LT	3'-0" x 6'-8"	D	45	SEE ELEV.	3	45	6/107	7/107	6
22	DR	3'-0" x 6'-8"	D	-	3'-4" x 6'-10"	1	45W	6/107	7/107	31


NOTE:
ADDITIONAL FRESH AIR INTAKES FOR TWO (2)
EXISTING HEARTH UNITS IN TWO (2) EXISTING
CLASSROOMS OF THE EDUCATION BUILDING.

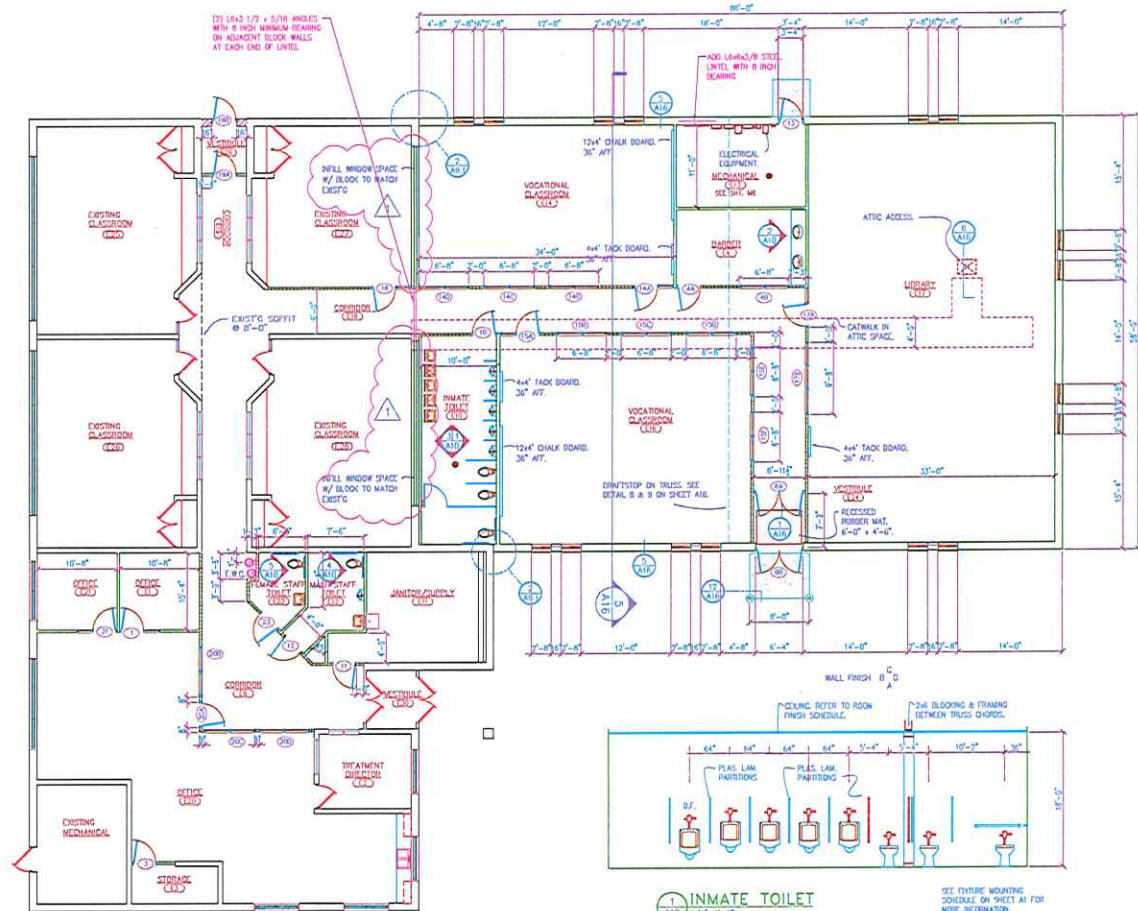


EDUCATION BLDG. PROPOSED PLAN

SCALE: 1/8" = 1'-0"


RENOVATED S.F. 5680
TOTAL 10658

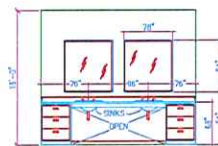


2 BARBER
A10 1/4"x1'-0"

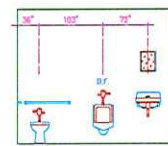


4 MALE STAFF TOILET
A10 1/4"x1'-0"

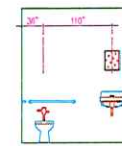


5 FEMALE STAFF TOILET
A10 1/4"x1'-0"

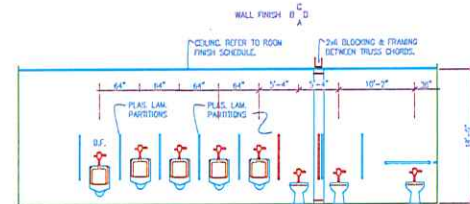

1 INMATE TOILET
A10 1/4"x1'-0"

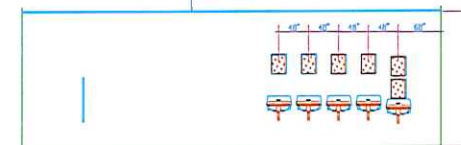


3 INMATE TOILET
A10 1/4"x1'-0"

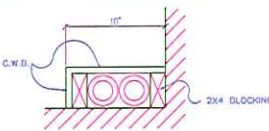


TYPICAL PIPE CHASE
N12

RECORD DRAWING
EDUCATION BUILDING FLOOR PLAN AND DETAILS



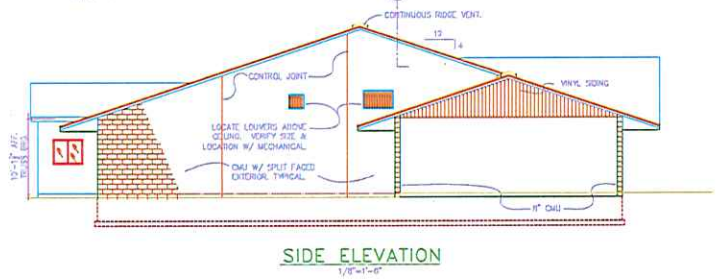

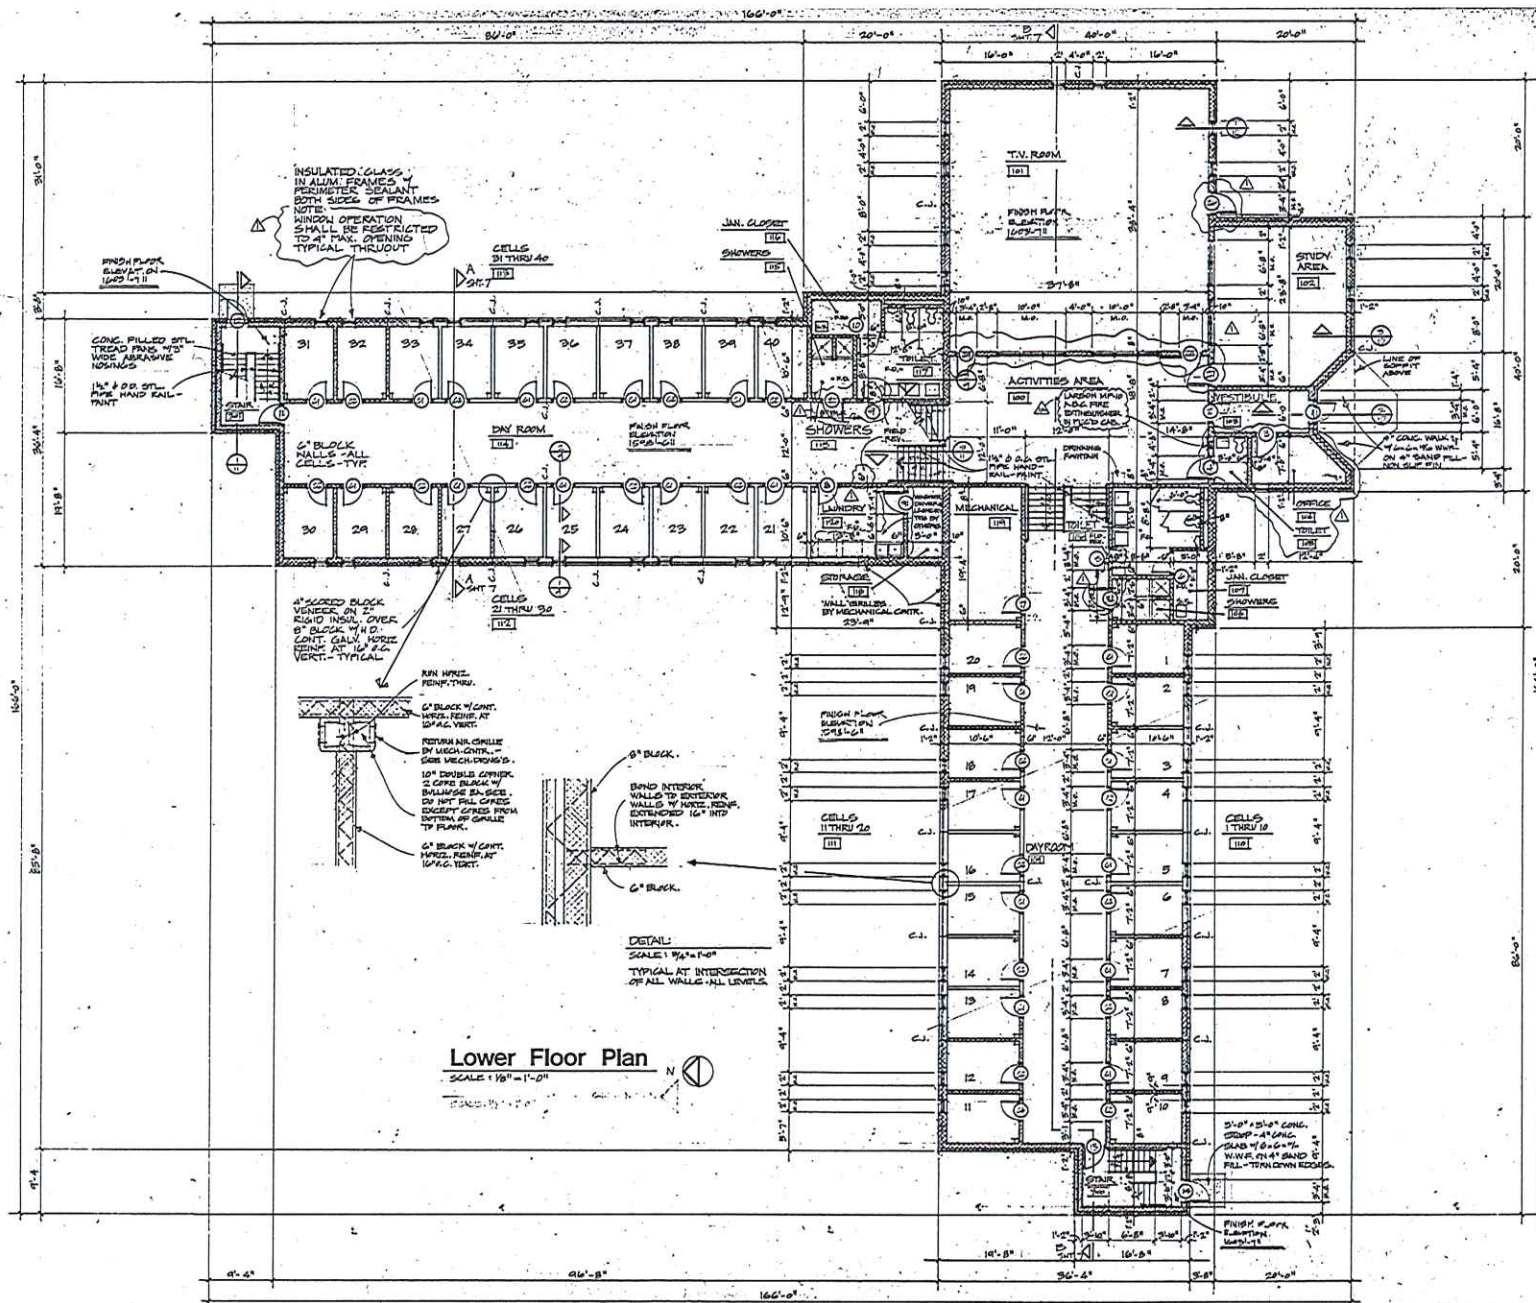

Lower Floor Plan

SCALE: 1/8" = 1'-0"

STANDARD: 10-1

Conventional Constructed
Modular Housing Units
MARQUETTE & CAMP QUINCY
ACCOUNT NO. 110-47-589-182
110-47-589-032

CLOSER
CONSTR. CO.
2050 ENTERPRISE ST.
MARQUETTE, MI 49855
(616) 732-1142


LANDMARK
ARCHITECTURAL
ASSOCIATES INC.
1400 BOSTON BLVD. S.E. • GAITHERSBURG, MD 20878
(301) 948-7070

DATE	CHANGES
9-28	FINAL CHECK REVIEW
10-1	FINAL CHECK REVIEW
10-1	FINAL CHECK REVIEW
10-1	FINAL CHECK REVIEW
10-1	FINAL CHECK REVIEW

LOCATION:
CAMP QUINCY
MARQUETTE, MICH.

UNIT NO. BUILDING A
JOB NO. 8541 A

DATE: AUGUST 1982

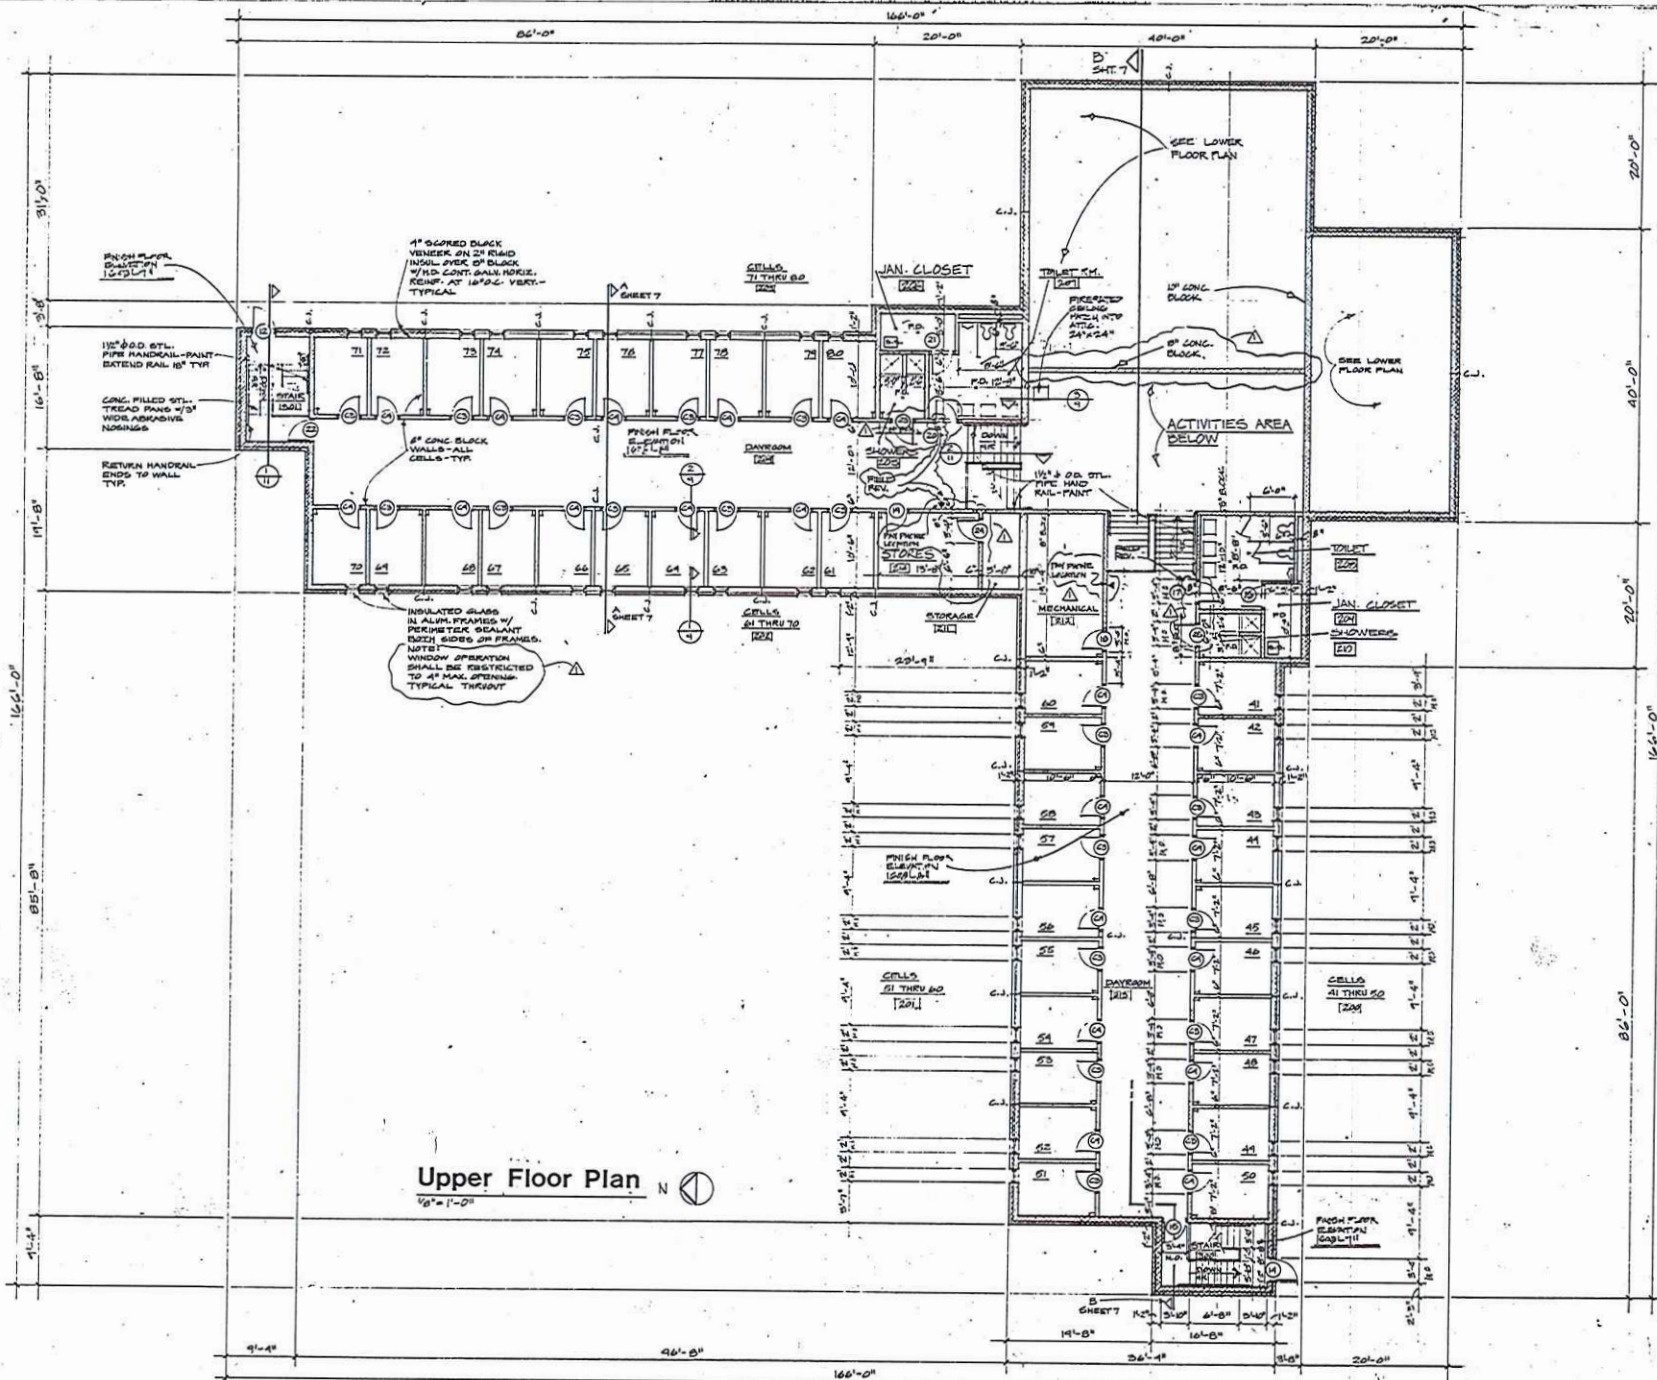

Upper Floor Plan N
1/8" = 1'-0"

Conventional Constructed
Modular Housing Units

MARQUETTE & CAMP OUBWAY
ACCOUNT NO. 110-47-4152-192

CLOSER
CONSTR. CO.

2050 ENTERPRISE ST.
MARQUETTE, MI 49855


LANDMARK
ARCHITECTURAL
ASSOCIATES INC.

1102 27TH AVE. SE. GRAND RAPIDS, MICHIGAN 49508

DATE	REVISION
8-29	FINAL CHECK REVISION
8-10	REVISION NO. 1
7-19	FINAL CHECK REVISION

LOCATION:
CAMP OUBWAY
MARQUETTE, MICH.

UNIT NO. BUILDING A
JOB NO. 8541 A
DATE: AUGUST 1987

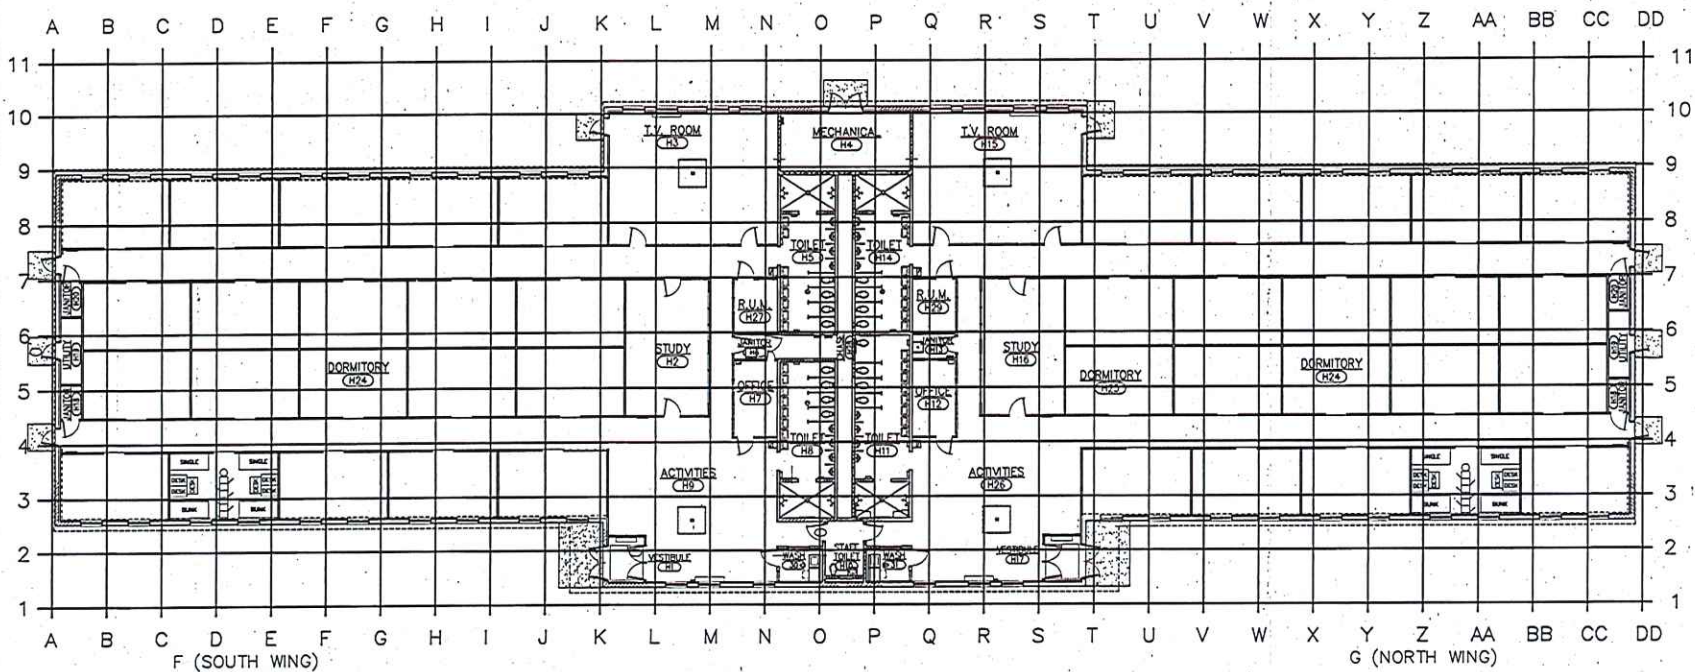

HOUSING UNIT 1

10 FOOT GRID

SCALE: 3/32" = 1'-0"

HOUSING UNIT 1 DURESS SYSTEM


U.P. ENGINEERS & ARCHITECTS, INC.
ENGINEERING ARCHITECTURE PLANNING ENVIRONMENTAL
1000 N. ZEEB RD. SUITE 100
ANN ARBOR MI 48106-1500
PH: 734.769.1234 FAX: 734.769.1235

STATE OF MICHIGAN
DEPARTMENT OF MANAGEMENT & BUDGET
Office of Design
and Construction


CAMP OJIBWAY EXPANSION PROJECT
MARENISCO, MICHIGAN
Sole File No. 472/98353.LEW Index No. 53045, 53046, 53047

DESIGNED BY	DATE	REVISION	BY
WLL	7/2/00		
SKANS			
DESIGNED BY	DATE	REVISION	BY
WLL	7/2/00		
SKANS			


DS-H1

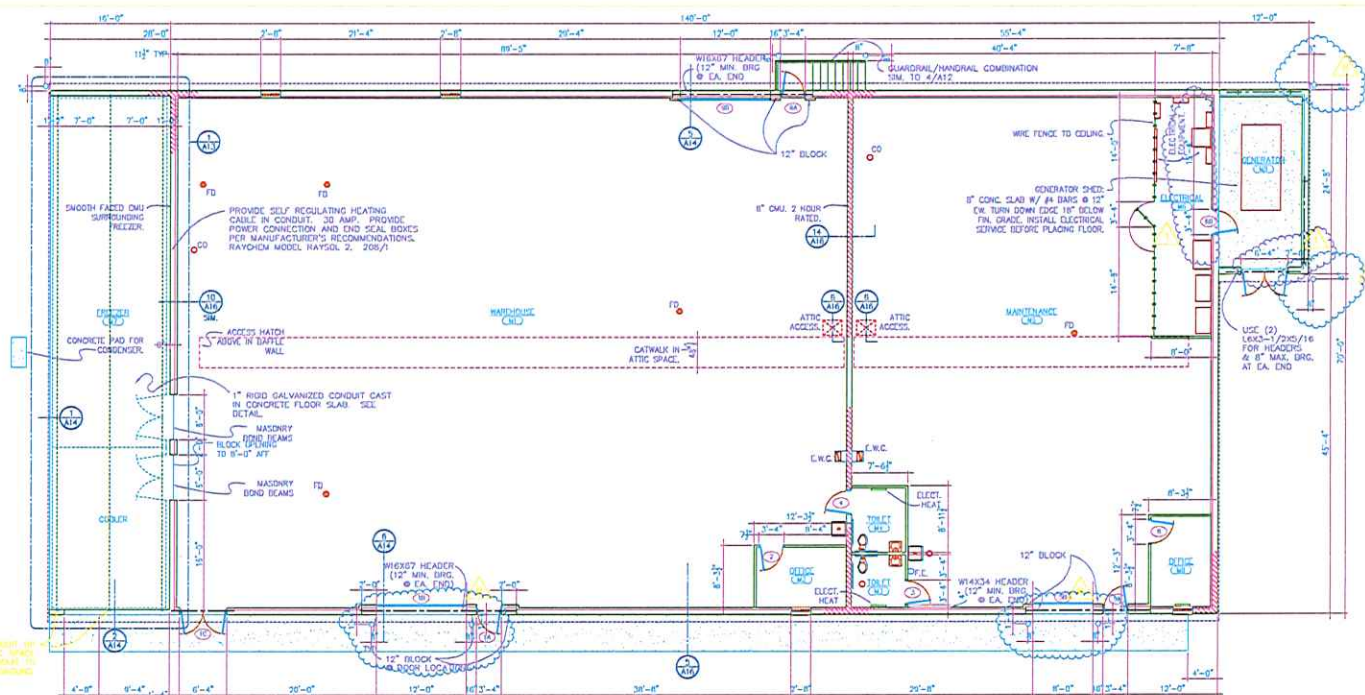


FLOOR PLAN

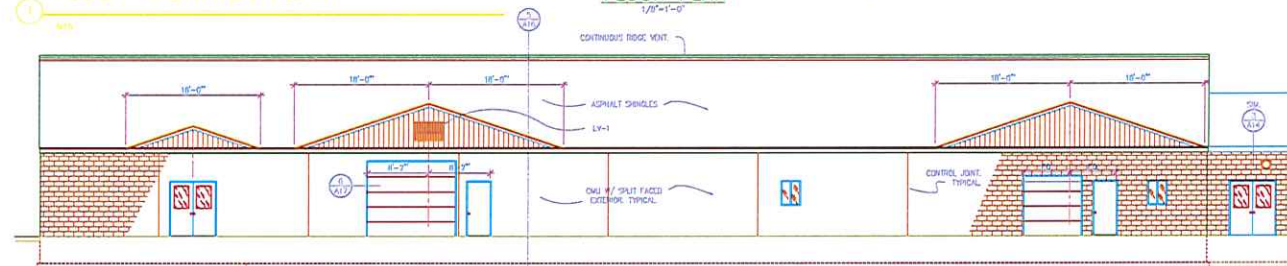

FRONT ELEVATION

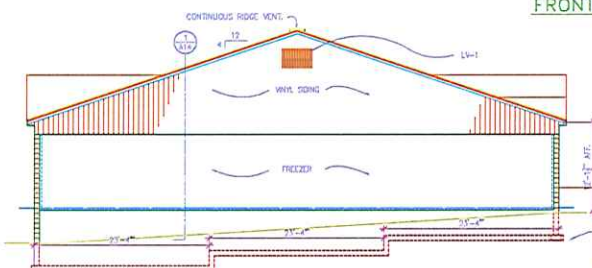


SIDE ELEVATION

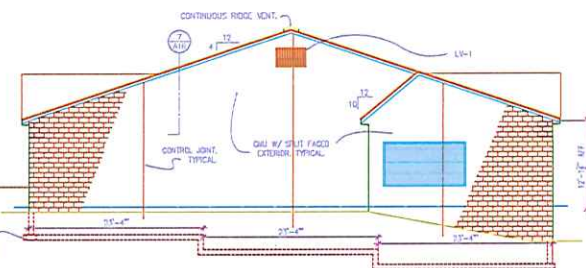


SIDE ELEVATION

1/8" = 1'-0" RECORD DRAWING
MAINTENANCE BUILDING FLOOR PLAN AND ELEVATIONS

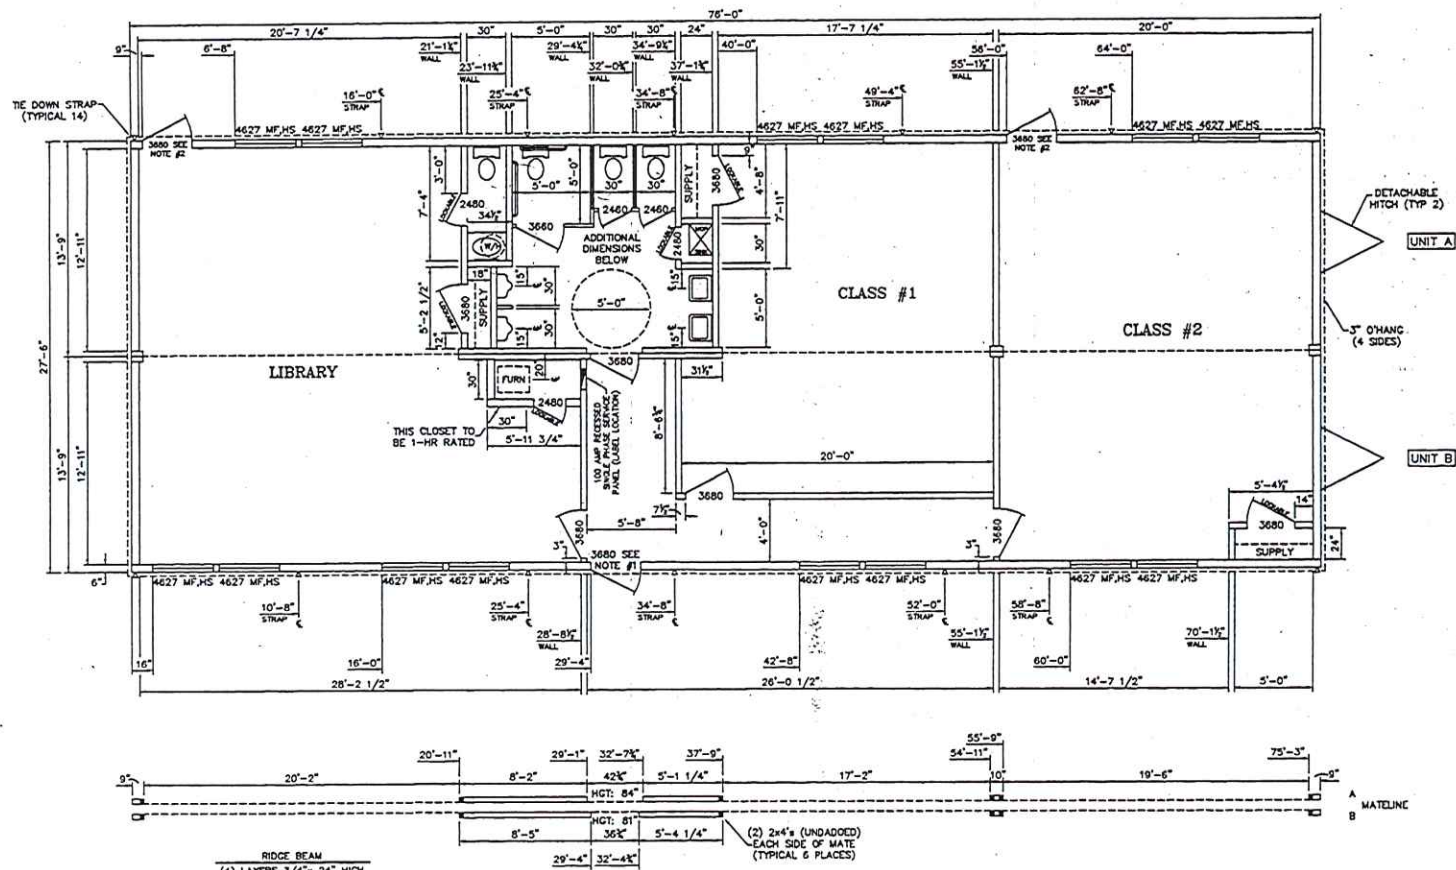

RIDGE BEAM
(4) LAYERS 3/4" x 24" HIGH
CDX PLYWOOD, 76'-0" LONG
48/24 INDEX APA, GROUP I
ALL PLIES, EACH SIDE

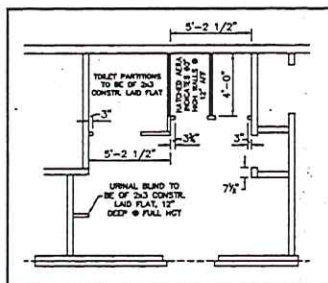

* ALL DOORS TO HAVE
LEVER HANDLES

NOTES:

- 1) DOOR TO BE 3680 STEEL w/ WOOD, BLANK, HYD CLOSER & PANIC HDWR (1)
- 2) DOOR TO BE 3680 STEEL w/ WOOD, BLANK, HYD CLOSER, PANIC HDWR & EXIT ONLY (NO EXTERIOR HANDLE) (2)
- 3) WINDOW TO BE D.I.C.
- 4) SHIP LOOSE 4" VINYL BASE

ALL DOORS MAY REQUIRE ADJUSTMENT
DUE TO SHIFTING DURING TRANSPORT.

COMMERCIAL STRUCTURES CORP. MUST
BE NOTIFIED PRIOR TO PERFORMING
ANY WARRANTY WORK. FAILURE TO
COMPLY WILL VOID THE WARRANTY
CONTRACT.

THESE DRAWINGS AND CONCEPTS ARE
THE SOLE PROPERTIES OF COMMERCIAL
STRUCTURES CORP. AND MAY NOT BE
REPRODUCED IN ANY FORM WITHOUT
THE EXPRESSED PERMISSION OF
COMMERCIAL STRUCTURES CORP.
THIS POLICY IS LEGALLY ENFORCED.

Commercial Structures corp. 2880/27'-6"x76'-0" LIB/CLASS		P.O. BOX 225 603 N. TOWNSHIP TR. NAPPANEE, WI 46330	
		REVISIONS NO. DATE	
CUSTOMER FOUR SEASONS HOUSING			
DRAWN BY WILDE	SCALE 3/16"=1'-0"	DATE 2/18/98	SERIAL NO. 2
PRODUCTION FLOOR PLAN		DRAWING NO.	

DESCRIPTION	FRAMING	INTERIOR	EXTERIOR	INSULATION	SHEATHING
FLOOR	2x6 @ 16"oc (TRANSVERSE)	3/4" PLYWOOD DECKING 1/8" TILE	BOTTOM BOARD	R-19 KRAFT	
WALLS	2x6 @ 16"oc BOCA 8'-0" CEILING HEIGHT	1/2" GYPSUM (RAW)	SIDING (VINYL LAP) TRIM (VINYL)	R-19 KRAFT	3/8" CDX PLYWOOD
PARTITIONS	2x4 @ 16"oc			R-11 KRAFT	
ROOF	70# BOCA MONO TRUSS	3/8" GYPSUM PRE-DECK w/ COMPRESSION STRIPS	FIBERGLASS SHINGLES OVER DBL LAYER OF FELT PAPER	R-40 KRAFT	1/2" CDX PLYWOOD