


WAYNE DISPOSAL SITE NO. 2

MASTER CELL VI CELL G1

RECORD PLAN

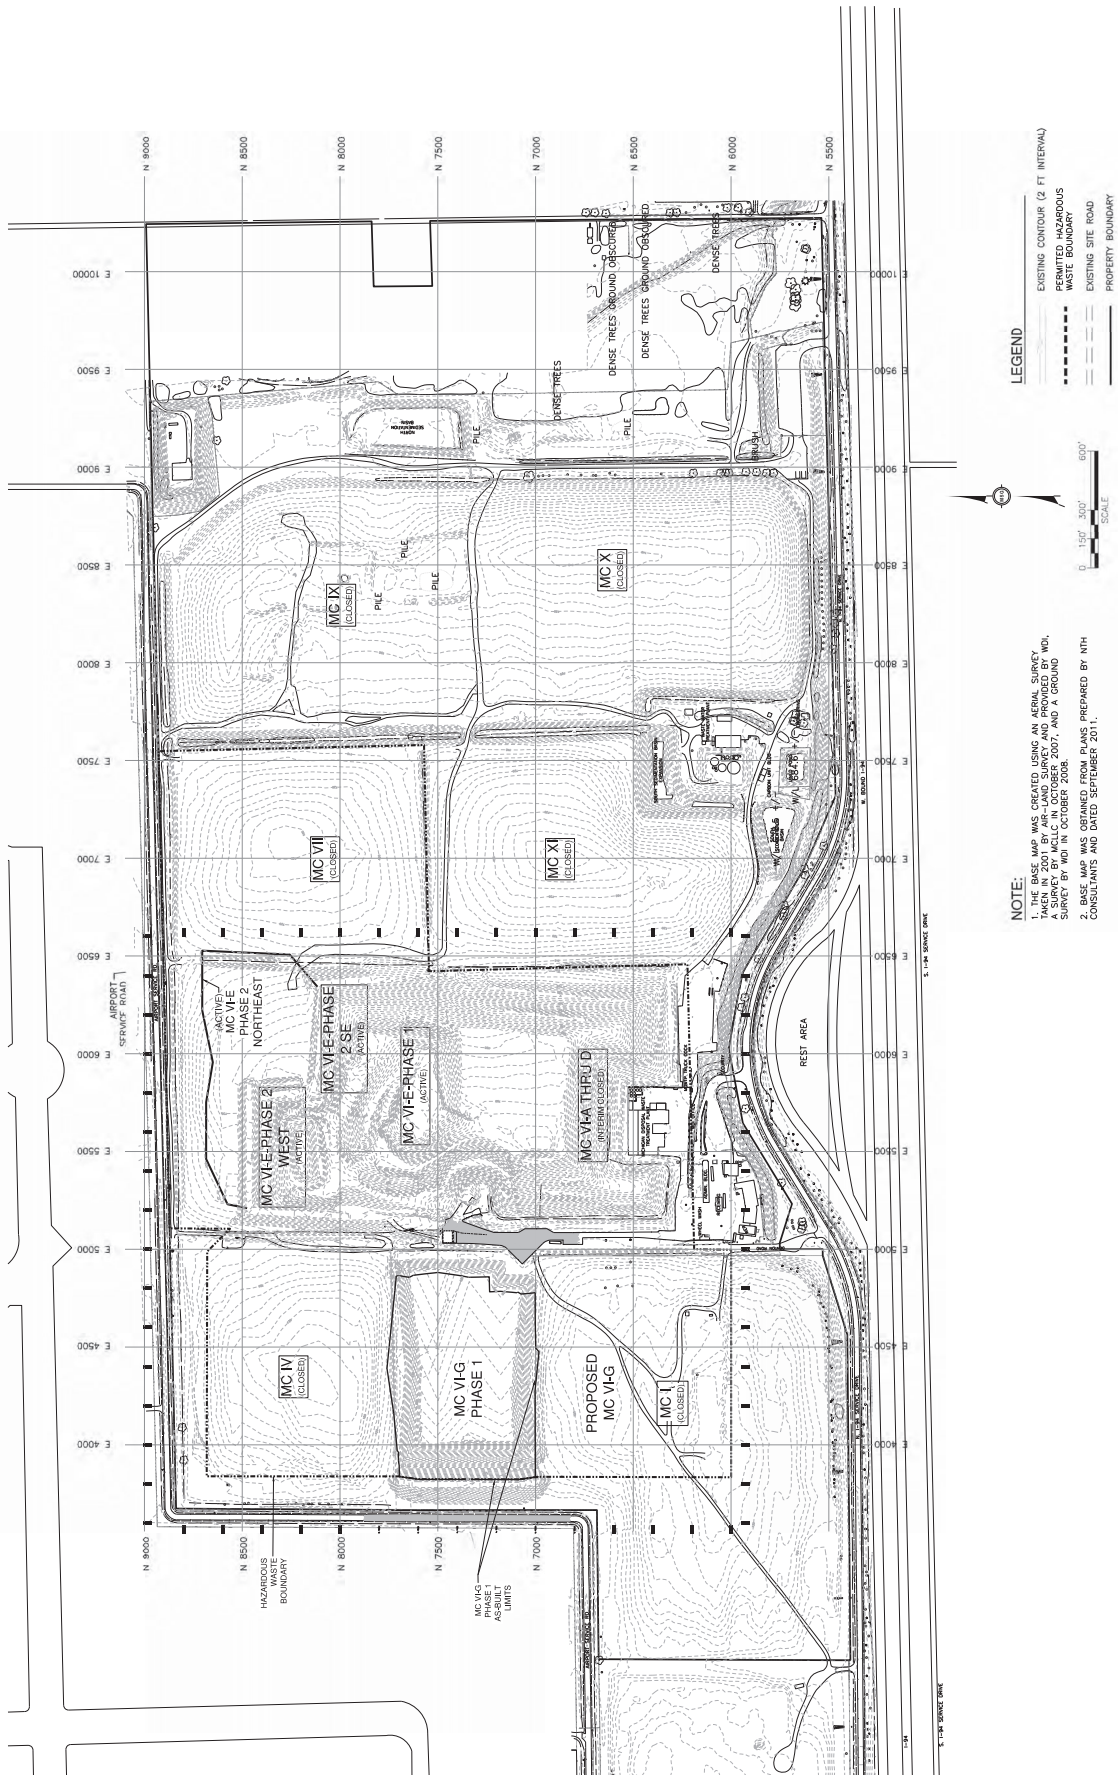

NOTE:


1. THE BASE MAP WAS CREATED USING AN AERIAL SURVEY TAKEN IN 2001 BY AIR-LAND SURVEY AND PROVIDED BY WOI. A SURVEY BY MCLLC BY OCTOBER 2007, AND A GROUND SURVEY BY WOI IN OCTOBER 2008.


2. BASE MAP WAS OBTAINED FROM PLANS PREPARED BY NTH CONSULTANTS AND DATED SEPTEMBER 2011.

LEGEND

EXISTING CONTOUR (2 FT INTERVAL)
PERMITTED HAZARDOUS
WASTE BOUNDARY
EXISTING SITE ROAD
PROPERTY BOUNDARY

A horizontal graphic scale bar with tick marks at 0, 150', 300', and 600'. The bar is divided into alternating black and white segments. The word "SCALE" is written vertically below the bar.

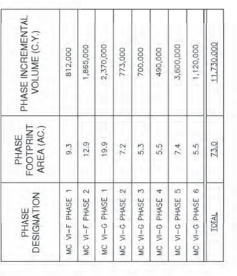

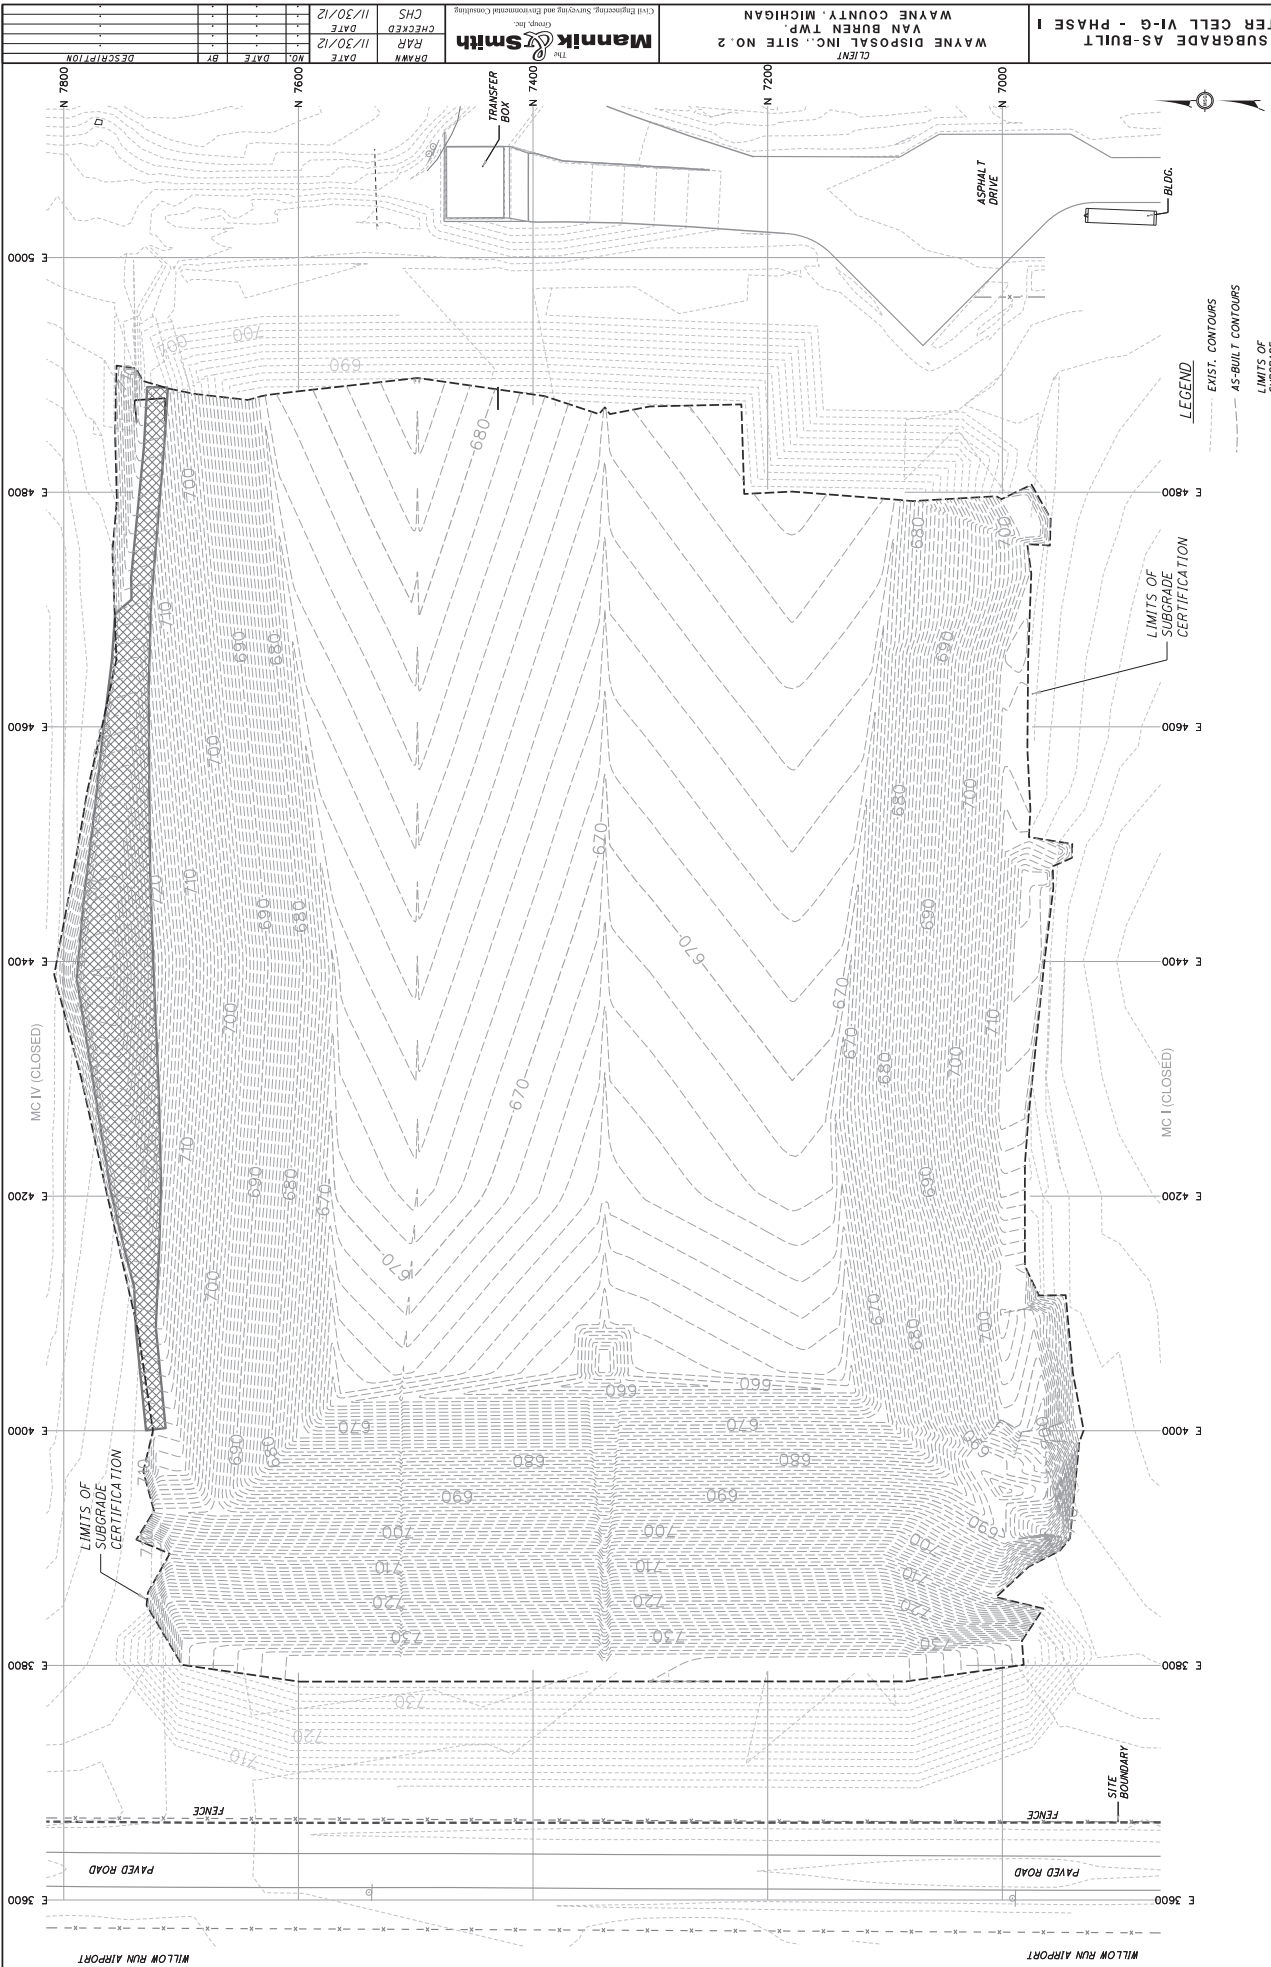

D

SECONDARY CLAY
AS-BUILT
MASTER CELL VI-G - PHASE I


WAYNE DISPOSAL INC., SITE NO. 2
VAN BUREN TWP.
WAYNE COUNTY, MICHIGAN

Mannik & Smith
Civil Engineering, Surveying and Environmental Consulting

DATE 11/30/12
CHECKED DATE 11/30/12
CHS


DATE 11/30/12
DRAWN DATE 11/30/12
RJR

DESCRIPTION

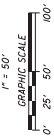

LEGEND
3.0 SECONDARY CLAY THICKNESS (FT)
--- LIMITS OF SECONDARY CLAY CERTIFICATION

NOTES:
1. CLAY THICKNESS VERIFICATION FROM TOP OF SUBGRADE TO TOP OF SECONDARY CLAY
2. REFER TO DRAWING F FOR AS-BUILT POINTS INFORMATION

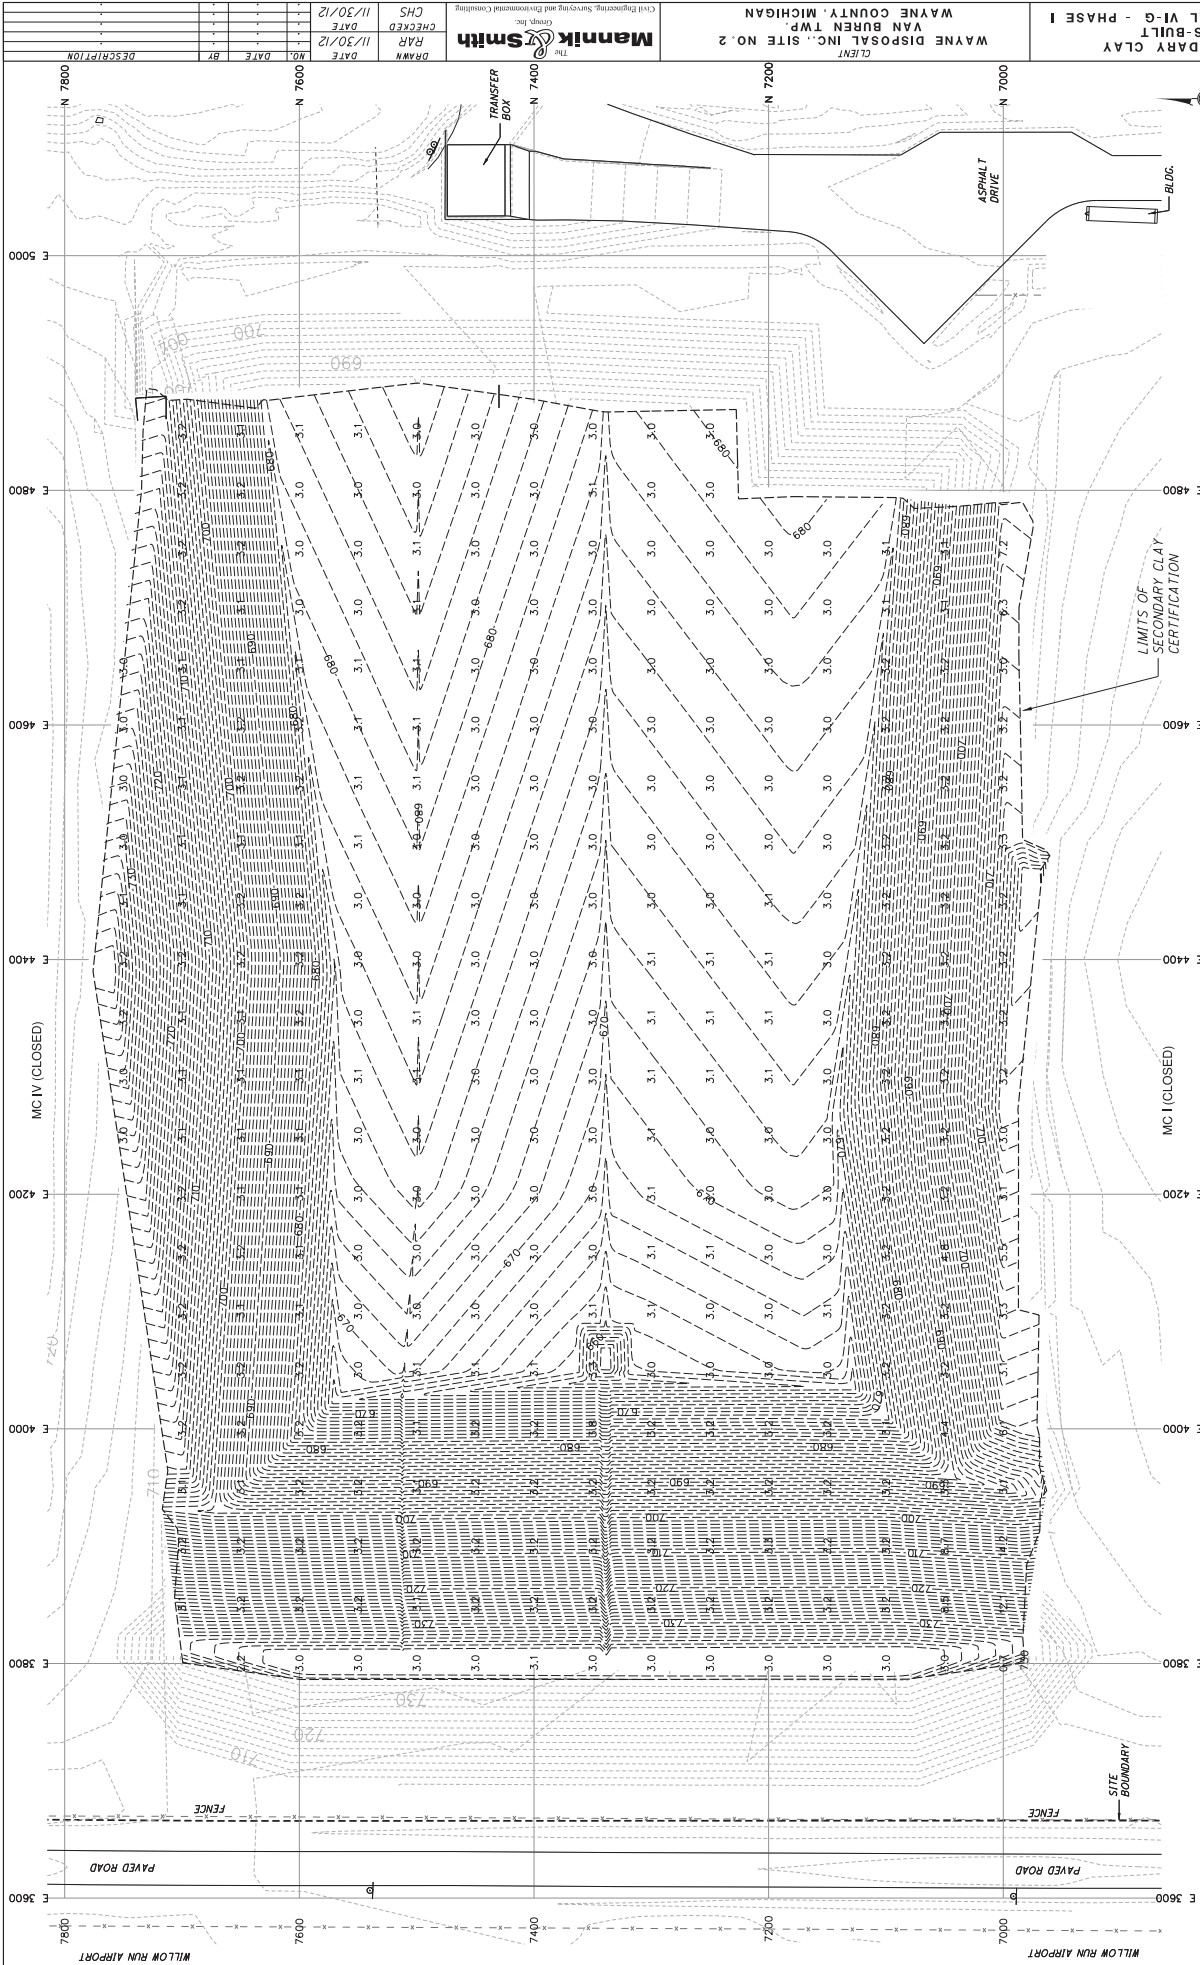

E

PRIMARY CLAY
AS-BUILT
MASTER CELL VI-G - PHASE I


WAYNE DISPOSAL INC., SITE NO. 2
VAN BUREN TWP.
WAYNE COUNTY, MICHIGAN

Mannik & Smith
Civil Engineering, Surveying and Environmental Consulting

CHS
CHECKED
DATE
11/30/12

DRW
DATE
11/30/12

DESCRIPTION

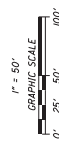

LEGEND
5.0 PRIMARY CLAY THICKNESS (FT)
--- LIMITS OF PRIMARY CLAY CERTIFICATION

NOTES:
1. CLAY THICKNESS VERIFICATION FROM TOP OF SECONDARY LINER TO TOP OF PRIMARY CLAY
2. REFER TO DRAWING F FOR AS-BUILT POINTS INFORMATION

