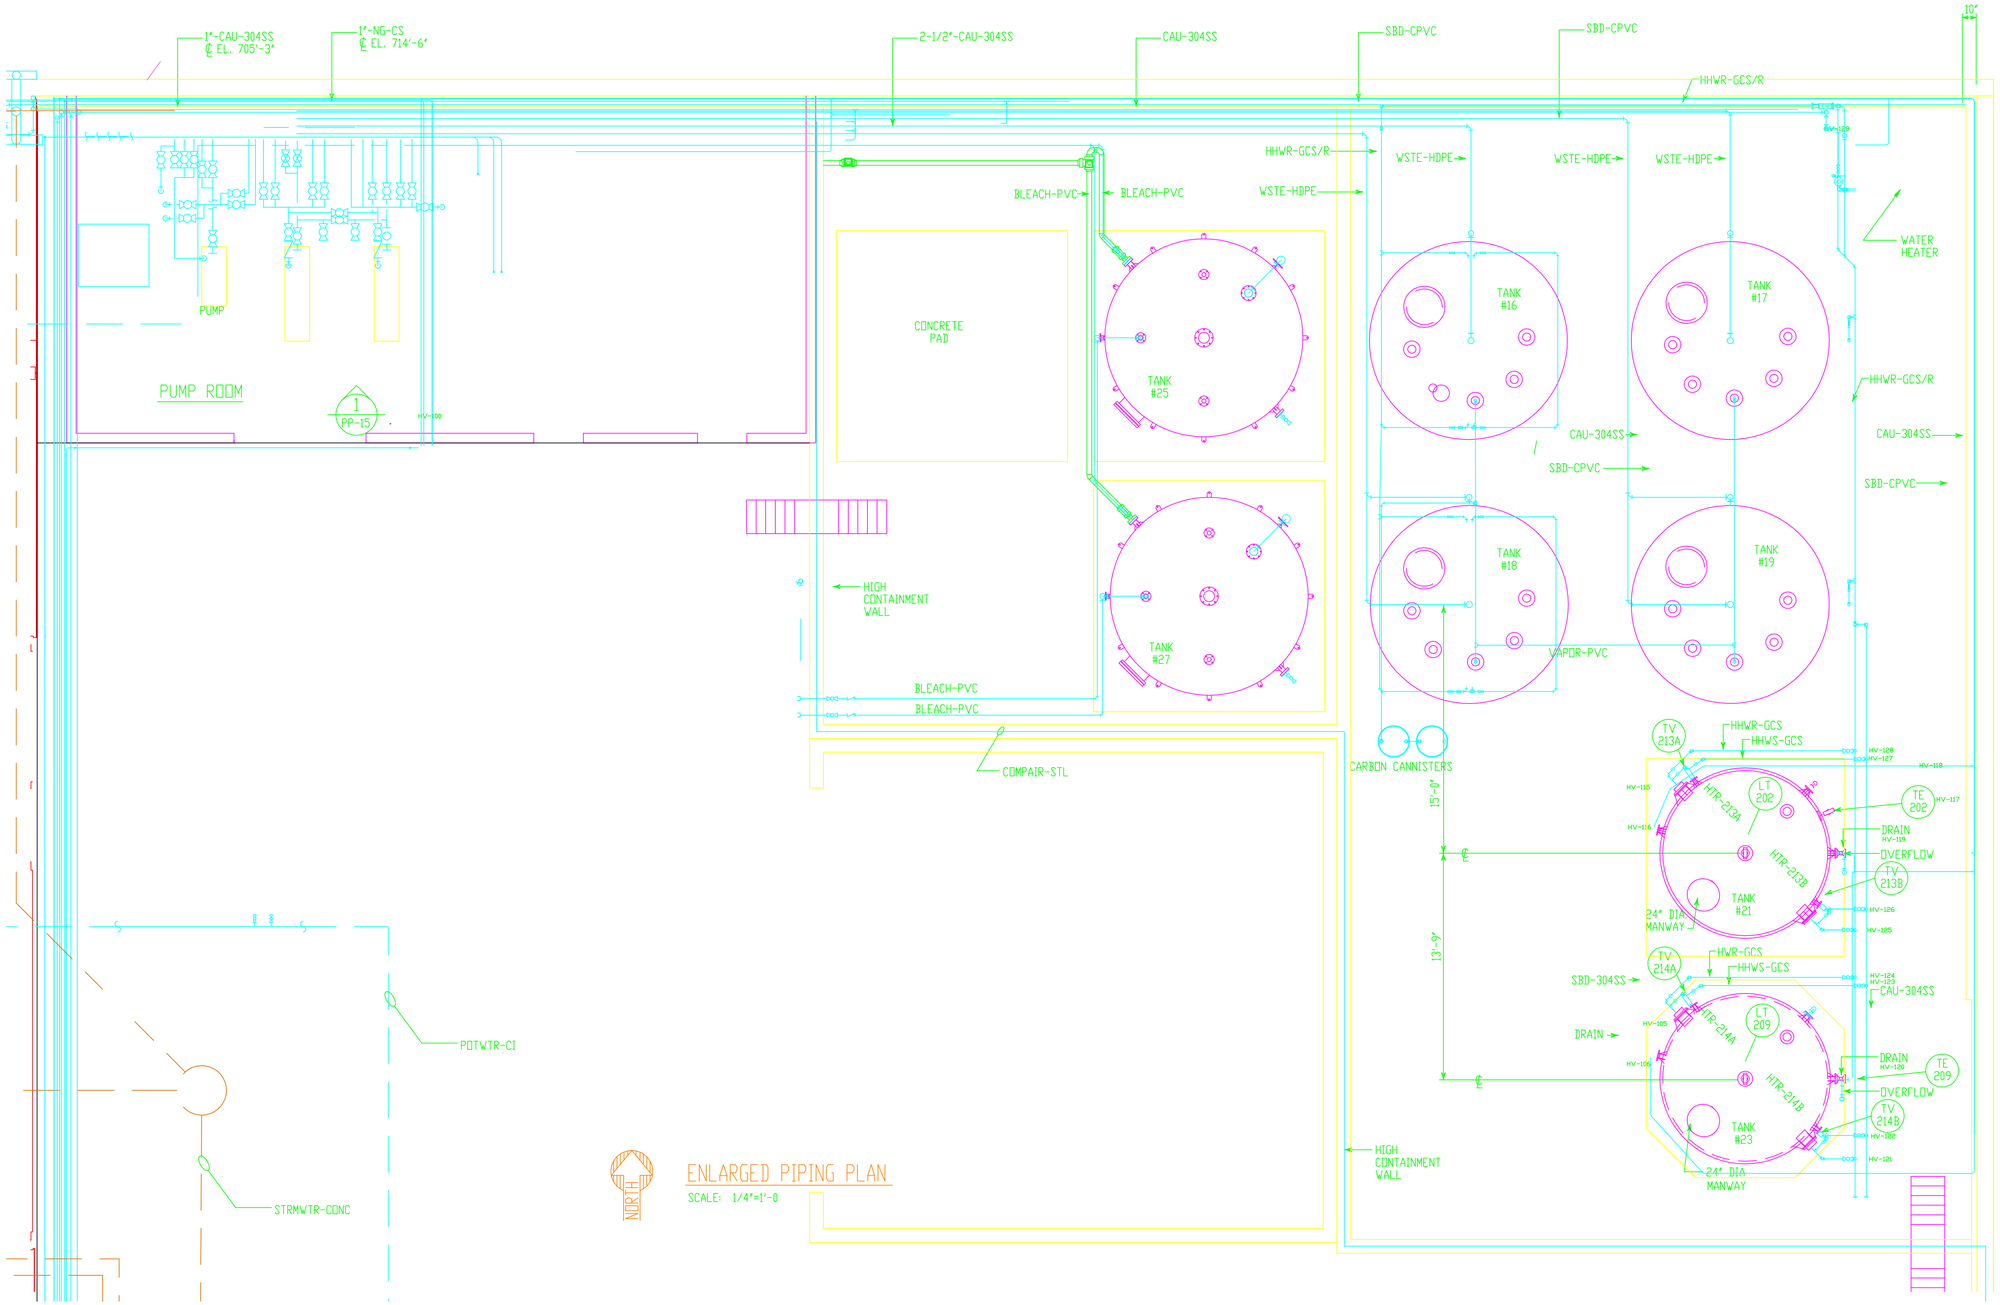

US ecology
49350 N. I-94 SERVICE DRIVE, BELLEVILLE, MI 48111
TEL. (800) 336-3265

REVISIONS		
A	2/23/00	As-built
B		
C		
D		
E		

FILENAME:
SCALE: N.T.S.
DRN BY: CAG
PROJ. FILE Lic
DATE: 2/14/00
SHEET ___ OF ___

MICHIGAN DISPOSAL WASTE TREATMENT PLANT

TANK FARM PIPING PLAN

PP2