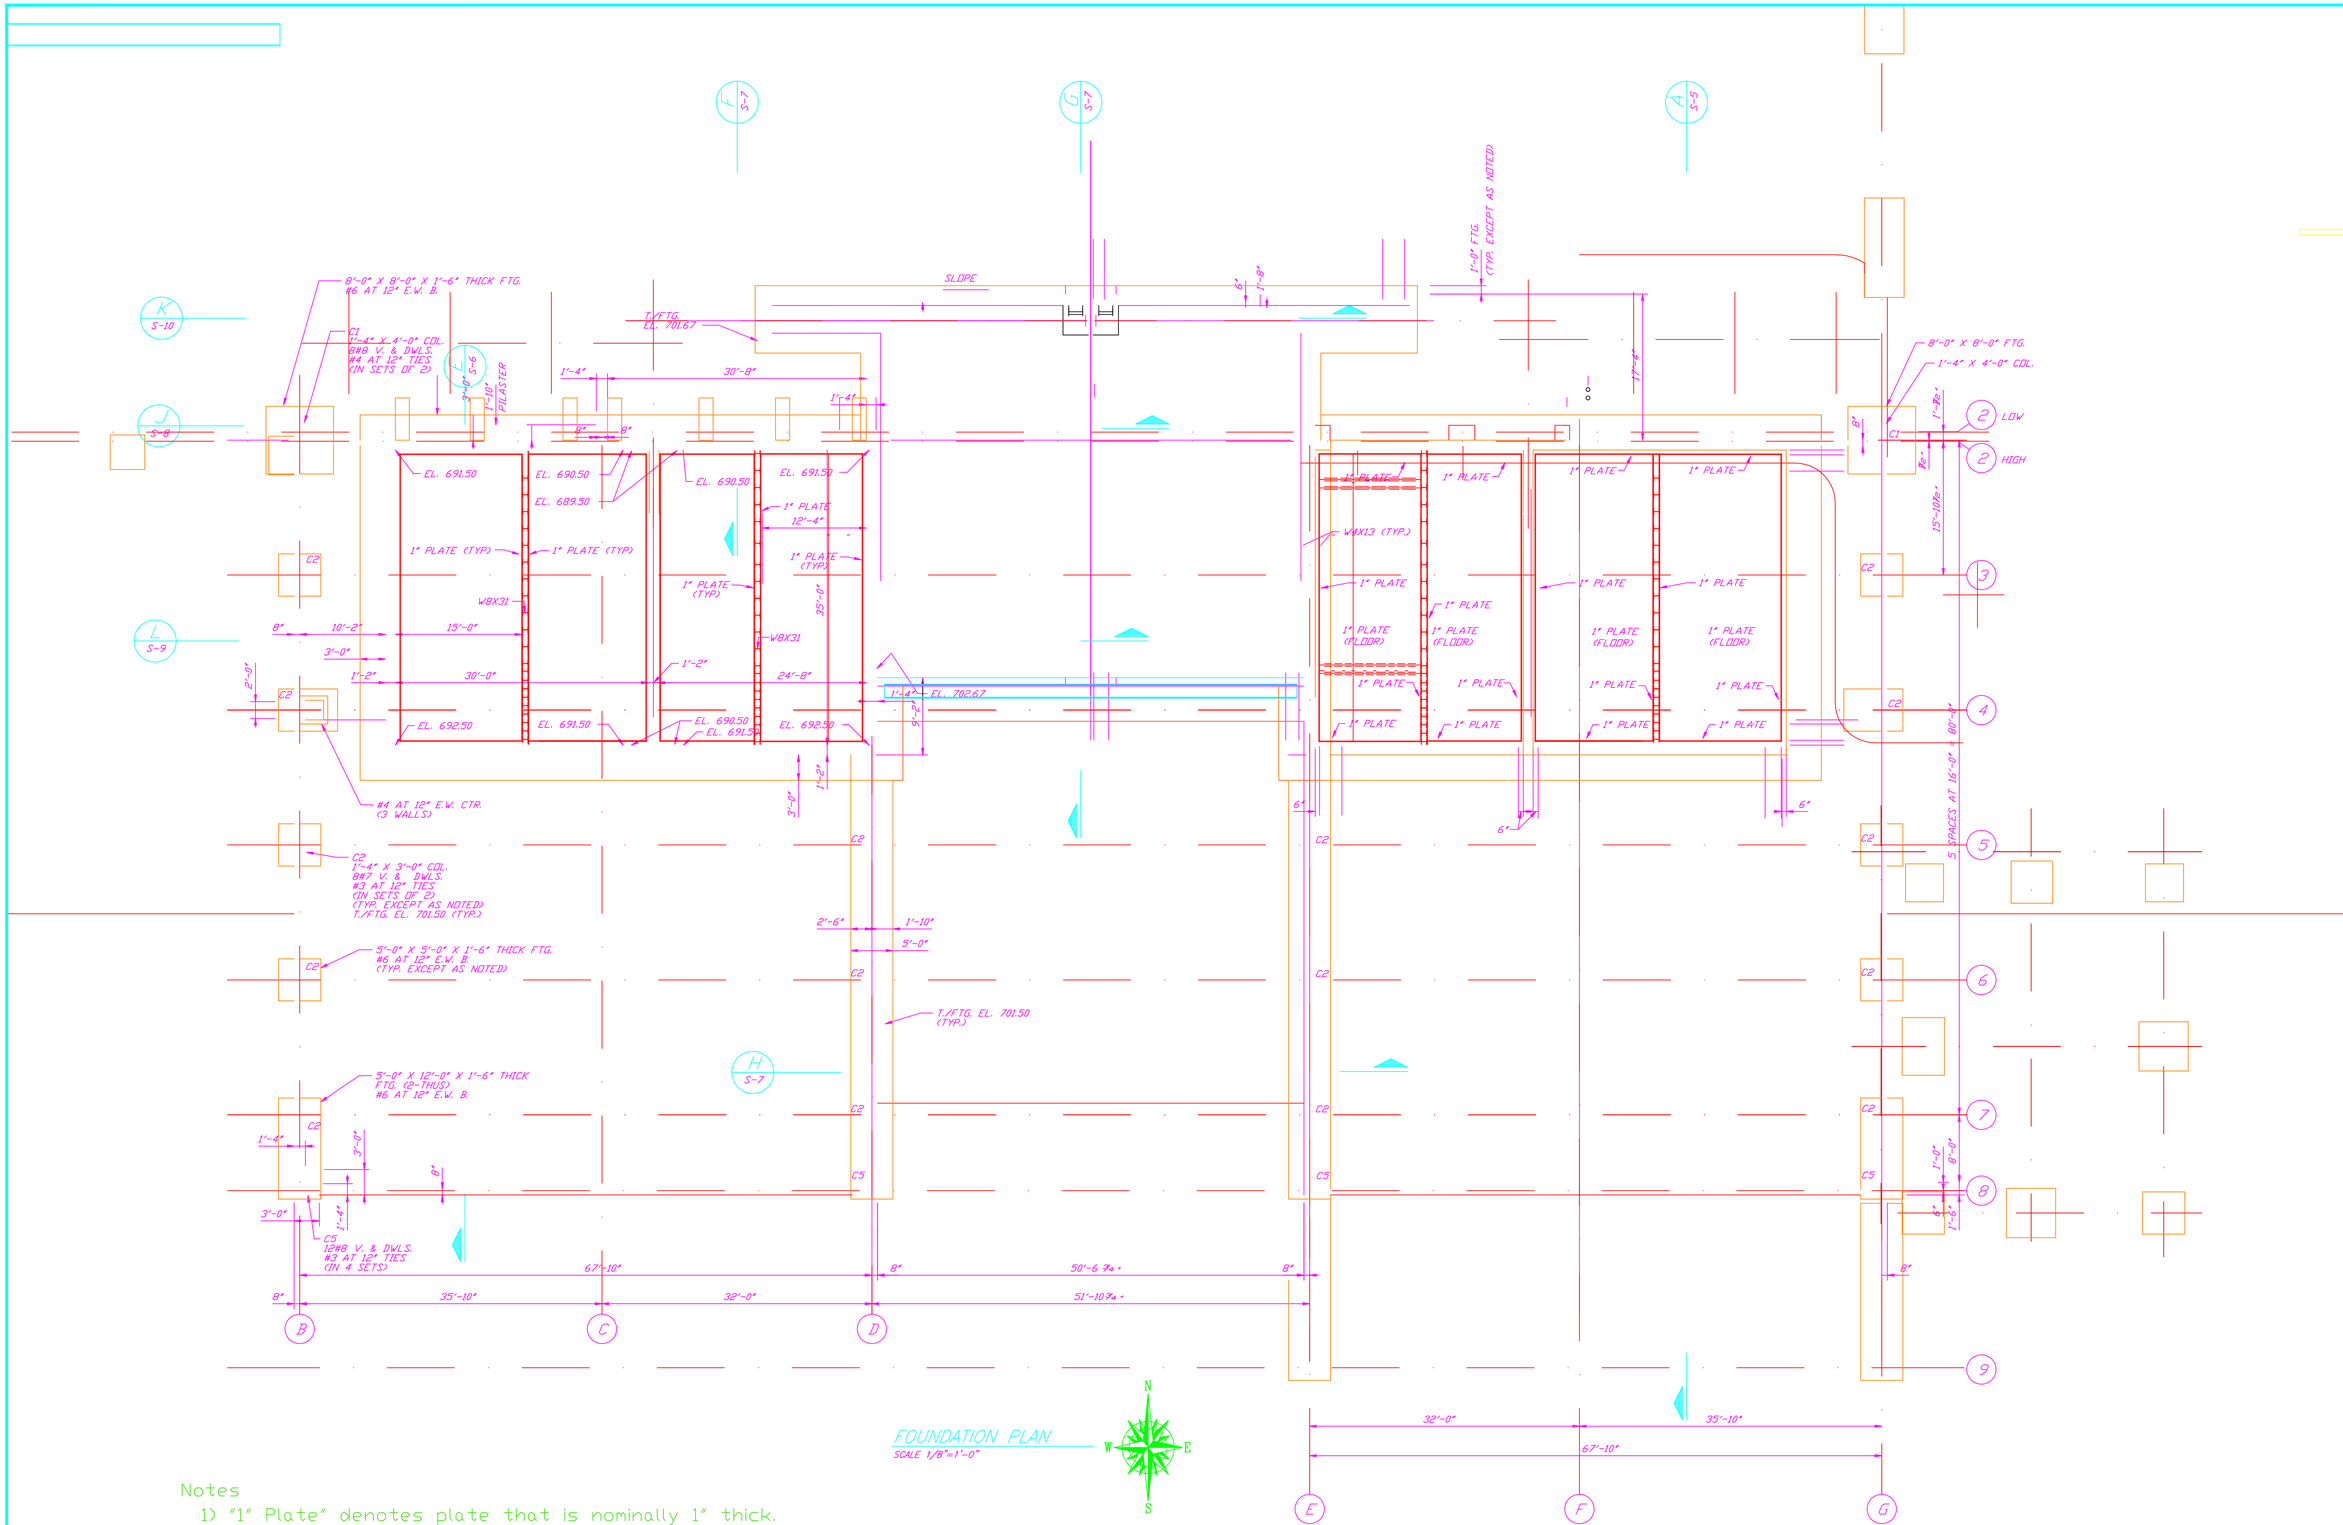

FOUNDATION PLAN
SCALE 1/8"=1'-0"

Notes

1) "1" Plate" denotes plate that is nominally 1" thick. A minimum 3/4" plate was installed, but thickness may be reduced due to wear and tear.

US ecology
49350 N. I-94 SERVICE DRIVE, BELLEVILLE, MI 48111
TEL. (800) 396-3265

REVISIONS		
A	4/25/04	Updated
B		
C		
D		
E		

FILENAME: Lic
SCALE: N.T.S.
DRN BY: CAG
PROJ. FILE: Lic
DATE: 3/4/95
SHEET ___ OF ___

MICHIGAN DISPOSAL WASTE TREATMENT PLANT
WASTE TREATMENT & STORAGE BAYS

FOUNDATION PLAN

C-1