



Road & Bridge Design Publications

Monthly Update – December 2023

Revisions for the month of **December** are listed and displayed below and will be included in projects submitted for the **April** letting.

E-mail road related questions to MDOT-Road-Design-Standards@michigan.gov.

E-mail bridge related questions to MDOT-Bridge-Design-Standards@michigan.gov.

Standard Plans

R-56-F: Guardrail Median Object Protection: Revised the details to include the use of the new Type 3M terminals instead of the Type 3B & Type 3T terminals. Also revised the median grading requirements (regardless of width) to slopes between 1:10 & 1:25.

R-60-J: Guardrail Types A, B, BD, T, TD, MGS-8, & MGS-8D: Modified the transition details on sheet 10 to specify attaching Type B or Type T guardrail to both Type 2M terminals and the new Type 3M terminals.

R-63-C: Guardrail Approach Terminal, Type 3M: Eliminated the Type 3B & 3T terminals in favor of two MASH approved (Type 3M) terminals. The information contained on this detail will supplement what is contained in a recently released FUSP and the manufacturer's drawings for this terminal type. Designers will need to call for both the special detail and the FUSP when a Type 3M terminal is required.

R-100-I: Seeding and Tree Planting: Revised the excavation area from 1.5 times the size of the root ball per side to 2 times the size of the root ball in total.

Road Design Manual

14.57 & 14.57.01: Plan Completion & Design Plan Submittal-Certification Acceptance: Revised section to current practice to comply with plan completion requirements & updated certification acceptance forms and procedures, including the use of stamps instead of signatures.

Bridge Design Manual

7.03.01 B. 4. g. & h.: Updated lap and development requirements at integral and semi-integral abutment deck slabs and approach slabs according to Guide 7.14.02 Series.

Bridge Design Guides

Table of Contents: Deleted Guides 7.14.01 and 7.14.01 A. Guides were for uncoated reinforcement. MDOT currently uses epoxy coated reinforcement in bridges and structures. Old Guide 7.14.02 now becomes 7.14.02A and old Guide 7.14.02A now becomes 7.14.02B. New Guide showing clear distance and clear cover (spacing thresholds) becomes Guide 7.14.02. Updated titles of all guides in 7.14.02 Series.



Road & Bridge Design Publications

Monthly Update – December 2023

5.16.01, 5.16.01A, 5.18.01, 5.18.01A, 5.27.03, 6.20.03, 6.20.03A, 6.20.03B, 6.20.04, 6.20.04A, 6.20.04B, 6.20.05, 6.20.05A, 6.60.12: Updated guides for lap development and modified development lengths (for hooks) according to AASHTO LRFD Bridge Design Specifications. Values will be determined from Guides 7.14.02 Series and 7.14.03 based on the bridge/structure element, reinforcement spacing and clear cover.

7.14.01 & 7.14.01A: Uncoated reinforcement guides are deleted/not updated.

7.14.02, .02A & .02B: Updated guides for lap and development lengths according to AASHTO LRFD Bridge Design Specifications. Added details and notes for clarity as to how values were derived and to allow for other options if projects don't exactly fall into all the categories of the tables. Guides were moved (given new designations), see description above in "Table of Contents".

7.14.03: Updated guide for modified development lengths (for hooks) according to AASHTO LRFD Bridge Design Specifications. Updated details and notes for clarity as to how values were derived and to allow for other options if projects don't exactly fall into all the categories of the tables.

Updates to the MDOT Cell Library, Sample Plans, and other automated tools may be required in tandem with some of this month's updates. Until such updates can be made, it is the designer's/detailer's responsibility to manually incorporate any necessary revisions to notes and plan details to reflect these revisions.

Index to Special Details

12-26-2023

6

SPECIAL DETAIL NUMBER	NUMBER OF SHEETS	TITLE	CURRENT DATE
21	2	GUARDRAIL AT INTERSECTIONS	6-6-22
24	8	GUARDRAIL ANCHORED IN BACKSLOPE TYPES 4B, 4T, & 4MGS-8	12-6-22
99	2	CHAIN LINK FENCE WITH WIRE ROPE	12-6-22
R-28-K	7	CURB RAMP AND DETECTABLE WARNING DETAILS	11-8-23
R-29-J	4	DRIVEWAY OPENINGS & APPROACHES, AND CONCRETE SIDEWALK	11-8-23
R-32-F	8	APPROACH CURB & GUTTER DOWNSPOUTS	9-20-22
R-32-SD	6	APPROACH CURB & GUTTER DOWNSPOUTS (FOR SAFETY SHAPES)	4-24-23
R-43-J	2	LOCATION OF TRANSVERSE JOINTS IN PLAIN CONCRETE PAVEMENT	1-4-22
R-44-G	7	CONCRETE PAVEMENT REPAIR	9-18-23
R-45-K	2	PAVEMENT REINFORCEMENT FOR BRIDGE APPROACH	1-4-22
R-53-A	22	TEMPORARY CONCRETE BARRIER LIMITED DEFLECTION	8-14-15
*R-56-F	6	GUARDRAIL MEDIAN OBJECT PROTECTION	10-10-23
*R-60-J	16	GUARDRAIL TYPES A, B, BD, T, TD, MGS-8, & MGS-8D	10-4-23
R-62-H	4	GUARDRAIL APPROACH TERMINAL TYPE 2M	6-16-22
*R-63-C	3	GUARDRAIL APPROACH TERMINAL TYPE 3M	10-2-23
R-66-E	4	GUARDRAIL DEPARTING TERMINAL TYPES B, T, & MGS	9-14-23
R-67-G	16	GUARDRAIL ANCHORAGE, BRIDGE, DETAILS	12-6-22
R-67-SD	6	GUARDRAIL ANCHORAGE, BRIDGE, DETAILS (FOR SAFETY SHAPES)	4-4-23
R-72-D	6	GUARDRAIL LONG SPAN INSTALLATIONS	8-23-22
R-73-F	3	GUARDRAIL OVER BOX OR SLAB CULVERTS	8-1-19
R-80-F	8	GRANULAR BLANKETS, UNDERDRAINS, OUTLET ENDINGS, & BULKHEADS	6-28-21
R-88-E	4	STEEL END SECTION	3-7-23
*R-100-I	4	SEEDING AND TREE PLANTING	12-8-23
R-110-B	3	PAVEMENT SAFETY EDGE	6-14-21
R-112-J	10	SHOULDER AND CENTER LINE CORRUGATIONS	8-2-23
R-126-I	5	PLACEMENT OF TEMPORARY CONCRETE & STEEL BARRIER	8-25-15
R-127-H	8	DELINEATOR INSTALLATIONS	8-11-23

*** Denotes New or Revised Special Detail to be included in projects for (beginning with) the April letting.**

Notes:

Former Standard Plans IV-87, IV-89, IV-90, and IV-91 Series, used for building cast-in-place concrete head walls for elliptical and circular pipe culverts, are now being replaced with plans that detail each specific size. The Bureau of Bridges & Structures, Structure Design Section, Special Structures Unit will provide special details for inclusion in construction plans for MDOT jobs. To assure prompt delivery, requests **must be made in advance**. Contact: MDOT-TriezenbergSquad@Michigan.gov


Former Standard Plans IV-93 and IV-94 series have been replaced with precast concrete box & three-sided culverts as per the 2020 Standard Specifications for Construction.

Index to Bridge Detail Sheets


12-26-2023

7

DETAIL NUMBER	NUMBER OF SHEETS	TITLE	CURRENT DATE
B-25-L	8	BRIDGE RAILING, AESTHETIC PARAPET TUBE	11-15-23
B-27-B	7	BRIDGE RAILING, 3 TUBE WITH PICKETS	11-17-23
B-28-A	7	BRIDGE BARRIER RAILING, TYPE 7	9-2-20
B-29-A	8	BRIDGE BARRIER RAILING, TYPE 6	9-2-20
B-102-D	4	STANDARD SLOPE PAVING DETAILS	9-18-23
EJ3AF	1 to 4	EXPANSION JOINT DETAILS (See Notes)	1-23-23
EJ4S	1 to 4	EXPANSION JOINT DETAILS (See Notes)	1-23-23
PC-1N	2	PRESTRESSED CONCRETE I-BEAM DETAILS (See Notes)	11-28-22
PC-2I	2	70" PRESTRESSED CONCRETE I-BEAM DETAILS (See Notes)	11-28-22
PC-4G	2	PRESTRESSED CONCRETE 1800 BEAM DETAILS (See Notes)	11-28-22
PC-5A	2	PRESTRESSED CONCRETE BULB-TEE BEAM DETAILS (See Notes)	11-28-22
<p>* Denotes New or Revised Special Detail to be included in projects for (beginning with) the April letting.</p> <p>Notes: Details EJ3AF & EJ4S are interactive, i.e., designers and detailers choose details based upon railing type and angle of crossing and fill in the project specific dimensions for the end plate. Place all details appropriate for the project (including the end plate), structure specific information, and the Expansion Joint Device quantity on the sheet. Add the sheet to the plans as a normal plan sheet. Call out and designate the location of the expansion joint device and the end plate on the Superstructure Sheet in the plan set.</p> <p>Details PC-1N, PC-2I, PC-4G, and PC-5A shall have structure specific information and quantities added to the sheet. The sheet shall then be added to the plans as a normal plan sheet.</p>			

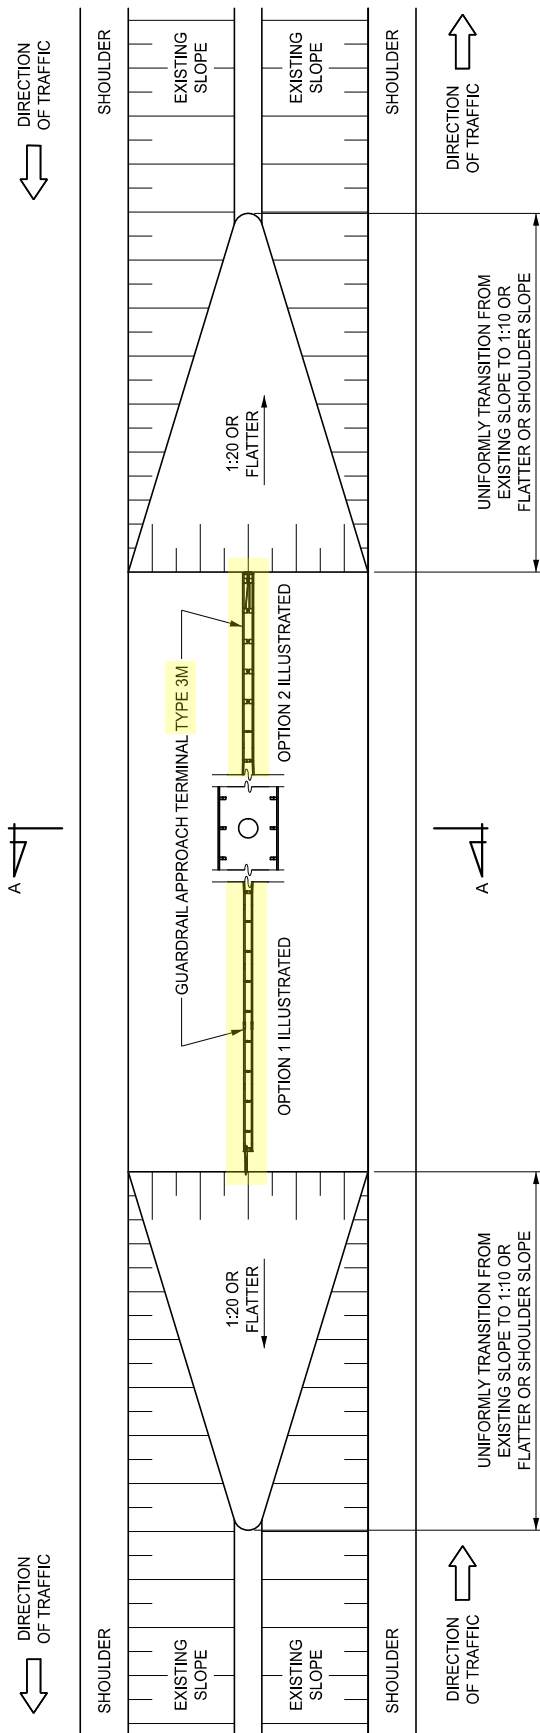

GRADING OF SLOPES AT PIERS

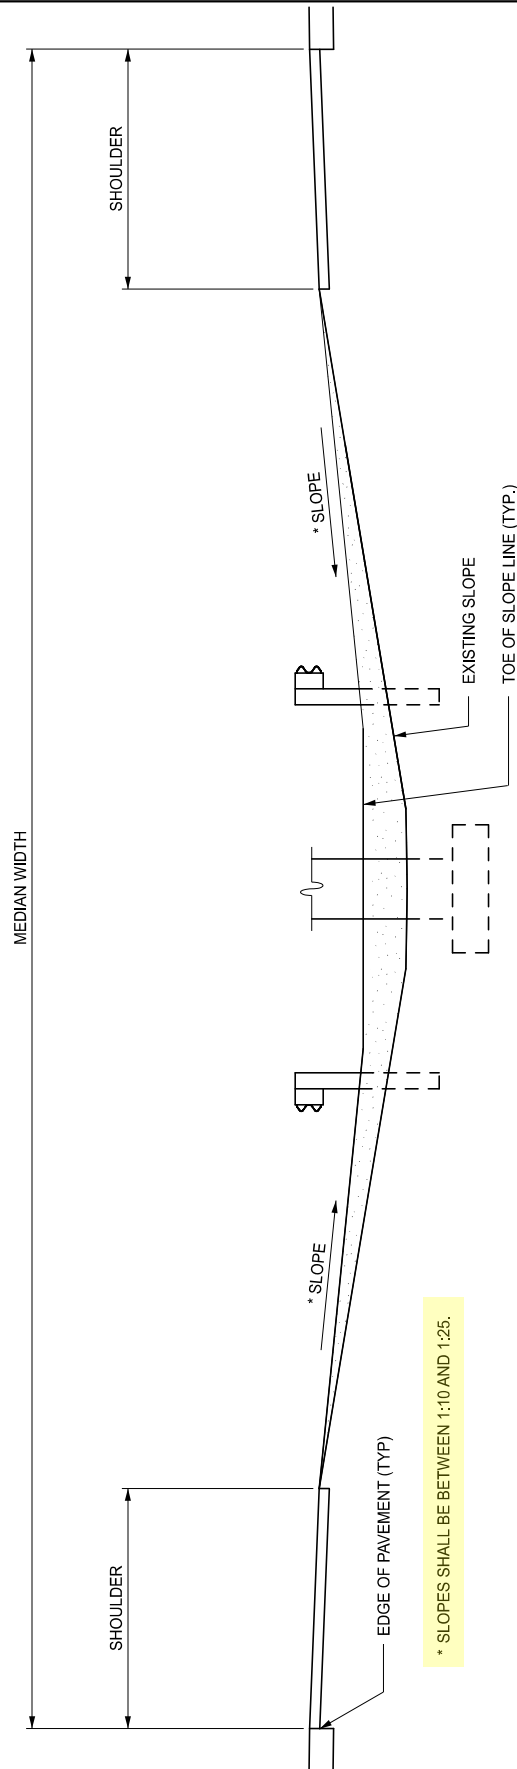


SECTION A-A


GRADING IN MEDIANS FROM 36' TO LESS THAN 70' IN WIDTH
USING GUARDRAIL TYPE MGS-8

DIRECTION
OF TRAFFIC

C

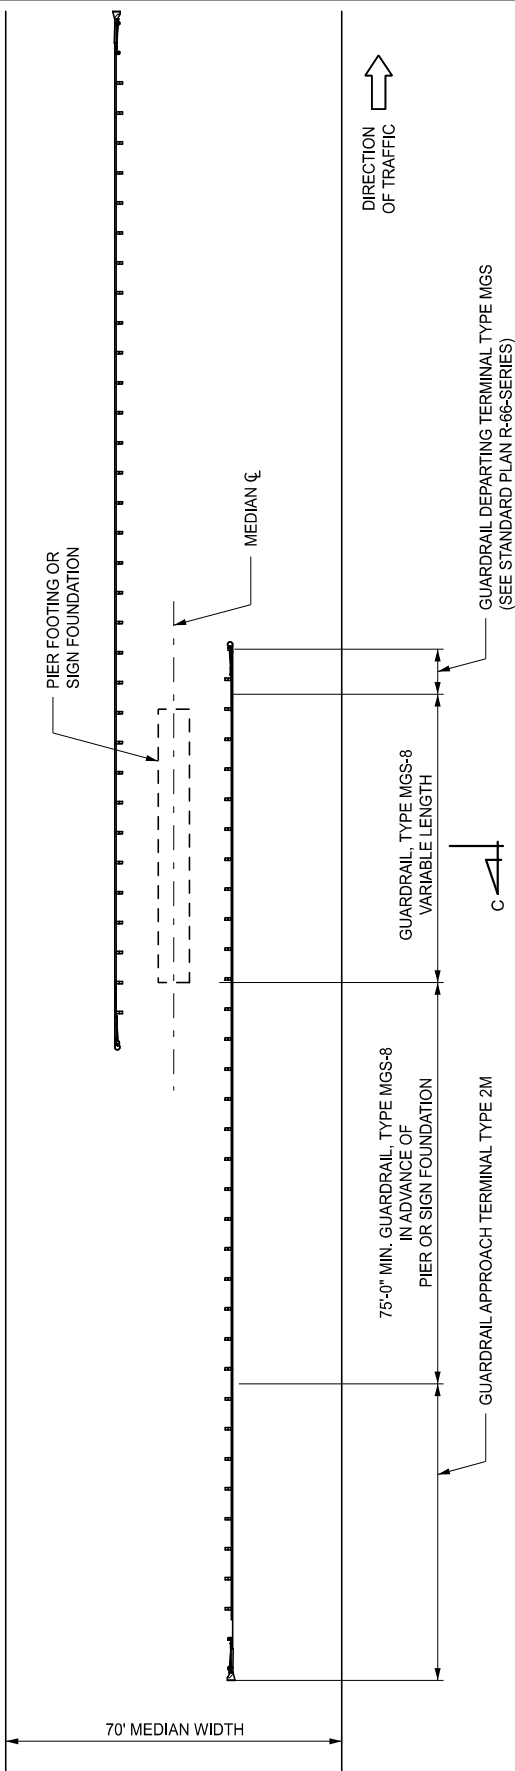

TWIN PARALLEL GUARDRAIL RUNS USING GUARDRAIL TYPE MGS-8

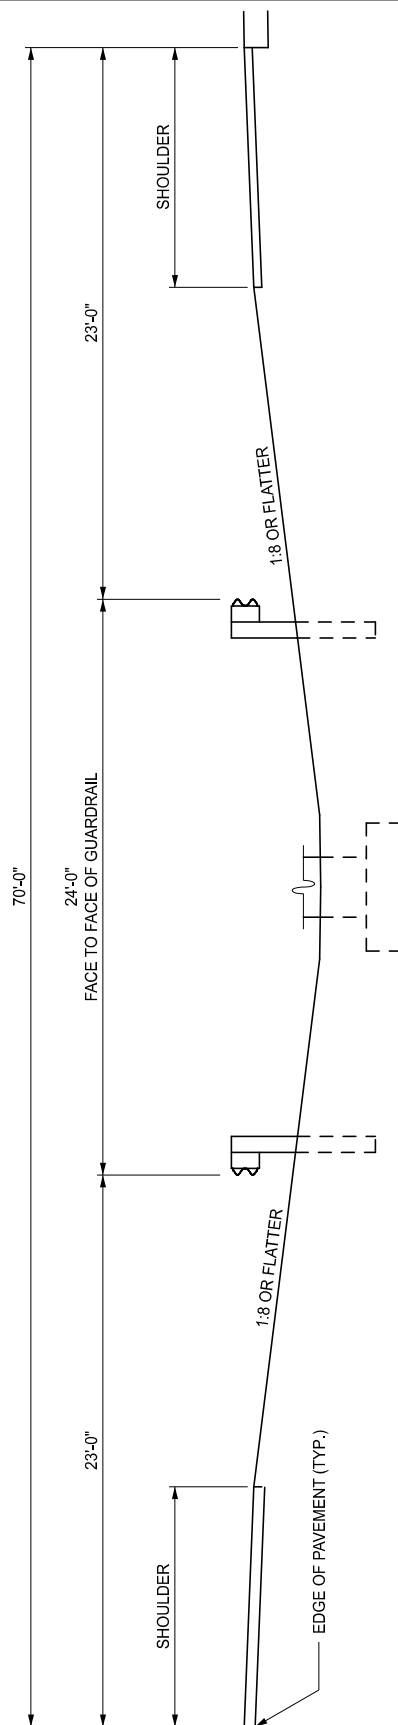

SECTION C-C

MEDIANS 70' IN WIDTH
USING GUARDRAIL TYPE MGS-8



DEPARTMENT DIRECTOR
BRADLEY C. WIEFERICH, PE

STANDARD PLAN FOR
GUARDRAIL MEDIAN OBJECT PROTECTION

(SPECIAL DETAIL)
FHWA APPROVAL


10/10/2023
PLAN DATE

R-56-F

SHEET
3 OF 6

GUARDRAIL APPROACH TERMINAL TYPE 3M
OPTION 2 ILLUSTRATED
(SEE STANDARD PLAN R-63-SERIES)

SEE DETAIL BELOW

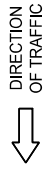

SEE DETAIL BELOW

MEDIAN WIDTH

DIRECTION OF TRAFFIC

FILLER WALL AND
FILLER WALL END BLOCK
(SEE STANDARD PLAN R-55-SERIES)

TYPICAL LAYOUT

PAID FOR AS GUARDRAIL ANCHORAGE BRIDGE, DETAIL M7 (EACH SIDE)

THRIE BEAM TERMINAL CONNECTOR
& THRIE BEAM EXPANSION SECTION
(SEE STANDARD PLAN R-67-SERIES)

TRANSITION GUARDRAIL TO CONNECT TO GUARDRAIL APPROACH TERMINAL TYPE 3M (OPTION 1 OR 2)

6'-3" POST SPACING

3'-1 1/2" POST SPACING

EXISTING PIER DIA.
OR WIDTH

VARIABLE WIDTH
TO MATCH PIER

PLAN VIEW

FILLER WALL AND FILLER WALL END BLOCK
(SEE STANDARD PLAN R-55-SERIES)

PAID FOR AS GUARDRAIL ANCHORAGE BRIDGE, DETAIL M7 (EACH SIDE)

51'-10 3/4"

6'-3" ASYMMETRICAL
THRIE BEAM TRANSITION

3'-1 1/2" POST SPACING (4 SPACES)

1'-6 3/4" POST SPACING (4 SPACES)

3'-1 1/2" POST SPACING (3 SPACES)

2'-1 1/2"

EXISTING PIER

THRIE BEAM TERMINAL CONNECTOR
& THRIE BEAM EXPANSION SECTION
(SEE STANDARD PLAN R-67-SERIES)

ELEVATION VIEW

GUARDRAIL WITH DIRECT CONNECTION TO PIER

SEE STANDARD PLAN R-67-SERIES FOR COMPLETE DETAIL OF GUARDRAIL ANCHORAGE BRIDGE, DETAIL M7



DEPARTMENT DIRECTOR
BRADLEY C. WIEFERICH, PE


STANDARD PLAN FOR GUARDRAIL MEDIAN OBJECT PROTECTION

(SPECIAL DETAIL)
FHWA APPROVAL

10/10/2023
PLAN DATE


R-56-F

SHEET
5 OF 6

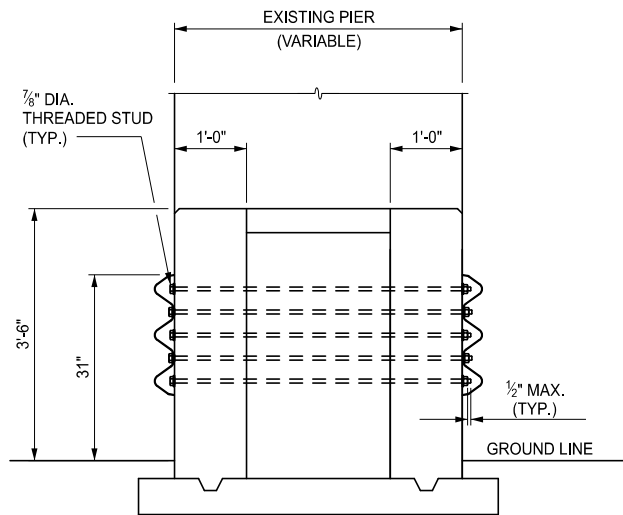


GUARDRAIL CONNECTION AT FILLER WALL

(FOR FILLER WALL DETAILS SEE STANDARD PLAN R-55-SERIES)

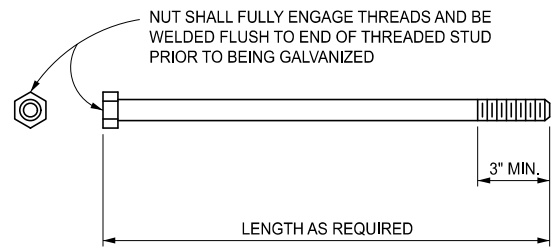


7/8" DIA. THREADED STUD

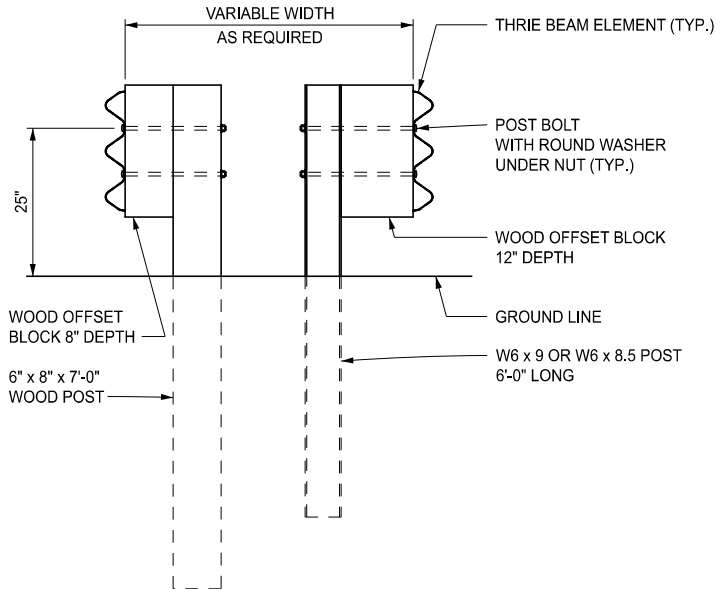

POST DETAIL

WHEN WIDTH CAN ACCOMMODATE
TWO GUARDRAIL POSTS

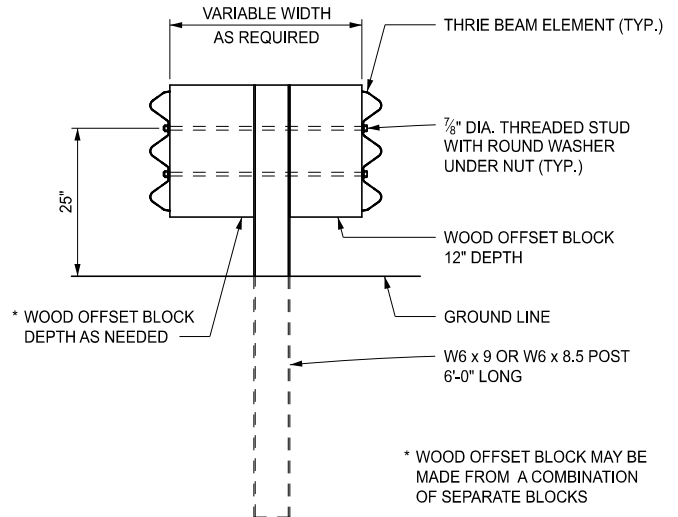

POST DETAIL

WHEN WIDTH CAN ACCOMMODATE
ONLY ONE GUARDRAIL POST



DEPARTMENT DIRECTOR
BRADLEY C. WIEFERICH, PE


STANDARD PLAN FOR GUARDRAIL MEDIAN OBJECT PROTECTION

(SPECIAL DETAIL)
FHWA APPROVAL


10/10/2023
PLAN DATE

R-56-F


SHEET
6 OF 6

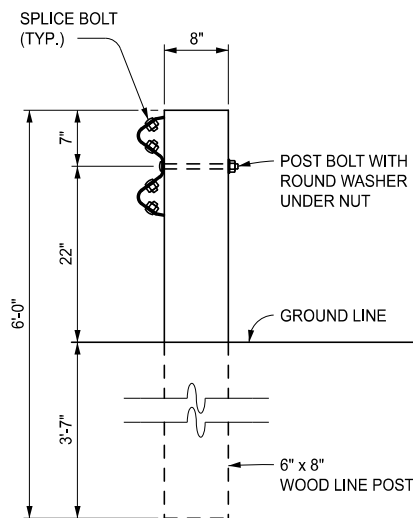

WOOD POST

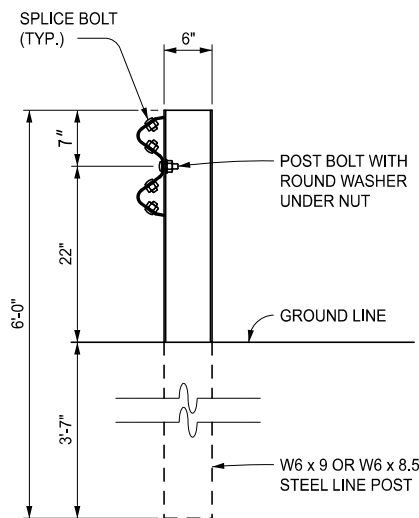

STEEL POST

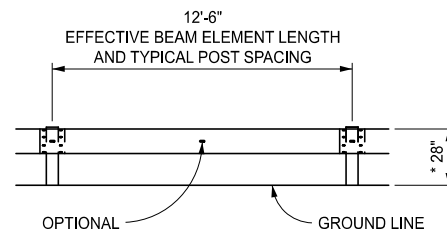

ELEVATION SHOWING POST SPACING

* SEE NOTES FOR GUARDRAIL IN CONJUNCTION WITH CURB

GUARDRAIL, TYPE A

APPROVED BY: _____
DIRECTOR, BUREAU OF FIELD SERVICES

APPROVED BY: _____
DIRECTOR, BUREAU OF DEVELOPMENT



DEPARTMENT DIRECTOR
BRADLEY C. WIEFERICH, PE


STANDARD PLAN FOR
GUARDRAIL, TYPES A, B, BD, T, TD, MGS-8, & MGS-8D

(SPECIAL DETAIL)
FHWA APPROVAL

10/04/2023
PLAN DATE



R-60-J

SHEET
1 OF 16

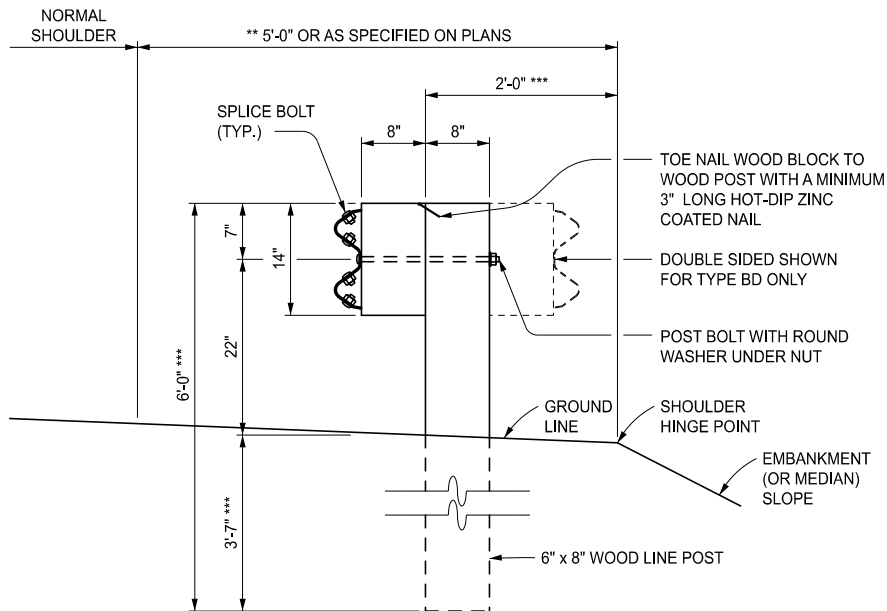

** FOR PAVED SHOULDER WIDTHS OF AT LEAST 12', USE 3'-0".


*** IF THE OFFSET FROM THE FACE OF POST TO THE SHOULDER HINGE POINT IS LESS THAN 2'-0" AND THE EMBANKMENT (OR MEDIAN) SLOPE IS STEEPER THAN 1:10, USE 8'-0" POST WITH THE ADDITIONAL LENGTH EMBEDDED.

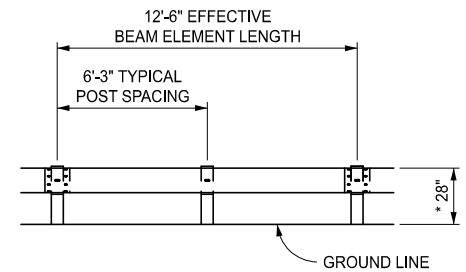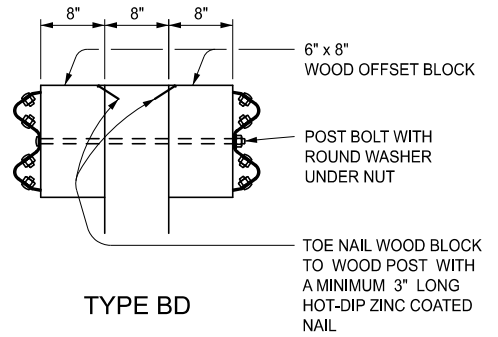

ELEVATION SHOWING POST SPACING


* SEE NOTES FOR GUARDRAIL IN CONJUNCTION WITH CURB

GUARDRAIL, TYPE B (OR BD) (WOOD POST)

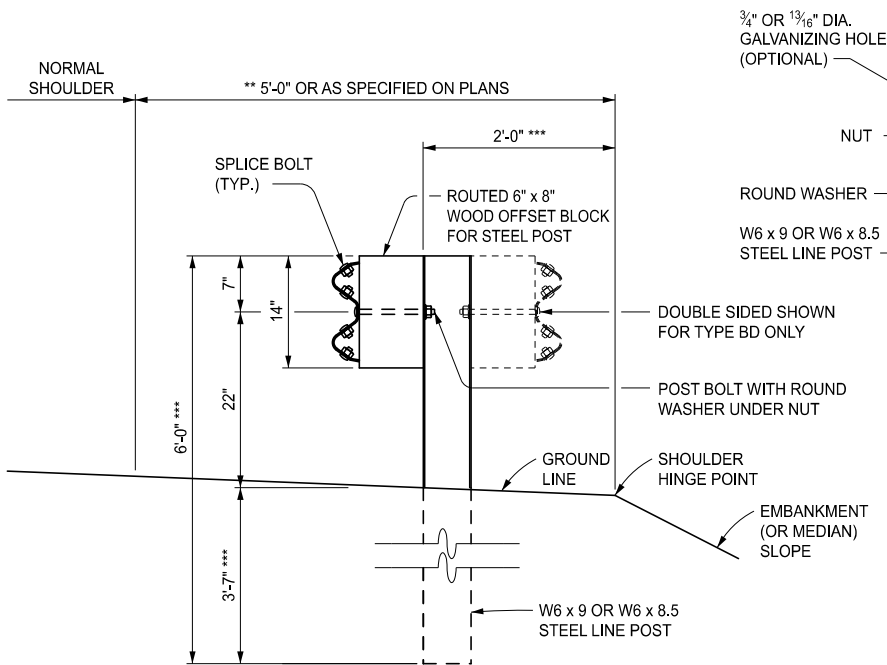

** FOR PAVED SHOULDER WIDTHS OF AT LEAST 12', USE 3'-0".

*** IF THE OFFSET FROM THE FACE OF POST TO THE SHOULDER HINGE POINT IS LESS THAN 2'-0" AND THE EMBANKMENT (OR MEDIAN) SLOPE IS STEEPER THAN 1:10, USE 8'-0" POST WITH THE ADDITIONAL LENGTH EMBEDDED.

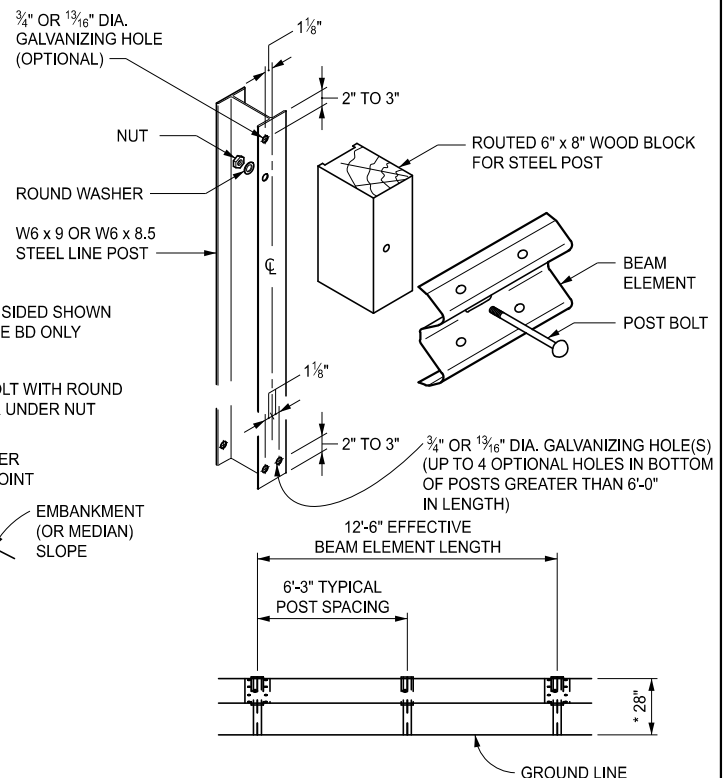

ELEVATION SHOWING POST SPACING

* SEE NOTES FOR GUARDRAIL IN CONJUNCTION WITH CURB

GUARDRAIL, TYPE B (OR BD) (STEEL POST)



DEPARTMENT DIRECTOR
BRADLEY C. WIEFERICH, PE


STANDARD PLAN FOR
GUARDRAIL, TYPES A, B, BD, T, TD, MGS-8, & MGS-8D

(SPECIAL DETAIL)
FHWA APPROVAL


10/04/2023
PLAN DATE

R-60-J

SHEET
2 OF 16

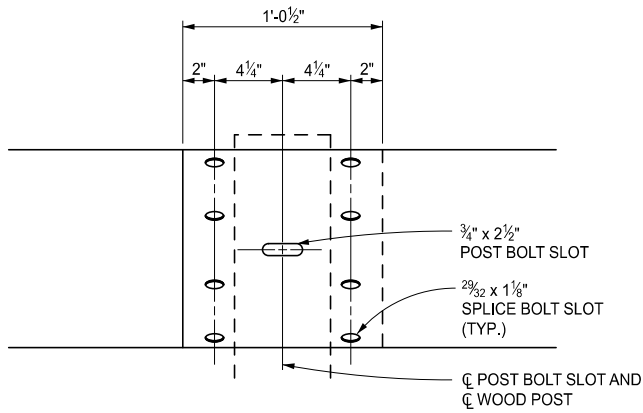


WOOD POST

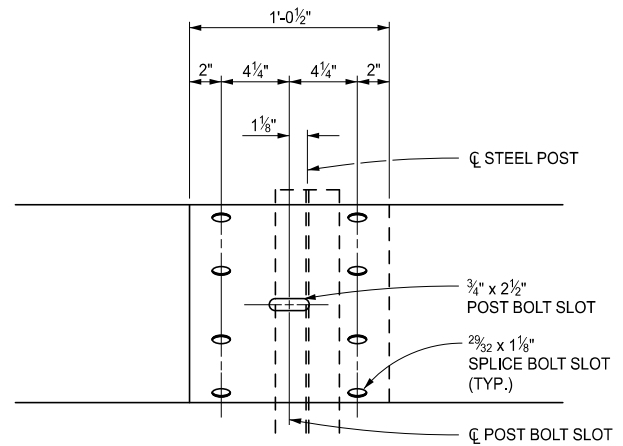


STEEL POST


BEAM ELEMENT SPLICE DETAILS

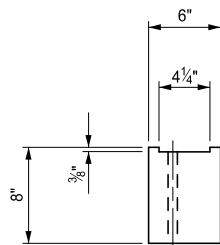

TOP

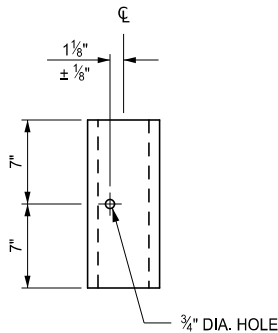


FRONT

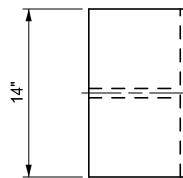


SIDE


FOR USE ON STEEL POSTS

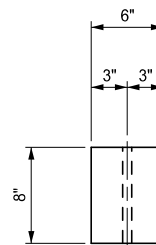

TOP

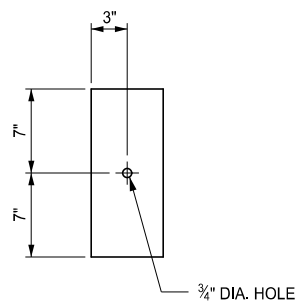

FRONT

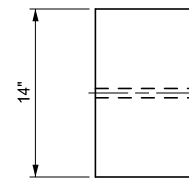

SIDE

FOR USE ON WOOD POSTS

(SEE NOTES ON SHEET 16 OF 16)

WOOD OFFSET BLOCKS FOR GUARDRAIL, TYPE B AND TYPE BD



DEPARTMENT DIRECTOR
BRADLEY C. WIEFERICH, PE


STANDARD PLAN FOR
GUARDRAIL, TYPES A, B, BD, T, TD, MGS-8, & MGS-8D

(SPECIAL DETAIL)
FHWA APPROVAL

10/04/2023
PLAN DATE


R-60-J

SHEET
3 OF 16

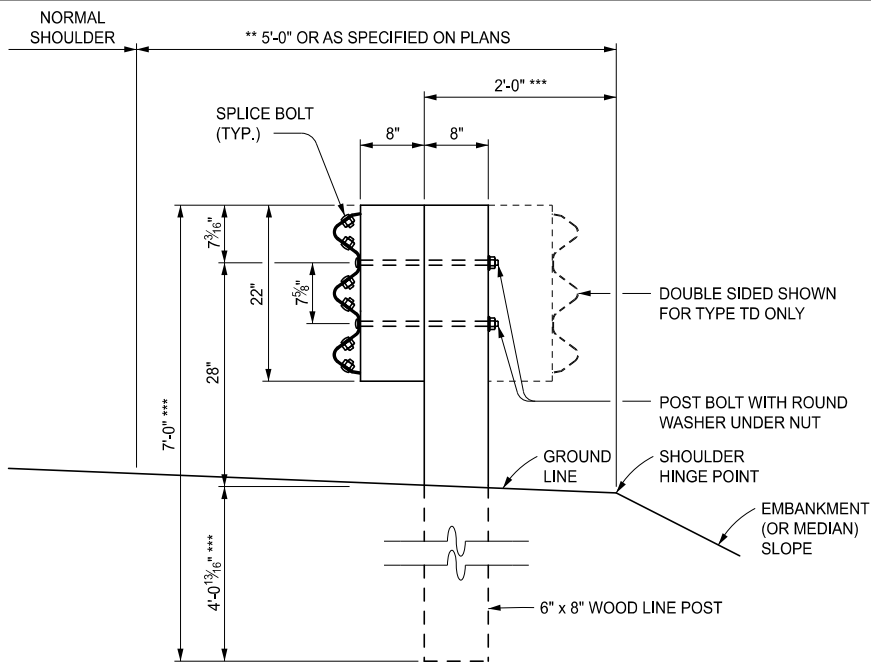

** FOR PAVED SHOULDER WIDTHS OF AT LEAST 12', USE 3'-0'.


*** IF THE OFFSET FROM THE FACE OF POST TO THE SHOULDER HINGE POINT IS LESS THAN 2'-0" AND THE EMBANKMENT (OR MEDIAN) SLOPE IS STEEPER THAN 1:10, USE 8'-0" POST WITH THE ADDITIONAL LENGTH EMBEDDED.

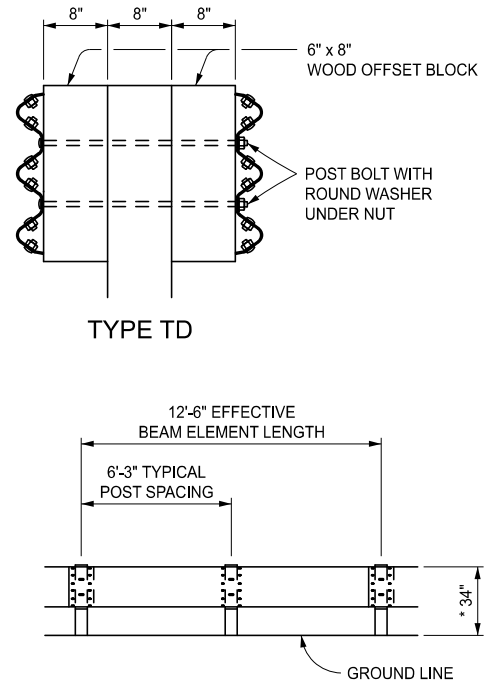

ELEVATION SHOWING POST SPACING


* SEE NOTES FOR GUARDRAIL IN CONJUNCTION WITH CURB

GUARDRAIL, TYPE T (OR TD) (WOOD POST)

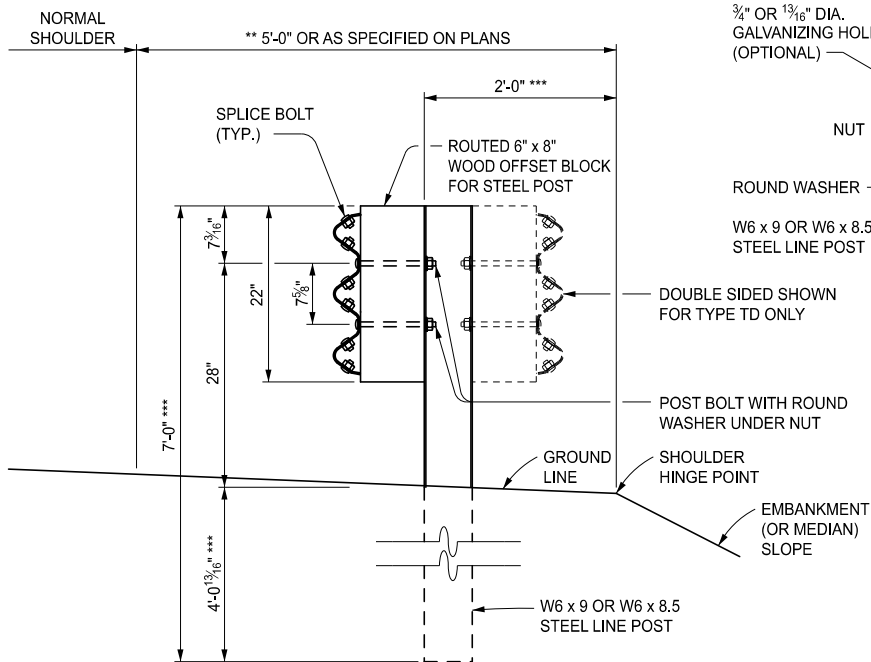

** FOR PAVED SHOULDER WIDTHS OF AT LEAST 12', USE 3'-0'.

*** IF THE OFFSET FROM THE FACE OF POST TO THE SHOULDER HINGE POINT IS LESS THAN 2'-0" AND THE EMBANKMENT (OR MEDIAN) SLOPE IS STEEPER THAN 1:10, USE 8'-0" POST WITH THE ADDITIONAL LENGTH EMBEDDED.

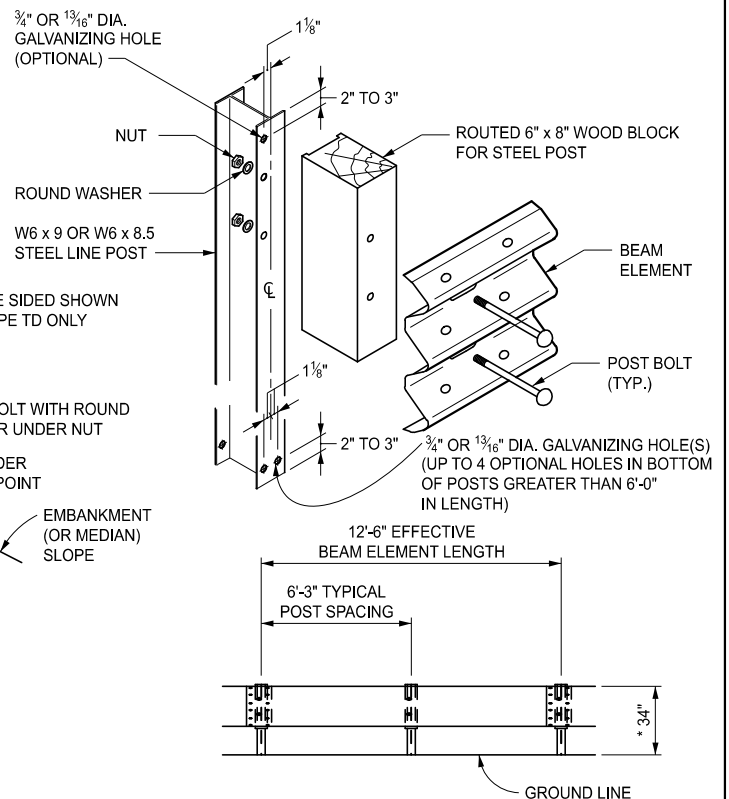

ELEVATION SHOWING POST SPACING

* SEE NOTES FOR GUARDRAIL IN CONJUNCTION WITH CURB

GUARDRAIL, TYPE T OR TD (STEEL POST)



DEPARTMENT DIRECTOR
BRADLEY C. WIEFERICH, PE

STANDARD PLAN FOR
GUARDRAIL, TYPES A, B, BD, T, TD, MGS-8, & MGS-8D


(SPECIAL DETAIL)
FHWA APPROVAL

10/04/2023
PLAN DATE

R-60-J

SHEET
4 OF 16


POST BOLT
CONNECTING STEEL POST
TO WOOD OFFSET BLOCK

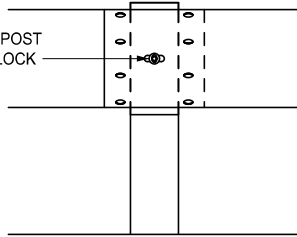

GUARDRAIL, TYPE B

WOOD POST


POST BOLT
CONNECTING STEEL POST TO
ROUTED WOOD OFFSET BLOCK

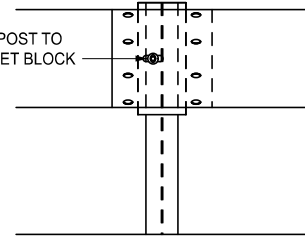

GUARDRAIL, TYPE B

STEEL POST


POST BOLT
CONNECTING STEEL POST
TO WOOD OFFSET BLOCK

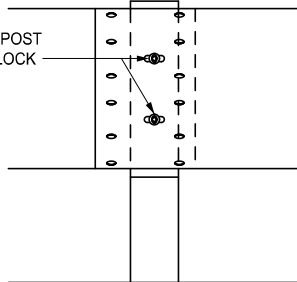

GUARDRAIL, TYPE T

WOOD POST

POST BOLT
CONNECTING STEEL POST TO
ROUTED WOOD OFFSET BLOCK

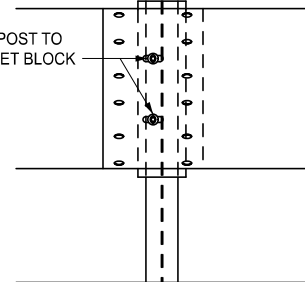

GUARDRAIL, TYPE T

STEEL POST

BLOCK AND POST CONNECTION DETAILS



DEPARTMENT DIRECTOR
BRADLEY C. WIEFERICH, PE


STANDARD PLAN FOR
GUARDRAIL, TYPES A, B, BD, T, TD, MGS-8, & MGS-8D

(SPECIAL DETAIL)
FHWA APPROVAL


10/04/2023
PLAN DATE

R-60-J

SHEET
5 OF 16

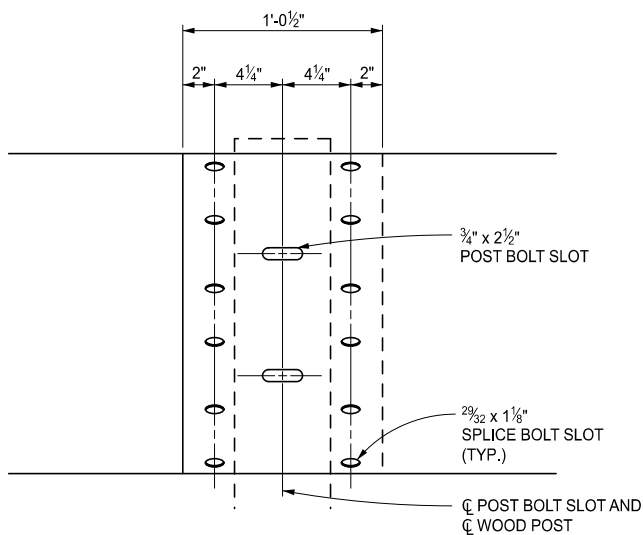


WOOD POST

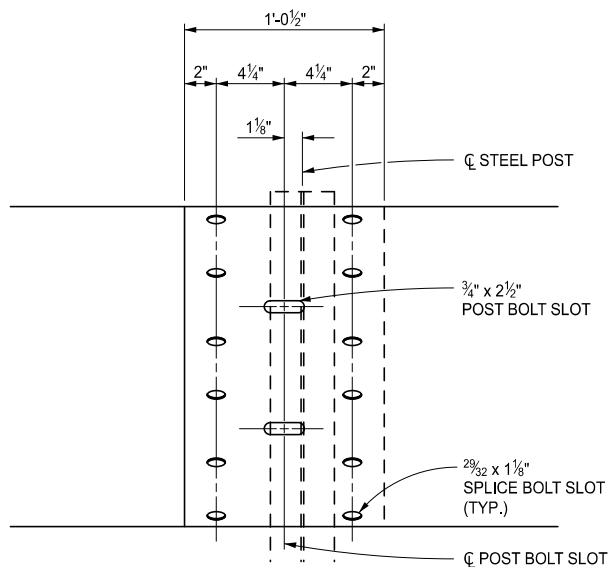


STEEL POST


THREE BEAM ELEMENT SPLICE DETAILS

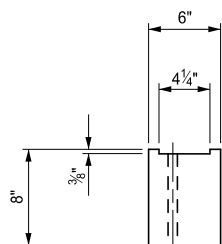

TOP

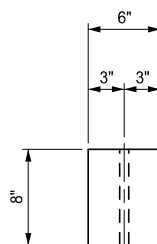


TOP

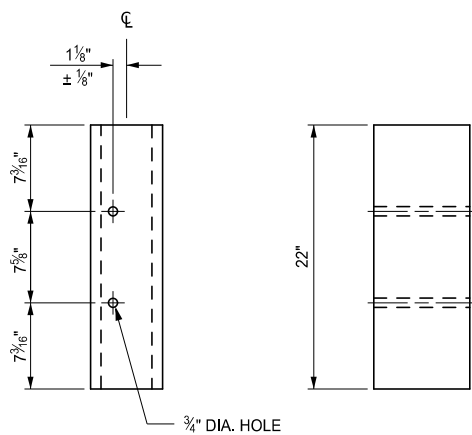

FRONT

SIDE

FOR USE ON STEEL POSTS

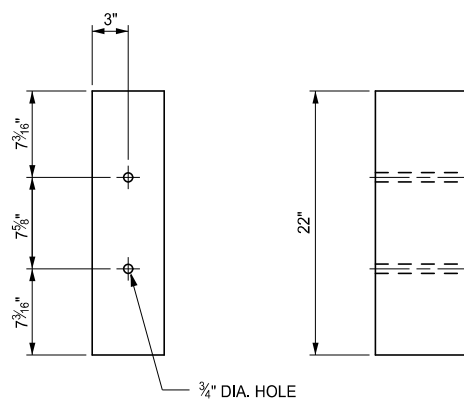

FRONT

SIDE

FOR USE ON WOOD POSTS
(SEE NOTES ON SHEET 16 OF 16)

WOOD OFFSET BLOCKS FOR GUARDRAIL, TYPE T AND TYPE TD



DEPARTMENT DIRECTOR
BRADLEY C. WIEFERICH, PE


STANDARD PLAN FOR
GUARDRAIL, TYPES A, B, BD, T, TD, MGS-8, & MGS-8D

(SPECIAL DETAIL)
FHWA APPROVAL

10/04/2023
PLAN DATE

R-60-J


SHEET
6 OF 16

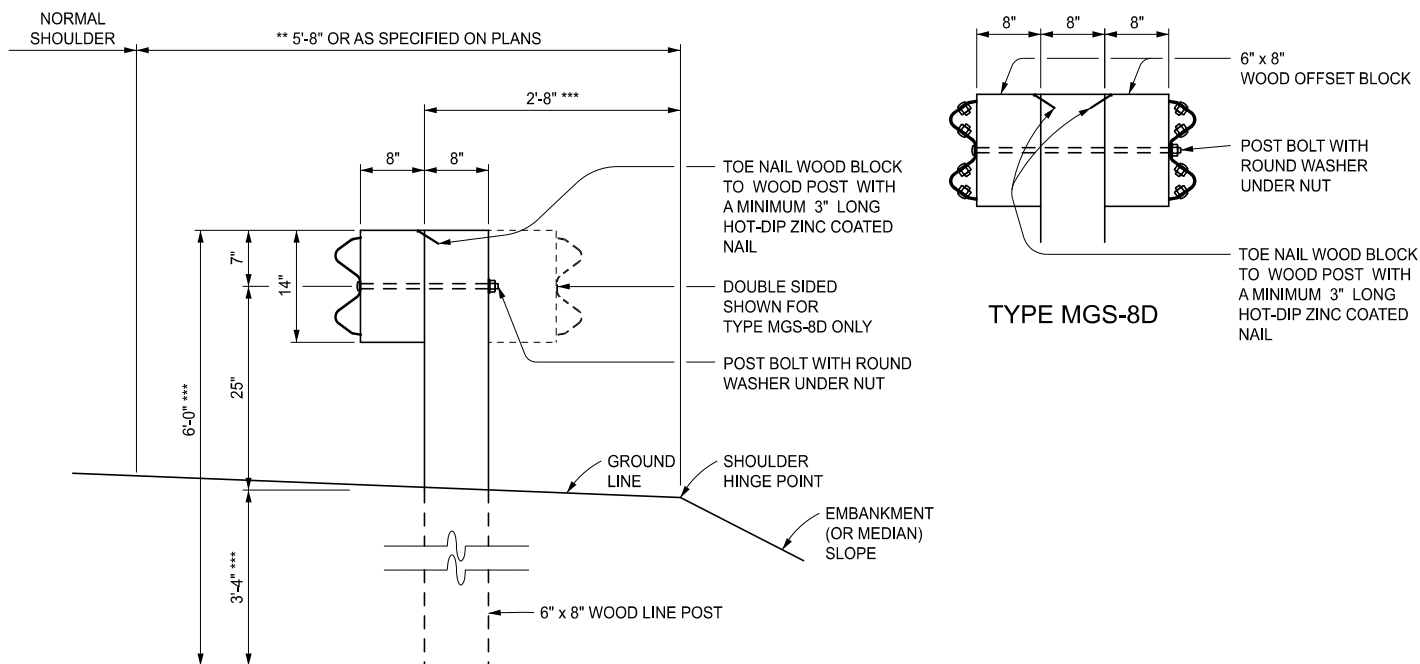

** FOR PAVED SHOULDER WIDTHS OF AT LEAST 12', USE 3'-8".

*** IF THE OFFSET FROM THE FACE OF POST TO THE SHOULDER HINGE POINT IS LESS THAN 2'-8" AND THE EMBANKMENT (OR MEDIAN) SLOPE IS STEEPER THAN 1:10, USE 9'-0" POST WITH THE ADDITIONAL LENGTH EMBEDDED.

GUARDRAIL, TYPE MGS-8 (OR MGS-8D) (WOOD POST)

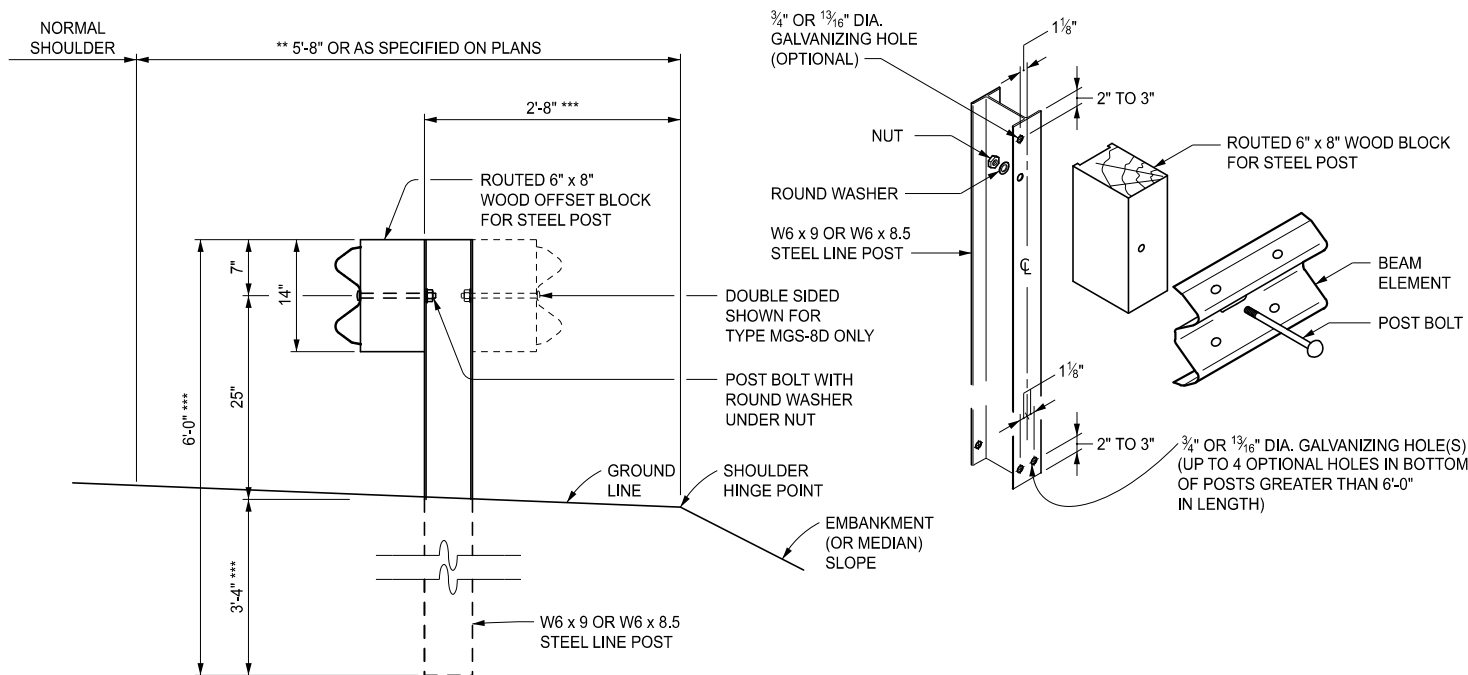

** FOR PAVED SHOULDER WIDTHS OF AT LEAST 12', USE 3'-8".

*** IF THE OFFSET FROM THE FACE OF POST TO THE SHOULDER HINGE POINT IS LESS THAN 2'-8" AND THE EMBANKMENT (OR MEDIAN) SLOPE IS STEEPER THAN 1:10, USE 9'-0" POST WITH THE ADDITIONAL LENGTH EMBEDDED.

GUARDRAIL, TYPE MGS-8 (OR MGS-8D) (STEEL POST)



DEPARTMENT DIRECTOR
BRADLEY C. WIEFERICH, PE

STANDARD PLAN FOR
GUARDRAIL, TYPES A, B, BD, T, TD, MGS-8, & MGS-8D


(SPECIAL DETAIL)
FHWA APPROVAL

10/04/2023
PLAN DATE

R-60-J


SHEET
7 OF 16

POST BOLT
CONNECTING WOOD POST
TO WOOD OFFSET BLOCK

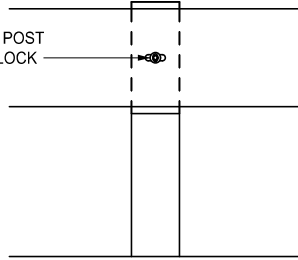


WOOD POST

POST BOLT
CONNECTING STEEL POST TO
ROUTED WOOD OFFSET BLOCK

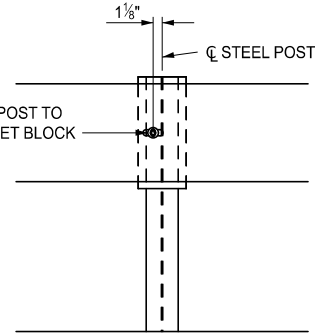


STEEL POST


BLOCK AND POST CONNECTION DETAILS

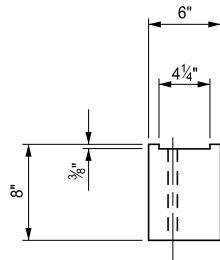


TOP

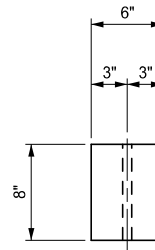

TOP

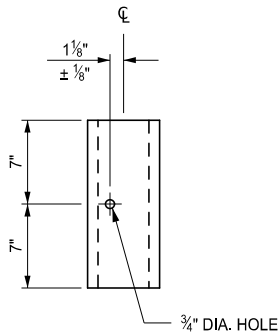


FRONT

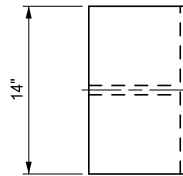


SIDE

FOR USE ON STEEL POSTS

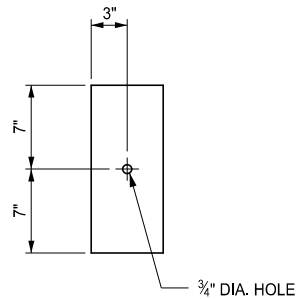

FRONT

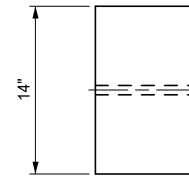

SIDE

FOR USE ON WOOD POSTS
(SEE NOTES ON SHEET 16 OF 16)

WOOD OFFSET BLOCKS FOR GUARDRAIL, TYPE MGS-8 AND TYPE MGS-8D



DEPARTMENT DIRECTOR
BRADLEY C. WIEFERICH, PE


STANDARD PLAN FOR
GUARDRAIL, TYPES A, B, BD, T, TD, MGS-8, & MGS-8D

(SPECIAL DETAIL)
FHWA APPROVAL

10/04/2023
PLAN DATE


R-60-J

SHEET
8 OF 16

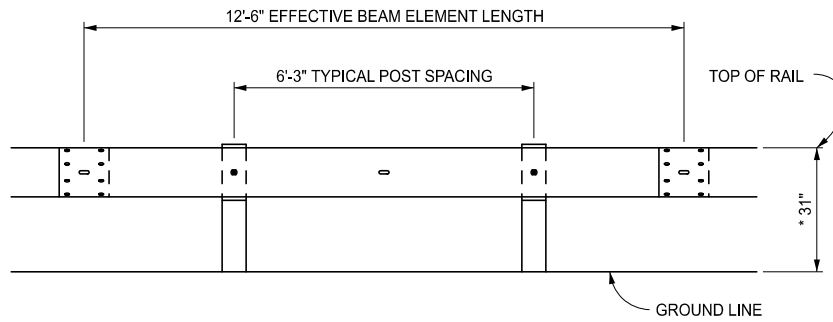


**ELEVATION SHOWING POST SPACING FOR
GUARDRAIL, TYPE MGS-8 OR MGS-8D**

* SEE NOTES FOR GUARDRAIL IN CONJUNCTION WITH CURB

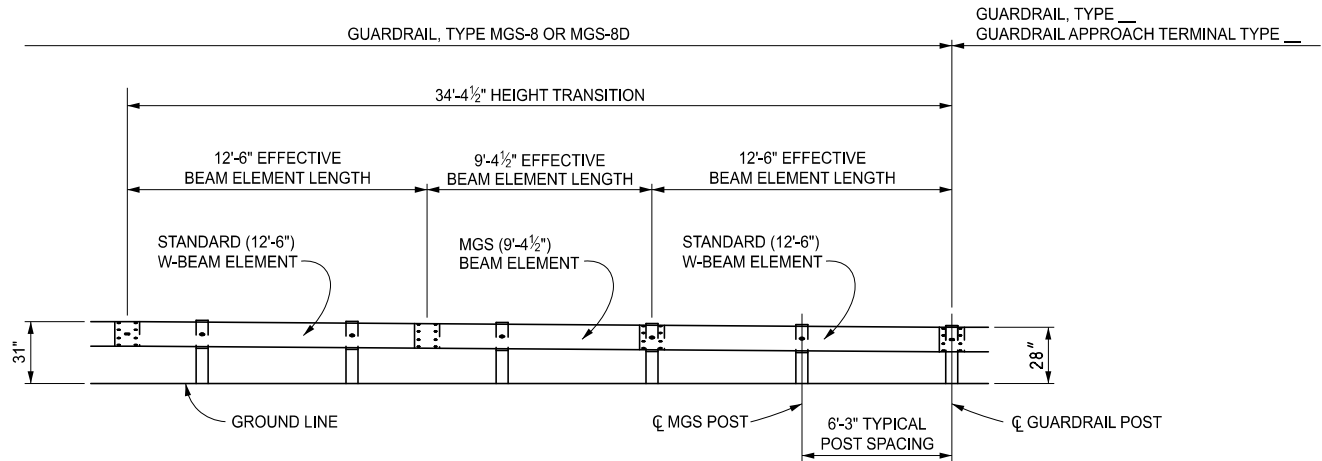

**ELEVATION SHOWING TRANSITION DETAIL FOR CONNECTING
GUARDRAIL, TYPE MGS-8 OR MGS-8D TO
GUARDRAIL, TYPE B, GUARDRAIL, TYPE BD, OR
GUARDRAIL APPROACH TERMINAL TYPE 1B, 2B, OR 3B**

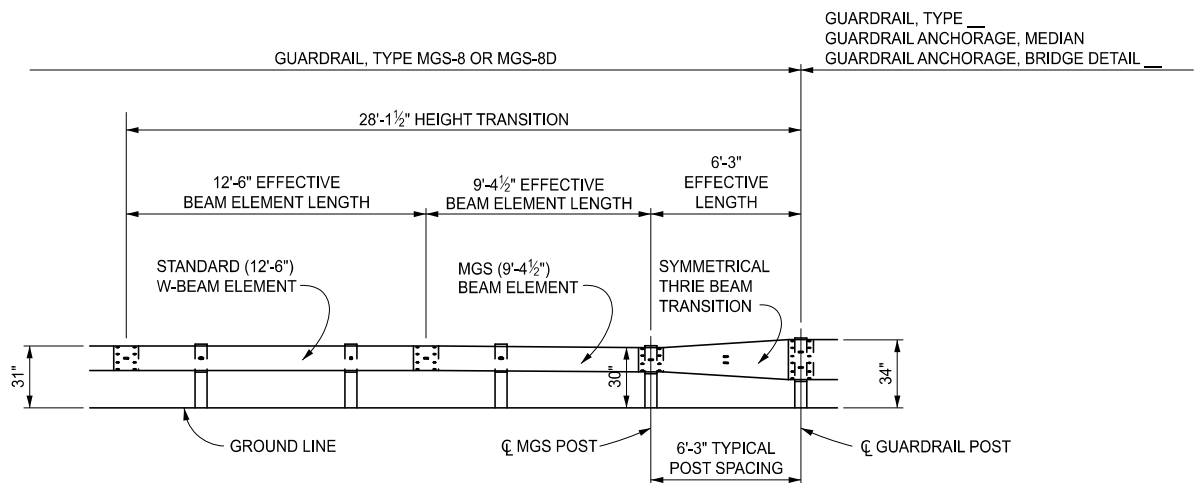

**ELEVATION SHOWING TRANSITION DETAIL FOR CONNECTING
GUARDRAIL, TYPE MGS-8 OR MGS-8D TO
GUARDRAIL, TYPE T, GUARDRAIL, TYPE TD,
GUARDRAIL ANCHORAGE, MEDIAN,
GUARDRAIL ANCHORAGE, BRIDGE DETAIL A1, T1, T4 OR T6**



DEPARTMENT DIRECTOR
BRADLEY C. WIEFERICH, PE


STANDARD PLAN FOR
GUARDRAIL, TYPES A, B, BD, T, TD, MGS-8, & MGS-8D

(SPECIAL DETAIL)
FHWA APPROVAL


10/04/2023
PLAN DATE

R-60-J

SHEET
9 OF 16

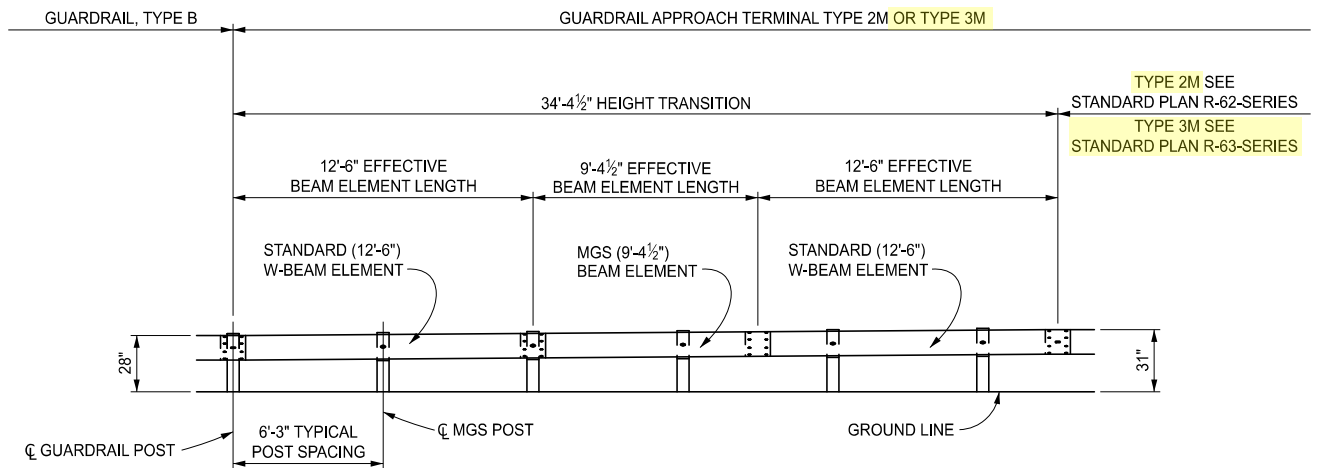

ELEVATION SHOWING TRANSITION DETAIL FOR CONNECTING
GUARDRAIL, TYPE B TO
GUARDRAIL APPROACH TERMINAL TYPE 2M OR TYPE 3M

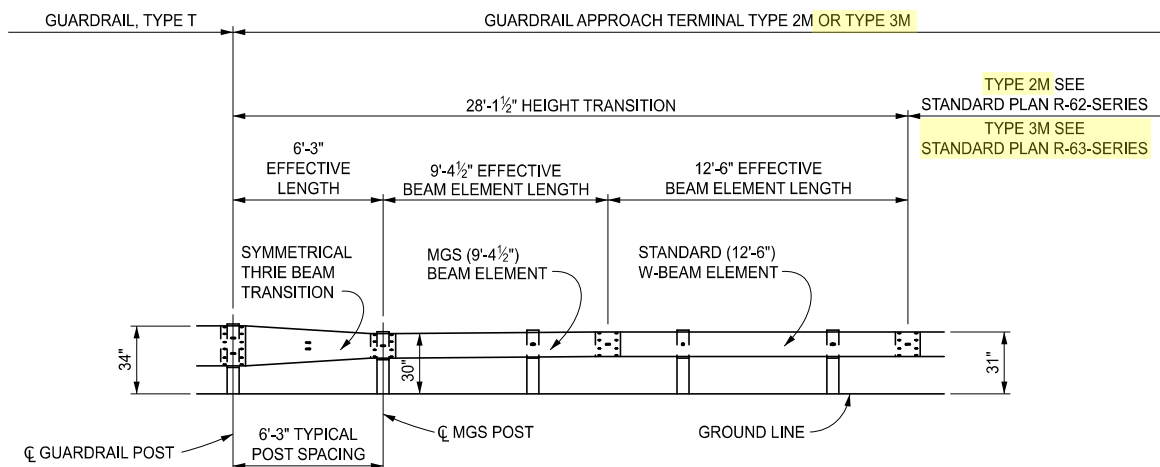

ELEVATION SHOWING TRANSITION DETAIL FOR CONNECTING
GUARDRAIL, TYPE T TO
GUARDRAIL APPROACH TERMINAL TYPE 2M OR TYPE 3M



DEPARTMENT DIRECTOR
BRADLEY C. WIEFERICH, PE


STANDARD PLAN FOR
GUARDRAIL, TYPES A, B, BD, T, TD, MGS-8, & MGS-8D

(SPECIAL DETAIL)
FHWA APPROVAL


10/04/2023
PLAN DATE

R-60-J


SHEET
10 OF 16

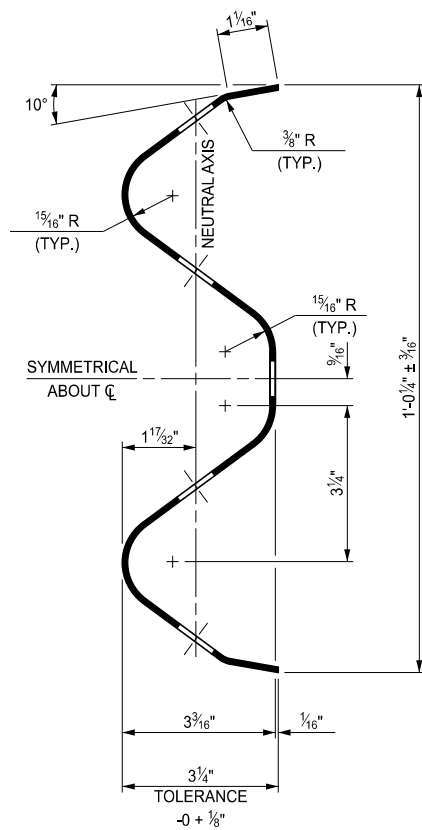


SECTION THROUGH BEAM ELEMENT

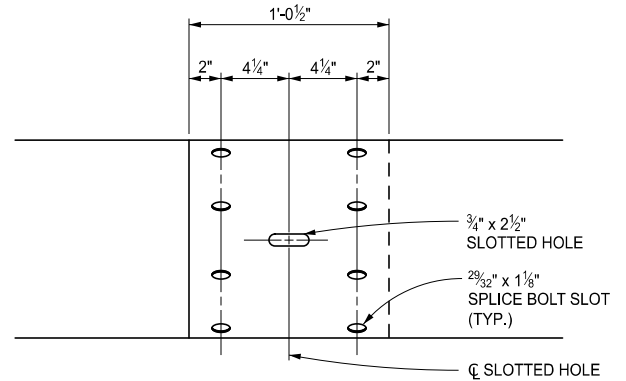

BEAM ELEMENT SPLICE DETAILS

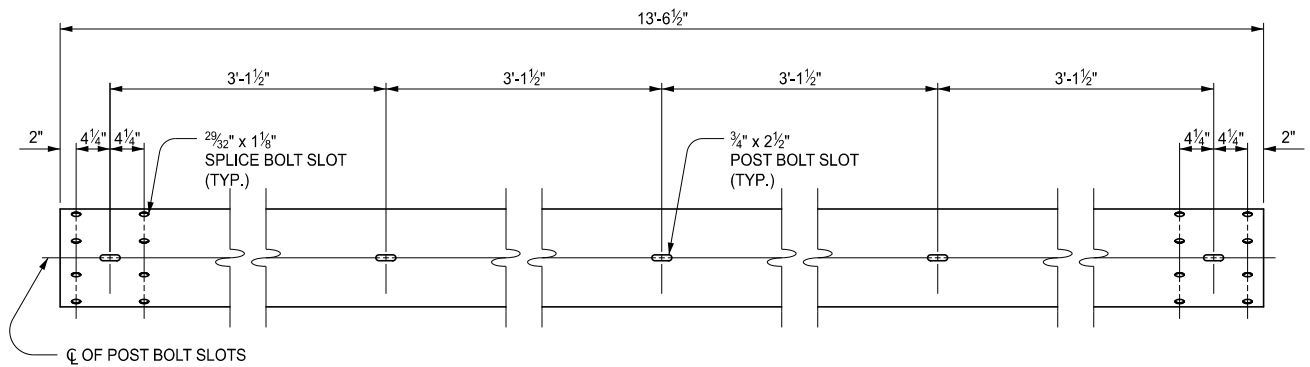

FRONT ELEVATION OF BEAM ELEMENT

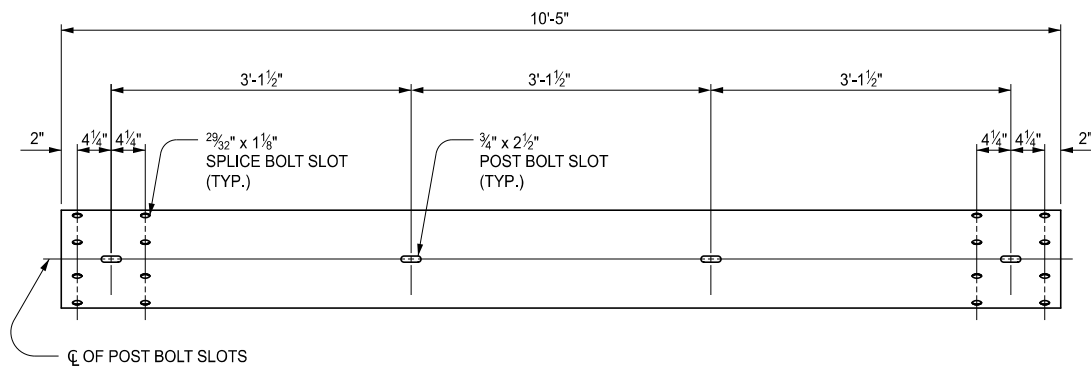

FRONT ELEVATION OF MGS (9'-4 1/2") BEAM ELEMENT



DEPARTMENT DIRECTOR
BRADLEY C. WIEFERICH, PE


STANDARD PLAN FOR
GUARDRAIL, TYPES A, B, BD, T, TD, MGS-8, & MGS-8D

(SPECIAL DETAIL)
FHWA APPROVAL


10/04/2023
PLAN DATE

R-60-J

SHEET
11 OF 16

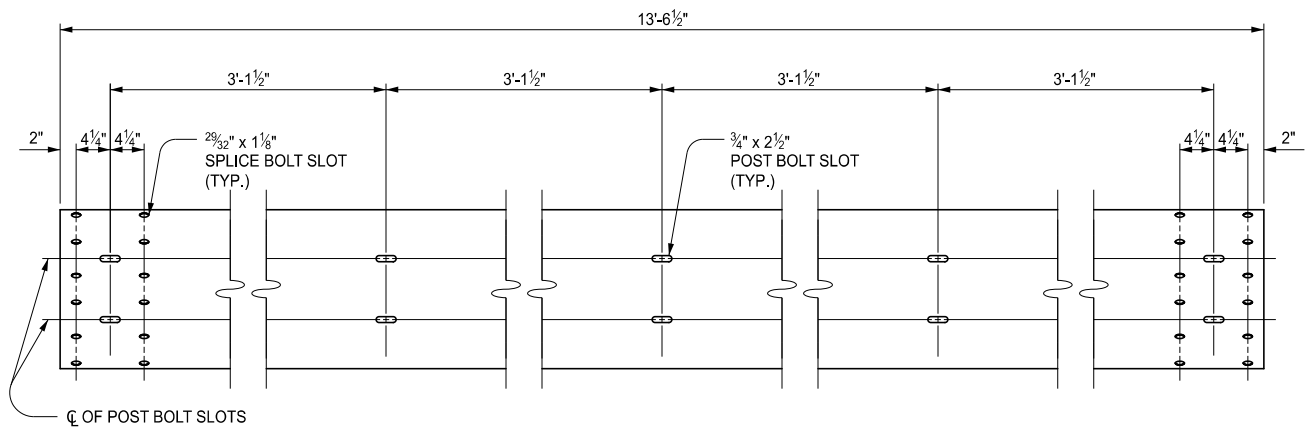

FRONT ELEVATION OF THRIE BEAM ELEMENT

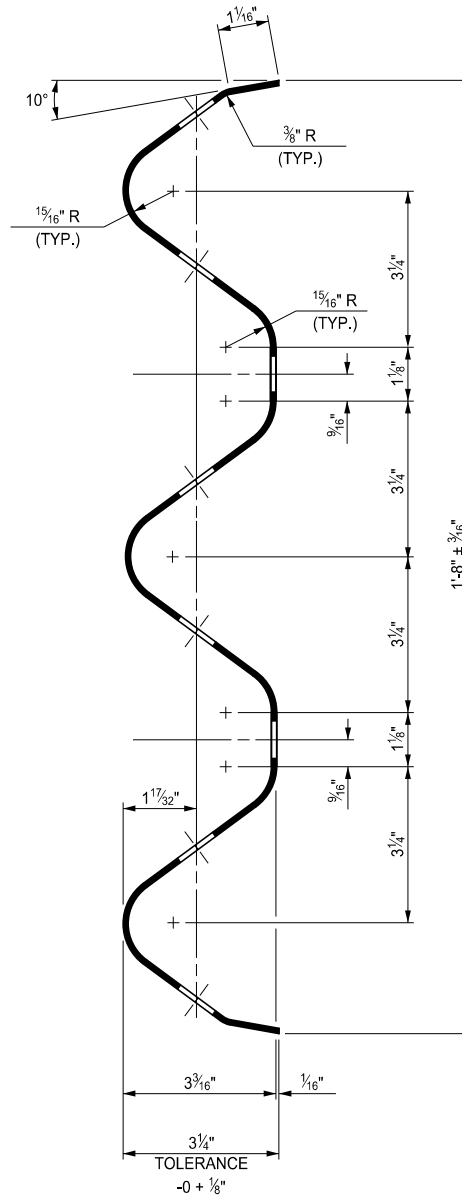

SECTION THROUGH THRIE BEAM ELEMENT
(FOR GUARDRAIL, TYPE T AND TD)



DEPARTMENT DIRECTOR
BRADLEY C. WIEFERICH, PE


STANDARD PLAN FOR
GUARDRAIL, TYPES A, B, BD, T, TD, MGS-8, & MGS-8D

(SPECIAL DETAIL)
FHWA APPROVAL



10/04/2023
PLAN DATE

R-60-J

SHEET
12 OF 16

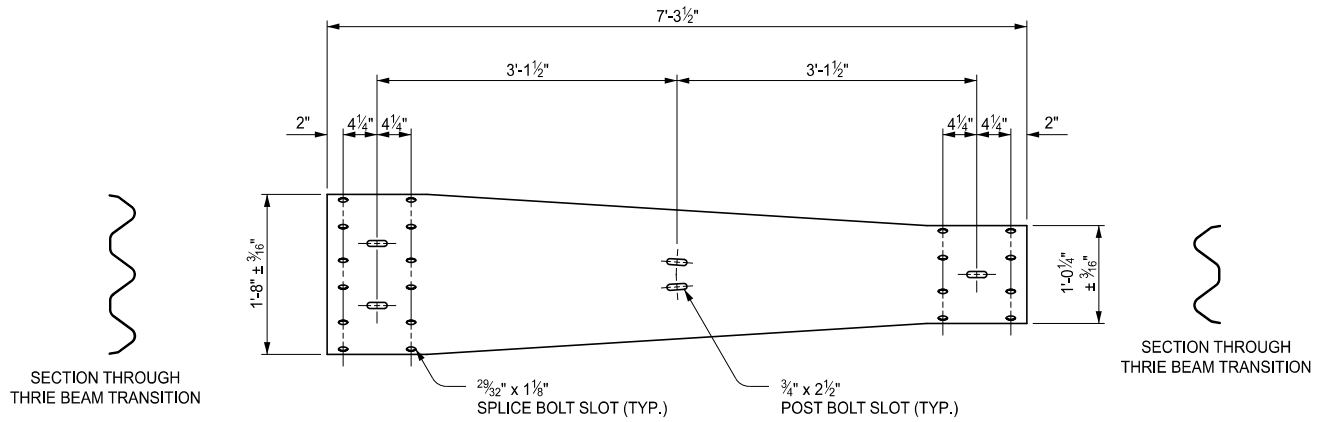

SYMMETRICAL THRIE BEAM TRANSITIONS

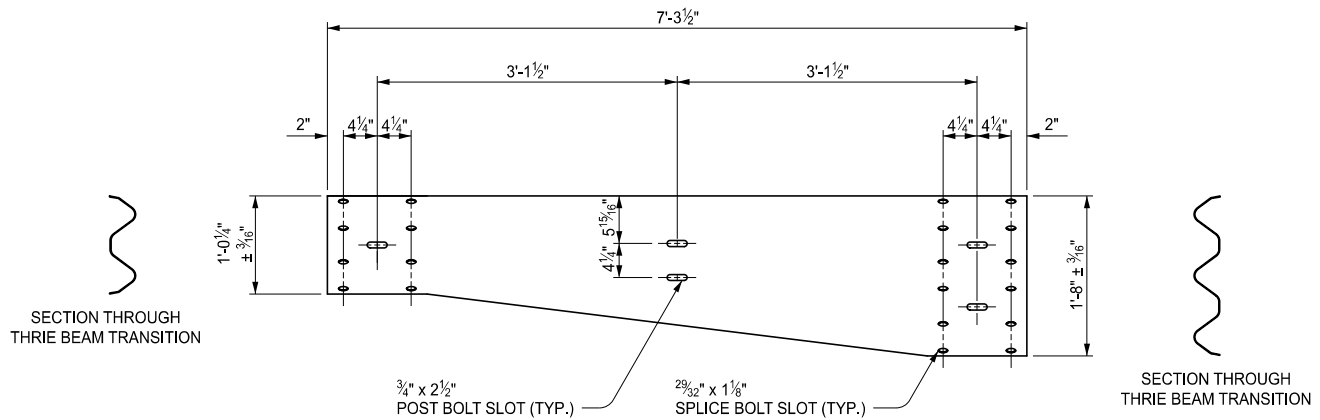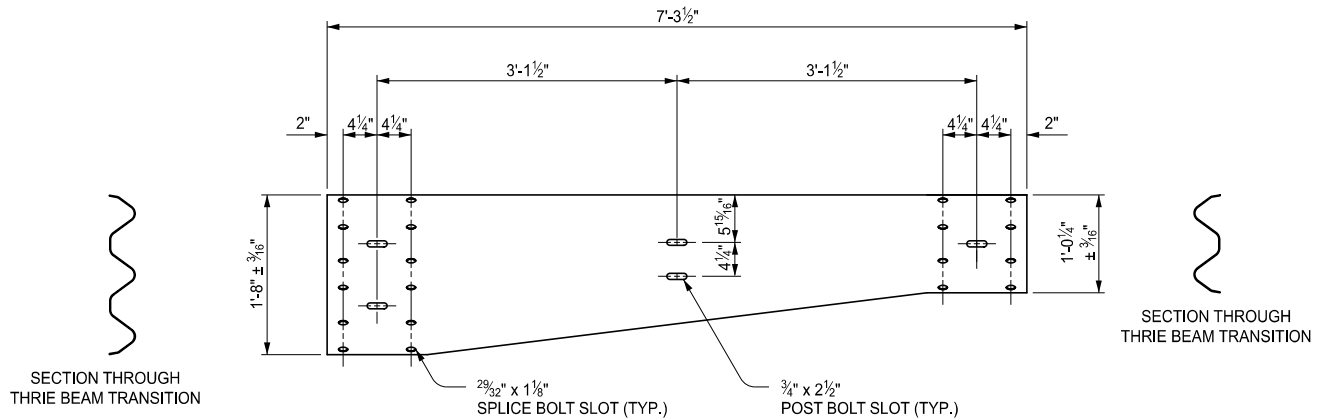

ASYMMETRICAL THRIE BEAM TRANSITIONS

NOTE: ASYMMETRICAL TRANSITION TYPE WILL VARY BY LOCATION DEPENDING ON GUARDRAIL LAYOUT



DEPARTMENT DIRECTOR
BRADLEY C. WIEFERICH, PE


STANDARD PLAN FOR
GUARDRAIL, TYPES A, B, BD, T, TD, MGS-8, & MGS-8D

(SPECIAL DETAIL)
FHWA APPROVAL

10/04/2023
PLAN DATE

R-60-J

SHEET
13 OF 16

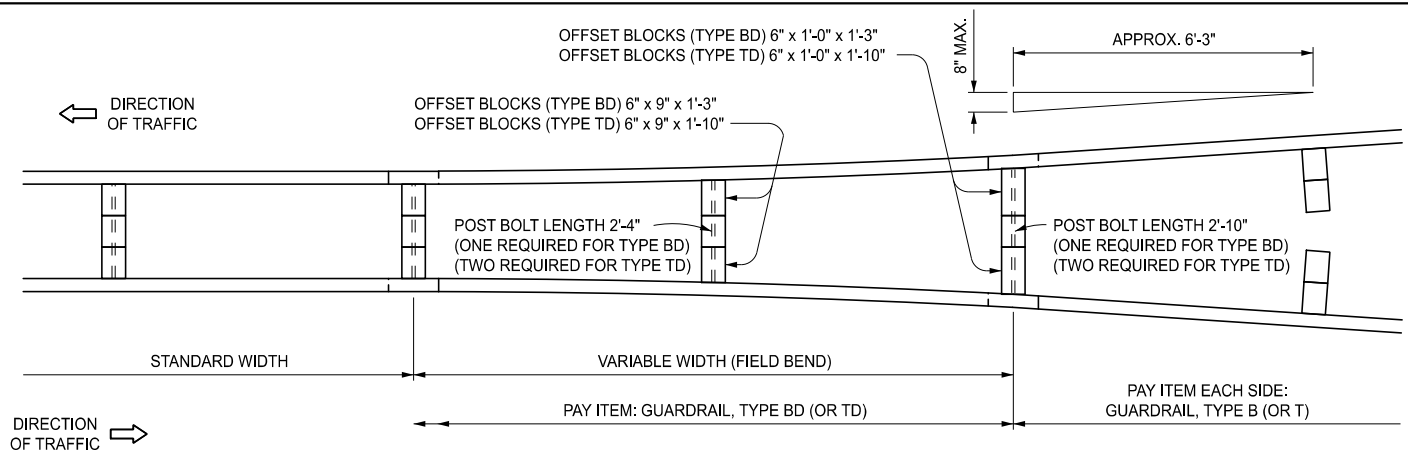


DETAIL SHOWING TRANSITION FROM GUARDRAIL, TYPE B (OR TYPE T)
TO GUARDRAIL, TYPE BD (OR TYPE TD)

POST BOLTS, SPLICE BOLTS AND WASHERS AT BEAM ELEMENT SPLICE POSTS AND AT INTERMEDIATE POSTS						
GUARDRAIL TYPE	POST	OFFSET BLOCK	POST BOLTS		SPLICE BOLTS (1 1/4" LONG) (NO. REQ'D)	WASHERS (ROUND) (NO. REQ'D)
			NO. REQ'D	LENGTH		
A	WOOD	N/A	1	9 1/2"	8	1
	STEEL	N/A	1	2"		1
B	WOOD	WOOD	1	18"	8	1
	STEEL	WOOD	1	9 1/2"		1
BD	WOOD	WOOD	1	* 26 1/2"	16	2
	STEEL	WOOD	2	9 1/2"		2
T	WOOD	WOOD	2	18"	12	2
	STEEL	WOOD	2	9 1/2"		2
TD	WOOD	WOOD	2	* 26 1/2"	24	4
	STEEL	WOOD	4	9 1/2"		4


THREE BEAM TRANSITIONS REQUIRE 20 SPLICE BOLTS EACH (12 ON TYPE T END AND 8 ON TYPE B END).

* EXCEPT AS SPECIFIED ON DETAIL SHOWING TRANSITION FROM GUARDRAIL, TYPE B (OR TYPE T) TO GUARDRAIL, TYPE BD (OR TYPE TD). POST BOLTS SHALL NOT EXTEND MORE THAN 1/2" BEYOND NUT.


MINIMUM POST BOLT THREAD LENGTH	
BOLT LENGTH	MINIMUM THREAD LENGTH
9 1/2"	1 3/4"
18"	2 1/2"
26 1/2"	3"

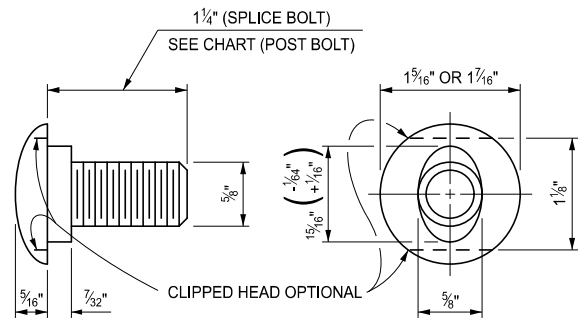


SPLICE BOLT AND POST BOLT

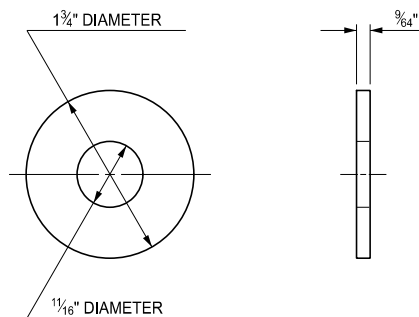

ROUND WASHER

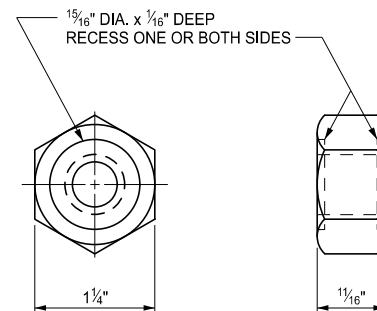

NUT

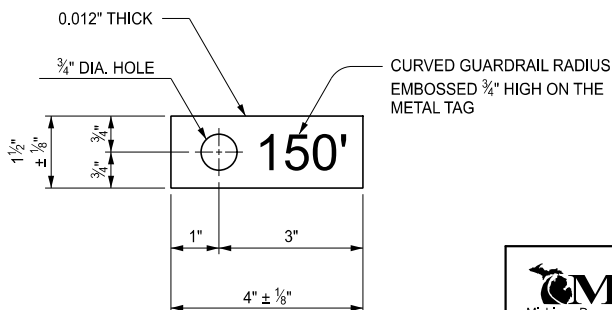

METAL TAG

FOR CURVED GUARDRAIL WITH RADIUS OF 150' OR LESS



DEPARTMENT DIRECTOR
BRADLEY C. WIEFERICH, PE


STANDARD PLAN FOR
GUARDRAIL, TYPES A, B, BD, T, TD, MGS-8, & MGS-8D

(SPECIAL DETAIL)
FHWA APPROVAL

10/04/2023
PLAN DATE

R-60-J

SHEET
14 OF 16

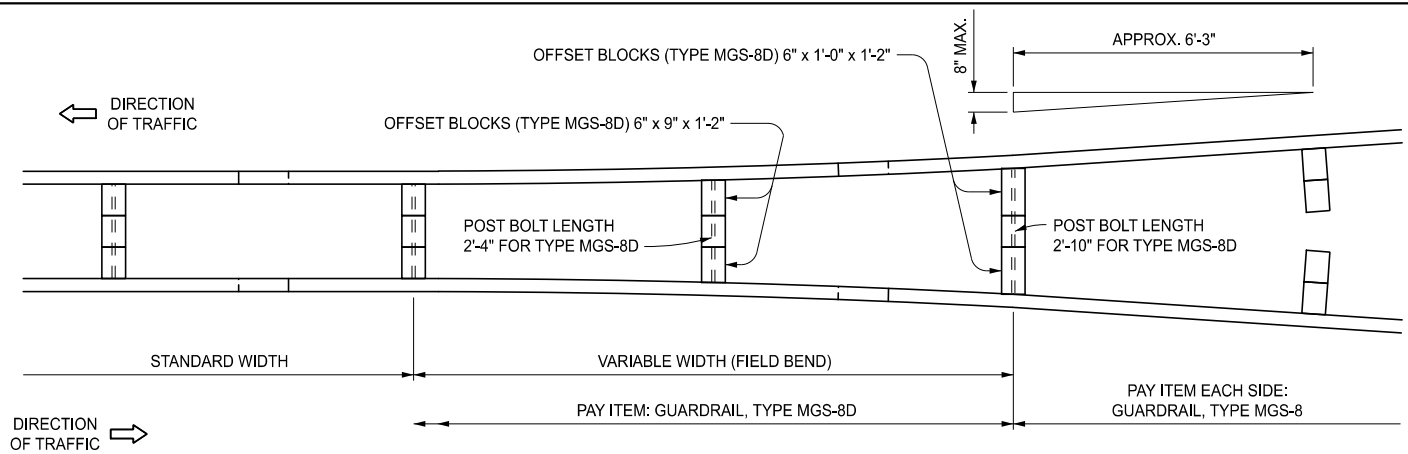

DETAIL SHOWING TRANSITION FROM
GUARDRAIL, TYPE MGS-8 TO GUARDRAIL, TYPE MGS-8D

POST BOLTS, SPLICE BOLTS AND WASHERS AT BEAM ELEMENT SPLICE POSTS AND AT INTERMEDIATE POSTS						
GUARDRAIL TYPE	POST	OFFSET BLOCK	POST BOLTS		SPLICE BOLTS (1¼" LONG) (NO. REQ'D)	WASHERS (ROUND) (NO. REQ'D)
			NO. REQ'D	LENGTH		
MGS-8	WOOD	WOOD	1	18"	8	1
	STEEL	WOOD	1	9½"		1
MGS-8D	WOOD	WOOD	1	* 26½"	16	—
	STEEL	WOOD	2	9½"		2

THREE BEAM TRANSITIONS REQUIRE 20 SPLICE BOLTS EACH (12 ON TYPE T END AND 8 ON TYPE MGS END).

* EXCEPT AS SPECIFIED ON DETAIL SHOWING TRANSITION FROM GUARDRAIL, TYPE MGS-8 TO GUARDRAIL, TYPE MGS-8D POST BOLTS SHALL NOT EXTEND MORE THAN ½" BEYOND NUT.

MINIMUM POST BOLT THREAD LENGTH	
BOLT LENGTH	MINIMUM THREAD LENGTH
9½"	1¾"
18"	2½"
26½"	3"



DEPARTMENT DIRECTOR
BRADLEY C. WIEFERICH, PE



STANDARD PLAN FOR
GUARDRAIL, TYPES A, B, BD, T, TD, MGS-8, & MGS-8D

(SPECIAL DETAIL)
FHWA APPROVAL


10/04/2023
PLAN DATE

R-60-J

SHEET
15 OF 16

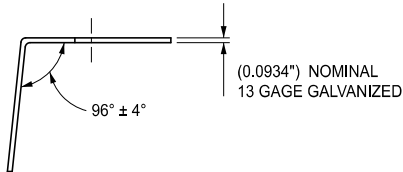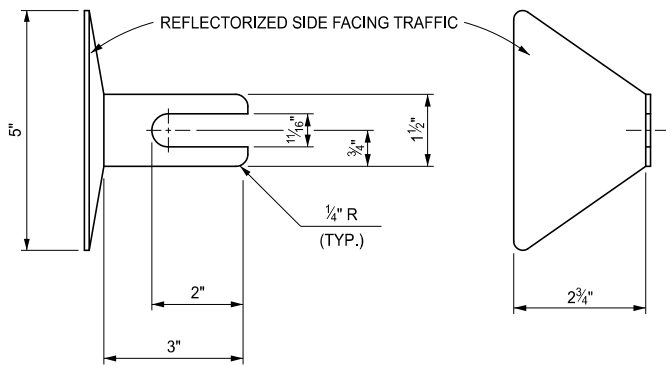

GUARDRAIL REFLECTOR

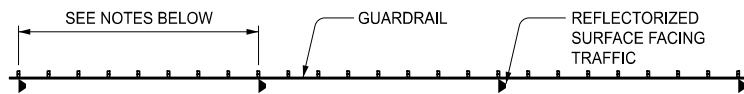


← DIRECTION OF TRAFFIC

← DIRECTION OF TRAFFIC




ONE-WAY TRAFFIC

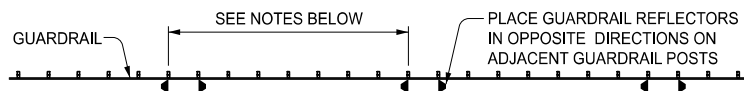

← DIRECTION OF TRAFFIC

→ DIRECTION OF TRAFFIC

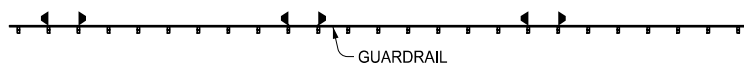

TWO-WAY TRAFFIC


PLACEMENT OF GUARDRAIL REFLECTORS

NOTES GOVERNING THE USE OF GUARDRAIL REFLECTORS


- GUARDRAIL REFLECTORS SHALL BE USED ON ALL STANDARD GUARDRAIL RUNS, REGARDLESS OF ROADWAY LIGHTING.
- GUARDRAIL REFLECTORS ARE TO BE SPACED AT THE FOLLOWING INTERVALS:
 - 50'-0" ON TANGENT SECTIONS AND CURVES WITH A RADIUS OF 1150' OR MORE.
 - 25'-0" ON CURVES WITH A RADIUS LESS THAN 1150'.
- FOR GUARDRAIL REFLECTOR PLACEMENT ON APPROACH TERMINALS, SEE THE APPROPRIATE GUARDRAIL APPROACH TERMINAL STANDARD PLAN.
- A GUARDRAIL REFLECTOR IS TO BE PLACED ON THE SECOND POST FROM THE GUARDRAIL DEPARTING TERMINAL.
- ON GUARDRAIL, TYPE T AND TYPE TD GUARDRAIL REFLECTORS ARE TO BE PLACED ON THE UPPER POST BOLT.
- GUARDRAIL REFLECTORS SHALL MATCH COLOR OF EDGE LINE.



DEPARTMENT DIRECTOR
BRADLEY C. WIEFERICH, PE

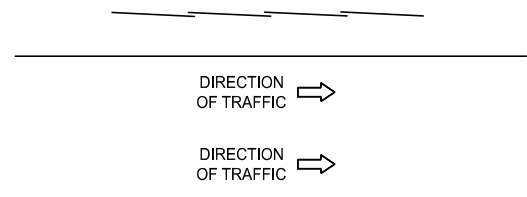

ONE-WAY TRAFFIC

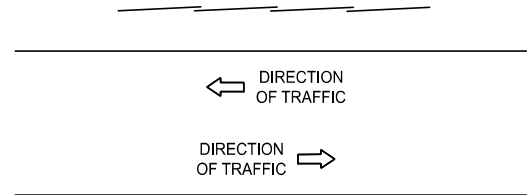

TWO-WAY TRAFFIC
DIRECTION OF RAIL LAP

NOTES:

DETAILS SPECIFIED ON THIS STANDARD ARE ACCORDING TO THE AASHTO-AGC-ARTBA JOINT COMMITTEE, TASK FORCE 13 PUBLICATION TITLED "A GUIDE TO STANDARDIZED HIGHWAY BARRIER HARDWARE."

BEAM ELEMENTS SHALL BE SHOP BENT TO PLAN RADIUS FOR CURVE RADIUS 150' OR LESS. A TAG IDENTIFYING THE CURVATURE OF THE SHOP BENT SECTION WILL BE REQUIRED FOR EACH CURVED ELEMENT.

SEE STANDARD PLAN R-62-SERIES OR R-63-SERIES FOR GUARDRAIL APPROACH TERMINALS, STANDARD PLAN R-66-SERIES FOR GUARDRAIL DEPARTING TERMINALS AND STANDARD PLAN R-67-SERIES FOR GUARDRAIL ANCHORAGE, BRIDGE.

WOOD POSTS WITH 1/2" BEVELS AT THE TOP MAY BE USED IN LIEU OF WOOD POSTS WITHOUT BEVELS SPECIFIED. THE LENGTH, WIDTH AND DEPTH OF THE POST SHALL BE AS SPECIFIED ON THIS STANDARD AND THE POST BOLT HOLES SHALL BE LOCATED TO ENSURE PROPER RAIL HEIGHT.

WOOD OFFSET BLOCKS WITH 1/2" BEVELS AT THE TOP AND BOTTOM OR A 1" BEVELED TOP MAY BE USED IN LIEU OF WOOD BLOCKS WITHOUT BEVELS SPECIFIED. THE LENGTH (FRONT AND BACK FACE), WIDTH AND DEPTH OF THE BLOCK SHALL BE AS SPECIFIED ON THIS STANDARD AND THE POST BOLT HOLES SHALL BE LOCATED TO ENSURE PROPER RAIL HEIGHT AND COMPATIBILITY WITH POST HOLES.

WHEN THE FACE OF GUARDRAIL IS PLACED FLUSH WITH FACE OF CURB, THE RAIL HEIGHT SHOULD BE MEASURED FROM THE FRONT EDGE OF THE GUTTER PAN, WHICH IS THE POINT ON THE GUTTER PAN THAT IS CLOSEST TO THE EDGE OF THE TRAVELED LANE. WHEN THE FACE OF THE GUARDRAIL PANEL IS LOCATED BEHIND THE CURB THE RAIL HEIGHT SHOULD BE MEASURED FROM THE GROUND JUST IN FRONT OF THE GUARDRAIL.


STANDARD PLAN FOR
GUARDRAIL, TYPES A, B, BD, T, TD, MGS-8, & MGS-8D

(SPECIAL DETAIL)
FHWA APPROVAL


10/04/2023
PLAN DATE

R-60-J

SHEET
16 OF 16

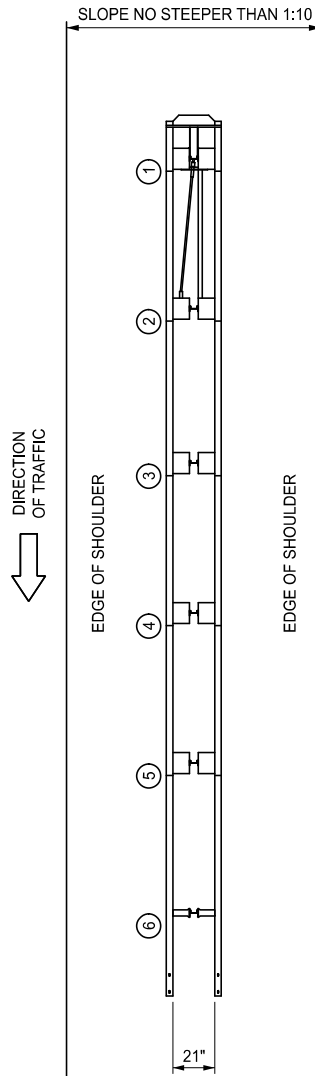

PLAN VIEW
(TRAFFIC FLOW MAY BE UNIDIRECTIONAL OR BIDIRECTIONAL)

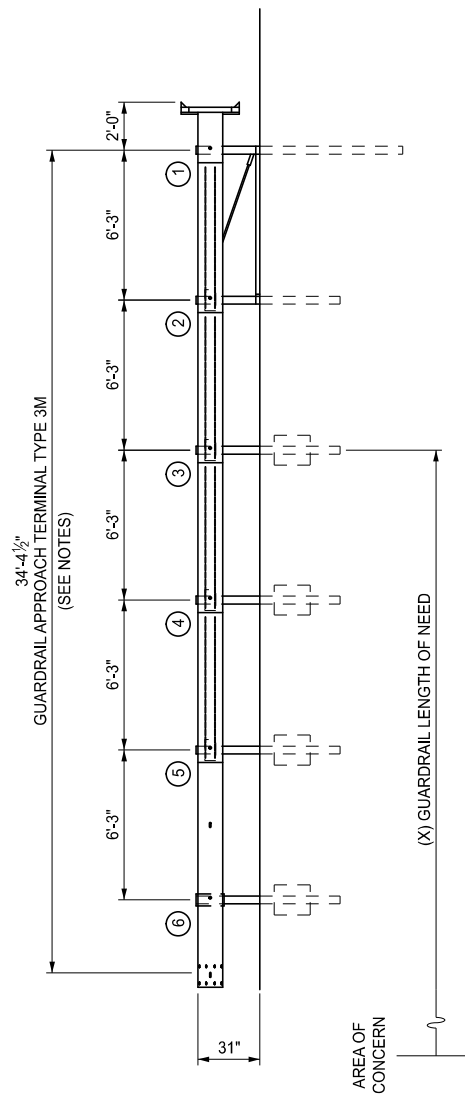

ELEVATION
GUARDRAIL APPROACH TERMINAL TYPE 3M
"MATT"

OPTION 2



DEPARTMENT DIRECTOR
BRADLEY C. WIEFERICH, PE

STANDARD PLAN FOR
GUARDRAIL APPROACH TERMINAL TYPE 3M

(SPECIAL DETAIL)
FHWA APPROVAL

10/02/2023
PLAN DATE

R-63-C

SHEET
2 OF 3

NOTES:

SEE STANDARD PLAN R-60-SERIES FOR ADDITIONAL TRANSITION LENGTHS WHEN ATTACHING TERMINALS TO OTHER THAN TYPE MGS-8 GUARDRAIL.

ALL POSTS, OFFSET BLOCKS, BEAM ELEMENTS, AND HARDWARE (INCLUDING BOLTS, NUTS, AND WASHERS) SHALL CONFORM TO THE MANUFACTURE'S DETAILS AND SPECIFICATIONS.

ALL 1:10 OR FLATTER SLOPES SHALL BE GRADED TO CLASS A SLOPE TOLERANCES. GUARDRAIL REFLECTORS AND OTHER ATTACHEMENTS ARE NOT TO BE USED ON THE GUARDRAIL APPROACH TERMINAL. PLACE RELECTORS BEGINNING ON STANDARD RUN OF GUARDRAIL.

USE REFLECTIVE SHEETING ACCORDING TO THE FOLLOWING TRAFFIC CONDITIONS:
(NOTE: ALTERNATE 3" BLACK AND 3" YELLOW STRIPES ON A 45° ANGLE)



TRAFFIC PASSING ON
THE LEFT SIDE



TRAFFIC PASSING ON
BOTH SIDES



TRAFFIC PASSING ON
THE RIGHT SIDE



DEPARTMENT DIRECTOR
BRADLEY C. WIEFERICH, PE


STANDARD PLAN FOR
GUARDRAIL APPROACH TERMINAL TYPE 3M

(SPECIAL DETAIL)
FHWA APPROVAL

10/02/2023
PLAN DATE


R-63-C

SHEET
3 OF 3

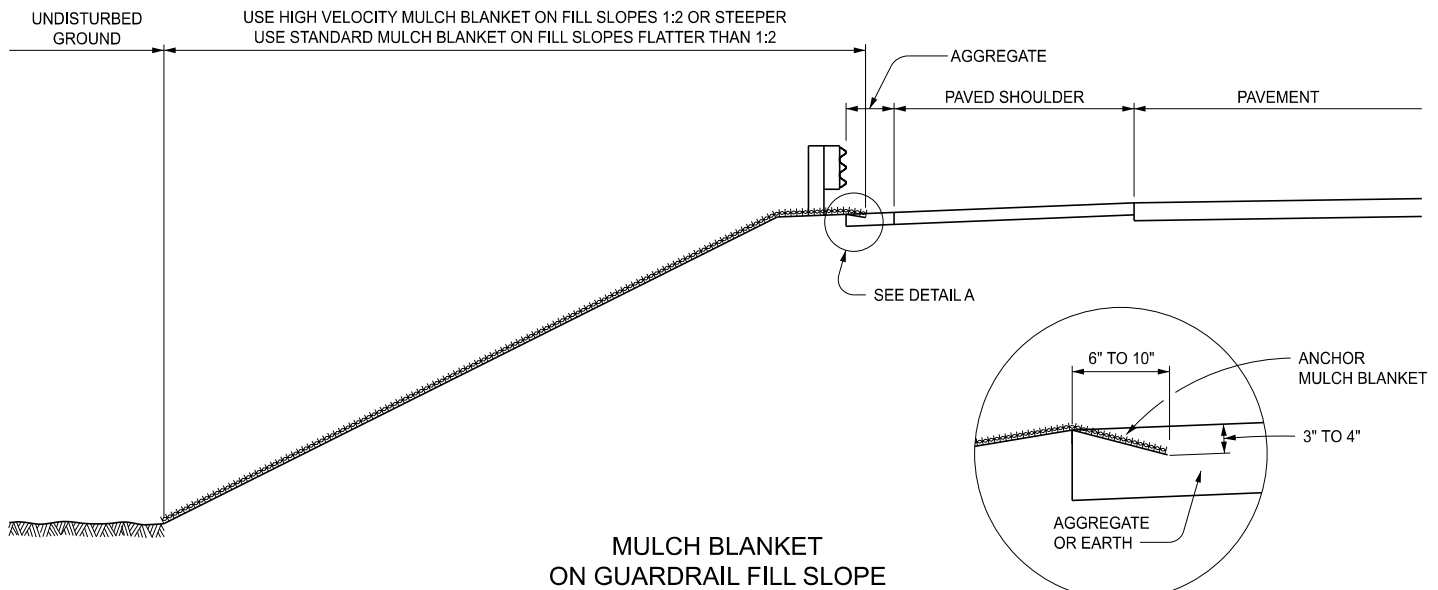


MULCH BLANKET
ON GUARDRAIL FILL SLOPE

DETAIL A

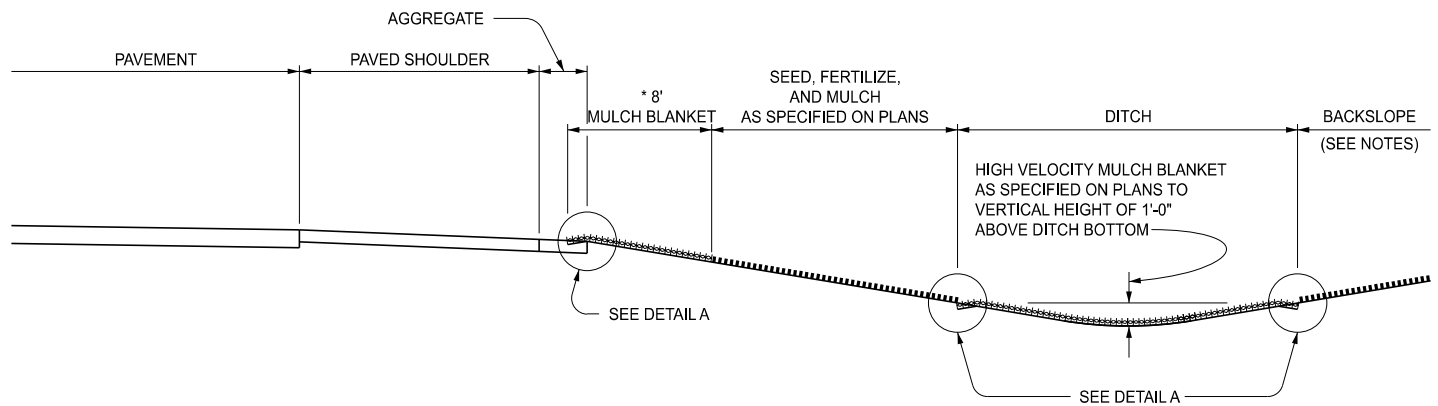

TYPICAL SLOPE AND DITCH PROTECTION

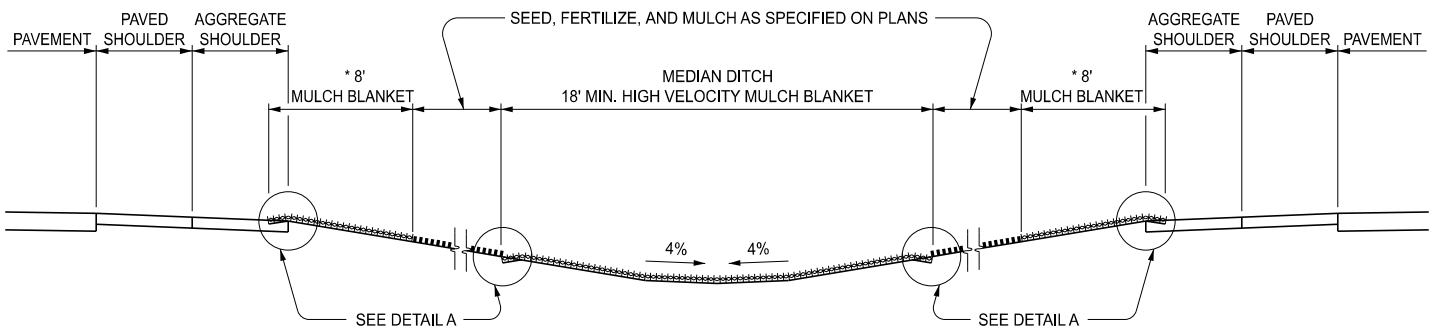

MULCH BLANKET SPILLWAY DITCH

* NOTE:

MULCH BLANKET SHALL BE USED ON BOTH SIDES OF NORMAL SECTIONS, HIGH SIDES OF ALL SUPERELEVATED SECTIONS, AND LOW SIDES OF PAVEMENTS HAVING A SUPERELEVATION OF 5% OR LESS. HIGH VELOCITY MULCH BLANKET SHALL BE USED ON THE LOW SIDE OF PAVEMENTS HAVING A RATE OF SUPERELEVATION GREATER THAN 5%.

APPROVED BY: _____
DIRECTOR, BUREAU OF FIELD SERVICES

APPROVED BY: _____
DIRECTOR, BUREAU OF DEVELOPMENT



DEPARTMENT DIRECTOR
BRADLEY C. WIEFERICH, PE


STANDARD PLAN FOR
SEEDING AND TREE PLANTING

(SPECIAL DETAIL)
FHWA APPROVAL


12/08/2023
PLAN DATE

R-100-I

SHEET
1 OF 4

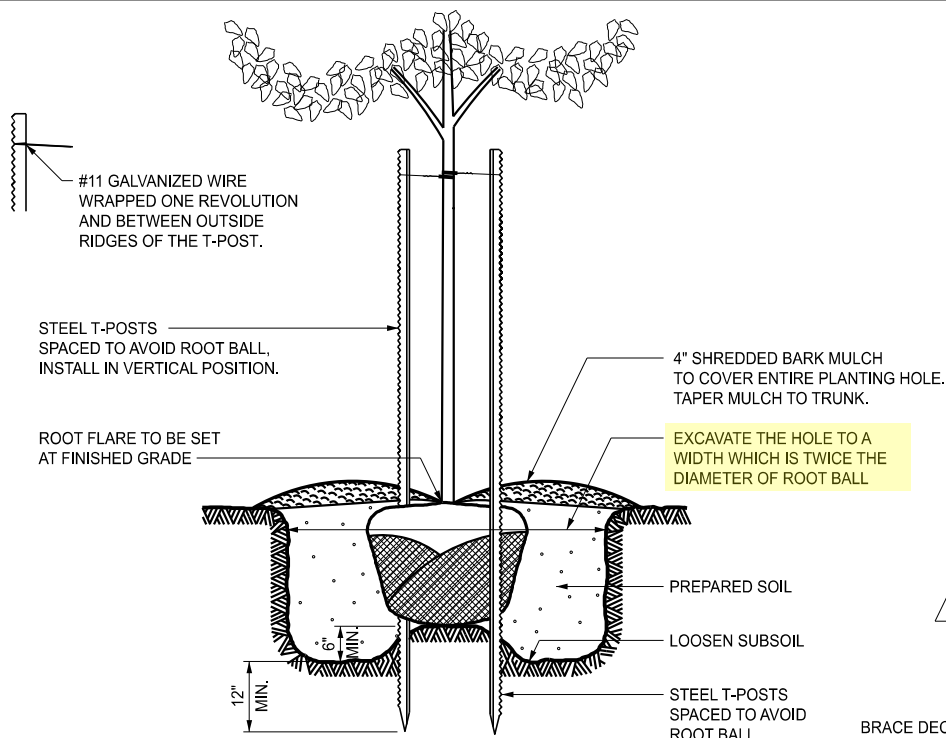


BRACING - VERTICAL STAKES

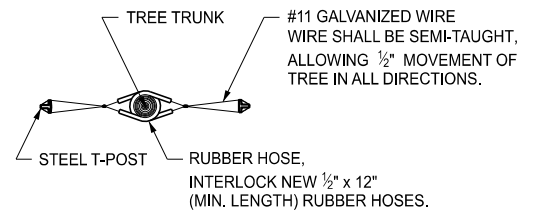

BRACING DETAIL


BRACE DECIDUOUS TREES 2" TO 4" IN CALIPER OR 8' OR MORE IN HEIGHT WITH TWO STAKES.

BRACE DECIDUOUS TREES LESS THAN 2" IN CALIPER OR 8' IN HEIGHT WITH ONE STAKE ON THE WESTERLY SIDE OF THE PLANT.

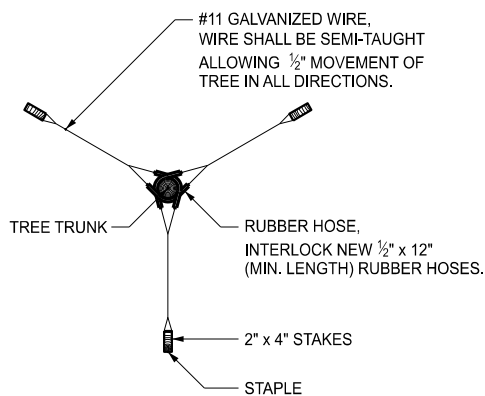


TRIPOD GUYING DETAIL

GUY EVERGREENS OVER 4" IN CALIPER OR 6' IN HEIGHT WITH THE TRIPOD METHOD AND UNDER 6' IN HEIGHT WITH TWO STAKES.

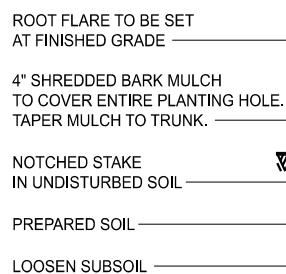

GUYING - TRIPOD METHOD

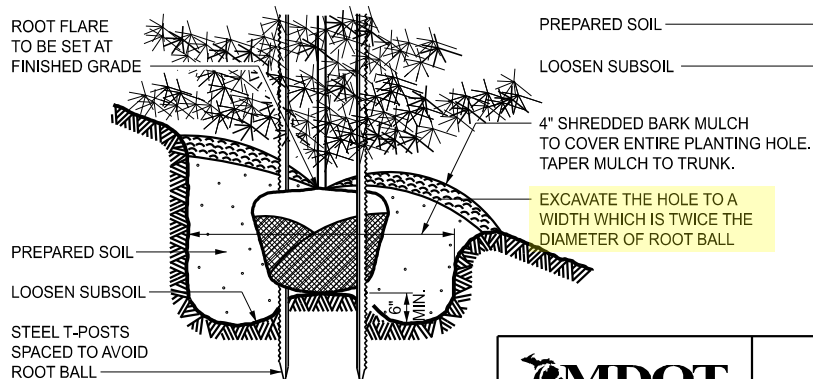

SLOPE PLANTING



DEPARTMENT DIRECTOR
BRADLEY C. WIEFERICH, PE

STANDARD PLAN FOR SEEDING AND TREE PLANTING

(SPECIAL DETAIL)
FHWA APPROVAL


12/08/2023
PLAN DATE

R-100-I

SHEET
2 OF 4




TREES AND SHRUBS SHALL NOT BE PLANTED WITHIN 50' AND 30' RESPECTIVELY OF THE NEAREST EDGE OF METAL - EXCEPT WHERE INACCESSIBLE TO VEHICLES.

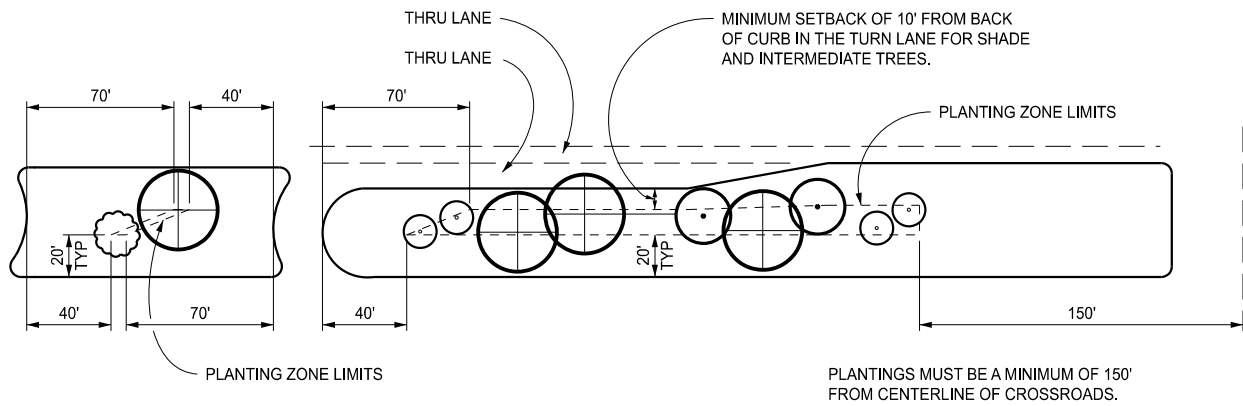

MEDIAN PLANTING

NOT TO SCALE

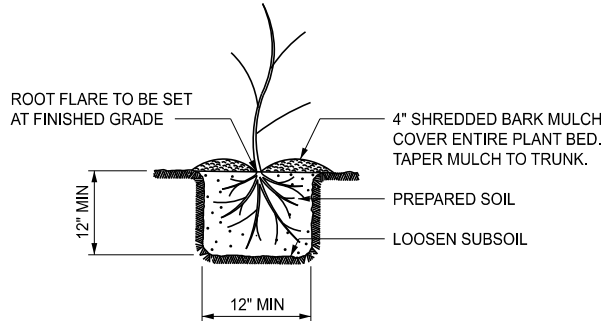

BARE ROOT PLANTS

PLANTING BARE ROOT PLANT MATERIAL

REFER TO THE "SPECIAL PROVISIONS FOR BARE ROOT PLANTING" FOR SHIPPING, STORAGE AND HANDLING REQUIREMENTS.

MAINTAIN ROOT MOISTURE BY KEEPING ROOTS IMMERSED IN WATER PRIOR TO PLANTING.


ROOT PRUNE AS NECESSARY TO REMOVE ALL DAMAGED OR BROKEN ROOTS, AND AS REQUIRED BY THE DISTRICT FORESTER OR RESOURCE SPECIALIST.

DIG PLANTING HOLES AT LEAST 12" WIDE AND 12" DEEP TO ACCOMMODATE ROOT MASS.

SET PLANTS PLUMB WITH THE ROOTS SPREAD PUT IN A NATURAL POSITION AT A DEPTH EQUAL TO THE DEPTH AT THE NURSERY.

HOLD PLANT FIRMLY AND PUDDLE (NOT TAMP) THE BACKFILL AROUND THE ROOTS WITH WATER. SUFFICIENT WATER SHALL BE USED TO ENSURE SATURATION OF THE BACKFILL, BUT CARE SHOULD BE TAKEN NOT TO OVERWATER, CAUSING A FLOATING SOIL MASS THAT PREVENTS COMPACTION AND MAY RESULT IN AIR POCKETS ADJACENT TO THE ROOTS. BACKFILL SHOULD BE FLUSH WITH THE GROUND AFTER COMPACTION.

COVER ENTIRE PLANT POCKET AREA WITH 4" MULCH AS SHOWN.

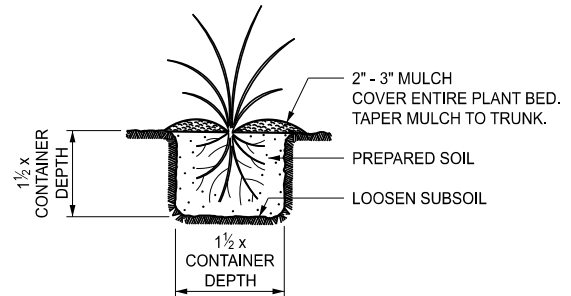

PERENNIAL PLANTS

FIRST AND SECOND WATERING AND CULTIVATION SHALL INCLUDE PERENNIAL BEDS.

PERENNIALS ARE TO BE FULLY DEVELOPED TWO YEAR #2 CONTAINER PLANTS.

ENTIRE PERENNIAL BED SHALL BE EXCAVATED DOWN 12" AND REPLACED WITH 12" OF PREPARED SOIL.

PERENNIAL BEDS ARE TO BE PAID FOR BY THE PAY ITEM 'SITE PREPARATION'.

SEEDING NOTES:

THIS STANDARD ILLUSTRATES THE TYPICAL USE OF SEEDING WITH MULCH, AS THESE ITEMS RELATE TO ROADWAY CONSTRUCTION. THE ACTUAL DESIGN AND MATERIALS USED TO CONSTRUCT THE COMPLETE SECTION, WHICH INCLUDES SEEDING WITH MULCHING, WILL BE ACCORDING TO THE PLANS AND THE STANDARD SPECIFICATIONS FOR CONSTRUCTION.

ITEMS CALLED FOR ON THIS STANDARD MAY ALSO BE USED DURING CONSTRUCTION AS AN EROSION CONTROL MEASURE. SEE STANDARD PLAN R-96-SERIES.

ALL DITCHES SHOULD HAVE HIGH VELOCITY MULCH BLANKET FOR EROSION CONTROL.

THE FIRST 8' BEHIND THE CURB OR SHOULDER IN URBAN MEDIAN AREAS WILL BE SEEDED, FERTILIZED, AND MULCHED WITH MULCH BLANKET. THE REMAINING AREAS WILL BE SEEDED, FERTILIZED, AND MULCHED WITH MULCH BLANKET OR STANDARD MULCH ANCHORED IN PLACE WITH A MULCH ADHESIVE OR WITH A MULCH NET.

ALL AREAS WHERE MULCH BLANKET IS CALLED FOR SHALL BE SEEDED, FERTILIZED, AND TOPSOILED AS SPECIFIED ON PLANS. NO MULCH OR ANCHORING MULCH IS REQUIRED WHERE MULCH BLANKET IS INSTALLED.

BACKSLOPE RESTORATION TREATMENT SHALL BE THE SAME AS THE FRONT SLOPE.



DEPARTMENT DIRECTOR
BRADLEY C. WIEFERICH, PE

STANDARD PLAN FOR SEEDING AND TREE PLANTING

(SPECIAL DETAIL)
FHWA APPROVAL

12/08/2023
PLAN DATE

R-100-I

SHEET
4 OF 4

MICHIGAN DESIGN MANUAL ROAD DESIGN

CHAPTER 14 PROCEDURES FOR PLAN PREPARATION INDEX (continued)

14.49 Section Deleted

14.50 FINAL CONSTRUCTABILITY REVIEW

14.51 INCENTIVE AND LIQUIDATED DAMAGES CLAUSES

14.51.01 Guidelines

14.51.02 Applications

14.51.03 Procedure

14.52 REVIEW OF PROJECT SCOPE, COST AND SCHEDULE

14.53 Section Deleted

14.54 FINAL PROJECT COORDINATION (FPC)

14.54.01 Requirements

14.54.02 Procedure

14.54.03 Attendees

14.55 CONTRACT SELECTION TEAM (DBE PROGRAM)

14.56 PACKAGING OR CONSOLIDATING PROJECTS

14.57 PLAN COMPLETION & DESIGN PLAN SUBMITTAL-CERTIFICATION ACCEPTANCE

14.57.01 Procedure

14.58 APPROVAL OF SPECIAL PROVISION

14.59 SHELF PROJECTS

14.60 SUBMISSION OF COMPLETED PLANS

14.60.01 General

14.60.02 Requirements

14.60.03 Exceptions

14.60.04 QA/QC Review

14.60.05 AASHTOWare Project (AP) Preconstruction Files

MICHIGAN DESIGN MANUAL ROAD DESIGN

14.57 (revised 12-26-2023)

PLAN COMPLETION & DESIGN PLAN SUBMITTAL - CERTIFICATION ACCEPTANCE (PPD Milestone 380M) (PPD Milestone 391M) (PPD Milestone 389M)

The Plan Completion date indicates 100% completion of the plans, proposal and supporting documents.

As part of the stewardship agreement with the FHWA, MDOT developed a procedure involving a system of checks/reviews to verify all requirements of the agreement are met. The Department also made the decision to use the majority of the process (completion of the Design Plan Submittal-Certification Acceptance (DPS-CA Form) on all projects (Federal and/or State funded), including those classified with FHWA Oversight (Risk Based Project Involvement (RBPI)). The verification is accomplished by completing the Certification Acceptance portion of the DPS-CA form. The form includes reviews (with confirmation utilizing dynamic Reviewed stamps) by several divisions and sections within MDOT. Once the DPS-CA form is completed with all applicable stamps, and stored in the ProjectWise Supporting Documents folder, it is submitted to the Specifications and Estimates Unit at final turn-in. The required stamps are listed below:

14.57 (continued)

- Bridge Design Unit (as applicable)
- Project Manager Licensed in the State of Michigan
- Quality Assurance Engineer
- Specifications and Estimates Engineer
- Utility Coordination and Permits (as applicable)
- Governmental Coordination and Engineering
- Office of Rail (as applicable)
- Force Account Work (as applicable)
- Geometric Design Engineer (pending CA form type and as applicable)
- Traffic Signs and Delineation (as applicable)
- Freeway Lighting (as applicable)
- Pavement Markings (as applicable)
- Traffic Signals (as applicable)
- Region/TSC Traffic and Safety
- Construction Engineer

MICHIGAN DESIGN MANUAL ROAD DESIGN

14.57 (continued)

The following documentation must be completed and stored in the applicable ProjectWise location prior to the final turn-in submittal to the Specifications and Estimate Unit as it pertains to the project.

- Environmental Classification (Form 1775)
- Special Design Considerations Memo
- Milestone Checklist
- Form 0334 – Exception to the Plan Review/FPC Meeting Process
- AASHTOWare Project Preconstruction Documents as noted on the Milestone Checklist
- Form 0268 – Project Cost Estimating Checklist
- Mitigation measures required in the environmental document (EIS, FONSI)
- Permits
- Environmental Classification/Certification
- ROW Certification
- PACS Report
- Proprietary Item Documentation
- Copies of Scope Verification and The Plan Review Meeting minutes.
- Design Exceptions / Variances
- Waiver-Planting Wildflower Expenditures
- Checklists for Supplemental Specifications, Notice to Bidders, and Special Provisions
- Constructability Review Checklist(s) (Form 1961 or 1960)
- Build America Buy America (BABA) Documentation
- Buy America Documentation
- Innovative Contracting Work Plans
- Warranties or Waivers for Warranties from applicable authorizing groups
- Pavement Selection Review Committee Approval Letter
- Contract Time Determination (CTD) and/or Critical Path Method Documentation
- Crash Analysis and Safety Review
- Value Engineering Results
- Interstate Access Change Request (IACR) Documentation
- 20 Yr Capacity Analysis

14.57 (continued)

- ITS Conformance Document (Form 2560)
- Incentive/Disincentive Project Documentation
- Guardrail Worksheets
- Exception Risk Analysis (Form 2912)
- Exception Risk Analysis – Special Provisions (Form 2908)
- Transportation Management Plan (TMP)
- Special Approval Documentation (i.e. Cold milling concrete pavement email or scope change approval email)
- Progress Clause
- MOT Special Provision
- Traffic Typical and Work Zone Device Special Details
- Frequently Used Special Provisions (FUSPs)
- Notice to Bidders (standard or unique)
- Project Coordination Clause
- Railroad Coordination Clause
- Utility Coordination Clause
- Supplemental Specifications
- Log of Plans
- Notice to Bidder Contact Information Sheet
- Approved Unique Special Provisions
- Stamped Completed Certification Acceptance File
- Digitally Signed / Completed Project Signature Sheet
- Completed/Packaged Plan Set
- Completed/Packaged Proposal

On FHWA Oversight projects, in addition to the Certification Acceptance Form being **complete**, the corresponding signed Risk Based Project Involvement Stewardship & Oversight Plan (RBPI S&O) form must also be obtained from FHWA, completed/signed, and placed in the ProjectWise Supporting Documents folder prior to submitting the final plan/proposal files to the Specifications and Estimates Unit.

Note – the applicable FHWA Area Engineer will supply the RBPI Stewardship & Oversight Plan form on applicable projects with FHWA Oversight.

MICHIGAN DESIGN MANUAL ROAD DESIGN

14.57.01 (revised 12-26-2023)

Procedure

1. Following the Final Project Coordination (FPC) Meeting, the design team will incorporate the accepted review comments and complete the final plans and proposal package.
2. When plans are 100% complete (Plan Completion – PPD Milestone 380M) the packaged plan and proposal files are placed in folder 6 – Letting Plans and Proposal in ProjectWise. The design team advances the file state to “PM Review in Progress”. The Project Manager is responsible for verifying all the agreed-upon revisions are incorporated into the plans.
3. The reviewers from the Omission and Errors Check (OEC) Review (PPD Task 3900) and those required to stamp the Certification Acceptance (CA) Form are notified with the file state change to “CA Sign Off” in ProjectWise. The OEC reviewers are responsible for verifying that their concerns have been resolved with the final plans. Certification Acceptance reviewers will stamp the CA form with the Licensed Project Manager stamping the CA form last (PPD Milestone 391M).
4. The Project Manager advances the completed files state to “Initiate Final Project Review” to submit the completed final turn-in plans to Specifications and Estimates (PPD Milestone 389M).
5. The Project Manager will also submit the Supporting Documents by selecting all files in that folder and changing state to “e-Prop – Initial Final Project Review – Supporting Documents” (PPD Milestone 389M).

14.58 (revised 1-23-2023)

APPROVAL OF SPECIAL PROVISIONS

In order to clarify terminology surrounding this subject, the following definitions are provided:

1. Standard Specifications.- The book of specifications approved for general application and repetitive use.
2. Supplemental Specifications.- Detailed specifications that add to or supersede the Standard Specifications.
3. Special Provisions.- Revisions or additions to the Standard and Supplemental Specifications applicable to an individual project.
4. Frequently Used Special Provisions.- An approved special provision with stable requirements applicable to a number of projects used on a regular basis.
5. Addendum - a change, addition and/or deletion to the contract documents occurring after a project is advertised but before the letting date.

Occasionally, information in the plan/proposal package may differ or conflict. To help in resolving such conflicts, the following order of preference has been established per the Standard Specifications for Construction:

1. All proposal material except those listed in subsections 104.06B through 104.06F
2. Special Provisions
3. Supplemental Specifications
4. Project Plans and Drawings
5. Standard Plans
6. Standard Specifications

MICHIGAN DESIGN MANUAL

BRIDGE DESIGN - CHAPTER 7: LRFD

7.03.01 (continued)

Abutment Design

B. Types

4. Integral and Semi-Integral Abutments

- f. (1-24-2022) Approach slabs are 20'-0" in length whenever possible.

Approach slabs 20'-0" in length are based on a longitudinal unsupported length of 10 feet measured along the centerline of the roadway, a slab thickness of 12" and a maximum concrete cover to the centerline of the bottom longitudinal reinforcement of 3". Deviation from these design parameters for specific projects requires a complete redesign of the approach slab.

Approach slabs with independent backwalls can be 6'-6" minimum length. For design speeds greater than 45 mph (posted > 40 mph) approach slabs may be up to 20' in length (measured along roadway centerline) as project and geometric limitations allow. Use shorter approach slab length (6'-6" min) if service road is in close proximity to the bridge abutment. (12-28-2015)

Abutments with a skew angle maintain the same skew angle at the end of the bridge approach slab and at the sleeper slab. Standard Plan [R-45-Series](#) reinforced approach pavements are cast perpendicular (90°) to the roadway centerline on the opposite end of the sleeper slab. See Standard Plan [R-43-Series](#). (12-28-2015)

Cast 12" minimum thickness (9" for independent backwalls) bridge approach slab from sleeper slab towards reference lines at night with "Superstructure Conc, Night Casting (High Performance)" and match the road approach thickness (9" minimum). (9-27-2021)

Use a 20' concrete approach pavement as detailed on Standard Plan [R-43](#) & [R-45](#) - Series located on the road approach side of the sleeper slab. (10-22-2012)

7.03.01 B. 4. f. (continued)

Designate approach slabs as separate pours in the pour sequence of the superstructure. (9-21-2015)

See Bridge Design Guide [6.20.03A](#), [.03B](#), [6.20.04](#) & [.04B](#) for approach slab details. (12-28-2015)

- g. Continue bottom mat of deck reinforcement past reference joint into the approach slab with independent backwalls. See Bridge Design Guides [6.20.03A](#) & [.03B](#). For dependent backwalls lap or develop EA bars from deck slab to bridge approach slab. See Bridge Design Guides [6.20.04](#) & [.04B](#). Provide adequate lap/development according to Bridge Guide 7.14.02 Series. (12-26-2023).
- h. Add extra reinforcement over beams at the reference joint that extend into the approach slab and into the bridge deck slab. Lap or develop extra EA bars over beams according to Bridge Guide 7.14.02 Series. (12-26-2023)
- i. Attach approach curb and gutter to the approach slab with bottom mat transverse reinforcement and to the bridge deck with bottom mat longitudinal reinforcement. Do not attach curb and gutter to the approach slab or the bridge deck on structures with return wingwalls. Using a bond breaker and sliding the approach slab over the return wingwalls is a design consideration. The extension of bridge railing to the sleeper slab will eliminate the need for curb and gutter in the bridge approach slab area. (1-24-2022)
- j. An inverted "T" sleeper slab shall be used with all approach slabs (except when Standard Plan [R-45-Series](#) approach is used by itself). Concrete to concrete slabs shall have an EJ3 (or EJ4) joint on the bridge side of the stub and an E3 joint on the road side. Place [R-45-Series](#) reinforced concrete slab on the road side of the inverted "T" sleeper slab. Provide elevations along stub of sleeper slab at construction centerline, lane lines and edge of metal. Provide elevations at toe of curb/barrier and top of curb if present. (1-24-2022)

CONTENTS

SECTION 7 - STEEL REINFORCEMENT

- 7.11.01 English Reinforcing Bars
- 7.14.02 Tension Development and Lap Splice Lengths Spacing Thresholds
- 7.14.02A Tension Development and Lap Splice Lengths Substructure
- 7.14.02B Tension Development and Lap Splice Lengths Superstructure
- 7.14.03 Minimum Dimensions for Standard Hooks in Tension
- 7.15.01, .02 Standard Reinforcing Bar Types

SECTION 8 - STRUCTURAL STEEL

- 8.06.02, .02A Welded Girder, Camber Diagram and Stiffener Details
- 8.06.03 Plate Girder Welding Details
- 8.07.01 Stud Shear Developer Details
- 8.11.03 Diaphragm and Connection Plate Details
- 8.11.04 End Diaphragm Connection Details 30° to 45°
- 8.11.05, .05A Lateral Bracing Details
- 8.11.06 End Cross Frames
- 8.11.07 Intermediate and Pier Cross Frames
- 8.11.08 Bolted Connections for Intermediate Diaphragms and Crossframes
- 8.14.02 Beam or Girder Suspender Design Table
- 8.15.01 Suspender Details for Cantilevered Plate Girders
- 8.15.01A Pin Detail
- 8.16.02 Suspender Details for Rolled Beams
- 8.21.01 CIP Pile Splices
- 8.21.02, .02A H Pile Splice Details
- 8.21.03 CIP Pile Point Details
- 8.26.01 Fastener Detailing Minimums
- 8.31.01 Guide for Selection of Bearing Types for Steel Structures
- 8.31.02 Offset Dimensions for Rocker Tilt
- 8.32.01, .02 Expansion Rockers - Steel Beams
- 8.32.03 - .06 Fixed Bearings - Steel Beams
- 8.32.07 Expansion Rocker with Provision for Uplift
- 8.42.01 Curved Steel Plate Bearing Details
- 8.43.01 Bearing Details for Prestressed Concrete I Beams
- 8.43.01A Bearing Details for Prestressed Concrete Box Beams


APPROVED BY: KCK

MICHIGAN DEPARTMENT OF TRANSPORTATION
BUREAU OF DEVELOPMENT

CANTILEVER ABUTMENT REINFORCING


ISSUED:	12/26/23
---------	----------

SUPERSEDES: 05/04/06

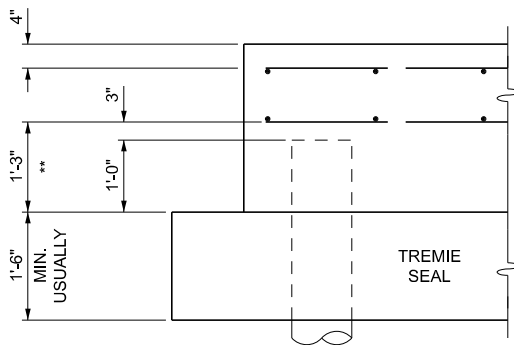


FOOTING WITH TREMIE SEAL

** 9" WHEN PILES NOT USED

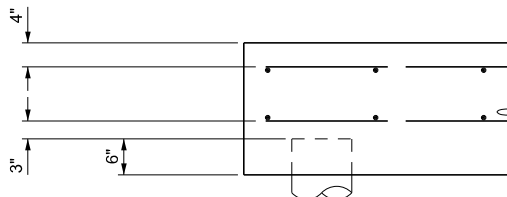

FOOTING ON PILES

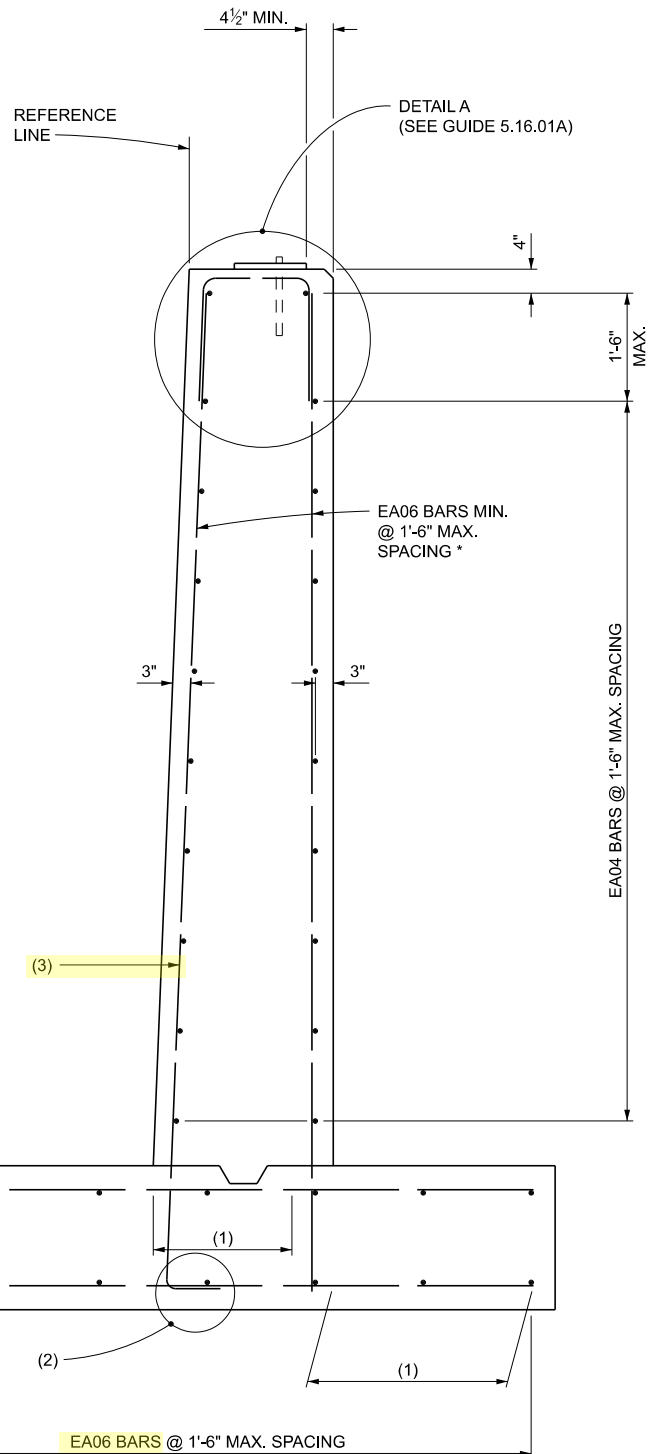

- (1) - SEE GUIDE 7.14.02 SERIES FOR MINIMUM DEVELOPMENT LENGTHS
- (2) - SEE GUIDE 7.14.03 FOR MINIMUM DIMENSIONS FOR STANDARD HOOKS IN TENSION
- (3) - IF LAPPING TENSION REINFORCEMENT EXTENDING OUT OF THE FOOTING WITH A SMALLER BAR IN THE ABUTMENT WALL, EXTEND THE TENSION REINFORCEMENT FROM THE FOOTING BEYOND THE POINT AT WHICH IT IS NO LONGER REQUIRED TO RESIST FLEXURE FOR A DISTANCE NOT LESS THAN WHAT IS REQUIRED IN AASHTO LRFD 5.10.8.1.2a.

NOTES:
THE DETAILED REINFORCEMENT IN THE ABUTMENT IS THE MINIMUM. THE DESIGN OF THE ABUTMENT MAY REQUIRE ADDITIONAL REINFORCEMENT OR INCREASING THE REINFORCEMENT AREA (DIAMETER) SHOWN TO MEET THE REQUIREMENTS IN AASHTO LRFD FOR FLEXURAL REINFORCEMENT AND FOR RESISTING SHRINKAGE AND TEMPERATURE STRESSES.

PREPARED BY
DESIGN DIVISION

5.16.01

DRAWN BY: BLT

CHECKED BY: VZ

APPROVED BY: KCK


MICHIGAN DEPARTMENT OF TRANSPORTATION

BUREAU OF DEVELOPMENT


CANTILEVER ABUTMENT REINFORCING

ISSUED: 12/26/23

SUPERSEDES: 05/04/06

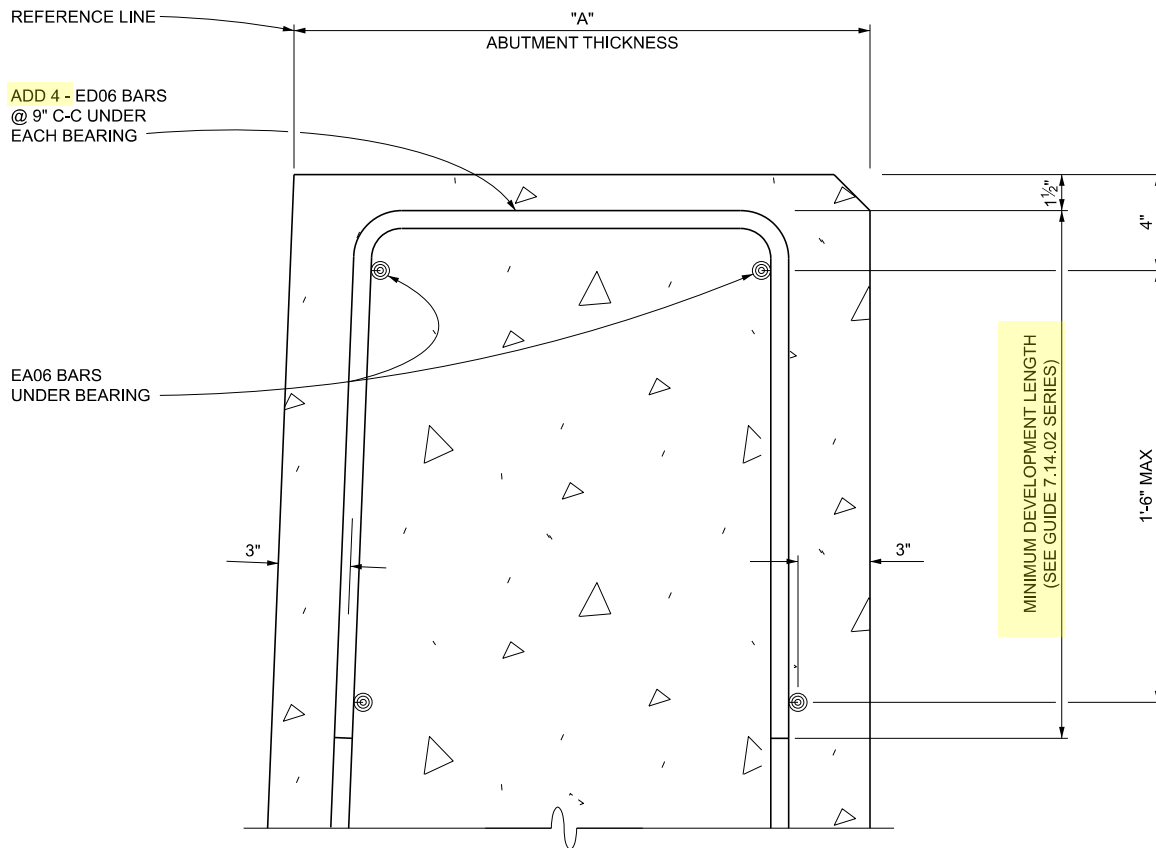

DETAIL A

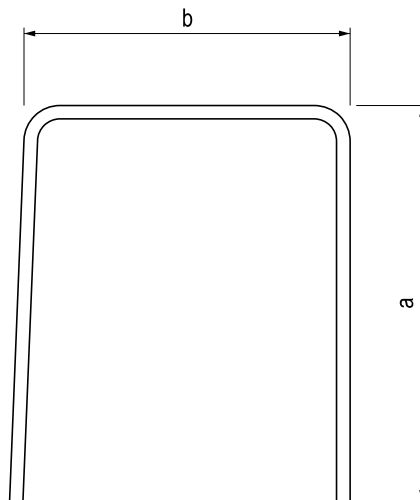

EA06 BAR

a = MINIMUM DEVELOPMENT LENGTH
(SEE GUIDE 7.14.02 SERIES)

b = A - 5 1/8"

USE THESE DETAILS FOR STEEL BEAM BRIDGES ONLY WITH EITHER DEPENDENT OR INDEPENDENT BACKWALLS.


PREPARED BY
DESIGN DIVISION

5.16.01A

DRAWN BY: BLT
CHECKED BY: VZ
APPROVED BY: KCK

MICHIGAN DEPARTMENT OF TRANSPORTATION
BUREAU OF DEVELOPMENT
CURTAINWALL ABUTMENT

ISSUED: 12/26/23
SUPERSEDES: 11/27/01

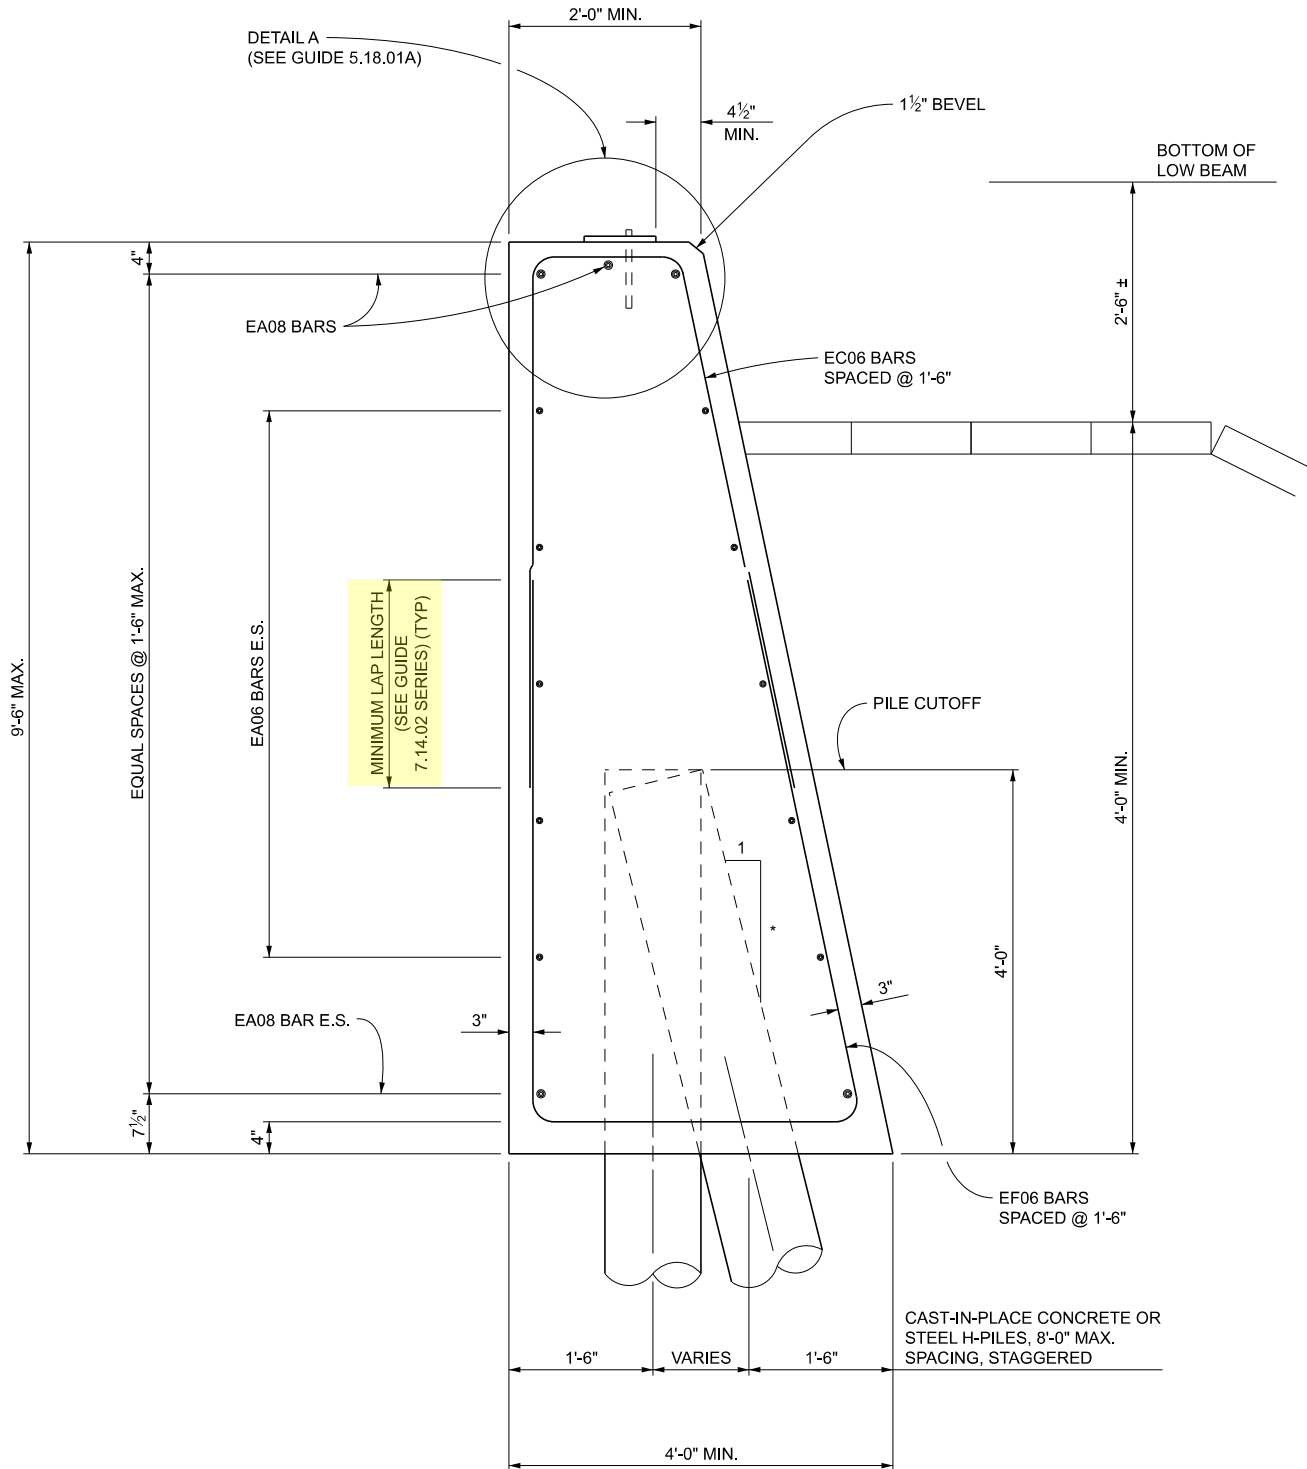

* FOR PILE BATTER, SEE BRIDGE DESIGN MANUAL 7.03.09

FOR ADDITIONAL REINFORCING DETAILS, SEE GUIDES 6.20.01 AND 6.20.03.


PREPARED BY
DESIGN DIVISION

5.18.01


DRAWN BY: BLT
CHECKED BY: VZ
APPROVED BY: KCK

MICHIGAN DEPARTMENT OF TRANSPORTATION
BUREAU OF DEVELOPMENT
CURTAINWALL ABUTMENT REINFORCEMENT

ISSUED: 12/26/23
SUPERSEDES: 11/27/01

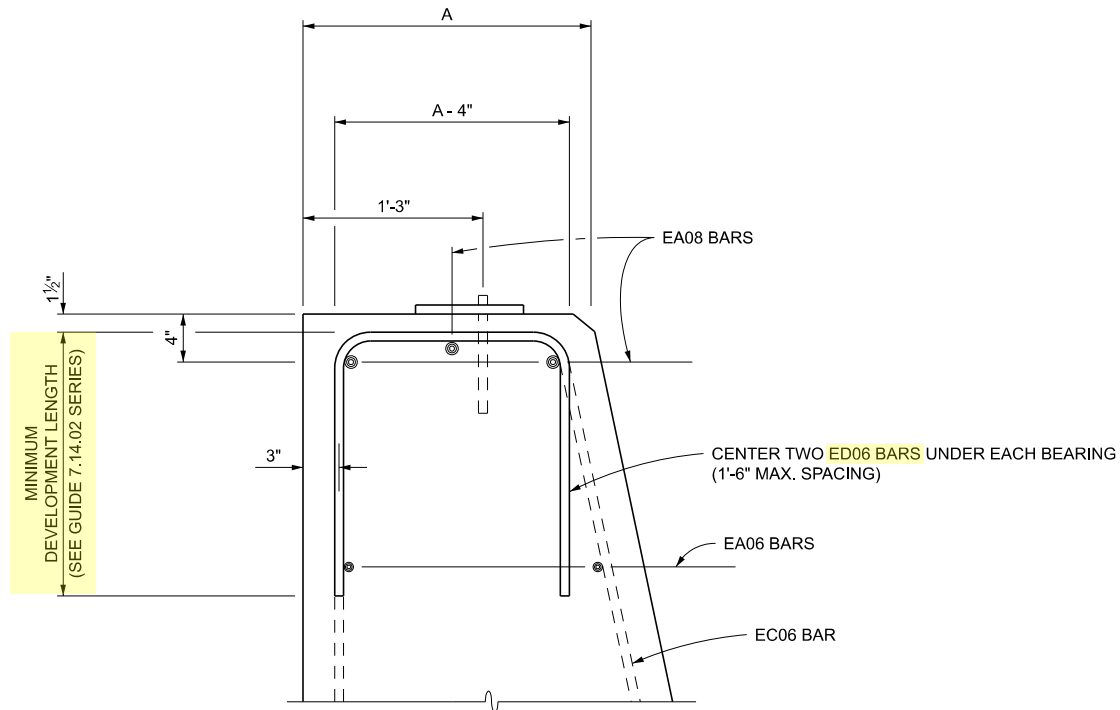

DETAIL A

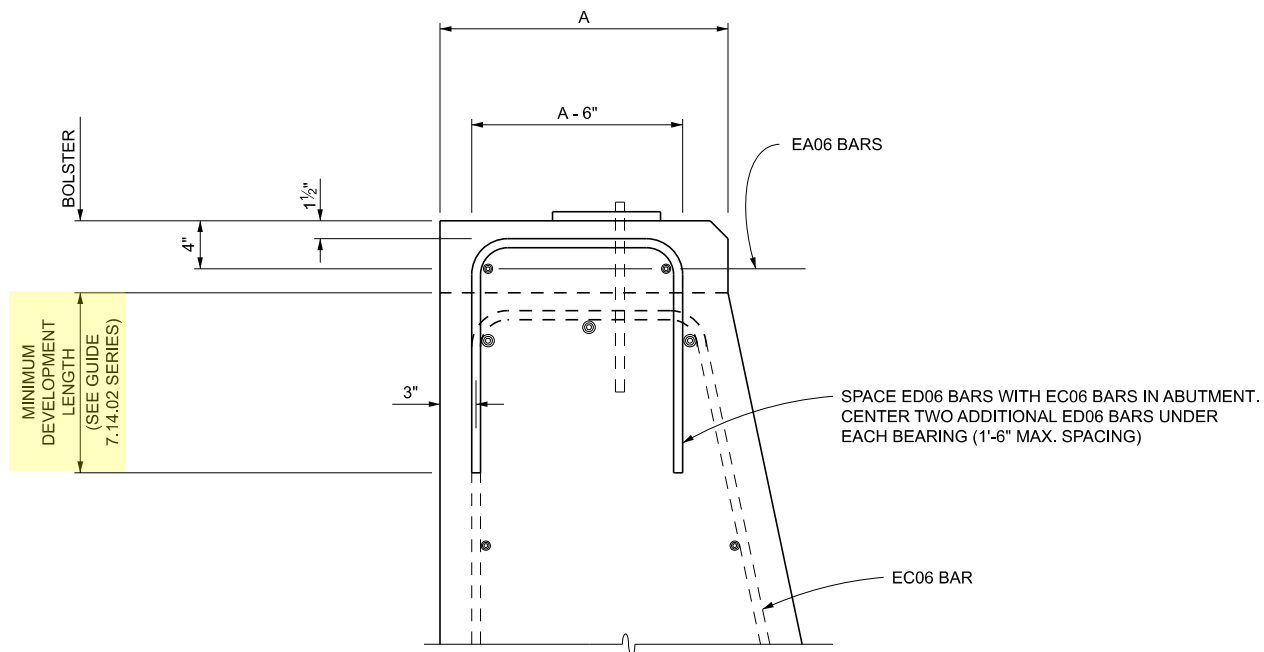

DETAIL A
(AT BOLSTER)

NOTE:
USE THESE DETAILS FOR STEEL BEAM BRIDGES WITH EITHER DEPENDENT OR INDEPENDENT BACKWALLS.


PREPARED BY
DESIGN DIVISION

5.18.01A

DRAWN BY: BLT
CHECKED BY: VZ
APPROVED BY: KCK

MICHIGAN DEPARTMENT OF TRANSPORTATION
BUREAU OF DEVELOPMENT
PIER CAP DETAILS
ROUND COLUMN PIERS

ISSUED: 12/26/23
SUPERSEDES: 11/27/01

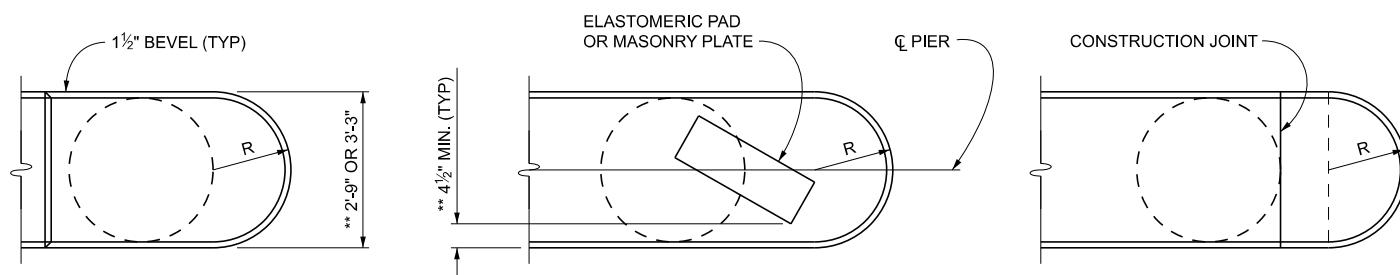


MIN. CANTILEVER WITHOUT
FUTURE WIDENING

MIN. CANTILEVER WITH
STRINGER ON CANTILEVER

MIN. CANTILEVER WITH
FUTURE WIDENING


** INCREASE WIDTH AS REQUIRED
TO PROVIDE 4 1/2" CLEARANCE

PLAN OF CAP

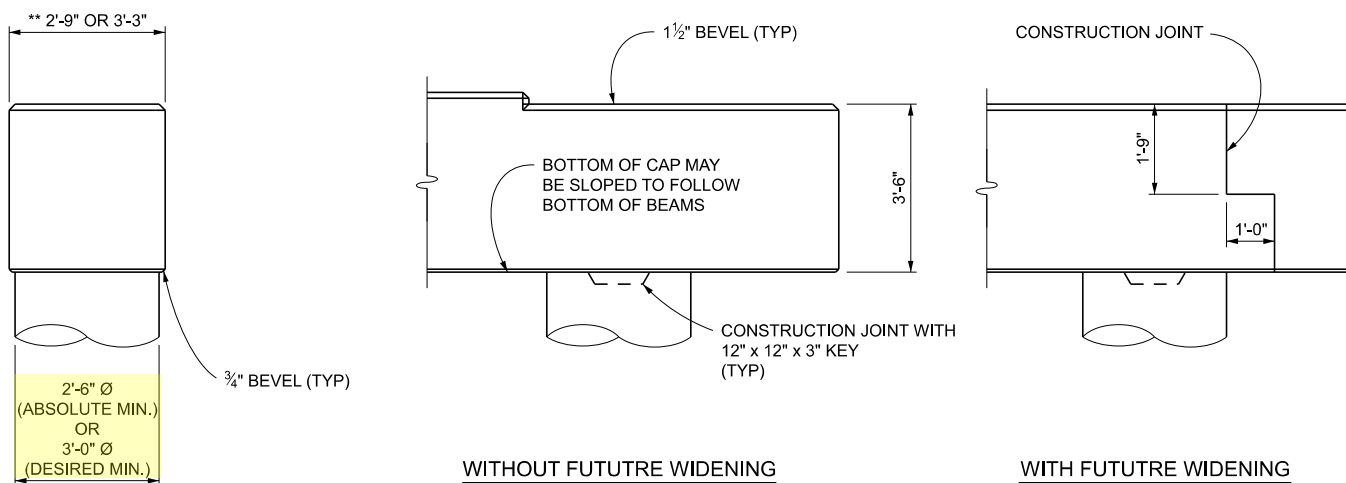

END VIEW

SIDE VIEW AT END OF CAP

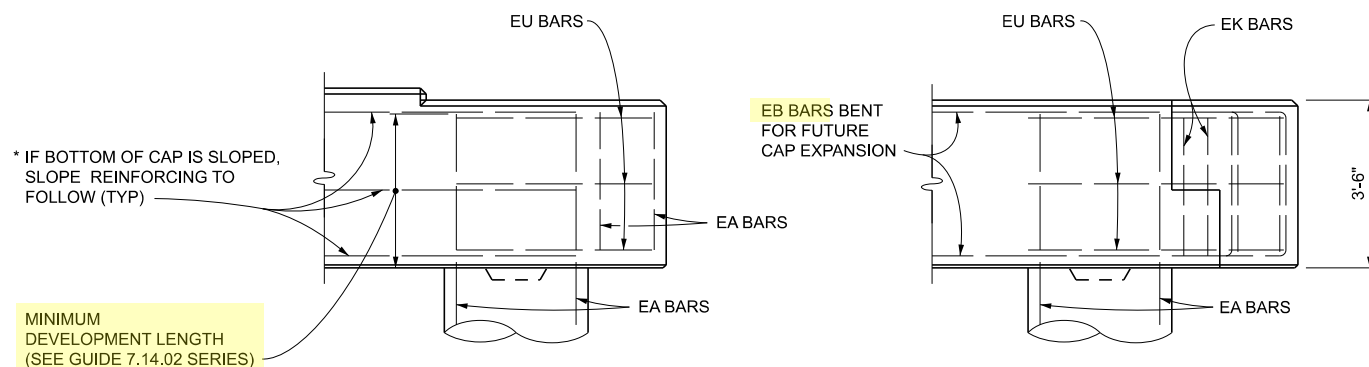

WITHOUT FUTURE WIDENING

WITH FUTURE WIDENING

CAP REINFORCEMENT


PREPARED BY
DESIGN DIVISION

5.27.03

DRAWN BY: BLT
CHECKED BY: VZ
APPROVED BY: KCK

MICHIGAN DEPARTMENT OF TRANSPORTATION
BUREAU OF DEVELOPMENT
TYPICAL SECTION THRU
INDEPENDENT BACKWALL

ISSUED: 12/26/23
SUPERSEDES: 11/28/22

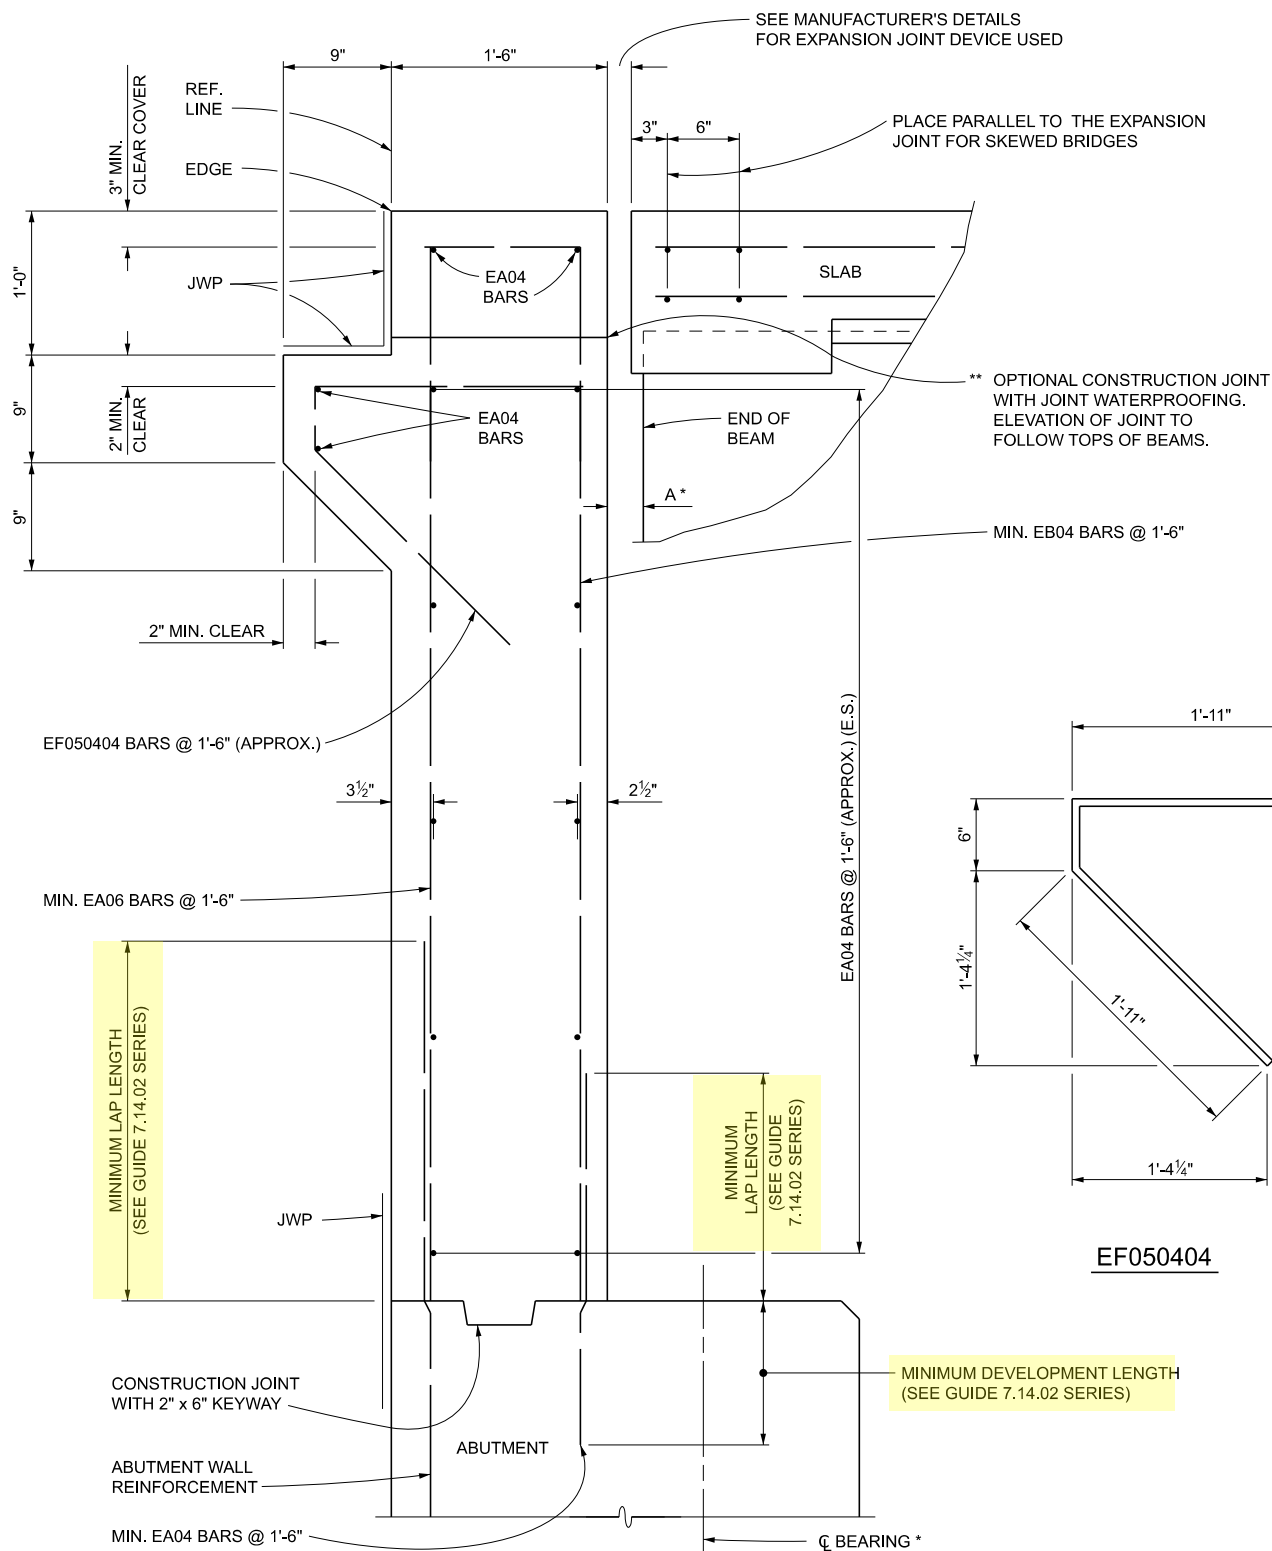

NOTE:
BARS WITH PREFIX "E" ARE TO BE EPOXY COATED.

PLAN NOTE:

** IF CONSTRUCTION JOINT IS USED, THERE WILL BE NO
PAYMENT FOR THE REQUIRED JOINT WATERPROOFING.

* TO ESTABLISH \bar{C} BEARING, USE $"A" = \frac{1}{2}$ TOTAL MOVEMENT
PARALLEL TO \bar{C} BEAM PLUS 1". FOR SKEWED BRIDGES,
"A" IS MEASURED AT CORNER OF FLANGE.


PREPARED BY
DESIGN DIVISION

6.20.03

DRAWN BY: BLT
CHECKED BY: VZ
APPROVED BY: KCK


MICHIGAN DEPARTMENT OF TRANSPORTATION
BUREAU OF DEVELOPMENT
TYPICAL SECTION THRU
INDEPENDENT BACKWALL WITH SLIDING SLAB

ISSUED: 12/26/23
SUPERSEDES: 09/25/26

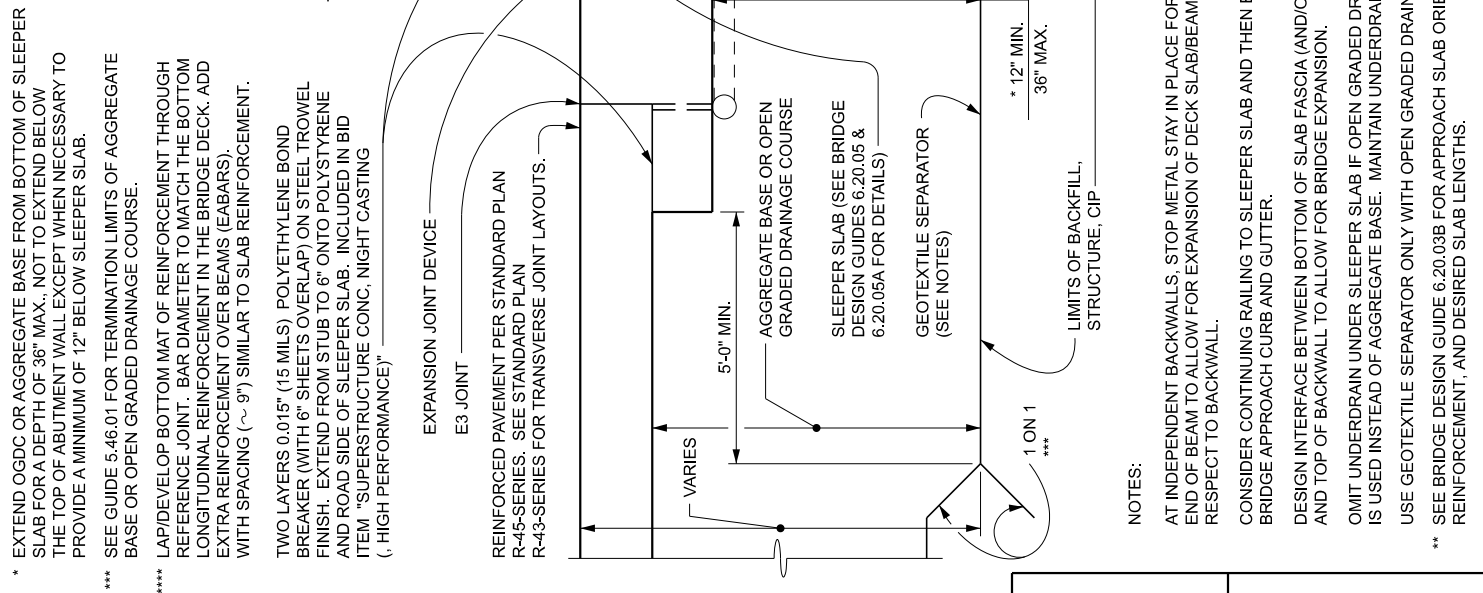

PREPARED BY
DESIGN DIVISION

6.20.03A

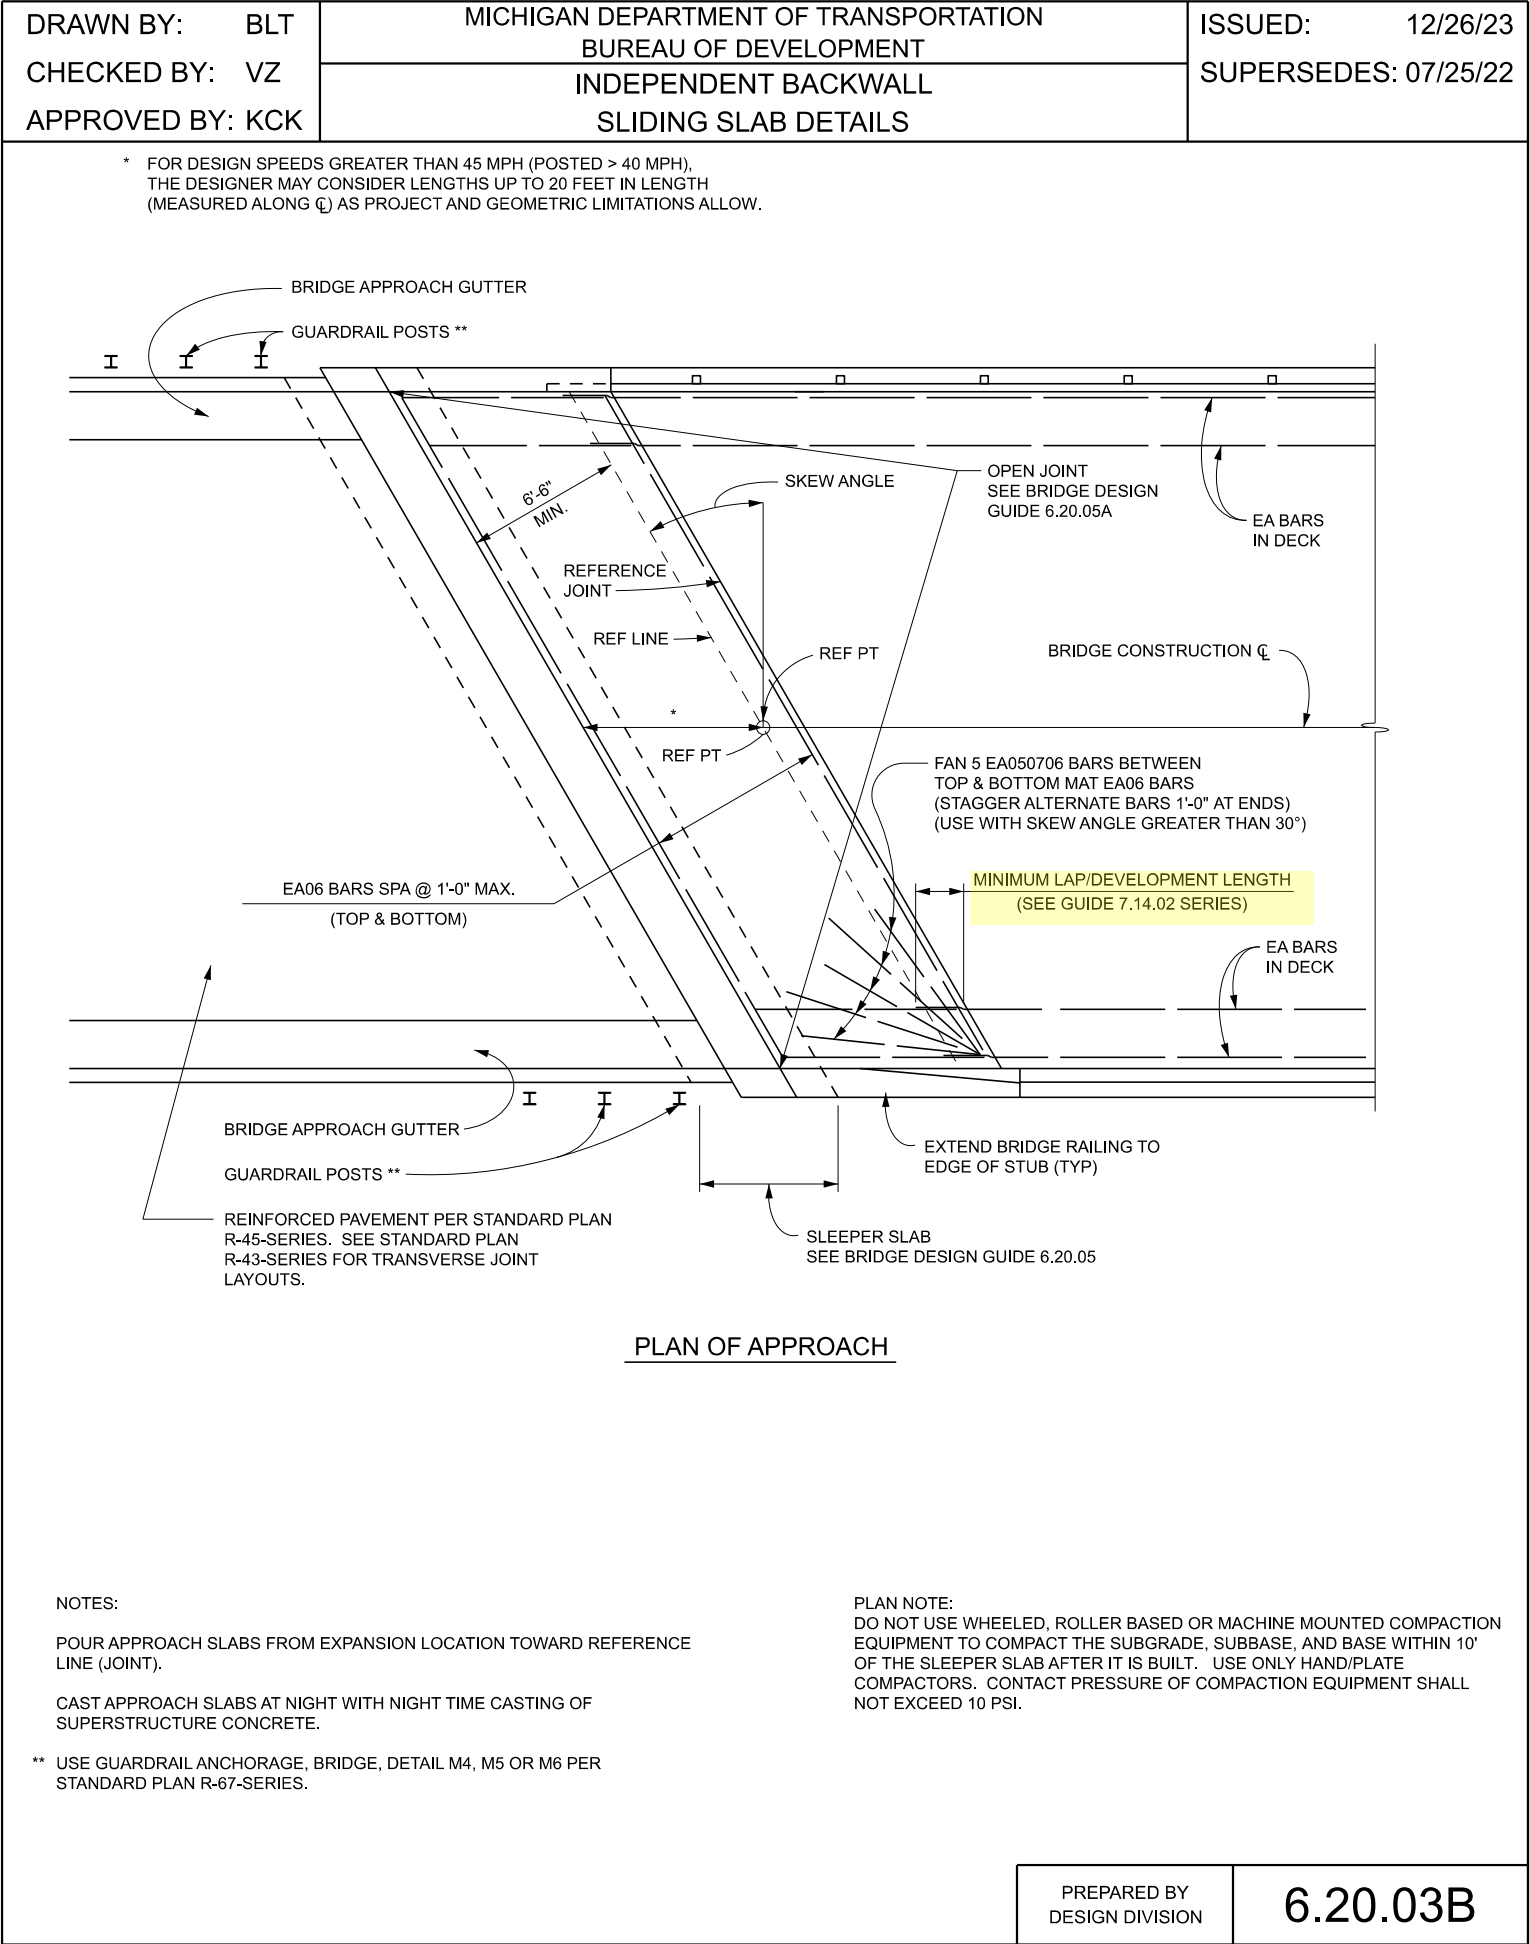

APPROVED BY: KCK

INTEGRAL AND SEMI-INTEGRAL ABUTMENT PARTIAL BACKWALL DETAILS

SUPERSEDES: 01/27/20





GROUT BARS IN BEAMS PRIOR TO CASTING BACKWALL, ALL GROUT AND MATERIALS, LABOR AND EQUIPMENT REQUIRED TO PLACE THE GROUT ARE INCLUDED IN THE BID ITEM "SUPERSTRUCTURE CONC, NIGHT CASTING".

6.20.04A

DRAWN BY: BLT
CHECKED BY: VZ
APPROVED BY: KCK

MICHIGAN DEPARTMENT OF TRANSPORTATION
BUREAU OF DEVELOPMENT
INTEGRAL AND SEMI-INTEGRAL ABUTMENT
EMPIRICAL APPROACH SLAB DETAILS

ISSUED: 12/26/23
SUPERSEDES: 07/25/22

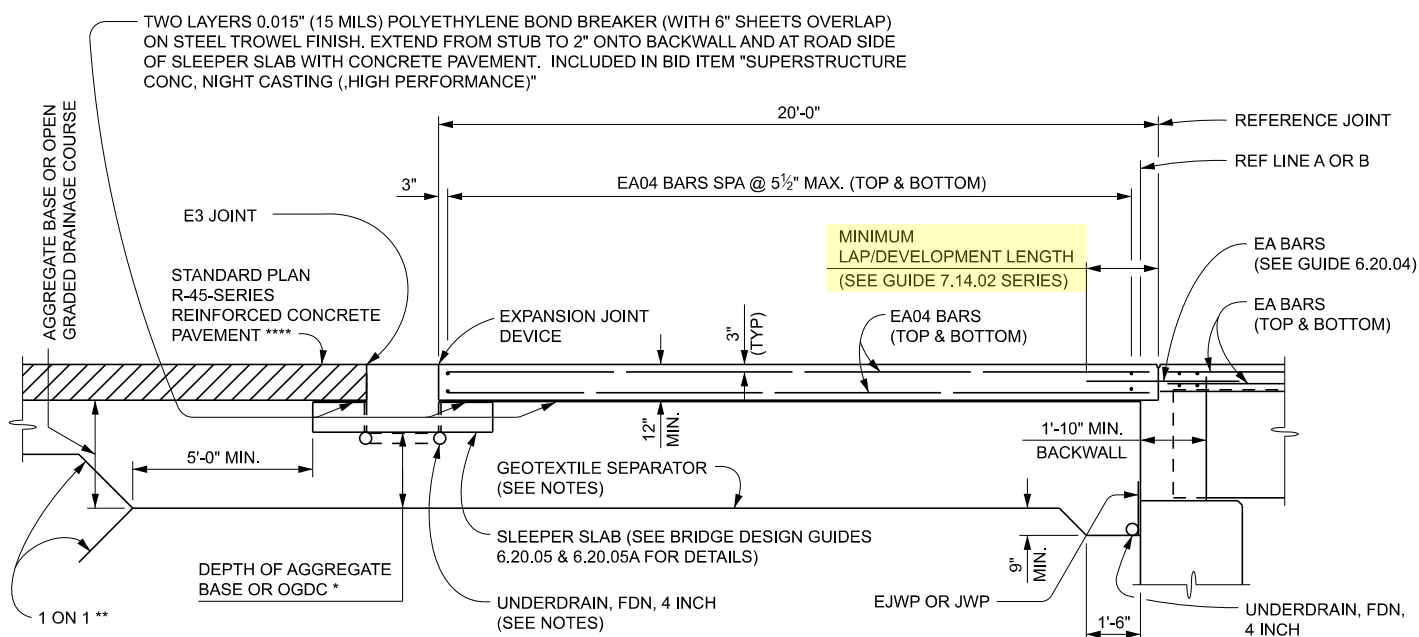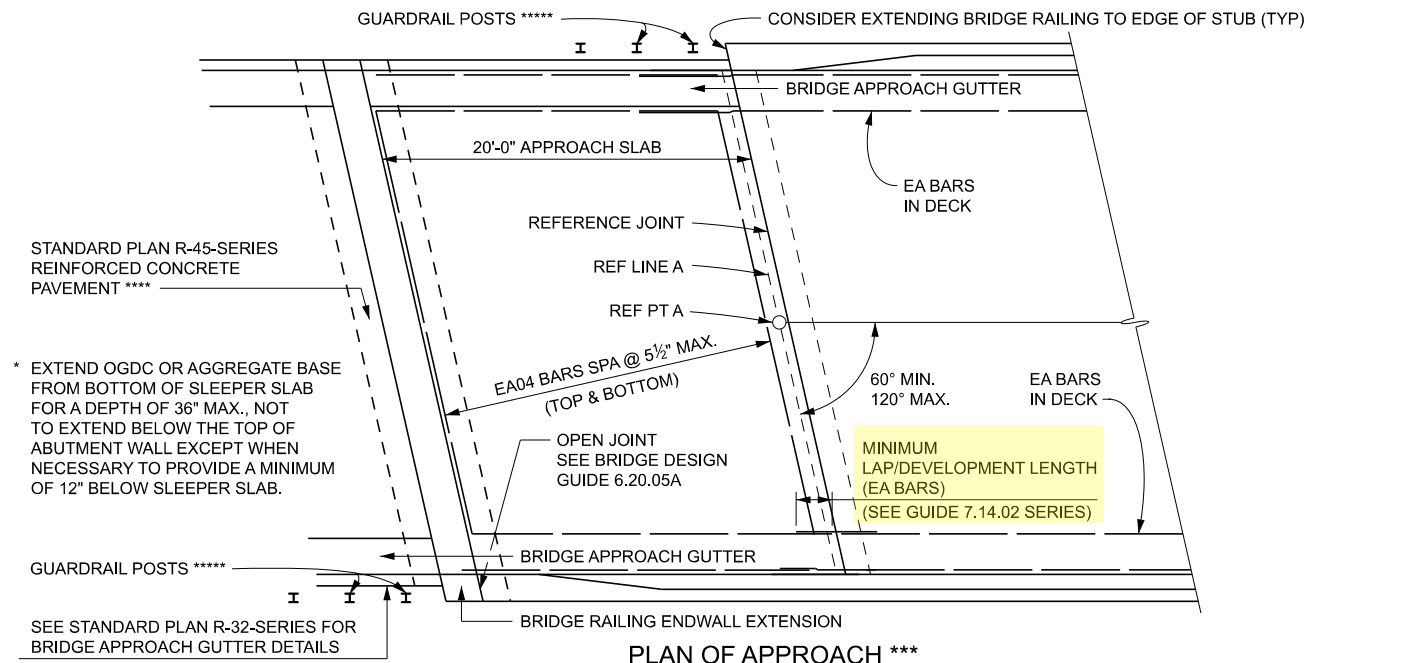

NOTES:

ATTACH APPROACH CURB AND GUTTER TO THE APPROACH SLAB WITH BOTTOM MAT TRANSVERSE REINFORCEMENT AND TO THE BRIDGE DECK WITH BOTTOM MAT LONGITUDINAL REINFORCEMENT.

POUR APPROACH SLABS FROM EXPANSION LOCATION TOWARD REFERENCE JOINT.

CAST APPROACH SLABS AT NIGHT WITH NIGHT TIME CASTING OF SUPERSTRUCTURE CONCRETE.

USE GEOTEXTILE SEPARATOR ONLY WITH OPEN GRADED DRAINAGE COURSE.

OMIT UNDERDRAIN UNDER SLEEPER SLAB IF OPEN GRADED DRAINAGE COURSE IS USED INSTEAD OF AGGREGATE BASE.

EMPIRICAL APPROACH SLABS (AS DETAILED ON THIS GUIDE) ARE NOT REQUIRED AT THE ENDS OF BRIDGES WITH A LENGTH CONTRIBUTING TO EXPANSION OF LESS THAN 50' FOR CONCRETE BEAM BRIDGES AND LESS THAN 25' FOR STEEL BEAM BRIDGES. INSTEAD, USE A PAVEMENT SEAT WITH STANDARD PLAN R-45-SERIES REINFORCED CONCRETE PAVEMENT.

** SEE GUIDE 5.46.01 FOR TERMINATION LIMITS OF AGGREGATE BASE OR OPEN GRADED DRAINAGE COURSE.

*** THE DETAILED BRIDGE APPROACH SLAB IS BASED ON A LONGITUDINAL UNSUPPORTED LENGTH OF 10 FEET MEASURED ALONG THE CENTERLINE OF THE ROADWAY, A SLAB THICKNESS OF 12" AND A MAXIMUM CONCRETE COVER TO THE CENTERLINE OF THE BOTTOM LONGITUDINAL REINFORCEMENT OF 3". DEVIATION FROM THESE DESIGN PARAMETERS FOR SPECIFIC PROJECTS REQUIRES A COMPLETE REDESIGN OF THE BRIDGE APPROACH SLAB.

**** USE INVERTED "T" SLEEPER SLAB FOR CONCRETE AND HMA ROAD APPROACH PAVEMENT. PLACE STANDARD PLAN R-45-SERIES REINFORCED CONCRETE PAVEMENT THEN CONCRETE OR HMA ROAD APPROACH PAVEMENT.

***** USE GUARDRAIL ANCHORAGE, BRIDGE, DETAIL M4, M5 OR M6 PER STANDARD PLAN R-67-SERIES.


PREPARED BY
DESIGN DIVISION

6.20.04B


DRAWN BY: BLT
 CHECKED BY: VZ
 APPROVED BY: KCK

MICHIGAN DEPARTMENT OF TRANSPORTATION
 BUREAU OF DEVELOPMENT
 SLEEPER SLAB DETAILS

ISSUED: 12/26/23
 SUPERSEDES: 07/25/22

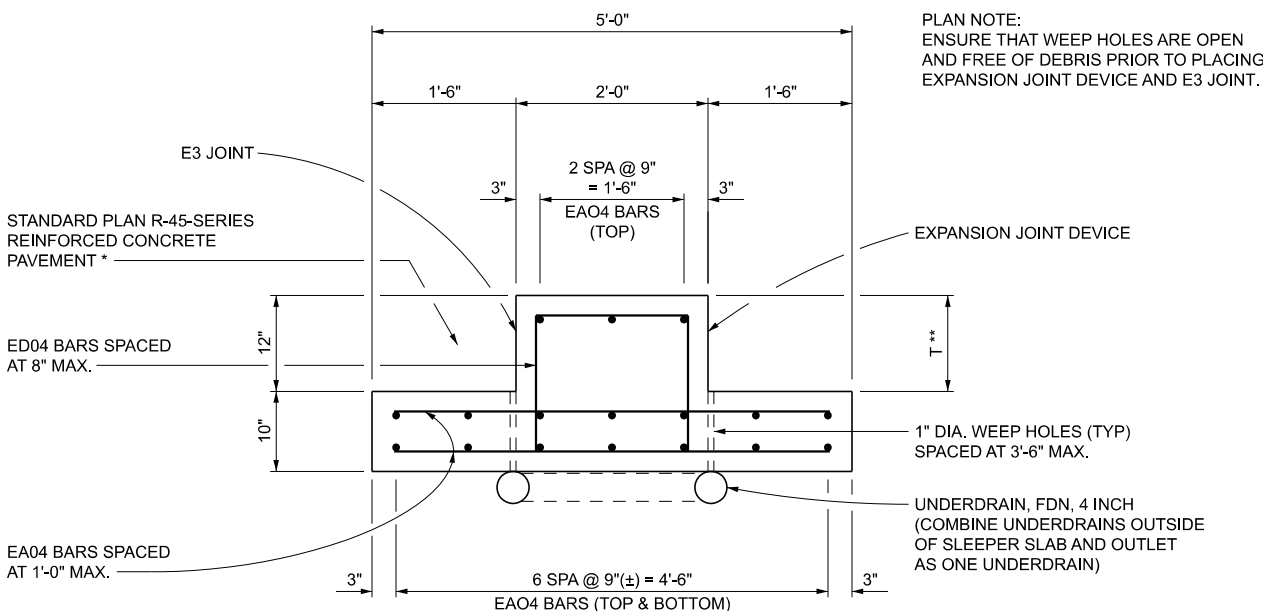

TYPICAL SECTION THRU SLEEPER SLAB

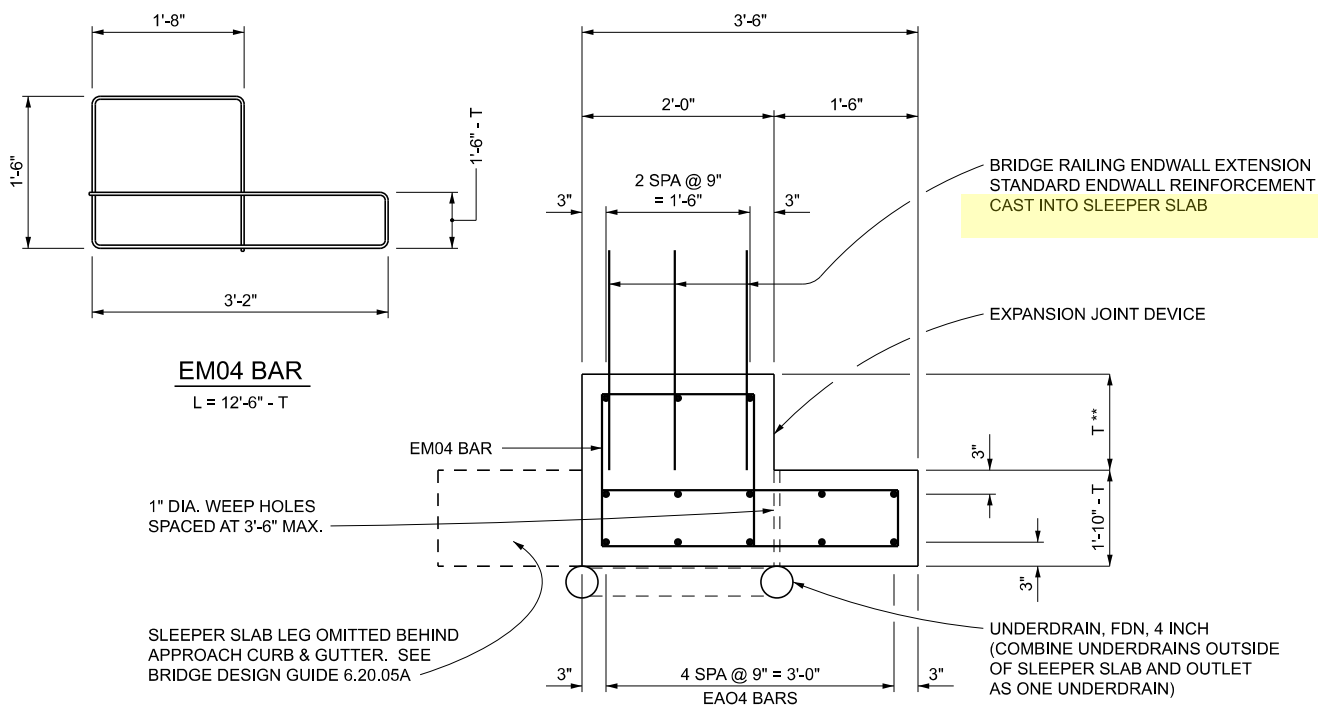

TYPICAL SECTION THRU END OF SLEEPER SLAB
 BELOW BRIDGE RAILING ENDWALL EXTENSION

NOTES:
 OMIT UNDERDRAIN UNDER SLEEPER SLAB IF OPEN GRADED DRAINAGE COURSE IS USED INSTEAD
 OF AGGREGATE BASE.

* USE STANDARD PLAN R-45-SERIES REINFORCED CONCRETE PAVEMENT WITH CONCRETE AND HMA
 ROAD APPROACHES. SEE STANDARD PLAN R-43-SERIES FOR TRANSVERSE JOINT LOCATIONS.

** T = APPROACH SLAB THICKNESS.
 12" MINIMUM FOR DEPENDENT BACKWALL.
 9" MINIMUM FOR INDEPENDENT BACKWALL.


PREPARED BY
 DESIGN DIVISION

6.20.05


DRAWN BY: BLT
CHECKED BY: VZ
APPROVED BY: KCK

MICHIGAN DEPARTMENT OF TRANSPORTATION
BUREAU OF DEVELOPMENT
SLEEPER SLAB DETAILS

ISSUED: 12/26/23
SUPERSEDES: 07/25/22

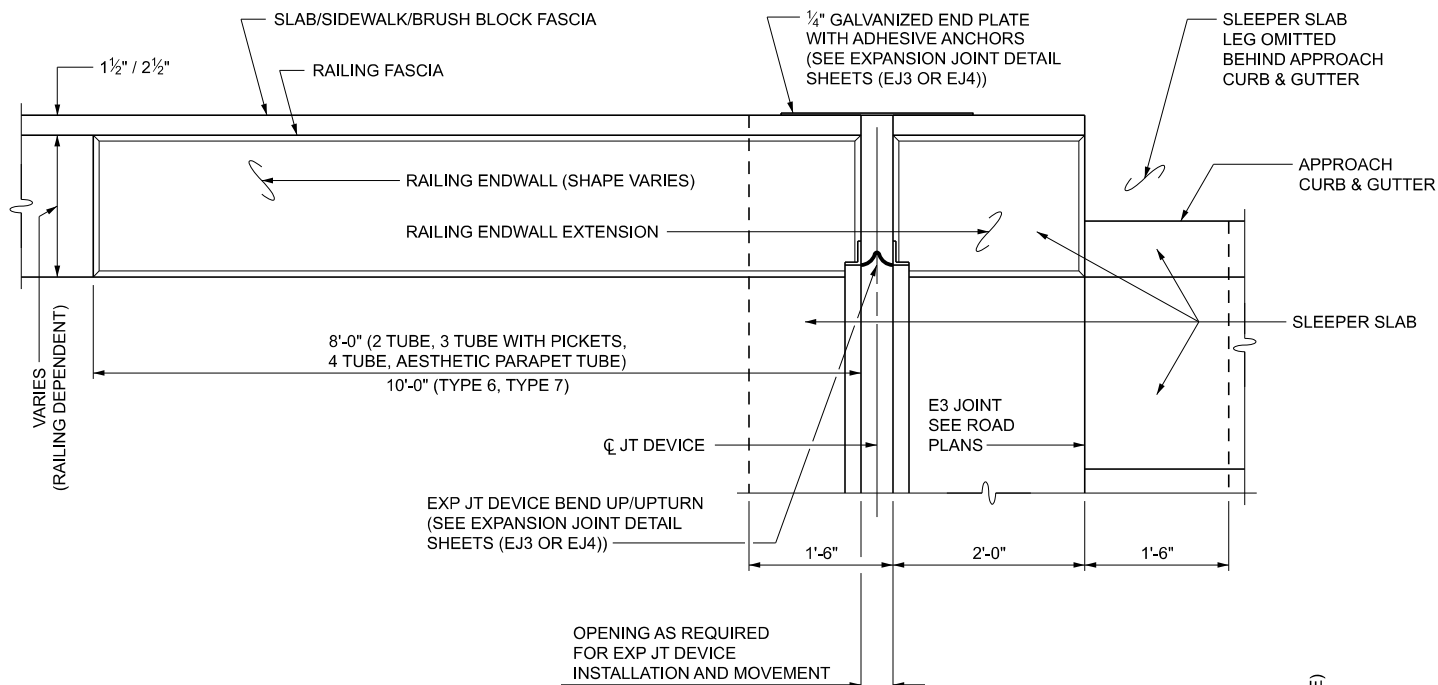

PLAN - ENDWALL EXTENSION DETAIL

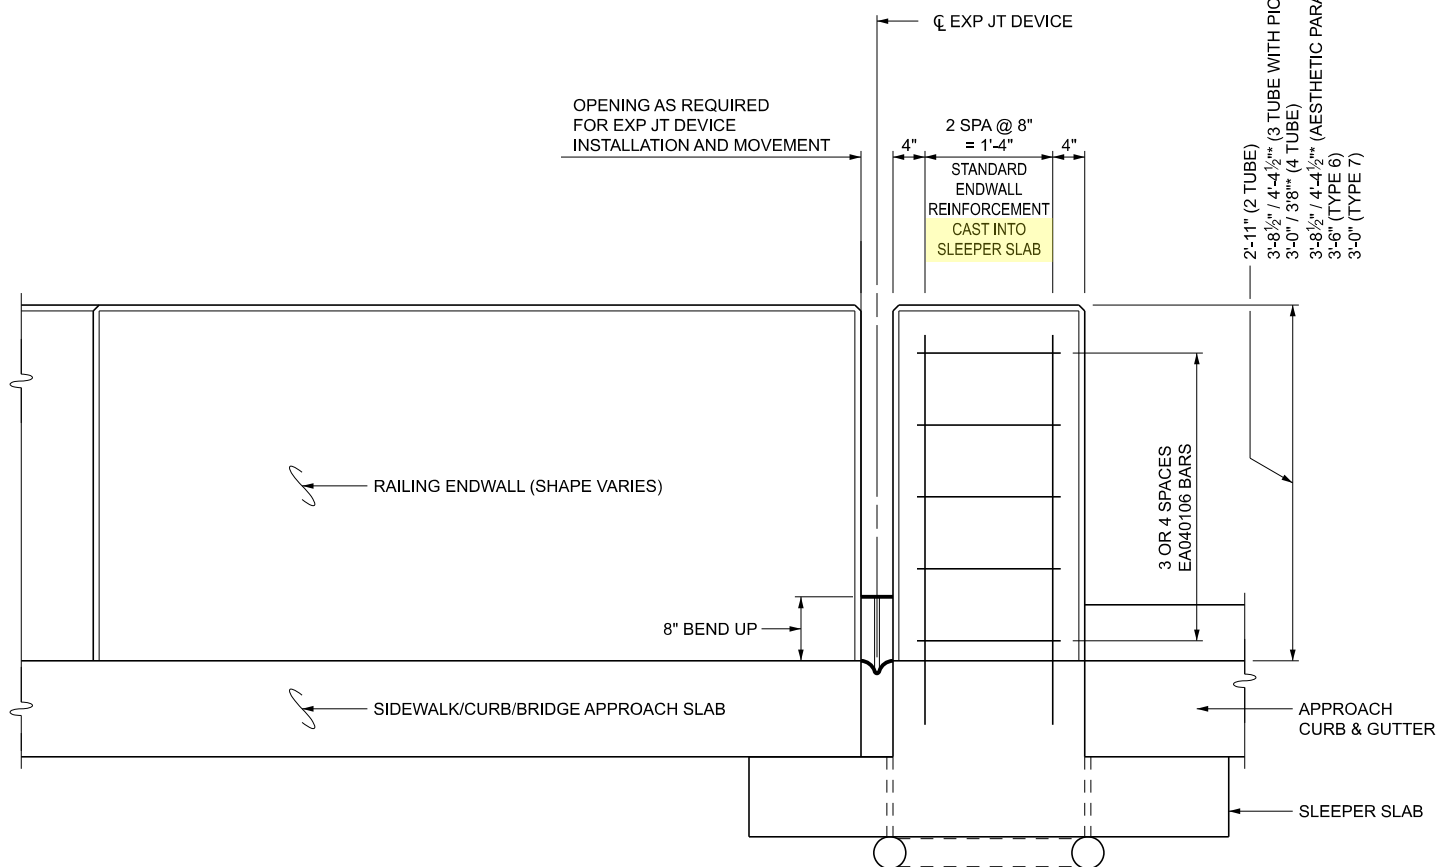

ENDWALL EXTENSION DETAIL

* HEIGHT WITH SIDEWALK


PREPARED BY
DESIGN DIVISION

6.20.05A

DRAWN BY: BLT
CHECKED BY: VZ
APPROVED BY: KCK

MICHIGAN DEPARTMENT OF TRANSPORTATION
BUREAU OF DEVELOPMENT
CONCRETE DIAPHRAGMS FOR
PRESTRESSED CONCRETE BEAMS/GIRDERS


ISSUED: 12/26/23
SUPERSEDES: 08/27/18

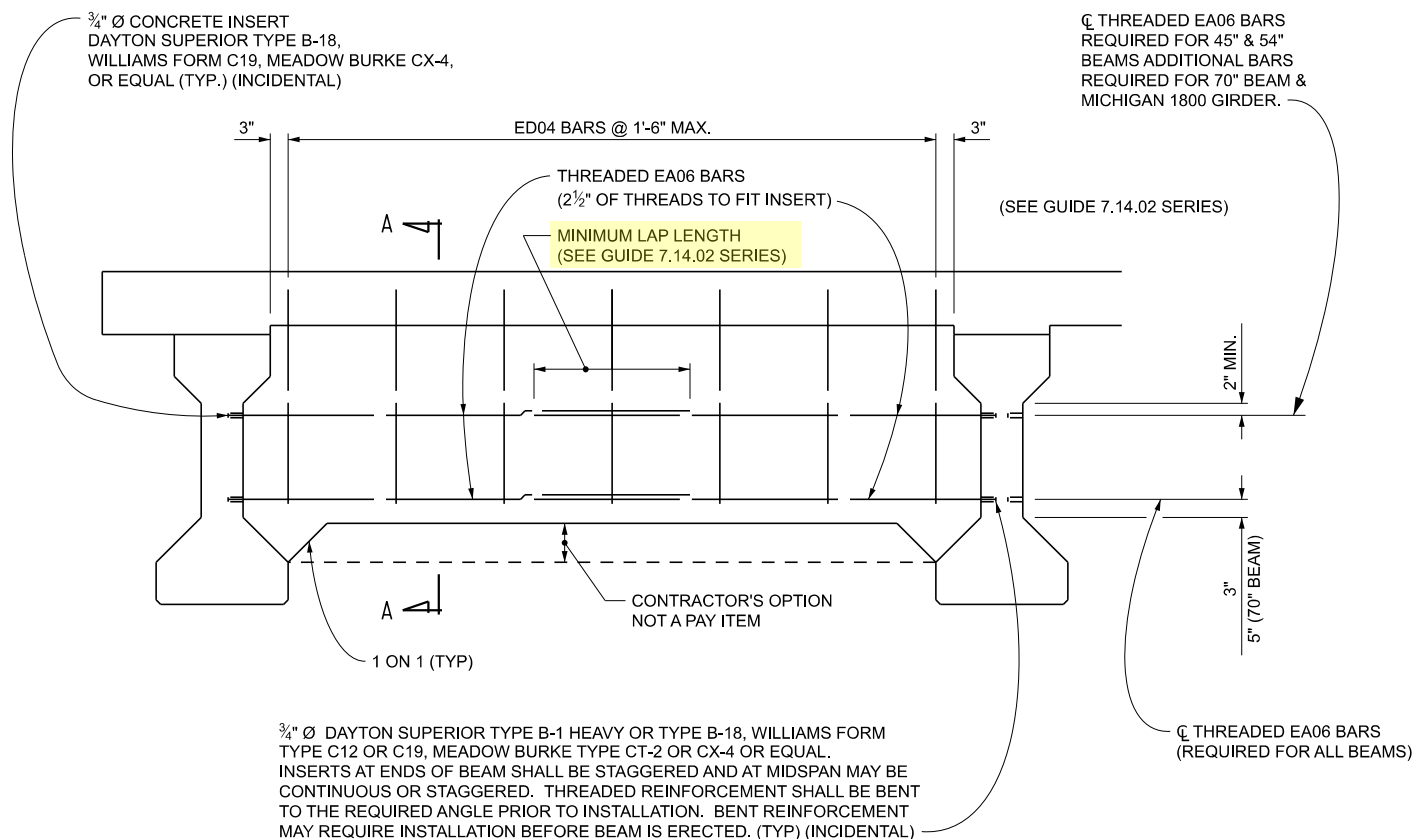


CONCRETE DIAPHRAGM ELEVATION

NOTES:

- 1 USE WHEN CONCRETE DIAPHRAGMS PREFERRED. USE WITH SIMPLE SPANS (NOT CONTINUOUS FOR LIVE LOAD) AT PIERS AND INDEPENDENT BACKWALLS WITH NO SLIDING SLAB. PLACE DIAPHRAGMS PARALLEL TO REF. LINE.
- 2 USE ONE INTERMEDIATE DIAPHRAGM AT MID-POINT.
- 3 FOR $60^\circ \leq \theta \leq 90^\circ$, PLACE INTERMEDIATE DIAPHRAGMS PARALLEL TO REF. LINE.
- 4 FOR ANGLE OF CROSSING $< 60^\circ$, SEE PLAN.
- 5 DO NOT POUR DECK UNTIL DIAPHRAGM CONCRETE ATTAINS A COMPRESSIVE STRENGTH OF 3000 PSI.

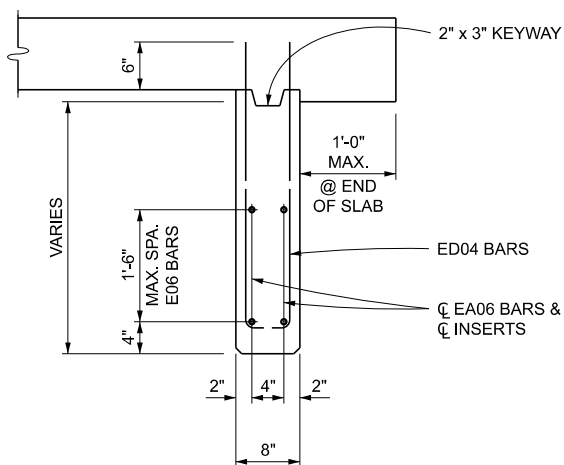

SECTION A-A

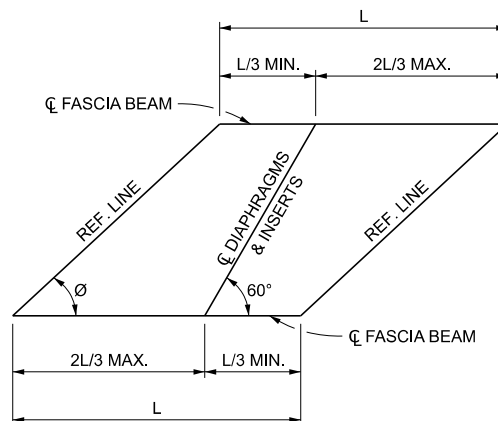

PLAN


PREPARED BY
DESIGN DIVISION

6.60.12

DRAWN BY: BLT
CHECKED BY: VZ
APPROVED BY: KCK

MICHIGAN DEPARTMENT OF TRANSPORTATION
BUREAU OF DEVELOPMENT
TENSION DEVELOPMENT AND LAP SPLICE LENGTHS
SPACING THRESHOLDS

ISSUED: 12/26/23
SUPERSEDES:

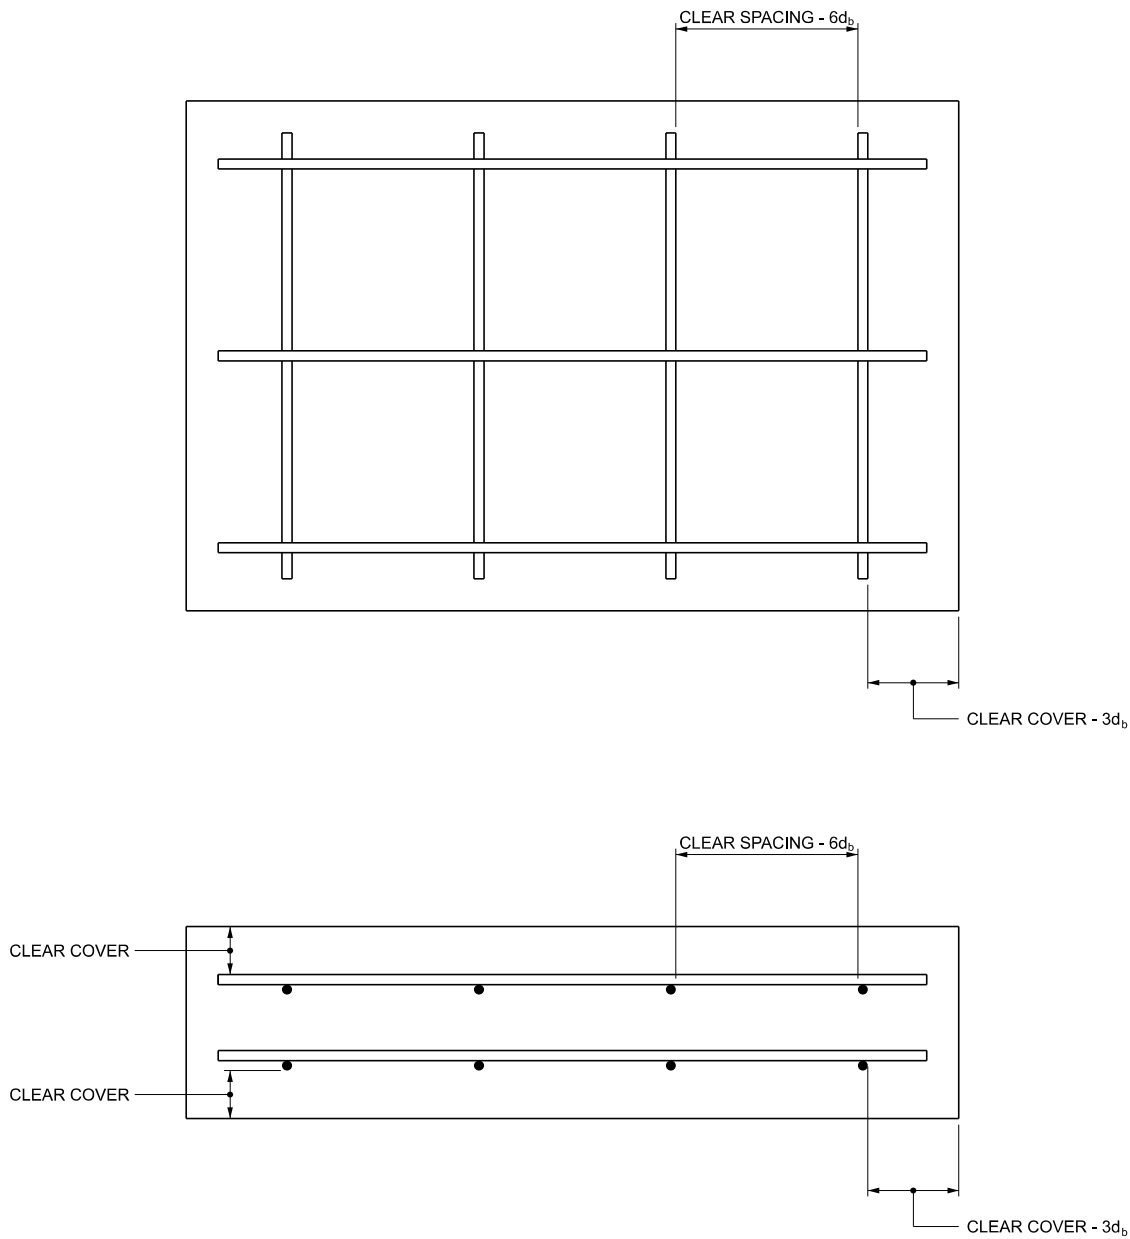

d_b = DIAMETER OF REINFORCING BAR
CLEAR SPACING = CENTER TO CENTER SPACING - DIAMETER OF REINFORCING BAR

DRAWN BY: BLT
CHECKED BY: VZ
APPROVED BY: KCK

MICHIGAN DEPARTMENT OF TRANSPORTATION
BUREAU OF DEVELOPMENT

TENSION DEVELOPMENT AND LAP SPLICE LENGTHS FOR
SUBSTRUCTURE

ISSUED: 12/26/23
SUPERSEDES: 11/27/01

EPOXY COATED REINFORCEMENT

$F'_c = 3.0 \text{ ksi}$

$F_y = 60.0 \text{ ksi}$

BAR SIZE	SPACING THRESHOLD *		BASIC DEVELOPMENT LENGTH (in) **	TENSION DEVELOPMENT LENGTH			
				$\leq 12"$ OF CONCRETE BELOW		$> 12"$ OF CONCRETE BELOW	
	$3d_b$ (in)	$6d_b$ (in)		CLEAR COVER $\geq 3d_b$ & CLEAR SPACING $\geq 6b_d$ (in)	ALL OTHER CASES (in)	CLEAR COVER $\geq 3d_b$ & CLEAR SPACING $\geq 6b_d$ (in)	ALL OTHER CASES (in)
3	$1\frac{1}{8}$	$2\frac{1}{4}$	32	16	20	20	22
4	$1\frac{1}{2}$	3	42	21	26	27	29
5	$1\frac{7}{8}$	$3\frac{3}{4}$	52	25	32	33	36
6	$2\frac{1}{4}$	$4\frac{1}{2}$	63	31	38	40	43
7	$2\frac{5}{8}$	$5\frac{1}{4}$	73	36	44	46	50
8	3	6	84	41	51	53	58
9	$3\frac{3}{8}$	$6\frac{3}{4}$	94	46	57	59	64
10	$3\frac{3}{4}$	$7\frac{1}{2}$	104	50	63	65	71
11	$4\frac{1}{8}$	$8\frac{1}{4}$	115	56	69	72	79

BAR SIZE	SPACING THRESHOLD *		TENSION LAP LENGTH			
			$\leq 12"$ OF CONCRETE BELOW		$> 12"$ OF CONCRETE BELOW	
	$3d_b$ (in)	$6d_b$ (in)	CLEAR COVER $\geq 3d_b$ & CLEAR SPACING $\geq 6b_d$ (in)	ALL OTHER CASES (in)	CLEAR COVER $\geq 3d_b$ & CLEAR SPACING $\geq 6b_d$ (in)	ALL OTHER CASES (in)
3	$1\frac{1}{8}$	$2\frac{1}{4}$	20	26	26	29
4	$1\frac{1}{2}$	3	27	33	35	38
5	$1\frac{7}{8}$	$3\frac{3}{4}$	33	41	43	46
6	$2\frac{1}{4}$	$4\frac{1}{2}$	40	50	52	56
7	$2\frac{5}{8}$	$5\frac{1}{4}$	46	57	60	65
8	3	6	53	66	69	75
9	$3\frac{3}{8}$	$6\frac{3}{4}$	59	74	77	84
10	$3\frac{3}{4}$	$7\frac{1}{2}$	65	82	85	92
11	$4\frac{1}{8}$	$8\frac{1}{4}$	72	90	94	102

* USE SPACING THRESHOLD VALUES IN DETERMINING THE APPROPRIATE COLUMN FROM WHICH TO SELECT THE DEVELOPMENT AND LAP LENGTH.

** IF THE PROJECT SPECIFIC CONDITIONS DO NOT FALL INTO ONE OF THE COLUMNS INCLUDED IN THE TABLE ABOVE OR ARE NOT IN ALIGNMENT WITH THE NOTES ON THIS BRIDGE DESIGN GUIDE CALCULATE THE TENSION DEVELOPMENT AND LAP LENGTHS USING THE BASIC DEVELOPMENT LENGTH FROM THE TABLE ABOVE AND THE APPROPRIATE MODIFICATION FACTORS OUTLINED IN AASHTO LRFD 5.10.8.

NOTES:

THE VALUES IN THE TABLE ABOVE ARE BASED ON THE REQUIREMENTS OUTLINED IN AASHTO LRFD 5.10.8.

THE VALUES IN THE TABLE ABOVE ASSUME THE AREA OF REINFORCEMENT PROVIDED IS EQUAL TO THE AREA OF REINFORCEMENT REQUIRED BY THE DESIGN ($\lambda_{ef} = 1.0$).

THE VALUES IN THE TABLE ABOVE ACCOUNT FOR THE TYPICAL CONFINEMENT REINFORCEMENT DETAILED IN THE MDOT BRIDGE DESIGN GUIDES ($\lambda_{rc} = 0.4$).

LAP LENGTHS ARE BASED ON CLASS B LAP SPLICES IN ACCORDANCE WITH AASHTO LRFD 5.10.8.4.3a.

DEVELOPMENT AND LAP LENGTHS IN THE TABLES ABOVE WILL BE CONSERVATIVE FOR UNCOATED REINFORCEMENT.

PREPARED BY
DESIGN DIVISION

7.14.02A

DRAWN BY: BLT
 CHECKED BY: VZ
 APPROVED BY: KCK

MICHIGAN DEPARTMENT OF TRANSPORTATION
 BUREAU OF DEVELOPMENT

TENSION DEVELOPMENT AND LAP SPLICE LENGTHS FOR
 SUPERSTRUCTURE

ISSUED: 12/26/23
 SUPERSEDES: 11/27/01

EPOXY COATED REINFORCEMENT

$F'_c = 4.0$ ksi

$F_y = 60.0$ ksi

BAR SIZE	SPACING THRESHOLD *		BASIC DEVELOPMENT LENGTH (in) **	TENSION DEVELOPMENT LENGTH			
				$\leq 12"$ OF CONCRETE BELOW		$> 12"$ OF CONCRETE BELOW	
	$3d_b$ (in)	$6d_b$ (in)		CLEAR COVER $\geq 3d_b$ & CLEAR SPACING $\geq 6b_d$ (in)	ALL OTHER CASES (in)	CLEAR COVER $\geq 3d_b$ & CLEAR SPACING $\geq 6b_d$ (in)	ALL OTHER CASES (in)
3	$1\frac{1}{8}$	$2\frac{1}{4}$	27	13	17	17	19
4	$1\frac{1}{2}$	3	36	18	22	23	25
5	$1\frac{7}{8}$	$3\frac{3}{4}$	45	22	27	29	31
6	$2\frac{1}{4}$	$4\frac{1}{2}$	54	26	33	34	37
7	$2\frac{5}{8}$	$5\frac{1}{4}$	63	31	38	40	43
8	3	6	72	35	44	45	49
9	$3\frac{3}{8}$	$6\frac{3}{4}$	81	39	49	51	56
10	$3\frac{3}{4}$	$7\frac{1}{2}$	90	46	57	59	65
11	$4\frac{1}{8}$	$8\frac{1}{4}$	99	55	69	72	78

BAR SIZE	SPACING THRESHOLD *		TENSION LAP LENGTH			
			$\leq 12"$ OF CONCRETE BELOW		$> 12"$ OF CONCRETE BELOW	
	$3d_b$ (in)	$6d_b$ (in)	CLEAR COVER $\geq 3d_b$ & CLEAR SPACING $\geq 6b_d$ (in)	ALL OTHER CASES (in)	CLEAR COVER $\geq 3d_b$ & CLEAR SPACING $\geq 6b_d$ (in)	ALL OTHER CASES (in)
3	$1\frac{1}{8}$	$2\frac{1}{4}$	17	22	22	24
4	$1\frac{1}{2}$	3	23	29	30	32
5	$1\frac{7}{8}$	$3\frac{3}{4}$	29	36	37	40
6	$2\frac{1}{4}$	$4\frac{1}{2}$	34	43	44	48
7	$2\frac{5}{8}$	$5\frac{1}{4}$	40	50	52	56
8	3	6	45	57	59	64
9	$3\frac{3}{8}$	$6\frac{3}{4}$	51	64	66	72
10	$3\frac{3}{4}$	$7\frac{1}{2}$	59	74	77	84
11	$4\frac{1}{8}$	$8\frac{1}{4}$	72	89	93	101

* USE SPACING THRESHOLD VALUES IN DETERMINING THE APPROPRIATE COLUMN FROM WHICH TO SELECT THE DEVELOPMENT AND LAP LENGTH.

** IF THE PROJECT SPECIFIC CONDITIONS DO NOT FALL INTO ONE OF THE COLUMNS INCLUDED IN THE TABLE ABOVE OR ARE NOT IN ALIGNMENT WITH THE NOTES ON THIS BRIDGE DESIGN GUIDE CALCULATE THE TENSION DEVELOPMENT AND LAP LENGTHS USING THE BASIC DEVELOPMENT LENGTH FROM THE TABLE ABOVE AND THE APPROPRIATE MODIFICATION FACTORS OUTLINED IN AASHTO LRFD 5.10.8.

NOTES:

THE VALUES IN THE TABLE ABOVE ARE BASED ON THE REQUIREMENTS OUTLINED IN AASHTO LRFD 5.10.8.

THE VALUES IN THE TABLE ABOVE ASSUME THE AREA OF REINFORCEMENT PROVIDED IS EQUAL TO THE AREA OF REINFORCEMENT REQUIRED BY THE DESIGN ($\lambda_{ef} = 1.0$).

THE VALUES IN THE TABLE ABOVE ACCOUNT FOR THE TYPICAL CONFINEMENT REINFORCEMENT DETAILED IN THE MDOT BRIDGE DESIGN GUIDES ($\lambda_{rc} = 0.4$).

LAP LENGTHS ARE BASED ON CLASS B LAP SPLICES IN ACCORDANCE WITH AASHTO LRFD 5.10.8.4.3a.

DEVELOPMENT AND LAP LENGTHS IN THE TABLES ABOVE WILL BE CONSERVATIVE FOR UNCOATED REINFORCEMENT.



PREPARED BY
 DESIGN DIVISION

7.14.02B

DRAWN BY: BLT
 CHECKED BY: VZ
 APPROVED BY: KCK

MICHIGAN DEPARTMENT OF TRANSPORTATION
 BUREAU OF DEVELOPMENT
 MINIMUM DIMENSIONS FOR STANDARD HOOKS IN TENSION

ISSUED: 12/26/23
 SUPERSEDES: 11/27/01

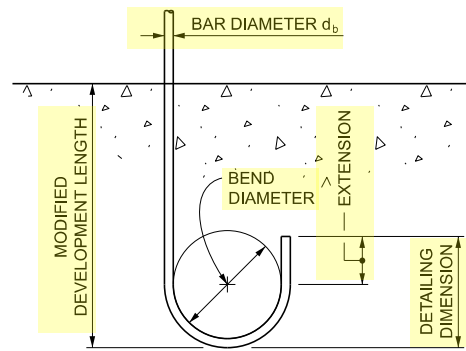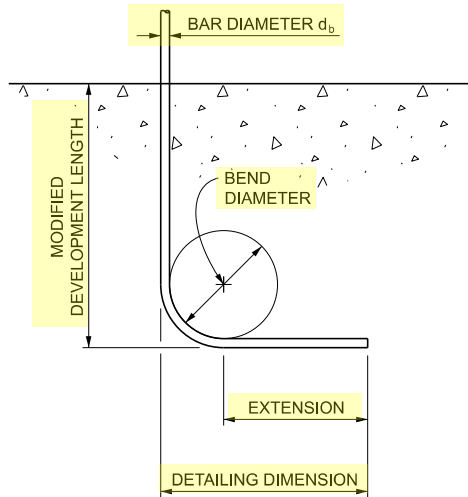

90 DEGREE HOOK END LENGTHS		
BAR NO.	EXTENSION LENGTH	DETAILING DIMENSION
3	5"	7"
4	6"	8"
5	8"	11"
6	9"	12"
7	11"	15"
8	12"	16"
9	14"	20"
10	16"	23"
11	17"	25"
14	21"	32"
18	28"	42"

180 DEGREE HOOK END LENGTHS		
BAR NO.	EXTENSION LENGTH	DETAILING DIMENSION
3	3"	5"
4	3"	5"
5	3"	6"
6	3"	6"
7	4"	8"
8	4"	8"
9	5"	11"
10	6"	13"
11	6"	14"
14	7"	18"
18	10"	24"

MINIMUM DIMENSIONS FOR STANDARD HOOKS IN TENSION						
BAR NO.	CLEAR SIDE COVER $\geq 2\frac{1}{2}"$			CLEAR SIDE COVER $\leq 2\frac{1}{2}"$		
	3 KSI CONCRETE	4 KSI CONCRETE	5 KSI CONCRETE	3 KSI CONCRETE	4 KSI CONCRETE	5 KSI CONCRETE
3	8"	7"	7"	10"	9"	8"
4	11"	10"	9"	14"	12"	11"
5	14"	12"	11"	17"	15"	13"
6	16"	14"	13"	20"	18"	16"
7	19"	16"	15"	24"	20"	18"
8	22"	19"	17"	27"	23"	21"
9	24"	21"	19"	30"	26"	24"
10	27"	24"	21"	34"	29"	26"
11	30"	26"	24"	38"	33"	29"
14	45"	39"	35"	45"	39"	35"
18	60"	52"	47"	60"	52"	47"

NOTES:

MODIFIED DEVELOPMENT LENGTHS ARE BASED ON THE REQUIREMENTS OUTLINED IN AASHTO LRFD 5.10.8.2.4 FOR STANDARD HOOKS IN TENSION WITHOUT CONFINEMENT OF STIRRUPS OR TIES.

THE DETAILING DIMENSION IS CALCULATED USING THE MINIMUM INSIDE BEND DIAMETERS OUTLINED IN AASHTO LRFD 5.10.2.1

THE MODIFIED DEVELOPMENT LENGTHS UTILIZE THE SPECIFIED CONCRETE COMPRESSIVE STRENGTHS AND A YIELD STRENGTH OF 60.0 KSI FOR THE STEEL REINFORCEMENT.

FOR ALL BAR SIZES WITH 90 DEGREE HOOKS, THE REQUIRED CLEAR COVER AT THE END OF THE EXTENSION BEYOND THE HOOK IS NOT LESS THAN 2 INCHES.

MODIFIED DEVELOPMENT LENGTHS WILL BE CONSERVATIVE FOR UNCOATED STEEL REINFORCEMENT.

THE MODIFIED DEVELOPMENT LENGTHS ASSUME THE AREA OF REINFORCEMENT PROVIDED IS EQUAL TO THE AREA OF REINFORCEMENT REQUIRED BY THE DESIGN ($\lambda_{ef} = 1.0$).

PREPARED BY
 DESIGN DIVISION

7.14.03